


PORTION OF GOVERNMENT LOT 5
NE 1/4, SE 1/4 SEC. 7, TWN 24N, RNGE 5E, W.M.
MERCER ISLAND, WA

GRAPHIC SCALE

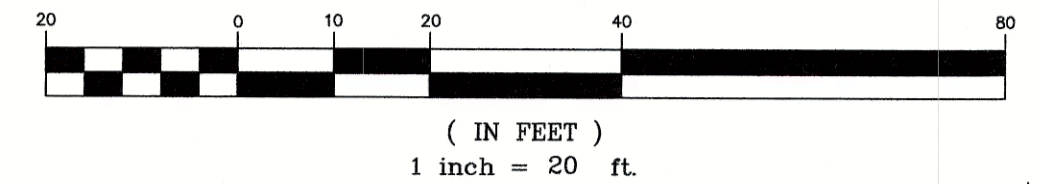


SURVEY NOTES

INSTRUMENT: SPECTRA FOCUS 35 TOTAL STATION
METHOD USED: FIELD TRAVERSE WITH ACTUAL
FIELD MEASUREMENTS AND ANGLES
WAC 332-130-090
DATE OF SURVEY: AUGUST 2018
BASIS OF BEARING: SW GENESEE ST
BENCHMARK: CITY OF MERCER ISLAND #2069
REBAR IN 1.5" IRON PIPE, INTERSECTION
OF SE 34TH & 97TH AVE SE
(ELE - 53.19' NAVD 88)
SITE BENCHMARK: SSMH LOCATED ON 97TH AVE SE
RIM EL - 81.25' NAVD 88)
REFERENCES: SP NO. M.I. SUB 0002-002
REC #20000516900001
LLR NO. SUB08-004
REC# 20090206900004

LEGEND

- CB (TYPE 1)
- STMH (TYPE 11)
- ⊙ SANITARY SEWER MH
- ⊗ WATER VALVE
- ⊕ WATER METER/SERVICE
- ⊙ FIRE HYDRANT
- ⊙ UTILITY POLE
- ← GUY WIRE
- TELEPHONE CABINET
- ⊙ SIGN
- ⊙ CONIFER TREE
- ⊙ DECIDUOUS TREE
- MAIL BOX
- ⊕ PK NAIL
- ⊕ MON IN CASE/
AS NOTED
- EX REBAR / PIPE
AS NOTED

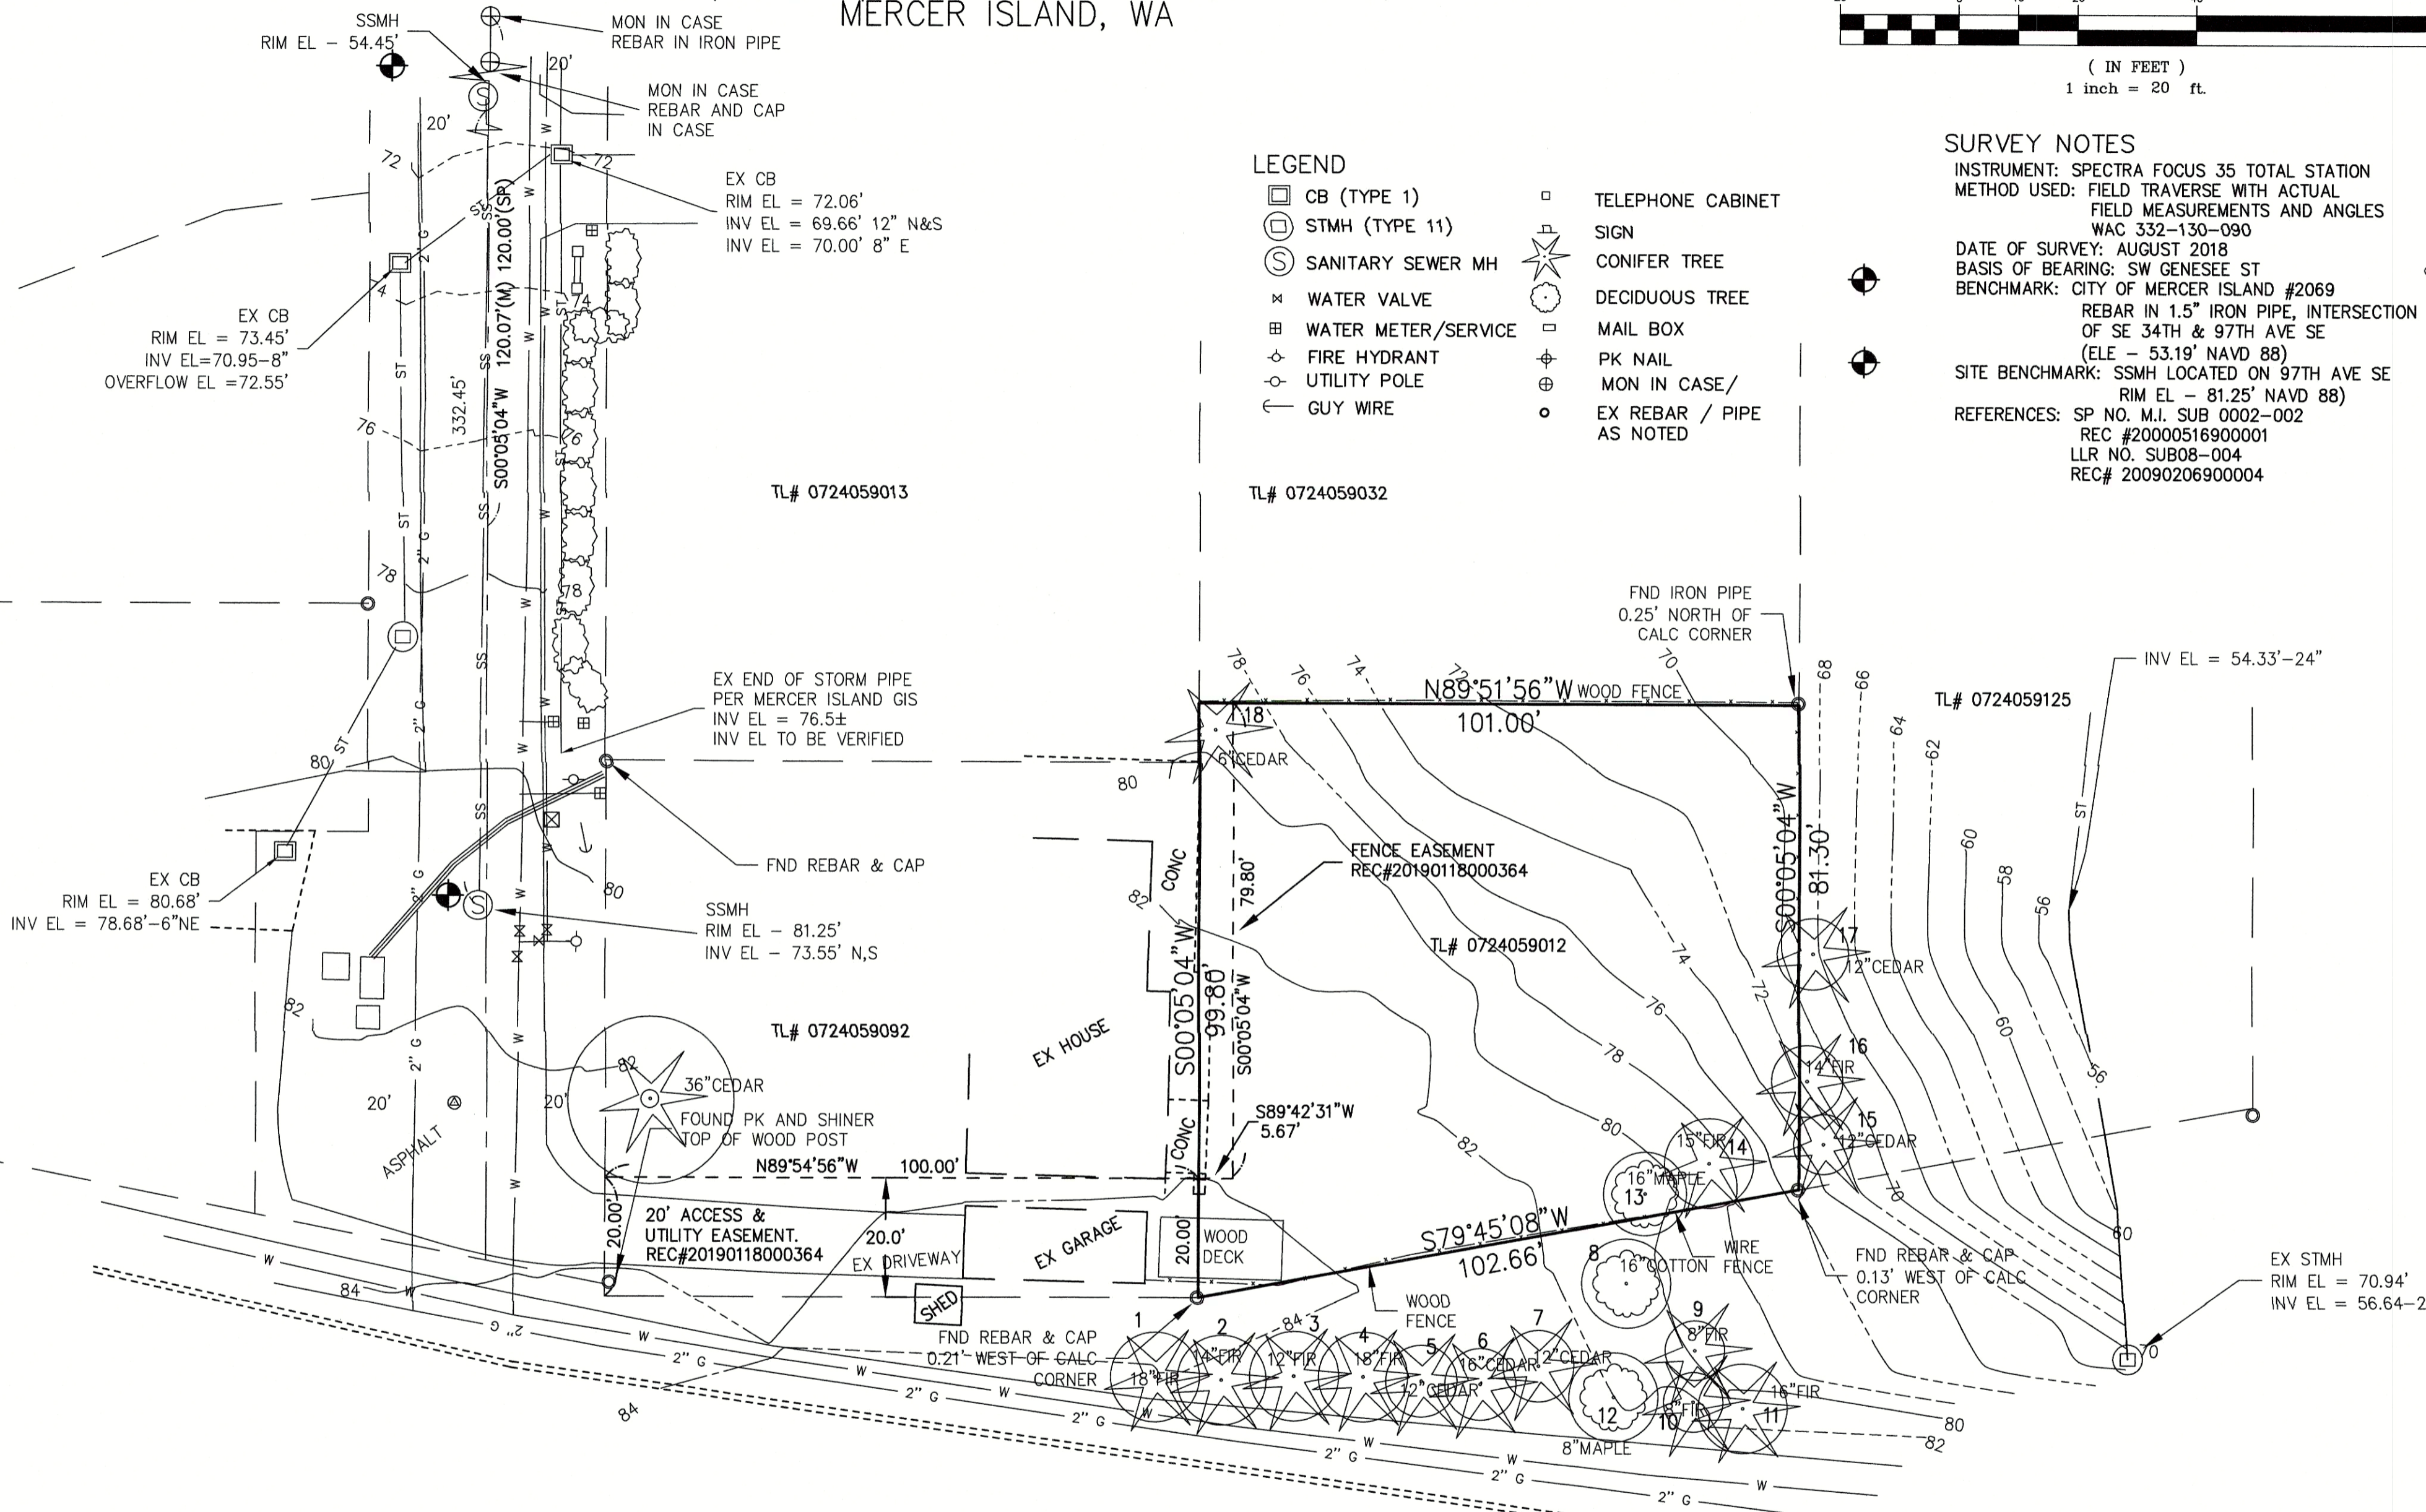


LEGAL DESCRIPTION

THAT PORTION OF GOVERNMENT LOT 5, SECTION 7, TOWNSHIP 24 NORTH, RANGE 5 EAST, W.M., IN KING COUNTY, WASHINGTON, DESCRIBED AS FOLLOWS:
BEGINNING AT A POINT 921.44 FET WEST AND 30.00 FEET NORTH OF THE SOUTHEAST CORNER OF SAID GOVERNMENT LOT 5;
THENCE NORTH PARALLEL WITH THE EAST LINE OF SAID GOVERNMENT LOT 220.00 FEET;
THENCE EAST ALONG A LINE 250.00 FEET NORTH AND PARALLEL WITH THE SOUTH LINE OF SAID GOVERNMENT LOT, 100.00 FEET;
THENCE NORTH PARALLEL WITH SAID EAST LINE, 100.00 FEET;
THENCE EAST PARALLEL WITH SAID SOUTH LINE 100.00 FEET;
THENCE SOUTH PARALLEL WITH SAID EAST LINE 320.00 FEET;
THENCE WEST PARALLEL WITH SAID SOUTH LINE 200.00 FEET TO THE POINT OF BEGINNING.

SITUATE IN THE COUNTY OF KING, STATE OF WASHINGTON.

REVISED 4/30/2020
REVISED 3/1/2019

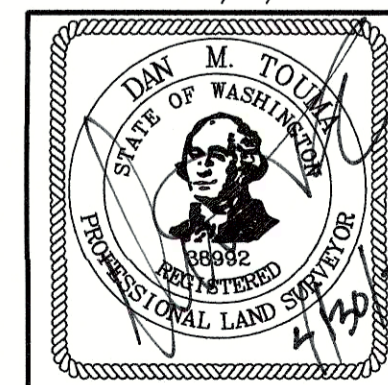


TOUMA ENGINEERS AND LAND SURVEYORS, PLLC

255 SW 41st STREET
RENTON, WASHINGTON 98057
425-251-0665 OFFICE
425-251-0625 FAX

BOUNDARY & TOPOGRAPHY
3440 97TH AVE SE
MERCER ISLAND, WA 98040

DWN. BY DJH	DATE AUGUST 2018 MARCH 2020	JOB NO. 1019-004-018
CHKD. BY DMT	SCALE NOTED	SHEET 1 OF 1

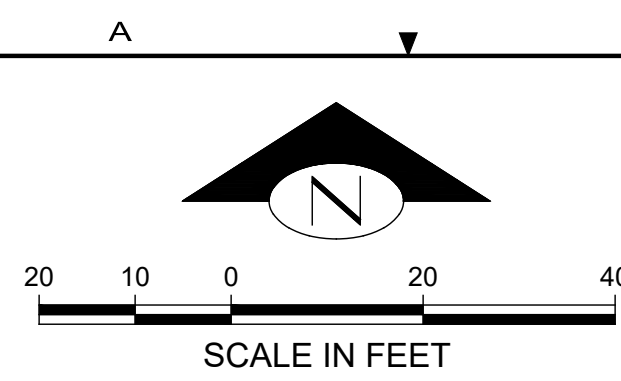

KEY NOTES:		
KEY	NOTE:	DETAIL/SHEET
1	INSTALL TEMPORARY INLET PROTECTION ON EX SD INLET OR CLOSEST SD INLET DOWNSTREAM OF SITE	B/C05
2	INSTALL TEMPORARY STABILIZED CONSTRUCTION ENTRANCE	C/C05
3	INSTALL APPROX 356 LF PERIMETER PROTECTION*	A/C05
4	TREE PROTECTION FENCING	TP/C01
5	EX DWY TO REMAIN	-
6	PROPOSED STOCKPILE LOCATION. CONTRACTOR TO DETERMINE FINAL LOCATION IN FIELD	-
7	CONTRACTOR TO SWEEP STREET DAILY OR MORE OFTEN IF NECESSARY TO REMOVE TRACKED SEDIMENT	-
8	EX GARAGE, WOOD DECK, AND SHED HAVE BEEN DEMOLISHED AND EX DWY HAS BEEN EXTENDED TO PROPERTY LINE	-
9	PROTECT EX HOUSE DURING CONSTRUCTION	-
10	EXISTING TREES TO REMAIN. CONSULT WITH ARBORIST IF TREE REMOVAL IS REQUIRED OR IF DISTURBANCE WILL OCCUR WITHIN DRIPLINE OF EX TREES (TYP)	-
11	TREE 13 TO BE REMOVED PER ARBORIST REPORT	-


* INSTALL PERIMETER PROTECTION, SUCH AS SILT FENCING, COMPOST SOCKS, OR STRAW WATTLES IN ACCORDANCE WITH VOL II OF THE 2014 DOE STORMWATER MANAGEMENT MANUAL FOR WESTERN WASHINGTON

LEGEND:

- STABILIZED CONSTRUCTION ENTRANCE
- ASPHALT
- PERIMETER PROTECTION
- TREE PROTECTION FENCING
- STOCKPILE LOCATION


POST-CONSTRUCTION SOIL QUALITY AND DEPTH NOTES:

- A TOPSOIL LAYER WITH A MINIMUM ORGANIC MATTER CONTENT OF 10% DRY WEIGHT IN PLANTING BEDS, AND 5% ORGANIC MATTER CONTENT IN TURF AREAS, AND A PH FROM 6.0 TO 8.0 OR MATCHING THE PH OF THE UNDISTURBED SOIL. THE TOPSOIL LAYER SHALL HAVE A MINIMUM DEPTH OF EIGHT INCHES EXCEPT WHERE TREE ROOTS LIMIT THE DEPTH OF INCORPORATION OF AMENDMENTS NEEDED TO MEET THE CRITERIA. SUBSOILS BELOW THE TOPSOIL LAYER SHOULD BE SCARIFIED AT LEAST 4 INCHES WITH SOME INCORPORATION OF THE UPPER MATERIAL TO AVOID STRATIFIED LAYERS, WHERE FEASIBLE.
- MULCH PLANTING BEDS WITH 2 INCHES OF ORGANIC MATERIAL.
- USE COMPOST AND OTHER MATERIALS THAT MEET ORGANIC CONTENT OUTLINED IN BMP T5.13 OF THE DOE MANUAL

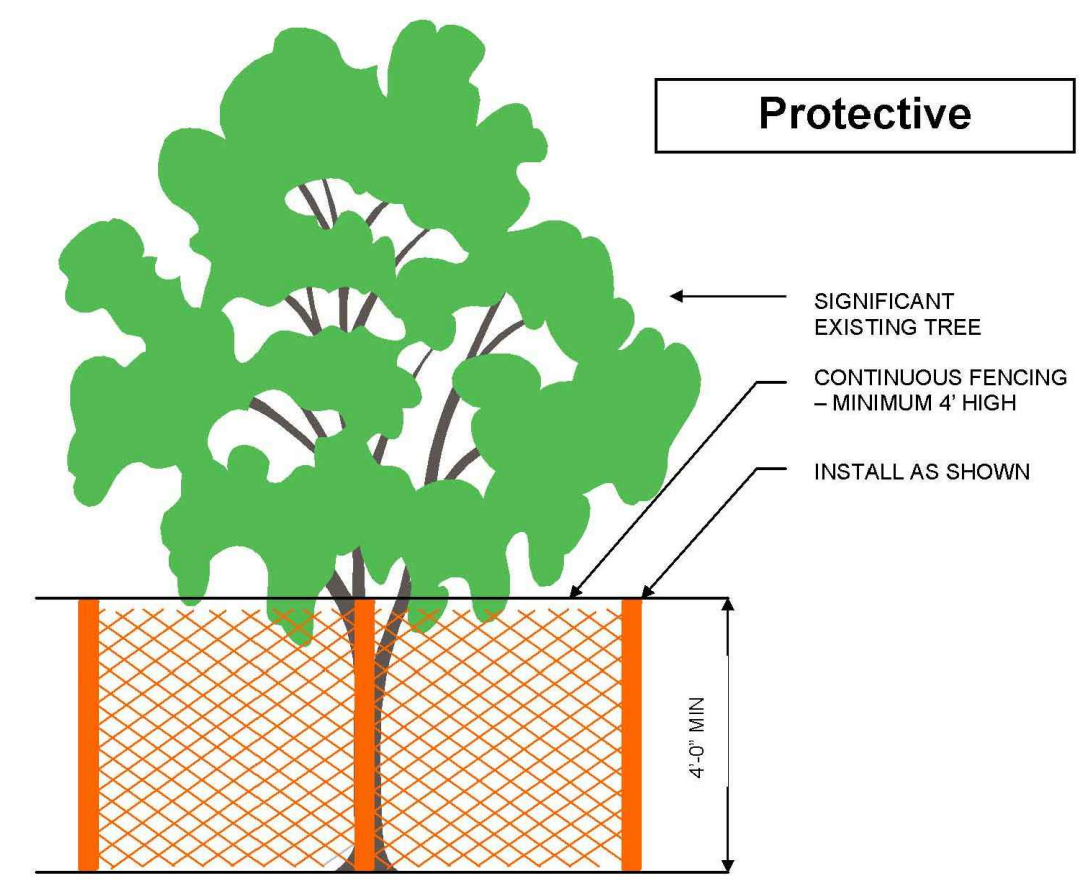

- PROTECTIVE FENCING SHALL BE LOCATED WHERE SHOWN ON PLANS. FENCE SHALL COMPLETELY ENCLOSE TREE(S) AT THE DRIPLINE OR BEYOND. AVOID DRIVING POSTS OR STAKES INTO MAJOR ROOTS. FENCE MUST REMAIN UP THROUGHOUT PROJECT.
- NO STOCKPILING OF MATERIALS, GRADE CHANGES, VEHICULAR TRAFFIC, OR STORAGE OF EQUIPMENT OR MACHINERY SHALL BE ALLOWED WITHIN THE LIMIT OF THE FENCING. PLEASE CALL ARBORIST FOR MITIGATION MEASURES IF FENCING MUST COME DOWN.
- TREATMENT OF ROOTS EXPOSED DURING CONSTRUCTION: FOR ROOTS OVER 1" IN DIAMETER DAMAGED DURING CONSTRUCTION, MAKE A CLEAN STRAIGHT CUT TO REMOVE DAMAGED PORTION OF ROOT. ALL EXPOSED ROOTS SHALL BE TEMPORARILY COVERED WITH DAMP BURLAP WITH CONTINUOUS IRRIGATION, TO PREVENT DRYING. COVER WITH SOIL AS SOON AS POSSIBLE - 3" OF MULCH RECOMMENDED.

TREE PROTECTION FENCING (TP C01)
NOT TO SCALE

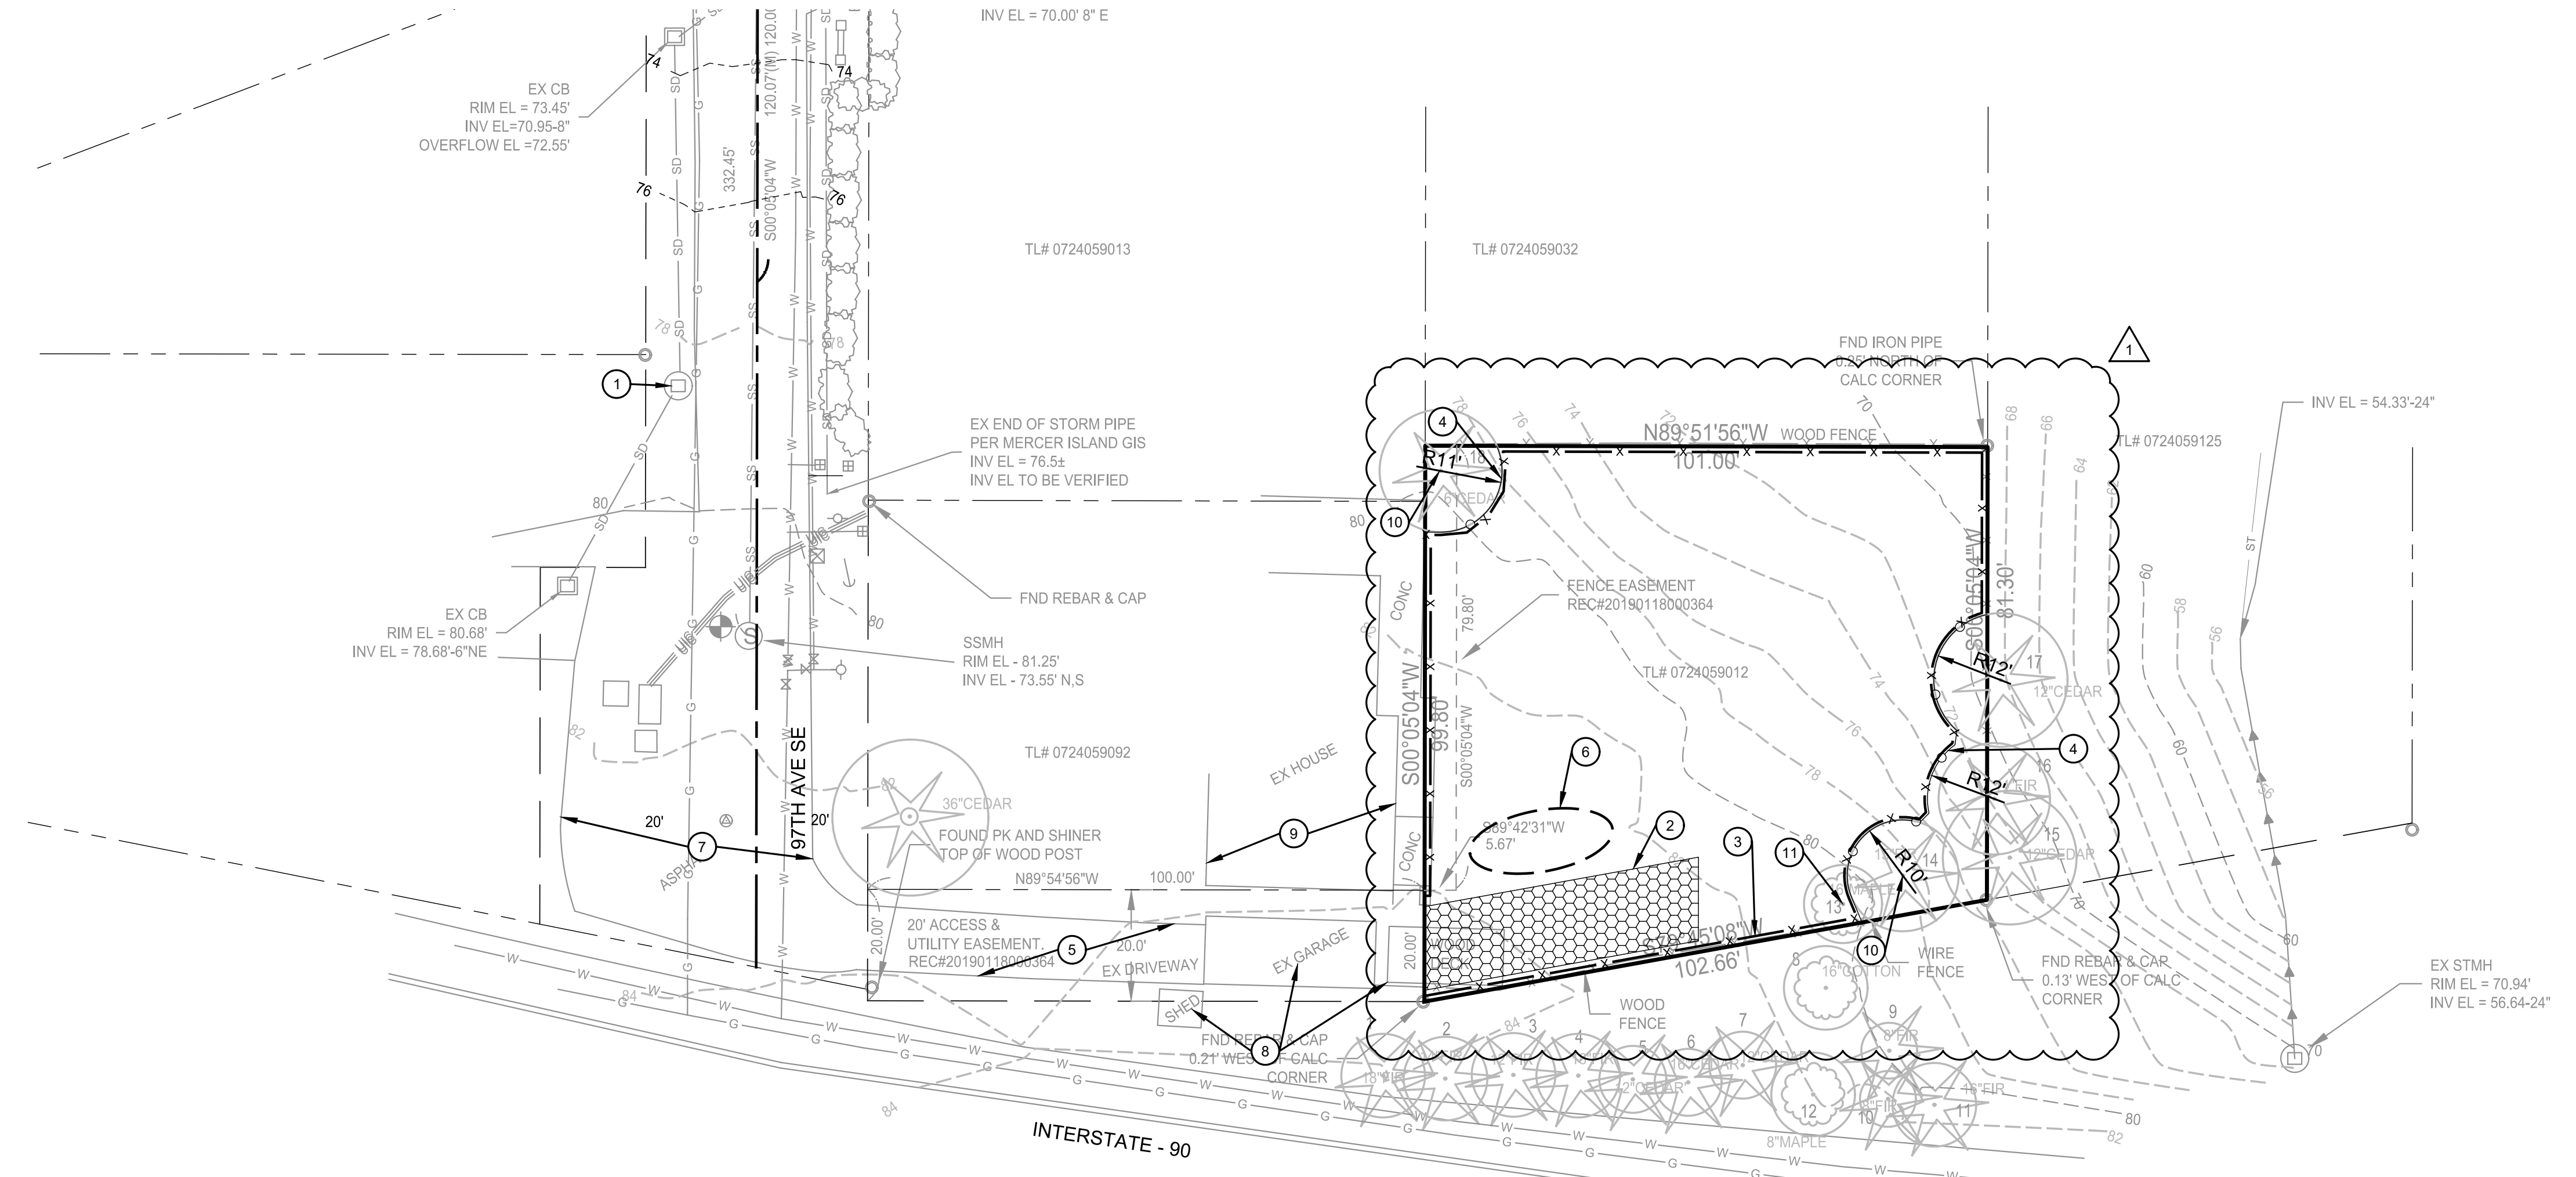

TREE PROTECTION STANDARDS:

- TREE PROTECTION FENCING SHALL BE ERECTED AT PRESCRIBED DISTANCE PER ARBORIST REPORT. FENCES SHALL BE CONSTRUCTED OF CHAIN LINK AND BE AT LEAST 4 FEET HIGH.
- INSTALL HIGHLY VISIBLE SIGNS ON PROTECTION FENCING SPACED NO FURTHER THAN 15 FEET APART. SIGNS SHALL STATE "TREE PROTECTION AREA-ENTRANCE PROHIBITED", AND "CITY OF MERCER ISLAND" CODE ENFORCEMENT PHONE NUMBER.
- NO WORK SHALL BE PERFORMED WITHIN PROTECTION FENCING UNLESS APPROVED BY PLANNING OFFICIAL. IN SUCH CASES, ACTIVITIES WILL BE APPROVED AND SUPERVISED BY A "QUALIFIED TREE PROFESSIONAL".
- THE ORIGINAL GRADE SHALL NOT BE ELEVATED OR REDUCED WITHIN PROTECTION FENCING WITHOUT THE PLANNING OFFICIAL AUTHORIZATION BASED ON RECOMMENDATIONS FROM A QUALIFIED PROFESSIONAL.
- NO BUILDING MATERIALS, SPOILS, CHEMICALS OR SUBSTANCES OF ANY KIND WILL BE PERMITTED WITHIN PROTECTION FENCING.
- PROTECTION FENCING SHALL BE MAINTAINED UNTIL THE PLANNING OFFICIAL AUTHORIZES ITS REMOVAL.
- ENSURE THAT ANY APPROVED LANDSCAPING WITHIN THE PROTECTED ZONE SUBSEQUENT TO THE APPROVED REMOVAL OF PROTECTION FENCING BE PERFORMED WITH HAND LABOR.

IN ADDITION TO THE ABOVE, THE PLANNING OFFICIAL MAY REQUIRE THE FOLLOWING:

- IF EQUIPMENT IS AUTHORIZED TO OPERATE WITHIN THE ROOT ZONE, THE AREA WILL BE MULCHED TO A DEPTH OF 6" OR COVERED WITH PLYWOOD OR SIMILAR MATERIAL TO PROTECT ROOTS FROM DAMAGE CAUSED BY HEAVY EQUIPMENT.
- MINIMIZE ROOT DAMAGE BY EXCAVATING A 2-FOOT DEEP TRENCH, AT EDGE OF PROTECTION FENCING TO CLEANLY SEVER THE ROOTS OF PROTECTED TREES.
- CORRECTIVE PRUNING TO AVOID DAMAGE FROM MACHINERY OR BUILDING ACTIVITY.
- MAINTENANCE OF TREES THROUGHOUT CONSTRUCTION PERIOD BY WATERING AND FERTILIZATION.

GENERAL NOTE:

- REFER TO 'ARBORIST TREE INVENTORY REPORT AND RETENTION PLAN' CREATED BY ANDREW LYON AND DATED 6/14/2019 (REVISED 5/8/2020) FOR ADDITIONAL TREE PROTECTION MEASURES AND INFORMATION.

PROJECT INFORMATION:
3440 97TH AVE SE
MERCER ISLAND, WA 98040

OWNER/APPLICANT:
IN MY BACKYARD, LLC
4701 W MERCER WAY
MERCER ISLAND, WA 98040

ARCHITECT:
J DESIGNS
2425 SW ROXBURY ST,
SEATTLE, WA 98106
PH: (206) 234.4469

CIVIL ENGINEER:
DAVIDO CONSULTING GROUP, INC.
9706 4TH AVE NE, SUITE 300
SEATTLE, WA 98115
PH: (206) 523.0024
CONTACT: BEN IDDISN, P.E.

SURVEYOR:
TOUMA ENGINEERS AND LAND SURVEYORS, PLLC
255 SW 41ST STREET,
RENTON, WA 98057
PH: (425) 251.0665


GEOTECHNICAL ENGINEER:
EARTH SOLUTIONS NW LLC
1805 136TH PLACE NE SUITE 201
BELLEVUE, WA 98005
PH: (425) 449-4704

NO.	DATE	BY	REVISIONS PER CITY REVIEW COMMENTS
1	6/5/2020	BI	

9706 4TH AVE NE
SUITE 300
SEATTLE, WA 98115
P: 206.523.0024
F: 206.523.1012
www.dcgengr.com



CALL 811
2 BUSINESS DAYS
BEFORE YOU DIG
(UNDERGROUND UTILITY LOCATIONS ARE APPROX.)

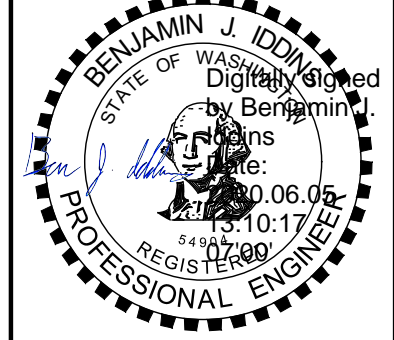

BASE MAP/TOPOGRAPHY PROVIDED BY OTHERS. DCG CANNOT BE HELD LIABLE FOR ACCURACY. CONTRACTOR SHALL FIELD VERIFY GRADES, UTILITIES, & ALL OTHER EX FEATURES & CONDITIONS. IF CONDITIONS ARE NOT AS SHOWN &/OR PLANS CANNOT BE CONSTRUCTED AS SHOWN, CONTACT DCG PRIOR TO CONSTRUCTION.

OWNER:
IN MY BACKYARD, LLC
4701 W MERCER WAY
MERCER ISLAND, WA 98040

PROJECT:
3440 97TH AVE SE
MERCER ISLAND, WA 98040
SMALL PARCEL ESC PLAN

PROJ. MANAGER: BI

DESIGNED BY: LG

DRAWN BY: JA

CHECKED BY: BI


SCALE: SCALE

DATE: 6/5/2020 **REV. SHEET** 1 OF 6

SHEET NUMBER
C01

CAD FILE NUMBER: \DCG\LOCAL\FILES\HARDWARE\DEVELOPMENT\3440 97TH AVE SE MERCER ISLAND\DWG\DRAWING\3440 97TH AVE SE MERCER ISLAND.DWG
AUTOCAD VERSION: CIVIL 3D 2018
DATE: 6/5/2020 12:26 PM - SHEET SET: 3440 97TH AVE SE - ORIGINAL SHEET SIZE: ANSI FULL BLEED D (34.00 X 22.00 INCHES)


CAD FILE NUMBER: \DCG\LOCAL\FILES\SHAREDClients\CIVIL\VALERIE DEVELOPMENT\3440 97TH AVE SE MERCER ISLAND\DWG\DRAWING\3440 97TH AVE SE MERCER ISLAND.DWG
 DATE: 6/5/2020 12:26 PM - SHEET SET: 3440 97TH AVE SE - ORIGINAL SHEET SIZE: ANSI FULL BLEED D (34.00 X 22.00 INCHES)
 AUTOCAD VERSION: CIVIL_3D_2018

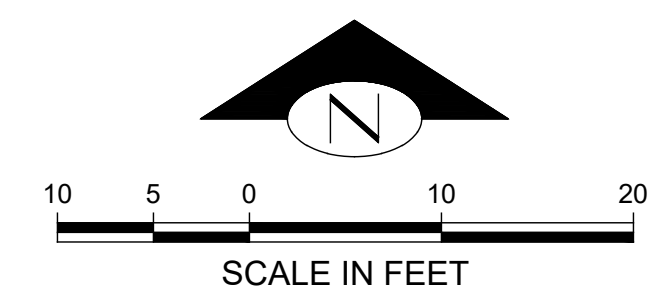

KEY NOTES		
KEY	DESCRIPTION	DETAIL/SHEET
①	EX MINOR CONTOUR (TYP)	-
②	EX MAJOR CONTOUR (TYP)	-
③	PROPOSED CONTOUR (TYP)	-
④	AMEND ALL DISTURBED PERVIOUS AREAS THAT WILL REMAIN PERVIOUS IN ACCORDANCE W/ BMP T5.13 IN CHAPTER 5 OF VOLUME V OF THE 2014 STORMWATER MANAGEMENT MANUAL FOR WESTERN WASHINGTON	-
⑤	LIMITS OF DISTURBANCE. PRIOR TO START OF CONSTRUCTION, CONTRACTOR TO STAKE LIMITS OF DISTURBANCE FOR ARBORIST SITE INSPECTION	-
⑥	SAWCUT EX ASPHALT AND MATCH EG	-
⑦	INSTALL ASPHALT THICKENED EDGE ALONG NORTH EDGE OF ACCESS EASEMENT DRIVEWAY (FLOWLINE 3" BELOW TOP OF THICKENED EDGE)	-
⑧	FLOWLINE OF ASPHALT THICKENED EDGE	-

LEGEND:

- ASPHALT
- LANDSCAPE
- TREE PROTECTION FENCING
- LIMITS OF DISTURBANCE

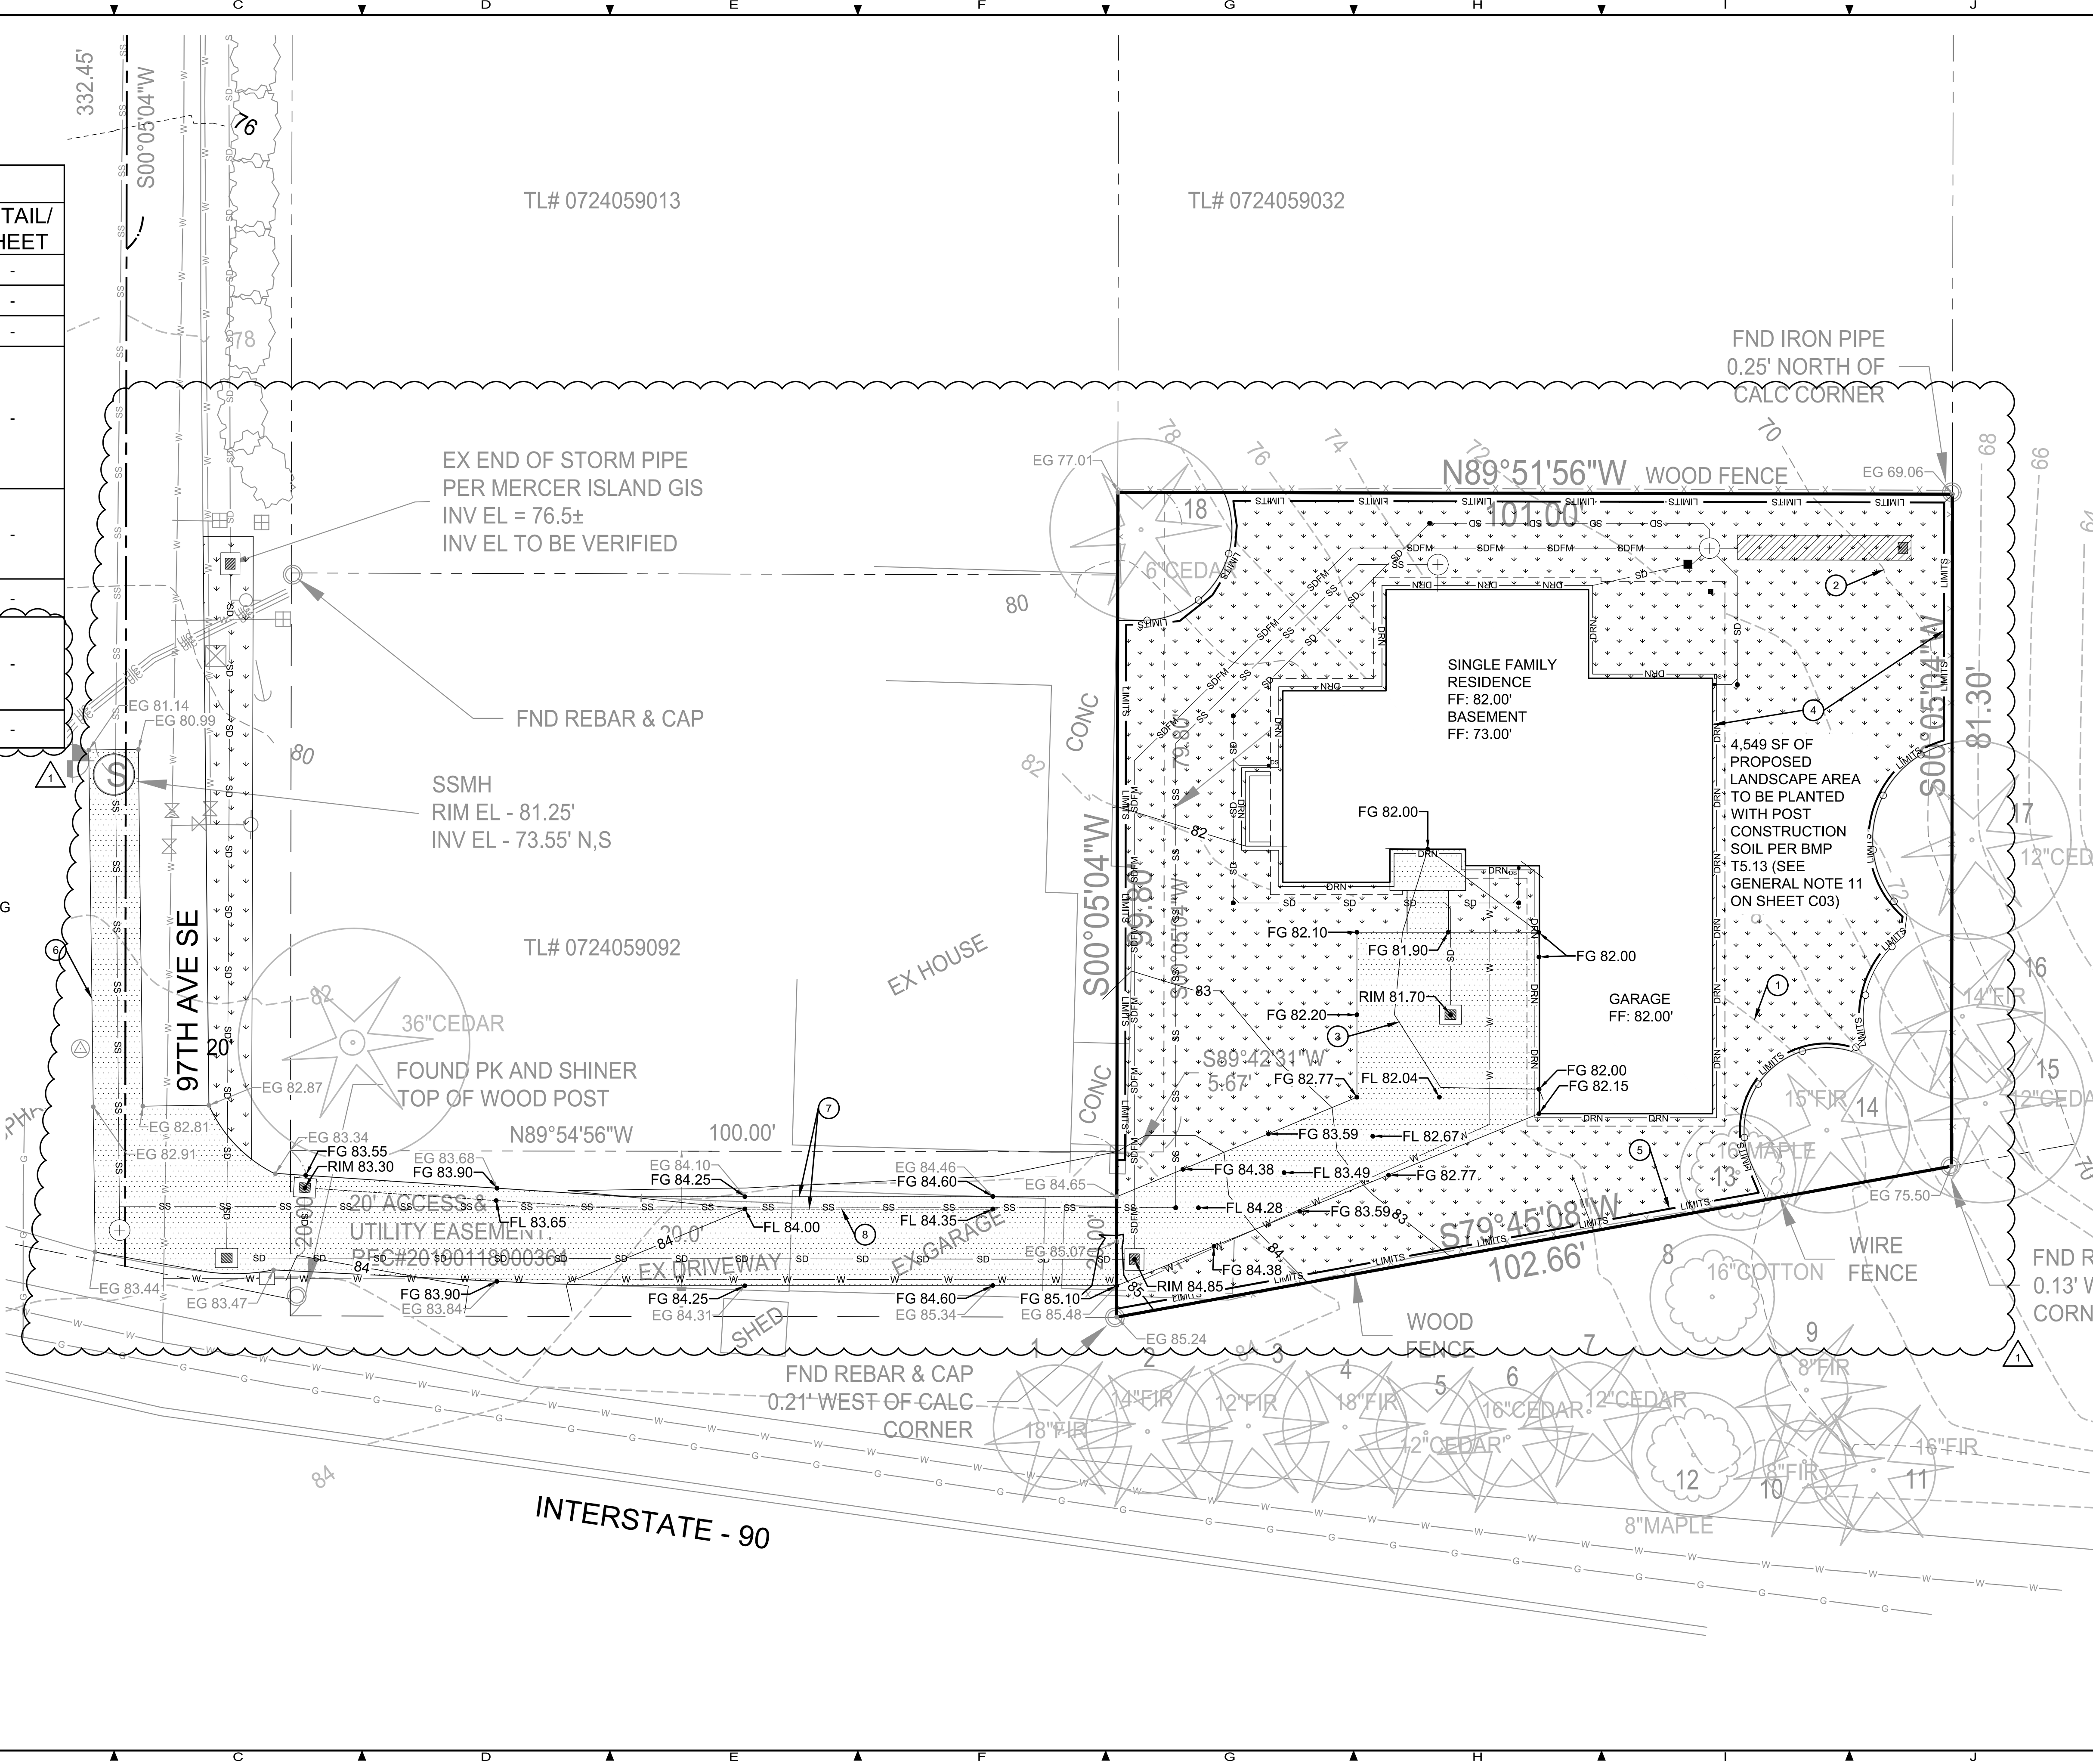


NO.	DATE	BY	REVISIONS PER CITY REVIEW COMMENTS
1	6/5/2020	BI	

9706 4TH AVE NE
 SUITE 300
 SEATTLE, WA 98115
 P: 206.523.0024
 F: 206.523.1012
 www.dcgengr.com



CALL 811
 2 BUSINESS DAYS
 BEFORE YOU DIG
(UNDERGROUND UTILITY LOCATIONS ARE APPROX.)

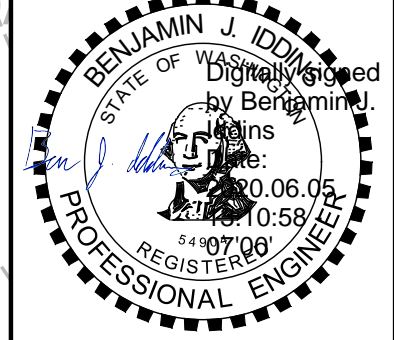

BASE MAP/TOPOGRAPHY PROVIDED BY OTHERS. DCG CANNOT BE HELD LIABLE FOR ACCURACY. CONTRACTOR SHALL FIELD VERIFY GRADES, UTILITIES, & ALL OTHER EX FEATURES & CONDITIONS. IF CONDITIONS ARE NOT AS SHOWN &/OR PLANS CANNOT BE CONSTRUCTED AS SHOWN, CONTACT DCG PRIOR TO CONSTRUCTION.

OWNER: IN MY BACKYARD, LLC
 4701 W MERCER WAY
 MERCER ISLAND, WA 98040


PROJECT: 3440 97TH AVE SE
 MERCER ISLAND, WA 98040
 GRADING PLAN

PROJ. MANAGER:	BI
DESIGNED BY:	LG
DRAWN BY:	JA
CHECKED BY:	BI
SCALE:	SCALE
DATE:	REV. SHEET
6/5/2020	A 2 OF 6


SHEET NUMBER
C02

CAD FILE NUMBER: \\DCG\LOCAL\FILES\SHAREDC\CLIENTS\CIVIL\VALERIE DEVELOPMENT\3440 97TH AVE SE MERCER ISLAND\DWG\DRAWING\3440 97TH AVE SE MERCER ISLAND.DWG
 AUTOCAD VERSION: CIVIL 3D 2018
 DATE: 6/5/2020 12:36 PM - SHEET SET: 3440 97TH AVE SE - ORIGINAL SHEET SIZE: ANSIFULL BLEED (84.00 X 22.00 INCHES)

KEY NOTES		
KEY	DESCRIPTION	DETAIL/SHEET
1	SD & WATER CROSSING 10" SD IE 78.31± 8" WATER IE 76.10± MAINTAIN MIN 1.0' VERTICAL SEPARATION AT CROSSING	-
2	CB - TYPE 1 W/ SOLID, LOCKING LID RIM 79.50 10" IE (S) 77.10 12" IE (N) 76.50± 2' MIN SUMP CONTRACTOR TO CONFIRM IE OF EX 12" CONCRETE PIPE AND ADJUST ONSITE STORM SYSTEM AS NECESSARY	E/C05
3	80 LF 10" DI @ 2.00% MIN SLOPE	-
4	CB - TYPE 1 W/ SOLID, LOCKING LID RIM 83.46 10" IE (E) 80.57 10" IE (N) 80.47 2' MIN SUMP	E/C05
5	109 LF 10" DI @ 2.00% MIN SLOPE	-
6	CB - TYPE 1 W/ SOLID, LOCKING LID RIM 85.10 3" IE (N) 83.33 (SDFM) 10" IE (W) 82.75	E/C05
7	140 LF 3" PVC SDFM	-
8	STORMWATER PUMP STATION W/ SOLID LOCKING LID RIM 71.29 4" IE (N,S,W,SE) 68.80 6" IE (E) 65.00 3" SDFM IE (W) 69.00 SUMP PER MANUFACTURER'S RECOMMENDATIONS	I/C06
9	2 LF 4" PVC SD @ 2.00% MIN SLOPE	-
10	12" AREA DRAIN RIM 71.40 4" IE (E) 69.00 4" IE (W) 69.10 (FTG DRN) 2' MIN SUMP	-
11	4" SOLID WALL PVC FOOTING DRAIN TIGHTLINE FROM BASEMENT LEVEL FOOTING DRAIN @ 2.00% MIN SLOPE 4" IE 70.00 @ BUILDING	-
12	2 LF 6" PVC SD TO BE LAID FLAT 6" IE 65.00	-
13	21 LF 36" Ø CMP FOR 148 CF EMERGENCY STORMWATER PUMP STATION STORAGE 36" IE 65.00	-
14	16 LF 4" PVC SD @ 2.00% MIN SLOPE	-
15	4" SDCO RIM 72.95 4" IE 69.60	F/C05
16	4" PVC ROOF DOWNSPOUT TIGHTLINE @ 2.00% MIN SLOPE & 2' MIN COVER (TYP)	-
17	4" ROOF DOWNSPOUT (TYP)	-
18	8 LF 6" SD @ 2.00% MIN	-
19	12" ACCESS PORT W/ OPEN GRATE LID FOR EMERGENCY OVERFLOW PATH IN CASE OF A PUMP FAILURE RIM 68.75	-
20	36 LF 4" PVC SD @ 2.00% MIN SLOPE	-
21	4" SDCO RIM 73.10 4" IE 70.60	F/C05
22	33 LF 4" PVC SD @ 2.00% MIN SLOPE	-
23	4" SDCO RIM 80.64 4" IE 77.95	F/C05
24	23 LF 4" PVC SD @ 2.00% MIN SLOPE	-
25	4" SDCO RIM 82.42 4" IE 78.45	F/C05
26	35 LF 4" PVC SD @ 2.00% MIN SLOPE	-
27	4" SDCO RIM 82.00 4" IE 79.15	F/C05
28	13 LF 4" PVC SD @ 2.00% MIN SLOPE	-

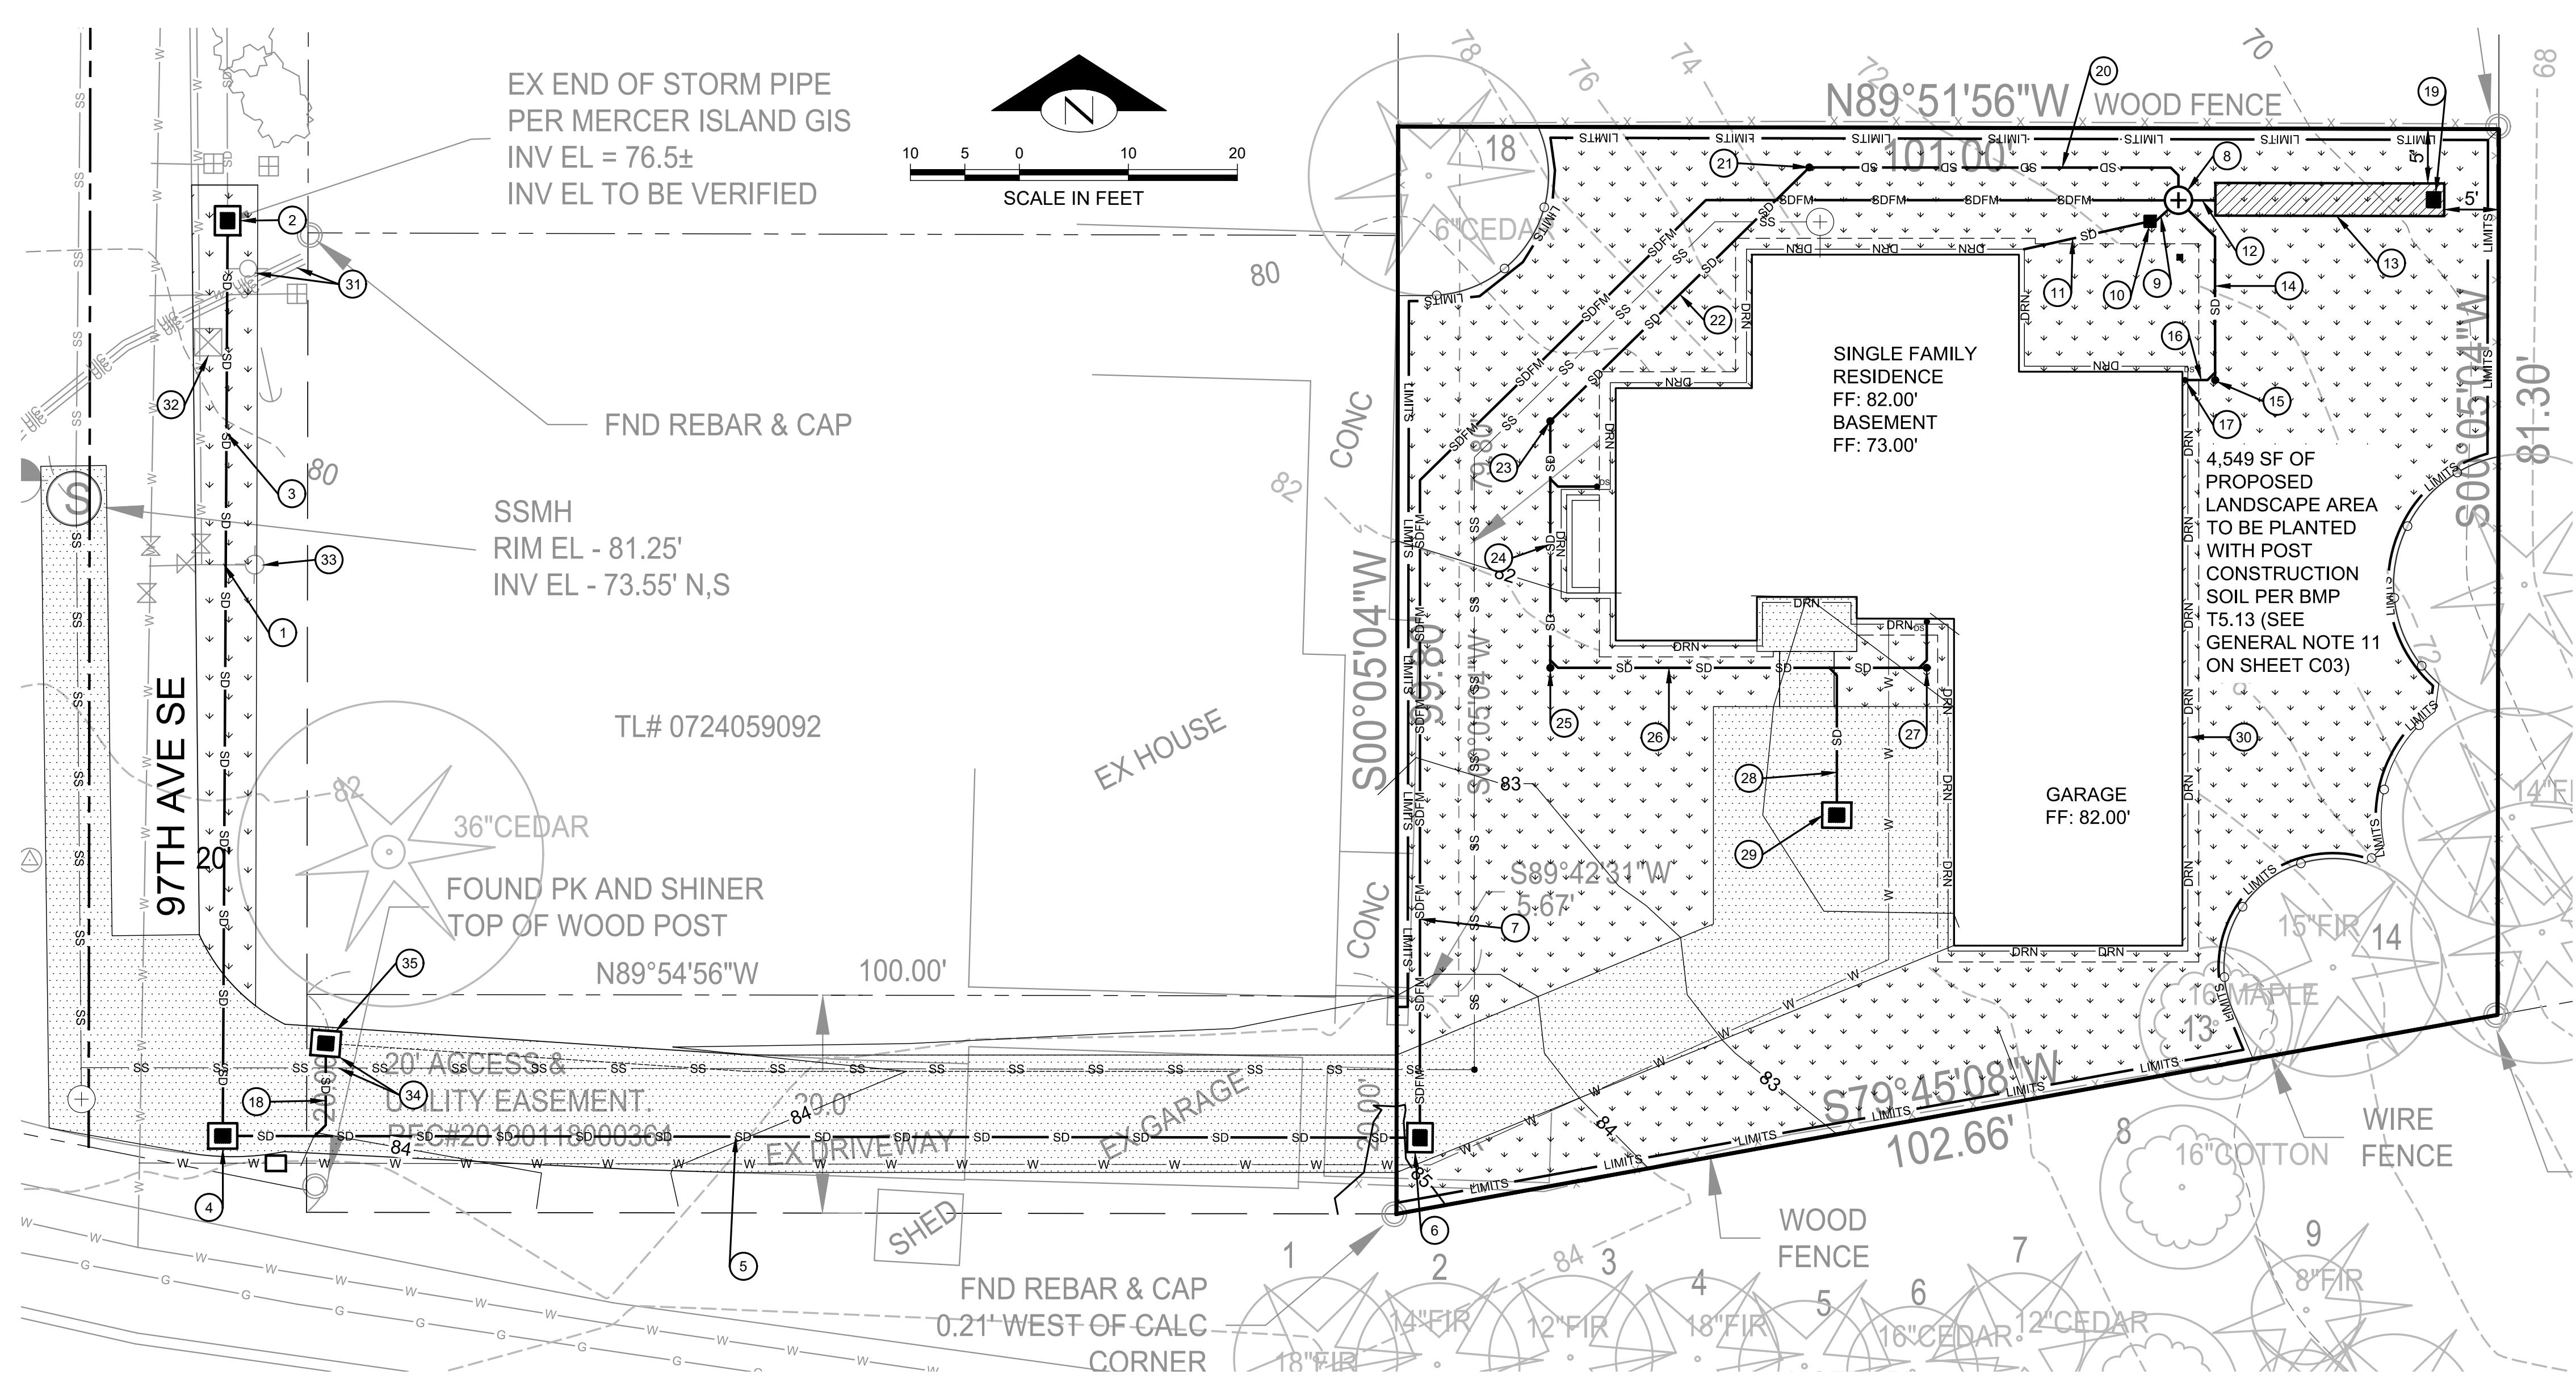

29	CB - TYPE 1 W/ OPEN-GRATE LID & OIL WATER SEPARATOR RIM 81.70 4" IE (N) 79.30 2' MIN SUMP	D&E/C05
30	PERIMETER FOOTING DRAIN - 4" PERFORATED PVC PIPE IN 6" MIN WASHED GRAVEL, WRAPPED IN NON-WOVEN FILTER FABRIC (TYP)	-
31	PROTECT EX POWER POLE AND UNDERGROUND POWER SERVICE DURING CONSTRUCTION	-
32	PROTECT EX MAILBOX DURING CONSTRUCTION AND REPLACE IN-KIND IF DAMAGED	-
33	PROTECT EX FIRE HYDRANT AND SERVICE DURING CONSTRUCTION	-
34	1" MIN CLEARANCE REQUIRED BETWEEN SSS & EDGE OF CB	-
35	CB - TYPE 1 W/ OPEN-GRATE LID & OIL WATER SEPARATOR RIM 83.30 6" IE (S) 80.90 2' MIN SUMP	D&E/C05

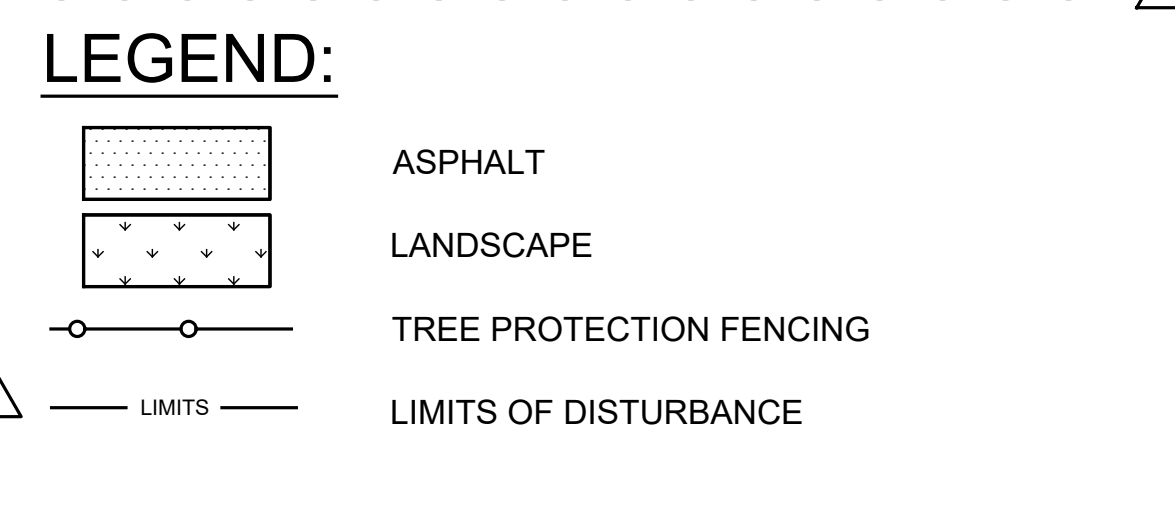

DRAINAGE NOTES:

ROOF DRAINS:

- NUMBER AND SIZE SHALL BE IN CONFORMANCE WITH THE UNIFORM PLUMBING CODE.
- DOWNSPOUTS SHALL BE TIED INTO A NON-PERFORATED, RIGID, SMOOTH-BORE PIPE, WHICH DRAINS TO AN APPROVED STORM SYSTEM.
- DRAINPIPE SHALL MEET MATERIAL STANDARDS FOR D2729 FOR P.V.C. PIPE, GR F-405 FOR SMOOTH-BORE H.D.P.E. PIPE.
- PROVIDE CLEANOUTS AT THE UPPER END OF THE SYSTEM AND AT EACH CUMULATIVE CHANGE OF DIRECTION IN EXCESS OF 135 DEGREES.
- ALL PIPE FITTINGS SHALL BE MADE OF THE SAME MATERIAL AS THE STRAIGHT PIPE. GLUED JOINTS SHALL USE A BONDING AGENT RECOMMENDED BY THE PIPE MANUFACTURER.

FOOTING DRAINS:

- FOOTING DRAINS SHALL BE INSTALLED AROUND ALL FOUNDATIONS WHICH ENCLOSE A CRAWL SPACE, CELLAR, BASEMENT, GARAGE OR OTHER BUILDING SPACE.
- DRAINS SHALL BE CONSTRUCTED OF PERFORATED PIPE INSTALLED AT THE BASE OF THE FOOTING.
- DRAIN PIPE SHALL MEET MATERIAL STANDARDS FOR D2729 FOR P.V.C. PIPE, WITH THE PERFORATIONS DIRECTED DOWNWARD.
- GRANULAR BACKFILL SHALL BE PLACED AROUND AND ABOVE THE FOOTING DRAIN TO A DEPTH OF 2/3 OF THE HEIGHT OF THE WALL.
- A FILTER FABRIC SHALL BE USED TO PREVENT SOIL PARTICLES FROM ENTERING THE FOOTING DRAIN. IT IS PREFERABLE THAT THE FABRIC BE PLACED BETWEEN THE GRANULAR BACKFILL AND THE NATIVE SOILS.


DRIVEWAY/PARKING AREA DRAINS:

- LARGE IMPERVIOUS AREAS USED FOR PARKING OR MANEUVERING OF VEHICLES SHALL BE SLOPED TO DRAIN TO ONE OR MORE CATCH BASINS.
- THE BASINS SHALL BE TIED INTO THE ON-SITE STORM DRAINAGE SYSTEM USING NON-PERFORATED PIPE OF THE SAME MATERIALS.
- AT LEAST ONE CATCH BASIN SHALL HAVE AN OIL SEPARATOR TO CLEAN THE WATER, OIL AND SILT PRIOR TO ENTERING THE APPROVED STORM SYSTEM.
- IN AREAS WHERE THE OFF-SITE STORM SYSTEM IS INADEQUATE, ON-SITE DETENTION OF RUNOFF MAY BE REQUIRED. (CONTACT THE DEVELOPMENT ENGINEER FOR MORE INFORMATION).

GENERAL:

- SLOPE ALL DRAIN LINES AT 2% MINIMUM TOWARD THE OUTLET.
- PROVIDE CLEANOUTS OR CONTROL STRUCTURES AS APPROPRIATE.
- ALL DRAINAGE PIPING AND STRUCTURES ARE SUBJECT TO INSPECTION PRIOR TO BACKFILLING.
- ROOF AND FOOTING DRAINS MAY BE COMBINED BEYOND THE LOWEST POINT OF THE FOOTING DRAIN.
- USE SAND COLLARS AT CB CONNECTIONS TO P.V.C. PIPE.
- UNLESS OTHERWISE SPECIFIED, 6" STORM DRAIN PIPE FOR ROOF DRAINS AND SEWER PIPE SHALL BE SDR35 PVC PIPE.
- ALL FOOTING DRAIN AND PERFORATED PIPE SHALL BE D2729 PVC PIPE WITH THE PERFORATIONS DIRECTED DOWNWARDS.
- ALL PERF PIPE SHALL BE 4" DIAMETER UNLESS OTHERWISE SHOWN.
- CONTRACTOR TO VERIFY INVERTS OF STORM DRAIN IN ROW AND ADJUST ONSITE STORM SYSTEM AS NECESSARY.
- CONTRACTOR TO FIELD LOCATE AND REROUTE ANY POTENTIAL UTILITY CONFLICTS WITH DETENTION FACILITY PRIOR TO CONSTRUCTION.

11. THE LAWN AND LANDSCAPE AREAS ARE REQUIRED TO PROVIDE POST-CONSTRUCTION SOIL QUALITY AND DEPTH IN ACCORDANCE WITH BMP T5.13. THE PROJECT CIVIL ENGINEER MUST PROVIDE A LETTER OF CERTIFICATION TO ENSURE THAT THE LAWN AND LANDSCAPE AREAS MEET THE POST-CONSTRUCTION SOIL QUALITY AND DEPTH REQUIREMENTS SPECIFIED ON THE APPROVED PLAN SET PRIOR TO FINAL INSPECTION OF THE PROJECT. CONTRACTOR MUST PROVIDE CIVIL ENGINEER W/ INFORMATION PROVING THE POST-CONSTRUCTION SOILS MEET THESE REQUIREMENTS.

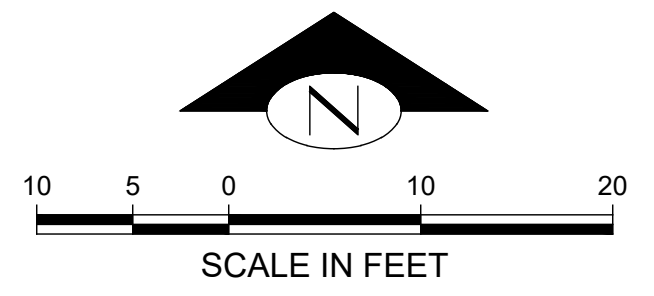

REVISION

NO.	DATE	BY	REVISIONS PER CITY REVIEW COMMENTS
1	6/5/2020	BI	

OWNER: IN MY BACKYARD, LLC
4701 W MERCER WAY
MERCER ISLAND, WA 98040

PROJECT: 3440 97TH AVE SE
MERCER ISLAND, WA 98040
DRAINAGE PLAN

PROJ. MANAGER: BI
DESIGNED BY: LG
DRAWN BY: JA
CHECKED BY: BI

SCALE: SCALE
DATE: 6/5/2020 REV. A SHEET 3 OF 6

SHEET NUMBER: **C03**


LEED AP
LEED ACCREDITED PROFESSIONAL & THE RELATED WORKS OWNED BY THE U.S. GREEN BUILDING COUNCIL & ARE AWARDED TO INDIVIDUALS UNDER LICENSE BY THE GREEN BUILDING CERTIFICATION INSTITUTE.

9706 4TH AVE NE
SUITE 300
SEATTLE, WA 98115
P: 206.523.0024
F: 206.523.1012
WWW.DCGENR.COM


DCG
CIVIL STRUCTURAL

CALL 811
2 BUSINESS DAYS
BEFORE YOU DIG
(UNDERGROUND UTILITY LOCATIONS ARE APPROX.)

BENJAMIN J. DODD
DIGITAL SIGNATURE
Benjamin J. Dodd
06.06.20
2018 12:15:52
REGISTERED PROFESSIONAL ENGINEER

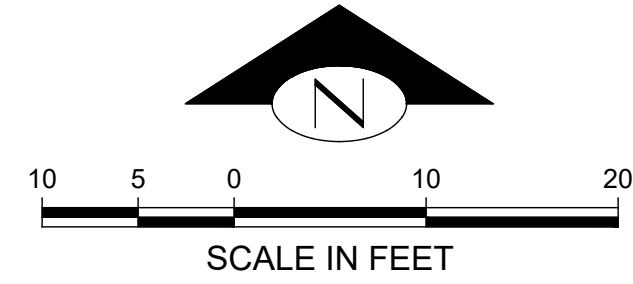

KEY NOTES		
KEY	DESCRIPTION	DETAIL/SHEET
1	EX MH TO BE ABANDONED. CONNECT NEW SS TO EX SS EX 8" SS IE 73.55	-
2	56 LF 8" PVC SS @ 2.00% MIN SLOPE	-
3	MH - TYPE 1 (48") RIM 83.35± 8" IE (N) 74.70	H/C05
4	128 LF 6" SS @ 2.00% MIN SLOPE	-
5	6" SSCO RIM 84.58 3" SSFM (N) IE 82.12 6" (W) IE 82.00	F/C05
6	97 LF 3" SSFM	-
7	SEWER PUMP STATION W/ SOLID LOCKING LID RIM 73.62 6" IE (S) 69.90 3" SDFM IE (W) 71.00 SUMP PER MANUFACTURER'S RECOMMENDATIONS	I/C06
8	2 LF 6" SSS @ 2.00% MIN SLOPE	-
9	6" SSS IE 70.00	-
10	CONNECT NEW 1" WATER SERVICE TO EX 8" DUCTILE IRON WATER MAIN W/ TAP (SIZE TO BE CONFIRMED BY OTHERS)	-
11	NEW 1" DOMESTIC WATER METER (SIZE TO BE CONFIRMED BY OTHERS)	-
12	INSTALL NEW 1" WATER SERVICE (SIZE TO BE CONFIRMED BY OTHERS)	-
13	EX 20' UTILITY EASEMENT	-
14	NEW SIDE SEWER CONNECTION TO 8" PVC SS 6" IE 75.49 (APPROX IE AFTER CONNECTION) 8" IE 74.66	G/C05

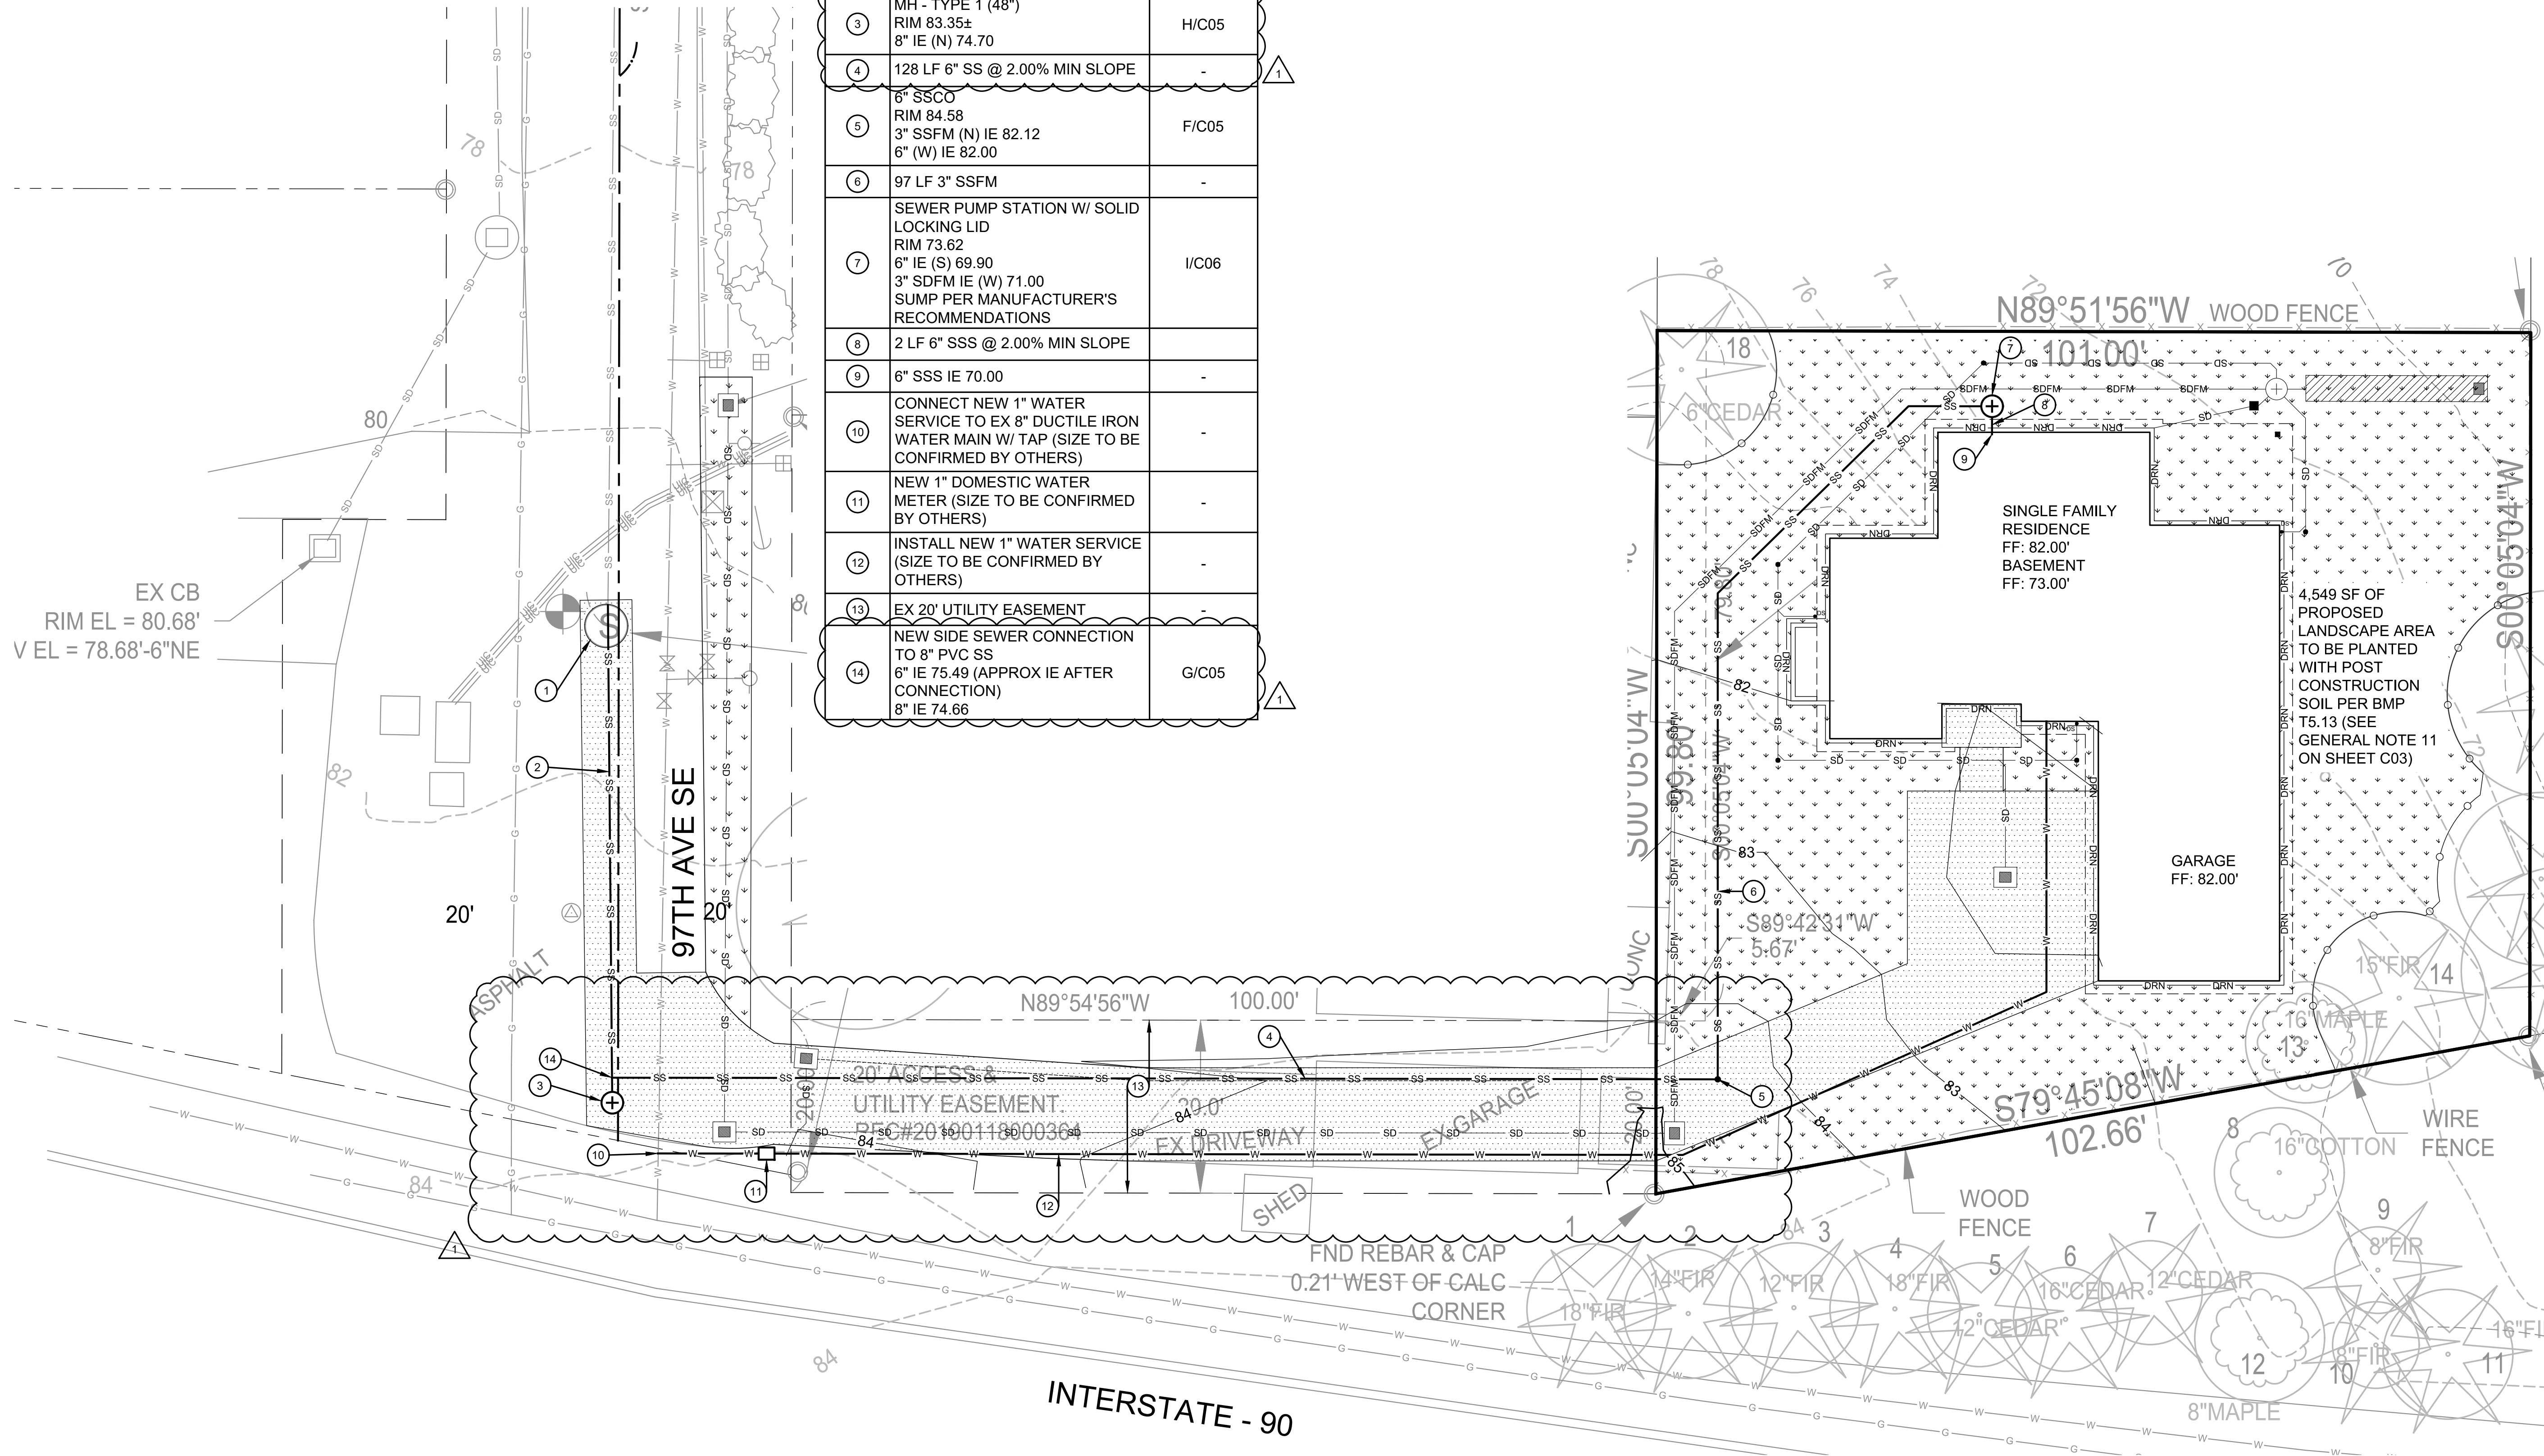


NO.	DATE	BY	REVISIONS PER CITY REVIEW COMMENTS
1	6/5/2020	BI	

9706 4TH AVE NE
SUITE 300
SEATTLE, WA 98115

DCG
Civil Structural

P: 206.523.0024
F: 206.523.1012
www.dcgengr.com

CALL 811
2 BUSINESS DAYS
BEFORE YOU DIG
(UNDERGROUND UTILITY LOCATIONS ARE APPROX.)

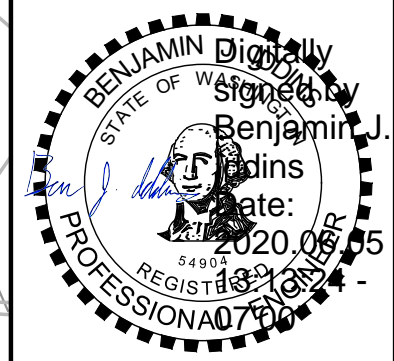

BASE MAP TOPOGRAPHY PROVIDED BY OTHERS. DCG CANNOT BE HELD LIABLE FOR ACCURACY. CONTRACTOR SHALL FIELD VERIFY GRADES, UTILITIES, & ALL OTHER EX FEATURES & CONDITIONS. IF CONDITIONS ARE NOT AS SHOWN &/OR PLANS CANNOT BE CONSTRUCTED AS SHOWN, CONTACT DCG PRIOR TO CONSTRUCTION.







OWNER: IN MY BACKYARD, LLC
4701 W MERCER WAY
MERCER ISLAND, WA 98040

PROJECT: 3440 97TH AVE SE
MERCER ISLAND, WA 98040
UTILITY PLAN



PROJ. MANAGER:	BI
DESIGNED BY:	LG
DRAWN BY:	JA
CHECKED BY:	BI
SCALE:	SCALE
DATE: 6/5/2020	REV. A
SHEET 4	OF 6

SHEET NUMBER
C04

CAD FILE NUMBER: \DCG\LOCAL FILES\SHAREDCG\CLIENTS\CIVIL\VALERE DEVELOPMENT\3440 97TH AVE SE MERCER ISLAND\DWG\DRAWING\3440 97TH AVE SE MERCER ISLAND.DWG
DATE: 6/5/2020 12:36 PM - SHEET SET: 3440 97TH AVE SE - ORIGINAL SHEET SIZE: ANSIFULL BLEED (34.00 X 22.00 INCHES)
AUTOCAD VERSION: CIVIL 3D 2018

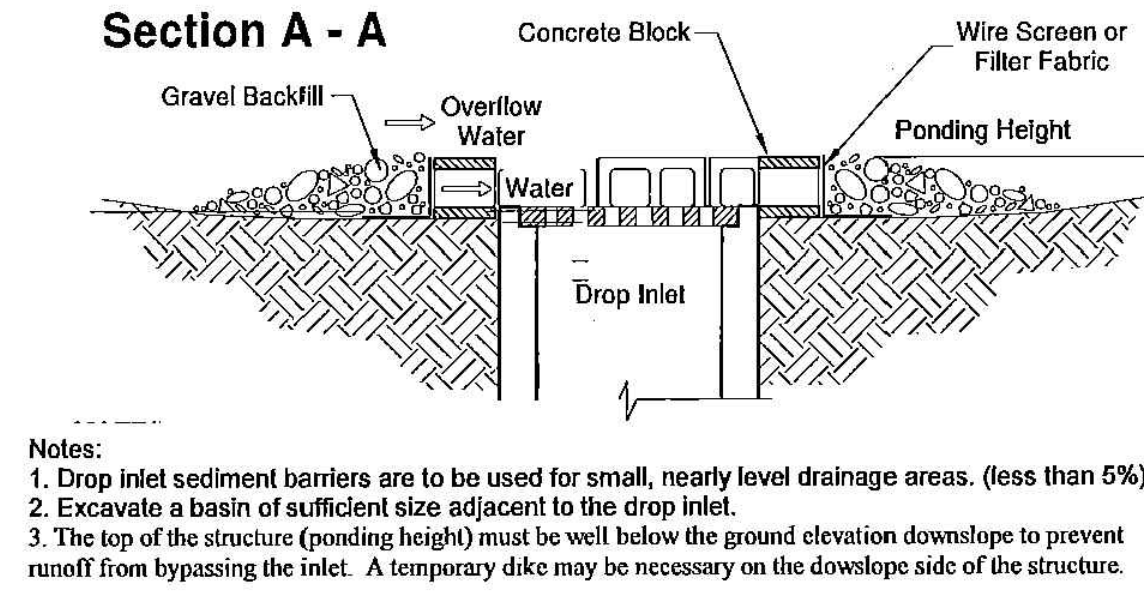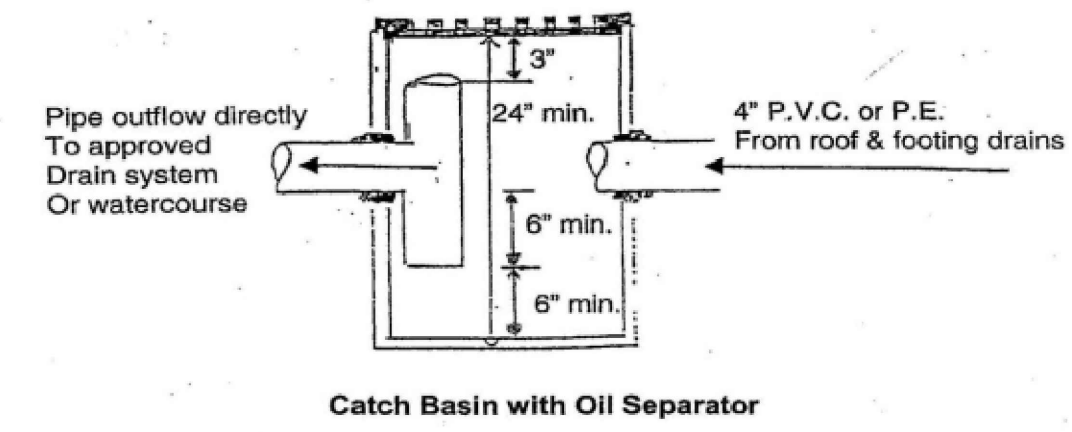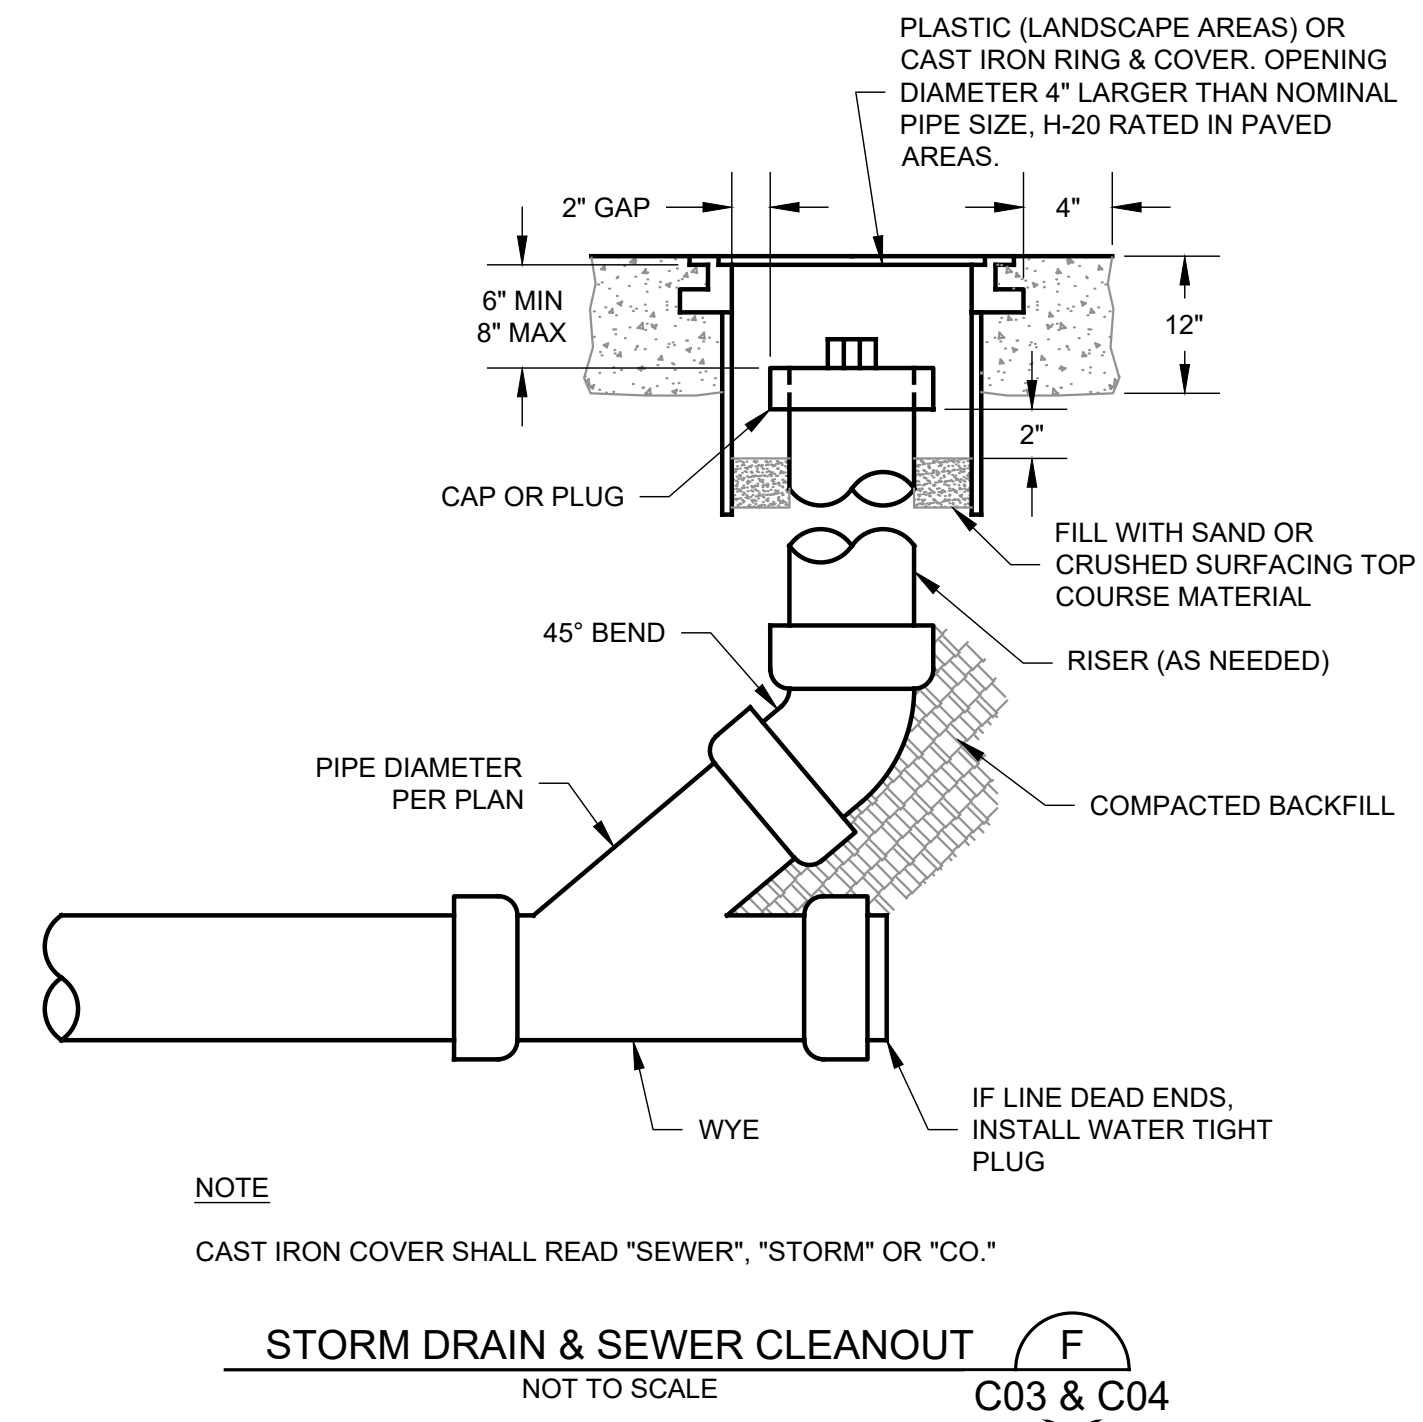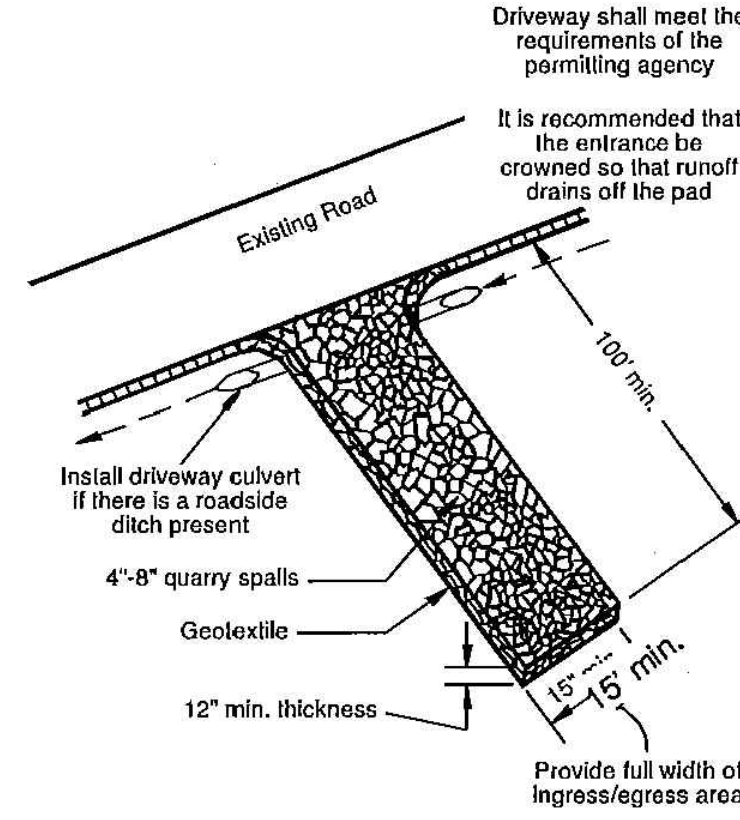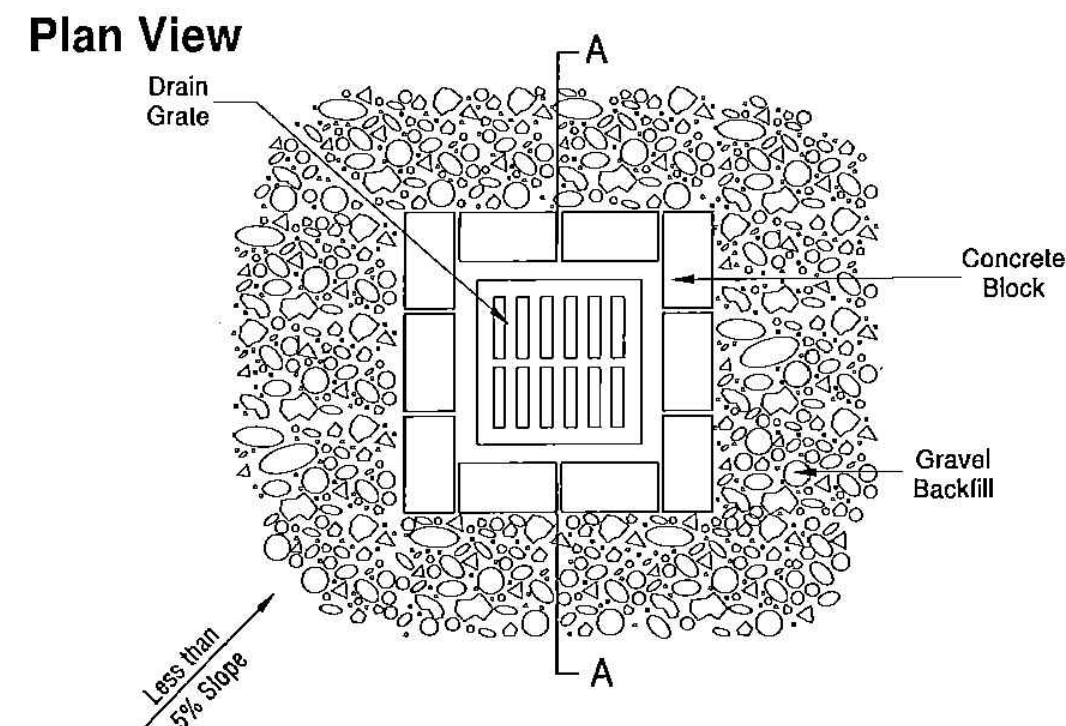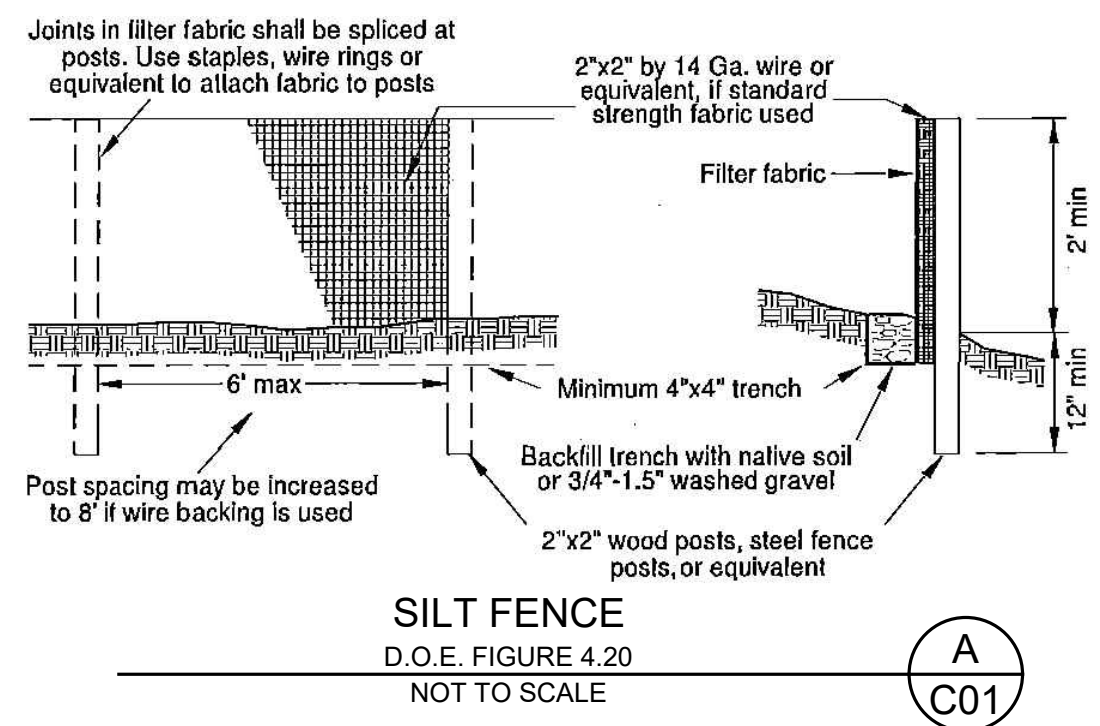


Notes:
1. Drop inlet sediment barriers are to be used for small, nearly level drainage areas. (less than 5%)
2. Excavate a basin of sufficient size adjacent to the drop inlet.
3. The top of the structure (ponding height) must be well below the ground elevation downslope to prevent runoff from bypassing the inlet. A temporary dike may be necessary on the downslope side of the structure.

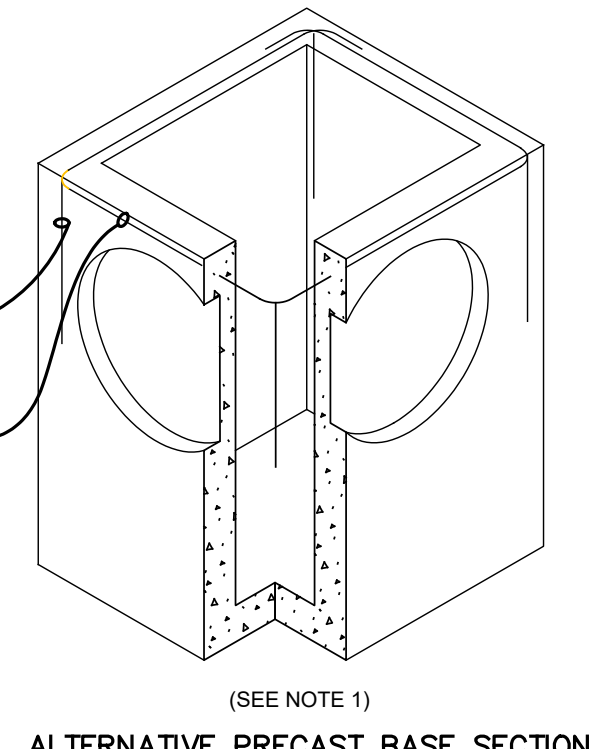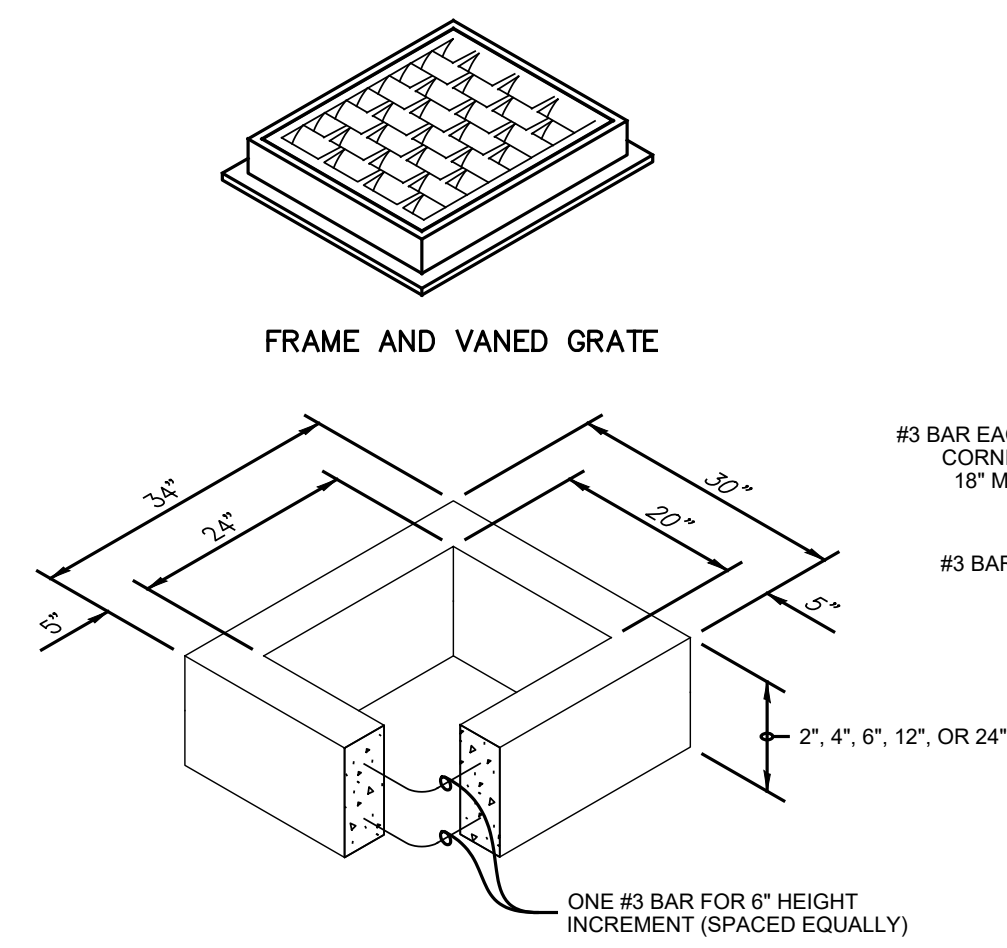


PIPE ALLOWANCES	
PIPE MATERIAL	MAXIMUM INSIDE DIAMETER
REINFORCED OR PLAIN CONCRETE	12"
ALL METAL PIPE	15"
CPSSP * (STD. SPEC. 9-05.20)	12"
SOLID WALL PVC (STD. SPEC. 9-05.12(1))	15"
PROFILE WALL PVC (STD. SPEC. 9-05.12(2))	15"


* CORRUGATED POLYETHYLENE STORM SEWER PIPE

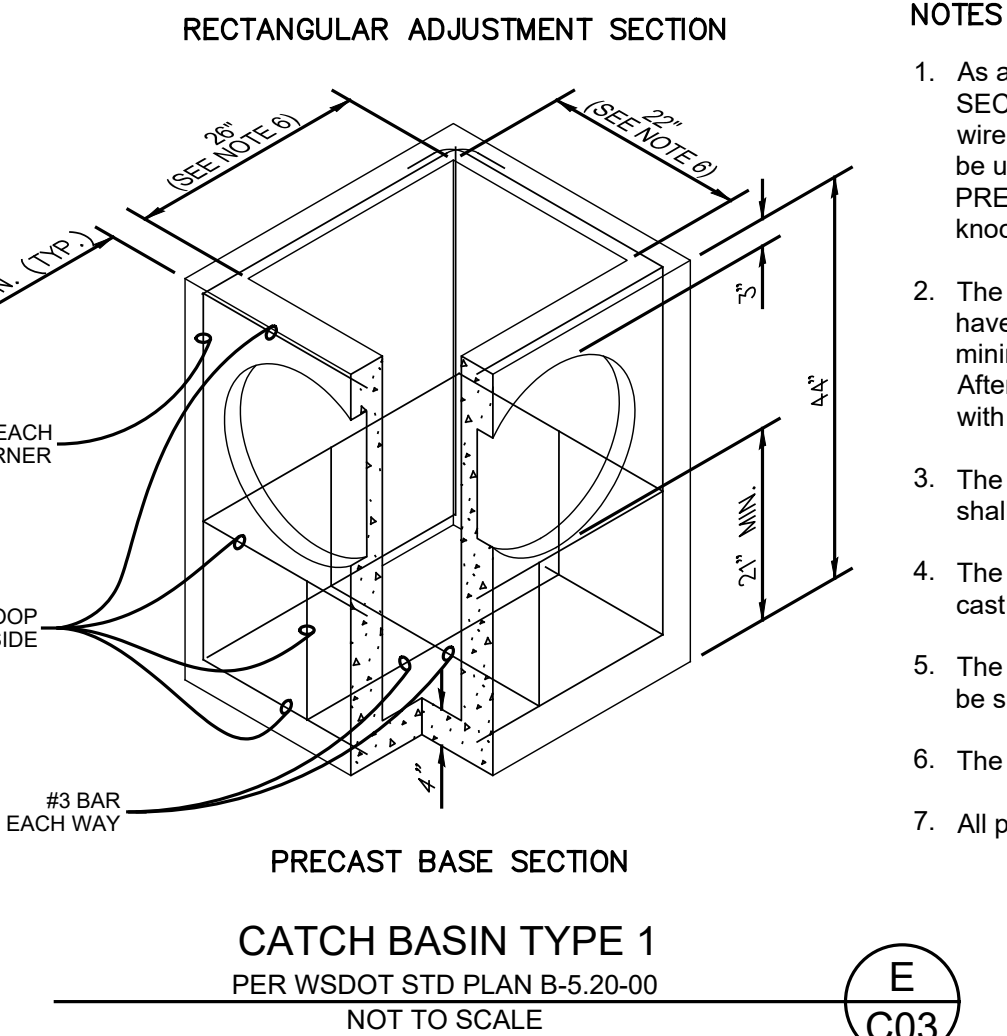

- NOTES**
- As acceptable alternatives to the rebar shown in the PRECAST BASE SECTION, fibers (placed according to the Standard Specifications), or wire mesh having a minimum area of 0.12 square inches per foot shall be used with the minimum required rebar shown in the ALTERNATIVE PRECAST BASE SECTION. Wire mesh shall not be placed in the knockouts.
 - The knockout diameter shall not be greater than 20". Knockouts shall have a wall thickness of 2" minimum to 2.5" maximum. Provide a 1.5" minimum gap between the knockout wall and the outside of the pipe. After the pipe is installed, fill the gap with joint mortar in accordance with Standard Specification 9-04.3.
 - The maximum depth from the finished grade to the lowest pipe invert shall be 5".
 - The frame and grate may be installed with the flange down, or integrally cast into the adjustment section with flange up.
 - The Precast Base Section may have a rounded floor, and the walls may be sloped at a rate of 1:24 or steeper.
 - The opening shall be measured at the top of the Precast Base Section.
 - All pickup holes shall be grouted full after the basin has been placed.

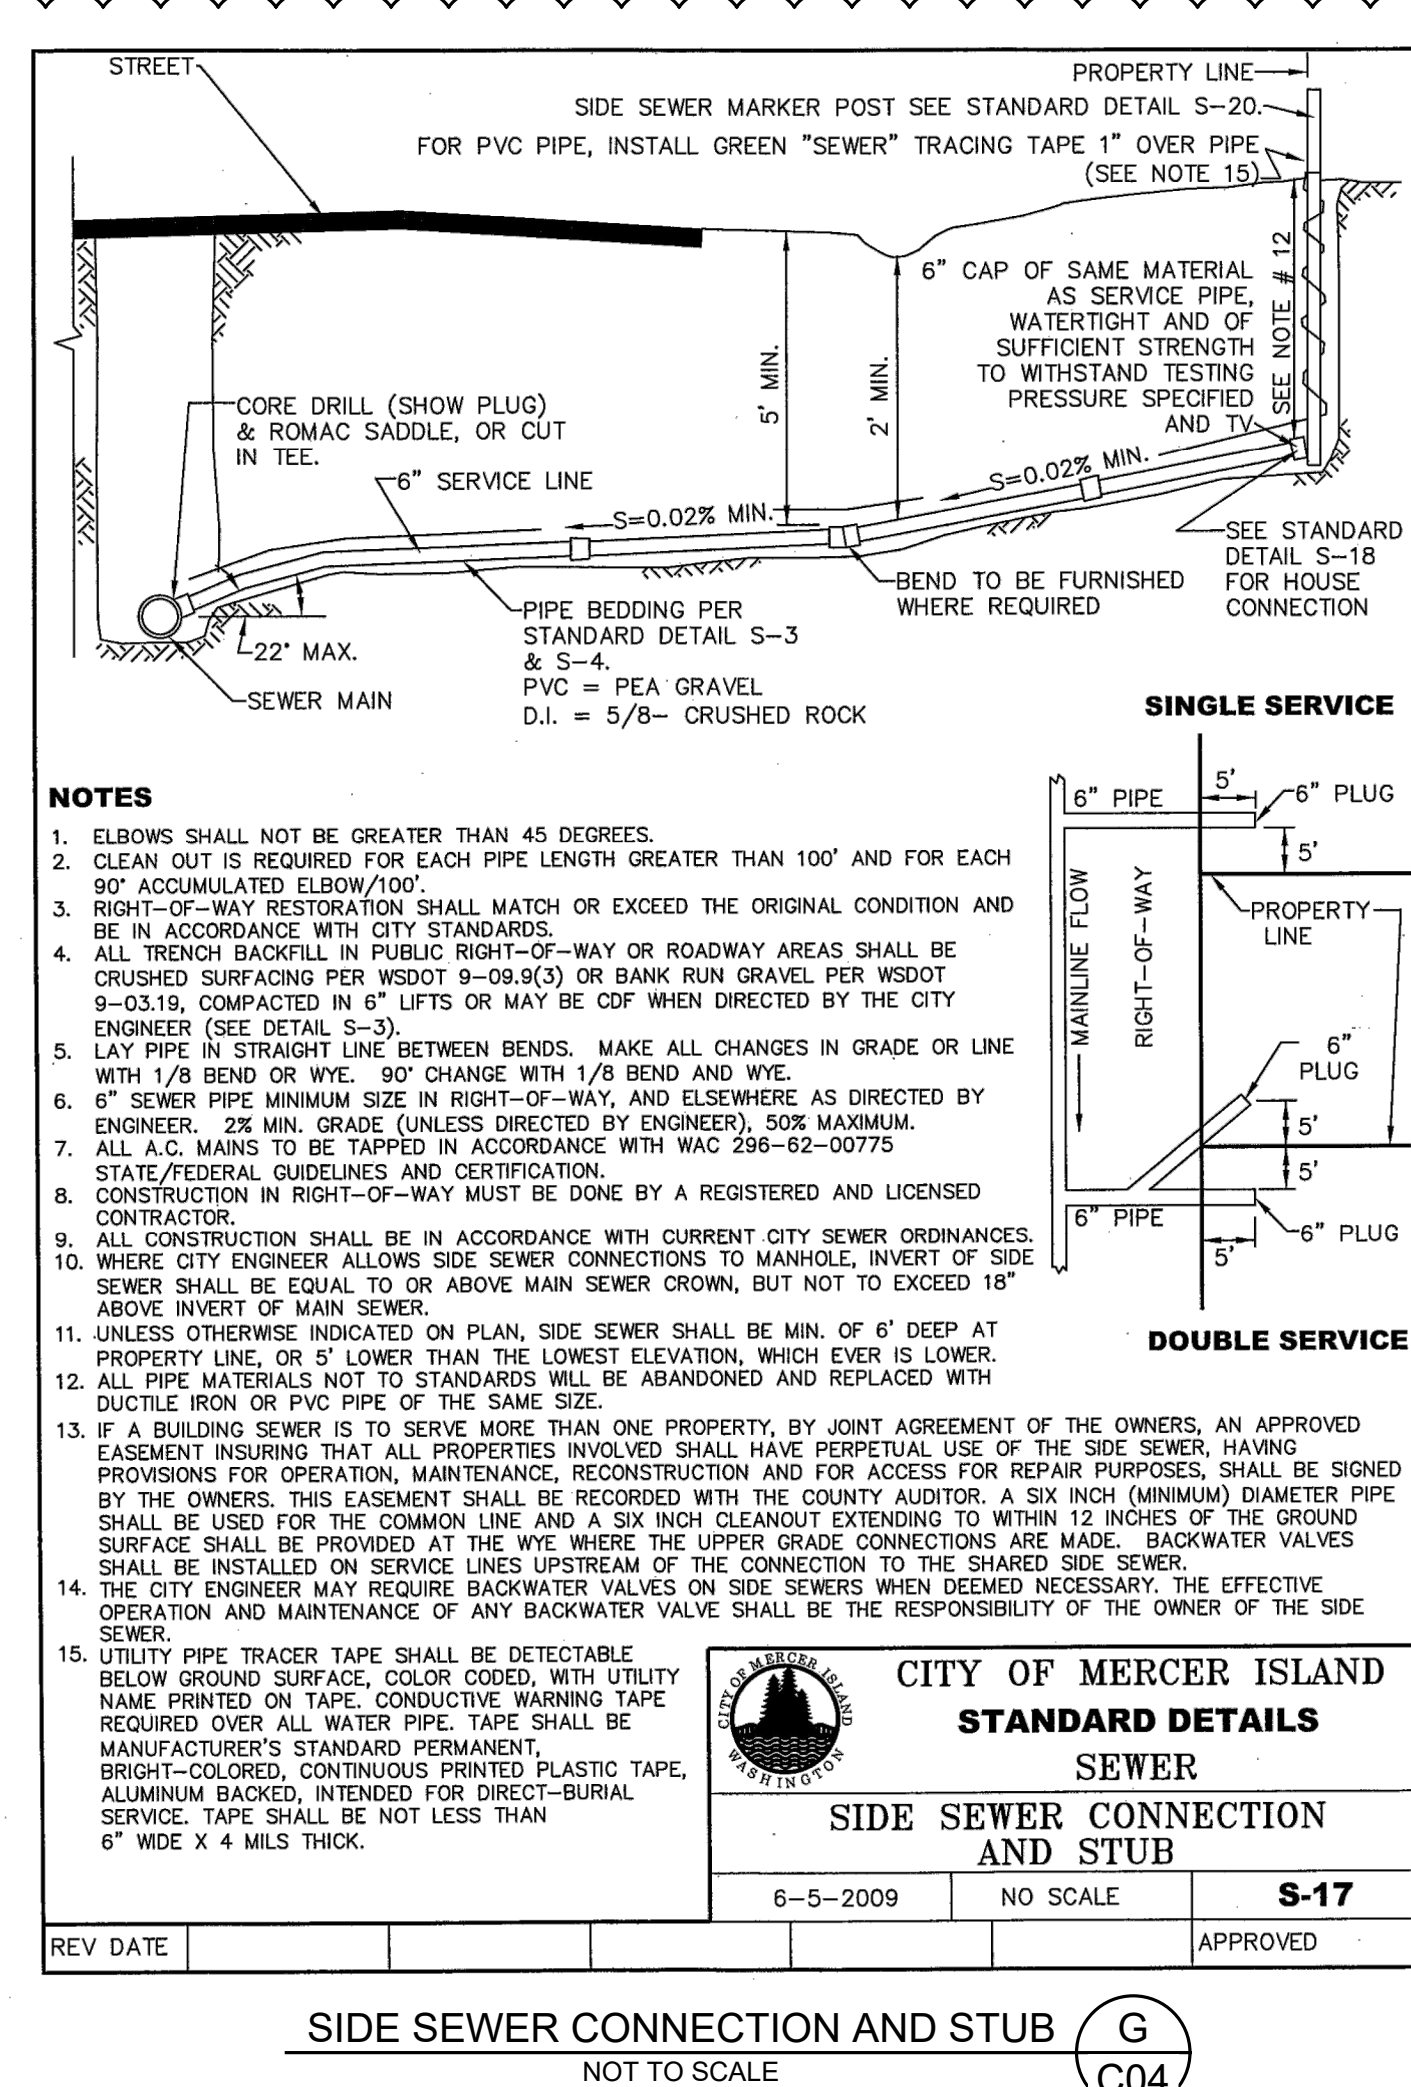

- NOTES**
- ELBOWS SHALL NOT BE GREATER THAN 45 DEGREES.
 - CLEAN OUT IS REQUIRED FOR EACH PIPE LENGTH GREATER THAN 100' AND FOR EACH 90° ACCUMULATED ELBOW/TEE.
 - RIGHT-OF-WAY RESTORATION SHALL MATCH OR EXCEED THE ORIGINAL CONDITION AND BE IN ACCORDANCE WITH CITY STANDARDS.
 - ALL TRENCH BACKFILL IN PUBLIC RIGHT-OF-WAY OR ROADWAY AREAS SHALL BE CRUSHED SURFACING PER WSDOT 9-09.9(3) OR BANK RUN GRAVEL PER WSDOT 9-03.19, COMPACTED IN 6" LIFTS OR MAY BE CDF WHEN DIRECTED BY THE CITY ENGINEER (SEE DETAIL S-3).
 - LAY PIPE IN STRAIGHT LINE BETWEEN BENDS. MAKE ALL CHANGES IN GRADE OR LINE WITH 1/8 BEND OR WYE. 90° CHANGE WITH 1/8 BEND AND WYE.
 - 6" SEWER PIPE MINIMUM SIZE IN RIGHT-OF-WAY, AND ELSEWHERE AS DIRECTED BY ENGINEER. 2% MIN. GRADE (UNLESS DIRECTED BY ENGINEER), 50% MAXIMUM.
 - ALL A.C. MAINS TO BE TAPPED IN ACCORDANCE WITH WAC 296-62-00775 STATE FEDERAL GUIDELINES AND CERTIFICATION.
 - CONSTRUCTION IN RIGHT-OF-WAY MUST BE DONE BY A REGISTERED AND LICENSED CONTRACTOR.
 - ALL CONSTRUCTION SHALL BE IN ACCORDANCE WITH CURRENT CITY SEWER ORDINANCES.
 - WHERE CITY ENGINEER ALLOWS SIDE SEWER CONNECTIONS TO MANHOLE, INVERT OF SIDE SEWER SHALL BE EQUAL TO OR ABOVE MAIN SEWER CROWN, BUT NOT TO EXCEED 18" ABOVE INVERT OF MAIN SEWER.
 - UNLESS OTHERWISE INDICATED ON PLAN, SIDE SEWER SHALL BE MIN. OF 6" DEEP AT PROPERTY LINE, OR 5' LOWER THAN THE LOWEST ELEVATION, WHICH EVER IS LOWER.
 - ALL PIPE MATERIALS NOT TO STANDARDS WILL BE ABANDONED AND REPLACED WITH DUCTILE IRON OR PVC PIPE OF THE SAME SIZE.
 - IF A BUILDING SEWER IS TO SERVE MORE THAN ONE PROPERTY, BY JOINT AGREEMENT OF THE OWNERS, AN APPROVED EASEMENT INSURING THAT ALL PROPERTIES INVOLVED SHALL HAVE PERPETUAL USE OF THE SIDE SEWER, HAVING PROVISIONS FOR OPERATION, MAINTENANCE, RECONSTRUCTION AND FOR ACCESS FOR REPAIR PURPOSES, SHALL BE SIGNED BY THE OWNERS. THIS EASEMENT SHALL BE RECORDED WITH THE COUNTY AUDITOR. A SIX INCH (MINIMUM) DIAMETER PIPE SHALL BE USED FOR THE COMMON LINE AND A SIX INCH CLEANOUT EXTENDING TO WITHIN 12 INCHES OF THE GROUND SURFACE SHALL BE PROVIDED AT THE WYE WHERE THE UPPER GRADE CONNECTIONS ARE MADE. BACKWATER VALVES SHALL BE INSTALLED ON SERVICE LINES UPSTREAM OF THE CONNECTION TO THE SHARED SIDE SEWER.
 - THE CITY ENGINEER MAY REQUIRE BACKWATER VALVES ON SIDE SEWERS WHEN DEEMED NECESSARY. THE EFFECTIVE OPERATION AND MAINTENANCE OF ANY BACKWATER VALVE SHALL BE THE RESPONSIBILITY OF THE OWNER OF THE SIDE SEWER.
 - UTILITY PIPE TRACER TAPE SHALL BE DETECTABLE BELOW GROUND SURFACE, COLOR CODED, WITH UTILITY NAME PRINTED ON TAPE. CONDUCTIVE WARNING TAPE REQUIRED OVER ALL WATER PIPE. TAPE SHALL BE MANUFACTURER'S STANDARD PERMANENT, BRIGHT-COLORED, CONTINUOUS PRINTED PLASTIC TAPE. TAPE SHALL BE NOT LESS THAN 6" WIDE X 4 MILS THICK.

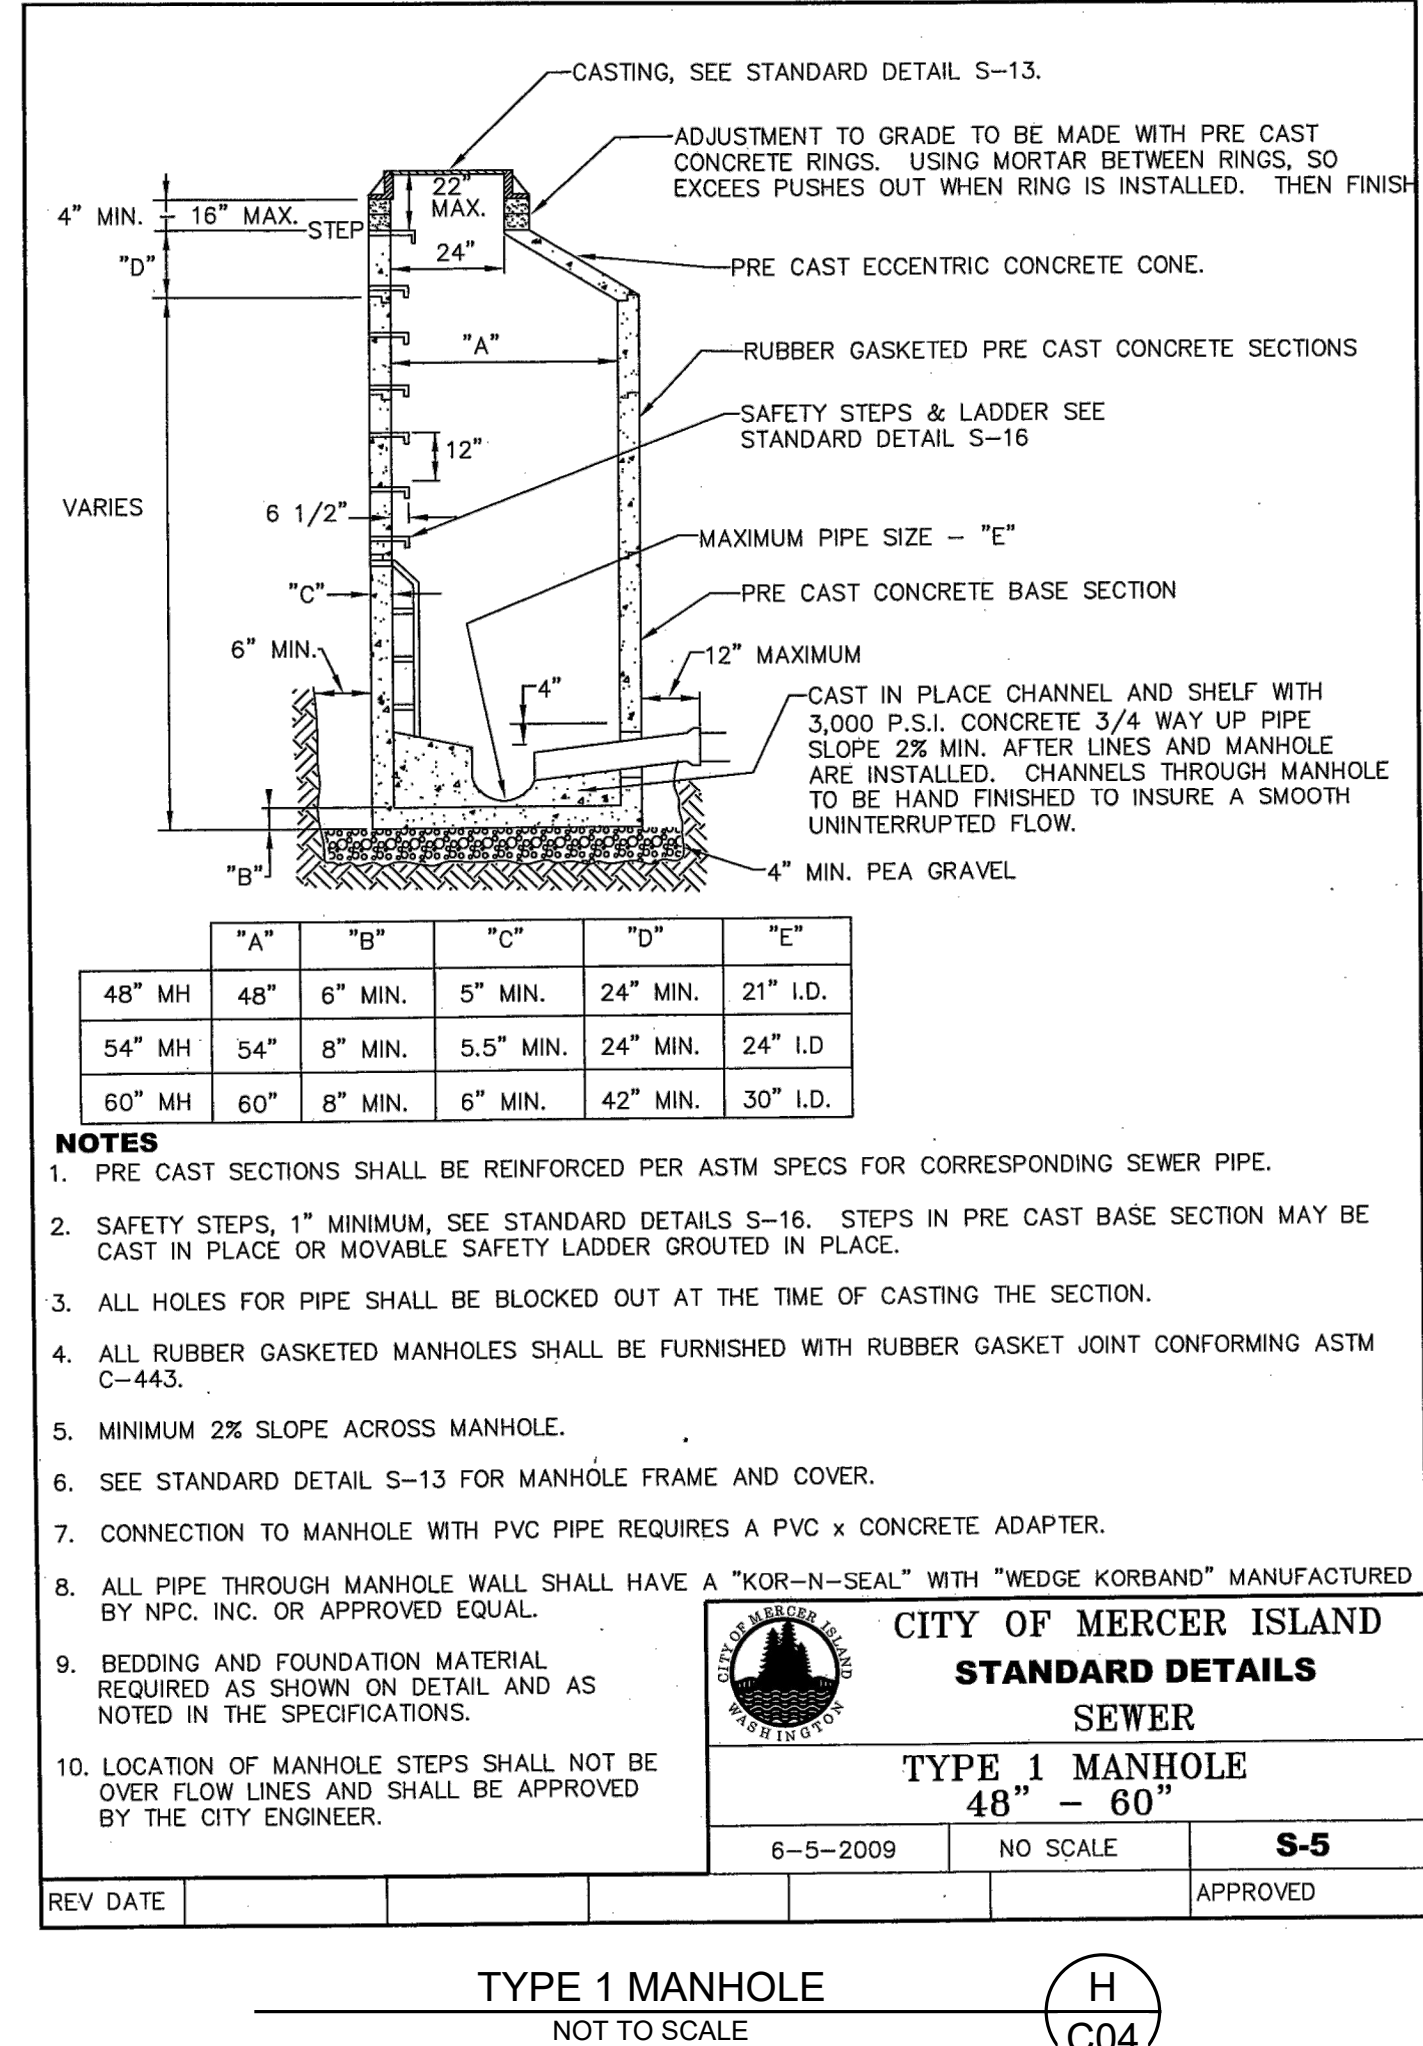

- NOTES**
- PRE CAST SECTIONS SHALL BE REINFORCED PER ASTM SPECS FOR CORRESPONDING SEWER PIPE.
 - SAFETY STEPS, 1" MINIMUM, SEE STANDARD DETAILS S-16. STEPS IN PRE CAST BASE SECTION MAY BE CAST IN PLACE OR MOVABLE SAFETY LADDER GROUTED IN PLACE.
 - ALL HOLES FOR PIPE SHALL BE BLOCKED OUT AT THE TIME OF CASTING THE SECTION.
 - ALL RUBBER GASKETED MANHOLES SHALL BE FURNISHED WITH RUBBER GASKET JOINT CONFORMING ASTM C-443.
 - MINIMUM 2% SLOPE ACROSS MANHOLE.
 - SEE STANDARD DETAIL S-13 FOR MANHOLE FRAME AND COVER.
 - CONNECTION TO MANHOLE WITH PVC PIPE REQUIRES A PVC X CONCRETE ADAPTER.
 - ALL PIPE THROUGH MANHOLE WALL SHALL HAVE A "KOR-N-SEAL" WITH "WEDGE KORBAND" MANUFACTURED BY NPC, INC. OR APPROVED EQUAL.
 - BEDDING AND FOUNDATION MATERIAL REQUIRED AS SHOWN ON DETAIL AND AS NOTED IN THE SPECIFICATIONS.
 - LOCATION OF MANHOLE STEPS SHALL NOT BE OVER FLOW LINES AND SHALL BE APPROVED BY THE CITY ENGINEER.

CAD FILE NUMBER: \\DCG\LOCAL\FILES\DCG\Clients\Civil\VALERIE DEVELOPMENT\3440 97TH AVE SE MERCER ISLAND\DWG\3440 97TH AVE SE MERCER ISLAND.DWG
AUTOCAD VERSION: CIVIL_3D_2018


DCG CIVIL STRUCTURAL

9706 4TH AVE NE SUITE 300 SEATTLE, WA 98115
P: 206.523.0024 F: 206.523.1012 www.dcgengr.com

LEED AP
LEED ACCREDITED PROFESSIONAL & THE RELATED ACTIVITIES ARE OWNED BY THE U.S. GREEN BUILDING COUNCIL & AWARDED TO INDIVIDUALS UNDER LICENSE BY THE GREEN BUILDING CERTIFICATION INSTITUTE.

REVISION PER CITY REVIEW COMMENTS
DATE: 6/5/2020 BY: BI
No. A

CALL 811
2 BUSINESS DAYS
BEFORE YOU DIG
(UNDERGROUND UTILITY LOCATIONS ARE APPROX.)

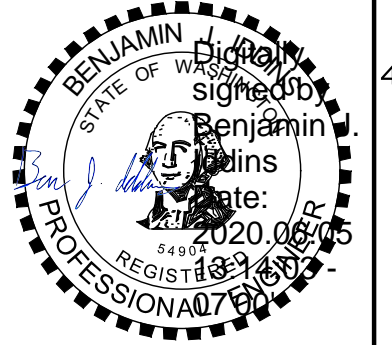

BASE MAP/TOPOGRAPHY PROVIDED BY OTHERS. DCG CANNOT BE HELD LIABLE FOR ACCURACY. CONTRACTOR SHALL FIELD VERIFY GRADES, UTILITIES, & ALL OTHER EXISTING FEATURES & CONDITIONS. IF CONDITIONS ARE NOT AS SHOWN &/OR PLANS CANNOT BE CONSTRUCTED AS SHOWN, CONTACT DCG PRIOR TO CONSTRUCTION.

OWNER: IN MY BACKYARD, LLC
4701 W MERCER WAY
MERCER ISLAND, WA 98040

PROJECT: 3440 97TH AVE SE
MERCER ISLAND, WA 98040
ESC & DRAINAGE DETAILS

PROJ. MANAGER:	BI
DESIGNED BY:	LG
DRAWN BY:	JA
CHECKED BY:	BI
SCALE:	SCALE
DATE:	REV. SHEET
6/5/2020	A 5 OF 6

SHEET NUMBER
C05

SANITARY SIDE SEWER PUMP SPECIFICATIONS	
GENERAL DESCRIPTION	SUBMERSIBLE SEWAGE EJECTOR PUMP
DESIGN FLOW & TDH	28 GPM @ 15.34' TDH (BASED ON FORCE MAIN DIAM. AND LENGTH PER PLAN DOUBLED TO ACCOUNT FOR MINOR LOSSES)
MINIMUM SOLIDS HANDLING	2" MIN
PUMP EFFICIENCY	PER MANUFACTURER'S RECOMMENDATIONS OPERATING RANGE
PUMP ELECTRICAL	SINGLE PHASE
PUMP CONTROLS	PER MANUFACTURER'S RECOMMENDATIONS
PUMP MOUNTING & DISCHARGE	PER MANUFACTURER'S RECOMMENDATIONS
DISCHARGE MANIFOLD	PER MANUFACTURER'S RECOMMENDATIONS
FORCE MAIN & FITTINGS	3" (USED FOR TDH CALCS. CAN USE 2" MIN UP TO 4" MAX BUT REQUIRES RECALCULATION OF TDH)
CONTROL/FLOAT SPECIFICATIONS	PER MANUFACTURER'S RECOMMENDATIONS



NOTES:

1. THESE SPECIFICATIONS ARE SCHEMATIC IN NATURE AND SHALL BE CONFIRMED BY THE SUPPLIER AND CONTRACTOR.
2. PUMP FLOATS/CONTROLS AND DISCHARGE VALVES SHALL BE FIELD TESTED AND ADJUSTED TO ACHIEVE DESIGN FLOW AND OPTIMUM PUMP CYCLE TIMES PER MANUFACTURER'S RECOMMENDATIONS.
3. DUPLEX PUMP STATION IS REQUIRED.

STORMWATER PUMP SPECIFICATIONS	
GENERAL DESCRIPTION	SUBMERSIBLE STORMWATER EJECTOR PUMP
DESIGN FLOW & TDH	40 GPM @ 21.96' TDH (BASED ON FORCE MAIN DIAM. AND LENGTH PER PLAN DOUBLED TO ACCOUNT FOR MINOR LOSSES)
MINIMUM SOLIDS HANDLING	3/4" MIN
PUMP EFFICIENCY	PER MANUFACTURER'S RECOMMENDATIONS OPERATING RANGE
PUMP ELECTRICAL	SINGLE PHASE
PUMP CONTROLS	PER MANUFACTURER'S RECOMMENDATIONS
PUMP MOUNTING & DISCHARGE	PER MANUFACTURER'S RECOMMENDATIONS
DISCHARGE MANIFOLD	PER MANUFACTURER'S RECOMMENDATIONS
FORCE MAIN & FITTINGS	3" (USED FOR TDH CALCS. CAN USE 2" MIN UP TO 4" MAX BUT REQUIRES RECALCULATION OF TDH)
CONTROL/FLOAT SPECIFICATIONS	PER MANUFACTURER'S RECOMMENDATIONS

NOTES:

1. THESE SPECIFICATIONS ARE SCHEMATIC IN NATURE AND SHALL BE CONFIRMED BY THE SUPPLIER AND CONTRACTOR.
2. PUMP FLOATS/CONTROLS AND DISCHARGE VALVES SHALL BE FIELD TESTED AND ADJUSTED TO ACHIEVE DESIGN FLOW AND OPTIMUM PUMP CYCLE TIMES PER MANUFACTURER'S RECOMMENDATIONS.
3. DUPLEX PUMP STATION IS REQUIRED.
4. DESIGN FOOTING DRAIN FLOW IS ASSUMED TO BE LESS THAN OR EQUAL TO 10 GPM. GEOTECHNICAL ENGINEER TO OBSERVE INSTALLATION OF FOOTING DRAINS TO VERIFY FLOWRATE IS ADEQUATE. IF HIGHER RATES ARE OBSERVED IN THE FIELD, CONTACT ENGINEER.

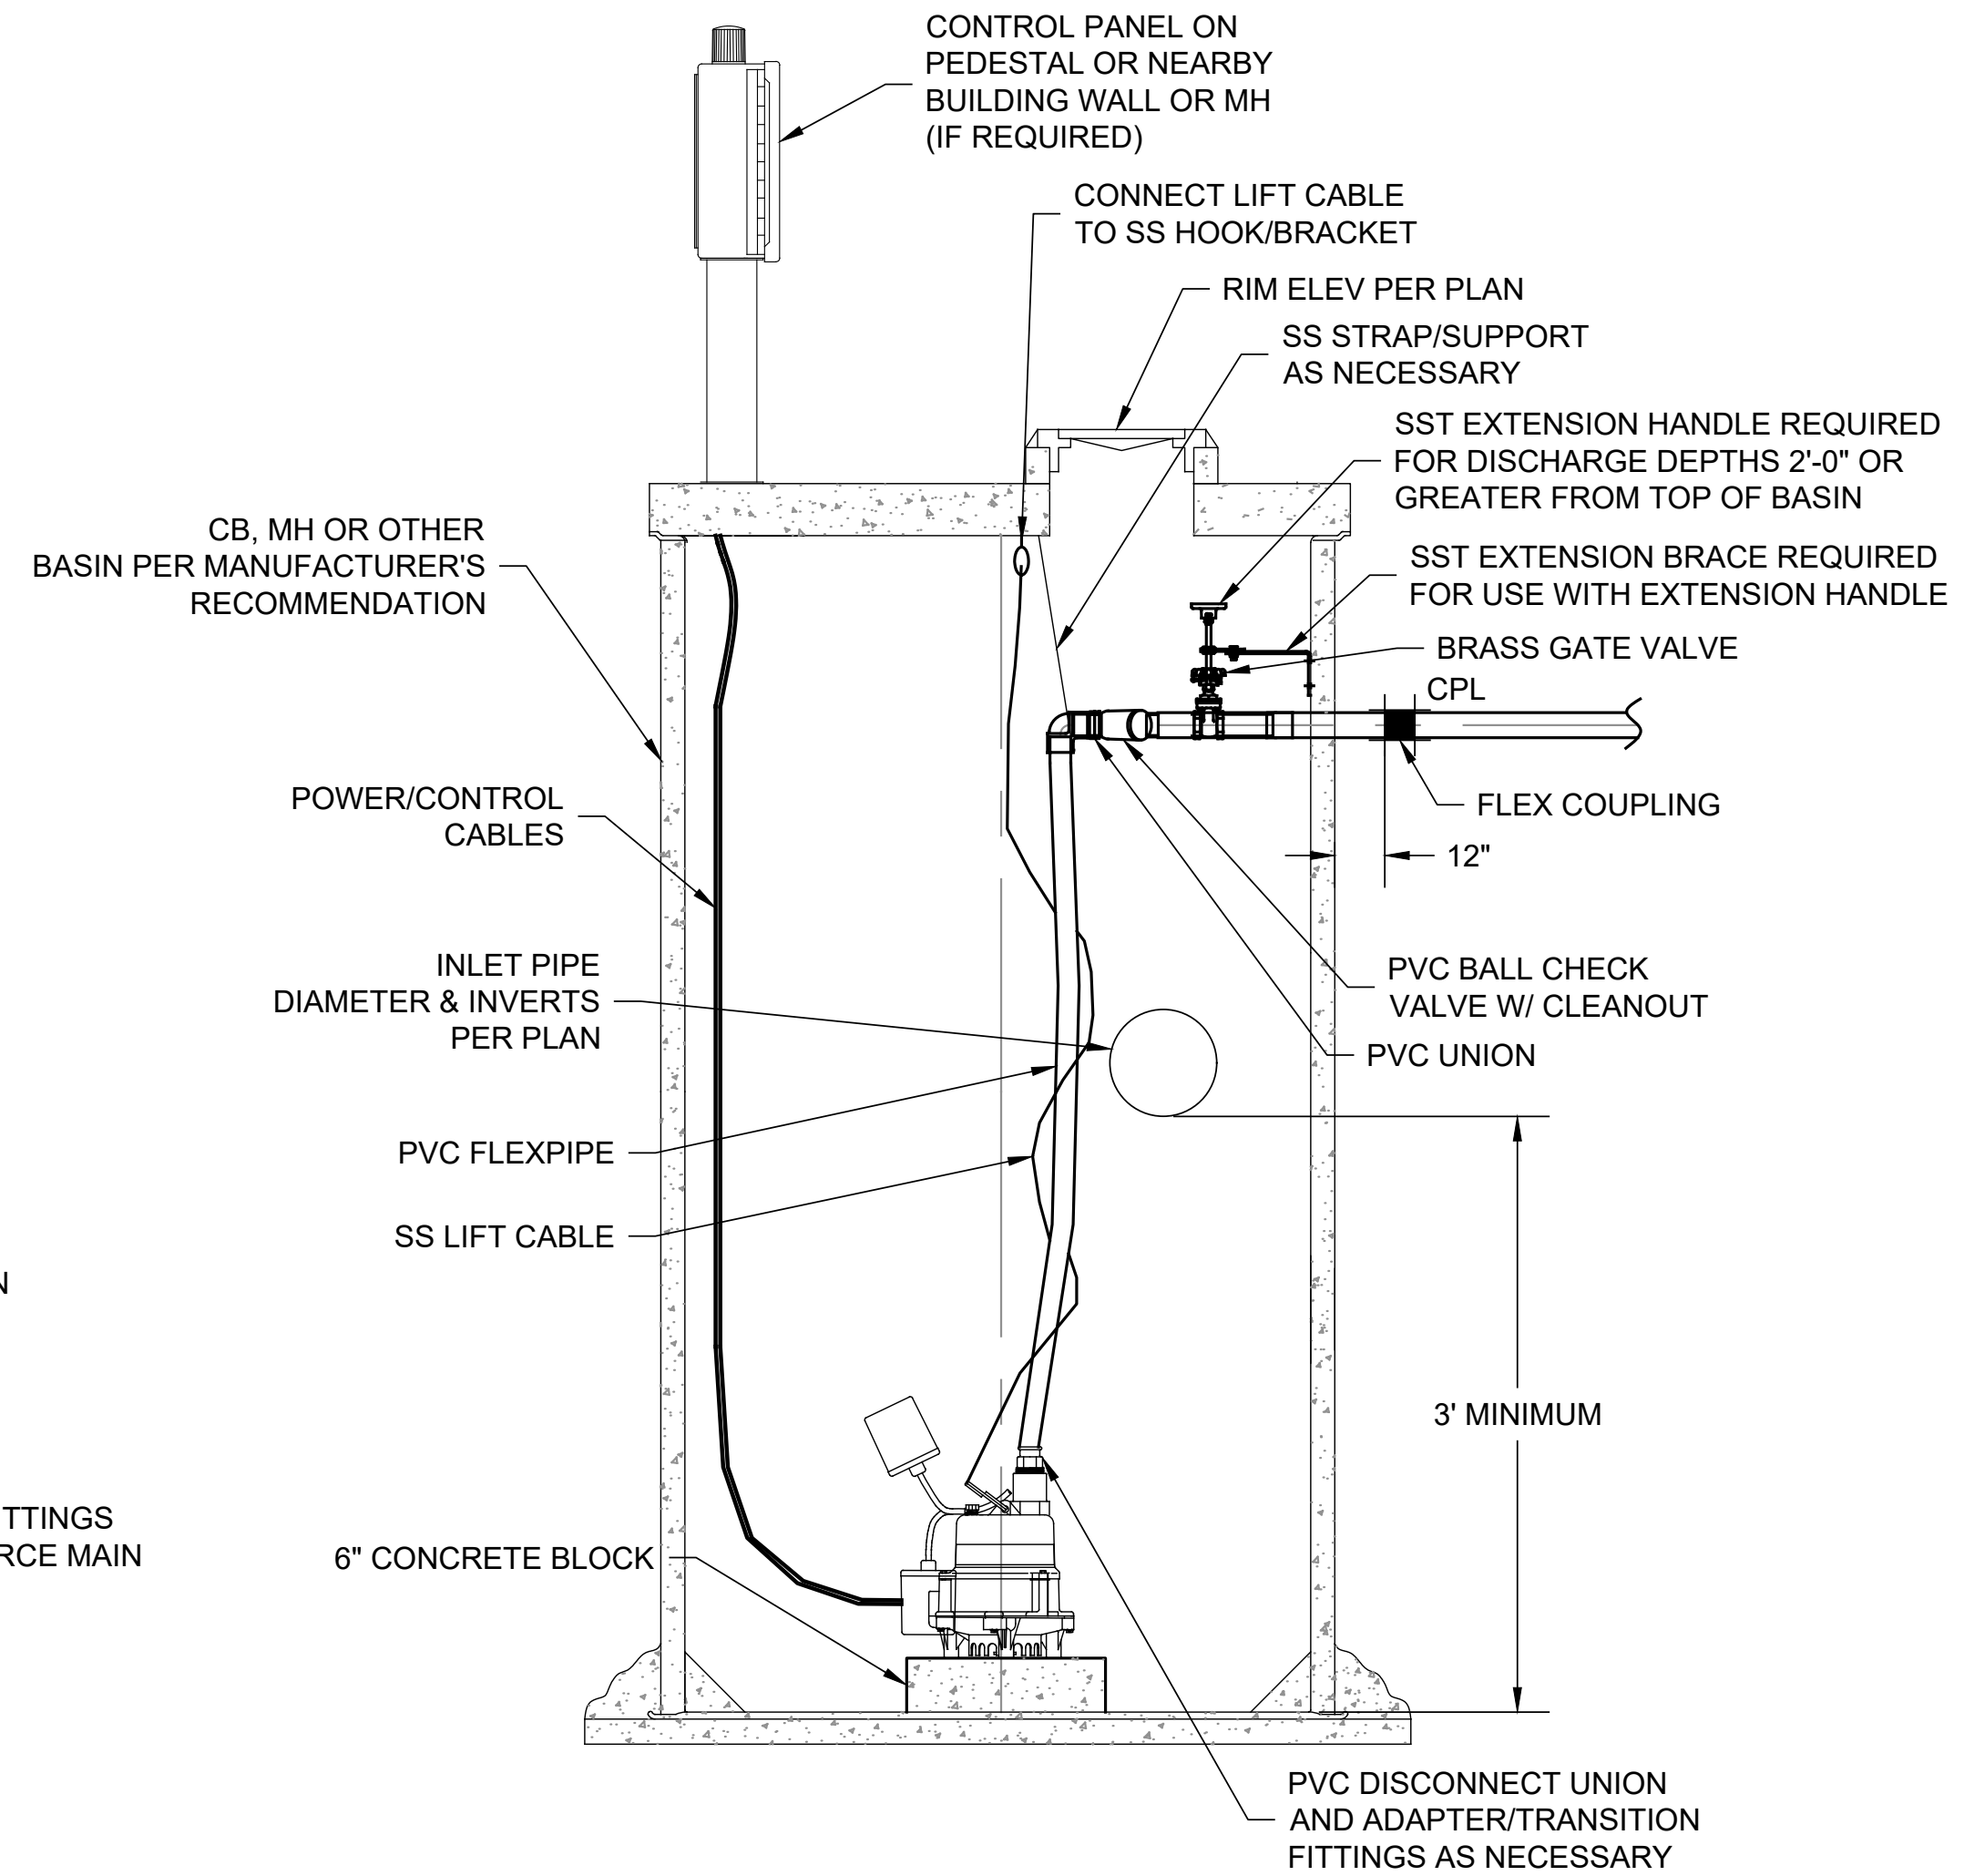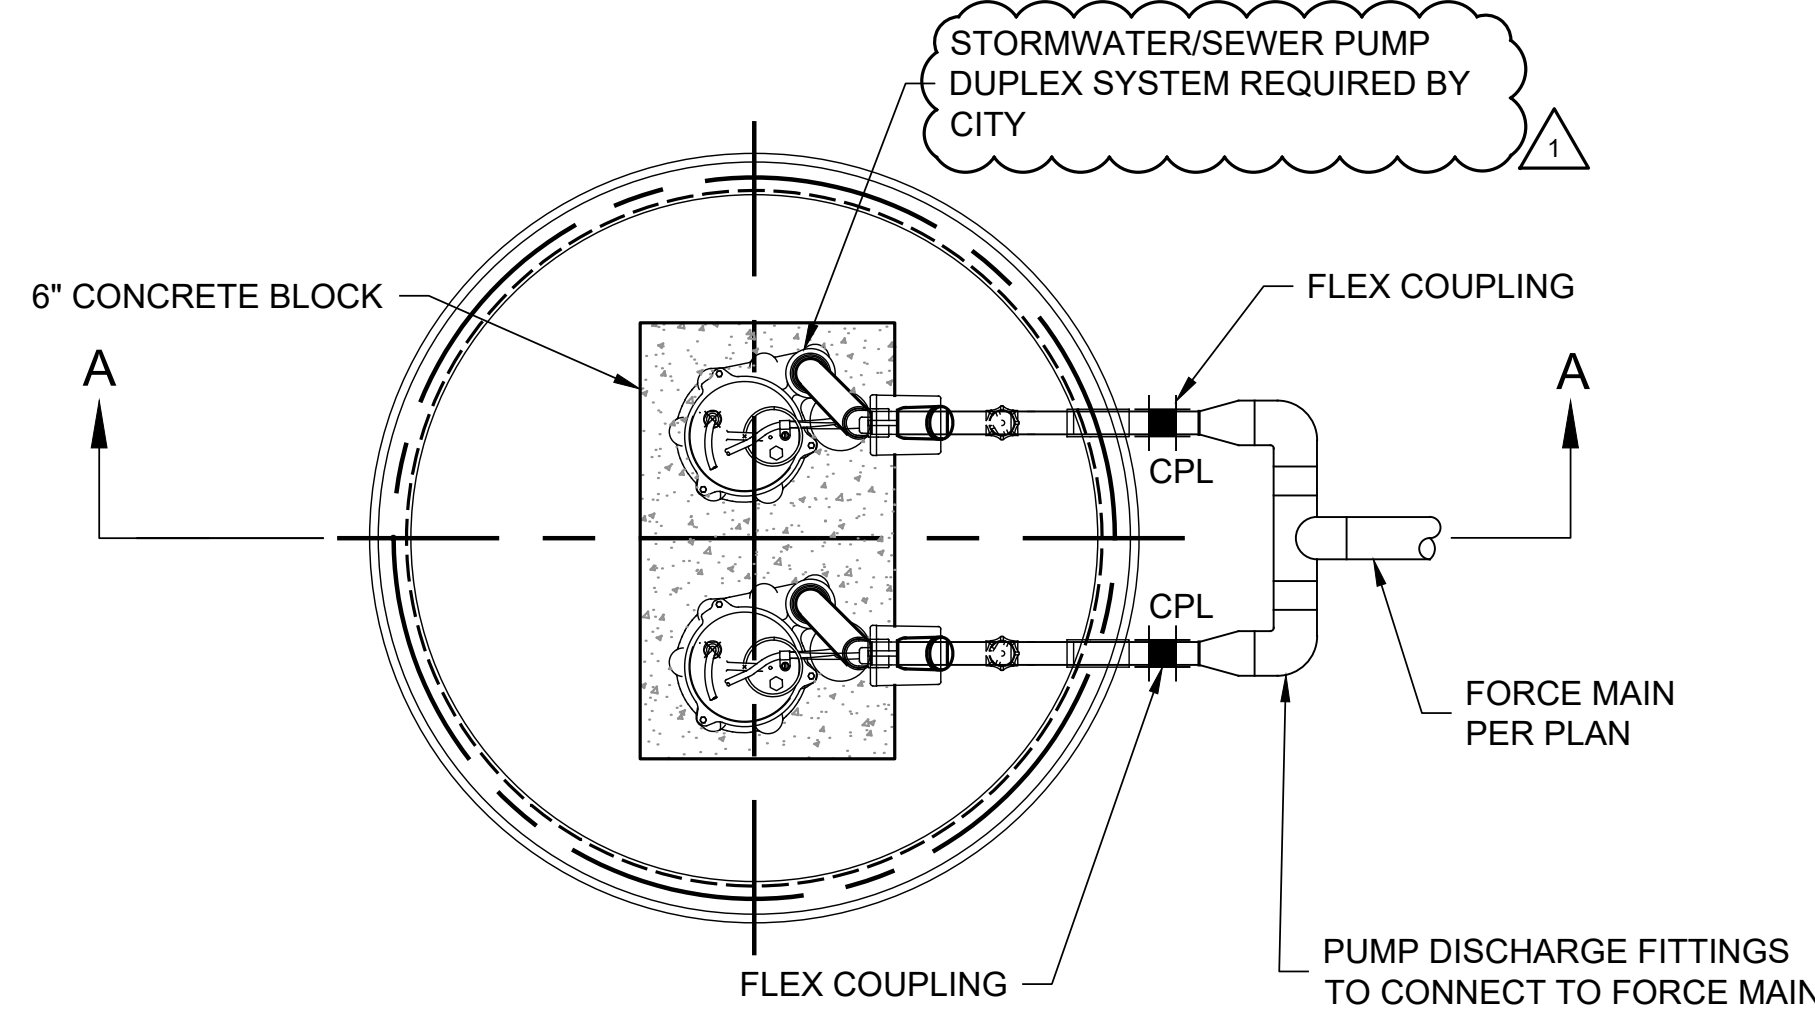


PUMP GENERAL NOTES:

1. IF A PUMP IS REQUIRED TO CONNECT THE SIDE SEWER FORCE LINE TO A SIDE SEWER OR PUBLIC MAIN, THE PERMITTEE SHALL ATTACH A COPY OF THE PUMP MANUFACTURER'S SPECIFICATIONS TO THE SIDE SEWER PERMIT APPLICATION. THE PUMP SPECIFICATIONS SHALL INCLUDE GALLONS PER MINUTE (GPM) AND THE TOTAL SYSTEM HEAD (STATIC HEAD AND DYNAMIC HEAD).
2. PUMPS SHALL BE SPECIFICALLY DESIGNED FOR THE APPLICABLE USE (E.G., DRAINAGE DISCHARGES OR WASTEWATER DISCHARGES) USING THE PUMP MANUFACTURER'S RECOMMENDED OPERATING GUIDELINES.
3. NO MORE THAN ONE PROPERTY SHALL BE CONNECTED TO ANY PUMP SYSTEM, INCLUDING THE FORCE-LINE.
4. SEPARATE PUMP SYSTEMS (WET WELLS, PUMPS, ETC) ARE REQUIRED FOR DRAINAGE AND WASTEWATER APPLICATIONS, IF PUMPING IS REQUIRED OR PROPOSED.
5. A DUPLEX PUMP SYSTEM IS REQUIRED UNLESS OTHERWISE APPROVED BY THE CITY OF MERCER ISLAND.
6. PROJECTS WHICH PROPOSE PUMP SYSTEMS AND ARE LOCATED WITHIN A DESIGNATED GEOLOGIC HAZARD AREA MAY BE SUBJECT TO ADDITIONAL SIDE SEWER AND GEOTECHNICAL REQUIREMENTS PER THE CITY OF MERCER ISLAND.
7. THE DISCHARGE PIPE (FORCE-LINE) SHALL HAVE A NON-CORROSIVE CHECK-VALVE, A "QUICK-RELEASE" CONNECTOR/FITTING, AND A NON-CORROSIVE GATE-VALVE TO FACILITATE PUMP REMOVAL. THE PIPE SHALL HAVE A MINIMUM INSIDE DIAMETER OF TWO-INCHES FOR INJECTOR PUMPS, ONE-AND-ONE QUARTER-INCHES FOR GRINDER PUMPS, OR THREE-INCHES FOR DUPLEX PUMP SYSTEMS, OR PER MANUFACTURER RECOMMENDATIONS. THE DISCHARGE FORCE LINE SHALL BE PVC SCHEDULE 40 OR SCHEDULE 80 OR DUCTILE IRON OR AS APPROVED BY THE SITE INSPECTOR.
8. A FORCE-LINE PIPE MAY NOT CONNECT DIRECTLY TO A PUBLIC MAIN. PRIOR TO CONNECTING TO THE PUBLIC MAIN OR ENCROACHING ON THE PUBLIC PLACE, THE FORCE-LINE SHALL DISCHARGE INTO A STANDARD, GRAVITY-FLOW SECTION OF SIDE SEWER PIPE THAT IS AT LEAST 10 FEET IN LENGTH (SEE EXHIBIT 11).
9. FORCE-LINE SECTIONS OF PIPE ARE REQUIRED TO HAVE "PIG PORTS" FOR THE FOLLOWING TWO CONDITIONS: A. A MAXIMUM OF 100 FOOT INTERVALS; AND B. WHEREVER FITTING BENDS TOTAL 135°.
10. THE FORCE-LINE PIPE LOCATED OUTSIDE THE BUILDING SHALL BE PRESSURE TESTED PER REQUIREMENTS OF PART V SECTION Q, TESTING. DPD ALSO REQUIRES THAT THE PUMP BE OPERATIONAL PRIOR TO FINALIZING THE SIDE SEWER PERMIT.
11. THE PUMP SHALL BE INSTALLED IN A CHAMBER THAT IS READILY SERVICEABLE. THE TANK SHALL BE MADE OF NON-POROUS, NON-CORROSIVE, STRUCTURALLY SOUND MATERIAL SUCH AS PLASTIC, FIBERGLASS, STAINLESS STEEL, OR CONCRETE. IF A CONCRETE TANK IS USED, A FIBERGLASS REINFORCED PLASTIC OF POLYURETHANE HYBRID POLYMER RESIN OR EQUIVALENT SHALL BE INSTALLED IN THE CONCRETE CHAMBER. THE LINER MAY BE CAST INTEGRAL WITH THE PRECASTING OF THE MAINTENANCE HOLE OR FIELD ASSEMBLED AND SEALED IN THE PRECAST CONCRETE SECTIONS.
12. PUMP SYSTEMS SHALL BE DESIGNED AND INSTALLED TO PROVIDE EASY ACCESS FROM THE GROUND SURFACE TO ALL MECHANICAL AND ELECTRICAL DEVICES.
13. AN AUDIBLE ALARM SYSTEM IS RECOMMENDED FOR PUMP SYSTEMS.
14. AN ELECTRICAL PERMIT IS REQUIRED FOR AN ELECTRICAL HOOKUP OF A PUMP IF A NEW CIRCUIT IS REQUIRED FOR THE PUMP.
15. PUMPS LOCATED WITHIN A BUILDING ARE SUBJECT TO SEATTLE-KING COUNTY DEPARTMENT OF PUBLIC HEALTH INSPECTION.
16. PUMP SYSTEMS SHALL BE OWNED, OPERATED, MAINTAINED, REPAIRED, AND REPLACED (AS NEEDED) BY PROPERTY OWNER(S) SERVED BY SUCH SYSTEM.
17. THE PUMP SYSTEMS SHALL HAVE DUAL, ALTERNATING PUMPS WITH EMERGENCY ON-SITE, BACK-UP POWER SUPPLY AND AN EXTERNAL ALARM SYSTEM FOR SYSTEM FAILURE AND HIGH WATER LEVEL INDICATOR.
18. THE PRIVATE PROPERTY OWNER(S) SHALL BE RESPONSIBLE FOR ANY AND ALL CLAIMS FOR INJURIES AND DAMAGE DUE TO THE OPERATION OR NON-OPERATION OF THE PUMP SYSTEM.

DUPLEX PUMP STATION I
C03 & C04

REVISION	BY	DATE	REVISIONS PER CITY REVIEW COMMENTS
	BI	6/5/2020	
<p>9706 4TH AVE NE SUITE 300 SEATTLE, WA 98115 P: 206.523.0024 F: 206.523.1012 www.dcgengr.com</p> <p>DCG civil structural</p> <p>CALL 811 2 BUSINESS DAYS BEFORE YOU DIG (UNDERGROUND UTILITY LOCATIONS ARE APPROX.)</p> <p>BENJAMIN J. DODD Digital Signed by Benjamin J. Dodd Date: 2020.06.05 15:05:52 REGISTERED PROFESSIONAL ENGINEER</p> <p>BASE MAP/TOPOGRAPHY PROVIDED BY OTHERS. DCG CANNOT BE HELD LIABLE FOR ACCURACY. CONTRACTOR SHALL FIELD VERIFY GRADES, UTILITIES, & ALL OTHER EXISTING FEATURES & CONDITIONS. IF CONDITIONS ARE NOT AS SHOWN &/OR PLANS CANNOT BE CONSTRUCTED AS SHOWN, CONTACT DCG PRIOR TO CONSTRUCTION.</p> <p>OWNER: IN MY BACKYARD, LLC 4701 W MERCER WAY MERCER ISLAND, WA 98040</p> <p>PROJECT: 3440 97TH AVE SE MERCER ISLAND, WA 98040 PUMP STATION DETAILS</p> <p>PROJ. MANAGER: BI DESIGNED BY: LG DRAWN BY: JA CHECKED BY: BI</p> <p>SCALE: SCALE DATE: 6/5/2020 REV. SHEET A 6 OF 6</p> <p>SHEET NUMBER C06</p>			

CAD FILE NUMBER: \DCG\LOCAL FILES\SHAREDClients\Civil\VALIERE DEVELOPMENT\3440 97TH AVE SE MERCER ISLAND\DWG\DRAWING\3440 97TH AVE SE MERCER ISLAND.DWG
 DATE: 6/5/2020 12:36 PM - SHEET SET: 3440 97TH AVE SE - ORIGINAL SHEET SIZE: ANSIFULL BLEED (34.00 X 22.00 INCHES)
 AUTOCAD VERSION: CIVIL 3D 2018

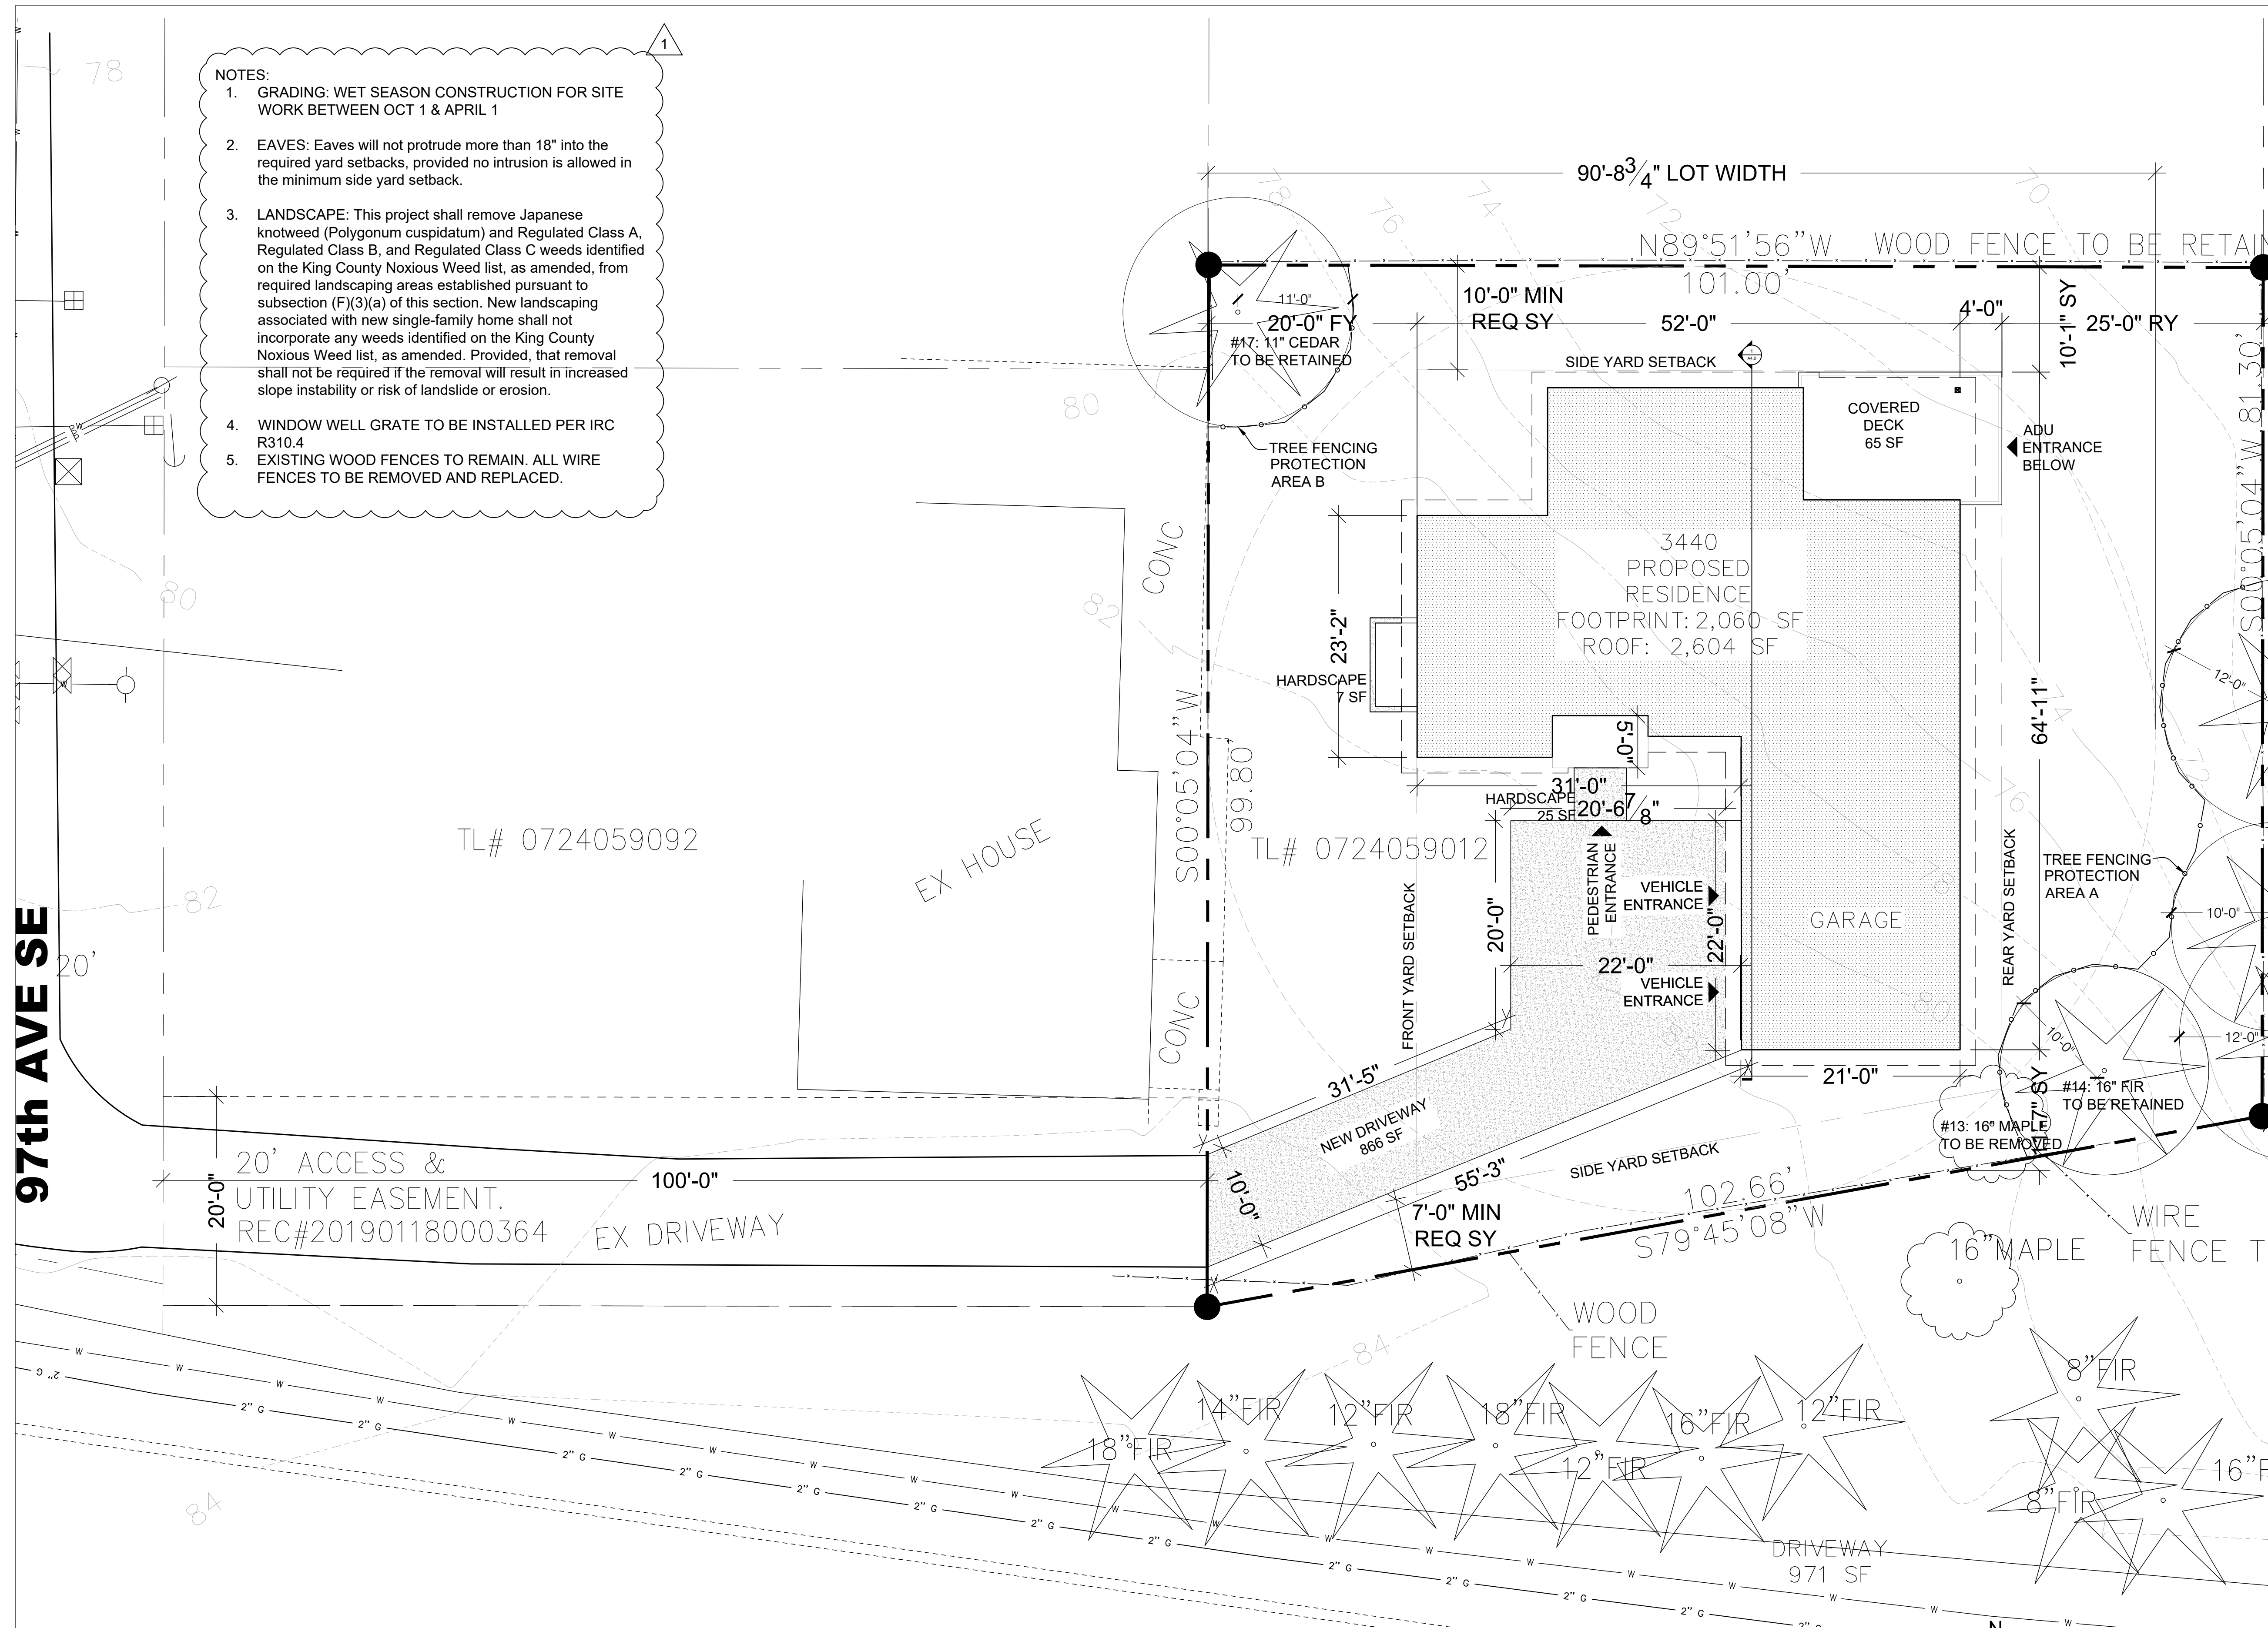

- NOTES:**
1. GRADING: WET SEASON CONSTRUCTION FOR SITE WORK BETWEEN OCT 1 & APRIL 1
 2. EAVES: Eaves will not protrude more than 18" into the required yard setbacks, provided no intrusion is allowed in the minimum side yard setback.
 3. LANDSCAPE: This project shall remove Japanese knotweed (*Polygonum cuspidatum*) and Regulated Class A, Regulated Class B, and Regulated Class C weeds identified on the King County Noxious Weed list, as amended, from required landscaping areas established pursuant to subsection (F)(3)(a) of this section. New landscaping associated with new single-family home shall not incorporate any weeds identified on the King County Noxious Weed list, as amended. Provided, that removal shall not be required if the removal will result in increased slope instability or risk of landslide or erosion.
 4. WINDOW WELL GRATE TO BE INSTALLED PER IRC R310.4
 5. EXISTING WOOD FENCES TO REMAIN. ALL WIRE FENCES TO BE REMOVED AND REPLACED.

PROJECT TEAM:
 OWNER: RICK POSMANTUR
 SURVEYOR: DAN TOUMA
 IN MY BACKYARD, LLC 425.251.0665
 ENGINEER: MULHERN & KULP
 GENERAL CONTRACTOR: VANN LANZ
 215.646.8001 206.499.1277
ASSESSOR'S PARCEL NUMBER:
 072405-9012
LEGAL DESCRIPTION:
 BEG AT A PT 921.44 FT W & 30 FT N OF SE COR GL 5 TH N PLL E LN SD GL 220 FT TH E 100 FT TH N 100 FT TH E 100 FT TH S 320 FT TH W 200 FT TO POB LESS STATE HWY


SCOPE:
 CONSTRUCT (1) NEW SINGLE FAMILY RESIDENCE W/ ADU (REF PERMIT#: ADU19-008).
LAND USE COMPLIANCE:
 ZONE: R9.6
 LOT SQ FT: 8,800 SF
GROSS FLOOR AREA:
 19.02.020.D 8,800*45% = 3,960SF max allowed
 525 SF (GARAGE) + 866 SF (BSMT) - 535 SF (BSMT AREA EXCLUSION) + 1,538 SF (FL1) + 1,497 SF (FL 2) + 90 SF (STAIRS) + 60 SF (CLG HT MODIFIER) = PROVIDED: 4,061 SF
LOT COVERAGE:
 19.02.020.F 8,800*40% = 3,520SF max allowed
 2,604 (ROOF) + 866 (DRIVEWAY): TOTAL PROVIDED: 3,470 SF

LOT SLOPE: 84'-69'=15' * 100 / 141'11" = 10.6 DEGREE SLOPE
HARDSCAPE:
 WALKWAYS: 25 SF
 DECKS UNCOVERED: 65 SF
 WDW WELL RET WALL: 7 SF
 TOTAL PROVIDED: 97 SF
HEIGHT LIMIT:
 19.02.020.E MAX ALLOWED: 30 FT
 PROVIDED: 28'-2.5"
YARDS:
 19.02.020.G FY MIN REQ: 20'
 PROVIDED: 20'-3.5"
 RY MIN REQ: 25'
 PROVIDED: 25'-25"
 SY MIN REQ: 17%
 PROVIDED: 8'-7" & 11'-7"
TREE REQUIREMENTS:
 MIN 30% of existing trees to be retained.
 PROVIDED: 66% RETAINED

PARKING: REQ: (2) space per dwelling unit.
 PROVIDED: (2)

- INDEX:**
- | | |
|----------------------------------|------------------------------|
| COVERSHEET | A2.3: ROOF PLAN |
| SURVEY | A3.0: ELEVATION |
| C01: ESC PLAN | A3.1: ELEVATIONS & SCHEDULES |
| C02: GRADING PLAN | A3.2: ELEVATION |
| C03: DRAINAGE PLAN | A4.0: SECTION & DTLS |
| C04: UTILITY PLAN | A5.0: GENERAL NOTES |
| C05: ESC & DRN DTLS | |
| C06: PUMP STN DTLS | |
| A1.0: SITE PLAN & CODE ANALYSIS | S-0 STRUC. NOTES |
| A1.1: AVE HT DIA. & LOT COV DIA. | S-1.0 FOUNDTN PLAN |
| A1.2: BLDG PAD DIA. | S-2.0 1ST FL FRMG PLAN |
| A2.0: BSMNT PLAN | S-2.1 2ND FLR FRMG PLAN |
| A2.1: MAIN FL PLAN | S-3.0 ROOF FRMG PLAN |
| A2.2: UPPER FL PLAN | LB-1 STRUCT DTLS |
| | LB-2 STRUCT DTLS |
| | LB-3 STRUCT DTLS |
| | SD.01 FOUNDTN DTLS |
| | SD.02 FOUNDTN DTLS |

VICINITY MAP

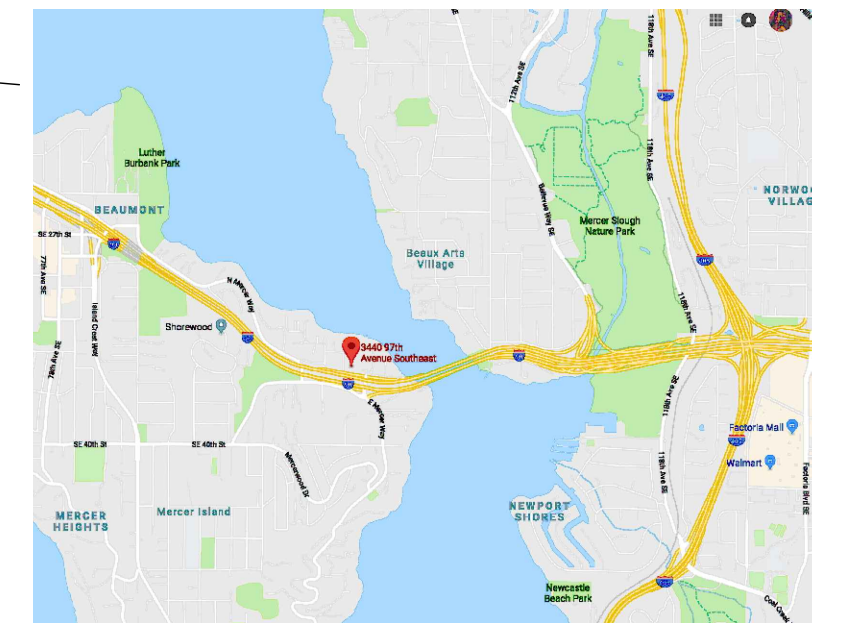

J D DESIGNS
 4606 MARINE VIEW DR
 TACOMA, WA 98422
 206.234.4469
 JACQUELINE@JDESIGNS5SEATTLE.COM

SUBMITTAL	DATE
INTAKE	2/4/2019
RE-DESIGN	3/8/2019
RE-SUBMIT	6/14/2019
RE-SUBMIT	7/24/2019
RE-SUBMIT	8/6/2019
CORR I	3/2/2020

SUN CREEK HOUSE
 3440 97TH AVE SE
 MERCER ISLAND, WA

DRAWING INFORMATION

OWNER:
 MY BACKYARD, LLC

PROJECT# 1901-198


DRAWING NAME:
 SITE PLAN


DRAWING NAME:
 SITE PLAN

A I . O

1 SITE PLAN

SCALE: 1/8" = 1'-0"

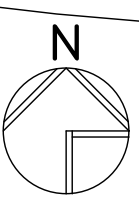

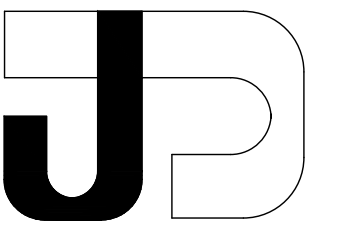

J DESIGNS

4606 MARINE VIEW DR
TACOMA, WA 98422
206.234.4469
JACQUELINE@
JDESIGNS5SEATTLE.COM

SUBMITTAL	DATE
INTAKE	2/4/2019
RE-DESIGN	3/8/2019
RE-SUBMIT	6/14/2019
RE-SUBMIT	7/24/2019
RE-SUBMIT	8/6/2019
CORR 1	3/2/2020

SUN CREEK HOUSE
3440 97TH AVE SE
MERCER ISLAND, WA


DRAWING INFORMATION

OWNER:
MY BACKYARD, LLC

PROJECT# 1901-198

DRAWING NAME:
DIAGRAMS


A.I.I

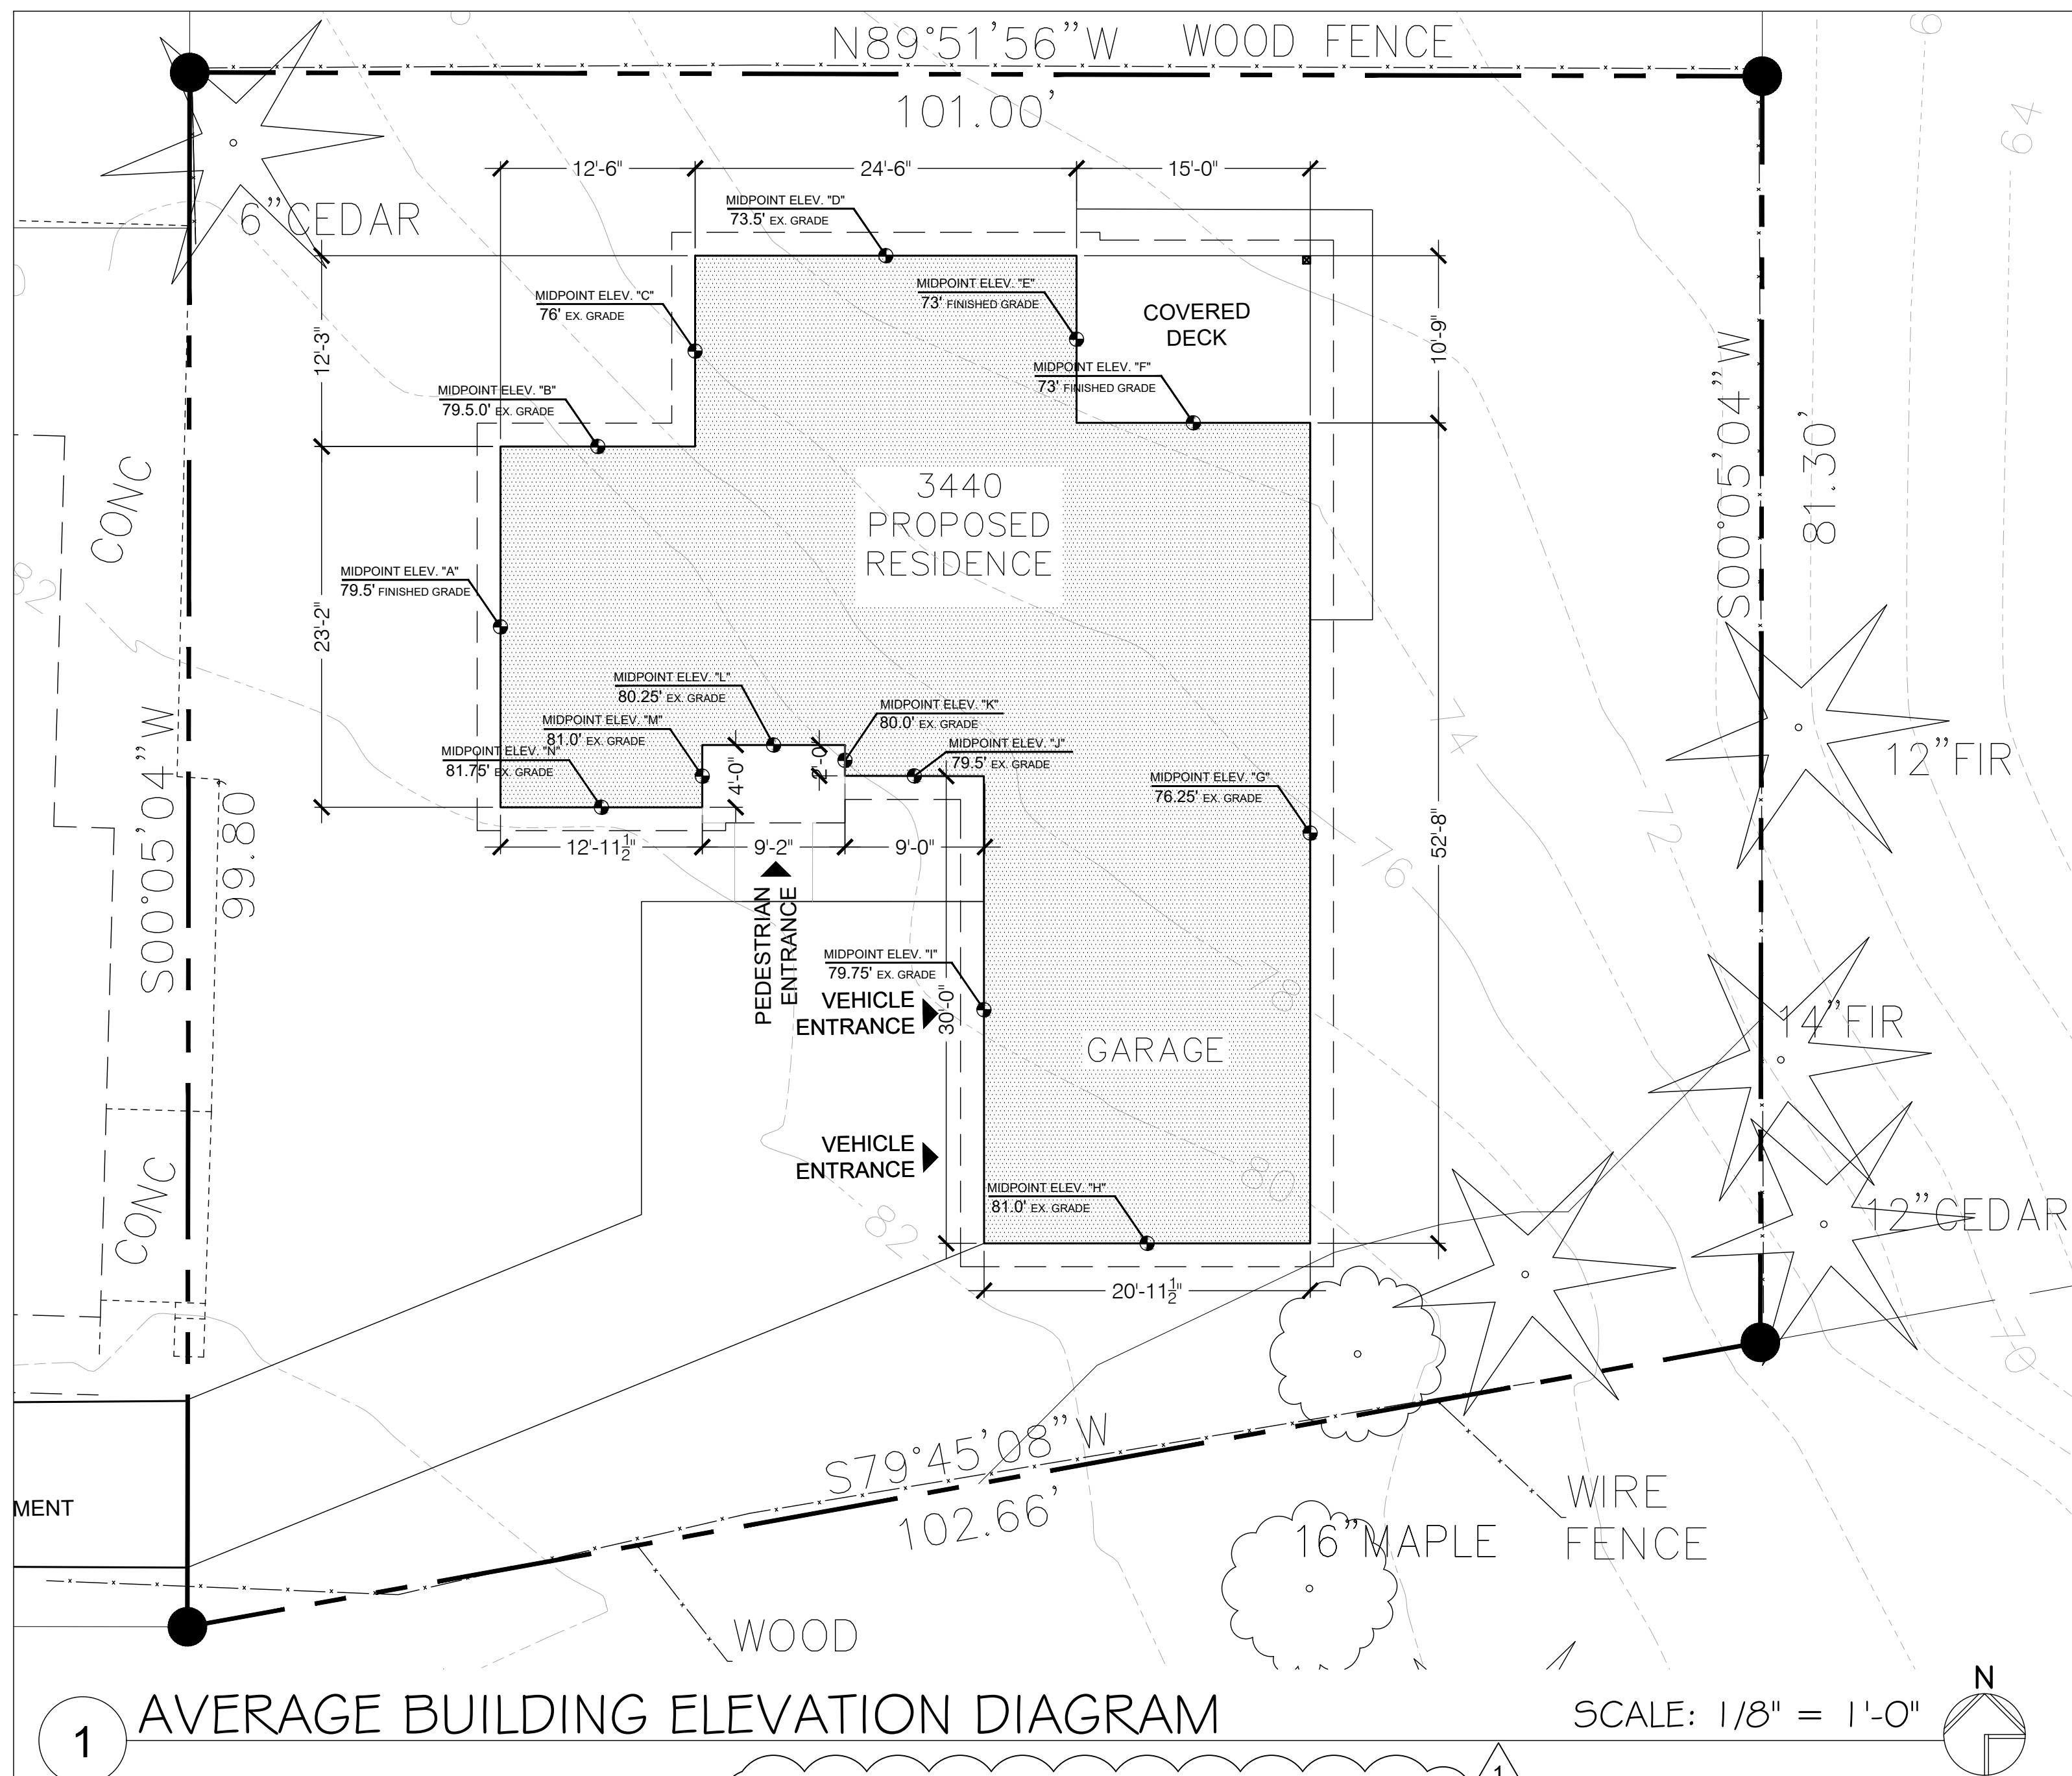

1 AVERAGE BUILDING ELEVATION DIAGRAM

SCALE: 1/8" = 1'-0"


AVE GRADE CALCS

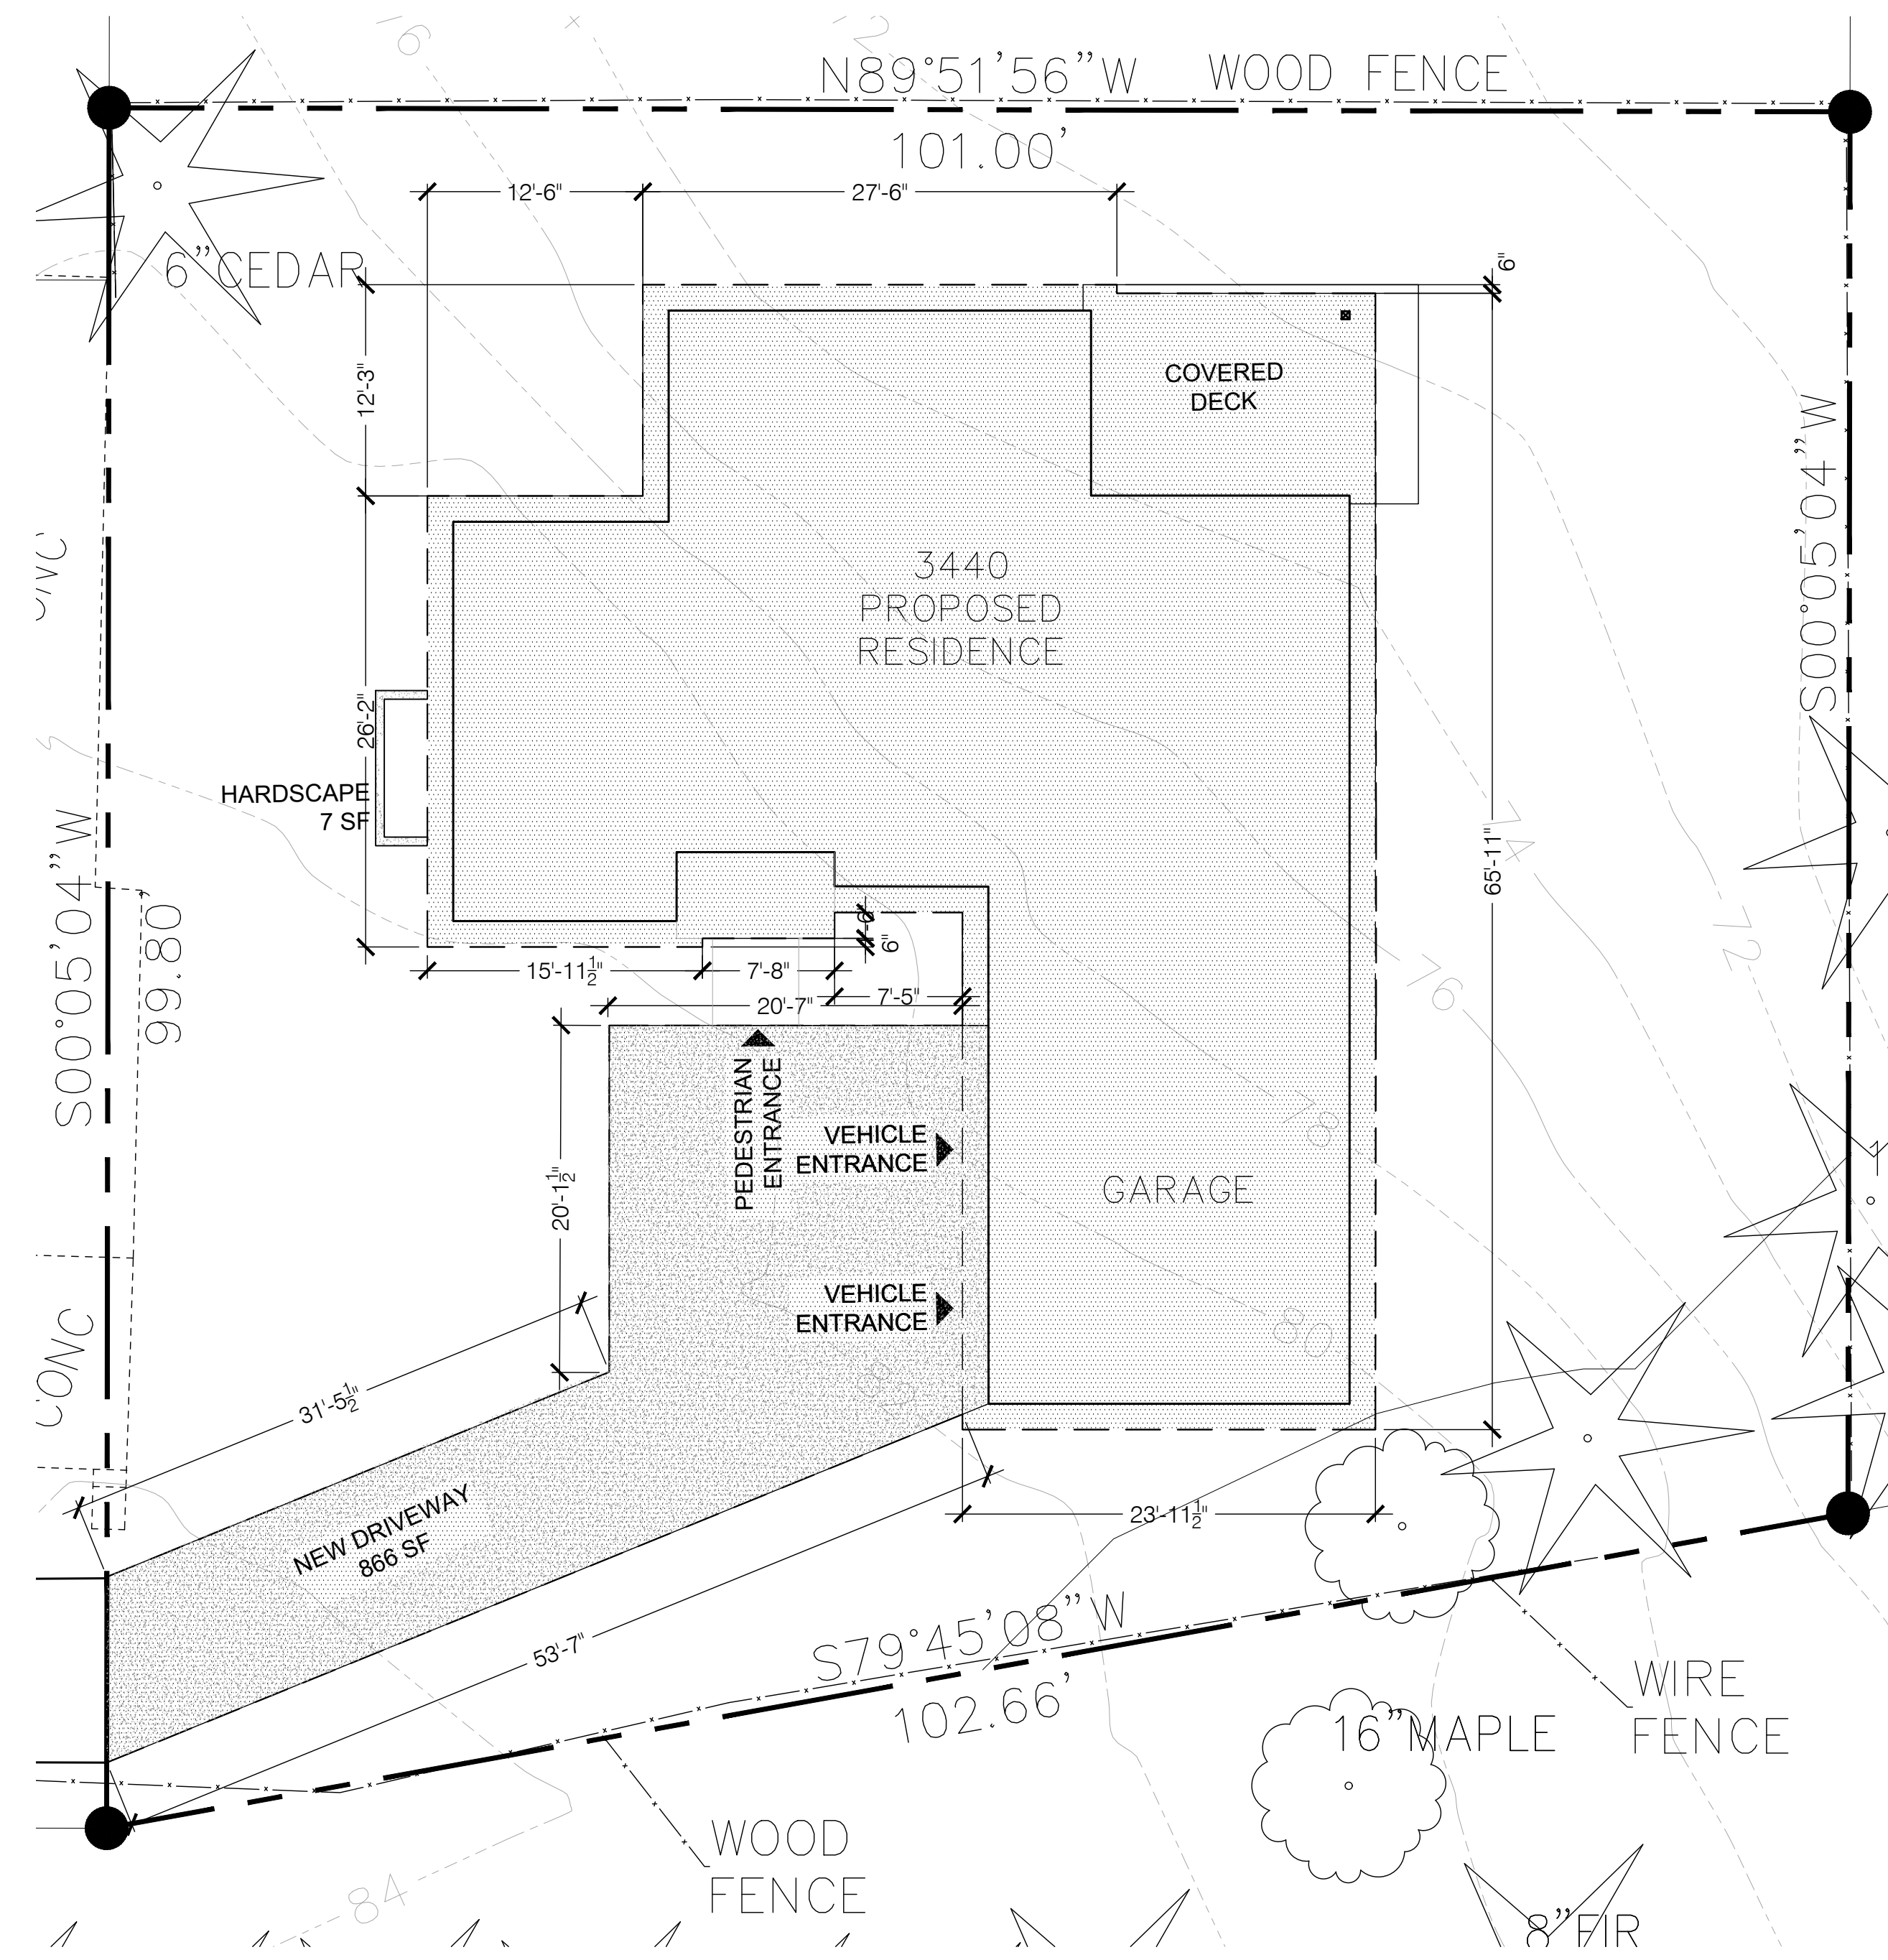

2 LOT COVERAGE DIAGRAM

SCALE: 1/8" = 1'-0"

LOT COVERAGE: 8,800*40% = 3,520SF max allowed
PROVIDED: 3,464 SF

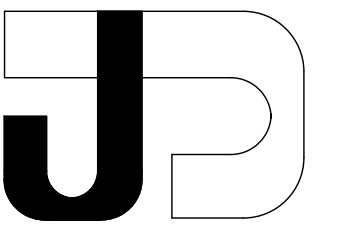

J DESIGNS

4606 MARINE VIEW DR
TACOMA, WA 98422
206.234.4469
JACQUELINE@
JDESIGNSSEATTLE.COM

SUBMITTAL	DATE
INTAKE	2/4/2019
RE-DESIGN	3/8/2019
RE-SUBMIT	6/14/2019
RE-SUBMIT	7/24/2019
RE-SUBMIT	8/6/2019
CORR I	3/2/2020

SUN CREEK HOUSE
3440 97TH AVE SE
MERCER ISLAND, WA

DRAWING INFORMATION


OWNER:
MY BACKYARD, LLC

PROJECT# 1901-198

DRAWING NAME:


DIAGRAMS

A1.2

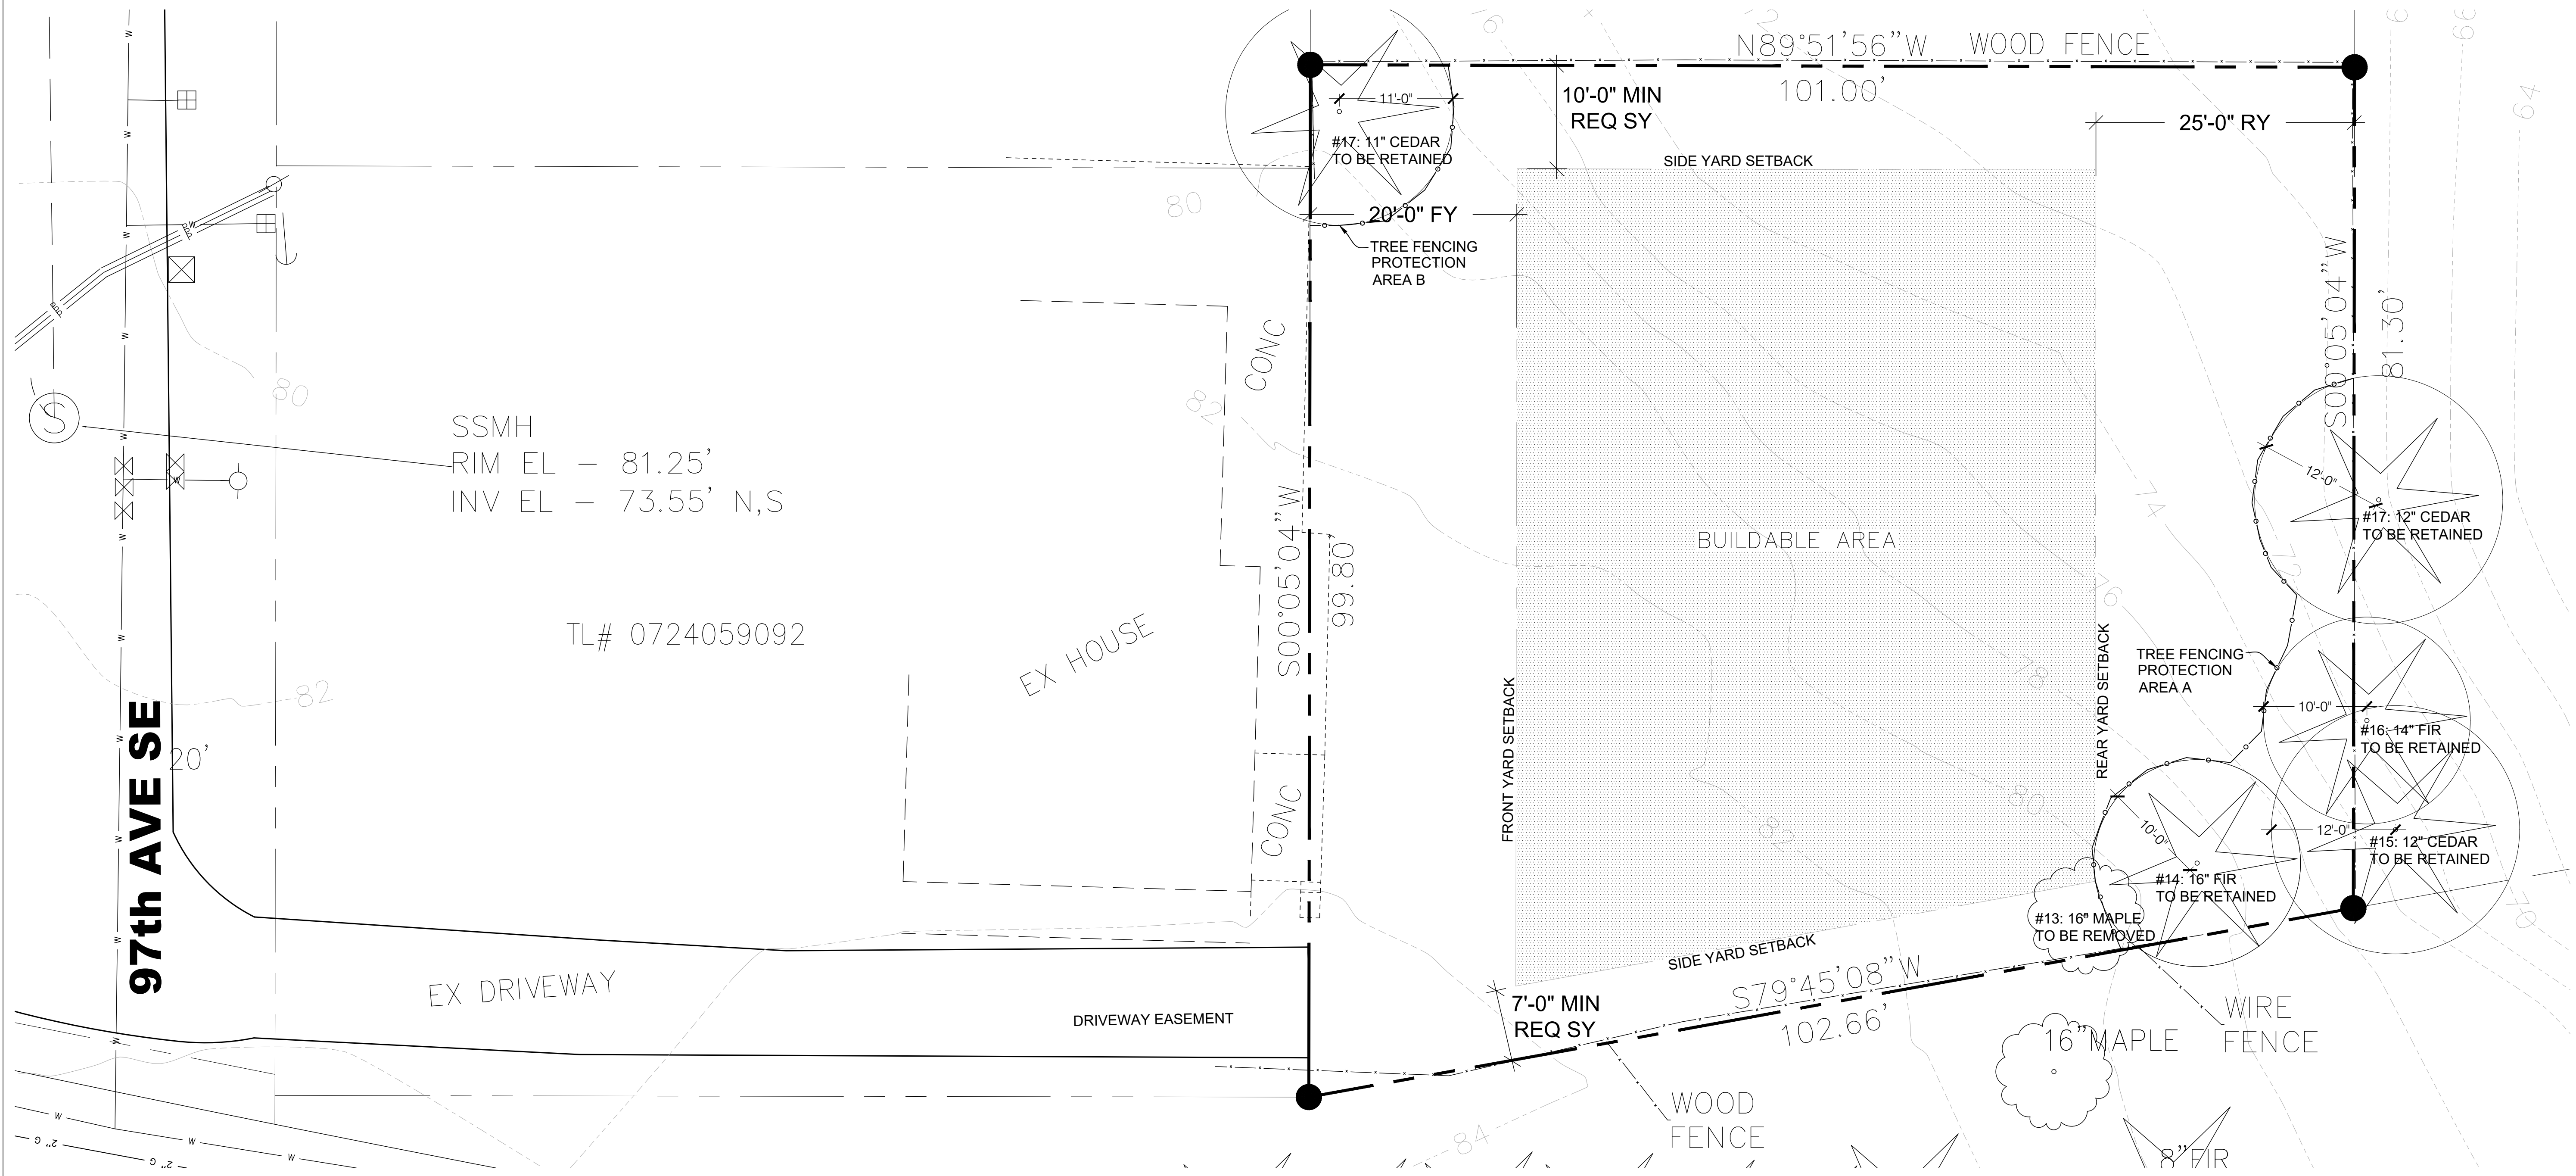

1 BUILDING PAD AREA DIAGRAM

SCALE: 1/8" = 1'-0"

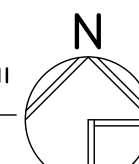

SUBMITTAL	DATE
INTAKE	2/4/2019
RE-DESIGN	3/8/2019
RE-SUBMIT	6/14/2019
RE-SUBMIT	7/24/2019
RE-SUBMIT	8/6/2019
CORR I	3/2/2020

SUN CREEK HOUSE
3440 97TH AVE SE
MERCER ISLAND, WA

DRAWING INFORMATION


OWNER:
MY BACKYARD, LLC

PROJECT# 1901-198

DRAWING NAME:

FLOOR PLAN


A2.0

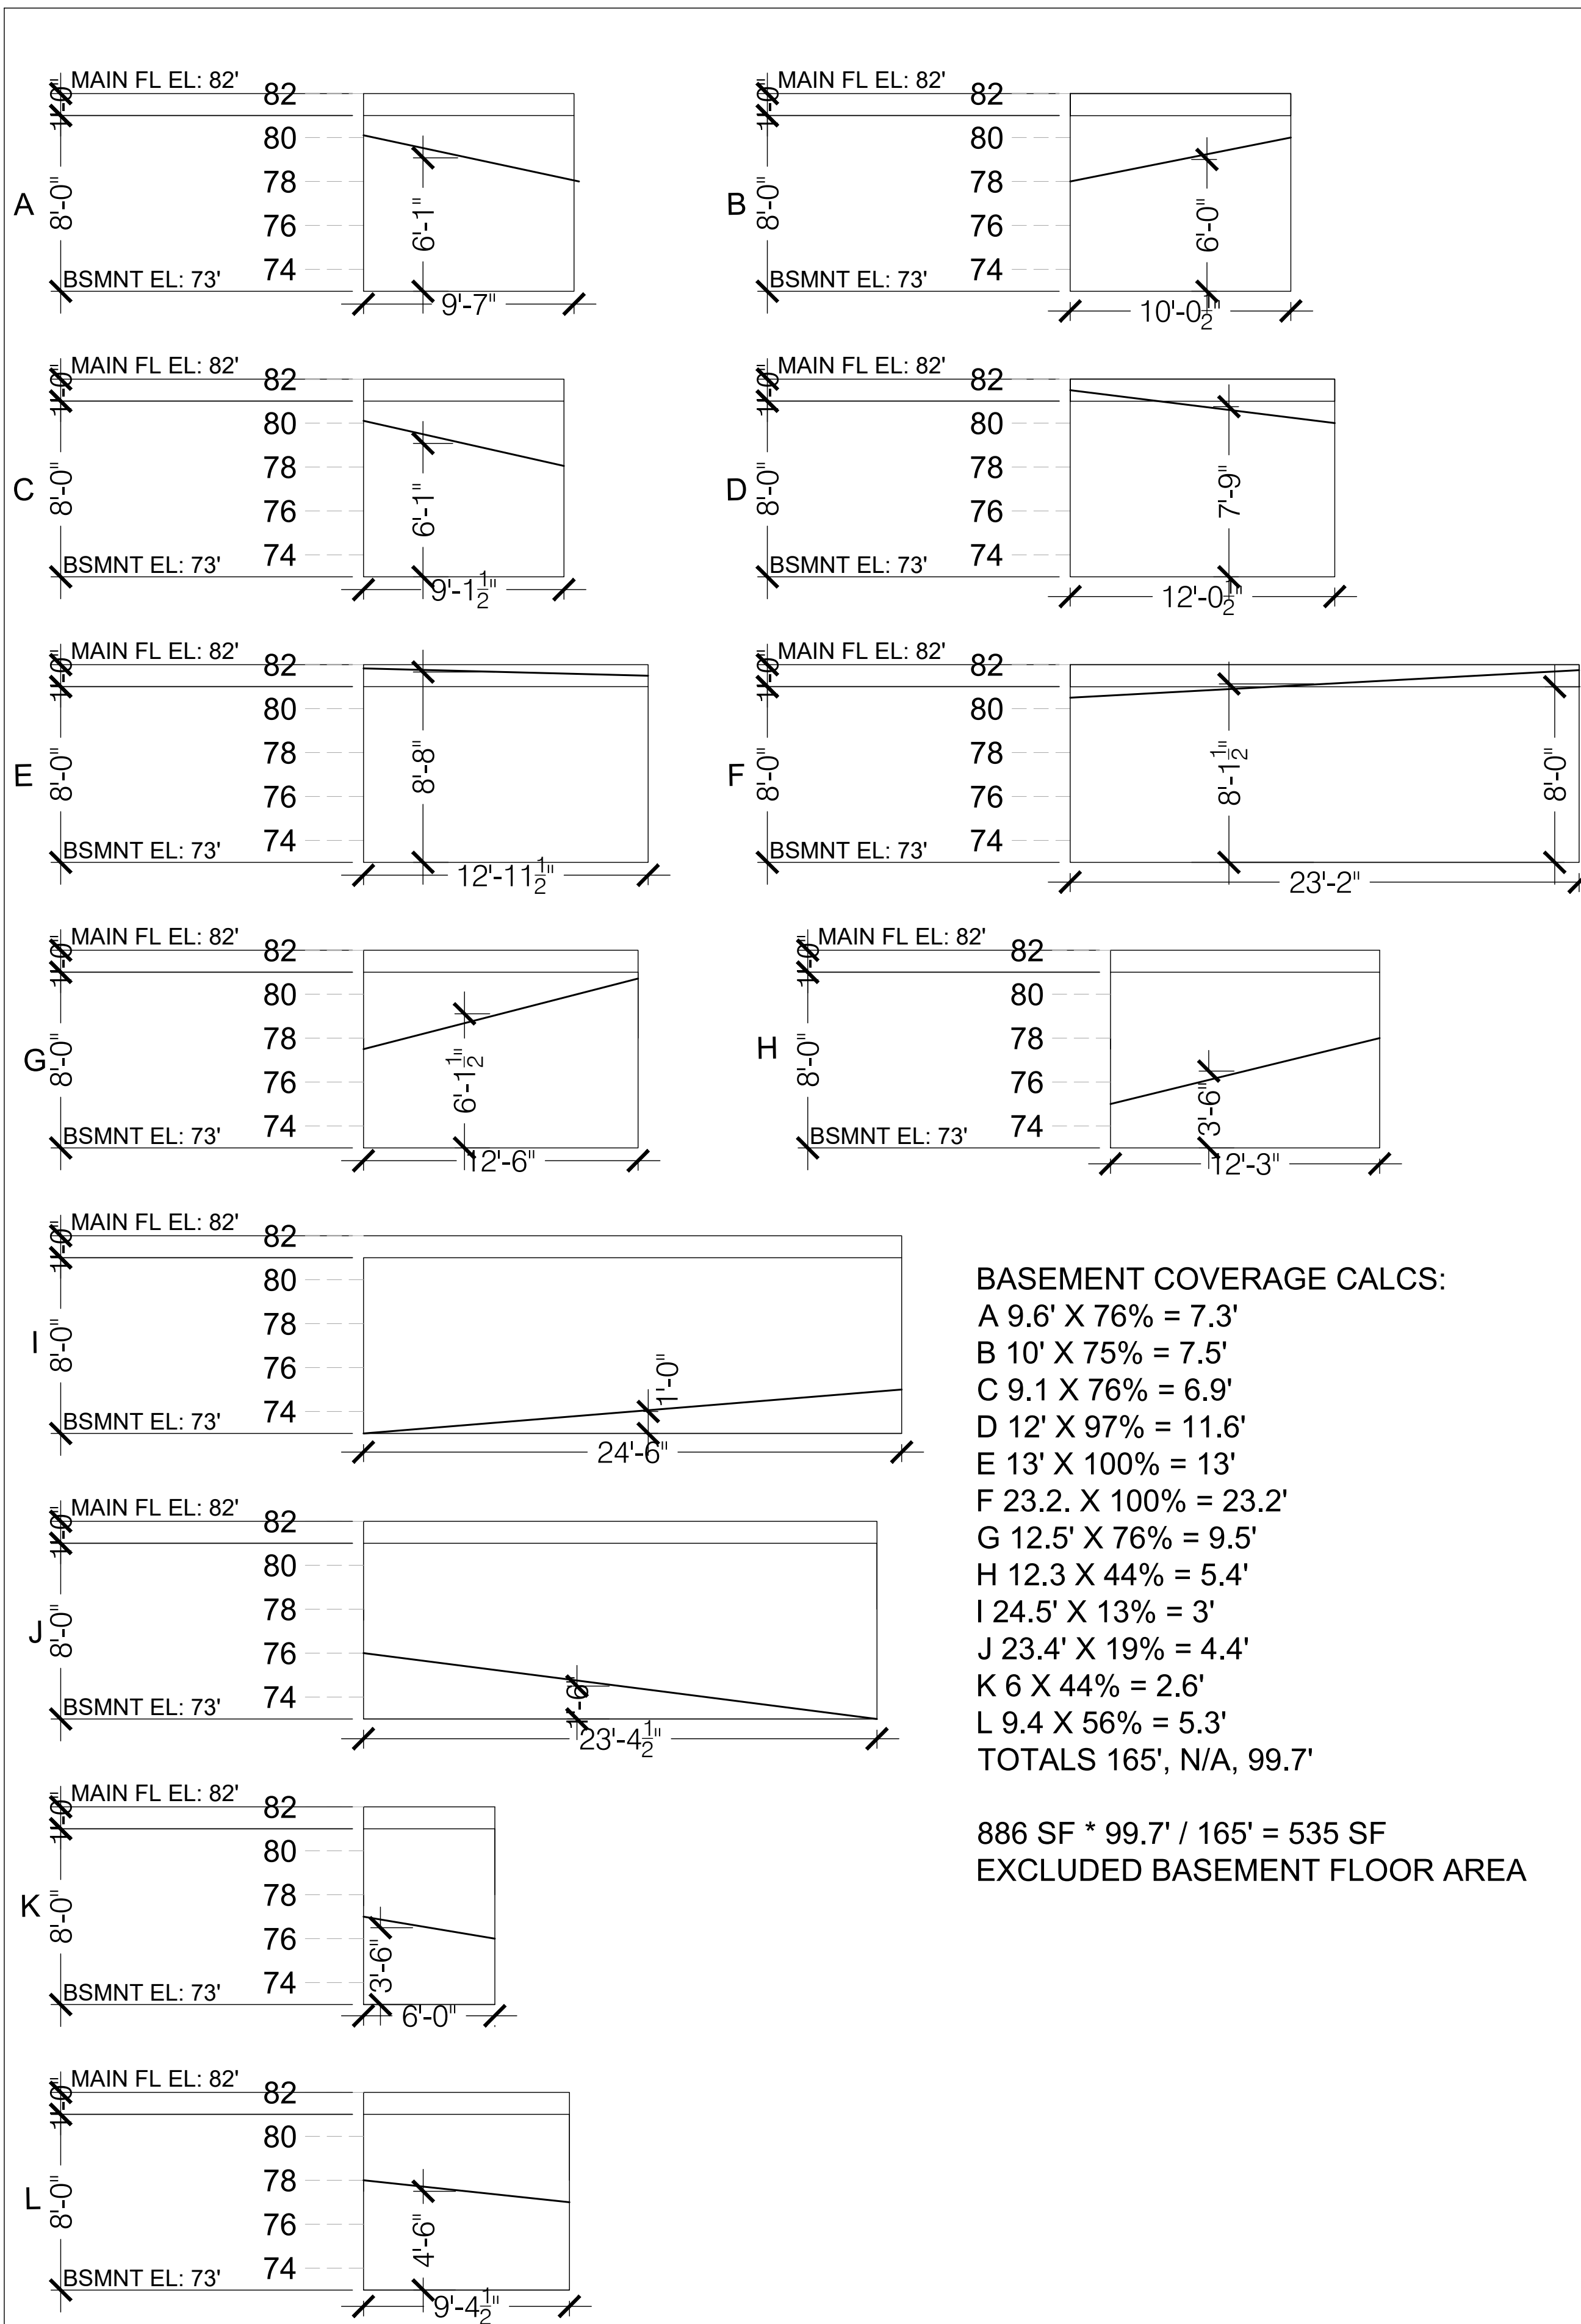

BASEMENT COVERAGE CALCS:

- A 9.6' X 76% = 7.3'
- B 10' X 75% = 7.5'
- C 9.1 X 76% = 6.9'
- D 12' X 97% = 11.6'
- E 13' X 100% = 13'
- F 23.2' X 100% = 23.2'
- G 12.5' X 76% = 9.5'
- H 12.3 X 44% = 5.4'
- I 24.5' X 13% = 3'
- J 23.4' X 19% = 4.4'
- K 6 X 44% = 2.6'
- L 9.4 X 56% = 5.3'
- TOTALS 165', N/A, 99.7'

886 SF * 99.7' / 165' = 535 SF
EXCLUDED BASEMENT FLOOR AREA

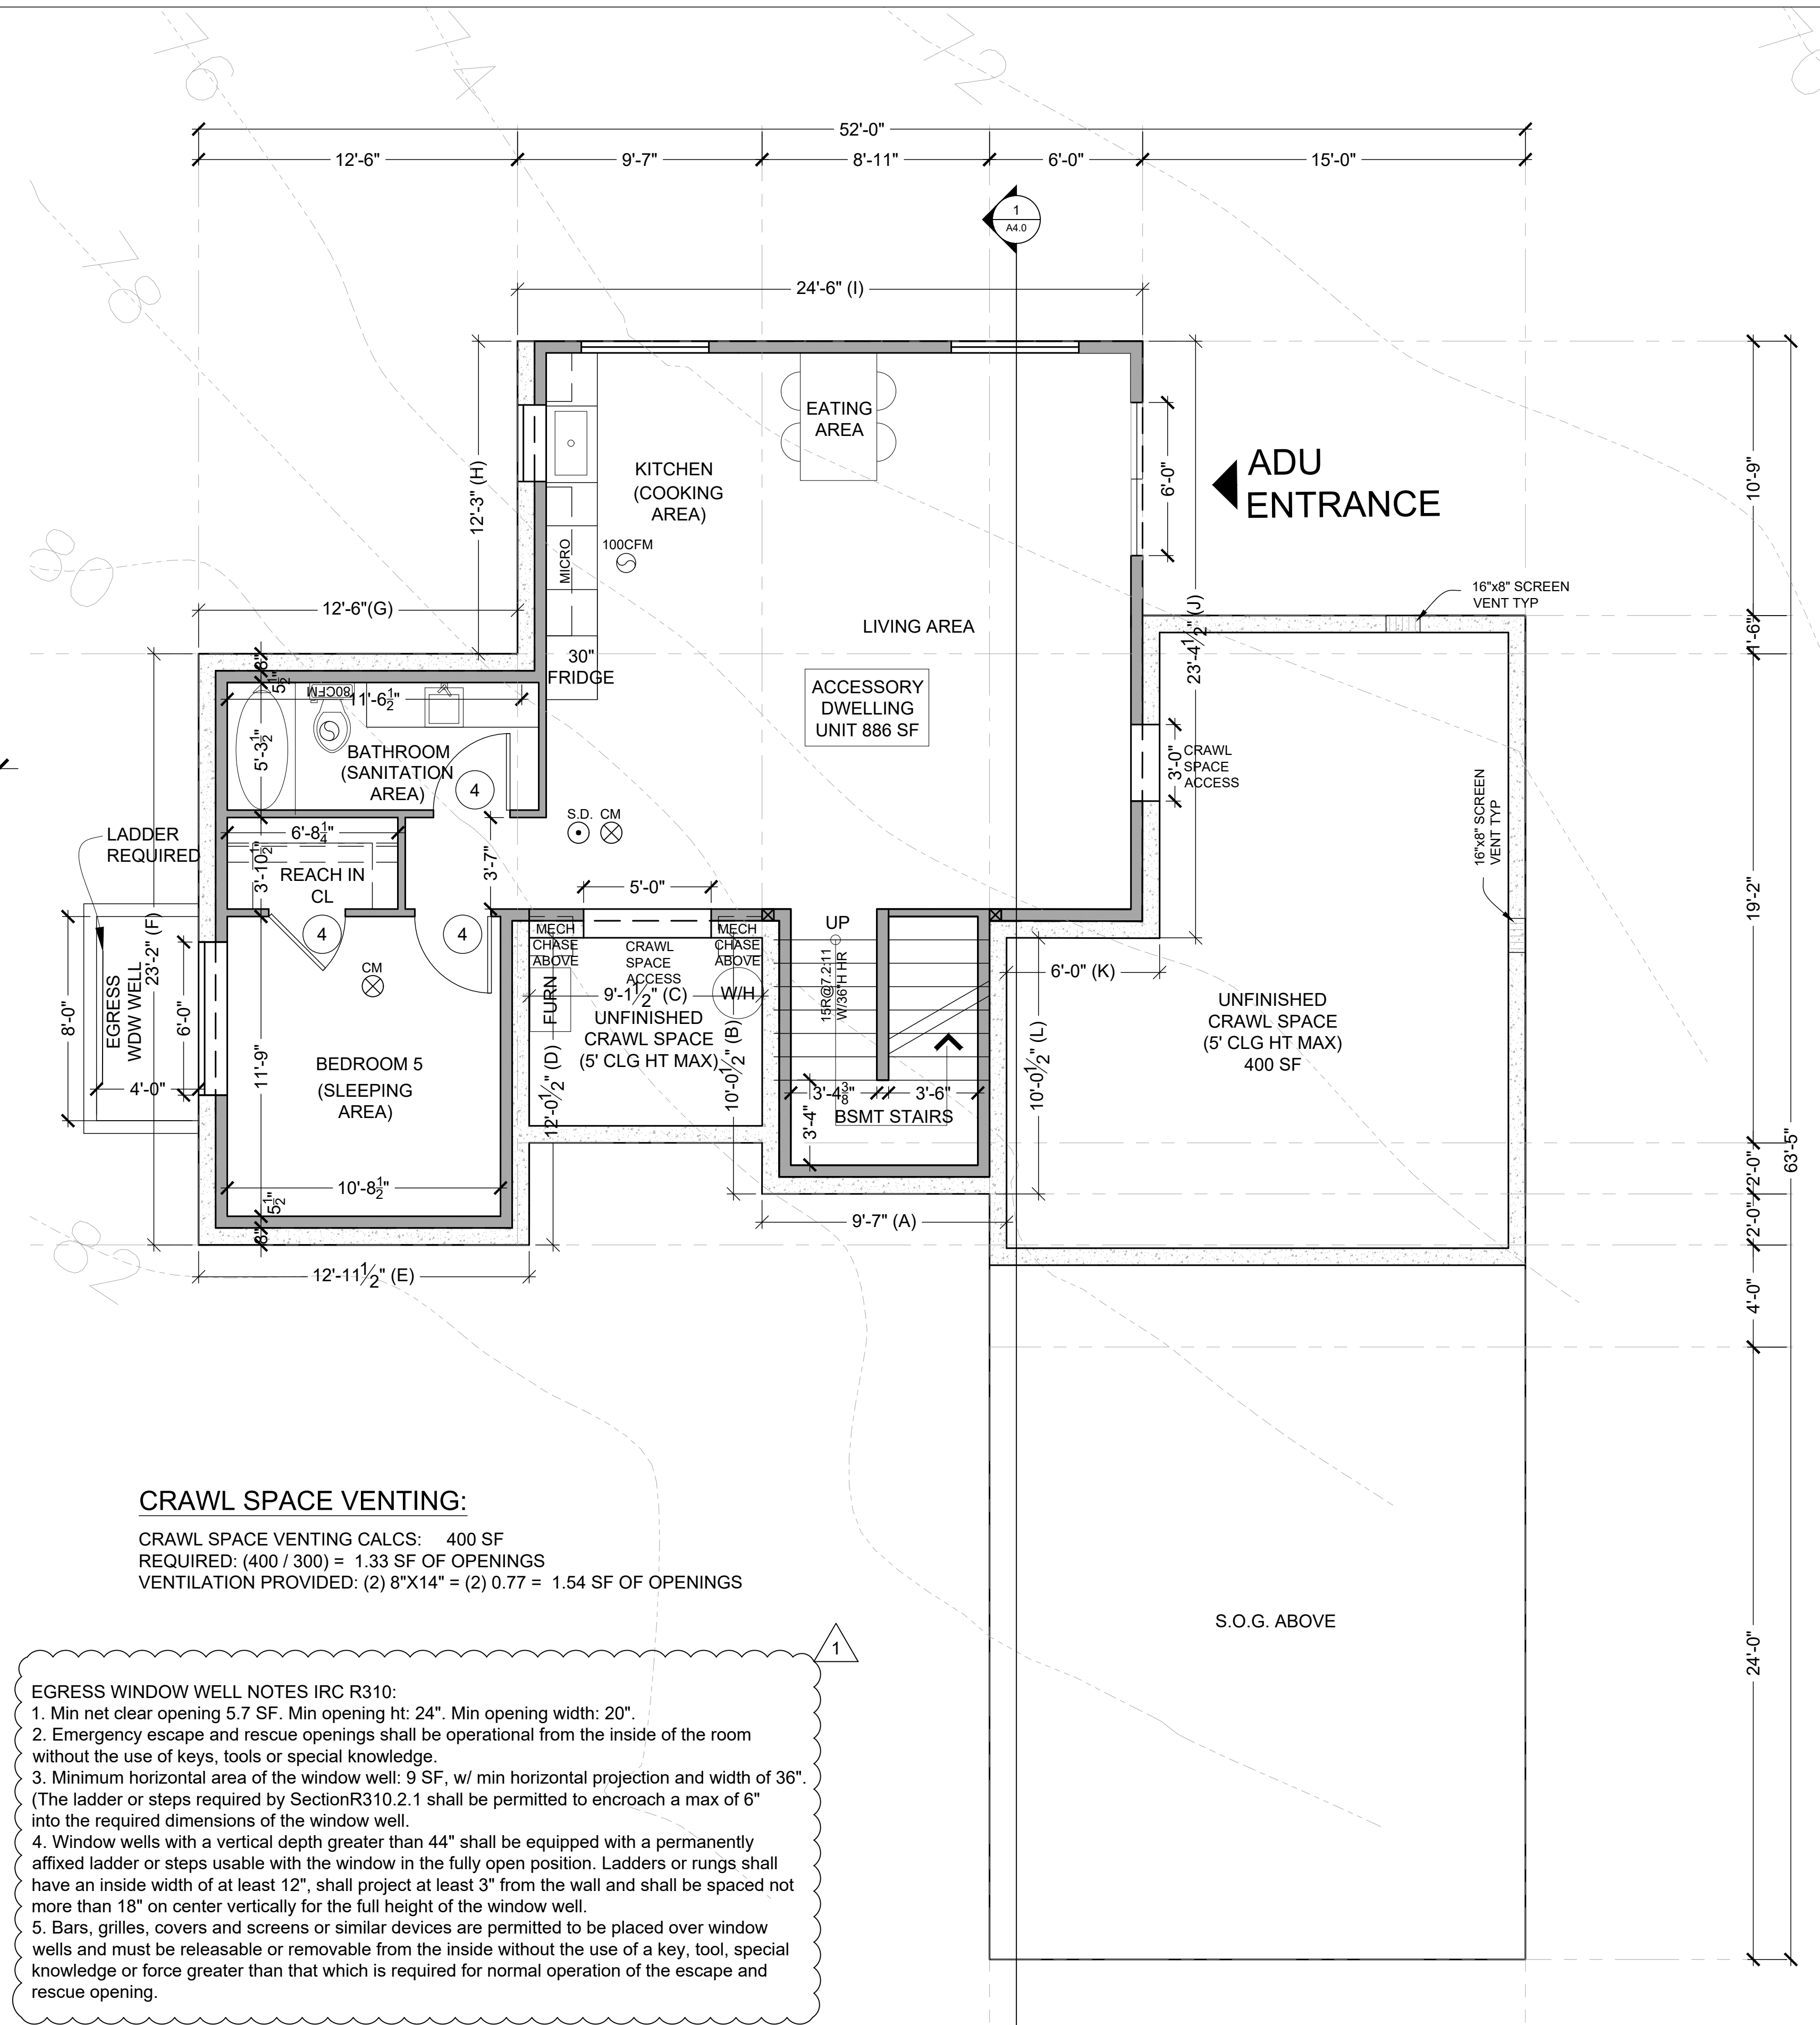

CRAWL SPACE VENTING:

CRAWL SPACE VENTING CALCS: 400 SF
REQUIRED: (400 / 300) = 1.33 SF OF OPENINGS
VENTILATION PROVIDED: (2) 8"X14" = (2) 0.77 = 1.54 SF OF OPENINGS


EGRESS WINDOW WELL NOTES IRC R310:

1. Min net clear opening 5.7 SF. Min opening ht: 24". Min opening width: 20".
2. Emergency escape and rescue openings shall be operational from the inside of the room without the use of keys, tools or special knowledge.
3. Minimum horizontal area of the window well: 9 SF, w/ min horizontal projection and width of 36". (The ladder or steps required by Section R310.2.1 shall be permitted to encroach a max of 6" into the required dimensions of the window well.
4. Window wells with a vertical depth greater than 44" shall be equipped with a permanently affixed ladder or steps usable with the window in the fully open position. Ladders or rungs shall have an inside width of at least 12", shall project at least 3" from the wall and shall be spaced not more than 18" on center vertically for the full height of the window well.
5. Bars, grilles, covers and screens or similar devices are permitted to be placed over window wells and must be releasable or removable from the inside without the use of a key, tool, special knowledge or force greater than that which is required for normal operation of the escape and rescue opening.

BSMNT WALL COVERAGE DIAGRAMS

1 BASEMENT PLAN

SCALE: 1/4" = 1'-0"

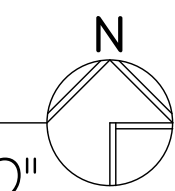


NOTES:

1. EXTERIOR LIGHTING SHALL BE SHIELDED AND DIRECTED AWAY FROM RESIDENTIALLY ZONED LOTS.
2. FACTORY BUILT FIREPLACE TO BE ZERO-CLEARANCE, AND LISTED, LABELED, & TESTED IN ACCORDANCE WITH UL 127. REQUIRES 6 SQ INCHES MIN OF OUTSIDE COMBUSTION AIR.
3. PROVIDE AN APPROVED CARBON & SMOKE ALARM OUTSIDE EACH SEPARATE SLEEPING AREA IN THE IMMEDIATE VICINITY OF THE BEDROOM.
4. EXTERIOR WINDOW & DOOR HEADERS SHALL BE INSULATED WITH A MIN OF R-10 INSULATION.
5. A MIN OF 75% OF PERMANENTLY INSTALLED LAMPS IN LIGHTING FIXTURES SHALL BE HIGH-EFFICACY LAMPS.
6. EXHAUST AIR SHALL VENT DIRECTLY TO THE EXTERIOR OF THE BUILDING PER M1501.1 and M1506.2
7. ALL INTERIOR DOORS WILL HAVE 1/2" UNDERCUT ABOVE FINISHED FLOOR.
8. CONCEALED WALL SPACES (MECHANICAL CHASES) TO HAVE FIRE BLOCKING PER IRC R302.11


ENERGY COMPLIANCE NOTES:

7. SUM OF 3.5 ENERGY CREDITS BY OPTIONS SELECTED:
- .5PT 1A: EFFICIENT BUILDING ENVELOPE
VERT FEN U= .28, FLR= R-38, SOG=R-10
 - 1PT 3A: HIGH EFFICIENCY HVAC EQUIP
GAS FURNACE WITH MIN AFUE OF 96%
Rheem RTGH-95DVLN-1
 - .5PT 5A: EFFICIENT WATER HEATING
MAX FLOW RATES FOR ALL SHOWERHEAD AND KITCHEN FAUCETS SHALL BE RATED 1.75GPM OR LESS & ALL OTHER LAV FAUCETS SHALL BE RATED AT 1.0 GMP OR LESS.
 - 1.5PT 5C: EFFICIENT WATER HEATER
MIN EF .91"

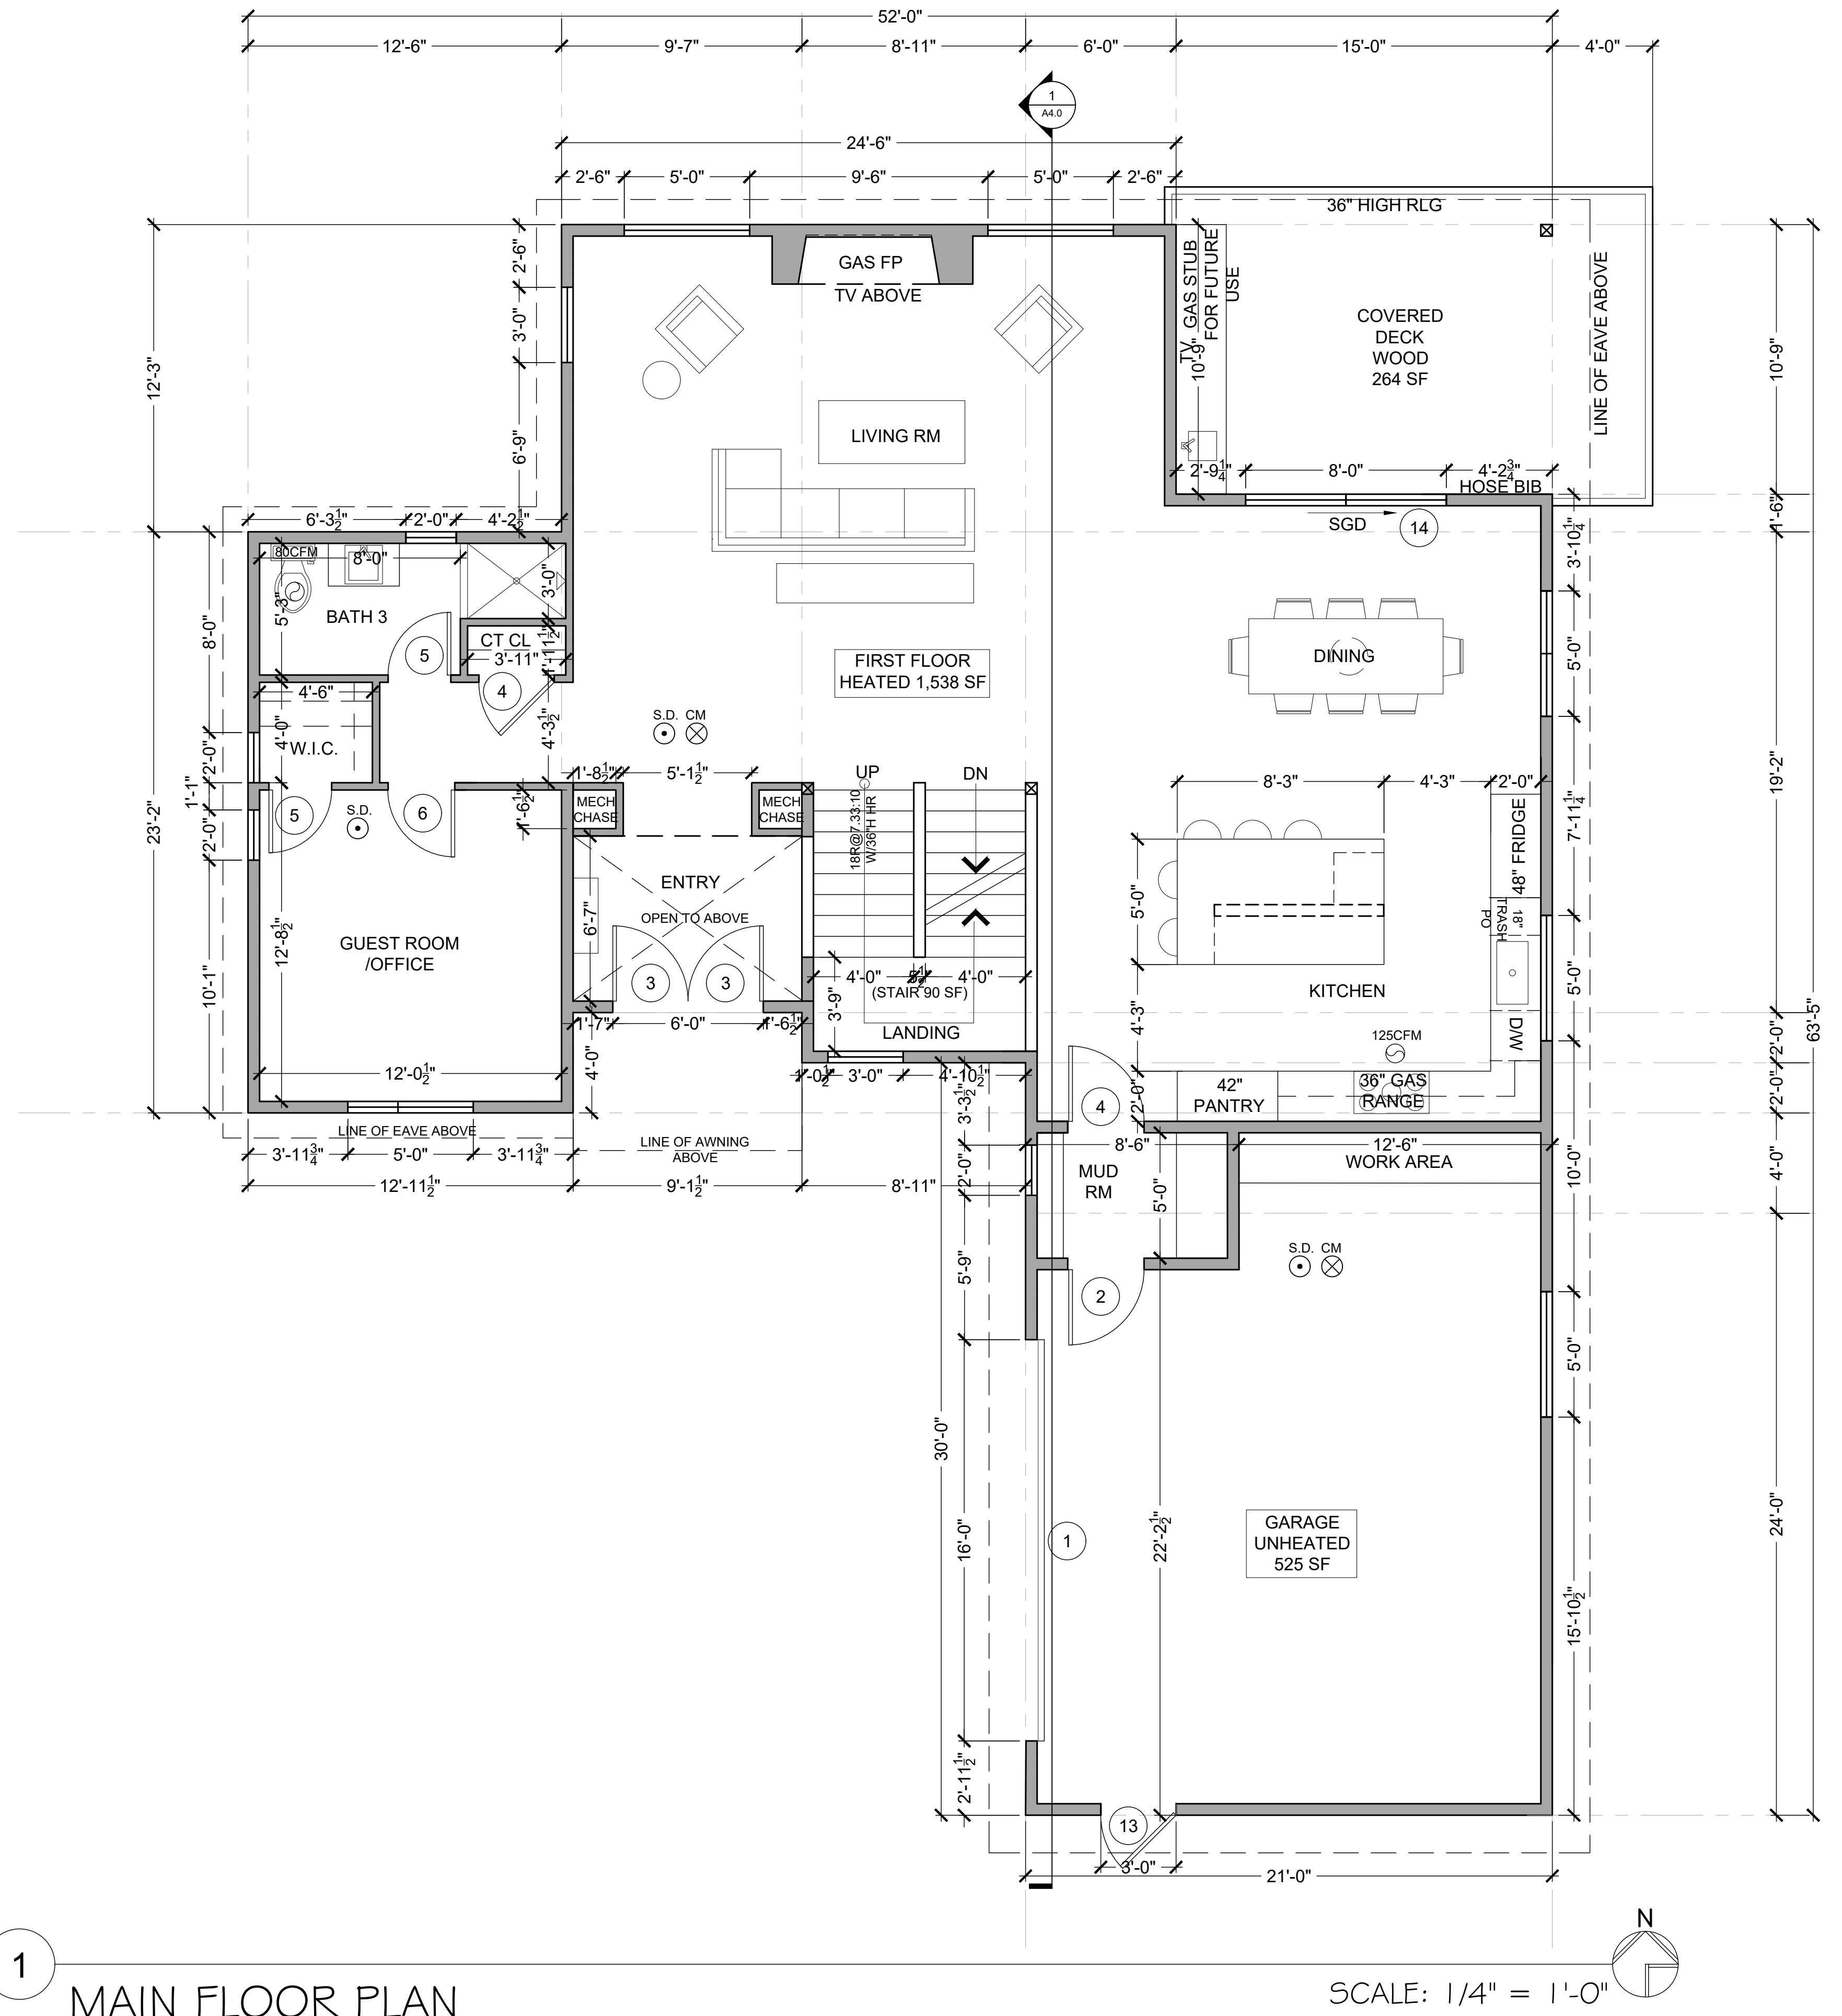

1 MAIN FLOOR PLAN

SCALE: 1/4" = 1'-0"

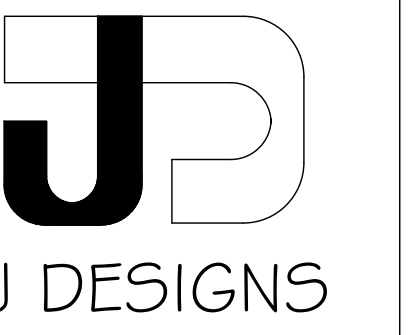

4606 MARINE VIEW DR
TACOMA, WA 98422
206.234.4469
JACQUELINE@
JDESIGNS5SEATTLE.COM

SUBMITTAL	DATE
INTAKE	2/4/2019
RE-DESIGN	3/8/2019
RE-SUBMIT	6/14/2019
RE-SUBMIT	7/24/2019
RE-SUBMIT	8/6/2019
CORR I	3/2/2020

SUN CREEK HOUSE
3440 97TH AVE SE
MERCER ISLAND, WA


DRAWING INFORMATION

OWNER:
MY BACKYARD, LLC

PROJECT# 1901-198

DRAWING NAME:
FLOOR PLAN

A2.1

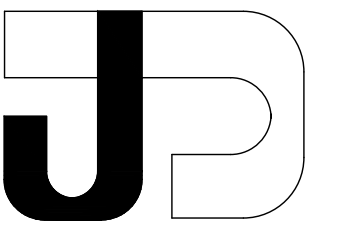

J DESIGNS

4606 MARINE VIEW DR
TACOMA, WA 98422
206.234.4469
JACQUELINE@
JDESIGNSSEATTLE.COM

SUBMITTAL	DATE
INTAKE	2/4/2019
RE-DESIGN	3/8/2019
RE-SUBMIT	6/14/2019
RE-SUBMIT	7/24/2019
RE-SUBMIT	8/6/2019
CORR I	3/2/2020

SUN CREEK HOUSE
3440 97TH AVE SE
MERCER ISLAND, WA


DRAWING INFORMATION

OWNER:
MY BACKYARD, LLC

PROJECT# 1901-198

DRAWING NAME:
ROOF PLAN


A2.2

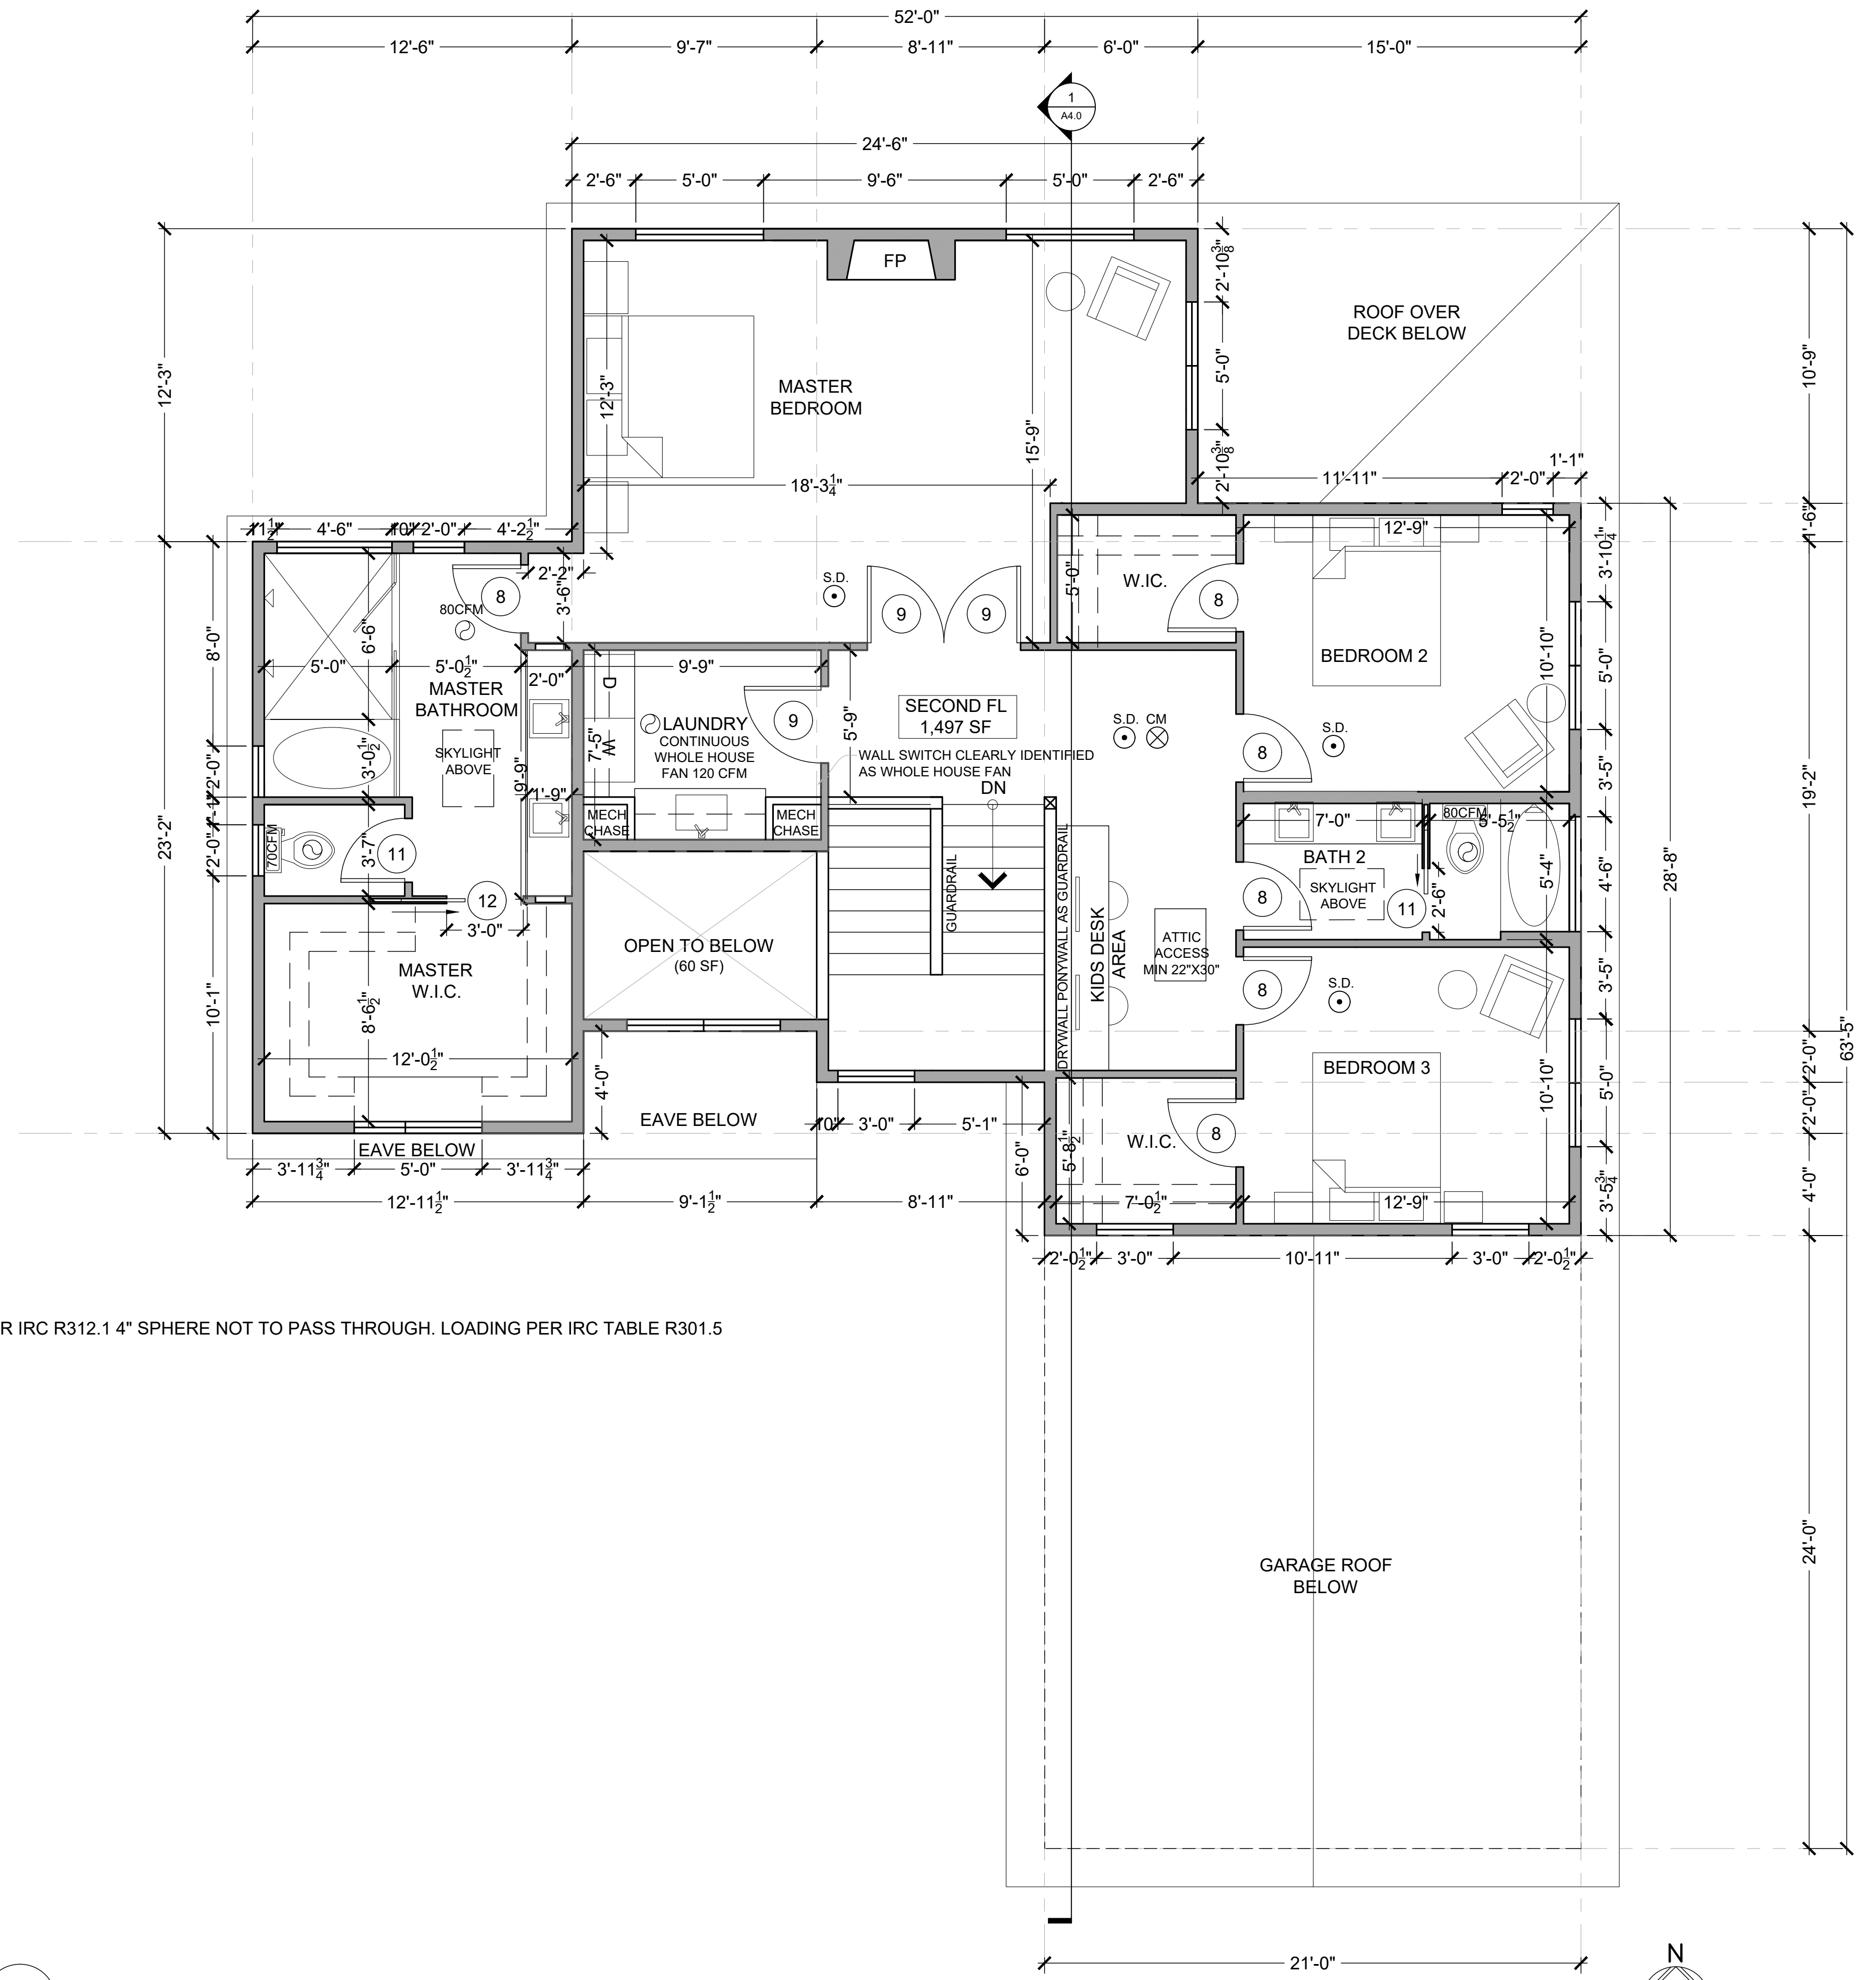

NOTES:
1. GUARDRAILS: PER IRC R312.1 4" SPHERE NOT TO PASS THROUGH. LOADING PER IRC TABLE R301.5

1 UPPER FLOOR PLAN

SCALE: 1/4" = 1'-0"

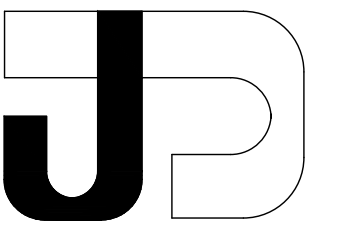

J DESIGNS

4606 MARINE VIEW DR
TACOMA, WA 98422
206.234.4469
JACQUELINE@
JDESIGNS5SEATTLE.COM

SUBMITTAL	DATE
INTAKE	2/4/2019
RE-DESIGN	3/8/2019
RE-SUBMIT	6/14/2019
RE-SUBMIT	7/24/2019
RE-SUBMIT	8/6/2019
CORR I	3/2/2020

SUN CREEK HOUSE
3440 97TH AVE SE
MERCER ISLAND, WA

DRAWING INFORMATION

OWNER:
MY BACKYARD, LLC

PROJECT# 1901-198

DRAWING NAME:
ROOF PLAN

A2.3

- NOTES:
VENTILATION AND INDOOR AIR QUALITY (VIAQ)
- A. Continuously operating whole house fan is proposed.
 - B. Provide outdoor air inlet with 4 sq. in. min net free area conforming to WA State VIAQ for each habitable space.


ROOF VENTILATION

ROOF AREA OVER HEATED SPACE: 2,061 SF
VENTILATION REQUIRED:
(2,061 sf / 150) x 144 si/sf = 1,978.6 si req'd

PROPOSED PARAPET VENTS:
Provide continuous 1" strip at underside of eave
w (2) 2.5" dia. holes/ft at blocking

EAVES - 238.8 lf X 9.8 si/lf = 2,332.4 si



TOTAL VENTILATION PROVIDED: 2,332.4 si > 1,978.6 si

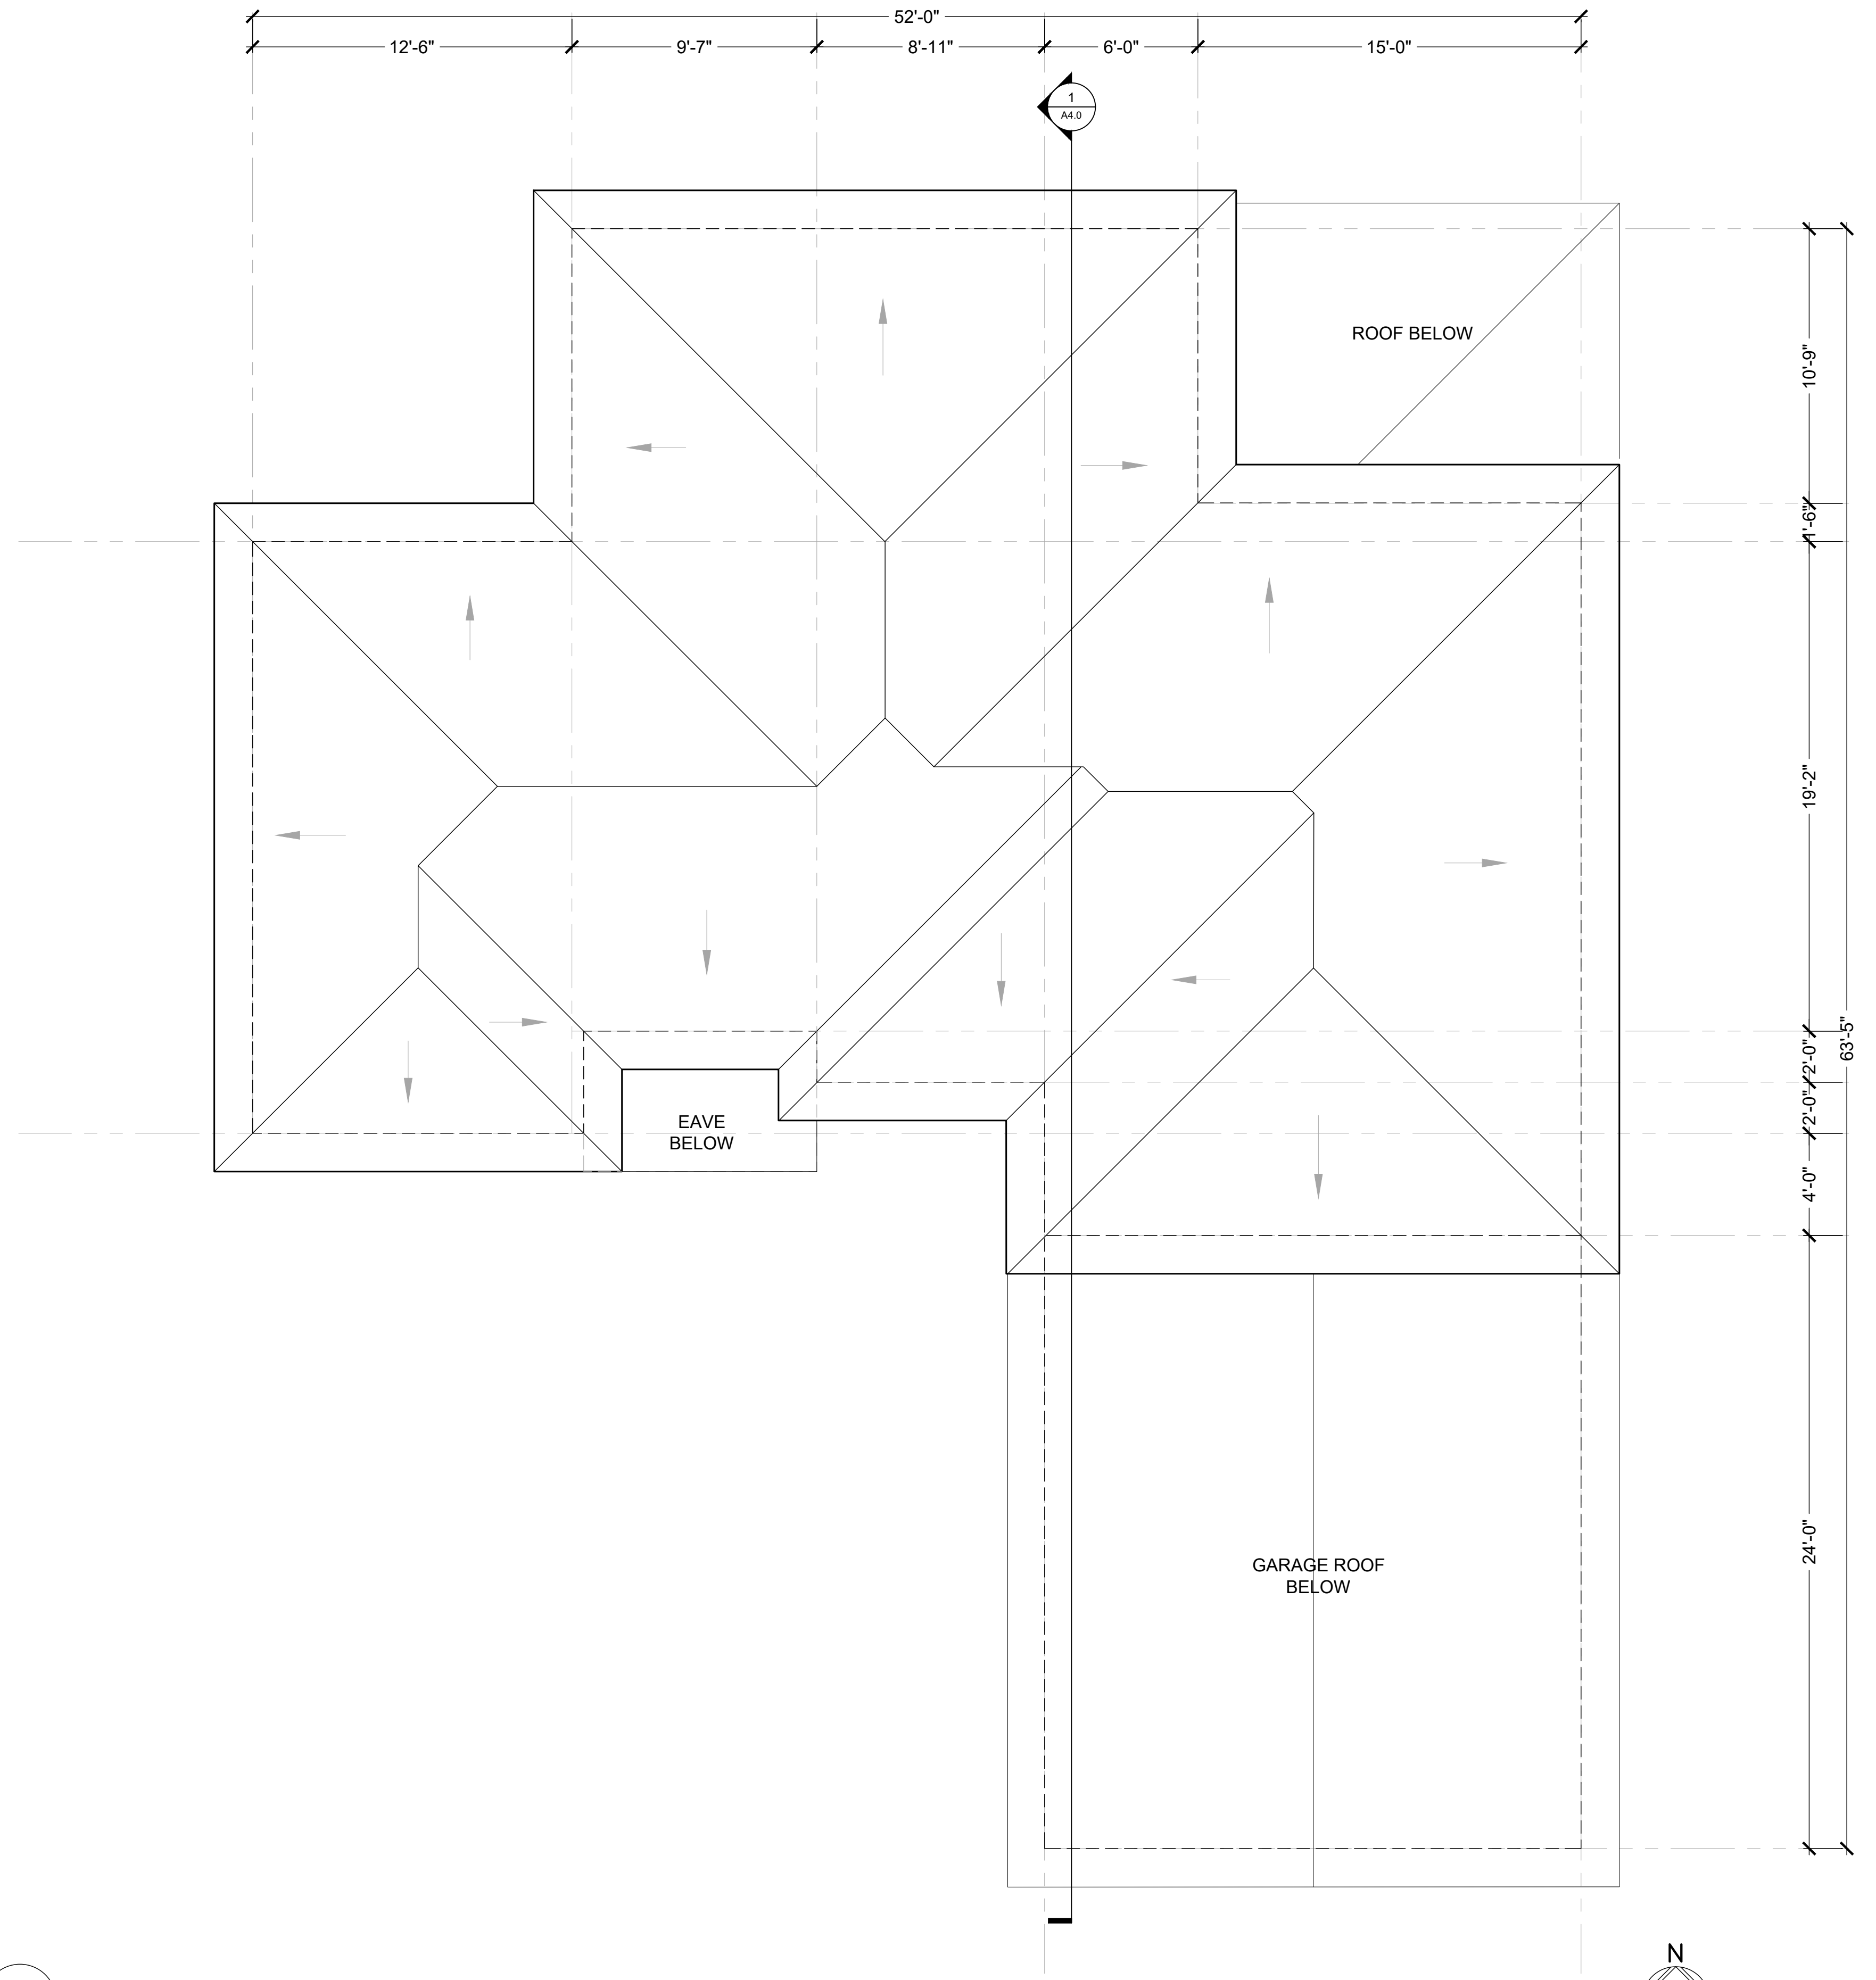

1 ROOF PLAN

SCALE: 1/4" = 1'-0"



MAX BLDG HT LIMIT: 107.6'

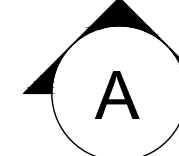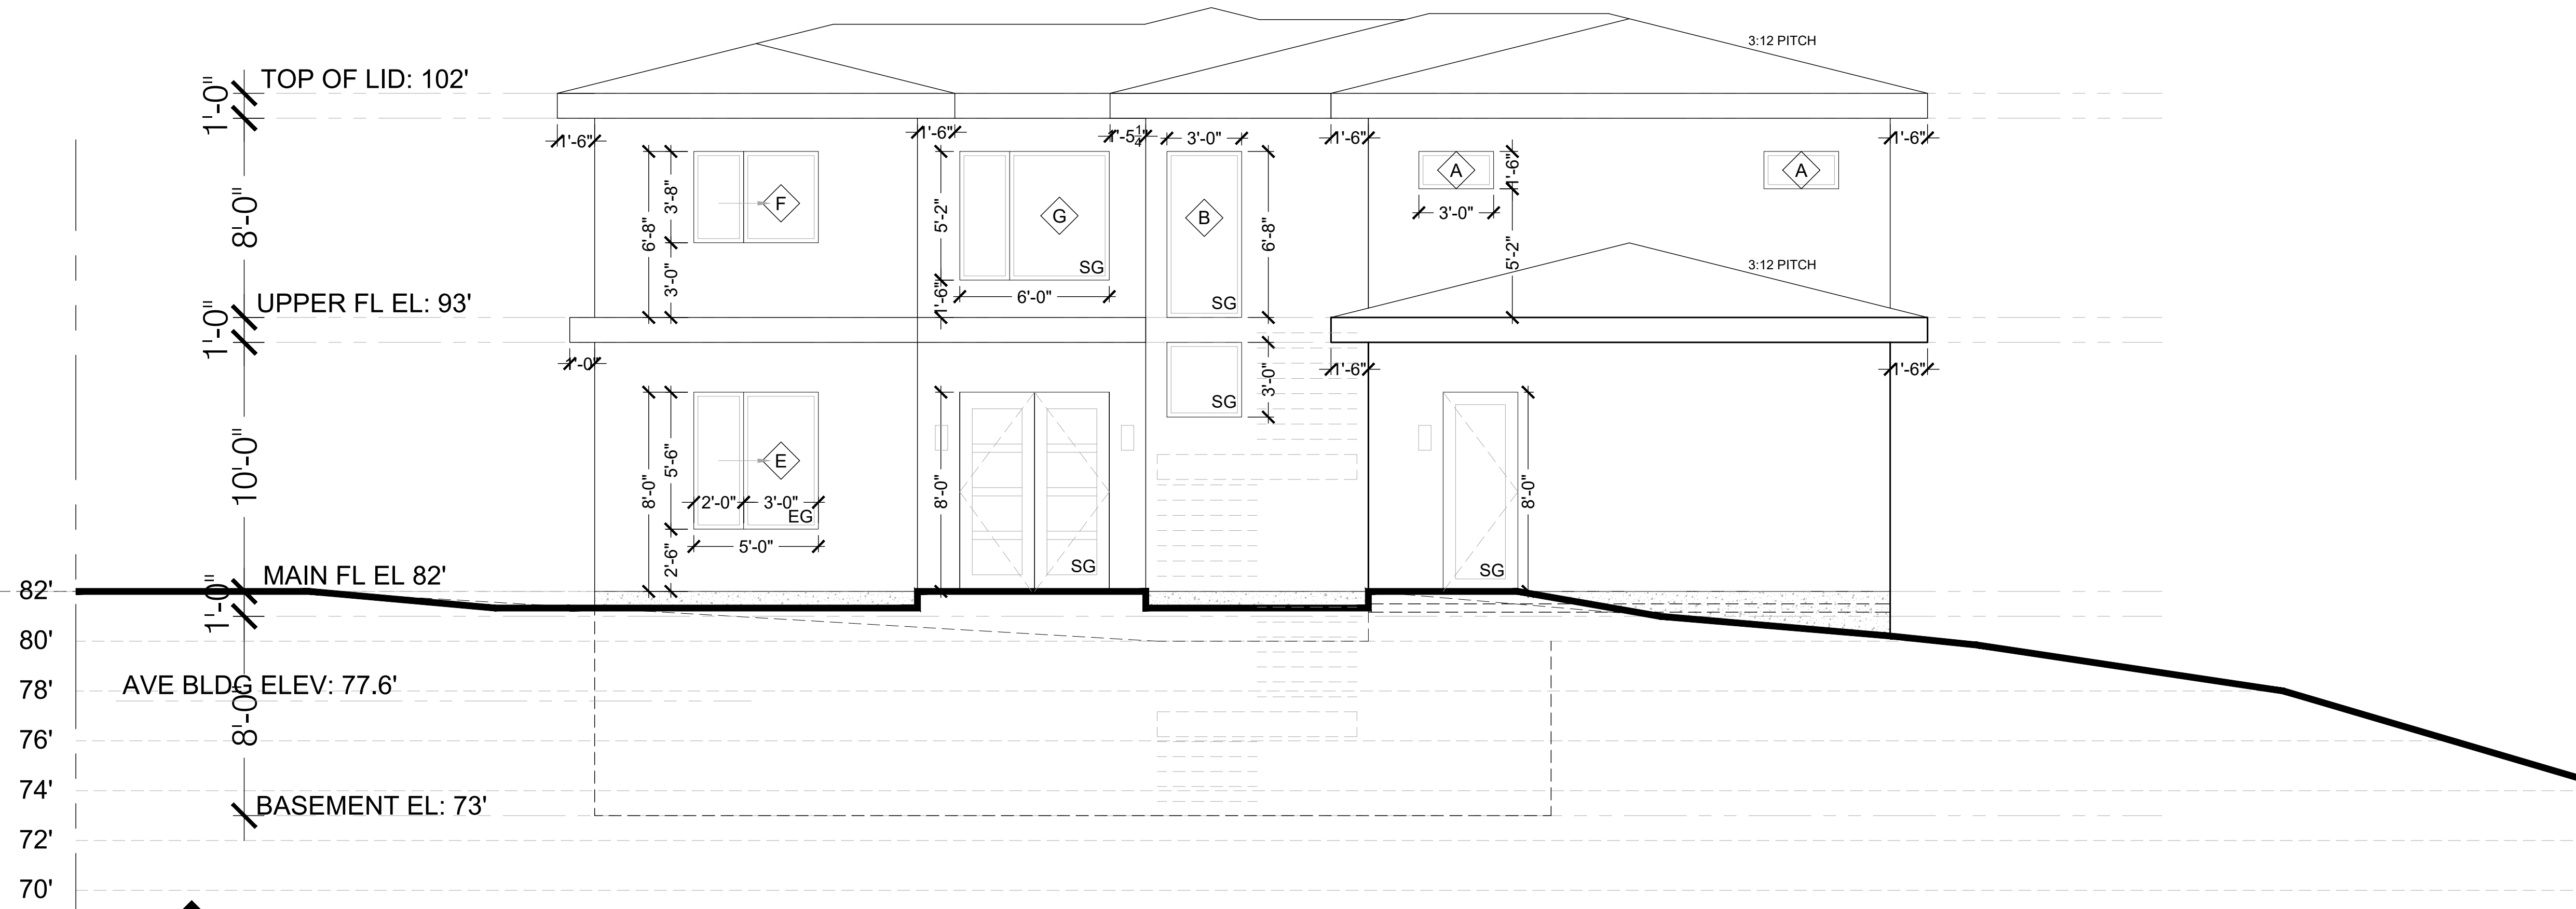

SOUTH ELEVATION


MAX BLDG HT LIMIT: 107.6'

SCALE: 1/4" = 1'-0"

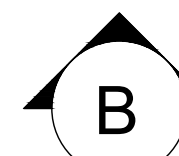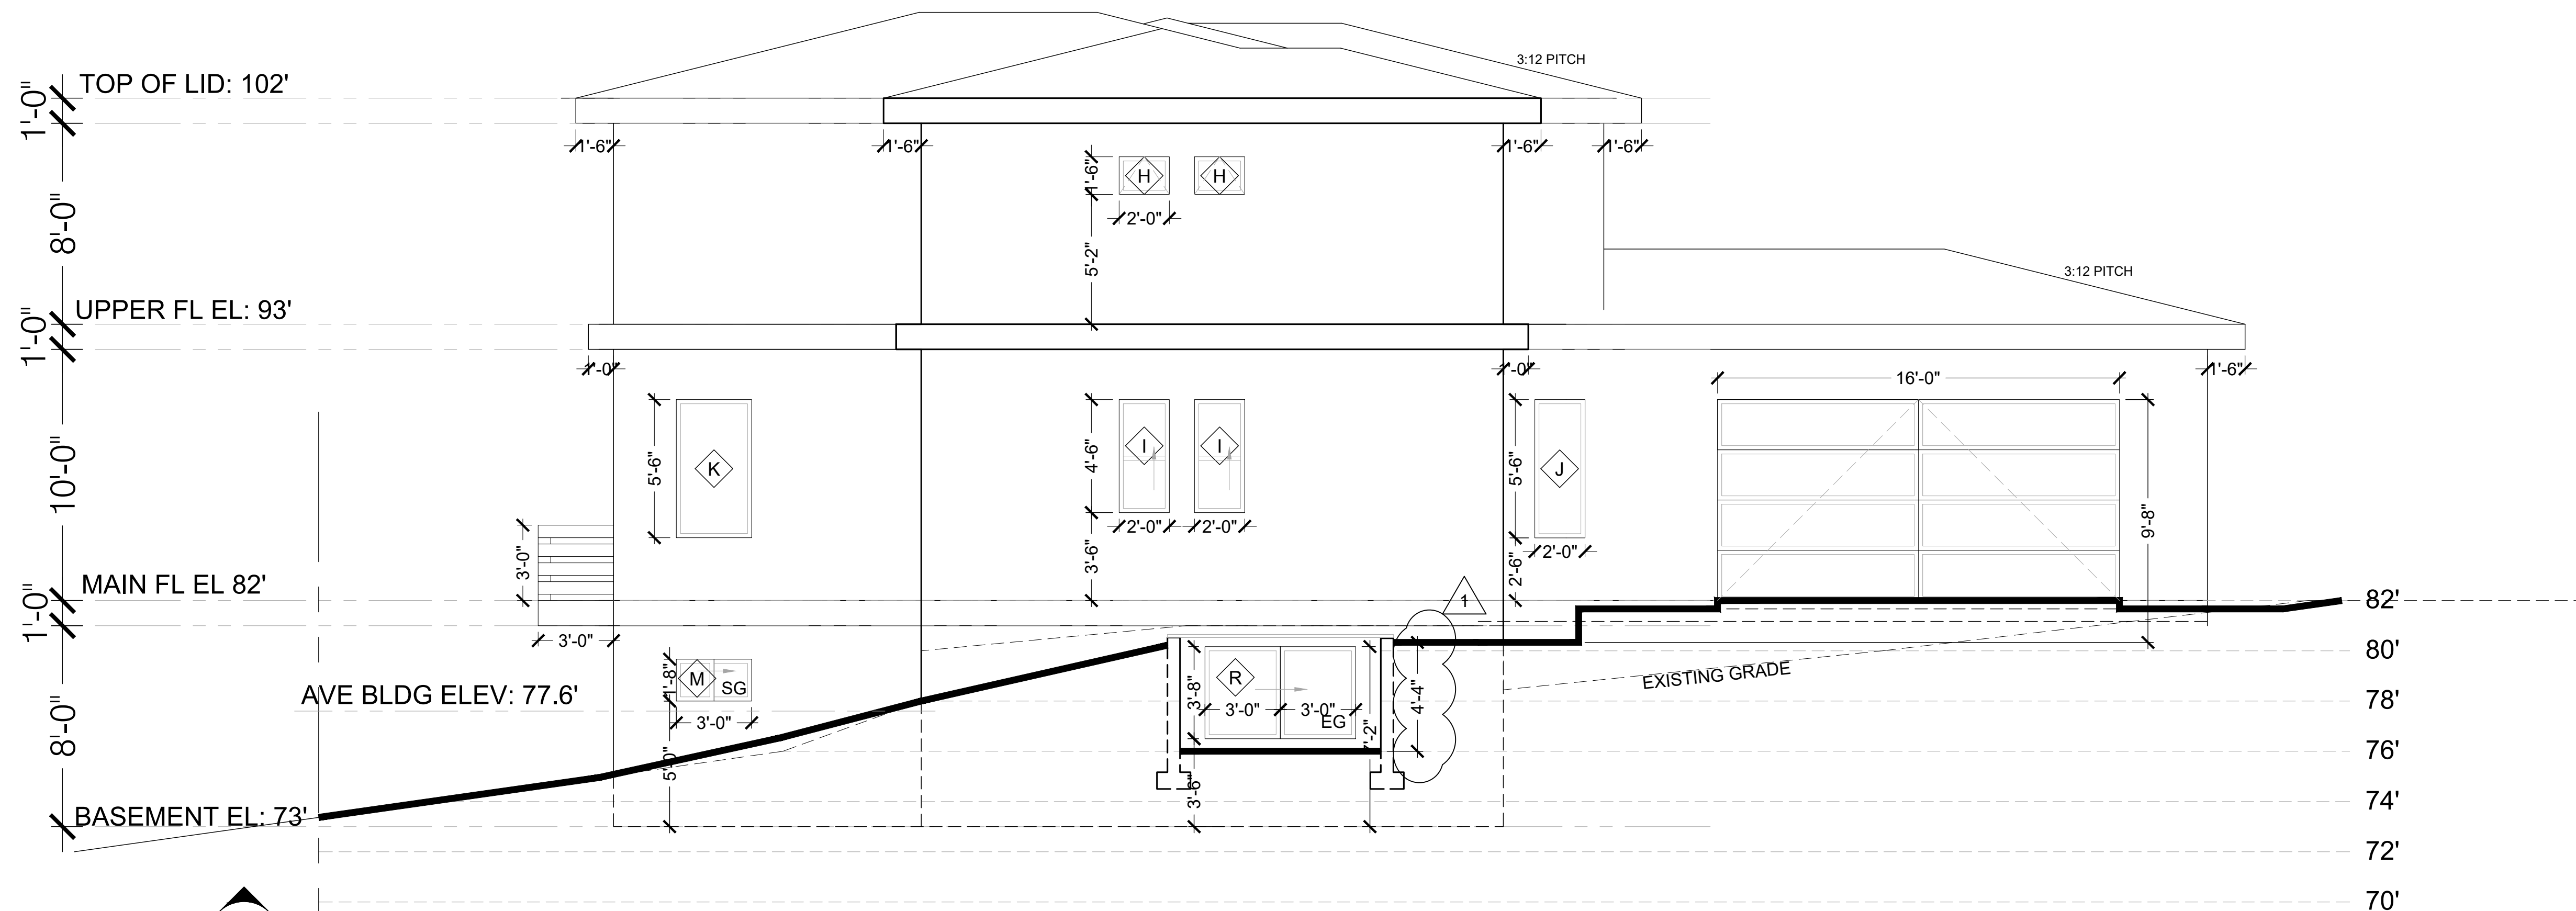

WEST ELEVATION

SCALE: 1/4" = 1'-0"

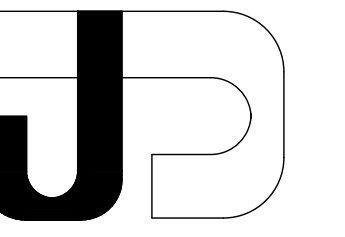

J DESIGNS

4606 MARINE VIEW DR
 TACOMA, WA 98422
 206.234.4469
 JACQUELINE@
 JDESIGNS5SEATTLE.COM

SUBMITTAL	DATE
INTAKE	2/4/2019
RE-DESIGN	3/8/2019
RE-SUBMIT	6/14/2019
RE-SUBMIT	7/24/2019
RE-SUBMIT	8/6/2019
CORR I	3/2/2020

SUN CREEK HOUSE
 3440 97TH AVE SE
 MERCER ISLAND, WA


DRAWING INFORMATION

OWNER:
 MY BACKYARD, LLC

PROJECT# 1901-198


DRAWING NAME:
ELEVATIONS

A3.0

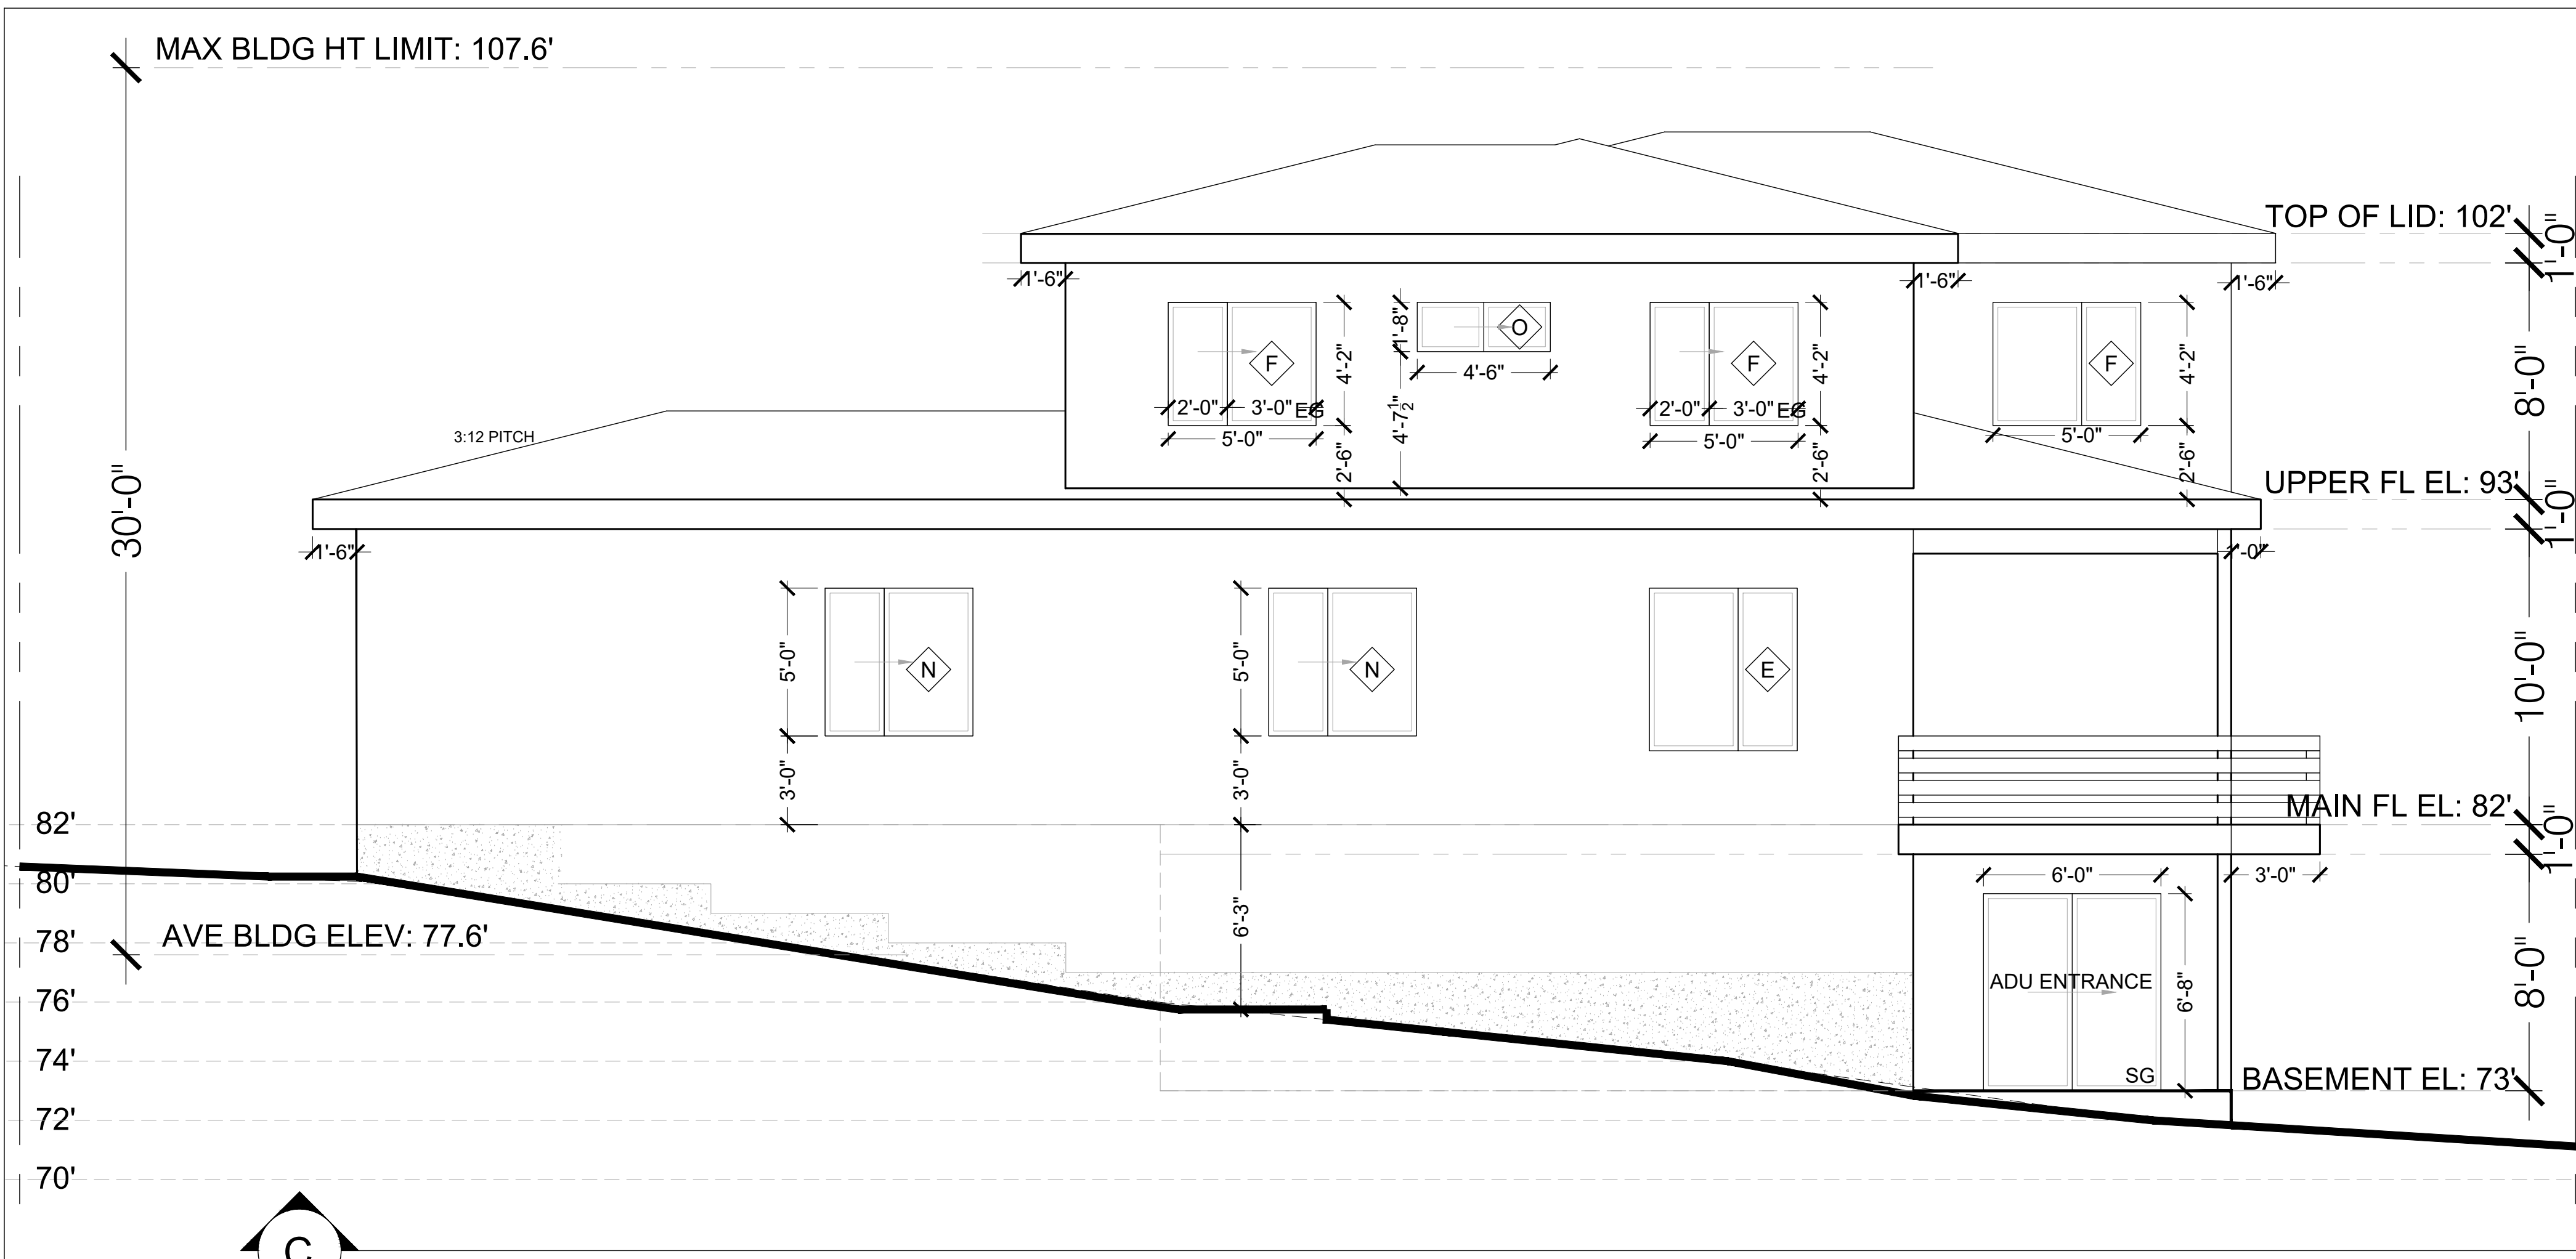

EAST ELEVATION

SCALE: 1/4" = 1'-0"

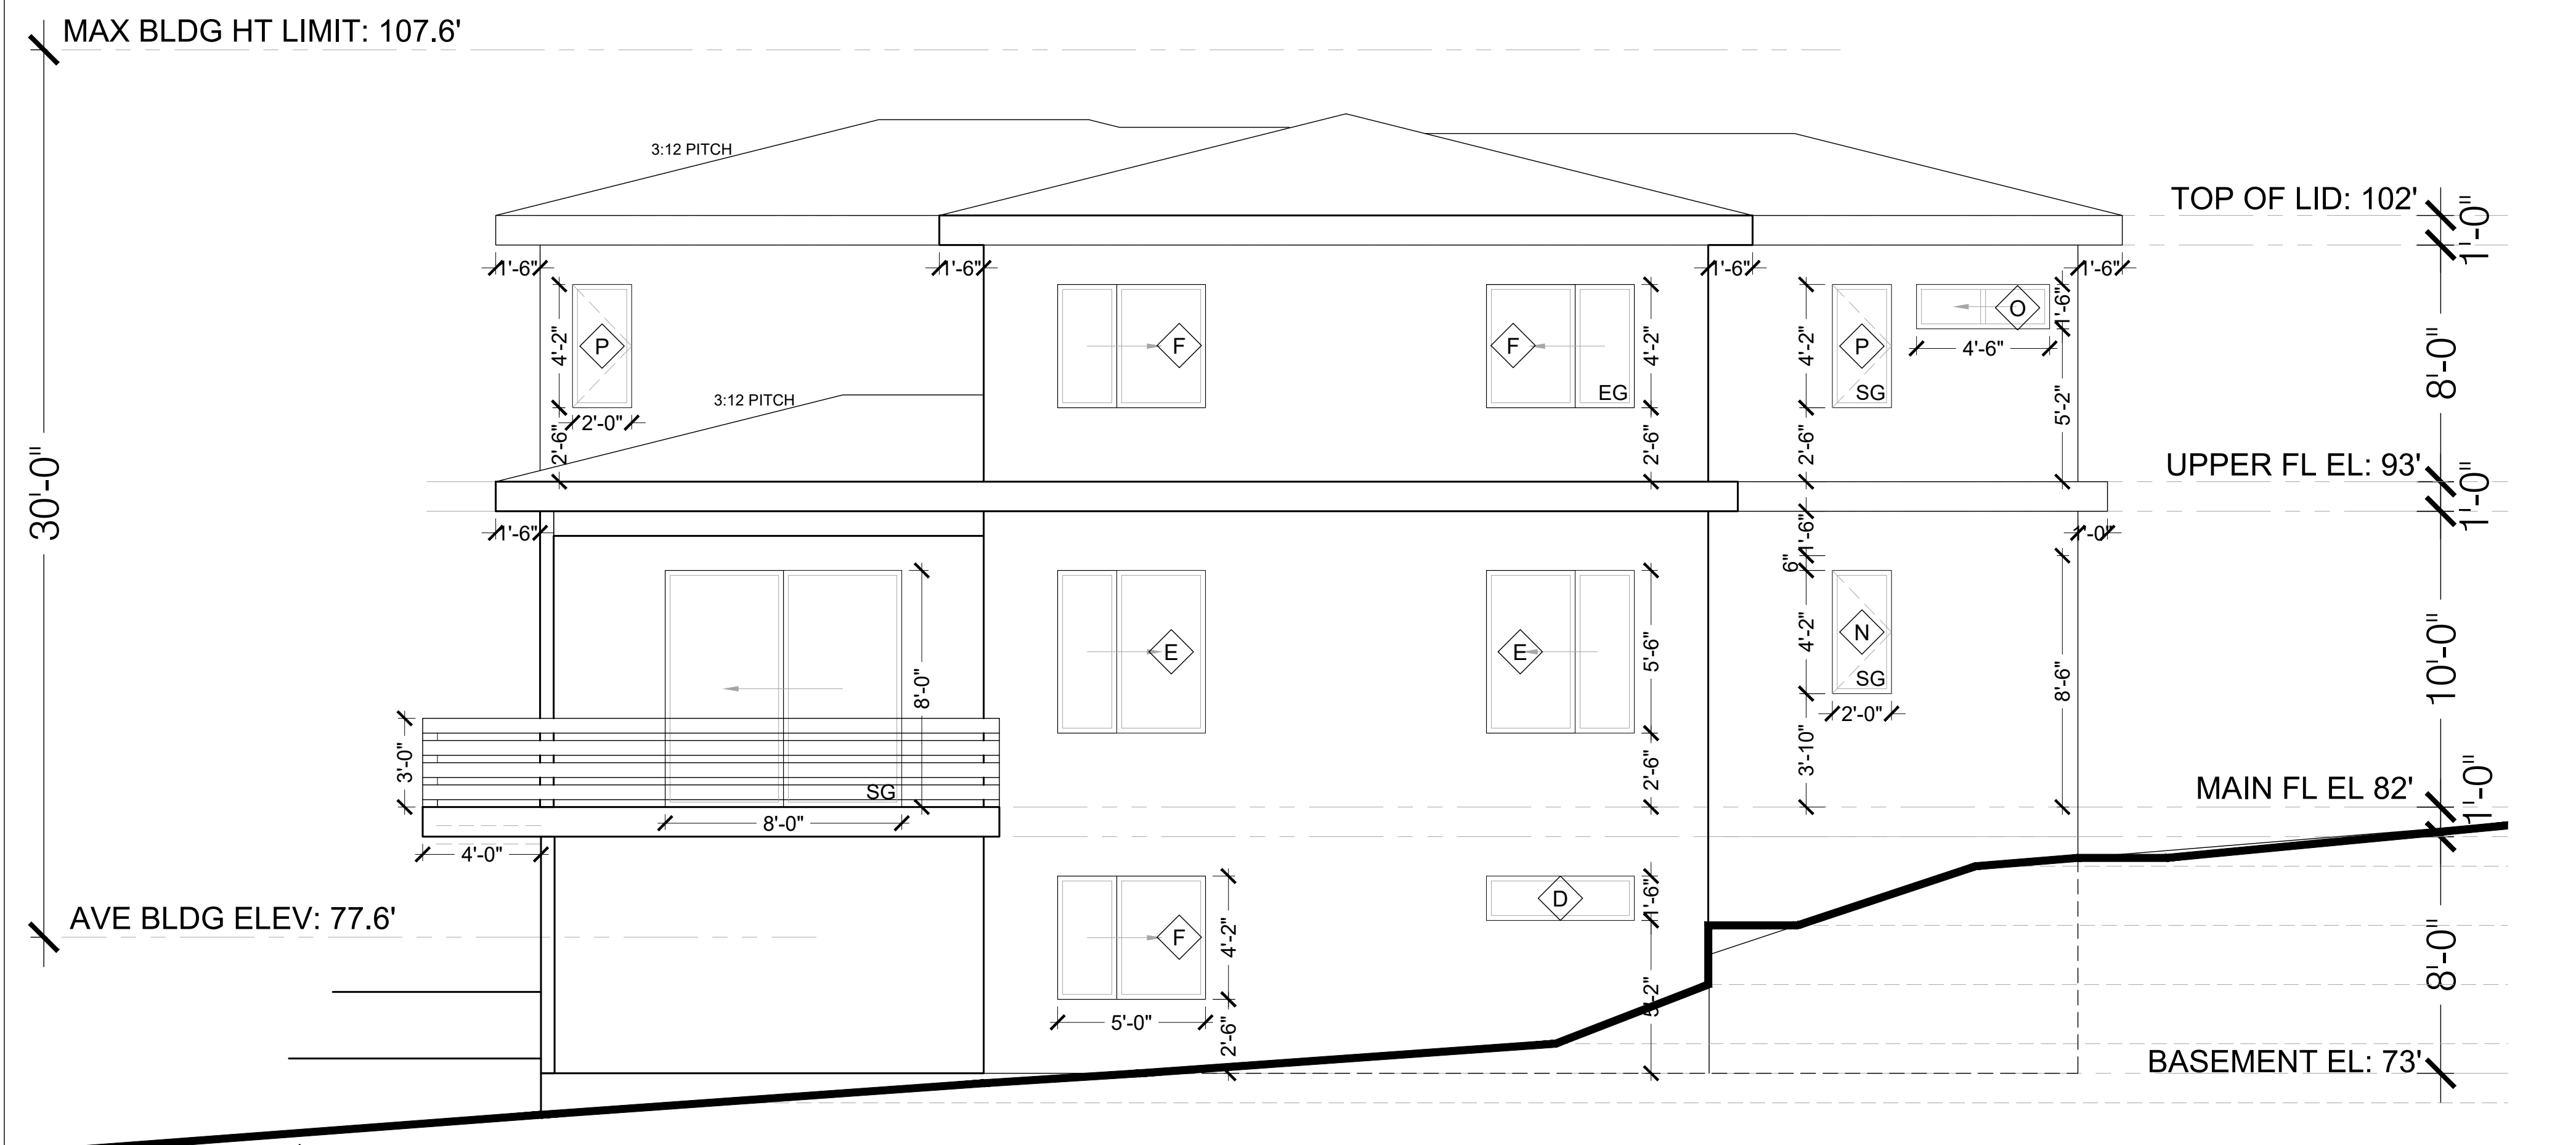

NORTH ELEVATION


SCALE: 1/4" = 1'-0"

WINDOW SCHEDULE								
NO.	SIZE	TYPE	# OF TYPE	MAT'L	MFR	MODEL	U-FACTOR	NOTES
A	3'-0" x 1'-6"	FIX	2	VINYL	ATRIUM	9000 PICTURE WDW	0.28	
B	3'-0" x 6'-8"	FIX	1	VINYL	ATRIUM	9000 PICTURE WDW	0.28	SAFETY GLASS
C	3'-0" x 3'-0"	FIX	1	VINYL	ATRIUM	9000 PICTURE WDW	0.28	SAFETY GLASS
D	5'-0" x 1'-6"	FIX	1	VINYL	ATRIUM	9000 PICTURE WDW	0.28	
E	5'-0" x 5'-6"	SL	1	VINYL	ATRIUM	9000 HORIZ SLIDER	0.28	
F	5'-0" x 4'-2"	SL	2	VINYL	ATRIUM	9000 HORIZ SLIDER	0.28	EGRESS
G	6'-0" x 5'-2"	FIX	1	VINYL	ATRIUM	9000 PICTURE WDW	0.28	SAFETY GLASS
H	2'-0" x 1'-6"	AWN	2	VINYL	ATRIUM	9000 HORIZ SLIDER	0.28	
I	2'-0" x 4'-6"	SH	2	VINYL	ATRIUM	9000 HORIZ SLIDER	0.28	
J	2'-0" x 5'-6"	FIX	1	VINYL	ATRIUM	9000 PICTURE WDW	0.28	
K	3'-0" x 5'-6"	FIX	1	VINYL	ATRIUM	9000 PICTURE WDW	0.28	
M	3'-0" x 1'-8"	SL	1	VINYL	ATRIUM	9000 HORIZ SLIDER	0.28	
N	5'-0" x 5'-0"	SL	2	VINYL	ATRIUM	9000 HORIZ SLIDER	0.28	
O	4'-6" x 1'-6"	SL	2	VINYL	ATRIUM	9000 HORIZ SLIDER	0.28	
P	4'-2" x 2'-0"	CSMT	2	VINYL	ATRIUM	9000 CASEMENT	0.28	
Q	5'-0" x 2'-0"	FIX	2	VINYL	ATRIUM	9000 PICTURE WDW	0.28	
R	6'-0" x 3'-8"	SL	1	VINYL	ATRIUM	9000 HORIZ SLIDER	0.28	EGRESS

- WINDOW NOTES:
- ALL WINDOWS AND DOORS SHALL BE LABELED "NFRC certified".
 - SG = SAFETY GLASS
 - EG = EGRESS
 - ALL EGRESS (EMERGENCY ESCAPE AND RESCUE OPENINGS) SHALL HAVE A MINIMUM NET CLEAR OPENING OF 5.7 SF (5 SF AT GROUND LEVEL) THE MIN NET CLEAR OPENING SHALL BE 24" HIGH X 20" WIDE.
 - THEY SHALL HAVE A MAX SILL HT OF 44" ABOVE FINISHED FLOOR TO THE BOTTOM OF THE CLEAR OPENING.
 - EMERGENCY ESCAPE AND RESCUE OPENINGS SHALL BE OPERATIONAL FROM THE INSIDE OF THE ROOM WITHOUT THE USE OF KEYS, TOOLS OR SPECIAL KNOWLEDGE.
 - GENERAL CONTRACTOR SHALL PROVIDE MANUFACTURER'S DATA ON ALL WINDOWS SHOWING COMPLIANCE WITH THE 2015 WASHINGTON STATE ENERGY CODES.
 - DIMENSIONS INDICATE ROUGH FRAMED OPENINGS - MANUFACTURER TO SIZE WINDOWS ACCURATELY

# DOOR SCHEDULE							
N O.	SIZE	FUNCTI ON	STYLE	MAT'L	MFR	MODEL	NOTES
1	16'-0" x 7'-0"	OVERHEA D	FROSTED GLASS & ALUMINUM	MTL			
2	3'-0" x 8'-0" x 1 3/8"	SWING	FLUSH	WOOD	SIMPSON	FIRE RATED	20 MIN RATED SELF CLOSING
3	3'-0" x 8'-0" x 1 3/4"	SWING	EXT 5 LITE	WOOD	SIERRA PACIFIC		SG, U-VALUE: 0.28 CLEAR
4	3'-0" x 8'-0" x 1 3/4"	SWING	FLUSH	WOOD	SIMPSON	INTERIOR 20	
5	2'-6" x 8'-0" x 1 3/8"	SWING	FLUSH	WOOD	SIMPSON	INTERIOR 20	
6	2'-8" x 8'-0" x 1 3/8"	SWING	FLUSH	WOOD	SIMPSON	INTERIOR 20	
7	2'-6" x 6'-8" x 1 3/8"	SWING	FLUSH	WOOD	SIMPSON	INTERIOR 20	
8	2'-8" x 6'-8" x 1 3/8"	SWING	FLUSH	WOOD	SIMPSON	INTERIOR 20	
9	3'-0" x 6'-8" x 1 3/8"	SWING	FLUSH	WOOD	SIMPSON	INTERIOR 20	
10	3'-0" x 6'-8" x 1 1/2"	BARN DOOR	SHAKER W MIRROR	WOOD W/ MIRROR	SIMPSON	INTERIOR 20	
11	2'-6" x 6'-8" x 1 3/8"	POCKET	FLUSH	WOOD	SIMPSON		
12	3'-0" x 6'-8" x 1 3/8"	POCKET	FLUSH	WOOD	SIMPSON		
13	3'-0" x 8'-0" x 1 3/4"	SWING	EXT FULL LITE	WOOD	SIERRA PACIFIC		SG, U-VALUE: 0.28 CLEAR
14	8'-0" x 8'-0" x 1 3/4"	SLIDER	EXT FULL LITE	VINYL	ATRIUM	SL 890 Series	SG, U-VALUE: 0.28

- DOOR NOTES:
- GENERAL CONCTRACOR SHALL PROVIDE MANUFACTURER'S DATA ON ALL WINDOWS SHOWING COMPLIANCE WITH THE 2015 WASHINGTON STATE ENERGY CODES.
 - DIMENSIONS INDICATE DOOR SIZES, NOT ROUGH OPENINGS, VERIFY ALL DOOR TYPES AND HARDWARE W/OWNER PRIOR TO ORDERING.
 - ALL DOORS WITH GLAZING TO BE NFRC CERTIFIED AND LABELED.
 - DOORS SEPARATING UNHEATED AND HEATED SPACE TO BE U=.28 MAX PER WSEC 2015.

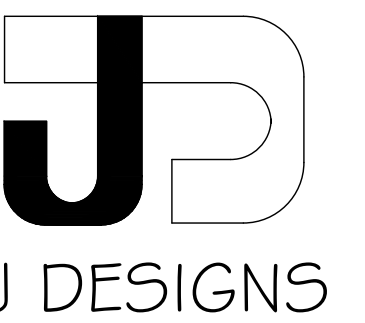

4606 MARINE VIEW DR
TACOMA, WA 98422
206.234.4469
JACQUELINE@
JDESIGNS5SEATTLE.COM

SUBMITTAL	DATE
INTAKE	2/4/2019
RE-DESIGN	3/8/2019
RE-SUBMIT	6/14/2019
RE-SUBMIT	7/24/2019
RE-SUBMIT	8/6/2019
CORR I	3/2/2020


SUN CREEK HOUSE
3440 97TH AVE SE
MERCER ISLAND, WA


DRAWING INFORMATION

OWNER:
MY BACKYARD, LLC


PROJECT# 1901-198

DRAWING NAME:
ELEVATIONS

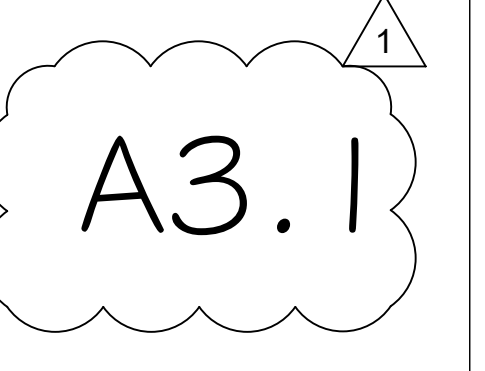


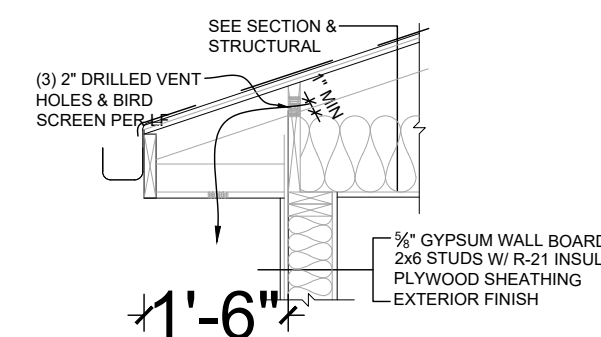

2 EAVE VENT DTL
SCALE: 1/2" = 1'-0"

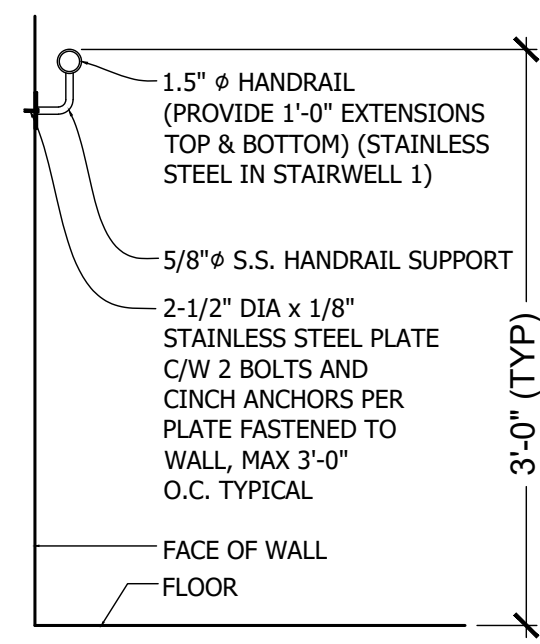


3 HAND RAIL (TYP) DTL
SCALE: 1/2" = 1'-0"

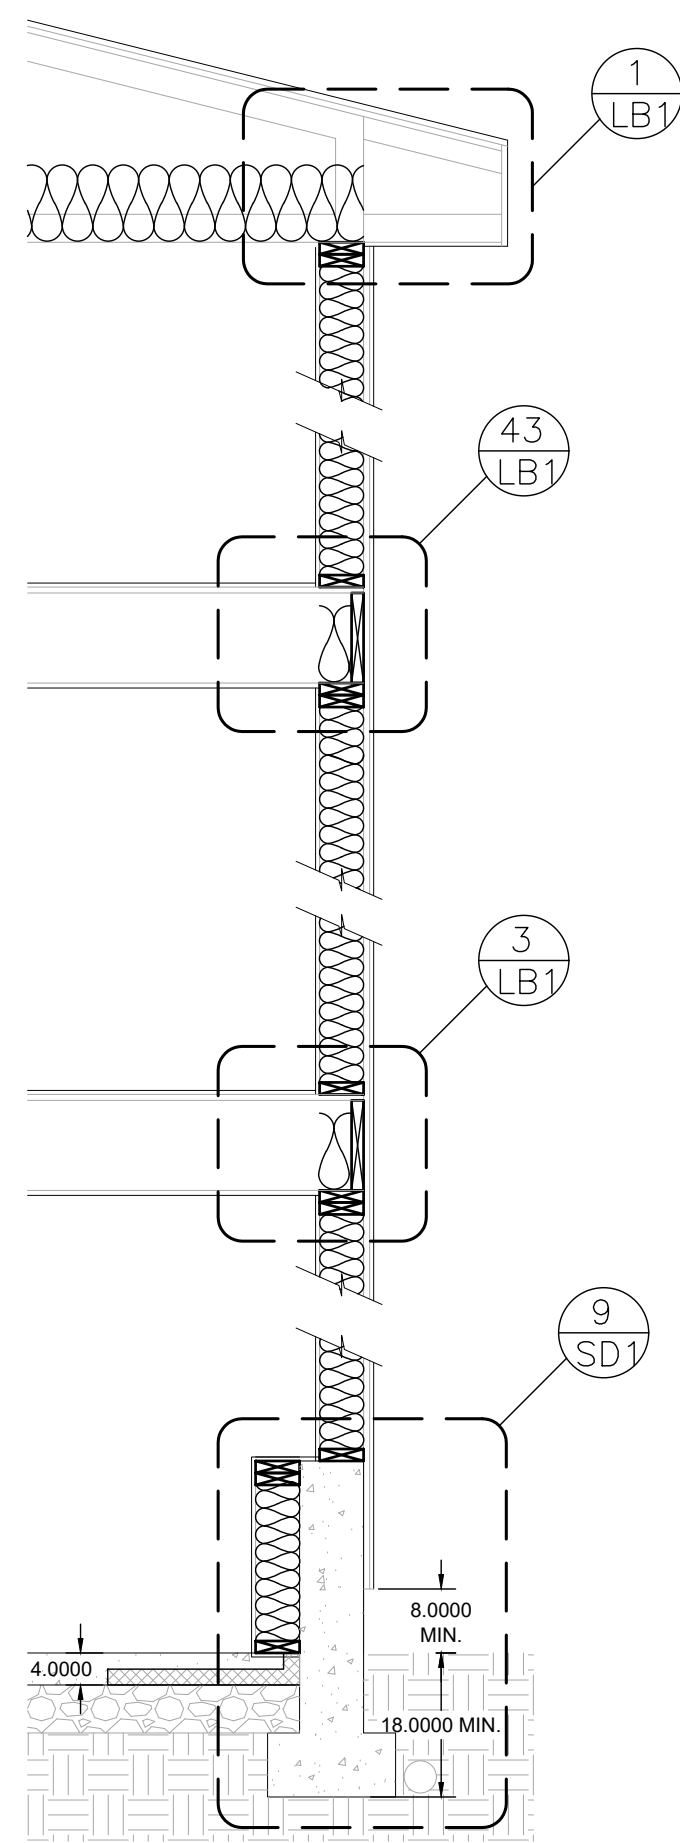


4 STAIR (TYP) DTL
SCALE: 1/2" = 1'-0"

NOTES:


- SPACING BTWN INTERMEDIATE GUARDRAIL MEMBERS TO BE A MAXIMUM OF 4' CLEAR SUCH THAT A SPHERE OF 4" DIA SHALL NOT PASS THROUGH ANY OPENING.
- HANDRAIL ENDS SHALL BE RETURNED OR SHALL TERMINATE IN THE NEWEL POSTS OR SAFETY TERMINALS PER SBC 1009.11.6.
- MIN STAIR TREAD WIDTH OF A WINDER TO BE 6' AT NARROWEST POINT

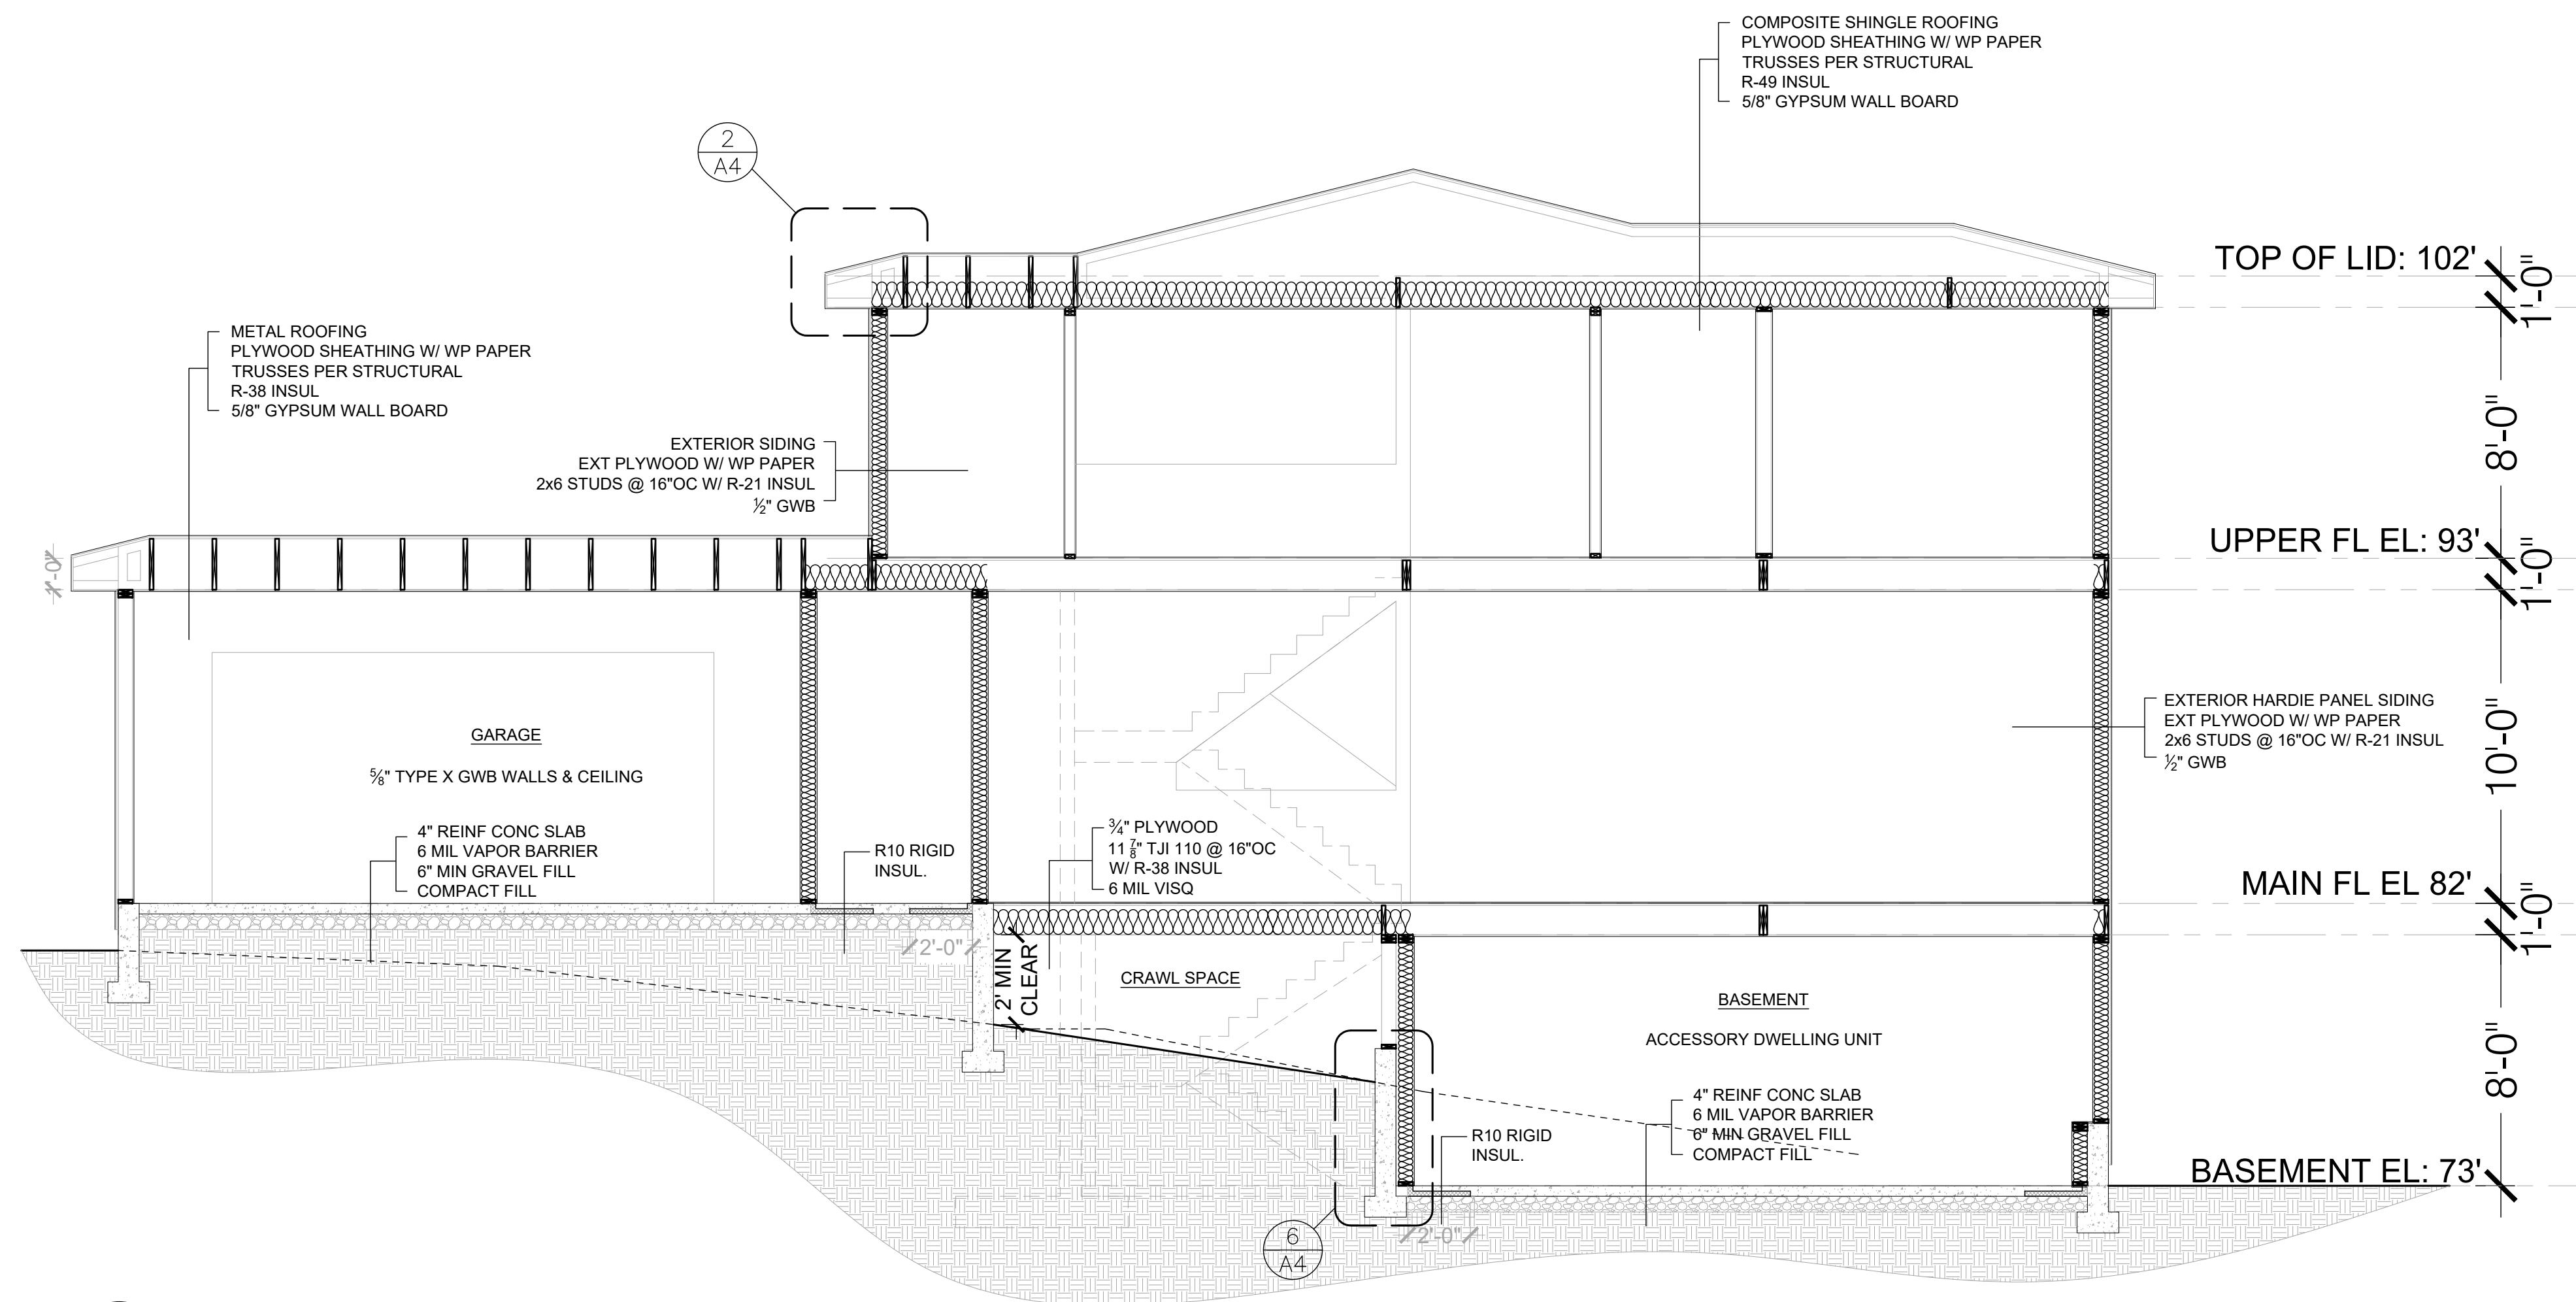

1 SECTION
SCALE: 1/4" = 1'-0"

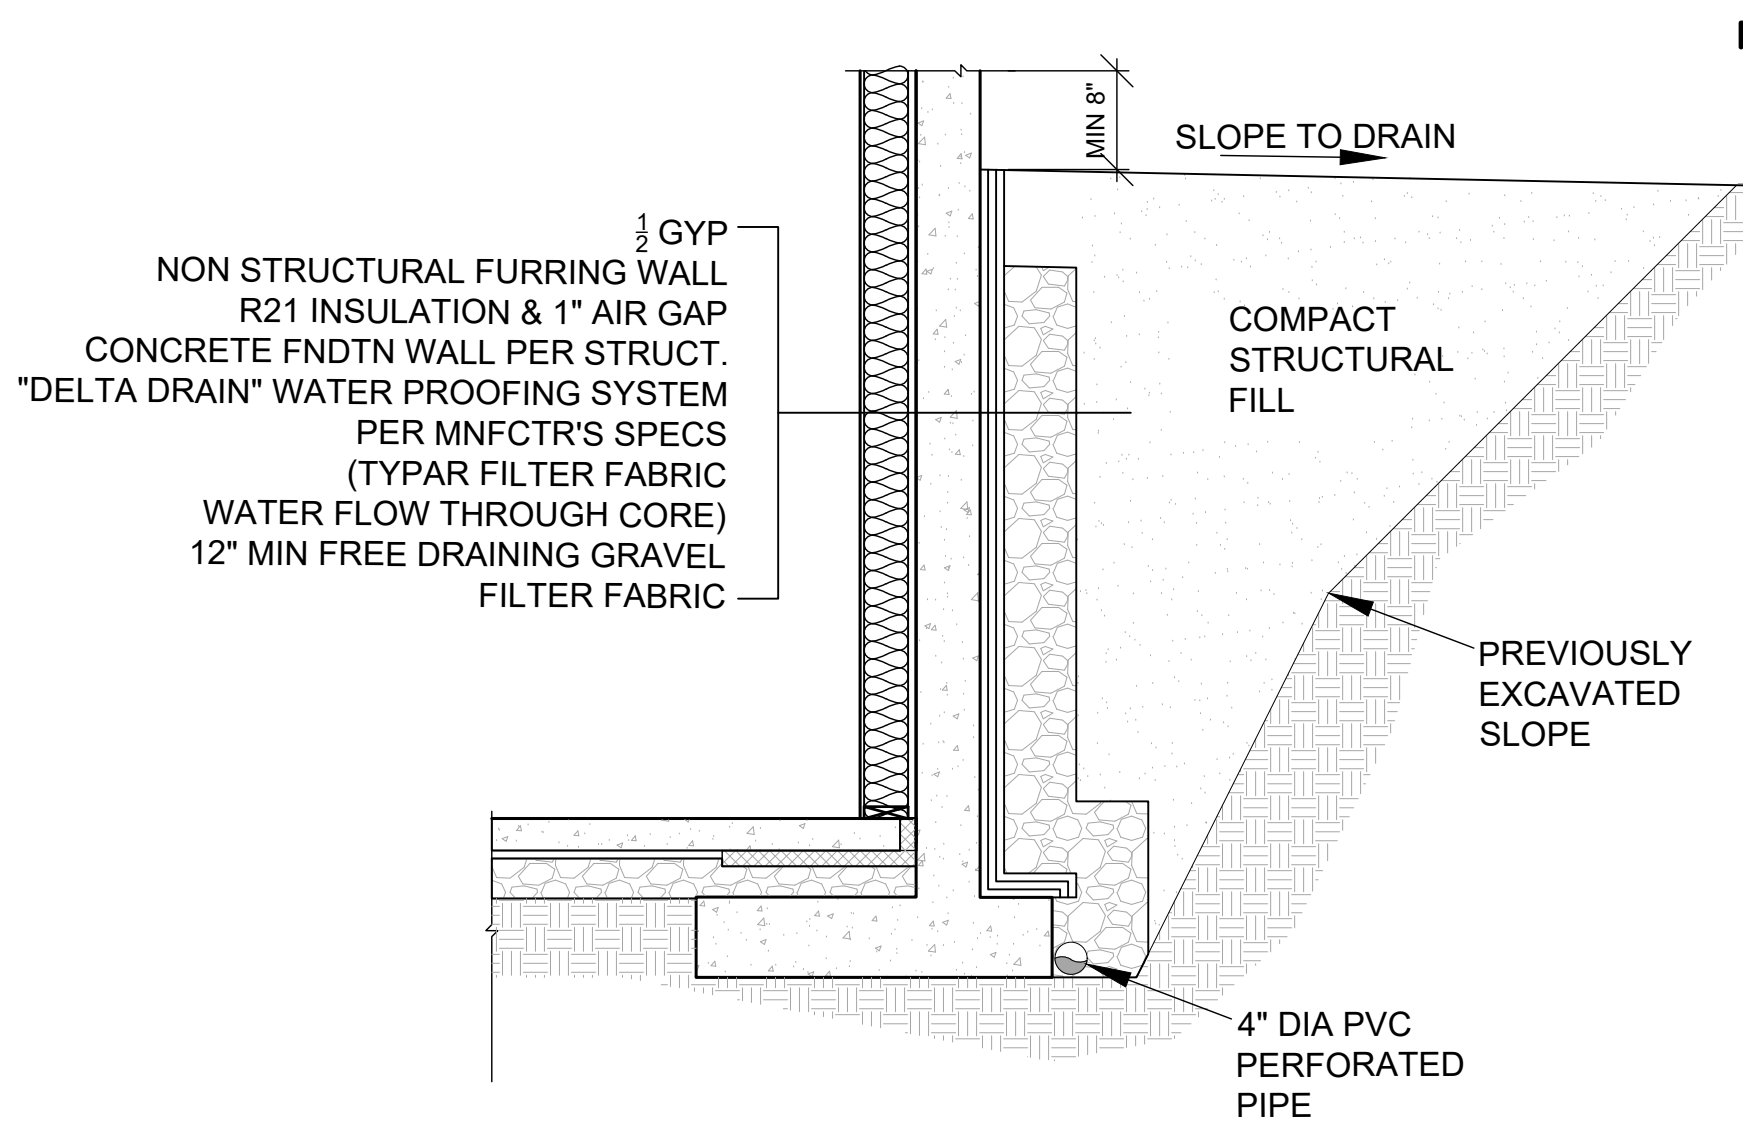

6 BSMNT WATER-PROOFING DTL (TYP)
SCALE: 1/2" = 1'-0"

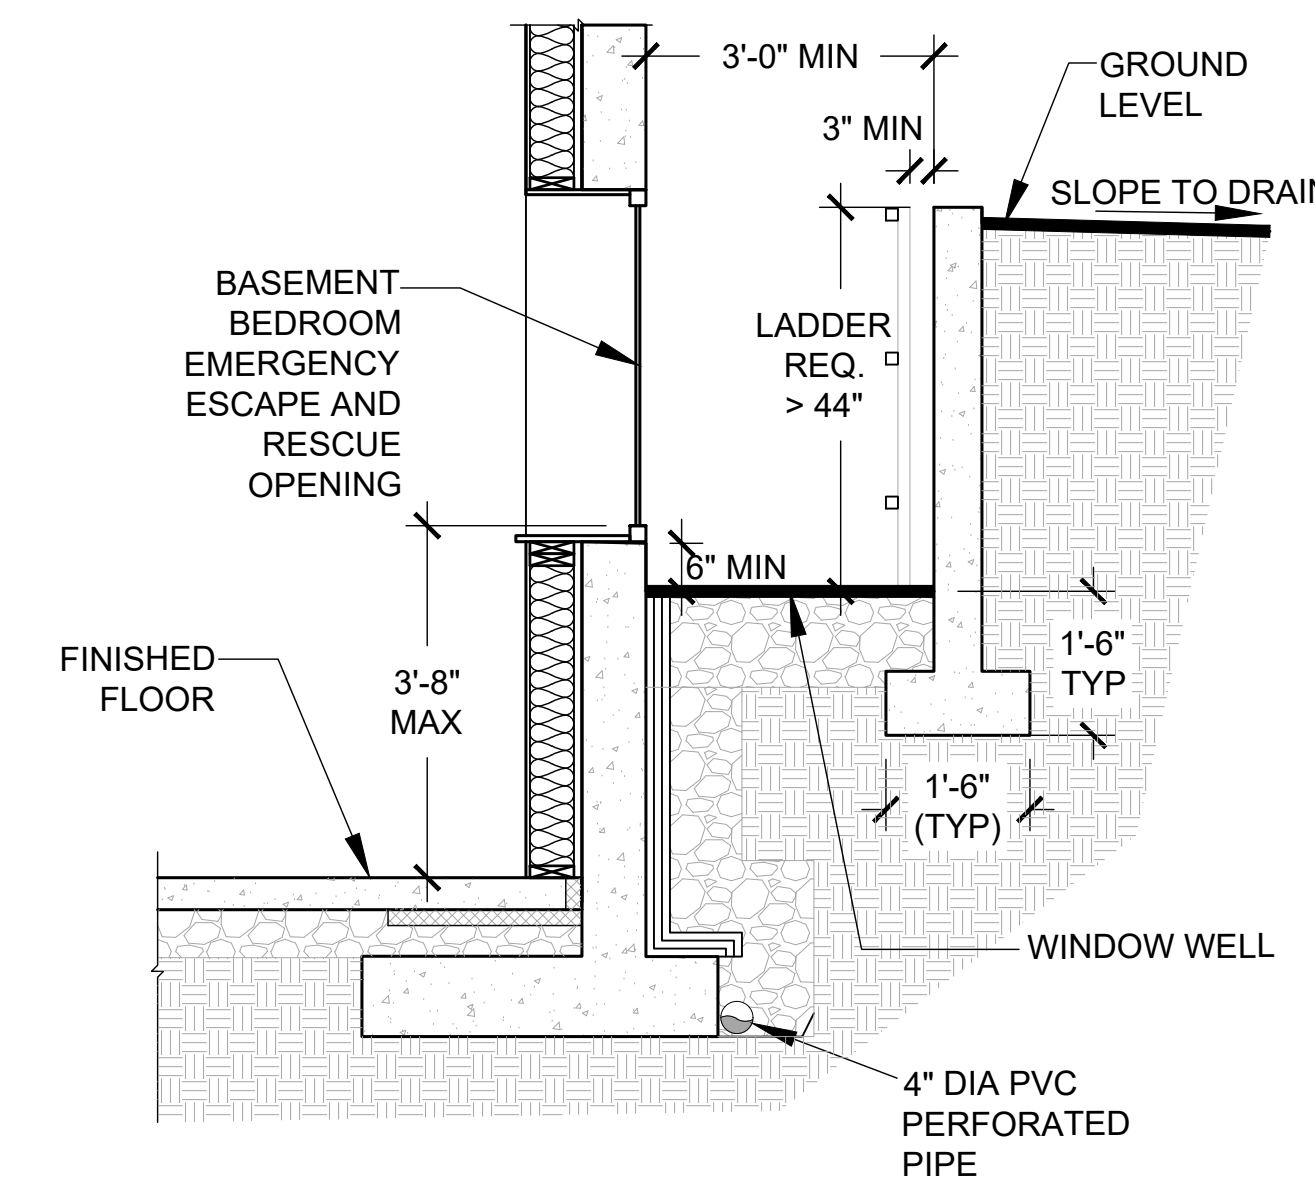


7 WINDOW WELL DETAIL (TYP)

5 EXT. WALL ASSMBLY (TYP) DTL
SCALE: 1/2" = 1'-0"

NOTE:

- ALL FOOTINGS ARE PLANNED AT DEPTH WHERE MEDIUM-DENSE SOIL IS ANTICIPATED. IF THE CONTRARY IS DISCOVERED PLACE STRUCTURAL FILL DIRECTLY ON COMPETENT SOIL AND CONSULT GEOTECHNICAL ENGINEER.
- DO NOT DIRECT DOWN SPOUTS TO FOOTING DRAIN.
- RECOMMENDED TEMPORARY EXCAVATIONS & SLOPES PER GEO REPORT:
 FILL, (REGARDLESS OF IN-SITU DENSITY): 1.5H:1V
 WHERE GROUNDWATER SEEPAGE IS DISCOVERED: 1.5H:1V
 LOOSE TO MED DENSE SOILS: 1.5H:1V
 MEDIUM TO DENSE NATIVE SOIL: 1H:1V
 *ANY PROPOSED STEEPER TEMPORARY CUTS MUST BE APPROVED BY ESNW.

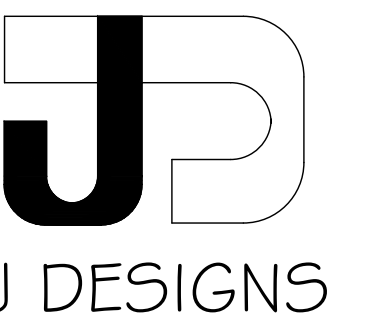

4606 MARINE VIEW DR
TACOMA, WA 98422
206.234.4469
JACQUELINE@
JDESIGNS5SEATTLE.COM

SUBMITTAL	DATE
INTAKE	2/14/2019
RE-DESIGN	3/8/2019
RE-SUBMIT	6/14/2019
RE-SUBMIT	7/24/2019
RE-SUBMIT	8/6/2019
CORR 1	3/2/2020

SUN CREEK HOUSE
3440 97TH AVE SE
MERCER ISLAND, WA

DRAWING INFORMATION

OWNER:
MY BACKYARD, LLC

PROJECT# 1901-198

DRAWING NAME:

SECTION

A4.0

GENERAL NOTES

- A. These notes are in abbreviate form. The intent is to further define those areas of work not clearly delineated on the drawings. The quality of workmanship throughout shall be first class and all materials shall meet or exceed the normal industry standards applicable in each case.
- B. All work is to be performed in strict compliance with the 2015 Washington State Energy Code, Residential Provisions, and all applicable provisions of prevailing local, state, and federal codes and ordinances, including appropriate licensing laws including any local amendments.
- C. Notify and consult with Designer if discrepancies are found between drawings and site conditions and/or building or zoning requirements prior to start of work. Any consequences resulting from these discrepancies will be the Contractors sole responsibility and expense if Designer is not consulted before area in question is constructed.
- D. Contractor shall verify field conditions prior to start of work. If measurements or conditions differ from drawings, notify Owner prior to start of work. Bring any conflicts to the attention of the Designer whereupon a final decision will be made.
- E. Dimensional strings are generated by a computer drafting program that usually rounds the dimension to the nearest 1/8 of an inch. Therefore, it would be possible that a string of multiple dimensions and an overall dimensions of the same string could vary by 1/8 of an inch. Please notify the Designer whether a verification of a dimension is needed or dimensions to 1/16" are required.
- F. Do not scale drawing. During the reprographic process, proportions may have been altered. Use written dimensions. Where conflicts exist, notify the Designer immediately.
- G. Contractor to maintain in force at all times, insurance as required by Article II of the General Conditions of the Contract for Construction, AIA Document A201. Certificates evidencing said insurance shall be provided to the Owner, prior to commencement of any work.
- H. Contractor is solely responsible for all construction means and methods and shall maintain the structural integrity of any construction until all final lateral and vertical load carrying systems are completed - approvals from the Designer do not extend to approval of construction means and methods
- I. Drawings are for a complete installation with full-functional assemblies - contractor is to field verify all dimensions and conditions prior to any work and shall be responsible for all work and materials including those finished by subcontractors.

GENERAL REQUIREMENTS

- A. Provide all required temporary facilities and all temporary utilities as required to keep facility in operation during construction. Contractor is responsible for all costs associated with temporary facilities and temporary utilities
- B. Construction Barricades: Provide construction barricade as required to keep Public and Employees safe, following all applicable federal, state and city cods and regulations.

DRAWINGS / PERMITS BY OTHERS

It is the contractor's responsibility to provide additional drawings and permits as required to complete this project. The following list is by no means meant to be comprehensive, rather suggestive of the possible types of additional permits, drawings, and submittals that may be required during the course of the project. Depending on the project, some of the following permits, drawing, and submittals could come up including others not listed below:

- Provide information to City regarding disposal of excess soil. (if any)
- Provide Design / obtain Permit for any required Shoring Work. (if any)
- Provide Drawings / obtain Permit for Plumbing Work
- Provide Drawings / obtain Permit for Electrical Work
- Obtain Permit for Storm Sewer Design & Hook-Up
- Obtain Street Use Permits for any Street Work. (if any)
- Apply & pay for required Water Meters.

Any deferred submittal shall be submitted to the Building Department for review and approval. (if any)

SOILS AND SITE WORK PER 401.4 (site-specific geotechnical reports shall govern)

- A. Excavation cuts are to be no steeper than 1:1, horizontal to vertical.
- B. Fill to be free of debris, organic contaminants and rock fragments larger than 6 inches. Use free-draining sand or sand and gravel conditioned to appropriate moisture content for adequate compaction. Fill shall contain no more than 5% fines relative to the fraction passing the 3/4" sieve. For house, slab or pavement areas, compaction of fill to be at least 95% of the maximum dry density (MDD) per ASTM D-1557 testing procedures. Utility trench backfill in settlement-sensitive areas to be compacted at least 90% of the MDD, except for the top 2 feet which should be compacted to 95% of the MDD.
- C. Structural fill to be placed in loose layers of not more than 8" layers for heavy equipment, or 4" for lightweight compaction equipment. Fill should be conditioned to the proper moisture content for compaction. Compact each lift before placing subsequent layers
- D. For footings supported on structural fill, the zone of structural fill should extend laterally out from the footing edges a distance at least equal to the thickness of the structural fill. Structural fill placed beneath footing should be compacted to at least 95% of the MDD in accordance with ASTM D-1557.
- E. All exterior and interior footings to be at least 18" and 12" respectively below the lowest finished adjacent grade.
- F. Crawl space per R408.

FRAMING (Site-specific structural engineering shall govern)

- A. All materials and workmanship shall conform to the requirements of the drawings, notes, specifications, and all applicable codes and ordinances.
- B. All frame construction shall conform to minimum standards of IBC/IRC. Fastening requirements to be in accordance with IBC. See Structural Drawings Structural Notes, and specifications for any other notes that may relate specifically to grades and sizing of all framing member.
- C. Columns and posts located on concrete or masonry floors or decks exposed to the weather or to water splash or in basements and which support permanent structures shall be supported by concrete piers or metal pedestals projecting above floors unless approved

- wood of natural resistance to decay or treated wood is used. The pedestals shall project at least 6 inches above exposed earth and at least 1 inch above such floors.
- Per IBC penetrations, soffits, drop & cove ceilings
 - Wood/Earth separation per R317
- D. Maintain all integrity of required 1 hour separations between different Occupancy Types. See Drawings and details for Required One and Two Hour Party Walls between units.
 - Garage/Dwelling per R302.5 & 302.6
- E. Where installation includes manufactured products, comply with the manufacturer's applicable instructions and recommendations for installation. Verify rough-in dimensions for equipment and provide buck-outs, backing and jacks as required.
- F. All Guardrails per R312 to be 36" high minimum from finished floor line. Openings in railing assemblies are not to exceed 4" in one direction. Guardrails and handrails to withstand a 200 lbf/sf concentrated load applied in any direction at any point along the top. Guardrail in-fill components (all those except the handrail), balusters and panel fillers shall be designed to withstand a horizontally applies normal load of 50 lbs on an area equal to 1 square foot. This load need not be assumed to act concurrently with any other live load requirement. Handrails to be between 1 1/2" dia. and 2" dia. with clearance of 1 1/2" between rail and wall surface. mount between 34" and 38" off stair nosing.
- G. DECKING: All wood exposed to weather, such as wood used for deck framing including decking, railings, joists, beams, and posts shall be pressure treated or of wood with natural resistance to decay.
- H. Unless noted otherwise, dimensions are to face of studs, face of foundation walls, centerline of columns, centerline of doors and windows. When exterior walls are dimensioned as 6", they include 1/2" sheathing over 2x6 studs @ 16" oc.

INSULATION AND GLAZING PER R40

- A. Service hot water pipes shall be insulated per WSEC table R403.5.1.
- B. All wall and ceiling insulation shall have a vapor retarder (such as craft paper faced insulation, a special interior paint, vapor retardant foil or other approved vapor retarders) facing to be installed on the interior side of wall/ceiling/foor.
- C. Insulation and facing material shall have a flame spread index not to exceed 25 with smoke developed not to exceed 450 per IRC R316.
- D. Int. denotes standard framing 16inches on center with headers insulated with a minomu of R-10 insulation.
- E. Section R403.1:
 - A residential energy compliance certificate complying with SEC R401.3 is required to be completed by the design professional or builder and permanently posted within 3' of the electrical panel prior to final inspection.
 - Fenestration U-factors and SHGC
 - Type and efficiency of heating/cooling/service water heating equipment.
 - Duct leakage rates and test conditions
 - Blower door air leakage results (if conducted)
- F. Section 403.2.2 Sealing
 - Ducts to be leak tested in accordance with WSU RS-33 in accordance with either of following:
 - Post construction test: Max 4 cfm/100 sq.ft conditioned floor area at pressure differential of 0.1" w.g. (25 Pa), with registers sealed
 - Rough-in test: Max 4 cfm/100 sq.ft conditioned floor area at pressure differential of 0.1" w.g. (25 Pa),@0.1" w.c.,with registers. Max 3cfm if air handler not installed.
 - R402. Building air leakage testing, verified as having air leakage rate not exceeding 5 air changes per hour. Testing to be conducted with blower door at a pressure of 0.2 inches w.g. (50 Pascals). The written test results shall be signed by tester and provided to code official. Testing shall be performed after creation of all penetrations of the building thermal envelope.
- H. Section R403.1.1:
 - Each dwelling unit is required to be provided with at least one programmable thermostat for the regulation of temperature.
 - Min. weekday/weekend 5-2 programmable schedule.
 - For primary system, min. 2 programmable setback periods/day.
 - Heating only: temperature range= 55-70 degrees F
 - Cooling only: temperature range= 78-85 degrees F
 - Combined heating/cooling: temperature range = 55-85 degrees F.
- J. Section R404 High Efficacy Luminaries.
 - 75% of permanent lighting fixtures to be high efficacy lamps
- K. Additional Energy Efficiency Requirements R406
 - Small Dwelling unit (need 1.5 points from Table R406.2): less than 1500sf conditioned floor area & less than 300 sf fenestration area
 - Medium Dwelling unit (need 3.5 points from Table R406.2)
 - Large Dwelling unit (need 4.5 points from Table R406.2): over 5000 sf conditioned floor area

MECHANICAL

- A. Provide 1/2" gypsum wall board for non-rated assemblies and 5/8" type "x" gypsum wall board for 1-hour rated assemblies with all exposed joints and fastener heads smooth and flush with surface of board. joints taped and prepared for application of finish. use water-resistant board at all wet areas to 4'-0" AFF.
- B. "Recommended Specifications for the Application and Finishing of Gypsum Board," latest edition, as published by the Gypsum Association (also published as ANSI 97.1 and "Using Gypsum Board and Ceiling," latest edition).
- C. When gypsum board is used as a base for tile or wall panels for tub, shower or water closet compartment walls, water resistant gypsum backing board shall be used per IRC section R702.4.2.
- A. HVAC and Plumbing work shall be performed in a "Bidder-Design" manner. The Contractor shall submit such systems separately for permit.
- B. It is the Contractor's responsibility to design systems that meet all requirements and codes. Contractor shall submit drawings, pay for, and obtain permit and perform work in a manner that meets or exceeds the recognized workmanship standards for the industry.
- C. All drawings are to be submitted for review and approval to the Owner before performing work.
- D. Heating is electric or gas either piping of hydronic heat or forced air via duct and furnace, to be determined. All furnaces shall be listed and labeled by an approved agency and installed per listed specifications.
- E. IC Chapter 24 covers fuel gas applications
- F. appliances intended for installation in closets, alcoves or confined spaces shall be si listed per code, IMC.
- G. appliances installed in garages or other areas where they may be subject to mechanical damage shall be suitable guarded against such damage by being installed behind protective barriers or by being elevated or located out of the normal path of vehicles.
- H. Equipment located in a garage and capable of igniting flammable vapors shall be installed with the pilots and burners or heating elements and switches at least 18 inches above the floor level.
- I. Appliances designed to be in a fixed position shall be securely fastened in place. Supports for appliances shall be designed and constructed to sustain vertical and horizontal loads within the stress limitations in the building code and IMC.
- J. Verify types, Manufacturer, and locations of all plumbing fixtures and faucets with Owner prior to purchasing and/or installing.
- K. Vent outlet for gas appliances shall be 3' minimum away from operable windows, and 10' minimum away from fresh air intakes per WSEC and IRC chapter 24

WATER CONSERVATION NOTES

- A. Showers to be equipped to limit water flow to 2.5 CFM
- B. Toilets to meet State Energy Code.

FIREPLACE NOTES (see IRC Chapter 10; Pre-fab metal per R1002, R1003, R1005)

- A. Gas fireplace shall be approved by the building official as applicable for safe use or comply with applicable nationally recognized standards as evidenced by the listing and labeling by an approved agency such as the EPA.
- B. Instruction manuals for installation, operation repair and maintenance shall be left and attached to the appliance by the installer.
- C. Direct vent outlet for fireplace shall be 3' minimum away from operable windows, and 10' minimum away from fresh air intakes per per WSEC.

VENTILATION per SRC M1507

- A. Continuously operating whole house fan is proposed.
- B. Provide outdoor air inlet with 4 sq. in. min net free area for each habitable space.

INDOOR AIR QUALITY NOTES

- A. Range exhaust & dryers: Domestic kitchen range ventilation and domestic clothes dryers shall be of metal and have smooth interior surfaces. Ducts shall be substantially airtight and shall comply with the provisions of Chapter 6 UMC. Exhaust ducts shall terminate outside the building and be equipped with back-draft dampers.
- B. Moisture exhaust ducts for clothes dryers shall terminate on the outside of the building and shall be equipped with a back-draft damper. Screens shall NOT be installed at the duct sheathing at the location of the vent.

- termination. Ducts for exhausting clothes dryers shall NOT be connected or installed with sheet metal screws or other fasteners which will obstruct the flow.
- C. Unless otherwise permitted or required by the dryer manufacturer's installation instructions and approved by the building official, dryer exhaust ducts shall not exceed a total combined horizontal and vertical length of 14 feet including two 90-degree elbows. Two feet shall be deducted for each 90-degree elbow in excess of two.
- SMOKE ALARM / DETECTORS PER IRC R314**
 - A. Smoke alarms shall be installed in the following locations:
 1. Each sleeping room
 2. Outside each separate sleeping area in the immediate vicinity of the bedrooms
 3. On each additional habitable story of the dwelling, including basements
 - B. When more than one smoke alarm is required to be installed within an individual dwelling unit the alarm devices shall be interconnected in such a manner that the actuation of one alarm will activate all of the alarms in the individual unit. The alarm shall be clearly audible in all bedroom over background noise levels with all intervening doors closed. All smoke alarms shall be listed and installed in accordance with the provisions of IRC and the household fire warning equipment provisions of NFPA 72. Primary power to come from building wiring per IRC R314 from commercial source with battery back-up.
 - C. Provide an approved carbon monoxide alarm on each level of the dwelling per R315.

FIRE-RESISTIVE REQUIREMENTS

- A. CONSTRUCTION PER R302
 - Interior & exterior bearing walls, & non-bearing walls to be type V_B construction as required
 - Floors & floor/ceilings to be type VB construction
 - Roofs & roofs/ceilings to be type VB construction
- NOTE: All garage interior walls, ceilings, structural support systems exposed therein, and voids under stairs shall be 1-hour construction per plans and details.
- B. TYPES OF CONSTRUCTION: Standards of Quality - Construction materials shall be labeled appropriately, as required by the local municipality, showing that they comply with local code standards for such materials as building paper, decking material, foam plastics, wall and roofing materials.
- C. FIRE RESISTIVE MATERIALS & SYSTEMS: Fire resistance ratings of walls, floors, roof assemblies shall meet criteria set forth in IBC or based on submitted information showing equivalent fire resistive rating.
- D. FIRE BLOCKING AND DRAFTSTOP PER R302.11, R302.12, 502.12 and R602.8
- E. PROTECTION OF STRUCTURAL MEMBERS: Thickness of protection over structural members shall be as per IBC. See wall types and sections in these drawings for specifics.
- F. COLUMN JACKETING: Where fire resistive covering on columns is exposed to injury from moving vehicles or other means, contractor shall protect area from damage and deterioration.

ELECTRICAL

- A. Electrical work shall be performed in a "Bidder-Design" manner. The contractor shall submit such systems separately for permit.
- B. It is the Contractor's responsibility to design systems that meet all requirements and codes. contractor shall submit drawings, pay for, and obtain permit and perform work in a manner that meets or exceeds the recognized workmanship standards for the industry.
- C. All drawings are to be submitted for review and approval to the Owner before performing work. Specific attention is to be paid regarding Owner-requested locations of electrical, phone and computer cabling port locations.
- D. Proper protection shall be provided around recessed light fixtures per manufacturer's recommendations so that overheating will not occur. Recessed light fixtures to be IC rated.
- E. At least 75% of permanent lighting fixtures to be high efficacy lamps - WSEC R404

STAIRS

- A. IRC R311.7, min 36" wide, max riser = 7 3/4", min tread = 10". Hand rails shall not project more than 4 1/2" into the 36" clear pathway on either side.
- B. LANDINGS: There shall be a floor of landing at the top and bottom of each stairway except a door swinging except a door swinging away from the stairs is ok for interior stairs. The width of each landing shall not be less then the width of the stairway served, min 36" in the direction of travel. Max 2% slope.
- C. HANDRAILS: 34" to 38", min 1 1/2" clear from wall, continuous from full-length of flight where risers are. Handrail ends shall be returned or terminate in newel posts or safety terminals. new posts can interrupt handrails at turns. The lowest tread may have a volute, turnout or newel. Handrails shall be of the two type listed in IRC 311.7 or provide equivalent graspability.

SECURITY per Seattle Residential Code Section R329

- A. Provide building entrance locks and observation ports at approx. 60" AFF in accordance with this section.

SOUND TRANSMISSION CONTROL per Seattle Residential Code section R330

- A. Assemblies separating dwelling units shall provide:
 - At walls: airborne sound insulation at STC 45 per, ASTM E 90.
 - At floor-ceiling airborne and impact sound insulation at an "Impact Insulation Class" (IIC) or min. 50 per ASTM E 492
- B. Fire-resistive integrity shall be maintained.

MINIMUM AREAS FOR HABITABLE ROOMS per R304:

- Common room: 120 SF; Cooking + Living or Living + Sleeping: 150 SF
- Kitchens are exempt from minimum area and dimensions.
- IRC DEFINITION OF HABITABLE SPACE: A space in a building for living, sleeping, eating or cooking. Bathrooms, toilet rooms, closets, halls, storage or utility spaces and similar areas are not considered habitable spaces.

CEILING HEIGHT per IRC R305

- A. Habitable spaces/rooms, hallways, corridors, bathroom, toilet rooms, laundry rooms and basements shall have a ceiling height not less than 7 feet measured from FINISH floor to FINISH ceiling. Beams at least 4 feet on center can project into space 6 inches.
- B. SLOPED CEILINGS: Not more than 50% of the REQUIRED floor area of a room/space is permitted to have a sloped ceiling less than 7 feet or a portion less than 5 feet. (i.e. minimum REQUIRED bedroom is 70 SF per R304.3, so at least 35 SF of a bedroom needs to have ceiling heights over 7 feet and the other 35 SF over 5 feet.

GARAGE requirements per R309

- ATTIC ACCESS per R807
- WEATHER PROTECTION per R703 & R903



4606 MARINE VIEW DR
TACOMA, WA 98422
206.234.4469
JACQUELINE@
JDESIGNS5SEATTLE.COM

SUBMITTAL	DATE
INTAKE	2/4/2019
RE-DESIGN	3/8/2019
RE-SUBMIT	6/14/2019
RE-SUBMIT	7/24/2019
RE-SUBMIT	8/6/2019
CORR 1	3/2/2020

SUN CREEK HOUSE
 3440 97TH AVE SE
 MERCER ISLAND, WA

DRAWING INFORMATION

OWNER:
MY BACKYARD, LLC

PROJECT# 1901-198

DRAWING NAME:

GENERAL NOTES

A5

GENERAL STRUCTURAL NOTES

FOUNDATION

- DESIGN IS BASED ON 2015 INTERNATIONAL RESIDENTIAL CODE
- DESIGN LOADS: SOIL 2,000 PSF ALLOWABLE BEARING PRESSURE
- CONCRETE SHALL ATTAIN THE FOLLOWING MINIMUM COMPRESSIVE STRENGTHS IN 28 DAYS, UNO: f_c = 3000 psi FOUNDATION WALLS 3000 psi FOOTINGS 2500 psi INTERIOR SLABS ON GRADE 3500 psi GARAGE 4 EXT. SLABS ON GRADE f_y = 60000 psi
- ALL CONCRETE EXPOSED TO THE WEATHER SHALL NOT HAVE LESS THAN 5% OR MORE THAN 1% AIR ENTRAINMENT.
- FOUNDATION WALL DESIGN IS BASED ON BACKFILL SOIL CLASSIFICATIONS OF SC, ML-CL, OR CL (60 pcf) SOIL.
- TYPICAL REINFORCEMENT DETAILS: LAP ALL REBAR 24" MIN. BEND BARS AND LAP AT CORNERS; PROVIDE 6" HOOK INTO SUPPORTING FOOTINGS WHEN FOOTINGS INTERSECT; PROVIDE 3" MINIMUM COVER AT THE BOTTOM BARS AND 1 1/2" COVER AT THE SIDES.
- FOUNDATION WALLS SHALL BE BRACED, PRIOR TO BACKFILLING, BY EITHER ADEQUATE TEMPORARY BRACING OR INSTALLATION OF FIRST FLOOR DECK.
- ALL FOOTINGS SHALL BEAR BELOW FROST LINE. CONSULT SOILS REPORT/ LOCAL MUNICIPALITY FOR MINIMUM DEPTH BELOW GRADE.
- FOOTINGS AND SLABS ON GRADE SHALL BEAR ON VIRGIN SOIL OR 95% COMPACTED FILL.
- PROVIDE CONTROL JOINTS AT ALL INSIDE CORNERS OF SLAB EDGES AND OTHER LOCATIONS WHERE SLAB CRACKS ARE LIKELY TO DEVELOP. (15'-0" O.C.)
- FASTEN SILL PLATES TO FOUNDATION WALLS WITH 3/8" DIA. ANCHOR BOLTS w/ MIN. 3"x3"x1/2" PLATE WASHERS (EDGE OF WASHER TO BE LOCATED WITHIN 1/8" OF EXTERIOR EDGE OF SILL PLATE) & NUTS @ 6'-0" O.C. @ 2-STORY & 4'-0" O.C. @ 3-STORY CONDITIONS w/ 1" MIN. EMBEDMENT INTO CONC. PROVIDE A MINIMUM OF 2 ANCHORS PER PLATE, 12" MAXIMUM FROM PLATE ENDS, UNO. (SEE FINI. DETAILS).
- ALL LUMBER EXPOSED TO WEATHER OR IN CONTACT w/ CONCRETE OR MASONRY FOUNDATION SHALL BE PRESERVATIVE TREATED HEM FIR #2.
- BUILDER TO VERIFY CORROSION-RESISTANCE COMPATIBILITY OF HARDWARE & FASTENERS IN CONTACT w/ PRESERVATIVE-TREATED WOOD. CONTACT LUMBER & HARDWARE SUPPLIERS TO COORDINATE.

LOADING AND DESIGN PARAMETERS

GRAVITY DESIGN LOADS:

- DEAD LOAD (PSF): ROOF TRUSS TOP CHORD 10 T ROOF TRUSS BOTTOM CHORD 10 GLASS ROOF 10 FLOOR (1-JOISTS) 10 TILE FLOORS 10
- LIVE LOAD (PSF): ROOF 20 RESIDENTIAL LIVING AREAS 40 RESIDENTIAL SLEEPING AREAS 30 RESIDENTIAL WOOD DECKS 40 GARAGE 50
- SNOW LOAD: GROUND SNOW LOAD (P_g) (PSF) 25 FLAT ROOF SNOW LOAD (P_f) (PSF) 25 SNOW EXPOSURE FACTOR (C_e) 0.9 SNOW LOAD IMPORTANCE FACTOR (I_s) 1.0 THERMAL FACTOR (C_t) 1.2

LATERAL DESIGN LOADS:

- WIND LOAD (IBC 1609): SPEED V_w (MPH) 110 WIND RISK CATEGORY 1 IMPORTANCE FACTOR (I_w) 1.0 EXPOSURE CATEGORY C INTERNAL PRESSURE COEFF. (C_{gi}) ±0.18 TOPOGRAPHIC FACTOR (K_z) 1.0
- SEISMIC LOAD (IBC 1601): SEISMIC RISK CATEGORY 1 SEISMIC IMPORTANCE FACTOR (I_s) 1.0 MAPPED SPECTRAL RESPONSE S_w 1.384 S_w 0.582 SITE CLASS C SPECTRAL RESPONSE COEFF. S_w 0.423 S_w 0.582 SEISMIC DESIGN CATEGORY: BASIC SEISMIC-FORCE-RESISTING SYS: LIGHT FRAMED WALLS w/WOOD STRUCTURAL PANELS ULTIMATE BASE SHEAR TRANS: 16k LONG: 16k SEISMIC RESPONSE COEFF. (C_d) TRANS: 0.142 LONG: 0.142 RESPONSE MODIFICATION FACTOR (R) TRANS: 6.5 LONG: 6.5 ANALYSIS PROCEDURE USED: EQUIVALENT LATERAL FORCE

LATERAL BRACING NOTES

THIS HOME HAS BEEN ENGINEERED TO RESIST LATERAL FORCES RESULTING FROM: 110 MPH WIND SPEED, EXP. C (ASCE 7-10 WIND MAP, PER IRC R301.2.1.1) RISK CAT. 2 & SEISMIC CAT. D2.

110 MPH WIND IN 2015 IRC MAP ENGINEERED DESIGN WAS COMPLETED PER 2015 IBC (SECTION 1609) & ASCE 7-10, AS PERMITTED BY R301.2 OF THE 2015 IRC. ACCORDINGLY, THIS MODEL, AS DOCUMENTED AND DETAILED HEREWITHIN, IS ADEQUATE TO RESIST THE CODE REQUIRED LATERAL FORCES, AND DOES NOT NEED TO CONFORM TO THE PRESCRIPTIVE PROVISIONS OF R602.10.

STANDARD EXTERIOR WALL SHEATHING SPECIFICATIONS

- 3/16" OSB OR 1/2" PLYWOOD:
- 3" o.c. EDGE NAILING (WHERE NOTED ON PLANS)
- 3/16" OSB OR 1/2" PLYWOOD: ONLY AT LOCATIONS INDICATED ON PLANS - SHEATH WALL SHOWN WITH 3/8" OSB. FASTEN SHEATHING w/ 2 1/2"x0.131" NAILS @ 3" O.C. AT EDGES AND 12" O.C. AT CENTER. ALL SHEATHING SHEET PANEL EDGES SHALL OCCUR OVER WALL FRAMING MEMBERS OR 2x HORIZONTAL BLOCKING SHALL BE PROVIDED TO SUPPORT PANEL EDGE. ALL EXTERIOR WALLS SHALL BE PROVIDED TO SUPPORT PANEL EDGE AND 3" O.C. FASTENING.

NOTES:

- LATERAL ANALYSIS ASSUMES STUD SPACING @ 16" o.c.
- ALL SHEAR WALLS SHALL HAVE DEL. TOP PLATES FASTENED TOGETHER w/ 3"x0.131" NAILS @ 8" o.c. USE (12x35"x0.131" NAILS AT EA. LAP SPLICE, (6) EA. SIDE OF JOINT (TYP. UNO)
- ALL EXTERIOR WALLS ARE CONTINUOUSLY SHEATHED.
- ALL INTERIOR SHEAR WALLS AND EXTERIOR WALLS ARE SHEATHED ABOVE AND BELOW OPENINGS.
- WHERE OSB/PLYWOOD SHEATHING IS APPLIED TO BOTH FACES OF A SHEAR WALL, PANEL JOINTS SHALL BE OFFSET TO FALL ON DIFFERENT FRAMING MEMBERS.

GENERAL STRUCTURAL NOTES

DESIGN PARAMETERS

- DESIGN IS BASED ON 2015 INTERNATIONAL RESIDENTIAL CODE
- WOOD FRAME ENGINEERING IS BASED ON NDS "NATIONAL DESIGN SPECIFICATION FOR WOOD CONSTRUCTION" - LATEST EDITION.

GENERAL FRAMING

- EXTERIOR BEARING WALLS SHALL BE 2x4 OR 2x6 (AS SHOWN ON PLANS) @ 16" O.C. (w/ DOUBLE TOP PLATE) HEM FIR (HF) #2 STUD GRADE LUMBER, OR BETTER, UNO.
- INTERIOR BEARING WALLS SHALL BE 2x4 OR 2x6 (AS SHOWN ON PLANS) @ 16" O.C. (w/ DOUBLE TOP PLATE) HEM FIR (HF) #2 STUD GRADE LUMBER, OR BETTER, UNO.
- ALL NON-BEARING INTERIOR STUD WALLS SHALL BE CONSTRUCTED WITH 2x STUD GRADE MEMBERS SPACED @ 24" O.C. (MAX.)
- ALL WALLS TALLER THAN TYP. PLATE HEIGHT SHALL BE CONSIDERED BALLJOON FRAMED & SHALL BE CONSTRUCTED FROM FLOOR TO UNDERSIDE OF FRAMING AT NEXT LEVEL. B.F. WALLS SHALL BE 2x4 OR 2x6 (AS SHOWN ON PLANS) HEM FIR (HF) #2 GRADE LUMBER, OR BETTER.
- ALL HEADERS SHALL BE SUPPORTED BY (1)2x JACK STUD @ (1)2x KING STUD, MINIMUM. THE NUMBER OF STUDS SPECIFIED AT A SUPPORT INDICATES THE NUMBER OF JACK STUDS REQUIRED, UNO.
- ALL 2x6 AND LARGER SOLID SAWN BEAMS/HEADERS SHALL BE HEM FIR #2 (HF #2) OR BETTER. ALL 4x6 AND LARGER SOLID SAWN LUMBER SHALL BE DOUG FIR #2 (DF #2) OR BETTER.
- ALL FRAMING LUMBER SHALL BE KILN DRIED TO 15% MC (KD-15).
- ALL TYP. NAIL FASTENER REQUIREMENTS ARE NOTED IN GENERAL NOTES, IN DETAILS, OR ON PLANS. ALL WALLS SPECIFIED ARE MIN. DIAMETER AND LENGTH REQUIRED FOR CONNECTION. ALL HANGER NAILS SHALL BE INSTALLED PER MANUFACTURER'S REQUIREMENTS FOR MAX. GRANTED CAPACITY. NOTE, HANGERS USE COMMON NAIL DIAMETERS NOT TRICAL. FRAMING SAWN LUMBER.
- FASTEN ALL BEAMS TO COLUMNS w/ (4) 3"x0.131" TOENAILS (MIN.) TYP. UNO.
- PROVIDE SOLID BLOCKING IN FLOOR SYSTEM UNDER ALL POSTS & HOLD-DOWNS CONTINUOUS TO FOUNDATION/BEARING. BLOCKING TO MATCH POST ABOVE.
- ENGINEERED LUMBER TO MEET OR EXCEED THE FOLLOWING:
 - LSL MEMBERS - Fb=2325 Psl; Fv=310 Psl; E=1.55x10⁶ Psl
 - LVL MEMBERS - Fb=2600 Psl; Fv=285 Psl; E=1.2x10⁶ Psl
 - GLB MEMBERS - Fb=2400 Psl; Fv=265 Psl; E=1.0x10⁶ Psl; DF/DF
- ENGINEERED LUMBER POSTS TO MEET OR EXCEED THE FOLLOWING:
 - LVL MEMBERS - Fb=2400 Psl; Fv=1100 Psl; E=1.0x10⁶ Psl
- FACE NAIL MULTI-PLY 2x BEAMS & HEADERS w/ 3-ROWS OF 3"x0.131" NAILS (MIN) @ 12" O.C. STAGGERED. APPLY NAILING FROM BOTH FACES @ 3-PLY OR MORE CONDITIONS. UTILIZE 2 ROWS OF NAILS FOR 2x6 & 2x8 MEMBERS.
- ALL MEMBERS SPECIFIED AS MULTI-PLY 1/8" SHALL BE FASTENED TOGETHER PER MANUFACTURER. EQUIVALENT WIDTH SOLID MATERIAL MAY BE USED AS EQUAL.
- FASTEN 2x WOOD PLATES TO TOP FLANGE OF STEEL BEAMS w/ P.A.F.s (HILT) X-U PING OR EQUAL) @ 16" O.C. STAGGERED, OR 1/2" DIA. BOLTS @ 48" O.C. STAGGERED.
- REFER TO IRC FASTENING SCHEDULE TABLE R602.3(1) FOR ALL CONNECTIONS, TYP. UNO.

HOLD-DOWN SCHEDULE

SYMBOL	SPECIFICATION
▶ HD-1	SIMPSON 5THD14 (RJ) HOLD-DOWN
▶ HD-5	SIMPSON CS16 STRAP TIE (14" END LENGTH)
▶ HD-6	SIMPSON MSTC40 STRAP TIE (CENTER STRAP ON FLOOR SYSTEM UNO.)
▶ HD-T	SIMPSON MSTC66 STRAP TIE (CENTER STRAP ON FLOOR SYSTEM UNO.)

SLAB ON GRADE
4" CONG. SLAB ON 6 MIL VAPOR BARRIER ON 4" MIN. GRANULAR FILL ON 95% COMPACTED FILL/VIRGIN SOIL

GARAGE SLAB
4" CONG. SLAB ON 4" MIN. GRANULAR FILL ON 95% COMPACTED FILL/VIRGIN SOIL

PORCH SLAB
4" CONG. SLAB ON GRADE ON 6 MIL VAPOR BARRIER ON 4" MIN. GRANULAR FILL ON 95% COMPACTED FILL/VIRGIN SOIL

MEANS & METHODS NOTES

THE STRUCTURE IS DESIGNED TO BE SELF SUPPORTING AND STABLE AFTER THE BUILDING IS FINISHED AND ALL PLAN, DETAIL, AND NOTE SPECIFICATIONS HAVE BEEN COMPLETED. IT IS THE CONTRACTOR'S SOLE RESPONSIBILITY TO DETERMINE THE FRECTION PROCEDURES AND SEQUENCE TO INSURE THE SAFETY OF THE BUILDING AND ITS COMPONENTS DURING CONSTRUCTION. THIS INCLUDES, BUT IS NOT LIMITED TO, THE ADDITION OF NECESSARY SHORING, SHEETING, TEMPORARY BRACING, GUTTS, AND TIE-DOWNS. CONTRACTOR SHALL BE RESPONSIBLE FOR ALL SHORING AND BRACING REQUIRED TO STABILIZE AND PROTECT EXISTING AND ADJACENT STRUCTURES AND SYSTEMS DURING COURSE OF DEMOLITION AND CONSTRUCTION OF THE PROJECT.

STRUCTURAL DESIGN AND SPECIFICATIONS ASSUME THAT ALL SUPPORTING AND NON-SUPPORTING ELEMENTS IN CONTACT WITH FLOOR FRAMING ARE LEVEL, INCLUDING, BUT NOT LIMITED TO: FOUNDATIONS, SLABS ON GRADE, BEAMS, WALLS, AND NON-BEARING ELEMENTS. IT IS THE CONTRACTOR'S RESPONSIBILITY TO VERIFY LEVELNESS AND MAKE ADJUSTMENTS AS NECESSARY, INCLUDING CONSIDERATION OF THOSE AREAS THAT MAY BE WITHIN CONTRACTUAL, INDUSTRY, OR WARRANTY TOLERANCES.

ADDITIONAL NOTES FOR TRUSS & I-JOIST MANUFACTURER

ROOF TRUSS, FLOOR TRUSS AND ENGINEERED JOISTS SHALL BE DESIGNED TO MEET THE DIFFERENTIAL DEFLECTION CRITERIA BELOW, UNLESS NOTED OTHERWISE ON PLAN. MULHERN & KULP CANNOT BE HELD RESPONSIBLE FOR ANY STRUCTURAL ISSUES RELATED TO ANY BUILDING COMPONENT IF COMPONENT SHOP DRAWINGS ARE NOT SUBMITTED TO MKP FOR REVIEW PRIOR TO FABRICATION, DELIVERY, OR INSTALLATION.

TRUSSES SHALL BE DESIGNED SO THAT DIFFERENTIAL DEFLECTION BETWEEN ADJACENT PARALLEL TRUSSES OR GIRDER TRUSSES DOES NOT EXCEED THE FOLLOWING:

- ROOF TRUSSES:
 - 1/4" DEAD LOAD
 - FLOOR TRUSSES, ATTIC TRUSSES, & I-JOISTS.
 - 1/8" DEAD LOAD
- FLOOR TRUSSES & ATTIC TRUSSES ADJACENT TO FLOOR FRAMING BY OTHERS:
 - LIMIT ABSOLUTE TRUSS DEFLECTION TO 3/16" DEAD LOAD. (NOT DIFFERENTIAL DEFLECTION)

LEGEND

- INTERIOR BEARING WALL
- BEARING WALL ABOVE (B.W.A.) OR SHEAR WALL ABOVE (S.W.A)
- BEAM / HEADER
- INTERIOR SHEAR WALL PANEL OR EXTERIOR SHEAR WALL w/ 3" o.c. EDGE NAILING
- AREA OF FLOOR SYSTEM DESIGNED FOR TILE
- JL METAL HANGER
- * INDICATES POST ABOVE. PROVIDE SOLID BLOCKING UNDER POST OR JAMB ABOVE.
- ▶ INDICATES HOLD-DOWN.



FLOOR FRAMING

- 1-JOISTS/TRUSSES SHALL BE DESIGNED BY MANUF. TO MEET OR EXCEED L/480 LIVE LOAD DEFLECTION CRITERIA AND SHALL RUN CONTINUOUS OVER SUPPORTS WHEREVER POSSIBLE. ALL LOADS SHOWN ON PLAN FOR MANUF. DESIGNS ARE ASD LEVEL LOADS, UNO. EXCLUDES STONE/HARDBL OR NET BED CONSTRUCTED FLOORS - CONTACT MKP FOR EXCLUDED DESIGNS.
- ALL METAL I-JOIST/TRUSS HANGERS SHALL BE SPECIFIED BY I-JOIST/TRUSS MANUFACTURER, UNLESS OTHERWISE NOTED.
- I-JOIST/TRUSS SHOP DRAWINGS SHALL BE SUBMITTED TO ARCHITECT AND ENGINEER FOR REVIEW AND APPROVAL PRIOR TO FABRICATION OR DELIVERY.
- 2x FLOOR JOISTS HAVE BEEN DESIGNERED TO MEET OR EXCEED L/360 LIVE LOAD DEFLECTION CRITERIA.
- TYPICAL 2x JOIST HANGERS (UNO. ON PLANS): SINGLE PLY: SIMPSON LUS20 DOUBLES: SIMPSON LUS20-2
- FLOOR SHEATHING SHALL BE 23/32" A.P.A. RATED 5/16"-1-FLOOR 24" O.C. EXPOSURE 1 (OR APPROVED EQUAL) WITH TONGUE AND GROOVE EDGES. FASTEN TO FRAMING MEMBERS w/ GLUE AND 2 1/2" x 0.131" NAILS @ 6" o.c. @ PANEL EDGES & @ 12" o.c. FIELD.
- ALL FLUSH CONNECTIONS SHALL BE CONNECTED WITH HANGER APPROPRIATE FOR MEMBER SIZE, UNO.
- FASTEN HANGERS TO SINGLE PLY FLUSH BEAMS w/ 1/2" LONG NAILS.

ROOF FRAMING

- FASTEN EACH ROOF TRUSS TO TOP PLATE w/ (3) 3"x0.131" TOENAILS (MIN) & (1) SIMPSON SDN15600 SCREW @ ALL BEARING POINTS. PROVIDE (2) SIMPSON SDN15600 SCREWS AT 2-PLY GIRDER TRUSSES, (3) SIMPSON SDN15600 SCREWS AT 3-PLY GIRDER TRUSSES AT ALL BEARING POINTS.
- FASTEN EACH ROOF RAFTER TO TOP PLATE WITH (1) SIMPSON SDN15600 SCREW. PROVIDE (2) SIMPSON SDN15600 SCREWS AT FLUSH BEAMS IN THE ROOF - AT ALL BEARING POINTS.
- ROOF SHEATHING SHALL BE 1/8" A.P.A. RATED SHEATHING 24/16 EXPOSURE 1 (OR APPROVED EQUAL). FASTEN TO FRAMING MEMBERS w/ 2 1/2" x 0.131" NAILS @ 6" o.c. AT PANEL EDGES & @ 12" o.c. AT INTERMEDIATE SUPPORTS. ROOF SHEATHING SHALL EXTEND BELOW ALL INSTANCES OF OVERFRAMING. BLOCKING SHALL BE INSTALLED AS REQUIRED TO LIMIT ROOF SHEATHING SPANS TO 24" MAX.
- ALL METAL HANGERS SHALL BE SPECIFIED BY THE TRUSS MANUFACTURER, UNLESS OTHERWISE NOTED.
- ROOF TRUSS SHOP DRAWINGS SHALL BE SUBMITTED TO ARCHITECT AND ENGINEER FOR REVIEW AND APPROVAL PRIOR TO FABRICATION OR DELIVERY.
- ROOF TRUSS SHOP DRAWINGS & CALCULATIONS SHALL BE PREPARED BY A WASHINGTON STATE LICENSED ENGINEER AND SHALL BE DESIGNED FOR UNBALANCED SNOW LOADING PER ASCE 7-10, SECTION 7.6.
- RECT AND INSTALL ROOF TRUSSES PER ITC-A & TPI'S 6051-1-08 GUIDE TO GOOD PRACTICE FOR HANDLING, INSTALLING & BRACING OF METAL PLATE CONNECTED WOOD TRUSSES.
- FASTEN OVER-FRAMED TRUSS SETS TO TRUSSES BELOW w/ (2) 3"x0.131" TOENAILS AT EA. TRUSS.
- SUPPORT PORCH & SHORT SPAN ROOF TRUSSES (UP TO 6' TRIB.) w/2x6 LEDGER FASTENED TO FRAMING w/ (3) 3"x0.131" NAILS @ 16" o.c.
- FASTEN ALL INTERIOR NON-BEARING PARTITION WALLS TO TRUSS BOTTOM CHORD ABOVE WITH SIMPSON STC CLIPS AT 24" o.c. MAX. PROVIDE BLOCKING BETWEEN THE TRUSS BOTTOM CHORDS AS REQUIRED FOR THE PARALLEL CONDITIONS.

seal:

M&K project number: 01A-18094

project mgr: NJM

drawn by: NJD

issue date: 01-21-19

REVISIONS:

date:	initial:
03/08/2014	NJD
02/28/2020	NJD
PLAN REVIEW	

STRUCTURAL NOTES

3440 97TH AVE.

MERCER ISLAND, WASHINGTON

sheat:


copyright: MULHERN & KULP Structural Engineering, Inc.

MULHERN+KULP

RESIDENTIAL STRUCTURAL ENGINEERING

300 Brooksidge Ave. Building 4 • Amber, PA 19002

P 215-848-4001 • mulhern@mulk.com

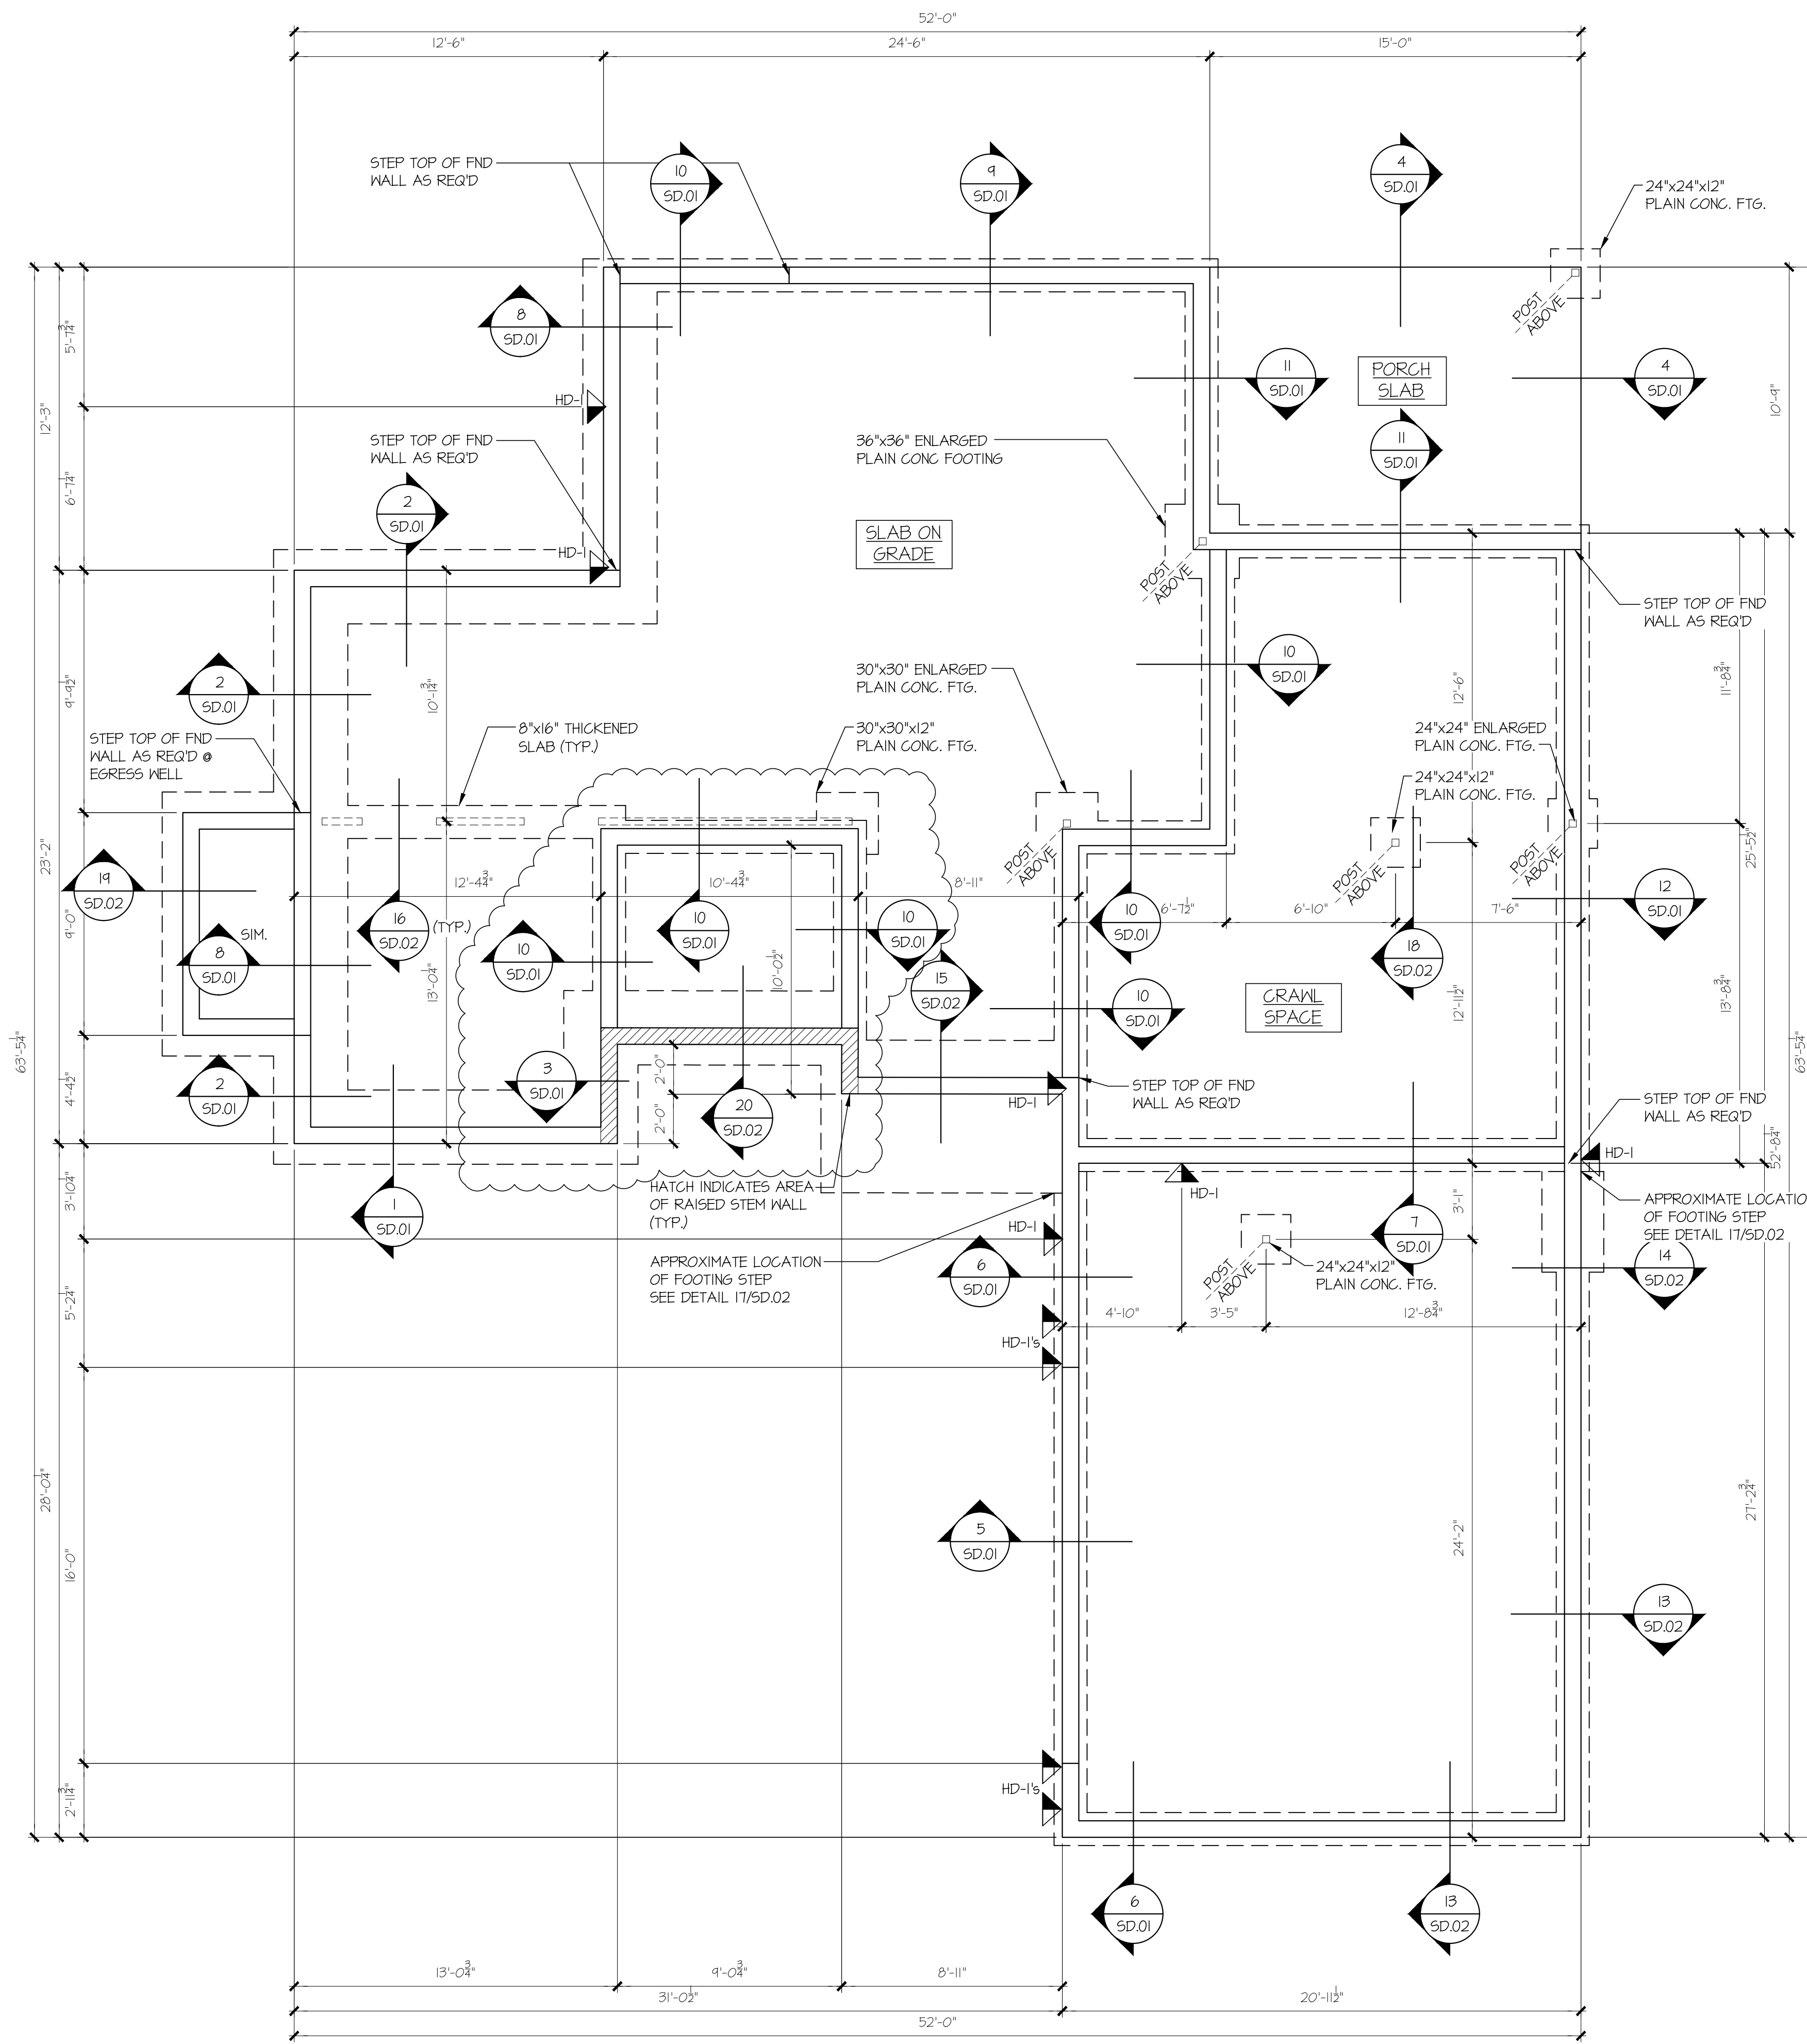

FOUNDATION PLAN
 1/4" = 1'-0"

HOLD-DOWN SCHEDULE	
SYMBOL	SPECIFICATION
▶ HD-1	SIMPSON STHD14 (R.J) HOLD-DOWN
▶ HD-5	SIMPSON CSI6 STRAP TIE (14" END LENGTH)
▶ HD-6	SIMPSON MSTC40 STRAP TIE (CENTER STRAP ON FLOOR SYSTEM U.N.O.)
▶ HD-7	SIMPSON MSTC66 STRAP TIE (CENTER STRAP ON FLOOR SYSTEM U.N.O.)

LEGEND	
•	INTERIOR BEARING WALL
◻	BEARING WALL ABOVE (B.W.A.) OR SHEARWALL ABOVE (S.W.A.)
—	BEAM / HEADER
---	INTERIOR SHEAR WALL PANEL OR EXTERIOR SHEAR WALL w/ 3" O.C. EDGE NAILING
◻	AREA OF FLOOR SYSTEM DESIGNED FOR TILE
JL	METAL HANGER
*	INDICATES POST ABOVE. PROVIDE SOLID BLOCKING UNDER POST OR JAMB ABOVE.
▶	INDICATES HOLD-DOWN

REFER TO S-O FOR TYPICAL STRUCTURAL NOTES & SCHEDULES


seal:
 copyright: MULHERN & KULP Structural Engineering, Inc.




M&K project number: 01A-18094
 project mgr: NJM
 draw by: NJD
 issue date: 01-21-19

REVISIONS:	
date:	initial:
03/08/2019	NJD
ARCH REVISIONS	
02/28/2020	NJD
PLAN REVIEW	

FOUNDATION PLAN
 3440 97TH AVE.
 MERCER ISLAND, WASHINGTON

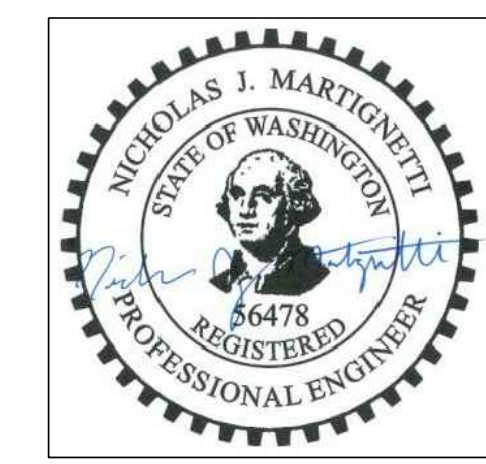

sheet:
S-1.0

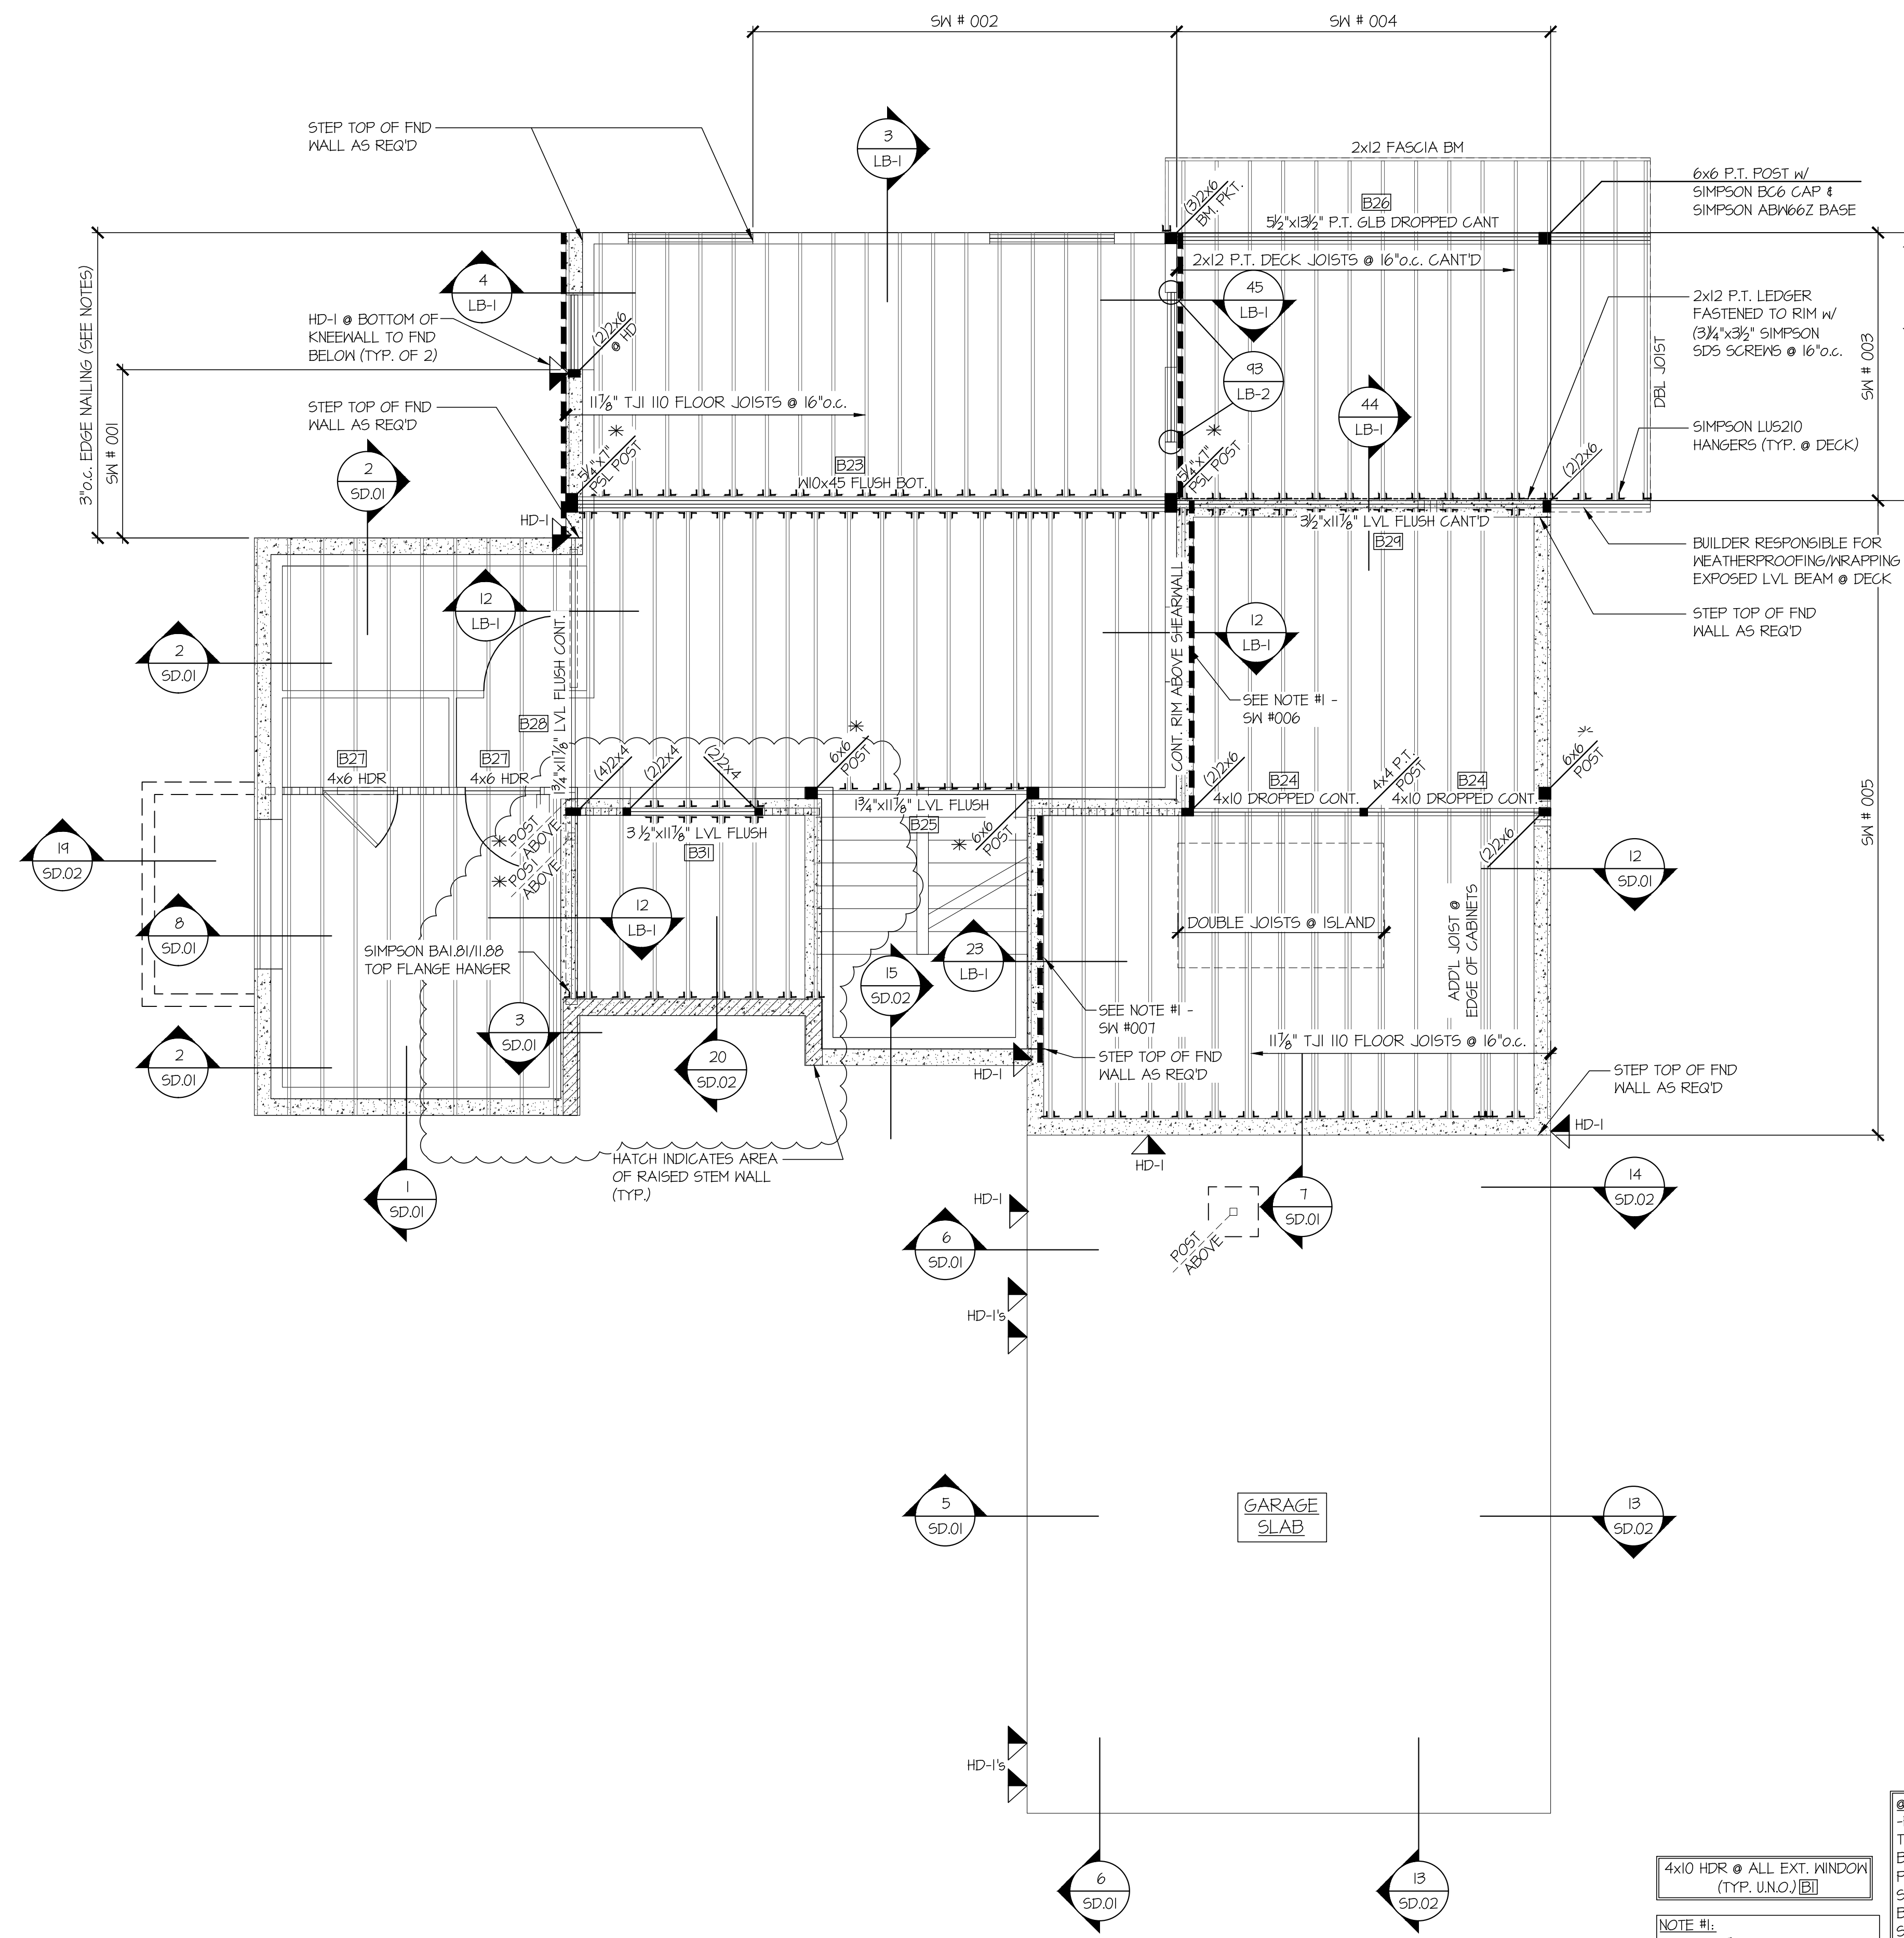

1ST FLOOR FRMG PLAN
1/4" = 1'-0"

4x10 HDR @ ALL EXT. WINDOW (TYP. UNQ.)

NOTE #11
PROVIDE 1/2" OSB/PLYWOOD SHEATHING AT KNEEWALL FASTENED PER TYP. EXT. WALL SHEATHING SPEC. DO NOT BLOCK PANEL EDGES, THIS WALL ONLY. (SEE NOTES)

FLUSH STL. BEAMS:
-FASTEN 2x WOOD PLATES TO TOP FLANGE OF STEEL BEAMS W/P.A.F.S. (HILTI) X-U PINS OR EQUAL @ 16" O.C. STAGGERED, OR 1/2" DIA. BOLTS @ 48" O.C., STAGGERED, (TYP.)
-FASTEN BOTTOM FLANGE OF STEEL BEAM TO POST @ EA. END w/ (4) 1/4" x 2 1/2" SIMPSON SDS SCREWS EA. SIDE OF BEAM.
-PROVIDE 2x PACKOUT w/ (2) 1/2" DIA. THRU BOLTS AS REQ'D FOR HANGER CONNECTION

HOLD-DOWN SCHEDULE	
SYMBOL	SPECIFICATION
▶ HD-1	SIMPSON STHD14 (R.J) HOLD-DOWN
▶ HD-5	SIMPSON CSI6 STRAP TIE (14" END LENGTH)
▶ HD-6	SIMPSON MSTC40 STRAP TIE (CENTER STRAP ON FLOOR SYSTEM U.N.Q.)
▶ HD-7	SIMPSON MSTC66 STRAP TIE (CENTER STRAP ON FLOOR SYSTEM U.N.Q.)

LEGEND	
◻	INTERIOR BEARING WALL
◻	BEARING WALL ABOVE (B.W.A.) OR SHEARWALL ABOVE (S.W.A.)
—	BEAM / HEADER
◻	INTERIOR SHEAR WALL PANEL OR EXTERIOR SHEAR WALL w/ 3" O.C. EDGE NAILING
◻	AREA OF FLOOR SYSTEM DESIGNED FOR TILE
JL	METAL HANGER
*	INDICATES POST ABOVE. PROVIDE SOLID BLOCKING UNDER POST OR JAMB ABOVE.
▶	INDICATES HOLD-DOWN


REFER TO S-O FOR TYPICAL STRUCTURAL NOTES & SCHEDULES

seal:
© copyright: MULHERN & KULP Structural Engineering, Inc.




M&K project number:	01A-18094
project mgr:	NJM
drawn by:	NJD
issue date:	01-21-19
REVISIONS:	
date:	initial:
03/08/2019	NJD
ARCH REVISIONS	NJD
02/28/2020	NJD
PLAN REVIEW	NJD

1ST FLR. FRMG. PLAN
3440 97TH AVE.
MERCER ISLAND, WASHINGTON

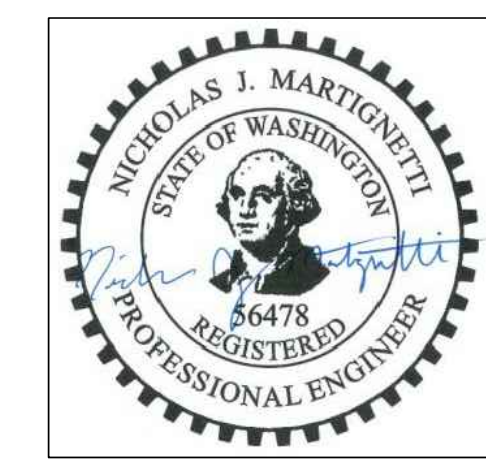

sheet:
S-2.0

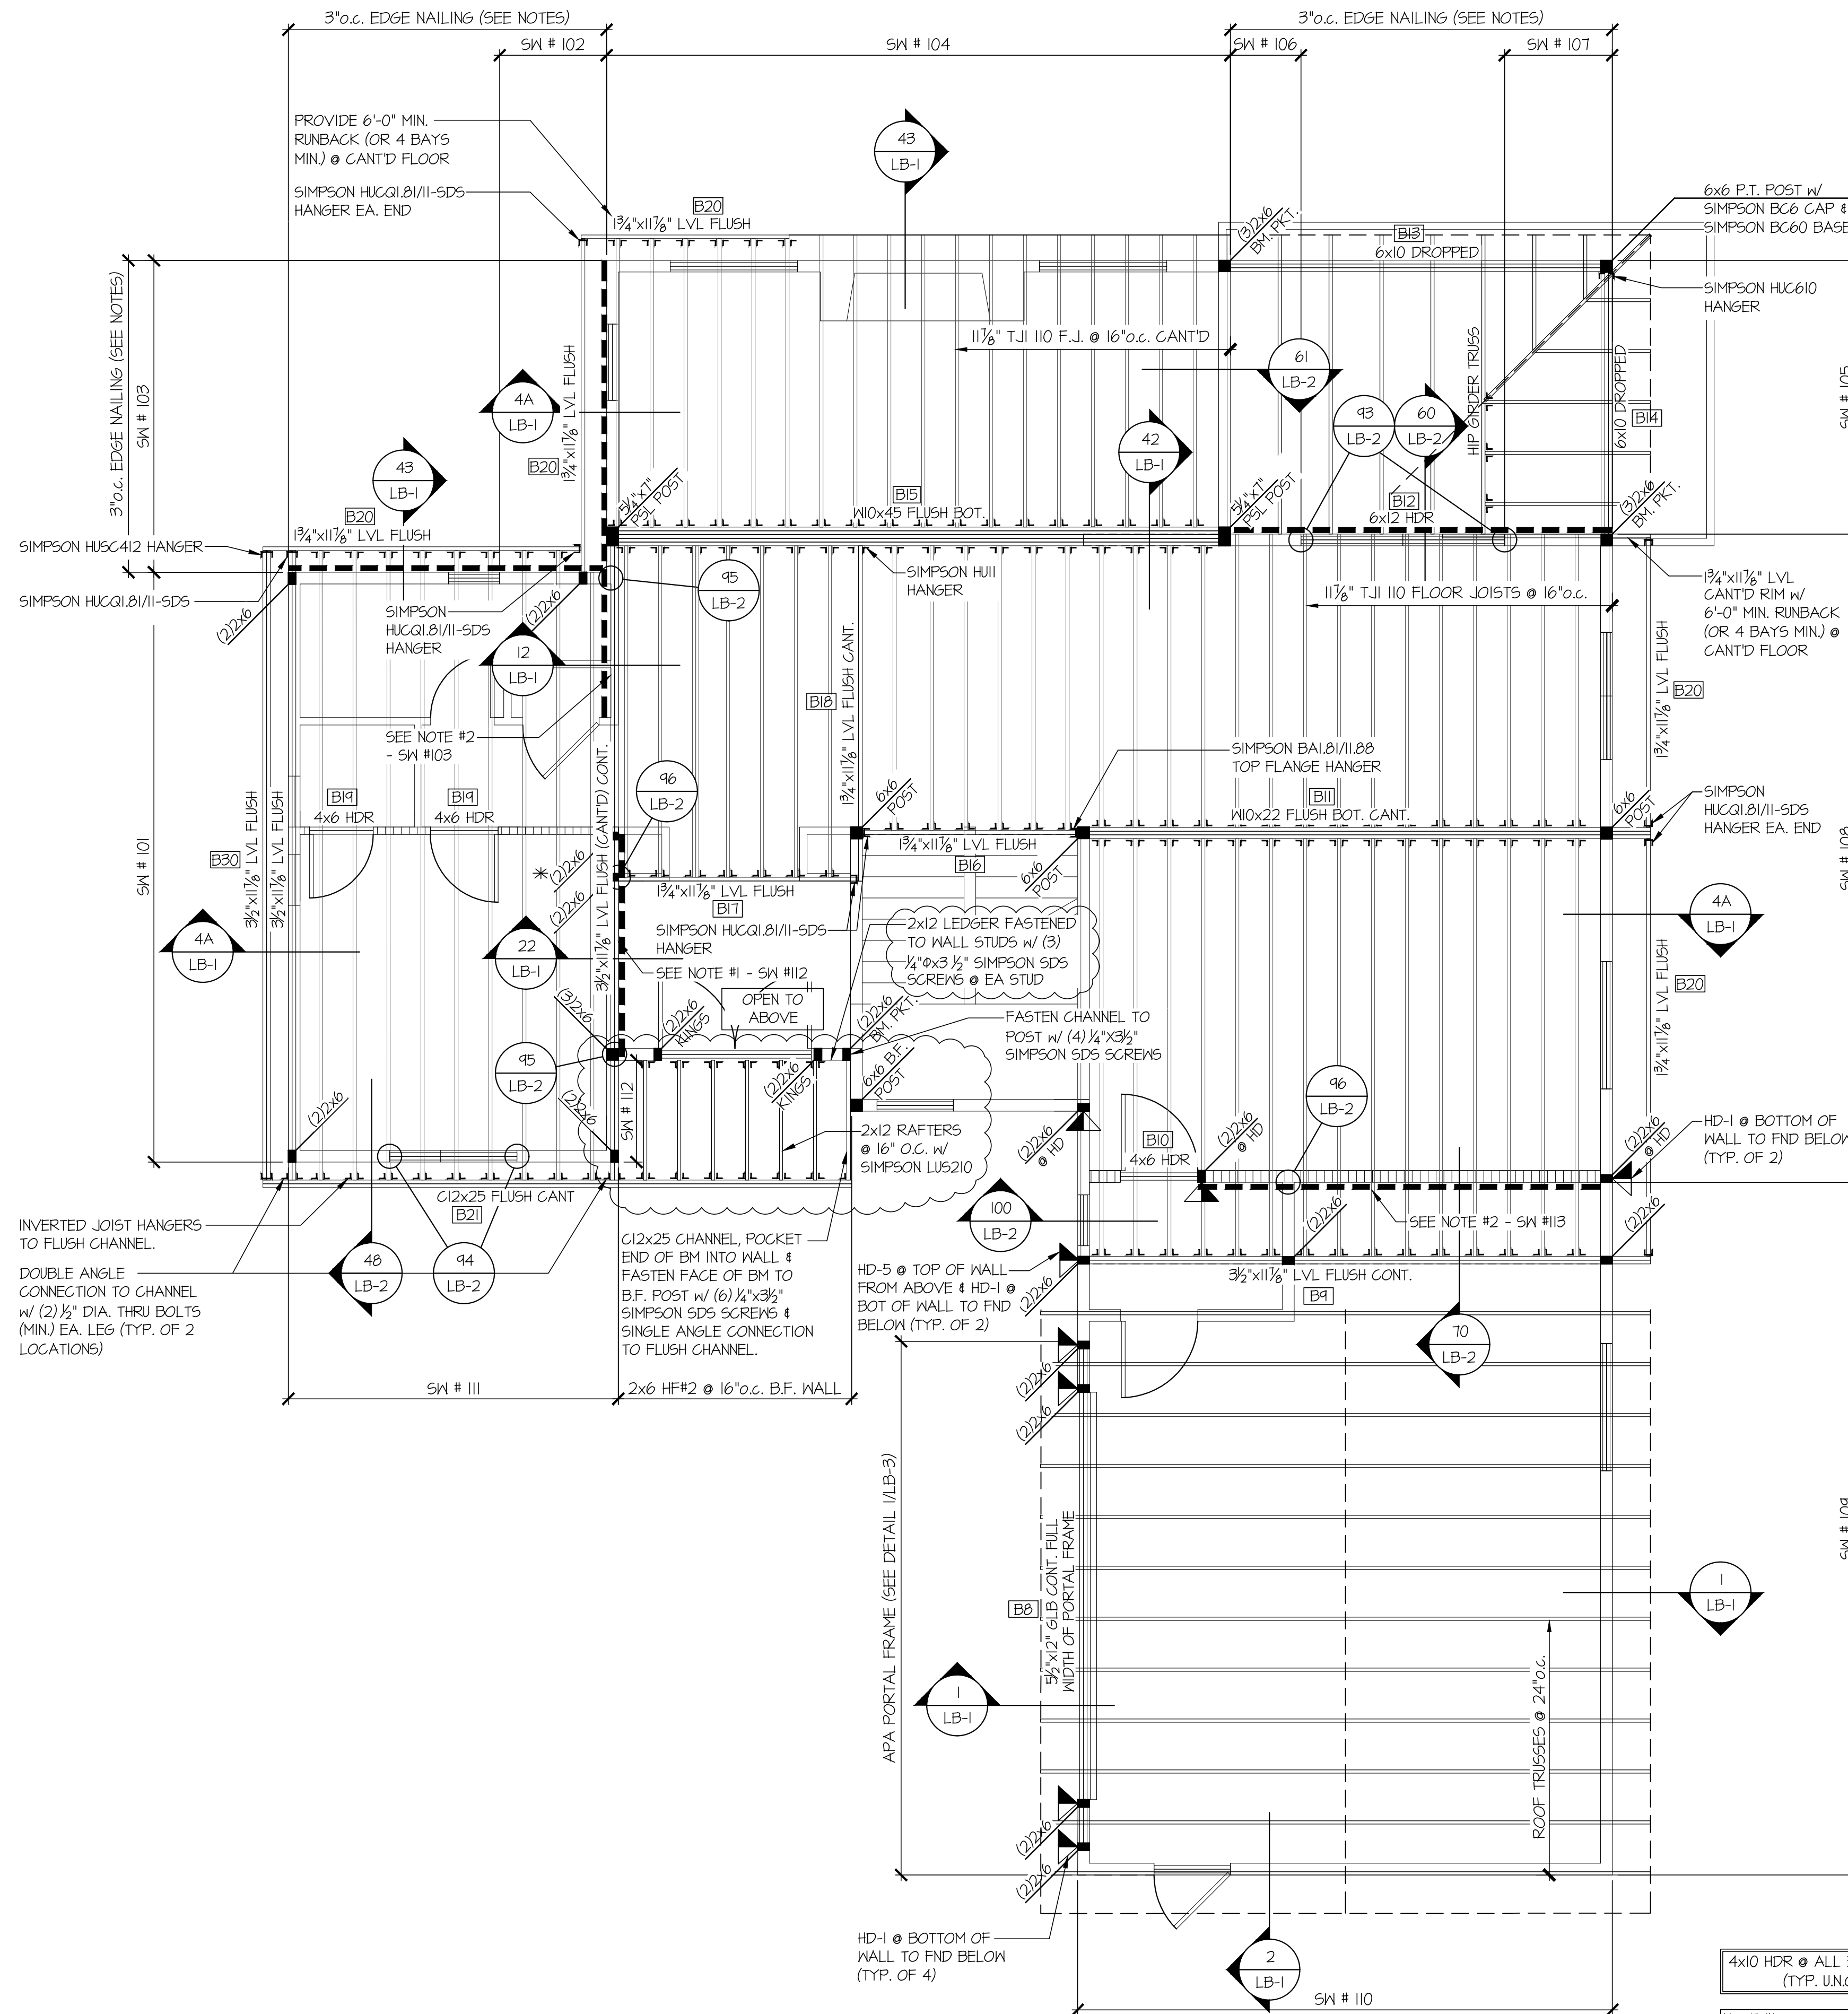

2ND FLOOR FRMG PLAN
1/4" = 1'-0"

4x10 HDR @ ALL EXT. WINDOW (TYP. UNO) [B]

NOTE #1:
PROVIDE 1/8" OSB/ PLYWOOD SHEATHING FASTENED PER TYP. EXT. WALL SHEATHING SPEC. (SEE NOTES)

NOTE #2:
PROVIDE 1/8" OSB/ PLYWOOD SHEATHING FASTENED PER 3" O.C. EXT. WALL SHEATHING SPEC. (SEE NOTES)

FLUSH STL. BEAMS:
-FASTEN 2x WOOD PLATES TO TOP FLANGE OF STEEL BEAMS W/ A.F.S (HILTI) X-U PINS OR EQUAL @ 16" O.C. STAGGERED, OR 1/2" DIA. BOLTS @ 48" O.C. STAGGERED (TYP.)
-FASTEN BOTTOM FLANGE OF STEEL BEAM TO POST @ EA. END W/ (4) 1/4" x 2 1/2" SIMPSON SDS SCREWS EA. SIDE OF BEAM.
-PROVIDE 2x PACKOUT W/ (2) 1/2" DIA. THRU BOLTS AS REQ'D FOR HANGER CONNECTION

HOLD-DOWN SCHEDULE	
SYMBOL	SPECIFICATION
▶ HD-1	SIMPSON 5THD14 (R.J) HOLD-DOWN
▶ HD-5	SIMPSON C516 STRAP TIE (14" END LENGTH)
▶ HD-6	SIMPSON M5TC40 STRAP TIE (CENTER STRAP ON FLOOR SYSTEM U.N.O.)
▶ HD-7	SIMPSON M5TC66 STRAP TIE (CENTER STRAP ON FLOOR SYSTEM U.N.O.)

LEGEND	
◻	INTERIOR BEARING WALL
◻	BEARING WALL ABOVE (B.W.A.), OR SHEARWALL ABOVE (S.W.A.)
◻	BEAM / HEADER
◻	INTERIOR SHEAR WALL PANEL OR EXTERIOR SHEAR WALL W/ 3" O.C. EDGE NAILING
◻	AREA OF FLOOR SYSTEM DESIGNED FOR TILE
JL	METAL HANGER
*	INDICATES POST ABOVE. PROVIDE SOLID BLOCKING UNDER POST OR JAMB ABOVE.
▶	INDICATES HOLD-DOWN

REFER TO S-O FOR TYPICAL STRUCTURAL NOTES & SCHEDULES

seal:
© copyright: MULHERN & KULP Structural Engineering, Inc.

MULHERN+KULP
RESIDENTIAL STRUCTURAL ENGINEERING
300 Brookside Ave. Building 4 • Amber, PA 18002
P 215-846-8001 • mulhernkulp.com


M&K project number:
01A-18094


project mgr: NJM
drawn by: NJD
issue date: 01-21-19

REVISIONS:	
date:	initial:
03/08/2019	NJD
02/28/2020	NJD
PLAN REVIEW	NJD

2ND FLR FRMG PLAN
3440 97TH AVE.
MERCER ISLAND, WASHINGTON

sheet:
S-2.1

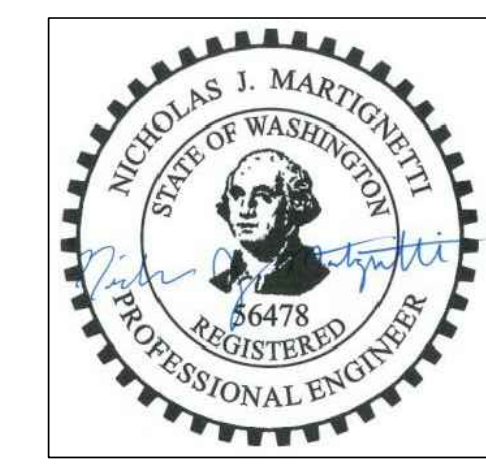

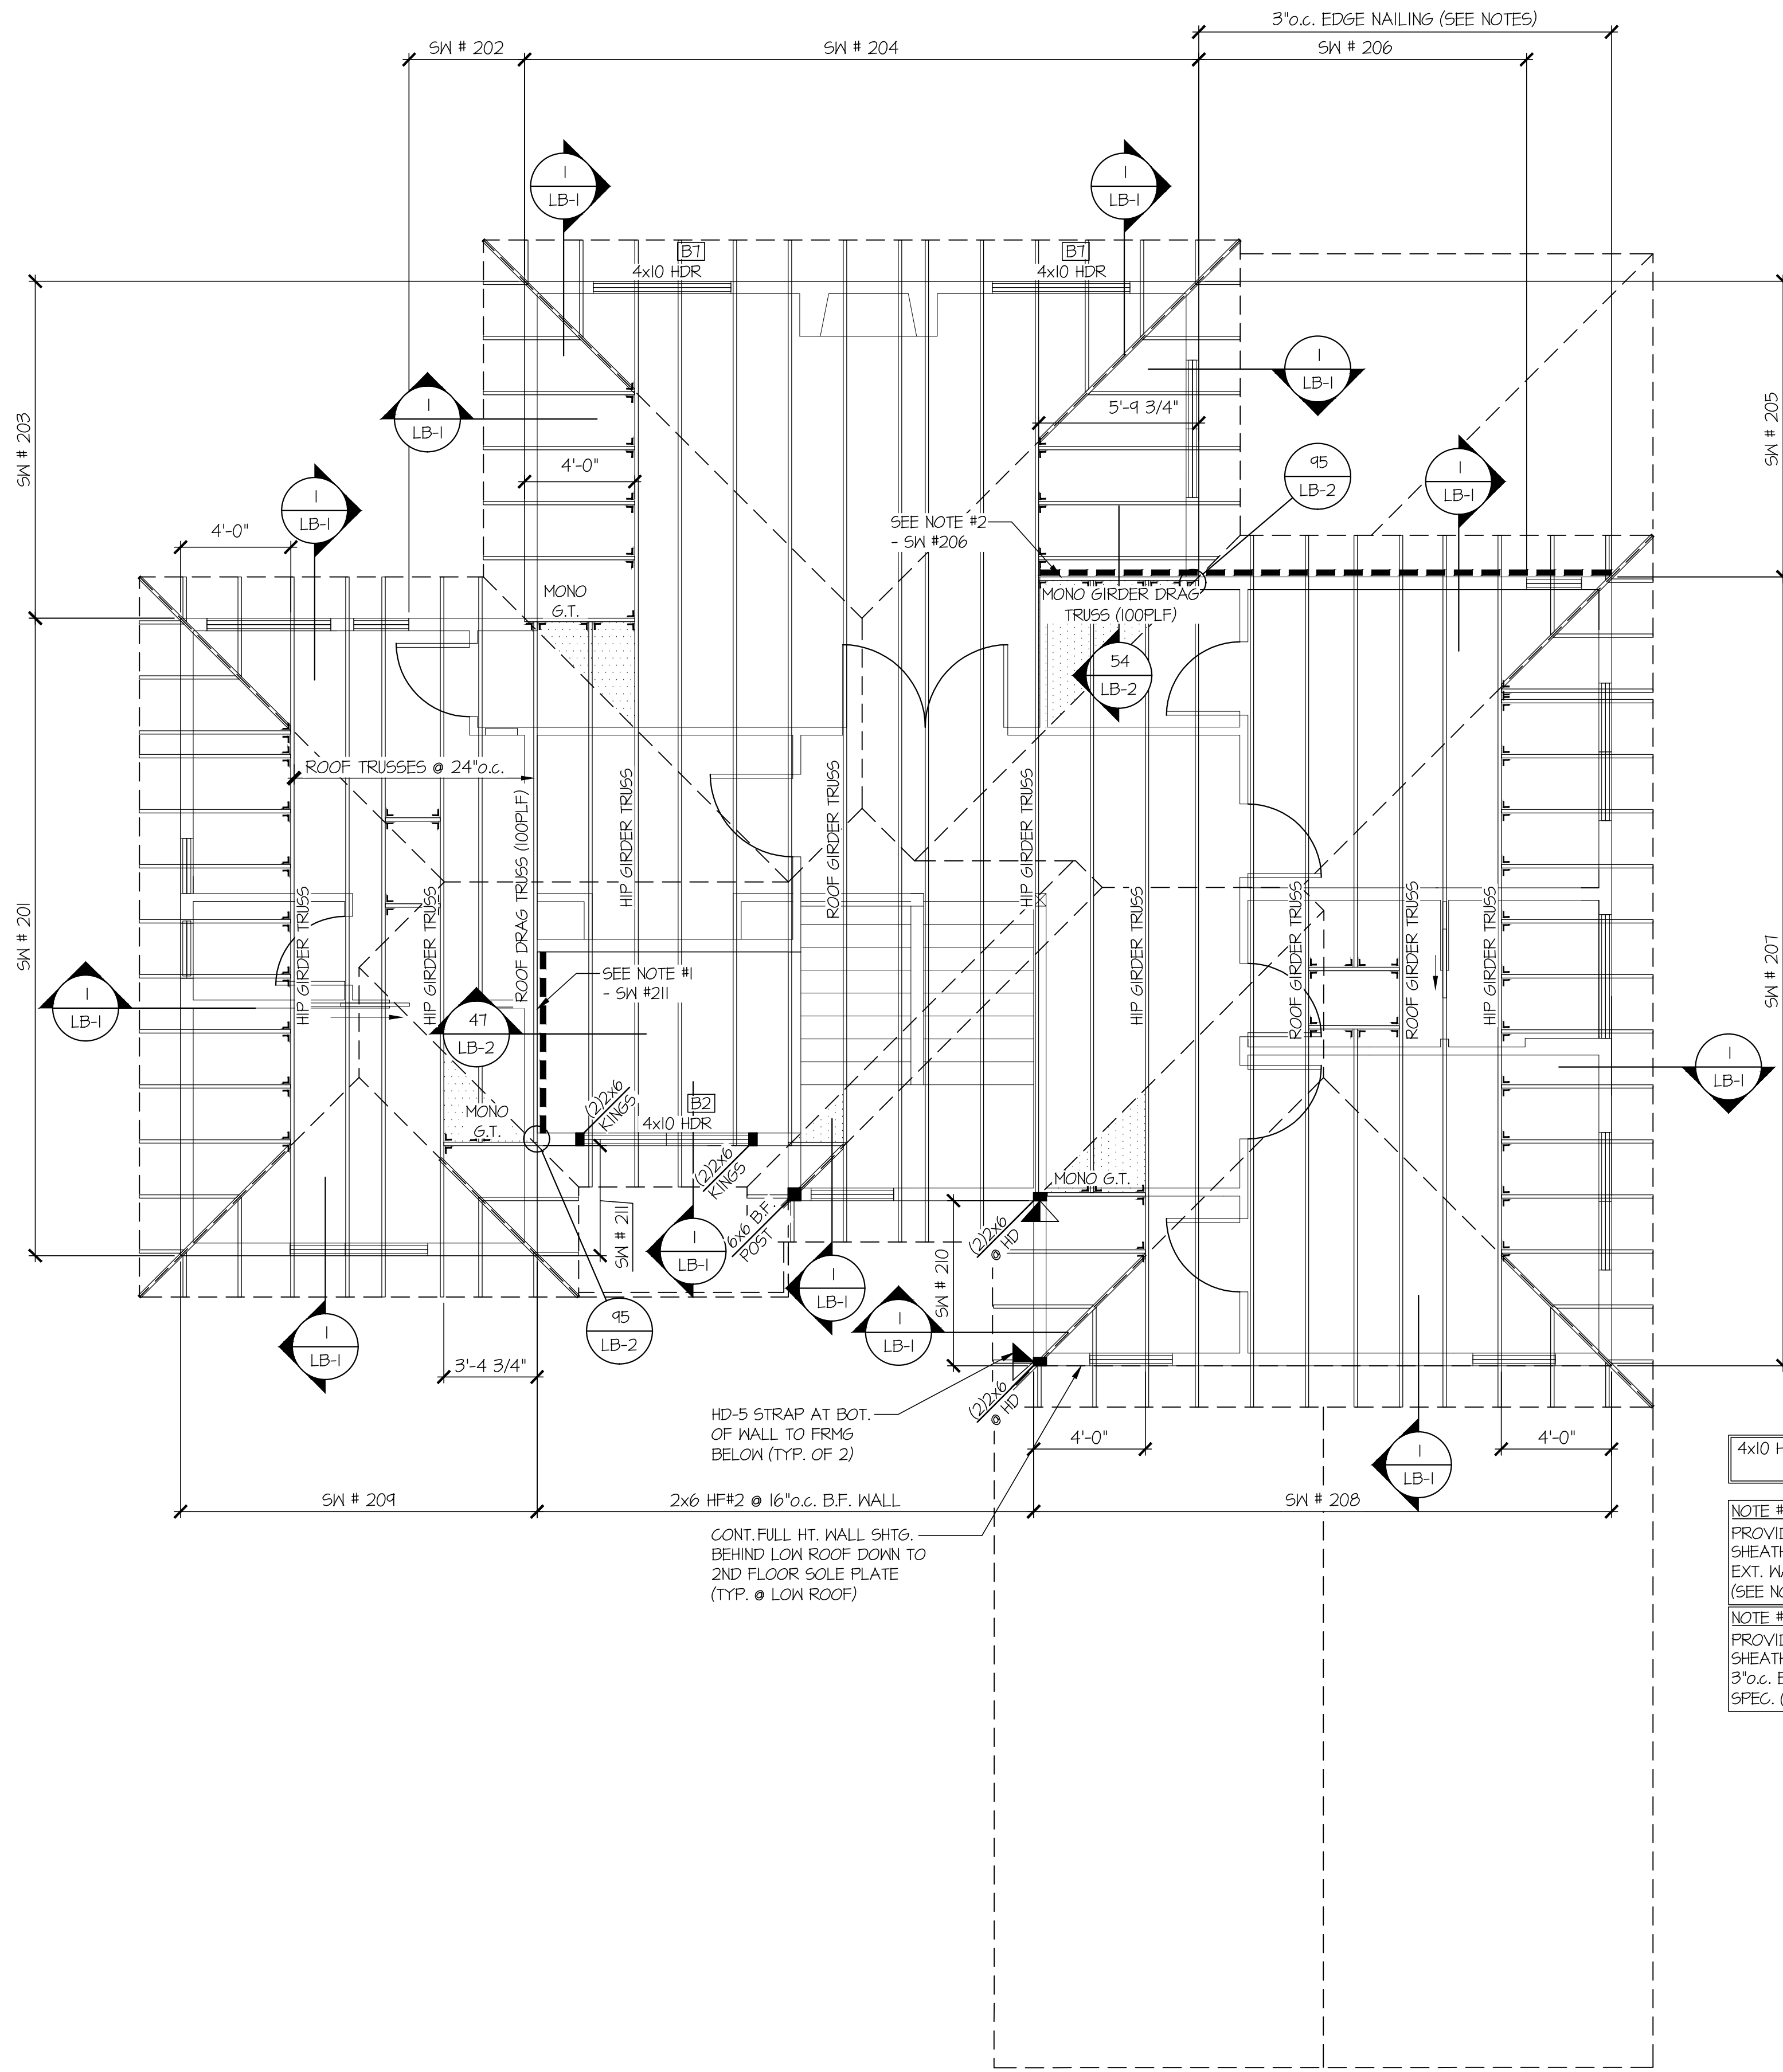

ROOF FRAMING PLAN
1/4" = 1'-0"

HOLD-DOWN SCHEDULE	
SYMBOL	SPECIFICATION
▶ HD-1	SIMPSON STHD14 (R.J) HOLD-DOWN
▶ HD-5	SIMPSON CSI6 STRAP TIE (14" END LENGTH)
▶ HD-6	SIMPSON M5TG40 STRAP TIE (CENTER STRAP ON FLOOR SYSTEM U.N.O.)
▶ HD-7	SIMPSON M5TG66 STRAP TIE (CENTER STRAP ON FLOOR SYSTEM U.N.O.)

LEGEND	
◻	INTERIOR BEARING WALL
◻	BEARING WALL ABOVE (B.W.A.), OR SHEARWALL ABOVE (S.W.A.)
—	BEAM / HEADER
◻	INTERIOR SHEAR WALL PANEL OR EXTERIOR SHEAR WALL w/ 3" o.c. EDGE NAILING
◻	AREA OF FLOOR SYSTEM DESIGNED FOR TILE
JL	METAL HANGER
*	INDICATES POST ABOVE. PROVIDE SOLID BLOCKING UNDER POST OR JAMB ABOVE.
▶	INDICATES HOLD-DOWN

REFER TO S-O FOR TYPICAL STRUCTURAL NOTES & SCHEDULES

4x10 HDR @ ALL EXT. WINDOW (TYP. U.N.O.) [B]

NOTE #1:
PROVIDE 1/8" OSB/ PLYWOOD SHEATHING FASTENED PER TYP. EXT. WALL SHEATHING SPEC. (SEE NOTES)

NOTE #2:
PROVIDE 1/8" OSB/ PLYWOOD SHEATHING FASTENED PER 3" o.c. EXT. WALL SHEATHING SPEC. (SEE NOTES)

seal:

© copyright: MULHERN & KULP Structural Engineering, Inc.




M&K project number: 01A-18094

project mgr: NJM
drawn by: NJD
issue date: 01-21-19


REVISIONS:	
date:	initial:
03/08/2019	NJD
ARCH REVISIONS 02/28/2020	NJD
PLAN REVIEW	NJD

ROOF FRMG. PLAN
3440 97TH AVE.
MERCER ISLAND, WASHINGTON

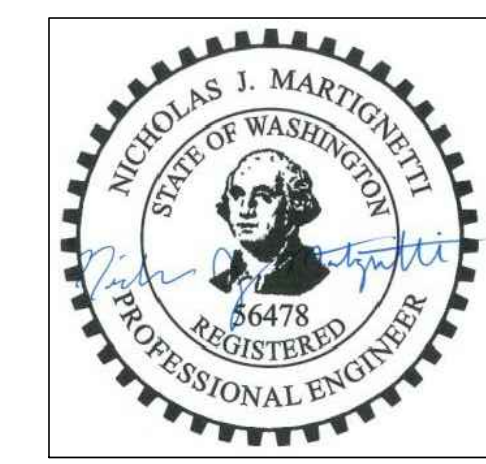


sheet:


S-3.0

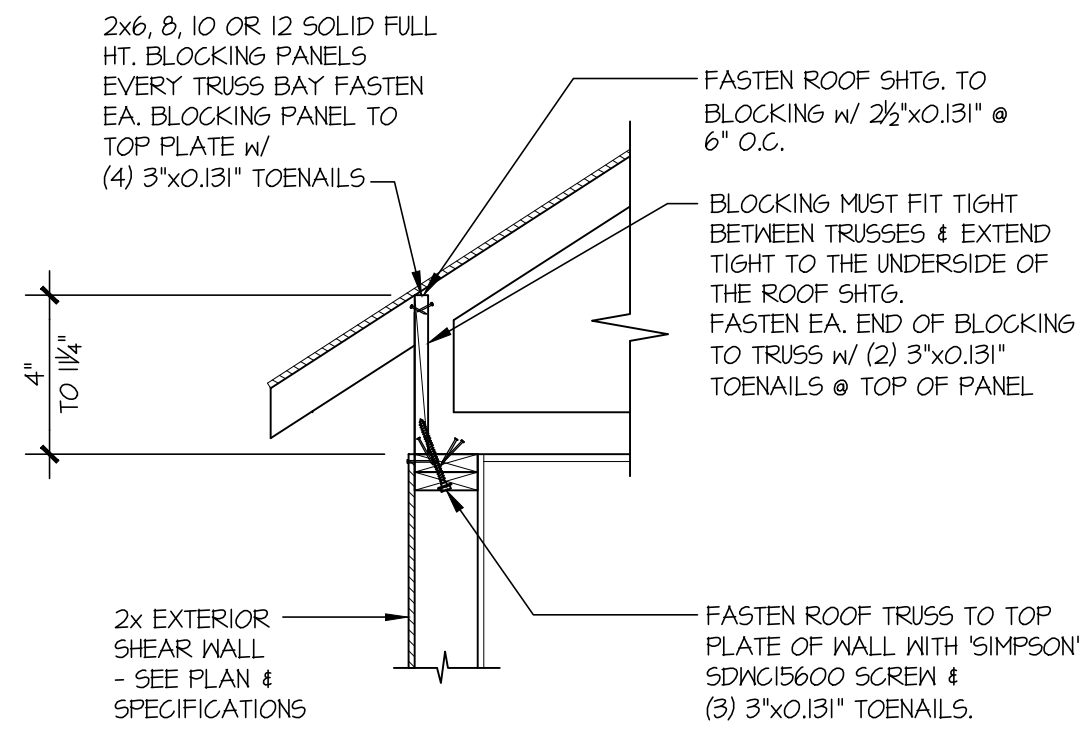


1 TYPICAL SHEAR TRANSFER DETAIL @ ROOF
SCALE: 3/4"=1'-0" HEEL HEIGHT BETWEEN 4" - 1 1/4"

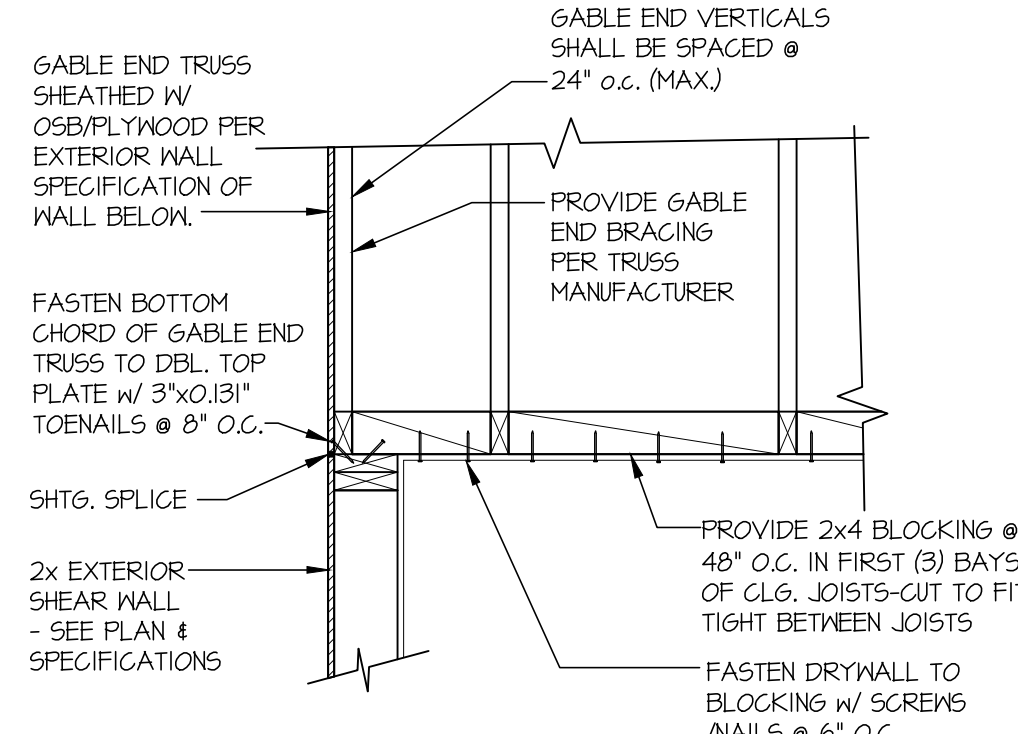


2 TYPICAL GABLE END DETAIL
SCALE: 3/4"=1'-0"

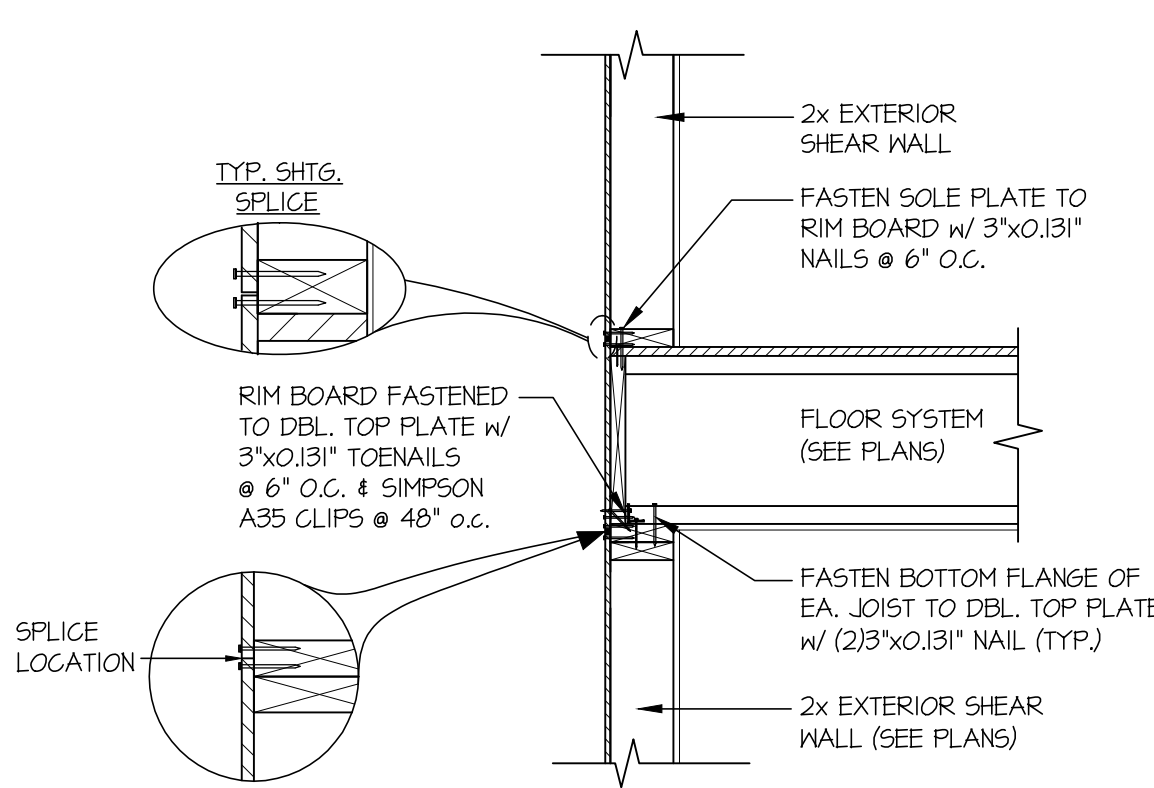


3 SECTION
SCALE: 3/4"=1'-0" PERPENDICULAR FRAMING

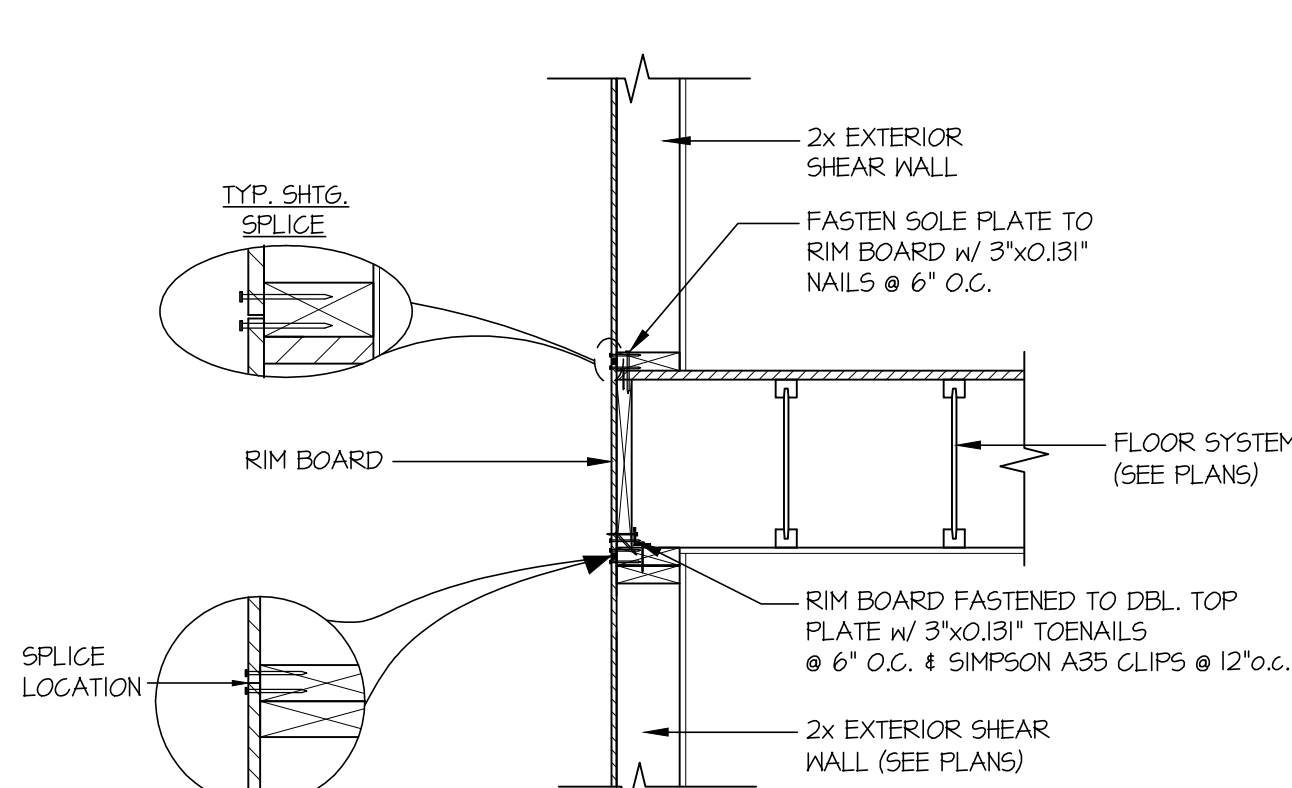


4 SECTION
SCALE: 3/4"=1'-0" PARALLEL FRAMING

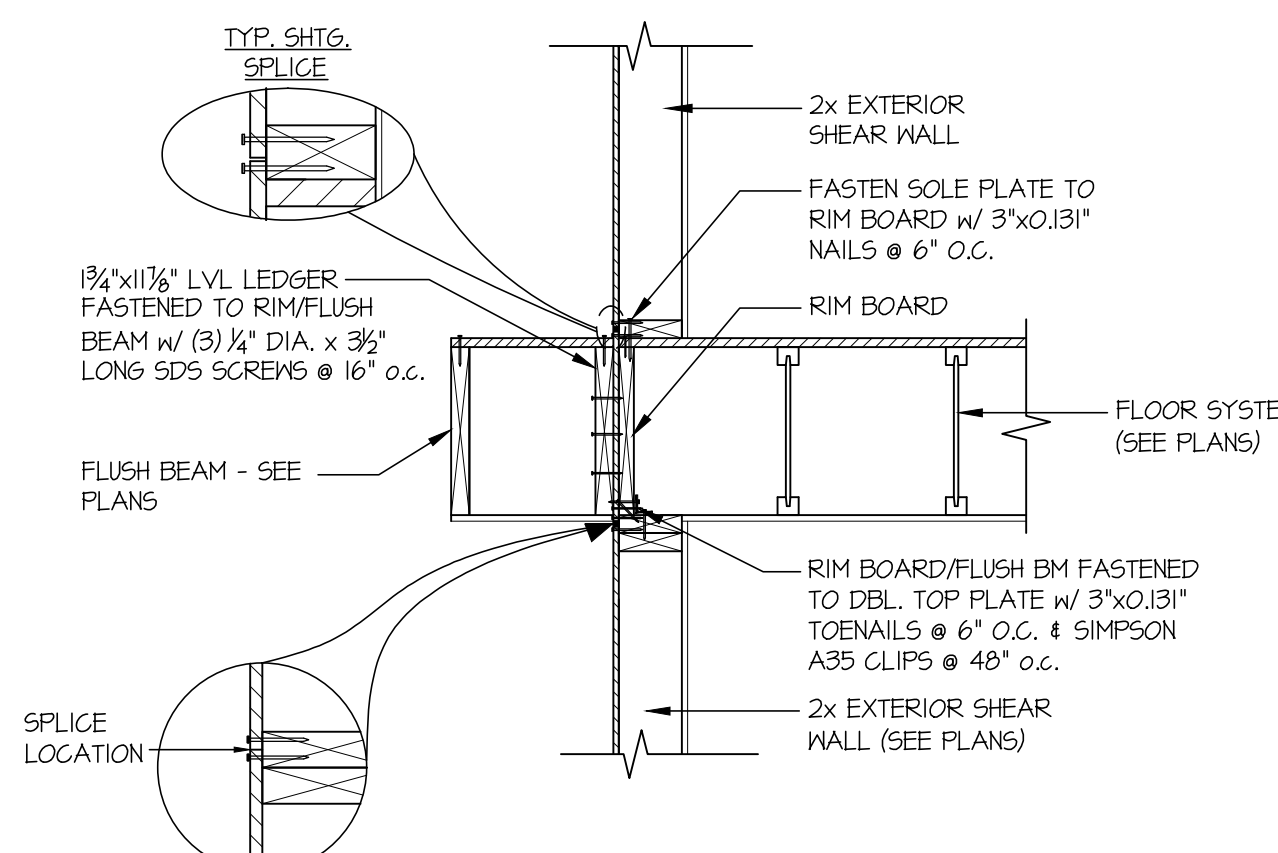


4A SECTION
SCALE: 3/4"=1'-0" PARALLEL FRAMING

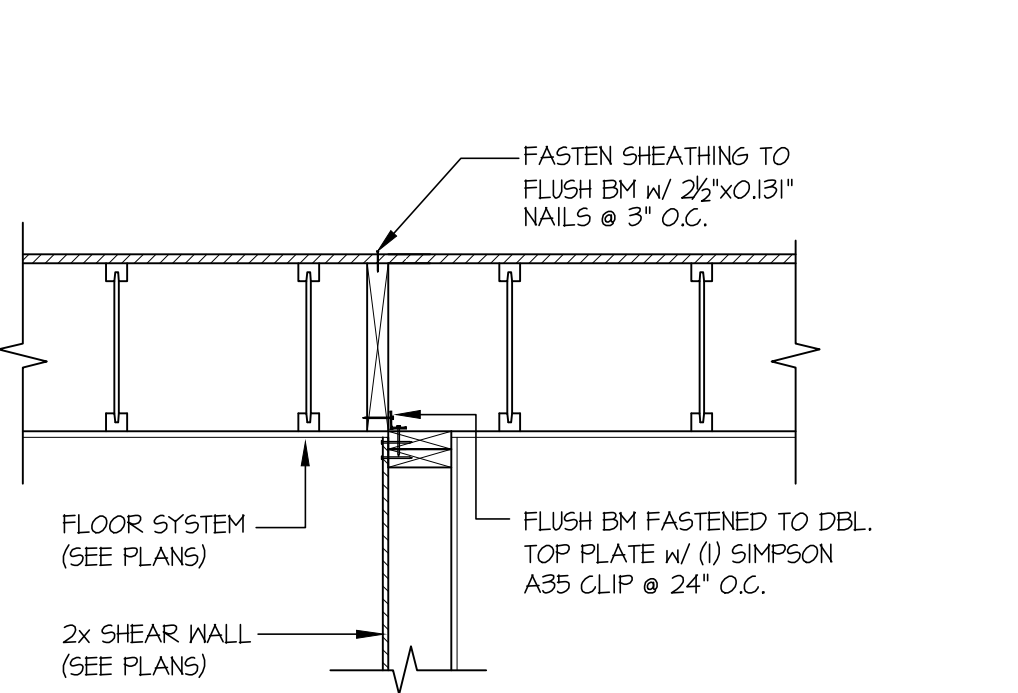


12 SECTION
SCALE: 3/4"=1'-0"

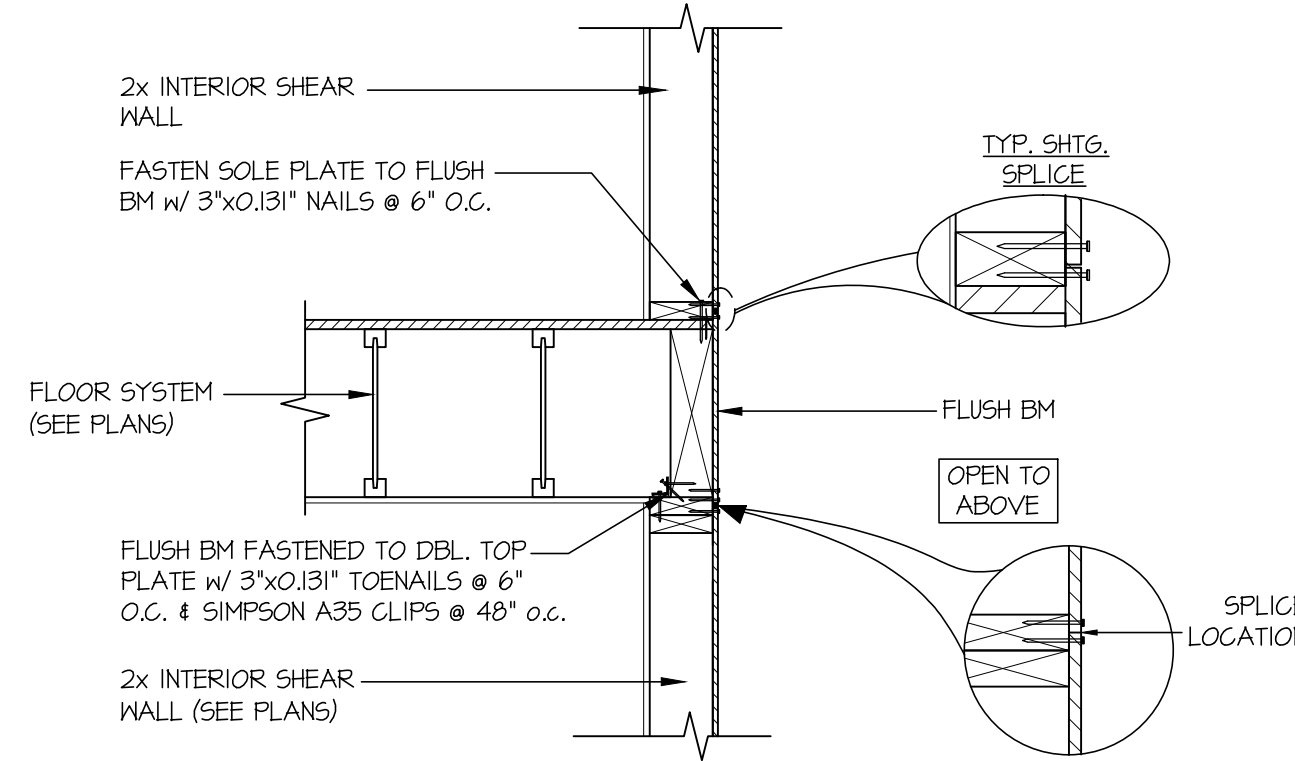


22 SECTION
SCALE: 3/4"=1'-0" EDGE OF FRAMING

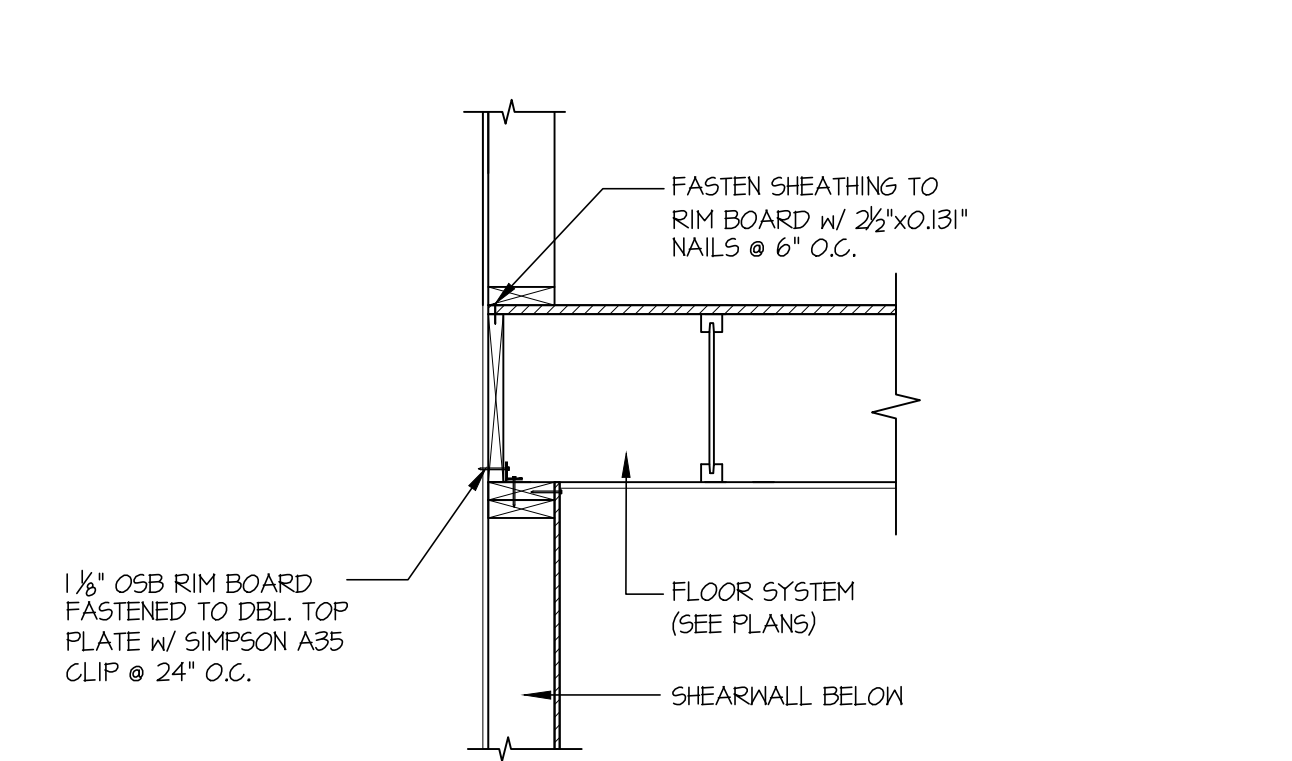


23 SECTION
SCALE: 3/4"=1'-0" EDGE OF FRAMING

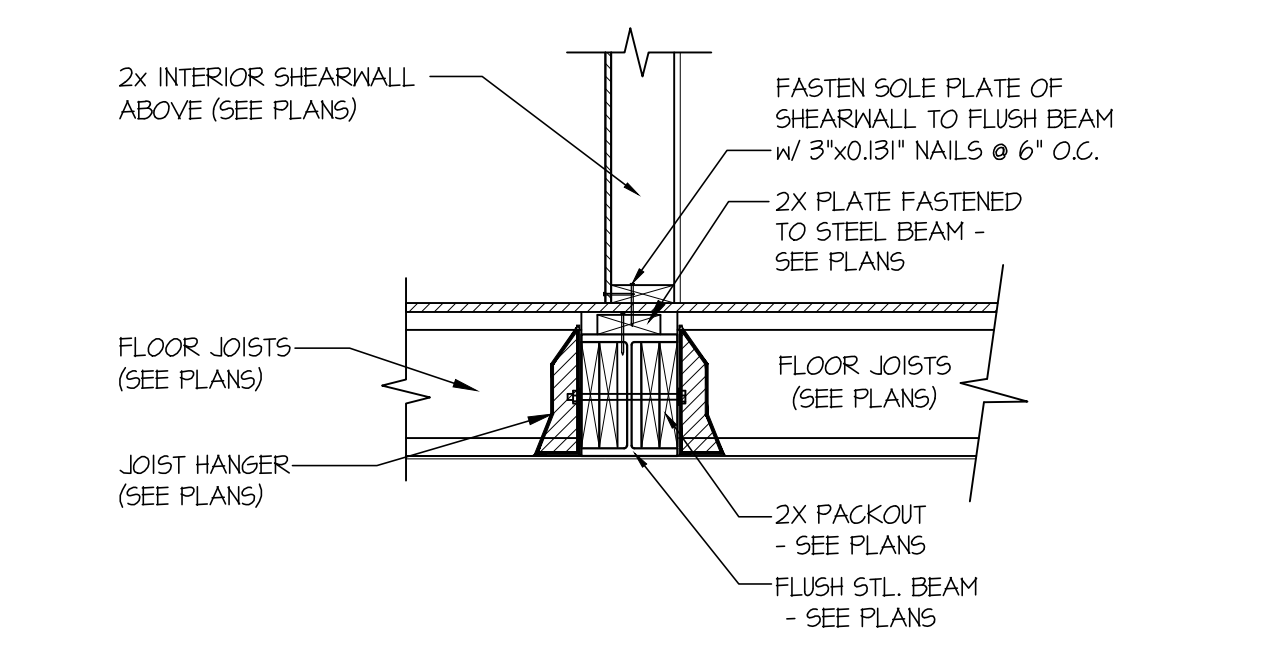


42 SECTION
SCALE: 3/4"=1'-0"

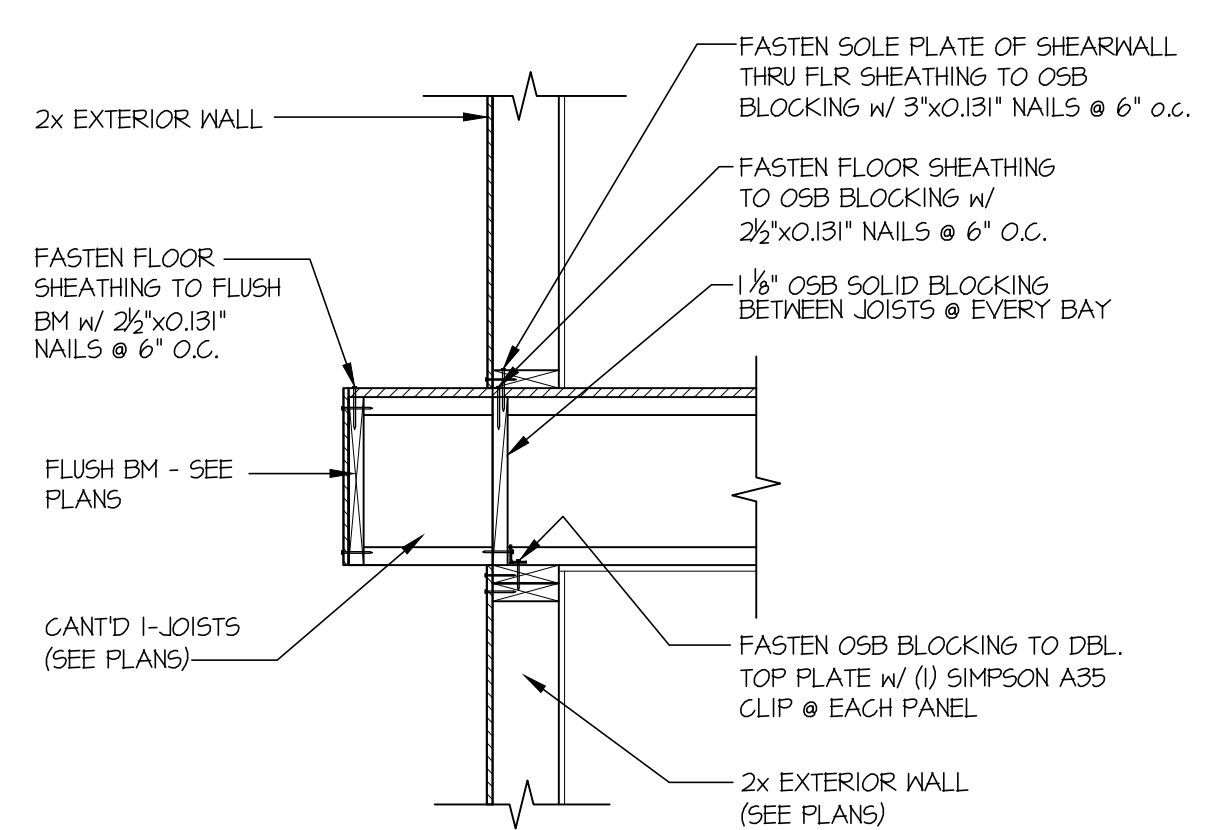


43 SECTION
SCALE: 3/4"=1'-0"

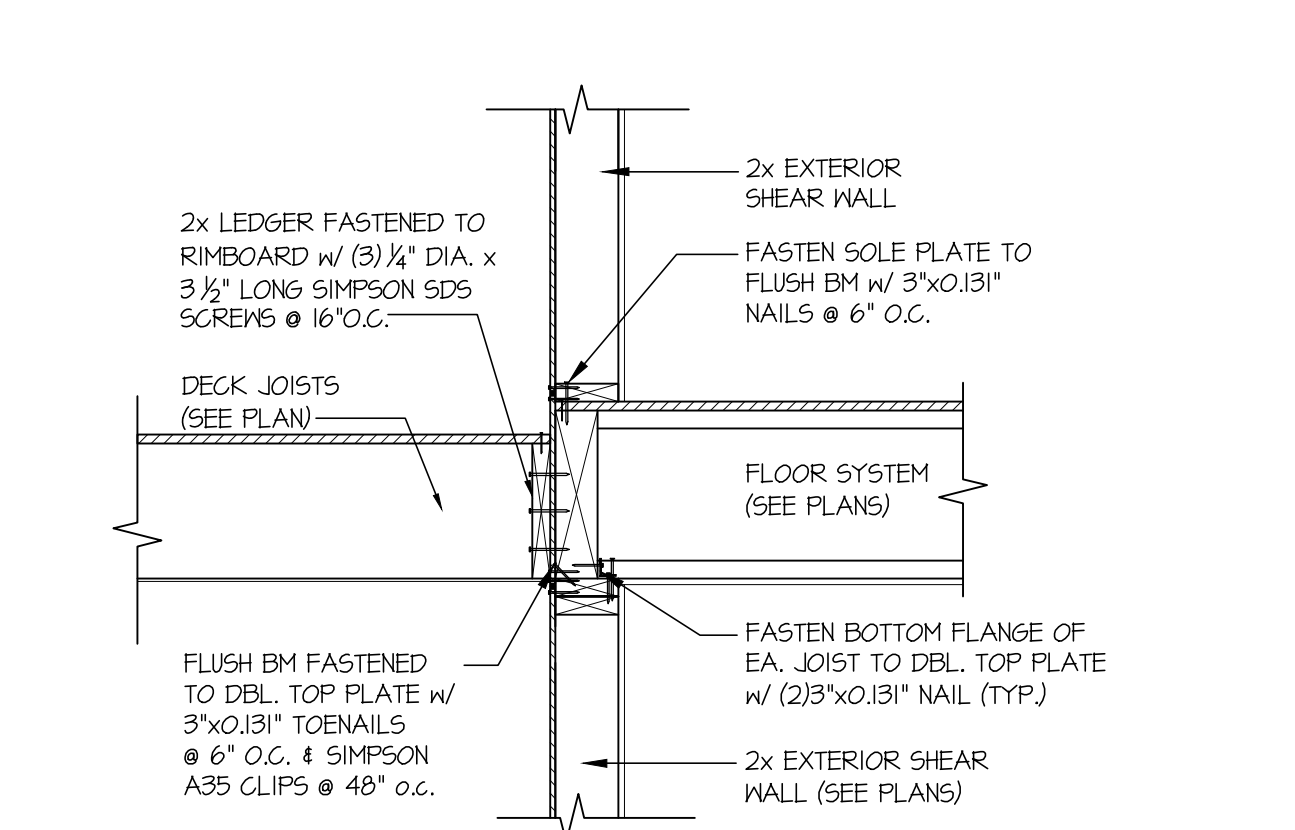


44 SECTION
SCALE: 3/4"=1'-0"

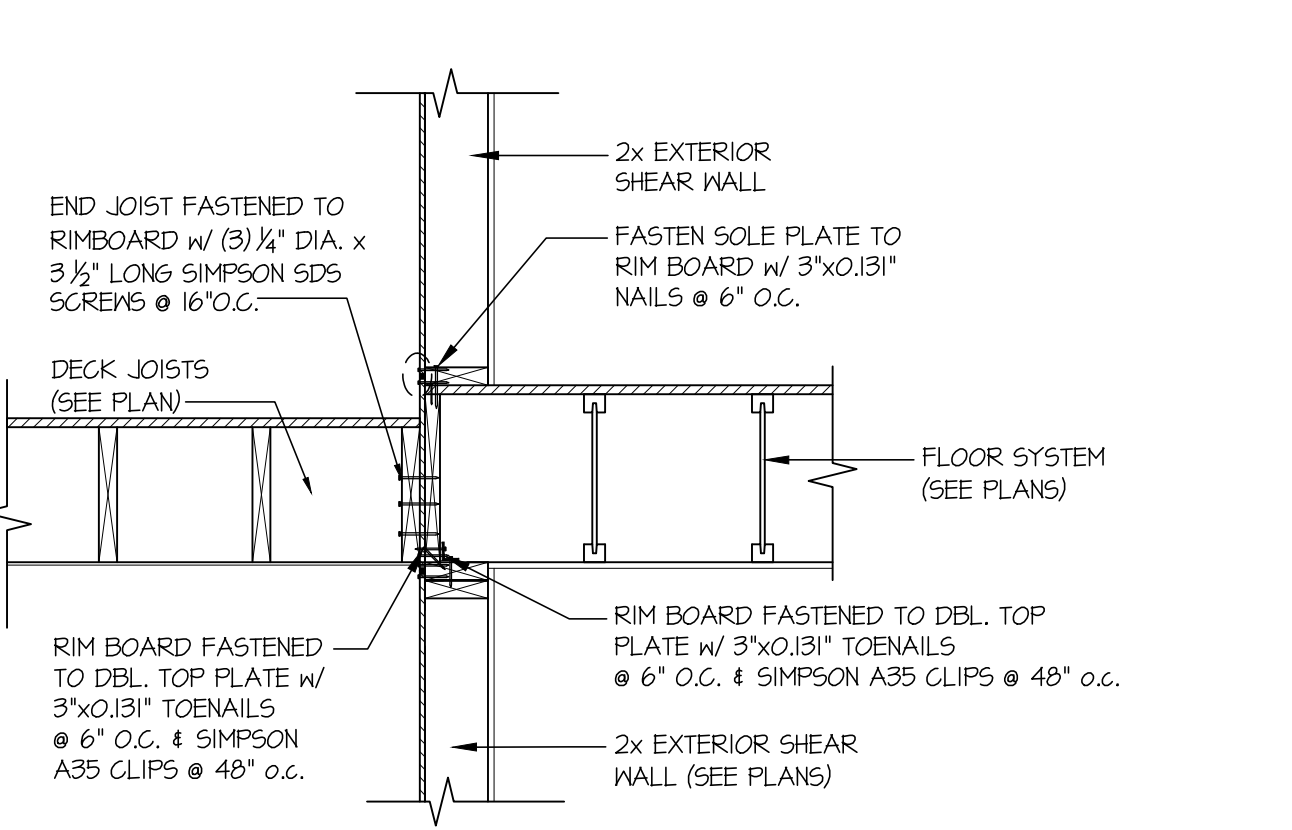

45 SECTION
SCALE: 3/4"=1'-0"

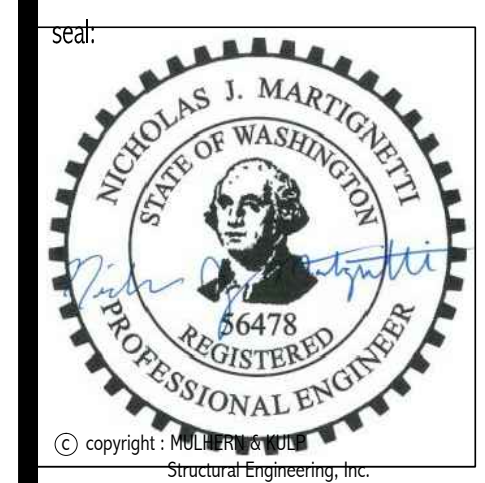

MULHERN+KULP
RESIDENTIAL STRUCTURAL ENGINEERING
300 Brookside Ave., Building 4 - Ambler, PA 19002
p. 215-966-9001 - mulhern+kulp.com

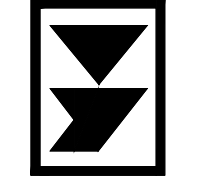

M&K project number:
01A-18094
project mgr: **NJM**
drawn by: **NJD**
issue date: **01-21-19**

REVISIONS:	
date:	initial:
03/08/2019	NJD
ARCH REVISIONS:	
02/28/2020	NJD
PLAN REVIEW:	

STRUCTURAL DETAILS
3440 97TH AVE.
MERCER ISLAND, WASHINGTON

sheet:
LB-1




MULHERN+KULP
RESIDENTIAL STRUCTURAL ENGINEERING
300 Brookside Ave., Building 4 - Ambler, PA 19002
p. 215-966-9001 • mulhernkulp.com


M&K project number:
01A-18094

proj mgr: **NJM**
drawn by: **NJD**
issue date: **01-21-19**


REVISIONS:	
date:	initial:
03/08/2019	NJD
02/28/2020	NJD
PLAN REVIEW	

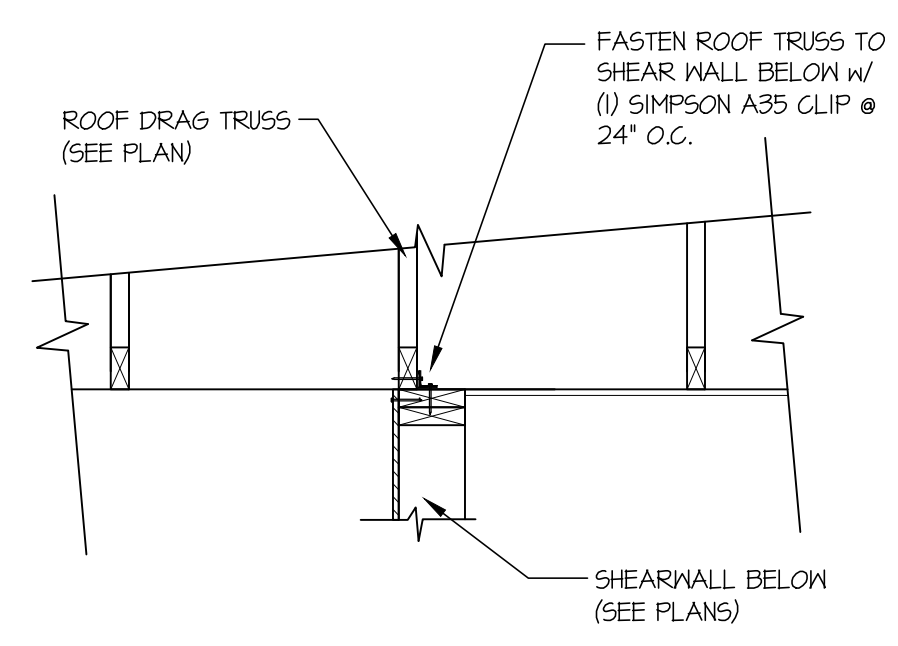


47 SECTION
SCALE: 3/4"=1'-0"

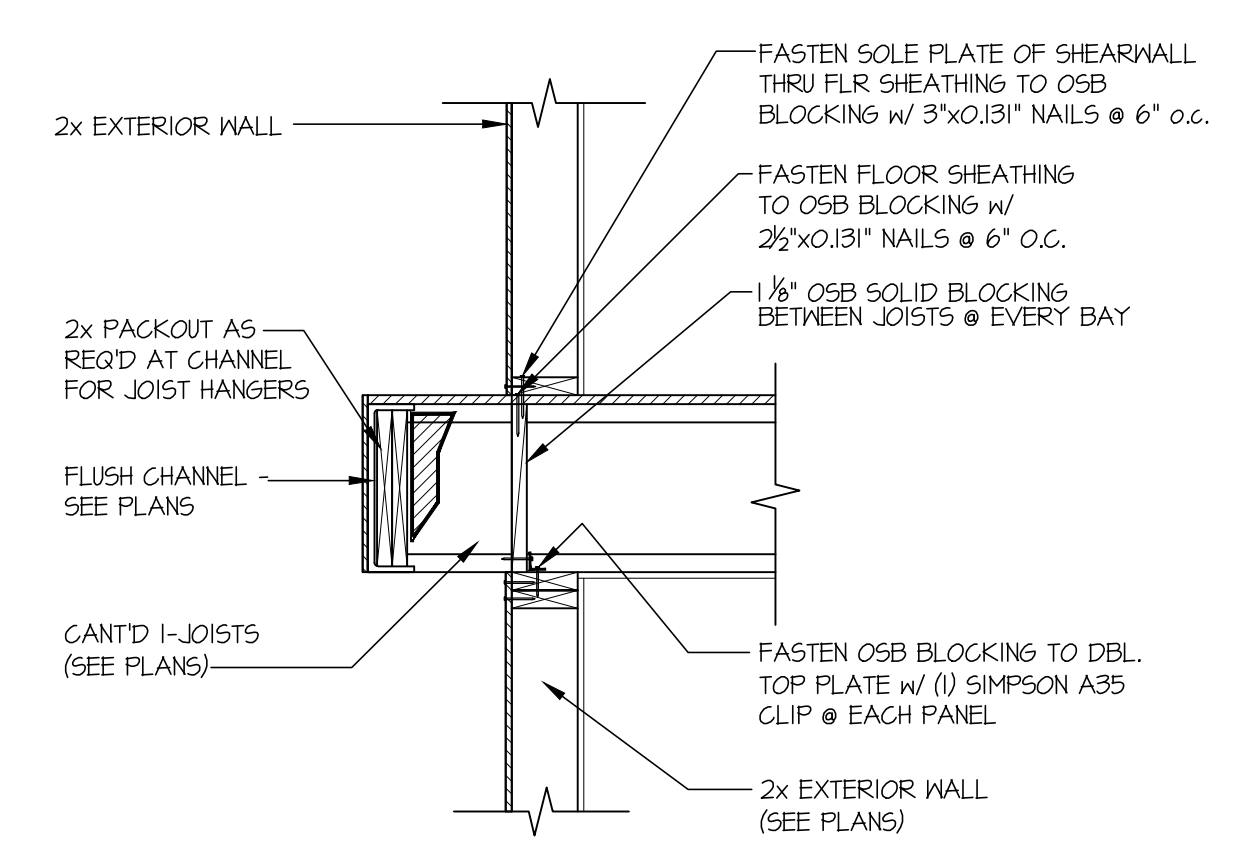


48 SECTION
SCALE: 3/4"=1'-0"

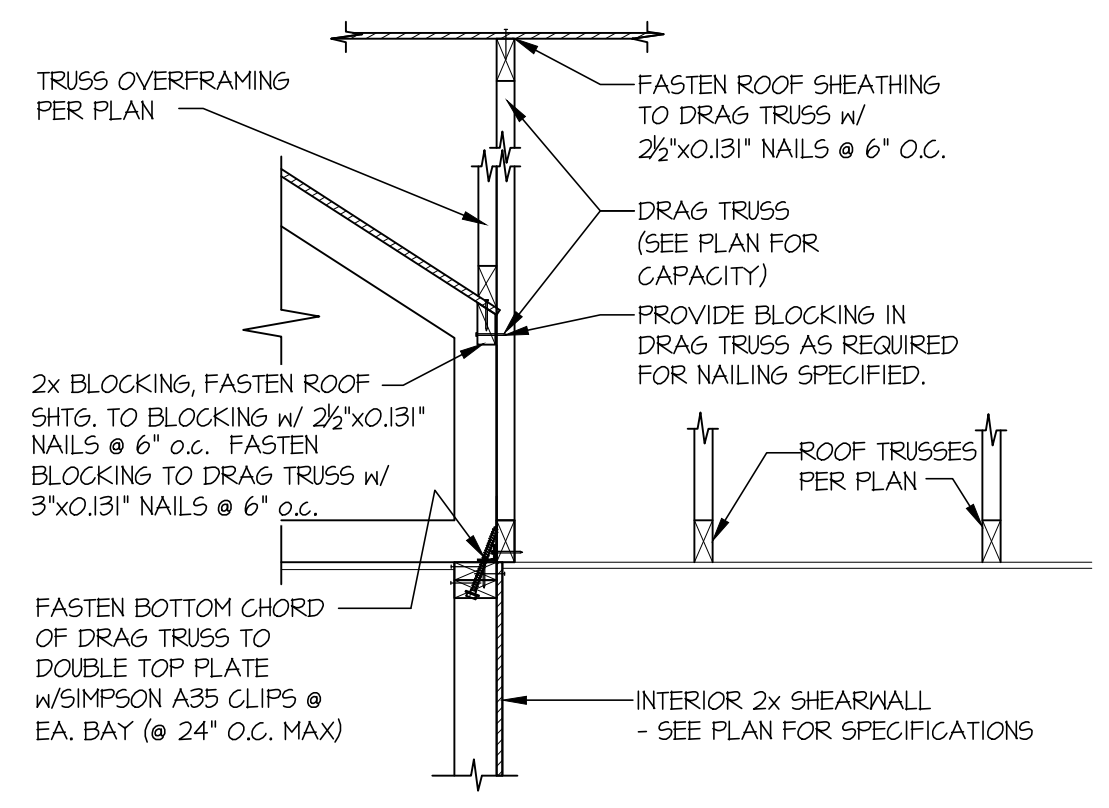


54 SECTION
SCALE: 3/4"=1'-0"

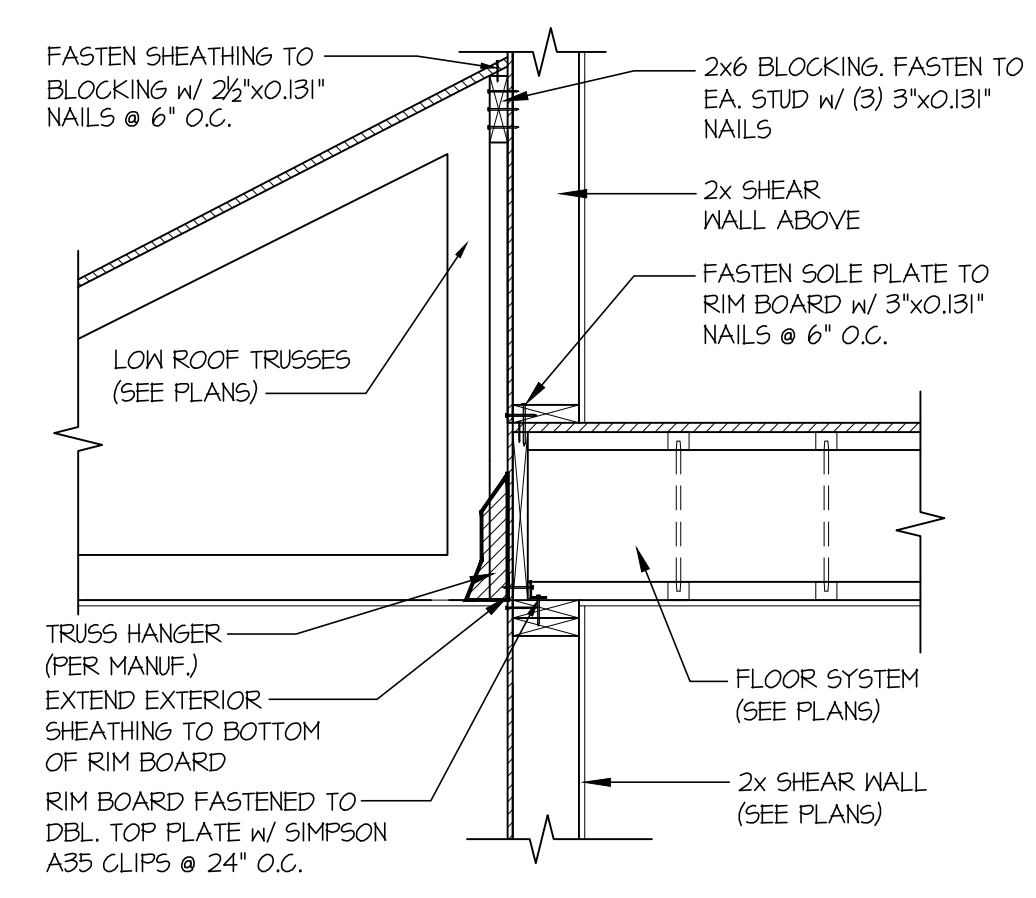


60 SECTION
SCALE: 3/4"=1'-0"

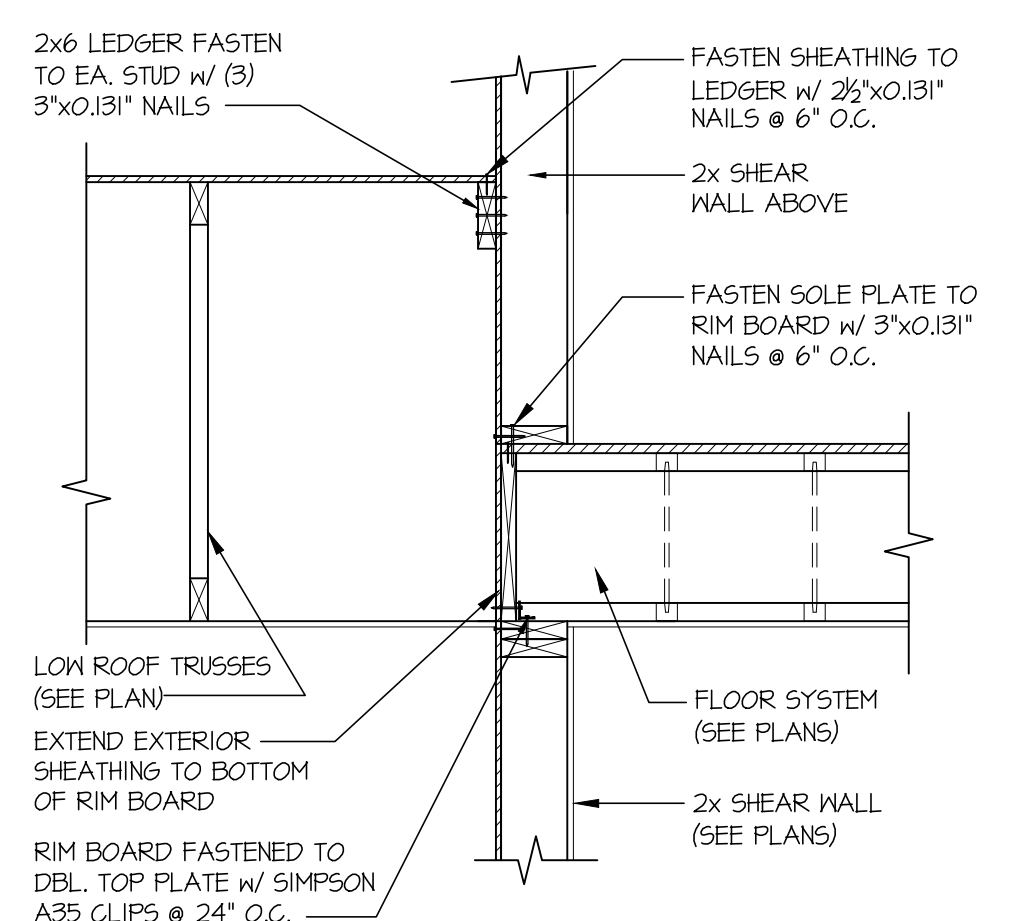


61 SECTION
SCALE: 3/4"=1'-0"

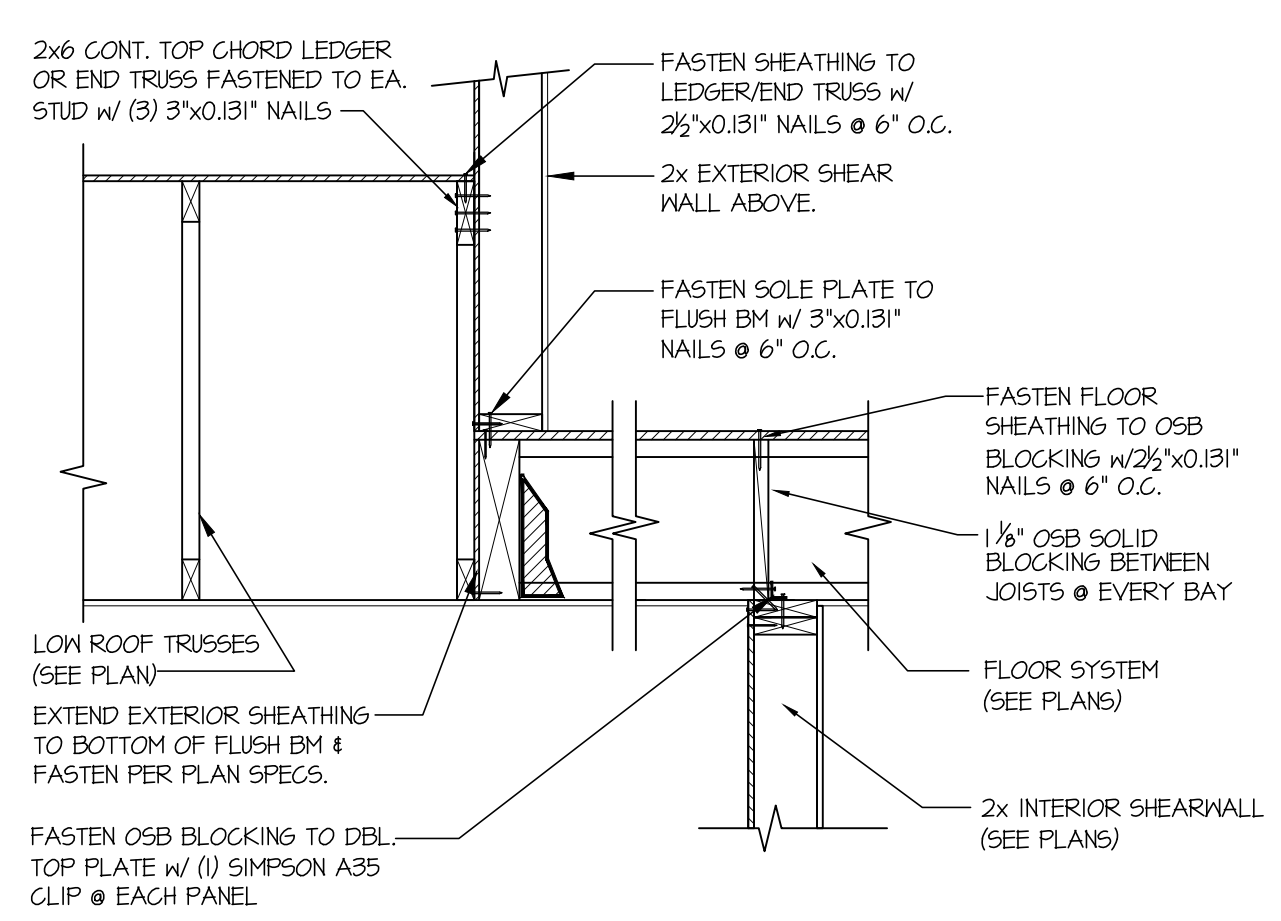


70 SECTION
SCALE: 3/4"=1'-0"

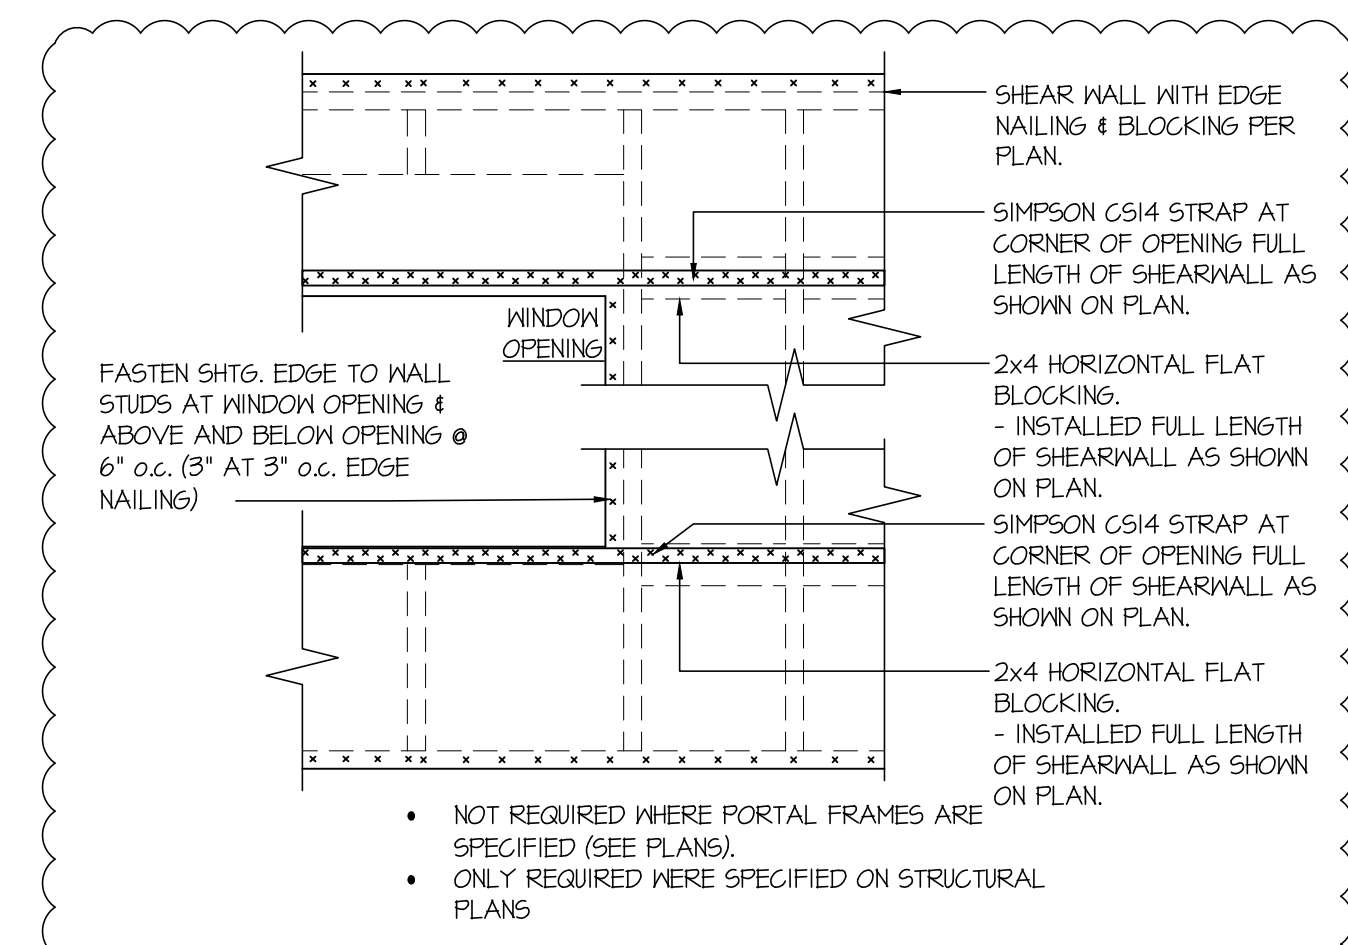


93 EXT. WALL & INT. SHEARWALL OPENING ELEVATION
SCALE: NTS

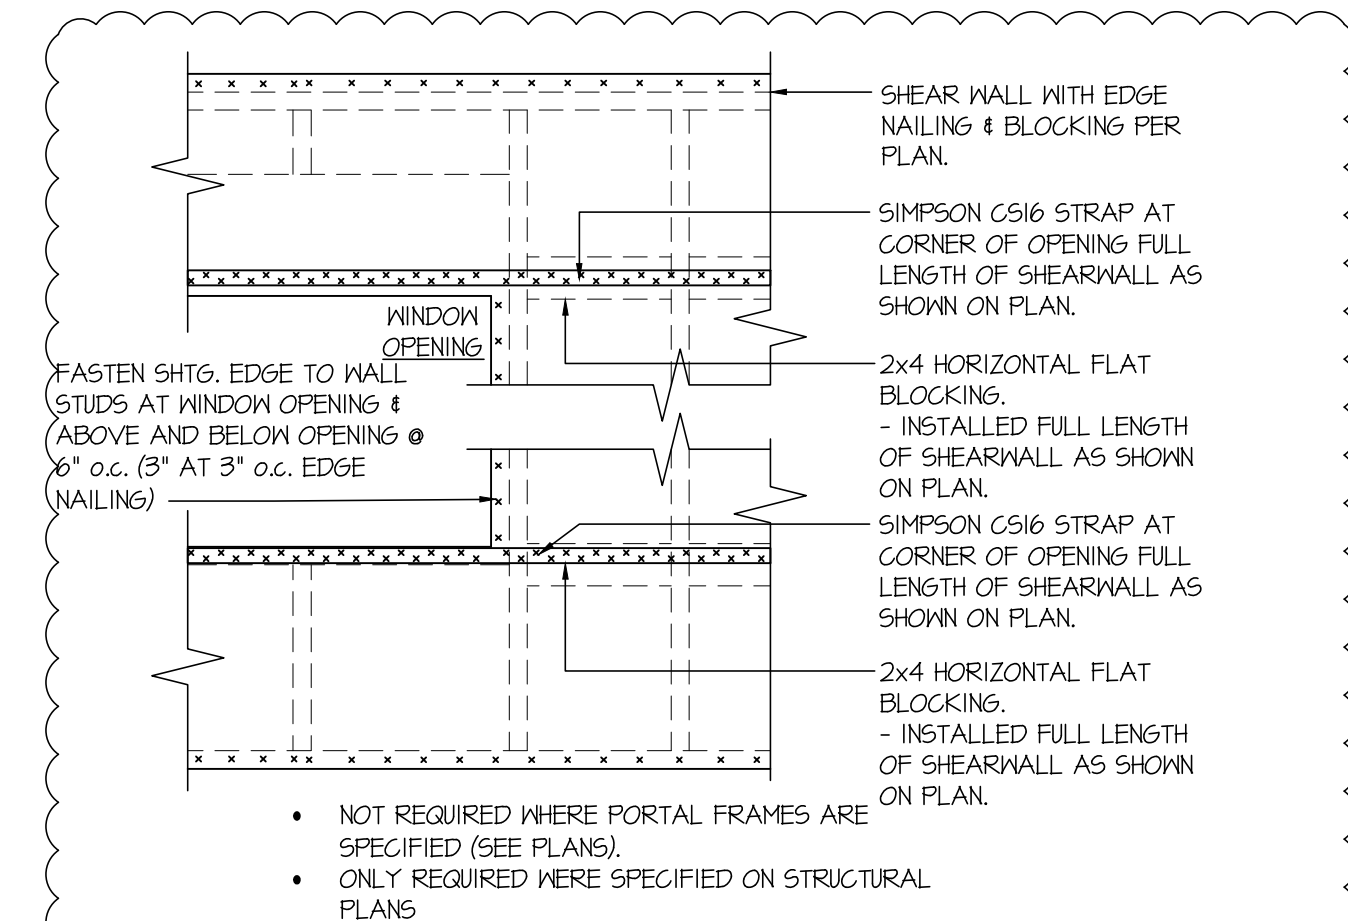


94 EXT. WALL & INT. SHEARWALL OPENING ELEVATION
SCALE: NTS

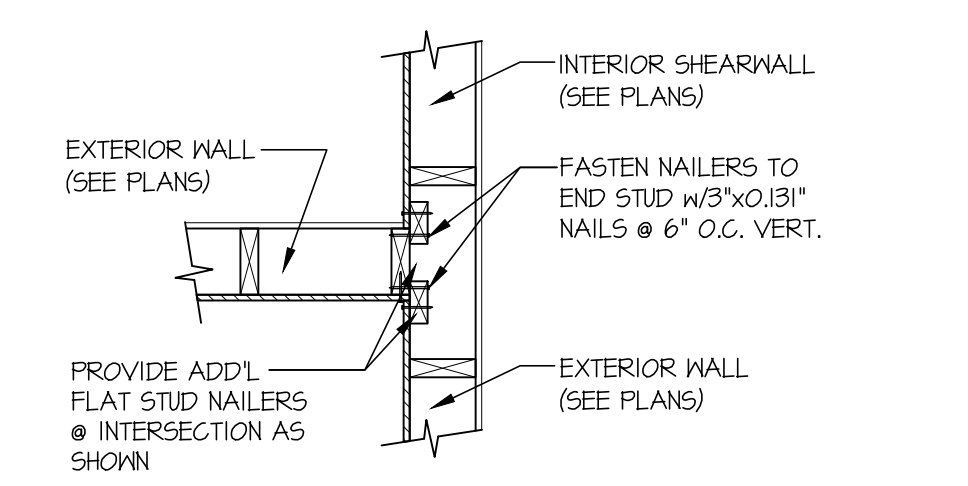

95 SHEAR TRANSFER DETAIL @ INTERSECTING INT. SHEARWALL
SCALE: 3/4"=1'-0" SHTG. ON SAME FACE

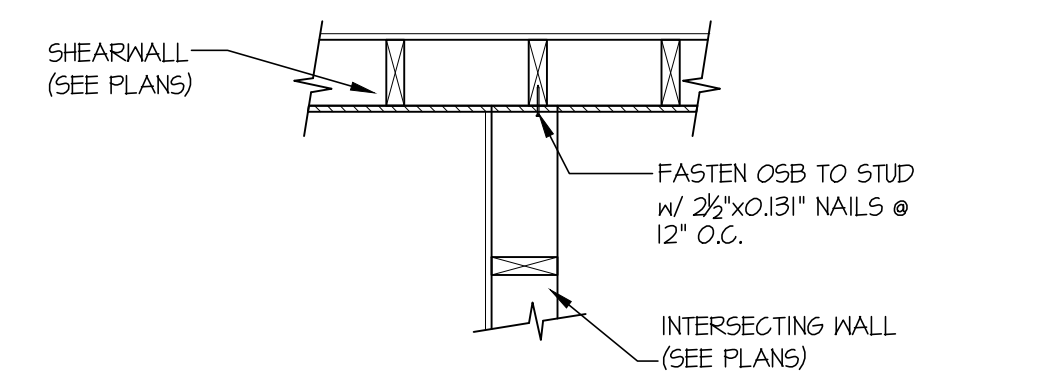


96 SHEAR TRANSFER DETAIL @ INTERSECTION
SCALE: 3/4"=1'-0"

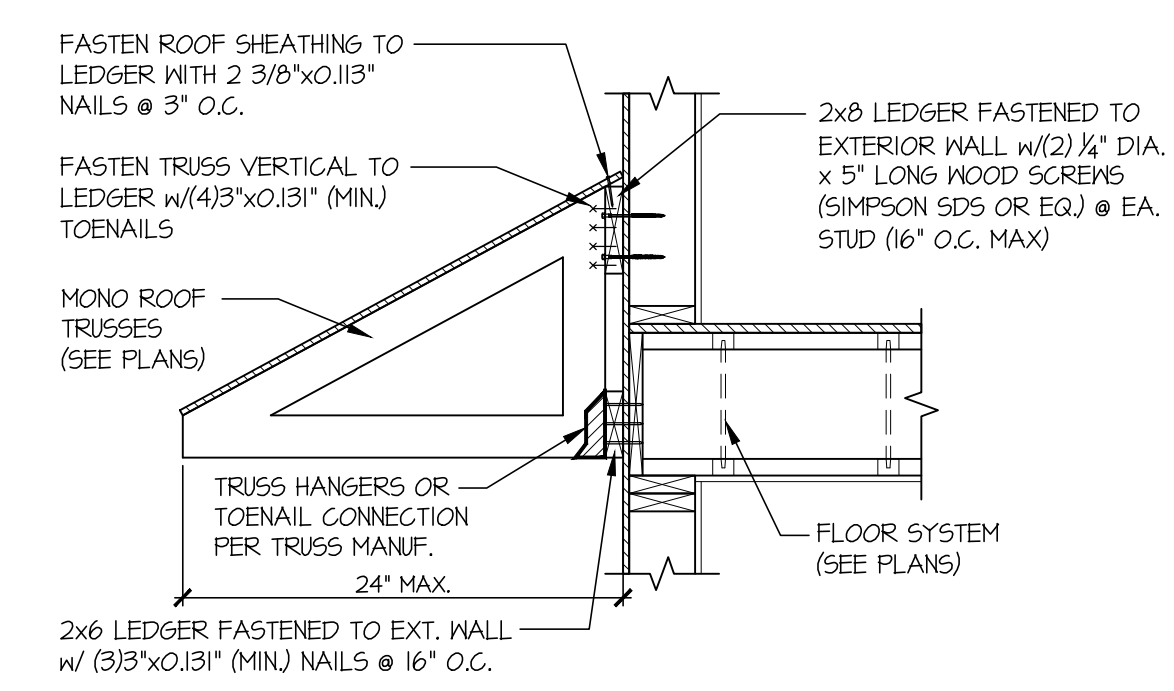

99 TYPICAL PENT ROOF DETAIL
SCALE: 3/4"=1'-0" (22x34)

STRUCTURAL DETAILS
3440 97TH AVE.
MERCER ISLAND, WASHINGTON

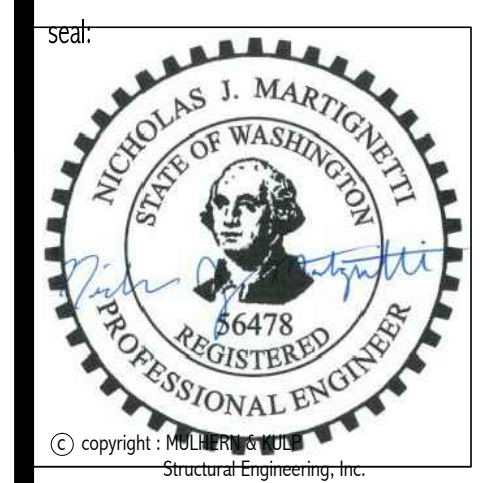








MULHERN+KULP
RESIDENTIAL STRUCTURAL ENGINEERING
300 Brookside Ave. Building 4 + Amber, PA 18002
P 215-846-8001 - mulhernkulp.com

M&K project number: 01A-18094

project mgr: NJM
drawn by: NJD
issue date: 01-21-19

REVISIONS:


date:	initial:
03/08/2019	NJD
02/28/2020	NJD
PLAN REVIEW	NJD

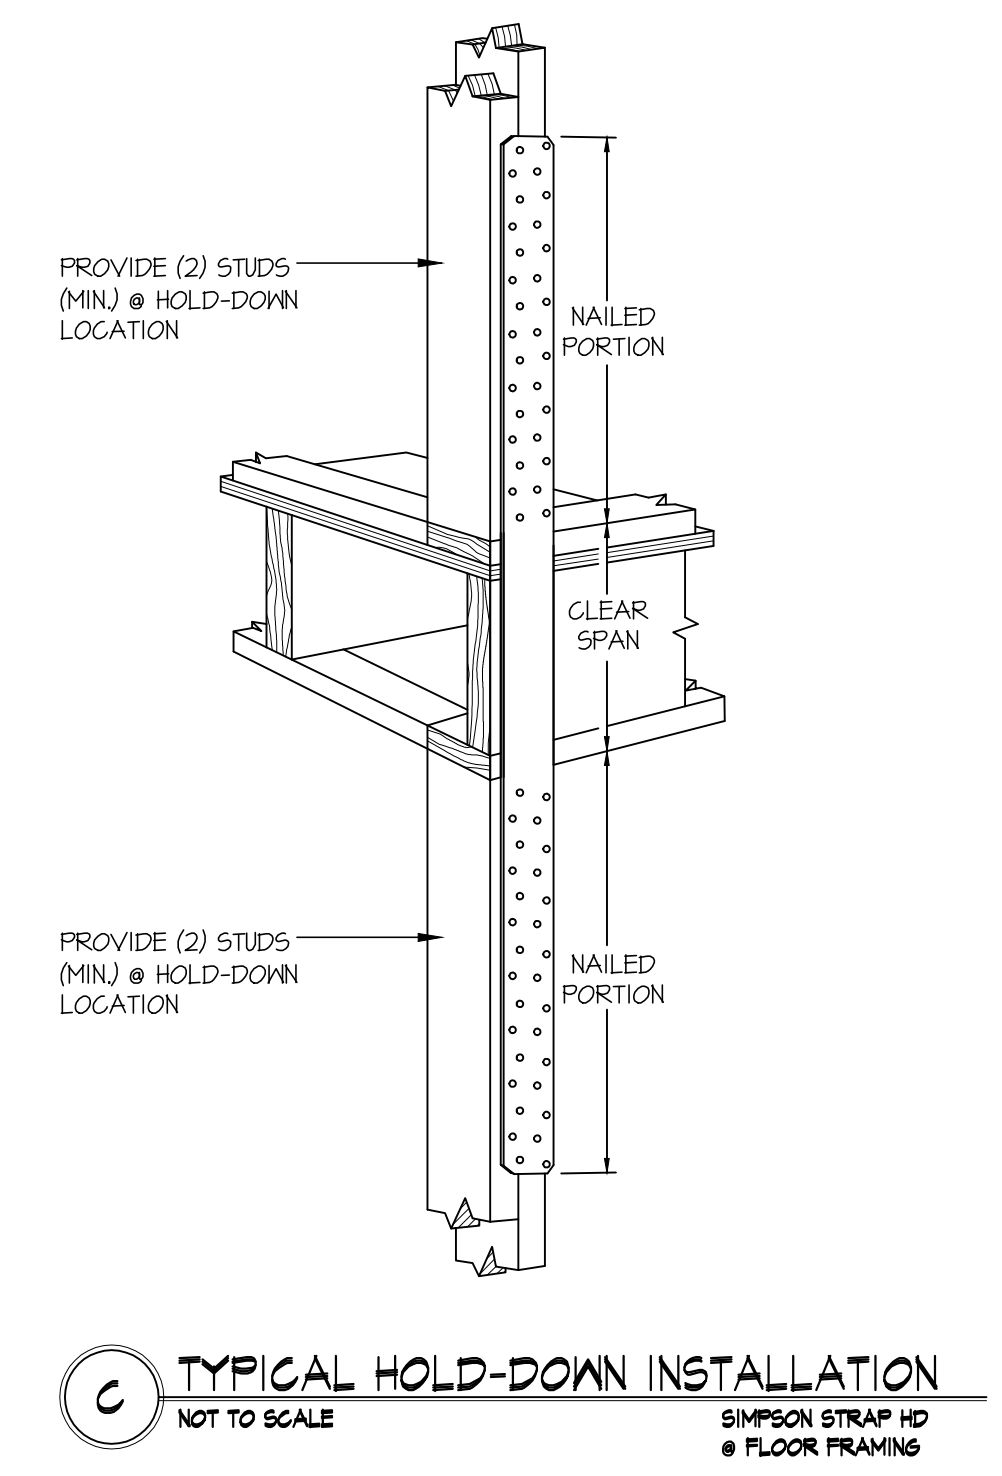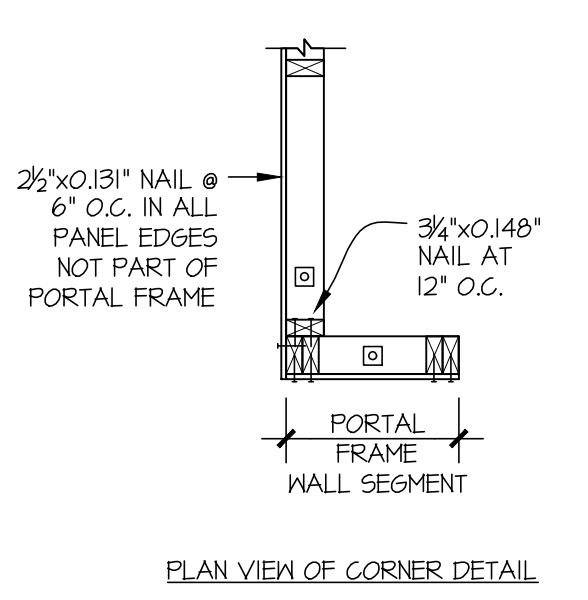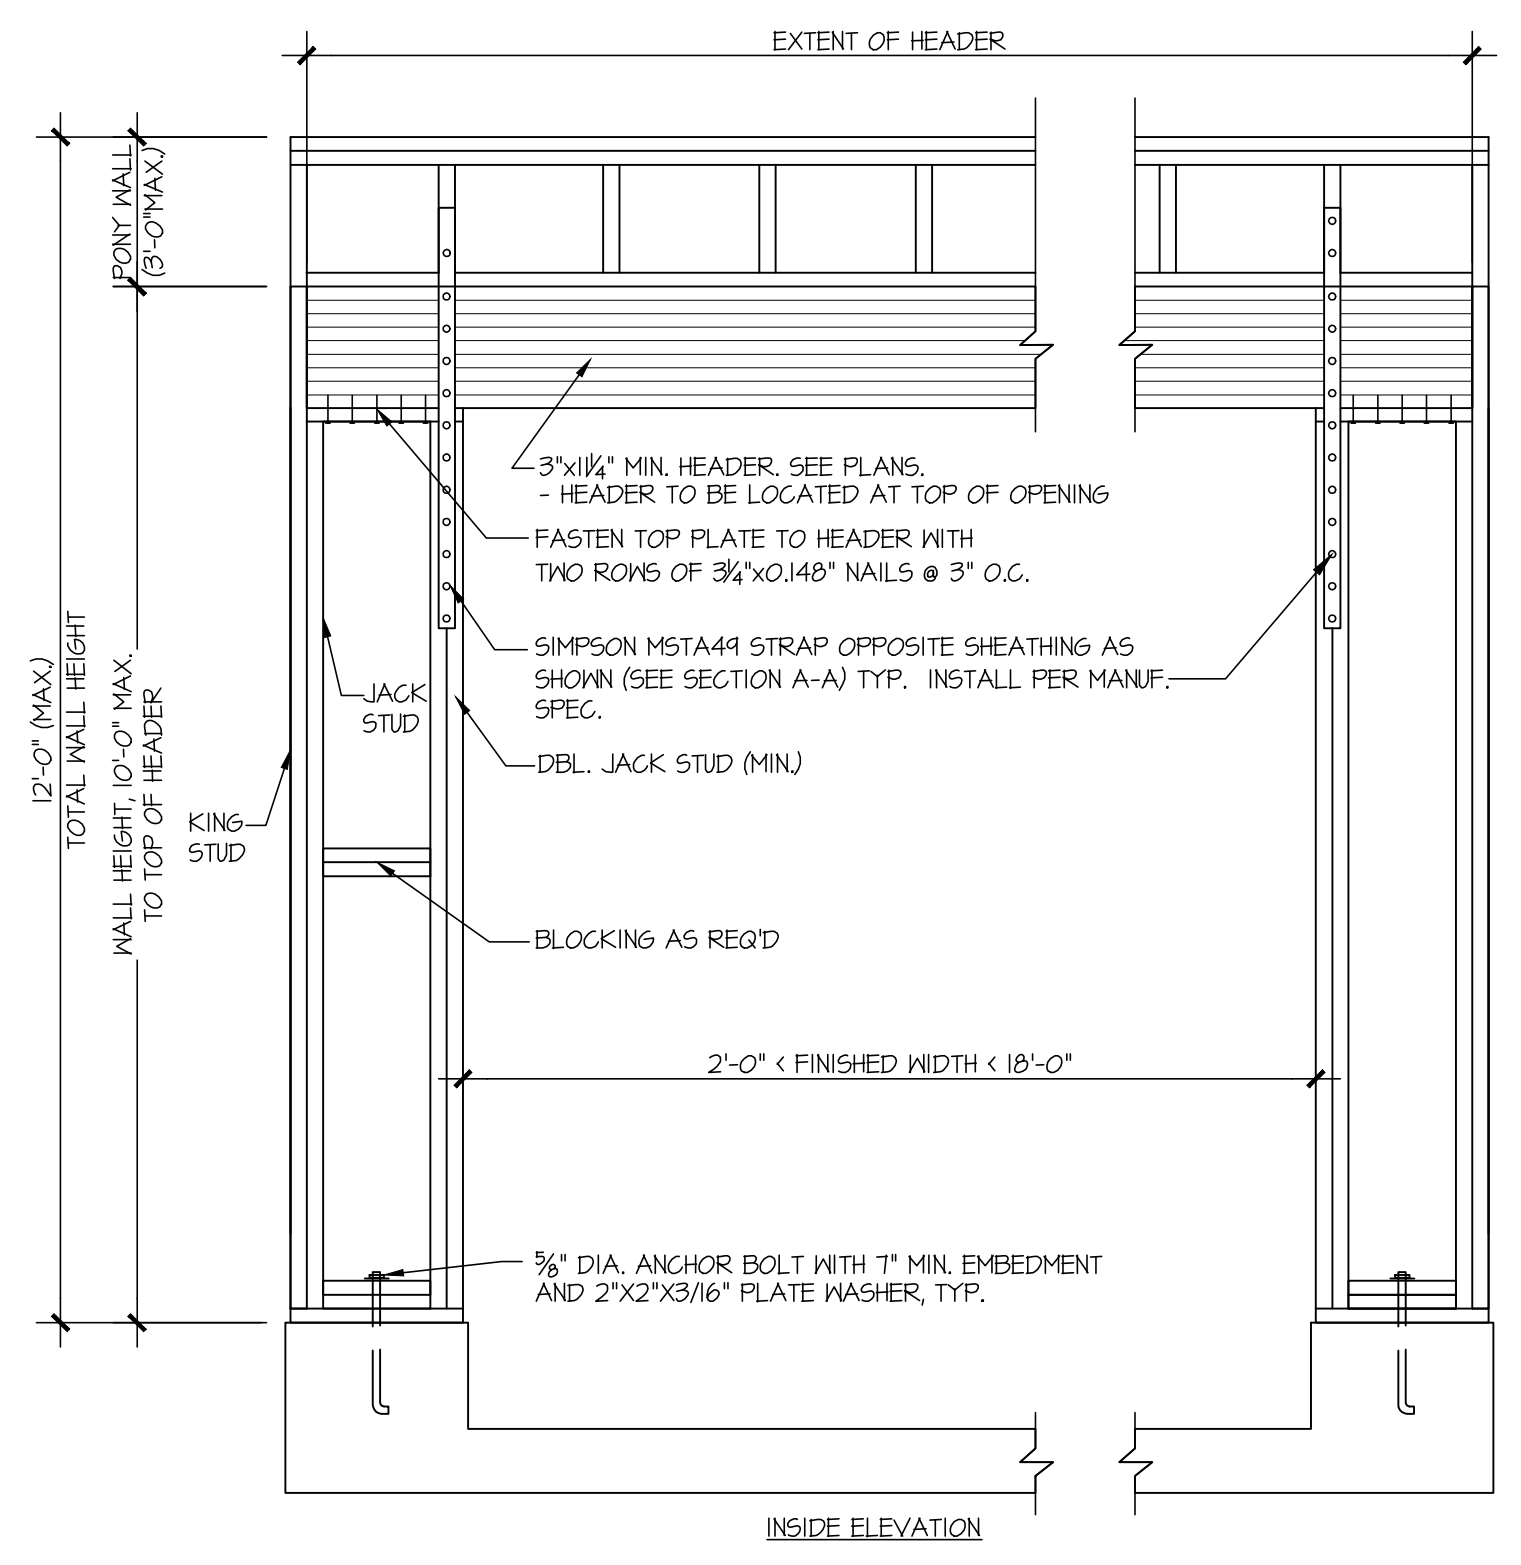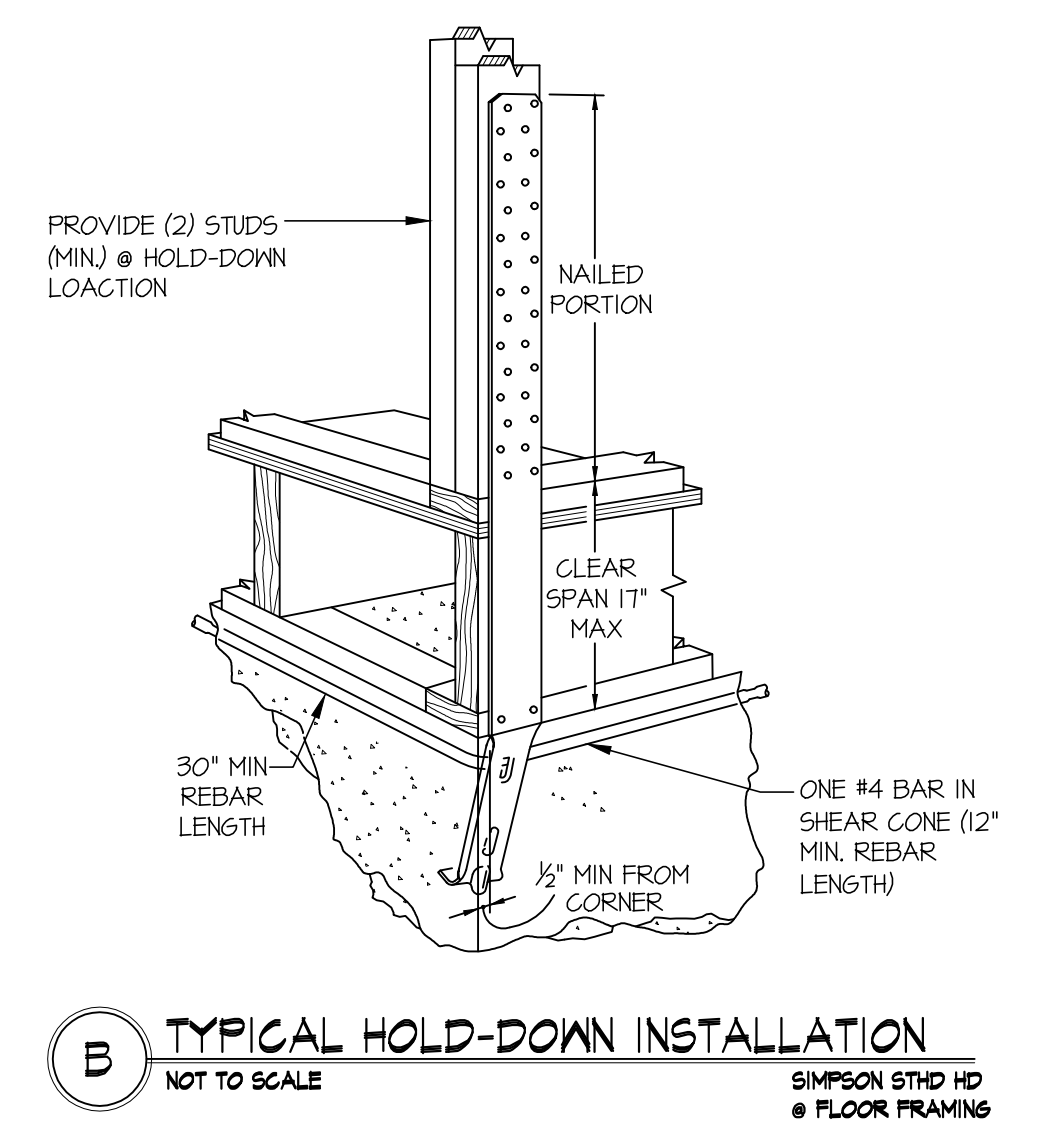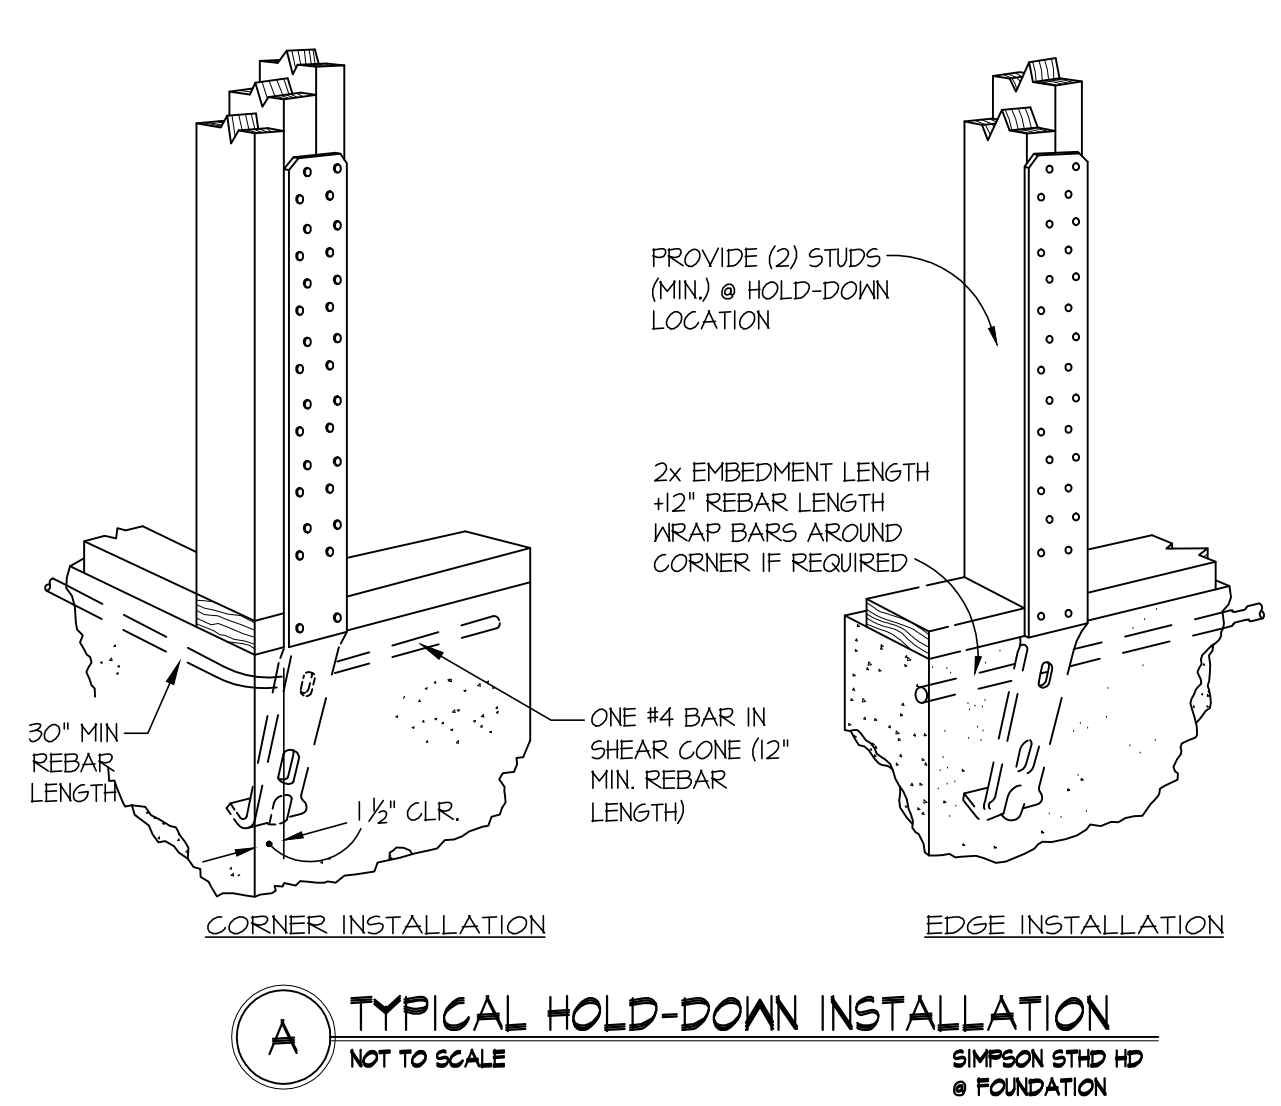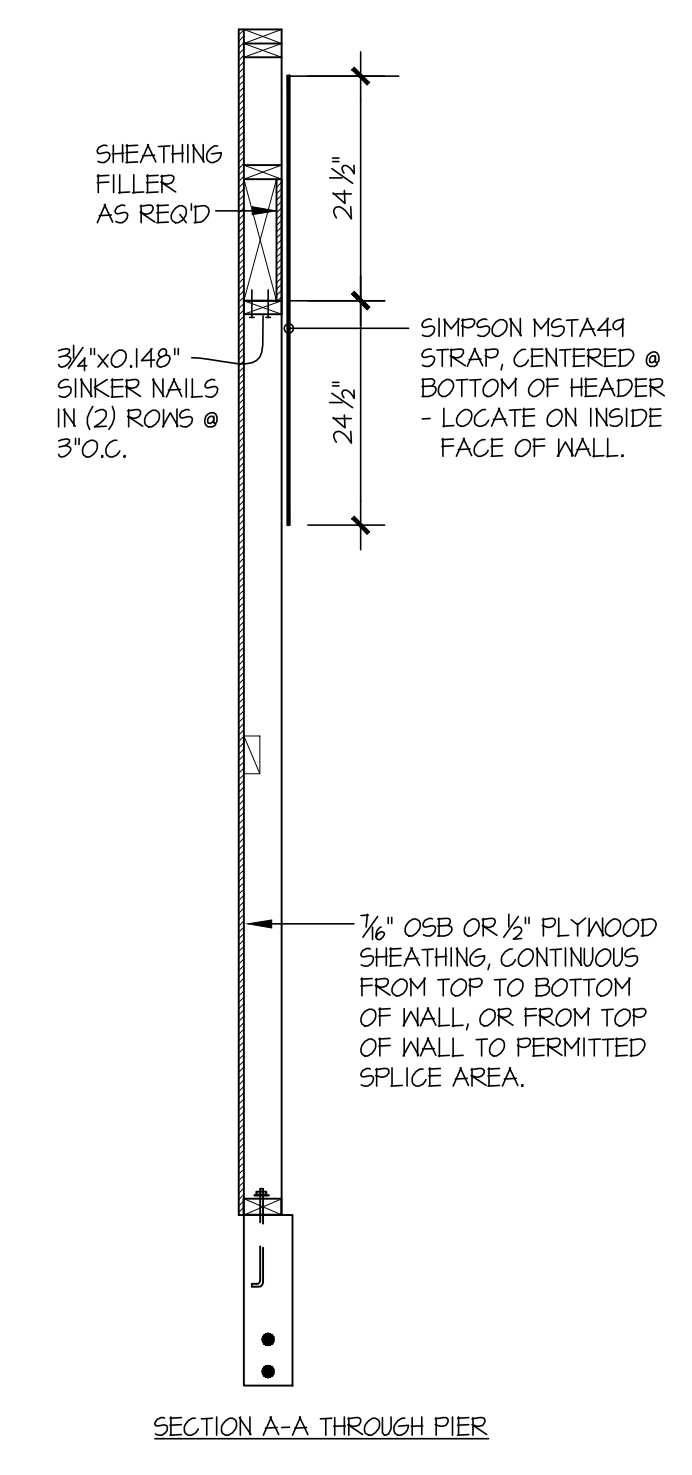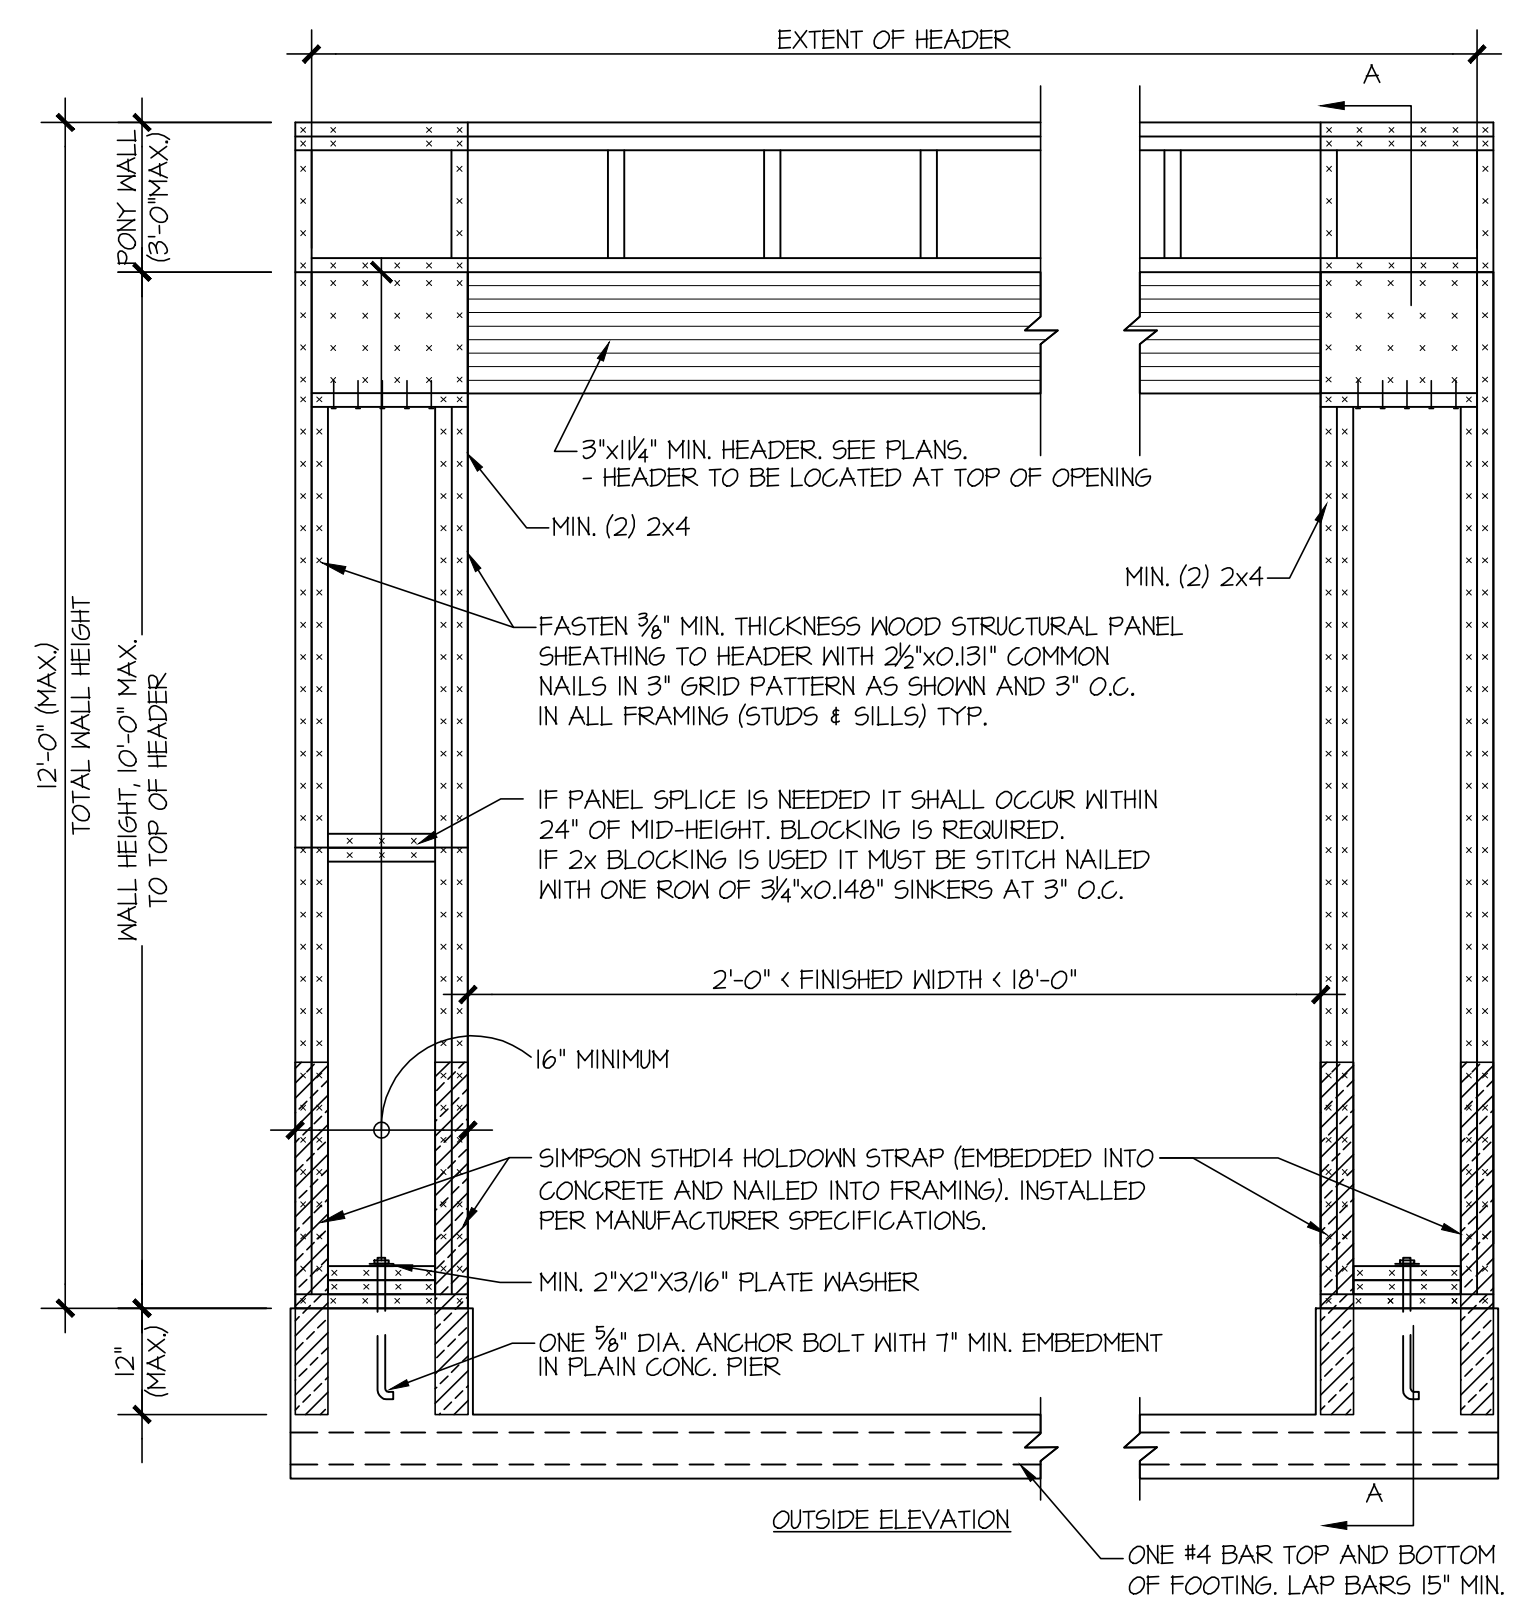


APA PORTAL FRAME DETAIL WITH HOLD-DOWNS
SCALE: N.T.S.

STRUCTURAL DETAILS
3440 97TH AVE.
MERCER ISLAND, WASHINGTON


sheet:
LB-3

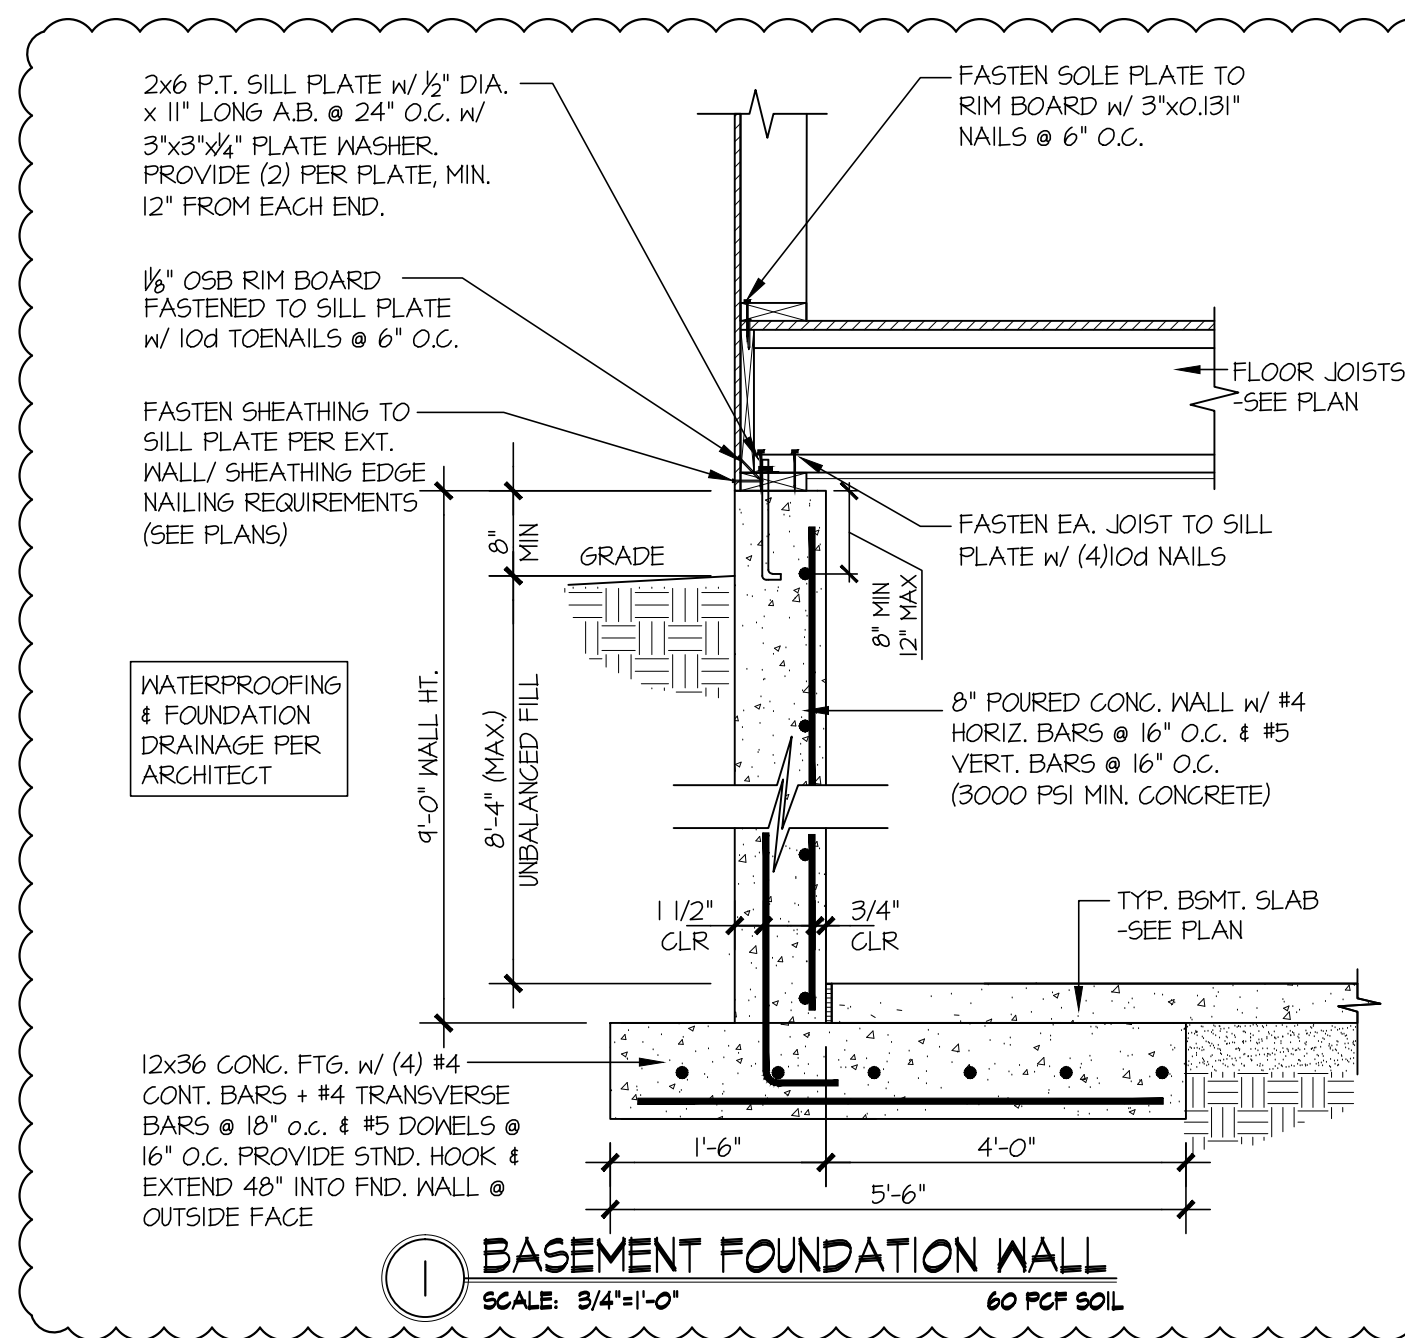


1 BASEMENT FOUNDATION WALL
SCALE: 3/4"=1'-0"
60 PCF SOIL

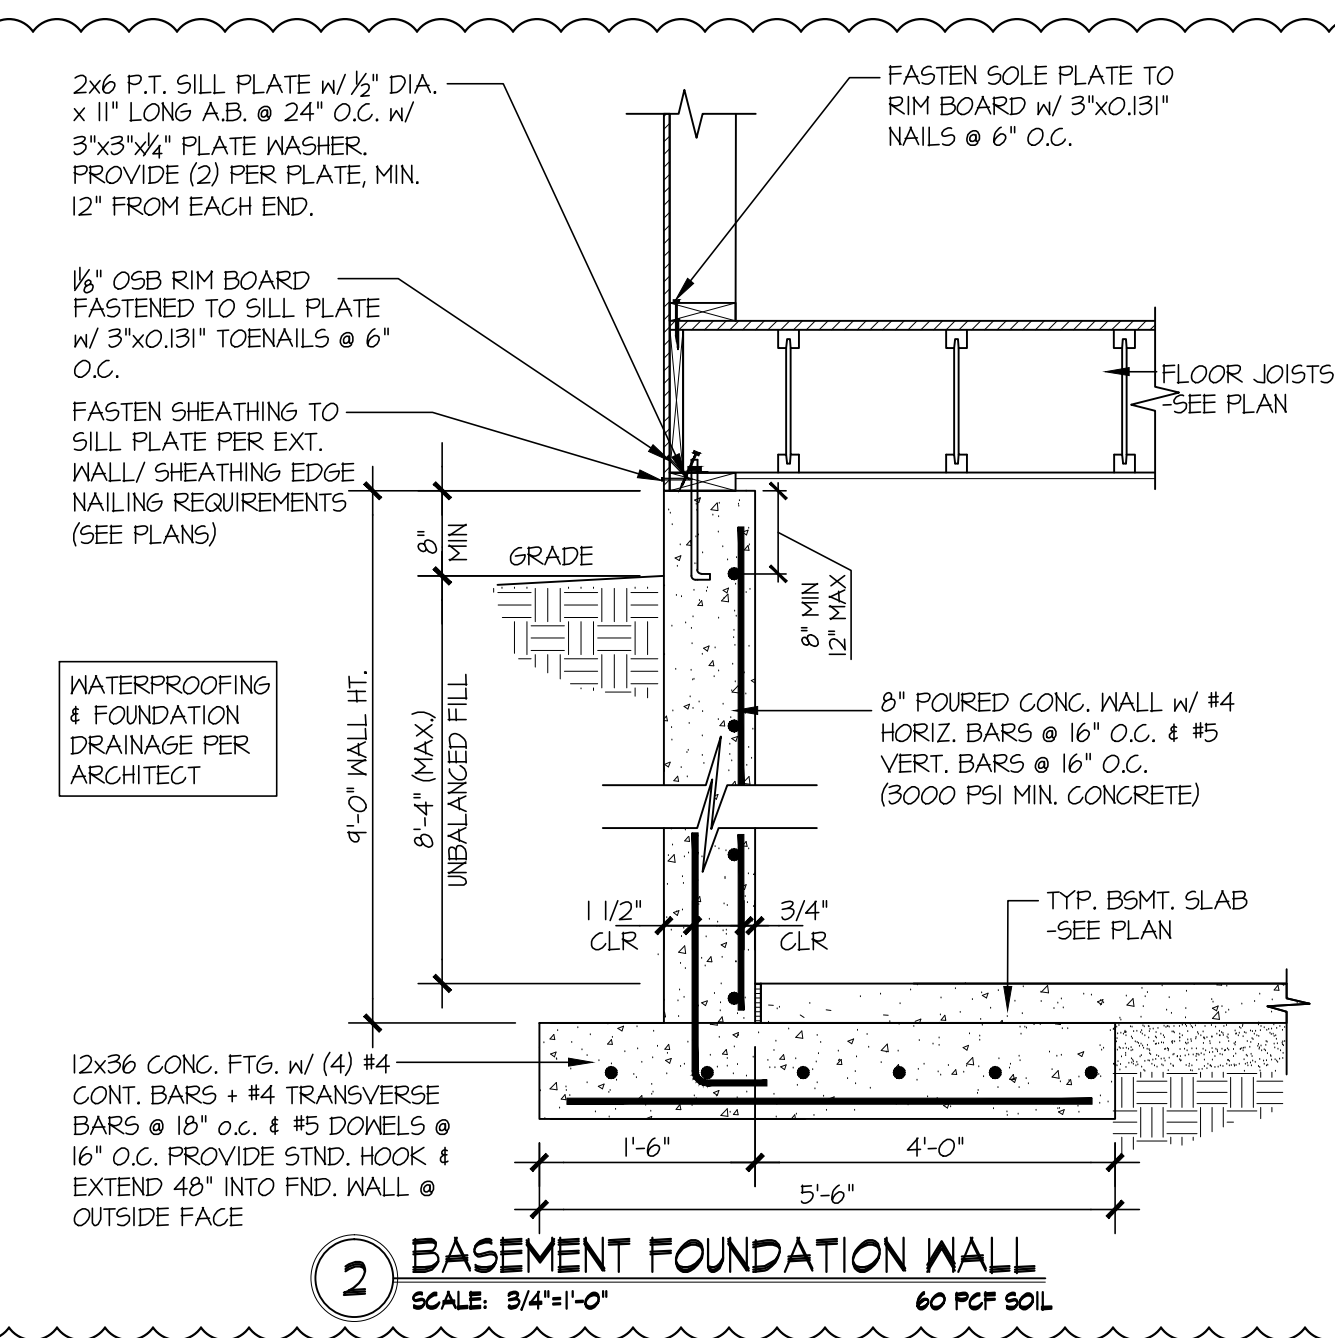


2 BASEMENT FOUNDATION WALL
SCALE: 3/4"=1'-0"
60 PCF SOIL

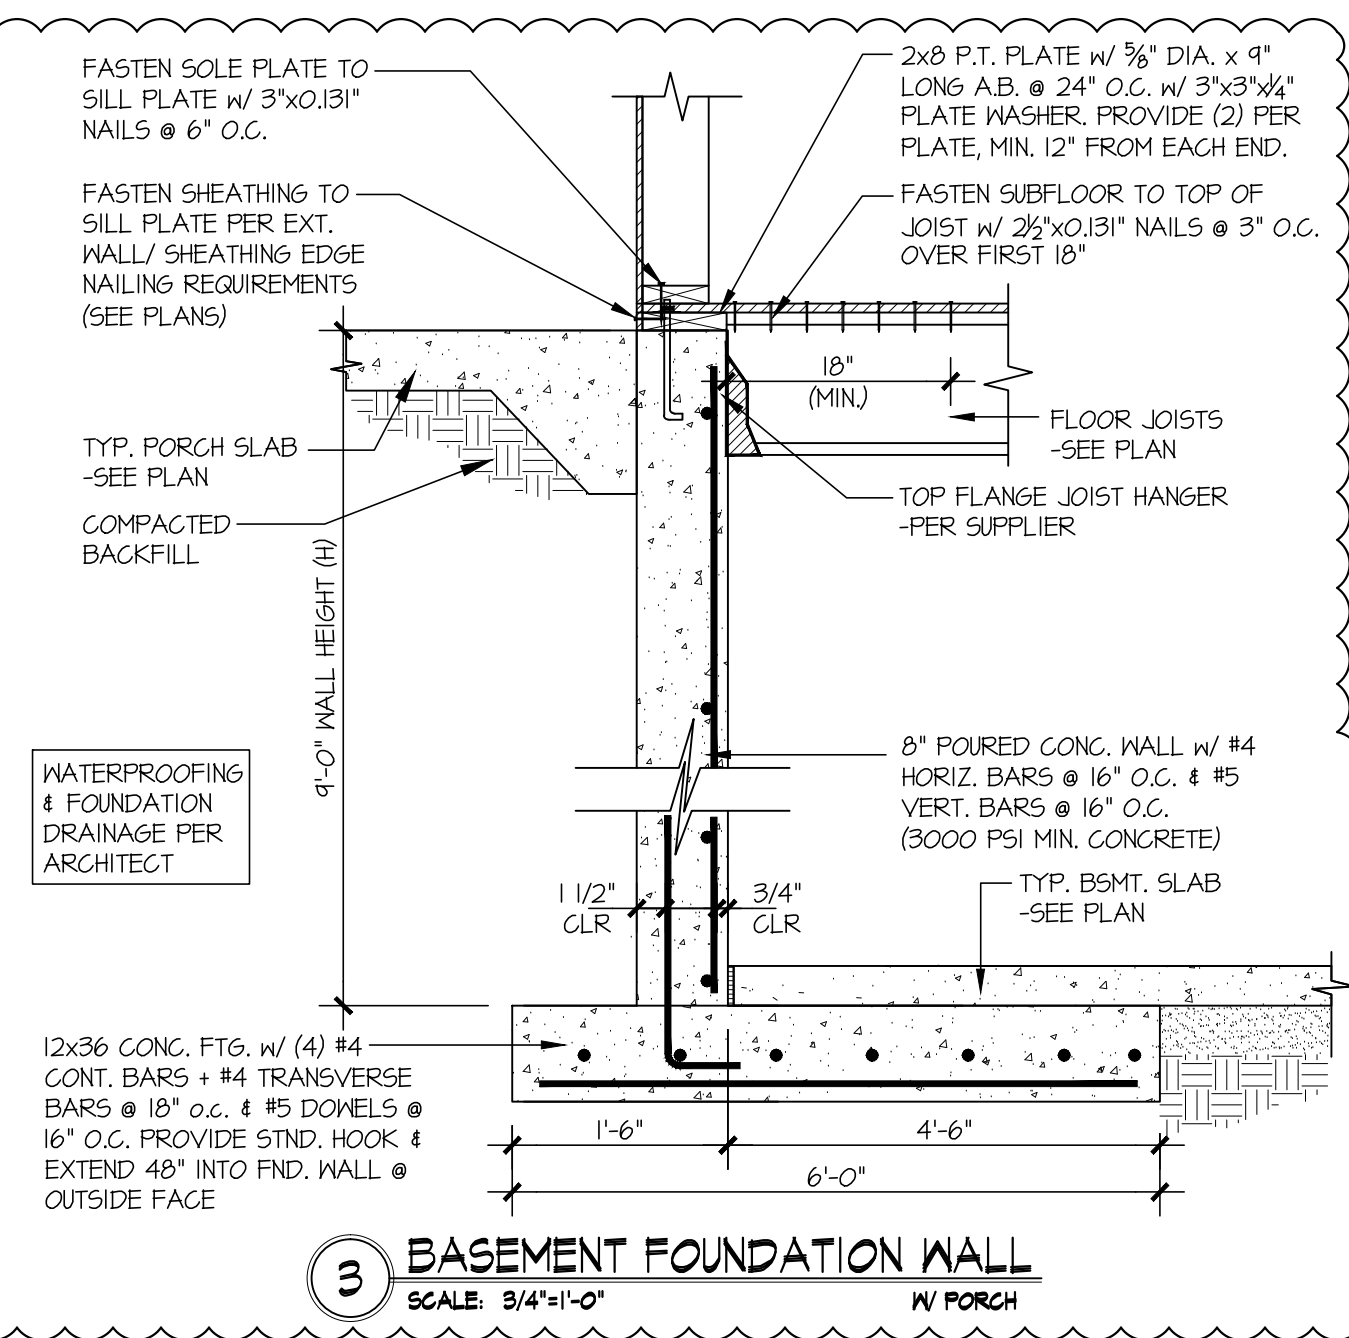


3 BASEMENT FOUNDATION WALL
SCALE: 3/4"=1'-0"
w/ PORCH

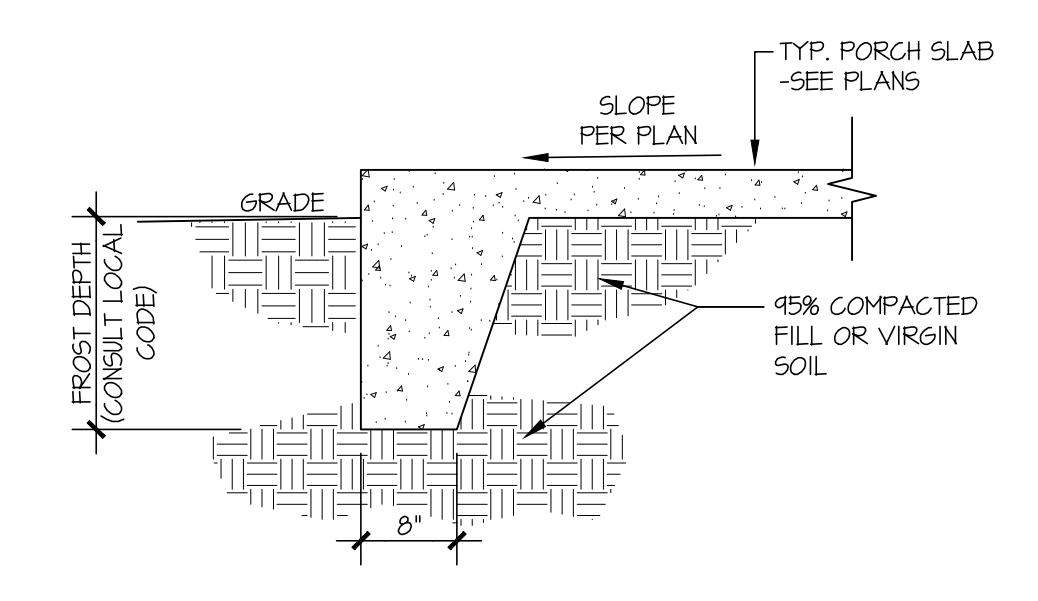


4 TYPICAL FOOTING @ PORCH SLAB
SCALE: 3/4"=1'-0"

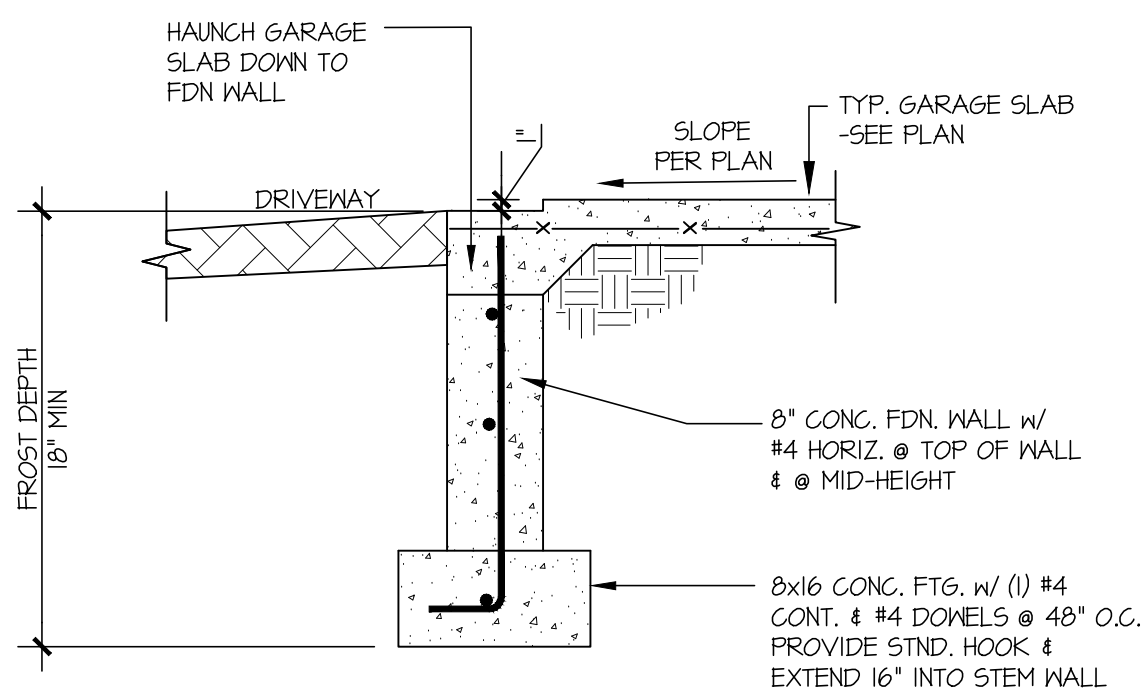


5 TYPICAL CONCRETE FOOTING @ GARAGE DOOR OPENING
SCALE: 3/4"=1'-0"

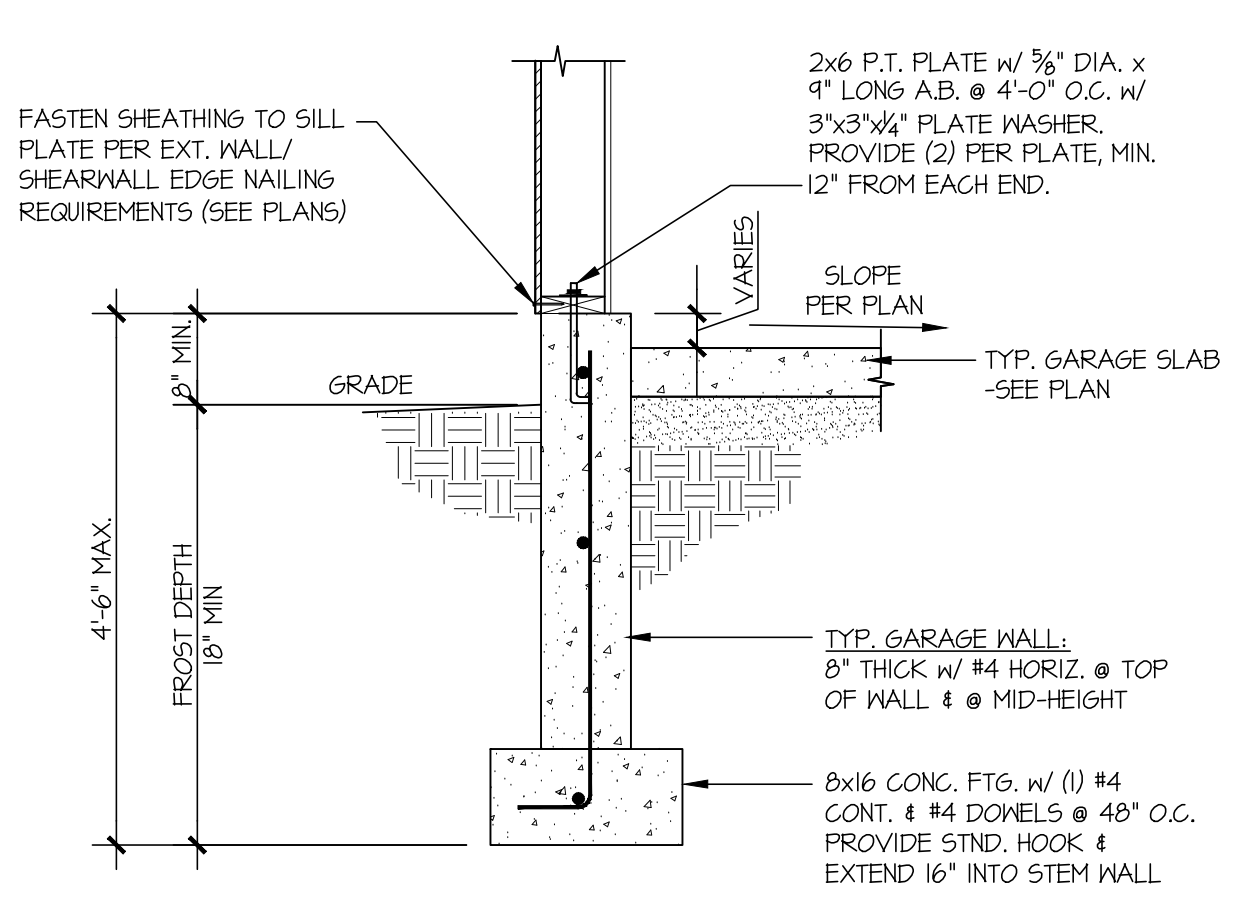


6 TYPICAL EXT. GARAGE FOUNDATION
SCALE: 3/4"=1'-0"

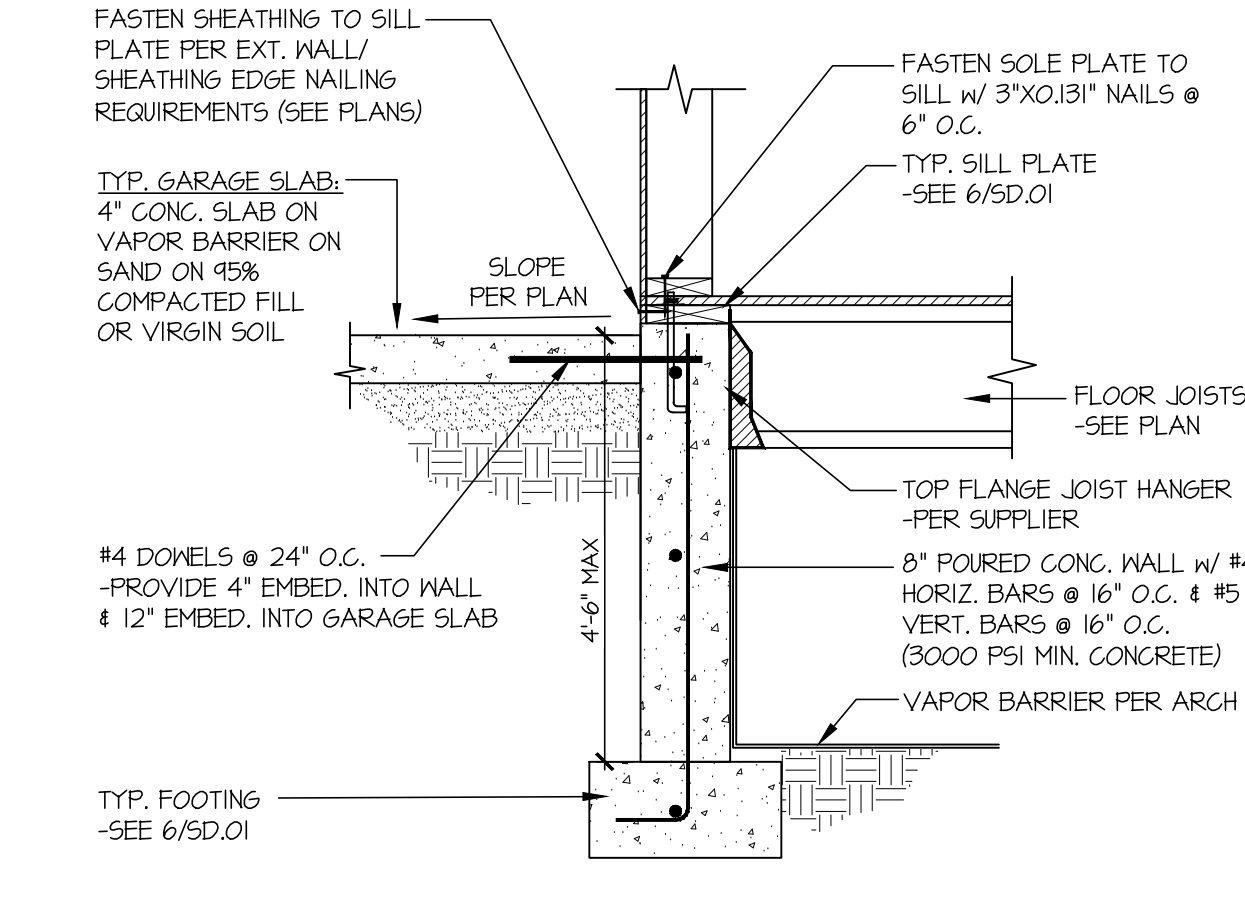


7 TYPICAL CRAWLSPACE FOUNDATION @ GARAGE
SCALE: 3/4"=1'-0"

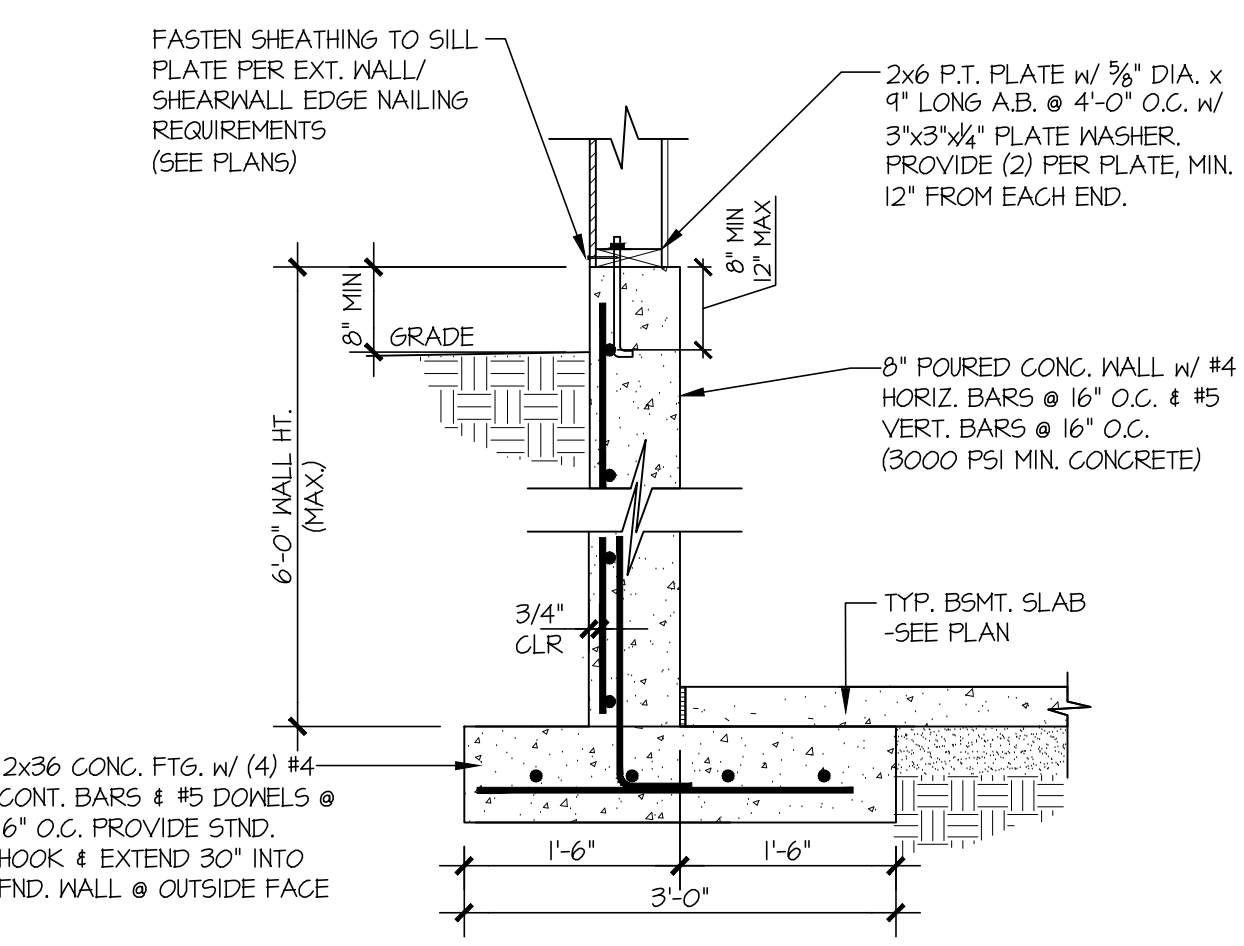


8 CANTILEVERED FOUNDATION WALL
SCALE: 3/4"=1'-0"

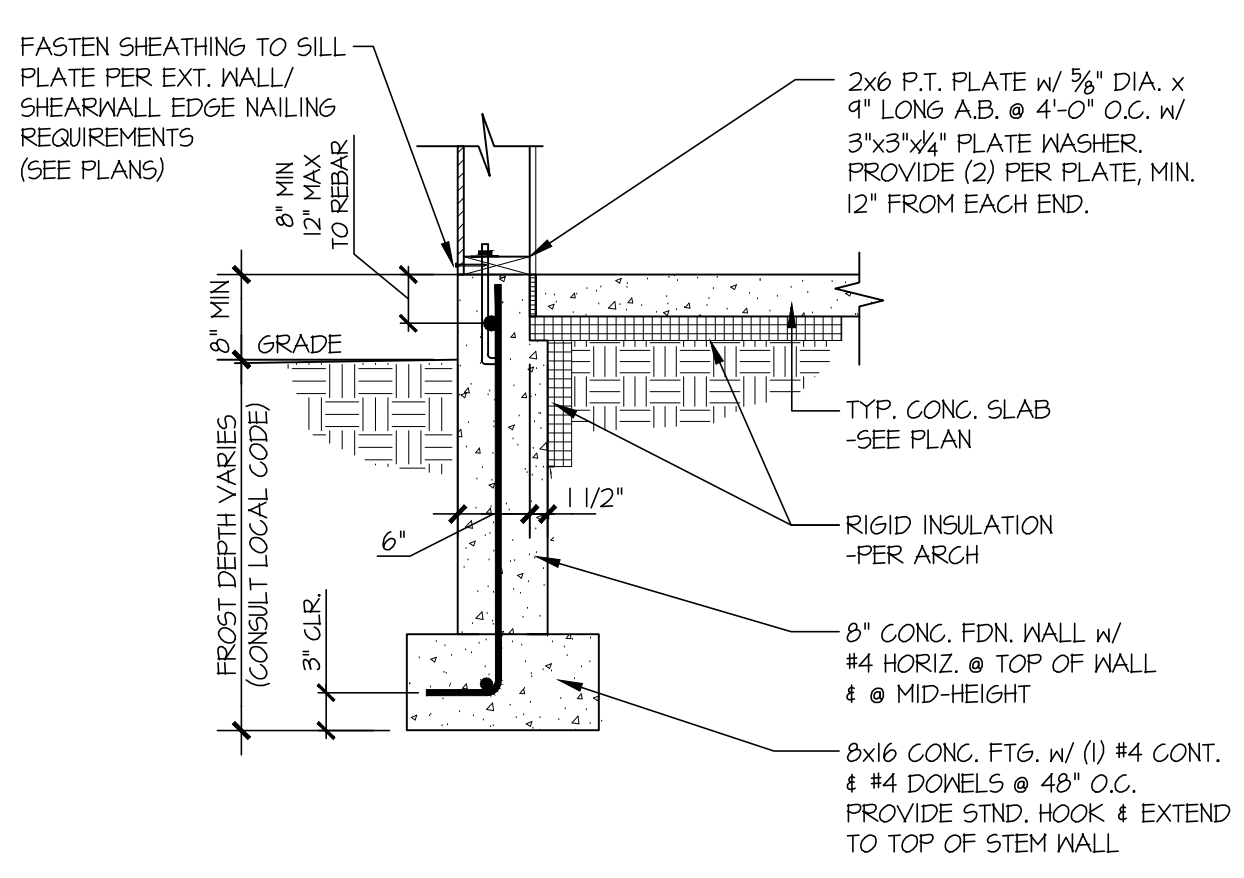


9 TYPICAL SLAB ON GRADE PERIMETER FOOTING
SCALE: 3/4"=1'-0"

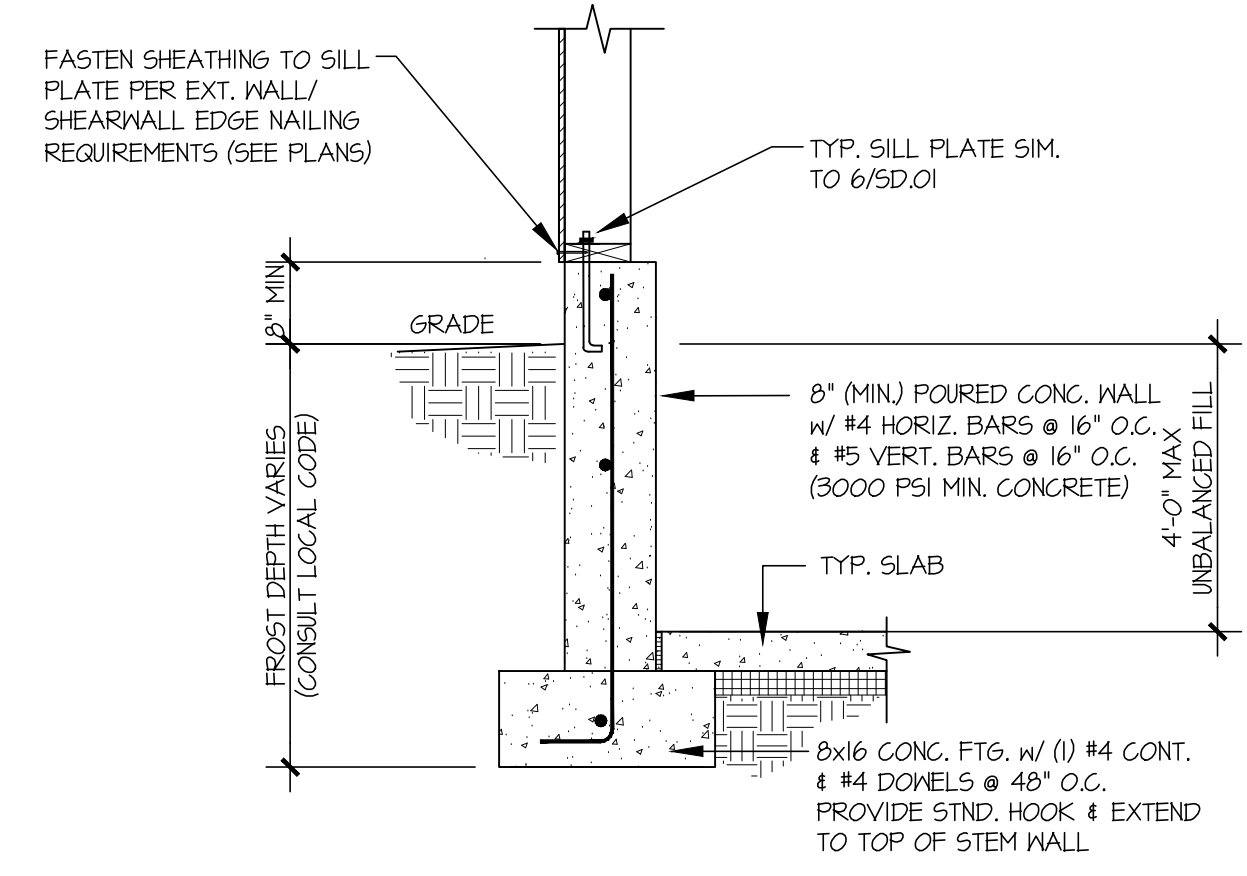


10 WOOD WALL @ LOW GRADE
SCALE: 3/4"=1'-0"

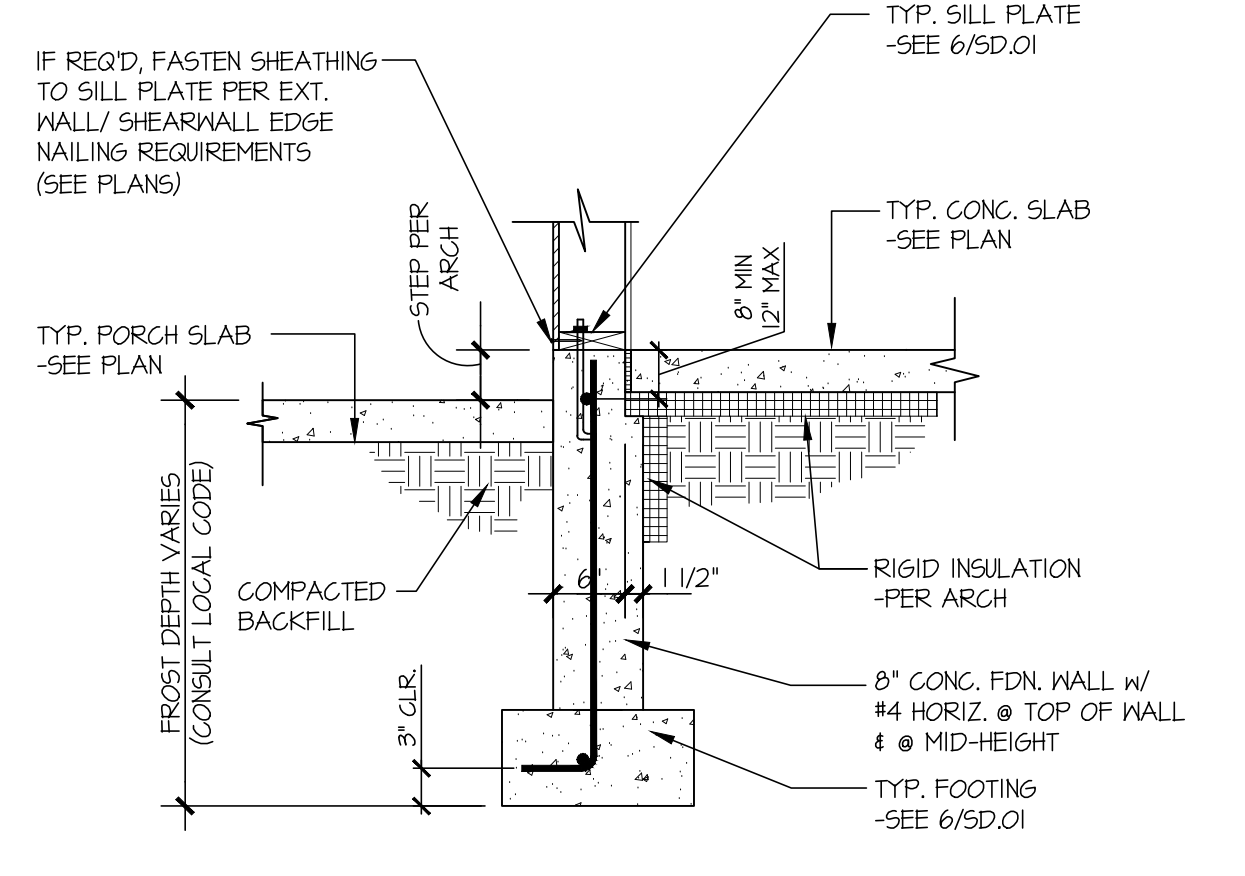

11 TYPICAL SLAB ON GRADE FOOTING @ GARAGE
SCALE: 3/4"=1'-0"

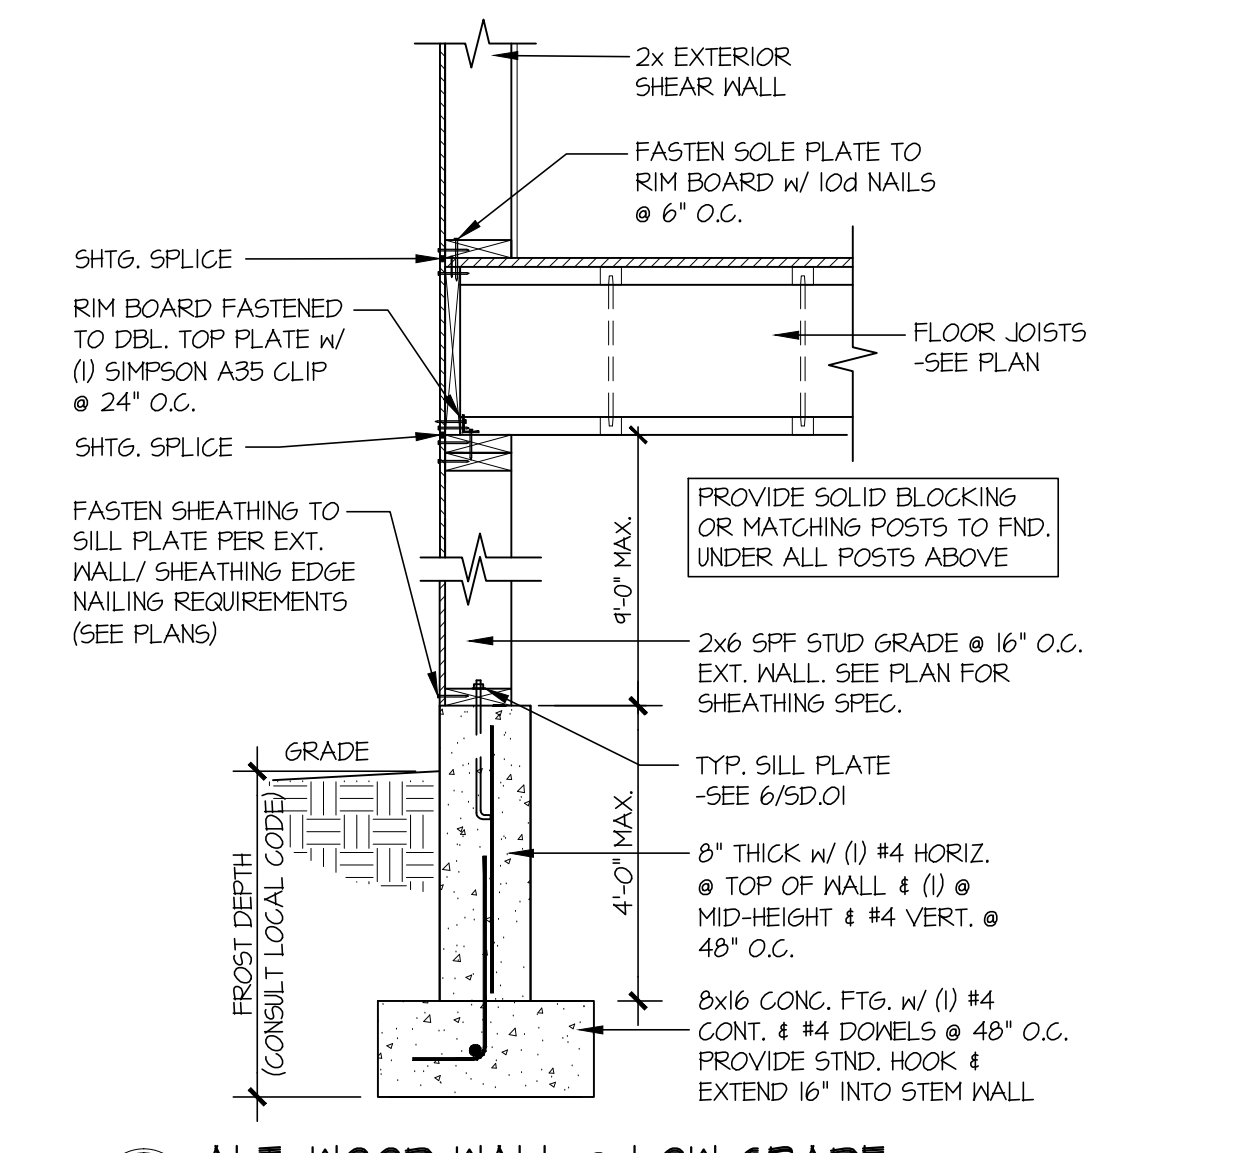

12 ALT. WOOD WALL @ LOW GRADE
SCALE: 3/4"=1'-0"

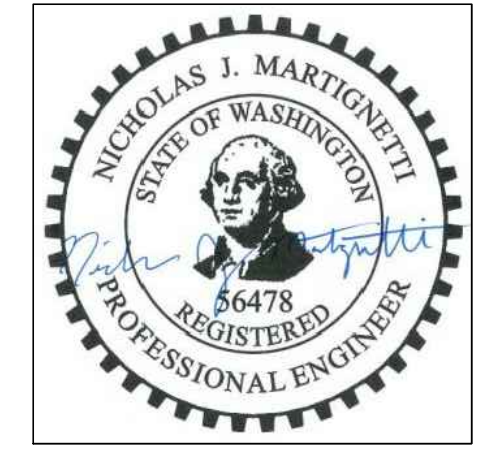

seal:
© copyright: MULHERN & KULP
Structural Engineering, Inc.


MULHERN+KULP
RESIDENTIAL STRUCTURAL ENGINEERING
300 Brookside Ave. Building 4 + Amber, PA 18002
P 215-846-8001 • mulhern@kulp.com

M&K project number:
01A-18094
project mgr: **NJM**
drawn by: **NJD**
issue date: **01-21-19**


REVISIONS:	
date:	initial:
03/08/2019	NJD
ARCH REVISIONS	
02/28/2020	NJD
PLAN REVIEW	

FOUNDATION DETAILS
3440 97TH AVE.
MERCER ISLAND, WASHINGTON


sheet:
SD.01

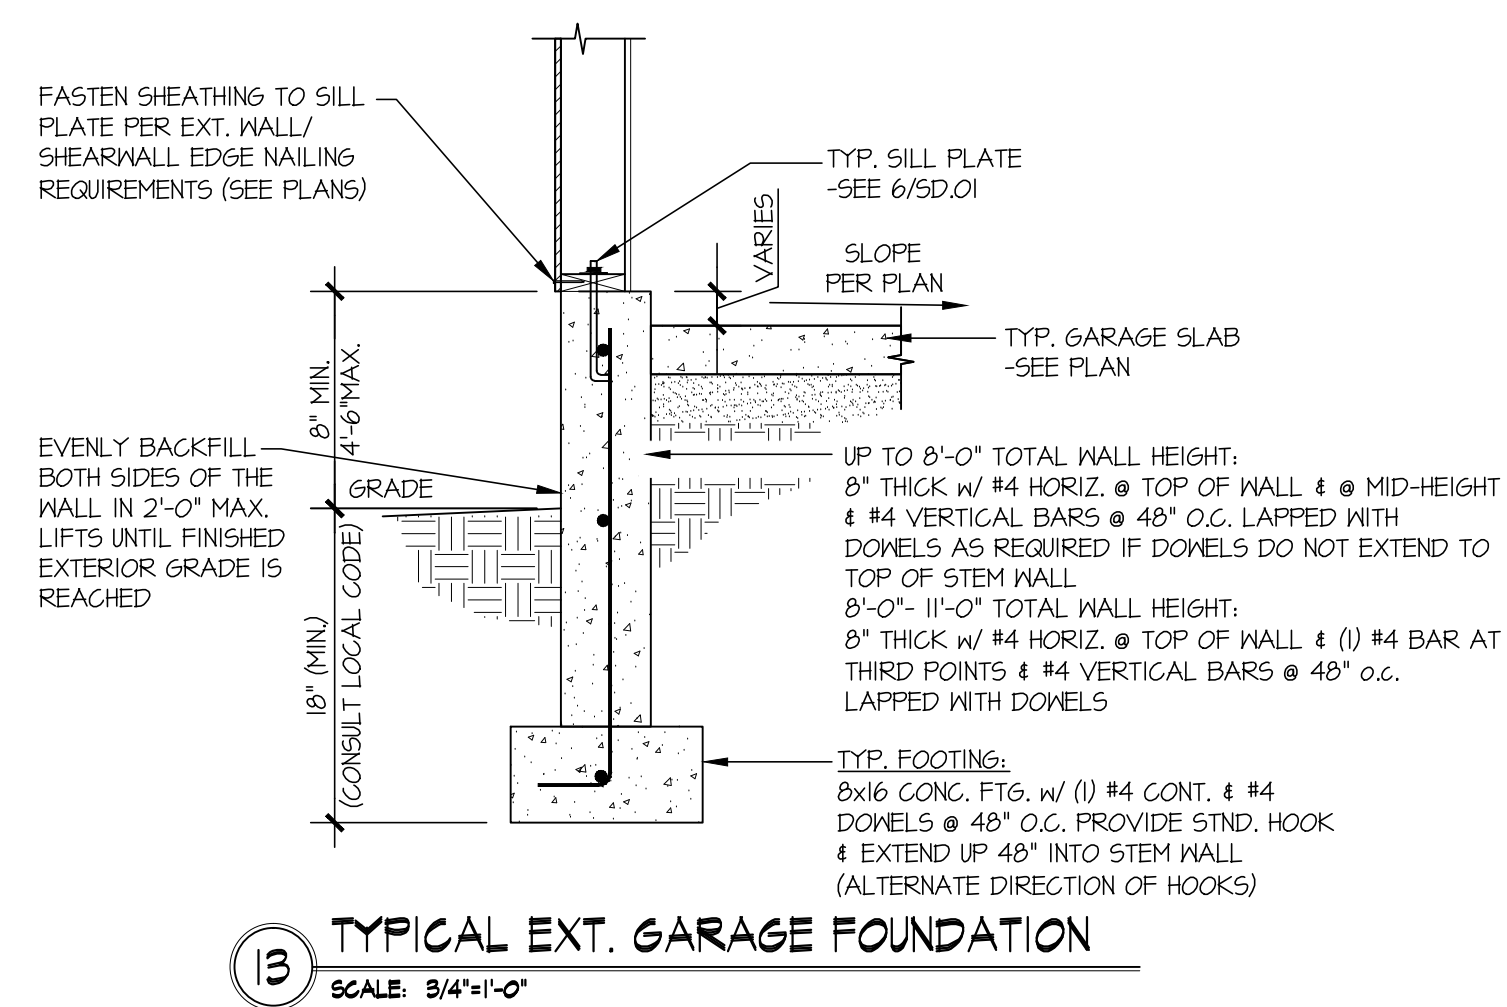


13 TYPICAL EXT. GARAGE FOUNDATION
SCALE: 3/4"=1'-0"

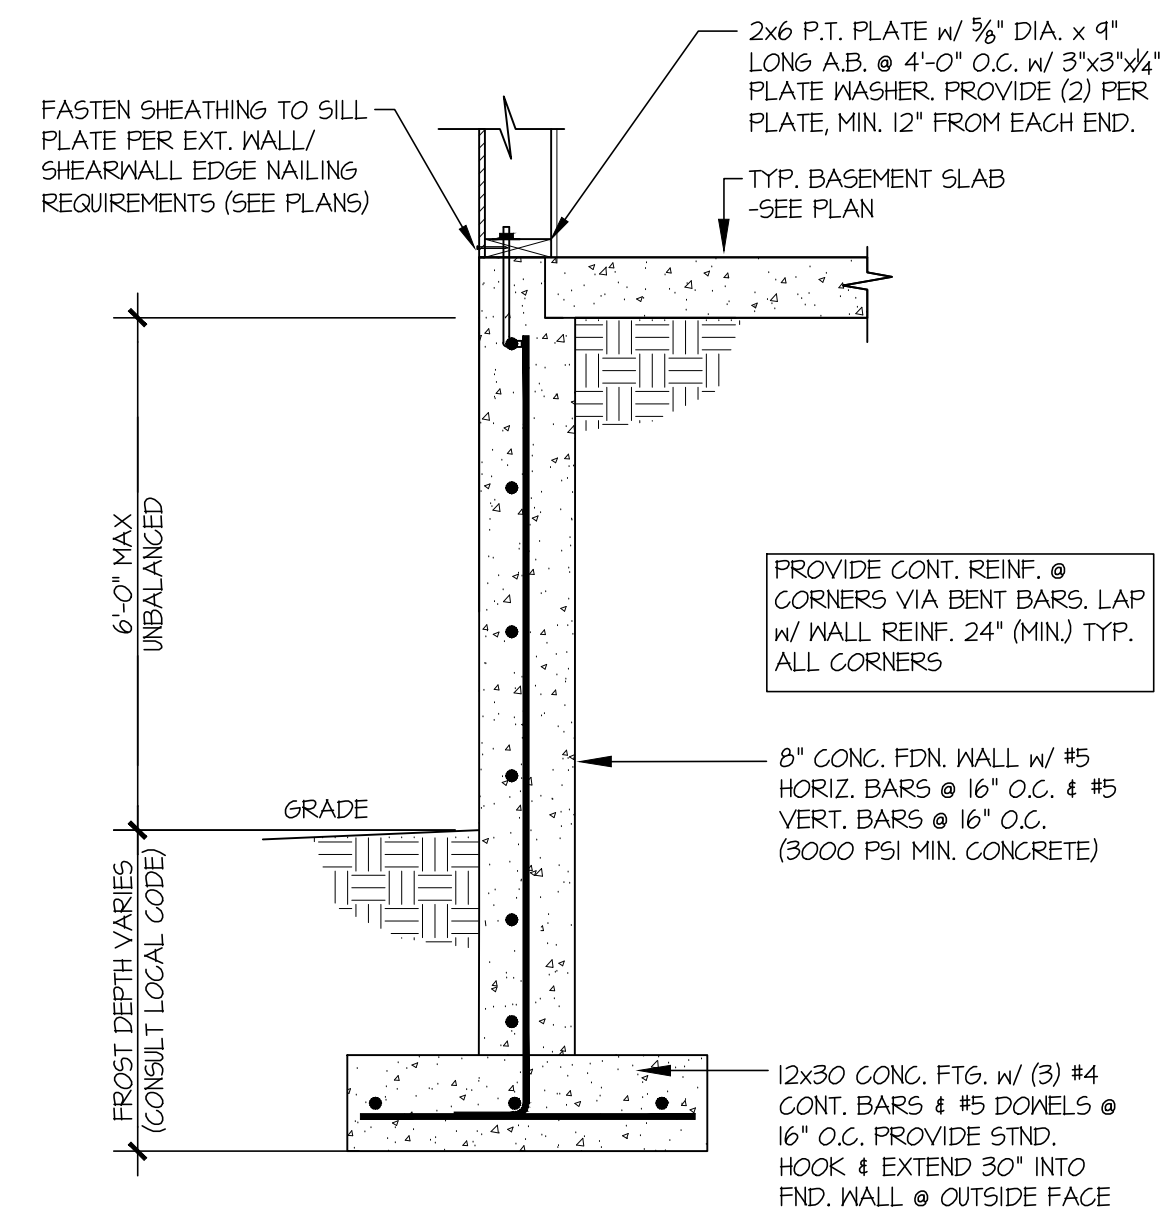


14 SECTION
SCALE: 3/4"=1'-0"

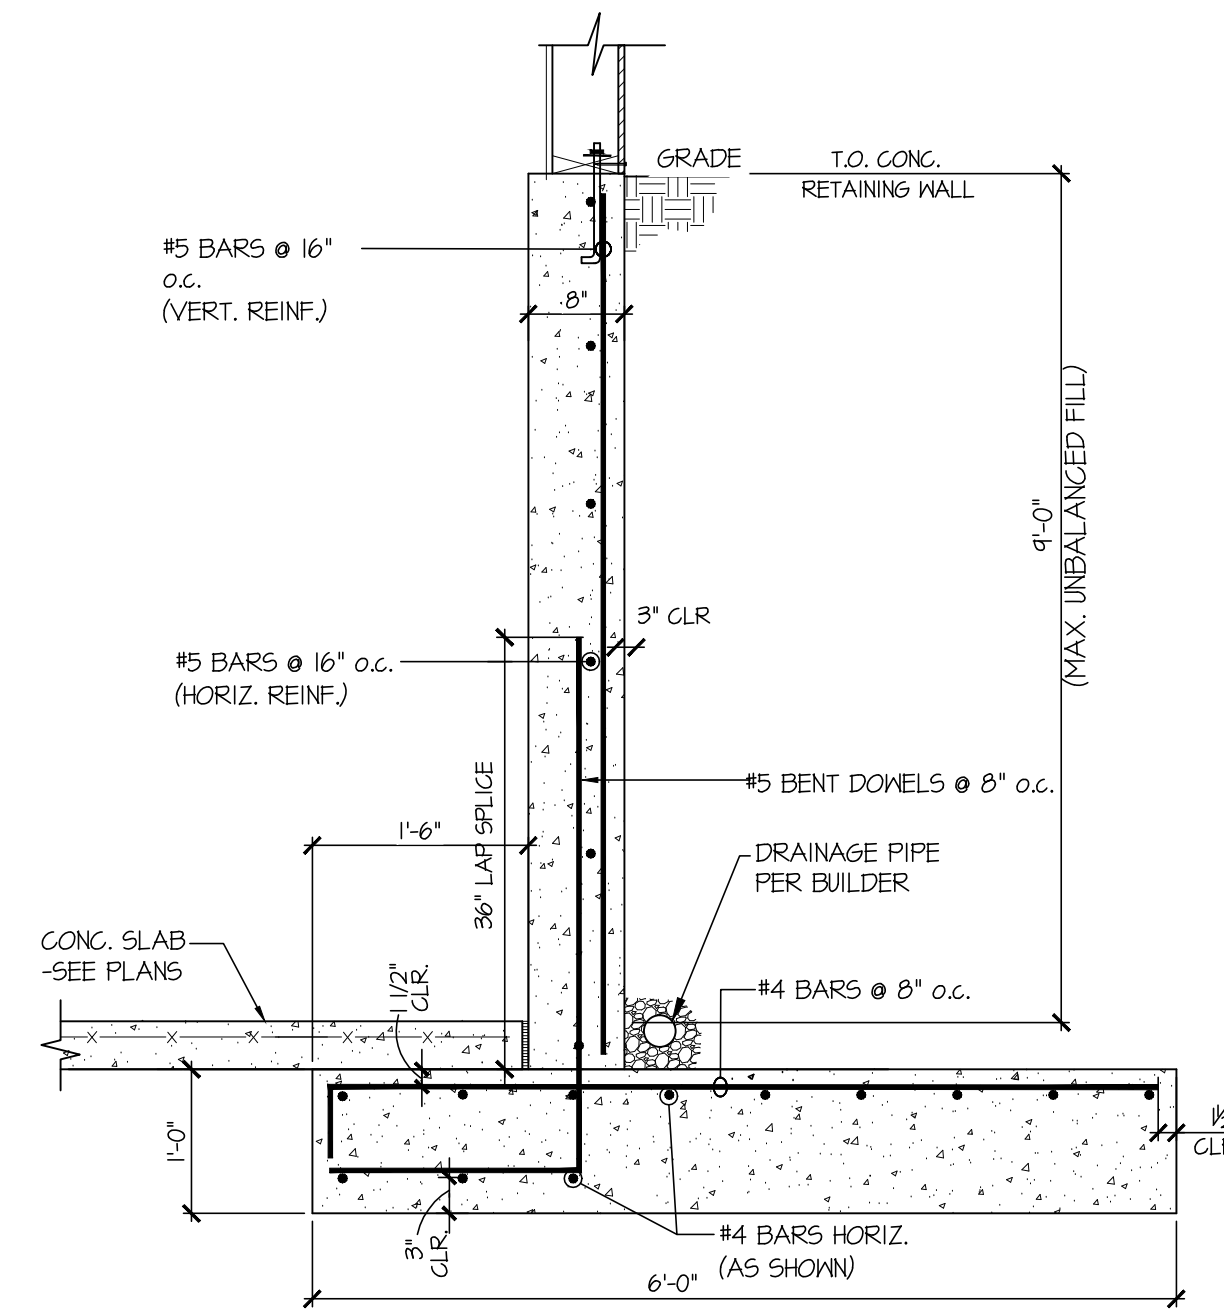


15 CONCRETE RETAINING WALL AT STAIRS
SCALE: 3/4"=1'-0"

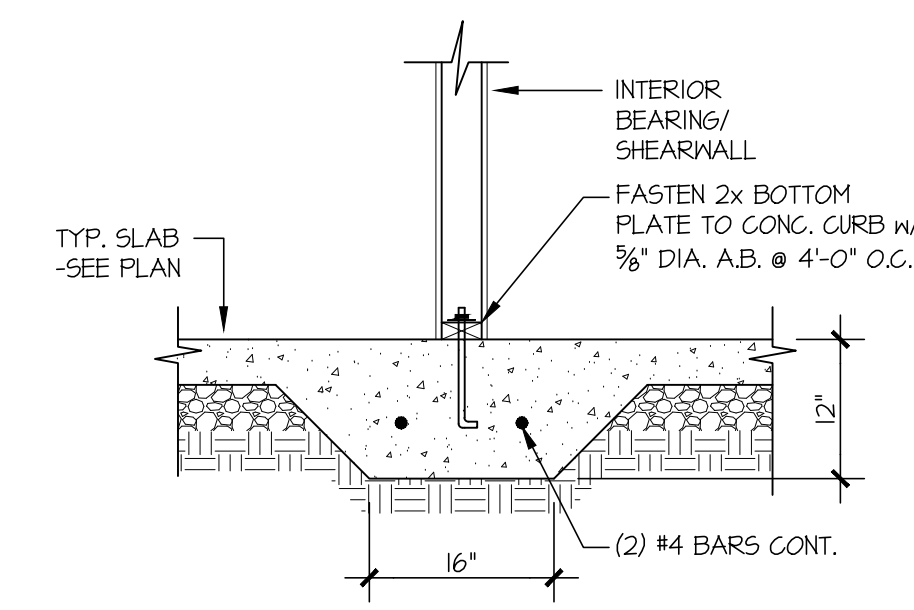


16 TYPICAL THICKENED SLAB @ INTERIOR BEARING WALL
SCALE: 3/4"=1'-0"

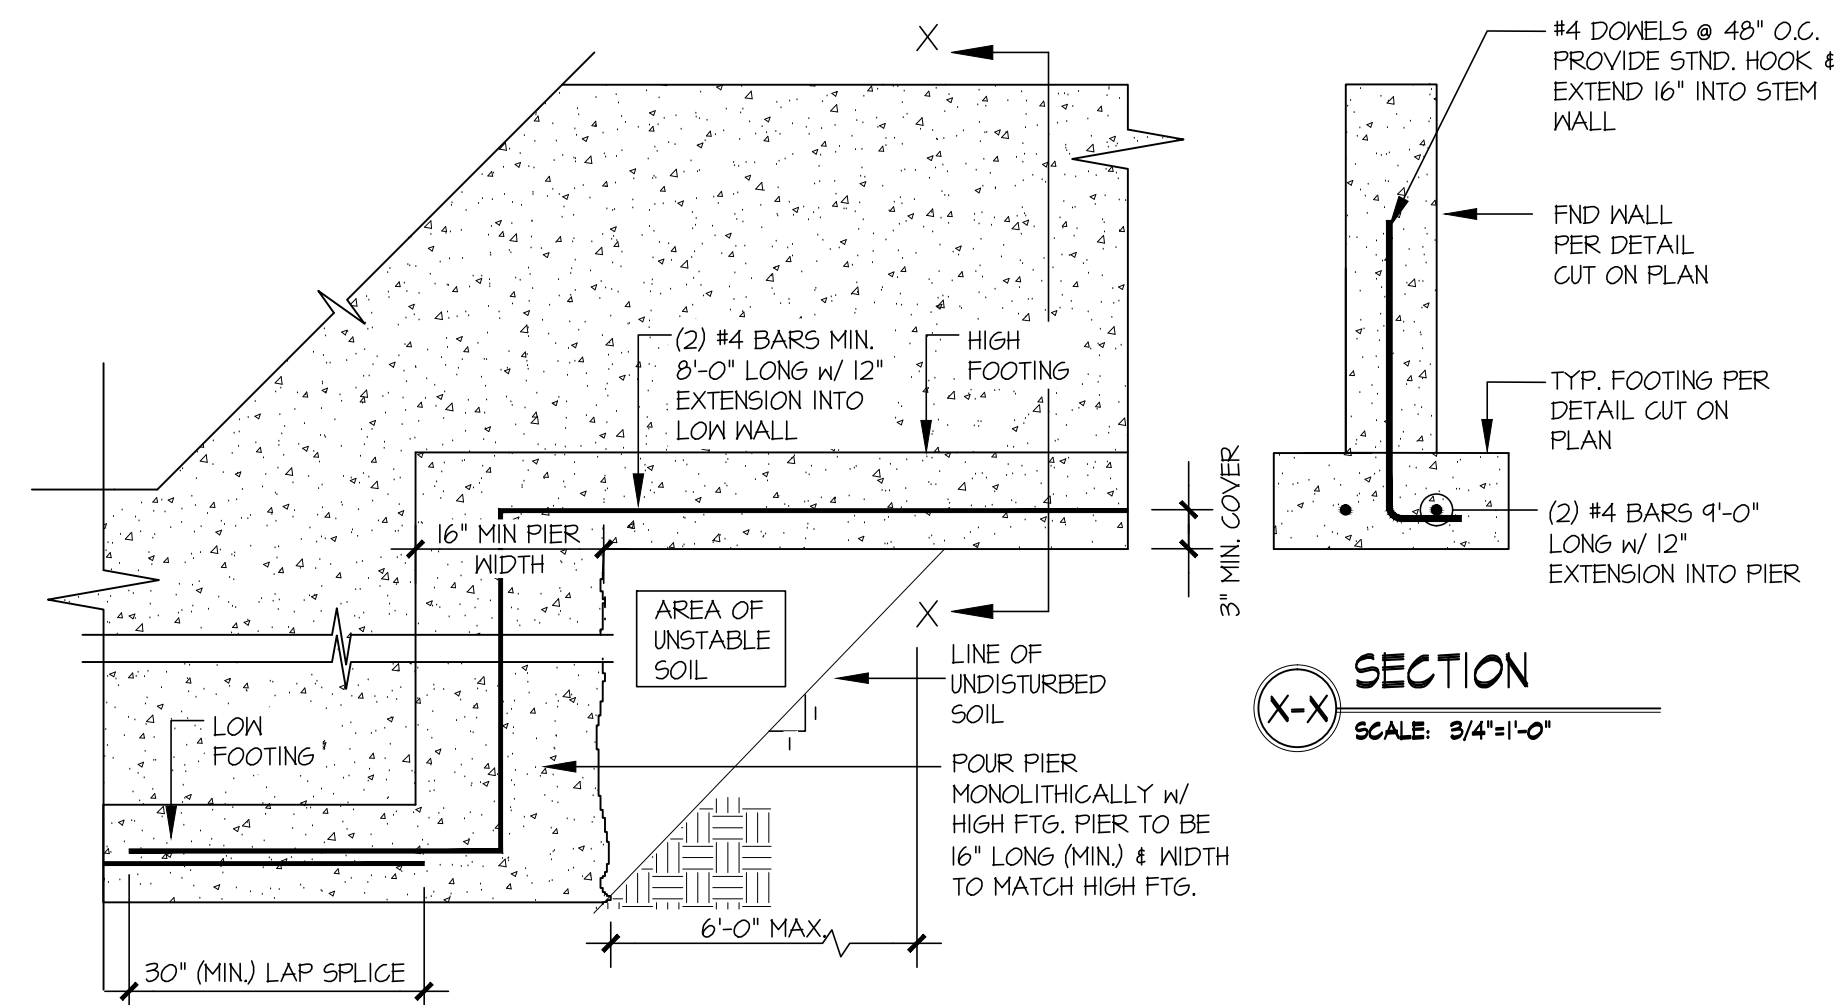


17 SECTION
SCALE: 3/4"=1'-0"

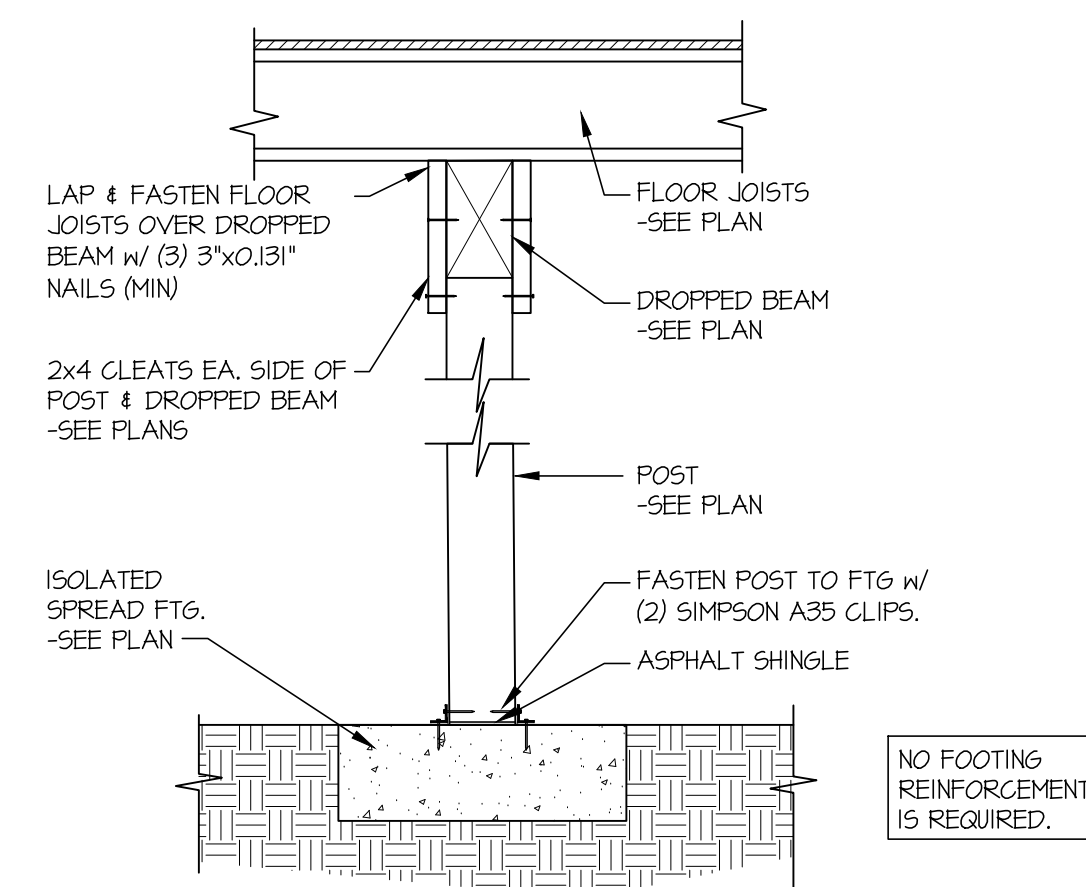

18 TYPICAL CRAWL SPACE FOOTING DETAIL
SCALE: 3/4"=1'-0"

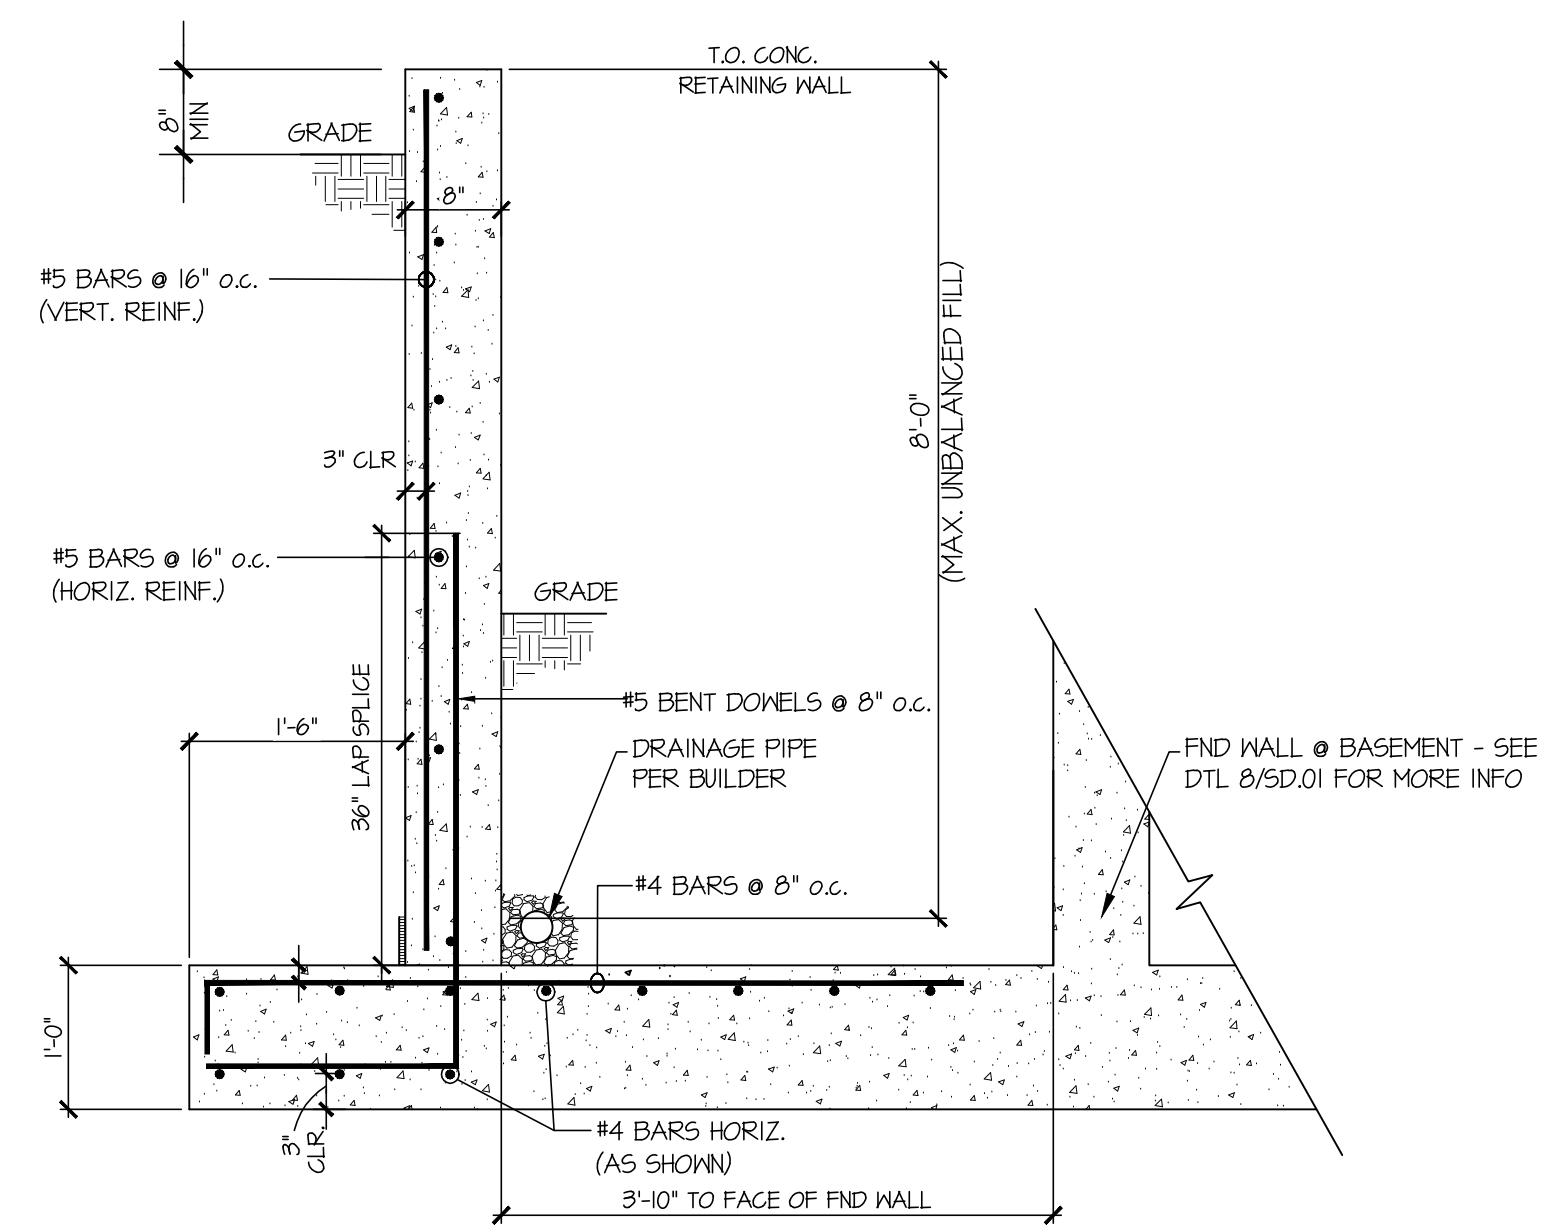

19 CONCRETE RETAINING WALL AT EGRESS
SCALE: 3/4"=1'-0"

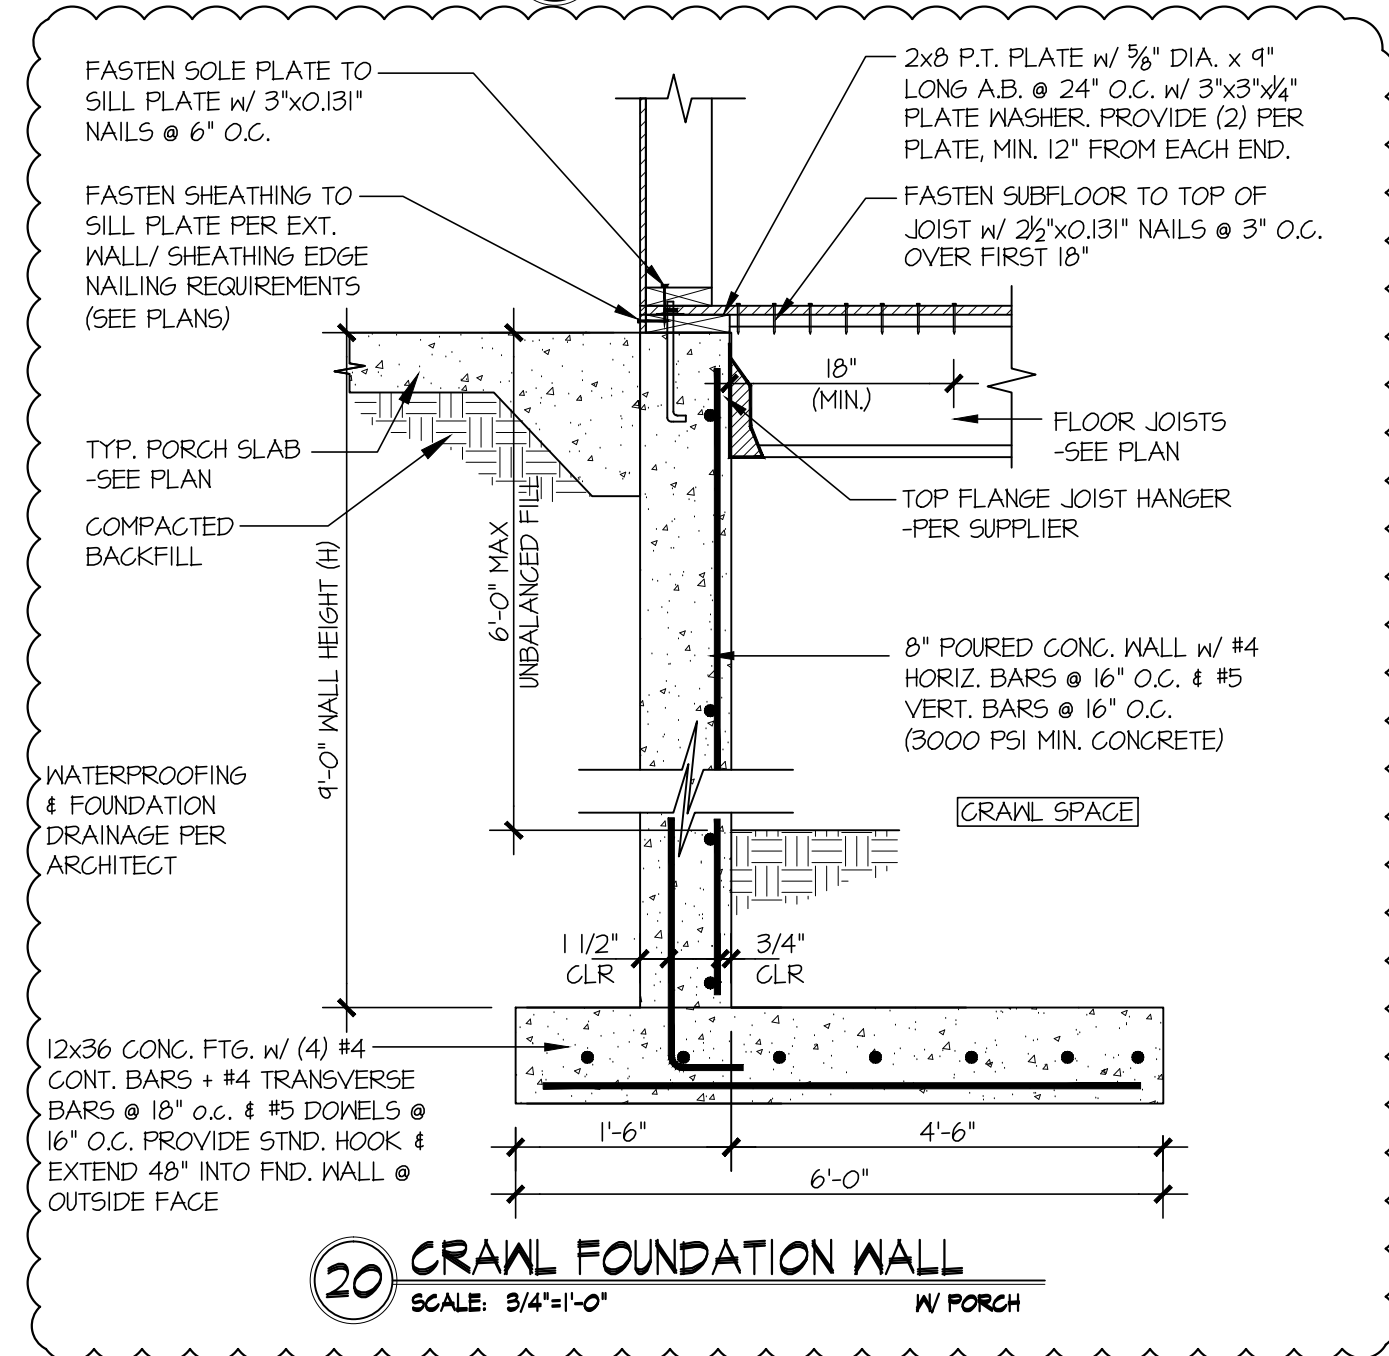

20 CRAWL FOUNDATION WALL w/ PORCH
SCALE: 3/4"=1'-0"

seal:


© copyright: MULHERN & KULP Structural Engineering, Inc.

MULHERN+KULP
RESIDENTIAL STRUCTURAL ENGINEERING
300 Brookside Ave. Building 4 + Amber, PA 18002
P 215-846-8001 • mulhernkulp.com

M&K project number:
01A-18094
project mgr: NJM
drawn by: NJD
issue date: 01-21-19

REVISIONS:	
date:	initial:
03/08/2019	NJD
ARCH REVISIONS	
02/28/2020	NJD
PLAN REVIEW	

FOUNDATION DETAILS
3440 97TH AVE.
MERCER ISLAND, WASHINGTON

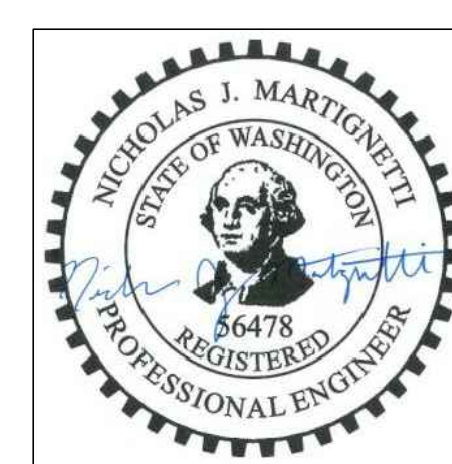

sheet:
SD.02