


2019 07 12
 Markups for membrane per Tony Case, Registered Architect
 tonycase@icloud.com
 206 300-3968

THIS AREA NOT INCLUDED
 IN SCOPE OF WORK
 (submit under future permit)

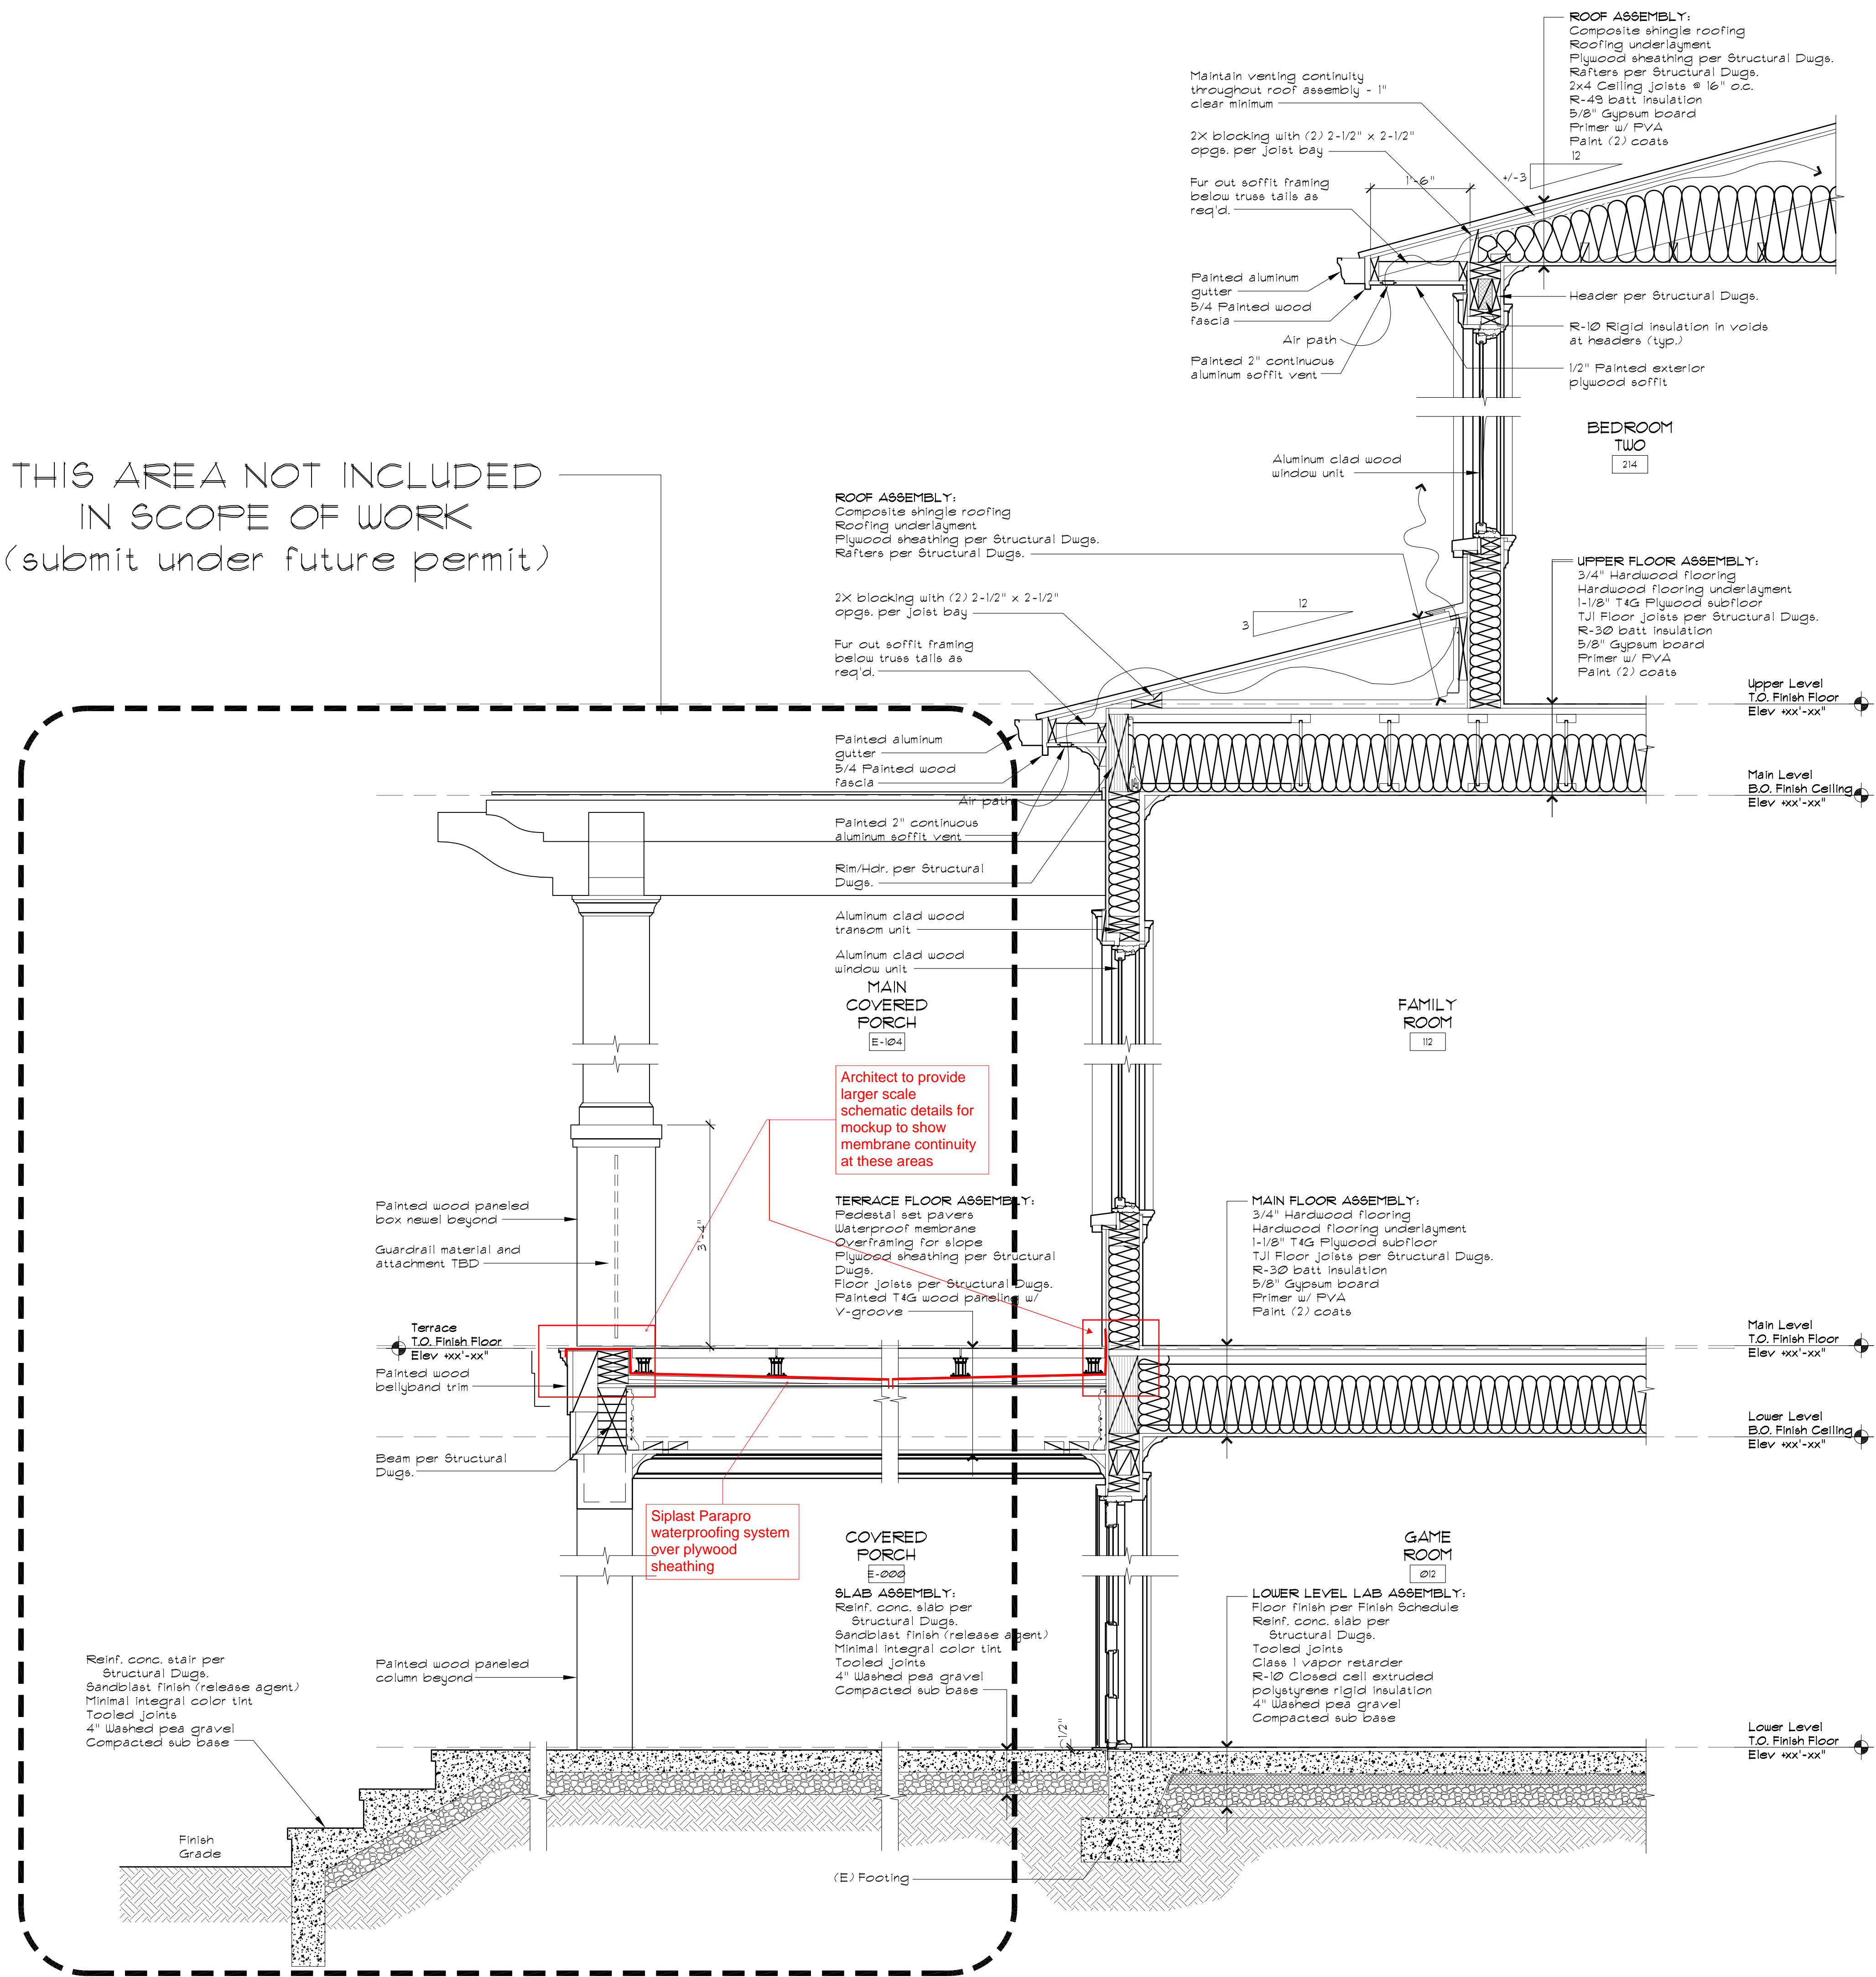

DRAWN BY
 DESIGN BY
 CHECKED BY
 APPROVED BY
 DATE
 December 1, 2018
 REVISIONS

STILLWELL HANSON ARCHITECTS
 46 ETRURIA STREET, SUITE 200
 SEATTLE, WASHINGTON 98109
 206 297 1504 PHONE
 206 297 1543 FAX

LBH RESIDENCE
 7450 NORTH MERCER WAY
 MERCER ISLAND, WASHINGTON

WALL SECTIONS

A-4.1

1 WALL SECTION
 Scale 3/4" = 1'-0"