



PROJECT DATA		PROPERTY DATA		ENERGY DATA	
<b>OWNER</b> LAI JONATHAN.L@DCLMANAGEMENT.COM 7505 92ND AVE SE MERCER ISLAND, WA 98040		<b>PROJECT ADDRESS</b> 7505 92ND AVE SE MERCER ISLAND, WA 98040		<b>PRESCRIPTIVE OPTION (ENERGY CREDIT 1A)</b>  <b>INSULATION VALUES</b> SLAB PERIMETER (FIRST 24") R-10 BELOW GRADE WALLS (EXTERIOR) R-10 BELOW GRADE WALLS (INTERIOR) R-21 ABOVE GRADE WALLS R-21 <b>FLOORS</b> ATTICS W/ 1" CLEAR VENT SPACE R-49 ADV FRAMED ATTICS W/ 1" CLEAR VAULTED JOISTS/RAFTERS R-38 <b>FENESTRATION</b> OVERHEAD GLAZING U-0.28 UP TO 90" U-0.50  *ALL NEW FENESTRATION TO BE NFRC CERTIFIED	
<b>ARCHITECT</b> JOSH PS 5406 SW BEACH DRIVE TER SEATTLE, WA 98116 SDCI ID: AC58960 CONTACT: S. JOSHUA BRINCKO (206 708 9933) JOSH@JOSHARCH.COM		<b>ZONING DESIGNATION</b> R-9.6  <b>19.02.020.E HEIGHT LIMIT</b> 30' FROM AVERAGE GRADE TO HIGHEST POINT OF ROOF (5' BONUS FOR CHIMNEYS ETC.)  <b>*FENCES MAX 72" HIGH (60" LATTICE ALLOWED UP TO 90")</b>			
<b>STRUCTURAL ENGINEER</b> SWENSON SAY FAGET 2124 3RD AVE #100 SEATTLE, WA 98121 CONTACT: KARL ROSMAN (206 443 6212) KROSMAN@SWENSONSAYFAGET.COM		<b>SETBACKS</b> FRONT: 20' NORTH SIDE: 7.5' SOUTH SIDE: 13.43' REAR: 25'			
<b>CONTRACTOR OWNER</b>  <b>GEOTECHNICAL ENGINEER</b> PANGELO 3213 EASTLAKE AVE E, SUITE B SEATTLE, WA 98102 CONTACT: SIEW L. TAN, P.E. (206 262 0370)		<b>LOT AREA</b> 11447 SF  <b>ASSESSOR'S TAX NUMBER</b> 257950-0188  <b>LEGAL DESCRIPTION</b> FLOODS LAKE SIDE TRS LOT "1" MERCER ISLAND SHORT PLAT NO 95-0521 REC NO 9602019001 SD SHORT PLAT DAF - POR OF LOT 2 BLK 5 OF FLOODS LAKE SIDE TRS - AKA LOT 4 OF THE SULLIVAN SEGREGATION APPROVED SUBD 03-22-63 OF CITY OF MERCER ISLAND REC NO 6903100404 PLAT BLOCK: 5 PLAT LOT: 2			
TABLE OF CONTENTS		CONSTRUCTION DATA		VENTILATION DATA	
SHT	DESCRIPTION	SCOPE OF WORK	REPLACE EXISTING DECK WITH PAVERS; ADD PATIO AND EXTERIOR KITCHENETTE	SYSTEM DESIGN	THIS SYSTEM IS DESIGN/BUILD (IRC CH. 15)
A1.0	SITE PLAN + PROJECT INFORMATION	AREA SUMMARY	<b>19.02.020.D.1.b MAX GROSS FLOOR AREA</b> (40%) 11,447 = 4578.8 SF MAX ALLOWED -4,500 SF EXISTING	SYSTEM CRITERIA	MINIMUM OF .35 AIR EXCHANGES PER HOUR FOR ALL HABITABLE ROOMS. MAXIMUM OF .50 AIR EXCHANGES PER HOUR FOR ALL HABITABLE ROOMS.
A1.1	GENERAL NOTES	<b>CONDITIONED SPACE</b>	LOWER LEVEL 660 SQ FT MAIN LEVEL 1940 SQ FT UPPER LEVEL 1560 SQ FT TOTAL 4160 SQ FT	SYSTEM COMPONENTS	TIMER INTAKE GRILL & DUCTING (FROM EXTERIOR) MOTORIZED DAMPER ELECTRIC AIR TEMPERING UNIT INTAKE BLOWER DISTRIBUTION DUCTING (HABITABLE ROOMS) DISTRIBUTION GRILLS (HABITABLE ROOMS) ELECTRIC EXHAUST FAN EXHAUST DUCTING EXHAUST PORT WITH BACK DRAFT DAMPER
A1.2	TESC	<b>UNCONDITIONED SPACE</b>	LOWER LEVEL 630 SQ FT TOTAL 630 SQ FT	SYSTEM FUNCTION	INTAKE BLOWER, AIR TEMPERING UNIT, AND EXHAUST FAN TO BE CONNECTED TO TIMER FOR SYNCHRONIZED, INTERMITTENT USE THROUGHOUT EACH DAY. FRESH AIR FROM THE EXTERIOR IS PULLED THROUGH AIR TEMPERING UNIT, THEN DISTRIBUTED THROUGH DUCTING TO ALL HABITABLE ROOMS. A BALANCED QUANTITY OF AIR IS SIMULTANEOUSLY EVACUATED FROM THE INTERIOR W/ THE EXHAUST FAN DUCTED TO EXT
A2.0	FLOOR PLAN	<b>SEE SHEET A1.0a FOR HARDSCAPE AND LOT COVERAGE</b>			
A3.0	ELEVATIONS	AVG GRADE CALC: WEIGHTED MIDPOINT SUM = 3850.9+3336.48+862.4+1921.38+1466.86+7713.02+5048.68+863.52+1211.74+820.4+2665.73+1259.4+6371.84+1676.8+2515.2+2478+817.6= 44,879.95 TOTAL LENGTH = 19.4+16.8+9.3+7.1+39.3+24.7+4.2+5.9+4+12.7+6+30.4+8+12+12+4 = 219.8 WEIGHTED SUM/LENGTH = 44879.95/219.8 = 204.19' AVERAGE GRADE			
A8.0	DETAILS				
S1.0-1.1	STRUCT GENERAL NOTES				
SSK	FOUNDATION PLAN AND ROOF FRAMING				



1 VICINITY MAP  
NOT TO SCALE

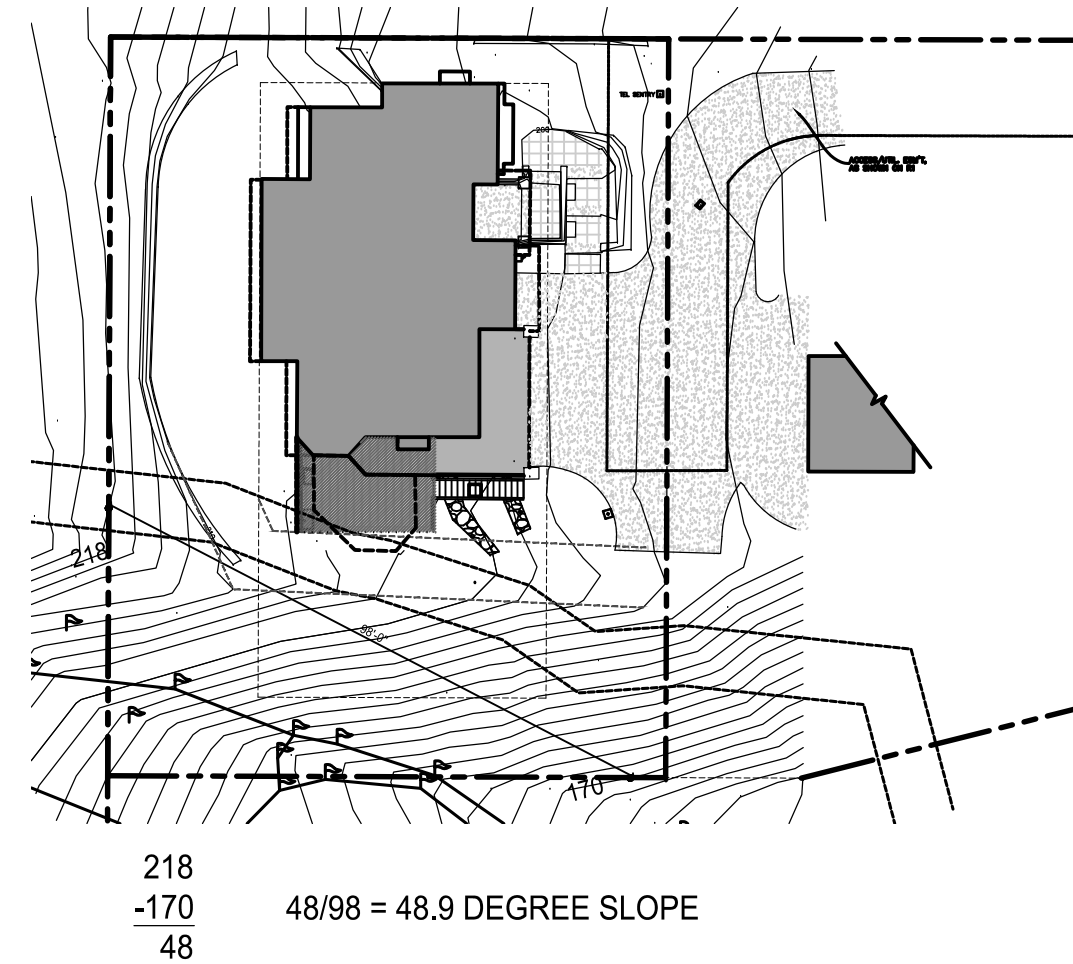

3 SLOPE DIAGRAM/CALC  
SCALE: 1/32" = 1'-0"

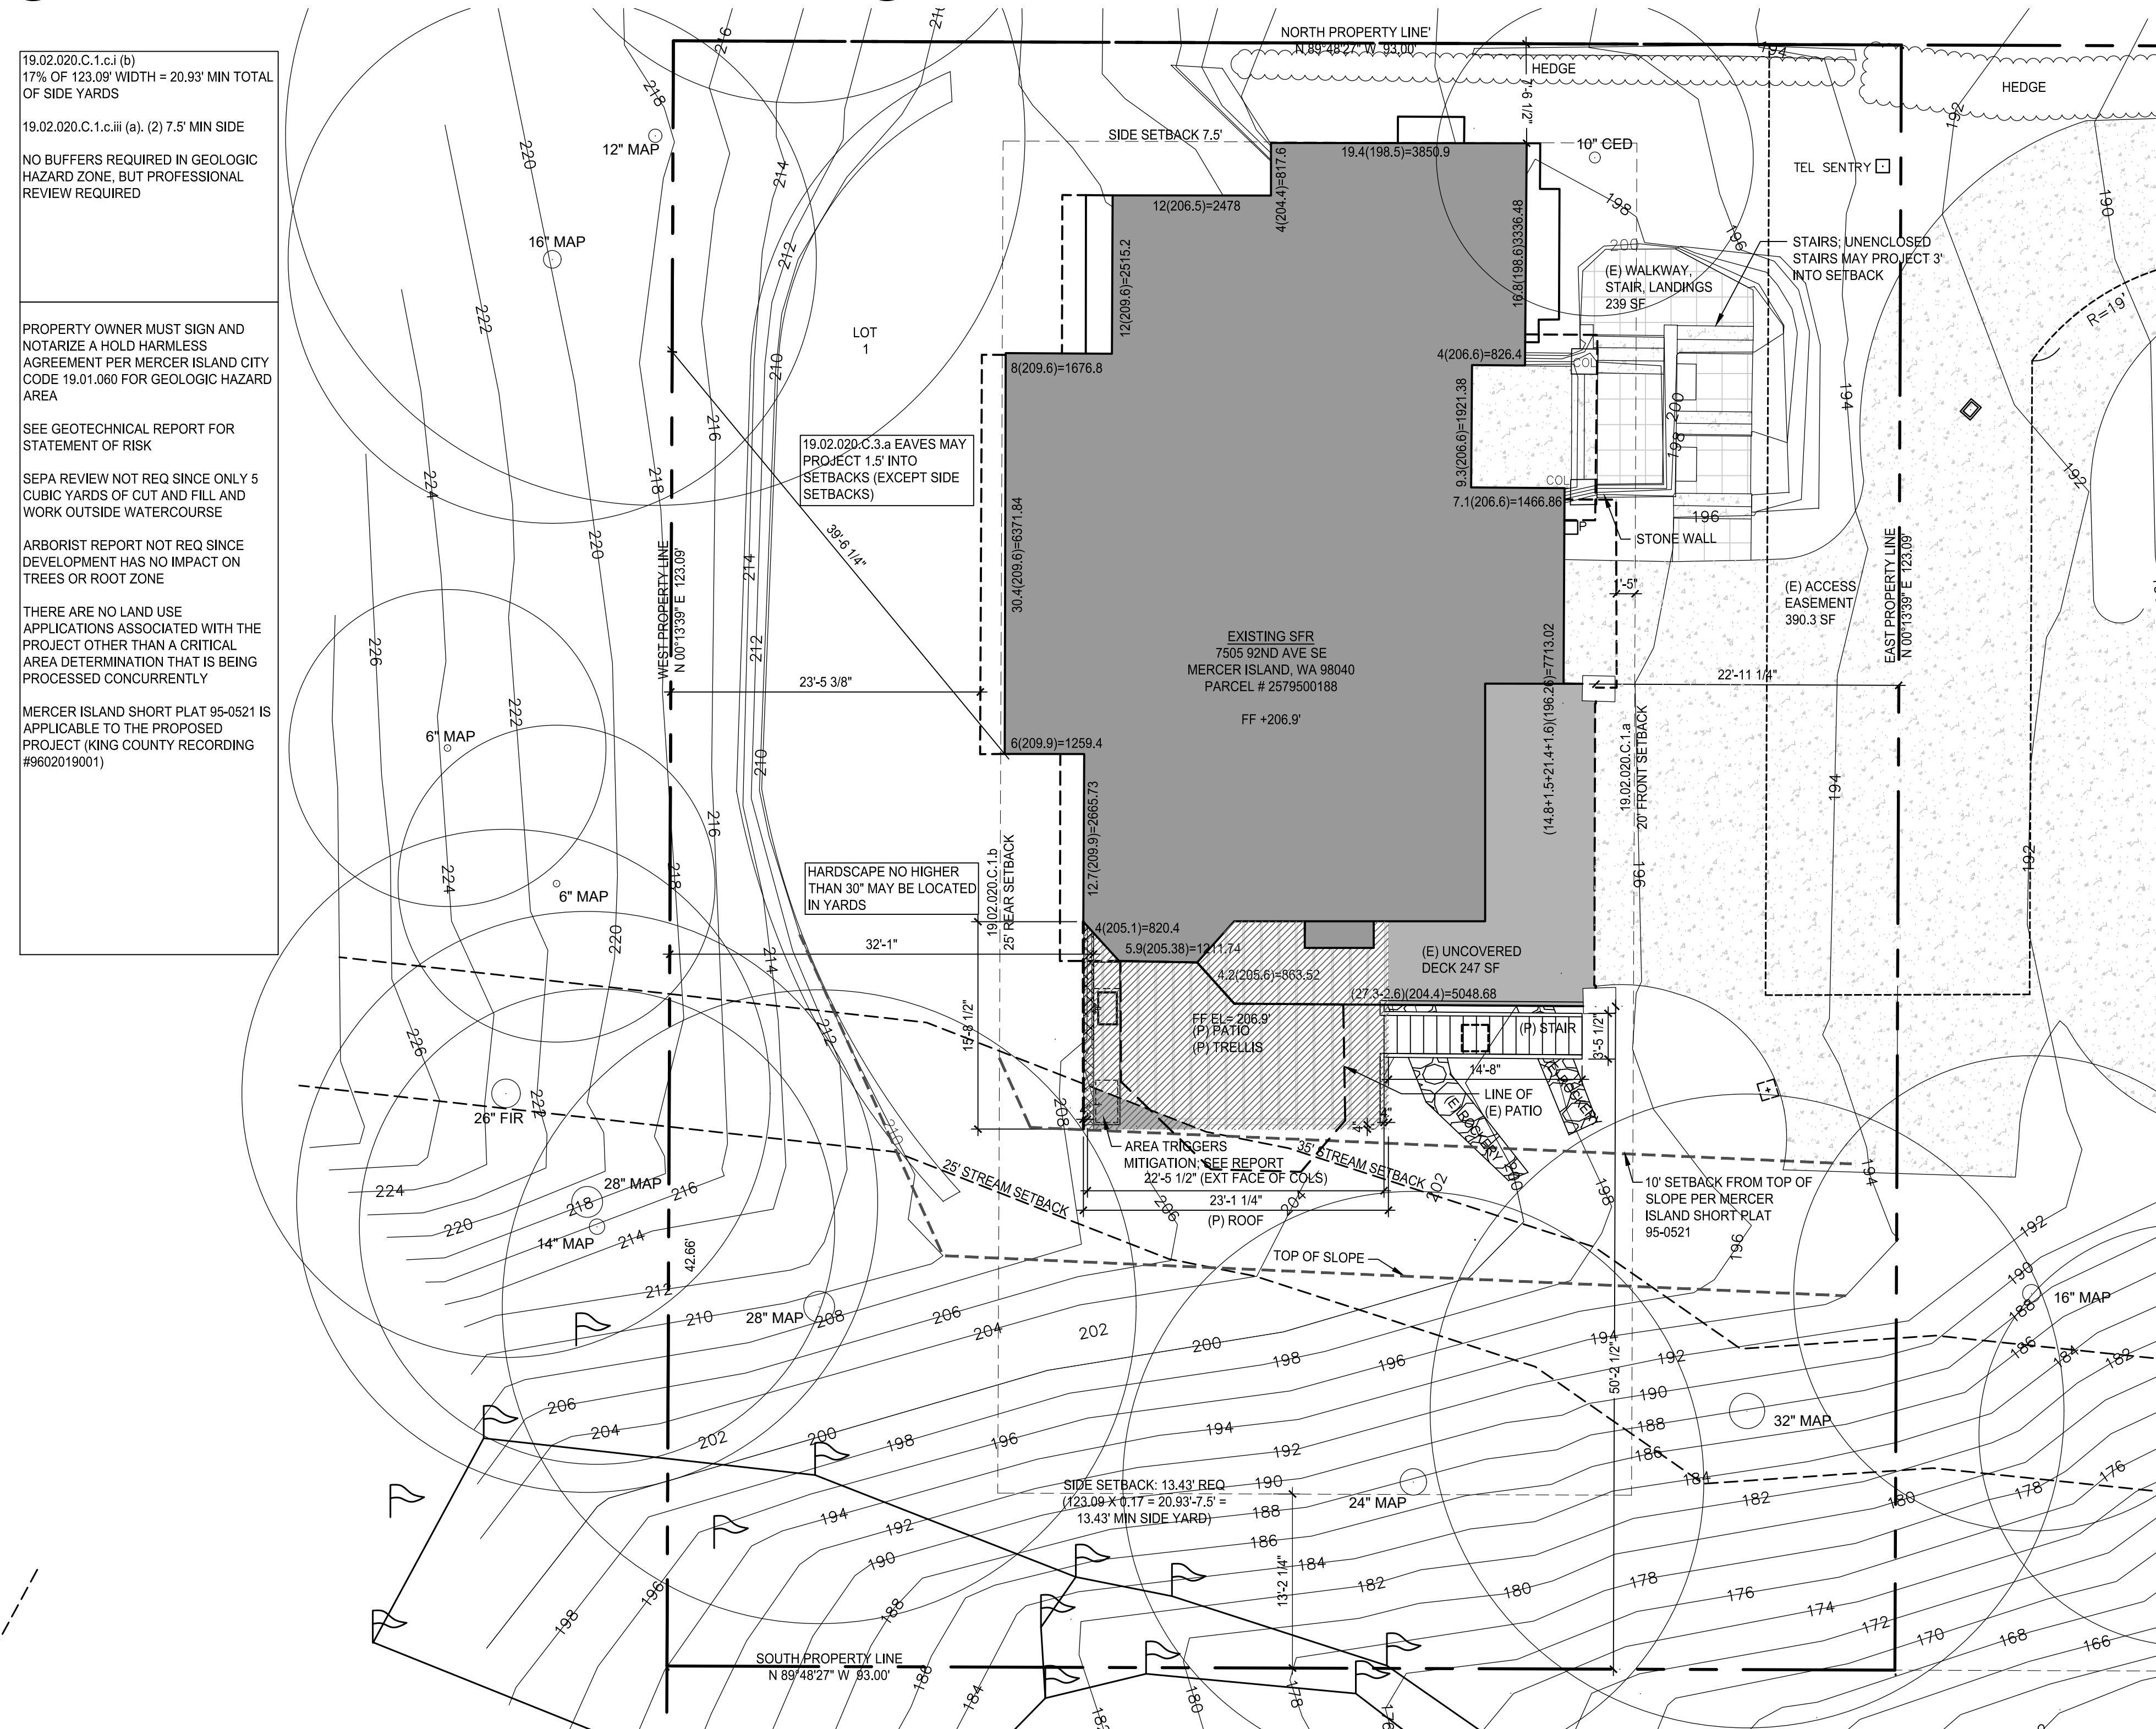

2 SITE PLAN (TO BE VERIFIED IN FIELD)  
SCALE: 1/8" = 1'-0"

All drawings, specifications, plans, ideas, arrangements, and design solutions represented or referred to are the property of and owned by Josh PS whether the project for which they are made is executed or not. They were created, evolved, developed and produced for the sole use on and in connection with this project and none of the above may be disclosed or given to or used by any person, firm, or corporation for any use or purpose whatsoever, including any other project, except upon written permission of Josh PS.

9388 REGISTERED ARCHITECT  
*S. JOSHUA BRINCKO*  
S. JOSHUA BRINCKO  
STATE OF WASHINGTON

DESIGN	SJB
DRAWN	CEC
CHECKED	SJB
DATE	[2019-0114 DESIGN] [2019-0621 PERMIT] [2020-0211 REV 1] [2020-0413 REV 2]

**LAI**  
7505 92ND AVE SE  
MERCER ISLAND WA 98040

PERMIT

SITE PLAN  
PROJECT INFORMATION



**A1.0**

All drawings, specifications, plans, ideas, arrangements, and design solutions represented or referred to are the property of and owned by Josh PS whether the project for which they are made is executed or not. They were created, evolved, developed and produced for the sole use on and in connection with this project and none of the above may be disclosed or given to or used by any person, firm, or corporation for any use or purpose whatsoever, including any other project, except upon written permission of Josh PS.

© COPYRIGHT 2020  
JOSH PS

9388

REGISTERED  
ARCHITECT  
*SJB*  
S. JOSHUA BRINCKO  
STATE OF WASHINGTON

**CONSTRUCTION DATA**

NET LOT AREA:  
11,447-390.3 ACCESS EASEMENT = 11,056.7 SF  
  
NET LOT AREA  
11,056.7 SQ FT  
  
19.02.020.G PARKING REQUIREMENTS:  
3 REQUIRED (MIN 2 COVERED)  
3 COVERED EXISTING CHANGED TO 2 COVERED  
\*1 PARKING SPACE USED AS STORAGE/WORKSPACE

ALLOWABLE BUILDING PAD (SHRT PLAT) 3470 SF

**LOT COVERAGE**

	EXISTING	EXISTING REMOVED	PROPOSED NEW
ROOF & CHIMNEY	2750.9 SF	0	0
DRIVEWAY	898 SF	0	0
TOTAL	3648.9 SF		

19.02.020.F.3.a LOT COVERAGE CALC:  
FOR LOTS SLOPED 30-50%, MAX 30% LOT COVERAGE (INCLUDING HOUSE, DRIVEWAY, ACCESSORY BUILDINGS) SEE DIAGRAM


NON CONFORMING LOT COVERAGE CALC:  
EXISTING LOT COVERAGE = 3648.9 SF  
ALLOWABLE LOT COVERAGE: (.30)(11056.7) = 3317.0 SF  
(E) NON CONFORMING LOT COVERAGE = 331.9 SF  
\*WHEN REMOVING LOT COVERAGE FROM A NON-CONFORMING CONDITION, THE REPLACEMENT CAN ONLY BE UP TO 50% OF THE NON-CONFORMING AREA (50% of 331.9 = 165.95)

TOTAL ALLOWABLE LOT COVERAGE INCLUDING 50% NONCONFORMING: 3482.95 SF  
\* NOT APPLICABLE SINCE NO CHANGE TO (E) LOT COVERAGE


**HARDSCAPE COVERAGE**

	EXISTING TO REMAIN	EXISTING TO BE REMOVED	PROPOSED NEW
WALKWAYS/STAIR	219 SF	0	53.9 SF
PATIO	207.1	30.6 SF	64.5 SF
ROCKERIES	309.2 SF	24.9	0
TOTAL	735.3 SF	+ N/A	+ 118.4 = 853.7 SF GRAND TOTAL

19.02.020.F.3.b.i MAX HARDSCAPE AREA:  
9% (11,056.7 NET LOT AREA) = 995.1 SF ALLOWED  
PROPOSED HARDSCAPE = 853.7 SF

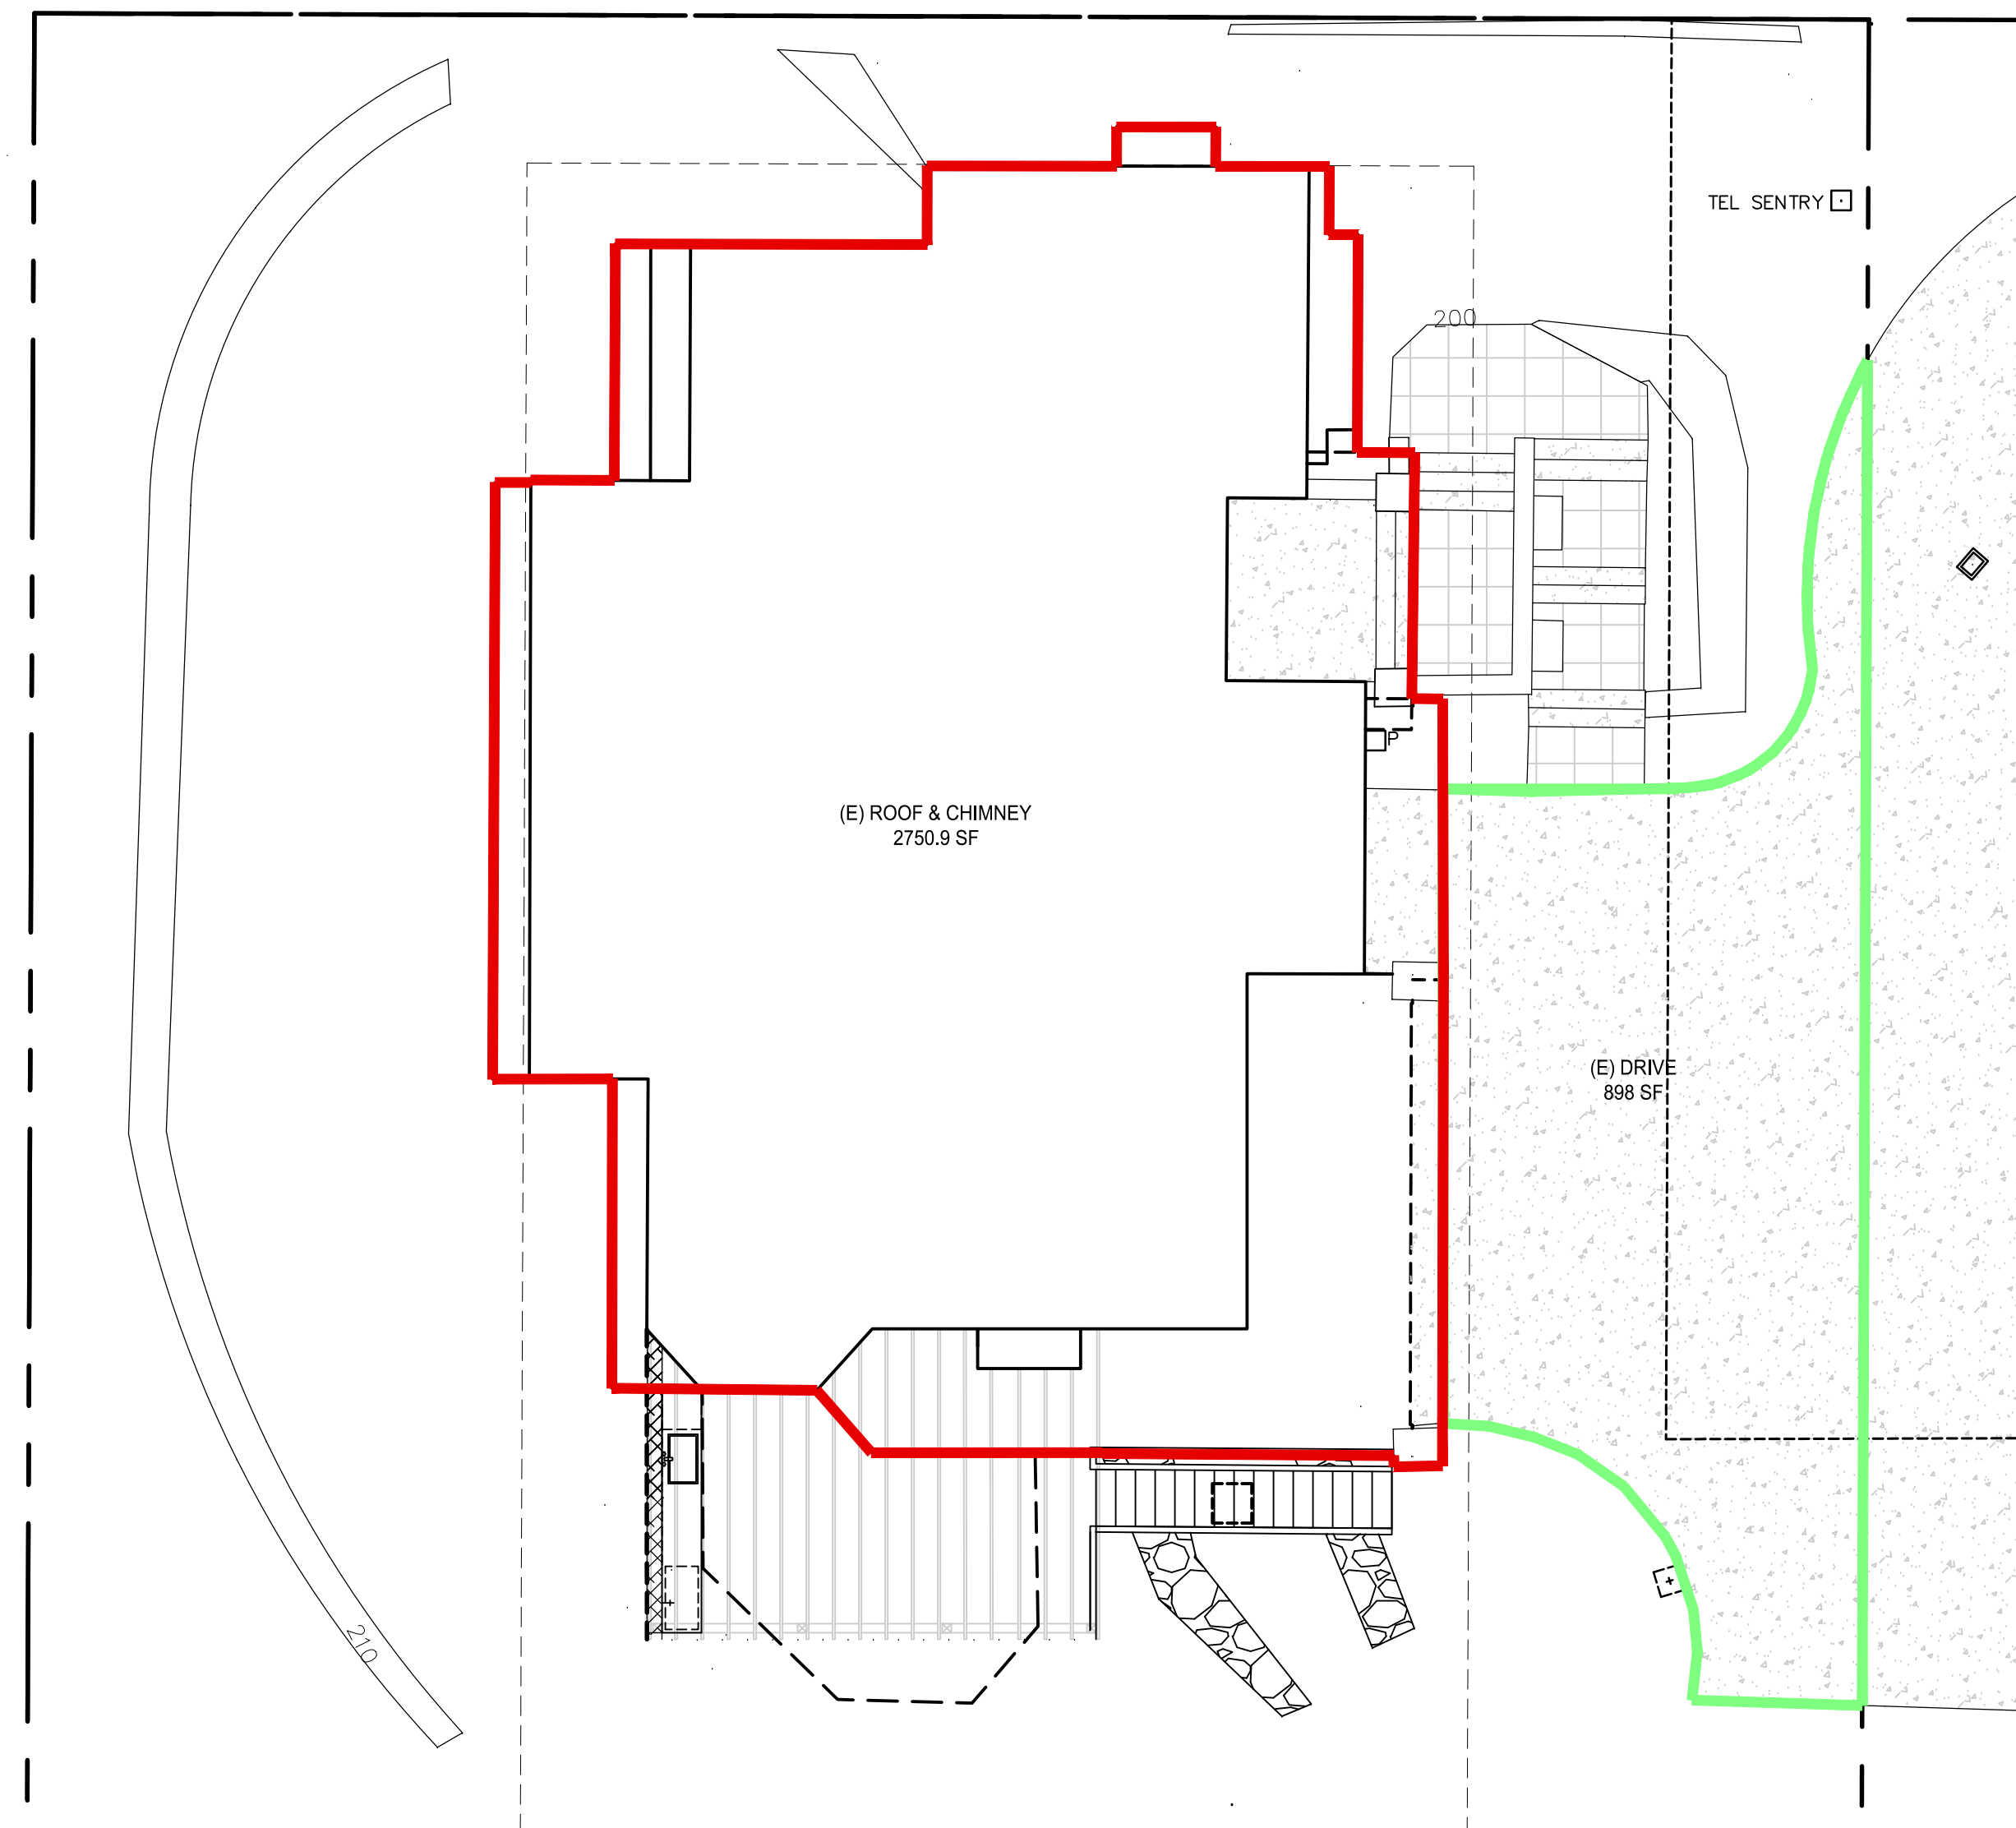

1 LOT COVERAGE DIAGRAM  
SCALE: 1/8" = 1'-0"

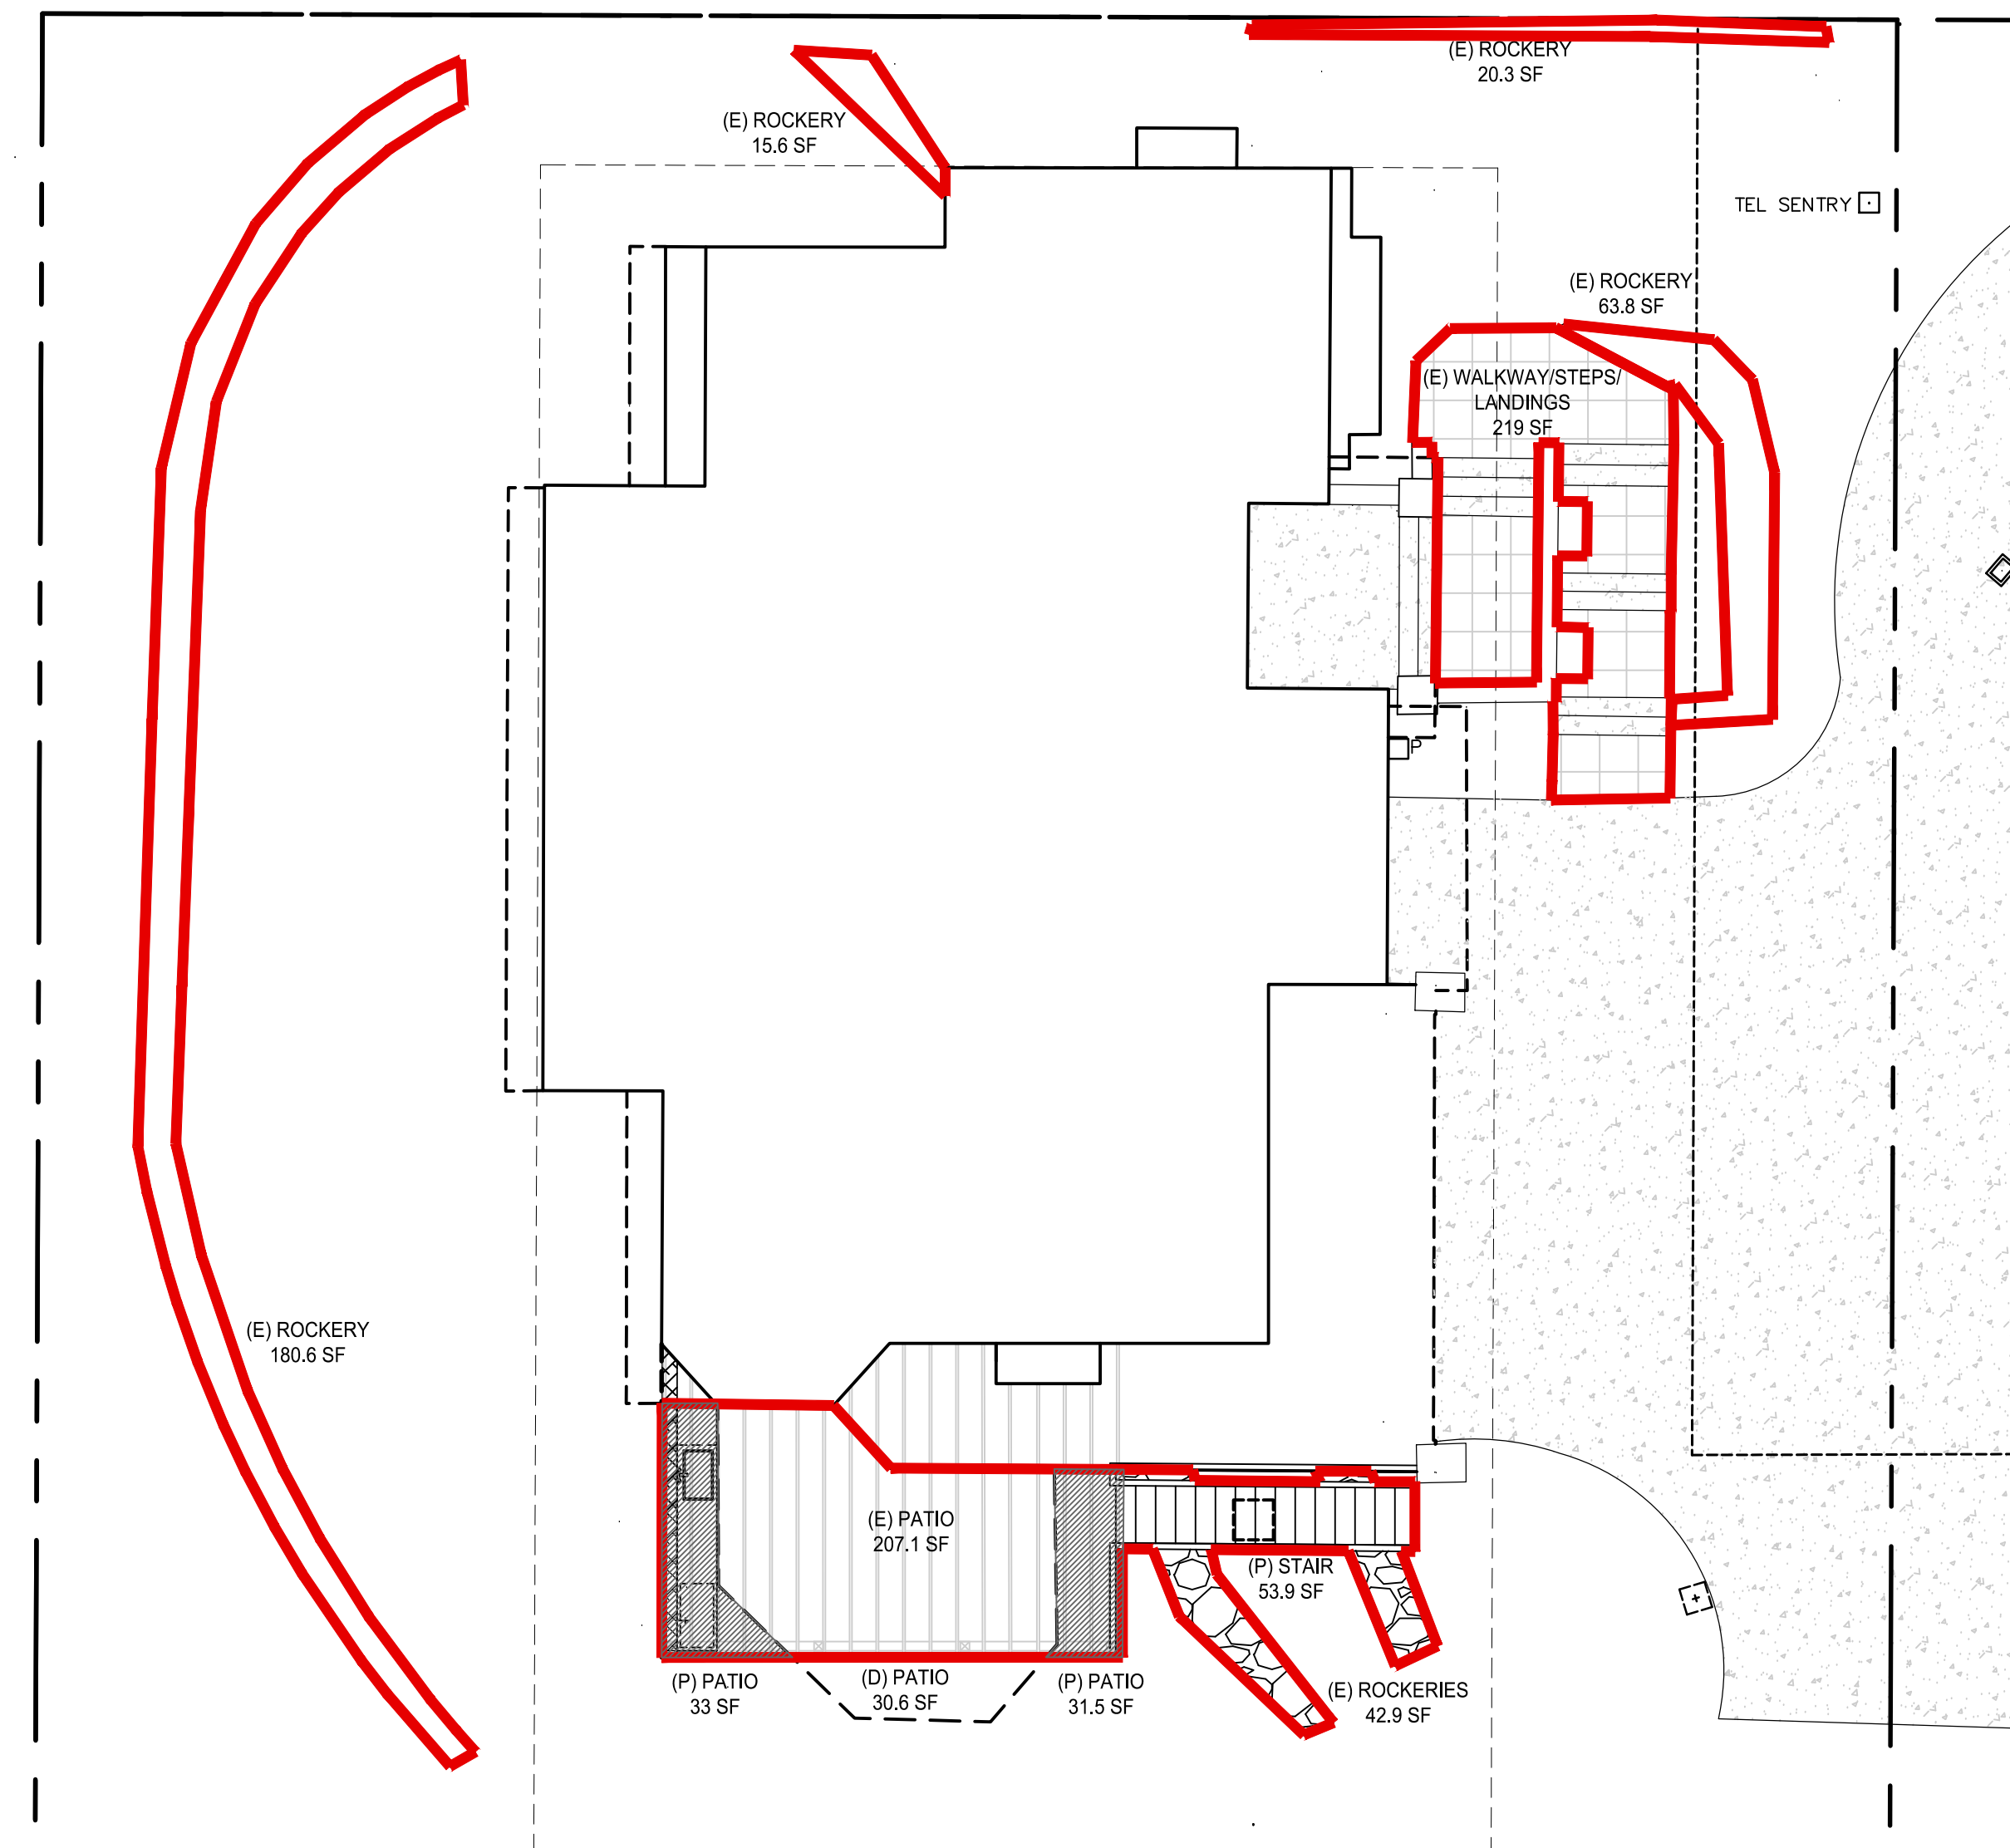

2 HARDSCAPE DIAGRAM  
SCALE: 1/8" = 1'-0"



DESIGN SJB  
DRAWN CEC  
CHECKED SJB  
DATE [2019-0114 DESIGN]  
[2019-0621 PERMIT]  
[2020-0211 REV 1]  
[2020-0413 REV 2]

LAI  
7505 92ND AVE SE  
MERCER ISLAND WA 98040

PERMIT

HARDSCAPE AND  
LOT COVERAGE  
DIAGRAMS



A1.0a

GENERAL NOTES

- 1. ALL WORK TO COMPLY WITH '2015 INTERNATIONAL RESIDENTIAL CODE' WITH JURISDICTION AMENDMENTS WHERE APPLICABLE.
2. ALL APPLICABLE CODES, ORDINANCES AND MINIMUM STRUCTURAL REQUIREMENTS TAKE PRECEDENCE OVER ALL DRAWINGS, NOTES AND SPECIFICATIONS.
3. CONTRACTOR MUST CONTACT ARCHITECT IMMEDIATELY FOR ANY DISCREPANCIES IN CONTRACT DOCUMENTS OR EXISTING CONDITIONS PRIOR TO PROCEEDING WITH WORK.
4. CONTRACTOR MUST CONTACT ARCHITECT IMMEDIATELY FOR ANY DISCREPANCIES BETWEEN CONTRACT DOCUMENTS AND APPLICABLE CODES PRIOR TO PROCEEDING WITH WORK.
5. CONTRACTOR TO VERIFY ALL DIMENSIONS, GRADES, AND EXISTING CONDITIONS BEFORE PROCEEDING WITH WORK.
6. CONTRACTOR SHALL VISIT THE SITE AND FAMILIARIZE HIMSELF/HERSELF WITH ALL ASPECTS OF THE WORK PRIOR TO CONTRACTING WITH THE OWNER TO PERFORM THE WORK.
7. CONTRACTOR SHALL VERIFY CONFORMANCE OF ACTUAL SOIL CONDITIONS WITH SOILS REPORT AND DESIGN ASSUMPTIONS.
8. CONTRACTOR SHALL BE RESPONSIBLE FOR ACQUIRING ALL NECESSARY PERMITS FOR THE WORK, EXCEPT FOR THE BUILDING PERMIT WHICH IS THE RESPONSIBILITY OF THE ARCHITECT.
9. CONTRACTOR'S GUARANTEE ON ALL MATERIALS AND WORKMANSHIP TO BE (1) YEAR FROM DATE OF COMPLETION UNLESS NOTED OTHERWISE IN CONTRACT.
10. REPETITIVE FEATURES MAY BE DRAWN ONLY ONCE, BUT SHALL BE PROVIDED AS IF DRAWN IN FULL. REPETITIVE NOTES MAY BE CALLED OUT ONLY ONCE AND INDICATED AS TYPICAL (TYP).
11. DIMENSIONS ARE TO FACE OF STUD OR FACE OF CONCRETE OR CENTERLINE OF INTERIOR COLUMNS UNLESS NOTED OTHERWISE.
12. THE CONTRACTOR IS RESPONSIBLE FOR COORDINATING MECHANICAL, ELECTRICAL, AND PLUMBING CONTRACTORS AND NOTIFYING THE ARCHITECT OF ANY DISCREPANCIES IN FRAMING PRIOR TO PROCEEDING WITH WORK.
13. THESE DRAWINGS ARE DESIGN-BUILD IN THE AREAS OF MECHANICAL, ELECTRICAL, AND PLUMBING.
14. THE GENERAL CONTRACTOR AND OTHER PARTIES DOING WORK ON BEHALF OF THE GENERAL CONTRACTOR INCLUDING BUT NOT LIMITED TO SUBCONTRACTORS AND ALL STAFF ARE REQUIRED TO BECOME FAMILIAR WITH ALL REGULATIONS REGARDING THE CONSTRUCTION, DEMOLITION, AND RELATED ACTIVITIES FOR THE PROJECT. ANY VIOLATIONS TO APPLICABLE REGULATIONS CAUSED BY THE PARTIES HEREIN SHALL BE THE RESPONSIBILITY OF THE GENERAL CONTRACTOR.
15. VISIBLE OVERLAPPING MATERIALS SUCH AS FLASHING TO BE LAPPED SUCH THAT SEAM IS NOT FACING STREET OR DOMINANT VIEW.
16. VENTS AND PENETRATIONS TO BE HIDDEN FROM VIEW FROM STREET OR DOMINANT VIEW.
17. THE GENERAL CONTRACTOR IS REQUIRED TO ORGANIZE A MEETING ON SITE WITH THE ARCHITECT AND ACTUAL LABORERS INSTALLING SIDING TO CONFIRM LOCATIONS OF EACH SIDING MATERIAL.

JOB SITE SAFETY

- 1. THE ARCHITECT HAS NOT BEEN RETAINED OR COMPENSATED TO PROVIDE DESIGN AND/OR CONSTRUCTION REVIEW SERVICES RELATING TO THE CONTRACTOR'S SAFETY PRECAUTIONS.
2. PERIODIC SITE VISITS PERFORMED BY THE ARCHITECT SHALL NOT BE CONSTRUED AS SUPERVISION OF ACTUAL CONSTRUCTION SAFETY PRECAUTIONS.
3. THE ARCHITECT IS NOT RESPONSIBLE FOR PROVIDING A SAFE PLACE FOR THE PERFORMANCE OF WORK BY THE CONTRACTOR OR THE CONTRACTOR'S EMPLOYEES OR EMPLOYEES OF SUPPLIERS OR SUBCONTRACTORS, OR FOR ACCESS, VISITS, USE, WORK, TRAVEL OR OCCUPANCY BY ANY PERSON.

SITE WORK

- 1. ALL EXCAVATION AND FILL SHALL BE STORED AND PROTECTED SUCH AS TO PREVENT RUN OFF OF MATERIAL TO ADJACENT PROPERTIES.
2. FOOTING DRAIN TO BE SEPARATE FROM ROOF AND IMPERVIOUS AREA DRAINS.
3. DOWNSPOUT DRAIN TO BE 4" DIAMETER TIGHTLINE UNLESS NOTED OTHERWISE.
4. FOOTING DRAIN TO BE 4" DIAMETER PERFORATED PIPE WRAPPED IN GEOTEXTILE FABRIC UNLESS NOTED OTHERWISE.
5. CONTRACTOR IS RESPONSIBLE FOR COMPLYING WITH REQUIRED SEPTIC AND/OR STORM WATER DETENTION SYSTEMS.
6. SUBSTANTIAL COMPLETION SHALL BE DEFINED AS A POINT IN WHICH ALL INSPECTIONS ARE APPROVED, AND THE BUILDING MAY BE USED FOR ITS INTENDED PURPOSE. THE BUILDER SHALL PRESENT A FINAL APPLICATION FOR PAYMENT TO THE OWNER AT THE POINT OF SUBSTANTIAL COMPLETION. ONCE THE FINAL APPLICATION FOR PAYMENT IS RECEIVED, THE OWNER SHALL PRESENT A PUNCHLIST TO THE GENERAL CONTRACTOR TO FINALIZE ANY MINOR ITEMS THAT MAY NEED REPAIRED, BUILT, ALTERED, OR OTHERWISE ADDRESSED TO BRING THE BUILDING IN CONFORMANCE WITH THE CONSTRUCTION DRAWINGS, CODE REQUIREMENTS, AND ORDINARY STANDARD OF CONSTRUCTION QUALITY. ONCE THE PUNCHLIST IS DELIVERED TO THE BUILDER, THE OWNER ACCEPTS RESPONSIBILITY FOR THE BUILDING AND UTILITIES AND MAY OCCUPY THE BUILDING FOR ITS INTENDED USE ONCE APPROVED BY THE BUILDER. THE WARRENTY PERIOD SHALL BEGIN AT THE TIME THE OWNER OCCUPIES THE BUILDING.

VENTILATION NOTES

- 1. ALL WORK TO COMPLY WITH THE 2015 IRC CHAPTER 15 WITH JURISDICTION AMENDMENTS.
2. SOURCE SPECIFIC FANS SHALL BE LOCATED IN ALL KITCHENS, BATHROOMS, WATER CLOSETS AND LAUNDRY FACILITIES. VENTILATION CAPACITY SHALL BE AT LEAST 50 C.F.M. FOR BATHROOMS AND LAUNDRY ROOMS (Intermittent use) AND 100 C.F.M. FOR KITCHENS (Intermittent use). DUCTING SHALL TERMINATE OUTSIDE THE BUILDING AND SHALL BE EQUIPPED WITH BACKDRAFT DAMPERS.
3. WHOLE HOUSE VENTILATION SYSTEM SHALL BE CAPABLE OF .35 AIR EXCHANGES PER HOUR BUT NO MORE THAN .50 AIR EXCHANGES PER HOUR UNDER NORMAL OPERATING CONDITIONS. OUTDOOR AIR SHALL BE PROVIDED TO ALL HABITABLE ROOMS. FAN SHALL HAVE A SONE RATING OF 1.5 OR LESS MEASURED AT 0.1 INCHES WATER GAUGE.
4. DUCT WORK SHALL CONFORM TO TABLE M1508.6.2 AND M1506.1 OF THE '2015 IRC CHAPTER 15' WITH JURISDICTION AMENDMENTS.
5. INSULATE DUCTS WITH MIN. R8 INSULATION. ALTHOUGH NO INSULATION IS REQUIRED IF THE DUCTS AND EQUIPMENT COMPLETELY ENCLOSED WITHIN THE BUILDING ENVELOPE.
6. PROVIDE A MINIMUM NET AREA OF 1 SQUARE FOOT OF VENTILATION AREA FOR EACH 150 SQUARE FEET OF CRAWLSPACE AREA. PLACE OPENINGS AS NEAR AS TO CORNERS AS PRACTICABLE AND SHALL PROVIDE CROSS VENTILATION.
7. ALL CRAWLSPACE VENTS TO BE PROVIDED WITH 1/4" NON-CORROSIVE WIRE MESH.
8. PROVIDE A MINIMUM NET AREA OF 1 SQUARE FOOT OF VENTILATION AREA FOR EVERY 150 SQUARE FEET OF ATTIC AREA. PROVIDE A CONTINUOUS 1 INCH MINIMUM AIR SPACE ABOVE INSULATION FOR CROSS VENTILATION. ALL ROOFS TO BE CROSS-VENTED U.N.O.
9. ALL ATTIC VENTS TO BE PROVIDED WITH 1/4" NON-CORROSIVE WIRE MESH OR APPROVED SOFFIT VENTS.
10. OUTDOOR AIR INLETS SHALL BE INSTALLED WITHIN EACH HABITABLE SPACE WITH NOT LESS THAN 4 SQUARE INCHES OF INLET AREA EACH WITH SCREENS AND CONTROLLABLE OPENINGS NOT WITHIN 10' OF AN APPLIANCE VENT OR PLUMBING DRAIN VENT OUTLET, NOT WITHIN A ROOM WITH FUEL BURNING APPLIANCES, NOT WITHIN ATTICS, CRAWLSPACES, OR GARAGES AND NOT WITHIN UNSANITARY OR ORDOROUS AREAS PER IRC M1507.3.4.4
11. PER SRC M1501.1 EXHAUST FAN VENTS SHALL TERMINATE OUTDOORS AND NOT IN ATTICS, SOFFITES, RIDGE VENTS, OR CRAWL SPACES. TERMINATIONS TO EXIT THE STRUCTURE WITH CLEARANCES MEETING SRC M1506.3. NOT LESS THAN 3 FEET FROM PROPERTY LINES, 3 FEET FROM OPERABLE OPENINGS INTO THE BUILDING AND 10 FEET FROM MECHANICAL AIR INTAKES.

MOISTURE PROTECTION

- 1. PROVIDE PRESSURE TREATED PLATES BETWEEN CONCRETE AND FRAMING.
2. PROVIDE A MINIMUM OF 12" CLEAR BETWEEN WOOD GIRDERS AND EARTH.
3. PROVIDE A MINIMUM OF 18" CLEAR BETWEEN WOOD JOISTS AND EARTH.
4. PROVIDE A MINIMUM OF 8" CLEAR BETWEEN WOOD POSTS AND EARTH.
5. PROVIDE A MINIMUM OF 1" CLEAR BETWEEN WOOD POSTS AND CONCRETE FLOORS.
6. CAULK ALL OPENINGS THOROUGHLY.
7. FLASH ALL OPENINGS WITH A MINIMUM OF 26 GAUGE GALVANIZED STEEL TO ACCEPTABLE INDUSTRY STANDARDS.
8. METAL COPING AT PARAPET TO BE A MINIMUM OF 22 GAUGE GALVANIZED STEEL.
9. JOSH RECOMMENDS WETS SEAL AND WET FLASH LIQUID APPLIED WEATHERPROOFING IN LIEU OF BUILDING PAPER OR HOUSEWRAP.

FIRE PROTECTION

- 1. THE GARAGE SHALL BE SEPERATED FROM THE RESIDENCE AND IT'S ATTIC BY NOT LESS THAN THE FOLLOWING:
- NOT LESS THAN (1) LAYER OF 5/8" TYPE "X" GYPSUM WALLBOARD APPLIED TO ALL GARAGE WALLS. NOT LESS THAN (2) LAYERS OF 5/8" TYPE "X" GYPSUM WALLBOARD AT CEILINGS.
- 1-3/8" MINIMUM THICK, SOLID CORE, OR HONEYCOMB CORE STEEL DOOR, OR A 20-MIN. FIRE-RATED DOOR.
- DUCTS PIERCING FIRE SEPARATION TO BE A MINIMUM OF 26 GAUGE, AND HAVE NO OPENINGS INTO THE GROUP "U" OCCUPANCY.
2. FIRE SEPARATION TO BE HORIZONTAL AND VERTICAL INCLUDING ALL STRUCTURAL MEMBERS SUPPORTING THE FIRE SEPARATION.
3. ALL ENCLOSED USEABLE SPACE UNDER STAIRWAYS SHALL BE (1) LAYER OF 5/8" TYPE "X" GYPSUM WALLBOARD ON ENCLOSED SIDE.
4. SMOKE DETECTORS SHALL BE HARD WIRED TO BUILDING POWER AND SHALL HAVE BATTERY BACKUP.
5. SMOKE DETECTORS SHALL BE AUDIBLE IN ALL SLEEPING ROOMS, AND OUTSIDE EACH SLEEPING AREA IN THE IMMEDIATE VICINITY OF THE BEDROOMS.
6. A MINIMUM OF (1) SMOKE DETECTOR SHALL BE INSTALLED ON EACH FLOOR INCLUDING THE GARAGE.
7. FIRESTOPPING AND DRAFTSTOPPING SHALL CONSIST OF 2" NOMINAL LUMBER.
8. FIRESTOPPING AND DRAFTSTOPPING IS REQUIRED IN THE FOLLOWING PLACES:
- CONCEALED SPACES AT ALL FLOOR AND CEILING LEVELS AND AT 10 FOOT INTERVALS ALONG THE LENGTH OF THE WALL.
- INTERCONNECTIONS BETWEEN CONCEALED VERTICAL AND HORIZONTAL SPACES (i.e. soffits)
- CONCEALED SPACES BETWEEN STAIR STRINGERS AT TOP AND BOTTOM OF THE RUN.
9. ROCK WOOL AROUND ALL OPENINGS FOR VENTS, PIPES, DUCTS, ETC.
10. EMERGENCY EGRESS WINDOWS SHALL MEET THE FOLLOWING REQUIREMENTS:
CLEAR OPEN WIDTH 20" (Minimum)
CLEAR OPEN HEIGHT 24" (Minimum)
CLEAR OPEN AREA 5.7 s.f. (Minimum)
SILL HEIGHT 44" (Maximum)
11. PREFABRICATED FIREPLACES SHALL BEAR U.L. OR I.C.B.O. SEAL OF APPROVAL AND SHALL BE INSTALLED PER MANUFACTURER INSTRUCTIONS.
12. APPLIANCE GENERATING A GLOW, A SPARK, OR FLAME MAY BE INSTALLED IN THE GARAGE PROVIDED THE HEATING ELEMENTS AND SWITCHES ARE 18" ABOVE THE FLOOR.
13. GARAGE FLOOR TO BE CONSTRUCTED OF NON COMBUSTIBLE MATERIAL (CONCRETE).

SHOP DRAWINGS

- 1. SHOP DRAWINGS ARE REVIEWED FOR DESIGN INTENT ONLY.
2. THE CONTRACTOR IS TO REVIEW AND APPROVE ALL SHOP DRAWINGS PRIOR TO SUBMITTING TO ARCHITECT OR STRUCTURAL ENGINEER.
3. SEE STRUCTURAL NOTES AND PROJECT SPECIFICATIONS FOR ADDITIONAL REQUIREMENTS AND CLARIFICATIONS REGARDING SHOP DRAWINGS.

EARTH WORK

- 1. EXTEND EXCAVATION DOWN TO UNDISTURBED SOIL OF THE SPECIFIED STRENGTH WITH A MINIMUM OF 18" BELOW LOWEST ADJACENT FINISH GRADE.
2. COMPACTED FILL TO BE WELL GRADED AND GRANULAR WITH NOT MORE THAN 5% PASSING A 200 SIEVE. PLACE IN 8" LOOSE LIFTS AND COMPACT TO 95% MODIFIED AASHO DENSITY AT OPTIMUM MOISTURE CONTENT.
3. BACKFILL BEHIND ALL RETAINING WALLS WITH FREE DRAINING GRANULAR FILL AND PROVIDE FOR SUBSURFACE DRAINAGE AS NOTED IN THE SOILS REPORT.

SAFETY AND SECURITY

- 1. DEADBOLTS WITH A MINIMUM THROW OF 1/2" AND A VIEWPORT ARE REQUIRED AT ALL EXTERIOR DOORS.
2. DEADBOLTS OR APPROVED LOCKING DEVICES ARE REQUIRED ON ALL SLIDING DOORS.
3. ALL LOCKS SHALL BE OPENABLE WITHOUT ANY SPECIAL KNOWLEDGE OR EFFORT.
4. WINDOWS WITHIN 10'-0" OF FINISHED GRADE SHALL BE PROVIDED WITH LATCHING DEVICES.
5. STAIRWAYS TO MEET THE FOLLOWING REQUIREMENTS: OCCUPANCIES LESS THAN 10
STAIR WIDTH 36" (Minimum)
TREAD WIDTH 10" (Minimum), 6" Minimum for Winders
RISER HEIGHT 7 3/4" (Maximum)
HEADROOM 80" (Minimum)
HANDRAIL HEIGHT 34" to 38" above nosing
HANDRAIL GRASP 1-1/4"(Min) to 2" (Max)
6. HANDRAIL INTERMEDIATE MEMBERS SHALL BE CONFIGURED AS TO PROHIBIT PASSING A 4" DIAMETER SPHERE THROUGH ANY OPENING.
7. GUARDRAILS SHALL BE A MINIMUM OF 36" ABOVE FINISH FLOOR.
8. GUARDRAIL INTERMEDIATE MEMBERS SHALL BE CONFIGURED AS TO PROHIBIT PASSING A 4" DIAMETER SPHERE THROUGH ANY OPENING.

GLAZING NOTES

- 1. ALL GLAZING TO BE (2) PANE INSULATED GLASS OR BETTER UNLESS NOTED OTHERWISE.
2. SLIDING DOORS TO BE SAFETY GLASS, LAMINATED GLASS, OR TEMPERED GLASS.
3. SHOWER DOORS AND ENCLOSURES TO BE SAFETY GLASS, LAMINATED GLASS, OR TEMPERED GLASS.
4. REFER TO WINDOW SCHEDULE FOR ADDITIONAL REQUIREMENTS.
5. JOSH RECOMMENDS CARDINAL GLASS W/ COATINGS AS SPECIFIED IN SHOP DRAWINGS.

BATHROOM NOTES

- 1. WALL COVERINGS IN SHOWERS TO BE MOISTURE RESISTANT MATERIAL TO 72" (Minimum) ABOVE DRAIN INLET.
2. TOILET TO HAVE CLEAR SPACE OF 30" WIDE (Minimum) AND 24" CLEAR (Minimum) IN FRONT OF STOOL.

INSPIRATIONAL COMMENTS

- 1. THIS PROJECT IS NOT A SPEC HOME. WE TAKE A LOT OF PRIDE IN CREATING A SPECIAL BUILDING CUSTOMIZED FOR THIS CLIENT, AND WE HOPE YOU WILL DO THE SAME. LETS WORK TOGETHER TO DO SOMETHING SPECIAL.
2. ALL WORK IS REQUIRED TO EXCEED YOUR ORDINARY LEVEL OF SATISFACTION. WE ARE EXCITED TO SHOW THIS PROJECT TO OUR FRIENDS AND FAMILY, AND WE HOPE YOU WILL SHARE THAT EXCITEMENT.
3. JUST BECAUSE SOMETHING WAS BUILT A CERTAIN WAY BEFORE, DOES NOT MEAN IT NEEDS TO BE BUILT A CERTAIN WAY NOW. THINK A LITTLE DIFFERENTLY, AND BE CREATIVE. EVERY CIRCUMSTANCE IS DIFFERENT, BUILD UPON YOUR PREVIOUS EXPERIENCES TO DO BETTER AND HONE YOUR SKILLS EVEN MORE. EVERY DETAIL IS A CHANCE TO PUSH YOUR LIMITS.
4. BE WILLING TO LEARN SOMETHING NEW AND TEACH SOMETHING NEW SINCE WE ARE ALL LEARNING AT ALL TIMES.

DRAWING LEGEND table with columns: SYMBOL, DESCRIPTION, REMARKS. Includes symbols for window, door, space number, grid line, match line, vertical datum point, surface material change, detail reference, section cut reference, interior elevation reference.

MATERIAL SYMBOL LEGEND table with columns: SYMBOL, DESCRIPTION, SYMBOL, DESCRIPTION. Includes symbols for earth/compact fill, gravel/porous fill, concrete, CMU/brick/stone veneer, gypsum wall board/plaster, steel or other metals, natural stone, rough wood framing, wood blocking, plywood, finish wood, batt insulation, rigid insulation.

ABBREVIATION LIST

ABBREVIATION LIST table with columns: ABBREVIATION, DESCRIPTION, ABBREVIATION, DESCRIPTION. Includes abbreviations like ABV, AC, ACT, AFF, ALT, ALUM, ARCH, BLDG, BMAB, BSMAT, BTB, CAB, CL, CMU, COL, CONC, CONST, CONT, CPT, CRV, CSMT, CY, d, D, DAFD, DSAB, DQTA, DBL, DCU, DIA, DIM, DL, DN, DS, DTL, DW, DWG, E, (E), EA, ELEC, ELEV, ENG, EQ, EQUIP, EXIST, EXT, FF, FIN, FLASH, FT, FTG, GA, GAL, GALV, GFI, GLB, GWB, GYP, HDWD, HR, HT, HW, IBC, IRC, ID, IDS, IN, INSUL, INT, JDI, LAM, LB, LF, LH, LL, MAX, MB, MECH, MANUF, MLP, MIN, MISC, MTL, N, (N), NA, NIC, NOM, NTS, O, ON CENTER, OD, (P), PERF, PERP, PL, PLAM, PLY, PSF, PSI, PTD, QTY, R, (R), RD, REF, REIN, REQ, RH, RM, RO, RV, S, SCHED, SF, SHMTL, SIM, SPECS, SQ, STD, STL, STOR, SYM, T, TEL, TEMP, T&G, TO, TOS, TOW, TV, TW, TYP, UNO, UCS, VCT, VER, VERT, VG, W, WT, WW, WJ, WWM, YD.

JOSH PS POLICIES

- 1. DO NOT USE BIFOLD DOORS FOR CLOSETS
2. DO NOT USE MATERIALS WITH WOOD GRAIN UNLESS THE MATERIAL IS WOOD
3. DO NOT USE GLASS BLOCK
4. METAL FABRICATION ONLY TO BE DONE BY GEORGETOWN METALWORKS UNLESS APPROVED OTHERWISE
5. DO NOT USE WHITE WINDOWS UNLESS APPROVED OTHERWISE
6. DO NOT PURCHASE APPLIANCES, DOORS, OR WINDOWS (OR ANY MATERIAL) WITHOUT JOSH APPROVAL
7. DO NOT TEAR DOWN ANY BUILDING OR LANDSCAPING UNLESS APPROVED OTHERWISE
8. DO NOT PUT STRUCTURE (JOISTS/RAFTERS/BEAMS) IN THE CENTER OF A HALL OR ROOM - WE PUT LIGHTING THERE
9. DO NOT USE ELECTROLUX OR FRIGIDAIRE APPLIANCES
10. DO NOT BEGIN CONSTRUCTION UNTIL THE FINAL PLANS HAVE BEEN REVIEWED WITH JOSH ARCHITECTS
11. INSTALL J BOXES FOR AN ELECTRICAL WALK-THROUGH WITH JOSH AND CLIENT PRIOR TO RUNNING WIRES
12. DO NOT LEAVE SPACES LESS THAN 2" BETWEEN TRIM(S) AND OTHER OBJECTS - WE WILL DESIGN WIDER TRIM OR SOME OTHER SOLUTION.
13. DO NOT TALK WITH THE BUILDING DEPARTMENT UNLESS YOU HAVE FIRST CONSULTED WITH JOSH
14. AESTHETICS OR STYLE ARE NOT PART OF OUR DESIGN PROCESS, SO PLEASE BASE DECISIONS ON PRACTICAL SOLUTIONS
15. THE BUILDER IS ENCOURAGED TO WEIGH-IN ON MORE EFFECTIVE AND EFFICIENT CONSTRUCTION METHODS AND SUGGEST BETTER WAYS OF BUILDING TO THE ARCHITECT
16. DIFFERENT MATERIALS MAY NOT BE COPLANAR (FLUSH)
17. BUILDING PAPER (OR HOUSE WRAP) MAY NOT BE EXPOSED FOR LONGER THAN A WEEK, OR IT SHOULD BE REPLACED
18. LIQUID APPLIED WATERPROOFING (PROSOCCO OR SIMILAR) IS HIGHLY RECOMMENDED OVER PAPER WEATHER BARRIERS
19. DO NOT INSTALL SOLAR PANELS UNTIL THE BUILDING HAS FIRST BEEN SUPER-INSULATED AND WRAPPED WITH INSULATION BOARD (REFLECTIVE SIDE FACING INTERIOR) WITH TAPED SEAMS
20. DISCUSS ANY UNCLEAR INFORMATION WITH JOSH AS SOON AS POSSIBLE, BE RESPONSIVE, AND BE A TEAM PLAYER
21. ROOF FASCIAS NOT TO EXCEED 10" IN HEIGHT


CODES REFERENCED table with rows: 2015 INTERNATIONAL RESIDENTIAL CODE (IRC), 2015 INTERNATIONAL BUILDING CODE (IBC), 2015 INTERNATIONAL MECHANICAL CODE (IMC), 2015 WASHINGTON STATE ENERGY CODE (WSEC)



206 708 9933 JoshArch.COM

All drawings, specifications, plans, ideas, arrangements, and design solutions represented or referred to are the property of and owned by Josh PS whether the project for which they are made is executed or not. They were created, evolved, developed and produced for the sole use on and in connection with this project and none of the above may be disclosed or given to or used by any person, firm, or corporation for any use or purpose whatsoever, including any other project, except upon written permission of Josh PS.

COPYRIGHT 2020 JOSH PS

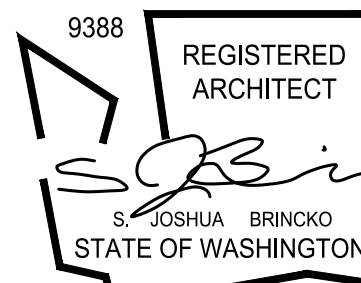

DESIGN SJB
DRAWN SJB
CHECKED SJB
DATE [2019-0114 DESIGN] [2019-0621 PERMIT] [2020-0211 REV 1] [2020-0413 REV 2]

LAI 7505 92ND AVE SE MERCER ISLAND WA 98040

PERMIT

GENERAL NOTES

A1.1

All drawings, specifications, plans, ideas, arrangements, and design solutions represented or referred to are the property of and owned by Josh PS whether the project for which they are made is executed or not. They were created, evolved, developed and produced for the sole use on and in connection with this project and none of the above may be disclosed or given to or used by any person, firm, or corporation for any use or purpose whatsoever including any other project, except upon written permission of Josh PS.

© COPYRIGHT 2020 JOSH PS

9388 REGISTERED ARCHITECT  
*Joshi Brinko*  
JOSHUA BRINKO  
STATE OF WASHINGTON

DESIGN	SJB
DRAWN	CEC
CHECKED	SJB
DATE	[2019-0114 DESIGN] [2019-0621 PERMIT] [2020-0211 REV 1] [2020-0413 REV 2]






LAI  
7505 92ND AVE SE  
MERCER ISLAND WA 98040

PERMIT

CSC

**A1.2**

CONSTRUCTION STORMWATER CONTROL STANDARD DETAILS

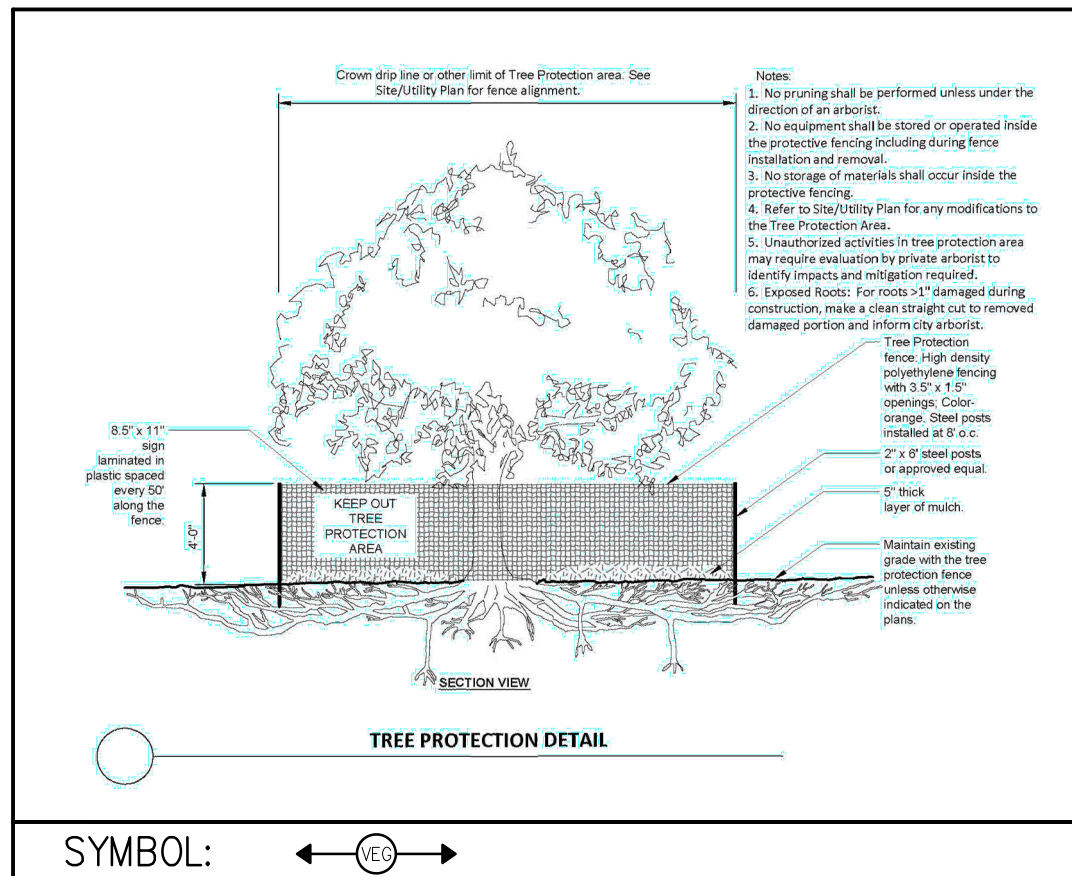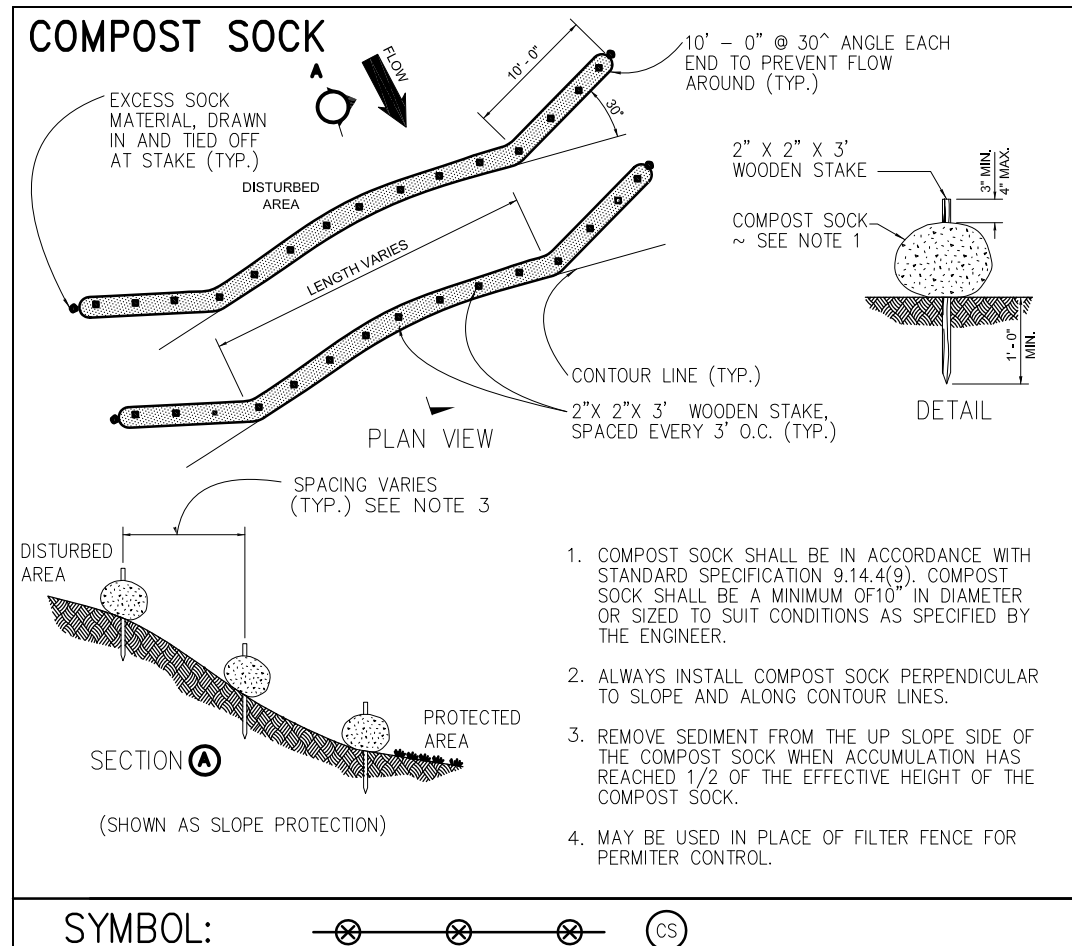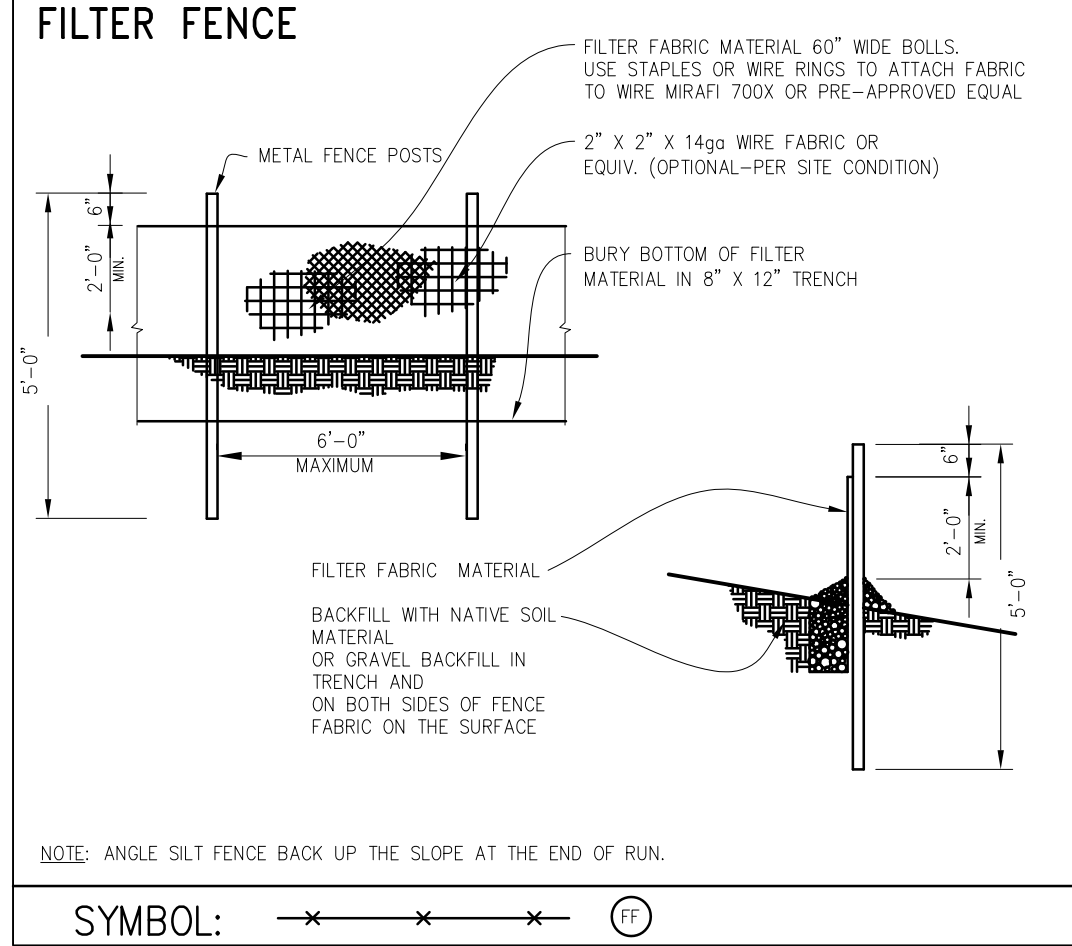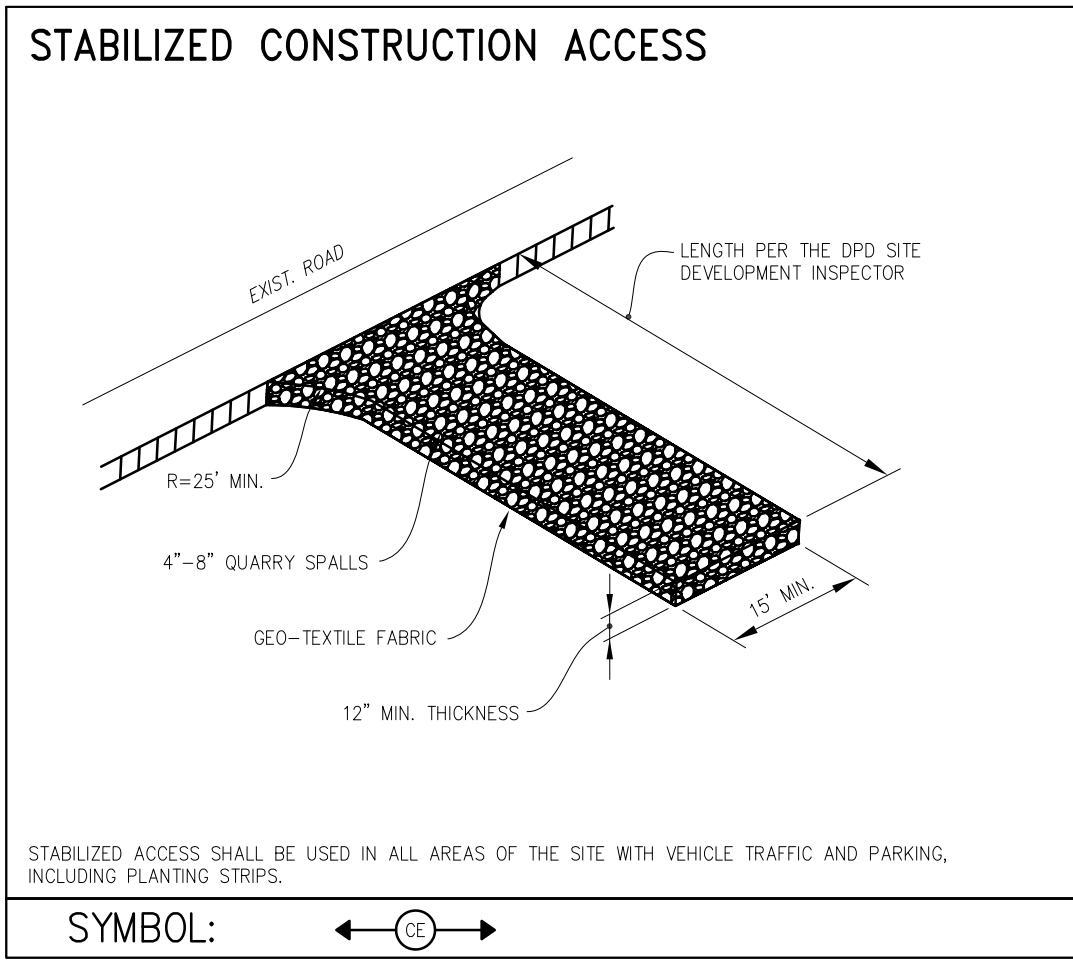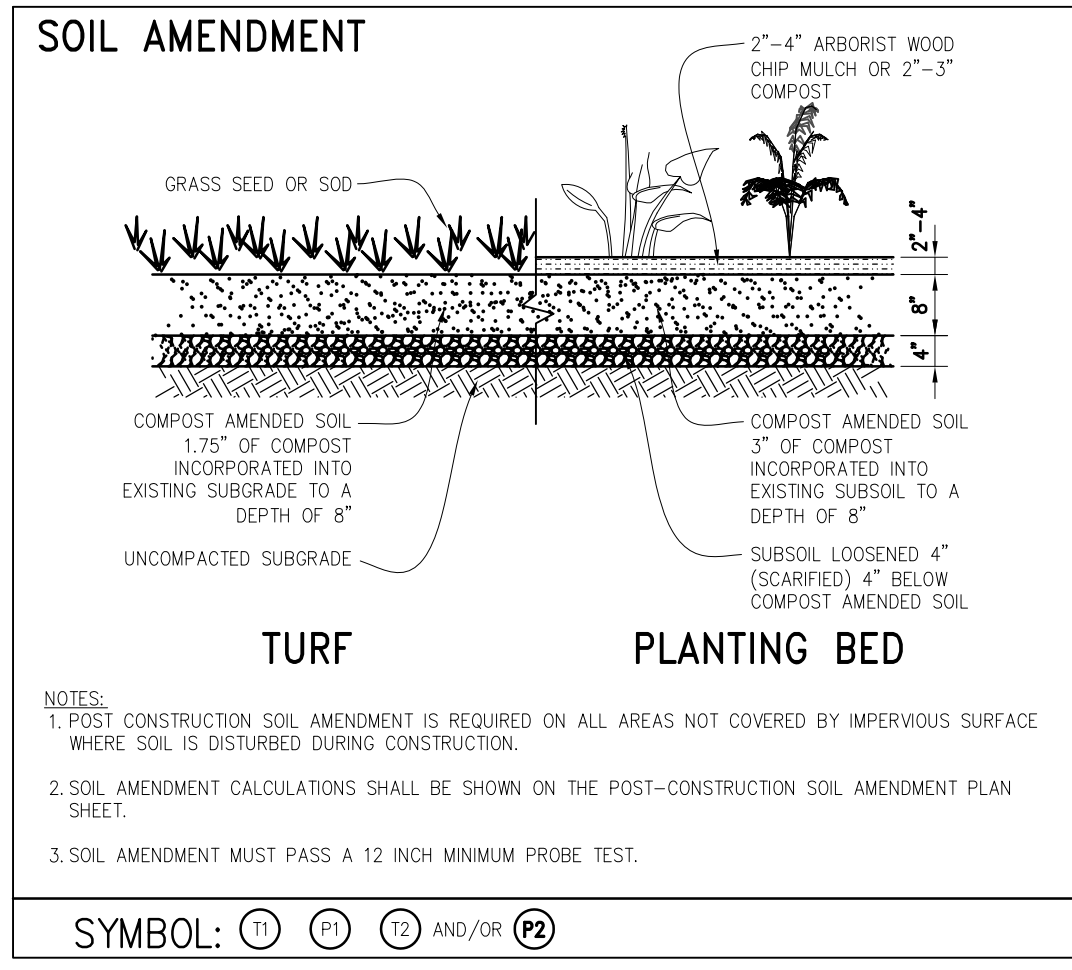

CONSTRUCTION STORMWATER CONTROL & POST CONSTRUCTION SOIL MANAGEMENT PLAN: SCALE 1/8" = 1'-0"

NOTE: THIS PLAN IDENTIFIES THE MINIMUM MEASURES REQUIRED; ADDITIONAL MEASURES MAY BE REQUIRED BASED ON CONSTRUCTION METHODS AND ACTUAL AREA OF DISTURBANCE.

# TOPOGRAPHIC & BOUNDARY SURVEY

## LEGAL DESCRIPTION

(PER STATUTORY WARRANTY DEED RECORDING# 199712231848)  
 LOT 1, MERCER ISLAND SHORT PLAT NUMBER 95-0521, RECORDED UNDER RECORDING NUMBER 9602019001, IN KING COUNTY, WASHINGTON, SAID SHORT PLAT DESCRIBED AS FOLLOWS:  
 LOT 4 OF THE SULLIVAN SEGREGATION APPROVED MARCH 22, 1963 BY THE CITY OF MERCER ISLAND, RECORDED UNDER RECORDING NUMBER 8903100404, IN KING COUNTY, WASHINGTON;  
 TOGETHER WITH AN EASEMENT FOR PRIVATE ROAD AND UTILITY EASEMENT, AS DELINEATED ON THE FACE OF THE SHORT PLAT.  
 SITUATE IN THE COUNTY OF KING, STATE OF WASHINGTON.

## BASIS OF BEARINGS

HELD BEARING OF N 89°56'57" W ALONG MONUMENTED S.E. 76TH ST. AS SHOWN HEREON AND AS SHOWN ON R2, AND AS REFERENCED ON R1

## REFERENCES

R1. MERCER ISLAND SHORT PLAT NO 95-0521, VOL. 107, PG. 186. RECORDS OF KING COUNTY, WASHINGTON.  
 R1. RECORD OF SURVEY, VOL. 75, PG. 106. RECORDS OF KING COUNTY, WASHINGTON.

## VERTICAL DATUM

NAVD88 PER GPS OBSERVATIONS

## SURVEYOR'S NOTES



1. THE TOPOGRAPHIC SURVEY SHOWN HEREON WAS PERFORMED IN JUNE OF 2018 & APRIL OF 2019. THE FIELD DATA WAS COLLECTED AND RECORDED ON MAGNETIC MEDIA THROUGH AN ELECTRONIC THEODOLITE. THE DATA FILE IS ARCHIVED ON DISC OR CD. WRITTEN FIELD NOTES MAY NOT EXIST. CONTOURS ARE SHOWN FOR CONVENIENCE ONLY. DESIGN SHOULD RELY ON SPOT ELEVATIONS.
2. ALL MONUMENTS SHOWN HEREON WERE LOCATED DURING THE COURSE OF THIS SURVEY UNLESS OTHERWISE NOTED.
3. BURIED UTILITIES SHOWN BASED ON RECORDS FURNISHED BY OTHERS AND VERIFIED WHERE POSSIBLE IN THE FIELD. TERRANE ASSUMES NO LIABILITY FOR THE ACCURACY OF THOSE RECORDS OR ACCEPT RESPONSIBILITY FOR UNDERGROUND LINES WHICH ARE NOT MADE PUBLIC RECORD. FOR THE FINAL LOCATION OF EXISTING UTILITIES IN AREAS CRITICAL TO DESIGN CONTACT THE UTILITY OWNER/AGENCY. AS ALWAYS, CALL 1-800-424-5555 BEFORE CONSTRUCTION.
4. SUBJECT PROPERTY TAX PARCEL NO. 257950-0188
5. SUBJECT PROPERTY AREA PER THIS SURVEY IS 11,447 ±S.F. (0.26 ACRES)
6. THIS SURVEY WAS PERFORMED WITHOUT THE BENEFIT OF A TITLE REPORT. EASEMENTS AND OTHER ENCUMBRANCES MAY EXIST THAT ARE NOT SHOWN HEREON.
7. FIELD DATA FOR THIS SURVEY WAS OBTAINED BY DIRECT FIELD MEASUREMENTS WITH A CALIBRATED ELECTRONIC 5-SECOND TOTAL STATION AND/OR SURVEY GRADE GPS OBSERVATIONS. ALL ANGULAR AND LINEAR RELATIONSHIPS ARE ACCURATE AND MEET THE STANDARDS SET BY WAC 332-130-090.

## LEGEND

AC UNIT	GAS METER
AREA DRAIN	HEDGE FOLIAGE LINE
BUILDING	INLET (TYPE 1)
CENTERLINE ROW	MONUMENT (SURFACE, FOUND)
CLEANOUT	POWER METER
COLUMN	REBAR/IRON PIPE AS NOTED (FOUND)
CULVERT PIPE	ROCKERY
CONCRETE SURFACE	STORM DRAIN LINE
RETAINING WALL	TELEPHONE SENTRY
DECK	WATER METER
UTILITY EASEMENT	TREE (AS NOTED)
WETLAND FLAG	STEEP SLOPE AREA

## VICINITY MAP


N.T.S.

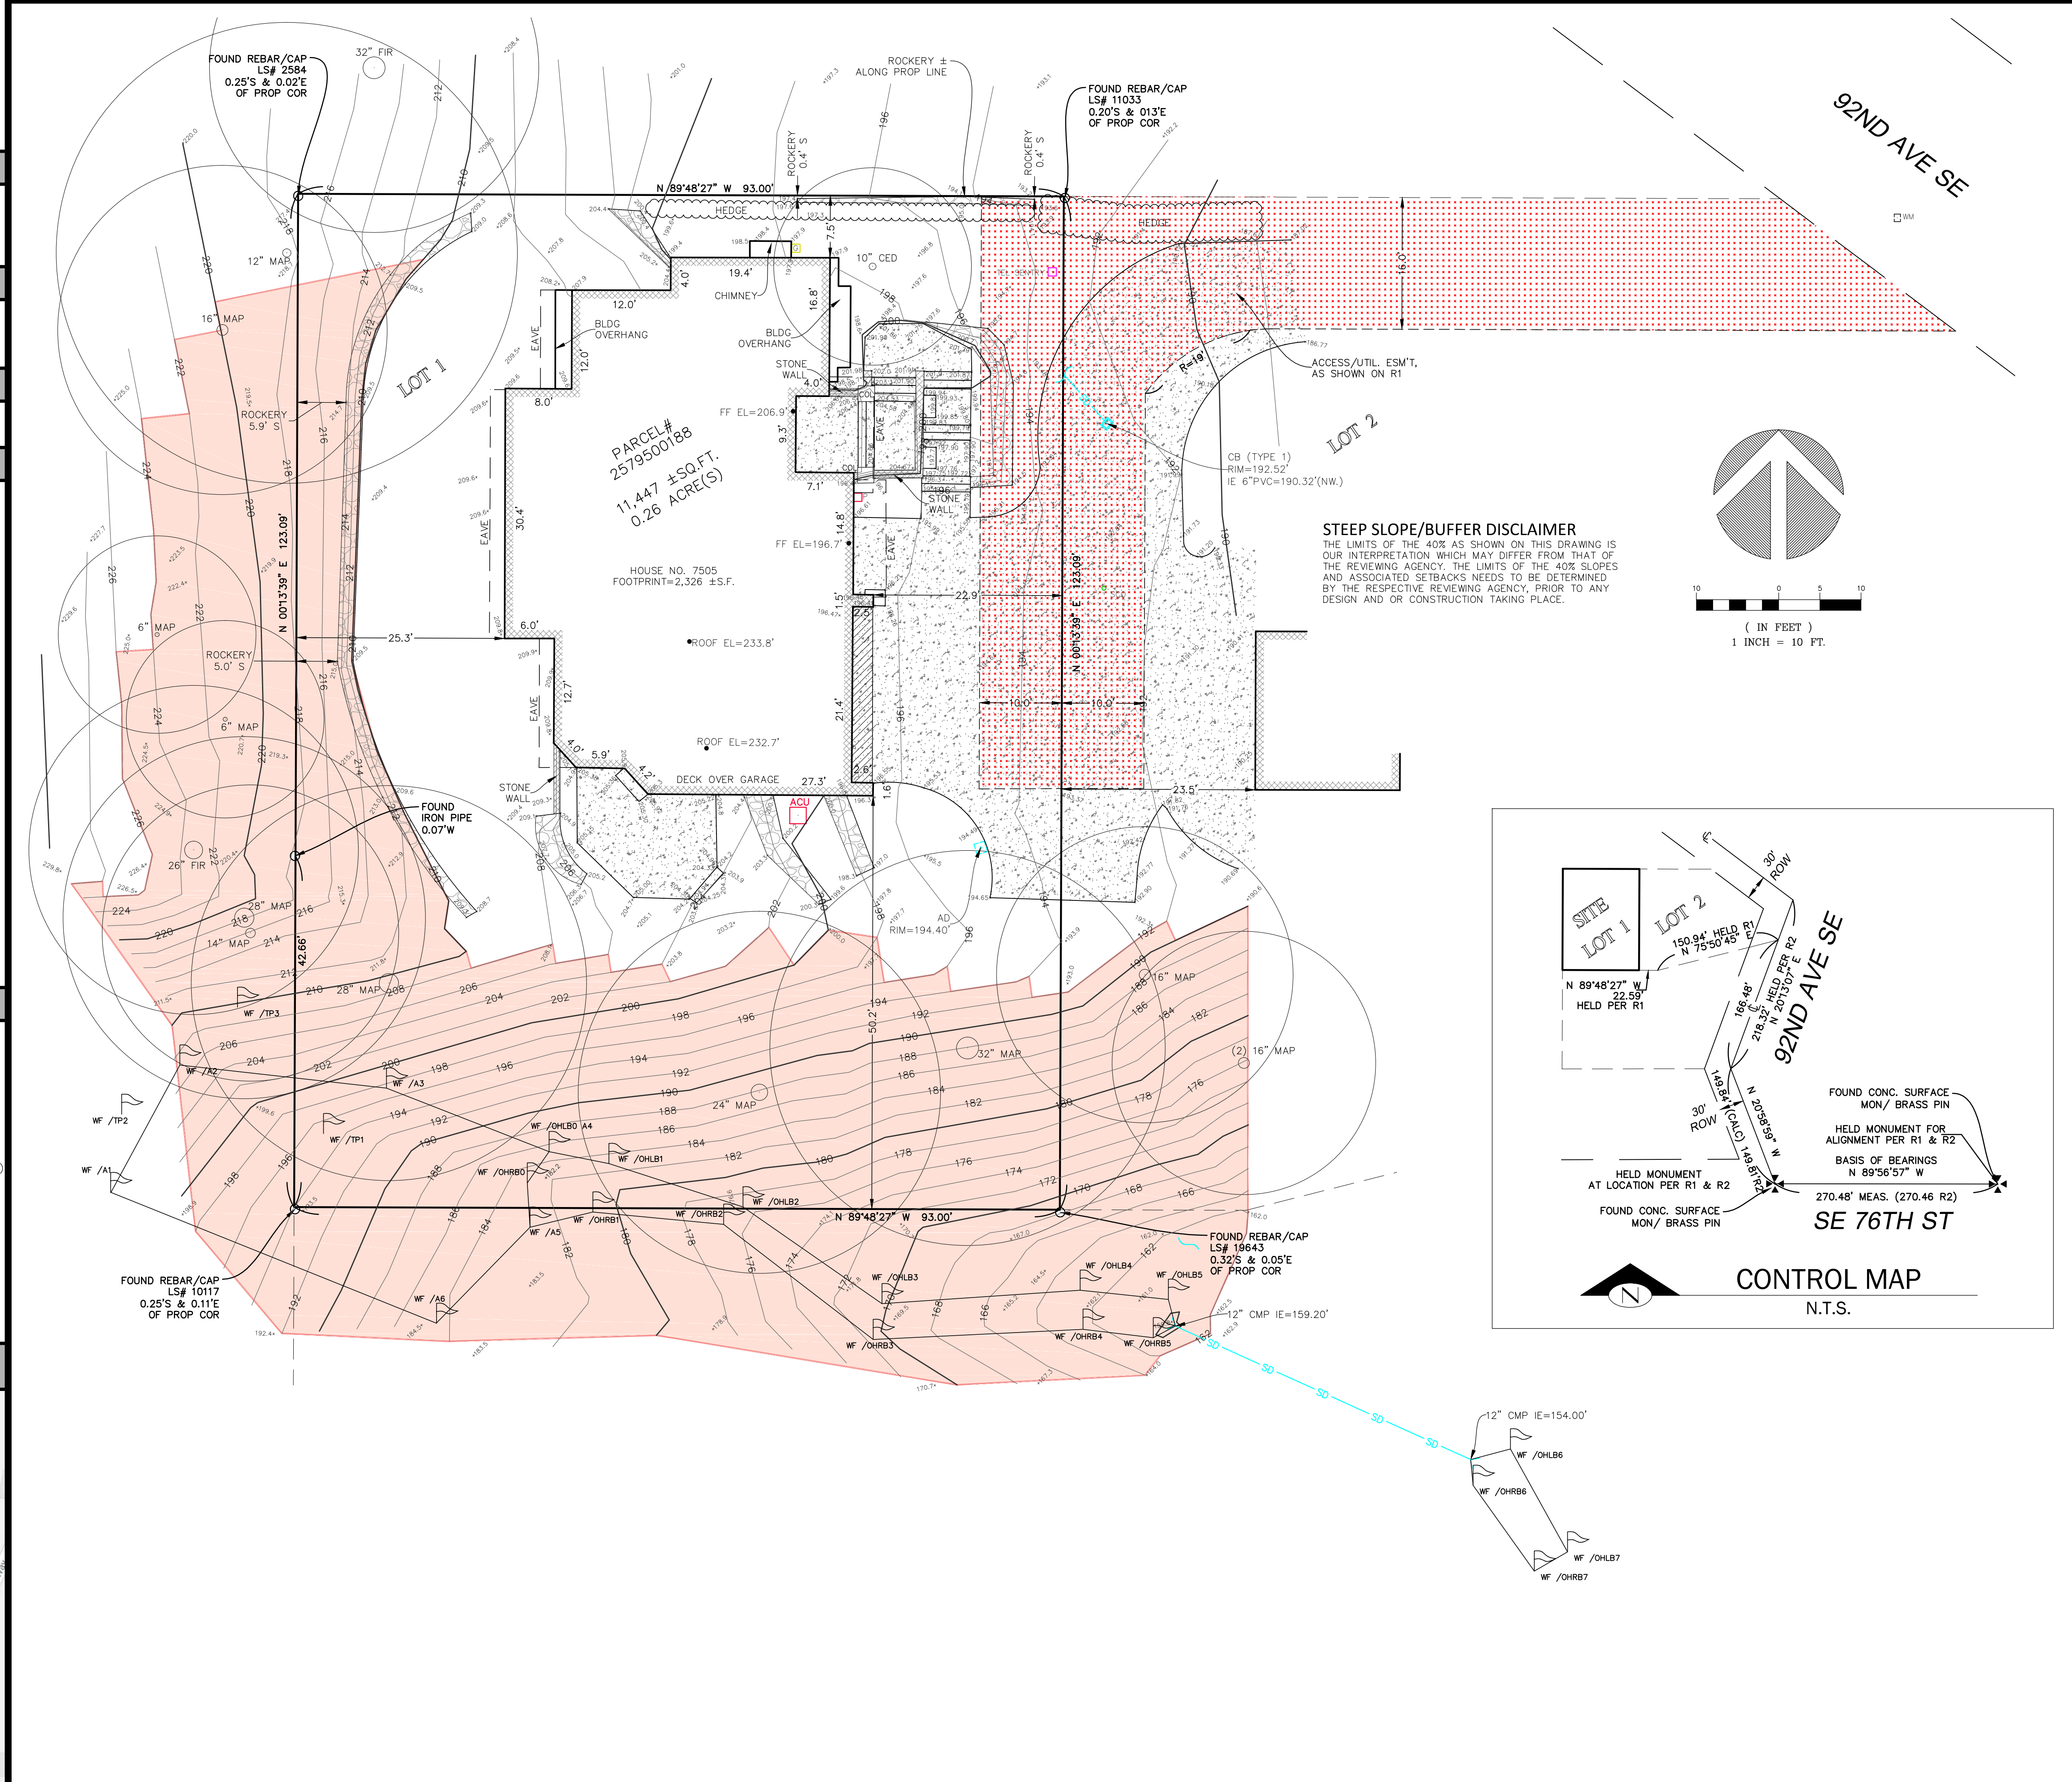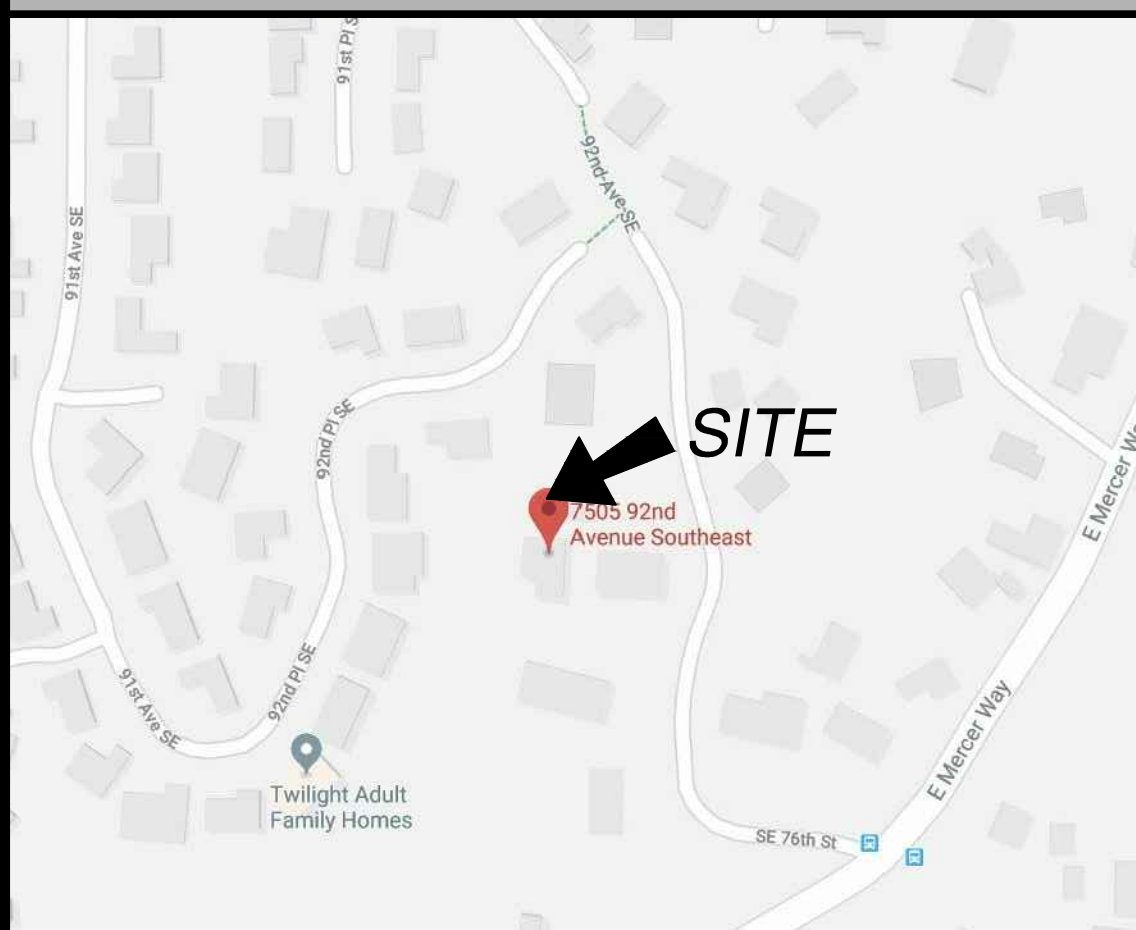

measure success

TOPOGRAPHIC & BOUNDARY SURVEY  
 NW 1/4 OF SE 1/4 SEC 30, TWP. 24 N., RGE 05 E., W.M.  
 PARCEL NO. 2579500188

LAI RESIDENCE  
 7505 92ND AVE SE  
 MERCER ISLAND, WA 98040

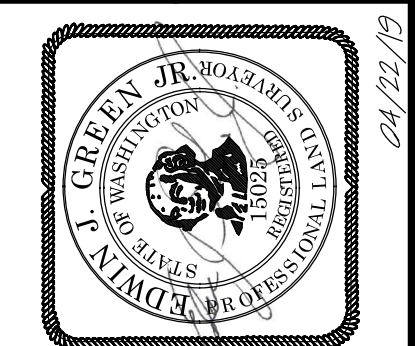

**Terrane**  
 10801 Main Street, Suite 102, Bellevue, WA 98004  
 phone 425.458.4488 support@terrane.net  
[www.terrane.net](http://www.terrane.net)

JOB NUMBER:	181046
DATE:	07/04/18
DRAFTED BY:	IDV/MD
CHECKED BY:	EJG/TMM
SCALE:	1" = 10'
REVISION HISTORY	
4/22/19	ADDED WETLAND
	INFO
SHEET NUMBER	
1 OF 1	



# JM TPO — 80 mil

Thermoplastic Polyolefin Membrane

Meets or exceeds the requirements of ASTM D 6878

### Features and Components


**Thickness Over Scrim:** Optimized and tested on a continual basis with a state-of-the-art thickness gauge to verify that the thickness valued by our customers is incorporated into the sheet.

**One of the Widest Melt Windows:** Promotes better welds over a wider variety of speeds and temperatures, and leads to a softer, more flexible and workable sheet.

**Reinforced fabric scrim layer and top-ply thickness:** Lends to durable physical properties including:

- Long-term weathering, UV resistance and heat-aging properties
- High breaking and tearing strength

**Optimized TPO formulation:** delivers high-performance ozone resistance, cool roof reflectivity and overall weather resistance.

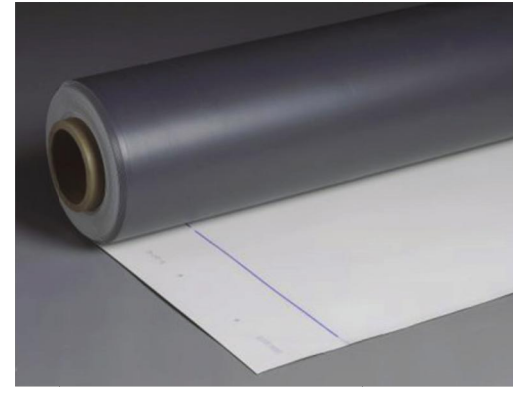

**Colors**  
Gray\* White Tan\*

\* Gray and Tan lead times are subject to availability and may require an upcharge for smaller projects.

**System Compatibility** This product may be used as a component in the following systems. Please reference product application for specific installation methods and information.

Multi-Ply	BUR	APP	SBS
Single-Ply	HA	CA	HW
	SA	MF	AD
	BA		

Key: HA = Hot Applied CA = Cold Applied HW = Heat Weldable SA = Self Adhered MF = Mechanically Fastened AD = Adhered BA = Ballasted

### Energy and the Environment

Standard	Color	Reflectivity		Emissivity
		Initial	3 Yr. Aged	
CRRC*	White	0.77	0.87	0.86
	Tan	0.70	0.86	
	Gray	0.62	0.90	
CA Title 24	White	0.77	0.87	SRI=75
	Tan	0.70	0.86	
	Gray	0.62	0.90	
ENERGY STAR*	White	0.77	0.87	95
	Tan	0.70	0.86	
	Gray	0.62	0.90	
LEED* (SRI)	White	0.77	0.87	81
	Tan	0.70	0.86	
	Gray	0.62	0.90	
Recycled Content	Post-consumer	0%	0%	5%
	Post-industrial	0%	0%	


The LEED\* Solar Reflectance Index (SRI) is calculated per ASTM E1990.

Product	Guarantee Term
JM TPO 80 mil	5, 10, 15, 20, 25, or 30 yrs

### Codes and Approvals



### Installation/Application

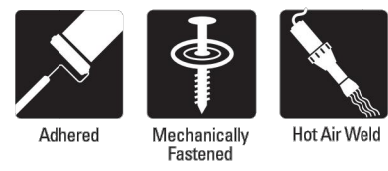

Refer to JM TPO application guides and detail drawings for instructions.

### Packaging and Dimensions

Roll Widths	5' (15.2 m)	6' (1.83 m)	8' (2.44 m)	10' (3.05 m)	12' (3.66 m)
Roll Lengths	375 ft	450 ft	600 ft	750 ft	900 ft
Roll Coverage	34.84 m <sup>2</sup>	41.81 m <sup>2</sup>	55.74 m <sup>2</sup>	69.66 m <sup>2</sup>	83.61 m <sup>2</sup>
Rolls per Pallet	8				
Pallet Weight	1400 lb (627.8 kg)	1680 lb (762.0 kg)	2300 lb (1043.1 kg)	2820 lb (1281.3 kg)	3420 lb (1551.3 kg)
Pallets per Truck*	28-32	22-26	18-20	14-16	11-13
Producing Location	Scottsboro, AL				

\*Assumes 40' flatbed truck and does not reflect pallets of accessories or impact of mixed sizes.

Refer to the Safety Data Sheet and product label prior to using this product. The Safety Data Sheet is available by calling (800) 922-5922 or on the Web at www.jm.com/roofing.

HOMEOWNER AND REPRESENTATIVES SHALL HOLD CITY OF MERCER ISLAND AND ALL OTHER PARTIES HARMLESS FOR THE USE OF THE MATERIALS REPRESENTED HEREIN

### PAVER PEDESTAL SPEC:

**BlackJack® Component**

**BlackJack® Height Chart**

**Technical Specifications**

Material	Recycled Polypropylene
Height Range	2 1/8" - 4" (24mm - 101.6mm)
Ultimate Compressive Strength*	15.1kN (3372.9lb)
Design Compressive Strength*	11.1kN (2479.5lb)
Flare Connection	White 3/8" x 1/8" (9.5mm x 3.2mm)
Base Diameter	7 1/2" (190.5mm) & 8 1/2" (215.9mm)
Spacer Tab Height	5/8" (15.9mm)
Spacer Tab Thickness	1/8" (3.2mm) gap between slabs
Joint Holder	1.34" to 1.51" (34mm to 38mm) joint width
Biological / Chemical Resistance	Unaffected by acids and alkalis. Good resistance to oil and turpentine.

**Accessories**

- B) Spacer Tabs 3mm
- B) Joint Holder
- B) Top Slope Connector

SYMBOL	DESCRIPTION	REMARKS
	EXHAUST FAN	See Mechanical Plans
	SMOKE ALARM	See Sheet A-C General Notes Fire Protection Section
	NEW WALL (Line of Studs)	2x studs @ 16" O.C.
	NEW SOUND WALL	Staggered 2x studs with rock wool sound batts
	EXISTING TO REMAIN	
	EXISTING TO REMOVE	

**GENERAL PROPOSED NOTES**

(D) = DEMOLITION  
(E) = EXISTING  
(P) = PROPOSED

(P) HEATER  
(P) MOTORIZED SCREENS  
(P) RAILING CONSISTENT WITH STYLE OF EXISTING  
(P) CEDAR CEILING WITH RECESSED CANS TO MATCH (E) ENTRY

**GENERAL DEMOLITION NOTES**

**JOSH**  
ARTISAN + ARCHITECT

206 708 9933 JoshArch.COM

All drawings, specifications, plans, ideas, arrangements, and design solutions represented or referred to are the property of and owned by Josh PS whether the project for which they are made is executed or not. They were created, evolved, developed and produced for the sole use on and in connection with this project and none of the above may be disclosed or given to or used by any person, firm, or corporation for any use or purpose whatsoever including any other project, except upon written permission of Josh PS.

© COPYRIGHT 2020 JOSH PS

9388 REGISTERED ARCHITECT

JOSHUA BRINCKO  
STATE OF WASHINGTON

# JM TPO — 80 mil

Thermoplastic Polyolefin Membrane

Meets or exceeds the requirements of ASTM D 6878

### Tested Physical Properties

Physical Properties	ASTM Test Method	Standard for ASTM D 6878 (Min.)	JM TPO - 80 mil MD*	JM TPO - 80 mil XMD**
Breaking Strength, min. lbf (N)	D 751	220 (976)	464 (2,064)	439 (1,953)
Elongation at Break, min %	D 751	15	29	31
Tearing Strength, min. lbf (N)	D 751	45 (200)	65 (289)	179 (796)
Factory Seam Strength, min. lbf (N)	D 751	66 (290)	137 (609)	
Thickness, min. in.	D 751	+/- 10% from Nominal	0.080 (Nominal)	
Thickness Over Scrim, min. in. (mm)	D 7635	0.015	0.033 (0.84)	
Water Absorption, max. %	D 471	3.0	0.03	
Brittleness Point, max. -40°F	D 2137	No Cracks	Pass	
Ozone Resistance	D1149	No Cracks	Pass	
Properties after Heat Aging @ 240°F	D 573	Pass/Fail	Pass	
Breaking Strength, % (after aging)	D 751	90	>90	>90
Elongation, % (after aging)	D 751	90	>90	>90
Tearing Strength, % (after aging)	D 751	60	>60	>60
Weight Change, max. % (after aging)	D 751	±1.0	0.22	
Linear Dimensional Change, max. % (after 6 hrs @ 158°F)	D 1204	±1.0	<0.1	
Accelerated Weathering, min	G 151 & G 155	10,080 kg/m <sup>2</sup> ·nm @ 340 nm (4,000 hrs @ 0.70 W)	>20,160 kg/m <sup>2</sup> (>8,000 hrs)	
Cracking (@ 7x magnification)	G 155	No Cracks	Pass	


\*MD = Machine Direction  
\*\*XMD = Cross-Machine Direction  
Note: All data represents tested values.

### Supplemental Testing


Physical Properties	ASTM Test Method	Standard for ASTM D 6878 (Min.)	JM TPO - 80 mil Result
Dynamic Puncture	D 5635	N/A	Pass @ 25 Joules
Static Puncture	D 5602	N/A	Pass @ 44 lb (20 kg)
Impact Resistance of Bituminous Roofing Systems	D 3746	N/A	Pass - minor indentations
Reflectance	C 1549	N/A	78%
	E 903	N/A	80%
	C 1371	N/A	0.87
Emittance	E 408	N/A	0.96
	E 1980	N/A	95
Resistance of Synthetic Polymer Material to Fungi	G 21	N/A	0 rating
Puncture Resistance (FTMS 101C, Method 2031)	N/A	N/A	526 lb (239 kg)
Moisture Vapor Transmission	E 96	N/A	0 g/m <sup>2</sup> per 24 hours
Hydrostatic Resistance, Mullen	D 751	N/A	474 PSI (3268 kPa)
Standard Test Method for Air Permeance of Building Materials	E 2178	N/A	Pass @ <0.0005 L/(s·m <sup>2</sup> ) (Pass @ <0.0001 CFM/ft <sup>2</sup> )

Refer to the Safety Data Sheet and product label prior to using this product. The Safety Data Sheet is available by calling (800) 922-5922 or on the Web at www.jm.com/roofing.

RS-8634 9-18 (Replaces 6-18)

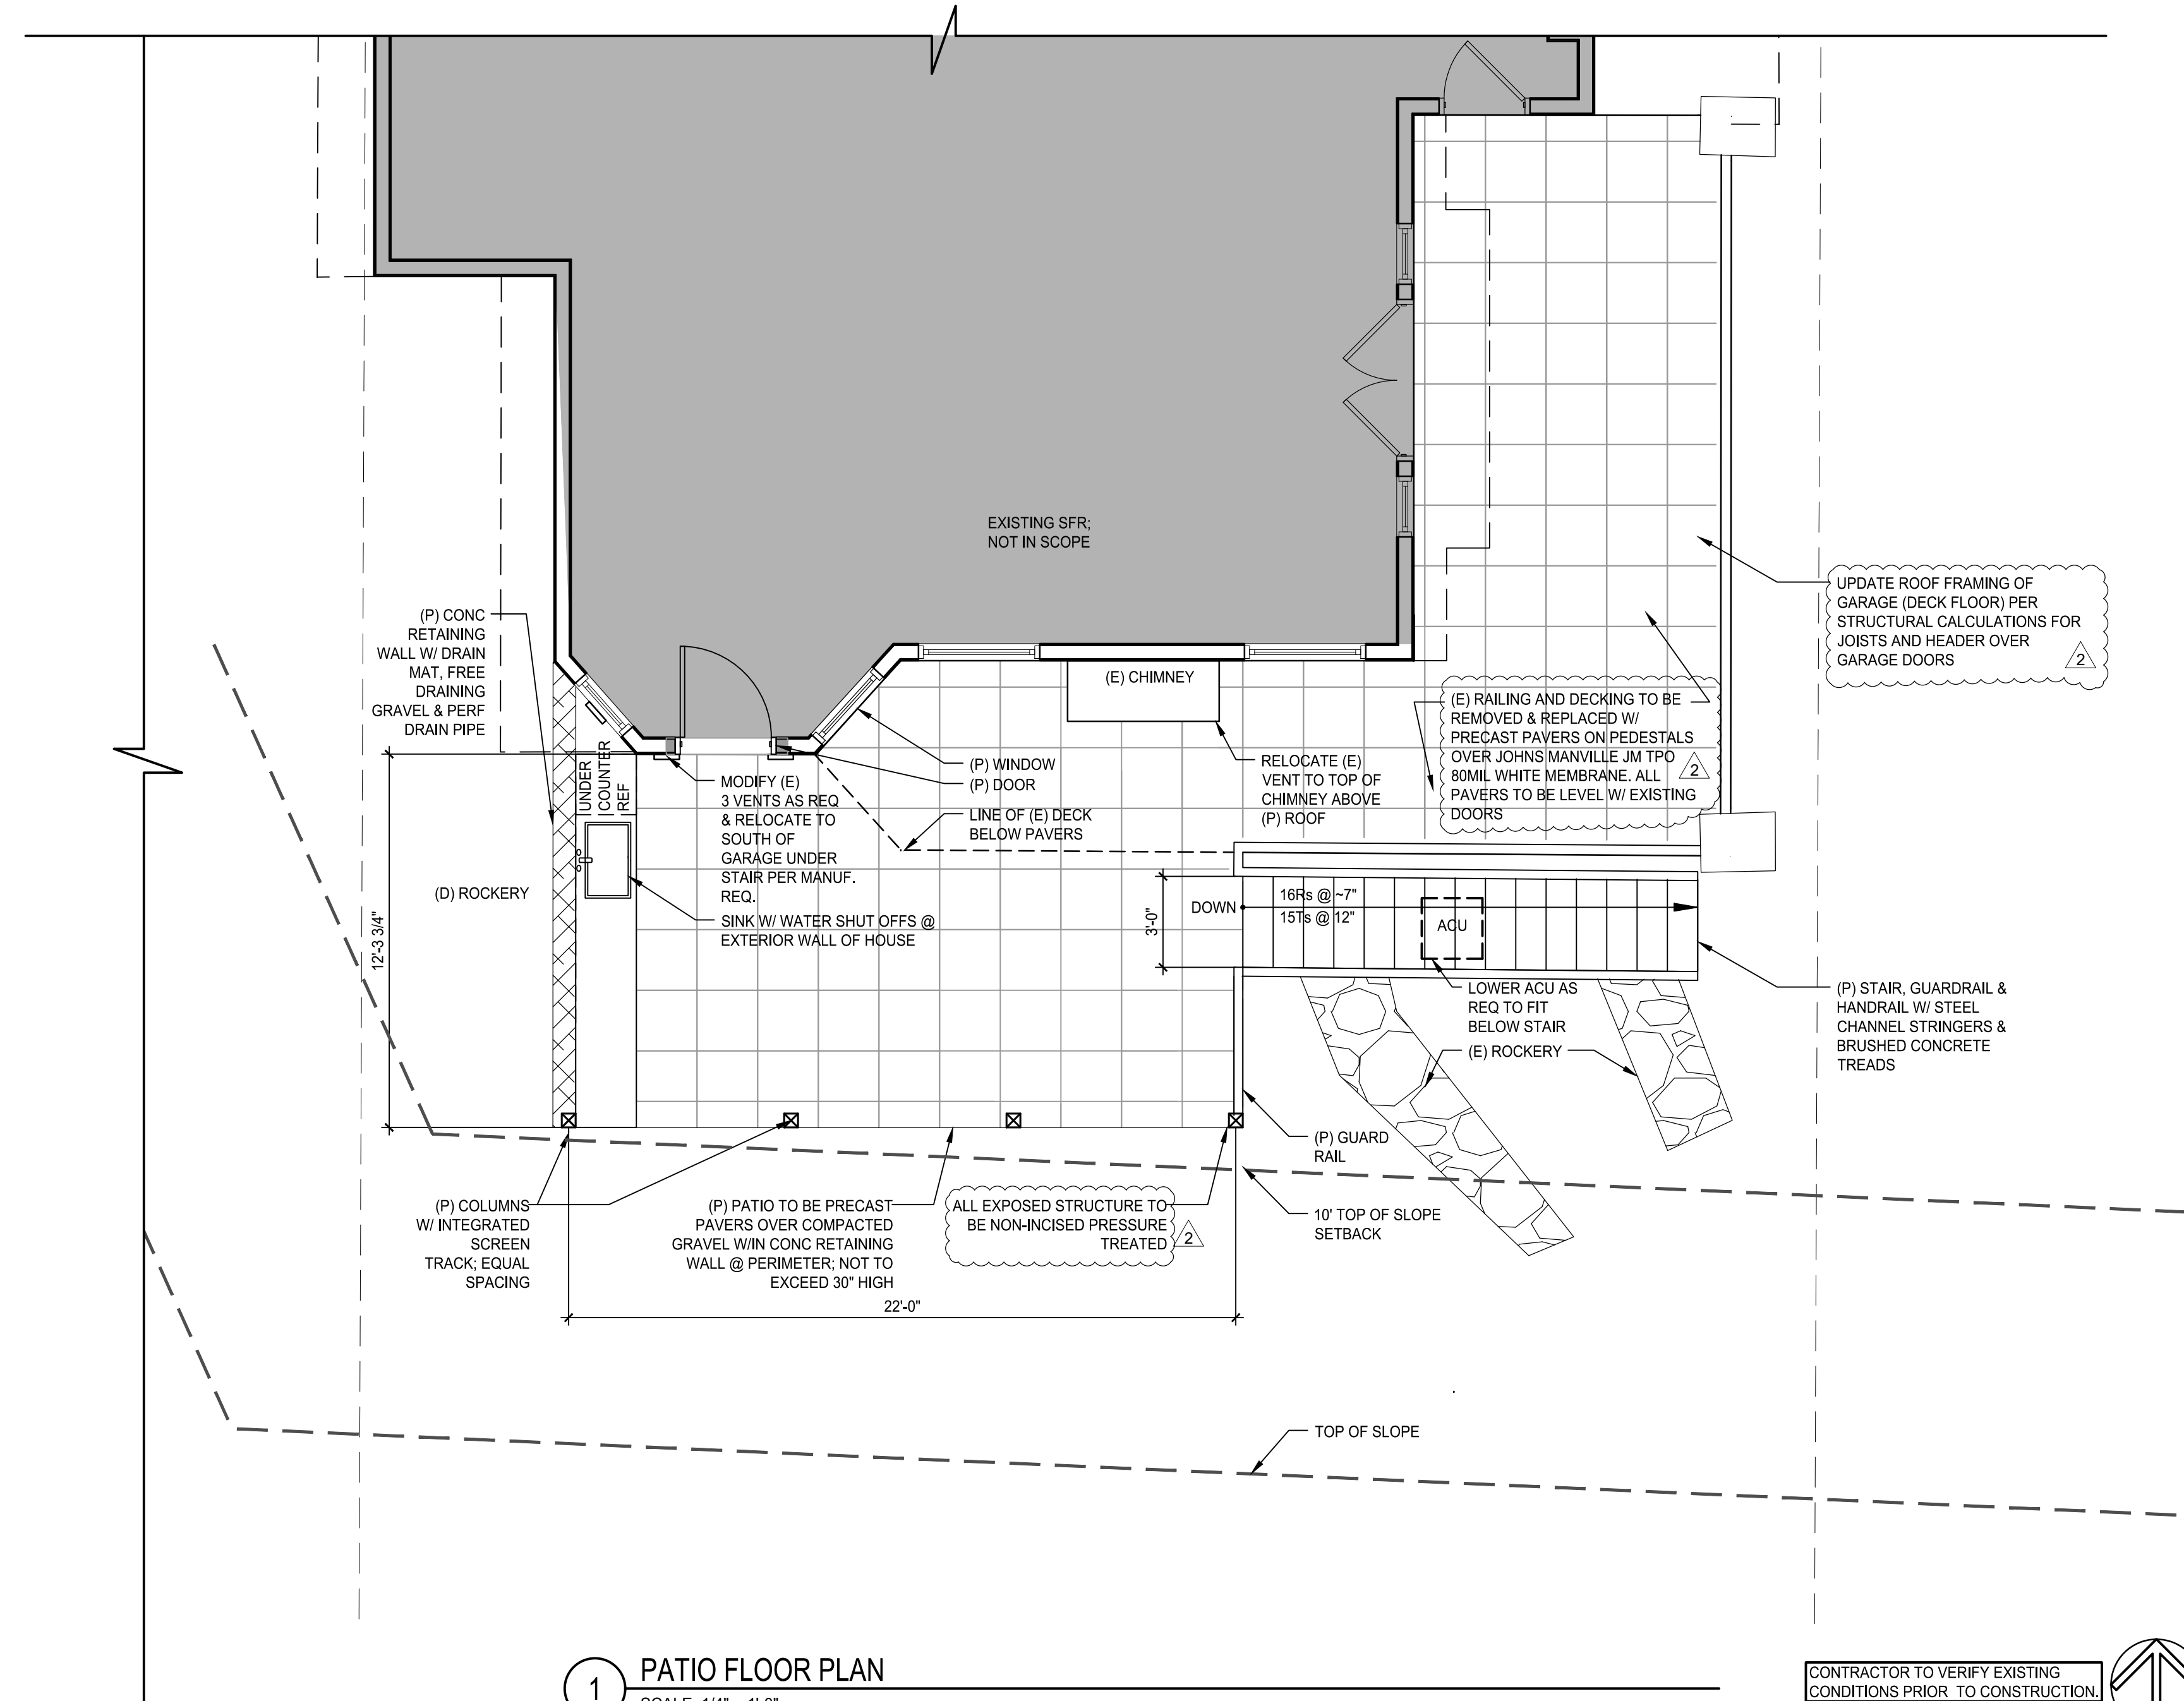

CONTRACTOR TO VERIFY EXISTING CONDITIONS PRIOR TO CONSTRUCTION. CONTRACTOR TO CONFIRM FINISHES TO BE MOCKED UP WITH ARCHITECT.

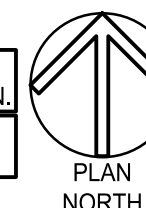

DESIGN	SJB
DRAWN	CEC
CHECKED	SJB
DATE	[2019-0114 DESIGN]
	[2019-0621 PERMIT]
	[2020-0211 REV 1]
	[2020-0413 REV 2]

LAI  
7505 92ND AVE SE  
MERCER ISLAND WA 98040

PERMIT  
MAIN FLOOR PLAN




# A2.0

ARCHITECT REQUIRES A MEETING WITH THE LABORERS INSTALLING SIDING AT THE BEGINNING OF THE FIRST WORKDAY TO EXPLAIN SIDING DETAILS AND SUBSEQUENT MEETINGS FOR EACH DIFFERENT SIDING MATERIAL TO BE INSTALLED.

All drawings, specifications, plans, ideas, arrangements, and design solutions represented or referred to are the property of and owned by Josh PS whether the project for which they are made is executed or not. They were created, evolved, developed and produced for the sole use on and in connection with this project and none of the above may be disclosed or given to or used by any person, firm, or corporation for any use or purpose whatsoever including any other project, except upon written permission of Josh PS.

© COPYRIGHT 2020 JOSH PS

9388 REGISTERED ARCHITECT  
*SJB*  
JOSHUA BRINCKO  
STATE OF WASHINGTON

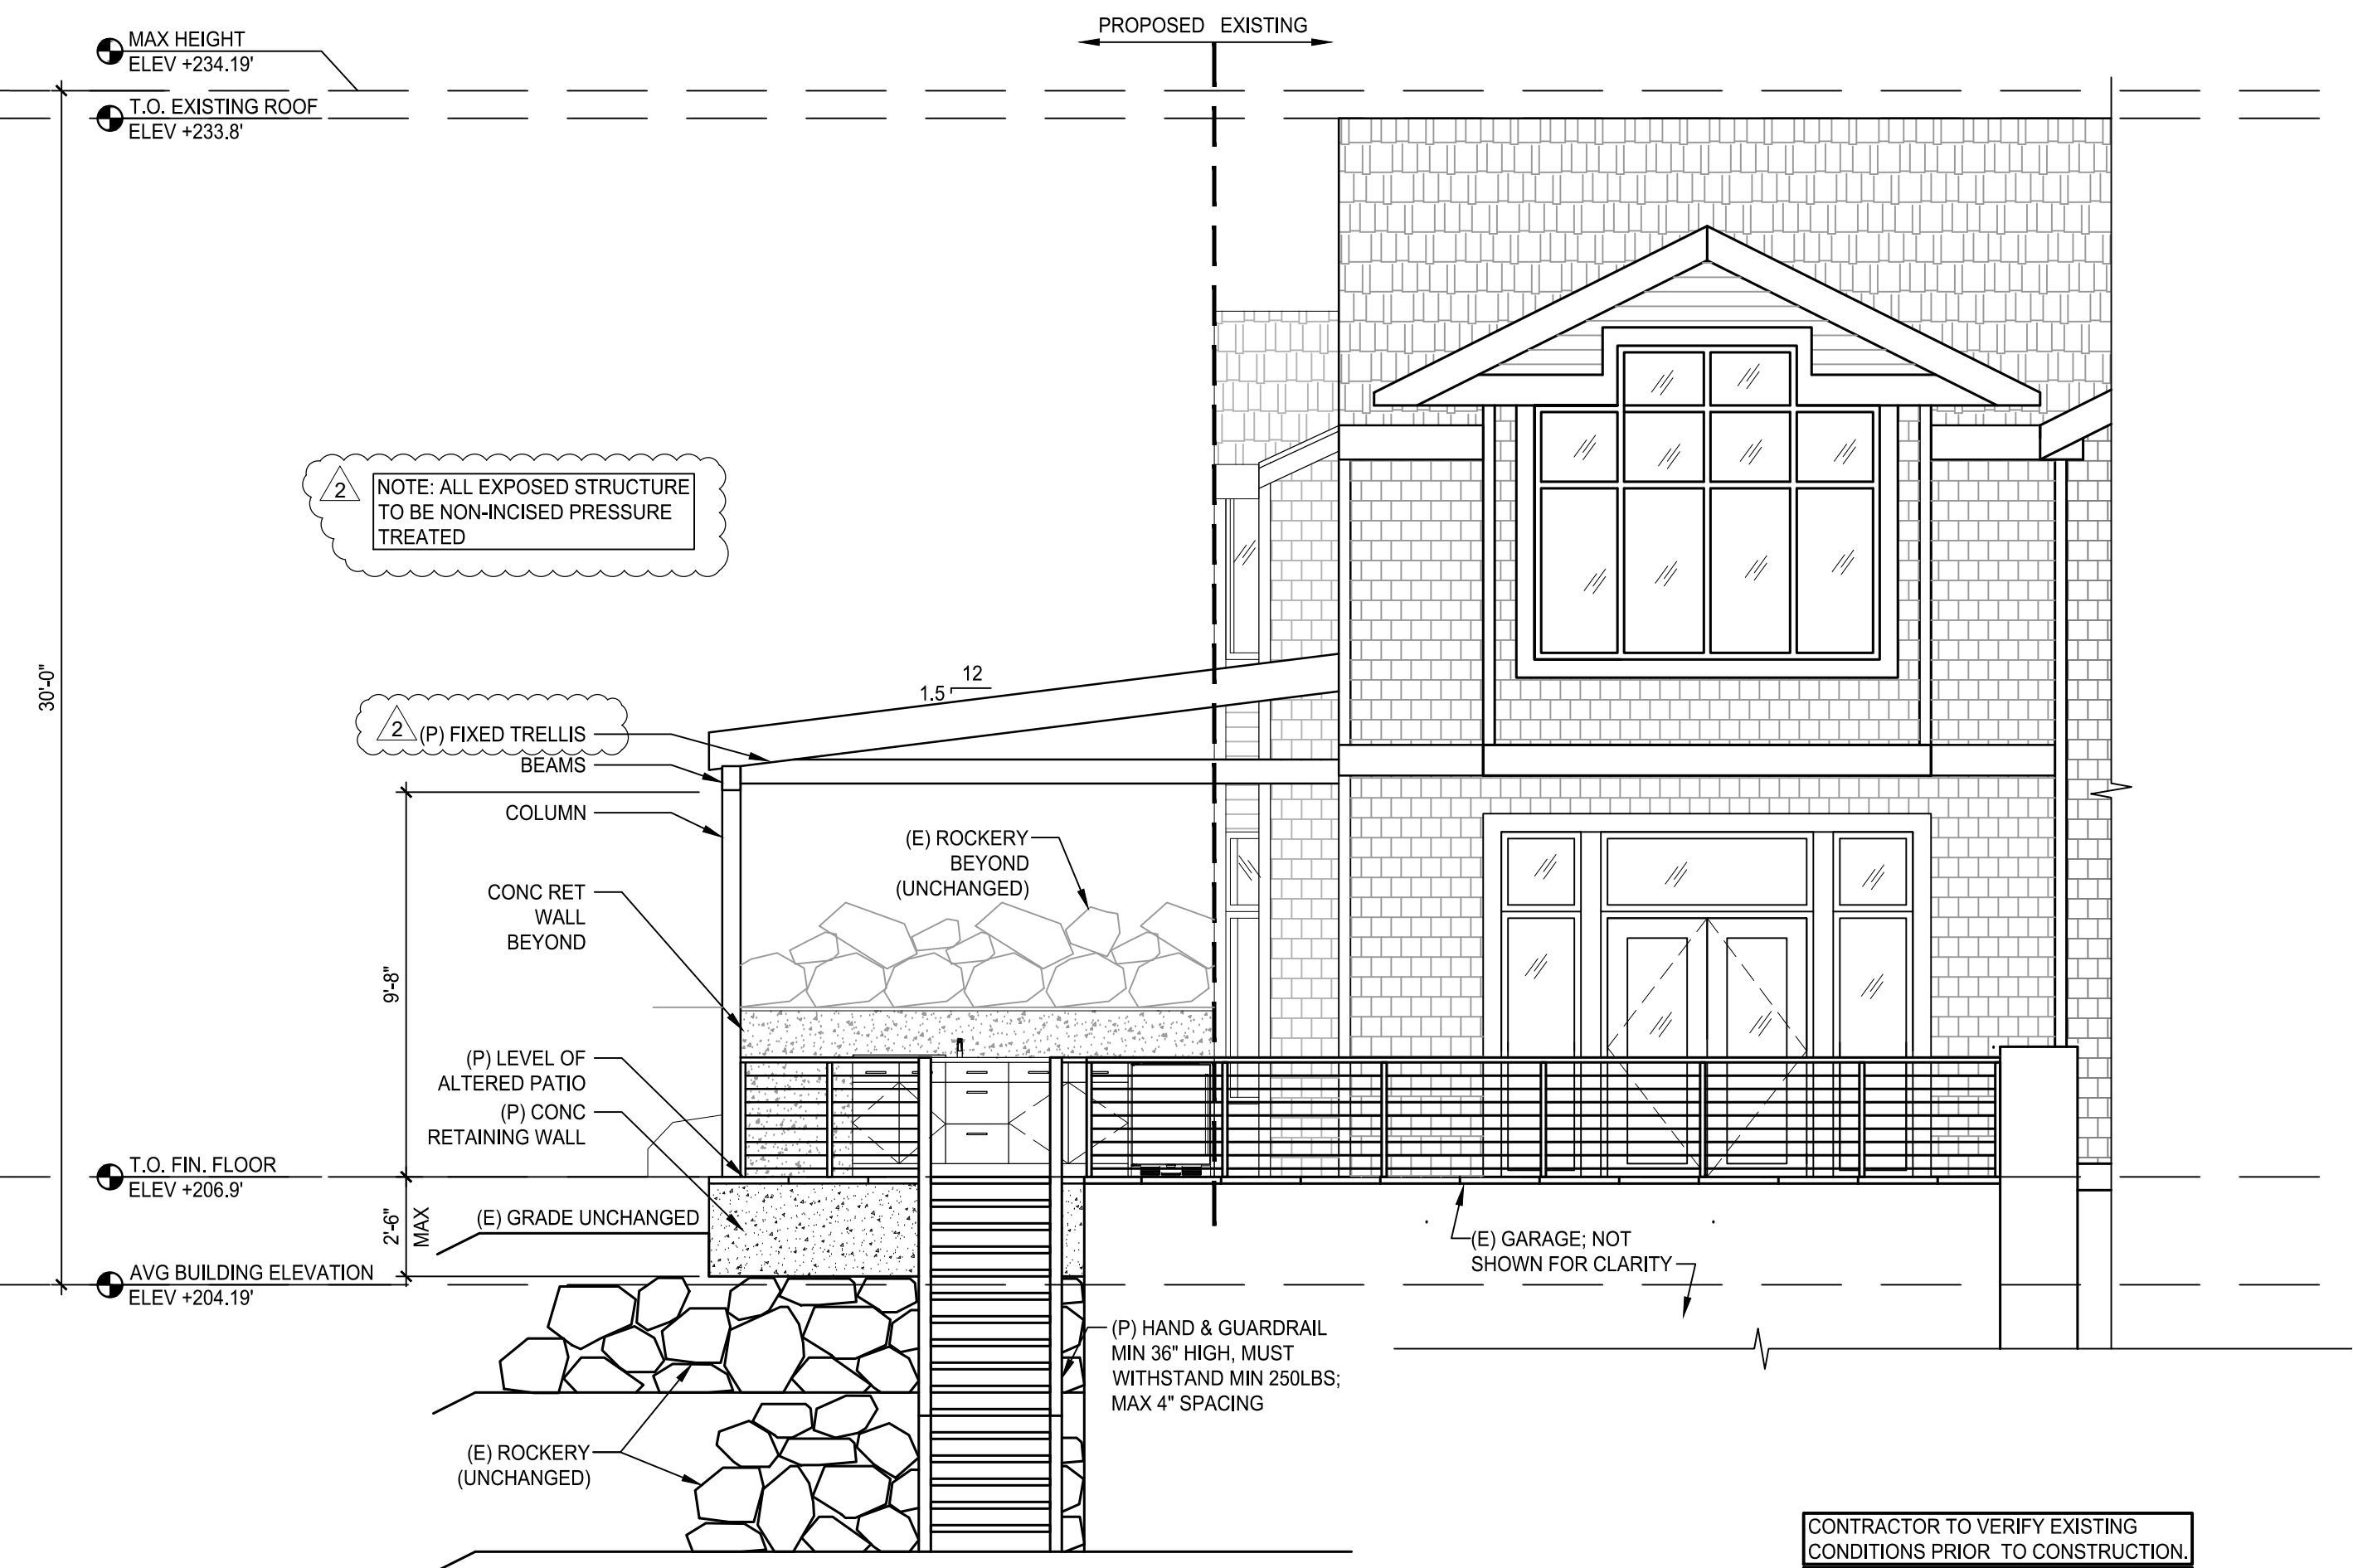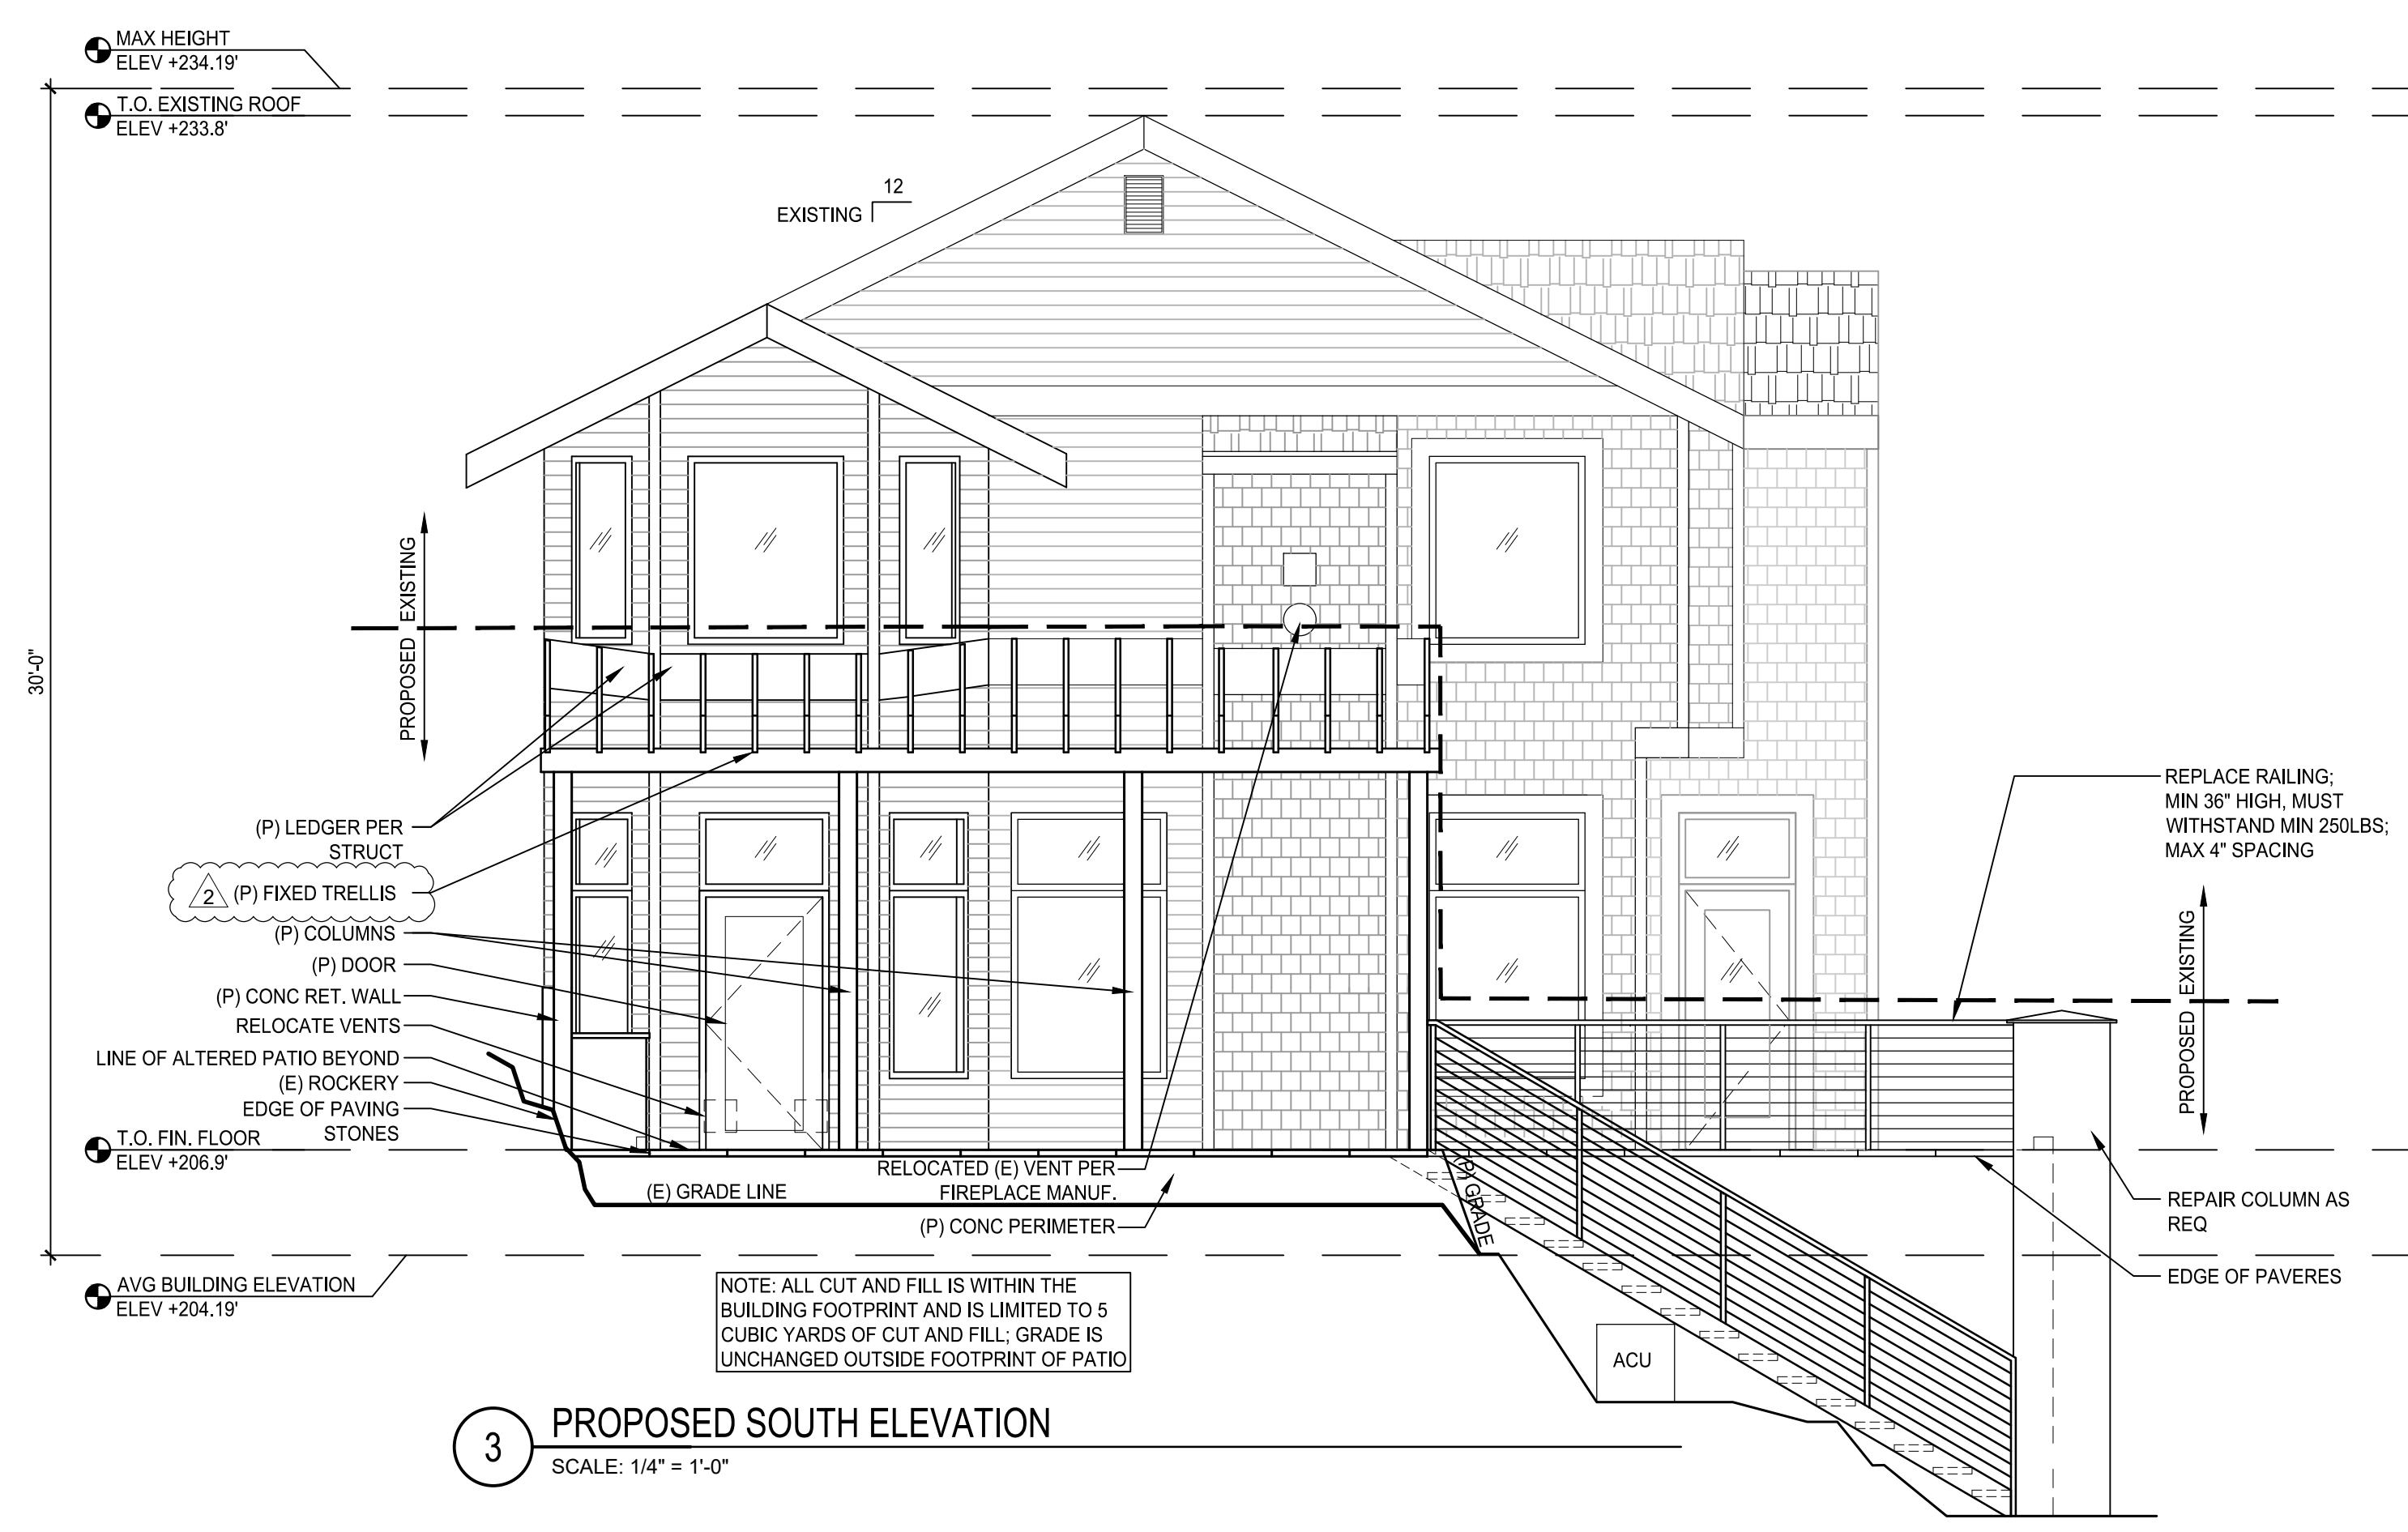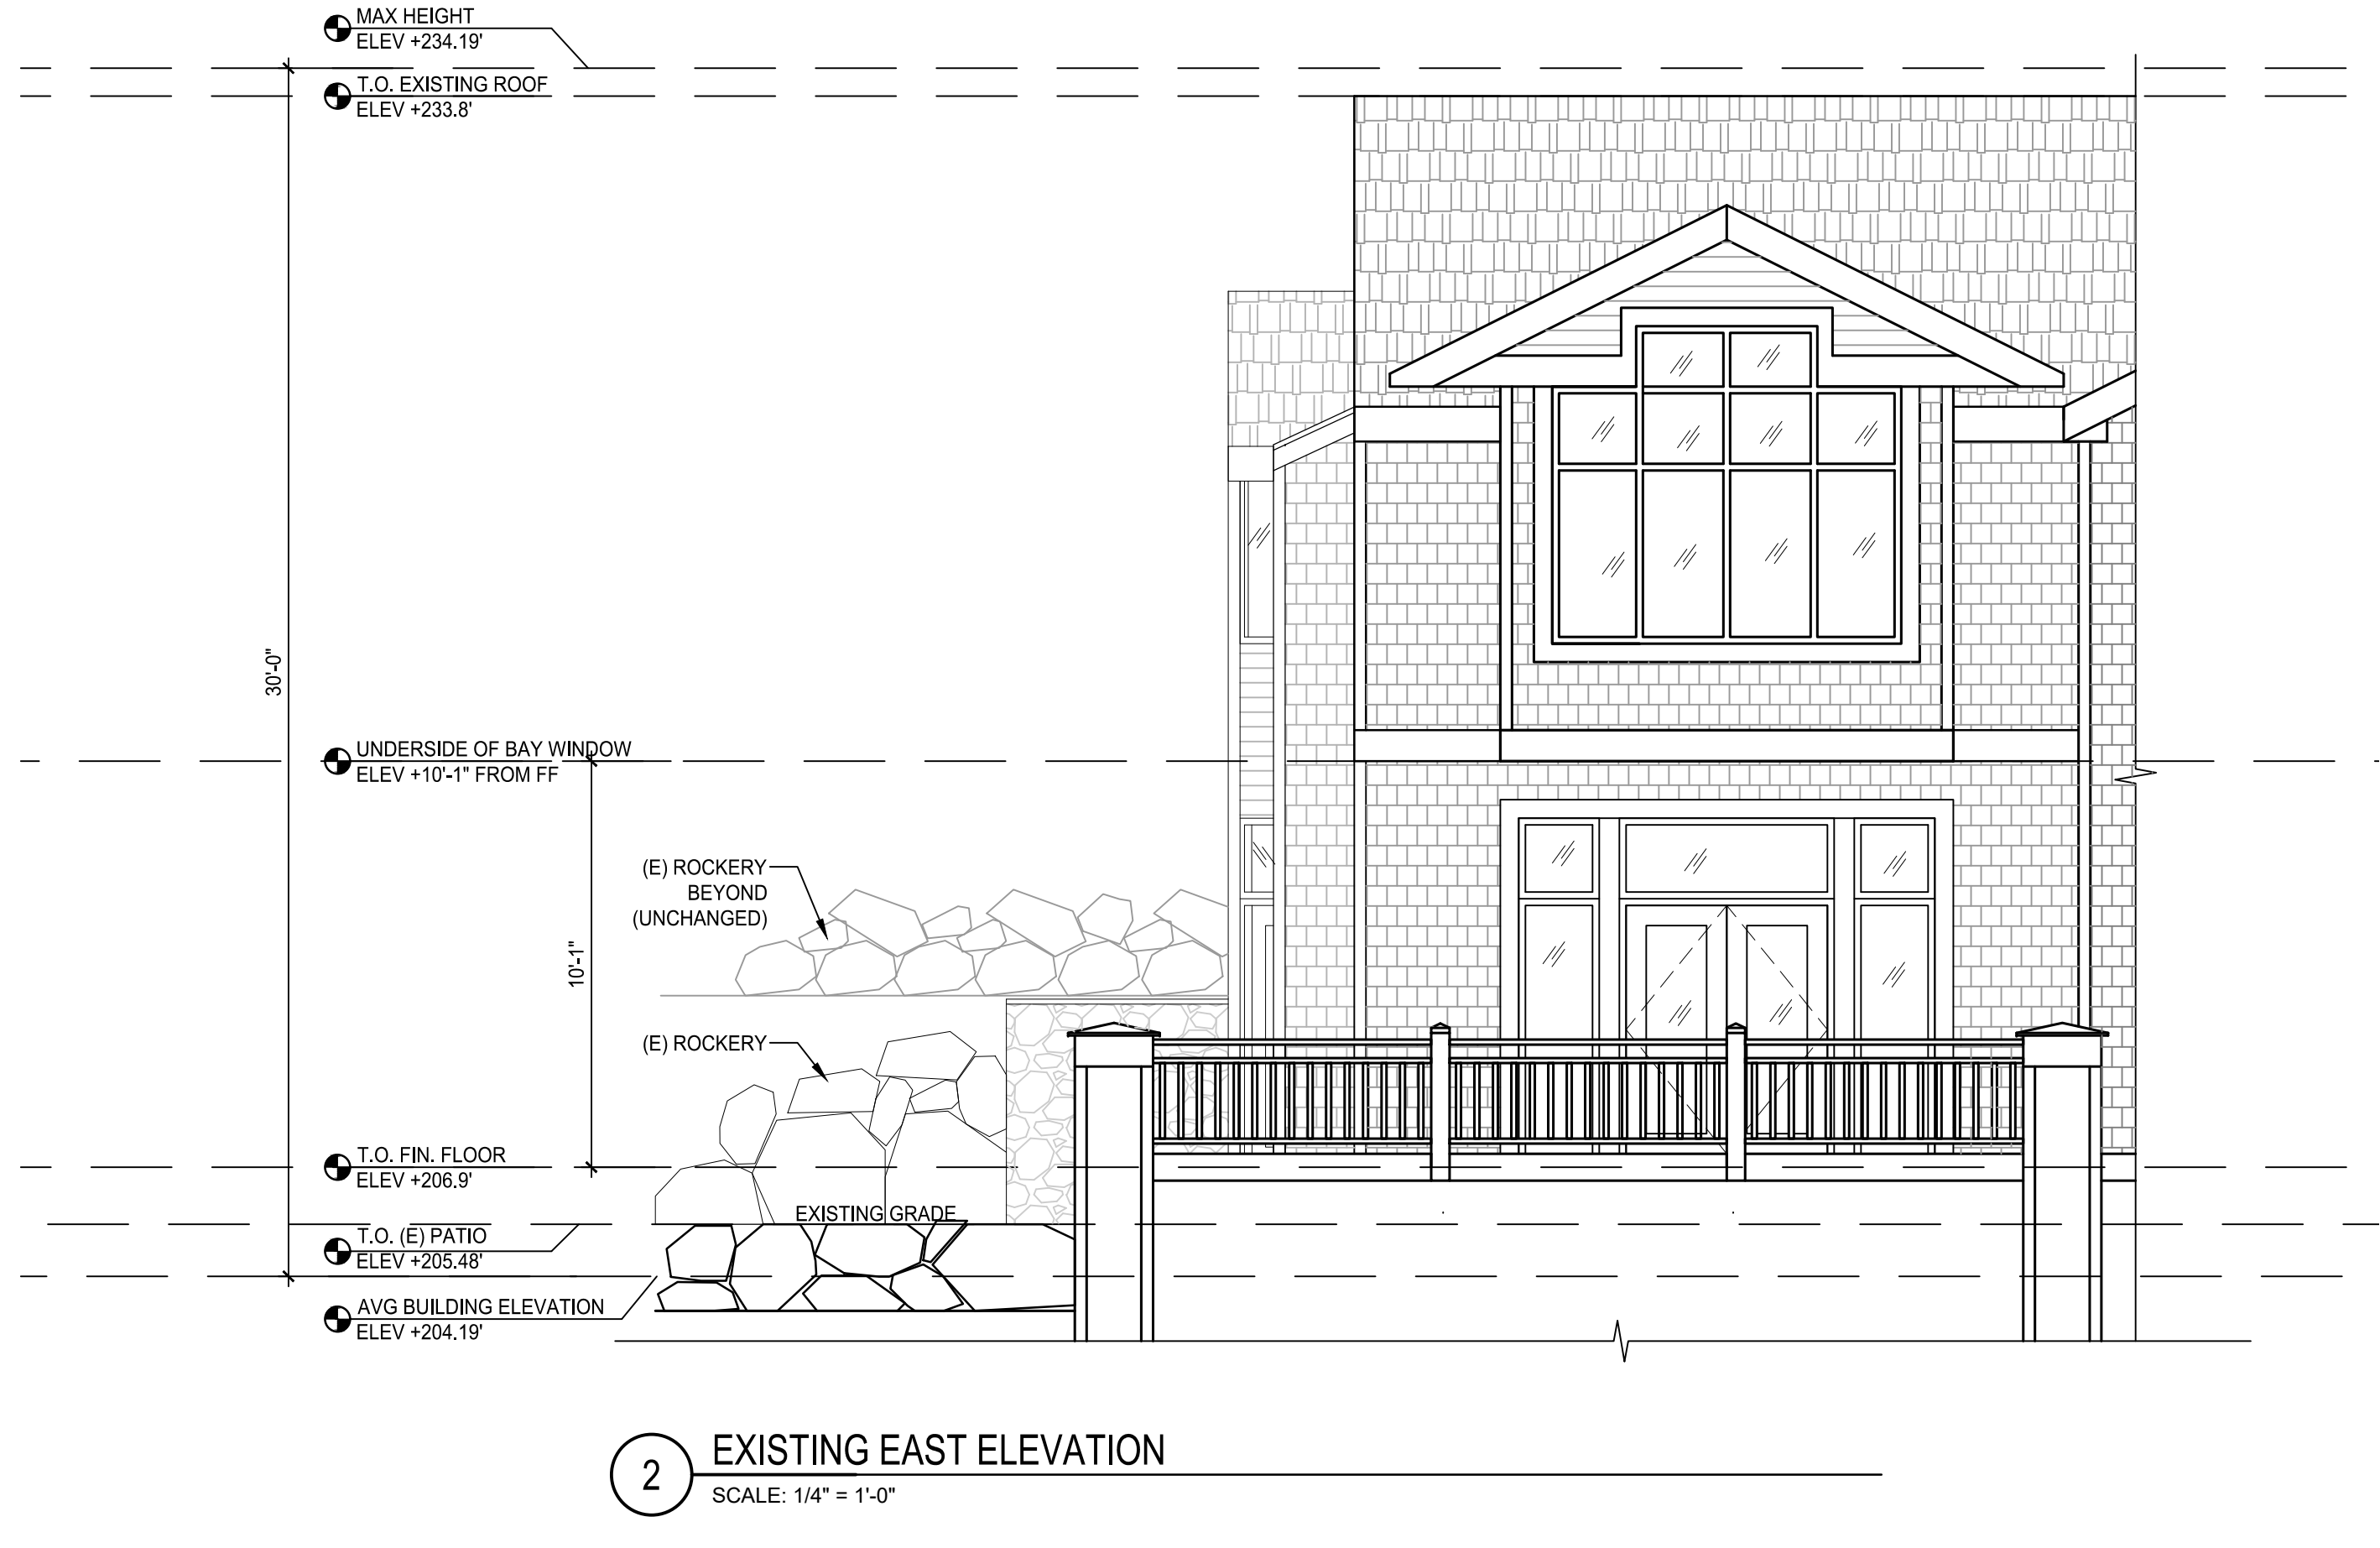

DESIGN	SJB
DRAWN	CEC
CHECKED	SJB
DATE	[2019-0114 DESIGN]
	[2019-0621 PERMIT]
	[2020-0211 REV 1]
	[2020-0413 REV 2]


LAI  
7505 92ND AVE SE  
MERCER ISLAND WA 98040

PERMIT  
ELEVATIONS


CONTRACTOR TO VERIFY EXISTING CONDITIONS PRIOR TO CONSTRUCTION. CONTRACTOR TO CONFIRM FINISHES TO BE MOCKED UP WITH ARCHITECT.

All drawings, specifications, plans, ideas, arrangements, and design solutions represented or referred to are the property of and owned by Josh PS whether the project for which they are made is executed or not. They were created, evolved, developed and produced for the sole use on and in connection with this project and none of the above may be disclosed or given to or used by any person, firm, or corporation for any use or purpose whatsoever including any other project, except upon written permission of Josh PS.


© COPYRIGHT 2020  
JOSH PS

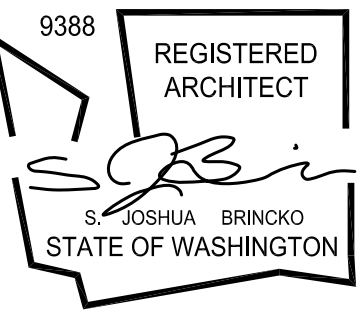


ARCHITECT REQUIRES A MEETING WITH THE LABORERS INSTALLING SIDING AT THE BEGINNING OF THE FIRST WORKDAY TO EXPLAIN SIDING DETAILS AND SUBSEQUENT MEETINGS FOR EACH DIFFERENT SIDING MATERIAL TO BE INSTALLED.

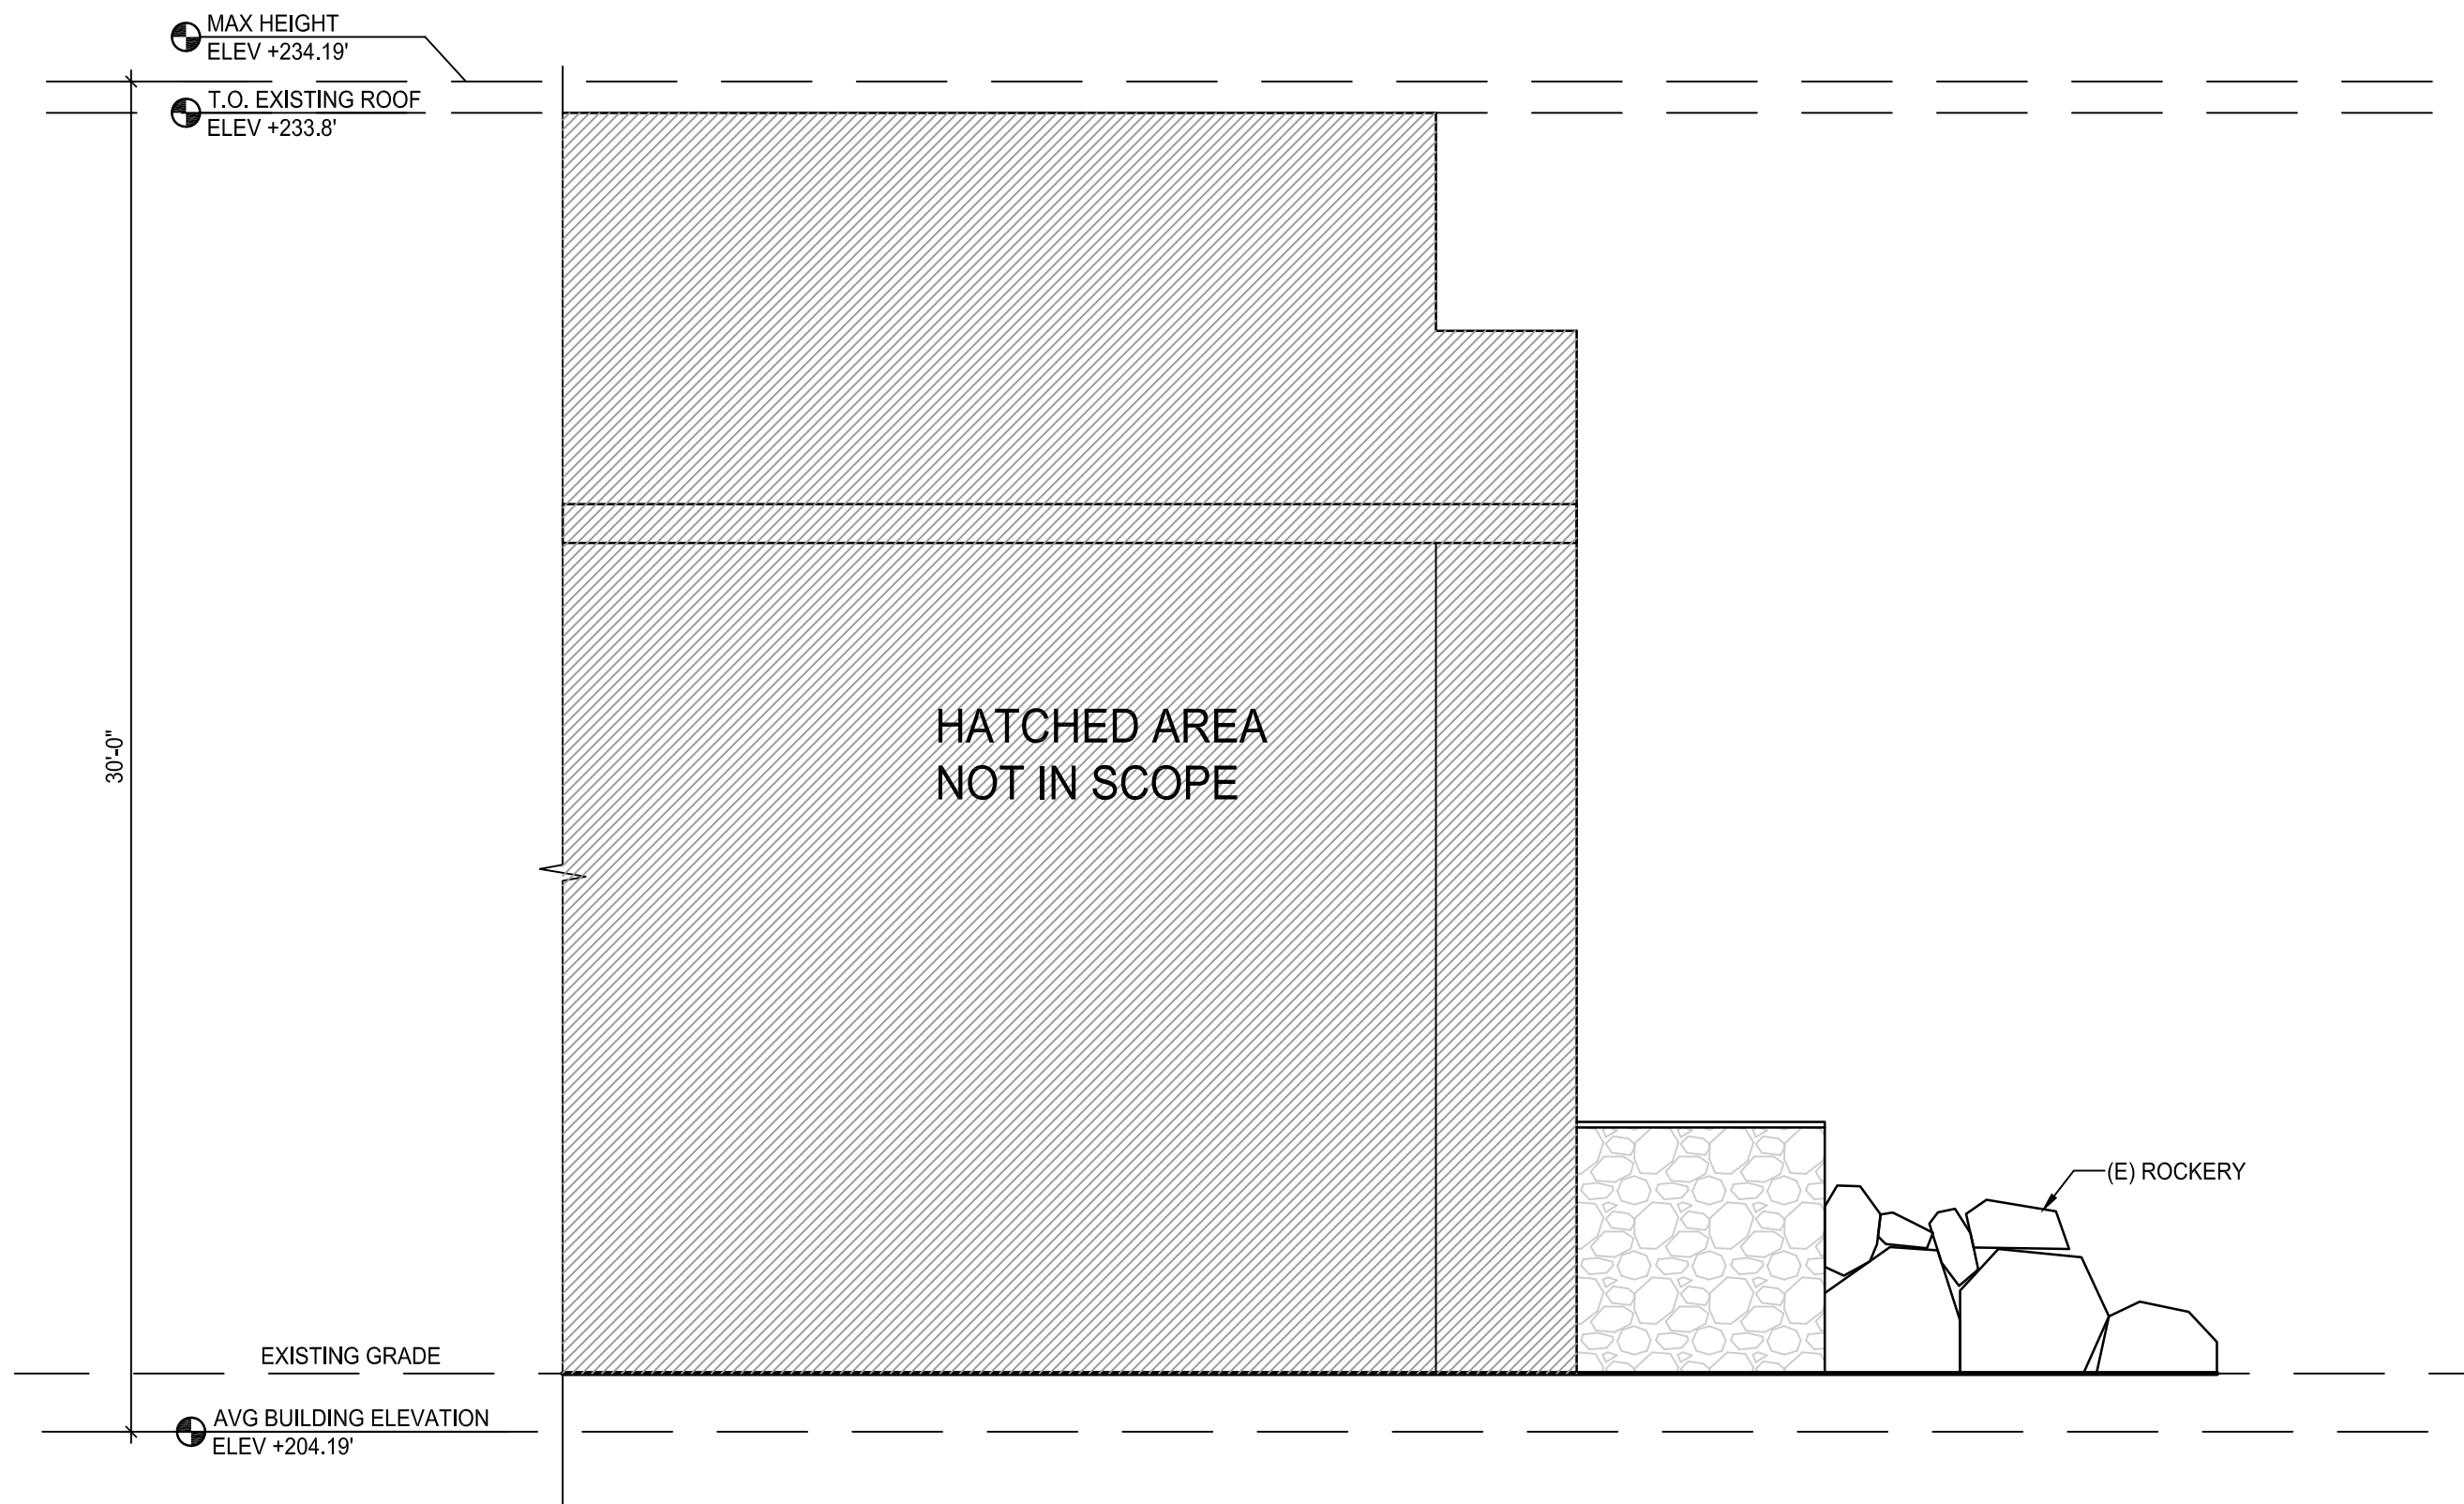


1 EXISTING WEST ELEVATION  
SCALE: 1/4" = 1'-0"

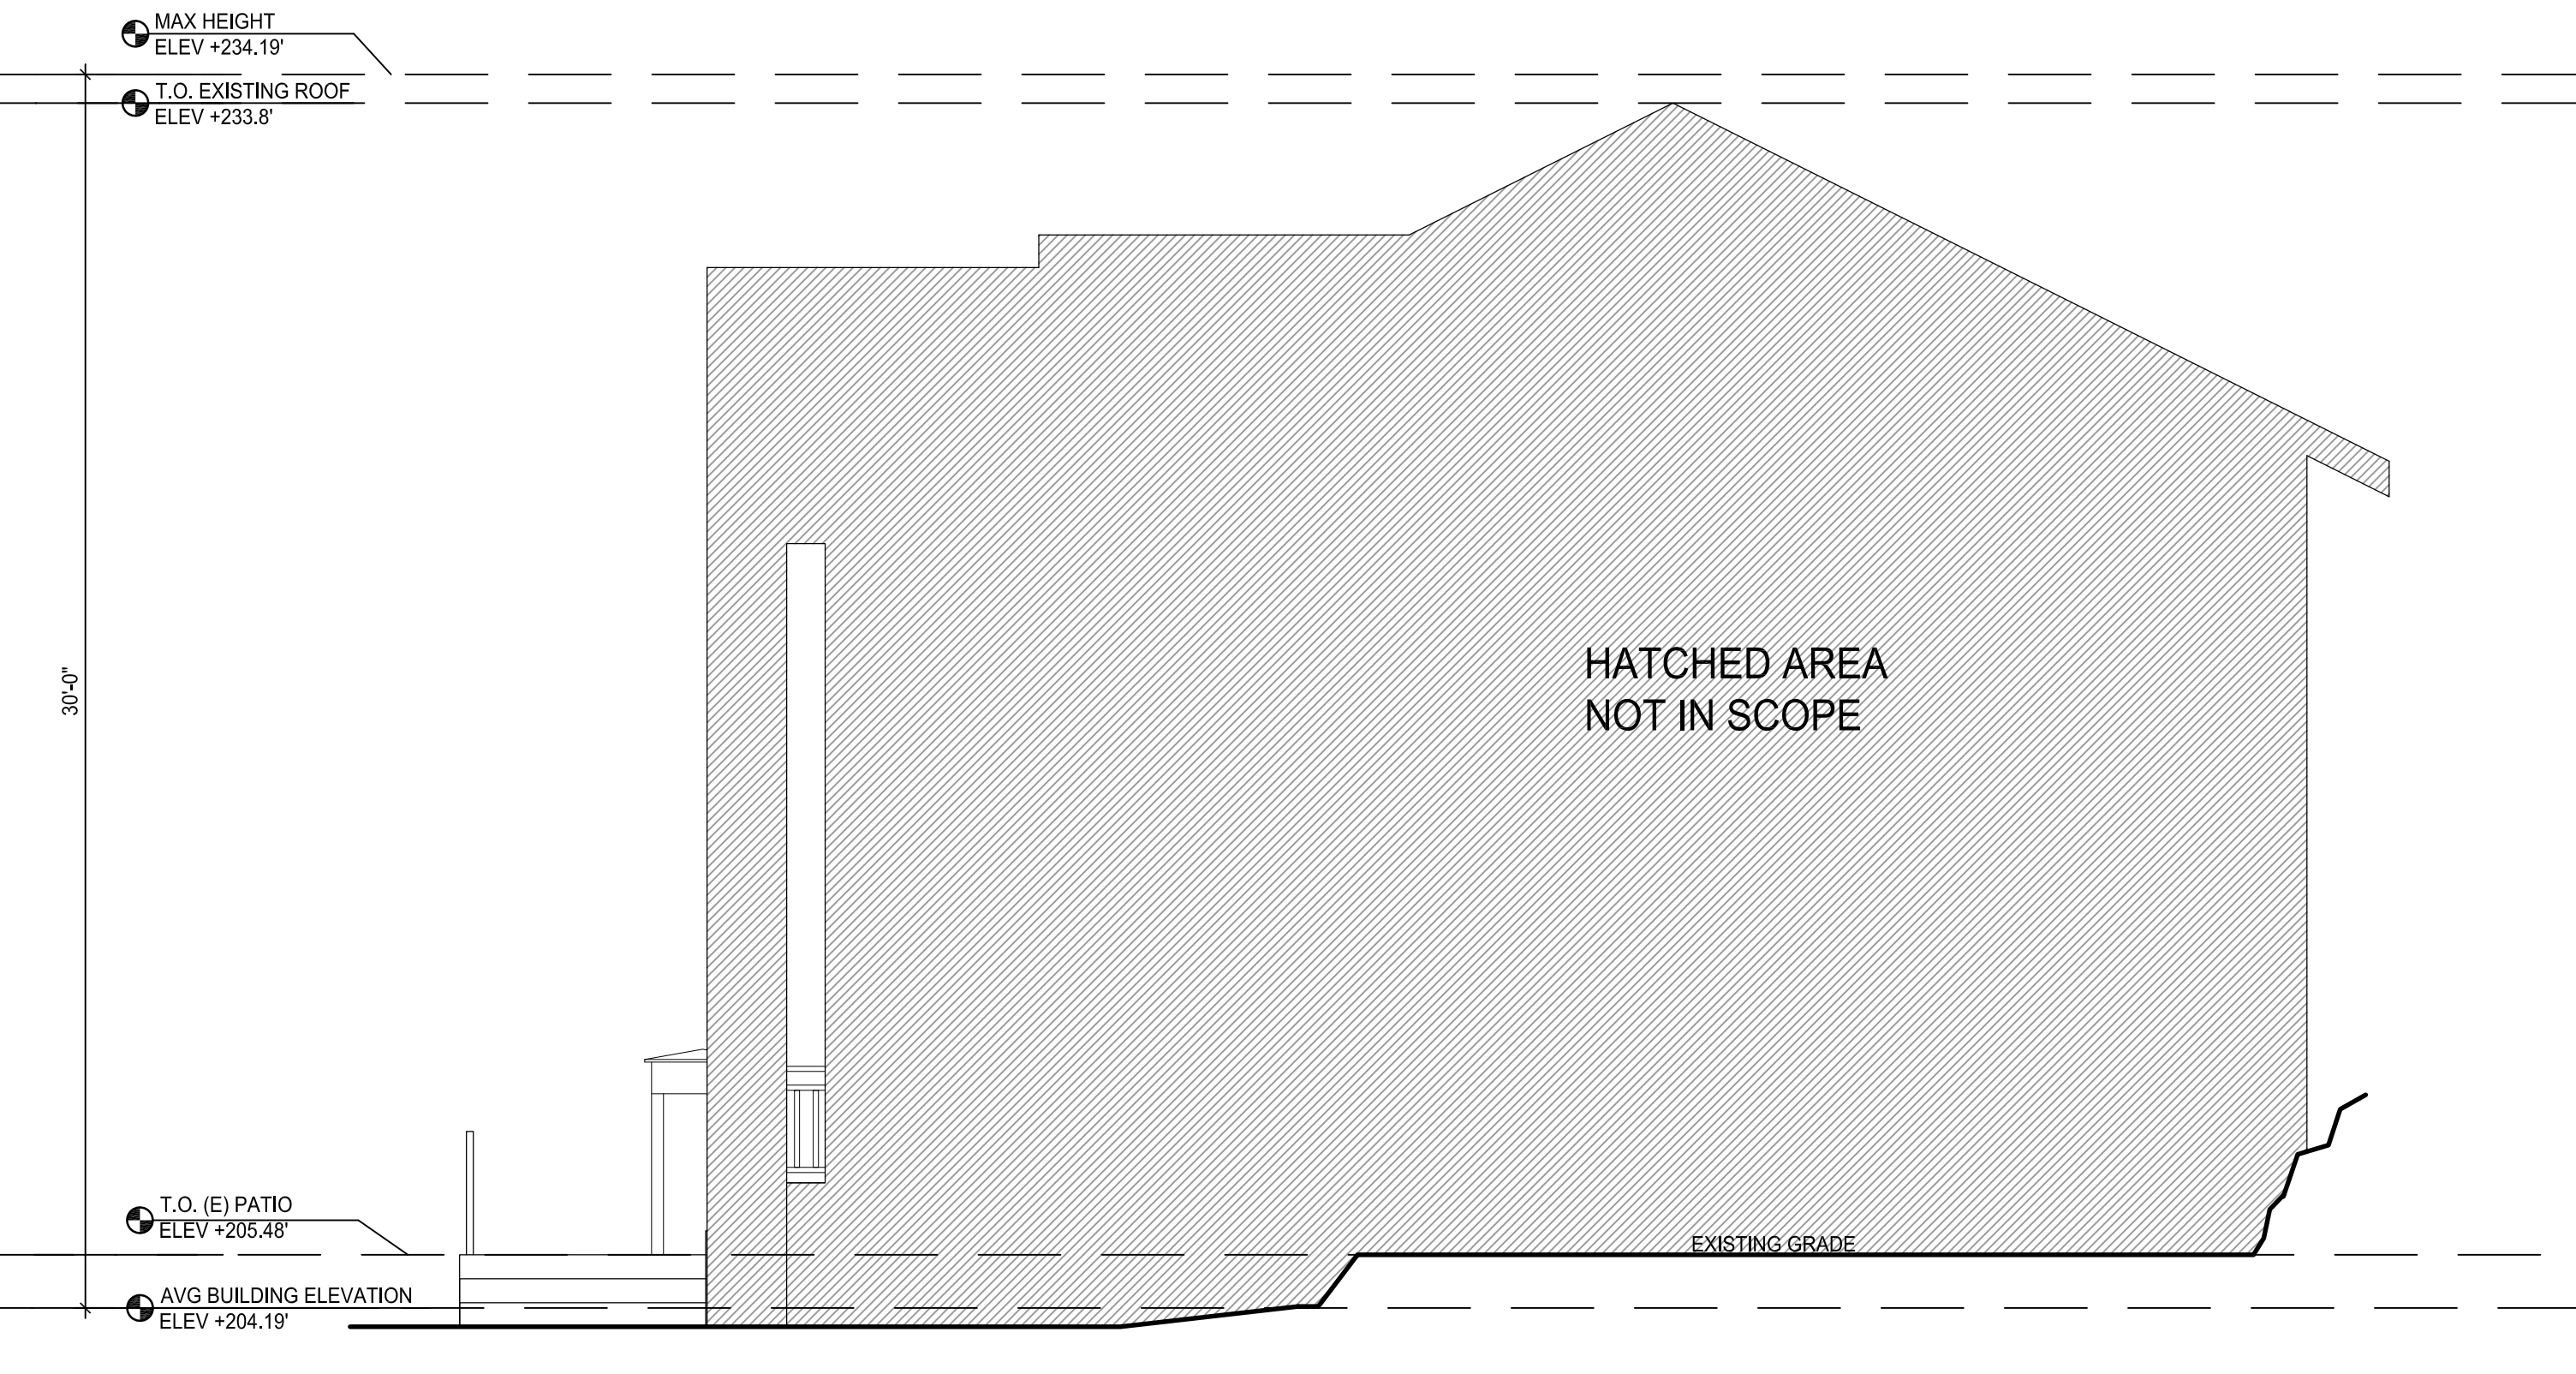

2 EXISTING NORTH ELEVATION  
SCALE: 1/4" = 1'-0"

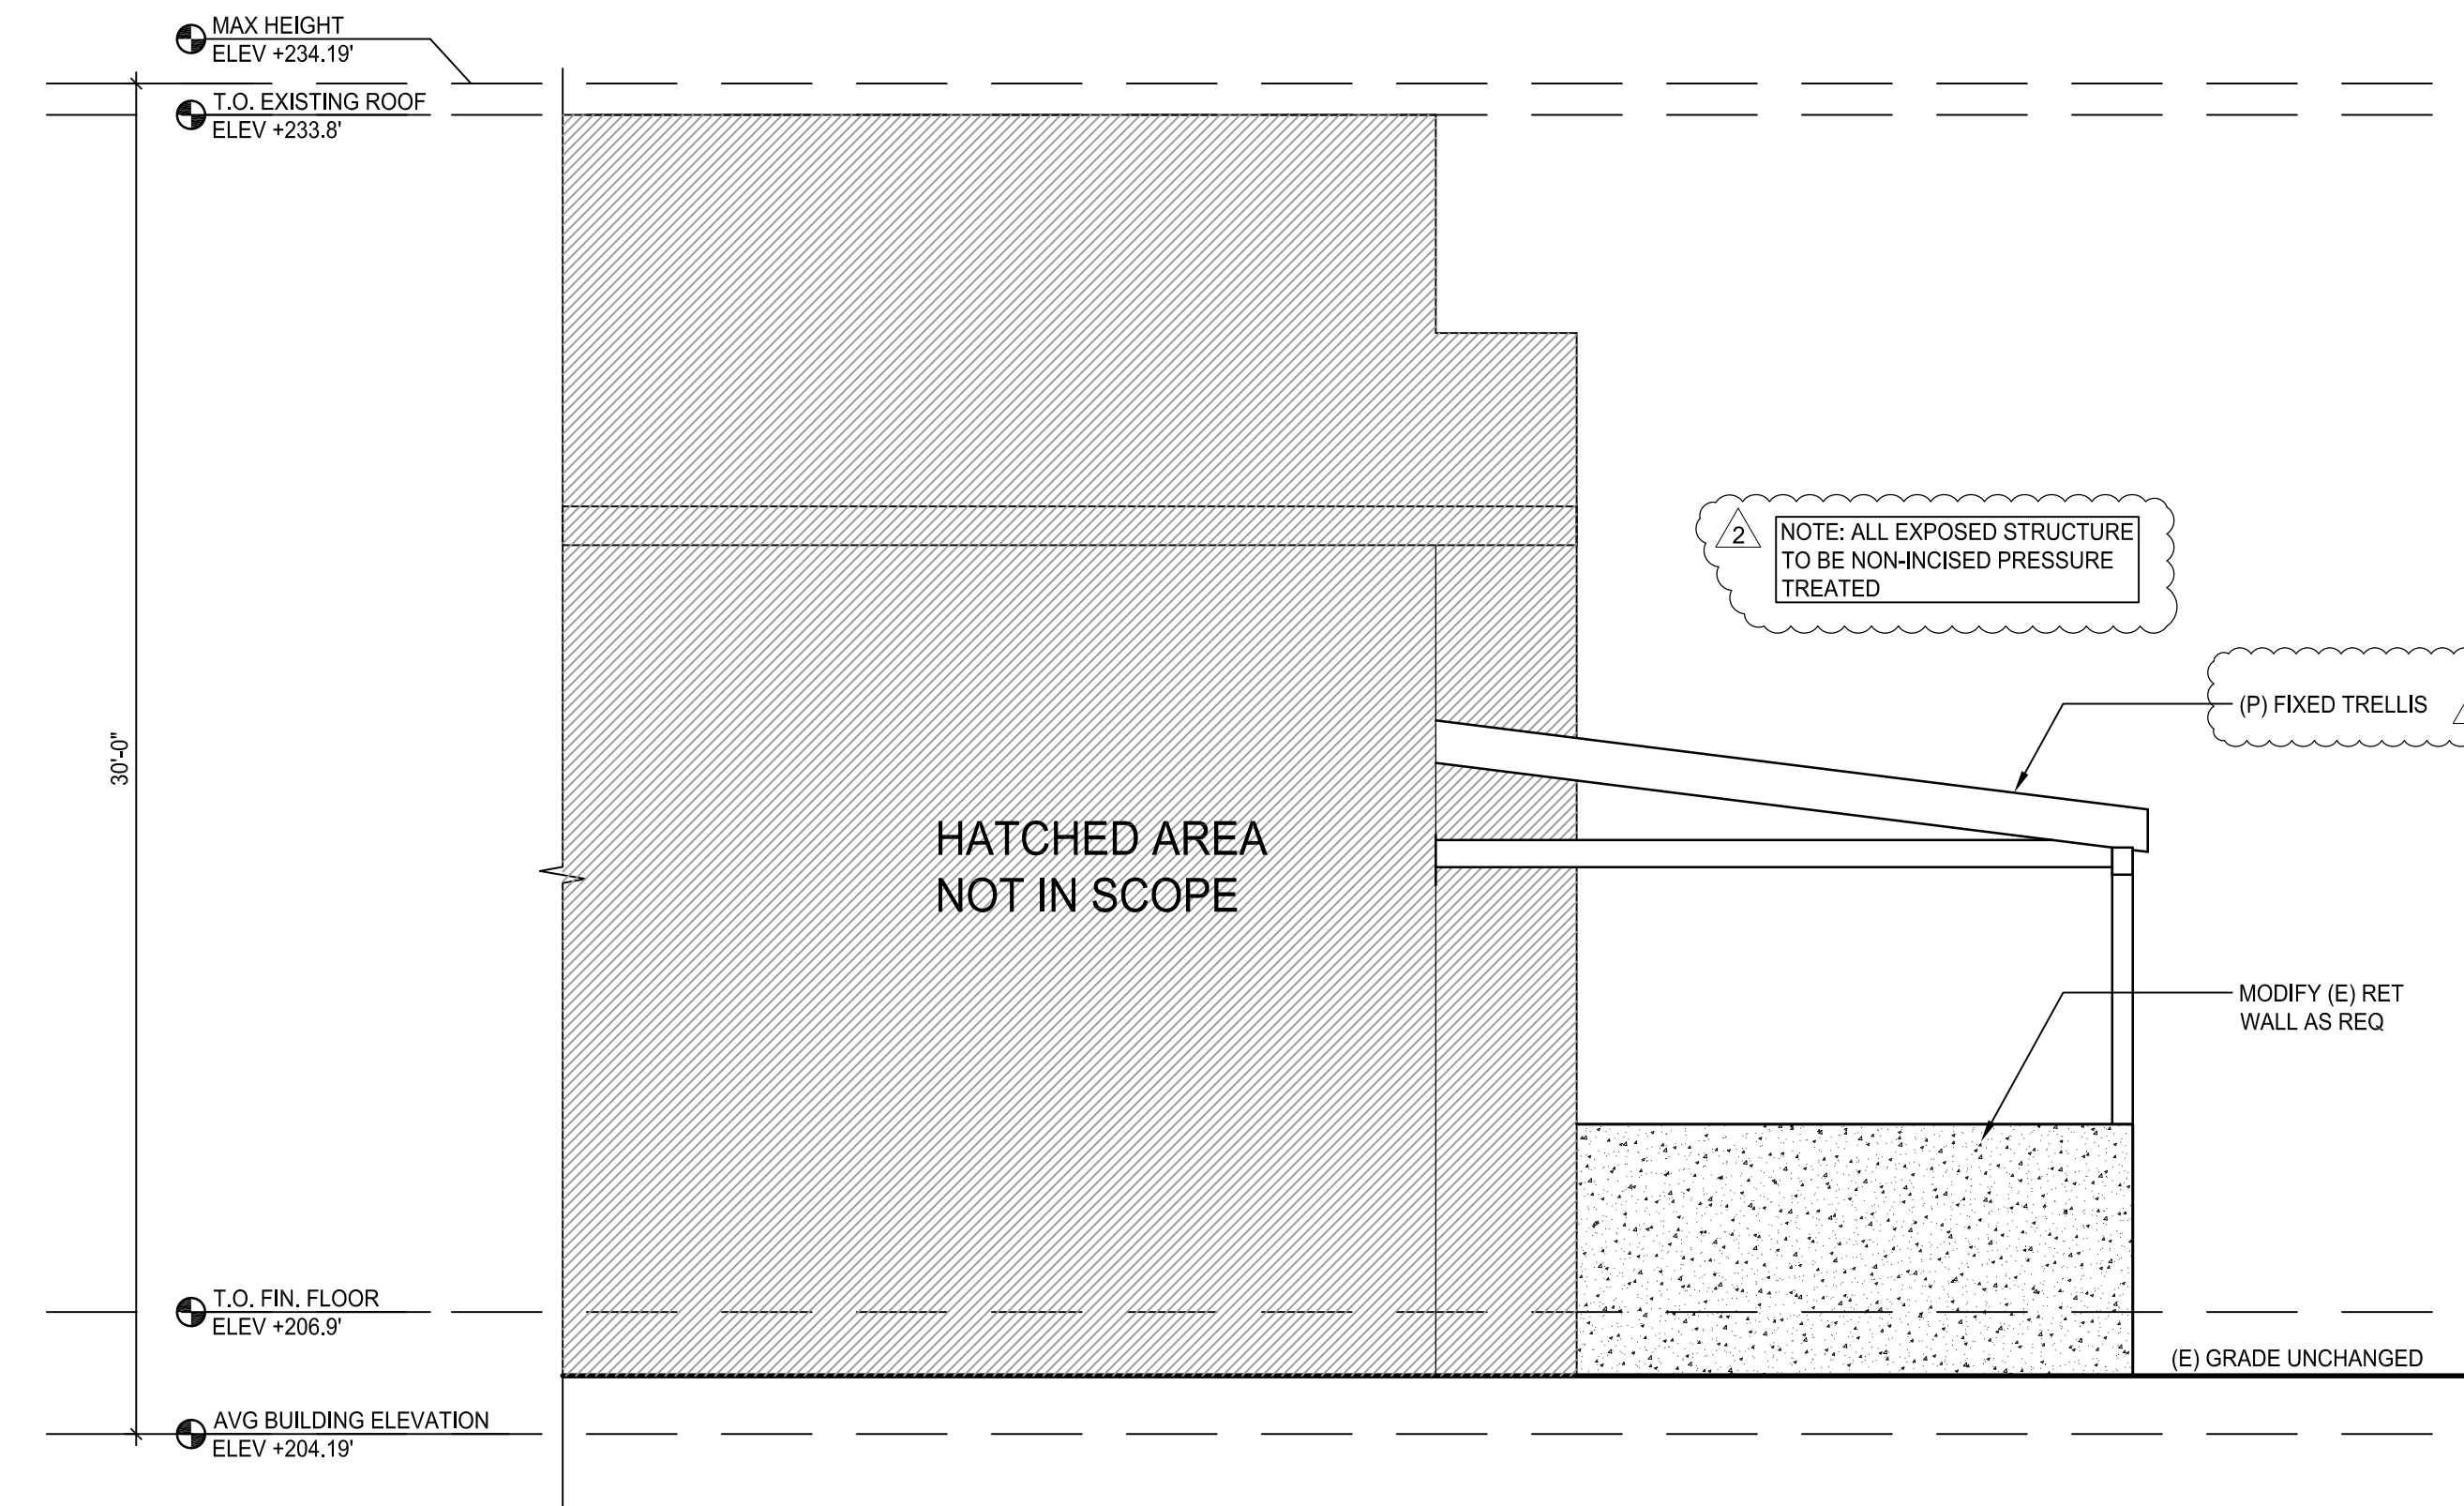

4 PROPOSED WEST ELEVATION  
SCALE: 1/4" = 1'-0"

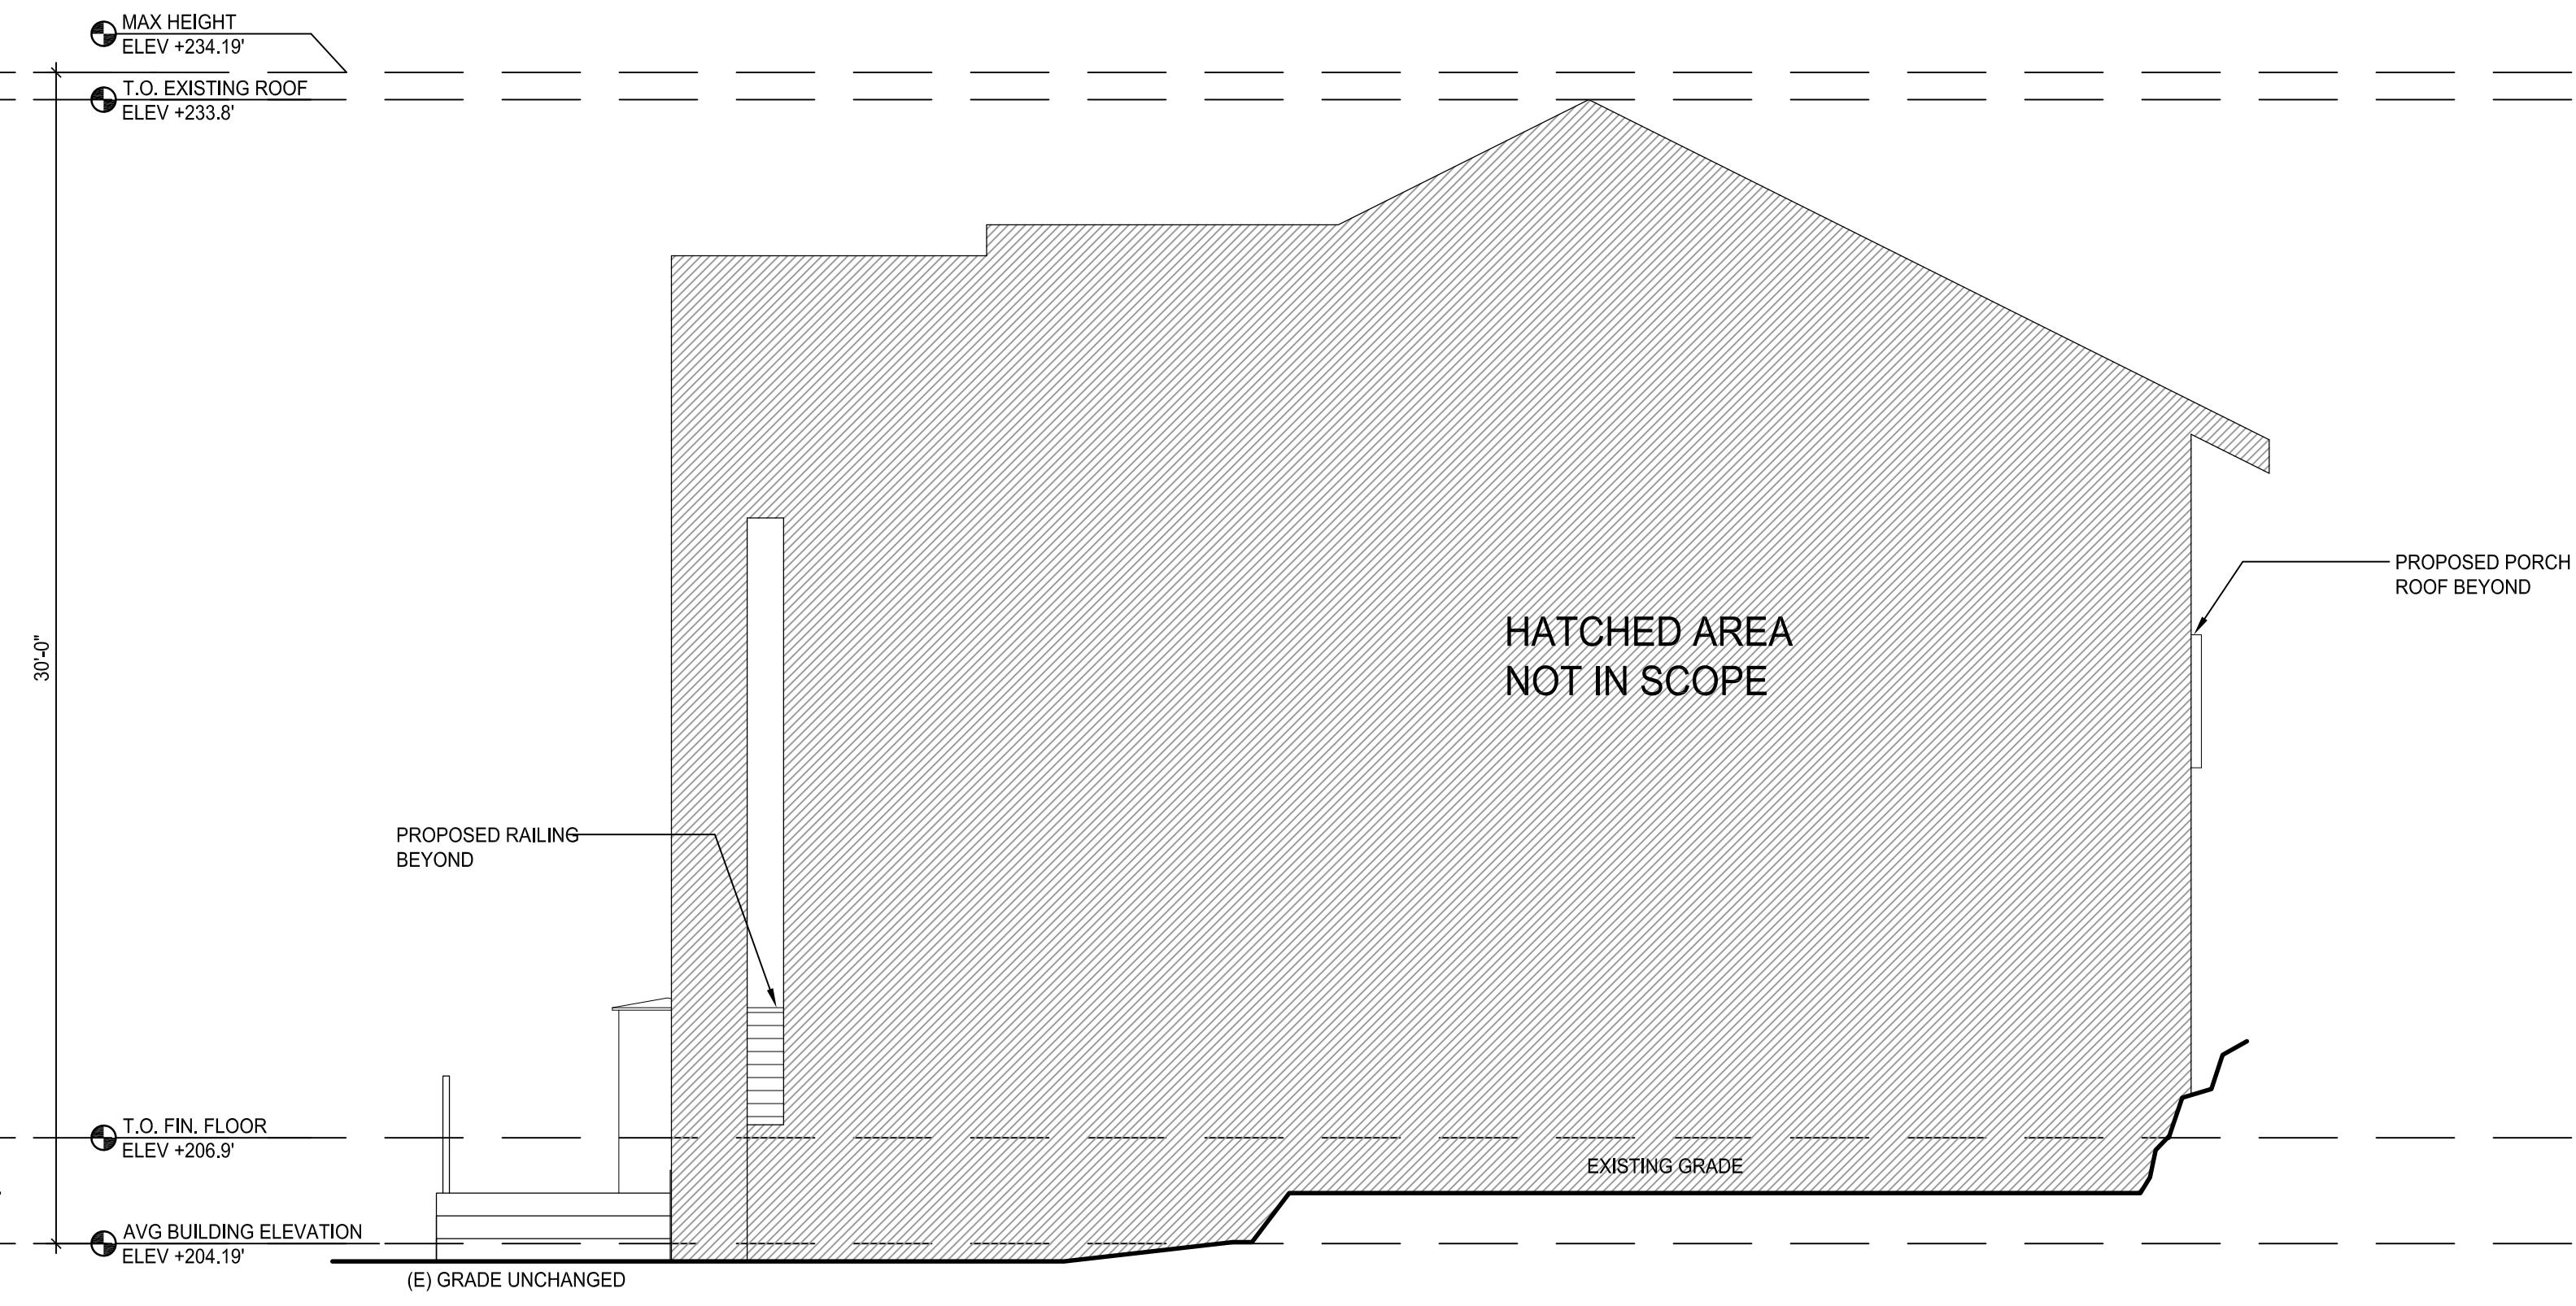

3 PROPOSED NORTH ELEVATION  
SCALE: 1/4" = 1'-0"

CONTRACTOR TO VERIFY EXISTING CONDITIONS PRIOR TO CONSTRUCTION.  
CONTRACTOR TO CONFIRM FINISHES TO BE MOCKED UP WITH ARCHITECT.

DESIGN	SJB
DRAWN	CEC
CHECKED	SJB
DATE	[2019-0114 DESIGN]
	[2019-0621 PERMIT]
	[2020-0211 REV 1]
	[2020-0413 REV 2]



LAI  
7505 92ND AVE SE  
MERCER ISLAND WA 98040

PERMIT  
ELEVATIONS




All drawings, specifications, plans, ideas, arrangements, and design solutions represented or referred to are the property of and owned by Josh PS whether the project for which they are made is executed or not. They were created, evolved, developed and produced for the sole use on and in connection with this project and none of the above may be disclosed or given to or used by any person, firm, or corporation for any use or purpose whatsoever including any other project, except upon written permission of Josh PS.


© COPYRIGHT 2020 JOSH PS

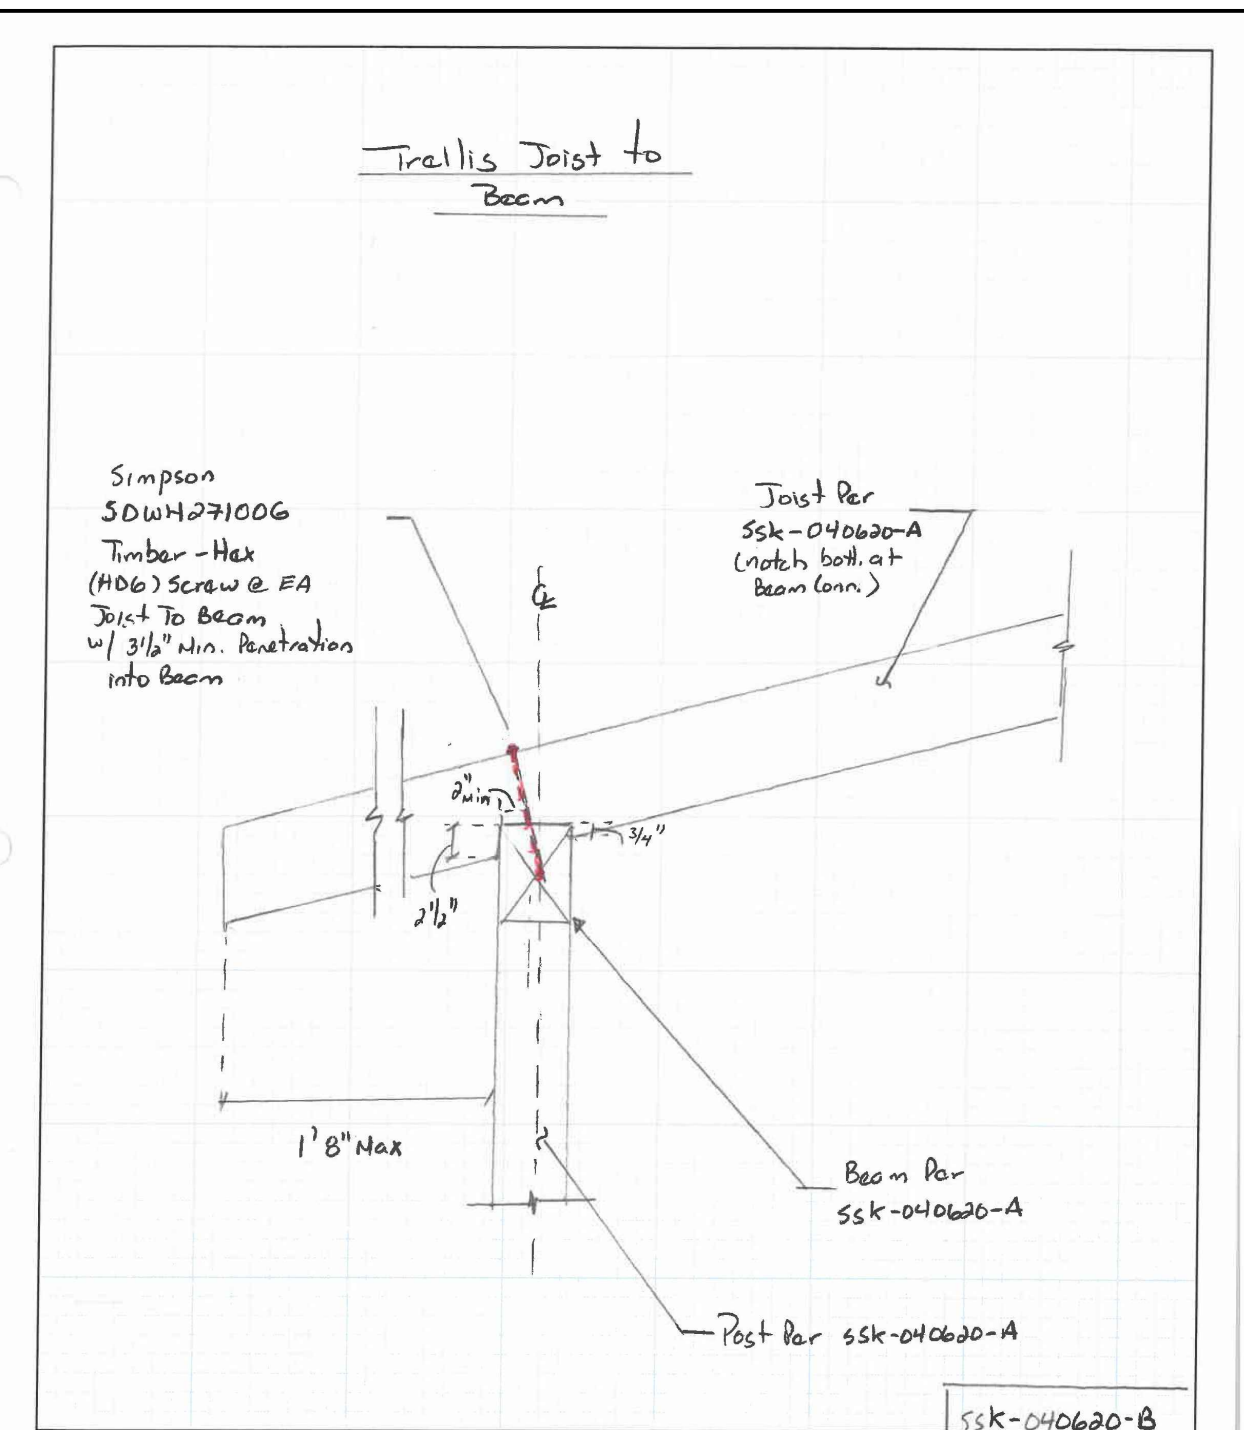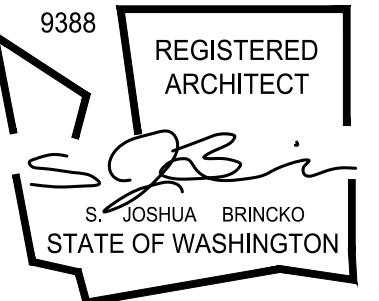


**QUANTUM | CONSULTING ENGINEERS**  
 Project: Lai Deck Roof Trellis Date: 04/06/2020 19175.02  
 Designer: MDA Project No: SSK-040620-B  
 Client: Josh Artisan + Arch Checked by: \_\_\_\_\_

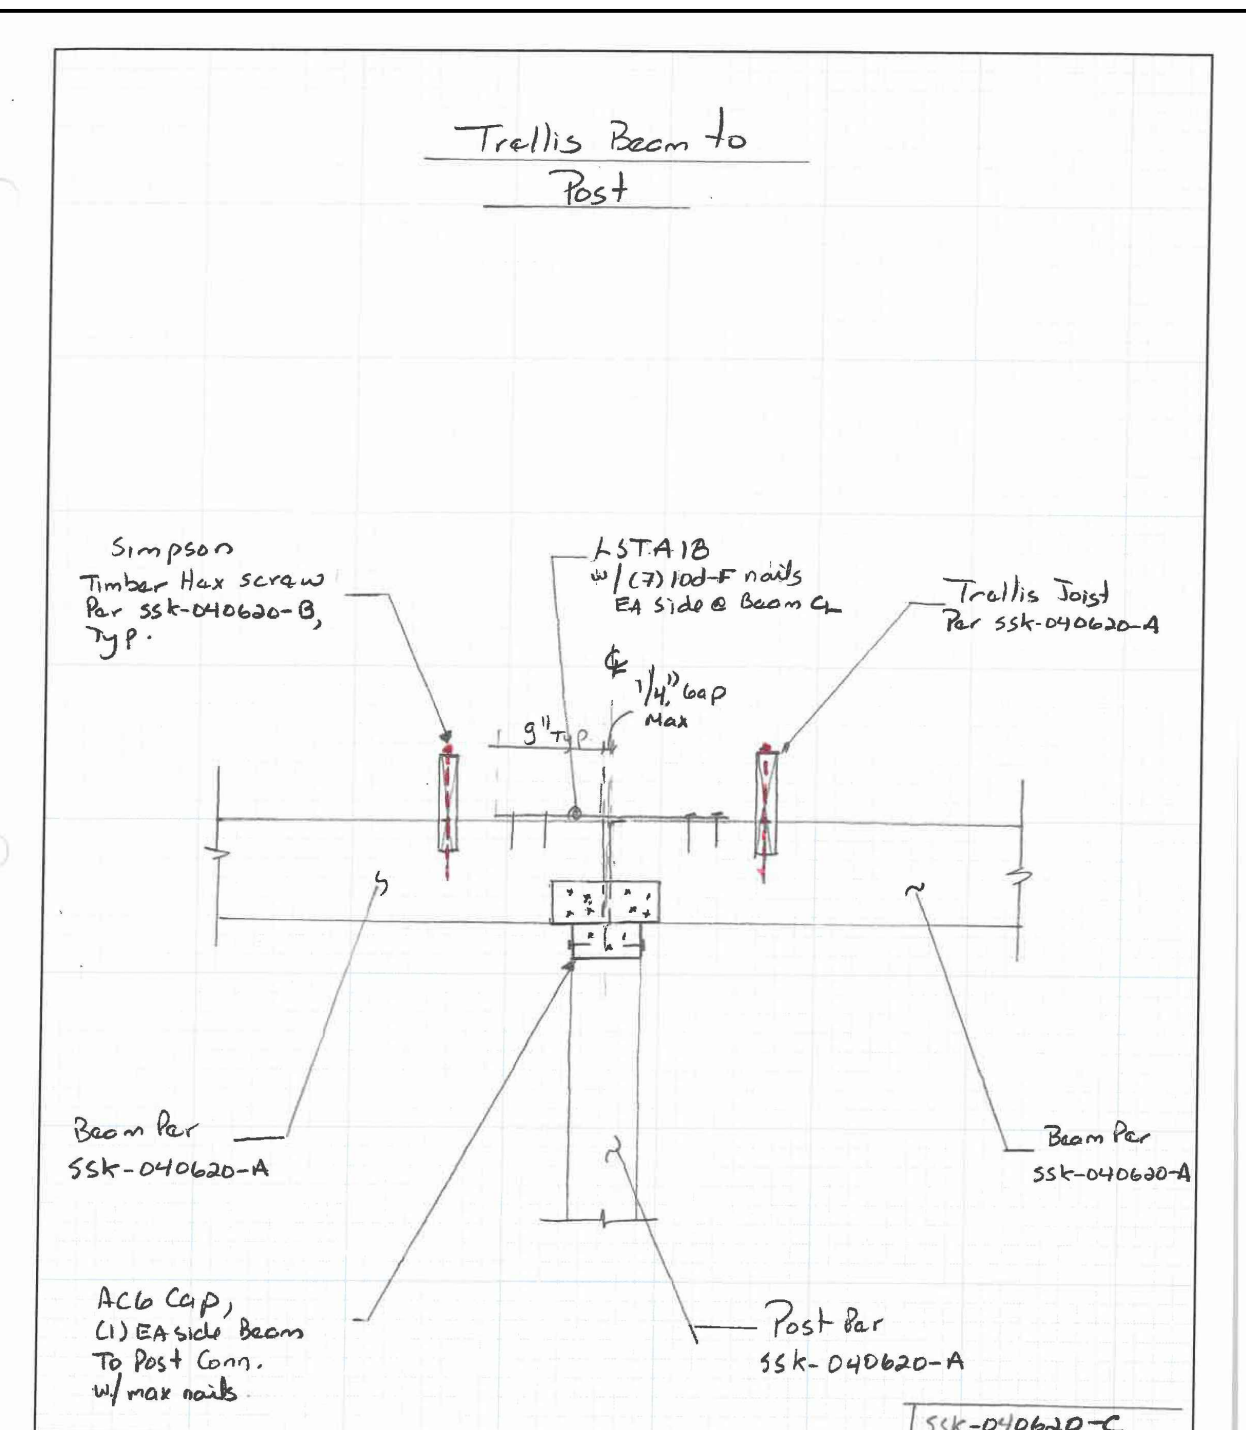


**QUANTUM | CONSULTING ENGINEERS**  
 Project: Lai Deck Roof Trellis Date: 04/06/2020 19175.02  
 Designer: MDA Project No: SSK-040620-C  
 Client: Josh Artisan + Architect Checked by: \_\_\_\_\_

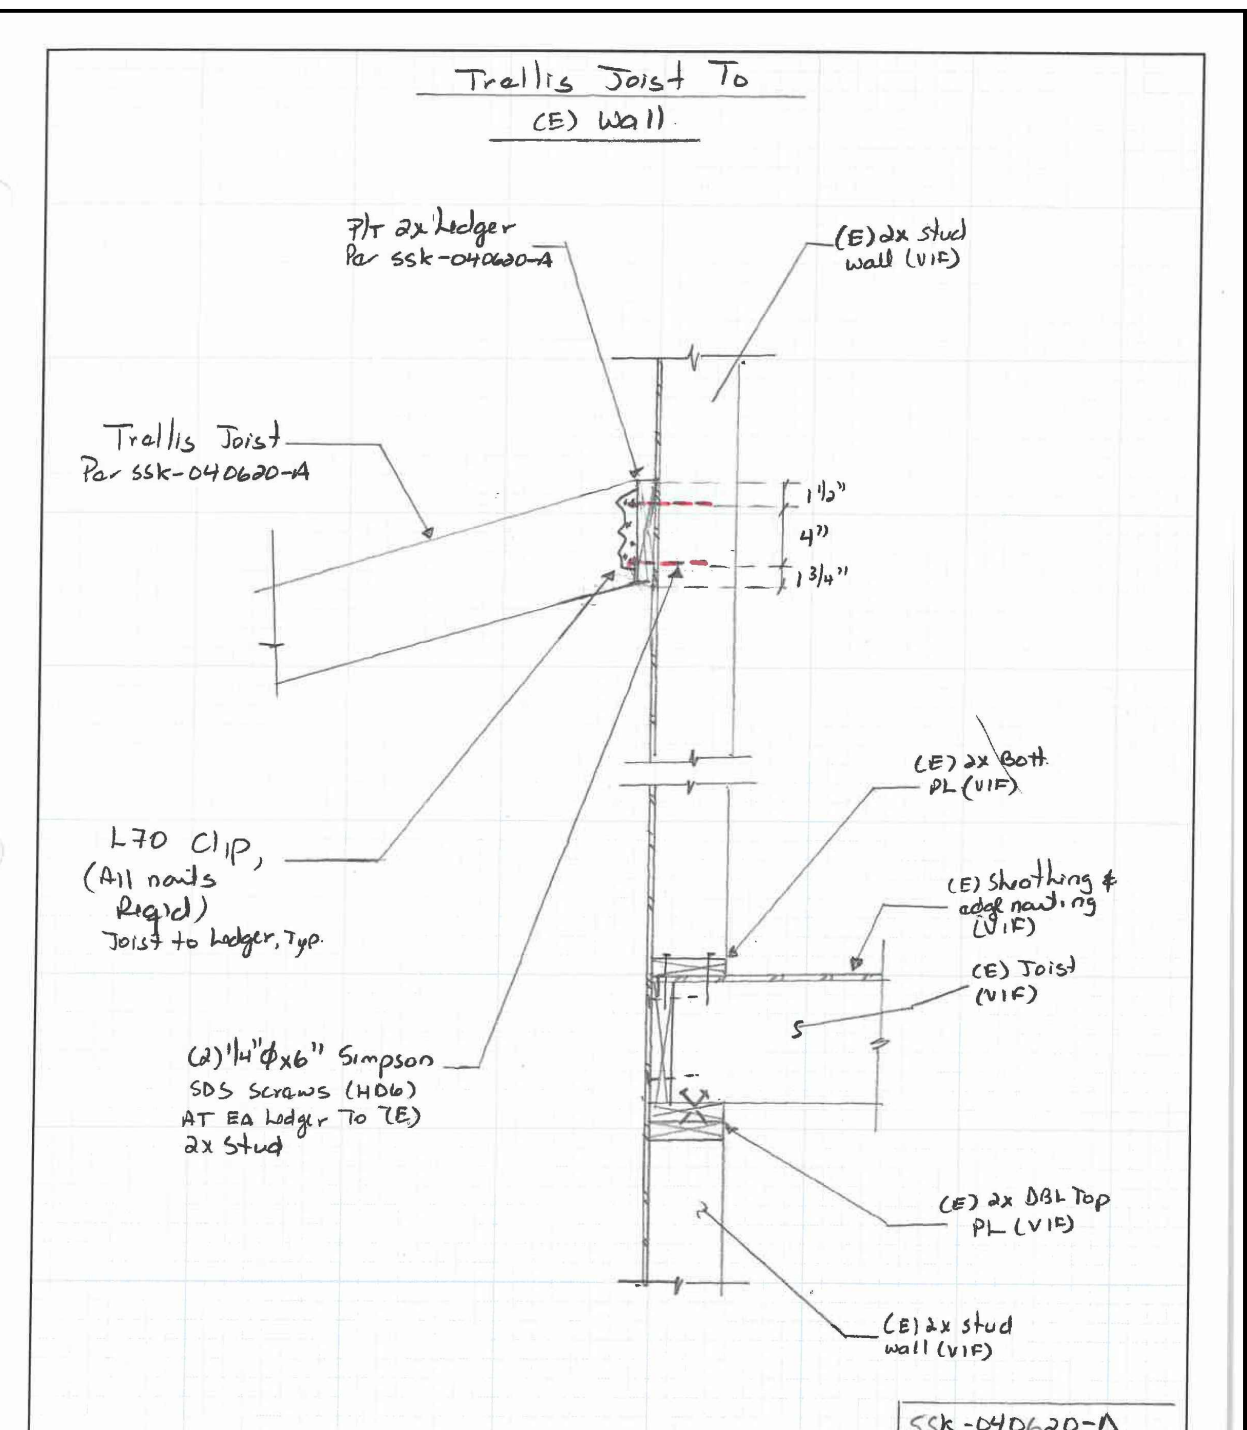


**QUANTUM | CONSULTING ENGINEERS**  
 Project: Lai Deck Roof Trellis Date: 04/06/2020 19175.02  
 Designer: MDA Project No: SSK-040620-D  
 Client: Josh Artisan + Arch Checked by: \_\_\_\_\_

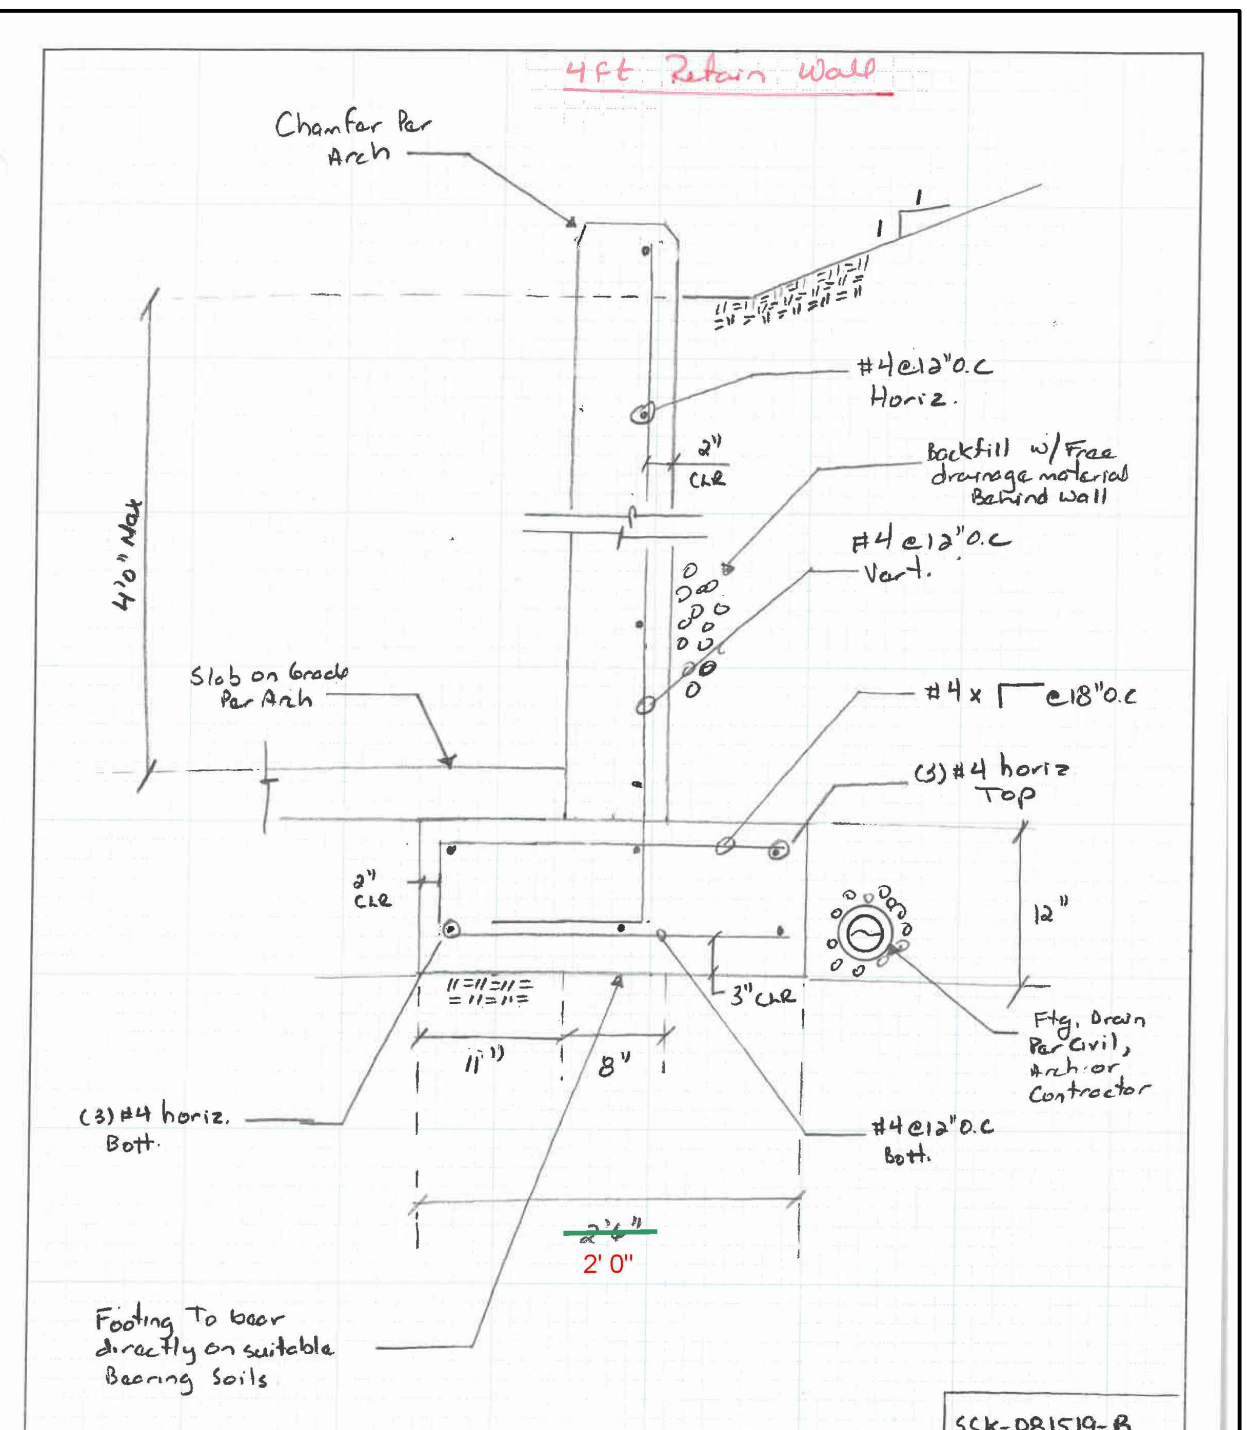


**QUANTUM | CONSULTING ENGINEERS**  
 Project: Lai Deck Roof Addition (Return Wall) Date: 08/15/2019 19175.01  
 Designer: MDA Project No: SSK-081519-B  
 Client: Josh Architect Checked by: \_\_\_\_\_

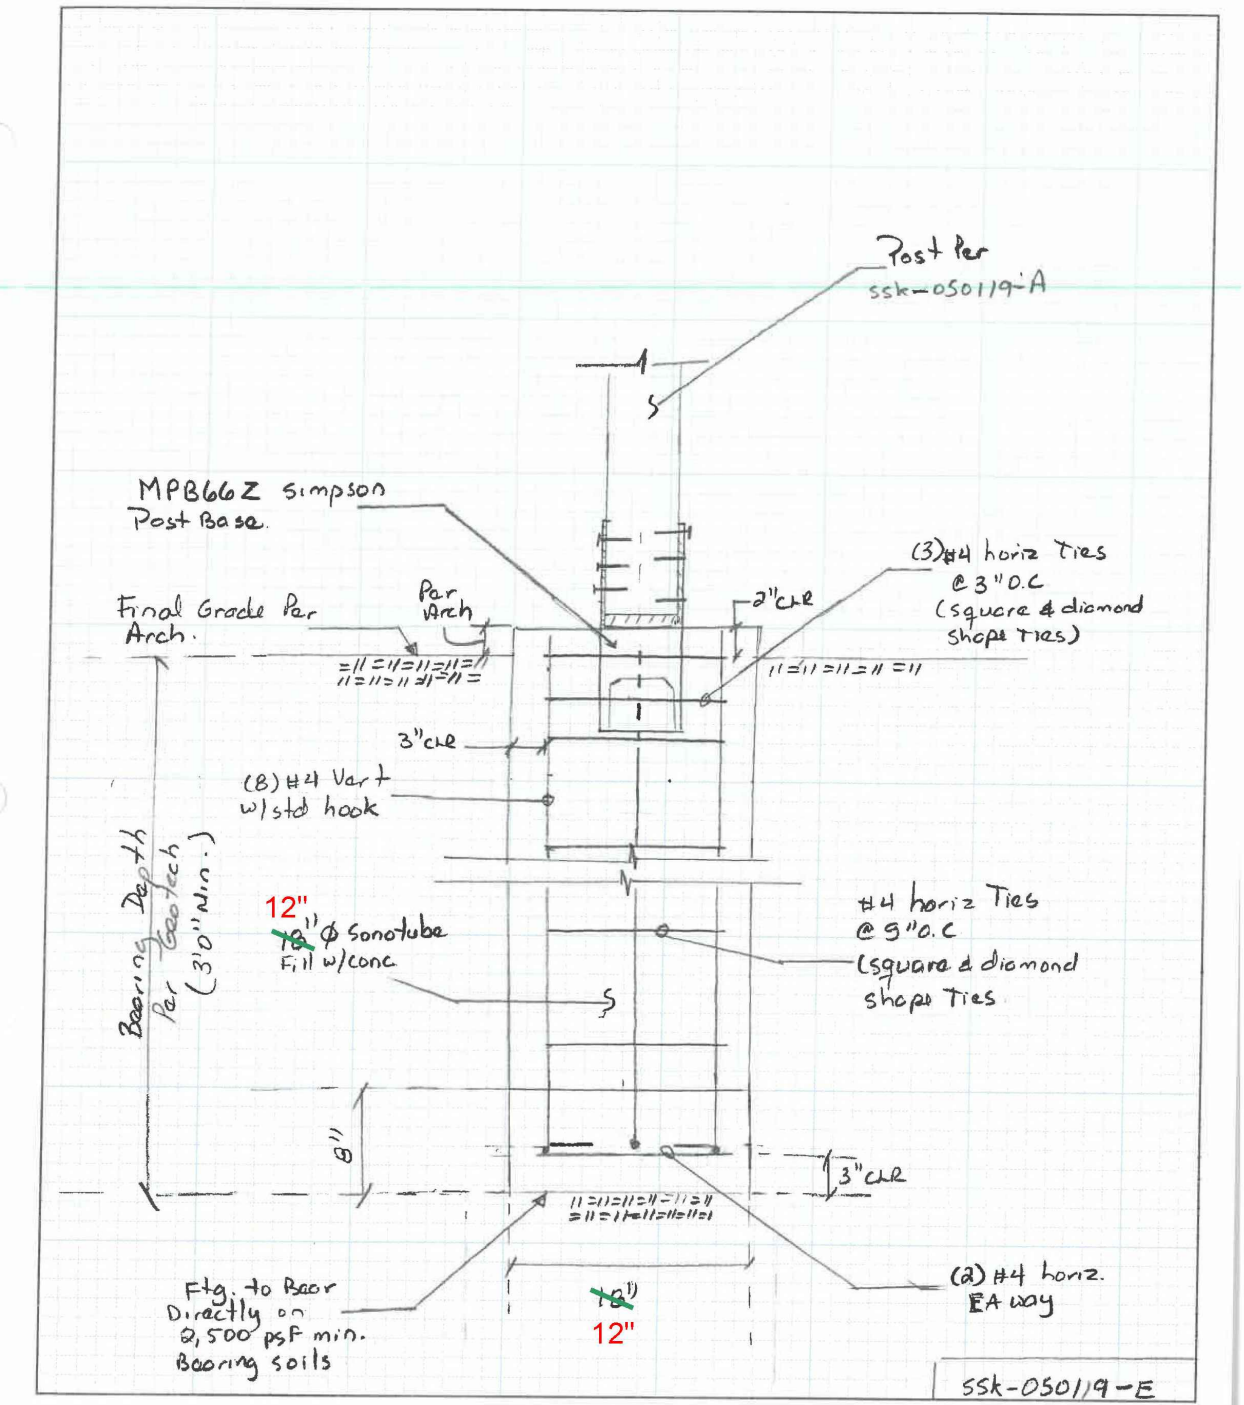

**QUANTUM | CONSULTING ENGINEERS**  
 Project: Lai Deck Roof Addition Date: 01/03/2020 19175.01  
 Designer: MDA Project No: SSK-050119-E  
 Client: Josh Artisan + Arch Checked by: \_\_\_\_\_

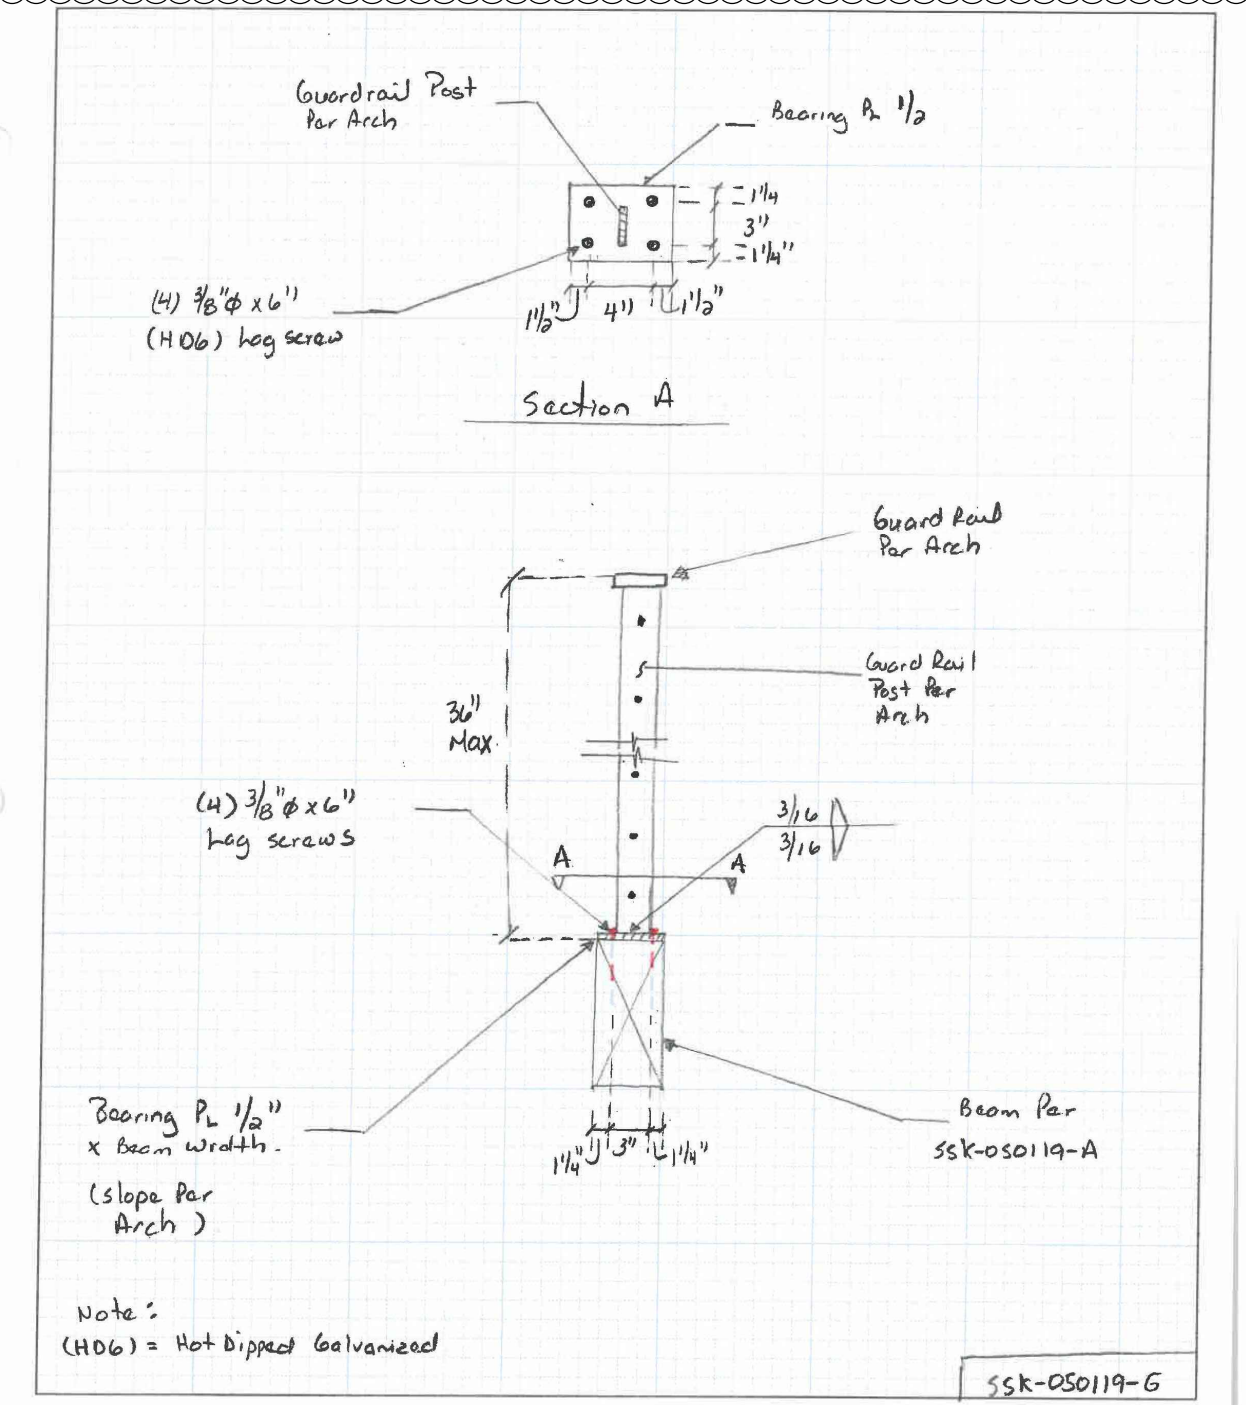

**QUANTUM | CONSULTING ENGINEERS**  
 Project: Lai Guard Rail Connection Date: 04/06/2020 19175.01  
 Designer: MDA Project No: SSK-050119-G  
 Client: Josh Artisan + Architect Checked by: \_\_\_\_\_

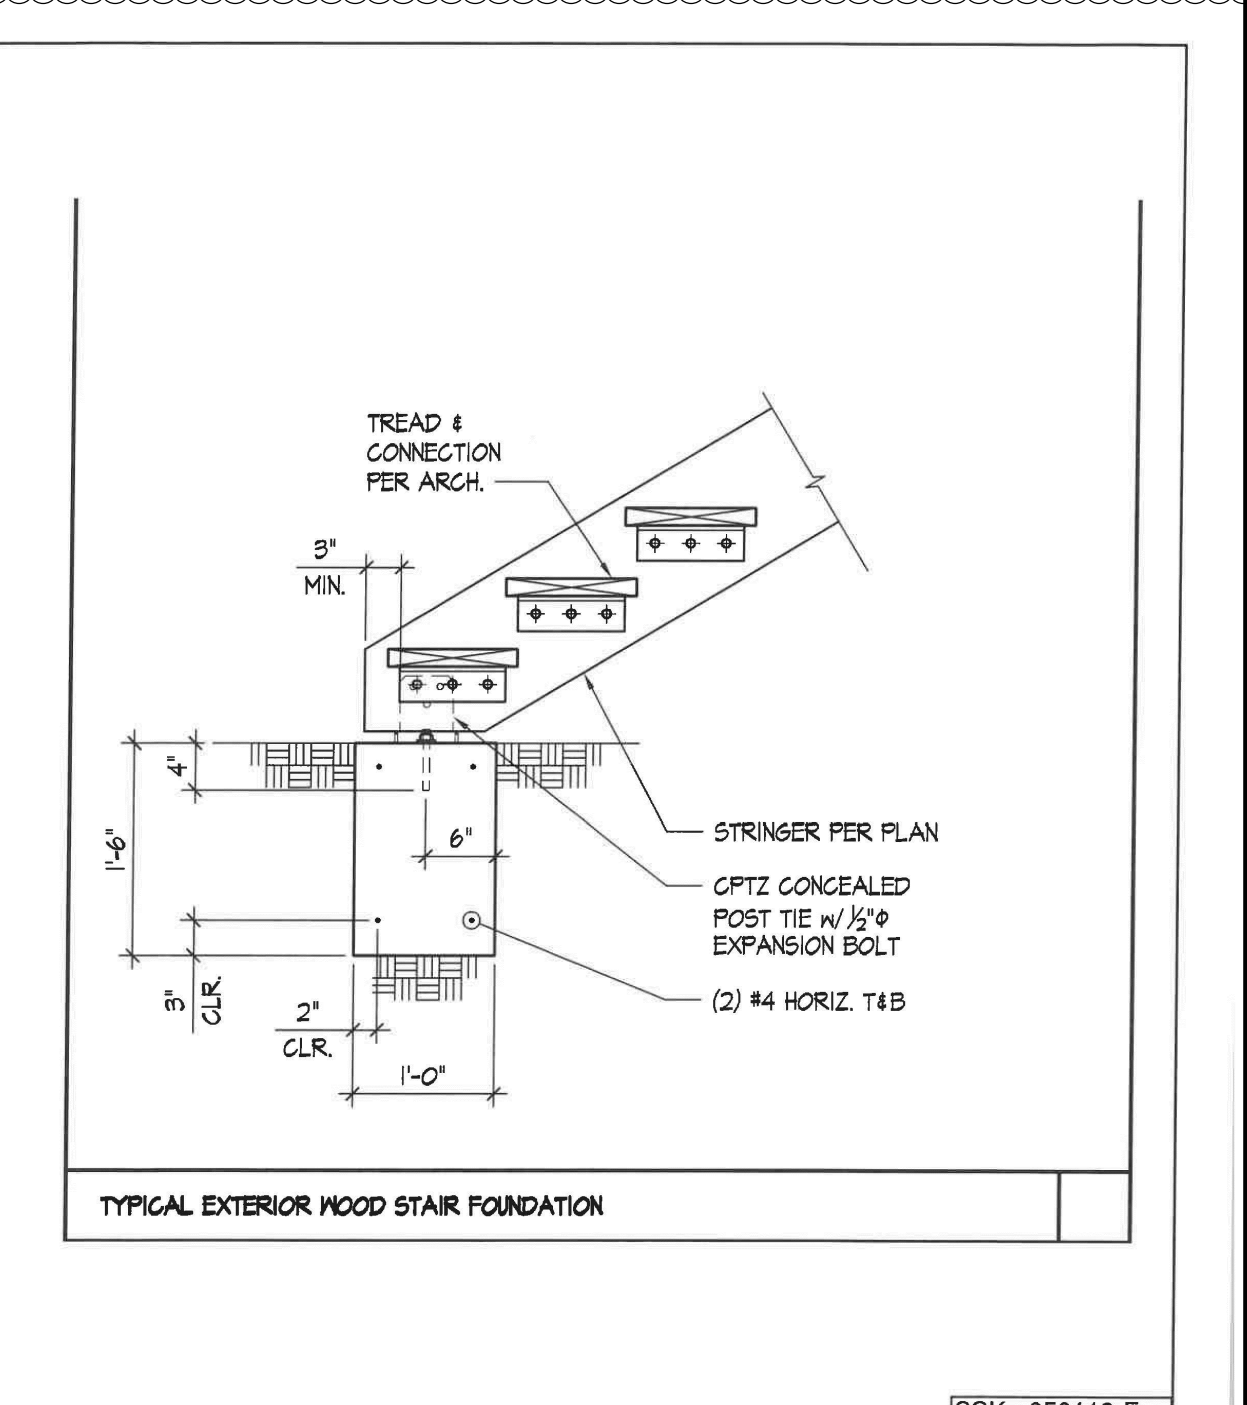

**QUANTUM | CONSULTING ENGINEERS**  
 Project: Lai Deck Roof Addition Date: 04/15/2019 19175.01  
 Designer: MDA Project No: SSK-050119-F  
 Client: Josh Artisan + Architect Checked by: \_\_\_\_\_

DESIGN	SJB
DRAWN	CEC
CHECKED	SJB
DATE	[2019-0114 DESIGN]
	[2019-0621 PERMIT]
	[2020-0211 REV 1]
	[2020-0413 REV 2]

**LAI**  
7505 92ND AVE SE  
MERCER ISLAND WA 98040

PERMIT  
DETAILS

**A8.0**



**GENERAL STRUCTURAL NOTES**

(The following apply unless shown otherwise on the plans)

WOOD CONTINUED

26. WOOD FASTENERS:

A. NAIL SIZES SPECIFIED ON DRAWINGS ARE BASED ON THE FOLLOWING SPECIFICATIONS:

Drawing ID Nail Name Nail Diameter Nail Length  
 "6d" 6d Common 0.113" 2"  
 "8d Box" 8d Box 0.113" 2-1/2"  
 "8d" 8d Common 0.131" 2-1/2"  
 "10d-F" 10d Framed 0.131" 3"  
 "10d" 10d Shear 0.148" 2-1/4"  
 "16d" 16d Sinker 0.148" 3-1/4"

IF CONTRACTOR PROPOSES THE USE OF ALTERNATE NAILS, THEY SHALL SUBMIT NAIL SPECIFICATIONS TO THE STRUCTURAL ENGINEER (PRIOR TO CONSTRUCTION) FOR REVIEW AND APPROVAL.

B. NAILS - SHEATHING FASTENERS TO FRAMING SHALL BE DRIVEN FLUSH TO FACE OF SHEATHING WITH NO COUNTERSINKING PERMITTED.

C. SCREWS SHALL BE WOOD SCREWS OF THE DIAMETER AND LENGTH NOTED ON THE DRAWINGS. SDS FASTENERS ARE SIMPSON STRONG DRIVE SCREWS.

D. HOT DIPPED GALVANIZED NAILS, BOLTS AND METAL PLATES - ALL NAILS, BOLTS AND METAL PLATES IN CONTACT WITH PRESSURE TREATED (INCLUDING FIRE-RETARDANT TREATED) LUMBER SHALL BE HOT DIPPED GALVANIZED.


27. WOOD FRAMING NOTES: THE FOLLOWING APPLY UNLESS OTHERWISE SHOWN ON THE PLANS:

A. ALL WOOD FRAMING DETAILS NOT SHOWN OTHERWISE SHALL BE CONSTRUCTED TO THE MINIMUM STANDARDS OF THE IBC. MINIMUM NAILING, UNLESS OTHERWISE NOTED, SHALL CONFORM TO IBC TABLE 2304.10.1. COORDINATE THE SIZE AND LOCATION OF ALL OPENINGS WITH MECHANICAL AND ARCHITECTURAL DRAWINGS. PROVIDE WASHERS UNDER THE HEADS AND NUTS OF ALL BOLTS AND LAG SCREWS BEARING ON WOOD. TIGHTEN BOLTS AND LAG SCREWS SNUGLY AGAINST WOOD FRAMING AFTER WOOD HAS REACHED SPECIFIED MOISTURE CONTENT.

B. ROOF FRAMING: PROVIDE DOUBLE JOISTS AROUND ALL OPENINGS IN ROOFS UNLESS OTHERWISE NOTED. PROVIDE SOLID BLOCKING AT ALL BEARING POINTS. NAIL ALL MULTI JOIST BEAMS TOGETHER WITH 10d-F NAILS @ 8' O.C. STAGGERED UNLESS OTHERWISE NOTED.


C. POSITIVE CONNECTIONS: PROVIDE THE FOLLOWING SIMPSON CONNECTORS AT TYPICAL FRAMING UNLESS OTHERWISE NOTED ON PLAN OR DETAIL. PROVIDE CG/ECCO CAPS AND FBS BASES AT POSTS. PROVIDE BC BASE WHERE POST BEARS ON WOOD FRAMING BELOW. PROVIDE LUS SERIES HANGERS FOR 2X FLOOR AND ROOF JOISTS. CONNECTORS SHALL BE SIZED TO MATCH THE SIZE OF THE FRAMING MEMBERS BEING CONNECTED. ALL CONNECTORS EXPOSED TO WEATHER OR IN DIRECT CONTACT WITH PRESSURE TREATED WOOD, SHALL BE HOT DIPPED GALVANIZED.

ABBREVIATIONS		ABBREVIATIONS	
@	At	L	Angle
d	Penny (Nails)	LL	Live Load
∅	Diameter	LLH	Long Leg Horizontal
		LLV	Long Leg Vertical
A.B.	Anchor Bolt	LONGIT.	Longitudinal
ADDL	Additional	LT. WT.	Lightweight
ALT.	Alternate		
APPROX.	Approximate	MATL.	Material
ARCH.	Architect	MAX.	Maximum
		MECH.	Mechanical
B.U.	Built-up	MEZZ	Mezzanine
B/	Bottom of	MF	Moment Frame
BF	Braced Frame	MFR.	Manufacturer
BLK.G.	Blocking	MIN.	Minimum
BLDG.	Building	MISC.	Miscellaneous
BM.	Beam	MK.	Mark
BOT.	Bottom		
BRG.	Bearing	N.	North
BTWN.	Between	N.S.	Near Side
		NIC	Not in Contract
¢	Centerline	NO.	Number
C	Camber	NOM.	Nominal
C TO C	Center to Center	NTS	Not to Scale
CIP	Cast in Place		
C.J.	Construction Joint or Control Joint	O.C.	On Center
CLG.	Ceiling	O.D.	Outside Diameter
CLR.	Clear	O.F.	Outside Face
CMU	Concrete Masonry Unit	O.H.	Opposite Hand
CNTR.	Center	OPNG.	Opening
COL.	Column	OPP.	Opposite
CONC.	Concrete		
CONN.	Connections	PAF	Powder Activated Fastener
CONST.	Construction	PC	Precast
CONT.	Continuous	PERM.	Permanent
CJP	Complete Joint Penetration	PERP.	Perpendicular
C/SK.	Countersink	PL or P <sup>l</sup>	Plate
		PLF	Pounds per Linear Foot
DBA.	Deformed Bar Anchor	PLYWD	Plywood
DBL.	Double	PJP	Partial Joint Penetration
DEG.	Degree	PREFAB.	Prefabricated
DET.	Detail	PROJ.	Project
DF	Doug Fir-Larch	PSF	Pounds per Square Foot
DIA.	Diameter	PSI	Pounds per Square Inch
DIAG.	Diagonal	P.T.	Post-Tensioning
DIAPH.	Diaphragm	P/T	Pressure-Treated
DIM.	Dimension		
DN.	Down	RAD.	Radius
DO	Dicto	REF.	Reference
DWG.	Drawing	REINF.	Reinforce or Reinforcement
		REQD.	Required
(E)	Existing	REV.	Revise
E.	East	R.O.	Rough Opening
EA.	Each		
E.F.	Each Face	S.	South
EL.	Elevation	SCH. or SCHED.	Schedule
ELEV.	Elevator	SECT.	Section
EMBED.	Embedment Length	SHT.	Sheet
ENGR.	Engineer	SIM.	Similar
E.N.	Each Way	SOG	Slab On Grade
EXP.	Expansion	SPEC.	Specification
EXT.	Exterior	SQ.	Square
		SQ. FT.	Square Feet
FDN.	Foundation	SQ. IN.	Square Inch (Inches)
FIN.	Finish	STD.	Standard
FLR.	Floor	STIFF.	Stiffener
FRP	Fiber Reinforced Polymer	STL.	Steel
F.S.	Far Side	STR.	Structural
FT.	Foot or Feet	SUB.	Substitute
FTG.	Footing	SYM.	Symmetrical
GA.	Gauge	T/	Top of
GALV.	Galvanized	T&B	Top and Bottom
GL	Glue Laminated	T&G	Tongue & Groove
GRD.	Grade	THRU	Through
GWB	Gypsum Wall Board	TEMP.	Temporary
		T.O.C.	Top of Concrete
HF	Hem Fir	T.O.S.	Top of Steel
HGR.	Hanger	T.O.W.	Top of Wall
HORIZ.	Horizontal	TRANS.	Transverse
HSS	Hollow Structural Section	TS	Tube Steel
HT.	Height	TYP.	Typical
I.D.	Inside Diameter	UON or UNO	Unless Otherwise Noted
I.F.	Inside Face		
IN.	Inch	VERT.	Vertical
INFO.	Information	VIF	Verify in Field
INT.	Interior		
		W.	West
JT.	Joint	W or w/	With
		WD	Wood
KSF	Kips per Square Foot	W.H.S.	Welded Headed Stud
KSI	Kips per Square Inch	W/O	Without
		WP	Work Point
		W.T.S.	Welded Threaded Stud
		WWF	Welded Wire Fabric
		X SECT.	Cross Section
		X-STR	Extra Strong

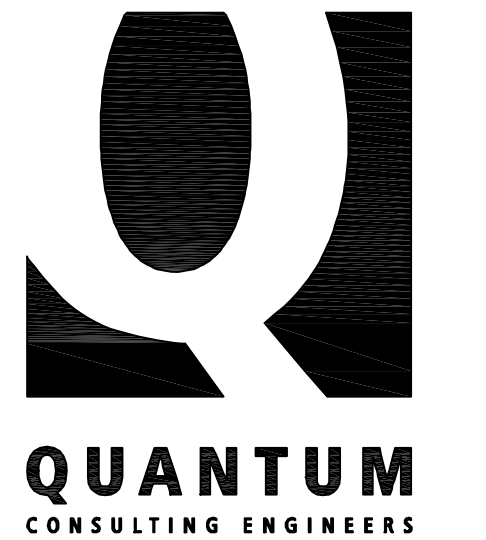

1511 THIRD AVENUE  
 SUITE 323  
 SEATTLE, WA 98101  
 TEL 206.957.3900  
 FAX 206.957.3901  
 www.quantumce.com

SEAL:

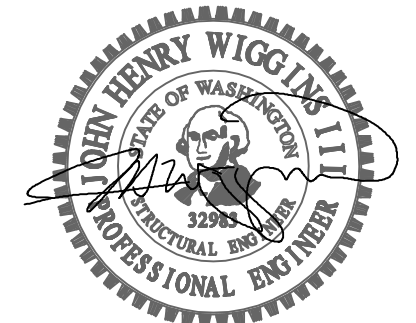

PROJECT:

**LAI DECK ROOF ADDITION**

7505 92ND AVE SE  
 MERCER ISLAND WA  
 98040

APPROVAL:


PERMIT SET	5/1/19
------------	--------

NO.	DESCRIPTION	DATE	BY
ISSUES: ○		REVISIONS: △	
P.M.	MDA		
P.E.	JHW		
DRAWN BY:	TTH		
SCALE:	AS SHOWN		
DATE:	TTH		
JOB NO.	19175.01		
SHEET TITLE:			






**GENERAL STRUCTURAL NOTES & ABBREVIATIONS**

SHEET NO.

File: 175-2107.dwg Plotfile: doc 04/20/2019 12:51 pm

ARCHITECT REQUIRES A MEETING WITH THE LABORERS INSTALLING SIDING AT THE BEGINNING OF THE FIRST WORKDAY TO EXPLAIN SIDING DETAILS AND SUBSEQUENT MEETINGS FOR EACH DIFFERENT SIDING MATERIAL TO BE INSTALLED.

All drawings, specifications, plans, ideas, arrangements, and design solutions represented or referred to are the property of and owned by Josh PS whether the project for which they are made is executed or not. They were created, evolved, developed and produced for the sole use on and in connection with this project and none of the above may be disclosed or given to or used by any person, firm, or corporation for any use or purpose whatsoever including any other project, except upon written permission of Josh PS.  
© COPYRIGHT 2018 JOSH PS

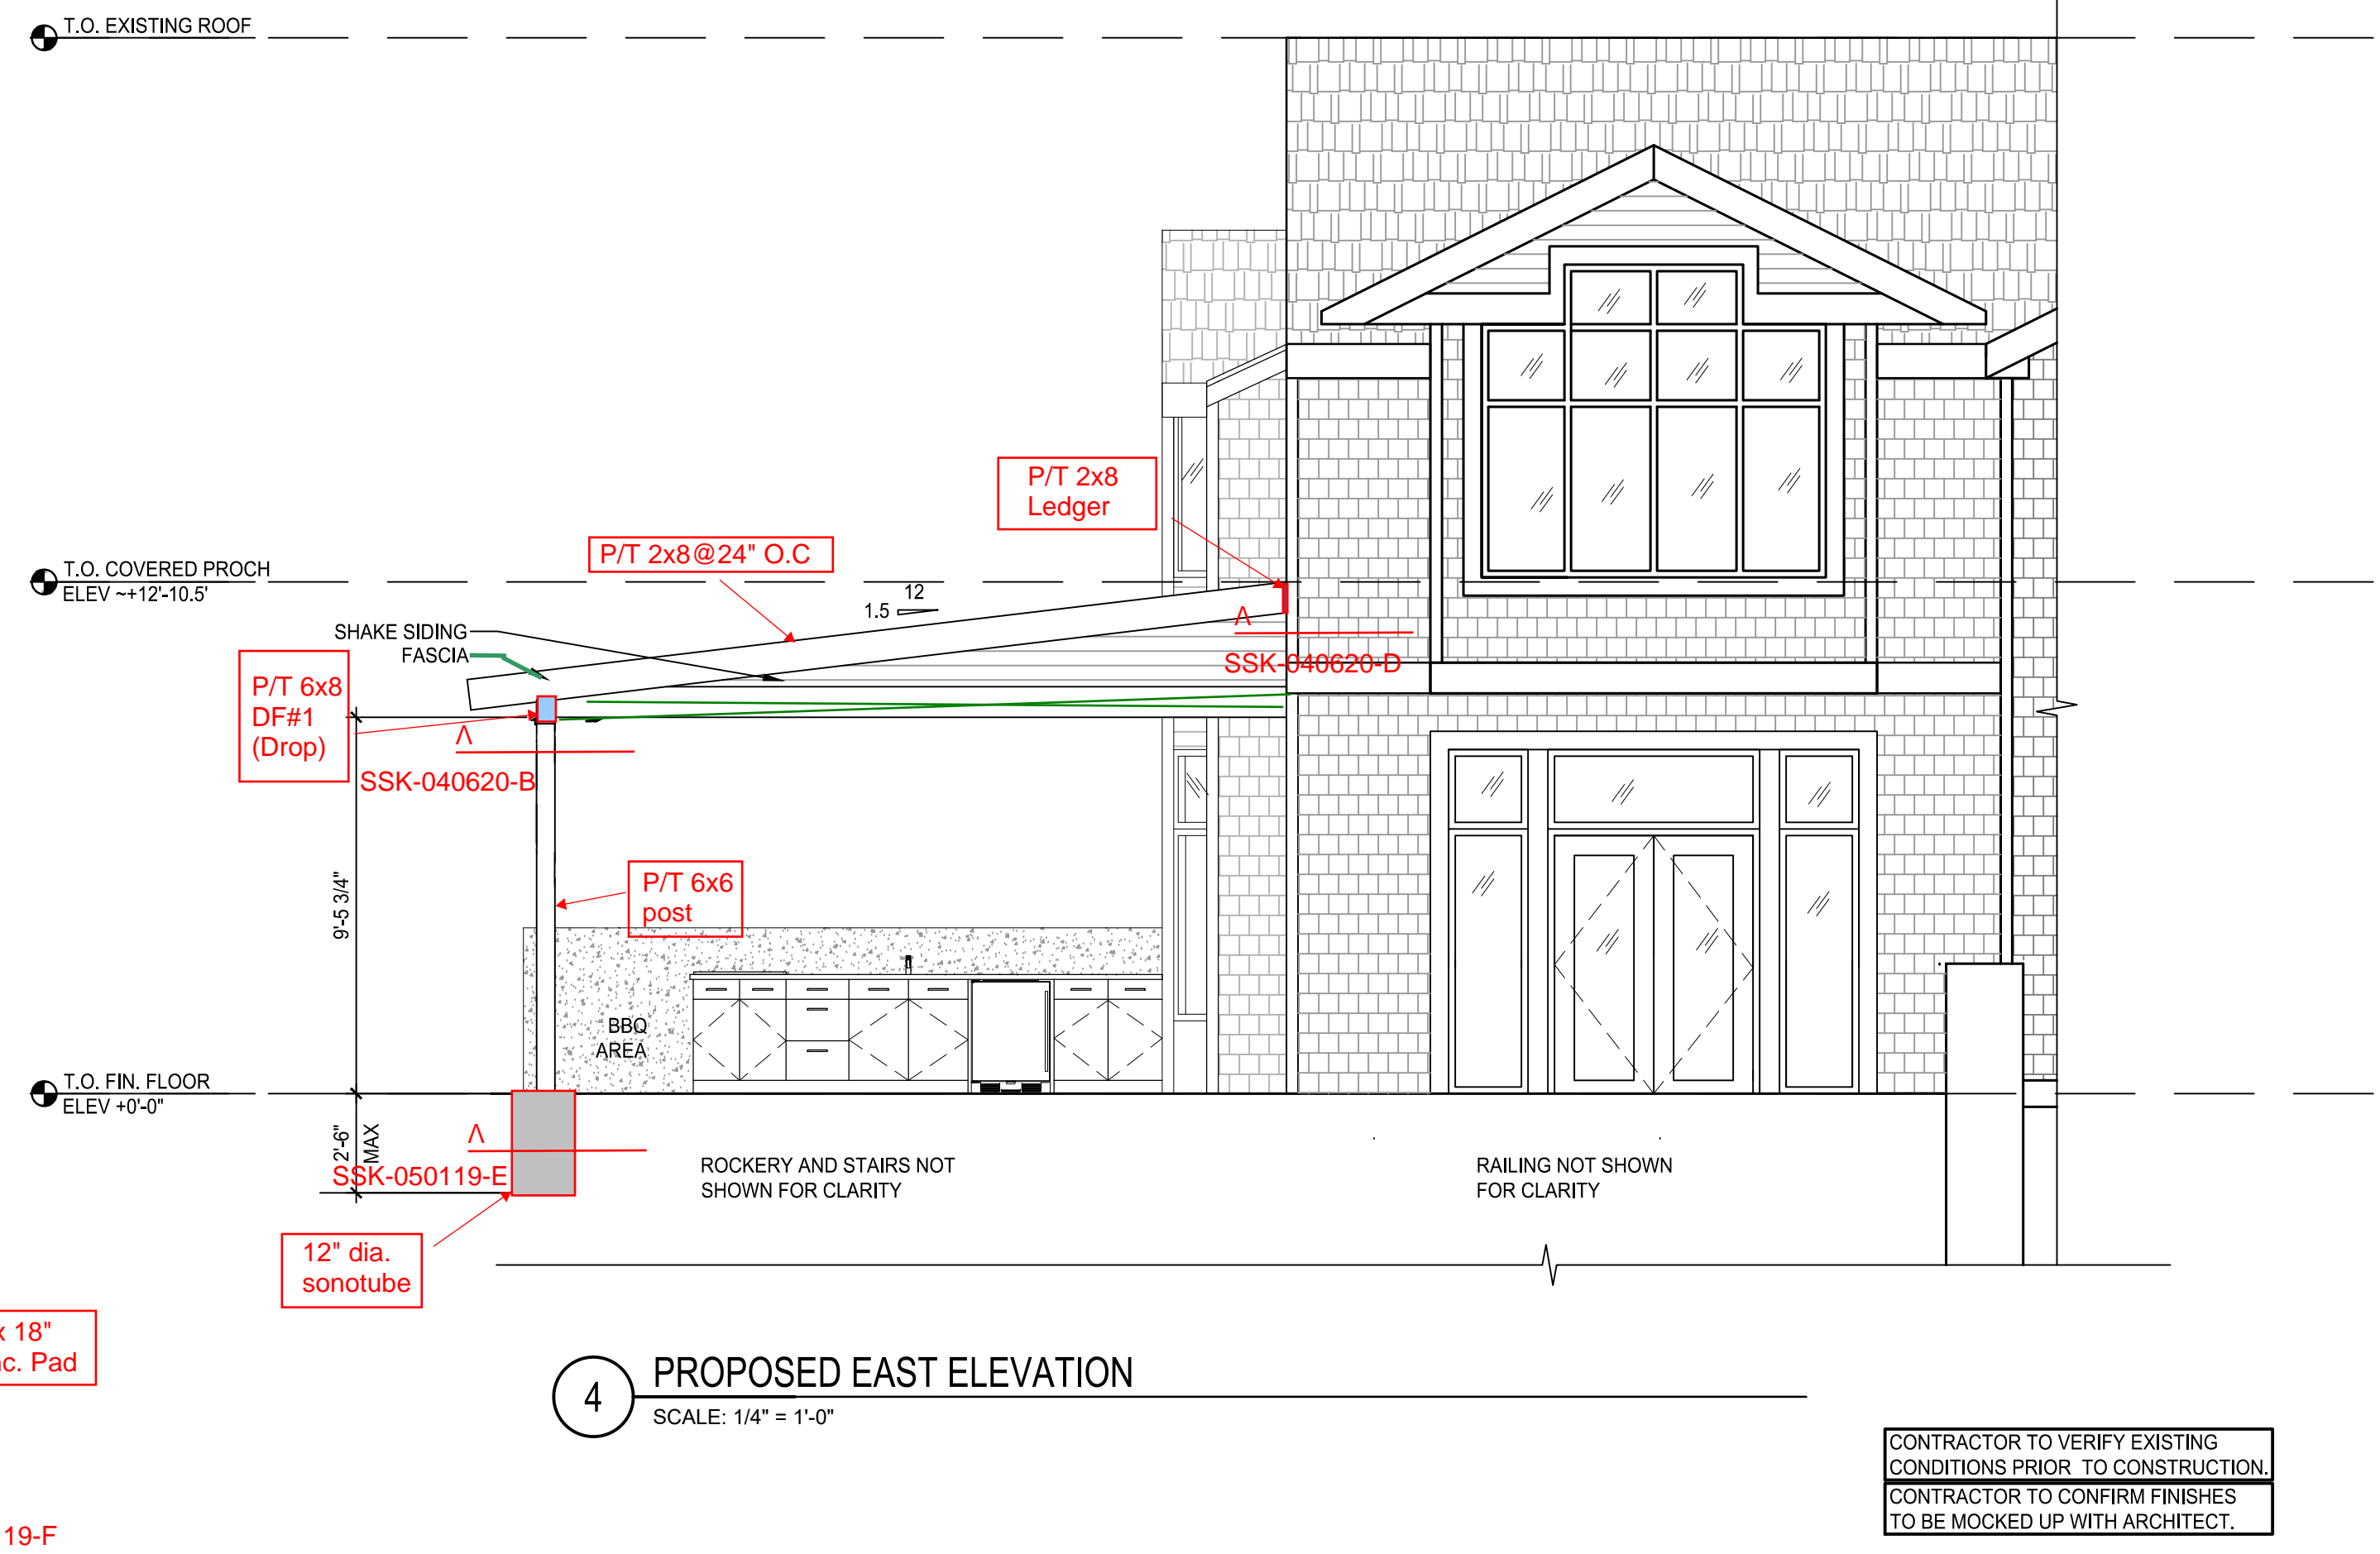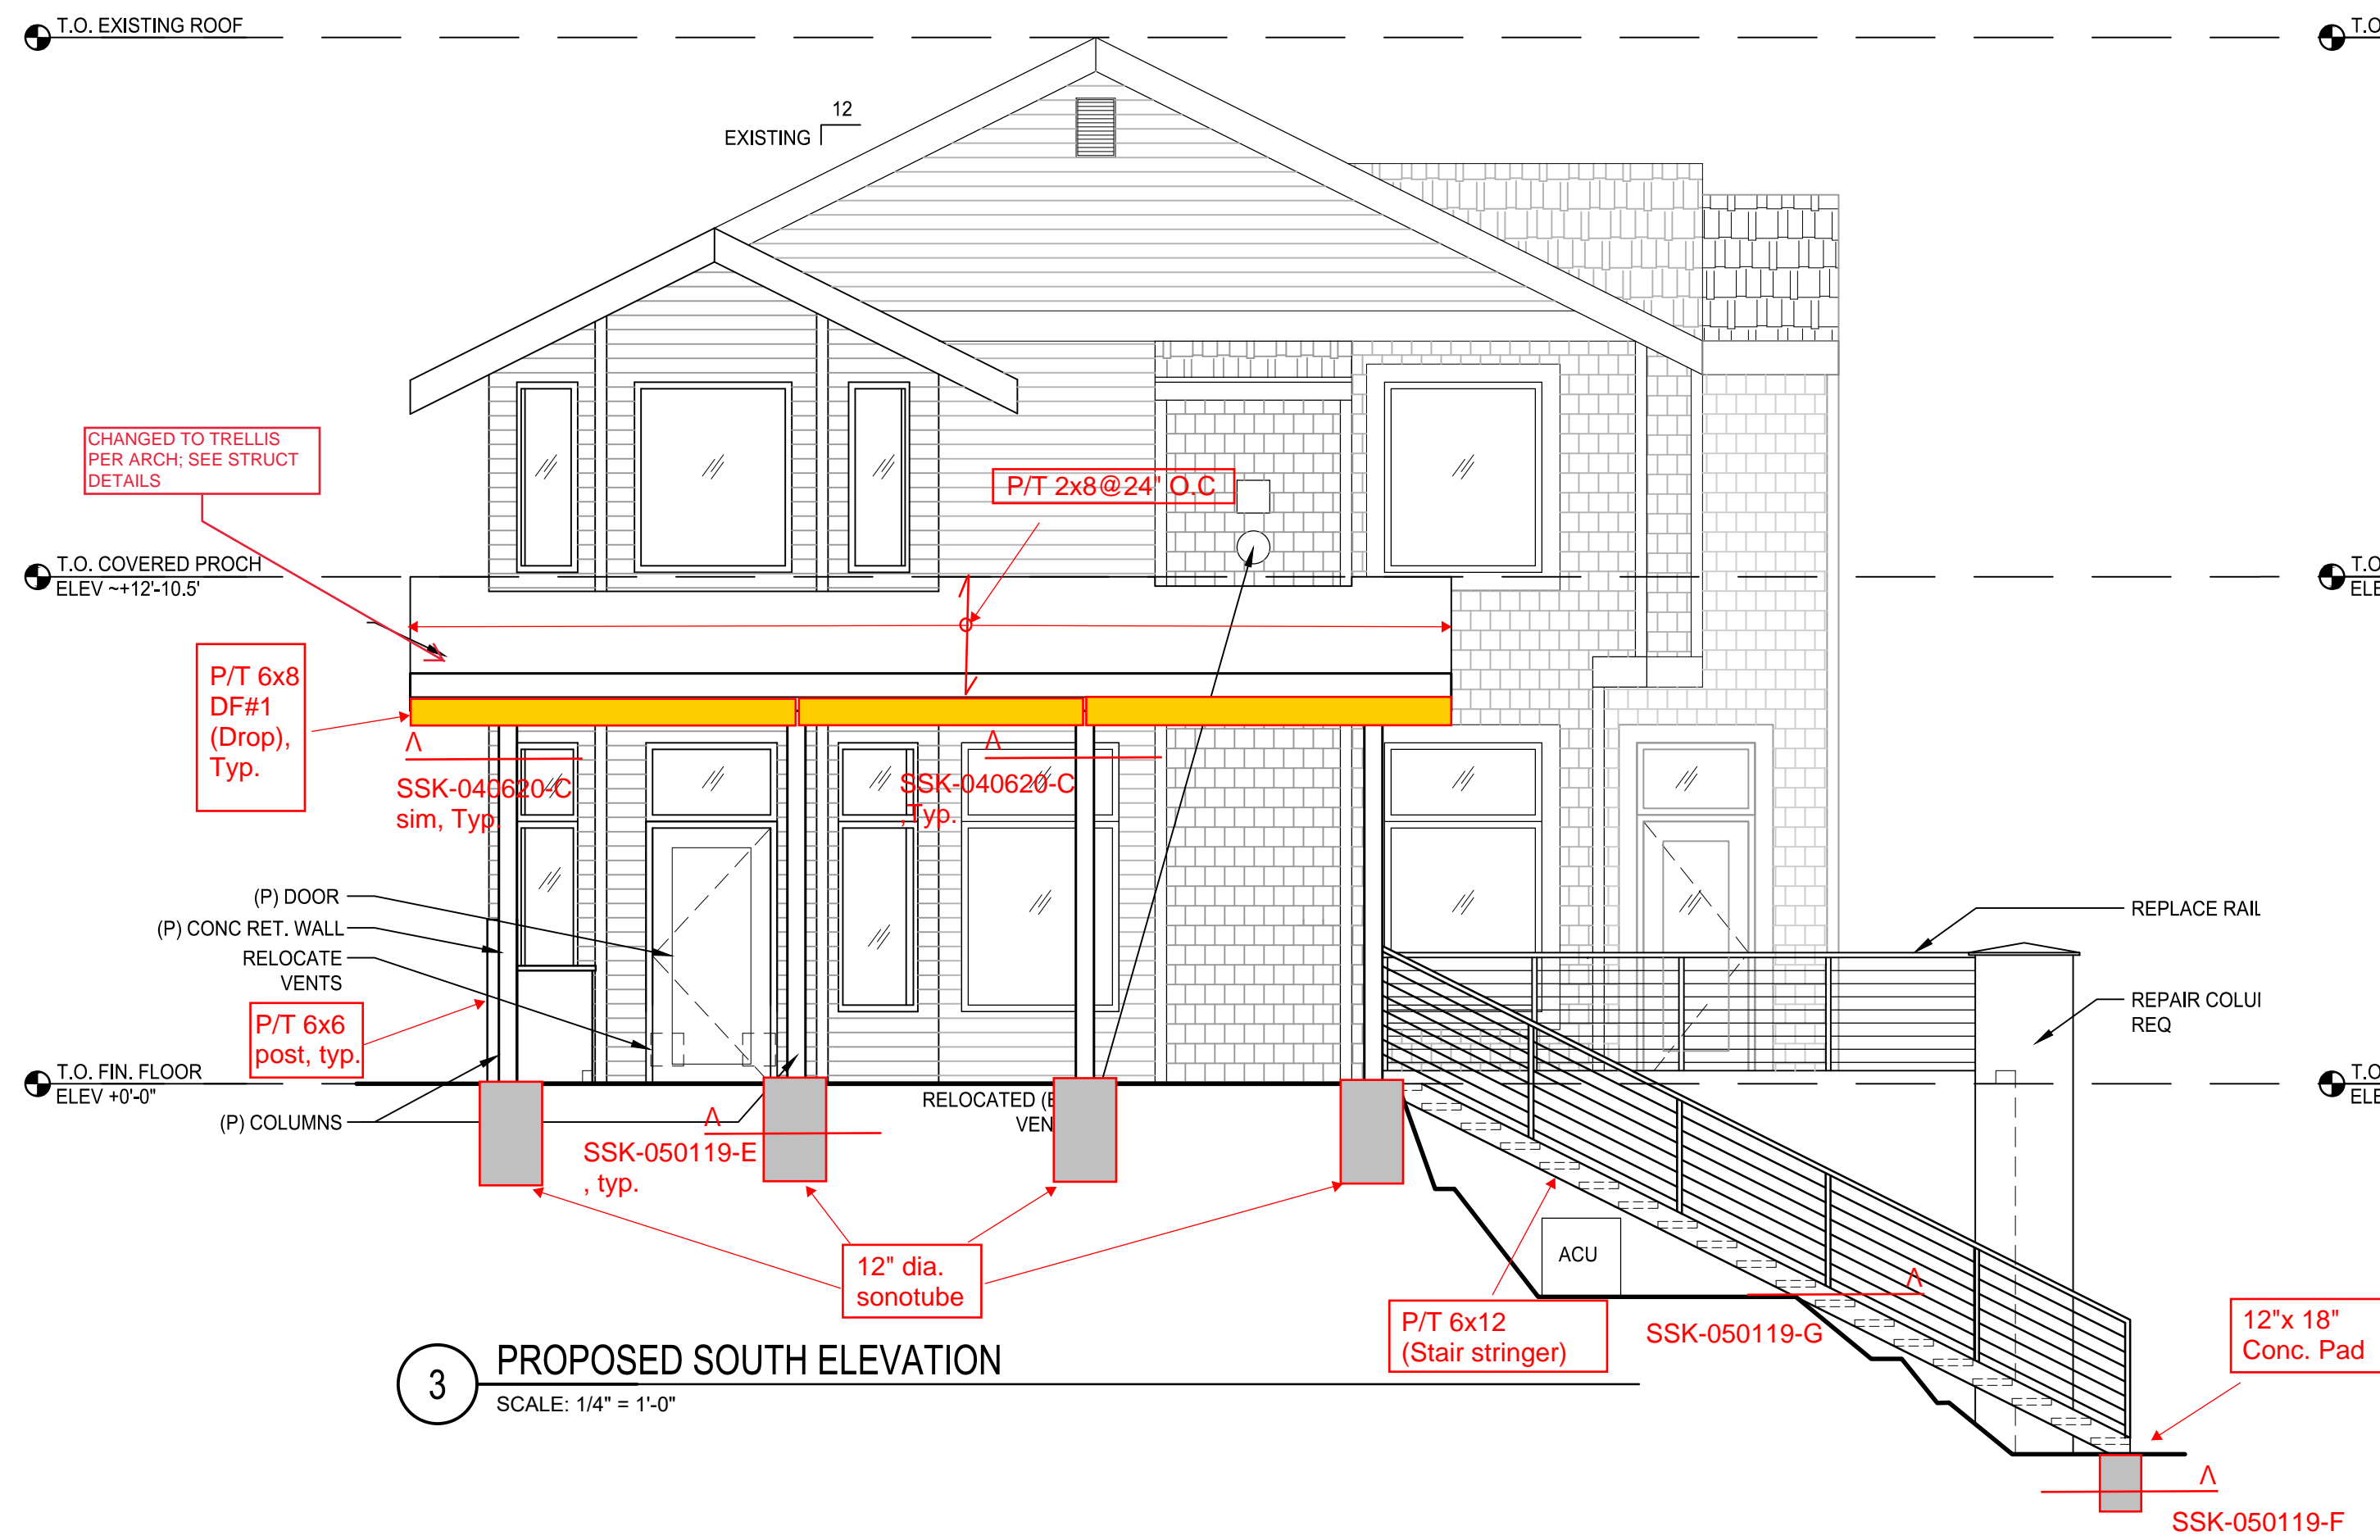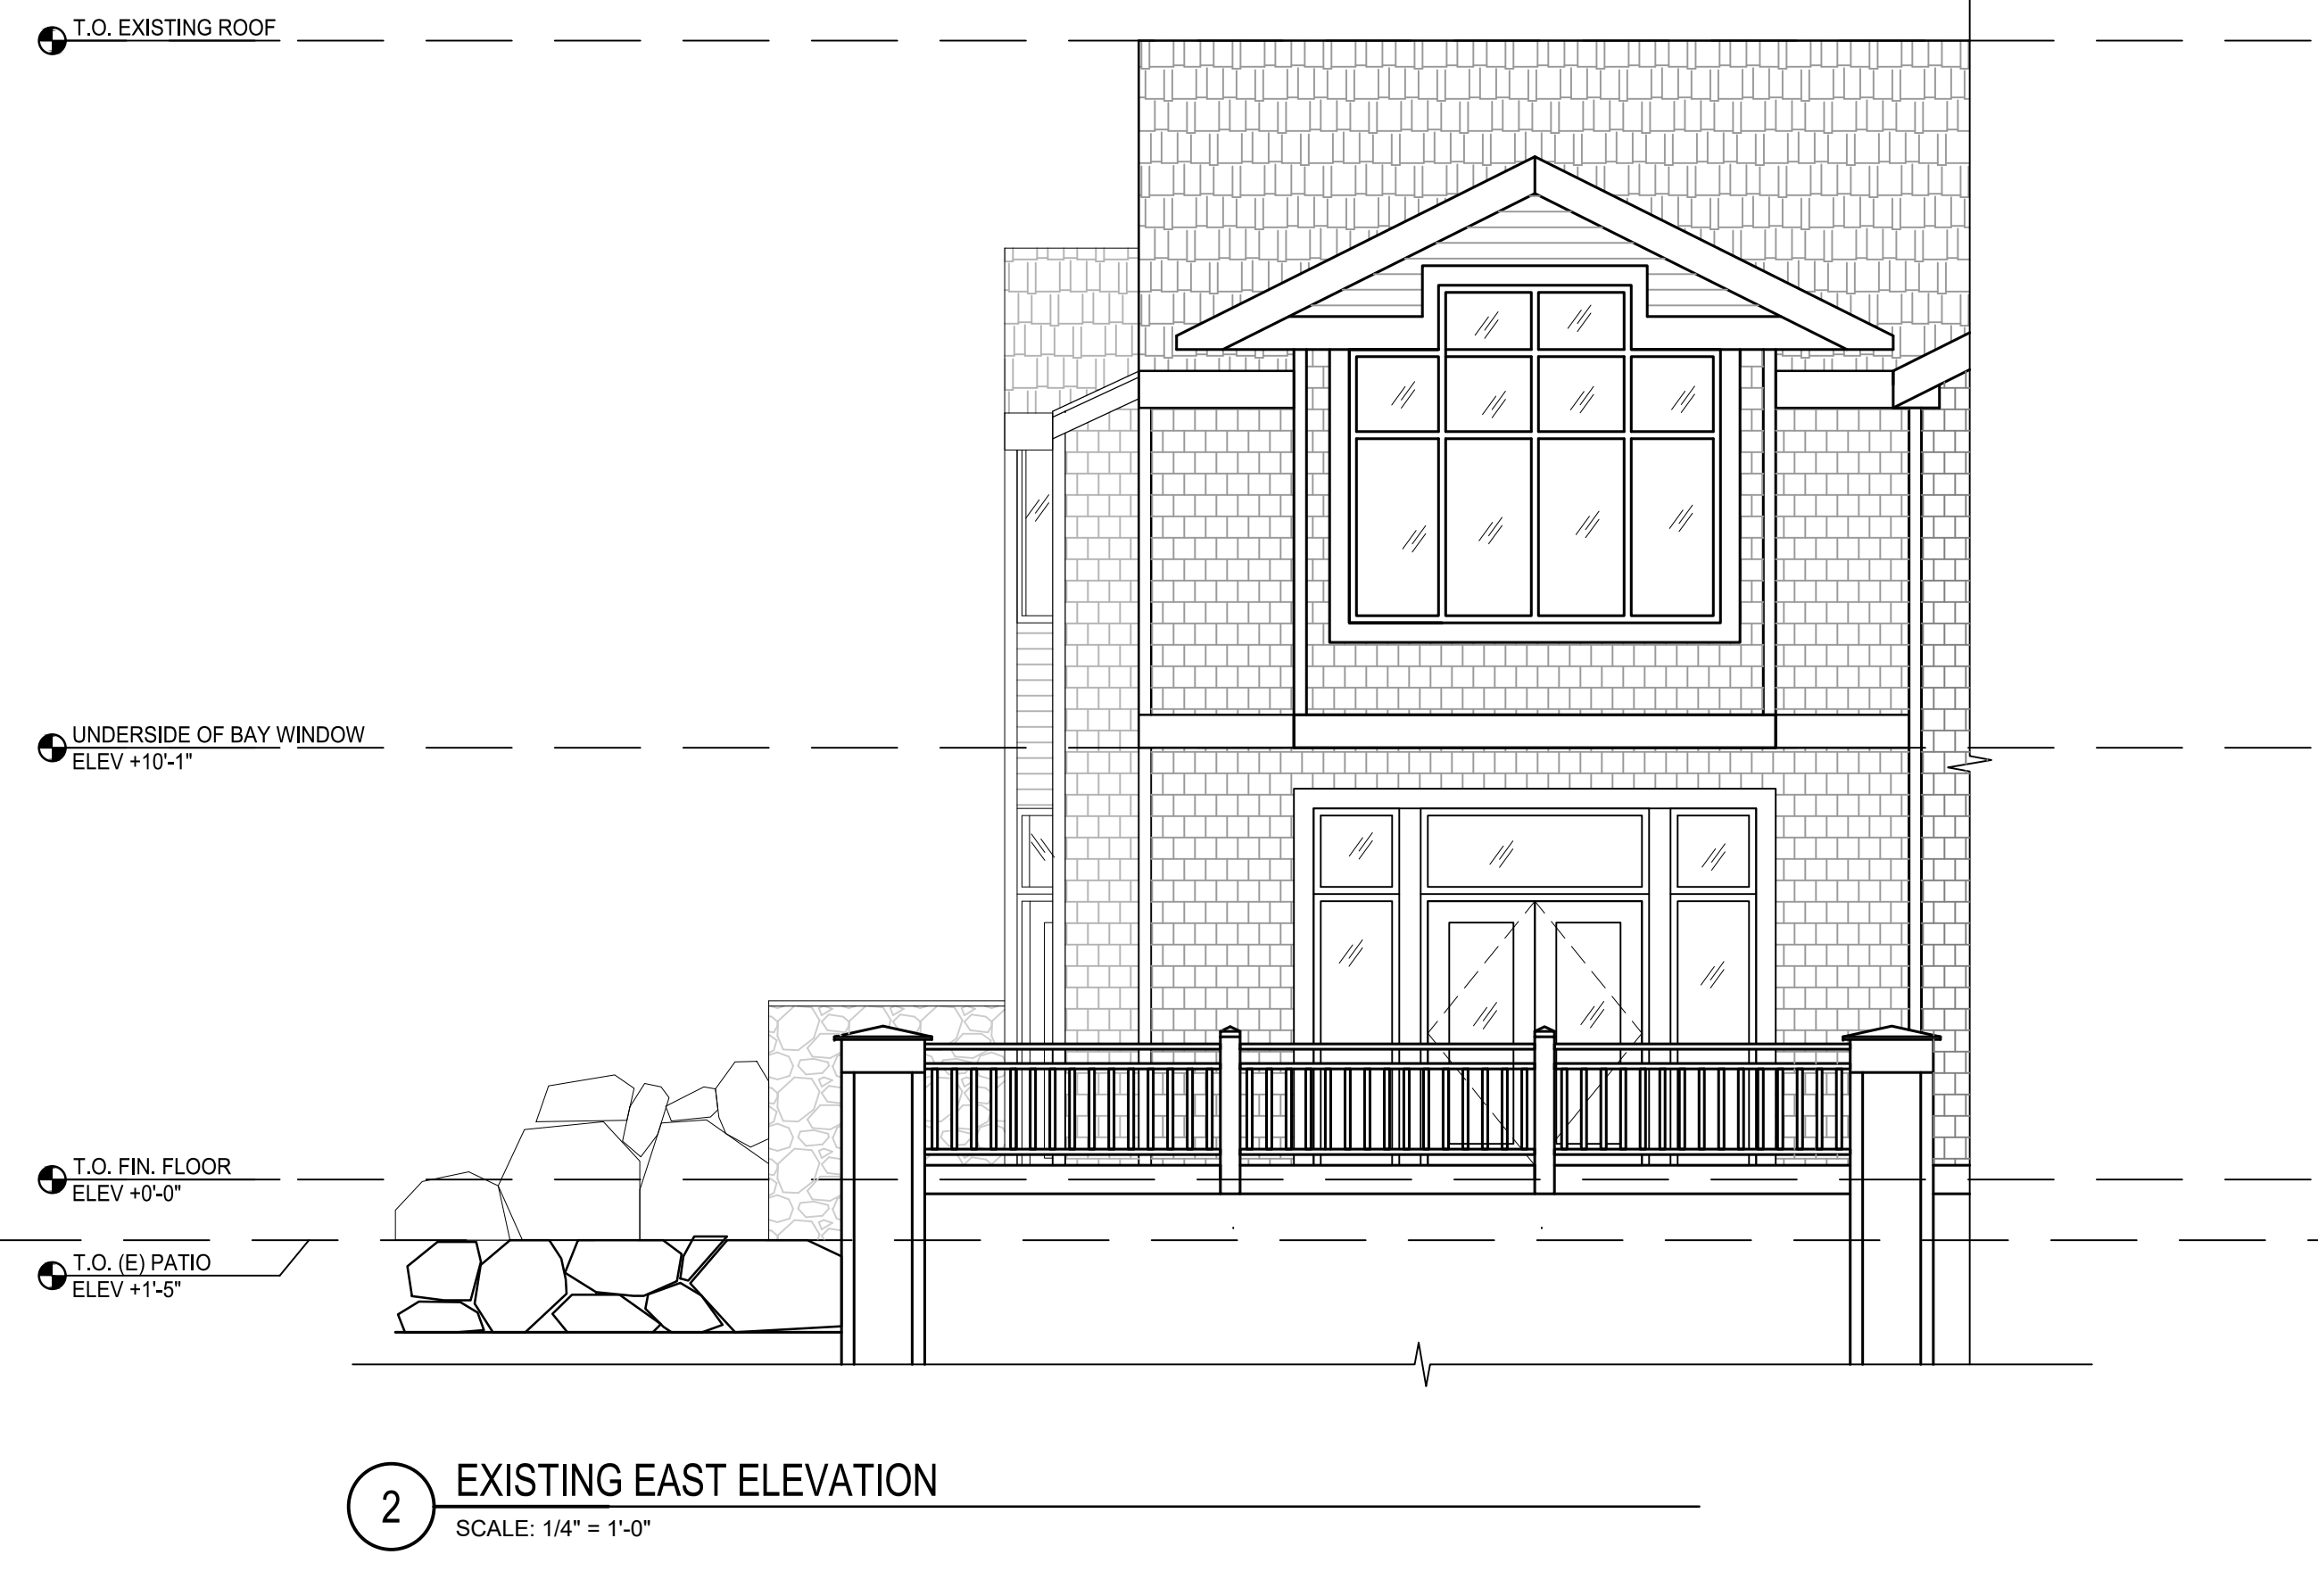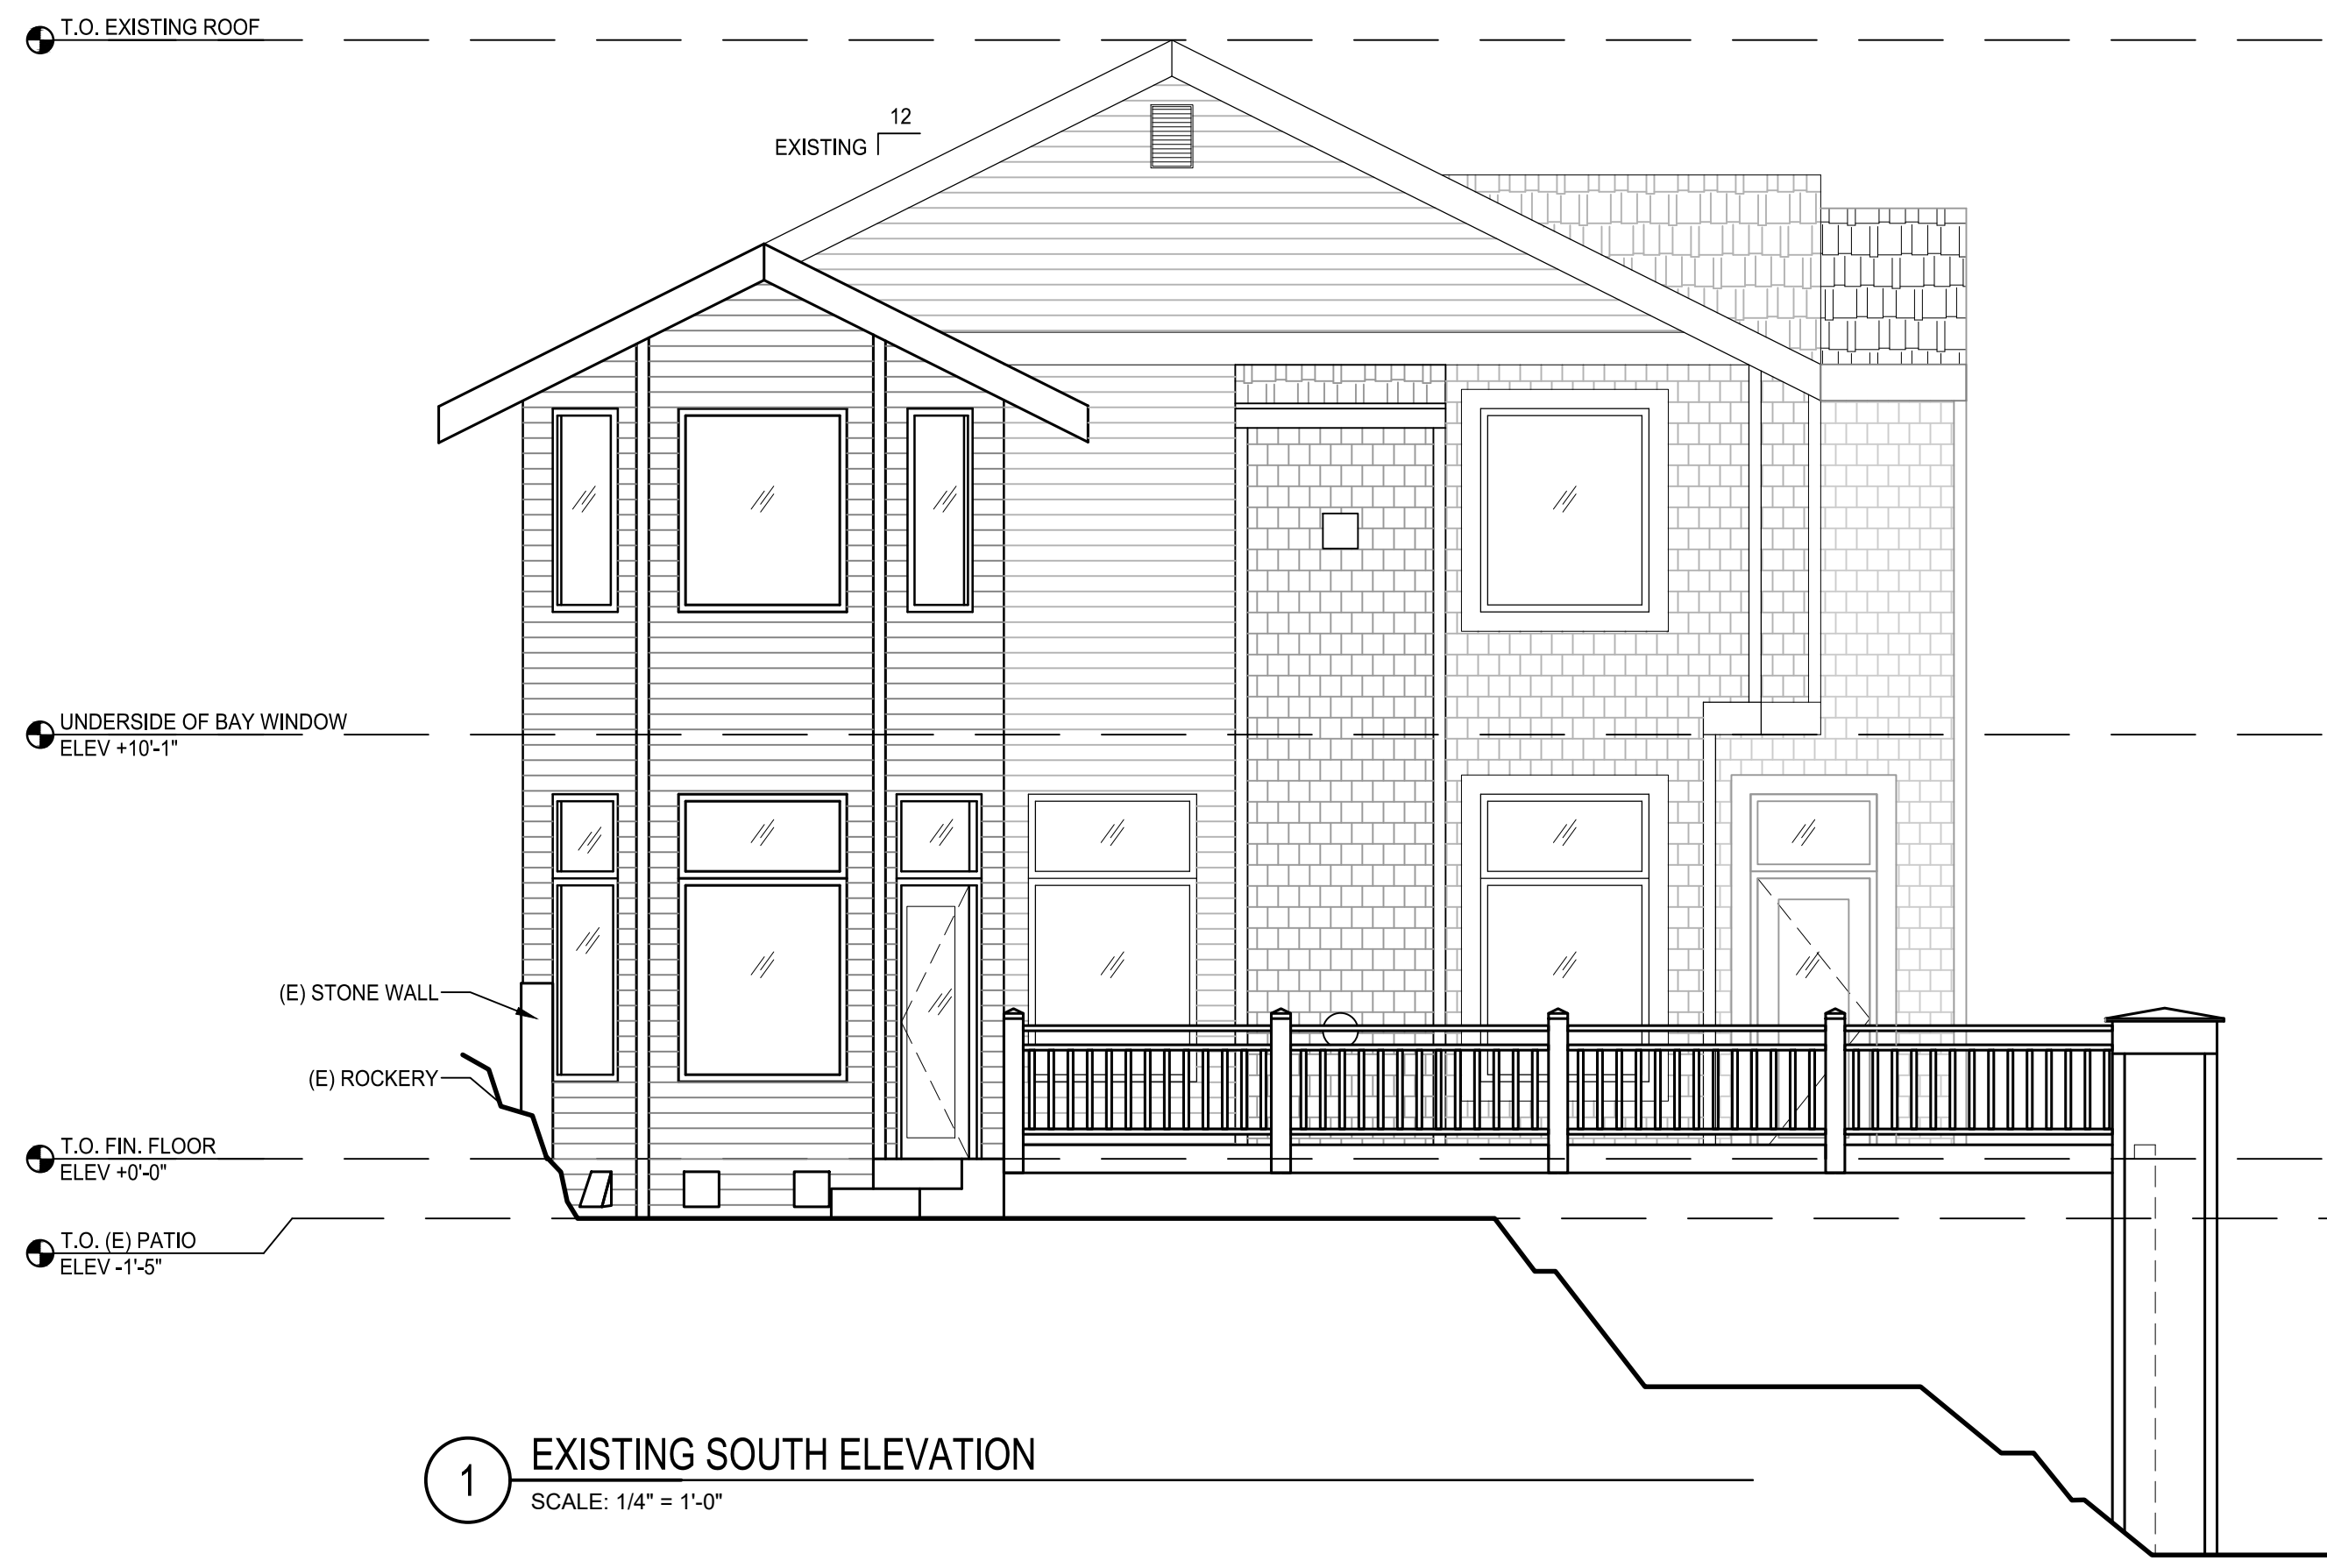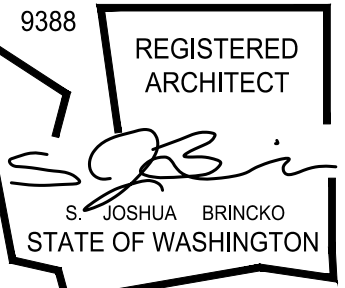

CONTRACTOR TO VERIFY EXISTING CONDITIONS PRIOR TO CONSTRUCTION. CONTRACTOR TO CONFIRM FINISHES TO BE MOCKED UP WITH ARCHITECT.

DESIGN SJB  
DRAWN CEC  
CHECKED SJB  
DATE [2019-0114 DESIGN]

[2020-0413 REV 2]



**LAI**  
7505 92ND AVE SE  
MERCER ISLAND WA 98040

PERMIT  
ELEVATIONS