

GENERAL NOTES

- CODE COMPLIANCE**
ALL WORK SHALL COMPLY WITH THE 2015 IBC, 2015 IMC, 2015 IFGC, 2015 FPC, 2015 UPC, 2015 IPMC, 2008 NEC, 2015 INTERNATIONAL ENERGY CONSERVATION CODE WITH WASHINGTON STATE AMENDMENTS, 2009 ICC A117.1, AND WITH ALL LOCAL CODES AND ORDINANCES.
- DIMENSIONS**
A. DO NOT SCALE DRAWINGS. VERIFY ALL DIMENSIONS PRIOR TO STARTING CONSTRUCTION. NOTIFY THE ARCHITECT OF DISCREPANCIES. IF WORK IS STARTED PRIOR TO NOTIFICATION, THE GENERAL AND SUBCONTRACTOR PROCEED AT THEIR OWN RISK.
B. UNLESS OTHERWISE NOTED, PLAN DIMENSIONS ARE TO FACE OF STUDS OR FACE OF CONCRETE WALLS. FACE OF STONE VENEER LIES 6" +/- OUTSIDE THE FACE OF FRAMING. INTERIOR PLAN DIMENSIONS ARE TO FACE OF STUDS UNLESS OTHERWISE NOTED.
C. VERIFY ALL ROUGH-IN DIMENSIONS FOR WINDOWS, DOORS, PLUMBING, ELECTRICAL FIXTURES AND APPLIANCES PRIOR TO COMMITMENT OF WORK. NOTIFY ARCHITECT OF ANY DISCREPANCIES OF DIMENSIONAL TOLERANCES REQUIRED.
- DOCUMENT REVIEW/VERIFICATION**
CONSULT WITH ARCHITECT REGARDING ANY SUSPECTED ERRORS, OMISSIONS, OR CHANGES ON PLANS BEFORE PROCEEDING WITH THE WORK.
- ROUGH OPENINGS/BACKING**
VERIFY SIZE AND LOCATION, AS WELL AS PROVIDE ALL OPENINGS THROUGH FLOORS AND WALLS. FURRING, CURBS, ANCHORS, INSERTS, EQUIPMENT BASES AND ROUGH BACKS/BACKING FOR SURFACE-MOUNTED ITEMS.
FURRING:
PROVIDE FURRING AS REQUIRED TO CONCEAL MECHANICAL AND/OR ELECTRICAL EQUIPMENT IN FINISHED AREAS. FURRING NOT SHOWN ON PLANS SHALL BE APPROVED BY ARCHITECT PRIOR TO CONSTRUCTION.
GRADES: VERIFY ALL GRADES AND THEIR RELATIONSHIP TO THE BUILDINGS.
- FLOOR LINES** "FLOOR LINE" REFERS TO TOP OF CONCRETE SLAB OR TOP OF WOOD SUBFLOOR.
- REPETITIVE FEATURES**: OFTEN DRAWN ONLY ONCE AND SHALL BE PROVIDED AS IF FULLY DRAWN.
- DOORS**:
DOORS NOT DIMENSIONALLY LOCATED SHALL BE 9" FROM STUD FACE TO EDGE OF DOOR, ROUGH OPENING OR CEILING AS SHOWN.
- WOOD MEMBERS IN CONTACT WITH CONCRETE**, AND/OR EXPOSED TO WEATHER: TO BE PRESSURE TREATED. TYPICAL. PROVIDE PRESSURE TREATED SILL PLATE IF FINISH GRADE IS WITHIN 9", TYPICAL.
- FRAMING**:
ALL NEW INTERIOR FRAME PARTITIONS TO BE 2X4 @ 16" O.C., & ALL NEW EXTERIOR FRAME PARTITIONS TO BE 2X6 @ 16" O.C., UNLESS OTHERWISE NOTED. VERIFY W/ STRUCTURAL DRAWINGS. EXISTING EXTERIOR WALLS ARE 2X4 STUDS @ 16" O.C., AND ARE TO REMAIN.
- VENTILATION**:
VENT ALL BATHROOM FANS, LAUNDRY FANS, RANGE HOODS AND DRYERS TO OUTSIDE ATMOSPHERE. BATHROOM/UTILITY ROOM FANS SHALL BE CAPABLE OF 5 AIR CHANGES PER HOUR AND SHALL BE VENTED DIRECTLY TO THE OUTSIDE THROUGH SMOOTH, RIGID, NON-CORROSIVE METAL, 24 GA. DUCTWORK. FLEX DUCTING IS NOT ALLOWED.
- FLUES**: FLUES TO BE LOCATED MINIMUM 2" FROM ALL COMBUSTIBLE MATERIALS.
- DOWNSPOUTS**: LOCATE NEW DOWNSPOUTS AS SHOWN ON ROOF PLAN, FLOOR PLANS & ELEVATIONS.
- OTHER DOCUMENTATION** REFERS TO STRUCTURAL, MECHANICAL, ELECTRICAL, AND/OR LANDSCAPE DRAWINGS FOR ADDITIONAL DRAWINGS, NOTES, SCHEDULES, AND SYMBOLS.
- PROTECTION**:
PROTECT ALL EXISTING FINISHES AND SURFACES. ANY DAMAGE WILL BE REPAIRED WITHOUT ADDITIONAL COST TO OWNER.
- PERMITS**:
SEPARATE ELECTRICAL, MECHANICAL, AND PLUMBING PERMITS ARE REQUIRED IN ADDITION TO THE BASIC BUILDING PERMIT
- ROOFING**:
PROVIDE NEW ROOFING TO MATCH EXISTING.
- EXHAUST DUCTS**:
PROVIDE BACKDRAFT DAMPERS AT ALL EXHAUST DUCTS. PROVIDE COMBUSTION AIR OPENINGS INTO FURNACE ROOM PER UMC 703.
- APPLIANCES**:
CLEARANCES OF UL LISTED APPLIANCES FROM COMBUSTIBLE MATERIALS SHALL BE AS SPECIFIED IN UL LISTING.
- WATER FLOW**:
SHOWER SHALL BE EQUIPPED WITH FLOW CONTROL DEVICE TO LIMIT WATER FLOW TO 2.5 GALLONS PER MINUTE.
- SMOKE DETECTORS**:
SMOKE & CARBON MONOXIDE THROUGHOUT NEW CONSTRUCTION, TO BE MONITORED PER FIRE DEPARTMENT REQUIREMENTS.
- FIREBLOCKING**:
FIREBLOCKING SHALL BE PROVIDED IN WOOD-FRAMED CONSTRUCTION PER 2015 IRC SECTION R302.11, SPECIFICALLY: 1) IN CONCEALED SPACES OF STUD WALLS AND PARTITIONS, 2) AT INTERCONNECTIONS BETWEEN CONCEALED VERTICAL AND HORIZONTAL SPACES, 3) IN CONCEALED SPACES BETWEEN STAIR STRINGERS AT T.O. & B.O. RUN, 4) AT OPENINGS AROUND VENTS, PIPES, ETC. AT CEILING AND FLOOR LEVEL.

PROJECT DATA

PROJECT ADDRESS: 6060 E. MERCER WAY
MERCER ISLAND, WA

PROPERTY TAX ID NUMBER: 192405-5269

SCOPE OF WORK: LOWER ADDITION OF ELEVATOR, NEW STAIRS, NEW WINDOWS AND DOORS
MAIN: NEW ELEVATOR, NEW STAIRS, NEW WINDOWS AND DOORS, RECONFIGURATION OF KITCHEN/DINING
UPPER: NEW ELEVATOR, NEW STAIRS, NEW RAISED PITCHED ROOF W/ SKYLIGHT, RECONFIGURATION OF MASTER SUITE, NEW WINDOWS AND DOORS

ZONING: R-15
CONSTRUCTION TYPE: TYPE V B
SEISMIC ZONE: 3
NUMBER OF STORIES: 2 STORIES + DAYLIGHT BASEMENT
FIRE PROTECTION: NONE
BUILDING HEIGHT: MAX. 30 FT ABOVE AVERAGE BUILDING ELEV.
GROSS FLOOR AREA: 12,000 SF OR 40% LOT AREA, WHICHEVER IS LESS
LOT AREA: 18,087 SF
LOT WIDTH: 80.0 FT
SETBACKS: FRONT LOT LINE = 20 FT
REAR LOT LINE = 25 FT
SIDE LOT LINES = LOTS 3'90" WIDTH: SUM OF 15 FT, BOTH 25 FT

PROJECT TEAM

OWNER: 6060 E. MERCER WAY
MERCER ISLAND, WA 98040
PHONE: 206.940.4611

STRUCTURAL: LONGITUDE ONE TWENTY
PHONE: 206.790.9502
CONTACT: MANS THURFJELL

ARCHITECT: STURMAN ARCHITECTS, INC.
9 - 103RD AVE. SUITE 203
BELLEVUE, WA 98004
PHONE: 425.451.7003
CONTACT: BRAD STURMAN

CONTRACTOR: MARCH-MACDONALD, INC.
9725 SE 36TH ST, STE. 401
MERCER ISLAND, WA 98040
PHONE: 206.232.9464
CONTACT: CLAY MARCH

LEGAL DESCRIPTION

BEGINNING AT A POINT 110 FEET NORTHERLY OF THE SOUTH LINE OF SAID SECTION 19 AND 517 FEET EASTERLY OF THE EAST MARGIN OF EAST MERCER WAY; THENCE NORTHERLY ON A LINE PERPENDICULAR TO SAID SOUTH SECTION LINE FOR A DISTANCE OF 45 FEET TO THE TRUE POINT OF BEGINNING; THENCE CONTINUING NORTHERLY ALONG SAID PERPENDICULAR LINE FOR A DISTANCE OF 56 FEET; THENCE EASTERLY ALONG A LINE PARALLEL TO AND 1200 FEET NORTHERLY OF SAID SOUTH LINE OF SECTION 19 TO THE SHORT OF LAKE WASHINGTON THENCE SOUTHERLY ALONG SAID SHORE OF LAKE WASHINGTON TO A LINE PARALLEL TO AND 1100 FEET NORTHERLY OF SAID SOUTH LINE OF SECTION 19 THENCE WESTERLY ALONG SAID PARALLEL LINE TO A POINT 475 FEET EASTERLY OF THE EAST RIGHT OF WAY MARGIN OF EAST MERCER WAY; THENCE NORTHEASTERLY IN A STRAIGHT LINE OF A DISTANCE OF APPROXIMATELY 62.94 FEET TO THE TRUE POINT OF BEGINNING

2015 WSEC CREDITS

THIS PROJECT IS CREATING LESS THAN 500 SF OF CONDITIONED SPACE, SO NO CREDITS ARE REQUIRED.

CUT/FILL

CUT = 0 C.Y.
FILL = 0 C.Y.

LEGEND:

- GRADE MAJOR CONTOUR
- GRADE MINOR CONTOUR
- SILT FENCE
- TREE PROTECTION FENCING
- POWER LINE
- GAS LINE
- TELEPHONE
- WATER LINE
- SANITARY SEWER LINE
- STORM DRAIN LINE
- AREA OF NEW OR REPLACED IMPERVIOUS
- AREA OF EXISTING IMPERVIOUS TO REMAIN
- AREA OF EXISTING IMPERVIOUS TO BE REMOVED

ENERGY NOTES


- CODE:** 2015 W.S.E.C. & 2015 IRC, WAC 51-11R CLIMATIC ZONE: ZONE #4-C MARINE
- SPACE HEAT TYPE:** NATURAL GAS, FORCED AIR SYSTEM THERMAL STANDARDS UNLIMITED OPTION FOR OPENINGS
- INSULATION VALUES:** WALLS: R-21
FLAT ATTIC/CEILING: R-49
VAULTED CEILING: R-38
FLOORS (OVER UNHEATED SPACES): R-30
SLAB-ON-GRADE: R-10
- AIR INFILTRATION:** MANUFACTURED DOORS/WINDOWS CONFORM TO SECTION R402.4.3 OF THE WASHINGTON STATE ENERGY CODE
- EXTERIOR JOINTS/OPENINGS:** SEAL, CAULK, GASKET OR WEATHERSTRIP TO LIMIT AIR LEAKAGE AT EXTERIOR JOINTS AROUND WINDOW AND DOOR FRAMES, OPENINGS BETWEEN WALLS AND FOUNDATION, BETWEEN WALLS AND ROOF, OPENINGS AT PENETRATIONS OF UTILITY SERVICES AND ALL OTHER SUCH OPENINGS IN THE BUILDING ENVELOPE
- MOISTURE CONTROL:** WALLS: VAPOR RETARDER BONDED TO BATT INSULATION. INSTALL WITH STAPLES NOT MORE THAN 8 INCHES ON CENTER AND WITH A GAP BETWEEN AND OVER FRAMING NOT GREATER THAN 1/16 OF AN INCH. OR VAPOR RETARDER OF ONE PERM CUP RATING (4 MIL POLYETHYLENE)
- ATTIC/CEILING:** VAPOR RETARDER OF ONE PERM CUP RATING (4 MIL POLYETHYLENE), INSTALL CONTINUOUSLY
- CRAWL SPACE:** 6 MIL POLYETHYLENE
- VENTILATION:** ATTICS WITH LOOSE FILL: N.A. BAFFLE VENT OPENINGS TO DEFLECT AIR ABOVE INSULATION SURFACE ENCLOSED JOIST OR RAFTER SPACES; PROVIDE MINIMUM OF ONE INCH CLEAR VENTED AIR SPACE ABOVE INSULATION. TAPER OR COMPRESS INSULATION AT PERIMETER TO INSURE PROPER VENTILATION, MAINTAINING MINIMUM OF R-38.
- HEATING & COOLING:** AIR SOURCE HEAT PUMP W/ MIN HSPF OF 9.0
- TEMP. CONTROL:** FOR HEATING AND COOLING, THERMOSTAT SHALL BE CAPABLE OF BEING SET FROM 55-85 DEGREES FAHRENHEIT AND OF OPERATING THE HEATING/COOLING SYSTEM IN SEQUENCE. THERMOSTAT TO BE AUTOMATIC DAY/NIGHT SETBACK TYPE.
- DUCT INSULATION:** THERMALLY INSULATE ALL PLENUMS, DUCTS AND ENCLOSURES IN ACCORDANCE WITH SECTION R403.3.1 OF THE WASHINGTON STATE ENERGY CODE.
- a. ALL HEATING DUCTS IN UNCONDITIONED SPACES SHALL BE INSULATED WITH A MIN. OF R-8. ALL SEAM JOINTS SHALL BE TAPED, SEALED AND FASTENED WITH THE MINIMUM OF FASTENERS PER WSEC.
b. DUCTS WITHIN A CONCRETE SLAB OR IN THE GROUND SHALL BE INSULATED TO R-10, WITH INSULATION DESIGNED TO BE USED BELOW GRADE.
- LIGHTING:** RECESSED LIGHTING FIXTURES INSTALLED IN BUILDING ENVELOPE SHALL COMPLY WITH WSEC PROVISIONS AND SHALL BE IC LISTED.
- PIPE INSULATION:** ALL HOT WATER PIPES, AND NON-RECIRCULATING COLD WATER PIPES LOCATED IN UNCONDITIONED SPACE SHALL BE INSULATED TO R-3 MIN. PLUMBING OR MECHANICAL CANNOT DISPLACE THE REQUIRED INSULATION.
- WHOLE HOUSE VENTILATION:**
- a. WHOLE HOUSE VENTILATION SHALL BE PROVIDED BY EXHAUST FAN PROVIDING 105 CFM RUNNING CONTINUOUSLY PER 2015 IRC TABLE M1507.3.3 (1&2). FAN SHALL BE LESS THAN .35 WATT PER CFM AND CONNECTED TO A 24 HOUR CLOCK TIMER AND HAVE A SONE RATING OF LESS THAN 1.0. VENTILATION SHALL BE ABLE TO OPERATE INDEPENDENTLY OF HEATING SYSTEM.
b. SYSTEM SHALL HAVE A 5"Ø SMOOTH FRESH AIR DUCT W/ LOUVER & SCREEN CONNECTED TO THE RETURN AIR STREAM 4' UPSTREAM OF THE AIR HANDLER AND INSULATED W/ R-4 MIN IN HEATED AREAS.
c. SHALL HAVE A FILTER WITH A MERV OF AT LEAST 6 INSTALLED IN AN EASILY ACCESSIBLE LOCATION.
d. FRESH AIR VENT SHALL BE LOCATED AWAY FROM SOURCES OF ODORS OR FUMES, MIN 10' FROM PLUMBING OR APPLIANCE VENTS, AWAY FROM ROOMS W/ FUEL BURNING APPLIANCES, AND OUT OF ATTICS, CRAWL SPACES, AND GARAGES.
e. AIRFLOW FOR WHOLE HOUSE EXHAUST FAN SHALL BE PROVIDED BY UNDERCUTTING INTERIOR DOORS 1/2" ABOVE FINISHED FLOOR, TYP.
- PLUMBING FIXTURES:** ALL PLUMBING FIXTURES SHALL CONFORM TO RCW 19.27.170
ALL TOILETS 1.6 GPM MAX URINALS 1.0 GPM MAX
SHOWERHEADS <1.75 GPM FAUCETS 2.5 GPM MAX LAVATORIES <1.0 GPM

ABE CALCS

AVERAGE BUILDING ELEVATION			
	Wall Length	Elevation Pt.	Wall Length X Elev. Pt.
A	90.625	59.5	5392.1875
B	11.625	55.0	639.375
C	14.65	53.0	776.45
D	24.5	47.0	1151.5
E	3.125	45.0	140.625
F	24.125	44.0	1061.5
G	49	49.0	2401
H	24.42	55.9	1365.078
I	1.33	59.2	78.736
J	15.667	59.2	927.4864
K	28.1	59.5	1671.95
L	3.83	59.5	227.885
M	32.5	59.5	1933.75
N	24	360.3	8647.2
	290.997	645.8	15833.7729

15833.7729 **54.41** Average Building Elevation 290.997

ABE KEY PLAN NO SCALE

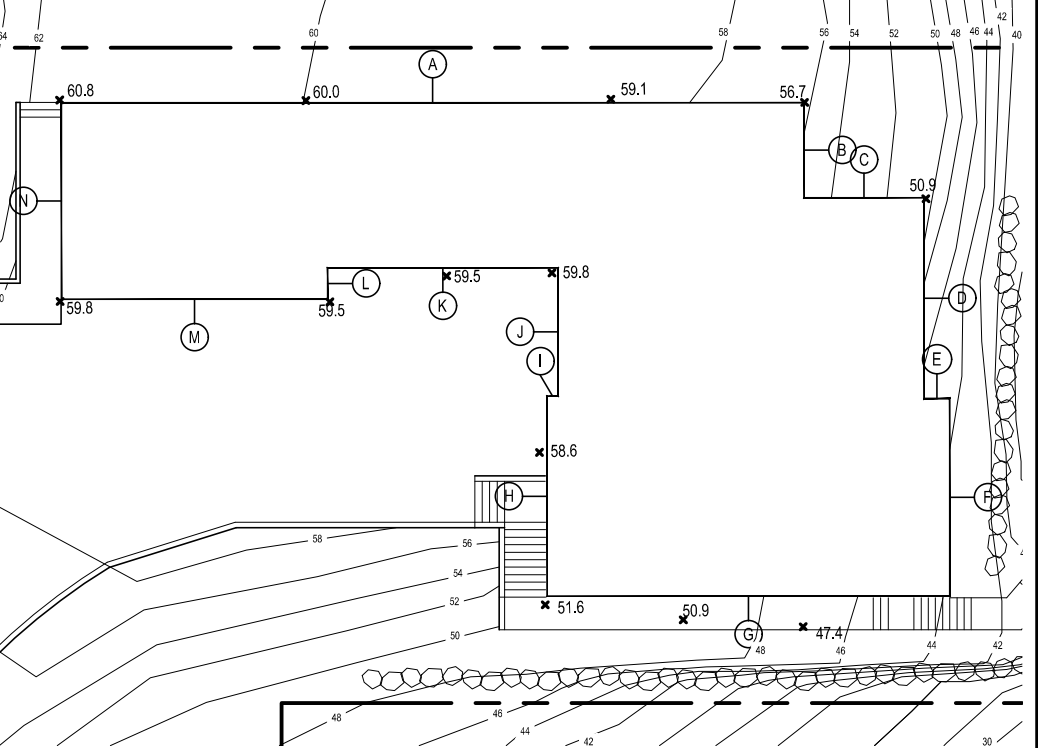

LOT COVERAGE (IMPERVIOUS AREA)

	GROSS LOT S.F.	MAIN STRUCT. & ROOF S.F.	DRIVES/ PARKING	TOTAL LOT COVERAGE	% LOT COVERAGE
EXISTING IMPERVIOUS AREA	18,087 SF	4762 SF	2280 SF	7042 SF	38.9 %
PROPOSED IMPERVIOUS AREA		4762 SF	2280 SF	7042 SF	38.9 %
NET GAIN/LOSS IMPERVIOUS AREA		+0 SF	+0 SF	+0 SF	+0 %
% ALLOWED IMPERVIOUS AREA				6330.45 SF ALLOWABLE	35 %

FRONT STEPS	CONC STEPS	IMPERVIOUS DECK	STAIRS & PAVER PATH	OPEN DECK	CONC. PATIO	TOTAL HARDSCAPE	% IMPERVIOUS
75.7 SF	76 SF	301 SF	432.5 SF	309 SF	374.7 SF	1568.9 SF	8.7 %
75.7 SF	71 SF	413 SF	383.2	309 SF	374.7 SF	1626.6 SF	8.9 %
+0 SF	-5 SF	+112 SF	-49.3 SF	+0 SF	+0 SF	+57.7 SF	+2.2 %
						1627.83 SF ALLOWABLE	9 %

HIGHEST EL: 70.1' -
LOWEST EL: 18.7'
ELEVATION DIFFERENCE= 51.4'

47.0' DIVIDED BY 210.0' (HORIZ. DIST. BTWN. HIGHEST & LOWEST ELEV.) = 24%

LOT SLOPE IS 24.5%, WHICH IS GREATER THAN 15% SO LOT COVERAGE ALLOWED IS 35%.

ADDITIONAL 9% OF LOT SIZE WILL DETERMINE ALLOWABLE HARDSCAPE SURFACE

SHEET INDEX

- A1.0 COVER SHEET - GENERAL & ENERGY NOTES, LEGAL, PROJECT DATA, CUT-FILL CALC, INDEX, SITE PLAN
- SURVEY
- A2.0 LOWER FLOOR PLAN
A2.1 MAIN FLOOR PLAN
A2.2 UPPER FLOOR PLAN
A2.3 ROOF PLAN
A3.0 EXTERIOR ELEVATIONS
A3.1 EXTERIOR ELEVATIONS
A4.0 BUILDING SECTIONS
A4.1 BUILDING SECTIONS
A4.2 BUILDING SECTIONS
A5.0 EXTERIOR DETAILS
- S-0 STRUCTURAL COVER SHEET
S-1 STRUCTURAL GENERAL NOTES
S-2 FOUNDATION PLAN
S-3 BASEMENT WALL FRAMING & SHEAR WALL PLAN
S-4 FIRST FLOOR FRAMING PLAN
S-5 FIRST FLOOR WALL FRAMING AND SHEAR WALL PLAN
S-6 SECOND FLOOR WALL FRAMING AND SHEAR WALL PLAN
S-7 ROOF FRAMING PLAN
- SD-1 STRUCTURAL DETAILS
SD-2 STRUCTURAL DETAILS

BUILDING AREA

	LOWER FLOOR	MAIN FLOOR	UPPER FLOOR	HEATED SUB-TOTAL	ATTACHED GARAGE	GRAND TOTAL	UNHEATED DECKS
EXISTING HOUSE:	1446 SF	2759 SF	1888 SF	6093 SF	780 SF	6873 SF	1832 SF
PROPOSED CHANGES:	+ 76 SF	+15 SF	+7 SF	+ 98 SF	+0 SF	+ 98 SF	+191 SF
PROPOSED HOUSE:	1522 SF	2774 SF	1895 SF	6191 SF	780 SF	6971 SF	2023 SF

GROSS FLOOR AREA

MAX GFA FOR R-15 IS EITHER 12,000 SQUARE FEET OR 40% OF THE LOT AREA, WHICHEVER IS LESS

40% OF 18,087 SF = 7,234.8 SF, SO THIS IS THE MAX ALLOWABLE GFA

THE PROPOSED GROSS FLOOR AREA OF THIS RESIDENCE IS AS FOLLOWS:

LOWER FLOOR: 1522 SF
MAIN FLOOR: 3554 SF
UPPER FLOOR: 1895 SF
TOTAL: 6971 SF


ADDITIONS
MASTER BEDROOM CEILING 12'-6" : 199.5 SF

SUBTRACTIONS
UPPER FLOOR STAIR ALLOWANCE: 75 SF

GRAND TOTAL: 7095.5 SF OR 39.2%

7095.5 SF OF GROSS FLOOR AREA IS LESS THAN MAXIMUM 7,234.8 SF

VICINITY MAP

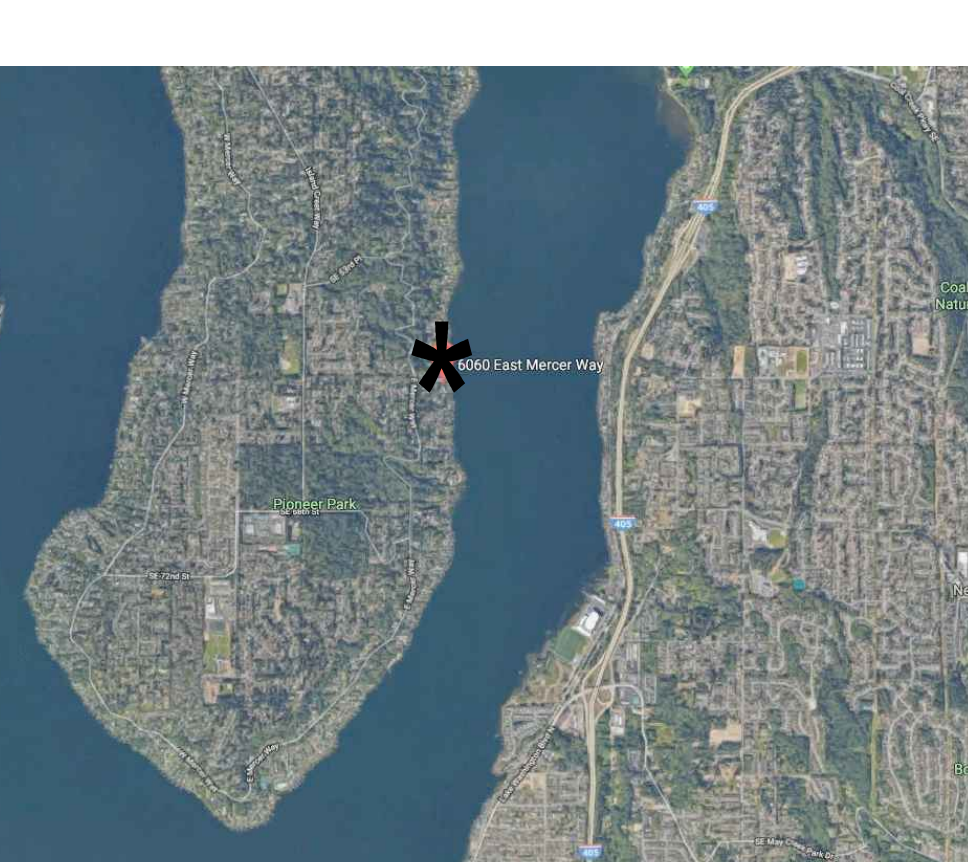

STURMAN ARCHITECTS

TEL (425) 451-7003

9 103rd Avenue NE
Suite 203
Bellevue, WA 98004

REGISTERED ARCHITECT

BRADLEY J. STURMAN
STATE OF WASHINGTON

www.sturmanarchitects.com
All Rights Reserved
© 2019

BAYLEY RESIDENCE PERMIT SET


**6060 E. MERCER WAY
MERCER ISLAND, WA 98040**


PHASE 2 GENERAL NOTES SITE PLAN

REVISIONS:

2019-02-27	DESIGN REVISIONS	
2019-04-04	DESIGN REVISIONS	


DRAWN BY: KE
CHECKED BY: BUS
SHEET **A1.0**
PLOT DATE: 9/6/2019

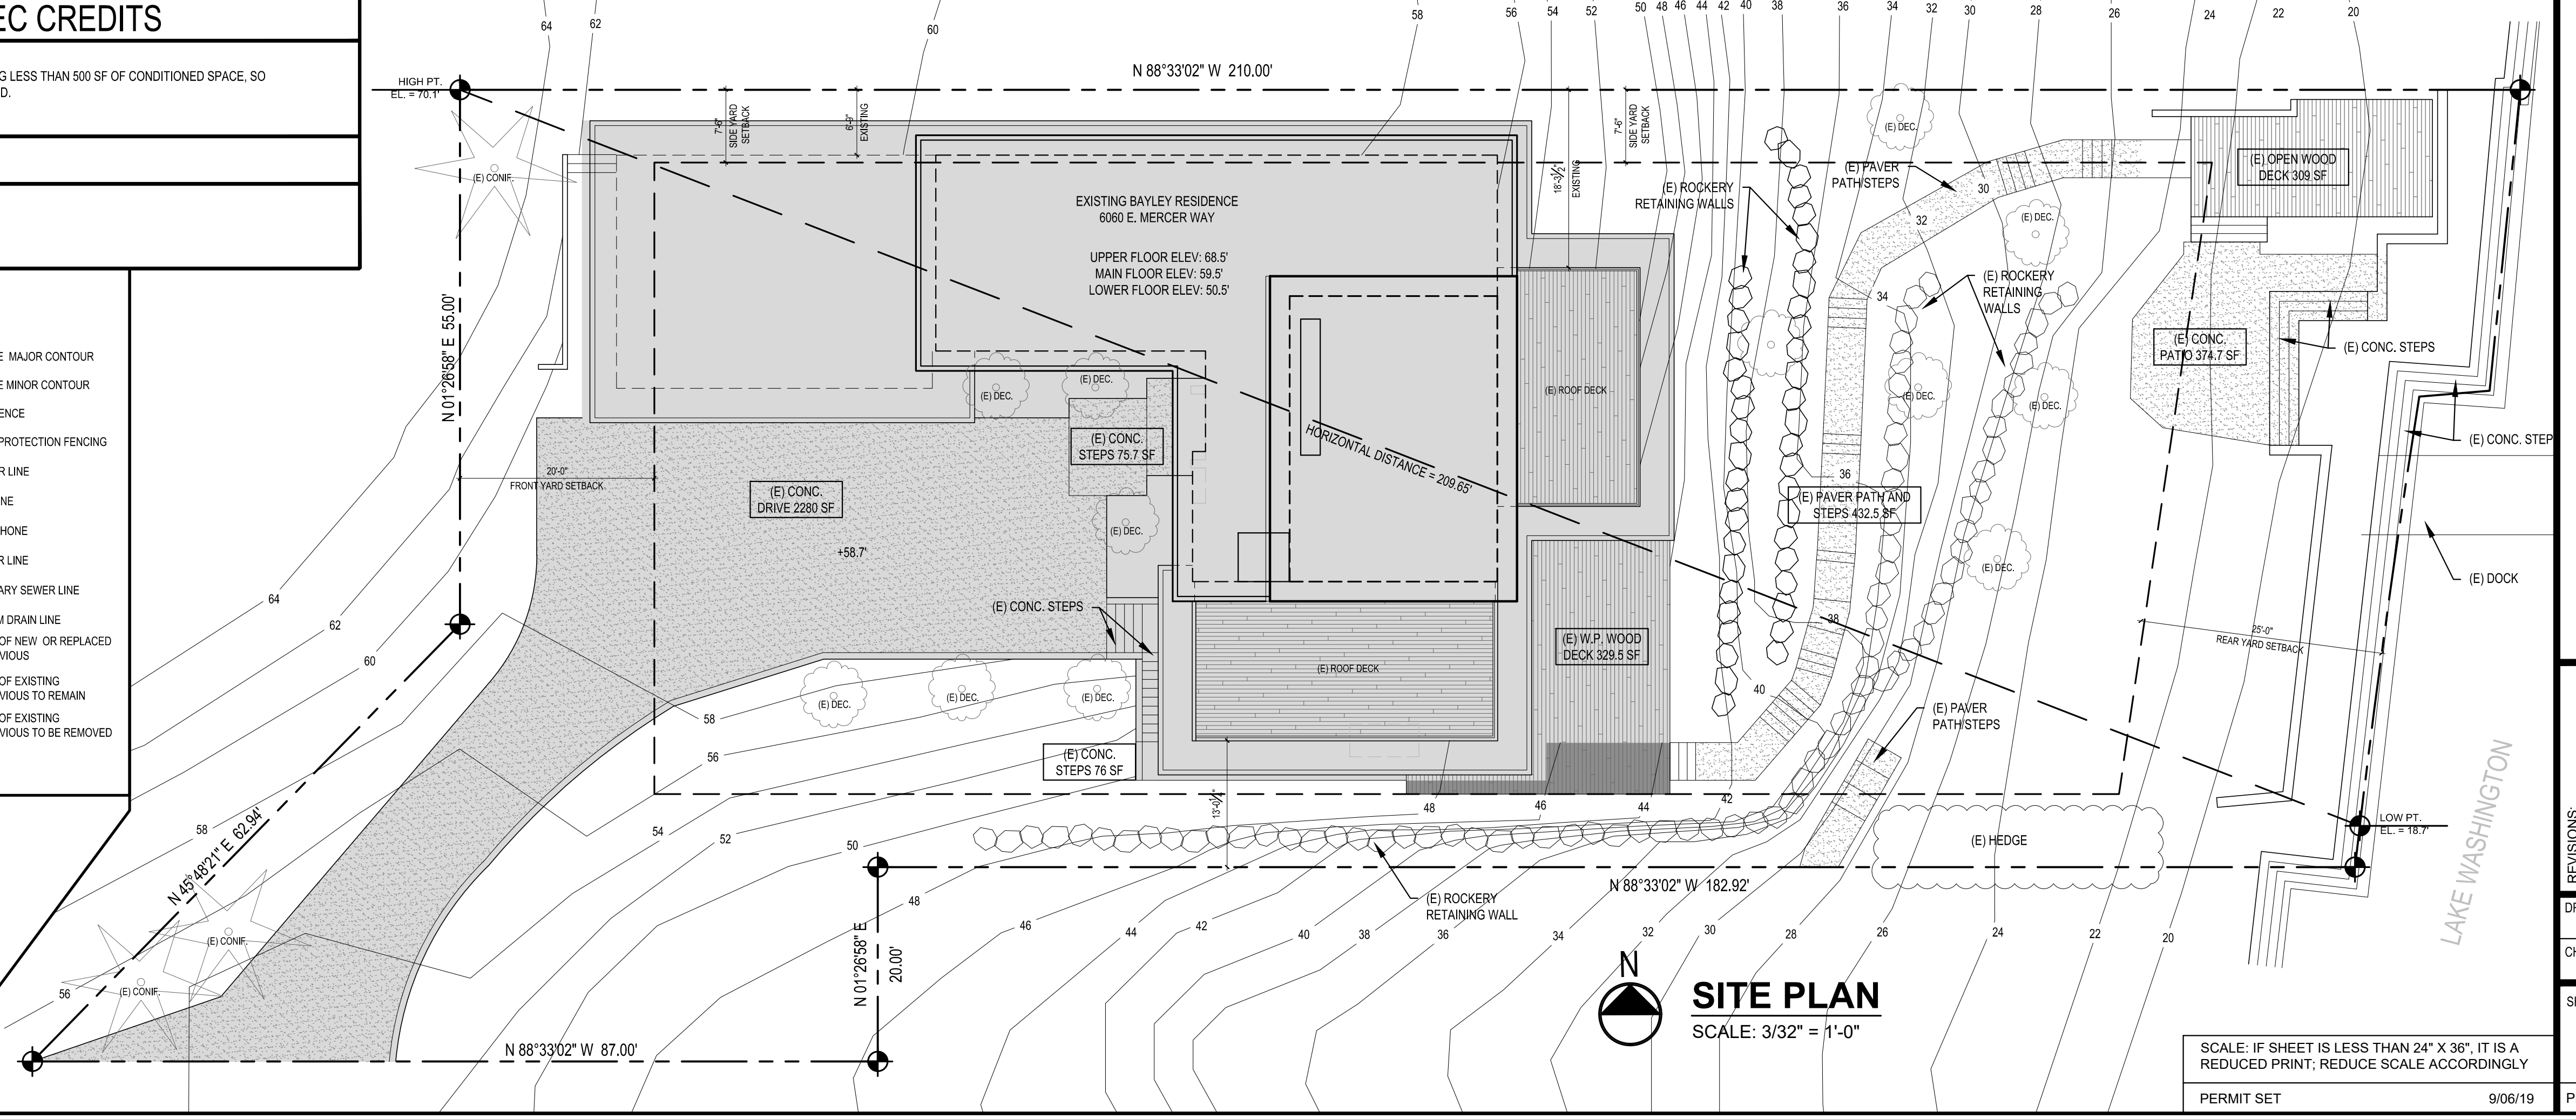

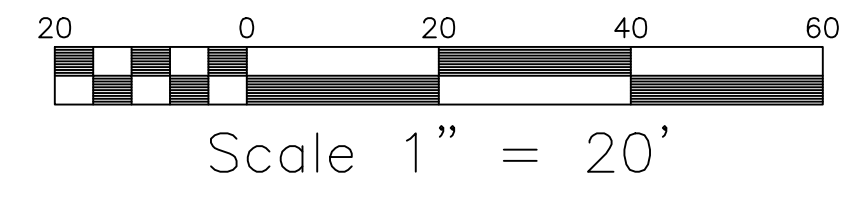

MERIDIAN & DATUM

ASSUMED MERIDIAN
DATUM IS NAVD-88

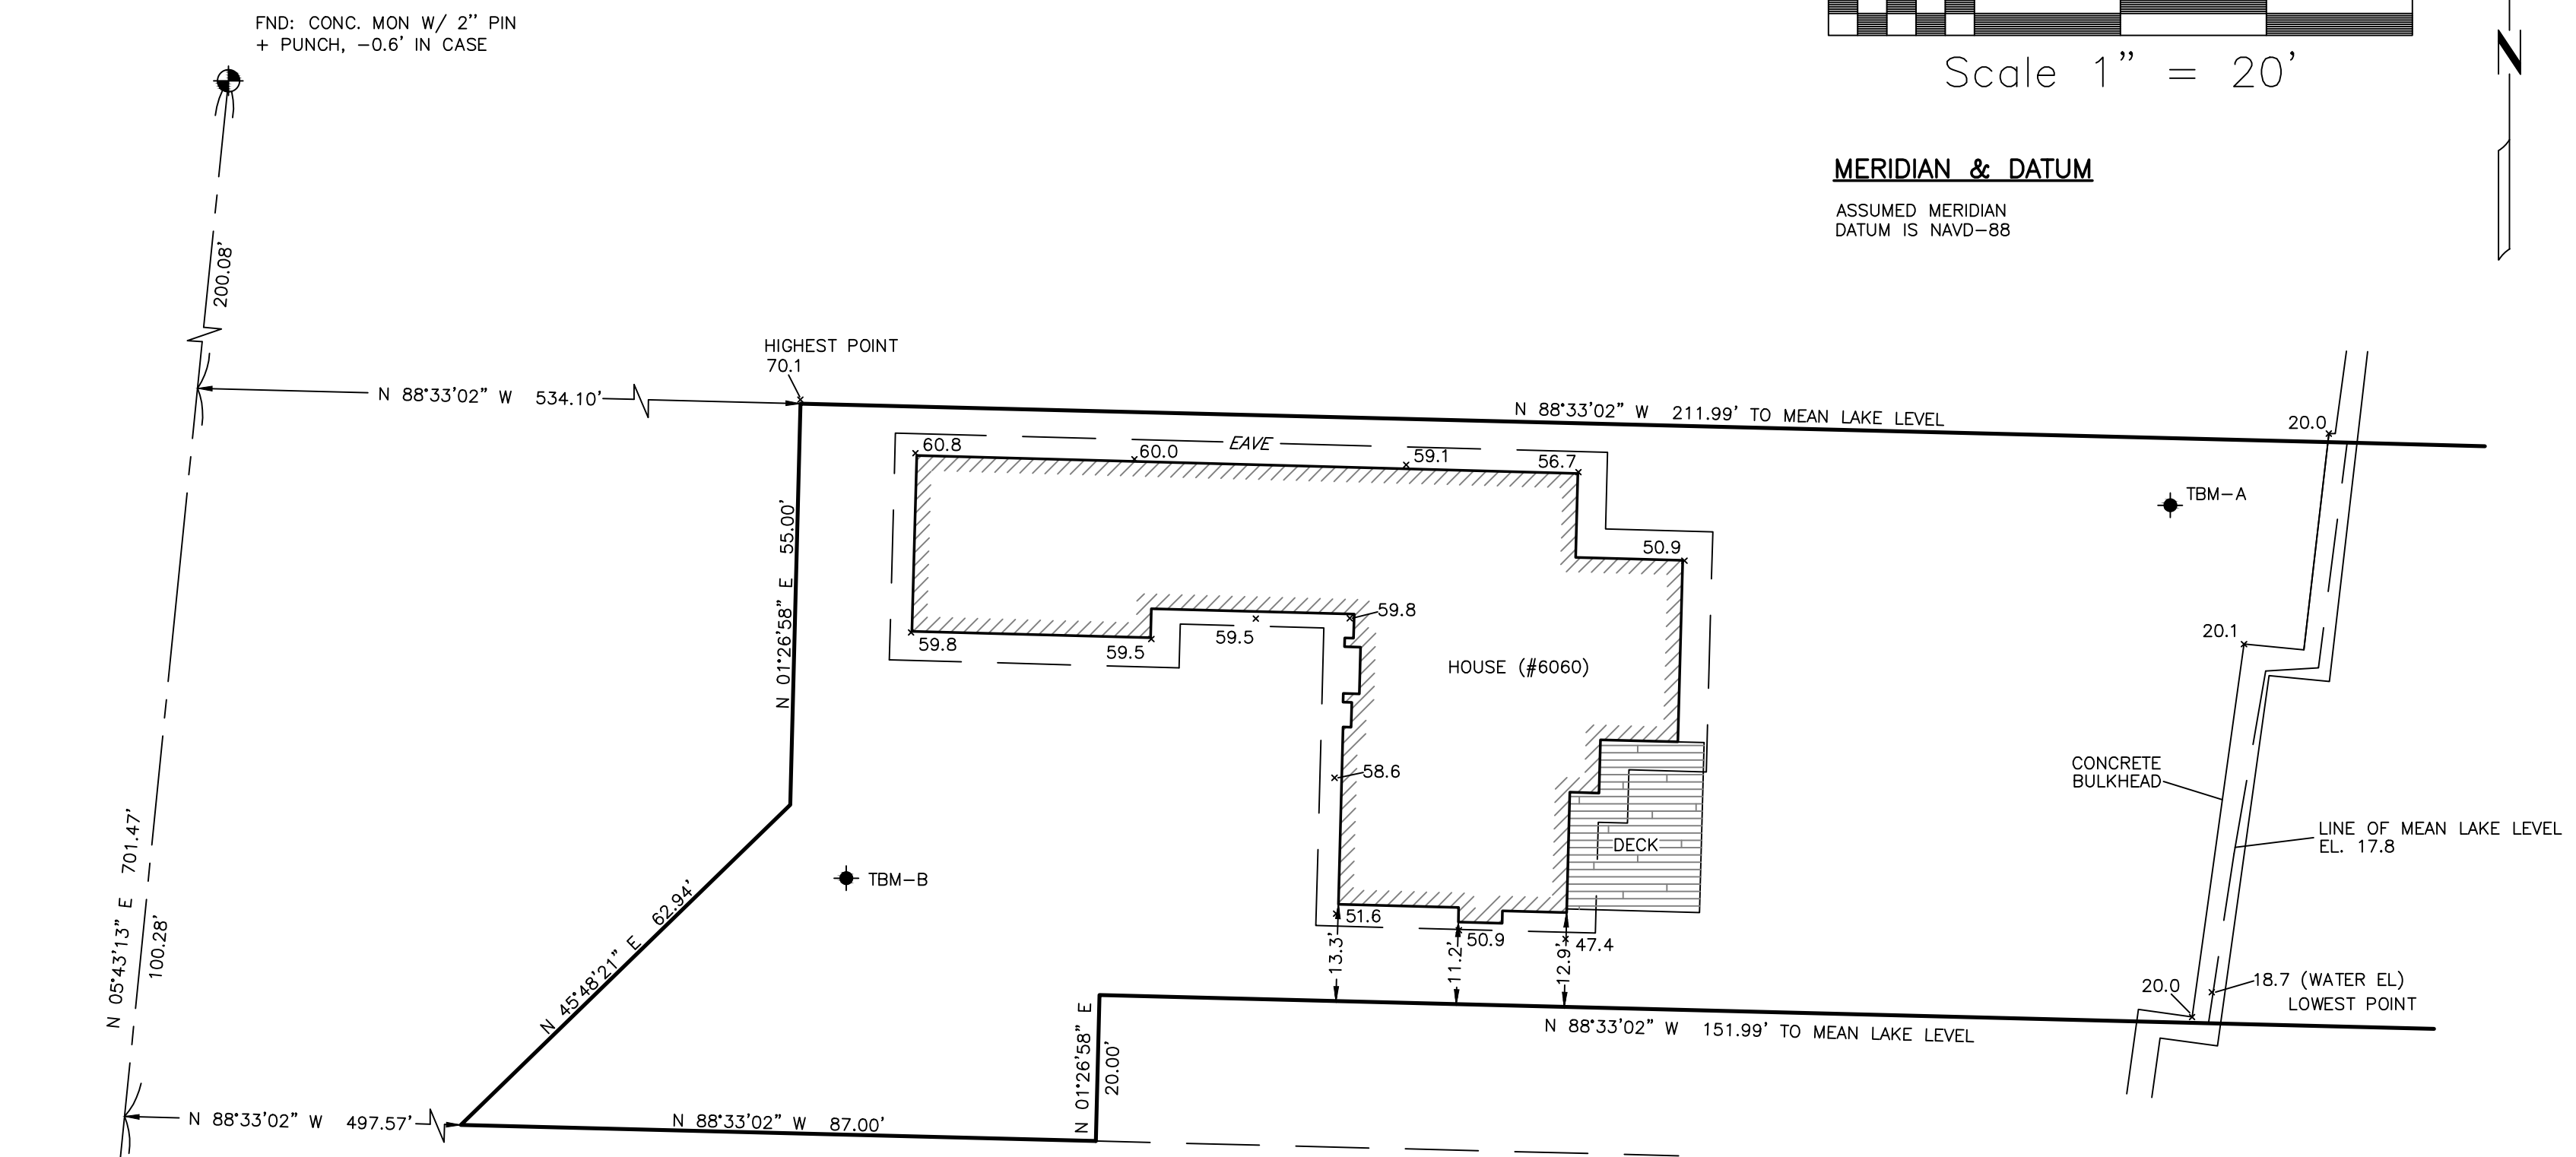

EAST MERCER WAY

LOT AREA

LAND AREA COMPUTED TO THE MEAN LAKE LEVEL OF 17.8 FEET NAVD 88 DATUM IS 18,087 SQ. FT.

EQUIPMENT & PROCEDURES

FIELD SURVEY CONDUCTED USING A COMBINATION OF GPS USING A REFERENCE NETWORK AND A 3" ELECTRONIC TOTAL STATION WAS USED FOR THIS FIELD TRAVERSE SURVEY. SURVEY PROCEDURES MEET OR EXCEED STATE STANDARDS AS SPECIFIED BY W.A.C. 332-130 WITH REGARD TO LINEAR AND ANGULAR CLOSURES. ALL MEASURING INSTRUMENTS FOR THIS SURVEY HAVE BEEN MAINTAINED ACCORDING TO MANUFACTURES SPECIFICATIONS AND HAVE BEEN COMPARED WITH A NATIONAL GEODETIC SURVEY CALIBRATED BASELINE WITHIN THE LAST 12 MONTHS.

LEGAL DESCRIPTION

THAT PORTION OF GOVERNMENT LOT 4 AND SECOND CLASS SHORELANDS ADJOINING SECTION 19, TOWNSHIP 24 NORTH, RANGE 5 EAST W.M., DESCRIBED AS FOLLOWS:
BEGINNING AT A POINT 1,100 FEET NORTHERLY OF THE SOUTH LINE OF SAID SECTION 19 AND 517 FEET EASTERLY OF THE EAST MARGIN OF EAST MERCER WAY; THENCE NORTHERLY ON A LINE PERPENDICULAR TO SAID SOUTH SECTION LINE FOR A DISTANCE OF 45 FEET TO THE TRUE POINT OF BEGINNING; THENCE CONTINUING NORTHERLY ALONG SAID PERPENDICULAR LINE FOR A DISTANCE OF 55 FEET; THENCE EASTERLY ALONG A LINE PARALLEL TO AND 1,200 FEET NORTHERLY OF SAID SOUTH LINE OF SECTION 19 TO THE SHORE OF LAKE WASHINGTON THENCE SOUTHERLY ALONG SAID SHORE OF LAKE WASHINGTON TO A LINE; PARALLEL TO AND 1,100 FEET NORTHERLY OF SAID SOUTH LINE OF SECTION 19; THENCE WESTERLY ALONG SAID PARALLEL LINE TO A POINT 475 FEET EASTERLY OF THE EAST RIGHT OF WAY MARGIN OF EAST MERCER WAY; THENCE NORTHEASTERLY IN A STRAIGHT LINE OF A DISTANCE OF APPROXIMATELY 62.94 FEET TO THE TRUE POINT OF BEGINNING.

TOGETHER WITH SHORELANDS ADJOINING;
EXCEPT THE FOLLOWING DESCRIBED TRACT;

BEGINNING AT A POINT ON A LINE WHICH IS PARALLEL TO AND 1,100 FEET NORTHERLY OF THE SOUTH LINE OF SAID SECTION 19 AND IS ALONG 560 FEET EASTERLY OF THE EAST RIGHT OF WAY MARGIN OF EAST MERCER WAY; THENCE NORTHERLY AT RIGHT ANGLES TO SAID SOUTH SECTION LINE FOR A DISTANCE OF 20 FEET; THENCE EASTERLY AND PARALLEL TO SAID SOUTH SECTION LINE TO THE SHORE LINE OF LAKE WASHINGTON; THENCE ALONG SAID SHORE OF LAKE WASHINGTON TO A POINT ON SAID LINE WHICH IS 1,100 FEET NORTHERLY OF AND PARALLEL TO THE SOUTH LINE OF SAID SECTION 19; THENCE WESTERLY ALONG SAID PARALLEL LINE TO THE POINT OF BEGINNING;

TOGETHER WITH SHORELANDS ADJOINING;
ALSO TOGETHER WITH AN EASEMENT FOR ROAD AND UTILITY PURPOSES OVER A PORTION OF SAID GOVERNMENT LOT 4, AS ESTABLISHED UNDER INSTRUMENT RECORDED UNDER RECORDING NO. 4712247;

EXCEPT THAT PORTION OF THE NORTH 1/2 OF SAID EASEMENT LYING EASTERLY OF THE WESTERLY LINE OF THE MAIN TRACT DESCRIBED ABOVE;
AND EXCEPT THAT PORTION OF THE SOUTH 1/2 OF SAID EASEMENT LYING EASTERLY OF A LINE 560 FEET EASTERLY OF THE EAST RIGHT-OF-WAY MATGIN OF EAST MERCER WAY;
SITUATE IN THE CITY OF MERCER ISLAND, COUNTY OF KING, STATE OF WASHINGTON.

BENCHMARKS

- ORIGINAL BM: 1/2" PIN ON CONC MONUMENT, -0.6' IN CASE AT INTERSECTION OF E MERCER WAY AND GLEN HOME ROAD. AKA GSOW ID BM-47810. ELEV. = 163.10
- TBM - A: SET PEN MARK. ELEV. = 24.72
- TBM - B: SET SCRIBED "X" IN CONCRETE. ELEV. = 58.94

GENERAL NOTES

1. WATER ELEVATION OBSERVED 5/2/19.
2. LOT AREA COMPUTED TO THE LINE OF MEAN LAKE LEVEL PER CORP OF ENGINEERS. THE ELEVATION CONVERTED TO NAVD 88 IS 17.8 FEET
3. NO PROPERTY CORNERS WHERE SET FOR THIS SURVEY.

FND: CONC. MON W/ 1" BRASS DISC + PUNCH, -1.3' IN CASE



4-18-19

REV. ADDED CONCRETE BULKHEAD AND SPOT ELEVATIONS -AA 5-6-19

Tye Surveyors PROFESSIONAL LAND SURVEYORS 10007 GREENWOOD AV. N. SEATTLE, WA. 98133 206-525-3660		
SCALE: 1"=20'	RON BAYLEY	DRAWN BY: RG
DATE: 4-18-19	MARCH MCDONALD	REVISED: TG
6060 E. MERCER WAY MERCER ISLAND, 98040		DRAWING NUMBER 19044
SITE PLAN		
SE/4, SE1/4, SEC. 19, T. 24 N., R. 5 E., W.M.		

REVISIONS:	DATE	BY	DESCRIPTION
1	2019-08-21	KE	DESIGN REVISIONS
2	2019-08-21	KE	DESIGN REVISIONS
3	2019-08-21	KE	DESIGN REVISIONS
4	2019-08-21	KE	DESIGN REVISIONS
5	2019-08-21	KE	DESIGN REVISIONS


DRAWN BY: KE

CHECKED BY: BJS


SHEET

A2.1

SCALE: IF SHEET IS LESS THAN 24" X 36", IT IS A REDUCED PRINT, REDUCE SCALE ACCORDINGLY
PERMIT SET 9/06/19
DECKING COND. BY SLEP

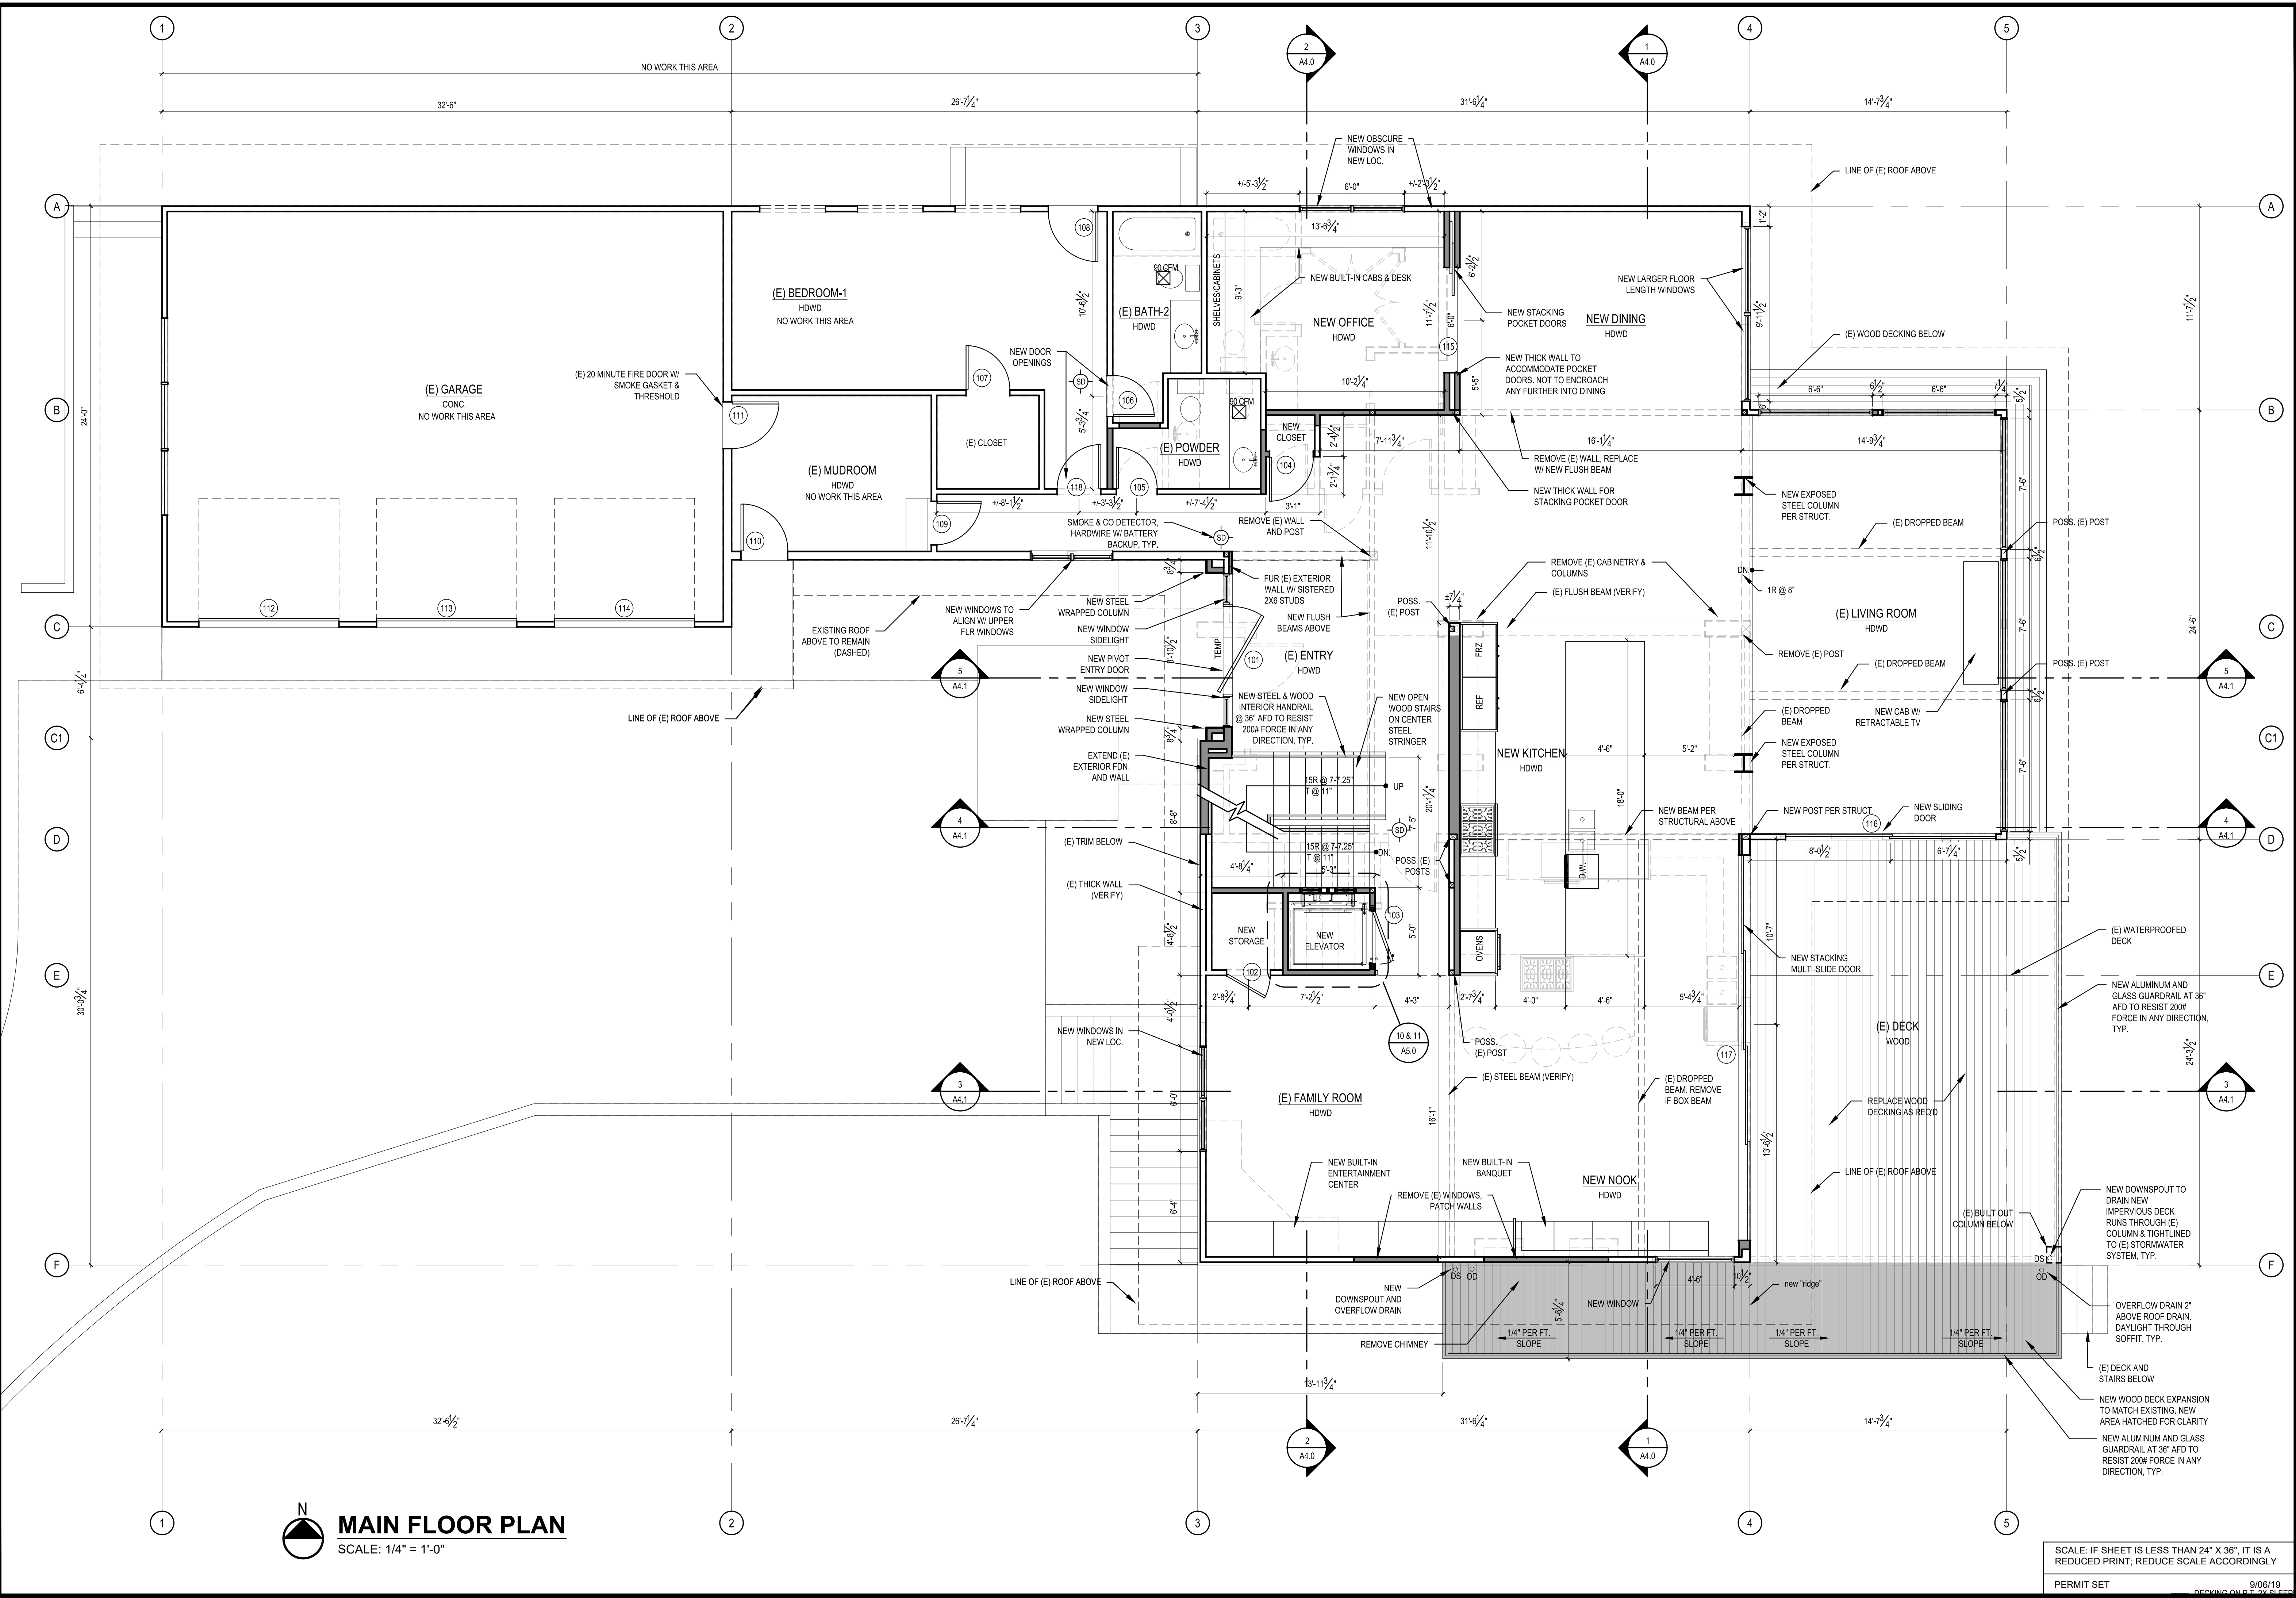

MAIN FLOOR PLAN
SCALE: 1/4" = 1'-0"

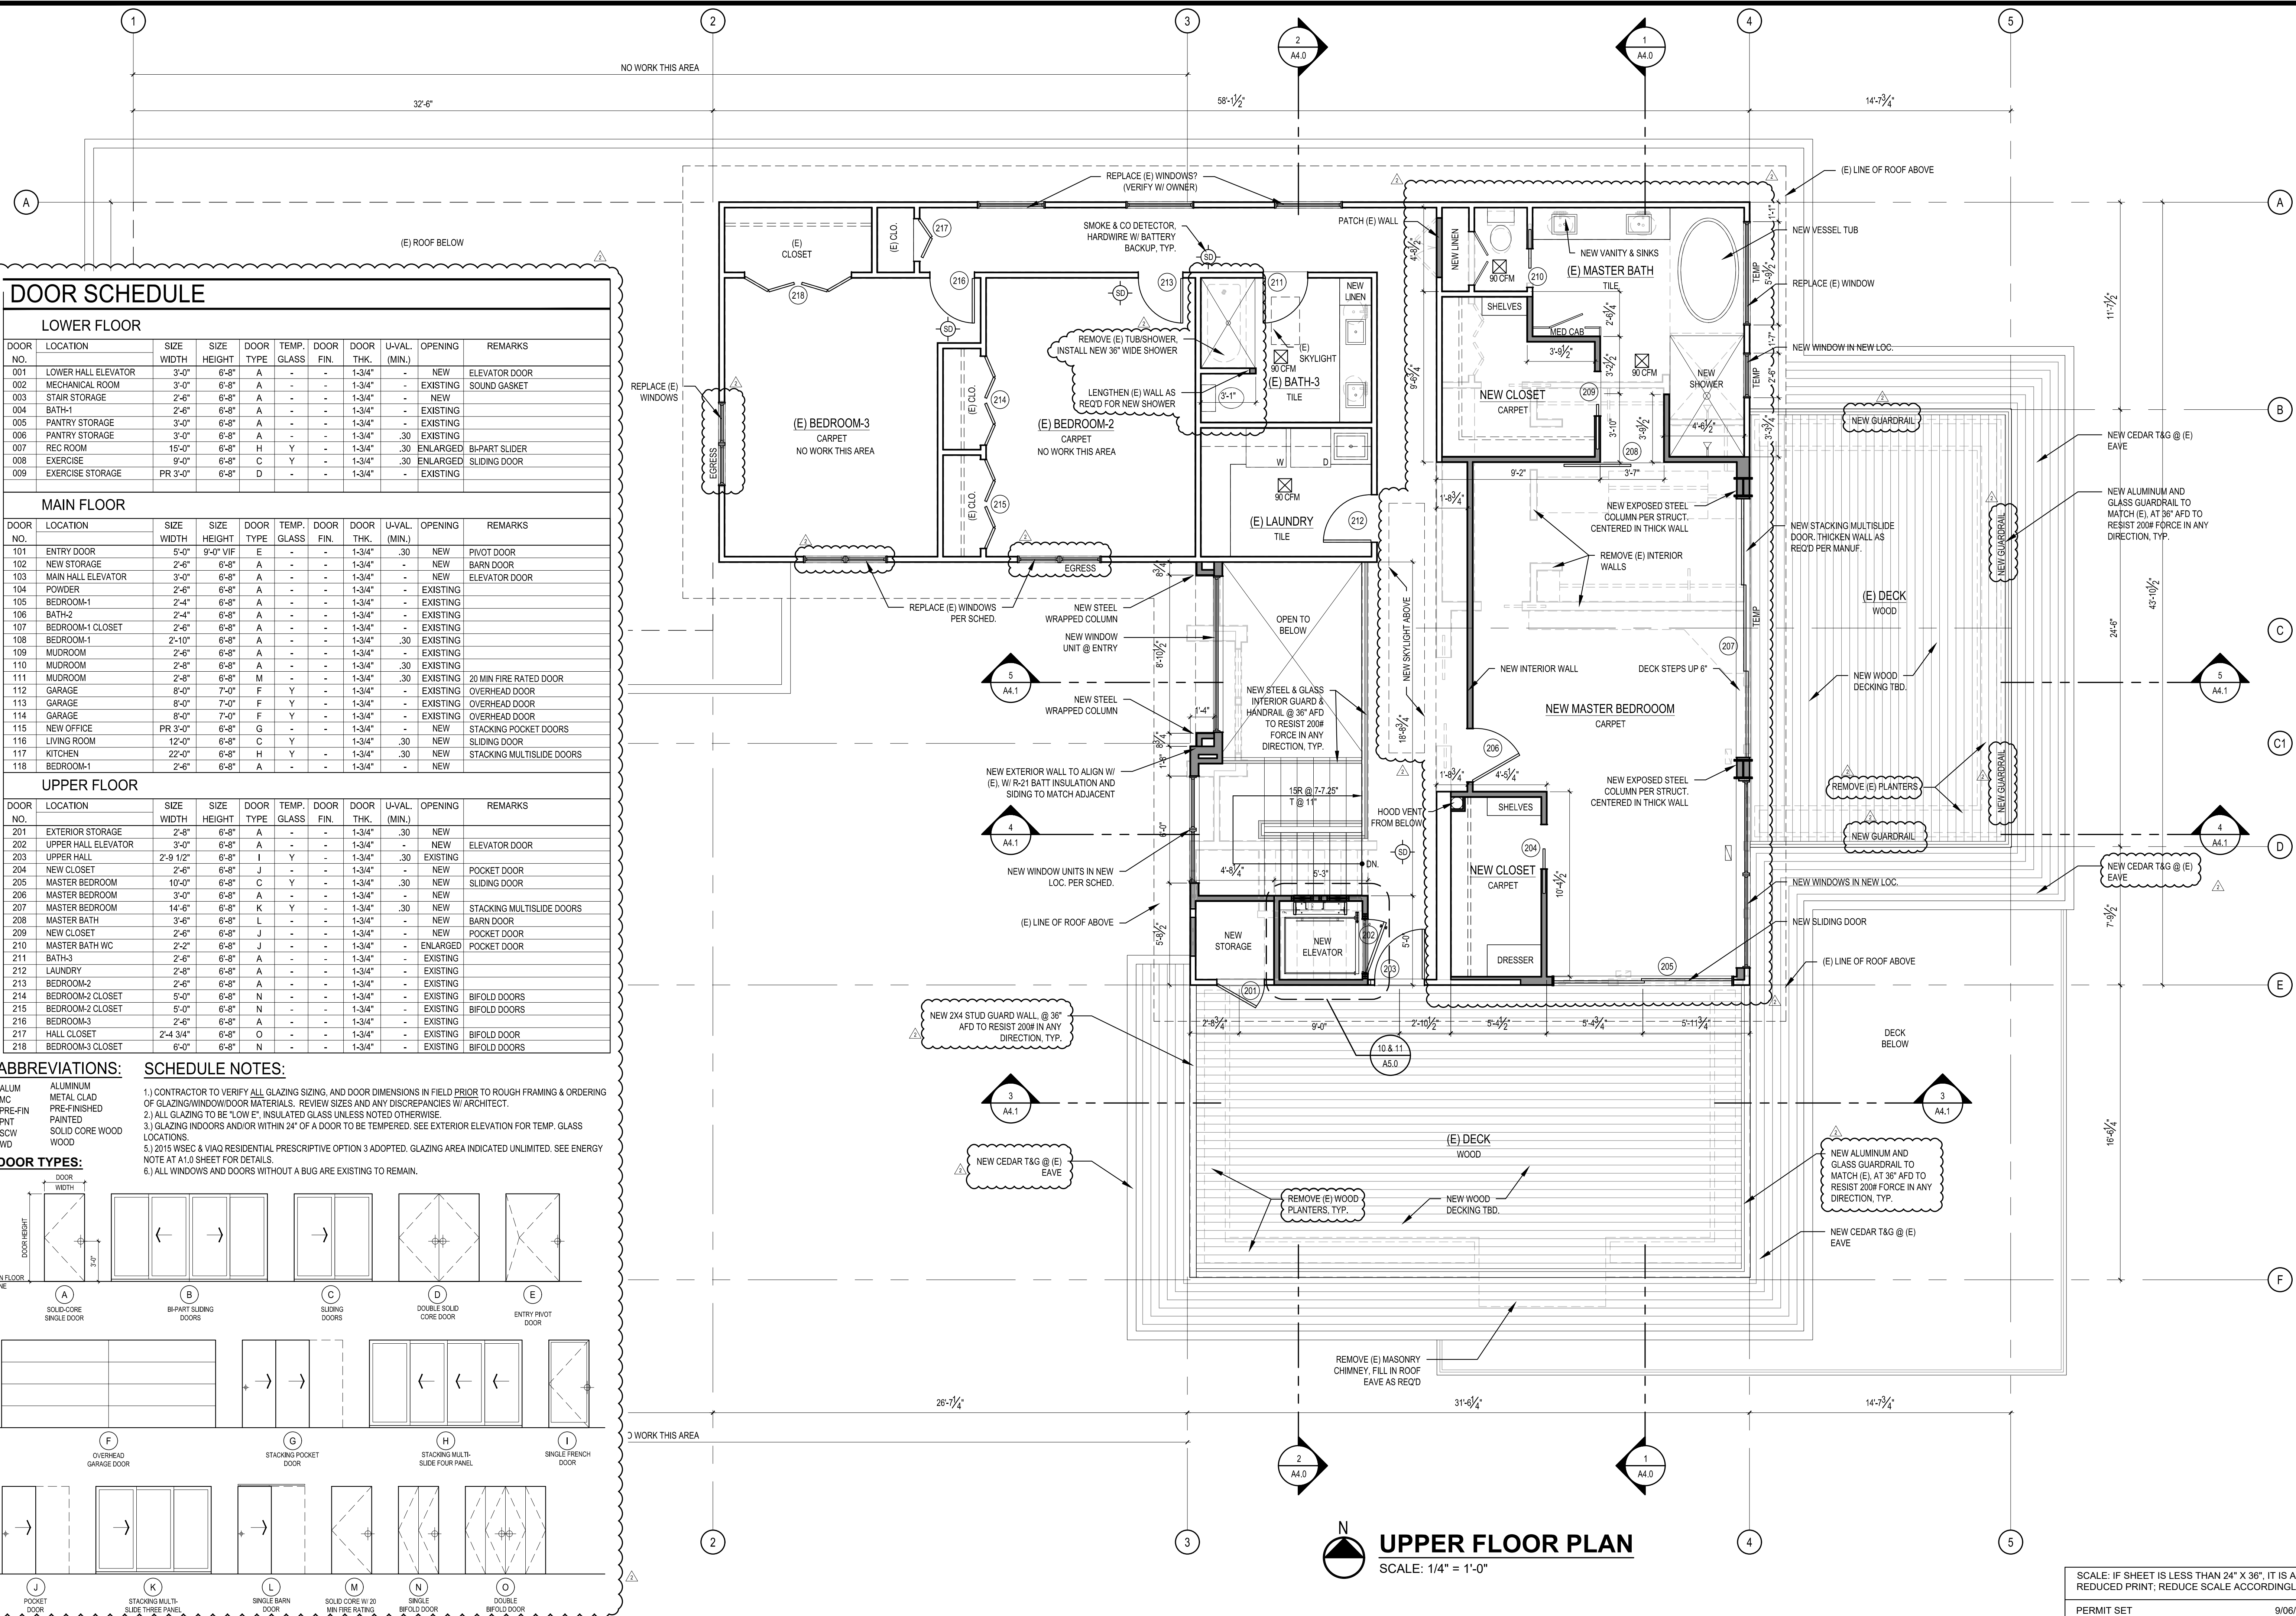

DOOR SCHEDULE

LOWER FLOOR

DOOR NO.	LOCATION	SIZE WIDTH	SIZE HEIGHT	DOOR TYPE	TEMP. GLASS	DOOR FIN.	DOOR THK.	U-VAL. (MIN.)	OPENING	REMARKS
001	LOWER HALL ELEVATOR	3'-0"	6'-8"	A	-	-	1-3/4"	-	NEW	ELEVATOR DOOR
002	MECHANICAL ROOM	3'-0"	6'-8"	A	-	-	1-3/4"	-	EXISTING	SOUND GASKET
003	STAIR STORAGE	2'-6"	6'-8"	A	-	-	1-3/4"	-	NEW	
004	BATH-1	2'-6"	6'-8"	A	-	-	1-3/4"	-	EXISTING	
005	PANTRY STORAGE	3'-0"	6'-8"	A	-	-	1-3/4"	-	EXISTING	
006	PANTRY STORAGE	3'-0"	6'-8"	A	-	-	1-3/4"	.30	EXISTING	
007	REC ROOM	15'-0"	6'-8"	H	Y	-	1-3/4"	.30	ENLARGED	BI-PART SLIDER
008	EXERCISE	9'-0"	6'-8"	C	Y	-	1-3/4"	.30	ENLARGED	SLIDING DOOR
009	EXERCISE STORAGE	PR 3'-0"	6'-8"	D	-	-	1-3/4"	-	EXISTING	

MAIN FLOOR

DOOR NO.	LOCATION	SIZE WIDTH	SIZE HEIGHT	DOOR TYPE	TEMP. GLASS	DOOR FIN.	DOOR THK.	U-VAL. (MIN.)	OPENING	REMARKS
101	ENTRY DOOR	5'-0"	9'-0" VIF	E	-	-	1-3/4"	.30	NEW	PIVOT DOOR
102	NEW STORAGE	2'-6"	6'-8"	A	-	-	1-3/4"	-	NEW	BARN DOOR
103	MAIN HALL ELEVATOR	3'-0"	6'-8"	A	-	-	1-3/4"	-	NEW	ELEVATOR DOOR
104	POWDER	2'-6"	6'-8"	A	-	-	1-3/4"	-	EXISTING	
105	BEDROOM-1	2'-4"	6'-8"	A	-	-	1-3/4"	-	EXISTING	
106	BATH-2	2'-4"	6'-8"	A	-	-	1-3/4"	-	EXISTING	
107	BEDROOM-1 CLOSET	2'-6"	6'-8"	A	-	-	1-3/4"	-	EXISTING	
108	BEDROOM-1	2'-10"	6'-8"	A	-	-	1-3/4"	.30	EXISTING	
109	MUDROOM	2'-6"	6'-8"	A	-	-	1-3/4"	-	EXISTING	
110	MUDROOM	2'-8"	6'-8"	A	-	-	1-3/4"	.30	EXISTING	
111	MUDROOM	2'-8"	6'-8"	M	-	-	1-3/4"	.30	EXISTING	20 MIN FIRE RATED DOOR
112	GARAGE	8'-0"	7'-0"	F	Y	-	1-3/4"	-	EXISTING	OVERHEAD DOOR
113	GARAGE	8'-0"	7'-0"	F	Y	-	1-3/4"	-	EXISTING	OVERHEAD DOOR
114	GARAGE	8'-0"	7'-0"	F	Y	-	1-3/4"	-	EXISTING	OVERHEAD DOOR
115	NEW OFFICE	PR 3'-0"	6'-8"	G	-	-	1-3/4"	-	NEW	STACKING POCKET DOORS
116	LIVING ROOM	12'-0"	6'-8"	C	Y	-	1-3/4"	.30	NEW	SLIDING DOOR
117	KITCHEN	22'-0"	6'-8"	H	Y	-	1-3/4"	.30	NEW	STACKING MULTISLIDE DOORS
118	BEDROOM-1	2'-6"	6'-8"	A	-	-	1-3/4"	-	NEW	


UPPER FLOOR

DOOR NO.	LOCATION	SIZE WIDTH	SIZE HEIGHT	DOOR TYPE	TEMP. GLASS	DOOR FIN.	DOOR THK.	U-VAL. (MIN.)	OPENING	REMARKS
201	EXTERIOR STORAGE	2'-8"	6'-8"	A	-	-	1-3/4"	.30	NEW	
202	UPPER HALL ELEVATOR	3'-0"	6'-8"	A	-	-	1-3/4"	-	NEW	ELEVATOR DOOR
203	UPPER HALL	2'-9 1/2"	6'-8"	I	Y	-	1-3/4"	.30	EXISTING	
204	NEW CLOSET	2'-6"	6'-8"	J	-	-	1-3/4"	-	NEW	POCKET DOOR
205	MASTER BEDROOM	10'-0"	6'-8"	C	Y	-	1-3/4"	.30	NEW	SLIDING DOOR
206	MASTER BEDROOM	3'-0"	6'-8"	A	-	-	1-3/4"	-	NEW	
207	MASTER BEDROOM	14'-8"	6'-8"	K	Y	-	1-3/4"	.30	NEW	STACKING MULTISLIDE DOORS
208	MASTER BATH	3'-8"	6'-8"	L	-	-	1-3/4"	-	NEW	BARN DOOR
209	NEW CLOSET	2'-6"	6'-8"	J	-	-	1-3/4"	-	NEW	POCKET DOOR
210	MASTER BATH WC	2'-2"	6'-8"	J	-	-	1-3/4"	-	ENLARGED	POCKET DOOR
211	BATH-3	2'-6"	6'-8"	A	-	-	1-3/4"	-	EXISTING	
212	LAUNDRY	2'-8"	6'-8"	A	-	-	1-3/4"	-	EXISTING	
213	BEDROOM-2	2'-6"	6'-8"	A	-	-	1-3/4"	-	EXISTING	
214	BEDROOM-2 CLOSET	5'-0"	6'-8"	N	-	-	1-3/4"	-	EXISTING	BIFOLD DOORS
215	BEDROOM-2 CLOSET	5'-0"	6'-8"	N	-	-	1-3/4"	-	EXISTING	BIFOLD DOORS
216	BEDROOM-3	2'-6"	6'-8"	A	-	-	1-3/4"	-	EXISTING	
217	HALL CLOSET	2'-4 3/4"	6'-8"	O	-	-	1-3/4"	-	EXISTING	BIFOLD DOOR
218	BEDROOM-3 CLOSET	6'-0"	6'-8"	N	-	-	1-3/4"	-	EXISTING	BIFOLD DOORS


ABBREVIATIONS:
ALUM ALUMINUM
MC METAL CLAD
PRE-FIN PRE-FINISHED
PNT PAINTED
SCW SOLID CORE WOOD
WD WOOD

DOOR TYPES:

SCHEDULE NOTES:
1.) CONTRACTOR TO VERIFY ALL GLAZING SIZING, AND DOOR DIMENSIONS IN FIELD PRIOR TO ROUGH FRAMING & ORDERING OF GLAZING/WINDOW/DOOR MATERIALS. REVIEW SIZES AND ANY DISCREPANCIES W/ ARCHITECT.
2.) ALL GLAZING TO BE "LOW E", INSULATED GLASS UNLESS NOTED OTHERWISE.
3.) GLAZING INDOORS AND/OR WITHIN 24" OF A DOOR TO BE TEMPERED. SEE EXTERIOR ELEVATION FOR TEMP. GLASS LOCATIONS.
4.) 2015 WSEC & VIAQ RESIDENTIAL PRESCRIPTIVE OPTION 3 ADOPTED. GLAZING AREA INDICATED UNLIMITED. SEE ENERGY NOTE AT A1.0 SHEET FOR DETAILS.
5.) ALL WINDOWS AND DOORS WITHOUT A BUG ARE EXISTING TO REMAIN.

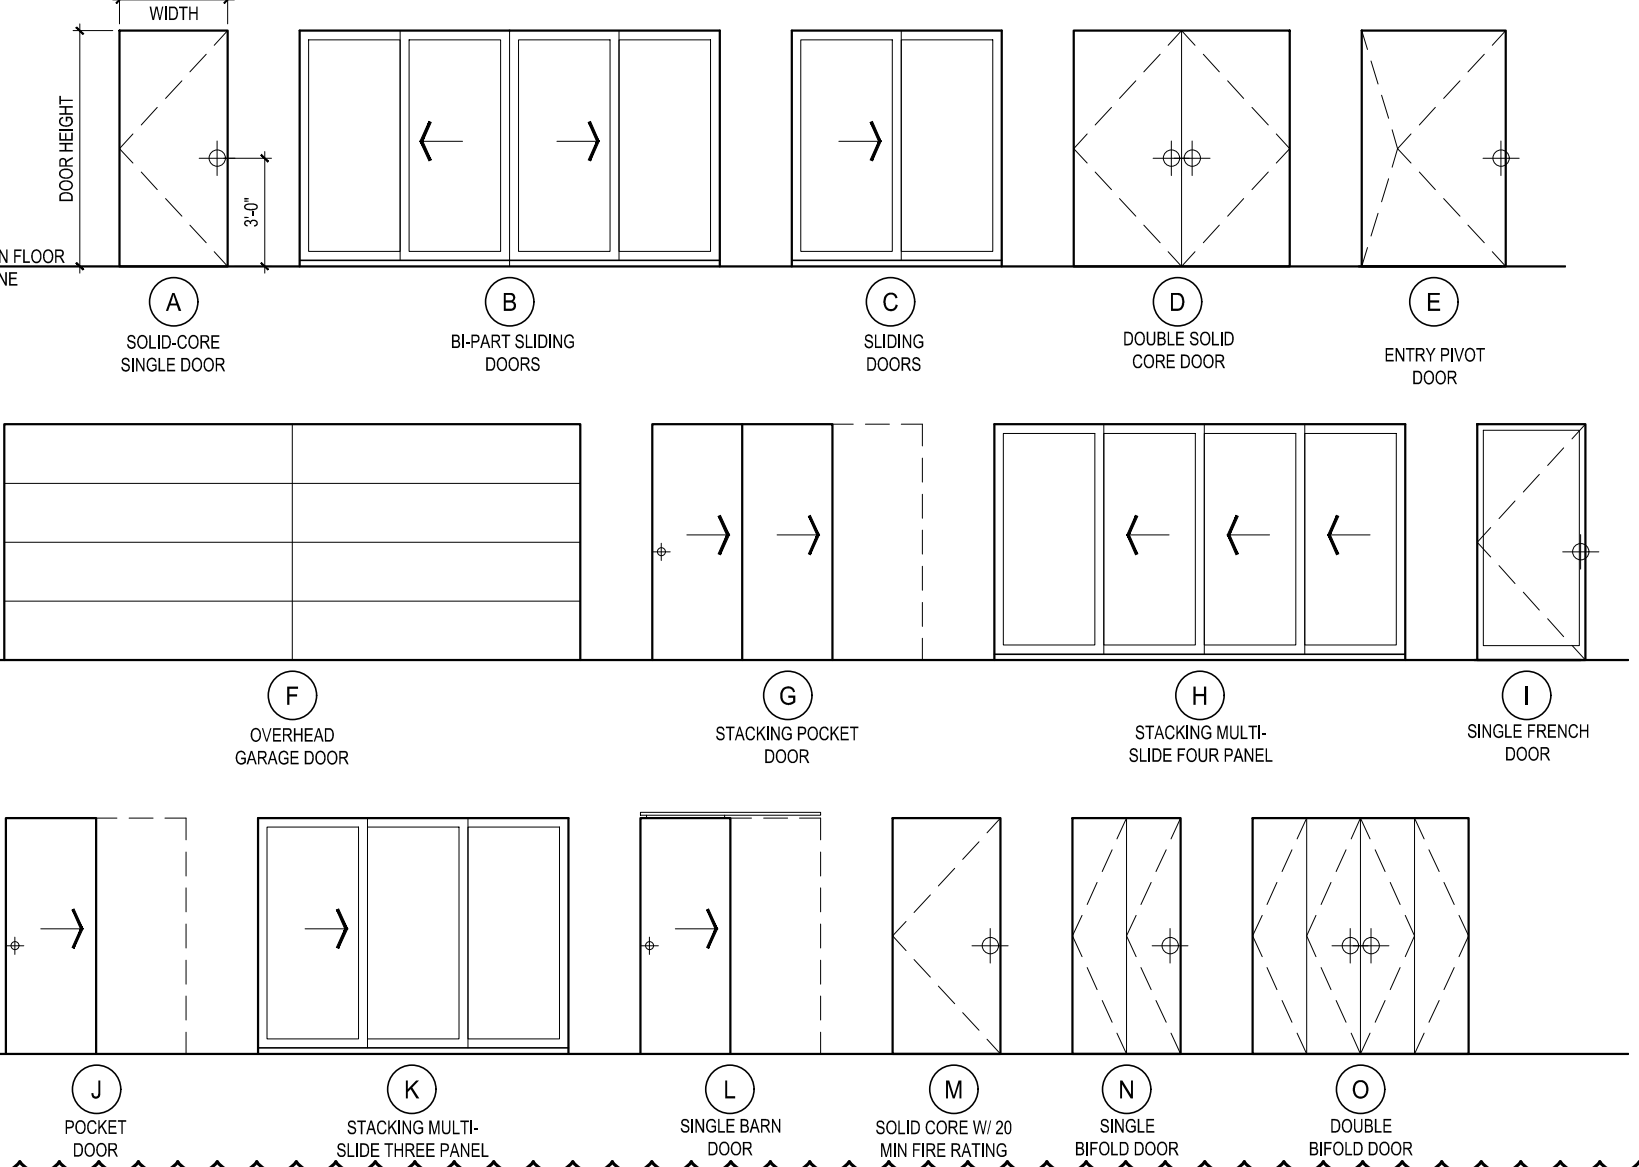

UPPER FLOOR PLAN
SCALE: 1/4" = 1'-0"

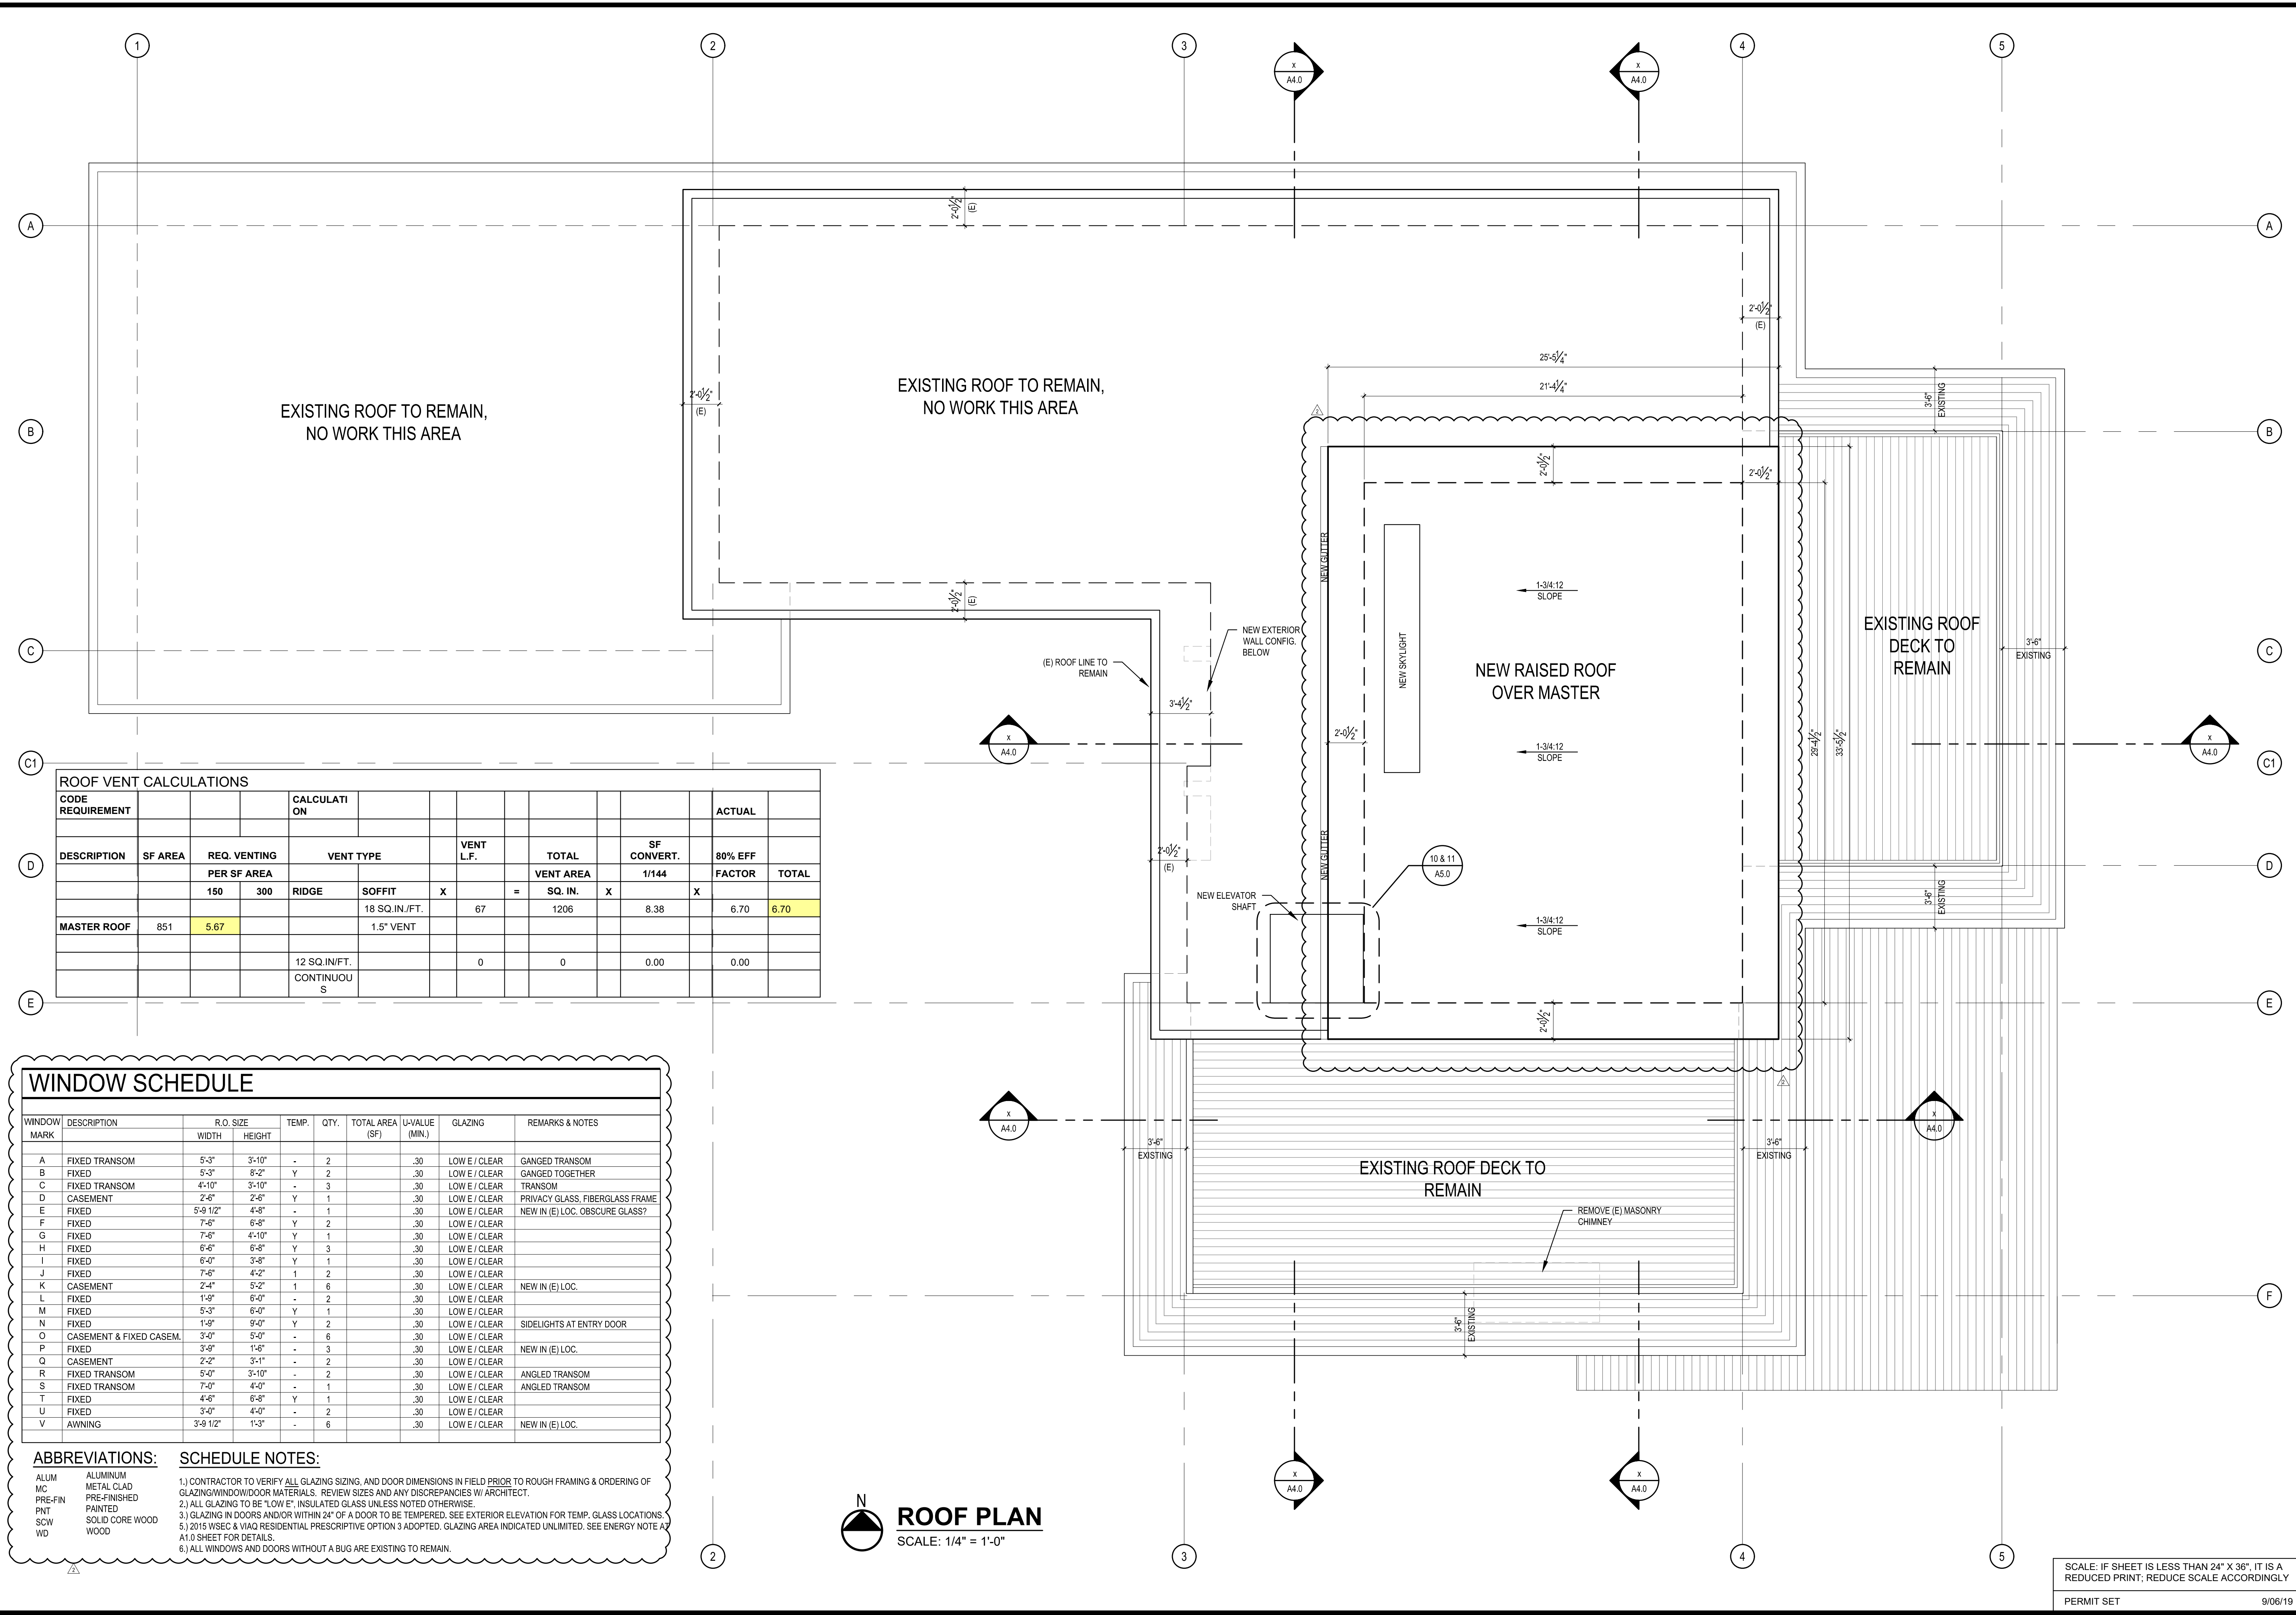

EXISTING ROOF TO REMAIN,
NO WORK THIS AREA

EXISTING ROOF TO REMAIN,
NO WORK THIS AREA

NEW RAISED ROOF
OVER MASTER

EXISTING ROOF
DECK TO REMAIN

EXISTING ROOF DECK TO
REMAIN

ROOF VENT CALCULATIONS									
CODE REQUIREMENT	REQ. VENTING		VENT TYPE		VENT L.F.	TOTAL	SF CONVERT.	80% EFF	ACTUAL
DESCRIPTION	SF AREA	PER SF AREA	RIDGE	SOFFIT	X	VENT AREA	1/144	FACTOR	TOTAL
		150		18 SQ. IN./FT.	67				
		300							
MASTER ROOF	851	5.67		1.5" VENT		1206	8.38	6.70	6.70
			12 SQ. IN./FT.	CONTINUOUS	0	0	0.00	0.00	0.00

WINDOW SCHEDULE

WINDOW MARK	DESCRIPTION	R.O. SIZE	TEMP.	QTY.	TOTAL AREA (SF)	U-VALUE (MIN.)	GLAZING	REMARKS & NOTES
		WIDTH	HEIGHT					
A	FIXED TRANSOM	5'-3"	3'-10"	-	2	.30	LOW E / CLEAR	GANGED TRANSOM
B	FIXED	5'-3"	8'-2"	Y	2	.30	LOW E / CLEAR	GANGED TOGETHER
C	FIXED TRANSOM	4'-10"	3'-10"	-	3	.30	LOW E / CLEAR	TRANSOM
D	CASEMENT	2'-6"	2'-6"	Y	1	.30	LOW E / CLEAR	PRIVACY GLASS, FIBERGLASS FRAME
E	FIXED	5'-8 1/2"	4'-8"	-	1	.30	LOW E / CLEAR	NEW IN (E) LOC. OBSCURE GLASS?
F	FIXED	7'-6"	6'-8"	Y	2	.30	LOW E / CLEAR	
G	FIXED	7'-6"	4'-10"	Y	1	.30	LOW E / CLEAR	
H	FIXED	6'-6"	6'-8"	Y	3	.30	LOW E / CLEAR	
I	FIXED	6'-0"	3'-8"	Y	1	.30	LOW E / CLEAR	
J	FIXED	7'-6"	4'-2"	1	2	.30	LOW E / CLEAR	
K	CASEMENT	2'-4"	5'-2"	1	6	.30	LOW E / CLEAR	NEW IN (E) LOC.
L	FIXED	1'-9"	6'-0"	-	2	.30	LOW E / CLEAR	
M	FIXED	5'-3"	6'-0"	Y	1	.30	LOW E / CLEAR	
N	FIXED	1'-9"	9'-0"	Y	2	.30	LOW E / CLEAR	SIDE LIGHTS AT ENTRY DOOR
O	CASEMENT & FIXED CASEM.	3'-0"	5'-0"	-	6	.30	LOW E / CLEAR	
P	FIXED	3'-9"	1'-6"	-	3	.30	LOW E / CLEAR	NEW IN (E) LOC.
Q	CASEMENT	2'-2"	3'-1"	-	2	.30	LOW E / CLEAR	
R	FIXED TRANSOM	5'-0"	3'-10"	-	2	.30	LOW E / CLEAR	ANGLED TRANSOM
S	FIXED TRANSOM	7'-0"	4'-0"	-	1	.30	LOW E / CLEAR	ANGLED TRANSOM
T	FIXED	4'-6"	6'-8"	Y	1	.30	LOW E / CLEAR	
U	FIXED	3'-0"	4'-0"	-	2	.30	LOW E / CLEAR	
V	AWNING	3'-8 1/2"	1'-3"	-	6	.30	LOW E / CLEAR	NEW IN (E) LOC.


ABBREVIATIONS: ALUM ALUMINUM, MC METAL CLAD, PRE-FIN PRE-FINISHED, PNT PAINTED, SCW SOLID CORE WOOD, WD WOOD

SCHEDULE NOTES:
1.) CONTRACTOR TO VERIFY ALL GLAZING SIZING, AND DOOR DIMENSIONS IN FIELD PRIOR TO ROUGH FRAMING & ORDERING OF GLAZING/WINDOW/DOOR MATERIALS. REVIEW SIZES AND ANY DISCREPANCIES W/ ARCHITECT.
2.) ALL GLAZING TO BE "LOW E", INSULATED GLASS UNLESS NOTED OTHERWISE.
3.) GLAZING IN DOORS AND/OR WITHIN 24" OF A DOOR TO BE TEMPERED. SEE EXTERIOR ELEVATION FOR TEMP. GLASS LOCATIONS.
4.) 2015 WSEC & IBC RESIDENTIAL PRESCRIPTIVE OPTION 3 ADOPTED. GLAZING AREA INDICATED UNLIMITED. SEE ENERGY NOTE A7 AT D SHEET FOR DETAILS.
5.) ALL WINDOWS AND DOORS WITHOUT A BUG ARE EXISTING TO REMAIN.


ROOF PLAN
SCALE: 1/4" = 1'-0"

SCALE: IF SHEET IS LESS THAN 24" X 36", IT IS A REDUCED PRINT, REDUCE SCALE ACCORDINGLY

REVISIONS:	2019-08-21 DESIGN REVISIONS	2019-04-04 DESIGN REVISIONS
DRAWN BY:	KE	
CHECKED BY:	BJS	
SHEET	A3.0	

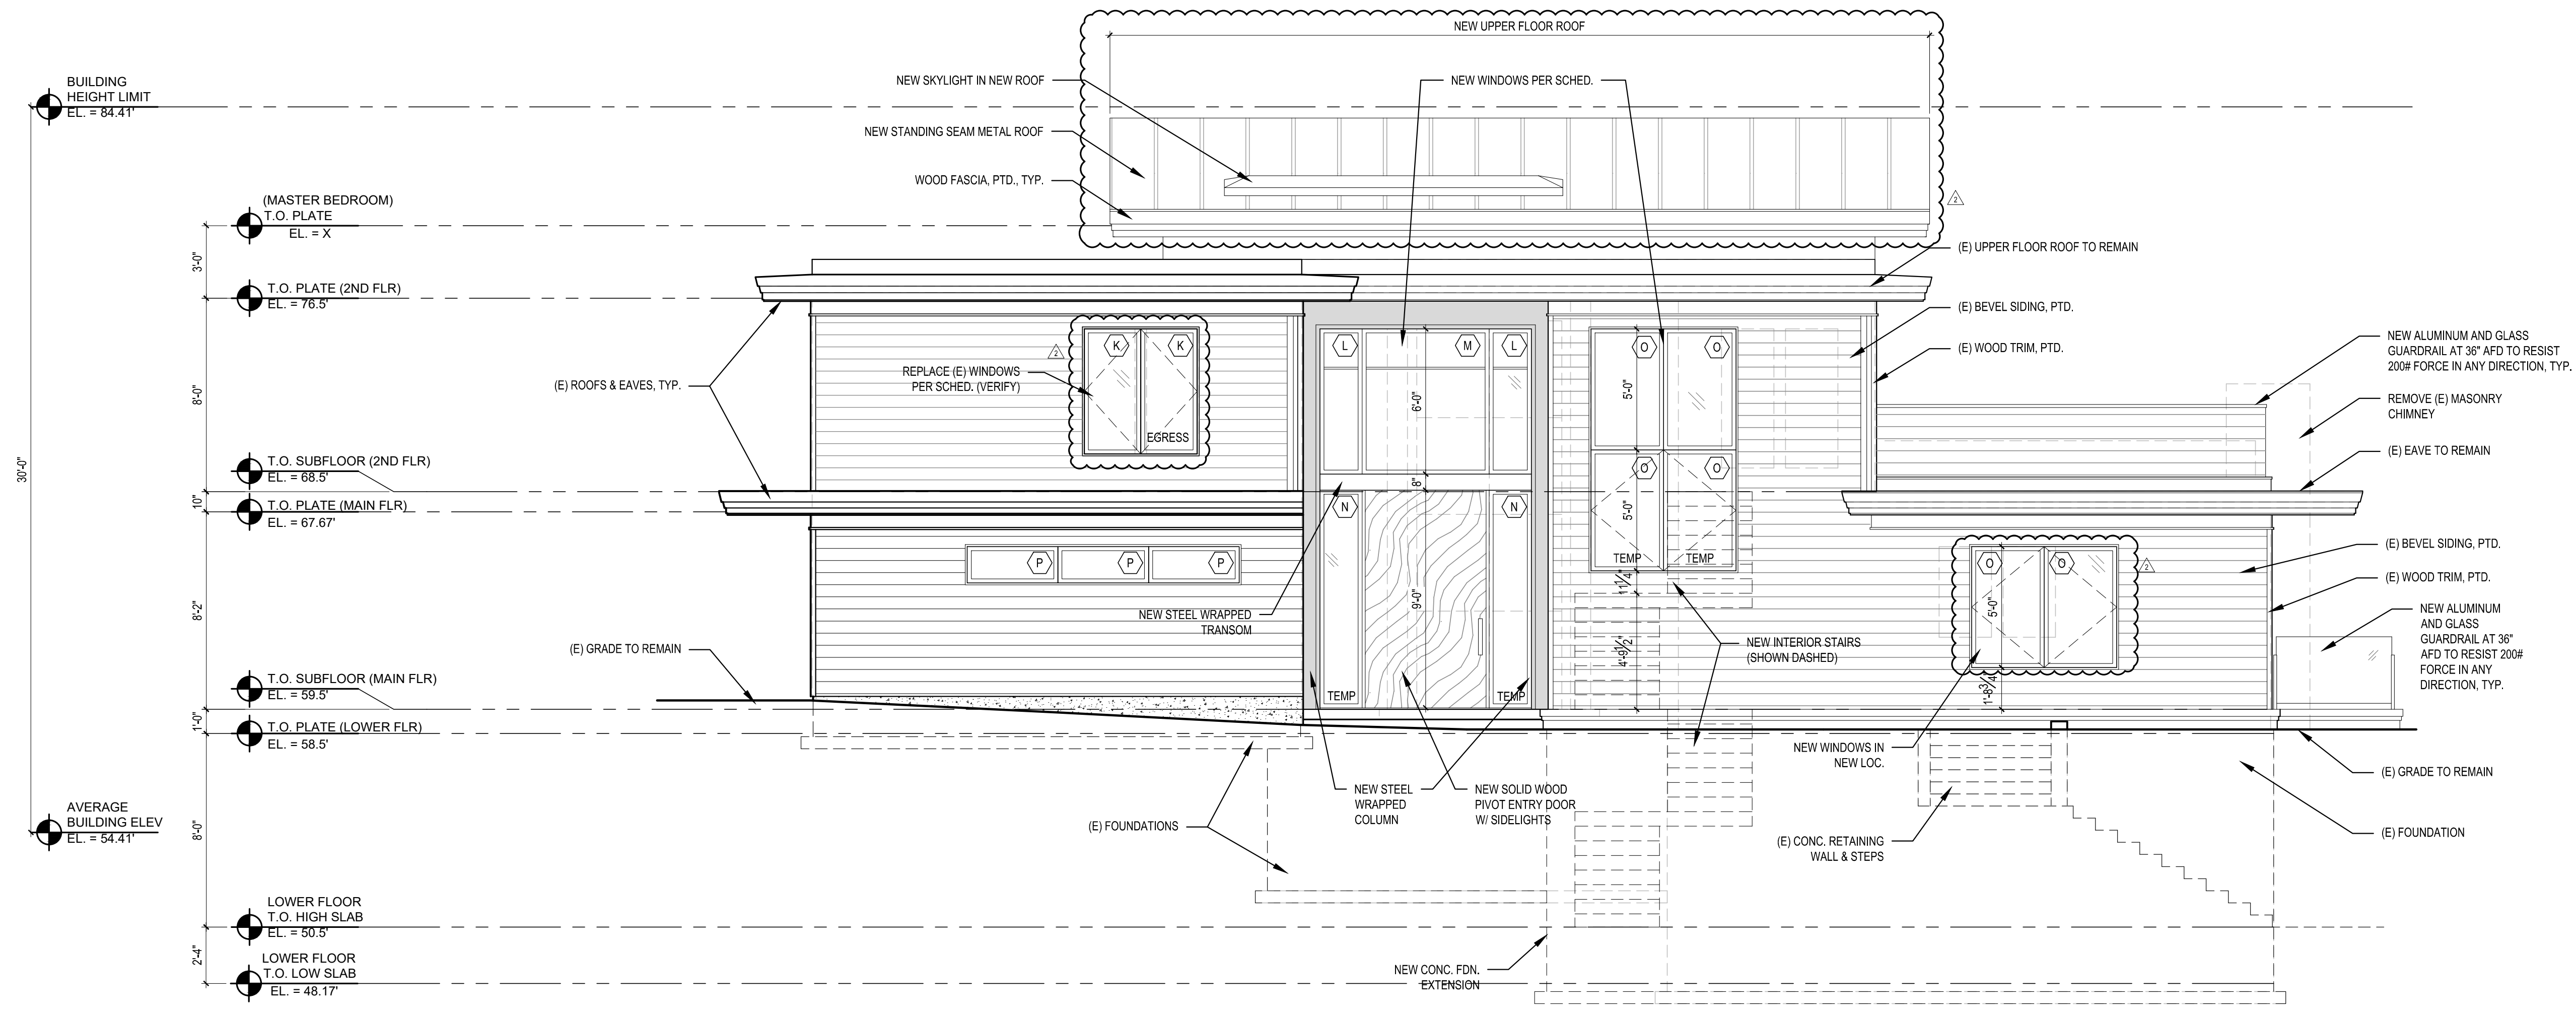


① WEST ELEVATION
SCALE: 1/4" = 1'-0"

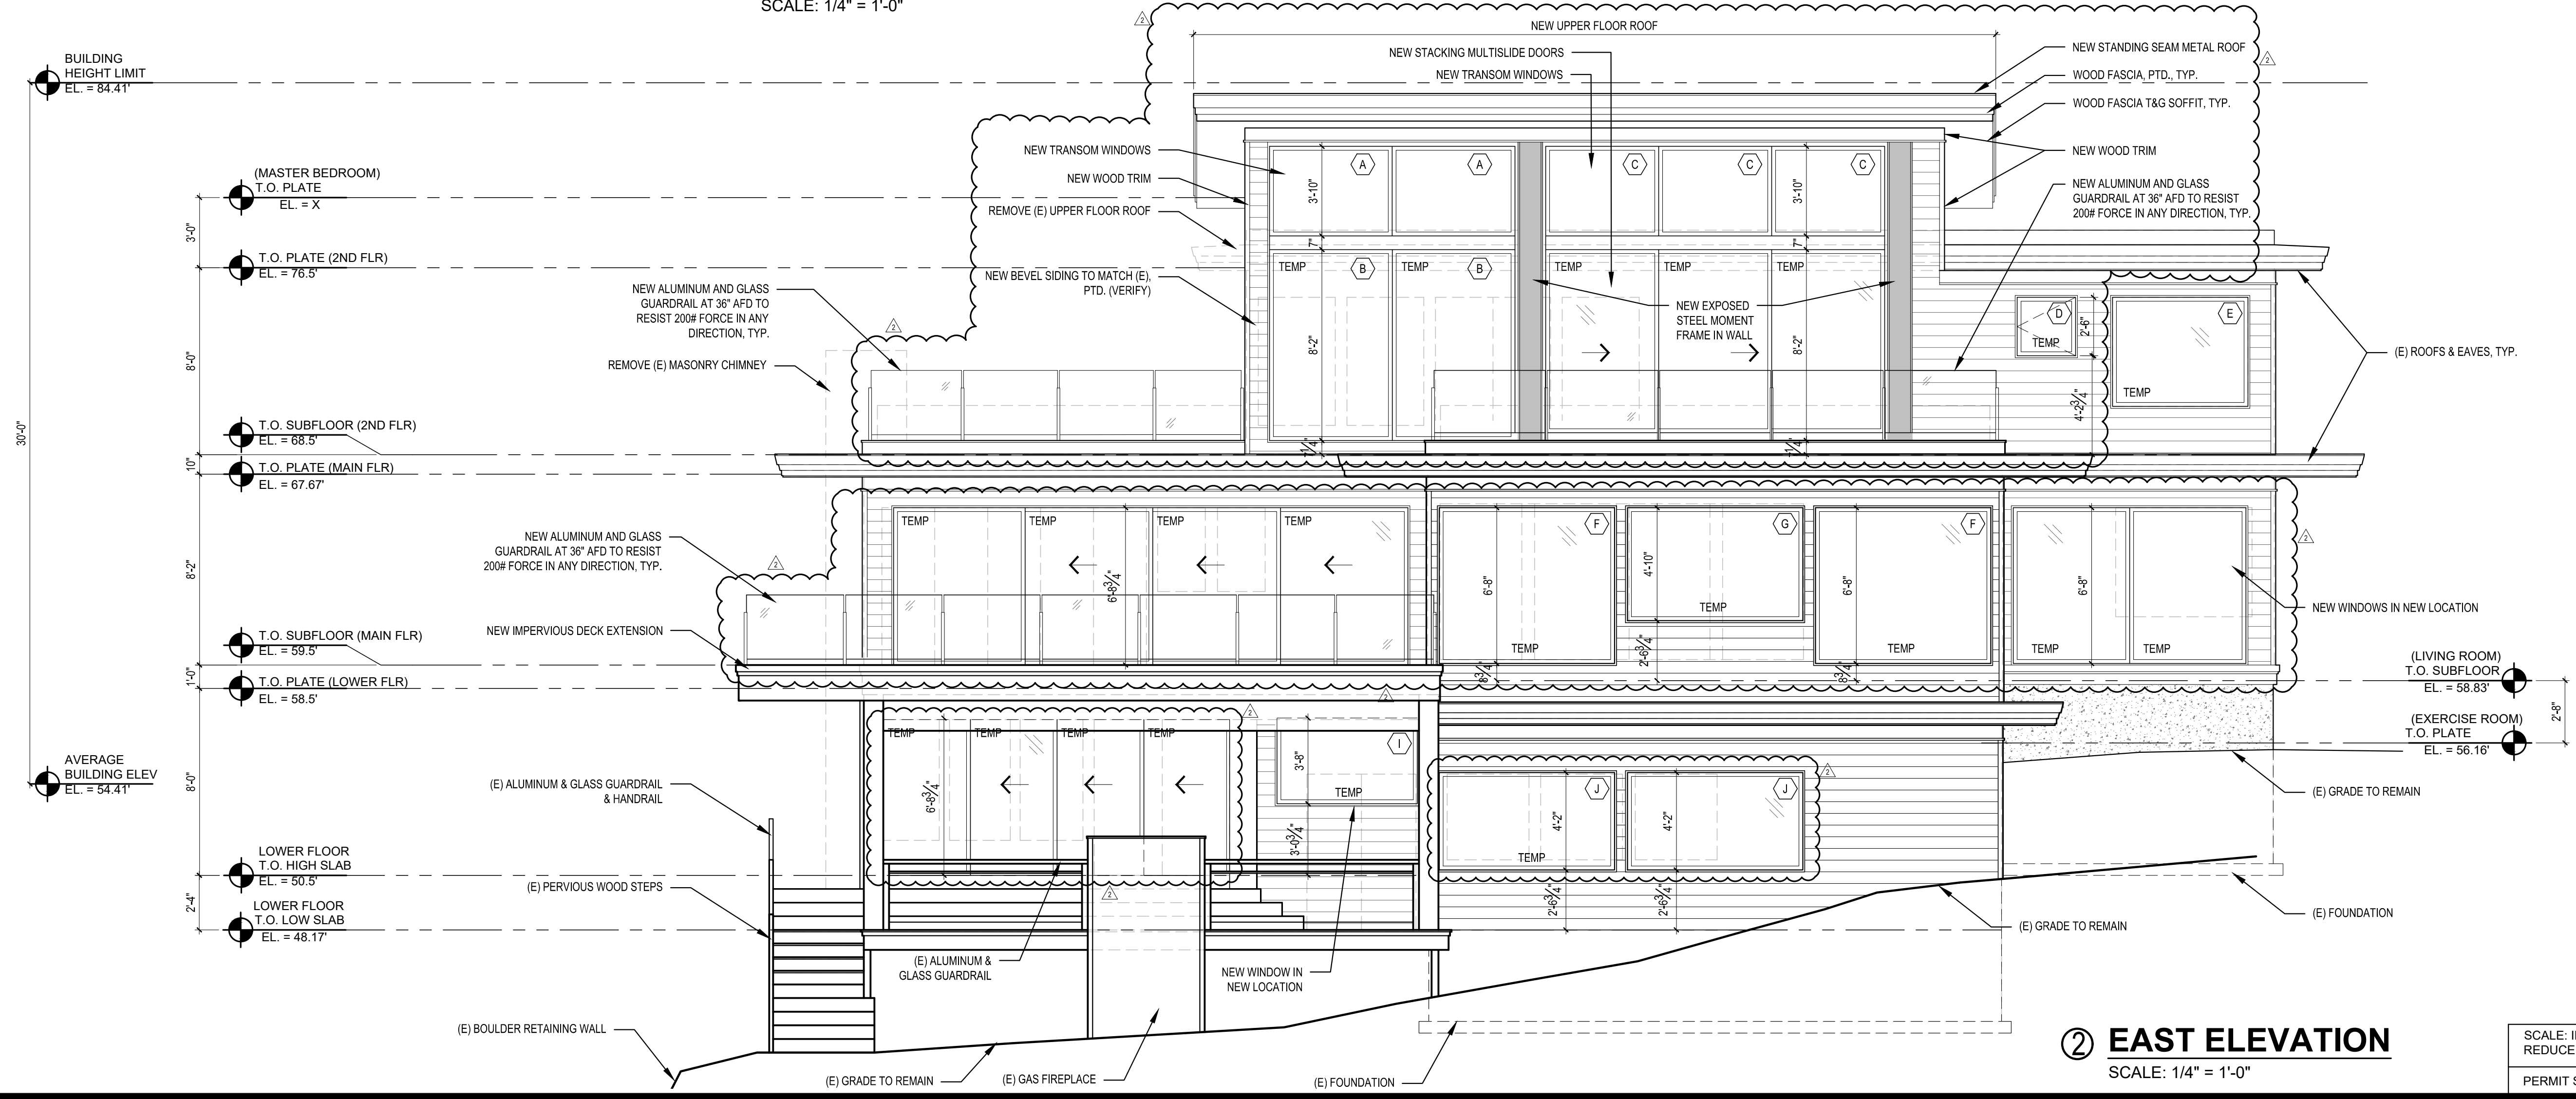


② EAST ELEVATION
SCALE: 1/4" = 1'-0"

SCALE: IF SHEET IS LESS THAN 24" X 36", IT IS A REDUCED PRINT; REDUCE SCALE ACCORDINGLY
PERMIT SET 9/06/19 PLOT DATE: 9/6/2019

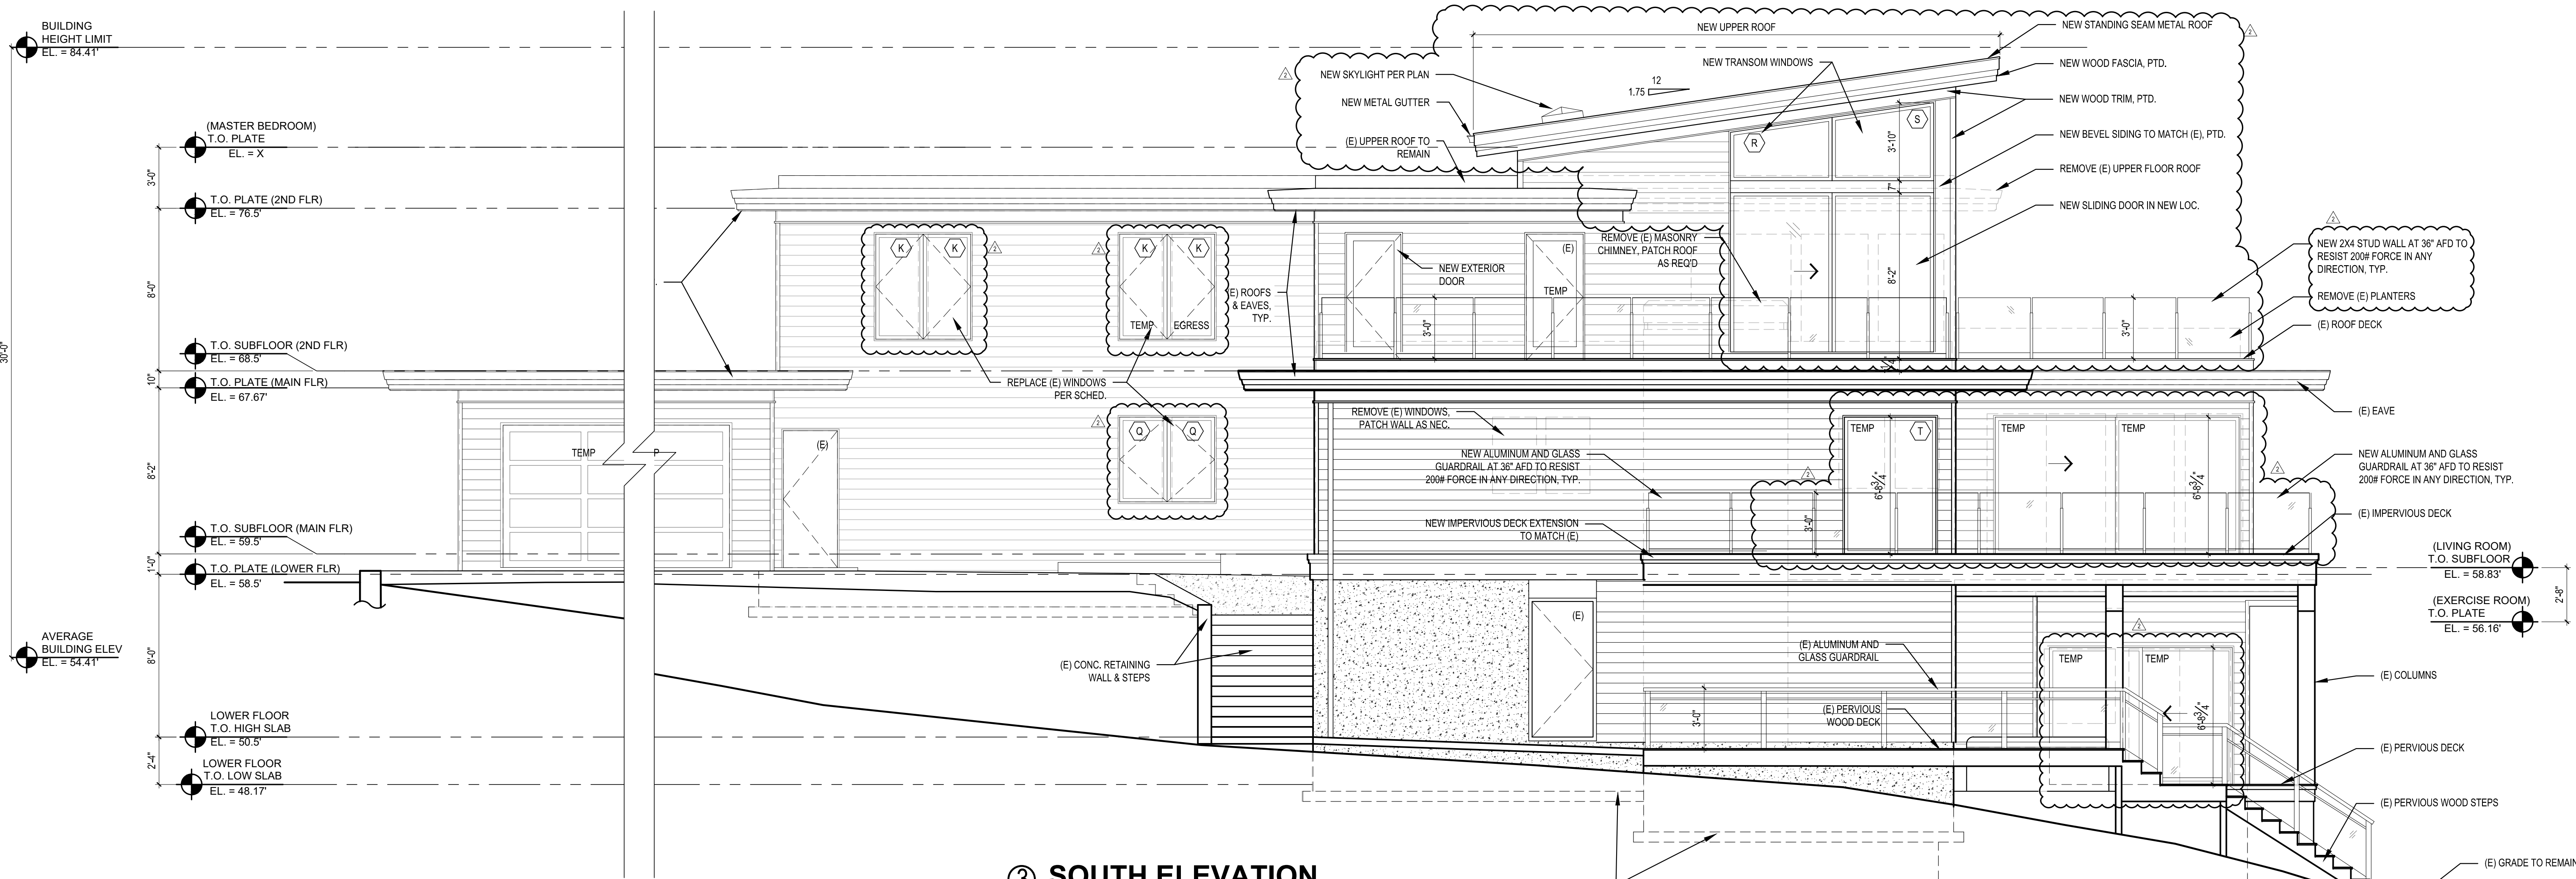

③ SOUTH ELEVATION
SCALE: 1/4" = 1'-0"

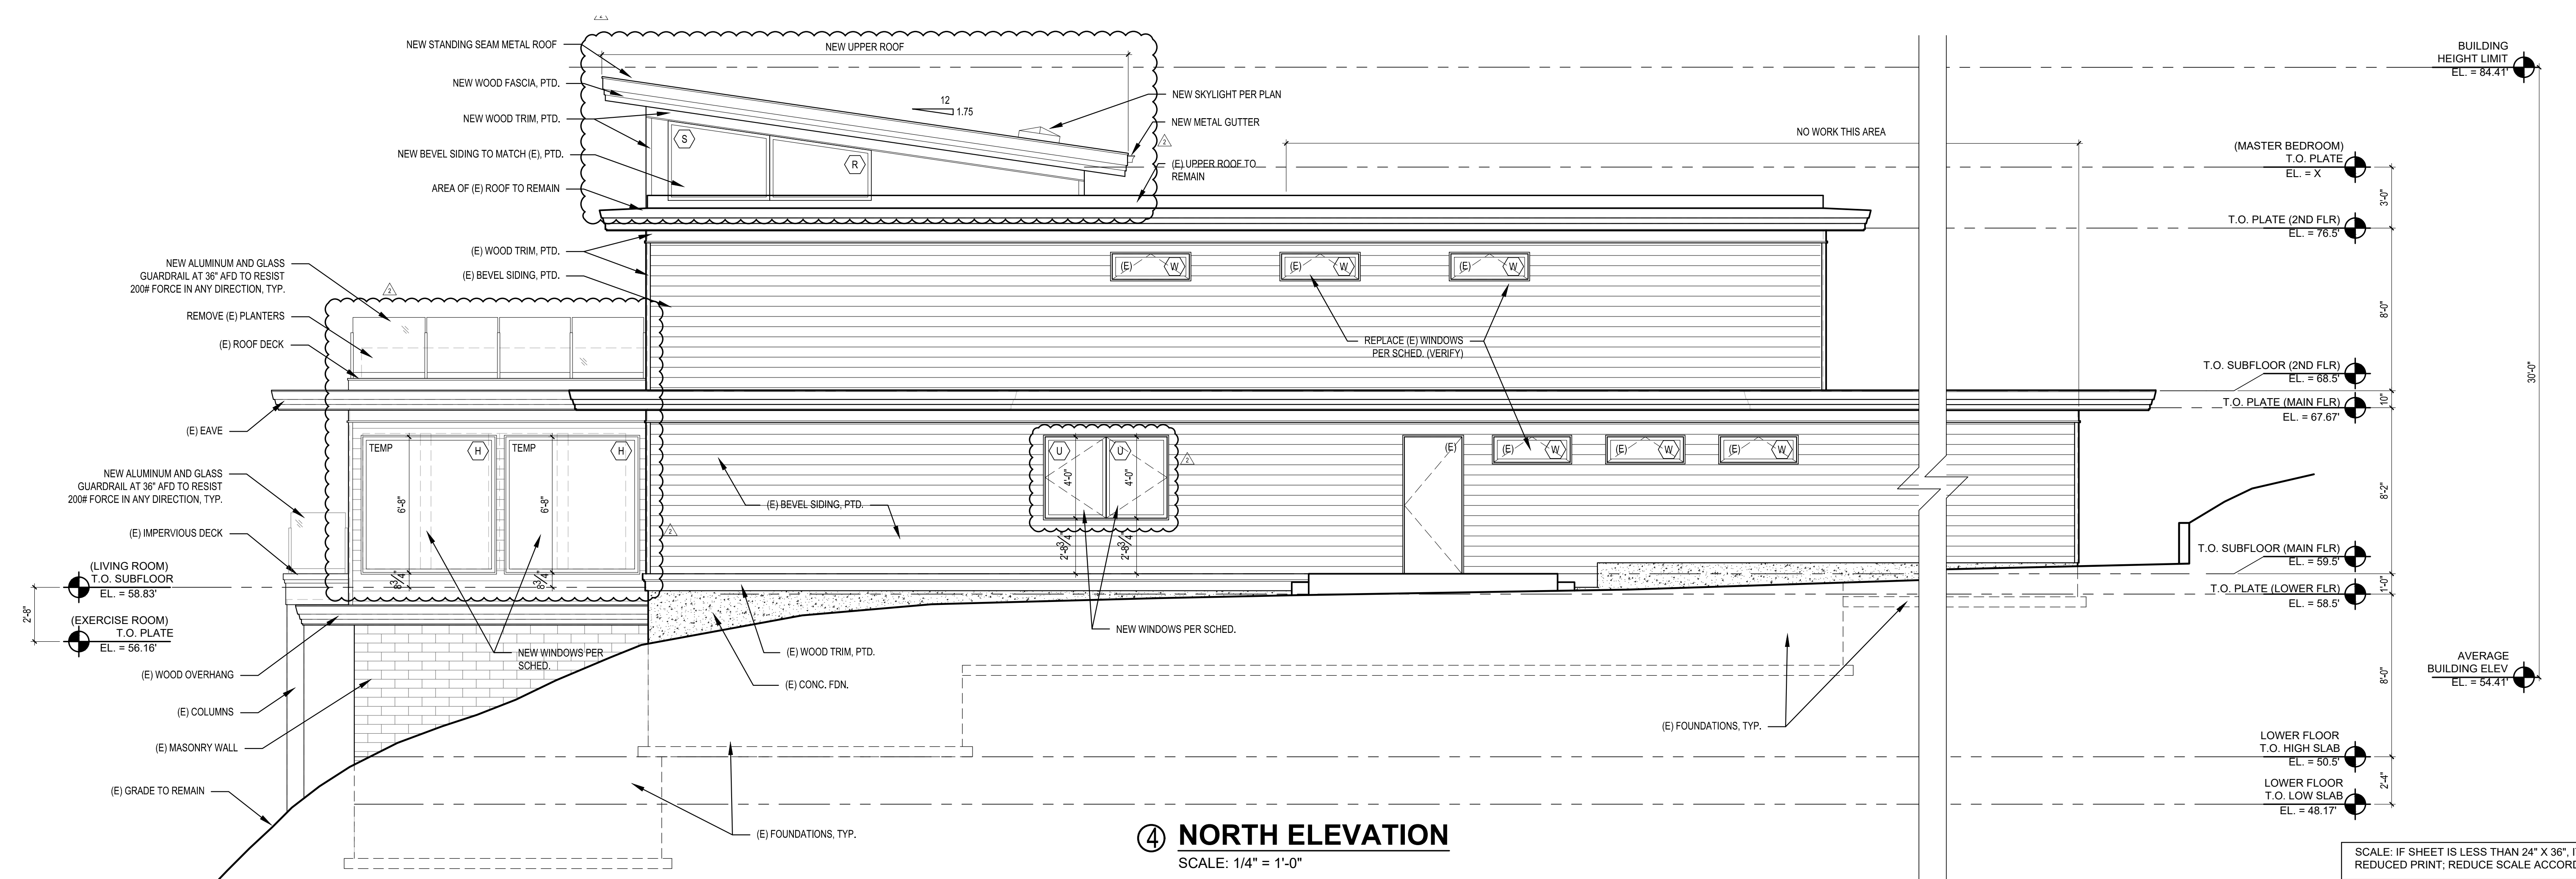

④ NORTH ELEVATION
SCALE: 1/4" = 1'-0"

REVISIONS:	2019-08-21 DESIGN REVISIONS	△
	2019-06-04 DESIGN REVISIONS	△
		△
		△
		△
DRAWN BY:	KE	
CHECKED BY:	BJS	
SHEET	A3.1	

REVISIONS:	2019-08-21 DESIGN REVISIONS	2019-04-04 DESIGN REVISIONS
△	△	△


DRAWN BY: KE

CHECKED BY: BJS


SHEET

A4.0



SCALE: IF SHEET IS LESS THAN 24" X 36", IT IS A REDUCED PRINT; REDUCE SCALE ACCORDINGLY
PERMIT SET 9/06/19 PLOT DATE: 9/6/2019

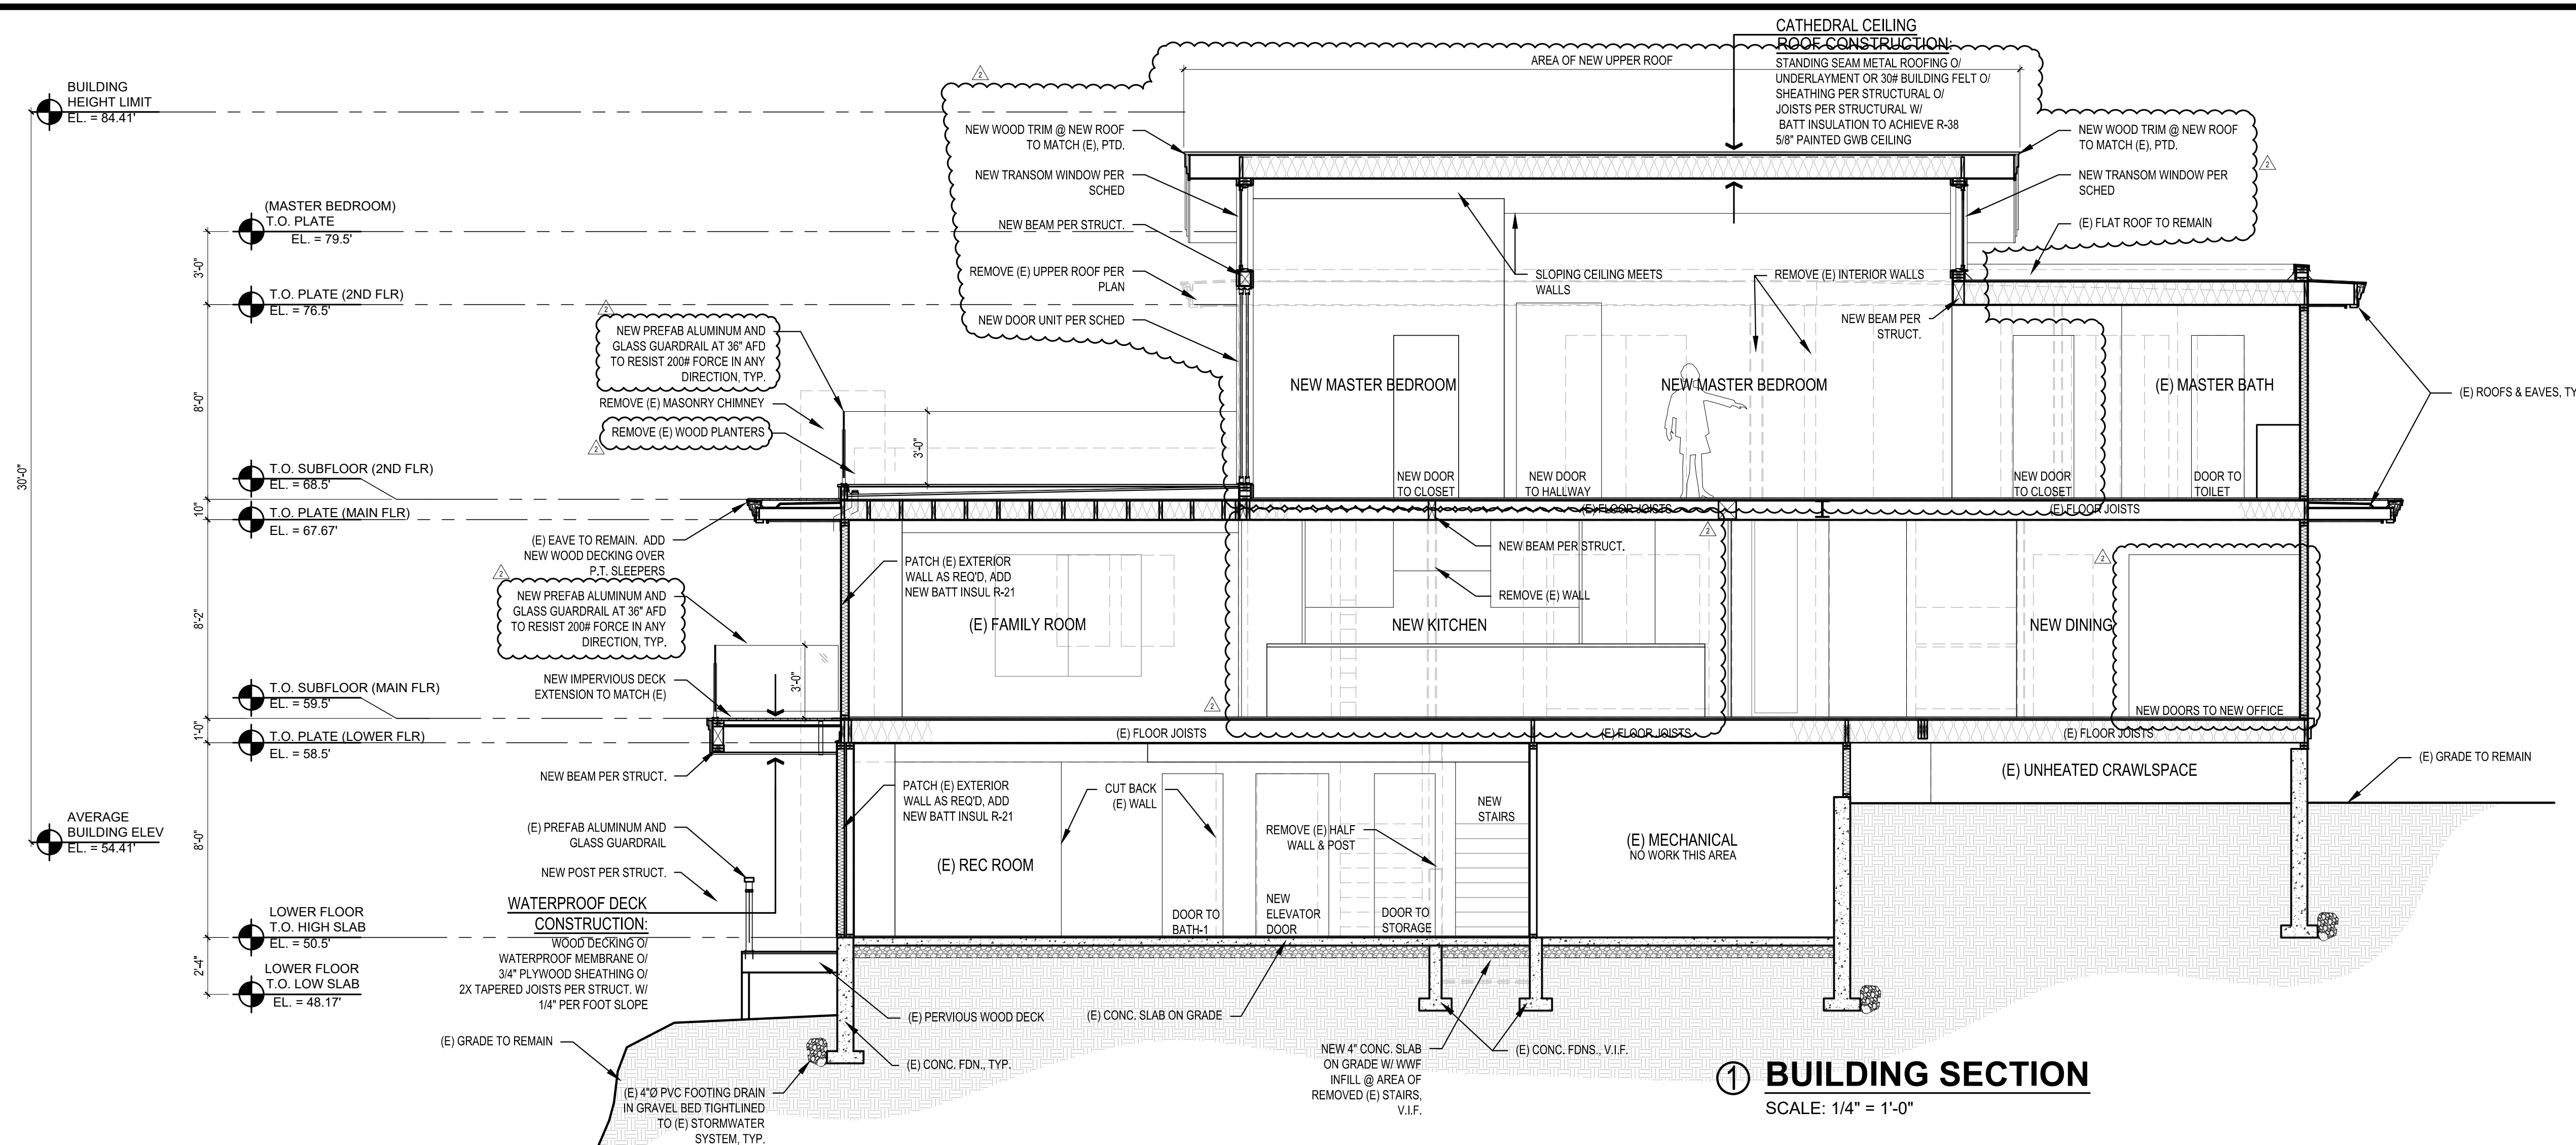



1 BUILDING SECTION
SCALE: 1/4" = 1'-0"

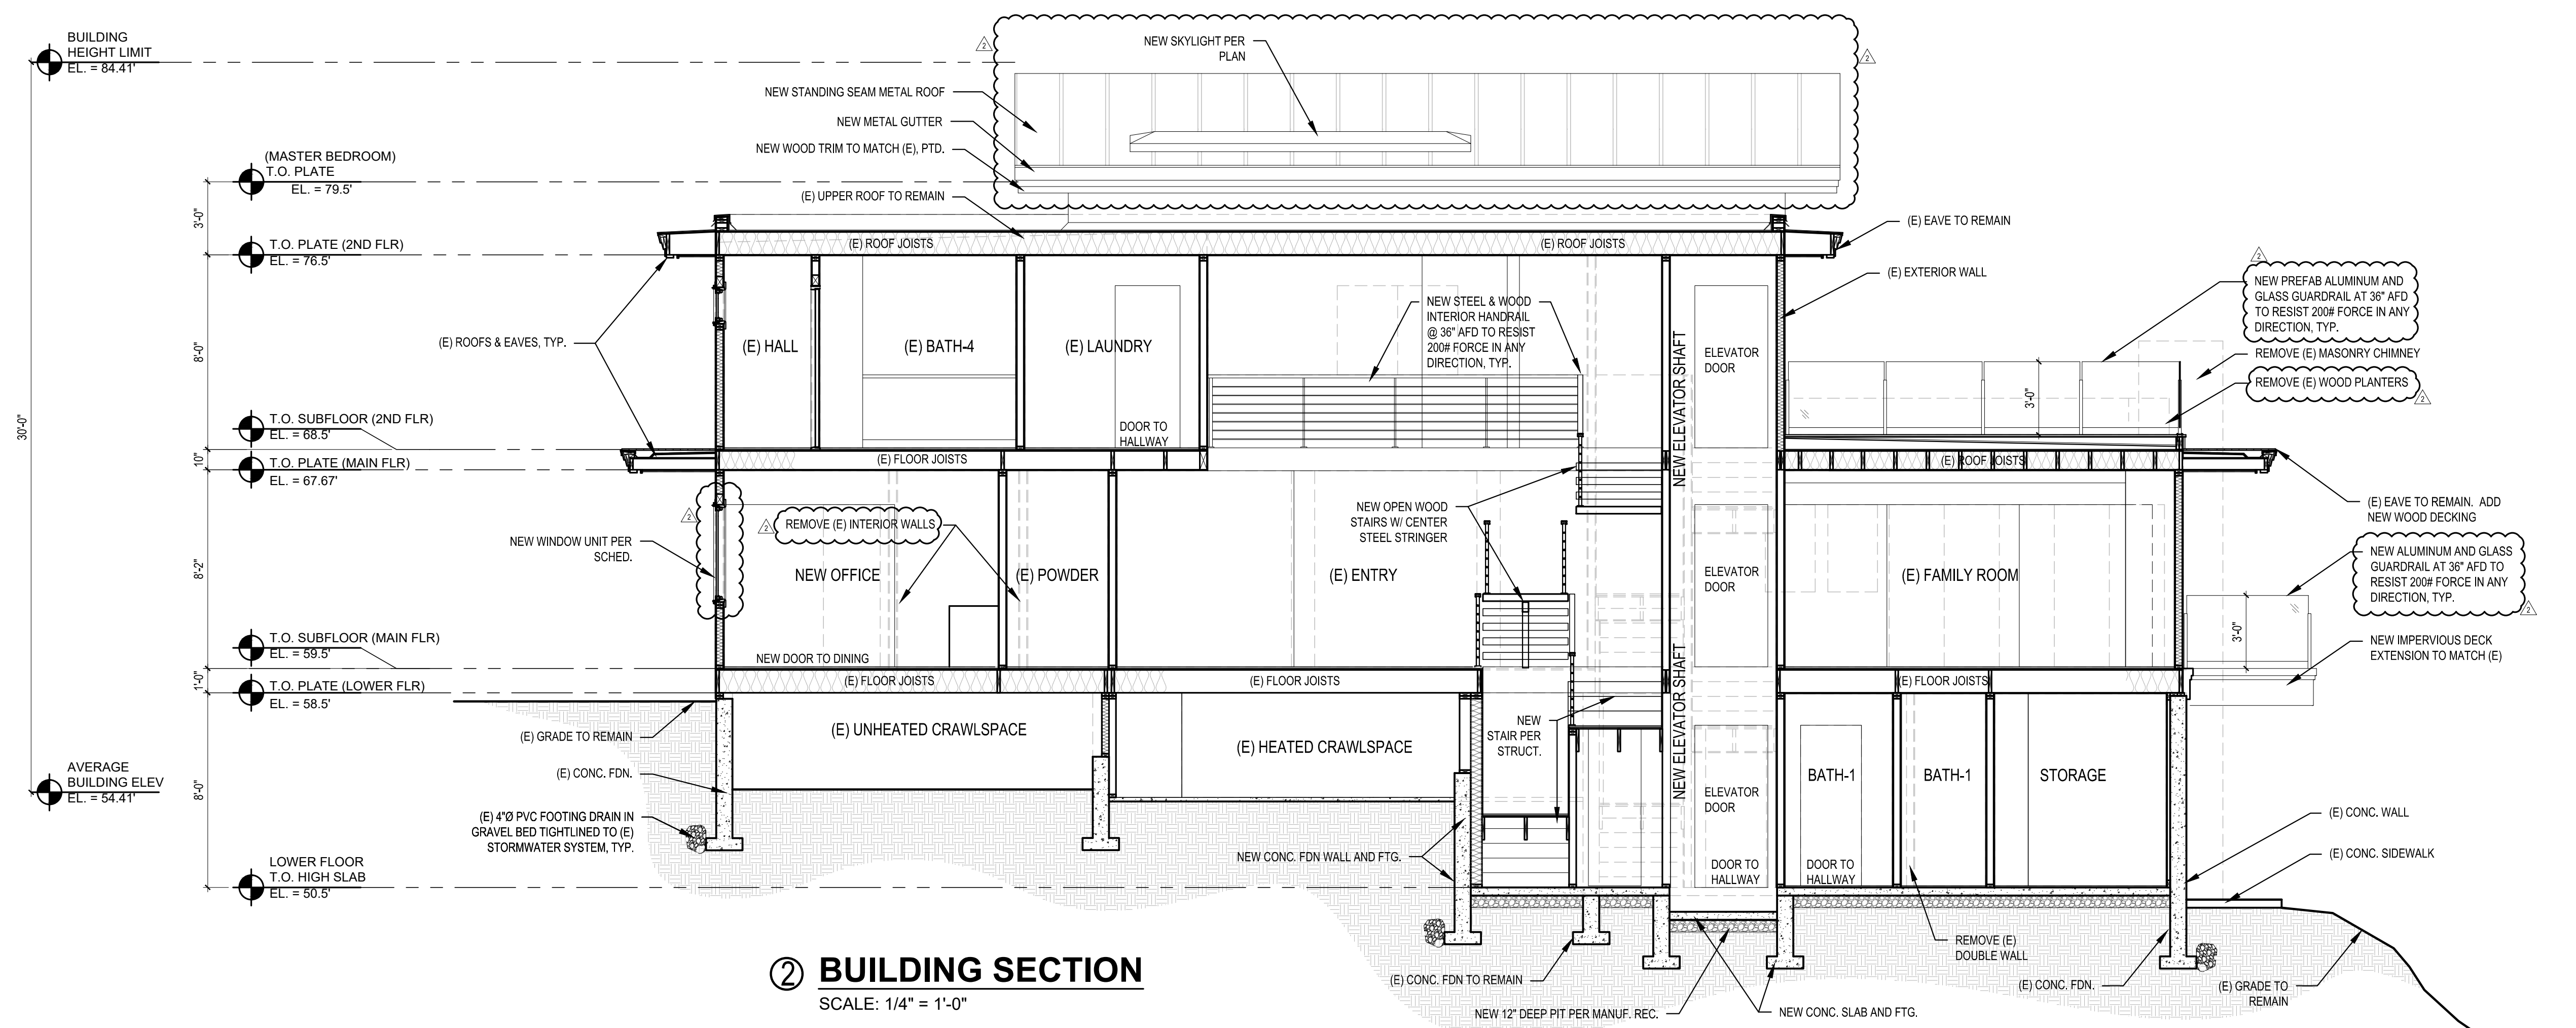

2 BUILDING SECTION
SCALE: 1/4" = 1'-0"

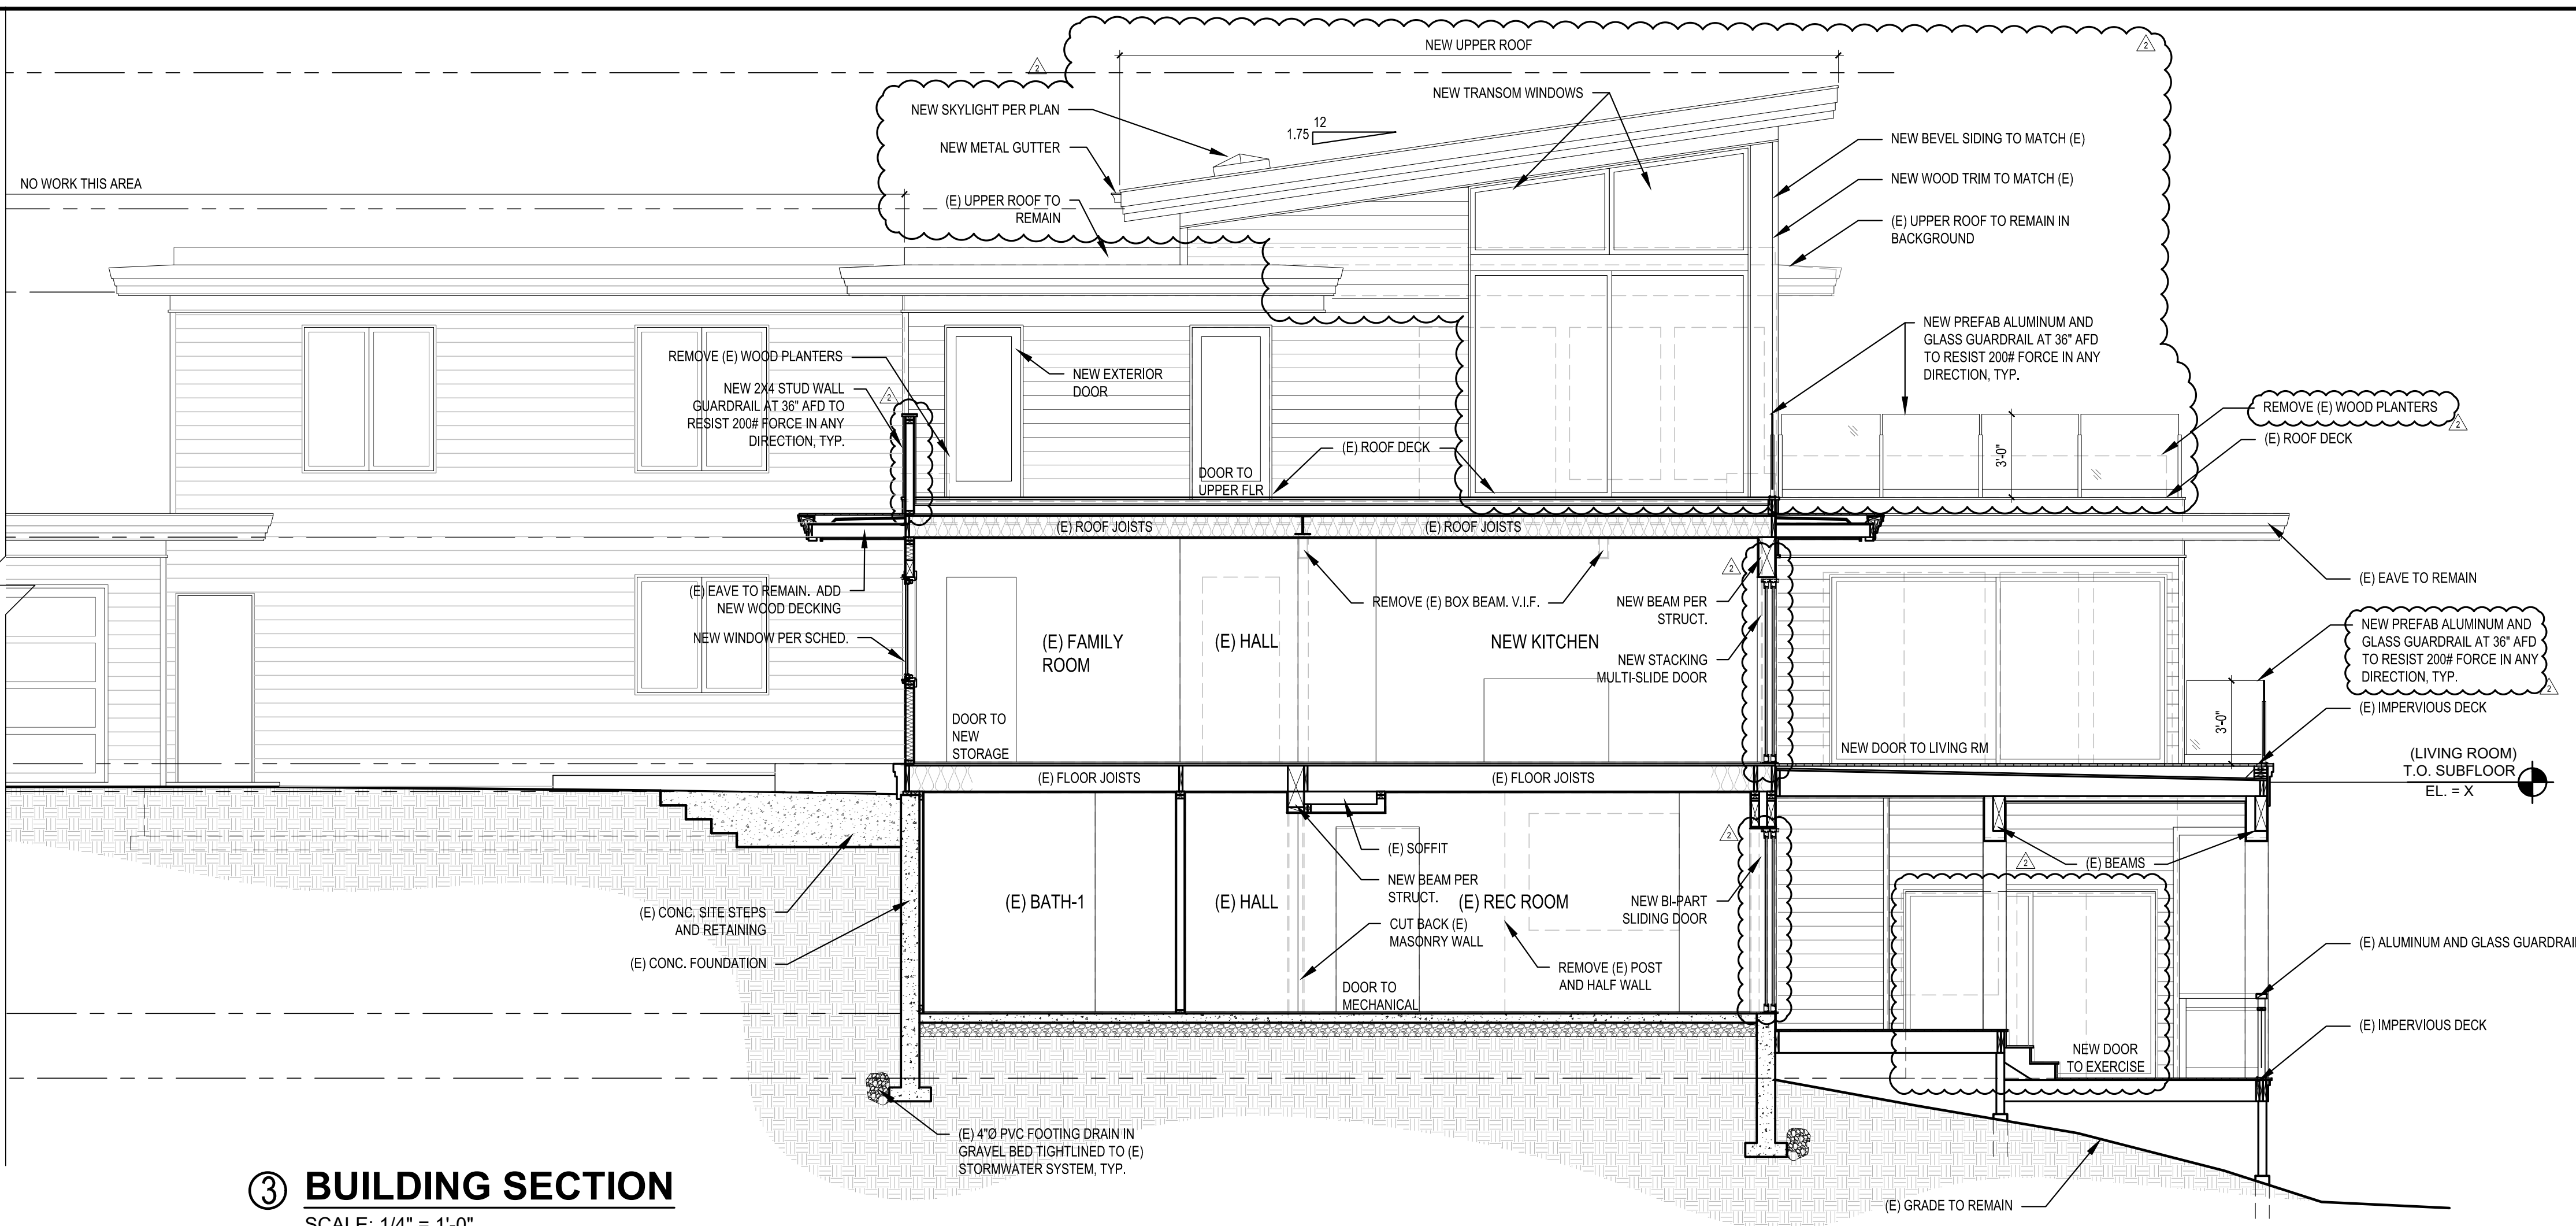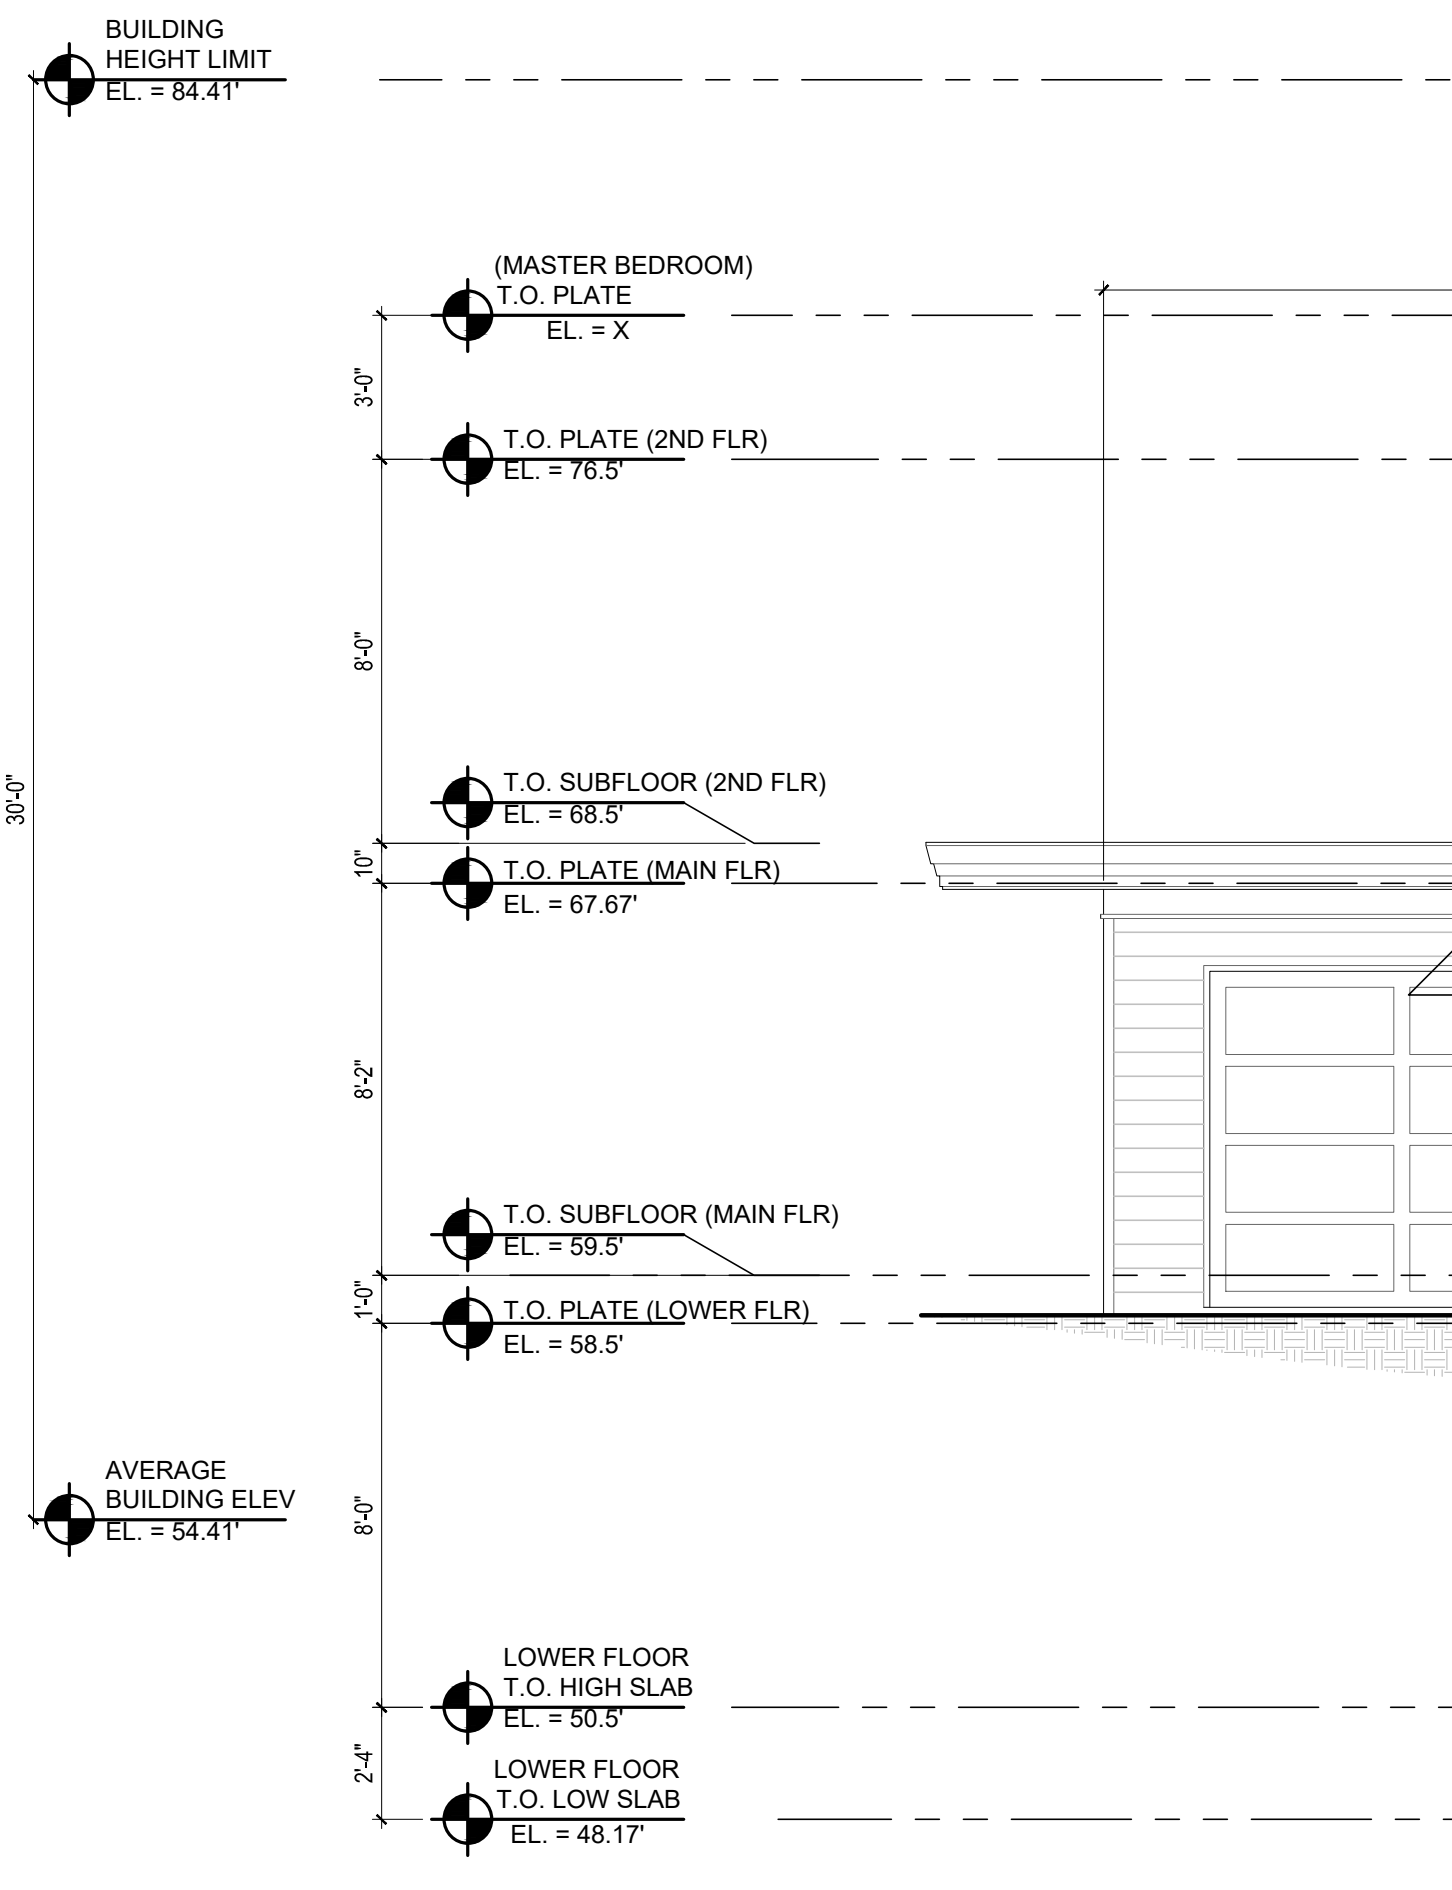

③ BUILDING SECTION
SCALE: 1/4" = 1'-0"

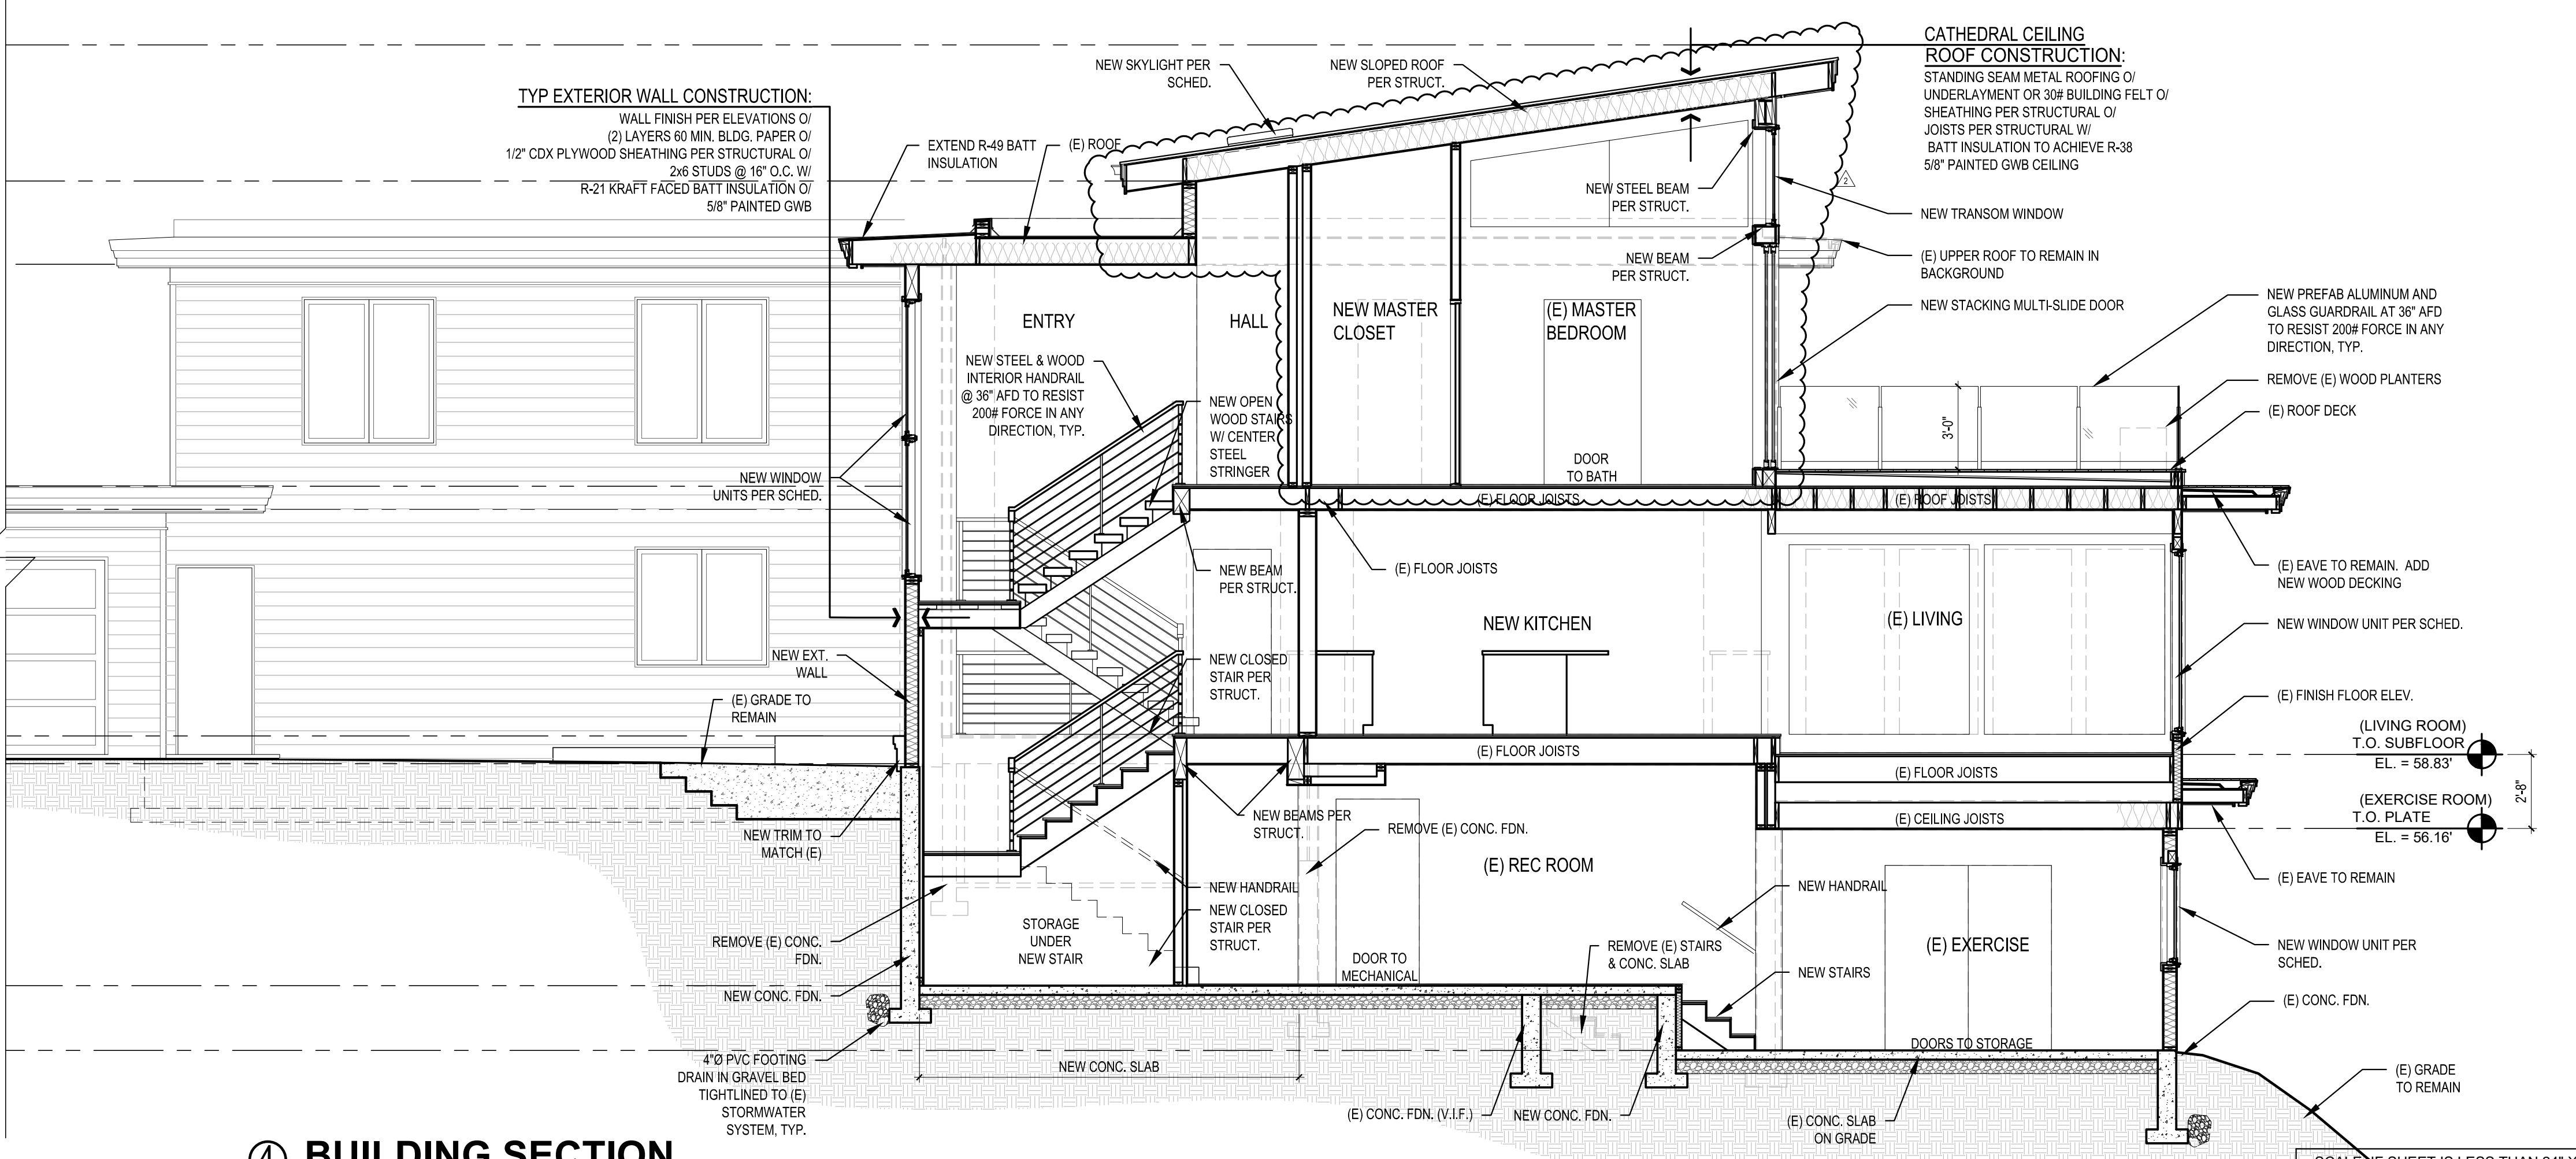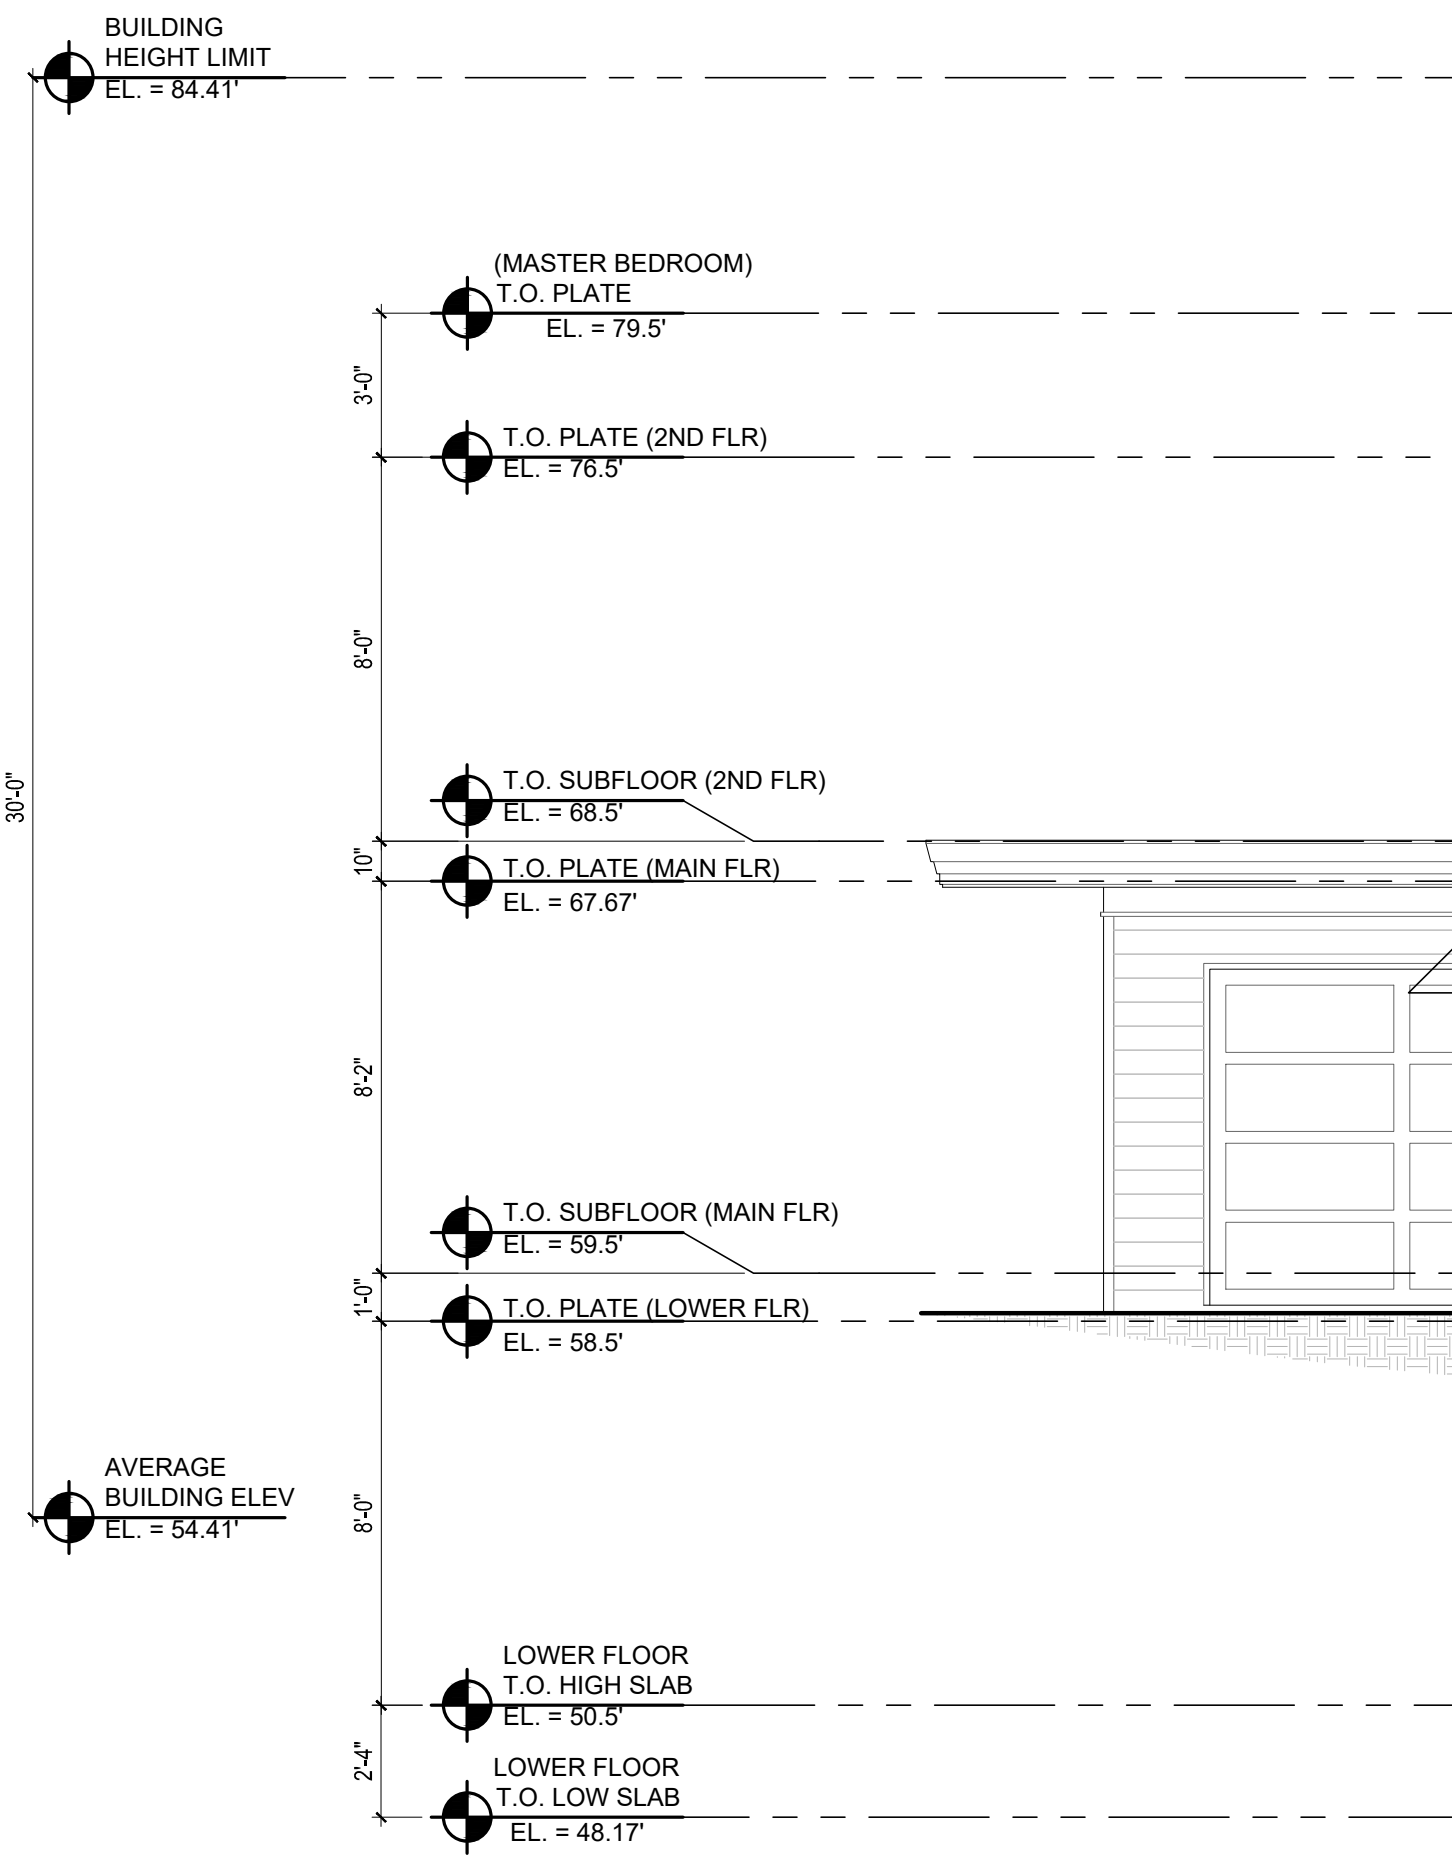

④ BUILDING SECTION
SCALE: 1/4" = 1'-0"

REVISIONS:	2019-02-27 DESIGN REVISIONS
	2019-04-04 DESIGN REVISIONS



DRAWN BY: KE

CHECKED BY: BJS

SHEET

A4.1

SCALE: SHEET IS LESS THAN 24" X 36", IT IS A REDUCED PRINT, REDUCE SCALE ACCORDINGLY
PERMIT SET 9/06/19 PLOT DATE: 9/6/2019

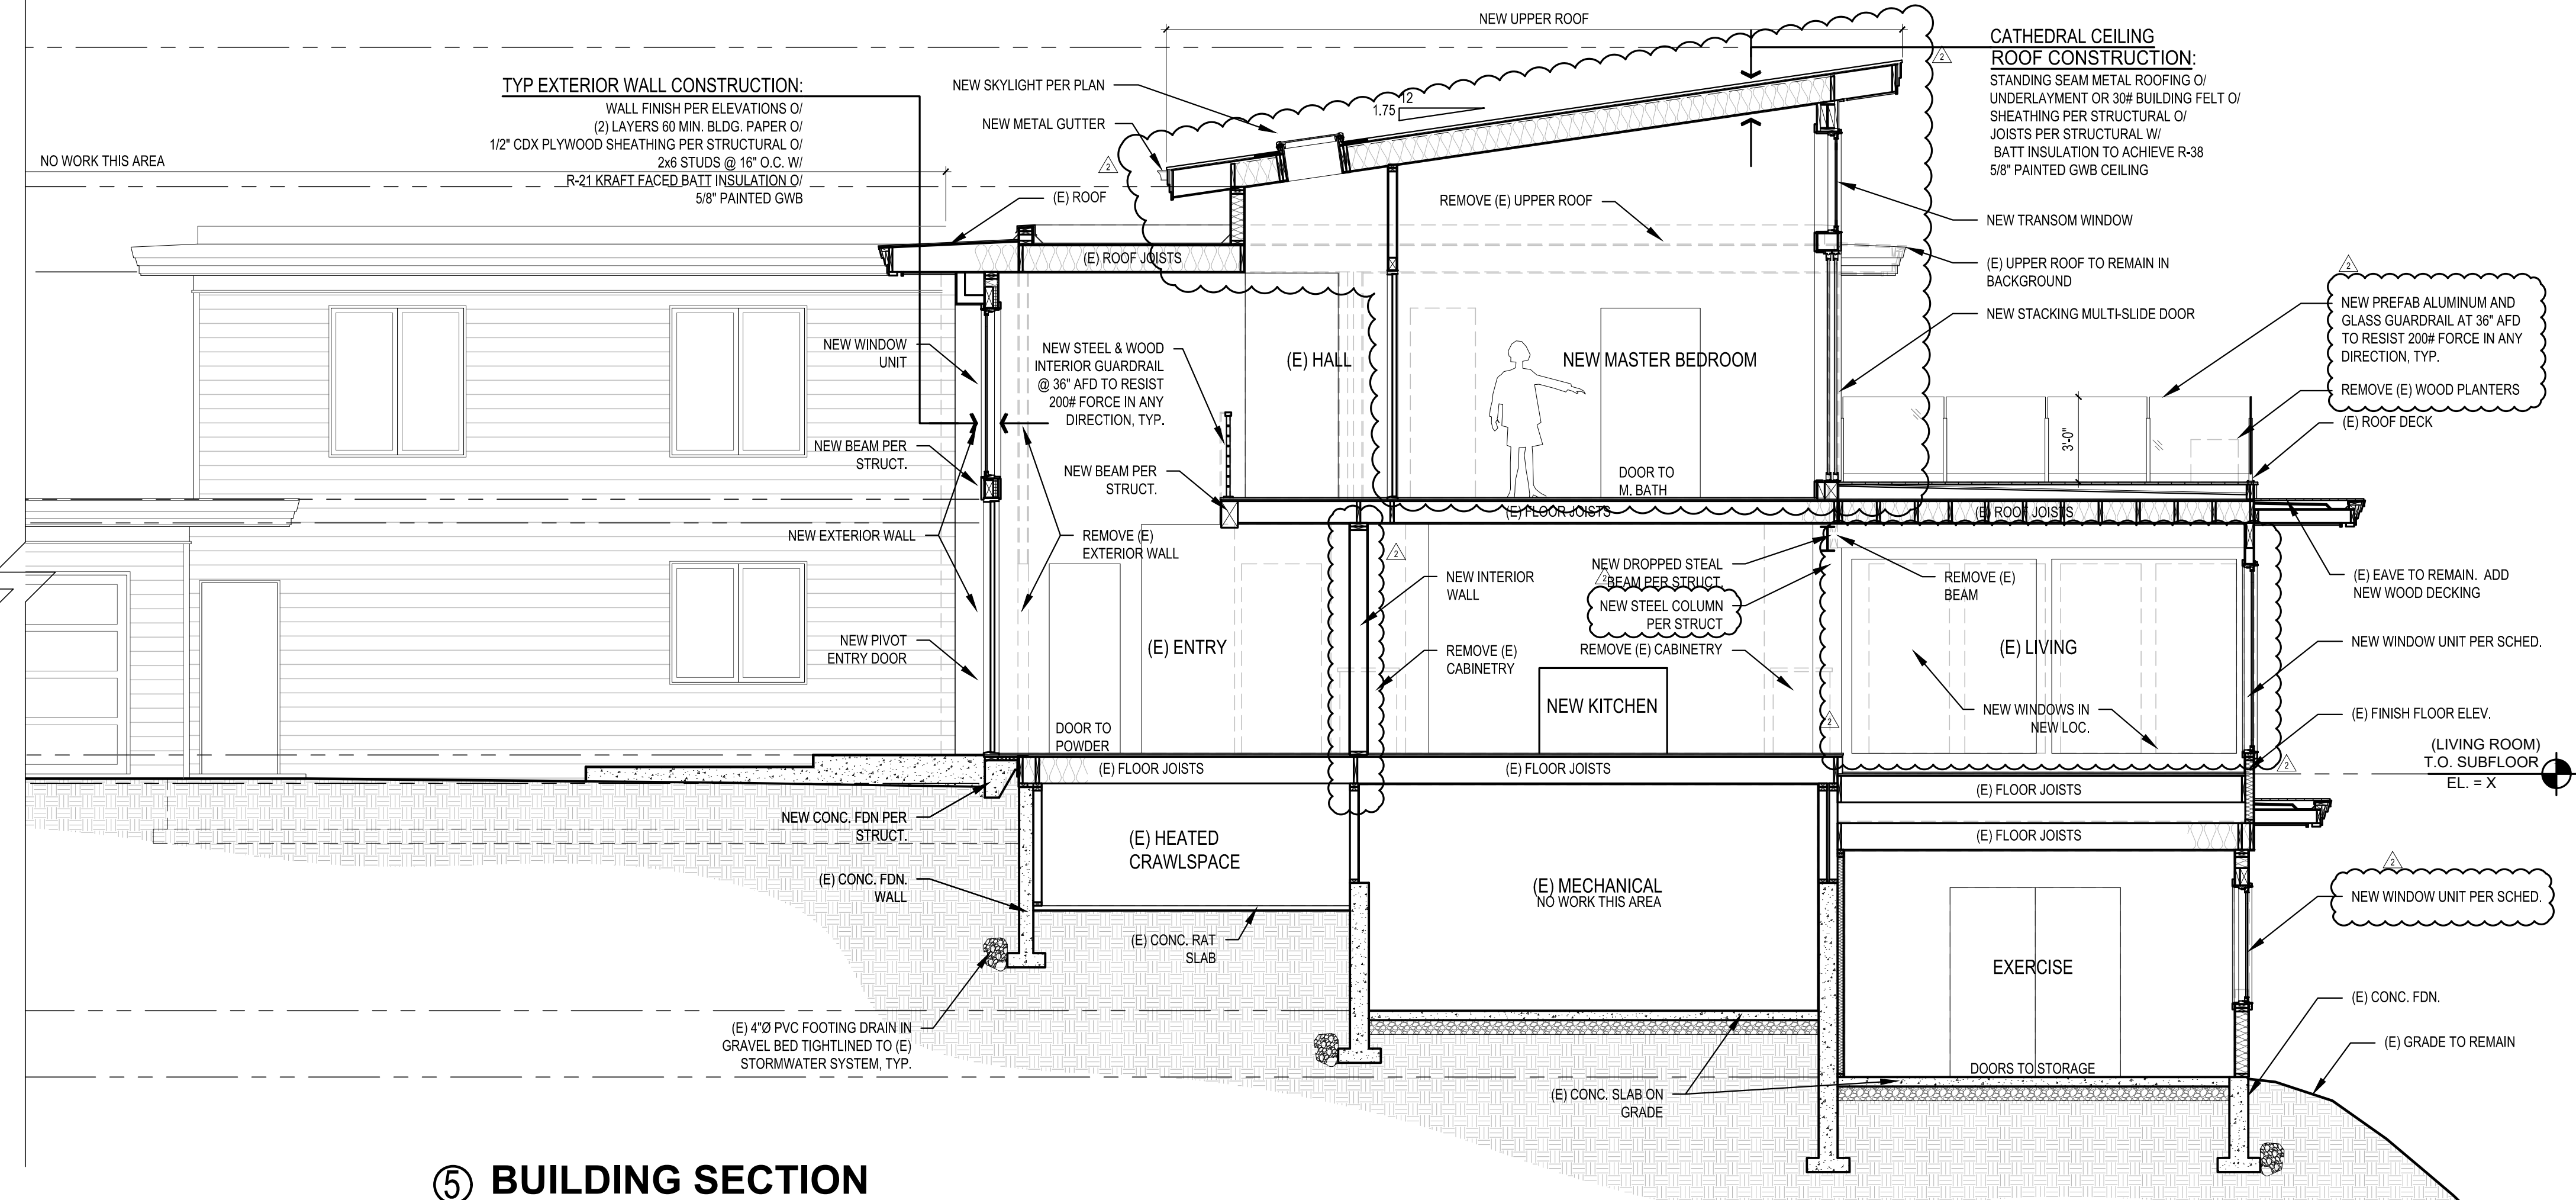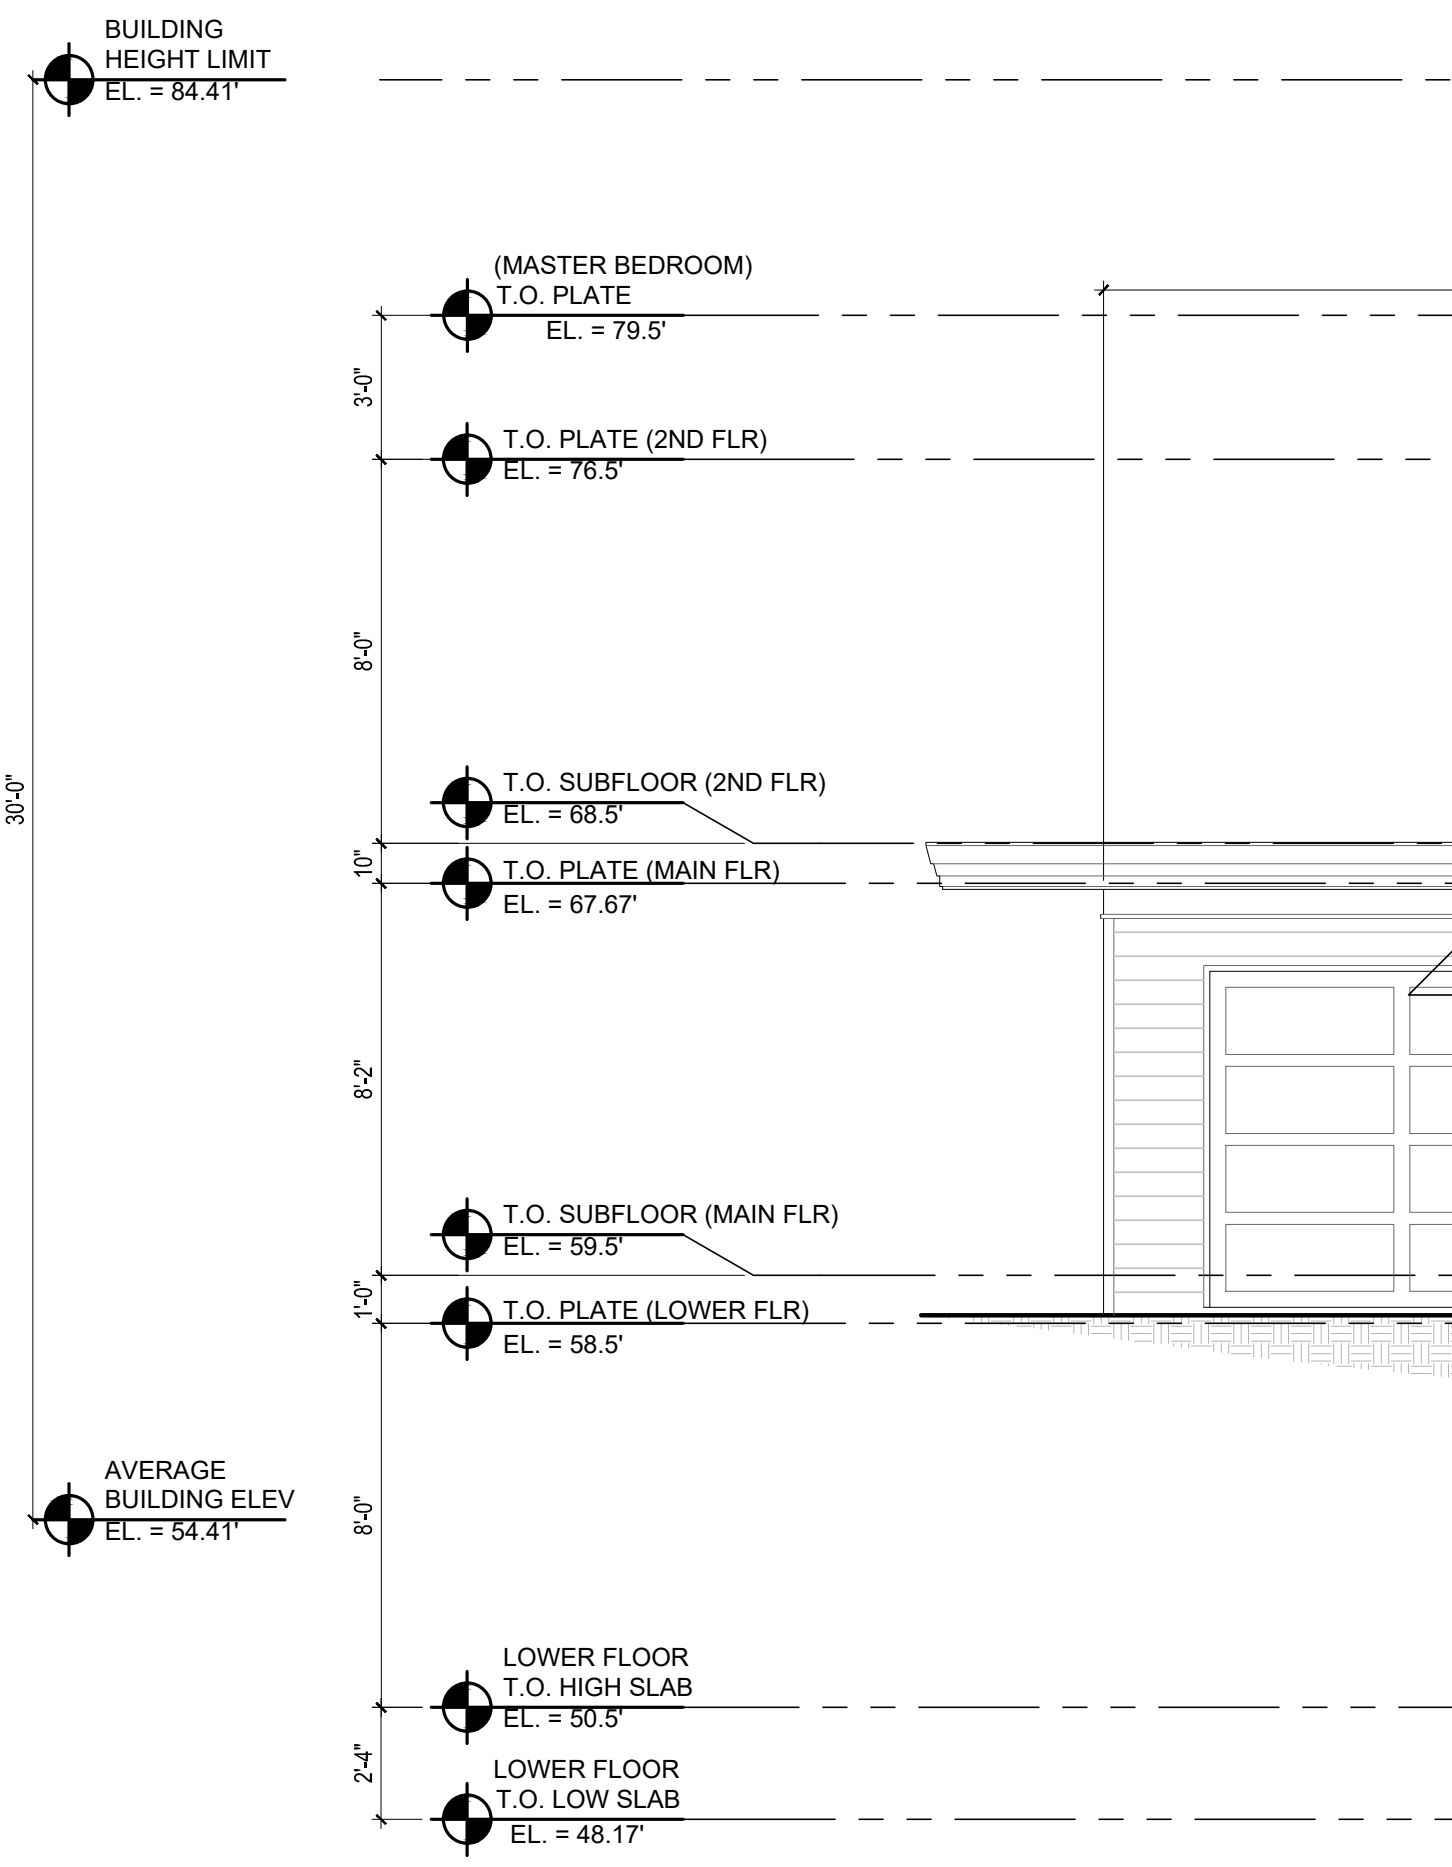

5 BUILDING SECTION
SCALE: 1/4" = 1'-0"

STURMAN ARCHITECTS
TEL (425) 451-7003
9 103rd Avenue NE
Suite 203
Bellevue, WA 98004

5522 REGISTERED ARCHITECT
BRADLEY J. STURMAN
STATE OF WASHINGTON

www.sturmanarchitects.com
All Rights Reserved
© 2019

BAYLEY RESIDENCE PERMIT SET
6060 E. MERCER WAY
MERCER ISLAND, WA 98040

PHASE 2 BUILDING SECTIONS


REVISIONS:

2019-03-27	DESIGN REVISIONS	
2019-04-04	DESIGN REVISIONS	


DRAWN BY: KE
CHECKED BY: BJS

SHEET
A4.2

SCALE: IF SHEET IS LESS THAN 24" X 36", IT IS A REDUCED PRINT; REDUCE SCALE ACCORDINGLY
PERMIT SET 9/06/19 PLOT DATE: 9/6/2019

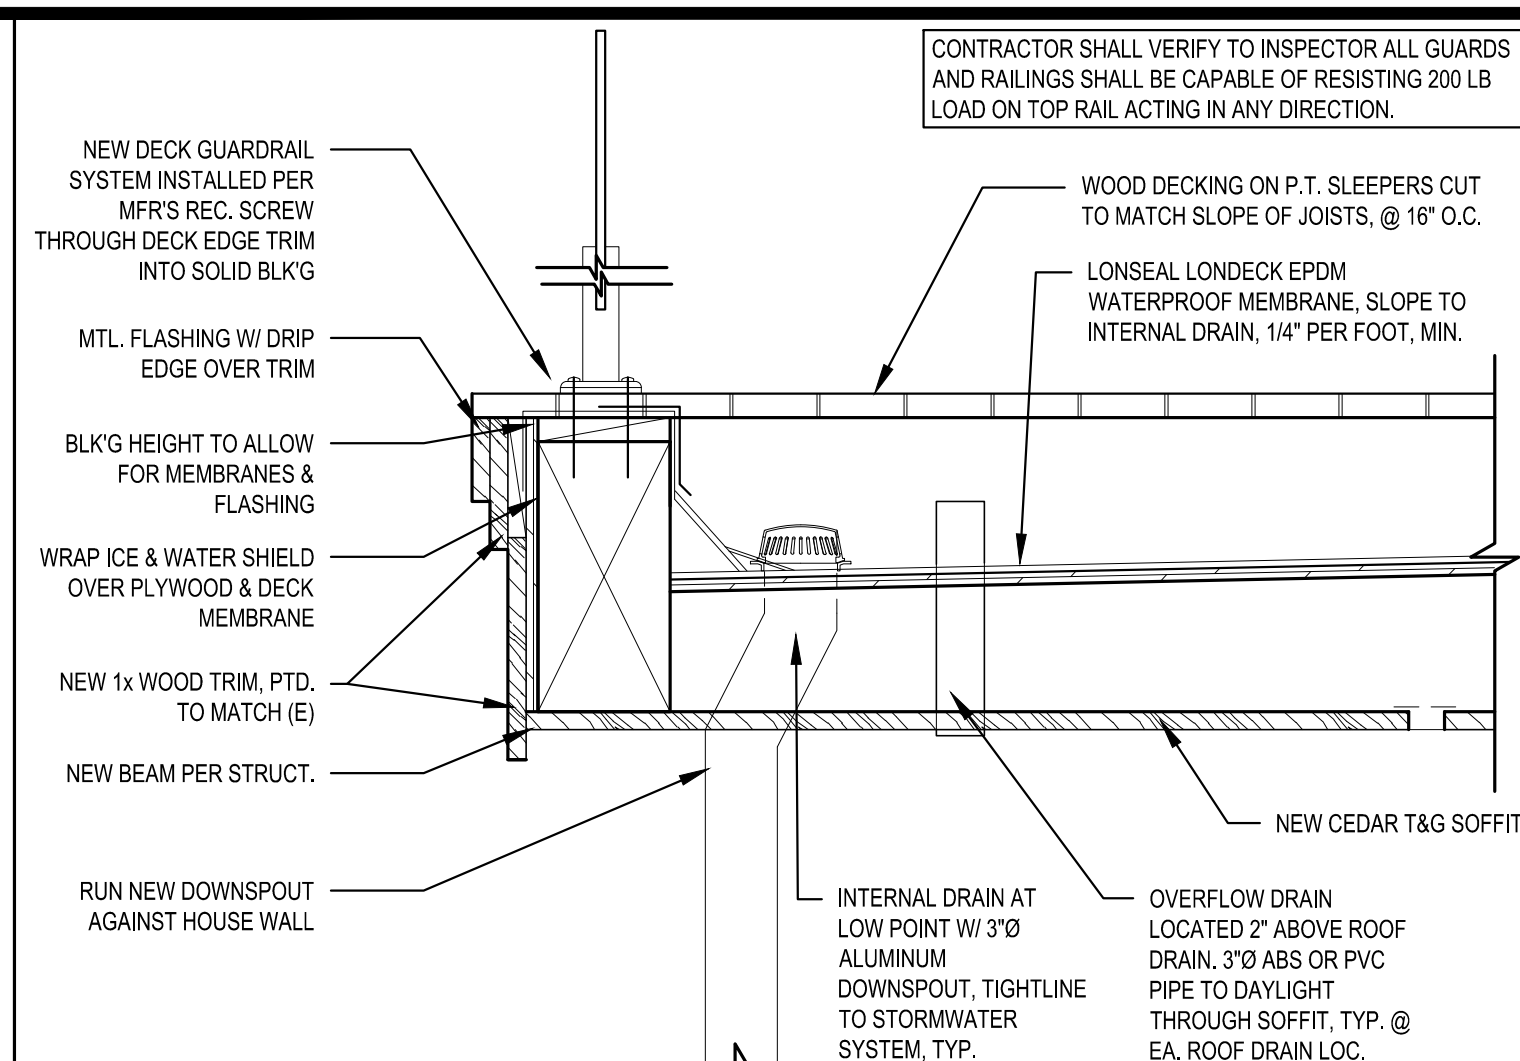


1 RAILING ATTACHMENT, DECK DRAIN
SCALE: 1-1/2" = 1'-0"

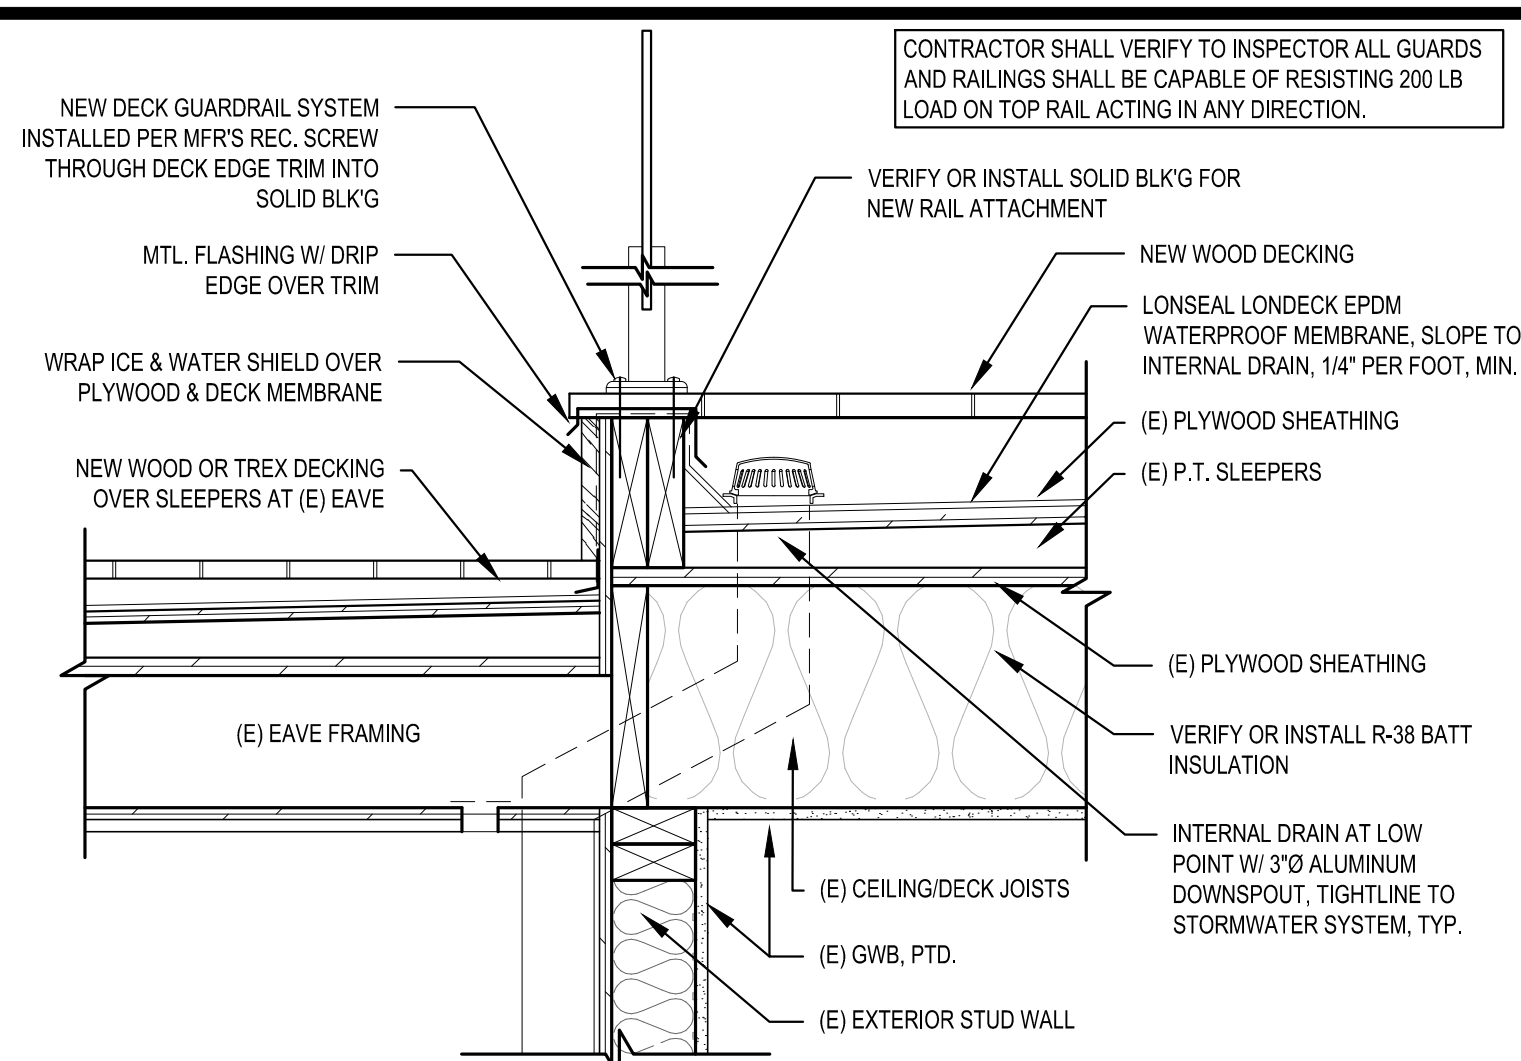


2 TYP. NEW RAIL ATTACHMENT @ (E) DECK
SCALE: 1-1/2" = 1'-0"




8 NOT USED
SCALE: 1-1/2" = 1'-0"

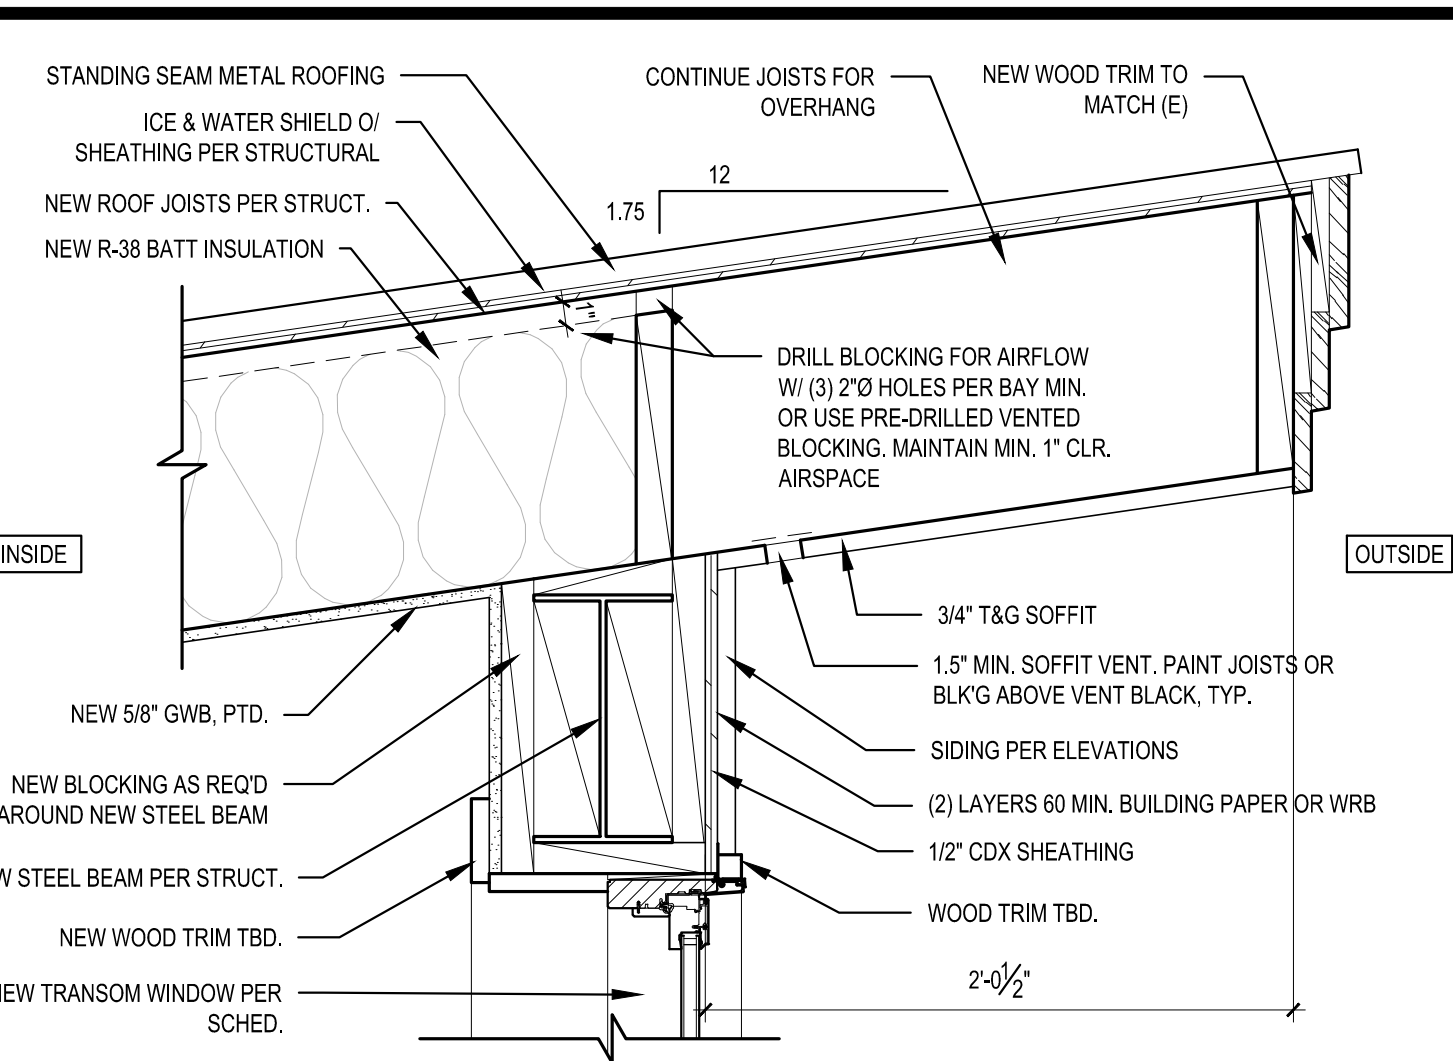


9 NEW EAVE CONDITION @ MOMENT FRAME
SCALE: 1-1/2" = 1'-0"

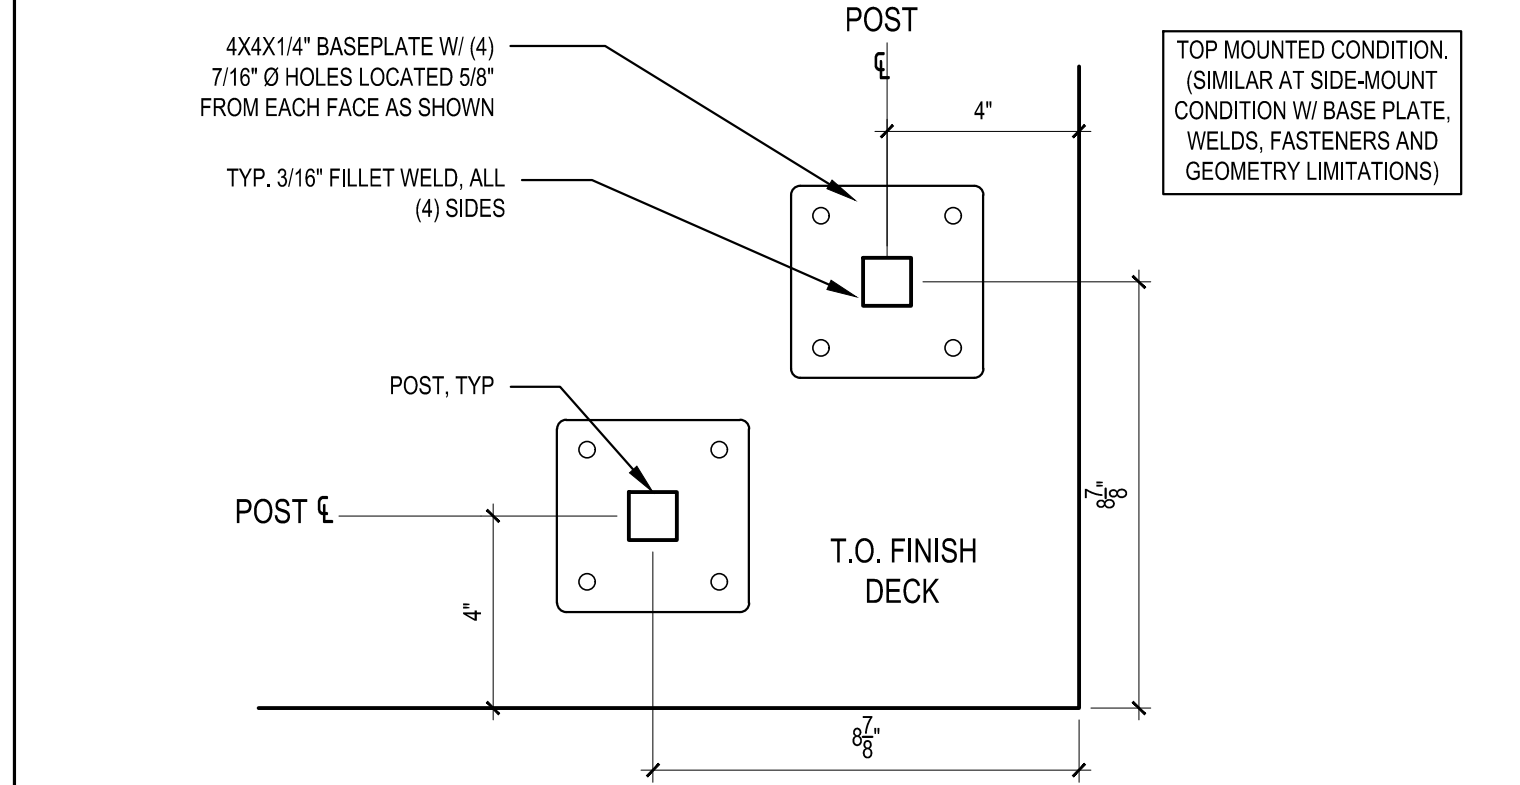


3 GUARDRAIL PLATE ATTACHMENT
SCALE: 3" = 1'-0"

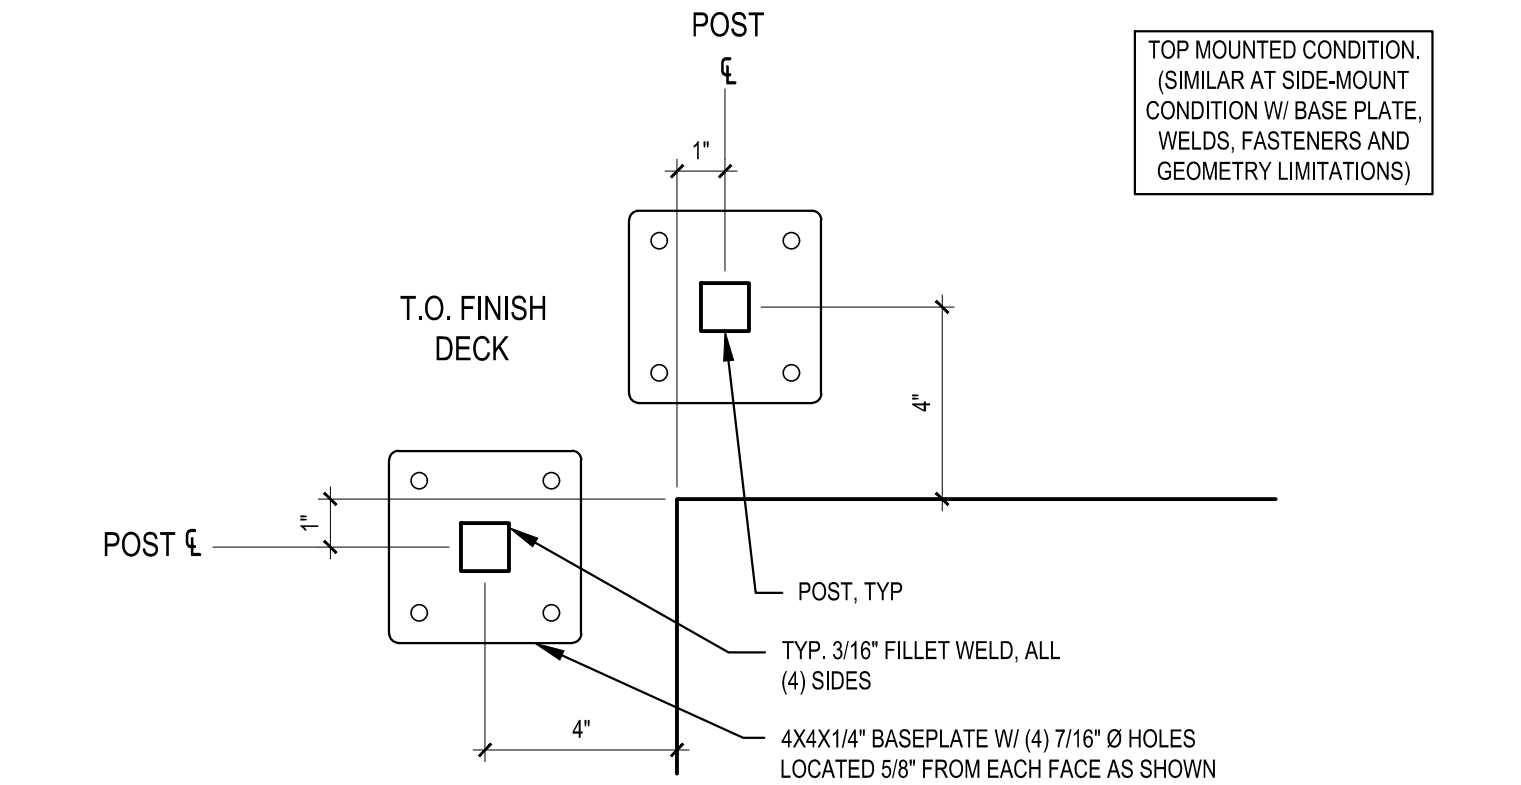


4 GUARDRAIL PLATE ATTACHMENT
SCALE: 3" = 1'-0"
SIM. AT SIDE-MOUNTED

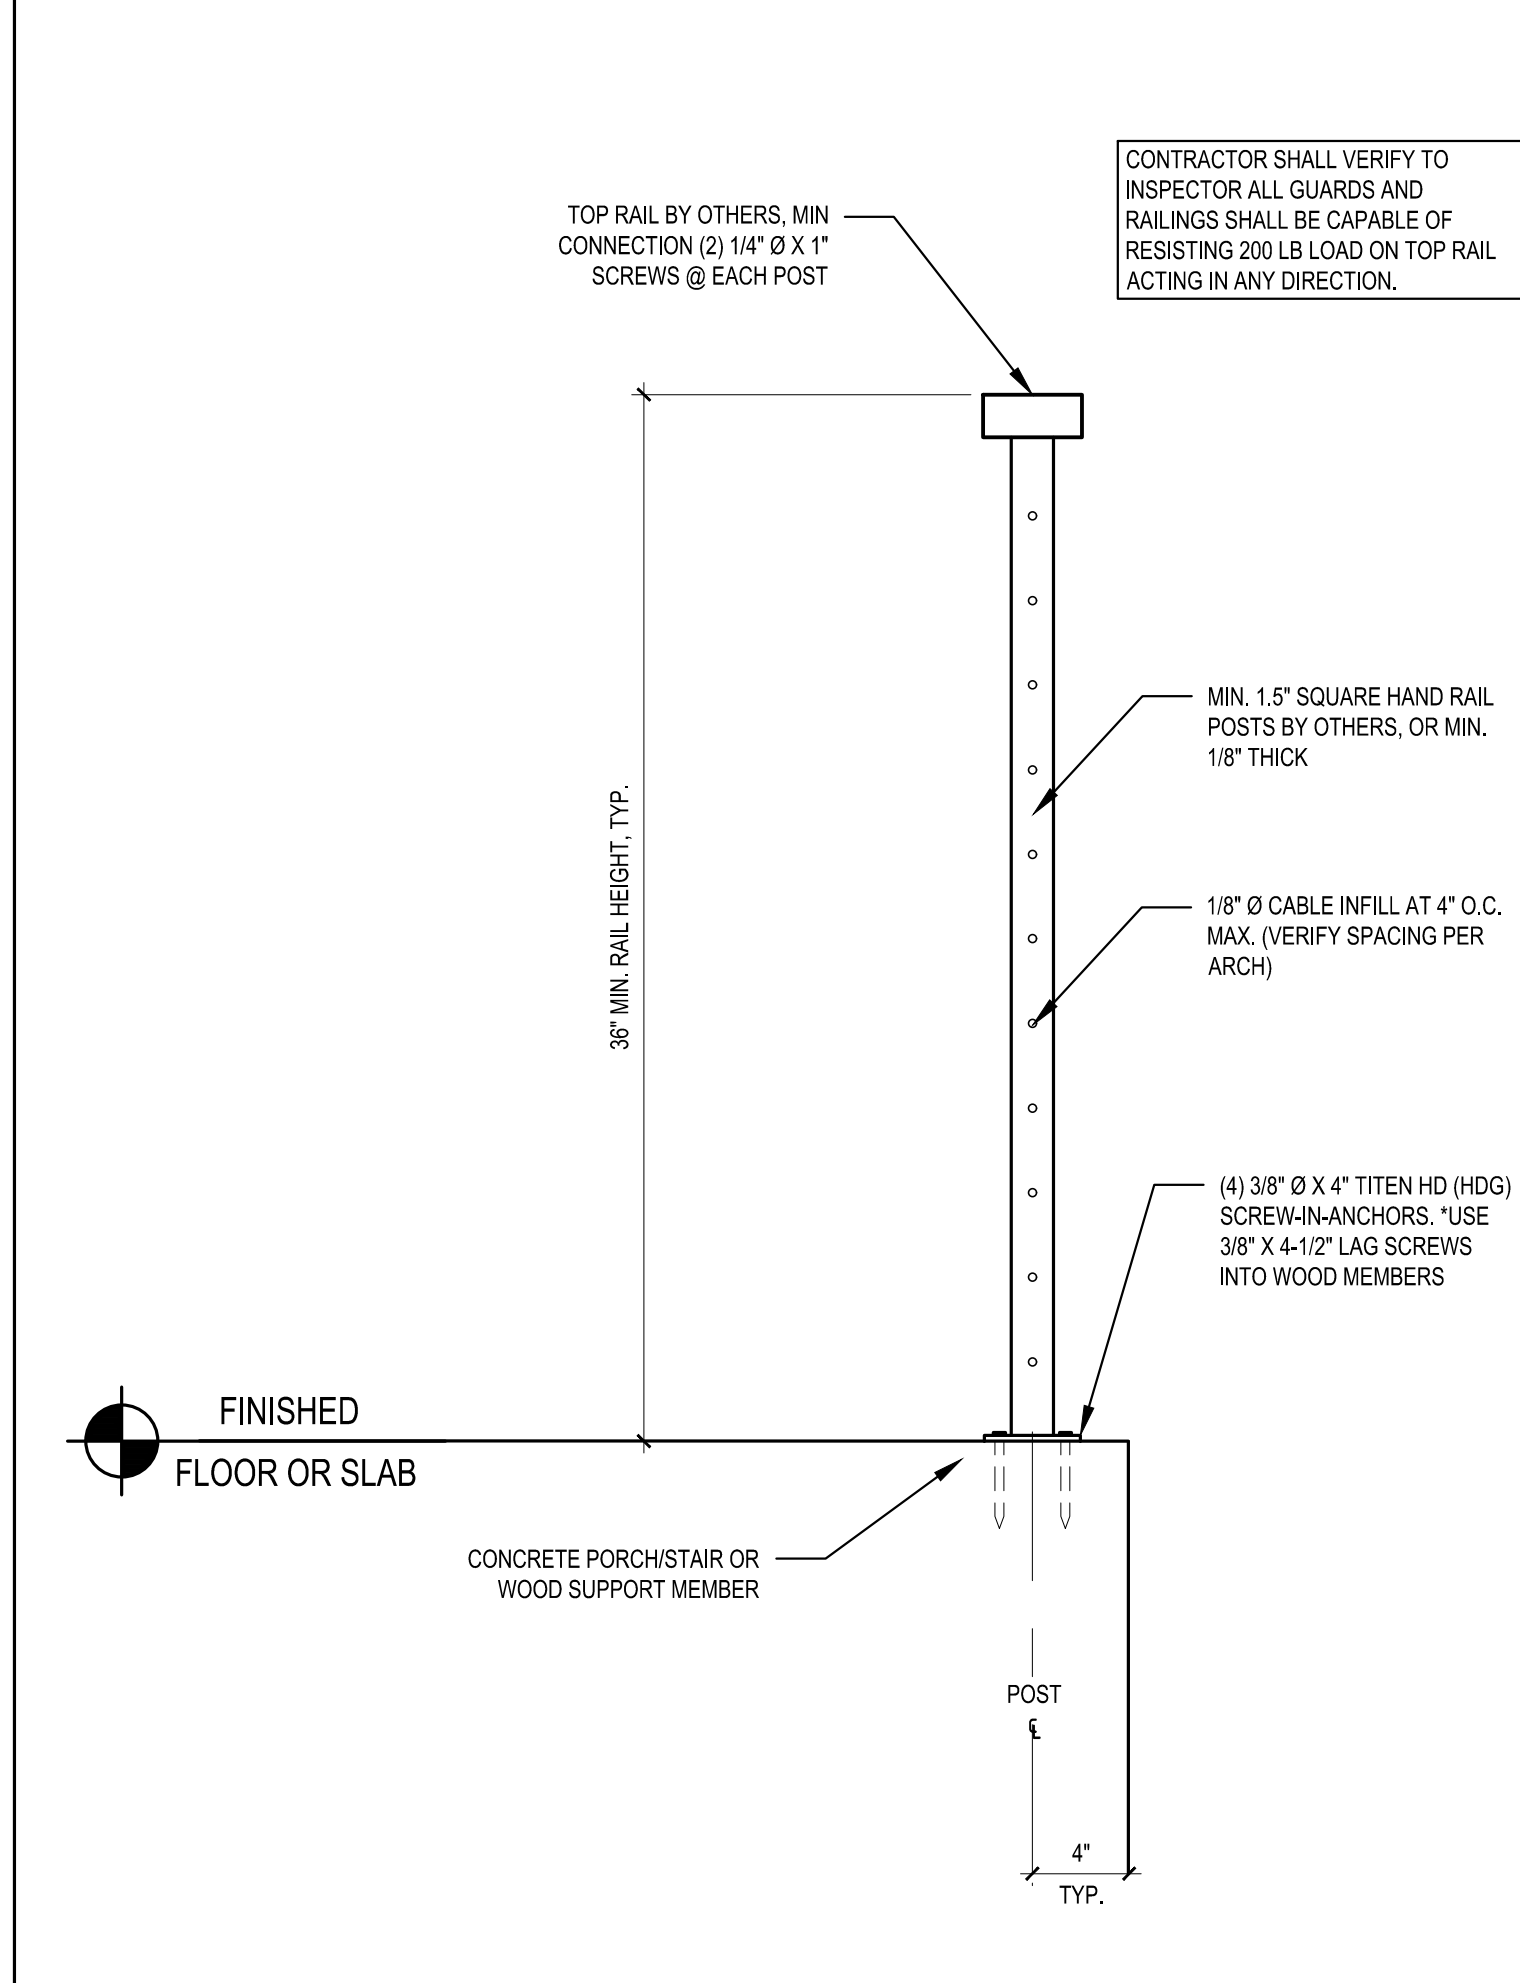



5 RAILING ATTACHMENT - TOP-MOUNTED
SCALE: 1-1/2" = 1'-0"

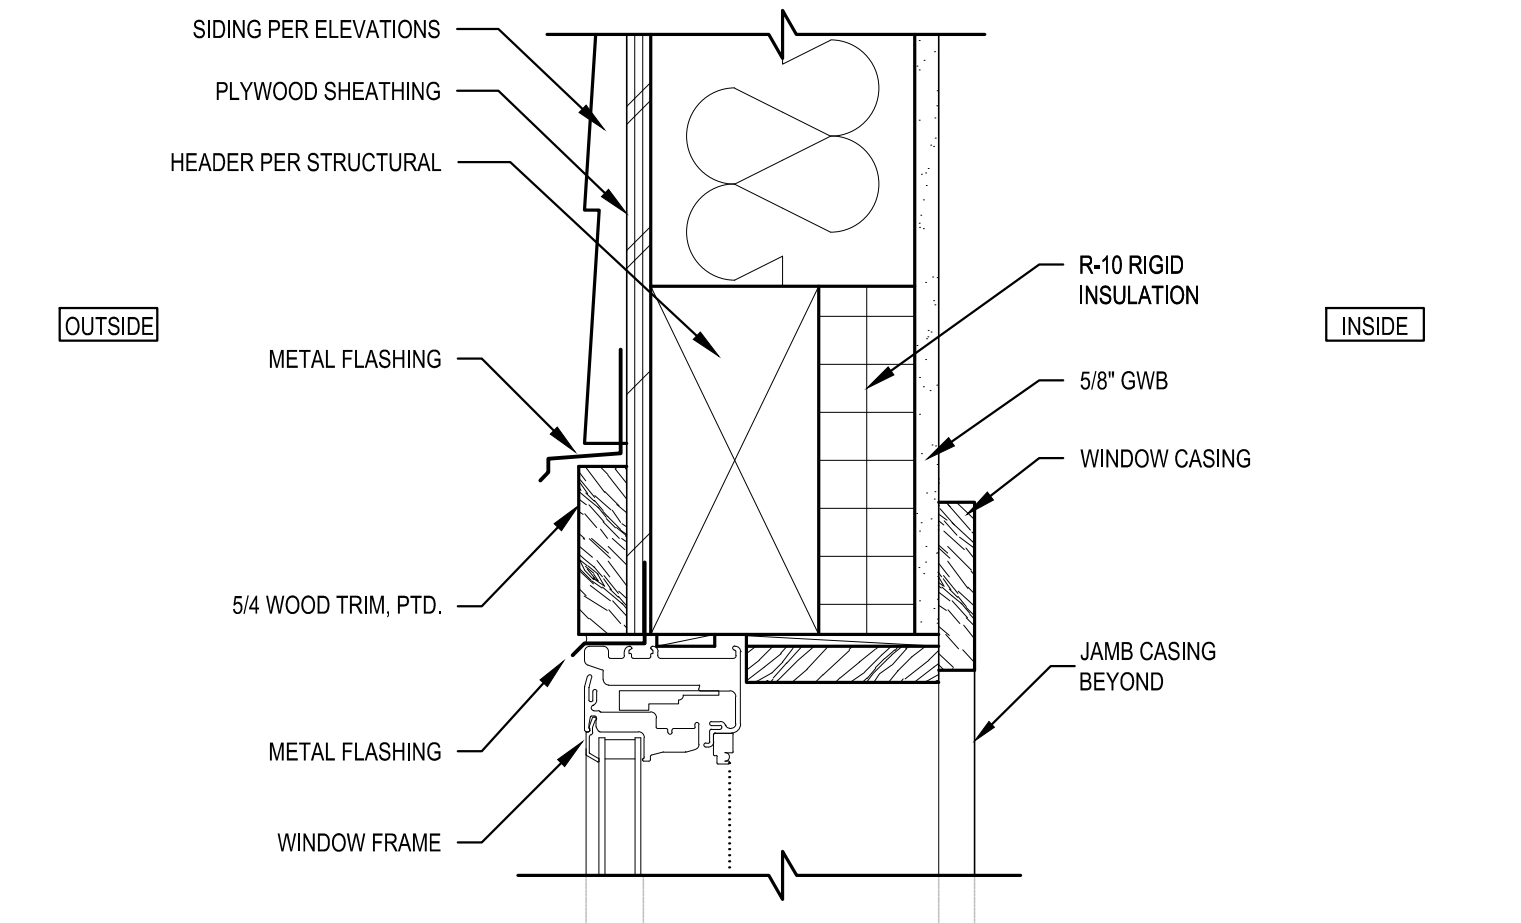


6 TYPICAL WINDOW HEAD DETAIL
SCALE: 3" = 1'-0"
SIM. AT WINDOW JAMB

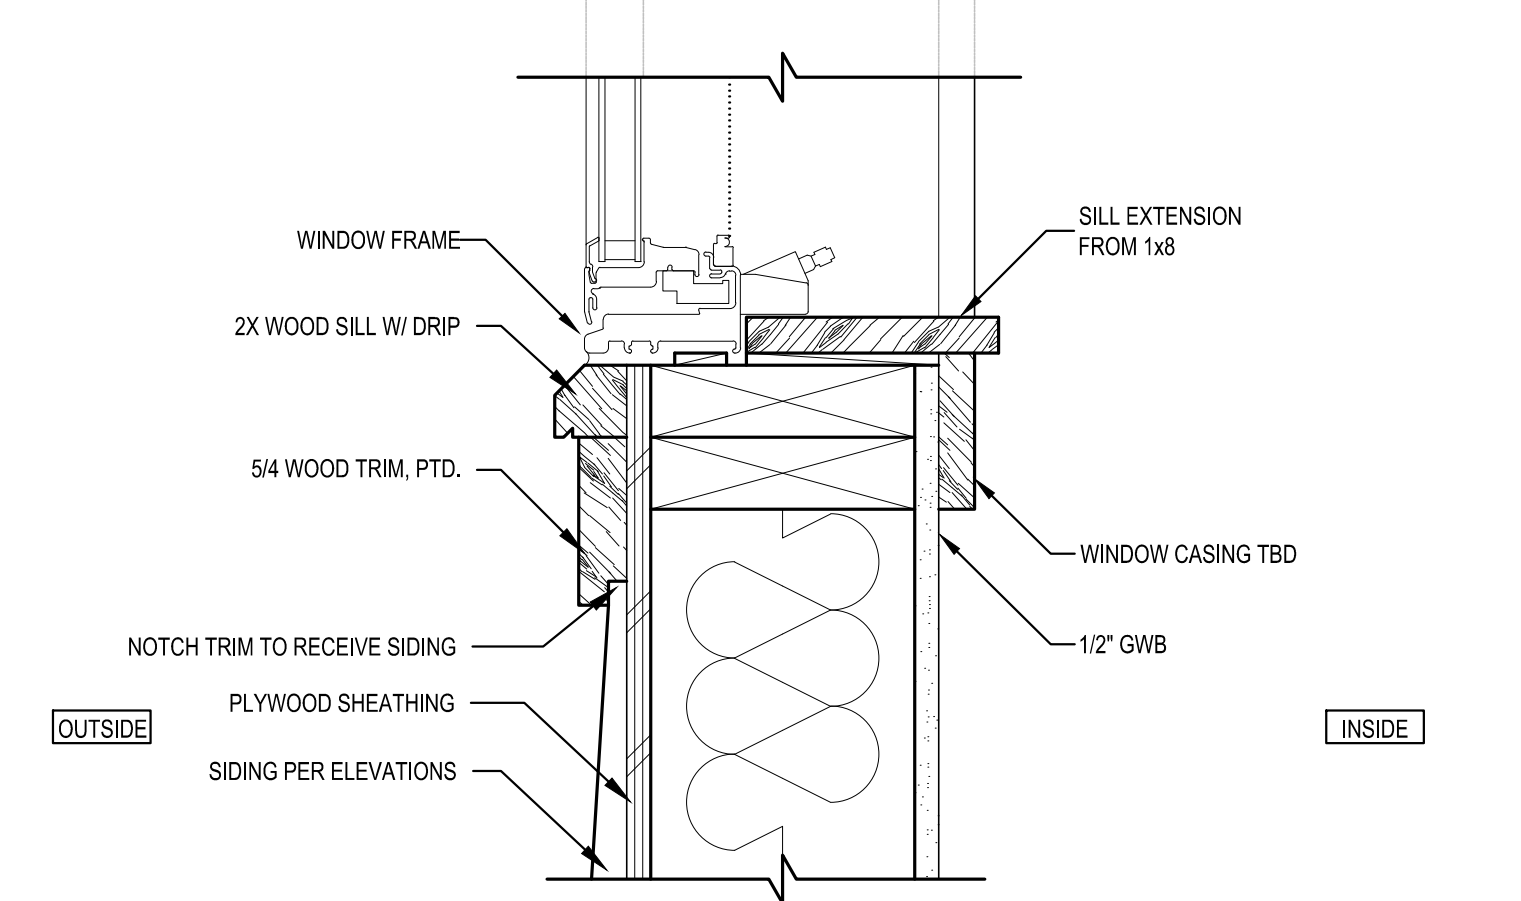


7 TYPICAL WINDOW SILL DETAIL
SCALE: 3" = 1'-0"

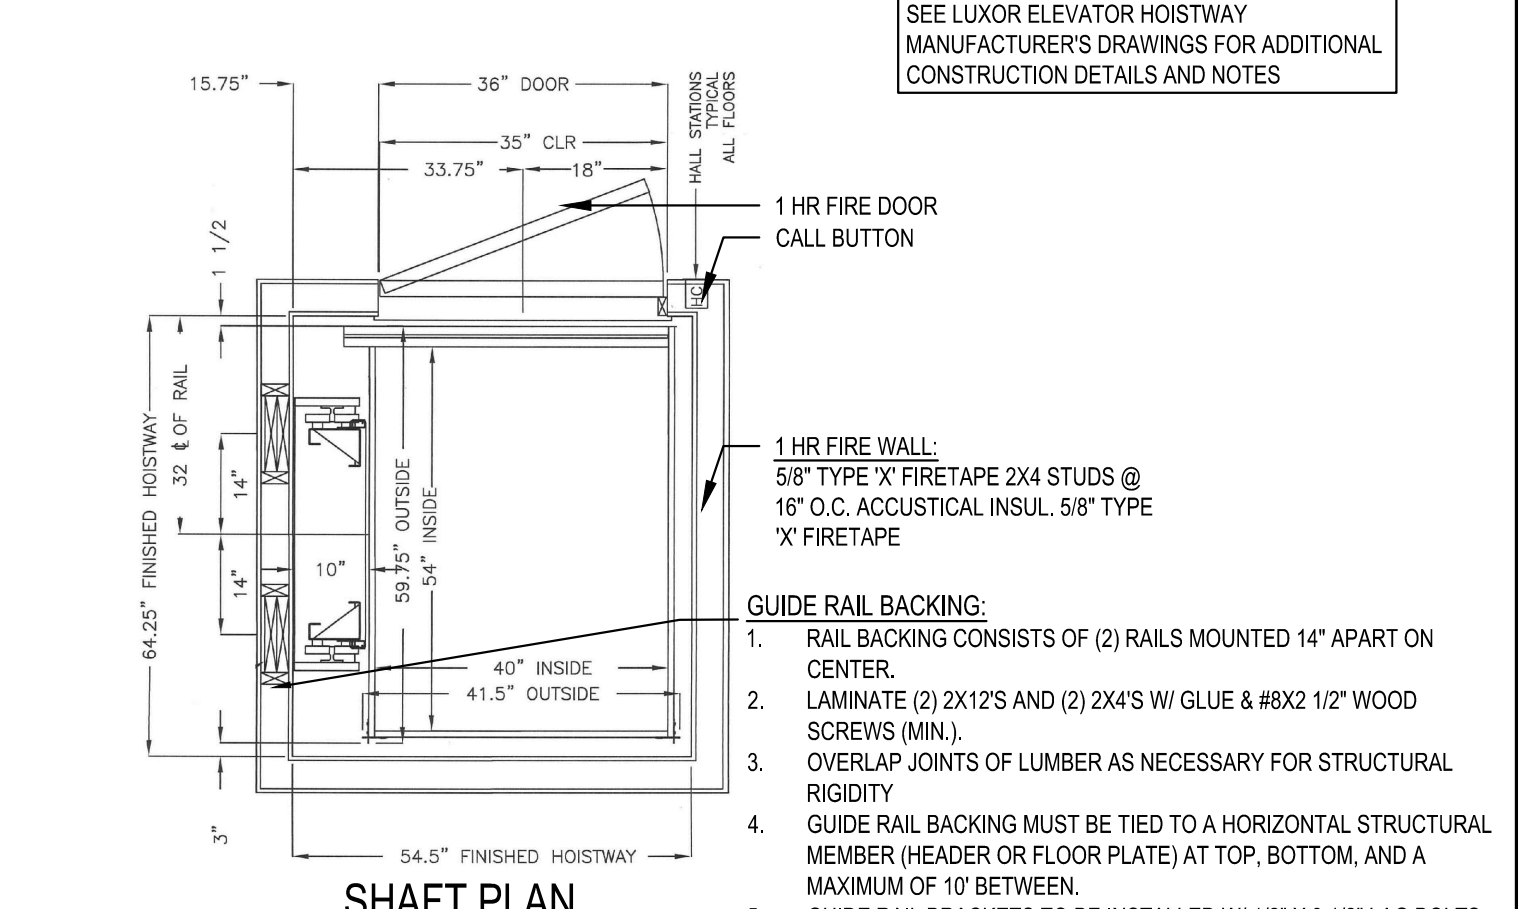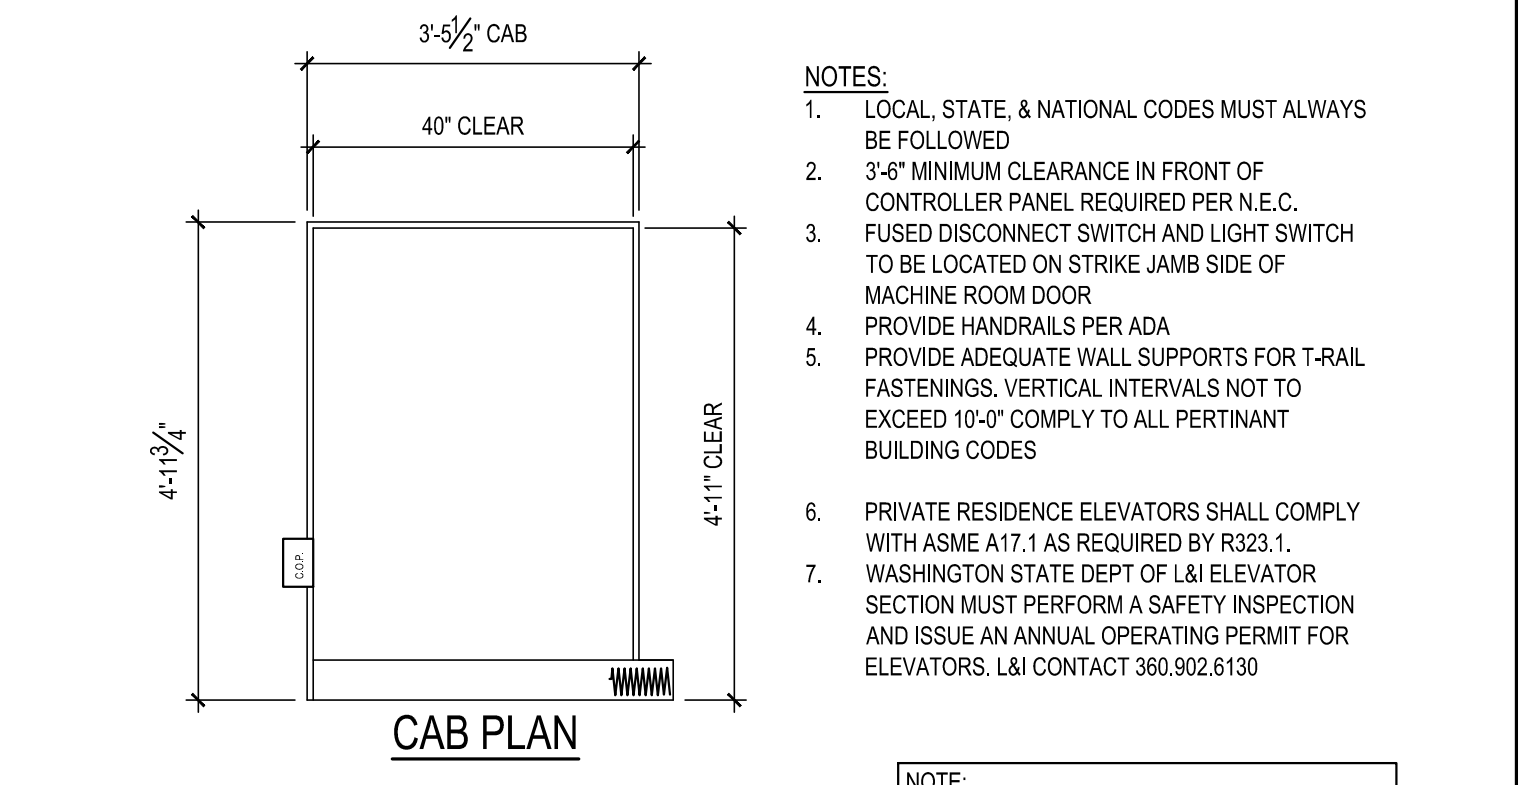

10 ELEVATOR PLAN
SCALE: 1/2" = 1'-0"

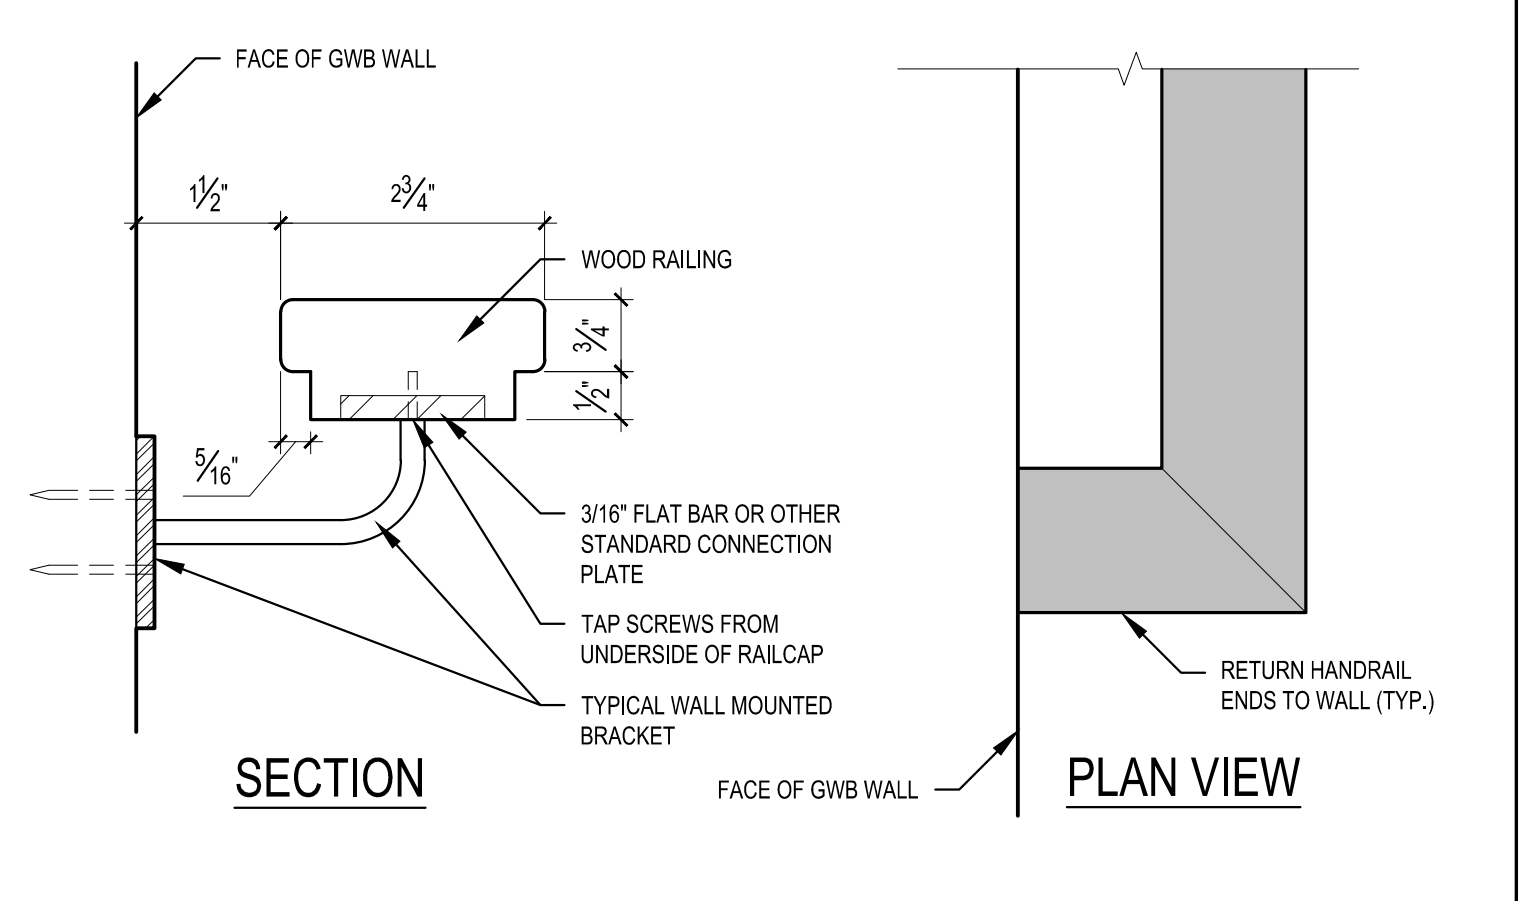

12 HANDRAIL DETAIL
SCALE: 6" = 1'-0"

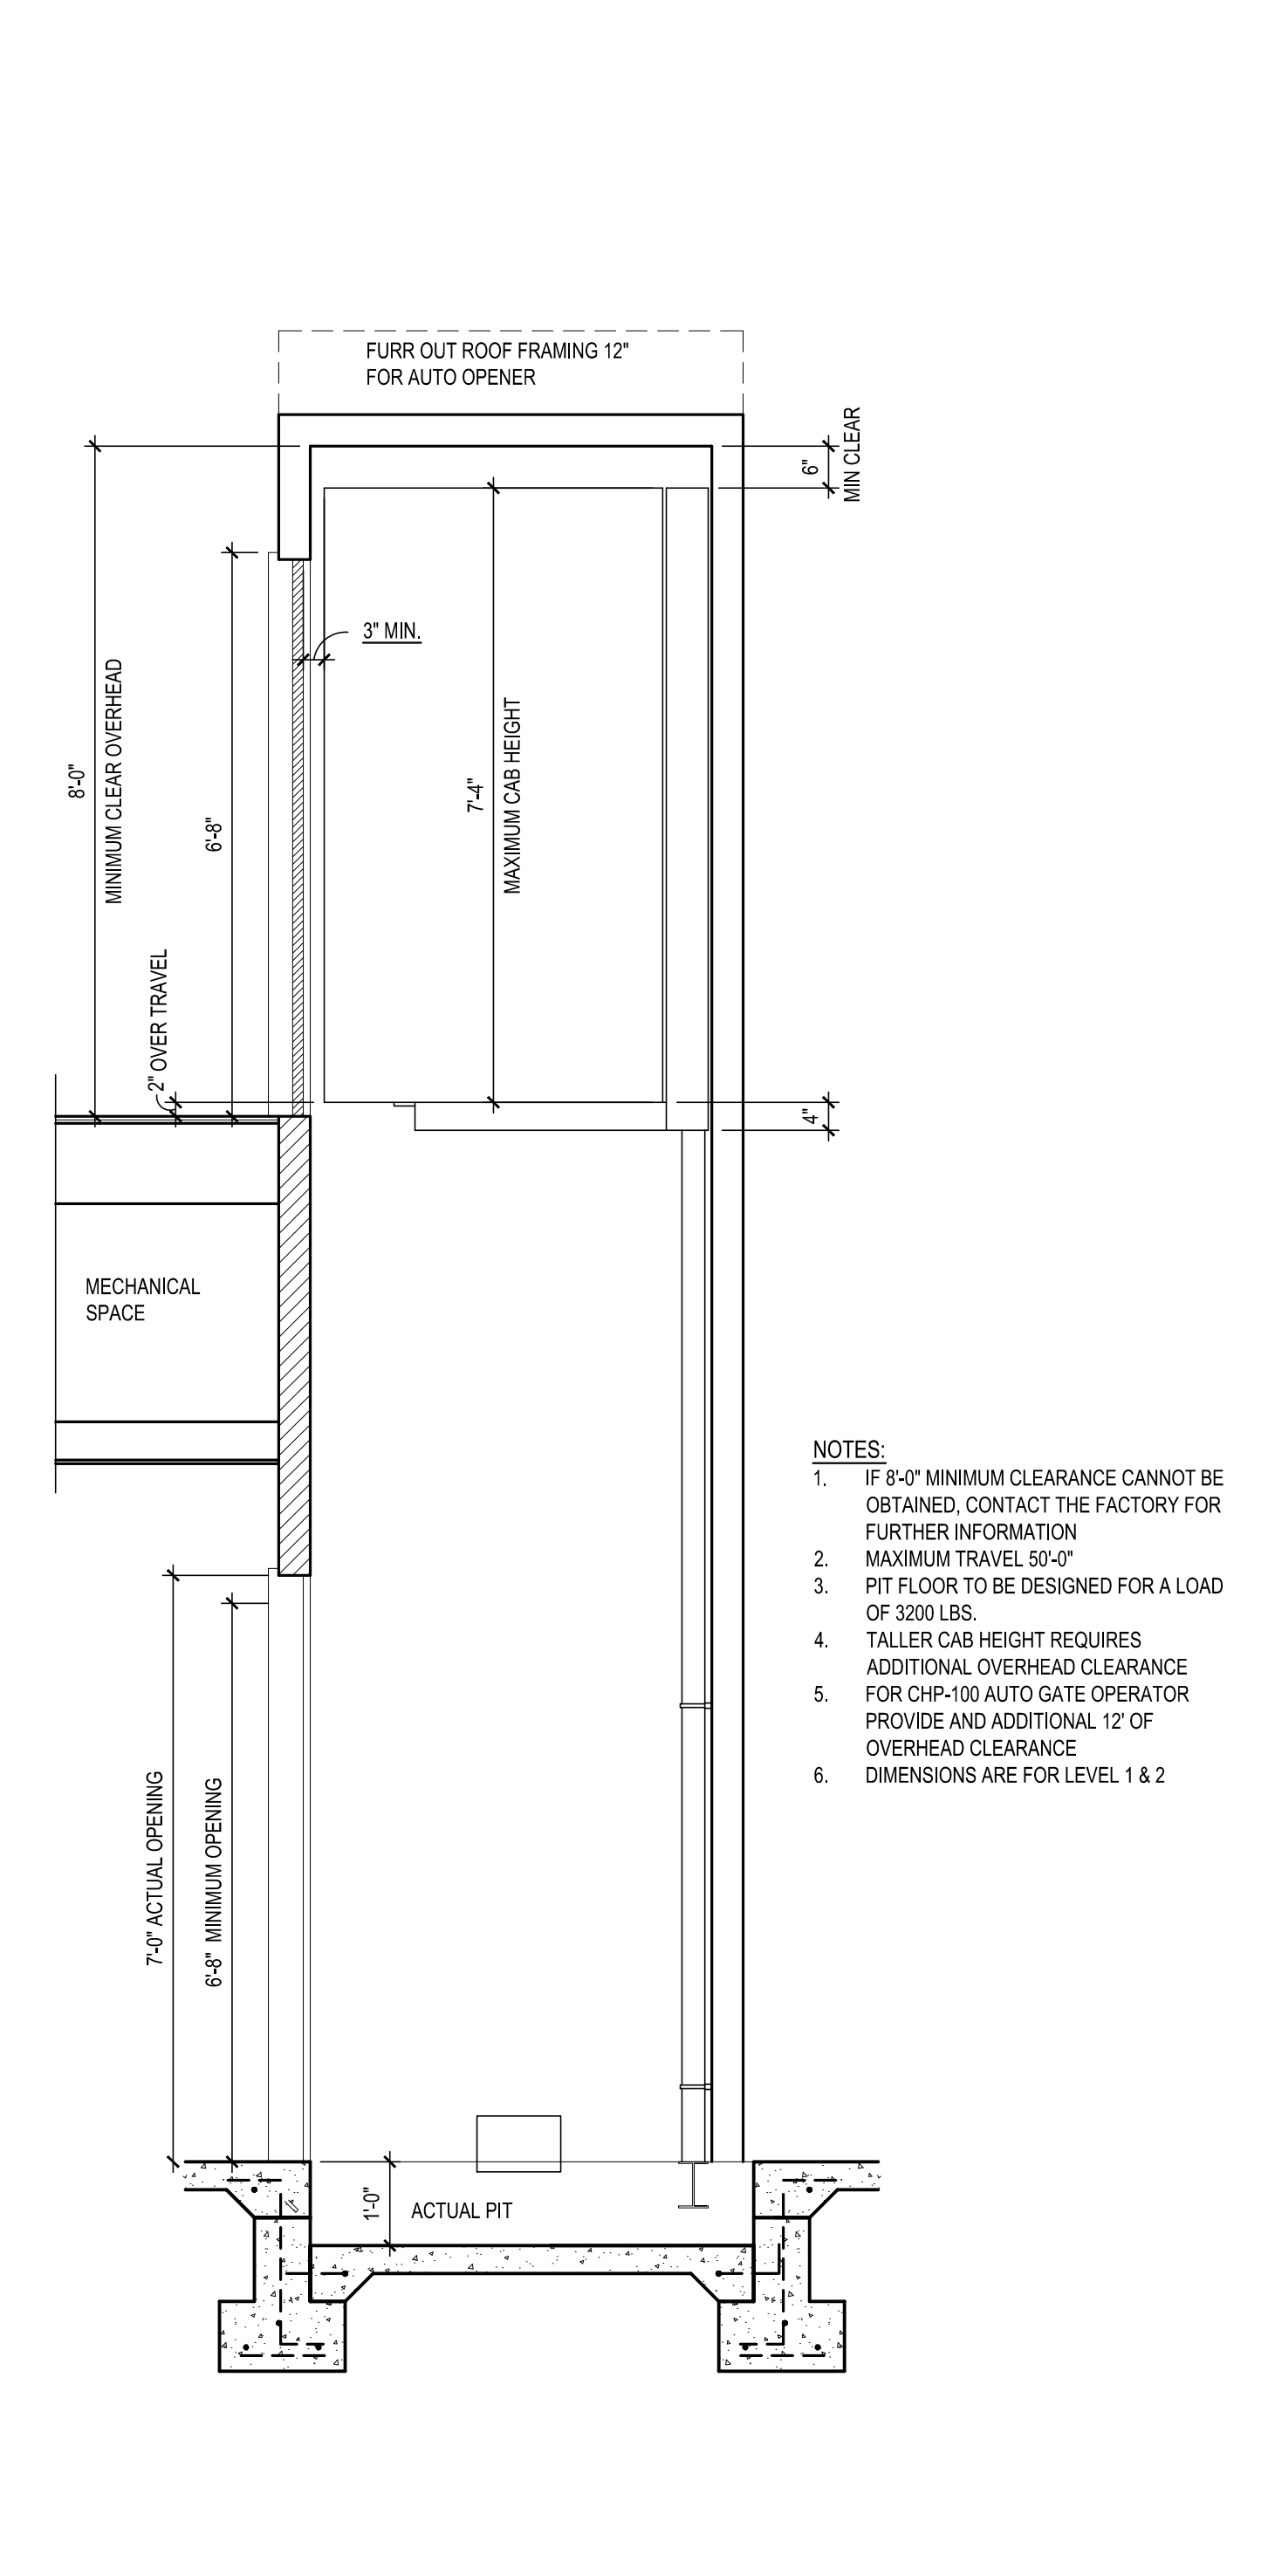

11 ELEVATOR SECTION
SCALE: 1/2" = 1'-0"

SCALE: IF SHEET IS LESS THAN 24" X 36", IT IS A REDUCED PRINT; REDUCE SCALE ACCORDINGLY

PERMIT SET 9/06/19

STURMAN ARCHITECTS

TEL (425) 451-7003

9 103rd Avenue NE Suite 203 Bellevue, WA 98004

REGISTERED ARCHITECT

BRADLEY J. STURMAN STATE OF WASHINGTON

www.sturmanarchitects.com All Rights Reserved © 2019

BAYLEY RESIDENCE PERMIT SET

6060 E. MERCER WAY MERCER ISLAND, WA 98040

PHASE 2 EXTERIOR DETAILS

REVISIONS:

2019-08-21	DESIGN REVISIONS	
2019-04-04	DESIGN REVISIONS	

DRAWN BY: KE

CHECKED BY: BJS

SHEET A5.0

PLOT DATE: 9/6/2019

THE BAYLEY RESIDENCE REMODEL

S190326-2

PROJECT INFORMATION

CLIENT
RON & JOAN BAYLEY
6060 E MERCER WAY
MERCER ISLAND, WA 98040

PROJECT ADDRESS
6060 E MERCER WAY
MERCER ISLAND, WA 98040

ARCHITECT
STURMAN ARCHITECTS
9 103RD AVENUE NE SUITE 203
BELLEVUE, WA 98004
PHONE: (425) 451- 7003
CONTACT: BRAD STURMAN

STRUCTURAL ENGINEER
L120 ENGINEERING & DESIGN
16329 118TH LN NE
BOTHELL, WA 98011
PHONE: (206) 790-9502
CONTACT: MANS THURFJELL, PE

CODES

ENGINEERED PER:
2015 (SRC) SEATTLE RESIDENTIAL CODE
2015 (SBC) SEATTLE BUILDING CODE


SHEET INDEX

COVER SHEET...S-0
STRUCTURAL GENERAL NOTES...S-1
FOUNDATION PLAN...S-2
BASEMENT WALL FRAMING AND SHEAR WALL PLAN...S-3
FIRST FLOOR FRAMING PLAN...S-4
FIRST FLOOR WALL FRAMING AND SHEAR WALL PLAN...S-5
SECOND FLOOR FRAMING PLAN...S-6
SECOND FLOOR WALL FRAMING AND SHEAR WALL PLAN...S-7
ROOF FRAMING PLAN...S-8

STRUCTURAL DETAILS...SD-1
STRUCTURAL DETAILS...SD-2
STRUCTURAL DETAILS...SD-3



LONGITUDE
ONE TWENTY^o
ENGINEERING & DESIGN

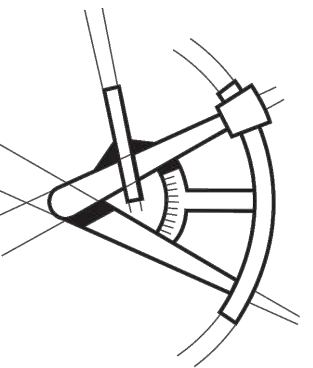

REVISIONS

DESCRIPTION	DATE	BY
- CLIENT REVISIONS - V2	8-20-2019	(PHASE 1)
CLIENT REVISIONS - P2	9-6-2019	(PHASE 2)

PROJECT NAME

THE BAYLEY
RESIDENCE REMODEL

PROJECT NUMBER

S190326-2

DRAWN BY - MR

CHECKED BY - MRT

SHEET DATE - 08/30/2019

SCALE

24X36 SHEET: 1/4" = 1'-0"




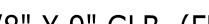



DESCRIPTION
COVER SHEET



PHASE 2
REVISIONS
S-0
SHEET

ROOF FRAMING NOTES

- GENERAL STRUCTURAL NOTES AND ABBREVIATIONS PER SHEET S-1.
- VERIFY ALL DIMENSIONS AND ELEVATIONS WITH ARCH.
- ROOF SHEATHING PER GENERAL NOTES. ALL SHEATHING TO BE GLUED AND NAILED TO FRAMING PER MANUFACTURER RECOMMENDATIONS. USE 8d COMMON NAILS (0.131" X 2 1/2") @ 6" O.C. AT PANEL EDGES AND AT ALL FRAMING DESIGNATED "WITH EDGE NAILING" OR "W/EN", AND 12" O.C. IN THE FIELD, UNO. PANEL EDGE JOINTS TO BE STAGGERED BETWEEN ADJACENT PANELS OF SHEATHING. PROVIDE GAP BETWEEN PANELS TO ALLOW FOR NATURAL EXPANSION/CONTRACTION (1/8" GAP TYP).
- ALL ROOF TRUSSES SHALL BE SPACED NO FURTHER APART THAN 24" O.C. AND SHALL BE CONNECTED TO TOP PLATE WITH H2.5 TIE UNO.
- ALL GIRDER TRUSSES SHALL BE CONNECTED TO TOP PLATE WITH TWO H6 TIES UNO.
- LOCATE ALL OPENINGS AND PENETRATIONS AND VERIFY NO CONFLICT WITH ROOF FRAMING, MECHANICAL, ELECTRICAL, AND PLUMBING DRAWINGS BY OTHERS.
- ALL BEAMS AND GIRDER TRUSSES SHALL BE SUPPORTED BY MIN TWO STUDS BELOW EACH END, UNLESS NOTED OTHERWISE ON PLAN. ALL BEAMS SHALL BE FRAMED FLUSH WITH JOISTS UNO. "DROPPED BEAM" OR "DB" INDICATES T/BEAM EQUAL B/JOISTS. "TOP FLUSH" OR "TF" INDICATES T/BEAM EQUAL T/JOISTS AND B/BEAM EXTENDING BELOW B/JOISTS. "BOTTOM FLUSH" OR "BF" INDICATES B/BEAM EQUAL B/JOISTS AND T/BEAM EXTENDING ABOVE T/JOISTS.
- ALL NON-BEARING WALLS TO BE FRAMED MIN 0.25" UNDER FLOOR SYSTEM.
- STUD QUANTITIES, POST SIZE, HOLDOWN, AND SHEARWALL REQUIREMENTS PER WALL FRAMING AND SHEARWALL PLAN BELOW.
- HORIZONTAL STRAPS INDICATED ON FRAMING PLANS SHALL BE CENTERED OVER THE TOP PLATE, BEAM, OR BLOCKING. STRAP LENGTH PER PLAN UNO.
- ALL HANGERS TO BE MANUFACTURED BY SIMPSON STRONG-TIE. INSTALLATION PER MANUFACTURER'S RECOMMENDATIONS. ALTERNATIVE SOLUTIONS SHALL BE SUBMITTED TO EOR FOR APPROVAL PRIOR TO INSTALLATION. REFER TO TYPICAL HANGER SCHEDULE FOR HANGER SIZE UNO ON PLAN OR DETAILS. HANGERS FOR ROOF TRUSSES BY OTHERS.
- ENGINEERED ROOF JOISTS AND ROOF TRUSSES TO BE DESIGNED BY OTHERS. REFER TO STRUCTURAL GENERAL NOTES FOR SUBMITTAL INFORMATION, AND DESIGN CRITERIA.
 - STANDARD DEAD AND LIVE LOADS SHALL BE USED FOR TRUSS DESIGN. REFERENCE STRUCTURAL GENERAL NOTES FOR MORE INFORMATION.
 - CHANGES TO LAYOUT MUST BE SUBMITTED TO THE ARCHITECT AND EOR FOR REVIEW AND APPROVAL.
 - TRUSS SUBMITTAL PACKAGE TO BE PROVIDED TO EOR FOR REVIEW. REFERENCE STRUCTURAL GENERAL NOTES FOR SUBMITTAL REQUIREMENTS.
 - (XXX LBS SHEAR/DRAW) INDICATES SHEAR TRANSFER LOAD. SHEAR TRUSS SHALL BE DESIGNED TO BE ABLE TO TRANSFER SPECIFIED LATERAL LOAD APPLIED AT THE TOP CHORD TO THE BOTTOM CHORD AND INTO SHEARWALL BELOW.
 - ROOF TRUSSES SHOULD BE DESIGNED FOR ADDITIONAL LOADS WHERE APPLICABLE AS SPECIFIED BY THE ARCHITECT (I.E. MECHANICAL UNITS, ROOF DECKS AND PATIOS, GREEN ROOFS, SOLAR UNITS AND ETC).
 - TRUSS DESIGN FOR BEARING AT TOP PLATES TO BE DESIGNED FOR COMPRESSION PERPENDICULAR TO GRAIN.
- FIRE-PROOFING AND MOISTURE-PROOFING REQUIREMENTS BY OTHERS.
- ROOF COVERINGS AND ROOFING MATERIAL BY OTHERS.
- ROOF DRAINAGE BY OTHERS.
- ATTIC VENTILATION BY OTHERS.
- FOR TYPICAL INSTALLATION DETAILS REFERENCE TO:
 - 13/SD-1 TYP DROPPED BEAM AT CUT PLATES
 - 14/SD-1 TYP BEAM-TO-BEAM AND BEAM-TO-BLKG DRAG CONNECTION
 - 15/SD-1 TYP BEAM-TO-T/PL DRAG CONNECTION
 - 16/SD-1 TYP BEAM-TO-BLKG-TO-T/PL CONNECTION
 - 17/SD-1 TYP NON-LOAD BEARING WALL FRAMING
 - 4/SD-2 TYP HIP ROOF FRAMING
 - 5/SD-2 TYP GABLE END ROOF FRAMING
 - 6/SD-2 TYP ROOF OVERFRAMING
 - 7/SD-2 TYP INTERIOR SHEAR TRUSS
 - 8/SD-2 TYP INTERIOR OFFSET SHEAR TRUSS
 - 9/SD-2 TYP TRUSS BLOCKING

FRAMING LEGEND


-  - GIRDER OR GABLE END TRUSS
-  - INTERIOR BEARING WALL
-  - ROOF OVERFRAMING
-  3 1/8" X 9" GLB (FH-5) - EXAMPLE REFERENCE TO BEAM OR TRUSS CALCULATION IN CALCULATION PACKAGE BEAM OR TRUSS MEMBER
-  - HANGER AS REQD
-  FLOOR/ROOF TRUSS OR JOIST SPAN DIRECTION
-  EXTENTS OF SIMILAR JOISTS OR TRUSSES

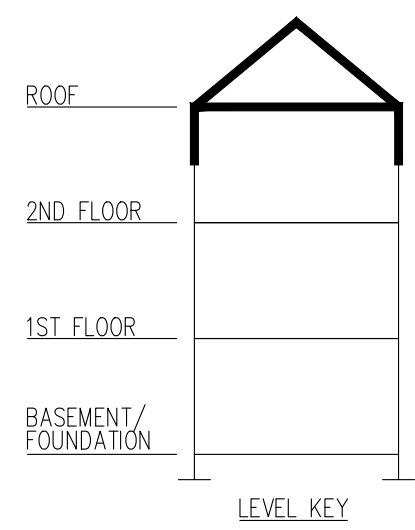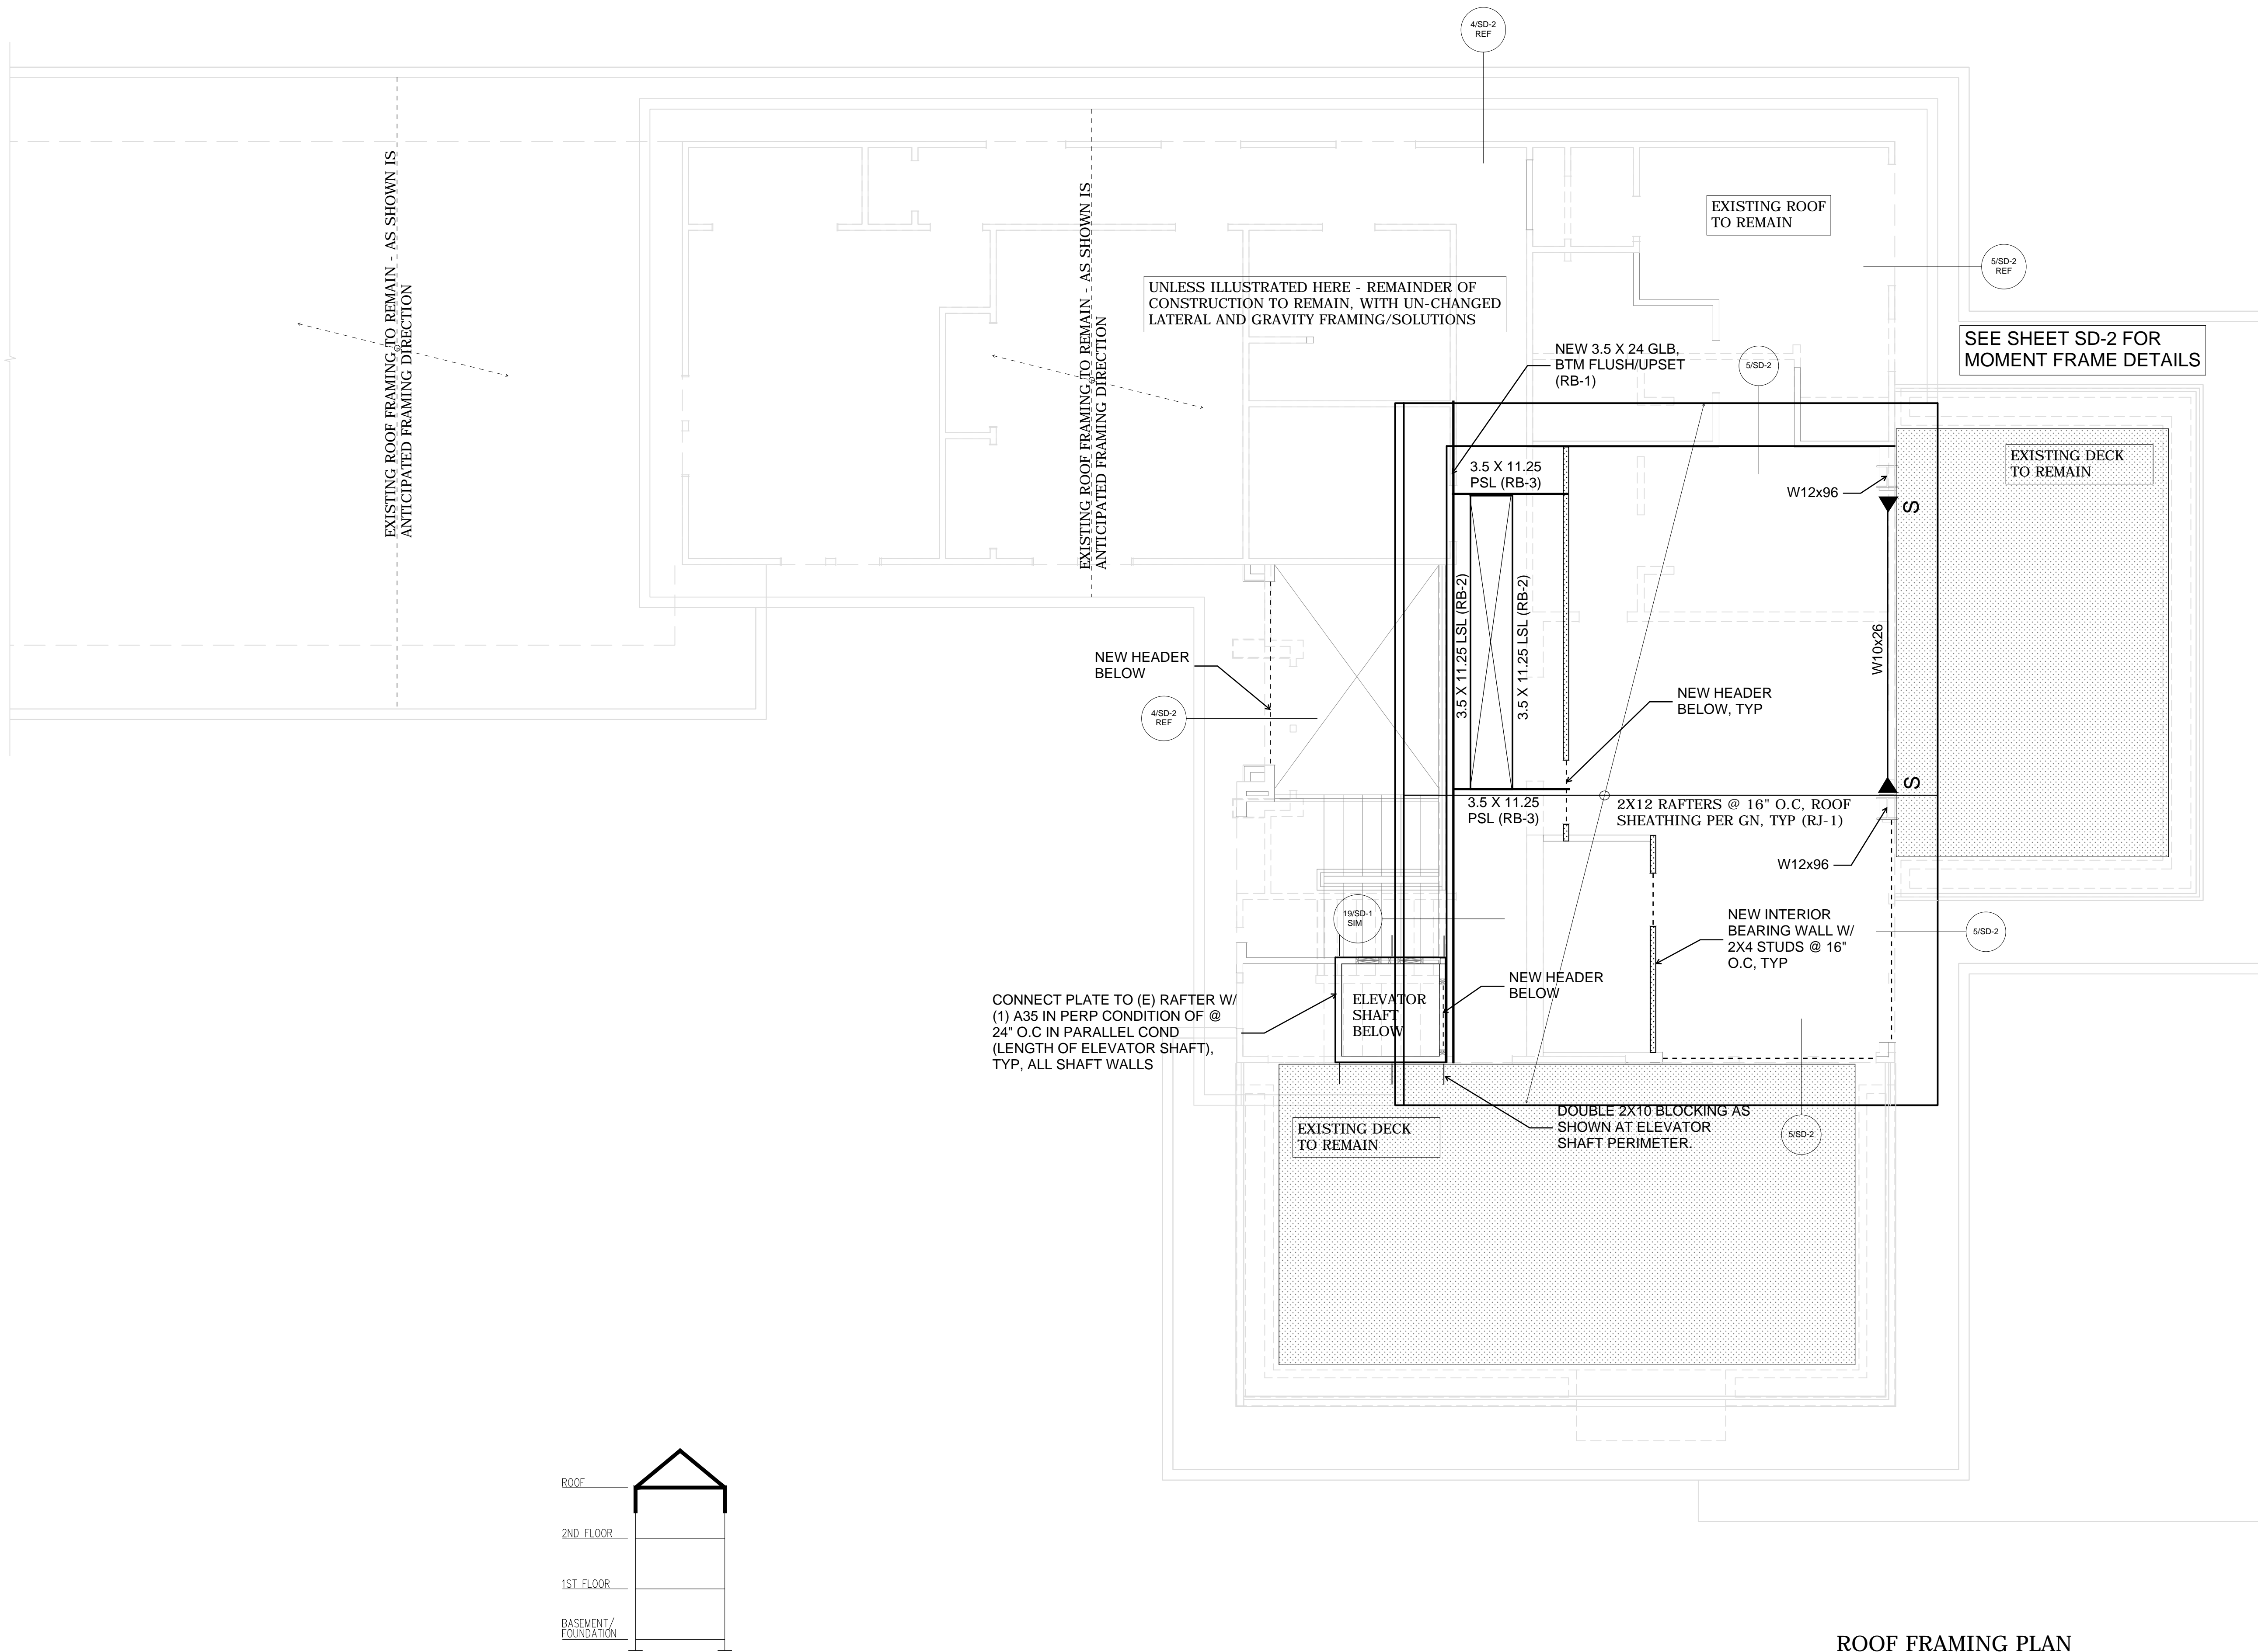

ROOF FRAMING PLAN



LONGITUDE ONE TWENTY ENGINEERING & DESIGN

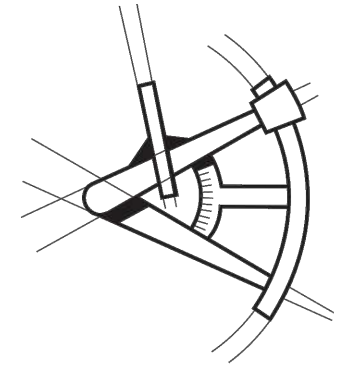

REVISIONS			
NO.	DESCRIPTION	DATE	BY
-	CLIENT REVISIONS - V2	8-20-2019	(PHASE 1)
-	CLIENT REVISIONS - P2	9-6-2019	(PHASE 2)

PROJECT NAME
THE BAYLEY RESIDENCE REMODEL

PROJECT NUMBER
S190326-2

DRAWN BY - MR


CHECKED BY - MRT

SHEET DATE - 08/30/2019

SCALE
24X36 SHEET: 1/4" = 1'-0"


DESCRIPTION
ROOF FRAMING PLAN
SHEET S-8
PHASE 2 REVISIONS

STEM WALL FOOTING SCHEDULE		
FOOTING WIDTH PER PLAN	FOOTING DEPTH	REINFORCEMENT
1'-4"	8"	(2)#4, CONT
2'-0"	10"	(3)#4, CONT
2'-6"	10"	(3)#4, CONT #4@12" O.C.

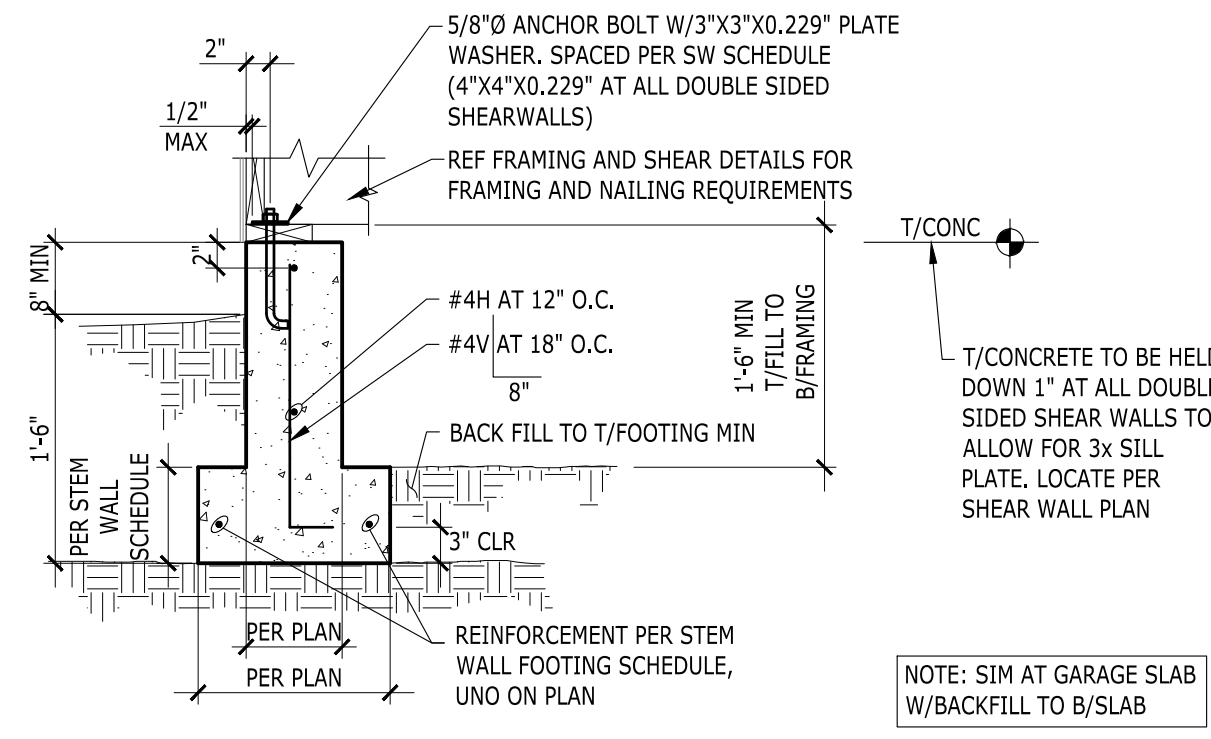


1 STEM WALL AT EXTERIOR

ISOLATED FOOTING SCHEDULE	
FOOTING SIZE PER PLAN	REINFORCEMENT
24" X 24" X 10"	(3)#4, EA WAY, BTM
30" X 30" X 10"	(3)#4, EA WAY, BTM
36" X 36" X 12"	(4)#4, EA WAY, BTM
48" X 48" X 12"	(5)#4, EA WAY, TOP/BTM
60" X 36" X 12"	(6)#4 SHORT, (4)#4 LONG, BTM

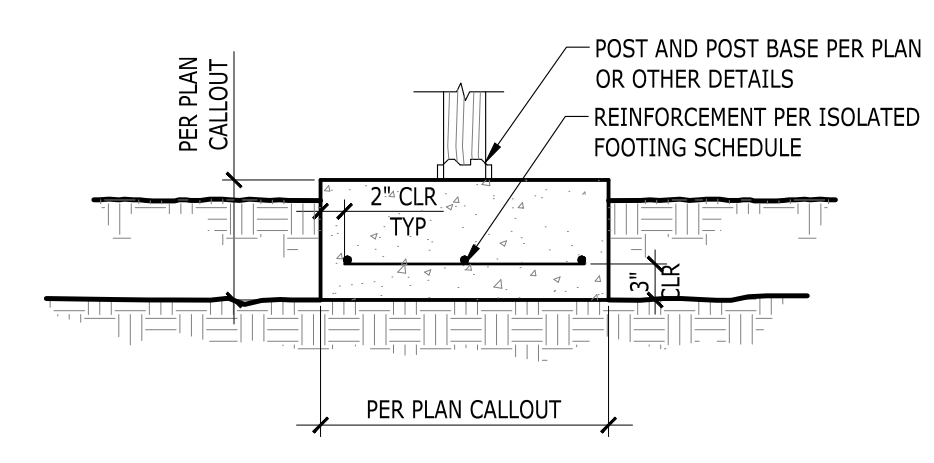


2 ISOLATED INTERIOR FOOTING

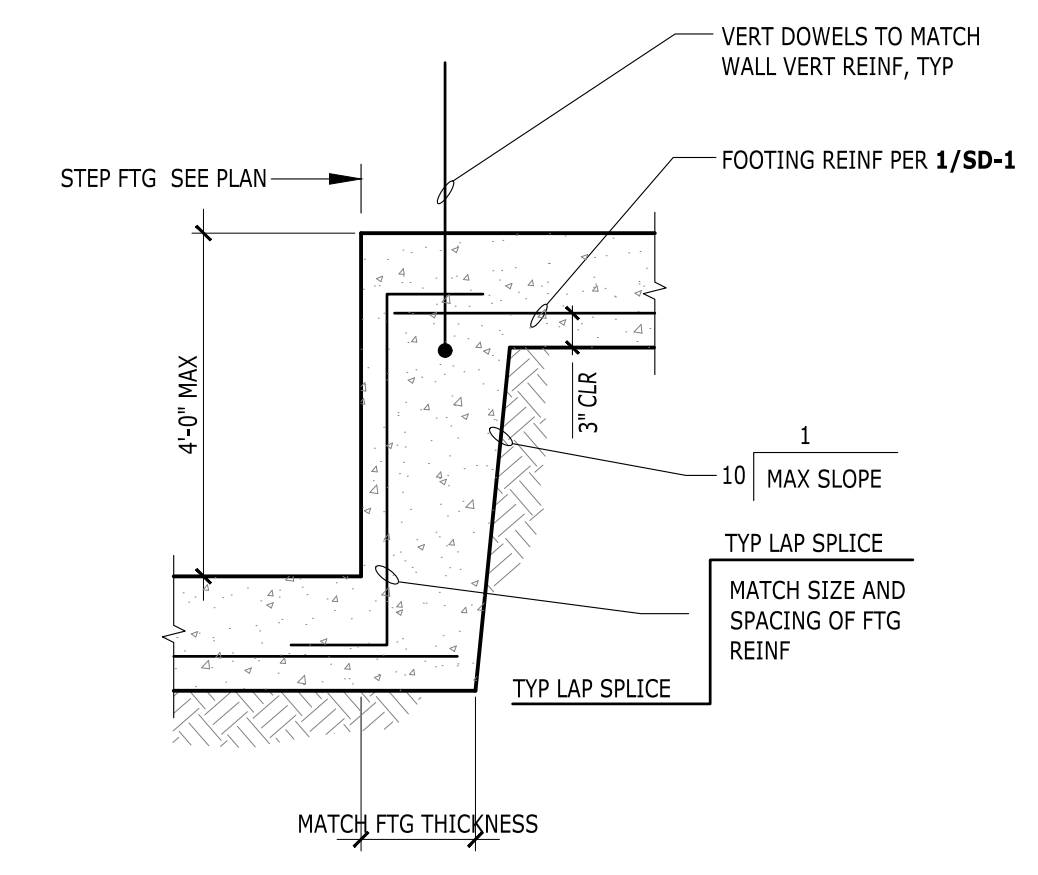


4 STEP AT WALL FOOTING

LAP SPLICE AND STANDARD HOOK LENGTH FOR CORNER BARS		
BAR SIZE PER WALL	LAP SPLICE LENGTH	STD HOOK LENGTH
#4	2'-6"	0'-8"
#5	3'-0"	0'-10"
#6	3'-8"	1'-0"
#8	5'-0"	1'-3"


IF INTERSECTING WALLS HAVE DIFFERENT SIZE OF HORIZONTAL REINFORCEMENT, CORNER BARS MATCHING LARGER REINFORCEMENT SIZE AND SPACING TO BE USED

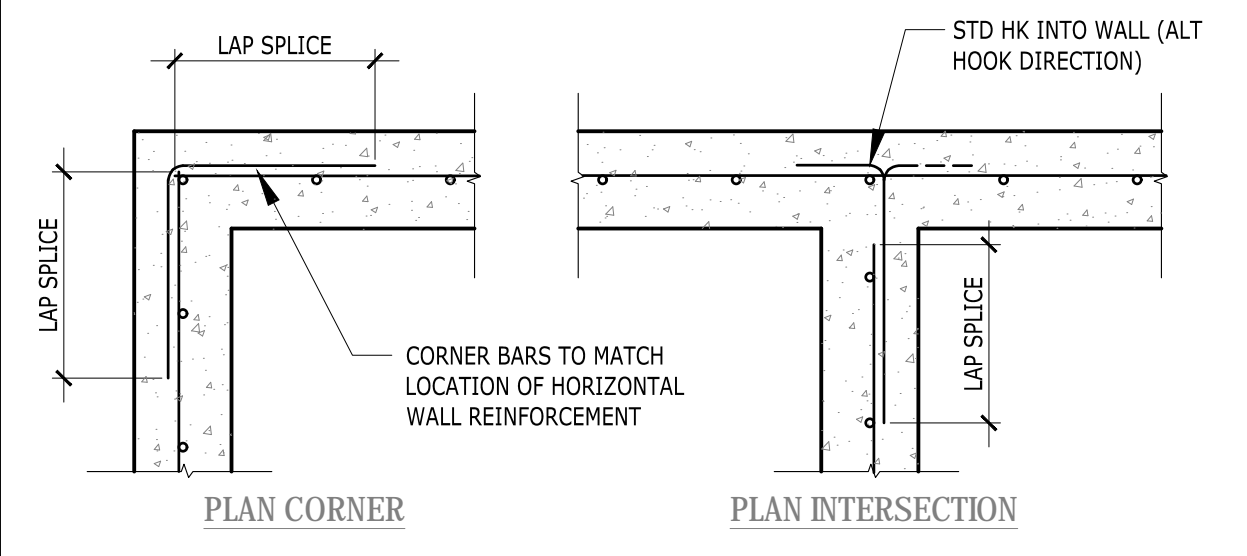


5 CORNER BARS AT CONCRETE WALLS

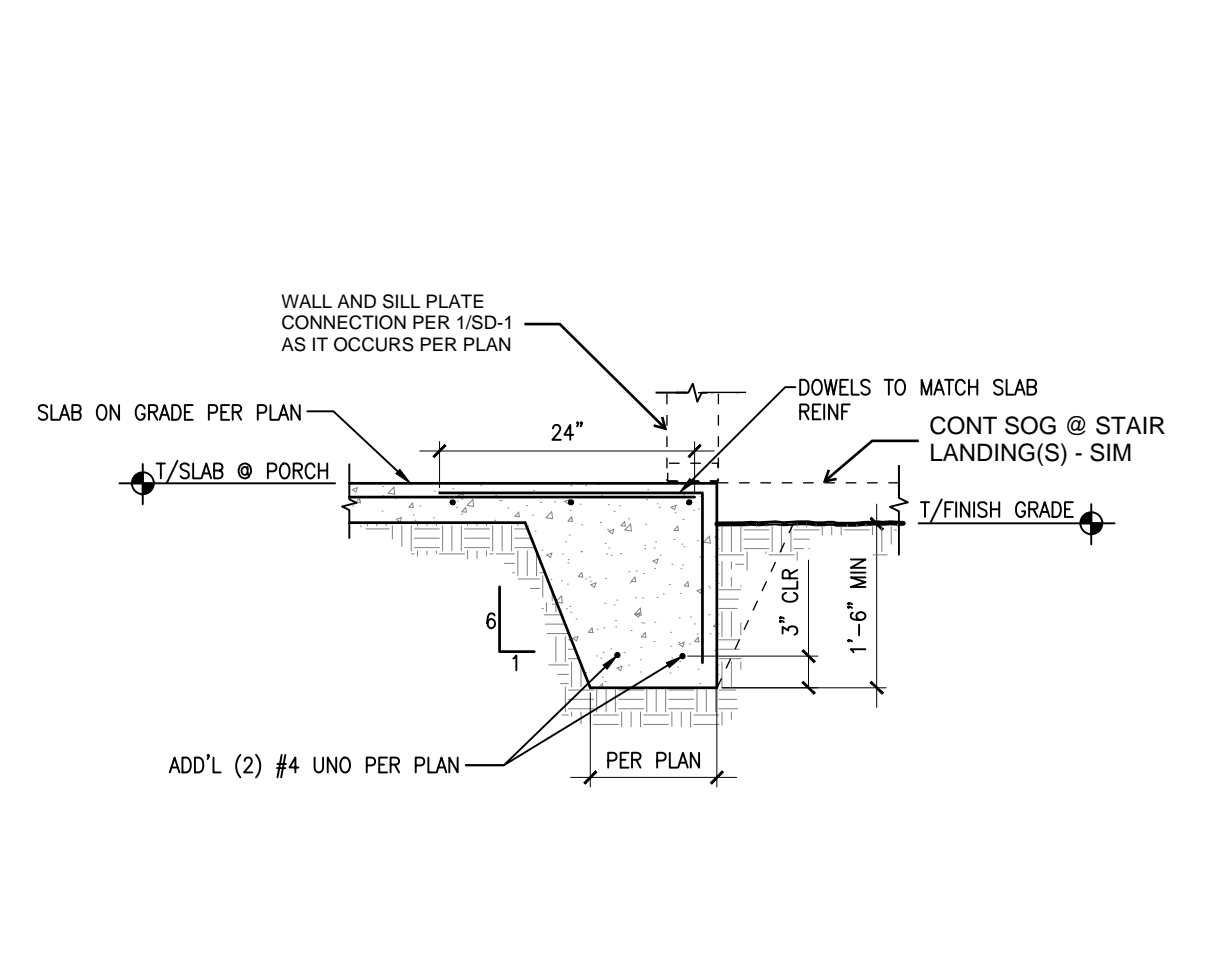


6 TYPICAL THICKENED SLAB EDGE TURN DOWN

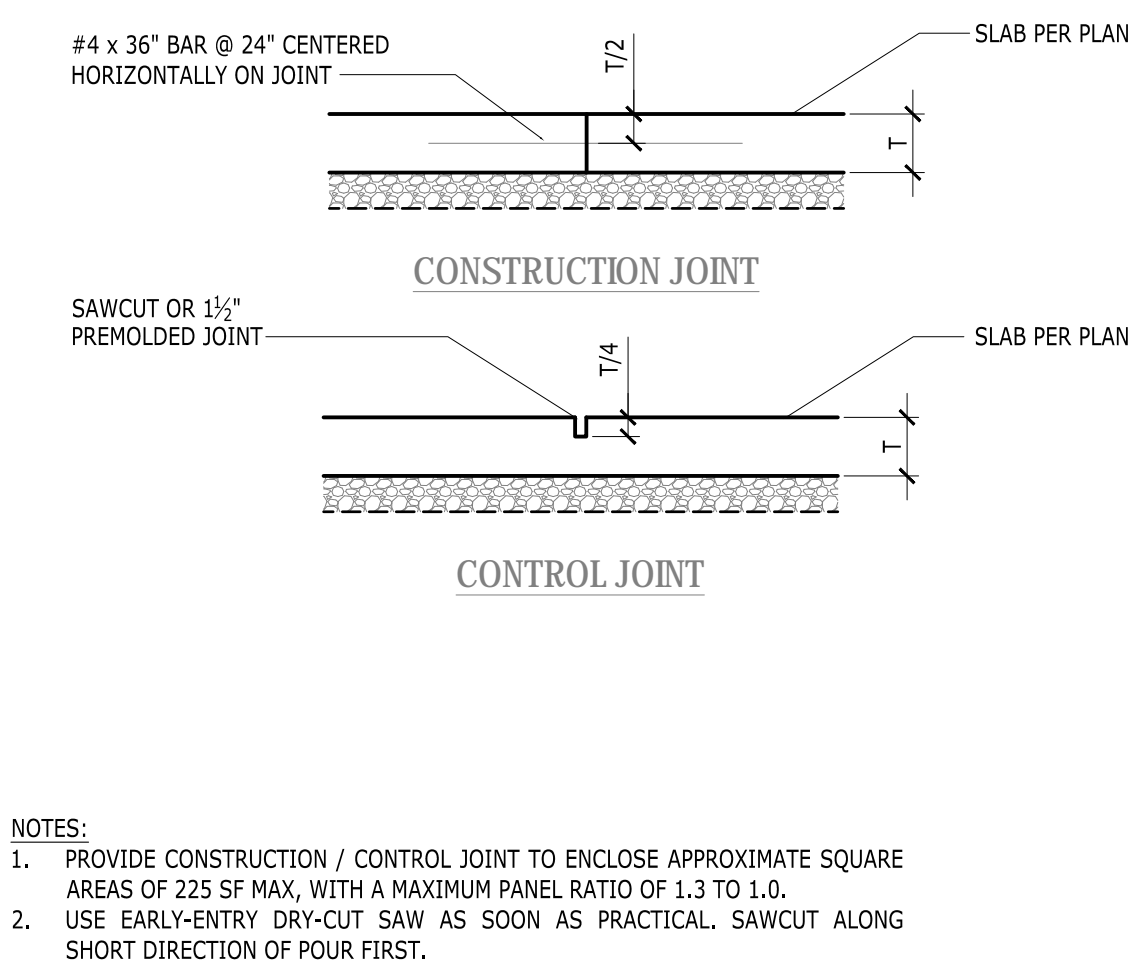


7 CONSTRUCTION/CONTROL JOINT DETAILS

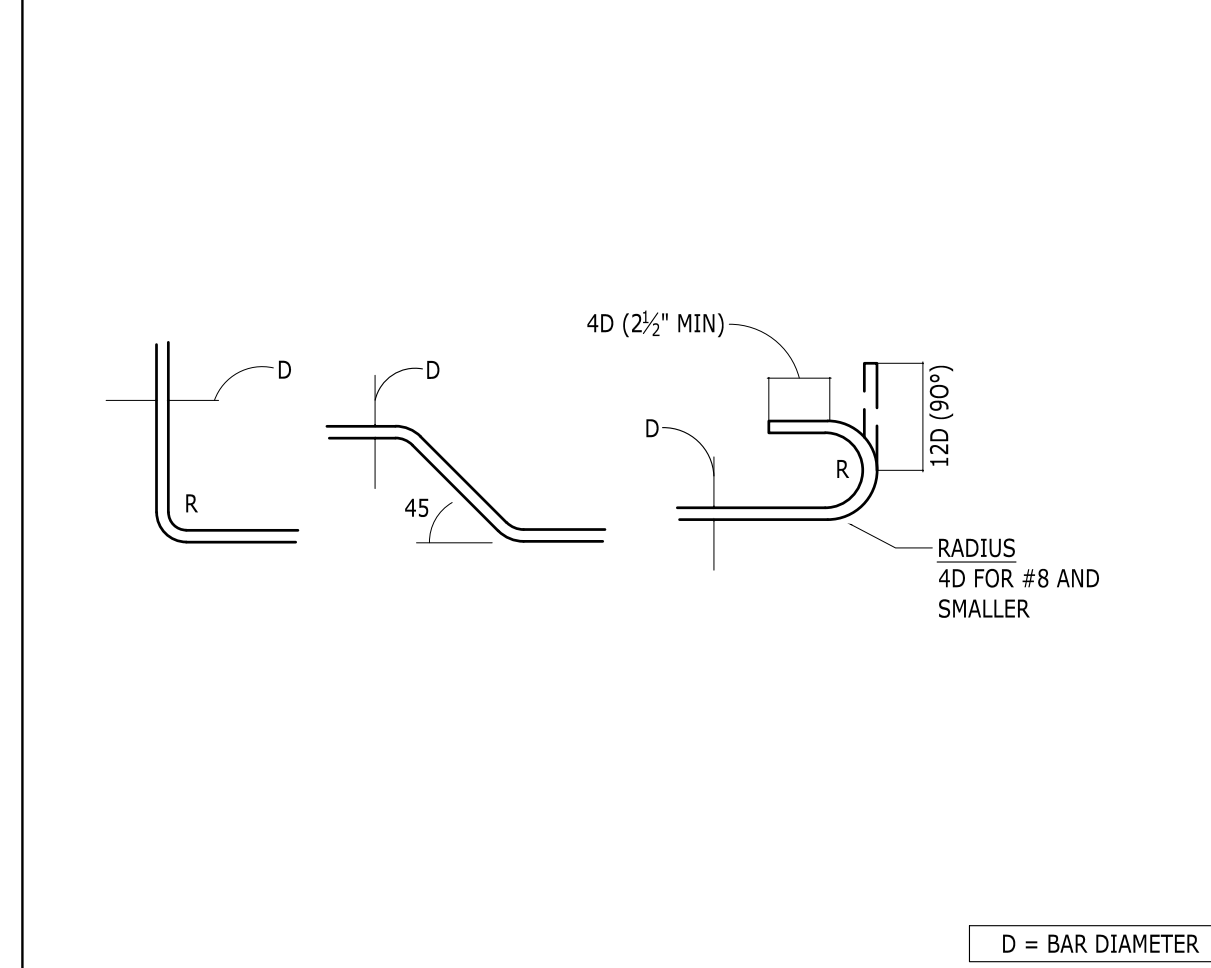


8 BAR BEND AND HOOK DETAILS

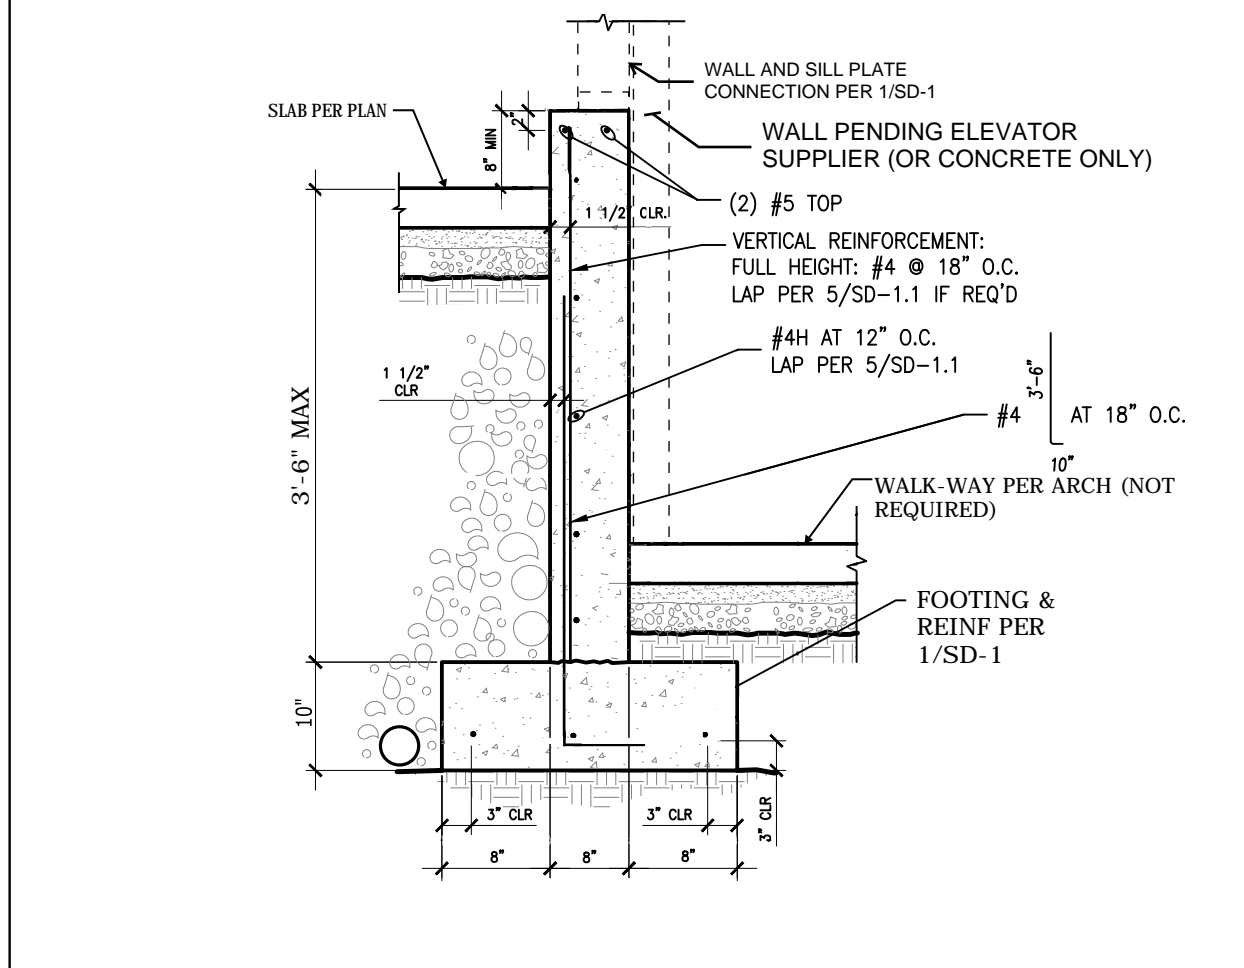


9 RETAINING WALL (4'-0" MAX BACKFILL)

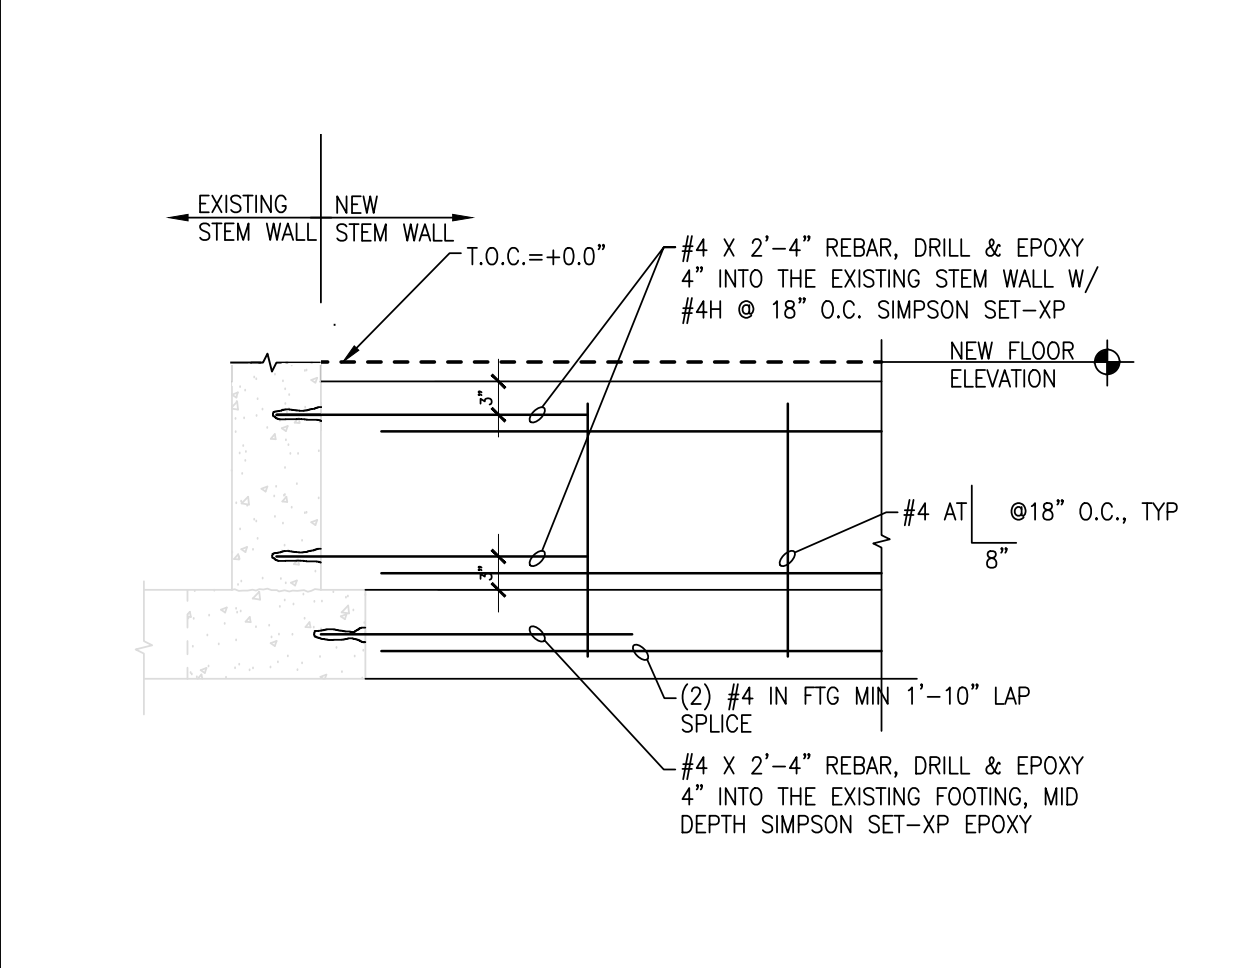


10 FOUNDATION DETAIL

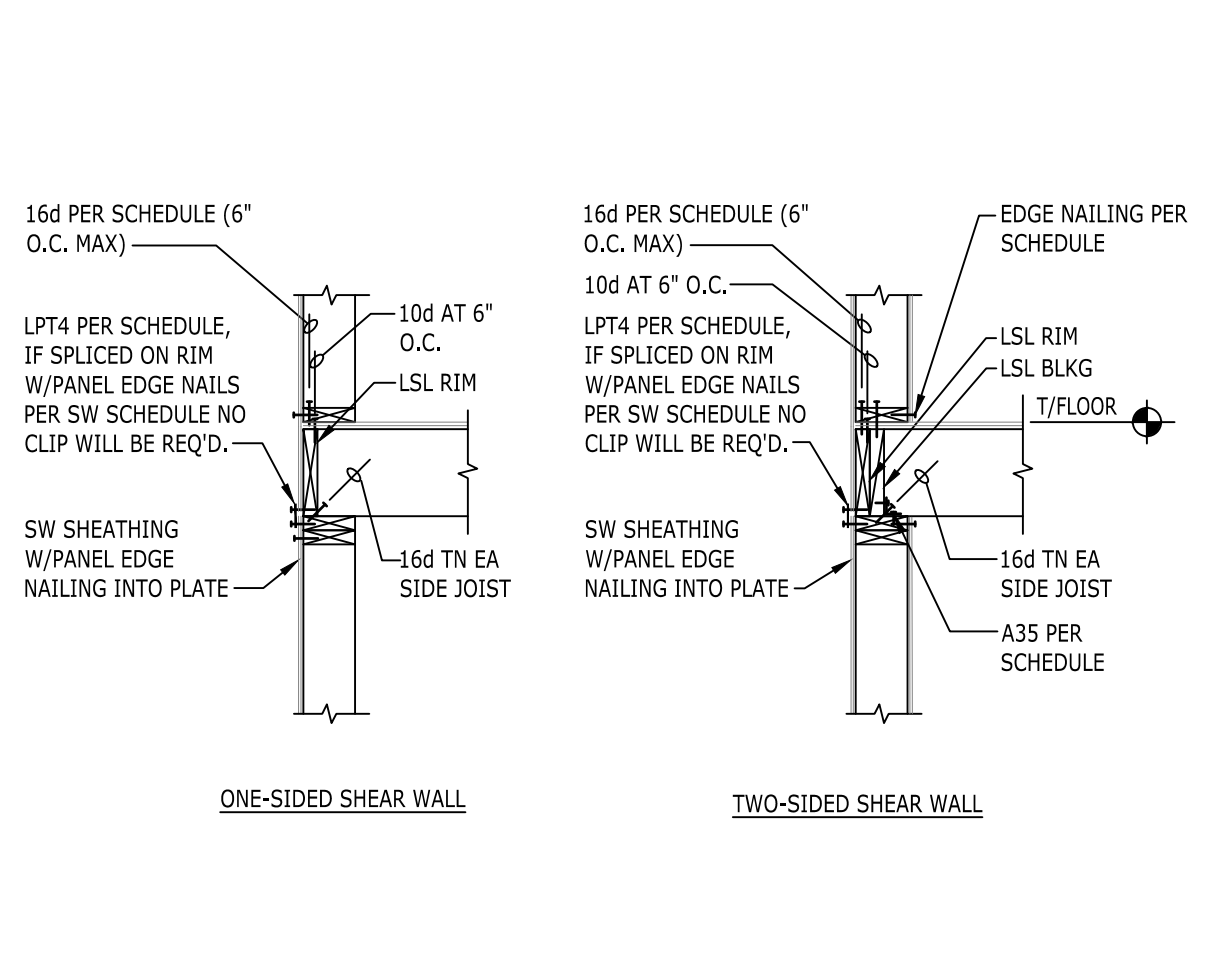


11 SHEAR TRANSFER AT EXTERIOR WALL

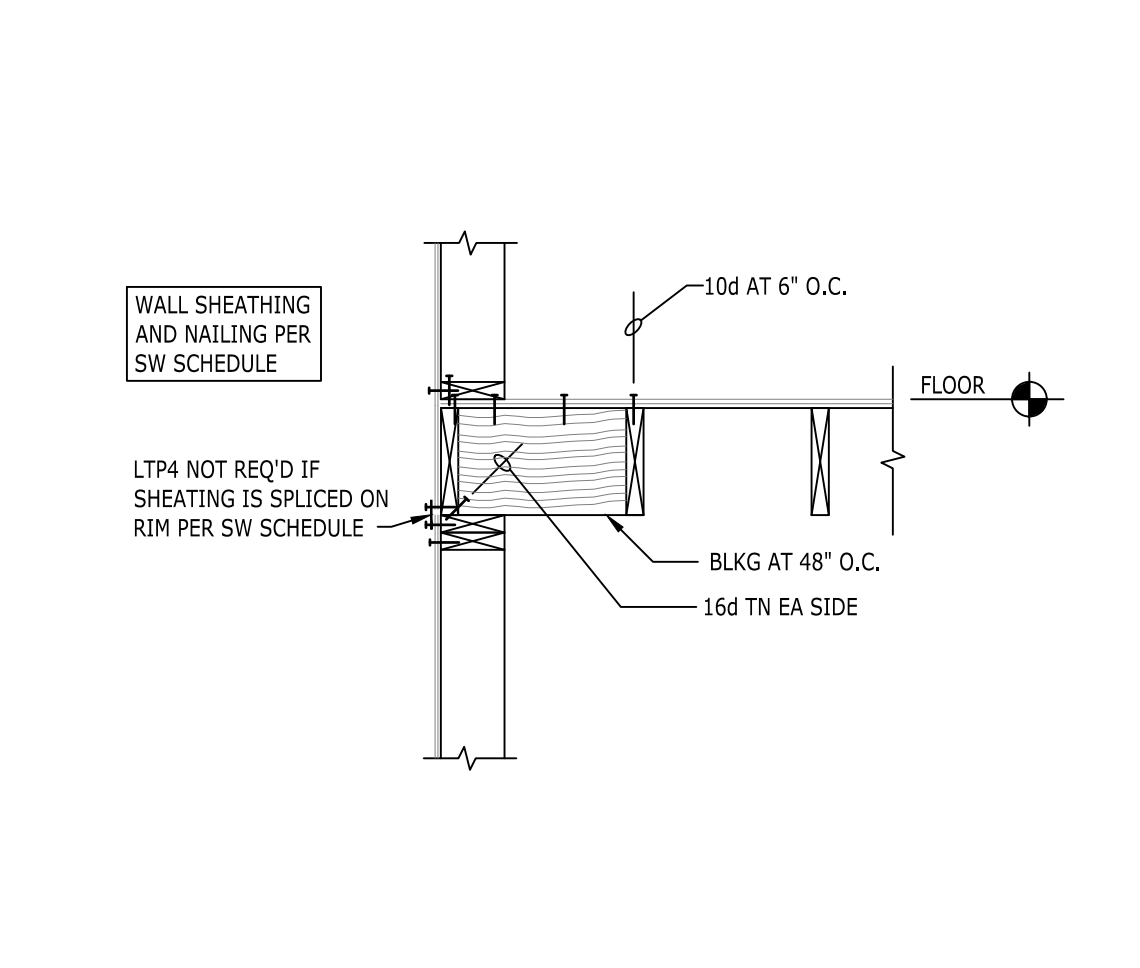


12 SHEAR TRANSFER AT EXTERIOR WALL

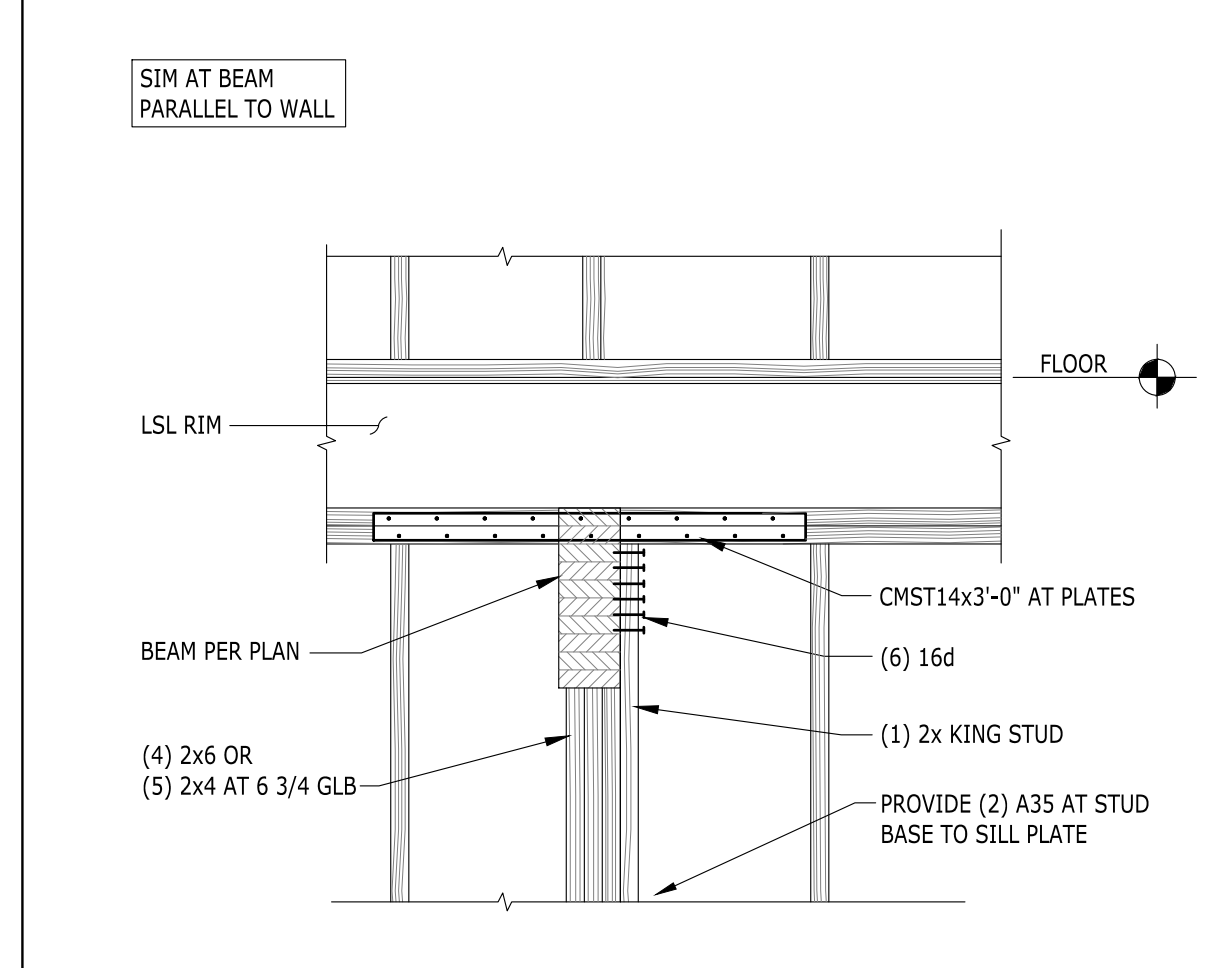


13 BEAM AT DISCONTINUOUS TOP PLATES

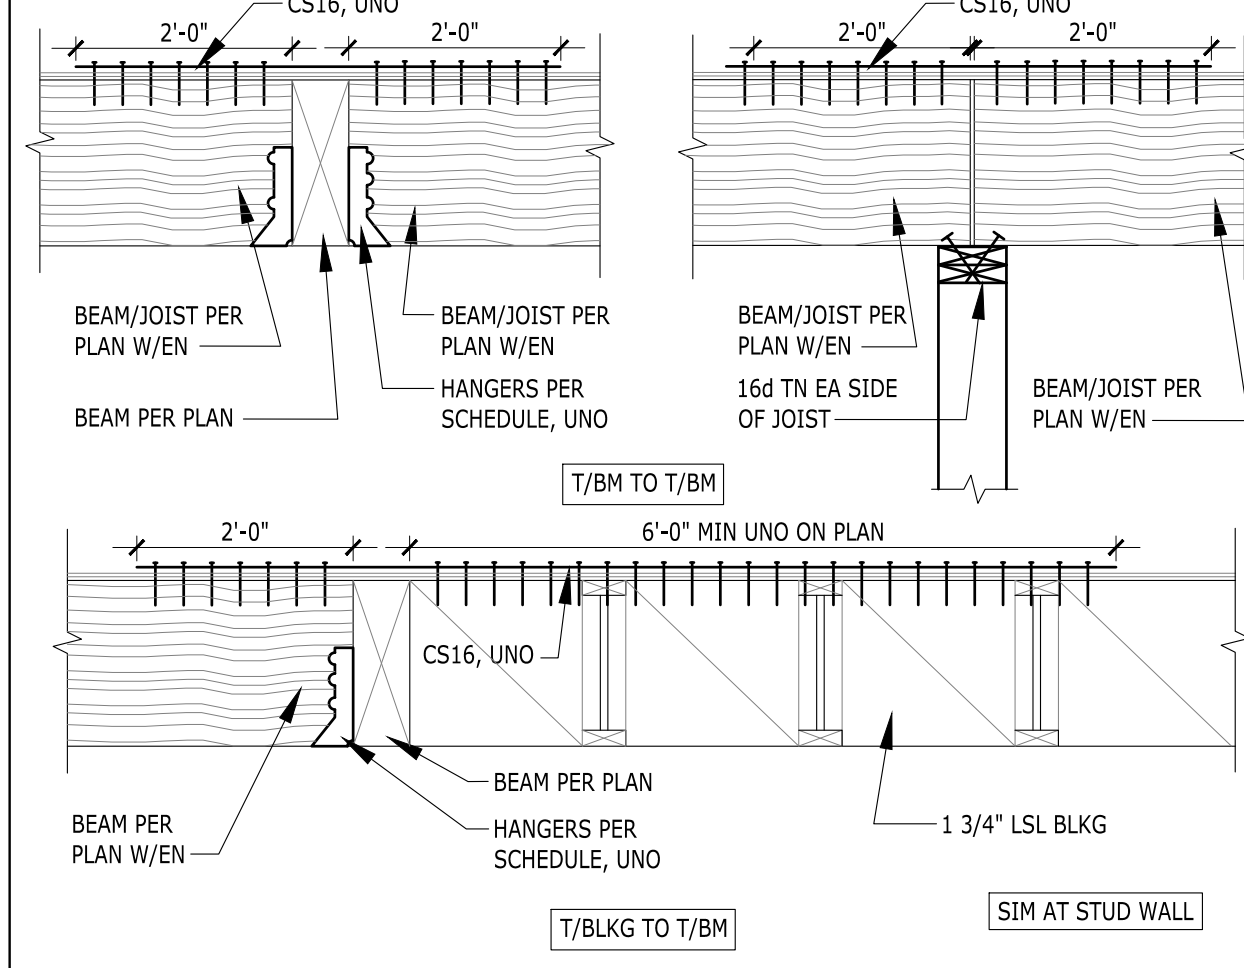


14 TENSION TIE AT FLOOR FRAMING

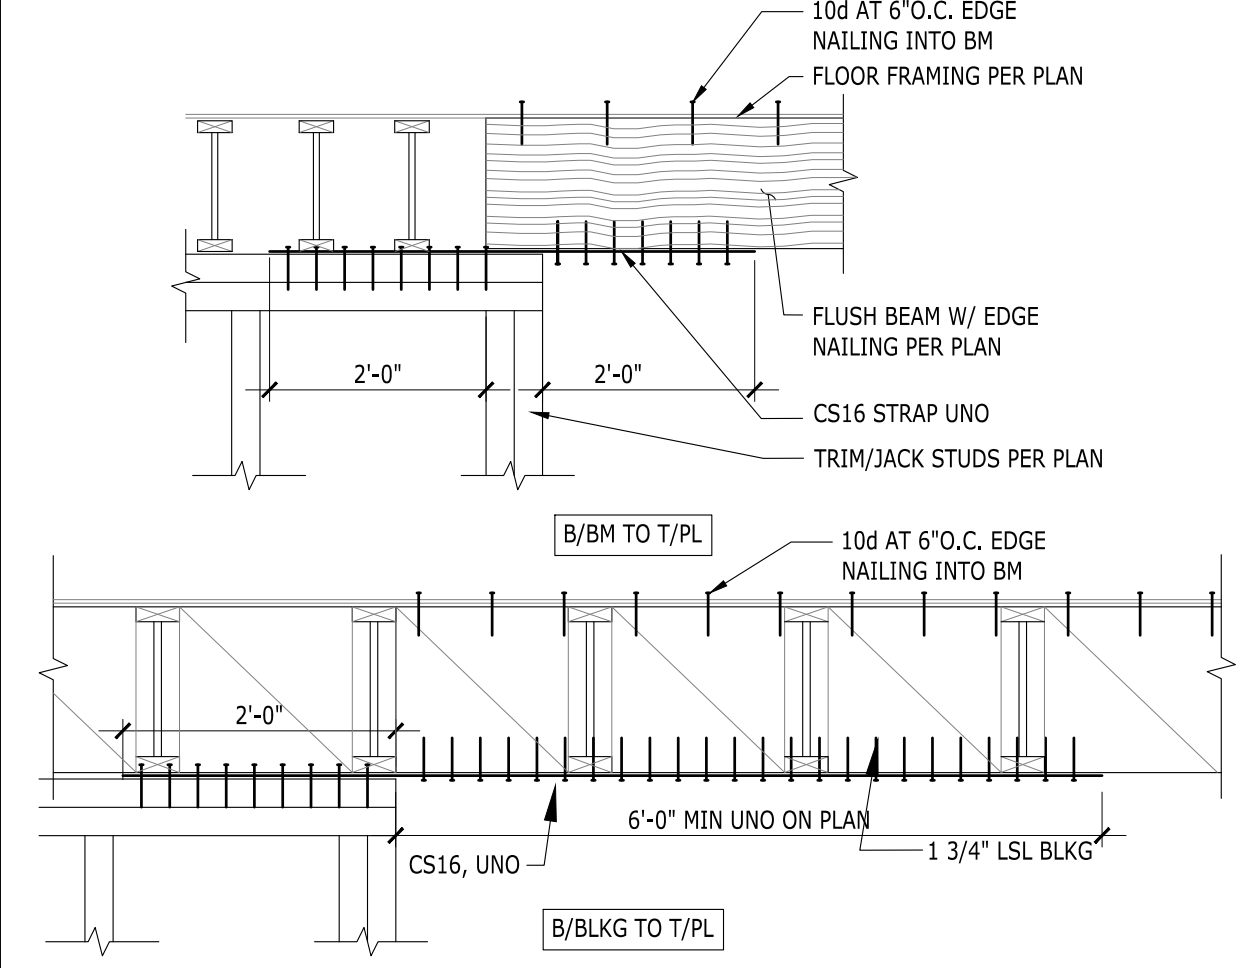


15 TENSION TIE AT FLOOR FRAMING

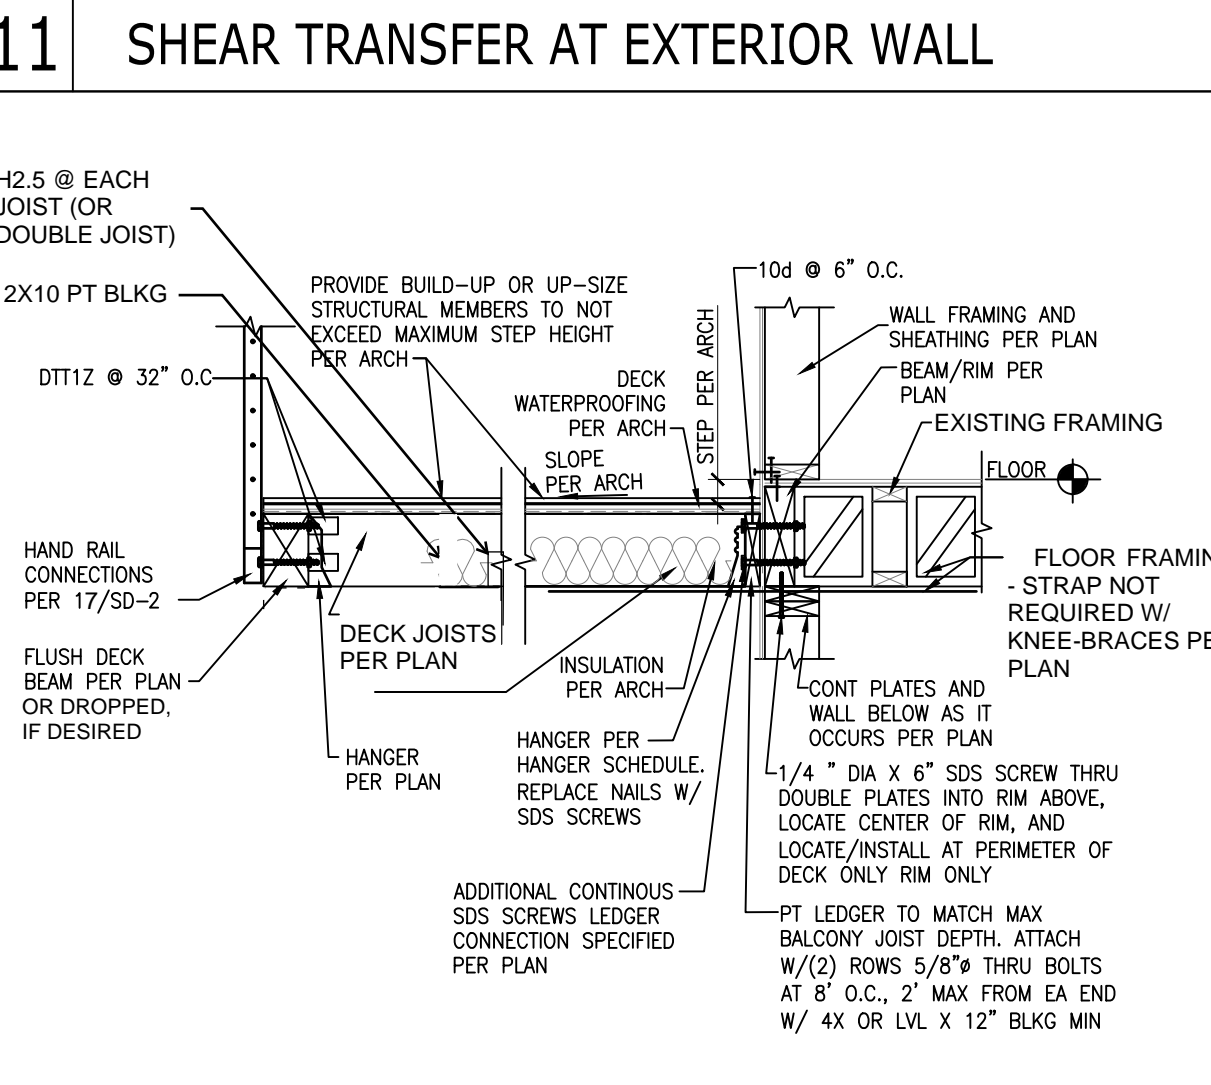


16 DECK FRAMING

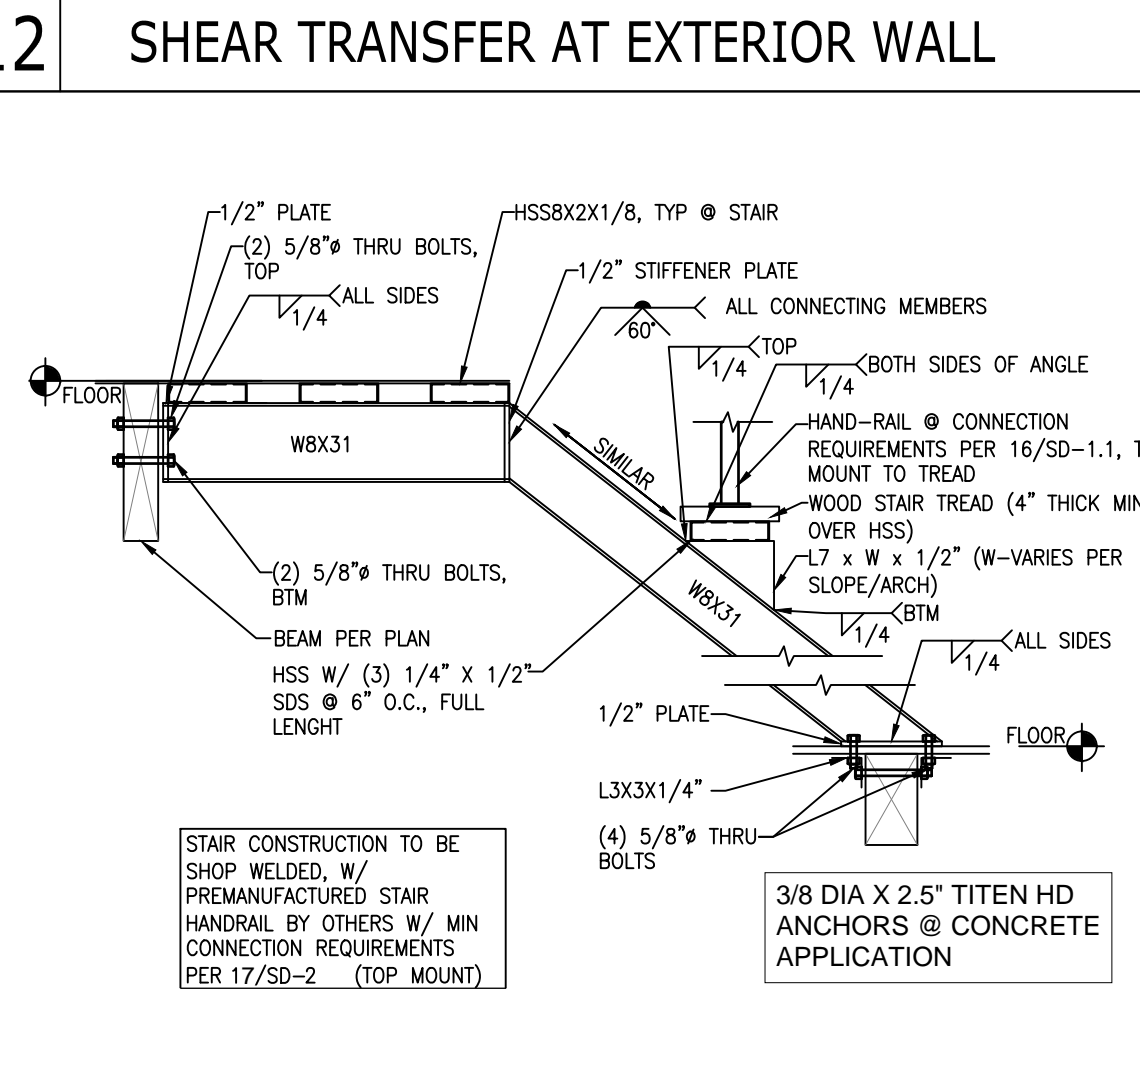


17 STAIR DETAIL

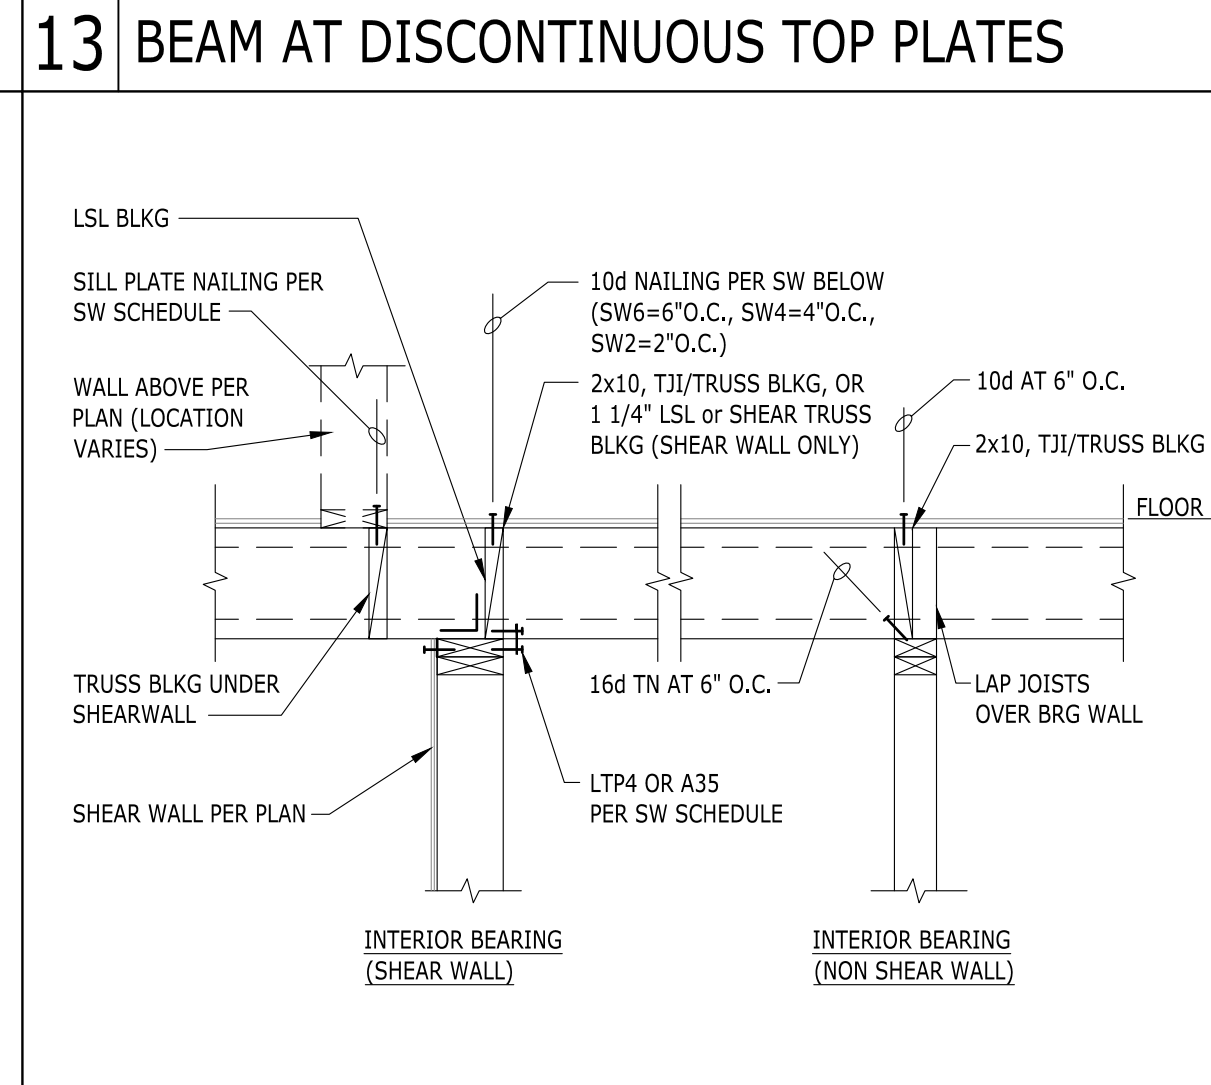

18 FLOOR FRAMING AT INTERIOR BEARING WALL

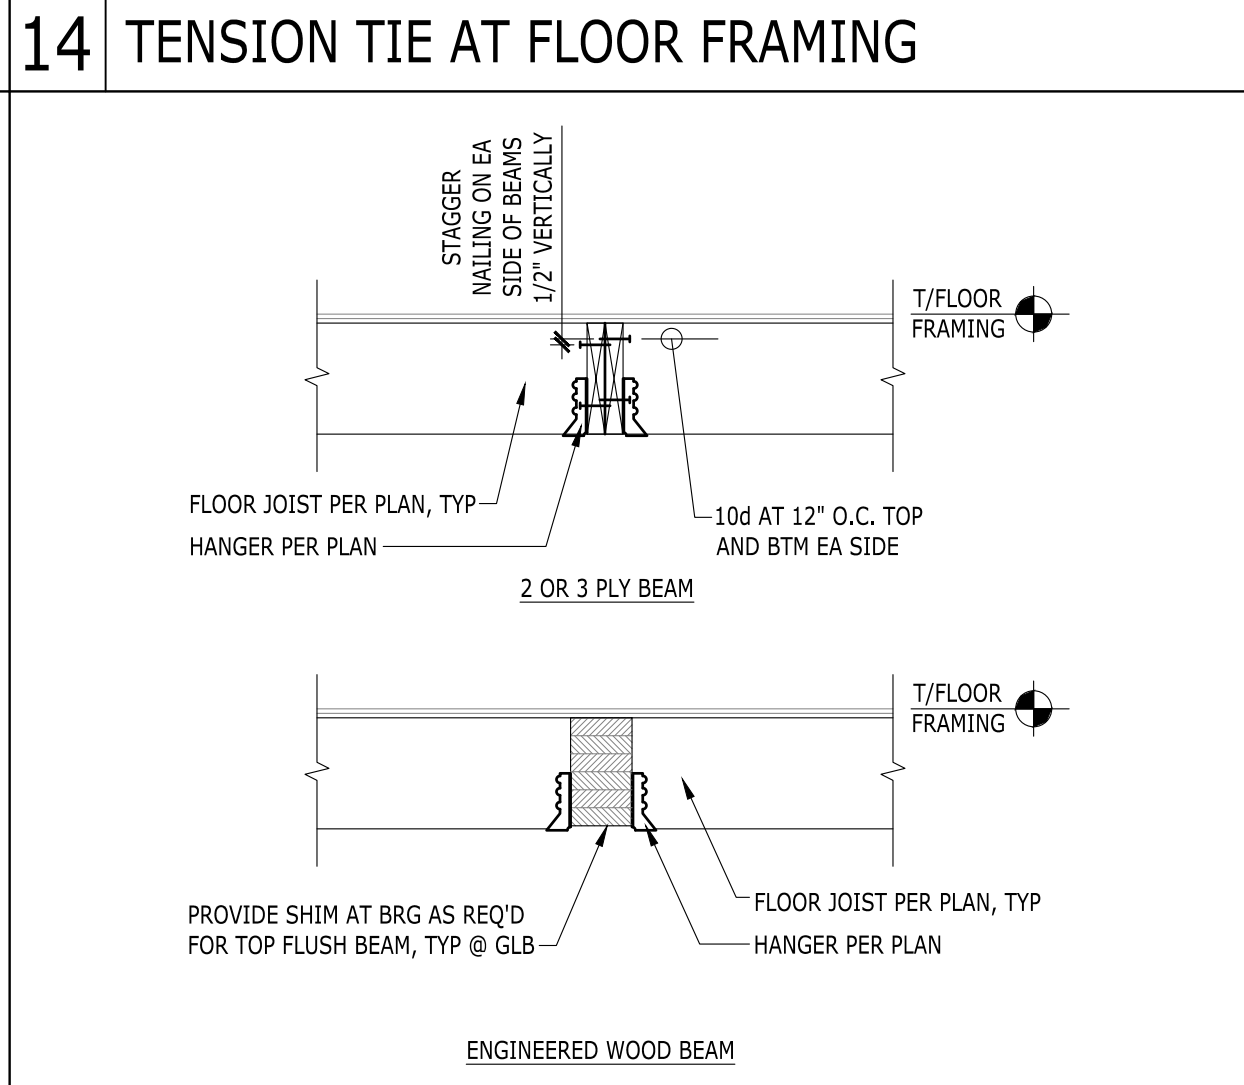


19 JOISTS TO FLUSH BEAM CONNECTION

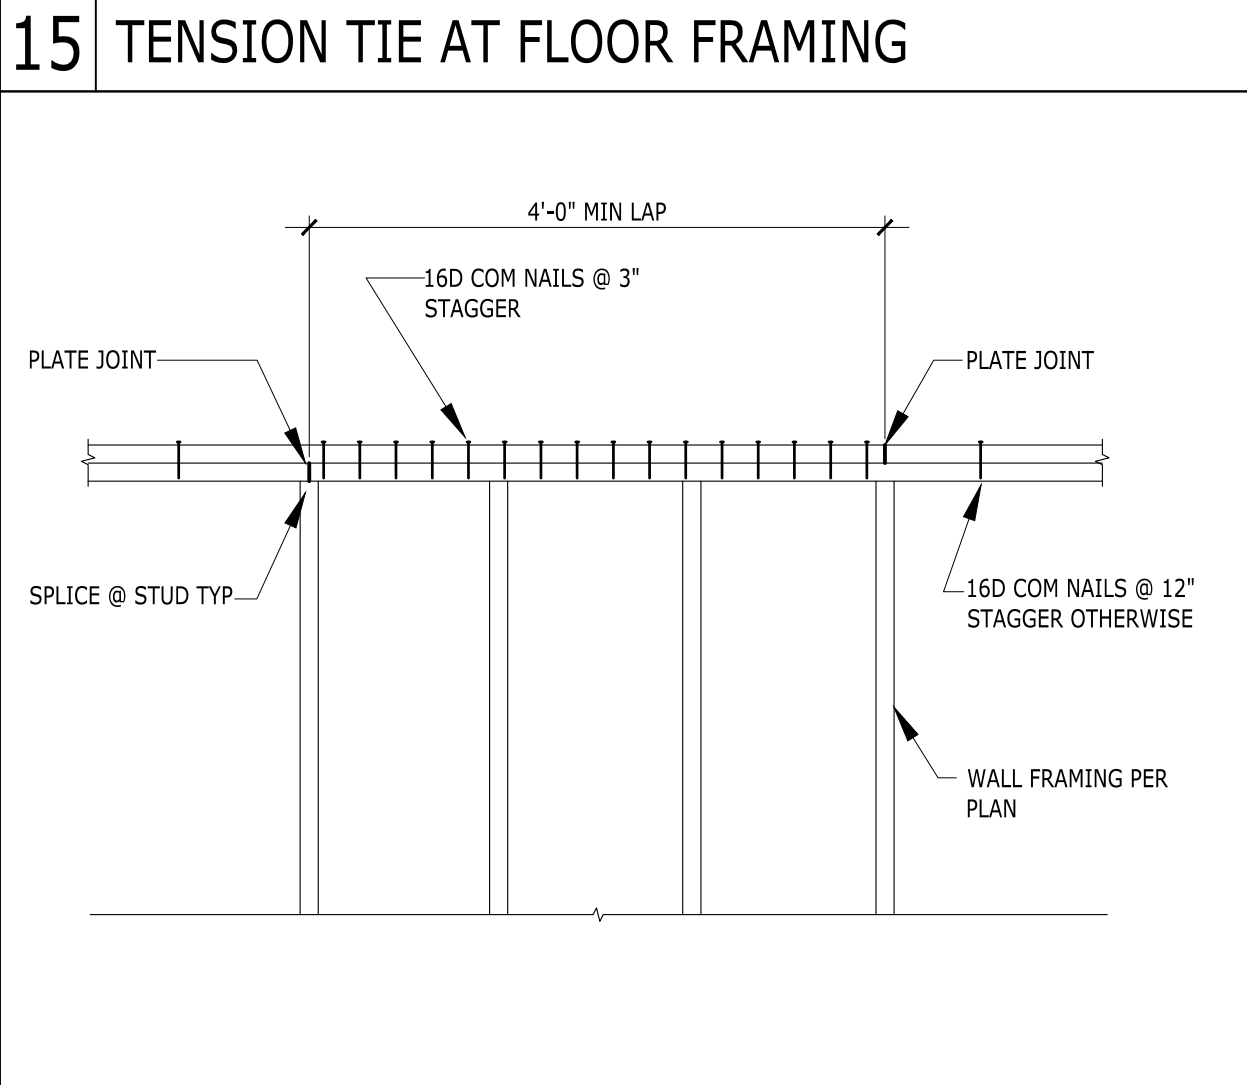

20 ELEVATION TOP PLATE SPLICE



LONGITUDE ONE TWENTY ENGINEERING & DESIGN

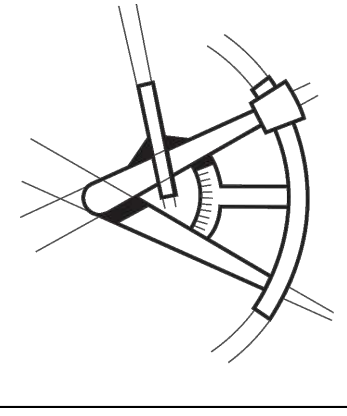

REVISIONS		
DESCRIPTION	DATE	BY
- CLIENT REVISIONS - V2	8-20-2019	
CLIENT REVISIONS - P2	9-6-2019 (PHASE 2)	

PROJECT NAME
THE BAYLEY RESIDENCE REMODEL

PROJECT NUMBER
S190326-2

DRAWN BY - MR

CHECKED BY - MT

SHEET DATE - 06/11/2018

SCALE
24X36 SHEET: 1/4" = 1'-0"

STRUCTURAL DETAILS

PHASE 2 REVISIONS

SHEET SD-1

REVISIONS:	DATE	DESCRIPTION
▲	2019-02-27	DESIGN REVISIONS
▲	2019-04-04	DESIGN REVISIONS
▲		
▲		
▲		

DRAWN BY: KE


CHECKED BY: BJS

SHEET

AB.1

SCALE: IF SHEET IS LESS THAN 24" X 36", IT IS A REDUCED PRINT; REDUCE SCALE ACCORDINGLY

PERMIT SET 9/06/19 PLOT DATE: 9/6/2019

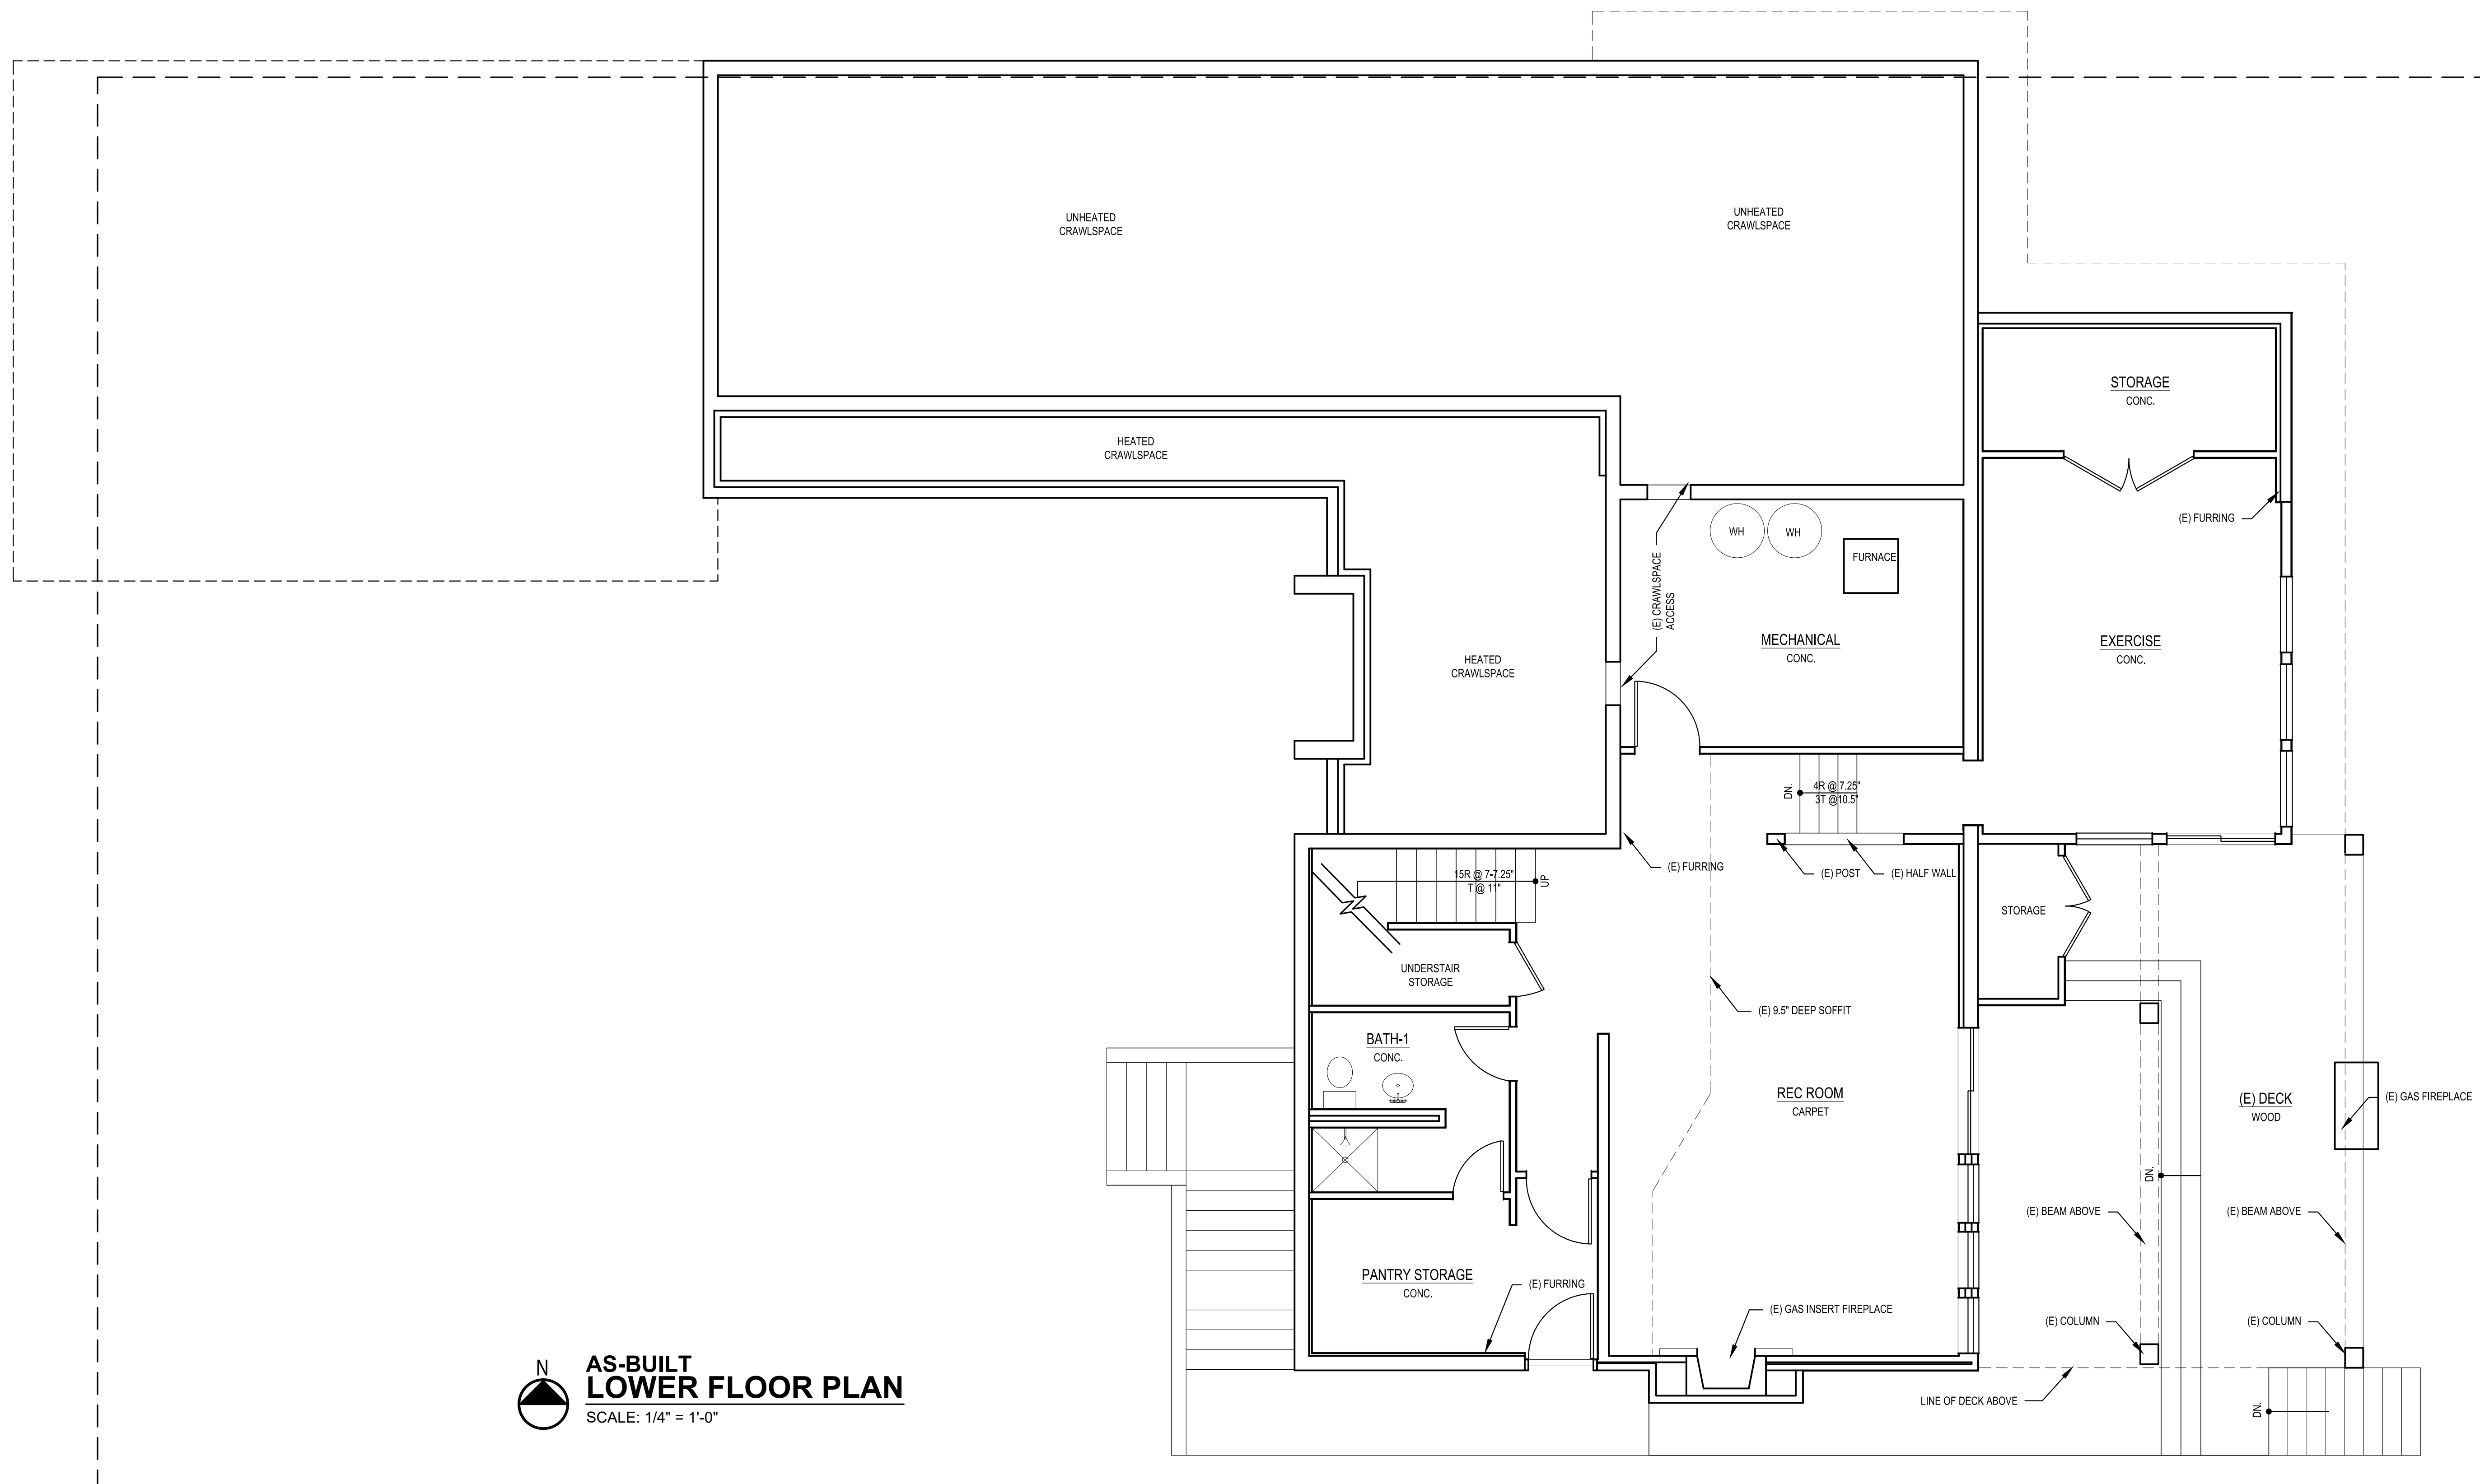

AS-BUILT
LOWER FLOOR PLAN
SCALE: 1/4" = 1'-0"

REVISIONS:	DATE	DESCRIPTION
▲	2019-03-27	DESIGN REVISIONS
▲	2019-04-04	DESIGN REVISIONS
▲		
▲		
▲		

DRAWN BY: KE


CHECKED BY: BJS

SHEET

AB.2

SCALE: IF SHEET IS LESS THAN 24" X 36", IT IS A REDUCED PRINT; REDUCE SCALE ACCORDINGLY

PERMIT SET 9/06/19 PLOT DATE: 9/6/2019

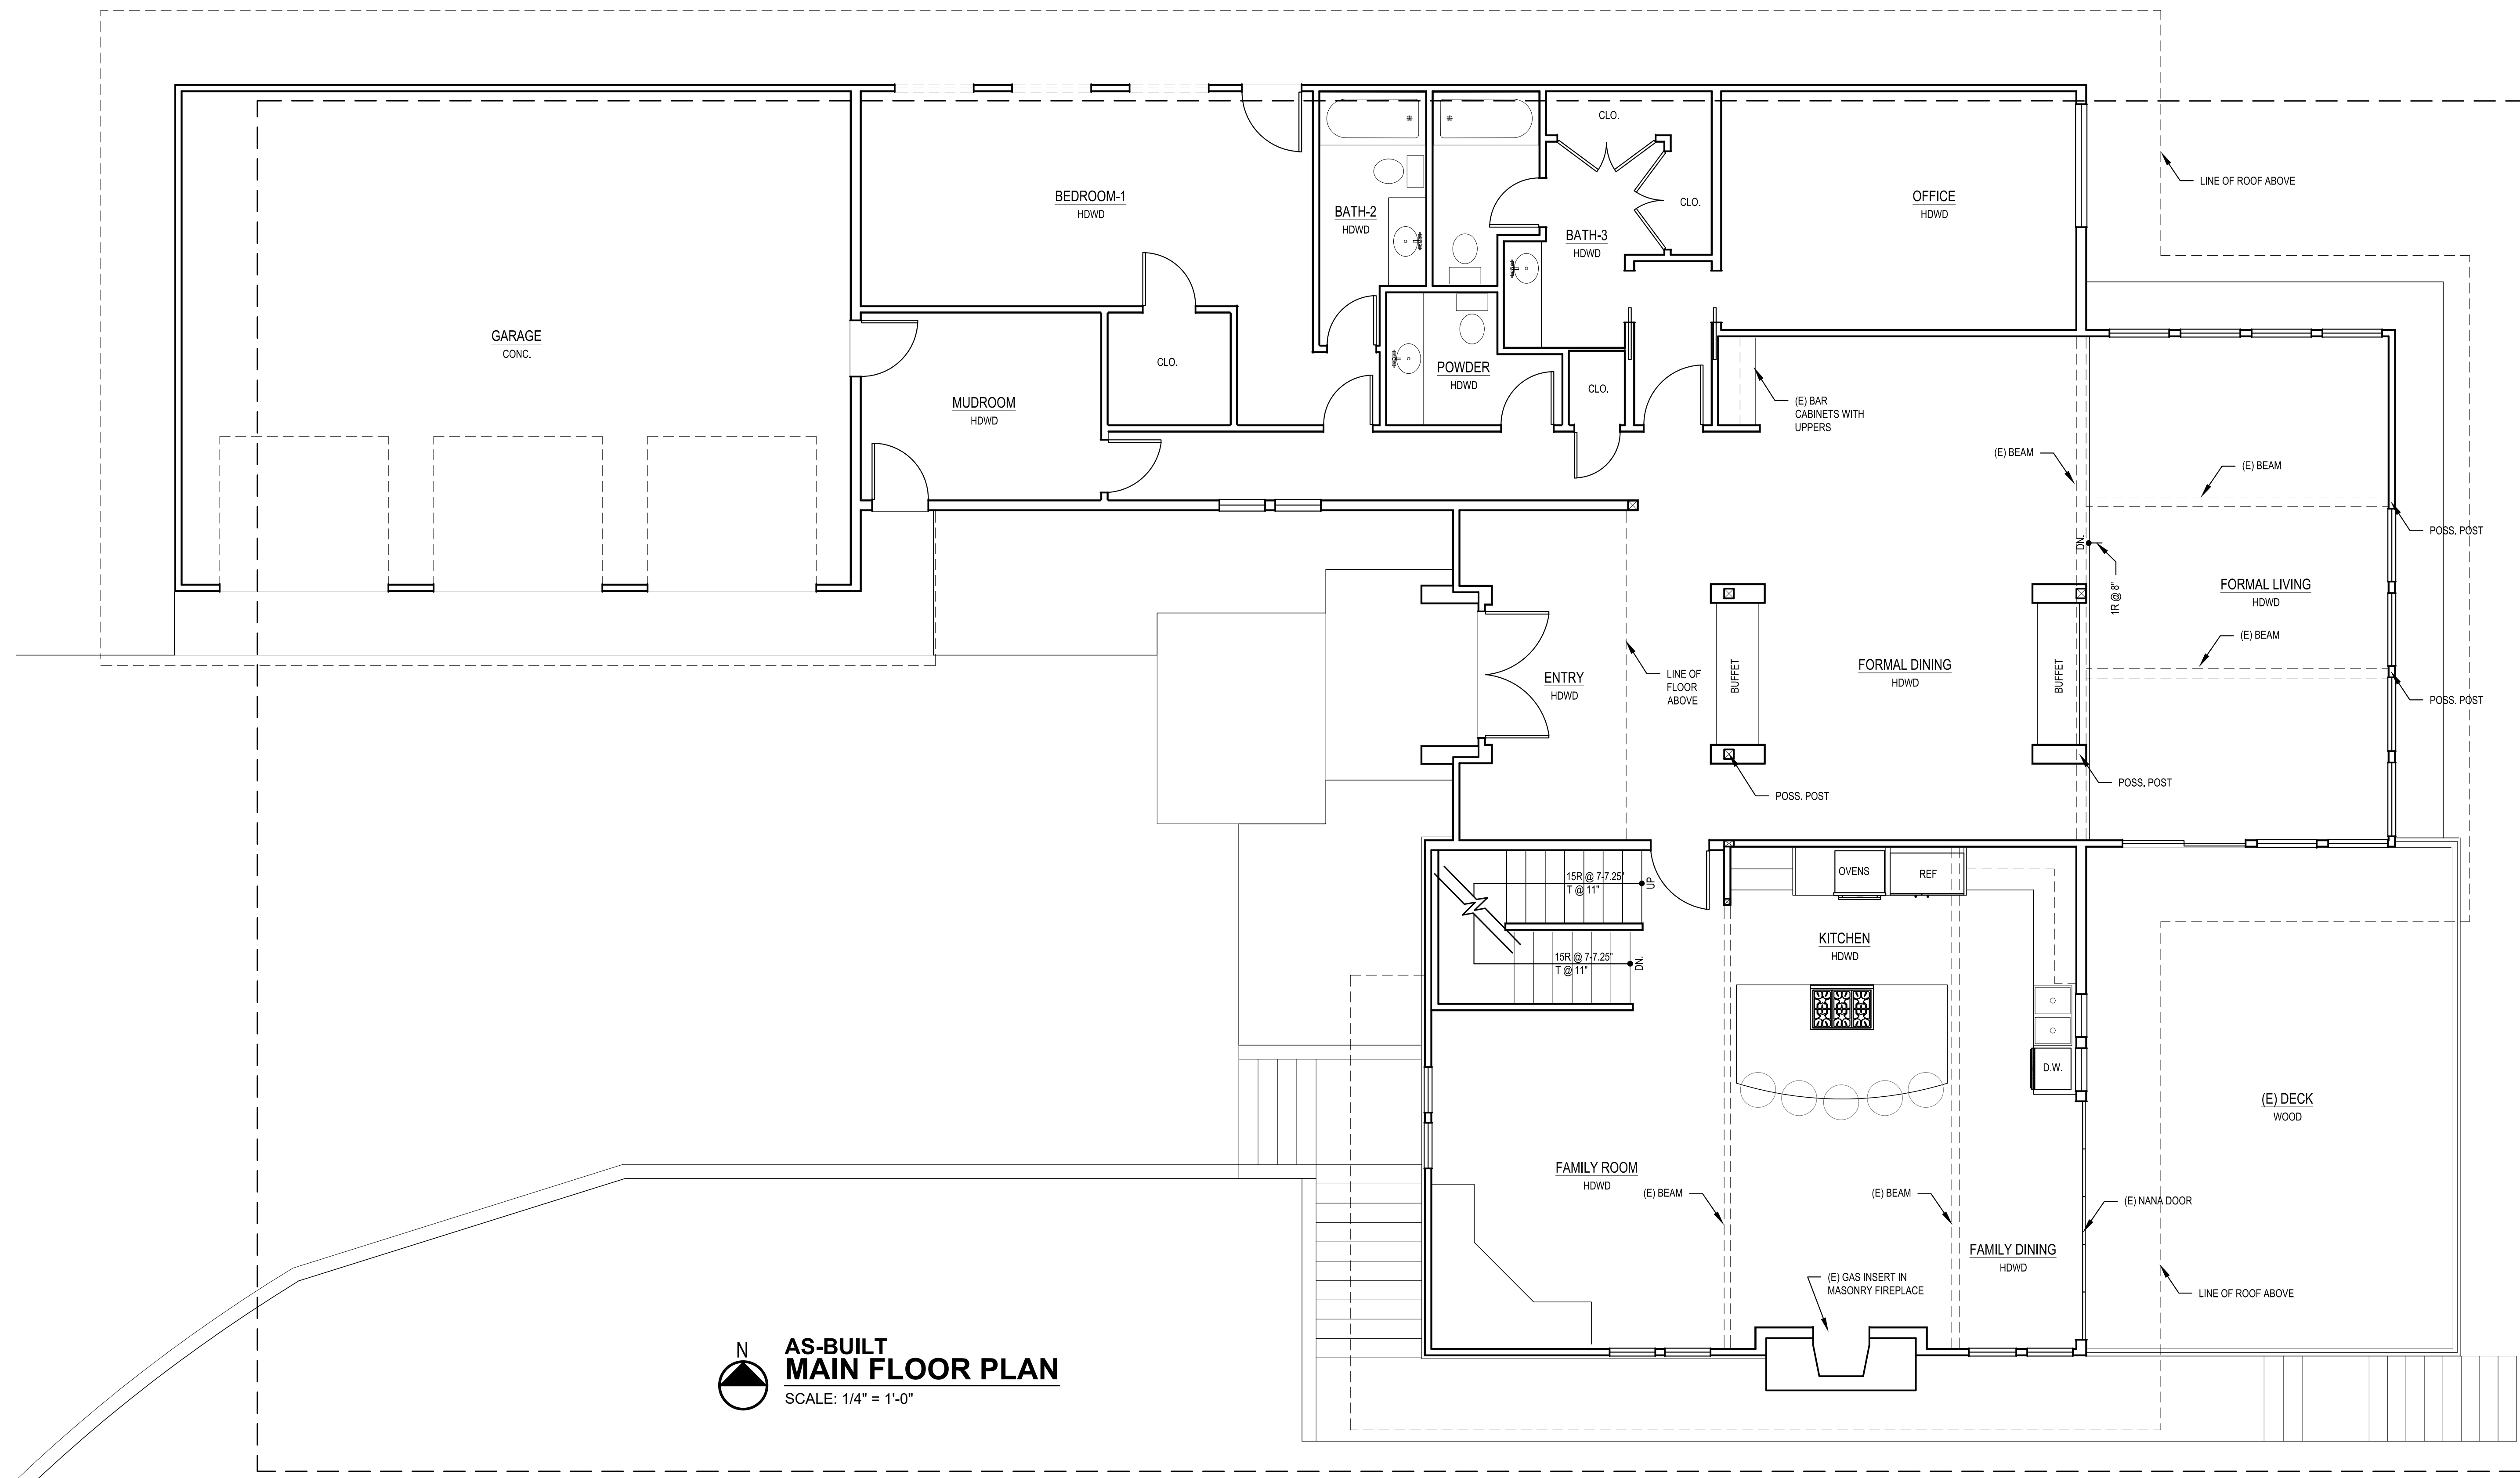

AS-BUILT
MAIN FLOOR PLAN
SCALE: 1/4" = 1'-0"

REVISIONS:	DATE	DESCRIPTION
▲	2019-02-27	DESIGN REVISIONS
▲	2019-04-04	DESIGN REVISIONS
▲		
▲		
▲		
▲		

DRAWN BY: KE


CHECKED BY: BJS

SHEET

AB.3

SCALE: IF SHEET IS LESS THAN 24" X 36", IT IS A REDUCED PRINT; REDUCE SCALE ACCORDINGLY

PERMIT SET 9/06/19 PLOT DATE: 9/6/2019

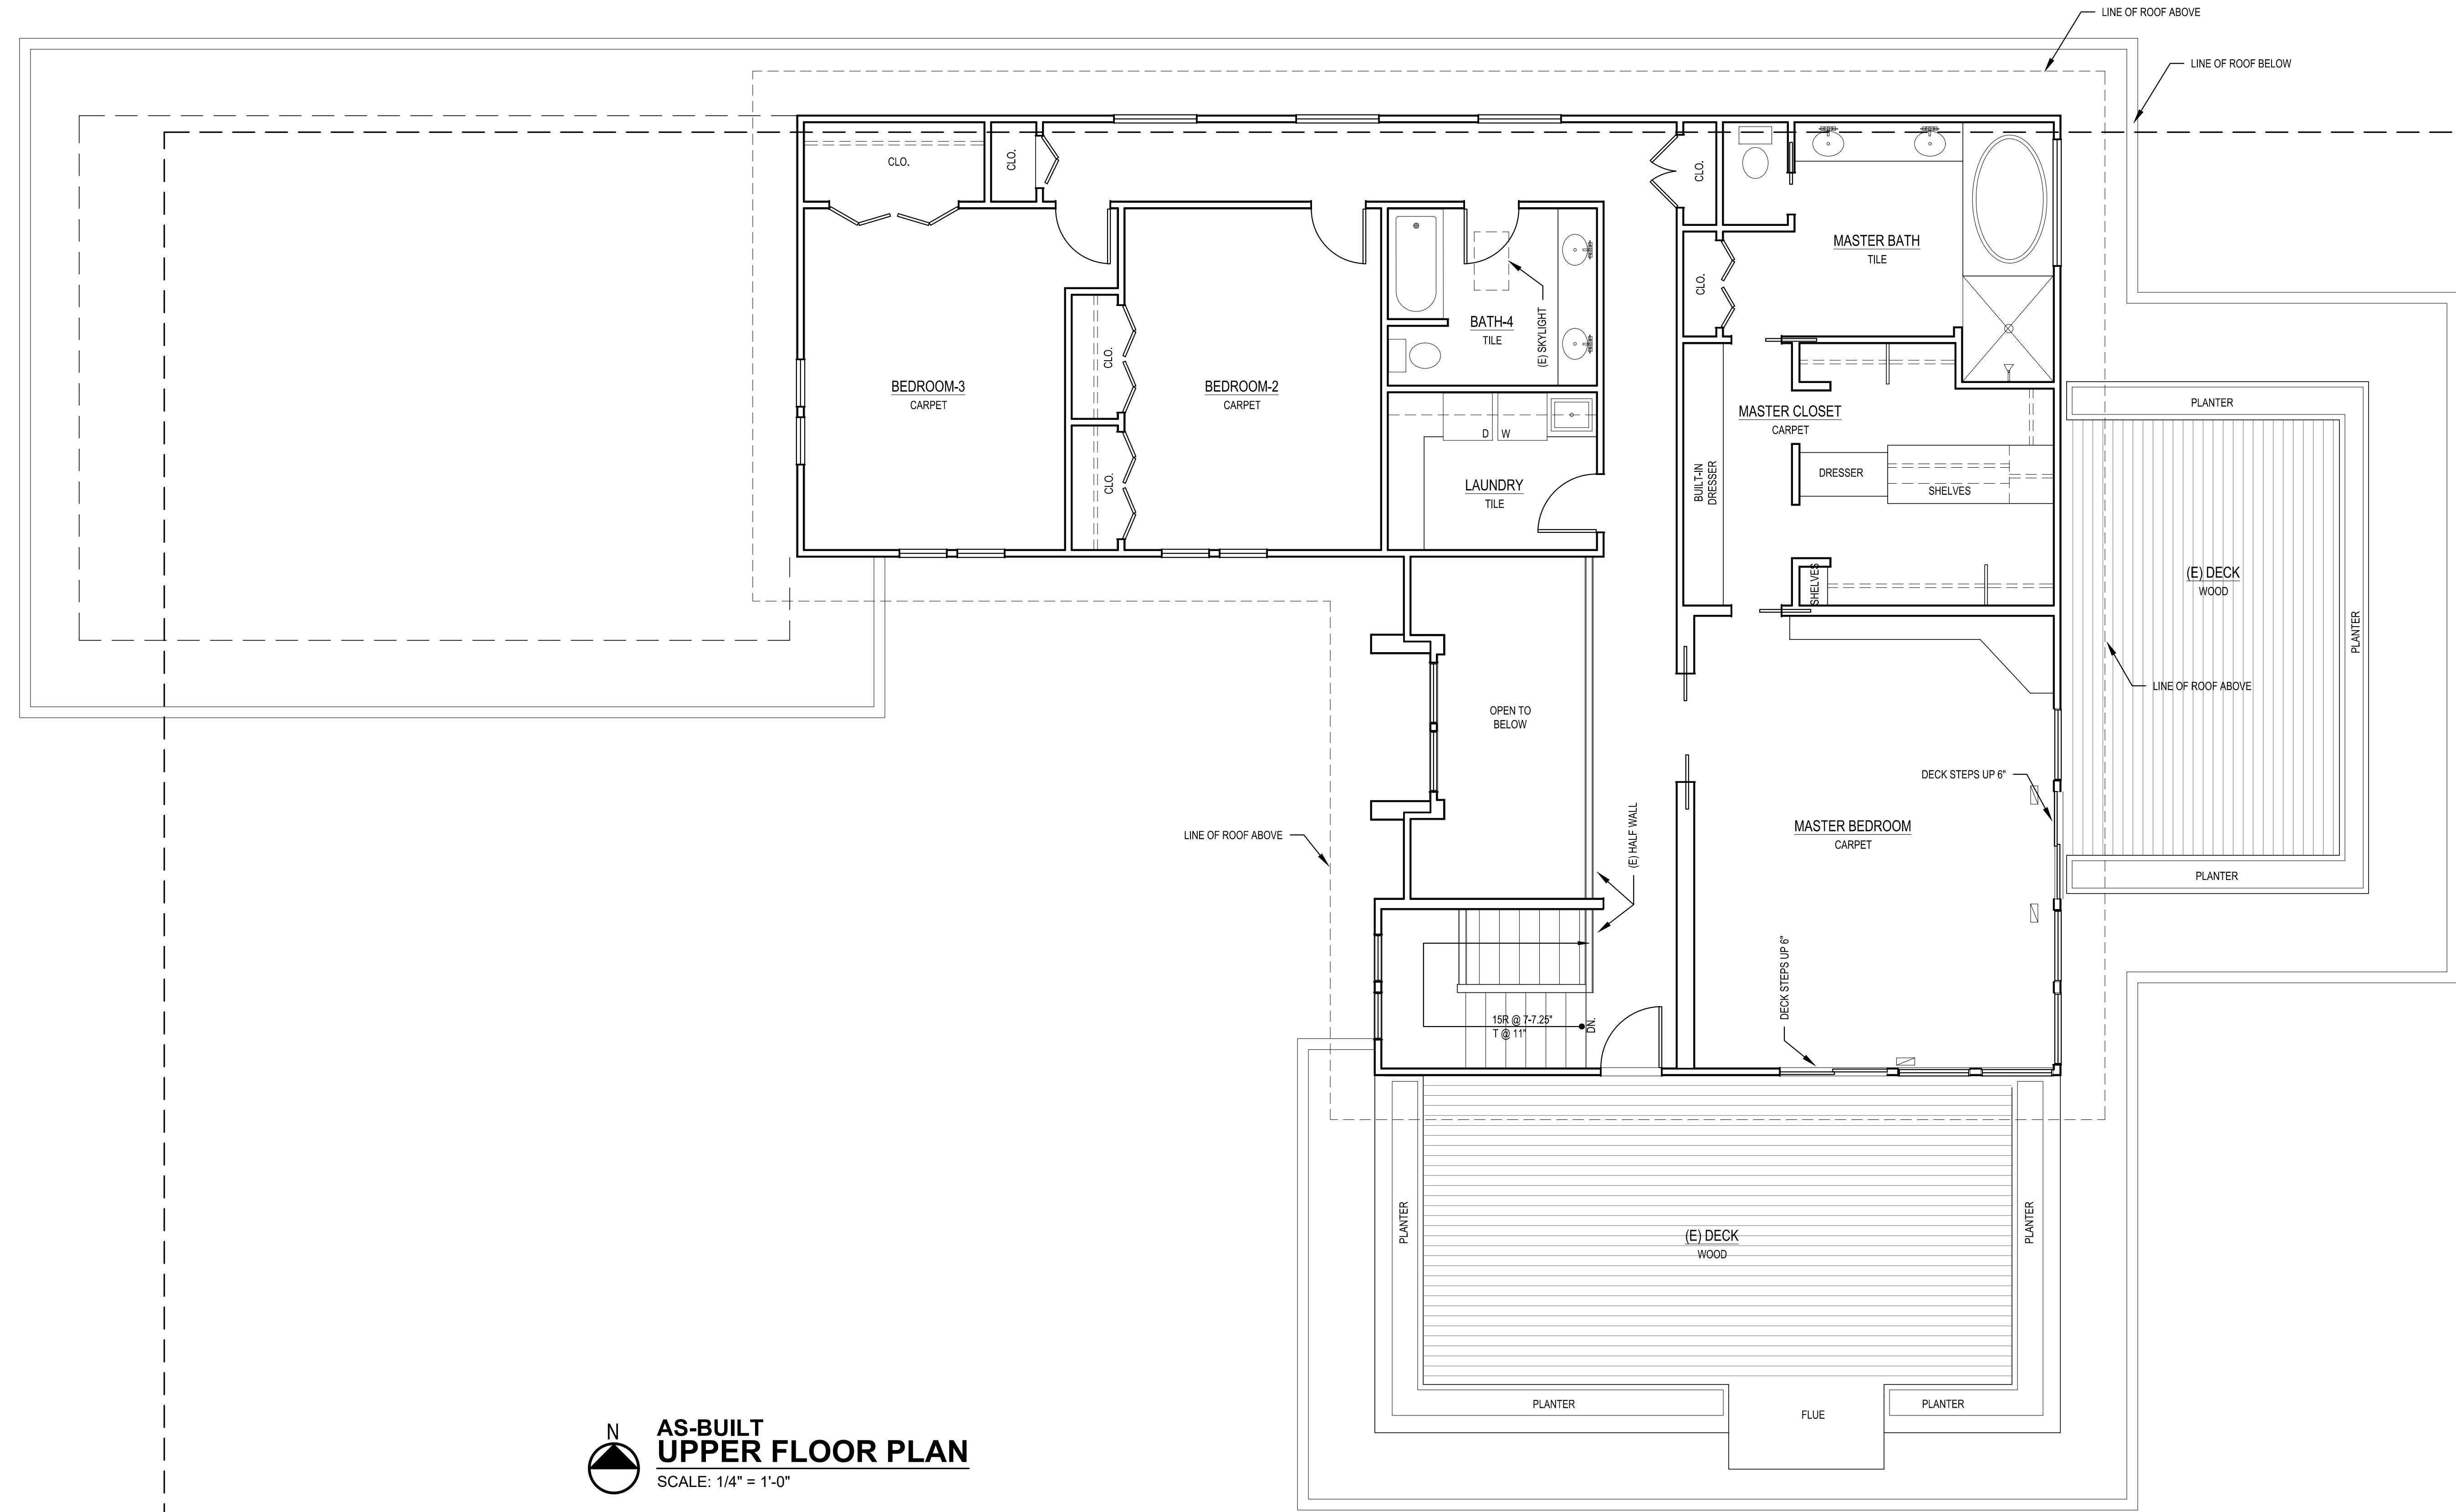

AS-BUILT
UPPER FLOOR PLAN
SCALE: 1/4" = 1'-0"