
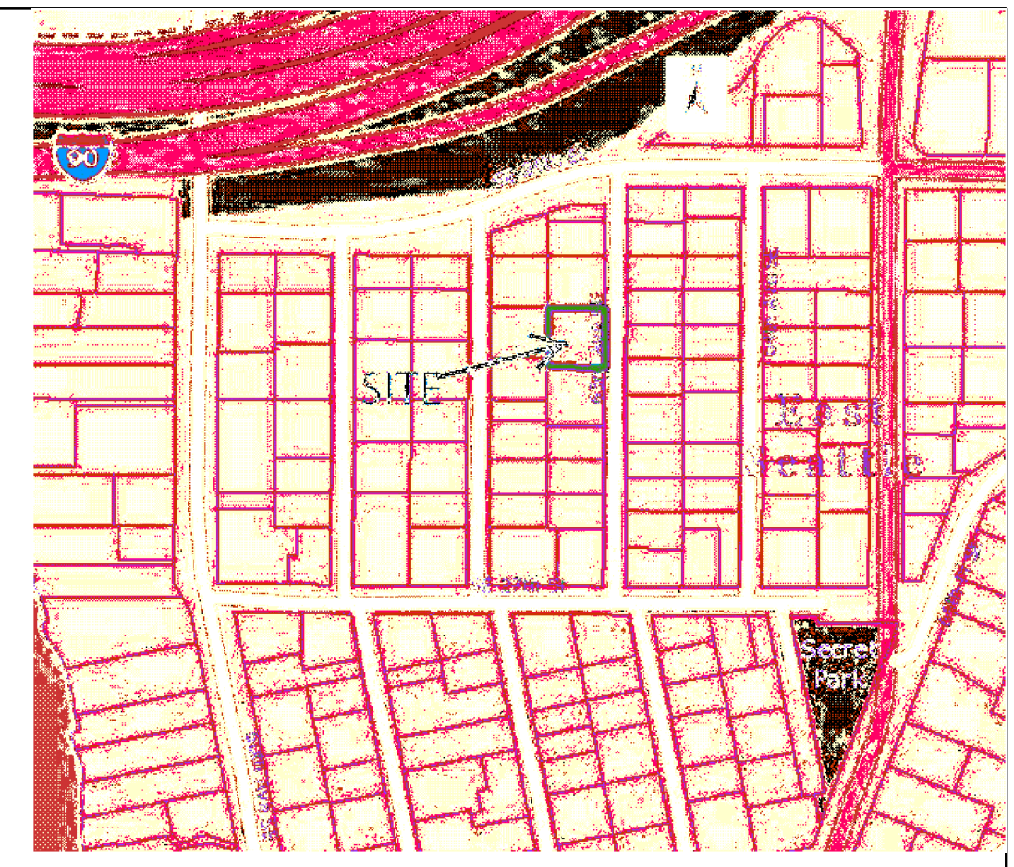


- LEGEND**
- FOUND CONCRETE MONUMENT IN CASE
  - FOUND REBAR AS DESCRIBED
  - ⊗ TACK IN LEAD FOUND
  - ⊗ POWER METER
  - ⊗ UTILITY POLE
  - ⊗ GAS METER
  - ⊗ SANITARY SEWER CLEANOUT
  - ⊗ SANITARY SEWER MANHOLE
  - ⊗ WATER VALVE
  - ⊗ FIRE HYDRANT
  - ⊗ WATER METER
  - ⊗ SIGN
  - SS— SANITARY SEWER LINE
  - SD— STORM DRAIN LINE
  - OHP— OVERHEAD POWER
  - OHU— OVERHEAD UTILITIES
  - X— CHAINLINK FENCE
  - WOOD FENCE
  - ▨ EX. CONCRETE WALL
  - ▨ EX. GRAVEL
  - ▨ CONCRETE SURFACE
  - ▨ EX. CONCRETE SURFACE
  - ⊗ EX. MAIL BOX

SA AMMEND SOIL PER BMP T5.13 (7,668SF)  
ADD 2.5" LAYER OF COMPOST ROTOTILL INTO SOIL

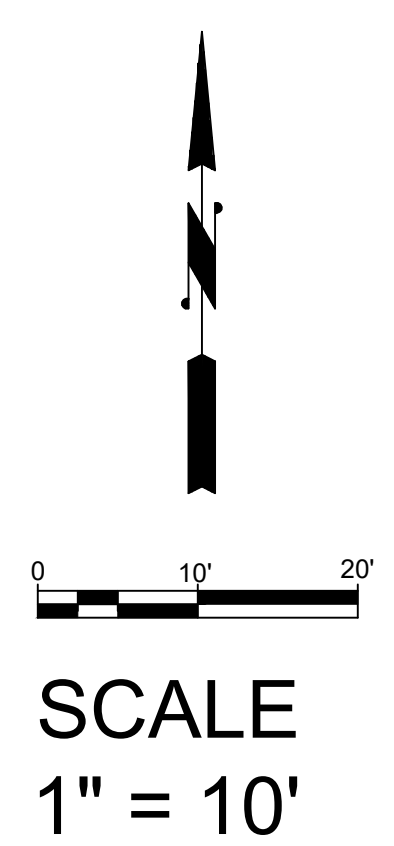

VICINITY MAP

PARCEL # 409950-0430

LEGAL: LAKE VIEW PLACE EAST SEATTLE N 1/2 OF LOT 14 ALL OF LOTS 15 THRU 17  
Plat Block: 4  
Plat Lot: 14-17

SLOPE LESS THAN 15% ALLOWABLE: 40%  
LOT SIZE: 10,500 SF  
ALLOWABLE IMPERVIOUS AREA: 4,200 SF

1ST LEVEL: 2,120 SF  
2ND LEVEL: 2,070 SF  
TOTAL: 4,190 SF  
GROSS FLOOR AREA: 4,190 SF

BASE HEIGHT 30'

TOTAL LOT AREA	10,500 SF
PRO. BUILDING FOOTPRINT INCLUDING GARAGE	2,184 SF
PRO. CONCRETE DRIVEWAY	531.8 SF
PRO. WALKWAY/PAVER	116.5 SF
TOTAL PROPOSED IMPERVIOUS	2,832.3 SF
TOTAL% PROPOSED IMPERVIOUS COVERAGE	= 27%
TOTAL NEW AND REPLACED IMPERVIOUS AREAS	= 2,944.65 SF OR 28%
TOTAL LOT AREA	10,500 SF
EX. FOOTING BUILDING	TBD 1,664 SF
EX. PARKING CARPORT	TBD 360 SF
EX. CONCRETE DRIVEWAY	TBD 517 SF
EX. CONCRETE	TBD 28.33 SF
EX. SHED	REMAINED 112.35 SF
TOTAL EX. IMPERVIOUS	2,681.68 SF
TOTAL% EX. IMPERVIOUS COVERAGE	= 25.5%
TOTAL EX. IMPERVIOUS REPLACEMENT	= 2,569.33 OR 24.5% COVERAGE
EX. DESKS	TBD 1,086.46 SF
EX. BRICKS	TBD 407.94 SF
EX. BRICKS REMAINED	105.16 SF

NOTE: SITE PLAN PROVIDED BY ATLAS ARCHITECT AND TOPO PROVIDED BY THOMAS- SITE SURVEYING, INC.

NOTE: THE UTILITY LOCATIONS MUST BE LOCATED BY THE CONTRACTOR BEFORE DIGGING. THE ENGINEER HAS NO RESPONSIBILITY FOR ANY UTILITIES HEREON GRAFTED ON THIS PLAN. CALL 811 BEFORE DIGGING.

THE LAWN AND LANDSCAPE AREAS ARE EXPECTED TO PROVIDE POST-CONSTRUCTION SOIL QUALITY AND DEPTH IN ACCORDANCE WITH BMPT5.13.

THE PROJECT CIVIL ENGINEER MUST PROVIDE A LETTER OF CERTIFICATION TO INSURE THAT THE LAWN AND LANDSCAPE AREAS ARE MEETING THE POST CONSTRUCTION SOIL QUALITY AND DEPTH REQUIREMENTS SPECIFIED ON THE APPROVED PLAN SET PRIOR TO FINAL INSPECTION OF THE PROJECT

NOTES:

- SITE PLAN PROVIDED BY ATLAS ARCHITECTS
- SURVEY PROVIDED BY SITE SURVEYING INC.
- CALL 1-800-424-5555 BEFORE YOU DIG
- CONTRACTOR TO FIELD VERIFY ELEVATIONS PRIOR TO CONSTRUCTION
- RE-USE EXISTING SEWER SERVICE
- CIVIL ENGINEER TO PROVIDE LETTER THAT POST-CONSTRUCTION SOIL QUALITY AND DEPTH REQUIREMENTS ARE MET PER BMP T5.13
- A TV INSPECTION OF THE SIDE SEWER WILL BE REQUIRED AND MUST BE ACCEPTED BY THE CITY OF MERCER ISLAND
- THE EXISTING WATER SERVICE SHALL BE CAPPED AND ABANDONED AT THE WATER MAIN IF REPLACED
- ALL EXISTING BUILDING AND PAVEMENT TO BE REMOVED
- CONTRACTOR MUST POT-HOLE STREET TO LOCATE UTILITIES PRIOR TO CONSTRUCTION
- PLAN MAY REQUIRE MODIFICATION AND REVIEW BY CITY AFTER POT-HOLING UTILITIES

NO	DATE	BY	APPR	REVISIONS
1	4/25/22	BPA		CHANGE DETENTION PIPE TO TANK

**ANSTEY ENGINEERING**  
ae 8627 NE 180th Street  
Bothell, WA 98011  
Ph: 206-303-7639  
Email: benanstey@ansteyengineering.com

4/25/2022

Approved By

BPA 12/17/19  
DESIGNED BY DATE

BPA 12/17/19  
DRAWN BY DATE

CHECKED BY DATE

MINGQIN LI & SUN YONG  
2423 63RD AVE SE  
MERCER ISLAND, WA 98040

**SITE & DRAINAGE PLAN**

AE2019-84 SHT 1 OF 1