


ASBUILT SURVEY  
8-2-2023

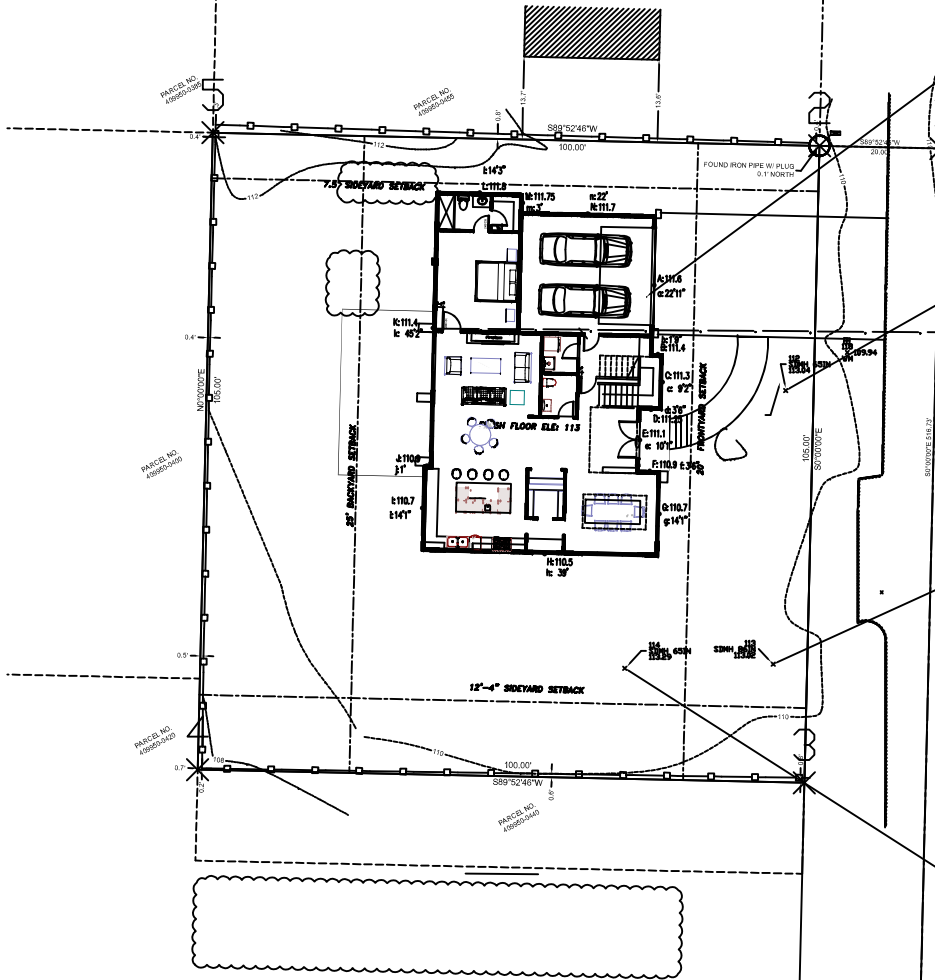

FF GARAGE 111.7  
FF HAUSE 113.1

SDMH 65"  
TOP 113.0  
IE 36" S 107.95  
BOTTOM 105.95

SDMH 86"  
TOP 113.0  
IE 36" CPP N 108.2  
IE 36" CPP W 108.2  
BOTTOM OF THE CUT OUT E 108.2  
BOTTOM 106.2

CB  
TOP 108.6  
IE 12" S 106.7  
IE 12" NE 105.0

SDMH 65"  
TOP 113.3  
IE 36" E 108.1  
BOTTOM 106.1