


ASBUILT SURVEY 8-2-2023
(NOT TO SCALE)

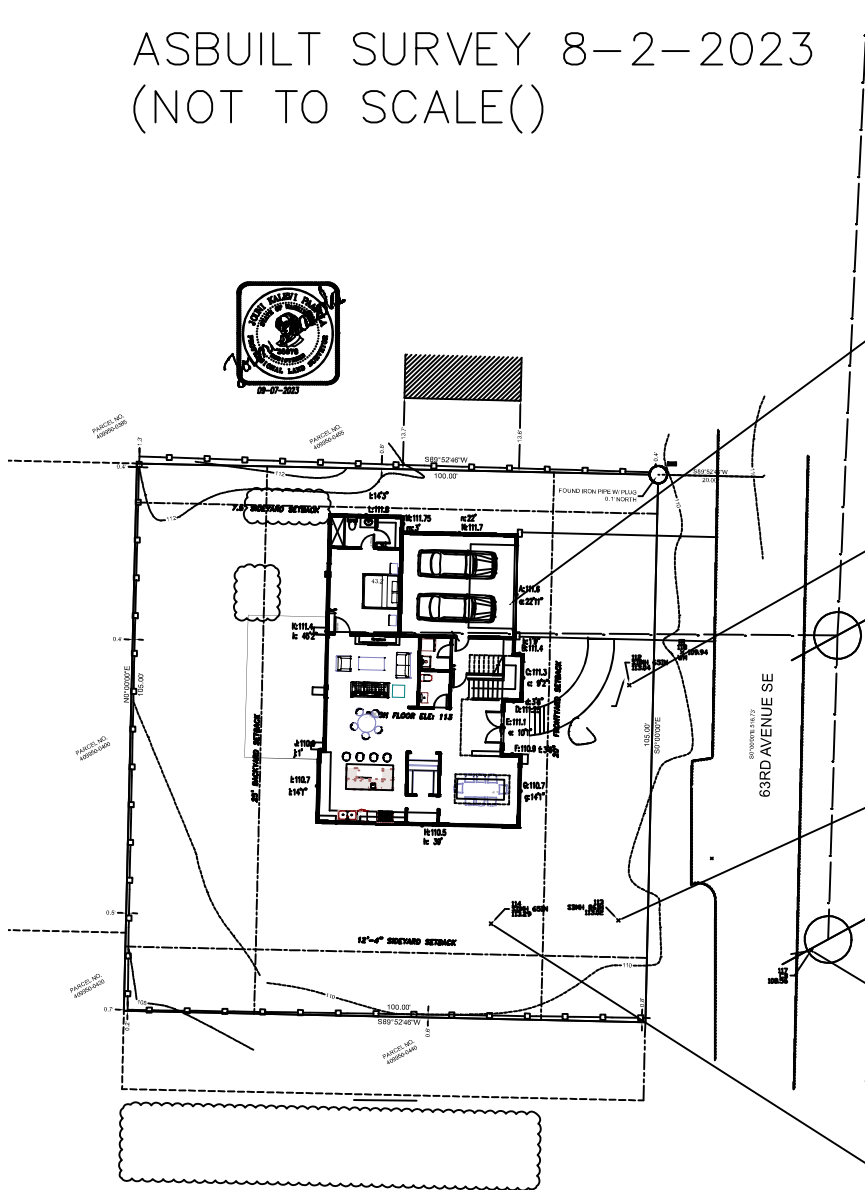

FF GARAGE 111.7

FF HAUSE 113.1

SDMH 65"
TOP 113.0
IE 36" S 107.95
BOTTOM 105.95

SDMH 86"
TOP 113.0
IE 36" CPP N 108.2
IE 36" CPP W 108.2
BOTTOM OF THE CUT OUT E 108.2
BOTTOM 106.2

CB
TOP 108.6
IE 12" S 106.7
IE 12" NE 105.0

SDMH 65"
TOP 113.3
IE 36" E 108.1
BOTTOM 106.1