TREE PROTECTION GUIDELINES

All remaining trees are to have a tree protection zone (TPZ) established before commencement of any construction or delivery activities. The following guidelines are to be observed and practiced during all construction activities.

- Access is to be restricted into TPZ's with readily visible temporary tree fencing along the LOD which completely surrounds the protected areas of retained trees. Fences shall be constructed of chain link and be at least 4 ft tall, constructed using pier block, and major roots should be avoided while staking. • Highly visible signs spaced no further than 15 feet shall be placed
- along sides of the TPZ fencing.
- Construction materials or supplies, soil, debris, vehicles, and equipment are not to be parked or stored within TPZ.
- TPZ fences must be inspected prior to the beginning of any construction activities.
- Assess crew and contractor penalties, if necessary, to keep the TPZ's intact.
- Check the integrity of TPZ fences weekly, and repair or replace as
- needed. • Wood chips should be used if possible to spread above root zones
- within the TPZ's to a depth of 6-8 inches for temporary protection. • Cement trucks must not deposit waste or rinse out trucks in the TPZ.
- Avoid grade changes or trenching within or near the TPZ. If it is unavoidable, then follow the guidelines below. • TPZ's may only be moved or accessed with permission from City Officials, and any work done within TPZ's must be done with a certified arborist present.
- If roots need to pruned, they should be cut with pruning saws, made flush with the side of the trench.
- Trees should be watered twice a week if construction is to take place during hot summer months.

If excavation occurs within the driplines of trees scheduled for retention, the following procedures must be followed to protect them:


- The contractor shall verify the vertical and horizontal location of existing utilities to avoid conflicts and maintain minimum clearances;
- adjustment shall be made to the grade of the new utility as required. • The inner root zone shall not be disturbed or cut (inner root zone =
- half the drip line radius). • ISA Certified arborist must work with equipment operators during
- trenching/ excavation. The Arborist should have a shovel, hand pruners, loppers, handsaw, and a sawsall.
- If roots one inch or larger are damaged by equipment, the Arborist shall stop the equipment and have the dirt excavated by hand until the root can be cleanly cut. A clean straight cut shall be made to remove the damaged portion of root, and if possible the roots should be covered in moist burlap until recovered with dirt the same day. • Boring or tunneling under roots of existing trees is a viable alternative to trenching through roots. It shall be performed under
- the supervision of an ISA Certified Arborist, and no roots 1 inch in diameter or larger shall be cut.
- The grade shall not be elevated or reduced within the critical root zone of trees to be preserved without the Planning Official's authorization based on recommendations from a qualified professional. The Planning Official may allow coverage of up to one half of the area of the tree's critical root zone with light soils (no clay) to the minimum depth necessary to carry out grading or landscaping plans, if it will not imperil the survival of the tree. Aeration devices may be required to ensure the tree's survival.

TREE RETENTION/ PROVISION CALCULATION

EXISTING ON-SITE TRE	ES	RETAIN	REMOVE	DBH	CREDIT
TREE #1	FLOWERING CHERRY	X		12"	2
TREE #2	Cedrus Atlantica, Atlas Cedar	X		29.5"	10
TREE #3	Quercus, Pin Oak	x		24.8"	8
TREE #4	Acer palmatum, Japanese Maple	x		12.5"	2
TREE #5	Acer palmatum, Japanese Maple		Х	11.0"	1
TREE #6	Cedrus Atlantica, Atlas Cedar	x		26.0"	9
TREE #7	Acer Macrophyllum, Big Leaf Maple	X		17.4"	4
TREE #8	Fraxines, Ash	X		21.0"	6
TREE #9	Fraxines, Ash	X		14.0"	3
NEW TREES TO REPLA					
TREE #10	Amelanchier Alnifolia, Western Serviceberry	X (NEW) REPLACEME NT		2"	
TREE #11	Amelanchier Alnifolia, Western Serviceberry	X (NEW) REPLACEME NT		2"	
EXISTING OFF-SITE TR	EES w/ OVERHANGING LIMBS				
TREE # OS 1	Cuppreseocyparis Leylandii, Layland	X		est 18"	
TREE # OS 2	Cuppreseocyparis Leylandii, Layland	X		est 21"	
TREE # OS 3	Populus Nigra, Black Cottonwood	X		est 44"	
TOTAL CREDITS PROPOSED					45
LOT SIZE				0.50	ACRES
TREES PER ACRE	PER KZC 95.33			30.0	
TOTAL CREDITS REQUIRED					5.0
	I MINIMUM SIZE WORTH ONE TREE CREDIT AS OUTUN				

SUPLEMENTAL TREES TO MEET MINIMUM SIZE WORTH ONE TREE CREDIT AS OUTLINED IN KZC 95.33(4)

	21,700	
LOT SIZE LOT COVEREAGE ZONE % - RS 9.6 <15%		S
SLOPE - 40%	8,680	S
	E 2,374	
		5
VEHICULAR USE	2,646	ç
TOTAL EXISTING LOT COVERAGE	5,020	ç
NEW LOT COVERAGE		
EXISTING LOT COVERAGE REMOVED	(797)	S
MAIN STRUCTURE ROOF AREA	511	S
ACCESSORY STRUCTURE ROOF AREA	625	S
VEHICULAR USE	250	S
COVERED PATIOS/DECKS	73	S
NEW LOT COVERAGE	1,459	ę
TOTAL LOT COVERAGE AREA	5,682	S
%	26.18%	, 0
HARDSCAPE COVERAG		
LOT SIZE	21,700	S
BORROWED FROM LOT COVEREAGE	2,998	S
HARDSCAPE AREA ALLOWED = 9%+ BORROWED AREA	4,951	S
% HARDSCAPE AREA ALLLOWED	22.82%	_
EXISTING HARDSCAPE COVE	RAGE	
UNCOVERED DECKS	468	ç
UNCOVERED PATIOS WALKWAYS	1,007 260	
STAIRS	451	S
ROCKERIES/RETAINING WALLS	181	3
	101	
HARDSCAPE COVERAGE	2,367	S
HARDSCAPE AREAS REMOVED	(728)	S
NEW HARDSCAPE COVERA	GE	
UNCOVERED DECKS - REPLACED	75	S
UNCOVERED PATIOS	60	5
DOCK PATH	233	S
STAIRS	49	ç
NEW RETAINING WALL	29	S
COVERED DECK	60	S
TOTAL NEW HARDSCAPE COVERAGE	506	S
TOTAL HARDSCAPE AREA	1,751 8.07%	S
	8.07%	
GROSS LOT COVERAGE % GROSS LOT COVERAGE CH	34.25%	0
EXISTING LOT COVERAGE	5,020	
EXISTING HARDSCAPE COVERAGE	2,367	_
TOTAL EXISTING GROSS COVERAGE	7,387	
REMOVED EXIST. LOT COVERAGE	(797)	Ş
REMOVED EXIST. HARDSCAPE	(728)	Ś
TOTAL REMOVED COVERAGE	-1,525	ę
NEW LOT COVERAGE	1,459	
NEW HARDSCAPE COVERAGE	506	
	1,965	
TOTAL NEW COVERAGE	,	
TOTAL NEW COVERAGE NEW GROSS COVERAGE TOTAL:	7,827	Ś

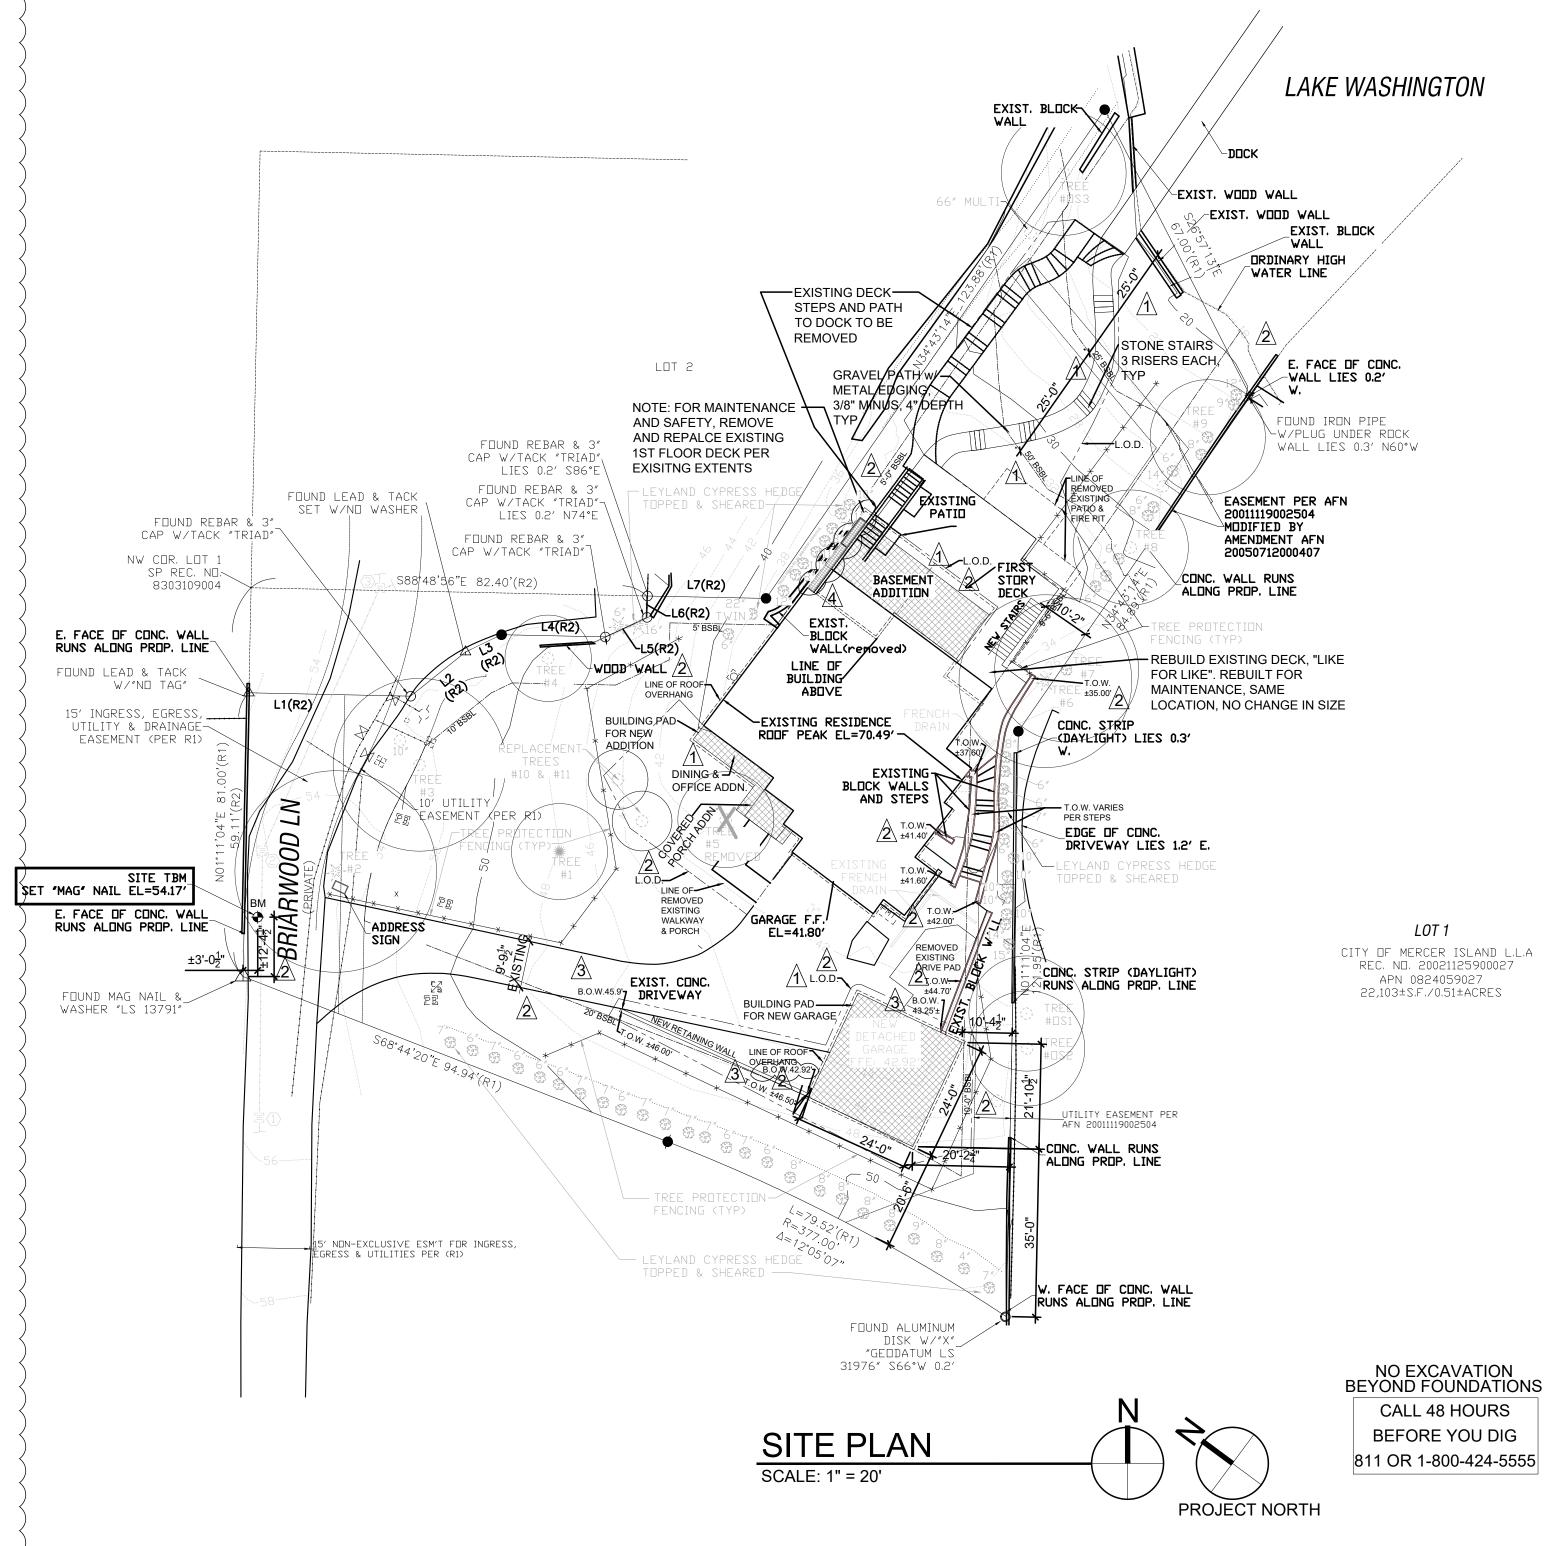

EXIST. AREA	REMOVED AREA		1
2 (1 (m) (NEW/ADD AREA	TOTAL
,430		100	1,530
,677		67	1,744
,290	681	400	1,009
505			505
		92	92
4,902	681	659	4,880
		576	576
ZONE	ALLOWED GROSS FLOOR AREA (SF)	ALLOWED GROSS FLOOR AREA (%)	
R9.6	8,000	36.87%	
	,677 ,290 505 4,902 ZONE	,677 ,290 681 505 4,902 681 20NE ALLOWED GROSS FLOOR AREA (SF)	,677 67 ,290 681 400 ,05 92 ,902 681 659 ,902 681 576 ,200 ALLOWED GROSS ALLOWED GROSS ,902 ALLOWED GROSS ALLOWED GROSS

FIRE AREA CALCULATION

(FROM INSIDE PERIMETER OF THE EXTERIOR WALLS)			
AREA	SQ. FTG.		
BASEMENT	1,638		
1st FLOOR	1,663		
2nd FLOOR	1,756		
ATTACHED GRAGE	486		
COVERED PORCH	64		
COVERED DECKS	363		
COVERED PATIO	126		
TOTAL FIRE SF:	6,096		

9820 SE 35TH PLACE, MERCER ISLAND, WA. 98040


LOT SLOPE:

HIGHEST ELEVATION POINT OF LOT: 54.4 FEET 18.0 FEET LOWEST ELEVATION POINT OF LOT: 36.4 FEET ELEVATION DIFFERENCE: HORIZONTAL DISTANCE BETWEEN POINTS: 254.7 FEET

LOT SLOPE: 14.3%

_____ ______ SD ______ SD _____ ------WATER SERVICE -----LINE OF ROOF ABOVE ------ ABE RECTANGLE - · - · - · - PROPERTY LINE _____

SYMBOL LEGEND: _ CENTER LINE SANITARY SEWER GAS SERVICE _ STORM DRAINAGE _ UNDERGROUND POWER - SETBACK LINE _EXISTING CONTOUR _ PROPOSED CONTOUR ------ EASEMENT LINE - TREE FENCE RETAINING WALL _____ LINE OF DISTURBANCE

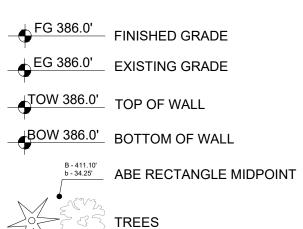

N Zali




TREE DRIPLINE

TREE TO BE REMOVED

CONCRETE

BM BENCH MARK SSMH SANITARY SEWER MANHOLE

S 88° 52' 32" E 296.84' BEARING

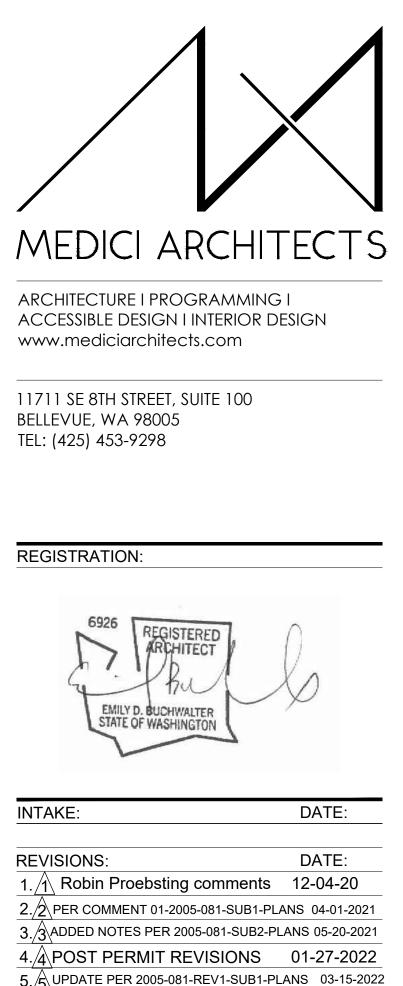

PROJECT / CLIENT:

9820 SE 35TH PLACE ACHIN & MARY CHEN 9820 SE 35TH PLACE MERCER ISLAND, WA 98040

JOB ADDRESS: 9820 SE 35TH PLACE MERCER ISLAND, WA 98040 PARCEL # 082405-9027

DRAWING NAME: SITE PLAN Drawn By: JMG,RB Checked By: EB Owner Approval: PHASE: **CONSTRUCTION DOCUMENTS** This drawing is the exclusive property of Medici Architects, and can be reproduced only with the permission of the Architect. Variations and modifications to work shown on this drawing shall not be carried out without written permission from the Architect. APPROVED FOR CONSTRUCTION:


PLOT SCALE: 1:1

DATE:


PROJECT No.: 2020 007


12-22-2020


A0.1

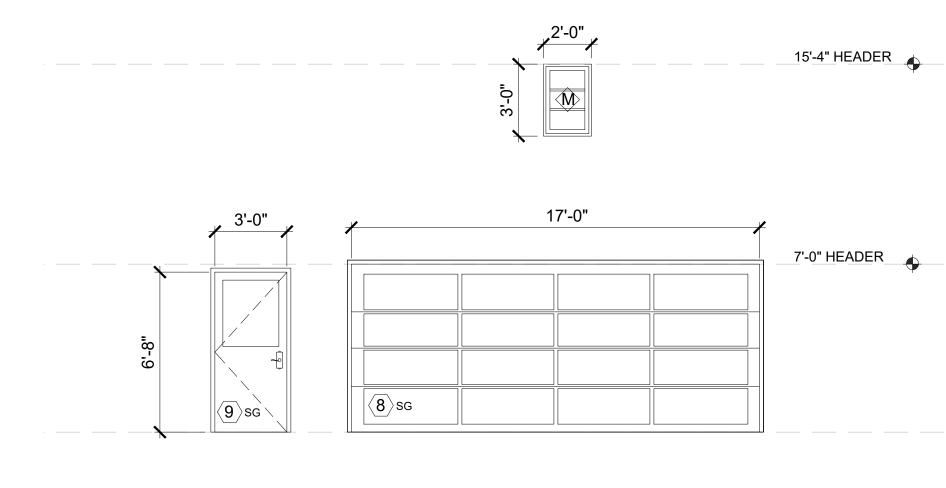


DETACHED GARAGE DOOR AND WINDOWS ELEVATIONS SCALE: 1/4" = 1'-0"

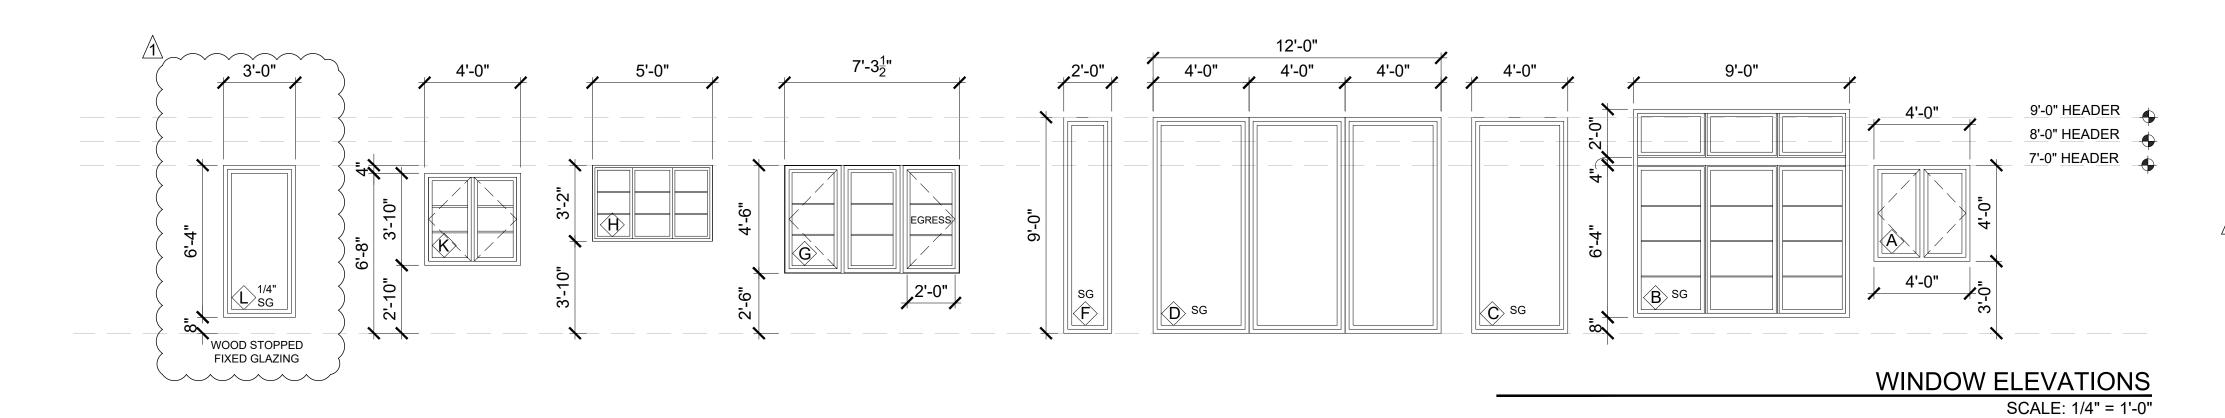

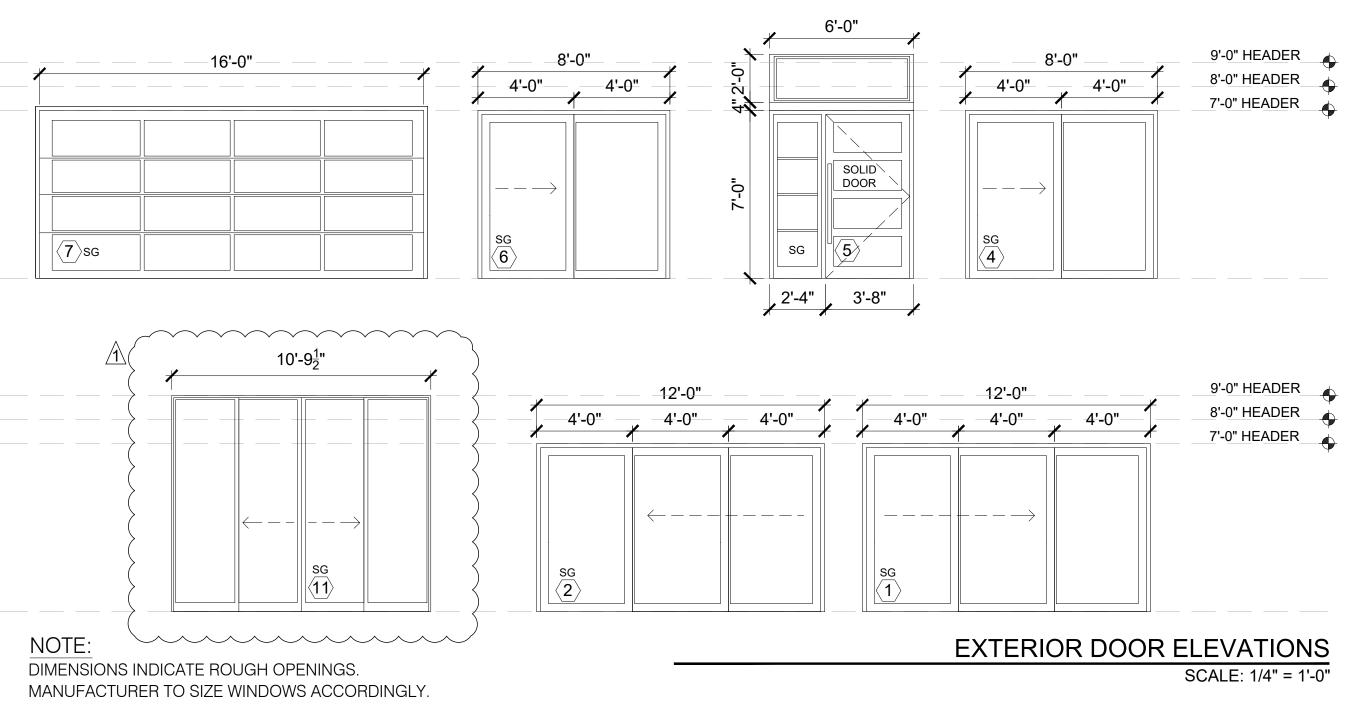


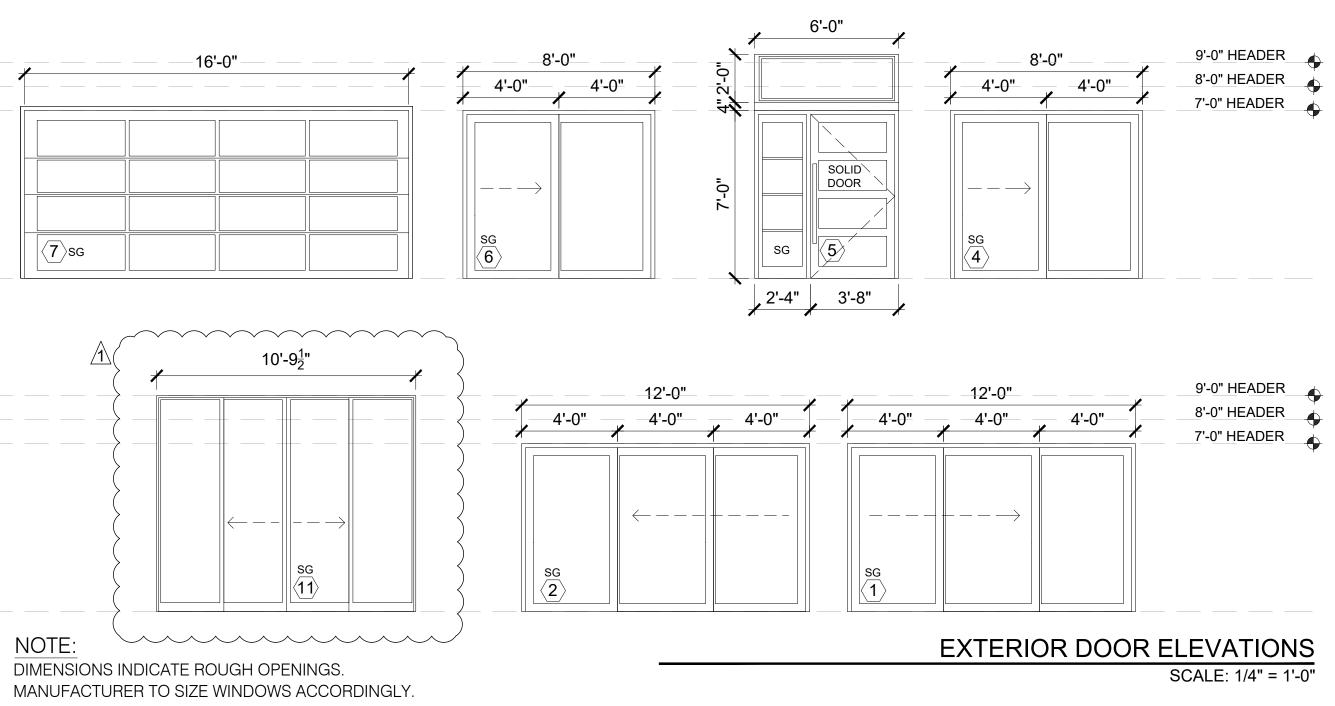


FIELD MEASURE PRIOR TO ORDERING.VERIFY SIZE REQUIREMENTS FOR EGRESS.

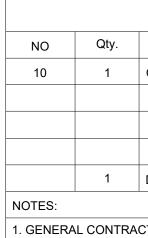


2. ALL EXTERIOR TRUE 3. VERIFY ALL DOOR T

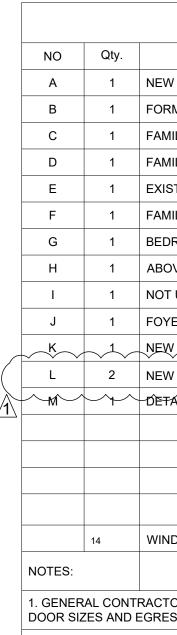


2. ALL EXTERIOR TRUE I 3. ALL WINDOWS TO BE NFRC CERTIFIED AND LABELED

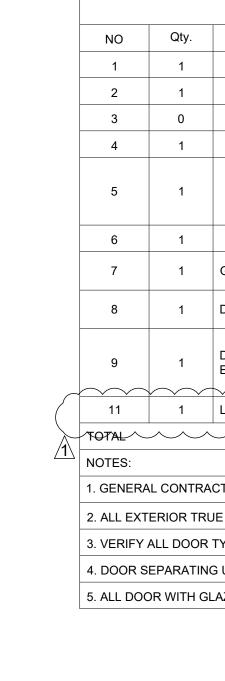

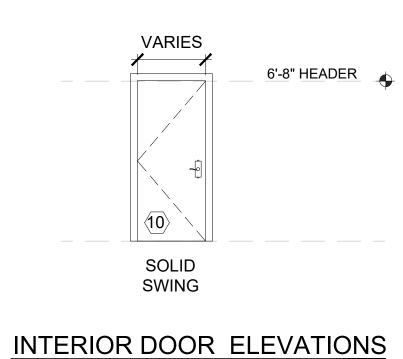

SCALE: 1/4" = 1'-0"

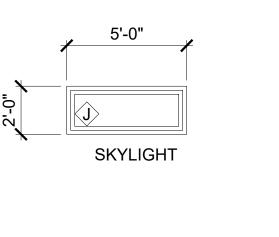



INTERIOR DOOR SCHEDULE						
LOCATION	w	н	MANUF	TYPE	HARDWARE	REMARKS
OFFICE	2'-8"	6'-8"	TBD	SOLID SWING		
					ALL HARDWARE TO BE	
					BRUSHED NICKEL FINISH 2- PAIR OF BUTT HINGES FOR	
					8'-0" DOORS	
DOOR COUNT						
	·					
TOR SHALL PROVIDE MANUFACTURER'S DA	TA ON ALL	WINDOWS	SHOWING CO	OMPLIANCE WITH THE 2015 WASHIN	IGTON STATE ENERGY CODE.	
DIVIDED FIXED TRANSOM GLAZING TO BE POSITIONED AT UPPER SASH LOCATION.						
PES & HARDWARE W/OWNER PRIOR TO ORDERING.						

4. DOOR SEPARATING UN-HEATED FROM HEATED SPACE TO BE U=.28 MAX. PER WSEC 2015

WINDOW SCHEDULE

LOCATION	WIDTH	HEIGHT	AREA	MANUF.	U-VAL	TYPE	SCREEN	HARDWARE	REMARKS
NEW EXERCISE ROOM	4'-0"	4'-0"	16.00	TBD	0.28	CSMT/CSMT	Y	TBD	
ORMAL DINING ROOM	9'-0"	8'-4"	74.70	TBD	0.28	FIXED	Ν	TBD	TRANSOM,GRIDS
AMILY ROOM	4'-0"	9'-0"	36.00	TBD	0.28	FIXED	Ν	TBD	SAFETY GLASS
AMILY ROOM	12'-0"	9'-0"	18.00	TBD	0.28	FIXED	Ν	TBD	SAFETY GLASS, MULLED
XISTING WINDOWS									
AMILY ROOM	2'-0"	9'-0"	18.00	TBD	0.28	FIXED	Ν	TBD	SAFETY GLASS
BEDROOM 3	7'-3.5"	4'-6"	32.85	TBD	0.28	CSMT/CSMT/CSMT	Y	TBD	EGRESS, GRIDS
ABOVE FOYER	5'-0"	3'-2"	15.50	TBD	0.28	FIXED	Ν	TBD	GRIDS, SAFETY GLASS
NOT USED	0	0	0.00						
OYER	2'-0"	5'-0"	10.00	TBD	0.43	SKYLIGHT	Ν	TBD	SKYLIGHT
	4'-0"	3'-10"	8.34	TBD	0.28	CSMT/CSMT	Y	TBD	GRIDS
IEW EXERCISE RM INTERIOR	3'-0"	6'-4"	37.80	TBD		FIXED	Ν	TBD	SAFETY G;ASS
DETACHED GARAGE WINDOW	2'-0"	<u> </u>	6.00			ŕłxéd	$\sim N$	TBD	NON CONDITIONED
			229.39		0.28		64.23		
			10.00	SF	0.43		4.3		NOTE: SEE A0.3 & A4.0,1,2 FOR
VINDOW COUNT						U X A =	68.53		WINDOW DIVISIONS
CTOR SHALL PROVIDE MANUFACTU RESS REQUIREMENTS PRIOR TO OF					│ THE 2015 WA	SHINGTON STATE ENERGY	CODE. CONTR	ACTOR TO FIELD	VERIFY ALL WINDOW AND
JE DIVIDED FIXED TRANSOM GLAZIN	IG TO BE POSITIO	ONED AT UPPER	SASH						
BE NFRC CERTIFIED AND LABELED									

EXTERIOR DOOR SCHEDULE

LOCATION	W	Н	MANUF.	AREA	U-VAL	TYPE	CONFIGURATION	HARDWARE	REMARKS
NEW EXERCISE ROOM	12'-0"	7'-0"	TBD	84.0	0.28	SLIDING	ХХО		SAFETY GLASS
NEW SITTING ROOM	12'-0"	7'-0"	TBD	84.0	0.28	SLIDING	ХХО		SAFETY GLASS
NOT USED	0	0	TBD	0.0	0.28				
KITCHEN	8'-0"	7'-0"	TBD	56.0	0.28	SLIDING	XO		SAFETY GLASS
FOYER	6'-0"	9'-0"	TBD	54.0	0.28	SOLID SWING WITH SIDE LITE & TRAMSOM		ALL HARDWARE TO BE BRUSHED NICKEL FINISH 2- PAIR OF BUTT HINGES FOR 6'-8"/ 8'-0" DOORS	SAFETY GLASS
MASTER BEDROOM	8'-0"	7'-0"	TBD	56.0	0.28	SLIDING	XO		SAFETY GLASS
GARAGE	16'-0"	7'-0"	TBD			OVER HEAD GARAGE DOOR	X	GARAGE DOOR OPENER, S PATT	
DETACHED GARAGE	17'-0"	7'-0"	TBD			OVER HEAD GARAGE DOOR	X	GARAGE DOOR OPENER, S PATT	
DETACHED GARAGE ENTRY	3'-0"	8'-0"	TBD	~~~~	0.28	SOLID SWING	x	ALL HARDWARE TO BE BRUSHED NICKEL FINISH 2- PAIR OF BUTT HINGES FOR 6'-8"/ 8'-0" DOORS	1/2 LIGHT, SAFTY GLASS
LIVING ROOM	11'-0"	9'-0"	TBD	99.0	0.28	SLIDING	OXXO		SAFETY GLASS
			~~SE~~~		0.28	TOTALUXAS	121.2		~~~~~~
CTOR SHALL PROVIDE MANUE									


1. GENERAL CONTRACTOR SHALL PROVIDE MANUFACTURER'S DATA ON ALL WINDOWS SHOWING COMPLIANCE WITH THE 2015 WASHINGTON STATE ENERGY CODE.

2. ALL EXTERIOR TRUE DIVIDED FIXED TRANSOM GLAZING TO BE POSITIONED AT UPPER SASH LOCATION.

3. VERIFY ALL DOOR TYPES & HARDWARE W/OWNER PRIOR TO ORDERING.

4. DOOR SEPARATING UN-HEATED FROM HEATED SPACE TO BE U=.28 MAX. PER WSEC 2015

5. ALL DOOR WITH GLAZING TO BE NFRC CERTIFIED AND LABELED

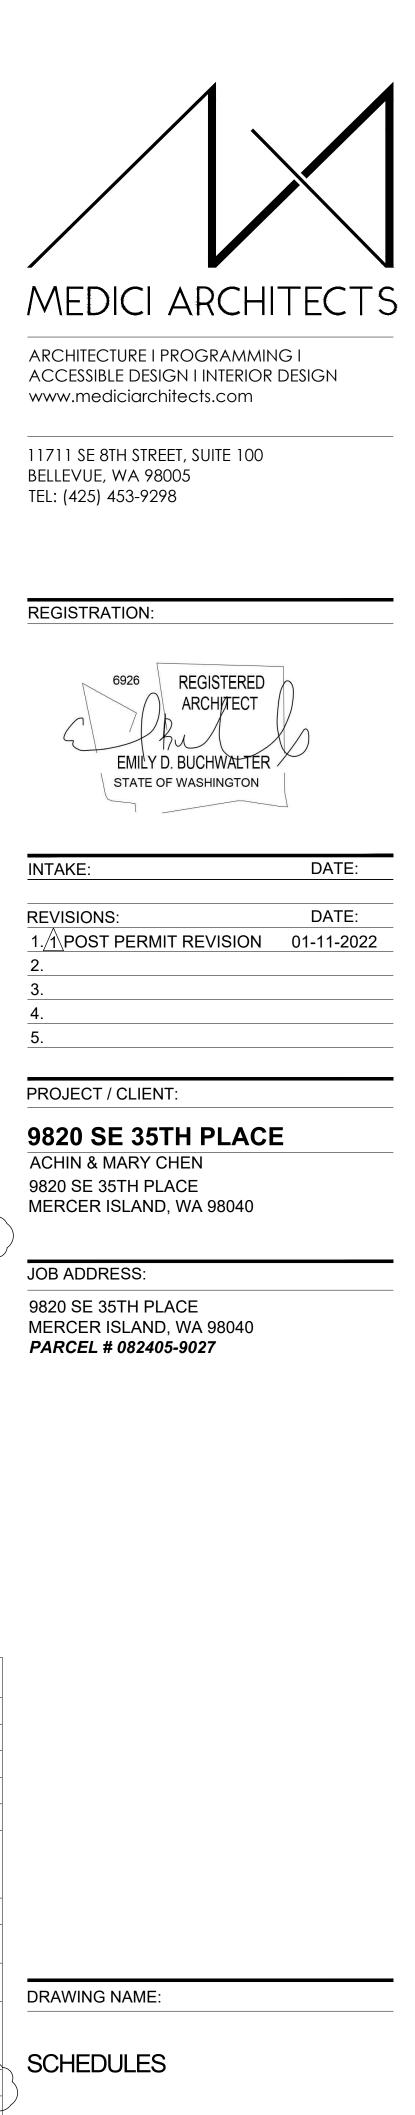

Drawn By: JMG,RB Checked By: EB Owner Approval:

PHASE: **CONSTRUCTION DOCUMENTS**

This drawing is the exclusive property of Medici Architects, and can be reproduced only with the permission of the Architect. Variations and modifications to work shown on this drawing shall not be carried out without written permission from the Architect.


П


A0.4

APPROVED FOR CONSTRUCTION:


PROJECT No.: 2020 007 DATE: 12-22-2020

PLOT SCALE: 1:1

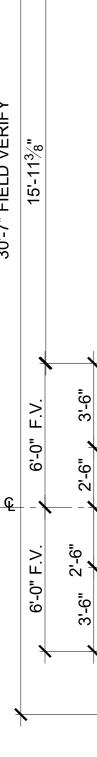

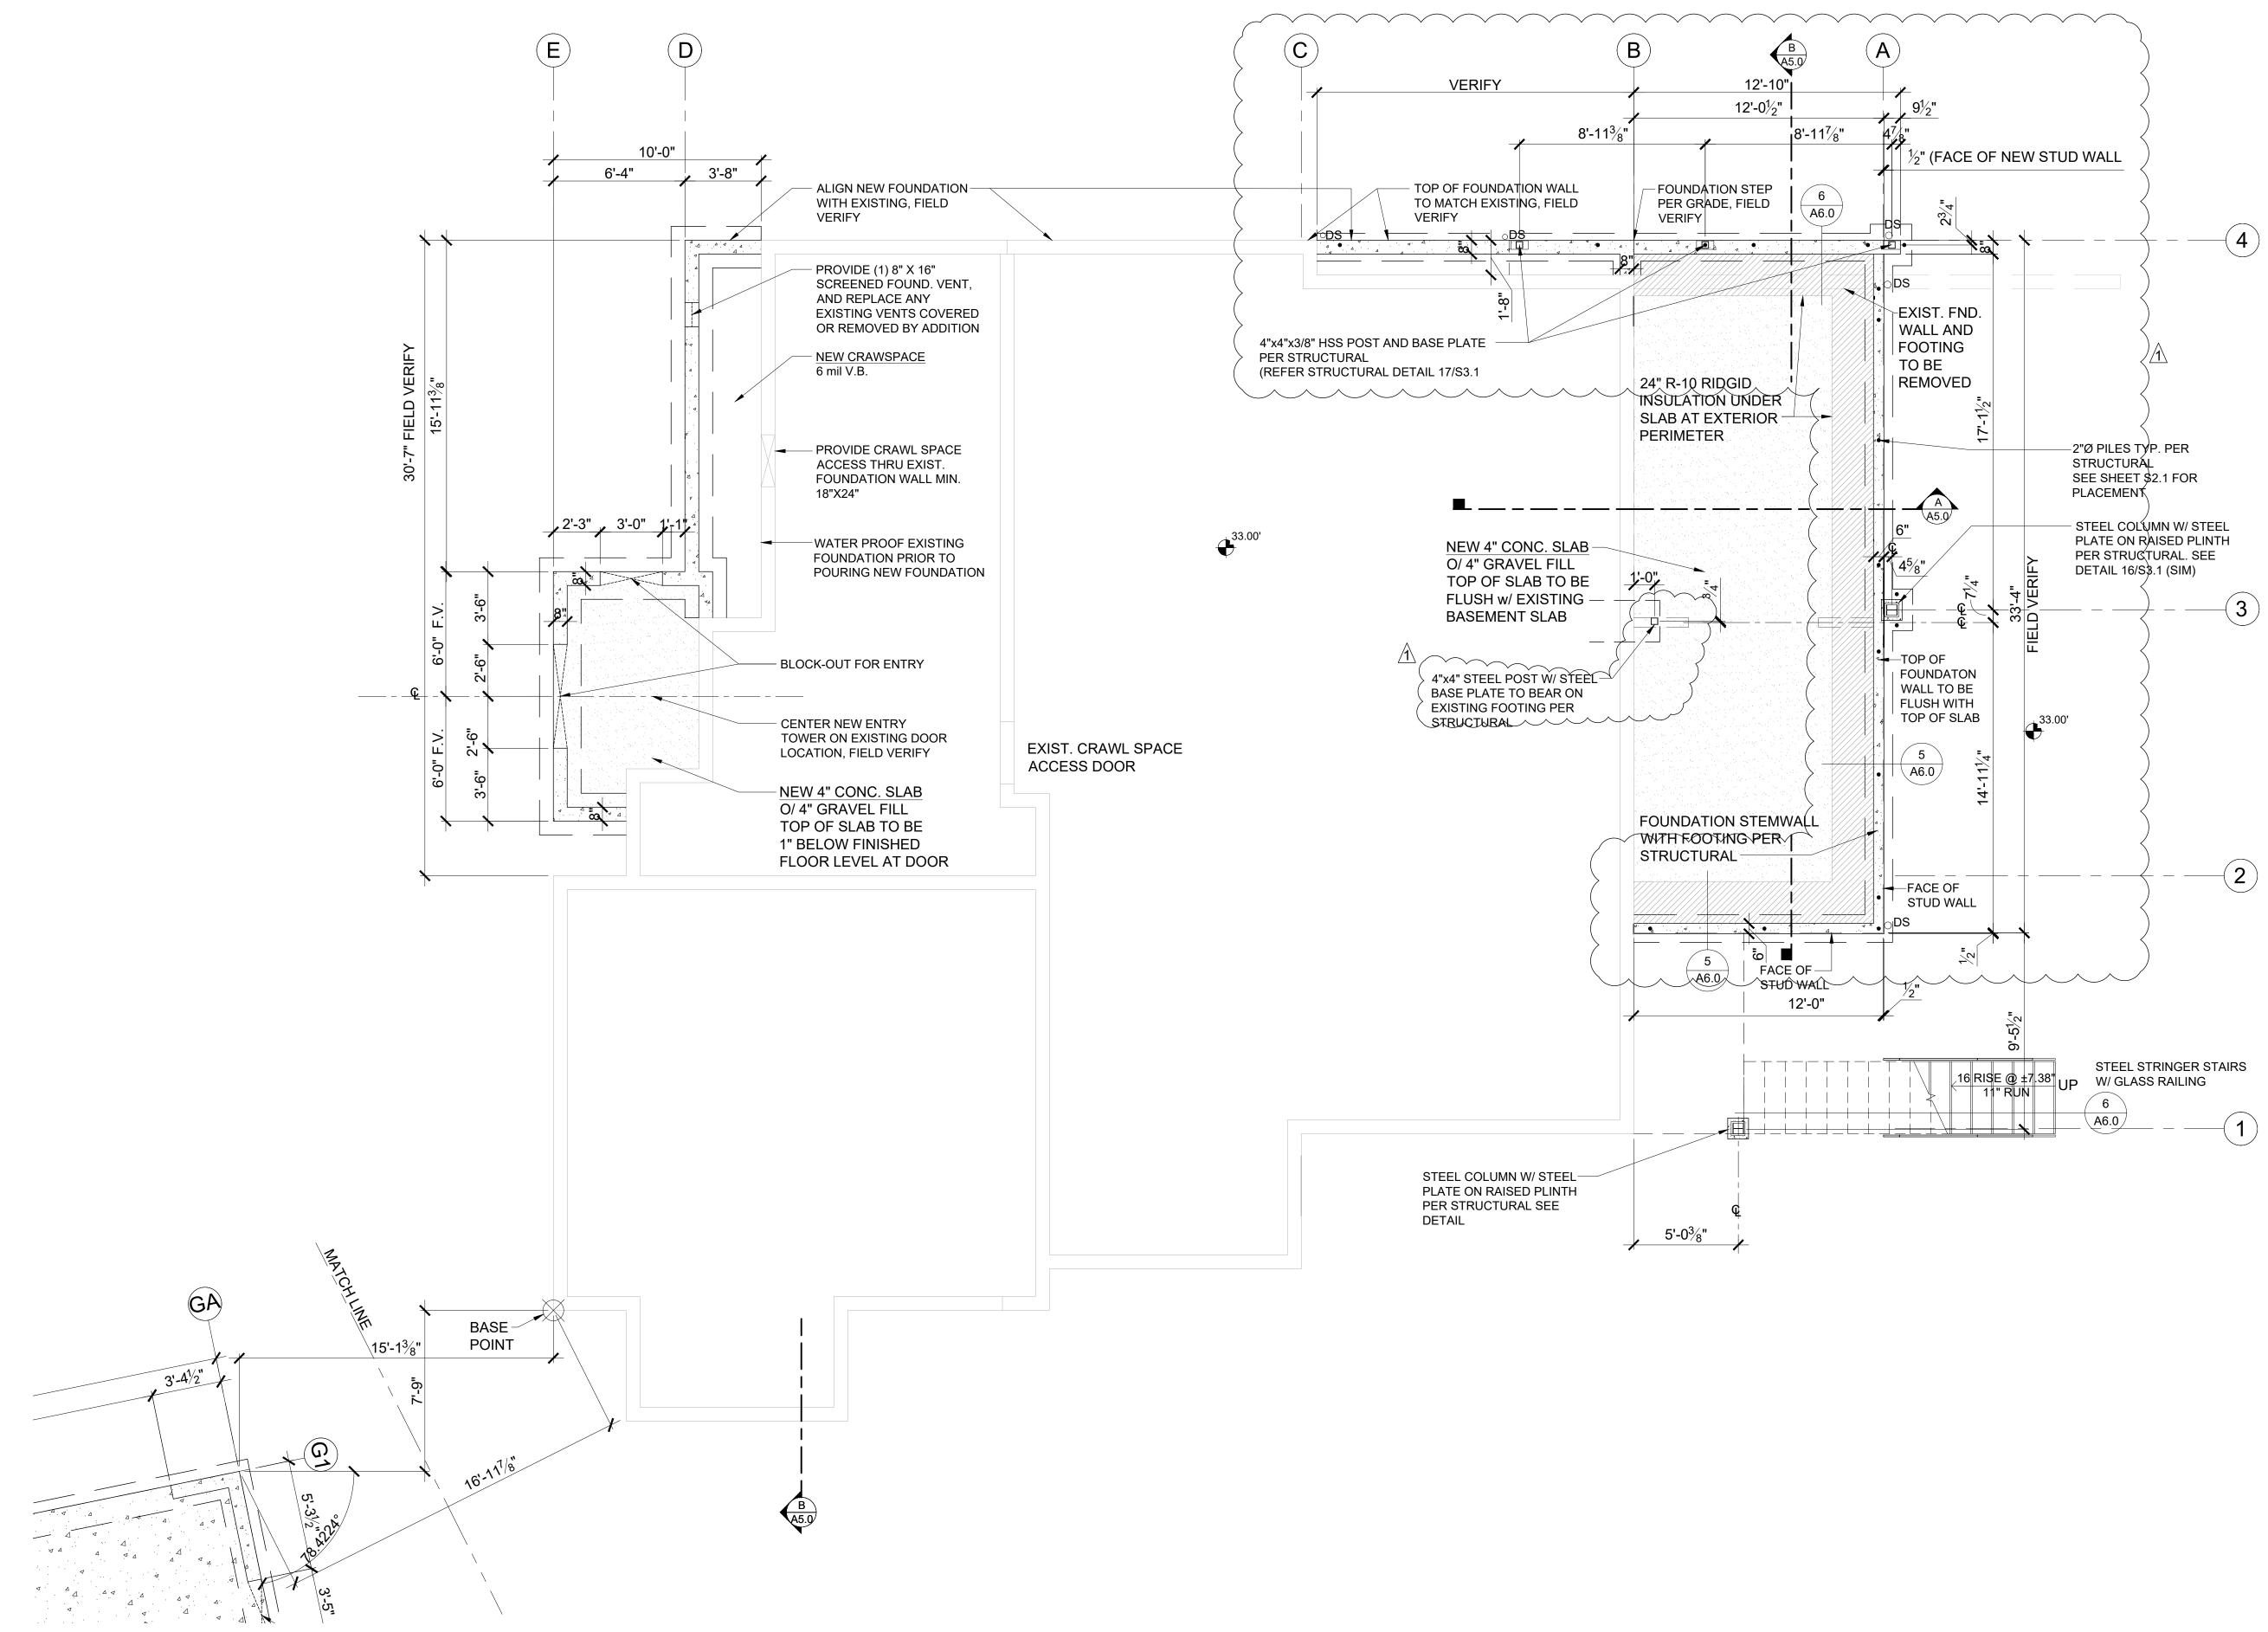

FOUNDATION PLAN SCALE: 1/4" = 1'-0"

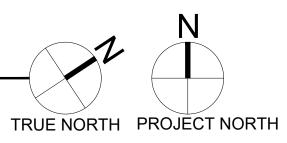

CRAWL SPACE - VENTILATION CALCULATION						
Added Crawl Space Area:	51	s.f.				
Ventilation Required:	51	s.f. x 144 s.i.1 /1,500*=	4.9	s.i. Req'd		
Use:	16"x8"	Foundation Vents				
Vent Area =	98.0	s.l 25% reduction + 1/4" mesh	73.5	s.l.		
Number of vents required:	4.9	s.l. / vent area	0.1	vents		
Provide:	1.0		73.5	Provided		
Total Min. Ventilation Provided =	73.5	s.i. IS GREATER THAN	4.9	s.i. Req'd		
* 2015 IRC - PER R408.1 THE TOTAL OF THE UNDER-FLOOR AREA WHER RETARDER MATERIAL AND THE REG	RE THE GROUND S	SURFACE IS COVERED WITH AN A	PPROVED CLAS	SS I VAPOR		

SYMBOL LEGEND

EXIST.FOUNDATION WALL

SLAB ON GRADE

NEW FOUNDATION WALL w/ FOOTING

POST - VERIFY SIZE AND TYPE

WITH STRUCTURAL PLAN


CRAWL SPACE VENT



ARCHITECTURE I PROGRAMMING I ACCESSIBLE DESIGN I INTERIOR DESIGN www.mediciarchitects.com

11711 SE 8TH STREET, SUITE 100 BELLEVUE, WA 98005 TEL: (425) 453-9298

REGISTRATION:

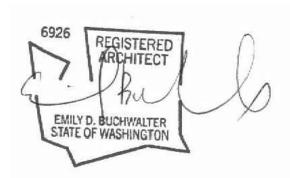

INTAKE:

REVISIONS: DATE: 1. A POST PERMIT REVISIONS 01-24-2022


DATE:


PROJECT / CLIENT:

9820 SE 35TH PLACE ACHIN & MARY CHEN 9820 SE 35TH PLACE MERCER ISLAND, WA 98040


JOB ADDRESS: 9820 SE 35TH PLACE MERCER ISLAND, WA 98040 PARCEL # 082405-9027

DRAWING NAME: FOUNDATION PLAN Drawn By: JMG,RB Checked By: EB Owner Approval: PHASE: CONSTRUCTION DOCUMENTS This drawing is the exclusive property of Medici Architects, and can be reproduced only with the permission of the Architect. Variations and modifications to work shown on this drawing shall not be carried out without written permission from the Architect. APPROVED FOR CONSTRUCTION: PROJECT No.: 2020 007 DATE: 12-22-2020 A1.0

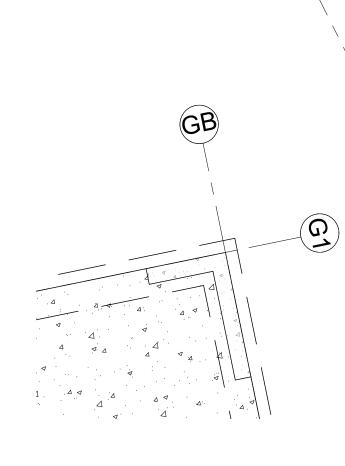

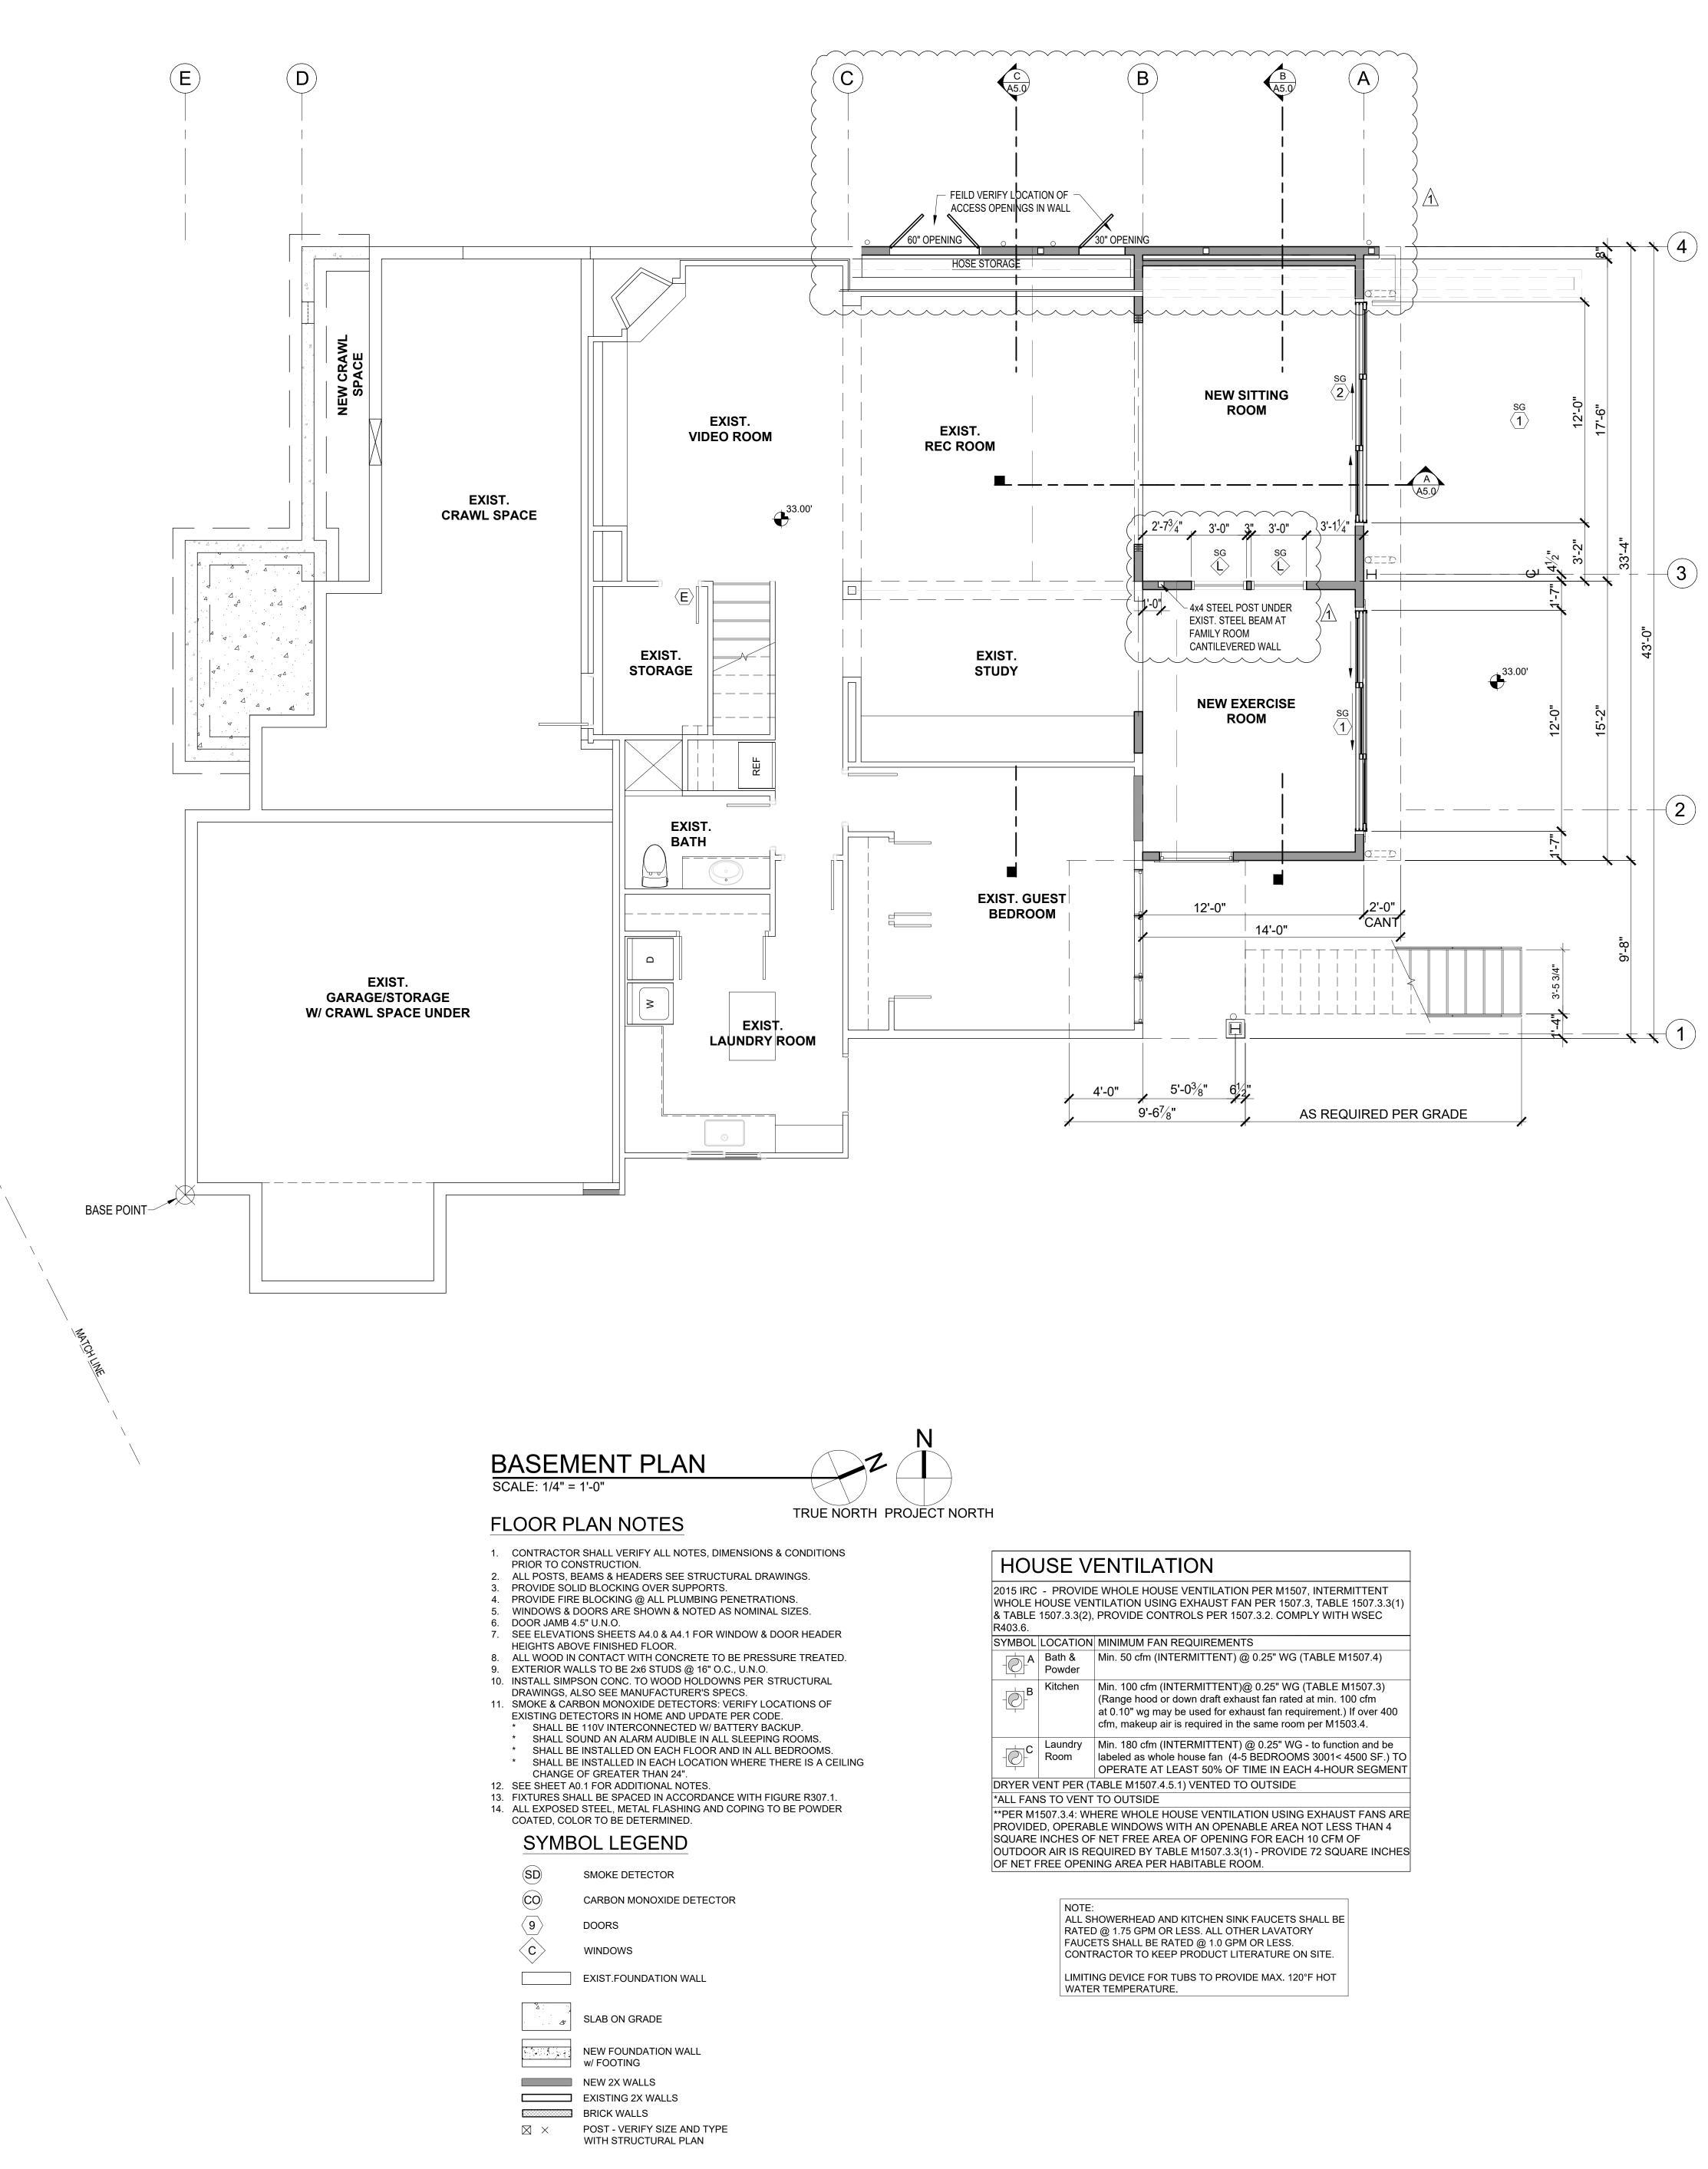


2015 IRC - PROVIDE WHOLE HOUSE VENTILATION PER M1507, INTERMITTENT WHOLE HOUSE VENTILATION USING EXHAUST FAN PER 1507.3, TABLE 1507.3.3(1) & TABLE 1507.3.3(2), PROVIDE CONTROLS PER 1507.3.2. COMPLY WITH WSEC R403.6.					
SYMBOL	LOCATION	MINIMUM FAN REQUIREMENTS			
	Bath & Powder	Min. 50 cfm (INTERMITTENT) @ 0.25" WG (TABLE M1507.4)			
- B	Kitchen	Min. 100 cfm (INTERMITTENT)@ 0.25" WG (TABLE M1507.3) (Range hood or down draft exhaust fan rated at min. 100 cfm at 0.10" wg may be used for exhaust fan requirement.) If over 400 cfm, makeup air is required in the same room per M1503.4.			
	Laundry Room	Min. 180 cfm (INTERMITTENT) @ 0.25" WG - to function and be labeled as whole house fan (4-5 BEDROOMS 3001< 4500 SF.) TO OPERATE AT LEAST 50% OF TIME IN EACH 4-HOUR SEGMENT			

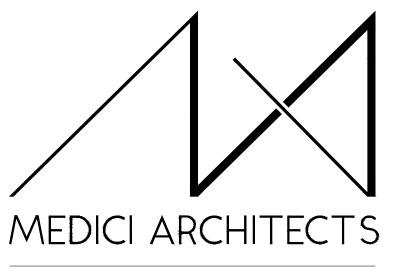

ARCHITECTURE | PROGRAMMING | ACCESSIBLE DESIGN I INTERIOR DESIGN www.mediciarchitects.com

11711 SE 8TH STREET, SUITE 100 BELLEVUE, WA 98005 TEL: (425) 453-9298

REGISTRATION:

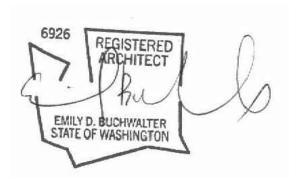

INTAKE:

DATE: **REVISIONS**: 1. A POST PERMIT REVISIONS 01-24-2022


DATE:


PROJECT / CLIENT:

9820 SE 35TH PLACE ACHIN & MARY CHEN 9820 SE 35TH PLACE MERCER ISLAND, WA 98040

DRAWING NAM	E:	
BASEMENT CONSTRUC		N
Drawn By: JM	MG,RB	
Checked By: El		
Owner Approval:	1 1	
PHASE:		
CONSTRUCTIO	N DOCUMEN	TS
This drawing is the Architects, and ca permission of the <i>i</i> modifications to we shall not be carried from the Architect.	n be reproduced Architect. Variat ork shown on th d out without wr	d only with the tions and is drawing
	R CONSTRUC	TION:
PROJECT No.:	2020 007	
DATE:	12-22-2020	
PLOT SCALE: 1	:1	A2.0

GB

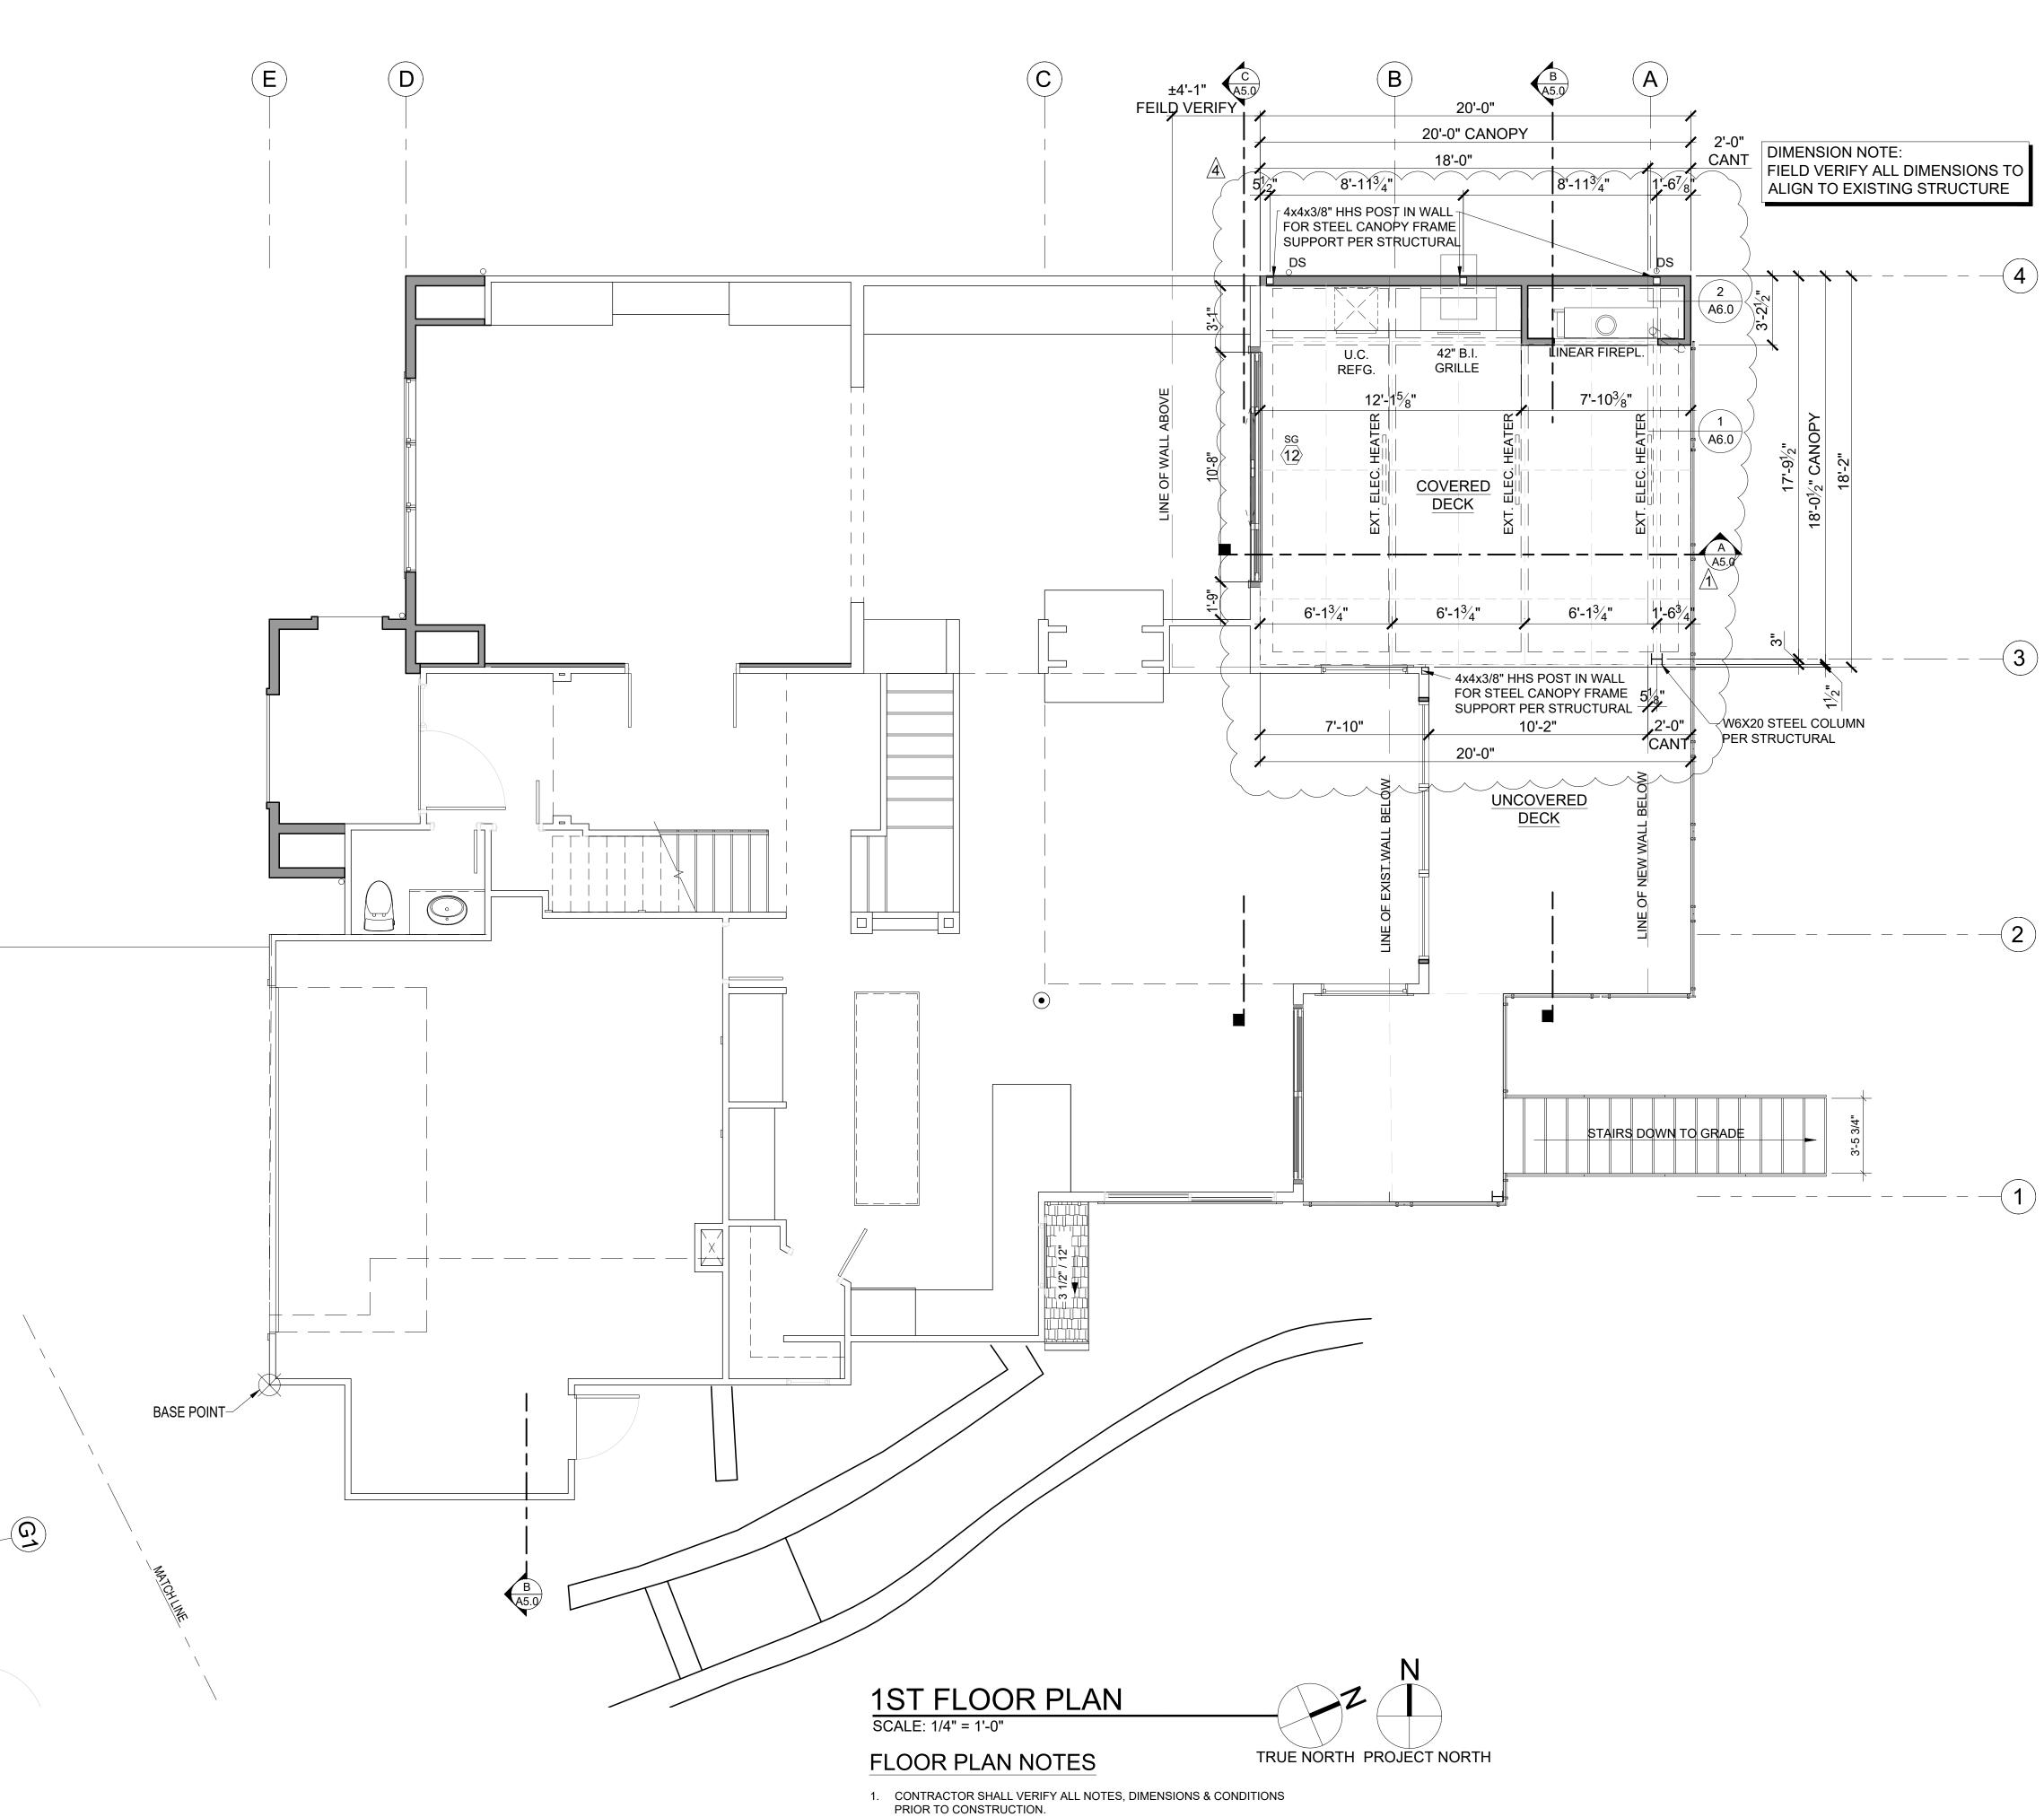

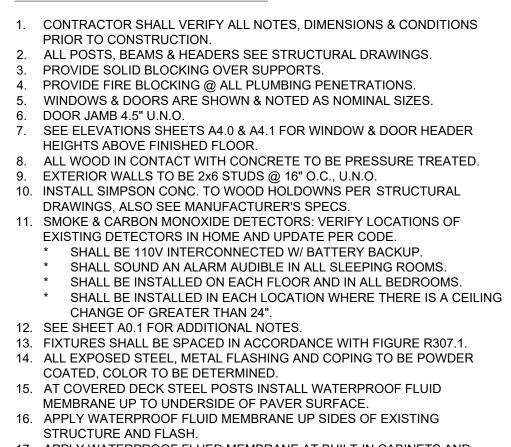

FIREPLACE WALL AND FLASH.

LEGEND

SYMBOL LEGEND					
SD	SMOKE DETECTOR				
CO	CARBON MONOXIDE DETECTOR				
9	DOORS				
¢	WINDOWS				
	EXIST.FOUNDATION WALL				
2 	SLAB ON GRADE				
	NEW FOUNDATION WALL w/ FOOTING				
	NEW 2X WALLS EXISTING 2X WALLS				

V 2X WALLS TING 2X WALLS BRICK WALLS \boxtimes × POST - VERIFY SIZE AND TYPE WITH STRUCTURAL PLAN

17. APPLY WATERPROOF FLUED MEMBRANE AT BUILT-IN CABINETS AND


HOUSE VENTILATION

2015 IRC - PROVIDE WHOLE HOUSE VENTILATION PER M1507, INTERMITTENT WHOLE HOUSE VENTILATION USING EXHAUST FAN PER 1507.3, TABLE 1507.3.3(1) & TABLE 1507.3.3(2), PROVIDE CONTROLS PER 1507.3.2. COMPLY WITH WSEC R403.6.					
SYMBOL	LOCATION	MINIMUM FAN REQUIREMENTS			
	Bath & Powder	Min. 50 cfm (INTERMITTENT) @ 0.25" WG (TABLE M1507.4)			
	Kitchen	Min. 100 cfm (INTERMITTENT)@ 0.25" WG (TABLE M1507.3) (Range hood or down draft exhaust fan rated at min. 100 cfm at 0.10" wg may be used for exhaust fan requirement.) If over 400 cfm, makeup air is required in the same room per M1503.4.			
-C	Laundry Room	Min. 180 cfm (INTERMITTENT) @ 0.25" WG - to function and be labeled as whole house fan (4-5 BEDROOMS 3001< 4500 SF.) TO OPERATE AT LEAST 50% OF TIME IN EACH 4-HOUR SEGMENT			
DRYER V	ENT PER (T	ABLE M1507.4.5.1) VENTED TO OUTSIDE			
*ALL FAN	IS TO VENT	TO OUTSIDE			

**PER M1507.3.4: WHERE WHOLE HOUSE VENTILATION USING EXHAUST FANS ARE PROVIDED, OPERABLE WINDOWS WITH AN OPENABLE AREA NOT LESS THAN 4 SQUARE INCHES OF NET FREE AREA OF OPENING FOR EACH 10 CFM OF OUTDOOR AIR IS REQUIRED BY TABLE M1507.3.3(1) - PROVIDE 72 SQUARE INCHES OF NET FREE OPENING AREA PER HABITABLE ROOM.

> NOTE: ALL SHOWERHEAD AND KITCHEN SINK FAUCETS SHALL BE RATED @ 1.75 GPM OR LESS. ALL OTHER LAVATORY FAUCETS SHALL BE RATED @ 1.0 GPM OR LESS. CONTRACTOR TO KEEP PRODUCT LITERATURE ON SITE.


LIMITING DEVICE FOR TUBS TO PROVIDE MAX. 120°F HOT WATER TEMPERATURE.

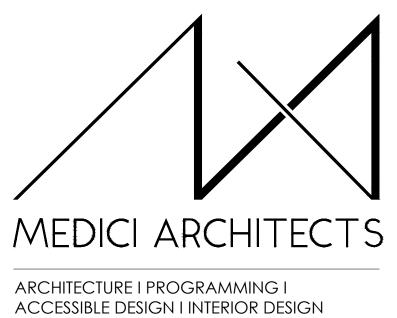

www.mediciarchitects.com

11711 SE 8TH STREET, SUITE 100 BELLEVUE, WA 98005 TEL: (425) 453-9298

REGISTRATION:

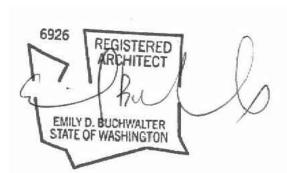

INTAKE:


DATE: **REVISIONS**: 1./1 COMMENT 01-2005-081-SUB1-PLANS 04-01-2021 2./2 UPDATED COMMENT PER SUB2-PLANS 06-03-2021 3./3 UPDATED COMMENT PER SUB3-PLANS 07-13-2021 4.4 UPDATED DOOR OUTDOOR KITCHEN 01-28-2022


DATE:

PROJECT / CLIENT:

9820 SE 35TH PLACE ACHIN & MARY CHEN 9820 SE 35TH PLACE MERCER ISLAND, WA 98040

DRAWING NAME	Ξ:	
1ST FLOOR CONSTRUC		
Drawn By: JM Checked By: EB Owner Approval:		
PHASE:		
CONSTRUCTION	N DOCUMENTS	
Architects, and can permission of the A modifications to wo	e exclusive property of Medici on be reproduced only with the Architect. Variations and ork shown on this drawing I out without written permission	
APPROVED FOR	R CONSTRUCTION:	_ 7
PROJECT No.:	2020 007	
DATE:	12-22-2020	
PLOT SCALE: 1:	A2.1	

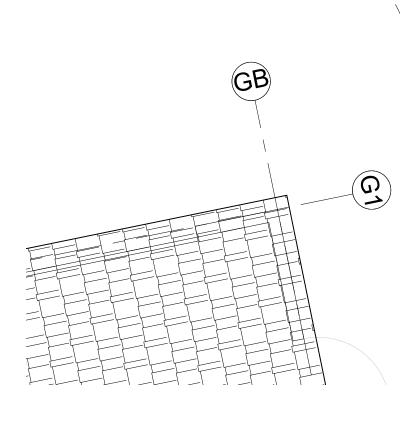

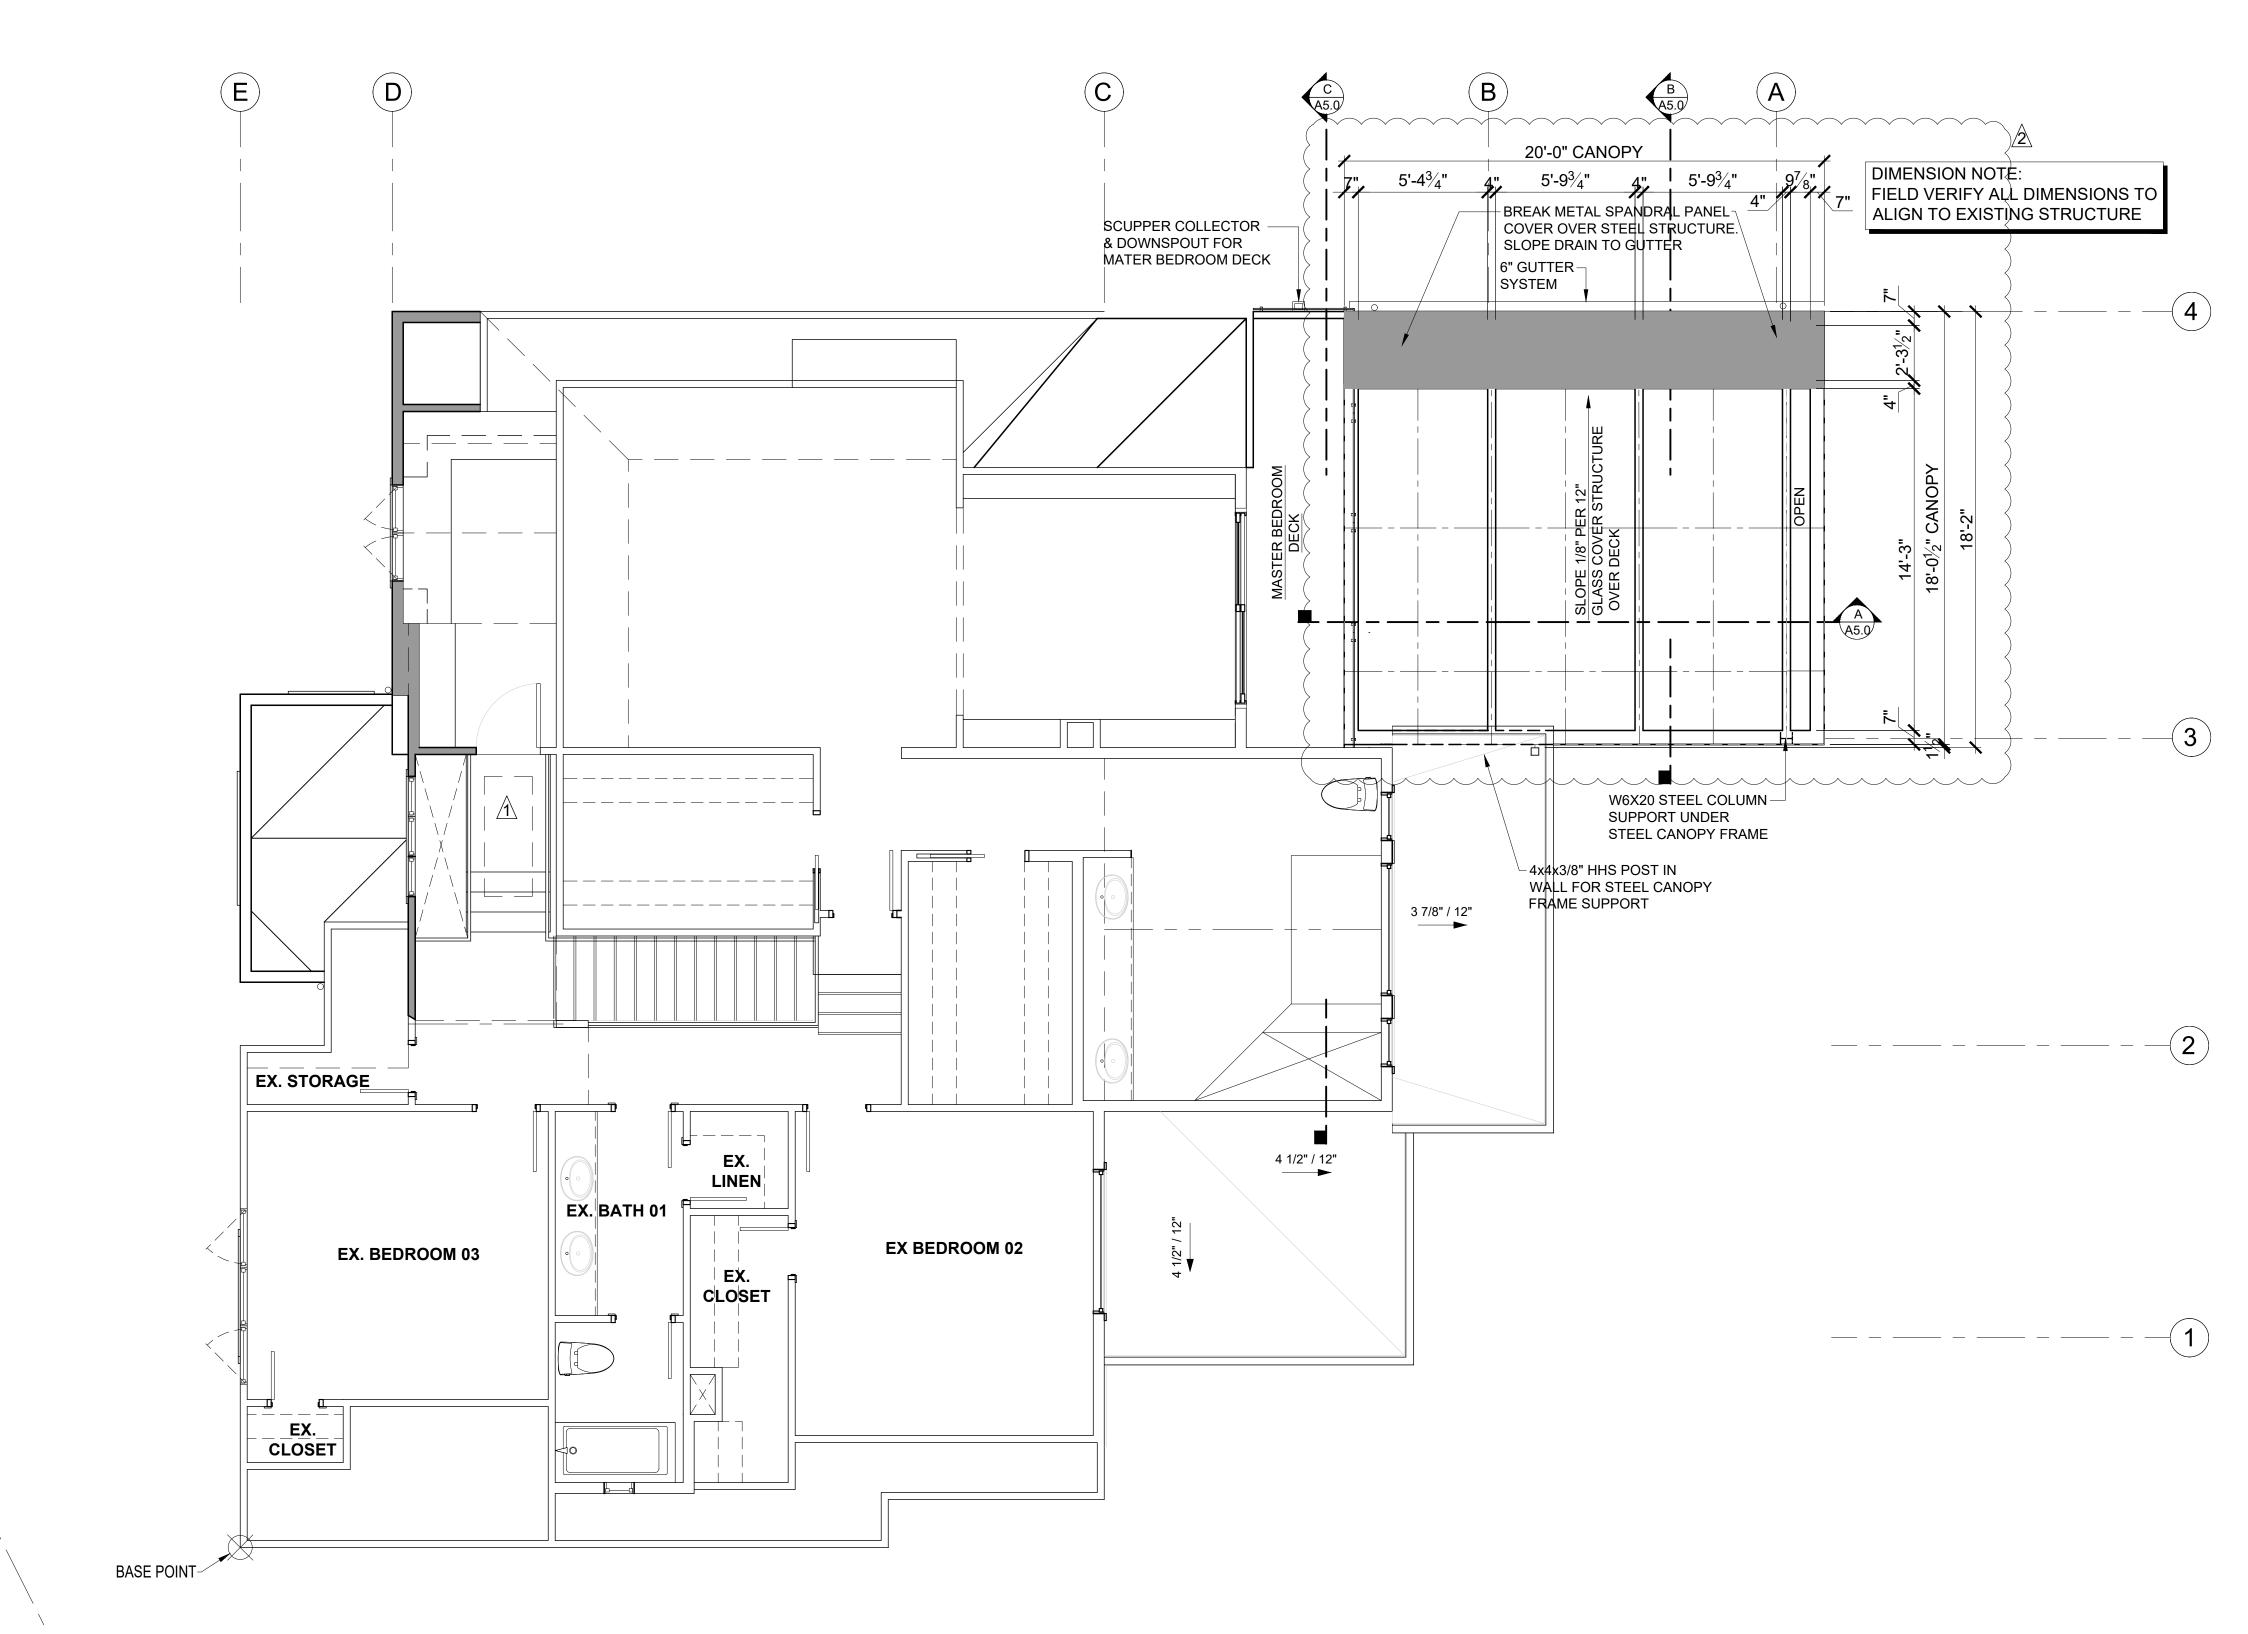


2ND FLOOR PLAN SCALE: 1/4" = 1'-0"

FLOOR PLAN NOTES

1.	CONTRACTO	OR SHALL VERIFY ALL NOTE			
		ONSTRUCTION.			
2.		BEAMS & HEADERS SEE S			
3.		LID BLOCKING OVER SUPF			
4.		RE BLOCKING @ ALL PLUMI			
5.		DOORS ARE SHOWN & NO			
6. 7		4.5 0.N.O. TIONS SHEETS A4.0 & A4.1 F			
7.		OVE FINISHED FLOOR.			
8.	-	N CONTACT WITH CONCRE			
0. 9.		VALLS TO BE 2x6 STUDS @			
10.		IPSON CONC. TO WOOD HO			
10.		ALSO SEE MANUFACTURE			
11.	,	ARBON MONOXIDE DETECT			
		ETECTORS IN HOME AND U			
	* SHALL E	BE 110V INTERCONNECTED			
	* SHALL S	SOUND AN ALARM AUDIBLE			
		BE INSTALLED ON EACH FL			
		BE INSTALLED IN EACH LOC			
		E OF GREATER THAN 24".			
		A0.1 FOR ADDITIONAL NOT			
		HALL BE SPACED IN ACCOR			
14.					
	COATED, COLOR TO BE DETERMINED.				
	SYM	BOL LEGEND			
	SD	SMOKE DETECTOR			
	\sim				
	CO	CARBON MONOXIDE DE			
	9	DOORS			
	$\langle c \rangle$	WINDOWS			

WINDOWS $\langle C \rangle$ EXIST.FOUNDATION WALL SLAB ON GRADE

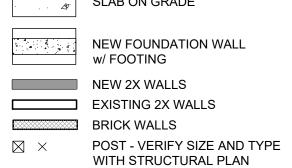



TRUE NORTH PROJECT NORTH

TES, DIMENSIONS & CONDITIONS STRUCTURAL DRAWINGS.

PPORTS. MBING PENETRATIONS. NOTED AS NOMINAL SIZES.

FOR WINDOW & DOOR HEADER

RETE TO BE PRESSURE TREATED. @ 16" O.C., U.N.O.

HOLDOWNS PER STRUCTURAL RER'S SPECS. CTORS: VERIFY LOCATIONS OF UPDATE PER CODE.

ED W/ BATTERY BACKUP. E IN ALL SLEEPING ROOMS. FLOOR AND IN ALL BEDROOMS. OCATION WHERE THERE IS A CEILING

TES. ORDANCE WITH FIGURE R307.1. NG AND COPING TO BE POWDER

DETECTOR


HOUSE VENTILATION

2015 IRC - PROVIDE WHOLE HOUSE VENTILATION PER M1507, INTERMITTENT WHOLE HOUSE VENTILATION USING EXHAUST FAN PER 1507.3, TABLE 1507.3.3(1) & TABLE 1507.3.3(2), PROVIDE CONTROLS PER 1507.3.2. COMPLY WITH WSEC R403.6. SYMBOL LOCATION MINIMUM FAN REQUIREMENTS A Bath & Min. 50 cfm (INTERMITTENT) @ 0.25" WG (TABLE M1507.4) Kitchen Min. 100 cfm (INTERMITTENT)@ 0.25" WG (TABLE M1507.3) B (Range hood or down draft exhaust fan rated at min. 100 cfm at 0.10" wg may be used for exhaust fan requirement.) If over 400 cfm, makeup air is required in the same room per M1503.4. Laundry
RoomMin. 180 cfm (INTERMITTENT) @ 0.25" WG - to function and be
labeled as whole house fan (4-5 BEDROOMS 3001< 4500 SF.) TO</th> -C OPERATE AT LEAST 50% OF TIME IN EACH 4-HOUR SEGMENT

DRYER VENT PER (TABLE M1507.4.5.1) VENTED TO OUTSIDE *ALL FANS TO VENT TO OUTSIDE

**PER M1507.3.4: WHERE WHOLE HOUSE VENTILATION USING EXHAUST FANS ARE PROVIDED, OPERABLE WINDOWS WITH AN OPENABLE AREA NOT LESS THAN 4 SQUARE INCHES OF NET FREE AREA OF OPENING FOR EACH 10 CFM OF OUTDOOR AIR IS REQUIRED BY TABLE M1507.3.3(1) - PROVIDE 72 SQUARE INCHES OF NET FREE OPENING AREA PER HABITABLE ROOM.


> NOTE: ALL SHOWERHEAD AND KITCHEN SINK FAUCETS SHALL BE RATED @ 1.75 GPM OR LESS. ALL OTHER LAVATORY FAUCETS SHALL BE RATED @ 1.0 GPM OR LESS. CONTRACTOR TO KEEP PRODUCT LITERATURE ON SITE. LIMITING DEVICE FOR TUBS TO PROVIDE MAX. 120°F HOT WATER TEMPERATURE.

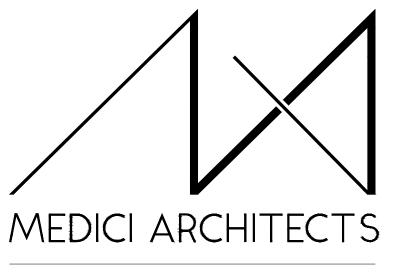

ARCHITECTURE | PROGRAMMING | ACCESSIBLE DESIGN I INTERIOR DESIGN www.mediciarchitects.com

11711 SE 8TH STREET, SUITE 100 BELLEVUE, WA 98005 TEL: (425) 453-9298

REGISTRATION:

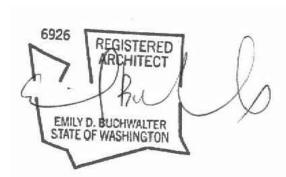

INTAKE:

REVISIONS: DATE: 1./1 PER COMMENT 01-2005-081- 04-01-2021 2. SUB1-PLANS 3. 2 POST PERMIT REVISIONS 04-01-2021

DATE:

PROJECT / CLIENT:


9820 SE 35TH PLACE ACHIN & MARY CHEN 9820 SE 35TH PLACE MERCER ISLAND, WA 98040


DRAWING NAM	E:	
2ND FLOOF CONSTRUC	-	N
Drawn By: JM	/IG,RB	
Checked By: Ef		
Owner Approval:		
PHASE:		
CONSTRUCTIO	N DOCUMEN	TS
This drawing is the Architects, and can permission of the / modifications to we shall not be carried from the Architect.	n be reproduced Architect. Varia ork shown on th d out without wr	d only with the tions and is drawing
	R CONSTRUC	TION:
PROJECT No.:	2020 007	
DATE:	12-22-2020	
PLOT SCALE: 1	:1	A2.2

60"x36" DUAL GLAZED – TEMPERED GLASS SKYLIGHT

ROOF EXIST. ROOF

 
BASE POINT



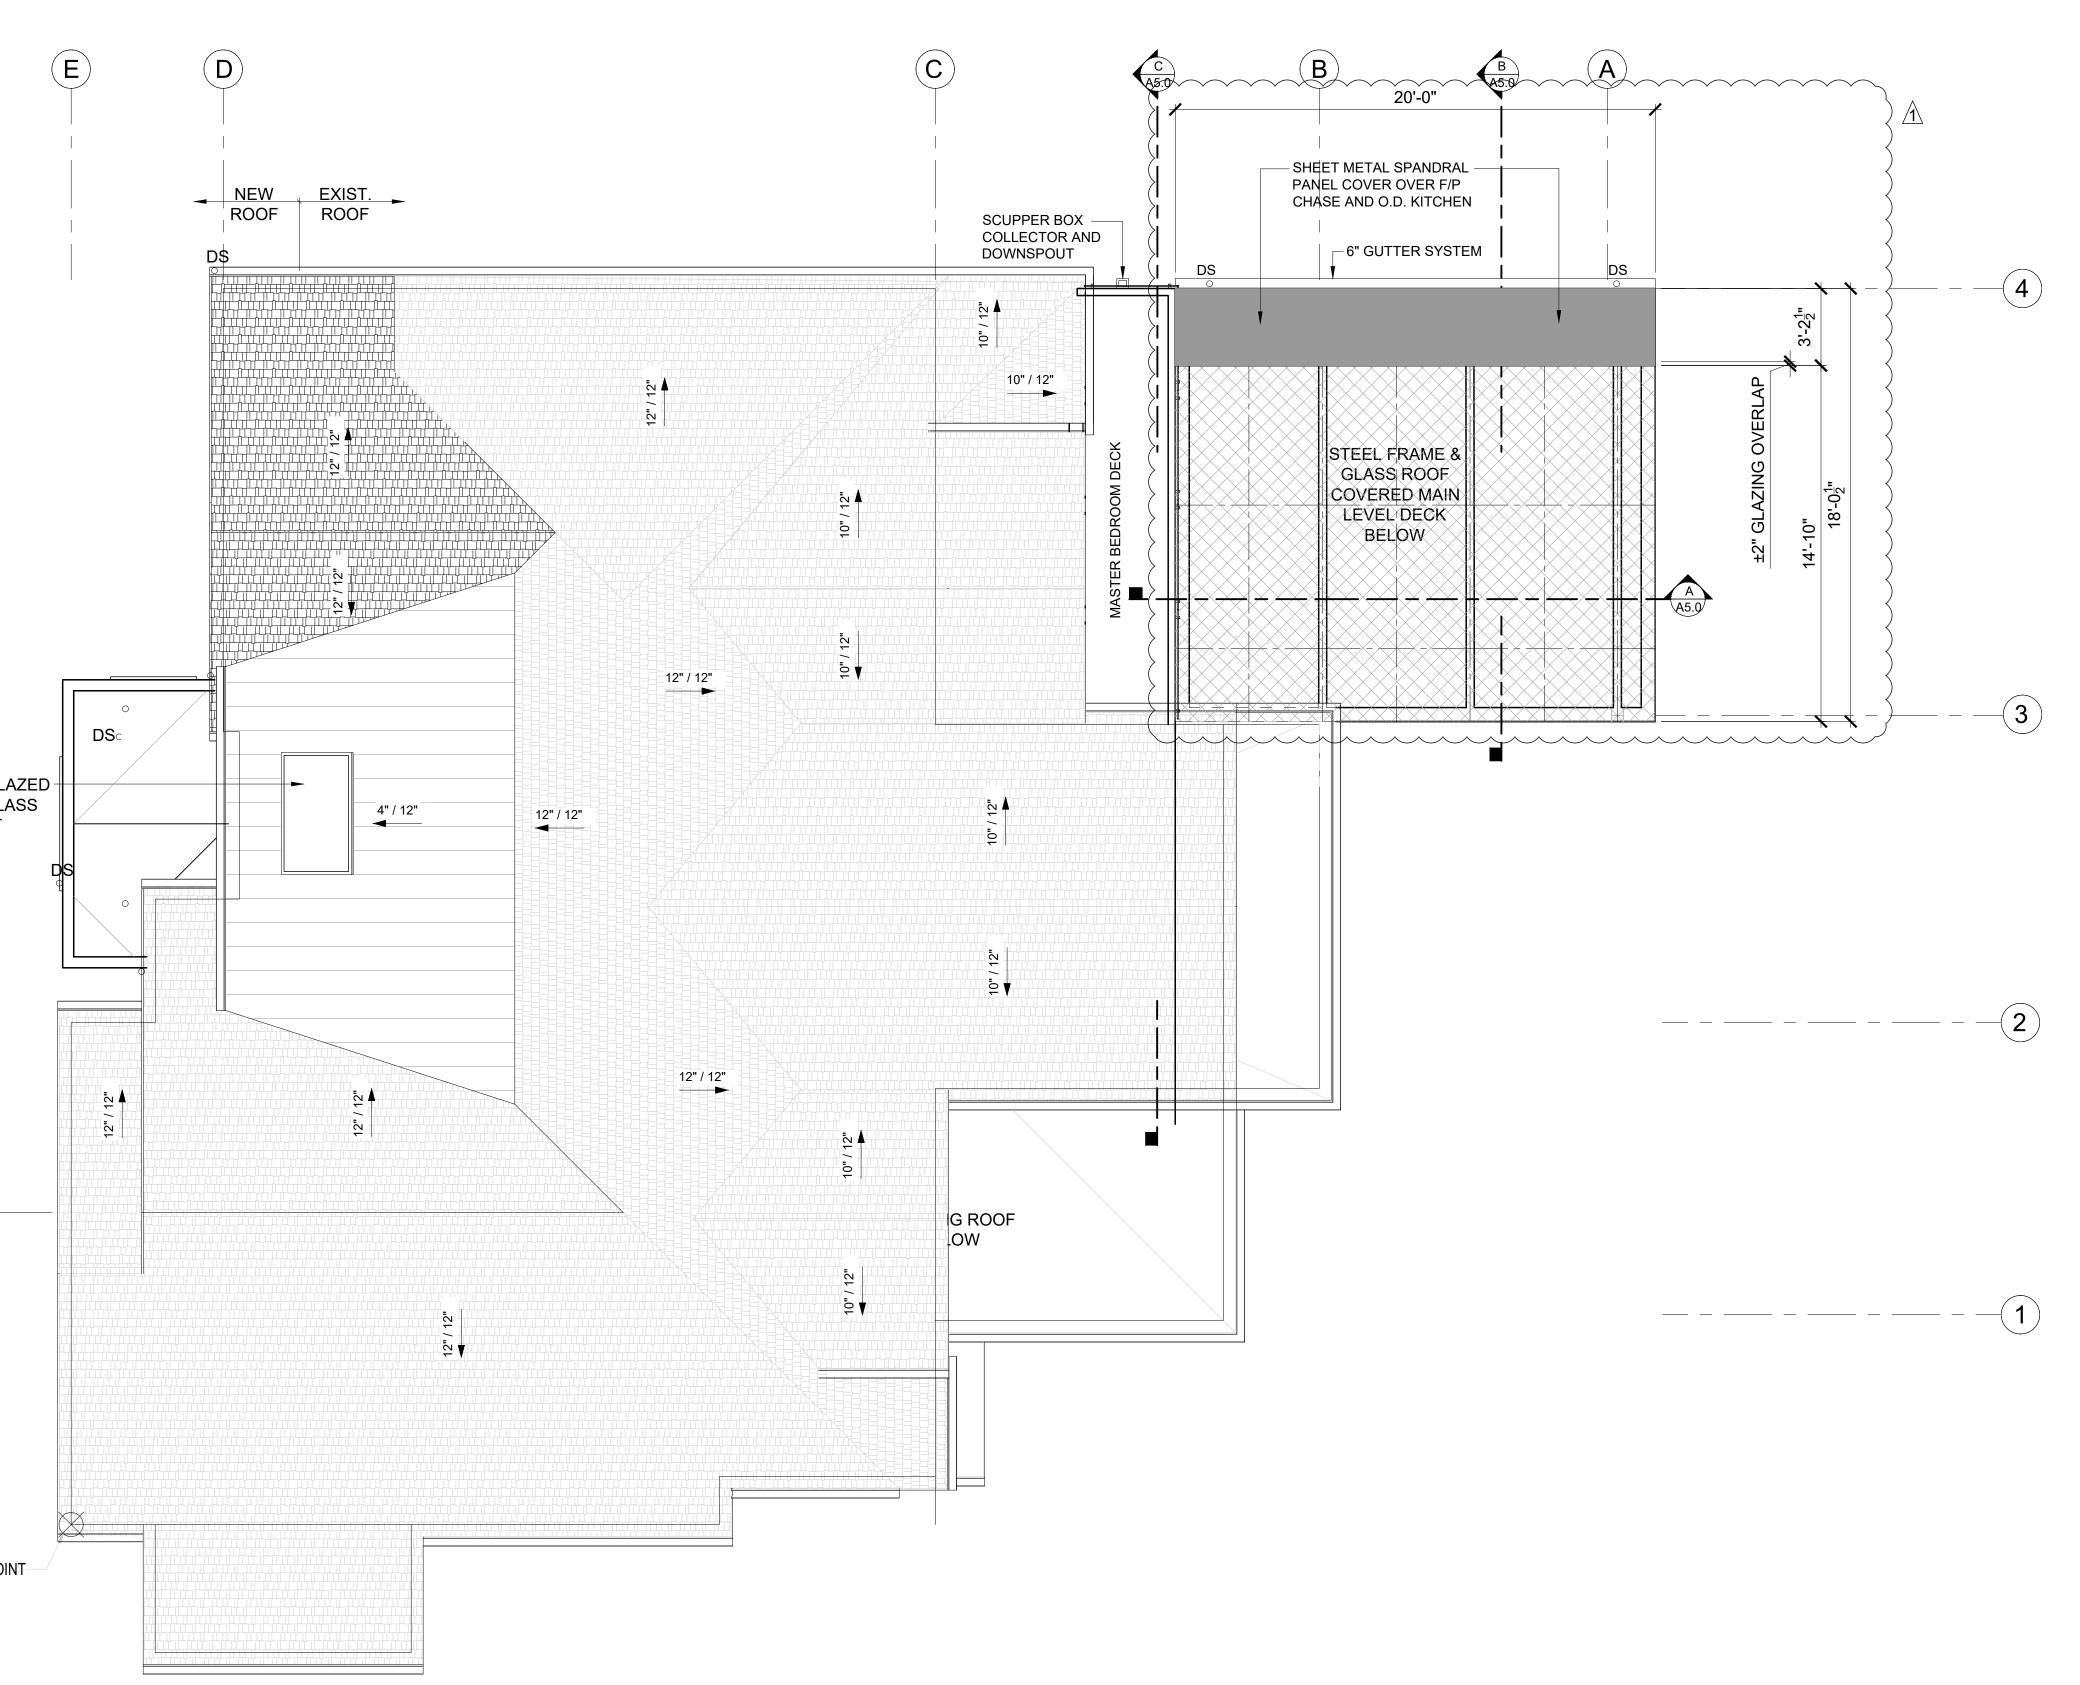

ROOF PLAN SCALE: 1/4" = 1'-0" TRUE NORTH PROJECT NORTH

ROOF - VENTILATION CALCULATION				
Stick built Roof Construction:				
Roof Area:	356.7	s.f.		
Ventilation Required:	356.7	s.f. x 144 s.i. / 300*=	171.2	s.i. Req'd
Proposed Ventilation :				
SmartVent Shingle vent (upper or ridge)	4.5	s.i. nfa / l.f.=	4.5	s.i. / l.f.
Provide :	20.0	I.f. Upper Ventilation =	90.0	s.i.
SmartVent Shingle vent (lower roof edge)	4.5	s.i. nfa / l.f. =	4.5	s.i.
Provide:	20.0	I.f. Eave Edge Ventilation =	90.0	
Total Ventilation Provided	180.0	s.i. IS GREATER THAN	171.2	s.i. Req'd

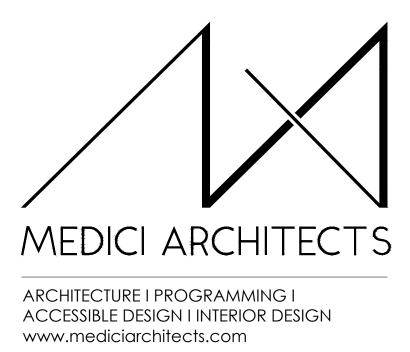

11711 SE 8TH STREET, SUITE 100 BELLEVUE, WA 98005 TEL: (425) 453-9298

REGISTRATION:




INTAKE:

REVISIONS:	DATE:
1/1 POST PERMIT UPDATES	01-28-2022
2.	
3.	
4.	
5	

DATE:


PROJECT / CLIENT:

9820 SE 35TH PLACE ACHIN & MARY CHEN 9820 SE 35TH PLACE MERCER ISLAND, WA 98040

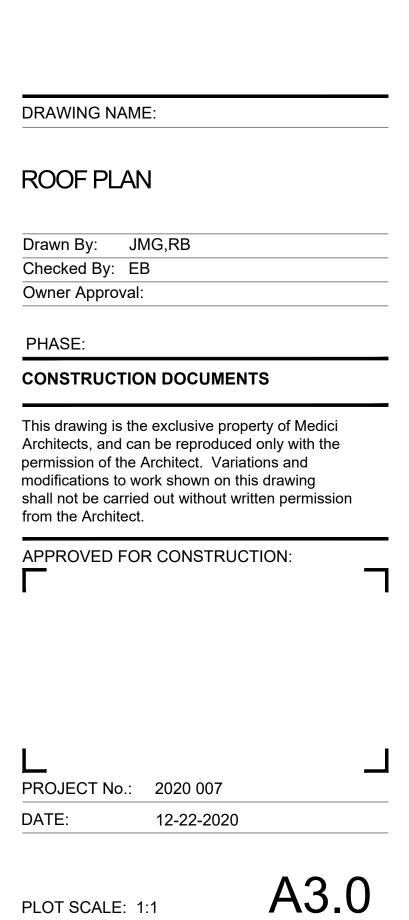

ELEVATIONS NOTES & KEY NOTES:

- 1. VERIFY SHEAR WALL NAILING & HOLDOWNS PER STRUCTURAL PLAN & SCHEDULE PRIOR TO INSTALLING SIDING.
- 2. MATCH EXISTING CEDAR SIDING PROFILE AND EXPOSURE, PAINT TO MATCH. INTERWEAVE NEW CEDAR SIDING TO OLD AND EXTEND VAPOR BARRIER MINIMUM OF 6
- INCHES. TRANSITIONS TO BE SEAMLESS. 3. CAULK ALL EXTERIOR JOINTS & PENETRATIONS.
- 4. AT NEW AND REMODELED CONSTRUCTION AREAS PROVIDE APPROVED CORROSION
- RESISTANT FLASHING AT EXTERIOR WALL ENVELOPE PER I.R.C. R703.4.
- 5. AT NEW AND REMODELED CONSTRUCTION AREAS PROVIDE FLASHING AT ROOF
- PENETRATIONS PER I.R.C. R903.2 & R903.2.1. 6. AT NEW AND REMODELED CONSTRUCTION AREAS PROVIDE PRE FINISHED CONTINUOUS ALUMINUM GUTTERS, SCUPPER AND DOWN SPOUTS - COLOR TO MATCH ADJACENT EXTERIOR MATERIAL FINISH. ROOF DRAINS AND SCUPPERS SHALL BE INSTALLED PER IRC SECTION R903.4. PROVIDE EMERGENCY OVERFLOW PER IRC SECTION 1503.4.1. TYPICAL SEE ROOF PLAN SHEET A3.0. DIRECT CONNECT FOOTING DRAINS AND DOWN SPOUTS PER CIVIL DRAWINGS.
- 7. SEE SHEET A0.1 FOR ADDITIONAL NOTES.
- 8. STUCCO VENEER: 3-COAT PORTLAND CEMENT STUCCO SHALL HAVE A SCRATCH, BROWN AND FINISH COATS OF PORTLAND CEMENT EXTERIOR PLASTER PER IRC SECTION R703.6.2; SAND FINISH COAT WITH INTEGRAL COLOR, OVER EXTERIOR METAL LATH PER IRC SECTION R703.6.1. TOTAL THICKNESS APPROXIMATELY 7/8". PROVIDE WEEP SCREEDS PER IRC SECTION R703.6.2.1
- 9. LIGHTING AT EXTERIOR DOORS, TYP.
- **10. POWDER COATED COPING**
- 11. TPO ROOFING: MECHANICALLY ATTACHED ROOFING SYSTEM, LIGHT GRAY, SCRIM-REINFORCED THERMOPLASTIC POLYOLEFIN (TPO) MEMBRANE. PERIMETER SHEETS ARE INSTALLED ALONG THE BUILDING EDGES AND FIELD MEMBRANE SHEETS ARE MECHANICALLY ATTACHED TO THE ROOF DECK WITH THE APPROPRIATE FASTENERS AND FASTENING PLATES. ADJOINING SHEETS OF MEMBRANE ARE OVERLAPPED AND JOINED TOGETHER WITH A MINIMUM 1-1/2" WIDE HOT AIR WELD. INSTALL PER MANUFACTURER
- 12. MATCH EXISTING SHAKE ROOF AND FINISH TO MATCH, INSTALL PER INDUSTRY
- STANDARDS 13.12" STANDING SEAM METAL ROOFING, INSTALL PER INDUSTRY STANDARDS. COLOR FINISH TO BE SELECTED BY OWNER.
- 14. POWDER COATED STEEL FRAME FOR INSTALLATION OF TEMPERED LAMINATED GLASS
- ROOF CANOPY, INSTALL BY ROOF CANOPY MANUFACTURER.
- 15. POWDER COATED STEEL COLUMN OR C-CHANNEL PER STRUCTURAL. 16. FIRE PLACE VENT
- 17. HOOD VENT OVER BARBEQUE.
- 18. FRONT ENTRY DOOR: FRONT ENTRY DOOR SHALL BE ALUMINUM, MINIMUM1-3/4" THICK, 42" WIDE SINGLE SOLID DOOR WITH ONE SIDELIGHT AND TRANSOM WINDOW ABOVE, DOUBLE-GLAZED SAFETY GLASS, WITH LOW-E. PROVIDE ANODIZED METAL THRESHOLD, CYLINDER ENTRY LOCK ACCESS AND DEADBOLT DRILLING. U-VALUE OF DOORS TO BE 0.30 (2015 WSEC) OR BETTER. PROVIDE EUTHERM ALUMINUM DOOR OR EQUAL AS APPROVED BY ARCHITECT.
- 19. GLASS RAILING HANDRAIL: SIDE MOUNTED FRAMELESS GLASS RAIL SYSTEM WITH NON-GLARE TEMPERED GLASS PANELS.
- 20. WINDOWS: (CLIMATE ZONE 4C OF THE 2015 WSEC TABLE R402.1.1) ALL WINDOWS SHALL BE DOUBLE-PANED MINIMUM, PERFORMANCE AND CONSTRUCTION TO CONFORM WITH IRC SECTION R612. HARDWARE FINISH SHALL MATCH DOOR HARDWARE. ALL CASEMENT OPENINGS SHALL HAVE ROTO HARDWARE. ALL OPENINGS WEATHER-STRIPPED BY MANUFACTURER; GENERAL CONTRACTOR SHALL INSTALL "Z"-FLASHING AT HEADS OF ALL WINDOWS AND SEAL WINDOW PERIMETER PER MANUFACTURER'S SPECIFICATIONS.
- 21.PORCELAIN PAVERS DECK SYSTEM INSTALL PER PORCELANOSA MANUFACTURER INSTRUCTIONS.
- 22.WOOD DECKING OVER RIPPED CEDAR DECK JOIST OVER 3/4" MARINE BOARD WATER MEMBRANE ROOFING PER IRC. R905.13 AND CLOSED CELL SPAY FOAM R-38. 23.STONE TILE VENEER.
- 24.BLACKEN STAINLESS STEEL

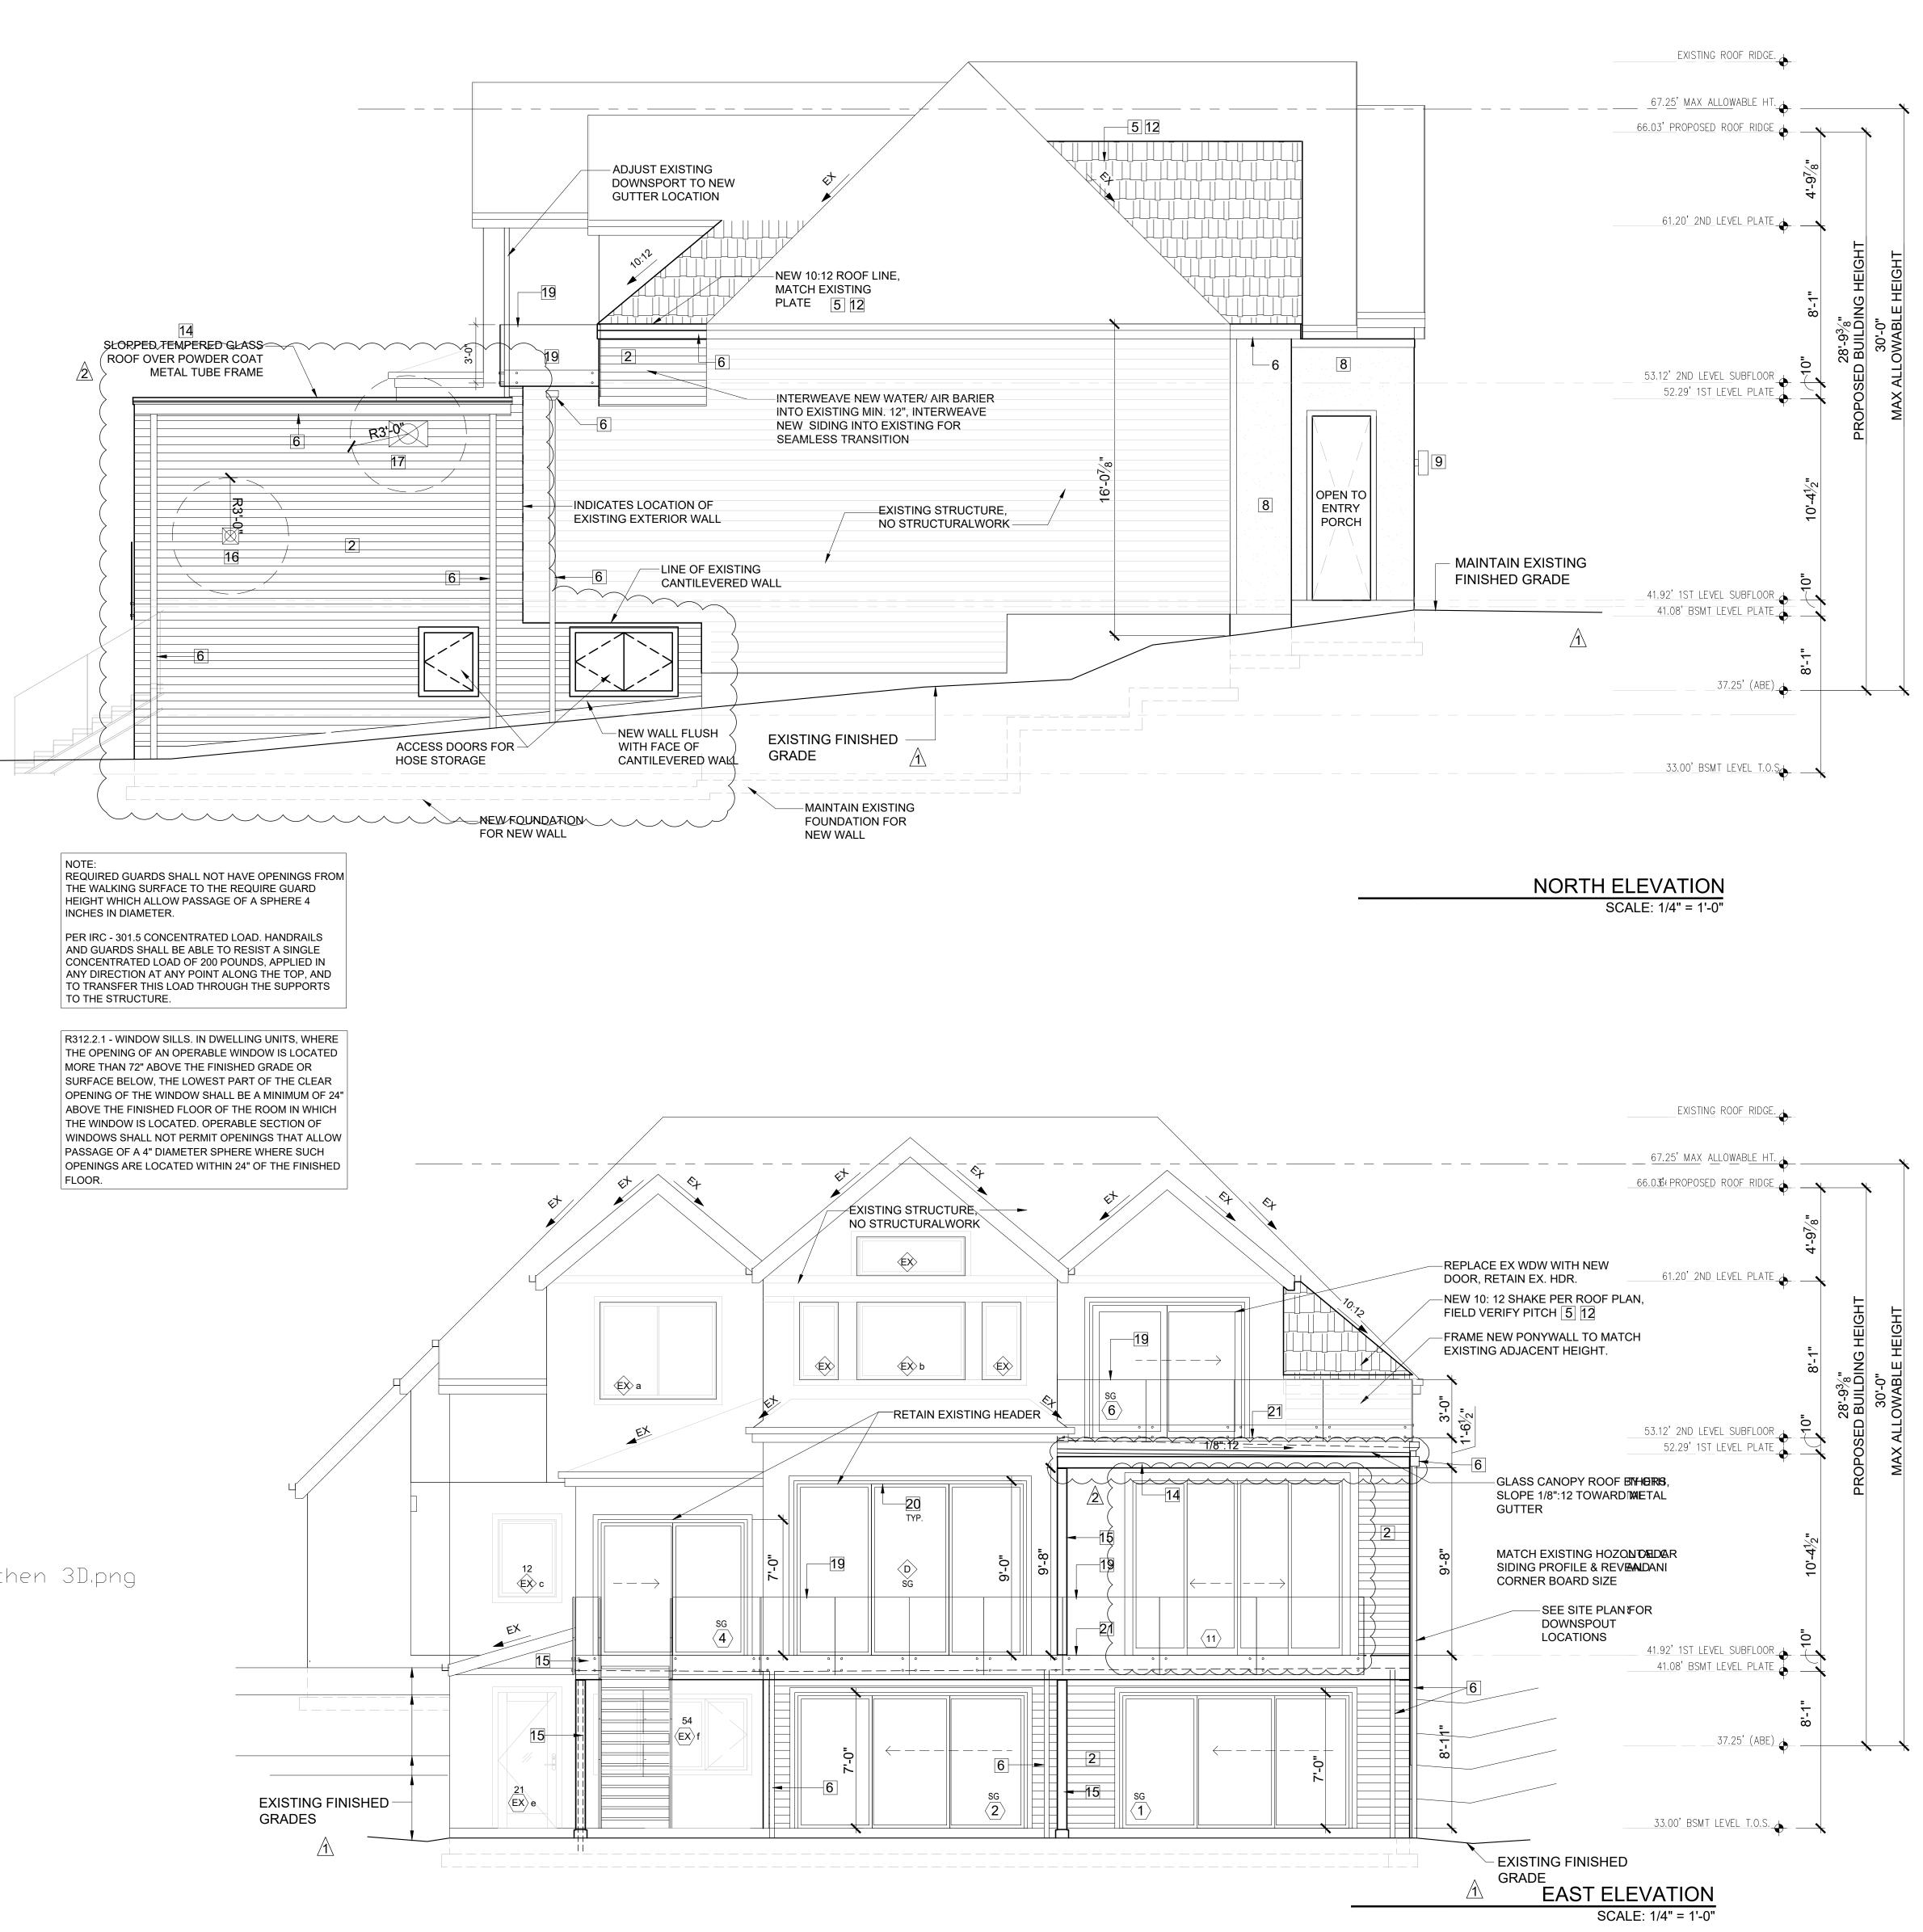




ARCHITECTURE | PROGRAMMING | ACCESSIBLE DESIGN I INTERIOR DESIGN www.mediciarchitects.com

11711 SE 8TH STREET, SUITE 100 BELLEVUE, WA 98005 TEL: (425) 453-9298

REGISTRATION:

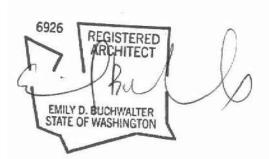

INTAKE:

DATE: **REVISIONS**: 1./1 PER COMMENT 01-2005-081- 04-01-2021 2 SUB1-PLANS 3. 2 POST PERMIT UPDATES 01-28-2022

DATE:

PROJECT / CLIENT:

9820 SE 35TH PLACE ACHIN & MARY CHEN 9820 SE 35TH PLACE MERCER ISLAND, WA 98040


JOB ADDRESS: 9820 SE 35TH PLACE MERCER ISLAND, WA 98040 PARCEL # 082405-9027

DRAWING NAME:


ELEVATIONS

Drawn By: JMG,RB Checked By: EB Owner Approval: PHASE: CONSTRUCTION DOCUMENTS This drawing is the exclusive property of Medici Architects, and can be reproduced only with the permission of the Architect. Variations and modifications to work shown on this drawing shall not be carried out without written permission from the Architect. APPROVED FOR CONSTRUCTION:

PROJECT No.: 2020 007 DATE: 12-22-2020 A4.0

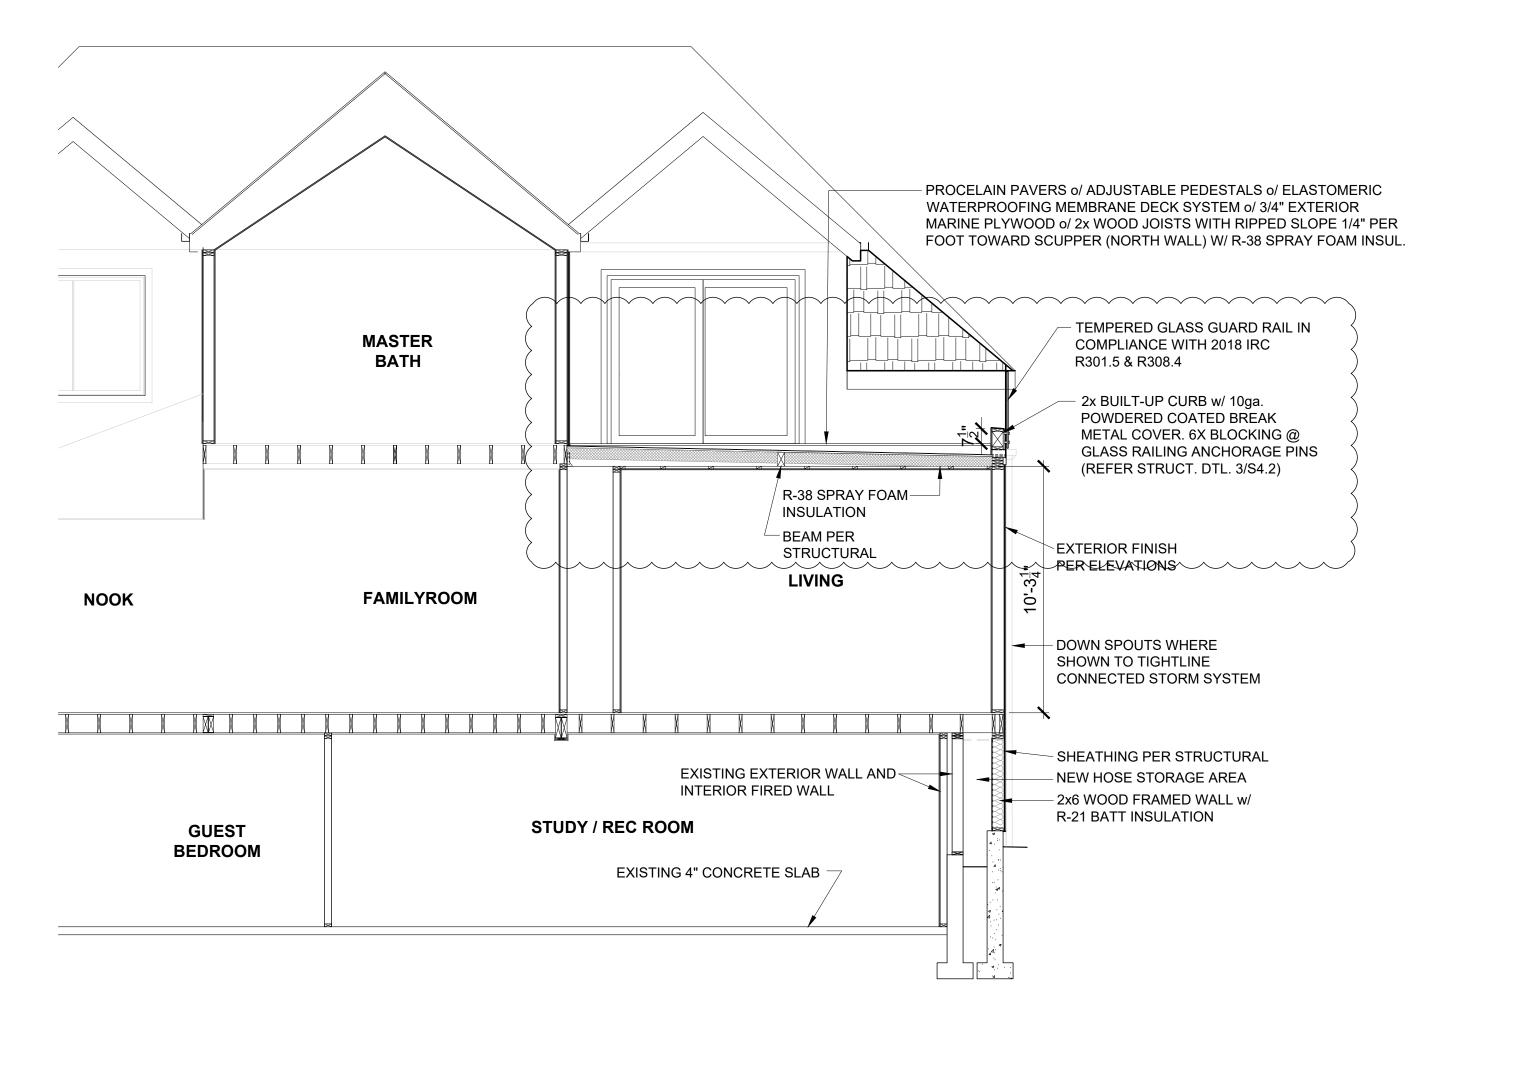

SCALE: 1/4" = 1'-0"

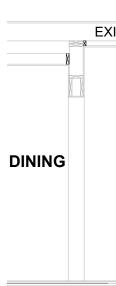

EXTERIOR FINISH -

PER ELEVATIONS

SHEATHING PER -

SCALE: 1/4" = 1'-0"


STRUCTURAL

THERMAL INSULATION: Walls (below-grade, exterior): Walls (below-grade, interior): Walls (above-grade): Headers: Ceilings (advanced framing):


Ceilings (standard framing): Ceilings (vaulted): Floors: Slab:


Solid doors:

Windows & doors with glazing: Skylights:

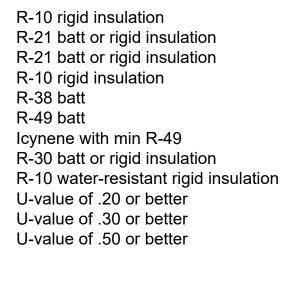



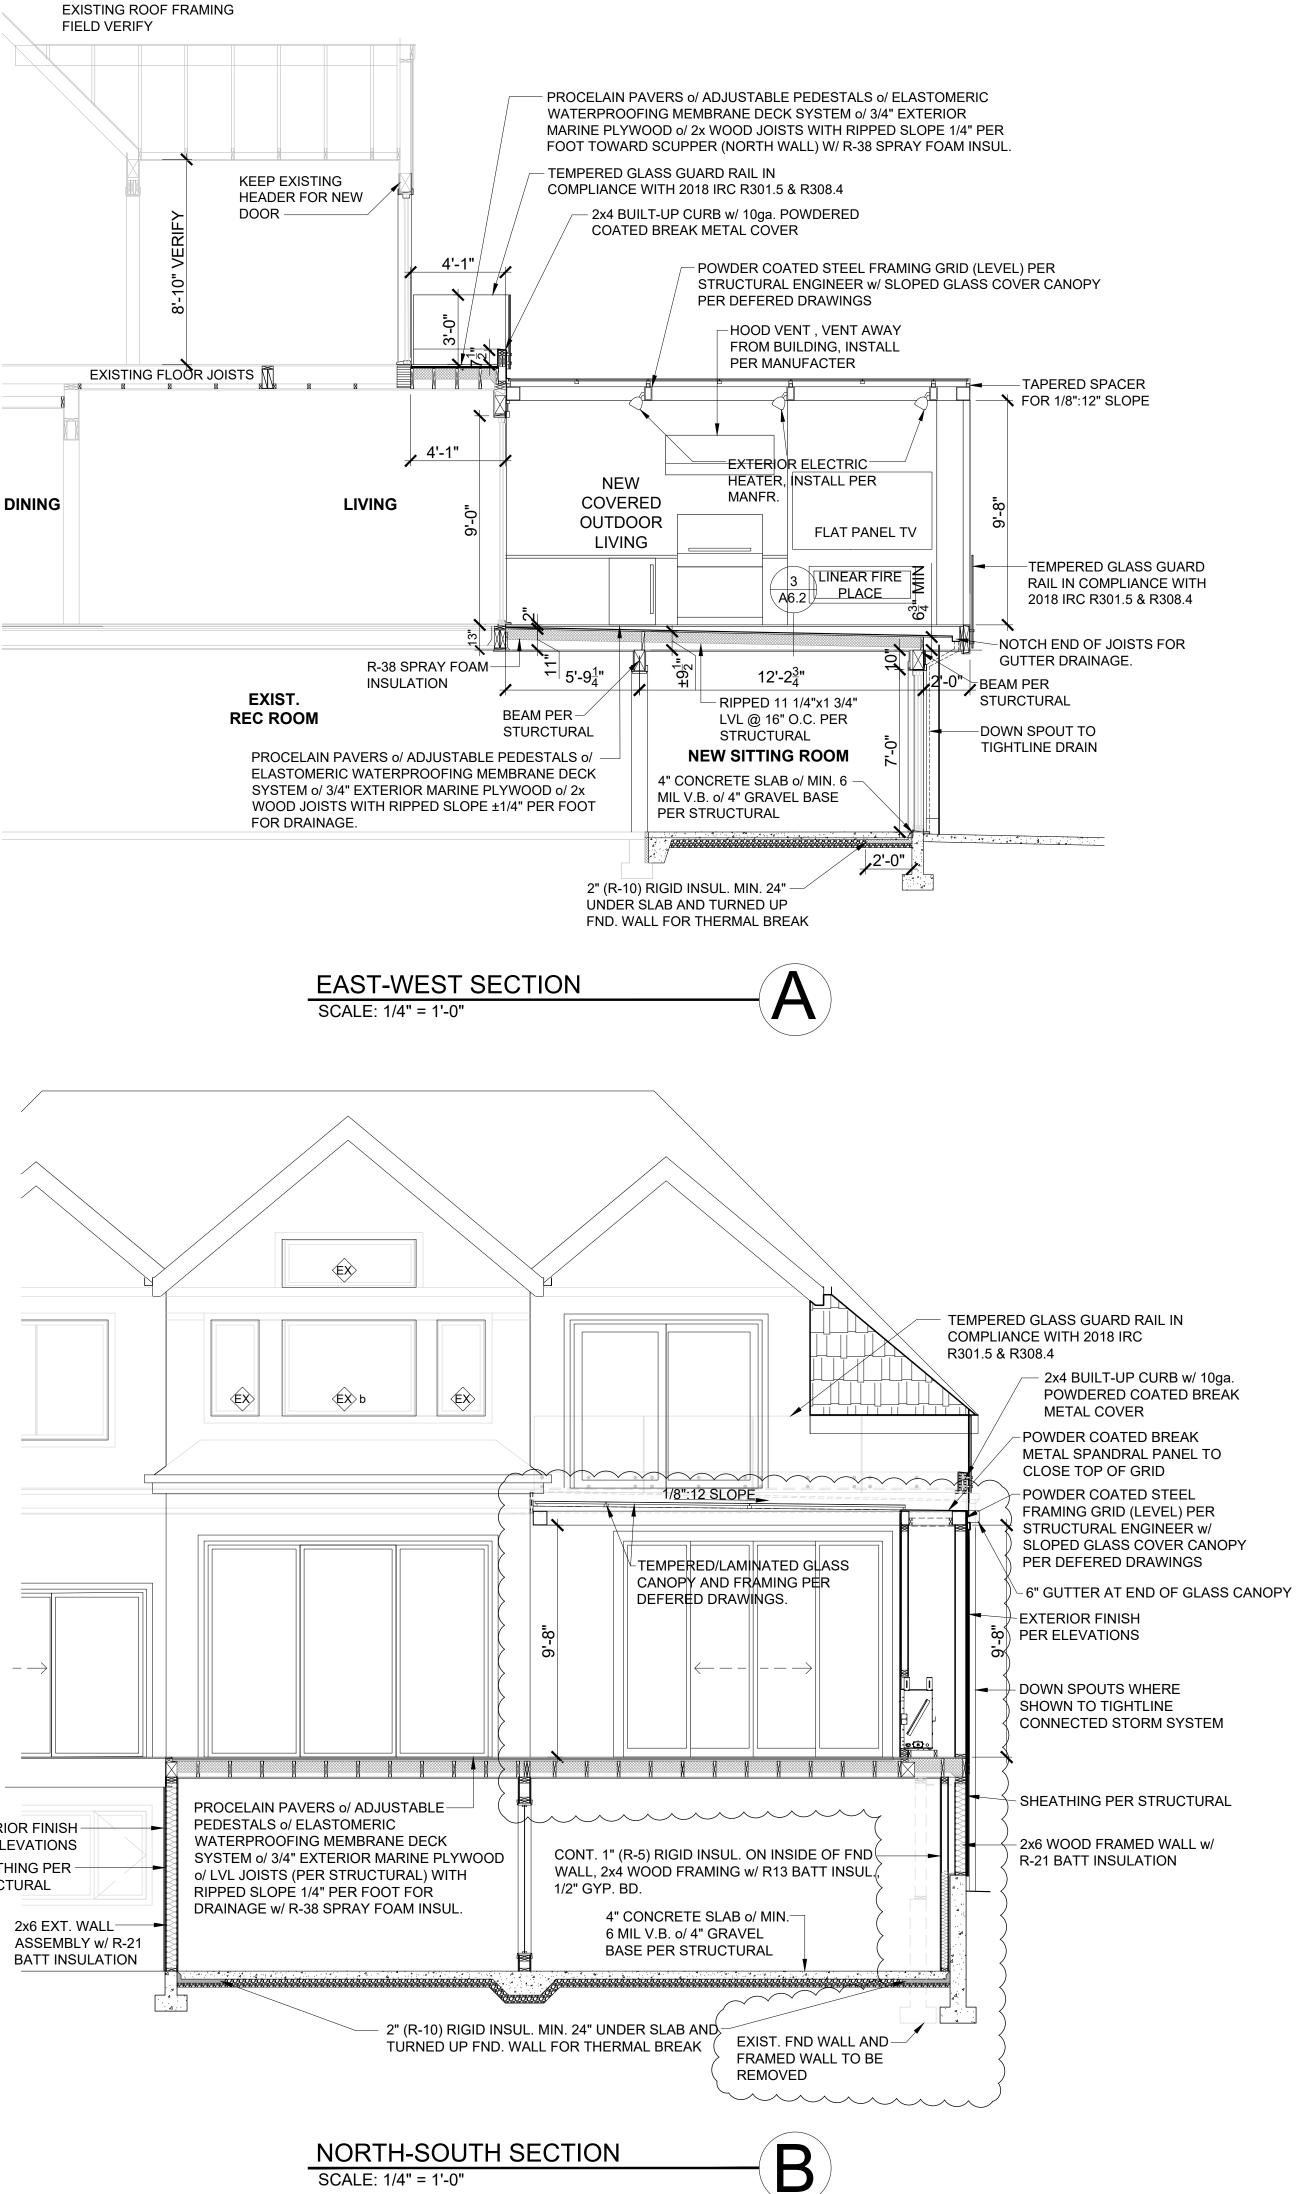

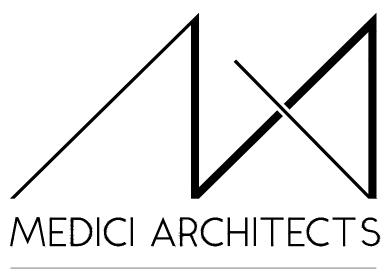

ARCHITECTURE I PROGRAMMING I ACCESSIBLE DESIGN I INTERIOR DESIGN www.mediciarchitects.com

11711 SE 8TH STREET, SUITE 100 BELLEVUE, WA 98005 TEL: (425) 453-9298

REGISTRATION: 6926 RCHITE EMILY D. BUCHWALTER STATE OF WASHINGTON INTAKE: DATE:

DATE: **REVISIONS**: 1. 1 POST PERMIT CHANGES 01-28-2022

PROJECT / CLIENT:

9820 SE 35TH PLACE ACHIN & MARY CHEN 9820 SE 35TH PLACE MERCER ISLAND, WA 98040

JOB ADDRESS: 9820 SE 35TH PLACE MERCER ISLAND, WA 98040 PARCEL # 082405-9027

DRAWING NAME:


SECTIONS

Drawn By:	JMG,RB
Checked By:	EB
Owner Approv	al:
PHASE:	
CONSTRUCT	ION DOCUMENTS
Architects, and permission of th modifications to	the exclusive property of Medici can be reproduced only with the e Architect. Variations and work shown on this drawing ried out without written permission act.
APPROVED F	OR CONSTRUCTION:

DATE: 12-22-2020 A5.0

PROJECT No.: 2020 007

16	XXX SCALE: 1" = 1'-0"	12-	XXX SCALE: 1" = 1'-0"
15	XXX SCALE: 1" = 1'-0"	11-	XXX SCALE: 1" = 1'-0" PORSELAN TPO MEMB
14	XXX SCALE: 1" = 1'-0"	10-	3/4" MARINI PLYWOOD R-38 SPRAN INSULATION 1 3/4"x7 1/4" DECK PE SCALE: 1" = 1'-0"
13	XXX SCALE: 1" = 1'-0"	9-	XXX SCALE: 3" = 1'-0"

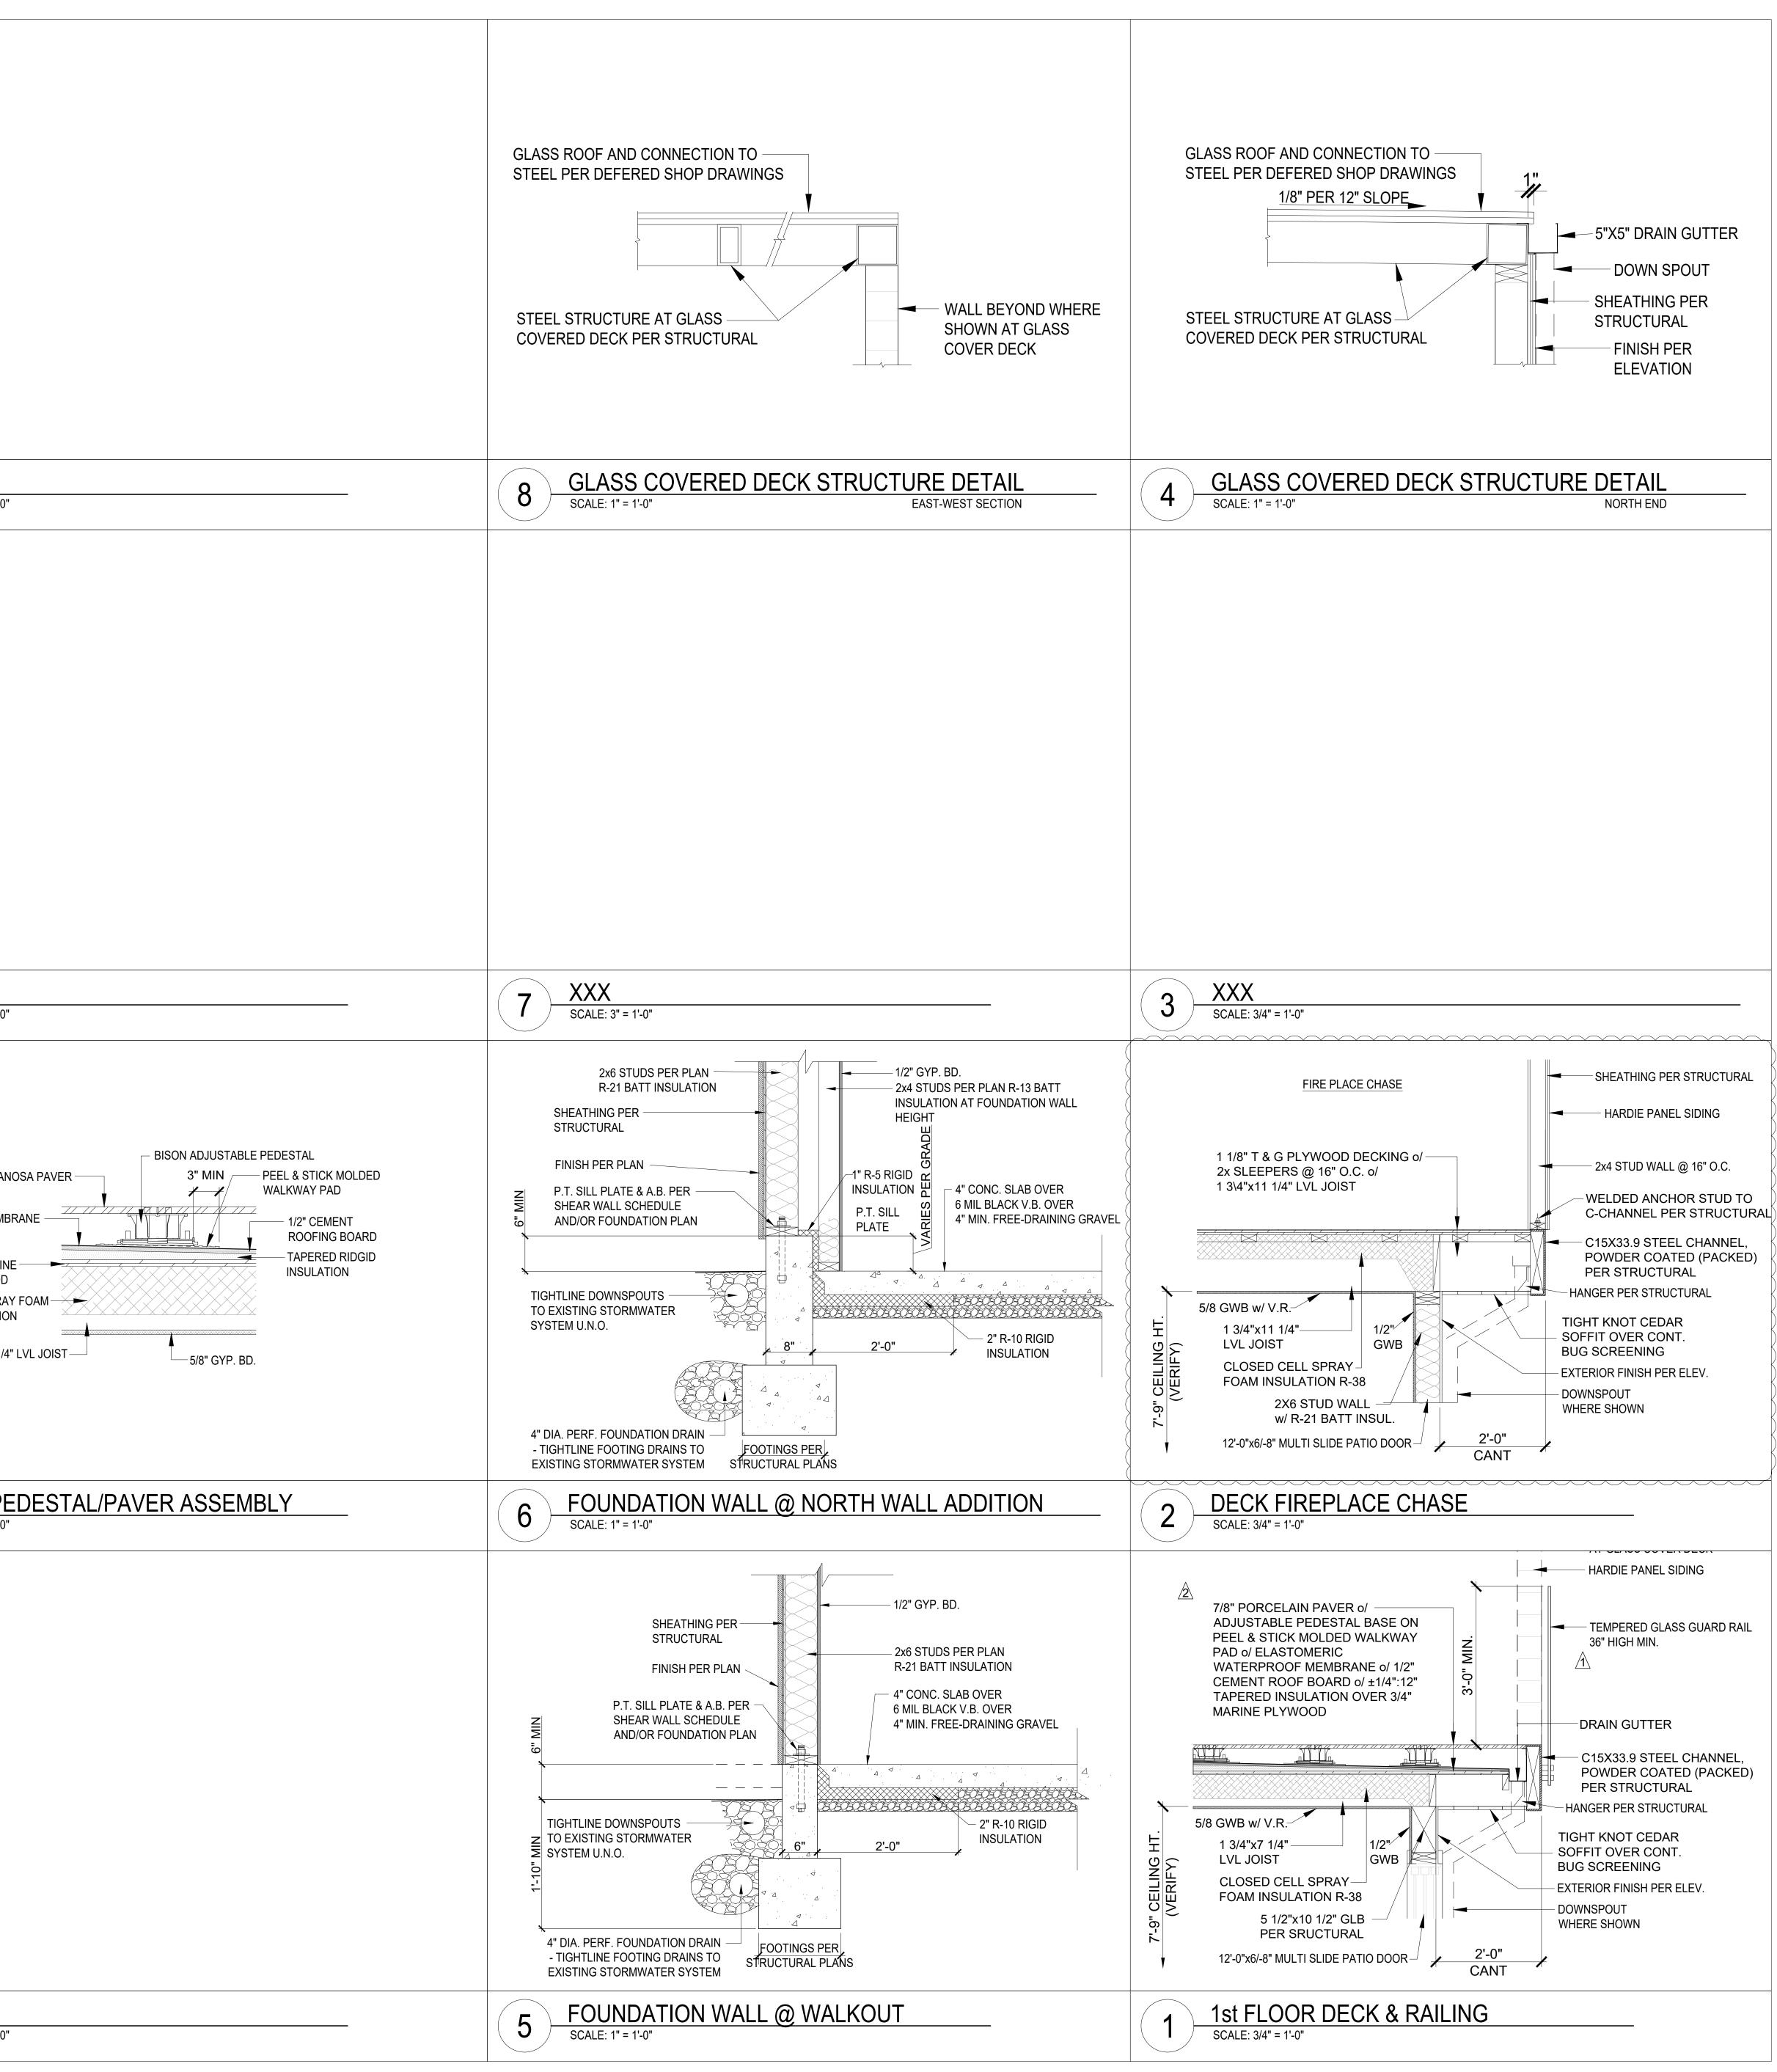



ACCESSIBLE DESIGN I INTERIOR DESIGN www.mediciarchitects.com

11711 SE 8TH STREET, SUITE 100 BELLEVUE, WA 98005 TEL: (425) 453-9298

REGISTRATION:

 INTAKE:
 DATE:

 REVISIONS:
 DATE:

 1.1 PER COMMENT 01-2005-081 04-01-2021

 2.
 SUB1-PLANS

 3.2 UPDATED COMMENT PER
 07-13-2021

 4.
 SUB3-PLANS

 5.3 Detial added
 02-17-2022

 PROJECT / CLIENT:

 9820 SE 35TH PLACE

ACHIN & MARY CHEN 9820 SE 35TH PLACE MERCER ISLAND, WA 98040

JOB ADDRESS: 9820 SE 35TH PLACE MERCER ISLAND, WA 98040 **PARCEL # 082405-9027**

DRAWING NAME:

DETAILS

Drawn By:	JMG,RB			
Checked By:	EB			
Owner Approval:				

PHASE:


CONSTRUCTION DOCUMENTS

This drawing is the exclusive property of Medici Architects, and can be reproduced only with the permission of the Architect. Variations and modifications to work shown on this drawing shall not be carried out without written permission from the Architect.

APPROVED FOR CONSTRUCTION:

 PROJECT No.:
 2020 007

 DATE:
 12-22-2020

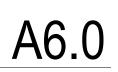

<u>GENERAL STRUCTURAL NOTES</u>

(THE FOLLOWING APPLY UNLESS SHOWN OTHERWISE ON THE PLANS.)

<u>A. GENERAL</u>

1. ALL MATERIALS, WORKMANSHIP, DESIGN, AND CONSTRUCTION FOR NEW CONSTRUCTION SHALL CONFORM TO THE DRAWINGS, SPECIFICATIONS, AND THE INTERNATIONAL BUILDING CODE (IBC), 2015 EDITION.

2. STRUCTURAL DRAWINGS SHALL BE USED IN CONJUNCTION WITH ARCHITECTURAL DRAWINGS FOR BIDDING AND CONSTRUCTION. CONTRACTOR SHALL VERIFY DIMENSIONS AND CONDITIONS FOR COMPATIBILITY AND SHALL NOTIFY ARCHITECT OF ANY DISCREPANCIES PRIOR TO CONSTRUCTION. SEE ARCHITECTURAL DRAWINGS FOR EXACT LOCATIONS AND DIMENSIONS OF DOOR AND WINDOW OPENINGS. SEE MECHANICAL DRAWINGS FOR SIZE AND LOCATION OF MISCELLANEOUS MECHANICAL OPENINGS.

3. CONTRACTOR SHALL VERIFY ALL EXISTING DIMENSIONS, MEMBER SIZES, AND CONDITIONS PRIOR TO COMMENCING ANY WORK. ALL DIMENSIONS OF EXISTING CONSTRUCTION SHOWN ON THE DRAWINGS ARE INTENDED AS GUIDELINES ONLY AND MUST BE VERIFIED.

4. DEMOLITION: CONTRACTOR SHALL VERIFY ALL EXISTING CONDITIONS BEFORE COMMENCING ANY DEMOLITION. SHORING SHALL BE INSTALLED TO SUPPORT EXISTING CONSTRUCTION AS REQUIRED AND IN A MANNER SUITABLE TO THE WORK SEQUENCE. EXISTING REINFORCING SHALL BE SAVED WHERE AND AS NOTED ON THE PLANS. SAW CUTTING, IF AND WHERE USED, SHALL NOT CUT EXISTING REINFORCING THAT IS TO BE SAVED. DEMOLITION DEBRIS SHALL NOT BE ALLOWED TO DAMAGE OR OVERLOAD THE EXISTING STRUCTURE. LIMIT CONSTRUCTION LOADING (INCLUDING DEMOLITION DEBRIS) ON EXISTING FLOOR SYSTEMS TO 40 PSF.

4.1 ALL OPENINGS THROUGH EXISTING CONCRETE WALLS, SLABS AND BEAMS SHALL BE ACCOMPLISHED BY SAW CUTTING AND/OR CORING WHEREVER POSSIBLE. SAW CUT TO TERMINATE AT CORING AT CORNERS OF OPENING. DO NOT OVERCUT CORNERS.

4.2 CONTRACTOR SHALL VERIFY ALL EXISTING CONDITIONS AND LOCATION OF MEMBERS PRIOR TO CUTTING ANY OPENINGS.

4.3 SMALL ROUND OPENINGS THROUGH CONCRETE SHALL BE ACCOMPLISHED BY CORE DRILLING IF POSSIBLE.

4.4 WHERE NEW REINFORCING TERMINATES AT EXISTING CONCRETE, DOWEL BARS SHALL BE DRILLED AND EPOXIED INTO EXISTING CONCRETE TO MATCH NEW HORIZONTAL REINFORCING AS NOTED ON PLANS.

5. CONTRACTOR SHALL CHECK FOR DRYROT AT ALL EXTERIOR WALLS, EXISTING TOILET ROOM FLOORS AND WALLS, AREAS SHOWING WATER STAINS, AND ALL WOOD MEMBERS IN THE BASEMENT AND CRAWL SPACES. ALL ROT SHALL BE REMOVED AND DAMAGED MEMBERS SHALL BE REPLACED OR REPAIRED AS DIRECTED BY THE STRUCTURAL ENGINEER OR ARCHITECT.

6. CONTRACTOR SHALL PROVIDE TEMPORARY BRACING FOR THE STRUCTURE AND STRUCTURAL COMPONENTS OF THE NEW CONSTRUCTION UNTIL ALL FINAL CONNECTIONS HAVE BEEN COMPLETED IN ACCORDANCE WITH THE PLANS. THE CONTRACTOR SHALL ALSO PROVIDE TEMPORARY BRACING AND SHORING OF THE EXISTING BUILDING(S) IN WHICH PORTIONS OF THE EXISTING STRUCTURE ARE TO BE REMOVED OR MODIFIED. THIS TEMPORARY BRACING AND SHORING SHALL REMAIN IN PLACE UNTIL NEW CONSTRUCTION AND/OR STRUCTURAL MODIFICATIONS ARE COMPLETED. THE CONTRACTOR SHALL DESIGN, PROVIDE MATERIALS FOR AND INSTALL (AND REMOVE IF NECESSARY) SUCH TEMPORARY WORK.

7. CONTRACTOR SHALL BE RESPONSIBLE FOR ALL SAFETY PRECAUTIONS AND THE METHODS, TECHNIQUES, SEQUENCES OR PROCEDURES REQUIRED TO PERFORM HIS WORK. STRUCTURAL DESIGN OF THE BUILDING IS BASED ON RESISTANCE TO DEAD LOADS, CODE SPECIFIED LATERAL LOADS, AND MAXIMUM EXPECTED SERVICE LOADS. NO CONSIDERATION HAS BEEN GIVEN TO LOADS WHICH WILL BE INDUCED BY ERECTION PROCEDURES. THE CONTRACTOR SHALL VERIFY, TO THE SATISFACTION OF HIM/HERSELF AND THE OWNER, THE ABILITY OF THE STRUCTURE TO RESIST ALL ERECTION LOADS WITHOUT EXCEEDING THE ALLOWABLE STRESSES OF THE MATERIALS USED. WHERE ERECTION LOADS WOULD OVERSTRESS THE STRUCTURE, THE CONTRACTOR SHALL SUBMIT DESIGN DOCUMENTS FOR TEMPORARY BRACING AND STRENGTHENING, INCLUDING FABRICATION AND ERECTION DRAWINGS, TO THE ARCHITECT FOR REVIEW. THESE DOCUMENTS SHALL BEAR THE SEAL AND SIGNATURE OF A REGISTERED STRUCTURAL ENGINEER IN THE STATE OF WASHINGTON. THE CONTRACTOR SHALL PROVIDE, INSTALL AND IF NECESSARY REMOVE SUCH TEMPORARY WORK AS REQUIRED.

8. CONTRACTOR-INITIATED CHANGES SHALL BE SUBMITTED IN WRITING TO THE ARCHITECT AND STRUCTURAL ENGINEER FOR APPROVAL PRIOR TO FABRICATION OR CONSTRUCTION. CHANGES SHOWN ON SHOP DRAWINGS ONLY WILL NOT SATISFY THIS REQUIREMENT.

9. DRAWINGS INDICATE GENERAL AND TYPICAL DETAILS OF CONSTRUCTION. WHERE CONDITIONS ARE NOT SPECIFICALLY INDICATED, BUT ARE OF SIMILAR CHARACTER TO DETAILS SHOWN, SIMILAR DETAILS OF CONSTRUCTION SHALL BE USED, SUBJECT TO REVIEW AND APPROVAL BY THE ARCHITECT AND THE STRUCTURAL ENGINEER.

10. ALL STRUCTURAL SYSTEMS WHICH ARE TO BE COMPOSED OF COMPONENTS TO BE FIELD ERECTED SHALL BE SUPERVISED BY THE SUPPLIER DURING MANUFACTURING, DELIVERY, HANDLING, STORAGE AND ERECTION IN ACCORDANCE WITH INSTRUCTIONS PREPARED BY THE SUPPLIER.

11. INSPECTIONS: INSPECTIONS OF THE WOOD FRAMING, THE STEEL REBAR AND WOOD FORMS FOR CONCRETE FOOTINGS & FOUNDATIONS, AND CONCRETE SLABS ARE REQUIRED PER IBC SECTION 110.3.

12. SPECIAL INSPECTION: SHALL BE PERFORMED BY A CERTIFIED TESTING AGENCY, DESIGNATED BY THE ARCHITECT OR ENGINEER, AND APPROVED BY THE OWNER.

THE SPECIAL INSPECTION AGENCIES SHALL PRODUCE REPORTS AND KEEP RECORDS PER IBC SECTION 1704.2.4.

THE SPECIAL INSPECTION AGENCIES SHALL INSPECT FABRICATORS PER IBC SECTION 1704.2.5. IF FABRICATOR IS REGISTERED & APPROVED TO PERFORM THE WORK WITHOUT SPECIAL INSPECTION PER IBC 1704.2.5.1, FABRICATOR SHALL SUBMIT A CERTIFICATE OF COMPLIANCE TO THE BUILDING OFFICIAL PER IBC SECTION 1704.2.5.1. AT COMPLETION OF FABRICATION.

THE SPECIAL INSPECTION AGENCIES DUTIES SHALL INCLUDE THE FOLLOWING:

12.1 STEEL CONSTRUCTION: VERIFY AND/OR INSPECT STEEL CONSTRUCTION PER QUALITY ASSURANCE INSPECTION REQUIREMENTS OF AISC 360. THIS INCLUDES (BUT IS NOT LIMITED TO) STRUCTURAL STEEL,

HIGH-STRENGTH BOLTING, WELDING, AND JOINTS OF STEEL FRAMES.

(12.2 PILE & PIER FOUNDATIONS: SPECIAL INSPECTIONS OF PIER OR PILE FOUNDATIONS ARE REQUIRED PER IBC SECTIONS 1705.7 AND 1704.8.

13. SHOP DRAWINGS FOR REINFORCING STEEL STRUCTURAL STEEL, GLUED LAMINATED MEMBERS, ENGINEERED LUMBER SHALL BE SUBMITTED TO THE ARCHITECT AND STRUCTURAL ENGINEER FOR REVIEW PRIOR TO FABRICATION OF THESE ITEMS.

ENGINEER OF RECORD SHALL REVIEW SHOP DRAWINGS FOR DESIGN INTENT ONLY. DIMENSIONS AND QUANTITIES ARE NOT GUARANTEED BY THE ENGINEER OF RECORD, AND THEREFORE, MUST BE VERIFIED BY THE GENERAL CONTRACTOR. DRAWINGS FOR COMPONENTS DESIGNED PRIMARILY BY OTHERS SHALL BE APPROVED BY THE COMPONENT DESIGNER PRIOR TO CURSORY REVIEW BY THE ENGINEER OF RECORD FOR LOADS IMPOSED ON THE BASIC STRUCTURE. SUBMITTALS SHALL INCLUDE A REPRODUCIBLE AND A COPY; REPRODUCIBLE WILL BE REVIEWED AND RETURNED. SHOP DRAWINGS MUST BE REVIEWED AND STAMPED BY CONTRACTOR PRIOR TO REVIEW BY ENGINEER.

14. PRE-MANUFACTURED, PRE-ENGINEERED STRUCTURAL COMPONENTS SHALL BE DESIGNED BASED ON THE CRITERIA PRESENTED IN THE CONTRACT DOCUMENTS. THE COMPONENT DESIGNER IS RESPONSIBLE FOR CODE CONFORMANCE, TEMPORARY AND PERMANENT BRACING AND ALL NECESSARY CONNECTIONS, INCLUDING CONNECTIONS TO THE PRIMARY STRUCTURE, NOT SPECIFICALLY CALLED OUT ON THE ARCHITECTURAL OR STRUCTURAL DRAWINGS. SHOP DRAWINGS SHALL INDICATE THE MAGNITUDE AND DIRECTION OF ALL LOADS IMPOSED ON THE PRIMARY STRUCTURE. SHOP DRAWINGS AND CALCULATIONS SHALL BE SUBMITTED PER PARAGRAPH "A.13." OF THESE NOTES.

15. DEFERRED SUBMITTALS – THE FOLLOWING ITEMS ARE CONSIDERED TO BE DEFERRED SUBMITTALS UNDER SECTION 107.3.4.1 OF THE INTERNATIONAL BUILDING CODE AND MUST BE SUBMITTED TO THE ARCHITECT OR THE ENGINEER FOR REVIEW. THESE ITEMS WILL THEN BE FORWARDED TO THE BUILDING OFFICIAL FOR APPROVAL. THE DEFERRED SUBMITTAL ITEMS SHALL NOT BE INSTALLED UNTIL THEIR DESIGN AND SUBMITTAL DOCUMENTS HAVE BEEN APPROVED BY THE BUILDING OFFICIAL. DESIGN SUBMITTALS SHALL BEAR THE STAMP AND SIGNATURE OF A REGISTERED STRUCTURAL ENGINEER IN THE STATE OF WASHINGTON * PRE-ENGINEERED GLASS STAIR TREADS, GLASS GUARDRAILS AND GLASS ROOF.

B. DESIGN CRITERIA

1.	DESIGN LOADS	
	ROOF LIVE LOAD ROOF DEAD LOAD FLOOR LIVE LOAD (RESIDENTIAL) FLOOR DEAD LOAD DECK LIVE LOAD DECK DEAD LOAD	25 PSF (SNOW*, IS=1.0) 15 PSF (20 PSF @ GLASS ROOF) 40 PSF (REDUCIBLE) 15 PSF 60 PSF (REDUCIBLE) 20 PSF
	WIND (ASCE 7-10)	V_{ULT} = 110 MPH, V_{ASD} = 85 MPH, (3 SEC GUST) ENCLOSED BUILDING, EXPOSURE "C", IW=1.0, KZT = 1.0
	EARTHQUAKE (ASCE 7–10)	SITE CLASS D OCCUPANCY CATEGORY II (IE = 1.0) SEISMIC DESIGN CATEGORY D SS =1.382G, S1 = $0.531G$ SDS= $0.921G$, SD1 = $0.531G$
		R=6.5, R = 1.3 $V_{ULT} = C_S W = 0.129 W$
		EQUIVALENT LATERAL FORCE PROCEDURE LATERAL LOADS ARE RESISTED BY STRUCTURAL WOOD PANEL SHEAR WALLS & DIAPHRAGMS
	ALLOWABLE SOIL PRESSURE** LATERAL EARTH PRESSURE**	

55 PCF AT-REST\14H SEISMIC 250 PSF PASSIVE

0.35 COEFFICIENT OF FRICITION

**SOILS REPORT REFERENCE: GEOTECHNICAL REPORT, PROPOSED ADDITION AND NEW GARAGE, 9820 SE 35th PL, MERCER ISLAND, WA, PREPARED BY GEO GROUP NORTHWEST INC, DATED AUGUST 20, 2020, REPORT #G-5207. GEO GROUP NORTHWEST DAILY FIELD REPORT DATED 02/08/2022.

1. FOUNDATION EXCAVATION, BACKFILL AND COMPACTION SHALL CONFORM TO SPECIFICATION REQUIREMENTS. THIS CONSTRUCTION WORK, INCLUDING DRAINAGE, SHORING AND SUCH OTHER RELATED WORK AS REQUIRED, SHALL BE CONDUCTED BY THE CONTRACTOR UNDER THE OBSERVATION AND DIRECTION OF THE GEOTECHNICAL ENGINEER.

 2. FOOTINGS SHALL BEAR ON SOLID UNDISTURBED EARTH (CONTROLLED, COMPACTED STRUCTURAL FILL OR BOTH) AT LEAST 18" BELOW LOWEST ADJACENT FINISHED GRADE. MATERIAL TO BE COMPACTED TO 95% MINIMUM OF MAXIMUM DRY DENSITY AS DETERMINED BY ASTM D1557.
 3. FOOTINGS MAY BE POURED IN NEAT EXCAVATIONS PROVIDED SIZE IS INCREASED 3" AT EACH INTERFACE WITH SOIL.

4. ALL FOOTING EXCAVATIONS SHALL BE HAND CLEANED PRIOR TO PLACING CONCRETE.

5. ALL ABANDONED FOOTINGS, UTILITIES, ETC. THAT INTERFERES WITH NEW CONSTRUCTION SHALL BE REMOVED.

6. CONTRACTOR SHALL PROVIDE FOR DESIGN AND INSTALLATION OF ALL CRIBBING, SHEATHING, AND SHORING REQUIRED TO SAFELY RETAIN EXCAVATIONS.

7. BACKFILL BEHIND ALL WALLS WITH WELL DRAINING, GRANULAR FILL MATERIAL, AND PROVIDE PERFORATED PIPE DRAINS AS DESCRIBED IN THE SOILS REPORT. BACKFILL BEHIND WALLS SHALL NOT BE PLACED BEFORE THE WALL IS PROPERLY SUPPORTED BY THE FLOOR SLAB, OR TEMPORARY BRACING. ALL FOOTINGS SHALL BE CENTERED BELOW CENTERLINE OF COLUMNS OR WALLS ABOVE, UNLESS NOTED OTHERWISE.

C1. PIN PILE FOUNDATION
1. PIN PILE TO BE 2" DIAMETER SCHEDULE GALVANIZED 80 PIPE. PIN PILE DESIGN CAPACITY IS 6 KIPS
2. PIN PILES ARE TO BE DRIVEN USING A 90-POUND OR 140-POUND PNEUMATIC JACKHAMMER UNTIL REFUSAL. REFUSAL IS DEFINED AS A PENETRATION RESISTANCE OF LESS THAN 1
3. PIN PILE TO EXTEND 6" MINIMUM INTO PILE CAP. PROVIDE COMPRESSION FIT CAP. 4. PIPE PILE TO BE SPLICED WITH COMPRESSION FIT SLEEVED COUPLER OR COMPLETE PENETRATION WELD.
5. THE GEOTECHNICAL ENGINEER OF RECORD OR HIS/HER REPRESENTATIVE SHALL PROVIDE FULL-TIME OBSERVATION OF PILE INSTALLATION AND TESTING TO VERIFY THE DRIVING REFUSAL
6. A MINIMUM OF 3% OF THE PILES (1 MINIMUM AND UP TO 5 PILES MAXIMUM) SHOULD BE LOAD TESTED TO VERIFY DESIGN LOAD CAPACITIES. ALL LOAD TESTS SHALL BE PERFORMED
D. CONCRETE
1. ULTIMATE STRENGTH DESIGN PER INTERNATIONAL BUILDING CODE AND ACI 318–14.
2. CONCRETE SHALL MEET THE FOLLOWING MINIMUM REQUIREMENTS
2.1 CONCRETE SHALL ATTAIN A 28-DAY STRENGTH OF F'C = 3,500 PSI AND MIX SHALL CONTAIN NOT LESS THAN $5-1/2$ SACKS OF CEMENT PER CUBIC YARD AND SHALL BE PROPORTIONED TO PRODUCE A SLUMP OF 5" OR LESS. EXPOSURE CLASS F1, S0, WO & CO. DESIGN IS BASED ON F'C = 2,500 PSI.
3. THE MINIMUM AMOUNTS OF CEMENT AND MAXIMUM AMOUNTS OF WATER MAY BE CHANGED IF A CONCRETE DESIGN MIX IS SUBMITTED TO THE STRUCTURAL ENGINEER AND THE BUILDING DEPARTMENT FOR APPROVAL TWO WEEKS PRIOR TO PLACING ANY CONCRETE. THE CONCRETE PERFORMANCE MIX SHALL INCLUDE THE AMOUNTS OF CEMENT, FINE AND COARSE AGGREGATE, WATER AND ADMIXTURES AS WELL AS THE WATER CEMENT RATIO, SLUMP, CONCRETE YIELD AND SUBSTANTIATING STRENGTH DATA IN ACCORDANCE WITH ACI 318, CHAPTERS 19 AND 26. ALL CONCRETE EXPOSED TO FREEZING TEMPERATURES WHILE CURING AND ALL CONCRETE PERMANENTLY EXPOSED TO WEATHER SHALL BE AIR-ENTRAINED WITH AN AIR-ENTRAINING
AGENT CONFORMING TO ACI 318. TOTAL AIR CONTENT SHALL BE 6% IN ACCORDANCE WITH TABLE 19.3.3.1. NO ADMIXTURES, OTHER THAN FOR AIR-ENTRAINMENT AS NOTED ABOVE, SHALL BE USED WITHOUT PRIOR REVIEW BY THE STRUCTURAL ENGINEER.
4. REINFORCING
REINFORCING STEEL SHALL BE DEFORMED BARS CONFORMING TO ASTM A615 (INCLUDING SUPPLEMENT S1), GRADE 60, FY = 60,000 PSI. REINFORCEMENT FOR COLUMNS, WALLS, WALL TO FOOTING DOWELS, AND WOOD SHEAR WALL HOLD DOWNS TO BE A706 UNLESS CERTIFIED MILL CERTIFICATES CONFORMING TO ACI 318 20.2.2.5 ARE PROVIDED. WELDED WIRE REINFORCEMENT: ASTM A82 AND ASTM A185, SPLICE WITH AT LEAST ONE FULL MESH. PLACE AT MID-DEPTH, OR SLIGHTLY ABOVE, OF SLAB. MATERIAL TO BE SUPPLIED IN FLAT SHEETS.
5. REINFORCING STEEL SHALL BE DETAILED (INCLUDING HOOKS AND BENDS) IN ACCORDANCE WITH ACI 318 (LATEST EDITION). LAP ALL CONTINUOUS REINFORCEMENT PER NOTE D.6. PROVIDE CORNER BARS AT ALL WALL INTERSECTIONS. LAP CORNER BARS PER NOTE D.6. LAP ADJACENT MATS OF WELDED WIRE REINFORCEMENT A MINIMUM OF 8" AT SIDES AND ENDS. NO BARS PARTIALLY EMBEDDED IN HARDENED CONCRETE SHALL BE FIELD BENT UNLESS SPECIFICALLY SO DETAILED OR APPROVED BY THE STRUCTURAL ENGINEER.
6. REINFORCING STEEL LAPS AND EMBEDMENT SHALL BE AS NOTED BELOW, UNLESS NOTED OTHERWISE: DEVELOPMENT LENGTH – COMPRESSION 20 BAR DIAM. – 24″ MINIMUM
DEVELOPMENT LENGTH – TENSION 48 BAR DIAM. – (#11 BAR – 54 BAR DIA.) DEVELOPMENT LENGTH – TENSION, TOP BAR* 64 BAR DIAM. – (#11 BAR – 70 BAR DIA.)
LAP SPLICE LENGTH – COMPRESSION 30 BAR DIAM. – 24″ MINIMUM LAP SPLICE LENGTH – TENSION 64 BAR DIAM. – (#11 BAR – 70 BAR DIAM.)
LAP SPLICE LENGTH - TENSION, TOP BAR* 80 BAR DIAM (#11 BAR - 90 BAR DIAM.) *TOP BARS ARE HORIZONTAL REINFORCEMENT SO PLACED THAT MORE THAN 12" OF CONCRETE IS CAST IN THE MEMBER BELOW THE BAR.
ALL HOOKS SHALL BE "STANDARD" IN ACCORDANCE WITH ACI 318. REINFORCING SHALL NOT BE TACK WELDED. DO NOT WELD GRADE 60 REINFORCING.
7. HIGH STRENGTH THREADED RODS (STRESSED AND NON-STRESSED) SHALL BE DYWIDAG THREADBARS WITH APPROPRIATE ANCHORAGE PLATES, NUTS, AND COUPLERS AS MANUFACTURED BY DICKERHOFF AND WINDMANN, INC., IN CONFORMANCE WITH ASTM A722 (FPU = 150,000).
8. MECHANICAL SPLICING OF REINFORCING BARS, WHERE INDICATED ON THE DRAWINGS, SHALL BE BY AN INTERNATIONAL CODE COUNSEL (ICC) APPROVED SYSTEM (SUCH AS LENTON, FOX-HOWLETT, ETC.) AND SHALL DEVELOP 125% OF THE SPECIFIED YIELD STRENGTH OF THE BARS. SPLICE LOCATIONS OF ALTERNATE BARS SHALL BE OFFSET BY A DISTANCE WHICH CONFORMS TO THE ICC REPORT OF THE SPLICE USED.
9. CONCRETE PROTECTION (COVER) FOR REINFORCING STEEL SHALL BE AS FOLLOWS: FOOTINGS AND OTHER UNFORMED SURFACES, EARTH FACE 3"
FORMED SURFACES EXPOSED TO EARTH (I.E. WALLS BELOW GROUND) OR WEATHER (#6 BARS OR LARGER) 2" (#5 BARS OR SMALLER) 1–1/2" COLUMN TIES OR SPIRALS AND BEAM STIRRUPS 1–1/2" JOISTS, SLABS AND WALLS (INTERIOR FACE) 3/4"
10. NON-SHRINK GROUT SHALL BE FURNISHED BY AN APPROVED MANUFACTURER AND SHALL BE MIXED AND PLACED IN STRICT ACCORDANCE WITH THE MANUFACTURER'S PUBLISHED RECOMMENDATIONS. GROUT SHALL BE NON-SHRINK, CEMENT-BASED AND HAVE A MINIMUM COMPRESSIVE STRENGTH AT 28 DAYS OF F'C = 5000 PSI WHEN TESTED IN ACCORDANCE WITH ASTM C109.
 ADHESIVE ANCHOR SYSTEM SHALL BE SET-XP OR SET-3G EPOXY BY SIMPSON STRONG-TIE, HIT-HY 200-A OR HIT-RE 500 V3 BY HILTI, AC200+ BY DEWALT, OR APPROVED EQUAL. ALL WOOD PLATES IN DIRECT CONTACT WITH CONCRETE OR MASONRY SHALL BE PRESSURE-TREATED (SEE WOOD SECTION).
E. STRUCTURAL STEEL
1. STRUCTURAL STEEL DESIGN, FABRICATION, AND ERECTION SHALL BE BASED ON THE AISC 360 "SPECIFICATION FOR THE DESIGN, FABRICATION AND ERECTION OF STRUCTURAL STEEL FOR BUILDINGS," LATEST EDITION, PLUS ALL REFERENCED CODES.
 ALL "W" (WIDE FLANGE BEAM AND COLUMN) SHAPES SHALL CONFORM TO ASTM A992. HP SHAPES SHALL CONFORM TO ASTM A572, FY = 50 KSI. PLATES, BARS AND OTHER ROLLED SHAPES SHALL CONFORM TO ASTM A36, FY = 36 KSI, UNLESS CALLED OUT OTHERWISE ON PLAN. STEEL PIPE SHALL BE SCHEDULE 40 CONFORMING TO ASTM A53, TYPE E OR S, GRADE B, FY = 35 KSI. RECTANGULAR HSS SHALL CONFORM TO ASTM A500, GRADE B, FY = 46 KSI, ROUND HSS SHALL CONFORM TO ASTM A500, GRADE B, FY = 46 KSI, ROUND HSS SHALL CONFORM TO ASTM A500, GRADE B, FY = 42 KSI. ANCHOR BOLTS SHALL CONFORM TO ASTM A307 AND HAVE A WELDED HEAD. EMBED ANCHOR BOLTS A MINIMUM OF 7" INTO CONCRETE.
5. ALL CONNECTION BOLTS AT STEEL/STEEL CONNECTIONS SHALL BE ASTM A325 OR ASTM A490 AND SHALL BE INSTALLED, TIGHTENED, AND INSPECTED IN ACCORDANCE WITH THE AISC "SPECIFICATION FOR STRUCTURAL JOINTS USING ASTM A325 OR A 490 BOLTS." THE CRITERIA FOR SNUG-TIGHT CONNECTIONS SHALL APPLY TO ALL CONNECTIONS UNLESS SPECIFICALLY NOTED AS SLIP-CRITICAL ON THE STRUCTURAL DRAWINGS. WHERE CONNECTIONS ARE NOTED AS SLIP-CRITICAL, THE CONTRACTOR SHALL INSTALL PER CRITERIA FOR SLIP-CRITICAL
CONNECTIONS. SLIP-CRITICAL CONNECTIONS SHALL USE LOAD INDICATOR WASHERS OR TENSION CONTROL BOLTS. ALL BOLT HOLES SHALL BE STANDARD SIZE, UNLESS NOTED OTHERWISE. 5. THE CONTRACTOR SHALL BE RESPONSIBLE FOR THE COORDINATION OF THE SELECTION OF OPTIONAL DETAILS SHOWN ON THE DRAWINGS. THE CONTRACTOR SHALL ALSO BE RESPONSIBLE FOR ALL ERECTION AIDS AND JOINT PREPARATIONS THAT INCLUDE, BUT ARE NOT LIMITED TO: ERECTION ANGLES, LIFT HOLES, AND OTHER AIDS; WELDING PROCEDURES; REQUIRED ROOT OPENINGS; ROOT FACE DIMENSIONS; GROOVE ANGLES; BACKING BARS; COPES; SURFACE ROUGHNESS VALUES; AND TAPERS OF UNEQUAL PARTS.
6. EXPANSION BOLTS INTO CONCRETE SHALL BE "STRONG-BOLT 2" WEDGE ANCHORS BY SIMPSON STRONG-TIE, "KWIK BOLT TZ" WEDGE ANCHORS BY HILTI, POWER-STUD+ SD2, OR APPROVED EQUAL INSTALLED IN STRICT ACCORDANCE WITH THE MANUFACTURER'S PUBLISHED RECOMMENDATIONS, INCLUDING MINIMUM EMBEDMENT REQUIREMENTS. SPECIAL INSPECTION IS REQUIRED FOR ALL EXPANSION BOLT AND INSERT INSTALLATION. SUBMIT MANUFACTURER'S DATA SHEETS AND ICC REPORTS FOR ENGINEER'S REVIEW.
7. ALL WELDING SHALL BE IN CONFORMANCE WITH AISC AND AWS STANDARDS AND SHALL BE PERFORMED BY WABO CERTIFIED WELDERS USING E70XX ELECTRODES. WELDS, UNLESS OTHERWISE NOTED, SHALL BE 3/16" CONTINUOUS FILLET WELDS. WELDS SHOWN ON DRAWINGS ARE MINIMUM SIZES. INCREASE WELD SIZE TO AWS MINIMUM SIZES, BASED ON PLATE THICKNESS. WELDING OF REINFORCING BARS (IF REQUIRED) SHALL BE PERFORMED USING LOW HYDROGEN ELECTRODES. WELDING WITHIN 4" OF COLD BENDS IN REINFORCING STEEL IS NOT PERMITTED. SEE REINFORCING NOTE FOR MATERIAL REQUIREMENTS OF WELDED BARS. WELDING PROCEDURES SHALL BE SUBMITTED TO THE OWNER'S TESTING AGENCY FOR REVIEW BEFORE
STARTING FABRICATION OR ERECTION. ALL WELDS SHALL BE VISUALLY INSPECTED AT THE SITE BY A QUALIFIED INSPECTOR. ALL COMPLETE PENETRATION WELDS SHALL BE ULTRASONICALLY TESTED AT THE PLANT OR SITE BY A QUALIFIED INSPECTOR.
FIELD WELD ARROWS ARE SHOWN ONLY WHERE A FIELD WELD IS REQUIRED BY THE STRUCTURAL DESIGN. THE CONTRACTOR IS RESPONSIBLE FOR DETERMINING IF A WELD SHOULD BE SHOP OR FIELD WELDED IN ORDER TO FACILITATE THE STRUCTURAL STEEL ERECTION.
1. GLUED LAMINATED MEMBERS SHALL BE FABRICATED IN CONFORMANCE WITH ANSI STANDARD A190.1. EACH MEMBER SHALL BEAR AN AITC OR APA EWS IDENTIFICATION MARK AND SHALL BE ACCOMPANIED BY AN AITC OR APA EWS CERTIFICATE OF CONFORMANCE. ALL SIMPLE SPAN BEAMS SHALL BE DOUGLAS FIR COMBINATION 24F-V4, FB = 2,400 PSI, FV = 240 PSI. ALL CANTILEVERED BEAMS SHALL BE DOUGLAS FIR COMBINATION 24F-V8, FB = 2400 PSI, FV = 240 PSI. CAMBER ALL GLULAM BEAMS TO 2,000' RADIUS, UNLESS SHOWN OTHERWISE ON THE PLANS.
2. FRAMING LUMBER SHALL BE GRADED AND MARKED IN CONFORMANCE WITH WCLIB STANDARD GRADING RULES FOR WEST COAST LUMBER, LATEST EDITION. FURNISH TO THE FOLLOWING MINIMUM STANDARDS:
MIN. BASIC MEMBER SIZE SPECIES GRADE DESIGN STRESS
JOISTS AND RAFTERS: $2X, 3X$ HEM.FIR #2 FB = 850 PSI 4X HEM.FIR #2 FB = 850 PSI
BEAMS AND STRINGERS: 6X AND DOUG.FIR #1 FB = 1350 PSI LARGER
POSTS AND TIMBERS: 6X6, 6X8 DOUG.FIR #1 $FC = 1000 PSI$ FB = 1200 PSI
PLATES AT SHEAR WALLS AND BEARING WALLS:

GENERAL STRUCTURAL NOTES

ALL LUMBER WITH A LEAST DIMENSION OF 2" (NOMINAL) SHALL BE STAMPED SURFACE-DRY AND SHALL HAVE A MOISTURE CONTENT WHEN SURFACED AND WHEN INSTALLED OF NOT

MORE THAN 19 PERCENT. LUMBER WITH A LEAST DIMENSION OF 4" (NOMINAL) OR GREATER SHALL BE STAMPED SURFACE-GREEN AND AIR-DRIED TO A MOISTURE CONTENT OF NOT MORE

HEM.FIR #2 FB = 850 PSI

STUDS, PLATES, &

MISC. LIGHT FRAMING:

THAN 19 PERCENT PRIOR TO ITS USE IN FRAMING THE STRUCTURE.

3. MANUFACTURED LUMBER SHALL BE AS MANUFACTURED BY TRUS JOIST OR APPROVED EQUAL. REQUESTS FOR APPROVAL AS EQUAL WILL REQUIRE SUBMITTAL OF ICC REPORT EQUIVALENT TO ESR-1387 FOR LAMINATED STRAND LUMBER (LSL), LAMINATED VENEER LUMBER (LVL), OR PARALLEL STRAND LUMBER (PSL). THE MINIMUM ALLOWABLE DESIGN VALUES ARE AS FOLLOWS:

LSL - FB = 2,250; FV = 400 PSI; E = 1,500,000 PSI LVL - FB = 2,600; FV = 285 PSI; E = 1,800,000 PSI PSL - FB = 2,900; FV = 290 PSI; E = 2,000,000 PSI

4. SHEATHING SHALL BE APA PERFORMANCE RATED PANELS PER APA "PLYWOOD DESIGN SPECIFICATION", INCLUDING APPLICABLE SUPPLEMENTS, UNLESS NOTED OTHERWISE. PLYWOOD OR ORIENTED-STRAND BOARD (OSB) PANELS SHALL BE GRADE CD AND ALSO CONFORM TO DOC PS-1 & PS-2. ALL PANELS SHALL BE IDENTIFIED AS EXPOSURE 1 UNLESS NOTED OTHERWISE. PANEL RATING TO BE AS FOLLOWS UNLESS NOTED OTHERWISE:

ROOF: 19/32" (OR 5/8") THICK, 40/20 WALLS: 15/32" THICK, 32/16, OR 1/2" THICK, 24/0

FLOORS: 23/32" (OR 3/4") THICK, TONGUE & GROOVE, (48/24)

UNLESS NOTED OTHERWISE ON THE PLANS, ROOF AND FLOOR SHEATHING SHALL BE LAID UP WITH GRAIN PERPENDICULAR TO SUPPORTS AND NAILED WITH 8D NAILS @ 6"OC TO FRAMED PANEL EDGES AND OVER STUD WALLS SHOWN ON PLANS AND @ 12"OC (10"OC AT FLOORS) TO INTERMEDIATE SUPPORTS. PROVIDE APPROVED SHEATHING EDGE CLIPS @ 16"OC AT UNBLOCKED ROOF SHEATHING EDGES. ALL FLOOR SHEATHING EDGES SHALL HAVE APPROVED TONGUE—AND—GROOVE JOINTS AND EDGE CLIPS. PROVIDE SOLID BLOCKING AT ALL EDGES ONLY WHERE NOTED ON PLANS. TOENAIL BLOCKING TO SUPPORTS WITH 16D NAILS, UNLESS NOTED OTHERWISE.

UNLESS NOTED OTHERWISE ON THE PLANS, WALL SHEATHING MAY BE LAID UP HORIZONTALLY OR VERTICALLY, UNSUPPORTED EDGES SHALL BE BLOCKED AND ALL EDGES SHALL BE NAILED WITH 8D @ 6"OC, NAIL WITH 8D @ 12"OC AT INTERMEDIATE SUPPORTS. NAIL SHEAR WALL SHEATHING TO ALL HOLDOWN STUDS USING EDGE NAIL SPACING WHEN HOLDOWN STUD DOES NOT OCCUR AT PANEL EDGES.

SHEATHING NAILS SHALL BE DRIVEN FLUSH BUT SHALL NOT FRACTURE THE SURFACE OF THE SHEATHING.

5. INTERIOR WOOD MEMBERS IN DIRECT CONTACT WITH CONCRETE OR MASONRY SHALL BE PRESSURE-TREATED WITH SODIUM BORATE (SBX). WOOD MEMBERS EXPOSED TO WEATHER (UNPAINTED) OR IN DIRECT CONTACT WITH SOIL SHALL BE PRESSURE-TREATED WITH ALKALINE COPPER QUATERNARY (ACQ). NOTE THAT ACQ IS EXTREMELY CORROSIVE TO METALS. SBX IS NONTOXIC TO THE ENVIRONMENT. PROVIDE TWO LAYERS OF ASPHALT IMPREGNATED BUILDING PAPER BETWEEN UNTREATED LEDGERS, BLOCKING, ETC., AND CONCRETE OR MASONRY. ALL METAL CONNECTORS IN CONTACT WITH "ACQ" PRESSURE-TREATED LUMBER OR FIRE-RETARDANT-TREATED LUMBER SHALL BE TYPE 304 OR 316 STAINLESS STEEL. THIS INCLUDES WASHERS, SCREWS, NAILS, HANGERS, AND ANY OTHER MISCELLANEOUS LT. GAGE METAL CONNECTORS. WHERE ACQ LUMBER IS MISTAKENLY USED OR FOR FIRE-RETARDANT-TREATED LUMBER USED IN INTERIOR CONDITIONS, ASTM A 653, TYPE G185 ("HOT-DIP" GALVANIZED TO 1.85 OUNCES PER SQUARE FOOT) METAL CONNECTORS MAY BE USED IN LIEU OF STAINLESS STEEL. METAL CONNECTORS 1/2" THICK OR GREATER NEED NOT BE GALVANIZED FOR INTERIOR USE, NOR DO THEY NEED TO BE STAINLESS STEEL FOR EXTERIOR USE. METAL CONNECTORS 1/2" THICK OR GREATER NEED NOT BE GALVANIZED FOR INTERIOR USE, NOR DO THEY NEED TO BE STAINLESS STEEL FOR EXTERIOR USE. METAL CONNECTORS 1/2" THICK PLUS MUST BE GALVANIZED FOR EXTERIOR USE, UNLESS SPECIFIED OTHERWISE BY THE ARCHITECT.

6. WOOD FASTENER NOTES - THE FOLLOWING APPLY UNLESS OTHERWISE SHOWN ON THE PLANS:

6.1 NOTATIONS ON DRAWINGS RELATING TO FRAMING CLIPS, JOIST HANGERS AND OTHER CONNECTING DEVICES REFER TO CATALOG NUMBERS OF CONNECTORS MANUFACTURED BY THE SIMPSON STRONG-TIE COMPANY, DUBLIN, CALIFORNIA. EQUIVALENT DEVICES BY OTHER MANUFACTURERS MAY BE SUBSTITUTED, PROVIDED THEY HAVE ICC APPROVAL FOR EQUAL OR GREATER LOAD CAPACITIES. SUBMIT MANUFACTURER'S CATALOG AND ICC REPORTS TO ARCHITECT AND ENGINEER FOR REVIEW WHEN REQUESTING SUBSTITUTIONS. ALL SPECIFIED FASTENERS MUST BE USED AND PROPER INSTALLATION PROCEDURES MUST BE OBSERVED IN ORDER TO OBTAIN ICC APPROVED LOAD CAPACITIES. VERIFY THAT THE DIMENSIONS OF THE SUPPORTING MEMBER ARE SUFFICIENT TO RECEIVE THE SPECIFIED FASTENERS.

6.2 NAILS SHALL BE MANUFACTURED IN CANADA OR THE UNITED STATES IN SIZES AND TYPES AS FOLLOWS, UNLESS NOTED OTHERWISE:

PNEUMATIC NAILING – PLAIN SHANK, COATED OR GALVANIZED

8D = .131 diameter x 2-1/2" minimum length 10D = .148 diameter x 3" minimum length

16D = .162 DIAMETER X 3-1/4" MINIMUM LENGTH 20D = .192 DIAMETER X 4" MINIMUM LENGTH

HAND NAILING – SINKERS, COATED

8D = 11-1/2 GAGE X 2-3/8" 10D = 11 GAGE X 2-7/8"

16D = 9 GAGE X 3-1/4"

7. WOOD FRAMING NOTES - THE FOLLOWING APPLY UNLESS OTHERWISE SHOWN ON THE PLANS:

7.1 ALL WOOD FRAMING DETAILS NOT SHOWN OTHERWISE SHALL BE CONSTRUCTED TO THE MINIMUM STANDARDS OF THE INTERNATIONAL BUILDING CODE. MINIMUM NAILING, UNLESS OTHERWISE NOTED, SHALL CONFORM TO TABLE 2304.10.1 OF THE INTERNATIONAL BUILDING CODE. COORDINATE THE SIZE AND LOCATION OF ALL OPENINGS WITH MECHANICAL AND ARCHITECTURAL DRAWINGS.

7.2 WALL FRAMING: ALL STUD WALLS SHOWN AND NOT OTHERWISE NOTED SHALL BE 2X4 STUDS @ 16"OC AT INTERIOR WALLS AND 2X6 STUDS @ 16"OC AT EXTERIOR WALLS. TWO STUDS MINIMUM SHALL BE PROVIDED AT THE END OF ALL WALLS AND AT EACH SIDE OF ALL OPENINGS. UNLESS NOTED OTHERWISE A (2) 2X8 HEADER SHALL BE PROVIDED OVER ALL OPENINGS IN 2X4 STUD WALLS AND A (3) 2X8 HEADER OVER ALL OPENINGS IN 2X6 WALLS. SOLID BLOCKING FOR WOOD COLUMNS SHALL BE PROVIDED THROUGH FLOORS TO SUPPORT BELOW. PROVIDE CONTINUOUS SOLID BLOCKING AT MID-HEIGHT OF ALL STUD WALLS OVER 8'-0" IN HEIGHT.

 
ALL STUD WALLS SHOWN ON STRUCTURAL DRAWINGS SHALL HAVE THEIR LOWER PLATES ATTACHED TO WOOD FRAMING BELOW WITH 16D NAILS AT 12"OC STAGGERED OR BOLTED TO CONCRETE OR MASONRY WITH 5/8" DIAMETER BY 10" LONG ANCHOR BOLTS, EMBEDDED 7" AND SPACED AT 4^{\prime} -0"OC MAXIMUM, UNLESS NOTED OTHERWISE (UNO) ON PLANS. SHEAR WALLS REQUIRE MINIMUM 3"X3"X1/4" SQUARE PLATE WASHERS AT ALL ANCHOR BOLTS. REFER TO THE STRUCTURAL PLANS AND SHEAR WALL SCHEDULE FOR REQUIRED SHEATHING AND NAILING.


7.3 FLOOR AND ROOF FRAMING: PROVIDE DOUBLE JOISTS UNDER ALL PARALLEL PARTITIONS AND AROUND ALL OPENINGS IN FLOORS OR ROOFS UNLESS OTHERWISE NOTED. PROVIDE BRIDGING @ 8'-0"OC AND SOLID BLOCKING AT ALL BEARING POINTS. COORDINATE THE SIZE AND LOCATION OF ALL OPENINGS WITH ARCHITECTURAL AND MECHANICAL DRAWINGS.

TOENAIL JOISTS TO BEARING SUPPORTS WITH 16D NAILS. UNLESS NOTED OTHERWISE, ATTACH JOISTS TO FLUSH HEADERS OR BEAMS WITH SIMPSON "LU" SERIES METAL JOIST HANGERS TO SUIT JOIST SIZE. ALL DOUBLE JOISTS, BEAMS, AND SLOPED AND/OR SKEWED JOISTS SHALL BE CONNECTED TO FLUSH MEMBERS WITH U-SERIES JOIST HANGERS UNLESS NOTED OTHERWISE. SKEW AND SLOPE ALL CONNECTORS AS REQUIRED. FACE-NAIL ALL MULTI-JOIST BEAMS TOGETHER WITH 16D SPIKES @ 24"OC STAGGERED.

FOSSATTI PAWLAK STRUCTURAL ENGINEERS 1735 Westlake Ave N, Ste 205 Seattle, WA 98109 Phone:206.456.3071 Fax:206.456.3076 www.fossatti.com PROJECT \cap шZ ОШ L A W **ω** 2 ш ≤ Э́ III ∞ŏ S 7 \mathbf{O} 0 320 0H 98 98 A O Ľ REVISIONS NO. DATE _____ <u>11-4-20</u>____PERMIT 4/2/21 PERMIT RESPONSE 2/4/22 REVISIONS $\sqrt{3}$ 2/18/22 REVISIONS _____ 11/4/20 20-129 DATE JOB # DESIGN CHECKED AS NOTED SCALE DRAW SDCI STAMP SHEET TITLE GENERAL **STRUCTURAL** NOTES SHEET NO S1.1

3




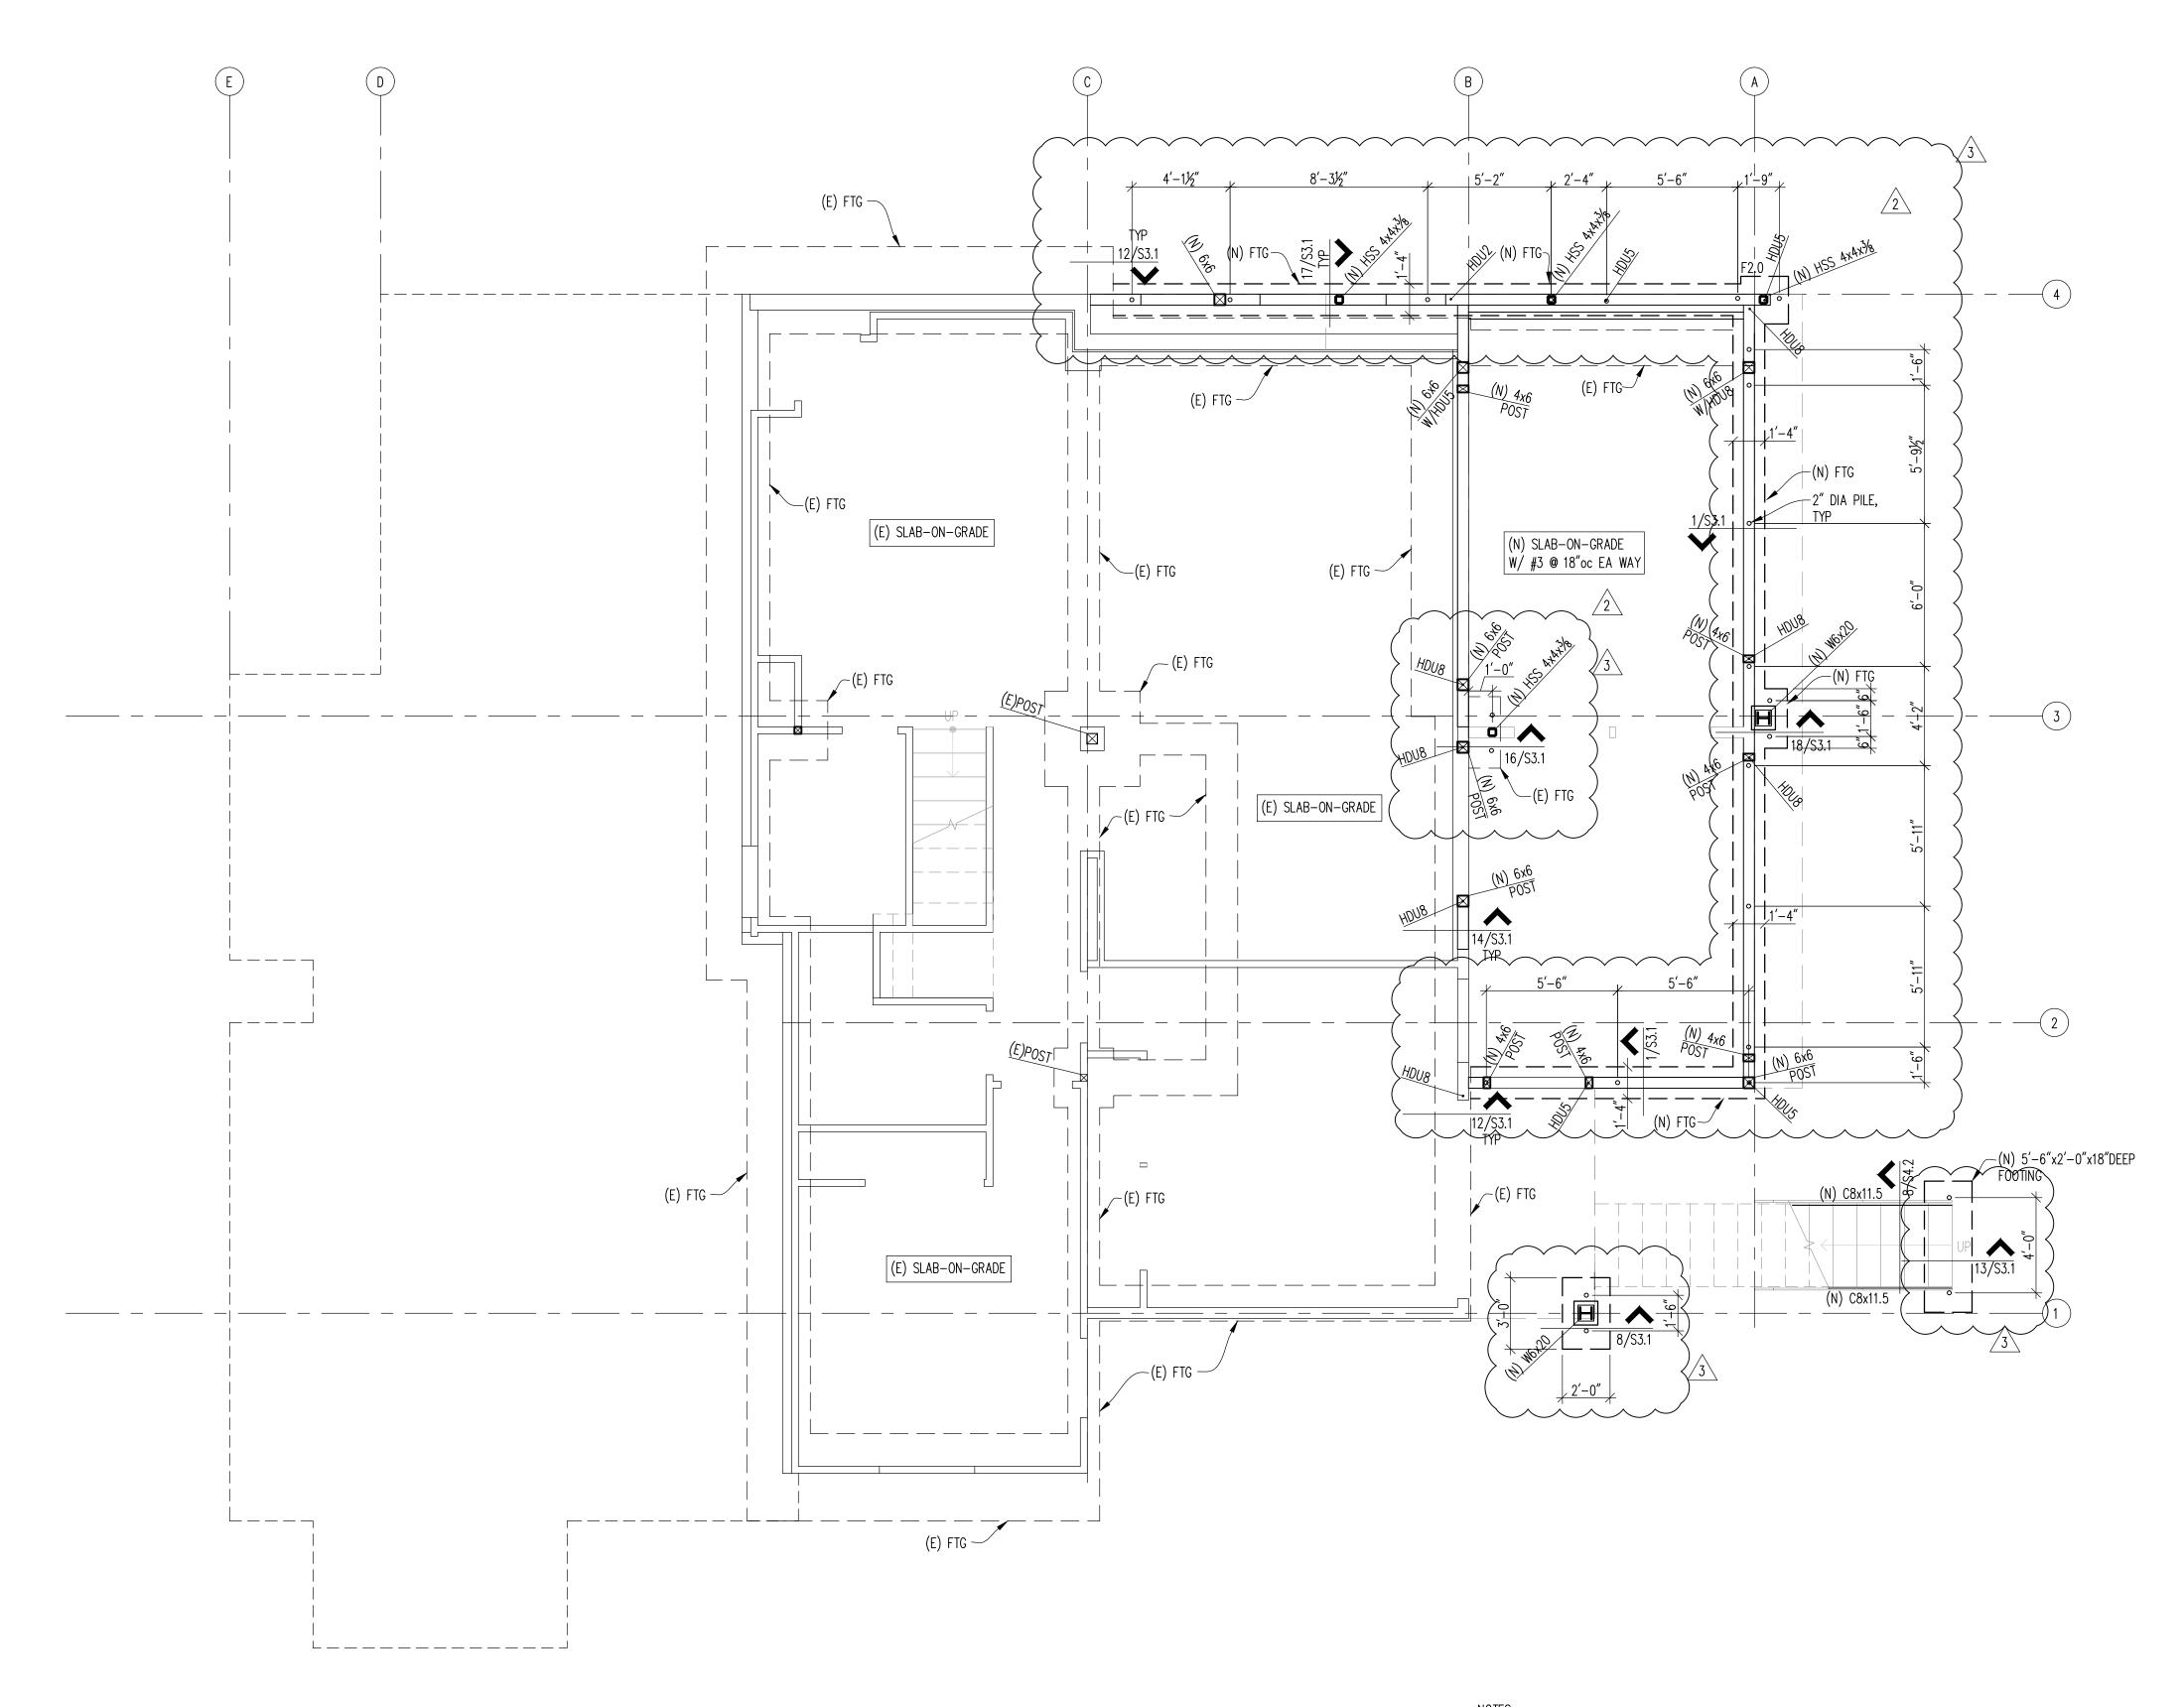



NOTES: 1. FX.X DENOTES FOOTING SIZE. FOOTING SCHEDULE: F2.0 IS 2'-0"x2'-0"x12" DEEP W/ (3) #5 EA WAY BOT 2. SEE ARCH FOR DIMENSIONS. 3. SEE ARCH FOR INSULATION BELOW SLAB-ON-GRADE, IF APPLICABLE. 4. WALLS SHOWN ARE BASEMENT LEVEL WALLS. 5. SEE SHEETS S3.X FOR CONCRETE DETAILS. 5. ↓ INDICATES HOLDOWN TYPE, SEE 10/S4.1 FOR HOLDOWN SCHEDULE. 6. SEE SHEET S2.2 FOR BASEMENT SHEARWALL LOCATIONS.




FOSSATTI PAWL FOSSATTI PAWLAK 1735 Westlake Ave N, Ste 205 Seattle, WA 98109 Phone:206.456.3071 Fax:206.456.3076 www.fossatti.com PROJECT 98 AC Ř REVISIONS NO. DATE _____ <u>11-4-20</u> PERMIT <u>4/2/21</u> PERMIT RESPONSE <u>2</u> <u>2/4/22</u> **REVISIONS** 3 2/18/22 REVISIONS -----11/4/20 20-129 JOB # DATE FPP CHECKED AM DESIGN AS NOTED SCALE LMS DRAW SDCI STAMP SHEET TITLE FOUNDATION PLAN SHEET NO. S2.1

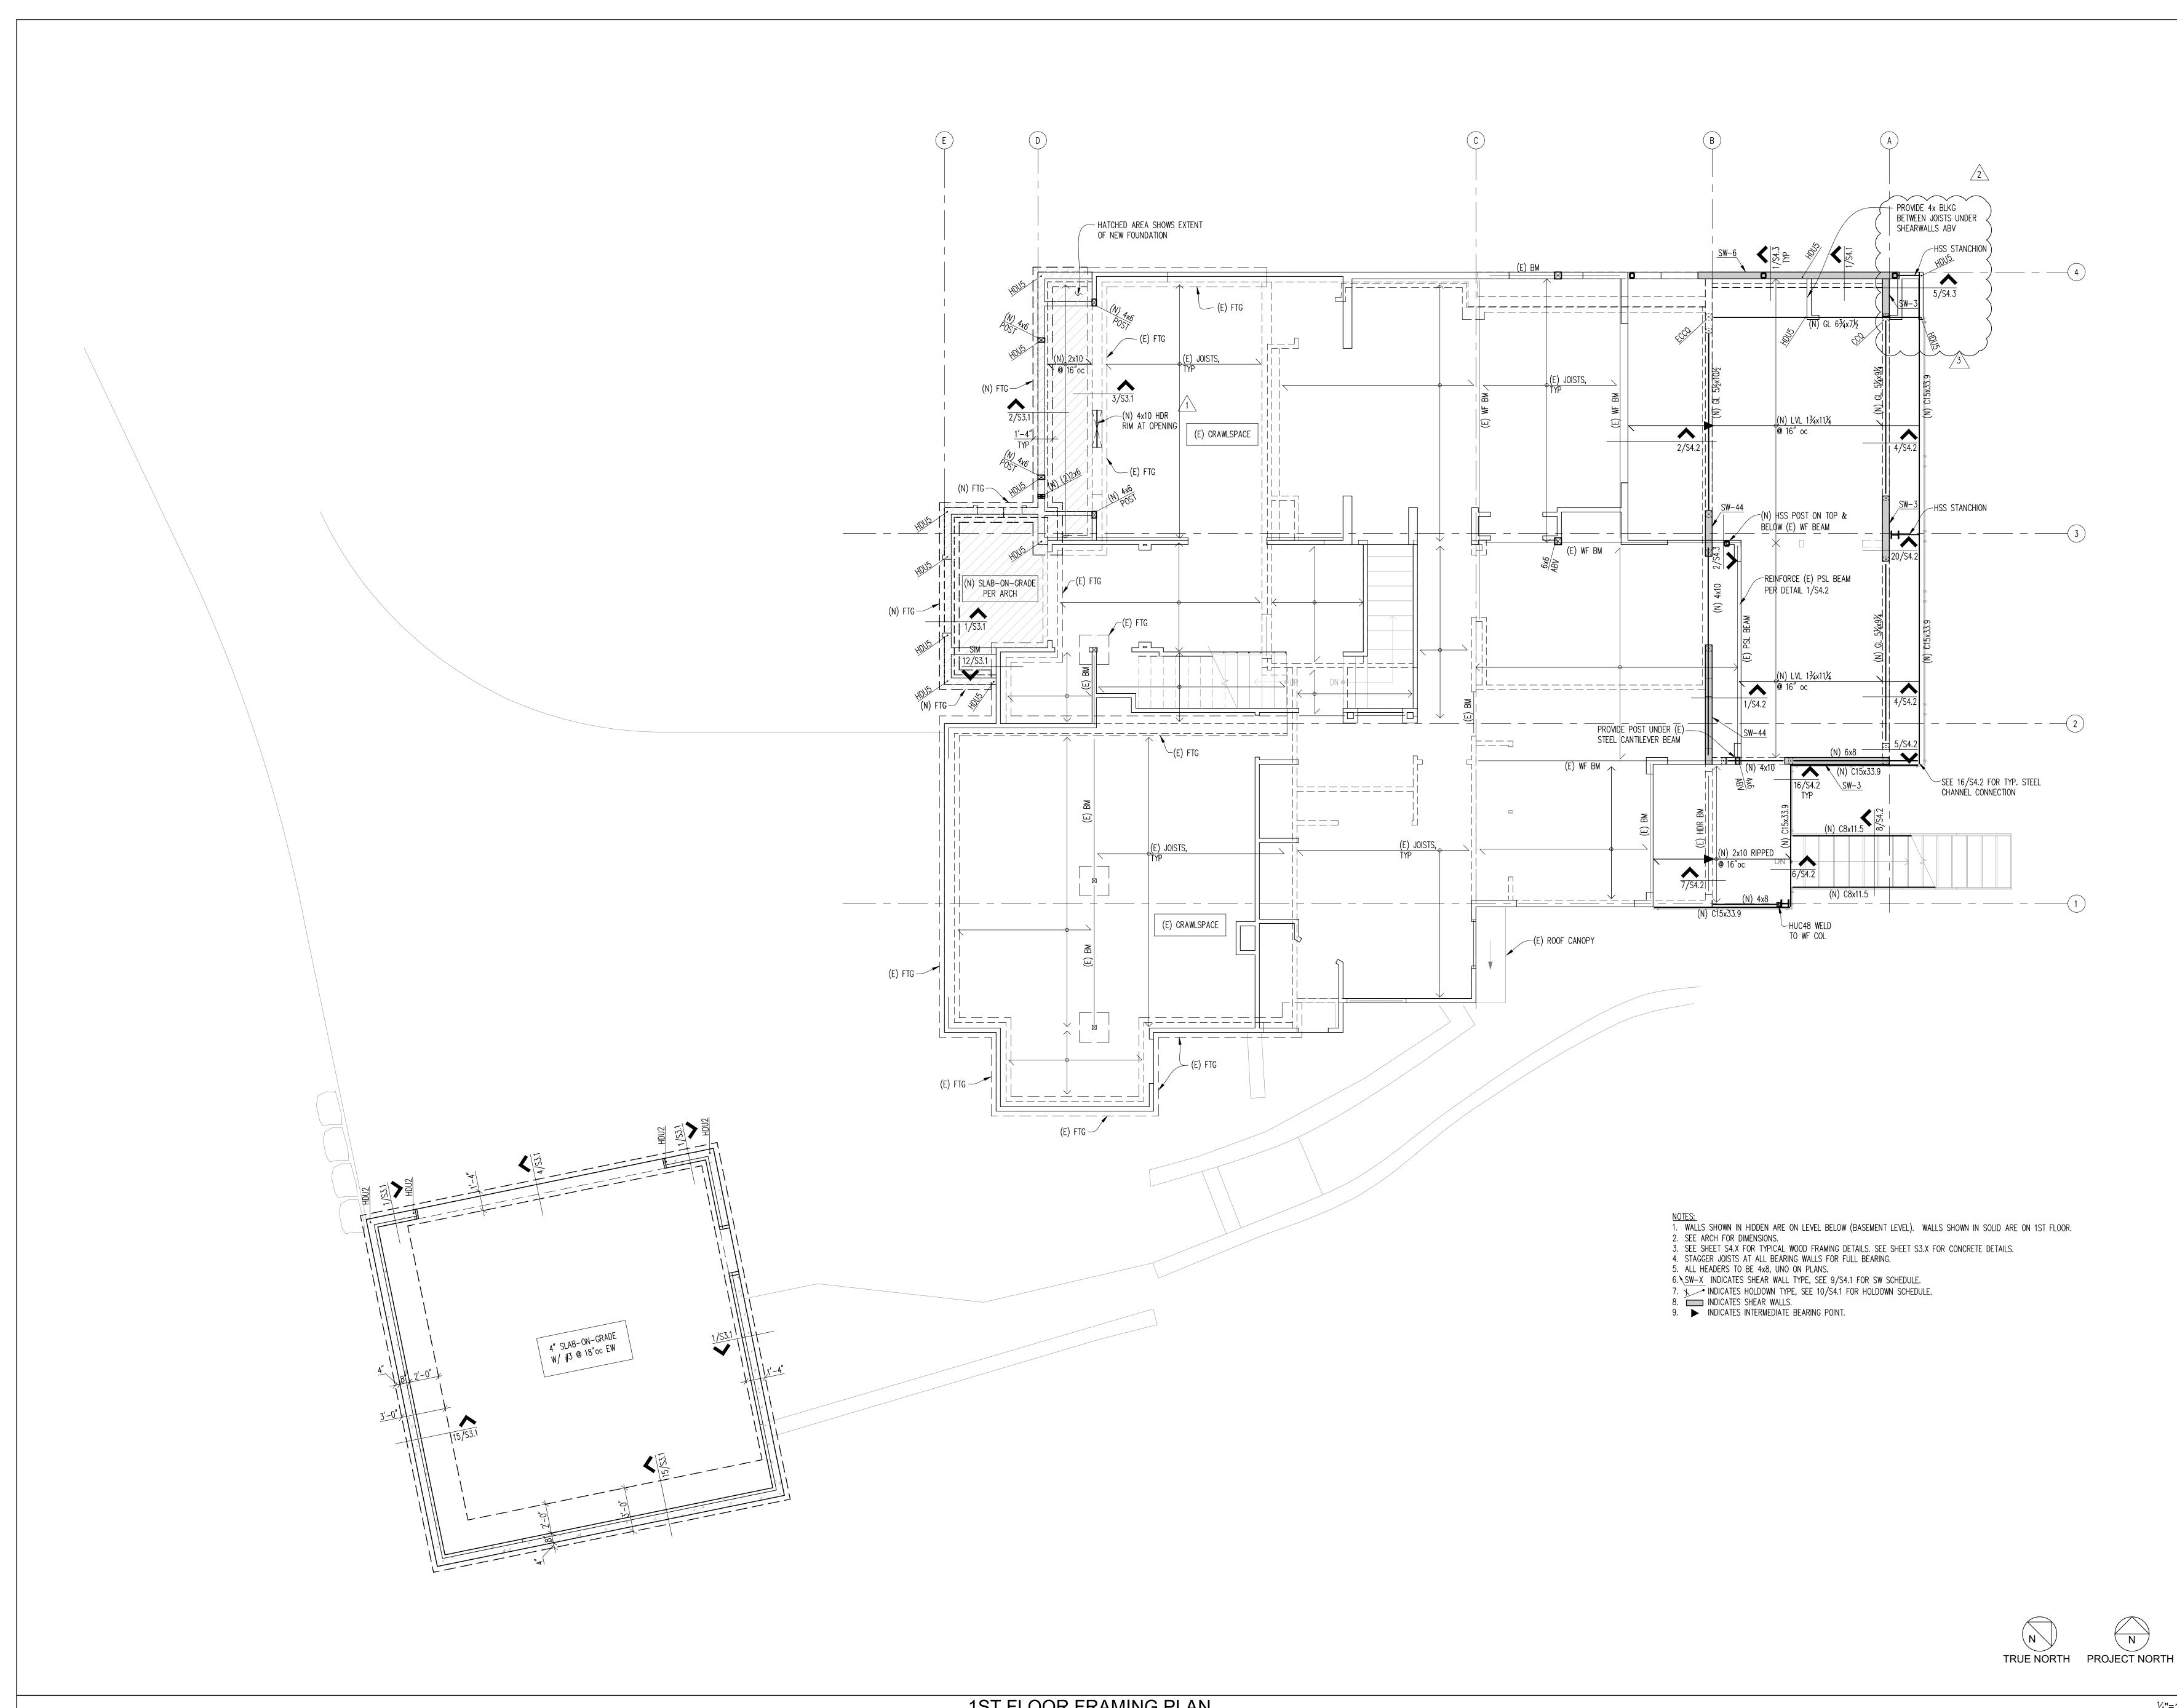

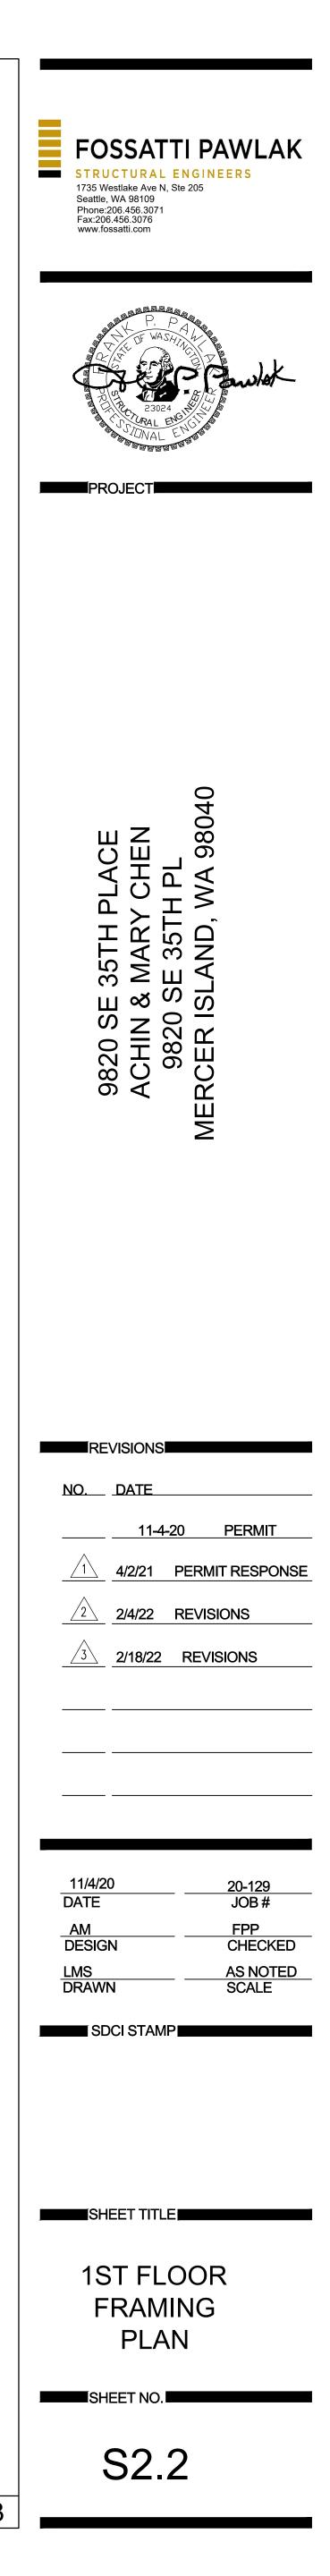


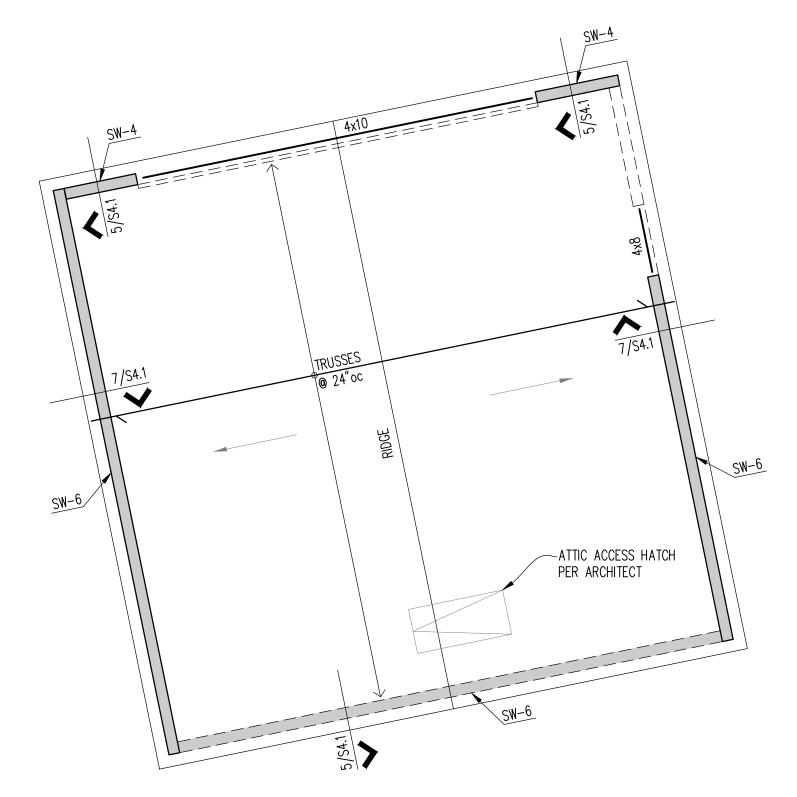


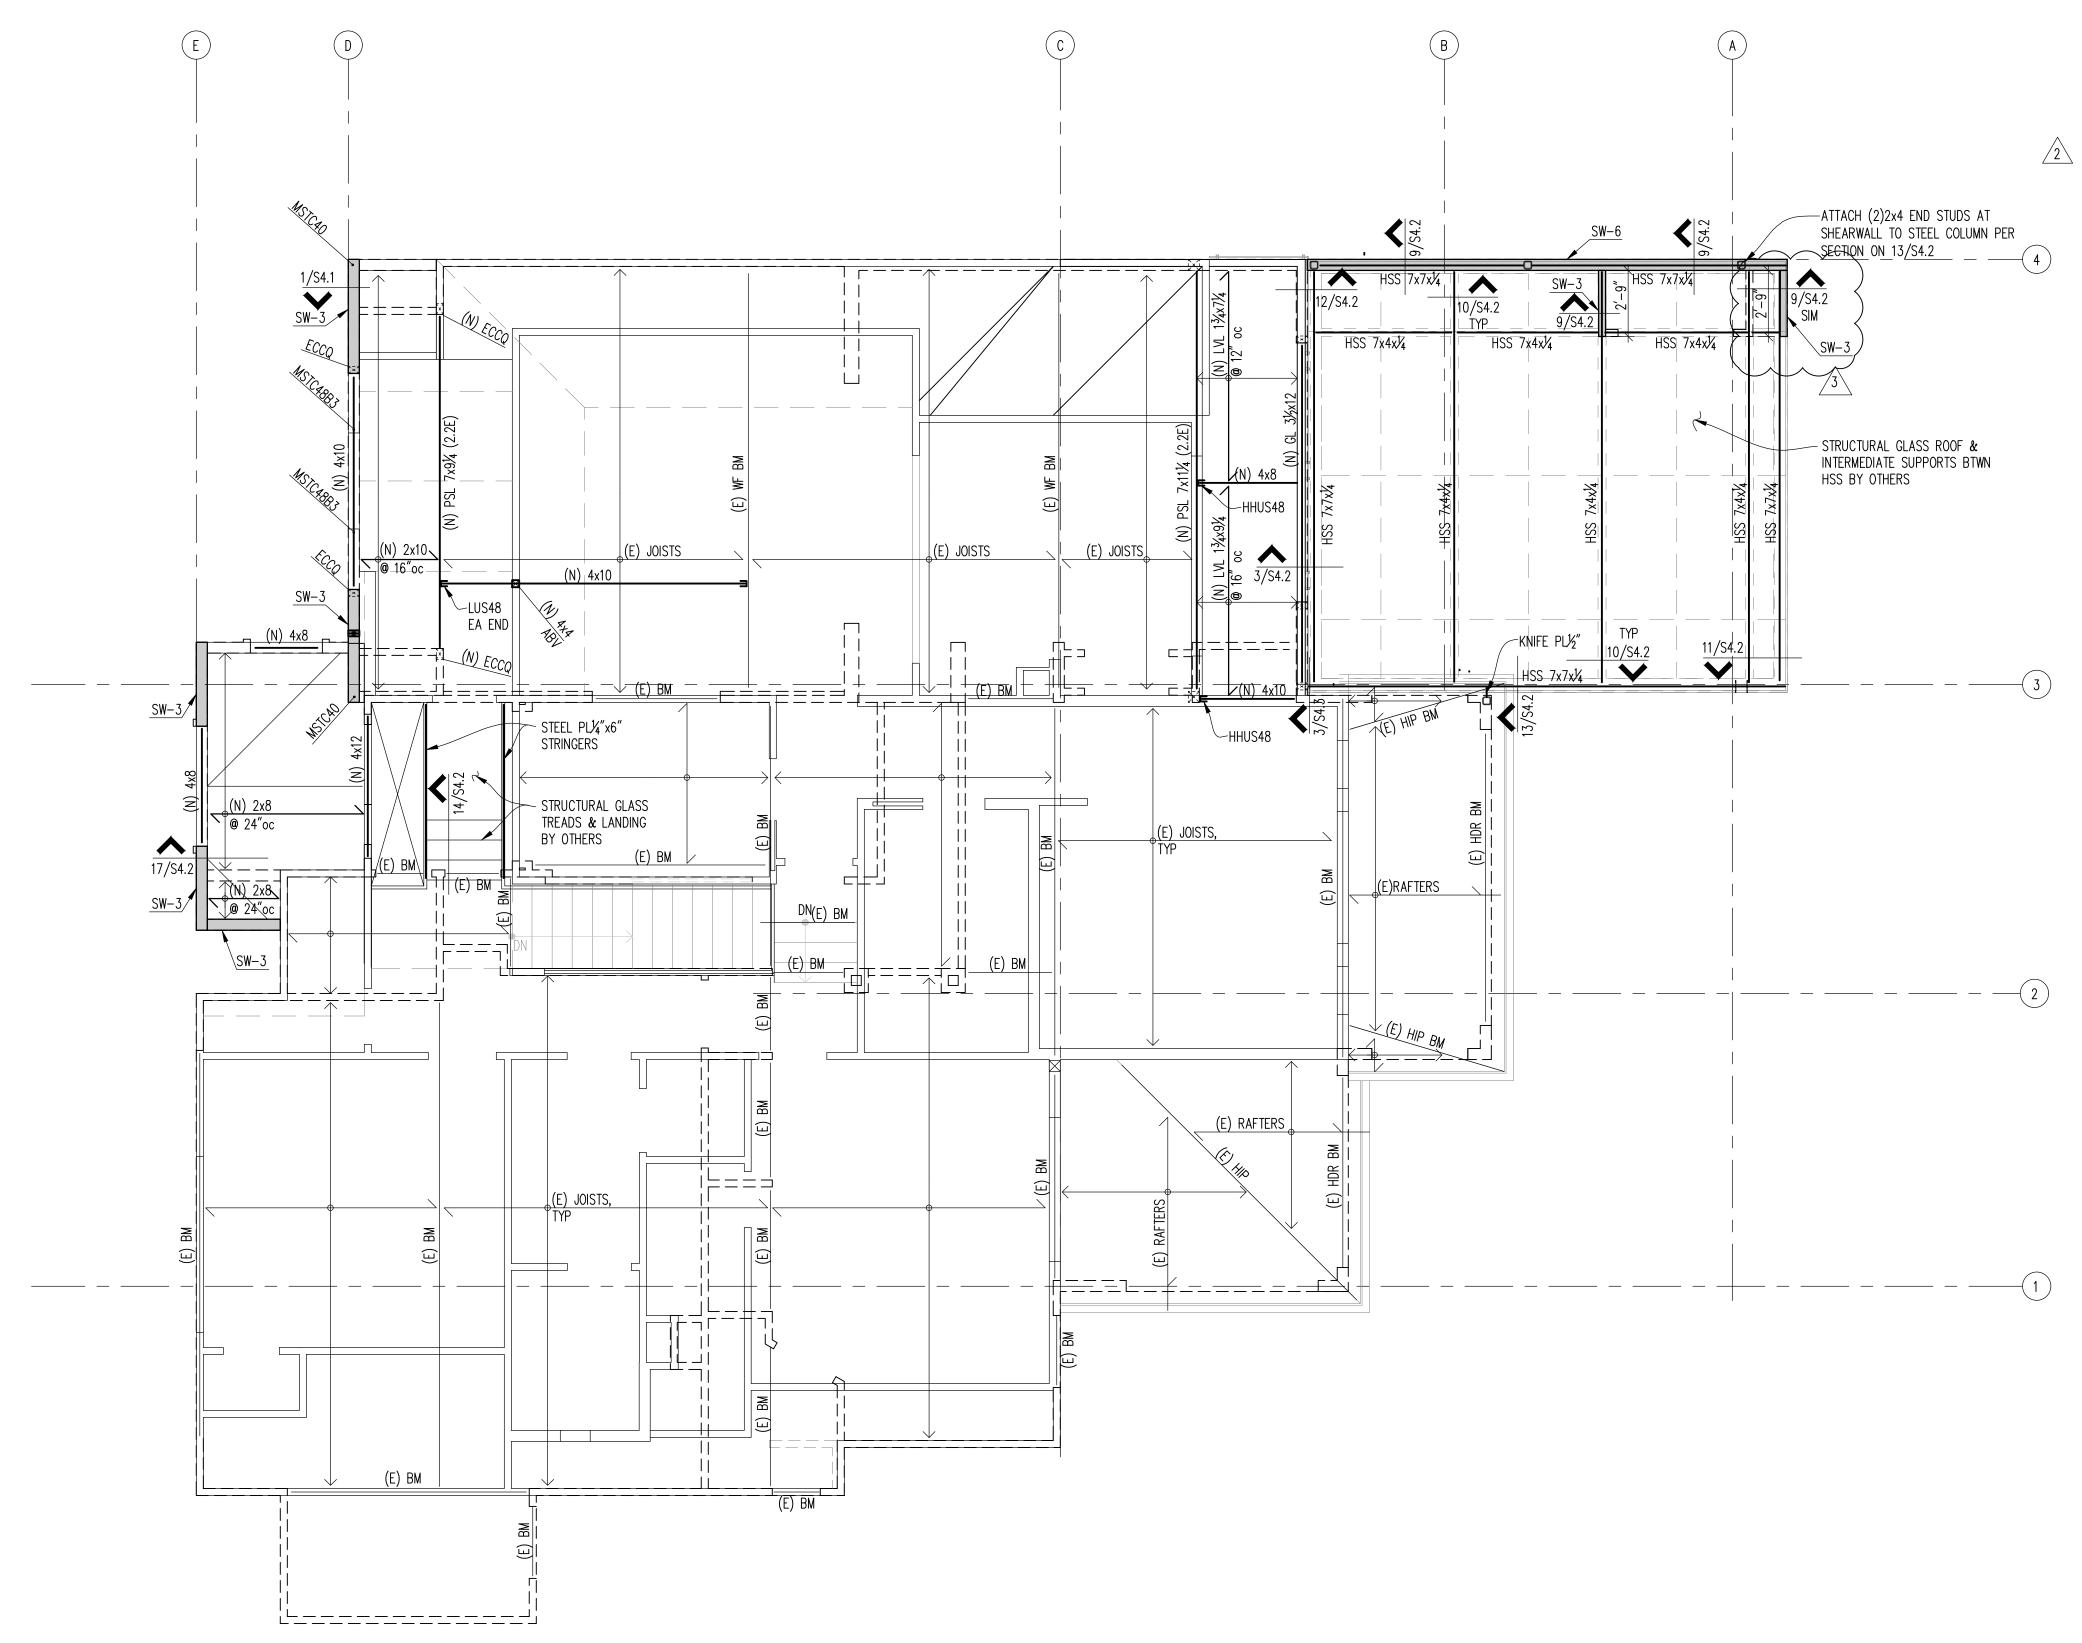


NOTES: 1. WALLS SHOWN IN HIDDEN ARE ON LEVEL BELOW (FIRST FLOOR). WALLS SHOWN IN SOLID ARE ON SECOND FLOOR. 2. SEE ARCH FOR DIMENSIONS. 3. SEE SHEET S4.X FOR TYPICAL WOOD FRAMING DETAILS. 4. STAGGER JOISTS AT ALL BEARING WALLS FOR FULL BEARING. 5. ALL HEADERS TO BE 4x8, UNO ON PLANS. 6. SW-X INDICATES SHEAR WALL TYPE, SEE 9/S4.1 FOR SW SCHEDULE. 7. MINICATES HOLDOWN TYPE. SEE 10/S4.1 FOR HOLDOWN SCHEDULE.

7. INDICATES HOLDOWN TYPE, SEE 10/S4.1 FOR HOLDOWN SCHEDULE.
8. INDICATES SHEAR WALLS.
9. INDICATES INTERMEDIATE BEARING POINT.

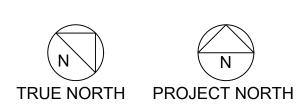

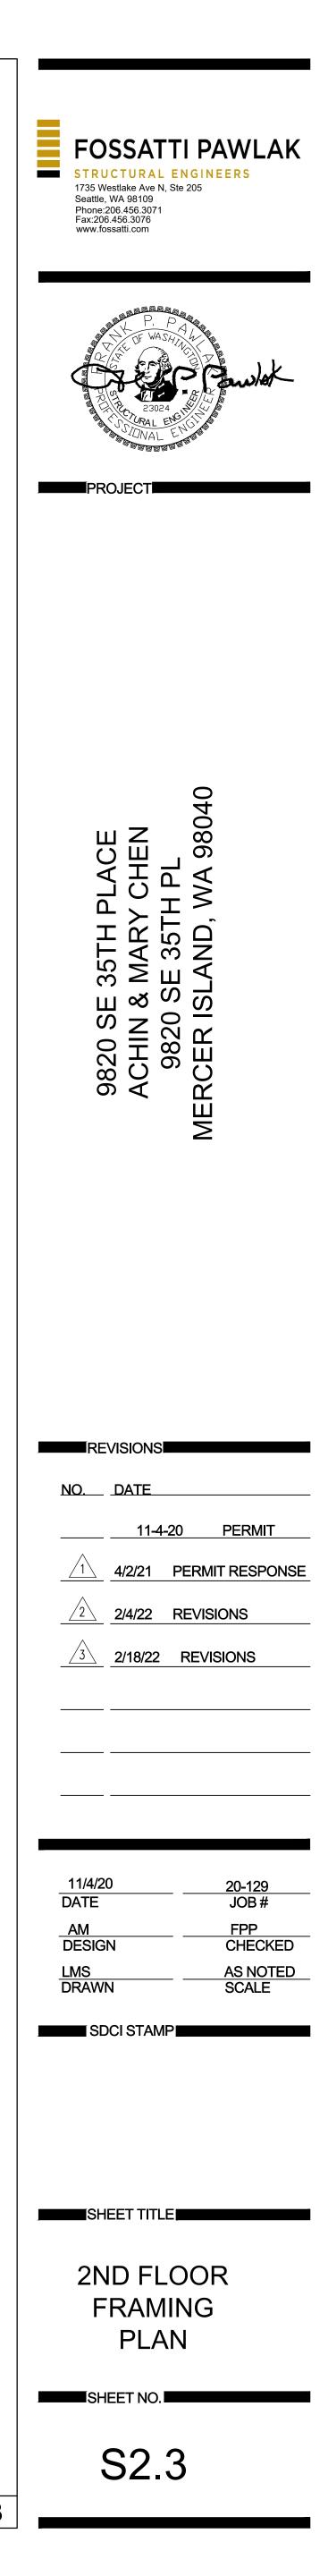



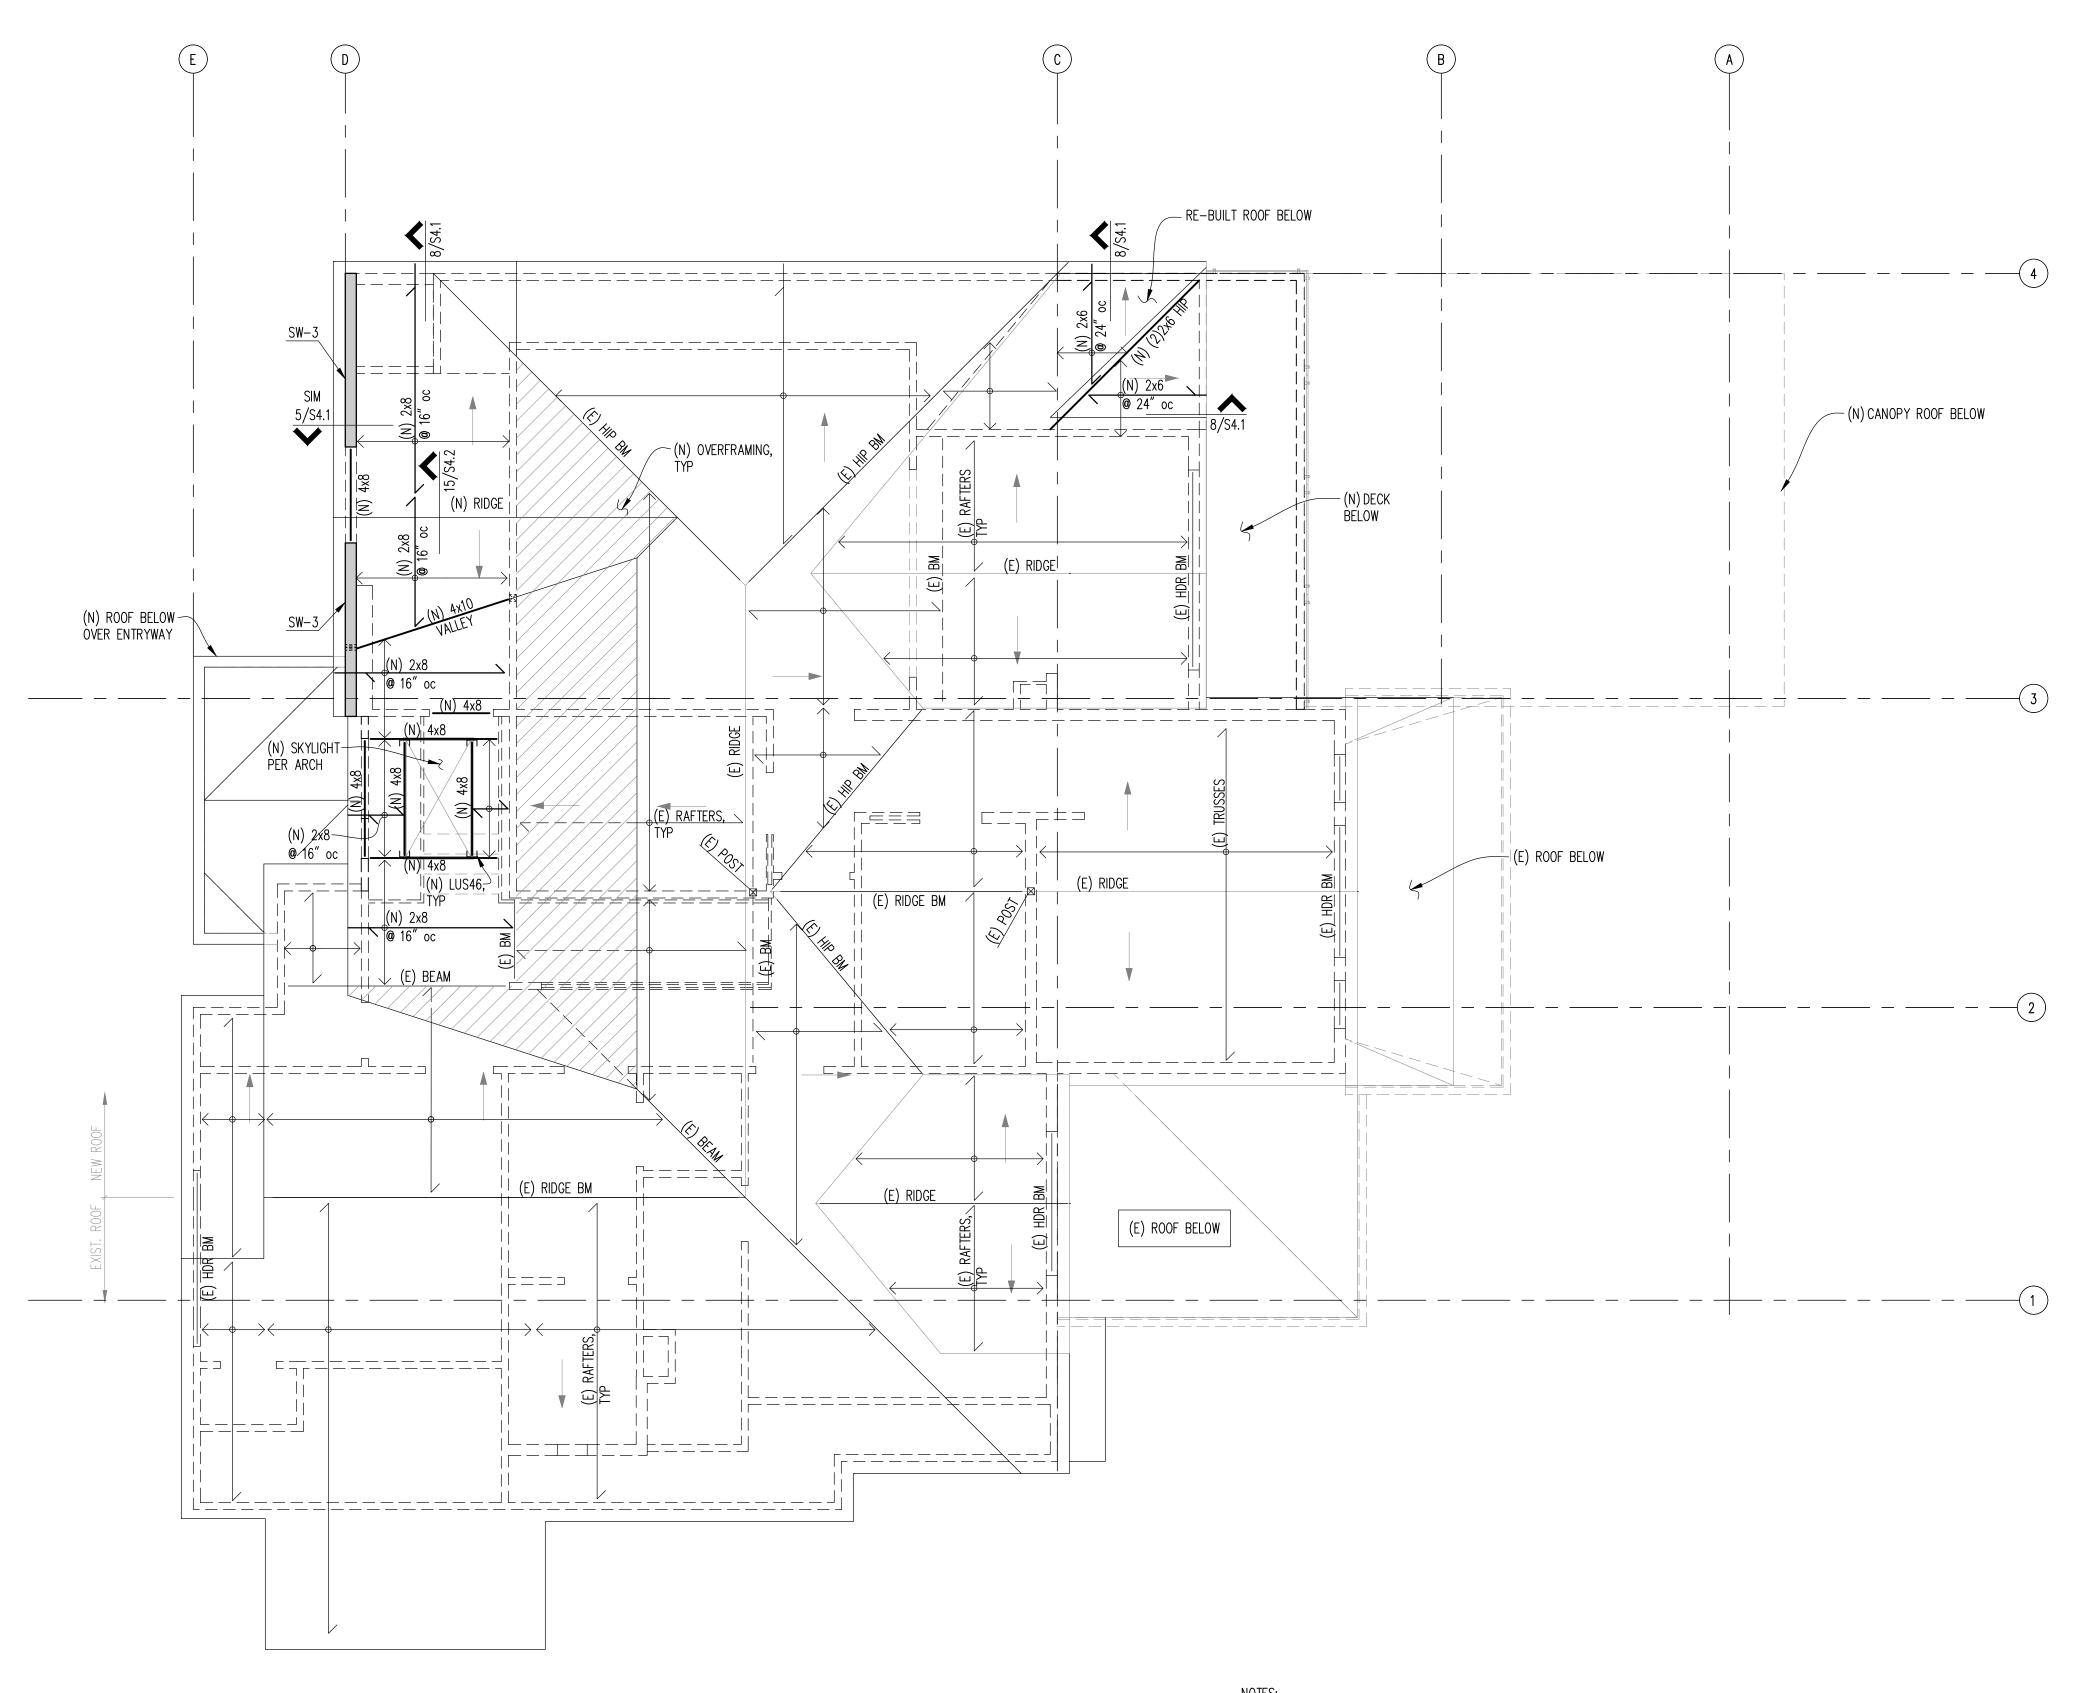

— (N) GARAGE BUILDING

ROOF FRAMING PLAN


<u>NOTES:</u> 1. WALLS SHOWN ARE ON LEVEL BELOW (SECOND FLOOR).


SEE ARCH FOR DIMENSIONS.
 SEE SHEET S4.X FOR TYPICAL WOOD FRAMING DETAILS.
 STAGGER JOISTS AT ALL BEARING WALLS FOR FULL BEARING.


5. ALL HEADERS TO BE 4x8, UNO ON PLANS.


6. <u>SW-X</u> INDICATES SHEAR WALL TYPE, SEE 9/S4.1 FOR SW SCHEDULE. 7. INDICATES SHEAR WALLS.


8. NIDICATES INTERMEDIATE BEARING POINT.

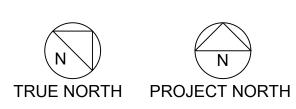

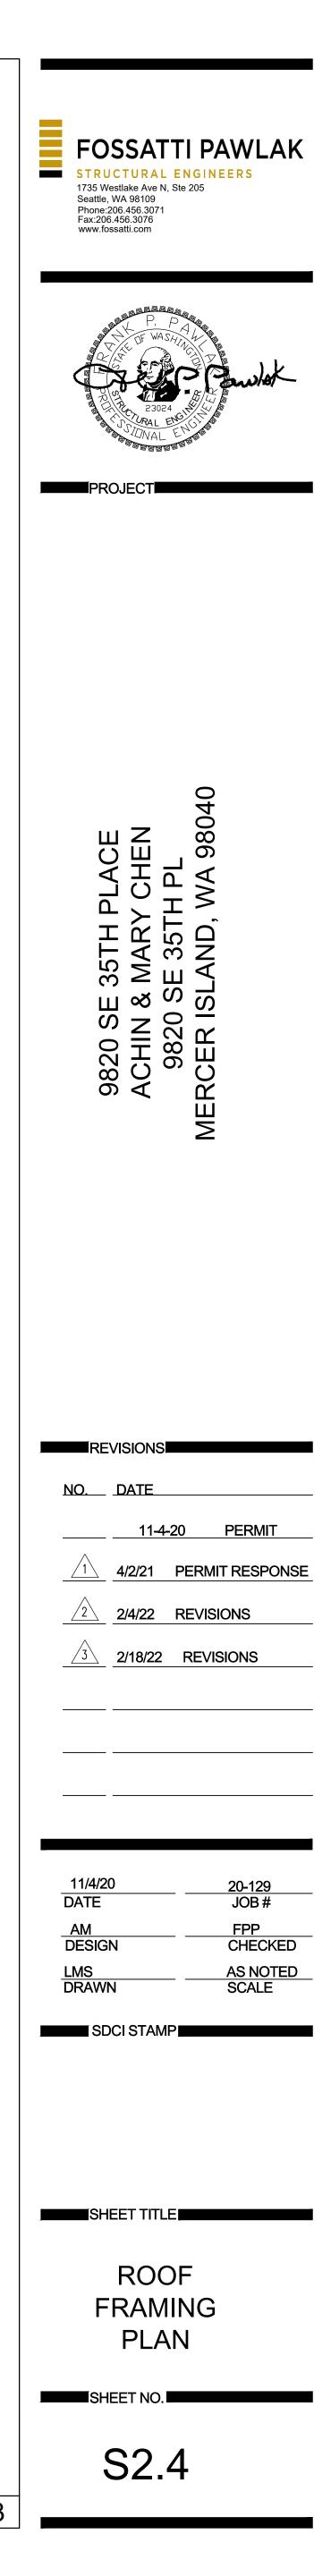

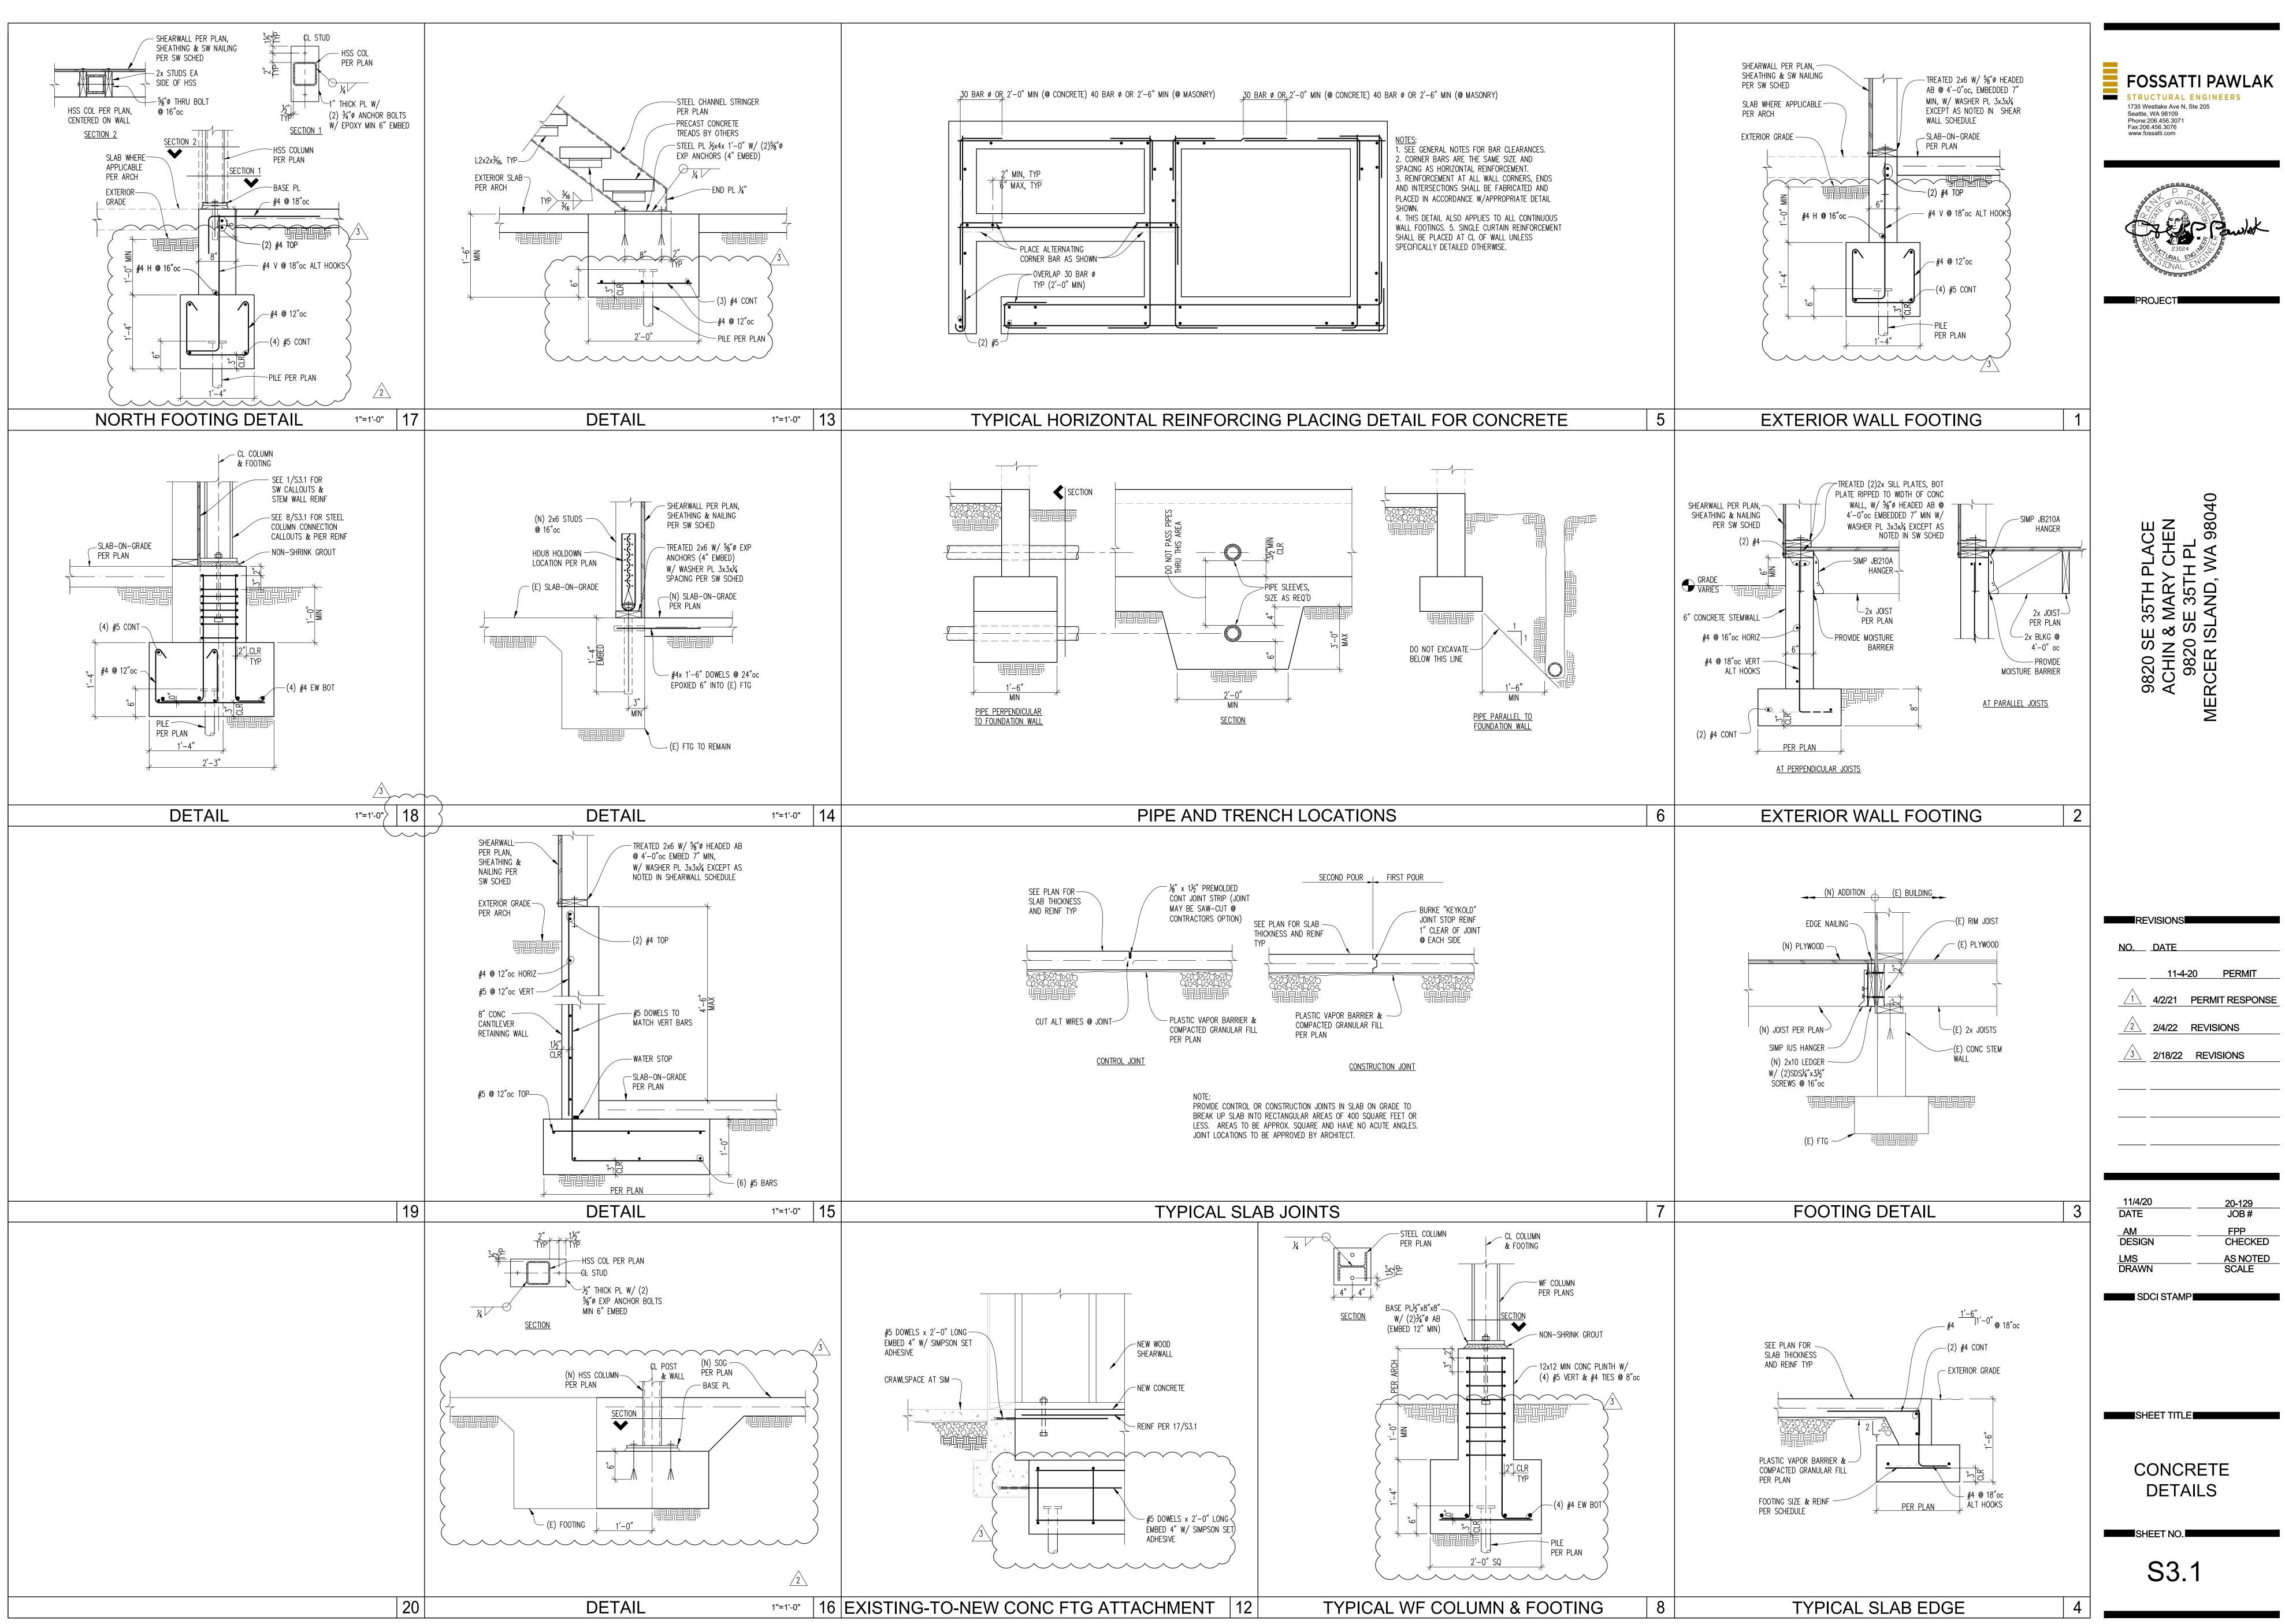

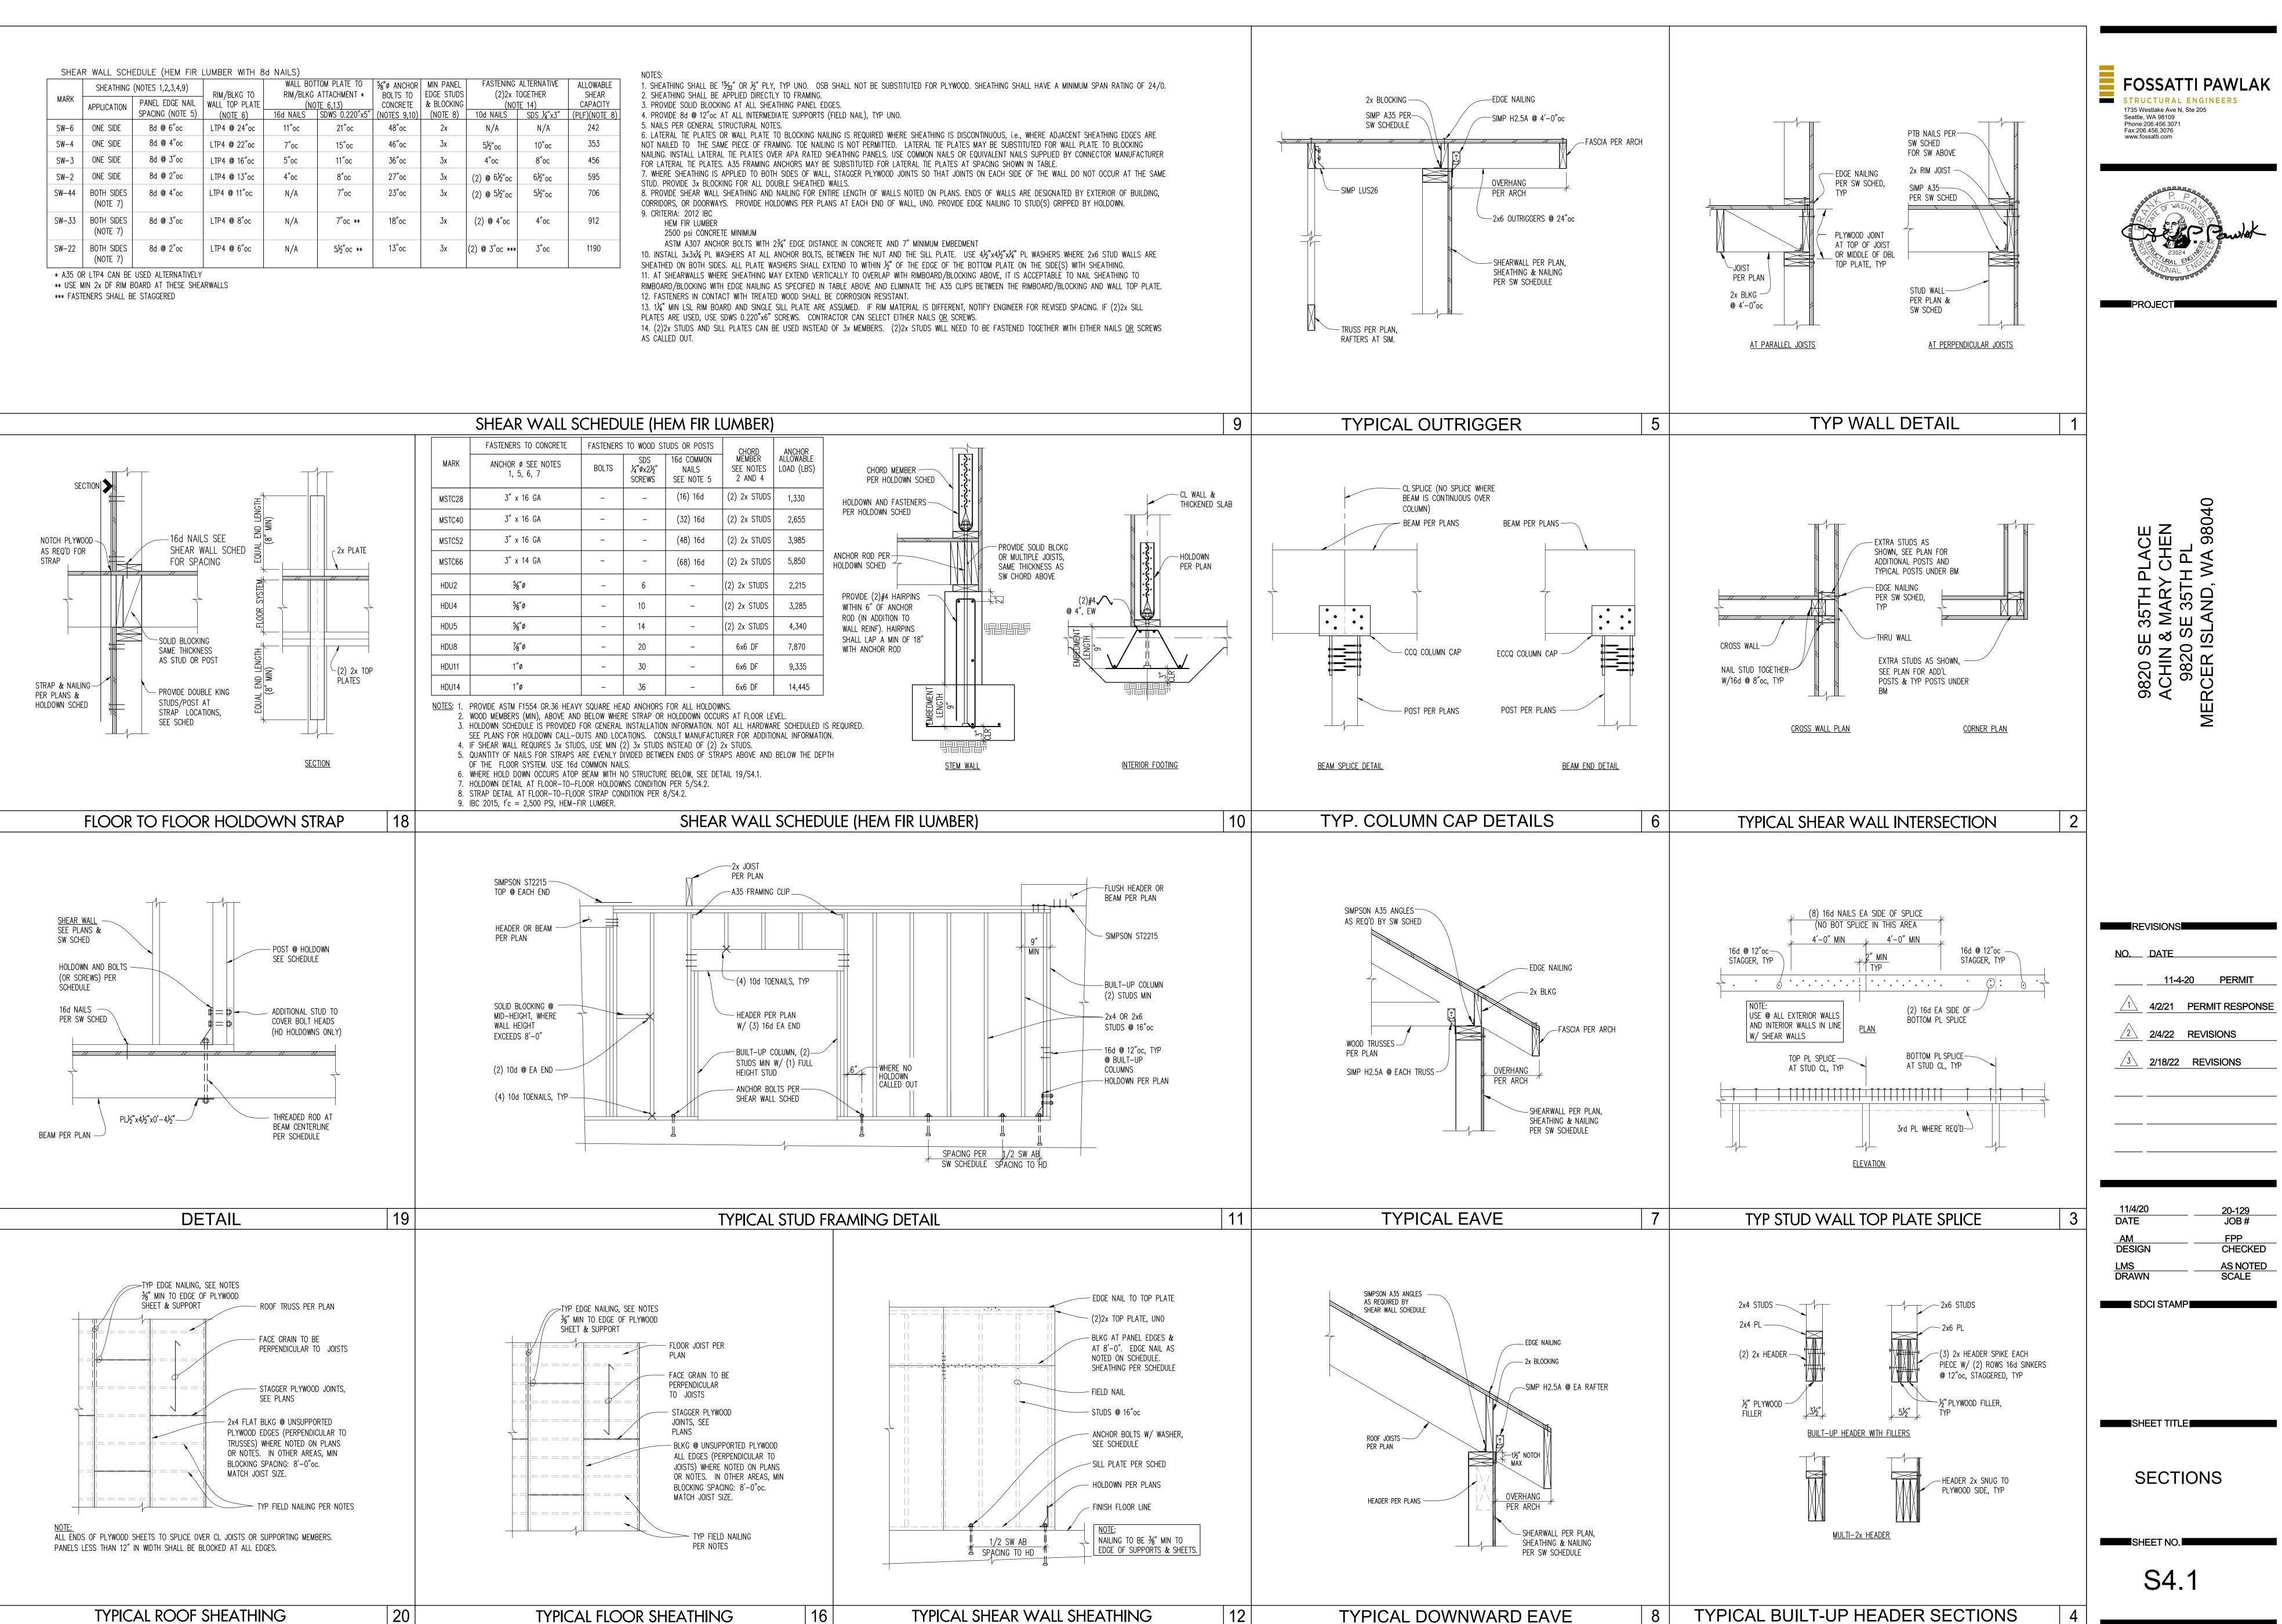

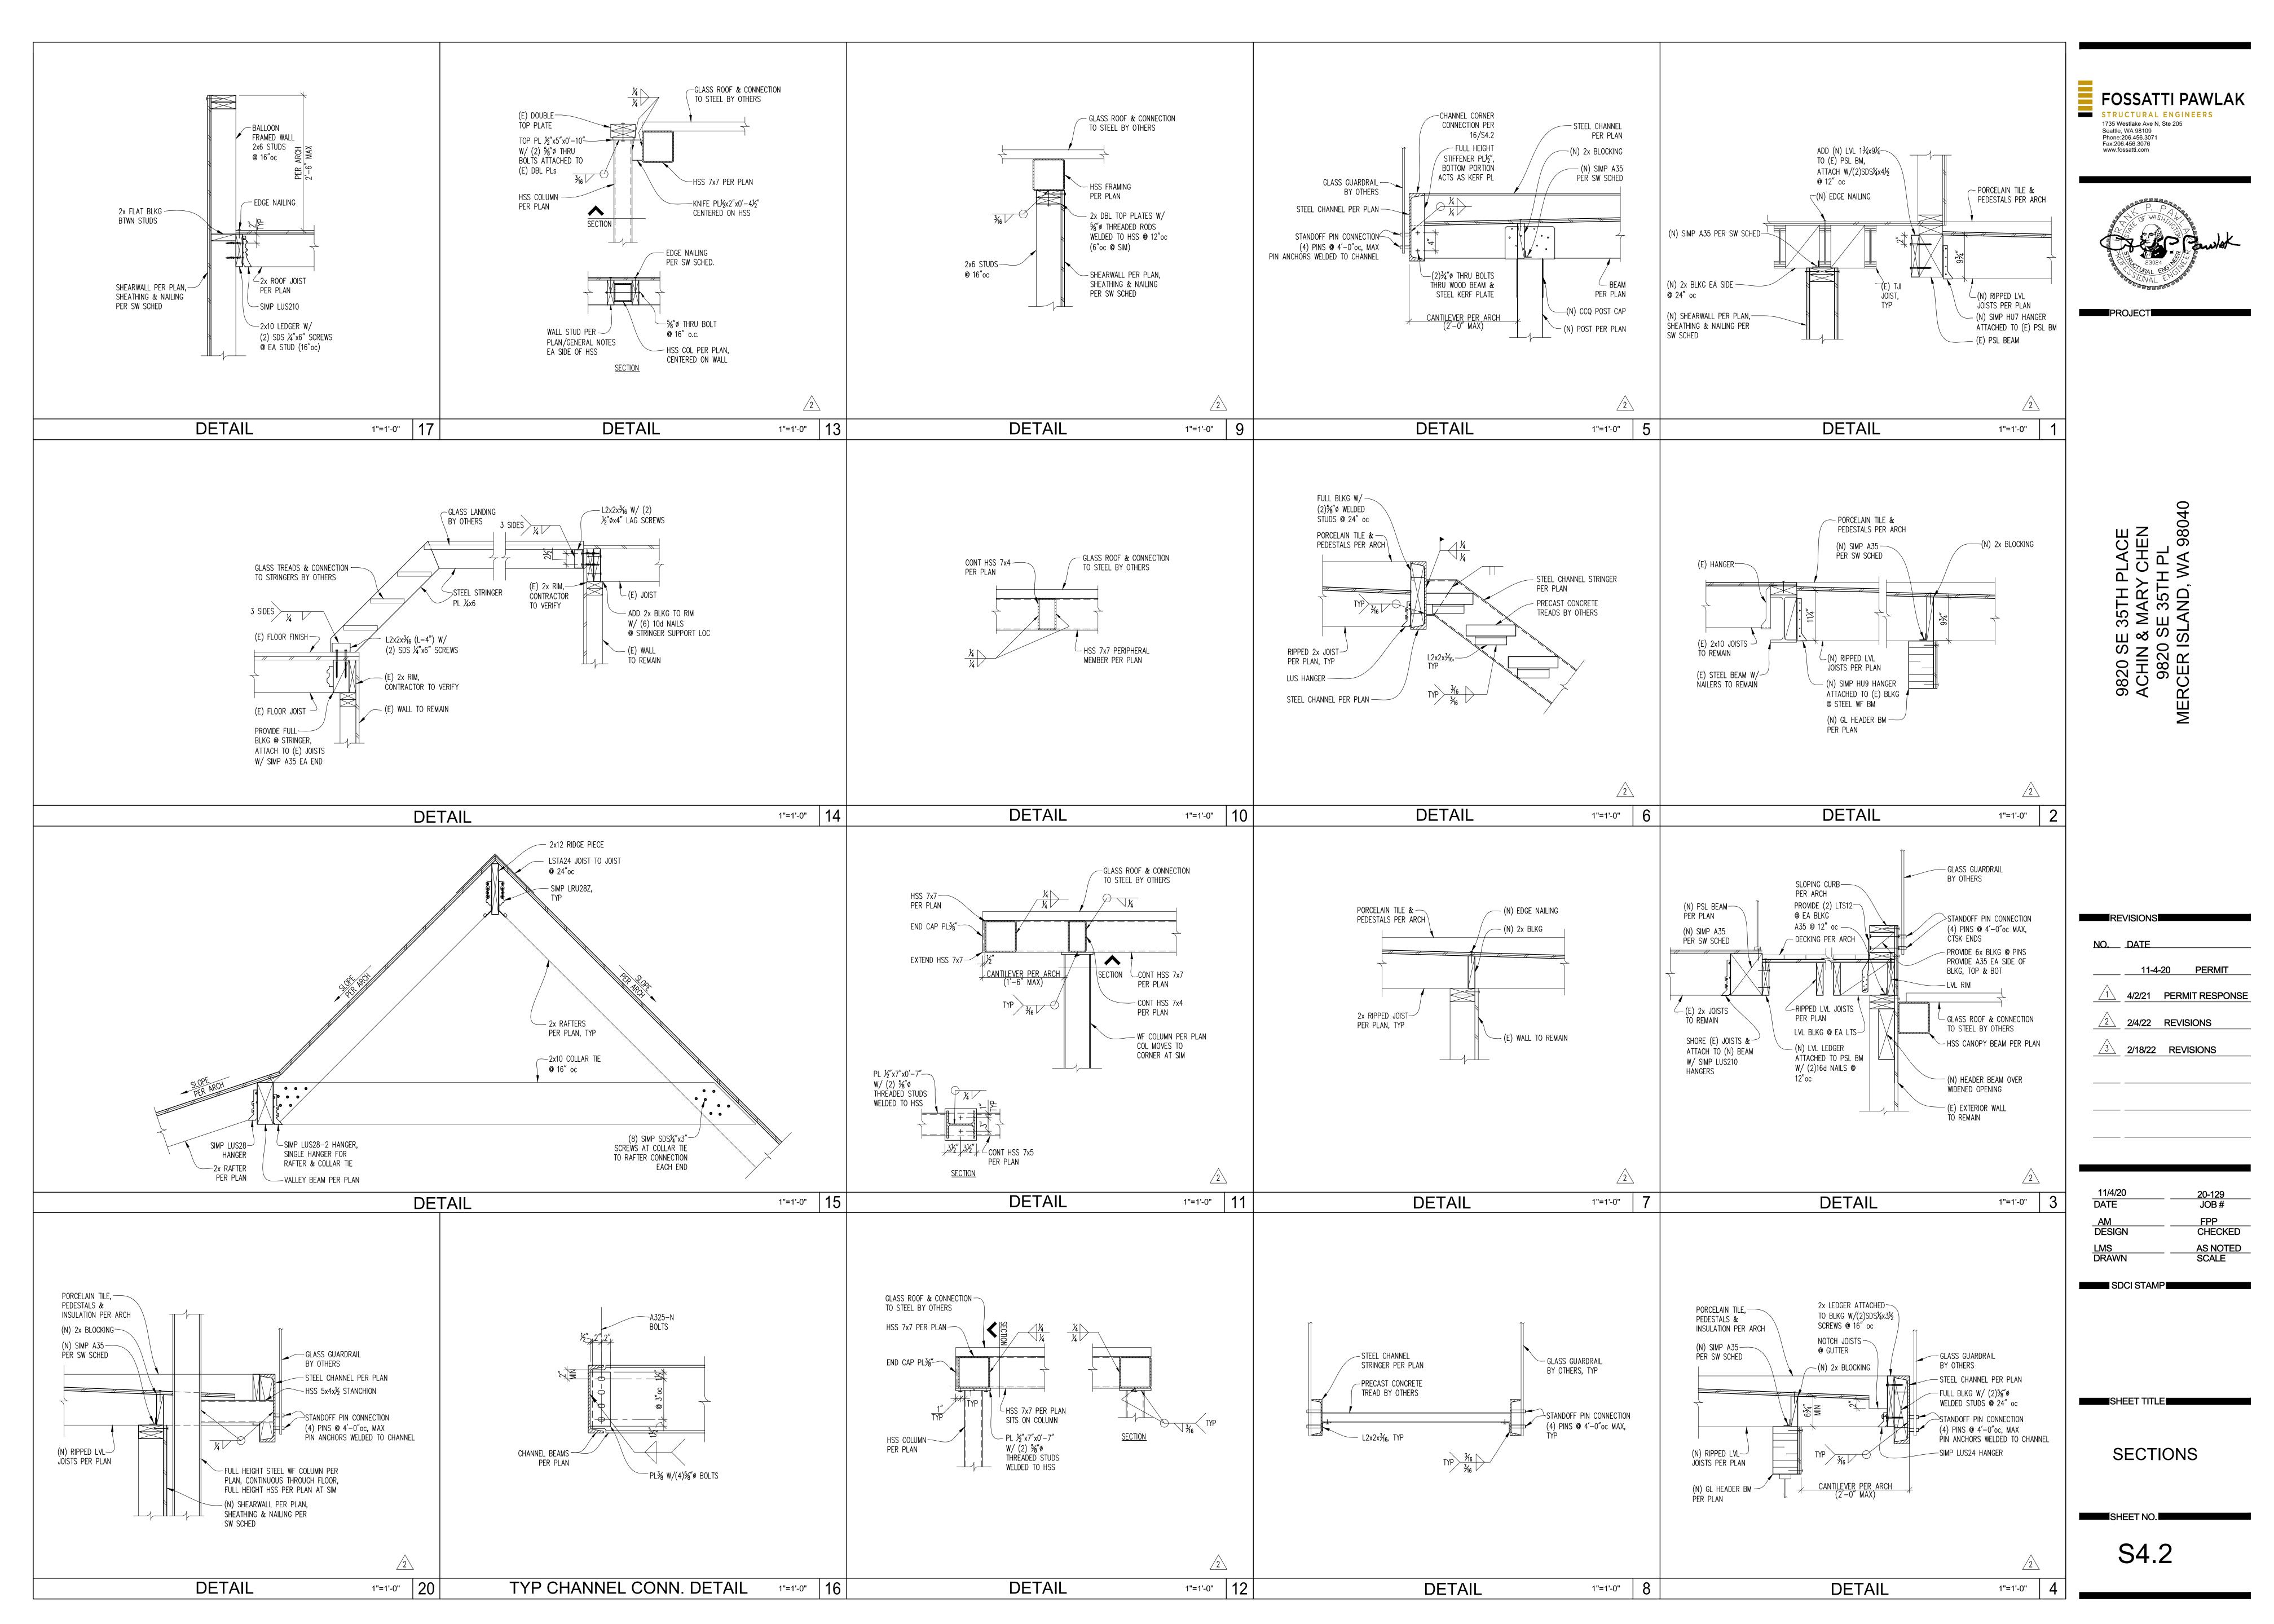

			PORCELAIN TILE, PEDESTALS & INSULATION PER ARCH (N) 2x BLOCKING (N) SIMP A35 PER SW SCHED (N) RIPPED LVL JOISTS PER PLAN
17	13	9	
18	14	10	
19	15	11	
20	16	12	

