

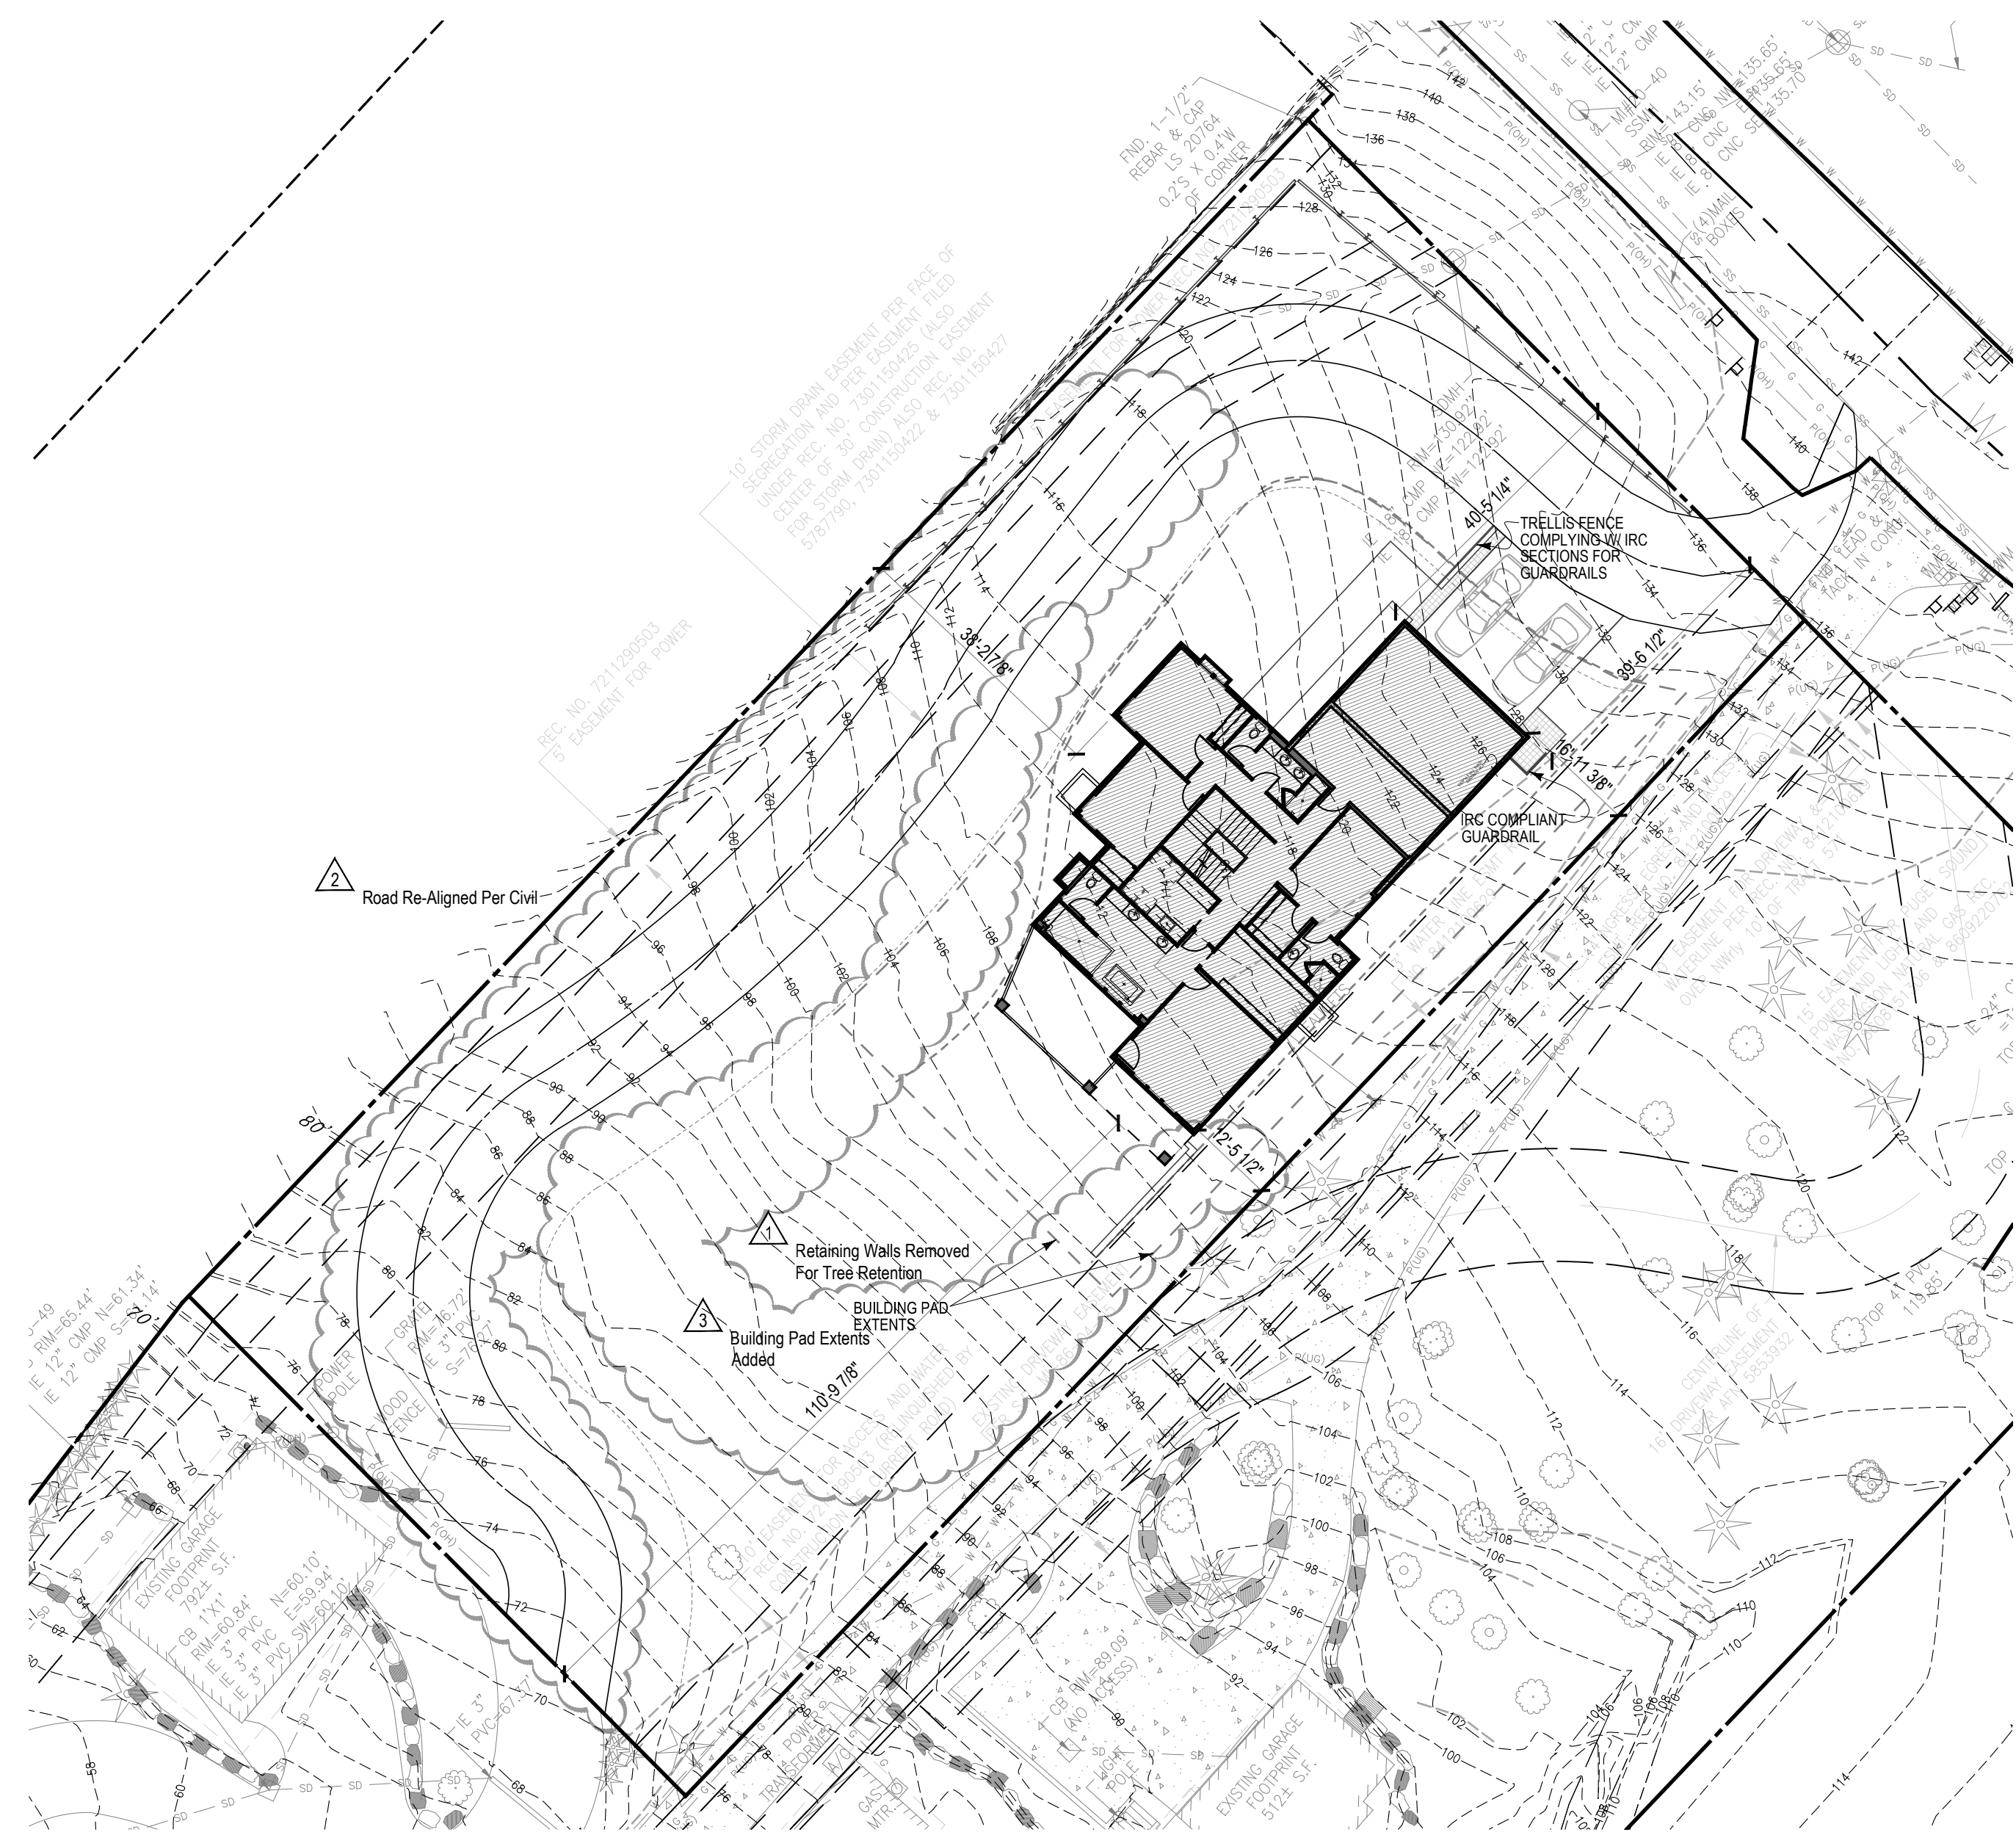


CALCULATION KEY

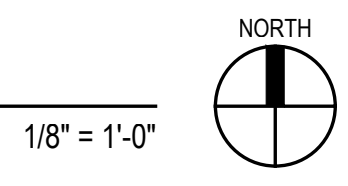

SITE PLAN

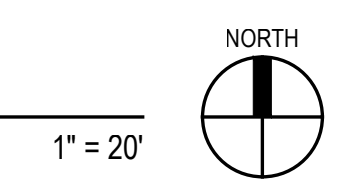

Point	Wall Length	Mid Pt Elev.	Weighted Value
a	14.0	115.2	1612.8
b	5.5	114.3	628.7
c	14.0	113.3	1583.4
d	6.5	112.3	730.0
e	3.7	112.3	415.5
f	2.0	112.3	224.6
g	5.0	112.2	561.0
h	2.0	111.5	223.0
i	6.8	110.5	751.4
j	21.0	108.8	2284.8
k	6.0	108.8	652.8
l	16.0	108.8	1740.8
m	34.0	113.8	3869.2
n	4.0	117.7	470.8
o	39.5	122.5	4834.8
p	24.0	127.3	3055.2
q	24.0	122.5	2940.0
r	12.3	117.8	1448.9
s	1.0	116.8	116.8
t	4.9	116.7	571.8
u	1.0	116.4	116.4
v	3.8	116.1	441.2

Avg. Height. = $29280.6 / 251.0 = 116.66'$
 Max. Hght. = $116.66 + 30.0 = 146.66'$

LOT COVERAGE	
ROAD	5157 SF
DRIVEWAY	391 SF
BUILDING	2495 SF
TOTAL	8043 SF

LOT AREA	23,034 SF
LOT COVERAGE	34.92%

ANCILLARY COVERAGE	
DECKS/RETAINING WALLS & WALKS	642 SF
ANCILLARY IMPERVIOUS	2.89%

Areas Revised Per New Road Path, Ancillary Impervious Calculations Added.

No changes in this revision

Note Added Per City
 PER MICC 19.02.020(F)(3)(D) TO REMOVE NOXIOUS WEEDS. ("DEVELOPMENT PROPOSALS FOR A NEW SINGLE-FAMILY HOME SHALL REMOVE JAPANESE KNOTWEED (POLYGONUM CUSPIDATUM) AND REGULATED CLASS A, REGULATED CLASS B, AND REGULATED CLASS C WEEDS IDENTIFIED ON THE KING COUNTY NOXIOUS WEEDS LIST, AS AMENDED, FROM REQUIRED LANDSCAPING AREAS ESTABLISHED PURSUANT TO SUBSECTION (F)(3)(A) OF THIS SECTION. NEW LANDSCAPING ASSOCIATED WITH NEW SINGLE-FAMILY HOME SHALL NOT INCORPORATE ANY WEEDS IDENTIFIED ON THE KING COUNTY NOXIOUS WEED LIST, AS AMENDED. PROVIDED, THAT REMOVAL SHALL NOT BE REQUIRED IF THE REMOVAL WILL RESULT IN INCREASED SLOPE INSTABILITY OR RISK OF LANDSLIDE OR EROSION.")

Note Added Per City
 AS PER MICC 19.07.060(D)(1)(D) BECAUSE THE DEVELOPMENT OF A GEOLOGIC HAZARD AREA IS PROPOSED ALL DISTURBED AREAS OUTSIDE OF BUILDING FOOTPRINTS AND INSTALLATION OF ALL IMPERVIOUS SURFACES BE LANDSCAPED.

Note Added Per City
 BUILDING PAD TO BE DEVELOPED IN A MANNER CONSISTENT WITH PROVISIONS OF MICC 19.09.090.

CODES:

- PLANS TO COMPLY WITH 2015 INTERNATIONAL RESIDENTIAL CODE (IRC), AND WASHINGTON STATE AMMENDMENTS. ALL APPLICABLE CODES TO BE FOLLOWED.
- 2015 INTERNATIONAL RESIDENTIAL BUILDING CODE (IRC)
 - 2015 INTERNATIONAL BUILDING CODE (IBC)
 - 2015 WASHINGTON STATE ENERGY CODE WAC 51-11 (WSEC)
 - MINIMUM DESIGN LOADS FO BUILDINGS AND OTHER STRUCTURES, ASCE 7-10 (ASCE)
 - 2015 SPECIAL DESIGN PROVISIONS FOR WIND AND SEISMIC (SDPWS)
 - MERCER ISLAND CITY CODE (MICC)

BUILDING

OCCUPANCY: R-3
 CONSTRUCTION TYPE: V-5
 ZONING: R-15 SINGLE FAMILY
 SETBACKS: FRONT 20'
 REAR 25'
 SIDE TOTAL 15'; 5'MIN.

MAIN LEVEL FLOOR AREA:	1,669 SF
MID LEVEL FLOOR ARE	1,898 SF
LOWER LEVEL FLOOR AREA	1,487 SF
TOTAL FLOOR AREA	5,054 SF
GARAGE AREA	576 SF


FIRE

80 SF ADDED IN MAIN LEVEL
 COMPLY WITH CURRENT EDITION OF NFPA 13, NFPA 13D, AND NFPA 13R; MERCER ISLAND BUILDING AND FIRE CODE. SEE MUNICIPAL CODE TITLE 17.

Tom Webb, Architect
 10303- 14th Avenue NW, Seattle, WA 98177
 TomW@KDW.net / (206) 390-1800



1628 46th Street SE, Everett, WA 98203
 point_of_vision@comcast.net
 (425) 772-8207

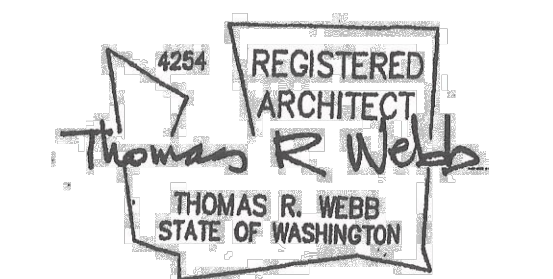

New Residence For:
James & Jessica Rudolf
 8253 West Mercer Way
 Mercer Island, Washington 98040

ISSUANCE	PERMIT SET
6-11-18 Retaining Walls Removed For Tree Retention, Lot Coverage, Various Notes Per City	5/15/18
11-12-18 Adjustments Per City Comments	
3-31-19 Building Pad Extents Added	

PROJECT INFORMATION	
PROJECT NO:	POV1740
PROJECT MANAGER:	TW
DRAWN BY:	BB

Site Plan, ABE Calcs & Project Information

SHEET NO

L:\pov-H2a\h2a\pov\POV1740 Rudolf Residence\POV1740 A1 Site.dwg, 3/31/2019 3:11:01 PM, Dell, Point Of Vision 2017

WINDOW SCHEDULE											
WDW #	WIDTH	Height	AREA(SF)	WDW TYPE	HEAD HEIGHT	UValue	UA	DETAILS			Remarks
								Head	Jamb	Sill	
1	60	72	30	SLIDING	+8'-0"	0.29	8.7	--	--	--	EGRESS COMPLIANT WINDOW
2	48	72	24	PICTURE	+8'-0"	0.28	6.72	--	--	--	
3	36	96	24	PICTURE	+8'-0"	0.28	6.72	--	--	--	
4	36	96	24	PICTURE	+8'-0"	0.28	6.72	--	--	--	
5	36	96	24	PICTURE	+8'-0"	0.28	6.72	--	--	--	
6	36	96	24	PICTURE	+8'-0"	0.28	6.72	--	--	--	
7	36	96	24	PICTURE	+8'-0"	0.28	6.72	--	--	--	
8	33	96	22	PICTURE	+8'-0"	0.28	6.16	--	--	--	
9	72	24	12	PICTURE	+8'-0"	0.28	3.36	--	--	--	
10	72	54	27	SLIDING	+8'-0"	0.29	7.83	--	--	--	
11	72	24	12	PICTURE	+8'-0"	0.28	3.36	--	--	--	
12	--	--	--	NOT USED	--	--	--	--	--	--	
13	--	--	--	NOT USED	--	--	--	--	--	--	
14	72	24	12	PICTURE	+8'-0"	0.28	3.36	--	--	--	
15	--	--	--	NOT USED	--	--	--	--	--	--	
16	--	--	--	NOT USED	--	--	--	--	--	--	
17	30	72	15	CASEMENT	+8'-0"	0.29	4.35	--	--	--	
18	60	72	30	SLIDING	+8'-0"	0.29	8.7	--	--	--	EGRESS COMPLIANT WINDOW
19	48	72	24	PICTURE	+8'-0"	0.28	6.72	--	--	--	
20	36	72	18	CASEMENT	+8'-0"	0.29	5.22	--	--	--	EGRESS COMPLIANT WINDOW
21	48	72	24	PICTURE	+8'-0"	0.28	6.72	--	--	--	
22	30	72	15	PICTURE	+8'-0"	0.28	4.2	--	--	--	
23	30	72	15	PICTURE	+8'-0"	0.28	4.2	--	--	--	
24	60	72	30	SLIDING	+8'-0"	0.29	8.7	--	--	--	
25	30	72	15	CASEMENT	+8'-0"	0.29	4.35	--	--	--	
26	36	72	18	CASEMENT	+8'-0"	0.29	5.22	--	--	--	
27	36	72	18	CASEMENT	+8'-0"	0.29	5.22	--	--	--	EGRESS COMPLIANT WINDOW
28	48	72	24	PICTURE	+8'-0"	0.28	6.72	--	--	--	
29	30	30	6.25	PICTURE	+8'-0"	0.28	1.75	--	--	--	
30	30	72	15	CASEMENT	+8'-0"	0.29	4.2	--	--	--	EGRESS COMPLIANT WINDOW
31	40	22	6.1	PICTURE	SEE ELEV.	0.28	1.708	--	--	--	TRAPEZOID-V.I.F.
32	40	34	9.4	PICTURE	SEE ELEV.	0.28	2.632	--	--	--	TRAPEZOID-V.I.F.
33	40	41	11.4	PICTURE	SEE ELEV.	0.28	3.192	--	--	--	TRAPEZOID-V.I.F.
34	40	34	9.4	PICTURE	SEE ELEV.	0.28	2.632	--	--	--	TRAPEZOID-V.I.F.
35	40	22	6.1	PICTURE	SEE ELEV.	0.28	1.708	--	--	--	TRAPEZOID-V.I.F.
36	--	--	--	NOT USED	--	--	--	--	--	--	
TOTAL			568.6				160.992				

2 Wdw. Updated

EXTERIOR DOOR SCHEDULE											
DR#	WIDTH	Height	AREA(SF)	WDW TYPE	HEAD HEIGHT	UValue	UA	DETAILS			Remarks
								Head	Jamb	Sill	
101	201	96	134.0	FOLDING	+8'-0"	0.30	40.2	--	--	--	SFTY. GL.
102	96	96	64.0	SLIDER	+8'-0"	0.30	19.2	--	--	--	SFTY. GL. U=0.30 or better for the full assembly
201	201	96	134.0	FOLDING	+8'-0"	0.30	40.2	--	--	--	SFTY. GL. U=0.30 or better for the full assembly
202	96	96	64.0	SLIDER	+8'-0"	0.30	19.2	--	--	--	SFTY. GL.
301	72	96	48.0	ENTRY	+8'-0"	0.30	14.4	--	--	--	SFTY. GL.
302	201	96	134.0	FOLDING	+8'-0"	0.30	40.2	--	--	--	SFTY. GL. U=0.30 or better for the full assembly
303	128	96	85.0	FOLDING	+8'-0"	0.30	25.5	--	--	--	SFTY. GL. U=0.30 or better for the full assembly
304	28	84	16.0	ENTRY	+7'-0"	0.30	4.8	--	--	--	SFTY. GL.
TOTAL			679.0			+8'-0"	0.30	203.7			

SUM OF AREA AND UA 1,247.6 364.692
AREA WEIGHTED U = UA / AREA 0.29

4 Dr. Wdw. Updated

CITY OF MERCER ISLAND



DEVELOPMENT SERVICES GROUP
9611 SE 36TH STREET | MERCER ISLAND, WA 98040
PHONE: 206.275.7605 | www.mercer.gov
Inspection Requests: Online: www.MyBuildingPermits.com VM: 206.275.7370

2015 WSEC & IRC Ventilation Worksheet (Effective July 1, 2016)

INFORMATION IN THESE WORKSHEETS MUST BE INCLUDED IN THE CONSTRUCTION DOCUMENTS
This set of worksheets has been developed to assist permit applicants with documenting compliance with the 2015 Washington State Energy Code. The following worksheets provide much of the required documentation for plan review. The details, systems, and ratings noted here must also be shown on the drawings.

PRESCRIPTIVE ENERGY CODE COMPLIANCE FOR CLIMATE ZONE MARINE 4

Component	Fenestration 1		Ceiling w/ Attic	Vented Ceiling	Wood Framed Wall (Int.) 2	Mass Wall (Above grade)	Below-Grade Wall 2,3	Framed Floor	Slab R-Value & Depth
	Vertical	Overhead							
Prescriptive Value	U. 0.30 max.	U. 0.50 max.	R-49 min.	R-38 min.	R-21 min.	R-21 min.	R-10/15/21 Int. + TB	R-30 min.	R-10 min. 2'

Fenestration is defined as skylights, fixed windows, vertical windows (fixed or movable), opaque doors, glazed doors, glazed block and combination opaque/glazed doors. Fenestration includes products with glass and non-glass glazing materials.
1 Int. (Intermediate framing) denotes standard framing 1 1/2" o.c. with headers insulated with a minimum R-10 insulation.
2 10/15/21 + TB means R-10 continuous insulation on the exterior of the wall, or R-15 on the continuous insulation on the interior of the wall, or R-21 cavity insulation plus a thermal break between the slab and the basement wall on the interior of the basement wall. 10/15/21 + TB shall be permitted to be met with R-13 cavity insulation on the interior of the basement wall plus R-5 continuous insulation on the interior or exterior of the wall. TB means thermal break between floor slab and basement wall.

Whole House Ventilation (Prescriptive)
Please check the appropriate box to describe which of the four prescriptive Whole House Ventilation Systems you will be using AND fill in the required whole house ventilation rate in CFM's. (See "2015 Residential Whole House Ventilation Rate" Handout.) A complete system required by one of the sections noted below must be specified on the drawings.

WHOLE HOUSE VENTILATION METHOD	Whole House Ventilation Rate
<input type="checkbox"/> Intermittent Whole House Ventilation Using Exhaust Fans & Fresh Air Inlets. (IRC M1507.3.4)	
<input type="checkbox"/> Intermittent Whole House Ventilation Integrated with a Forced Air System. (IRC M1507.3.5)	
<input type="checkbox"/> Intermittent Whole House Ventilation using a Supply Fan. (IRC M1507.3.6)	
<input checked="" type="checkbox"/> Intermittent Whole House Ventilation Using a Heat Recovery Ventilation System (IRC M1507.3.7)	120 cfm

Source Specific Exhaust Ventilation & Fan Efficiency

Required in each kitchen, bathroom, water closet compartment, laundry room, indoor swimming pool, spa and other rooms where water vapor or cooking odor is produced. (IRC M1507.4) Fan efficiency from WAC 51-11R - Table R403.6.1. Kitchen Hoods greater than 400 cfm require makeup air per IRC M1503.4.

Minimum Source Specific Ventilation Capacity Requirements	Bathrooms - Utility Rooms			Kitchens	In-line fan
	Intermittently operating	Continuous operation	Minimum Efficacy (cfm/watt)	50 cfm min	100 cfm min
	20 cfm min	25 cfm min	1.4 cfm/watt if <90cfm	2.8 cfm/watt if >90cfm	2.8 cfm/watt

Energy Efficiency Credits

Each dwelling unit shall comply with sufficient options from WSEC Table R406.2 so as to achieve the following minimum number of credits as described on the reverse side of this page.

- Small Dwelling Unit: 1.5 credits (Dwelling units less than 1500 SF in conditioned floor area with less than 300 square feet of fenestration area. Additions to existing building that are greater than 500 SF of heated floor area, but less than 1500 SF. TOTAL SQUARE FEET OF FENESTRATION: (doors, windows, skylights)
- Medium Dwelling Unit: 3.5 credits (All dwelling units not included in #1 or #3. Exception: Dwelling units serving R-2 occupancies shall require 2.5 credits.
- Large Dwelling Unit: 4.5 credits (Dwelling Units exceeding 5000 SF of conditioned floor area.
- Additions less than 500 SF: 0.5 credits

S:\DSG\FORMS\2017\Building\2015_WSEC_IRC_Ventilation.pdf


2015 WSEC - Table R406.2 - circle the options that you will be using for this project

OPTION	DESCRIPTION	CREDITS
1a	EFFICIENT BUILDING ENVELOPE 1a: Vertical fenestration U = 0.28 Floor R-38 Slab on grade R-10 perimeter and under entire slab Below grade slab R-10 perimeter and under entire slab. OR Compliance based on Section R402.1.4: Reduce the Total UA by 5%.	0.5
1b	EFFICIENT BUILDING ENVELOPE 1b: Vertical fenestration U = 0.25 Wall R-21 plus R-4 Floor R-38 Basement wall R-21 int plus R-5 ext Slab on grade R-10 perimeter and under entire slab Below grade slab R-10 perimeter and under entire slab. OR Compliance based on Section R402.1.4: Reduce the Total UA by 15%.	1.0
1c	EFFICIENT BUILDING ENVELOPE 1c: Prescriptive compliance is based on Table R402.1.1 with the following modifications: Vertical fenestration U = 0.22 Ceiling and angle-rafter or joist-vented R-49 advanced Wood frame wall R-21 int plus R-12 ext Floor R-38 Basement wall R-21 int plus R-12 ext Slab on grade R-10 perimeter and under entire slab Below grade slab R-10 perimeter and under entire slab OR Compliance based on Section R402.1.4: Reduce the Total UA by 30%.	2.0
1d	EFFICIENT BUILDING ENVELOPE 1d: Prescriptive compliance is based on Table R402.1.1 with the following modifications: Vertical fenestration U = 0.24. Projects using this option may not use Option 1a, 1b or 1c.	0.5
2a	AIR LEAKAGE CONTROL AND EFFICIENT VENTILATION 2a: Compliance based on R402.4.1.2: Reduce the tested air leakage to 3.0 air changes per hour maximum AND All whole house ventilation requirements as determined by Section M1507.3 of the International Residential Code shall be met with a high efficiency fan (maximum 0.35 watts/cfm), not interlocked with the furnace fan. Ventilations systems using a furnace including an ECM motor are allowed, provided that they are controlled to operate at low speed in ventilation only mode. To qualify to claim this credit, the building permit drawings shall specify the option being selected and shall specify the maximum tested building air leakage and shall show the qualifying ventilation system.	0.5
2b	AIR LEAKAGE CONTROL AND EFFICIENT VENTILATION 2b: Compliance based on Section R402.4.1.2: Reduce the tested air leakage to 2.0 air changes per hour maximum AND All whole house ventilation requirements as determined by Section M1507.3 of the International Residential Code shall be met with a heat recovery ventilation system with minimum sensible heat recovery efficiency of 30. To qualify to claim this credit, the building permit drawings shall specify the option being selected and shall specify the maximum tested building air leakage and shall show the heat recovery ventilation system.	1.0
2c	AIR LEAKAGE CONTROL AND EFFICIENT VENTILATION 2c: Compliance based on Section R402.4.1.2: Reduce the tested air leakage to 1.5 air changes per hour maximum. AND All whole house ventilation requirements as determined by Section M1507.3 of the International Residential Code shall be met with a heat recovery ventilation system with minimum sensible heat recovery efficiency of 0.85. To qualify to claim this credit, the building permit drawings shall specify the option being selected and shall specify the maximum tested building air leakage and shall show the heat recovery ventilation system.	1.5
3a	HIGH EFFICIENCY HVAC EQUIPMENT 3a: Gas, propane or oil-fired furnace with minimum AFUE of 94%, or Gas, propane or oil-fired boiler with minimum AFUE of 92%. Projects may only include credit from one space heating option, 3a, 3b, 3c or 3d. When a housing unit has two pieces of equipment (i.e., two furnaces) both must meet the standard to receive the credit. To qualify to claim this credit, the building permit drawings shall specify the option being selected and shall specify the heating equipment type and the minimum equipment efficiency.	1.0
3b	HIGH EFFICIENCY HVAC EQUIPMENT 3b: Air source heat pump with minimum COP of 9.0. Projects may only include credit from one space heating option, 3a, 3b, 3c or 3d. When a housing unit has two pieces of equipment (i.e., two furnaces) both must meet the standard to receive the credit. To qualify to claim this credit, the building permit drawings shall specify the option being selected and shall specify the heating equipment type and the minimum equipment efficiency.	1.0
3c	HIGH EFFICIENCY HVAC EQUIPMENT 3c: Closed-loop ground source heat pump with a minimum COP of 3.3 OR Open loop water source heat pump with a maximum pumping hydraulic head of 150 feet and minimum COP of 3.6. Projects may only include credit from one space heating option, 3a, 3b, 3c or 3d. When a housing unit has two pieces of equipment (i.e., two furnaces) both must meet the standard to receive the credit. To qualify to claim this credit, the building permit drawings shall specify the option being selected and shall specify the heating equipment type and the minimum equipment efficiency.	1.5
3d	HIGH EFFICIENCY HVAC EQUIPMENT 3d: Ductless Split System Heat Pumps, Zonal Control: In homes where the primary space heating system is zonal electric heating, a ductless heat pump system shall be installed and provide heating to the largest zone of the housing unit. Projects may only include credit from one space heating option, 3a, 3b, 3c or 3d. When a housing unit has two pieces of equipment (i.e., two furnaces) both must meet the standard to receive the credit. To qualify to claim this credit, the building permit drawings shall specify the option being selected and shall specify the heating equipment type and the minimum equipment efficiency.	1.0

Simple Heating System Size: Washington State

This heating system sizing calculator is based on the Prescriptive Requirements of the 2015 Washington State Energy Code (WSEC) and ACCA Manual J and S. This calculator will calculate heating loads only. ACCA procedures for sizing cooling systems should be used to determine cooling loads.
The glazing (window) and door portion of this calculator assumes the installed glazing and door products have an area weighted average U-factor of 0.30. The incorporated insulation requirements are the minimum prescriptive amounts specified by the 2015 WSEC.
Please fit out all of the green drop-downs and boxes that are applicable to your project. As you make selections in the drop-downs for each section, some values will be calculated for you. If you do not see the selection you need in the drop-down options, please call the WSU Energy Extension Program at (360) 956-2042 for assistance.


Project Information
Location: Mercer Island, WA 98115
Contact Information
Design Temperature: Mercer Island
Design Temperature Difference (AT): 45
Area of Building: 5,068 sq ft
Average Ceiling Height: 9.0 ft
Glazing and Doors: U-Factor X Area = UA
Insulation: U-Factor X Area = UA
Floors: U-Factor X Area = UA
Slab Below Grade: U-Factor X Length = UA
Location of Ducts: Unconditioned Space
Sum of UA: 779.42
Envelope Heat Load: 35,074 Btu / Hour
Air Leakage Heat Load: 22,124 Btu / Hour
Building Design Heat Load: 57,198 Btu / Hour
Building and Duct Heat Load: 62,917 Btu / Hour
Maximum Heat Equipment Output: 88,084 Btu / Hour

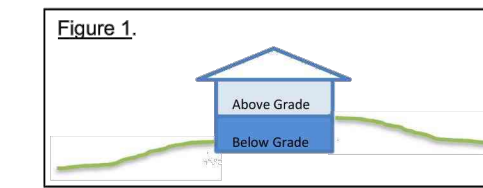

07/04/18

Forms Updated


New Residence For:
James & Jessica Rudolf
8253 West Mercer Way
Mercer Island, Washington 98040

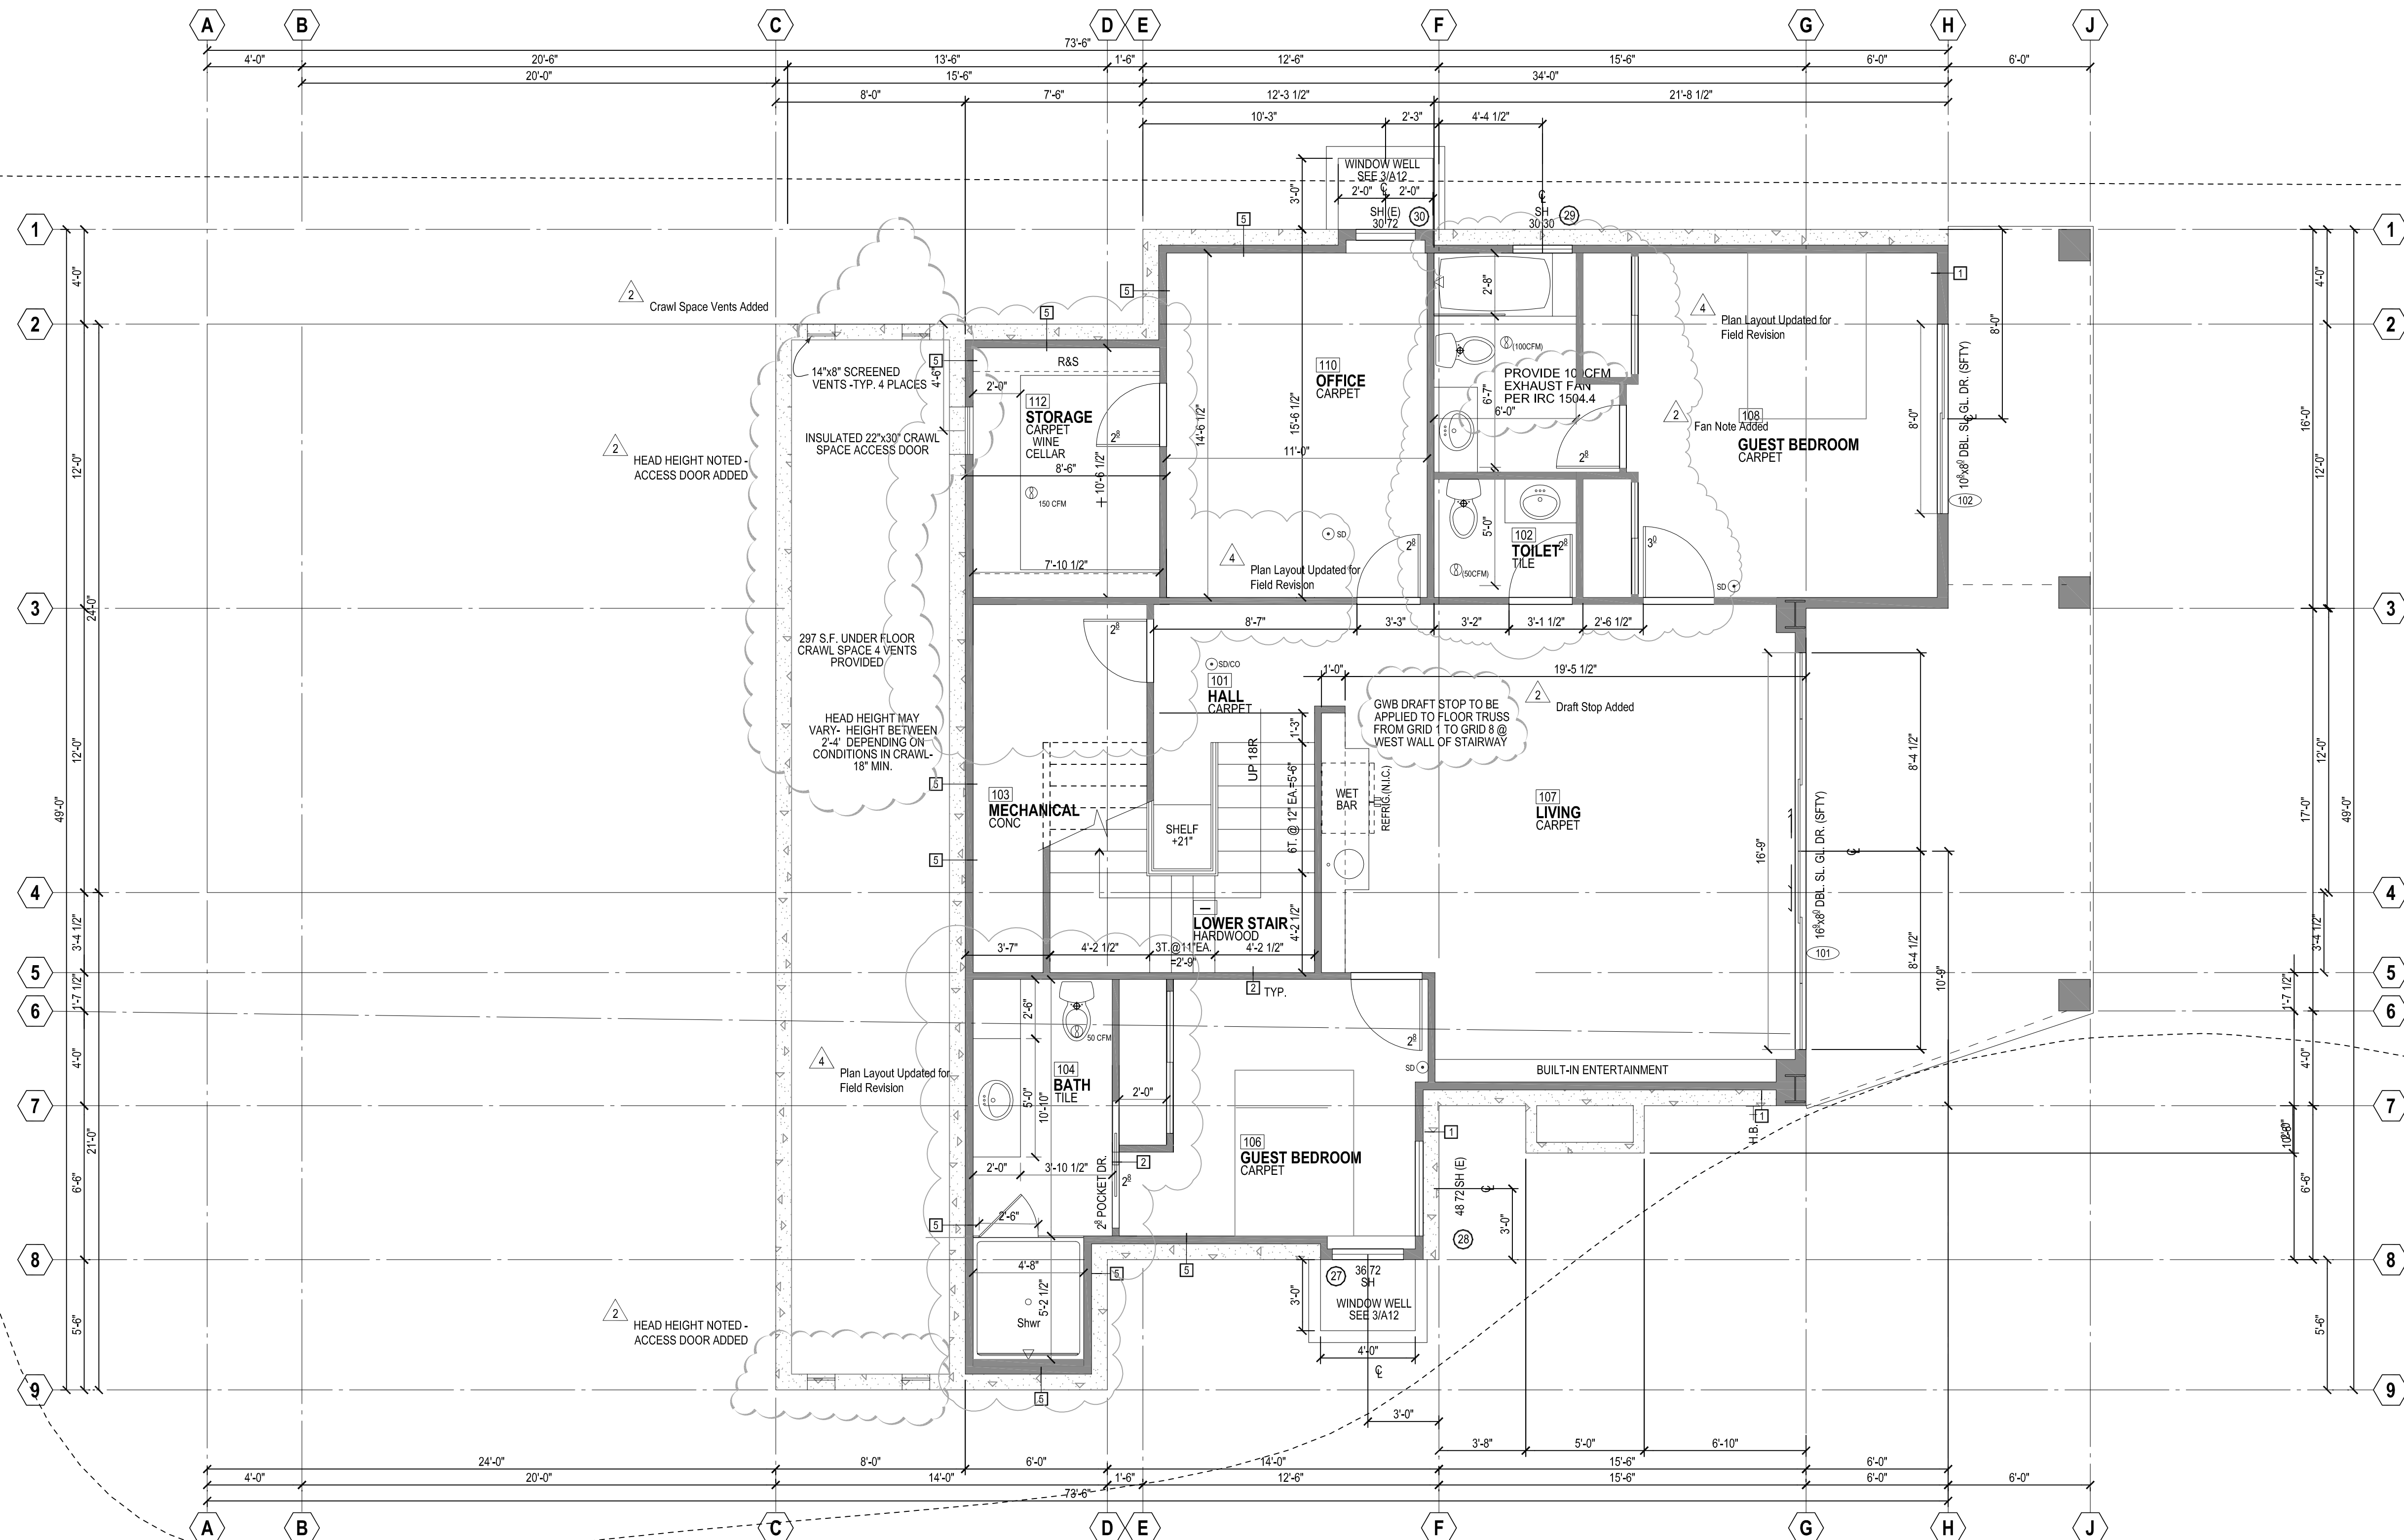

LOWER LEVEL FLOOR PLAN

LIVING 1487 S.F.

1/4" = 1'-0"

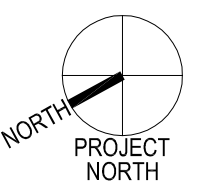

WALL TYPES

- [1] 2x6 @ 16" O.C. STUD WALL & SHEATHING PER STRUCTURAL- R-21 BATT INSULATION W/ VISQUEEN VAPOR BARRIER & 1/2" GWB ON INTERIOR SIDE
- [2] 2x4 @ 16" O.C. STUD WALL W/ 1/2" GWB EACH SIDE - TYPICAL @ ALL INTERIOR WALLS U.N.O.
- [3] 2x4 @ 16" O.C. STUD WALL & SHEATHING PER STRUCTURAL- 1/2" GWB ON INTERIOR SIDE.
- [4] 2x6 @ 16" O.C. STUD WALL & SHEATHING PER STRUCTURAL- R-21 BATT INSULATION W/ 5/8" TYPE "X" ON COLD SIDE TO UNDERSIDE OF ROOF SHEATHING -W/ VISQUEEN VAPOR BARRIER & 1/2" GWB ON INTERIOR SIDE
- [5] CONCRETE FOUNDATION WALL PER STRUCTURAL - 2x4 @ 16" O.C. FURRING - R-21 BATT INSULATION - 1/2" GWB
- [6] 2x6 @ 16" O.C. STUD WALL & SHEATHING PER STRUCTURAL- R-21 BATT INSULATION - 1/2" GWB ON COLD SIDE W/ VISQUEEN VAPOR BARRIER & 1/2" GWB ON INTERIOR SIDE


ISSUANCE PERMIT SET 5/15/18

[4] FIELD REVISION SUBMITTAL SET 1/25/2022

PROJECT INFORMATION	
PROJECT NO:	8253 W
PROJECT MANAGER:	TW
DRAWN BY:	BB

Lower Level Floor Plan


SHEET NO

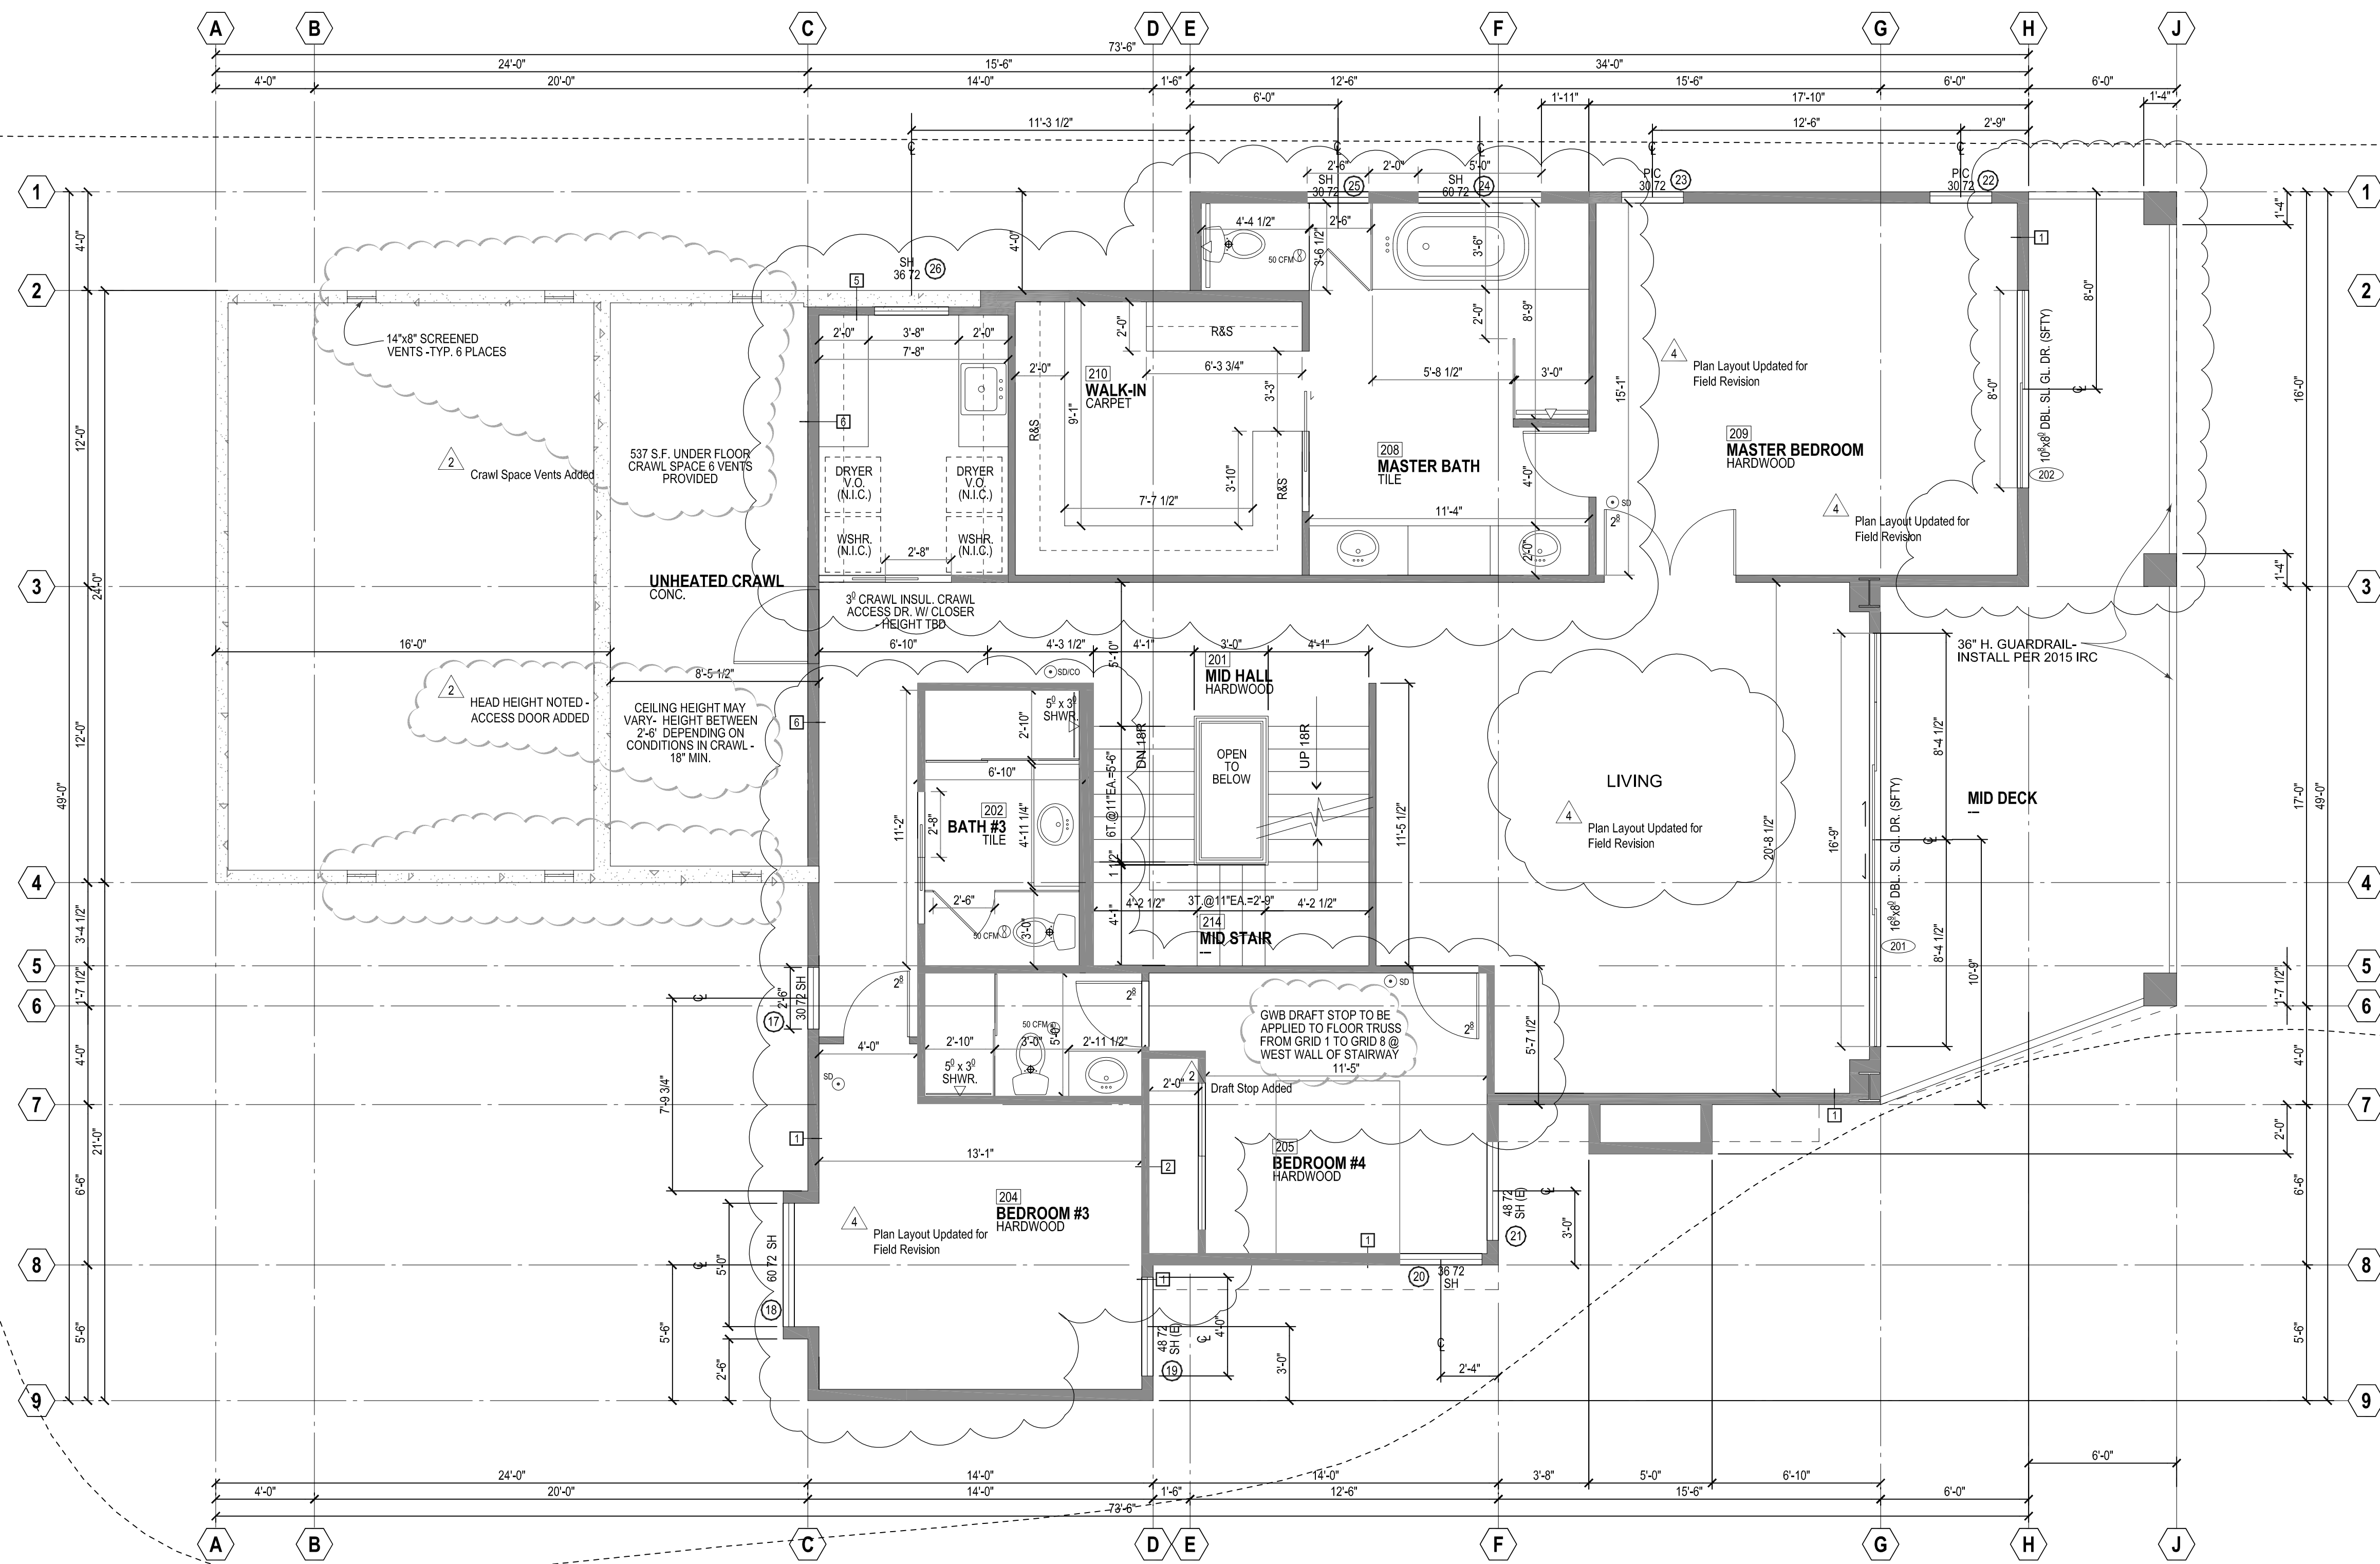

MID LEVEL FLOOR PLAN

1908 S.F.

1/4" = 1'-0"

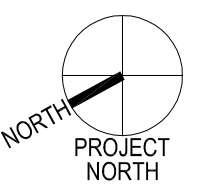

WALL TYPES

- 1 2x6 @ 16" O.C. STUD WALL & SHEATHING PER STRUCTURAL-R-21 BATT INSULATION W/ VISQUEEN VAPOR BARRIER & 1/2" GWB ON INTERIOR SIDE
- 2 2x4 @ 16" O.C. STUD WALL W/ 1/2" GWB EACH SIDE - TYPICAL @ ALL INTERIOR WALLS U.N.O.
- 3 2x4 @ 16" O.C. STUD WALL & SHEATHING PER STRUCTURAL-R-21 BATT INSULATION W/ VISQUEEN VAPOR BARRIER & 1/2" GWB ON INTERIOR SIDE
- 4 2x6 @ 16" O.C. STUD WALL & SHEATHING PER STRUCTURAL-R-21 BATT INSULATION W/ 5/8" TYPE "X" ON COLD SIDE TO UNDERSIDE OF ROOF SHEATHING - W/ VISQUEEN VAPOR BARRIER & 1/2" GWB ON INTERIOR SIDE
- 5 CONCRETE FOUNDATION WALL PER STRUCTURAL-2x4 @ 16" O.C. FURRING - R-21 BATT INSULATION - 1/2" GWB
- 6 2x6 @ 16" O.C. STUD WALL & SHEATHING PER STRUCTURAL-R-21 BATT INSULATION - 1/2" GWB ON COLD SIDE W/ VISQUEEN VAPOR BARRIER & 1/2" GWB ON INTERIOR SIDE

ALARM SCHEDULE

2015 IRC SECTIONS R314 R315		
SYMBOL	DESCRIPTION	REQUIREMENTS
SD	SMOKE ALARM	<ul style="list-style-type: none"> • 110 V INTERCONNECTED W/ BATTERY BACKUP • INSTALLED ON EACH FLOOR AND IN EACH SLEEPING AREA • LISTED IN ACCORDANCE WITH UL 217 AND INSTALLED PER THE HOUSEHOLD FIRE WARNING EQUIPMENT PROVISIONS OF NEPA 72
CS1000	COMBINATION SMOKE ALARM CARBON MONOXIDE ALARM	<ul style="list-style-type: none"> • INSTALLED OUTSIDE OF EACH SEPARATE SLEEPING AREA IN THE IMMEDIATE VICINITY OF THE BEDROOMS • SMOKE ALARM REQUIREMENTS PER ABOVE • CARBON MONOXIDE ALARMS TO BE INSTALLED IN DWELLING UNITS WITHIN WHICH FUEL-FIRED APPLIANCES ARE INSTALLED AND IN DWELLING UNITS THAT HAVE ATTACHED GARAGES • CARBON MONOXIDE ALARMS LISTED AS COMPLYING WITH UL 2034 AND INSTALLED PER MANUFACTURERS INSTALLATION INSTRUCTIONS

VENTILATION SCHEDULE

2015 IRC SECTIONS M1507 M1508		
SYMBOL	LOCATION	MINIMUM FAN REQUIREMENTS
CFM	BATH, POWDER, LAUNDRY	<ul style="list-style-type: none"> • MIN 50 CFM AT 0.25" WG TABLE M1507.3
CFM	KITCHEN	<ul style="list-style-type: none"> • MINIMUM 100 CFM AT 0.25" WG (IRC TABLE M1507.3) • RANGE HOOD OR DOWN DRAFT EXHAUST FAN RATED AT MIN 100 CFM AT 0.10" WG MAY BE USED FOR EXHAUST FAN REQUIREMENT.
WH	WHOLE HOUSE FAN	<ul style="list-style-type: none"> • 140 CFM AT 0.25" WG (IRC TABLE M1508.2) • WHOLE HOUSE FAN TO OPERATE AT LEAST ONCE EVERY HOURS • WHOLE HOUSE FANS LOCATED 4 FT OR LESS FROM INTERIOR GRILLE TO HAVE A SONE RATING OF 1.0 LESS MEASURED AT 0.1" WG

ALL FANS TO VENT TO OUTSIDE. ALL OTHER REQUIREMENTS OF THE 2015 WSEC AND 2015 IRC SECTIONS M1507 AND M1508 MUST BE MET.

New Residence For:
James & Jessica Rudolf
8253 West Mercer Way
Mercer Island, Washington 98040


ISSUANCE PERMIT SET: 5/15/18

FIELD REVISION SUBMITTAL SET: 1/25/2022

PROJECT INFORMATION
PROJECT NO: 8253 W
PROJECT MANAGER: TW
DRAWN BY: BB

Mid Level Floor Plan


SHEET NO

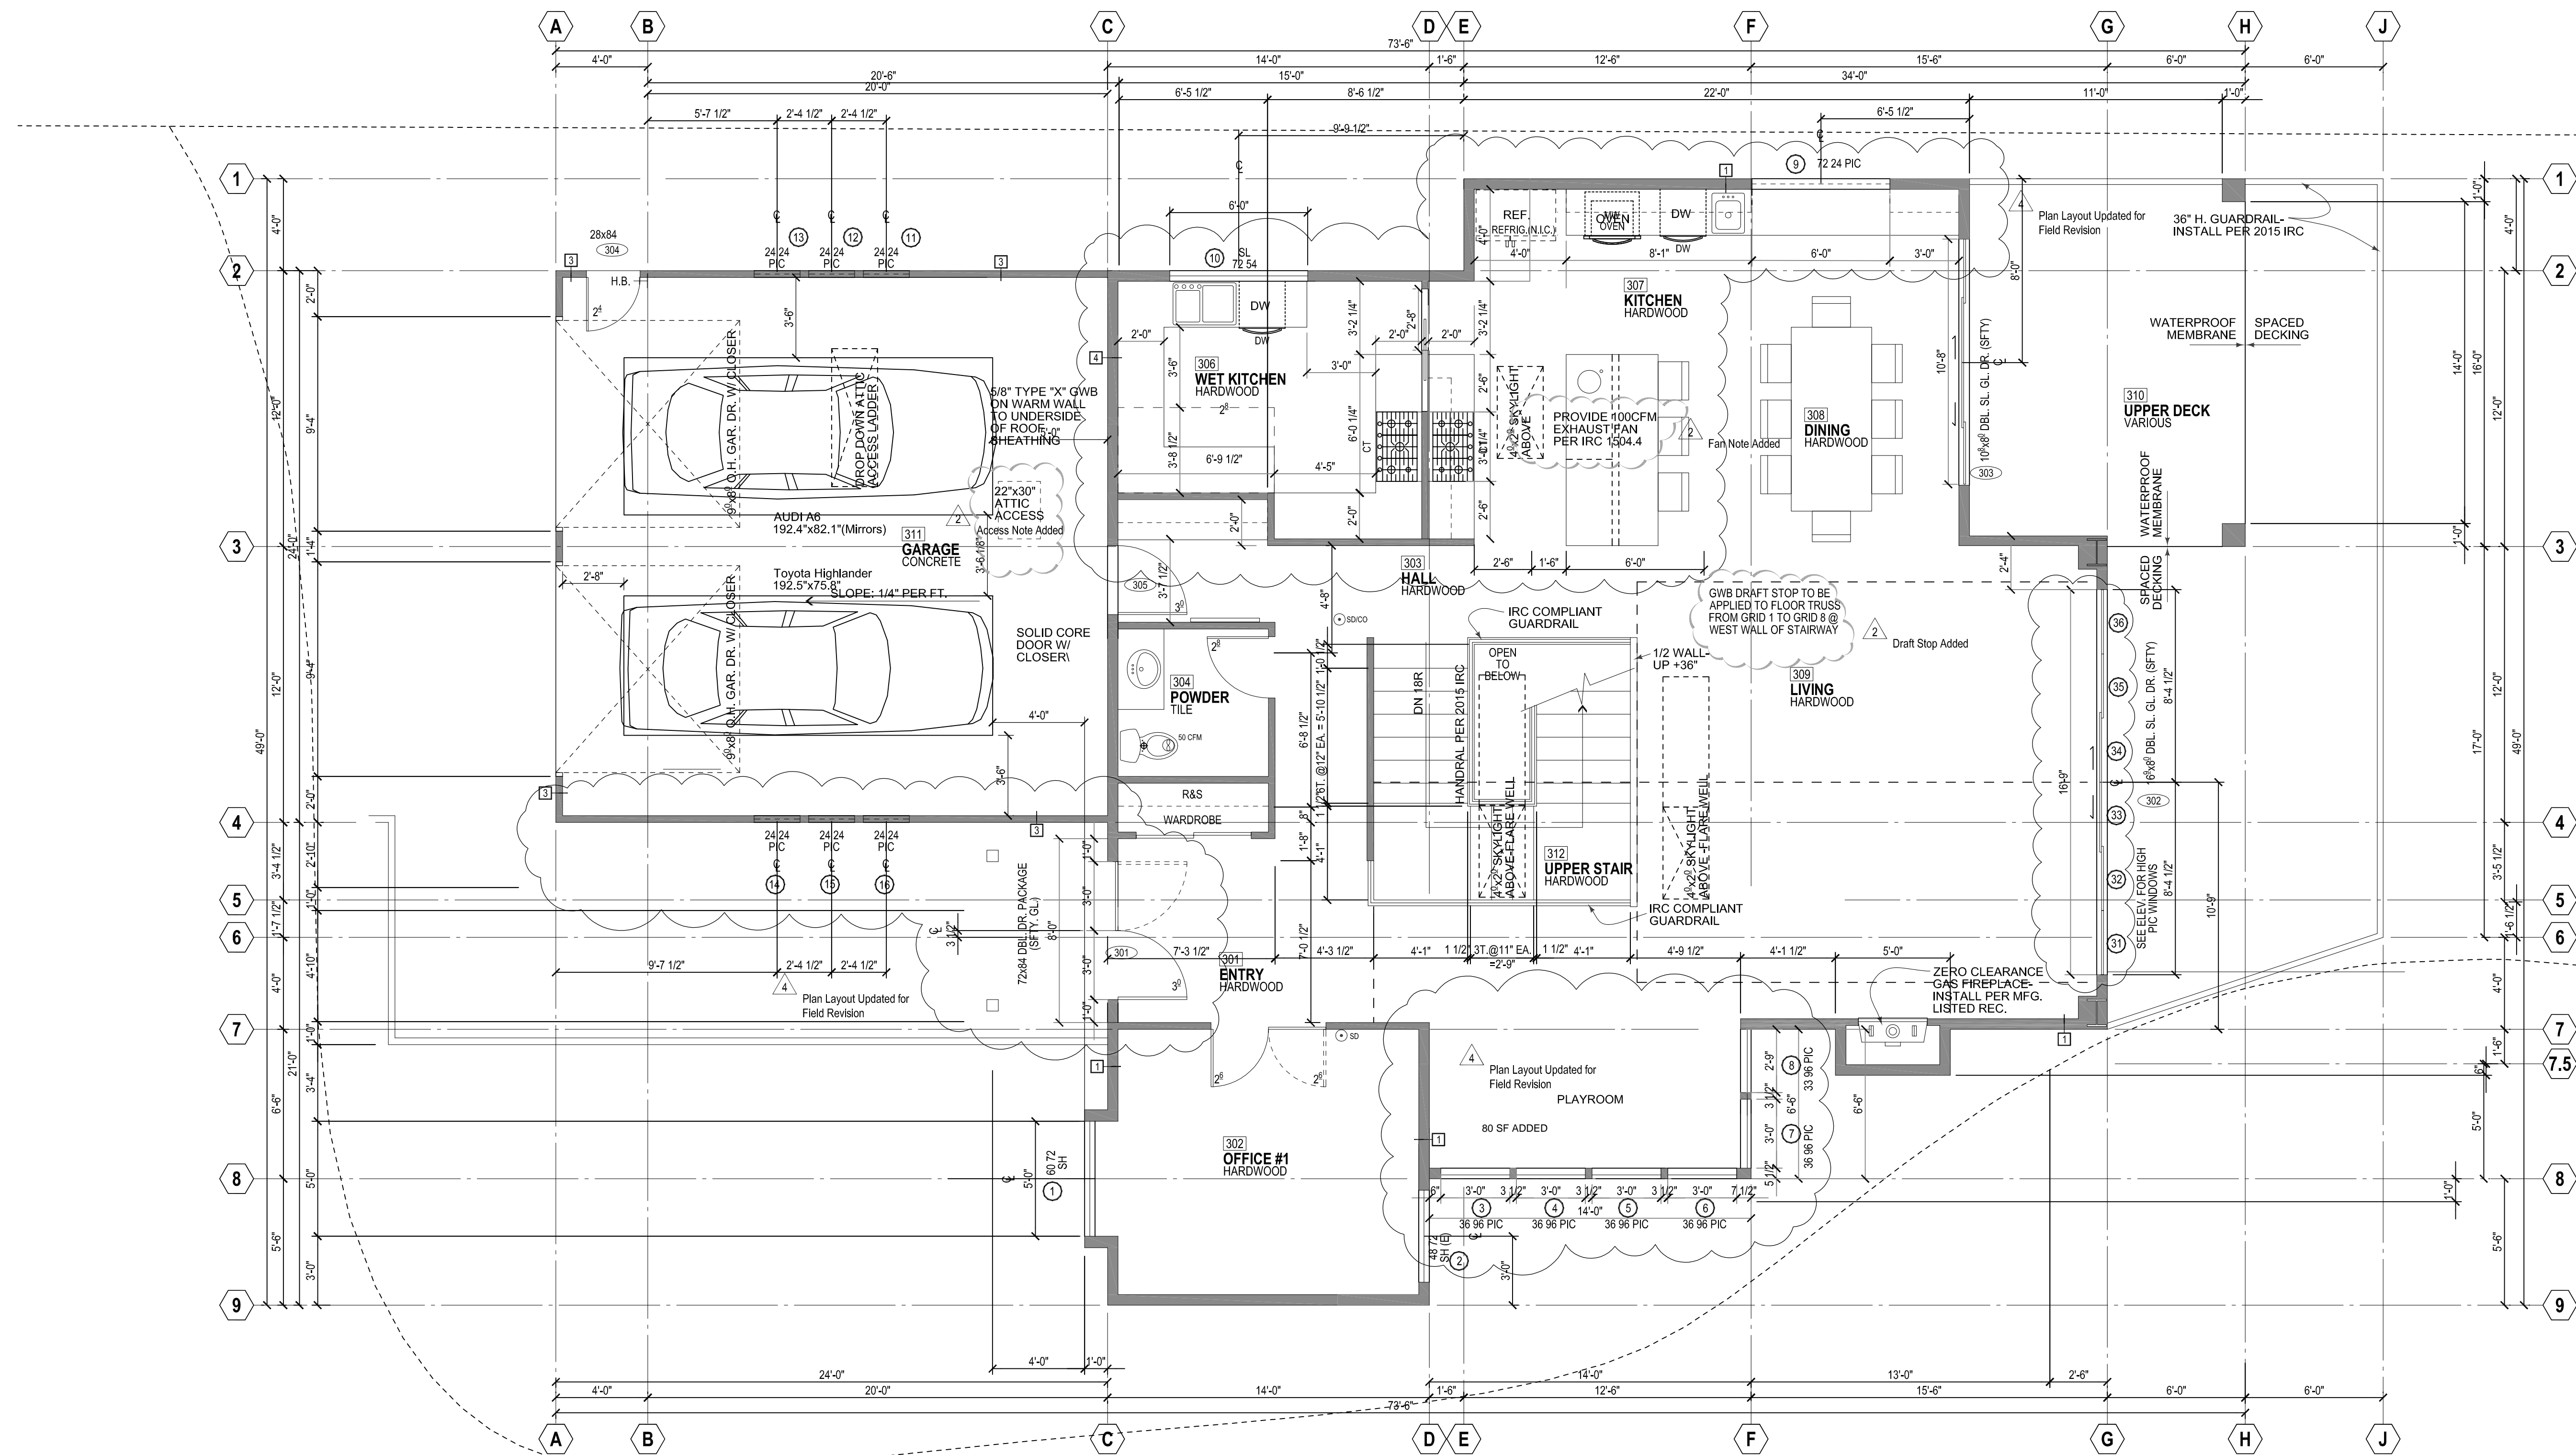

UPPER LEVEL FLOOR PLAN

LIVING 1729 S.F. / GARAGE 576 S.F.

1/4" = 1'-0"

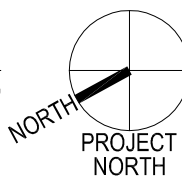

WALL TYPES

- [1] 2x6 @ 16" O.C. STUD WALL & SHEATHING PER STRUCTURAL-R-21 BATT INSULATION W/ VISQUEEN VAPOR BARRIER & 1/2" GWB ON INTERIOR SIDE
- [2] 2x4 @ 16" O.C. STUD WALL W/ 1/2" GWB EACH SIDE - TYPICAL @ ALL INTERIOR WALLS U.N.O.
- [3] 2x4 @ 16" O.C. STUD WALL & SHEATHING PER STRUCTURAL-1/2" GWB ON INTERIOR SIDE.
- [4] 2x6 @ 16" O.C. STUD WALL & SHEATHING PER STRUCTURAL-R-21 BATT INSULATION W/ 5/8" TYPE "X" ON COLD SIDE TO UNDERSIDE OF ROOF SHEATHING -W/ VISQUEEN VAPOR BARRIER & 1/2" GWB ON INTERIOR SIDE
- [5] CONCRETE FOUNDATION WALL PER STRUCTURAL - 2x4 @ 16" O.C. FURRING - R-21 BATT INSULATION - 1/2" GWB
- [6] 2x6 @ 16" O.C. STUD WALL & SHEATHING PER STRUCTURAL-R-21 BATT INSULATION -1/2" GWB ON COLD SIDE W/ VISQUEEN VAPOR BARRIER & 1/2" GWB ON INTERIOR SIDE

New Residence For:
James & Jessica Rudolf
8253 West Mercer Way
Mercer Island, Washington 98040

ISSUANCE PERMIT SET 5/15/18


FIELD REVISION SUBMITTAL SET 1/25/2022

PROJECT INFORMATION
PROJECT NO: 8253 W
PROJECT MANAGER: TW
DRAWN BY: BB


Upper Level Floor Plan

SHEET NO

A6

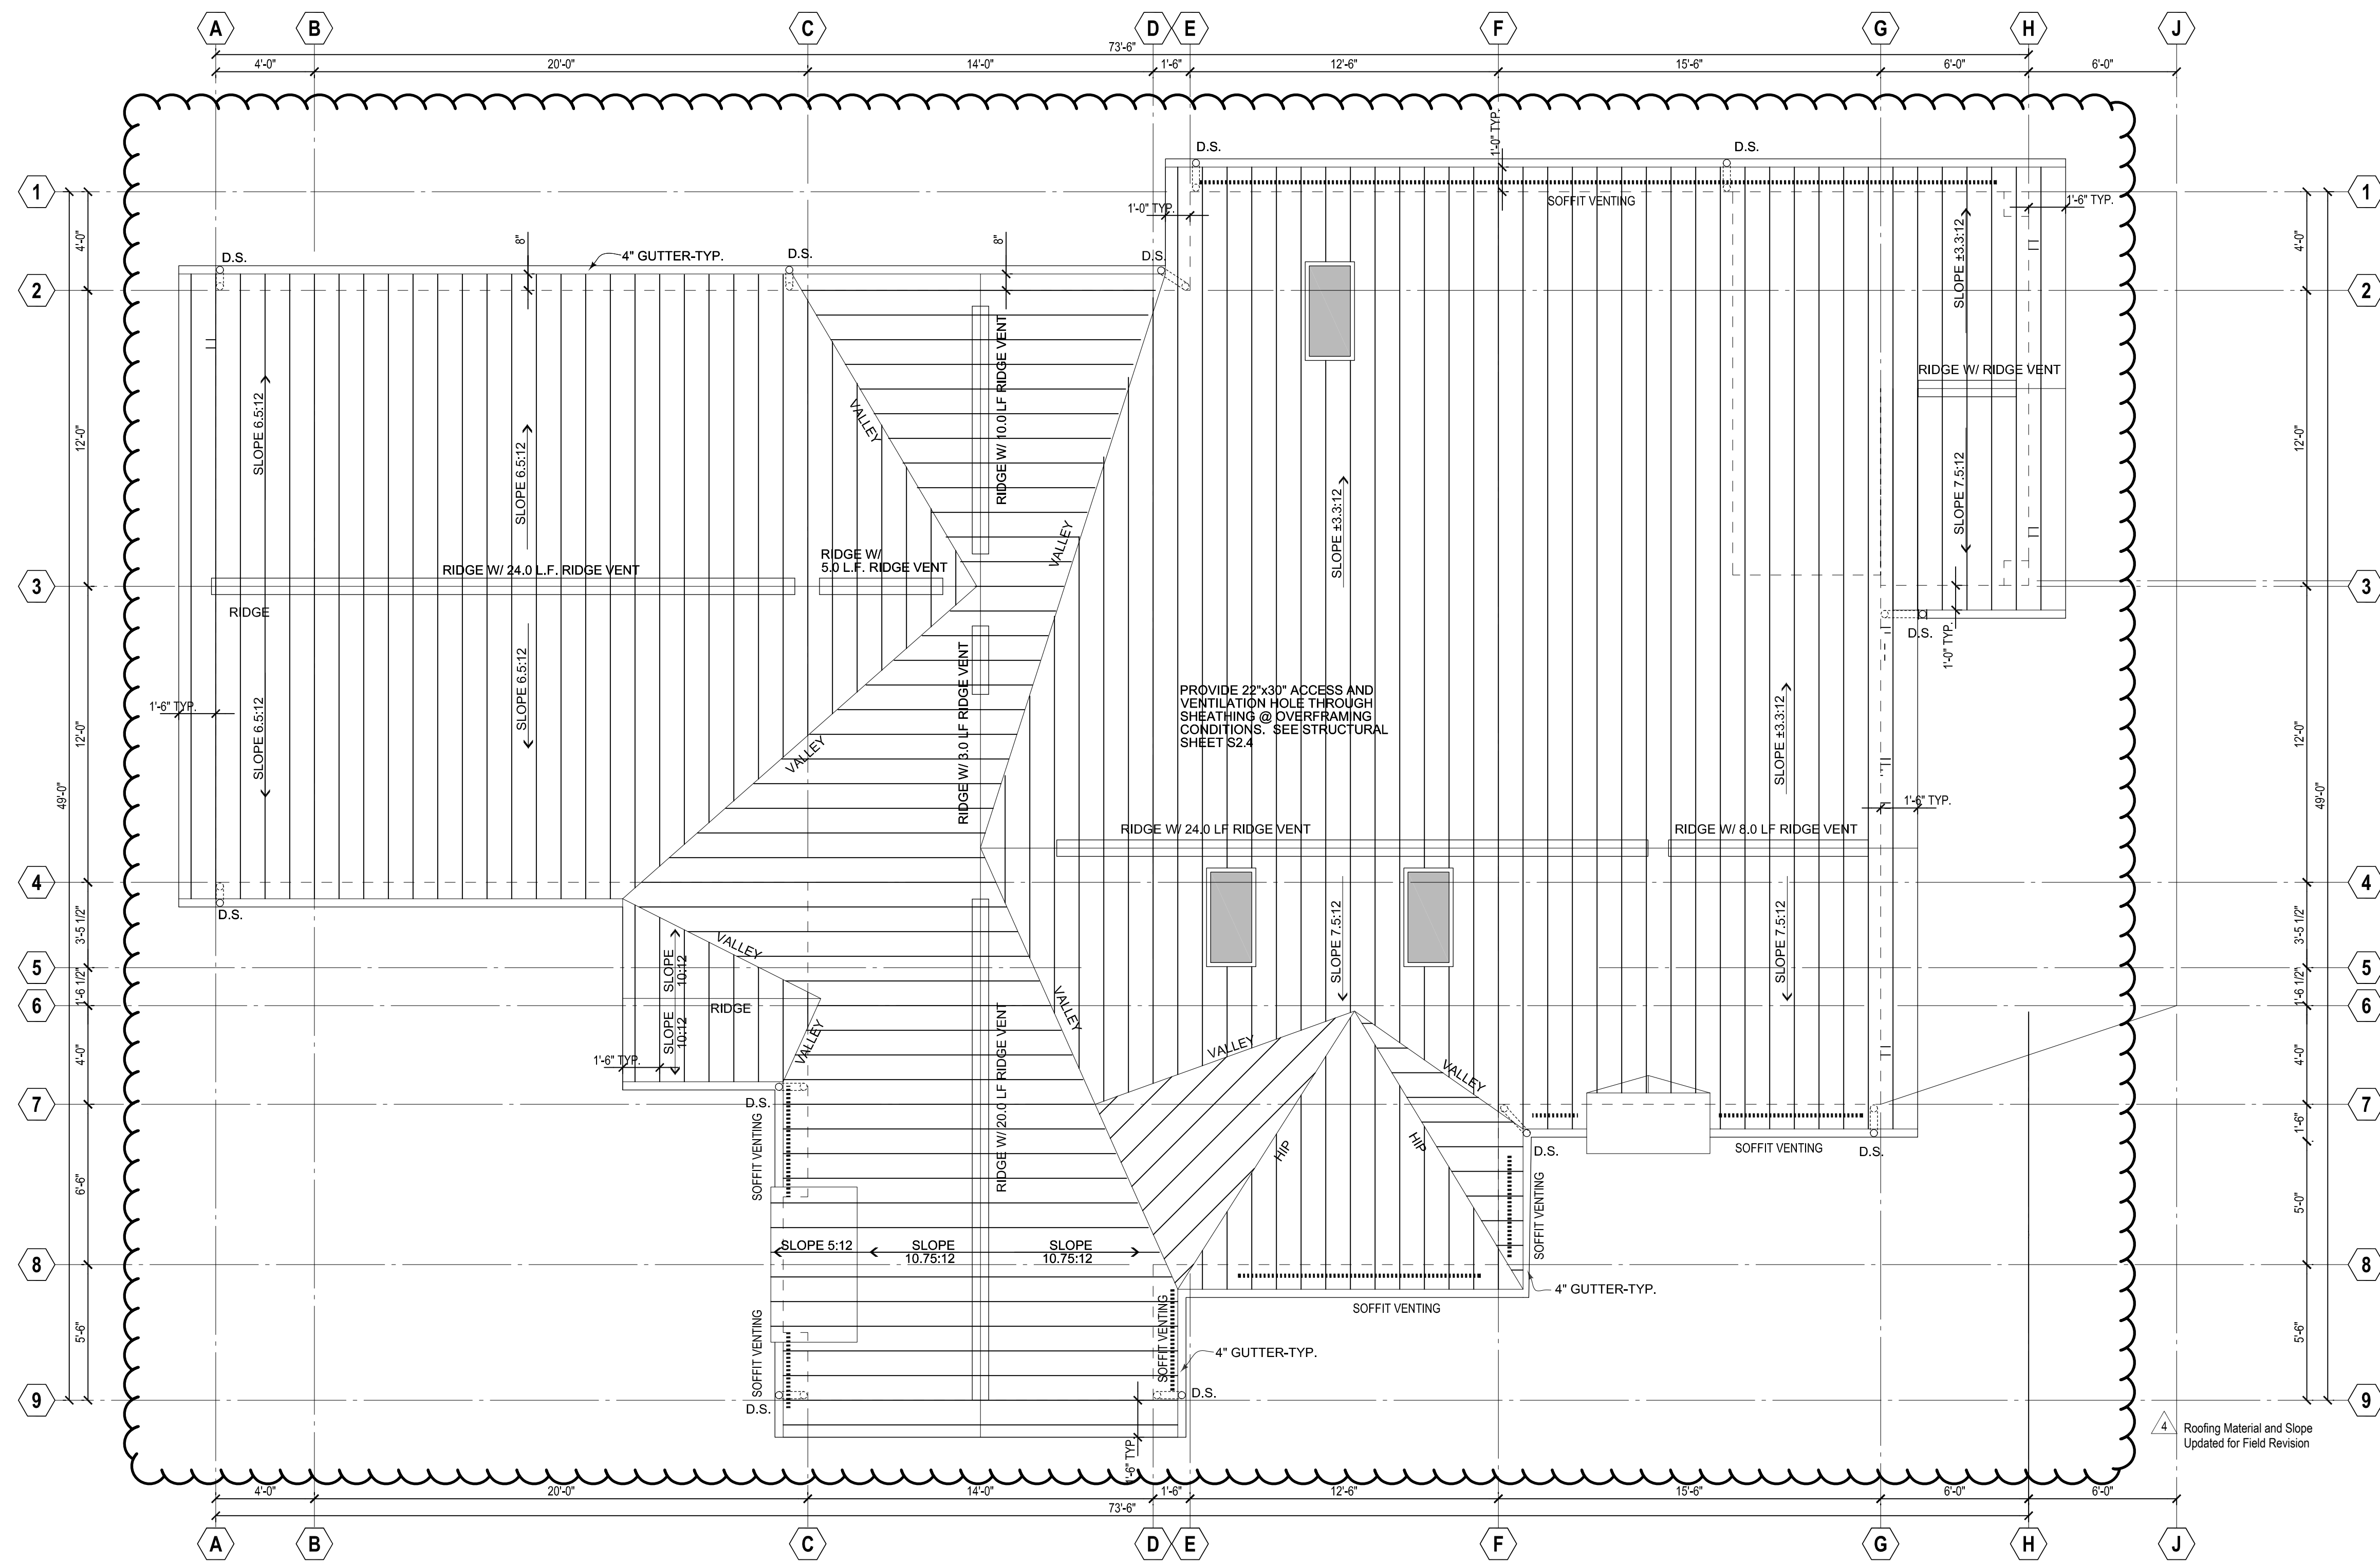

ROOF PLAN

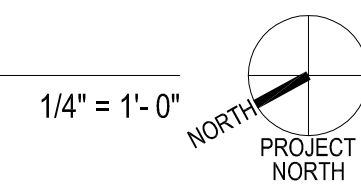

ROOF VENTILATION

WHOLE ROOF / ATTIC AREA
STANDARD PRE-MANUFACTURED OPEN TRUSS / ATTIC ASSEMBLY

- 1. ROOF ATTIC AREA: 2,672 S.F.
- 2. VENTILATION REQUIRED: 2,672 S.F. x 1/300 = 8.91 S.F.
8.91 S.F. = 1,283 S.I. (144 S.I. PER 1 S.F.)
- 3. LOW VENTILATION: CONTINUOUS CONCRETE FIBER BOARD PANEL W/
10 S.I. / L.F. - 40 L.F. SOFFIT PROVIDED.
10 S.I. x 40 L.F. = 400 S.I. VENTILATION
GABLE VENTS PROVIDING 180 S.I. EA.
4 PROVIDED x 180 S.I. = 720 S.I.
TOTAL LOW VENTILATION PROVIDED = 1120 S.I.
- 4. HIGH VENTILATION: PROPOSED GAF COBRA 3 RIDGE VENTILATION
18 S.I. / L.F. - 56 L.F. RIDGE VENT PROVIDED
18 S.I. x 56 L.F. = 1,008 S.I.
400 S.I. LOW + 1,008 S.I. HIGH = 1,408 S.I. TOTAL
1,408 S.I. > 1,283 S.I. OK
- 5. TOTAL VENTILATION :

ISSUANCE PERMIT SET 5/15/18


FIELD REVISION SUBMITTAL SET 1/25/2022

PROJECT INFORMATION	
PROJECT NO:	8253 W
PROJECT MANAGER:	TW
DRAWN BY:	BB

Roof Plan

SHEET NO

New Residence For:
James & Jessica Rudolf
 8253 West Mercer Way
 Mercer Island, Washington 98040

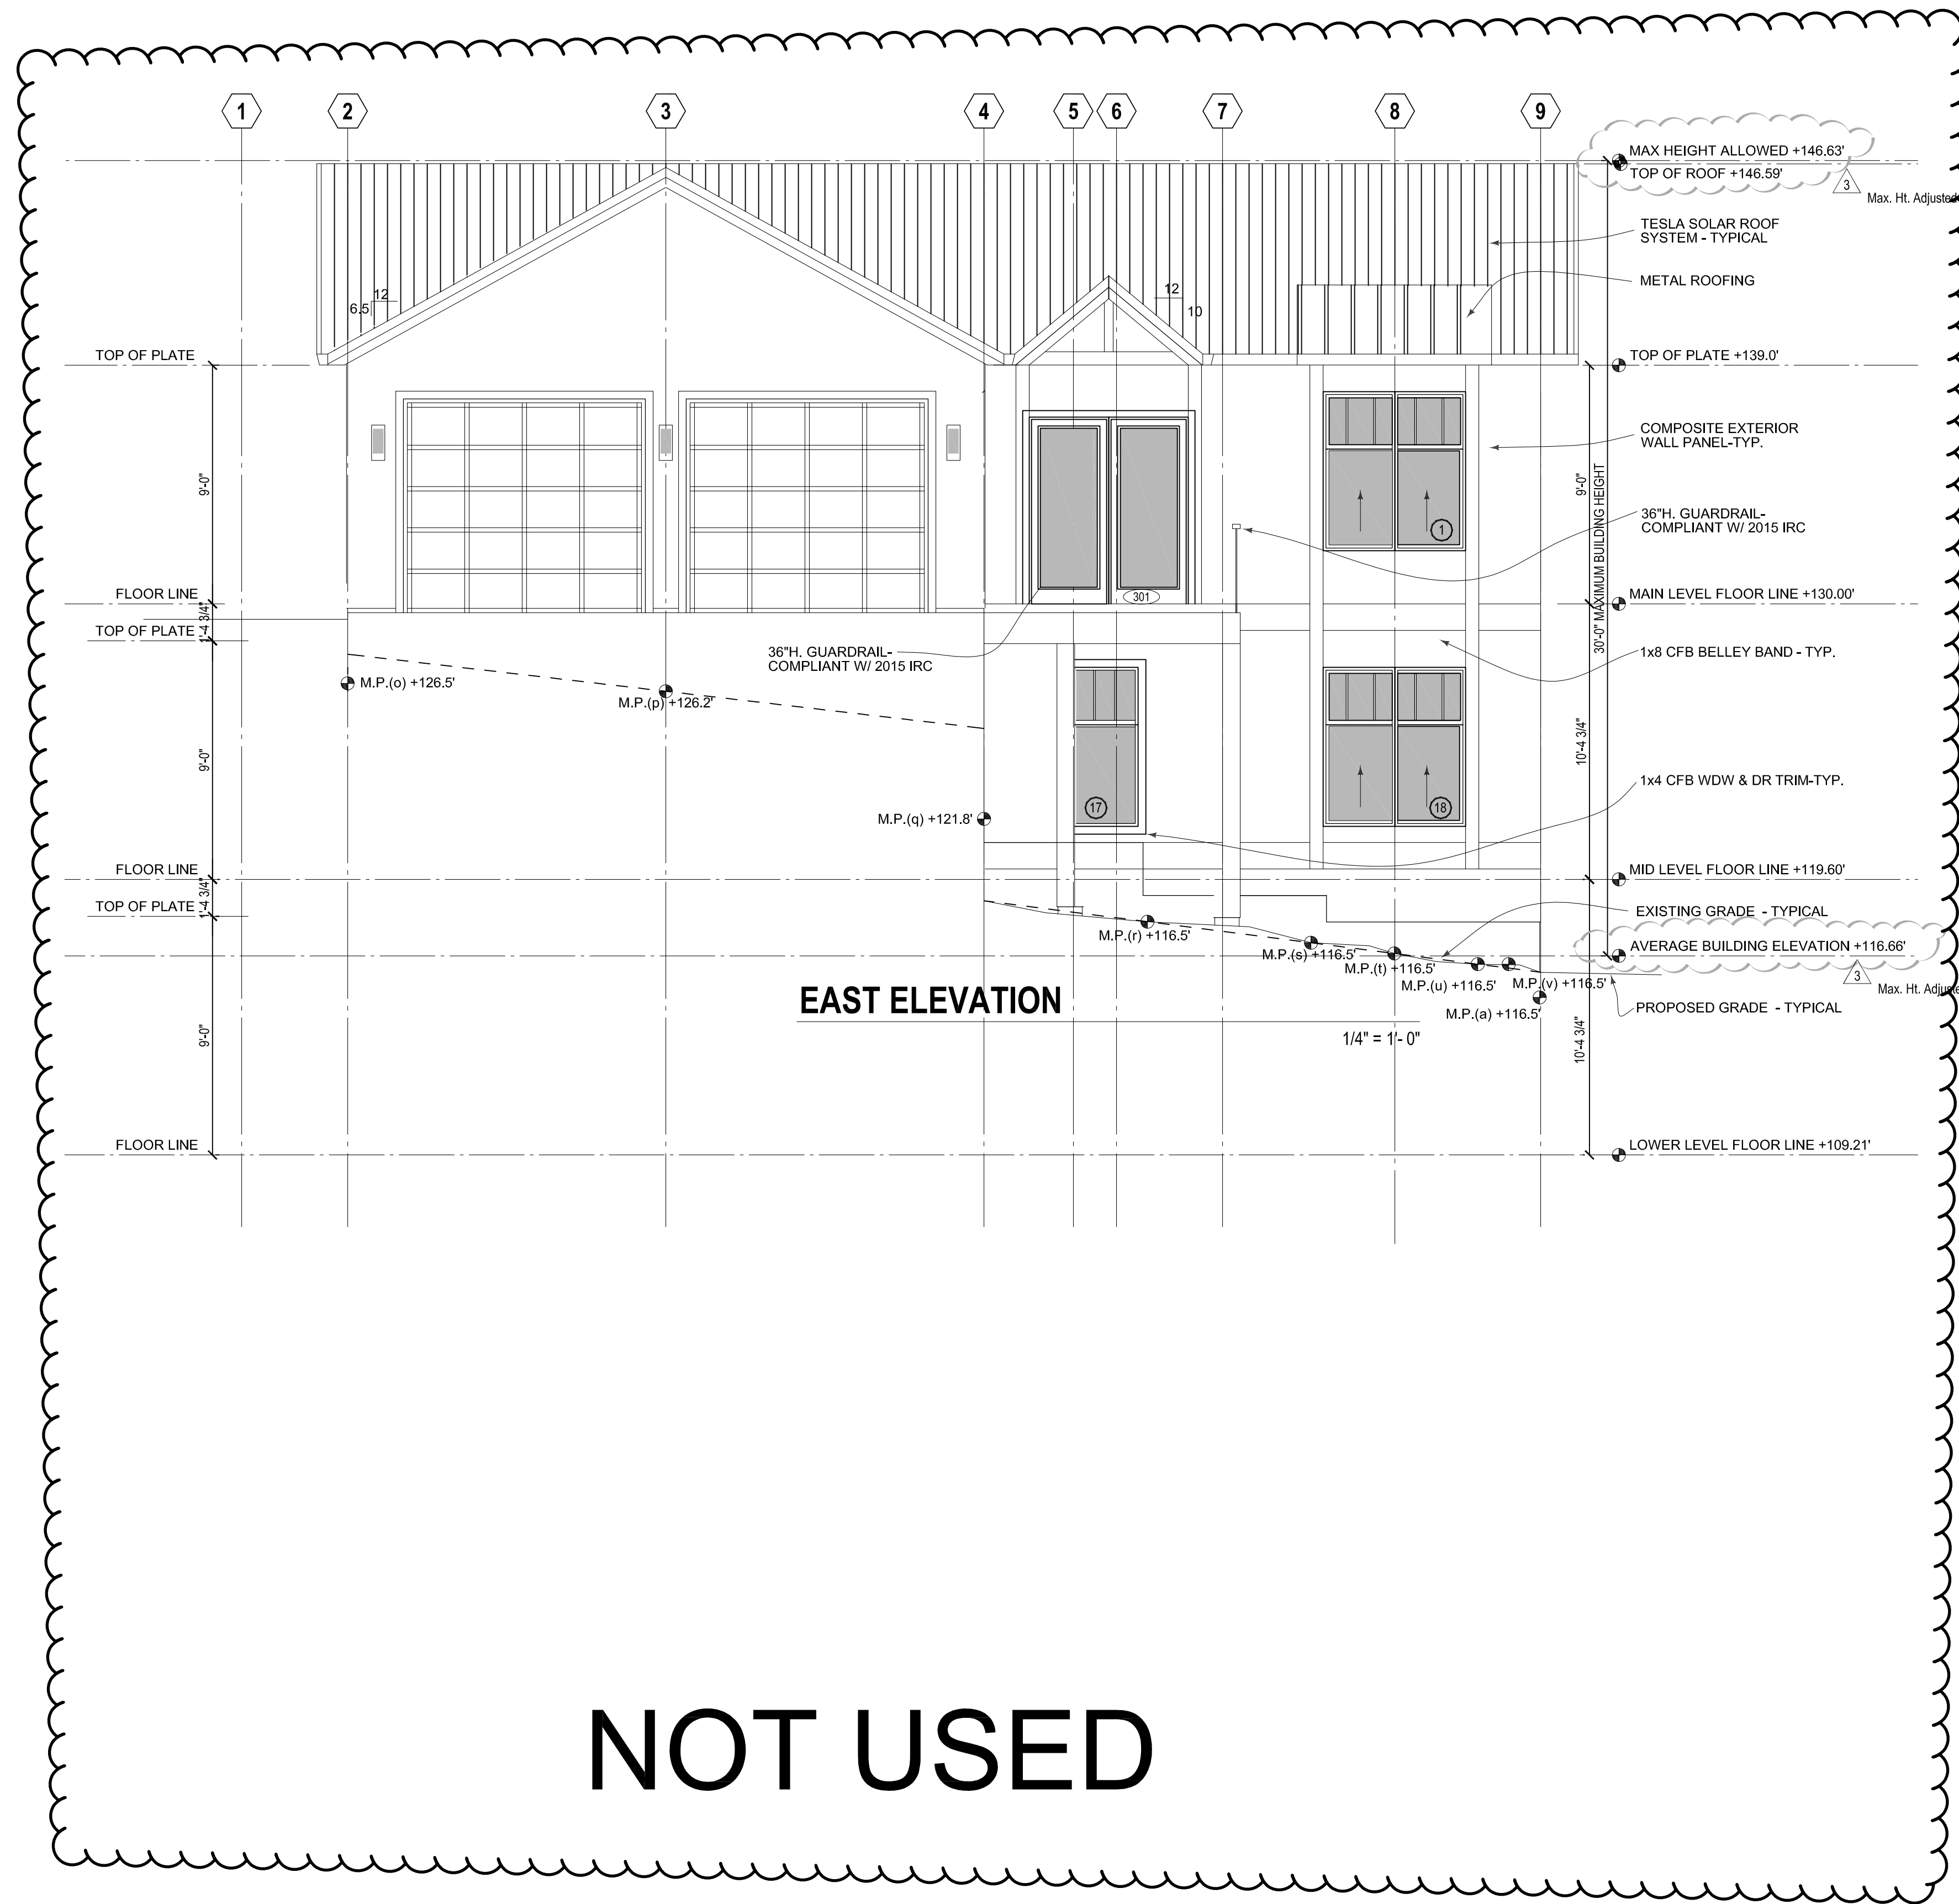

4 Ext. Finishes Updated for Field Revision

2 EAVE RETURN @ RAKE CORNER
 1-1/2" = 1'-0" SIMILAR DESIGN AT VARIOUS PITCHES - VERIFY W/ ARCHITECT

1 ROOF RAKE DETAIL
 1-1/2" = 1'-0" SIMILAR DESIGN AT VARIOUS PITCHES - VERIFY W/ ARCHITECT

ISSUANCE PERMIT SET 5/15/18

3 3-31-19 Maximum Building Height Clarified

4 FIELD REVISION SUBMITTAL SET 1/25/2022


PROJECT INFORMATION
 PROJECT NO: 8253 Me
 PROJECT MANAGER: TW
 DRAWN BY: BB

East Building Elevation

SHEET NO

A8

New Residence For:
James & Jessica Rudolf
 8253 West Mercer Way
 Mercer Island, Washington 98040

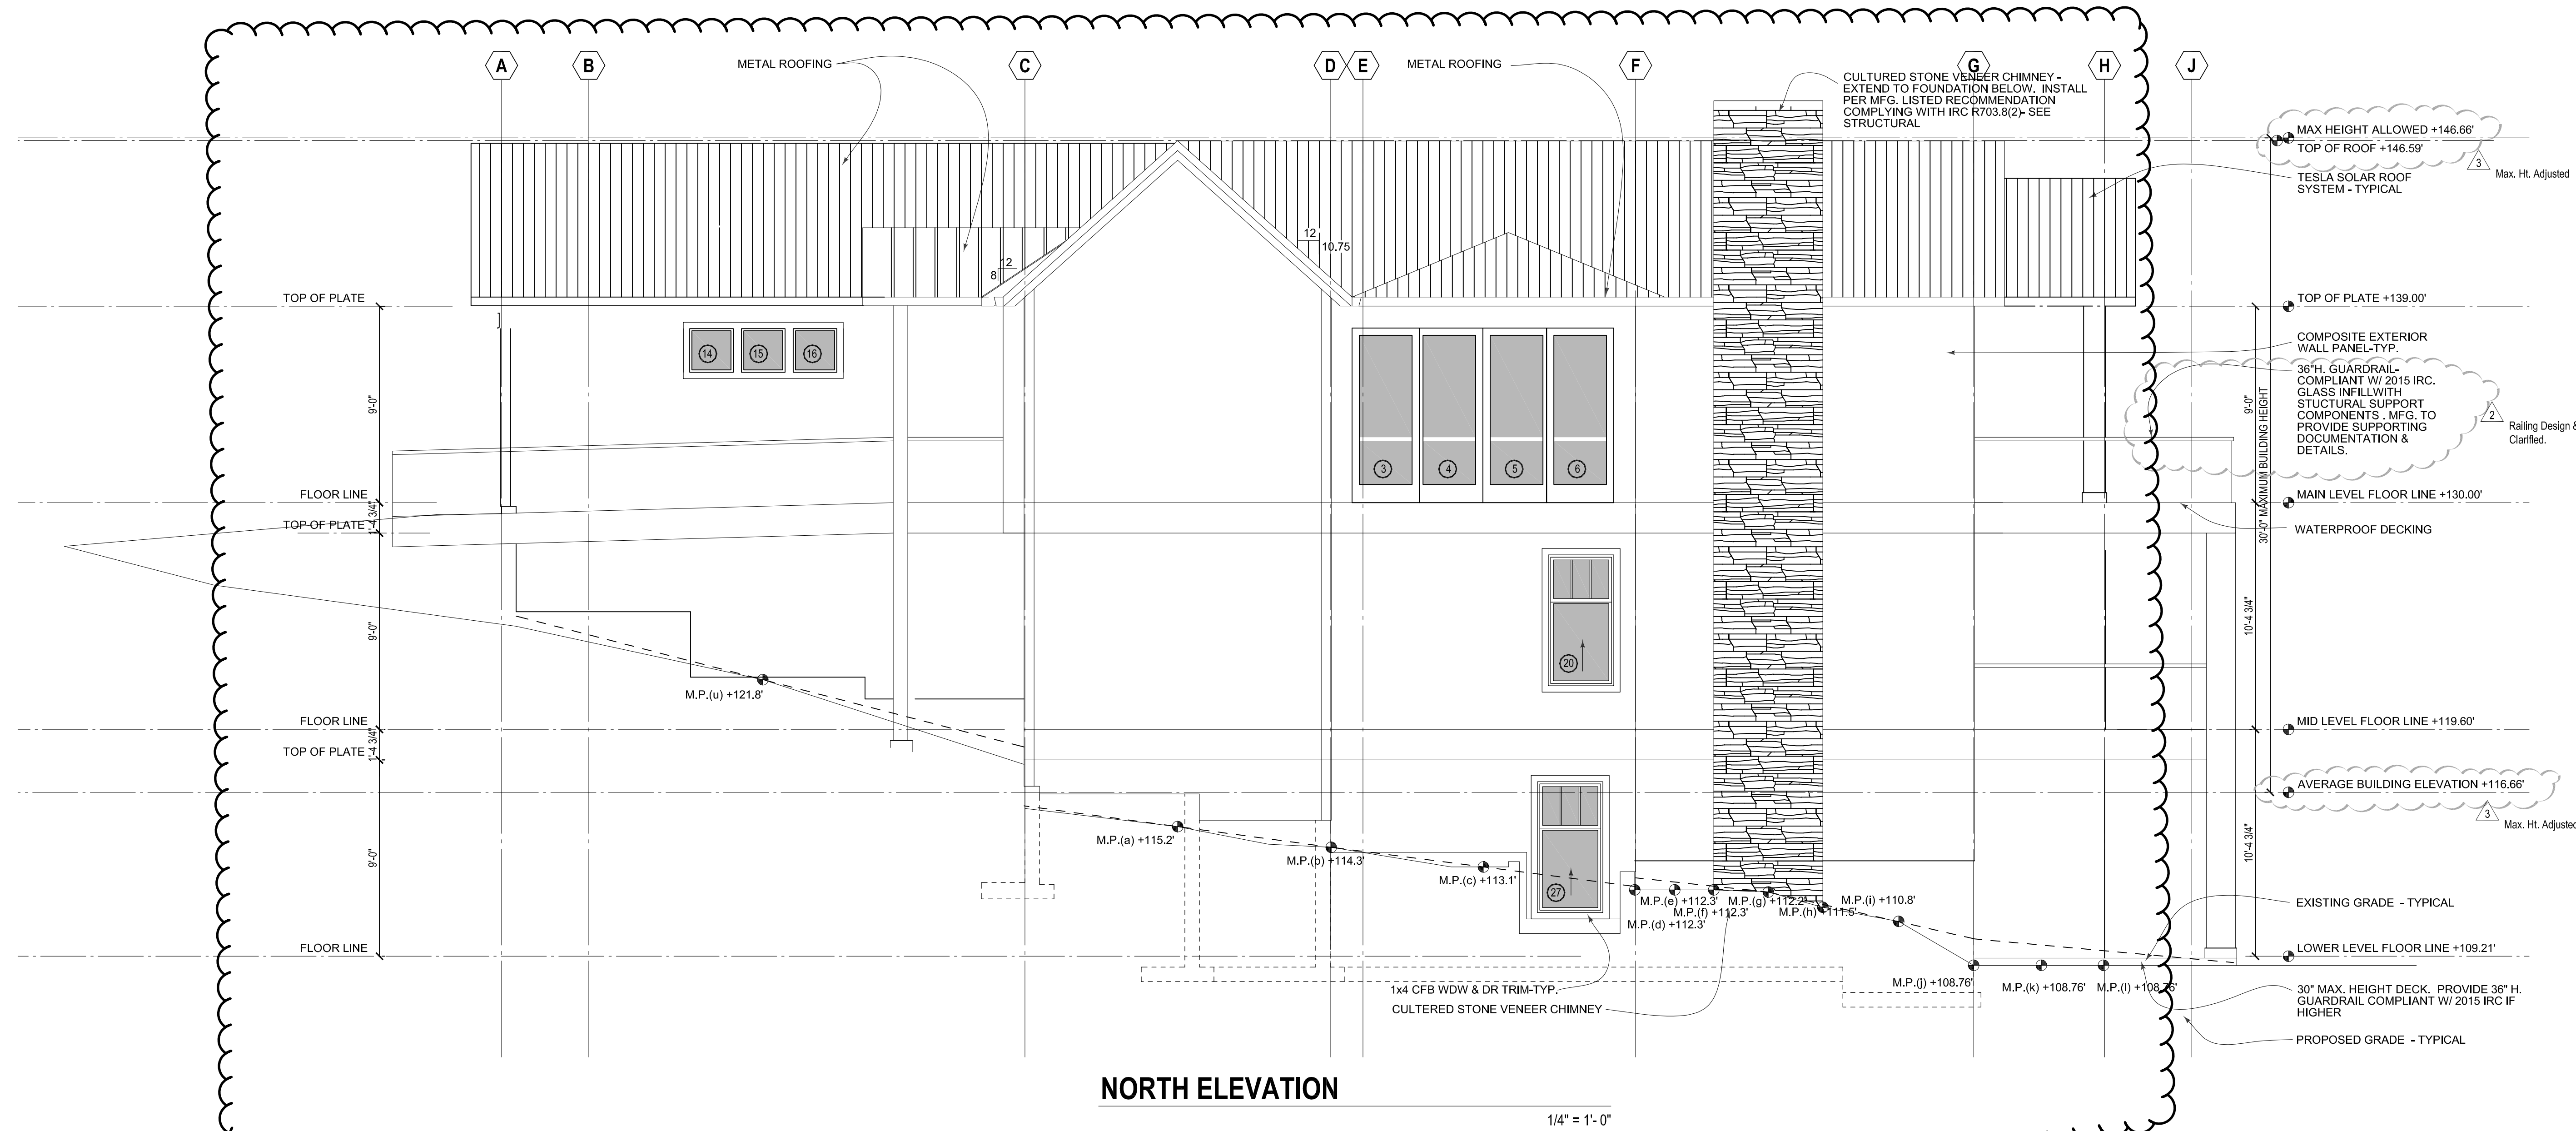

NORTH ELEVATION

1/4" = 1'-0"

NOT USED

2 **EAVE RETURN PLAN @ RAKE CORNER**
 1-1/2" = 1'-0" SIMILAR DESIGN AT VARIOUS PITCHES - VERIFY W/ ARCHITECT

4 Ext. Finishes Updated for Field Revision

ISSUANCE PERMIT SET 5/15/18

3 3-31-19 Maximum Building Height Clarified

4 FIELD REVISION SUBMITTAL SET 1/25/2022



PROJECT INFORMATION	
PROJECT NO:	8253 Me
PROJECT MANAGER:	TW
DRAWN BY:	BB

North Building Elevation


SHEET NO

A9

New Residence For:
James & Jessica Rudolf
 8253 West Mercer Way
 Mercer Island, Washington 98040

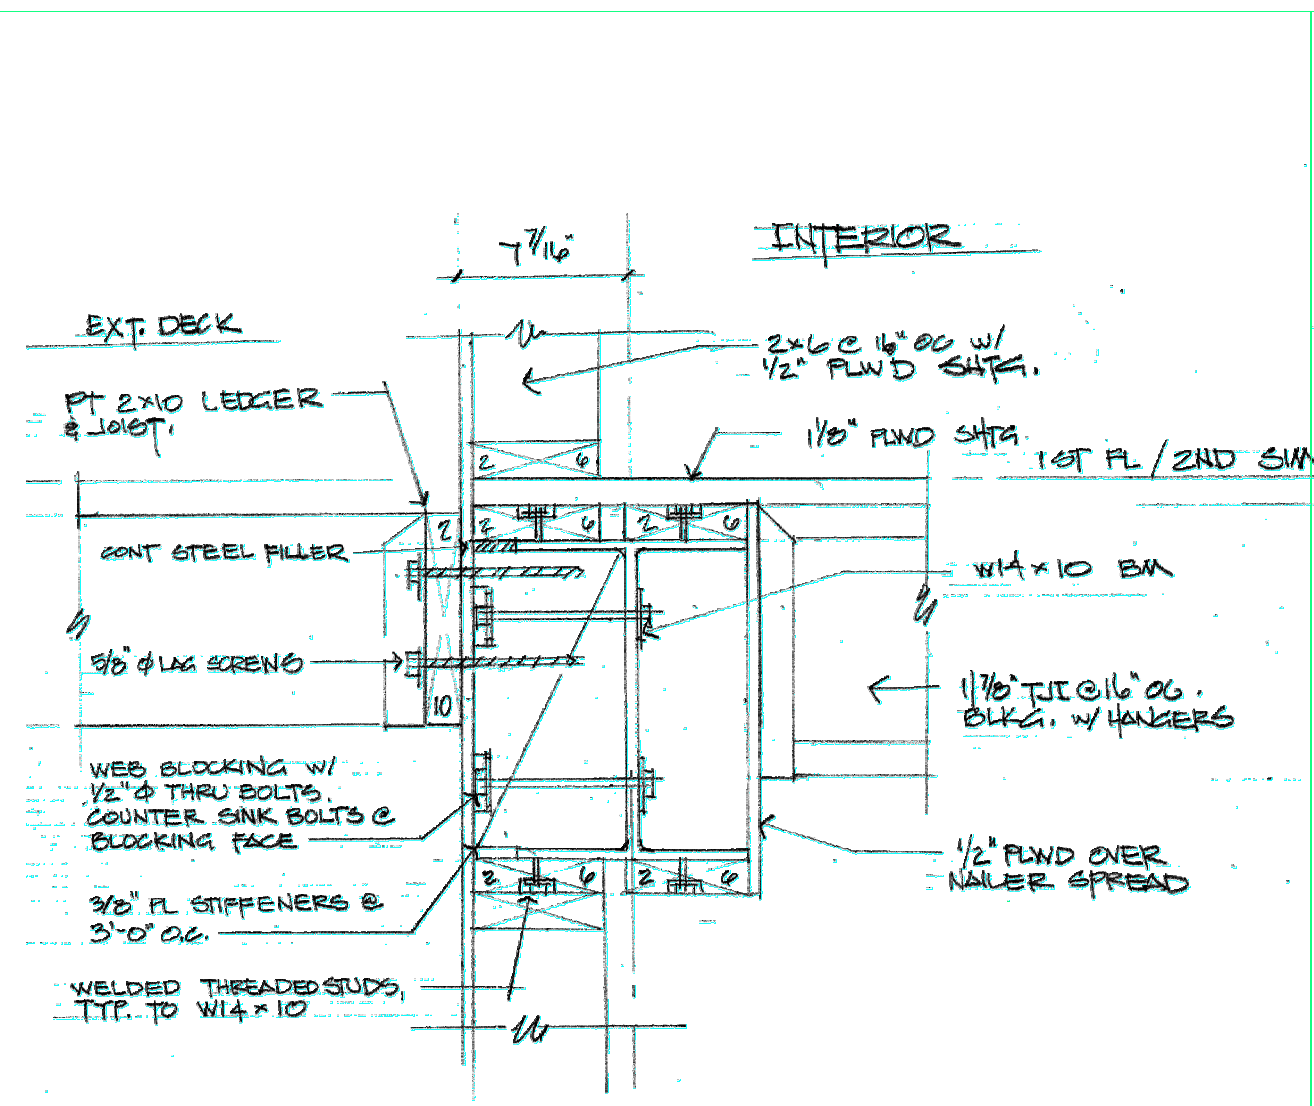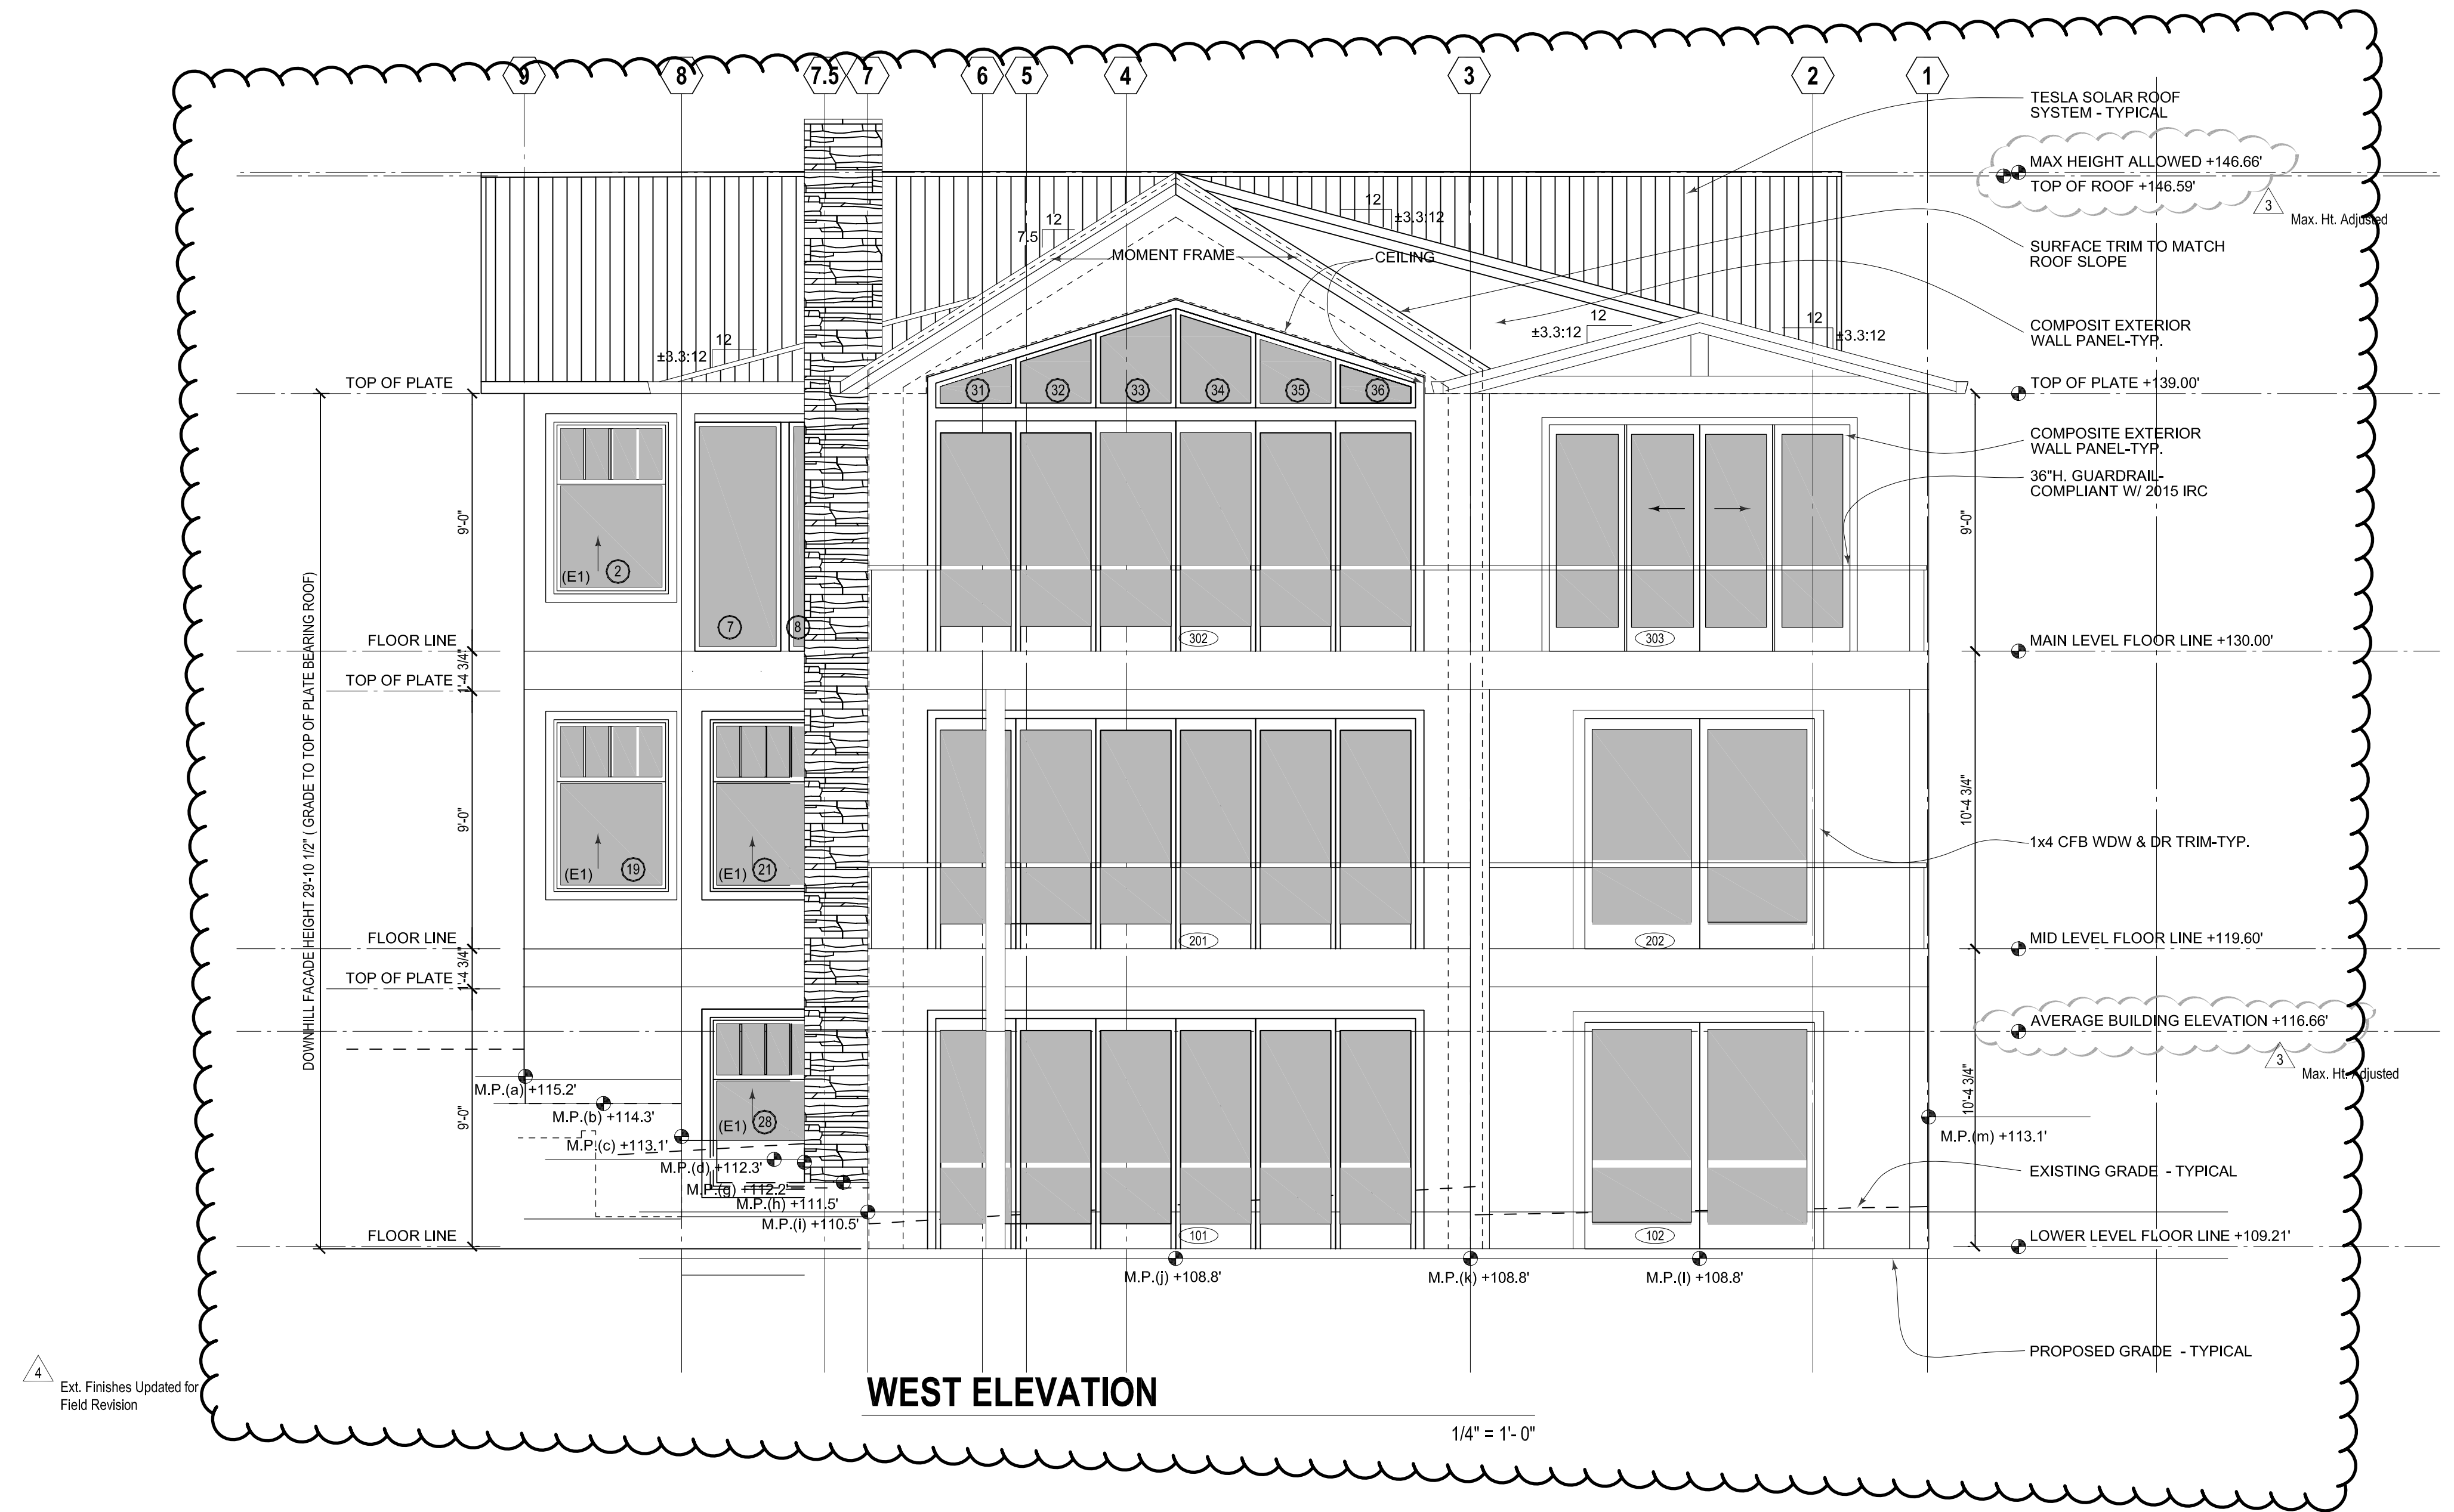

2 **DETAIL @ MOMENT FRAME BEAM**
 1-1/2" = 1'-0" SEE STRUCTURAL DETAIL

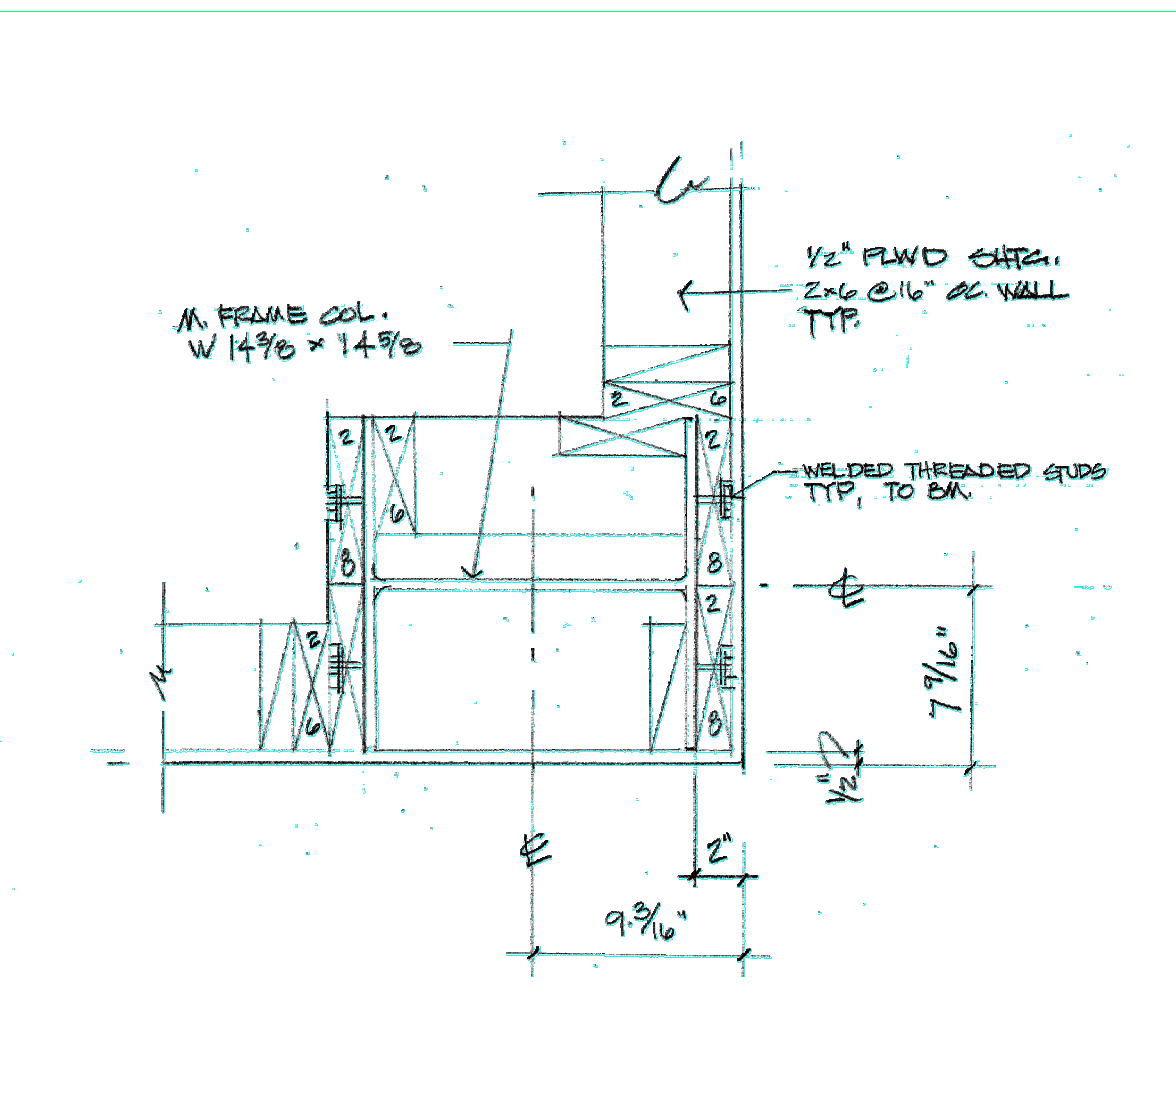

1 **MOMENT FRAME DETAIL @ COLUMN**
 1-1/2" = 1'-0" SEE STRUCTURAL DETAIL

ISSUANCE PERMIT SET 5/15/18

3-31-19 Maximum Building Height Clarified


4 FIELD REVISION SUBMITTAL SET 1/25/2022

PROJECT INFORMATION	
PROJECT NO:	8253 Me
PROJECT MANAGER:	TW
DRAWN BY:	BB

West Building Elevation

SHEET NO

A10

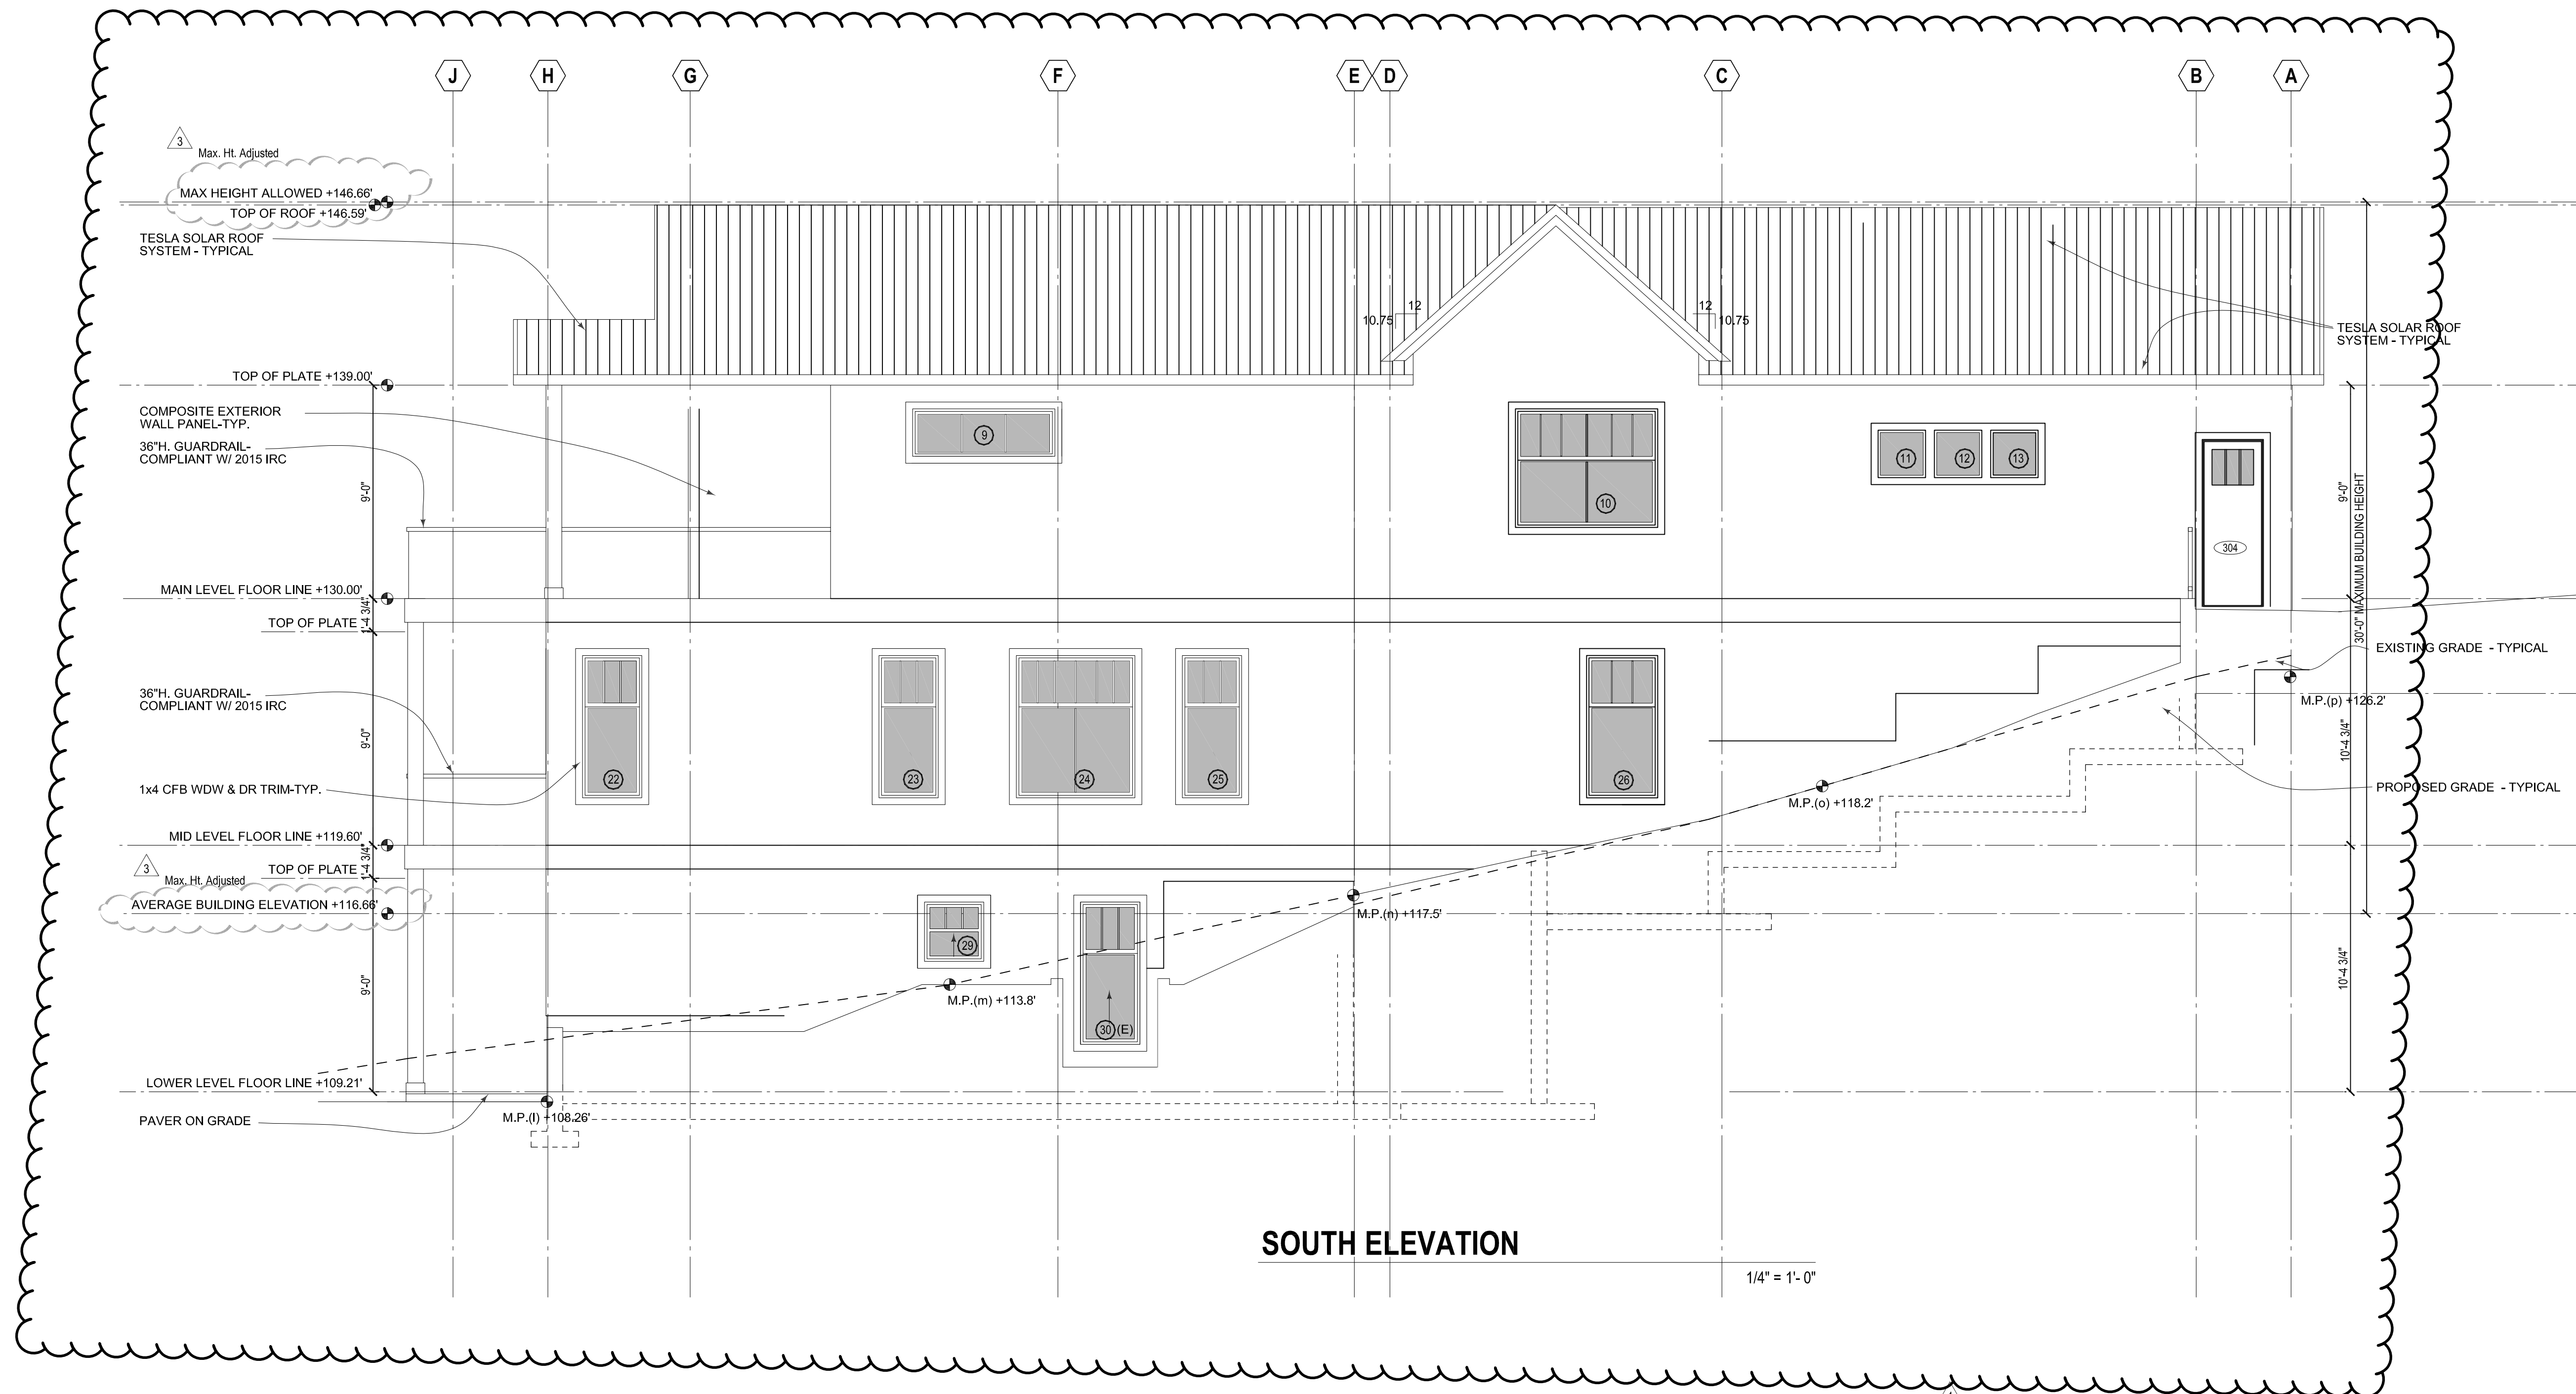

SOUTH ELEVATION

1/4" = 1'-0"

New Residence For:
James & Jessica Rudolf
 8253 West Mercer Way
 Mercer Island, Washington 98040

ISSUANCE PERMIT SET 5/15/18

3-31-19 Maximum Building Height Clarified

4 FIELD REVISION SUBMITTAL SET 1/25/2022


PROJECT INFORMATION
 PROJECT NO: 8253 Me
 PROJECT MANAGER: TW
 DRAWN BY: BB

South Building Elevation

SHEET NO

A11

4 Roof Truss Updated for Field Revision

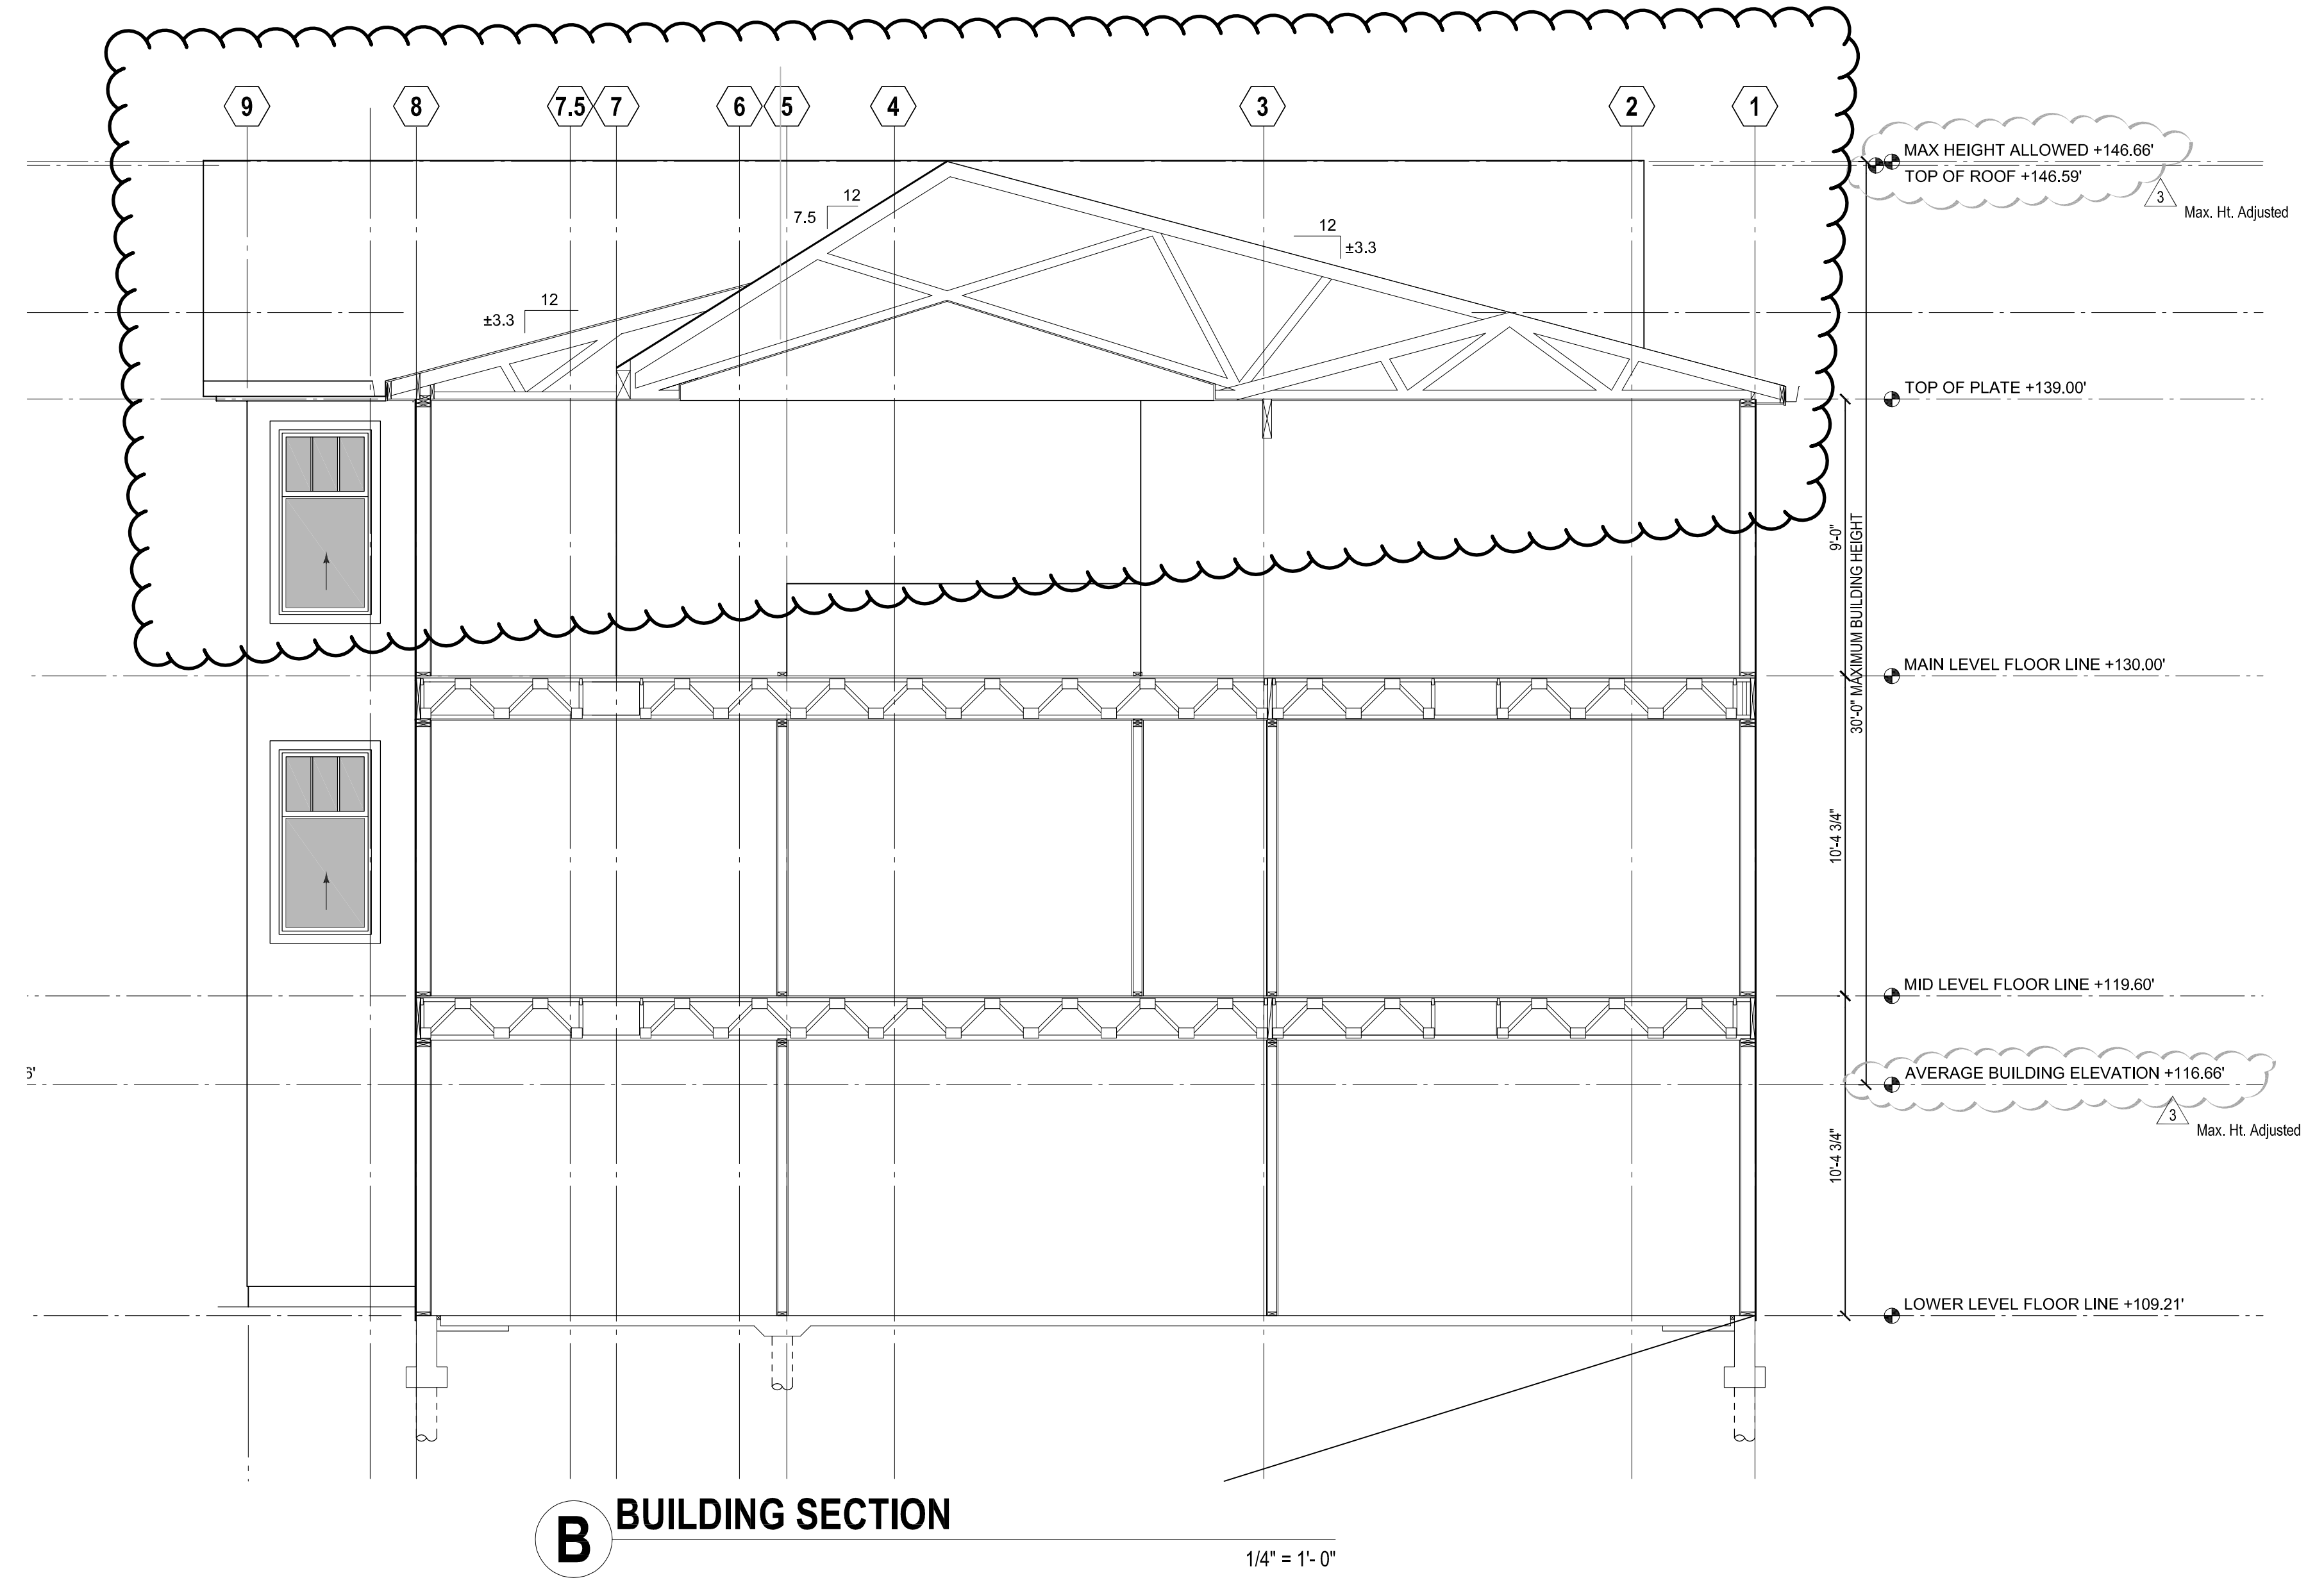

B BUILDING SECTION

1/4" = 1'-0"

TR Webb Homes

Tom Webb, Architect
10303- 14th Avenue NW, Seattle, WA 98177
TomW@KDW.net / (206) 390-1800

1628 46th Street SE, Everett, WA 98203
point_of_vision@comcast.net
(425) 772-8207

New Residence For:
James & Jessica Rudolf
8253 West Mercer Way
Mercer Island, Washington 98040

ISSUANCE PERMIT SET 5/15/18

3 3-31-19 Maximum Building Height Clarified

4 FIELD REVISION SUBMITTAL SET 1/25/2022

PROJECT INFORMATION	
PROJECT NO:	8253 Me
PROJECT MANAGER:	TW
DRAWN BY:	BB

Building Section B

SHEET NO

A13



MARK	DATE	DESCRIPTION
	05/11/18	PERMIT SUBMITTAL
	01/18/19	COMMENT RESPONSE
	11/02/21	CONSTRUCTION REVISIONS
	11/16/21	CONSTRUCTION REVISIONS

DESIGN:	JGG
DRAWN:	ZOS
CHECK:	GAG
JOB NO:	15227.10
DATE:	05/11/18

RUDOLF RESIDENCE
8253 W MERCER WAY
MERCER ISLAND, WA 98040

UPPER FLOOR FRAMING PLAN


FILE NAME

SHEET:


S2.3

THIS FLOOR FRAMING PLAN NOTES:

- REFER TO S2.2 FOR TYPICAL FLOOR FRAMING PLAN NOTES
- GARAGE FLOOR SHALL BE 3 1/2" CONCRETE TOPPING SLAB OVER 1 1/8" T&G DECKING. CONCRETE SHALL BE REINF W/ #3 @ 18" OC EA WAY. FLOOR DECKING SHALL HAVE 16d NAILS @ 6" OC AT ALL PANEL EDGES & DIAPHRAGM BOUNDARIES & 10" OC AT INTERMEDIATE FRAMING.
- THE DECK GLULAM BEAMS ARE CEDAR & WEATHER RESISTANT.
- DRAG TRUSS ON GRID G FROM GRIDS 1-3 SHALL BE NAILED TO FLOOR DIAPHRAGM @ 4" OC TRUSS MANUFACTURE TO ACCOUNT FOR MST STRAP @ TOP CHORD.

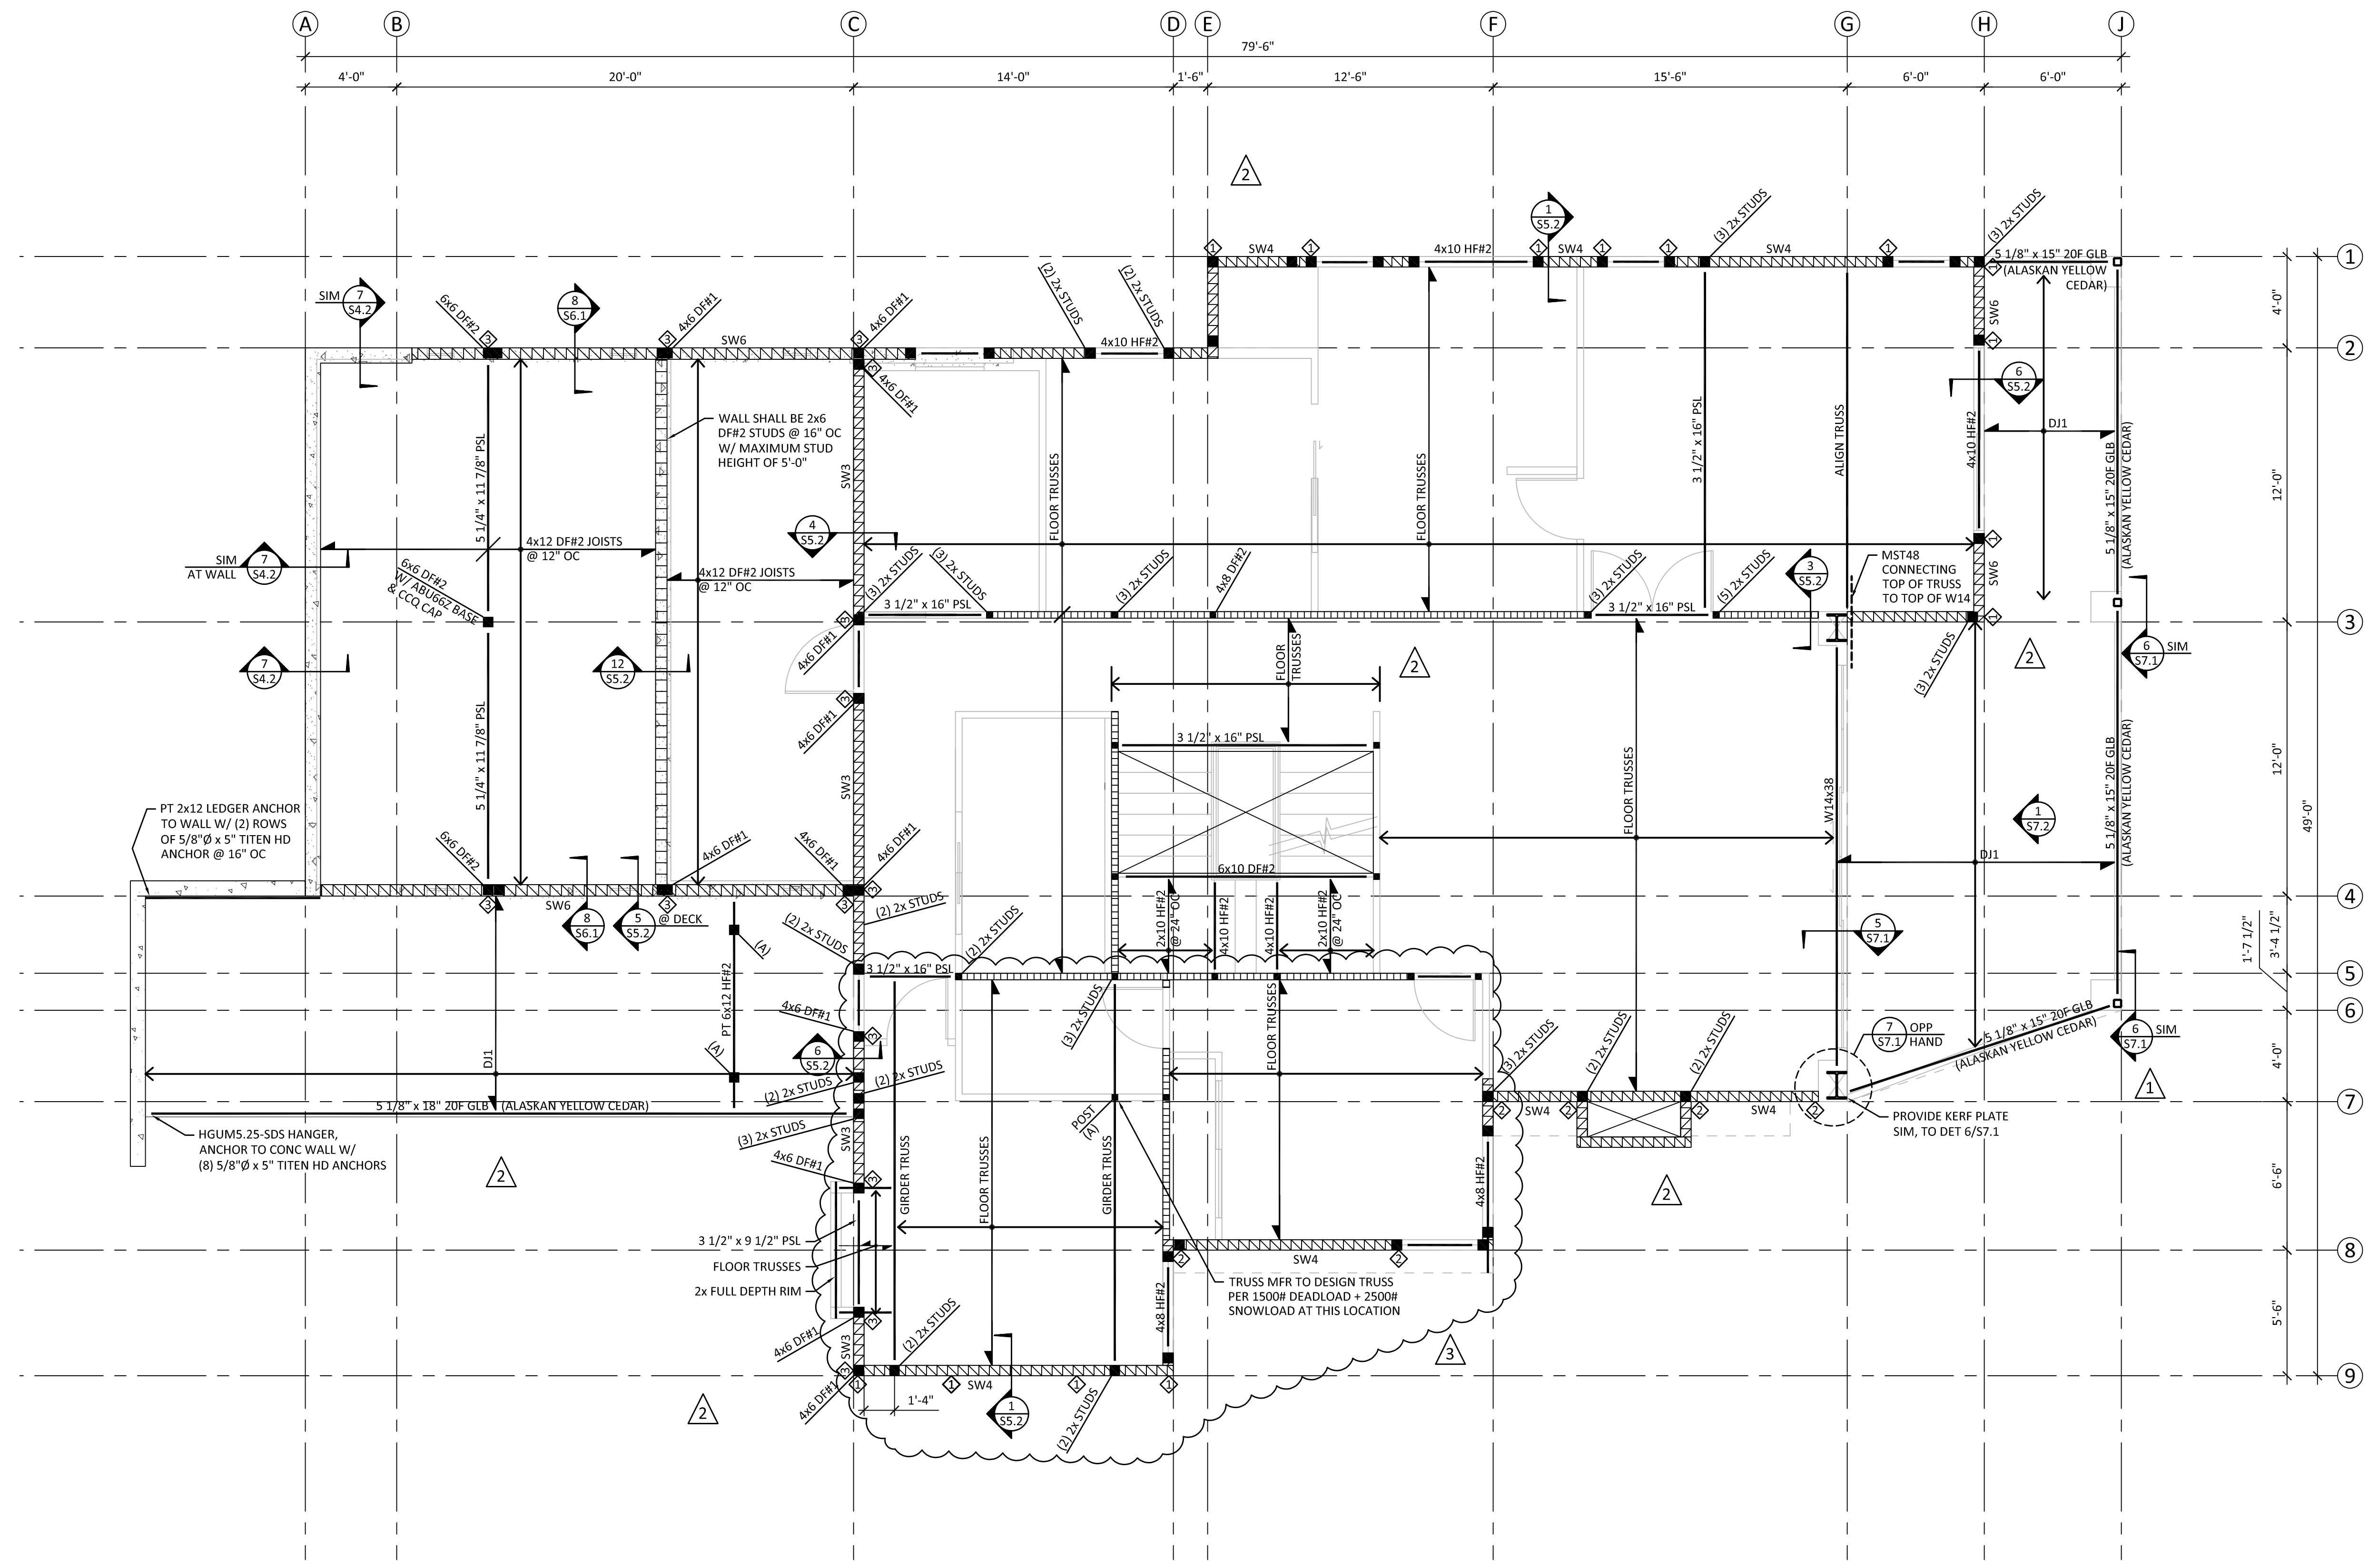

1 UPPER FLOOR FRAMING PLAN
SCALE: 1/4" = 1'-0"

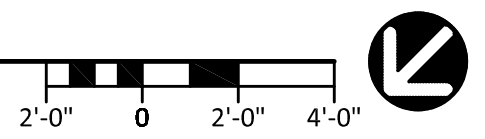





11/16/21

TYPICAL ROOF FRAMING PLAN NOTES:

- WALLS SHOWN ON ROOF FRAMING PLAN ARE WALLS BELOW ROOF FRAMING.
- BEAMS SHOWN ON ROOF FRAMING PLAN SHALL BE ABOVE DOUBLE TOP PLATE UNLESS USED AS A DOOR OR WINDOW HEADER. TRUSS MFR SHALL DESIGN TRUSSES TO ACCOMMODATE BEAMS ABOVE DOUBLE TOP PLATE.
- ROOF SHEATHING SHALL BE 5/8" PI 40/20 WITH 8d COMMON NAILS SPACED AT 6" OC AT ALL DIAPHRAGM BOUNDARIES, PANEL EDGES, SHEAR WALLS, COLLECTOR TRUSSES, AND BLOCKING OR TRUSS BLOCKING PANELS INDICATED ON PLANS. NAILING AT INTERMEDIATE FRAMING SHALL BE 8d COMMON NAILS @ 12" OC. REFER TO DETAIL 2/SS.1 FOR SHEATHING LAYOUT AND NAILING.
- UNLESS NOTED OTHERWISE, HEADERS AT ALL EXTERIOR WALLS SHALL BE 4x6 HF#2 WHERE MAXIMUM SPAN = 5'-5".
- UNLESS NOTED OTHERWISE, DOOR HEADERS AT INTERIOR BEARING WALLS SHALL BE 4x6 HF#2 WHERE MAXIMUM SPAN = 4'-6".
- STUD WALL FRAMING SHALL BE 2x HF STUDS @ 16" OC FOR ALL STUD WALLS SHOWN ON THE PLAN.
- REFER TO SHEET S6.1 FOR TYPICAL ROOF FRAMING DETAILS.
- REFER TO DETAIL 3/SS.1 FOR CONSTRUCTION OF MULTIPLE STUD COLUMNS.
- INDICATES COLUMN BELOW AND BEAM SHALL BE CONTINUED OVER COLUMN, TYP.
- REFER TO THE STRUCTURAL NOTES SHEET FOR COLUMNS SUPPORTING TYPICAL BEARING WALL HEADER BEAMS.
- HATCHED AREAS INDICATE VALLEY TRUSSES @ 24" OC APPLIED ABOVE PLYWOOD SHEATHING. REFER TO TYPICAL OVERFRAMING DETAIL ON S6.1.
- COLUMNS AND BEARING WALLS SHOWN ON PLAN SHALL BE CONTINUED DOWN TO THE FOUNDATION UNLESS CARRIED BY A BEAM BELOW.
- HOLD-DOWNS SHOWN ON ROOF FRAMING PLAN SHALL BE PLACED ON UPPER FLOOR LEVEL.
- ROOF TRUSSES SHALL BE PRE-ENGINEERED BY OTHERS AND SPACED AT 24" OC, TYP.
- ATTACH ALL ROOF TRUSSES TO WALLS BELOW WITH SIMPSON H2.5 HURRICANE TIES.
- ALIGN (2) STUDS MIN BELOW ENDS OF GIRDER TRUSSES UNO ON PLANS.
- PROVIDE ATTIC ACCESS AND VENTILATION OPENINGS IN ROOF SHEATHING AT OVERFRAMED AREAS PER THE ARCHITECTURAL DWGS.

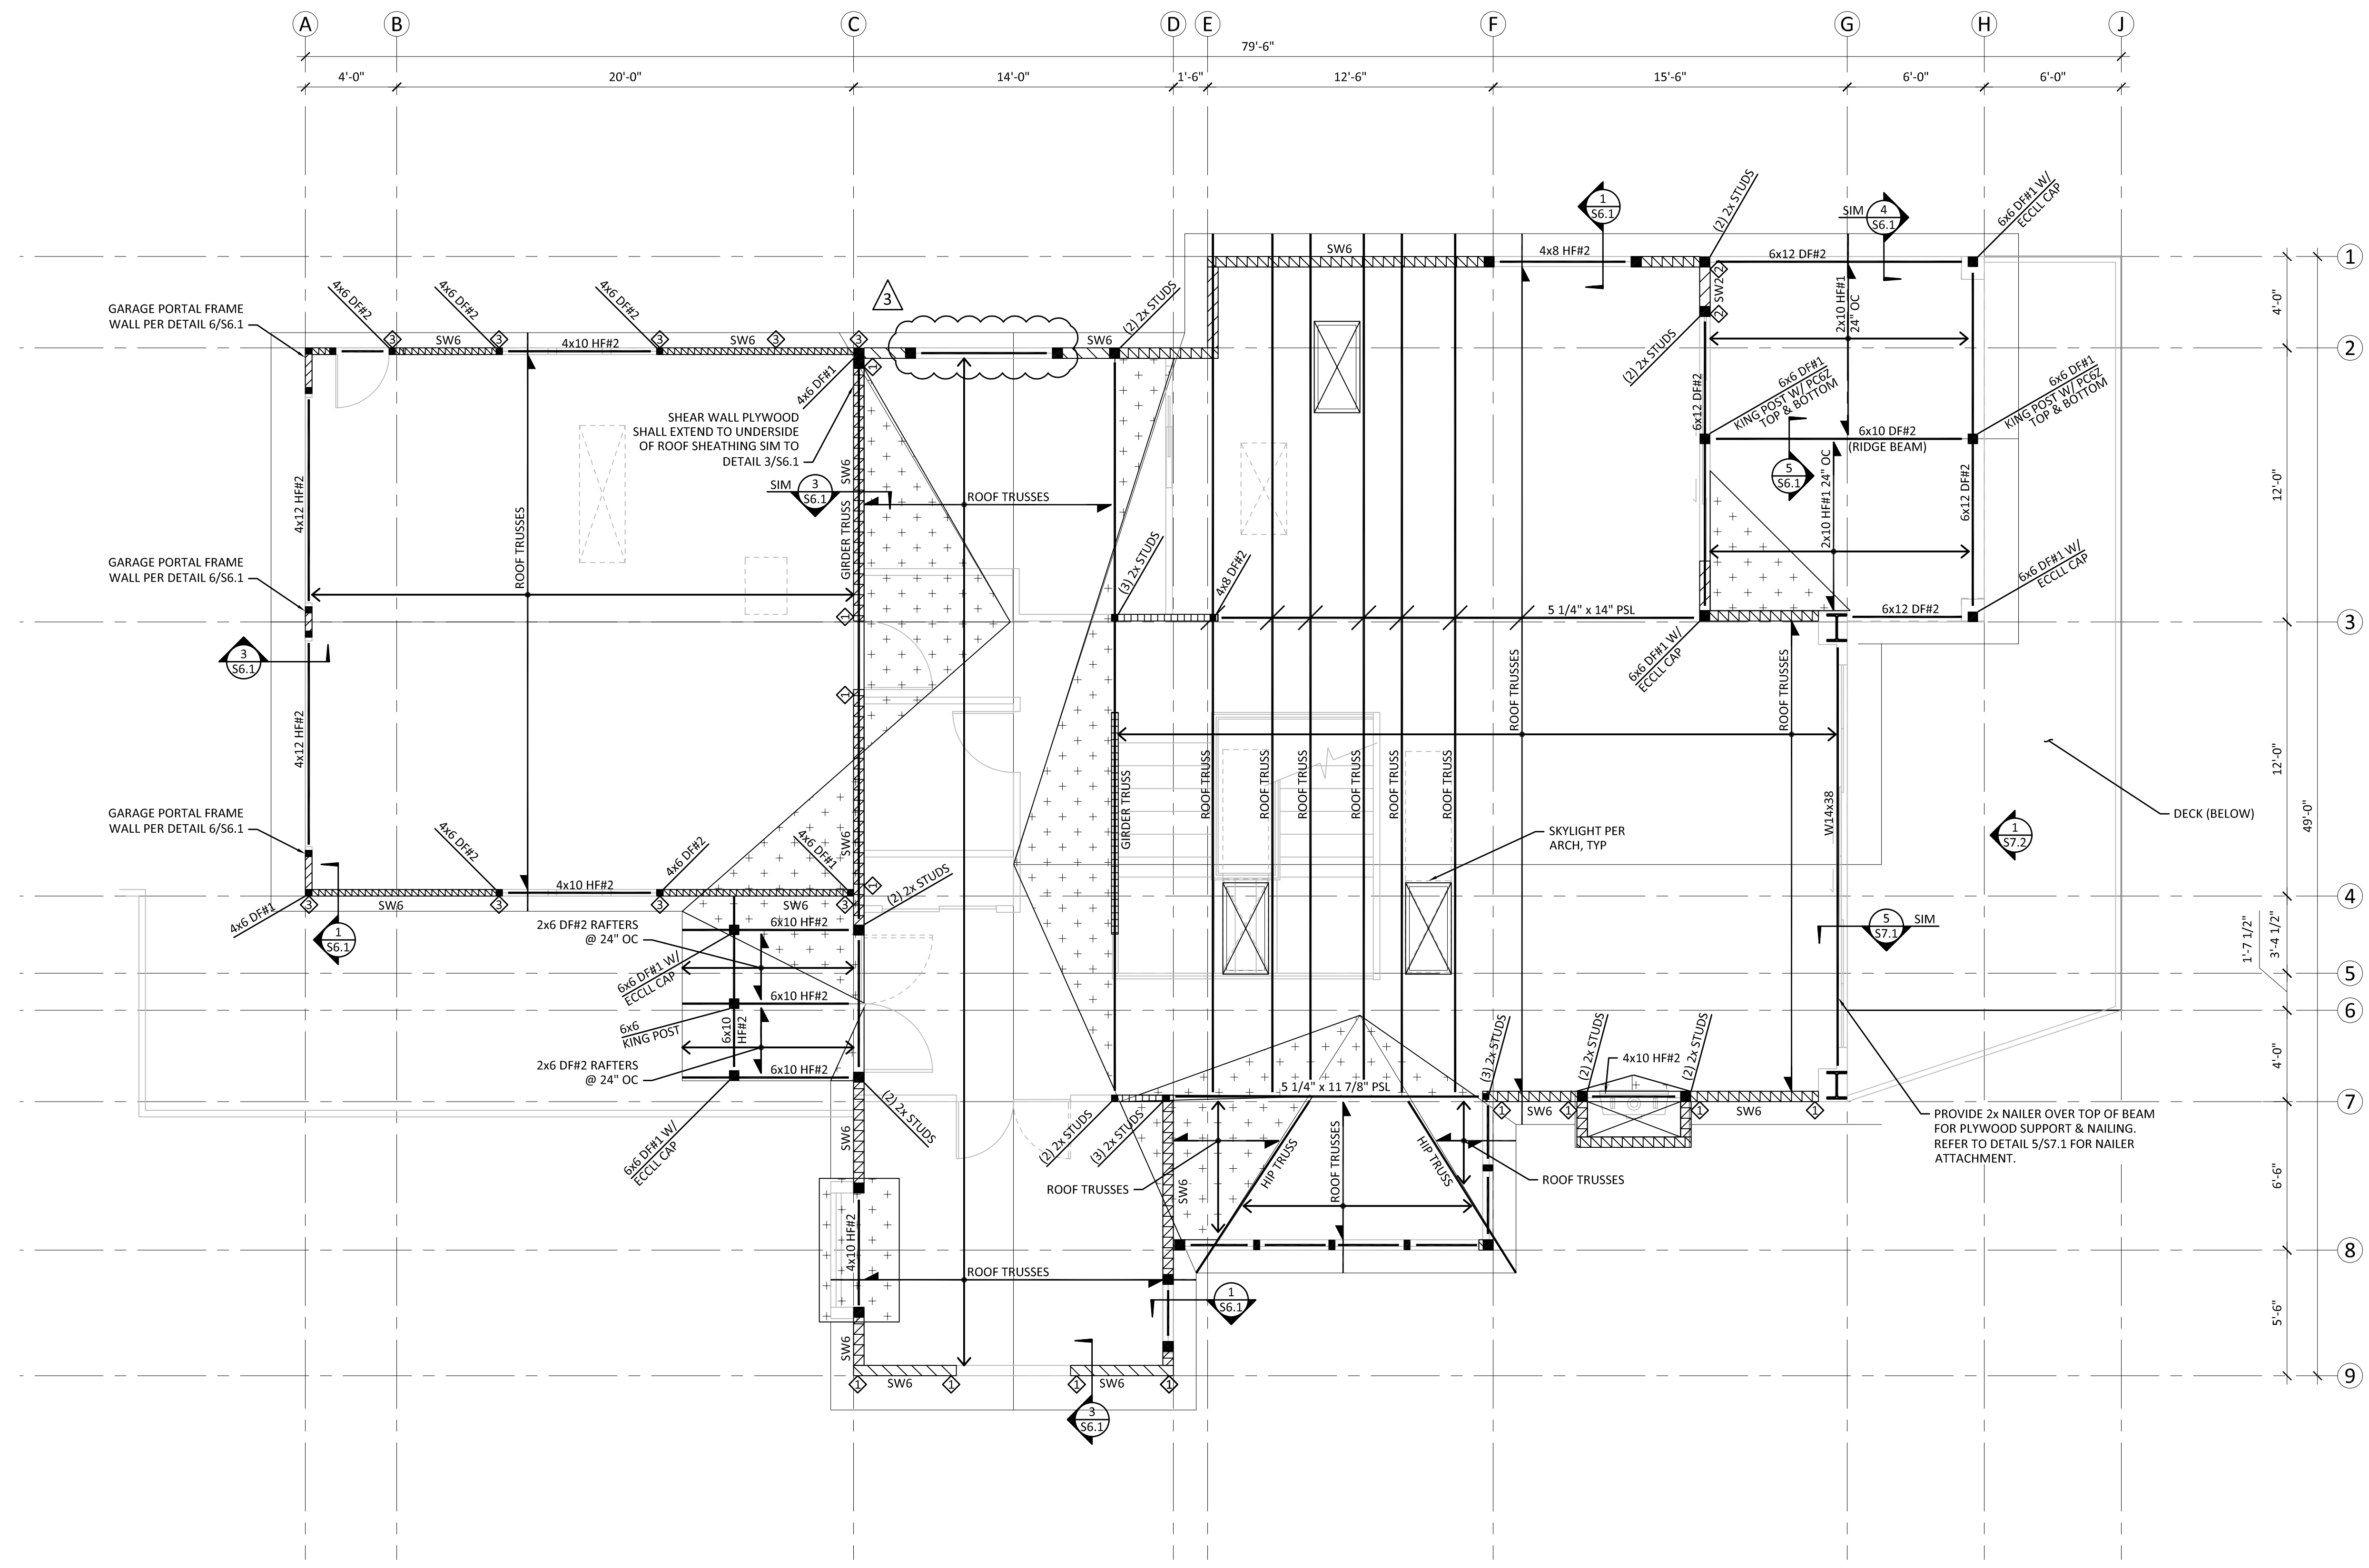

1 ROOF FRAMING PLAN
SCALE: 1/4" = 1'-0"

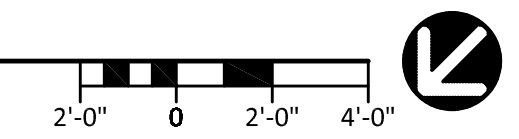

RUDOLF RESIDENCE
8253 W MERCER WAY
MERCER ISLAND, WA 98040

ROOF FRAMING PLAN






SHEET:
S2.4

FILE NAME:

DATE: 05/11/18

MARK	DATE	DESCRIPTION
	05/11/18	PERMIT SUBMITTAL
	01/18/19	COMMENT RESPONSE
A	11/02/21	CONSTRUCTION REVISIONS
A	11/16/21	CONSTRUCTION REVISIONS


DESIGN: JGG
DRAWN: ZOS
CHECK: GAG
JOB NO: 15227.10
DATE: 05/11/18

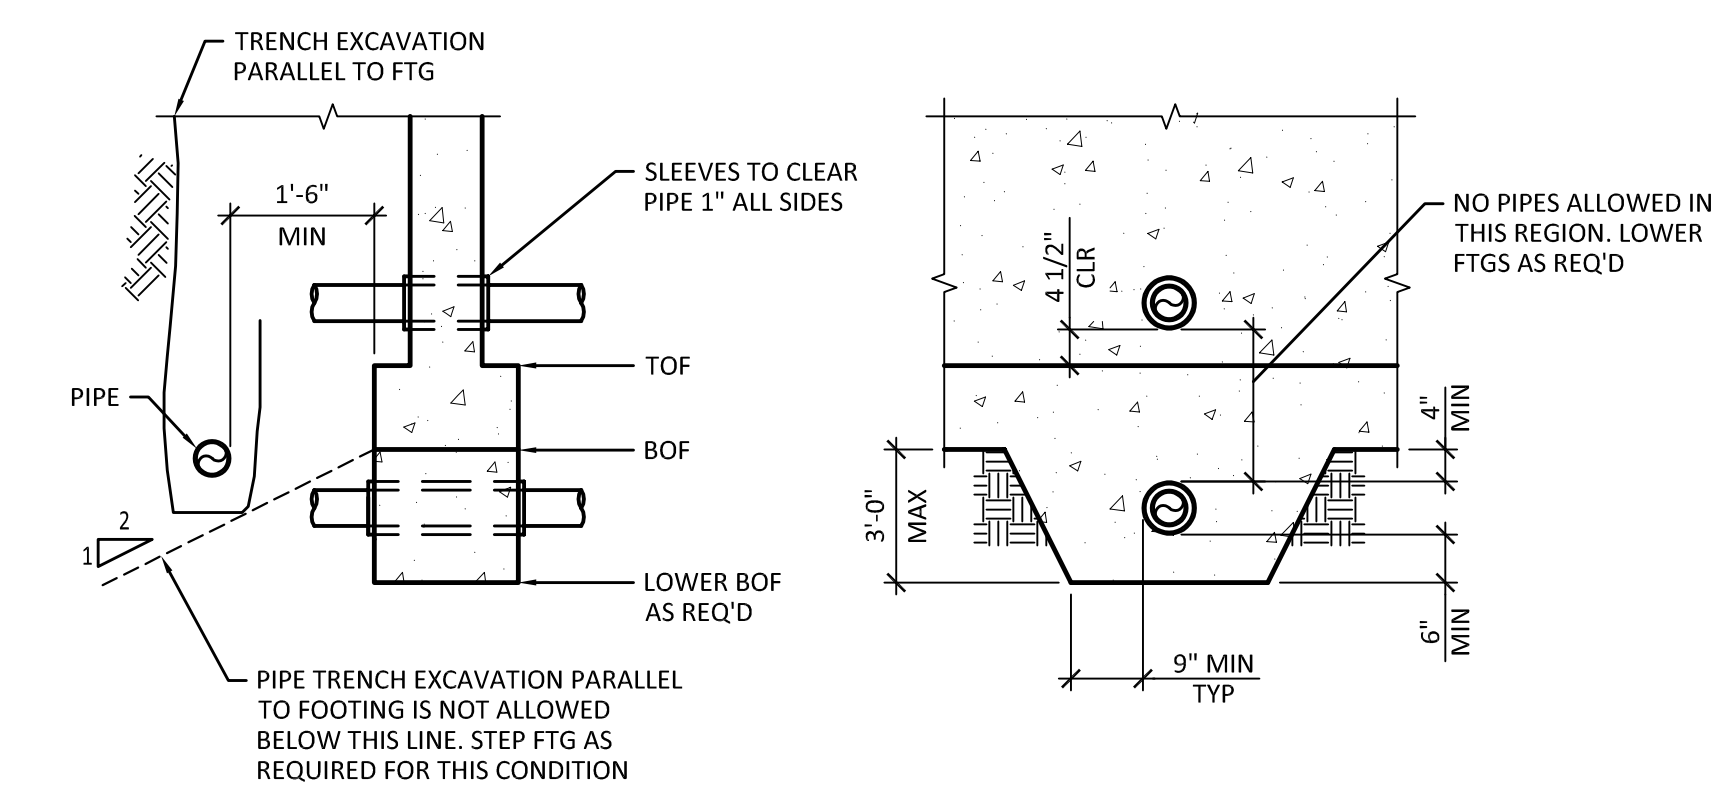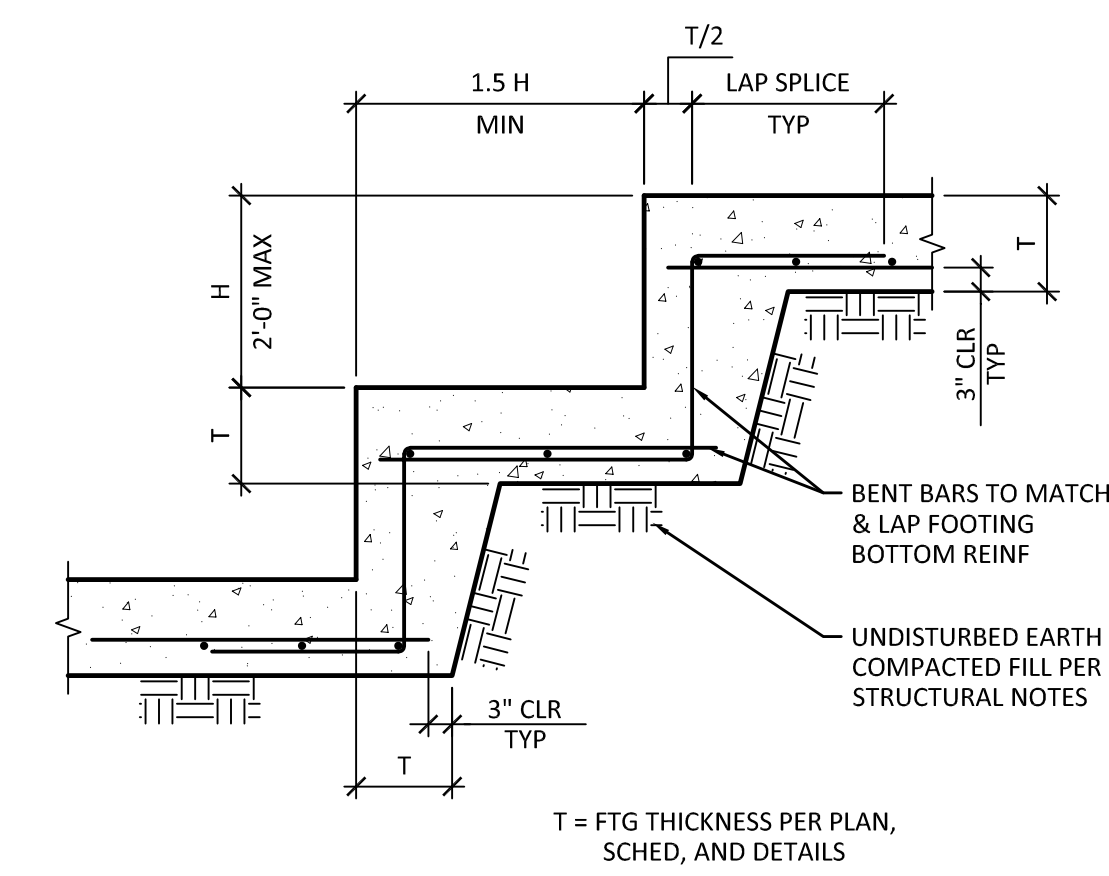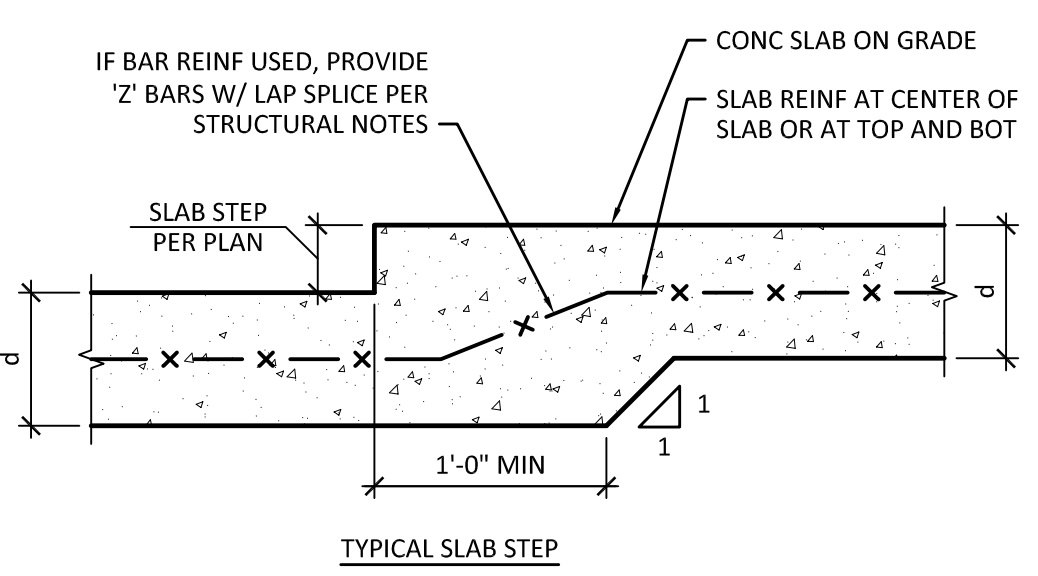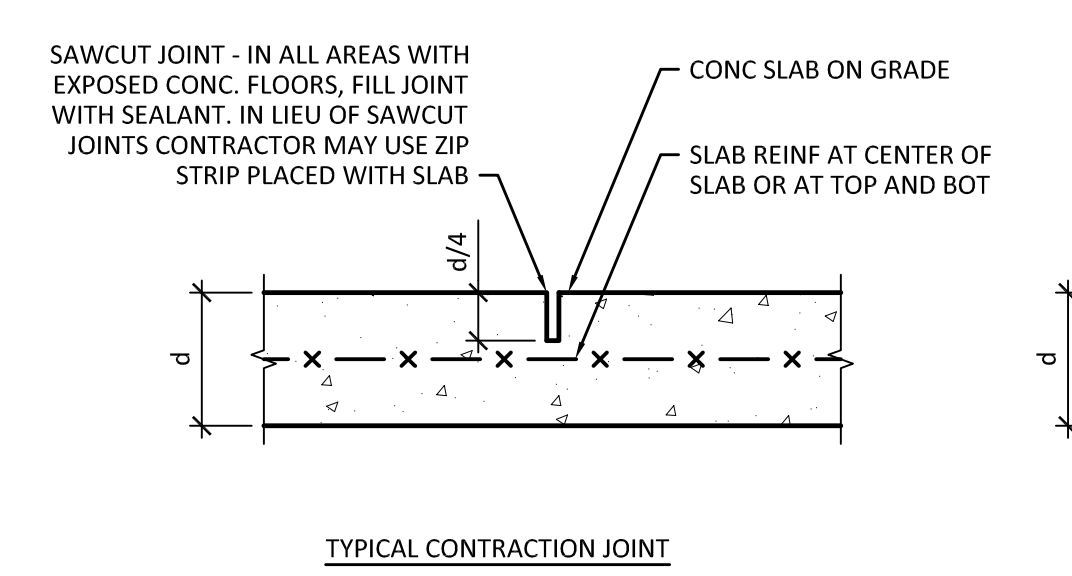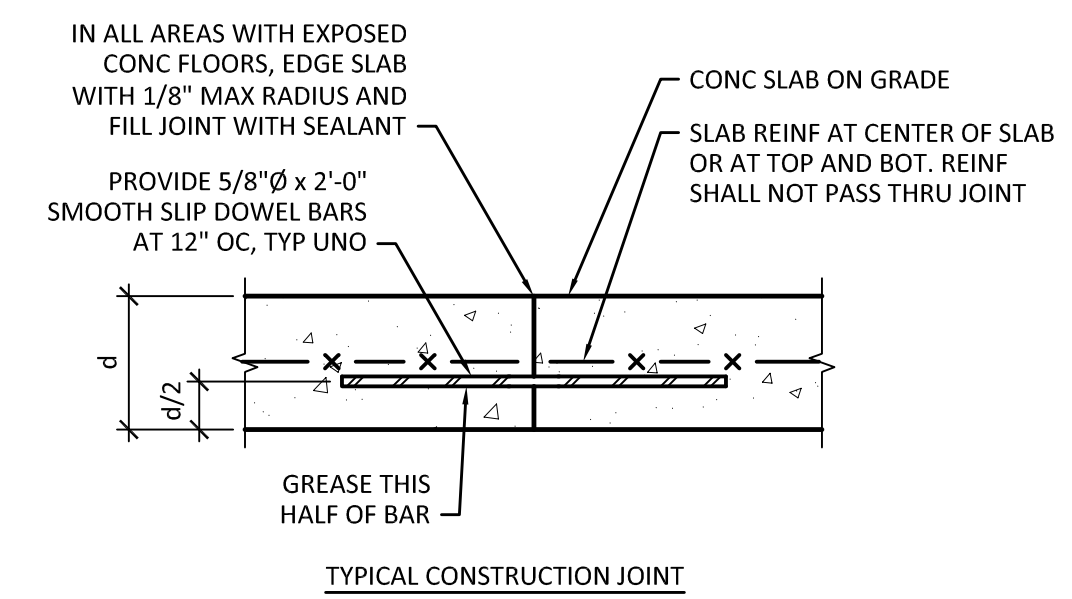


1 TYPICAL SLAB ON GRADE DETAILS
 SCALE: 1" = 1'-0"

2 TYPICAL STEPPED WALL FOOTING
 SCALE: 1/2" = 1'-0"


3 TYPICAL PIPE PENETRATION AT WALLS AND FOOTINGS
 SCALE: 1/2" = 1'-0"

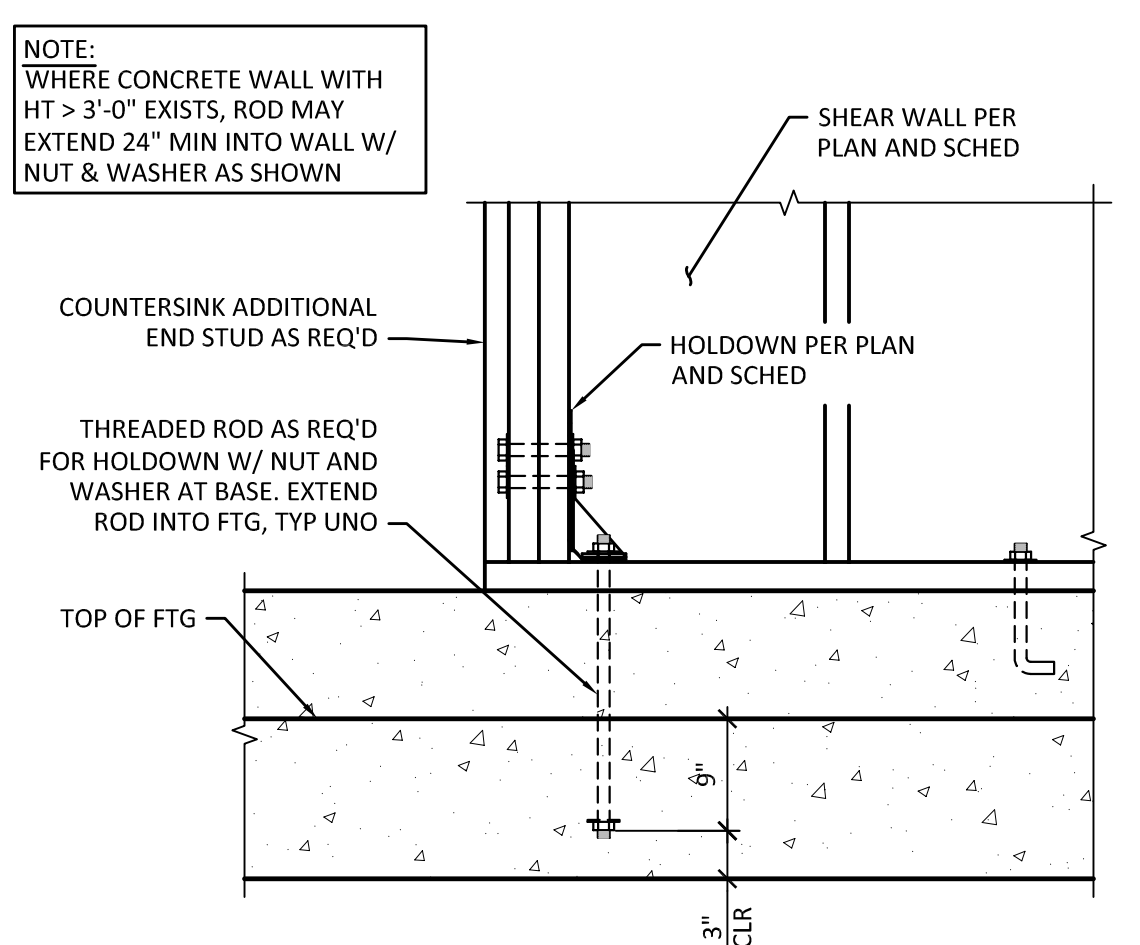


4 HOLDOWN DETAIL
 SCALE: 1" = 1'-0"

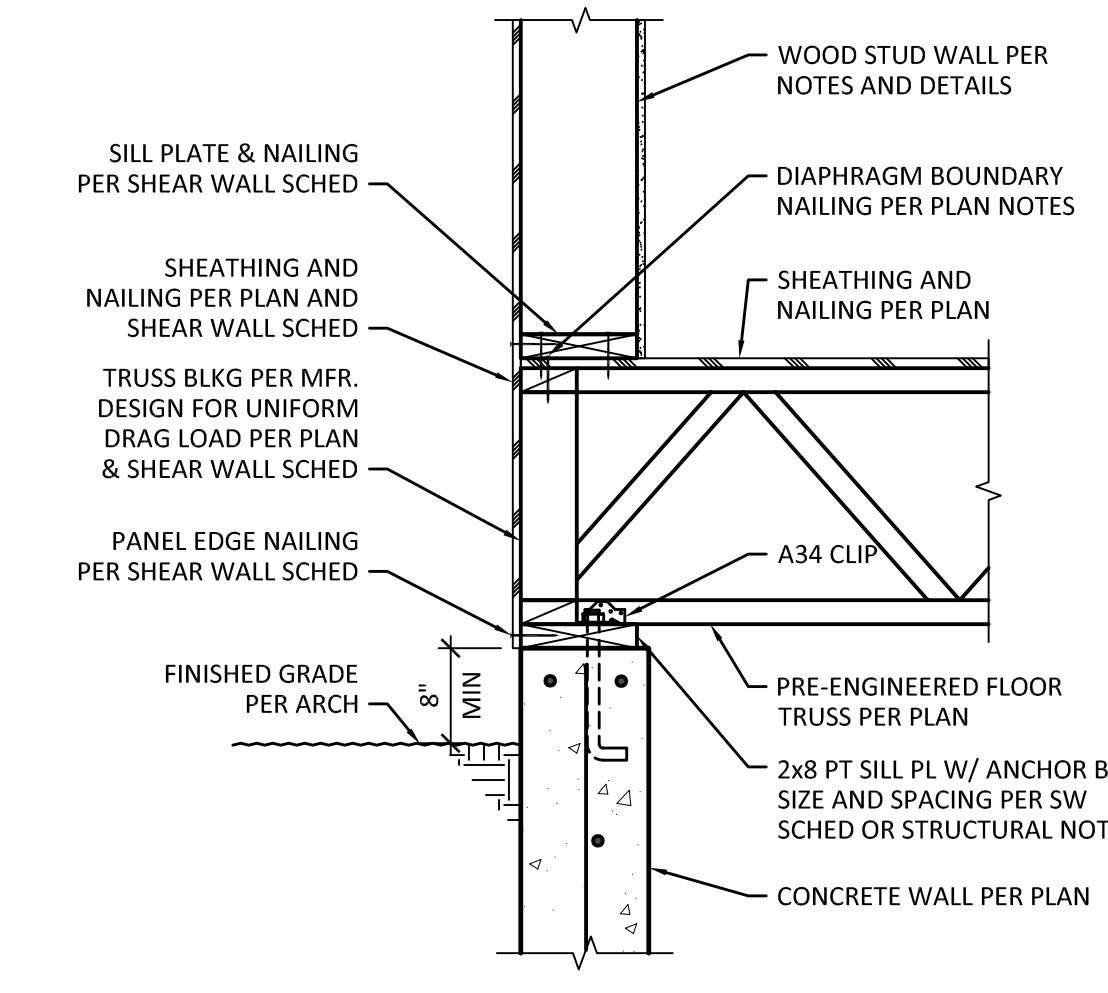

5 SECTION
 SCALE: 1" = 1'-0"

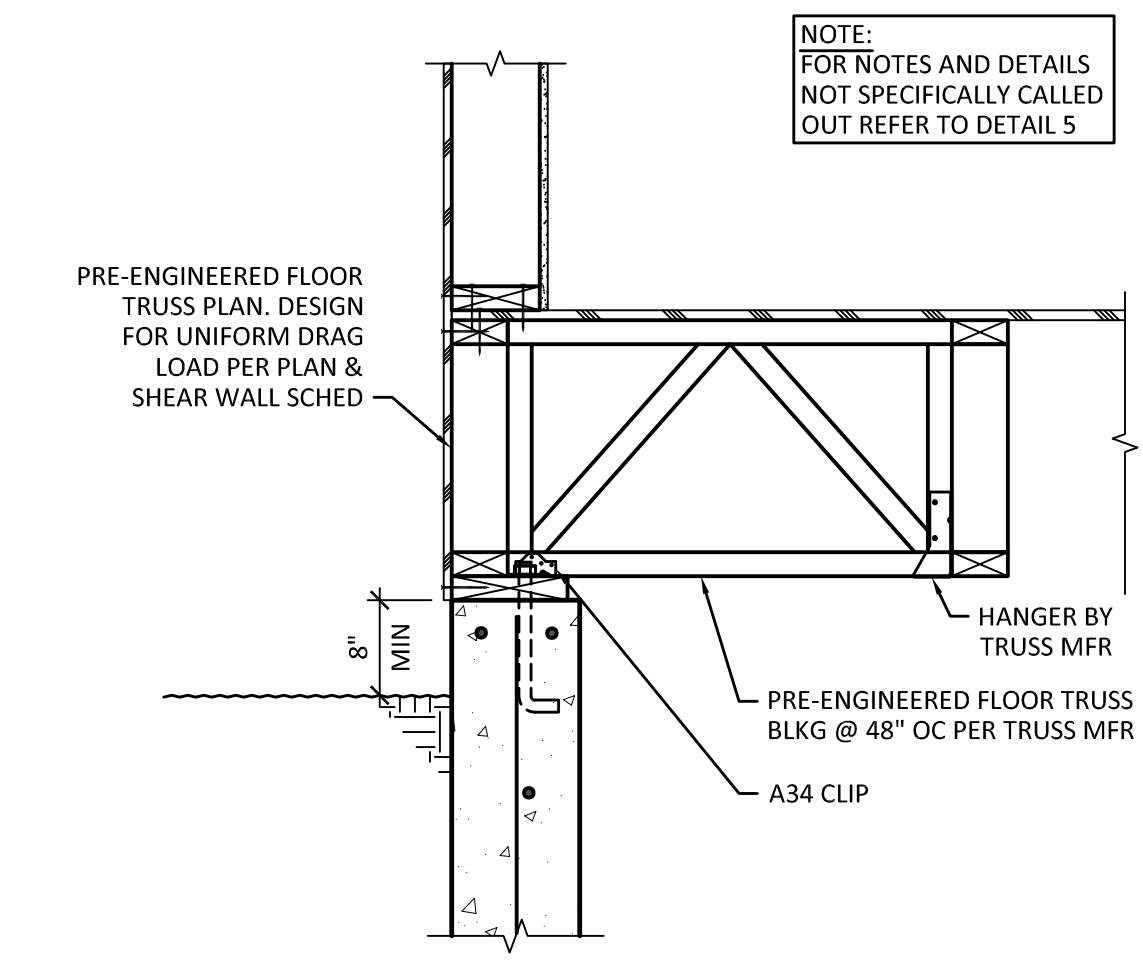

6 SECTION
 SCALE: 1" = 1'-0"

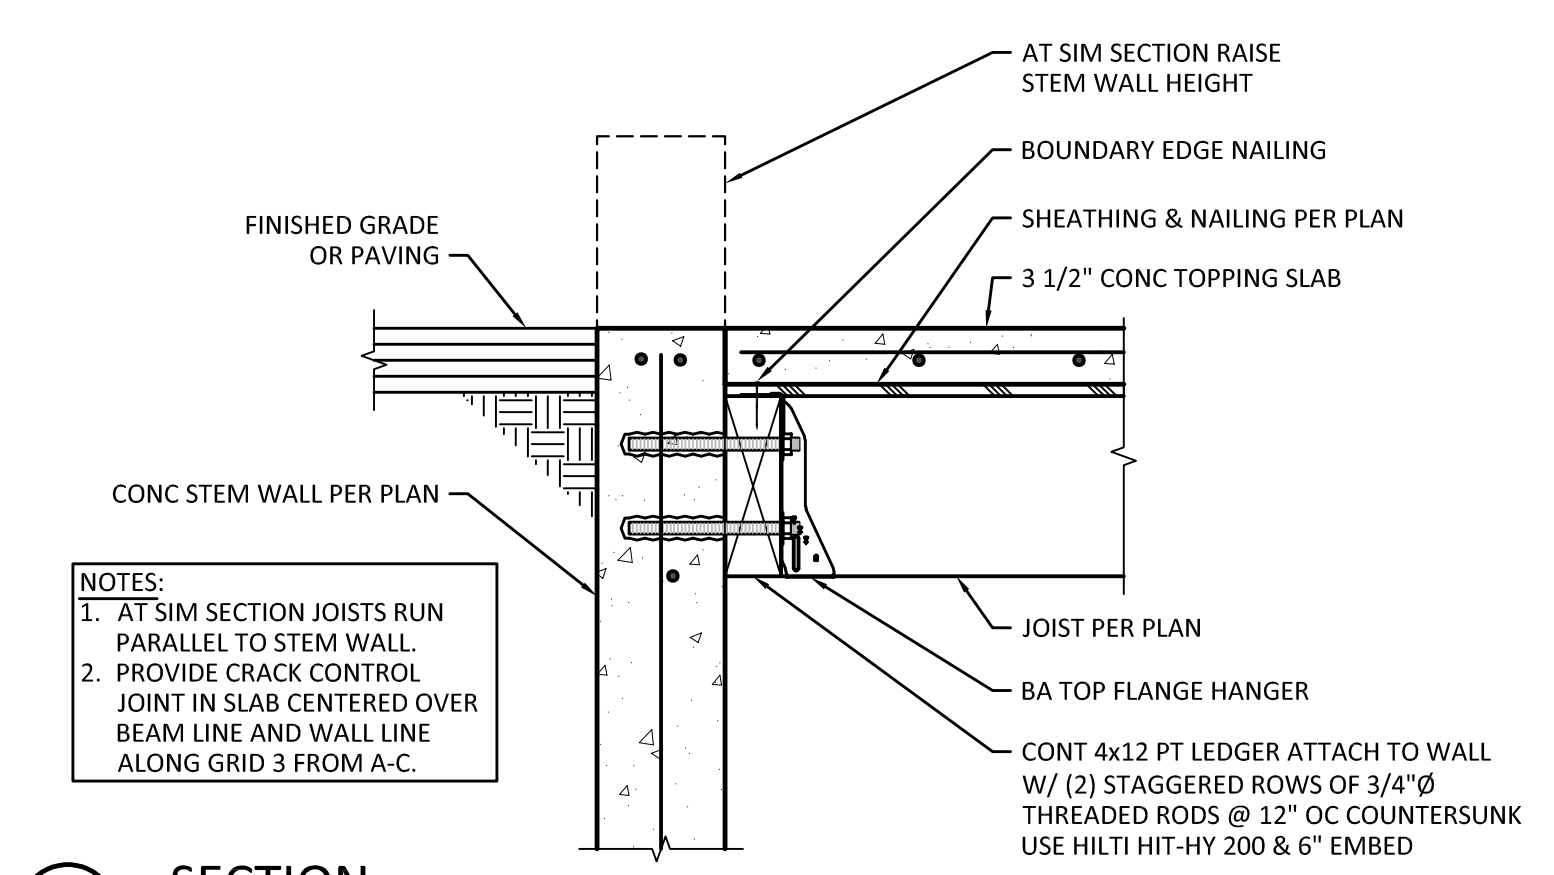

7 SECTION
 SCALE: 1/2" = 1'-0"

MARK	DATE	DESCRIPTION
	05/11/18	PERMIT SUBMITTAL
	01/18/19	COMMENT RESPONSE
	11/02/21	CONSTRUCTION REVISIONS
	11/16/21	CONSTRUCTION REVISIONS

DESIGN: JGG
 DRAWN: ZOS
 CHECK: GAG
 JOB NO: 15227.10
 DATE: 05/11/18

RUDOLF RESIDENCE
 8253 W MERCER WAY
 MERCER ISLAND, WA 98040

FOUNDATION DETAILS

SHEET:
S4.2