





**VERTICAL DATUM**

NAVD 88 (PER CITY OF MERCER ISLAND CONTROL)

**BENCHMARK**

CITY OF MERCER ISLAND CONTROL POINT 4331: FOUND 1" X 1" BRASS TACK IN CONC. DOWN 1.1" IN CASE, IN THE CENTERLINE OF WEST MERCER WAY NEAR THE NORTHEASTERLY CORNER OF SITE. ELEV=140.59

**BASIS OF BEARINGS**

N48°05'18"W BETWEEN THE FOUND CENTERLINE MONUMENTS ON WEST MERCER WAY

**REFERENCES**

- SEASPECT SHORT PLAT, M.J. FILE NO. SUB9706-005, MERCER ISLAND, WASHINGTON

**LEGEND**

- BOLLARD
- SIGN
- MAIL KIOSK
- GAS VALVE
- FIRE DEPARTMENT CONNECTION
- FIRE HYDRANT
- WATER METER
- WATER VALVE
- STORM DRAIN STUB
- CATCH BASIN TYPE I
- CATCH BASIN TYPE II
- STORM DRAIN MANHOLE
- SEWER STUB
- SEWER CLEANOUT
- SEWER MANHOLE
- POWER POLE
- POWER JUNCTION BOX
- POWER CONDUIT
- COMMUNICATION PEDESTAL
- FOUND CORNER AS NOTED

- BOF BOTTOM OF FLANGE
- TON TOP OF NUT
- R/C REBAR AND CAP
- BPA BUILDING PAD AREA

- ASPHALT
- POWER
- COMMUNICATIONS
- GAS
- STORM
- SEWER



LINE & CURVE TABLE			
TAG #	RADIUS	BEARING/Delta	LENGTH
C1	40.00	25°07'28"	17.54
C2	11.00	73°29'28"	14.11
C3	21.00	62°47'25"	23.01
C4	37.00	93°15'50"	60.23
C5	40.00	49°27'30"	34.53
L1		N46°02'37"W	13.38
L2		N45°22'28"E	5.78
L3		N45°08'30"E	10.00
L4		N47°48'50"E	4.32
L5		N12°38'32"E	4.44
L6		N46°43'20"E	1.66
L7		N47°44'18"W	5.86
L8		N47°44'18"W	5.97

**LEGAL DESCRIPTION**

LOTS 1, 2, 3 OF SEASPECT SHORT PLAT NO. SUB9706-005, RECORDED IN KING COUNTY, WASHINGTON UNDER RECORDING NUMBER 20040617900002.

**NOTES**

- THIS SURVEY HAS BEEN CONDUCTED WITHOUT THE BENEFIT OF A CURRENT TITLE REPORT.
- THIS SURVEY REPRESENTS VISIBLE PHYSICAL IMPROVEMENT CONDITIONS EXISTING ON APRIL 2, 2015. ALL SURVEY CONTROL INDICATED AS "FOUND" WAS RECOVERED FOR THIS PROJECT IN MARCH, 2015.
- ALL DISTANCES ARE IN FEET.
- THIS IS A FIELD TRAVERSE SURVEY. A SOKKIA FIVE SECOND COMBINED ELECTRONIC TOTAL STATION WAS USED TO MEASURE THE ANGULAR AND DISTANCE RELATIONSHIPS BETWEEN THE CONTROLLING MONUMENTATION AS SHOWN. CLOSURE RATIOS OF THE TRAVERSE MET OR EXCEEDED THOSE SPECIFIED IN WAC 332-130-090. ALL MEASURING INSTRUMENTS AND EQUIPMENT ARE MAINTAINED IN ADJUSTMENT ACCORDING TO MANUFACTURER'S SPECIFICATIONS.
- UTILITIES OTHER THAN THOSE SHOWN MAY EXIST ON THIS SITE. ONLY THOSE UTILITIES WITH EVIDENCE OF THEIR INSTALLATION VISIBLE AT GROUND SURFACE ARE SHOWN HEREIN. UNDERGROUND UTILITY LOCATIONS SHOWN ARE APPROXIMATE ONLY. UNDERGROUND CONNECTIONS ARE SHOWN AS STRAIGHT LINES BETWEEN SURFACE UTILITY LOCATIONS BUT MAY CONTAIN BENDS OR CURVES NOT SHOWN. SOME UNDERGROUND LOCATIONS SHOWN HEREON MAY HAVE BEEN TAKEN FROM PUBLIC RECORDS. CORE DESIGN ASSUMES NO LIABILITY FOR THE ACCURACY OF PUBLIC RECORDS.

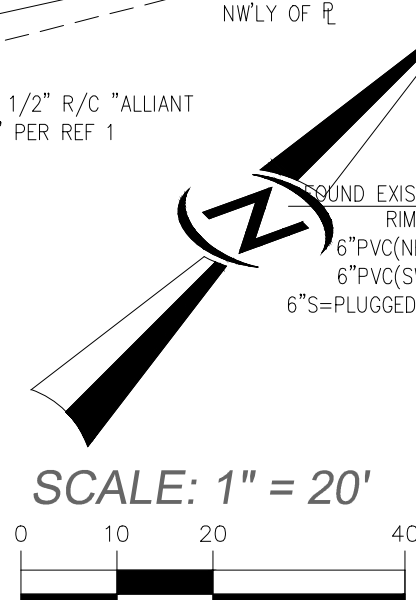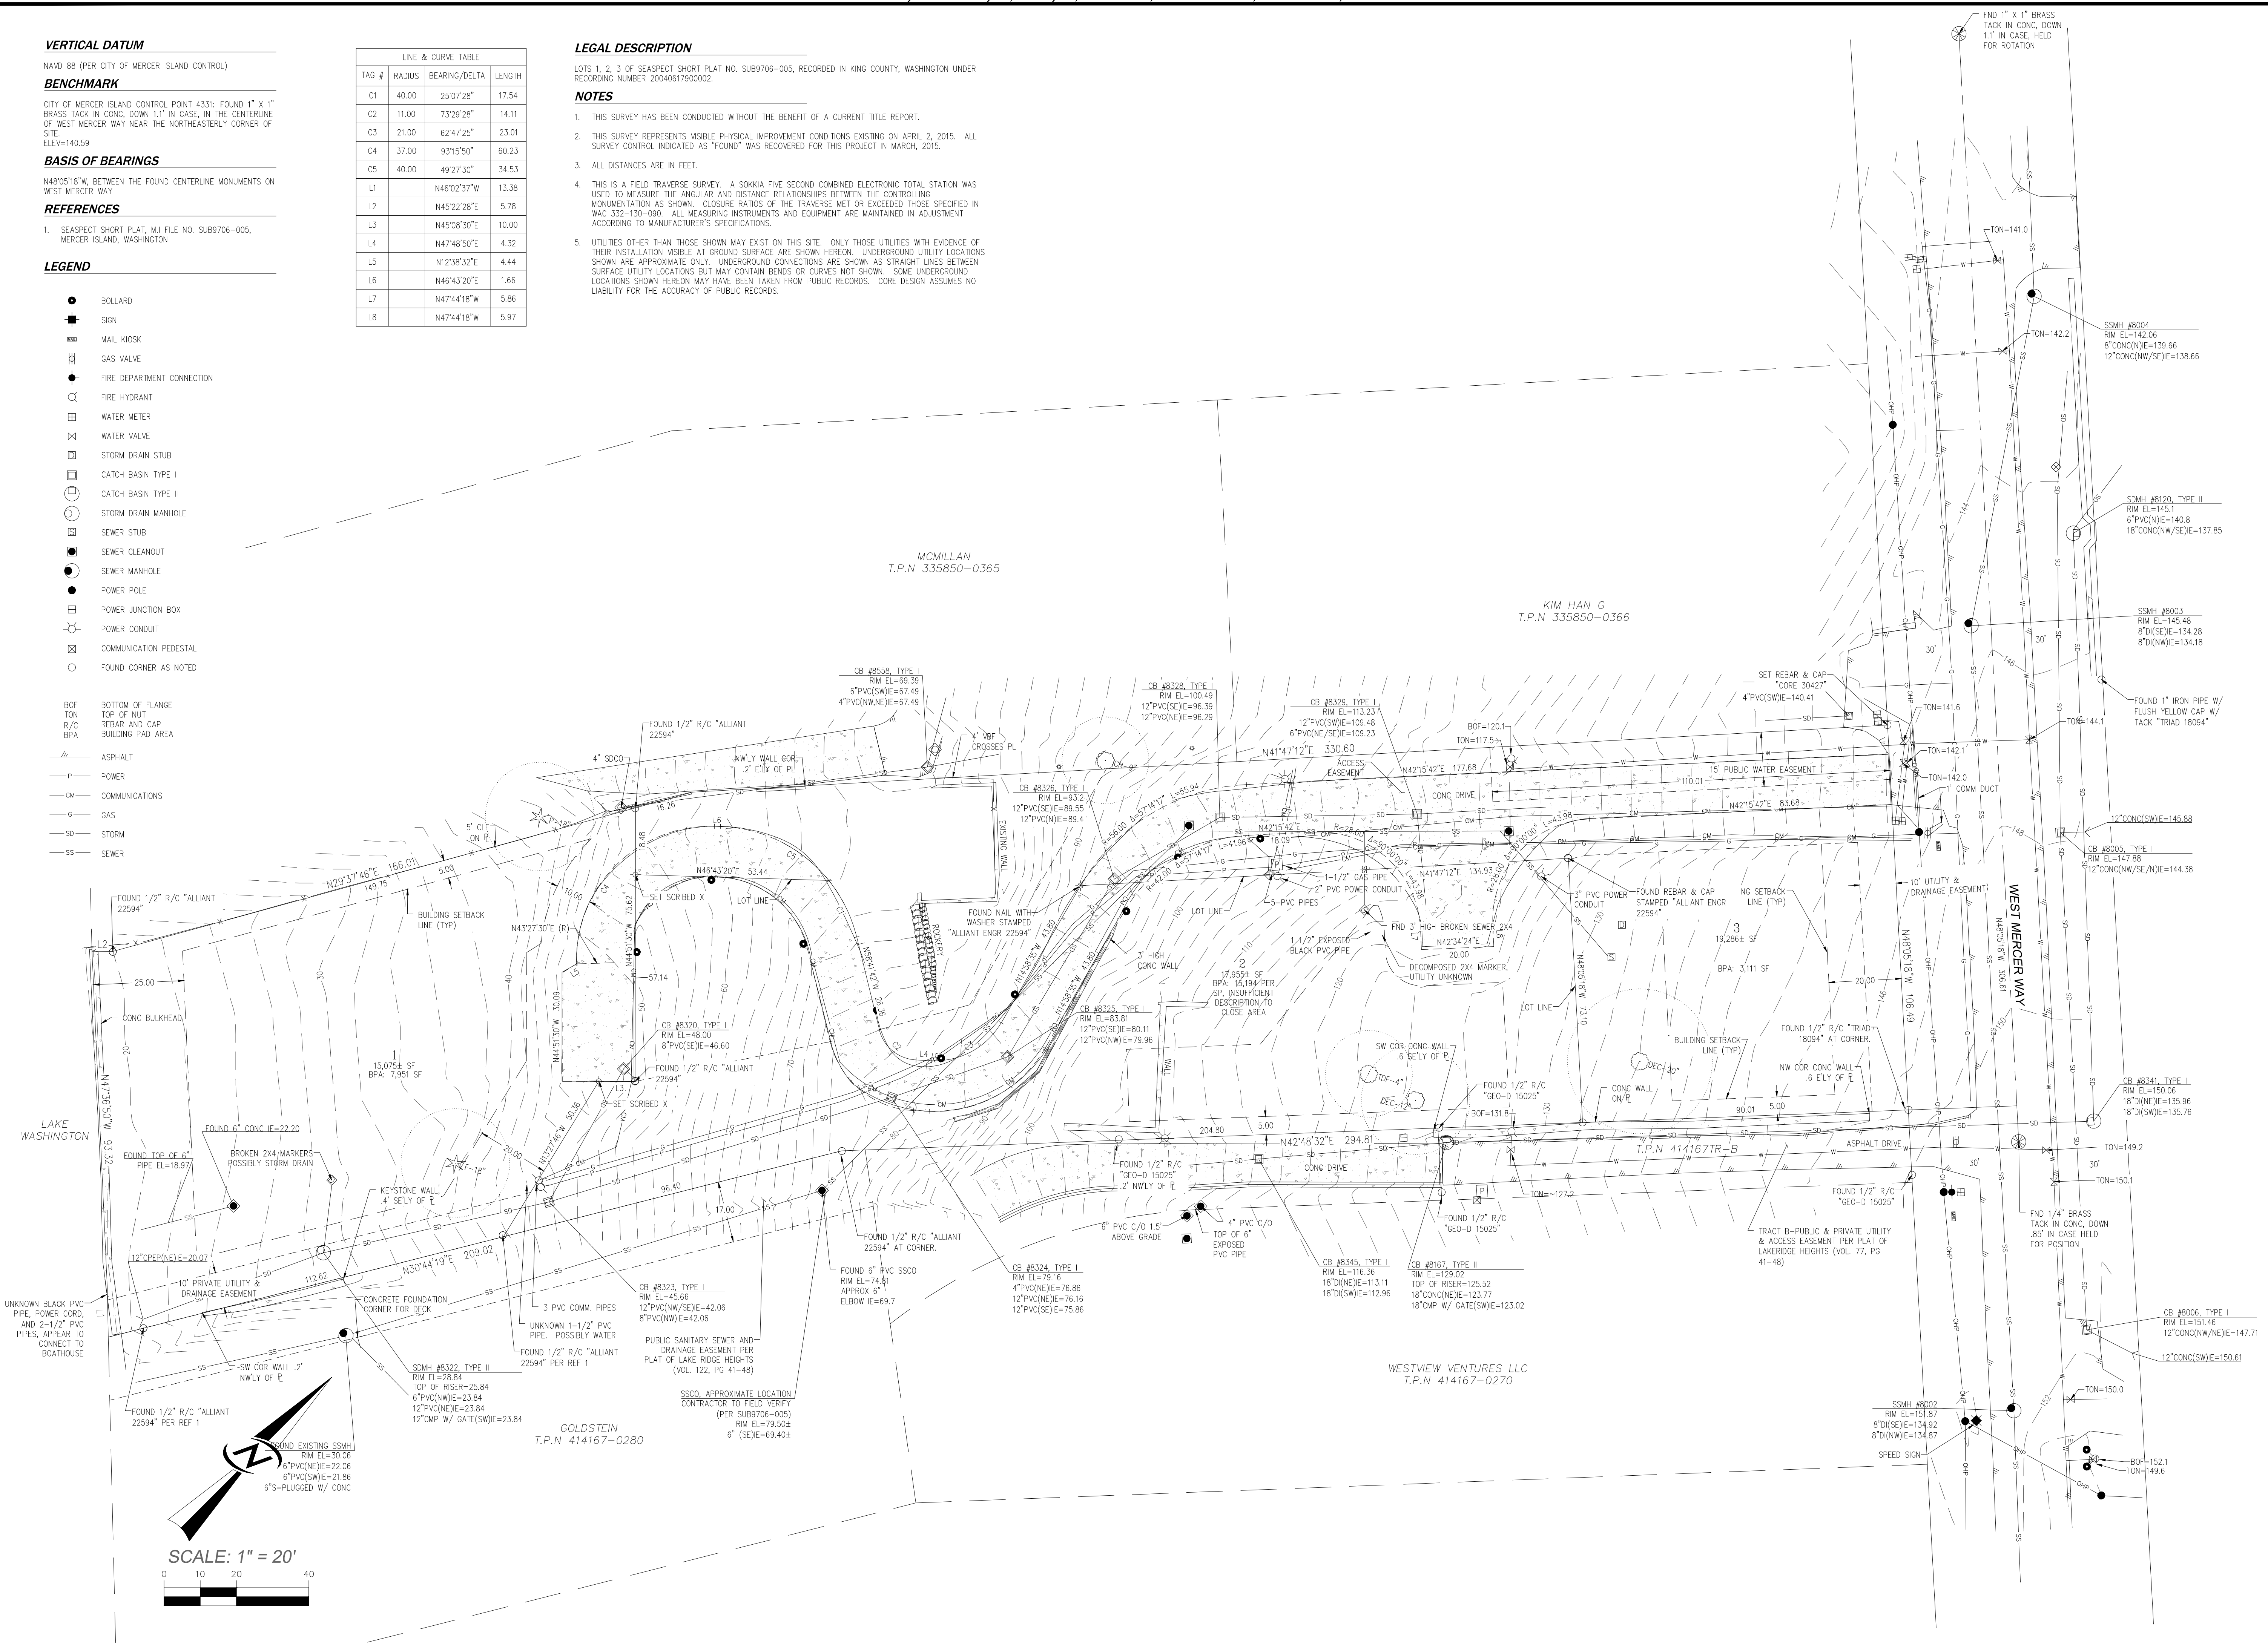


NO.	DATE	REVISIONS

14711 NE 29th Place, #101  
Bellevue, Washington 98007  
425.885.7877 Fax 425.885.7963

**CORE DESIGN**  
ENGINEERING • PLANNING • SURVEYING

**TOPOGRAPHIC SURVEY  
SEASPECT SHORT PLAT  
JOHN KAHAN**

DATE: 04/20/2015	DESIGNED: MRP/NRR	DRAWN: MRP/NRR	APPROVED: KJV	PROJECT MANAGER: KEVIN VANDERZANDEN, PLS
SHEET: 1	OF: 1	PROJECT NUMBER: 15039		

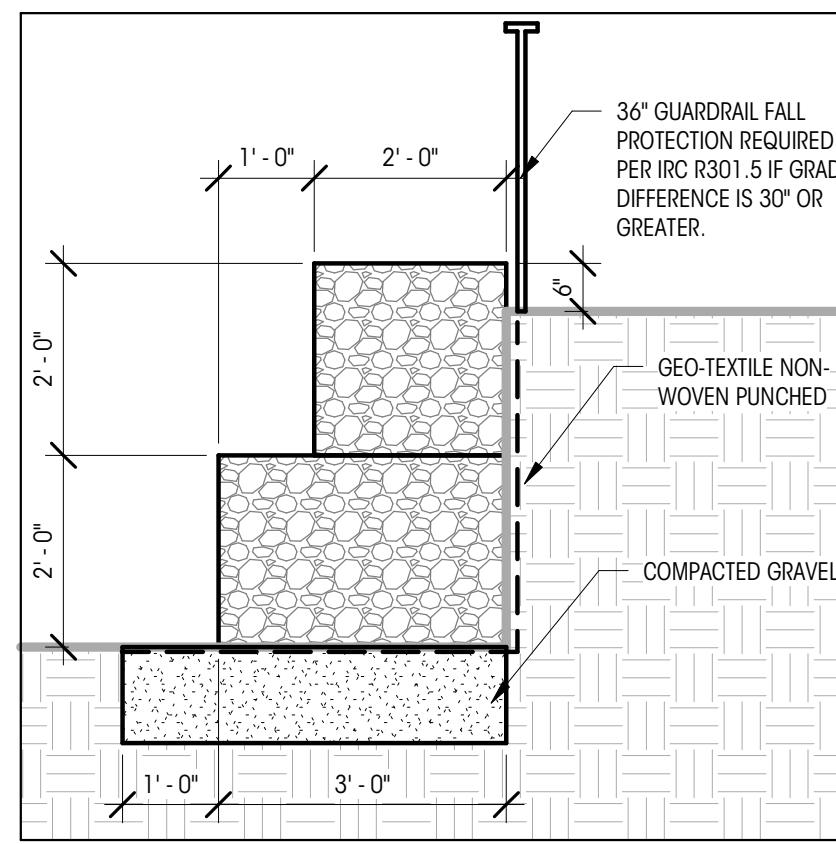

LANDSCAPE GABION WALL:  
NON-SETTLEMENT SENSITIVE LOCATIONS ONLY

2

1/2" = 1'-0"

### FRONT YARD ENCROACHMENT

POINT	ELEV. (FT.)	POINT	ELEV. (FT.)
A1	117.83	B1	130.45
A2	128.84	B2	130.75
A3	129.09	B3	131.16
A4	129.20	B4	131.47
A5	129.43	B5	131.82
TOTAL	634.39		655.65

AVERAGE A: 634.39 / 5 = **126.878'**  
 AVERAGE B: 655.65 / 5 = **131.13'**  
 ELEVATION DIFFERENCE BETWEEN A & B:  
 CONFORMANCE PER 19.02.040.D.1 & 2

### AVERAGE BUILDING ELEVATION (ABE)

WALL	MIDPOINT ELEV. (FT.)	WALL LENGTH (FT.)	PRODUCT
A	113.95	30.38	3,461.168
B	109	29.56	2,895.3
C	109	13.92	1,516.9
D	114.0	27.08	3,087.5
E	124.2	82.88	10,292.9
F	129.10	22.68	2,927.7
G	117.83	38.58	4,546.4
H	117.83	5.04	594.0764
I	117.83	3.5	412.4167
J	117.92	13.83	1,631.1806
K	117.67	3.5	411.8333
L	117.83	12.60	1,485.191
TOTALS		280.6	33,262.6

AVERAGE GRADE (ABE) 33,262.6' / 280.6' = **118.56'**  
 MAX ALLOWABLE HEIGHT 30' ABOVE AVERAGE GRADE  
 MAX HEIGHT ELEVATION / MAX BUILDING HEIGHT: 148.56'  
 PROPOSED BUILDING HEIGHT: 146.72'  
 MAXIMUM CHIMNEY HEIGHT PER 19.02.020.E.3: 153.56'

▲ AVERAGE BUILDING ELEVATION

### PROJECT DATA

EXISTING LOT AREA SUMMARY	PRODUCT
GROSS LOT AREA	17,955 SF
ACCESS EASEMENTS	2,711 SF
NET LOT AREA	15,244 SF
LOT SLOPE	90.6' / 301.2' = 30.08%

LOT COVERAGE	PRODUCT
BUILDING ROOF, GARAGE, COVERED DECK	3,198 SF
(E) FIRE DEPT PAVING	541 SF
(N) DRIVEWAY/PARKING	831 SF
TOTAL LOT COVERAGE	4,570 SF = 29.9% OF NET LOT AREA
ALLOWABLE LOT COVERAGE = 30%	15,244 X 0.3 = 4,573 SF

HARDSCAPE	PRODUCT
(E) SITE WALLS	142 SF
(N) SITE WALLS	261 SF
(N) ROCKERIES	150 SF
(N) UNCOVERED DECK	182 SF
(N) STAIRS	70 SF
TOTAL PERCENTAGE	805 / 15,244 = 5.3%

PROPOSED BUILDING AREA SUMMARY (GFA):	PRODUCT
PROPOSED LOWER LEVEL	1,904 SF
LOWER LEVEL BELOW GRADE REDUCTION	-1,207 SF
FINAL PROPOSED LOWER LEVEL	697 SF
PROPOSED MAIN LEVEL	1,629 SF
STAIR REDUCTION (PER 19.02.020 D.2.C)	-110 SF
FINAL PROPOSED MAIN LEVEL	1,519 SF
GARAGE	874 SF
PROPOSED OUTDOOR COVERED DECK	435 SF
PROPOSED UPPER LEVEL	2,112 SF
PROPOSED UPPER LEVEL 150% (PER 19.02.020 D.2.a)	
(209.52' x 1.5)	314 SF
TOTAL PROPOSED BUILDING AREA (GFA):	5,951 SF

PROPOSED GROSS FLOOR AREA:	PRODUCT
40% ALLOWABLE GFA	5,951 / 17,955 = 33.15% OF GROSS LOT AREA
	17,955 X 0.40 = 7,182 SF

### SITE PLAN LEGEND/NOTES

**SHEET REFERENCE NOTES:**

- SEE SHEET A101 FOR PROPOSED BUILDING PAD PLAN.
- SEE SHEET A102 - A103 FOR SITE EXCAVATION PLANS AND SECTIONS.
- SEE SHEET A105 FOR CRITICAL AREAS PLAN AND PLANTING PLAN.
- CONTINUOUS SPECIAL INSPECTIONS BY GEOTECHNICAL ENGINEER DURING EXCAVATION AND SHORING INSTALLATION SHALL BE PROVIDED.

**GENERAL PLAN NOTES:**

- ALL DIMENSIONS AT EXTERIOR WALLS TO FACE OF FRAMING AT EXT. FACE OF WALL AND TO FACE OF FRAMING AT INTERIOR WALLS.
- ALL DIMENSIONS AT INTERIOR WALLS ARE TO FACE OF FRAMING.
- ALL DIMENSIONS AT KITCHEN TO EDGE OF COUNTERTOPS, U.N.O.

**LEGEND:**


- SHARED DRIVEWAY
- 15' PUBLIC WATER EASEMENT
- PRIVATE UTILITY AND DRAINAGE EASEMENT (TO BE FIELD LOCATED PRIOR TO WALL CONSTRUCTION)
- PORTION OF LOT COVERED BY SHARED DRIVEWAY
- CONTOUR MAJOR
- CONTOUR MINOR
- PROPERTY LINE
- SETBACK
- BUILDING FOOTPRINT
- PAVING/HARDSCAPE/DECK
- ROOF OVERHANG
- (E) TREE TO REMAIN
- (N) TREE
- (E) TREE TO BE DEMOLISHED
- PORTION OF (N) DRIVEWAY
- (E) DRIVEWAY TO REMAIN
- PORTION OF SHARED DRIVEWAY DESIGNATED AS APPROVED FIRE DEPARTMENT TURNAROUND PER APPROVED SHORT PLAT

### SCOPE OF CHANGES:

- NO CHANGE TO ROOF OVERHANGS AT SETBACKS
- NO CHANGE TO VARIABLE SIDE YARD SETBACKS
- NO CHANGE DOWNHILL SLOPE GRADE OR RIDGE HEIGHT
- EXTEND GARAGE EAST INTO FRONT YARD SETBACK AS ALLOWED BY CODE 19.02.040.D
- FRONT YARD ENCROACHMENT CALCULATIONS ADDED
- SHIFT OF PARKING RETAINING WALLS TO NORTH AND SOUTH
- CHANGE ROOF OF AND EXTEND WESTERN PATIO TO THE WEST AND SOUTH
- CHANGE IN SOIL RETENTION WALL, PREVIOUSLY AS PART OF FOUNDATION SYSTEM, NOW MOVED TO WESTERN YARD ADJACENT TO ROAD IN ORDER TO ALLOW FOR LANDSCAPE WORK
- REVISED LEGAL DESCRIPTION AS A RESULT OF PROPERTY SALE
- CHANGE TO LOT COVERAGE AS A RESULT OF SHIFTED PARKING RETAINING & EXTENDED COVERED DECK
- CHANGES TO HARDSCAPE CALCULATIONS AS A RESULT OF SOIL STABILIZATION WALL, PATIO EXTENSION AND SITE STAIRS
- CHANGES TO GFA AS A RESULT OF EXTENDED GARAGE AND EXTENDED COVERED DECK
- REVISED LOCATION TO REPLACEMENT TREES
- CHANGE TO ABE AS A RESULT OF EXTENDED GARAGE AND EXTENDED COVERED DECK
- GRAPHICS/PATTERNS/HATCHES HAVE BEEN COORDINATED FOR CONSISTENCY
- MEETS AND BOUNDS ADDED TO ALL PROPERTY LINES

### GENERAL INFORMATION

<b>PROJECT ADDRESS</b>	8143 W MERCER WAY MERCER ISLAND, WA 98040
<b>PROJECT NUMBER</b>	2011-147
<b>ASSESSOR'S PARCEL #</b>	335850-0387
<b>LEGAL DESCRIPTION</b>	HILLMANS CD SEA SHORE LAKE FRONT "LOT 2" MERCER ISLAND SHORT PLAT NO SUB9706-005 REC NUMBER 2004061790002 SD SHORT PLAT DAF - LOT A OF MERCER ISLAND LOT LINE REVISION NO MI-90-05-09 (J-3) REC NO 9007109002 BEING A POR OF TRACTS 5-486-488-489-490-576-577 & 578 IN CD HILLMAN'S SEA SHORE LAKE FRONT GARDEN OF EDEN ADDITION TO THE CITY OF SEATTLE
<b>PROJECT DESCRIPTION</b>	NEW CONSTRUCTION OF A SINGLE FAMILY HOUSE
<b>ZONE</b>	R-15
<b>BUILDING TYPE</b>	SINGLE FAMILY RESIDENCE

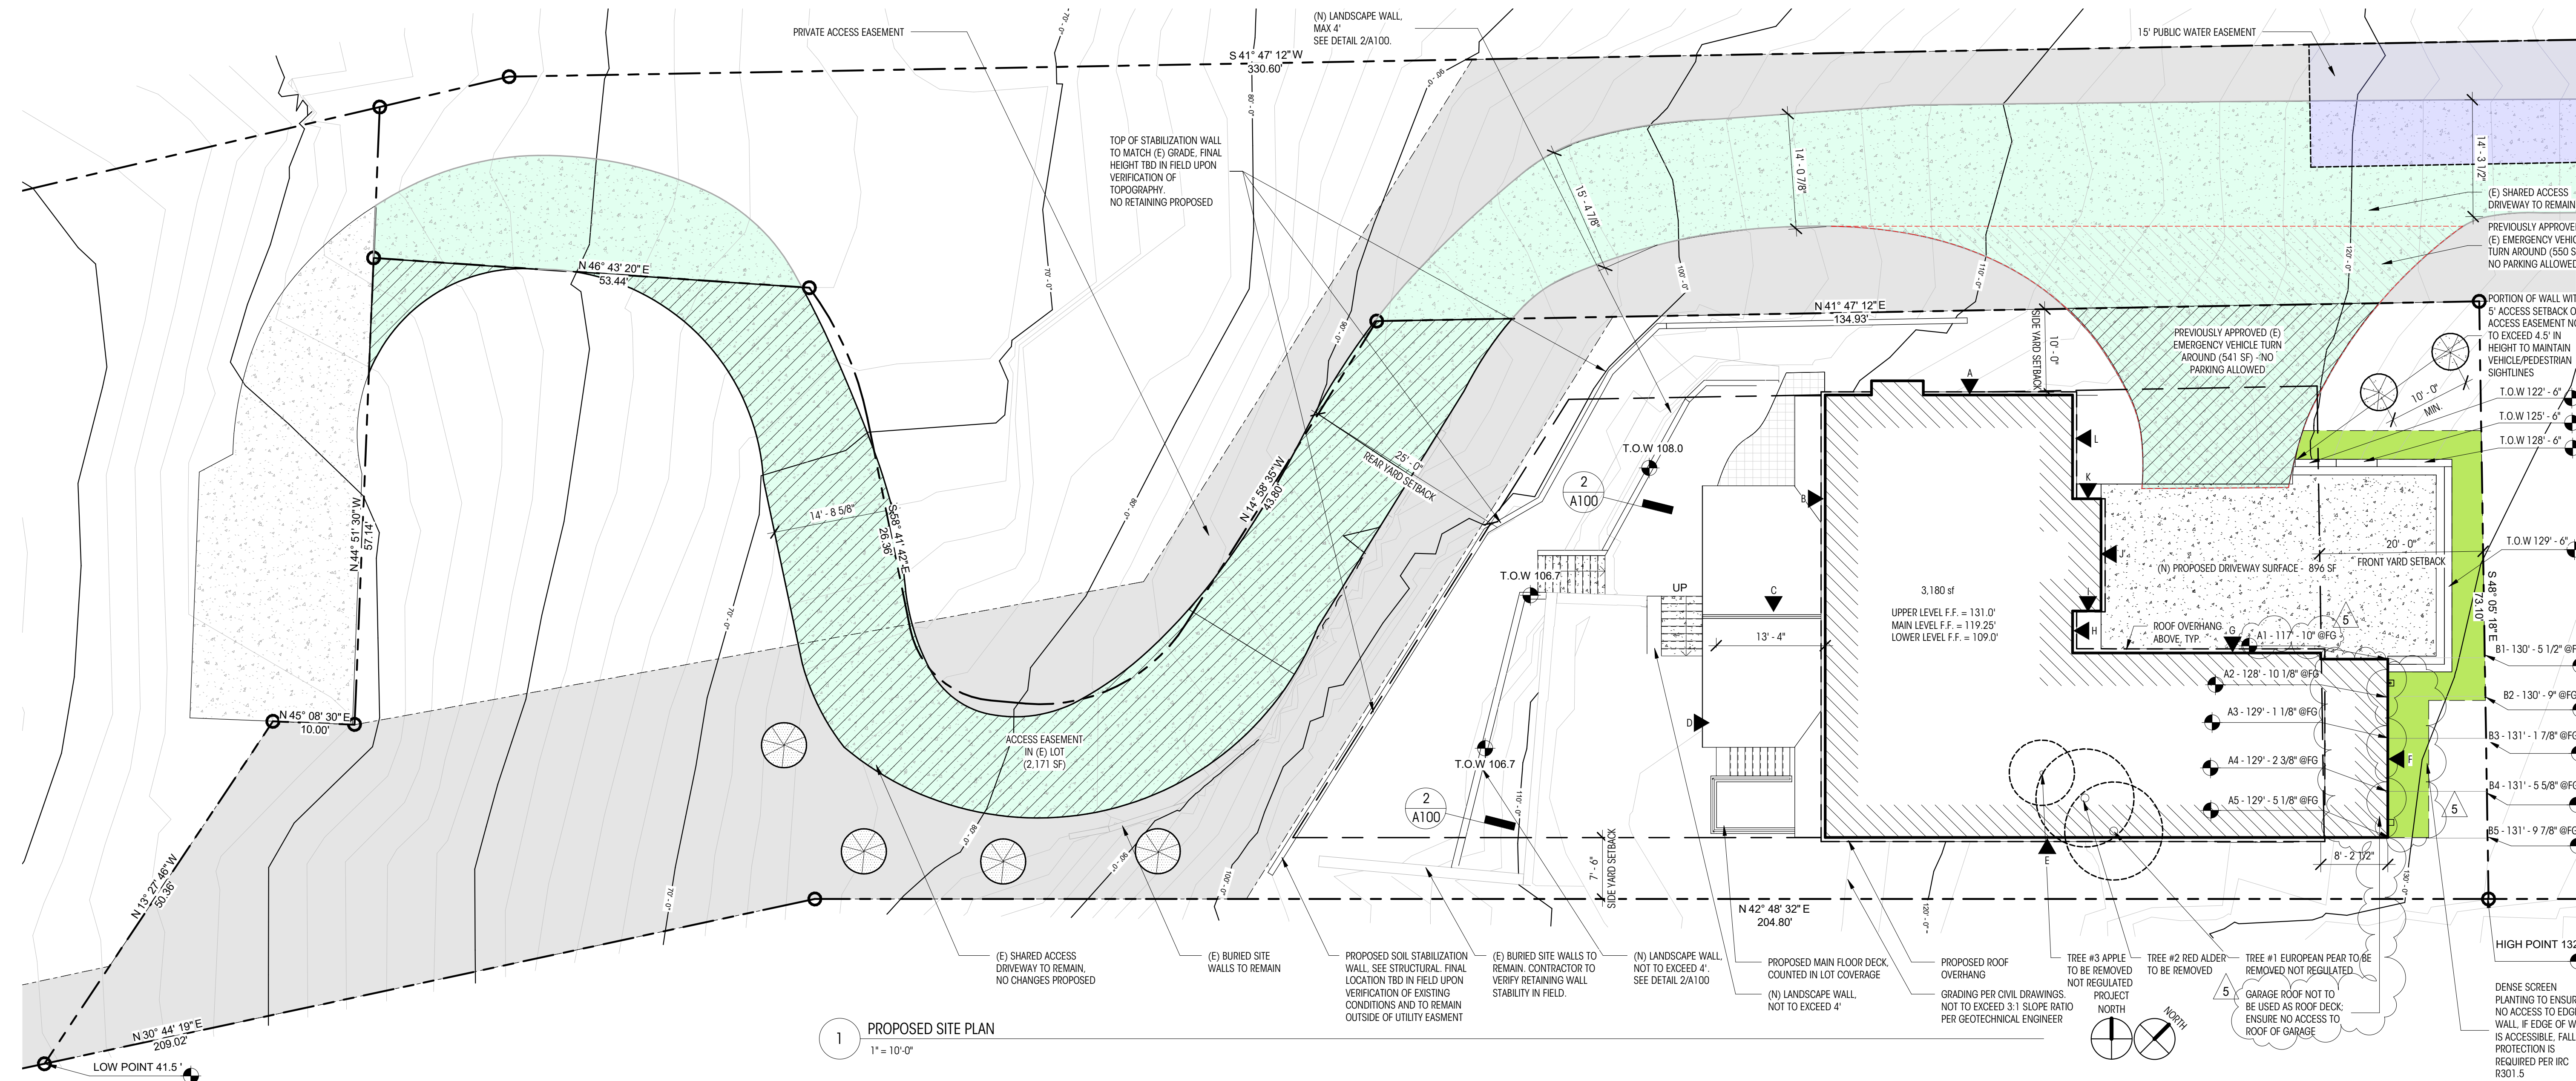

1 PROPOSED SITE PLAN  
1" = 10'-0"

**Brandt**  
 Design Group  
 66 Bell Street  
 Unit 1  
 Seattle, WA  
 98121  
 206.239.0850  
 brandtdesigninc.com  
 8843 REGISTERED ARCHITECT  
 STATE OF WASHINGTON

**CLARKSON RESIDENCE**  
 8143 WEST MERCER WAY  
 MERCER ISLAND, WA 98040  
 © COPYRIGHT 2022 BRANDT DESIGN, INC. SEATTLE, WA

PERMIT DRAWINGS  
 DATE: 06.10.22  
 SHEET SIZE: D (24X36)  
 REVISIONS  

NO.	DESCRIPTION	DATE
3	PERMIT REVISION	04.19.22
4	PERMIT REVISION 2	06.10.22
5	PERMIT REVISION 3	08.30.22

DRAWN BY: KJ/JM  
 CHECKED BY: BM

SITE PLAN  
 SCALE: As indicated

A100

DEDICATED APPROVAL STAMP SPACE

**SCOPE OF CHANGES:**

**\*\*NO CHANGES TO THIS SHEET\*\***

**BUILDING PAD & SETBACK LEGEND**

	CONTOUR MAJOR
	CONTOUR MINOR
	PROPERTY LINE
	SETBACK LINE
	PREVIOUSLY APPROVED BUILDING PAD - TO BE ABANDONED
	PROPOSED BUILDING PAD
	APPROVED FIRE DEPARTMENT TURNAROUND
	SHARED DRIVEWAY, COUNTED TOWARD LOT COVERAGE
	15' PUBLIC WATER EASEMENT
	PRIVATE UTILITY AND DRAINAGE EASEMENT

**PROJECT DATA**

EXISTING LOT AREA SUMMARY	
GROSS LOT AREA	17,955 SF
ACCESS EASEMENTS	2,711 SF
NET LOT AREA	15,244 SF
LOT SLOPE	90.6' / 301.2' = 30.08%

TREE REMOVAL	
(E) REGULATED TREES TO BE REMOVED	1
(N) TREES TO BE PLANTED AS REPLACEMENT	2

LOT COVERAGE	
BUILDING ROOF, GARAGE, COVERED DECK	3,198 SF
(E) FIRE DEPT PAVING	541 SF
(D) DRIVEWAY/PARKING	831 SF
TOTAL LOT COVERAGE	4,570 SF = 29.9% OF NET LOT AREA
ALLOWABLE LOT COVERAGE = 30%	15,244 X 0.3 = 4,573 SF

SETBACKS	
SIDE YARD	VARIABLE MINIMUM 7'-0"
FRONT YARD	20'
REAR YARD	25'



**Brandt**

**Design Group**


66 Bell Street  
Unit 1  
Seattle, WA  
98121

206.239.0850

brandtdesigninc.com

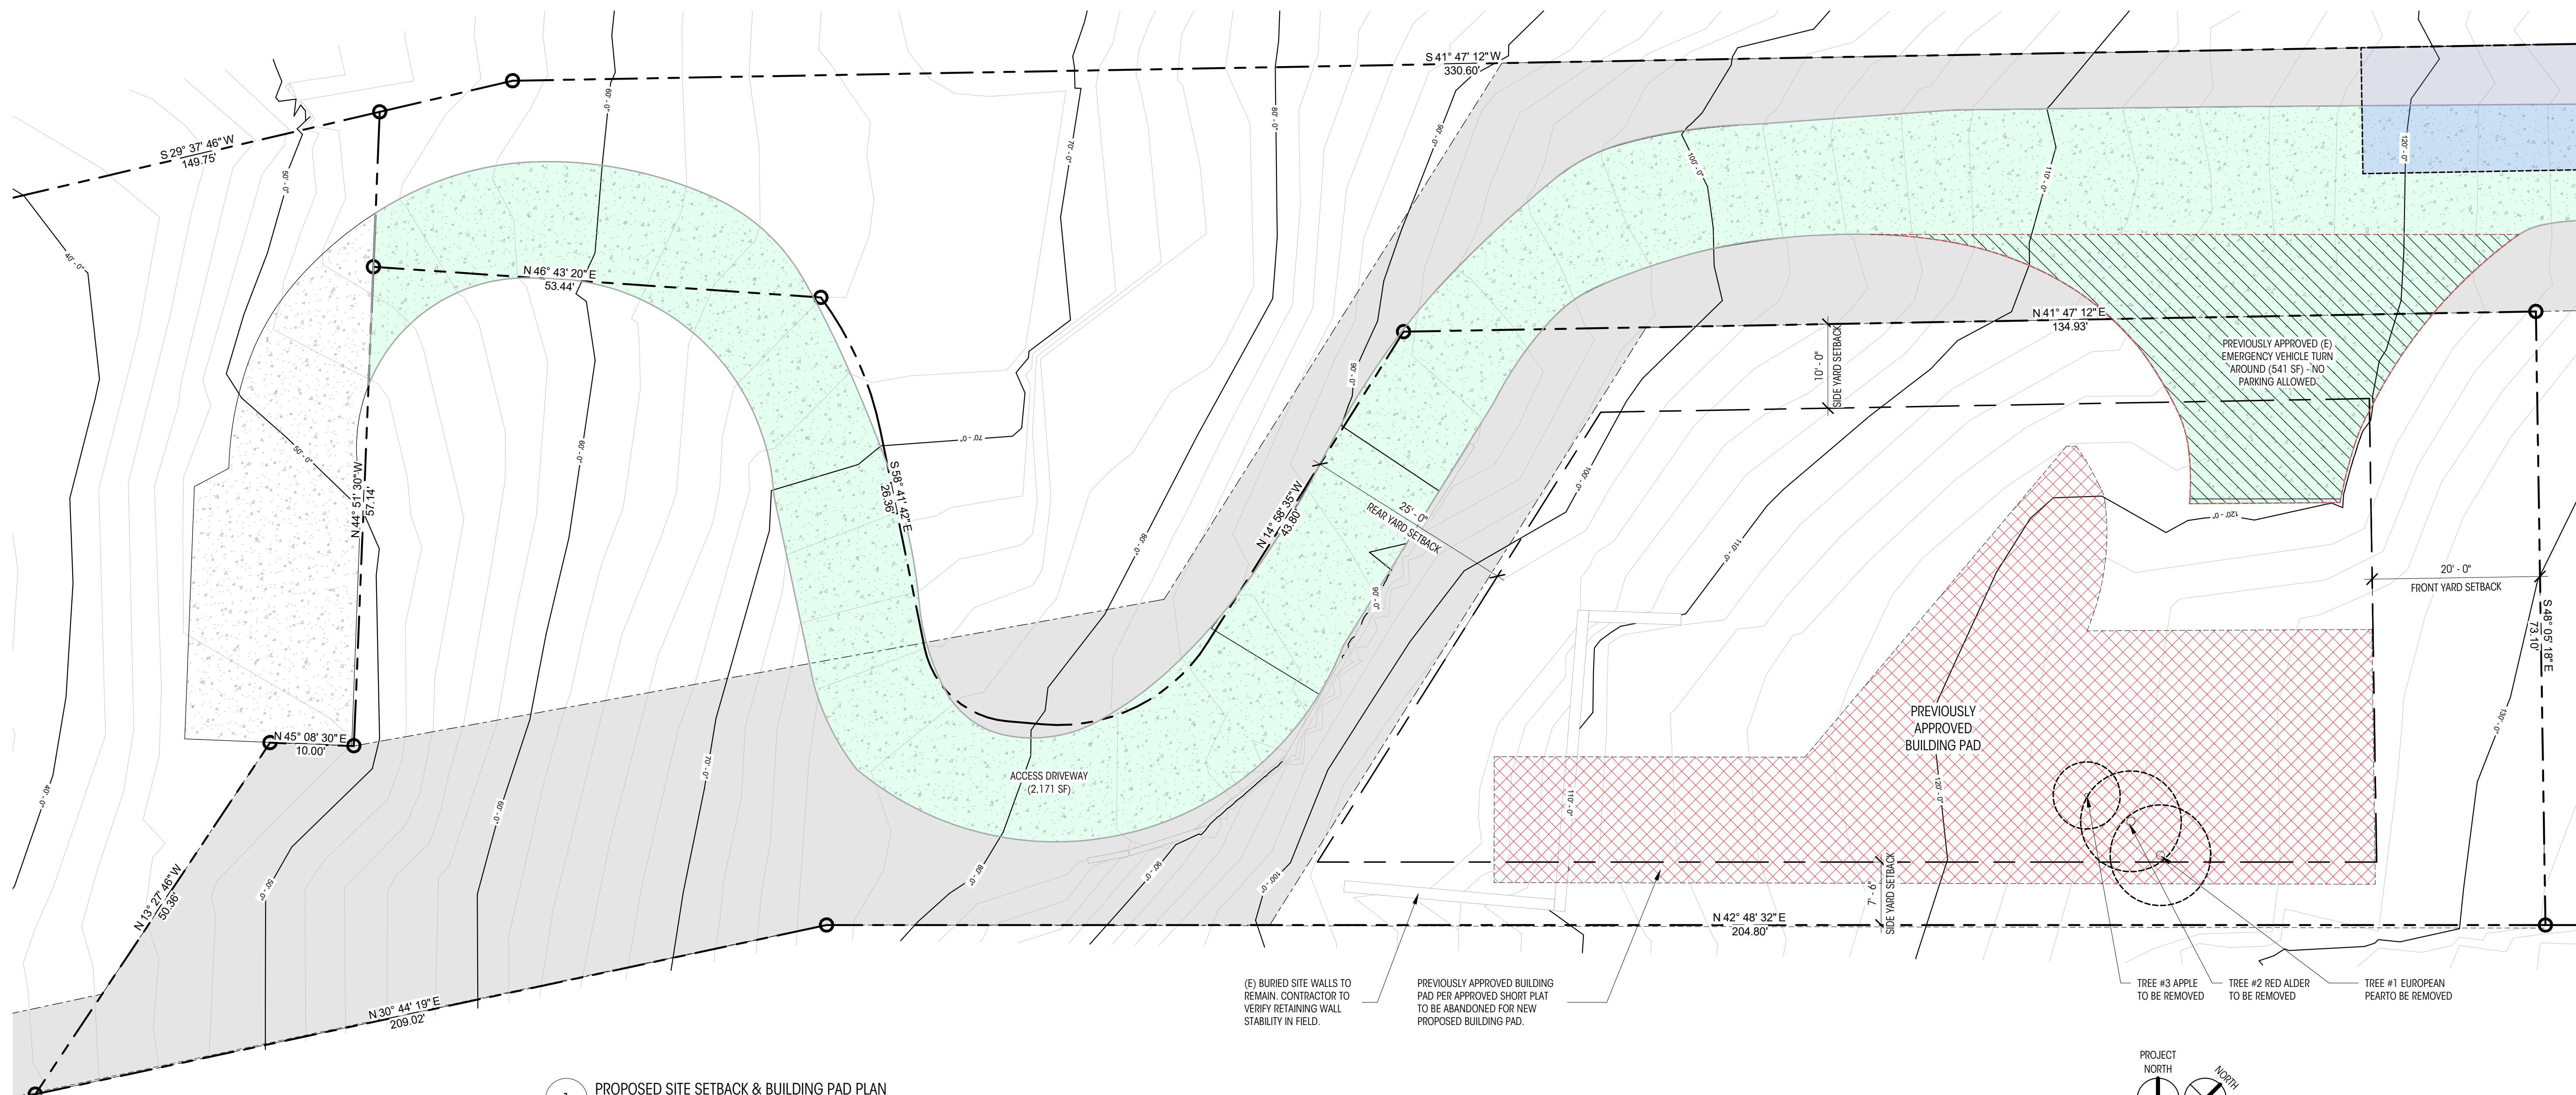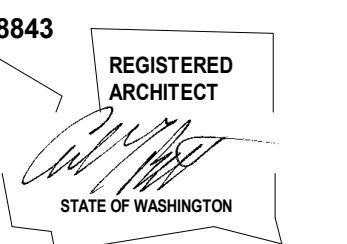

1 PROPOSED SITE SETBACK & BUILDING PAD PLAN  
1" = 10'-0"

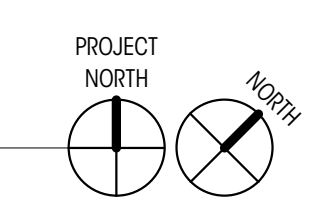

**CLARKSON RESIDENCE**  
8163 WEST MERCER WAY  
MERCER ISLAND, WA 98040  
© COPYRIGHT 2022 BRANDT DESIGN, INC. SEATTLE, WA

PERMIT DRAWINGS

DATE: 06.10.22

SHEET SIZE: D (24X36)

**REVISIONS**

NO.	DESCRIPTION	DATE
-----	-------------	------


DRAWN BY: KJ/JM  
CHECKED BY: BM

BUILDING PAD PLAN

SCALE: As indicated

**A101**

DEDICATED APPROVAL STAMP SPACE

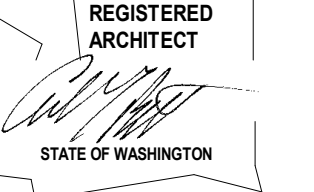

NO.	DESCRIPTION	DATE
3	PERMIT REVISION	04.19.22
4	PERMIT REVISION 2	06.10.22

**SCOPE OF CHANGES:**

- CHANGE IN SOIL RETENTION WALL: PREVIOUSLY AS PART OF THE FOUNDATION SYSTEM, NOW MOVED TO WESTERN YARD ADJACENT TO ROAD IN ORDER TO ALLOW FOR LANDSCAPE WORK
- REVISED FOUNDATION AS A RESULT OF SOIL STABILIZATION WALL LOCATION MOVE.
- LEVEL CHANGES: DRIVEWAY & GARAGE LEVEL DROP BY 15"; BASEMENT LEVEL DROP BY 12".
- GRAPHICS/PATTERNS/HATCHES HAVE BEEN COORDINATED FOR CONSISTENCY
- ADDITIONAL GRADING PROPOSED AS A RESULT OF THE ADDED LANDSCAPE WALLS.

**CONSTRUCTION MONITORING NOTES**

MONITOR ADJACENT BLDG. FOR SETTLEMENT. START MONITORING PRIOR TO DEMOLITION WEEKLY UNTIL PILE DRIVING IS COMPLETE. LEVELS TO BE MEASURED BY PROJECT SURVEYOR. CONTINUOUS SPECIAL INSPECTION BY THE GEOTECHNICAL ENGINEER DURING EXCAVATION AND SHORING INSTALLATION SHALL BE PROVIDED.


**EXCAVATION PLAN LEGEND**


	CONTOUR MAJOR
	CONTOUR MINOR
	EXTENT OF FOUNDATION EXCAVATION
	APPROVED FIRE DEPARTMENT TURNAROUND
	SHARED DRIVEWAY EASEMENT
	EXTENT OF PROPOSED GRADING
	DRILLED PILE FOR PERMANENT SHORING PER STRUCTURAL/GEOTECH
	DRILLED PILE FOR FOUNDATION PER STRUCTURAL/GEOTECH

**CONSTRUCTION PHASING**


- REMOVE TREES
- DRILL/INSTALL SHORING PILES FOR STABILIZATION WALL
- EXCAVATE REMAINING SITE
- SCRAPE BUILDING PAD
- FOUNDATION FORMWORK
- FOUNDATION INSTALL
- RETAINING WALL FORMWORK
- DRAIN MAT INSTALL & TRENCHING FOR DRAINAGE AND UTILITIES
- NON-STRUCTURAL RAT-SLAB INSTALL
- FORM PARKING PAD FOUNDATION
- POUR PARKING PAD FOUNDATIONS
- FORM PARKING PAD RETAINING WALLS
- FORM PARKING PAD & GARAGE SLAB
- POUR PARKING/GARAGE SLABS
- FINAL ROUGH GRADING
- FRAMING

NOTE: NO SOIL, WATER, OR DEBRIS FROM SITE ACTIVITIES WILL BE ALLOWED TO BE PLACED OR DISCHARGED ON THE SLOPE.

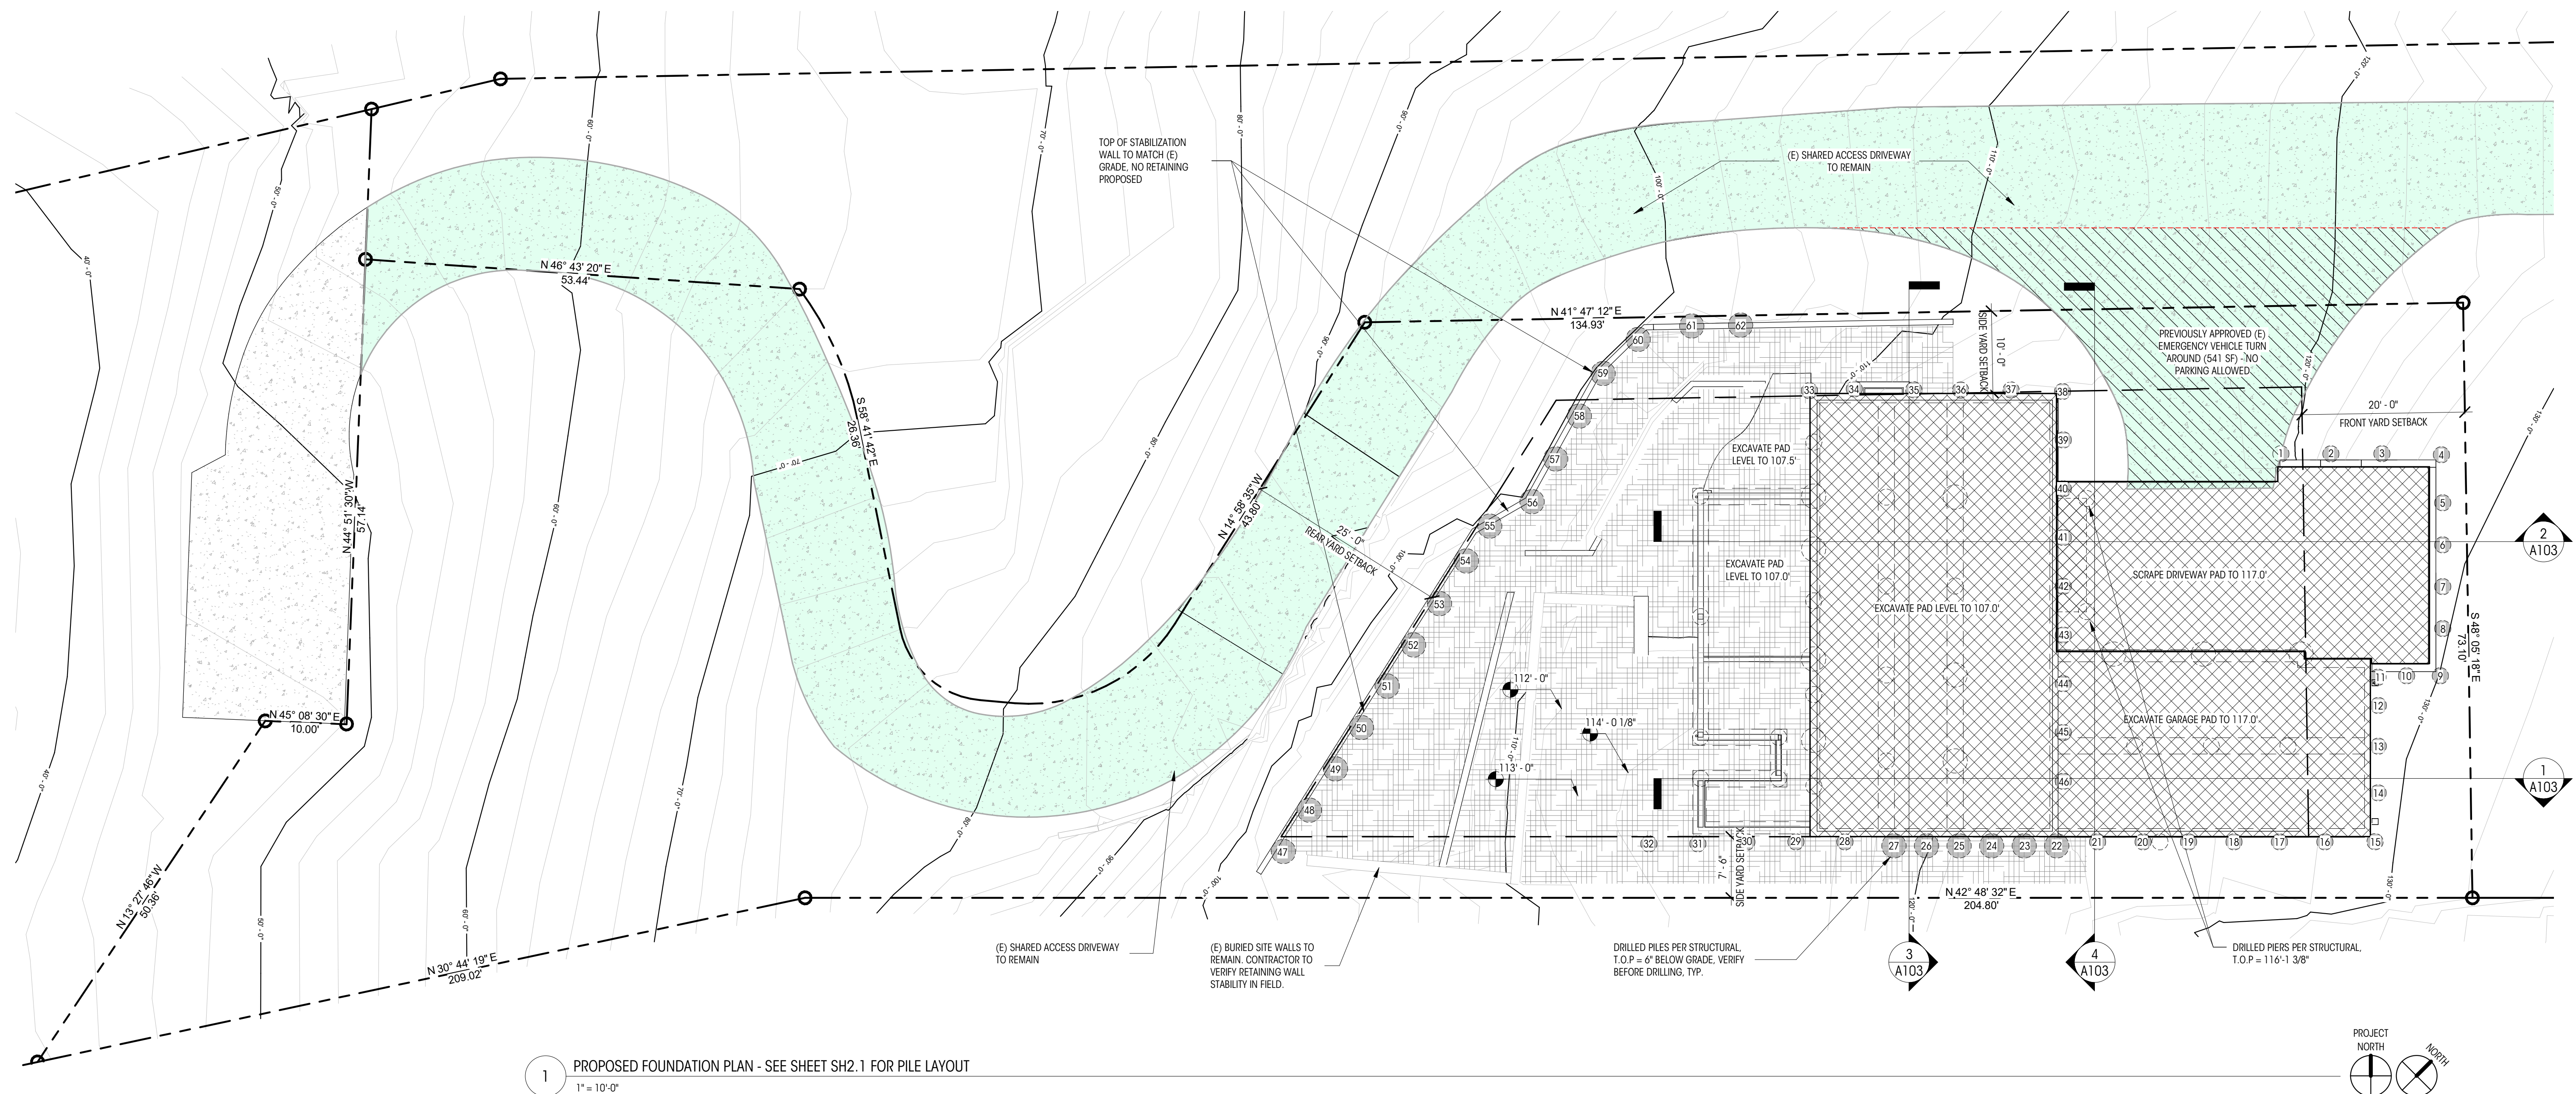


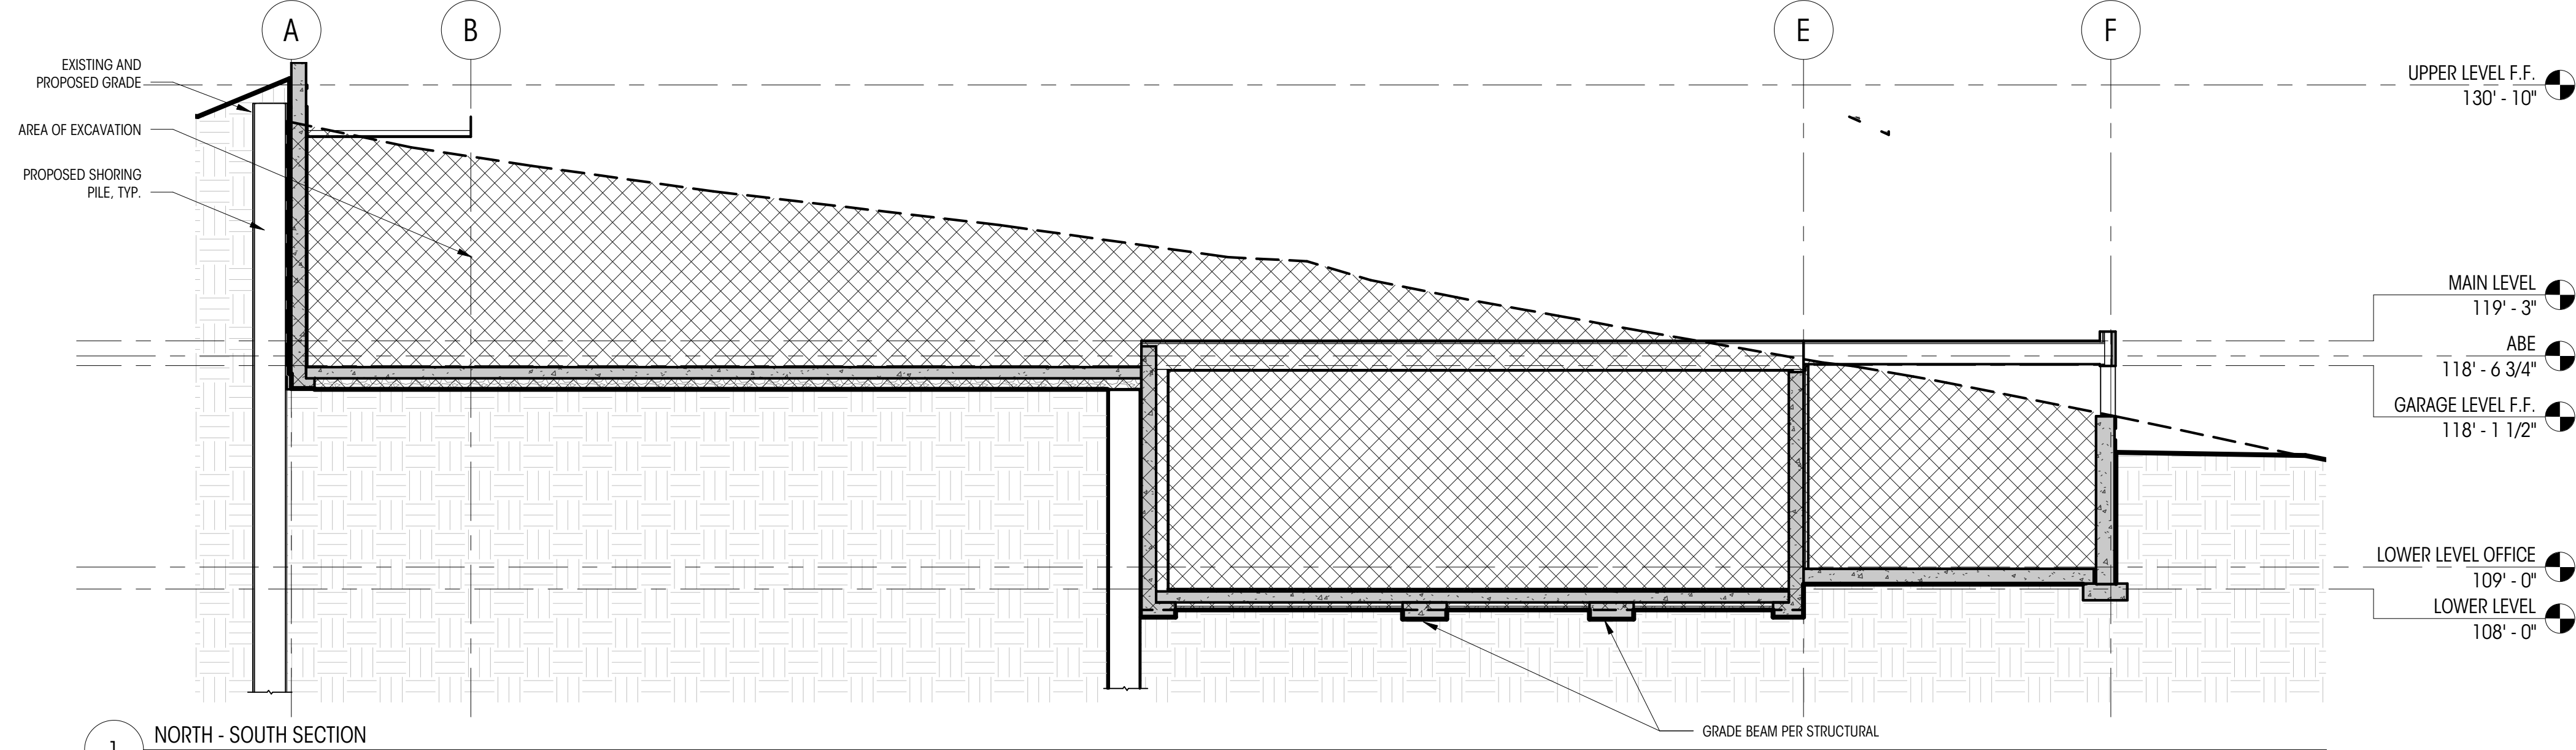


1 NORTH - SOUTH SECTION  
3/16" = 1'-0"

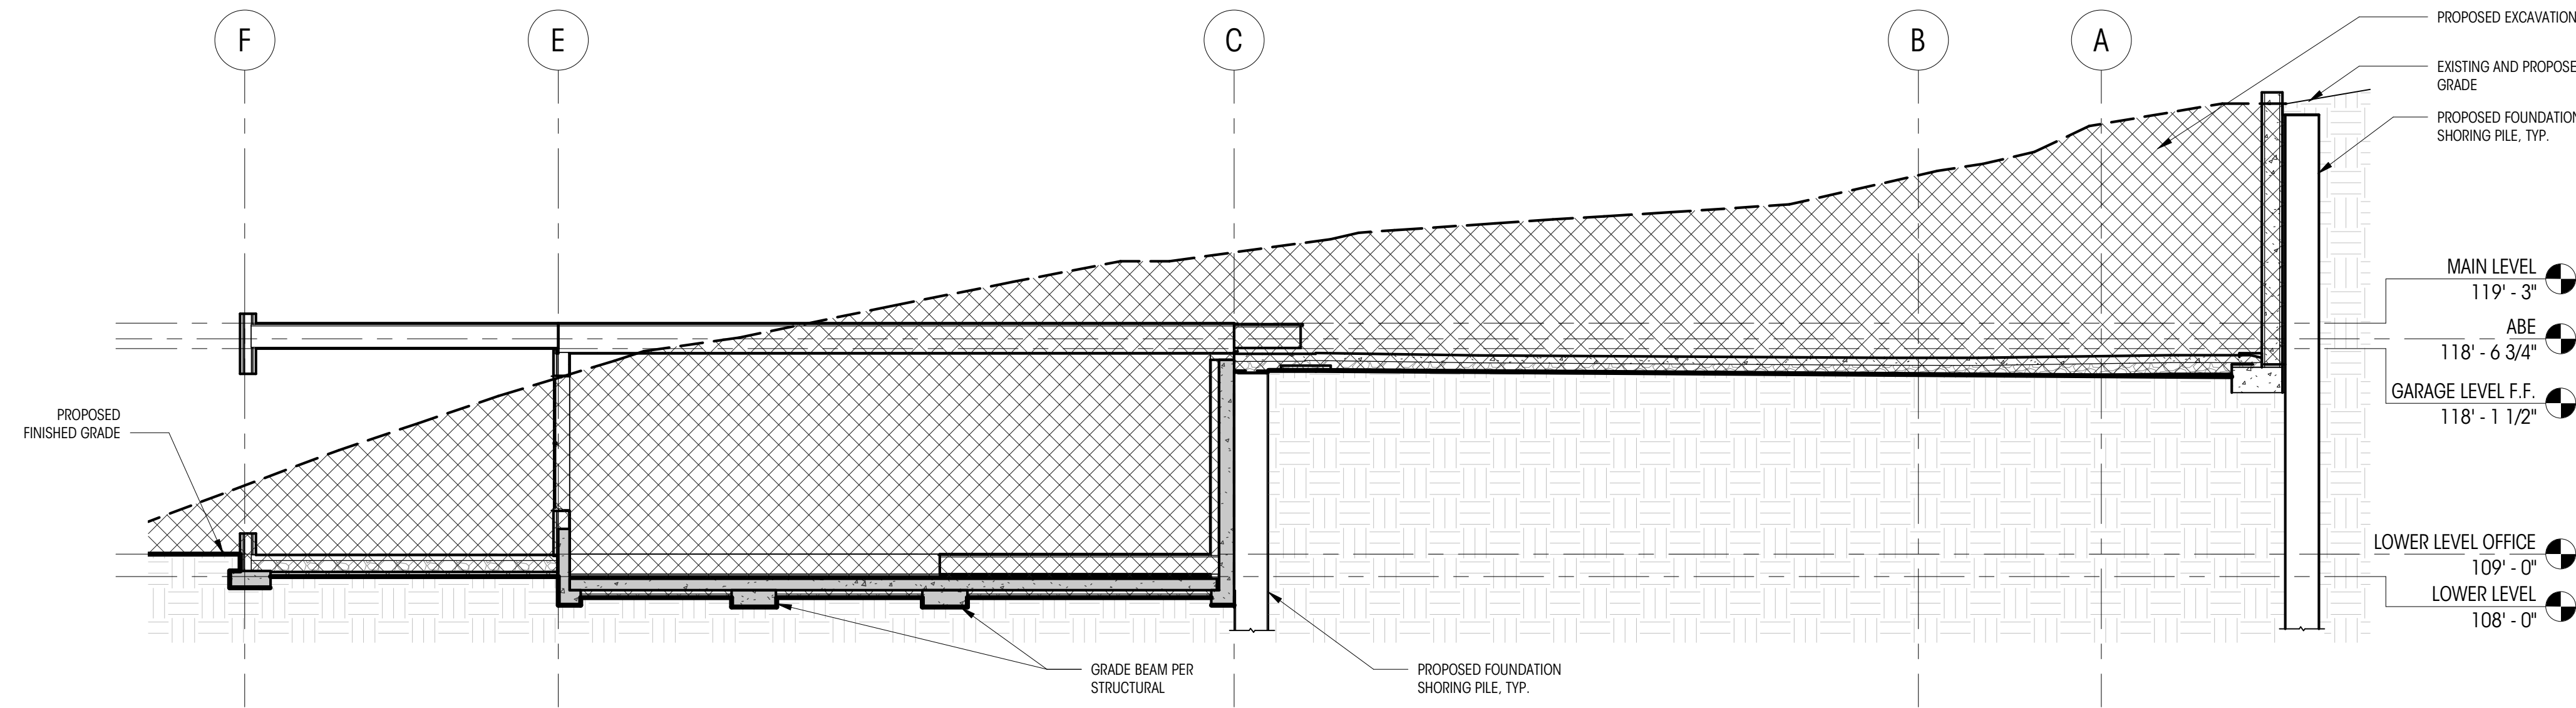

2 EAST - WEST SECTION  
3/16" = 1'-0"

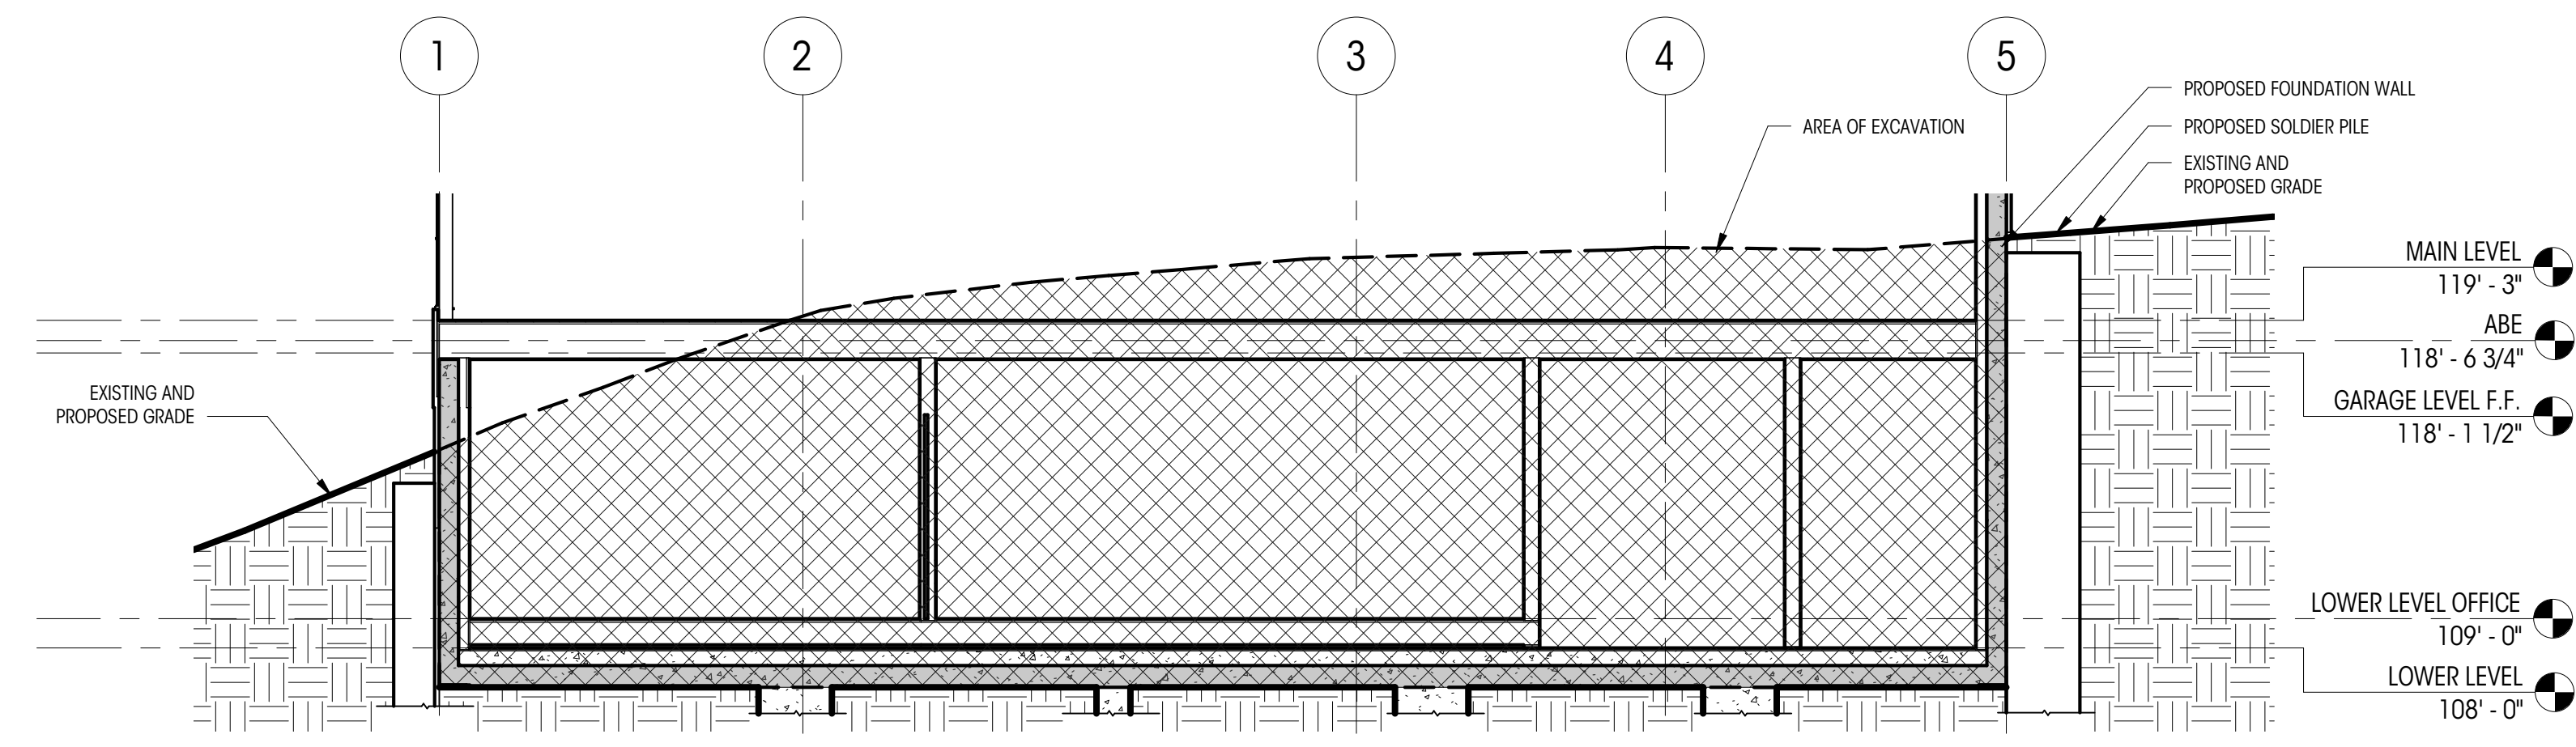

3 NORTH - SOUTH SECTION  
3/16" = 1'-0"

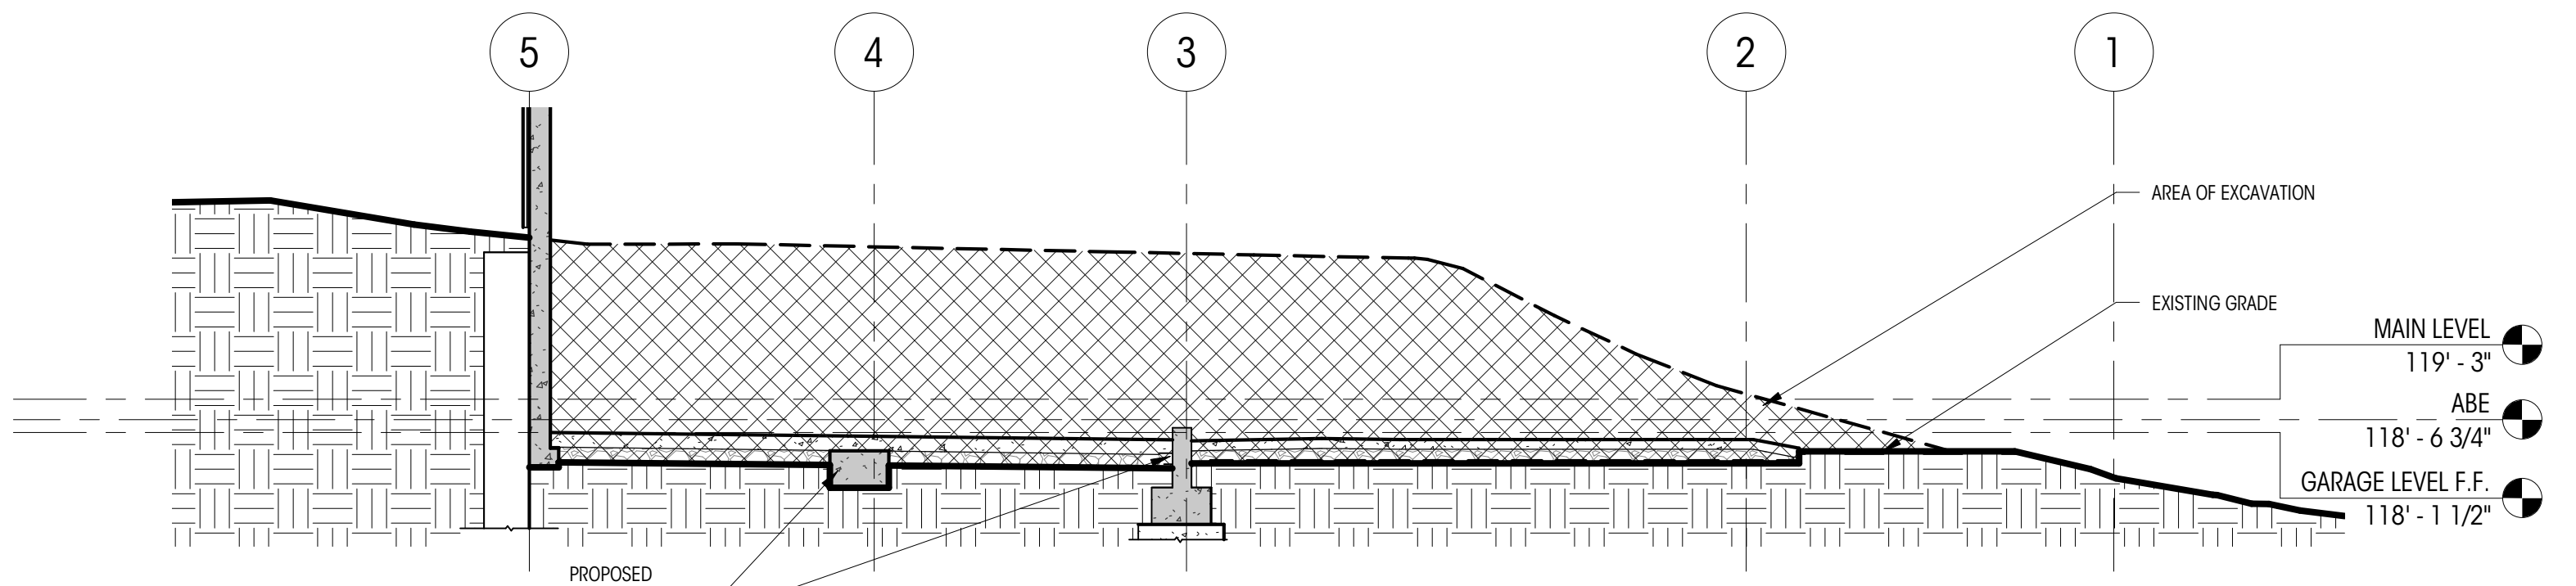

4 EAST - WEST SECTION  
3/16" = 1'-0"

**SITE EXCAVATION LEGEND**

	PROPOSED GRADE
	(E) GRADE
	ALTERED (E) GRADE
	PROPOSED FOUNDATION
	GRADE BEAM, PER STRUCTURAL
	FILL
	PROPOSED EXCAVATION
	EXISTING GRADE

**SCOPE OF CHANGES:**

- LEVEL CHANGES: DRIVEWAY & GARAGE LEVEL DROP BY 15"; BASEMENT LEVEL DROP BY 12"
- CHANGE TO ABE AS A RESULT OF EXTENDED GARAGE AND EXTENDED COVERED DECK
- VIEW NUMBERING HAS BEEN UPDATED FOR CONSISTENCY

**Brandt**

**Design Group**

66 Bell Street  
Unit 1  
Seattle, WA  
98121

206.239.0850

brandtdesigninc.com

8843  
REGISTERED ARCHITECT  
STATE OF WASHINGTON

**CLARKSON RESIDENCE**  
8163 WEST MERCER WAY  
MERCER ISLAND, WA 98040  
© COPYRIGHT 2022 BRANDT DESIGN, INC. SEATTLE, WA

PERMIT DRAWINGS

DATE: 06.10.22

SHEET SIZE: D (24X36)

**REVISIONS**

NO.	DESCRIPTION	DATE
3	PERMIT REVISION	04.19.22

DRAWN BY: KJ/JM  
CHECKED BY: BM

EXCAVATION SECTIONS

SCALE: As indicated

**A103**

DEDICATED APPROVAL STAMP SPACE

**SCOPE OF CHANGES:**

- REVISED LOCATION OF REPLACEMENT TREES
- SHIFT OF PARKING RETAINING WALLS TO NORTH AND SOUTH
- CHANGE IN SOIL RETENTION WALL: PREVIOUSLY AS PART OF THE FOUNDATION SYSTEM, NOW MOVED TO WESTERN YARD ADJACENT TO ROAD IN ORDER TO ALLOW FOR LANDSCAPE WORK
- REVISED FOUNDATION AS A RESULT OF SOIL STABILIZATION WALL LOCATION MOVE
- CHANGES TO HARDSCAPE CALCULATIONS AS A RESULT OF SOIL STABILIZATION WALL, PATIO EXTENSION AND SITE STAIRS
- GRAPHICS/PATTERNS/HATCHES HAVE BEEN COORDINATED FOR CONSISTENCY

**CRITICAL AREA LEGEND**

- STEEP SLOPE AREA
- PROPERTY SETBACK
- BUILDING FOOTPRINT
- APPROVED FIRE DEPARTMENT TURNAROUND
- LANDSCAPE WALL, 4' MAX.
- DENSE SCREEN PLANTING
- MOTORCOURT PLANTING STRIP

**SLOPE STABILIZATION PLANTING PLAN LEGEND**

- | VEGETATION | SPECIES COMMON NAME         | SPECIES LATIN NAME                |
|------------|-----------------------------|-----------------------------------|
|            | EDDIES WHITE WONDER DOGWOOD | <i>Cornus Nuttallii x Florida</i> |
|            | JAPANESE SNOWBELL           | <i>Styrax Japonicus</i>           |
|            | LADY FERN                   | <i>Athyrium Filix-Femina</i>      |

- | VEGETATION | SPECIES COMMON NAME   | SPECIES LATIN NAME             |
|------------|-----------------------|--------------------------------|
|            | SALAL                 | <i>Gaultheria Shalton</i>      |
|            | DEER FERN             | <i>Blechnum Spicant</i>        |
|            | OAK FERN              | <i>Gymnocarpium Dryopteris</i> |
|            | EVERGREEN HUCKLEBERRY | <i>Vaccinium Ovatum</i>        |

**NOTES:**

PER MICC 19.02.020(F)(3)(D), THE PROJECT SHALL REMOVE JAPANESE KNOTWEED (POLYGONUM CUSPIDATUM) AND REGULATED CLASS A, REGULATED CLASS B, AND REGULATED CLASS C WEEDS IDENTIFIED ON THE KING COUNTY NOXIOUS WEED LIST, AS AMENDED, FROM REQUIRED LANDSCAPING AREAS ESTABLISHED PURSUANT TO SUBSECTION (F)(3)(A) OF THIS SECTION. NEW LANDSCAPING ASSOCIATED WITH NEW SINGLE-FAMILY HOME SHALL NOT INCORPORATE ANY WEEDS IDENTIFIED ON THE KING COUNTY NOXIOUS WEED LIST, AS AMENDED, PROVIDED THAT REMOVAL SHALL NOT BE REQUIRED IF THE REMOVAL WILL RESULT IN INCREASED SLOPE INSTABILITY OR RISK OF LANDSLIDE OR EROSION.

**Brandt**


**Design Group**

66 Bell Street  
Unit 1  
Seattle, WA  
98121

206.239.0850

brandtdesigninc.com

8843

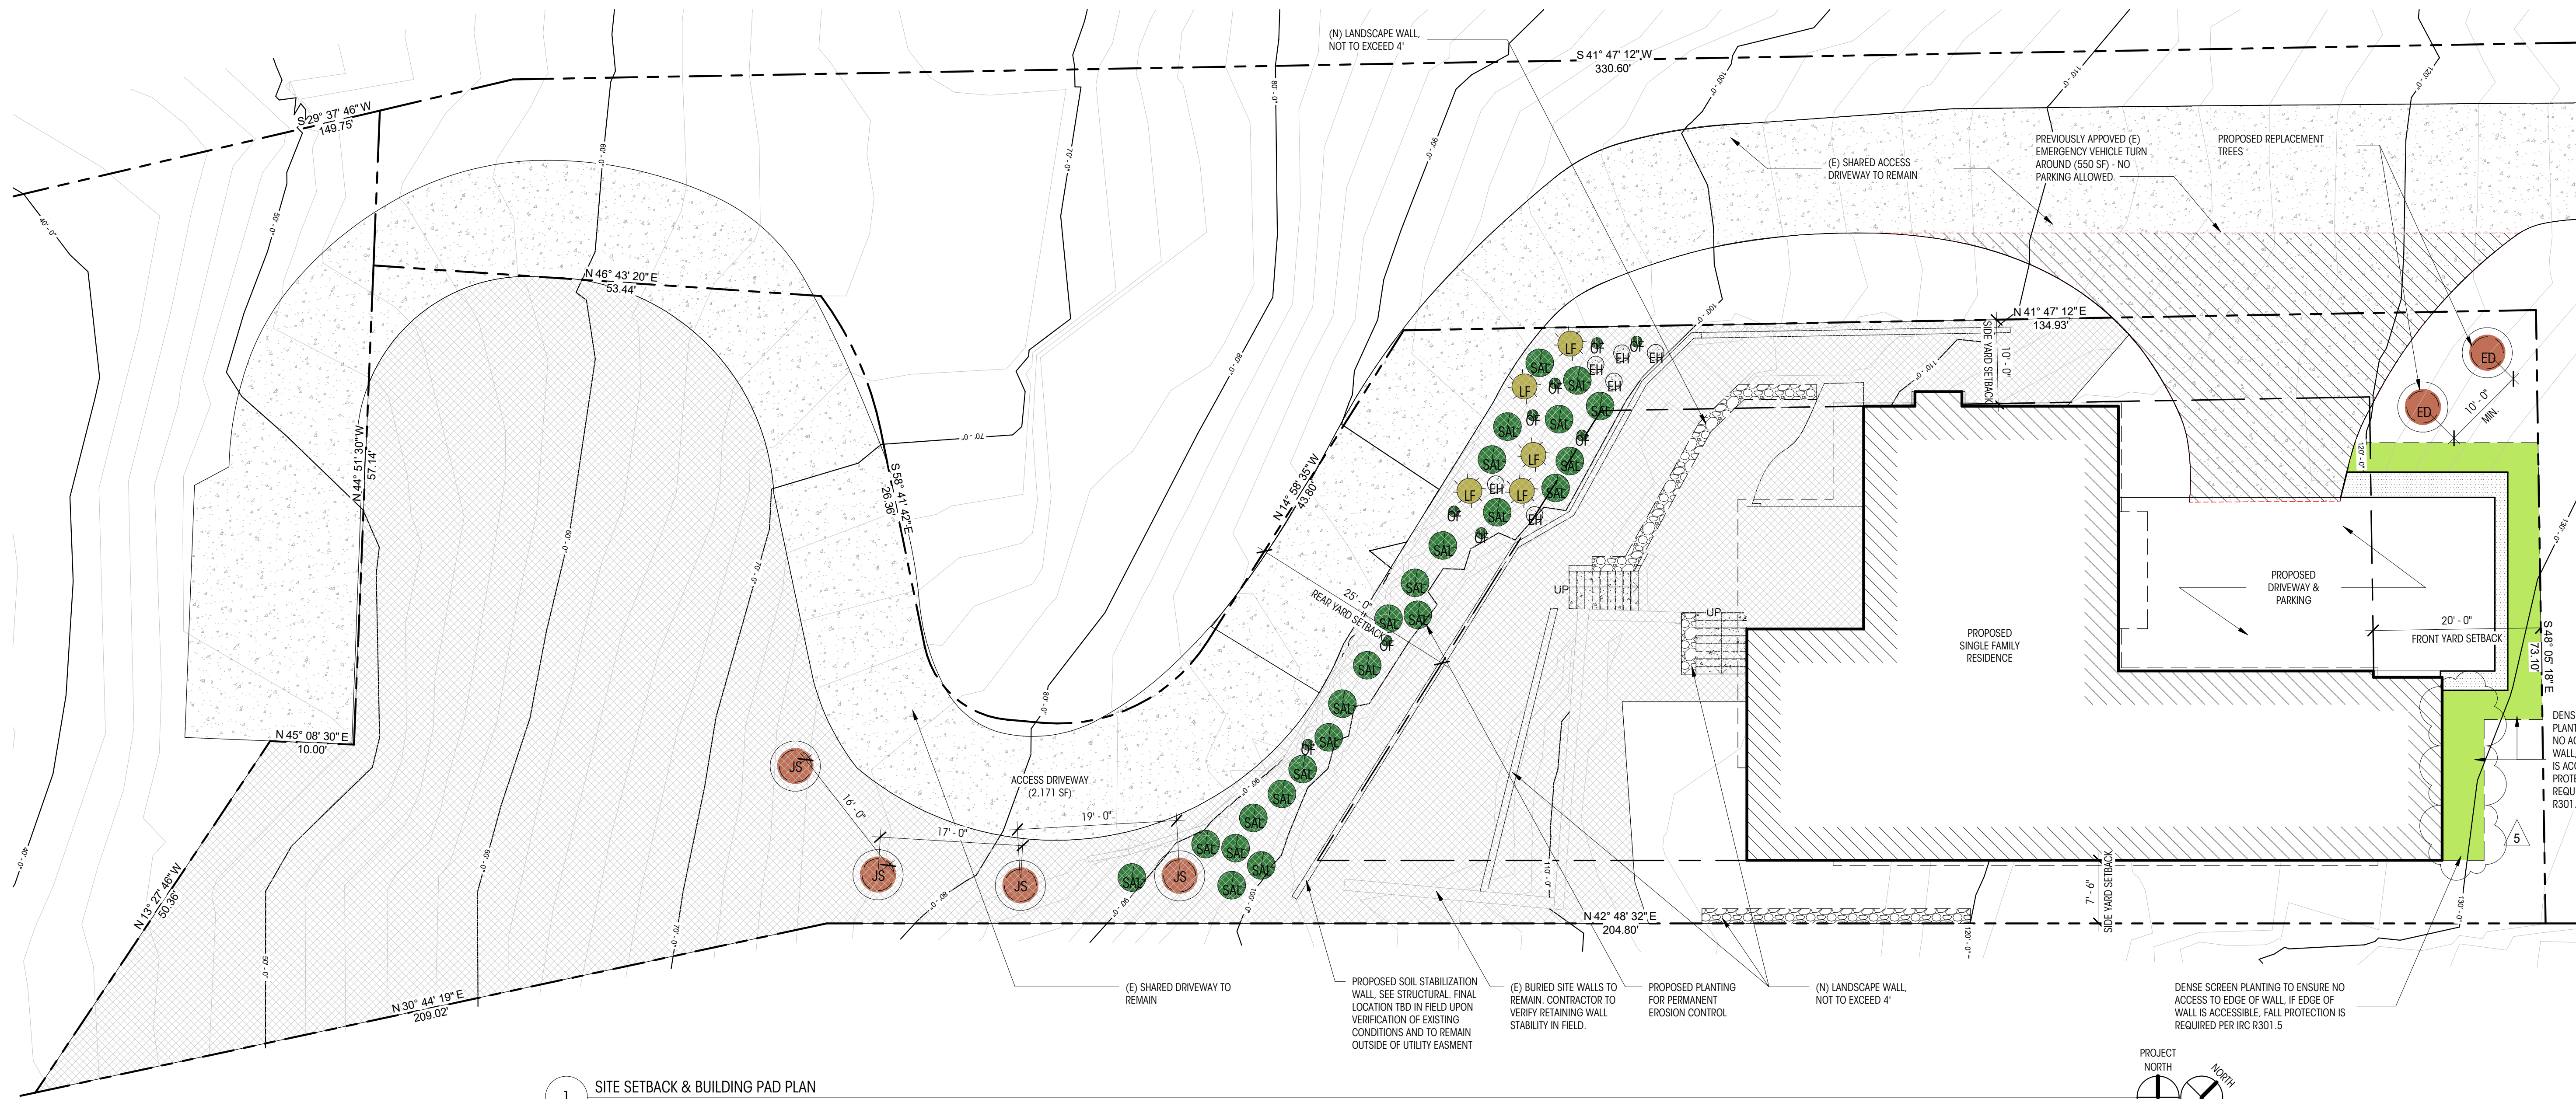

1 SITE SETBACK & BUILDING PAD PLAN  
1" = 10'-0"

**CLARKSON RESIDENCE**  
8163 WEST MERCER WAY  
MERCER ISLAND, WA 98040  
© COPYRIGHT 2022 BRANDT DESIGN, INC. SEATTLE, WA

PERMIT DRAWINGS

DATE: 06.10.22

SHEET SIZE: D (24X36)

**REVISIONS**

NO.	DESCRIPTION	DATE
3	PERMIT REVISION	04.19.22
4	PERMIT REVISION 2	06.10.22
5	PERMIT REVISION 3	08.30.22

DRAWN BY: K/J/M  
CHECKED BY: BM

CRITICAL AREA & TREE PLAN


SCALE: As Indicated

**A105**

DEDICATED APPROVAL STAMP SPACE




Section 36, Township 24N, Range 4E W.M.

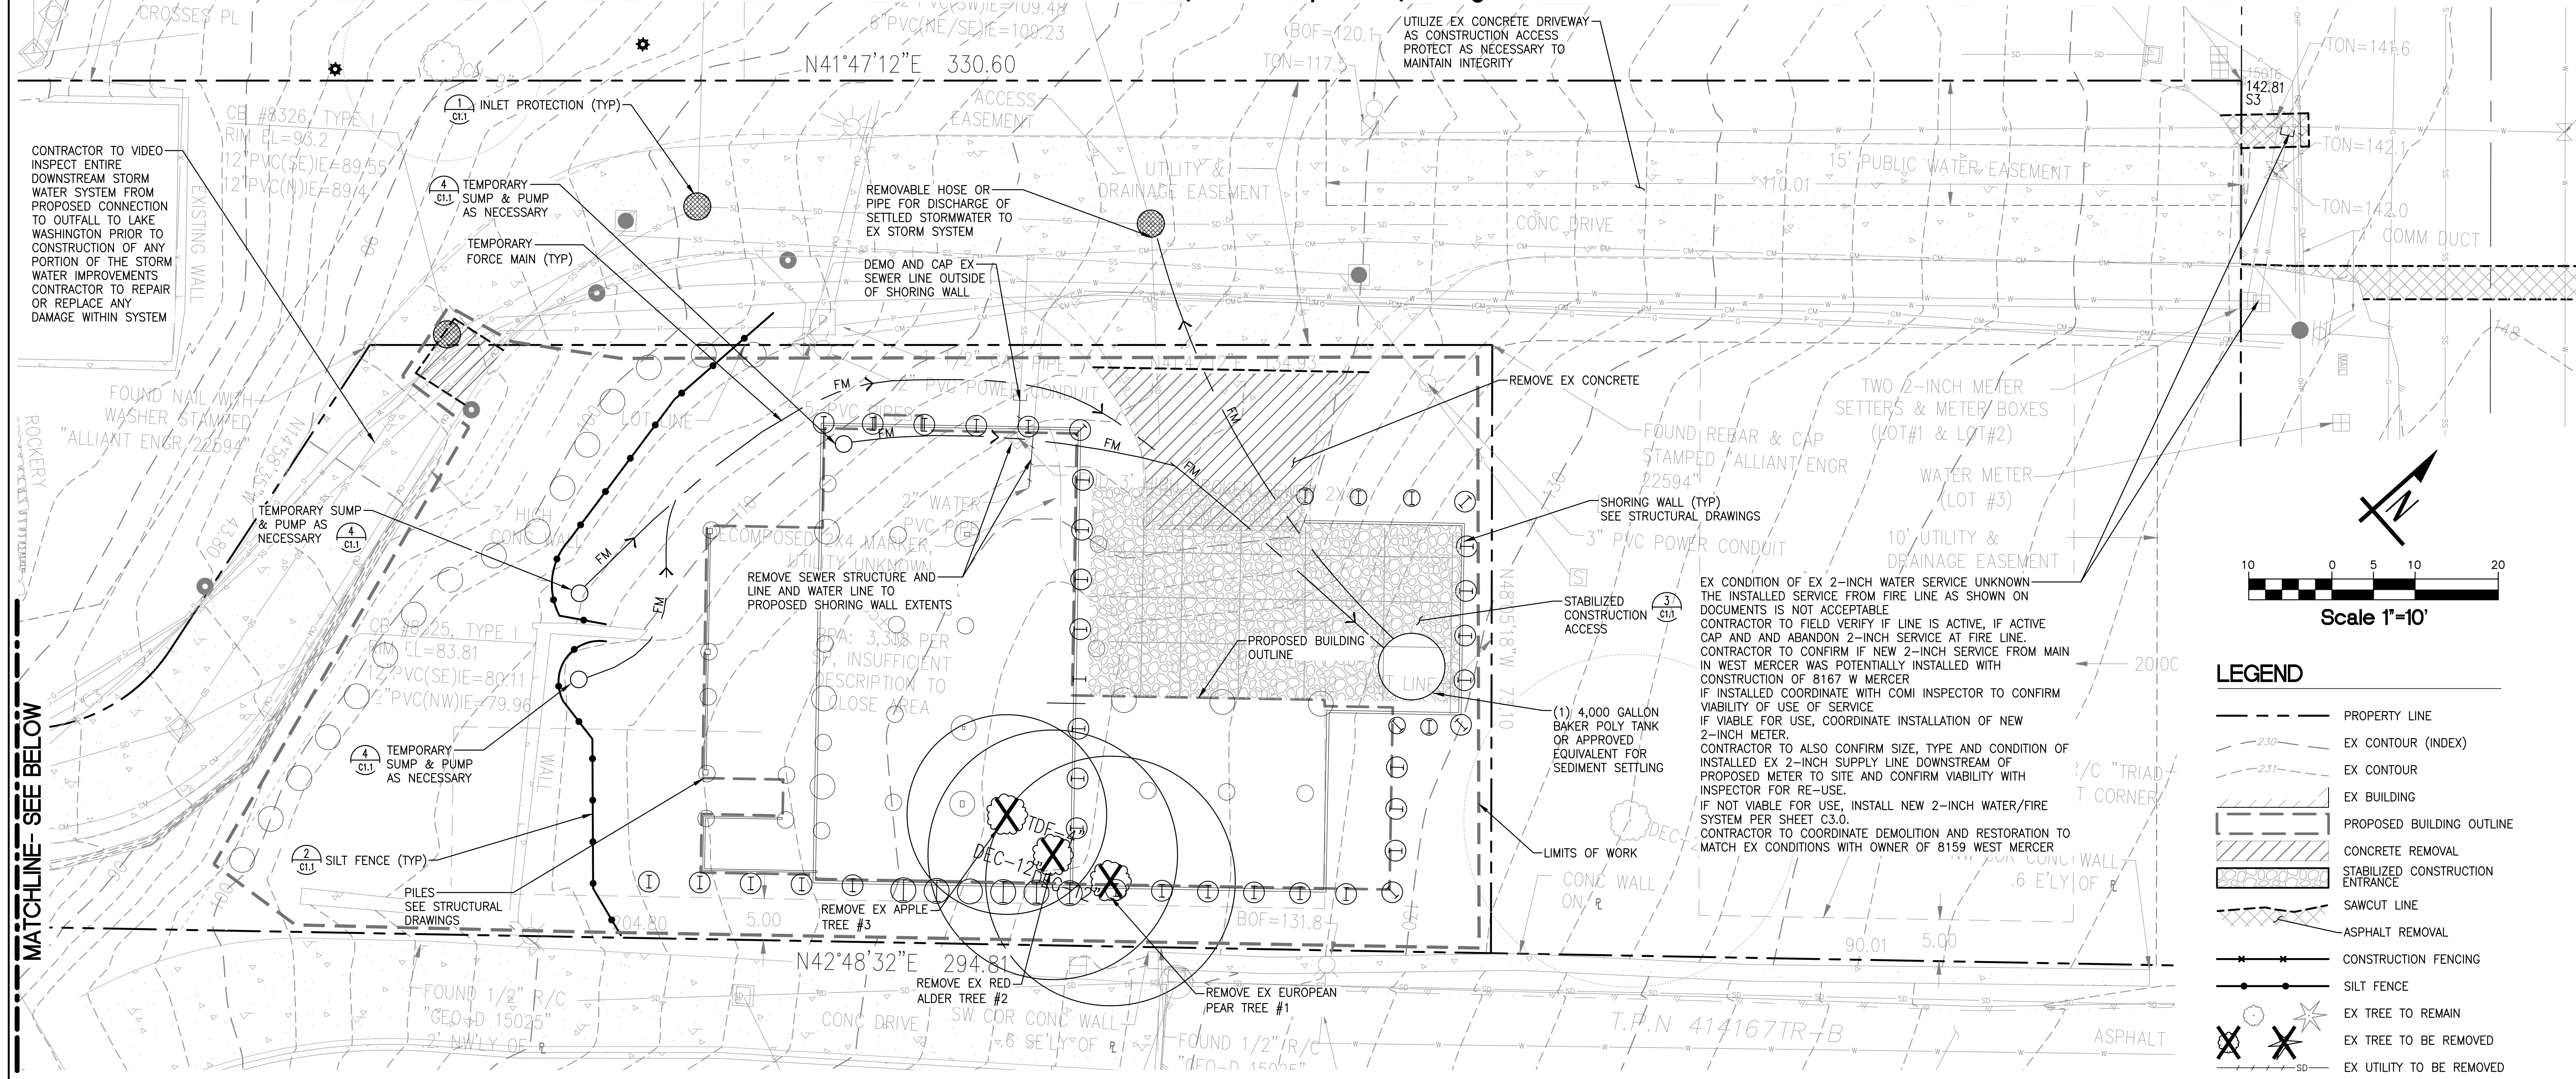


MATCHLINE- SEE BELOW

**LEGEND**


- PROPERTY LINE
- EX CONTOUR (INDEX)
- EX CONTOUR
- EX BUILDING
- PROPOSED BUILDING OUTLINE
- CONCRETE REMOVAL
- STABILIZED CONSTRUCTION ENTRANCE
- SAWCUT LINE
- ASPHALT REMOVAL
- CONSTRUCTION FENCING
- SILT FENCE
- EX TREE TO REMAIN
- EX TREE TO BE REMOVED
- EX UTILITY TO BE REMOVED
- INLET PROTECTION
- LIMITS OF WORK
- TEMP FORCE MAIN

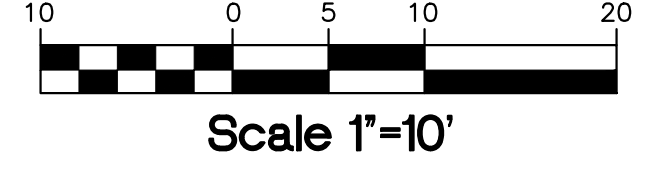

**NOTE:** NO SOIL, WATER, OR DEBRIS FROM SITE ACTIVITIES ARE ALLOWED TO BE PLACED OR DISCHARGED ON THE SLOPE.

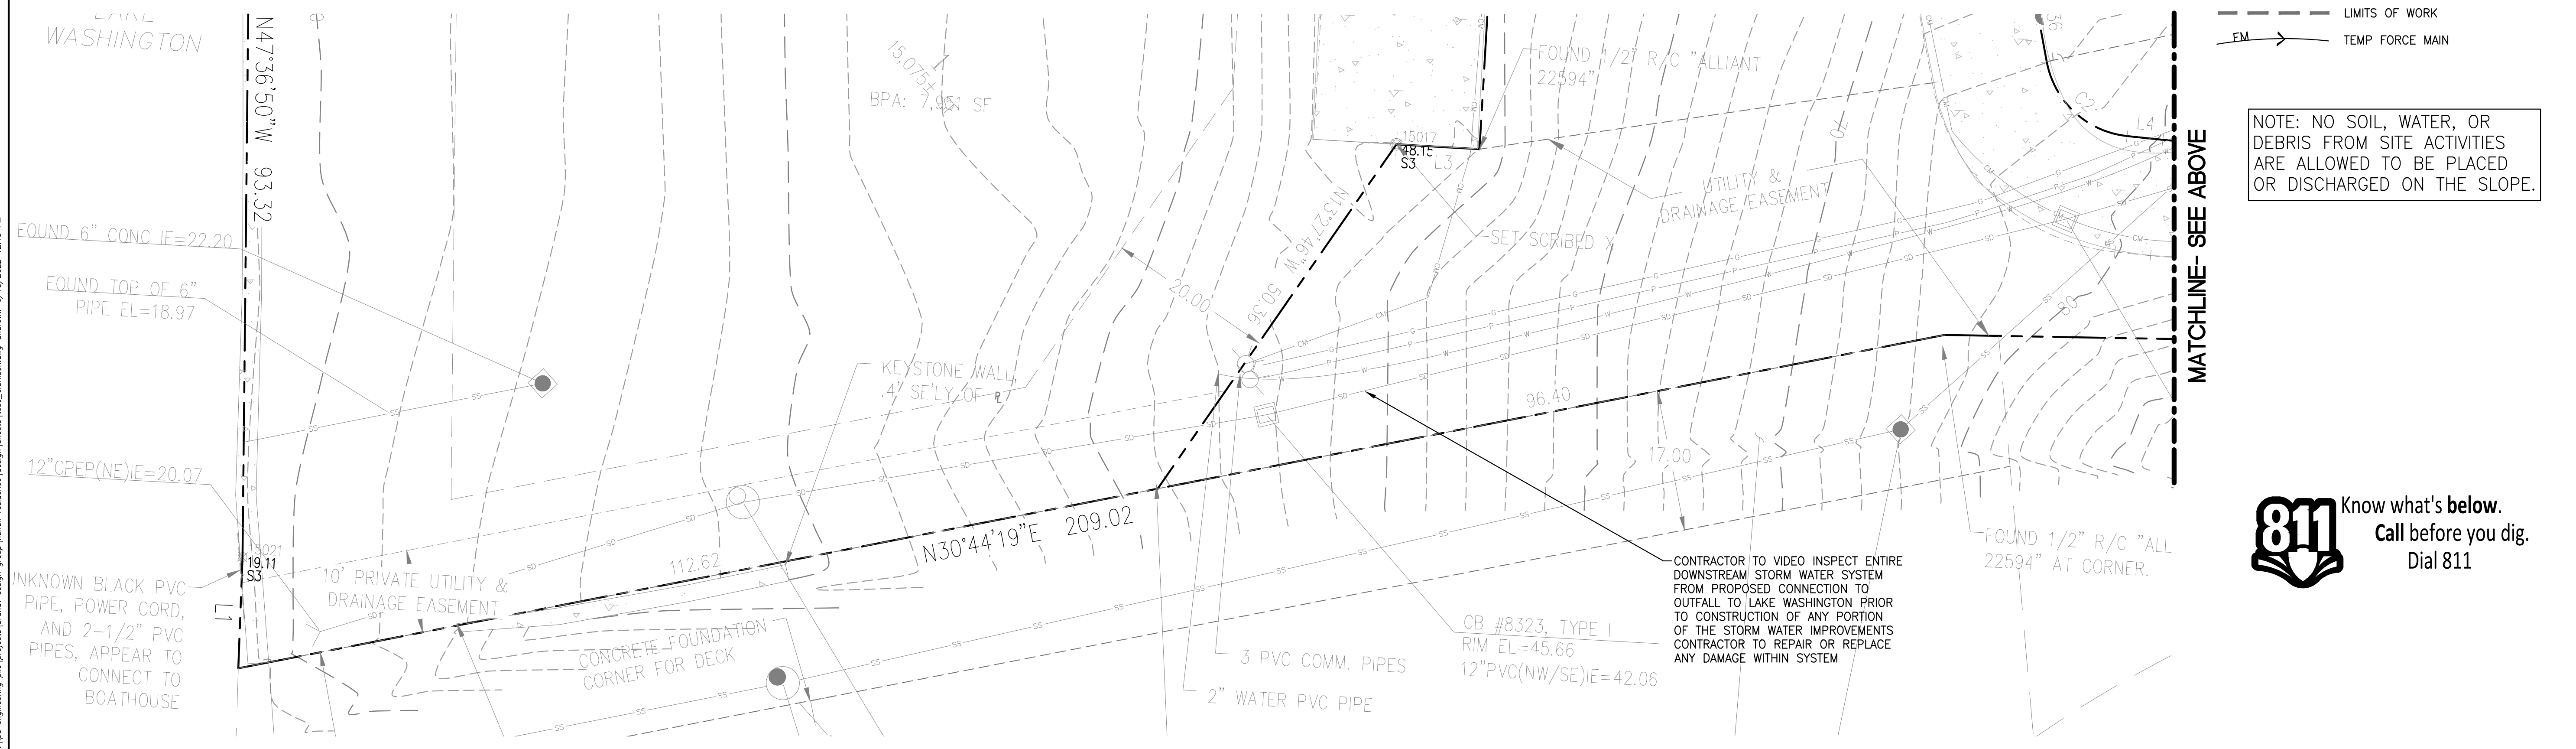

MATCHLINE- SEE ABOVE

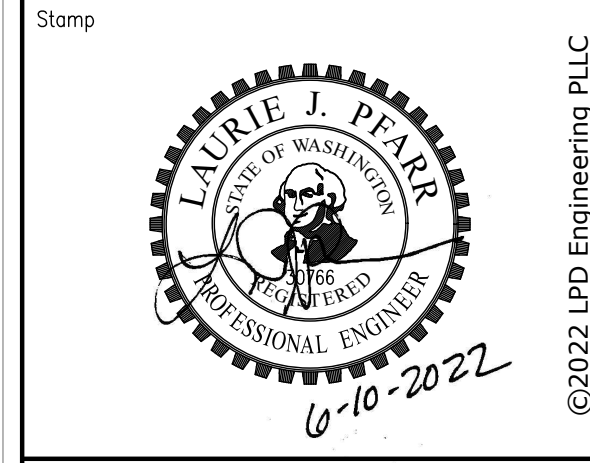

No.	Revisions	Date
1	PERMIT REVISIONS	04/20/2022
2	PERMIT REVISIONS	06/10/2022

Project Name

**CLARKSON RESIDENCE  
8163 W MERCER WAY**

City of Mercer Island, Washington


Project No.	272-20-01
Issue Date	04/20/2022
Scale	AS NOTED
Designed	ACW
Drawn	KES
Checked	LJP
Approved	LJP

**TESC & DEMOLITION PLAN**

Sheet **C1.0**


© LPD engineering pllc projects/broad design group/labor residence design/laurie ferrer/8163\_w\_mercer\_way\_04/20/2022\_12:43 PM

PERMIT DOCUMENTS

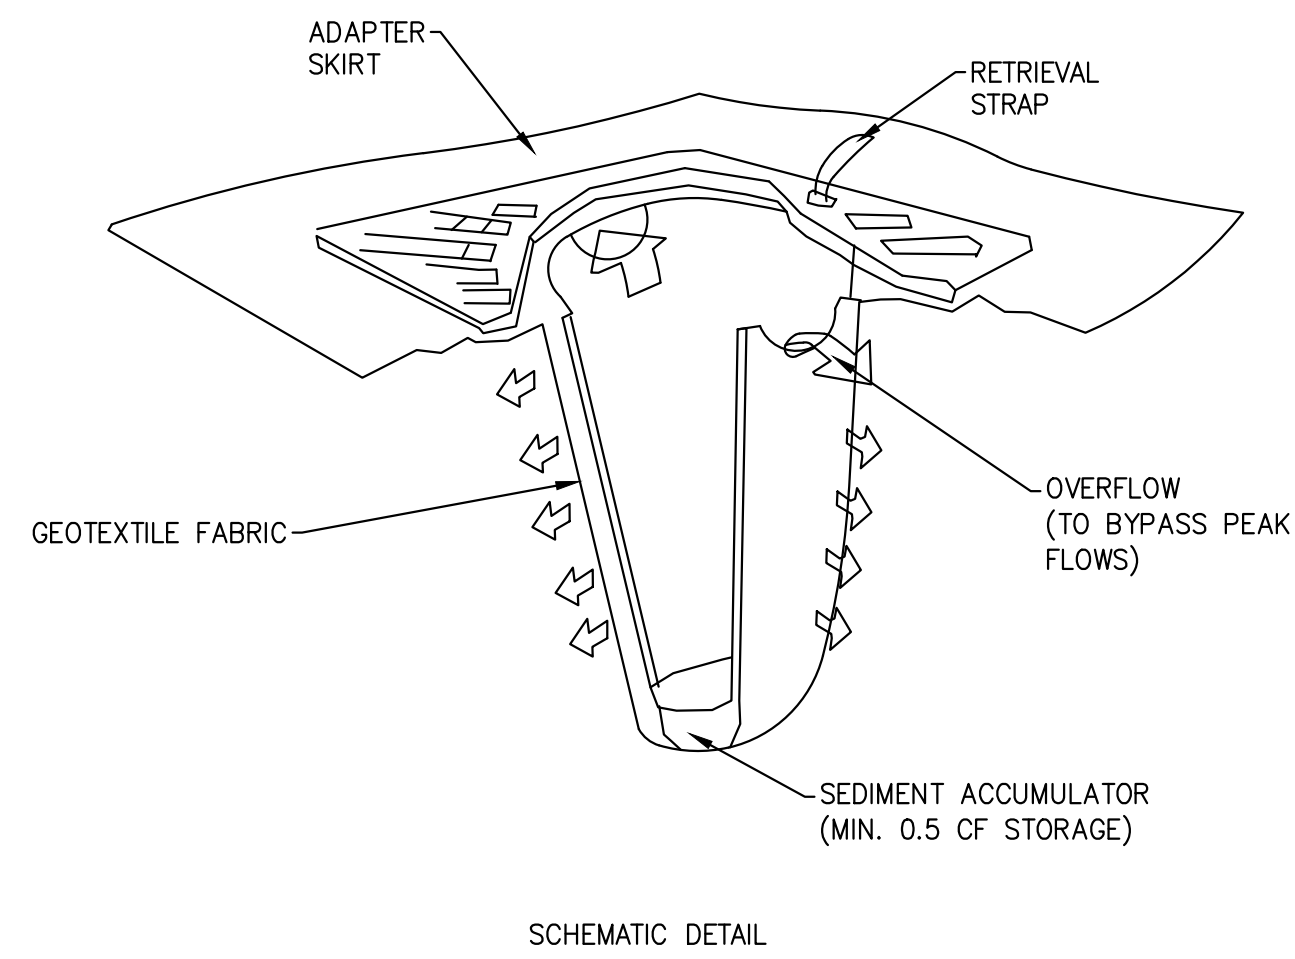


PROVIDE "STREAMGUARD SEDIMENT CATCH BASIN INSERT" OR APPROVED EQUAL MANUFACTURER'S NAME: BOWHEAD ENVIRONMENTAL & SAFETY ADDRESS: P.O. BOX 375 PRESTON, WA 98050 TELEPHONE: FOR INFORMATION: (800) 909-3677 WWW.SHOPBOWHEAD.COM


INLET PROTECTION 1

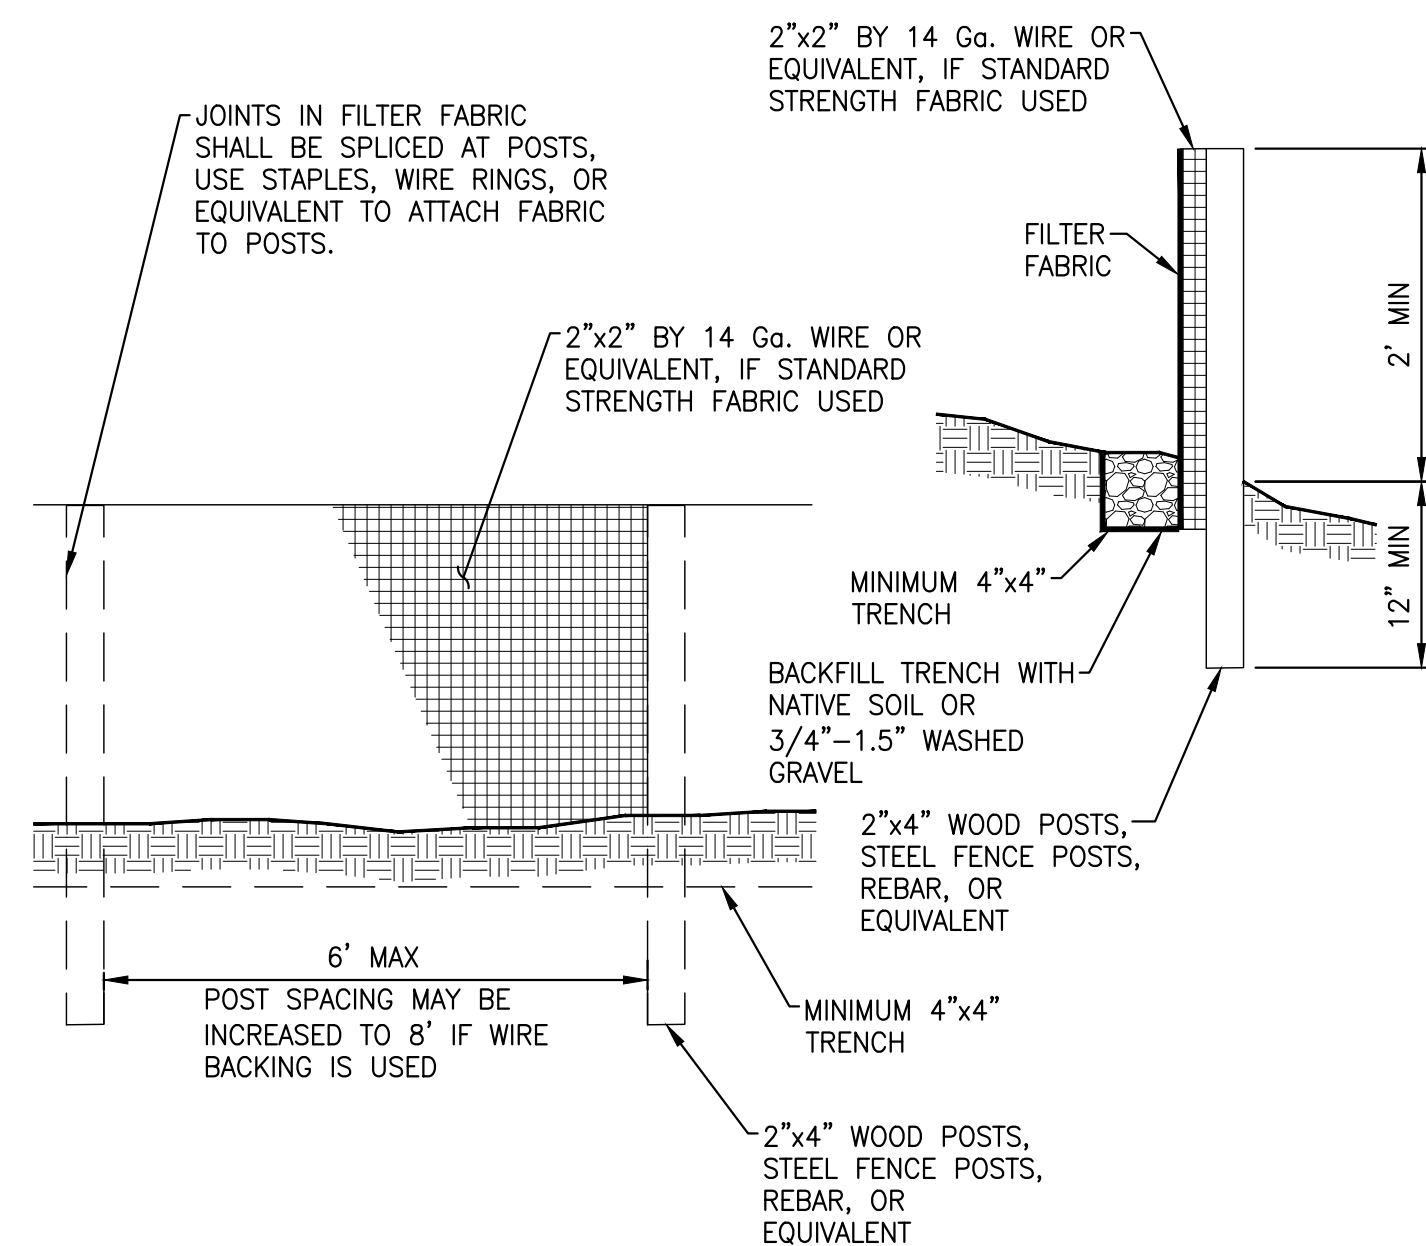

SILT FENCE 2

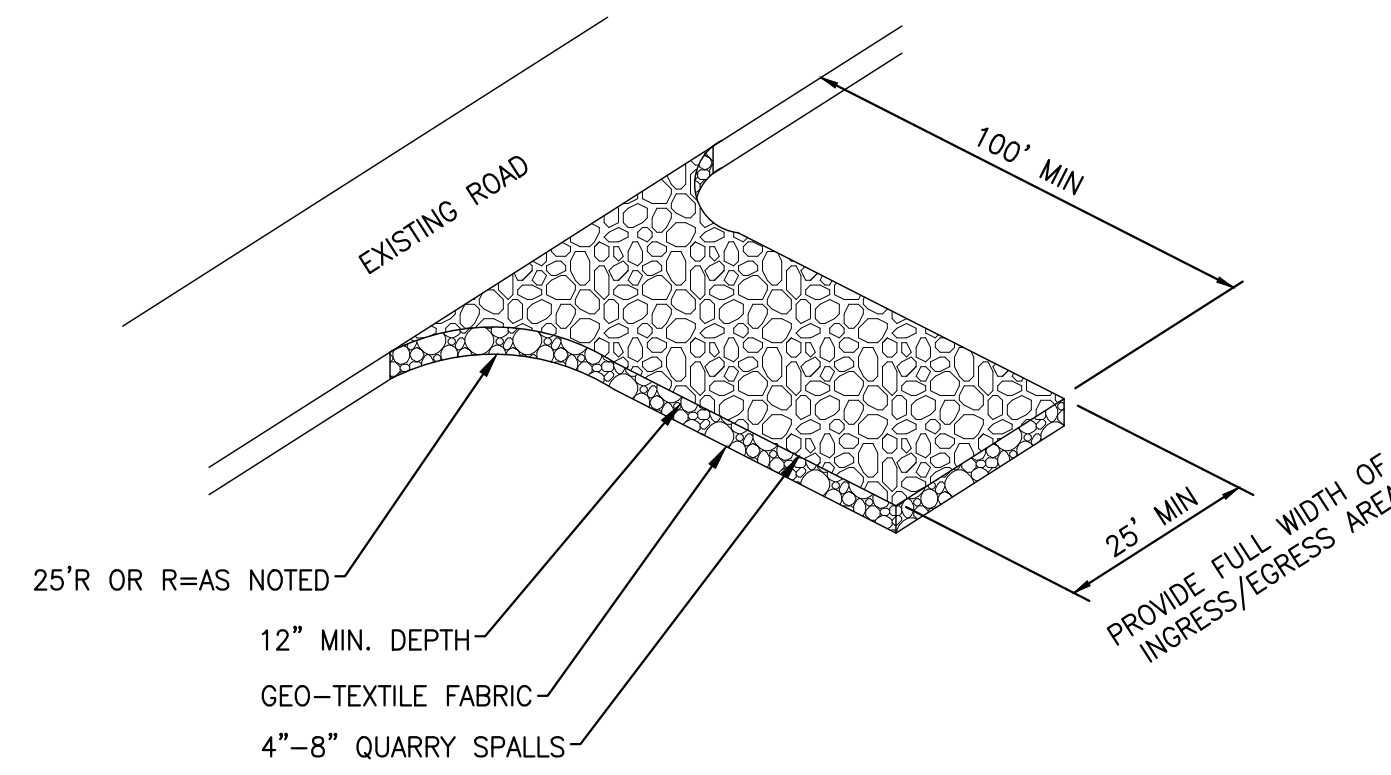

STABILIZED CONSTRUCTION ENTRANCE 3

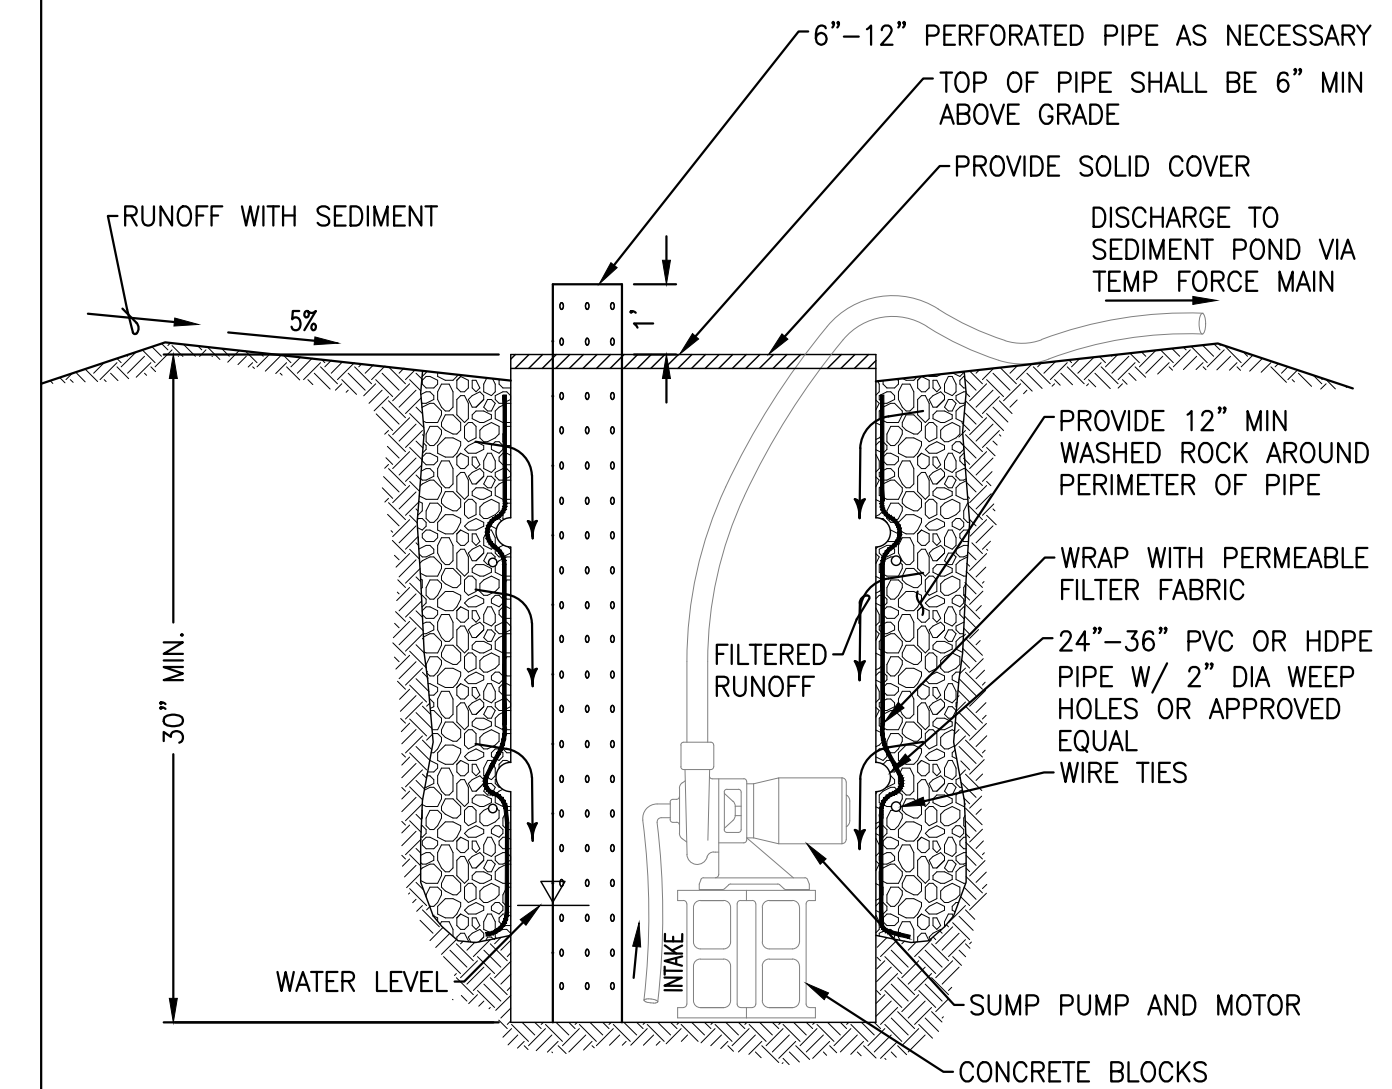

TEMPORARY SUMP & PUMP 4

**EROSION AND SEDIMENTATION CONTROL NOTES**

- THE IMPLEMENTATION OF THESE EROSION SEDIMENTATION CONTROL (ESC) PLANS AND THE CONSTRUCTION, MAINTENANCE, REPLACEMENT, AND UPGRADING OF THESE ESC FACILITIES IS THE RESPONSIBILITY OF THE CONTRACTOR UNTIL ALL CONSTRUCTION IS APPROVED.
- THE ESC FACILITIES SHOWN ON THIS PLAN MUST BE CONSTRUCTED IN CONJUNCTION WITH ALL CLEARING AND GRADING ACTIVITIES IN SUCH A MANNER AS TO INSURE THAT SEDIMENT-LADEN WATER DOES NOT ENTER THE DRAINAGE SYSTEM OR VIOLATE APPLICABLE WATER STANDARDS, AND MUST BE COMPLETED PRIOR TO ALL OTHER CONSTRUCTION.
- THE ESC FACILITIES SHOWN ON THIS PLAN ARE THE MINIMUM REQUIREMENTS FOR ANTICIPATED SITE CONDITIONS. DURING THE CONSTRUCTION PERIOD, THESE ESC FACILITIES SHALL BE UPGRADED (E.G. ADDITIONAL SUMPS, RELOCATION OF DITCHES AND SILT FENCES), AS NEEDED FOR UNEXPECTED STORM EVENTS. ADDITIONALLY MORE ESC FACILITIES MAY BE REQUIRED TO ENSURE COMPLETE SILTATION CONTROL. THEREFORE, DURING THE COURSE OF CONSTRUCTION IT SHALL BE THE OBLIGATION AND RESPONSIBILITY OF THE CONTRACTOR TO ADDRESS ANY NEW CONDITIONS THAT MAY BE CREATED BY THEIR ACTIVITIES AND TO PROVIDE ADDITIONAL FACILITIES OVER AND ABOVE THE MINIMUM REQUIREMENTS AS MAY BE NEEDED.
- THE ESC FACILITIES SHALL BE INSPECTED DAILY DURING NON-RAINFALL PERIODS, EVERY HOUR (DAYLIGHT) DURING A RAINFALL EVENT AND AT THE END OF EVERY RAINFALL BY THE PERMIT HOLDER/CONTRACTOR AND MAINTAINED AS NECESSARY TO ENSURE THEIR CONTINUED FUNCTIONING. IN ADDITION, TEMP. SILTATION PONDS AND ALL TEMP. SILTATION CONTROLS SHALL BE MAINTAINED IN A SATISFACTORY CONDITION UNTIL SUCH TIME THAT CLEARING AND OR CONSTRUCTION IS COMPLETED, PERMANENT DRAINAGE FACILITIES ARE OPERATIONAL, AND THE POTENTIAL FOR EROSION HAS PASSED.
- ANY AREA STRIPPED OF VEGETATION, INCLUDING ROADWAY EMBANKMENTS WHERE NO FURTHER WORK IS ANTICIPATED FOR A PERIOD OF SEVEN (7) DAYS, SHALL BE IMMEDIATELY STABILIZED WITH THE APPROVED ESC METHODS (E.G. SEEDING, MULCHING, NETTING, EROSION, BLANKETS, ETC.).
- ANY AREAS NEEDING ESC MEASURES, NOT REQUIRING IMMEDIATE ATTENTION, SHALL BE ADDRESSED WITHIN SEVEN (7) DAYS.
- THE ESC FACILITIES ON INACTIVE SITES SHALL BE INSPECTED AND MAINTAINED A MINIMUM OF ONCE A MONTH OR WITHIN THE 48 HOURS FOLLOWING A STORM EVENT.
- AT NO TIME SHALL MORE THAN ONE FOOT OF SEDIMENT BE ALLOWED TO ACCUMULATE WITHIN A CATCH BASIN. ALL CATCH BASINS AND CONVEYANCE LINES SHALL BE CLEANED PRIOR TO PAVING. THE CLEANING OPERATION SHALL NOT FLUSH SEDIMENT LADEN WATER INTO DOWNSTREAM SYSTEM.
- WHERE SEEDING FOR TEMPORARY EROSION CONTROL IS REQUIRED, FAST GERMINATING GRASSES SHALL BE APPLIED AT AN APPROPRIATE RATE (E.G. ANNUAL OR PERENNIAL RYE APPLIED AT APPROXIMATELY 80 POUNDS PER ACRE).
- WHERE STRAW MULCH FOR TEMPORARY EROSION CONTROL IS REQUIRED, IT SHALL BE APPLIED AT A MINIMUM THICKNESS OF THREE INCHES.
- ALL WORK AND MATERIALS SHALL BE IN ACCORDANCE WITH THE CITY OF MERCER ISLAND STANDARDS AND SPECIFICATIONS.
- EROSION/SEDIMENTATION CONTROL FACILITIES SHALL BE CONSTRUCTED IN ACCORDANCE WITH THE DETAILS IN DEPARTMENT OF ECOLOGY STORMWATER MANAGEMENT MANUAL, UNLESS OTHERWISE APPROVED BY THE CITY ENGINEER.
- A COPY OF THE APPROVED EROSION CONTROL PLANS MUST BE ON THE JOB SITE WHENEVER CONSTRUCTION IS IN PROGRESS.
- TEMPORARY EROSION/SEDIMENTATION CONTROLS SHALL BE INSTALLED & OPERATING PRIOR TO ANY GRADING OR LAND CLEARING.
- WHEREVER POSSIBLE, MAINTAIN NATURAL VEGETATION FOR SILT CONTROL.
- ALL CUT AND FILL SLOPES 5:1 (5 FEET HORIZONTAL TO 1 FOOT VERTICAL) OR STEEPER THAT WILL BE LEFT EXPOSED FOR MORE THAN 7 DAYS SHALL BE PROTECTED BY JUTE MATTING, PLASTIC SHEETING, MULCH, OR OTHER APPROVED STABILIZATION METHOD AND PROVIDED WITH ADEQUATE RUNOFF CONVEYANCE TO INTERCEPT RUNOFF AND CONVEY IT TO AN APPROVED STORM DRAIN.
- OFF-SITE STREETS MUST BE KEPT CLEAN AT ALL TIMES. IF DIRT IS DEPOSITED ON THE PUBLIC STREET, THE STREET SHALL BE CLEANED. ALL VEHICLES SHALL LEAVE THE SITE BY WAY OF THE CONSTRUCTION VEHICLE ENTRANCE AND SHALL BE CLEANED OF MUD PRIOR TO EXITING ONTO THE STREET. SILT SHALL BE CLEANED FROM ALL CATCH BASINS WHEN THE BOTTOM HALF BECOMES FILLED WITH SILT.
- ANY CATCH BASIN COLLECTING WATER FROM THE SITE, WHETHER THEY ARE ON OR OFF OF THE SITE, SHALL HAVE THEIR GRATES COVERED WITH FILTER FABRIC DURING CONSTRUCTION.
- IF ANY PORTION OF THE EROSION/SEDIMENTATION CONTROL ELEMENTS ARE DAMAGED OR NOT FUNCTIONING, OR IF THE CLEARING LIMIT BOUNDARY BECOMES NON-DEFINED, IT SHALL BE REPAIRED IMMEDIATELY.

EROSION AND SEDIMENTATION CONTROL NOTES 9

**CITY OF MERCER ISLAND NOTES**

- ANY CHANGES TO THE APPROVED PLANS REQUIRES CITY APPROVAL THROUGH A REVISION.
- APPLICANT IS RESPONSIBLE FOR ANY DAMAGES TO UNDERGROUND UTILITIES CAUSED FROM THIS CONSTRUCTION.
- CATCH BASIN FILTERS SHOULD BE PROVIDED FOR ALL STORM DRAIN CATCH BASIN/INLETS DOWNSLOPE AND WITHIN 500 FEET OF THE CONSTRUCTION AREA. CATCH BASIN FILTERS SHOULD BE DESIGNED BY THE MANUFACTURER FOR USE AT CONSTRUCTION SITES AND APPROVED BY THE CITY INSPECTOR. CATCH BASIN FILTERS SHOULD BE INSPECTED FREQUENTLY, ESPECIALLY AFTER STORM EVENTS. IF THE FILTER BECOMES CLOGGED, IT SHOULD BE CLEANED OR REPLACED.
- CONTRACTORS SHALL VERIFY LOCATIONS AND DEPTHS OF UTILITIES.
- AT LEAST 48 HOURS PRIOR TO CONSTRUCTION, CALL "ONE CALL" AT 1.800.425.5555.
- DO NOT BACKFILL WITH NATIVE MATERIAL ON PUBLIC RIGHT-OF-WAY. ALL MATERIAL MUST BE IMPORTED.
- EROSION CONTROL: ALL "LAND DISTURBING ACTIVITY" IS SUBJECT TO PROVISIONS OF MERCER ISLAND ORDINANCE 95C-118 "STORM WATER MANAGEMENT." SPECIFIC ITEMS TO BE FOLLOWED AT YOUR SITE.
- PROTECT ADJACENT PROPERTIES FROM ANY INCREASED RUNOFF OR SEDIMENTATION DUE TO THE CONSTRUCTION PROJECT THROUGH THE USE OF APPROPRIATE "BEST MANAGEMENT PRACTICES" (BMP) EXAMPLES INCLUDE, BUT ARE NOT LIMITED TO, SEDIMENT TRAPS, SEDIMENT PONDS, FILTER FABRIC FENCES, VEGETATIVE BUFFER STRIPS OR BIOENGINEERED SWALES.
- CONSTRUCTION ACCESS TO SITE SHOULD BE LIMITED TO ONE ROUTE. STABILIZE ENTRANCE WITH QUARRY SPALLS TO PREVENT SEDIMENT FROM LEAVING THE SITE OR ENTERING THE STORM DRAINS.
- PREVENT SEDIMENT, CONSTRUCTION DEBRIS, PAINTS, SOLVENTS, ETC., OR OTHER TYPES OF POLLUTION FROM ENTERING PUBLIC STORM DRAINS. KEEP ALL POLLUTION ON YOUR SITE.
- ALL EXPOSED SOILS SHALL REMAIN DENUDED FOR NO LONGER THAN SEVEN (7) DAYS AND SHALL BE STABILIZED WITH MULCH, HAY, OR THE APPROPRIATE GROUND COVER. ALL EXPOSED SOILS SHALL BE COVERED IMMEDIATELY DURING ANY RAIN EVENT.
- INSTALLATION OF CONCRETE DRIVEWAYS, TREES, SHRUBS, IRRIGATION, BOULDERS, BERMS, WALLS, GATES, AND OTHER IMPROVEMENTS ARE NOT ALLOWED IN THE PUBLIC RIGHT-OF-WAY WITHOUT PRIOR APPROVAL, AND AN ENCROACHMENT AGREEMENT AND RIGHT OF WAY PERMIT FROM THE SENIOR DEVELOPMENT ENGINEER.
- OWNER SHALL CONTROL DISCHARGE OF SURFACE DRAINAGE RUNOFF FROM EXISTING AND NEW IMPERVIOUS AREAS IN A RESPONSIBLE MANNER. CONSTRUCTION OF NEW GUTTERS AND DOWNSPOUTS, DRY WELLS, LEVEL SPREADERS OR DOWNSTREAM CONVEYANCE PIPE MAY BE NECESSARY TO MINIMIZE DRAINAGE IMPACT TO YOUR NEIGHBORS. CONSTRUCTION OF MINIMUM DRAINAGE IMPROVEMENTS SHOWN OR CALLED OUT ON THIS PLAN DOES NOT IMPLY RELIEF FROM CIVIL LIABILITY FOR YOUR DOWNSTREAM DRAINAGE.
- POT HOLING THE PUBLIC UTILITIES IS REQUIRED PRIOR TO ANY GRADING ACTIVITIES LESS THAN 6" OVER THE PUBLIC MAINS (WATER, SEWER AND STORM SYSTEMS). IF THERE IS A CONFLICT, THE APPLICANT IS REQUIRED TO SUBMIT A REVISION FOR APPROVAL PRIOR TO ANY GRADING ACTIVITIES OVER THE PUBLIC MAINS.
- REMEMBER: EROSION CONTROL IS YOUR FIRST INSPECTION.
- ROOF DRAINS MUST BE CONNECTED TO THE STORM DRAIN SYSTEM AND INSPECTED BY THE PUBLIC WORKS DEPARTMENT PRIOR TO ANY BACKFILLING OF PIPE.
- SILT FENCE: CLEAN AND PROVIDE REGULAR MAINTENANCE OF THE SILT FENCE. THE FENCE IS TO REMAIN VERTICAL AND IS TO FUNCTION PROPERLY THROUGHOUT THE TERM OF THE PROJECT.
- WORK IN PUBLIC RIGHT OF WAY REQUIRES A RIGHT-OF-WAY USE PERMIT.
- REFER TO WATER SERVICE PERMIT FOR ACTUAL LOCATION OF NEW WATER METER AND SERVICE LINE DETERMINED BY MERCER ISLAND WATER DEPARTMENT.
- THE TV INSPECTION OF THE EXISTING SIDE SEWER TO THE CITY SEWER MAIN IS REQUIRED. IF THE RESULT OF THE TV INSPECTION IS NOT IN SATISFACTORY CONDITION, AS DETERMINED BY THE CITY OF MERCER ISLAND INSPECTOR, THE REPLACEMENT OF THE EXISTING SIDE SEWER IS REQUIRED. ALTERNATELY, A PRESSURE TEST OF THE SIDE SEWER, FROM SEWER MAIN TO POINT OF CONNECTION, MAY BE SUBSTITUTED FOR THE VIDEO INSPECTION.
- NEWLY INSTALLED SIDE SEWER REQUIRES A 4 P.S.I. AIR TEST OR PROVIDE 10' OF HYDROSTATIC HEAD TEST.
- THE LIMITS AND EXTENTS OF THE PAVEMENT IN THE PUBLIC RIGHT OF WAY SHALL BE DETERMINED BY THE CITY ENGINEER PRIOR TO FINALIZING THE PROJECT.
- TREE PROTECTION INSPECTION REQUIRED BEFORE ANY WORK BEGINS, CALL 206-275-7713.


CITY OF MERCER ISLAND NOTES 10

NOT USED 7


NOT USED 8

NOT USED 11

NOT USED 12

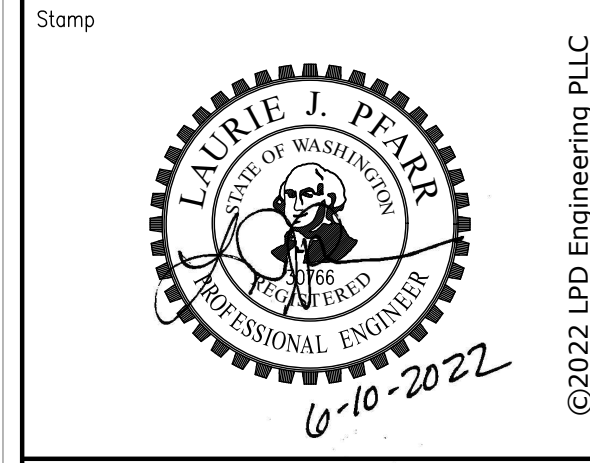

No.	Revisions	Date
1	PERMIT REVISIONS	04/20/2022
2	PERMIT REVISIONS	06/10/2022

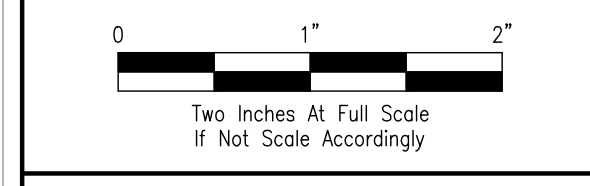

Project Name

**CLARKSON RESIDENCE  
 8163 W MERCER WAY**

City of Mercer Island, Washington

Project No.	272-20-01
Issue Date	04/20/2022
Scale	As Noted
Designed	ACW Checked LJP
Drawn	KES Approved LJP


Description  
**NOTES & TESC DETAILS**

Sheet  
**C1.1**


PERMIT DOCUMENTS

c:\lpd\engineering\plc\projects\lpd\design\lpd\residence\tesc\details\clarkson\residence\drawn 6/12/2022 12:43 PM

Section 36, Township 24N, Range 4E W.M.

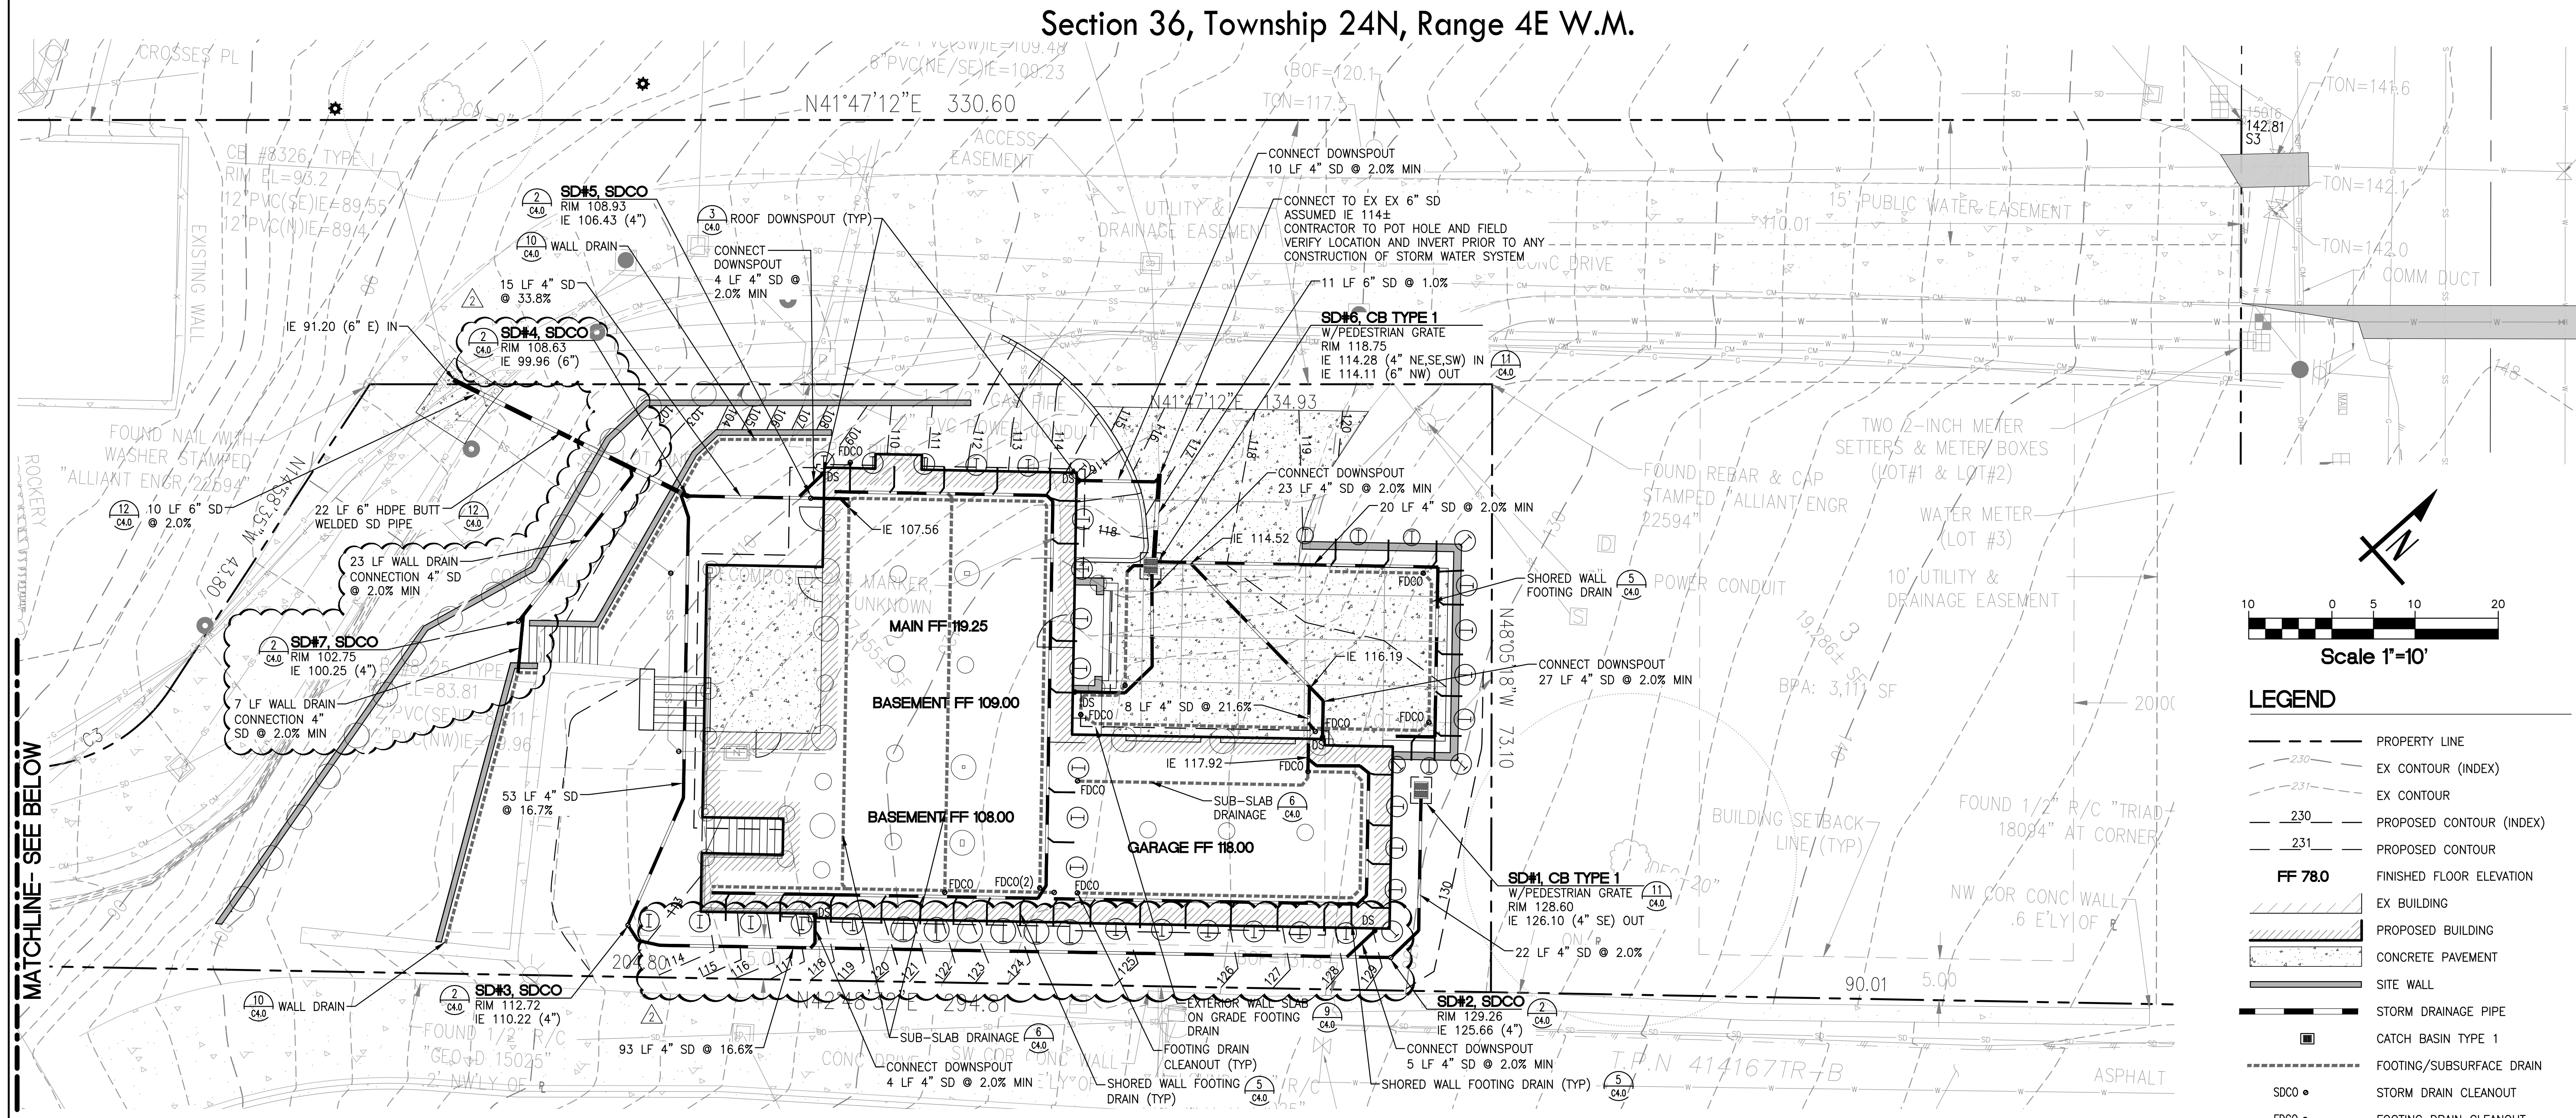


MATCHLINE- SEE BELOW

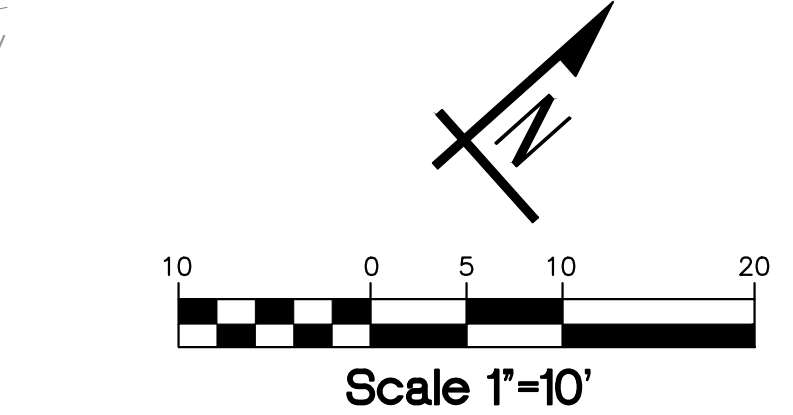


LEGEND

- PROPERTY LINE
- - - EX CONTOUR (INDEX)
- - - EX CONTOUR
- - - PROPOSED CONTOUR (INDEX)
- - - PROPOSED CONTOUR
- FF 78.0 FINISHED FLOOR ELEVATION
- EX BUILDING
- PROPOSED BUILDING
- CONCRETE PAVEMENT
- SITE WALL
- STORM DRAINAGE PIPE
- CATCH BASIN TYPE 1
- FOOTING/SUBSURFACE DRAIN
- SDCO • STORM DRAIN CLEANOUT
- FDCO • FOOTING DRAIN CLEANOUT
- DS • DOWNSPOUTS
- SS --- SIDE SEWER PIPE
- SEWER CLEANOUT
- SIDE SEWER CONNECTION


NOTE: NO SOIL, WATER, OR DEBRIS FROM SITE ACTIVITIES ARE ALLOWED TO BE PLACED OR DISCHARGED ON THE SLOPE.

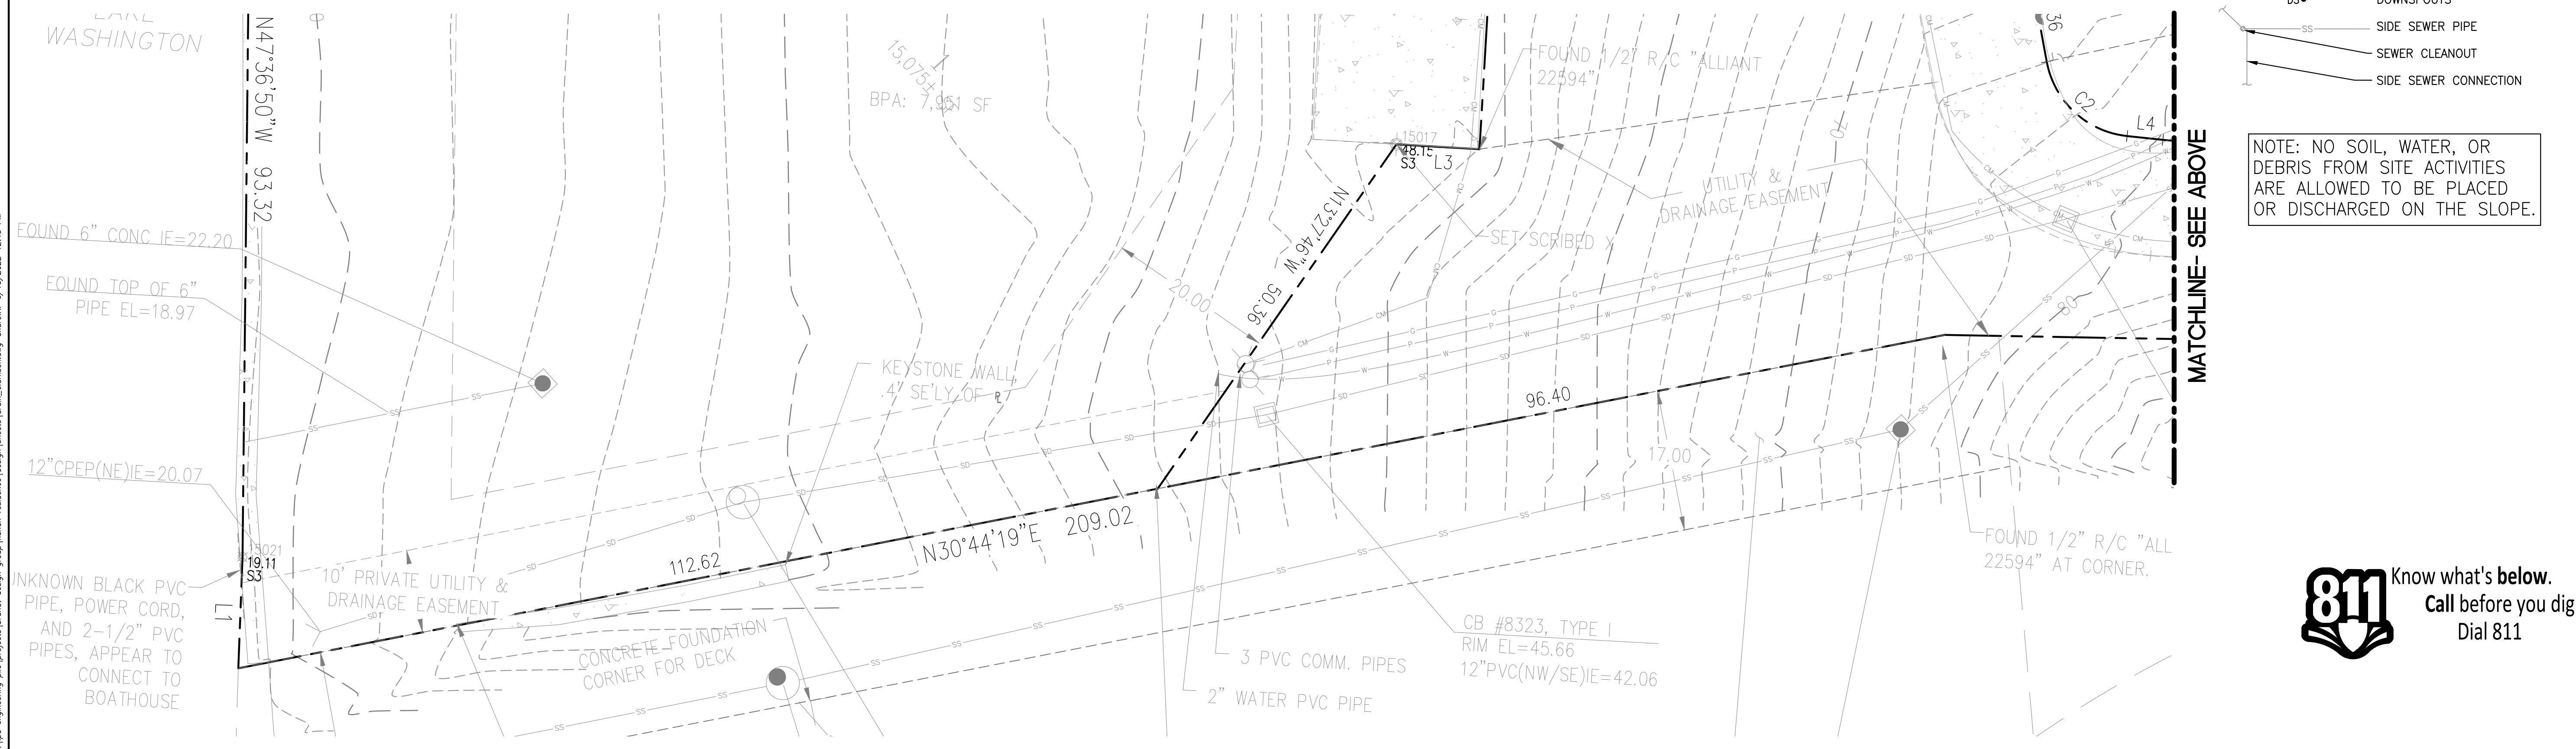

MATCHLINE- SEE ABOVE

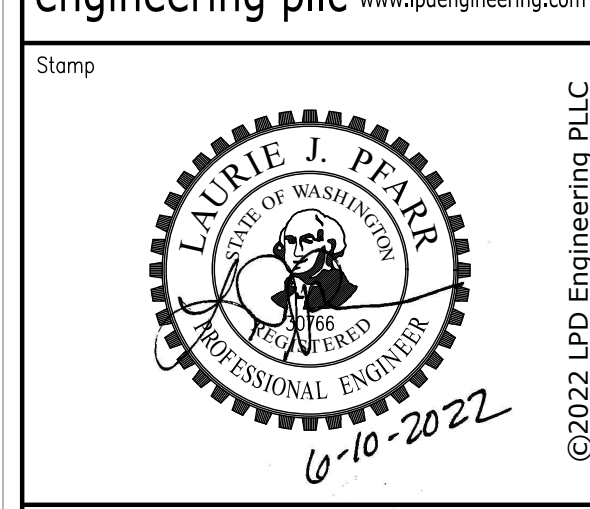

No.	Revisions	Date
1	PERMIT REVISIONS	04/20/2022
2	PERMIT REVISIONS	06/10/2022

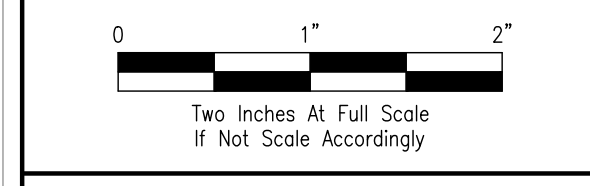

Project Name

CLARKSON RESIDENCE  
8163 W MERCER WAY

City of Mercer Island, Washington

Project No.	272-20-01
Issue Date	04/20/2022
Scale	AS NOTED
Designed	ACW
Drawn	KES
Checked	LJP
Approved	LJP




PERMIT DOCUMENTS  
DRAINAGE PLAN

Sheet  
C2.0



c:\lpd\engineering\plc\projects\bravest\design\groups\habitat\_residence\design\layouts\plan\_clarkson.rvt 6/13/2022 12:43 PM


Section 36, Township 24N, Range 4E W.M.

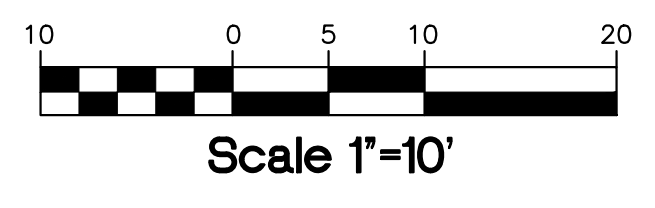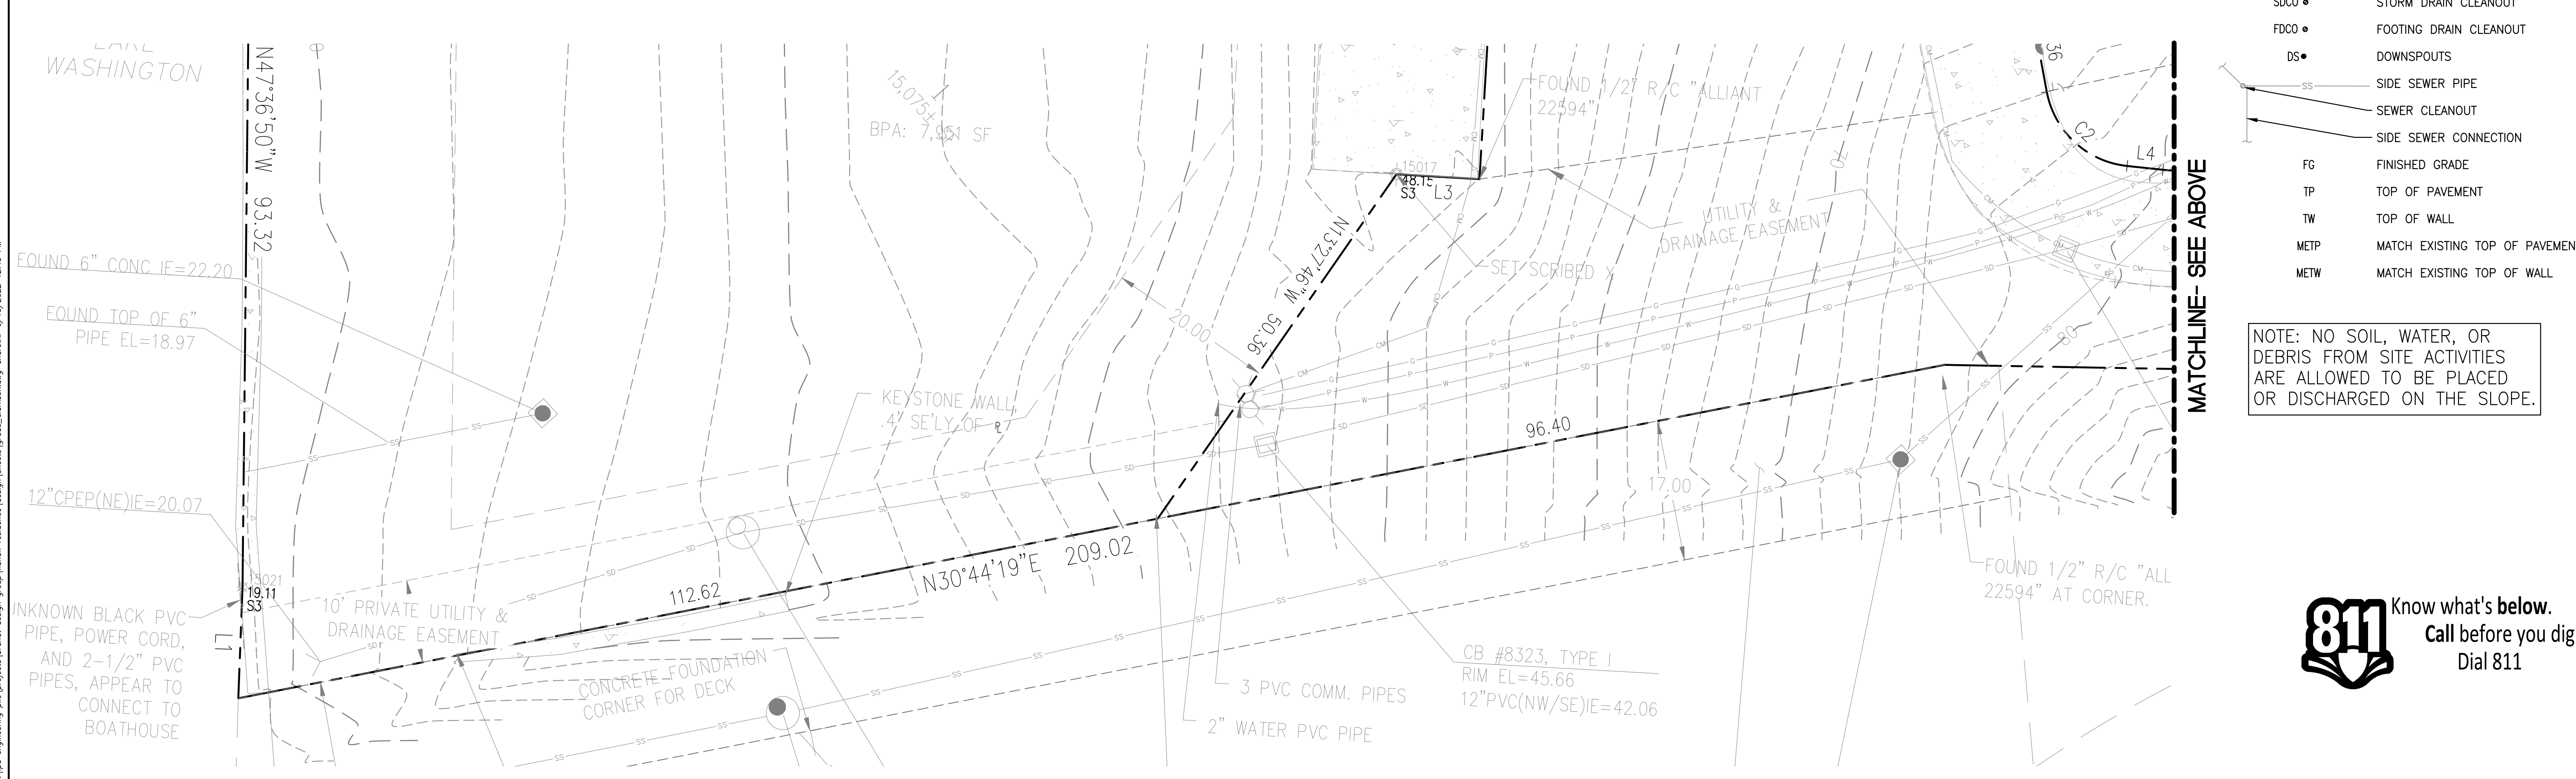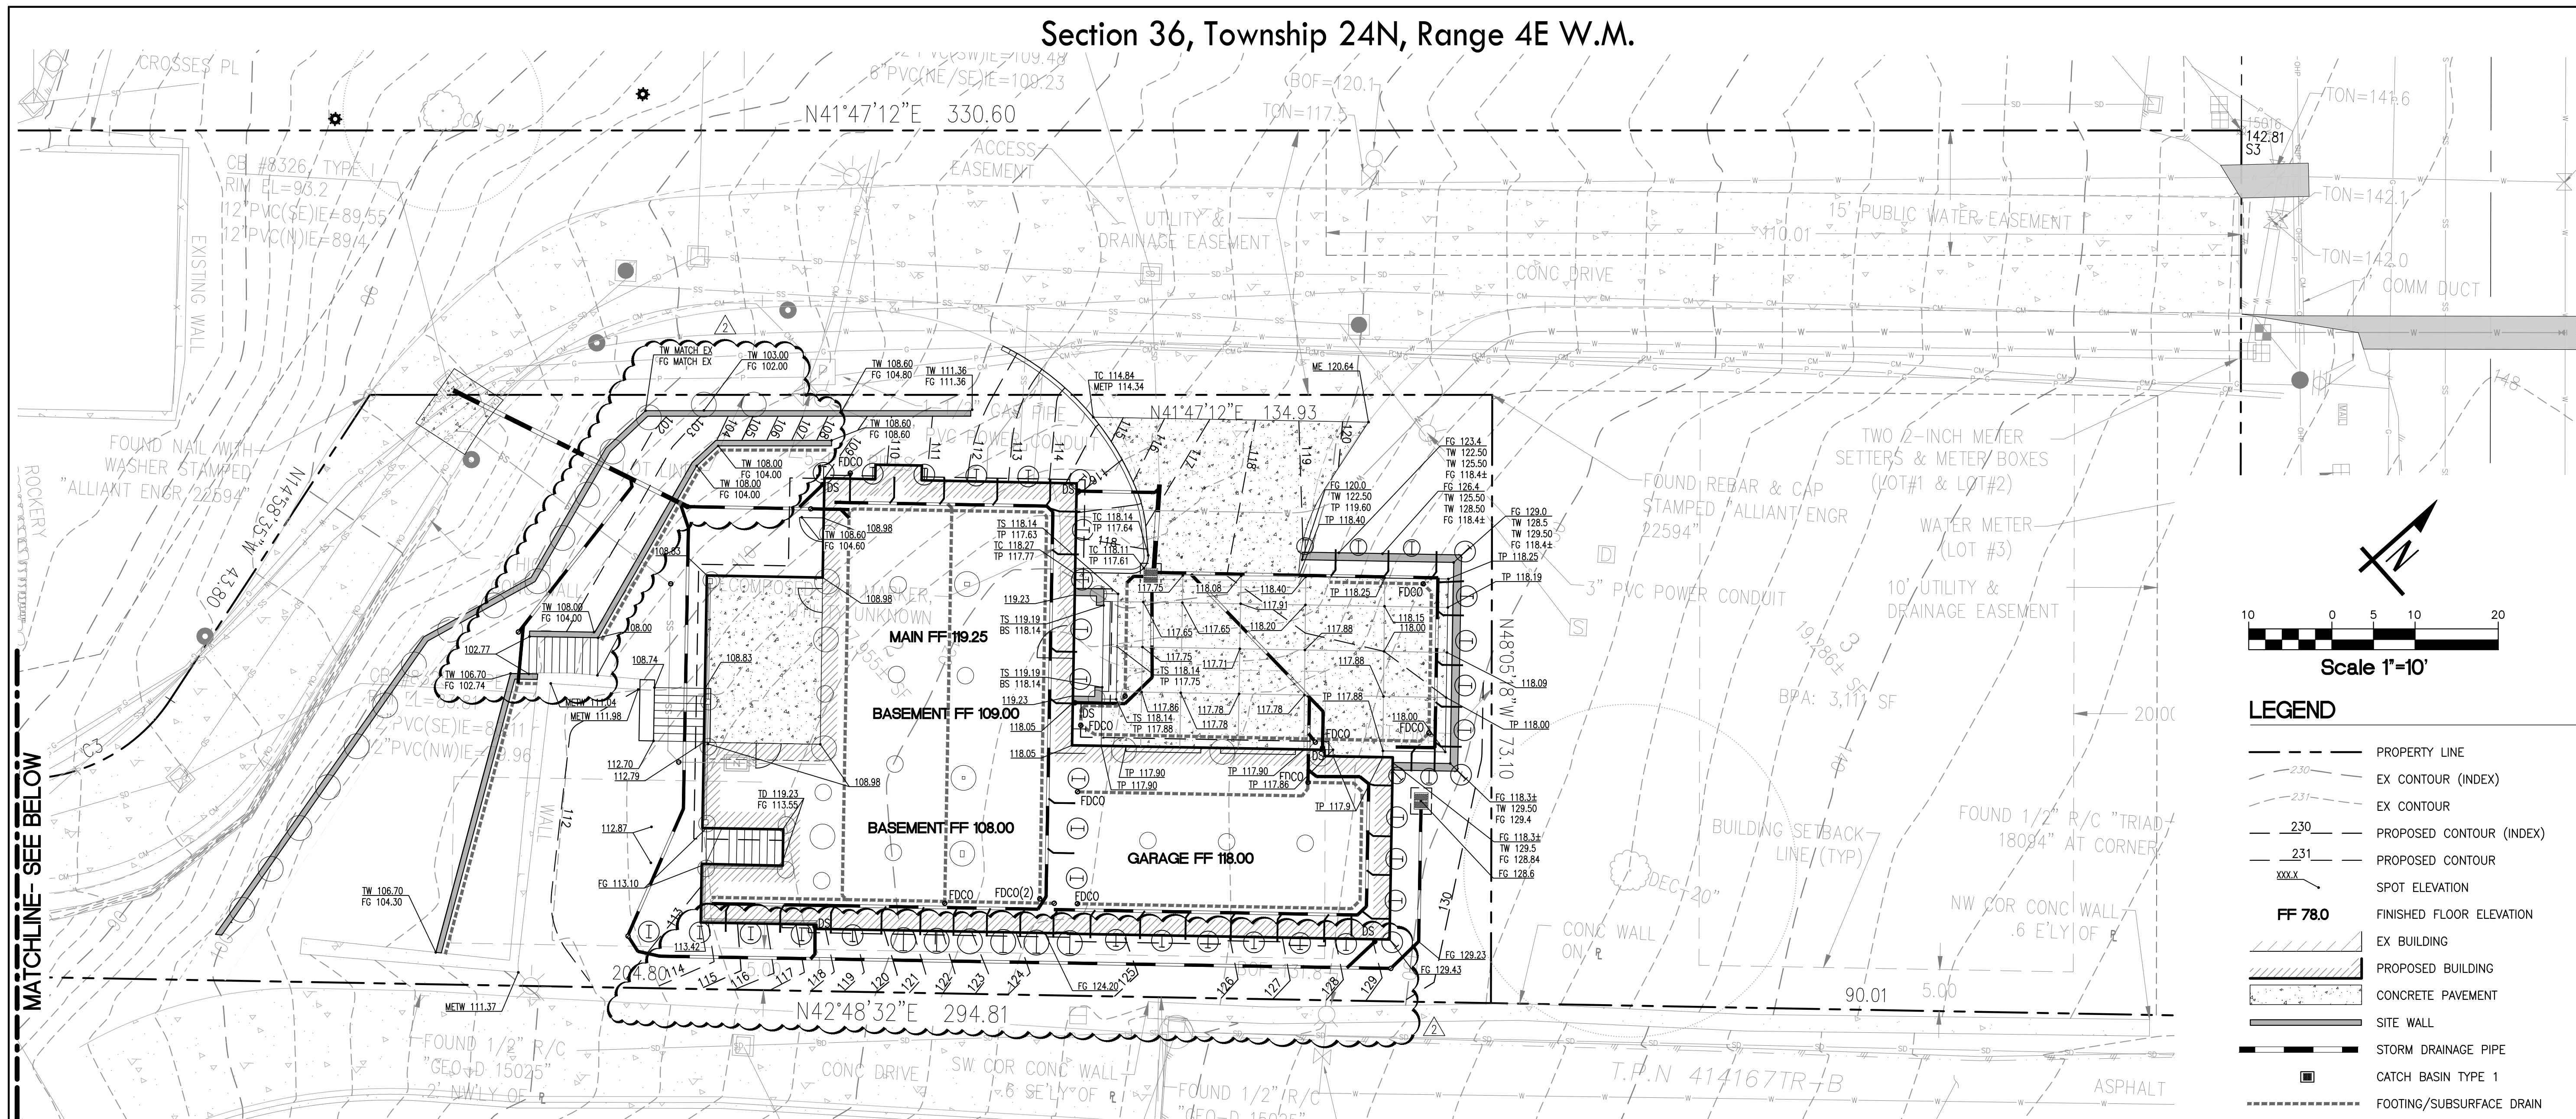


LEGEND

- PROPERTY LINE
- EX CONTOUR (INDEX)
- EX CONTOUR
- PROPOSED CONTOUR (INDEX)
- PROPOSED CONTOUR
- SPOT ELEVATION
- FF 78.0 FINISHED FLOOR ELEVATION
- EX BUILDING
- PROPOSED BUILDING
- CONCRETE PAVEMENT
- SITE WALL
- STORM DRAINAGE PIPE
- CATCH BASIN TYPE 1
- FOOTING/SUBSURFACE DRAIN
- SDCO • STORM DRAIN CLEANOUT
- FDCO • FOOTING DRAIN CLEANOUT
- DS • DOWNSPOUTS
- SS • SIDE SEWER PIPE
- SEWER CLEANOUT
- SIDE SEWER CONNECTION
- FG FINISHED GRADE
- TP TOP OF PAVEMENT
- TW TOP OF WALL
- METP MATCH EXISTING TOP OF PAVEMENT
- METW MATCH EXISTING TOP OF WALL

NOTE: NO SOIL, WATER, OR DEBRIS FROM SITE ACTIVITIES ARE ALLOWED TO BE PLACED OR DISCHARGED ON THE SLOPE.

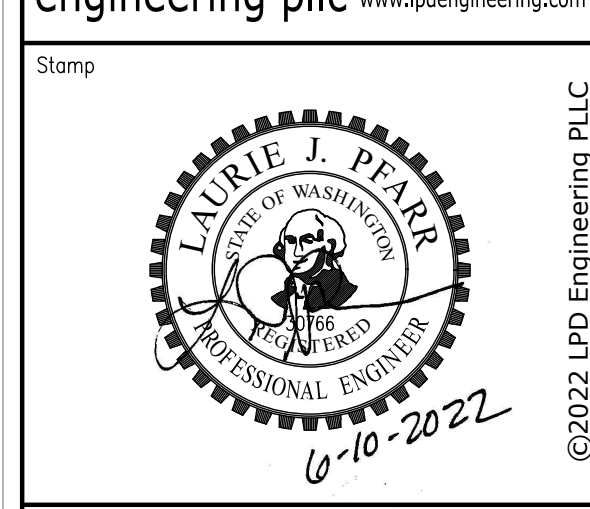

No.	Revisions	Date
1	PERMIT REVISIONS	04/20/2022
2	PERMIT REVISIONS	06/10/2022

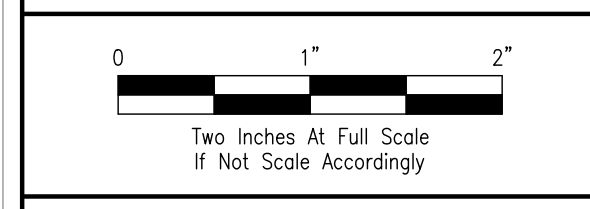

Project Name

**CLARKSON RESIDENCE**  
**8163 W MERCER WAY**  
 City of Mercer Island, Washington

Project No.	272-20-01
Issue Date	04/20/2022
Scale	AS NOTED
Designed	ACW
Drawn	KES
Checked	LJP
Approved	LJP

**GRADING PLAN**


PERMIT DOCUMENTS

Know what's below.  
 Call before you dig.  
 Dial 811


C2.1

© LPD engineering pllc projects/browns design group/urban residence design/landscaping/6/17/2022 12:43 PM

Section 36, Township 24N, Range 4E W.M.

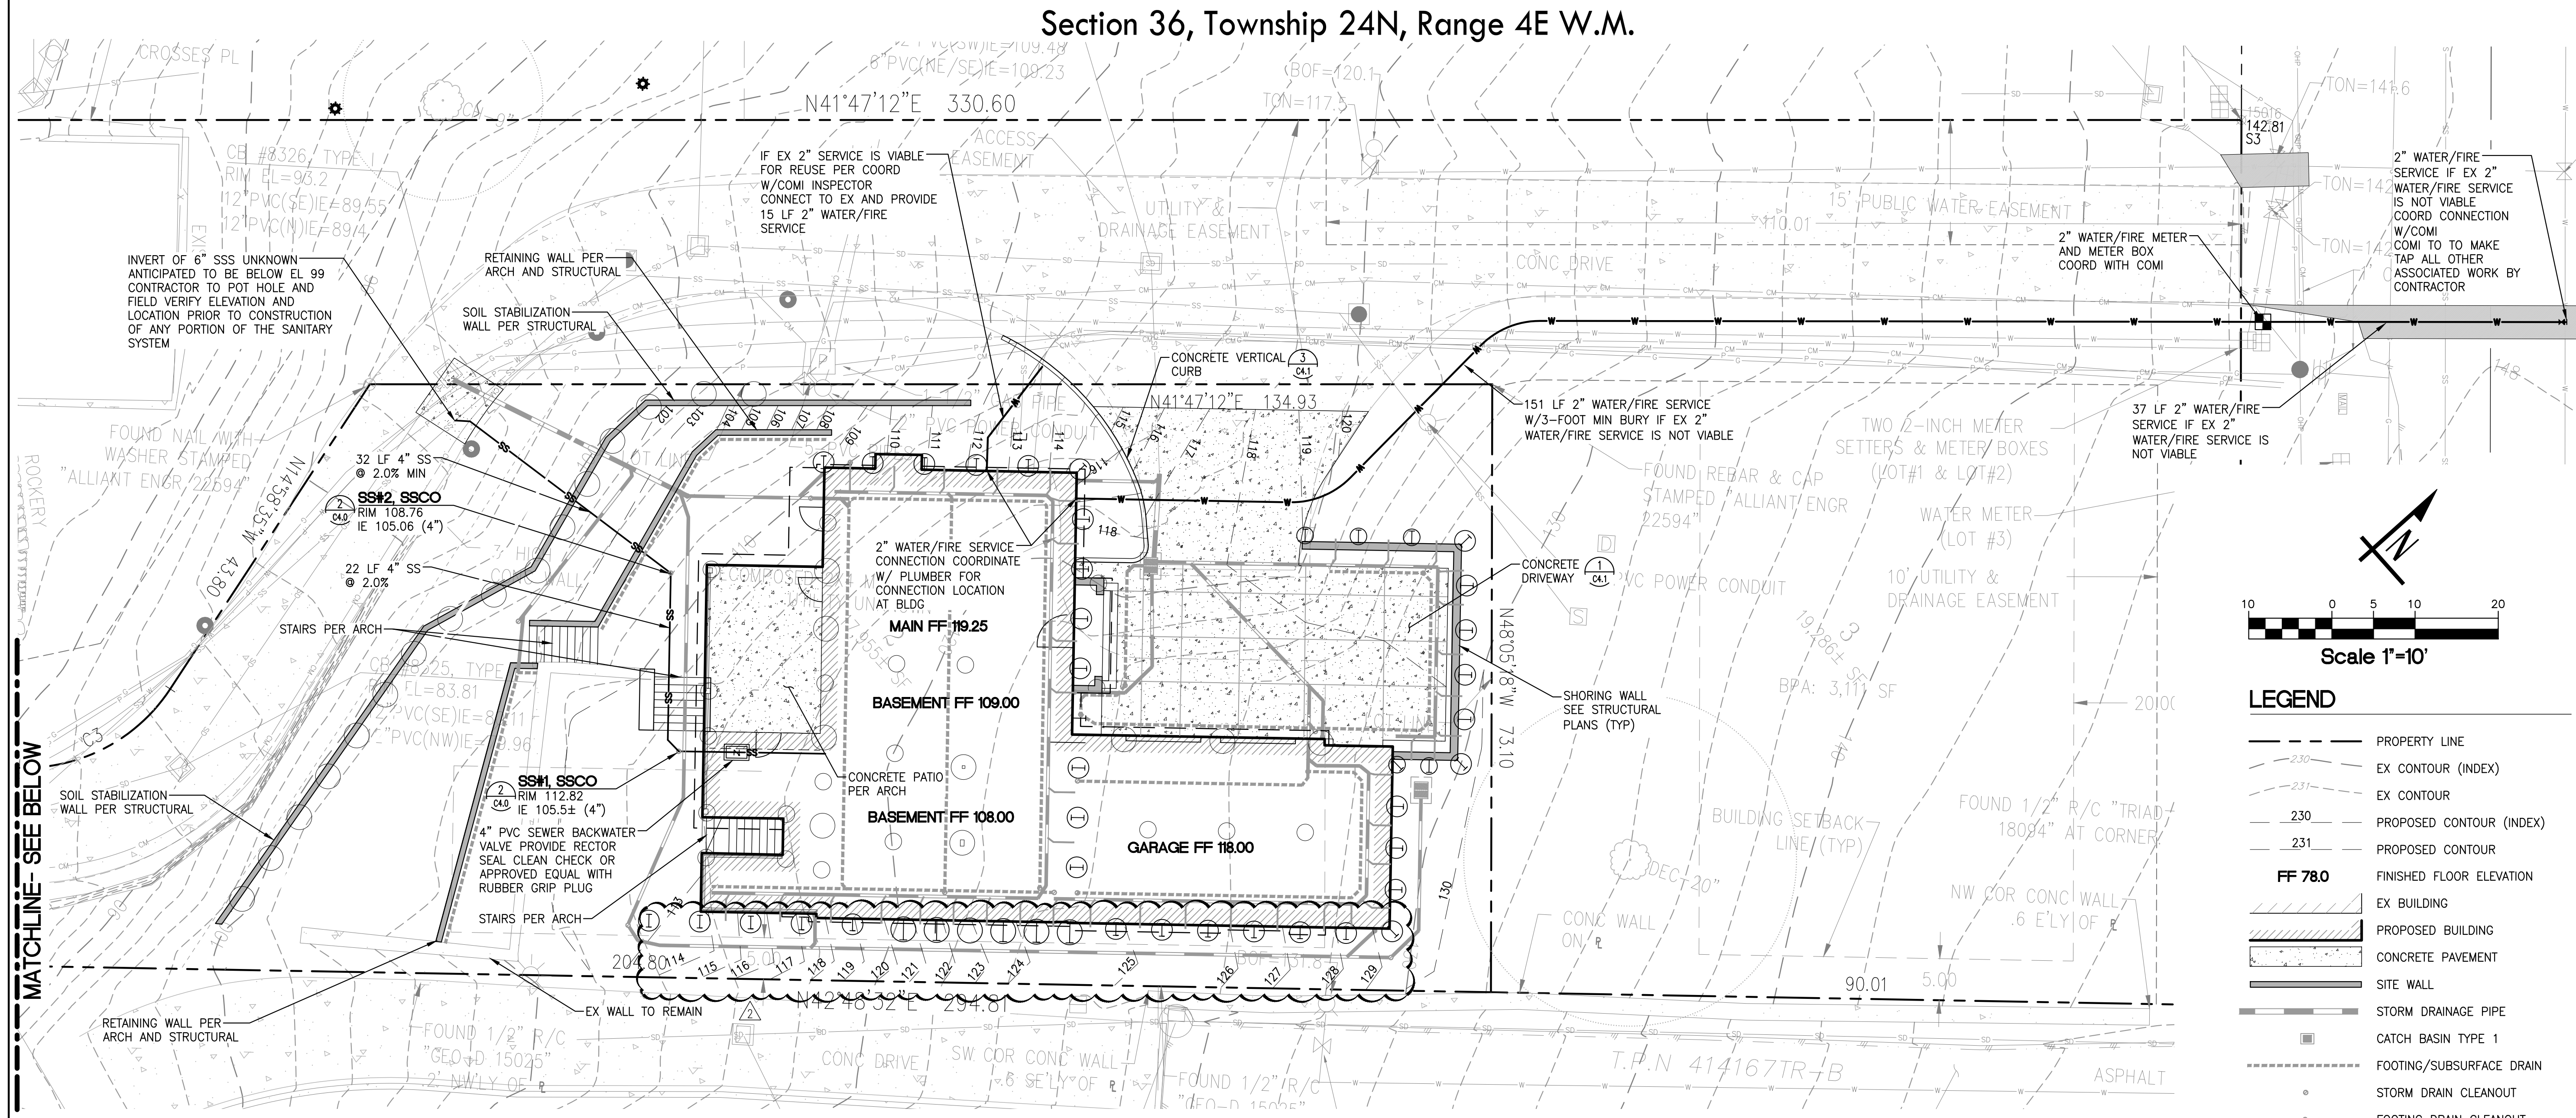


MATCHLINE- SEE BELOW

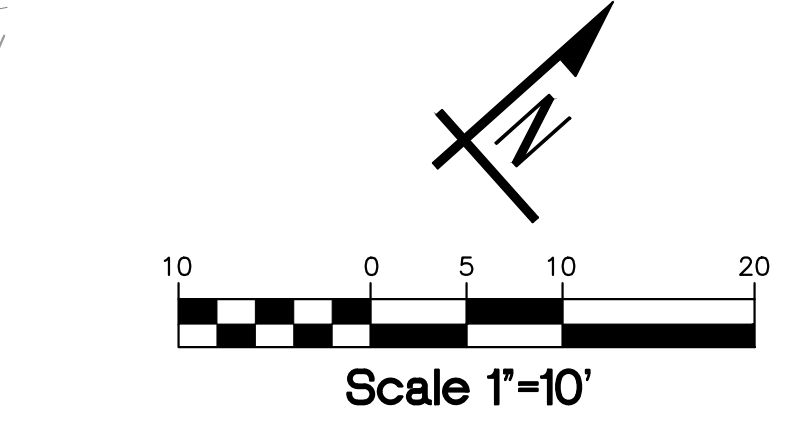


**LEGEND**

- PROPERTY LINE
- - - EX CONTOUR (INDEX)
- - - EX CONTOUR
- - - PROPOSED CONTOUR (INDEX)
- - - PROPOSED CONTOUR
- FF 78.0 FINISHED FLOOR ELEVATION
- ▨ EX BUILDING
- ▨ PROPOSED BUILDING
- ▨ CONCRETE PAVEMENT
- ▨ SITE WALL
- STORM DRAINAGE PIPE
- CATCH BASIN TYPE 1
- - - FOOTING/SUBSURFACE DRAIN
- STORM DRAIN CLEANOUT
- FOOTING DRAIN CLEANOUT
- DOWNSPOUTS
- SSCO SIDE SEWER PIPE
- SS SEWER CLEANOUT
- SSC SIDE SEWER CONNECTION


NOTE: NO SOIL, WATER, OR DEBRIS FROM SITE ACTIVITIES ARE ALLOWED TO BE PLACED OR DISCHARGED ON THE SLOPE.

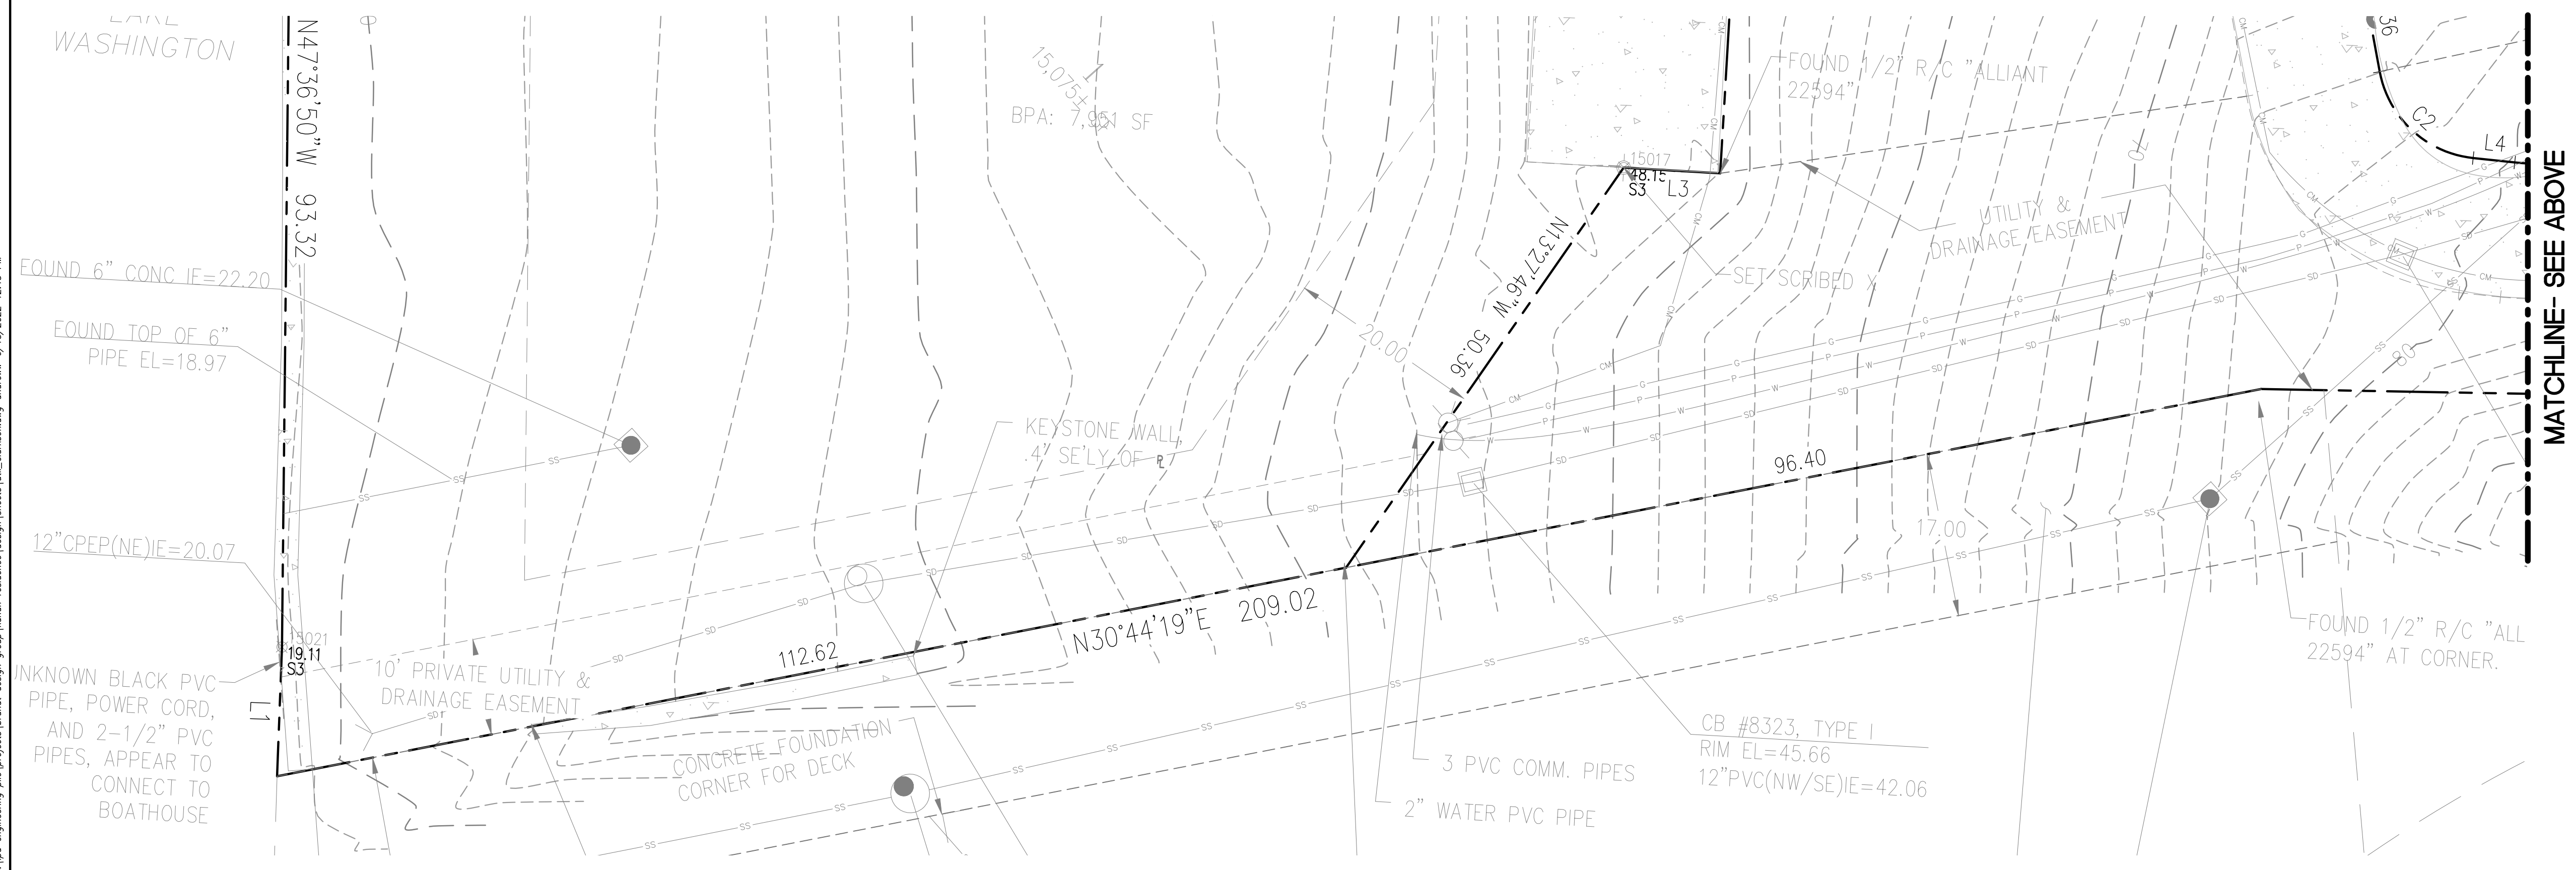

MATCHLINE- SEE ABOVE

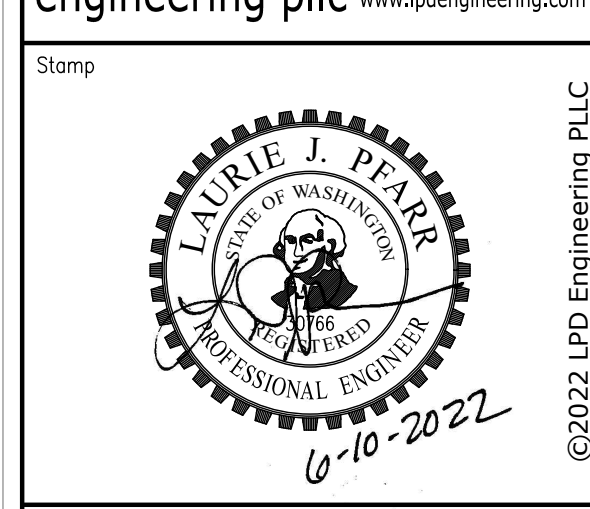

No.	Revisions	Date
1	PERMIT REVISIONS	04/20/2022
2	PERMIT REVISIONS	06/10/2022

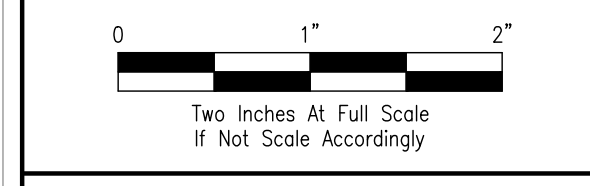

Project Name

**CLARKSON RESIDENCE  
8163 W MERCER WAY**

City of Mercer Island, Washington

Project No.	272-20-01
Issue Date	04/20/2022
Scale	AS NOTED
Designed	ACW
Drawn	KES
Checked	LJP
Approved	LJP



**PERMIT DOCUMENTS**

**UTILITIES & PAVING PLAN**


Sheet  
**C3.0**



c:\lpd\engineering\plc\projects\brw\design\_group\labor\_residence\design\layouts\util\clarkson.dwg andrwm 6/13/2022 12:41 PM

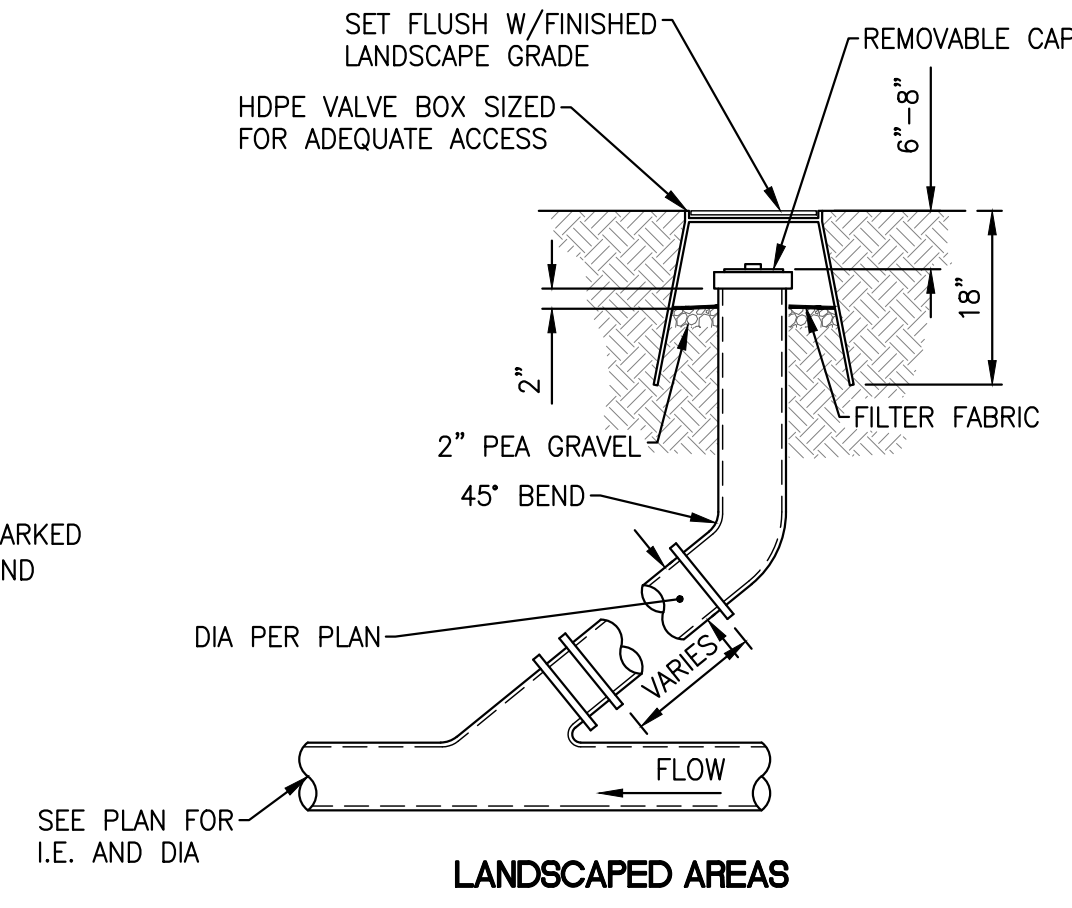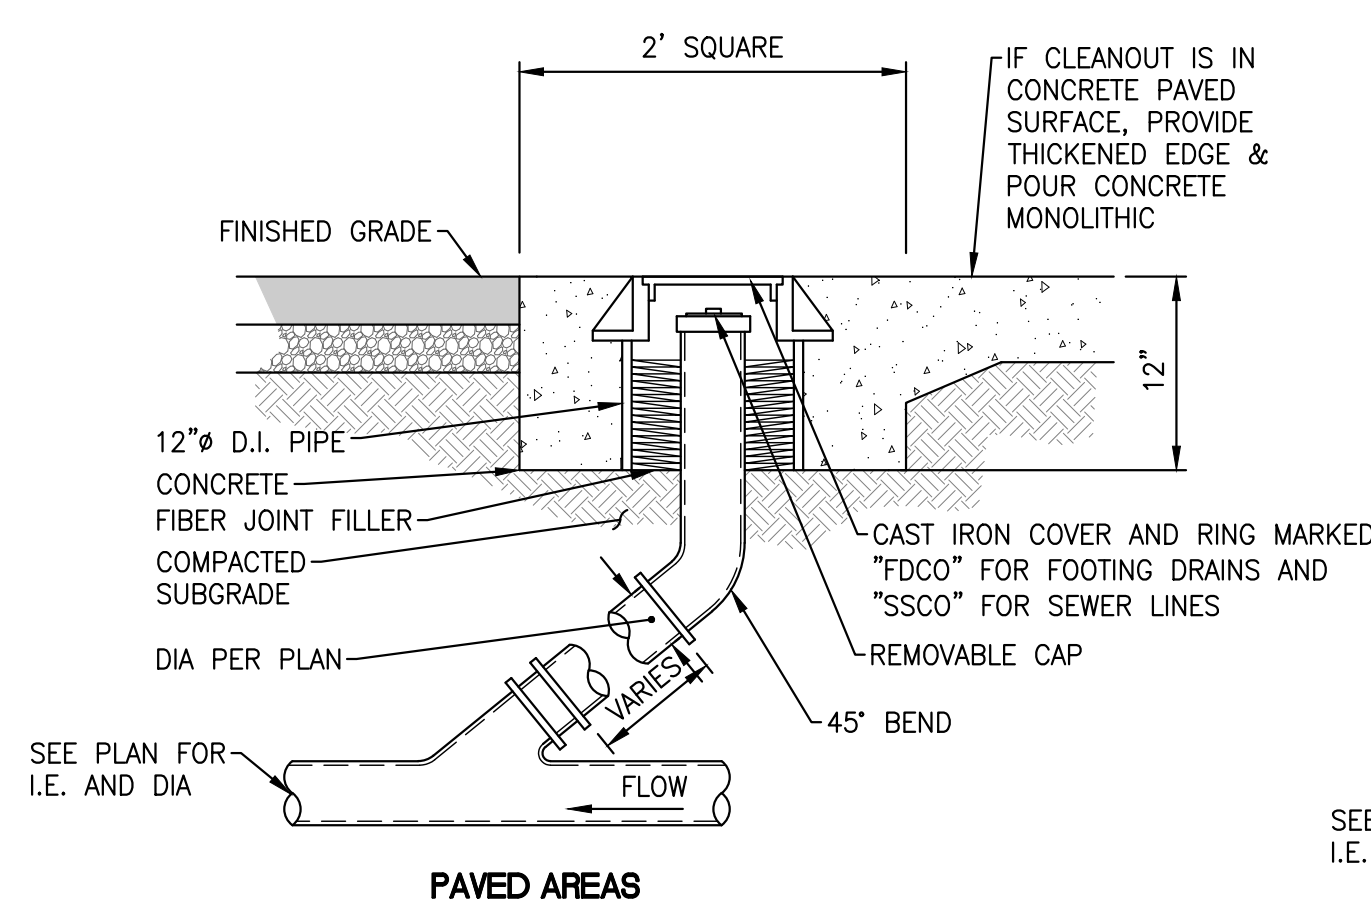


NTS  
CLEANOUT 2

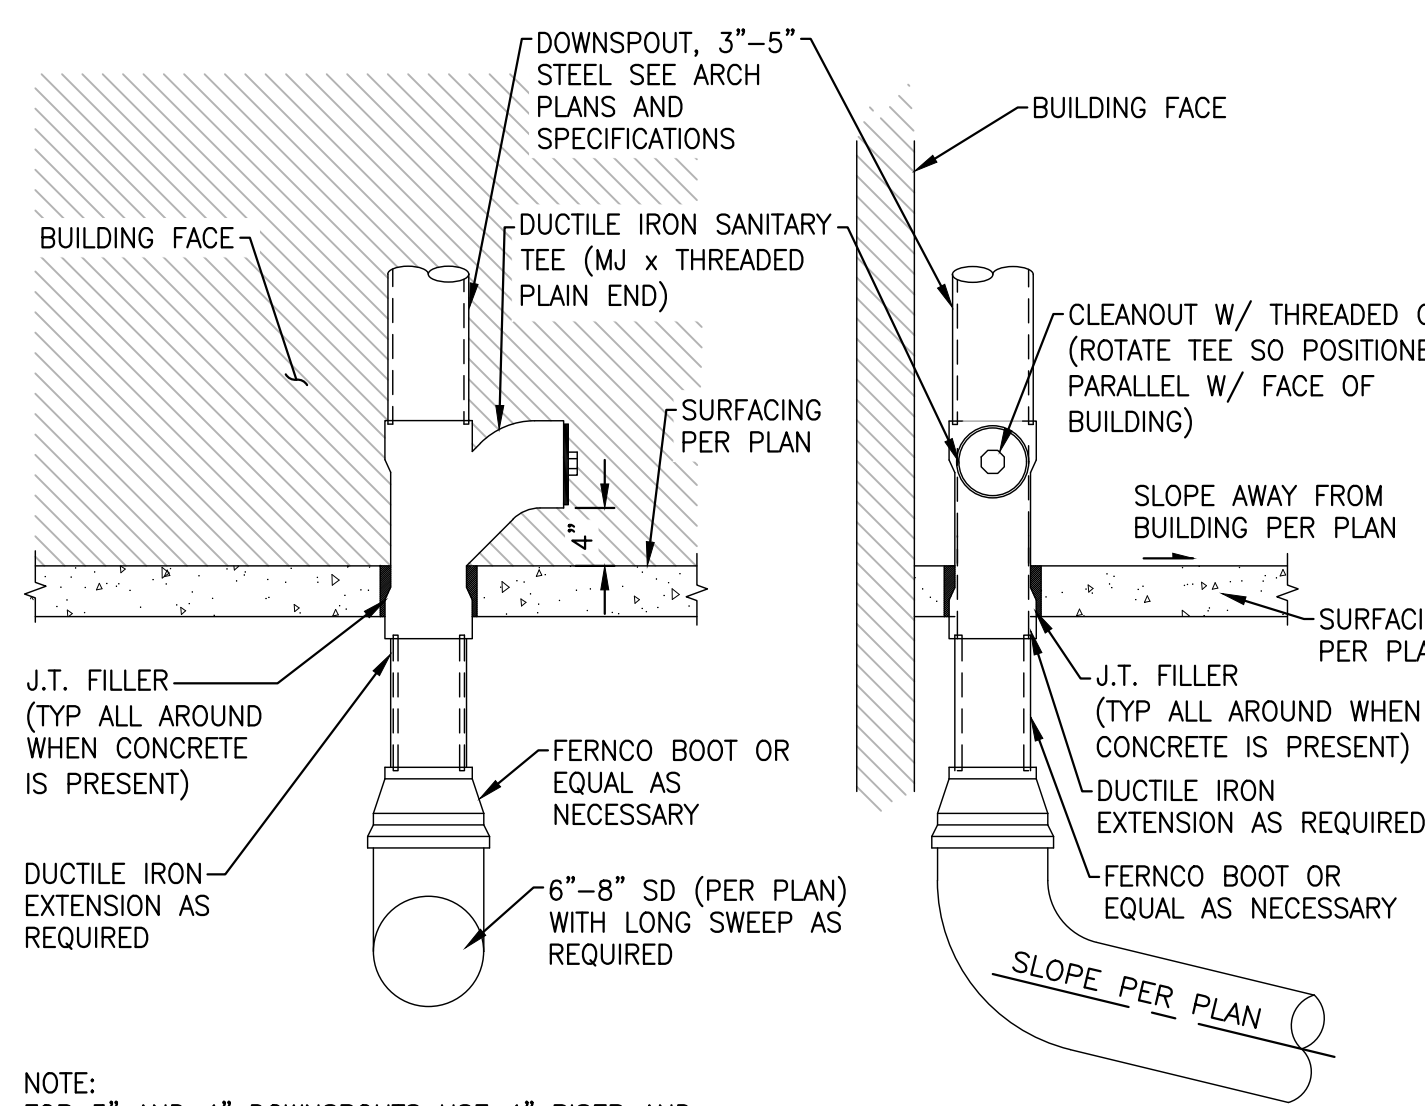


NOTE:  
FOR 3" AND 4" DOWNSPOUTS USE 4" RISER AND TEE. FOR 5" DOWNSPOUTS USE 6" RISER AND TEE.

NTS  
ROOF DOWNSPOUT 3

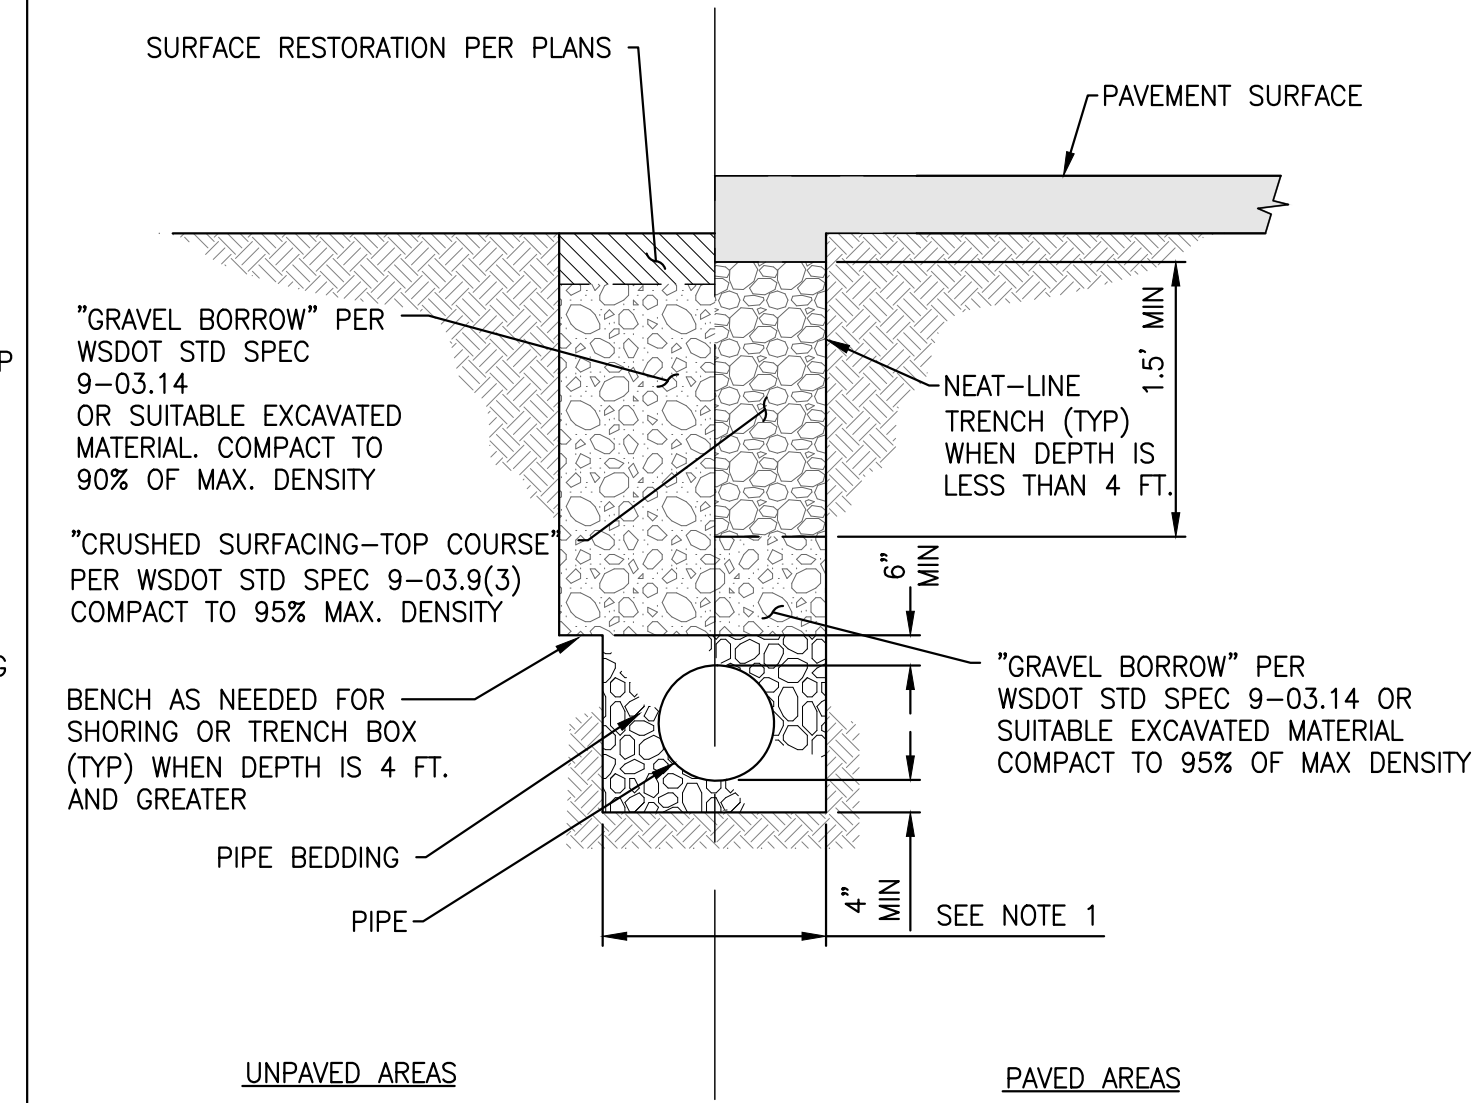


NOTE:  
1. MAXIMUM WIDTH OF TRENCH AT TOP OF PIPE  
\* 30" FOR PIPE UP TO AND INCLUDING 12" NOMINAL DIAMETER.

NTS  
PIPE BEDDING 4

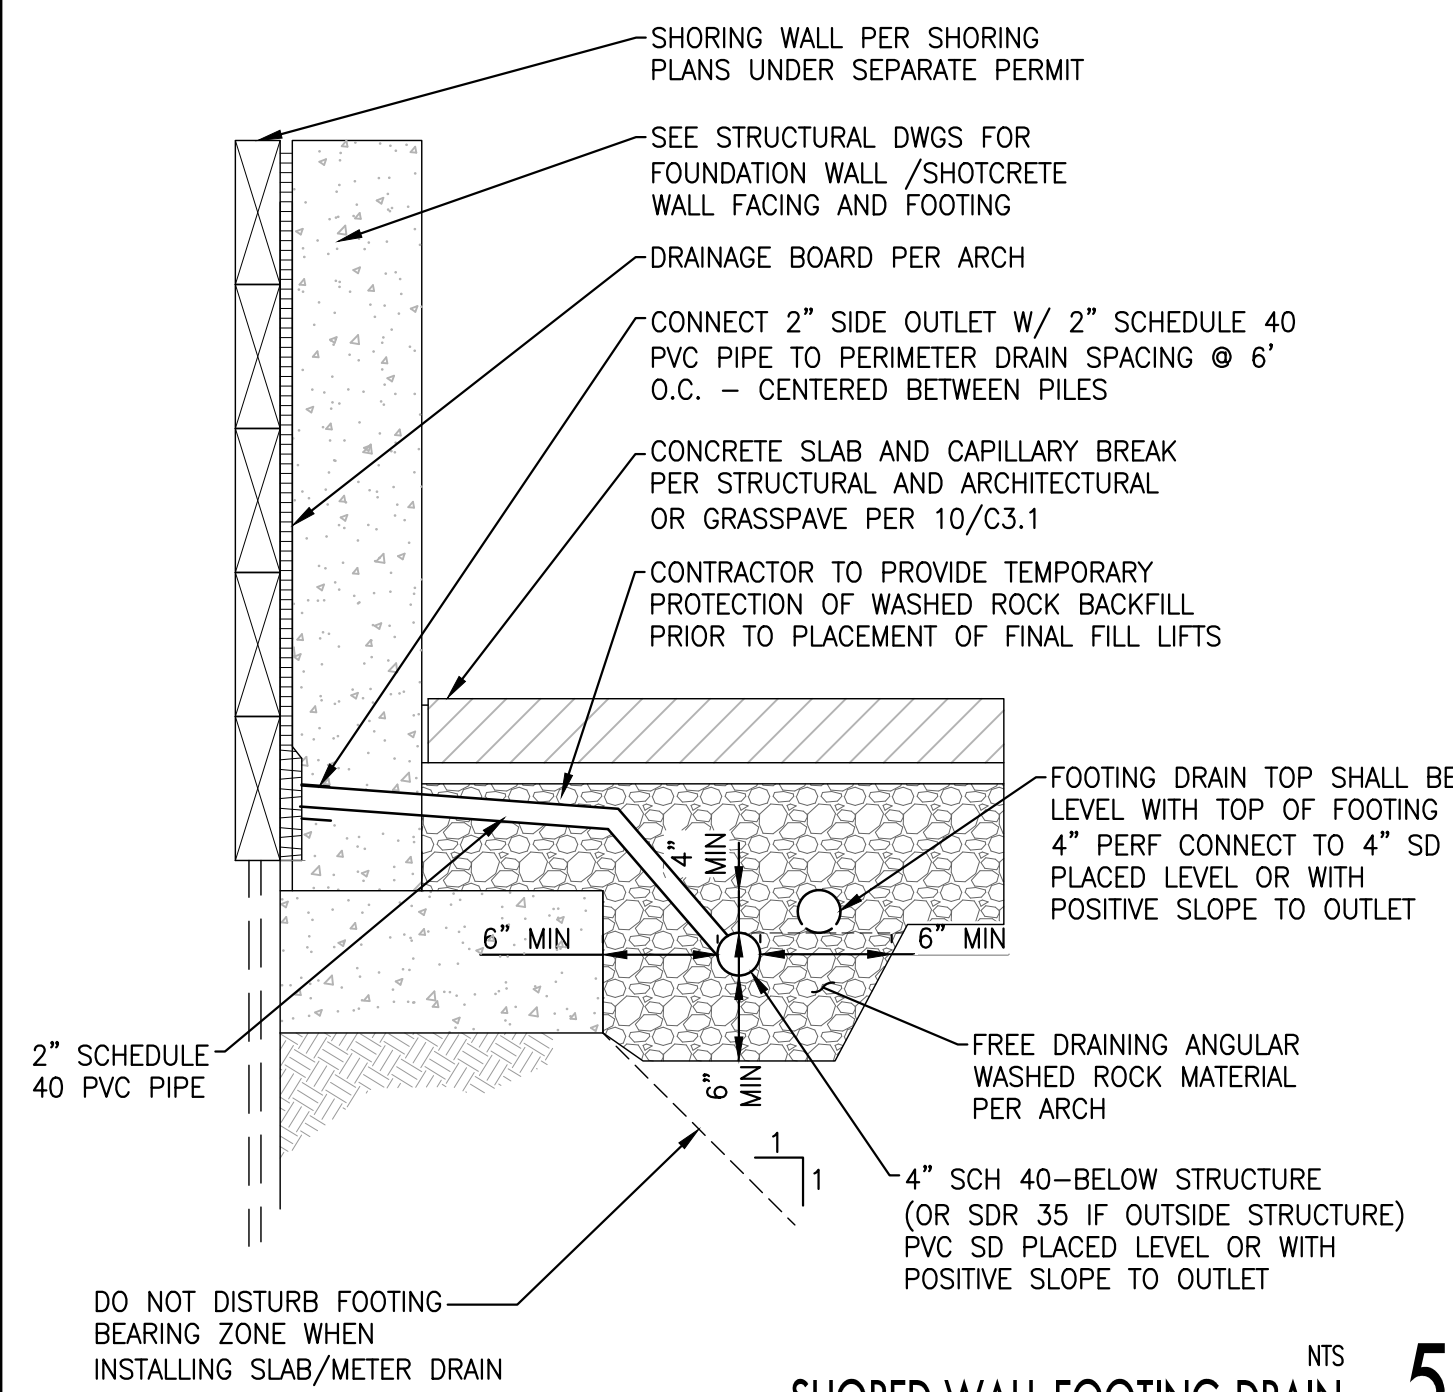


NTS  
SHORED WALL FOOTING DRAIN 5

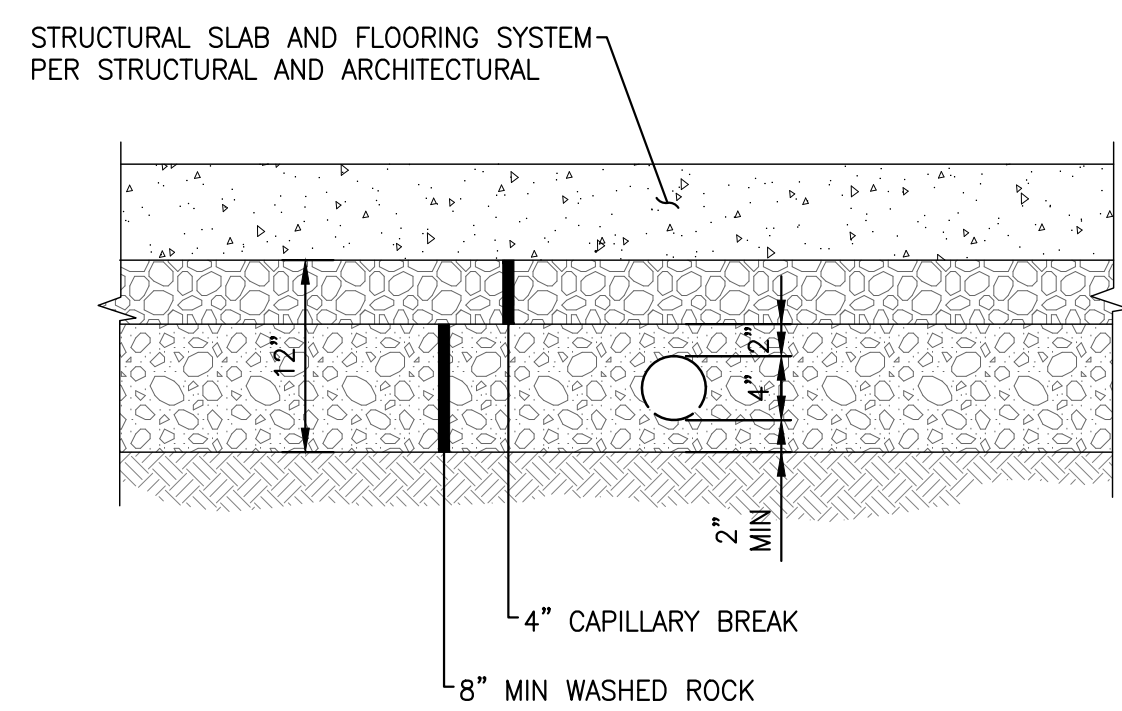


NOTE:  
1. TYPE 22 CAN BE USED AS AN ALTERNATIVE TO 4" CAPILLARY BREAK AND 8" WASHED ROCK

NTS  
SUB-SLAB DRAINAGE 6

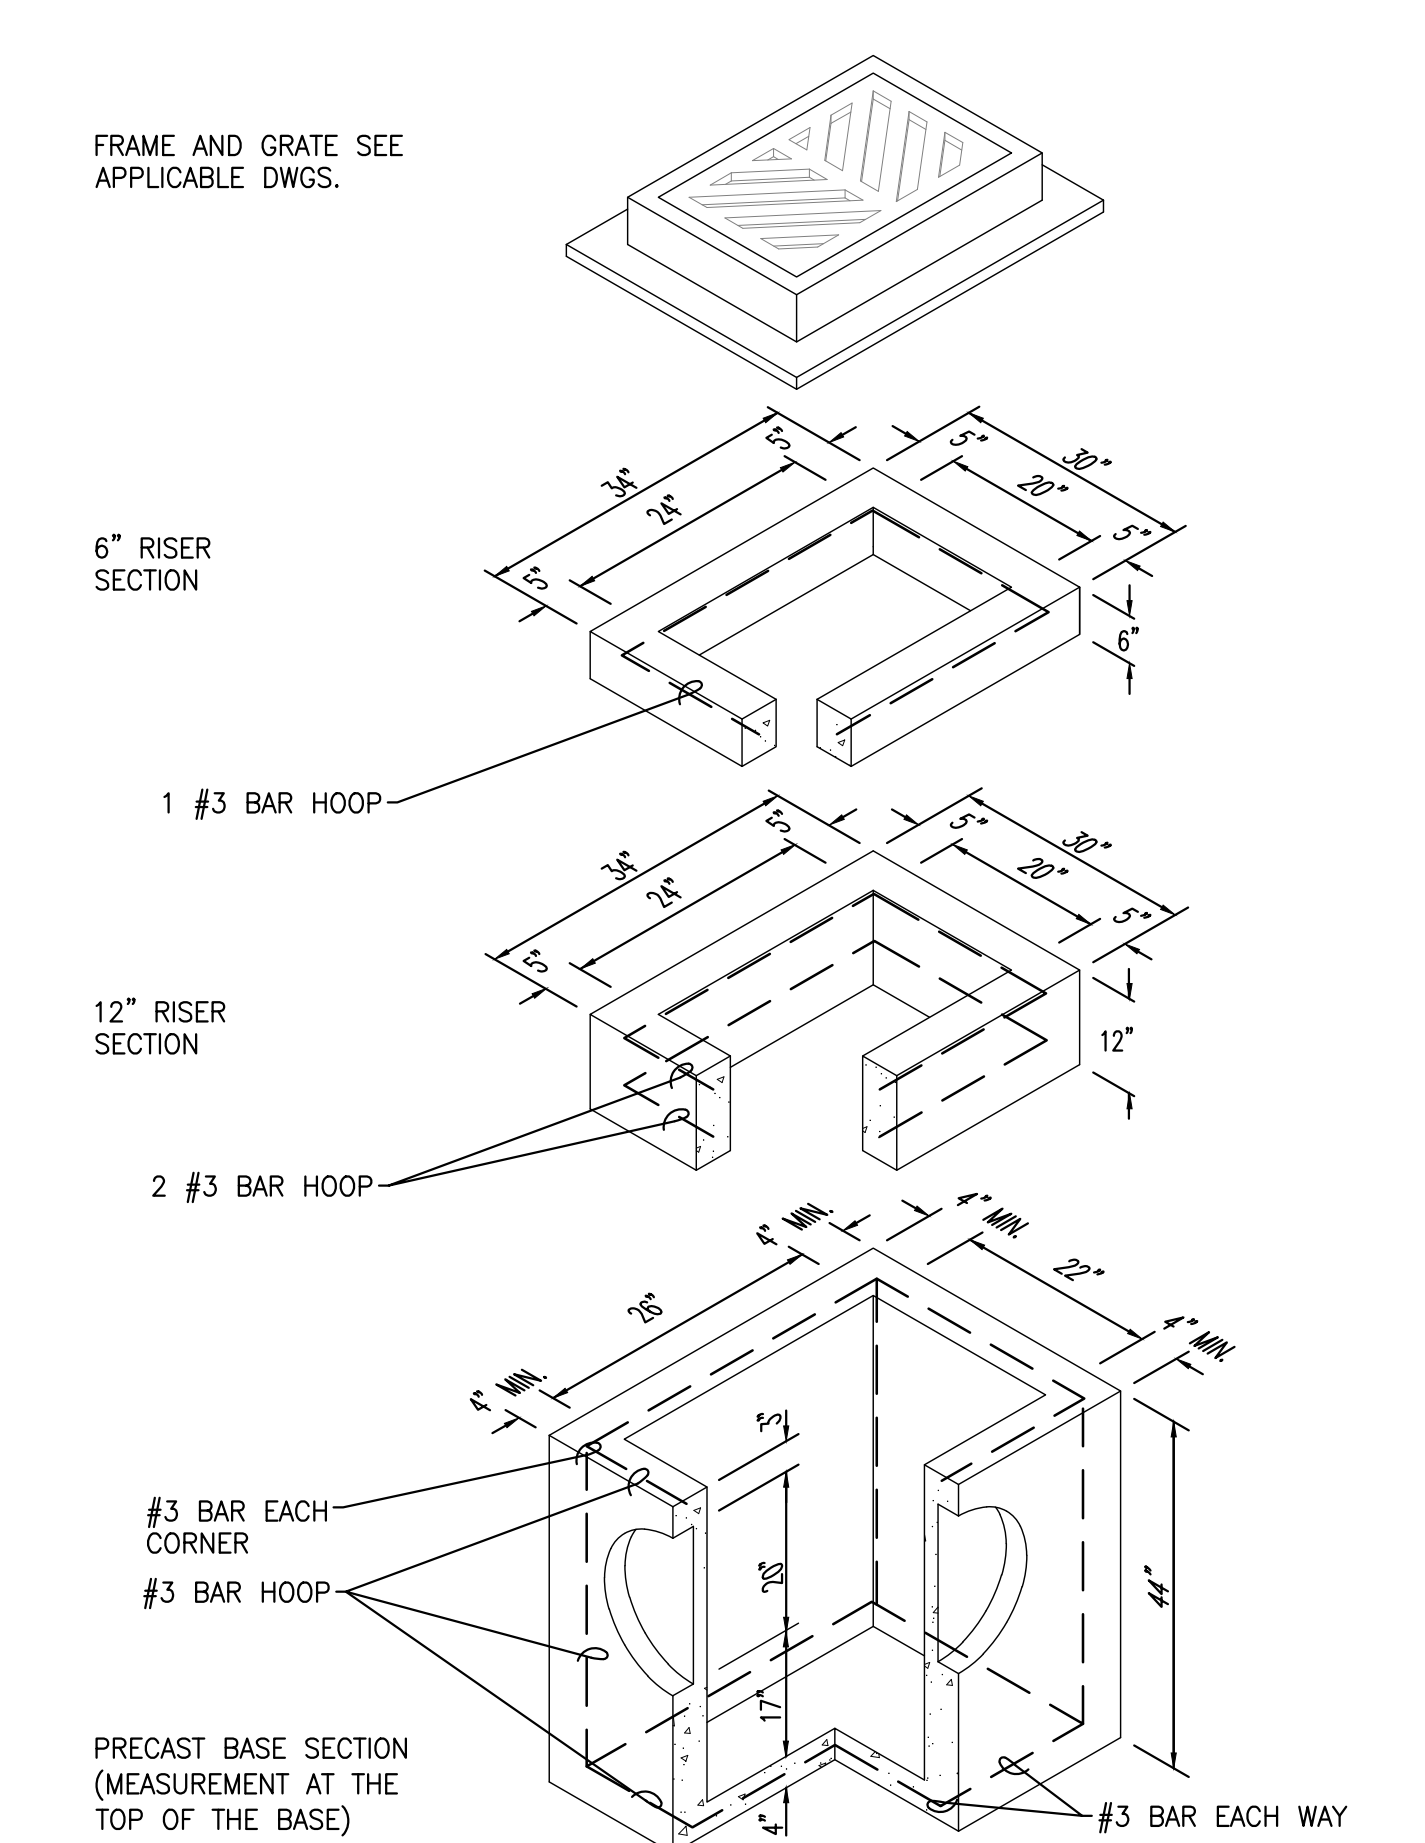


- NOTES:
- CATCH BASINS SHALL BE CONSTRUCTED IN ACCORDANCE WITH ASTM C478 (AASHTO M 199) & C890 UNLESS OTHERWISE SHOWN ON PLANS OR NOTED IN THE WSDOT/APWA STANDARD SPECIFICATIONS.
  - AS AN ACCEPTABLE ALTERNATIVE TO REBAR, WELDED WIRE FABRIC HAVING A MIN. AREA OF 0.12 SQUARE INCHES PER FOOT MAY BE USED. WELDED WIRE FABRIC SHALL COMPLY TO ASTM A497 (AASHTO M 221). WIRE FABRIC SHALL NOT BE PLACED IN KNOCKOUTS.
  - ALL REINFORCED CAST-IN-PLACE CONCRETE SHALL BE CLASS 4000.
  - PRECAST BASES SHALL BE FURNISHED WITH CUTOUTS OR KNOCKOUTS. KNOCKOUTS SHALL HAVE A WALL THICKNESS OF 2" MIN. ALL PIPE SHALL BE INSTALLED IN FACTORY PROVIDED KNOCKOUTS. UNUSED KNOCKOUTS NEED NOT BE GROUTED IF WALL IS LEFT INTACT.
  - ROUND KNOCKOUTS MAY BE ON ALL 4 SIDES, WITH MAX. DIA. OF 20". KNOCKOUTS MAY BE EITHER ROUND OR "D" SHAPE.
  - KNOCKOUT OR CUTOUT HOLE SIZE IS EQUAL TO PIPE OUTER DIA. PLUS CATCH BASIN WALL THICKNESS.
  - THE MAX. DEPTH FROM THE FINISHED GRADE TO THE PIPE INVERT IS 5'-0".
  - THE TAPER ON THE SIDES OF THE PRECAST BASE SECTION AND RISER SECTION SHALL NOT EXCEED 1/2"/FT.
  - CATCH BASIN FRAME AND GRATE SHALL BE IN ACCORDANCE WITH STANDARD SPECIFICATIONS AND MEET THE REQUIREMENTS OF FEDERAL SPECIFICATION RR-F-62ID. MATING SURFACES SHALL BE FINISHED TO ASSURE NON-ROCKING FIT WITH ANY COVER POSITION.
  - FRAME AND GRATE MAY BE INSTALLED WITH FLANGE DOWN OR CAST INTO RISER.
  - FOR CATCH BASINS IN PARKING LOTS REFER TO WSDOT STD PLAN B-5.60-01.
  - EDGE OF RISER OR BRICK SHALL NOT BE MORE THAN 2" FROM VERTICAL EDGE OF CATCH BASIN WALL.
  - CATCH BASIN INSTALLATION SHALL BE PER CONTRACT DOCUMENTS AND DETAILS.


NTS  
CATCH BASIN TYPE 1 11

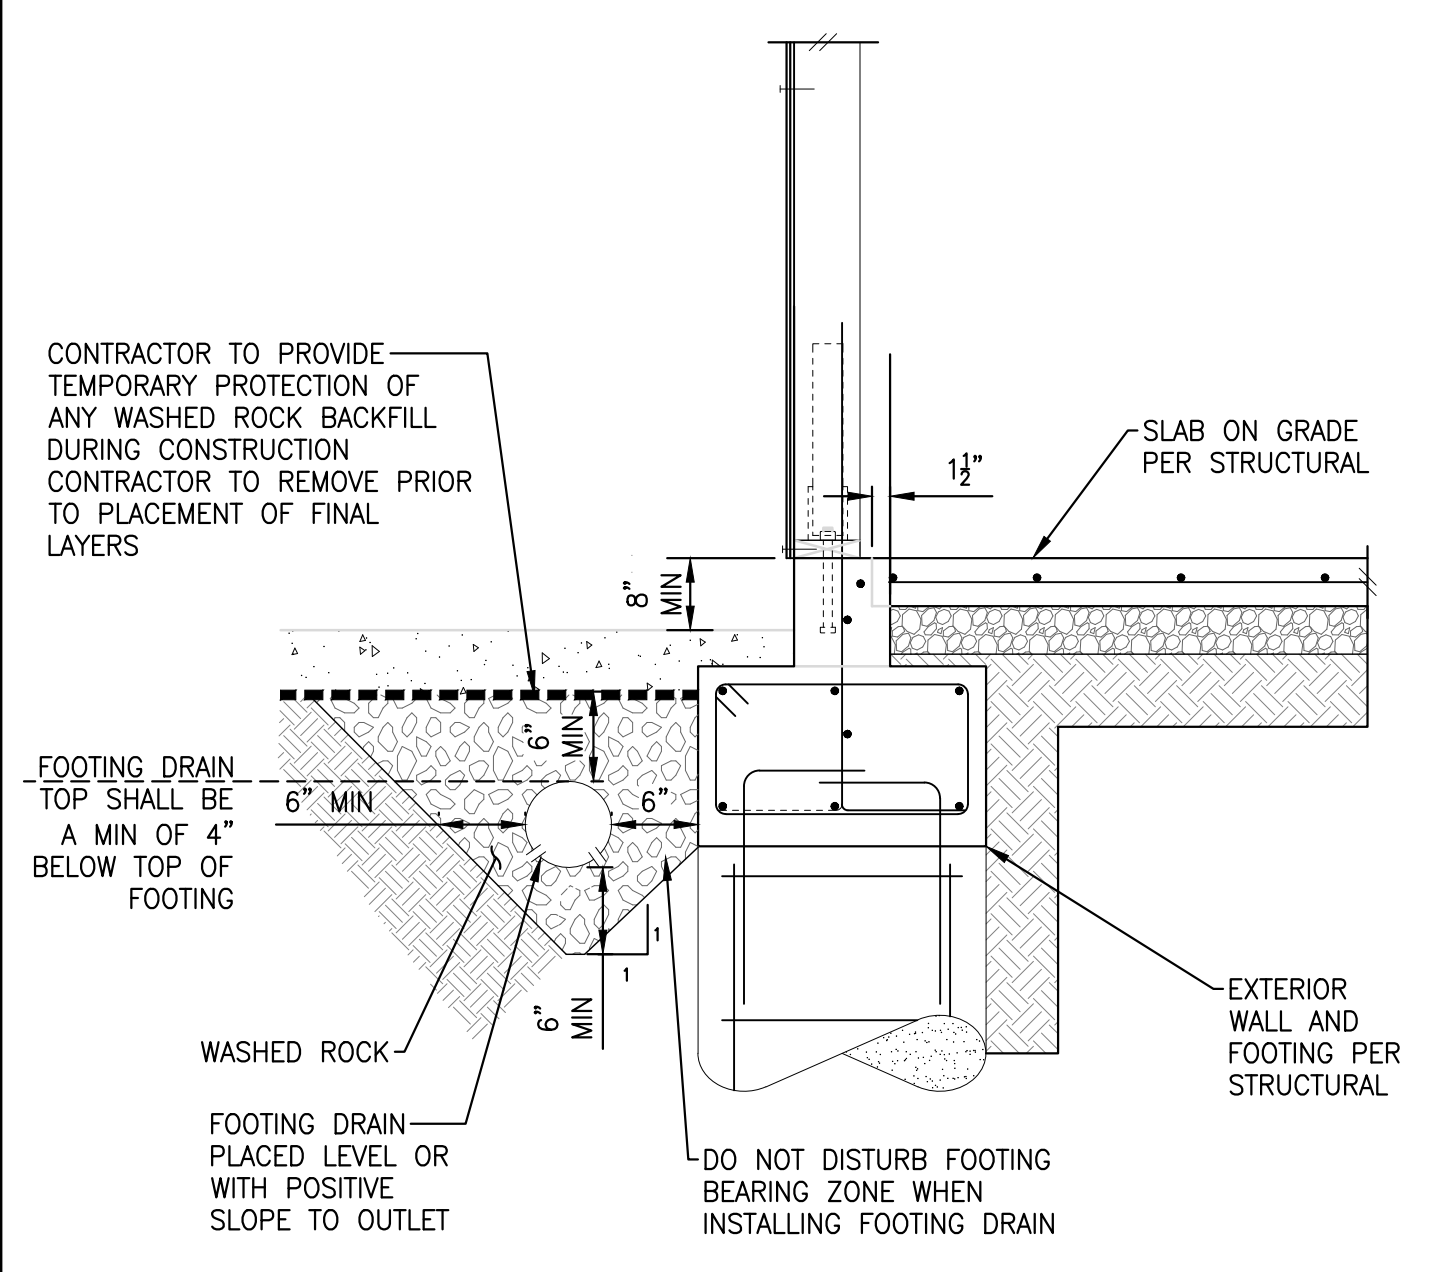

NTS  
EXTERIOR WALL SLAB ON GRADE FOOTING DRAIN 9

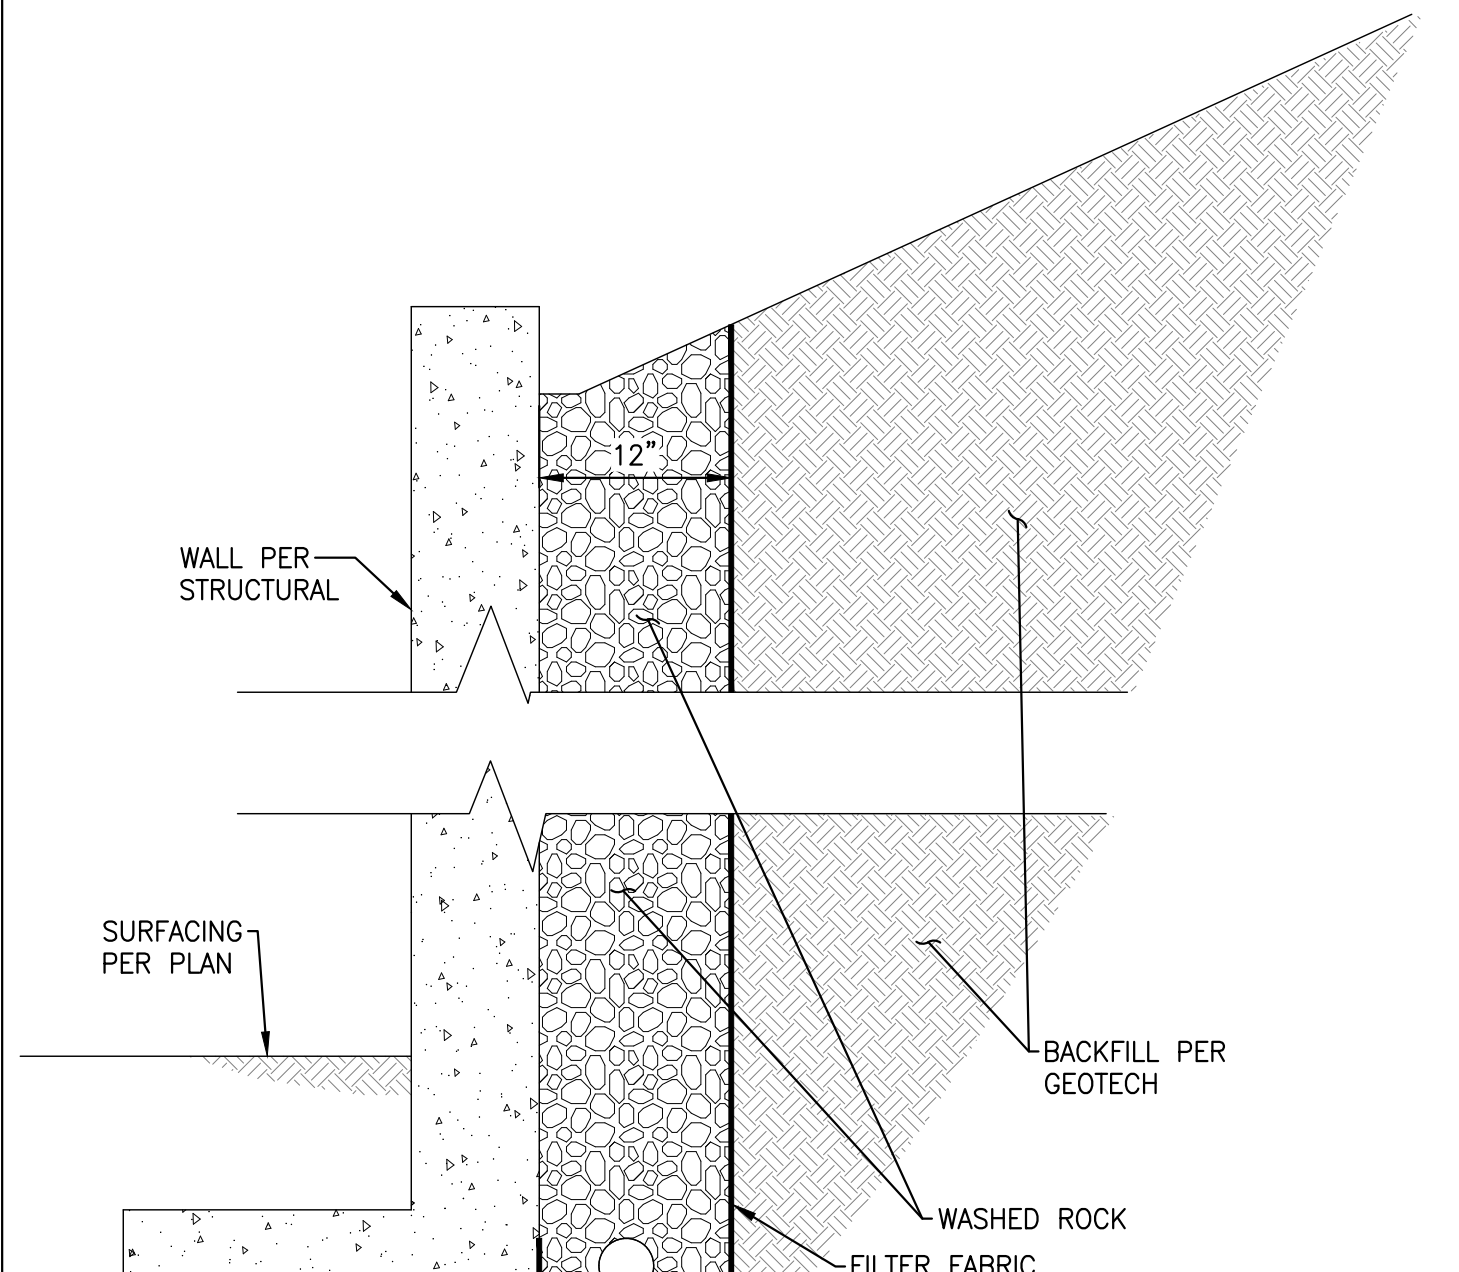


NTS  
WALL DRAIN 10

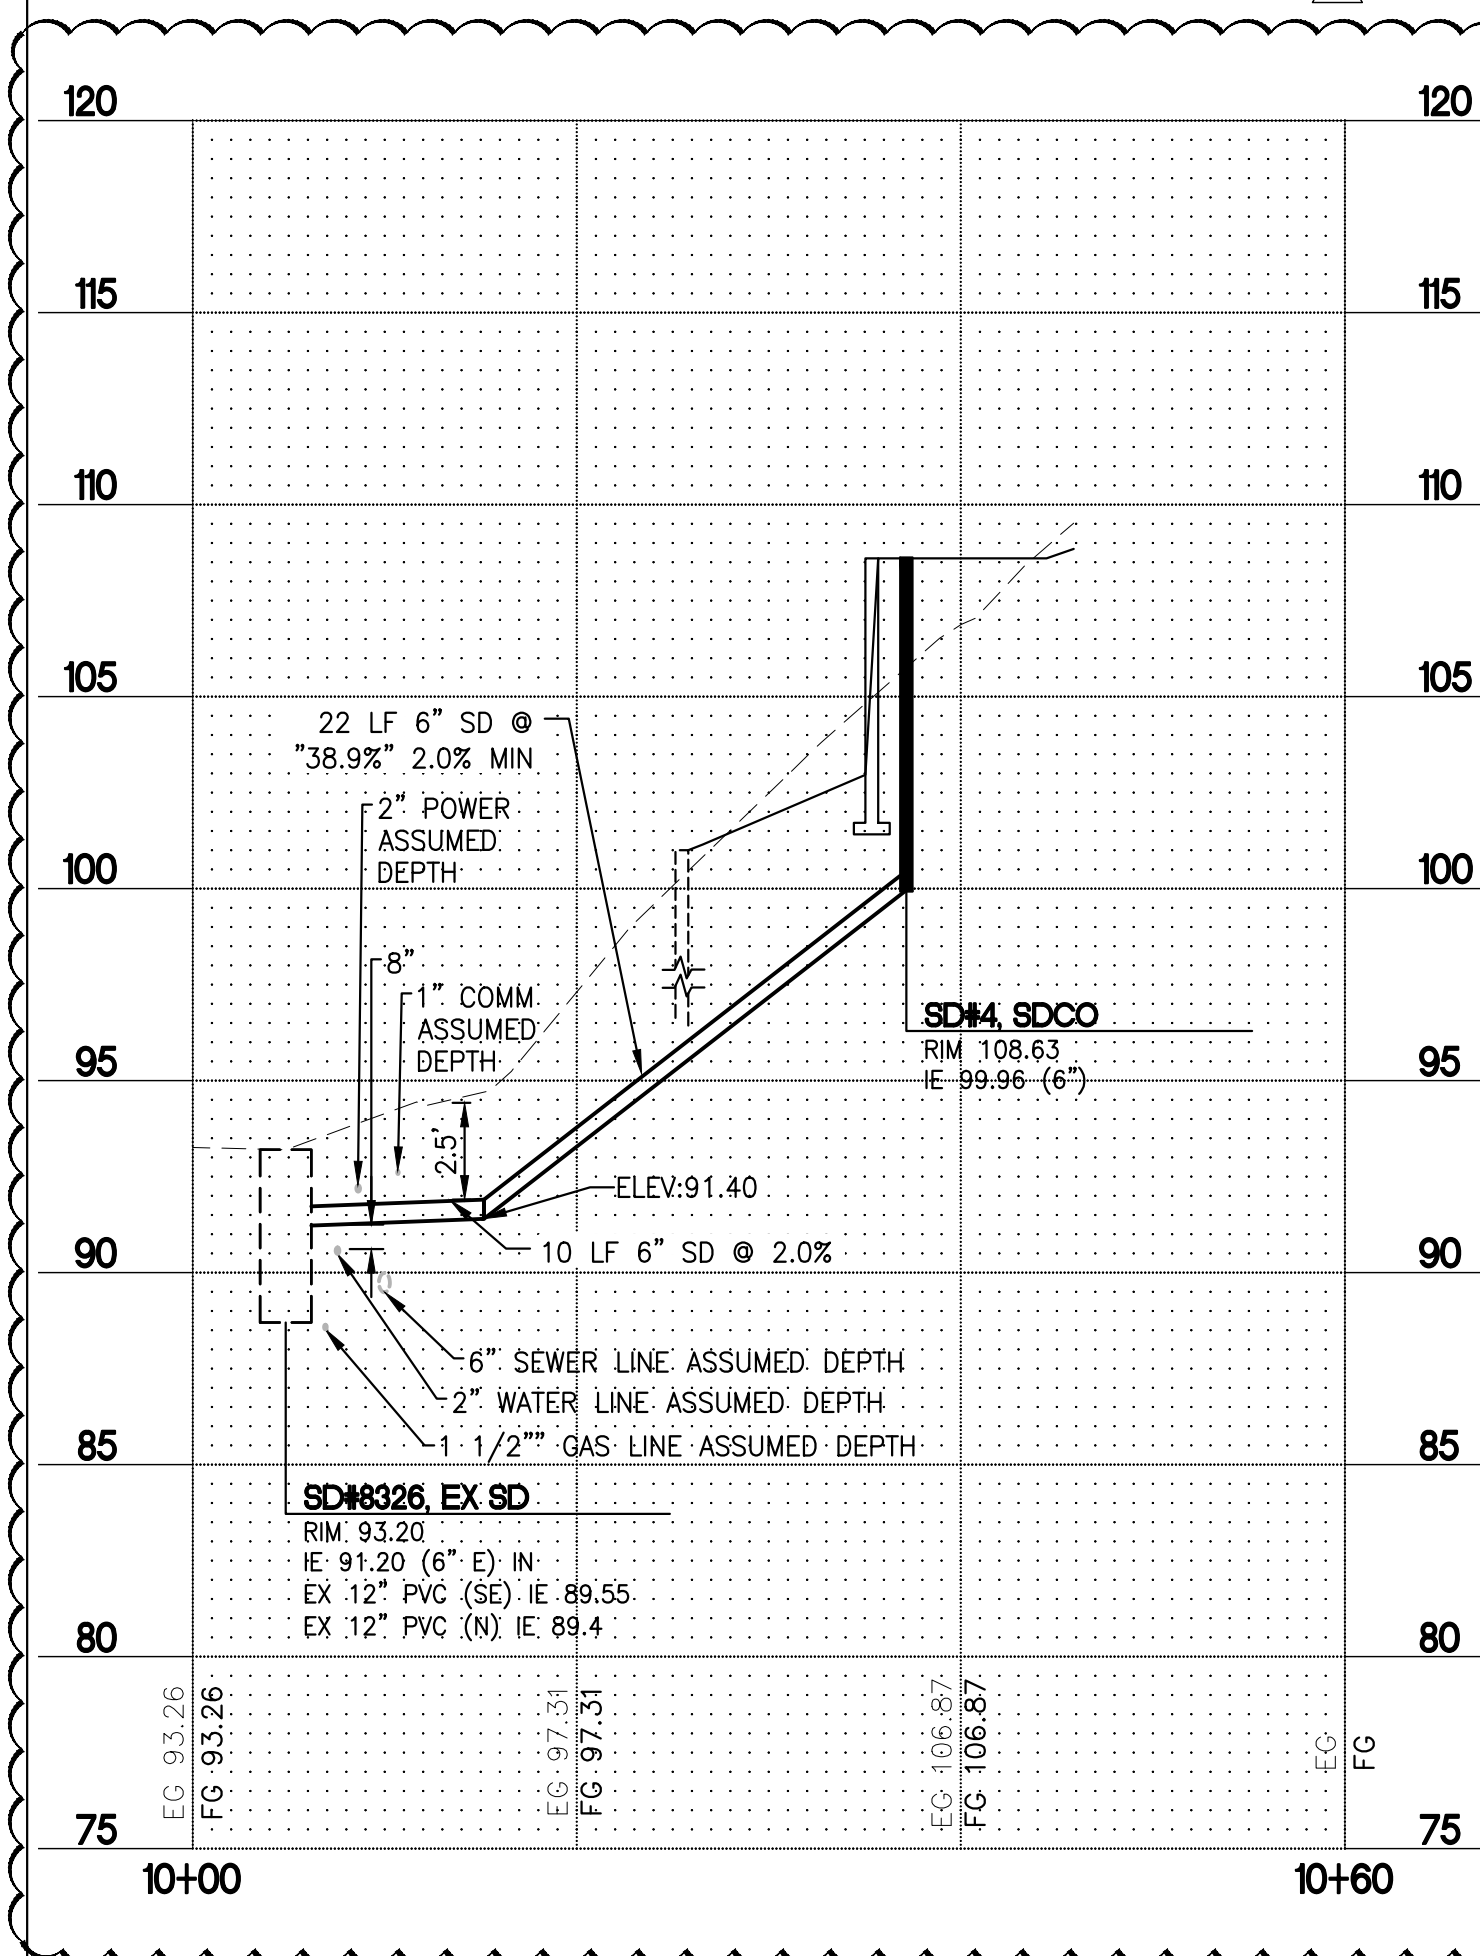

NTS  
SD#4 TO EX SD PROFILE 12



No.	Revisions	Date
1	PERMIT REVISIONS	04/20/2022
2	PERMIT REVISIONS	06/10/2022

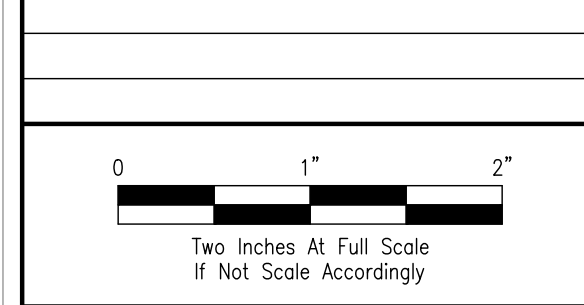


Project Name

**CLARKSON RESIDENCE  
8163 W MERCER WAY**  
City of Mercer Island, Washington

Project No.	272-20-01
Issue Date	04/20/2022
Scale	As Noted
Designed	ACW
Drawn	KES
Checked	LJP
Approved	LJP

**DRAINAGE &  
UTILITIES  
DETAILS**

Sheet  
**C4.0**

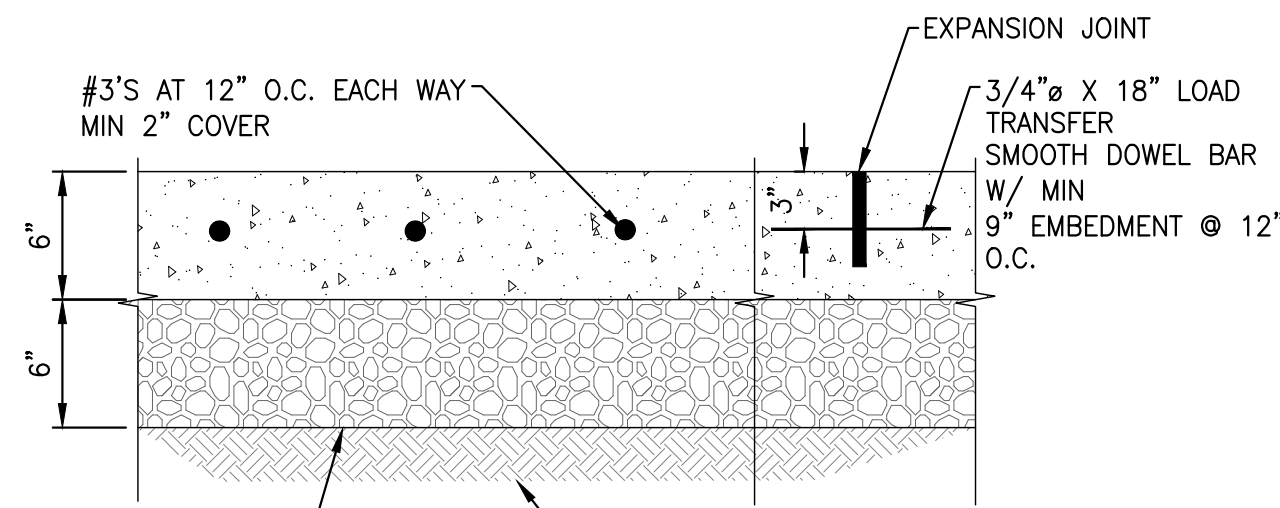


6" CRUSHED SURFACING BASE COURSE PER WSDOT SECTION 9-03.9(3) OR SUITABLE ON-SITE MATERIAL COMPACT TO 95% MAX DENSITY

12" MIN GRAVEL BORROW COMPACTED TO 95% MAX DENSITY OR EX SUBGRADE MATERIAL FIRM AND UNYIELDING


- NOTE:
1. MINIMUM CONCRETE 3000 PSI (5 1/2 SACK)
  2. PROVIDE CONSTRUCTION OR CONTRACTION JOINTS TO BREAK INTO AREAS OF 144 SF OR LESS. NO ACUTE ANGLES. JOINT LOCATIONS TO BE APPROVED BY THE ARCHITECT.
  3. PROOF ROLL EXISTING SUBGRADE AND REMOVE ANY SOFT SPOTS

NTS  
CONCRETE DRIVEWAY 1

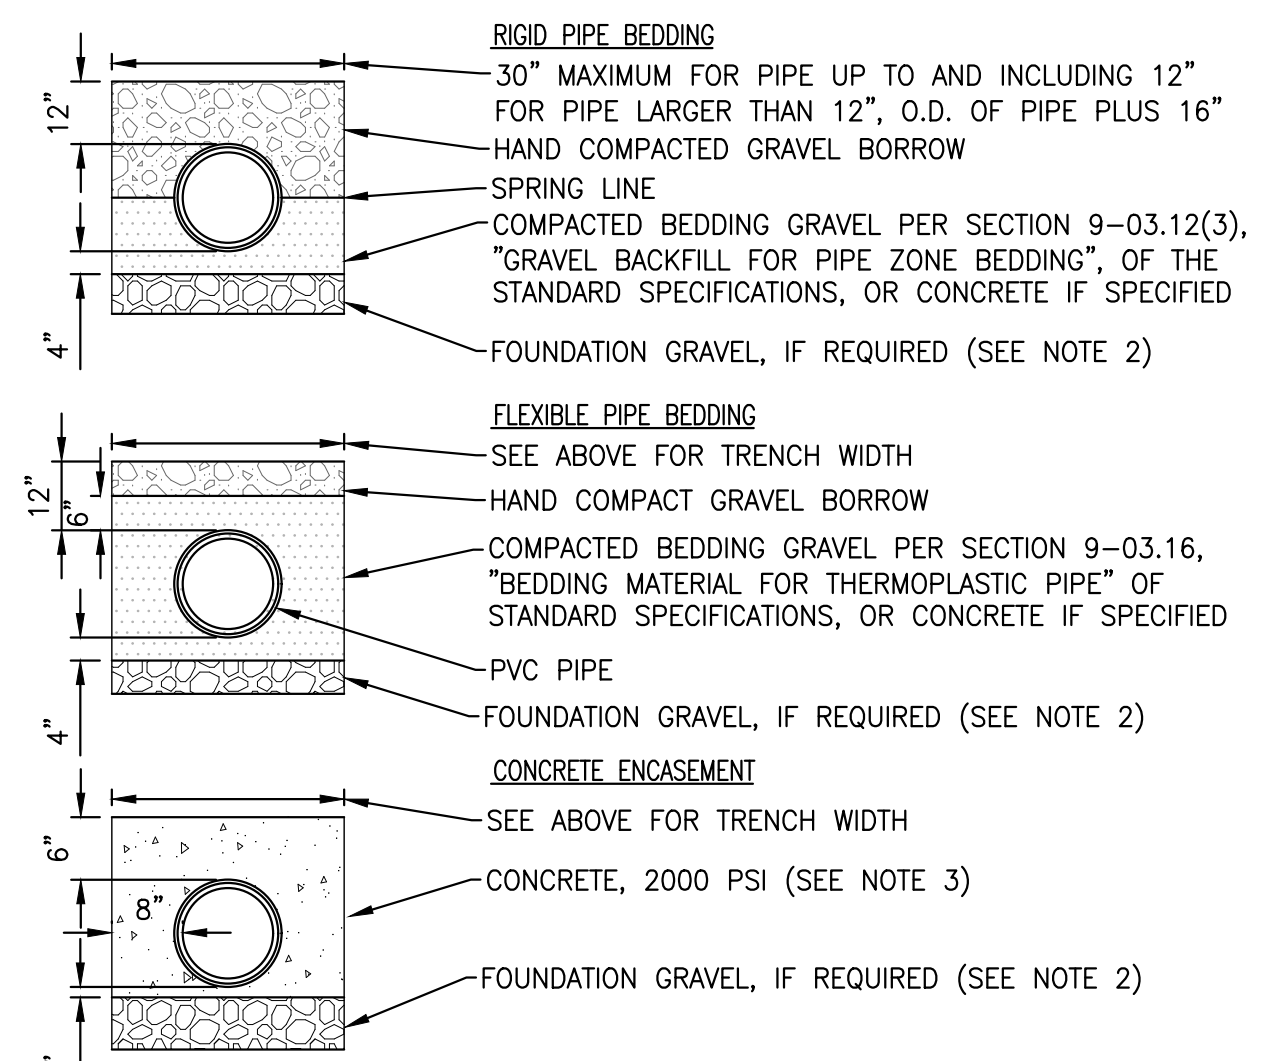

- NOTES:
1. COMPACTED CRUSHED SURFACING TOP COURSE PER SECTION 9-03.9(3), "CRUSHED SURFACING", OF THE STANDARD SPECIFICATIONS CAN ALSO BE USED AS BEDDING GRAVEL.
  2. EXCAVATE UNSTABLE MATERIAL DOWN TO FIRM SOIL AND REPLACE WITH FOUNDATION GRAVEL PER SECTION 9-03.9(1), "BALLAST", OF THE STANDARD SPECIFICATIONS
  3. THE CONTRACTOR SHALL BE RESPONSIBLE FOR ANCHORING PIPE TO PREVENT FLOTATION DURING CONCRETE PLACEMENT.

NTS  
PIPE TRENCH 2

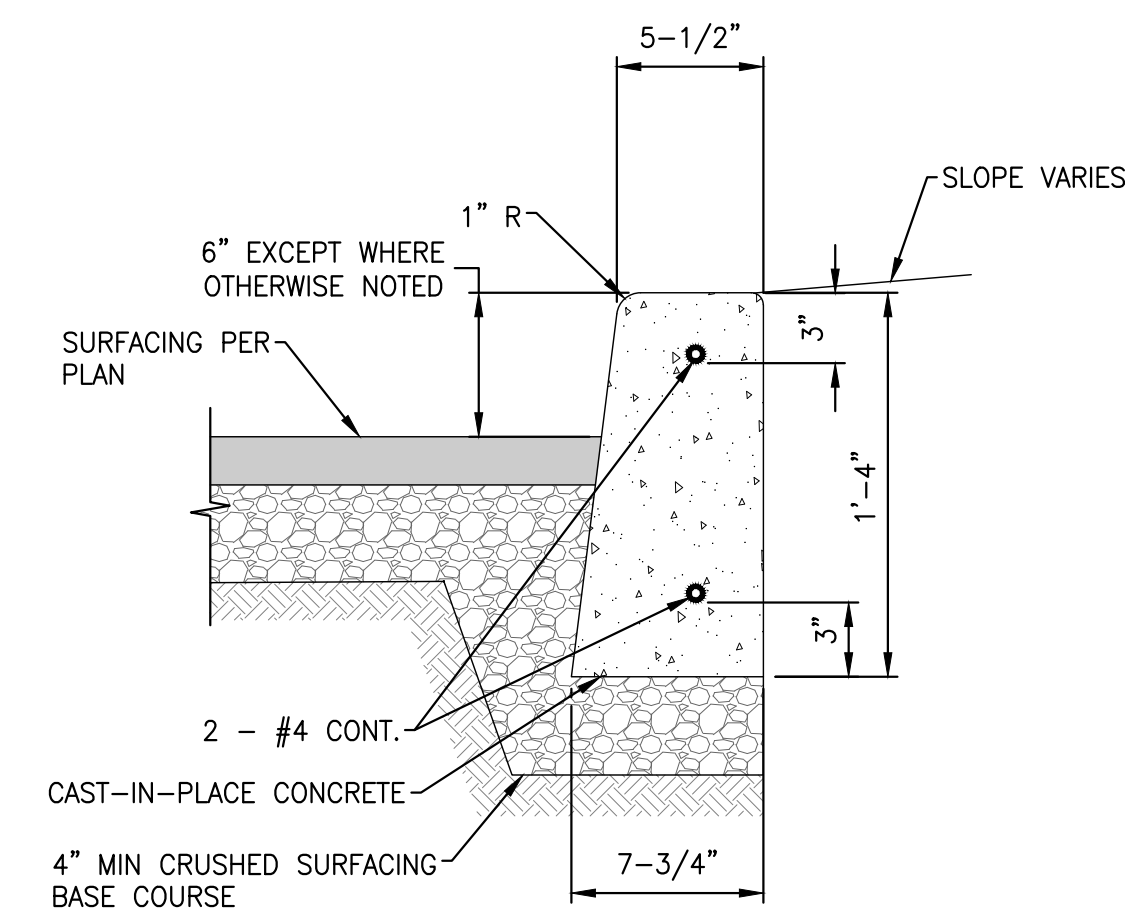

NTS  
CONCRETE VERTICAL CURB 3

NTS  
NOT USED 5

NTS  
NOT USED 6

NTS  
NOT USED 7


NTS  
NOT USED 8

NTS  
NOT USED 9


NTS  
NOT USED 10

NTS  
NOT USED 11

NTS  
NOT USED 12

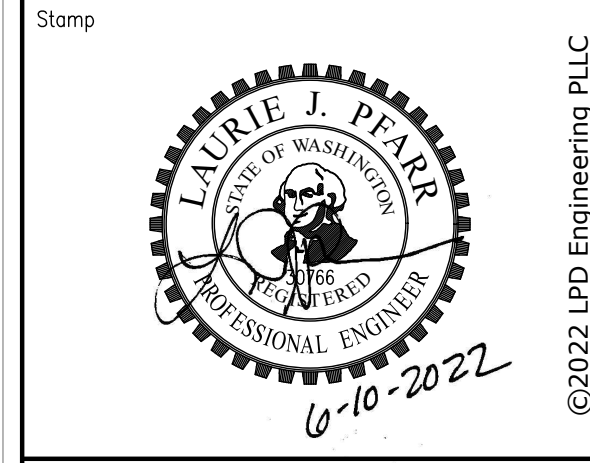

No.	Revisions	Date
1	PERMIT REVISIONS	04/20/2022
2	PERMIT REVISIONS	06/10/2022

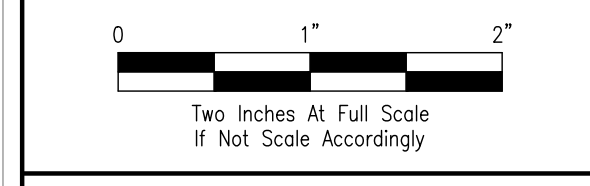

Project Name

**CLARKSON RESIDENCE**  
**8163 W MERCER WAY**  
City of Mercer Island, Washington


Project No.	272-20-01
Issue Date	04/20/2022
Scale	As Noted
Designed	ACW Checked LJP
Drawn	KES Approved LJP

Description  
**PAVING DETAILS**

Sheet  
**C4.1**

PERMIT DOCUMENTS

NO.	DESCRIPTION	DATE
3	PERMIT REVISION	04.19.22
4	PERMIT REVISION 2	06.10.22

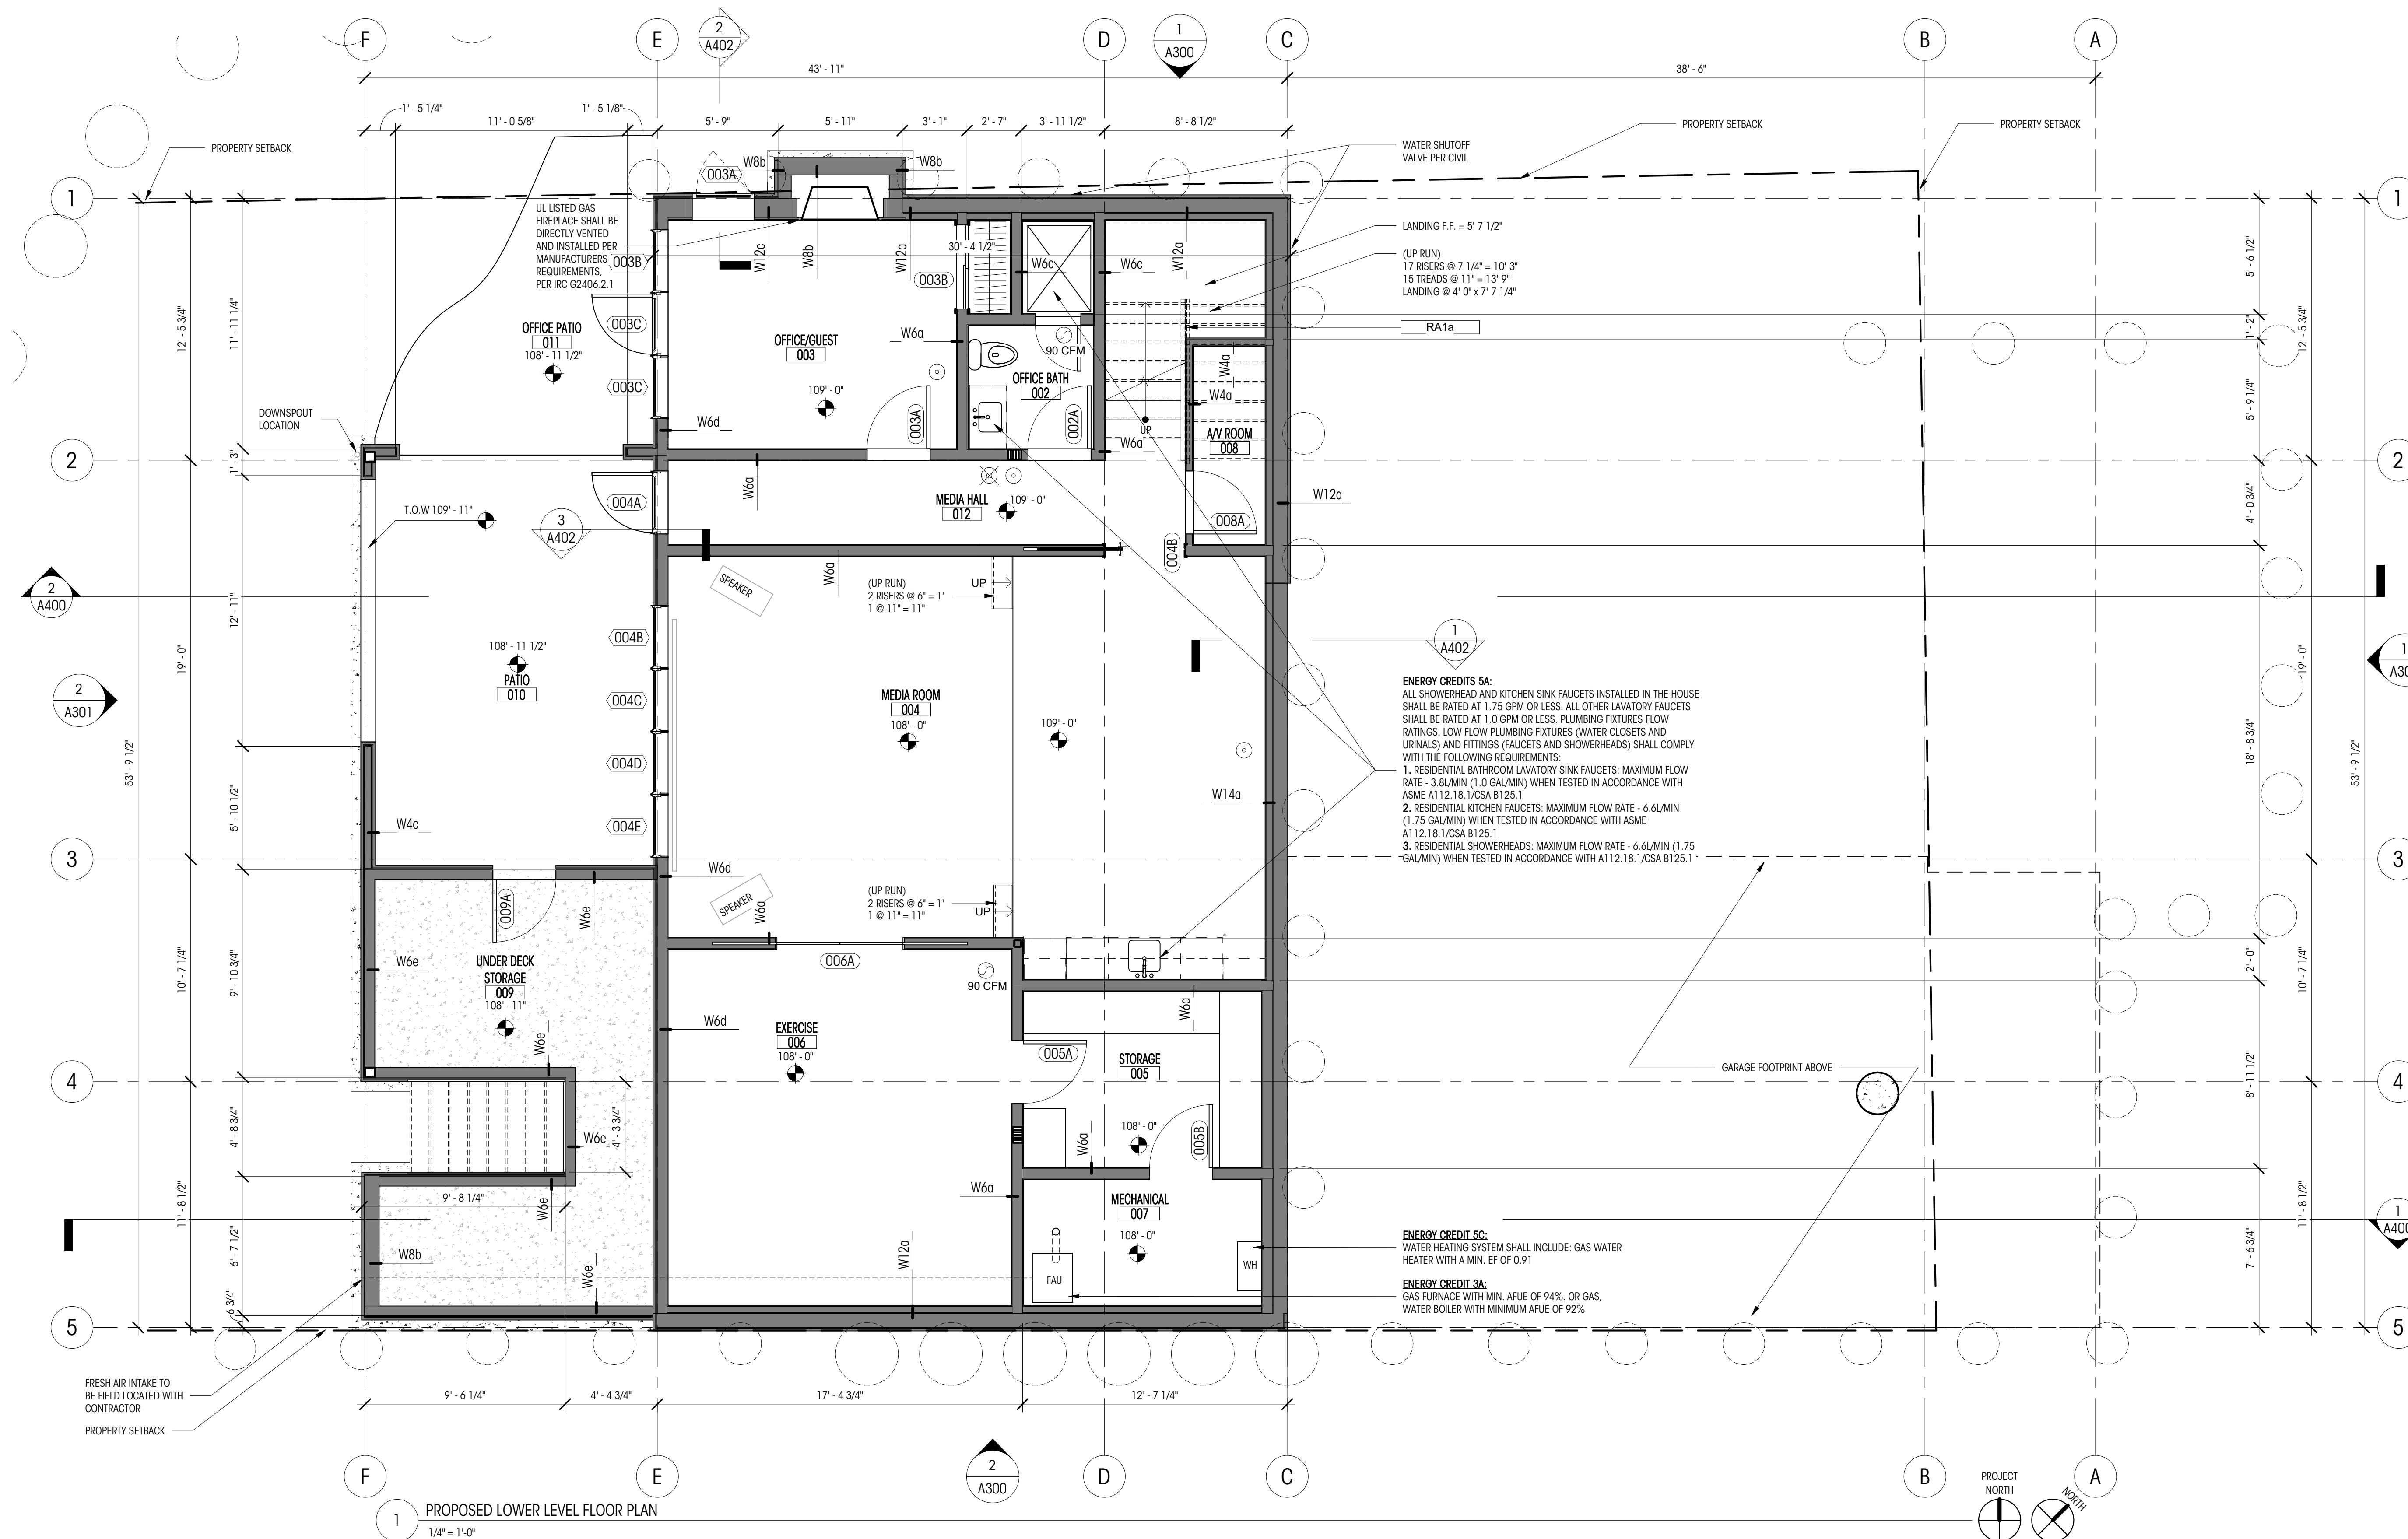

PROPOSED LOWER LEVEL FLOOR PLAN  
1/4" = 1'-0"


SCOPE OF CHANGES:

- NON-STRUCTURAL INTERIOR LAYOUT CHANGES TO BASEMENT LEVEL.
- ADDITION OF FIREPLACE AT BASEMENT LEVEL.
- ADDITION OF PATIO AT BASEMENT LEVEL.
- WINDOW SIZE & LOCATION CHANGES.
- EXTENDED WESTERN PATIO TO THE NORTH AND SOUTH
- LEVEL CHANGES: DRIVEWAY & GARAGE LEVEL DROP BY 12"; BASEMENT LEVEL DROP BY 12";
- CHANGE TO ABE AS A RESULT OF EXTENDED GARAGE AND EXTENDED COVERED DECK.
- CHANGES TO HARDSCAPE CALCULATIONS AS A RESULT OF SOIL STABILIZATION WALL, PATIO EXTENSION AND SITE STAIRS.
- GRID LINES HAVE BEEN UPDATED FOR CLEAR EFFICIENT DIMENSIONS.

BASEMENT LEVEL BELOW GRADE AREA CALC

WALL SEGMENT	LENGTH	COVERAGE	RESULT
A	30.38'	59%	17.78'
B	54.13'	100%	54.13'
C	30.38'	100%	30.38'
D	13.88'	78%	10.83'
E	7.04'	61%	4.32'
F	9.69'	59%	5.67'
G	4.31'	57%	2.45'
H	9.69'	57%	5.51'
I	10.31'	55%	5.70'
J	13.92'	0%	0.00'
K	31.98'	0%	0.00'
L	00.5'	62%	0.31'
TOTAL	216.19'		137.08'

TOTAL BASEMENT GSF = 1,904 SF  
PORTION OF EXCLUDED BASEMENT FLOOR AREA: (137.08/216.19) X 1,904 = 1,207 SF  
NET BASEMENT GRA: (1,904 - 1,207) = 697 SF

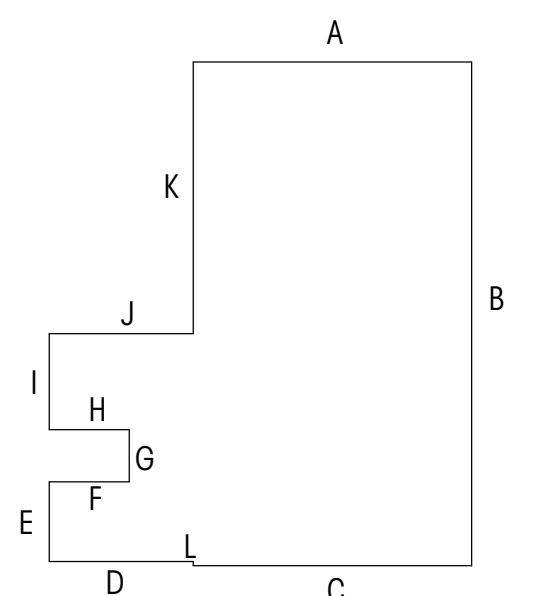

LEGEND

- 200A WINDOW ID
- 100A DOOR ID
- 100A FINISH ID
- SMOKE DETECTOR
- SMOKE/CARBON MONOXIDE DETECTOR
- FAN - 100 CFM U.N.O.
- ELEVATION DATUM (EL=148.5' (+0'-0'))
- GRIDLINE
- NEW WALL
- PLANTER AREA
- ROOF LINE ABOVE
- DENSE SCREEN PLANTING
- PROPOSED UPPER LEVEL 150% (PER 19.02.020.D.2.a)

NOTES

- ALL DIMENSIONS AT EXTERIOR WALLS TO FACE OF FRAMING OR TO EXT. FACE OF CONCRETE, U.N.O.
  - ALL DIMENSIONS AT INTERIOR WALLS TO FACE OF FINISH (5/8" GWB ASSUMED AT EA. SIDE OF WALL) OR TO FACE OF CONCRETE, U.N.O.
  - ALL DIMENSIONS AT KITCHEN TO EDGE OF COUNTERTOPS, U.N.O.
- RA1a PRE-MANUFACTURED 3'-0" HIGH GUARDRAIL TO RESTRICT PASSAGE OF A 4" SPHERE.  
CONTRACTOR SHALL VERIFY TO INSPECTOR ALL GUARDS AND RAILINGS SHALL BE CAPABLE OF RESISTING 200LBS ON TOP RAIL ACTING IN ANY DIRECTION AS REQUIRED BY IRC R301.5, TYP. DESIGN AND CONNECTION UNDER DEFERRED SUBMITTAL.
- RA1b HANDRAIL @ 3" ABOVE STAIR NOSING PER IRC R311.7.8, TYP.
- FI1a UL LISTED GAS FIREPLACE SHALL BE DIRECT VENTED AND INSTALLED PER MANUFACTURER'S REQUIREMENTS, PER IRC G2406.2.1

WHOLE HOUSE VENTILATION CALCS

PROPOSED CONDITIONED SF =	5,704 SF
NUMBER OF BEDROOMS =	6
AIRFLOW IN CFM REQUIRED FOR CONTINUOUS VENTILATION = 120 CFM	25%
RUN TIME PERCENTAGE IN EACH 4 HOUR SEGMENT =	25%
FACTOR =	4
<b>CALCULATION</b>	120 CFM X 4 = 480 CFM


2015 IRC SECTION M1507, WA AMENDED 403.8.1 & 403.8.5.1 - INTERMITTENT WHOLE HOUSE VENTILATION  
PER IRC TABLE M1507.3.3(1)(2) A 25% RUN-TIME IN EACH 4-HOUR SEGMENT REQUIRES A 480 CFM FAN(S) TO BE PROVIDED FOR THE REQUIRED WHOLE-HOUSE VENTILATION. THIS VENTILATION REQUIREMENT WILL BE HANDLED BY A BALANCED VENTILATION SYSTEM IN CONJUNCTION WITH FORCED AIR UNIT. SEE WA STATE VENTILATION NOTES SECTION 1507.3.5.1 ON SHEET A001 REGARDING VENTILATION REQUIREMENTS BASED INTEGRATED WITH A FORCED AIR UNIT.  
\*OUTDOOR AIR INLET DUCT TO BE FIELD LOCATED WITH HVAC SUBCONTRACTOR IN CONJUNCTION WITH PLACING EXHAUST DUCTS IN ORDER TO AVOID CONFLICT.

ENERGY CREDIT

2a	AIR LEAKAGE CONTROL & EFFICIENT VENTILATION: COMPLIANCE BASED ON R402.4.1.2.	5
3a	HIGH EFFICIENCY HVAC EQUIPMENT: GAS, PROPANE OR OIL FIRE FURNACE WITH MIN. AFUE OF 94% OR GAS, PROPANE OR OIL FIRE BOILER WITH MIN. AFUE OF 92%. ALL SHOWERHEAD AND KITCHEN SINK FAUCETS INSTALLED IN THE HOUSE SHALL BE RATED AT 1.0 GPM OR LESS. ALL OTHER LAVATORY FAUCETS SHALL BE RATED AT 1.75 GPM OR LESS. PLUMBING FIXTURES FLOW RATINGS, LOW FLOW PLUMBING FIXTURES (WATER CLOSETS AND URINALS) AND FITTINGS (FAUCETS AND SHOWERHEADS) SHALL COMPLY WITH THE FOLLOWING REQUIREMENTS: 1. RESIDENTIAL BATHROOM LAVATORY SINK FAUCETS: MAXIMUM FLOW RATE - 3.8L/MIN (1.0 GAL/MIN) WHEN TESTED IN ACCORDANCE WITH ASME A112.18.1/CSA B125.1 2. RESIDENTIAL KITCHEN FAUCETS: MAXIMUM FLOW RATE - 6.6L/MIN (1.75 GAL/MIN) WHEN TESTED IN ACCORDANCE WITH ASME A112.18.1/CSA B125.1 3. RESIDENTIAL SHOWERHEADS: MAXIMUM FLOW RATE - 6.6L/MIN (1.75 GAL/MIN) WHEN TESTED IN ACCORDANCE WITH A112.18.1/CSA B125.1	1.0
5c	GAS WATER HEATING SYSTEM W/ A MINIMUM EF OF 0.91	0.5
		1.5
<b>TOTAL</b>		<b>3.5</b>



NO.	DESCRIPTION	DATE
3	PERMIT REVISION	04.19.22
4	PERMIT REVISION 2	06.10.22

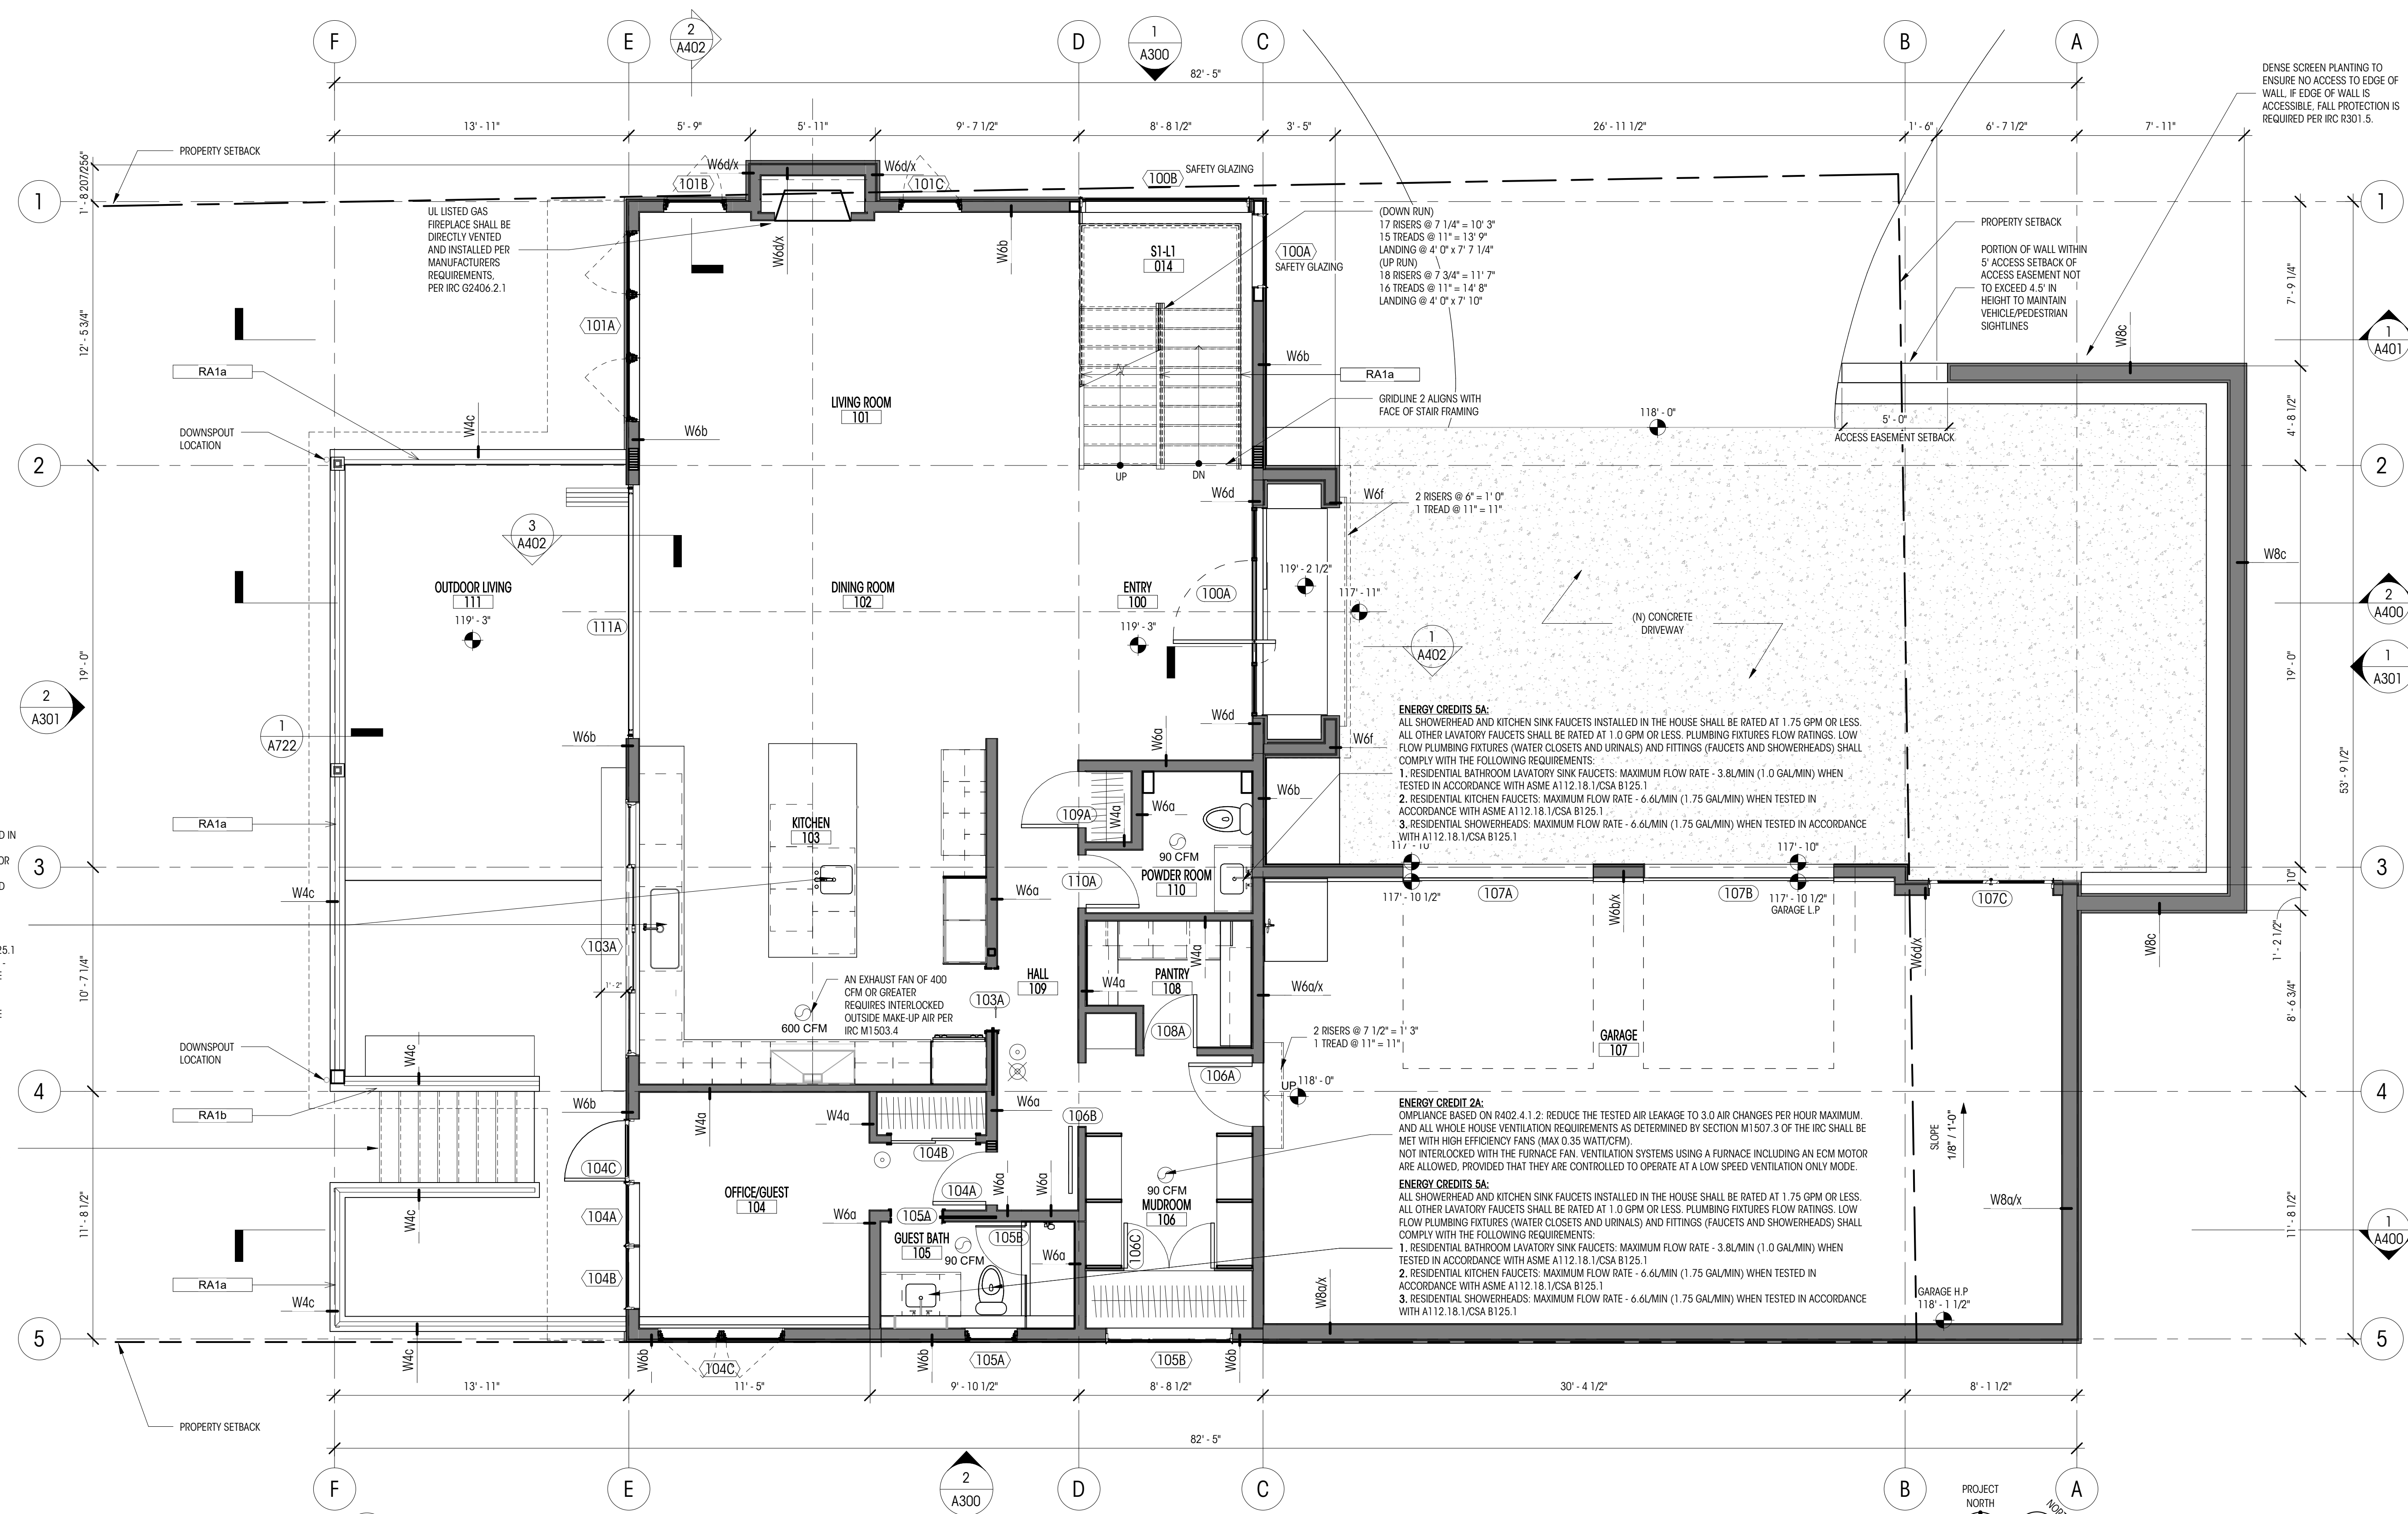

**ENERGY CREDITS 5A:**  
ALL SHOWERHEAD AND KITCHEN SINK FAUCETS INSTALLED IN THE HOUSE SHALL BE RATED AT 1.75 GPM OR LESS. ALL OTHER LAVATORY FAUCETS SHALL BE RATED AT 1.0 GPM OR LESS. ALL OTHER LAVATORY FAUCETS SHALL BE RATED AT 1.0 GPM OR LESS. PLUMBING FIXTURES FLOW RATINGS: LOW FLOW PLUMBING FIXTURES (WATER CLOSETS AND URINALS) AND FITTINGS (FAUCETS AND SHOWERHEADS) SHALL COMPLY WITH THE FOLLOWING REQUIREMENTS:  
1. RESIDENTIAL BATHROOM LAVATORY SINK FAUCETS: MAXIMUM FLOW RATE - 3.8L/MIN (1.0 GAL/MIN) WHEN TESTED IN ACCORDANCE WITH ASME A112.18.1/CSA B125.1  
2. RESIDENTIAL KITCHEN FAUCETS: MAXIMUM FLOW RATE - 6.6L/MIN (1.75 GAL/MIN) WHEN TESTED IN ACCORDANCE WITH ASME A112.18.1/CSA B125.1  
3. RESIDENTIAL SHOWERHEADS: MAXIMUM FLOW RATE - 6.6L/MIN (1.75 GAL/MIN) WHEN TESTED IN ACCORDANCE WITH A112.18.1/CSA B125.1

8 RISERS @ 7 1/4" = 4' 10"  
8 TREADS @ 11" = 7' 4"

EXTERIOR WATERPROOF STAIR: PAVER TILES O/ DURADECK OR APPROVED ALTERNATE MEMBRANE O/ 3/4" PLYWOOD O/ P.T. STAIR STRINGERS FASTENED TO DECK FRAMING. SLOPE FINISH SLIGHTLY TOWARDS YARD FOR POSITIVE SURFACE DRAINAGE AWAY FROM HOUSE.  
\*WATERPROOFING MUST BE APPROVED FOR USE AS A DECKING DECK AND FOR THE INSTALLATION OF THE DECKING DIRECTLY ON THE MEMBRANE PER ICC-ES WALKING DECKS CRITERIA.

**ENERGY CREDITS 5A:**  
ALL SHOWERHEAD AND KITCHEN SINK FAUCETS INSTALLED IN THE HOUSE SHALL BE RATED AT 1.75 GPM OR LESS. ALL OTHER LAVATORY FAUCETS SHALL BE RATED AT 1.0 GPM OR LESS. PLUMBING FIXTURES FLOW RATINGS: LOW FLOW PLUMBING FIXTURES (WATER CLOSETS AND URINALS) AND FITTINGS (FAUCETS AND SHOWERHEADS) SHALL COMPLY WITH THE FOLLOWING REQUIREMENTS:  
1. RESIDENTIAL BATHROOM LAVATORY SINK FAUCETS: MAXIMUM FLOW RATE - 3.8L/MIN (1.0 GAL/MIN) WHEN TESTED IN ACCORDANCE WITH ASME A112.18.1/CSA B125.1  
2. RESIDENTIAL KITCHEN FAUCETS: MAXIMUM FLOW RATE - 6.6L/MIN (1.75 GAL/MIN) WHEN TESTED IN ACCORDANCE WITH ASME A112.18.1/CSA B125.1  
3. RESIDENTIAL SHOWERHEADS: MAXIMUM FLOW RATE - 6.6L/MIN (1.75 GAL/MIN) WHEN TESTED IN ACCORDANCE WITH A112.18.1/CSA B125.1

**ENERGY CREDIT 2A:**  
COMPLIANCE BASED ON R402.4.1.2: REDUCE THE TESTED AIR LEAKAGE TO 3.0 AIR CHANGES PER HOUR MAXIMUM. AND ALL WHOLE HOUSE VENTILATION REQUIREMENTS AS DETERMINED BY SECTION M1507.3 OF THE IRC SHALL BE MET WITH HIGH EFFICIENCY FANS (MAX 0.35 WATT/CFM). NOT INTERLOCKED WITH THE FURNACE FAN. VENTILATION SYSTEMS USING A FURNACE INCLUDING AN ECM MOTOR ARE ALLOWED, PROVIDED THAT THEY ARE CONTROLLED TO OPERATE AT A LOW SPEED VENTILATION ONLY MODE.

**ENERGY CREDITS 5A:**  
ALL SHOWERHEAD AND KITCHEN SINK FAUCETS INSTALLED IN THE HOUSE SHALL BE RATED AT 1.75 GPM OR LESS. ALL OTHER LAVATORY FAUCETS SHALL BE RATED AT 1.0 GPM OR LESS. PLUMBING FIXTURES FLOW RATINGS: LOW FLOW PLUMBING FIXTURES (WATER CLOSETS AND URINALS) AND FITTINGS (FAUCETS AND SHOWERHEADS) SHALL COMPLY WITH THE FOLLOWING REQUIREMENTS:  
1. RESIDENTIAL BATHROOM LAVATORY SINK FAUCETS: MAXIMUM FLOW RATE - 3.8L/MIN (1.0 GAL/MIN) WHEN TESTED IN ACCORDANCE WITH ASME A112.18.1/CSA B125.1  
2. RESIDENTIAL KITCHEN FAUCETS: MAXIMUM FLOW RATE - 6.6L/MIN (1.75 GAL/MIN) WHEN TESTED IN ACCORDANCE WITH ASME A112.18.1/CSA B125.1  
3. RESIDENTIAL SHOWERHEADS: MAXIMUM FLOW RATE - 6.6L/MIN (1.75 GAL/MIN) WHEN TESTED IN ACCORDANCE WITH A112.18.1/CSA B125.1

**SCOPE OF CHANGES:**

- INTERIOR LAYOUT CHANGES TO MAIN LEVEL
- ENTRY DESIGN CHANGE
- WINDOW SIZE & LOCATION CHANGES
- EXTENDED WESTERN PATIO TO THE NORTH AND SOUTH
- LEVEL CHANGES: DRIVEWAY & GARAGE LEVEL DROP BY 12"
- SHIFT OF PARKING RETAINING WALLS TO NORTH AND SOUTH
- EXTEND GARAGE EAST INTO FRONT YARD SETBACK AS ALLOWED BY CODE 19.02.040.D

**LEGEND**

- ◊ EL= 148.5' (+0'-0") MAIN LEVEL FIN. FLR. — ELEVATION DATUM
- — GRIDLINE
- ◻ — NEW WALL
- ◻ — PLANTER AREA
- ◻ — ROOF LINE ABOVE
- ◻ — DENSE SCREEN PLANTING
- ◻ — PROPOSED UPPER LEVEL 150% (PER 19.02.020.D.2.a)
- ◻ — WINDOW ID (200A)
- ◻ — DOOR ID (100A)
- ◻ — FINISH ID (100A)
- — SMOKE DETECTOR
- ⊗ — SMOKE/CARBON MONOXIDE DETECTOR
- — FAN - 100 CFM U.N.O.

**NOTES**

1. ALL DIMENSIONS AT EXTERIOR WALLS TO FACE OF FRAMING OR TO EXT. FACE OF CONCRETE, U.N.O.
  2. ALL DIMENSIONS AT INTERIOR WALLS TO FACE OF FINISH (5/8" GWB ASSUMED AT EA. SIDE OF WALL) OR TO FACE OF CONCRETE, U.N.O.
  3. ALL DIMENSIONS AT KITCHEN TO EDGE OF COUNTERTOPS, U.N.O.
- RA1a PRE-MANUFACTURED 3'-0" HIGH GUARDRAIL TO RESTRICT PASSAGE OF A 4" SPHERE. CONTRACTOR SHALL VERIFY TO INSPECTOR ALL GUARDS AND RAILINGS SHALL BE CAPABLE OF RESISTING 200LBS ON TOP RAIL ACTING IN ANY DIRECTION AS REQUIRED BY IRC R301.5, TYP. DESIGN AND CONNECTION UNDER DEFERRED SUBMITTAL.
- RA1b HANDRAIL @ 3" ABOVE STAIR NOSING PER IRC R311.7.8, TYP.
- FI1a UL LISTED GAS FIREPLACE SHALL BE DIRECT VENTED AND INSTALLED PER MANUFACTURER'S REQUIREMENTS, PER IRC G2406.2.1

**WHOLE HOUSE VENTILATION CALCS**


PROPOSED CONDITIONED SF =	5,704 SF
NUMBER OF BEDROOMS =	6
AIRFLOW IN CFM REQUIRED FOR CONTINUOUS VENTILATION = 120 CFM	25%
RUN TIME PERCENTAGE IN EACH 4 HOUR SEGMENT =	4
FACTOR =	
<b>CALCULATION</b>	120 CFM X 4 = <b>480 CFM</b>

2015 IRC SECTION M1507. WA AMENDED 403.8.1 & 403.8.5.1 - INTERMITTENT WHOLE HOUSE VENTILATION  
PER IRC TABLES M1507.3.3(1/2) A 25% RUN-TIME IN EACH 4-HOUR SEGMENT REQUIRES A 480 CFM FAN(S) TO BE PROVIDED FOR THE REQUIRED WHOLE-HOUSE VENTILATION. THIS VENTILATION REQUIREMENT WILL BE HANDLED BY A BALANCED VENTILATION SYSTEM IN CONJUNCTION WITH FORCED AIR UNIT. SEE WA STATE VENTILATION NOTES SECTION 1507.3.5.1 ON SHEET A001 REGARDING VENTILATION REQUIREMENTS BASED INTEGRATED WITH A FORCED AIR UNIT.  
\*OUTDOOR AIR INLET DUCT TO BE FIELD LOCATED WITH HVAC SUBCONTRACTOR IN CONJUNCTION WITH PLACING EXHAUST DUCTS IN ORDER TO AVOID CONFLICT.

**ENERGY CREDIT**

2a	AIR LEAKAGE CONTROL & EFFICIENT VENTILATION: COMPLIANCE BASED ON R402.4.1.2.	5
3a	HIGH EFFICIENCY HVAC EQUIPMENT: GAS, PROPANE OR OIL FIRE FURNANCE WITH MIN. AFUE OF 94% OR GAS, PROPANE OR OIL FIRE BOILER WITH MIN. AFUE OF 92% ALL SHOWERHEAD AND KITCHEN SINK FAUCETS INSTALLED IN THE HOUSE SHALL BE RATED AT 1.75 GPM OR LESS. ALL OTHER LAVATORY FAUCETS SHALL BE RATED AT 1.0 GPM OR LESS. PLUMBING FIXTURES FLOW RATINGS: LOW FLOW PLUMBING FIXTURES (WATER CLOSETS AND URINALS) AND FITTINGS (FAUCETS AND SHOWERHEADS) SHALL COMPLY WITH THE FOLLOWING REQUIREMENTS: 1. RESIDENTIAL BATHROOM LAVATORY SINK FAUCETS: MAXIMUM FLOW RATE - 3.8L/MIN (1.0 GAL/MIN) WHEN TESTED IN ACCORDANCE WITH ASME A112.18.1/CSA B125.1 2. RESIDENTIAL KITCHEN FAUCETS: MAXIMUM FLOW RATE - 6.6L/MIN (1.75 GAL/MIN) WHEN TESTED IN ACCORDANCE WITH ASME A112.18.1/CSA B125.1 3. RESIDENTIAL SHOWERHEADS: MAXIMUM FLOW RATE - 6.6L/MIN (1.75 GAL/MIN) WHEN TESTED IN ACCORDANCE WITH A112.18.1/CSA B125.1	1.0
5c	GAS WATER HEATING SYSTEM W/ A MINIMUM EF OF 0.91	0.5 1.5
<b>TOTAL</b>		<b>3.5</b>

NO.	DESCRIPTION	DATE
3	PERMIT REVISION	04.19.22
4	PERMIT REVISION 2	06.10.22
5	PERMIT REVISION 3	08.30.22

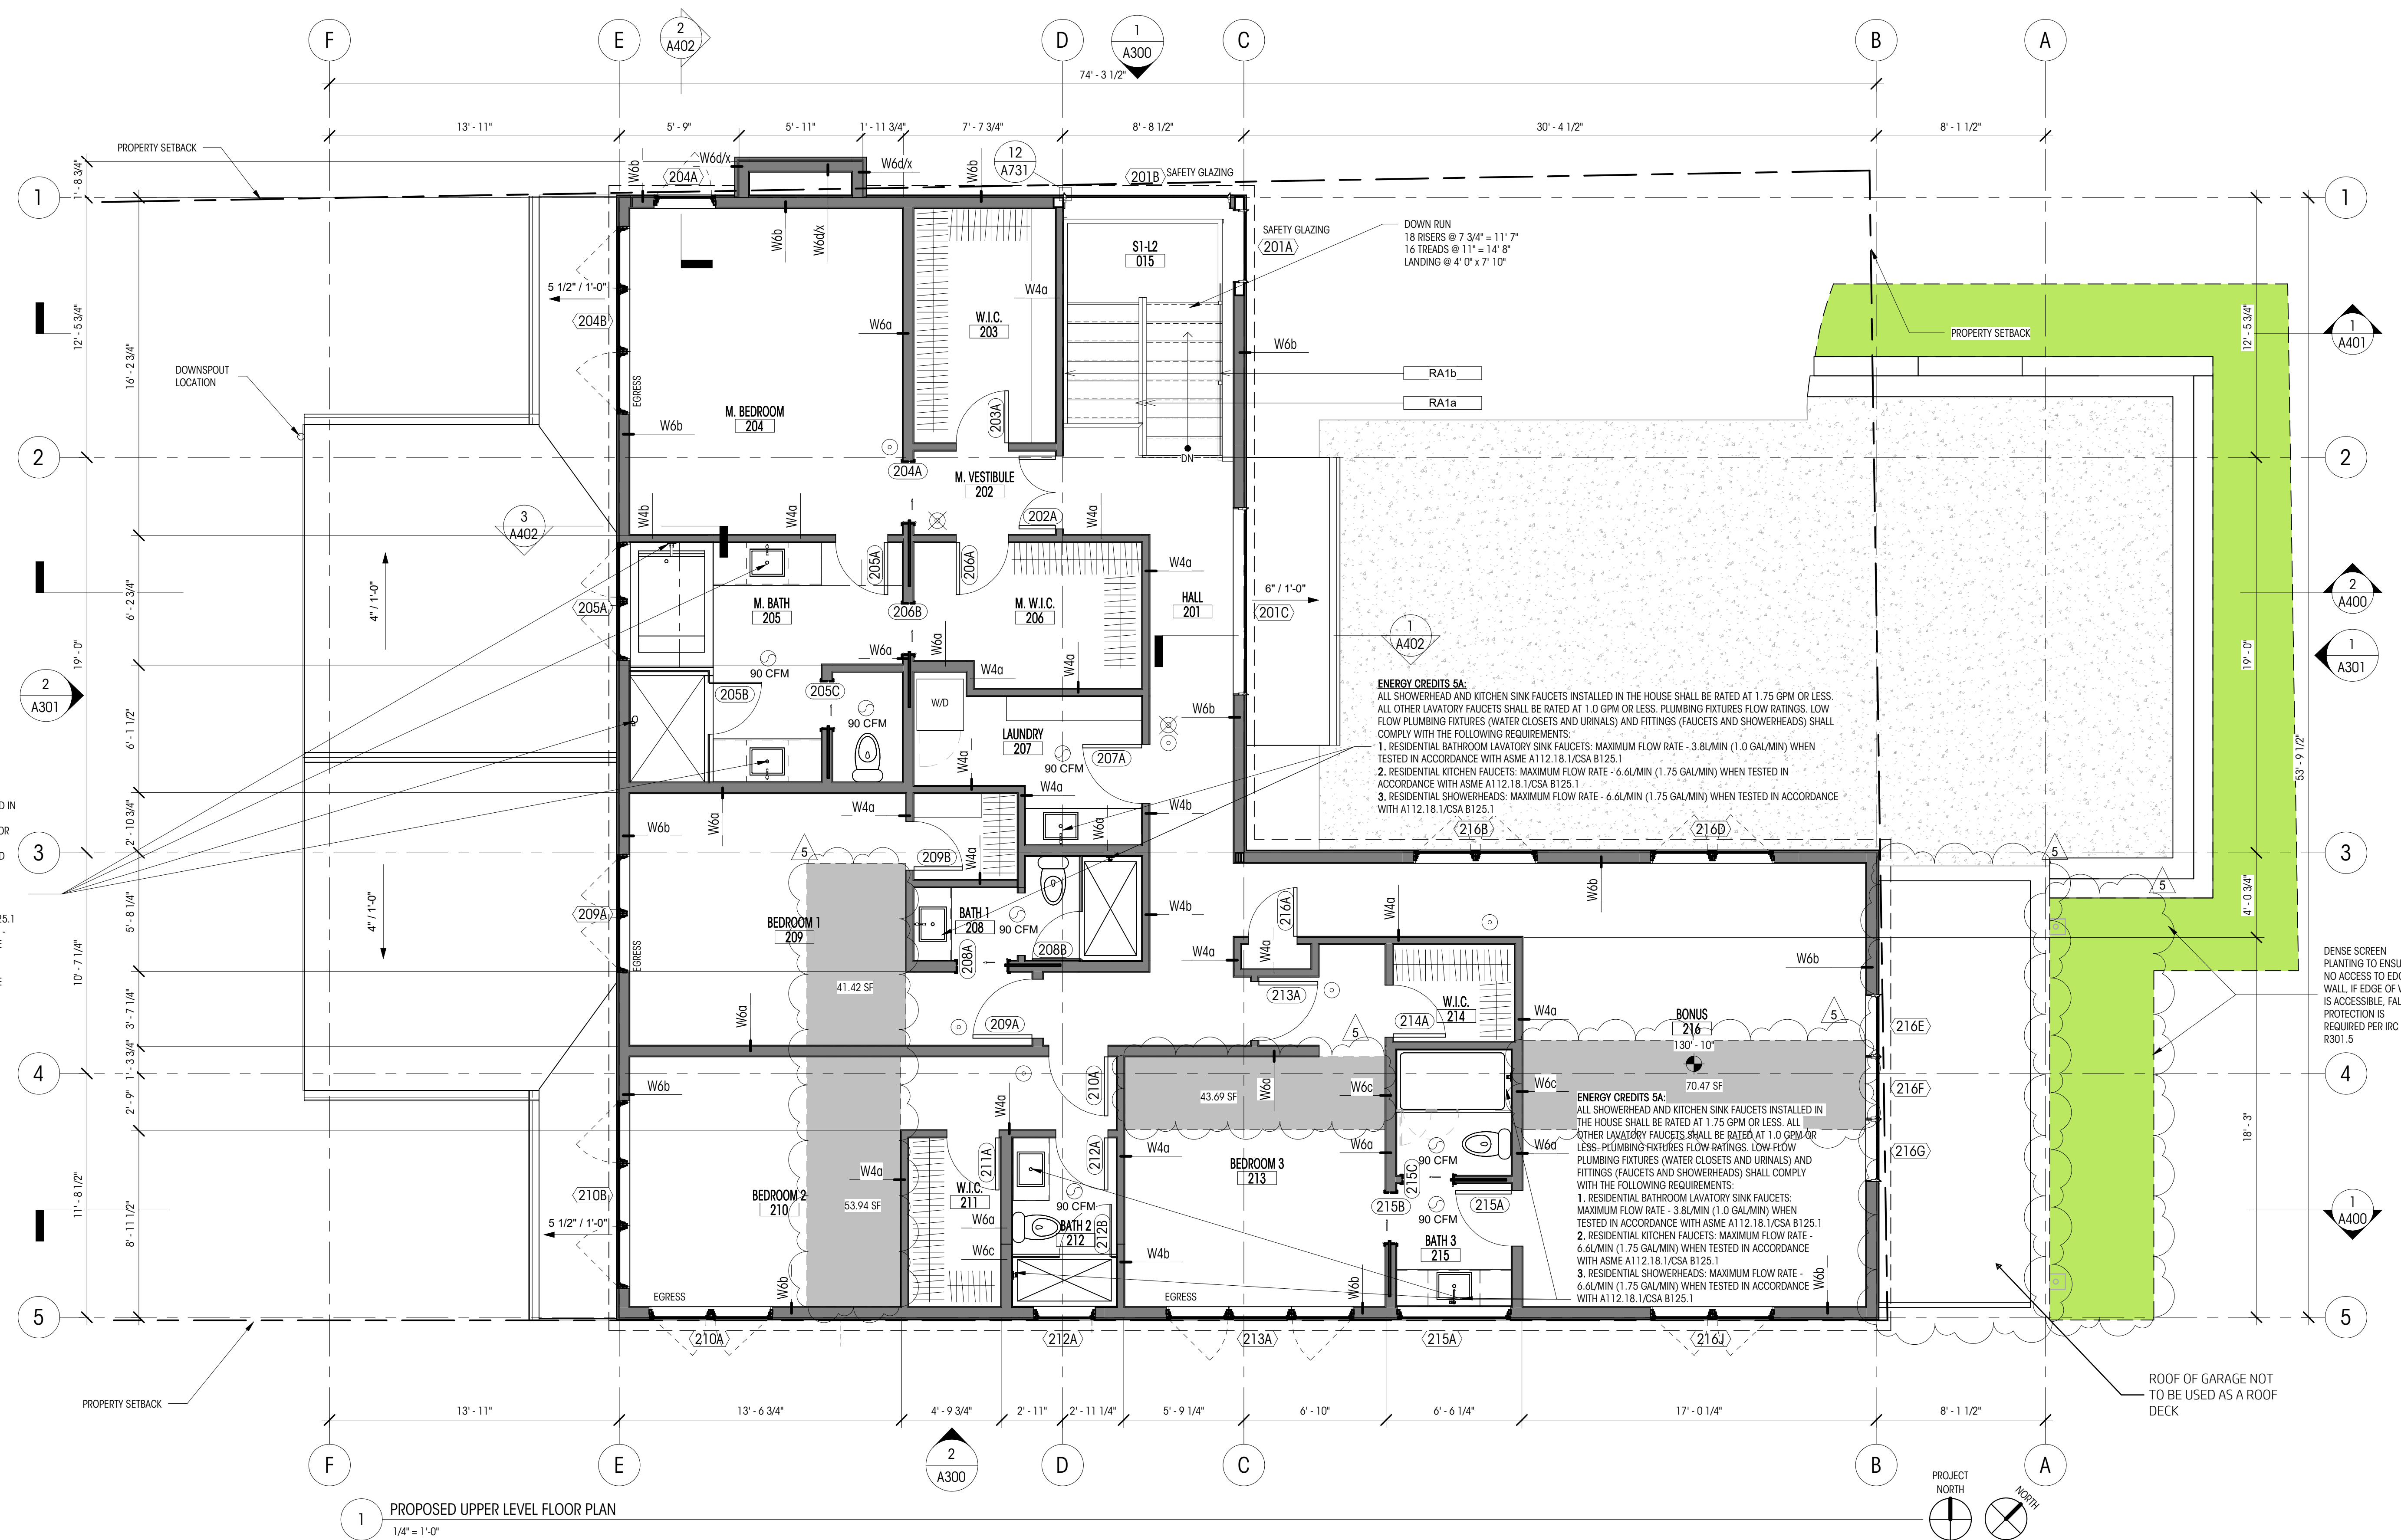

**ENERGY CREDITS 5A:**  
ALL SHOWERHEAD AND KITCHEN SINK FAUCETS INSTALLED IN THE HOUSE SHALL BE RATED AT 1.75 GPM OR LESS. ALL OTHER LAVATORY FAUCETS SHALL BE RATED AT 1.0 GPM OR LESS. PLUMBING FIXTURES FLOW RATINGS, LOW FLOW PLUMBING FIXTURES (WATER CLOSETS AND URINALS) AND FITTINGS (FAUCETS AND SHOWERHEADS) SHALL COMPLY WITH THE FOLLOWING REQUIREMENTS:  
1. RESIDENTIAL BATHROOM LAVATORY SINK FAUCETS: MAXIMUM FLOW RATE - 3.8L/MIN (1.0 GAL/MIN) WHEN TESTED IN ACCORDANCE WITH ASME A112.18.1/CSA B125.1  
2. RESIDENTIAL KITCHEN FAUCETS: MAXIMUM FLOW RATE - 6.6L/MIN (1.75 GAL/MIN) WHEN TESTED IN ACCORDANCE WITH ASME A112.18.1/CSA B125.1  
3. RESIDENTIAL SHOWERHEADS: MAXIMUM FLOW RATE - 6.6L/MIN (1.75 GAL/MIN) WHEN TESTED IN ACCORDANCE WITH A112.18.1/CSA B125.1

**SCOPE OF CHANGES:**

- INTERIOR LAYOUT CHANGES TO UPPER LEVEL.
- WINDOW SIZE & LOCATION CHANGES.
- EXTENDED WESTERN PATIO TO THE NORTH AND SOUTH.
- ELIMINATION OF UPPER LEVEL DECK, MAIN FLOOR DECK TO RECEIVE STANDARD GABLE ROOF.
- ADDED DORMERS AT UPPER LEVEL BONUS ROOM.
- OMISSION OF FIREPLACE AT UPPER LEVEL.
- SHIFT OF PARKING RETAINING WALLS TO NORTH AND SOUTH.
- ADDITION OF AWNING ROOFS OVER OFFICE & LIVING ROOM.
- EXTEND GARAGE EAST INTO FRONT YARD SETBACK AS ALLOWED BY CODE 19.02.040.D
- ADDED DECK AT ROOF OF THE EXTENDED GARAGE AREA.
- BATHROOM REVISIONS RESULT IN 1 ADDITIONAL TOILET AND 1 ADDITIONAL SHOWER

**LEGEND**

- ◻ 200A WINDOW ID
- ◻ 100A DOOR ID
- ◻ 100A FINISH ID
- SMOKE DETECTOR
- ⊗ SMOKE/CARBON MONOXIDE DETECTOR
- FAN - 100 CFM U.N.O.
- ELEVATION DATUM
- GRIDLINE
- NEW WALL
- ▨ PLANTER AREA
- ROOF LINE ABOVE
- DENSE SCREEN PLANTING
- ▨ PROPOSED UPPER LEVEL 150% (PER 19.02.020.D.2.g)

**NOTES**

- ALL DIMENSIONS AT EXTERIOR WALLS TO FACE OF FRAMING OR TO EXT. FACE OF CONCRETE, U.N.O.
  - ALL DIMENSIONS AT INTERIOR WALLS TO FACE OF FINISH (5/8" GWB ASSUMED AT EA. SIDE OF WALL) OR TO FACE OF CONCRETE, U.N.O.
  - ALL DIMENSIONS AT KITCHEN TO EDGE OF COUNTERTOPS, U.N.O.
- RA1a PRE-MANUFACTURED 3'-0" HIGH GUARDRAIL TO RESTRICT PASSAGE OF A 4" SPHERE.  
CONTRACTOR SHALL VERIFY TO INSPECTOR ALL GUARDS AND RAILINGS SHALL BE CAPABLE OF RESISTING 200LBS ON TOP RAIL ACTING IN ANY DIRECTION AS REQUIRED BY IRC R301.5, TYP. DESIGN AND CONNECTION UNDER DEFERRED SUBMITTAL.
- RA1b HANDRAIL @ 3" ABOVE STAIR NOSING PER IRC R311.7.8, TYP.
- FI1a UL LISTED GAS FIREPLACE SHALL BE DIRECT VENTED AND INSTALLED PER MANUFACTURER'S REQUIREMENTS, PER IRC G2406.2.1

**WHOLE HOUSE VENTILATION CALCS**


PROPOSED CONDITIONED SF =	5,704 SF
NUMBER OF BEDROOMS =	6
AIRFLOW IN CFM REQUIRED FOR CONTINUOUS VENTILATION = 120 CFM	
RUN TIME PERCENTAGE IN EACH 4 HOUR SEGMENT =	25%
FACTOR =	4
<b>CALCULATION</b>	120 CFM X 4 = <b>480 CFM</b>

2015 IRC SECTION M1507, WA AMENDED 403.8.1 & 403.8.5.1 - INTERMITTENT WHOLE HOUSE VENTILATION  
PER IRC TABLES M1507.3.3(1/2) A 25% RUN-TIME IN EACH 4-HOUR SEGMENT REQUIRES A 480 CFM FAN(S) TO BE PROVIDED FOR THE REQUIRED WHOLE-HOUSE VENTILATION. THIS VENTILATION REQUIREMENT WILL BE HANDLED BY A BALANCED VENTILATION SYSTEM IN CONJUNCTION WITH FORCED AIR UNIT. SEE WA STATE VENTILATION NOTES SECTION 1507.3.5.1 ON SHEET A01 REGARDING VENTILATION REQUIREMENTS BASED INTEGRATED WITH A FORCED AIR UNIT.  
\*OUTDOOR AIR INLET DUCT TO BE FIELD LOCATED WITH HVAC SUBCONTRACTOR IN CONJUNCTION WITH PLACING EXHAUST DUCTS IN ORDER TO AVOID CONFLICT.


**ENERGY CREDIT**

2a	AIR LEAKAGE CONTROL & EFFICIENT VENTILATION: COMPLIANCE BASED ON R402.4.1.2.	5
3a	HIGH EFFICIENCY HVAC EQUIPMENT: GAS, PROPANE OR OIL FIRE FURNACE WITH MIN. AFUE OF 94% OR GAS, PROPANE OR OIL FIRE BOILER WITH MIN. AFUE OF 92% ALL SHOWERHEAD AND KITCHEN SINK FAUCETS INSTALLED IN THE HOUSE SHALL BE RATED AT 1.75 GPM OR LESS. ALL OTHER LAVATORY FAUCETS SHALL BE RATED AT 1.0 GPM OR LESS. PLUMBING FIXTURES FLOW RATINGS, LOW FLOW PLUMBING FIXTURES (WATER CLOSETS AND URINALS) AND FITTINGS (FAUCETS AND SHOWERHEADS) SHALL COMPLY WITH THE FOLLOWING REQUIREMENTS: 1. RESIDENTIAL BATHROOM LAVATORY SINK FAUCETS: MAXIMUM FLOW RATE - 3.8L/MIN (1.0 GAL/MIN) WHEN TESTED IN ACCORDANCE WITH ASME A112.18.1/CSA B125.1 2. RESIDENTIAL KITCHEN FAUCETS: MAXIMUM FLOW RATE - 6.6L/MIN (1.75 GAL/MIN) WHEN TESTED IN ACCORDANCE WITH ASME A112.18.1/CSA B125.1 3. RESIDENTIAL SHOWERHEADS: MAXIMUM FLOW RATE - 6.6L/MIN (1.75 GAL/MIN) WHEN TESTED IN ACCORDANCE WITH A112.18.1/CSA B125.1	1.0
5c	GAS WATER HEATING SYSTEM W/ A MINIMUM EF OF 0.91	0.5
		1.5
<b>TOTAL</b>		<b>3.5</b>

NO.	DESCRIPTION	DATE
3	PERMIT REVISION	04.19.22
4	PERMIT REVISION 2	06.10.22

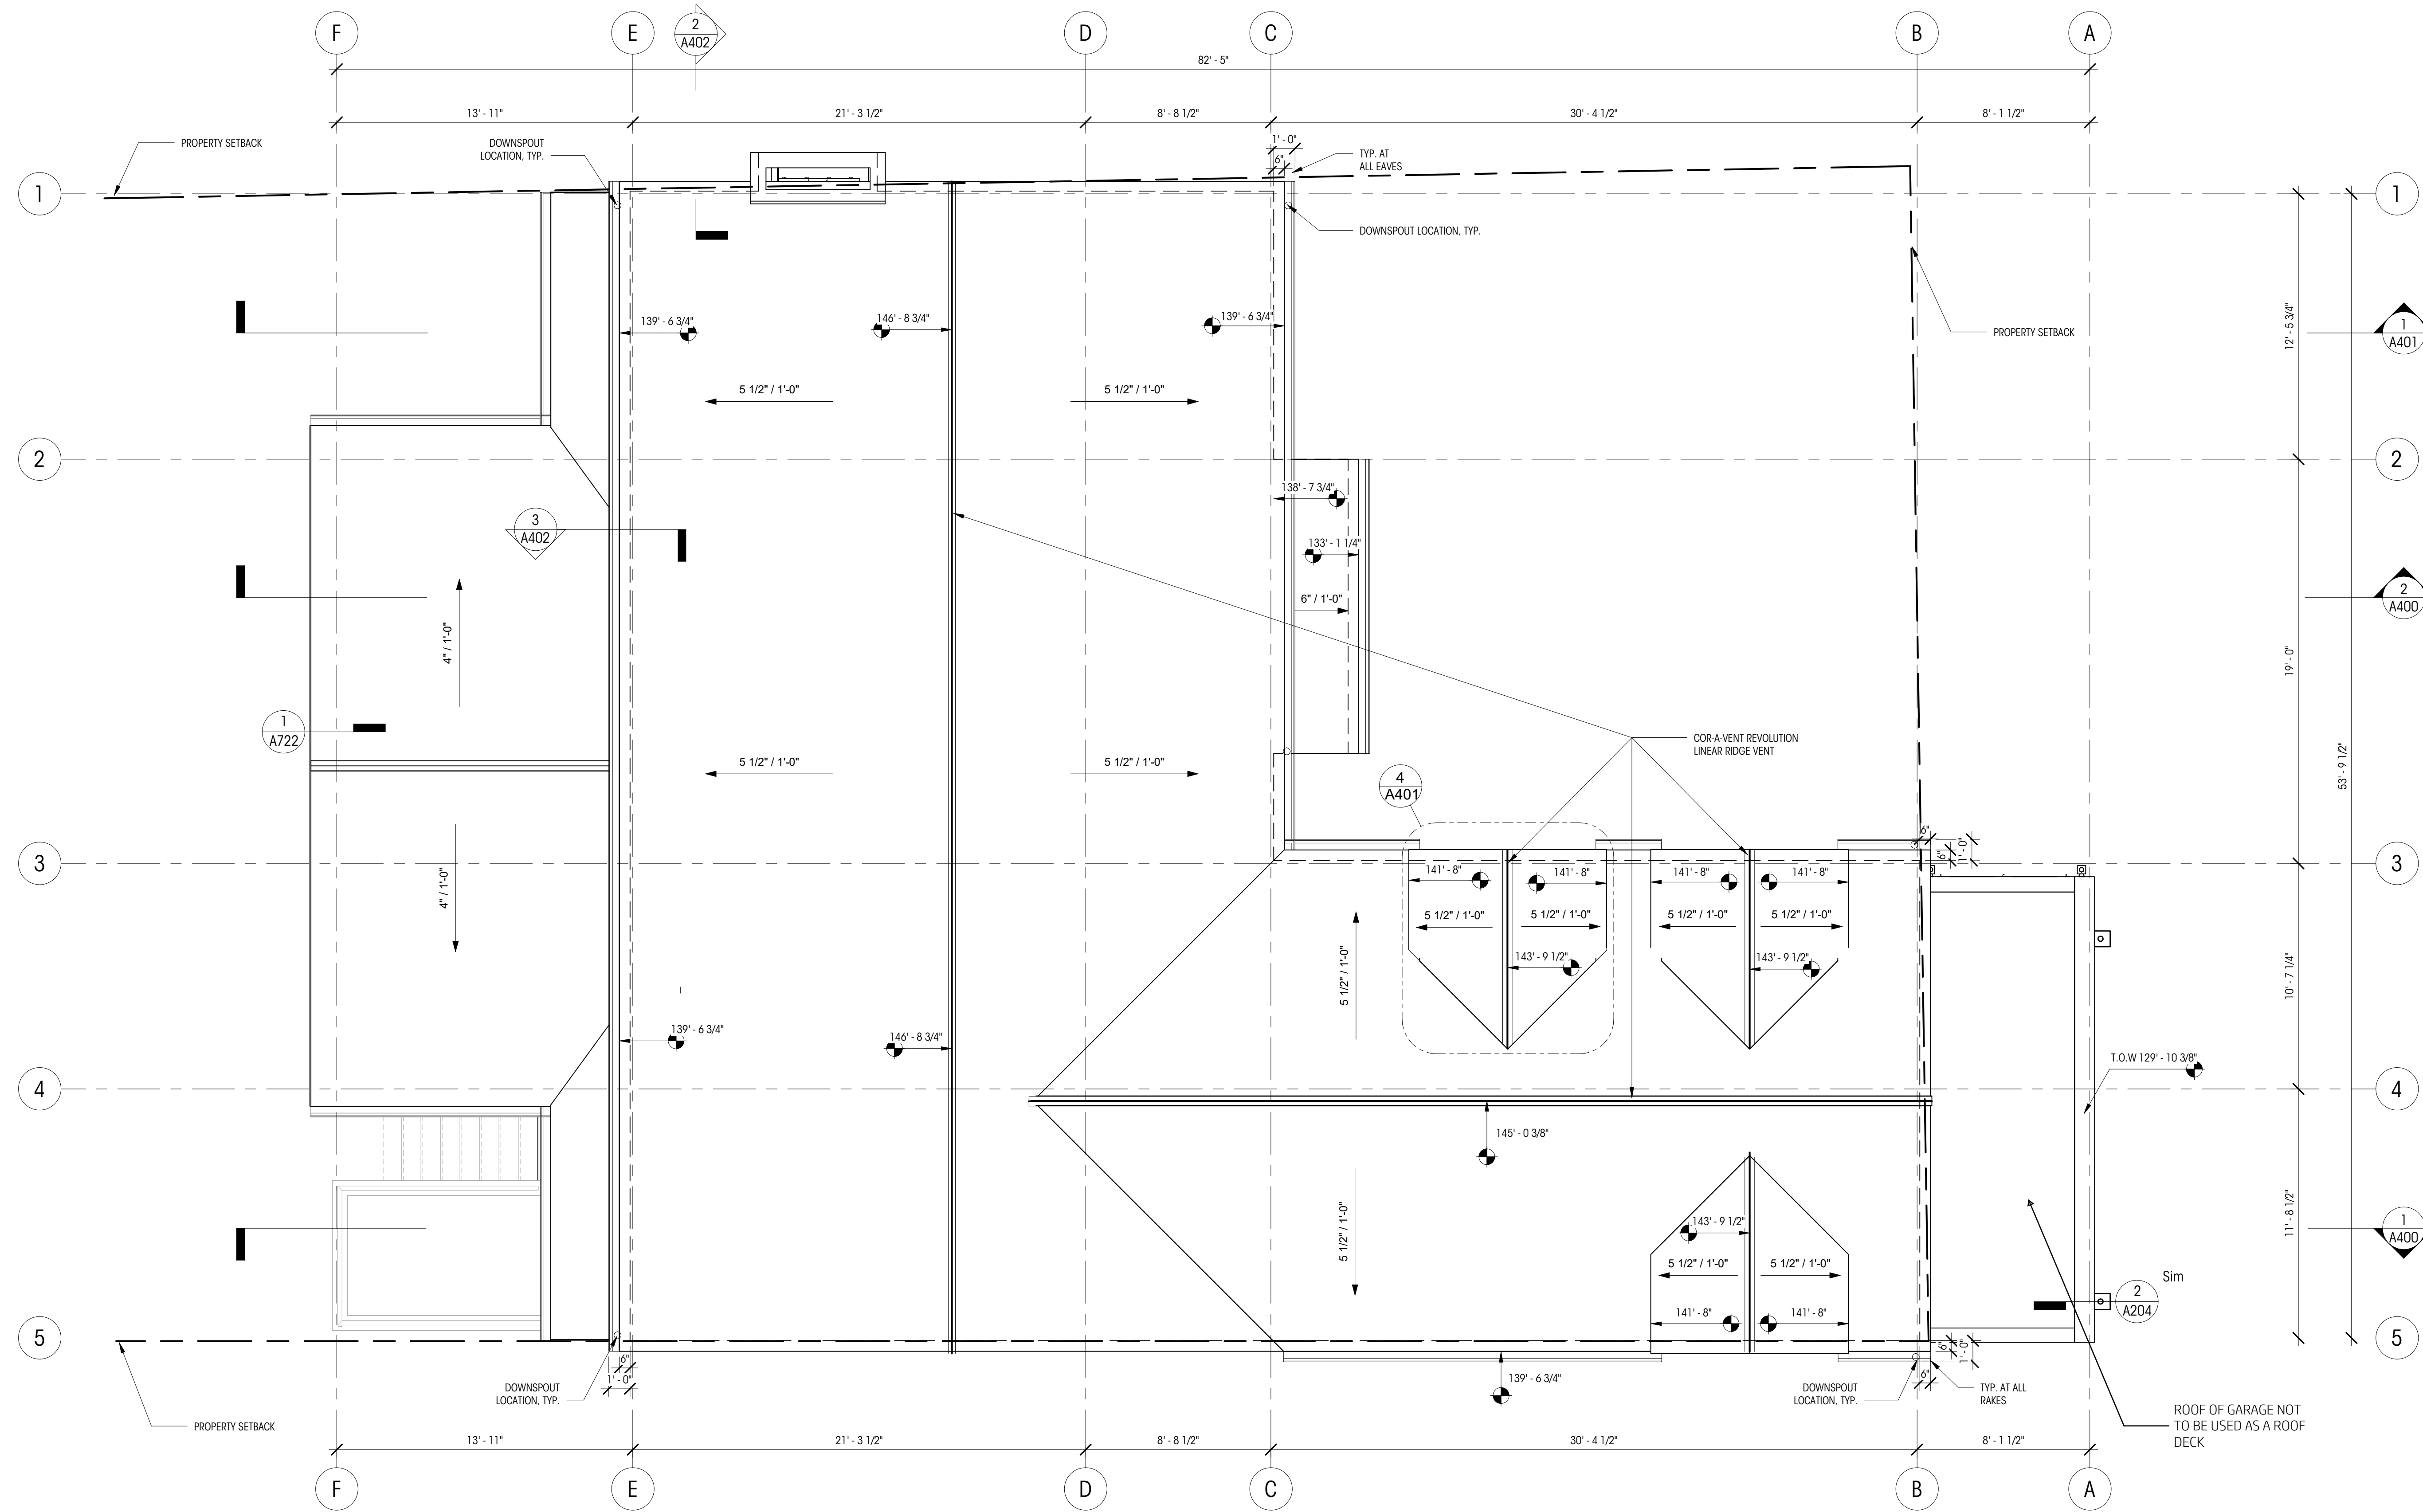

1 PROPOSED ROOF PLAN  
1/4" = 1'-0"

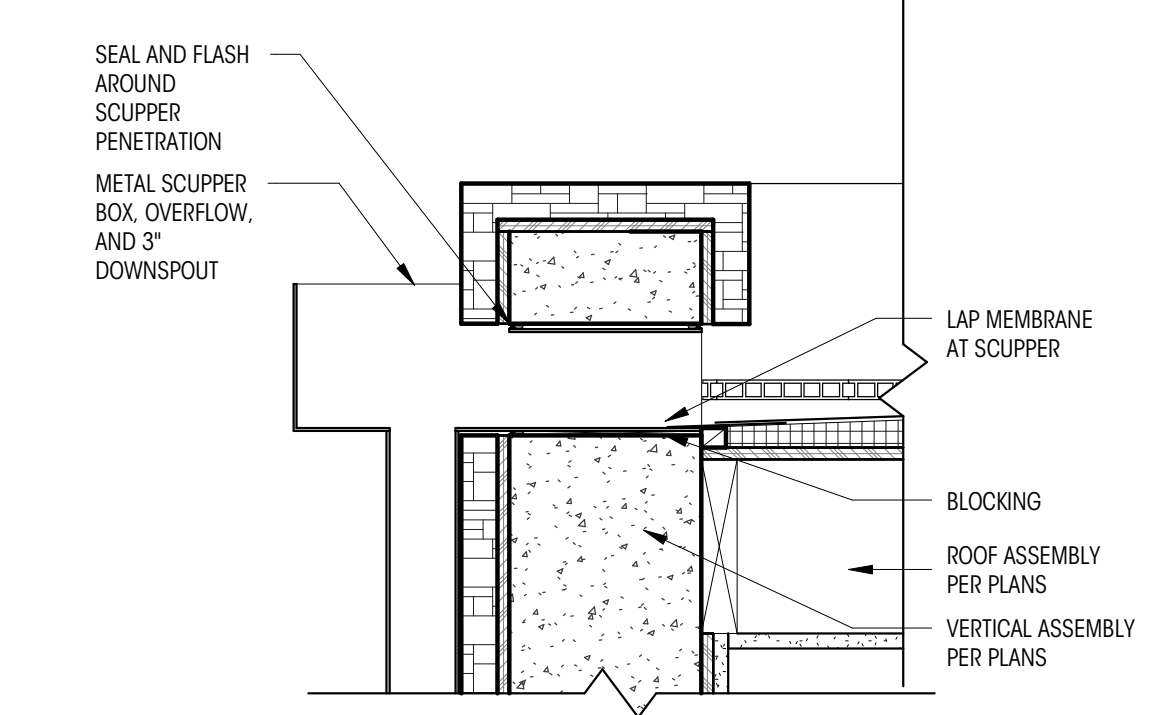

SCOPE OF CHANGES:

- CHANGE ROOF OF AND EXTEND WESTERN PATIO TO THE WEST AND SOUTH
- ADDED DORMERS AT UPPER LEVEL BONUS ROOM
- ADDED DECK AT ROOF OF THE EXTENDED GARAGE AREA.
- ADDED DETAIL FOR EXTENDED DECK DRAINAGE
- UPDATED ROOF VENTING CALCS AS A RESULT OF DORMER ADDITION
- REDUCED ROOF PITCH FROM 6:12 TO 5.5:12.

LEGEND

- (200A) WINDOW ID
- (100A) DOOR ID
- (100A) FINISH ID
- SMOKE DETECTOR
- SMOKE/CARBON MONOXIDE DETECTOR
- FAN - 100 CFM U.N.O.
- ELEVATION DATUM (EL= 148.5' (+0'-0") MAIN LEVEL FIN. FLR.)
- GRIDLINE
- NEW WALL
- PLANTER AREA
- ROOF LINE ABOVE
- DENSE SCREEN PLANTING
- PROPOSED UPPER LEVEL 150% (PER 19.02.020.D.2.q)

NOTES

- ALL DIMENSIONS AT EXTERIOR WALLS TO FACE OF FRAMING OR TO EXT. FACE OF CONCRETE, U.N.O.
  - ALL DIMENSIONS AT INTERIOR WALLS TO FACE OF FINISH (5/8" GWB ASSUMED AT EA. SIDE OF WALL) OR TO FACE OF CONCRETE, U.N.O.
  - ALL DIMENSIONS AT KITCHEN TO EDGE OF COUNTERTOPS, U.N.O.
- RA1a PRE-MANUFACTURED 3'-0" HIGH GUARDRAIL TO RESTRICT PASSAGE OF A 4" SPHERE  
CONTRACTOR SHALL VERIFY TO INSPECTOR ALL GUARDS AND RAILINGS SHALL BE CAPABLE OF RESISTING 200LBS ON TOP RAIL ACTING IN ANY DIRECTION AS REQUIRED BY IRC R301.5, TYP. DESIGN AND CONNECTION UNDER DEFERRED SUBMITTAL.
- RA1b HANDRAIL @ 3'0" ABOVE STAIR NOSING PER IRC R311.7.8, TYP.
- FI1a UL LISTED GAS FIREPLACE SHALL BE DIRECT VENTED AND INSTALLED PER MANUFACTURERS'S REQUIREMENTS, PER IRC G2406.2.1

ROOF VENTILATION CALCS

REQUIRED VENTILATION - 1 SF/300 SF OF TOTAL ROOF AREA

TOTAL ATTIC/CONDITIONED AREA = 2306 SF  
REQUIRED VENTILATION = 2306/300 = 7.68 SF = 1105.92 SQ.IN.  
RIDGE 1/3RD = 1105.92 SF X .33 = 364.95 SQ.IN.  
SOFFIT/EAVE 2/3RD = 1114 SF X .66 = 729.90 SQ.IN.

SOFFIT/EAVE BLOCKING VENTILATION  
1 5/8" HOLE = 1.77 SQ.IN.; 729.90 SQ.IN./1.77 SQ.IN. = 420 HOLES REQUIRED  
233.58LF/420 HOLES = 1 HOLE PER 6.67'


PROPOSED VENTILATION - 1.5" HOLES @ 6 1/2" O.C.

RIDGE BLOCKING VENTILATION  
TOTAL PROJECT RIDGES = 125'-4" = 1504 LINEAR INCHES OF RIDGE  
1" VENT WIDTH AT BLOCKING X 1504' OF RIDGE = 1504 SQ.IN. OF ROOF VENTING


RIDGE AND EAVE VENTING:  
PROJECT RIDGES 125.33'  
TOTAL VENTING LINEAR FEET 125.33'  
VENTS @ 12 SQ.IN. / FT NFVA: 125.33' X 12 1504 SQ.IN.

COR-A-VENT REVOLUTION RIDGE VENT PROVIDES 12 SQ.IN. NFVA PER LINEAR FOOT

NO.	DESCRIPTION	DATE
3	PERMIT REVISION	04.19.22
4	PERMIT REVISION 2	06.10.22
5	PERMIT REVISION 3	08.30.22

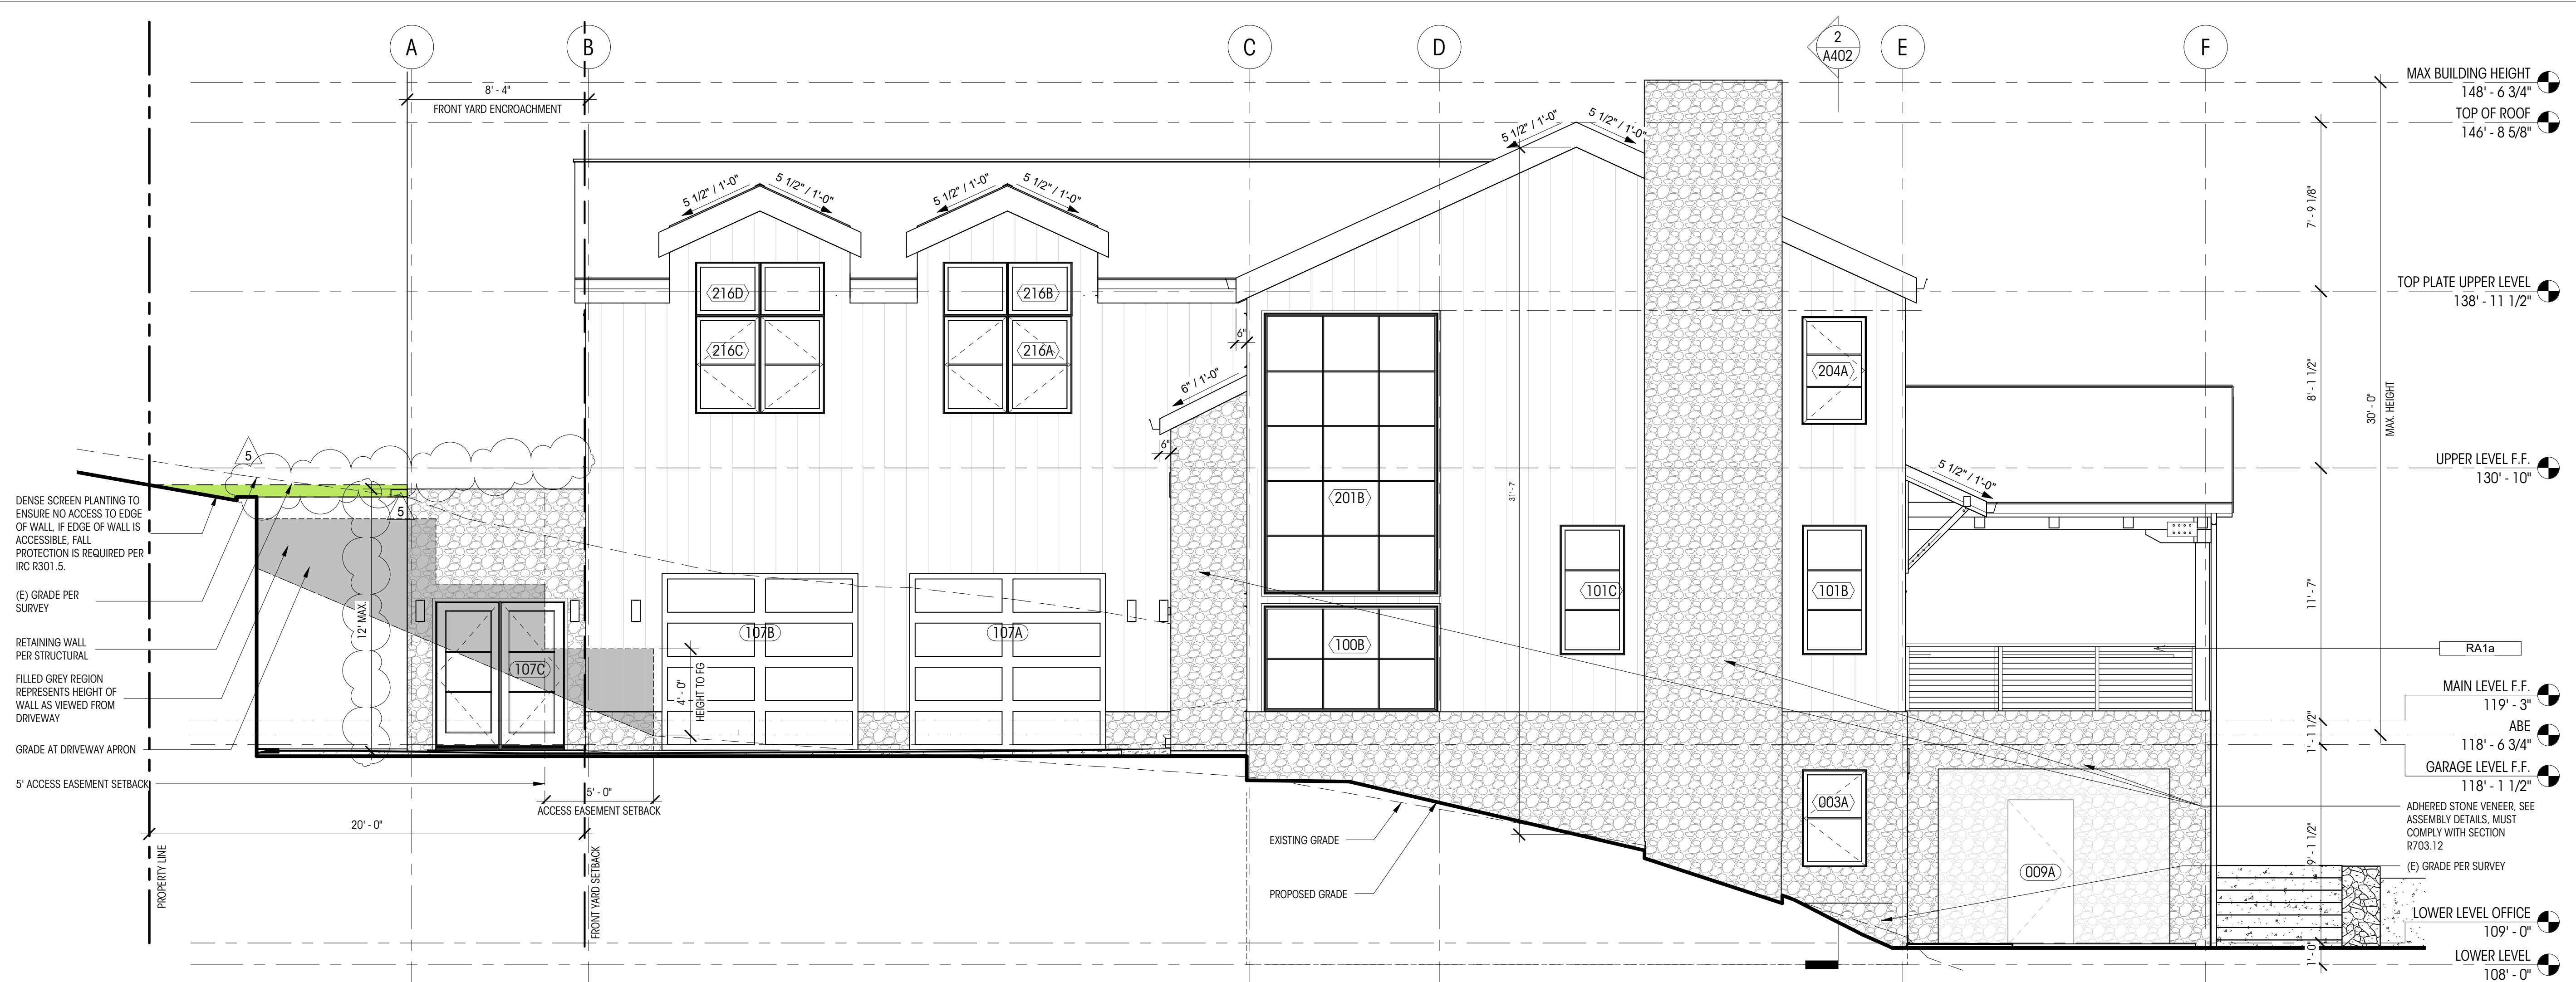

1 PROPOSED NORTH ELEVATION  
1/4" = 1'-0"

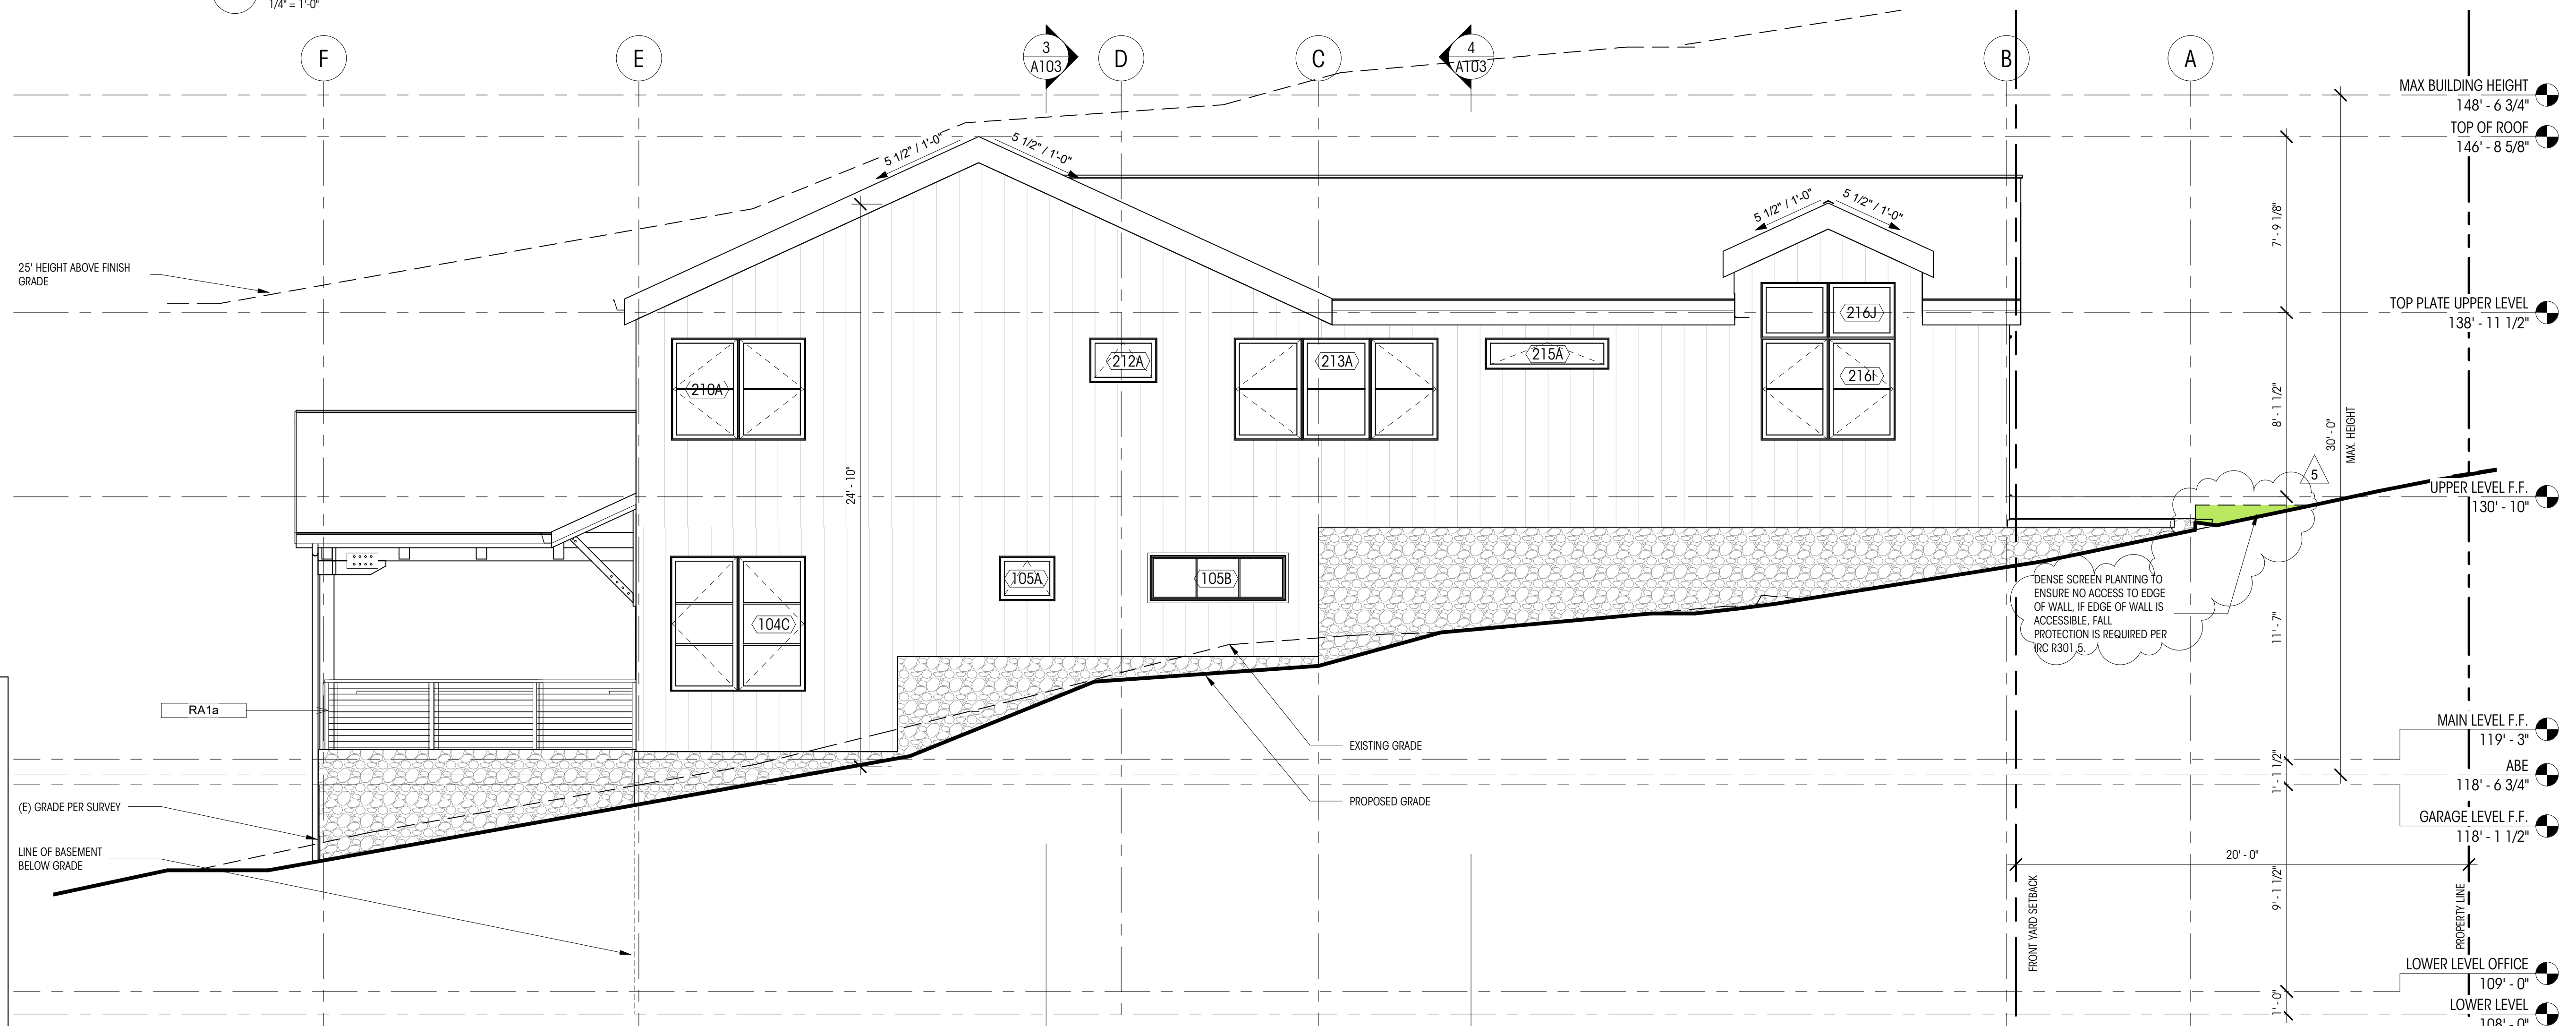

2 PROPOSED SOUTH ELEVATION  
1/4" = 1'-0"

SCOPE OF CHANGES :

- CHANGE ROOF OF AND EXTEND WESTERN PATIO TO THE WEST AND SOUTH
- ADDED DORMERS AT UPPER LEVEL BONUS ROOM
- EXTEND GARAGE EAST INTO FRONT YARD SETBACK AS ALLOWED BY CODE 19.02.040.D
- WINDOW SIZE & LOCATION CHANGES
- LEVEL CHANGES:
  - a. DRIVEWAY & GARAGE LEVEL DROP BY 15"
  - b. BASEMENT LEVEL DROP BY 12"
  - c. UPPER LEVEL DROP BY 2"
  - d. FRAMED FLOOR 12" ABOVE BASEMENT FLOOR.
  - e. CHANGE TO ABE AS A RESULT OF EXTENDED GARAGE AND EXTENDED COVERED DECK
  - f. CHANGE TO MAX HEIGHT AS A RESULT OF THE ADJUSTMENT TO THE ABE.
  - g. TOP PLATE LEVEL ADJUSTED UP BASED ON ROOF FRAMING
  - h. ROOF OF ROOF HAS LOWERED AS A RESULT OF REDUCED ROOF PITCH
- SITE WALL MATERIAL CHANGE
- UPDATED STEPPING FOUNDATION WALL PROFILE TO MATCH STRUCTURAL

NO.	DESCRIPTION	DATE
3	PERMIT REVISION	04.19.22
4	PERMIT REVISION 2	06.10.22
5	PERMIT REVISION 3	08.30.22



1 PROPOSED EAST ELEVATION  
1/4" = 1'-0"




2 PROPOSED WEST ELEVATION  
1/4" = 1'-0"


**SCOPE OF CHANGES :**

- CHANGE ROOF OF AND EXTEND WESTERN PATIO TO THE WEST AND SOUTH
- ADDED DORMERS AT UPPER LEVEL BONUS ROOM
- EXTEND GARAGE EAST INTO FRONT YARD SETBACK AS ALLOWED BY CODE 19.02.040.D
- WINDOW SIZE & LOCATION CHANGES
- LEVEL CHANGES:
  - a. DRIVEWAY & GARAGE LEVEL DROP BY 12"
  - b. BASEMENT LEVEL DROP BY 12"
  - c. FRAMED FLOOR 12" ABOVE BASEMENT FLOOR.
  - d. CHANGE TO ABE AS A RESULT OF EXTENDED GARAGE AND EXTENDED COVERED DECK
  - e. CHANGE TO MAX HEIGHT AS A RESULT OF THE ADJUSTMENT TO THE ABE
  - f. TOP PLATE LEVEL ADJUSTED UP 2 5/8".

NO.	DESCRIPTION	DATE
3	PERMIT REVISION	04.19.22
4	PERMIT REVISION 2	06.10.22
5	PERMIT REVISION 3	08.30.22

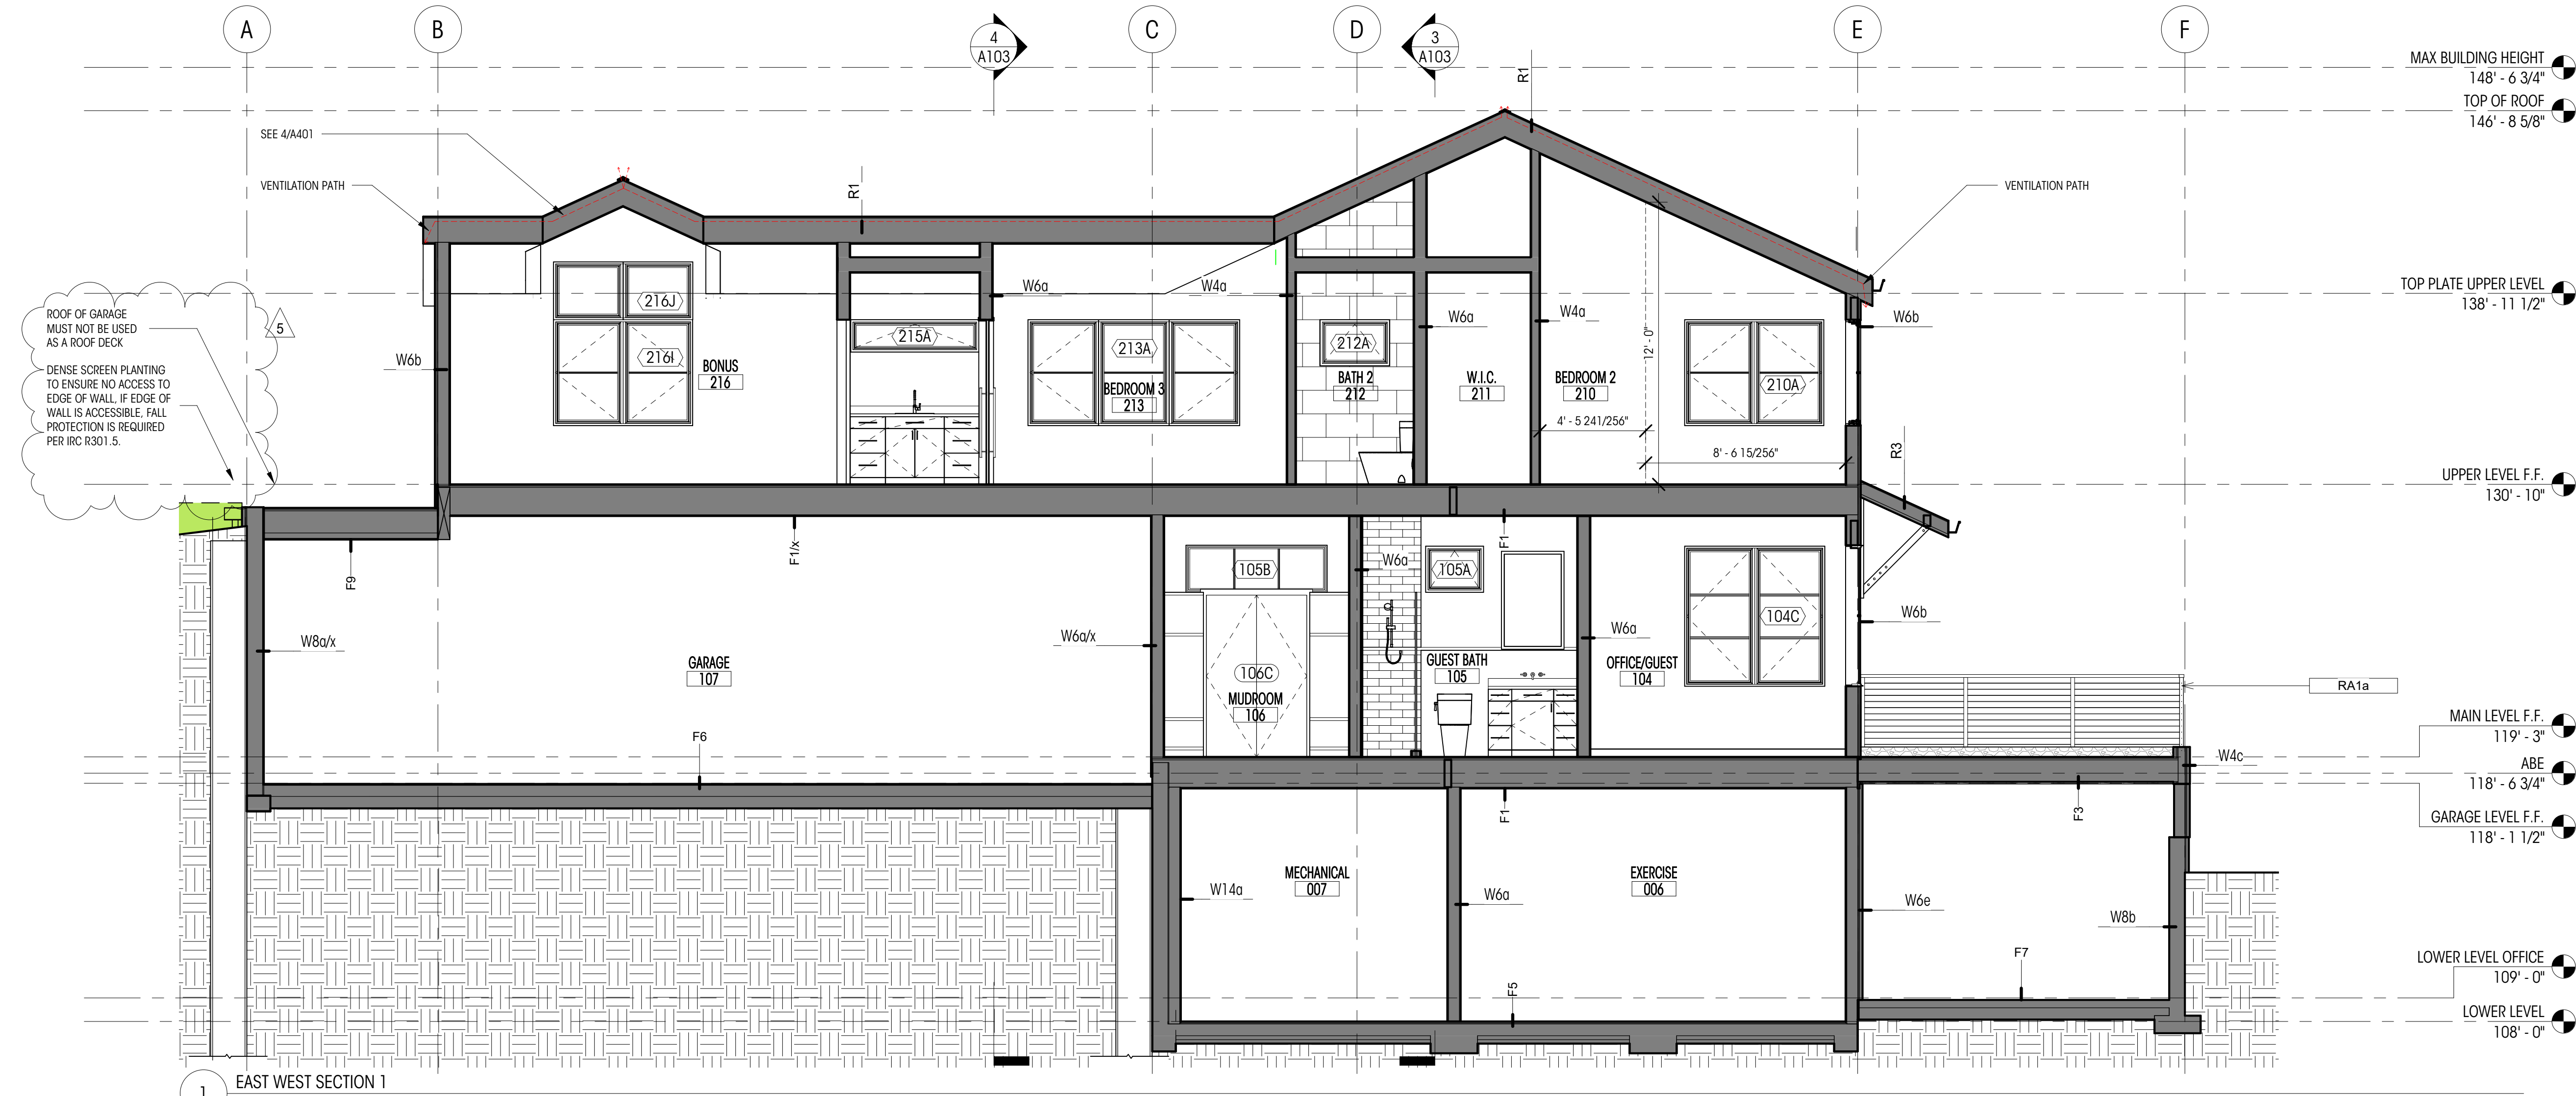

1 EAST WEST SECTION 1  
1/4" = 1'-0"

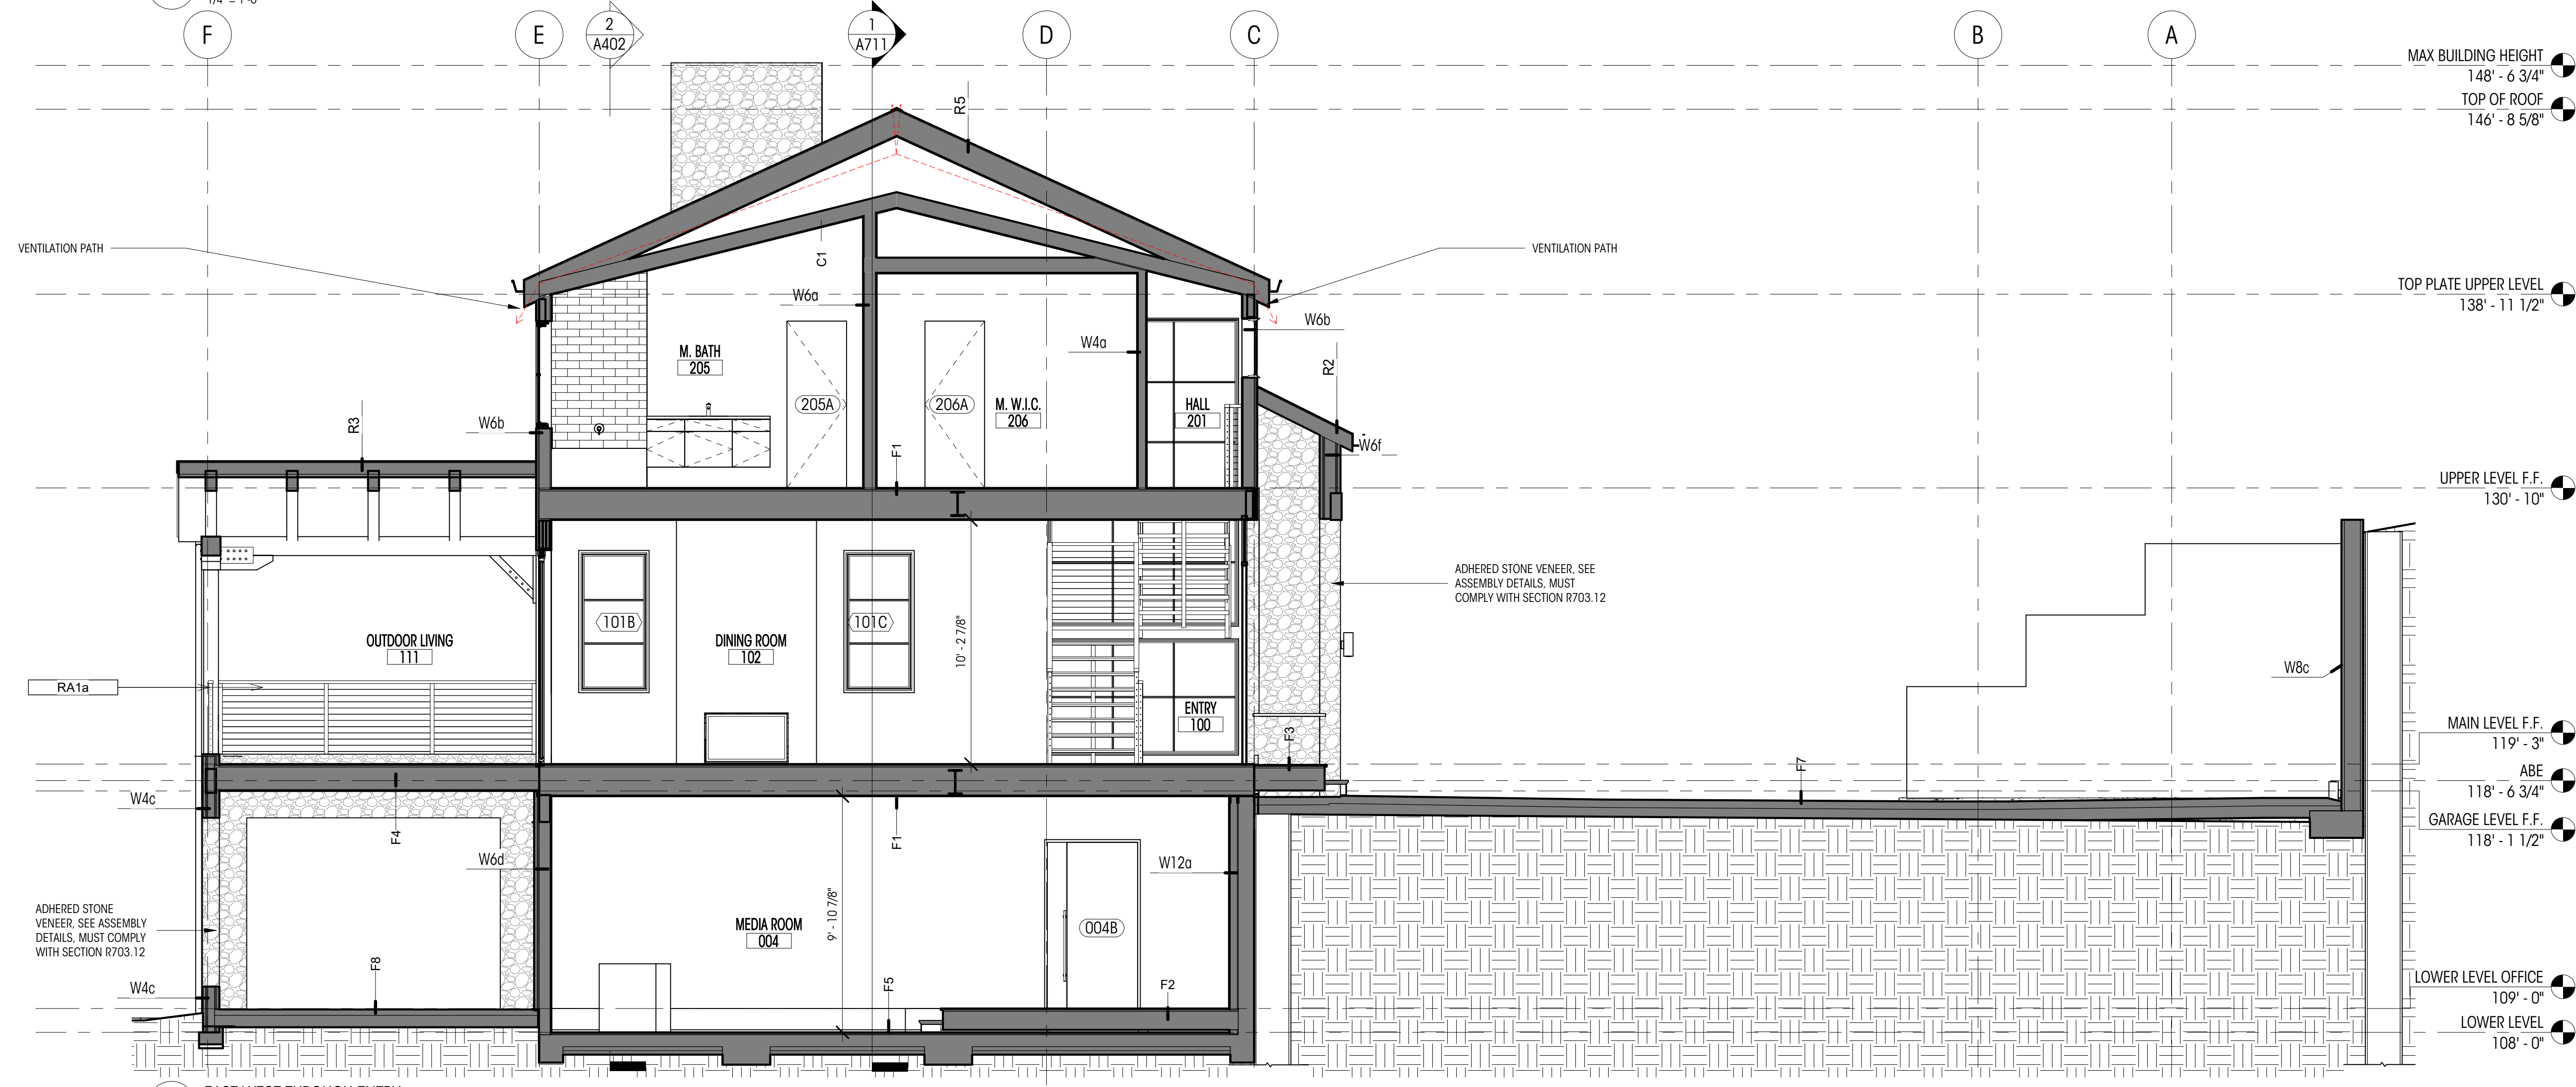

2 EAST WEST THROUGH ENTRY  
1/4" = 1'-0"

**SCOPE OF CHANGES :**

- VIEW NUMBERING UPDATED AND ADJUSTED FOR CLARIFICATION
- CHANGE ROOF OF AND EXTEND WESTERN PATIO TO THE WEST AND SOUTH
- ENTRY DESIGN CHANGE
- ADDED DORMERS AT UPPER LEVEL BONUS ROOM
- EXTEND GARAGE EAST INTO FRONT YARD SETBACK AS ALLOWED BY CODE 19.02.040 D
- SHEET LAYOUT ADJUSTED FOR ORGANIZATIONAL PURPOSES
- PREVIOUS "VIEW 1" HAS MOVED TO SHEET A401 AND STAYED "VIEW 1"
- LEVEL CHANGES:
  - a. DRIVEWAY & GARAGE LEVEL DROP BY 15"
  - b. BASEMENT LEVEL DROP BY 12"
  - c. UPPER LEVEL DROP BY 2"
  - d. FRAMED FLOOR 12" ABOVE BASEMENT FLOOR.
  - e. CHANGE TO ABE AS A RESULT OF EXTENDED GARAGE AND EXTENDED COVERED DECK
  - f. CHANGE TO MAX HEIGHT AS A RESULT OF THE ADJUSTMENT TO THE ABE
  - g. TOP PLATE LEVEL ADJUSTED UP BASED ON ROOF FRAMING
  - h. ROOF OF ROOF HAS LOWERED AS A RESULT OF REDUCED ROOF PITCH

ROOF OF GARAGE MUST NOT BE USED AS A ROOF DECK





DENSE SCREEN PLANTING TO ENSURE NO ACCESS TO EDGE OF WALL. IF EDGE OF WALL IS ACCESSIBLE, FALL PROTECTION IS REQUIRED PER IRC R301.5.

ADHERED STONE VENEER, SEE ASSEMBLY DETAILS. MUST COMPLY WITH SECTION R703.12

MAX BUILDING HEIGHT	148' - 6 3/4"
TOP OF ROOF	146' - 8 5/8"
TOP PLATE UPPER LEVEL	138' - 11 1/2"
UPPER LEVEL F.F.	130' - 10"
MAIN LEVEL F.F.	119' - 3"
ABE	118' - 6 3/4"
GARAGE LEVEL F.F.	118' - 1 1/2"
LOWER LEVEL OFFICE	109' - 0"
LOWER LEVEL	108' - 0"




MAX BUILDING HEIGHT	148' - 6 3/4"
TOP OF ROOF	146' - 8 5/8"
TOP PLATE UPPER LEVEL	138' - 11 1/2"
UPPER LEVEL F.F.	130' - 10"
MAIN LEVEL F.F.	119' - 3"
ABE	118' - 6 3/4"
GARAGE LEVEL F.F.	118' - 1 1/2"
LOWER LEVEL OFFICE	109' - 0"
LOWER LEVEL	108' - 0"

NO.	DESCRIPTION	DATE
3	PERMIT REVISION	04.19.22
4	PERMIT REVISION 2	06.10.22

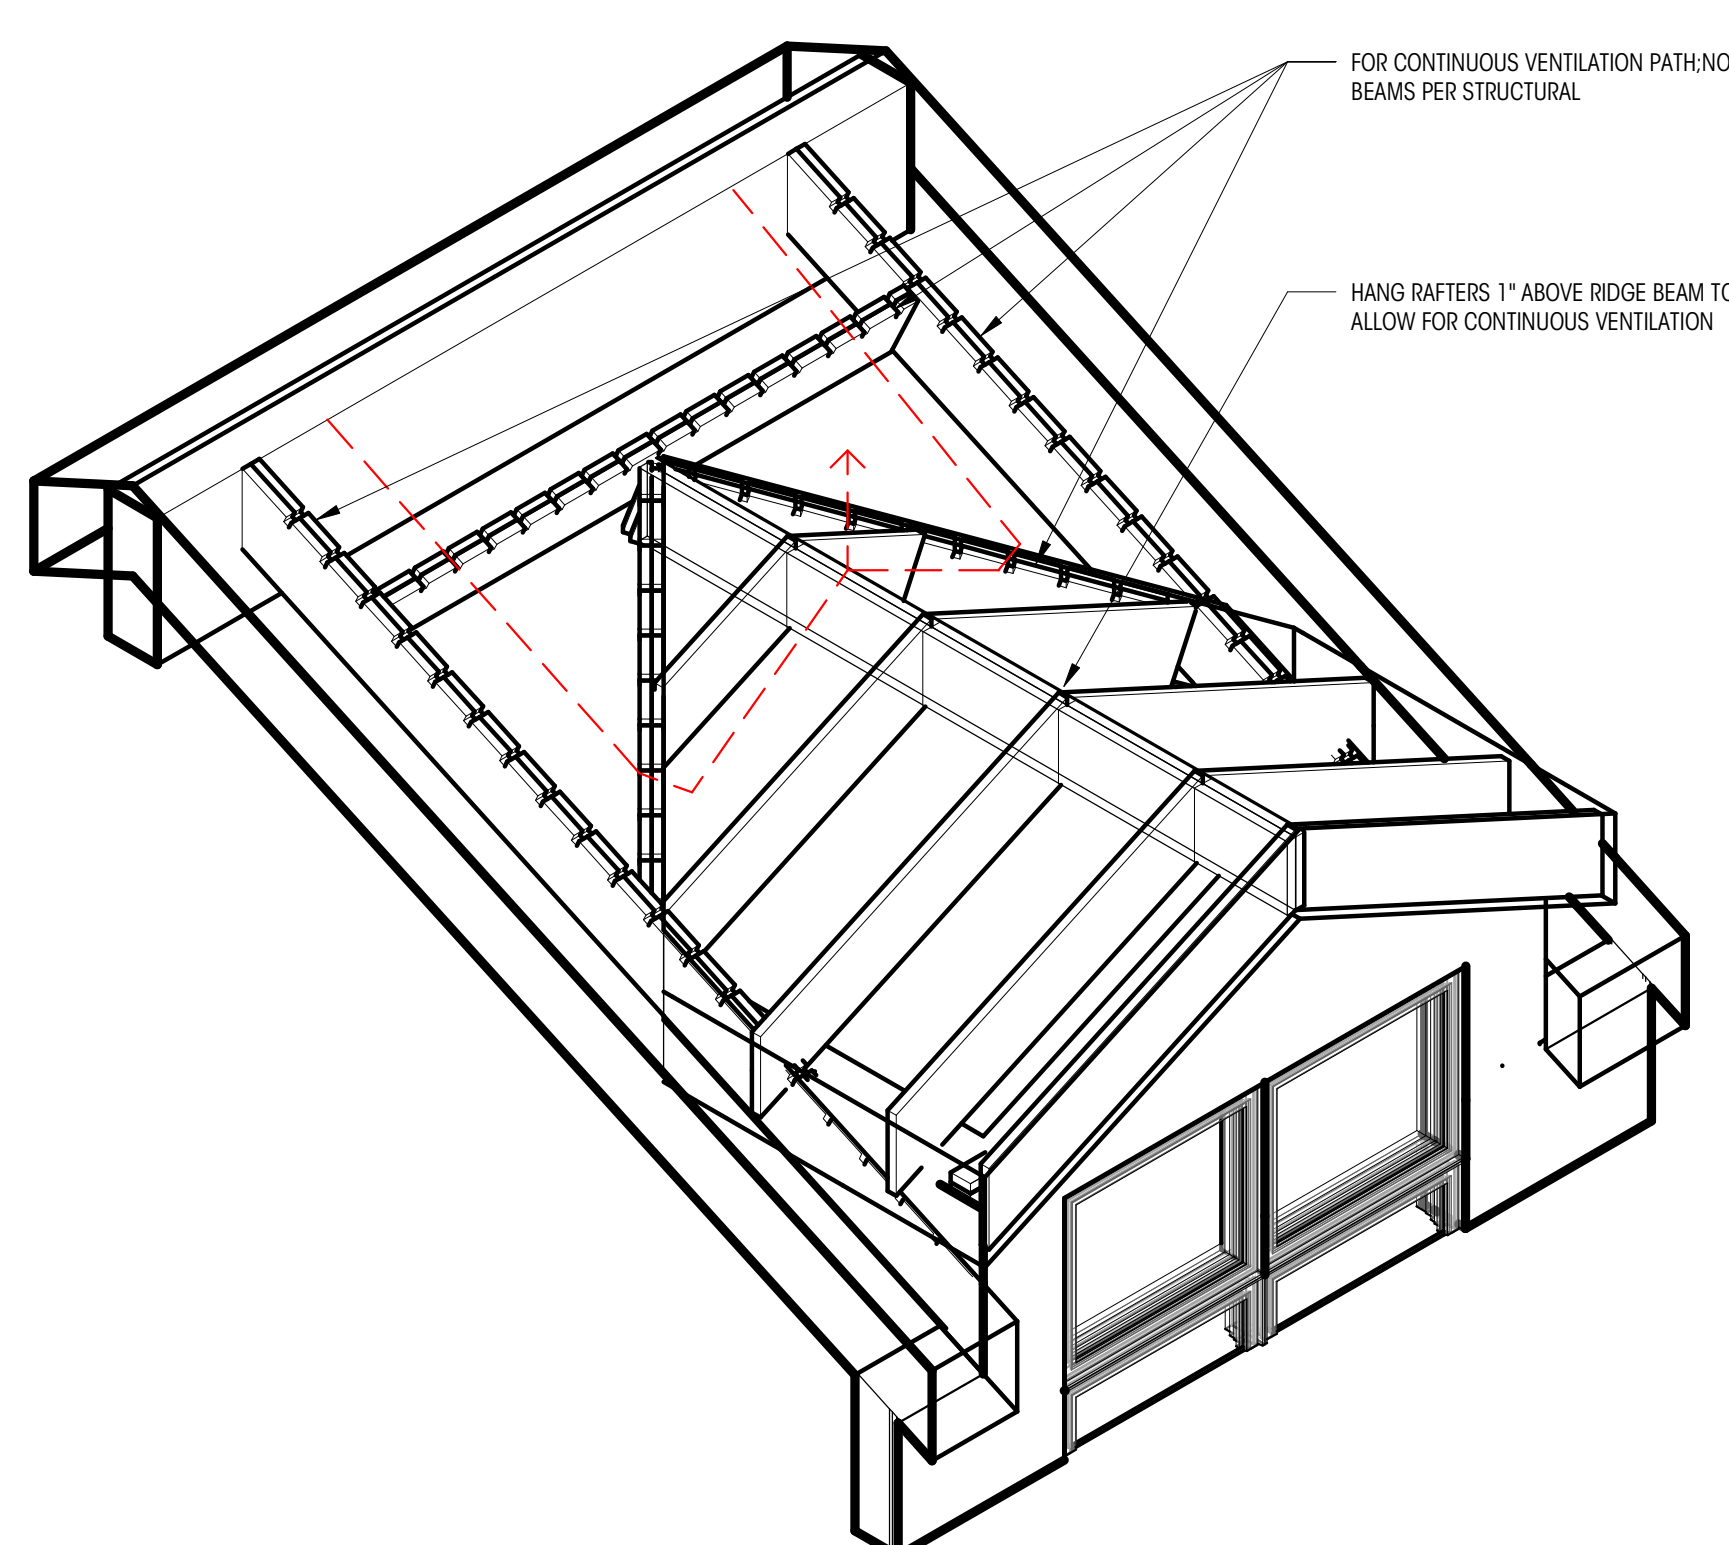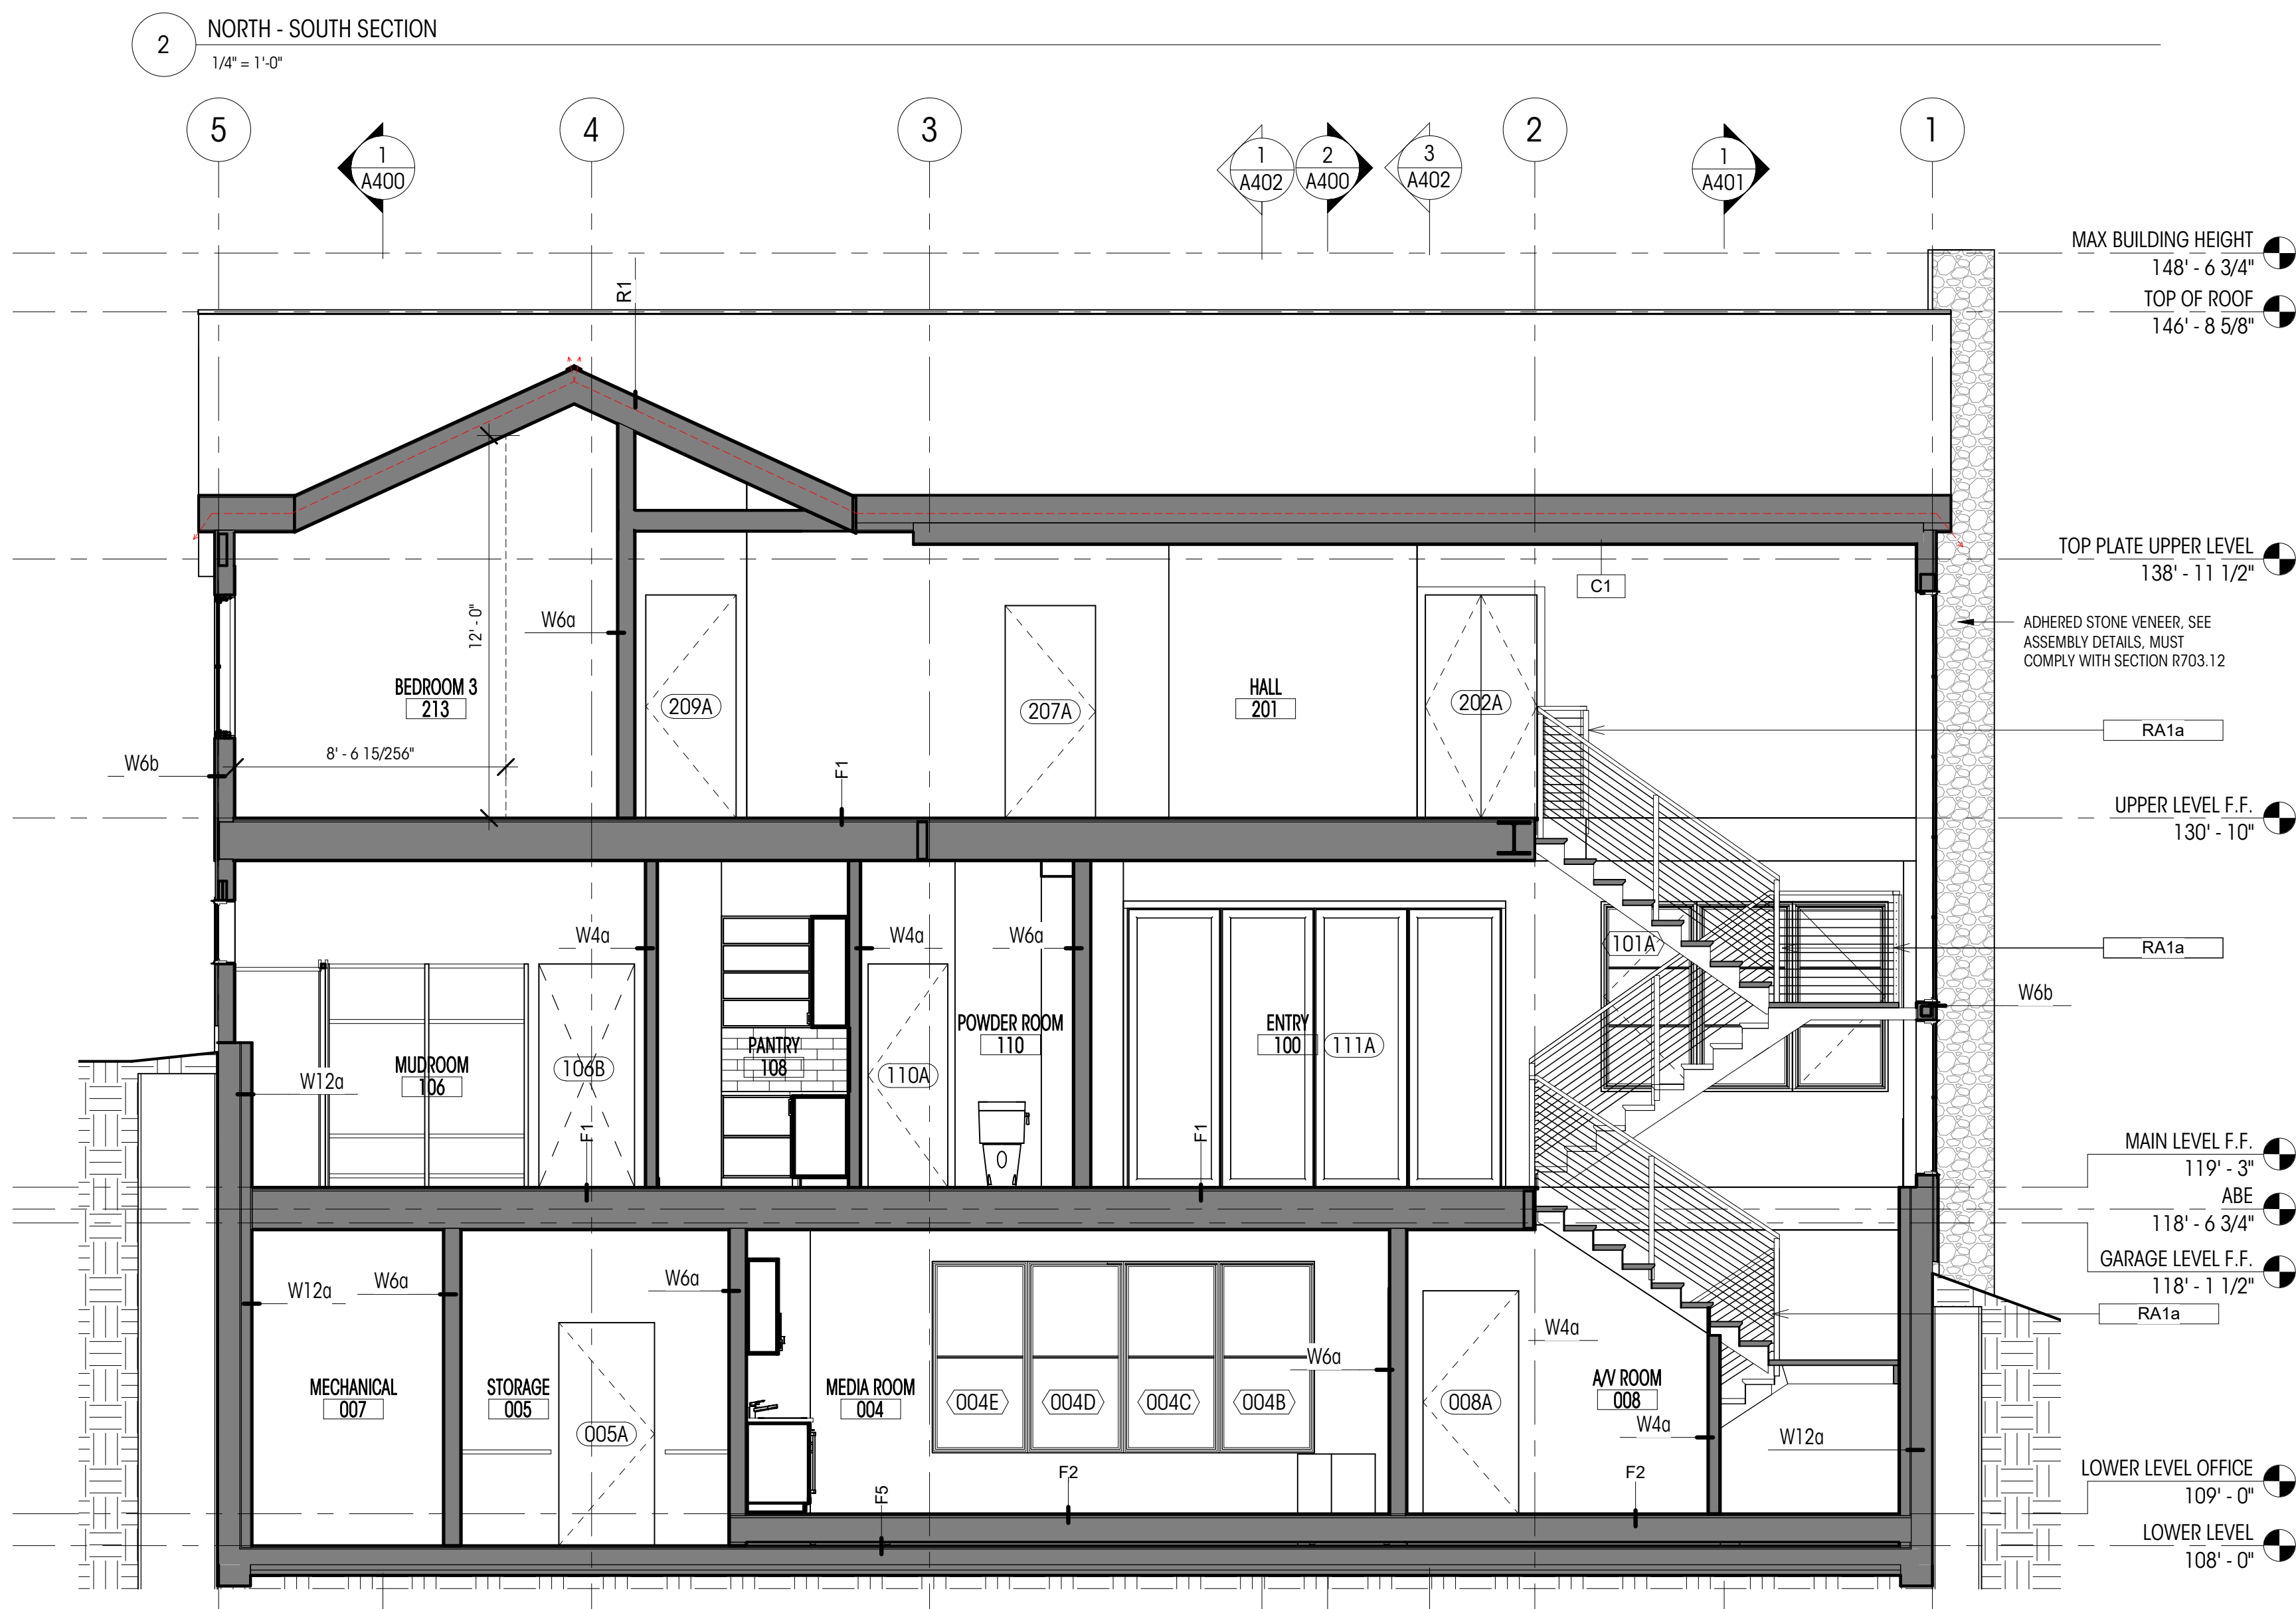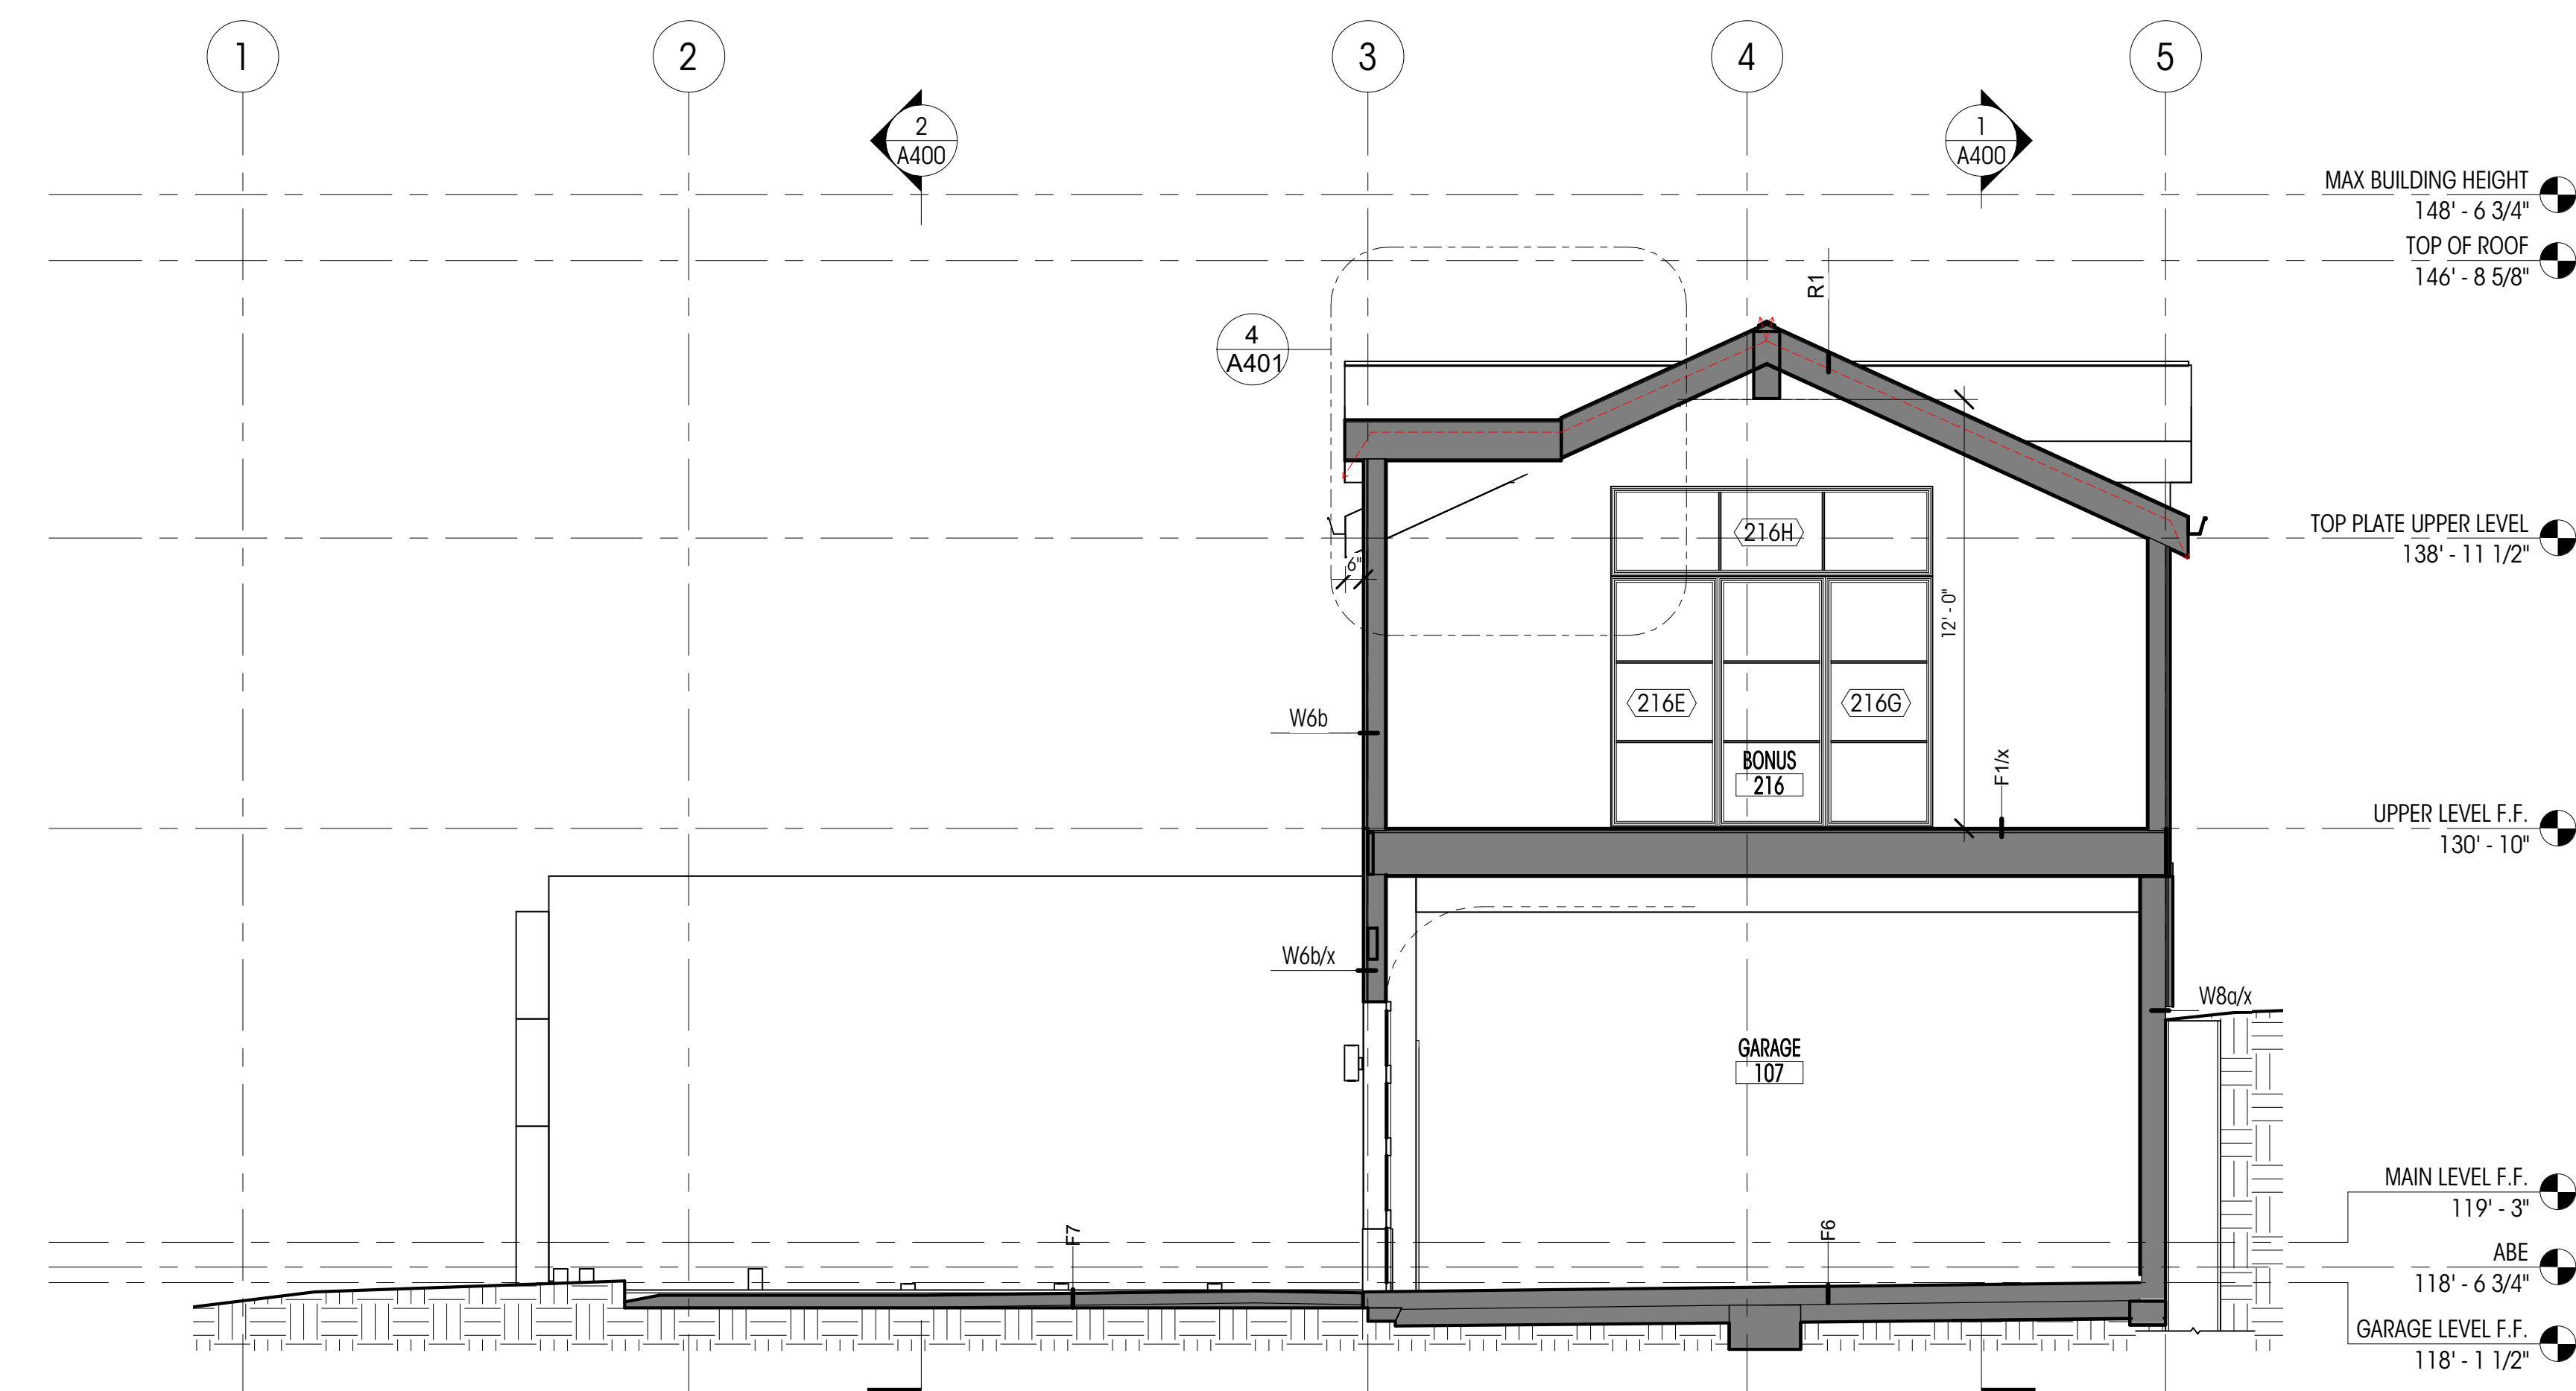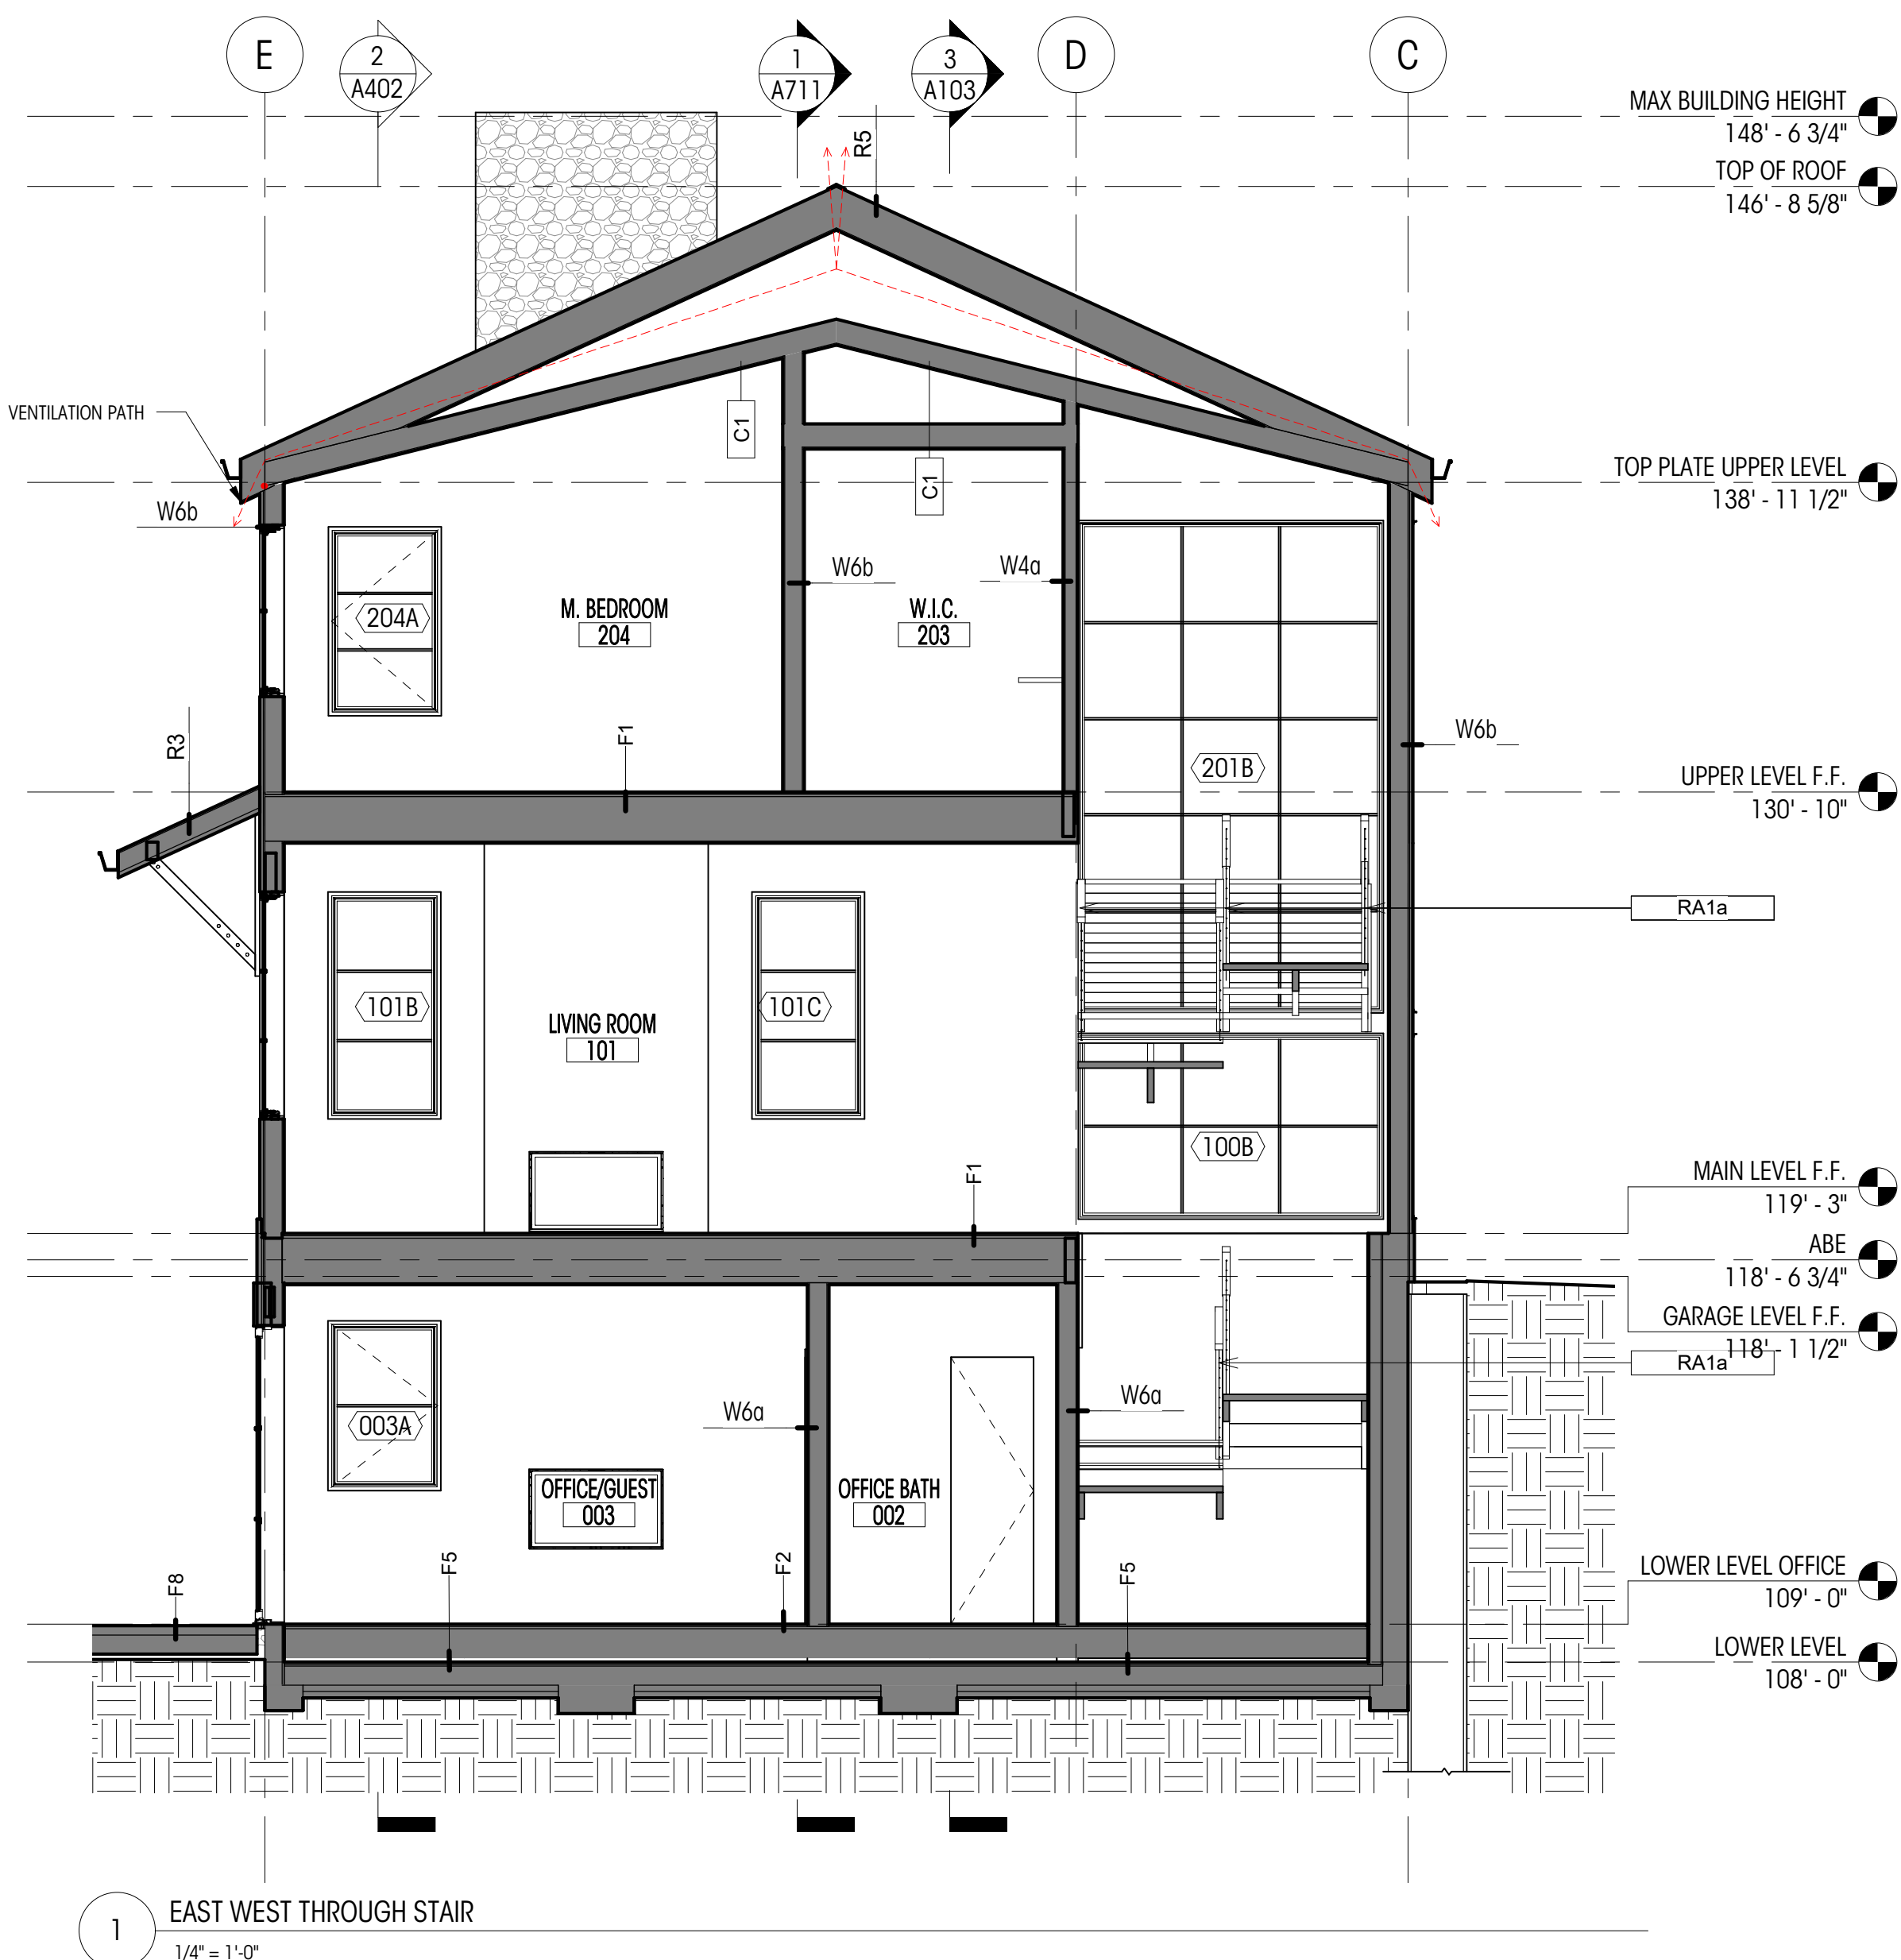

**SCOPE OF CHANGES :**

- VIEW NUMBERING UPDATED AND ADJUSTED FOR CLARIFICATION
- CHANGE ROOF OF AND EXTEND WESTERN PATIO TO THE WEST AND SOUTH
- LEVEL CHANGES: DRIVEWAY & GARAGE LEVEL DROP BY 12"; BASEMENT LEVEL DROP BY 12"
- ENTRY DESIGN CHANGE
- ADDED DORMERS AT UPPER LEVEL BONUS ROOM
- EXTEND GARAGE EAST INTO FRONT YARD SETBACK AS ALLOWED BY CODE 19.02.040.D
- SHEET LAYOUT ADJUSTED FOR ORGANIZATIONAL PURPOSES
- 1. "VIEW 1" WAS MOVED FROM SHEET A400 AND STAYED "VIEW 1"
- LEVEL CHANGES:
  - a. DRIVEWAY & GARAGE LEVEL DROP BY 15"
  - b. BASEMENT LEVEL DROP BY 12"
  - c. UPPER LEVEL DROP BY 2"
  - d. FRAMED FLOOR 12" ABOVE BASEMENT FLOOR
  - e. CHANGE TO ABE AS A RESULT OF EXTENDED GARAGE AND EXTENDED COVERED DECK
  - f. CHANGE TO MAX HEIGHT AS A RESULT OF THE ADJUSTMENT TO THE ABE.
  - g. TOP PLATE LEVEL ADJUSTED UP BASED ON ROOF FRAMING
  - h. TOP OF ROOF HAS LOWERED AS A RESULT OF REDUCED ROOF PITCH

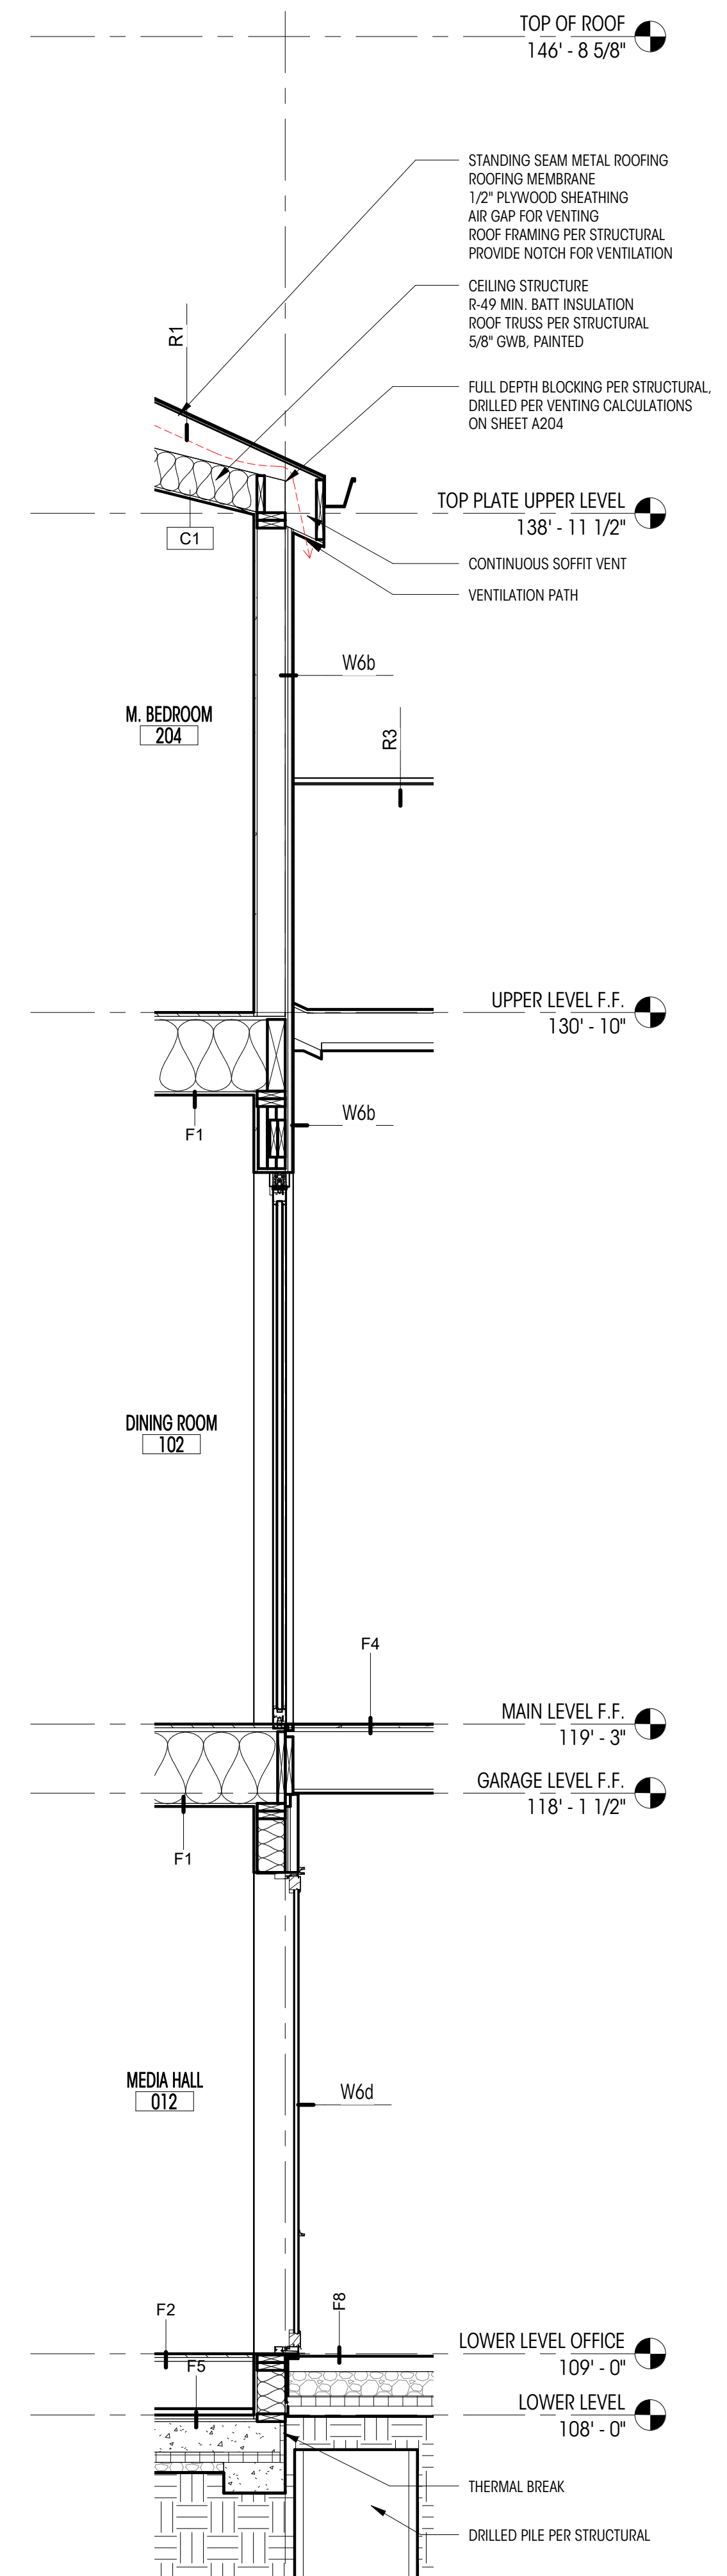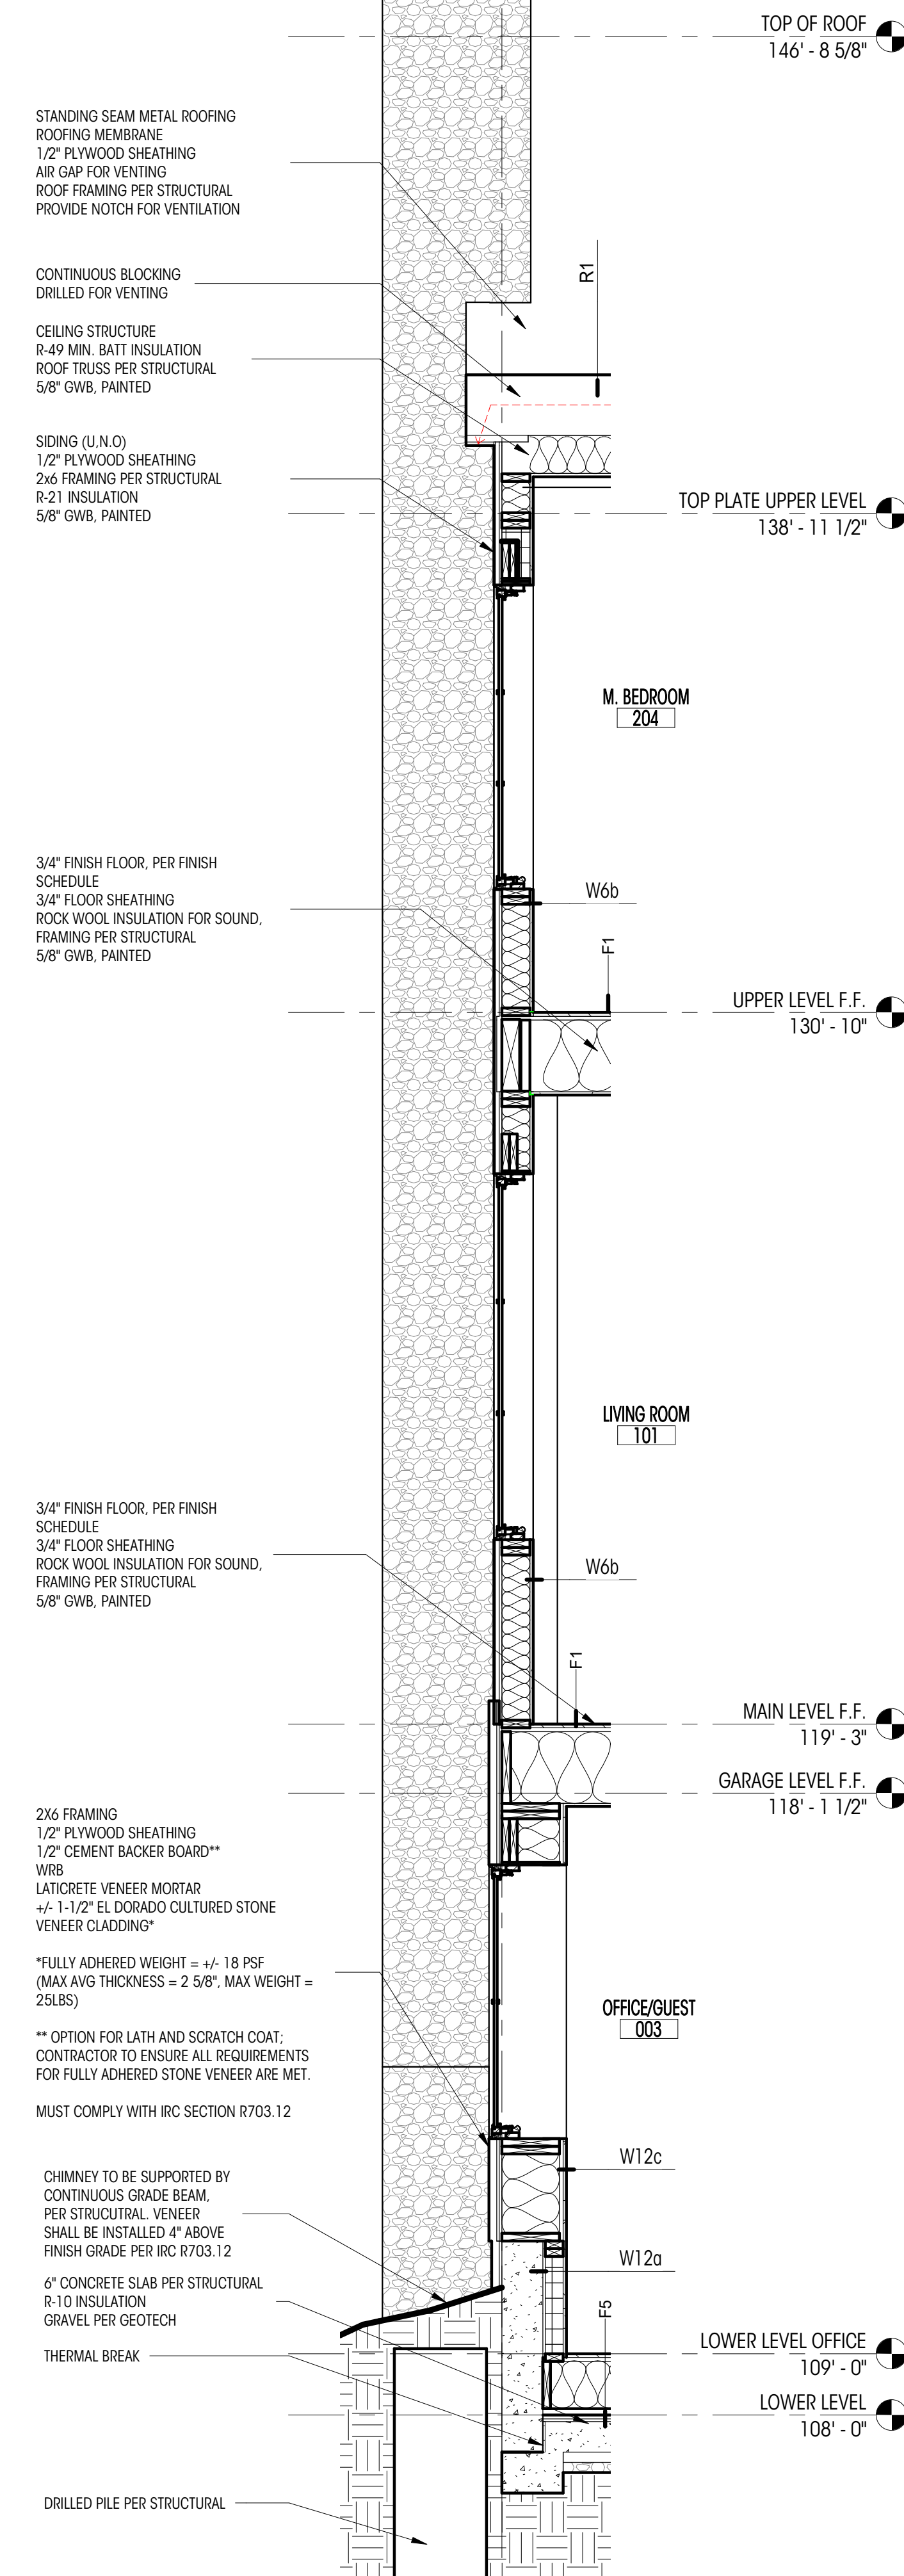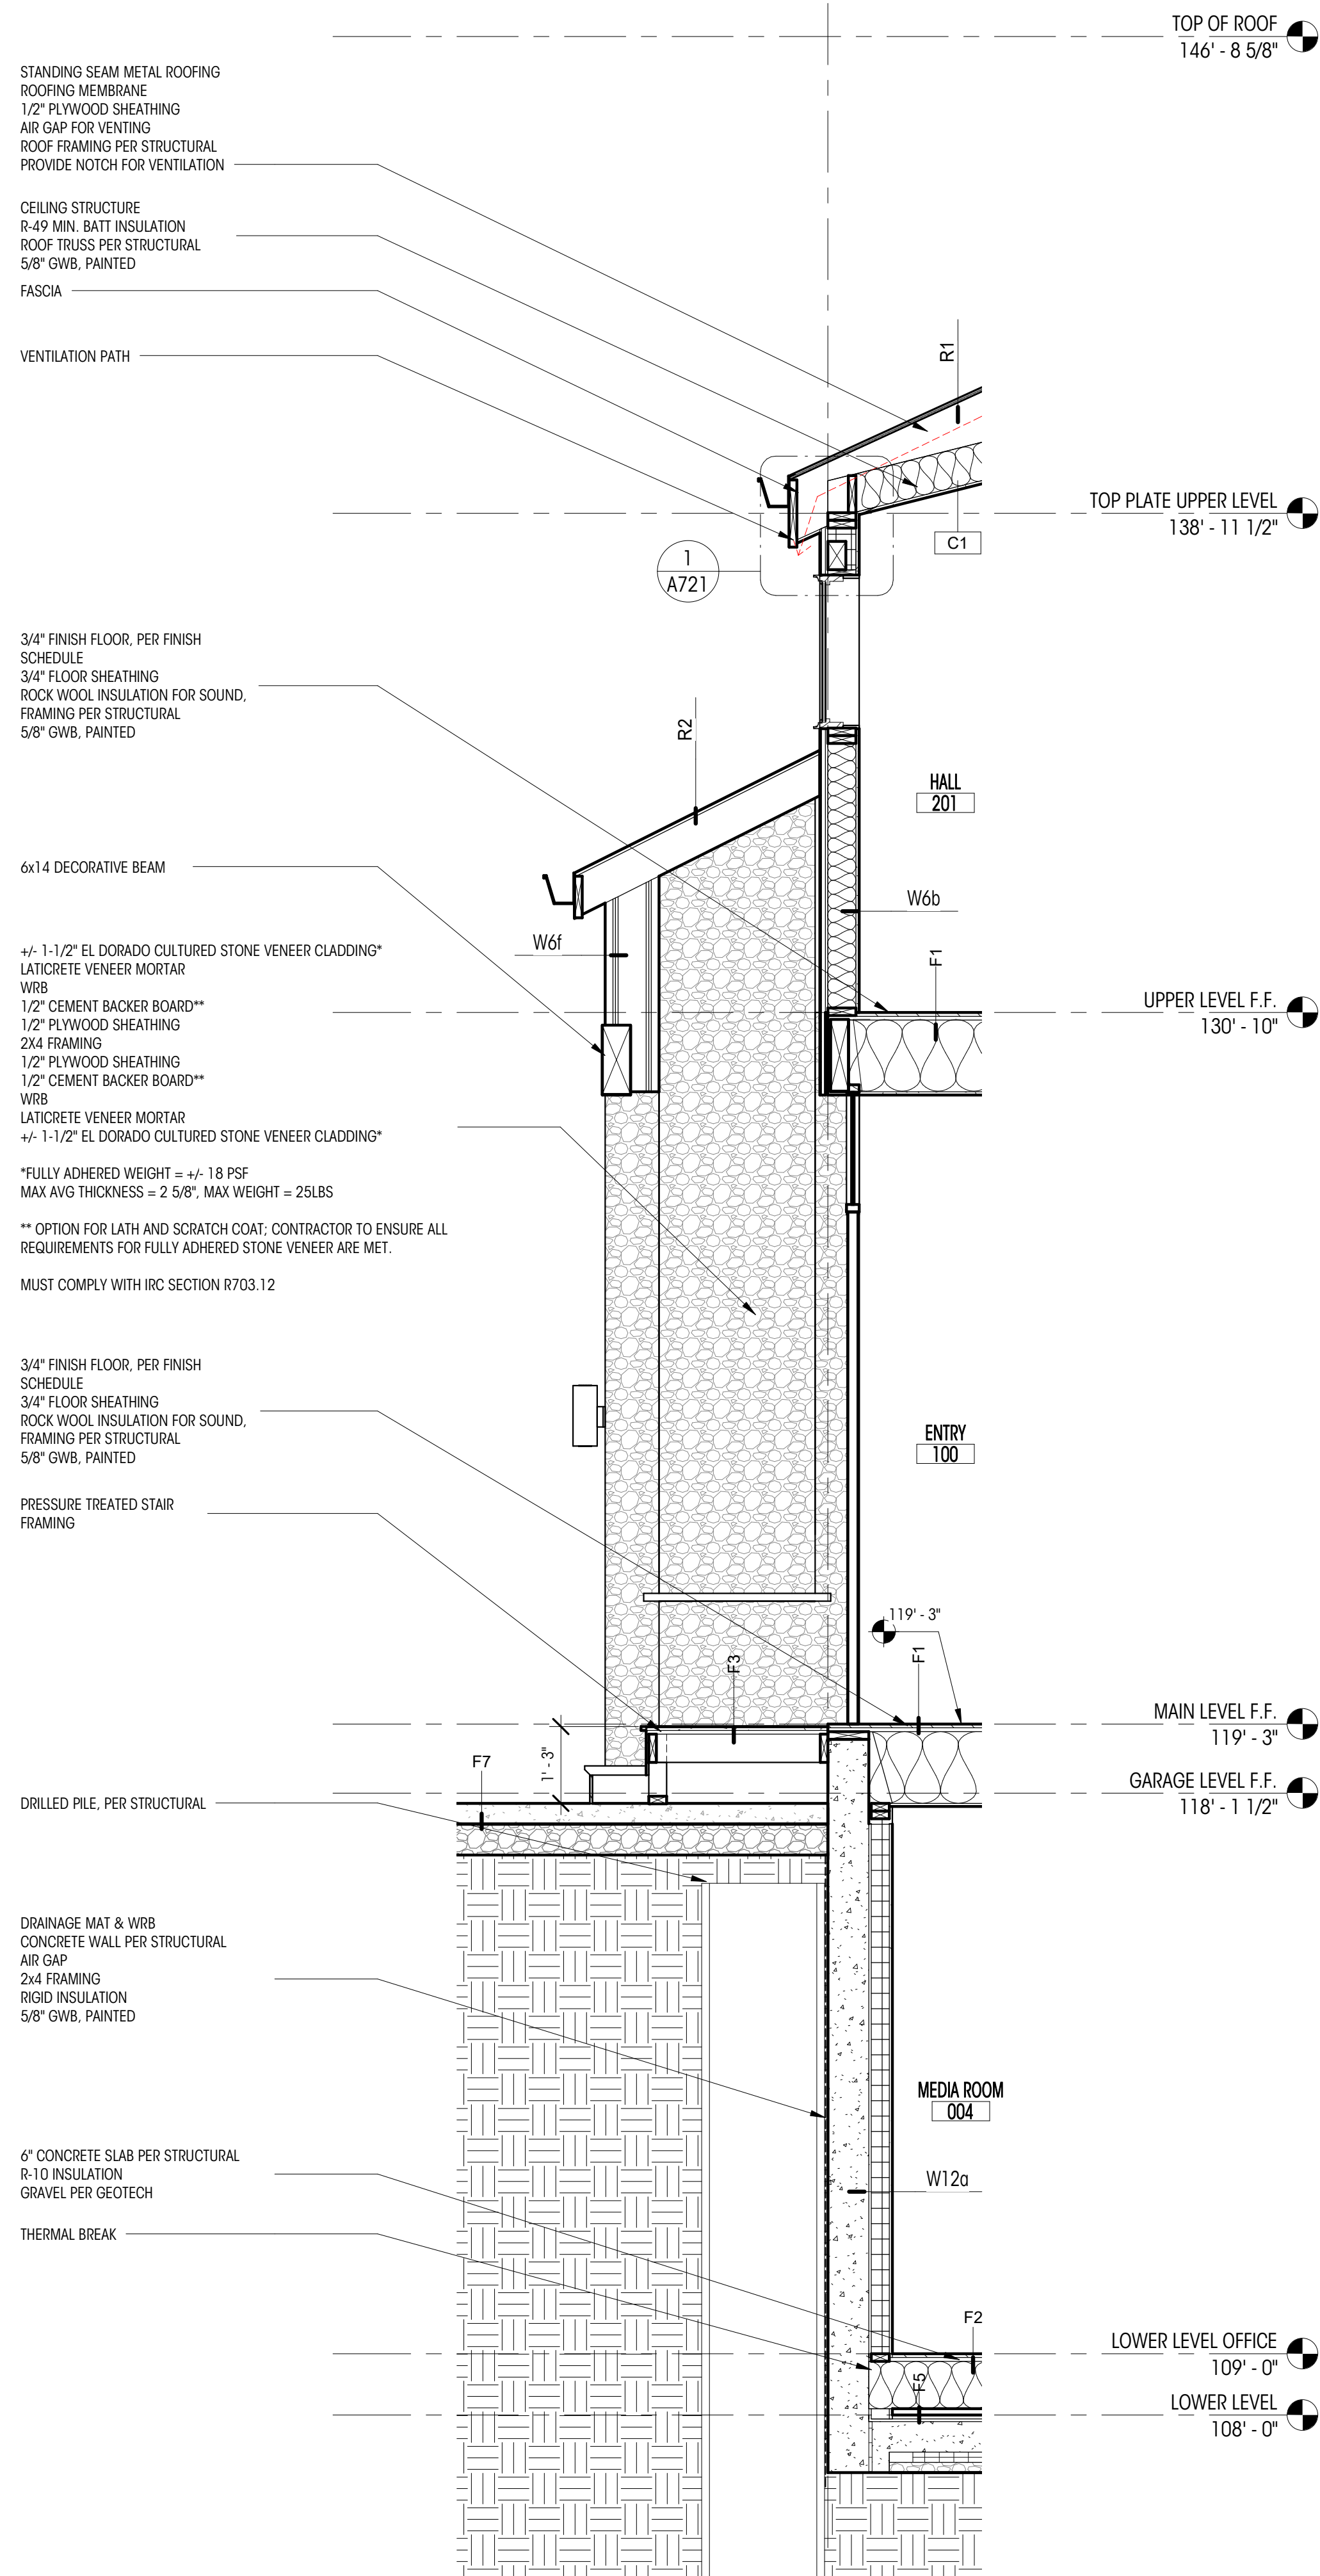


**SCOPE OF CHANGES :**

- ENTRY DESIGN CHANGE
- LEVEL CHANGES:
  - a. DRIVEWAY & GARAGE LEVEL DROP BY 15"
  - b. BASEMENT LEVEL DROP BY 12"
  - c. UPPER LEVEL DROP BY 2"
  - d. FRAMED FLOOR 12" ABOVE BASEMENT FLOOR.
  - e. CHANGE TO ABE AS A RESULT OF EXTENDED GARAGE AND EXTENDED COVERED DECK
  - f. CHANGE TO MAX HEIGHT AS A RESULT OF THE ADJUSTMENT TO THE ABE.
  - g. TOP PLATE LEVEL ADJUSTED UP BASED ON ROOF FRAMING
  - h. ROOF OF ROOF HAS LOWERED AS A RESULT OF REDUCED ROOF PITCH.






# VERTICAL ASSEMBLIES

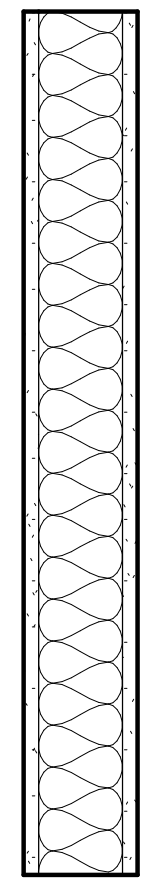


- 5/8" GWB, PAINTED
- 2x4 FRAMING
- ROCK WOOL INSULATION (FOR SOUND)
- 5/8" GWB, PAINTED

W4a

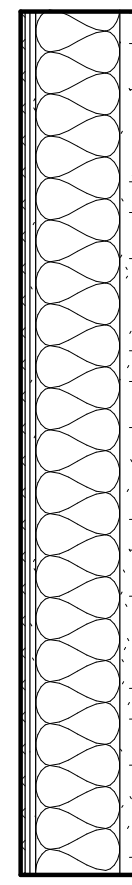

- 3/16" TILE
- 3/16" MORTAR BED
- 1/4" CEMENT BOARD
- 2x4 FRAMING
- ROCK WOOL INSULATION (FOR SOUND)
- 5/8" GWB, PAINTED

W4b

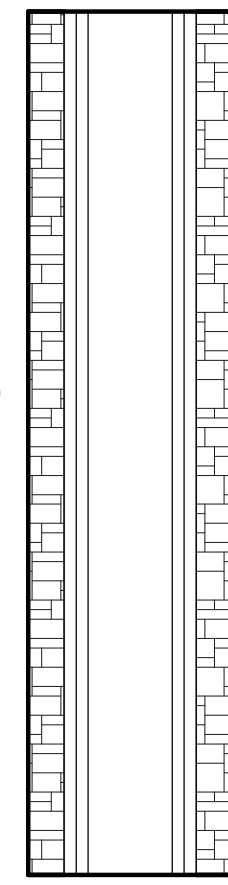

- +/- 1 1/2" EL DORADO CULTURED STONE
- LATICRETE VENEER MORTAR
- 1/2" CEMENT BOARD
- 2x4 FRAMING
- 1/2" CEMENT BOARD
- LATICRETE VENEER MORTAR
- +/- 1 1/2" EL DORADO CULTURED STONE


\*FULLY ADHERED WEIGHT = +/- 18 PSF  
(MAX AVG THICKNESS = 2 5/8", MAX WEIGHT = 25LBS)

\*\* OPTION FOR LATH AND SCRATCH COAT:  
CONTRACTOR TO ENSURE ALL REQUIREMENTS FOR FULLY ADHERED STONE VENEER ARE MET.

MUST COMPLY WITH IRC SECTION R703.12

W4C


(DECK CURB)

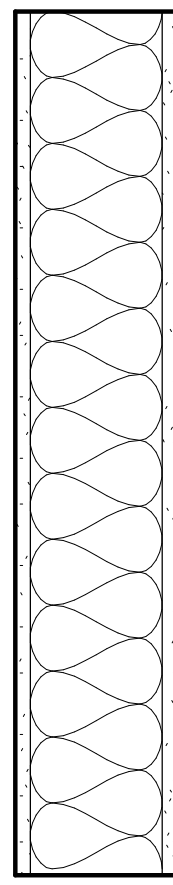

- 5/8" GWB, PAINTED
- 2x6 FRAMING
- ROCK WOOL INSULATION (FOR SOUND)
- 5/8" GWB, PAINTED

W6a


(\*'X' WHERE TYPE X GWB)

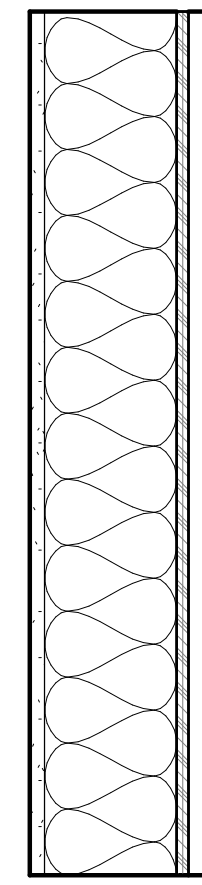

- 5/8" GWB, PAINTED
- 2x6 FRAMING
- R-21 MIN INSULATION
- 1/2" PLYWOOD SHEATHING
- WRB
- 1" VERTICAL FURRING STRIP
- EXTERIOR SIDING - TBD


W6b

(\*'X' WHERE TYPE X GWB)

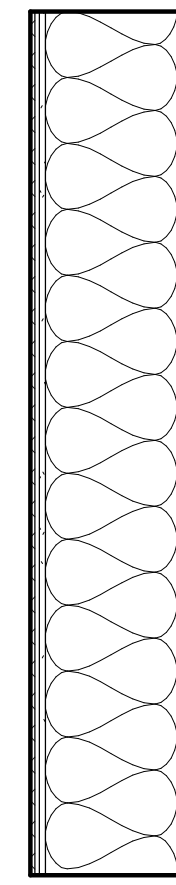

- 3/16" TILE
- 3/16" MORTAR BED
- 1/4" CEMENT BOARD
- 2x6 FRAMING
- ROCK WOOL INSULATION (FOR SOUND)
- 5/8" GWB, PAINTED

W6c

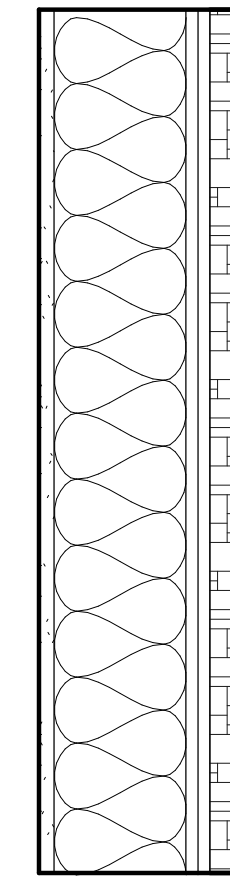

- 5/8" TYPE 'X' GWB, PAINTED
- 2x6 FRAMING
- 1/2" PLYWOOD
- 1/2" LATICRETE VENEER MORTAR
- +/- 1 1/2" EL DORADO CULTURED STONE
- DRAINAGE MAT & WRB


\*FULLY ADHERED WEIGHT = +/- 18 PSF  
(MAX AVG THICKNESS = 2 5/8", MAX WEIGHT = 25LBS)

\*\* OPTION FOR LATH AND SCRATCH COAT:  
CONTRACTOR TO ENSURE ALL REQUIREMENTS FOR FULLY ADHERED STONE VENEER ARE MET.

MUST COMPLY WITH IRC SECTION R703.12

W6d

(\*'X' WHERE TYPE X GWB)

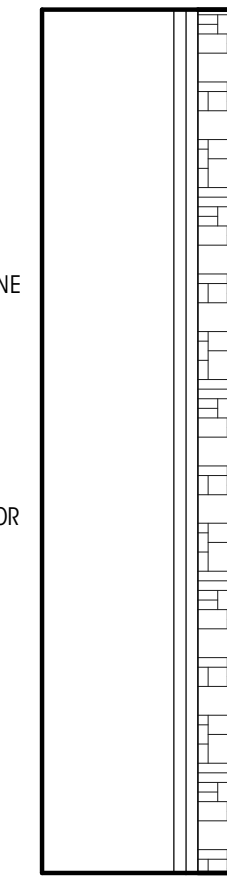


- 2x6 FRAMING
- 1/2" PLYWOOD
- +/- 1 1/2" LATICRETE VENEER MORTAR
- +/- 1 1/2" EL DORADO CULTURED STONE
- DRAINAGE MAT & WRB

\*FULLY ADHERED WEIGHT = +/- 18 PSF  
(MAX AVG THICKNESS = 2 5/8", MAX WEIGHT = 25LBS)

\*\* OPTION FOR LATH AND SCRATCH COAT:  
CONTRACTOR TO ENSURE ALL REQUIREMENTS FOR FULLY ADHERED STONE VENEER ARE MET.

MUST COMPLY WITH IRC SECTION R703.12

W6e

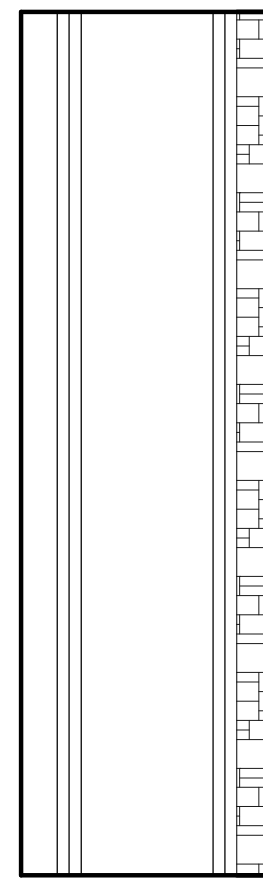


- +/- 1-1/2" EL DORADO CULTURED STONE VENEER CLADDING\*
- 1/2" LATICRETE VENEER MORTAR
- WRB
- 1/2" PLYWOOD SHEATHING
- 2x6 FRAMING
- 1/2" PLYWOOD SHEATHING
- WRB
- 1/2" LATICRETE VENEER MORTAR
- +/- 1-1/2" EL DORADO CULTURED STONE VENEER CLADDING\*

\*FULLY ADHERED WEIGHT = +/- 18 PSF  
(MAX AVG THICKNESS = 2 5/8", MAX WEIGHT = 25LBS)

\*\* OPTION FOR LATH AND SCRATCH COAT:  
CONTRACTOR TO ENSURE ALL REQUIREMENTS FOR FULLY ADHERED STONE VENEER ARE MET.

MUST COMPLY WITH IRC SECTION R703.12

W6f

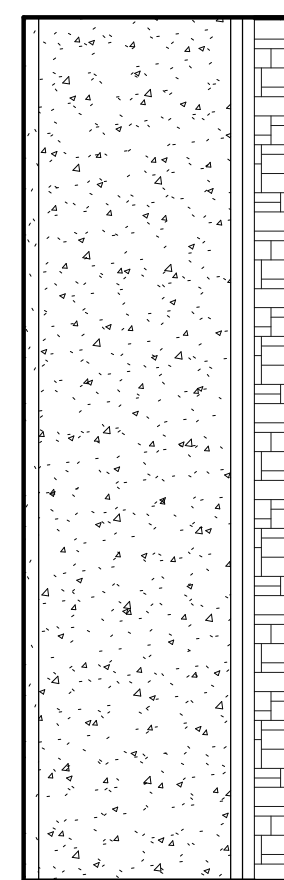

- 5/8" TYPE 'X' GWB, PAINTED
- 8" CONCRETE WALL PER STRUCTURAL
- 1/2" PLYWOOD
- 1/2" LATICRETE VENEER MORTAR
- +/- 1 1/2" EL DORADO CULTURED STONE
- DRAINAGE MAT & WRB


\*FULLY ADHERED WEIGHT = +/- 18 PSF  
(MAX AVG THICKNESS = 2 5/8", MAX WEIGHT = 25LBS)

\*\* OPTION FOR LATH AND SCRATCH COAT:  
CONTRACTOR TO ENSURE ALL REQUIREMENTS FOR FULLY ADHERED STONE VENEER ARE MET.

MUST COMPLY WITH IRC SECTION R703.12

W8a

(\*'X' WHERE TYPE X GWB)

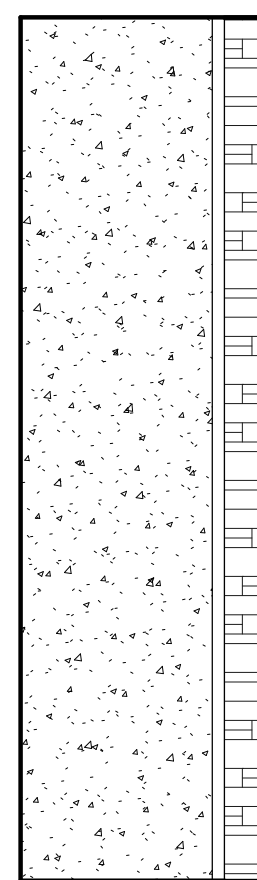


- 8" CONCRETE
- 1/2" LATICRETE VENEER MORTAR
- +/- 1-1/2" EL DORADO CULTURED STONE VENEER CLADDING\*

\*FULLY ADHERED WEIGHT = +/- 18 PSF  
(MAX AVG THICKNESS = 2 5/8", MAX WEIGHT = 25LBS)

\*\* OPTION FOR LATH AND SCRATCH COAT:  
CONTRACTOR TO ENSURE ALL REQUIREMENTS FOR FULLY ADHERED STONE VENEER ARE MET.

MUST COMPLY WITH IRC SECTION R703.12


W8b

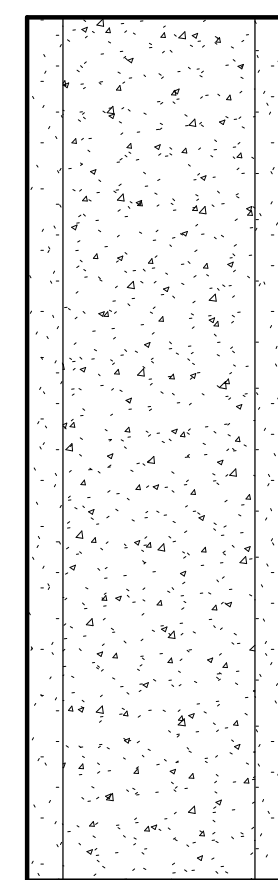

- 1 1/2" PLASTER
- 8" CONCRETE WALL PER STRUCTURAL
- 1 1/2" PLASTER

W8c

(DRIVEWAY PERIMETER)

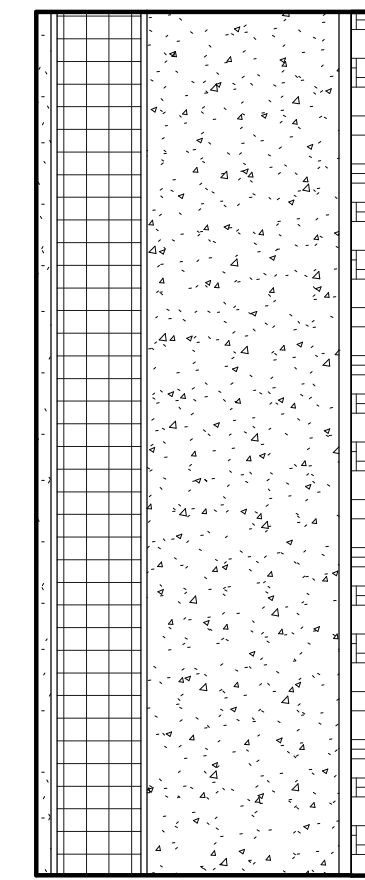


- 5/8" GWB, PAINTED
- 2x4 FURRING
- R-21 INSULATION
- 1/2" AIRGAP
- 8" CONCRETE WALL PER STRUCTURAL
- 1/2" LATICRETE VENEER MORTAR
- +/- 1-1/2" EL DORADO CULTURED STONE VENEER CLADDING\*

\*FULLY ADHERED WEIGHT = +/- 18 PSF  
(MAX AVG THICKNESS = 2 5/8", MAX WEIGHT = 25LBS)

\*\* OPTION FOR LATH AND SCRATCH COAT:  
CONTRACTOR TO ENSURE ALL REQUIREMENTS FOR FULLY ADHERED STONE VENEER ARE MET.

MUST COMPLY WITH IRC SECTION R703.12

W12a

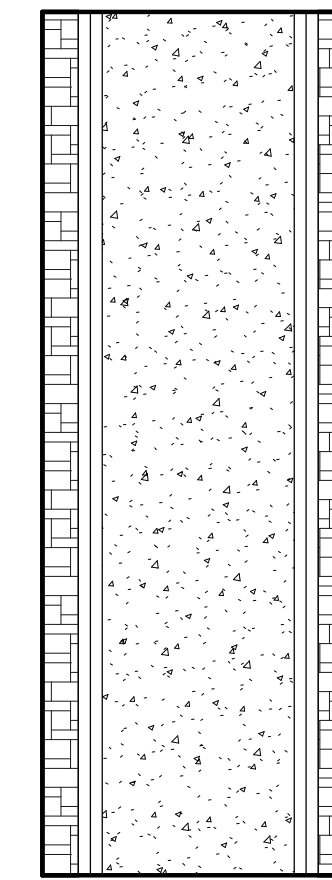


- +/- 1-1/2" EL DORADO CULTURED STONE VENEER CLADDING\*
- 1/2" LATICRETE VENEER MORTAR
- 8" CONCRETE WALL
- 1/2" LATICRETE VENEER MORTAR
- +/- 1-1/2" EL DORADO CULTURED STONE VENEER CLADDING\*

\*FULLY ADHERED WEIGHT = +/- 18 PSF  
(MAX AVG THICKNESS = 2 5/8", MAX WEIGHT = 25LBS)

\*\* OPTION FOR LATH AND SCRATCH COAT:  
CONTRACTOR TO ENSURE ALL REQUIREMENTS FOR FULLY ADHERED STONE VENEER ARE MET.

MUST COMPLY WITH IRC SECTION R703.12

W12b

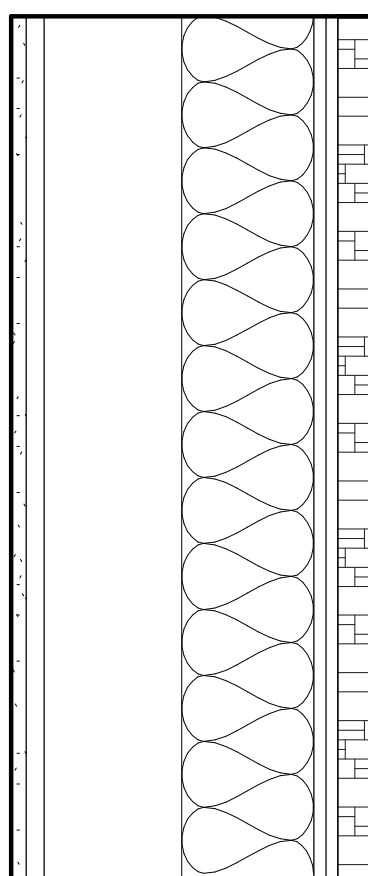


- 5/8" GYP
- 12x FRAMING
- 1/2" PLYWOOD SHEATHING
- 1/2" CEMENT BACKER BOARD\*\*
- WRB
- LATICRETE VENEER MORTAR
- +/- 1-1/2" EL DORADO CULTURED STONE VENEER CLADDING\*

\*FULLY ADHERED WEIGHT = +/- 18 PSF  
(MAX AVG THICKNESS = 2 5/8", MAX WEIGHT = 25LBS)

\*\* OPTION FOR LATH AND SCRATCH COAT:  
CONTRACTOR TO ENSURE ALL REQUIREMENTS FOR FULLY ADHERED STONE VENEER ARE MET.

MUST COMPLY WITH IRC SECTION R703.12

W12c

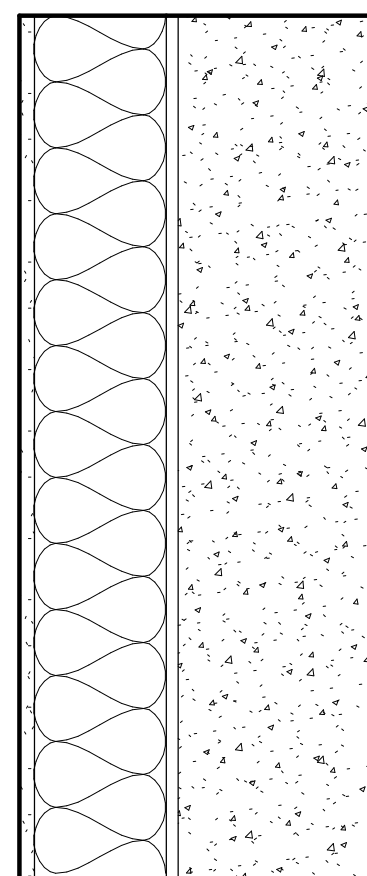

- 5/8" GWB, PAINTED
- 2x6 FRAMING PER STRUCTURAL
- R-21 BATT INSULATION
- 1/2" AIRGAP
- 8" CONCRETE WALL PER STRUCTURAL
- DRAINAGE MAT & WRB

W14a

Brandt

Design Group

66 Bell Street  
Unit 1  
Seattle, WA  
98121

206.239.0850

brandtdesigninc.com

8843



CLARKSON RESIDENCE

8163 WEST MERCER WAY  
MERCER ISLAND, WA 98040

© COPYRIGHT 2022 BRANDT DESIGN, INC. SEATTLE, WA

PERMIT DRAWINGS

DATE: 06.10.22

SHEET SIZE: D (24X36)

REVISIONS

NO.	DESCRIPTION	DATE
3	PERMIT REVISION	04.19.22

DRAWN BY: KJ/JM  
CHECKED BY: BM

ASSEMBLY DETAILS

SCALE: 1 1/2" = 1'-0"


### SCOPE OF CHANGES:

- HORIZONTAL ASSEMBLIES HAVE BEEN MOVED TO SHEET A701
- ASSEMBLIES RENAMED BASED ON FRAMING - IF NAME CHANGE ONLY, NAME CLOUDED
- ASSEMBLIES ADDED - FULL ASSEMBLY CLOUDED
- ASSEMBLIES UPDATED

A700

DEDICATED  
APPROVAL  
STAMP SPACE


# HORIZONTAL ASSEMBLIES

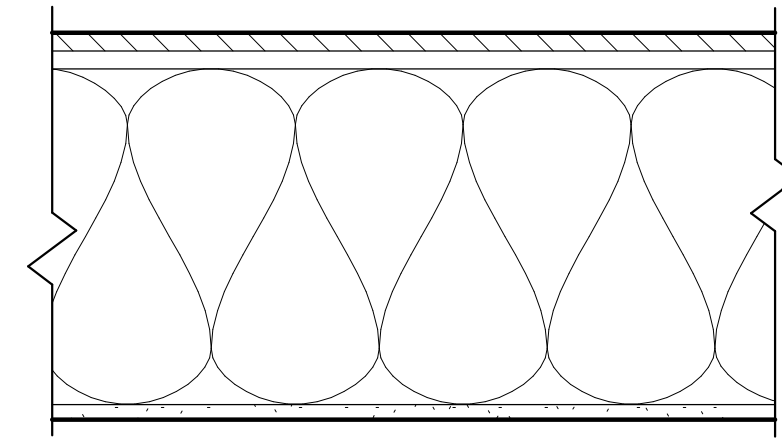

3/4" FINISHED FLOOR  
3/4" PLYWOOD SHEATHING  
1 1/4" TJI PER STRUCTURAL  
ROCK WOOL INSULATION  
(R-38 ABOVE THE GARAGE)  
5/8" DRYWALL  
(TYPE 'X' @ GARAGE)


F1

(\*X WHERE TYPE X  
GWB)

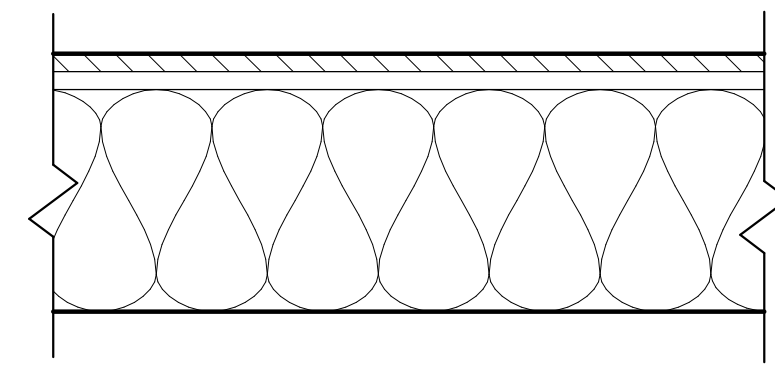

3/4" ENGINEERING WOOD FLOOR  
3/4" PLYWOOD  
ROCKWOOL INSULATION  
2X10 FRAMING


F2

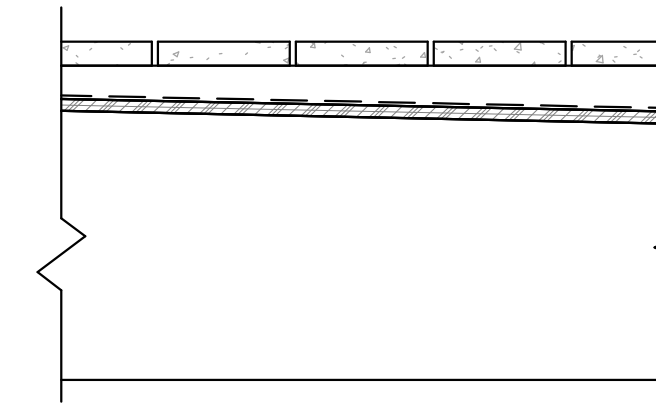

PAVER TILES  
RIPPED FURRING, SLOPE 1/8":12"  
'DURADECK' OR APPROVED ALTERNATE MEMBRANE" O/ 3/4"  
PLYWOOD  
FLOOR FRAMING PER STRUCT RIPPED 1/8":12"

F3


\*WATERPROOFING MUST BE APPROVED FOR USE AS A WALKING  
DECK AND FOR THE INSTALLATION OF THE DECKING DIRECTLY ON  
THE MEMBRANE PER ICC-ES WALKING DECKS CRITERIA

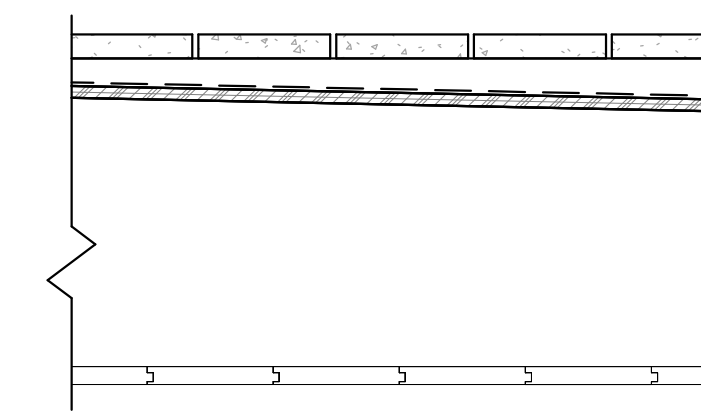

PAVER TILES  
RIPPED FURRING, SLOPE 1/8":12"  
'DURADECK' OR APPROVED ALTERNATE MEMBRANE" O/ 3/4"  
PLYWOOD  
FLOOR FRAMING PER STRUCT RIPPED 1/8":12"  
1X CEDAR T&G STAINED


F4

\*WATERPROOFING MUST BE APPROVED FOR USE AS A WALKING  
DECK AND FOR THE INSTALLATION OF THE DECKING DIRECTLY ON  
THE MEMBRANE PER ICC-ES WALKING DECKS CRITERIA

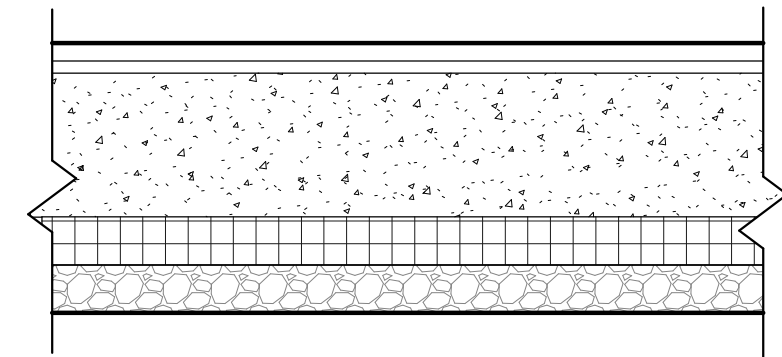


3/4" ENGINEERING WOOD FLOOR  
1/2" UNDERLAYMENT  
6" CONCRETE PER STRUCTURAL SLAB  
VAPOR BARRIER  
R-10 RIGID INSULATION  
2" GRAVEL

F5

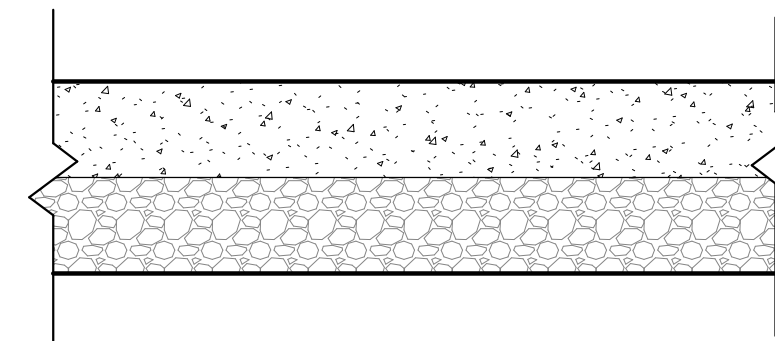


4" CONCRETE SLAB  
4" GRAVEL

F6

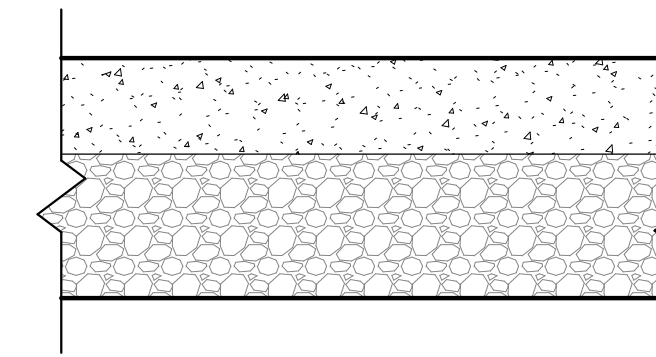


4" CONCRETE  
6" GRAVEL

F7

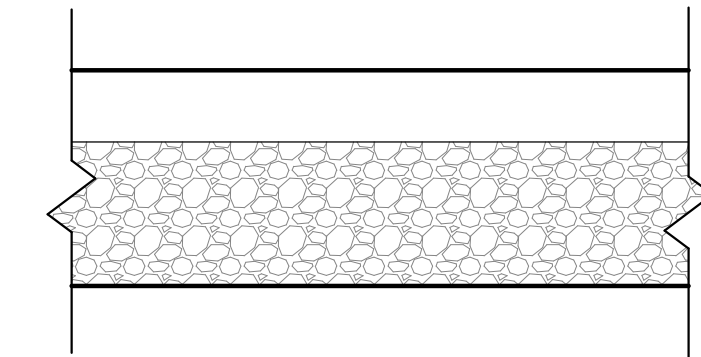

3" PAVERS  
6" GRAVEL


F8

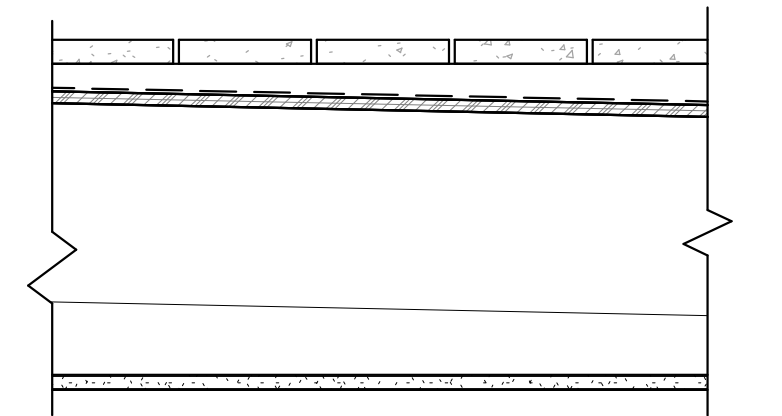

PAVER TILE OR COMPOSITE DECK  
RIPPED FURRING, SLOPE 1/8":12"  
'DURADECK' OR APPROVED ALTERNATE MEMBRANE"  
O/ 3/4" PLYWOOD  
FLOOR FRAMING PER STRUCT SLOPED AT 1/8": 12"  
RIPPED CEILING FRAMING TO ALIGN WITH ADJACENT CEILING FRAMING  
5/8" TYPE 'X' GYPSUM WALL BOARD


F9

\*WATERPROOFING MUST BE APPROVED FOR USE AS A WALKING  
DECK AND FOR THE INSTALLATION OF THE DECKING DIRECTLY ON  
THE MEMBRANE PER ICC-ES WALKING DECKS CRITERIA

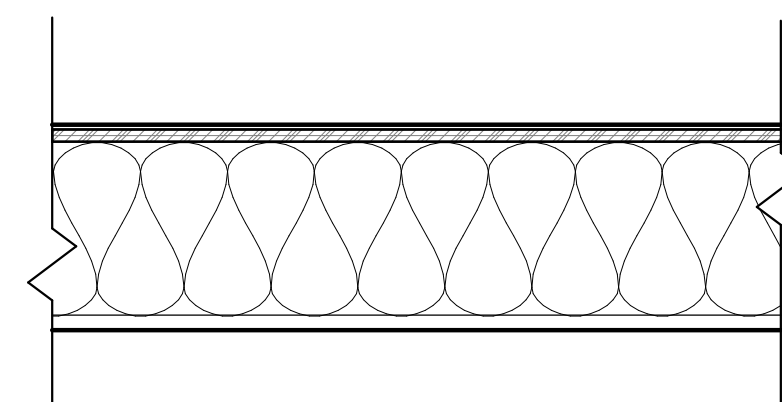


3/16" ASPHALT SHINGLES  
ROOFING MEMBRANE  
1/2" PLYWOOD  
R-38 MIN. INSULATION - ENSURE 1" AIRGAP  
FOR VENTING  
2X FRAMING PER STRUCTURAL  
5/8" GWB, PAINTED

R1

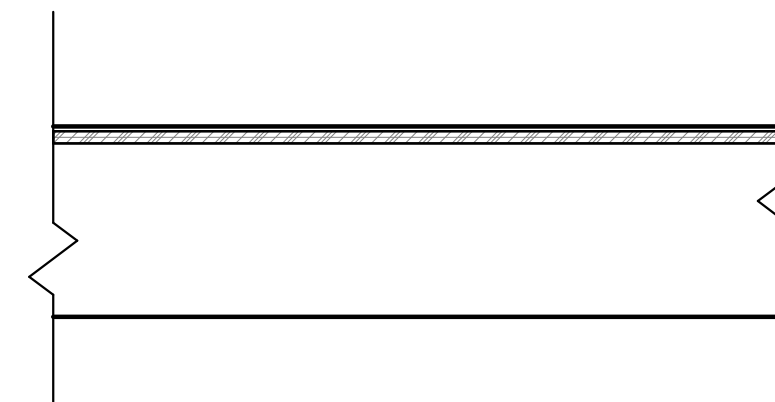


3/16" ASPHALT SHINGLES  
ROOFING MEMBRANE  
1/2" PLYWOOD  
ROOF TRUSS PER STRUCTURAL

R2

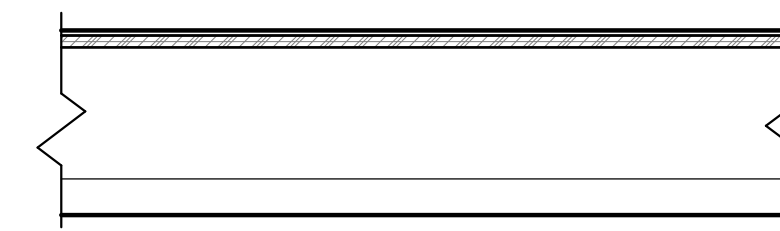


3/16" ASPHALT SHINGLES  
1/2" PLYWOOD  
2x FRAMING PER STRUCTURAL  
1 1/2" CEDAR T&G

R3

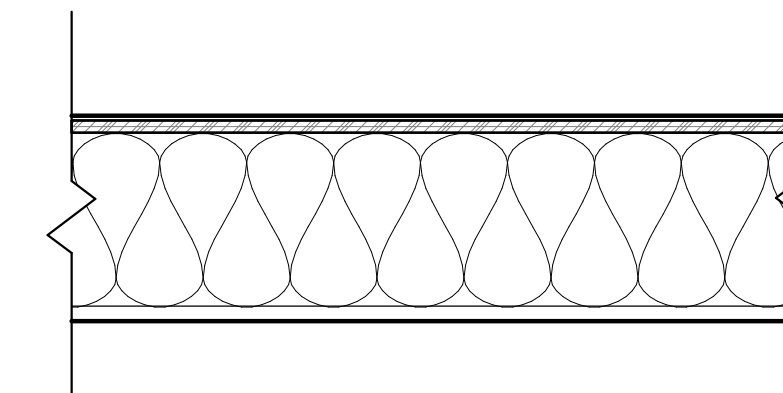


3/16" ASPHALT SHINGLES  
ROOFING MEMBRANE  
1/2" PLYWOOD  
R-38 MIN. INSULATION - ENSURE 1" AIRGAP  
FOR VENTING  
ROOF TRUSS PER STRUCTURAL  
5/8" GWB, PAINTED

R4

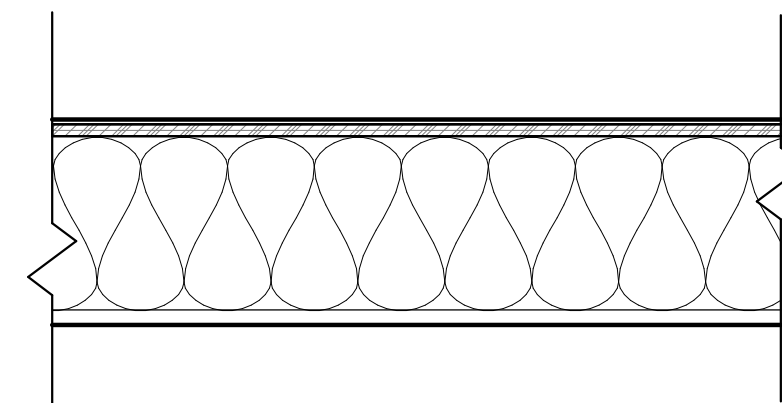


3/16" ASPHALT SHINGLES  
ROOFING MEMBRANE  
1/2" PLYWOOD  
R-38 MIN. INSULATION - ENSURE 1" AIRGAP  
FOR VENTING  
ROOF TRUSS PER STRUCTURAL  
5/8" GWB, PAINTED

R5

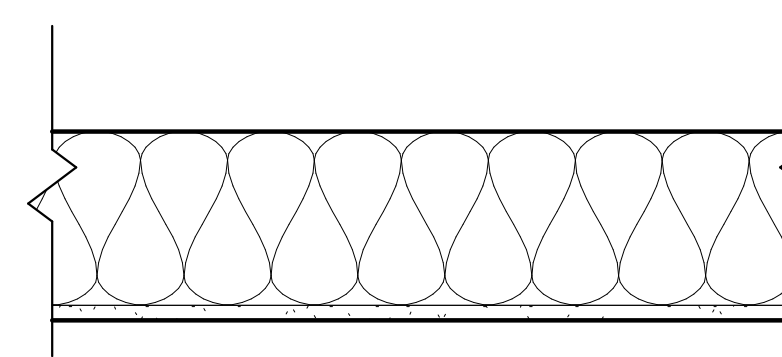

R-49 MIN. BATT INSULATION  
ROOF TRUSS PER STRUCTURAL  
5/8" GWB, PAINTED

C1

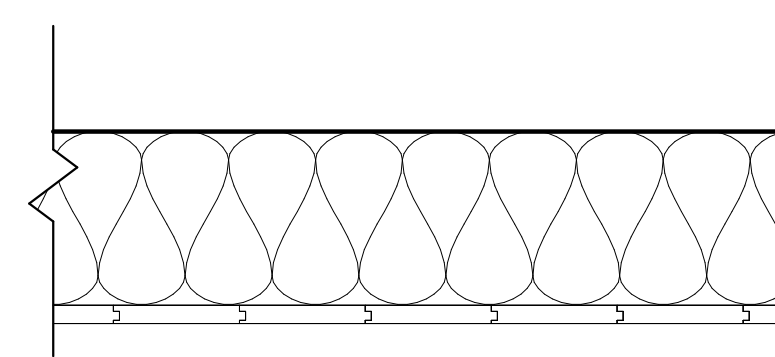


2X8 FRAMING  
3/4" T&G FINISH

C2

**SCOPE OF CHANGES:**

- NEW SHEET FOR ORGANIZATION OF ASSEMBLIES
- UPDATED ASSEMBLY TYPES
- ASSEMBLIES RENAMED BASED ON FRAMING - IF NAME CHANGE ONLY, NAME CLOUDED
- ASSEMBLIES ADDED - FULL ASSEMBLY CLOUDED

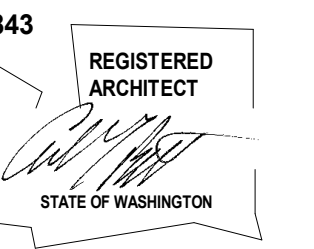

NO.	DESCRIPTION	DATE
3	PERMIT REVISION	04.19.22



General Structural Notes

THE FOLLOWING APPLY UNLESS SHOWN OTHERWISE ON THE DRAWINGS

WOOD

35. FRAMING LUMBER SHALL BE S-DRY, KD, OR MC-19, AND GRADED AND MARKED IN CONFORMANCE WITH WCLIB STANDARD "GRADING RULES FOR WEST COAST LUMBER NO. 17", OR WMPA STANDARD, "WESTERN LUMBER GRADING RULES 2011". FURNISH TO THE FOLLOWING MINIMUM STANDARDS:

Table with columns for JOISTS AND BEAMS, BEAMS, POSTS, and STUDS, PLATES & MISC. FRAMING, detailing member sizes, species (e.g., Hem-Fir, Douglas Fir-Larch), and minimum base values (Fb, Fc).

36. GLUED LAMINATED MEMBERS SHALL BE FABRICATED IN CONFORMANCE WITH ASTM AND ANSI/AITC STANDARDS. EACH MEMBER SHALL BEAR AN AITC OR APA-EWS IDENTIFICATION MARK AND SHALL BE ACCOMPANIED BY AN AITC OR APA-EWS CERTIFICATE OF CONFORMANCE.

37. MANUFACTURED LUMBER, PSL, LVL, AND LSL SHOWN ON PLAN ARE BASED PRODUCTS MANUFACTURED BY THE WEYERHAEUSER CORPORATION IN ACCORDANCE WITH ICC-ES REPORT ESR-1387.

Table listing properties for PSL (2.0E), LVL (2.0E), and LSL (1.55E), including Fb, E, and Fv values.

ALTERNATE MANUFACTURED LUMBER MANUFACTURERS MAY BE USED SUBJECT TO REVIEW AND APPROVAL BY THE ARCHITECT AND STRUCTURAL ENGINEER.

MANUFACTURED LUMBER PRODUCTS SHALL BE INSTALLED WITH A MOISTURE CONTENT OF 12% OR LESS. THE CONTRACTOR SHALL MAKE PROVISIONS DURING CONSTRUCTION TO PREVENT THE MOISTURE CONTENT OF INSTALLED BEAMS FROM EXCEEDING 12%.

38. PREFABRICATED PLYWOOD WEB JOIST DESIGN SHOWN ON PLANS IS BASED ON JOISTS MANUFACTURED BY THE WEYERHAEUSER CORPORATION. ALTERNATE PLYWOOD WEB JOIST MANUFACTURERS MAY BE USED SUBJECT TO REVIEW AND APPROVAL BY THE ARCHITECT AND STRUCTURAL ENGINEER.

39. PREFABRICATED CONNECTOR PLATE WOOD ROOF TRUSSES SHALL BE DESIGNED BY THE MANUFACTURER IN ACCORDANCE WITH THE "NATIONAL DESIGN STANDARD FOR METAL PLATE-CONNECTED WOOD TRUSS CONSTRUCTION, ANSI/TPI 1" BY THE TRUSS PLATE INSTITUTE FOR THE SPANS AND CONDITIONS SHOWN ON THE PLANS.

Table listing loads for TOP CHORD LIVE LOAD, TOP CHORD DEAD LOAD, BOTTOM CHORD DEAD LOAD, and TOTAL LOAD.

Table listing WIND UPLIFT (TOP CHORD) and BOTTOM CHORD LIVE LOAD.

WOOD TRUSSES SHALL UTILIZE APPROVED CONNECTOR PLATES (GANGNAIL OR EQUAL). SUBMIT SHOP DRAWINGS AND DESIGN CALCULATIONS TO THE ARCHITECT AND STRUCTURAL ENGINEER FOR REVIEW PRIOR TO FABRICATION.

40. PLYWOOD SHEATHING SHALL BE GRADE C-D, EXTERIOR GLUE OR STRUCTURAL II, EXTERIOR GLUE IN CONFORMANCE WITH DOC PS 1 OR PS 2. ORIENTED STRAND BOARD OF EQUIVALENT THICKNESS, EXPOSURE RATING AND PANEL INDEX MAY BE USED IN LIEU OF PLYWOOD.

ROOF SHEATHING SHALL BE 1/2" (NOMINAL) WITH SPAN RATING 32/16.

FLOOR SHEATHING SHALL BE 3/4" (NOMINAL) WITH SPAN RATING 48/24.

WALL SHEATHING SHALL BE 1/2" (NOMINAL) WITH SPAN RATING 24/0.

PROVIDE APPROVED PLYWOOD EDGE CLIPS CENTERED BETWEEN JOISTS/TRUSSES AT UNBLOCKED ROOF SHEATHING EDGES. ALL FLOOR SHEATHING EDGES SHALL HAVE APPROVED T&G JOINTS OR SHALL BE SUPPORTED WITH SOLID BLOCKING.

REFER TO WOOD FRAMING NOTES BELOW FOR TYPICAL NAILING REQUIREMENTS.

41. ALL WOOD IN DIRECT CONTACT WITH CONCRETE OR MASONRY SHALL BE PRESSURE-TREATED WITH AN APPROVED PRESERVATIVE OR (2) LAYERS OF ASPHALT IMPREGATED BUILDING PAPER SHALL BE PROVIDED BETWEEN UNTREATED WOOD AND CONCRETE OR MASONRY.

42. PRESERVATIVE TREATED WOOD SHALL BE TREATED PER AWPA STANDARD U1 TO THE USE CATEGORY EQUAL TO OR HIGHER THAN THE INTENDED APPLICATION.

43. FASTENERS AND TIMBER CONNECTORS USED WITH TREATED WOOD SHALL HAVE CORROSION RESISTANCE AS INDICATED IN THE FOLLOWING TABLE, UNLESS OTHERWISE NOTED.

Table with columns: WOOD TREATMENT, CONDITION, PROTECTION. Lists requirements for Ammonia carriers, interior dry, wet, and exterior conditions.

INTERIOR DRY CONDITIONS SHALL HAVE WOOD MOISTURE CONTENT LESS THAN 19%. WOOD MOISTURE CONTENT IN OTHER CONDITIONS (INTERIOR WET, EXTERIOR WET, AND EXTERIOR DRY) IS EXPECTED TO EXCEED 19%.

44. TIMBER CONNECTORS CALLED OUT BY LETTERS AND NUMBERS SHALL BE "STRONG-TIE" BY SIMPSON COMPANY, AS SPECIFIED IN THEIR CATALOG NUMBER C-C-2019.

ALL 2X JOISTS SHALL BE CONNECTED TO FLUSH BEAMS WITH "LUS" SERIES JOIST HANGERS. ALL TJI JOISTS SHALL BE CONNECTED TO FLUSH BEAMS WITH "ITS" SERIES JOIST HANGERS.

WHERE CONNECTOR STRAPS CONNECT TWO MEMBERS, PLACE ONE-HALF OF THE NAILS OR BOLTS IN EACH MEMBER.

ALL SHIMS SHALL BE SEASONED AND DRIED AND THE SAME GRADE (MINIMUM) AS MEMBERS CONNECTED.

45. WOOD FASTENERS

A. NAIL SIZES SPECIFIED ON DRAWINGS ARE BASED ON THE FOLLOWING SPECIFICATIONS:

Table with columns: SIZE, LENGTH, DIAMETER. Lists specifications for 6d, 8d, 10d, 12d, and 16d box nails.

IF CONTRACTOR PROPOSES THE USE OF ALTERNATE NAILS, THEY SHALL SUBMIT NAIL SPECIFICATIONS TO THE STRUCTURAL ENGINEER (PRIOR TO CONSTRUCTION) FOR REVIEW AND APPROVAL.

NAILS - PLYWOOD (APA RATED SHEATHING) FASTENERS TO FRAMING SHALL BE DRIVEN FLUSH TO FACE OF SHEATHING WITH NO COUNTERSINKING PERMITTED.

B. ALL BOLTS IN WOOD MEMBERS SHALL CONFORM TO ASTM A307. PROVIDE WASHERS UNDER THE HEADS AND NUTS OF ALL BOLTS AND LAG BOLTS BEARING ON WOOD.

46. NOTCHES AND HOLES IN WOOD FRAMING:

A. NOTCHES ON THE ENDS OF SOLID SAWN JOISTS AND RAFTERS SHALL NOT EXCEED ONE-FOURTH THE JOIST DEPTH. NOTCHES IN THE TOP OR BOTTOM OF SOLID SAWN JOISTS SHALL NOT EXCEED ONE-SIXTH THE DEPTH AND SHALL NOT BE LOCATED IN THE MIDDLE THIRD OF THE SPAN.

B. IN EXTERIOR WALLS AND BEARING PARTITIONS, ANY WOOD STUD IS PERMITTED TO BE CUT OR NOTCHED TO A DEPTH NOT EXCEEDING 25 PERCENT OF ITS WIDTH. A HOLE NOT GREATER IN DIAMETER THAN 40 PERCENT OF THE STUD WIDTH IS PERMITTED TO BE BORED IN ANY WOOD STUD.

C. NOTCHES AND HOLES IN MANUFACTURED LUMBER AND PREFABRICATED PLYWOOD WEB JOISTS SHALL BE PER THE MANUFACTURERS RECOMMENDATIONS UNLESS OTHERWISE NOTED.

47. WOOD FRAMING NOTES--THE FOLLOWING APPLY UNLESS OTHERWISE SHOWN ON THE PLANS:

A. ALL WOOD FRAMING DETAILS NOT SHOWN OTHERWISE SHALL BE CONSTRUCTED TO THE MINIMUM STANDARDS OF THE INTERNATIONAL BUILDING CODE, THE AITC "TIMBER CONSTRUCTION MANUAL" AND THE AWC "NATIONAL DESIGN SPECIFICATION FOR WOOD CONSTRUCTION".


B. WALL FRAMING: REFER ARCHITECTURAL DRAWINGS FOR THE SIZE OF ALL WALLS. ALL STUDS SHALL BE SPACED AT 16" O.C. UNO. TWO STUDS MINIMUM SHALL BE PROVIDED AT THE END OF ALL WALLS AND AT EACH SIDE OF ALL OPENINGS, AND AT BEAM OR HEADER BEARING LOCATIONS.

ALL WALLS SHALL HAVE A SINGLE BOTTOM PLATE AND A DOUBLE TOP PLATE. END NAIL TOP PLATE TO EACH STUD WITH TWO 16d NAILS, AND TOENAIL OR END NAIL EACH STUD TO BOTTOM PLATE WITH TWO 16d NAILS.

ALL STUD WALLS SHALL HAVE THEIR LOWER WOOD PLATES ATTACHED TO WOOD FRAMING BELOW WITH TWO ROWS OF 16d NAILS @ 12" ON-CENTER, OR ATTACHED TO CONCRETE BELOW WITH 5/8" DIAMETER ANCHOR BOLTS @ 4'-0" ON-CENTER EMBEDDED 7" MINIMUM.

C. FLOOR AND ROOF FRAMING: PROVIDE DOUBLE JOISTS UNDER ALL PARALLEL PARTITIONS THAT EXTEND OVER MORE THAN HALF THE JOIST LENGTH AND AROUND ALL OPENINGS IN FLOORS OR ROOFS UNLESS OTHERWISE NOTED.

UNLESS OTHERWISE NOTED ON THE PLANS, PLYWOOD ROOF AND FLOOR SHEATHING SHALL BE LAID UP WITH GRAIN PERPENDICULAR TO SUPPORTS AND NAILED AT 6" ON-CENTER WITH 8d NAILS TO FRAMED PANEL EDGES.

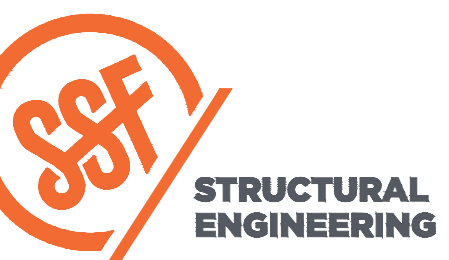

1124 Third Avenue - Suite 100 - Seattle, WA 98121
p: 206.443.6212 ssfengineers.com
934 Broadway - Tacoma, WA 98402
p: 253.284.9470 ssfengineers.com

Copyright 2022 Swenson Say Fagitt - All Rights Reserved

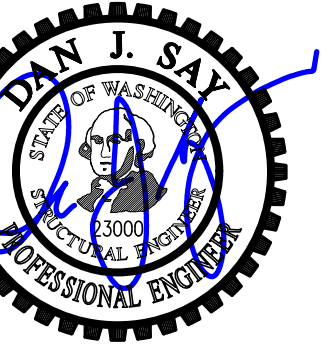


Table with columns: DESIGN, DRAWN, CHECKED, APPROVED. Lists HAA, BDM, NHD, BDM, DJS.

Table with columns: REVISIONS, revision number, description, date. Lists corrections and permit revisions.

DPD:

PROJECT TITLE:

Clarkson Residence
8163 West Mercer Way
Mercer Island, WA 98040

ARCHITECT:

Brandt Design Group
66 Bell Street, Unit 1
Seattle, WA 98121
PH 206.239.0850

ISSUE:

PERMIT

SHEET TITLE:

General Structural Notes

SCALE:

DATE: December 24, 2020

PROJECT NO: 01519-2021-11

SHEET NO:

S1.2

**Statement of Special Inspections**

Special inspections shall be provided per the requirements of IBC section 1705 and as noted herein

**SOILS**

VERIFICATION AND INSPECTION TASK	CONTINUOUS	PERIODIC	COMMENTS	REFERENCES
1. VERIFY MATERIALS BELOW SHALLOW FOUNDATIONS ARE ADEQUATE TO ACHIEVE THE DESIGN BEARING CAPACITY		X		IBC 1705.6
2. VERIFY EXCAVATIONS ARE EXTENDED TO PROPER DEPTH AND HAVE REACHED PROPER MATERIAL		X		
3. PERFORM CLASSIFICATION AND TESTING OF COMPACTED FILL MATERIALS		X		
4. VERIFY USE OF PROPER MATERIALS, DENSITIES AND LIFT THICKNESSES DURING PLACEMENT AND COMPACTION OF COMPACTED FILL	X			
5. PRIOR TO PLACEMENT OF COMPACTED FILL, OBSERVE SUBGRADE AND VERIFY THAT SITE HAS BEEN PREPARED PROPERLY		X		

**DRIVEN DEEP FOUNDATION ELEMENTS**

VERIFICATION AND INSPECTION TASK	CONTINUOUS	PERIODIC	COMMENTS	REFERENCES
1. VERIFY ELEMENT MATERIALS, SIZES AND LENGTHS COMPLY WITH THE REQUIREMENTS	X			IBC 1705.7
2. DETERMINE CAPACITIES OF TEST ELEMENTS AND CONDUCT ADDITIONAL LOAD TESTS AS REQUIRED	X			
3. OBSERVE DRIVING OPERATIONS AND MAINTAIN COMPLETE AND ACCURATE RECORDS FOR EACH ELEMENT	X			
4. VERIFY PLACEMENT LOCATIONS AND PLUMBNESS, CONFIRM TYPE AND SIZE OF HAMMER, RECORD NUMBER OF BLOWS PER FOOT OF PENETRATION, DETERMINE REQUIRED PENETRATIONS TO ACHIEVE DESIGN CAPACITY, RECORD TIP AND BUTT ELEVATIONS AND DOCUMENT ANY DAMAGE TO FOUNDATION ELEMENT	X			
5. SEE STEEL CONSTRUCTION INSPECTION REQUIREMENTS FOR STEEL PILE ELEMENTS				IBC 1705.2
6. SEE CONCRETE CONSTRUCTION INSPECTION REQUIREMENTS FOR CONCRETE AND CONCRETE FILLED ELEMENTS				IBC 1705.3
7. FOR SPECIALTY ELEMENTS, PERFORM ADDITIONAL INSPECTIONS AS DETERMINED BY THE REGISTERED DESIGN PROFESSIONAL IN RESPONSIBLE CHARGE				

**CAST-IN-PLACE DEEP FOUNDATION ELEMENTS**

VERIFICATION AND INSPECTION TASK	CONTINUOUS	PERIODIC	COMMENTS	REFERENCES
1. OBSERVE DRILLING OPERATIONS AND MAINTAIN COMPLETE AND ACCURATE RECORDS FOR EACH ELEMENT	X			IBC 1705.8
2. VERIFY PLACEMENT LOCATIONS AND PLUMBNESS, CONFIRM ELEMENT DIAMETERS, BELL DIAMETERS (if applicable), LENGTHS, EMBEDMENT INTO BEDROCK (if applicable) AND ADEQUATE END-BEARING STRATA CAPACITY. RECORD CONCRETE OR GROUT VOLUMES	X			
3. SEE CONCRETE CONSTRUCTION INSPECTION REQUIREMENTS FOR CONCRETE ELEMENTS				IBC 1705.3

**STRUCTURAL STEEL**


VERIFICATION AND INSPECTION TASK	CONTINUOUS	PERIODIC	COMMENTS	REFERENCE
<b>1. FABRICATED AND ERECTED STEEL:</b>				
a. COMPLIANCE WITH DETAILS SHOWN ON CONSTRUCTION DOCUMENTS		X		AISC 360, SECTION N5
b. APPLICATION OF JOINT DETAILS AT EACH CONNECTION		X		
<b>2. INSPECTION OF HIGH STRENGTH BOLTING:</b>				
a. SNUG-TIGHT JOINTS		X		IBC 1705.2.1 AISC 360, SECTION M2.5 SECTION N5.6
b. PRE-TENSIONED AND SLIP-CRITICAL JOINTS USING TURN-OF-NUT WITH MATCHMARKING, TWIST-OFF BOLT OR DIRECT TENSION INDICATOR METHODS OF INSTALLATION		X		
c. PRE-TENSIONS AND SLIP-CRITICAL JOINTS USING TURN-OF-NUT WITHOUT MATCHMARKING OR CALIBRATED WRENCH METHODS OF INSTALLATION	X			
<b>3. MATERIAL VERIFICATION OF WELD FILLER MATERIALS:</b>				
a. IDENTIFICATION MARKINGS TO CONFORM TO AWS SPECIFICATIONS IN THE APPROVED CONSTRUCTION DOCUMENTS		X		AISC 360, SECTION A3.5 AND APPLICABLE AWS A5 DOCUMENTS
b. MANUFACTURER'S CERTIFICATE OF COMPLIANCE REQUIRED		X		
<b>4. INSPECTION OF WELDING:</b>				
a. COMPLETE AND PARTIAL JOINT PENETRATION GROOVE WELD	X			IBC 1705.2.1 AWS D1.1
b. MULTIPASS FILLET WELDS	X			AISC 360 SECTION N5.4
c. SINGLE PASS FILLET WELDS > 9/16"	X			
d. PLUG AND SLOT WELDS	X			
e. SINGLE PASS FILLET WELDS ≤ 9/16"		X		
<b>5. INSPECTION OF STEEL FRAME JOINT DETAILS FOR COMPLIANCE:</b>				
a. DETAILS SUCH AS BRACING AND STIFFENING		X		IBC 1705.2.1
b. MEMBER LOCATIONS		X		
c. APPLICATION OF JOINT DETAILS AT EACH CONN.		X		
<b>6. MATERIAL VERIFICATION OF HIGH-STRENGTH BOLTS, NUTS, AND WASHERS:</b>				
a. IDENTIFICATION MARKINGS TO CONFORM TO ASTM STANDARDS SPECIFIED IN THE APPROVED CONSTRUCTION DOCUMENTS		X		AISC 360, SECTION A3.3 AND APPLICABLE ASTM MATERIAL STANDARDS
b. MANUFACTURER'S CERTIFICATE OF COMPLIANCE REQUIRED		X		

**CONCRETE AND CONCRETE REINFORCING**

VERIFICATION AND INSPECTION TASK	CONTINUOUS	PERIODIC	COMMENTS	REFERENCE
<b>1. INSPECTION OF REINFORCING STEEL INCLUDING PRESTRESSING TENDONS, AND PLACEMENT</b>				
		X		IBC 1908.4 ACI 318: Ch. 20, 25.2, 25.3, 26.6.1-26.6.3
<b>2. INSPECTION OF ANCHORS CAST IN CONCRETE</b>				
		X		ACI 318: 17.8.2
<b>3. INSPECTION OF POST-INSTALLED ANCHORS IN HARDENED CONCRETE MEMBERS:</b>				
a. ADHESIVE ANCHORS INSTALLED HORIZONTALLY OR UPWARDLY INCLINED ORIENTATIONS	X		SEE ICC-ES ESR REPORT FOR ADDITIONAL REQUIREMENTS	ACI 318: 17.8.2.4
b. MECHANICAL ANCHORS AND ADHESIVE ANCHORS NOT DEFINED IN 3-g		X	SEE ICC-ES ESR REPORT FOR ADDITIONAL REQUIREMENTS	ACI 318: 17.8.2
<b>4. VERIFYING USE OF REQUIRED DESIGN MIX</b>				
		X		IBC 1904.1 IBC 1904.2 IBC 1908.2 IBC 1908.3 ACI 318: Ch. 19, 26.4.3, 26.4.4
<b>5. INSPECTION DURING CONCRETE MIXING:</b>				
a. CONCRETE MIXES PREPARED IN A BATCH PLANT THAT IS NOT CERTIFIED BY THE CITY OF SEATTLE		X	CITY OF SEATTLE ONLY, NOT REQUIRED IF THE PROPORTIONS OF INGREDIENTS ARE ESTABLISHED IN ACCORDANCE WITH SBC 1905.1.10 OR IF THE MIX HAS BEEN GRANTED CONTINUOUS APPROVAL BY THE BUILDING OFFICIAL	SBC 1705.3.3
b. MIXES WITH $f'_c > 6000\text{psi}$		X		
c. STRUCTURAL LIGHT WEIGHT CONCRETE		X		
<b>6. PRIOR TO CONCRETE PLACEMENT, FABRICATE SPECIMENS FOR STRENGTH TESTS, PERFORM SLUMP AND AIR CONTENT TESTS, AND DETERMINE THE TEMPERATURE OF THE CONCRETE</b>				
	X			IBC 1908.10 ASTM C 172 ASTM C 31 ACI 318: 26.5, 26.12
<b>7. INSPECTION OF CONCRETE AND SHOTCRETE PLACEMENT FOR PROPER APPLICATION TECHNIQUES</b>				
	X			IBC 1908.6 -1908.8 ACI 318: 26.5
<b>8. VERIFY MAINTENANCE OF SPECIFIED CURING TEMPERATURE AND TECHNIQUES</b>				
		X		IBC 1908.9 ACI 318: 26.5.3-26.5.5
<b>9. INSPECT ERECTION OF PRE-CAST CONCRETE MEMBERS</b>				
		X		ACI 318: 26.9
<b>10. VERIFICATION OF IN-SITU CONCRETE STRENGTH PRIOR TO STRESSING OF TENDONS IN POST-TENSIONED CONCRETE AND PRIOR TO REMOVAL OF SHORES AND FORMS FROM BEAMS AND STRUCTURAL SLABS</b>				
		X		ACI 318: 26.11.2
<b>11. INSPECT FORMWORK FOR GENERAL CONFORMITY TO APPROVED PLANS FOR SIZE, SHAPE, LOCATION AND DIMENSIONS OF THE CONCRETE MEMBER BEING FORMED</b>				
		X		ACI 318: 26.11.2(b)
<b>12. REINFORCING BAR WELDING:</b>				
a. VERIFY WELDABILITY OF REINFORCING BARS OTHER THAN ASTM A706		X		AWS D1.4 ACI 318: 26.6.4
b. INSPECT SINGLE-PASS FILLET WELDS, MAXIMUM 9/16", OTHER THAN C & D		X		
c. WELDING OF REINFORCING STEEL RESISTING FLEXURAL AND AXIAL FORCES IN INTERMEDIATE AND SPECIAL MOMENT FRAMES AND BOUNDARY ELEMENTS OF SPECIAL STRUCTURAL WALLS OF CONCRETE AND SHEAR REINFORCEMENT	X			
d. WELDING SHEAR REINFORCEMENT	X			
e. WELDING OF OTHER REINFORCEMENT STEEL	X			
<b>13. MECHANICAL COUPLERS FOR REINFORCING</b>				
			SEE ICC-ES ESR REPORT FOR REQUIREMENTS	

**NOTES**

- TESTING AND SPECIAL INSPECTION REPORTS SHALL BE PREPARED FOR EACH INSPECTION ITEM ON A DAILY BASIS WHENEVER WORK IS PERFORMED ON THAT ITEM. REPORTS SHALL BE DISTRIBUTED TO OWNER, CONTRACTOR, BUILDING OFFICIAL, ARCHITECT, AND STRUCTURAL ENGINEER.
- STRUCTURAL OBSERVATIONS SHALL BE PERFORMED BY THE STRUCTURAL ENGINEER OF RECORD OR DESIGNATED REPRESENTATIVE IN ACCORDANCE WITH IBC 1704.6. STRUCTURAL OBSERVATIONS SHALL BE PERFORMED AS FOLLOWS:
  - PERIODIC VISUAL OBSERVATION OF STRUCTURAL SYSTEMS FOR GENERAL CONFORMANCE TO CONSTRUCTION DOCUMENTS AT SIGNIFICANT CONSTRUCTION STAGES
  - REVIEW OF TESTING AND INSPECTION REPORTS
  - REPORTS SHALL BE PREPARED FOR EACH SITE VISIT AND SHALL BE DISTRIBUTED TO ARCHITECT.
- WHERE APPLICABLE, SEE ALSO IBC SECTION 1705.11, SPECIAL INSPECTION FOR WIND RESISTANCE AND IBC SECTION 1705.12, SPECIAL INSPECTION FOR SEISMIC RESISTANCE
- "STRUCTURAL STEEL" REFERS TO STEEL CONSTRUCTION DEFINED BY AISC 303, "CODE OF STANDARD PRACTICE FOR STEEL BUILDINGS AND BRIDGES."

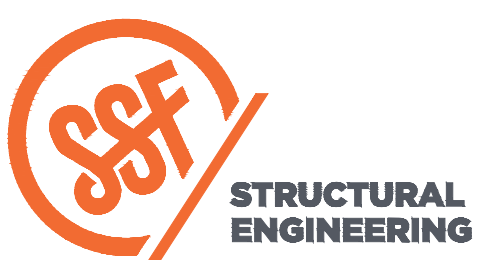

2124 Third Avenue - Suite 100 - Seattle, WA 98121  
P: 206.443.6212  
ssfengineers.com

934 Broadway - Tacoma, WA 98402  
P: 253.284.9470  
ssfengineers.com

Copyright 2022 Swenson Slay Fajét - All Rights Reserved



DESIGN: HAA, BDM  
DRAWN: NHD  
CHECKED: BDM  
APPROVED: DJS

REVISIONS:		
1	Corrections	May 4, 2021
2	Corrections 2	Aug. 13, 2021
3	Permit Revisions	Apr. 22, 2022
4	Corrections	Jun. 10, 2022

DPD:

PROJECT TITLE:  
**Clarkson Residence**  
8163 West Mercer Way  
Mercer Island, WA 98040

ARCHITECT:  
**Brandt Design Group**  
66 Bell Street, Unit 1  
Seattle, WA 98121  
PH 206.239.0850

ISSUE:  
**PERMIT**

SHEET TITLE:  
**Special Inspection Notes**

SCALE:  
DATE: December 24, 2020  
PROJECT NO: 01519-2021-11  
SHEET NO:

**S1.3**



DESIGN: HAA, BDM  
DRAWN: NHD  
CHECKED: BDM  
APPROVED: DJS

REVISIONS:

1	Corrections	May 4, 2021
2	Corrections 2	Aug. 13, 2021
3	Permit Revisions	Apr. 22, 2022
4	Corrections	Jun. 10, 2022

DPD:

PROJECT TITLE:  
**Clarkson Residence**  
8163 West Mercer Way  
Mercer Island, WA 98040


ARCHITECT:  
**Brandt Design Group**  
66 Bell Street, Unit 1  
Seattle, WA 98121  
PH 206.239.0850

ISSUE:  
**PERMIT**

SHEET TITLE:  
**Lower Foundation Plan**

SCALE: 1/4" = 1'-0" U.N.O.  
DATE: December 24, 2020  
PROJECT NO: 01519-2021-11  
SHEET NO:

**S2.1**

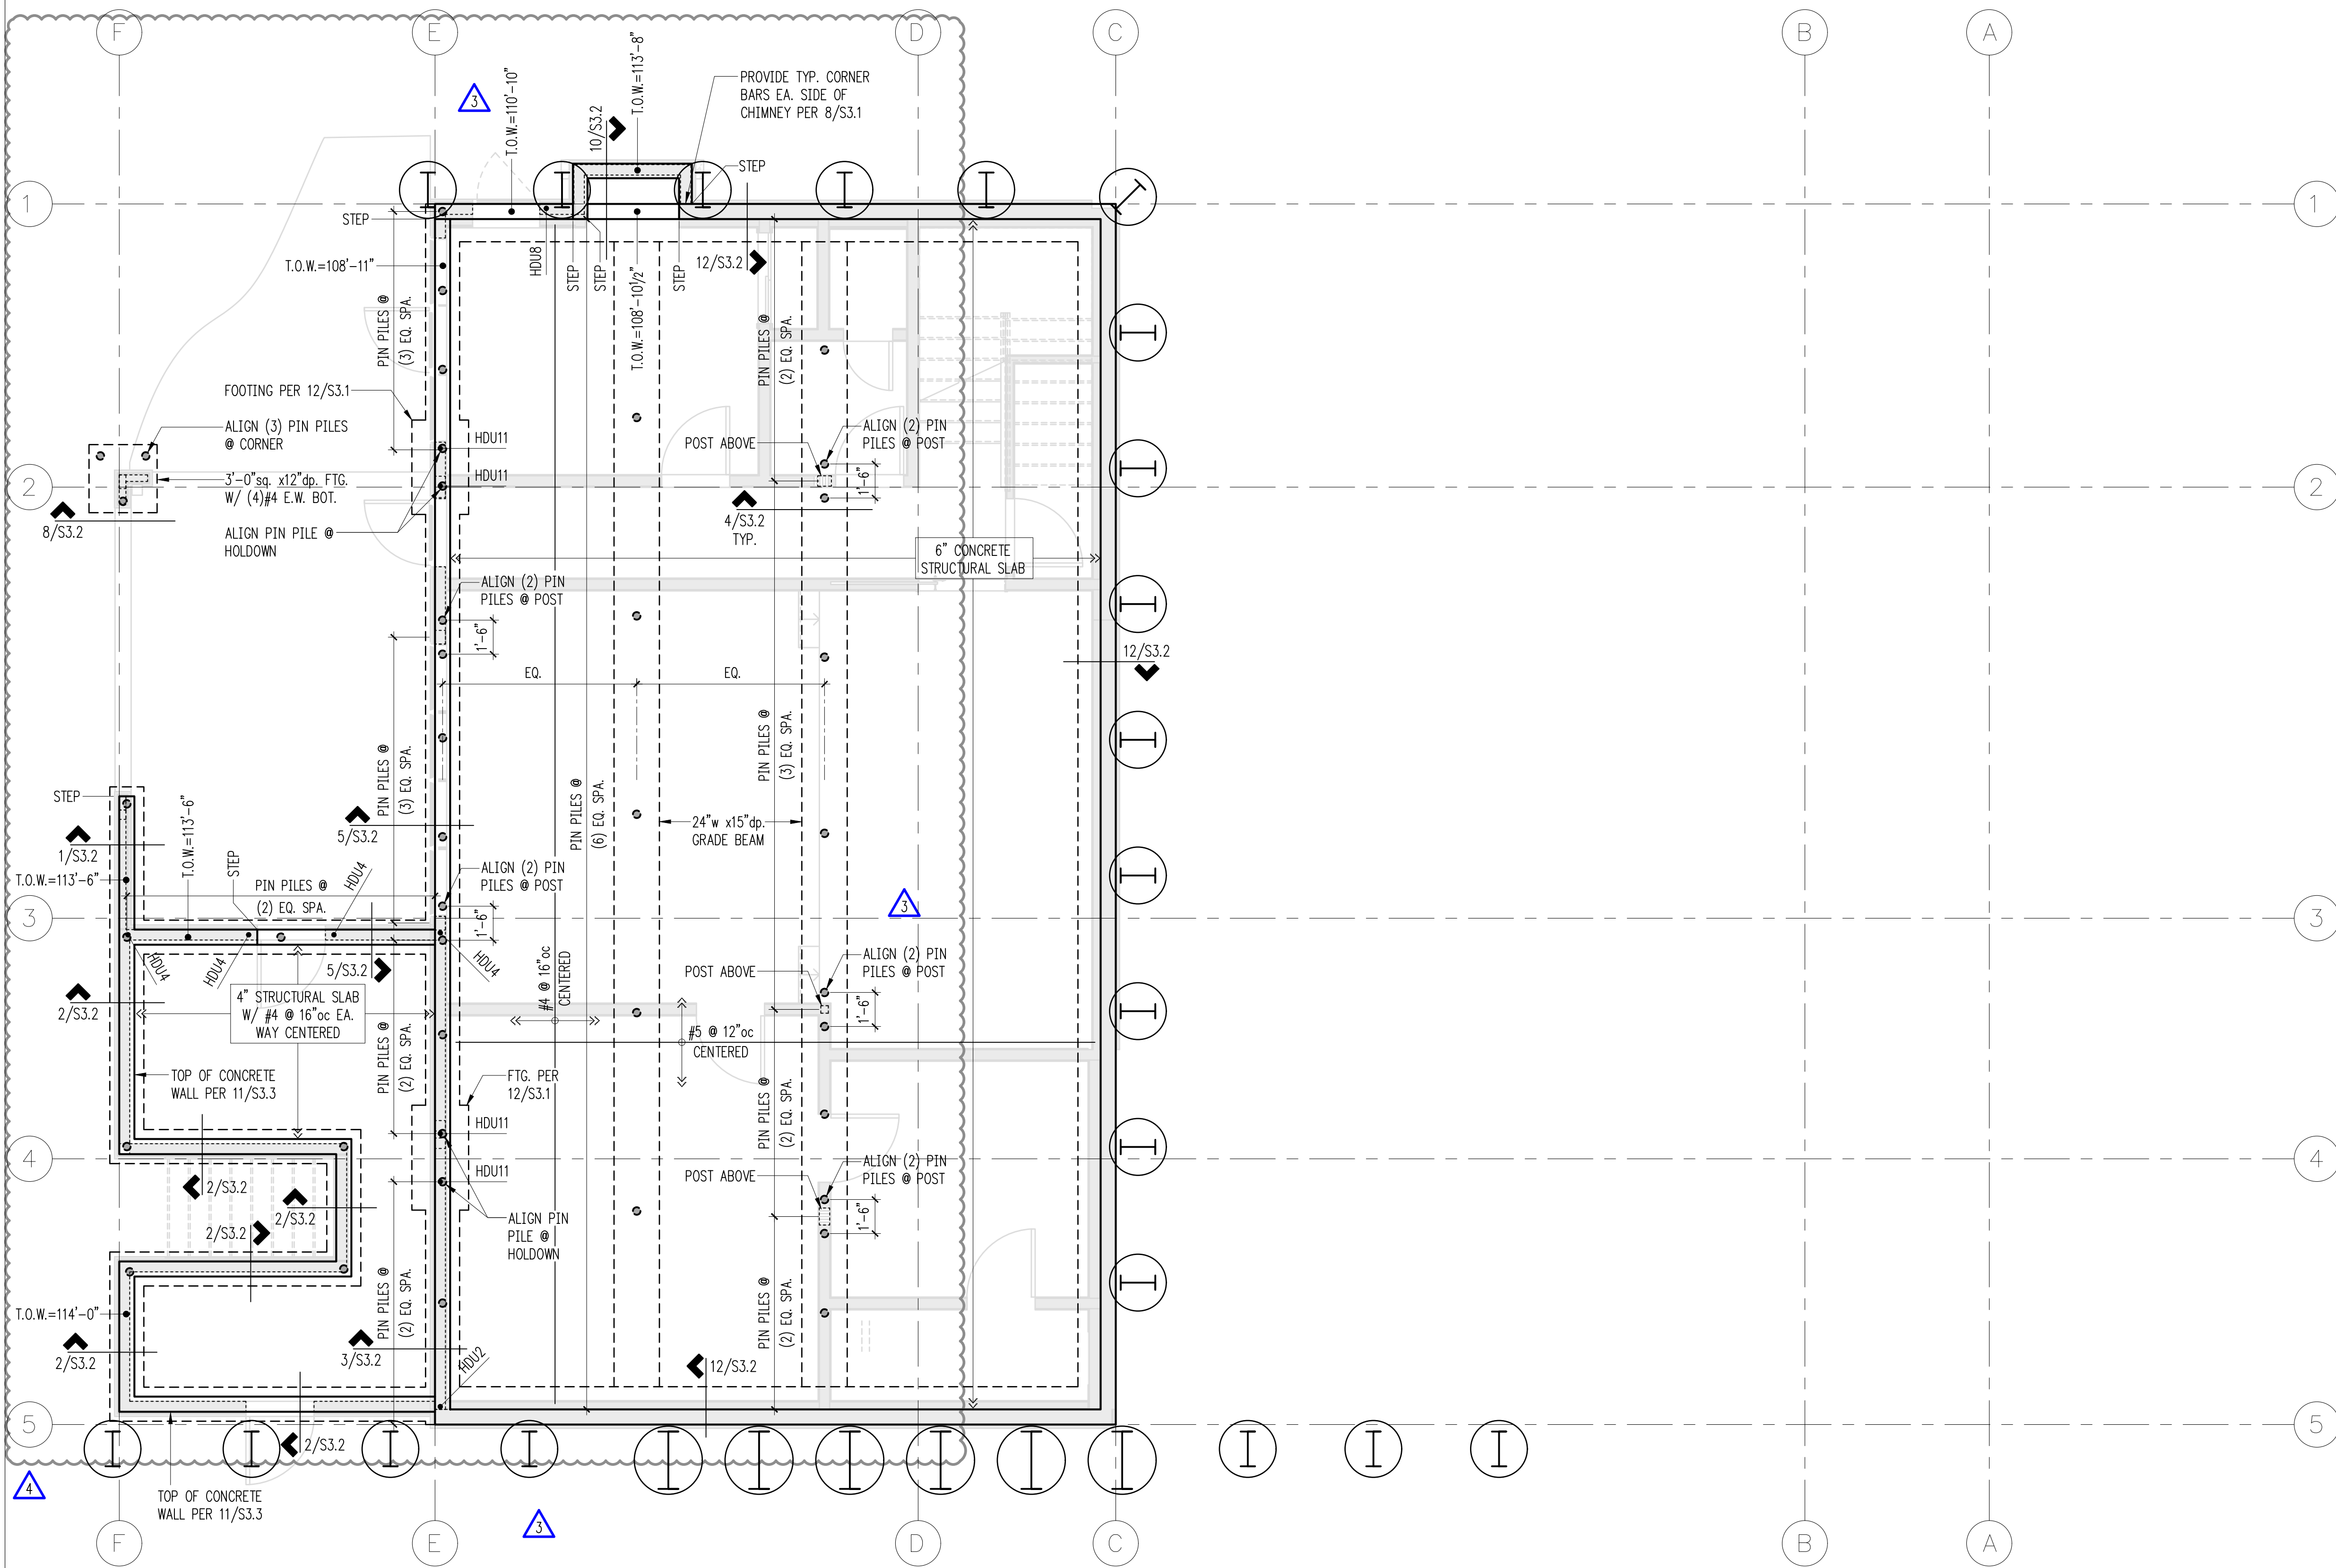


**Legend**

- STRUCTURAL WALL OR POST ABOVE
- STEM WALL & FOOTING
- HDUx HOLDOWN PER 12/S3.1
- SHORING PILE PER SH2.1
- 4" PIN PILE (41 total this sheet)  
NOTE: PIN PILES SUBSTITUTED FOR AUGER CAST PILES; PILES PER GEOTECH REPORT
- T.O.W. TOP OF WALL ELEVATION. ELEVATIONS ARE ESTIMATES, CONTRACTOR TO CONFIRM W/ ARCHITECT & ACTUAL SITE CONDITIONS

**Plan Notes**

1. DO NOT SCALE DRAWINGS. REFER TO ARCHITECTURAL DRAWINGS FOR ALL DIMENSIONS.
2. REFER TO GENERAL STRUCTURAL NOTES FOR ADDITIONAL REQUIREMENTS.
3. THE BOTTOM OF ALL EXTERIOR FOOTINGS SHALL BE 18" MINIMUM BELOW EXTERIOR GRADE.
4. ALL POSTS ABOVE SHALL BEAR FULLY ON BEAMS OR POSTS BELOW AND SHALL HAVE FULL CONTINUOUS BEARING THROUGH FLOORS TO FOUNDATION.
5. INTERIOR SLABS ON GRADE PER PLAN. BELOW SLAB PROVIDE A 10-MIL VAPOR BARRIER OVER 6" MINIMUM FREE DRAINING GRAVEL OVER FIRM NATIVE SOILS OR STRUCTURAL FILL.
6. GEOTECHNICAL SPECIAL INSPECTOR SHALL BE CONTINUOUSLY PRESENT DURING PIN PILE INSTALLATION AND LOAD TESTING.
7. AT LEAST 3% OF THE PIN PILES, BUT NO MORE THAN 5 PILES, SHALL BE LOAD TESTED TO TWICE THE DESIGN PILE LOAD. ALL LOAD TESTS SHALL BE PERFORMED IN ACCORDANCE WITH THE PROCEDURE OUTLINED IN ASTM D1143.

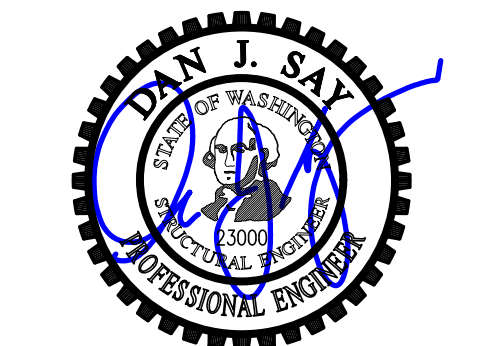

DESIGN: HAA, BDM  
DRAWN: NHD  
CHECKED: BDM  
APPROVED: DJS

REVISIONS:

1	Corrections	May 4, 2021
2	Corrections 2	Aug. 13, 2021
3	Permit Revisions	Apr. 22, 2022
4	Corrections	Jun. 10, 2022

DPD:

PROJECT TITLE:  
**Clarkson Residence**  
8163 West Mercer Way  
Mercer Island, WA 98040

ARCHITECT:  
**Brandt Design Group**  
66 Bell Street, Unit 1  
Seattle, WA 98121  
PH 206.239.0850


ISSUE:

**PERMIT**

SHEET TITLE:  
**Main Floor Framing/Upper Foundation Plan**

SCALE: 1/4" = 1'-0" U.N.O.  
DATE: December 24, 2020  
PROJECT NO: 01519-2021-11  
SHEET NO:

**S2.2**

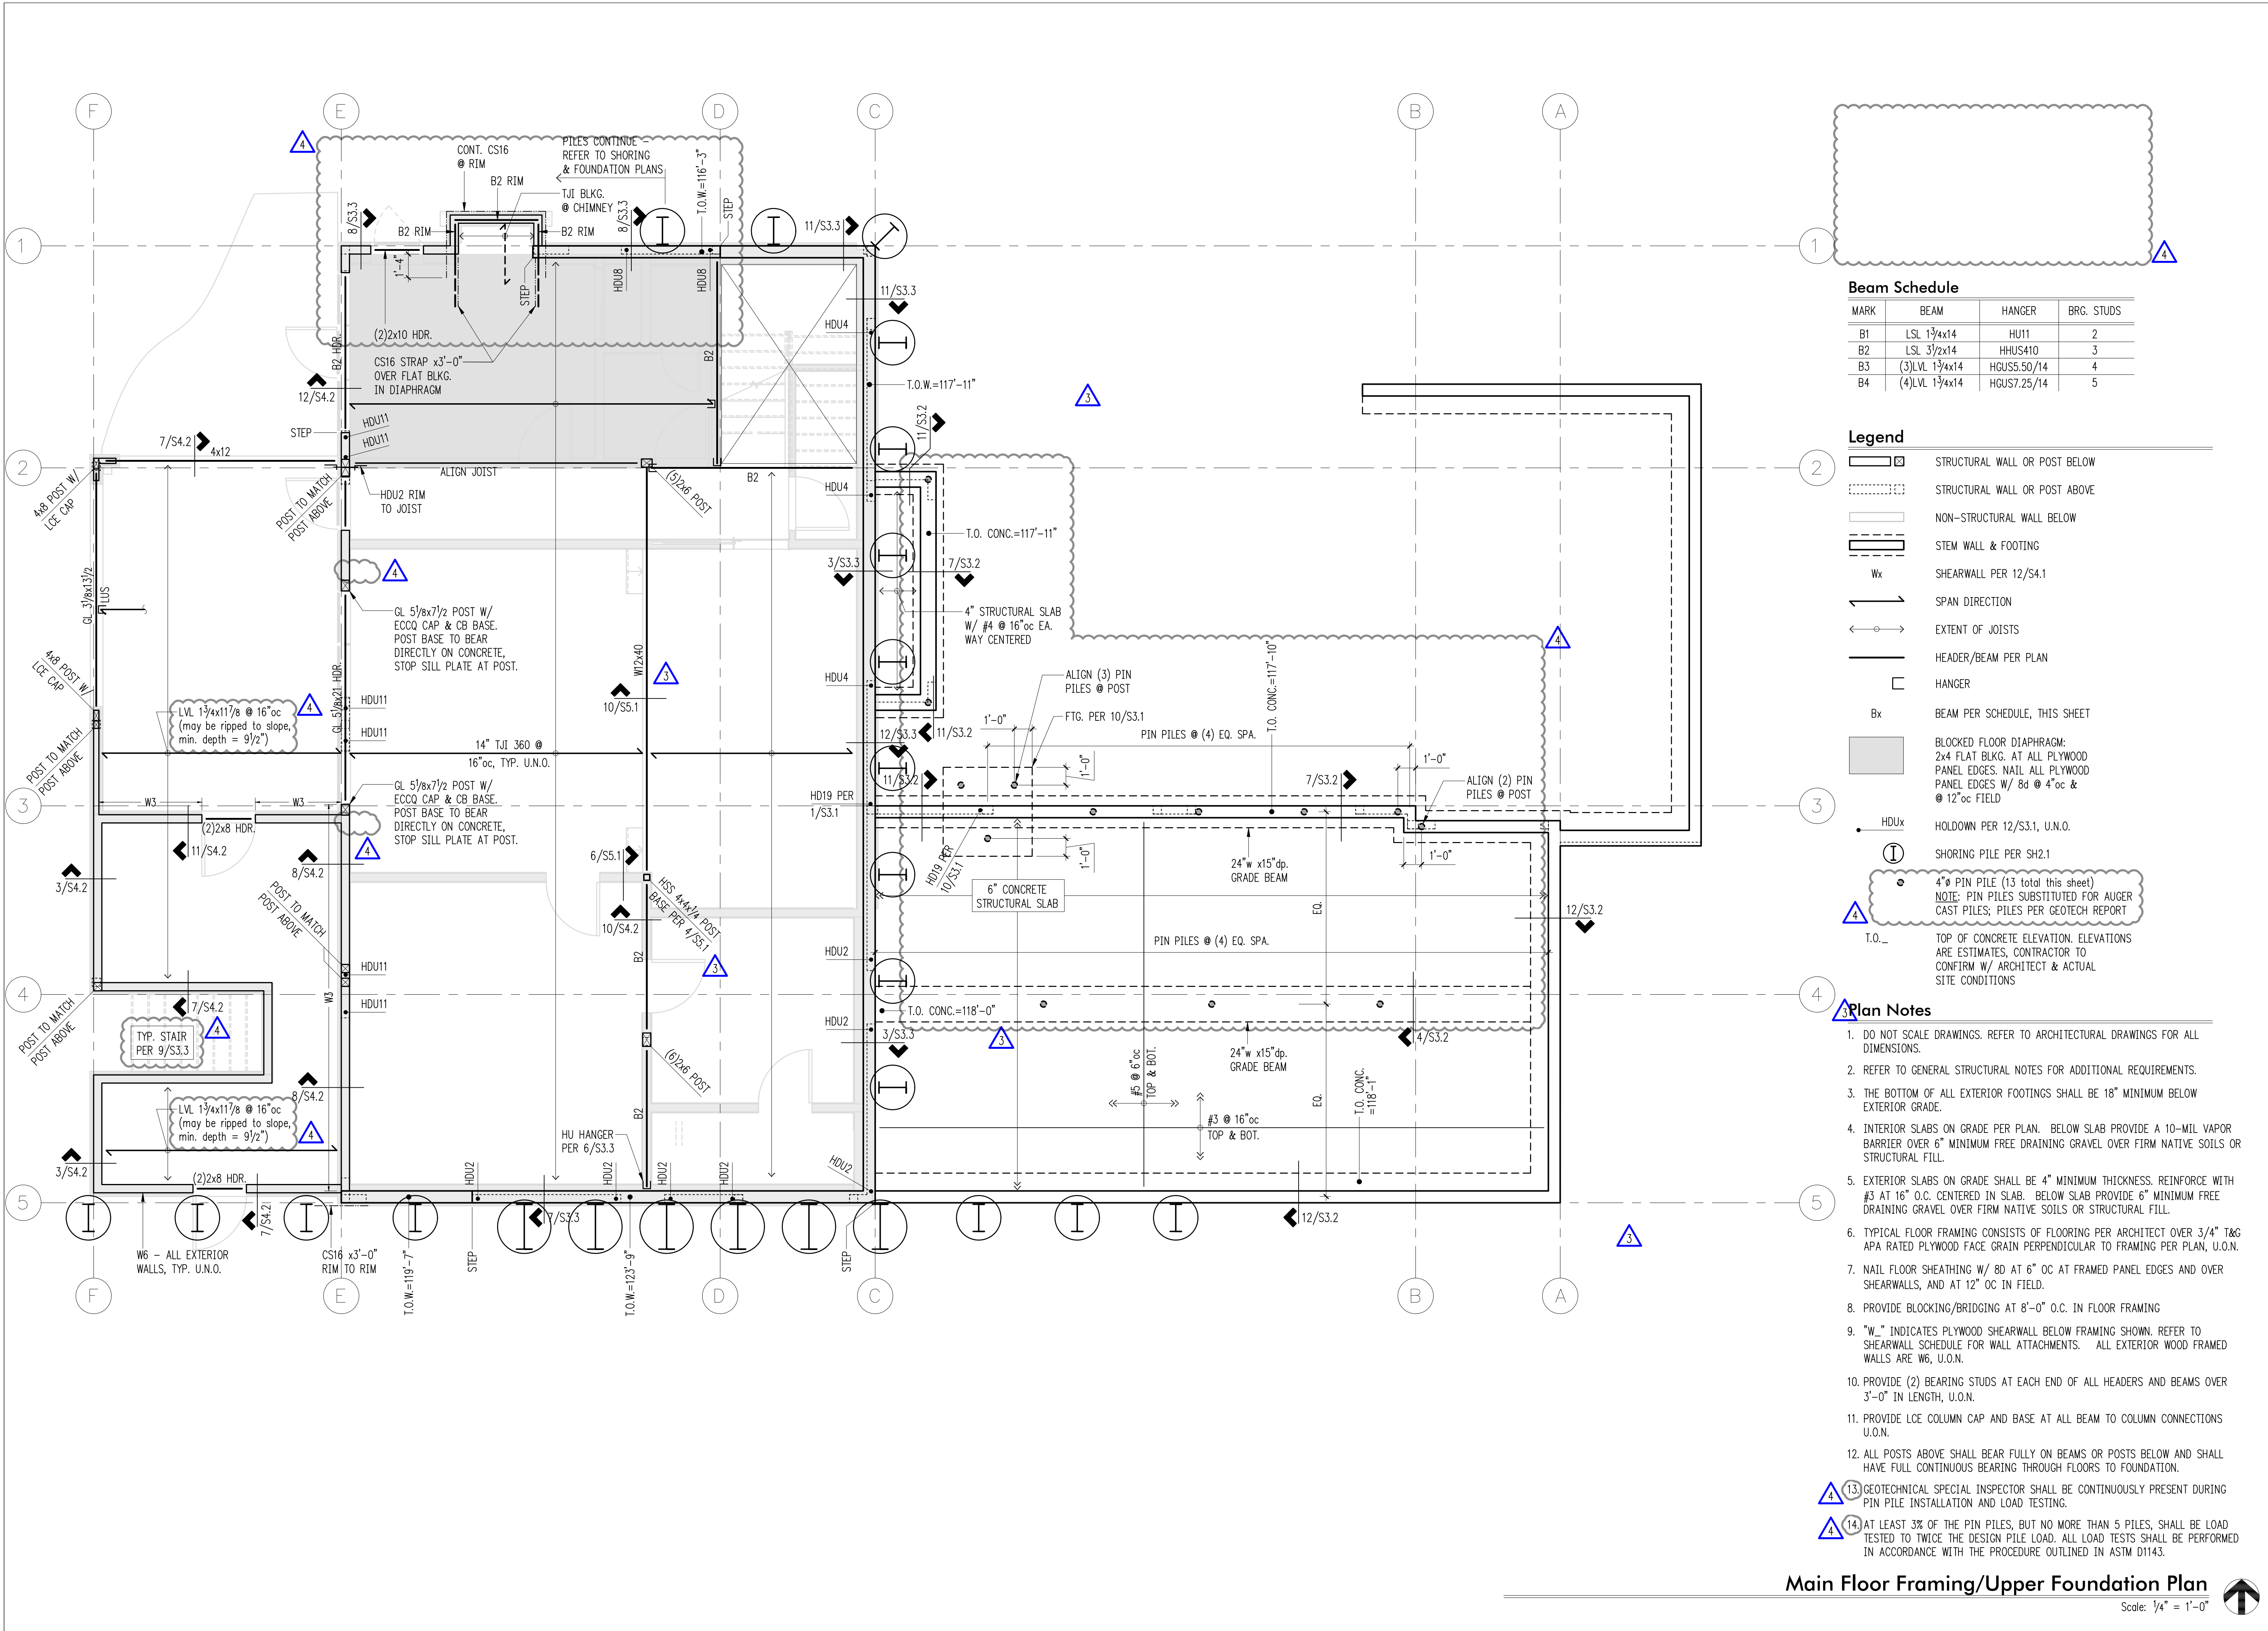

**Beam Schedule**

MARK	BEAM	HANGER	BRG. STUDS
B1	LSL 1 3/4x14	HU11	2
B2	LSL 3/2x14	HHUS410	3
B3	(3)LVL 1 3/4x14	HGUS5.50/14	4
B4	(4)LVL 1 3/4x14	HGUS7.25/14	5

- Legend**
- STRUCTURAL WALL OR POST BELOW
  - STRUCTURAL WALL OR POST ABOVE
  - NON-STRUCTURAL WALL BELOW
  - STEM WALL & FOOTING
  - SHEARWALL PER 12/S4.1
  - SPAN DIRECTION
  - EXTENT OF JOISTS
  - HEADER/BEAM PER PLAN
  - HANGER
  - BEAM PER SCHEDULE, THIS SHEET
  - BLOCKED FLOOR DIAPHRAGM:  
2x4 FLAT BLKG. AT ALL PLYWOOD  
PANEL EDGES. NAIL ALL PLYWOOD  
PANEL EDGES W/ 8d @ 4"oc &  
@ 12"oc FIELD
  - HOLDOWN PER 12/S3.1, U.N.O.
  - SHORING PILE PER SH2.1
  - 4" PIN PILE (13 total this sheet)  
NOTE: PIN PILES SUBSTITUTED FOR AUGER  
CAST PILES; PILES PER GEOTECH REPORT
  - T.O.\_ TOP OF CONCRETE ELEVATION. ELEVATIONS  
ARE ESTIMATES, CONTRACTOR TO  
CONFIRM W/ ARCHITECT & ACTUAL  
SITE CONDITIONS

- Plan Notes**
- DO NOT SCALE DRAWINGS. REFER TO ARCHITECTURAL DRAWINGS FOR ALL DIMENSIONS.
  - REFER TO GENERAL STRUCTURAL NOTES FOR ADDITIONAL REQUIREMENTS.
  - THE BOTTOM OF ALL EXTERIOR FOOTINGS SHALL BE 18" MINIMUM BELOW EXTERIOR GRADE.
  - INTERIOR SLABS ON GRADE PER PLAN. BELOW SLAB PROVIDE A 10-MIL VAPOR BARRIER OVER 6" MINIMUM FREE DRAINING GRAVEL OVER FIRM NATIVE SOILS OR STRUCTURAL FILL.
  - EXTERIOR SLABS ON GRADE SHALL BE 4" MINIMUM THICKNESS. REINFORCE WITH #3 AT 16" O.C. CENTERED IN SLAB. BELOW SLAB PROVIDE 6" MINIMUM FREE DRAINING GRAVEL OVER FIRM NATIVE SOILS OR STRUCTURAL FILL.
  - TYPICAL FLOOR FRAMING CONSISTS OF FLOORING PER ARCHITECT OVER 3/4" T&G APA RATED PLYWOOD FACE GRAIN PERPENDICULAR TO FRAMING PER PLAN, U.N.O.
  - NAIL FLOOR SHEATHING W/ 8D @ 6" OC AT FRAMED PANEL EDGES AND OVER SHEARWALLS, AND AT 12" OC IN FIELD.
  - PROVIDE BLOCKING/BRIDGING AT 8'-0" O.C. IN FLOOR FRAMING
  - "W\_" INDICATES PLYWOOD SHEARWALL BELOW FRAMING SHOWN. REFER TO SHEARWALL SCHEDULE FOR WALL ATTACHMENTS. ALL EXTERIOR WOOD FRAMED WALLS ARE W6, U.N.O.
  - PROVIDE (2) BEARING STUDS AT EACH END OF ALL HEADERS AND BEAMS OVER 3'-0" IN LENGTH, U.N.O.
  - PROVIDE LCE COLUMN CAP AND BASE AT ALL BEAM TO COLUMN CONNECTIONS U.N.O.
  - ALL POSTS ABOVE SHALL BEAR FULLY ON BEAMS OR POSTS BELOW AND SHALL HAVE FULL CONTINUOUS BEARING THROUGH FLOORS TO FOUNDATION.
  - GEOTECHNICAL SPECIAL INSPECTOR SHALL BE CONTINUOUSLY PRESENT DURING PIN PILE INSTALLATION AND LOAD TESTING.
  - AT LEAST 3% OF THE PIN PILES, BUT NO MORE THAN 5 PILES, SHALL BE LOAD TESTED TO TWICE THE DESIGN PILE LOAD. ALL LOAD TESTS SHALL BE PERFORMED IN ACCORDANCE WITH THE PROCEDURE OUTLINED IN ASTM D1143.

**Main Floor Framing/Upper Foundation Plan**  
Scale: 1/4" = 1'-0"





DESIGN: HAA, BDM  
DRAWN: NHD  
CHECKED: BDM  
APPROVED: DJS

REVISIONS:

1	Corrections	May 4, 2021
2	Corrections 2	Aug. 13, 2021
3	Permit Revisions	Apr. 22, 2022
4	Corrections	Jun. 10, 2022

DPD:

PROJECT TITLE:  
**Clarkson Residence**  
8163 West Mercer Way  
Mercer Island, WA 98040


ARCHITECT:  
**Brandt Design Group**  
66 Bell Street, Unit 1  
Seattle, WA 98121  
PH 206.239.0850

ISSUE:  
**PERMIT**  
SHEET TITLE:

**Upper Floor Framing Plan**

SCALE: 1/4" = 1'-0" U.N.O.  
DATE: December 24, 2020  
PROJECT NO: 01519-2021-11  
SHEET NO:

**S2.3**

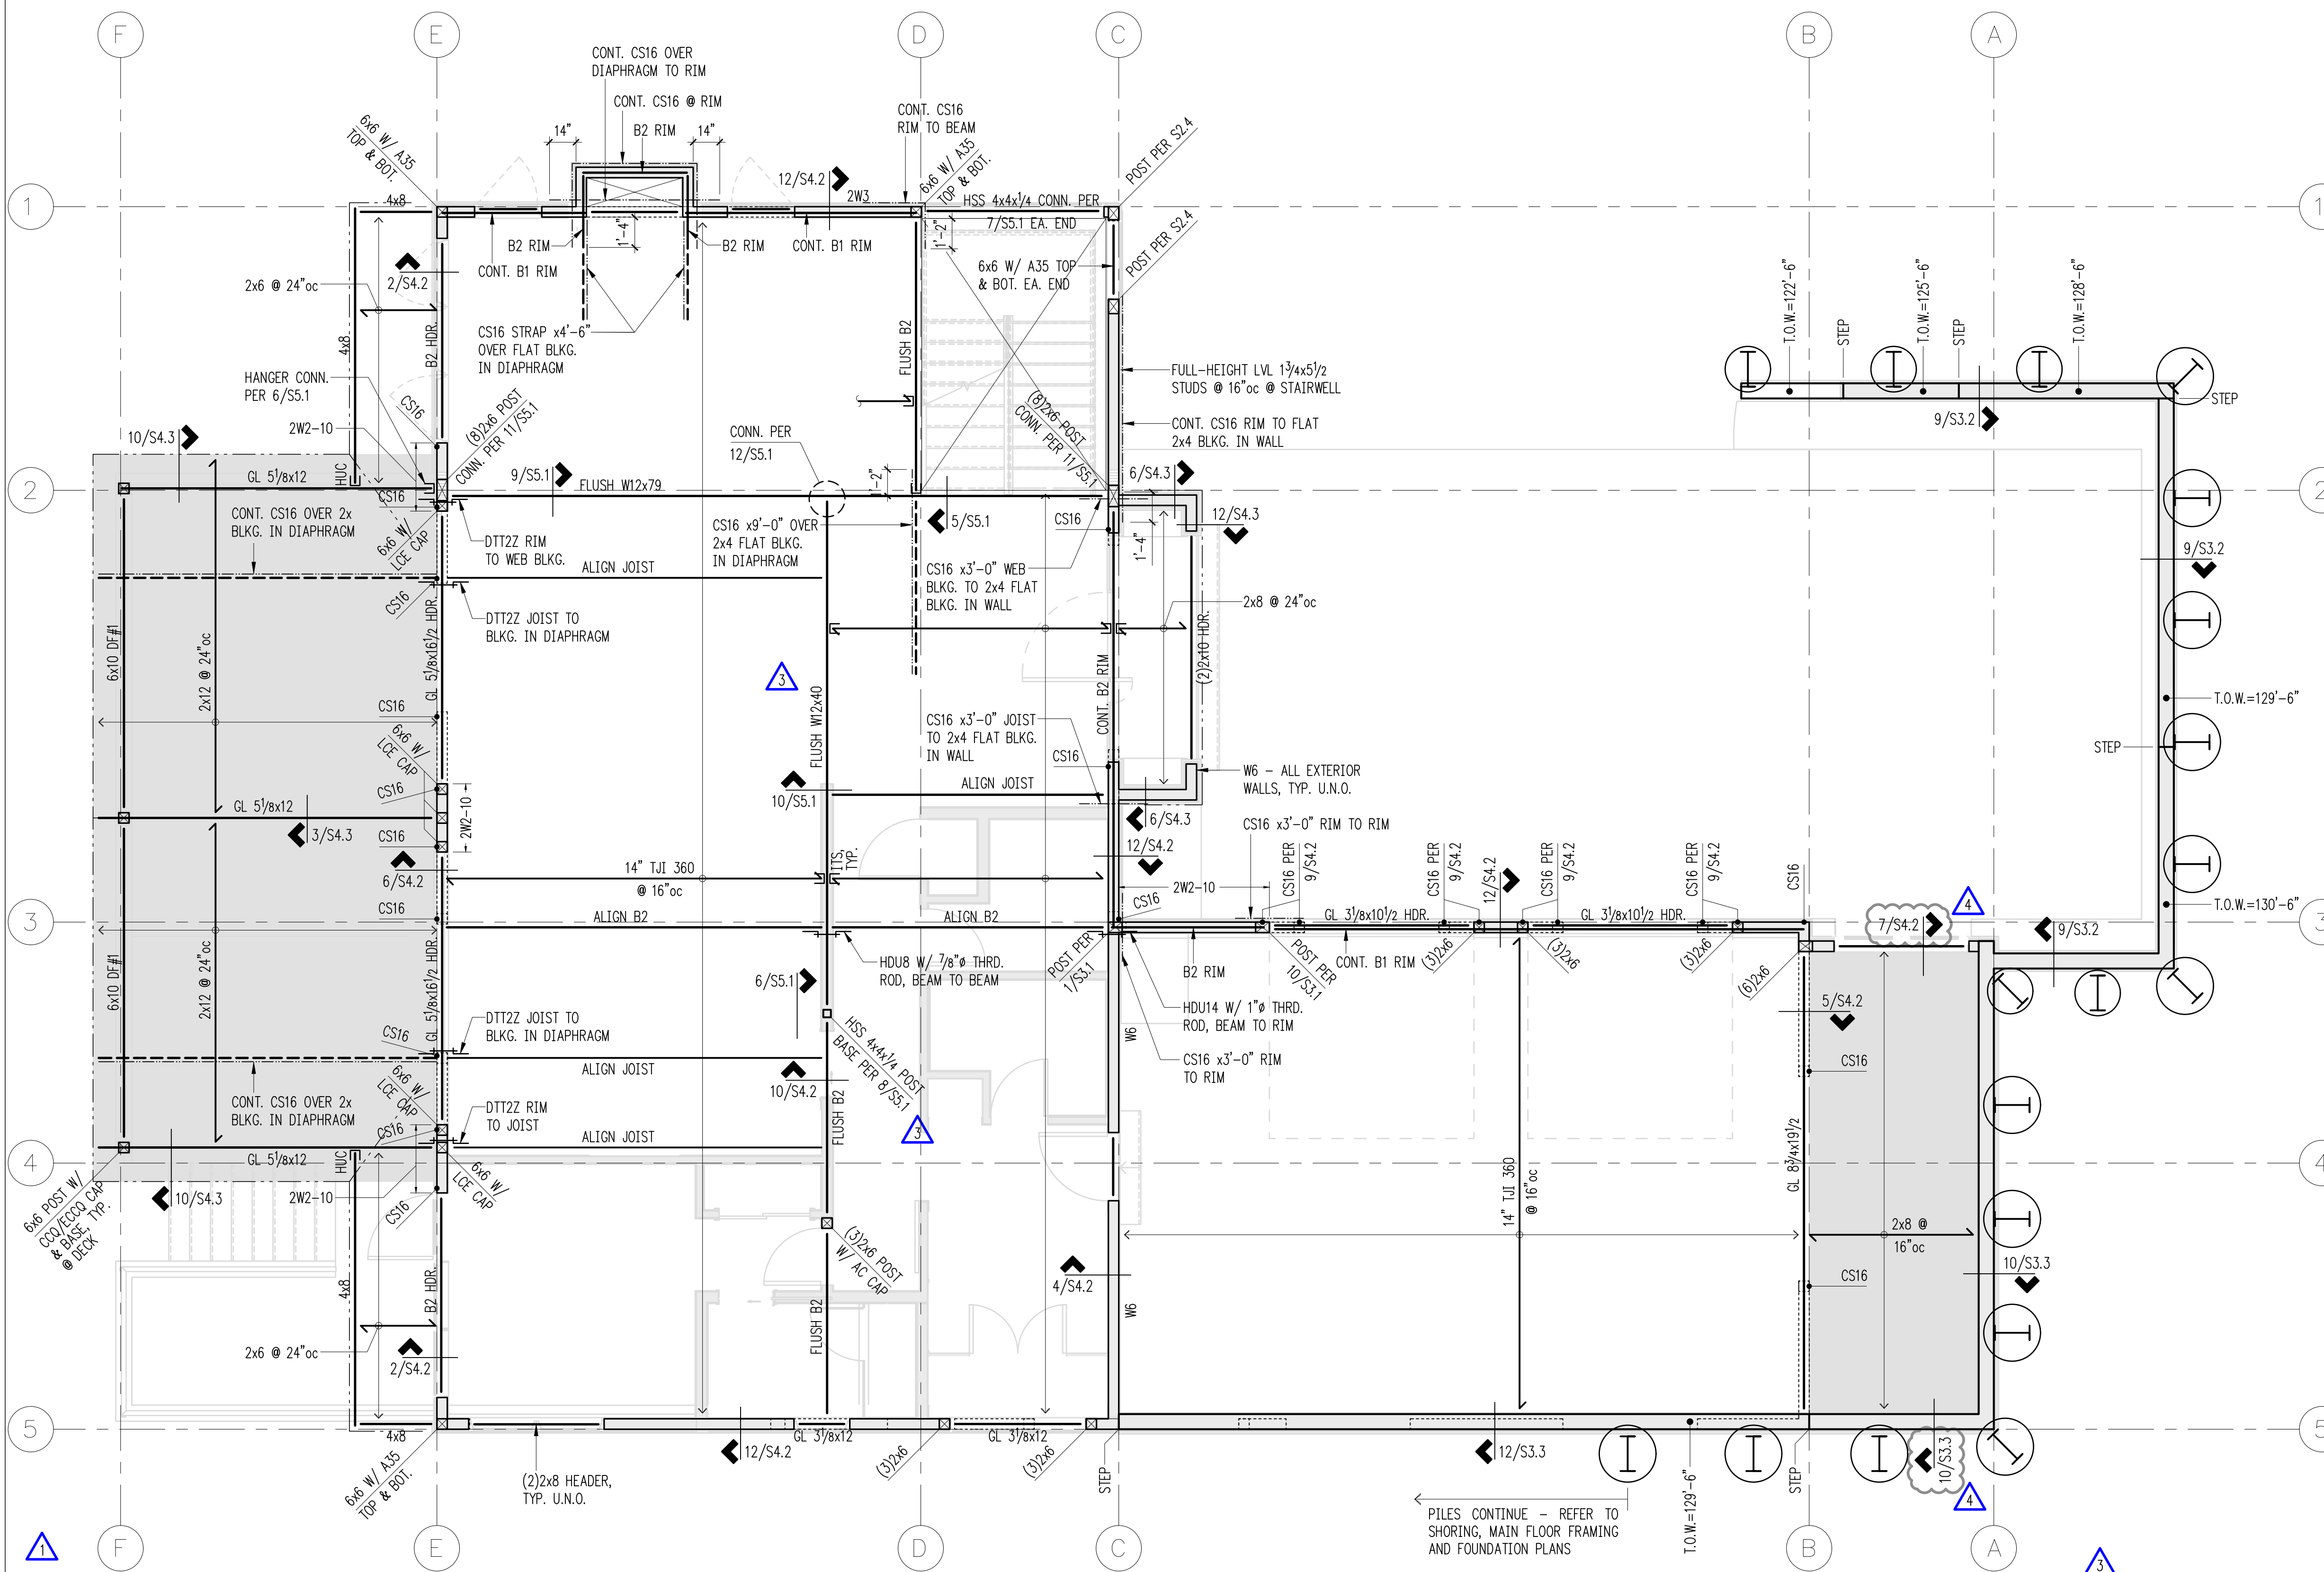

**Beam Schedule**

MARK	BEAM	HANGER	BRG. STUDS
B1	LVL 1 3/4x14	HU11	2
B2	LSL 3/2x14	HHUS410	3
B3	(3)LVL 1 3/4x14	HGUS5.50/14	4
B4	(4)LVL 1 3/4x14	HGUS7.25/14	5

**Legend**

- STRUCTURAL WALL OR POST BELOW
- STRUCTURAL WALL OR POST ABOVE
- NON-STRUCTURAL WALL BELOW
- SHEARWALL PER 12/S4.1
- SPAN DIRECTION
- EXTENT OF JOISTS
- HEADER/BEAM PER PLAN
- HANGER
- BEAM PER SCHEDULE, THIS SHEET
- BLOCKED DIAPHRAGM: 2x4 FLAT BLKG. AT ALL PLYWOOD PANEL EDGES. NAIL ALL PLYWOOD PANEL EDGES W/ 8d @ 4"oc & @ 12"oc FIELD
- HOLDOWN PER 12/S3.1
- STRAP PER 5/S4.1
- SHORING PILE PER SH2.1
- T.O.W. TOP OF WALL ELEVATION. ELEVATIONS ARE ESTIMATES, CONTRACTOR TO CONFIRM W/ ARCHITECT & ACTUAL SITE CONDITIONS

**Plan Notes**

1. DO NOT SCALE DRAWINGS. REFER TO ARCHITECTURAL DRAWINGS FOR ALL DIMENSIONS.
2. REFER TO GENERAL STRUCTURAL NOTES FOR ADDITIONAL REQUIREMENTS.
3. TYPICAL FLOOR FRAMING CONSISTS OF FLOORING PER ARCHITECT OVER 3/4" T&G APA RATED PLYWOOD FACE GRAIN PERPENDICULAR TO FRAMING PER PLAN, U.O.N.
4. NAIL FLOOR SHEATHING W/ 8D AT 6" OC AT FRAMED PANEL EDGES AND OVER SHEARWALLS, AND AT 12" OC IN FIELD.
5. PROVIDE BLOCKING/BRIDGING AT 8'-0" O.C. IN FLOOR FRAMING
6. "W." INDICATES PLYWOOD SHEARWALL BELOW FRAMING SHOWN. REFER TO SHEARWALL SCHEDULE FOR WALL ATTACHMENTS. ALL EXTERIOR WOOD FRAMED WALLS ARE W6, U.O.N.
7. PROVIDE (2) BEARING STUDS AT EACH END OF ALL HEADERS AND BEAMS OVER 3'-0" IN LENGTH, U.O.N.
8. PROVIDE (2) BEARING STUDS AT ALL BEAM TO COLUMN CONNECTIONS U.O.N.
9. ALL POSTS ABOVE SHALL BEAR FULLY ON BEAMS OR POSTS BELOW AND SHALL HAVE FULL CONTINUOUS BEARING THROUGH FLOORS TO FOUNDATION.

**Upper Floor Framing Plan**  
Scale: 1/4" = 1'-0"





DESIGN: HAA, BDM  
DRAWN: NHD  
CHECKED: BDM  
APPROVED: DJS

REVISIONS:

1	Corrections	May 4, 2021
2	Corrections 2	Aug. 13, 2021
3	Permit Revisions	Apr. 22, 2022
4	Corrections	Jun. 10, 2022

DPD:

**Legend**

- STRUCTURAL WALL OR POST BELOW
- NON-STRUCTURAL WALL BELOW
- Wx SHEARWALL PER 12/S4.1
- SPAN DIRECTION
- EXTENT OF JOISTS
- HEADER/BEAM PER PLAN
- HANGER
- G.T. GIRDER TRUSS
- OVERFRAME W/ 2x6 @ 24"oc. POST DOWN TO FRAMING BELOW @ 4'-0"oc

\* TOP OF BEAMS MAY BE NOTCHED 1"x1" @ 6"oc. NOTCHES SHALL BE CENTERED BETWEEN DIAPHRAGM NAILING PER PLAN NOTE 8

**Plan Notes**

- DO NOT SCALE DRAWINGS. REFER TO ARCHITECTURAL DRAWINGS FOR ALL DIMENSIONS.
- REFER TO GENERAL STRUCTURAL NOTES FOR ADDITIONAL REQUIREMENTS.
- "W\_" INDICATES PLYWOOD SHEARWALL BELOW FRAMING SHOWN. REFER TO SHEARWALL SCHEDULE FOR WALL ATTACHMENTS. ALL EXTERIOR WOOD FRAMED WALLS ARE W6, U.O.N.
- PROVIDE (2) BEARING STUDS AT EACH END OF ALL HEADERS AND BEAMS OVER 3'-0" IN LENGTH, U.O.N.
- PROVIDE LCE COLUMN CAP AND BASE AT ALL BEAM TO COLUMN CONNECTIONS U.O.N.
- ALL POSTS ABOVE SHALL BEAR FULLY ON BEAMS OR POSTS BELOW AND SHALL HAVE FULL CONTINUOUS BEARING THROUGH FLOORS TO FOUNDATION.
- TYPICAL ROOF FRAMING CONSISTS OF ROOFING PER ARCHITECTURAL DRAWINGS OVER 1/2" CDX OR 7/16" O.S.B. APA RATED SHEATHING (EXPOSURE 1), FACE GRAIN PERPENDICULAR TO FRAMING PER PLAN, U.O.N.
- NAIL ROOF SHEATHING WITH 8D AT 6" O.C. AT ALL FRAMED PANEL EDGES AND OVER SHEARWALLS, AND AT 12" O.C. FIELD.
- PROVIDE H1 AT ENDS OF ALL RAFTERS OR TRUSSES, U.O.N.

PROJECT TITLE:  
**Clarkson Residence**  
8163 West Mercer Way  
Mercer Island, WA 98040

ARCHITECT:  
**Brandt Design Group**  
66 Bell Street, Unit 1  
Seattle, WA 98121  
PH 206.239.0850


ISSUE:  
**PERMIT**


SHEET TITLE:  
**Roof Framing Plan**

SCALE: 1/4" = 1'-0" U.N.O.  
DATE: December 24, 2020  
PROJECT NO: 01519-2021-11  
SHEET NO:


**Roof Framing Plan**  
Scale: 1/4" = 1'-0"

**S2.4**

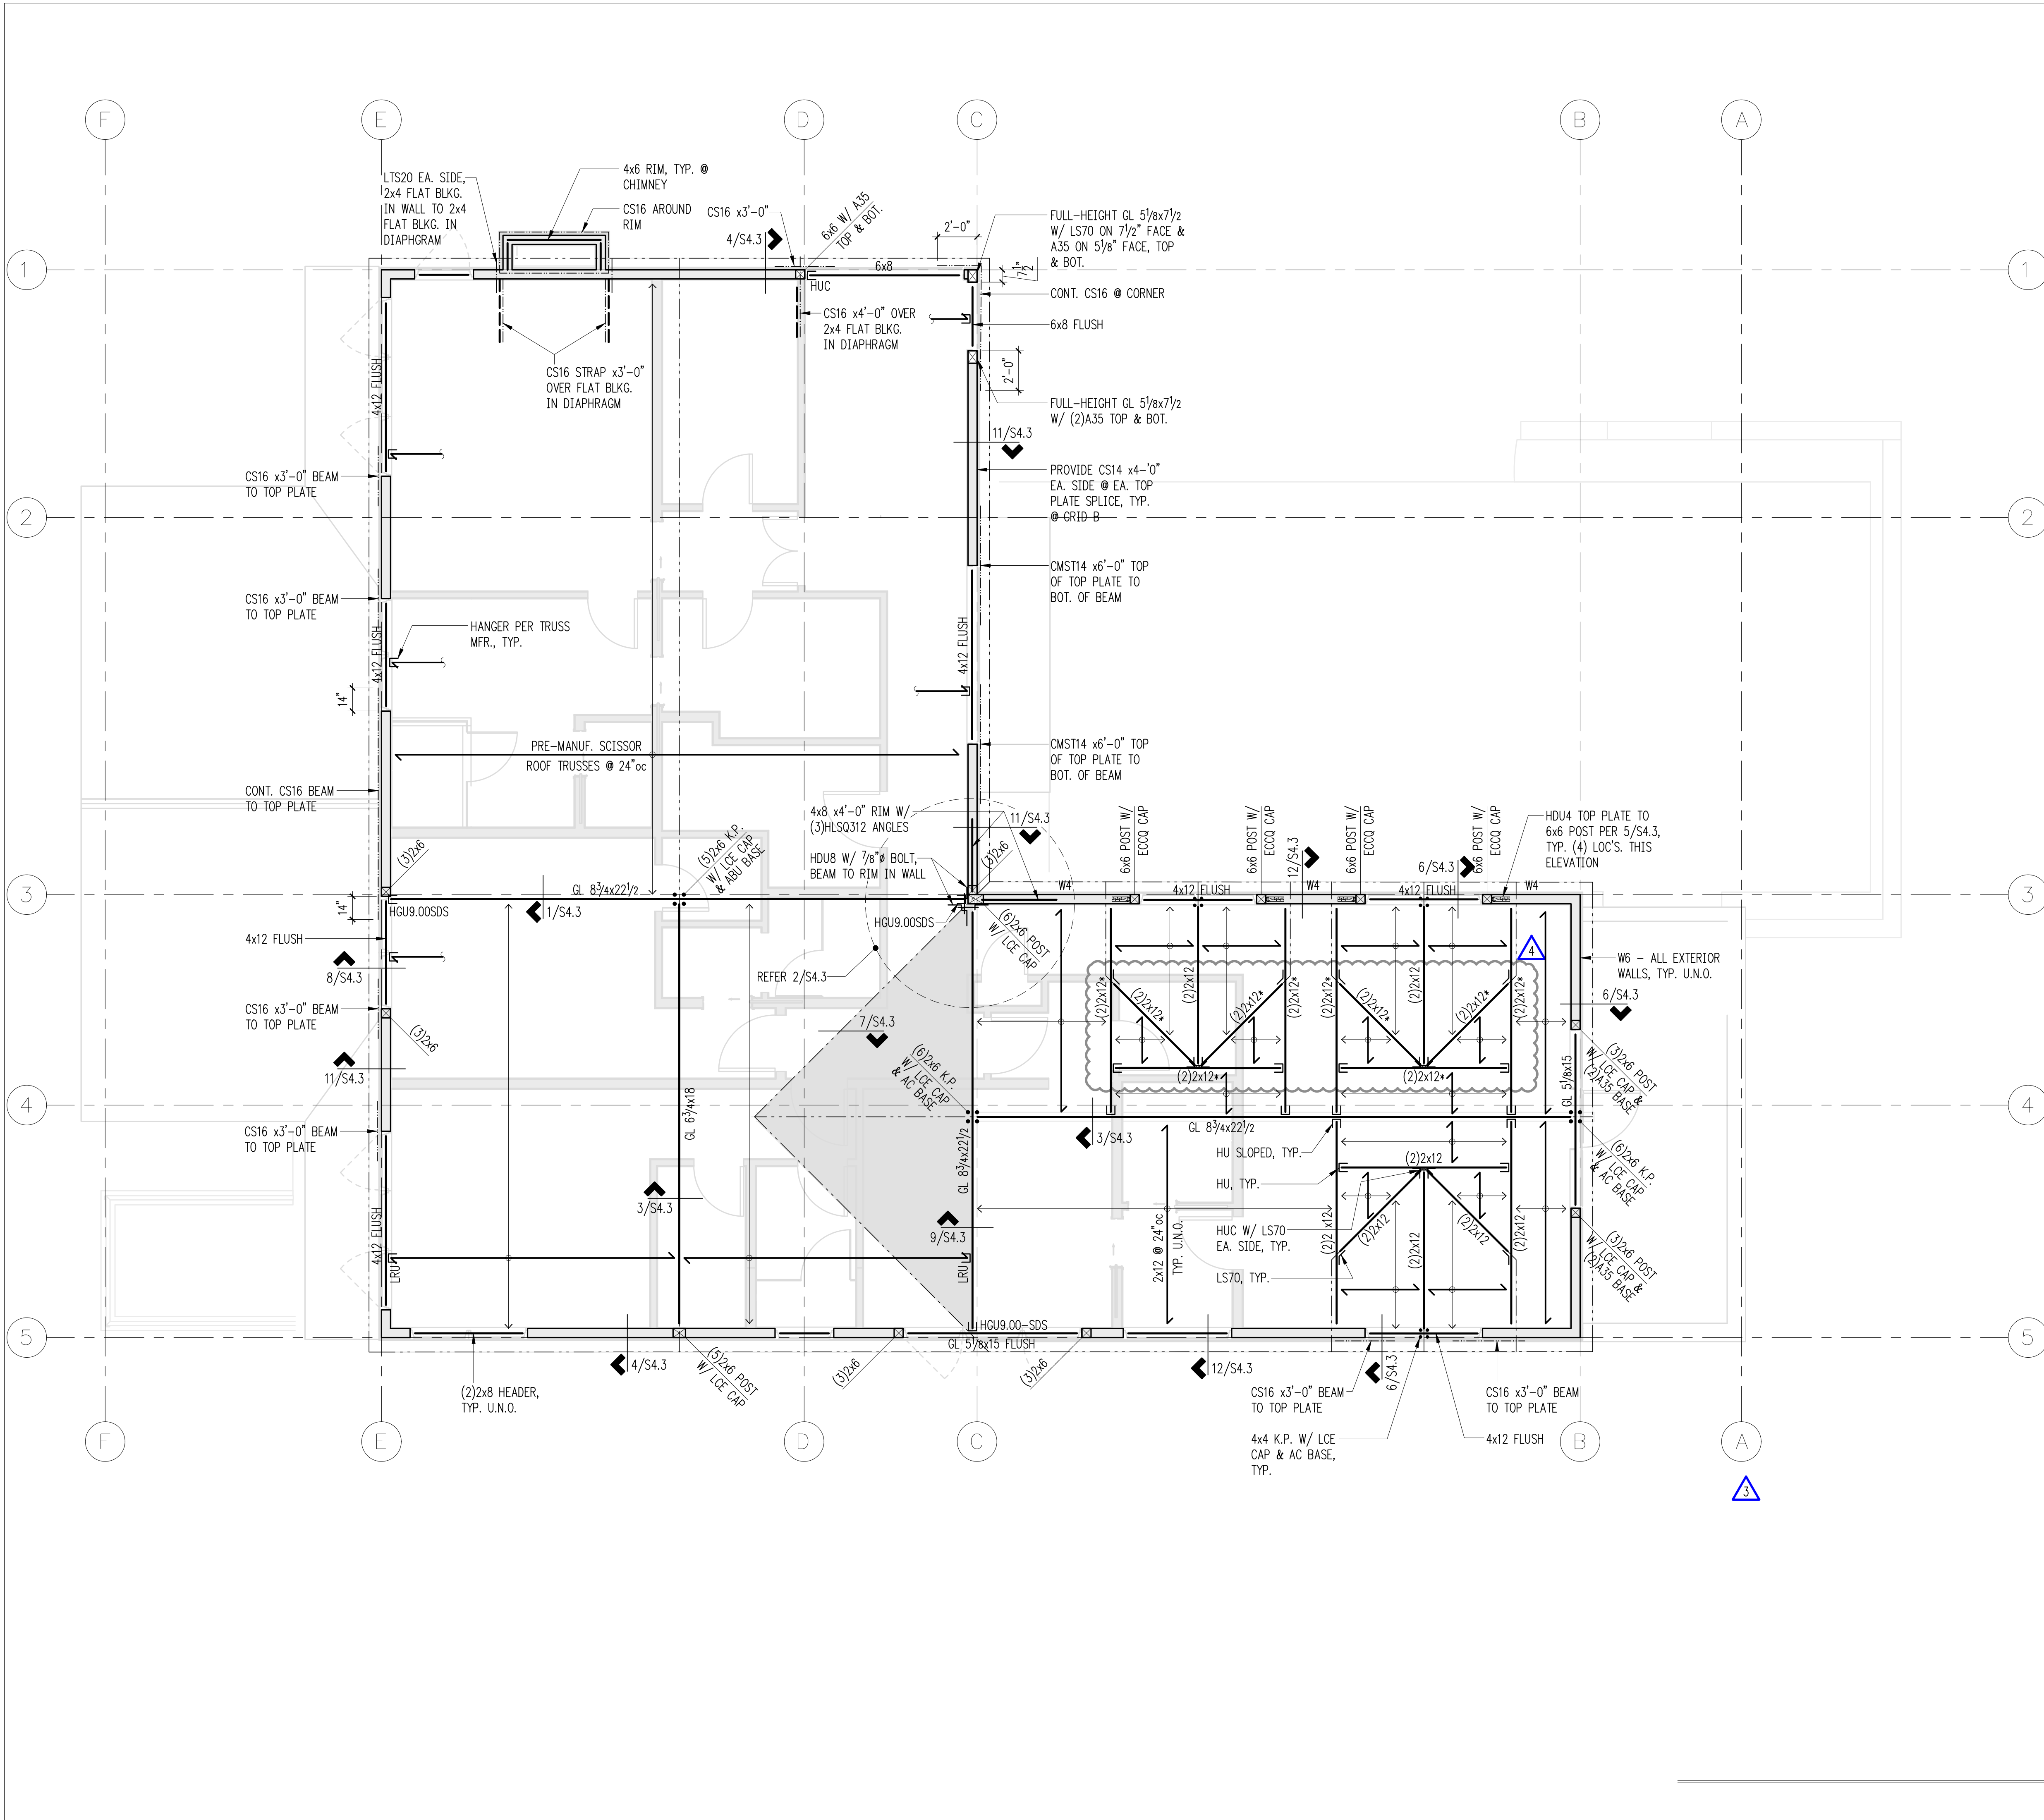


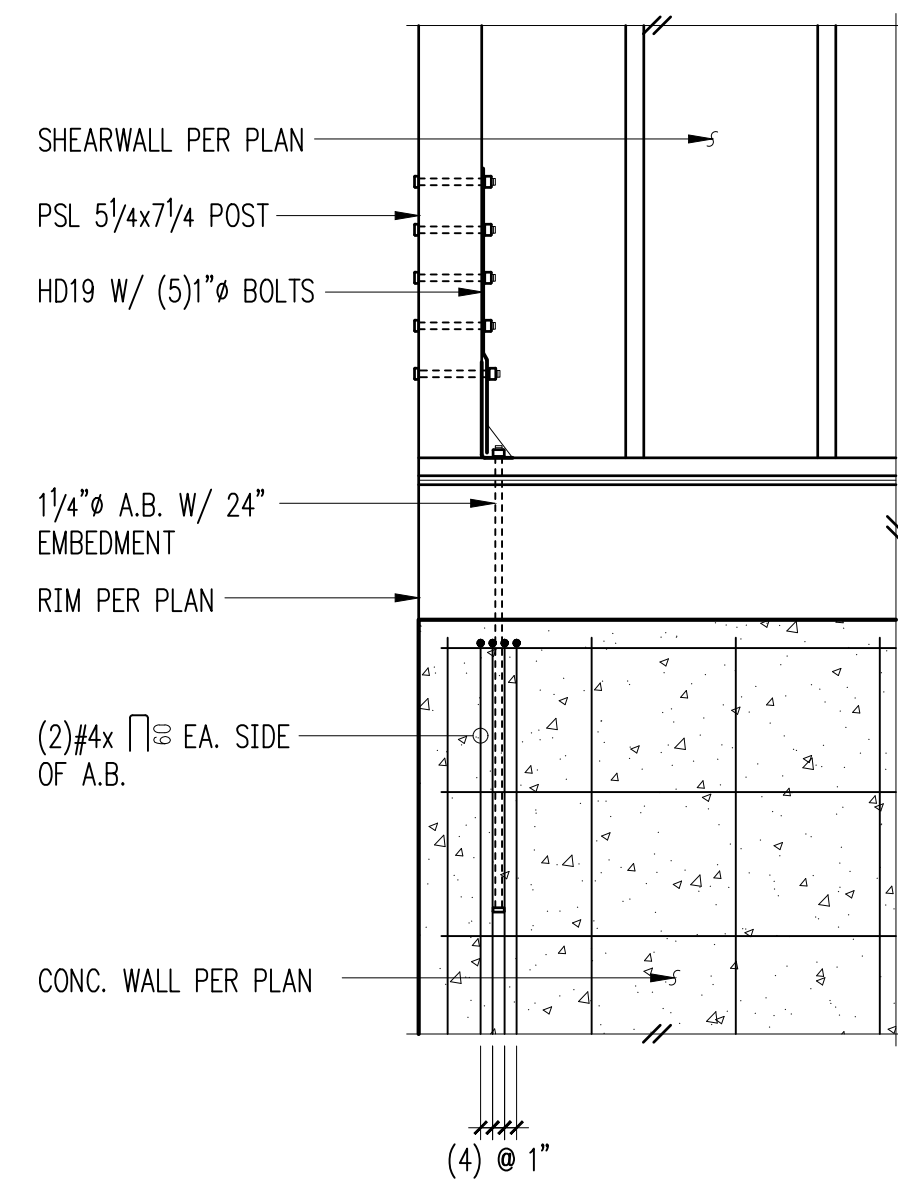


Typical HD19 Holdown **1**

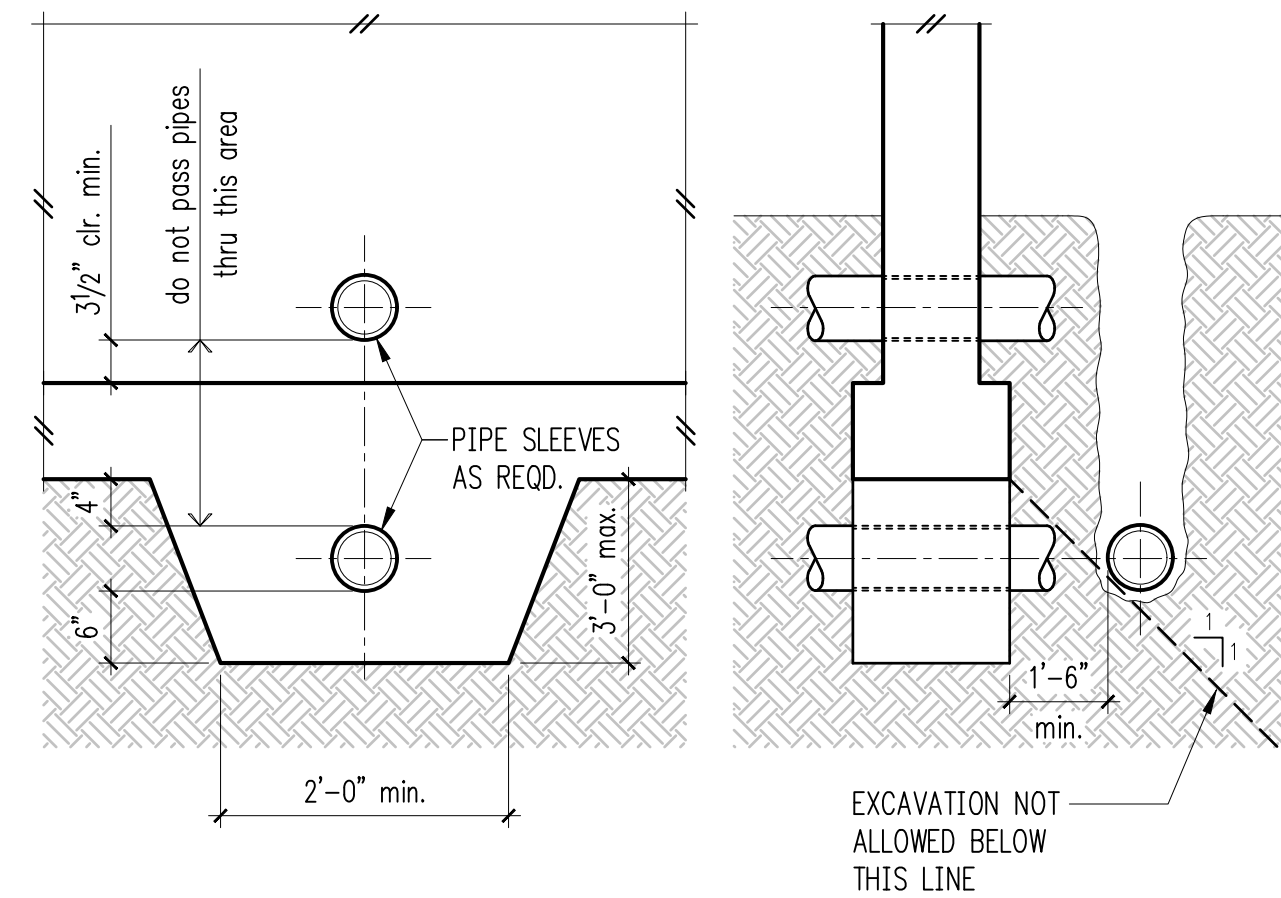


Pipe and Trench Locations **2**

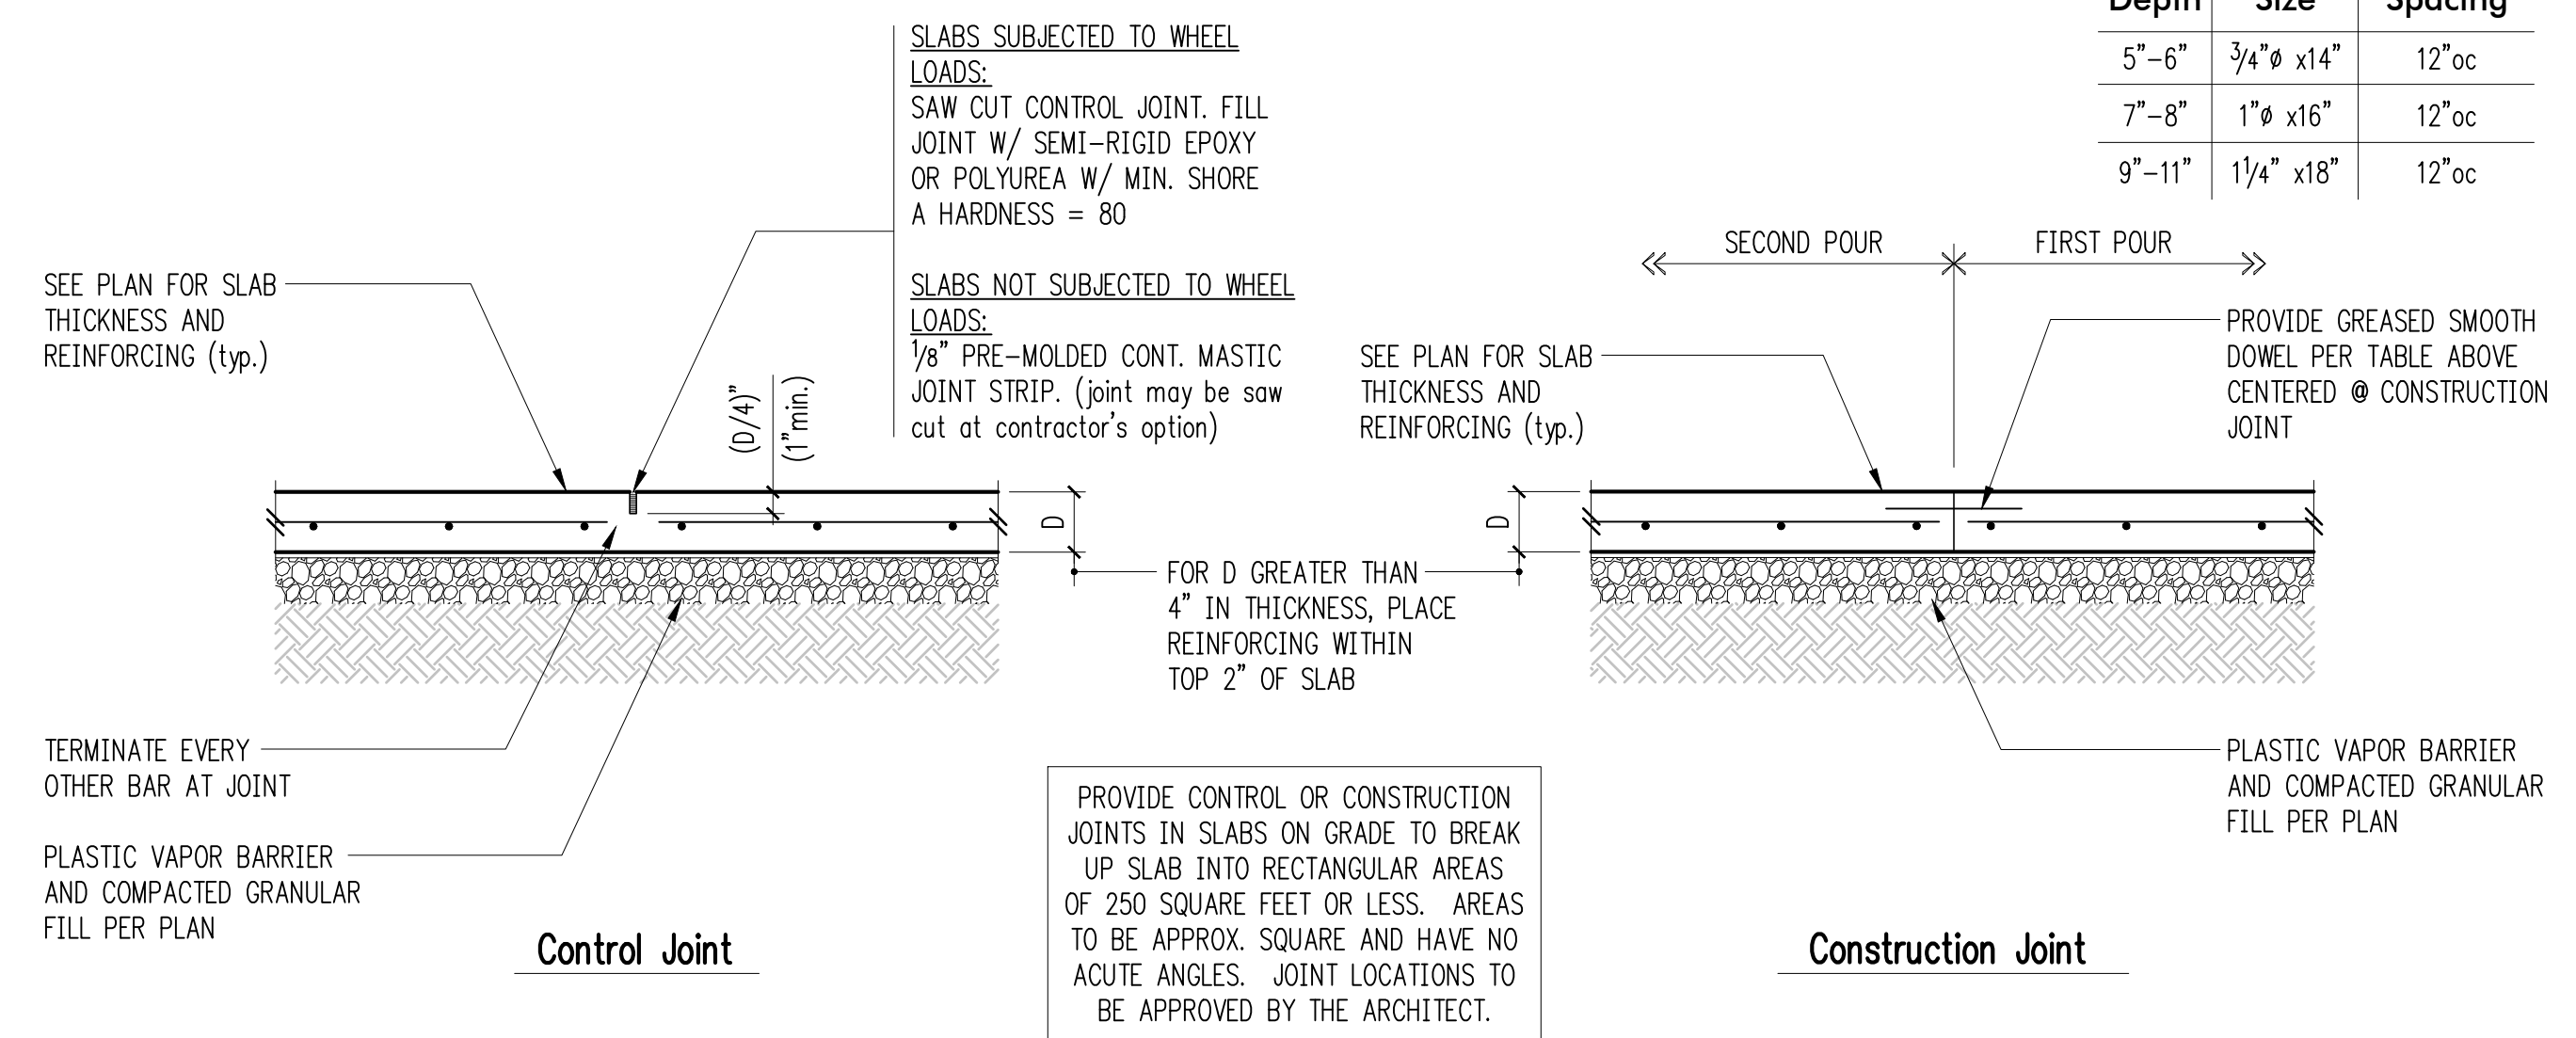


Typical Slab Joints (rebar) **4**

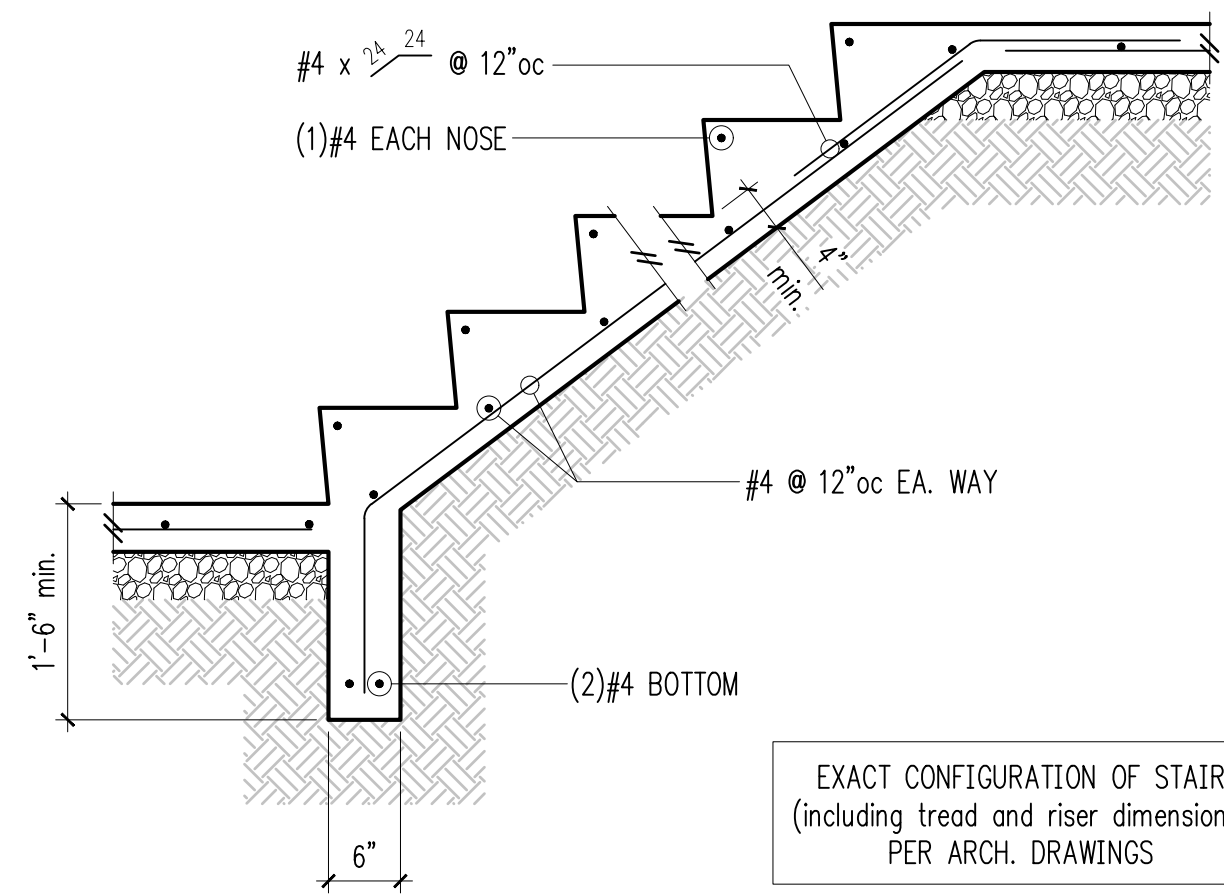


Typical Stair On Grade **5**

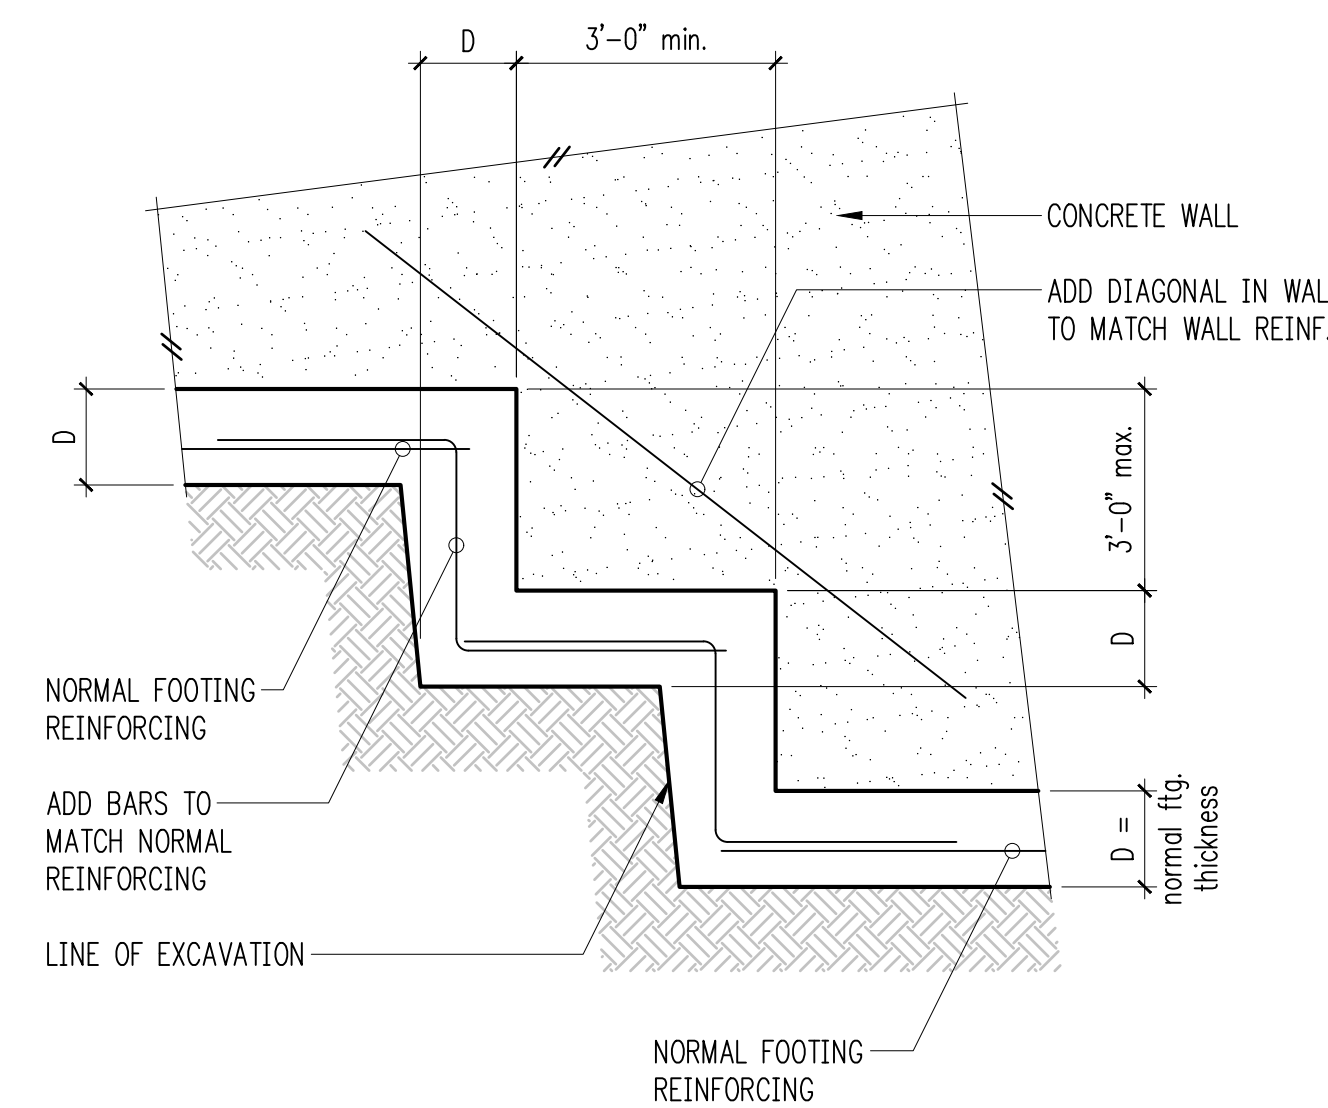


Typical Stepped Footing **6**

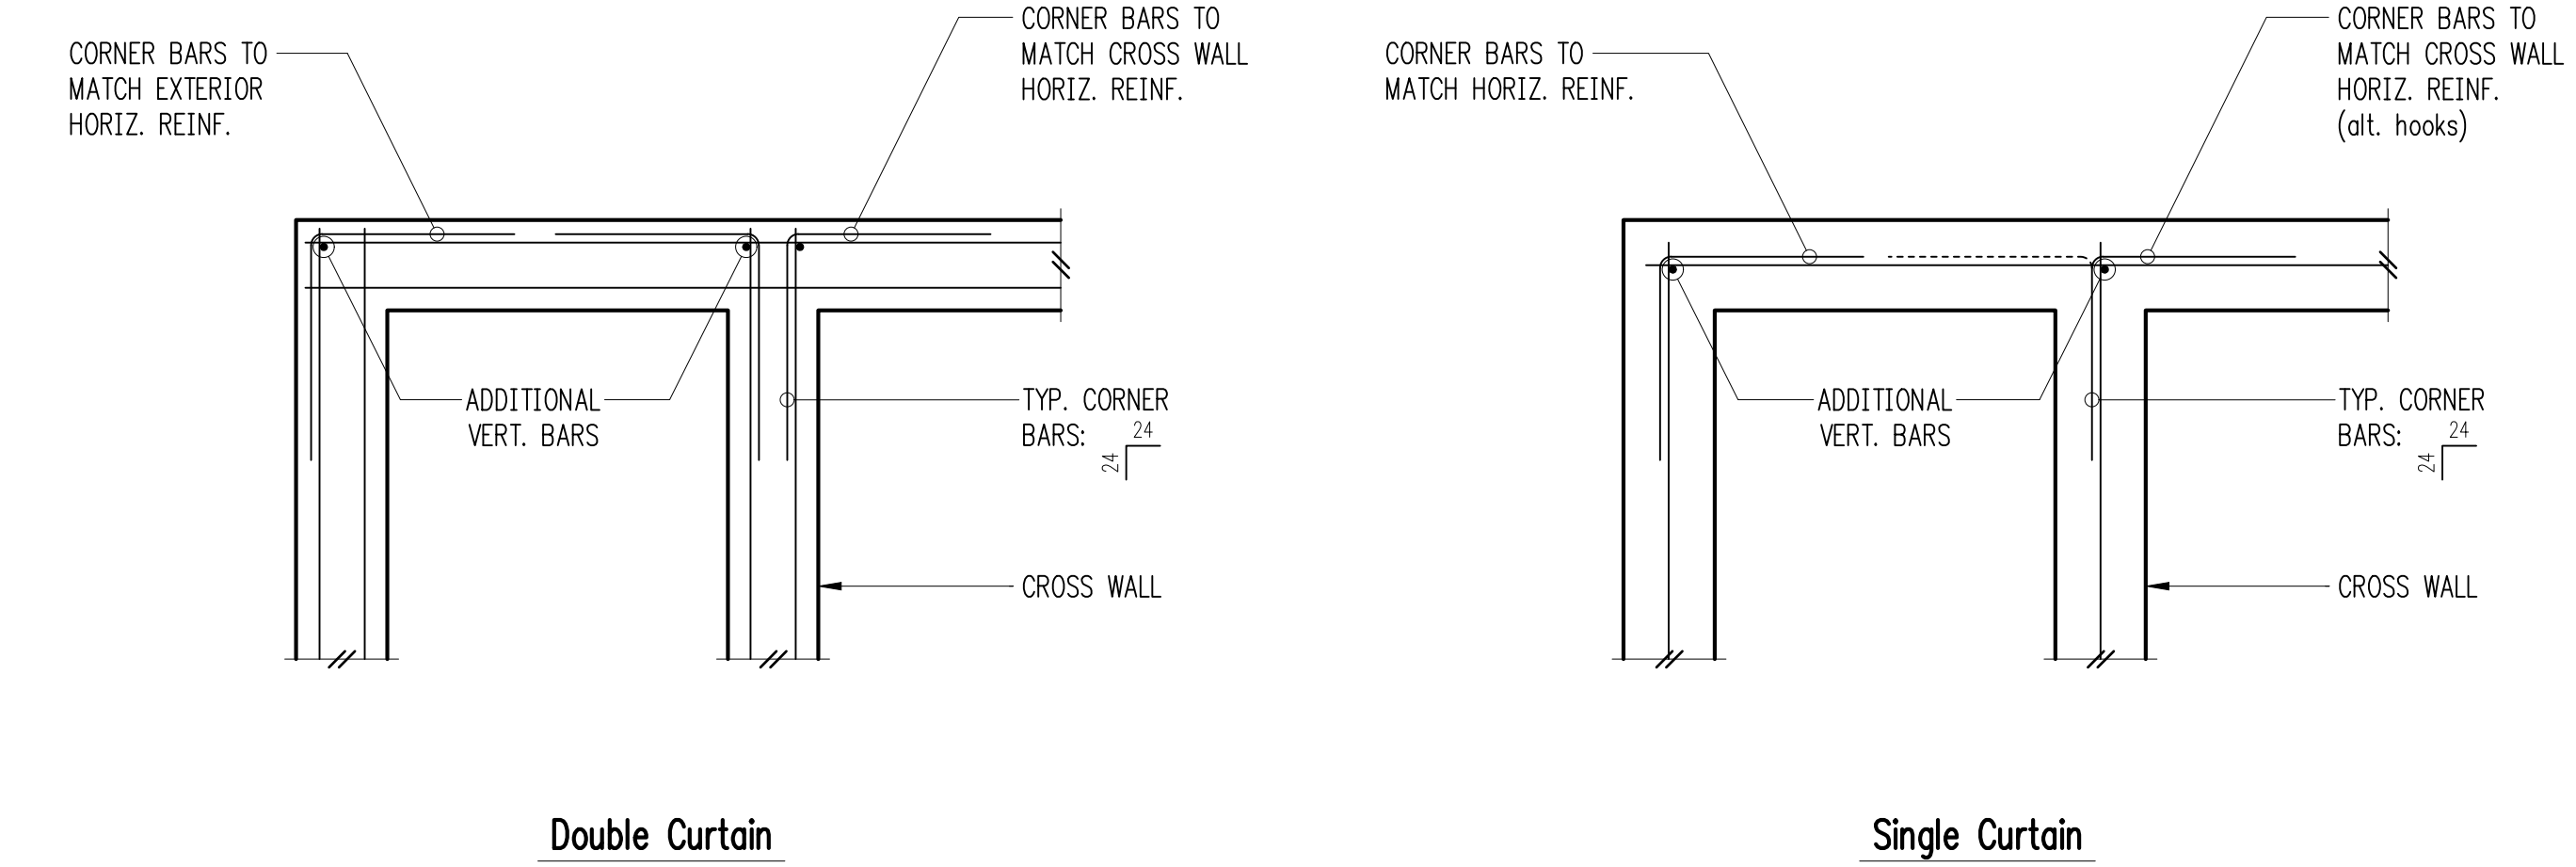

Typical Corner Bars at Concrete Walls and Footings **8**

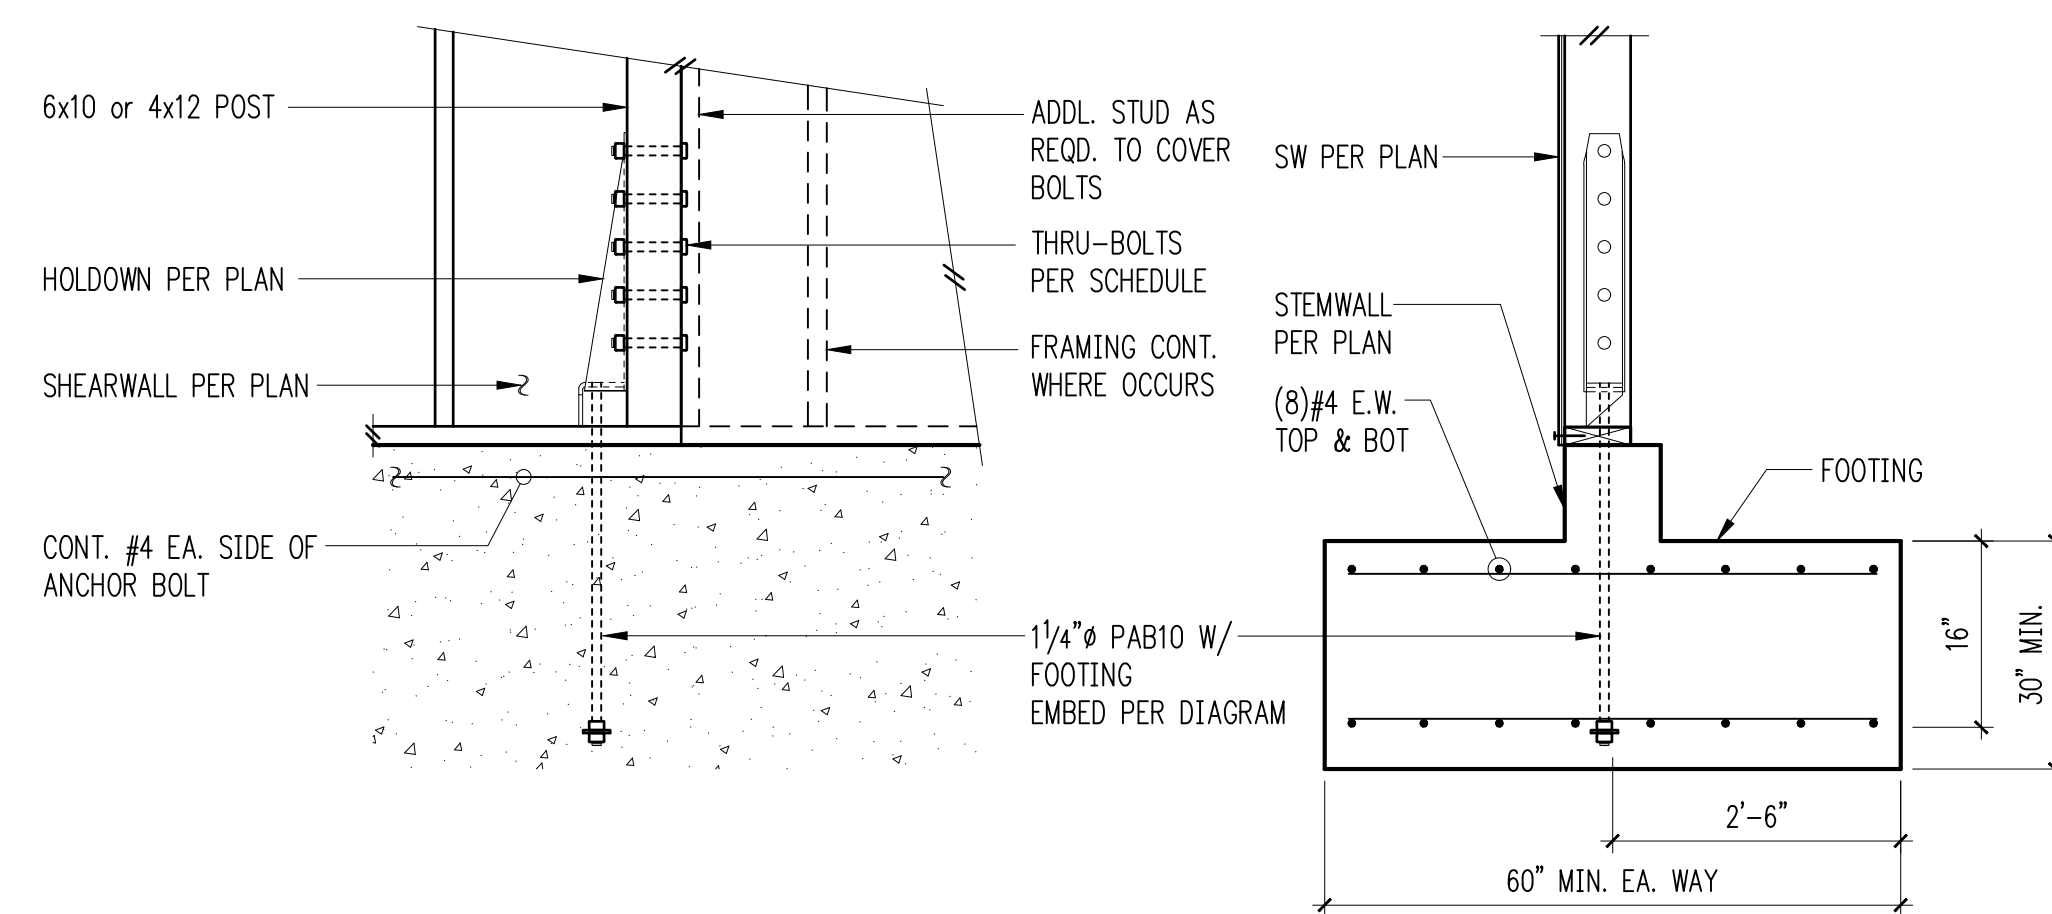

Typical HD19 Holdown **10**

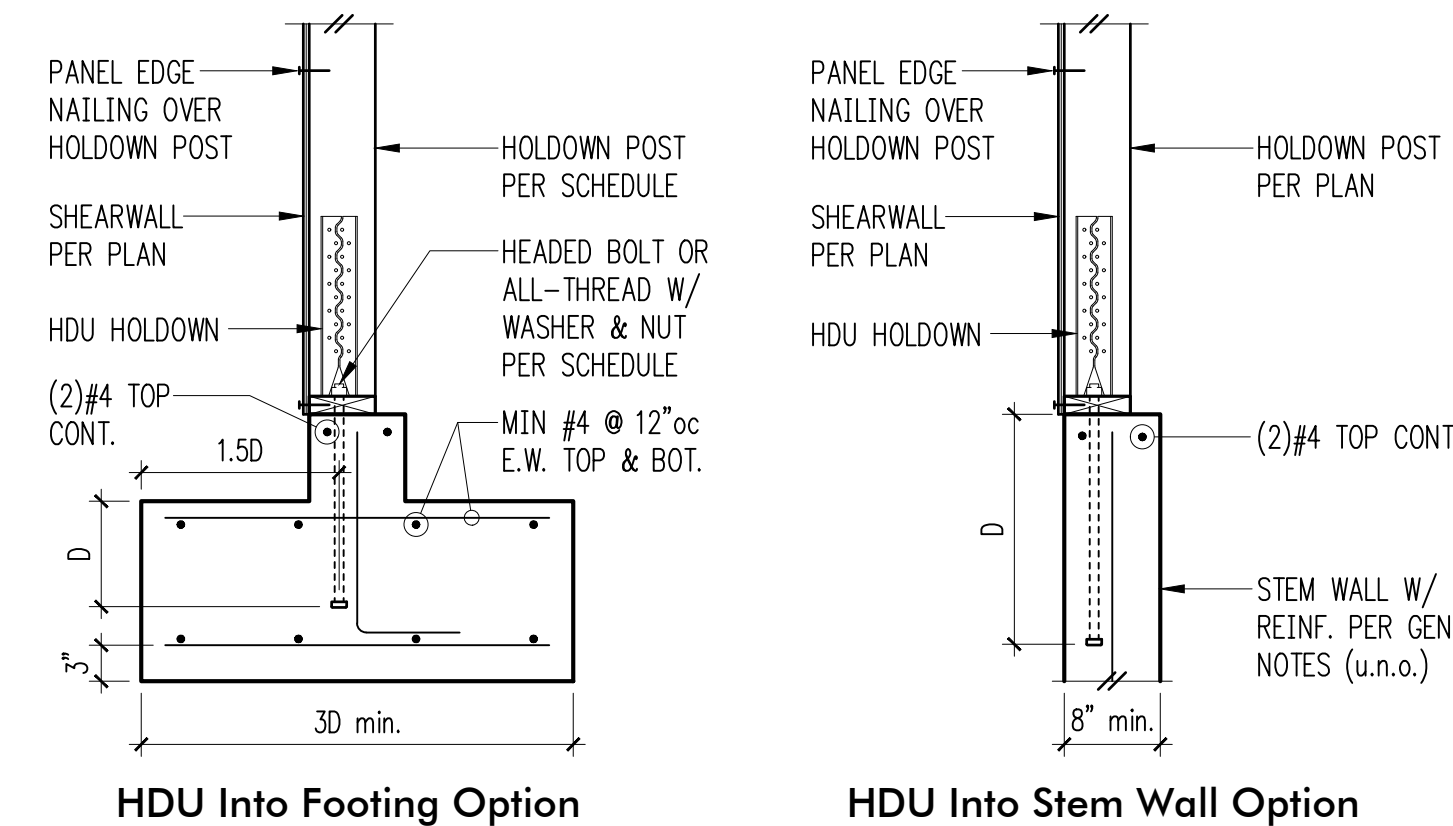


Holdown Schedule

Plan Mark	Screws	Anchor Bolt	Min. A.B. Embed (D)		Holdown Post	
			Stem Wall	Footing	if 2x4	if 2x6
HDU2-SDS2.5	(6)SDS 1/4"x2 1/2"	5/8" Ø	12"	4"	(2) 2x4	(2) 2x6
HDU4-SDS2.5	(10)SDS 1/4"x2 1/2"	5/8" Ø	SB9x24	6"	4x4	4x6
HDU5-SDS2.5	(14)SDS 1/4"x2 1/2"	5/8" Ø	SB9x24	7"	4x4	4x6
HDU8-SDS2.5	(20)SDS 1/4"x2 1/2"	7/8" Ø	SSTB28	8"	4x6	6x6
HDU11-SDS2.5	(30)SDS 1/4"x2 1/2"	1" Ø	SB1x30	10"	4x8	6x6
HDU14-SDS2.5	(36)SDS 1/4"x2 1/2"	1" Ø	N/A	12"	4x8	6x6

① MINIMUM SIZE OF POST AT END OF WALL UNLESS OTHERWISE NOTED ON FRAMING PLANS.

Typical HDU Holdown **12**

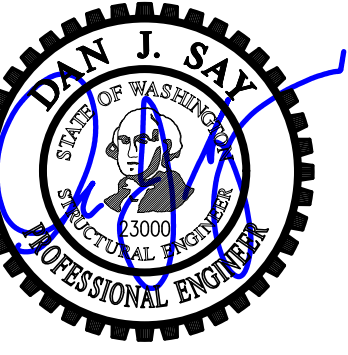

DESIGN: HAA, BDM  
DRAWN: NHD  
CHECKED: BDM  
APPROVED: DJS

REVISIONS:

1	Corrections	May 4, 2021
2	Corrections 2	Aug. 13, 2021
3	Permit Revisions	Apr. 22, 2022
4	Corrections	Jun. 10, 2022


DPD:

PROJECT TITLE:  
**Clarkson Residence**  
8163 West Mercer Way  
Mercer Island, WA 98040

ARCHITECT:  
**Brandt Design Group**  
66 Bell Street, Unit 1  
Seattle, WA 98121  
PH 206.239.0850

ISSUE:  
**PERMIT**  
SHEET TITLE:

**Typical Concrete Details**  
SCALE: 3/4" = 1'-0" U.N.O.  
DATE: December 24, 2020  
PROJECT NO: 01519-2021-11  
SHEET NO:

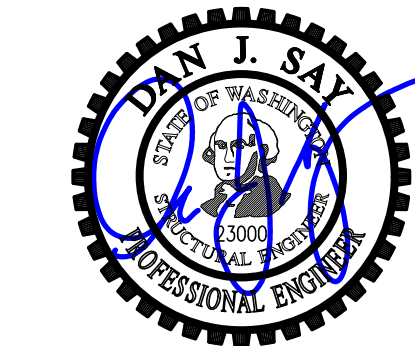

DESIGN: HAA, BDM  
 DRAWN: NHD  
 CHECKED: BDM  
 APPROVED: DJS

REVISIONS:

1	Corrections	May 4, 2021
2	Corrections 2	Aug. 13, 2021
3	Permit Revisions	Apr. 22, 2022
4	Corrections	Jun. 10, 2022

DPD:

PROJECT TITLE:  
**Clarkson Residence**  
 8163 West Mercer Way  
 Mercer Island, WA 98040


ARCHITECT:  
**Brandt Design Group**  
 66 Bell Street, Unit 1  
 Seattle, WA 98121  
 PH 206.239.0850

ISSUE:  
**PERMIT**


SHEET TITLE:  
**Foundation Details**

SCALE: 3/4" = 1'-0" U.N.O.  
 DATE: December 24, 2020  
 PROJECT NO: 01519-2021-11  
 SHEET NO:


**S3.2**

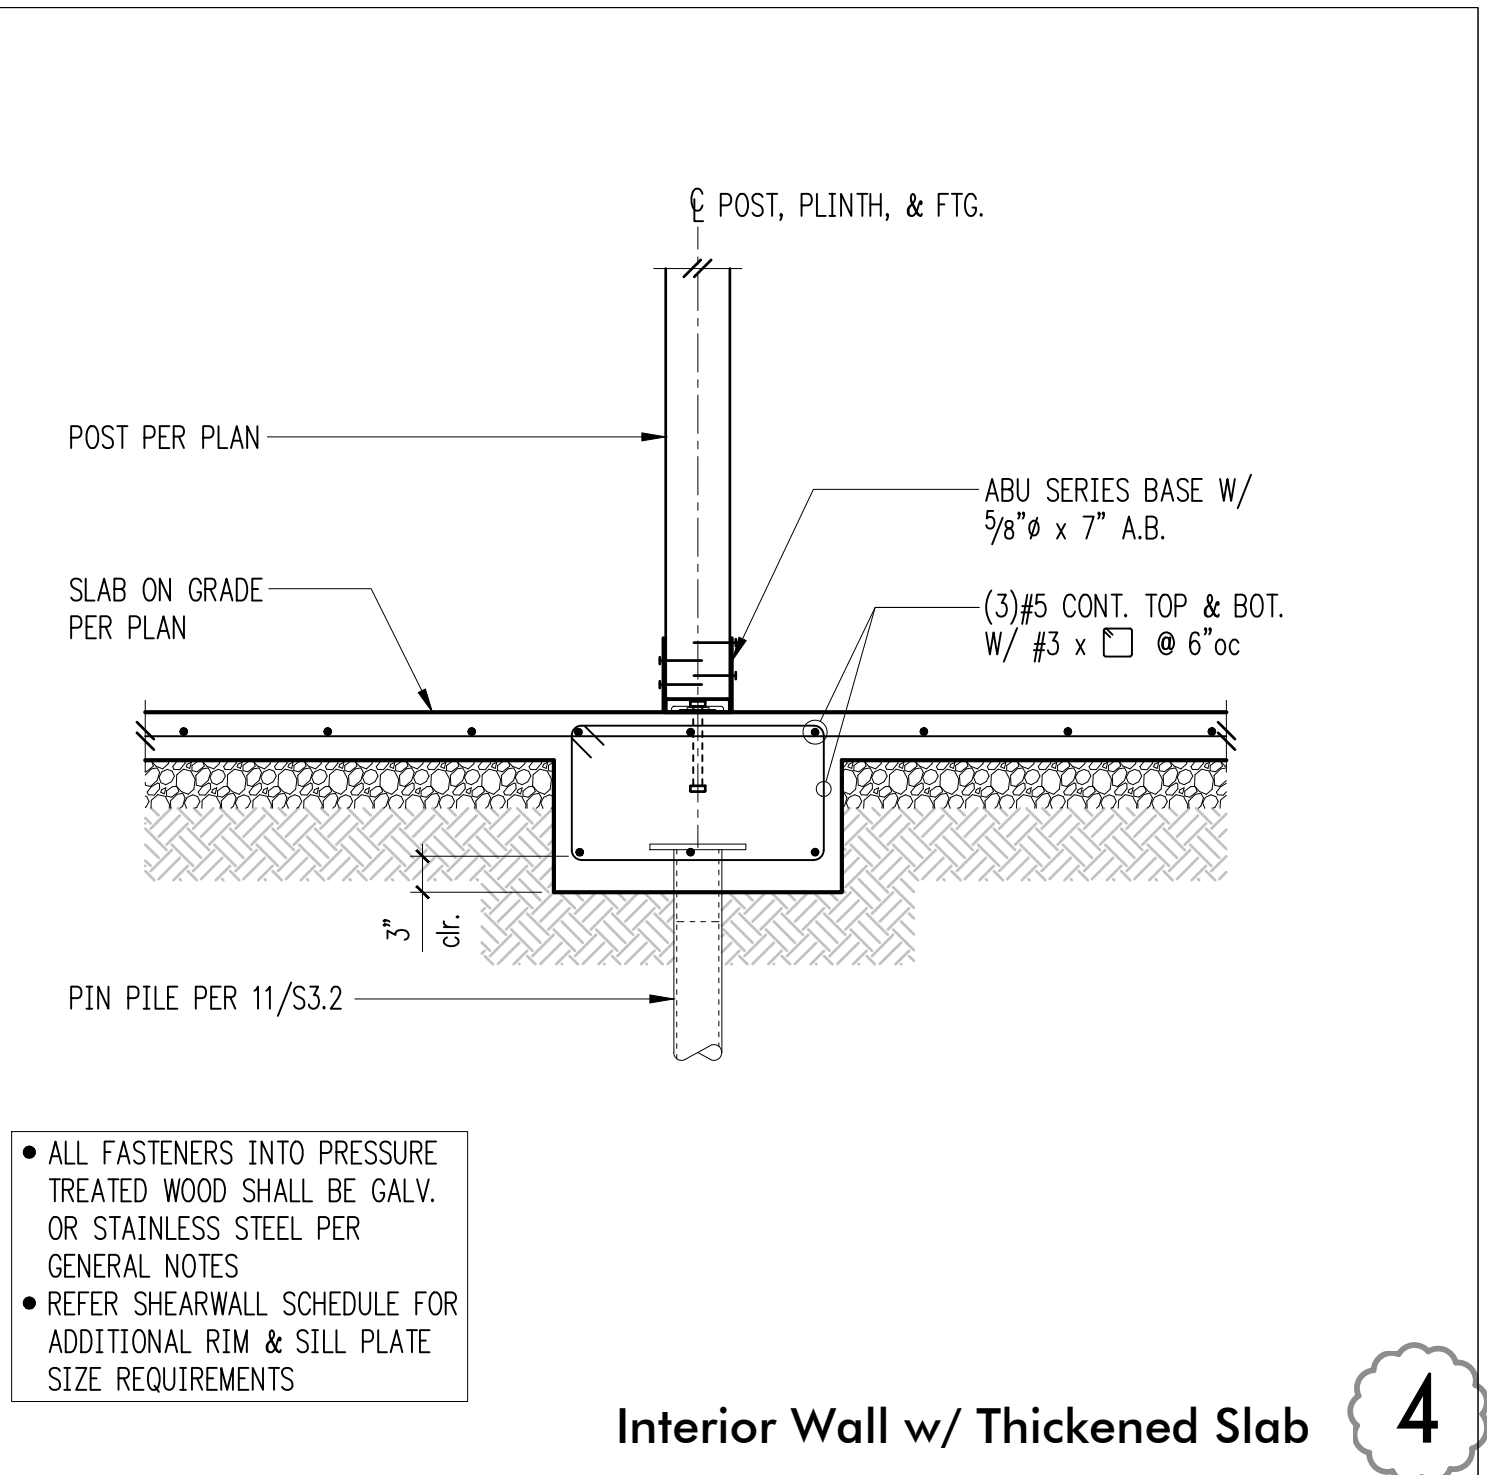


**Interior Wall w/ Thickened Slab 4**

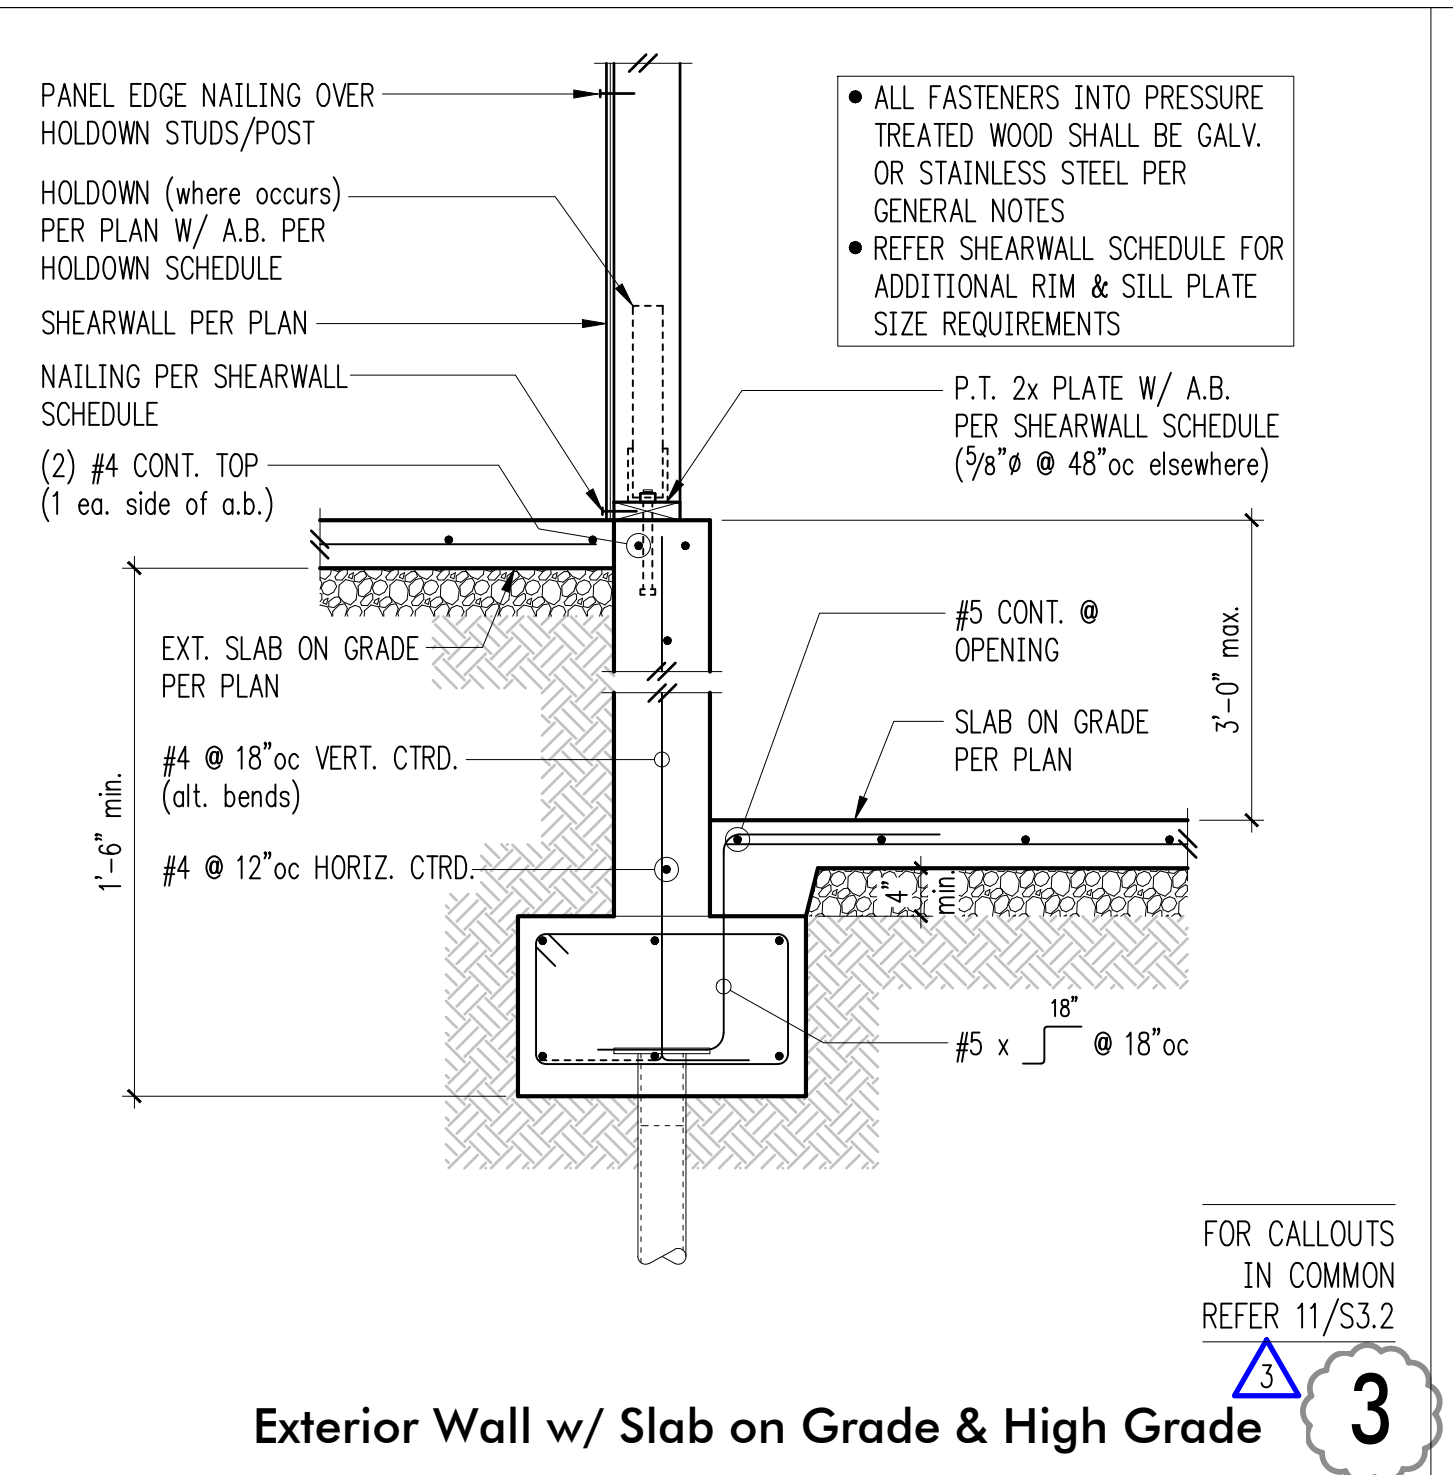


**Exterior Wall w/ Slab on Grade & High Grade 3**

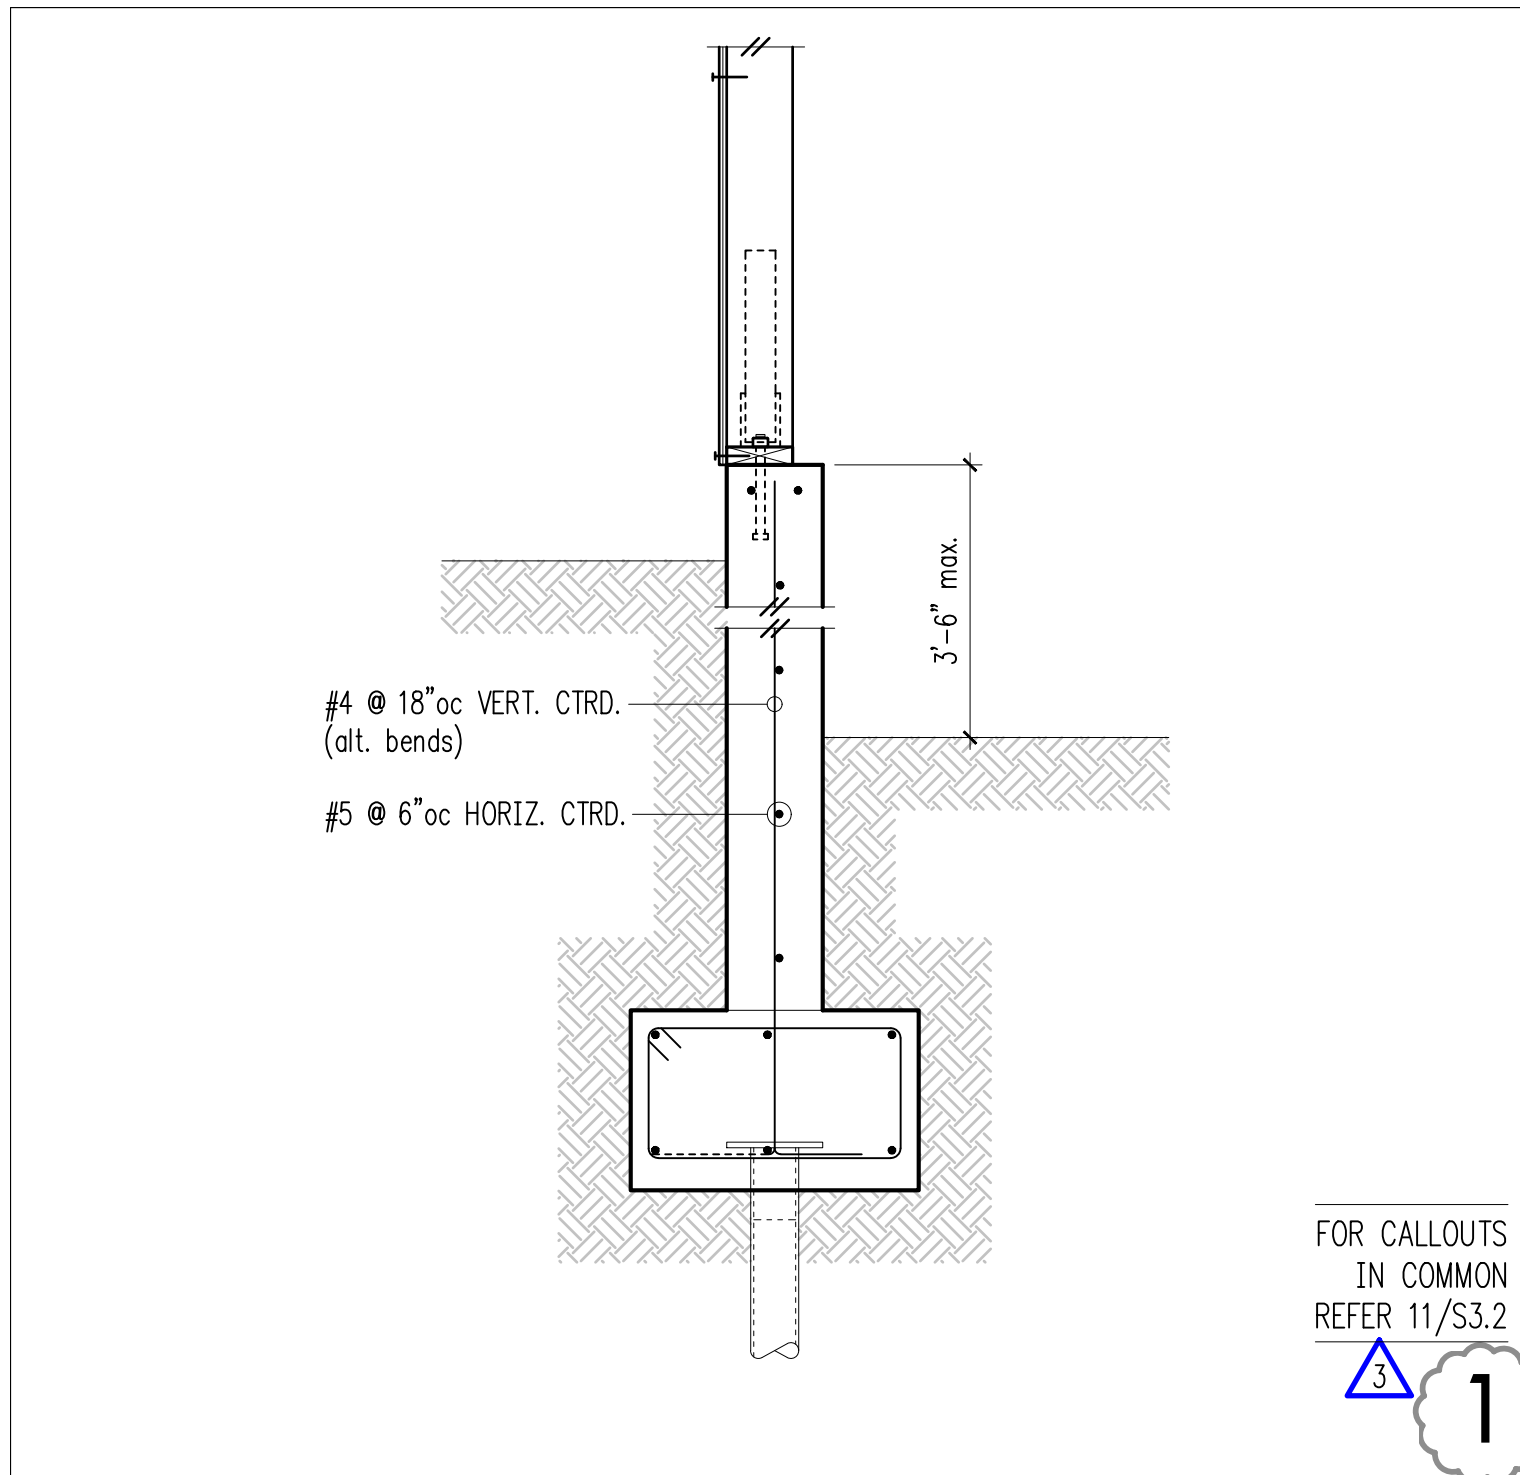


**1**  
 FOR CALLOUTS IN COMMON REFER 11/S3.2

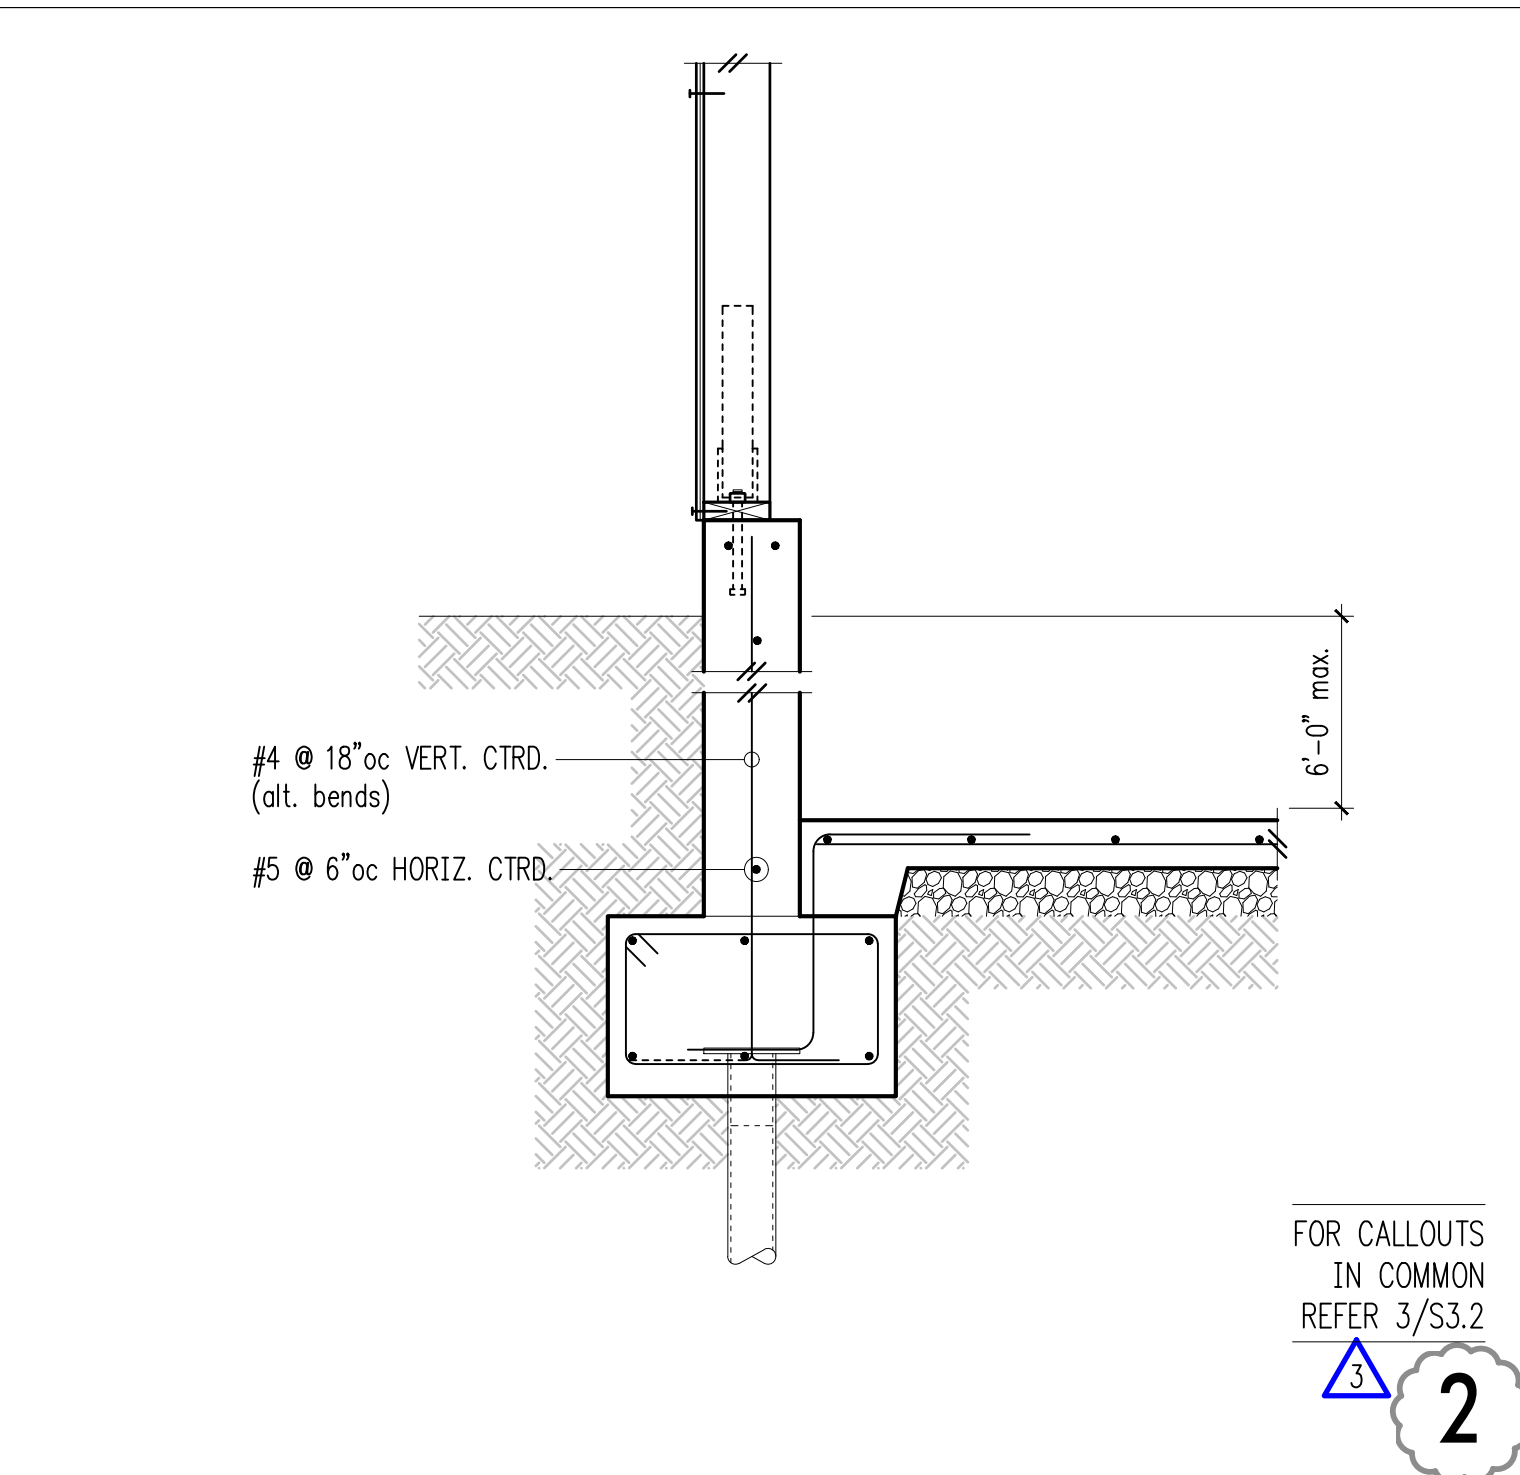


**2**  
 FOR CALLOUTS IN COMMON REFER 3/S3.2

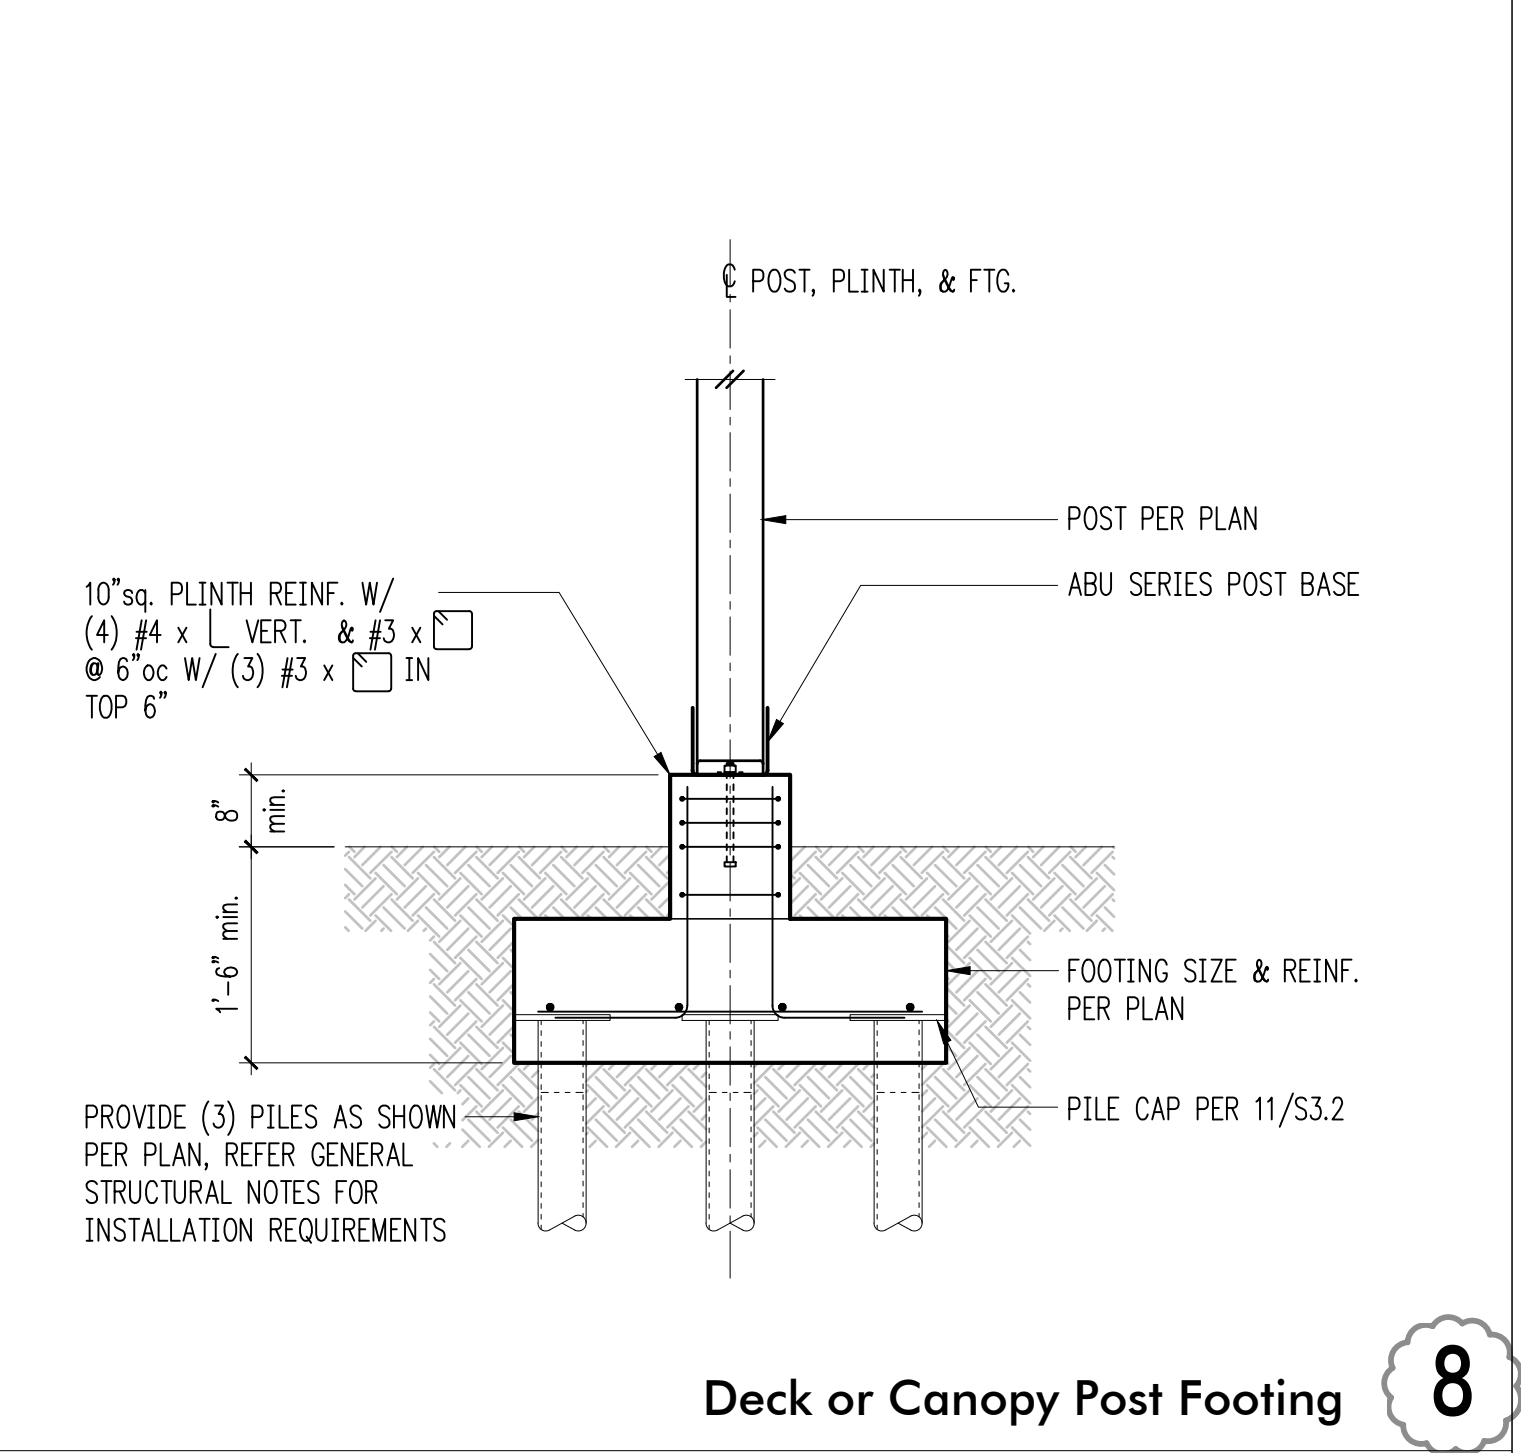


**Deck or Canopy Post Footing 8**

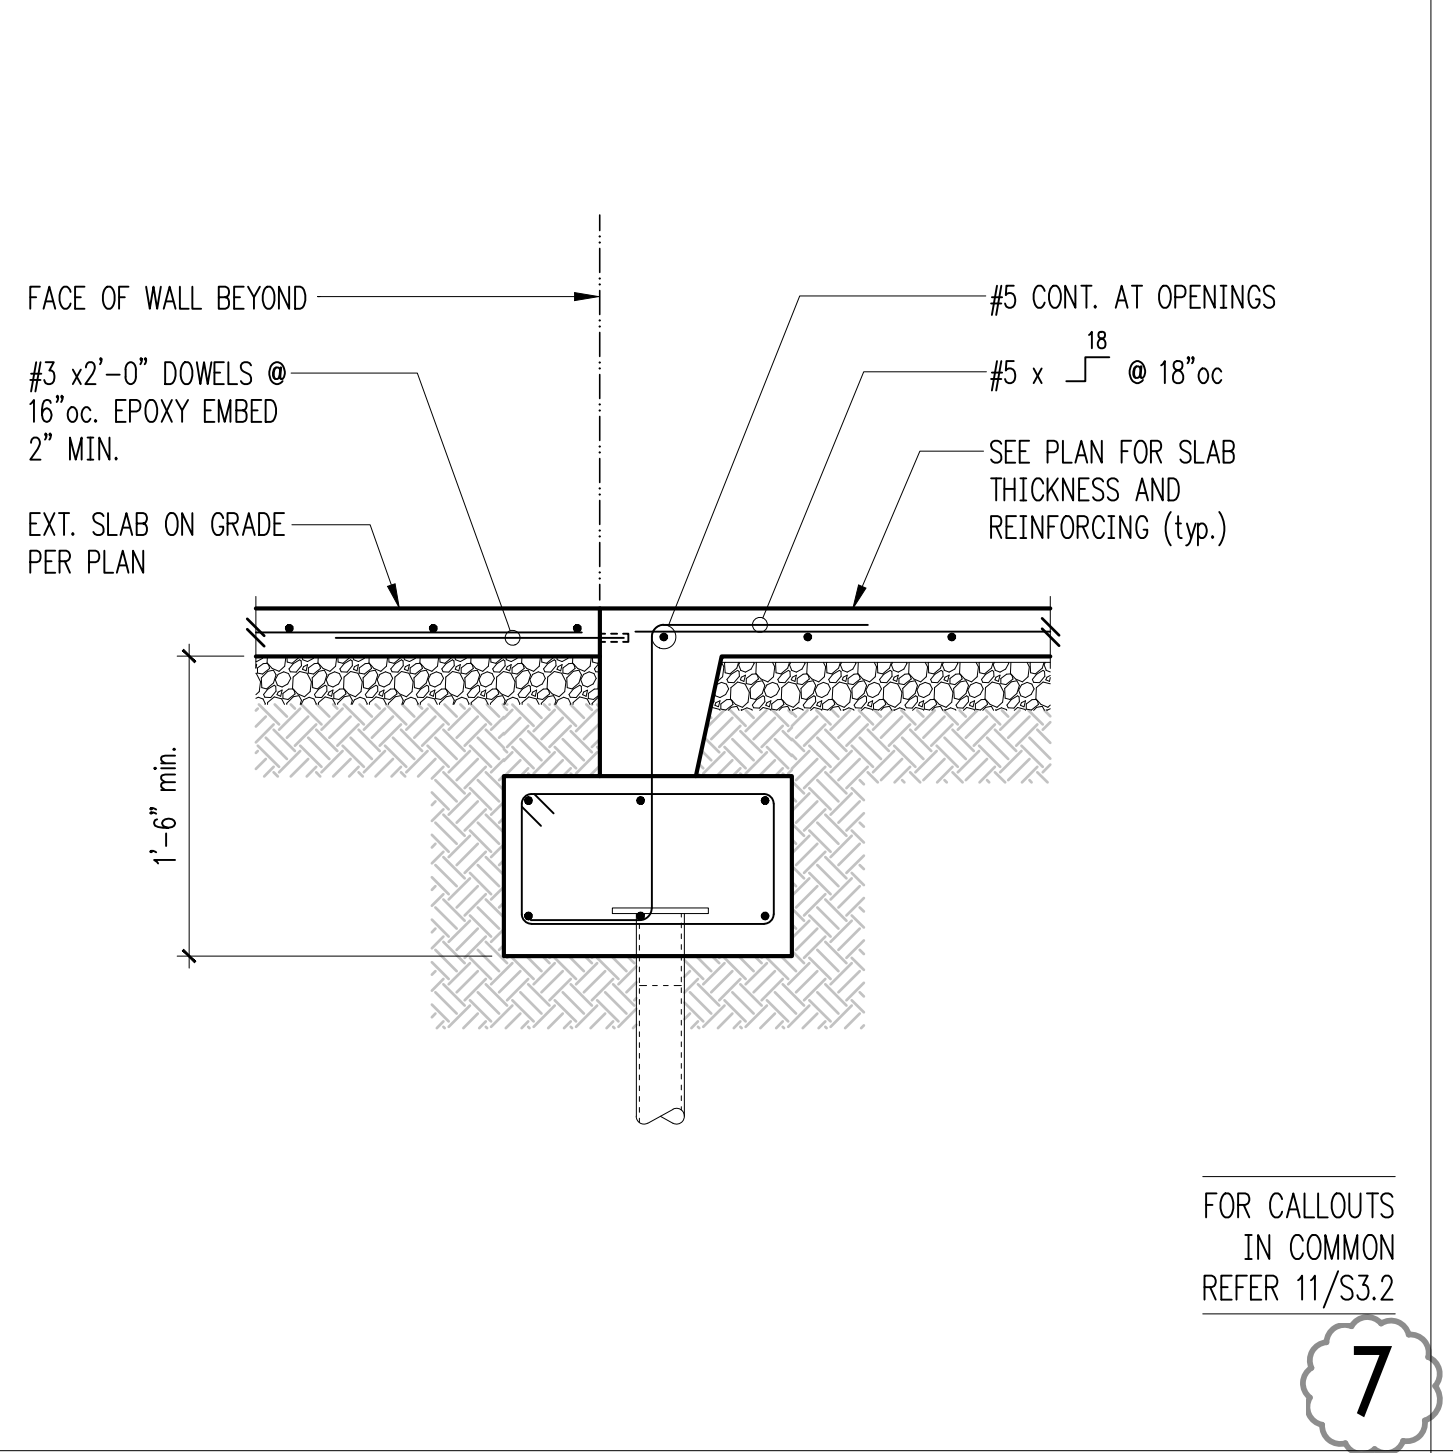


**7**  
 FOR CALLOUTS IN COMMON REFER 11/S3.2

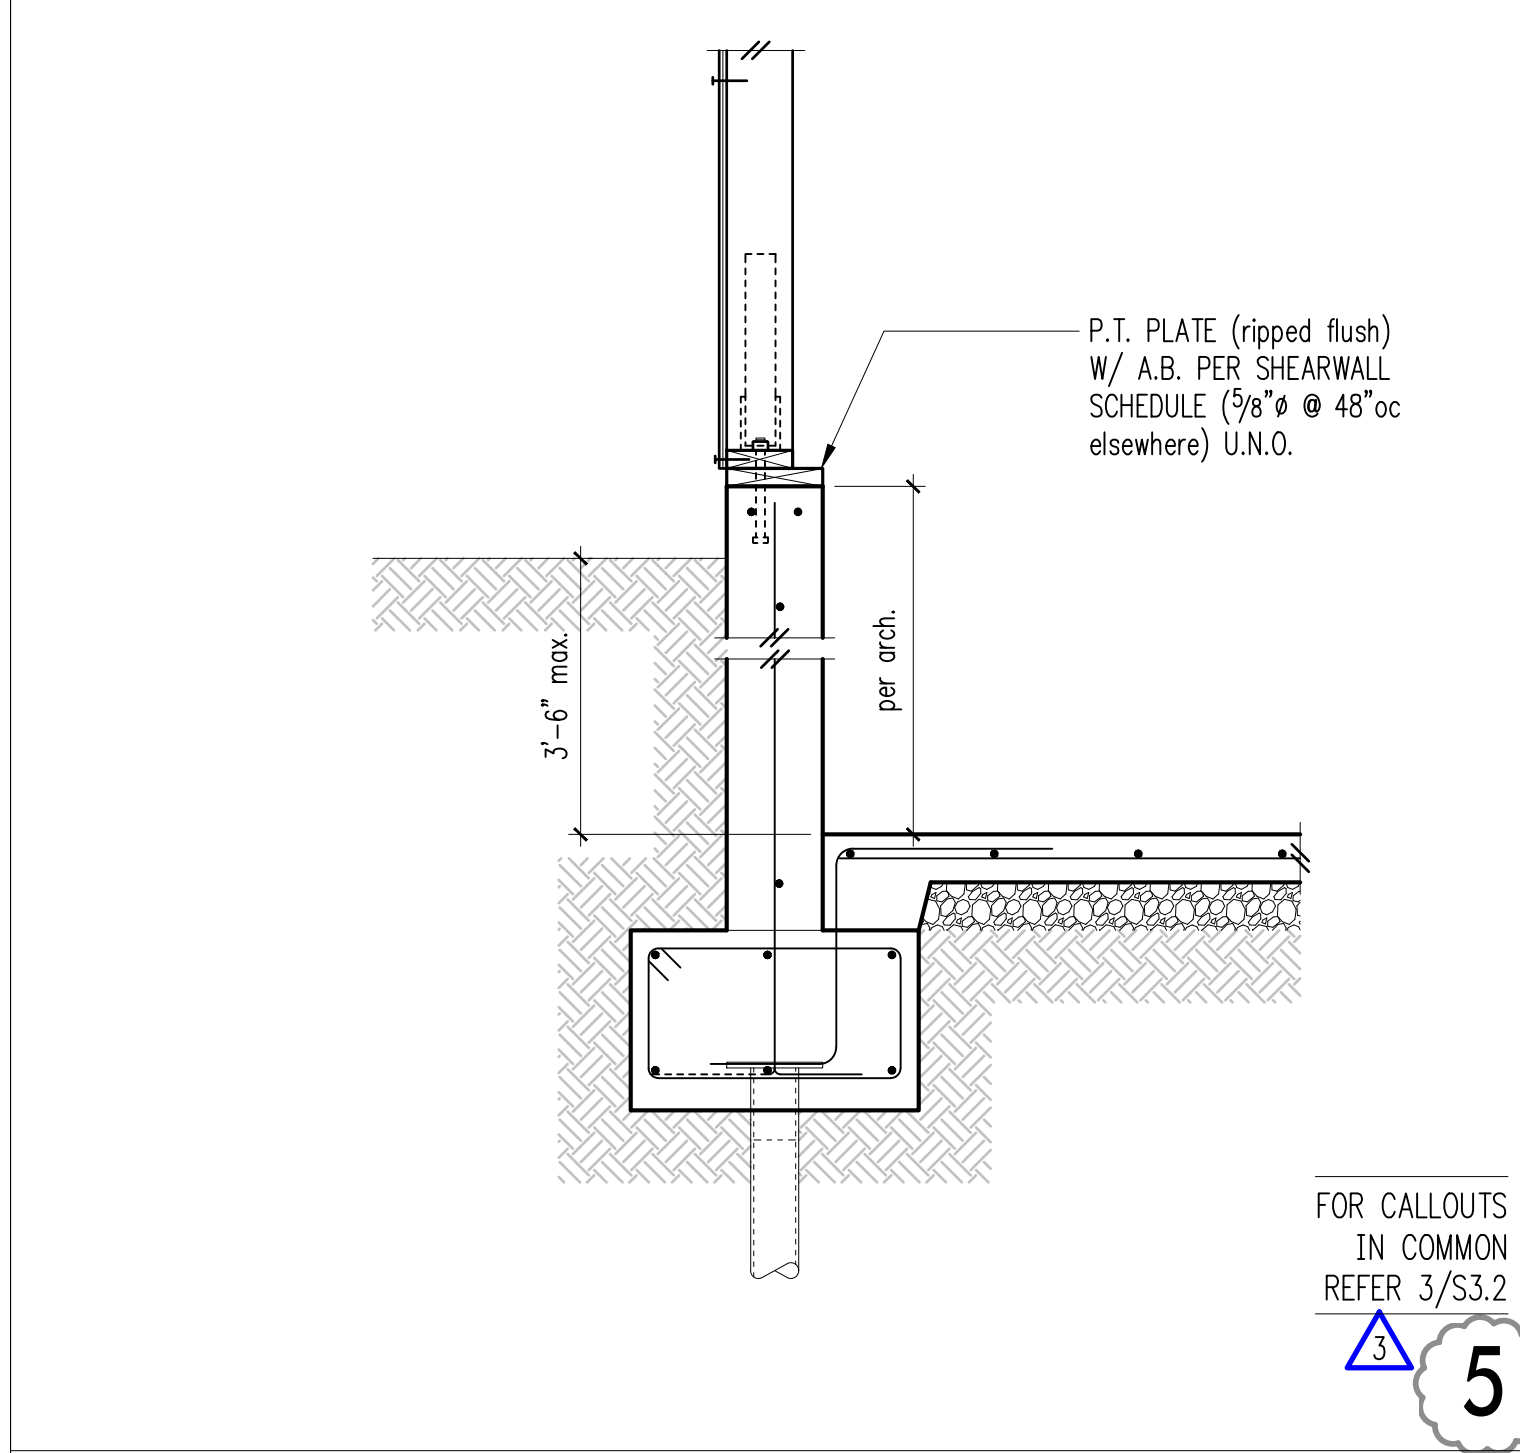


**5**  
 FOR CALLOUTS IN COMMON REFER 3/S3.2

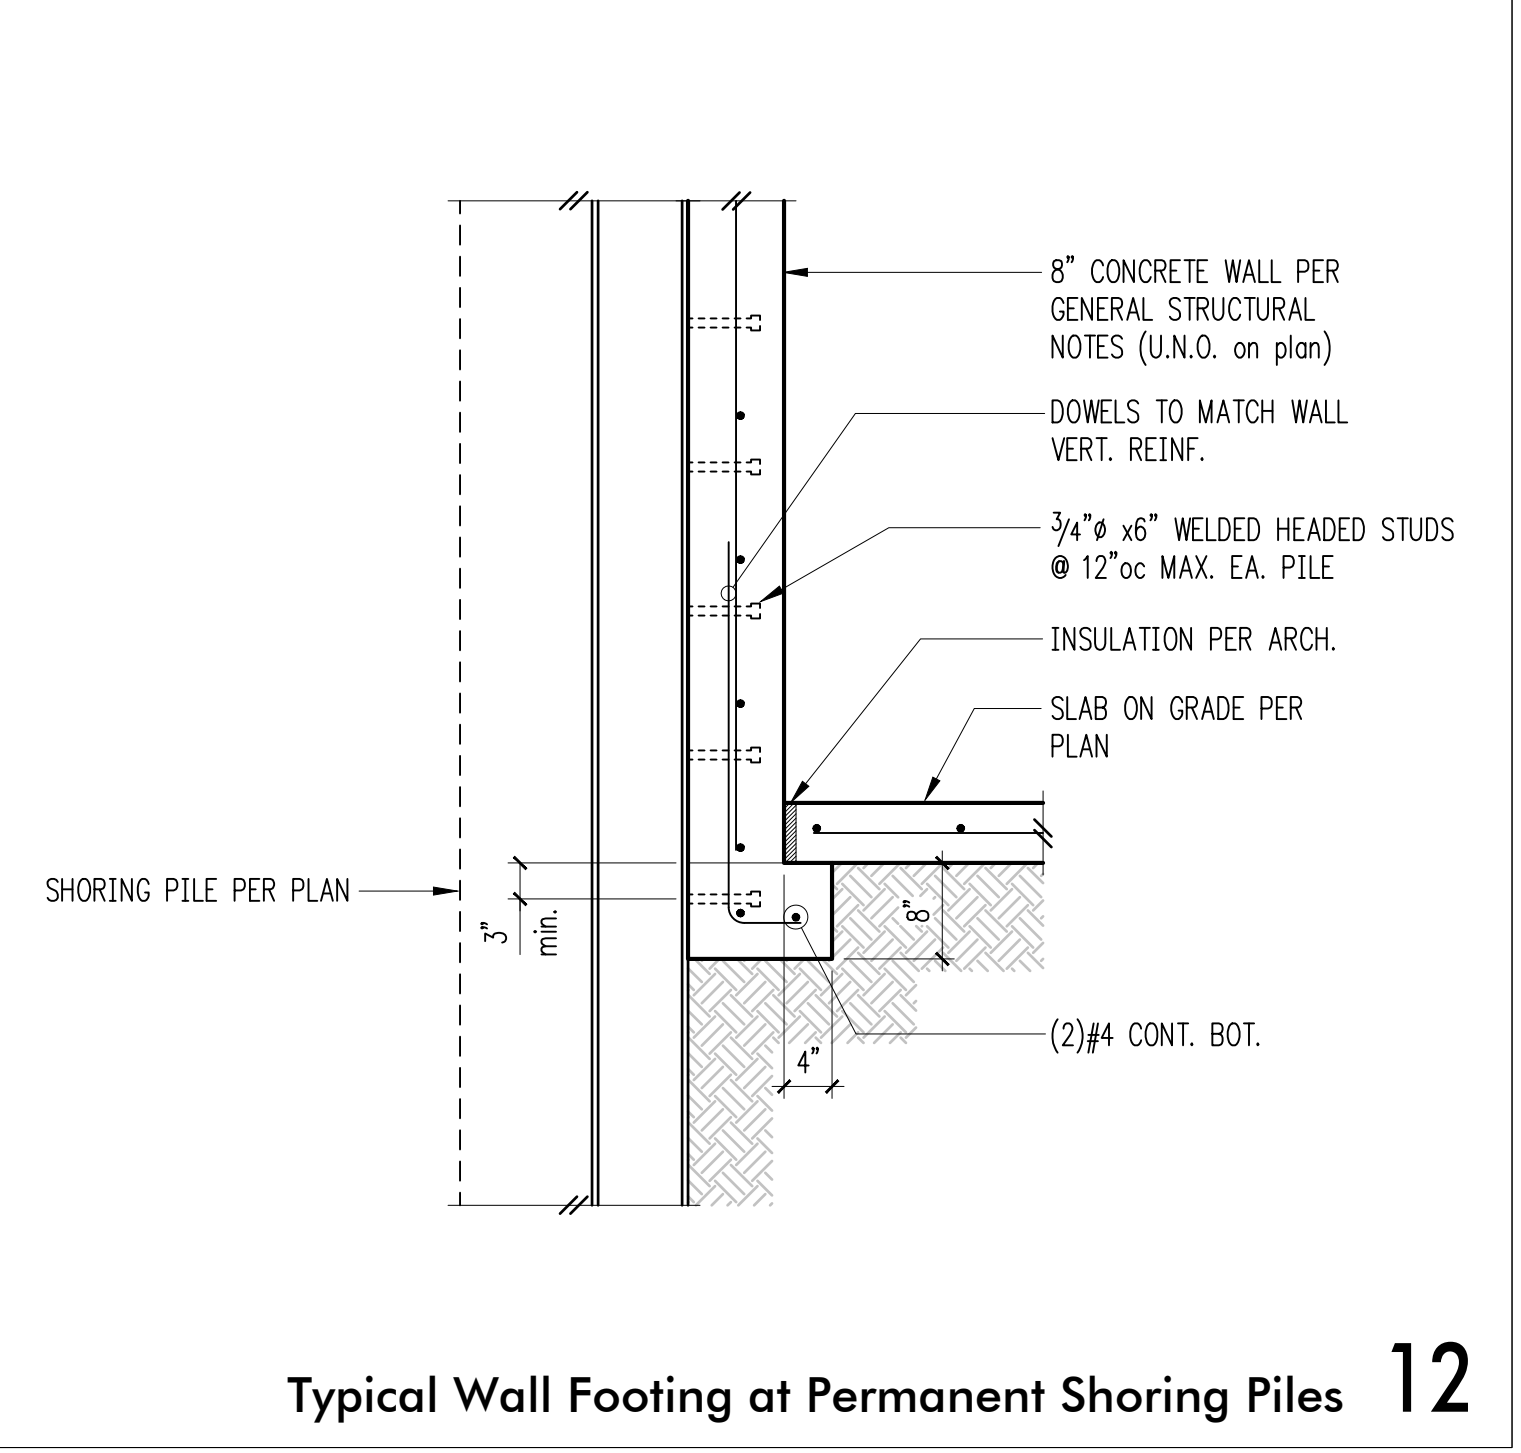


**Typical Wall Footing at Permanent Shoring Piles 12**

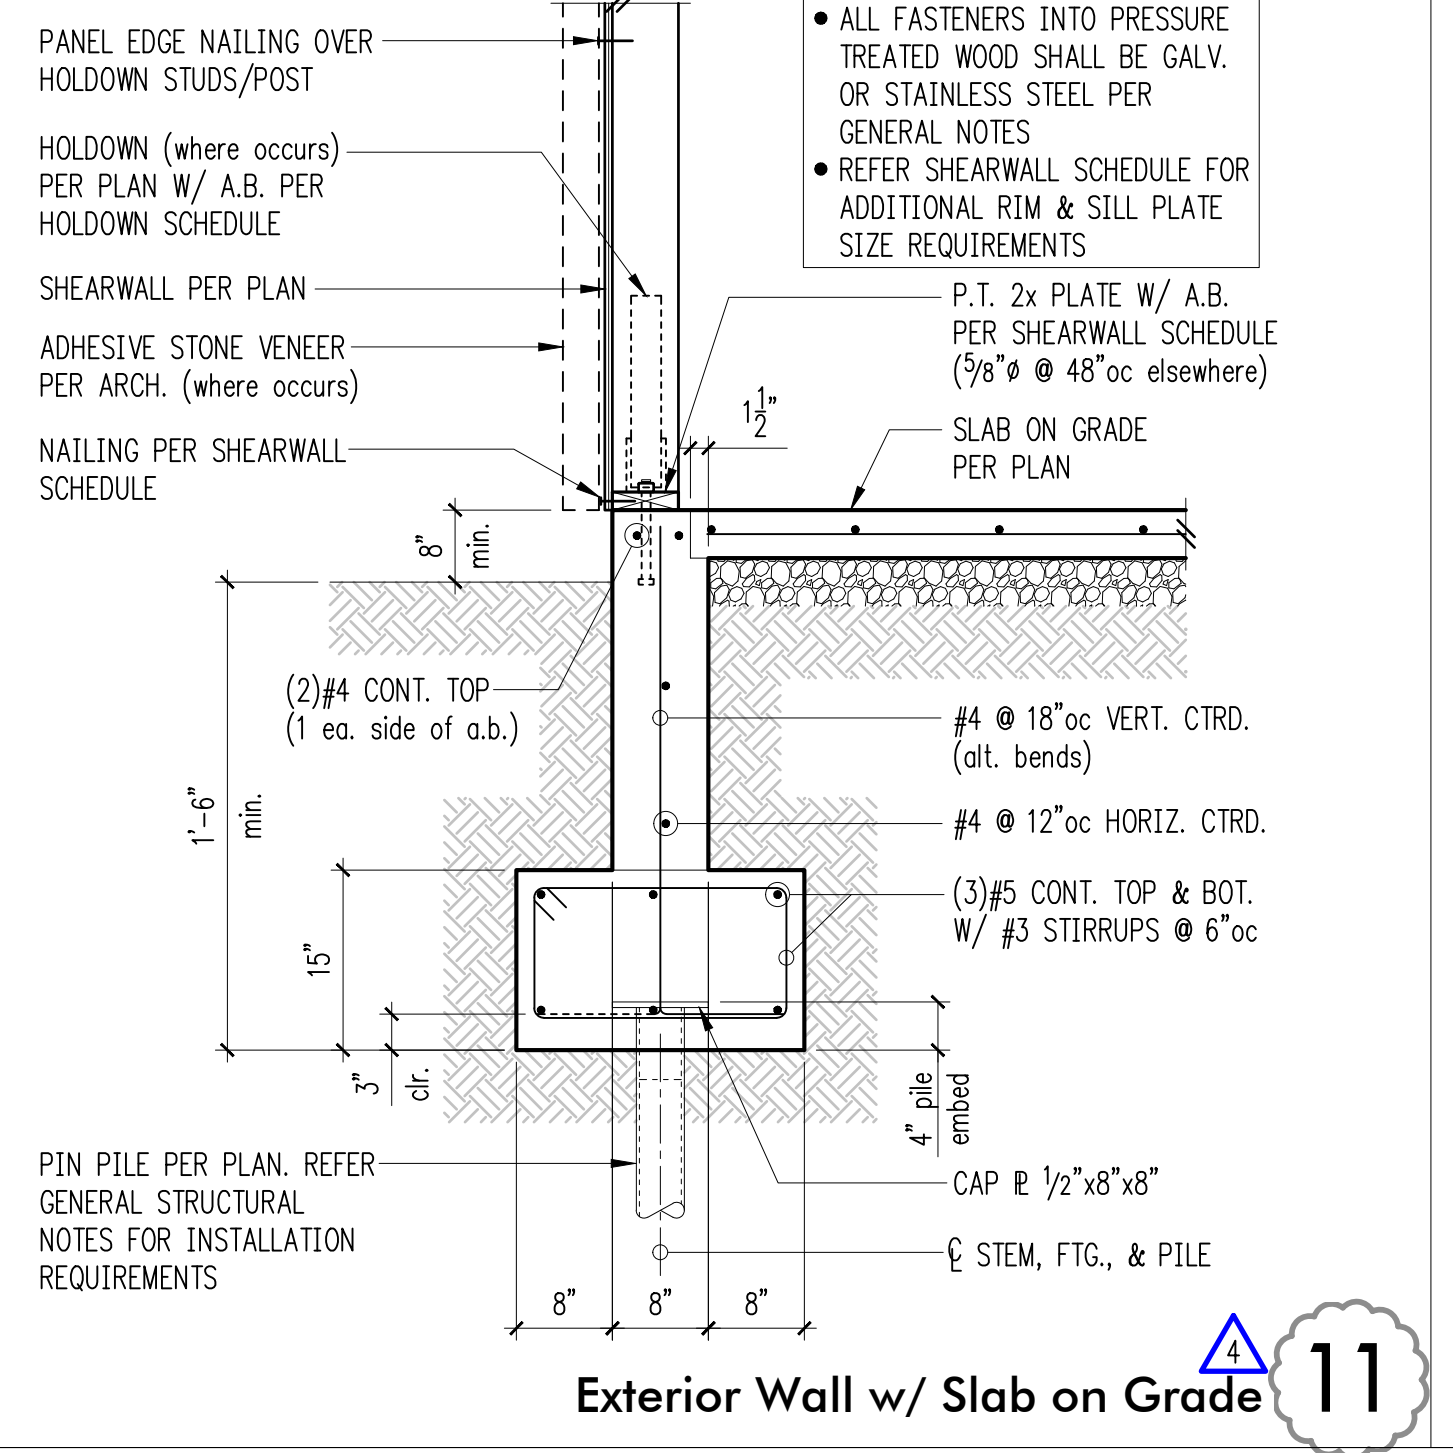


**Exterior Wall w/ Slab on Grade 11**

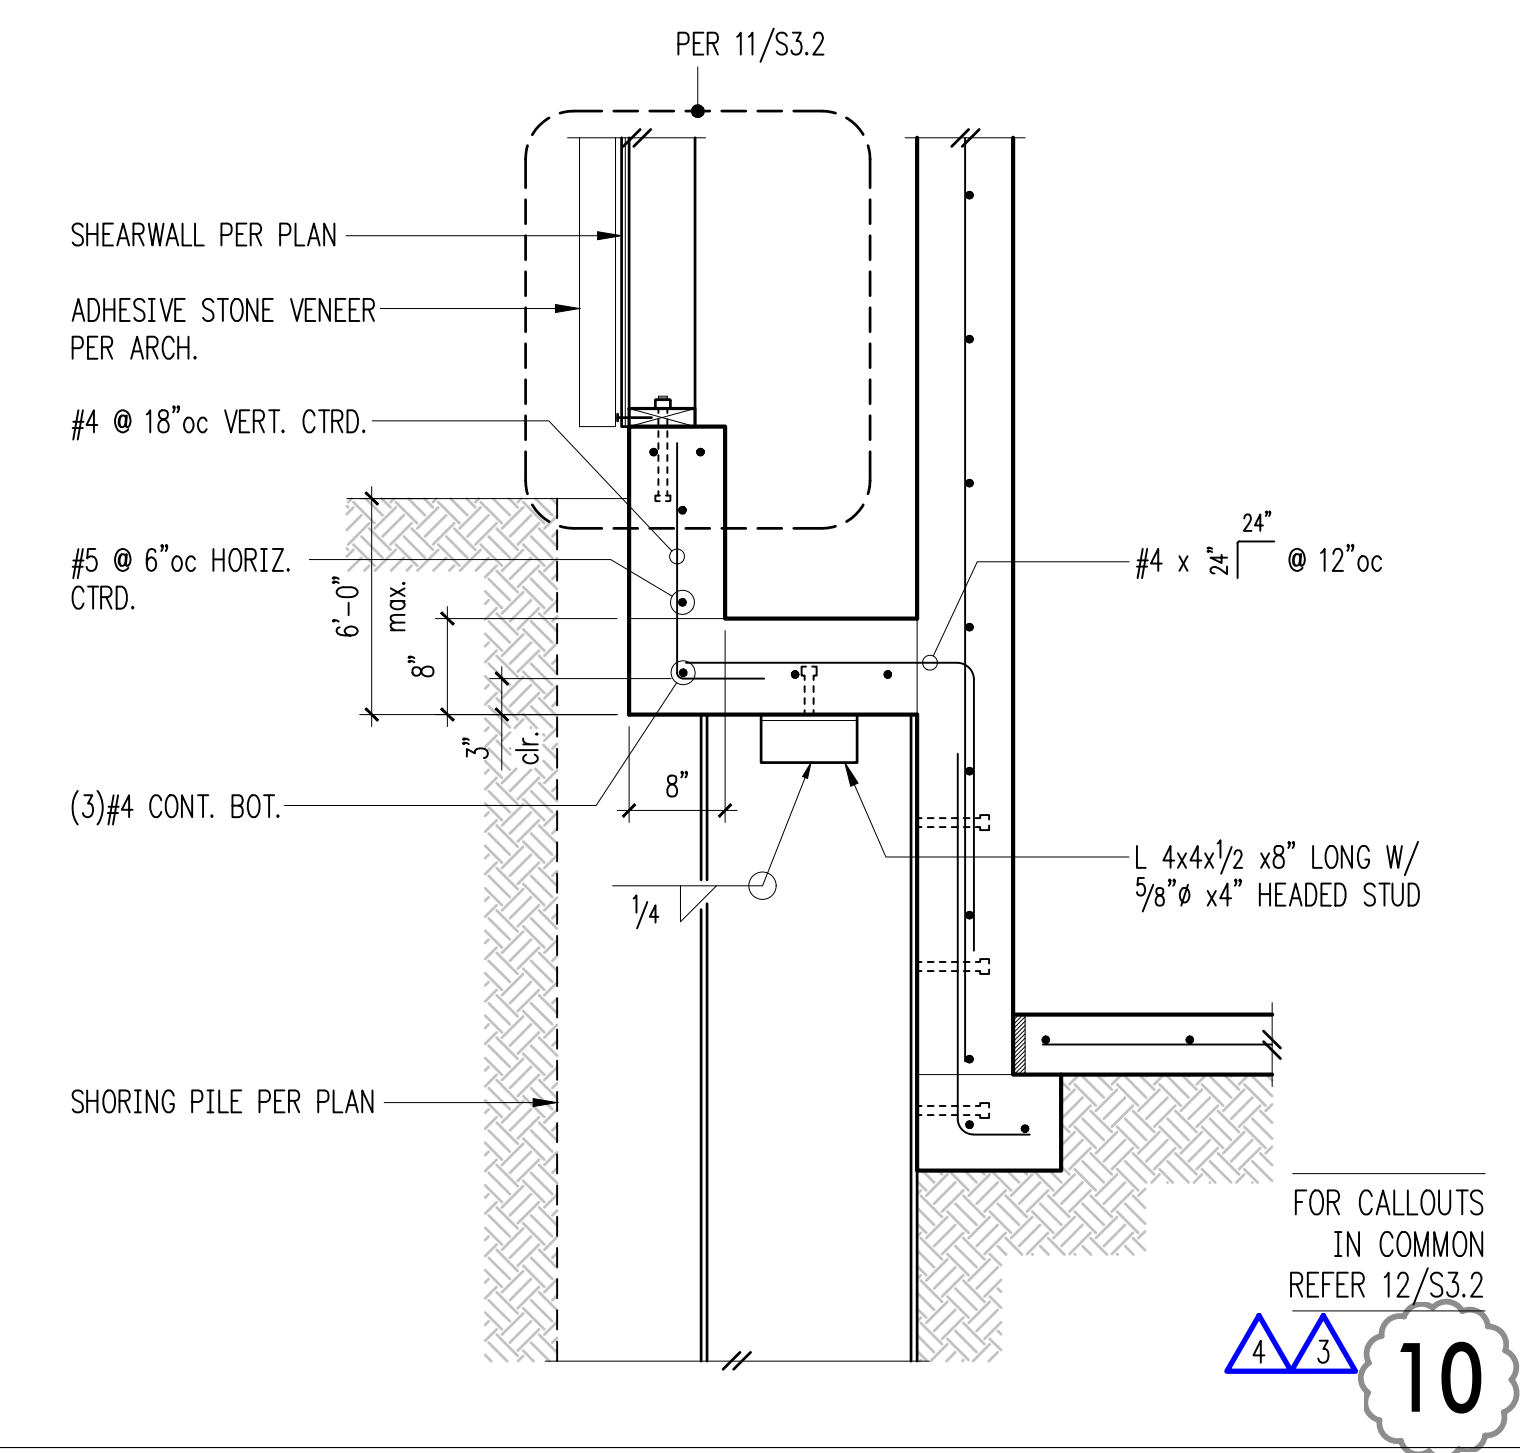

**10**  
 FOR CALLOUTS IN COMMON REFER 12/S3.2

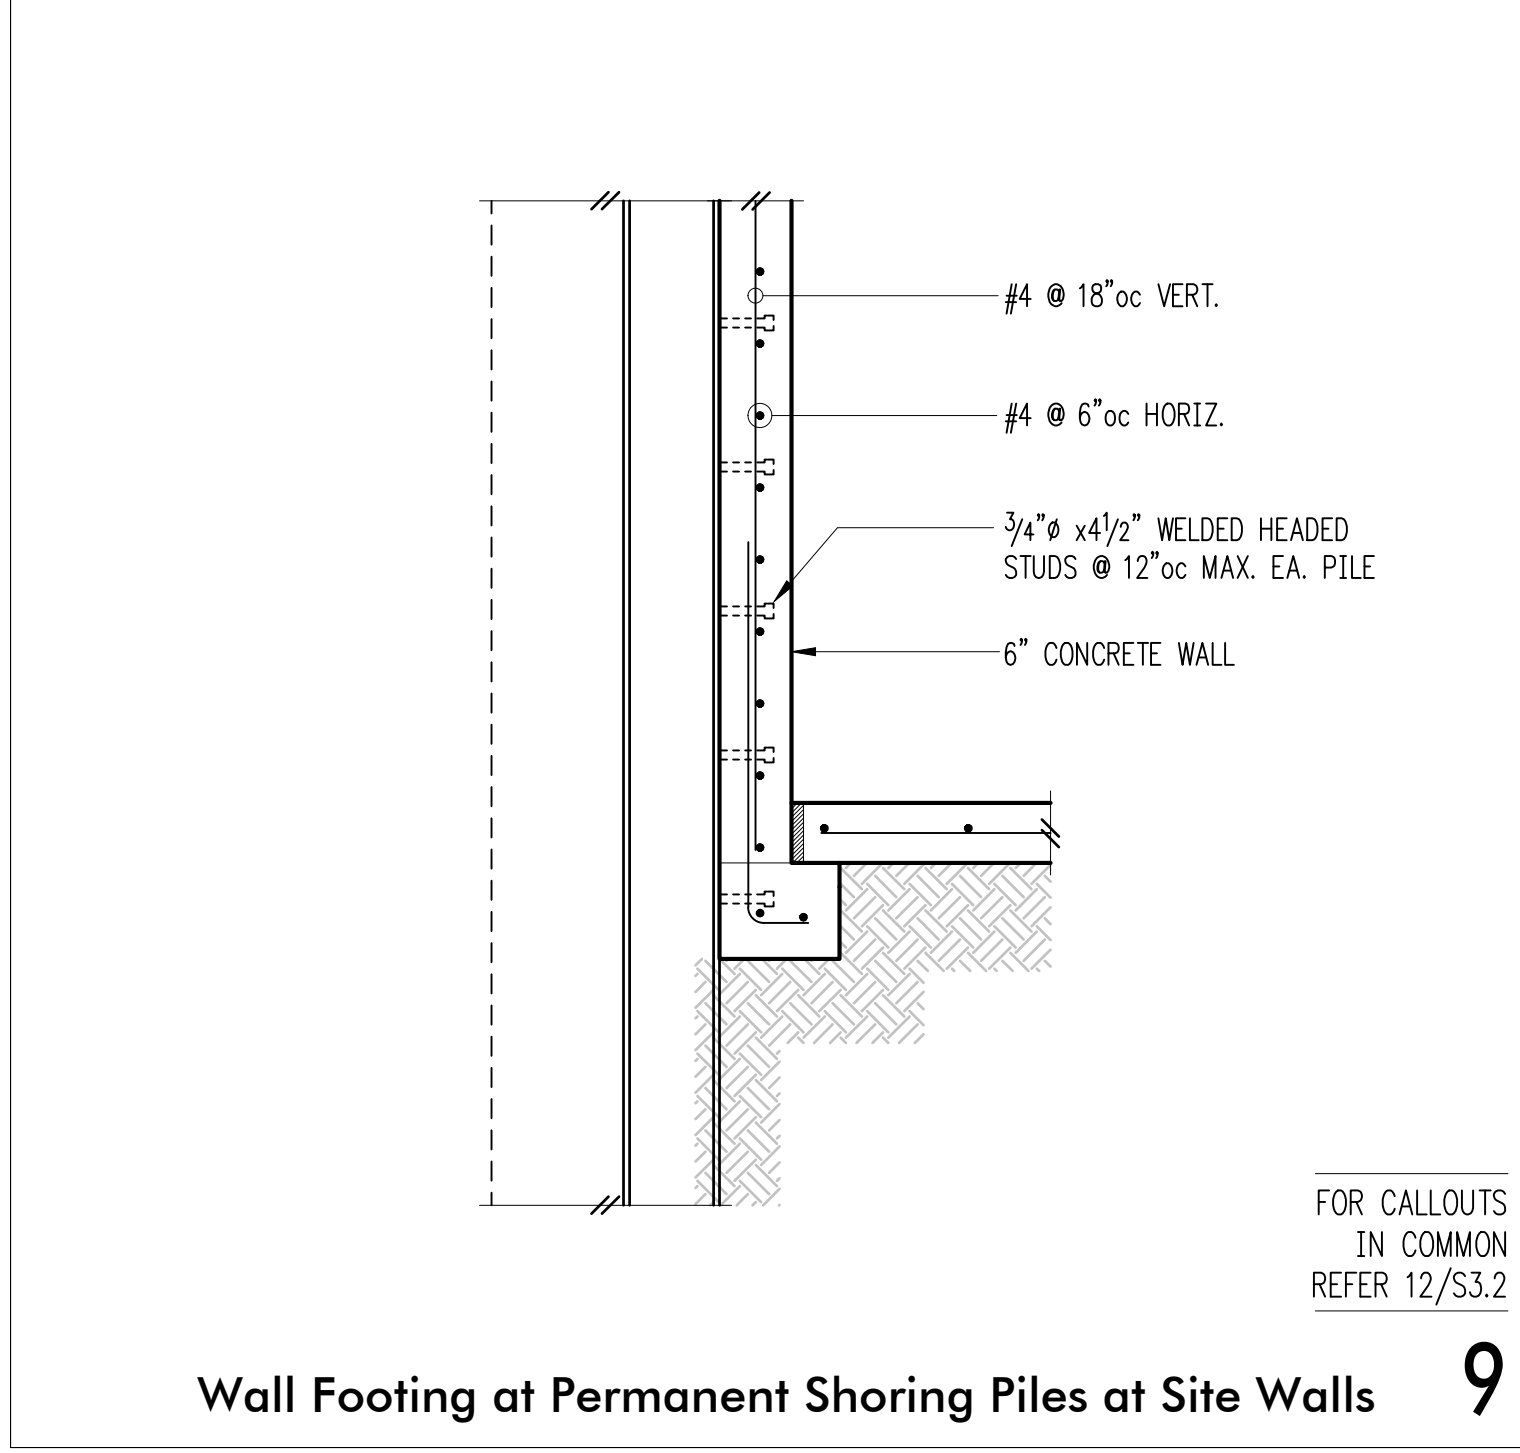

**Wall Footing at Permanent Shoring Piles at Site Walls 9**

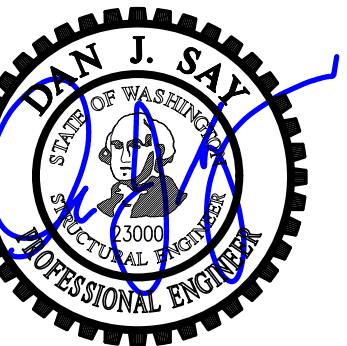

DESIGN: HAA, BDM  
 DRAWN: NHD  
 CHECKED: BDM  
 APPROVED: DJS

REVISIONS:

1	Corrections	May 4, 2021
2	Corrections 2	Aug. 13, 2021
3	Permit Revisions	Apr. 22, 2022
4	Corrections	Jun. 10, 2022


PROJECT TITLE:  
 Clarkson Residence  
 8163 West Mercer Way  
 Mercer Island, WA 98040

ARCHITECT:  
 Brandt Design Group  
 66 Bell Street, Unit 1  
 Seattle, WA 98121  
 PH 206.239.0850


ISSUE:  
**PERMIT**  
 SHEET TITLE:

**Foundation Details**  
 SCALE: 3/4" = 1'-0" U.N.O.  
 DATE: December 24, 2020  
 PROJECT NO: 01519-2021-11  
 SHEET NO:


**S3.3**

 


1

 

2

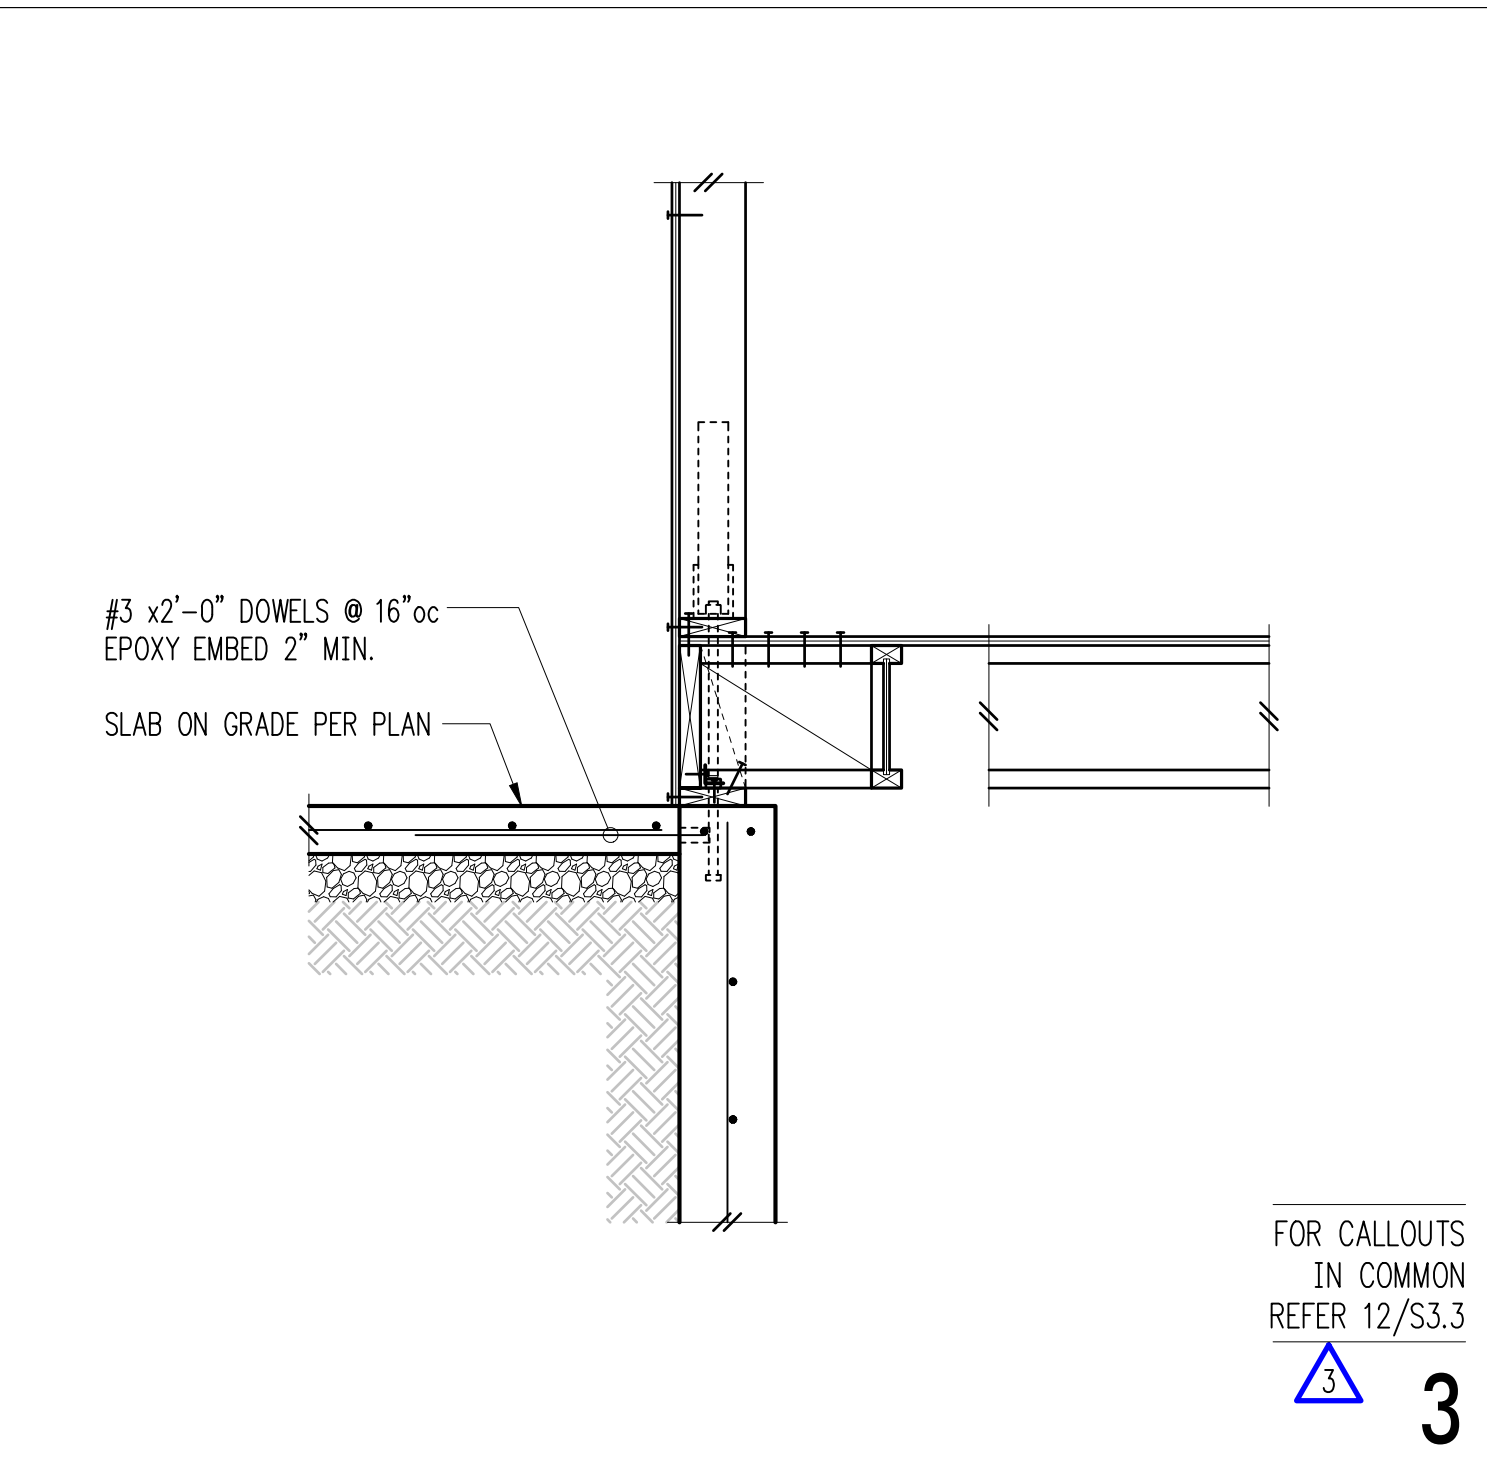


FOR CALLOUTS IN COMMON REFER 12/S3.3  
 3

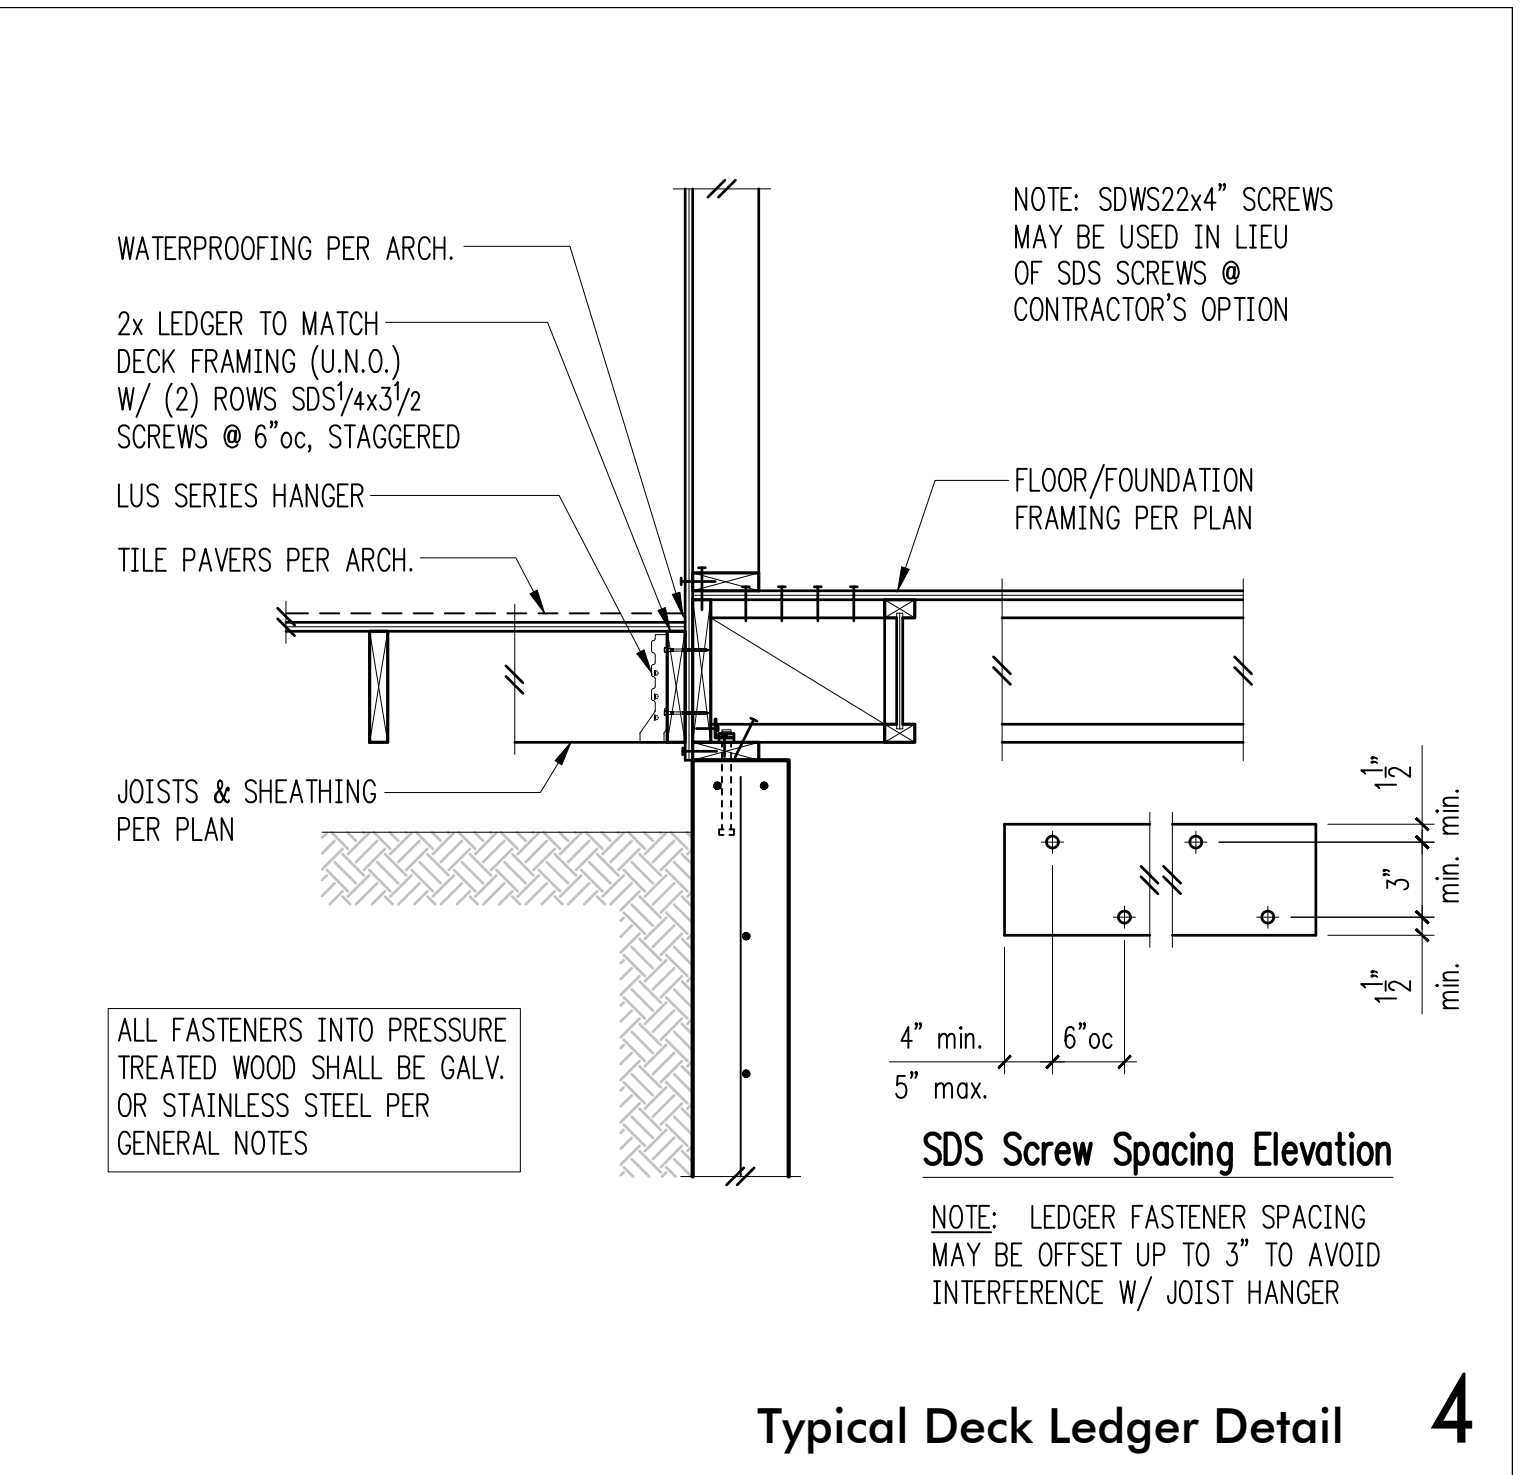


Typical Deck Ledger Detail 4




5

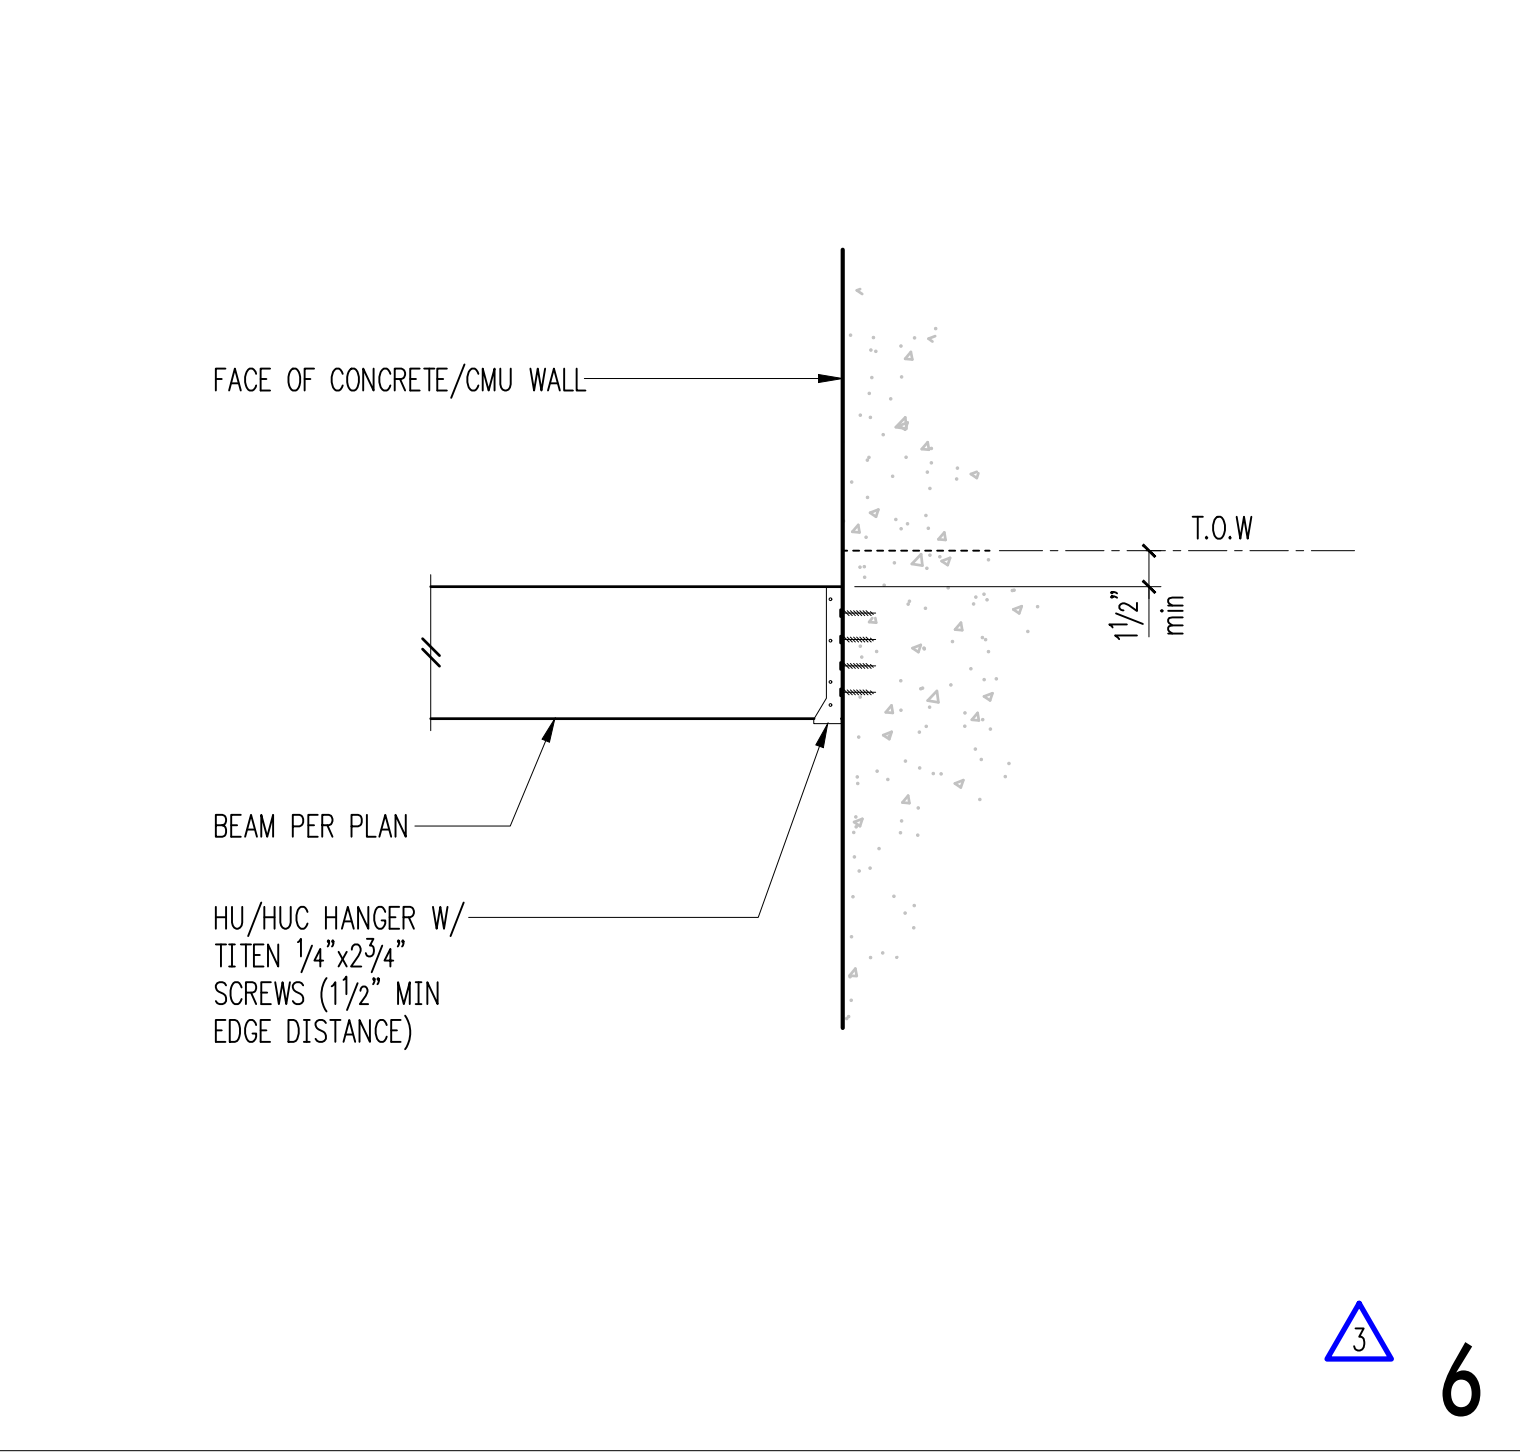


6

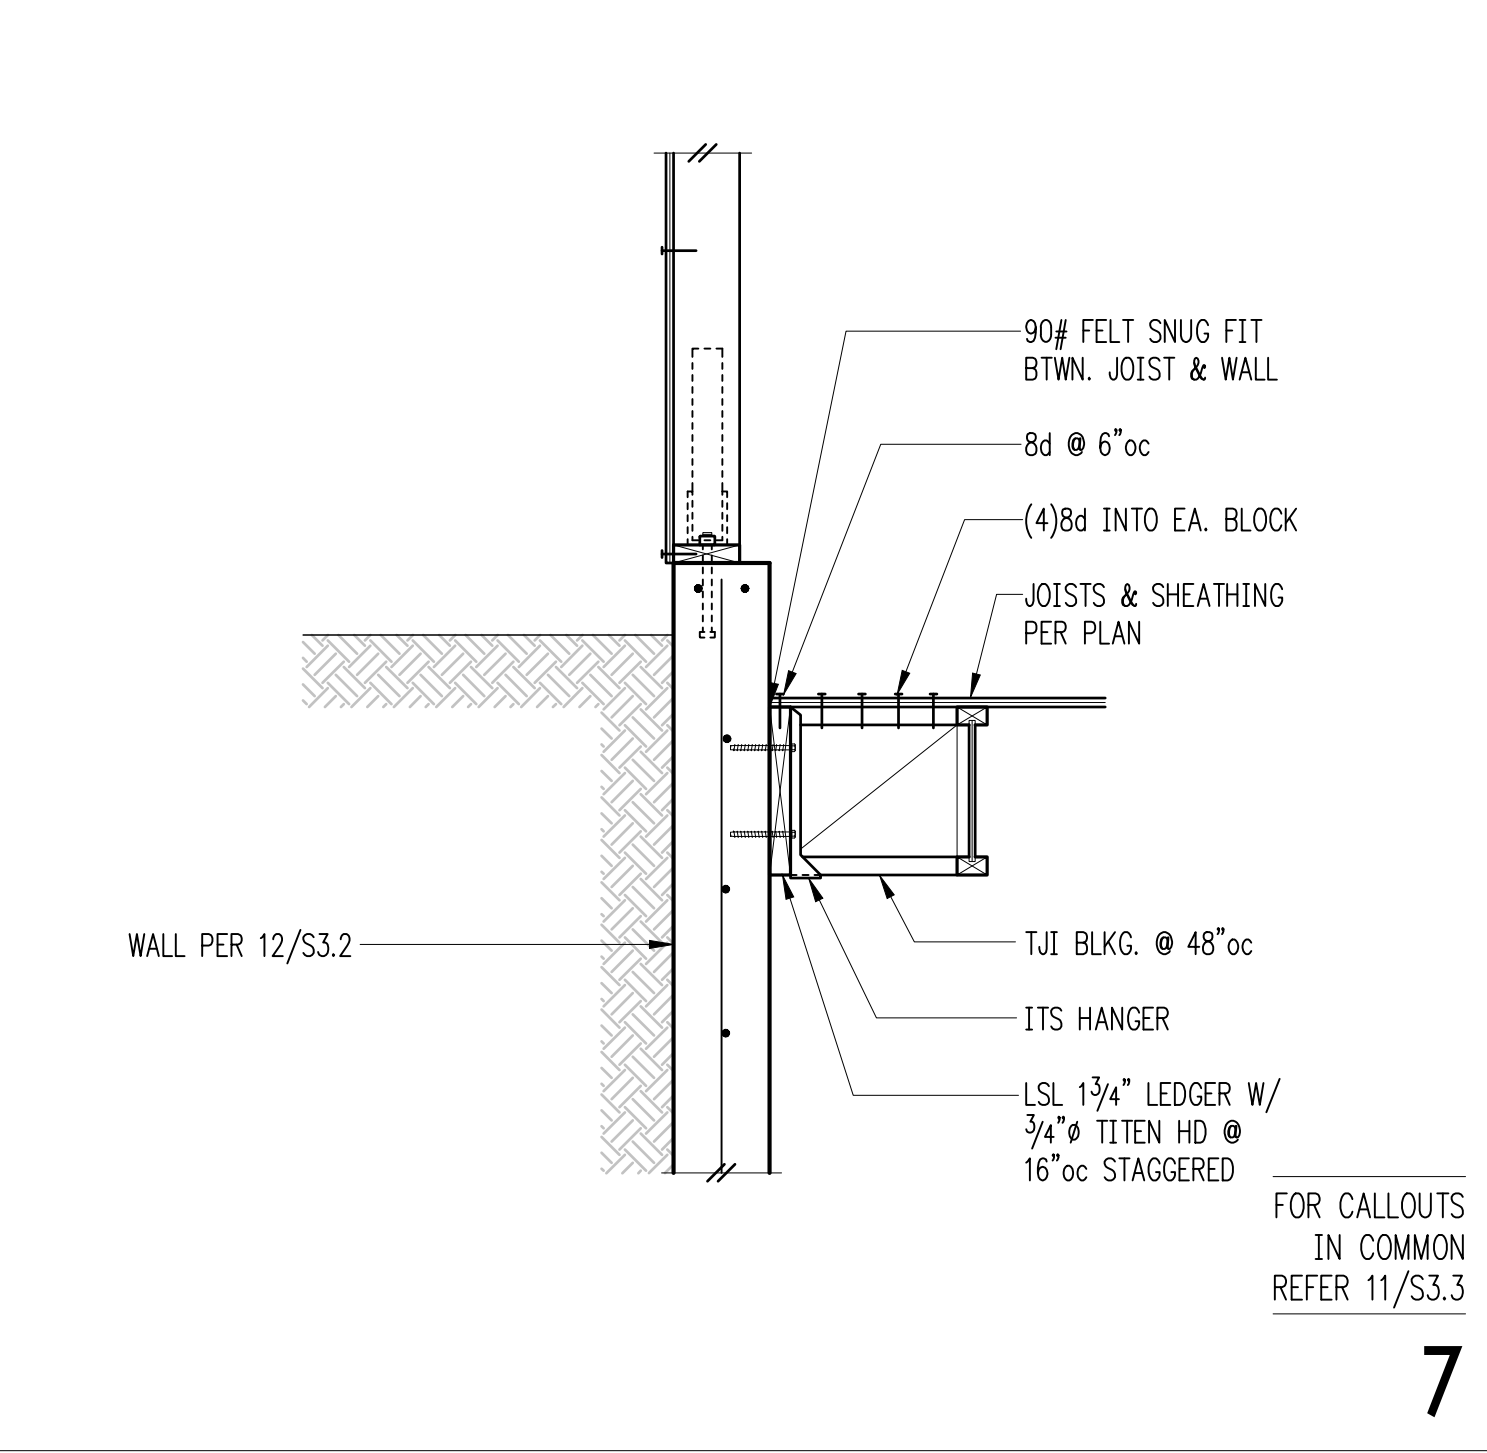


FOR CALLOUTS IN COMMON REFER 11/S3.3  
 7

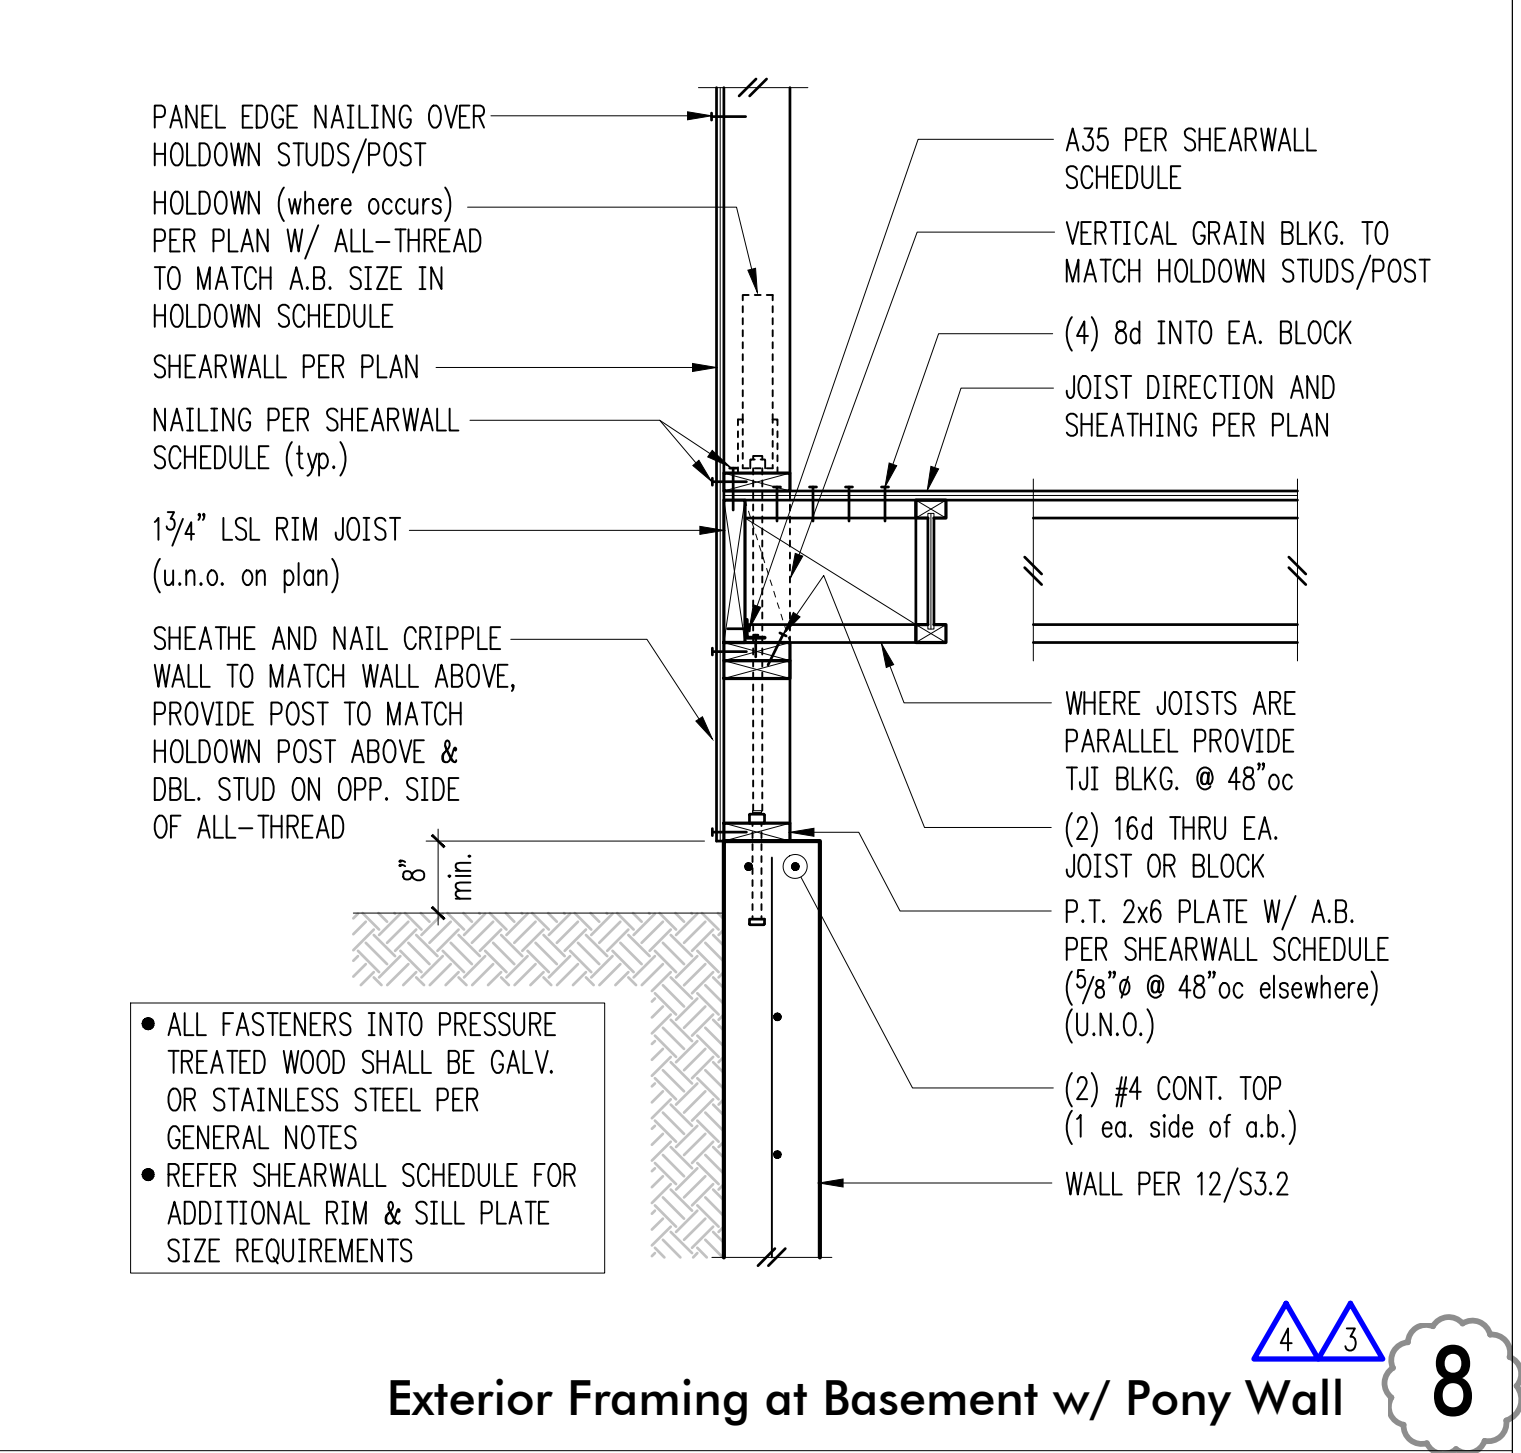


Exterior Framing at Basement w/ Pony Wall 8

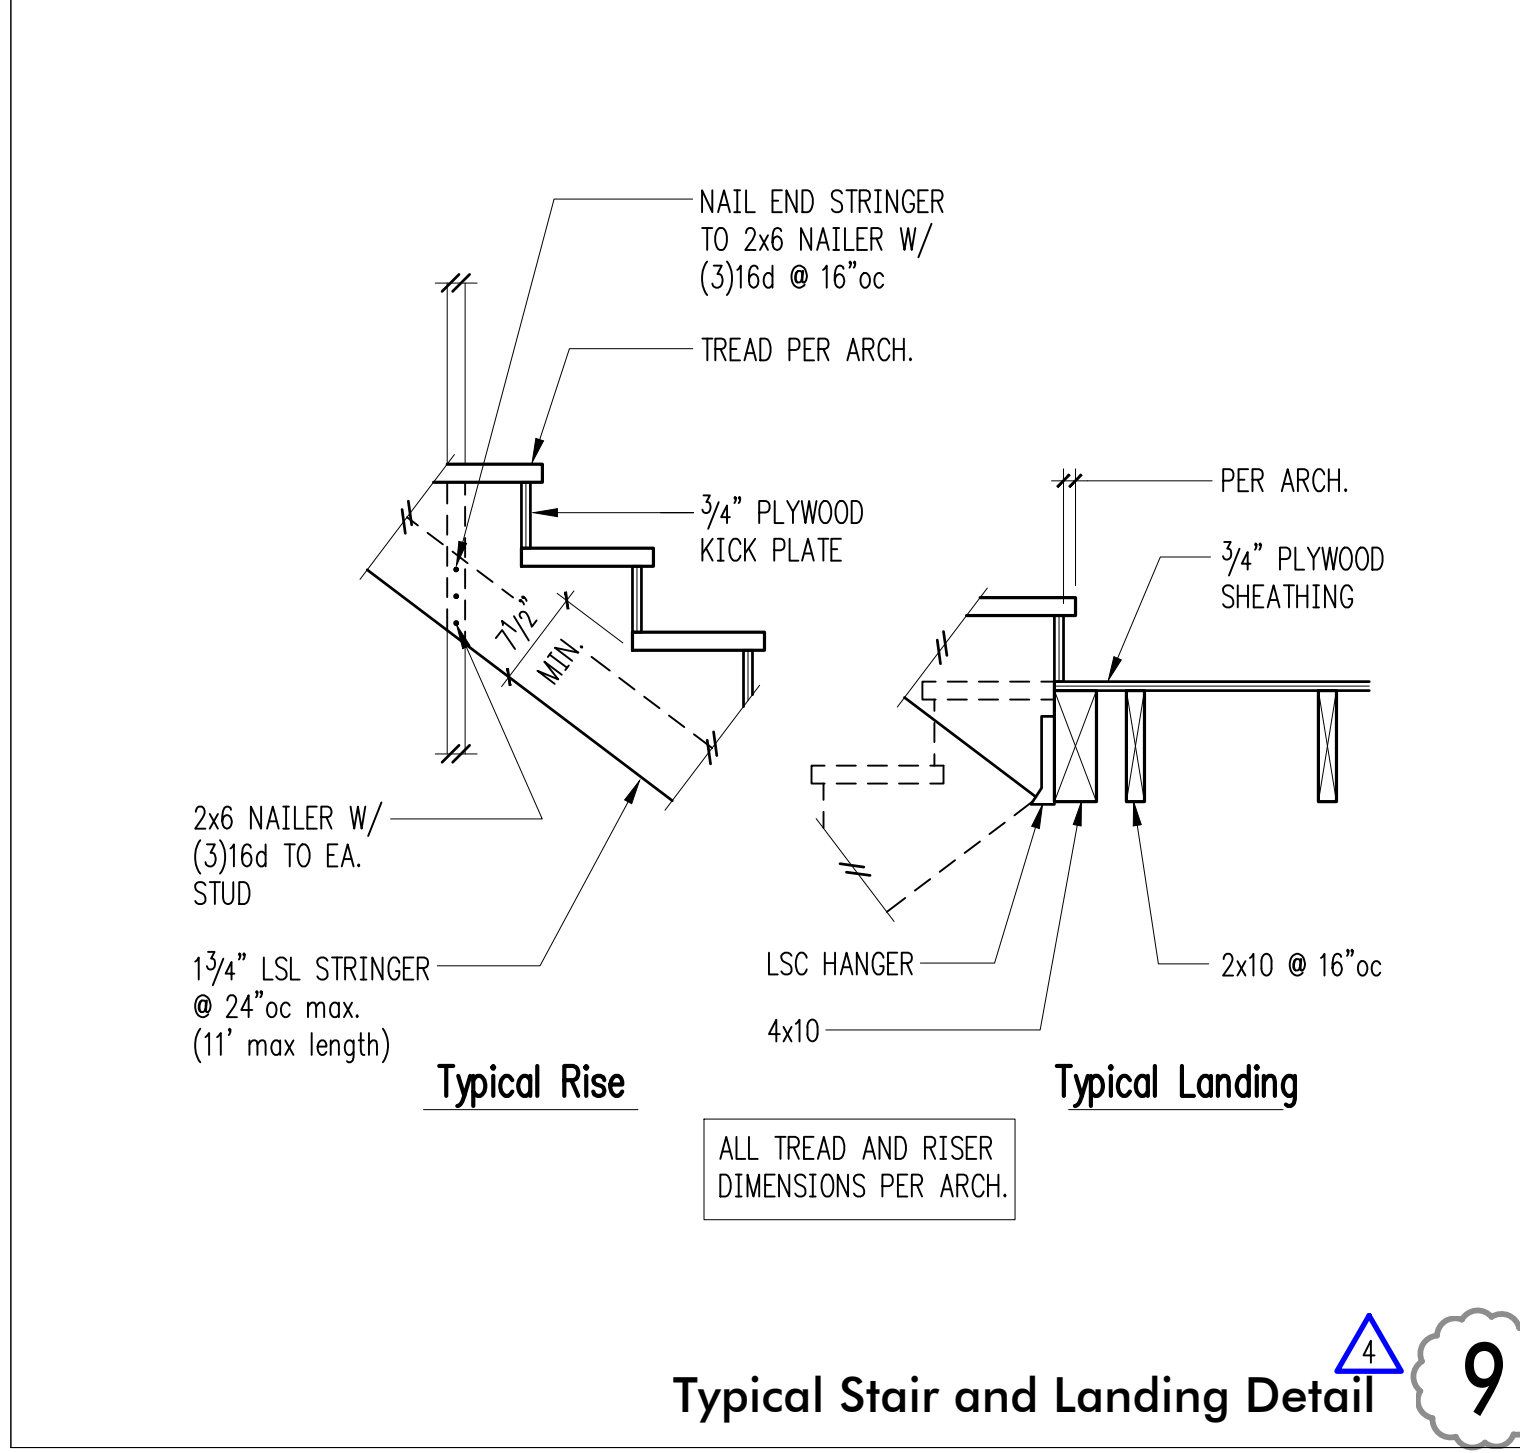


9

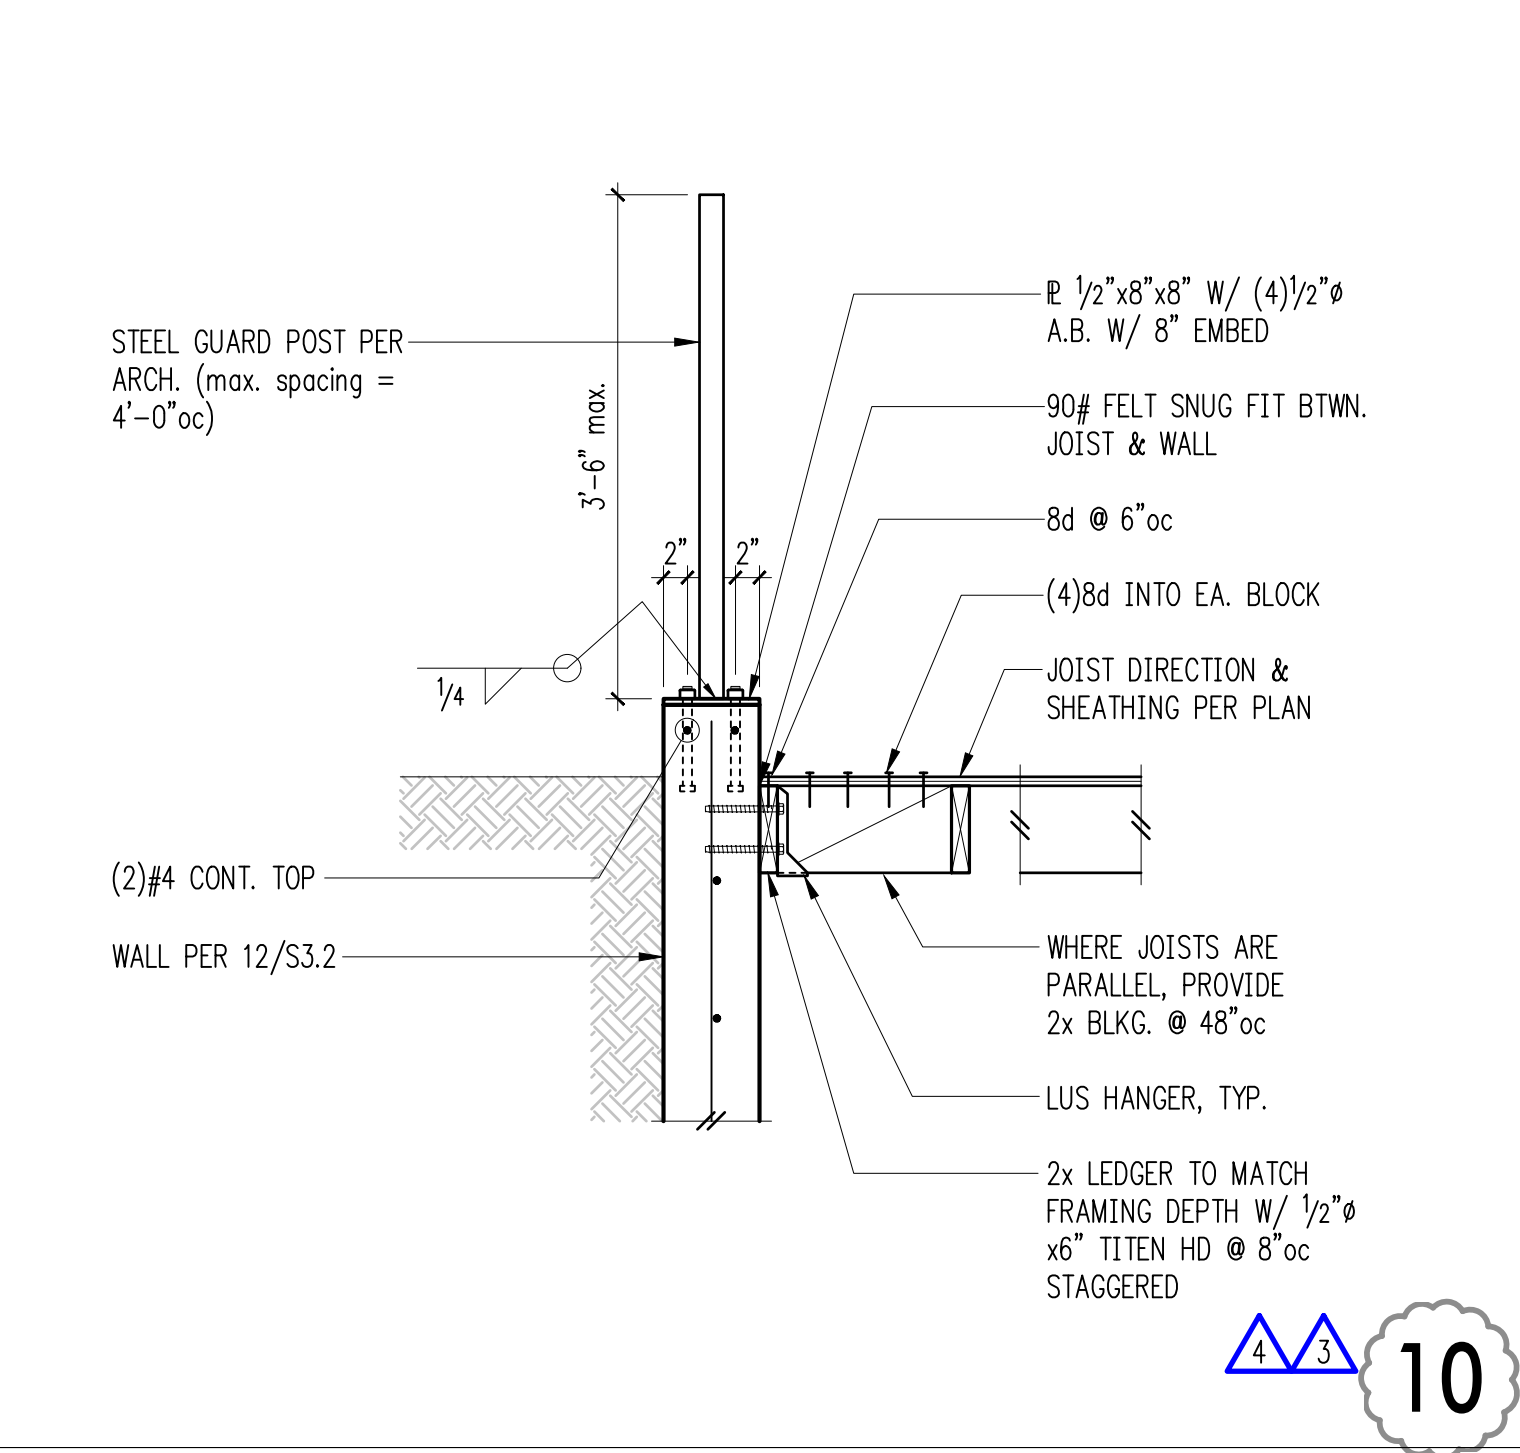

10

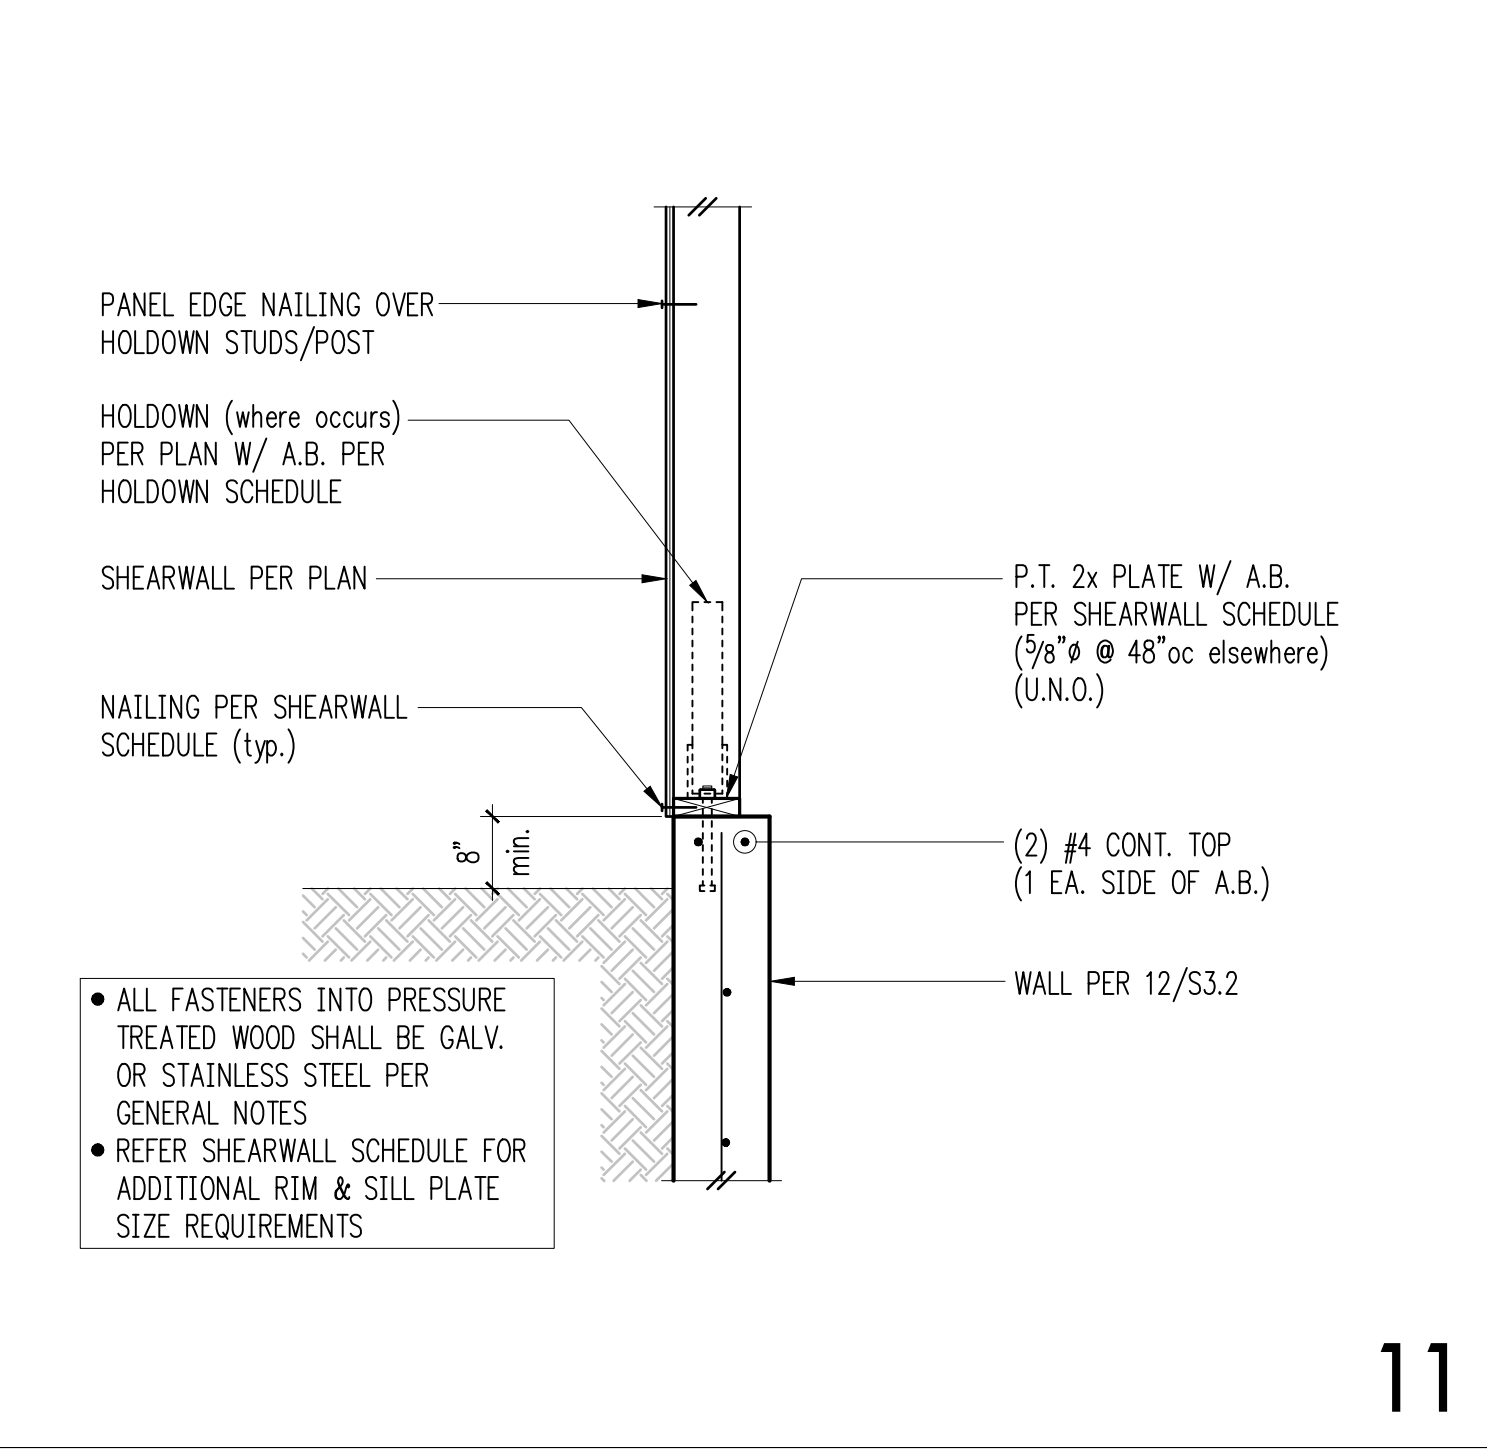

11

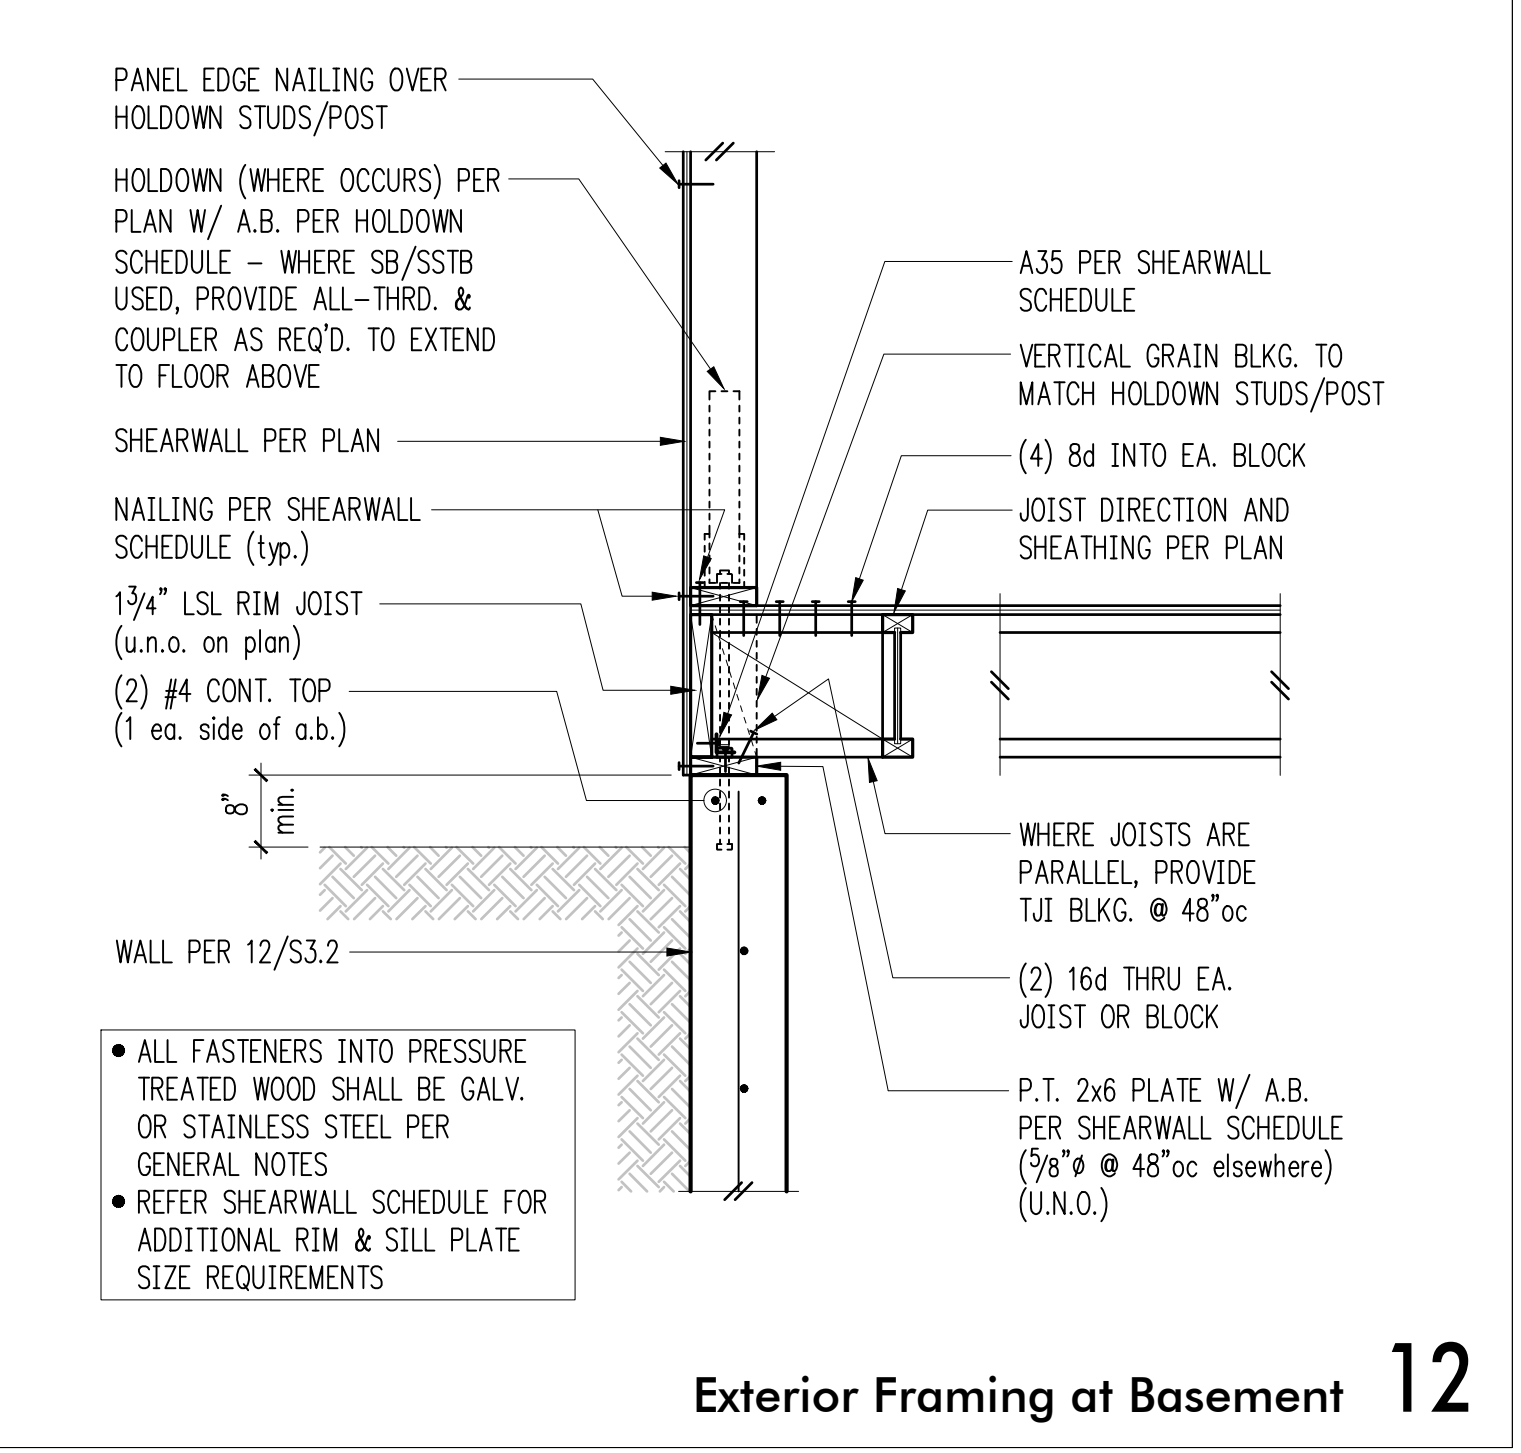

Exterior Framing at Basement 12



DESIGN: HAA, BDM  
DRAWN: NHD  
CHECKED: BDM  
APPROVED: DJS

REVISIONS:

1	Corrections	May 4, 2021
2	Corrections 2	Aug. 13, 2021
3	Permit Revisions	Apr. 22, 2022
4	Corrections	Jun. 10, 2022

DPD:

PROJECT TITLE:  
**Clarkson Residence**  
8163 West Mercer Way  
Mercer Island, WA 98040

ARCHITECT:  
**Brandt Design Group**  
66 Bell Street, Unit 1  
Seattle, WA 98121  
PH 206.239.0850

ISSUE:

**PERMIT**

SHEET TITLE:

**Typical Wood Framing Details**

SCALE: 3/4" = 1'-0" U.N.O.

DATE: December 24, 2020

PROJECT NO: 01519-2021-11


SHEET NO:

**S4.1**


	A	B	C
PLAN VIEW			
SECTION			
# OF WOOD BMS (LVL)	2-1 3/4"	3-1 3/4"	4-1 3/4"
SDW22 SCREW SIZE	0.220x3	0.220x5	0.220x6
# OF SDW22 SCREWS	2	2	2
SPACING OF SDW22 SCREWS	12"OC	12"OC	12"OC

NOTES:  
- MIN. SCREW END DISTANCE = 6"  
NOTE: MAY USE SDS 1/4"  
@ CONTRACTORS OPTION

**Sistering Schedule for Multi Beams (SDWS) 1**

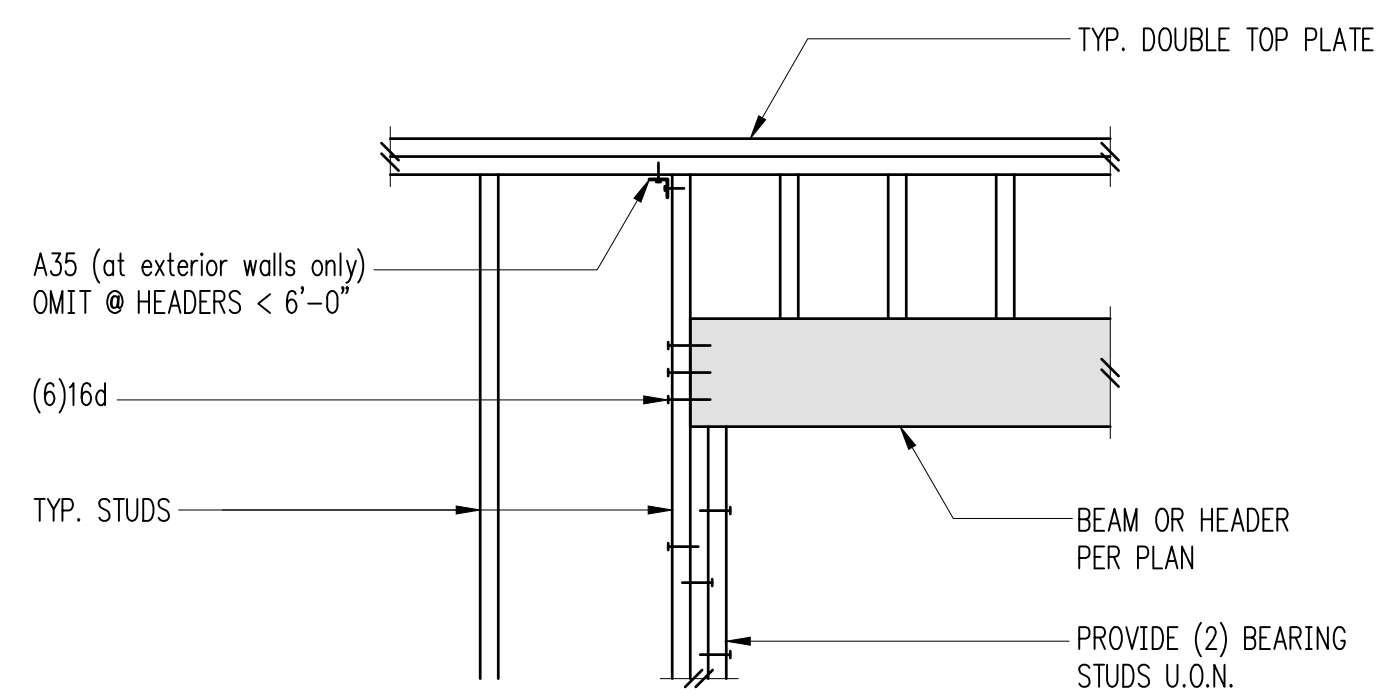


**Typical Header Support w/2 Bearing Studs 2**

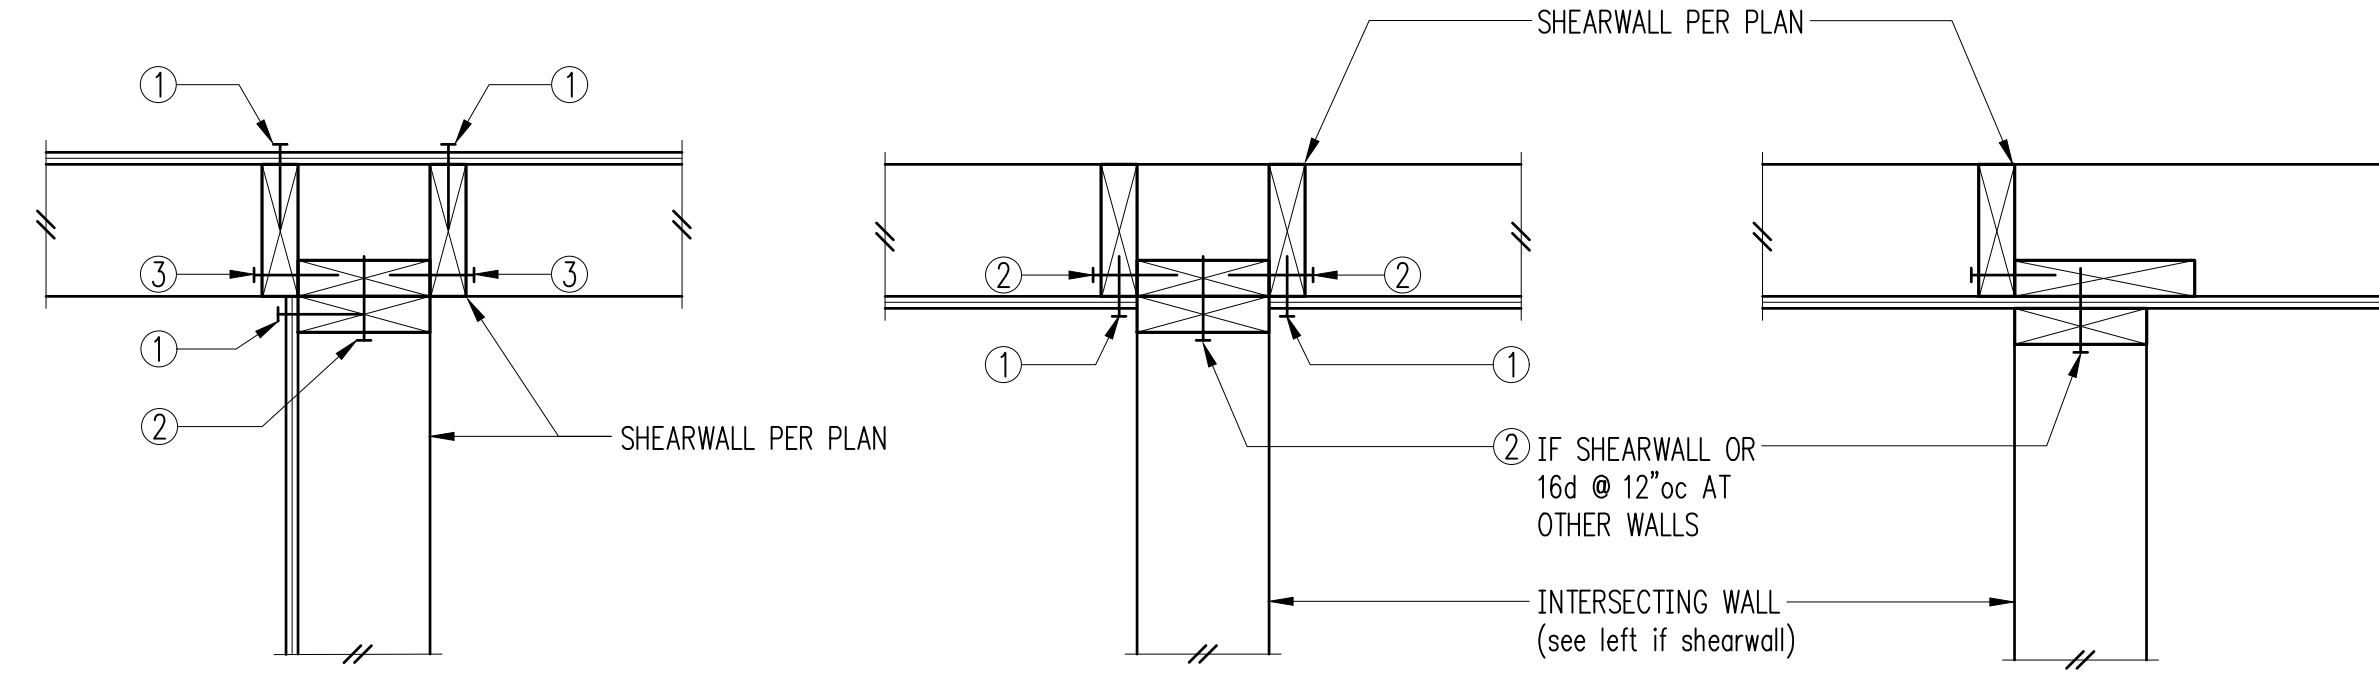

- 1 PLYWOOD PANEL EDGE NAILING PER SHEARWALL SCHEDULE
- 2 BASE PLATE NAILING PER SHEARWALL SCHEDULE
- 3 16d @ 8"oc


**Typical Shearwall Intersections 4**

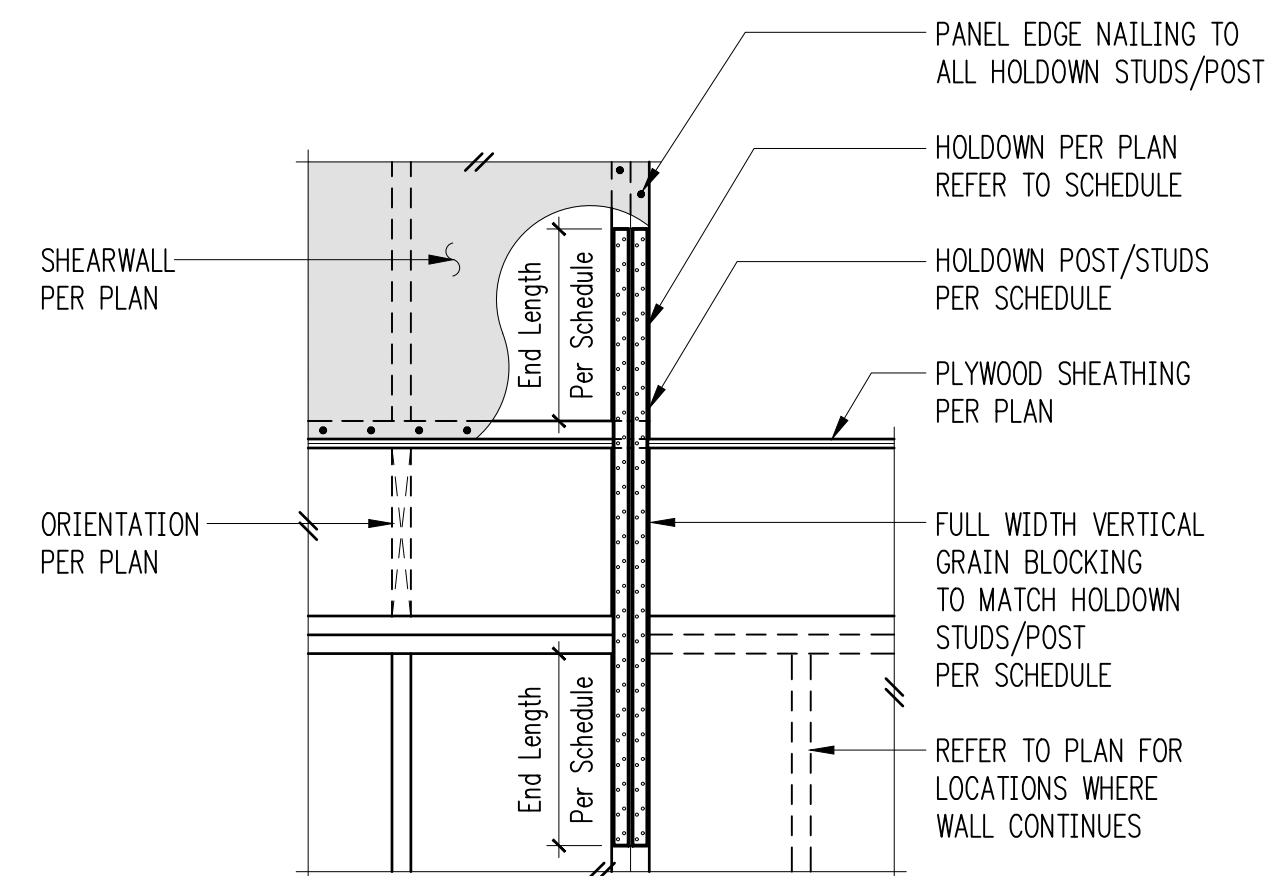


**Holddown Strap Schedule**

Plan Mark	End Length	#Nails Ea. End Length	Holddown Studs/Post if 2x4	if 2x6
CS16	1'-2"	(13) 8d	(1) 2x4	(1) 2x6
CMST14	2'-6"	(33) 10d	4x6	4x6
CMST12	3'-3"	(43) 10d	4x8	6x6

**Typical Holddown Schedule 5**

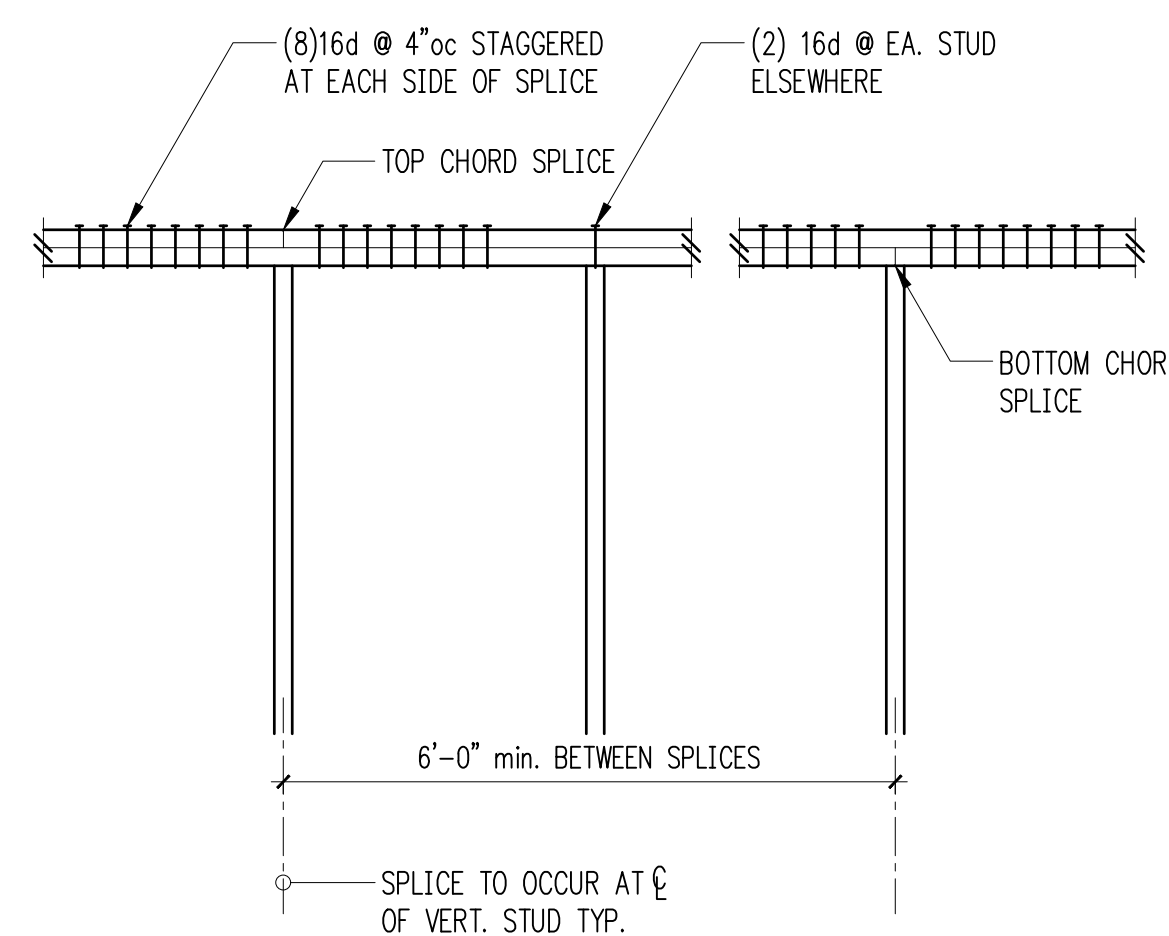


**Typical Top Plate Splice 6**

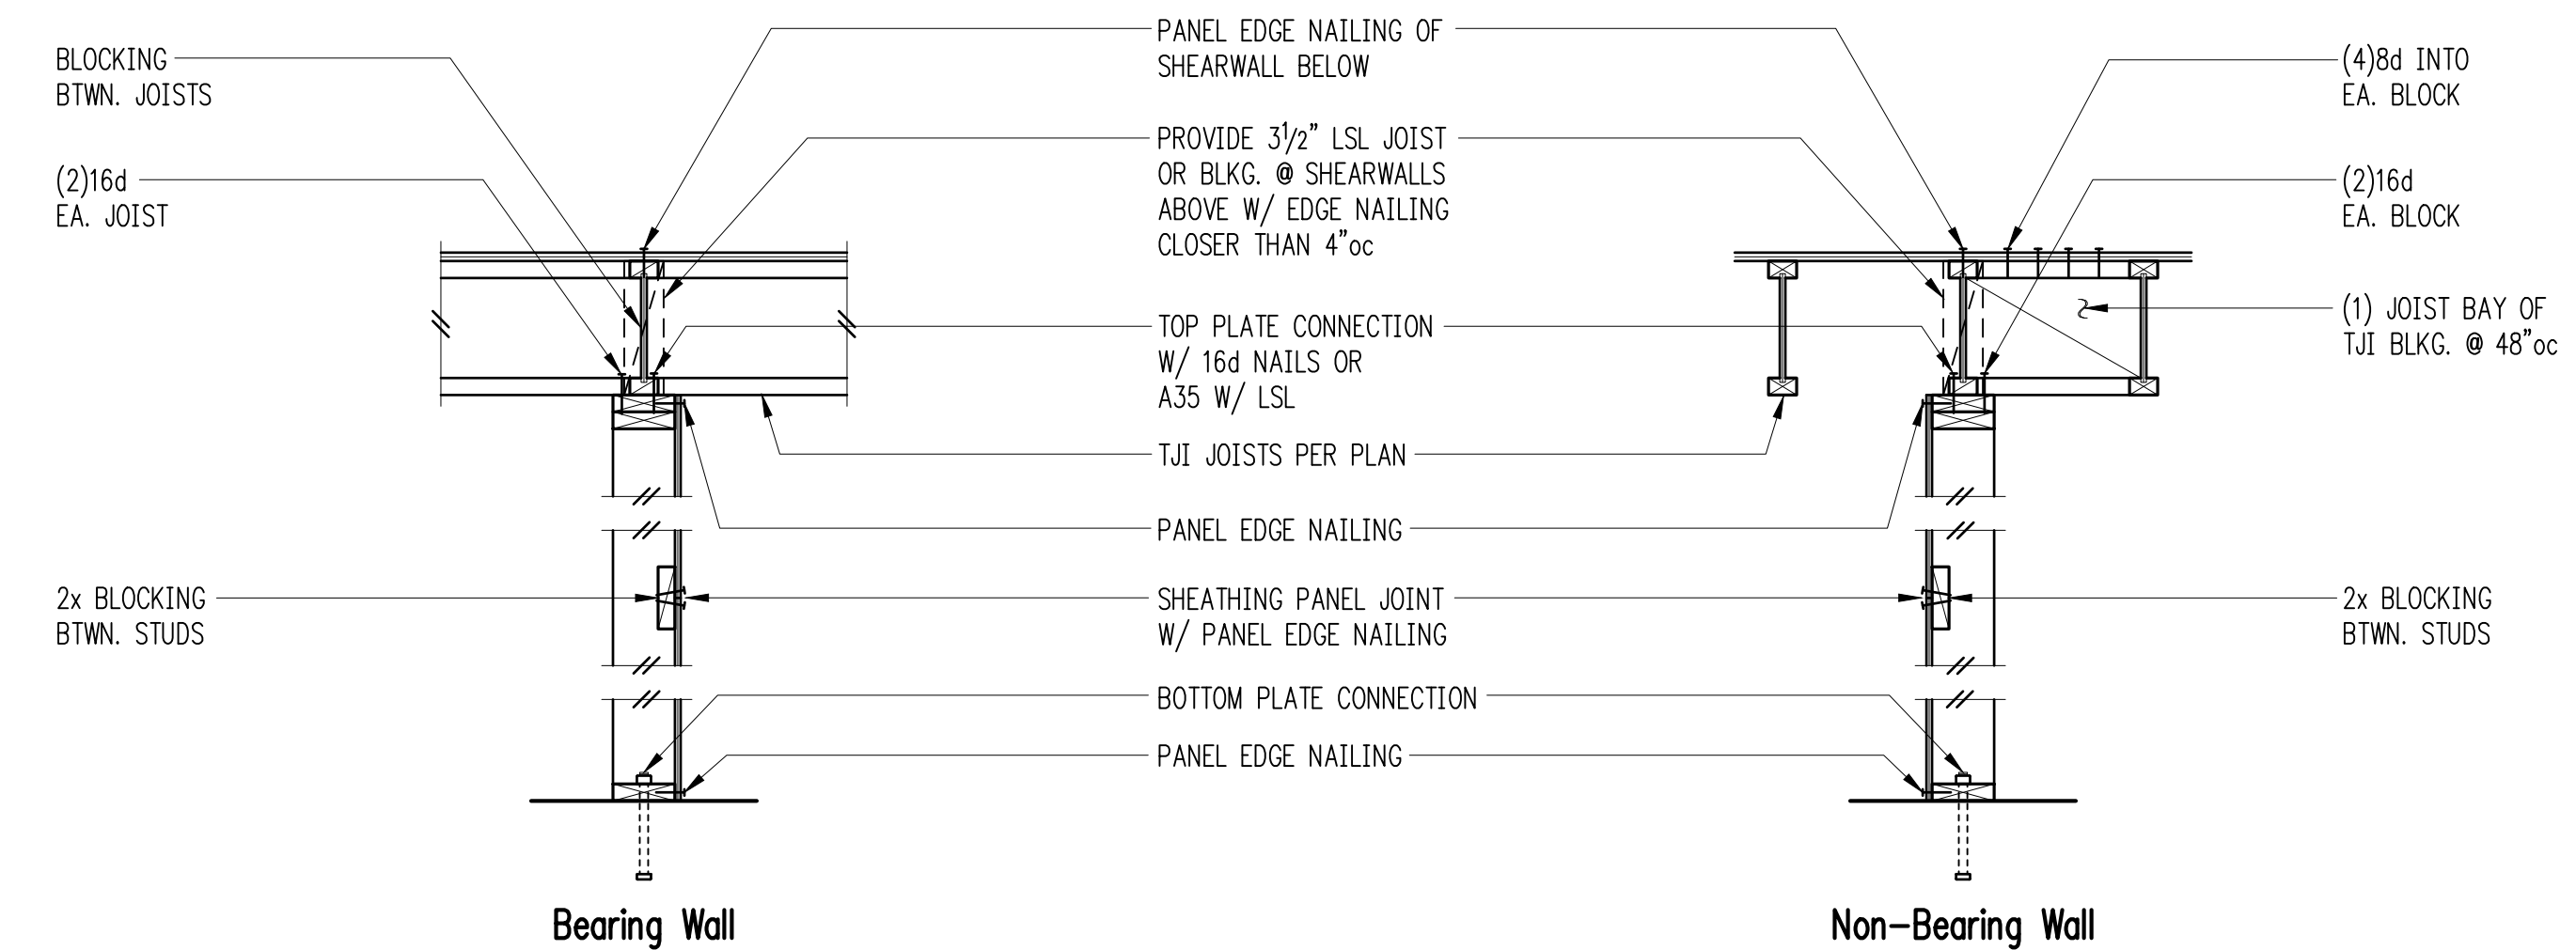


NOTE:  
SEE SHEARWALL SCHEDULE FOR ALL NAILING AND CONNECTIONS, NOT OTHERWISE NOTED


**Typical Shearwall Construction 8**

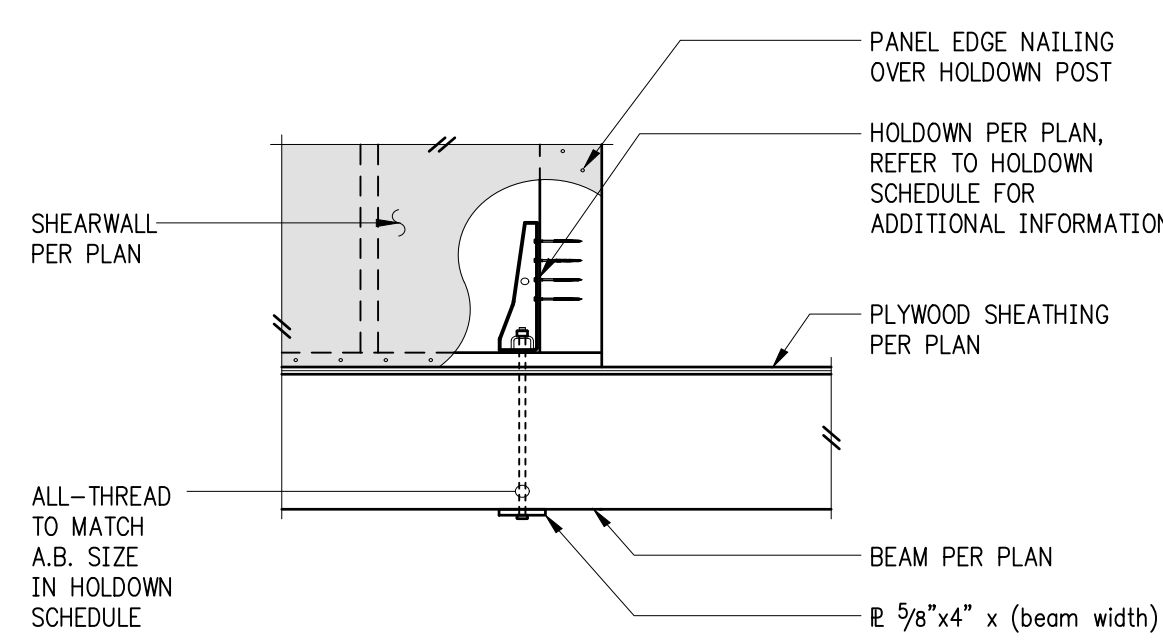

**HDU at Floor Beam 9**

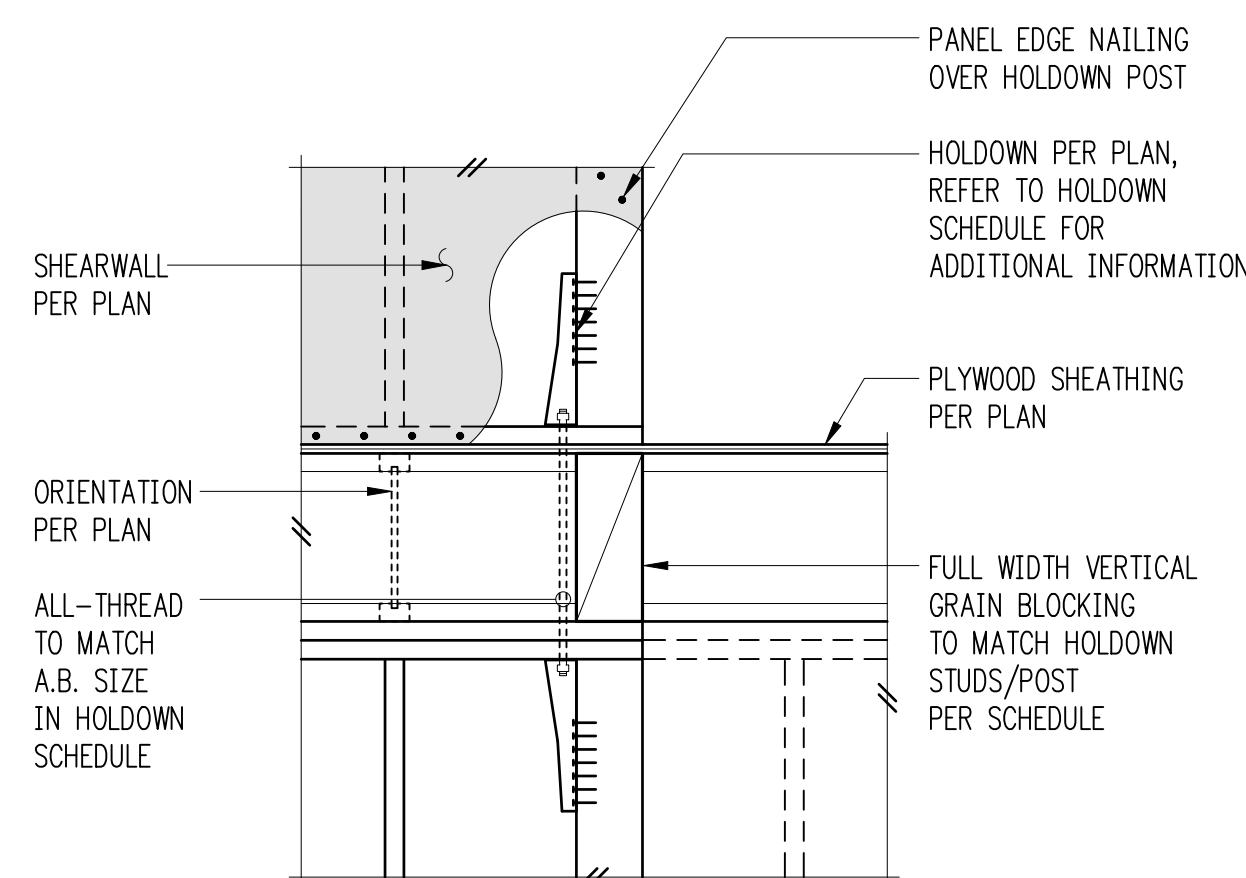

**Typical HDU Holdowns 10**

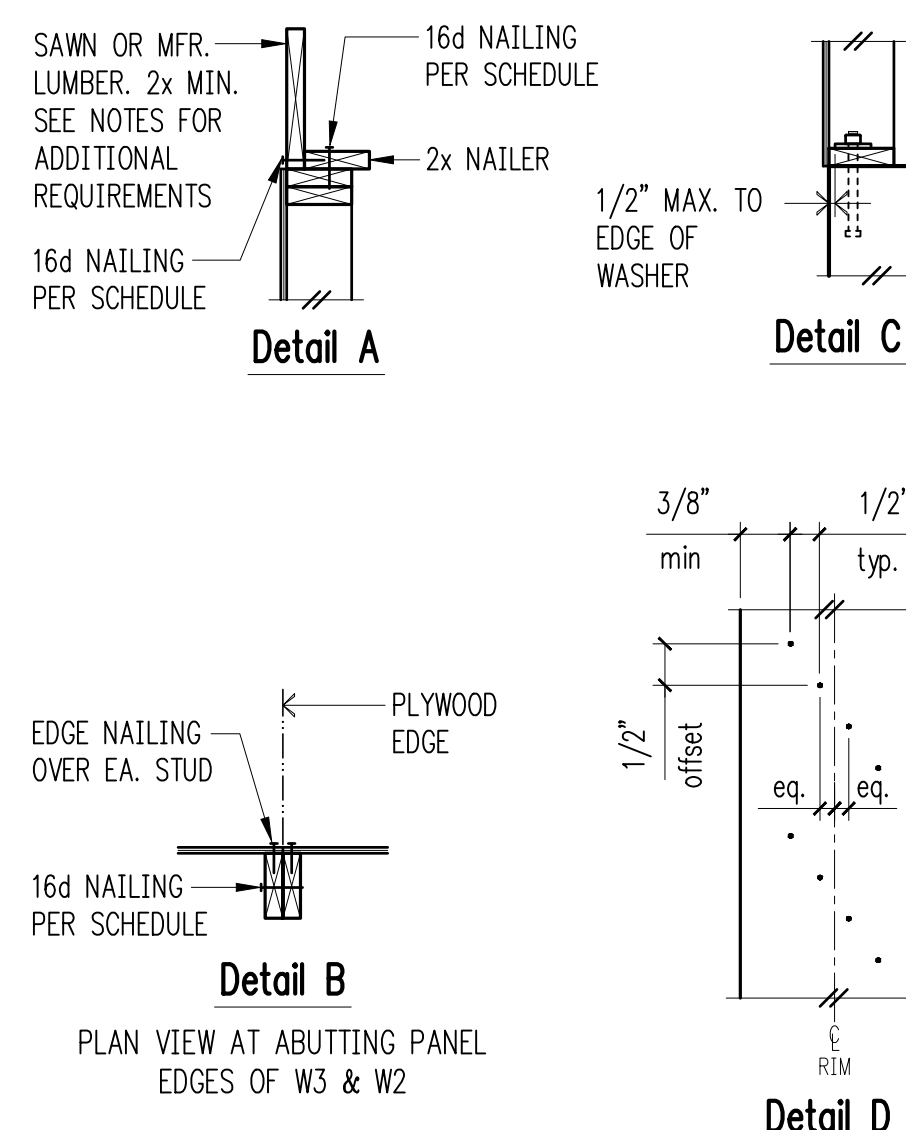


**Shearwall Schedule ①②③④⑤⑥⑦⑧**


Mark	Sheathing	Panel Edge Nailing	Top Plate Connection		Base Plate Connection	
			if TJI	if Wood ④	at Wood ①②	at Concrete
W6	15/32" CDX PLYWOOD	8d @ 6"oc	16d @ 6"oc	A35 @ 24"oc ⑩	16d @ 6"oc	5/8" A.B. @ 48"oc
W4	15/32" CDX PLYWOOD	8d @ 4"oc	16d @ 4"oc	A35 @ 16"oc ⑩	(2)rows 16d @ 6"oc	5/8" A.B. @ 32"oc
W3 ④	15/32" CDX PLYWOOD	8d @ 3"oc	(2)rows 16d @ 4"oc	A35 @ 12"oc ⑩	(2)rows 16d @ 6"oc	5/8" A.B. @ 24"oc
W2 ④	15/32" CDX PLYWOOD	8d @ 2"oc	(2)rows 16d @ 4"oc	A35 @ 9"oc ⑩	(2)rows 16d @ 4"oc ⑬	5/8" A.B. @ 16"oc
2W3 ⑤	15/32" CDX PLYWD. EA. SIDE	8d @ 3"oc EA. SIDE	n/a	A35 @ 6"oc	(3)rows 16d @ 4"oc ⑬	5/8" A.B. @ 16"oc
2W2 ⑤	15/32" CDX PLYWD. EA. SIDE	8d @ 2"oc EA. SIDE	n/a	HGA10KT @ 8"oc	(3)rows 16d @ 4"oc ⑬	5/8" A.B. @ 12"oc
2W2-10 ⑤⑬	15/32" CDX PLYWD. EA. SIDE	10d @ 2"oc EA. SIDE	n/a	HGA10KT @ 6"oc	(4)rows 16d @ 4"oc ⑬	5/8" A.B. @ 12"oc

- ① BLOCK PANEL EDGES WITH 2x MIN. LAID FLAT AND NAIL PANELS TO INTERMEDIATE SUPPORTS WITH 8d @ 12"oc.
- ② 8d NAILS SHALL BE 0.131" x 2 1/2" (common) - 16d NAILS SHALL BE 0.135" x 3 1/2" (box) - 10d NAILS SHALL BE 0.148" x 3" (common).
- ③ EMBED ANCHOR BOLTS AT LEAST 7". EXPANSION BOLTS MAY BE SUBSTITUTED FOR ANCHOR BOLTS WITH 4" EMBEDMENT. TITEN HD SCREW ANCHORS MAY BE SUBSTITUTED FOR ANCHOR BOLTS W/ 4" EMBEDMENT. ALL BOLTS SHALL HAVE 3" x 3" x 1/4" MIN. PLATE WASHERS. PLATE WASHERS SHALL EXTEND TO WITHIN 1/2" OF THE EDGE OF THE BOTTOM PLATE ON THE SIDE WITH SHEATHING. SEE DETAIL C.
- ④ 3x STUDS OR DOUBLE STUDS NAILED TOGETHER W/ BASE PLATE NAILING ARE REQUIRED AT ABUTTING PANEL EDGES OF W3 AND W2. SEE DETAIL B. WHERE 3x STUDS ARE USED FOR W2, STAGGER NAILS AT ADJOINING PANEL EDGES.
- ⑤ 3x FOUNDATION SILL PLATES ARE REQUIRED FOR 2W3 AND 2W2. 3x STUDS ARE REQUIRED AT ABUTTING PANEL EDGES AND PANEL JOINTS SHALL BE OFFSET EACH SIDE OF WALL. STAGGER NAILS AT ADJOINING PANEL EDGES. 3x STUD, MIN., REQUIRED AT END OF SHEARWALL.
- ⑥ TWO STUDS MINIMUM ARE REQUIRED AT EACH END OF ALL SINGLE-SIDED SHEARWALLS. ALL END STUDS SHALL RECEIVE PANEL EDGE NAILING. SEE PLANS AND HOLDOWN SCHEDULE FOR ALTERNATE REQUIREMENTS.
- ⑦ ALL EXTERIOR WALLS SHALL BE W6, UNLESS NOTED OTHERWISE.
- ⑧ 7/16" O.S.B. MAY BE SUBSTITUTED FOR 15/32" CDX, EXCEPT AT 10d PANEL EDGE NAILING.
- ⑨ LTP4s (HORIZONTAL ORIENTATION) W/ 8d COMMON MAY BE SUBSTITUTED FOR A35s AT CONTRACTORS OPTION.
- ⑩ A 2x NAILER ATTACHED W/ BASE PLATE NAILING PER DETAIL A MAY BE SUBSTITUTED FOR A35s AT CONTRACTORS OPTION.
- ⑪ AT MULTI-ROW NAILING, MINIMUM OFFSET BETWEEN ROWS AND ROW SPACING 1/2", SEE DETAIL D.
- ⑫ LVL RIMS PERMITTED AT SINGLE SIDED SHEAR WALLS ONLY.
- ⑬ PROVIDE (3) ROWS 16d @ 6"oc AT LVL RIMS.
- ⑭ MINIMUM RIM OR JOIST 3/2" WIDE BELOW SHEARWALL.
- ⑮ STUDS AND PLATES SHALL BE DOUGLAS FIR-LARCH NO. 2 AT 2W2-10 SHEARWALL.

 
**Shearwall Schedule 12**




1

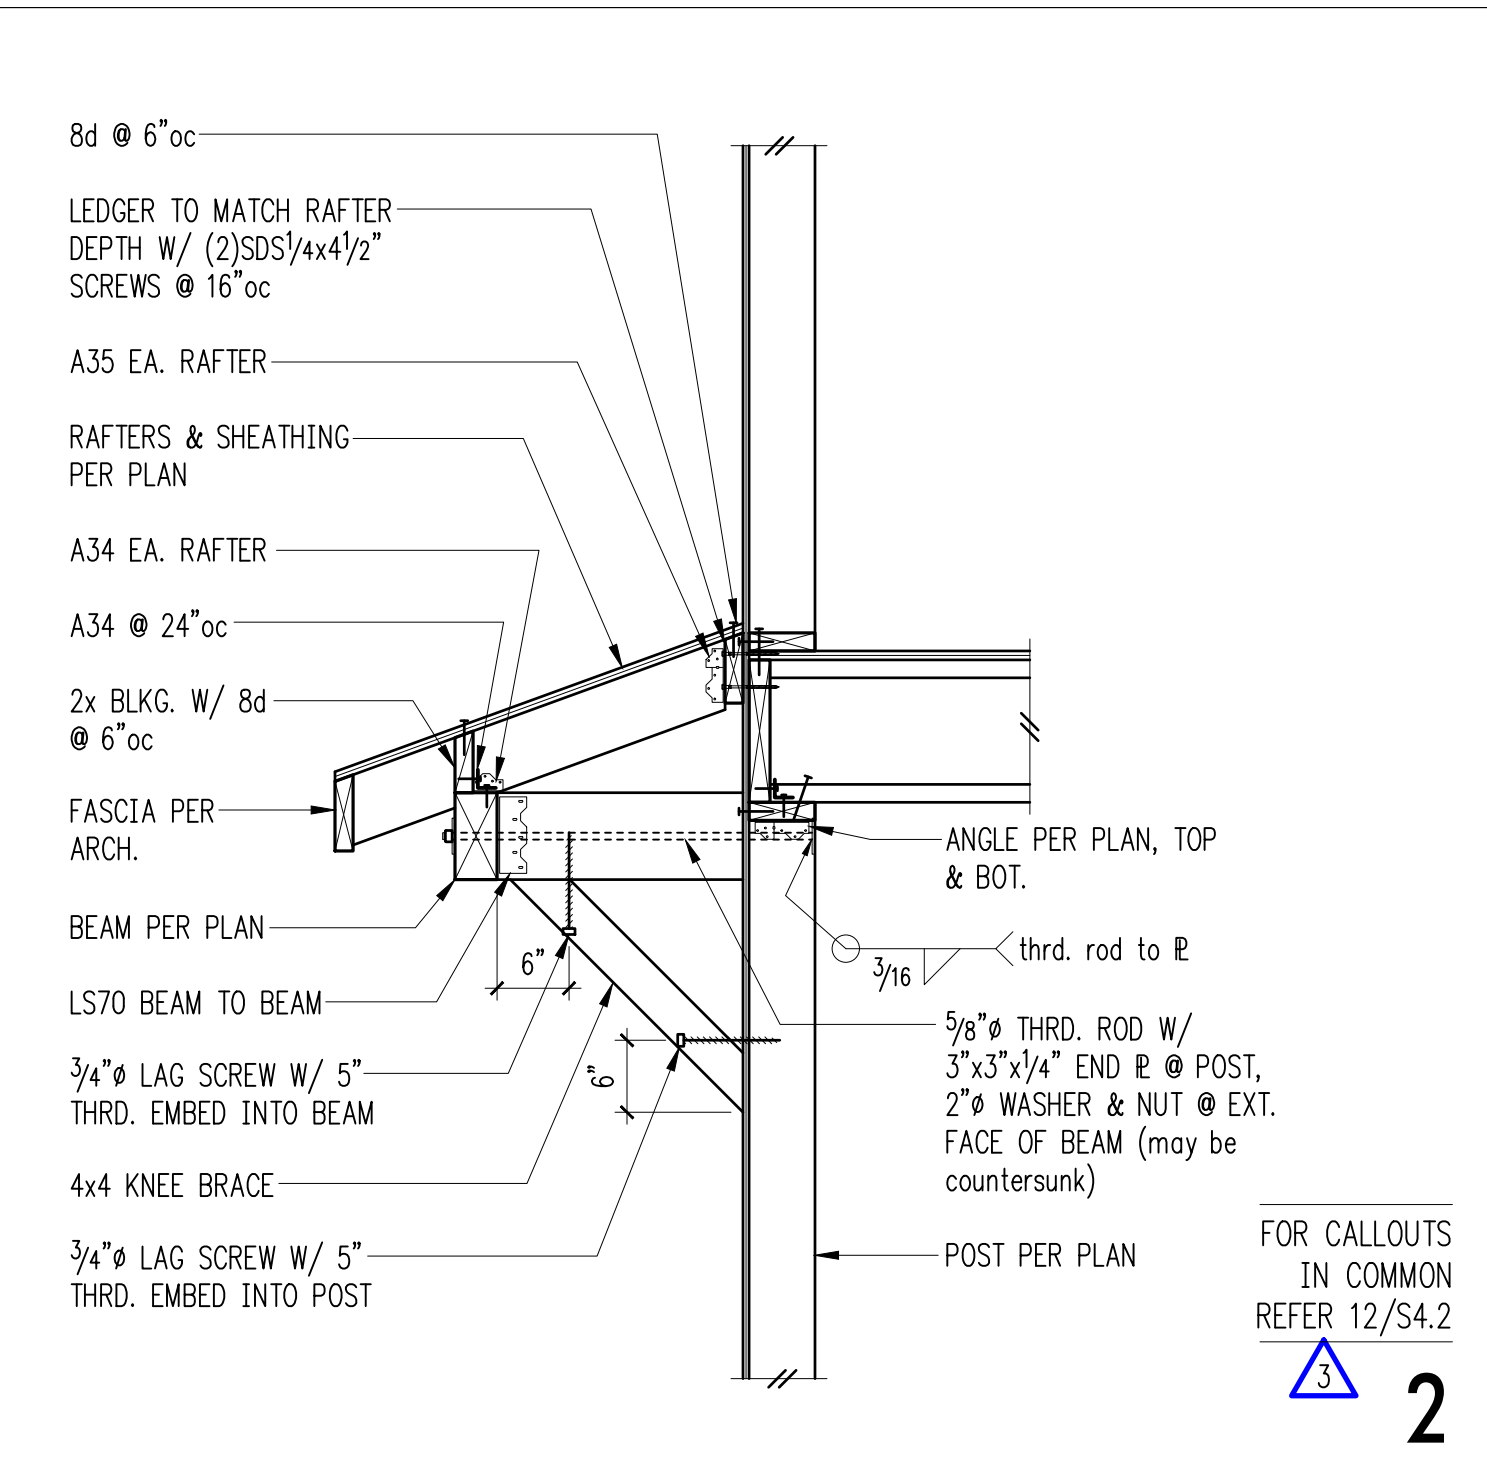


2

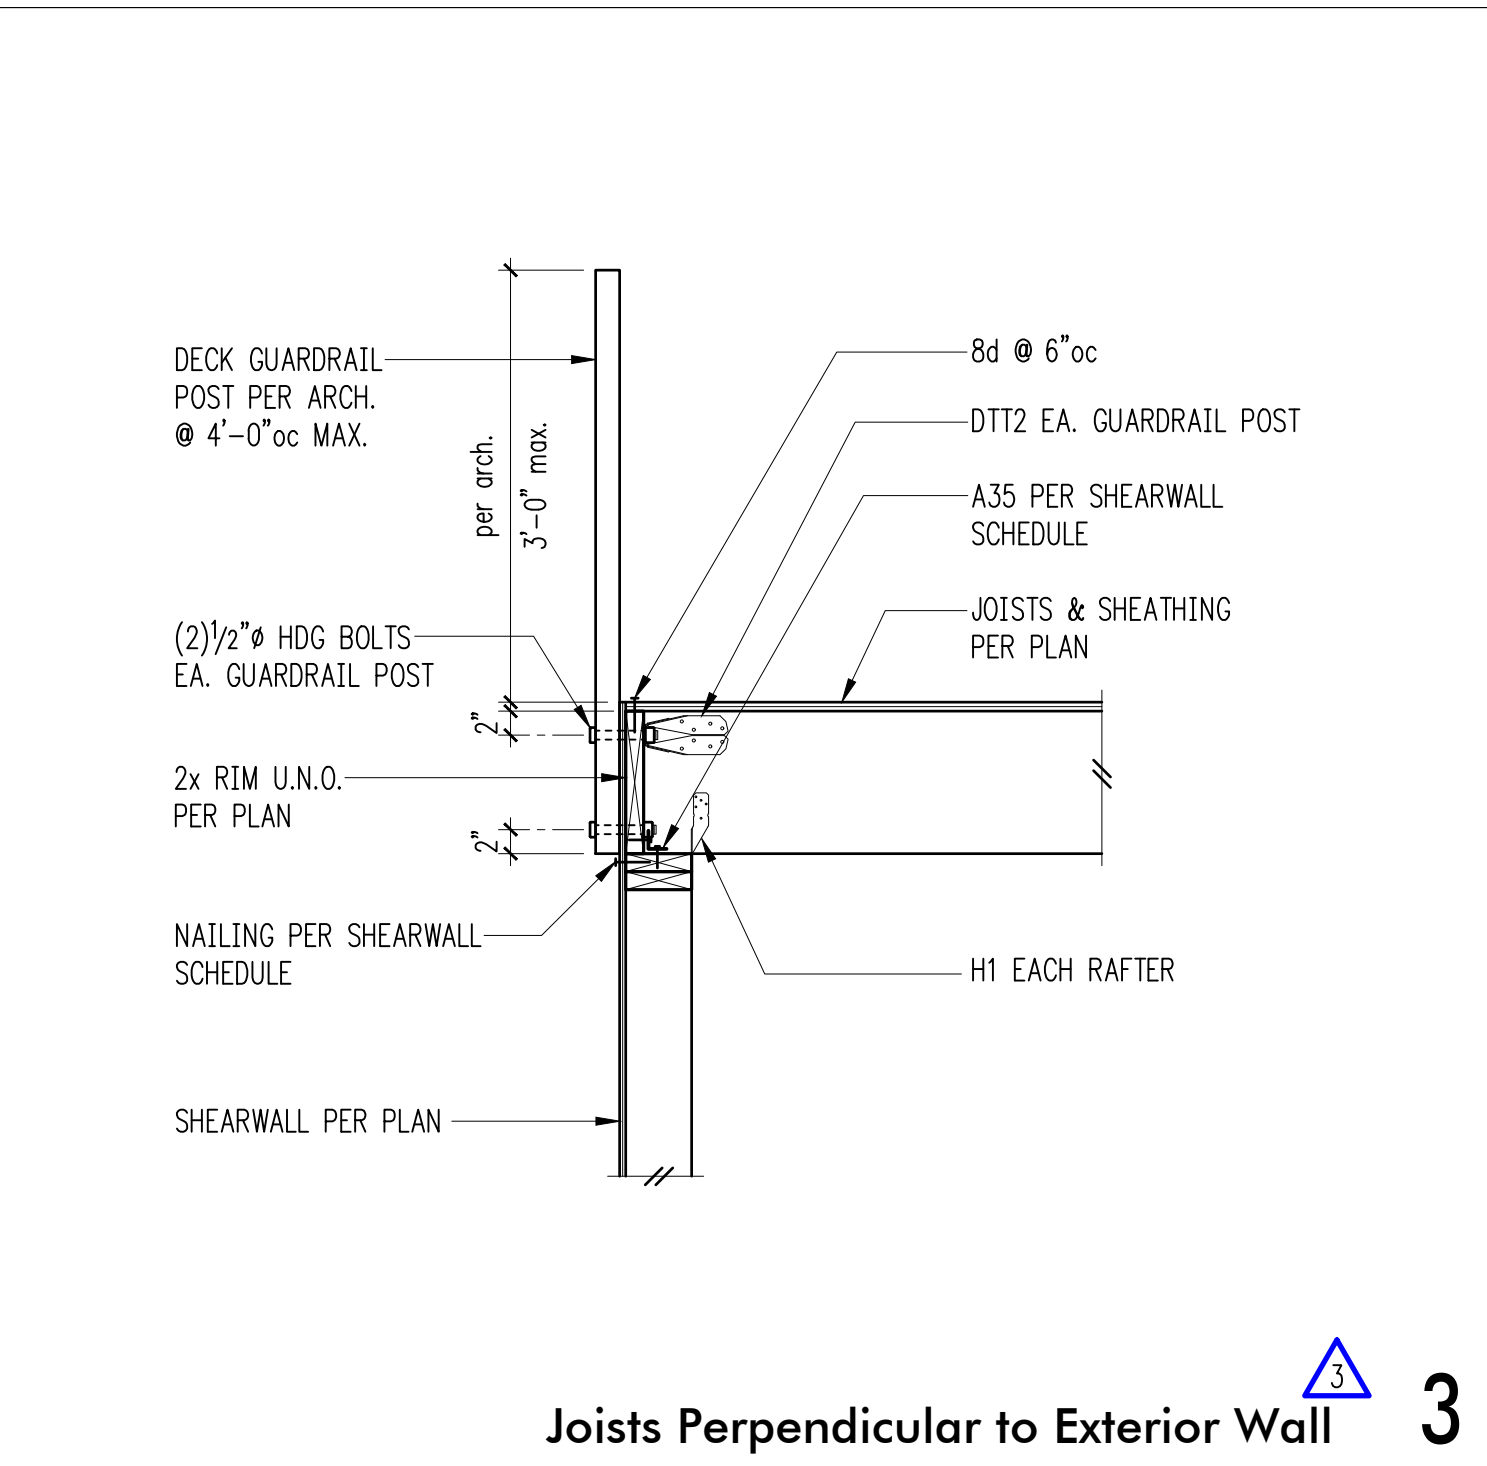


3

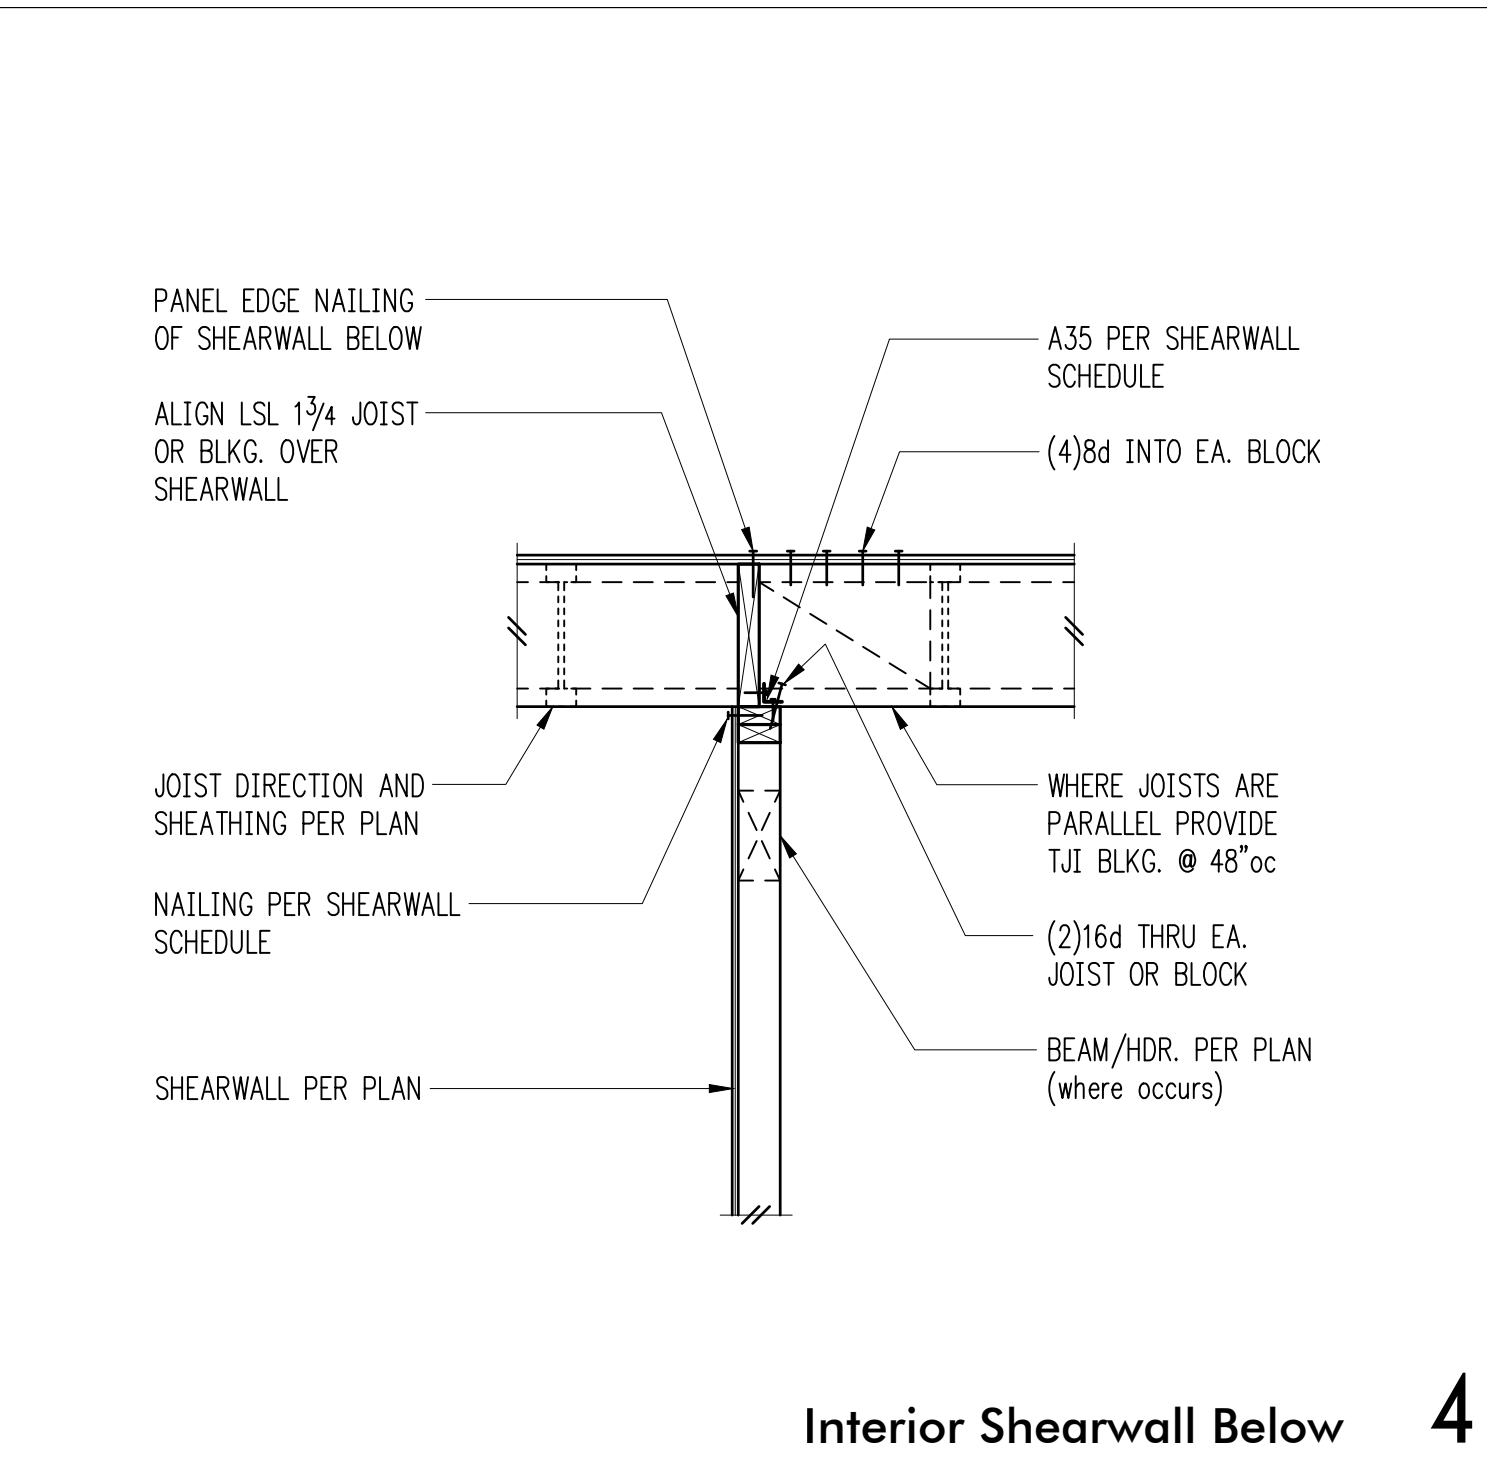


4

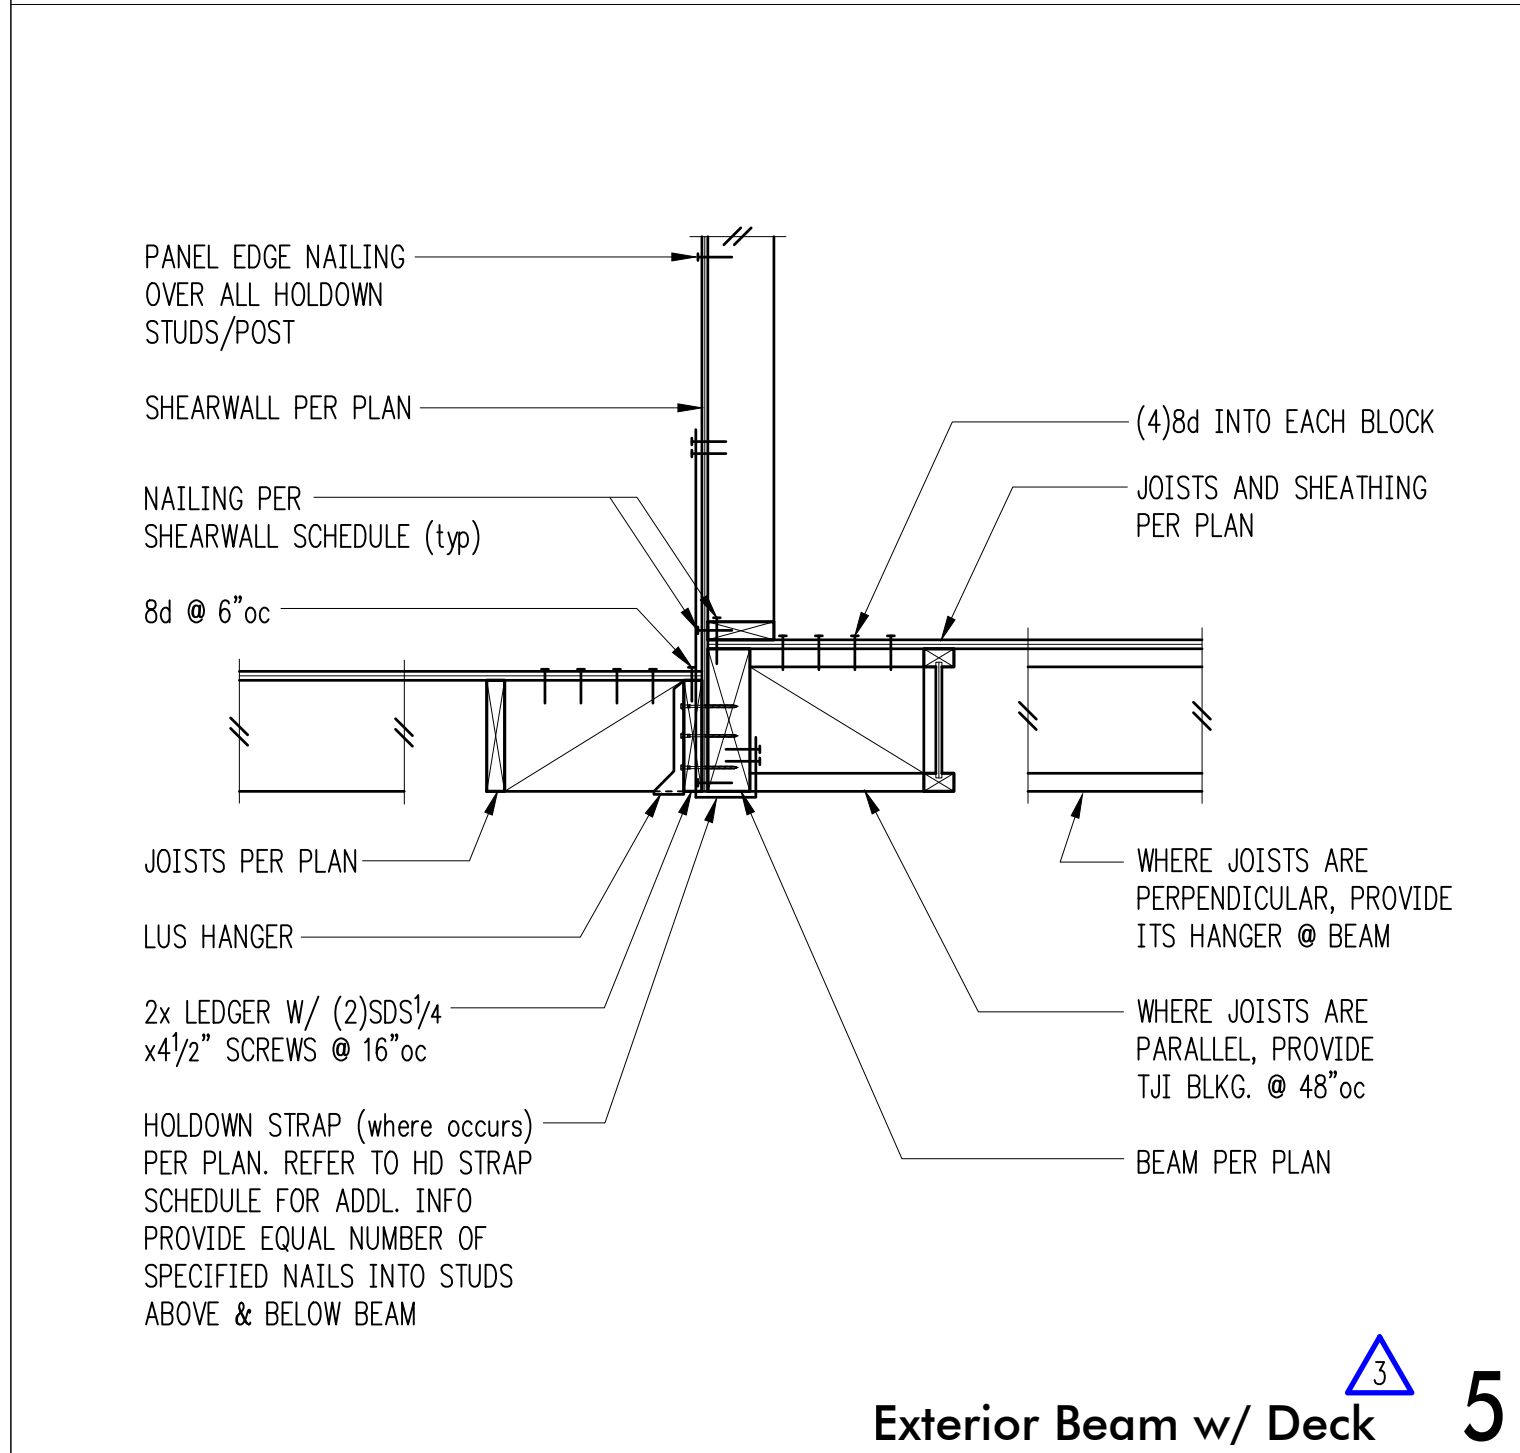


5

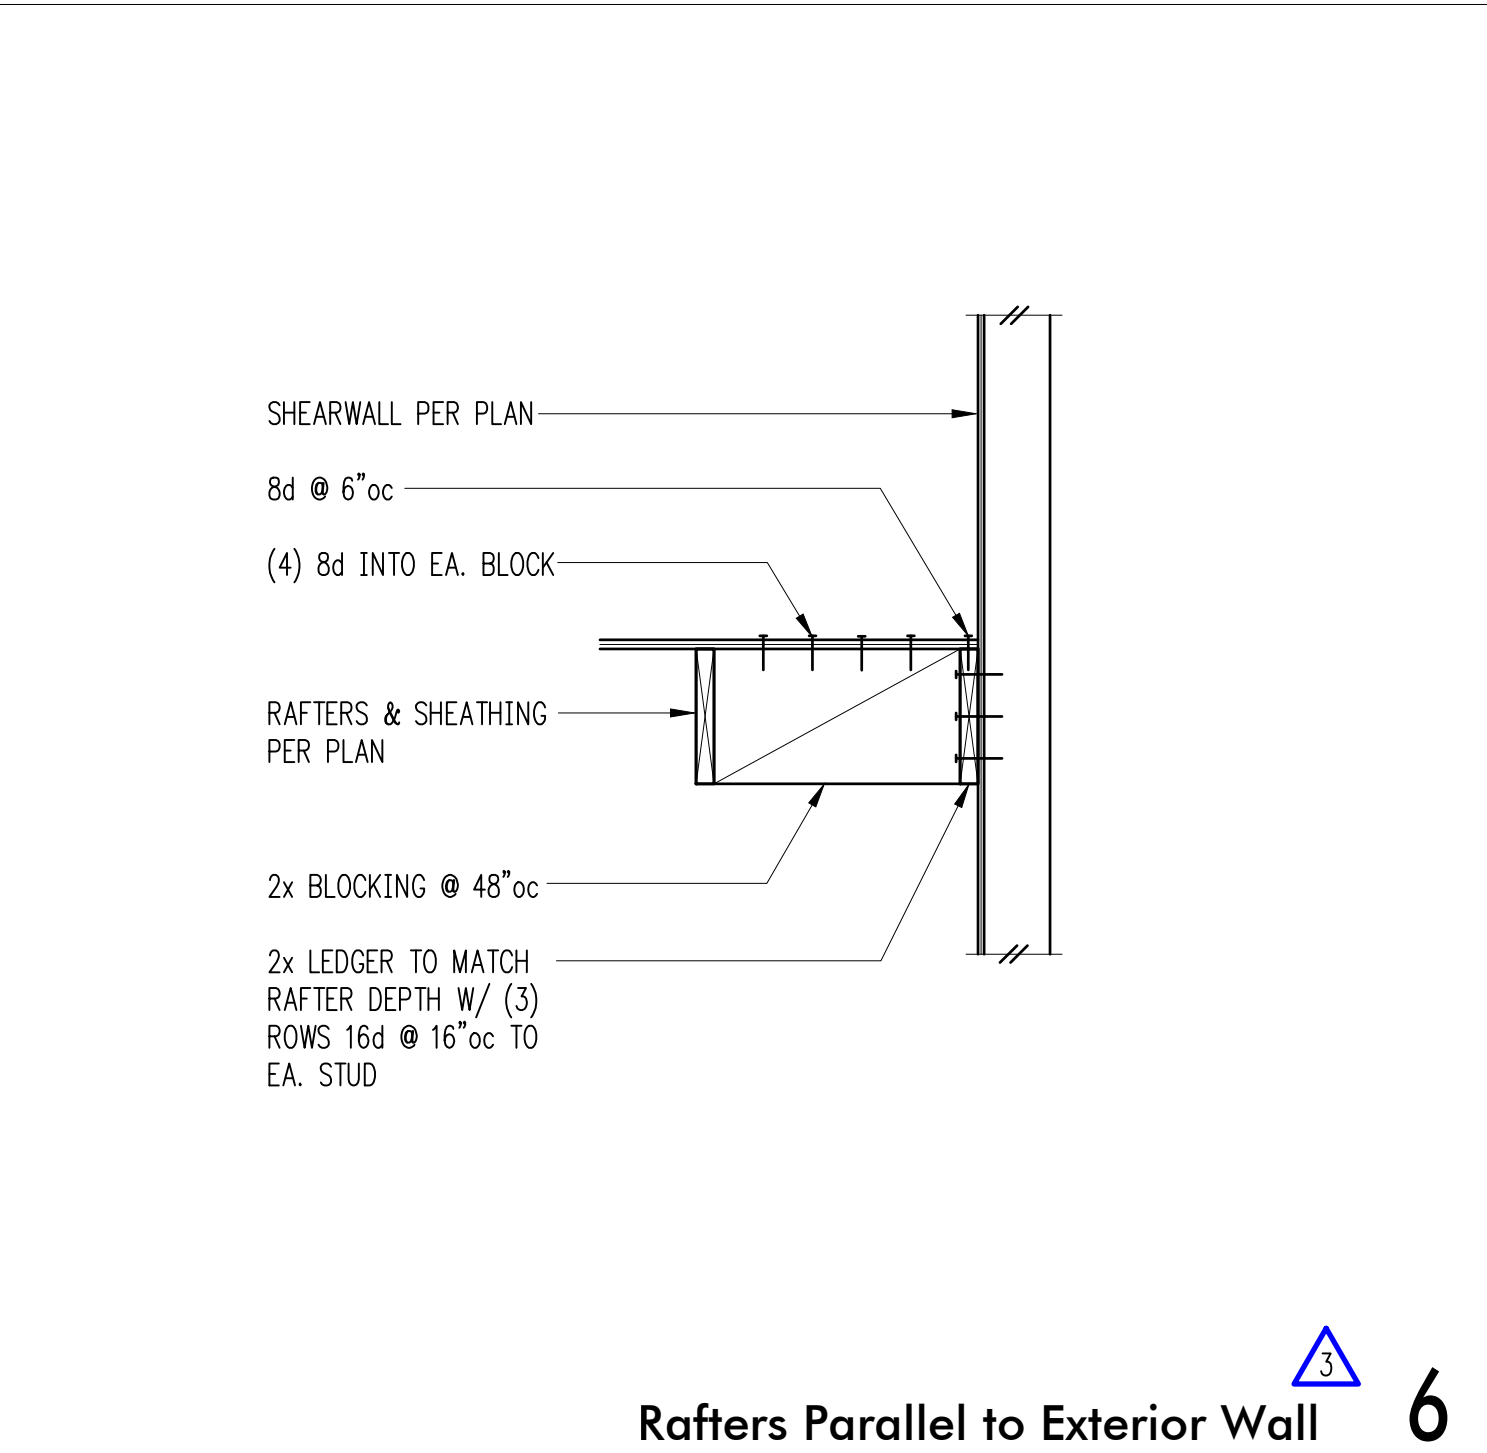


6

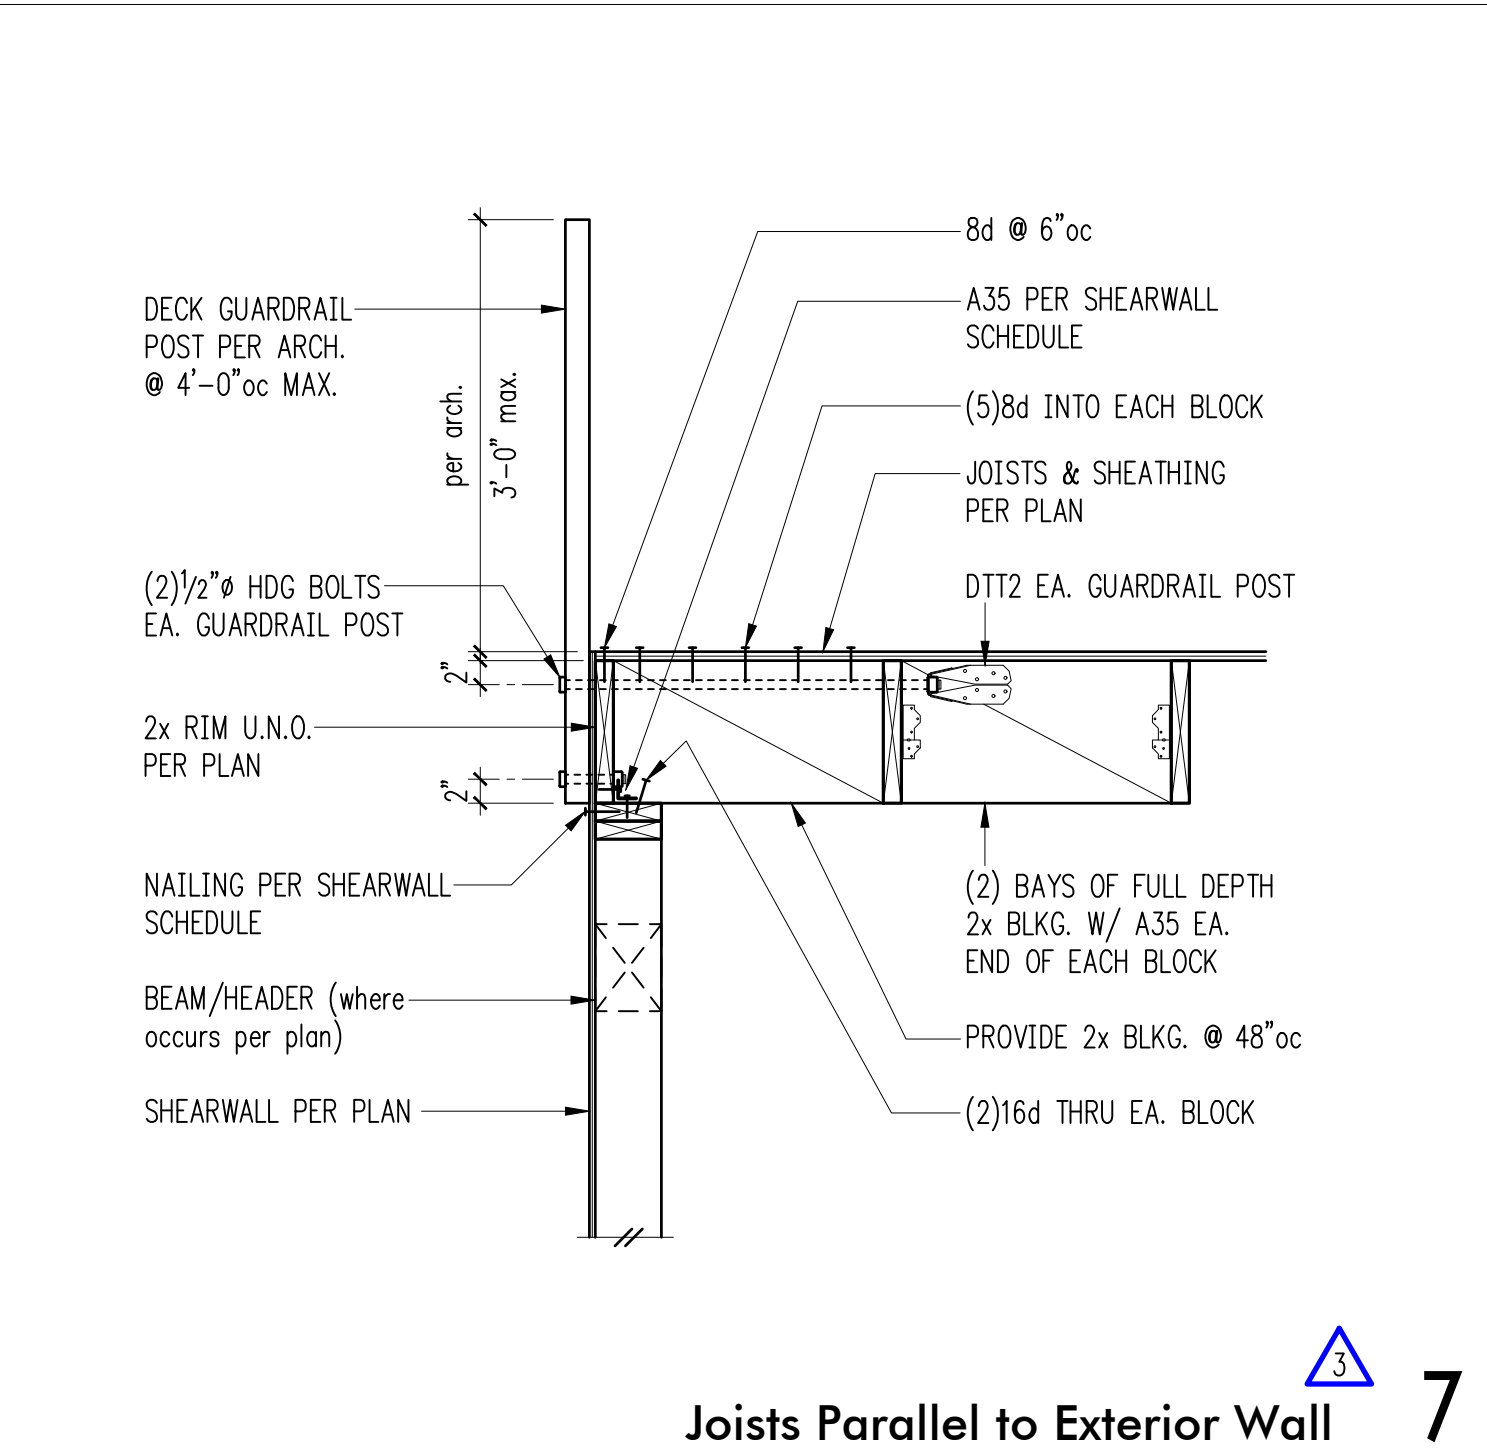


7

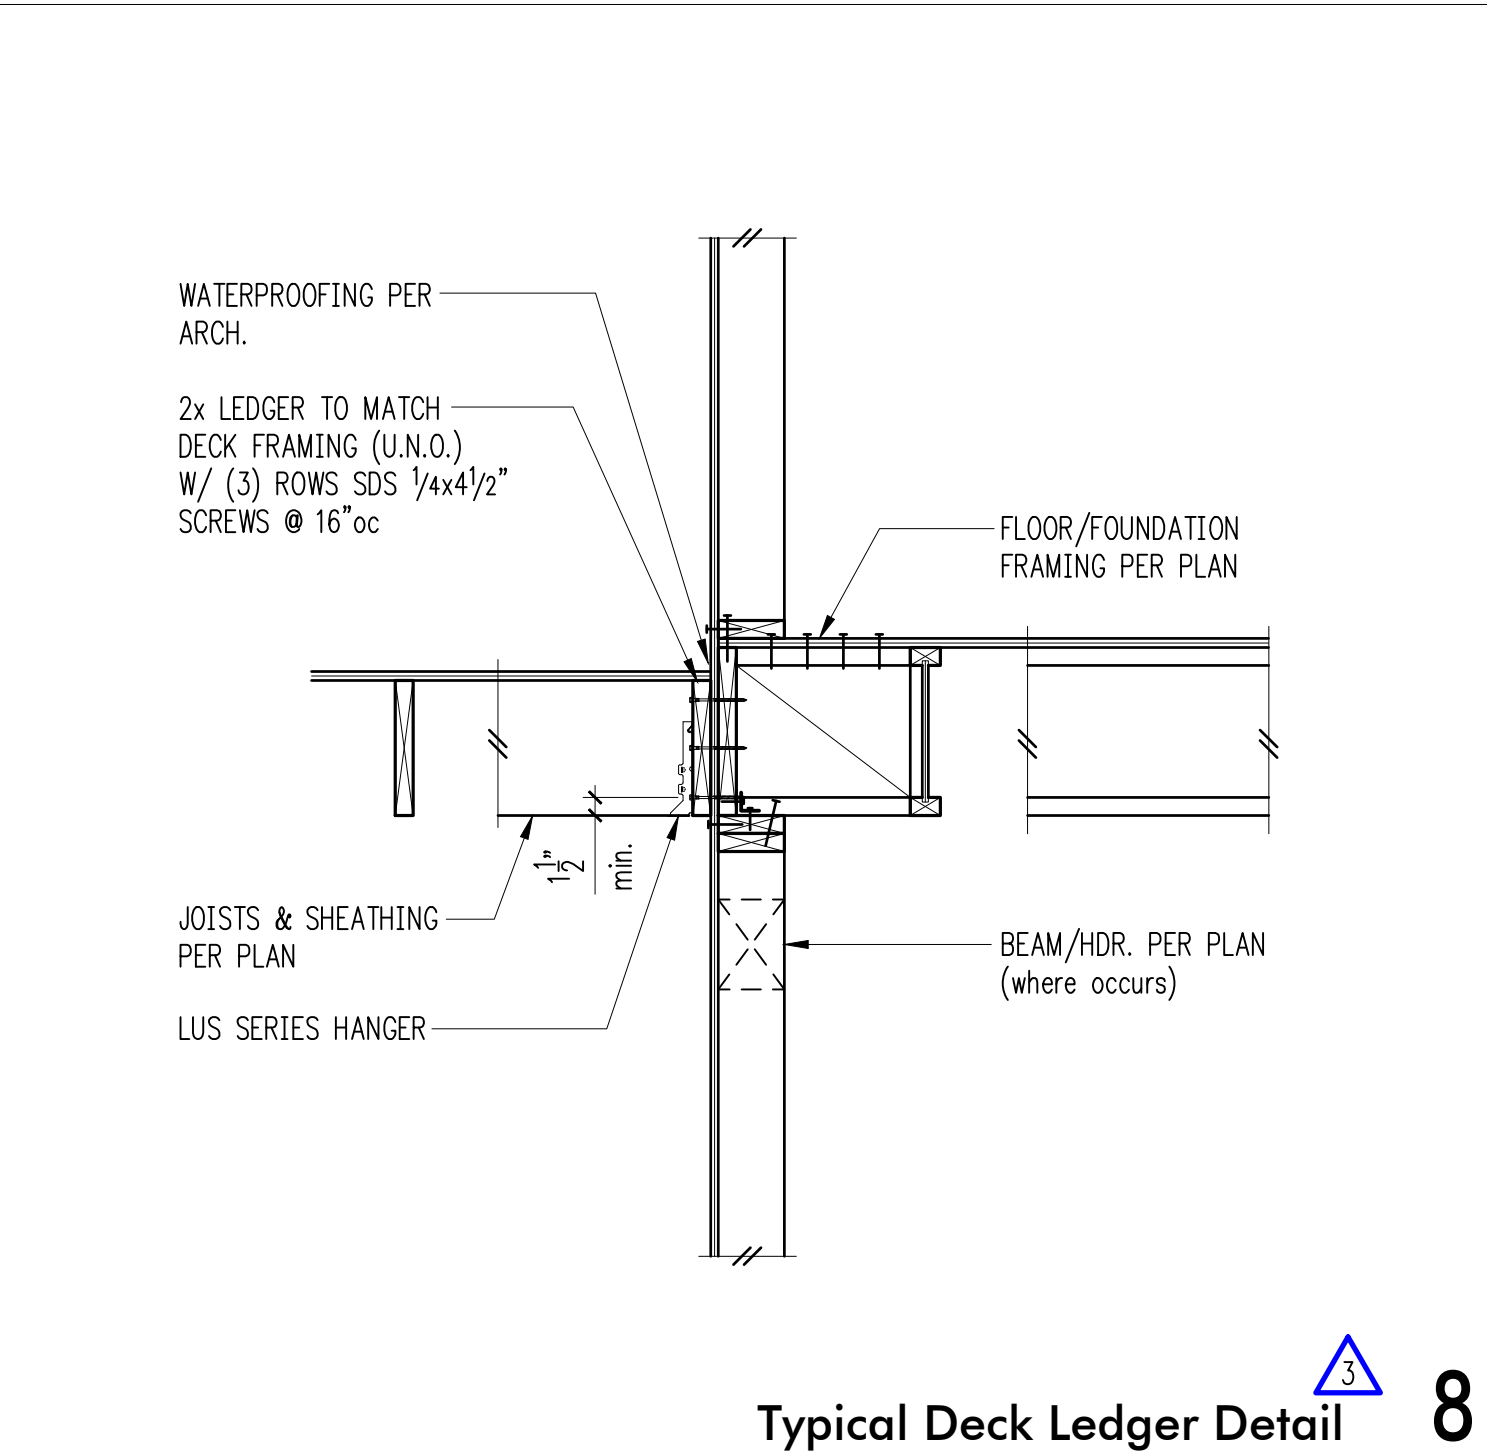


8

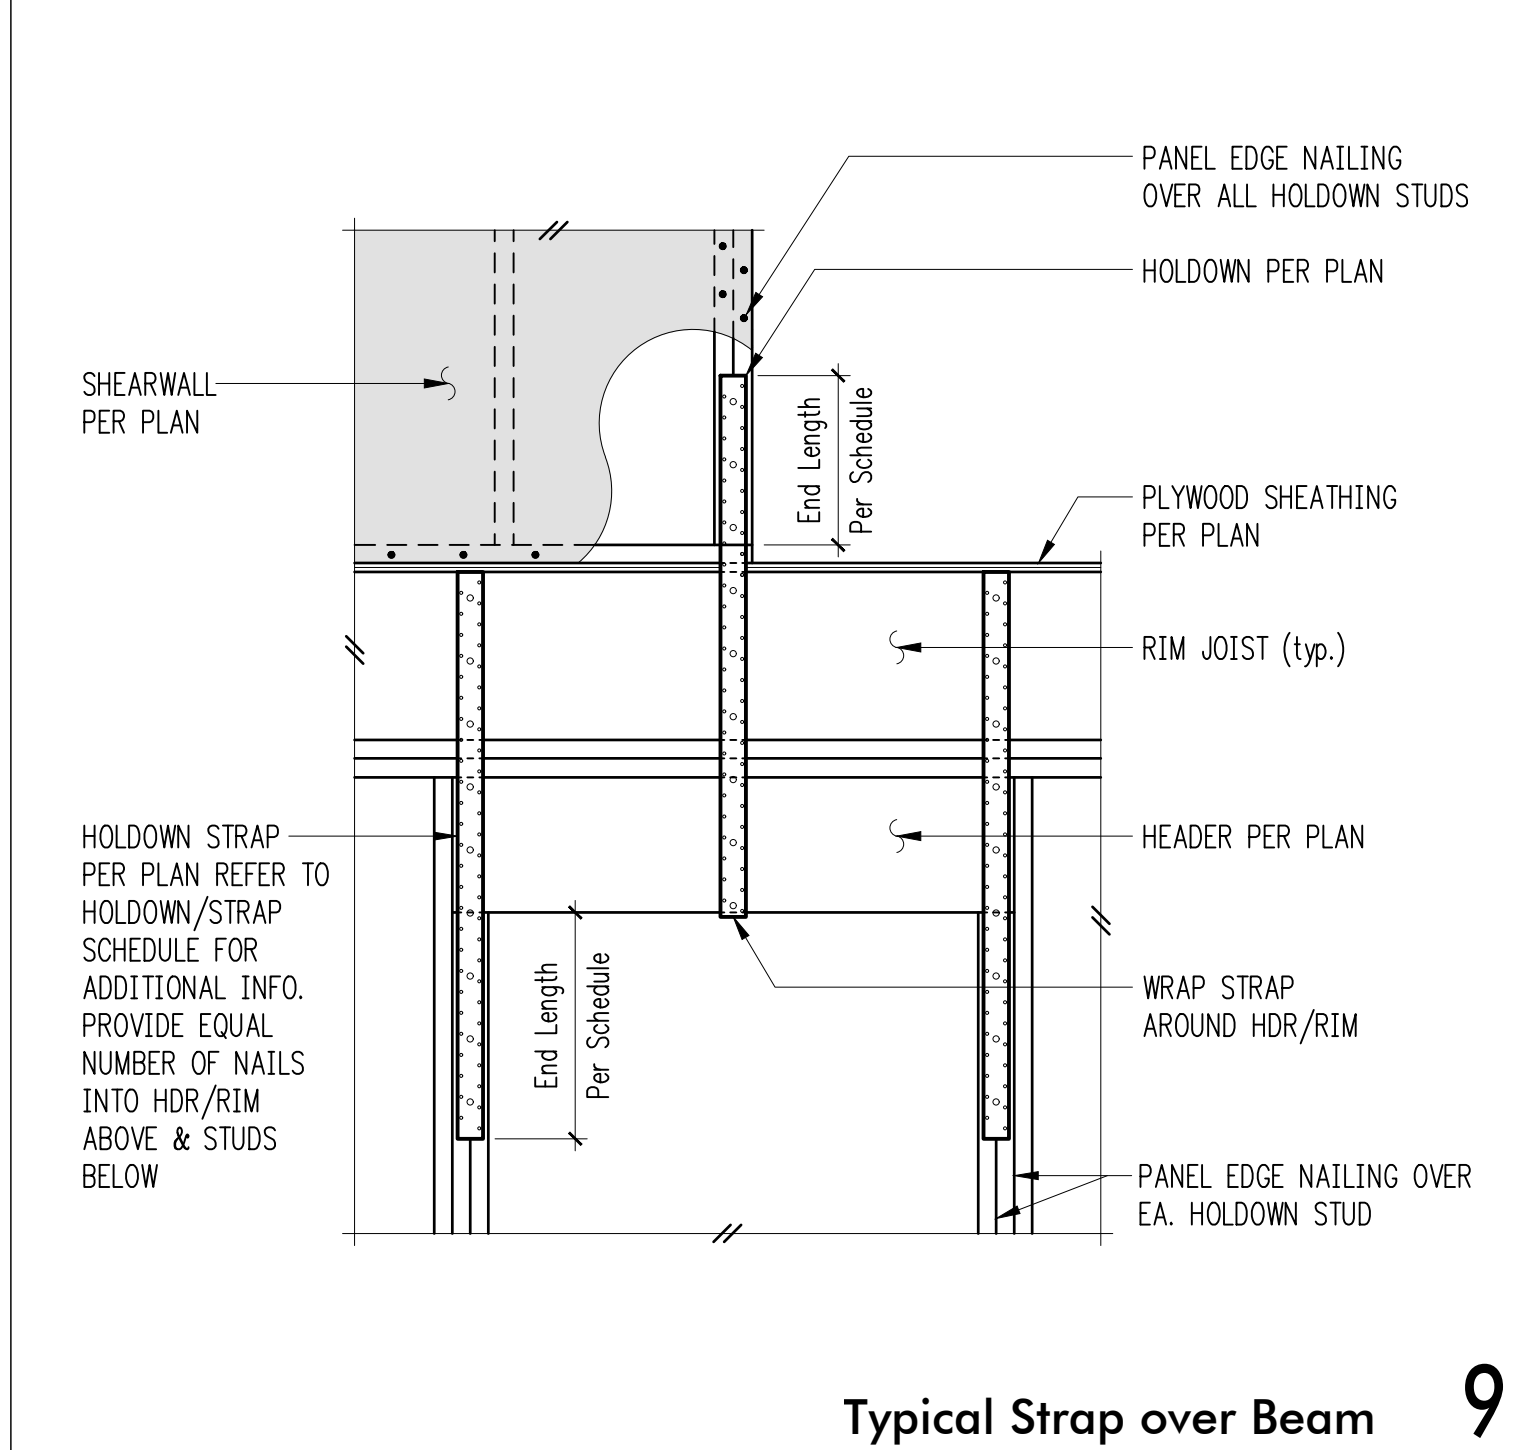


9

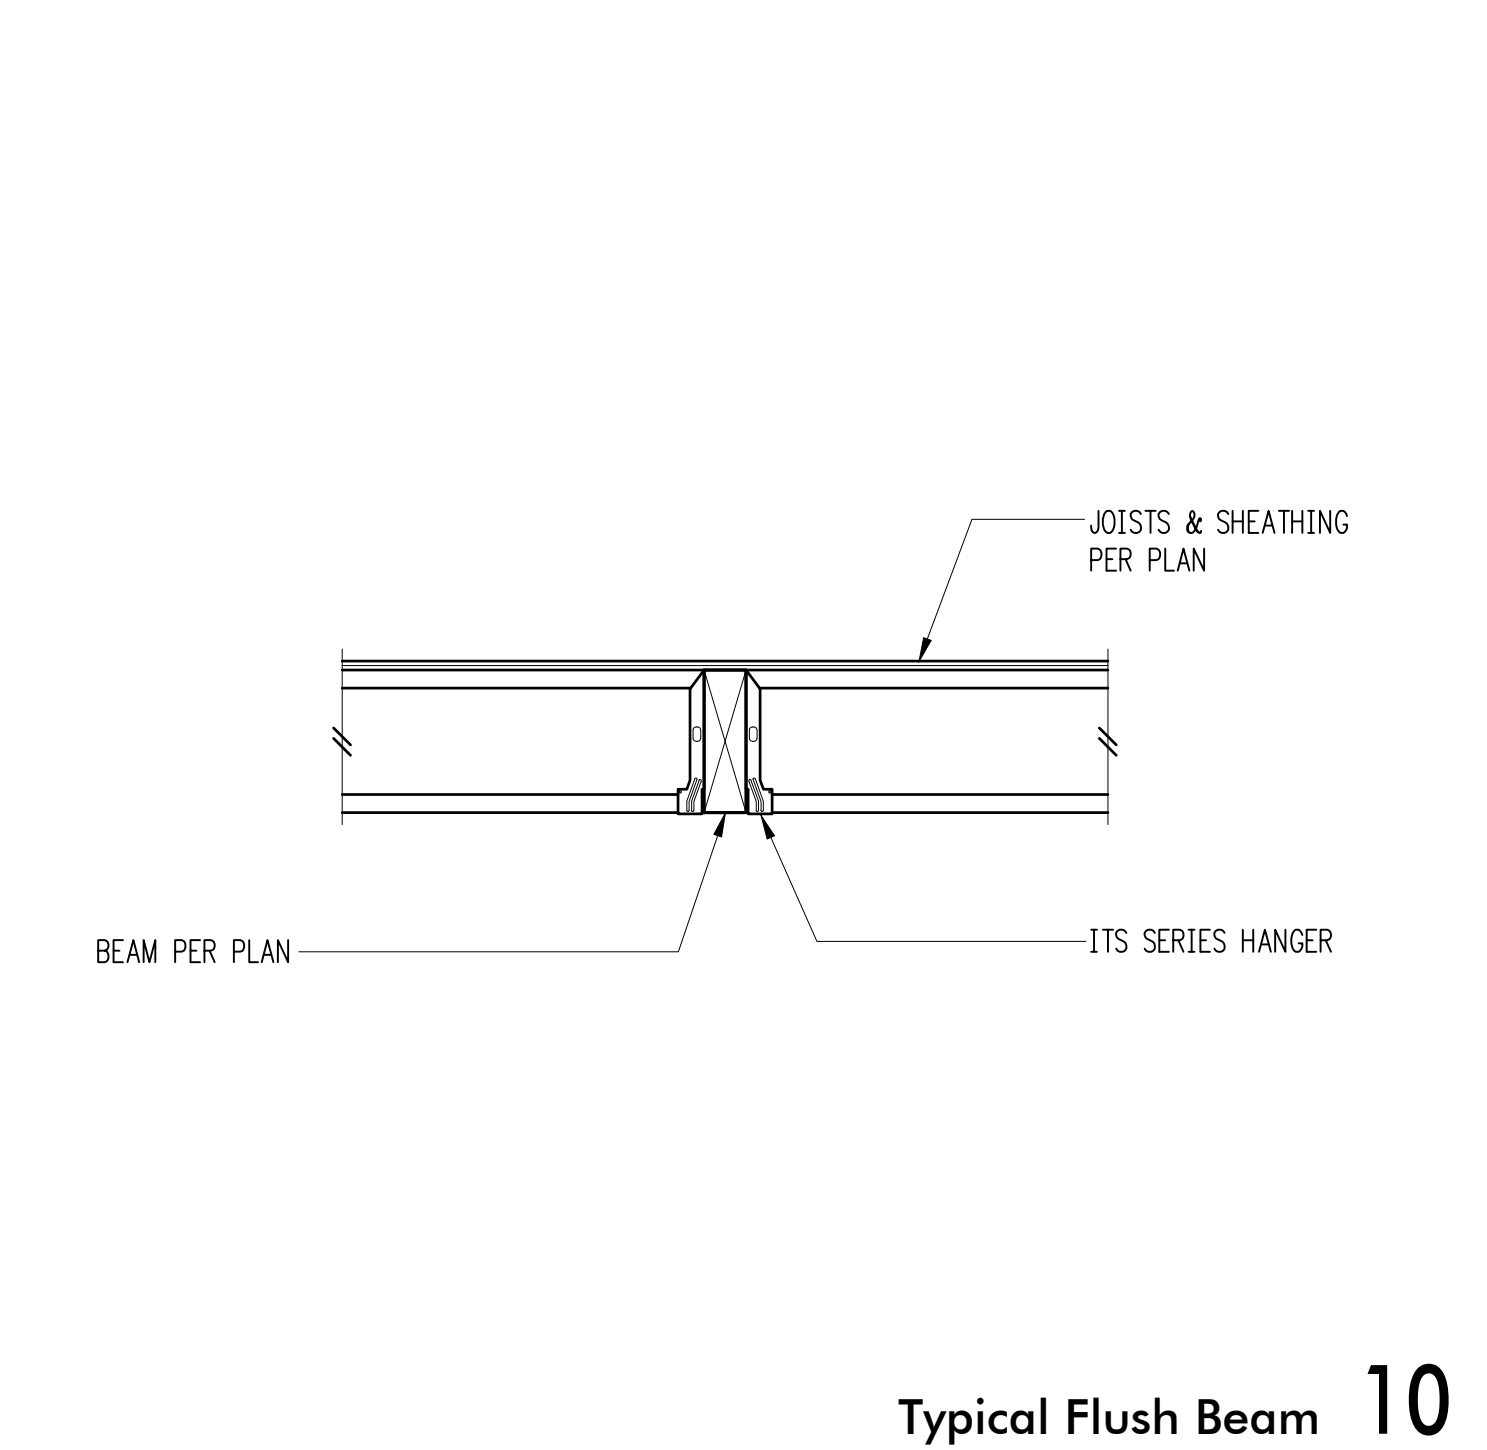


10

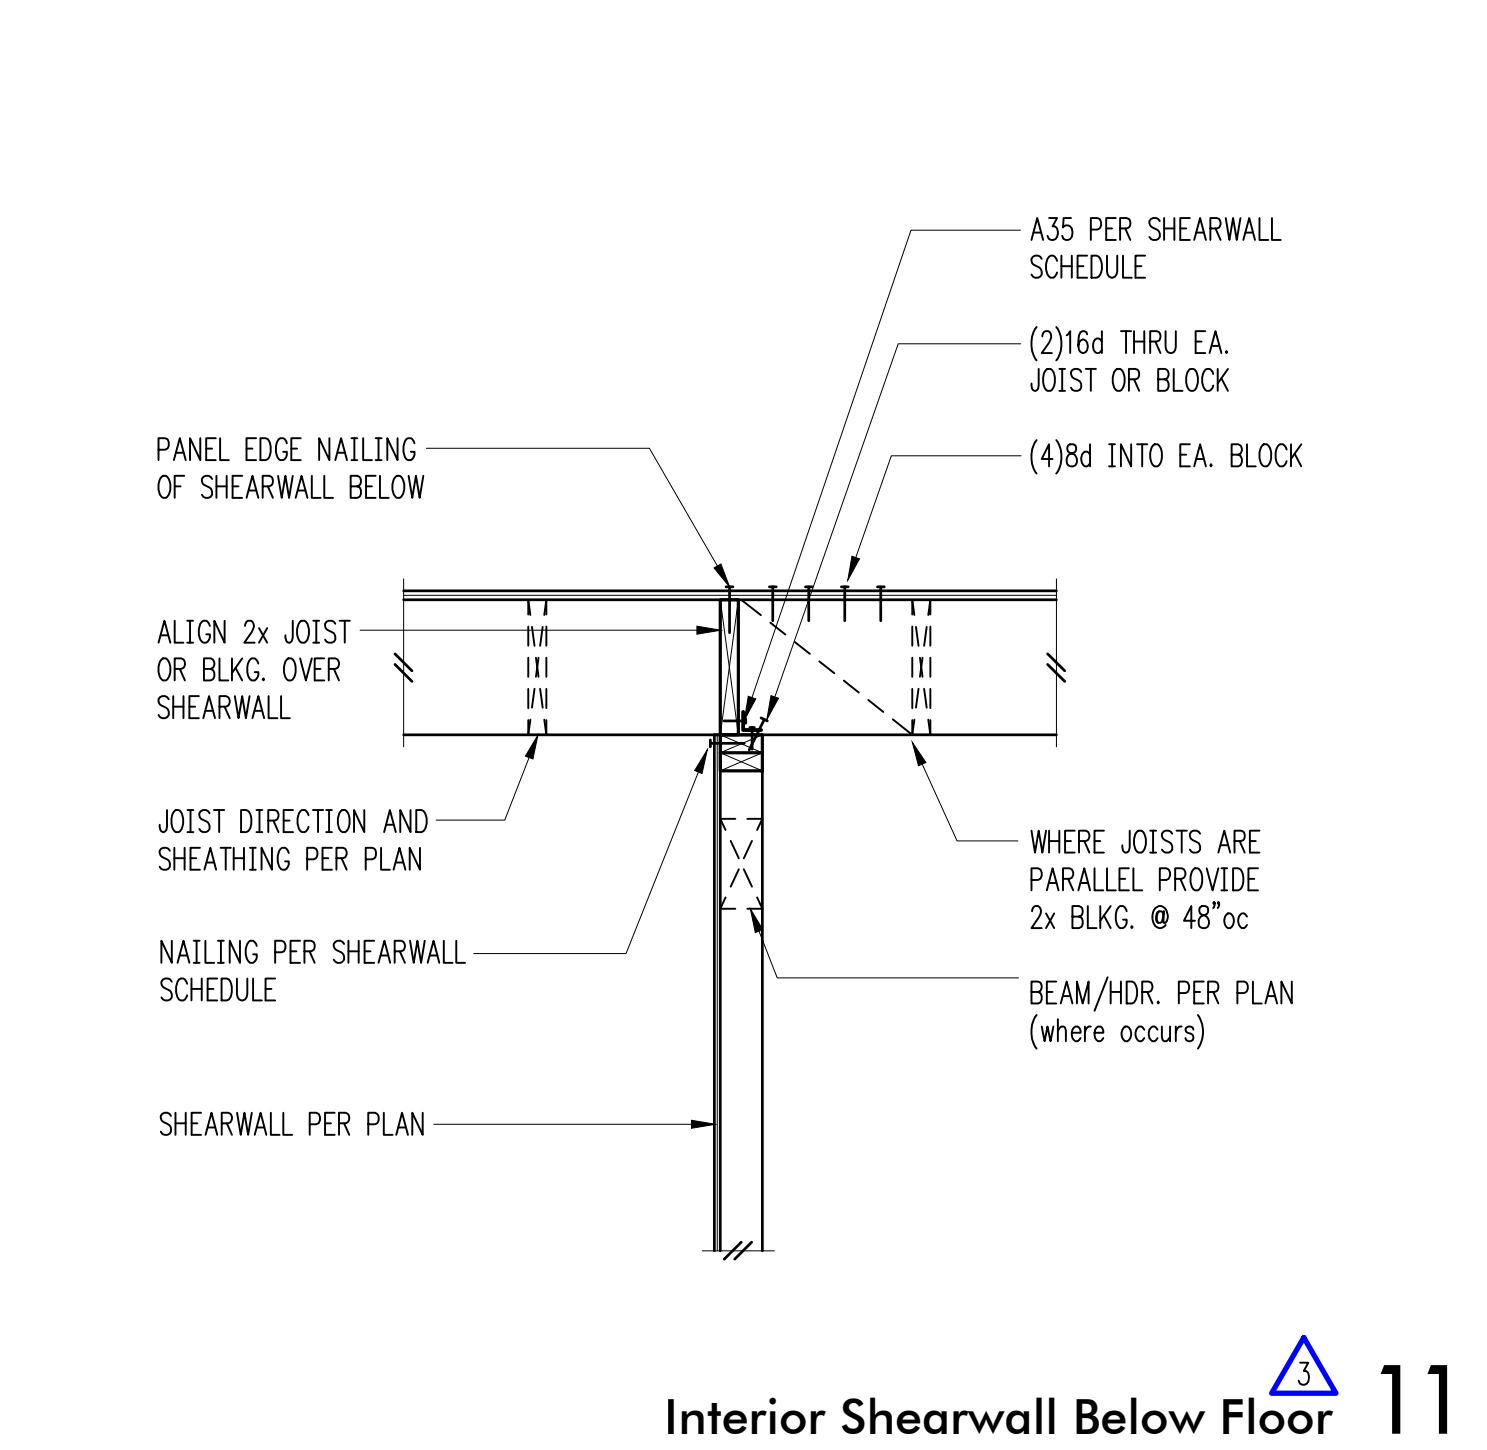

11

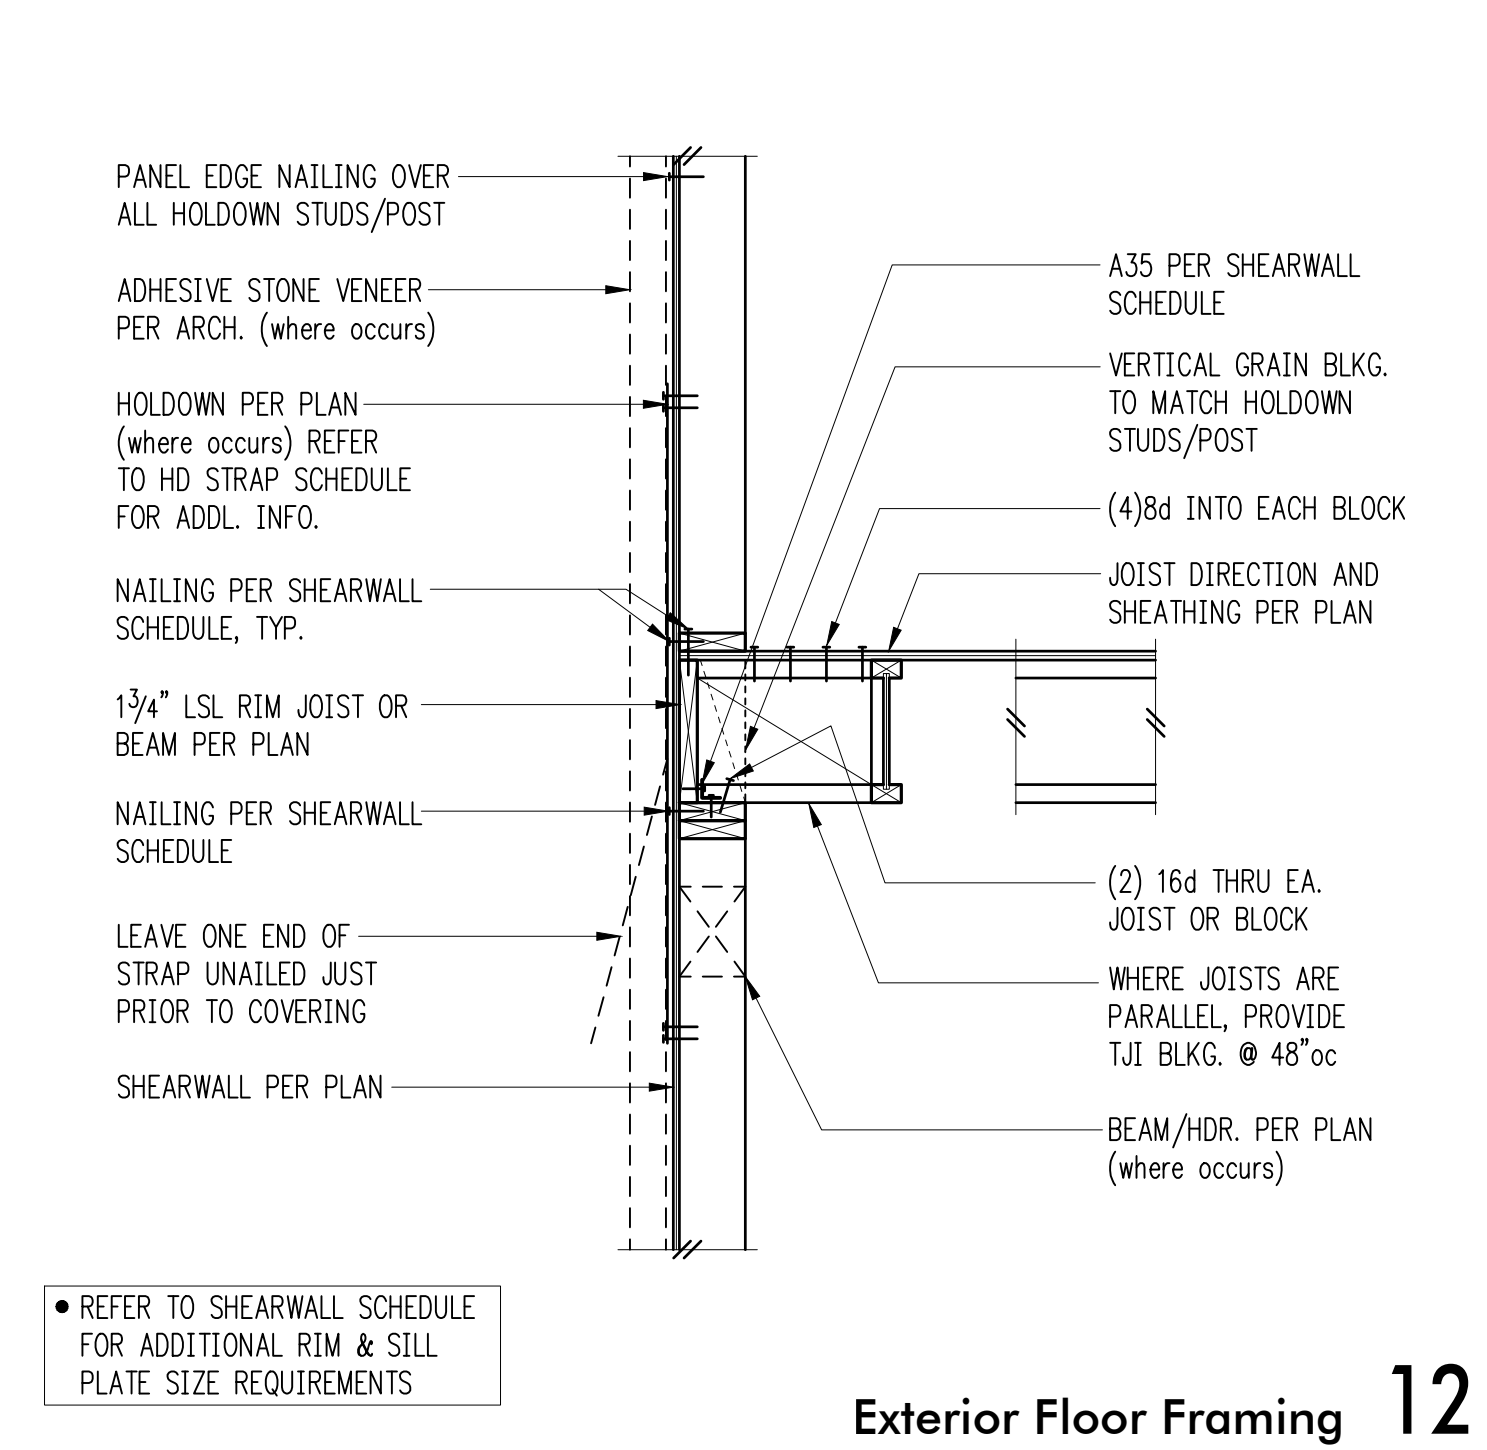

12

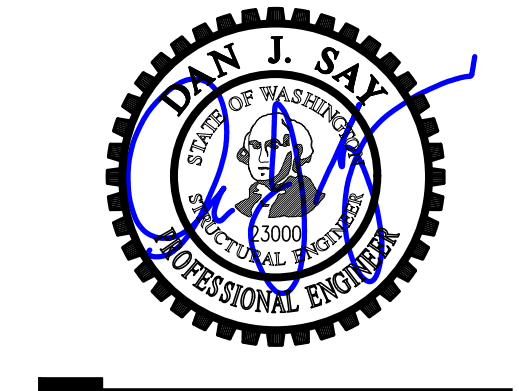

DESIGN: HAA, BDM  
 DRAWN: NHD  
 CHECKED: BDM  
 APPROVED: DJS

REVISIONS:

1	Corrections	May 4, 2021
2	Corrections 2	Aug. 13, 2021
3	Permit Revisions	Apr. 22, 2022
4	Corrections	Jun. 10, 2022


DPD:

PROJECT TITLE:  
**Clarkson Residence**  
 8163 West Mercer Way  
 Mercer Island, WA 98040


ARCHITECT:  
**Brandt Design Group**  
 66 Bell Street, Unit 1  
 Seattle, WA 98121  
 PH 206.239.0850

ISSUE:  
**PERMIT**  
 SHEET TITLE:


**Wood Framing Details**  
 SCALE: 3/4" = 1'-0" U.N.O.  
 DATE: December 24, 2020  
 PROJECT NO: 01519-2021-11  
 SHEET NO:

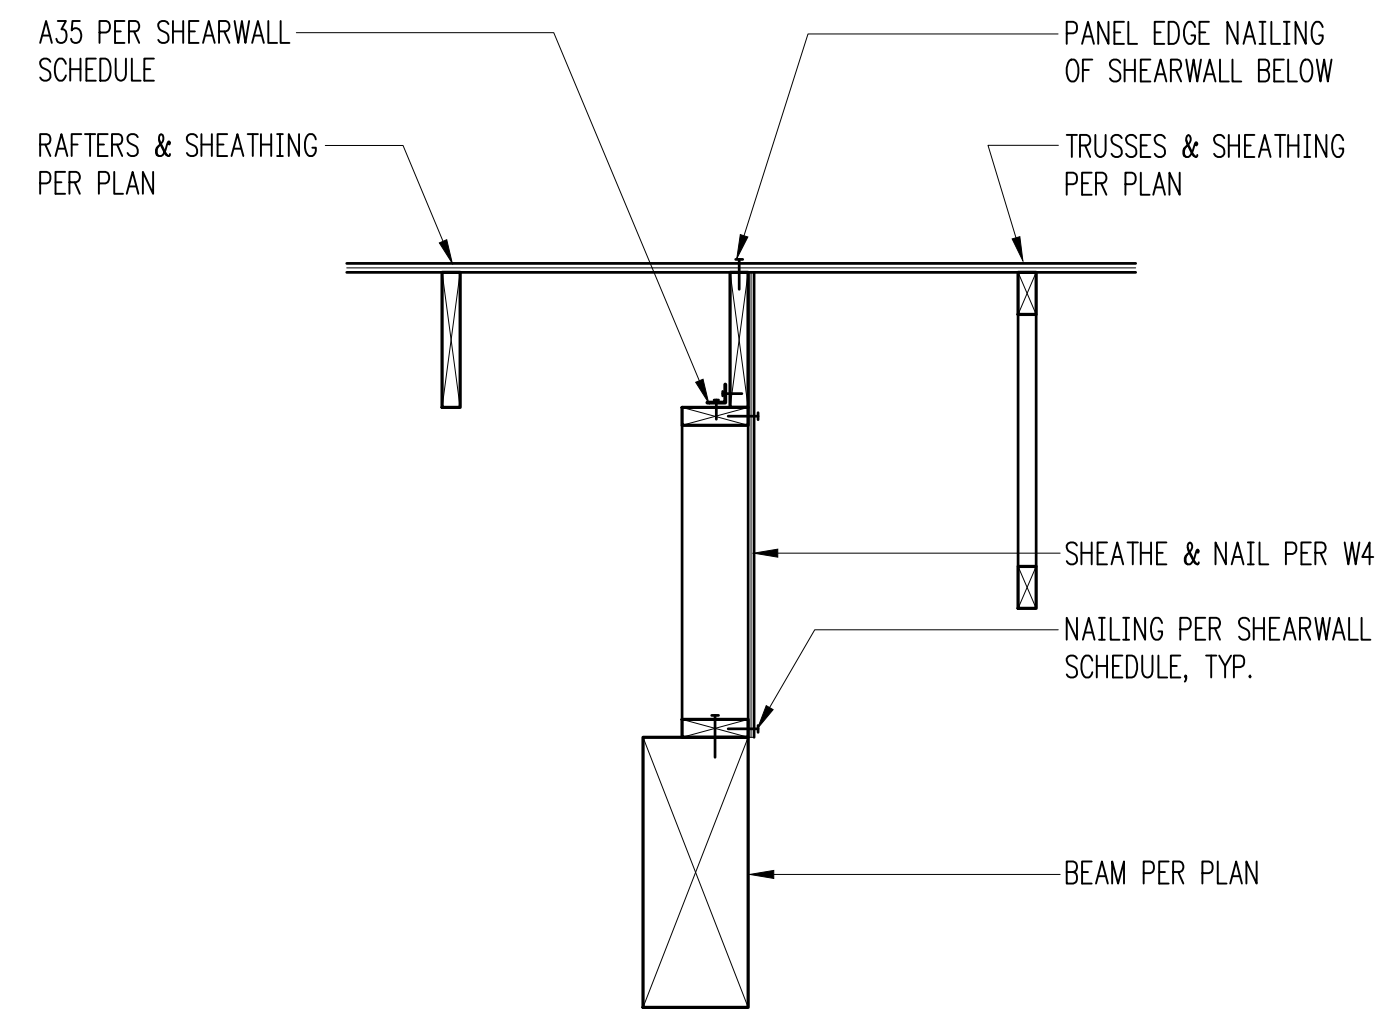


3 1

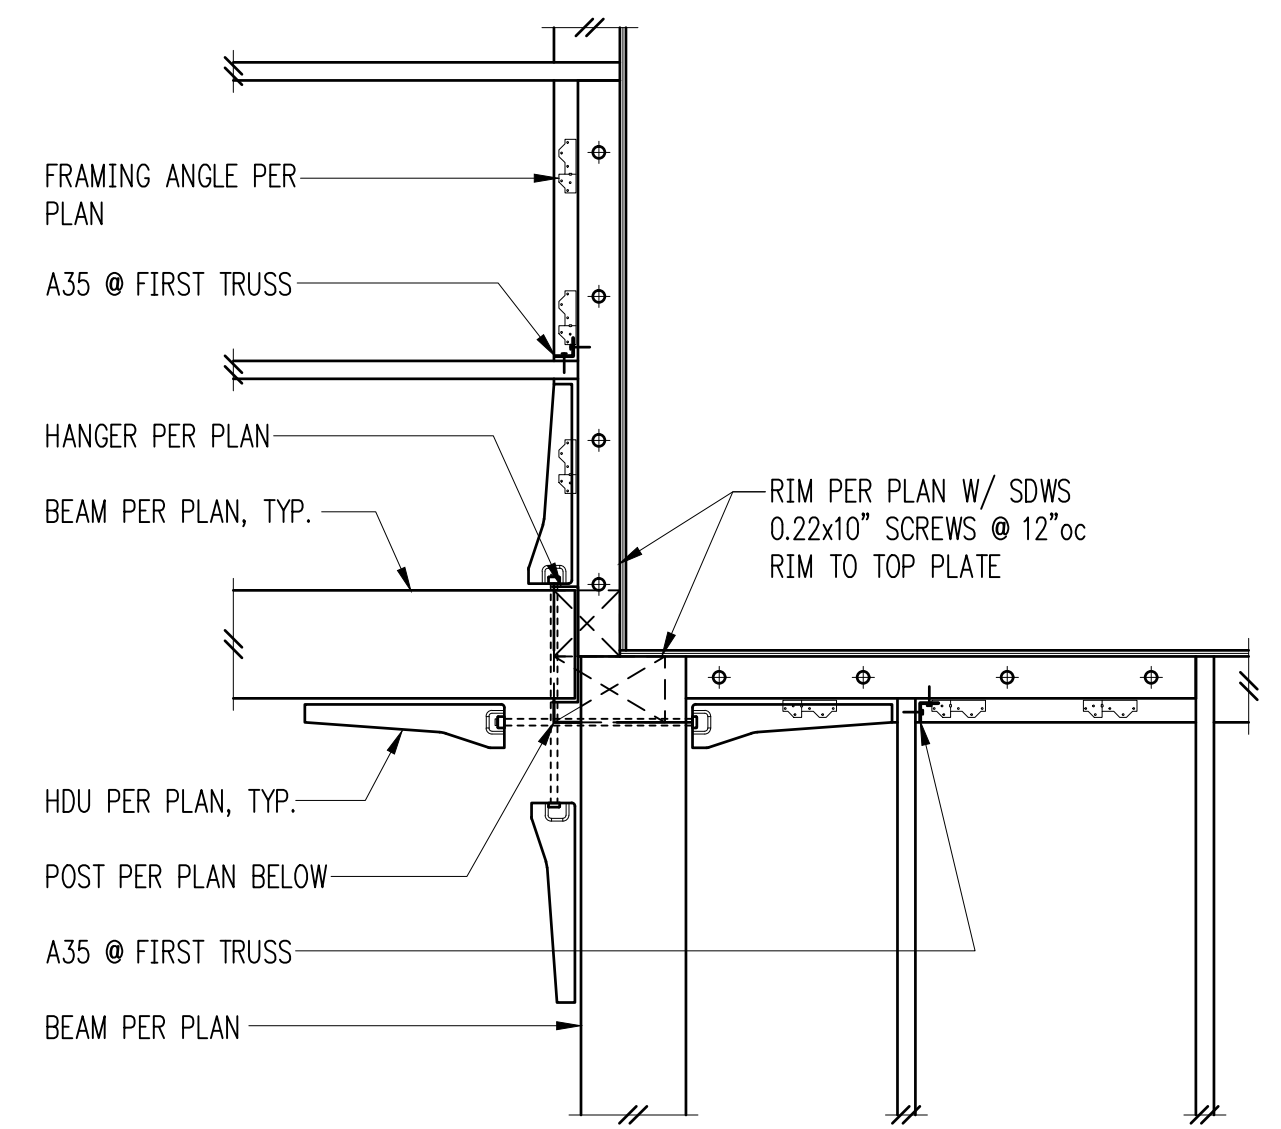


Plan View 3 2

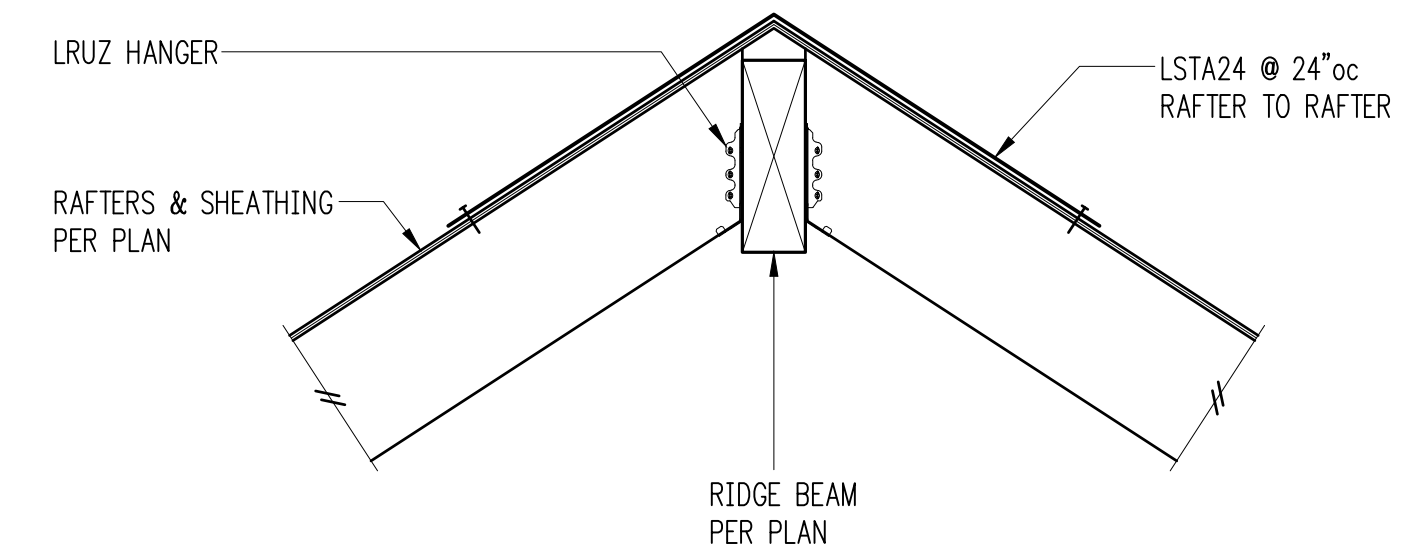


Ridge Beam w/ LRU Hangers 3

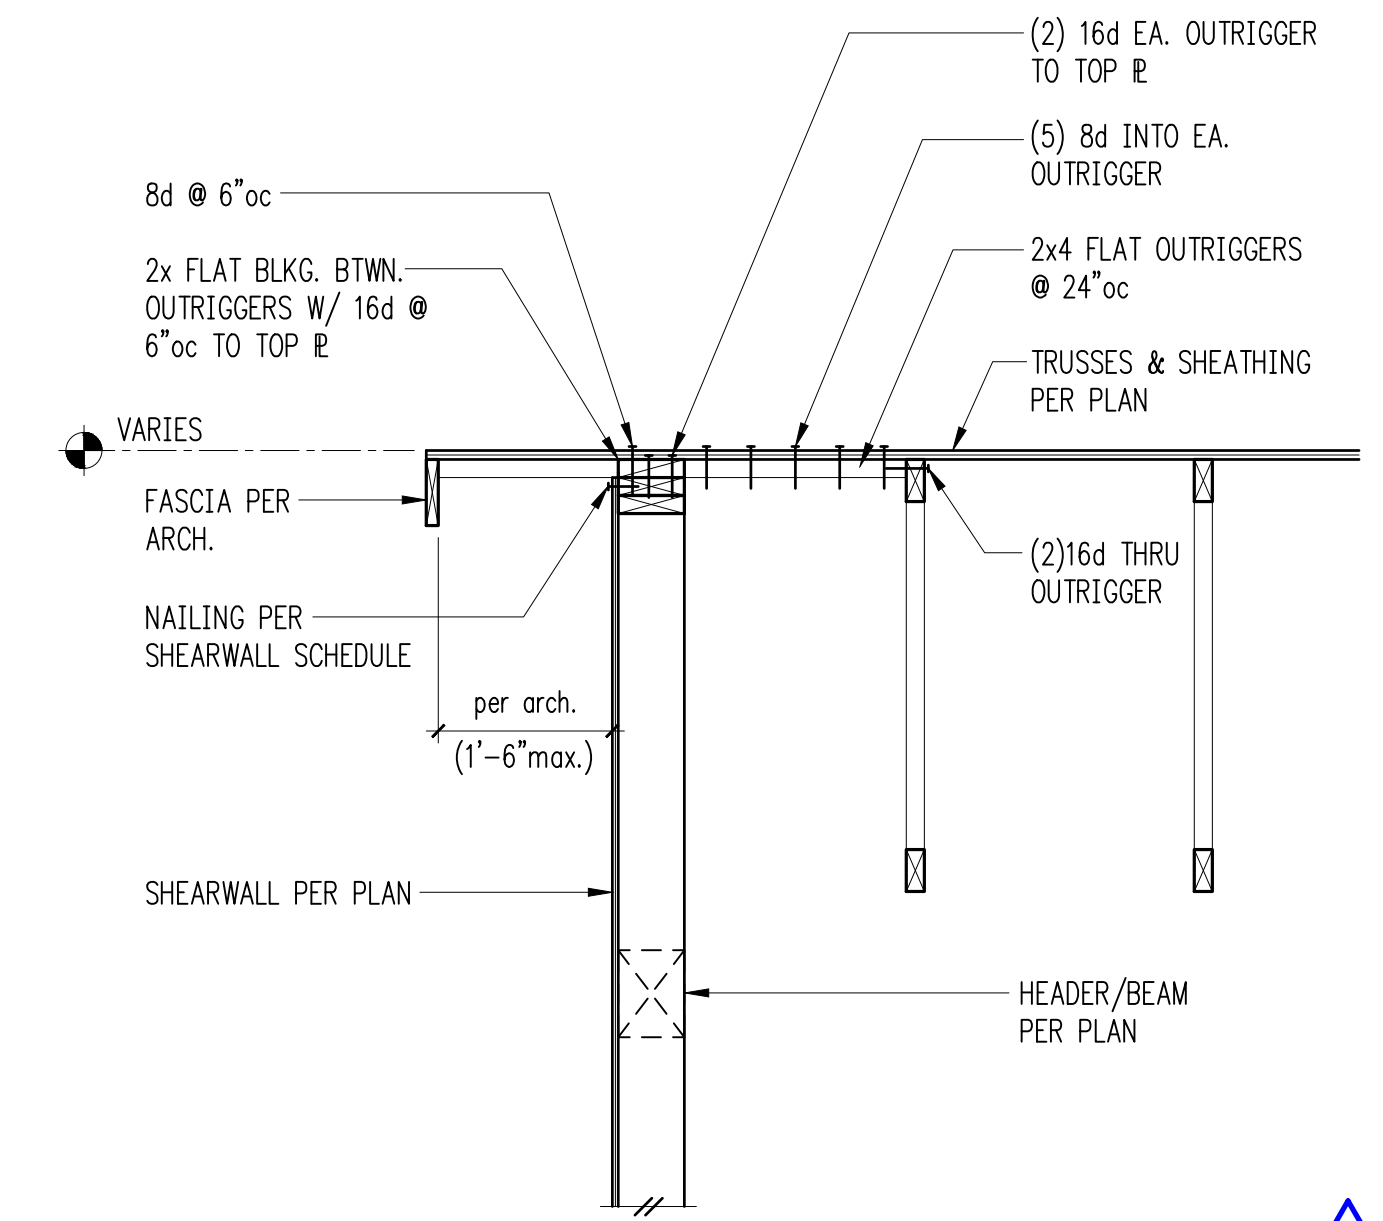


Trusses Parallel to Exterior Wall w/ Flat Outrigger 3 4

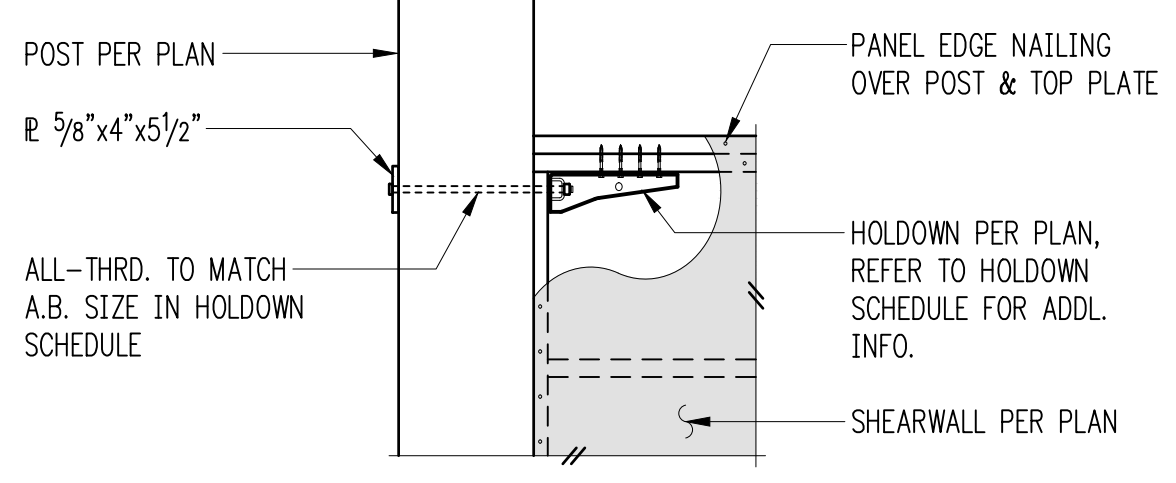


3 5

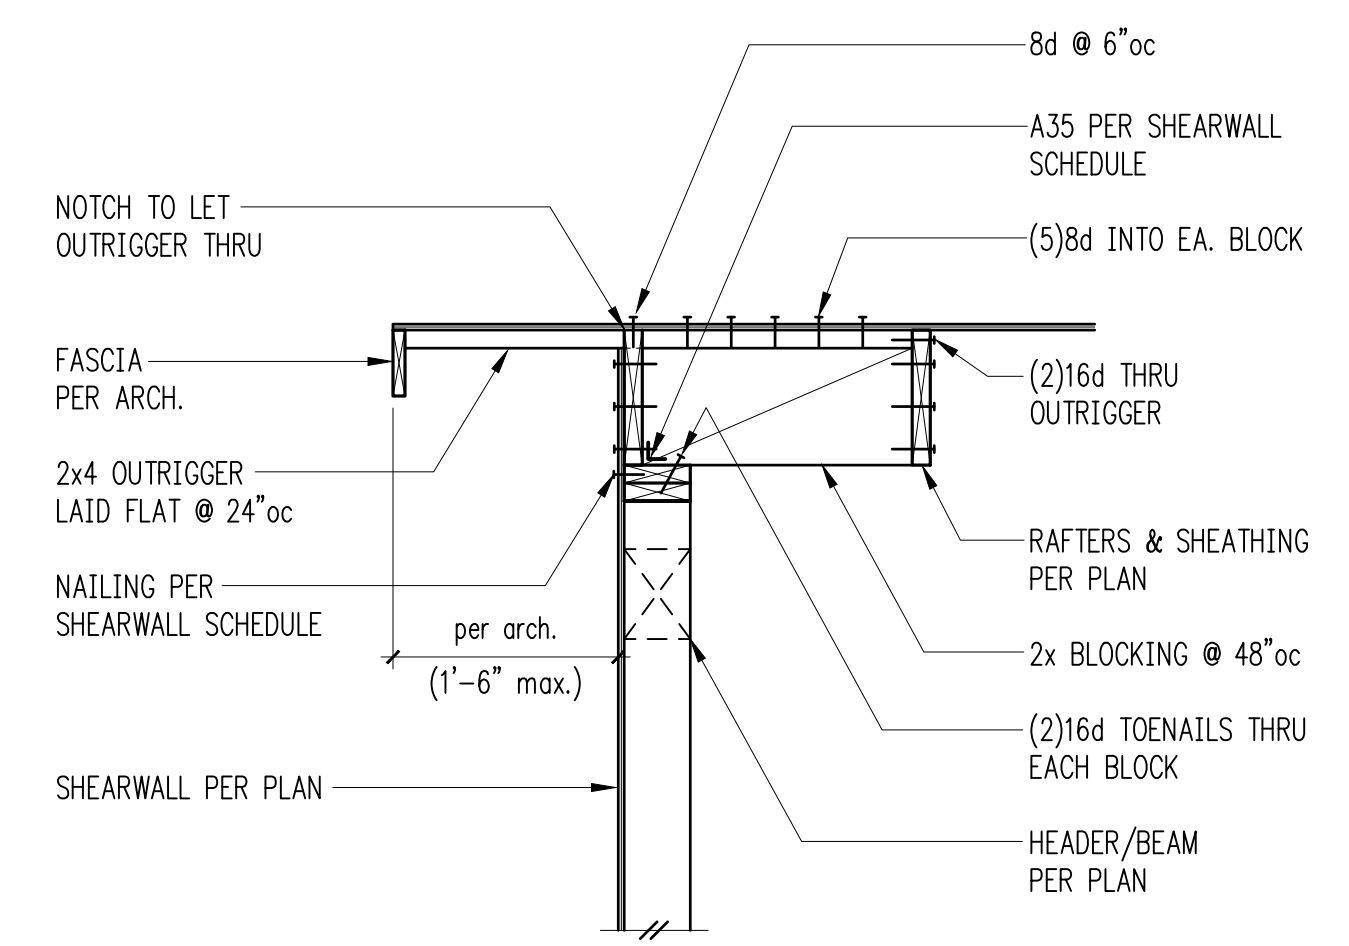


Exterior Non-Bearing Wall 3 6

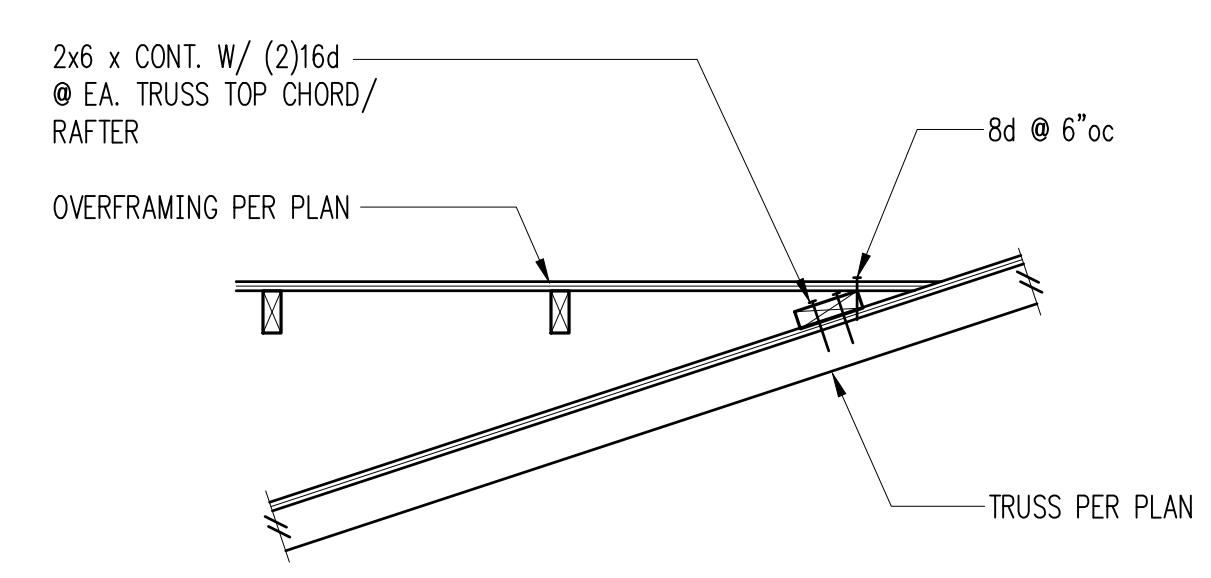


Overframing Connection 3 7

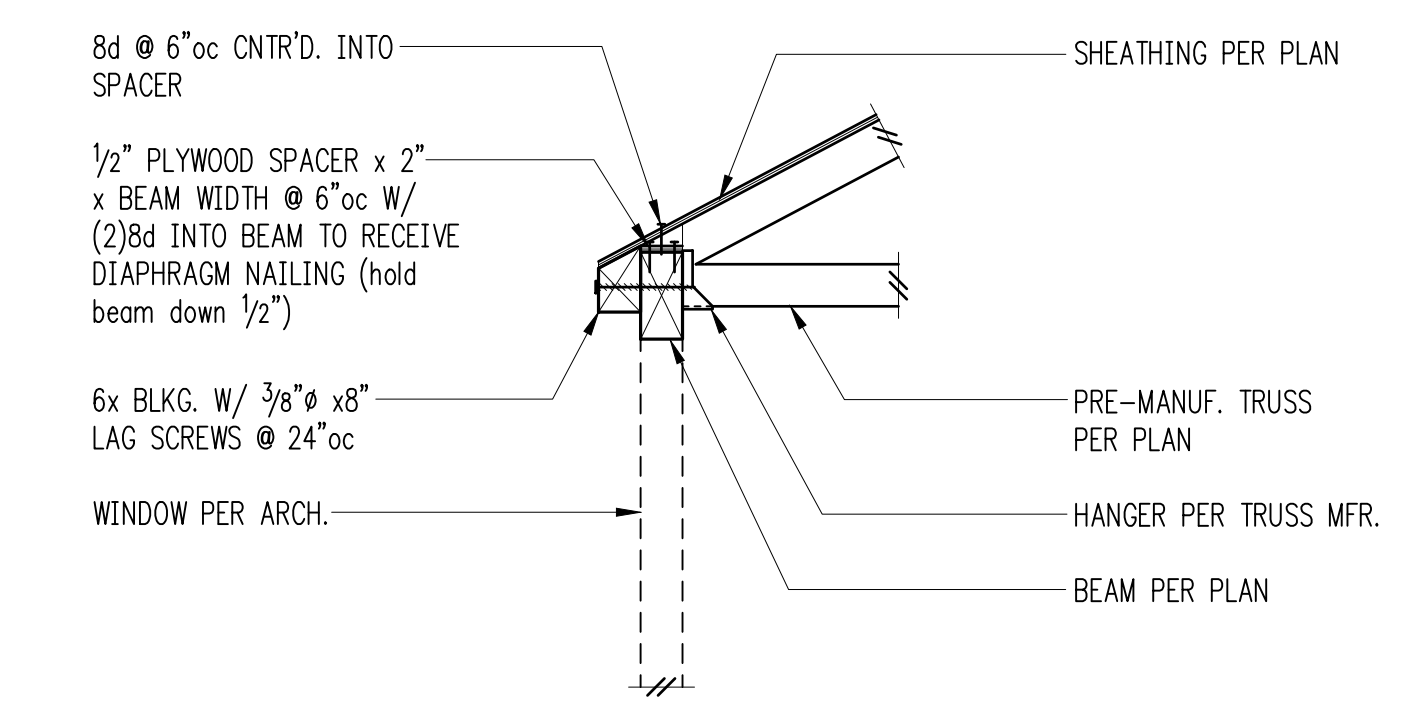


3 8

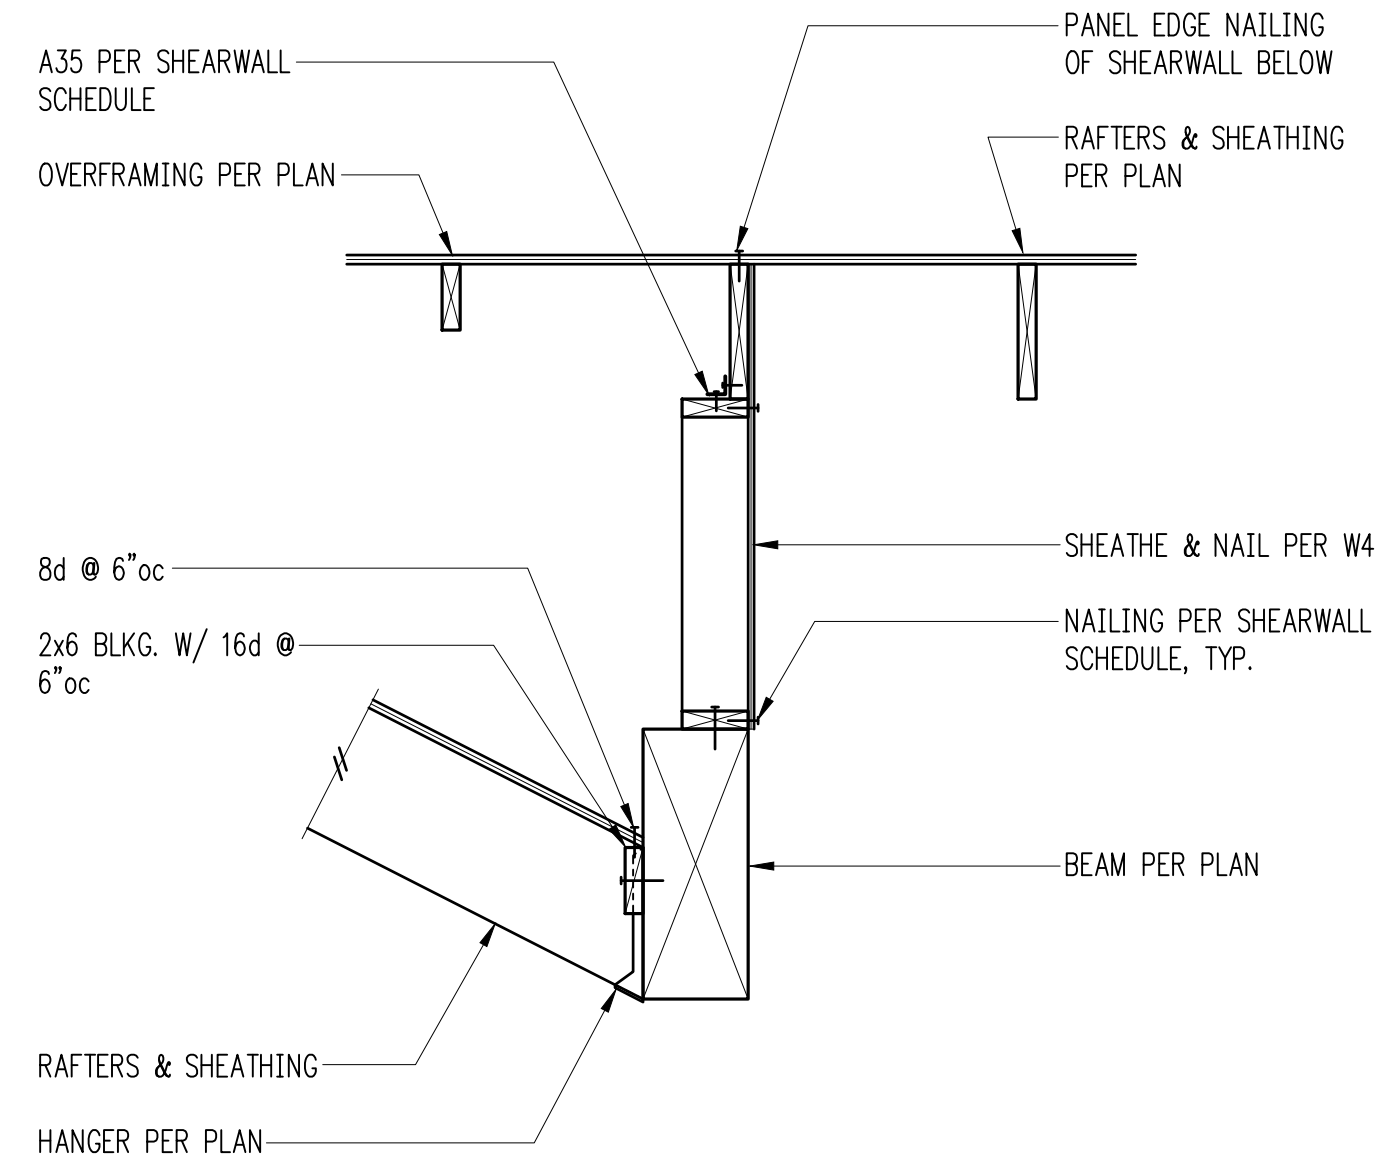


3 9

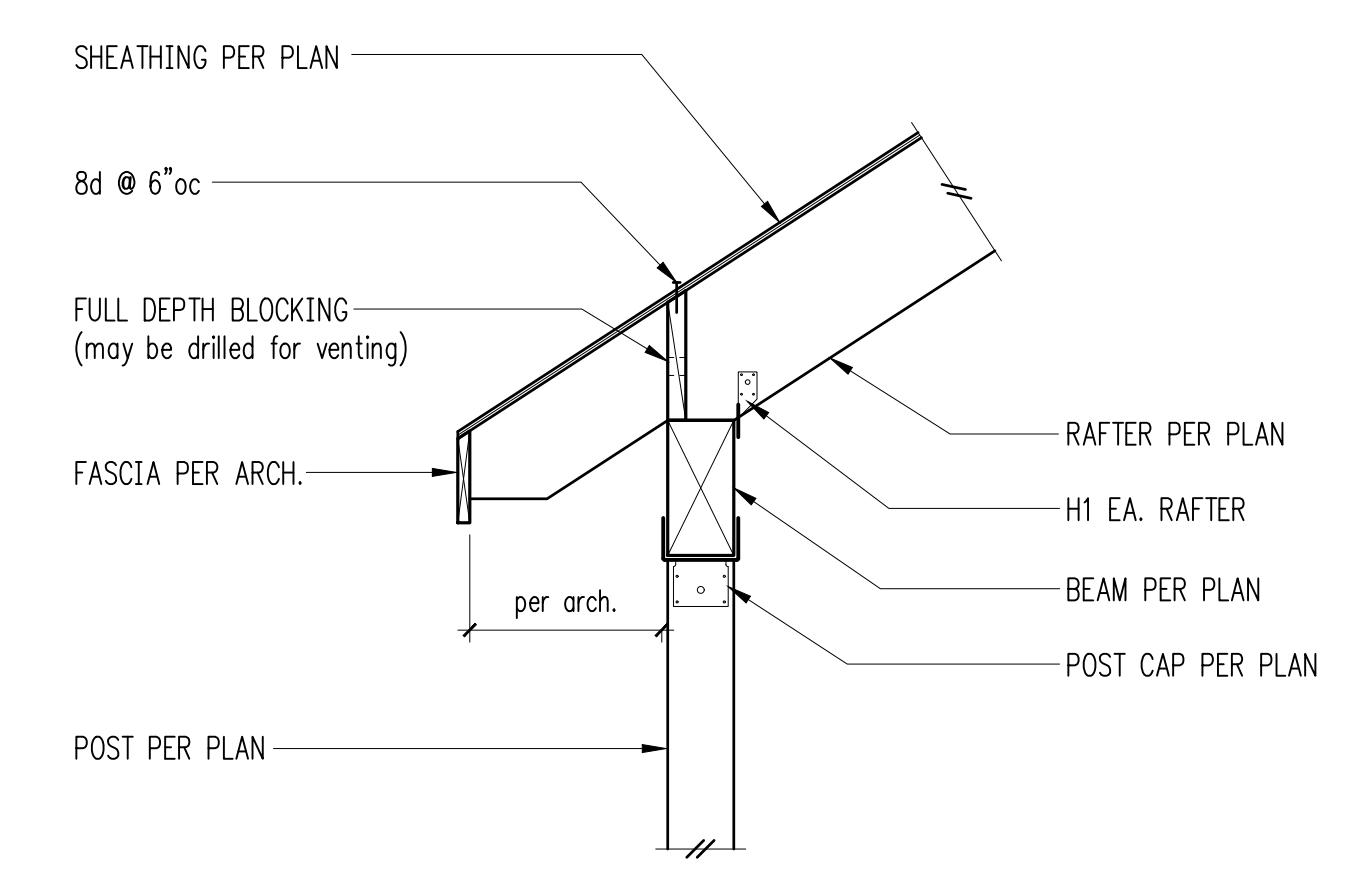


Beam & Post 3 10

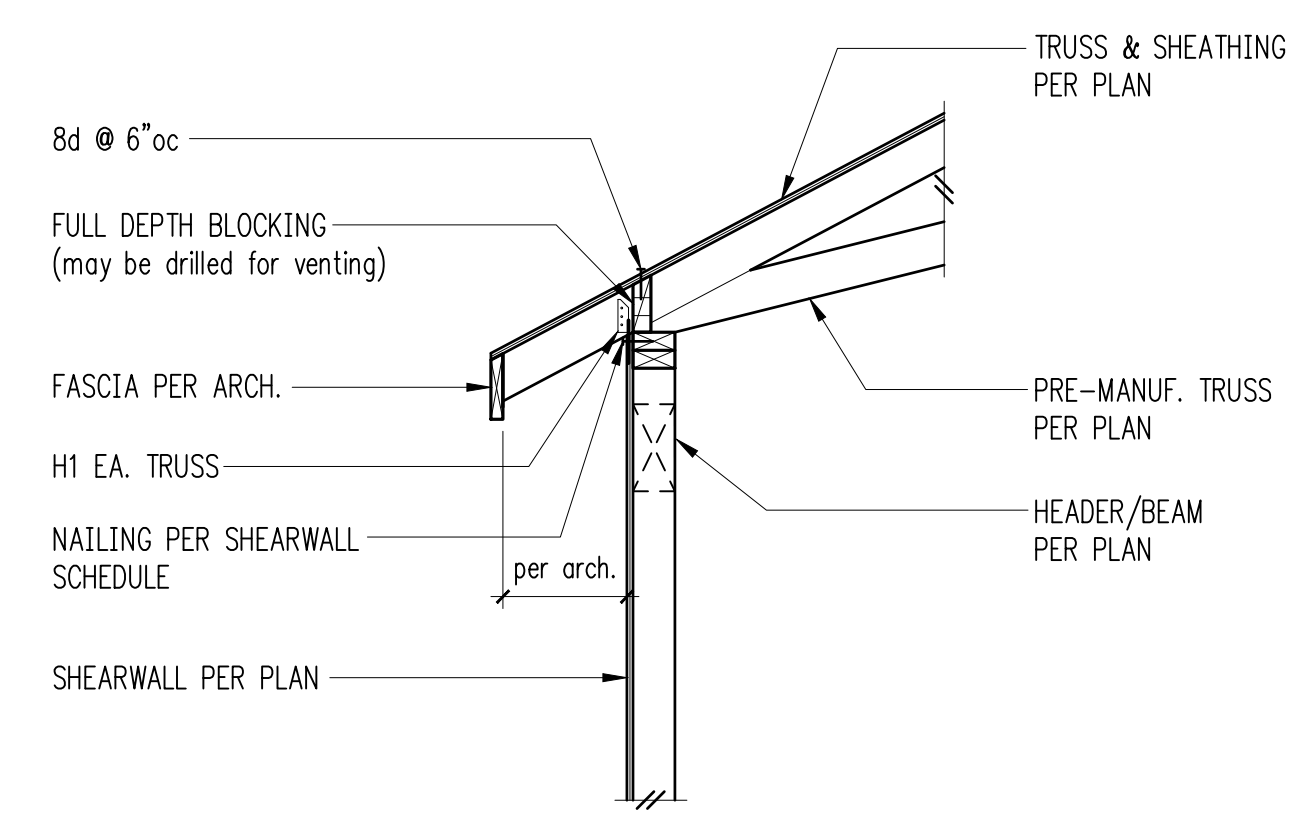

Scissors Trusses Exterior Bearing Wall 3 11

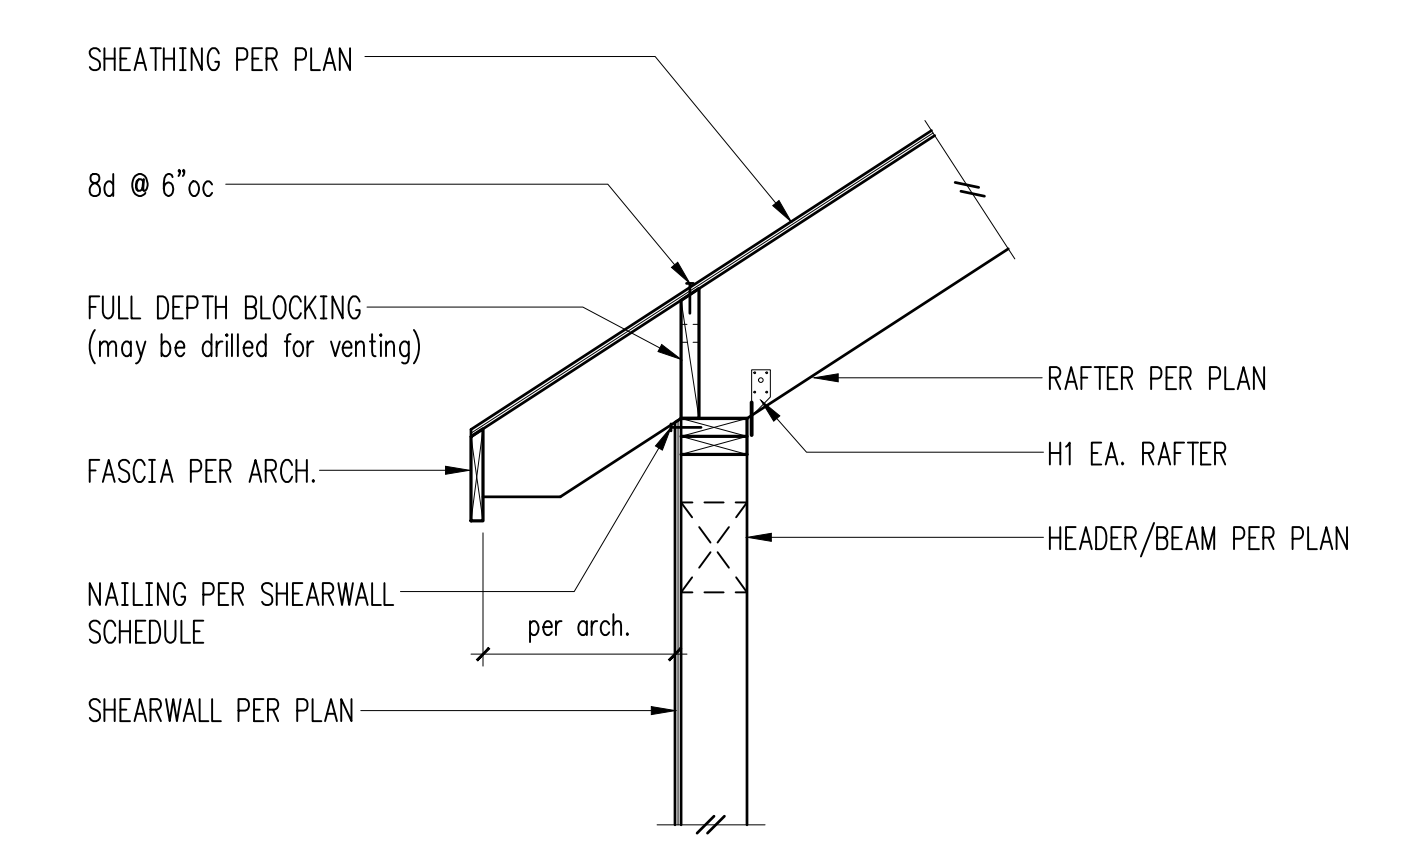

Exterior Bearing Wall 3 12

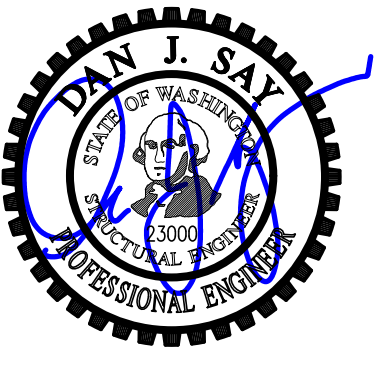

DESIGN: HAA, BDM  
 DRAWN: NHD  
 CHECKED: BDM  
 APPROVED: DJS

REVISIONS:

1	Corrections	May 4, 2021
2	Corrections 2	Aug. 13, 2021
3	Permit Revisions	Apr. 22, 2022
4	Corrections	Jun. 10, 2022

DPD:

PROJECT TITLE:  
**Clarkson Residence**  
 8163 West Mercer Way  
 Mercer Island, WA 98040


ARCHITECT:  
**Brandt Design Group**  
 66 Bell Street, Unit 1  
 Seattle, WA 98121  
 PH 206.239.0850

ISSUE:  
**PERMIT**

SHEET TITLE:  
**Wood Framing Details**

SCALE: 3/4" = 1'-0" U.N.O.  
 DATE: December 24, 2020  
 PROJECT NO: 01519-2021-11  
 SHEET NO:



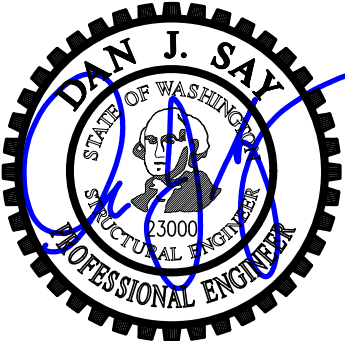


DESIGN: HAA, BDM  
DRAWN: NHD  
CHECKED: BDM  
APPROVED: DJS

1

2

3

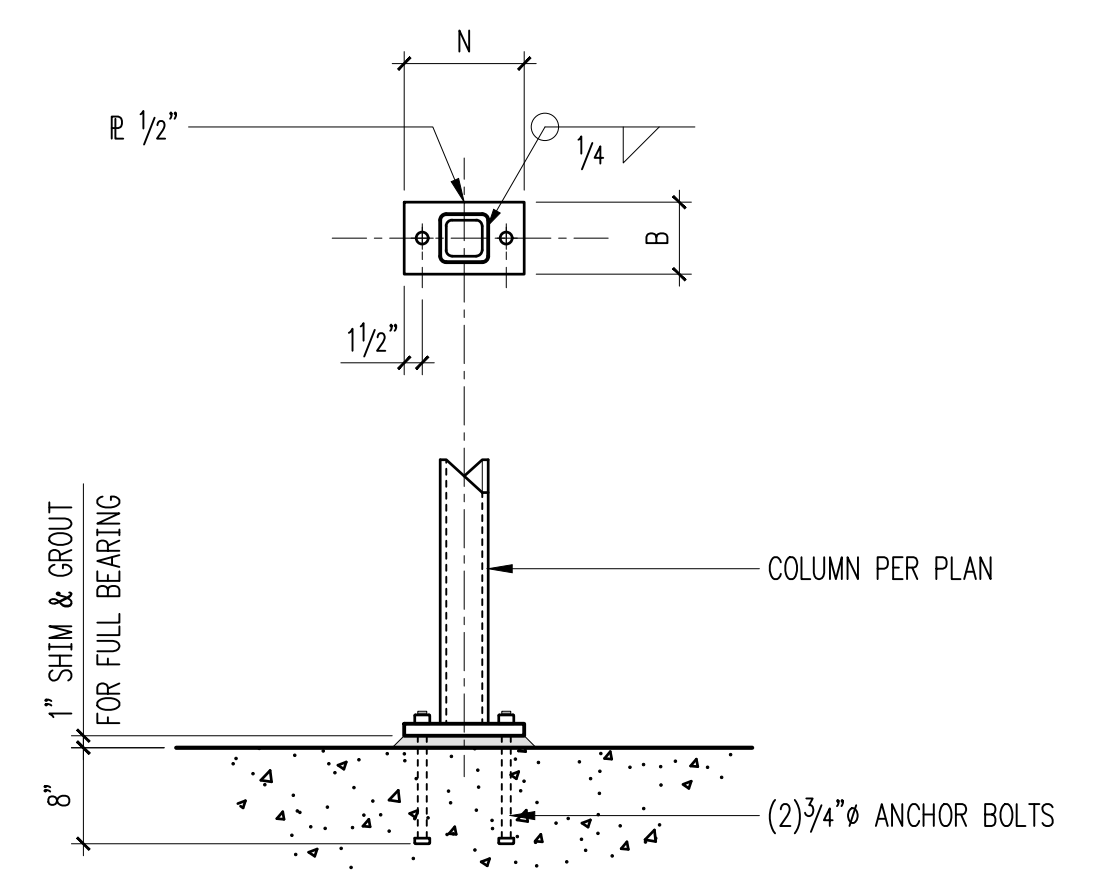

Baseplate - HSS Column 4

REVISIONS:

1	Corrections	May 4, 2021
2	Corrections 2	Aug. 13, 2021
3	Permit Revisions	Apr. 22, 2022
4	Corrections	Jun. 10, 2022

DPD:

PROJECT TITLE:  
**Clarkson Residence**  
8163 West Mercer Way  
Mercer Island, WA 98040


ARCHITECT:  
**Brandt Design Group**  
66 Bell Street, Unit 1  
Seattle, WA 98121  
PH 206.239.0850

ISSUE:  
**PERMIT**


SHEET TITLE:  
**Steel Details**

SCALE: 3/4" = 1'-0" U.N.O.  
DATE: December 24, 2020  
PROJECT NO: 01519-2021-11  
SHEET NO:


**S5.1**

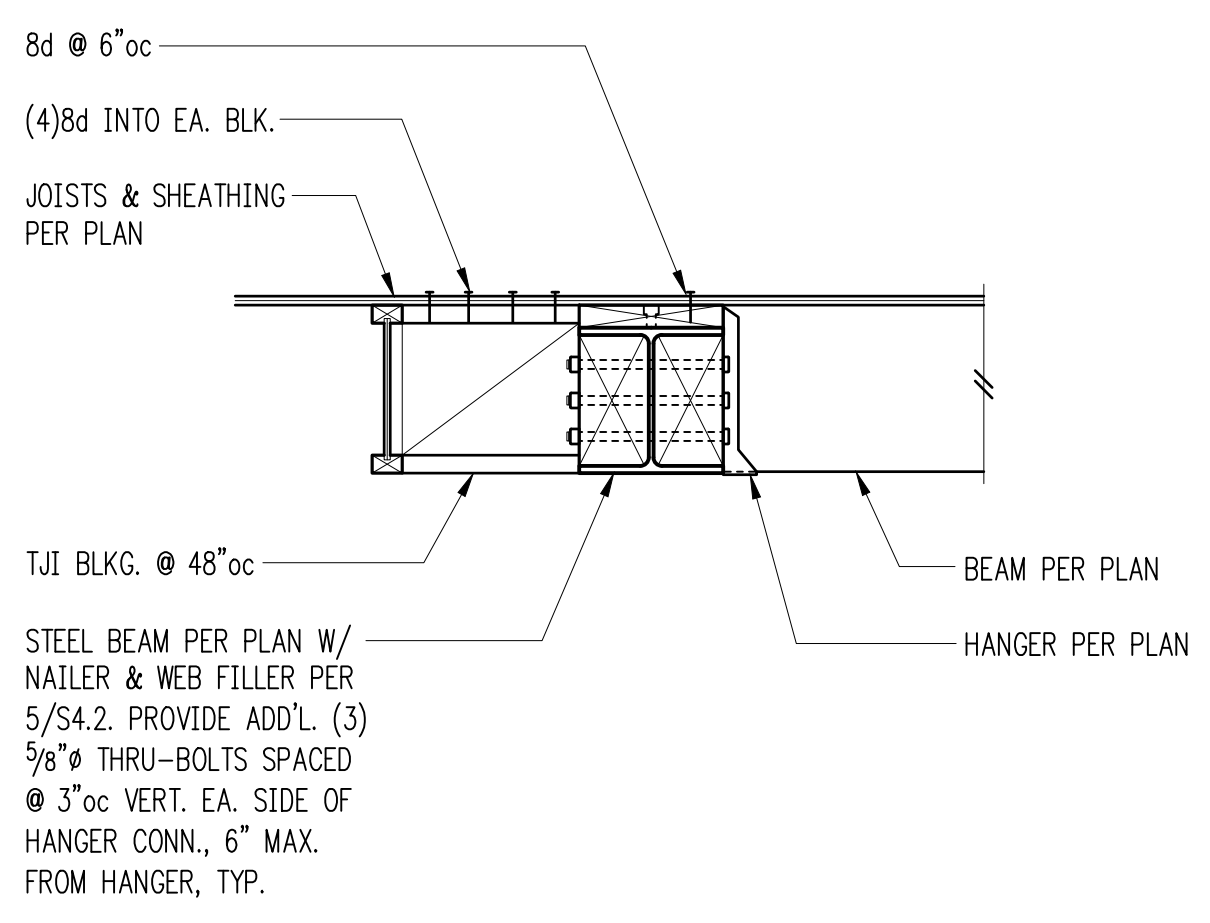


5

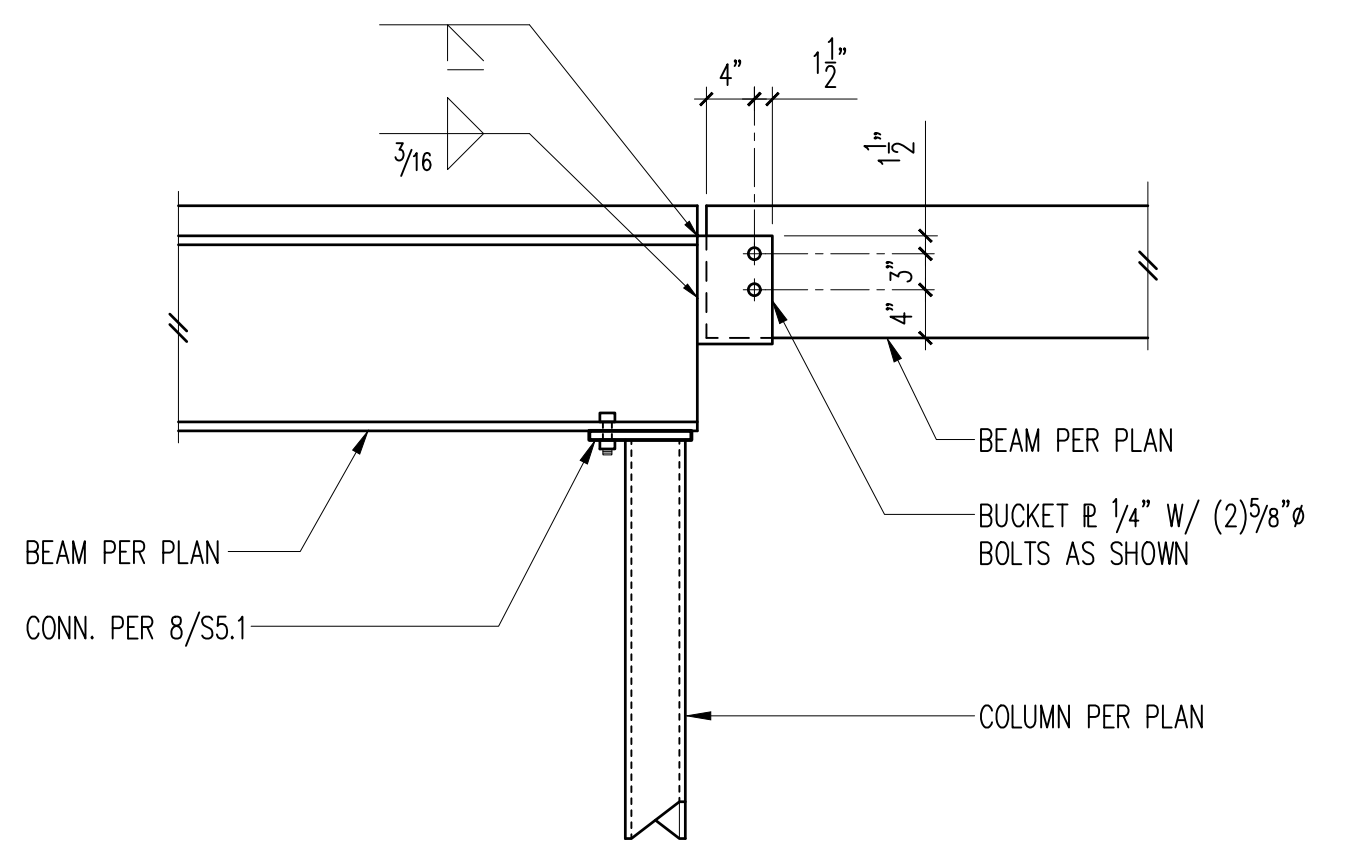

Beam/Plate Connection - Steel/Wood 6

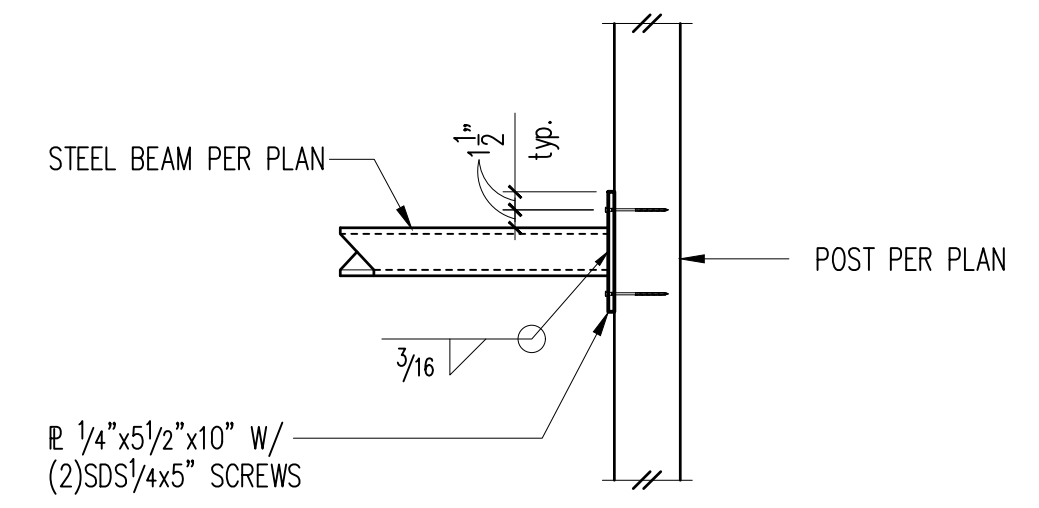


7

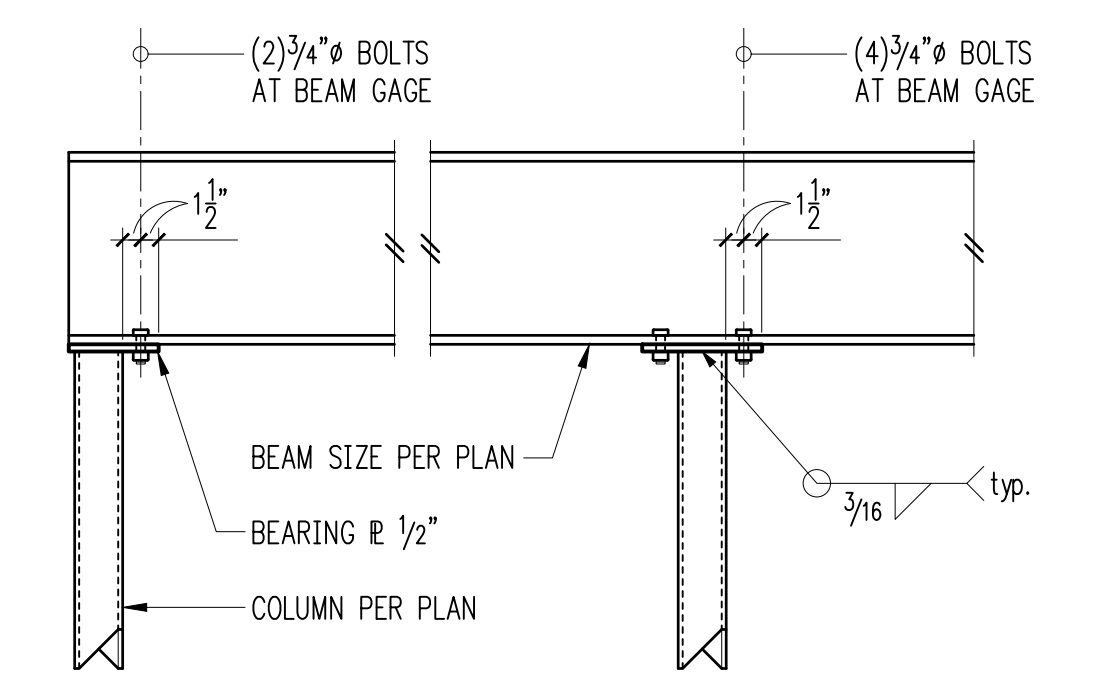


Typical Beam Bearing on HSS or Pipe Column 8


NOTE:  
BEARING PLATE THICKNESS SHALL BE  
3/4" WHERE DEPTH OF SUPPORTED  
MEMBER EXCEEDS 24"

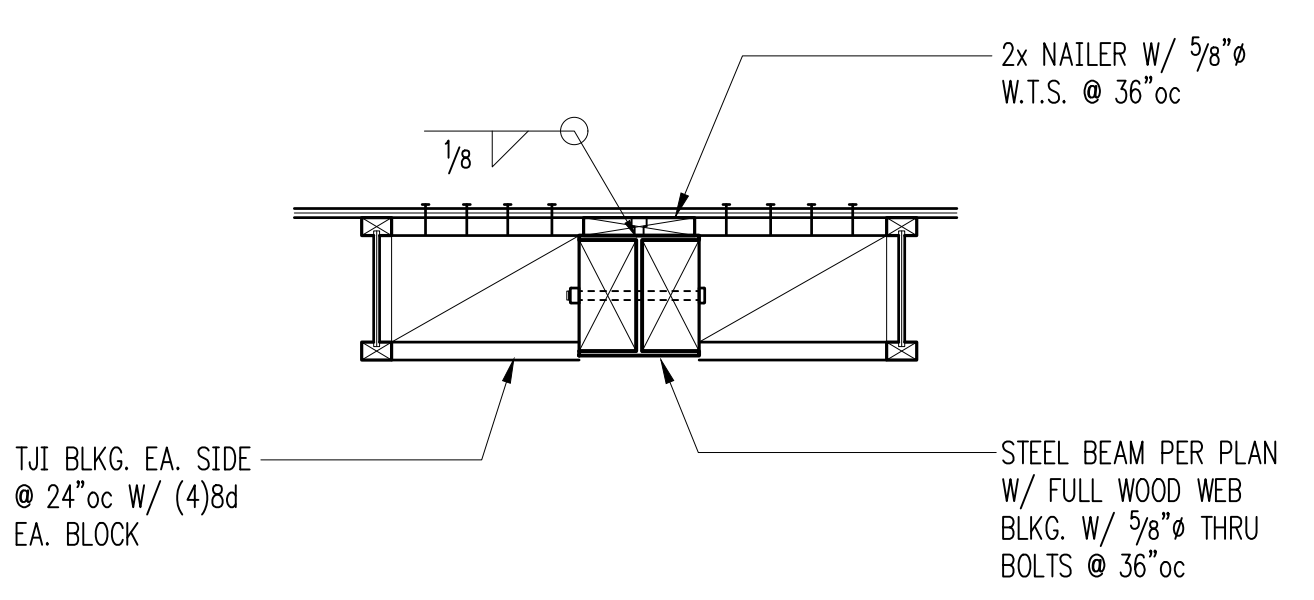


Steel Beam Parallel to Framing 9

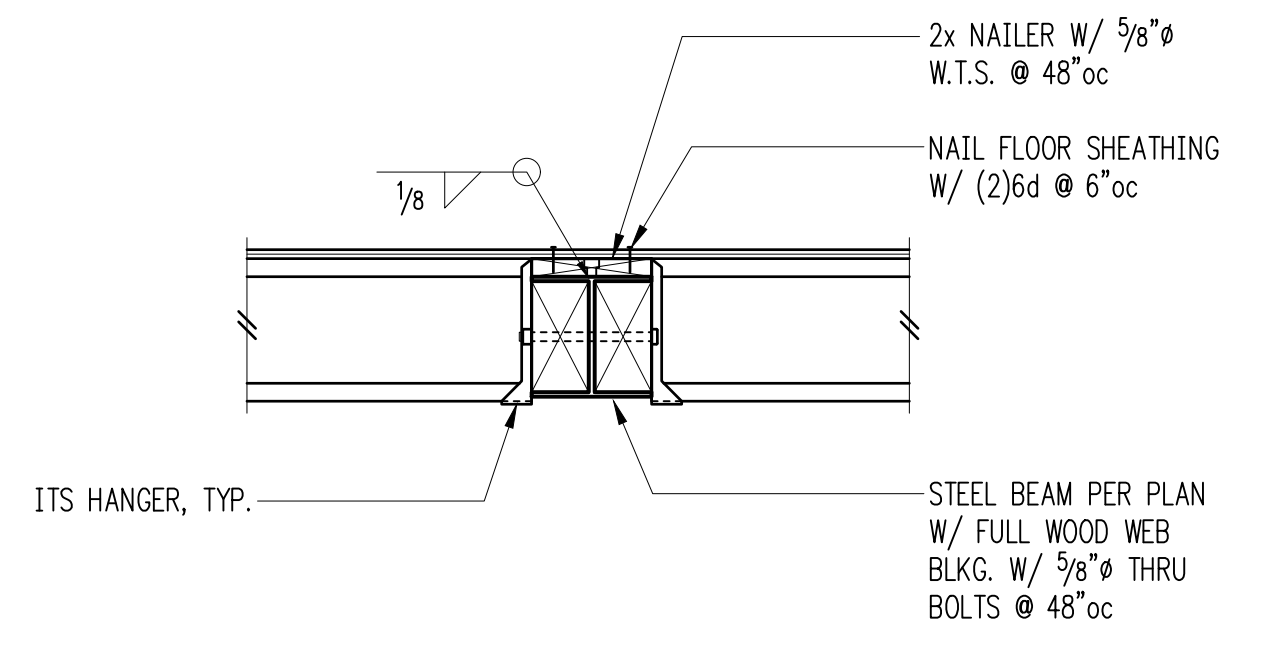

Steel Beam Perpendicular to Framing 10

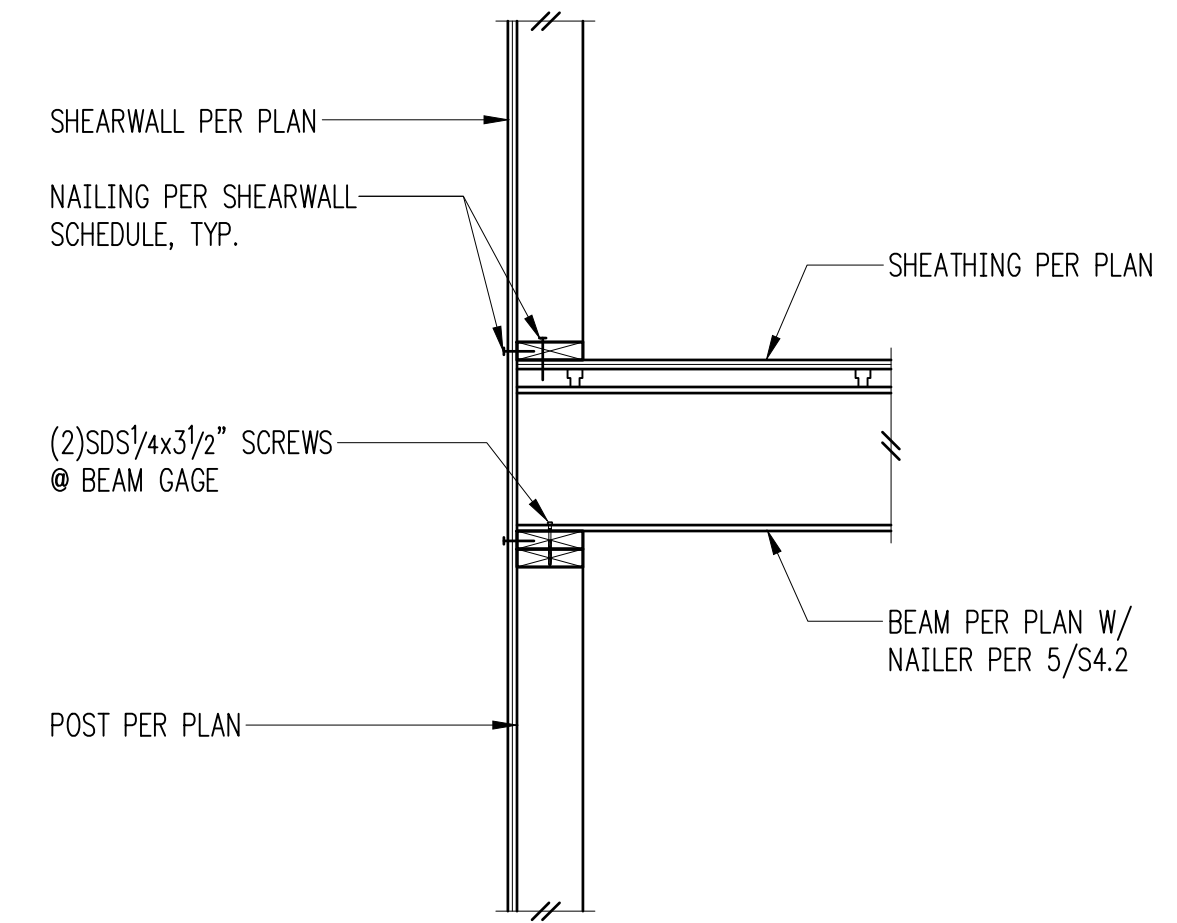

11

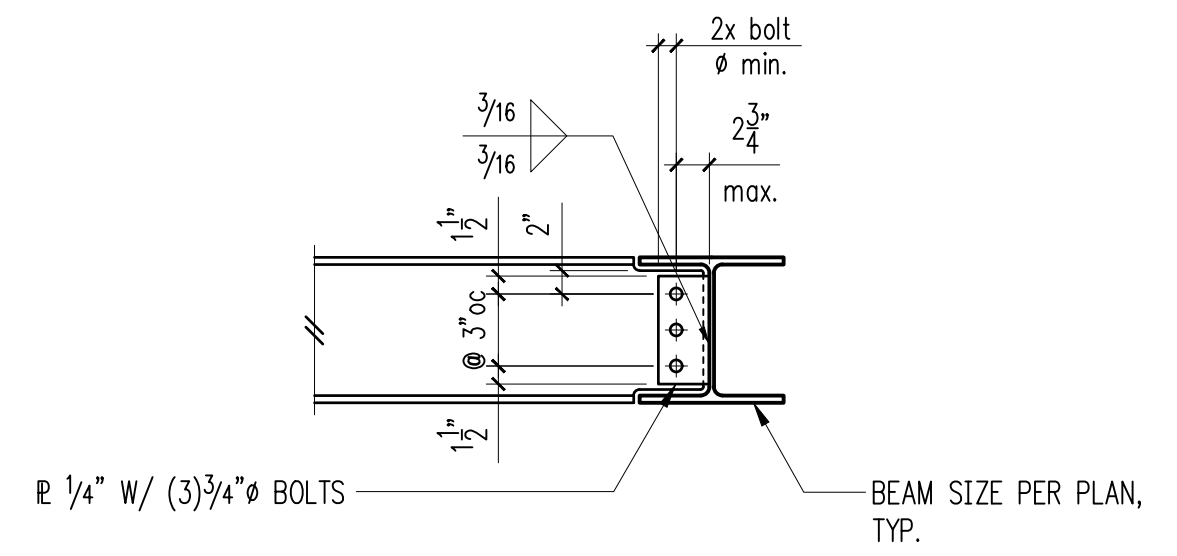

NOTES:  
1. STANDARD OR SLOTTED HOLES MAY BE USED.  
2. BOLT TYPE A325N.  
3. MATERIAL - A36

12





DESIGN: HAA, BDM  
DRAWN: NHD  
CHECKED: BDM  
APPROVED: DJS

REVISIONS:

1	Corrections	May 4, 2021
2	Corrections 2	Aug. 13, 2021
3	Permit Revisions	Apr. 22, 2022
4	Corrections	Jun. 10, 2022

DPD:

PROJECT TITLE:  
**Clarkson Residence**  
8163 West Mercer Way  
Mercer Island, WA 98040

ARCHITECT:  
**Brandt Design Group**  
66 Bell Street, Unit 1  
Seattle, WA 98121  
PH 206.239.0850

ISSUE:  
**PERMIT**

SHEET TITLE:

**Shoring Plan**


SCALE: 3/16" = 1'-0" U.N.O.

DATE: December 24, 2020

PROJECT NO: 01519-2021-11

SHEET NO:

**SH2.1**

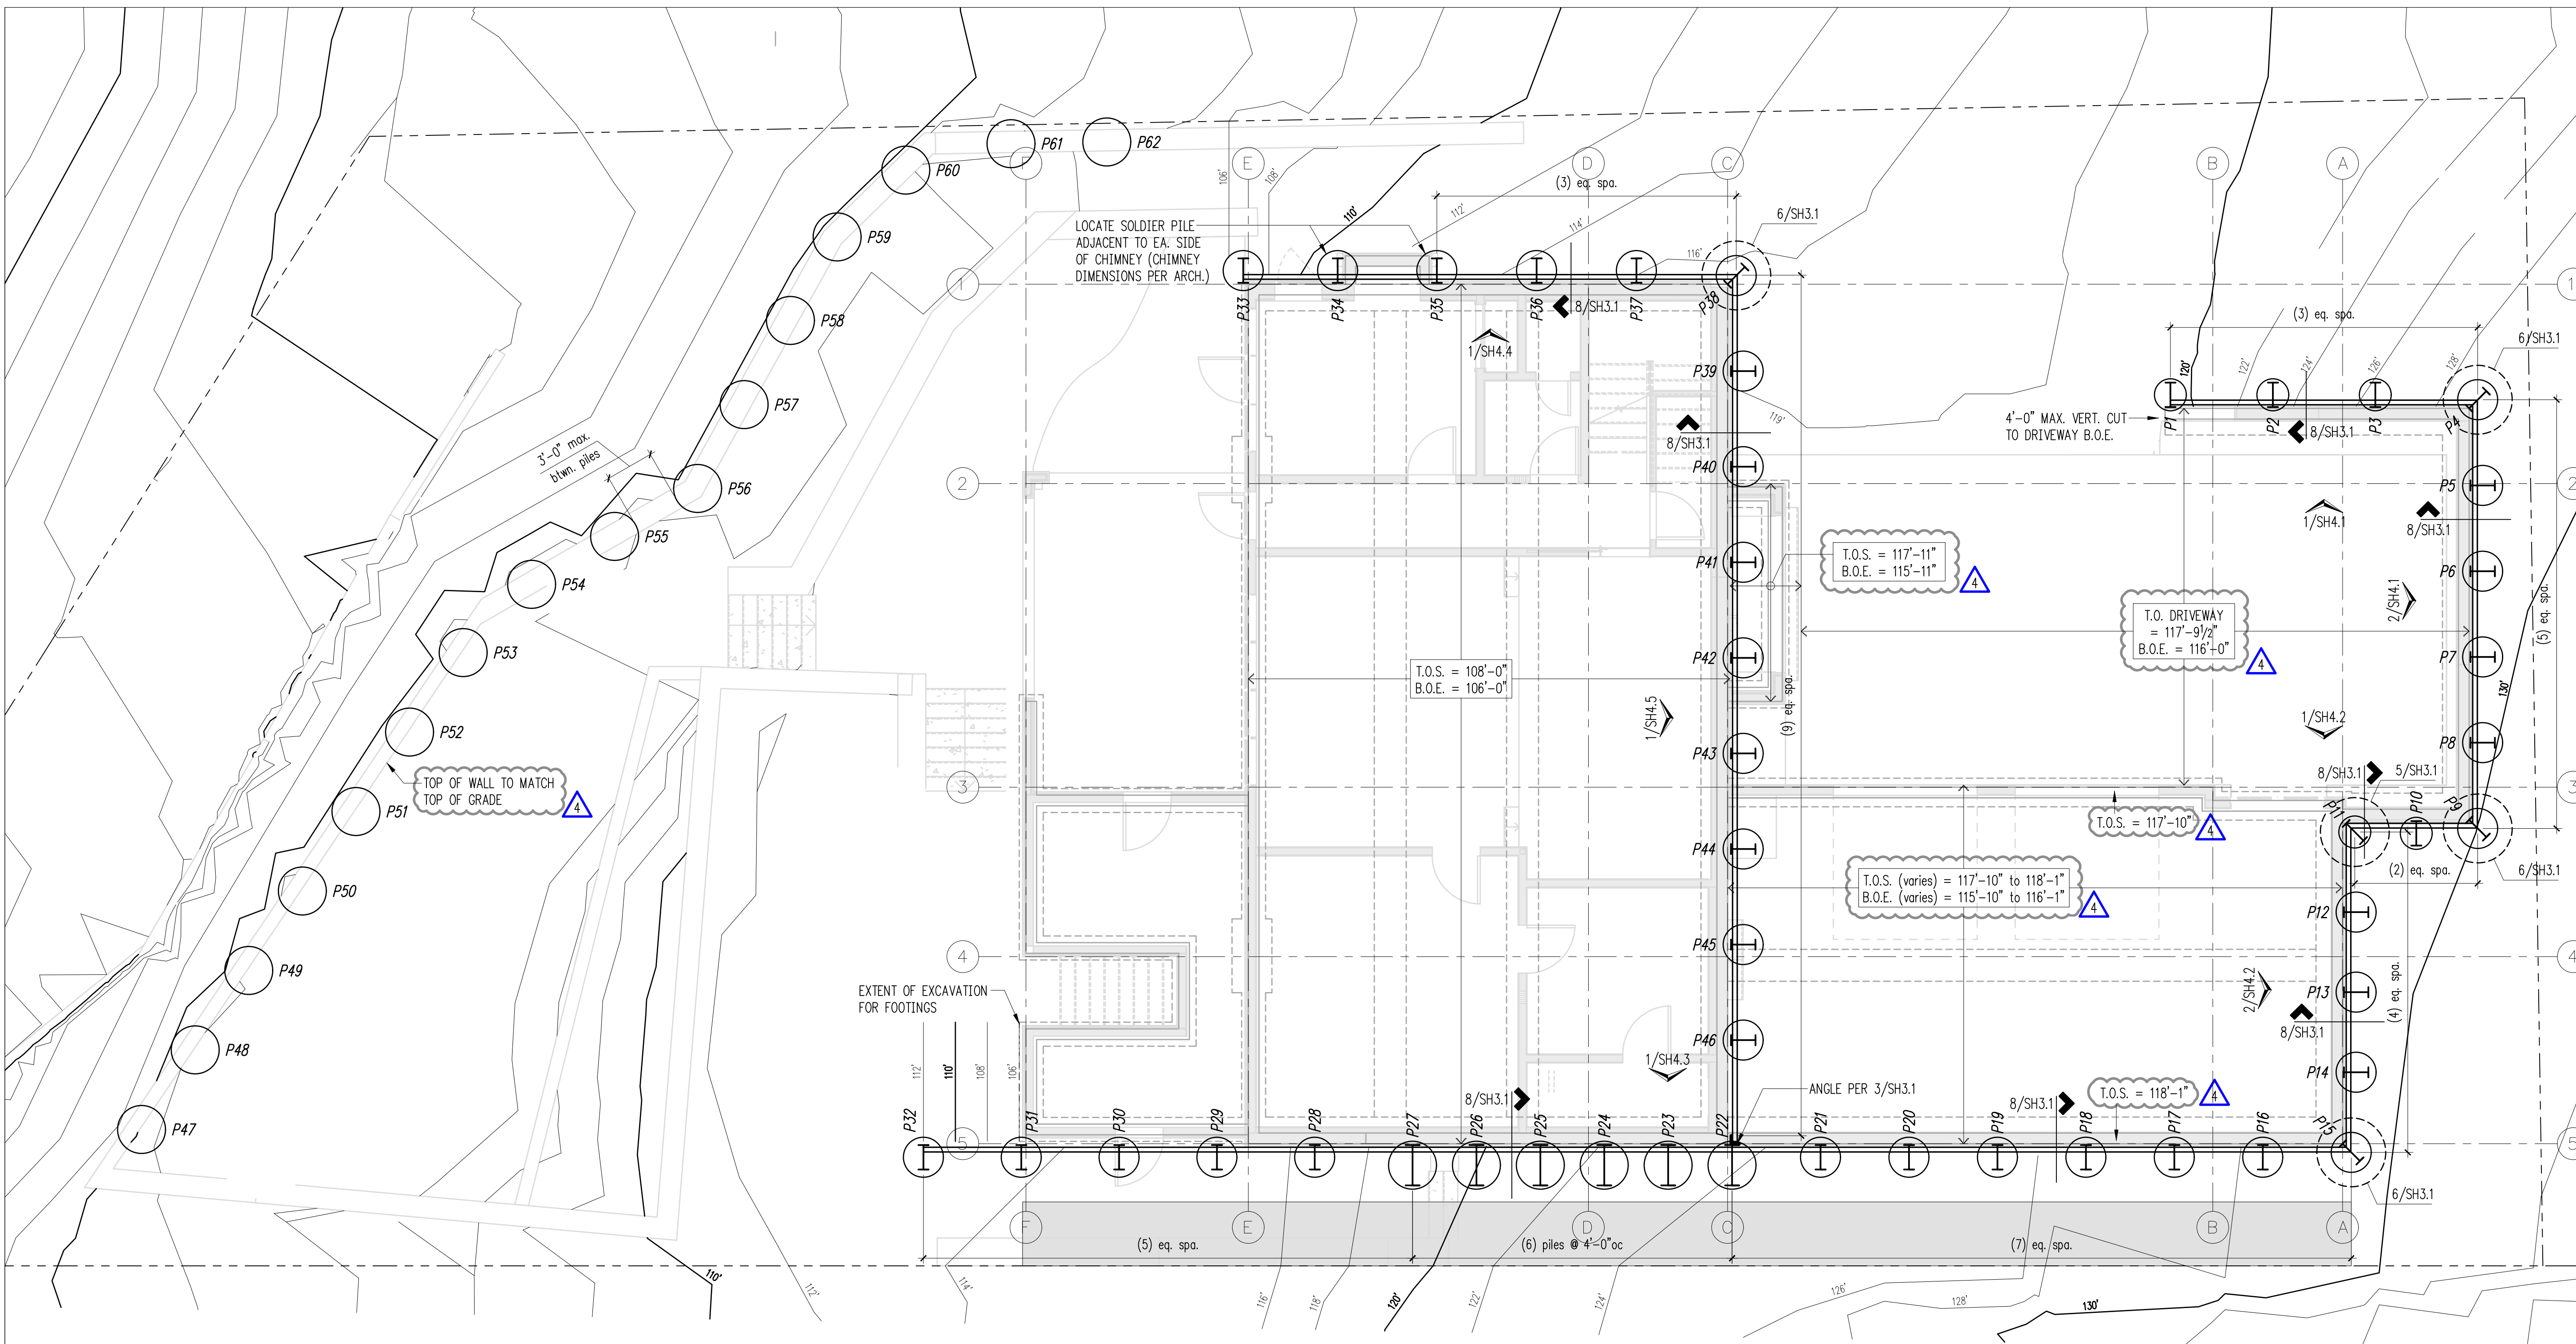


**Plan Notes**

- DO NOT SCALE DRAWINGS. REFER TO ARCHITECTURAL DRAWINGS FOR ALL DIMENSIONS.
- TYPICAL TIMBER LAGGING SHALL CONSIST OF 4x12 HF #2 WITH A BASE VALUE OF FB=900 PSI UNLESS NOTED OTHERWISE ON PLAN.
- OBSTRUCTIONS MAY BE ENCOUNTERED DURING EXCAVATION AND SHORING/PILE INSTALLATION. NOTIFY ENGINEER OF RECORD AND GEOTECHNICAL ENGINEER IF OBSTRUCTIONS PREVENT INSTALLATION OF PILES PER PLANS.
- FOR EACH PILE UTILIZING LEAN CONCRETE, THE REQUIRED VOLUME OF GROUT SHALL BE CALCULATED PRIOR TO, AND MONITORED DURING INSTALLATION. GROUTING OPERATIONS SHALL BE STOPPED IF THE PUMPED GROUT VOLUME EXCEEDS THE CALCULATED GROUT VOLUME BY 10%.
- REFER TO GENERAL STRUCTURAL NOTES FOR ADDITIONAL REQUIREMENTS.
- MAXIMUM GRAVITY LOAD ON SOLDIER PILE = 35k (ALLOWABLE)

**Legend**


- STEM WALL & FOOTING PER S2.1 & S2.2
- SHORING PILE PER SCHEDULE, THIS SHEET
- T.O.S. TOP OF SLAB
- B.O.E. BOTTOM OF EXCAVATION
- ADJACENT DRIVEWAY SURCHARGE APPLIED TO PILES P15-P31

**Loading Diagram**

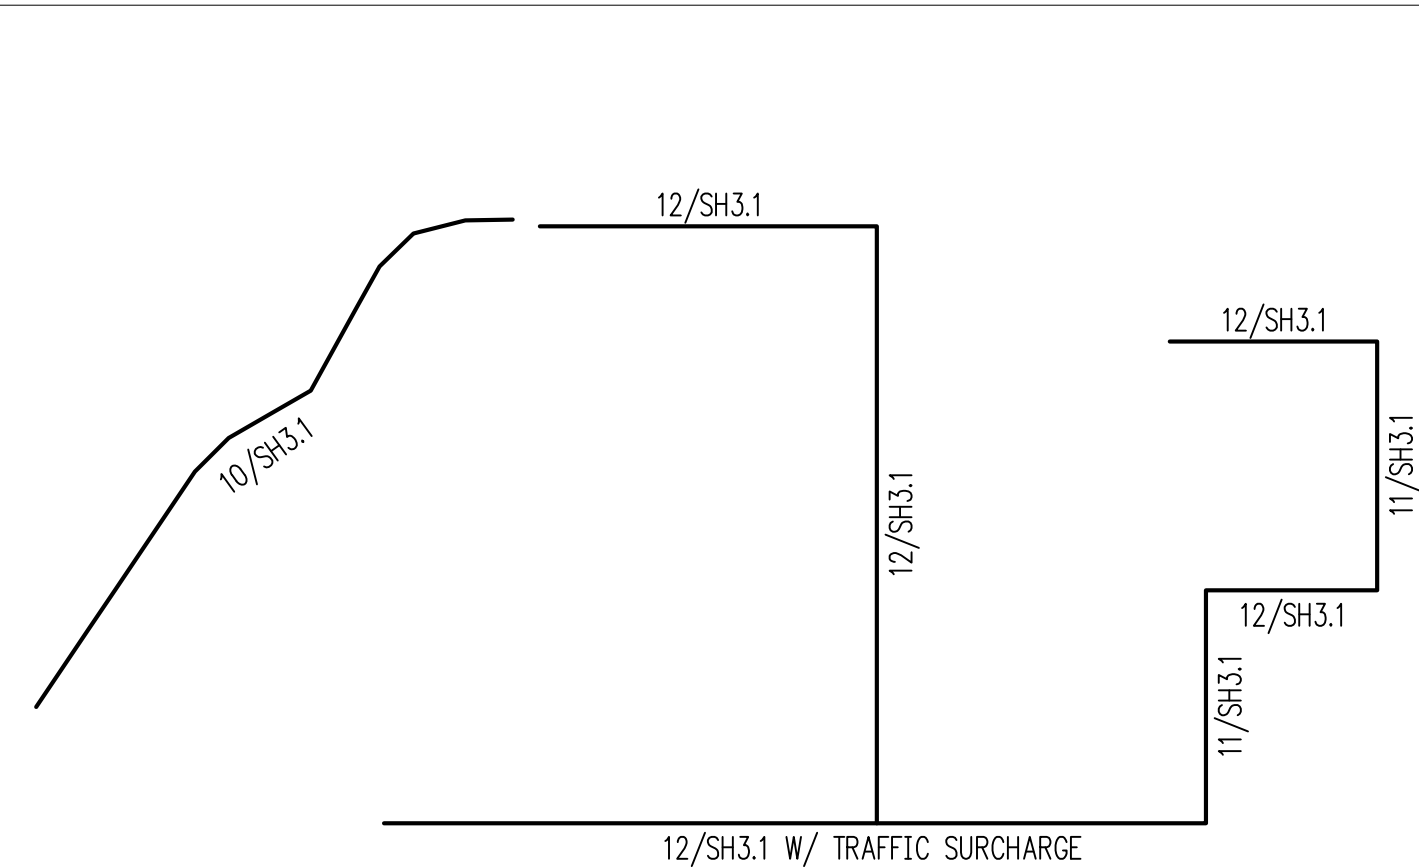

**Pile Schedule**

MARK	AUGER DIA. (min.)	STEEL PILE SIZE	PERM./TEMP.	MIN. EMBED D	MAX. SHORING HEIGHT
P1-P3	24"	W18x50	PERM.	22'-0"	11'-0"
P4-P9	30"	W24x84	PERM.	28'-0"	14'-0"
P10	30"	W18x65	PERM.	24'-0"	13'-0"
P11-P14	30"	W24x84	PERM.	26'-0"	13'-0"
P15-P21	30"	W24x84	PERM.	25'-0"	13'-0"
P22-P27	42"	W33x169	PERM.	36'-0"	18'-0"
P28-P32	30"	W18x86	PERM.	22'-0"	11'-0"
P33-P37	30"	W18x50	PERM.	17'-0"	10'-0"
P38-P46	30"	W18x86	PERM.	23'-0"	13'-0"
P47-P62 (stabilization piles)	36"	W30x90	PERM.	21'-0" (below elev. 89'-0")	16'-0" (max. elev. 105'-0")

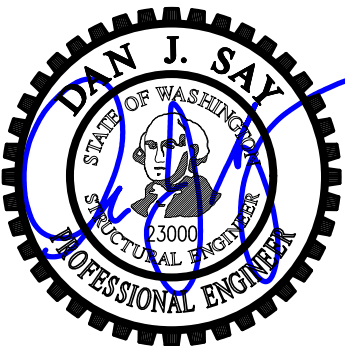

DESIGN: HAA, BDM  
DRAWN: NHD  
CHECKED: BDM  
APPROVED: DJS

REVISIONS:

1	Corrections	May 4, 2021
2	Corrections 2	Aug. 13, 2021
3	Permit Revisions	Apr. 22, 2022
4	Corrections	Jun. 10, 2022

DPD:

PROJECT TITLE:  
**Clarkson Residence**  
8163 West Mercer Way  
Mercer Island, WA 98040

ARCHITECT:  
**Brandt Design Group**  
66 Bell Street, Unit 1  
Seattle, WA 98121  
PH 206.239.0850

ISSUE:  
**PERMIT**

SHEET TITLE:

**Shoring Details**


SCALE: 3/4" = 1'-0" U.N.O.

DATE: December 24, 2020


PROJECT NO: 01519-2021-11

SHEET NO:

 
**SH3.1**




1

 

2

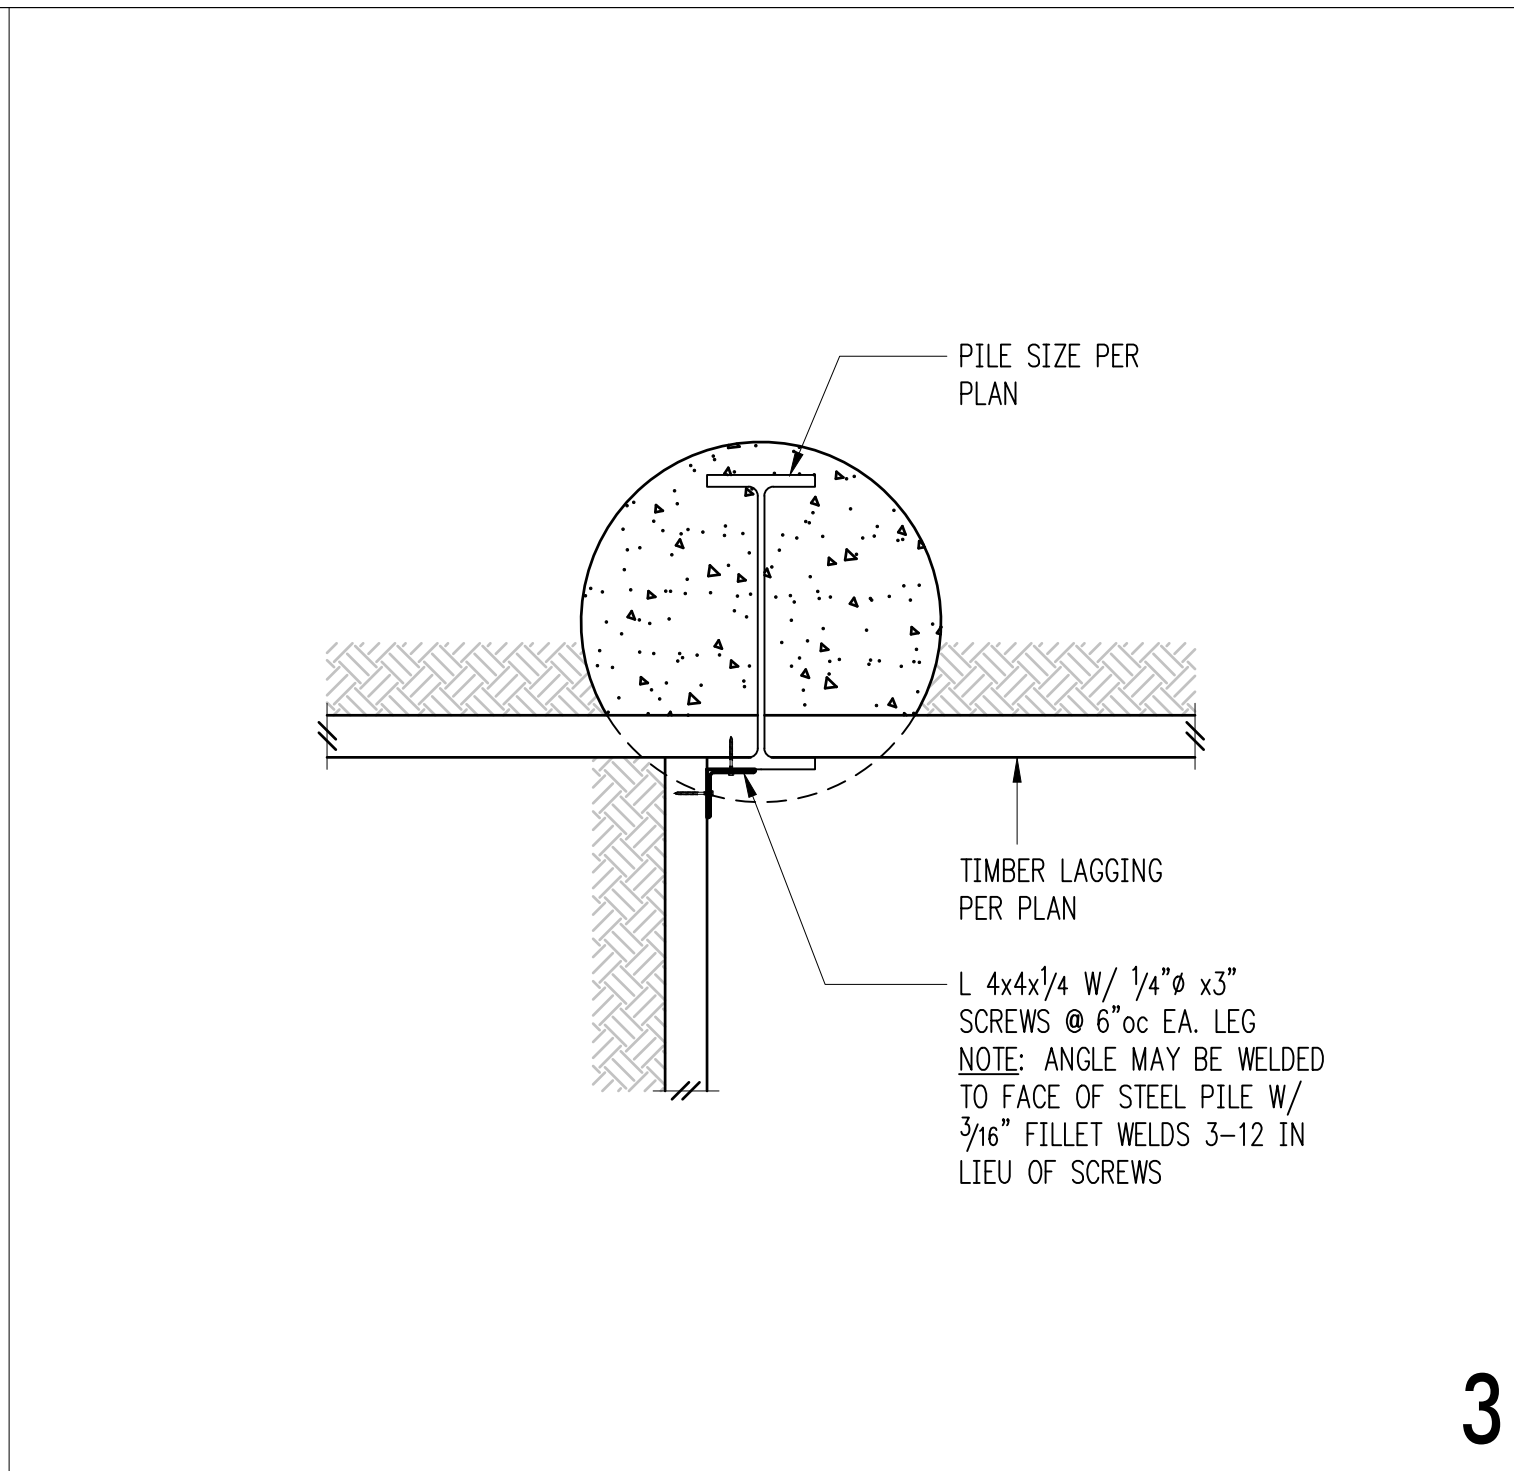


3

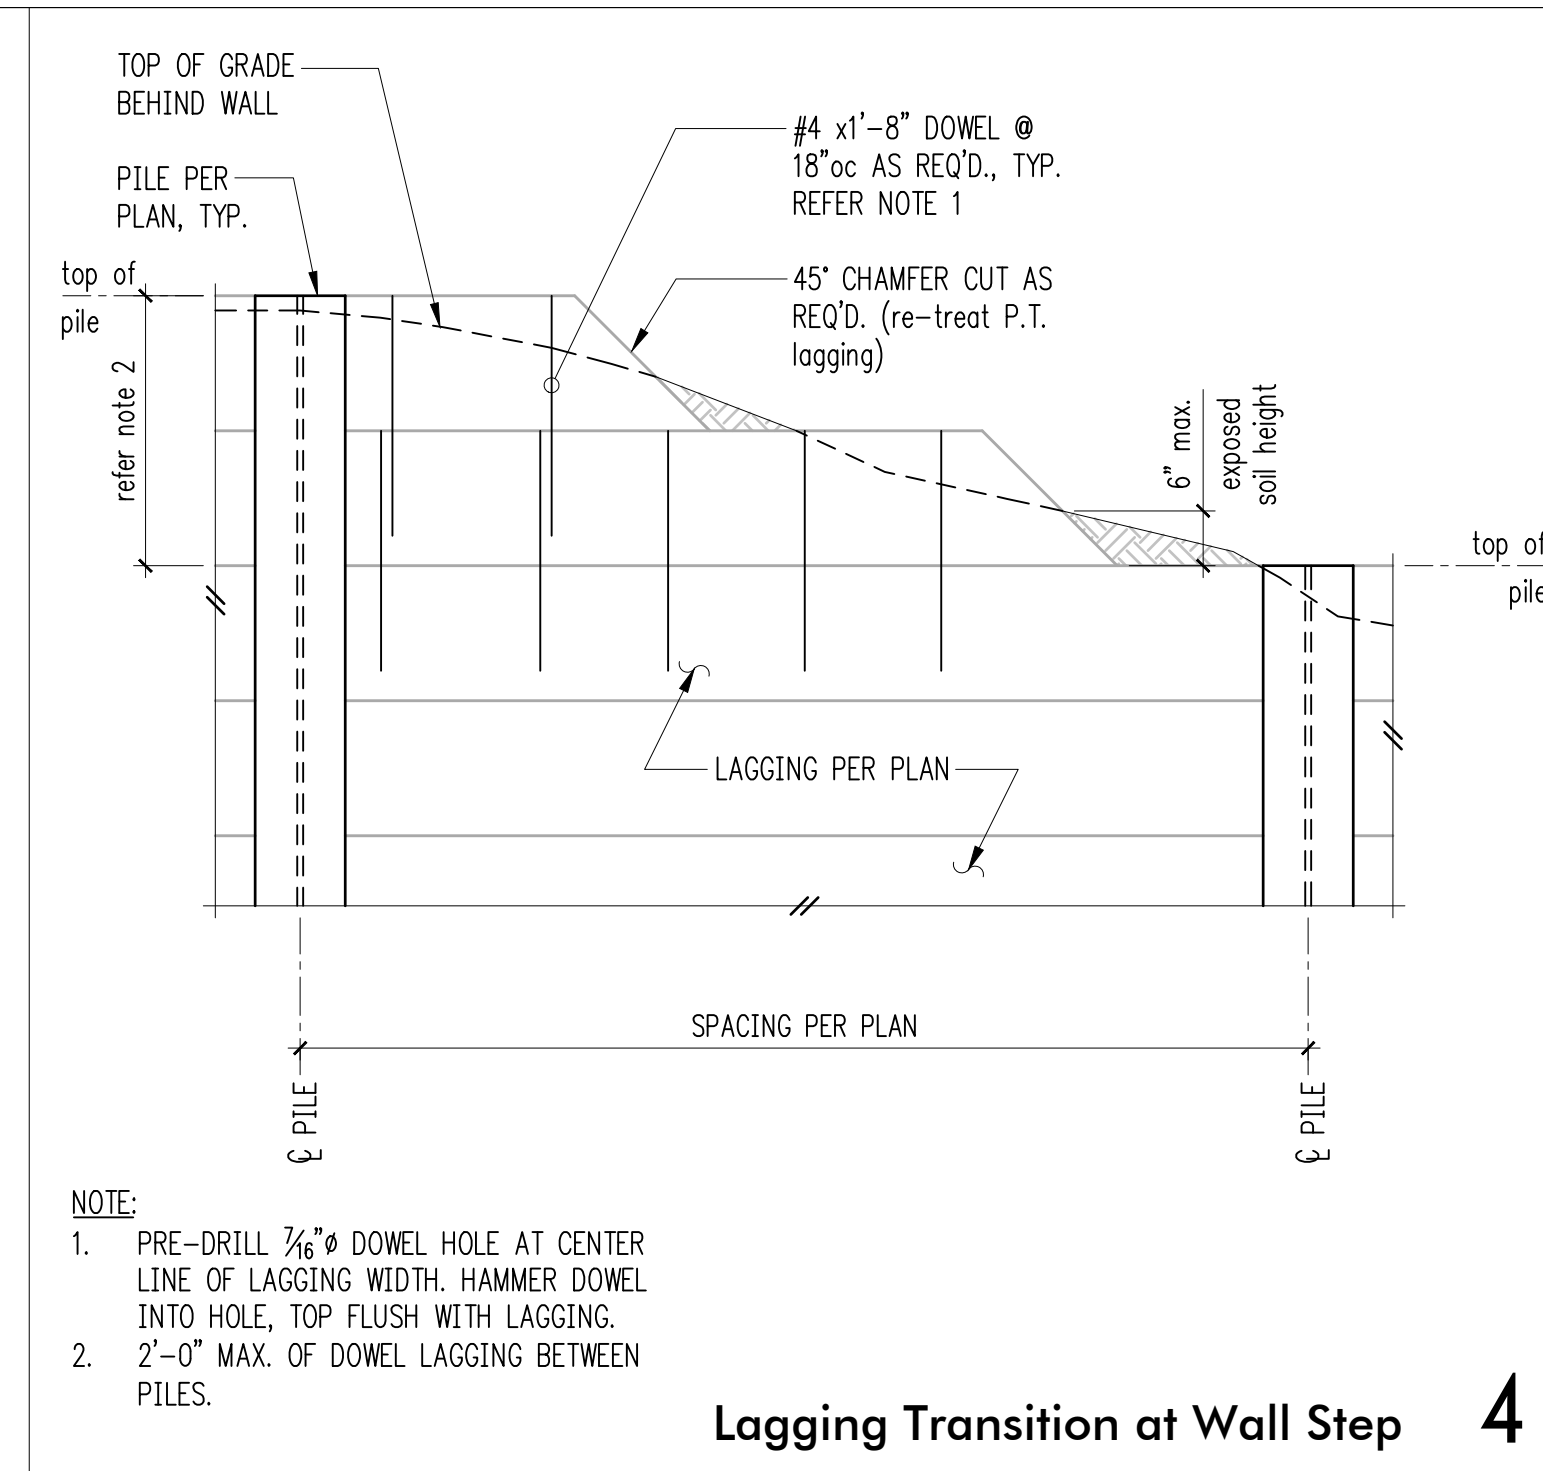


4

- NOTE:
- PRE-DRILL 3/8" Ø DOWEL HOLE AT CENTER LINE OF LAGGING WIDTH. HAMMER DOWEL INTO HOLE, TOP FLUSH WITH LAGGING.
  - 2'-0" MAX. OF DOWEL LAGGING BETWEEN PILES.


Lagging Transition at Wall Step

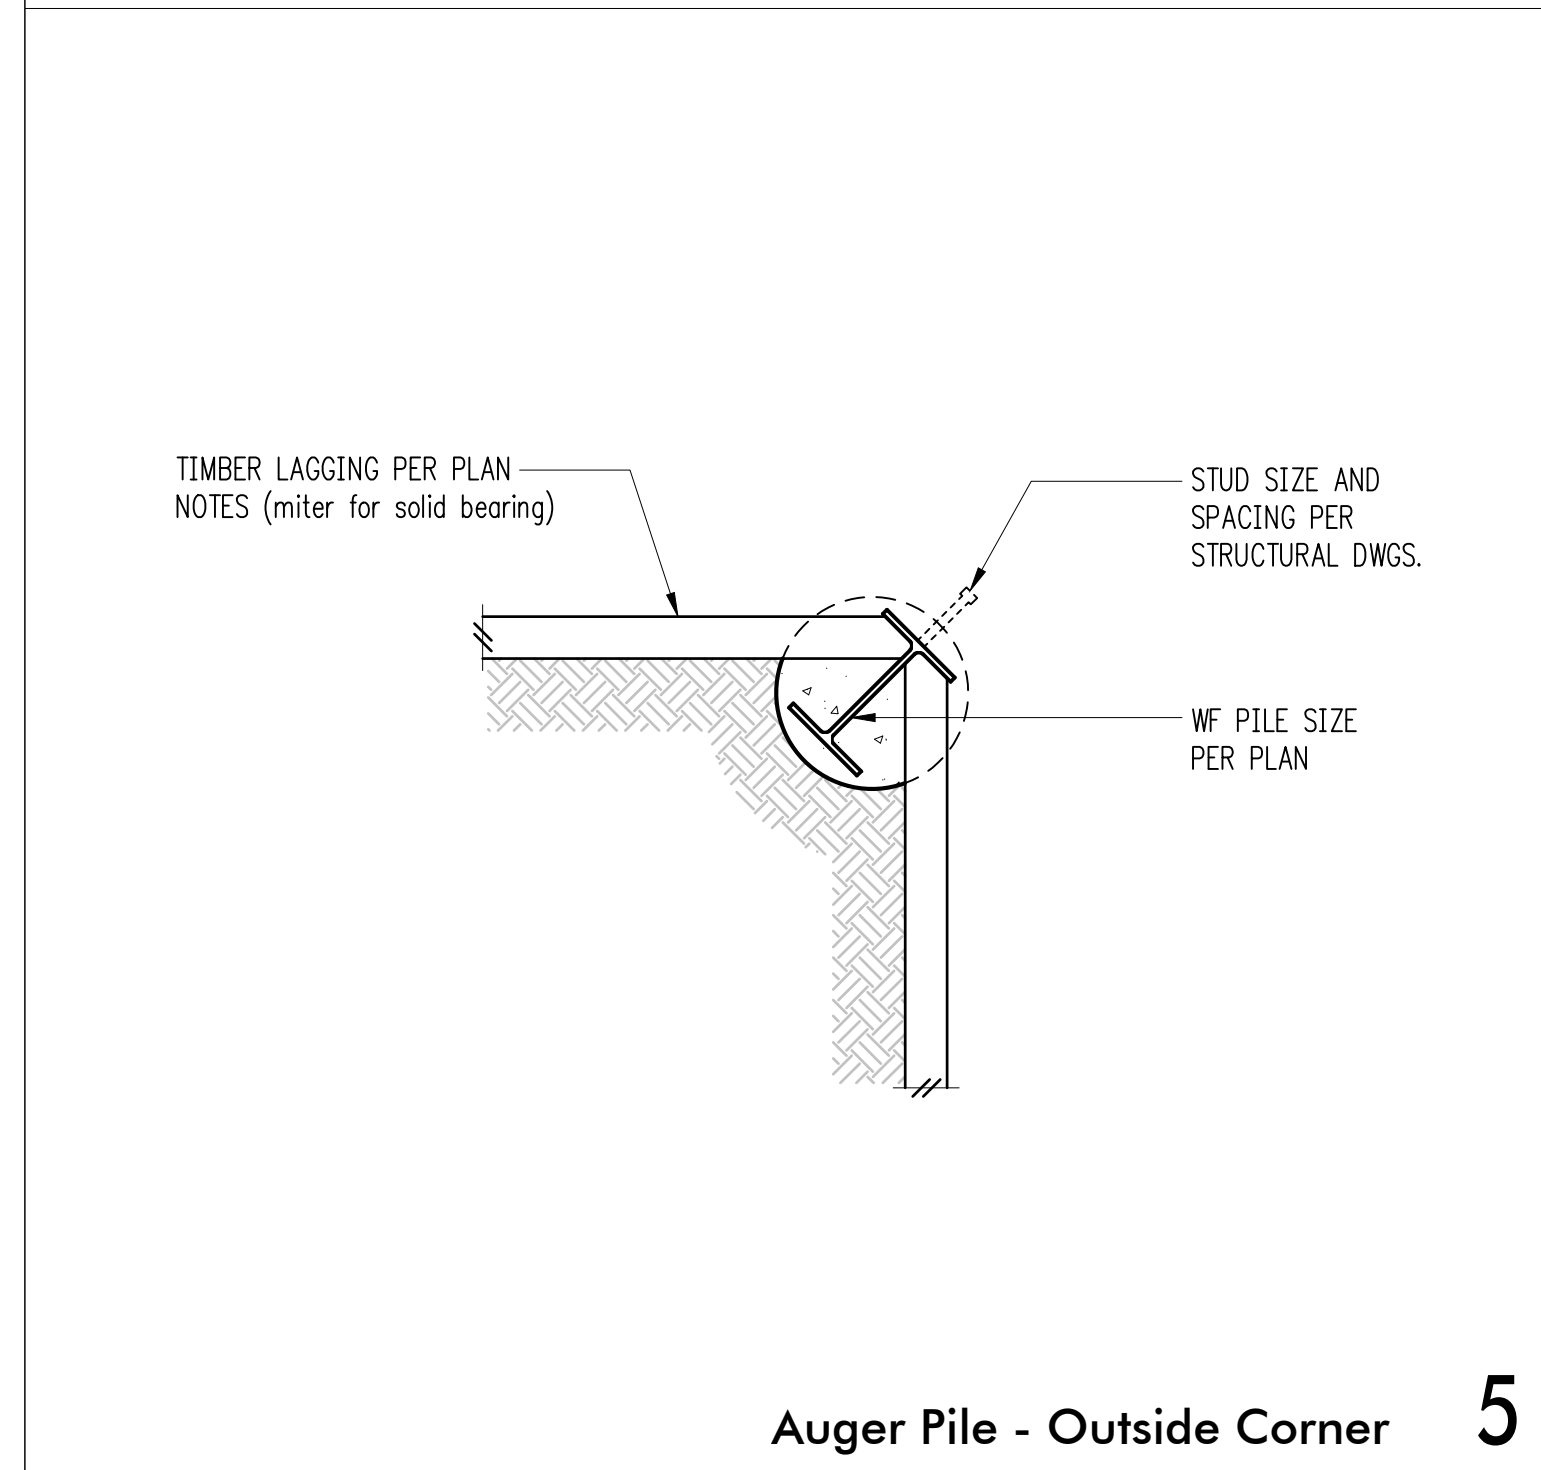


Auger Pile - Outside Corner 5

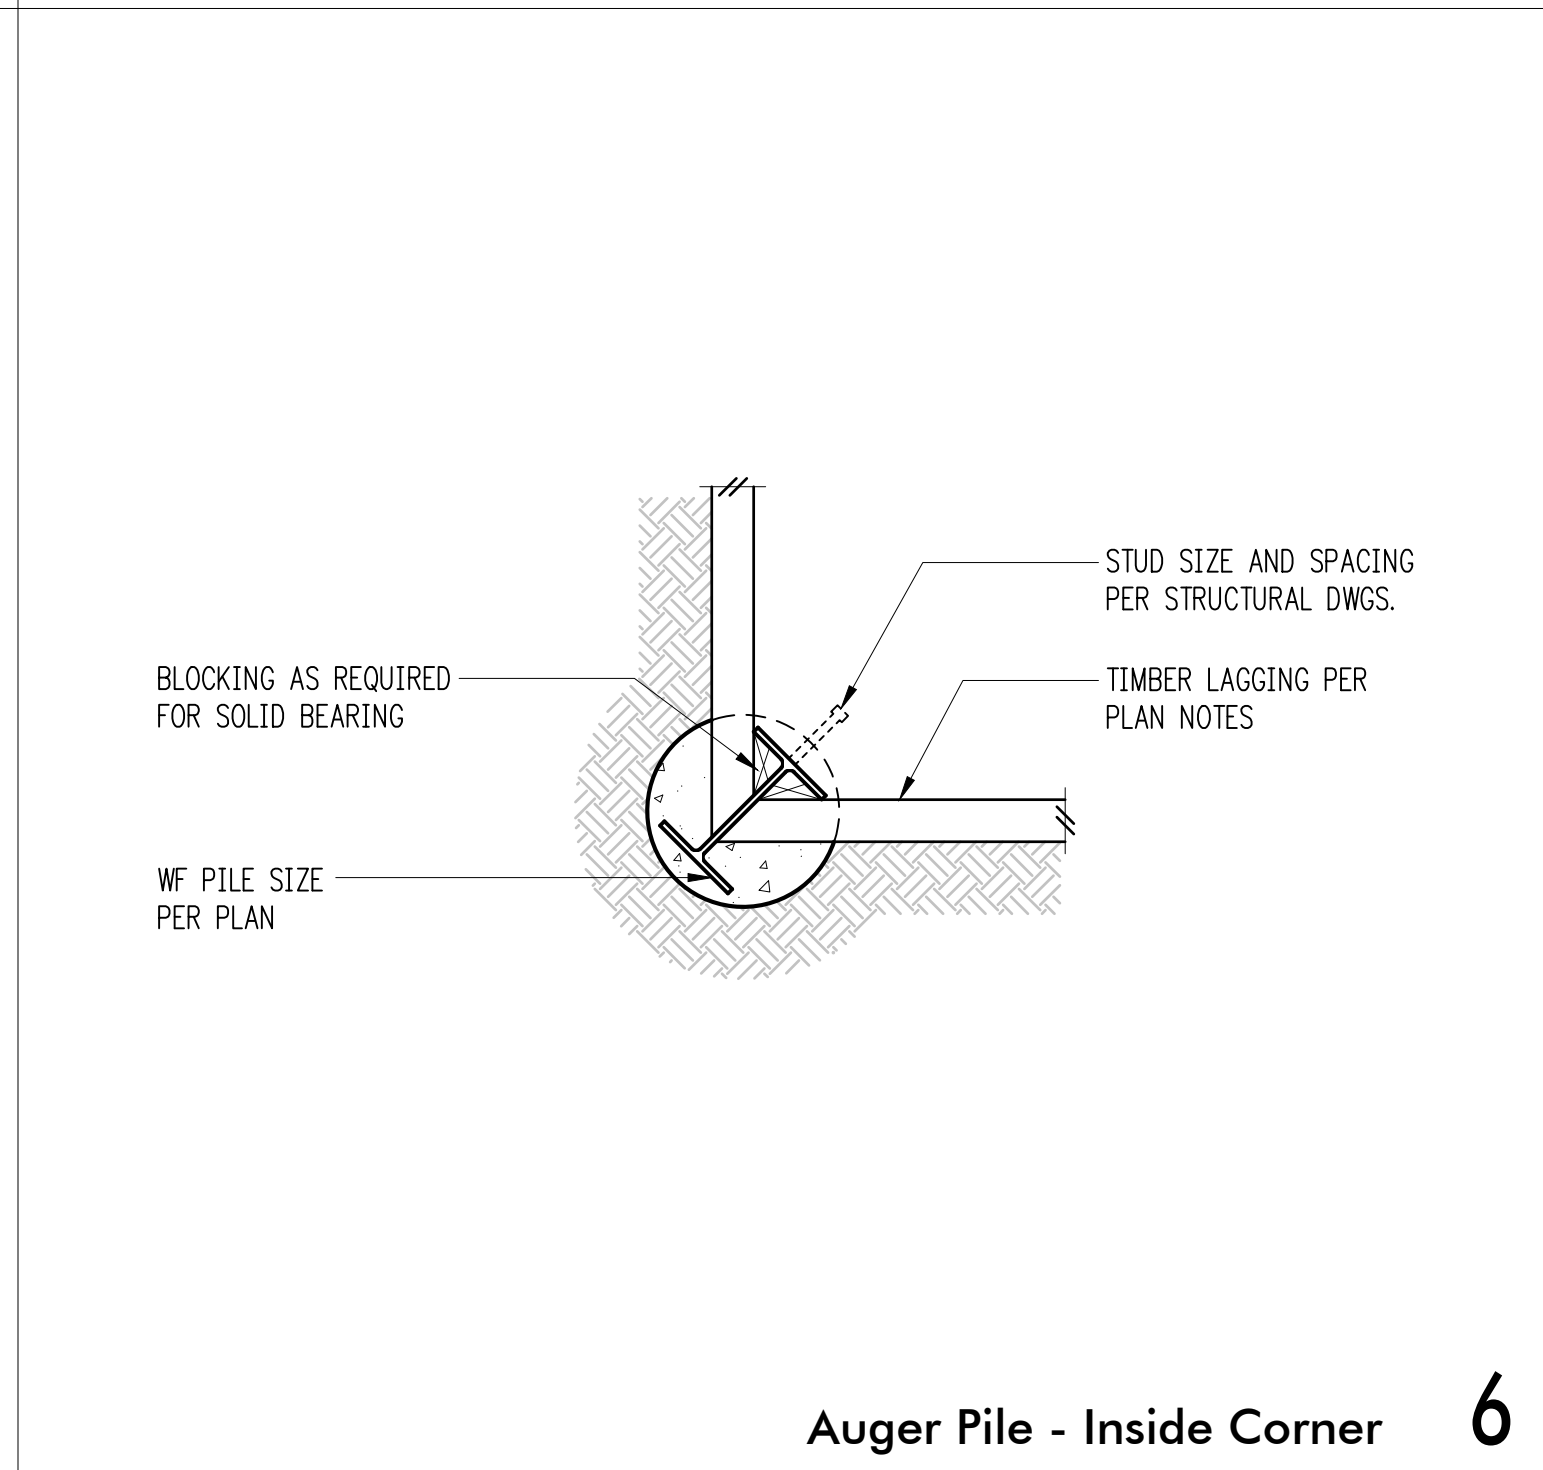

Auger Pile - Inside Corner 6

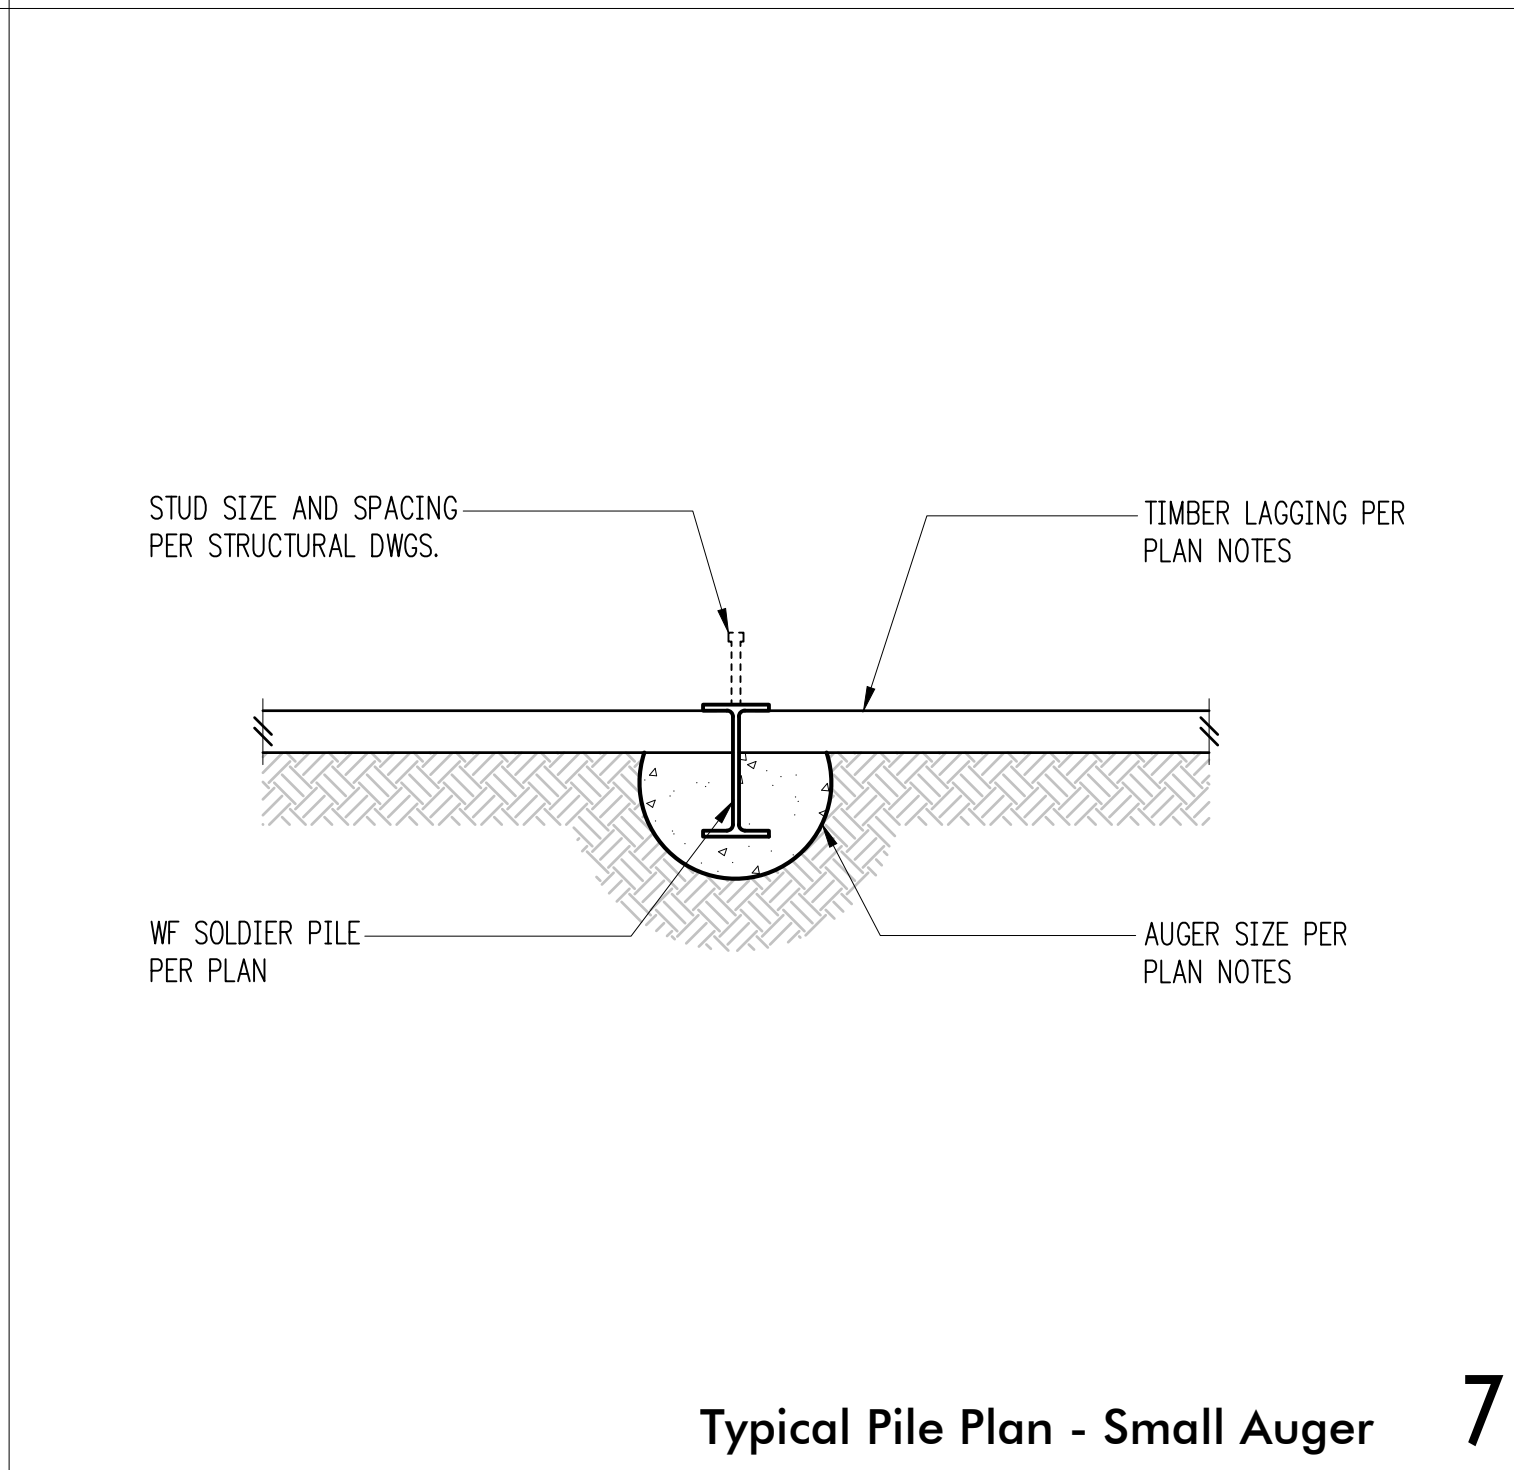


Typical Pile Plan - Small Auger 7

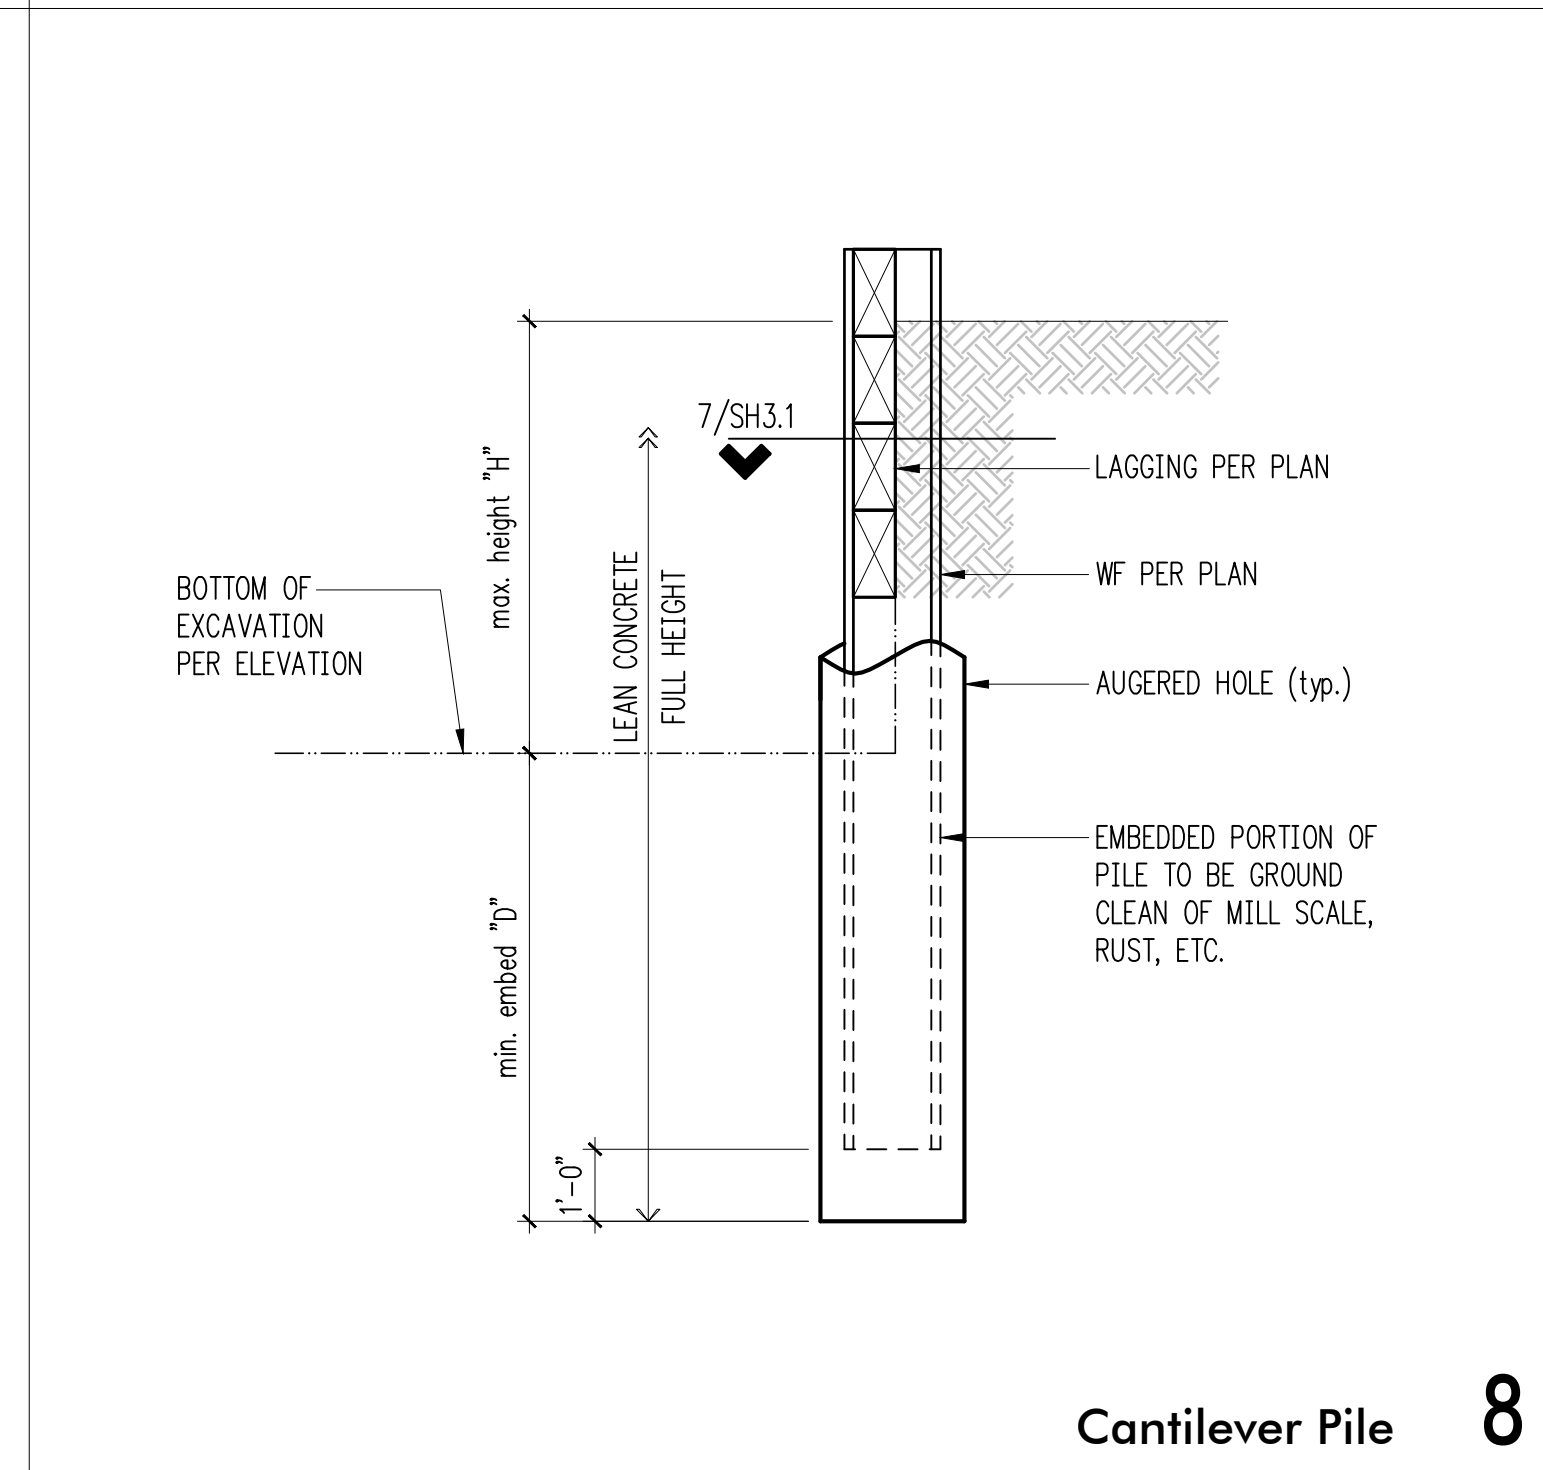


Cantilever Pile 8



9

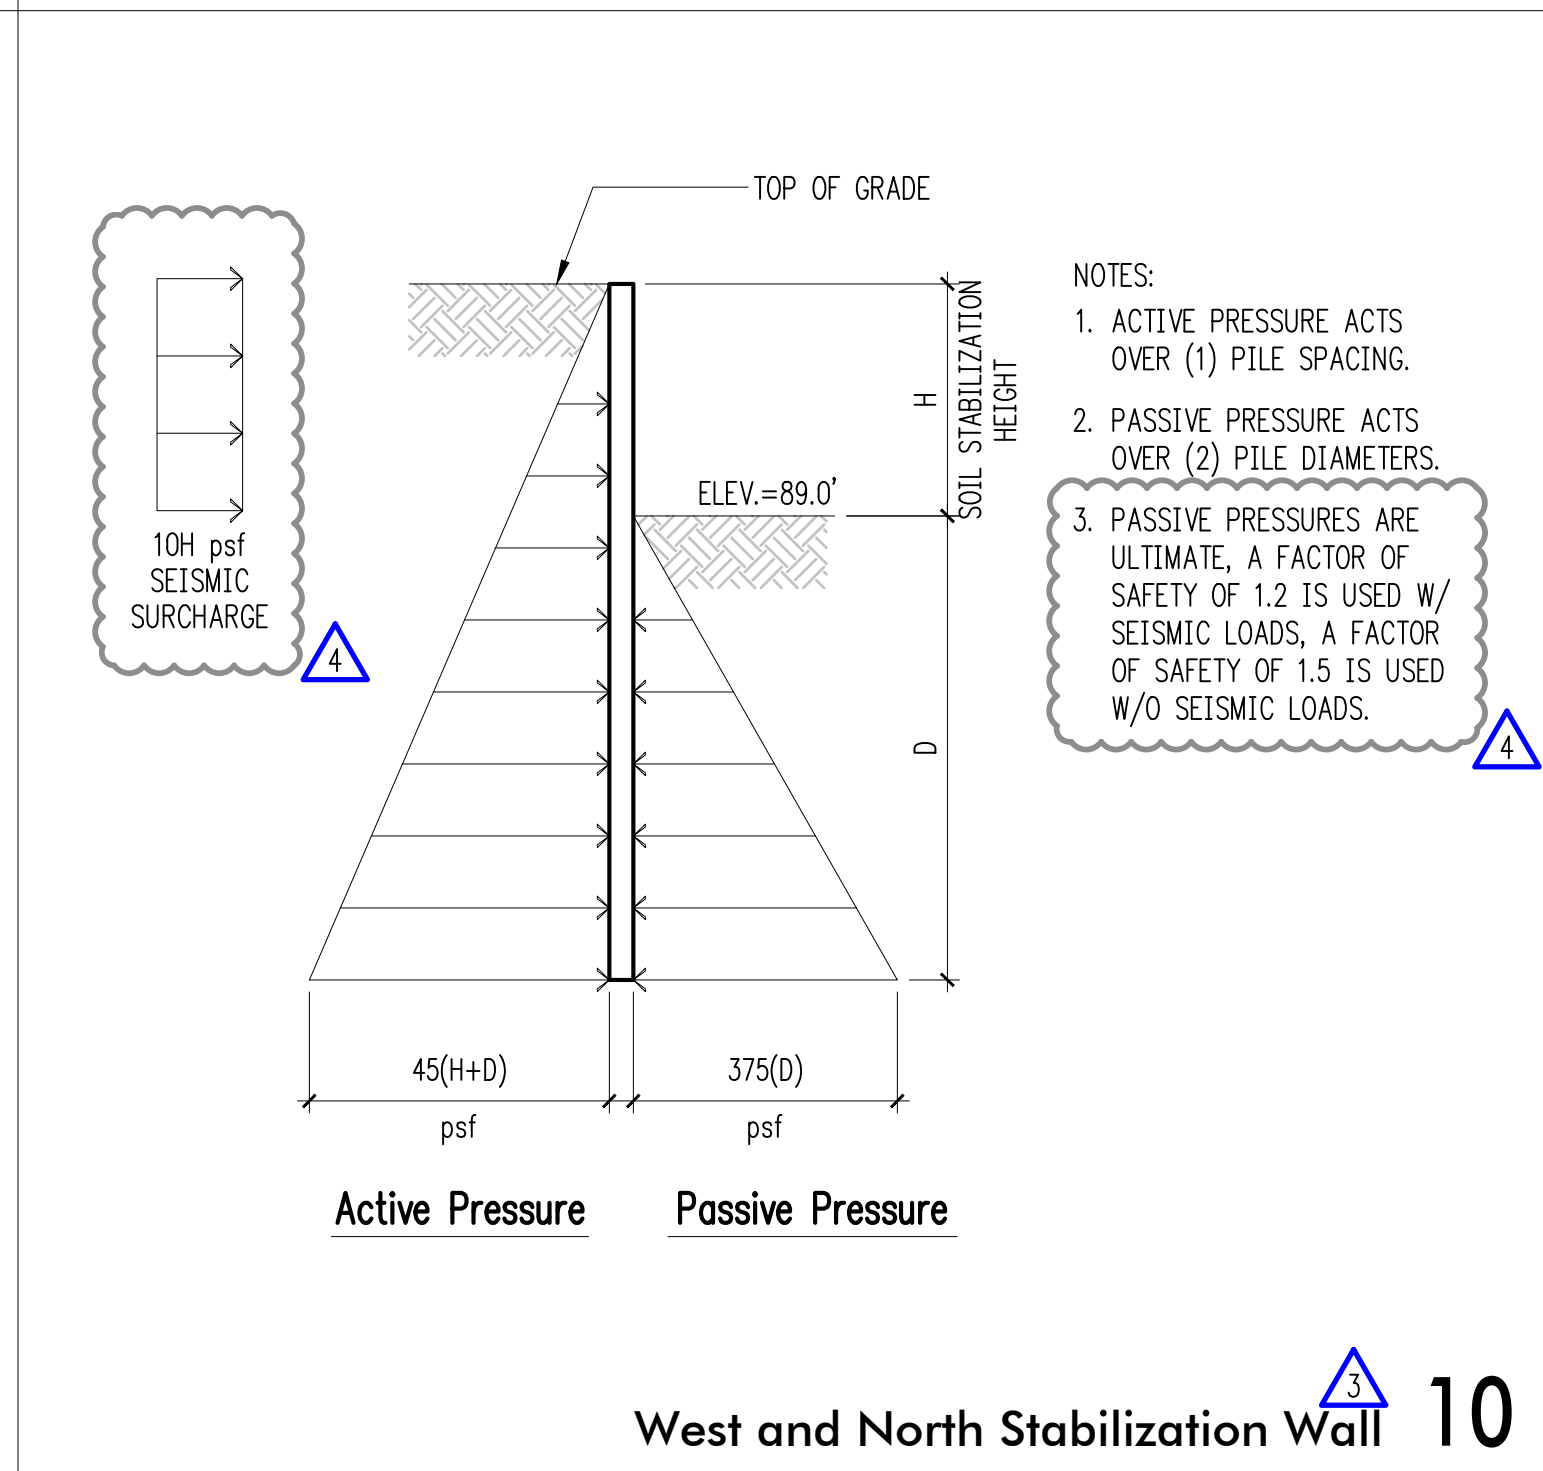


West and North Stabilization Wall 10

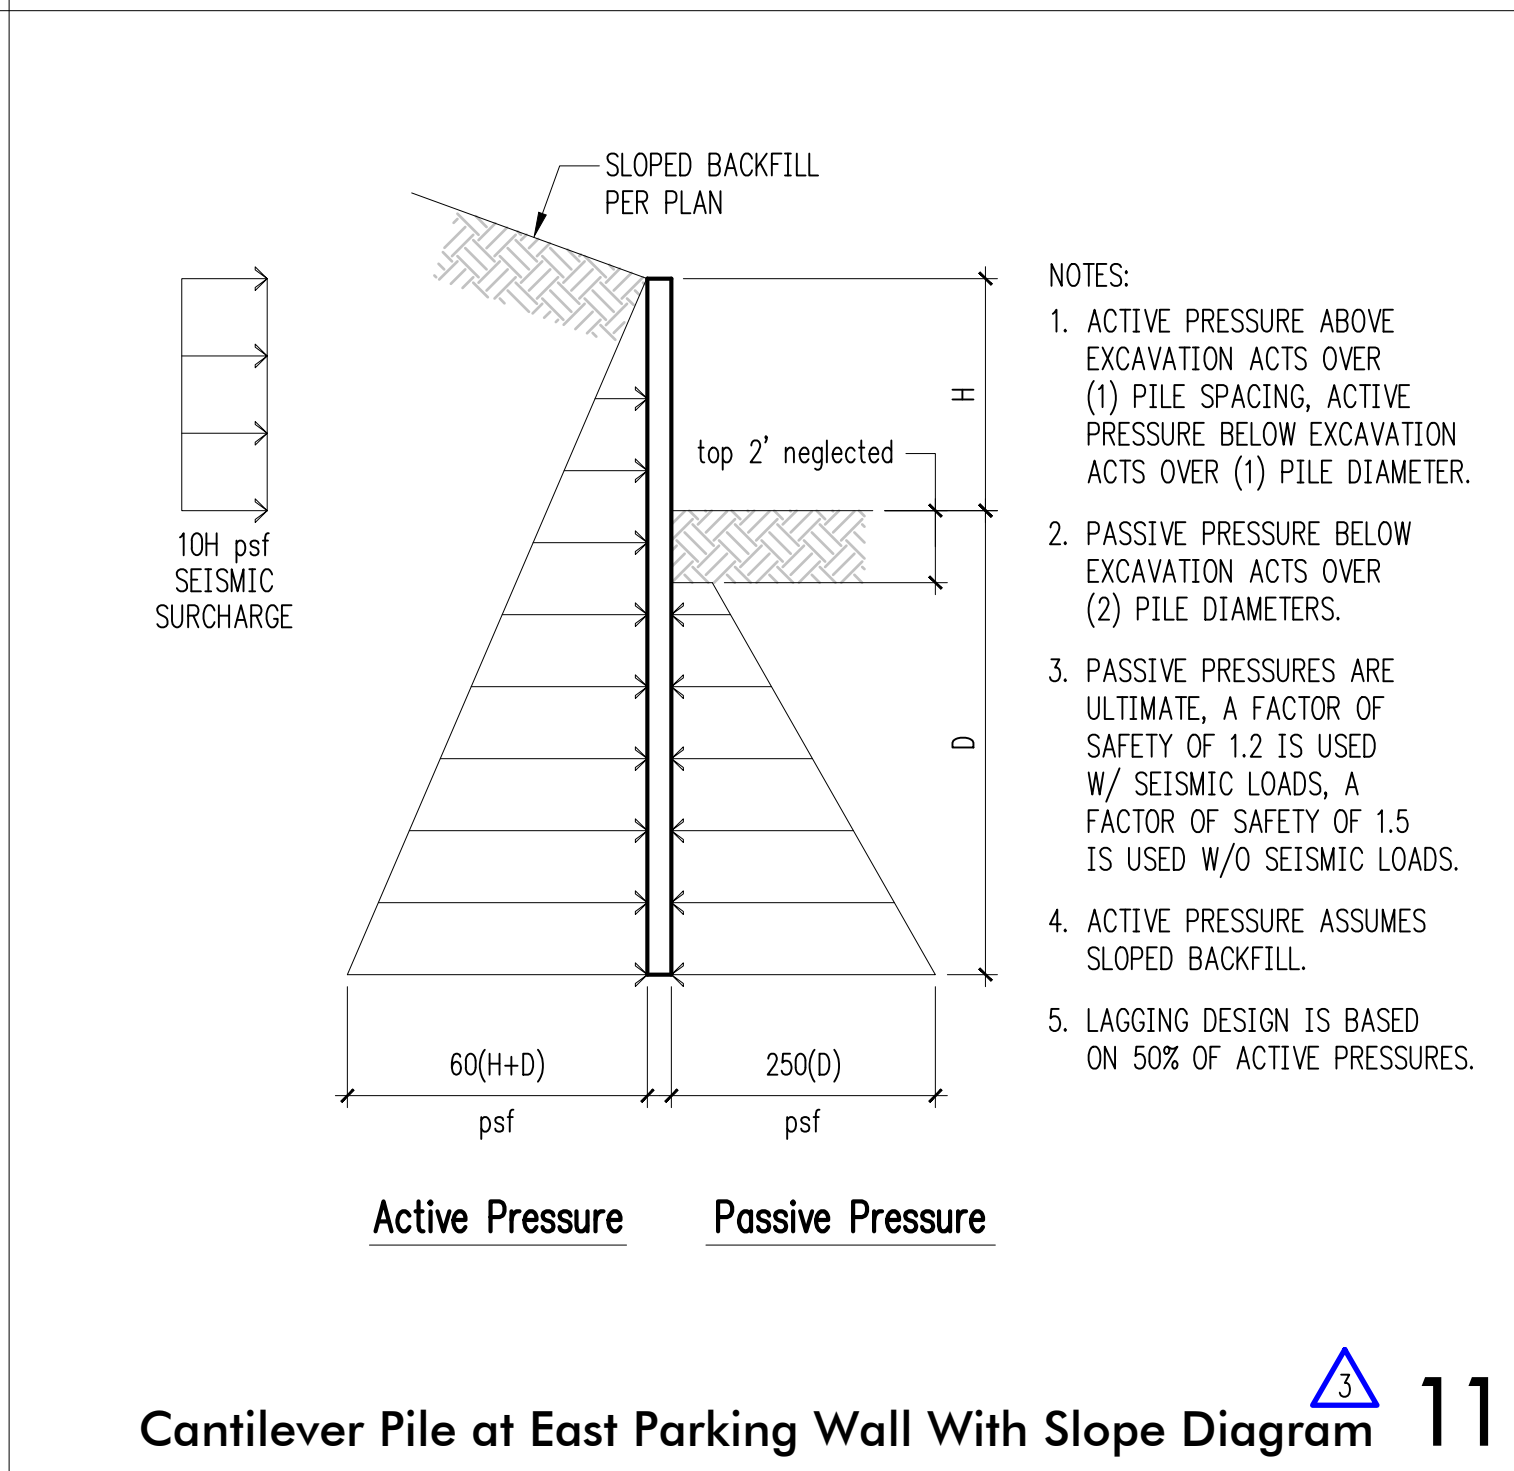


11

Cantilever Pile at East Parking Wall With Slope Diagram 11

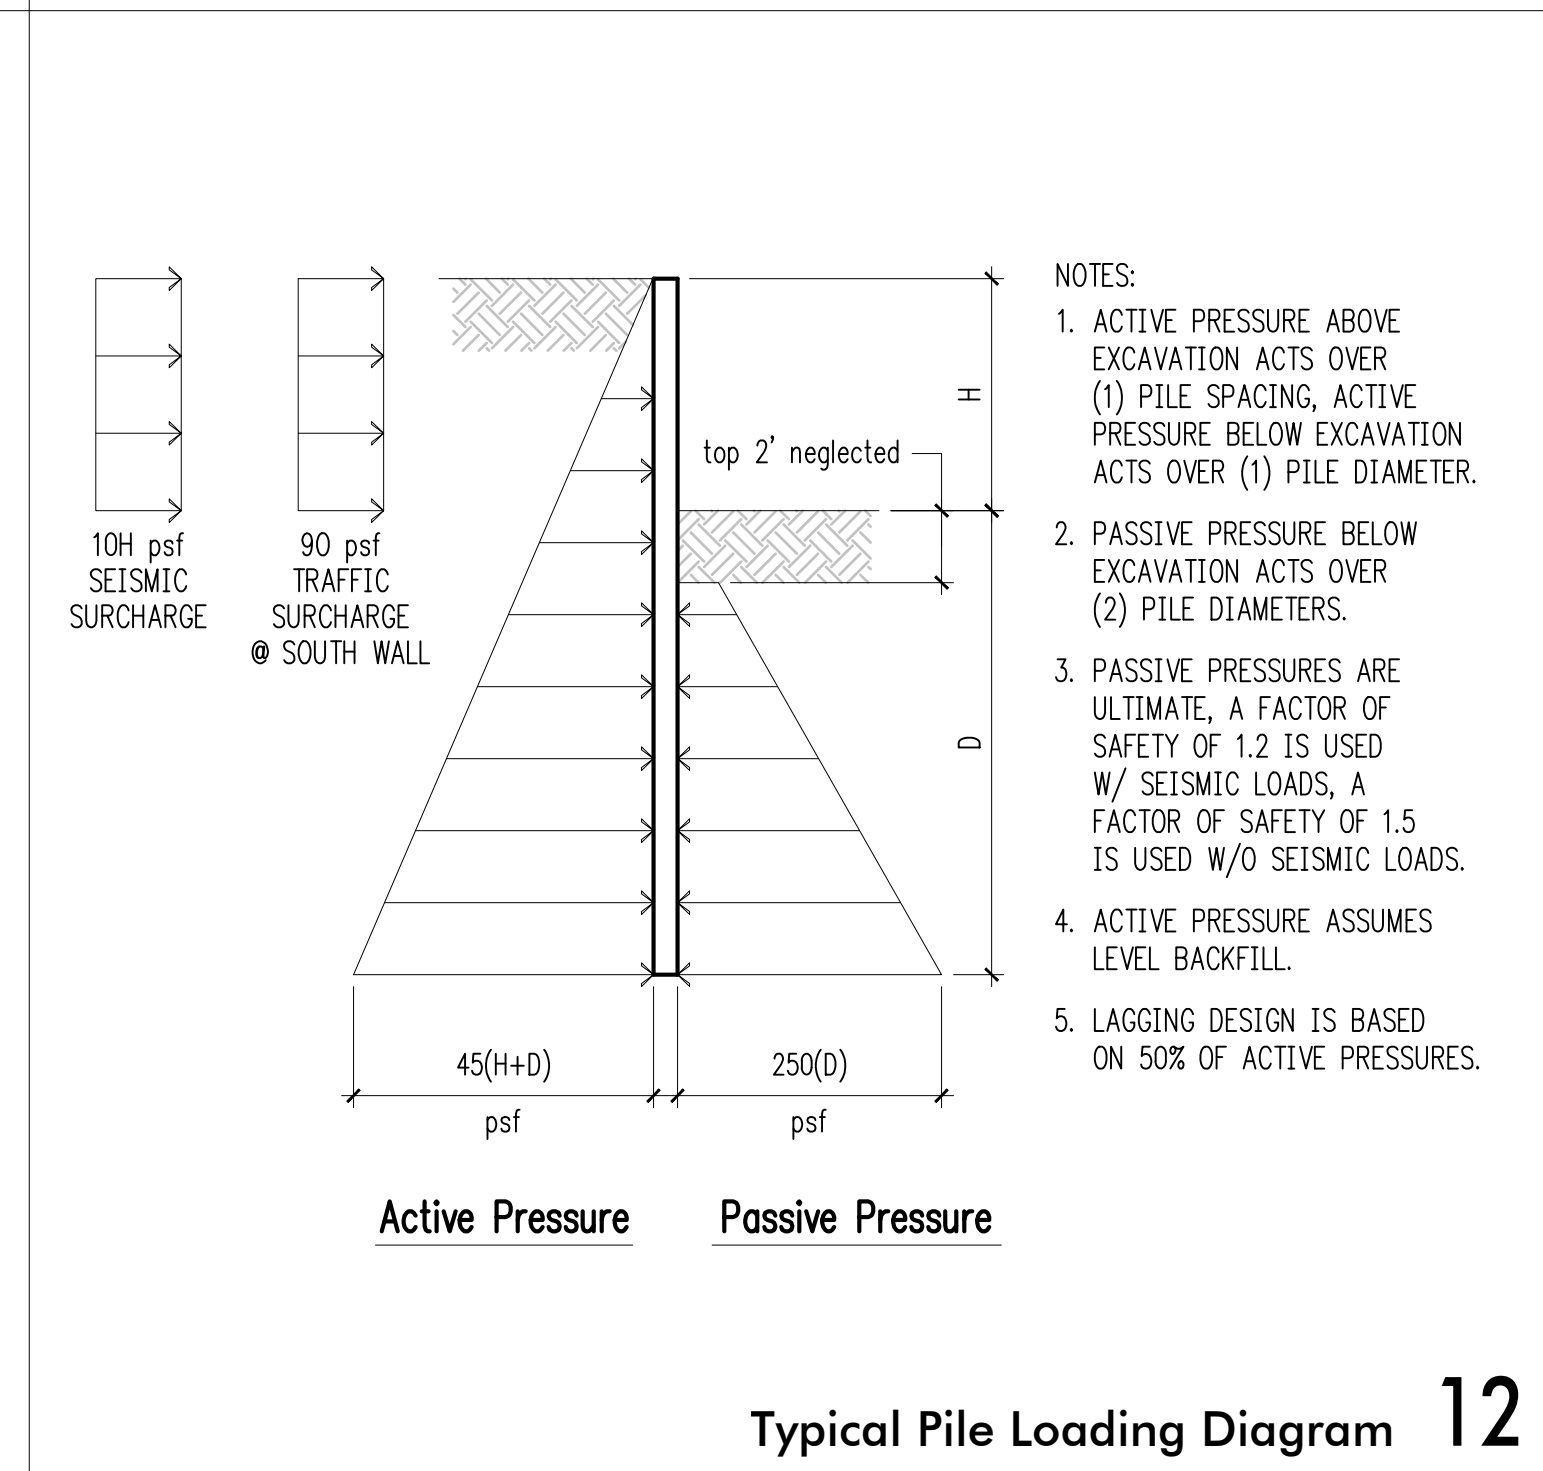

12

Typical Pile Loading Diagram 12

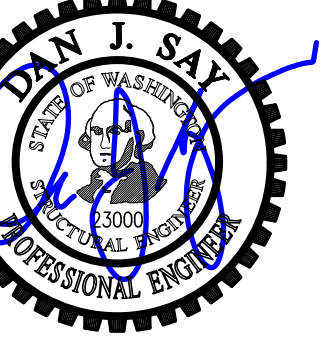

DESIGN: HAA, BDM  
DRAWN: NHD  
CHECKED: BDM  
APPROVED: DJS

REVISIONS:

1	Corrections	May 4, 2021
2	Corrections 2	Aug. 13, 2021
3	Permit Revisions	Apr. 22, 2022
4	Corrections	Jun. 10, 2022

DPD:

PROJECT TITLE:  
**Clarkson Residence**  
8163 West Mercer Way  
Mercer Island, WA 98040


ARCHITECT:  
**Brandt Design Group**  
66 Bell Street, Unit 1  
Seattle, WA 98121  
PH 206.239.0850

ISSUE:  
**PERMIT**

SHEET TITLE:  
**Shoring  
Elevations**


SCALE: 1/4" = 1'-0" U.N.O.  
DATE: December 24, 2020  
PROJECT NO: 01519-2021-11  
SHEET NO:

**SH4.1**

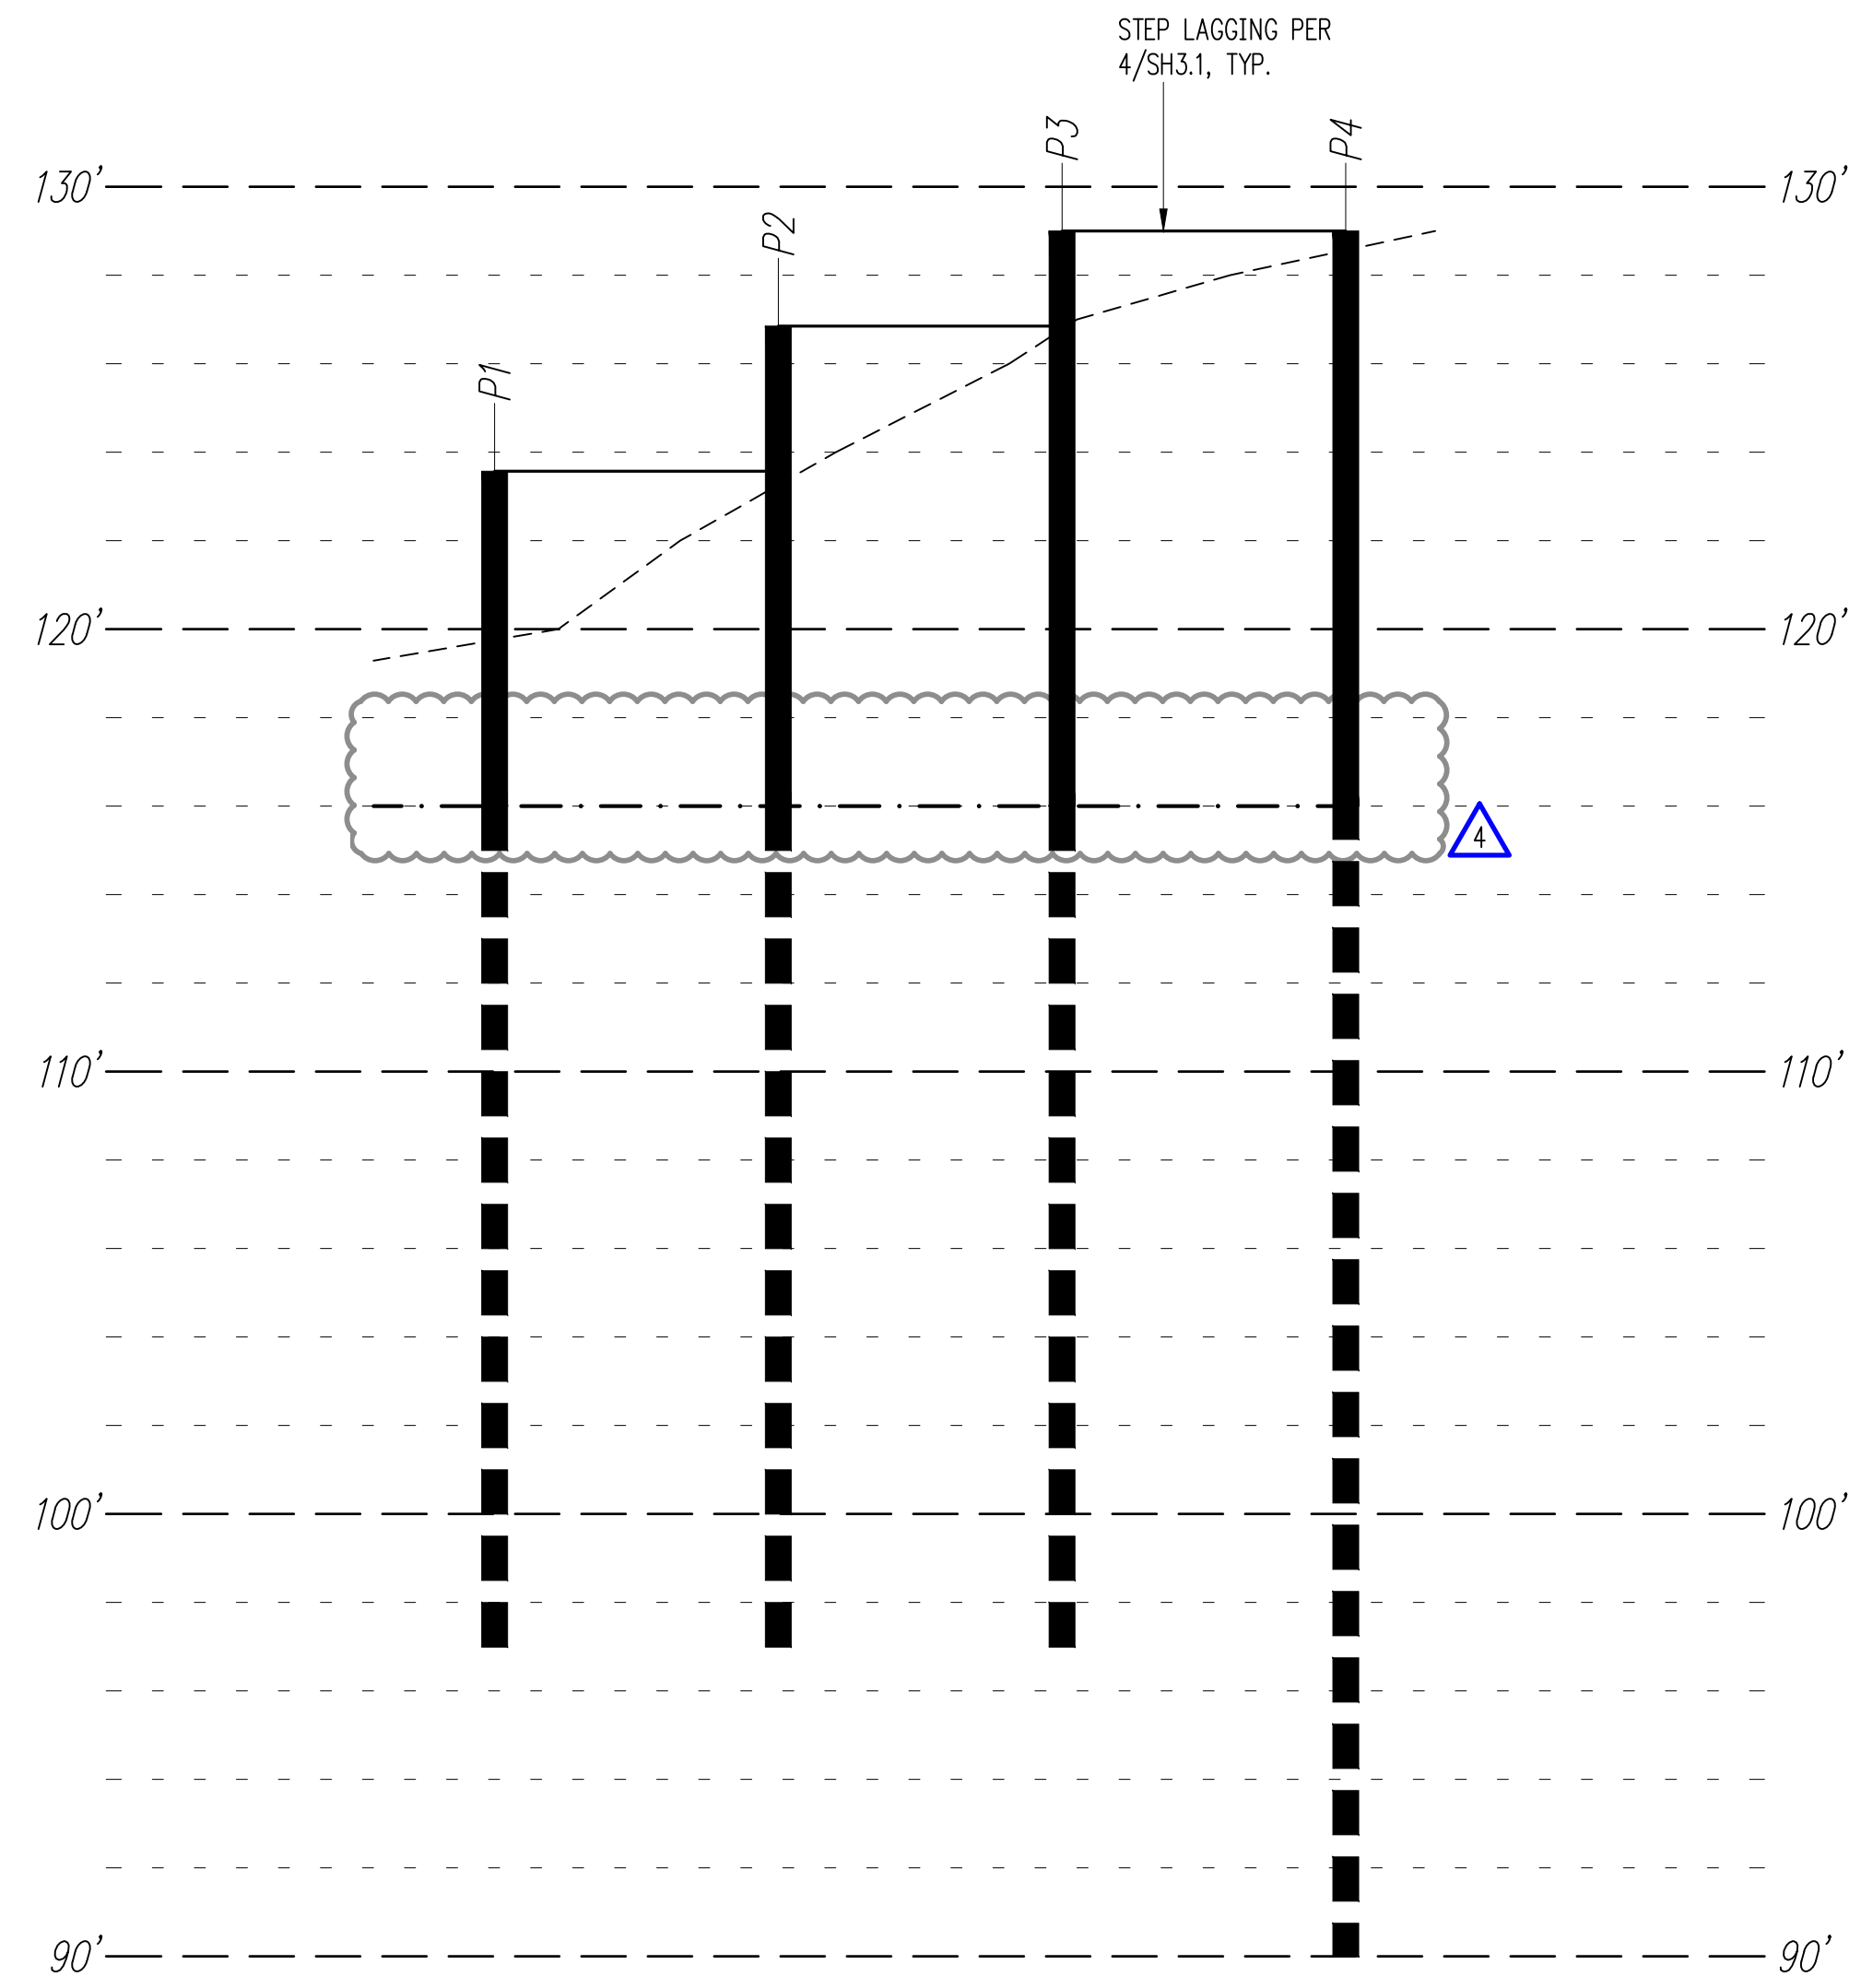


**Legend**  
 - - - - - APPROXIMATE TOP OF GRADE  
 - . - . - BOTTOM OF EXCAVATION  
 — Px — STEEL PILE PER PLAN/SCHEDULE  
 ——— 4x LAGGING

**North Shoring Elevation** ①  
 LOOKING NORTH  
 Scale: 1/4" = 1'-0"

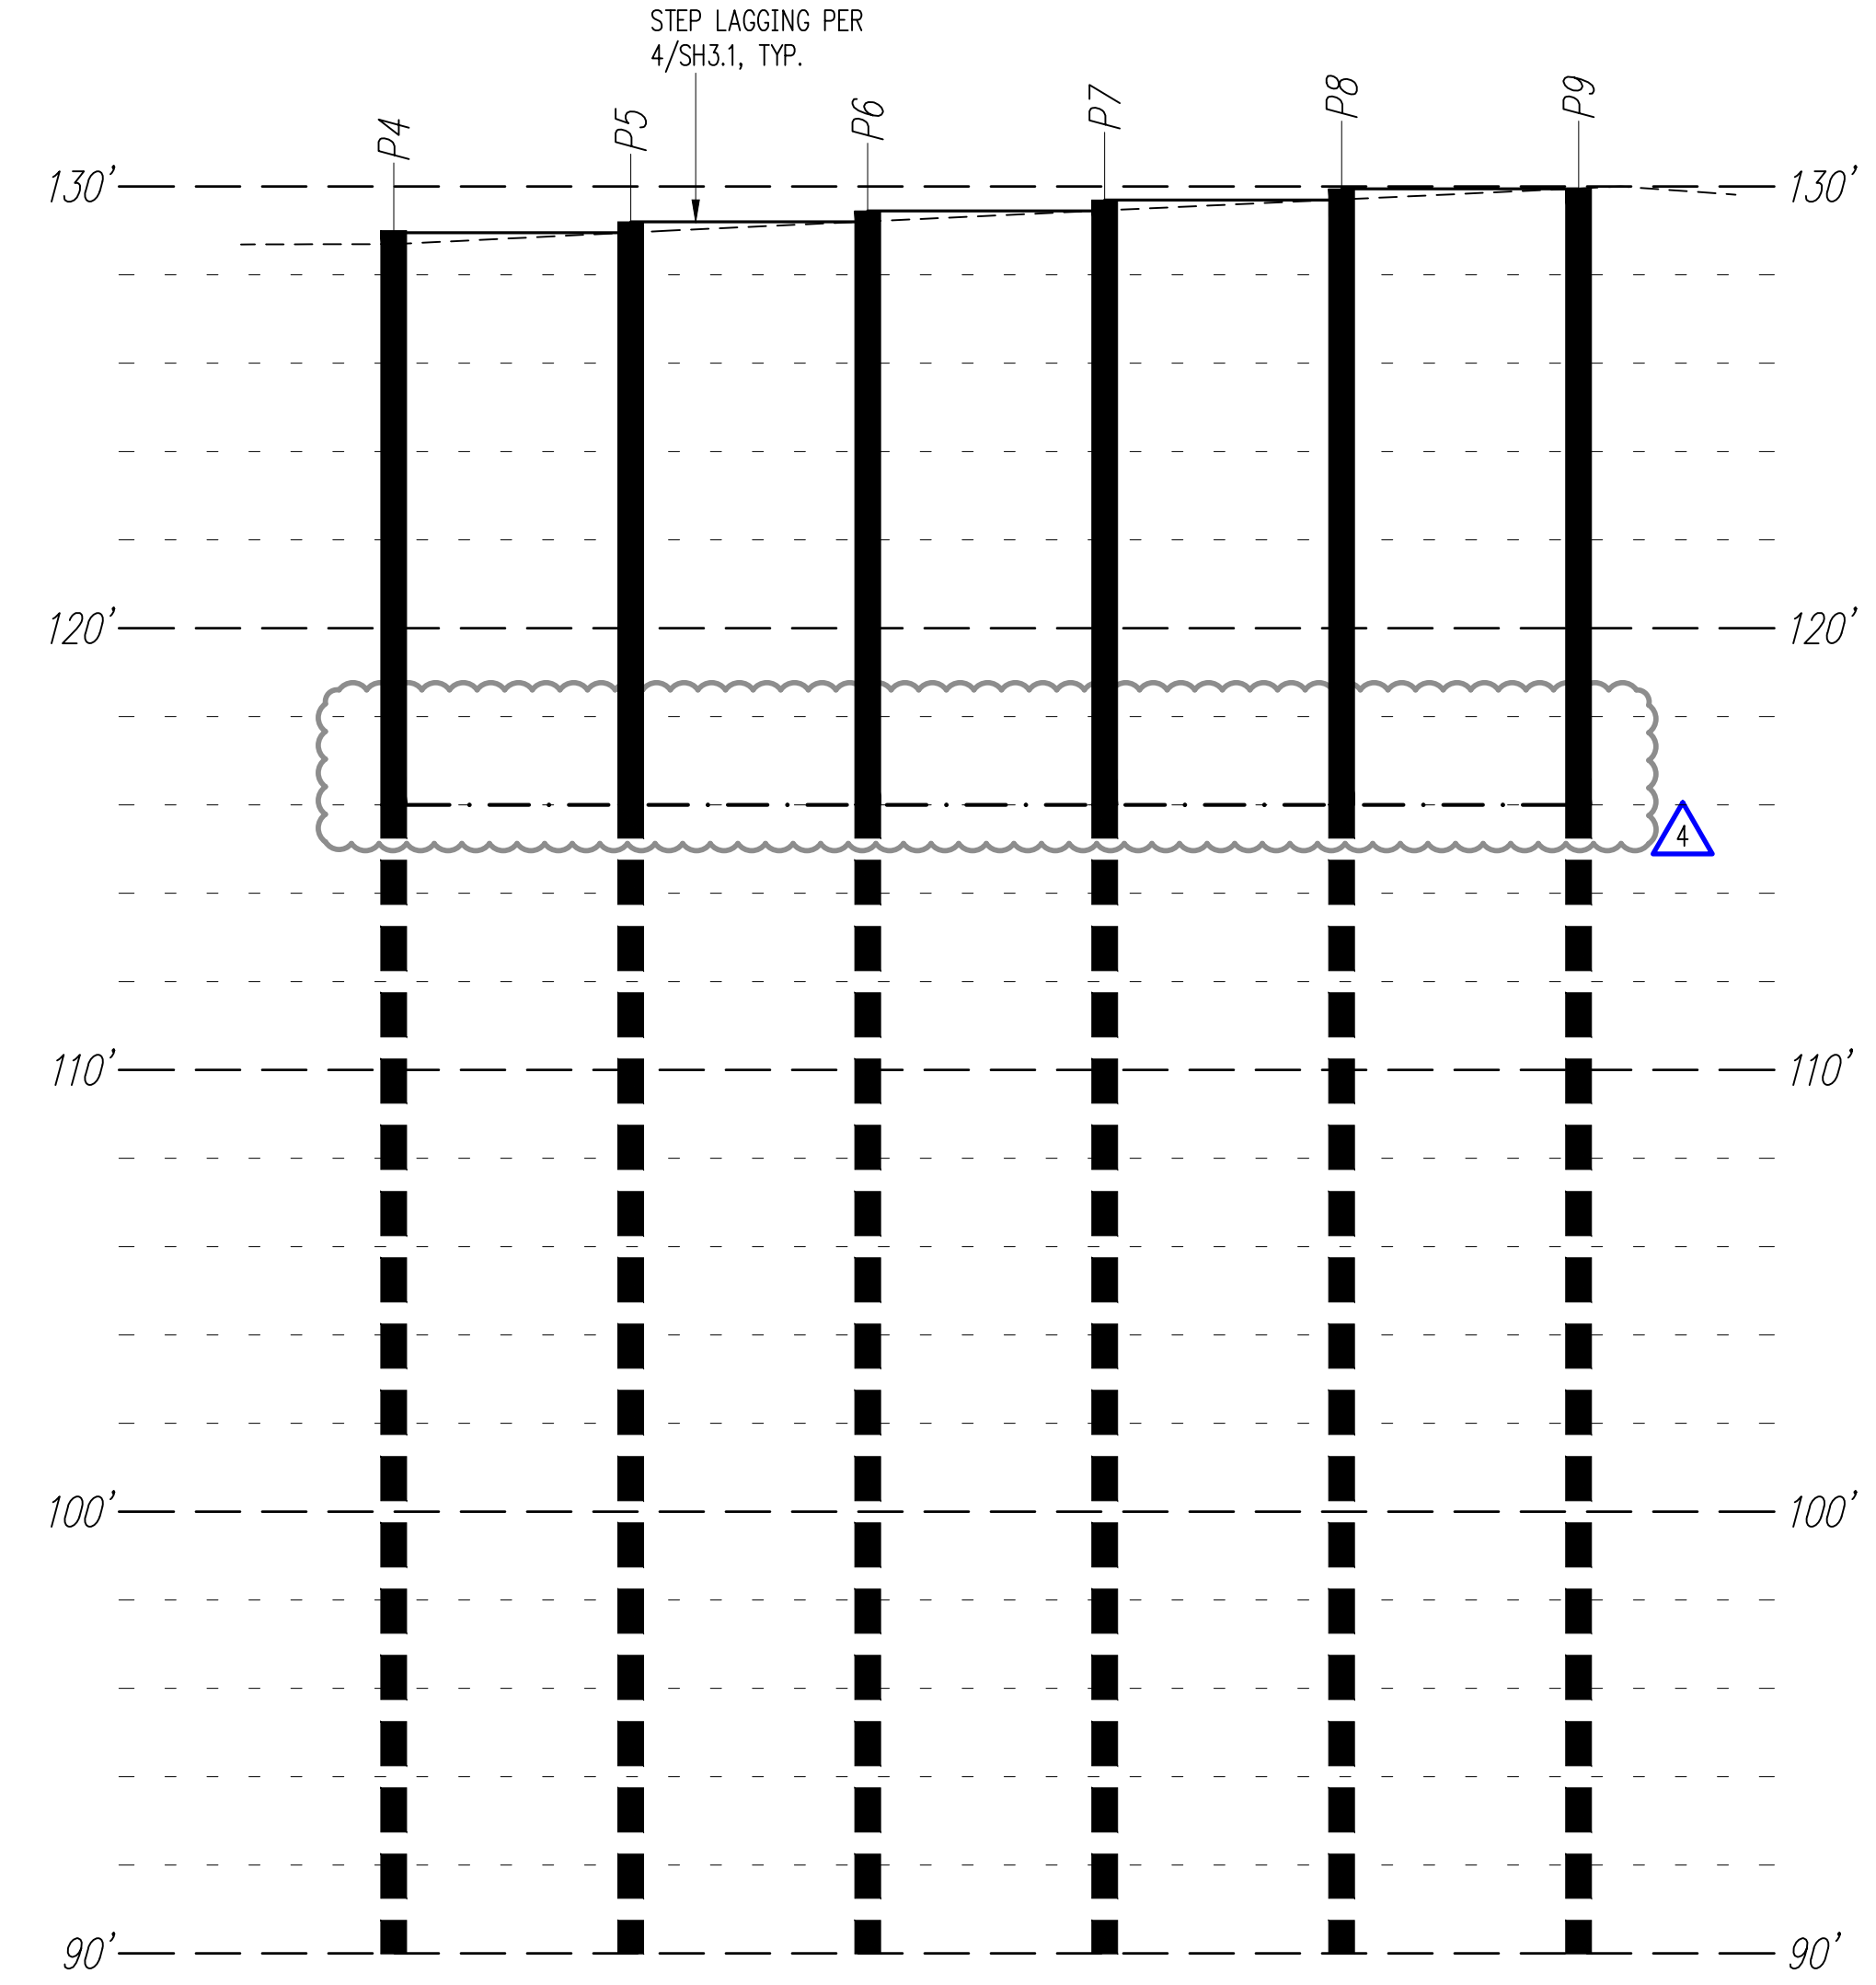

**Legend**  
 - - - - - APPROXIMATE TOP OF GRADE  
 - . - . - BOTTOM OF EXCAVATION  
 — Px — STEEL PILE PER PLAN/SCHEDULE  
 ——— 4x LAGGING

**East Shoring Elevation** ②  
 LOOKING EAST  
 Scale: 1/4" = 1'-0"

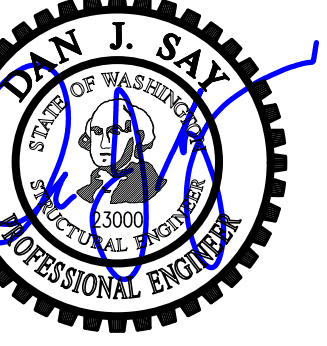

DESIGN: HAA, BDM  
DRAWN: NHD  
CHECKED: BDM  
APPROVED: DJS

REVISIONS:

1	Corrections	May 4, 2021
2	Corrections 2	Aug. 13, 2021
3	Permit Revisions	Apr. 22, 2022
4	Corrections	Jun. 10, 2022

DPD:

PROJECT TITLE:  
**Clarkson Residence**  
8163 West Mercer Way  
Mercer Island, WA 98040


ARCHITECT:  
**Brandt Design Group**  
66 Bell Street, Unit 1  
Seattle, WA 98121  
PH 206.239.0850

ISSUE:  
**PERMIT**

SHEET TITLE:  
**Shoring  
Elevations**


SCALE: 1/4" = 1'-0" U.N.O.  
DATE: December 24, 2020  
PROJECT NO: 01519-2021-11  
SHEET NO:

**SH4.2**

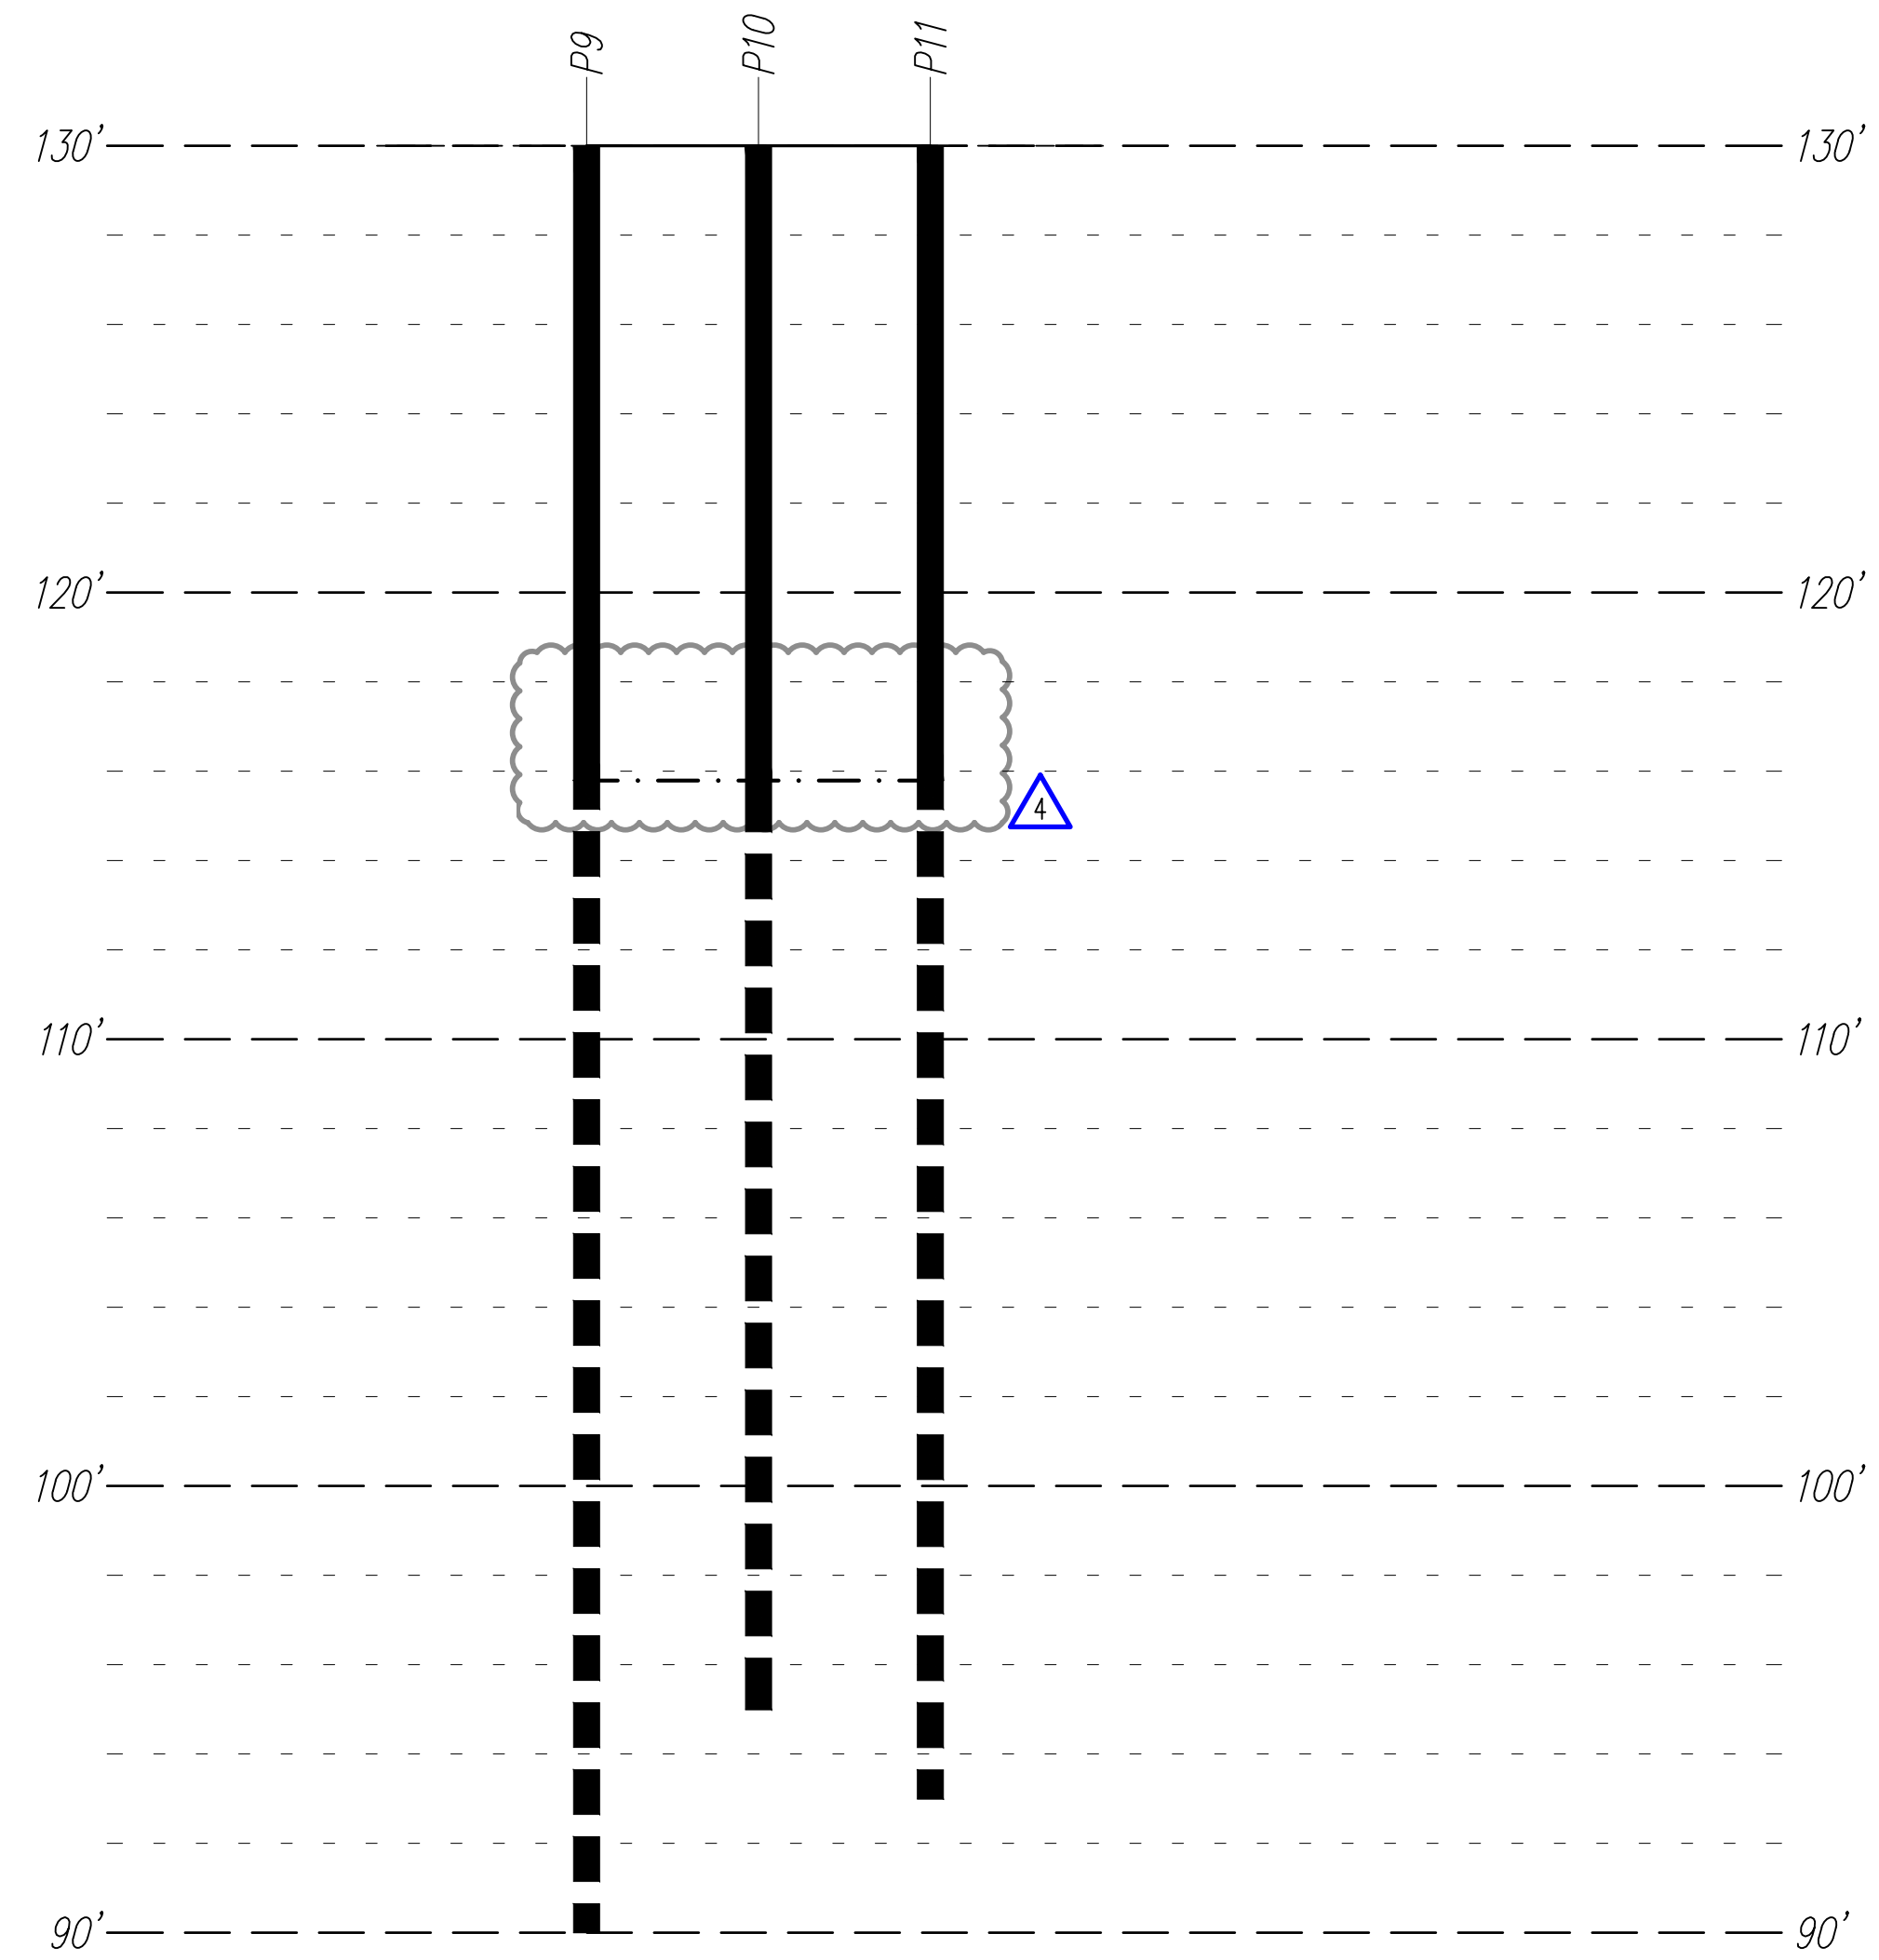

**Legend**  
 - - - - - APPROXIMATE TOP OF GRADE  
 - · - · - BOTTOM OF EXCAVATION  
 — Px — STEEL PILE PER PLAN/SCHEDULE  
 ——— 4x LAGGING

**South Shoring Elevation** ①  
 LOOKING SOUTH  
 Scale: 1/4" = 1'-0"

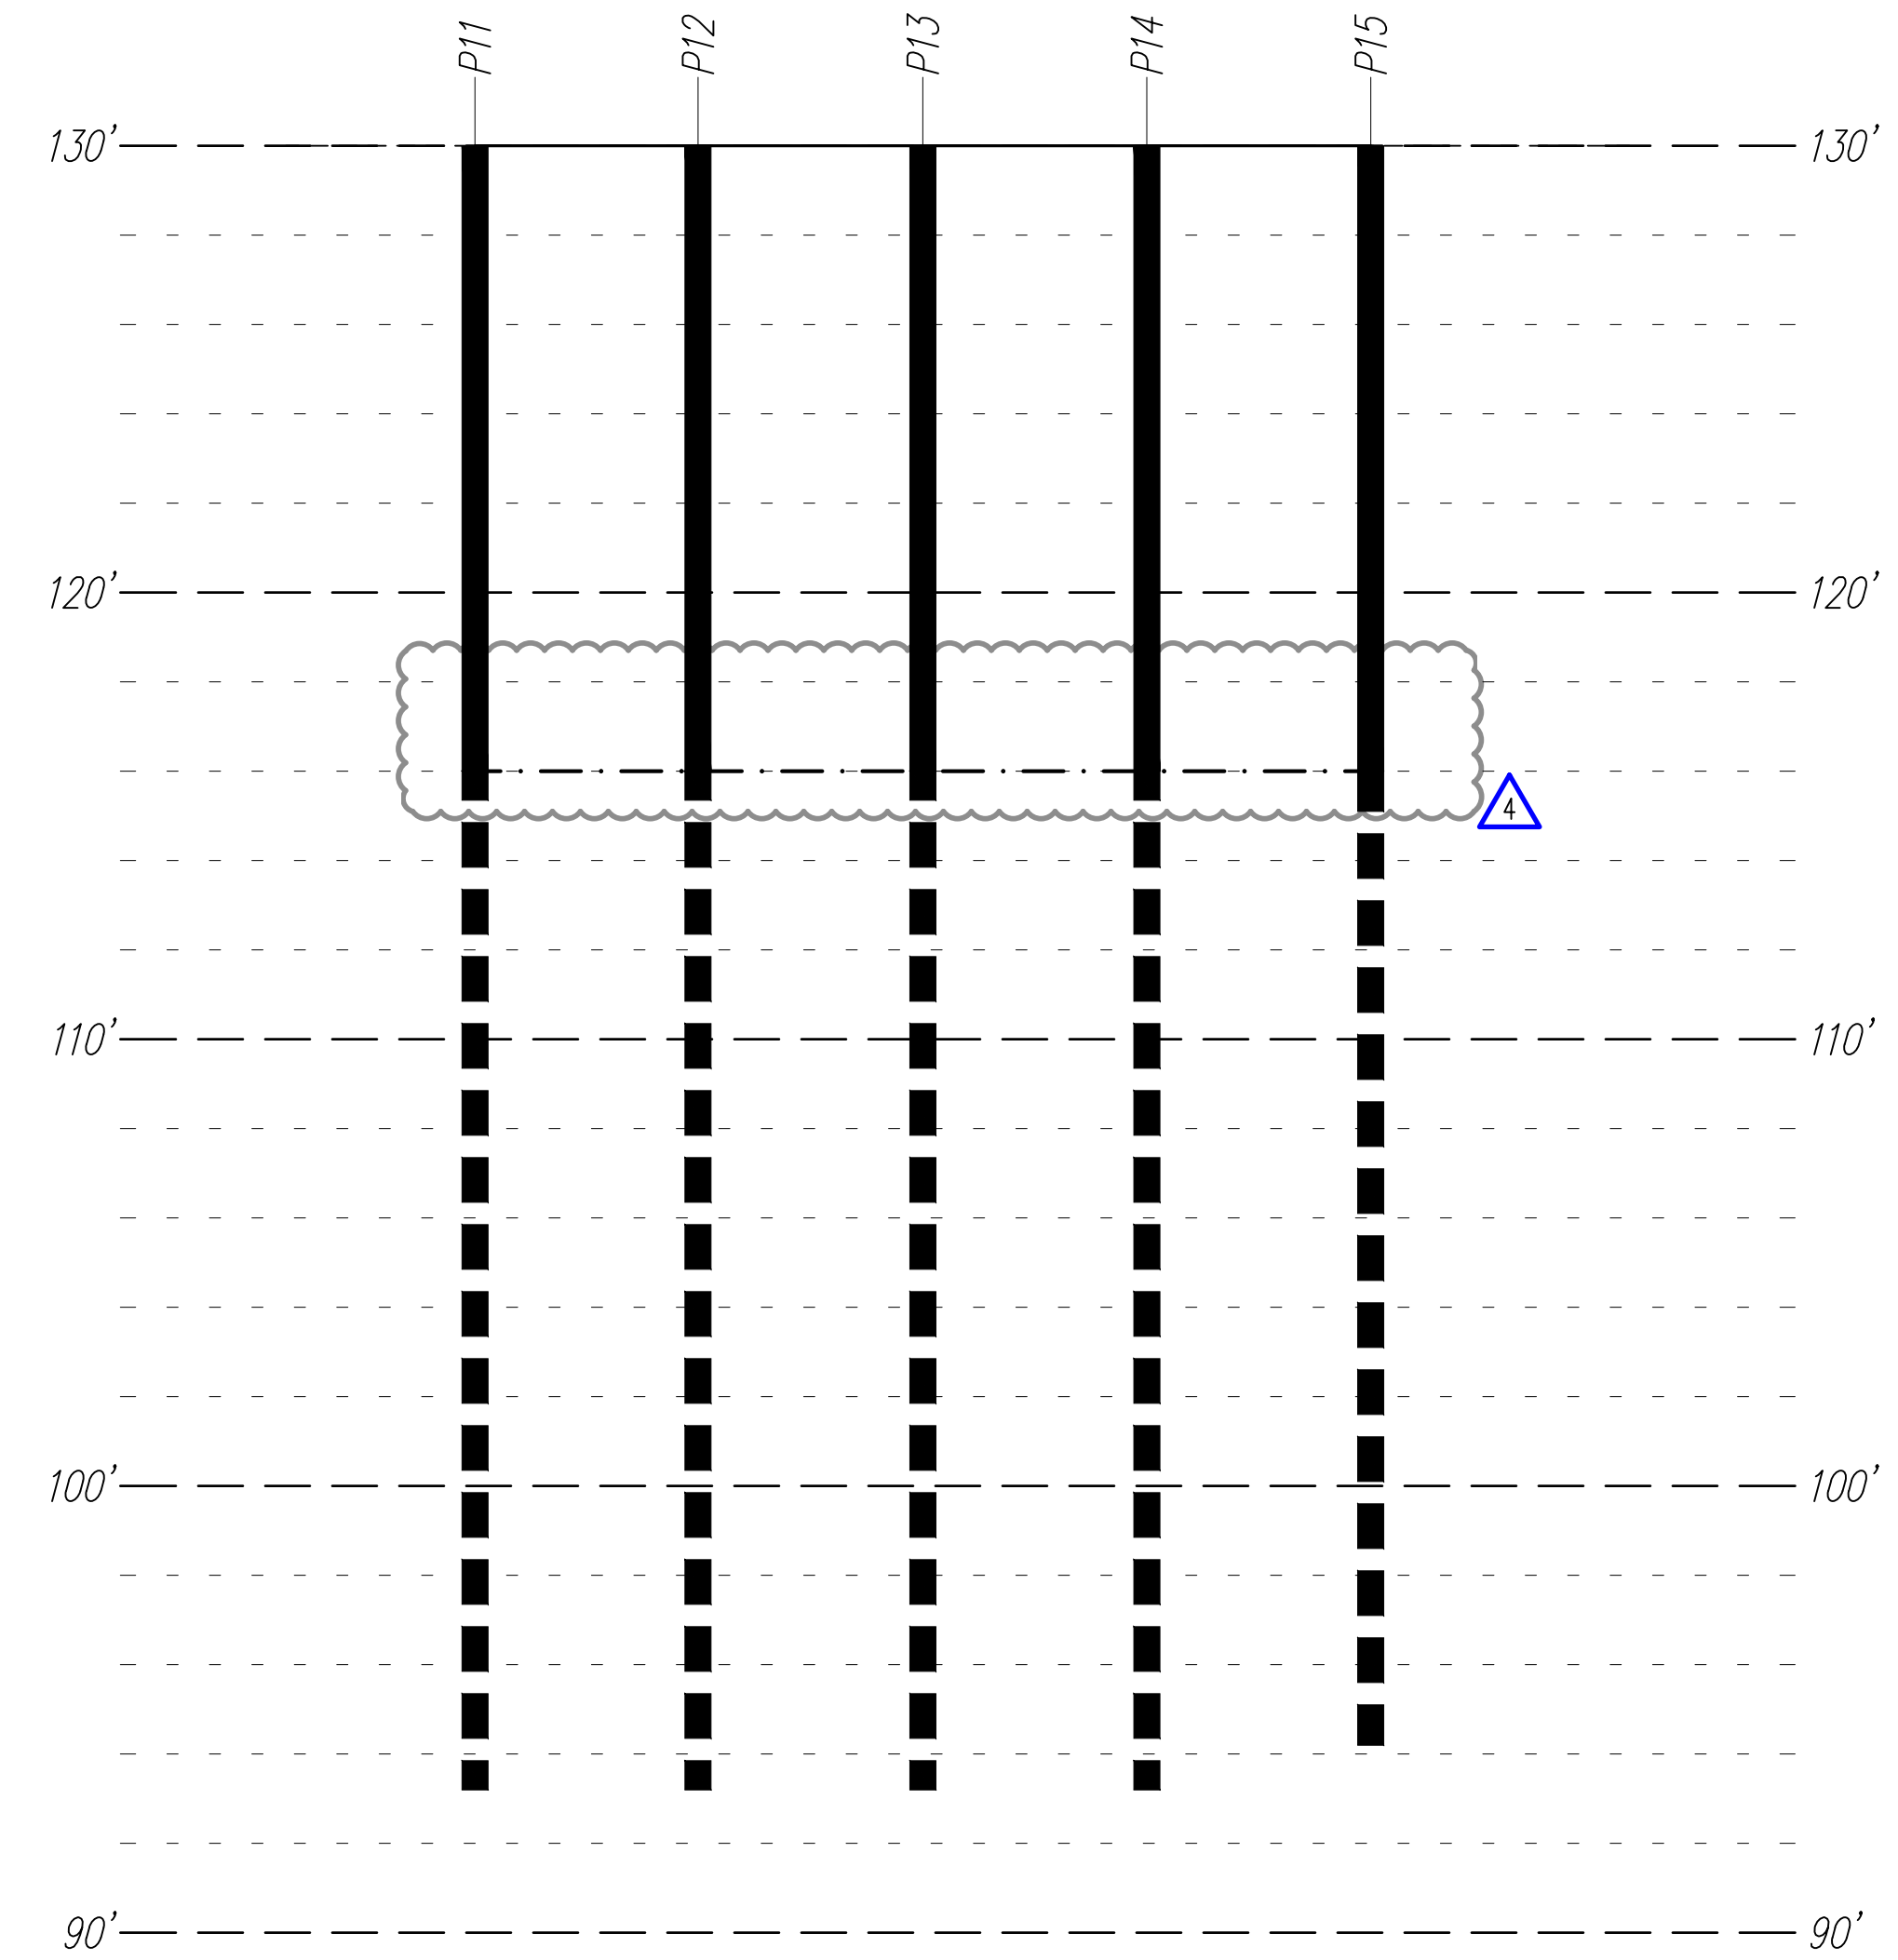

**Legend**  
 - - - - - APPROXIMATE TOP OF GRADE  
 - · - · - BOTTOM OF EXCAVATION  
 — Px — STEEL PILE PER PLAN/SCHEDULE  
 ——— 4x LAGGING

**East Shoring Elevation** ②  
 LOOKING EAST  
 Scale: 1/4" = 1'-0"



DESIGN: HAA, BDM  
 DRAWN: NHD  
 CHECKED: BDM  
 APPROVED: DJS

REVISIONS:		
1	Corrections	May 4, 2021
2	Corrections 2	Aug. 13, 2021
3	Permit Revisions	Apr. 22, 2022
4	Corrections	Jun. 10, 2022

DPD:

PROJECT TITLE:  
**Clarkson Residence**  
 8163 West Mercer Way  
 Mercer Island, WA 98040


ARCHITECT:  
**Brandt Design Group**  
 66 Bell Street, Unit 1  
 Seattle, WA 98121  
 PH 206.239.0850

ISSUE:  
**PERMIT**

SHEET TITLE:  
**Shoring Elevations**

SCALE: 1/4" = 1'-0" U.N.O.  
 DATE: December 24, 2020  
 PROJECT NO: 01519-2021-11  
 SHEET NO:

**SH4.3**

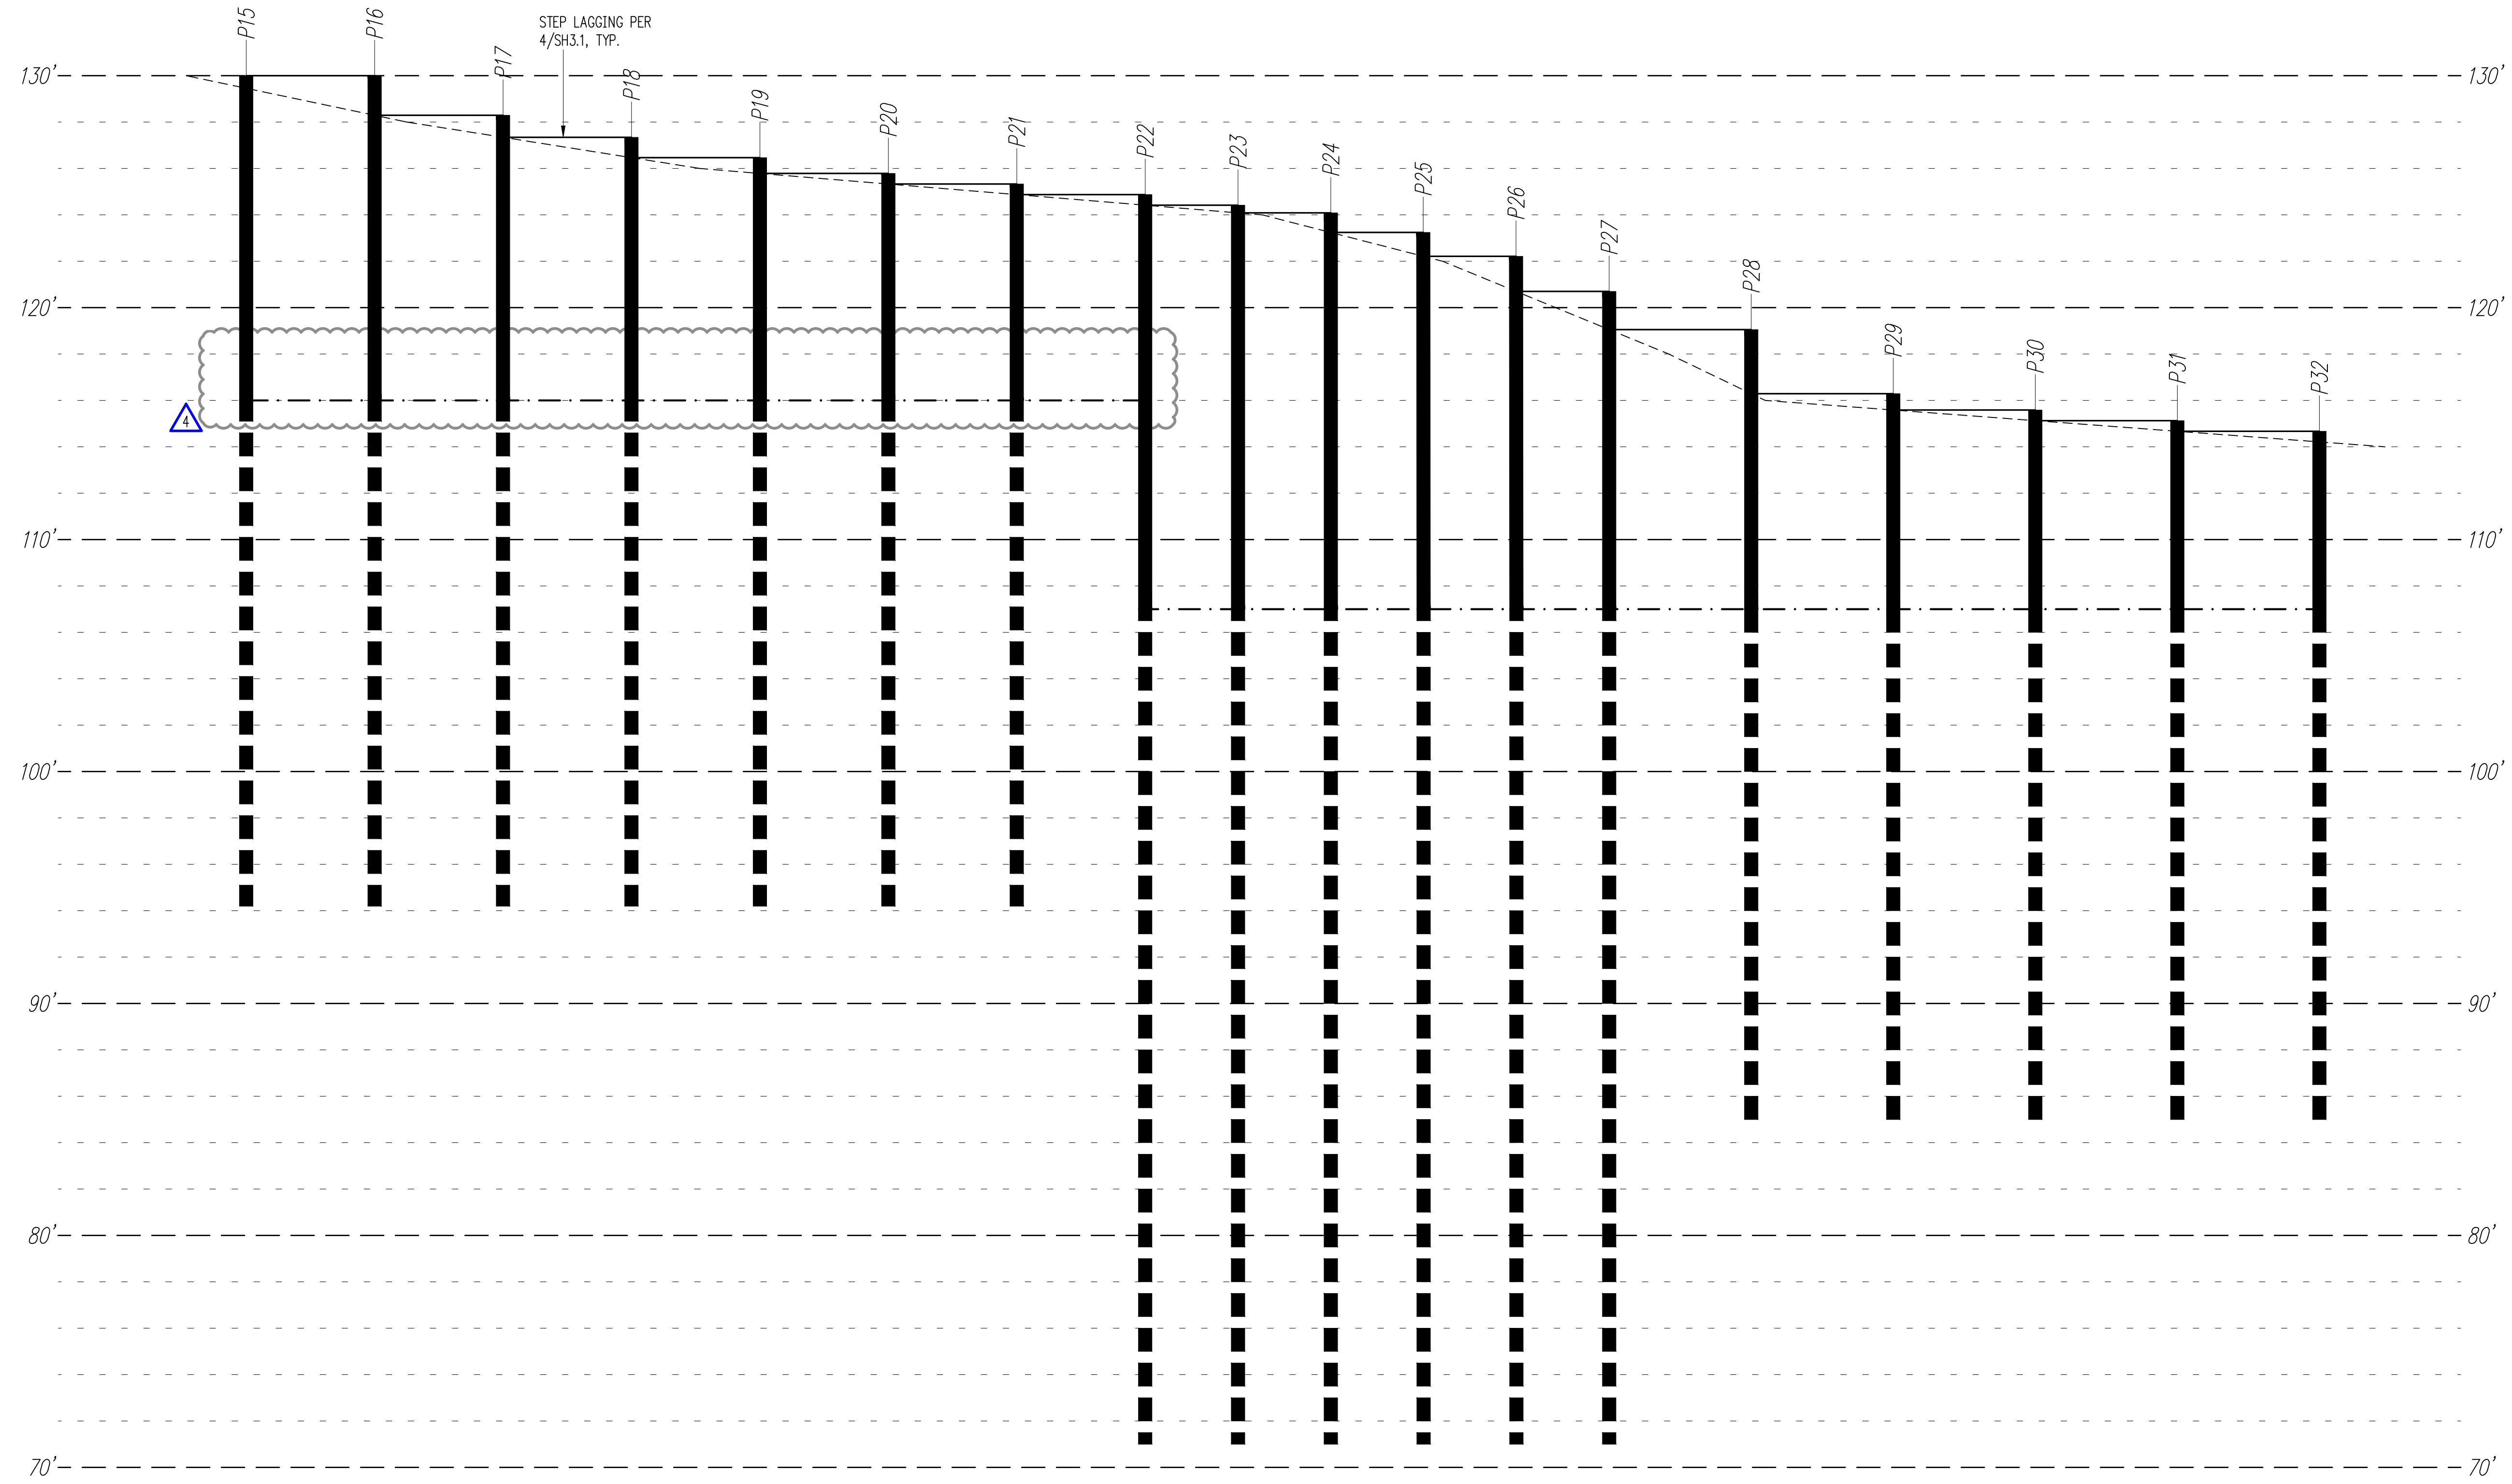


**Legend**

---	APPROXIMATE TOP OF GRADE
— · —	BOTTOM OF EXCAVATION
— Px	STEEL PILE PER PLAN/SCHEDULE
—	4x LAGGING

**South Shoring Elevation**

LOOKING SOUTH  
 Scale: 1/4" = 1'-0"

1

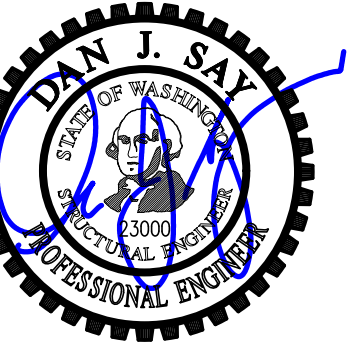

DESIGN: HAA, BDM  
 DRAWN: NHD  
 CHECKED: BDM  
 APPROVED: DJS

REVISIONS:

1	Corrections	May 4, 2021
2	Corrections 2	Aug. 13, 2021
3	Permit Revisions	Apr. 22, 2022
4	Corrections	Jun. 10, 2022

DPD:

PROJECT TITLE:  
**Clarkson Residence**  
 8163 West Mercer Way  
 Mercer Island, WA 98040


ARCHITECT:  
**Brandt Design Group**  
 66 Bell Street, Unit 1  
 Seattle, WA 98121  
 PH 206.239.0850

ISSUE:  
**PERMIT**

SHEET TITLE:  
**Shoring Elevations**

SCALE: 1/4" = 1'-0" U.N.O.  
 DATE: December 24, 2020  
 PROJECT NO: 01519-2021-11  
 SHEET NO:

**SH4.4**

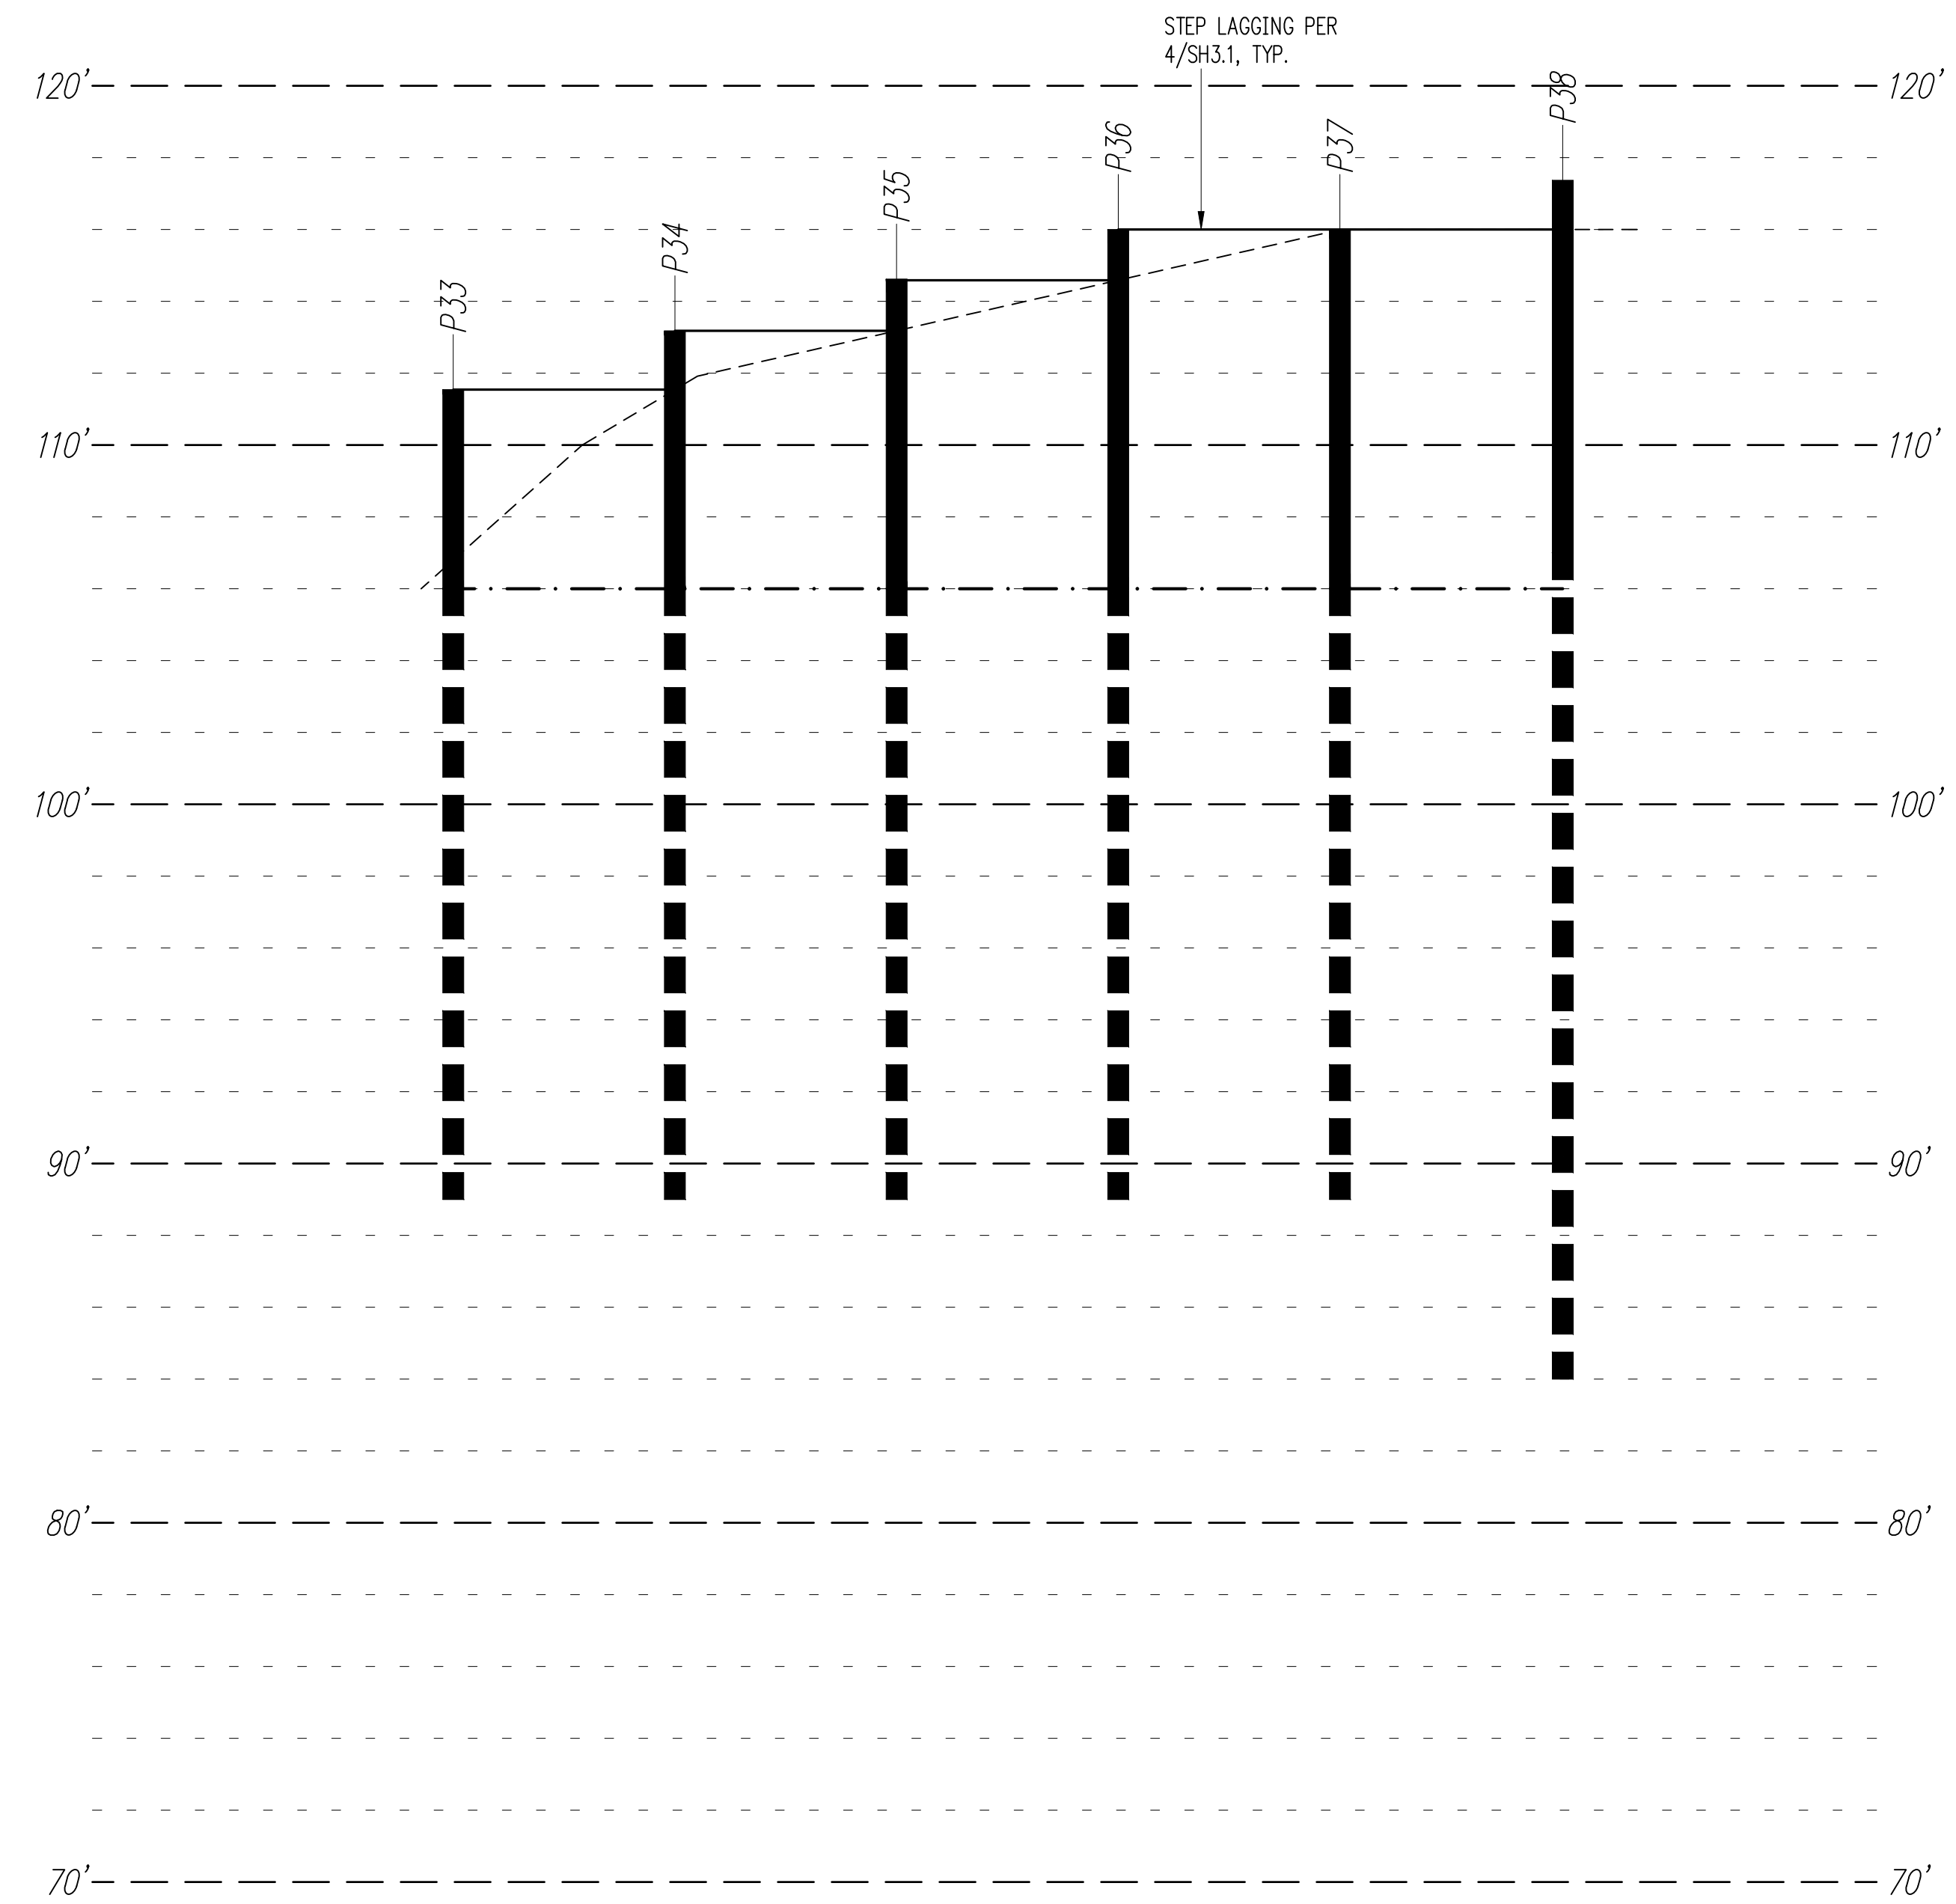

**Legend**

-----	APPROXIMATE TOP OF GRADE
— · —	BOTTOM OF EXCAVATION
—Px—	STEEL PILE PER PLAN/SCHEDULE
—	4x LAGGING

**North Shoring Elevation**

LOOKING NORTH  
 Scale: 1/4" = 1'-0"

1





DESIGN: HAA, BDM  
DRAWN: NHD  
CHECKED: BDM  
APPROVED: DJS

REVISIONS:

1	Corrections	May 4, 2021
2	Corrections 2	Aug. 13, 2021
3	Permit Revisions	Apr. 22, 2022
4	Corrections	Jun. 10, 2022

DPD:

PROJECT TITLE:  
**Clarkson Residence**  
8163 West Mercer Way  
Mercer Island, WA 98040


ARCHITECT:  
**Brandt Design Group**  
66 Bell Street, Unit 1  
Seattle, WA 98121  
PH 206.239.0850

ISSUE:  
**PERMIT**

SHEET TITLE:  
**Shoring  
Elevations**

SCALE: 1/4" = 1'-0" U.N.O.  
DATE: December 24, 2020  
PROJECT NO: 01519-2021-11  
SHEET NO:

**SH4.5**

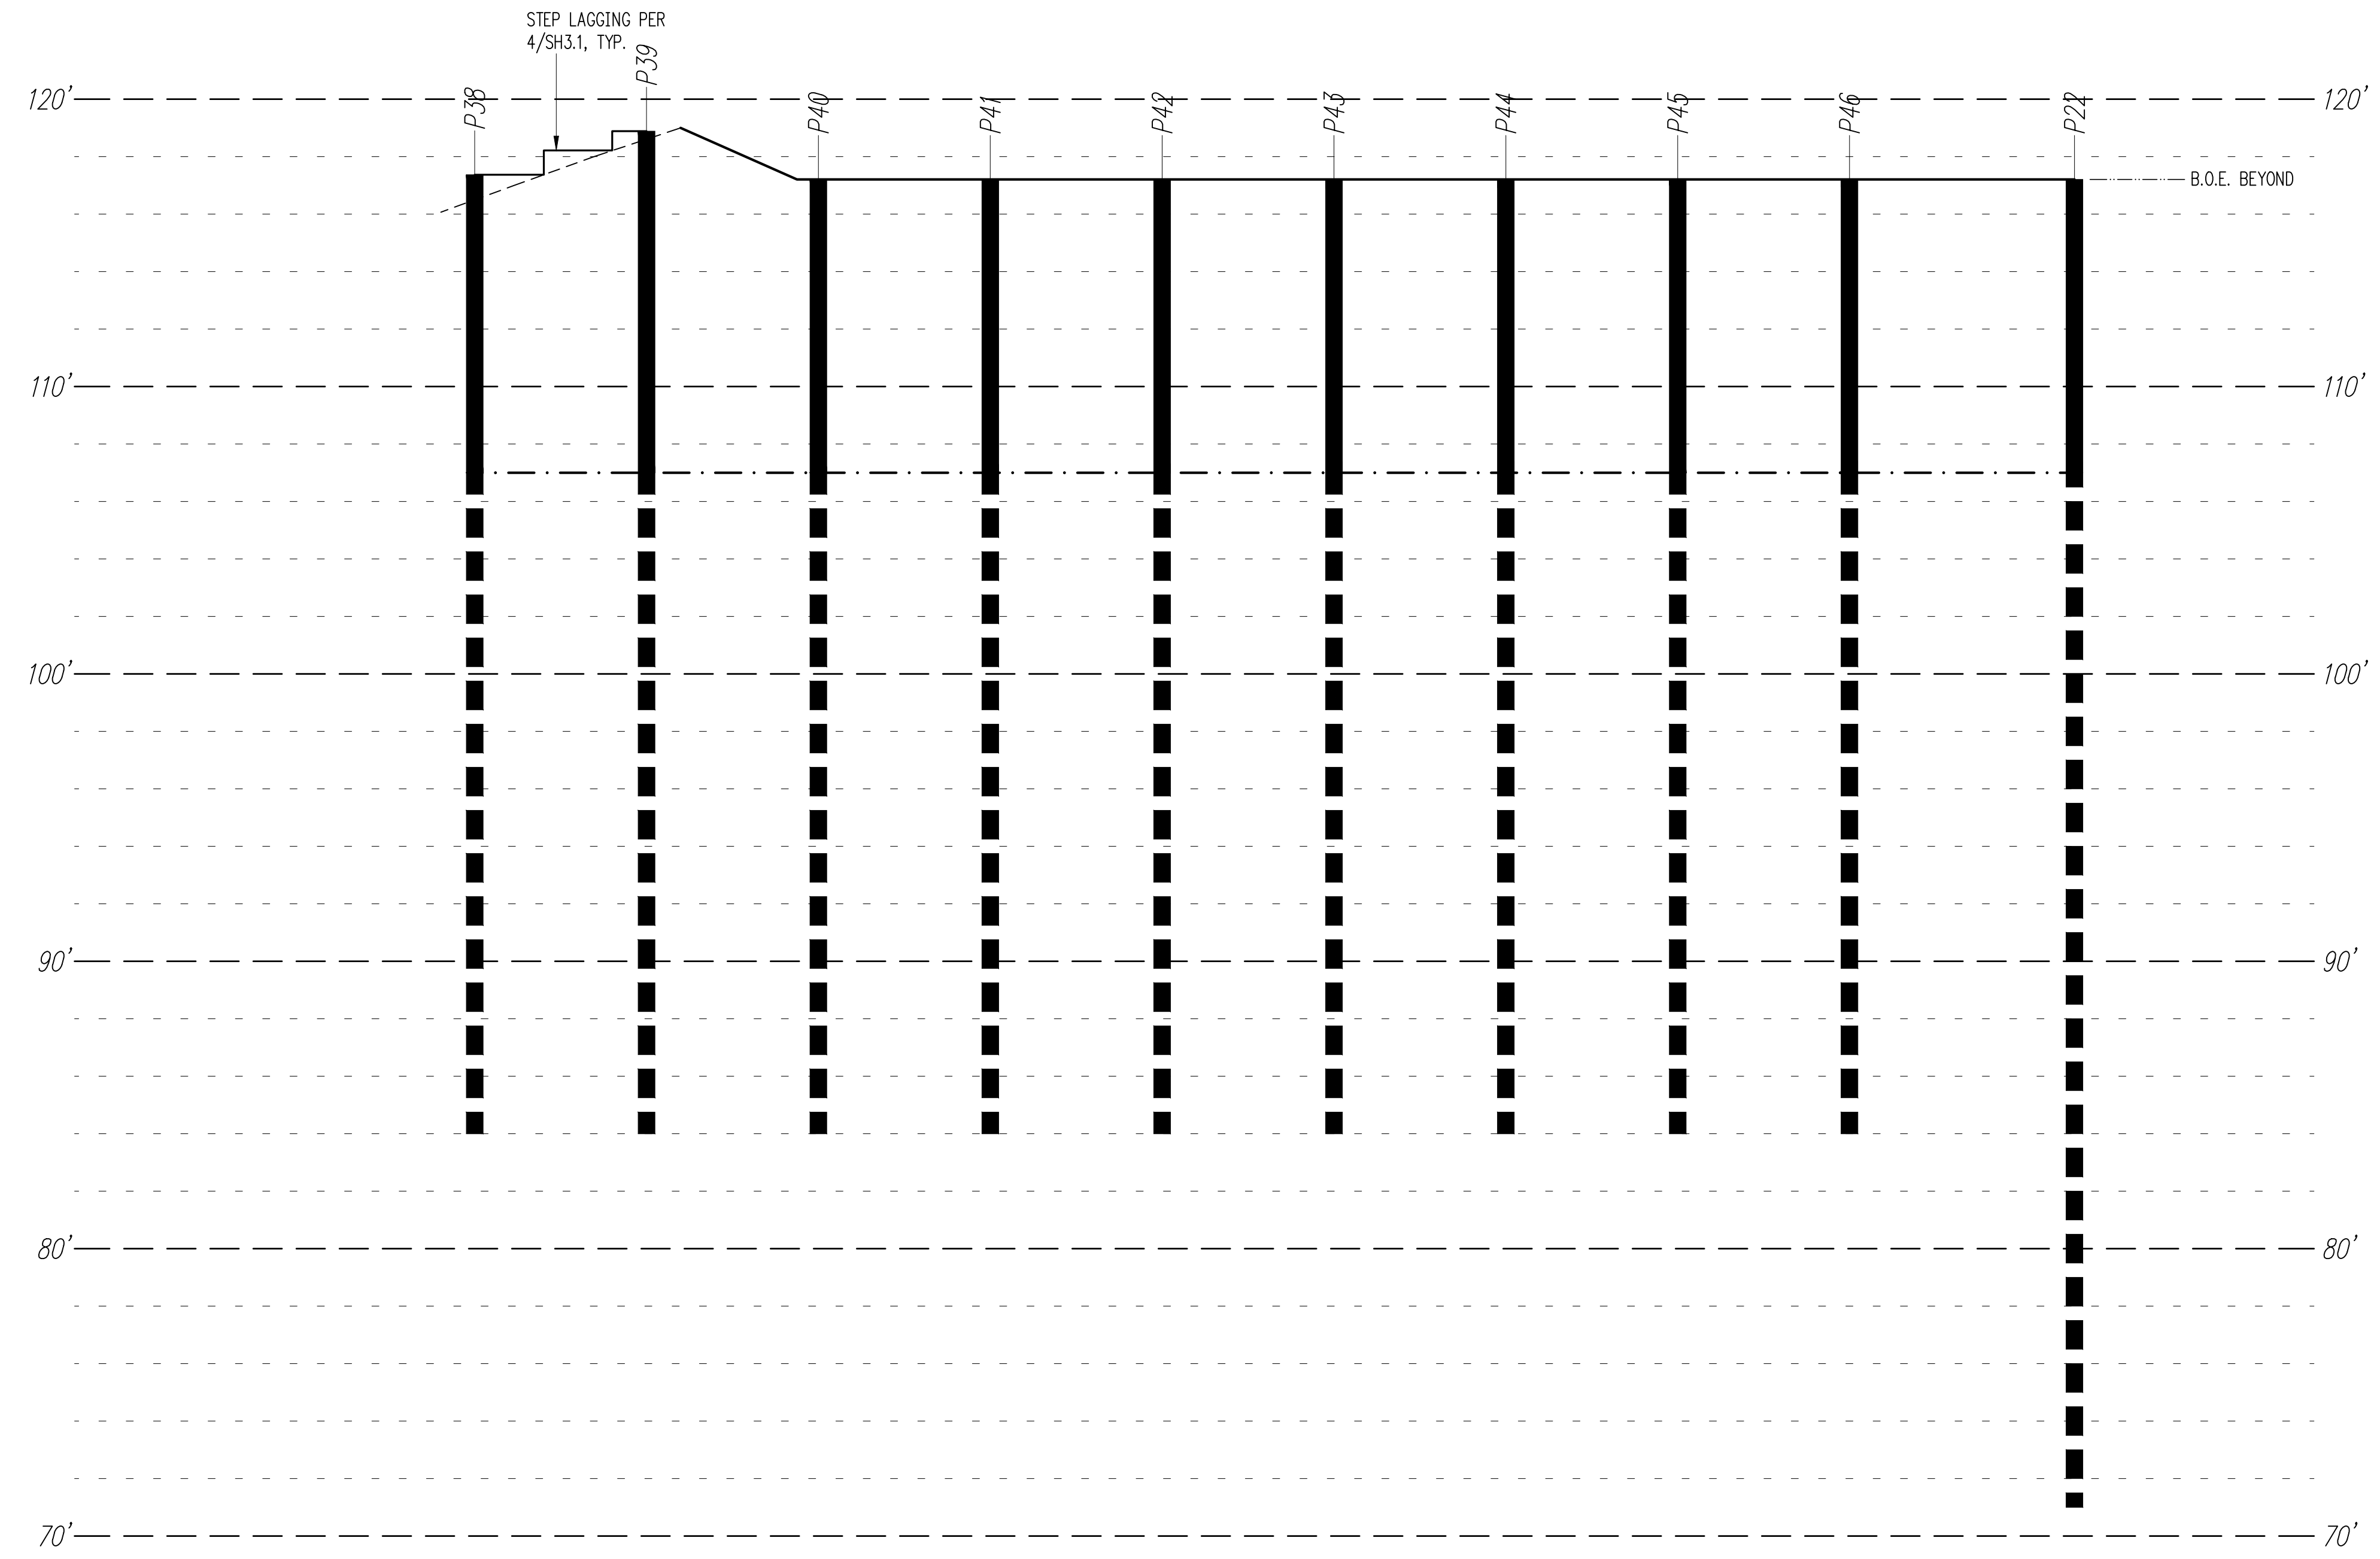

**Legend**

- APPROXIMATE TOP OF GRADE
- - - BOTTOM OF EXCAVATION
- Px— STEEL PILE PER PLAN/SCHEDULE
- 4x LAGGING

**East Shoring Elevation** ①  
LOOKING EAST  
Scale: 1/4" = 1'-0"