HEAT PUMP SPECS: CREDITS CLAIMED

Make: MRCOOL

Model: DIY-18-HPWMAH-230C25

Energy Star Rated: HSPF 9 1.00

APPLIANCE SPECS. 0.50

Vent-less Dryer: Samsung DVE456100P Samsung WF45R6100AP Clothes Washer: Frigidaire FFEH3054U S/W/B Stove: Frigidaire FFHB2750T D/S/P/E Refrigerator: Frigidaire FFID2426T D/S Dish Washer:

Note: All Electric & Energy Star Rated

WATER HEATER SPECS. 0.50

Model: RTEX-24 Make: Rheem

Type: Electric Tank less

EFFICENT BUILDING ENVALOPE: 1.00

3.00 (Required 3.00)

Specification Sheets for all provided

CHAPTER 1: ADMINISTRATION

TITLE, SCOPE AND PURPOSE

THIS COVERSHEET HAS BEEN PREPARED IN A GENERIC OUTLINE FORM FOLLOWING THI STANDARDS SET BY THE INTERNATIONAL RESIDENTIAL CODE (IRC). NOT ALL ITEMS ARE NECESSARILY REQUIRED TO COMPLETE THIS SPECIFIC PROJECT, COORDINATE PLANS

- THIS SET OF WORKING DRAWINGS IS CONSIDERED A "BUILDER SET" AND DOES NOT CONTRACTOR/OWNER RESPONSIBILITY TO PROVIDE AND COORDINATE SPECIFICATIONS INCLUDING PRODUCT SELECTION AND INSTALLATION OR ASSEMBLY. ITEMS CALLED OU
- DO NOT SCALE THESE DRAWINGS FOR CRITICAL DIMENSIONS. VERIFY ALL DIMENSIONS AND DATUM'S BEFORE COMMENCING WORK AND BE RESPONSIBLE FOR THEIR ACCURACY AND REPORT DISCREPANCIES / OMISSIONS TO THE ARCHITECT IMMEDIATELY.

CHAPTER 3: BUILDING PLANNING

DESIGN CRITERIA

[B] R301.2 CLIMATIC AND GEOGRAPHIC DESIGN CRITERIA. BUILDINGS SHALL BE CONSTRUCTED IN ACCORDANCE WITH THE PROVISIONS SET FORTH IN THE IRC. ADDITIONAL CRITERIA SHALL BE ESTABLISHED BY THE LOCAL JURISDICTION AND SET FORTH IN TABLE R301.2(1) CLIMATIC AND GEOGRAPHIC DESIGN CRITERIA

GROUND SNOW LOAD:	25
WIND SPEED:	PER STRUCT MOLERATE 18" MODERATE 26 NO 175
SEISMIC DESIGN CATEGORY:	PER STRUCT
SUBJECT TO DAMAGE FROM:	
WEATHERING:	MOCERATE
FROST LINE DEPTH:	18"
TERMITE:	MODERATE
WINTER DESIGN TEMP:	26
ICE SHIELD UNDERLAYMENT REQUIRED:	NO
FLOOD HAZARDS:	
AIR FREEZING INDEX:	175
MEAN ANNUAL TEMP:	50.5

THE ACTUAL WEIGHTS OF MATERIALS AND CONSTRUCTION SHALL BE USED FOR DETERMINING DEAD LOAD. DEAD LOADS USED FOR THIS PROJECT ARE AS FOLLOWS:

	15 PSF
	12 PSF
	10 PSF

THE MINIMUM UNIFORMLY DISTRIBUTED LIVE LOAD SHALL BE AS PROVIDED IN

TABLE R301.5.

ABLE R301.5 MINIMUM UNIFORMLY DISTRIBUTED	LIVE LOADS
ATTICS WITH STORAGE:	2C PSF
WITHOUT STORAGE:	1C PSF
	4C PSF
EXTERIOR BALCONIES:	6C PSF
FIRE ESCAPES:	4C PSF
GUARDRAILS AND HANDRAILS:	2CO PLF
GUARDRAIL IN-FILL COMPONENTS:	2CO PLF
PASSENGER VEHICLE GARAGES:	2CO PSF
ROOMS OTHER THAN SLEEPING ROOMS:	4C PSF
SLEEPING ROOMS:	3C PSF

ROOF SHALL BE DESIGNED FOR THE LIVE LOAD INDICATED IN <u>TABLE R301.6</u> THE SNOW LOAD INDICATED IN TABLE R301.2(1), WHICHEVER IS GREATER.

4C PSF

MINIMUM ROOF LIVE LOADS IN POUNDS-FORCE PER SQUARE

ROOF SLOPE:	TRIBUTARY LOADED AREA IN SQUARE FEET FOR ANY STRUCTURAL MEMBER					
	0 to 200	2001 to 600	Over 600			
FLAT OR RISE LESS THAN 4" PER FOOT (1:3).	20	16	12			
RISE LESS 4" PER FLOOR (1:3) to 12" PER FOOT (1:1).	16	14	12			
RISE 12" PER FOOT (1:1) AND GREATER.	12	12	12			

301.8 NOMINAL SIZES.

..WHERE DIMENSIONS OF LUMBER ARE SPECIFIED, THEY SHALL BE DEEMED TO BE NOMINAL DIMENSIONS UNLESS SPECIFICALLY DESIGNATED AS ACTUAL DIMENSIONS.

317.1 LOCATION REQUIRED.'

IN AREAS SUBJECT TO DECAY DAMAGE AS ESTABLISHED BY TABLE R301.2(1)-LOCATIONS REQUIRED BY SECTION R317.1, SHALL BE PRESERVATIVE-TREATED IN ACCORDANCE WITH AWPA U1 FOR THE SPECIES, PRODUCT, PRESERVATIVE AND END USE. PRESERVATIVES SHALL BE LISTED IN SECTION 4 OF AWPA U1

317.1.1 FIELD TREATMENT FIELD-CUT ENDS, NOTCHES AND DRILLED HOLES OF PRESERVATIVE-TREATED WOOD SHALL BE

TREATED IN THE FIELD IN ACCORDANCE WITH AWPA M4. 6.1 GENERAL

ALL CUTS, HOLES AND INJURIES SUCH AS ABRASIONS OR HOLES FROM REMOVAL OF NAILS AND SPIKES WHICH MAY PENETRATE THE TREATED ZONE SHALL BE FIELD TREATED. AN AWPA ACCEPTED PRESERVATIVE SYSTEM, DETERMINED APPROPRIATE IN ACCORDANCE WITH AWPA M4 SECTION 7, SHALL

BE USED FOR FIELD TREATMENT. APPLY PRESERVATIVES IN ACCORDANCE WITH THE PRODUCT LABEL.

COAT ANY SURFACE THAT IS EXPOSED BY DAMAGE OR FIELD FABRICATION WHILE NOT USING EXCESS PRESERVATIVE

ANY EXCESS PRESERVATIVE NOT ABSORBED BY THE WCOD PRODUCT SHALL BE CLEANED FROM THE SURFACE PRIOR TO THE USE OF THE PRODUCT. BORED HOLES FOR CONNECTORS OR BOLTS MAY BE TREATED BY PUMPING COAL- TAR ROOFING CEMENT MEETING ASTM D5643 INTO HOLES USING A

GREASE GUN OR SIMILAR DEVICE. CAREFUL ATTENTION SHOULD BE GIVEN TO MATERIALS PLACED INTO WET **ENVIRONMENTS**

AREA TO BE TREATED SHALL BE CLEAN, DRY AND FREE OF EXCESS PRESERVATIVE.

7.1 PRESERVATIVES

THE PRESERVATIVE SYSTEM FOR FIELD TREATMENT SHALL BE DETERMINED BY

THE TYPE OF PRESERVATIVE ORIGINALLY USED TO PROTECT THE PRODUCT. THE PRESERVATIVES DESIGNATED IN AWPA M4 SECTIONS 7.1.1, AND 7.1.2 ARE SUITABLE ALTERNATIVES WHEN NO MATCH CAN BE FOUND.

317.1.2 GROUND CONTACT

ALL WOOD IN CONTACT WITH THE GROUND SHALL BE APPROVED PRESSURE-PRESERVATIVE-TREATED WOOD SUITABLE FOR GROUND CONTACT USE

FASTENERS FOR PRESSURE PRESERVATIVE AND FIRE-RETARDANT-TREATED WOOD SHALL B

ONE-HALF-INCH DIAMETER OR GREATER STEEL BOLTS.

FASTENERS OTHER THAN NAILS AND TIMBER RIVETS SHALL BE PERMITTED TO BE OF MECHANICALLY DEPOSITED ZINC COATED STEEL WITH COATING WEIGHTS IN ACCORDANCE WITH ASTM B 695, CLASS 55 MINIMUM

CHAPTER 4: FOUNDATIONS

GENERAL

THE PROVISIONS SET FORTH IN CHAPTER 4 OF THE IRC SHALL CONTROL THE DESIGN AND CONSTRUCTION OF THE FOUNDATION AND FOUNDATION SPACES FOR ALL BUILDINGS. IN ADDITION TO THE PROVISIONS OF THIS CHAPTER, THE DESIGN AND CONSTRUCTION OF FOUNDATIONS IN AREAS PRONE TO FLOODING AS ESTABLISHED BY TABLE R301.2(1) SHALL MEET THE PROVISIONS OF SECTION R322

IN AREAS LIKELY TO HAVE EXPANSIVE, COMPRESSIBLE, SHIFTING OR OTHER UNKNOWN SOIL CHARACTERISTICS, THE BUILDING OFFICIAL SHALL DETERMINE WHETHER TO REQUIRE A SOIL TEST TO DETERMINE THE SOIL'S CHARACTERISTICS AT A PARTICULAR LOCATION, 401.4.1 GEOTECHNICAL EVALUATION.

IN LIEU OF A COMPLETE GEOTECHNICAL EVALUATION, THE LOAD-BEARING VALUES IN TABLE R401.4.1 SHALL BE USED. TABLE R401.4.1 PRESUMPTIVE LOAD-BEARING VALUES OF

CLASS OF MATERIAL	LOAD BEARING PRESSURE (PSF)
CRYSTALLINE BEDROCK	12,000
SEDIMENTARY AND FOLIATED ROCK	4,000
SANDY GRAVEL AND/OR GRAVEL (GW AND GP)	3,000
SAND, SILTY SAND, CLAYEY SAND, SILTY GRAVEL AND CLAYEY GRAVEL (SW,SP,SM,SC,GM & GC)	2,000***
CLAY, SANDY CLAY, SILTY CLAY, CLAYEY SILT, SILT AND SANDY SILT (CI, ML, MH & CH)	1,500

***U.N.O. 2,000 PSF SOIL BEARING IS ASSUMED FOR THIS PROJECT. VERIFY WITH STRUCTURAL NOTES

R402 MATERIALS

402.2 CONCRETE.

CONCRETE SHALL HAVE A MINIMUM SPECIFIED COMPRESSIVE STRENGTH AS SHOWN IN TABLE R402.2. CONCRETE SUBJECT TO WEATHERING AS INDICATED IN TABLE R301.2(1) SHALL BE AIR ENTRAINED AS SPECIFIED IN TABLE R402.2

TABLE R402.2

MINIMUM SPECIFIED COMPRESSIVE STRENGTH OF CONCRETE

TYPE OF LOCATIONS OF CONC. CONSTRUCTION	TRIBLTARY LOADED AREA IN SQUARE FOR ANY STRUCTURAL MEMBER			
	NEGLIGIBLE	MODERATE	SEVERE	
BASEMENT WALLS, FNDN'S EXPOSED TO WEATHER.	2,500 psi	2,500 psi	2,500 psi	
BASEMENT SLABS & INTERIOR SLABS ON GRADE, EXCEPT GAR. FLOOR SLABS.	2,500 psi	2,500 psi	2,500 psi	
BASEMENT WALLS, FNDN WALLS, EXTERIOR WALLS EXPOSED TO WEATHER.	2,500 psi	3,000 psi	3,000 psi	
PORCHES, CARPORT SLABS & STEPS EXPOSED TO WEATHER & GARAGE FLOOR SLABS.	2,500 psi	3,000 psi	3,500 psi	
2400				

FOOTINGS

403.1 GENERAL

ALL EXTERIOR WALLS SHALL BE SUPPORTED ON CONTINUOUS SOLID OR FULLY GROUTED MASONRY OR CONCRETE FOOTINGS, WOOD FOUNDATIONS, OR OTHER APPROVED STRUCTURAL SYSTEMS, WHICH SHALL BE OF SUFFICIENT DESIGN TO ACCOMMODATE ALL LOADS ACCORDING TO SECTION R301 AND BE CONSTRUCTED IN ACCORDANCE WITH THE PROVISIONS OF SECTION R403, OF THE IRC . FOOTINGS SHALL BE SUPPORTED ON UNDISTURBED NATURAL SOILS OR ENGINEERED FILL.

403.1.4.1 FROST PROTECTION.

FOUNDATION WALLS, PIERS AND OTHER PERMANENT SUPPORTS OF BUILDINGS AND STRUCTURES SHALL BE PROTECTED FROM FROST BY EXTENDING FOOTINGS BELOW THE FROST LINE AS SPECIFIED IN TABLE R301.2(1);. EXCEPTION: DECKS NOT SUPPORTED BY A DWELLING NEED NOT BE PROVIDED WITH

FOOTINGS THAT EXTEND BELOW THE FROST LINE.

403.1.6 FOUNDATION ANCHORAGE.

WHEN BRACED WALL PANELS ARE SUPPORTED DIRECTLY ON CONTINUOUS FOUNDATIONS, THE WALL WOOD SILL PLATE SHALL BE ANCHORED TO THE FOUNDATION IN ACCORDANCE WITH SECTION 403.1.6, OF THE IRC.

SILL PLATE SHALL BE ANCHORED TO THE FOUNDATION WITH ANCHOR BOLTS SPACED A MAXIMUM OF 6 FEET ON CENTER. THERE SHALL BE A MINIMUM OF TWO BOLTS PER PLATE SECTION WITH ONE BOLT LOCATED NOT MORE THAN 12 INCHES FROM EACH END OF THE PLATE SECTION.

BOLTS SHALL BE AT LEAST 1/2 INCH IN DIAMETER AND SHALL EXTEND A MINIMUM OF 7 INCHES INTO MASONRY OR CONCRETE SILLS AND SOLE PLATES SHALL BE PROTECTED AGAINST DECAY AND TERMITES

WHERE REQUIRED BY SECTIONS R318 AND R319, OF THE IRC. EXCEPTION: FOUNDATION ANCHOR STRAPS, SPACED AS REQUIRED TO PROVIDE

EQUIVALENT ANCHORAGE TO 1/2-INCH-DIAMETER ANCHOR BOLTS.

403.1.6.1 FOUNDATION ANCHORAGE IN SEISMIC DESIGN CATEGORIES DO, D1, D2, AND E.

IN ADDITION TO THE REQUIREMENTS OF SECTION R403.1.6, THE FOLLOWING REQUIREMENTS SHALL APPLY TO WOOD LIGHT-FRAME STRUCTURES IN SEISMIC DESIGN CATEGORIES D1 AND D2.

- 1/4" X 3" X 3" PLATE WASHERS CONFORMING TO <u>SECTION R602.11.1</u> SHALL BE
- USED ON EACH BOLT INTERIOR BRACED WALL PLATES SHALL HAVE ANCHOR BOLTS SPACED AT NOT MORE
- THAN 6 FEET ON CENTER AND LOCATED WITHIN 12 INCHES FROM THE ENDS OF EACH PLATE SECTION WHEN SUPPORTED ON A CONTINUOUS FOUNDATION. INTERIOR BEARING WALL SOLE PLATES SHALL HAVE ANCHOR BOLTS SPACED AT NOT MORE THAN 6 FEET ON CENTER AND LOCATED WITHIN 12 INCHES FROM THE ENDS

OF EACH PLATE SECTION WHEN SUPPORTED ON A CONTINUOUS FOUNDATION.

THE MAXIMUM ANCHOR BOLT SPACING SHALL BE 4 FEET FOR BUILDINGS OVER TWO STORIES IN HEIGHT. STEPPED CRIPPLE WALLS SHALL CONFORM TO SECTION R602.11.3.

FOUNDATION WALLS

404.1 CONCRETE AND MASONRY FOUNDATION WALLS

CONCRETE AND MASONRY FOUNDATION WALLS SHALL BE SELECTED AND CONSTRUCTED IN ACCORDANCE WITH THE PROVISIONS OF SECTION R404.1.3 OF THE IRC OR IN ACCORDANCE WITH ACI 318, NCMA TR68-A OR ACI 530/ASCE 5/TMS 402 OR OTHER APPROVED STRUCTURAL STANDARDS.

404.3 WOOD SILL PLATES.

WOOD SILL PLATES SHALL BE A MINIMUM OF 2-INCH BY 4-INCH NOMINAL LUMBER. SILL PLATE ANCHORAGE SHALL BE IN ACCORDANCE WITH SECTIONS R403.1.6 AND R602.11

CHAPTER 5: FLOORS

R501 **GENERAL**

501.1 APPLICATION

FLOOR CONSTRUCTION SHALL BE IN ACCORDANCE TO THE PROVISIONS SET FORTH IN CHAPTER 5 OF THE IRC.

FOR FLOOR CONSTRUCTION LOADING, SEE SECTION R301

CHAPTER 6: WALL CONSTRUCTION

GENERAL

WALL CONSTRUCTION SHALL BE IN ACCORDANCE TO THE PROVISIONS SET FORTH IN CHAPTER 6 OF THE IRC.

FOR WALL CONSTRUCTION LOADING, SEE SECTION R301

R602.3. DESIGN & CONSTRUCTION

SEE TABLE R602.3(1) ON THIS SHEET FOR FASTENER / NAILING SCHEDULE

EXTERIOR WINDOWS AND GLASS DOORS

613.<u>1 GENERAL</u>

THE PROVISIONS SET FORTH IN SECTION 613 OF THE IRC, SHALL CONTROL THE PERFORMANCE AND CONSTRUCTION REQUIREMENTS FOR EXTERIOR WINDOW SYSTEMS INSTALLED IN WALL SYSTEMS. WATERPROOFING, SEALING AND FLASHING SYSTEMS ARE NOT INCLUDED IN THE SCOPE OF THIS SECTION

613.2 PERFORMANCE. EXTERIOR WINDOWS AND DOORS SHALL BE DESIGNED TO RESIST THE DESIGN WIND

LOADS SPECIFIED IN TABLE R301.2(2) ADJUSTED FOR HEIGHT AND EXPOSURE PER TABLE R301.2(3).

CHAPTER 7: WALL COVERING

R701 **GENERAL**

THE PROVISIONS SET FORTH IN CHAPTER 7 OF THE IRC, SHALL CONTROL THE DESIGN

WEATHER PROTECTION FOR THE INSTALLATION IS PROVIDED. EXTERIOR SHEATHING SHALL BE DRY BEFORE APPLYING EXTERIOR COVER.

CHAPTER 8: ROOF-CEILING CONSTRUCTION

GENERAL

801.1 APPLICATION.

THE PROVISIONS SET FORTH IN CHAPTER 8 OF THE IRC, SHALL CONTROL THE DESIGN AND CONSTRUCTION OF THE ROOF-CEILING SYSTEM FOR ALL BUILDINGS.

801.2 REQUIREMENTS ROOF AND CEILING CONSTRUCTION SHALL BE CAPABLE OF ACCOMMODATING ALL LOADS

IMPOSED ACCORDING TO SECTION R301 AND OF TRANSMITTING THE RESULTING LOADS TO THE SUPPORTING STRUCTURAL ELEMENTS. 801.3 ROOF DRAINAGE.

IN AREAS WHERE EXPANSIVE OR COLLAPSIBLE SOILS ARE KNOWN TO EXIST, ALL DWELLINGS

SHALL HAVE A CONTROLLED METHOD OF WATER DISPOSAL FROM ROOFS THAT WILL

COLLECT AND DISCHARGE ALL ROOF DRAINAGE TO THE GROUND SURFACE AT LEAST 5 FEET FROM FOUNDATION WALLS OR TO AN APPROVED DRAINAGE SYSTEM.

CHAPTER 9: ROOF ASSEMBLIES **GENERAL**

901.1 SCOPE THE PROVISIONS SET FORTH IN CHAPTER 9 OF THE IRC, SHALL GOVERN THE DESIGN, MATERIALS, CONSTRUCTION AND QUALITY OF ROOF ASSEMBLIES.

2015 UNIFORM PLUMBING CODE

PROTECTION OF PIPING, MATERIALS, AND STRUCTURES

SECTION 313.12 RATPROOFING

STRAINER PLATES ON DRAIN INLETS SHALL HAVE 1/2-INCH OPENINGS MAX. METER BOXES SHALL BE CONSTRUCTED IN SUCH A MANNER THAT RATS CANNOT

ENTER A BLDG BY FOLLOWING THE SERVICE PIPES FROM THE BOX INTO THE BLDG. WHERE OPENINGS HAVE BEEN MADE IN WALLS, FLOORS, OR CLGS FOR THE PASSAGE OF PIPES, SUCH OPENINGS SHALL BE CLOSED AND PROTECTED BY THE INSTALLATION

OF APPROVED METAL COLLARS SECURELY FASTENED TO THE ADJOINING STRUCTURE. TUB WASTE OPENINGS IN FRAMED CONSTRUCTION TO CRAWL SPACES AT OR BELOW THE FIRST FLOOR SHALL BE PROTECTED BY THE INSTALLATION OF APPROVED METAL COLLARS OR METAL SCREEN, WITH ½-INCH OPENINGS MAX, AND SECURELY FASTENED TO THE ADJOINING STRUCTURE.

COMPLIANCE PATH PRESCRIPTIVE: International Residential Code 2018 (IRC 2018) with MA State Amendments

 \geq IRC ∞ 0 Q NC






DATE: 06.12.20 REV #12: 01.24.24 DRAWN BY: K.C.

AS BUILT GHT CALCULATIOI

OM & KIM TSO DDITION & ADU

SH DESIGN LINES LL 475 544 99076




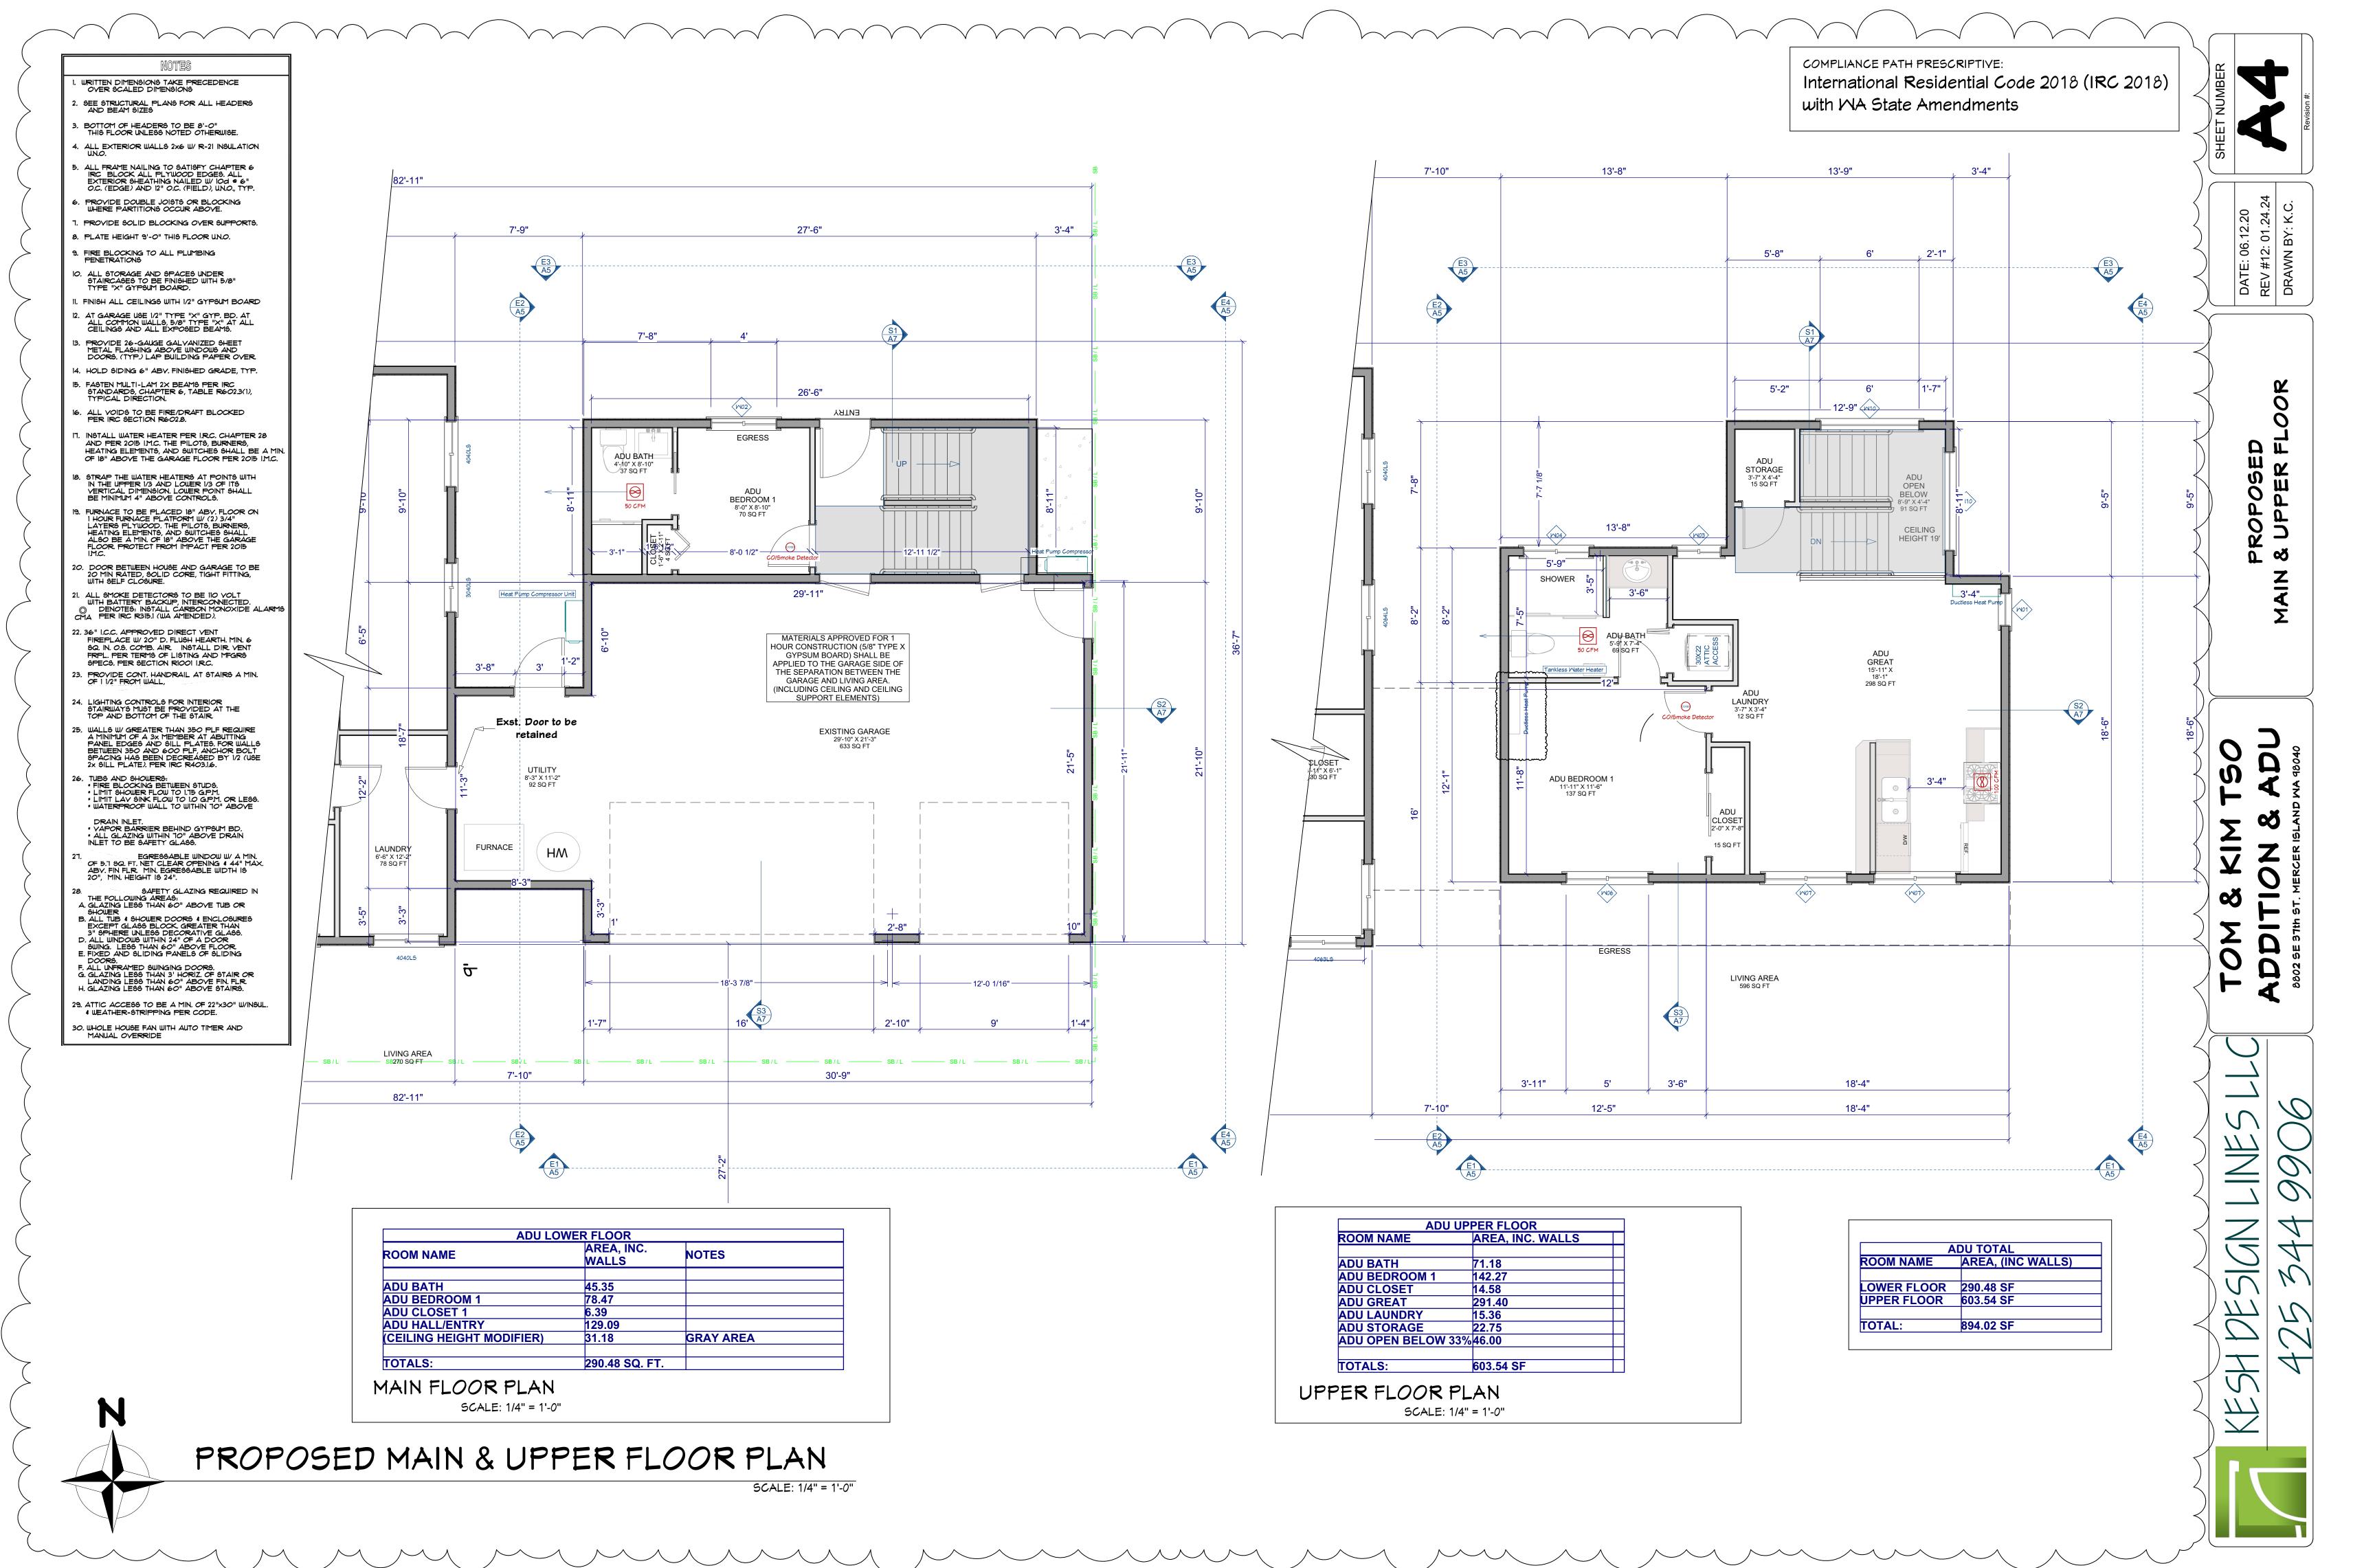


- ke n of tures

installation

specifications)

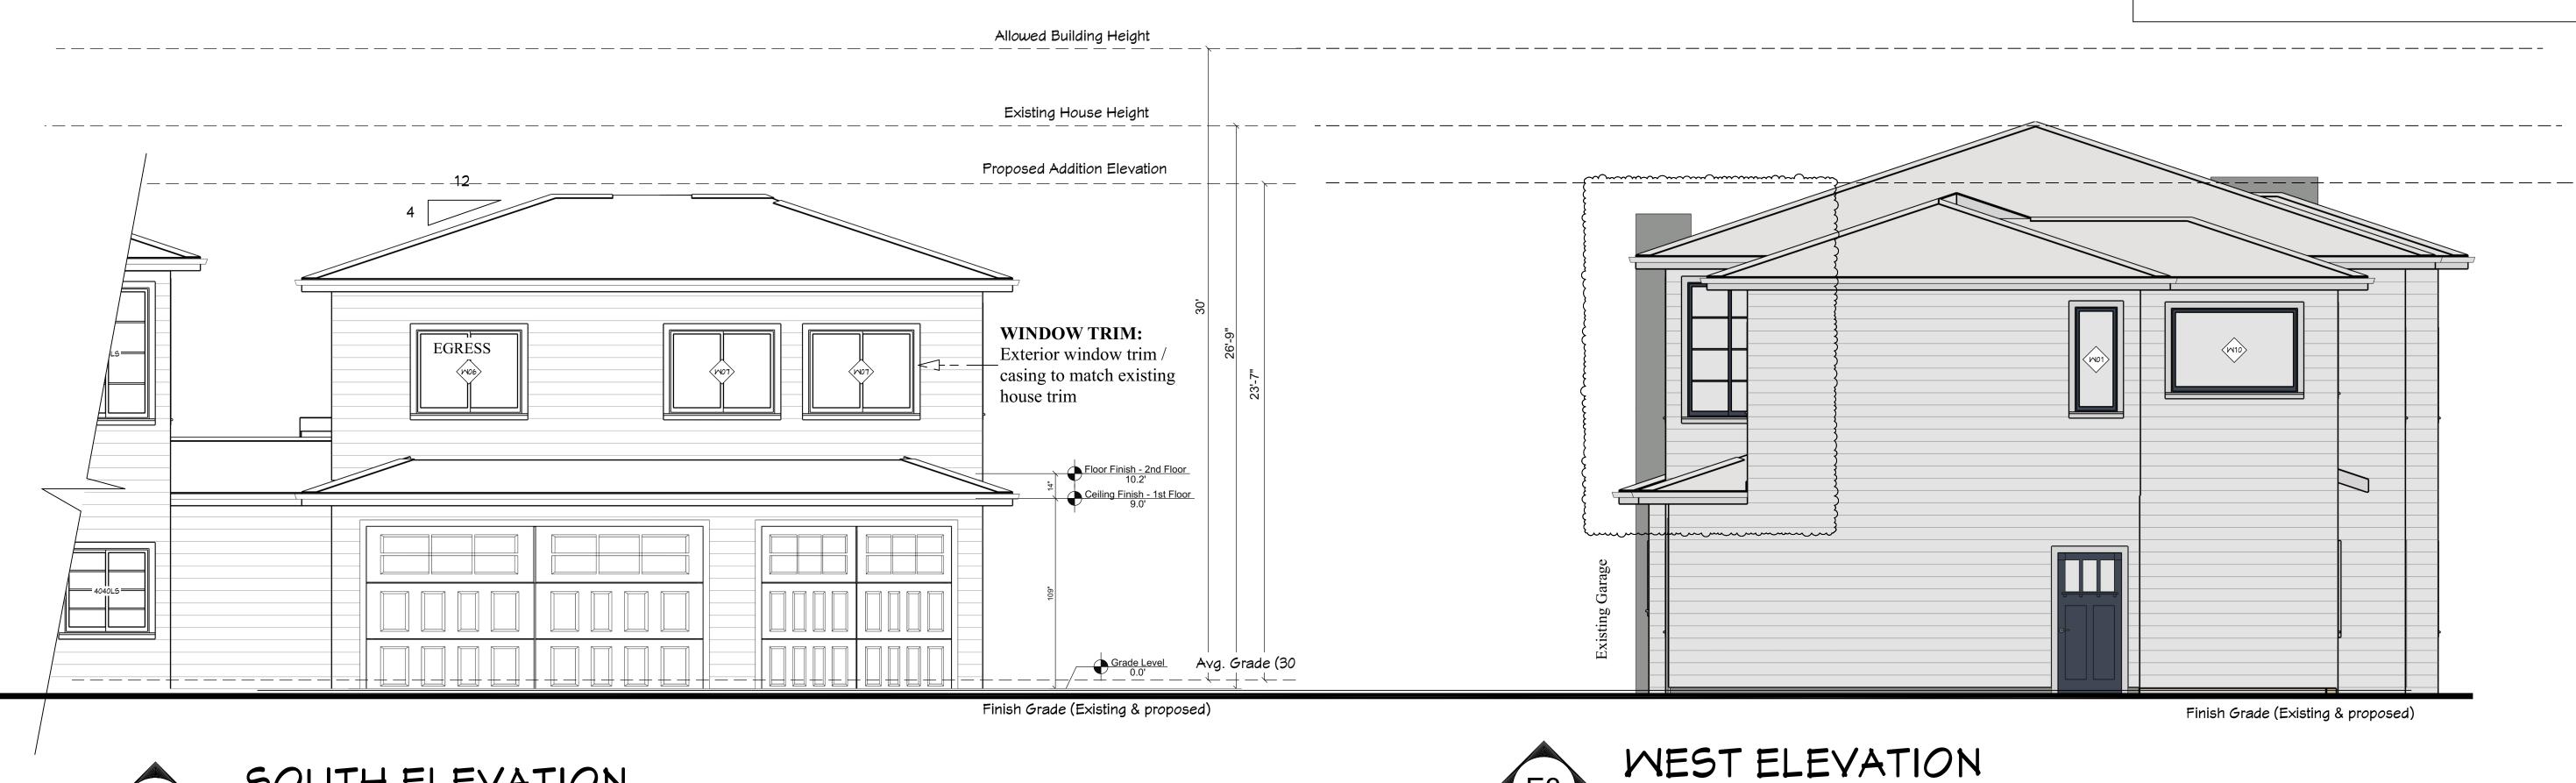

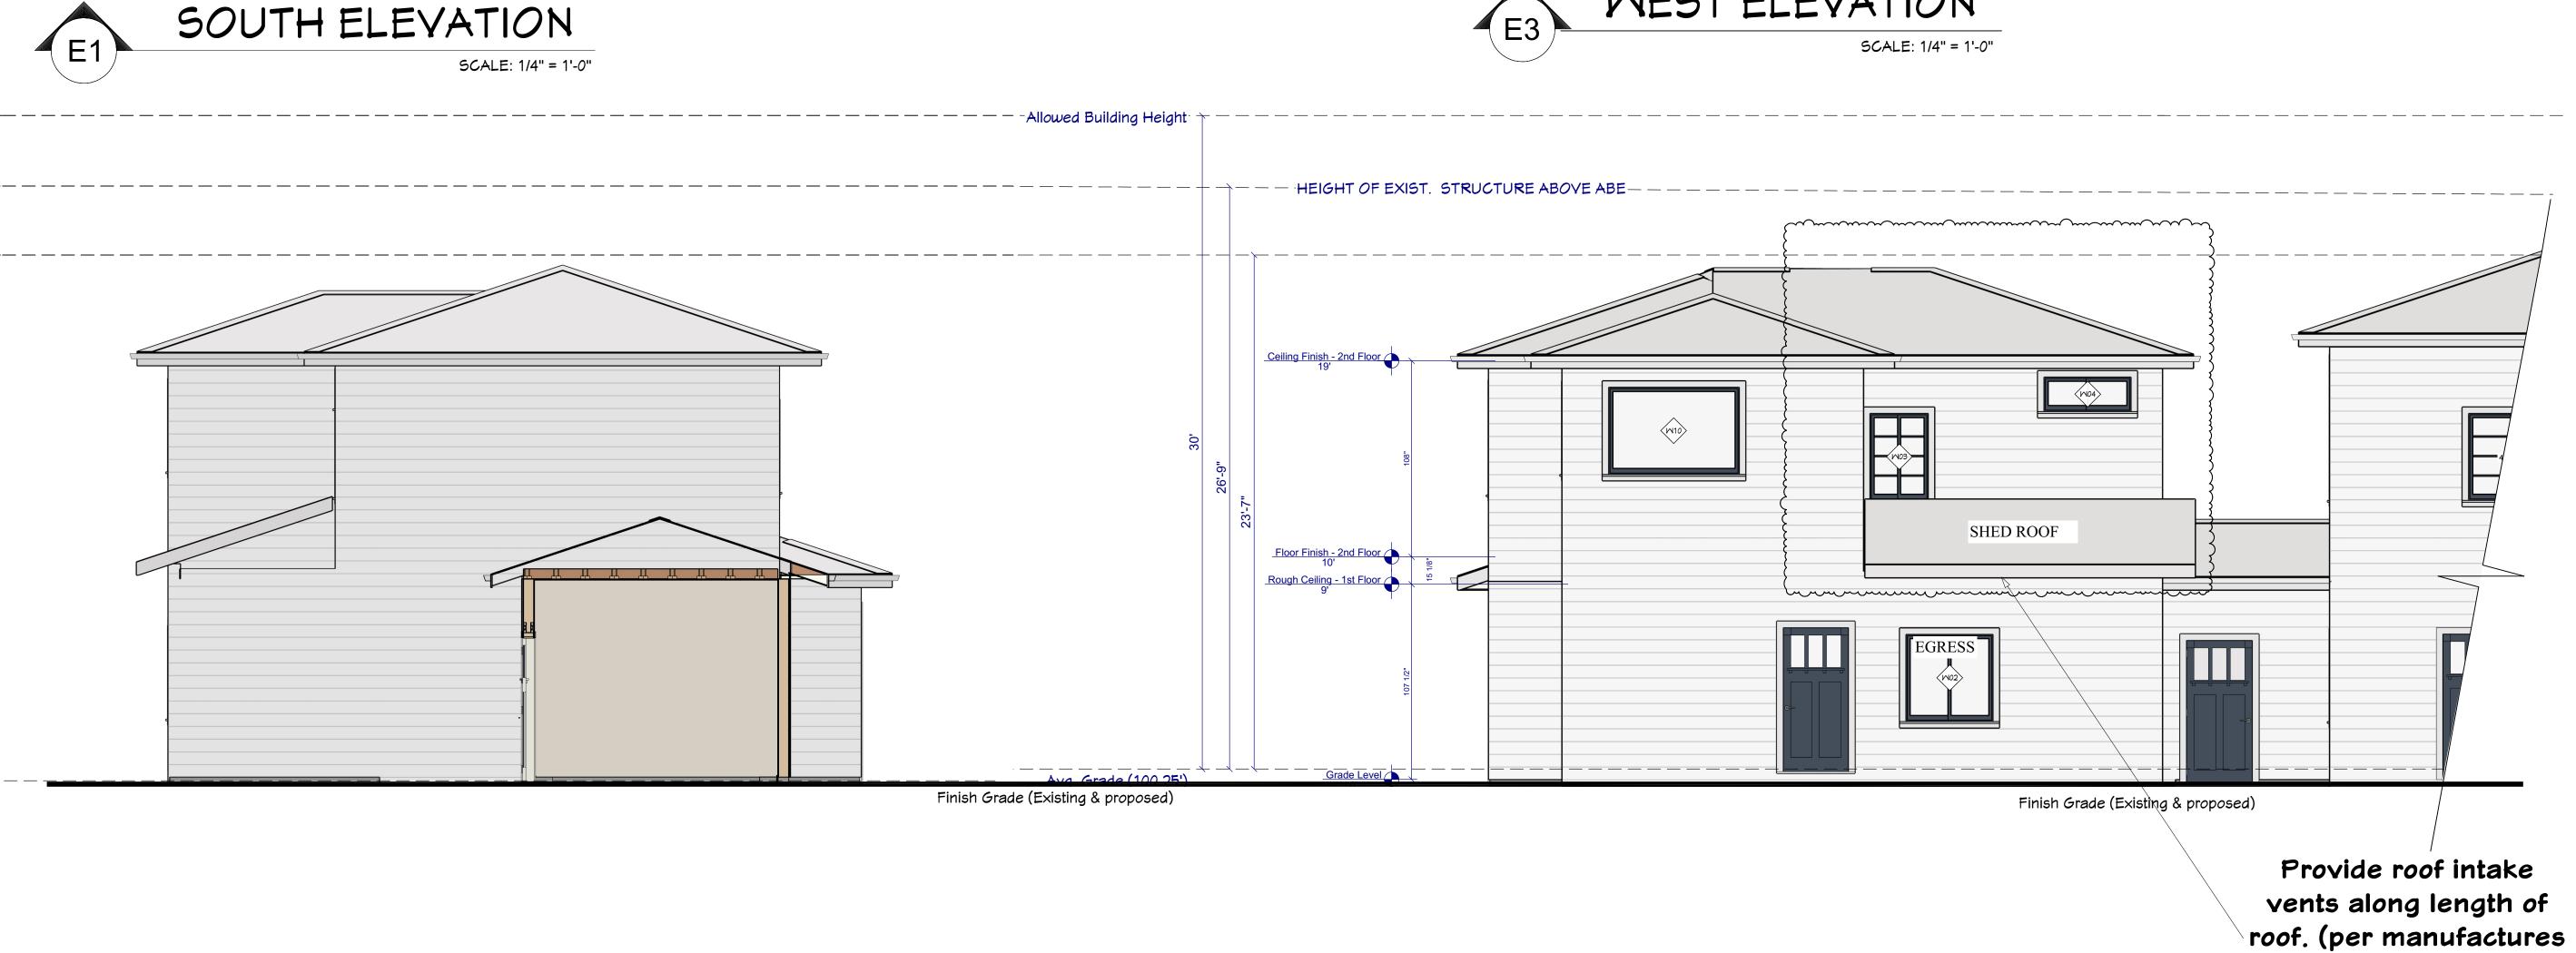







SEE NEW STRUCTURAL (S) SHEETS

KESH DESIGN LINES LLC


425 544 9906

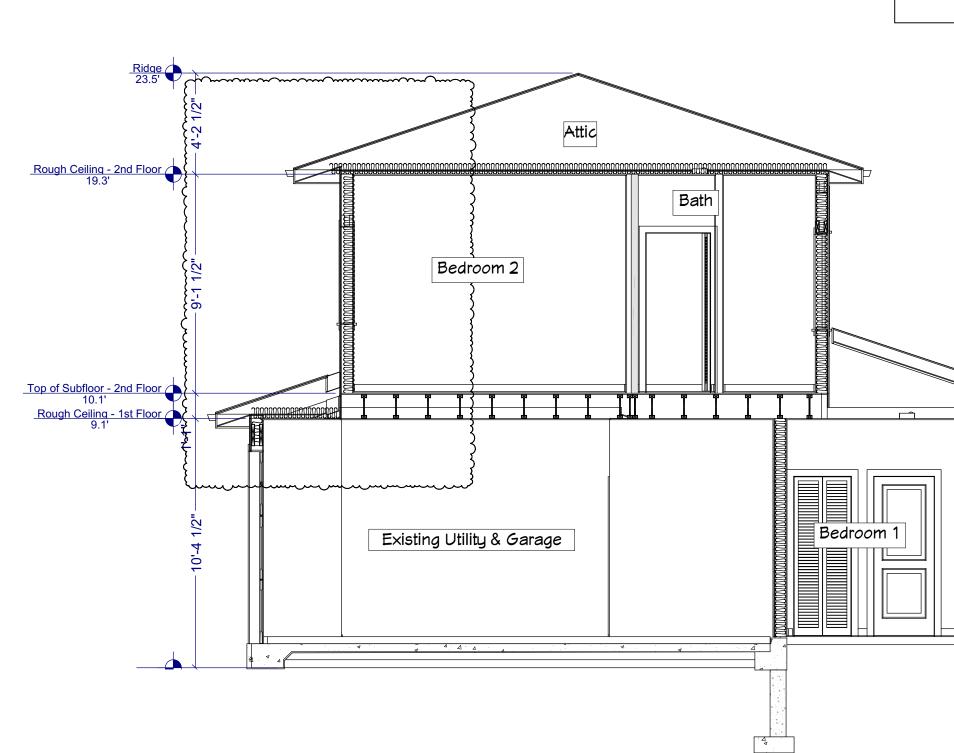




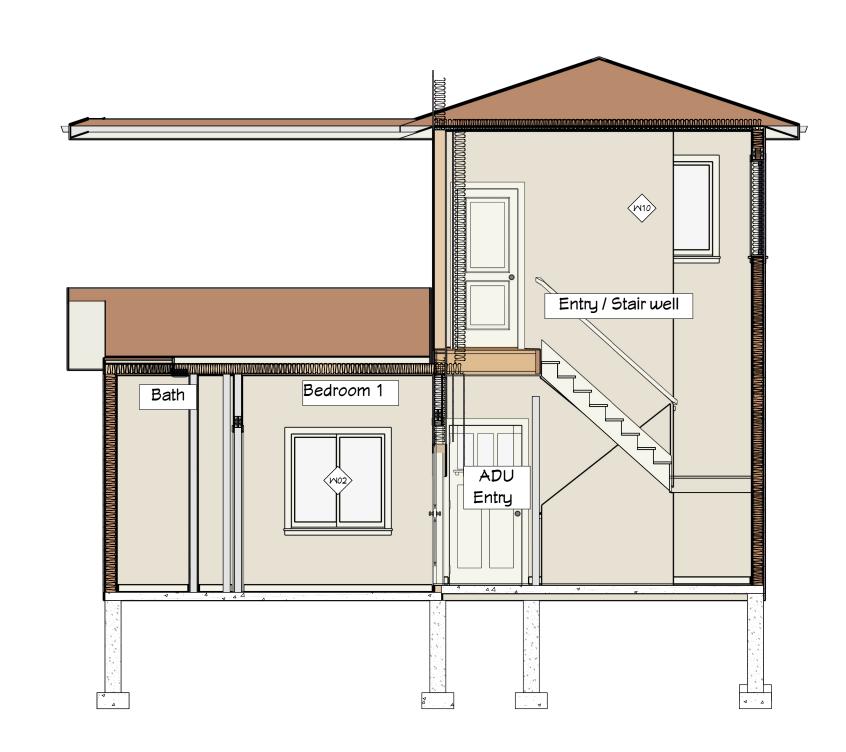



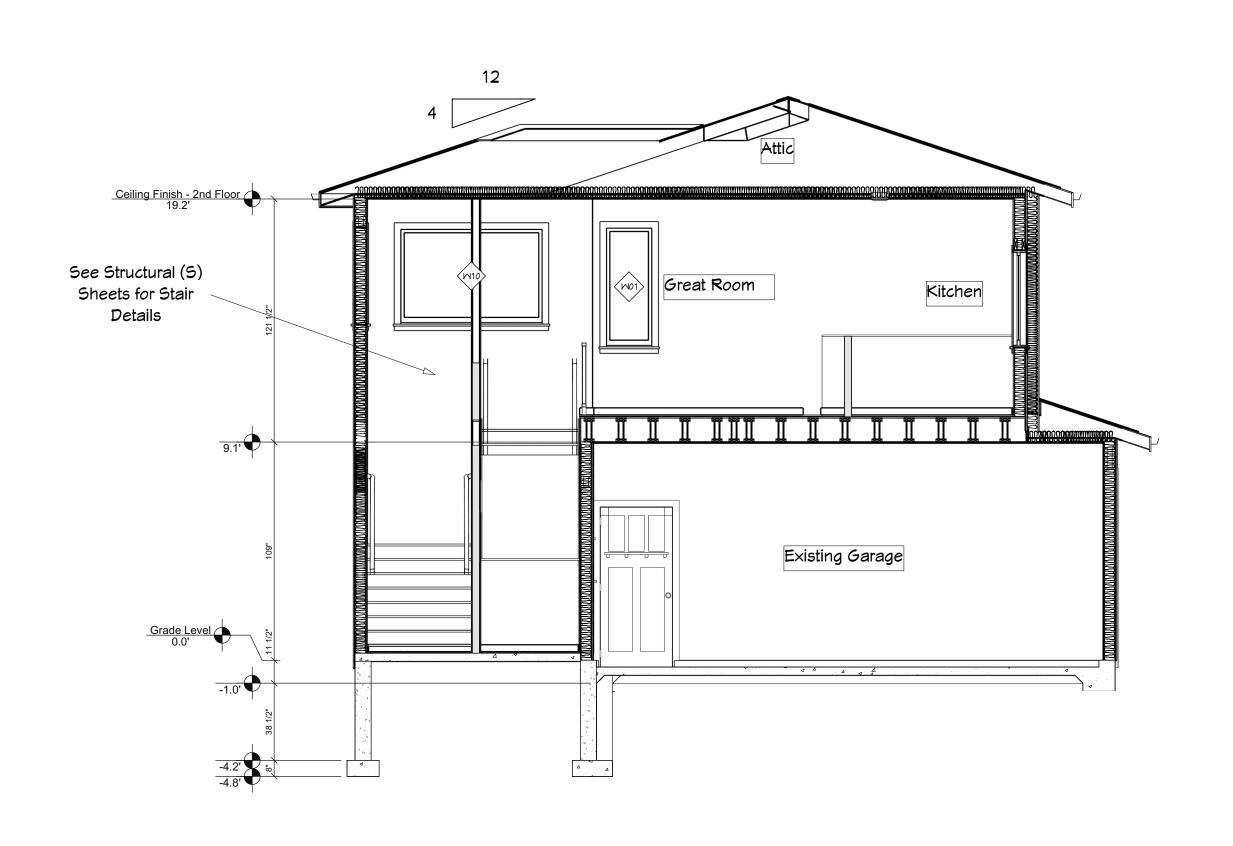



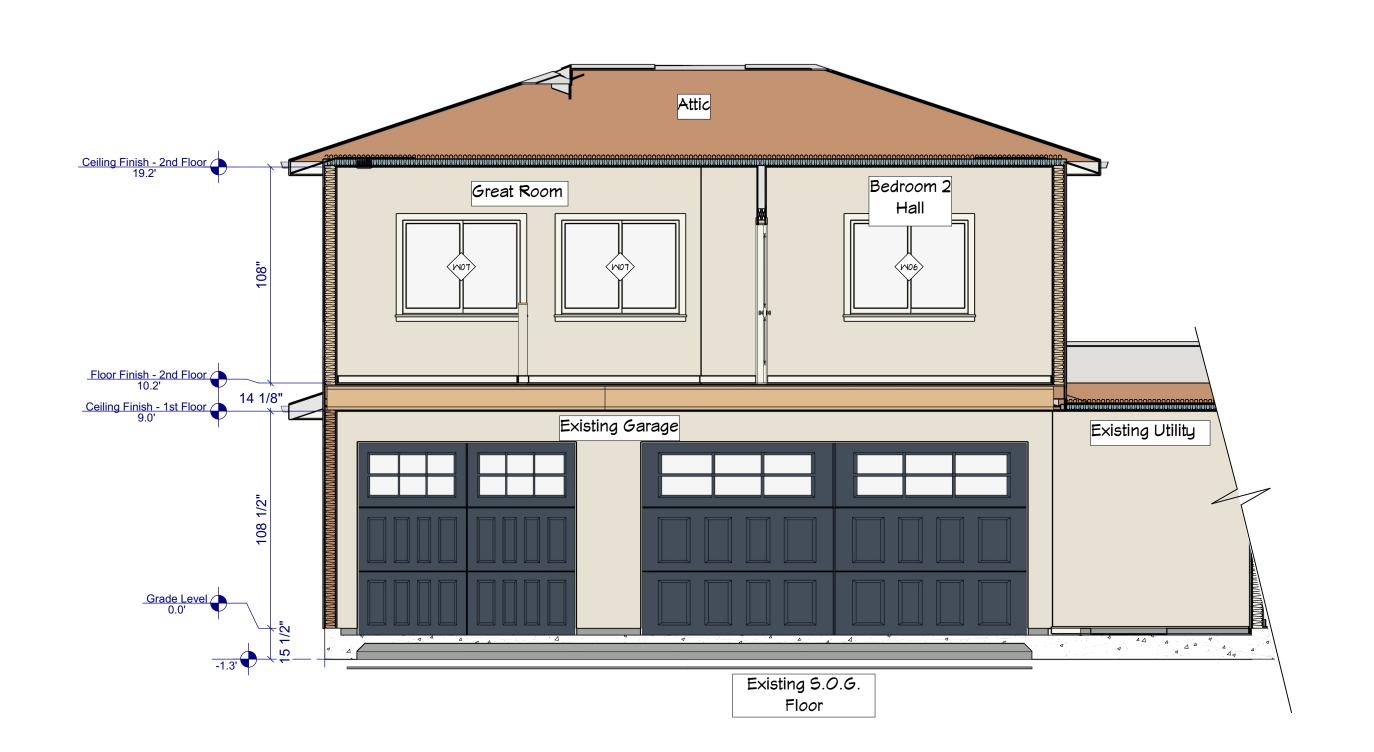



-UPPER FLOOR CEILING ASSEMBLY:

Bottom Truss Ceiling Min. R-49 Batt Insulation 1/2" GWB

TYP. EXTERIOR WALL CONSTRUCTION:

Siding to match existing Wood Lap house siding. 5# felt building wrap 2x6 studs @ 16 OC (std framing) Min. R-21 Batt Insulation (Heated Spaces) 1/2" GWB @ inside face per plan

-UPPER FLOOR ASSEMBLY:


See Structural for Floor Joists & subfloor details

1HR U311 STC 50 - CEILING ASSEMBLY

U311: Resilient furring channels attached 24" o.c. horizontally to one side of 2x4 wood studs 16" or 24" o.c. with 1-1/4" type W screws. 1/2" x 3" gypsum board filler strips attached to floor and ceiling plates with 1-1/4" type W screws 3'-0" o.c. 5/8" (15.9 mm) Fire-Shield C Gypsum Board applied horizontally to channel with 1" type S screws 12" o.c. on all edges and intermediate channels and attrached to top and bottom plates with 1-7/8" type S screws 12" o.c. Vertical butt joints between studs back-blocked with 20" long piece of resilient channel. 5/8" (15.9 mm) Fire-Shield C Gypsum Board applied horizontally on opposite side directly to wood studs with 1-1/4" type W screws spaced 12" o.c. Horizontall joints in line, vertical joints staggered each side. Mineral wool insulation 3" thick friction fit between studs.

FLOOR ASSEMBLY:

Finish floor by owner New S.O.G. Concrete floor Min. R10 Rigid Insulation Compact Crushed Rock

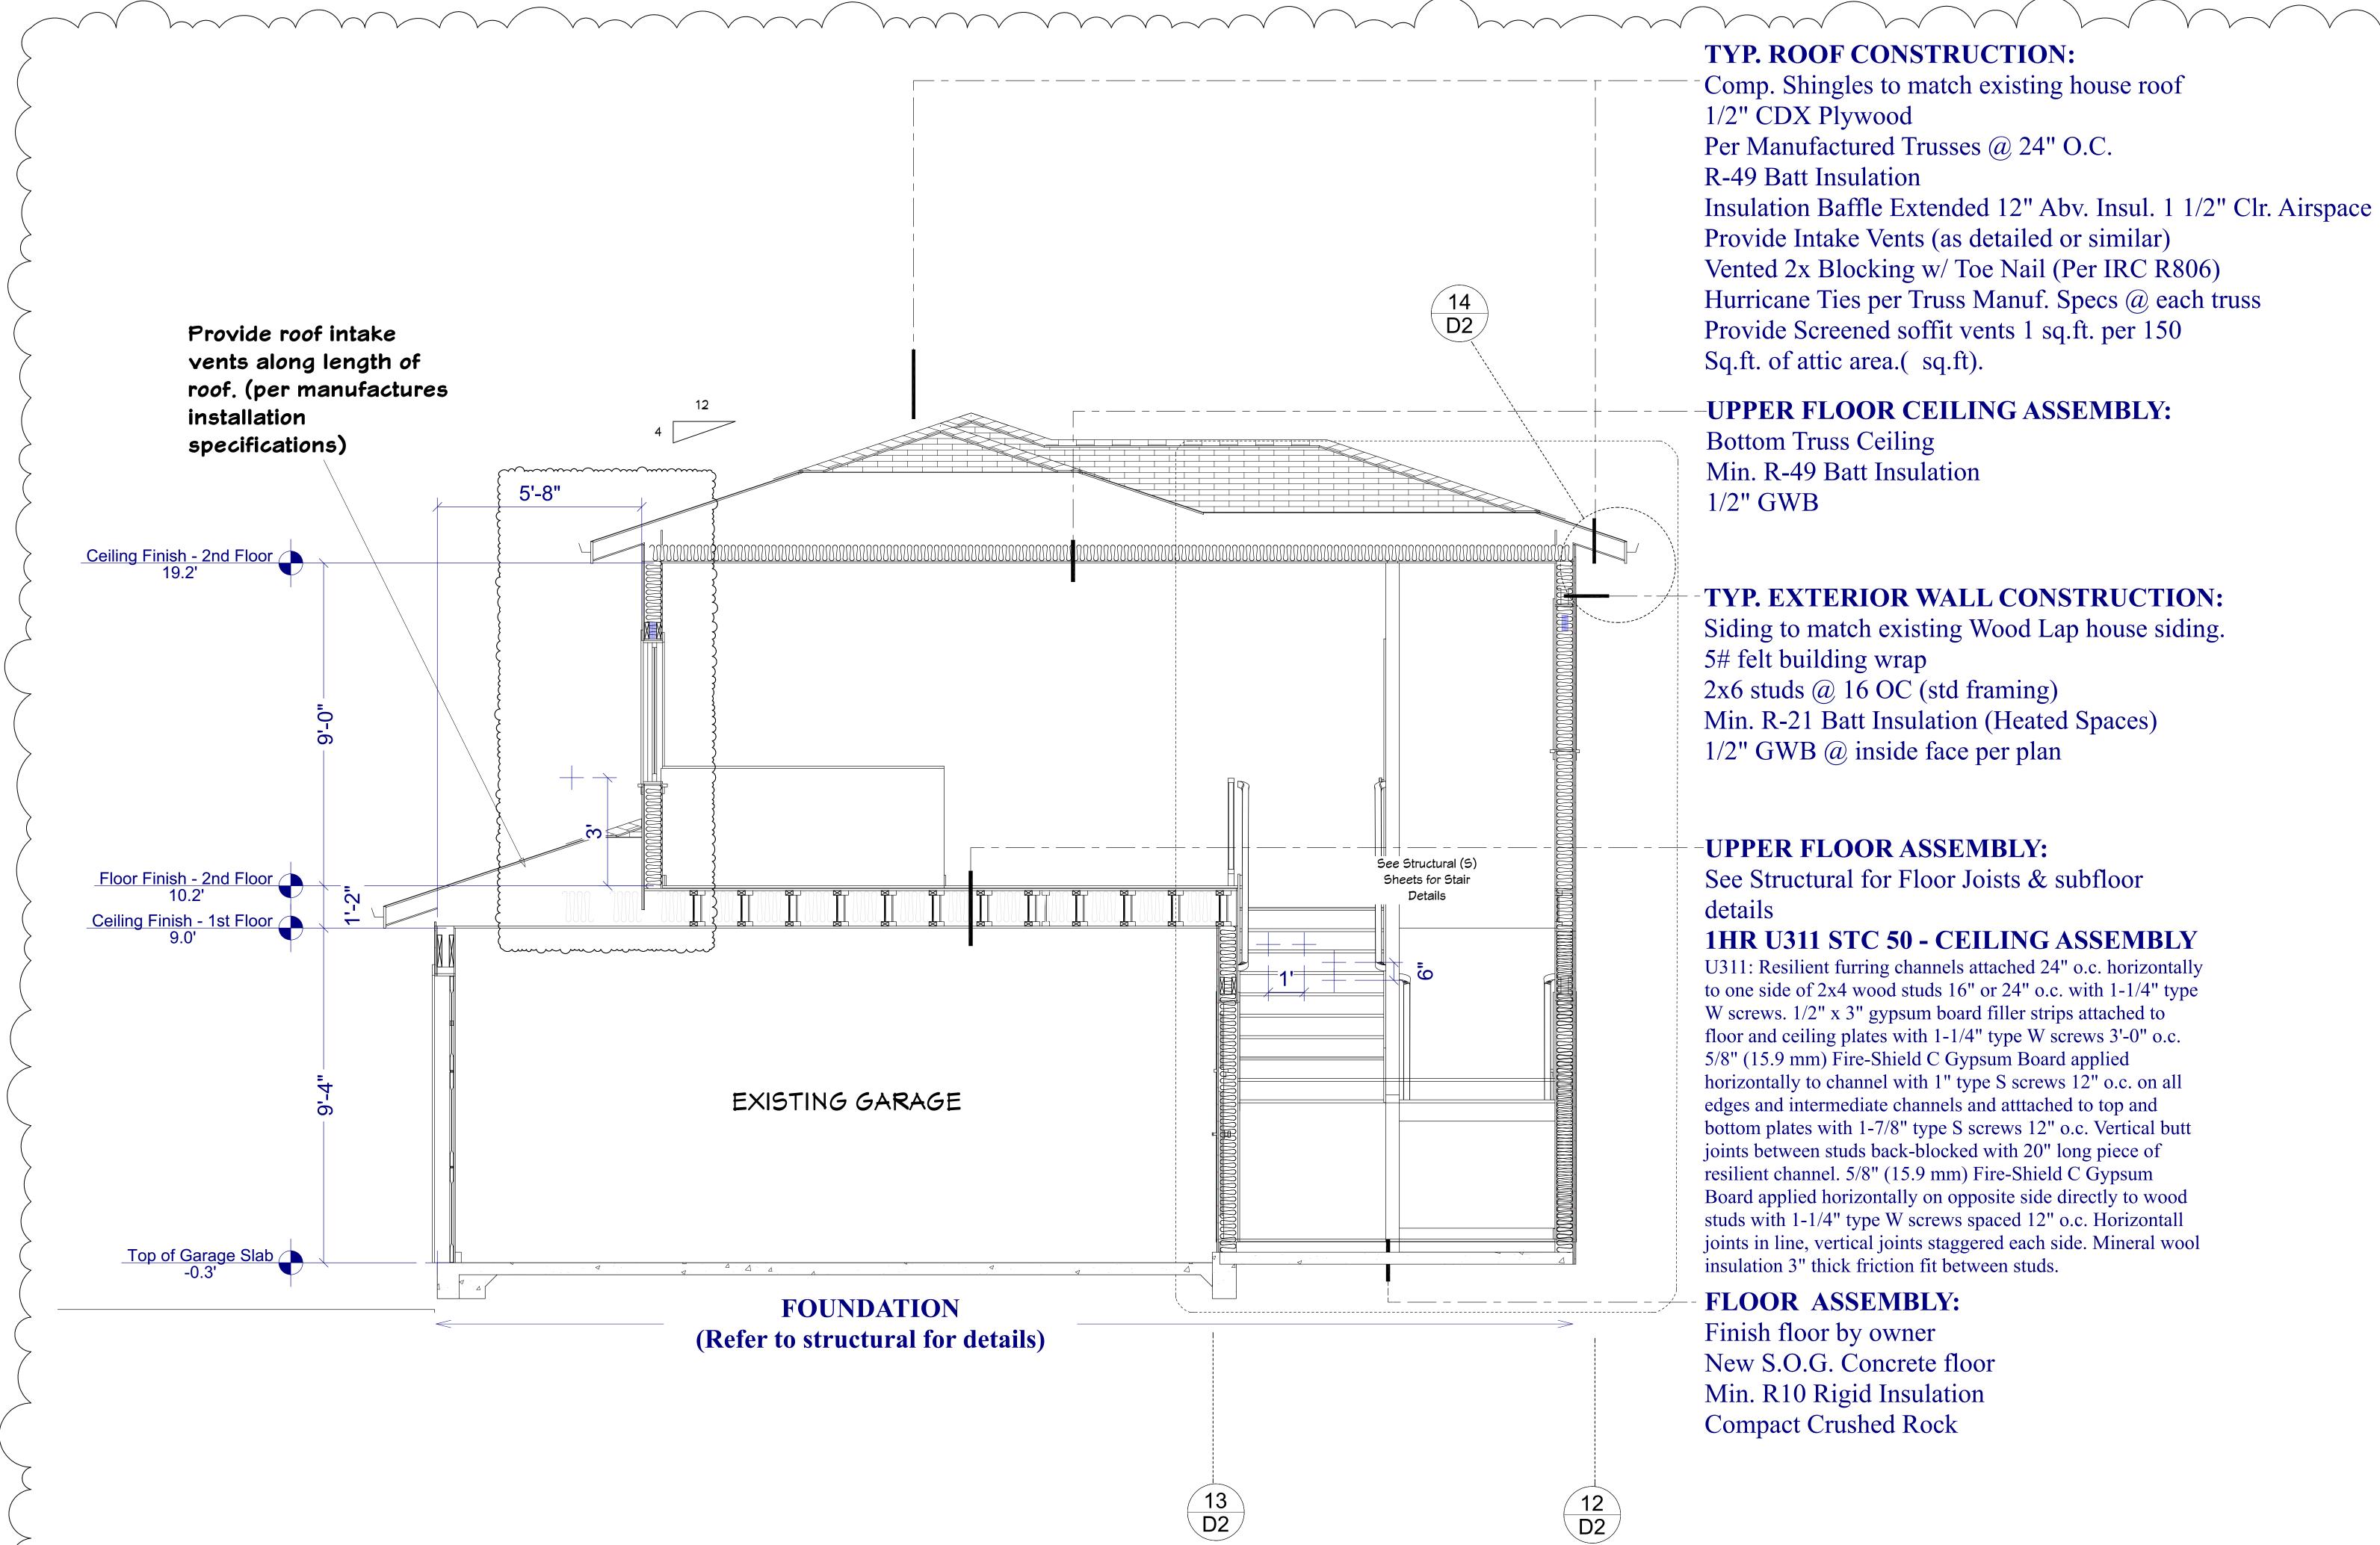



SECTION SCALE: 1/2" = 1'-0"


COMPLIANCE PATH PRESCRIPTIVE: International Residential Code 2018 (IRC 2018) with MA State Amendments

KESH DESIGN LINES LLC

SEE NEW STRUCTURAL (S) SHEETS

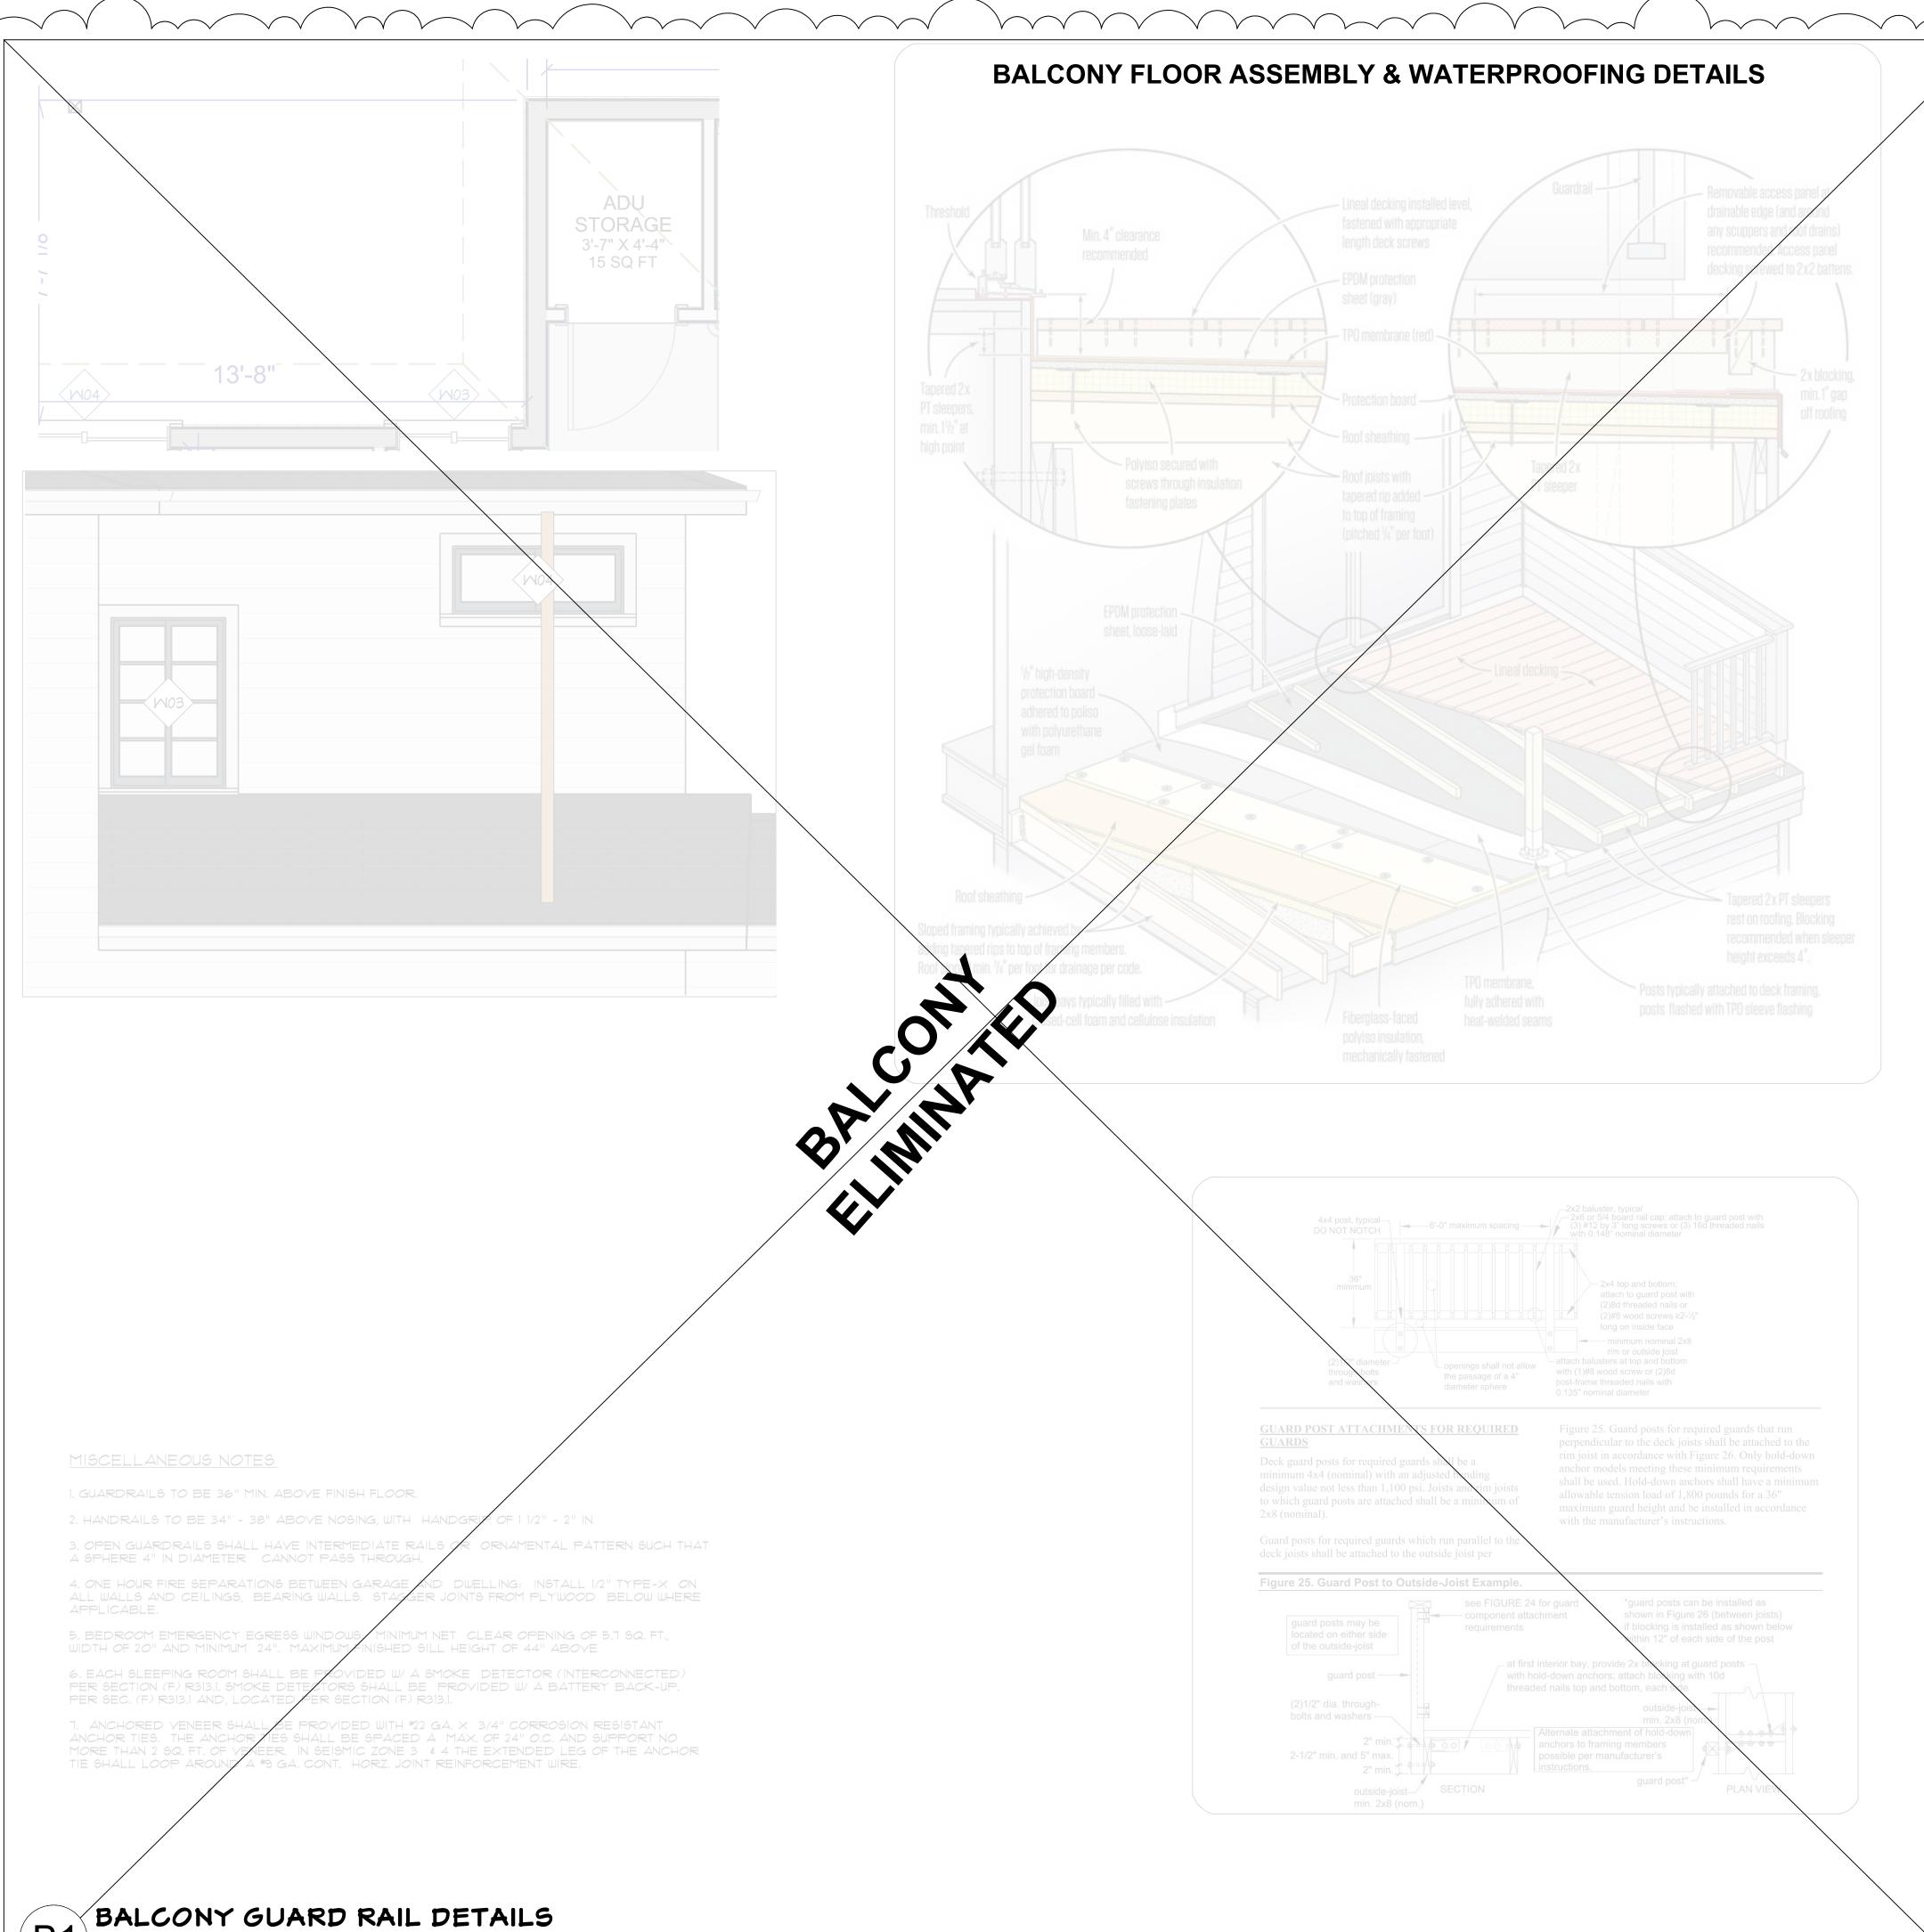

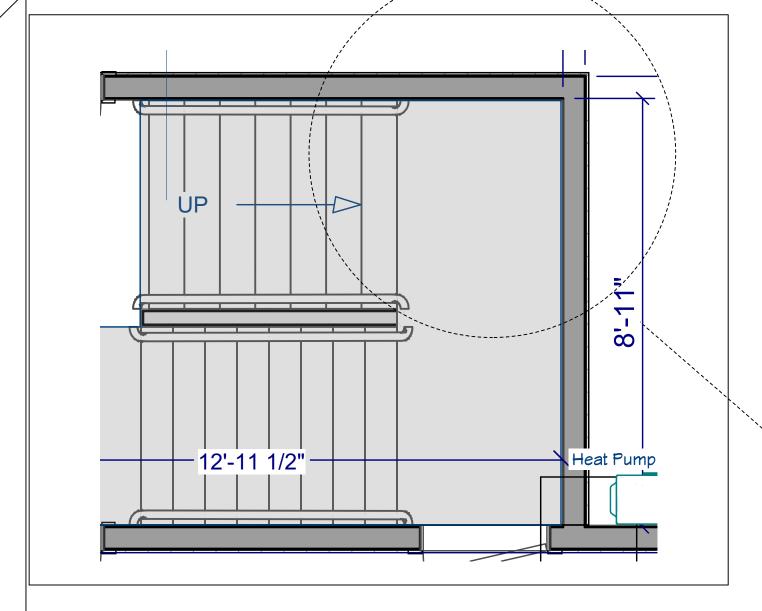

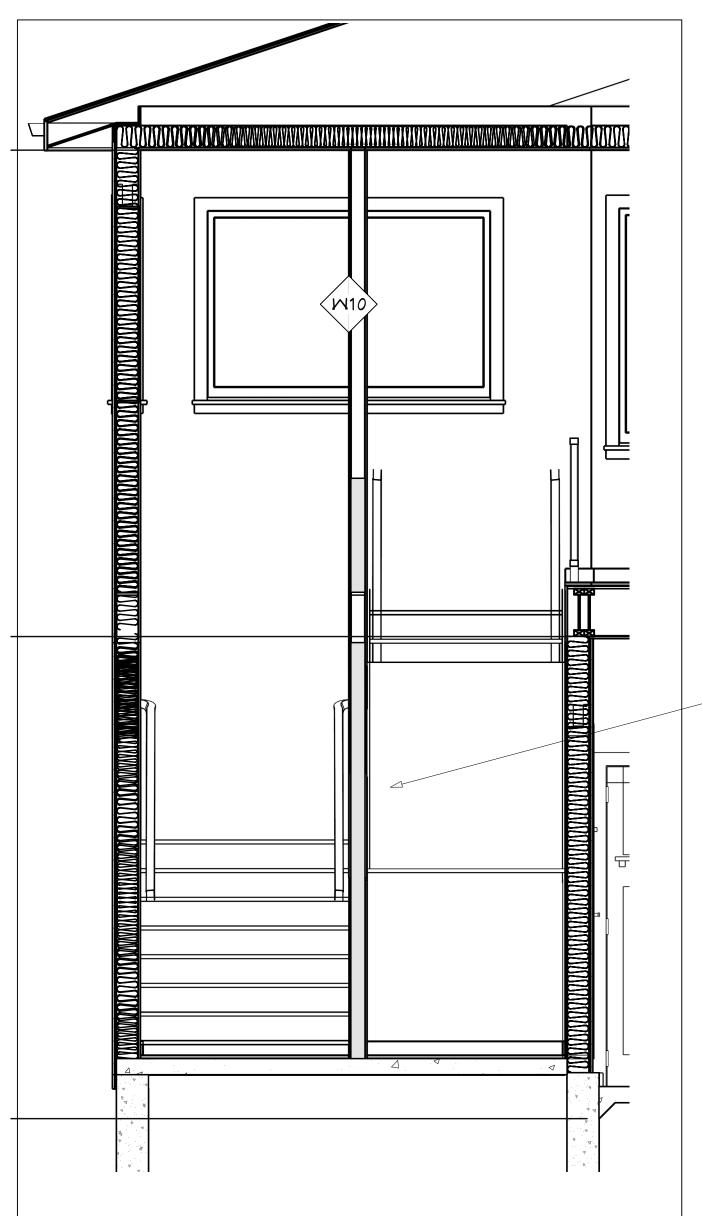

See Structural (S) Sheets for Stair Details

STAIR DETAILS

24" O.C. TYPICAL UN.O.

3. ALL TRUSSES TO BE AT 24" O.C.

2. ALL RAFTERS TO BE: 2x12 HF *2 AT

TYPICAL UN.O.

4. PROVIDE ROOF VENTS PER SEC.

R806 IRC.

5. ROOF PITCH TO BE 4 : 12 PICAL

UNLESS OTHERWISE NOTED.

6. 36" O.H. TYPICAL @ EAVES & 6" O.H. TYPICAL @ GABLE ENDS, RAKES.

7. APPROVED ANCHORS SHALL BE USED AT ALL CONNECTIONS OF RAFTERS, JACK OR HIP TRUSSES TO MAIN GIRDER TRUSS (PER TRUSS MANUF.) WHERE APPLICABLE. PROVIDE "SIMPSON" HI FRAMING ANCHORS AT EVERY RAFTER/TRUSS AT EACH END AND AT GABLE END TRUSSES.

 δ . VENTED BLOCKING OVER SUPPORTS

9. CHIMNEY HEIGHT TO BE 2'-0" MIN.
ABOVE ANY PORTION OF BUILDING
WITHIN 10'-0" PER IRC SECTION
RIOOLS

10. BRACING: (STICK FRAMED AREAS ONLY)

(2) 2x4 UP TO IO' LONG.
(2) 2x6 IO' TO I4' LONG.
(3) 2x6 OVER I4' LONG.

11. PLATE HEIGHTS:

* MAIN FLOOR 9'-O", TYP. UN.O. * UPPER FLOOR 9'-O", TYP. UN.O

12. TRUSSES:

SIMPSON STC).

CARRY MFGR. STAMP.
DO NOT ALTER WITHOUT BUILDING DEPARTMENT APPROVAL.

INSTALL AND BRACE PER MFGR. SPEC.
NON-BEARING WALLS SHALL BE HELD DOWN FROM THE TRUSS BOTTOM CHORDS WITH AN APPROVED FASTENER (SUCH AS

13. CONTRACTOR TO VERIFY LOCATION OF ALL ROOF SUPPORT BRACING OR POSTING AND PROVIDE ADEQUATE BEARING TO FOUNDATION.

14. HANGERS AT POSITIVE CONNECTIONS TO BE SIMPSON OR EQUAL.

TRUSS FRAMING NOTES

TRUSS ENGINEERING: PER IRC R802.10.1
TRUSS ENGINEER OF RECORD WHO WILL
REVIEW, APPROVE AND NOTE ON THE
DOCUMENTS THAT THEY HAVE FOUND TO
BE IN GENERAL CONFORMANCE WITH
THE DESIGN OF THE BUILDING. THE
ENGINEER-APPROVED DOCUMENTS WILL
THEN BE FORWARDED TO THE BUILDING
OFFICIAL FOR REVIEW AND APPROVAL
'PRIOR TO FRAMING INSPECTION'. CITY
APPROVED DOCUMENTS SHALL BE ON
THE JOB SITE AT INSPECTIONS. TRUSS
ENGINEERING SHALL INCLUDE SPECIFIC
TRUSS BRACING REQUIREMENTS.

NOTE

VENTILATION GALCULATIONS
AND REQUIREMENTS

AT LEAST 40% & NOT MORE THAN 50% OF REQUIRED VENTS SHALL BE IN UPPER PORTION OF VENTILATED ROOF SPACE (MIN. 3' ABOVE EAVE OR CORNICE VENTS) WITH THE BALANCE OF REQUIRED VENTILATION PROVIDED BY EAVE VENTING

PER IRC 806.1 ENCLOSED ATTICS AND ENCLOSED RAFTER SPACES FOR WHERE CEILINGS ARE APPLIED DIRECTLY TO THE UNDERSIDE OF ROOF RAFTERS SHALL HAVE CROSS VENTILATION OF EACH SEPARATE SPACE BY VENTILATING OPENINGS PROTECTED AGAINST THE ENTRANCE OF RAIN OR SNOW. VENTILATING OPENINGS SHALL BE PROVIDED WITH CORROSION RESISTANT WIRE MESH, WITH 1/8" MIN. 4 1/4" MAX. OPENINGS.


IF EAVE VENTS ARE INSTALLED INSULATION SHALL NOT OBSTRUCT THE FREE FLOW OF AIR (MIN. 1" SPACE BETWEEN INSULATION AND ROOF SHEATHING: @ VENT LOCATION.

BAFFLING OF THE VENT OPENINGS SHALL BE INSTALLED. BAFFLES SHALL BE RIGID AND WIND-DRIVEN MOISTURE RESISTANT. IF FEASIBLE BAFFLES SHOULD BE INSTALLED FROM THE TOP OF THE OUTSIDE OF THE EXTERIOR WALL, EXTENDING INWARD, TO A POINT 6" VERTICALLY ABOVE THE HEIGHT OF NON-COMPRESSED INSULATION, \$ 12" VERTICALLY ABOVE LOOSE FILL INSULATION. (ALL CALCULATIONS WILL BE NET FREE AREA)

1444 SQ. FT. OF ATTIC AREA/300=4.81 SQ. FT. OF VENTILATION REQUIRED (694 SQ. INCHES) HIGH VENT = 347 Sq. In. LOW VENT = 347 Sq. In.

> NOTE: EAVE VENTING PROVIDED BY (3)-2" DIAMETER "BIRD HOLES" PER EAVE BLOCK. (71/2" Sq. In. PER BLOCK).

NOTE: UPPER ROOF VENTING PROVIDED BY 1"X1" ROOF VENTS. (49 # IN. PER VENT) EPDM or OTHER MEMBRANE ROOF ON LOWER LEVEL (per manufactures installation instructions)

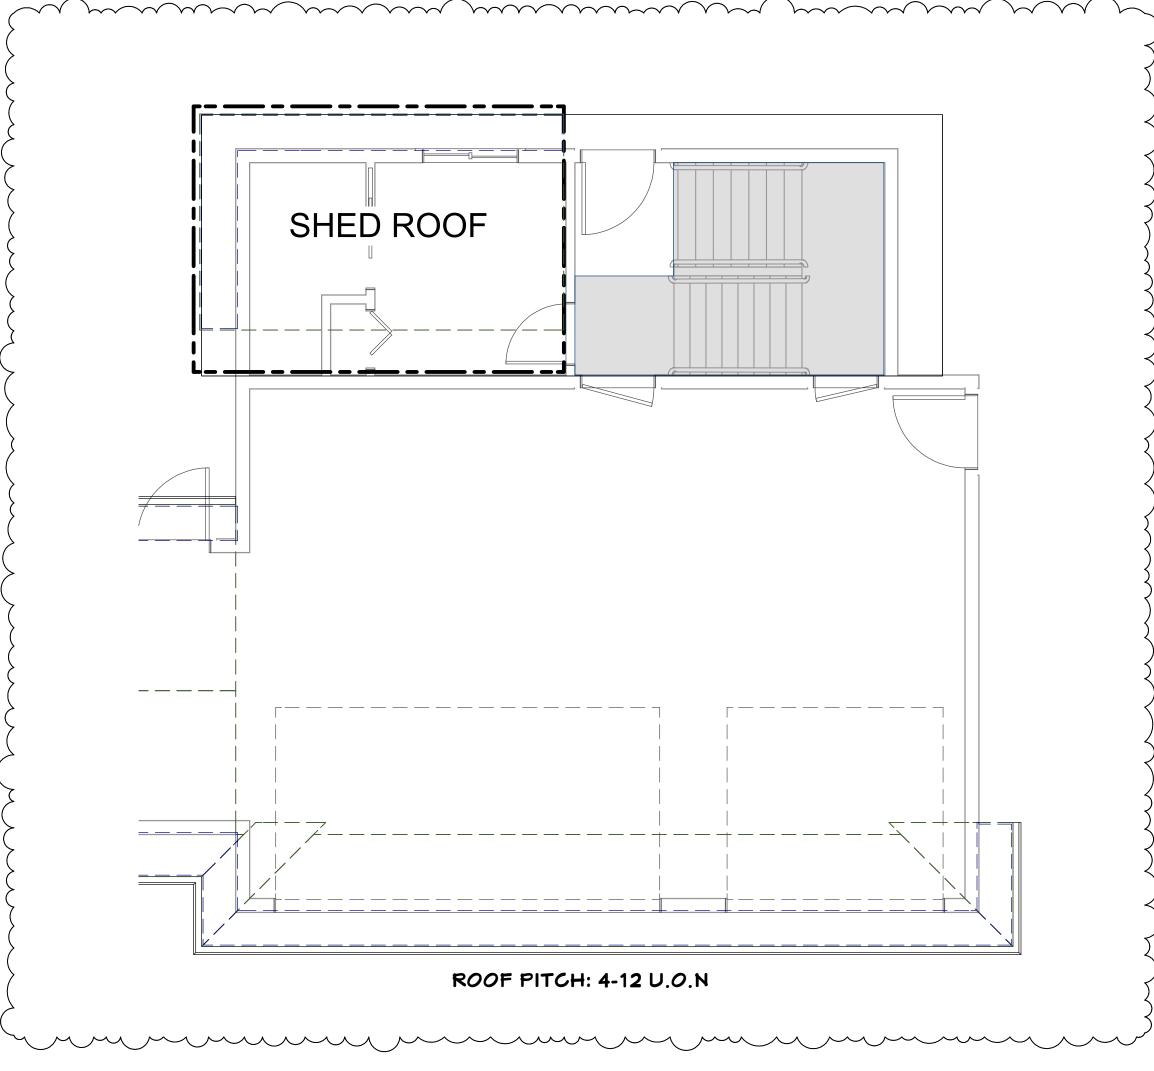

FLAT ROOF DETAILS FB-221 Through Wall Scupper - Isometric Through Wall Scupper Detail TPA COATED METAL SCUPPER TPA COATED METAL SLE TPA FLEECE BACKED MEMBRANE - HEAT WELDED LAPS BACKER ROD AIR SEAL ON ALL FOUR FLANGES EAT WELDED LAPS D WOOD NAILER CE BACKED MEMBRAN (METAL ONLY) VE OR HOT ASPHALT MEMBRANE SET IN **ROOF INSULATION** COPING AFTER IN-STALLATION. CORNERS TPA STRIP OVER COATED METAL SEE DETAIL FB-220 FB-222 Gravel Stop - Scupper 232 Roof Edge with Gutter - TPA MEMBRANE STRIP BOND BREAKER TPA COATED METAL DRIP STAGGERED 3" O.C. - HEAT WELD TPA MEMBRANE - SHEET METAL GUTTER - WOOD NAILER TPA FLEECE BACKED OR HOT ASPHALT METAL, FASTEN 16" O.C NOTES: FOR FASCI N 8" INSTALL IN TWO SECTIONS

ROOF PLAN

SCALE: 1/4" = 1'-0"

FIREBLOCKING AND DRAFTSTOPPING

PER IRC SECTION R602.8 FIREBLOCKING SHALL BE PROVIDED TO CUT OFF ALL CONCEALED VERTICAL AND HORIZONTAL DRAFT OPENINGS AND TO FORM AN EFFECTIVE FIRE BARRIER BETWEEN STORIES AND BETWEEN A TOP STORY AND THE ROOF SPACE. FIREBLOCKING SHALL BE PROVIDED IN WOOD FRAME CONSTRUCTION IN THE FOLLOWING LOCATIONS:

1) IN CONCEALED SPACED OF STUD WALLS AND PARTITIONS, INCLUDING FURRED SPACES AND PARALLEL ROWS OF STUDS OR STAGGERED STUDS AS FOLLOWS: A) VERTICALLY AT THE CEILING AND FLOOR LEVELS. B) HORIZONTALLY AT INTERVALS NOT EXCEEDING 10 FEET.

2) AT ALL INTERCONNECTIONS BETWEEN CONCEALED VERTICAL AND HORIZONTAL SPACES SUCH AS OCCUR IN SOFFITS, DROP CEILINGS, AND COVE CEILINGS.
3) IN CONCEALED SPACES BETWEEN STAIR STRINGERS AT THE TOP AND BOTTOM OF THE RUN. ENCLOSED SPACES UNDER STAIRS SHALL COMPLY WITH SECTION PRIVATE.

STAIRS SHALL COMPLY WITH SECTION R31122.

4) AT OPENINGS AROUND VENTS, PIPES, DUCTS, CABLES AND WIRES AT CEILING AND FLOOR LEVEL, WITH AN APROVED MATERIAL TO RESIST THE FREE PASSAGE OF FLAME AND PRODUCTS OF COMBUSTION.

5) FOR THE FIREBLOCKING OF CHIMNEYS AND FIREPLACES SEE IRC SECTION RIOO3.19
6) FIREBLOCKING OF CORNICES OF A TWO FAMILY DWELLING IS REQUIRED AT THE LINE OF DWELLING UNIT SEPERATION.
FIREBLOCKING MATERIALS SHALL CONSIST OF MATERIAL LISTED IN IRC SECTION R602.8.1. LOOSE FILL INSULATION
MATERIAL SHALL NOT BE USED AS A FIREBLOCK UNLESS SPECIFICALLY TESTED IN THE FORM AND MANNER INTENDED.
THE INTEGRITY OF ALL FIREBLOCKS SHALL BE MAINTAINED.

PER IRC SECTION R502.12 DRAFTSTOPPING: WHEN THERE IS USABLE SPACE BOTH ABOVE AND BELOW THE CONCEALED SPACE OF A FLOOR/CEILING ASSEMBLY, DRAFTSTOPS SHALL BE INSTALLED SO THAT THE AREA OF THE CONCEALED SPACE DOES NOT EXCEED 1,000 SF. DRAFTSTOPPING SHALL DIVIDE THE CONCEALED SPACE INTO APROX. EQUAL AREAS. WHERE THE ASSEMBLY IS ENCLOSED BY A FLOOR MEMBRANE ABOVE AND A CEILING MEMBRANE BELOW DRAFTSTOPPING. SHALL BE PROVIDED IN FLOOR/CEILING ASSEMBLIES UNDER THE FOLLOWING CIRCUMSTANCES:

1) CEILING IS SUSPENDED UNDER THE FLOOR FRAMING.

2) FLOOR FRAMING IS CONSTRUCTED OF TRUSS-TYPE OPEN-WEB OR PERFORATED MEMBERS.

DRAFTSTOPING MATERIALS SHALL CONSIST OF MATERIALS LISTED IN IRC SECTION R502.12.1.

WOOD TRUSSES

TRUSSES SHALL BE DESIGNED BY A REGISTERED WASHINGTON STATE ENGINEER AND FABRICATED FROM ONLY THESE DESIGNS. TRUSSES TO BE STAMPED BY THE MANUFACTURER OR BY A QUALITY CONTROL AGENCY SUCH AS THE WASHINGTON STATE TRUSS FABRICATORS COUNCIL. ROOF TRUSS DESIGN SHALL BE SUBMITTED FOR APPROVAL PRIOR TO FABRICATION. NON-BEARING WALLS SHALL BE HELD AWAY FROM THE TRUSS BOTTOM CHORD WITH AN APPROVED FASTENER (SUCH AS SIMPSON STC) TO ENSURE THAT THE TRUSS BOTTOM CHORD WILL NOT BEAR ON THE WALL. APPROVED HANGERS SHALL BE USED AT ALL CONNECTIONS OF RAFTERS, JACK OR HIP TRUSSES TO THE MAIN GIRDER TRUSS. ALL ROOF TRUSSES SHALL BE FRAMED AND TIED INTO THE FRAME WORK AND SUPPORTING WALLS SO AS TO FORM AN INTEGRAL PART OF THE WHOLE BUILDING. ROOF TRUSSES SHALL HAVE JOINTS WELL FITTED AND SHALL HAVE ALL TENSION MEMBERS WELL TIGHTENED BEFORE ANY LOAD IS PLACED UPON THE TRUSS. DIAGONAL AND SWAY BRACING SHALL BE USED TO BRACE ALL TRUSSES. TRUSSES SHALL BE DESIGNED FOR UNIFORM LOADING AS FOLLOWS:

TOP CHORD 35 PSF OF TRIBUTARY AREA BOTTOM CHORD 10 PSF OF TRIBUTARY AREA

ILE ROOF 45 PSF TOP CHORD AND 5 PSF BOTTOM CHORD

5/8" FORE CLAY (OR EQUIVALENT) PER IRC SECTION RIOOI.8

Per R802.10 Wood Trusses

ATTIC VENTILATION:
AREA / 300

PROVIDE 1" MIN. AIR GAP AT
EAVES WITH INSULATION
BAFFLES TYP. AT ALL

TRUSS BAYS.

PROVIDE GABLE VENTS ALL

ROOFLINE ABOVE

CONDITIONED AREA.

GABLE ENDS.

PROVIDE GALV. ROOF
VENTS ON BACKSIDE OF

1. ALL TRUSSES SHALL CARRY MANUFACTURERS STAMP.

2. ALL TRUSSES SHALL BE INSTALLED & BRACED TO MANUFACTURERS SPECIFICATIONS.

3. ALL TRUSSES WILL NOT BE FIELD ALTERED WITHOUT PRIOR BUILDING DEPT. APPROVAL OF ENGINEERING CALCULATIONS.

4. ALL TRUSSES SHALL HAVE DESIGN DETAILS & DRAWINGS ON SITE FOR FRAMING INSPECTION.

5. NON BEARING WALLS SHOULD BE HELD DOWN FROM THE TRUSS BOTTOM CHORD W/ SIMPSON STC TO INSURE THAT THE TRUSS BOTTOM CHORD WILL NOT BEAR ON THE WALL.

6. ALL CONNECTIONS OF RAFTERS, JACK OR HIP TRUSSES TO MAIN GIRDER TO BE PROVIDED BY TRUSS MANUFACTURE.


7. ALL ROOF FRAMING 24" O.C

8. ALL ROOF PITCH 8:12

9. SCISSORS TRUSS CEILING PITCH 2:12.

10. TRUSSES MANUFACTURED BY (TO BE DETERMINED)

11. ALL OVERHANGS 16".

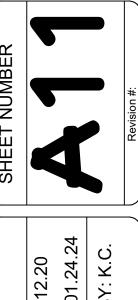

DATE: 06.12.20 REV #12: 01.24.24

OOF PLAN

TOM & KIM TSO ADDITION & ADL

1 DE SIGN LINES LI



TOM & KIM .

ADDITION &

BB02 SE 37th ST. MERCER ISLAND KESH PESIGN LINES LLC 425 544 9906

SEE NEW STRUCTURAL (S) SHEETS

	MINDOM SCHEDULE									
ROOM NAME	NUMBER	QTY	FLOOR	MIDTH	HEIGHT	EGR	TEM		U-FACTOR	3D EXTERIOR ELEVATION
ADU GREAT	M 01	1	2	24"	60"			SINGLE CASEMENT-HR	0. 2 8	
ADU BEDR <i>OO</i> M 1	M02	1	1	48"	48"	YES		LEFT SLIDING	0. 2 8	
ADU GREAT	M03	1	2	32 1/8"	48"			LEFT SLIDING	0. 2 8	
ADU BATH	M04	1	2	48"	19"			LEFT SLIDING	0.28	
ADU BEDROOM 1	M06	1	2	60"	48"	YES		RIGHT SLIDING	0.28	
ADU GREAT	MOT	2	2	60"	48"	YES		RIGHT SLIDING	0.28	
ADU OPEN BELOW	W 10	2	2	72"	48"		YES	FIXED GLASS	0. 2 8	

DOORS AND WINDOWS

DOORS TO THE EXTERIOR SHALL HAVE MAX. 1 3/4" STEP TO MIN 36" DEEP \times (12" + OPERABLE DOOR WIDTH) MIN. LANDING ALL GLAZING TO BE PER WSEC TABLE 6-1 UNLESS NOTED

ALL SKYLIGHTS AND SKYWALLS TO BE SAFETY LAMINATED GLASS UNLESS NOTED OTHERWISE. FRENCH DOORS TO BE DOUBLE GLAZED NON TESTED ASSUMED U VALUE OF .90, UNLESS NOTED

OTHERWISE, WITH SAFETY GLAZING. FACTORY BUILT WINDOWS TO BE CONSTRUCTED TO PERMIT MAXIMUM INFILTRATION OF 0.5 CFM PER LINEAL FOOT OF OPERABLE SASH PERIMETER AS TESTED BY STANDARD ASTM E 283.73.

CRITERIA ABOVE: BUT MUST BE MADE TIGHTLY FITTING AND WEATHER STRIPPED OR CAULKED.

SLIDING GLASS DOORS TO PERMIT MAXIMUM INFILTRATION OF 0.5 CFM INFILTRATION PER SQUARE FOOT OF DOOR AREA. EACH LIGHT SHALL BEAR THE MANUFACTURER'S LABEL DESIGNATING THE TYPE AND THICKNESS OF GLASS. IDENTIFICATION OF GLAZING, IN HAZARDOUS LOCATIONS SHALL BE IN ACCORDANCE WITH IRC, SECTION (B) 308.4

SITE BUILT AND MILL WORK SHOP BUILT WOODEN SASH ARE EXEMPT FROM INFILTRATION

PROVIDE SOLID CORE DOORS @ ENTRY AND FROM GARAGE TO LIVING AREAS (AS WELL AS ANY OTHER DOORS TO THE EXTERIOR: PROVIDE SELF-CLOSURE DEVICE ON DOOR TO GARAGE, PER IRC. SEE PLANS FOR:

- MAXIMUM GLAZING AREA. - GLAZING MFG. AND MODEL NUMBERS.

- WEIGHTED UA CALCULATION FOR SUB-STANDARD GLAZING.

SAFETY GLAZING LOCATIONS AS PER IRC SECTION (B) 308.4:

INGRESS AND EGRESS DOORS 2. SLIDING GLASS DOORS, SWINGING GLASS DOORS

3. SHOWER AND BATHTUB ENCLOSURES 4. GLAZING W/ THE EXPOSED EDGE WITHIN A 24" ARC OF EITHER VERTICAL EDGE OF A DOOR IN THE CLOSED POSITION, \$ BOTTOM EDGE IS LESS THAN 60" ABOVE THE WALKING SURFACE

5. GLAZING GREATER THAN 9 S.F. LESS THAN 18" ABOVE FINISHED FLOOR 6. GLAZING IN GUARDRAILS

1. GLAZING IN STAIRWELLS AND WITHIN 3' OF TOP / BOTTOM OF STAIRS. UNLESS NOTED OTHERWISE, INSULATION TO BE PER WSEC TABLE 6-1 INSULATION BAFFLES TO MAINTAIN 1" ABOVE INSULATION

BAFFLES TO EXTEND 6" ABOVE BATT INSULATION. BAFFLES TO EXTEND 12" ABOVE LOOSE FILL INSULATION.

INSULATE BEHIND TUBS/SHOWERS, PARTITIONS AND CORNERS. FACE STAPLE BATTS
FRICTION FIT FACED BATTS
USE 4 MIL POLY VAPOR RETARDER AT WALLS

USE PVA PAINT WITH A DRY CUP PERM RATING OF I MAX.

- WALLS BETWEEN HOUSE AND GARAGE HAVE TO HAVE R-21 U.N.O. - FLOORS ABY CRAWL SPACES, GARAGE, OR AT CANTILEVERS OVER GRADE HAVE TO HAVE

- ALL ATTIC AT CEILINGS HAVE TO HAVE R-38 (MIN.) U.N.O. - DUCTS IN UNHEATED SPACES HAVE TO HAVE R-8 - GAS WATER HEATERS SHALL MEET REQUIREMENTS OF 2012 UPC AND BE SO LABELED.

MISCELLANEOUS NOTES

1. GUARDRAILS TO BE 36" MIN. ABOVE FINISH FLOOR.

2. HANDRAILS TO BE 34" - 38" ABOVE NOSING, WITH HANDGRIP OF 1 1/2" - 2" IN

3. OPEN GUARDRAILS SHALL HAVE INTERMEDIATE RAILS OR ORNAMENTAL PATTERN SUCH THAT A SPHERE 4" IN DIAMETER CANNOT PASS THROUGH.

4. ONE HOUR FIRE SEPARATIONS BETWEEN GARAGE AND DWELLING: INSTALL 1/2" TYPE-X ON ALL WALLS AND CEILINGS, BEARING WALLS. STAGGER JOINTS FROM PLYWOOD BELOW WHERE

5. BEDROOM EMERGENCY EGRESS WINDOWS: MINIMUM NET CLEAR OPENING OF 5.7 SQ. FT., WIDTH OF 20" AND MINIMUM 24". MAXIMUM FINISHED SILL HEIGHT OF 44" ABOVE

6. EACH SLEEPING ROOM SHALL BE PROVIDED W/ A SMOKE DETECTOR (INTERCONNECTED) PER SECTION (F) R313.1. SMOKE DETECTORS SHALL BE PROVIDED W/ A BATTERY BACK-UP. PER SEC. (F) R313.1 AND, LOCATED PER SECTION (F) R313.1.

7. ANCHORED VENEER SHALL BE PROVIDED WITH #22 GA. X 3/4" CORROSION RESISTANT ANCHOR TIES. THE ANCHOR TIES SHALL BE SPACED A MAX. OF 24" O.C. AND SUPPORT NO MORE THAN 2 SQ. FT. OF VENEER. IN SEISMIC ZONE 3 \$ 4 THE EXTENDED LEG OF THE ANCHOR TIE SHALL LOOP AROUND A #9 GA. CONT. HORZ. JOINT REINFORCEMENT WIRE.

2018 Washington State Energy Code – Residential Prescriptive Energy Code Compliance for All Climate Zones in Washington Single Family – New & Additions (effective February 1, 2021)

These requirements apply to all IRC building types, including detached one- and two-family dwellings and multiple single-family dwellings (townhouses).

Project Information
8802 SE 37th ST. MERCER ISLAND WA 98040

Contact Information Kesh Chavda - KDL Designs LLC 425 344 9906

Instructions: This single-family project will use the requirements of the Prescriptive Path below and incorporate the minimum values listed. Based on the size of the structure, the appropriate number of additional credits are checked as chosen by the permit applicant.

Provide all information from the following tables as building permit drawings: Table R402.1 - Insulation and Fenestration Requirements by Component, Table R406.2 - Fuel Normalization Credits and 406.3 - Energy Credits.

Authorized Representative	Kesh Chavda	Date 04/12/2022
	All Climate Zones (Table R402.1.1	1)
	R-Value a	U-Factor ^a
Fenestration U-Factor ^b	n/a	0.30
Skylight U-Factor ^b	n/a	0.50
Glazed Fenestration SHGC b,e	n/a	n/a
Ceiling ^e	49	0.026
Wood Frame Wall ^{g,h}	21 int	0.056
Floor	30	0.029
Below Grade Wall c,h	10/15/21 int + TB	0.042
Slab ^{d,f} R-Value & Depth	10, 2 ft	n/a

- R-values are minimums. U-factors and SHGC are maximums. When insulation is installed in a cavity that is less a than the label or design thickness of the insulation, the compressed *R*-value of the insulation from Appendix
- Table A101.4 shall not be less than the *R*-value specified in the table. b The fenestration *U*-factor column excludes skylights.
- "10/15/21 +5TB" means R-10 continuous insulation on the exterior of the wall, or R-15 continuous insulation on
- the interior of the wall, or R-21 cavity insulation plus a thermal break between the slab and the basement wall at c the interior of the basement wall. "10/15/21 +5TB" shall be permitted to be met with R-13 cavity insulation on the interior of the basement wall plus R-5 continuous insulation on the interior or exterior of the wall. "5TB"
- d R-10 continuous insulation is required under heated slab on grade floors. See Section R402.2.9.1. For single rafter- or joist-vaulted ceilings, the insulation may be reduced to R-38 if the full insulation depth
- extends over the top plate of the exterior wall.

means R-5 thermal break between floor slab and basement wall.

- R-7.5 continuous insulation installed over an existing slab is deemed to be equivalent to the required perimeter f slab insulation when applied to existing slabs complying with Section R503.1.1. If foam plastic is used, it shall
- meet the requirements for thermal barriers protecting foam plastics. For log structures developed in compliance with Standard ICC 400, log walls shall meet the requirements for
- g climate zone 5 of ICC 400.
- Int. (intermediate framing) denotes framing and insulation as described in Section A103.2.2 including standard
- h framing 16 inches on center, 78% of the wall cavity insulated and headers insulated with a minimum of R-10

Prescriptive Path – Single Family

2018 Washington State Energy Code-R

2018 Washington State Energy Code – Residential Prescriptive Energy Code Compliance for All Climate Zones in Washington

Single Family – New & Additions (effective February 1, 2021) Each dwelling unit *in a residential building* shall comply with sufficient options from Table R406.2 (fuel normalization credits) and Table 406.3 (energy credits) to achieve the following minimum number of credits. To claim this credit, the building permit drawings shall specify the option selected and the maximum tested building air leakage, and show the qualifying ventilation system and its control sequence

of operation. 1. Small Dwelling Unit: 3 credits

Dwelling units less than 1,500 sf in conditioned floor area with less than 300 sf of fenestration area.

Additions to existing building that are greater than 500 sf of heated floor area but less than 1,500 sf. 2. Medium Dwelling Unit: 6 credits

All dwelling units that are not included in #1 or #3

3. Large Dwelling Unit: 7 credits Dwelling units exceeding 5,000 sf of conditioned floor area

4. Additions less than 500 square feet: 1.5 credits All other additions shall meet 1-3 above

Before selecting your credits on this Summary table, review the details in Table 406.3 (Single Family), on page 4.

	Summary of Tal	ble R406.2 and	406.3	
Heating Options	Fuel Normalization Descriptions		select ONE g option	User Notes
1	Combustion heating minimum NAECA ^b	0.0		
2	Heat pump ^c	1.0	•	
3	Electric resistance heat only - furnace or zonal	-1.0		
4	DHP with zonal electric resistance per option 3.4	0.5		
5	All other heating systems	-1.0		
Energy Options	Energy Credit Option Descriptions	energy option	select ONE on from each gory ^d	
1.1	Efficient Building Envelope	0.5		
1.2	Efficient Building Envelope	1.0		
1.3	Efficient Building Envelope	0.5	•	
1.4	Efficient Building Envelope	1.0		
1.5	Efficient Building Envelope	2.0		
1.6	Efficient Building Envelope	3.0		
1.7	Efficient Building Envelope	0.5		
2.1	Air Leakage Control and Efficient Ventilation	0.5		
2.2	Air Leakage Control and Efficient Ventilation	1.0		
2.3	Air Leakage Control and Efficient Ventilation	1.5		
2.4	Air Leakage Control and Efficient Ventilation	2.0		
3.1ª	High Efficiency HVAC	1.0		
3.2	High Efficiency HVAC	1.0		
3.3ª	High Efficiency HVAC	1.5		
3.4	High Efficiency HVAC	1.5		
3.5	High Efficiency HVAC	1.5		
3.6ª	High Efficiency HVAC	2.0		
4.1	High Efficiency HVAC Distribution System	0.5		
4.2	High Efficiency HVAC Distribution System	1.0		

Prescriptive Path – Single Family

2018 Washington State Energy Code-R

2018 Washington State Energy Code – Residential Prescriptive Energy Code Compliance for All Climate Zones in Washington Single Family – New & Additions (effective February 1, 2021)

	Summary of Table R406.2 (cont.)							
Energy Options	Energy Credit Option Descriptions (cont.)	Credits - select ONE energy option from each category ^c		User	Notes			
5.1 ^d	Efficient Water Heating	0.5						
5.2	Efficient Water Heating	0.5						
5.3	Efficient Water Heating	1.0	•					
5.4	Efficient Water Heating	1.5						
5.5	Efficient Water Heating	2.0						
5.6	Efficient Water Heating	2.5						
6.1 ^e	Renewable Electric Energy (3 credits max)	1.0						
7.1	Appliance Package	0.5	V					
	Total Credits		3.0	Calculate Total	Clear Form			

a. An alternative heating source sized at a maximum of 0.5 W/sf (equivalent) of heated floor area or 500 W,

- whichever is bigger, may be installed in the dwelling unit.
- b. Equipment listed in Table C403.3.2(4) or C403.3.2(5) c. Equipment listed in Table C403.3.2(1) or C403.3.2(2)
- d. You cannot select more than one option from any category EXCEPT in category 5. Option 5.1 may be combined with options 5.2 through 5.6. See Table 406.3.
- e. 1.0 credit for each 1,200 kWh of electrical generation provided annually, up to 3 credits max.
- See the complete Table R406.2 for all requirements and option descriptions. f. Use the single radiobutton in the upper right of the second column to deselect radiobuttons in that group.

lease print only pages 1 through 3 of this worksheet for submission to your building officia

For Building Officials Only			

NOTE: See Sheet A.02 for:

APPLIANCE SPECS. HEAT PUMP SPECS. WATER HEATER SPECS.









(2) 8d NAILS @ 6" O.C. AT
"BIRD BLOCKING"
SHEATHING BREAK
(3) EXTEND WALL SHEATHING


- TO TOP OF DOUBLE TOP PLATE


 4 SIMPSON HI, SDWC 6", OR TLOCØ6 ® EACH TRUSS TO RAFTER PERPENDICULAR TOP PLATE INTERSECTION U.N.O. (2) H2.5A FOR MULTI PLY OR MULTI SDWC OR TLOCØ6 U.N.O.
- MFR TRUSSES @ 24" O.C. W/
 PLAN ROOF SHEATHING
 NAIL W/ 8d @ 6" O.C. FOR
 PANEL EDGES AND 12 O.C.
 IN FIELD
- 6 SHEATH ALL GABLE ENDS
- TOE NAIL BIRD BLOCKING
 W (2) 8d NAILS


ROOF SHEATHING

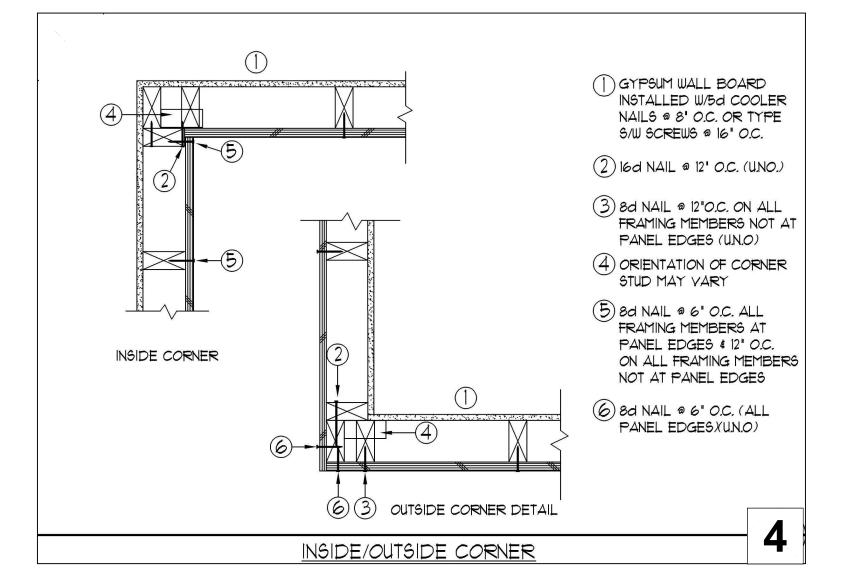


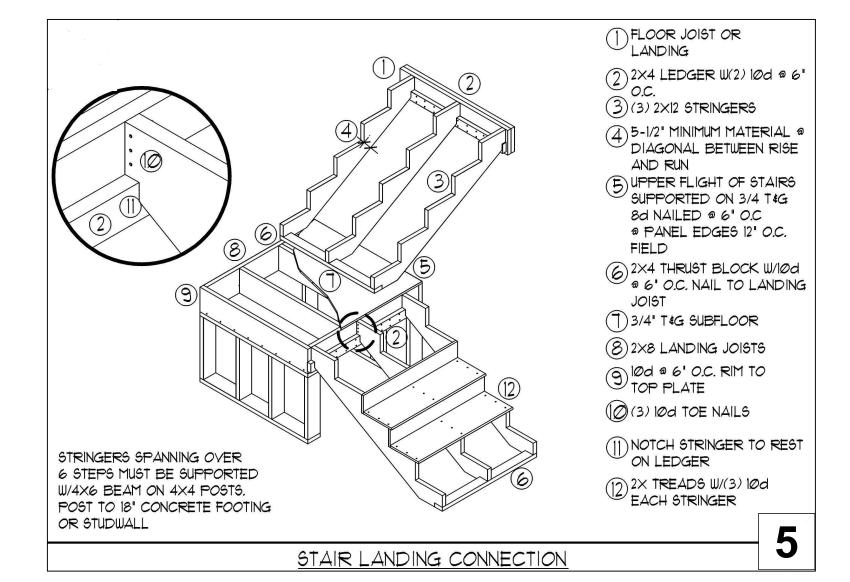


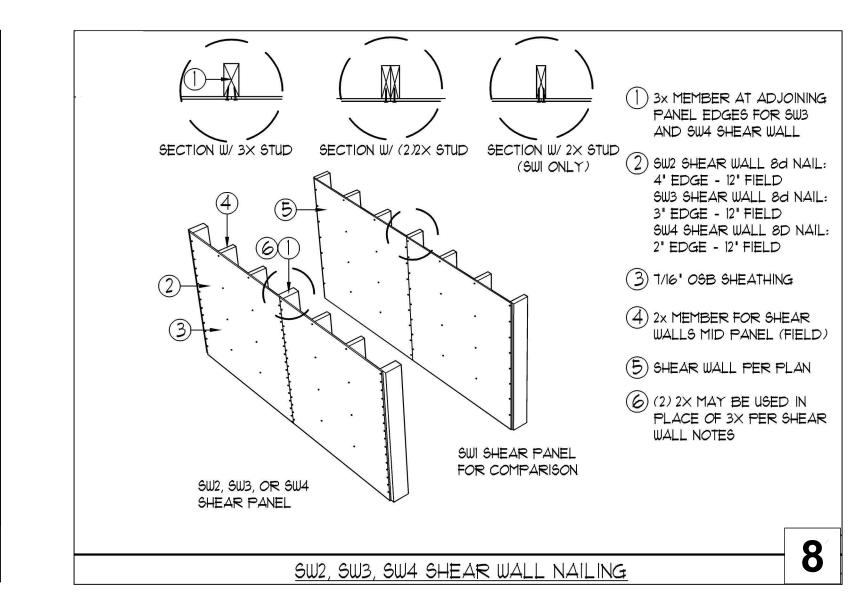

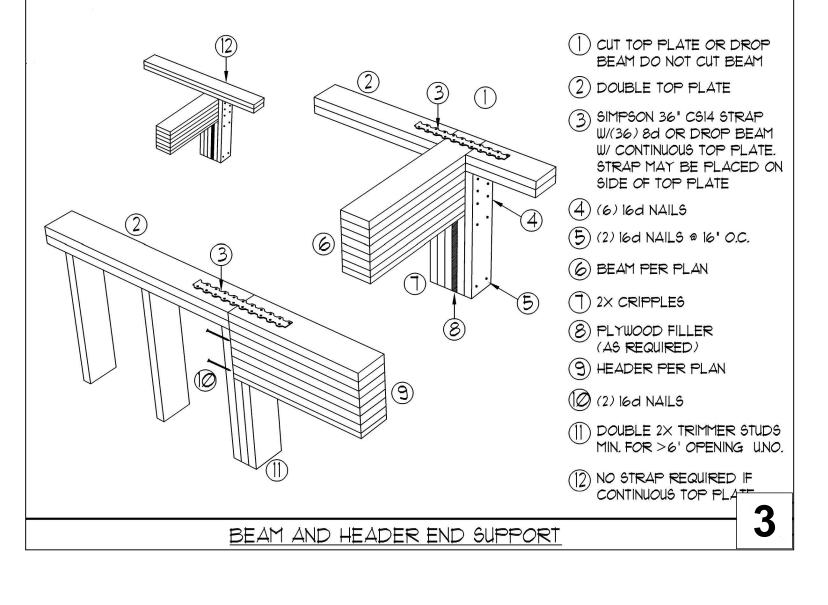


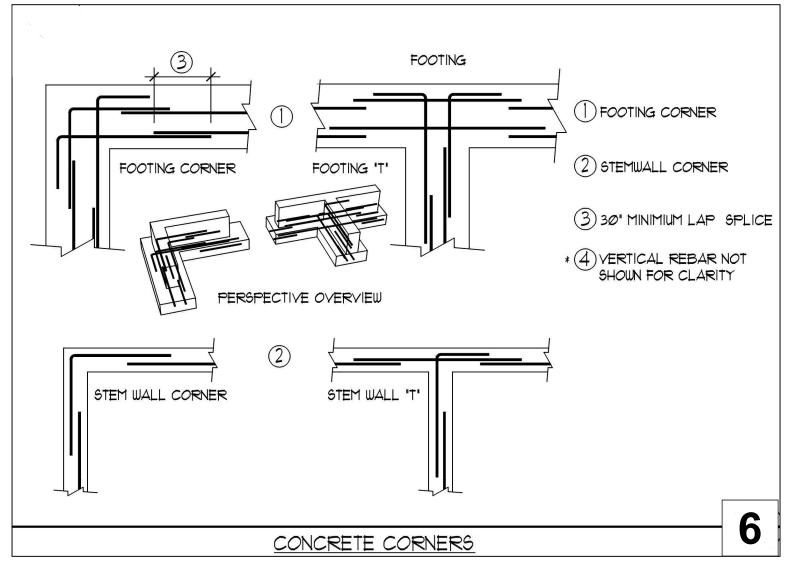

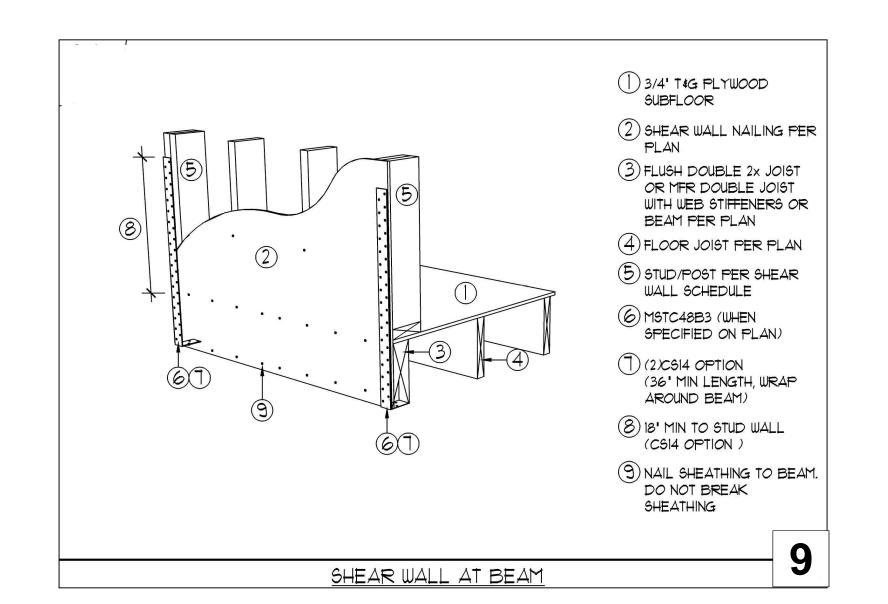

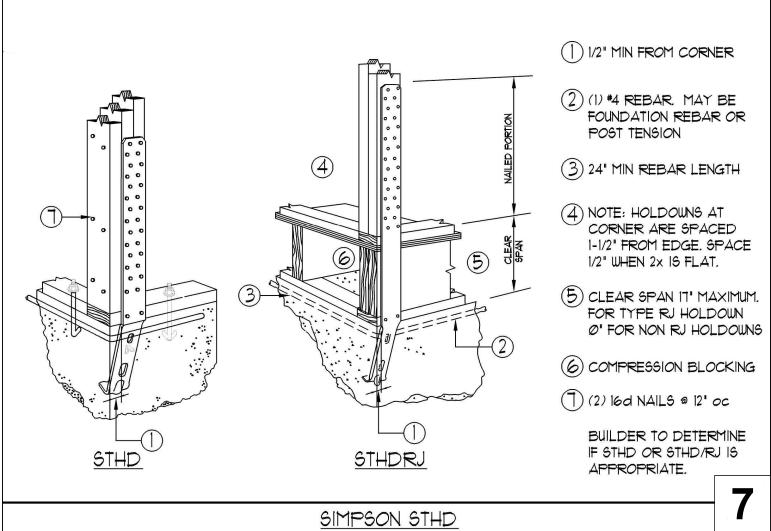




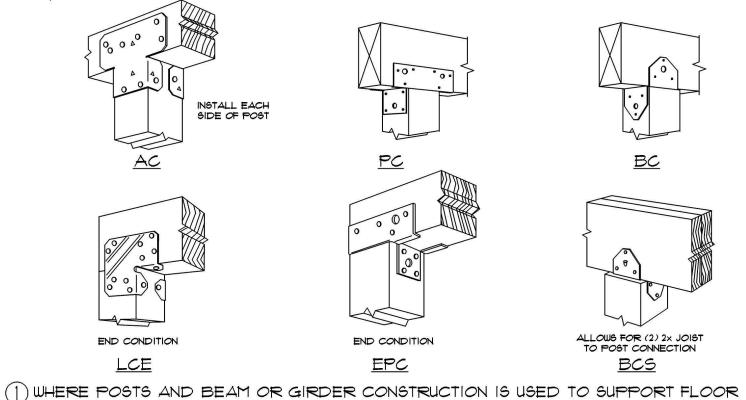

-) WHERE POSTS AND BEAM OR GIRDER CONSTRUCTION IS USED TO SUPPORT FLOOR FRAMING, POSITIVE CONNECTION SHALL BE PROVIDED TO ENSURE AGAINST UPLIFT AND LATERAL DISPLACEMENT.
-) ACE/LCE ELIMINATE THE NEED FOR RIGHT AND LEFTS. FOR USE W/ 4 imes OR 6 imes LUME
- 3 PC/EPC PROVIDES A CUSTOM CONNECTION FOR POST BEAM COMBINATIONS
 4 PBC/BCS OFFER A LIGHT CAP CONNECTION

BEAM TO POST CONNECTIONS

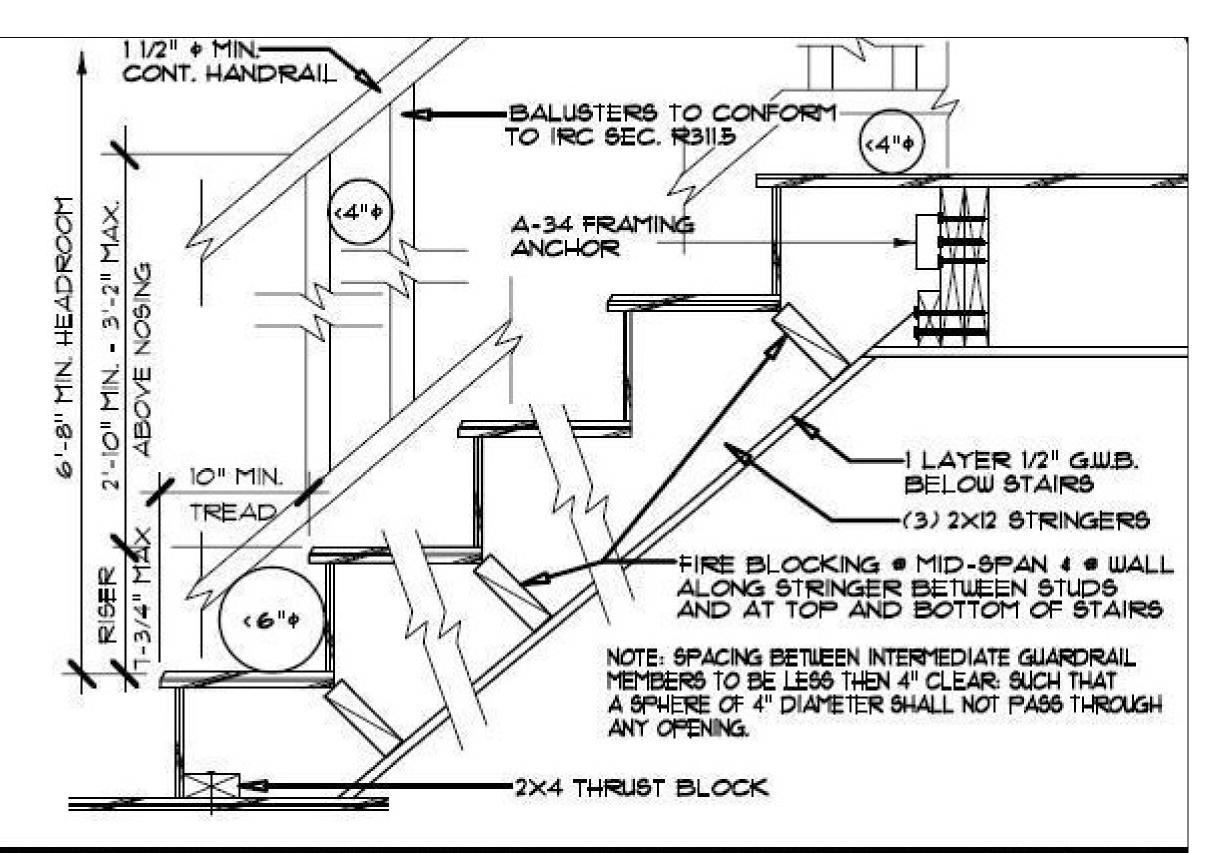

NOTES: PER IRC SECTION 3036, R315.1 ALL INTERIOR AND EXTERIOR STAIRWAYS SHALL BE PROVIDED WITH A MEANS TO ILLUMINATE THE STAIR INCLUDING LANDINGS & TREADS. INTERIOR STAIRWAYS SHALL BE PROVIDED WITH AN ARTIFICIAL LIGHT SOURCE LOCATED IN THE IMMEDIATE VICINITY OF THE LANDING OF THE STAIRWAY. EXTERIOR STAIRWAYS SHALL BE PROVIDED WITH A LIGHT SOURCE LOCATED IN THE IMMEDIATE VICINITY OF THE TOP OF THE LANDING OF THE STAIRWAY. LIGHTING CONTROLS SHALL BE ACCESSIBLE AT THE TOP & BOTTOM OF EACH STAIRWAY WITHOUT TRAVERSING ANY STEPS. 4 OR MORE RISERS TO HAVE AT LEAST ONE HANDRAIL RUNNING CONTINUOUS THROUGH FULL LENGTH OF STAIR 34' MIN. HT., 38" MAX. HEIGHT. END SHALL RETURN TO WALL OR NEWEL POST OR VOLUTE. HANDRAIL MUST BE STRONG ENOUGH TO RESIST A 200 LB. PT. LOAD IN ANY DIRECTION. HANDRAIL TO BE PRESENT ON AT LEAST ONE SIDE OF STAIR. HAND GRIP PORTION OF HANDRAILS SHALL HAVE CIRCULAR CROSS SECTION OF 11/4" MIN. & 23/4" MAX. EDGES SHALL HAVE A MIN. RADIUS OF 1/6". ALL REQUIRED GUARDRAILS TO BE 36' MIN. IN HEIGHT.



