


ON PLAN RWOOD DR.


JOB NO. DATE DRAWN BY DS

ENGINEER S.S.F.

REVISION DATE

SHEET

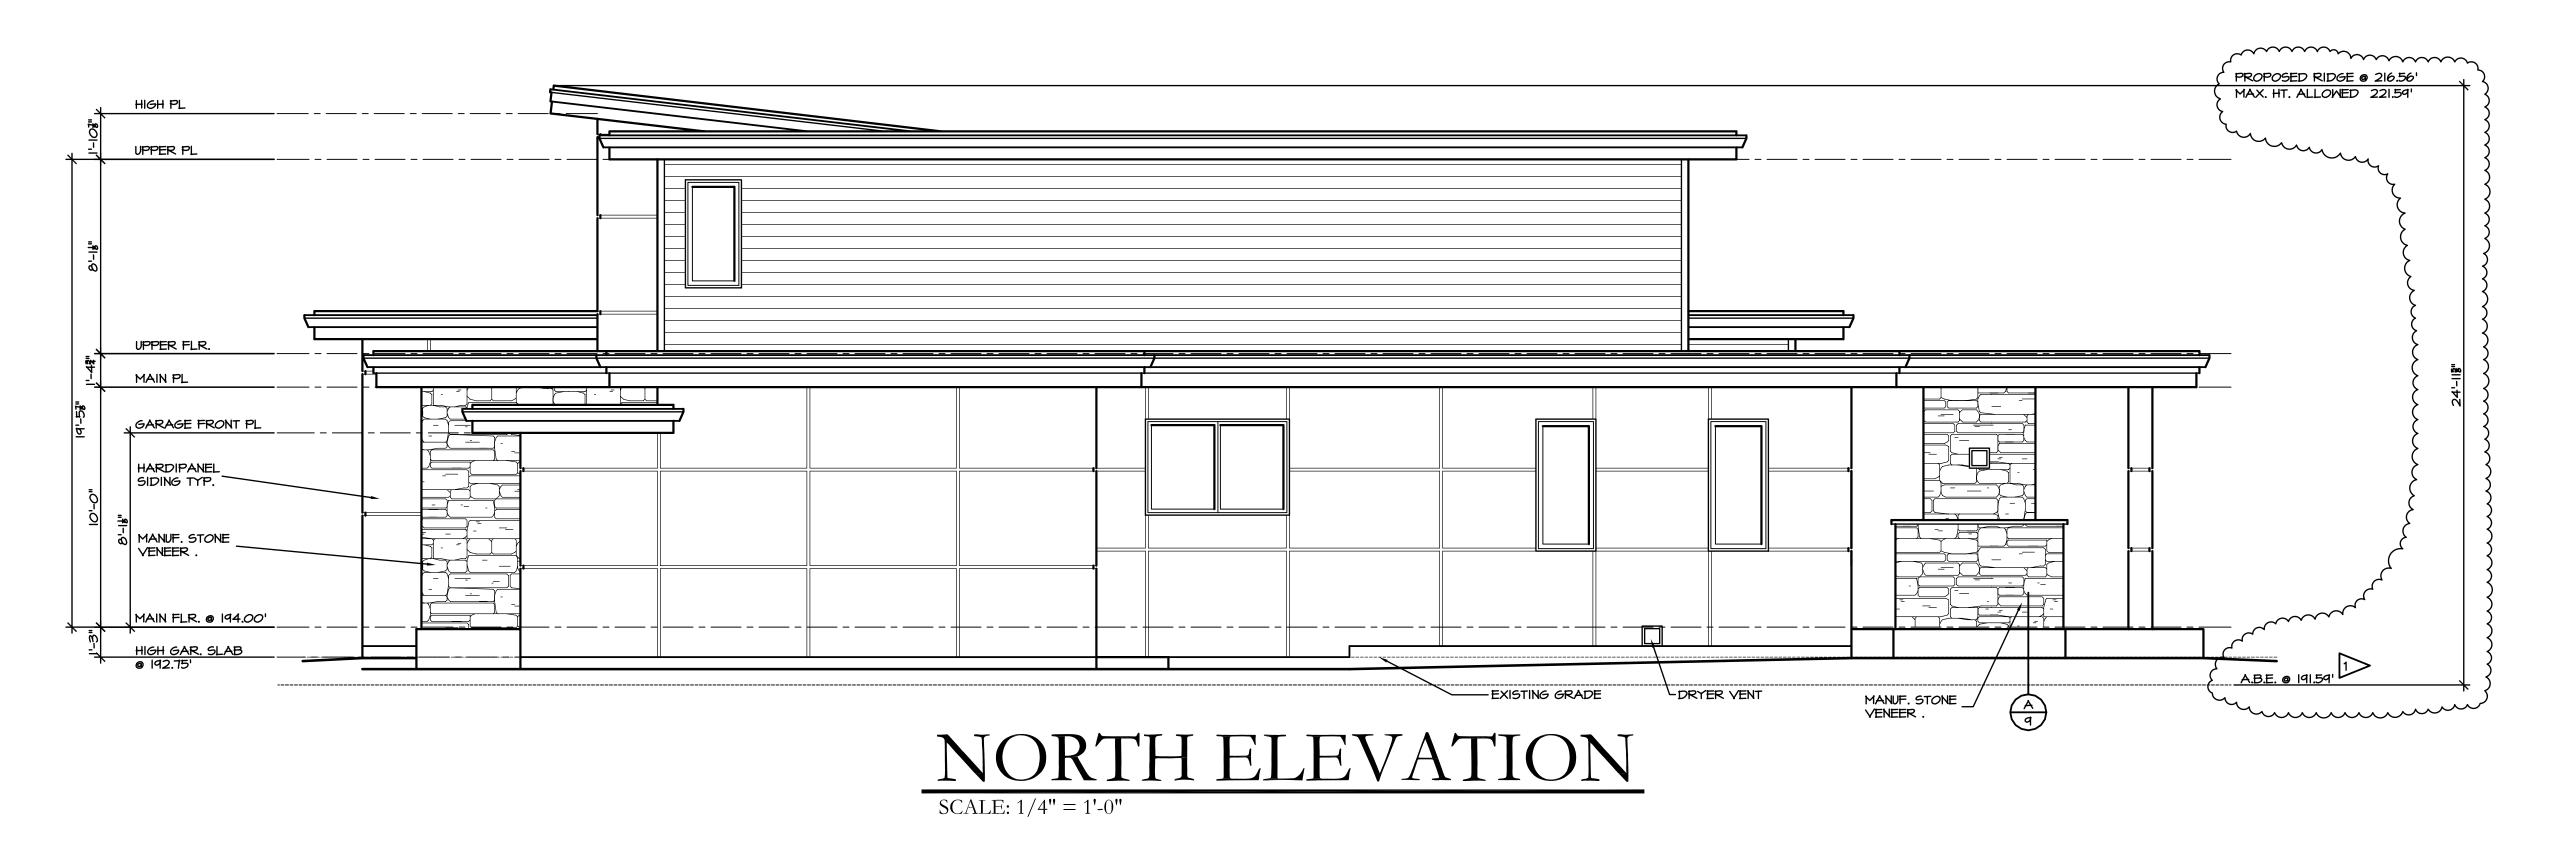

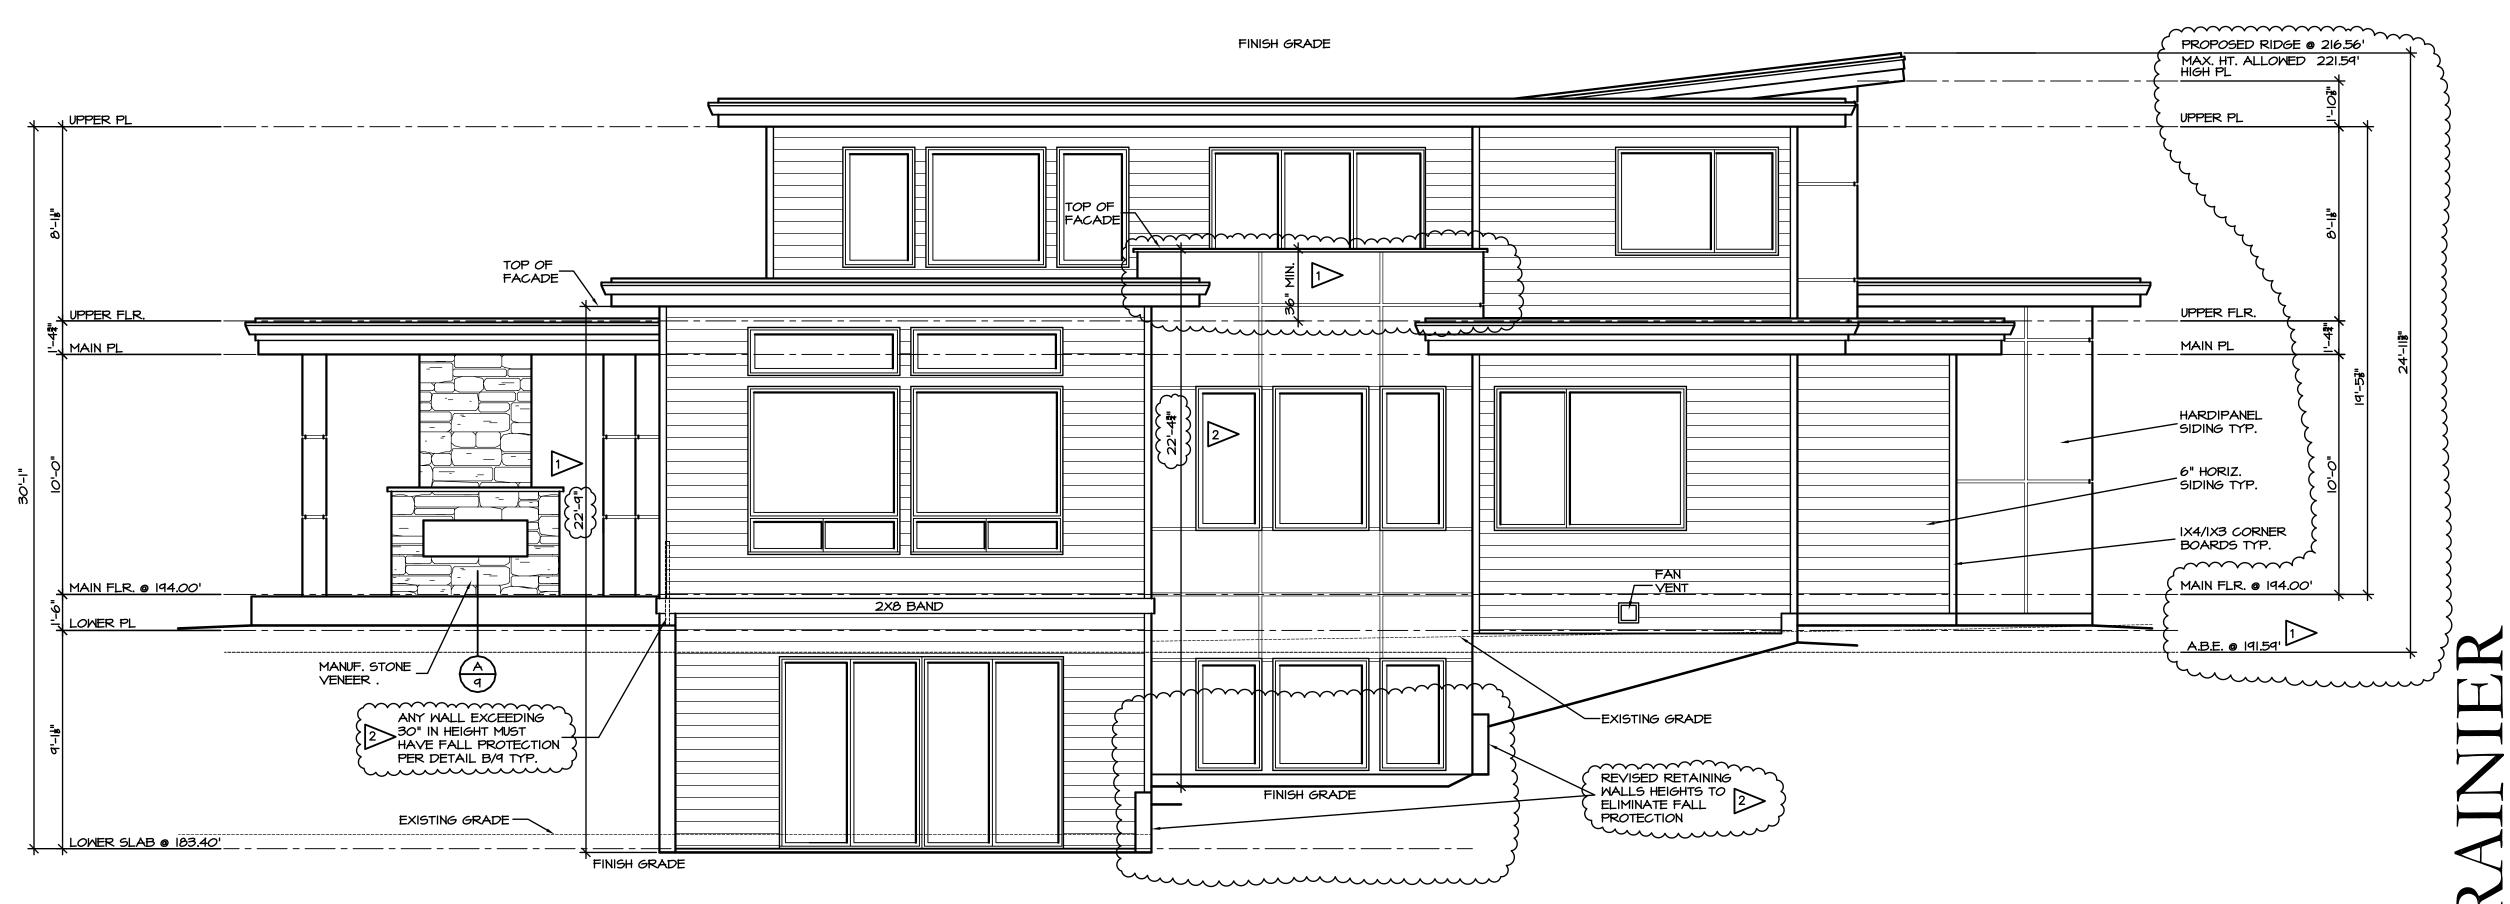

SOUTH ELEVATION


SCALE: 1/4'' = 1'-0''

'ATIONS MERCE

JOB NO. DATE 8/10/22 DRAWN BY DS

ENGINEER S.S.F.

REVISION DATE

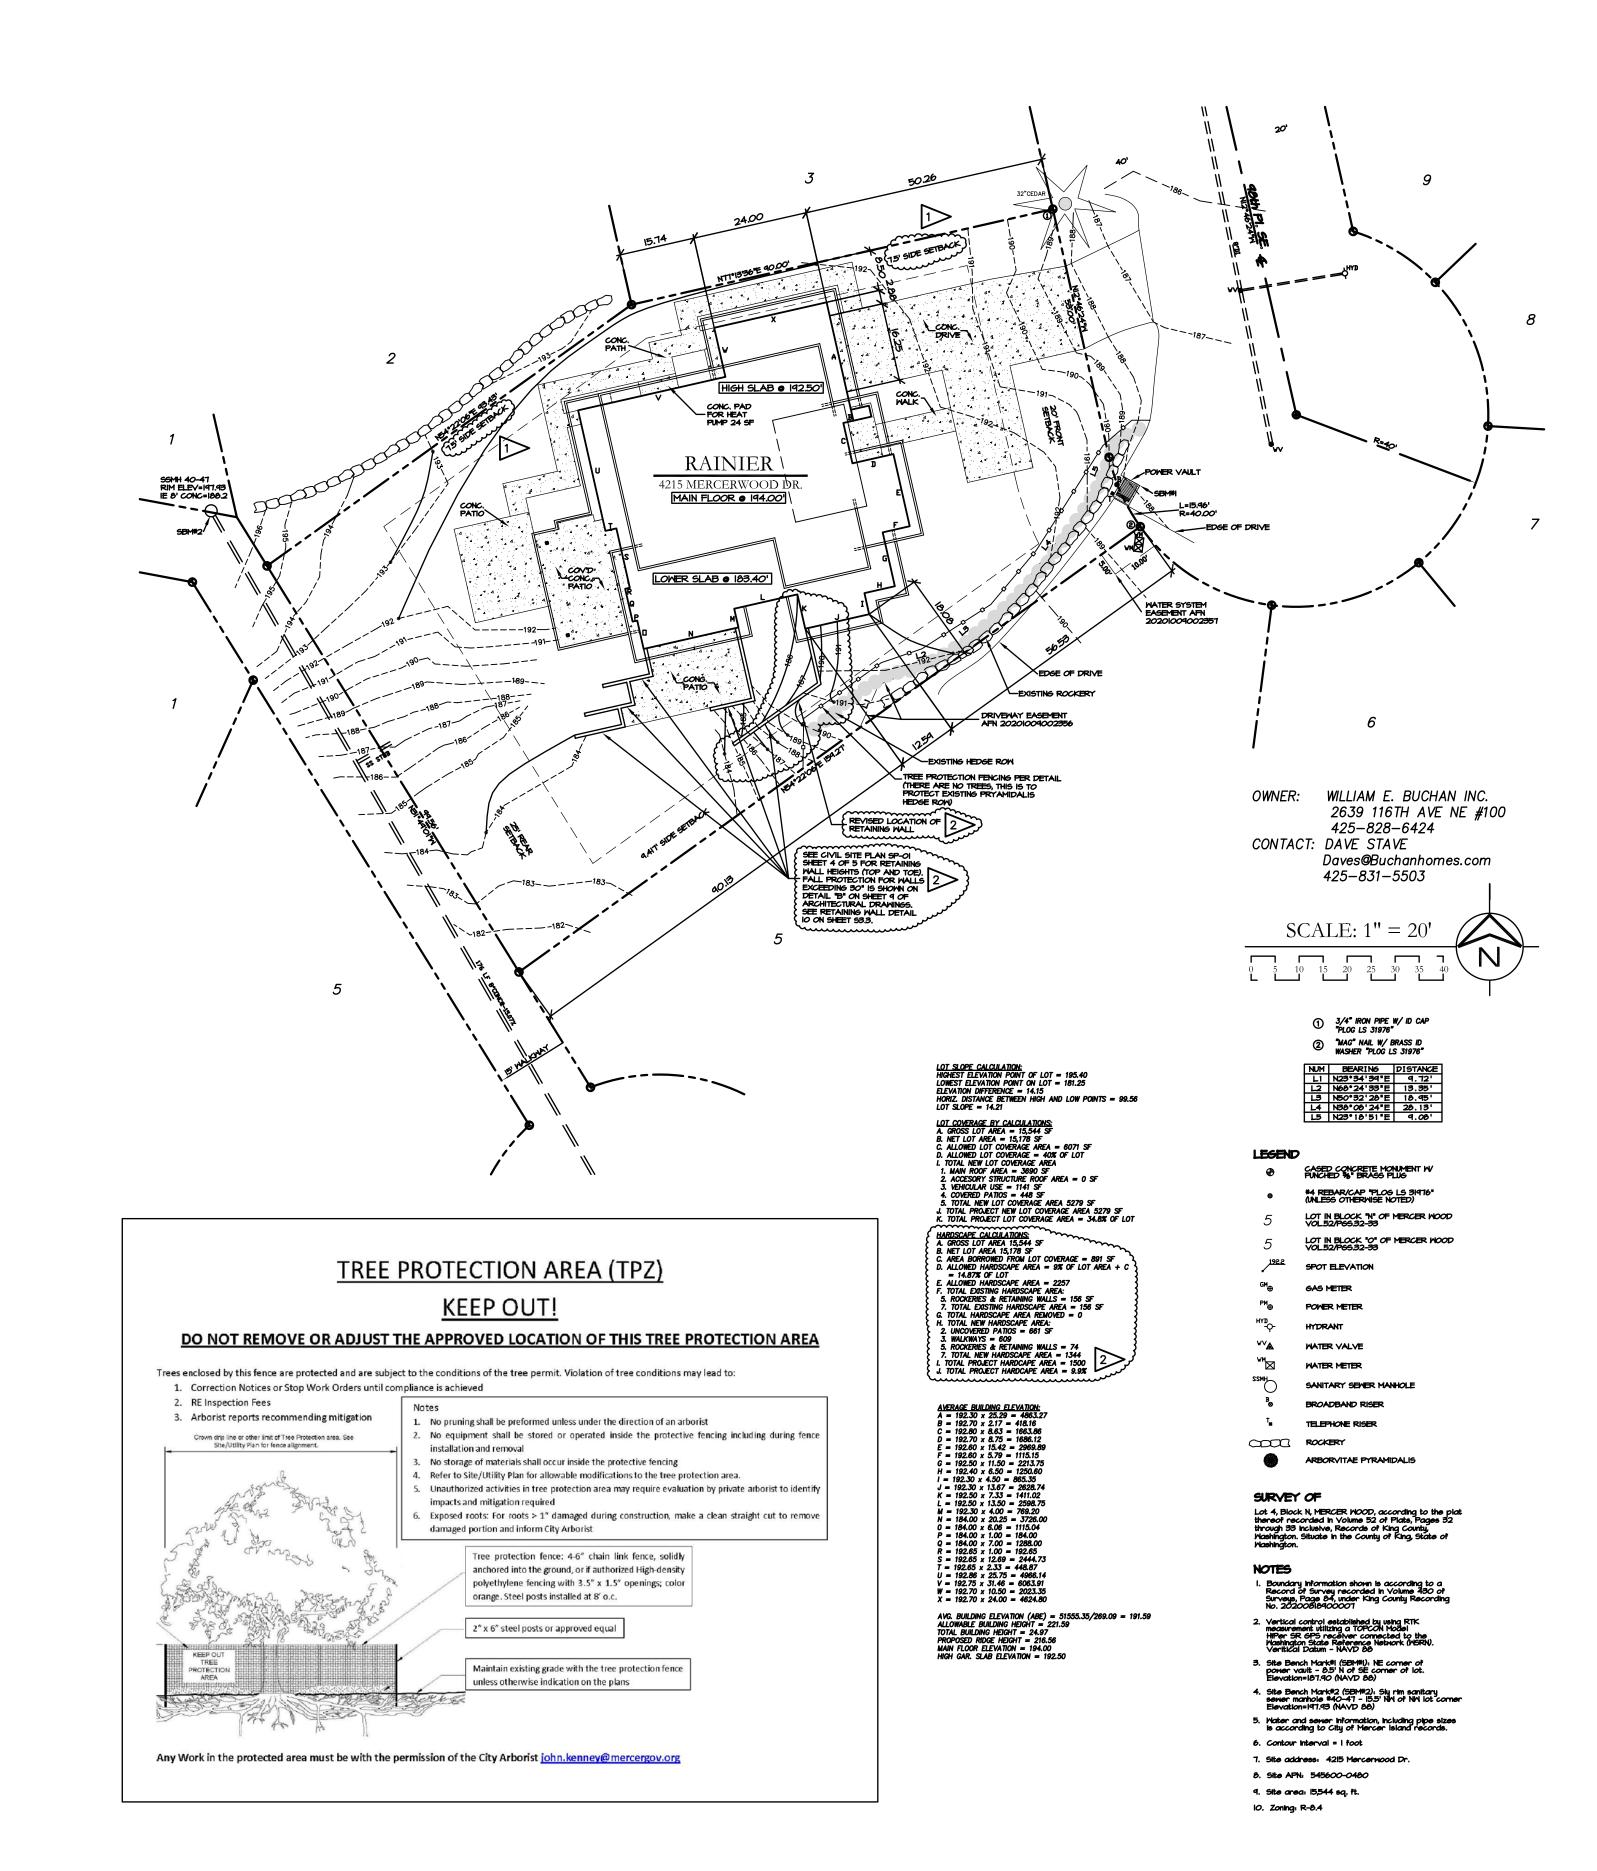

3/23/2 10/14/2

9118

DRAWN BY DS

ENGINEER

REVISION DATE

SHEET

VERTICAL DATUM

BENCHMARK

CITY OF MERCER ISLAND BENCHMARK NO. 2173

BRASS NAIL W/ PUNCH IN 3"X3" CONC @ INTX. 86TH AVE SE & SE 44TH ST

SITE BENCH MARK#1 (SBM#1): NE CORNER OF POWER VAULT - 8.5 N OF SE CORNER OF LOT. ELEVATION=187.90 (NAVD 88)

SITE BENCH MARK#2 (SBM#2): SLY RIM SANITARY SEWER MANHOLE #40-47 - 15.5' NW OF NW LOT CORNER ELEVATION=197.93 (NAVD 88)

HORIZONTAL DATUM & BASIS OF BEARING

PER THE PLAT OF MERCERWOOD ACCORDING TO THE PLAT THEROF RECORDED IN VOLUME 52 OF PLATS, PAGE 32, RECORDS OF KING COUNTY

ACCEPTED THE BEARING OF S 12°46'24" E FOR 150TH PLACE BASED ON FOUND MONUMENTS IN CASE PER RECORD OF SURVEY, RECORDING NO

LEGAL DESCRIPTION

LOT 4, BLOCK N, MERCER WOOD, ACCORDING TO THE PLAT THEREOF RECORDED IN VOLUME 52 OF PLATS, PAGES 32

SURVEY NOTES

- BOUNDARY INFORMATION SHOWN IS ACCORDING TO A RECORD OF SURVEY RECORDED IN VOLUME 430 OF SURVEYS, PAGE 84, UNDER KING COUNTY
- 2. VERTICAL CONTROL ESTABLISHED BY USING RTK MEASUREMENT UTILIZING A TOPCON MODEL HIPER SR GPS RECEIVER CONNECTED TO THE WASHINGTON STATE REFERENCE NETWORK (WSRN). VERITICAL DATUM - NAVD 88
- 3. SITE BENCH MARK#1 (SBM#1): NE CORNER OF POWER VAULT 8.5 N OF SE CORNER OF LOT. ELEVATION=187.90 (NAVD 88)
- 4. SITE BENCH MARK#2 (SBM#2): SLY RIM SANITARY SEWER MANHOLE #40-47 15.5' NW OF NW LOT CORNER ELEVATION=197.93 (NAVD 88)
- 5. WATER AND SEWER INFORMATION, INCLUDING PIPE SIZES IS ACCORDING TO CITY OF MERCER ISLAND RECORDS.
- 6. CONTOUR INTERVAL = 1 FOOT
- 7. SITE ADDRESS: 4215 MERCERWOOD DR.
- 8. SITE APN: 545600-0480
- 9. SITE AREA: 15,544 SQ. FT.

SITE DATA

HIGHEST ELEVATION OF LOT: 195.4 LOWEST ELEVATION OF LOT: 181.0 LOT SLOPE: 14.5% TOTAL SITE AREA: 15,544 SF 15,178 SF TOTAL SITE NET AREA: ALLOWED LOT COVERAGE: PROPOSED LOT COVERAGE * 5,178 SF (34.1%) 1,366 SF (9%) MAX. ALLOWED HARDSCAPE LEFTOVER AREA FROM LOT COVERAGE 891 SF (5.9) EXISTING HARDSCAPE 156 SF (1%)

PROPOSED HARDSCAPE 1,343 SF (8.9%) PROJECT IMPERVIOUS AREA: 6,677 SF (44%)

OVERHANGS, AND VEHICULAR DRIVING SURFACES AS DEFINED PER MIMC 19.16.010 OWNER / ARCHITECT

WILLIAM E. BUCHAN INC. 2630 116 AVE NE #100 BELLEVUE, WA 98004 (425) 831-5503 CONTACT: DAVID STAVE

ENGINEER


THE BLUELINE GROUP 25 CENTRAL WAY, SUITE 400 KIRKLAND, WA 98033 (425) 250-7224 CONTACT: TODD A. OBERG, PE

GEOTECH ENGINEER

TERRA ASSOCIATES, INC 12220 113TH AVE NE, SUITE 130 KIRKLAND, WA 98034 (425) 821–7777


CONTACT: CAROLYN S. DECKER, PE

4215 MERCERWOOD DR MERCER ISLAND SITE PLAN

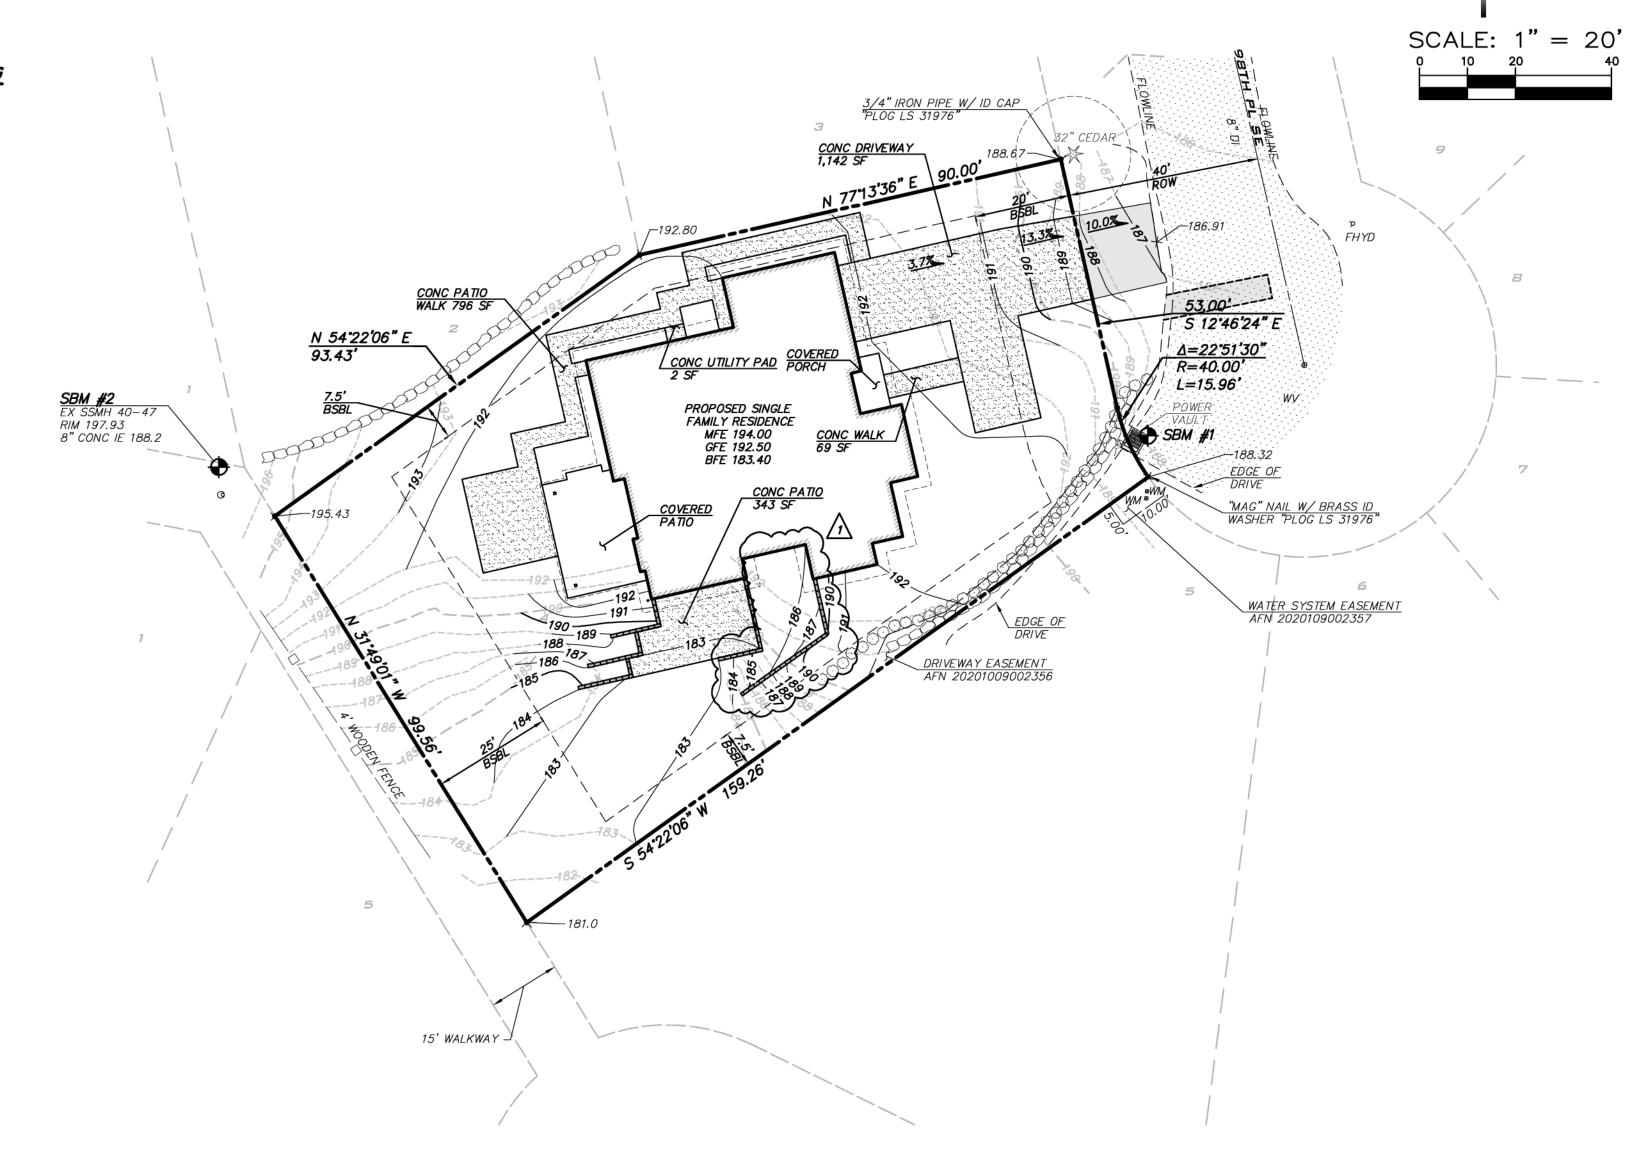


SHEET INDEX

- 1 CV-01 COVER SHEET
- 2 TP-01 TESC, DRAINAGE & TREE RETENTION PLAN
- 3 TP-02 TESC NOTES & DETAILS

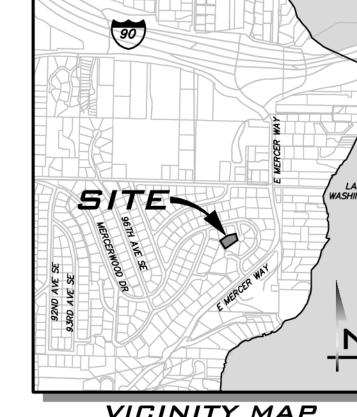

VICINITY MAP

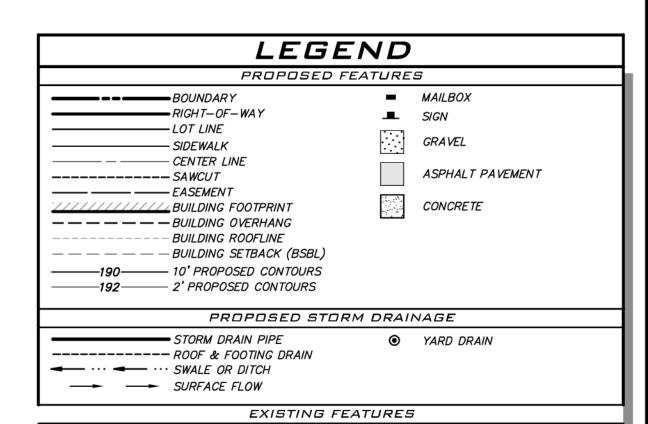

— — — — — ADJACENT PLAT/PARCEL LINE — — — — — ADJACENT RIGHT—OF—WAY — — — — — EASEMENT — — — — — — SURFACE FEATURES	☐ GAS METER ☐ GAS VALVE ☐ MAIL BOX ☐ SIGN EXISTING CONIFEROUS TREE
SS—SEWER MAIN WHER MAIN WHER MAIN WHER MAIN WHER FENCE BOARD FENCE RETAINING WALL ROCKERY CATCH BASIN, TYPE I SD PIPE FLOW SEWER MANHOLE SS PIPE FLOW SIRE HYDRANT WATER METER MGATE VALVE POWER POLE GUY ANCHOR POWER VAULT POWER METER	EXISTING DECIDUOUS TREE ORIP LINE CONIFEROUS TREE TO BE SAVED DECIDUOUS TREE TO BE SAVED EXISTING CONIFEROUS TREE TO BE REMOVED EXISTING DECIDUOUS TREE TO BE REMOVED ASPHALT CONCRETE GRAVEL
TESC FEATURES	
FILTER FENCE CONSTRUCTION FENCE INTERCEPTOR SWALE	RIPRAP PAD ROCK CHECK DAM

EXISTING UTILITY NOTE


LIMITS OF CLEARING

CLEARED AREA

EXISTING UTILITIES ARE SHOWN IN THE APPROXIMATE LOCATION. THERE IS NO GUARANTEE THAT ALL UTILITY LINES ARE SHOWN, OR THAT THE LOCATION, SIZE AND MATERIAL IS ACCURATE. THE CONTRACTOR SHALL UNCOVER ALL INDICATED PIPING WHERE CROSSING, INTERFERENCES, OR CONNECTIONS OCCUR PRIOR TO TRENCHING OR EXCAVATION FOR ANY PIPE OR STRUCTURES, TO DETERMINE ACTUAL LOCATIONS, SIZE AND MATERIAL. THE CONTRACTOR SHALL MAKE THE APPROPRIATE PROVISION FOR PROTECTION OF SAID FACILITIES. THE CONTRACTOR SHALL NOTIFY ONE CALL AT 8-1-1 (WASHINGTON811.COM) AND ARRANGE FOR FIELD LOCATION OF EXISTING FACILITIES BEFORE CONSTRUCTION.

✓ PIPE FLOW

INTERIM CATCH BASIN
PROTECTION (INSERT)

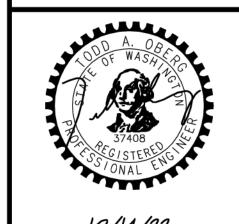

BLUELINE

25 CENTRAL WAY, SUITE 400.

KIRKLAND, WA 98033 P: 425.216.4051 F: 425.216.4052

WWW.THEBLUELINEGROUP.COM

PROJECT MANAGER:

PROJECT ENGINEER:

ALIREZA RAMEZANI, PE

YANNICK METS, PE

AS NOTED

DESIGNER:

LEE M. TOMKINS

ISSUE DATE:

10/14/2022

10/14/22

20-410 SHEET NAME: CV-01

- 4 SP-01 SITE PLAN
- 5 DT-01 DETAILS

BUILDING CALCULATIONS

SEE ARCHITECTURAL SITE PLAN FOR TREE RETENTION, BUILDING HEIGHTS AND FAR CALCULATIONS.

B. FLAG OR FENCE CLEARING LIMITS.

C. POST SIGN WITH NAME AND PHONE NUMBER OF TESC SUPERVISOR.

D. INSTALL CATCH BASIN PROTECTION IF REQUIRED. E. GRADE AND INSTALL CONSTRUCTION ENTRANCE(S).

BEST MANAGEMENT PRACTICES REMOVED IF APPROPRIATE.

F. INSTALL PERIMETER PROTECTION (SILT FENCE, BRUSH BARRIER, ETC.).

G. CONSTRUCT SEDIMENT PONDS AND TRAPS. H. GRADE AND STABILIZE CONSTRUCTION ROADS.

I. CONSTRUCT SURFACE WATER CONTROLS (INTERCEPTOR DIKES, PIPE SLOPE DRAINS, ETC.) SIMULTANEOUSLY WITH CLEARING AND GRADING FOR PROJECT DEVELOPMENT.

J. MAINTAIN EROSION CONTROL MEASURE IN ACCORDANCE WITH CITY OF MERCER ISLAND STANDARDS AND MANUFACTURER'S RECOMMENDATIONS.

K. RELOCATE EROSION CONTROL MEASURES OR INSTALL NEW MEASURES SO THAT AS SITE CONDITIONS CHANGE, THE EROSION AND SEDIMENT CONTROL IS ALWAYS IN ACCORDANCE WITH THE CITY TESC MINIMUM REQUIREMENTS.

L. COVER ALL AREAS WITHIN THE SPECIFIED TIME FRAME WITH STRAW, WOOD FIBER MULCH, COMPOST, PLASTIC SHEETING, CRUSHED ROCK OR EQUIVALENT.

M. STABILIZE ALL AREAS THAT REACH FINAL GRADE WITHIN 7 DAYS. N. SEED OR SOD ANY AREAS TO REMAIN UNWORKED FOR MORE THAN 30 DAYS. O. UPON COMPLETION OF THE PROJECT, ALL DISTURBED AREAS MUST BE STABILIZED AND

APPROVAL OF THIS EROSION/SEDIMENTATION CONTROL (ESC) PLAN DOES NOT CONSTITUTE AN APPROVAL OF PERMANENT ROAD OR DRAINAGE DESIGN (E.G., SIZE AND LOCATION OF ROADS, PIPES, RESTRICTORS, CHANNELS, RETENTION FACILITIES, UTILITIES, ETC.).

3. THE IMPLEMENTATION OF THIS ESC PLAN AND THE CONSTRUCTION, MAINTENANCE, REPLACEMENT, AND UPGRADING OF THESE ESC FACILITIES IS THE RESPONSIBILITY OF THE PERMITTEE/CONTRACTOR UNTIL ALL CONSTRUCTION IS APPROVED.

4. THE BOUNDARIES OF THE CLEARING LIMITS SHOWN ON THIS PLAN SHALL BE SET BY SURVEY AND CLEARLY FLAGGED IN THE FIELD BY A CLEARING CONTROL FENCE PRIOR TO CONSTRUCTION. DURING THE CONSTRUCTION PERIOD, NO DISTURBANCE OR REMOVAL OF ANY GROUND COVER BEYOND THE FLAGGED CLEARING LIMITS SHALL BE PERMITTED. THE FLAGGING SHALL BE MAINTAINED BY THE PERMITTEE/CONTRACTOR FOR THE DURATION OF

5. THE TESC FACILITIES SHOWN ON THIS PLAN MUST BE CONSTRUCTED PRIOR TO OR IN CONJUNCTION WITH ALL CLEARING AND GRADING ACTIVITIES IN SUCH A MANNER AS TO ENSURE THAT SEDIMENT-LADEN WATER DOES NOT ENTER THE DRAINAGE SYSTEM OR VIOLATE APPLICABLE WATER STANDARDS. WHEREVER POSSIBLE, MAINTAIN NATURAL VEGETATION FOR SILT CONTROL.

6. THE ESC FACILITIES SHOWN ON THIS PLAN ARE THE MINIMUM REQUIREMENTS FOR ANTICIPATED SITE CONDITIONS. DURING THE CONSTRUCTION PERIOD, THESE ESC FACILITIES SHALL BE UPGRADED (E.G., ADDITIONAL SUMPS, RELOCATION OF DITCHES AND SILT FENCES, ETC.) AS NEEDED FOR UNEXPECTED STORM EVENTS. ADDITIONALLY, MORE TESC FACILITIES MAY BE REQUIRED TO ENSURE COMPLETE SILTATION CONTROL. THEREFORE, DURING THE COURSE OF CONSTRUCTION IT SHALL BE THE OBLIGATION AND RESPONSIBILITY OF THE CONTRACTOR TO ADDRESS ANY NEW CONDITIONS THAT MAY BE CREATED BY HIS ACTIVITIES AND TO PROVIDE ADDITIONAL FACILITIES OVER AND ABOVE THE MINIMUM REQUIREMENTS AS MAY BE NEEDED.

THE ESC FACILITIES SHALL BE INSPECTED BY THE PERMITTEE/CONTRACTOR DAILY DURING NON-RAINFALL PERIODS, EVERY HOUR (DAYLIGHT) DURING A RAINFALL EVENT, AND AT THE END OF EVERY RAINFALL, AND MAINTAINED AS NÉCESSARY TO ENSURE THEIR CONTINUED FUNCTIONING. IN ADDITION, TEMPORARY SILTATION PONDS AND ALL TEMPORARY SILTATION CONTROLS SHALL BE MAINTAINED IN A SATISFACTORY CONDITION UNTIL SUCH TIME THAT CLEARING AND/OR CONSTRUCTION IS COMPLETED, PERMANENT DRAINAGE FACILITIES ARE OPERATIONAL, AND THE POTENTIAL FOR EROSION HAS PASSED. WRITTEN RECORDS SHALL BE KEPT DOCUMENTING THE REVIEWS OF THE ESC FACILITIES.

8. THE ESC FACILITIES ON INACTIVE SITES SHALL BE INSPECTED AND MAINTAINED A MINIMUM OF ONCE A MONTH OR WITHIN 48 HOURS FOLLOWING A STORM EVENT.

ALL DENUDED SOILS MUST BE STABILIZED WITH AN APPROVED TESC METHOD (E.G. SEEDING, MULCHING, PLASTIC COVERING, CRUSHED ROCK) WITHIN THE FOLLOWING TIMELINES: APRIL 1 TO OCTOBER 31 - SOILS MUST BE STABILIZED WITHIN 7 DAYS OF GRADING.

NOVEMBER 1 TO MARCH 31 - SOILS MUST BE STABILIZED WITHIN 2 DAYS OF GRADING. 10. AT NO TIME SHALL MORE THAN 1' OF SEDIMENT BE ALLOWED TO ACCUMULATE WITHIN A CATCH BASIN. ALL CATCH BASINS AND CONVEYANCE LINES SHALL BE CLEANED PRIOR TO PAVING. THE CLEANING OPERATION SHALL NOT FLUSH SEDIMENT-LADEN WATER INTO THE DOWNSTREAM SYSTEM.

11. STABILIZED CONSTRUCTION ENTRANCES SHALL BE INSTALLED AT THE BEGINNING OF CONSTRUCTION AND MAINTAINED FOR THE DURATION OF THE PROJECT. ADDITIONAL MEASURES, SUCH AS WASH PADS, MAY BE REQUIRED TO ENSURE THAT ALL PAVED AREAS

ARE KEPT CLEAN FOR THE DURATION OF THE PROJECT. 12. ANY PERMANENT RETENTION/DETENTION FACILITY USED AS A TEMPORARY SETTLING BASIN SHALL BE MODIFIED WITH THE NECESSARY EROSION CONTROL MEASURES AND SHALL PROVIDE ADEQUATE STORAGE CAPACITY. IF THE PERMANENT FACILITY IS TO FUNCTION ULTIMATELY AS AN INFILTRATION OR DISPERSION SYSTEM. THE FACILITY SHALL NOT BE USED AS A TEMPORARY SETTLING BASIN. NO UNDERGROUND DETENTION TANK, DETENTION VAULT, OR SYSTEM WHICH BACKS UNDER OR INTO A POND SHALL BE USED AS A TEMPORARY

13. WHERE SEEDING FOR TEMPORARY EROSION CONTROL IS REQUIRED, FAST GERMINATING GRASSES SHALL BE APPLIED AT AN APPROPRIATE RATE (EXAMPLE: ANNUAL OR PERENNIAL

RYE APPLIED AT APPROXIMATELY 80 POUNDS PER ACRE). 14. WHERE STRAW MULCH IS REQUIRED FOR TEMPORARY EROSION CONTROL, IT SHALL BE APPLIED AT A MINIMUM THICKNESS OF 2".

15. ALL EROSION/SEDIMENTATION CONTROL PONDS WITH A DEAD STORAGE DEPTH EXCEEDING 6" MUST HAVE A PERIMETER FENCE WITH A MINIMUM HEIGHT OF 3.

16. ALL WORK AND MATERIALS SHALL BE IN ACCORDANCE WITH CITY OF MERCER ISLAND

STANDARDS AND SPECIFICATIONS. 17. THE ESC FACILITIES SHALL BE CONSTRUCTED IN ACCORDANCE WITH THE DETAILS ON THE APPROVED PLANS. LOCATIONS MAY BE MOVED TO SUIT FIELD CONDITIONS, SUBJECT TO APPROVAL BY THE ENGINEER AND THE CITY OF MERCER ISLAND INSPECTOR.

18. A COPY OF THE APPROVED EROSION CONTROL PLANS MUST BE ON THE JOB SITE WHENEVER CONSTRUCTION IS IN PROGRESS.

19. ALL LOTS ADJOINING OR HAVING ANY NATIVE GROWTH PROTECTION EASEMENTS (NGPE) SHALL HAVE A 4' HIGH TEMPORARY CONSTRUCTION FENCE (CYCLONE OR PLASTIC MESH) SEPARATING THE LOT (OR BUILDABLE PORTIONS OF THE LOT) FROM THE AREA RESTRICTED BY THE NGPE AND SHALL BE INSTALLED PRIOR TO ANY GRADING OR CLEARING AND REMAIN IN PLACE UNTIL A DWELLING IS CONSTRUCTED AND OWNERSHIP TRANSFERRED TO THE FIRST OWNER /OCCUPANT.

20. CLEARING LIMITS SHALL BE DELINEATED WITH A CLEARING CONTROL FENCE. THE CLEARING CONTROL FENCE SHALL CONSIST OF A 6-FT. HIGH CHAIN LINK FENCE ADJACENT THE DRIP LINE OF TREES TO BE SAVED, WETLAND OR STREAM BUFFERS, AND SENSITIVE SLOPES. CLEARING CONTROL FENCES ALONG WETLAND OR STREAM BUFFERS OR UPSLOPE OF SENSITIVE SLOPES SHALL BE ACCOMPANIED BY AN EROSION CONTROL FENCE. IF APPROVED BY THE CITY, A FOUR-FOOT HIGH ORANGE MESH CLEARING CONTROL FENCE MAY BE USED TO DELINEATE CLEARING LIMITS IN ALL OTHER AREAS.

21. OFF-SITE STREETS MUST BE KEPT CLEAN AT ALL TIMES. IF DIRT IS DEPOSITED ON THE PUBLIC STREET SYSTEM, THE STREET SHALL BE IMMEDIATELY CLEANED WITH POWER SWEEPER OR OTHER EQUIPMENT. ALL VEHICLES SHALL LEAVE THE SITE BY WAY OF THE CONSTRUCTION ENTRANCE AND SHALL BE CLEANED OF ALL DIRT THAT WOULD BE DEPOSITED

ON THE PUBLIC STREETS. 22. ANY CATCH BASINS COLLECTING RUNOFF FROM THE SITE, WHETHER THEY ARE ON OR OFF THE SITE, SHALL HAVE THEIR GRATES COVERED WITH FILTER FABRIC DURING CONSTRUCTION. CATCH BASINS DIRECTLY DOWNSTREAM OF THE CONSTRUCTION ENTRANCE OR ANY OTHER CATCH BASIN AS DETERMINED BY THE CITY INSPECTOR SHALL BE PROTECTED WITH A "FILTER FABRIC SOCK" OR EQUIVALENT.

23. THE WASHED GRAVEL BACKFILL ADJACENT TO THE FILTER FABRIC FENCE SHALL BE REPLACED AND THE FILTER FABRIC CLEANED IF IT IS NONFUNCTIONAL BY EXCESSIVE SILT ACCUMULATION AS DETERMINED BY THE CITY OF MERCER ISLAND. ALSO, ALL INTERCEPTOR SWALES SHALL BE CLEANED IF SILT ACCUMULATION EXCEEDS ONE—QUARTER DEPTH.


24. ROCK FOR EROSION PROTECTION OF ROADWAY DITCHES, WHERE REQUIRED, MUST BE OF SOUND QUARRY ROCK, PLACED TO A DEPTH OF 1' AND MUST MEET THE FOLLOWING SPECIFICATIONS: 4"-8" ROCK/40 %-70 % PASSING; 2"-4" ROCK/30 %-40 % PASSING; AND


1"-2" ROCK/10 %-20 % PASSING. 25. IF ANY PART(S) OF THE CLEARING LIMIT BOUNDARY OR TEMPORARY EROSION/SEDIMENTATION


CONTROL PLAN IS/ARE DAMAGED, IT SHALL BE REPAIRED IMMEDIATELY. 26. ALL PROPERTIES ADJACENT TO THE PROJECT SITE SHALL BE PROTECTED FROM SEDIMENT

DEPOSITION AND RUNOFF. 27. DO NOT FLUSH CONCRETE BY-PRODUCTS OR TRUCKS NEAR OR INTO THE STORM DRAINAGE SYSTEM. IF EXPOSED AGGREGATE IS FLUSHED INTO THE STORM SYSTEM, IT COULD MEAN RE-CLEANING THE ENTIRE DOWNSTREAM STORM SYSTEM, OR POSSIBLY RE-LAYING THE

28. PRIOR TO THE OCTOBER 1 OF EACH YEAR (THE BEGINNING OF THE WET SEASON), ALL DISTURBED AREAS SHALL BE REVIEWED TO IDENTIFY WHICH ONES CAN BE SEEDED IN PREPARATION FOR THE WINTER RAINS. THE IDENTIFIED DISTURBED AREA SHALL BE SEEDED WITHIN ONE WEEK AFTER OCTOBER 1. A SITE PLAN DEPICTING THE AREAS TO BE SEEDED AND THE AREAS TO REMAIN UNCOVERED SHALL BE SUBMITTED TO THE PUBLIC WORKS CONSTRUCTION INSPECTOR. THE INSPECTOR CAN REQUIRE SEEDING OF ADDITIONAL AREAS IN ORDER TO PROTECT SURFACE WATERS, ADJACENT PROPERTIES, OR DRAINAGE FACILITIES.

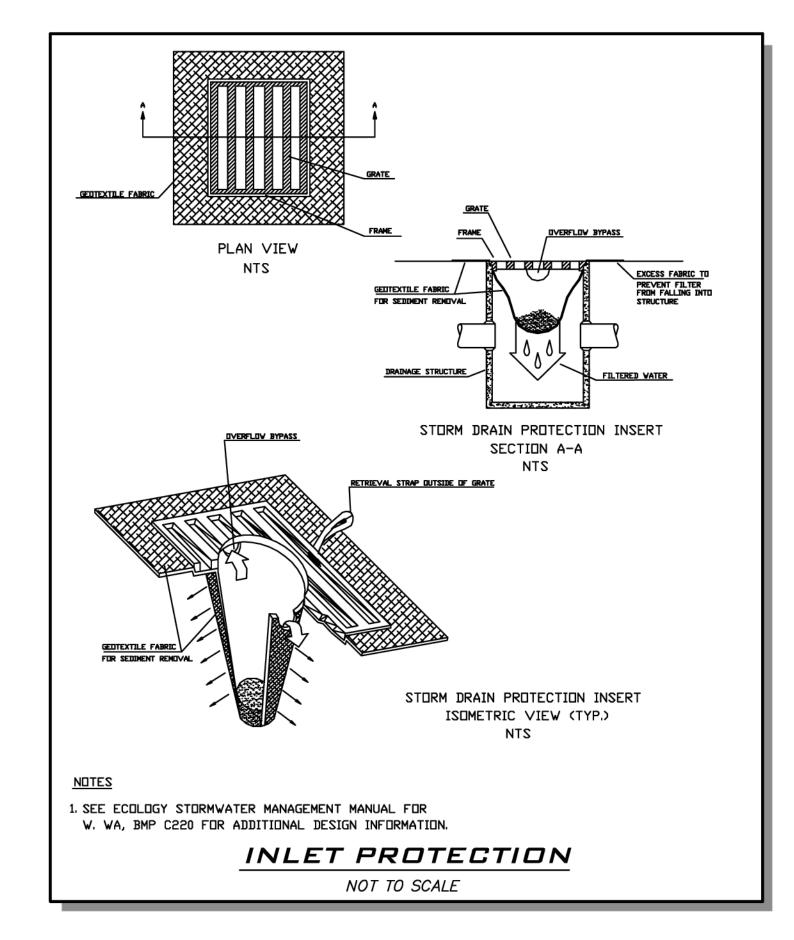

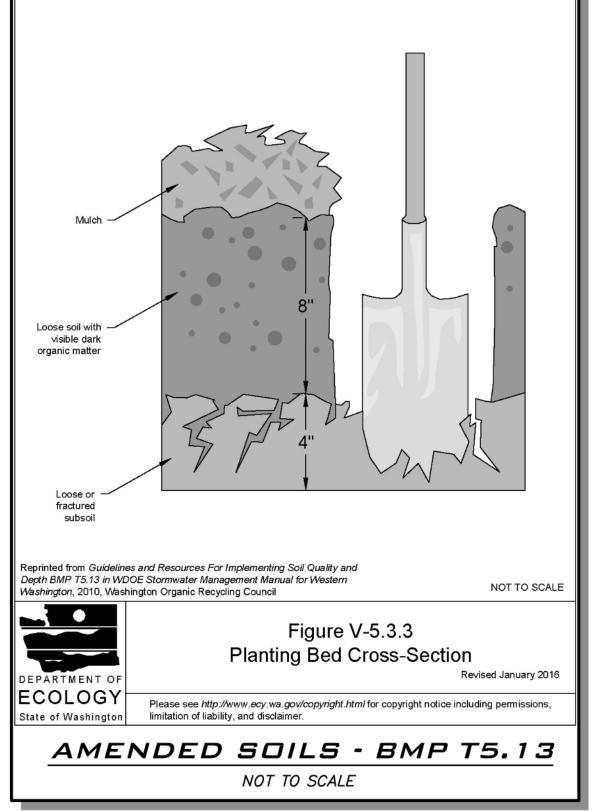

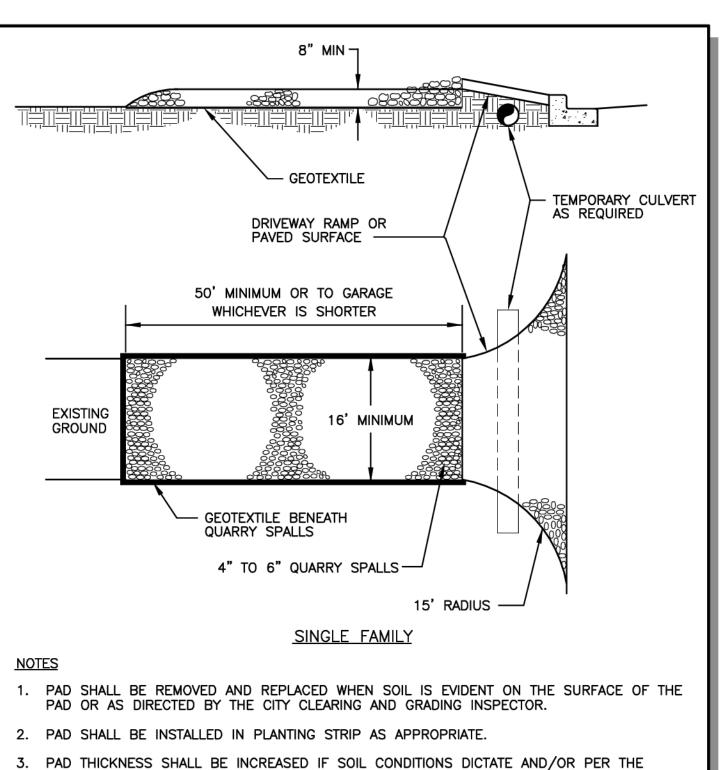


CONSTRUCTION ENTRANCE

NOT TO SCALE

DIRECTION OF THE CITY CLEARING AND GRADING INSPECTOR.

4. CONTRACTOR RESPONSIBLE FOR CURB & GUTTER CONDITION.

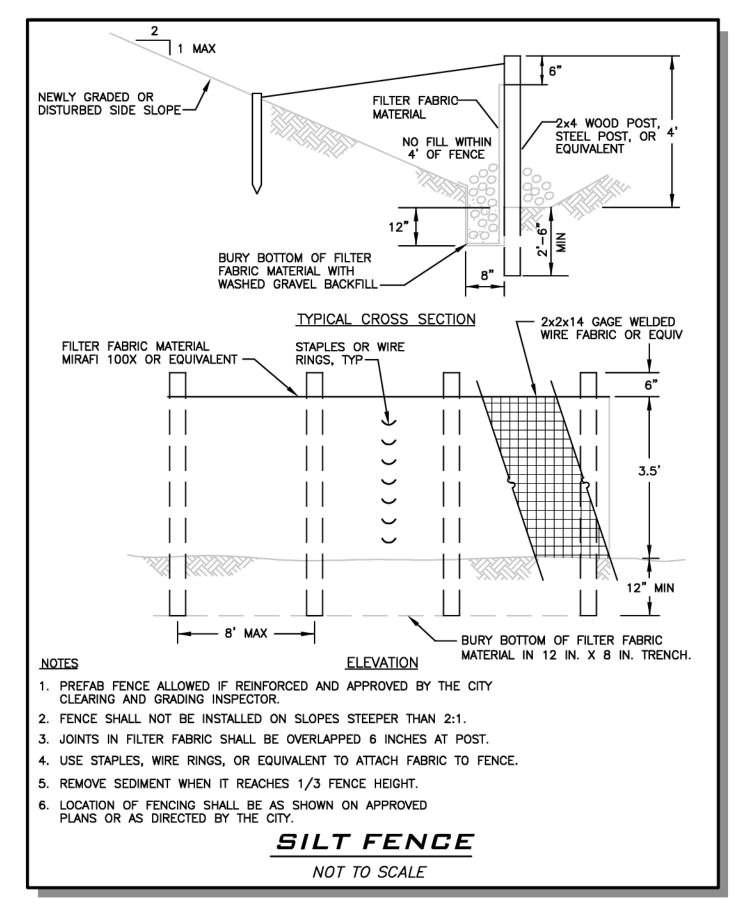

EXISTING UTILITY NOTE

EXISTING UTILITIES ARE SHOWN IN THE APPROXIMATE LOCATION. THERE IS NO GUARANTEE THAT ALL UTILITY LINES ARE SHOWN, OR THAT THE LOCATION, SIZE AND MATERIAL IS ACCURATE. THE CONTRACTOR SHALL UNCOVER ALL INDICATED PIPING WHERE CROSSING, INTERFERENCES, OR CONNECTIONS OCCUR PRIOR TO TRENCHING OR EXCAVATION FOR ANY PIPE OR STRUCTURES, TO DETERMINE ACTUAL LOCATIONS, SIZE AND MATERIAL. THE CONTRACTOR SHALL MAKE THE APPROPRIATE PROVISION FOR PROTECTION OF SAID FACILITIES. THE CONTRACTOR SHALL NOTIFY ONE CALL AT 8-1-1 (WASHINGTON811.COM) AND ARRANGE FOR FIELD LOCATION OF EXISTING FACILITIES BEFORE CONSTRUCTION.



25 CENTRAL WAY, SUITE 400. KIRKLAND, WA 98033 P: 425.216.4051 F: 425.216.4052 WWW.THEBLUELINEGROUP.COM

SCALE: AS NOTED PROJECT MANAGER:

YANNICK METS, PE PROJECT ENGINEER:

ALIREZA RAMEZANI, PE

DESIGNER: LEE M. TOMKINS

ISSUE DATE: 10/14/2022



10/14/22

20-410

SHEET NAME: TP-02

OΓ

© 2022 BLUELINE

BLUELINE

25 CENTRAL WAY, SUITE 400, KIRKLAND, WA 98033 P: 425.216.4051 F: 425.216.4052

PROJECT MANAGER: YANNICK METS, PE

PROJECT ENGINEER: ALIREZA RAMEZANI, PE

DESIGNER:

LEE M. TOMKINS ISSUE DATE:

10/14/22

20-410

SHEET NAME: SP-01

<u>4</u> of 5

CONTRACTOR SHALL NOTIFY ONE CALL AT 8-1-1 (WASHINGTON811.COM) AND ARRANGE FOR FIELD LOCATION OF EXISTING FACILITIES BEFORE CONSTRUCTION.

187.80


186.50


190.00

189.00

2.20

2.50

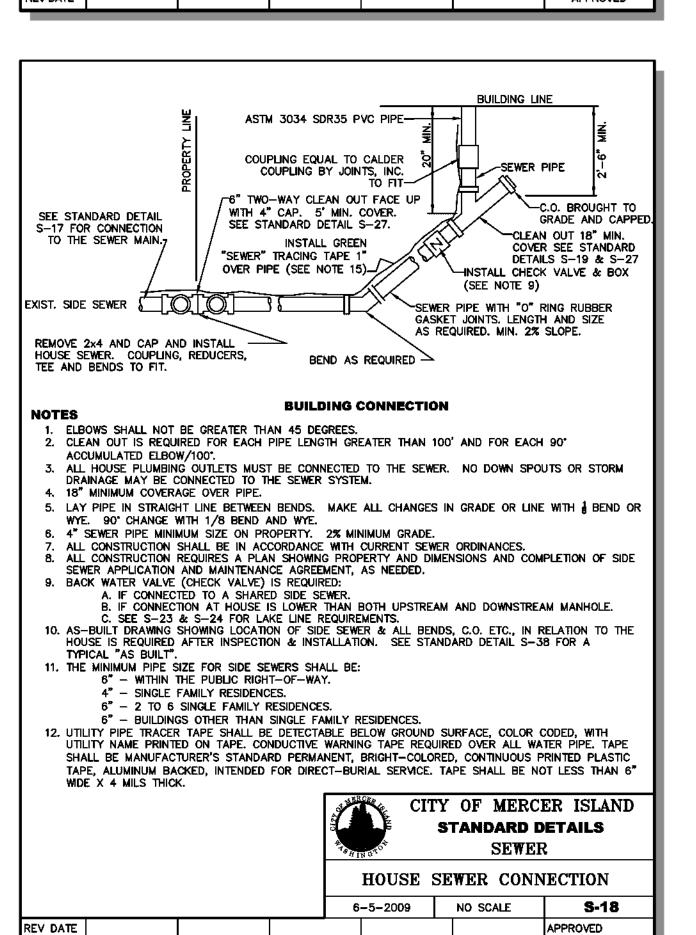

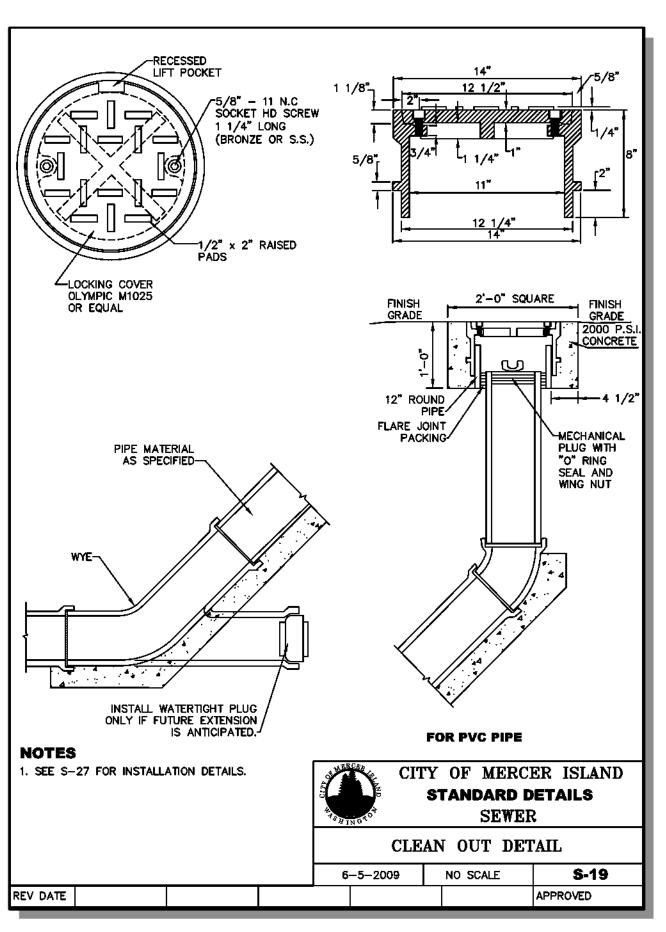

WHEN DEMOLISHING AN EXISTING BUILDING, THE BUILDING SIDE SEWER SHALL BE DISCONNECTED PRIOR TO REMOVAL OF BUILDING FOUNDATIONS. THE CONTRACTOR SHALL INSTALL A MECHANICAL PLUG WITH NON-SHRINK GROUT AT THE END OF THE SIDE SEWER TO REMAIN IN PLACE. DISCONNECTION'S SHALL BE PERFORMED IN THE PRESENCE OF THE CITY'S UTILITY INSPECTOR. THE CONTRACTOR SHALL PROVIDE AN AS-BUILT DRAWING DEPICTING THE DISCONNECTED SIDE SEWER UPON COMPLETION OF THE RECONNECTION WHEN RECONNECTING TO AN EXISTING SIDE SEWER, THE POINT OF RECONNECTION WILL BE DETERMINED BASED ON THE MAGNITUDE OF THE CONSTRUCTION ON THE PROPERTY. 1. PARTIAL INTERIOR REMODEL AND/OR BUILDING ADDITION - NO SIDE SEWER REPLACEMENT REQUIRED UNLESS A KNOWN PRÓBLEM EXISTS IN THE SIDE SEWER. 2. COMPLETE INTERIOR REMODEL OF RESIDENCE - ASSESS CONDITION OF EXISTING SIDE SEWER THROUGH VIDEO INSPECTION FROM BUILDING TO PROPERTY LINE AND REPLACE AS NEEDED. IF EXISTING SIDE SEWER IS ASBESTOS CEMENT OR CONCRETE, SIDE SEWER SHALL BE REPLACED FROM BUILDING TO PROPERTY LINE, UNLESS THE APPLICANT PROVES, TO THE SATISFACTION OF THE CITY ENGINEER, THAT THE SIDE SEWER IS WATER TIGHT AND IN SOUND CONDITION.* 3. COMPLETE INTERIOR REMODEL AND BUILDING ADDITION - NEW SIDE SEWER FROM BUILDING TO PROPERTY LINE.* 4. CONSTRUCTION OF A NEW SINGLE FAMILY RESIDENCE - NEW SIDE SEWER FROM BUILDING TO 5. BACK WATER VALVE INSTALLATION PER CITY ENGINEER, IF SCENARIO 2, 3 OR 4 IS DIRECTLY ATTACHED TO THE LAKE LINE. VIDEO INSPECTION OF THE EXISTING SIDE SEWER, BETWEEN THE PROPERTY LINE AND THE SEWER MAIN SHALL BE PERFORMED FOR SCENARIOS NUMBER 3 AND 4. PROVIDE A COPY OF THE VIDEO DOCUMENTATION TO THE CITY ENGINEER. REPLACEMENT OR REPAIR OF THAT PORTION OF THE SIDE SEWER BETWEEN THE PROPERTY LINE AND THE SEWER MAIN, WILL BE DETERMINED BY THE CITY ENGINEER, BASED ON THE VIDEO INSPECTION. *IF THE EXISTING SIDE SEWER IS PVC AND IS LESS THAN TEN YEARS OLD, THE SIDE SEWER DOES NOT HAVE TO BE REPLACED IF A VIDEO INSPECTION AND HYDROSTATIC PRESSURE TEST CONFIRMS THAT THE SIDE SEWER IS IN PROPER WORKING CONDITION. THESE TESTS SHALL BE PERFORMED AFTER ALL HEAVY EQUIPMENT THAT COULD DAMAGE THE SIDE SEWER IS OFF OF THE SITE. CITY OF MERCER ISLAND **\$TANDARD DETAIL\$** RESIDENTIAL SIDE SEWER DISCONNECTION & RECONNECTION 6-5-2009 NO SCALE S-22 APPROVED REV DATE

25 CENTRAL WAY, SUITE 400, KIRKLAND, WA 98033 P: 425.216.4051 F: 425.216.4052 WWW.THEBLUELINEGROUP.COM

SCALE: AS NOTED

PROJECT MANAGER: YANNICK METS, PE

PROJECT ENGINEER: ALIREZA RAMEZANI, PE


DESIGNER: LEE M. TOMKINS

ISSUE DATE:

ND DATE BY REVISIONS

ERCERWOOD D SITE PLAN

4215 MERCE SITE F

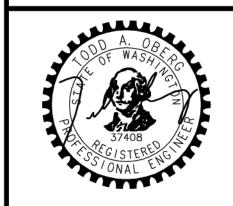

10/14/22

JOB NUMBER:

20-410 SHEET NAME: DT-01

янт <u>5</u> оғ <u>5</u>

EXISTING UTILITY NOTE

EXISTING UTILITIES ARE SHOWN IN THE APPROXIMATE LOCATION. THERE IS NO GUARANTEE THAT ALL UTILITY LINES ARE SHOWN, OR THAT THE LOCATION, SIZE AND MATERIAL IS ACCURATE. THE CONTRACTOR SHALL UNCOVER ALL INDICATED PIPING WHERE CROSSING, INTERFERENCES, OR CONNECTIONS OCCUR PRIOR TO TRENCHING OR EXCAVATION FOR ANY PIPE OR STRUCTURES, TO DETERMINE ACTUAL LOCATIONS, SIZE AND MATERIAL. THE CONTRACTOR SHALL MAKE THE APPROPRIATE PROVISION FOR PROTECTION OF SAID FACILITIES. THE CONTRACTOR SHALL NOTIFY ONE CALL AT 8-1-1 (WASHINGTON811.COM) AND ARRANGE FOR FIELD LOCATION OF EXISTING FACILITIES BEFORE CONSTRUCTION.