


HATCH REPRESENTS
 A.D.U. UNIT AND
 LOCATION TO
 BUILDING ENVELOPE

UPPER FLOOR PLAN
 1/4" = 1'-0"

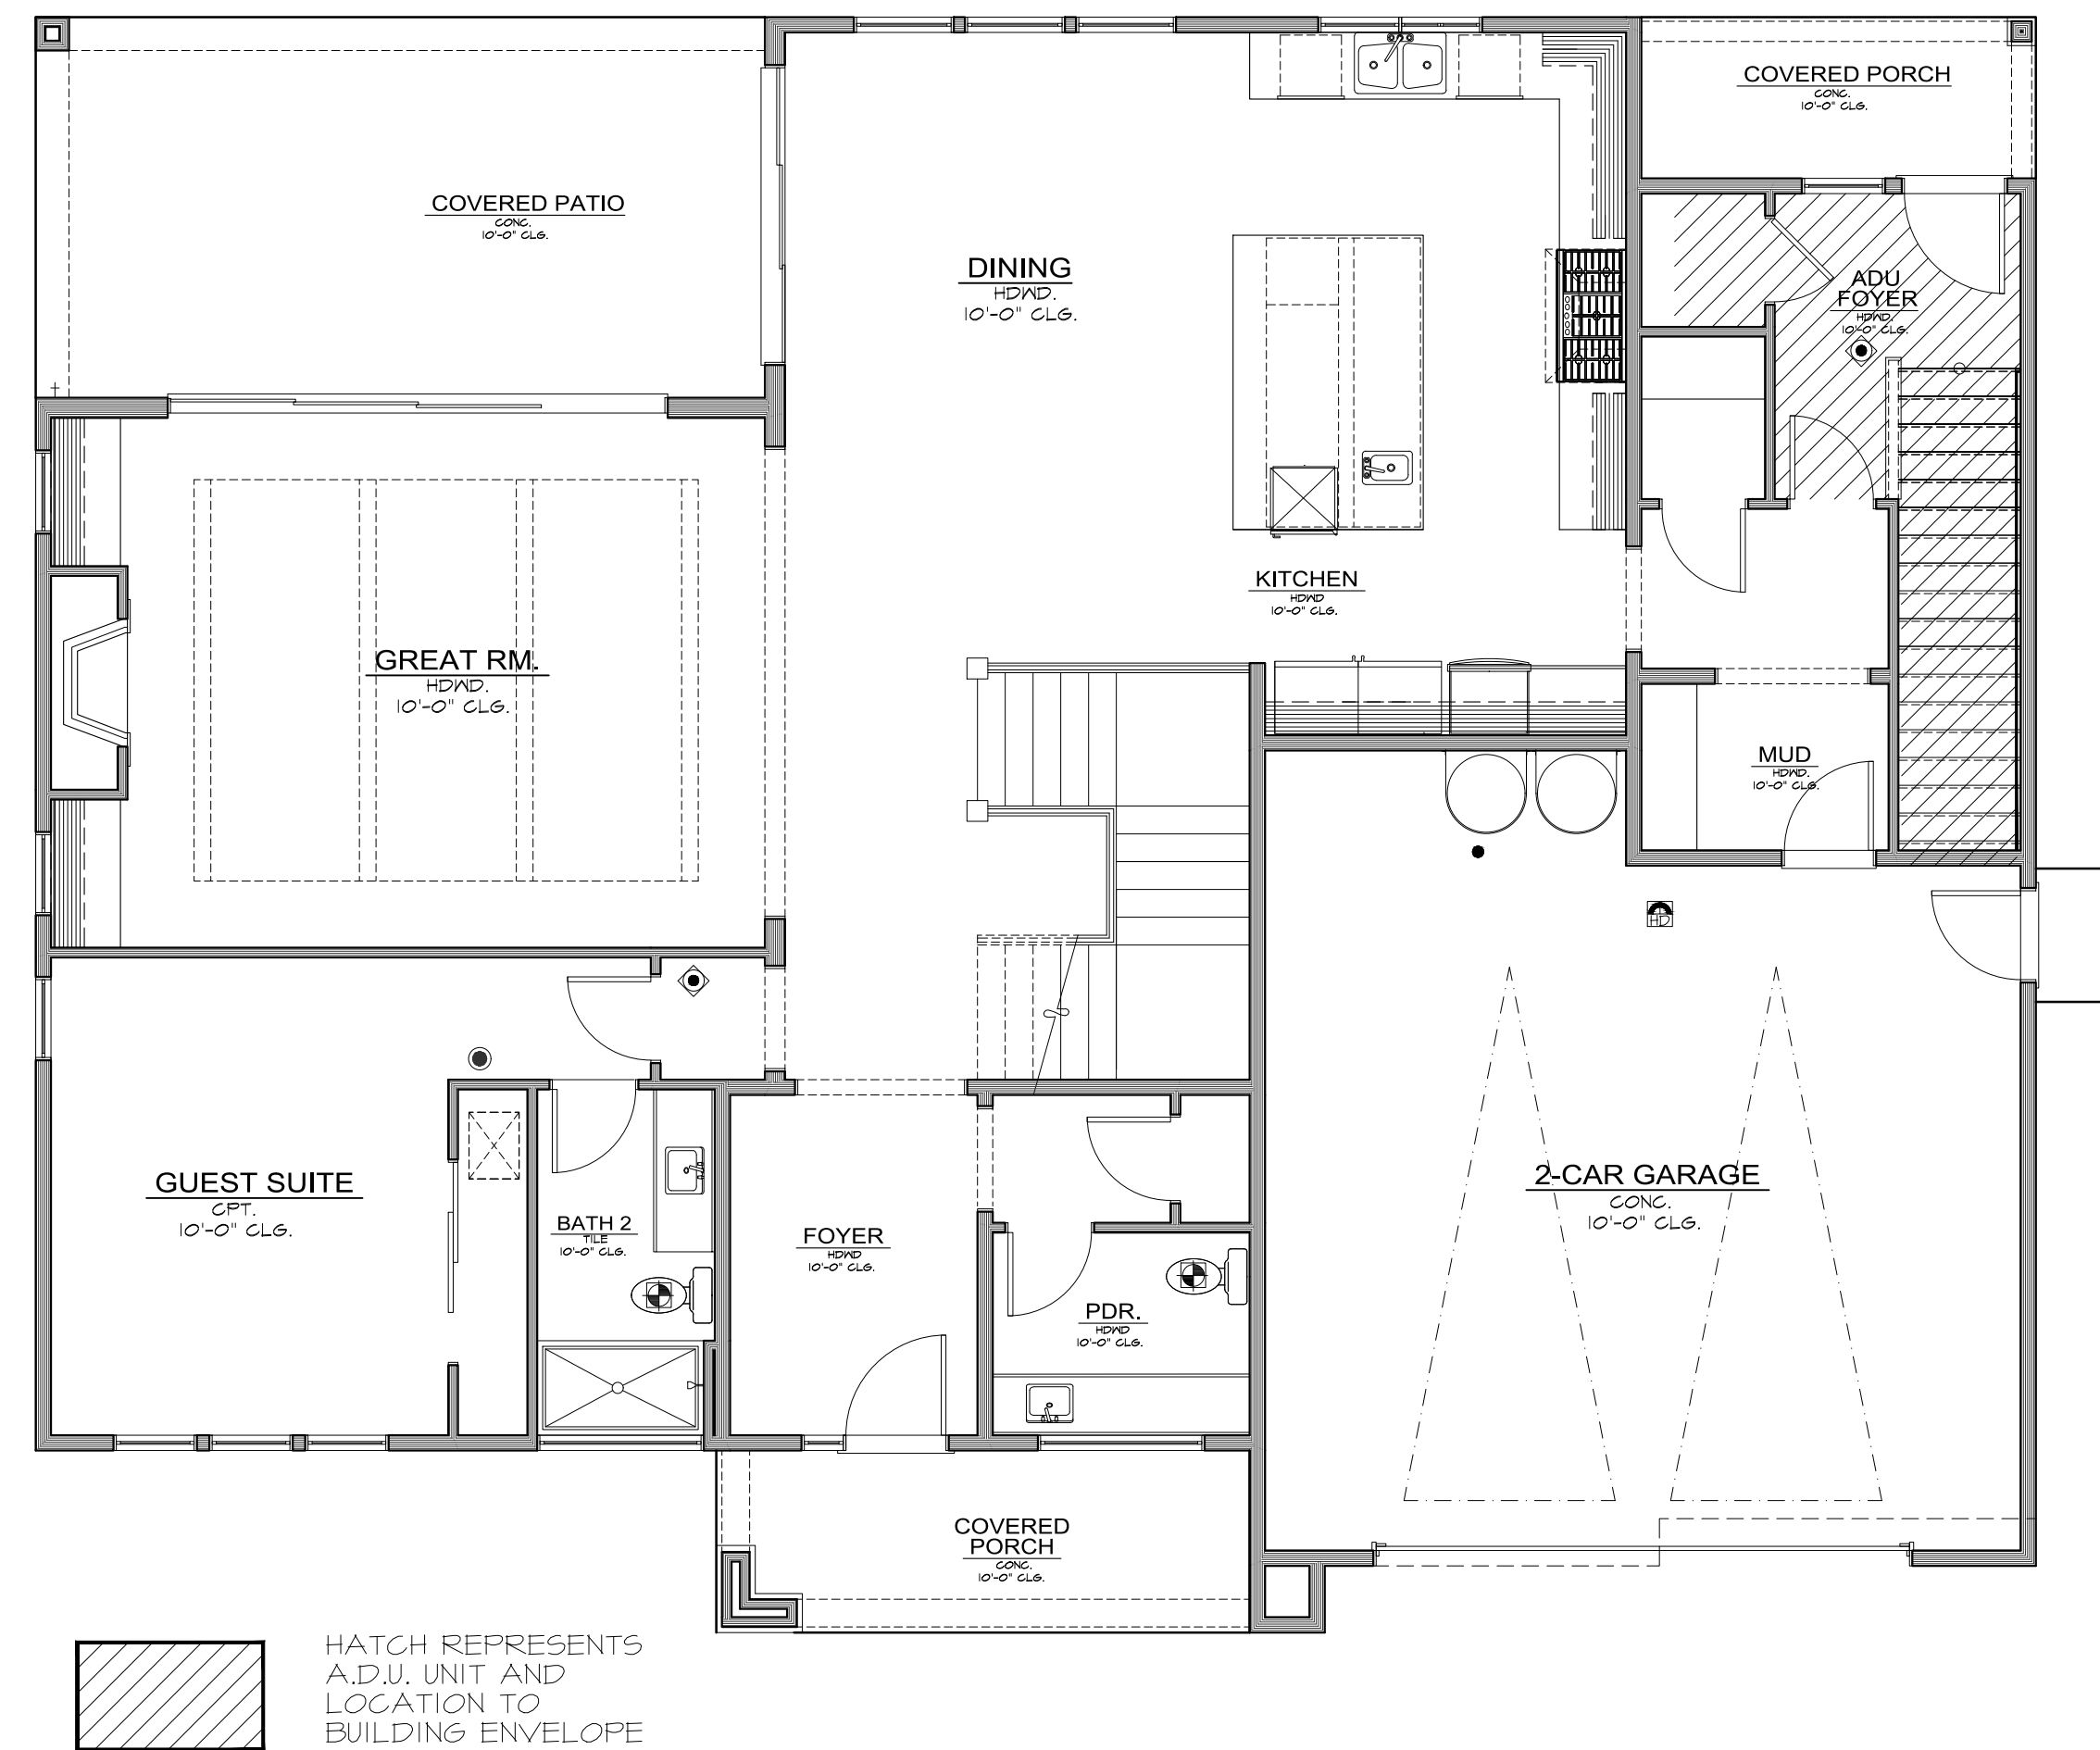

HATCH REPRESENTS
 A.D.U. UNIT AND
 LOCATION TO
 BUILDING ENVELOPE

MAIN FLOOR PLAN
 1/4" = 1'-0"

ADU PLAN INFORMATION

1/4" = 1'-0"

SQUARE FOOTAGE SUMMARY	
MAIN FLOOR/ MAIN LIVING	1,641 S.F.
MAIN FLOOR A.D.U.	194 S.F.
GARAGE	525 S.F.
SUB TOTAL	2,360 S.F.
UPPER FLOOR/ MAIN LIVING	1,669 S.F.
UPPER FLOOR A.D.U.	605 S.F.
MINUS A.D.U. STAIRS	-59 S.F.
MINUS MAIN STAIRS	-100 S.F.
SUB TOTAL	2,105 S.F.
TOTAL G.F.A.	4,540 S.F.
ALLOWABLE F.A.R. 45%	4,596 S.F.
PROPOSED	34.48
TOTAL NET AREA MAIN HOUSE	1,830 S.F.
GARAGE	525 S.F.
TOTAL NET A.D.U.	824 S.F.
SUB TOTAL	3,179 S.F.
COVERD PATIO	250 S.F.
COVERD PORCH	87 S.F.
OVERALL WIDTH	60'-0"
OVERALL DEPTH	48'-5 1/2"
NOTED: COVERD PORCH	

Method for Calculating Square Footage - ANSI Z90-2013 except, no separate distinction of above-grade or below-grade areas and shall be measured to the outside of studs not the exterior finished surface.
 Square Footage calculations for this house were made based on plan dimensions only and may vary from the finished square footage of the house as built.
 See Sheet "CODES" for additional Zoning required Area Calculations.

Issue	Issue Date	By	Description
△	07.11.22		CITY PLAN REVIEW COMMENTS

4537 90th AVE SE
Mercer Island, WA.

Job Number:

plan name: -
 marketing name: XXXXXX
 plan number: -
 mark sys. number: -

Conditions not specifically represented graphically or in writing or which conflict with the current International Residential Code (IRC.) or those of the local municipality then the current standards and requirements of each respectively shall govern.

The drawings in this set are instruments of service and shall remain the property of JayMarc Homes, LLC.

© 2017 JayMarc Homes, LLC. All rights reserved.

06.15.21
 Submittal Date


Sheet Title/Description
 JAYMARC HOMES
 Design Firm

R.R.
 Drawn by:

R.R./S.K.
 Checked by:

Primary Scale

A1.1
 of .

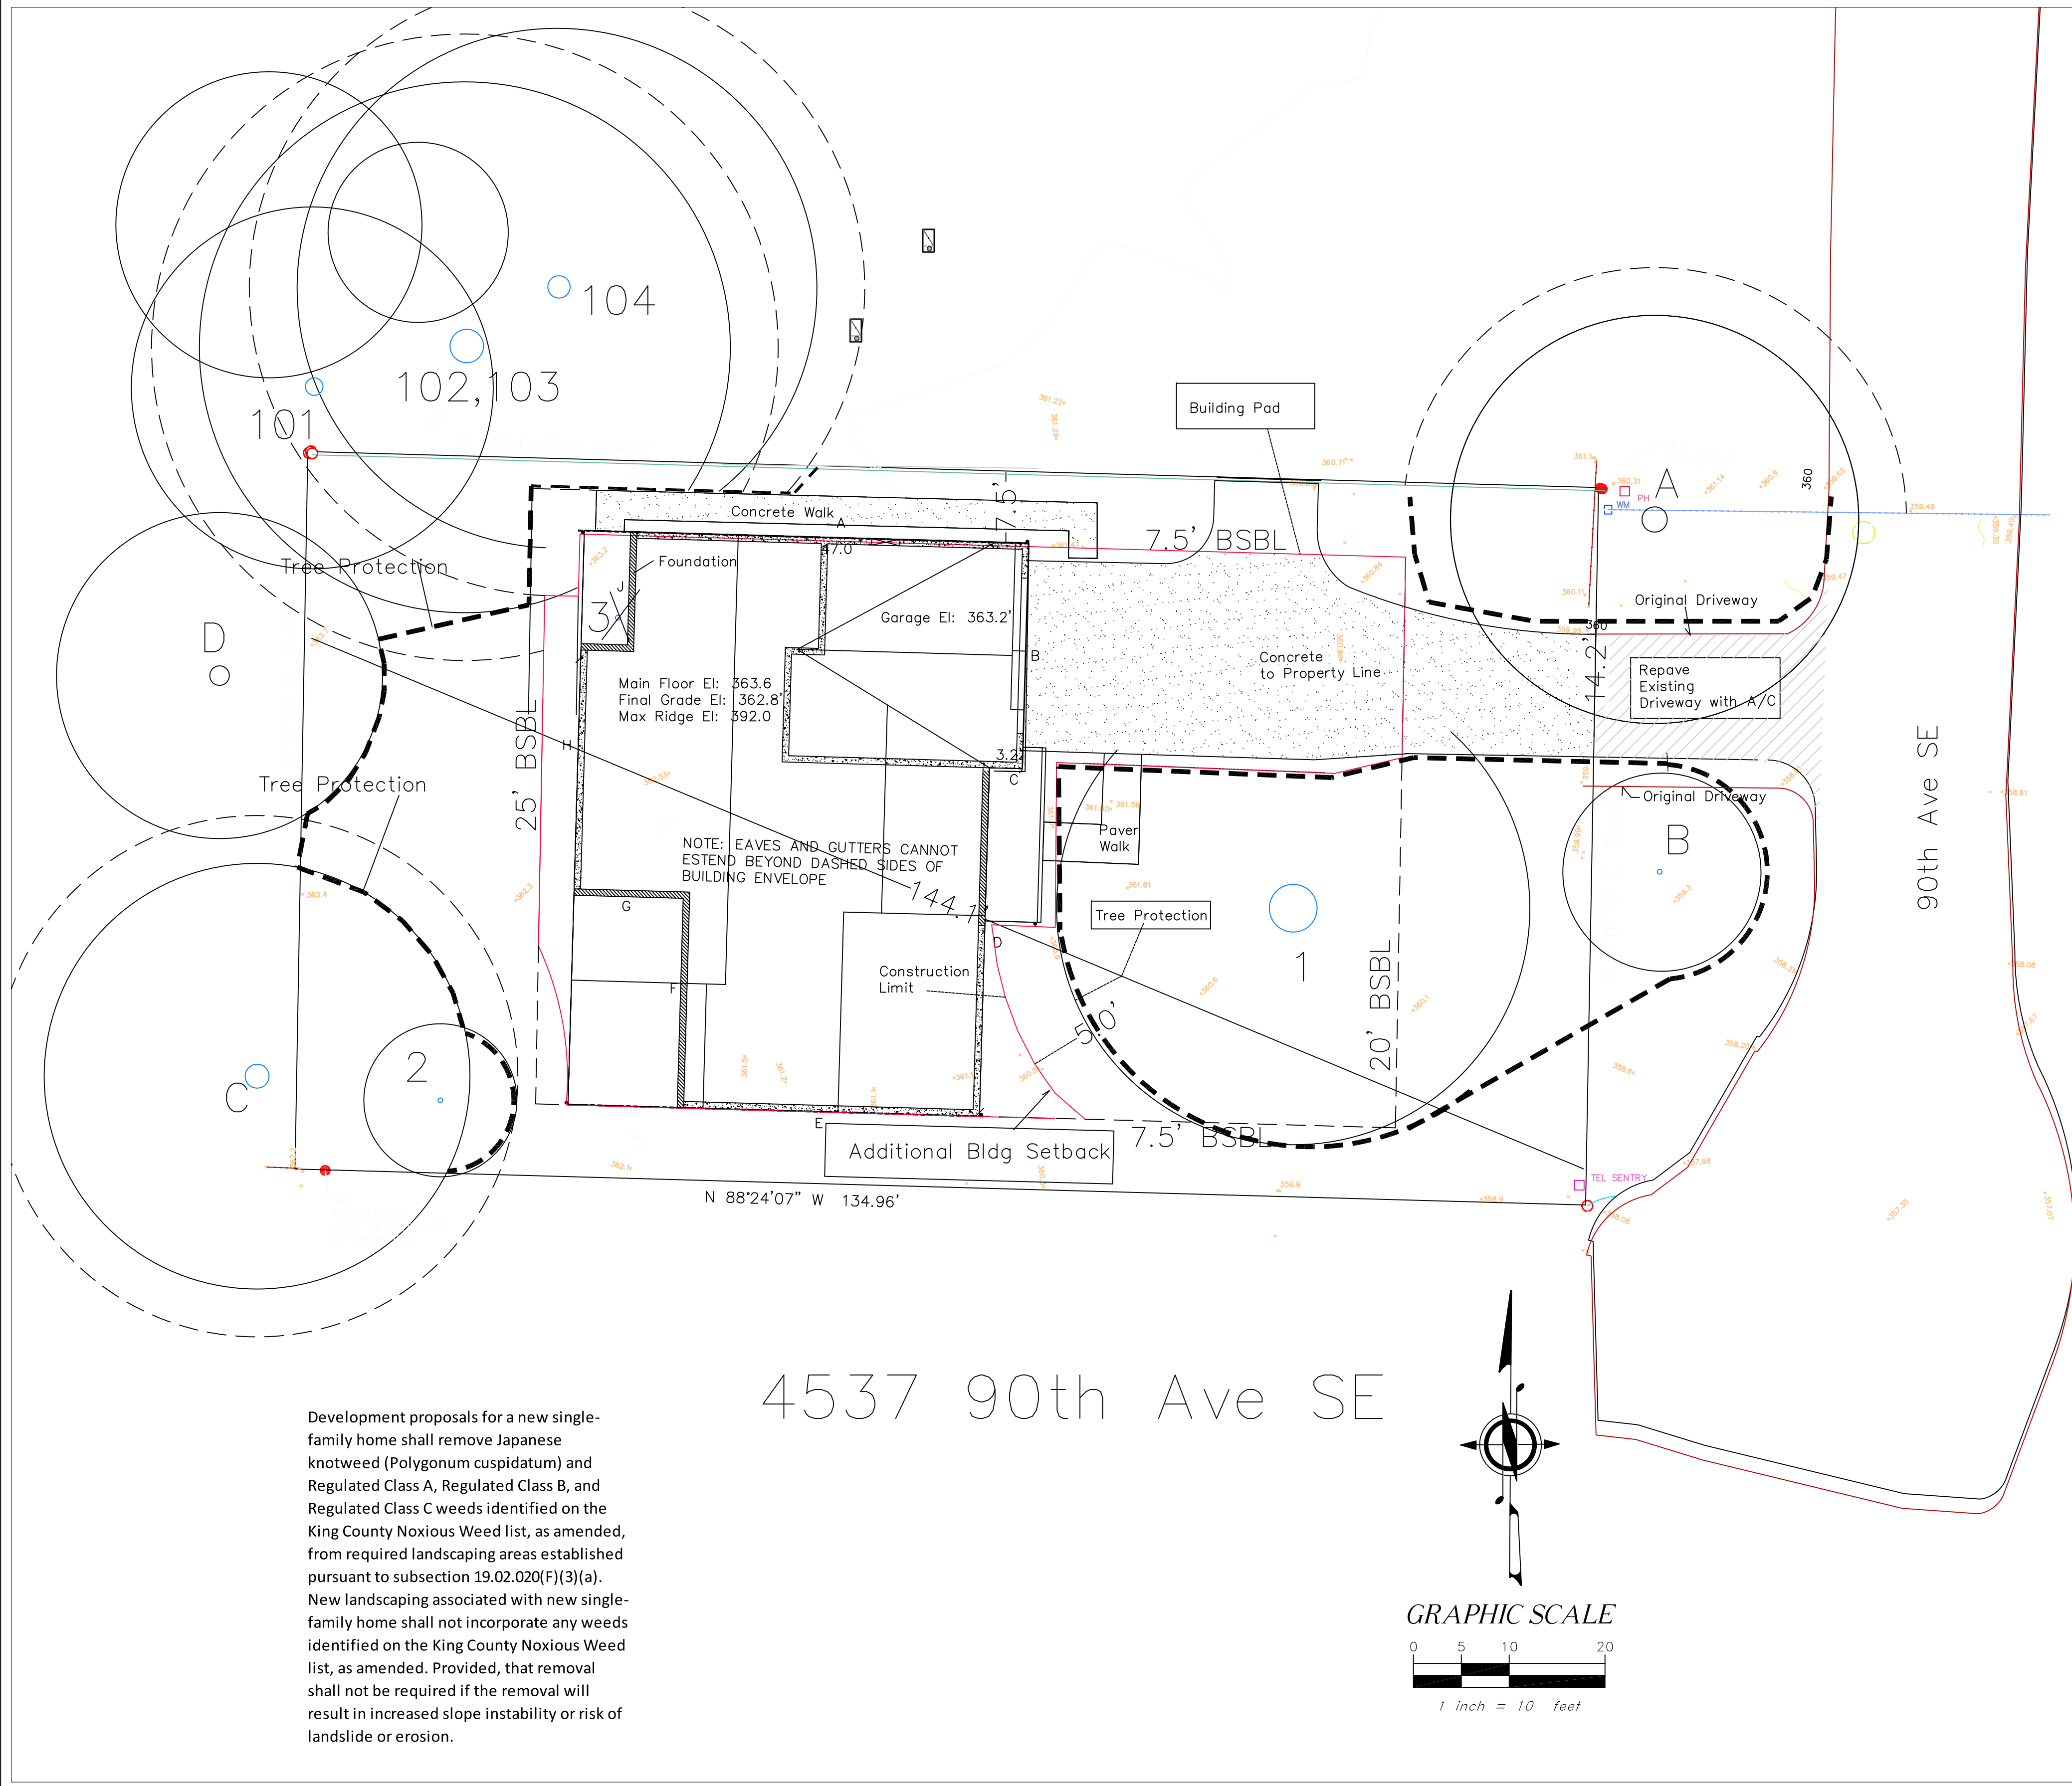

Development proposals for a new single-family home shall remove Japanese knotweed (*Polygonum cuspidatum*) and Regulated Class A, Regulated Class B, and Regulated Class C weeds identified on the King County Noxious Weed list, as amended, from required landscaping areas established pursuant to subsection 19.02.020(F)(3)(a). New landscaping associated with new single-family home shall not incorporate any weeds identified on the King County Noxious Weed list, as amended. Provided, that removal shall not be required if the removal will result in increased slope instability or risk of landslide or erosion.

4537 90th Ave SE



PROPERTY OWNER
 SABISABI, LLC
STREET ADDRESS
 4537 90th Ave SE, Mercer Island, WA 98040
PARCEL#
 191100195
LEGAL DESCRIPTION
 Lot 7, Block 3, Allview Heights Addition to Seattle, According to the plat recorded in Volume 16 of Plats, Page 20, King County Together with the east Half of the Vacated Alley Adjoining on the West.
ZONE: R-9.6
SETBACKS:
 Front Yard - 20'
 Rear Yard - 25'
 Side Yards - 7.5'/15'
HEIGHT LIMIT: 30' above ABE to roof peak
MAXIMUM LOT COVERAGE: 40%
MAXIMUM HARDSCAPE: 9%
MAXIMUM FAR: 40% + 5% ADU
PARKING SPACES PROVIDED: 3 GARAGE 2 DRIVEWAY
NO CRITICAL AREAS IMPACTED
No Onsite Utility Easements

Hardscape	
EXISTING	
Uncovered Patio	713
Total Existing	713
Existing Removed	-713
Net Existing Retained	0
NEW	
Walkways	239
Total New	239
Total New and Existing	239
Total Hardscape	2.36%

HEIGHT TABLE			
Segment	Length	El:	
A	41	362.7	14870.7
B	24	361.5	8676
C	3	361.5	1084.5
D	36	361.3	13006.8
E	32	361.2	11558.4
F	22	362	7964
G	11.5	362.2	4165.3
H	26	362.7	9430.2
I	4.5	363	1633.5
J	11.5	363.2	4176.8
	211.5		76566.2
Average		362	
Height Limit		30	
Elevation Limit		392.0	
		391.5	

LOT COVERAGE	
Lot Area	10,125
Allowed	40%
Allowed sf	4,050
New	
Eave Area	2,567
Driveway	1,140
New sf	3,707
Existing	
Eaves	3,178
Driveway	613
Total Existing	3,791
Existing Removed	(3,791)
Net Existing	-
Total	
Total New and Existing	3,707
%	36.6%

PARKING	
Covered	2 ea.
Driveway	2 ea.

LOT SLOPE CALCULATION	
High Point El:	363.7 ft
Low Point El:	358.3 ft
Elevation Difference	5.4 ft
Distance	144.1 ft
% Slope	3.75%

4537 TREE INVENTORY						
ONSITE TREES						
Tree ID	species	DBH	DRIP	EXCEPTIONAL	SAVE	REMOVE
1	Western red cedar	58.5	24	yes	yes	
2	Mountain Ash	6	6	small tree	yes	
3	Eastern Dogwood	6	16	small tree	No	YES
OFFSITE TREES						
A	Western Red Cedar	41.6	20	yes		
B	Mountain Ash	9	11	small tree		
C	Douglas Fir	35	21	yes		
D	Douglas Fir	24	16	Large Tree		
101	Doug Fir	24	18	yes, grove		
102	Doug Fir	36.5	14	yes, grove		
103	Doug Fir	40	26	yes, grove		
104	Doug Fir	30.5	26	yes, grove		


GROSS FLOOR AREA	
Main Floor/Main Living	1691 sf
Main Floor Garage	525 sf
Main Floor ADU	139 sf
Total Main Floor	2355 sf
Second Floor Main Living	1659 sf
Second Floor Stair Deduction	-87 sf
Second Floor ADU	685 sf
ADU Stair Deduction	-59 sf
Total Second Floor	2198 sf
Total GFA	4553 sf
Allowable GFA 45%/wADU	4556 sf
Proposed %	44.9 %

JayMarc Homes, LLC
 7525 SE 24th St, #487
 Mercer Island, WA 98040
 425 281 2706


Site Plan
 4537 90th Ave SE
 Mercer Island, WA

Drawn by
 GU
 3-21-22
 8-19-22


A2.1

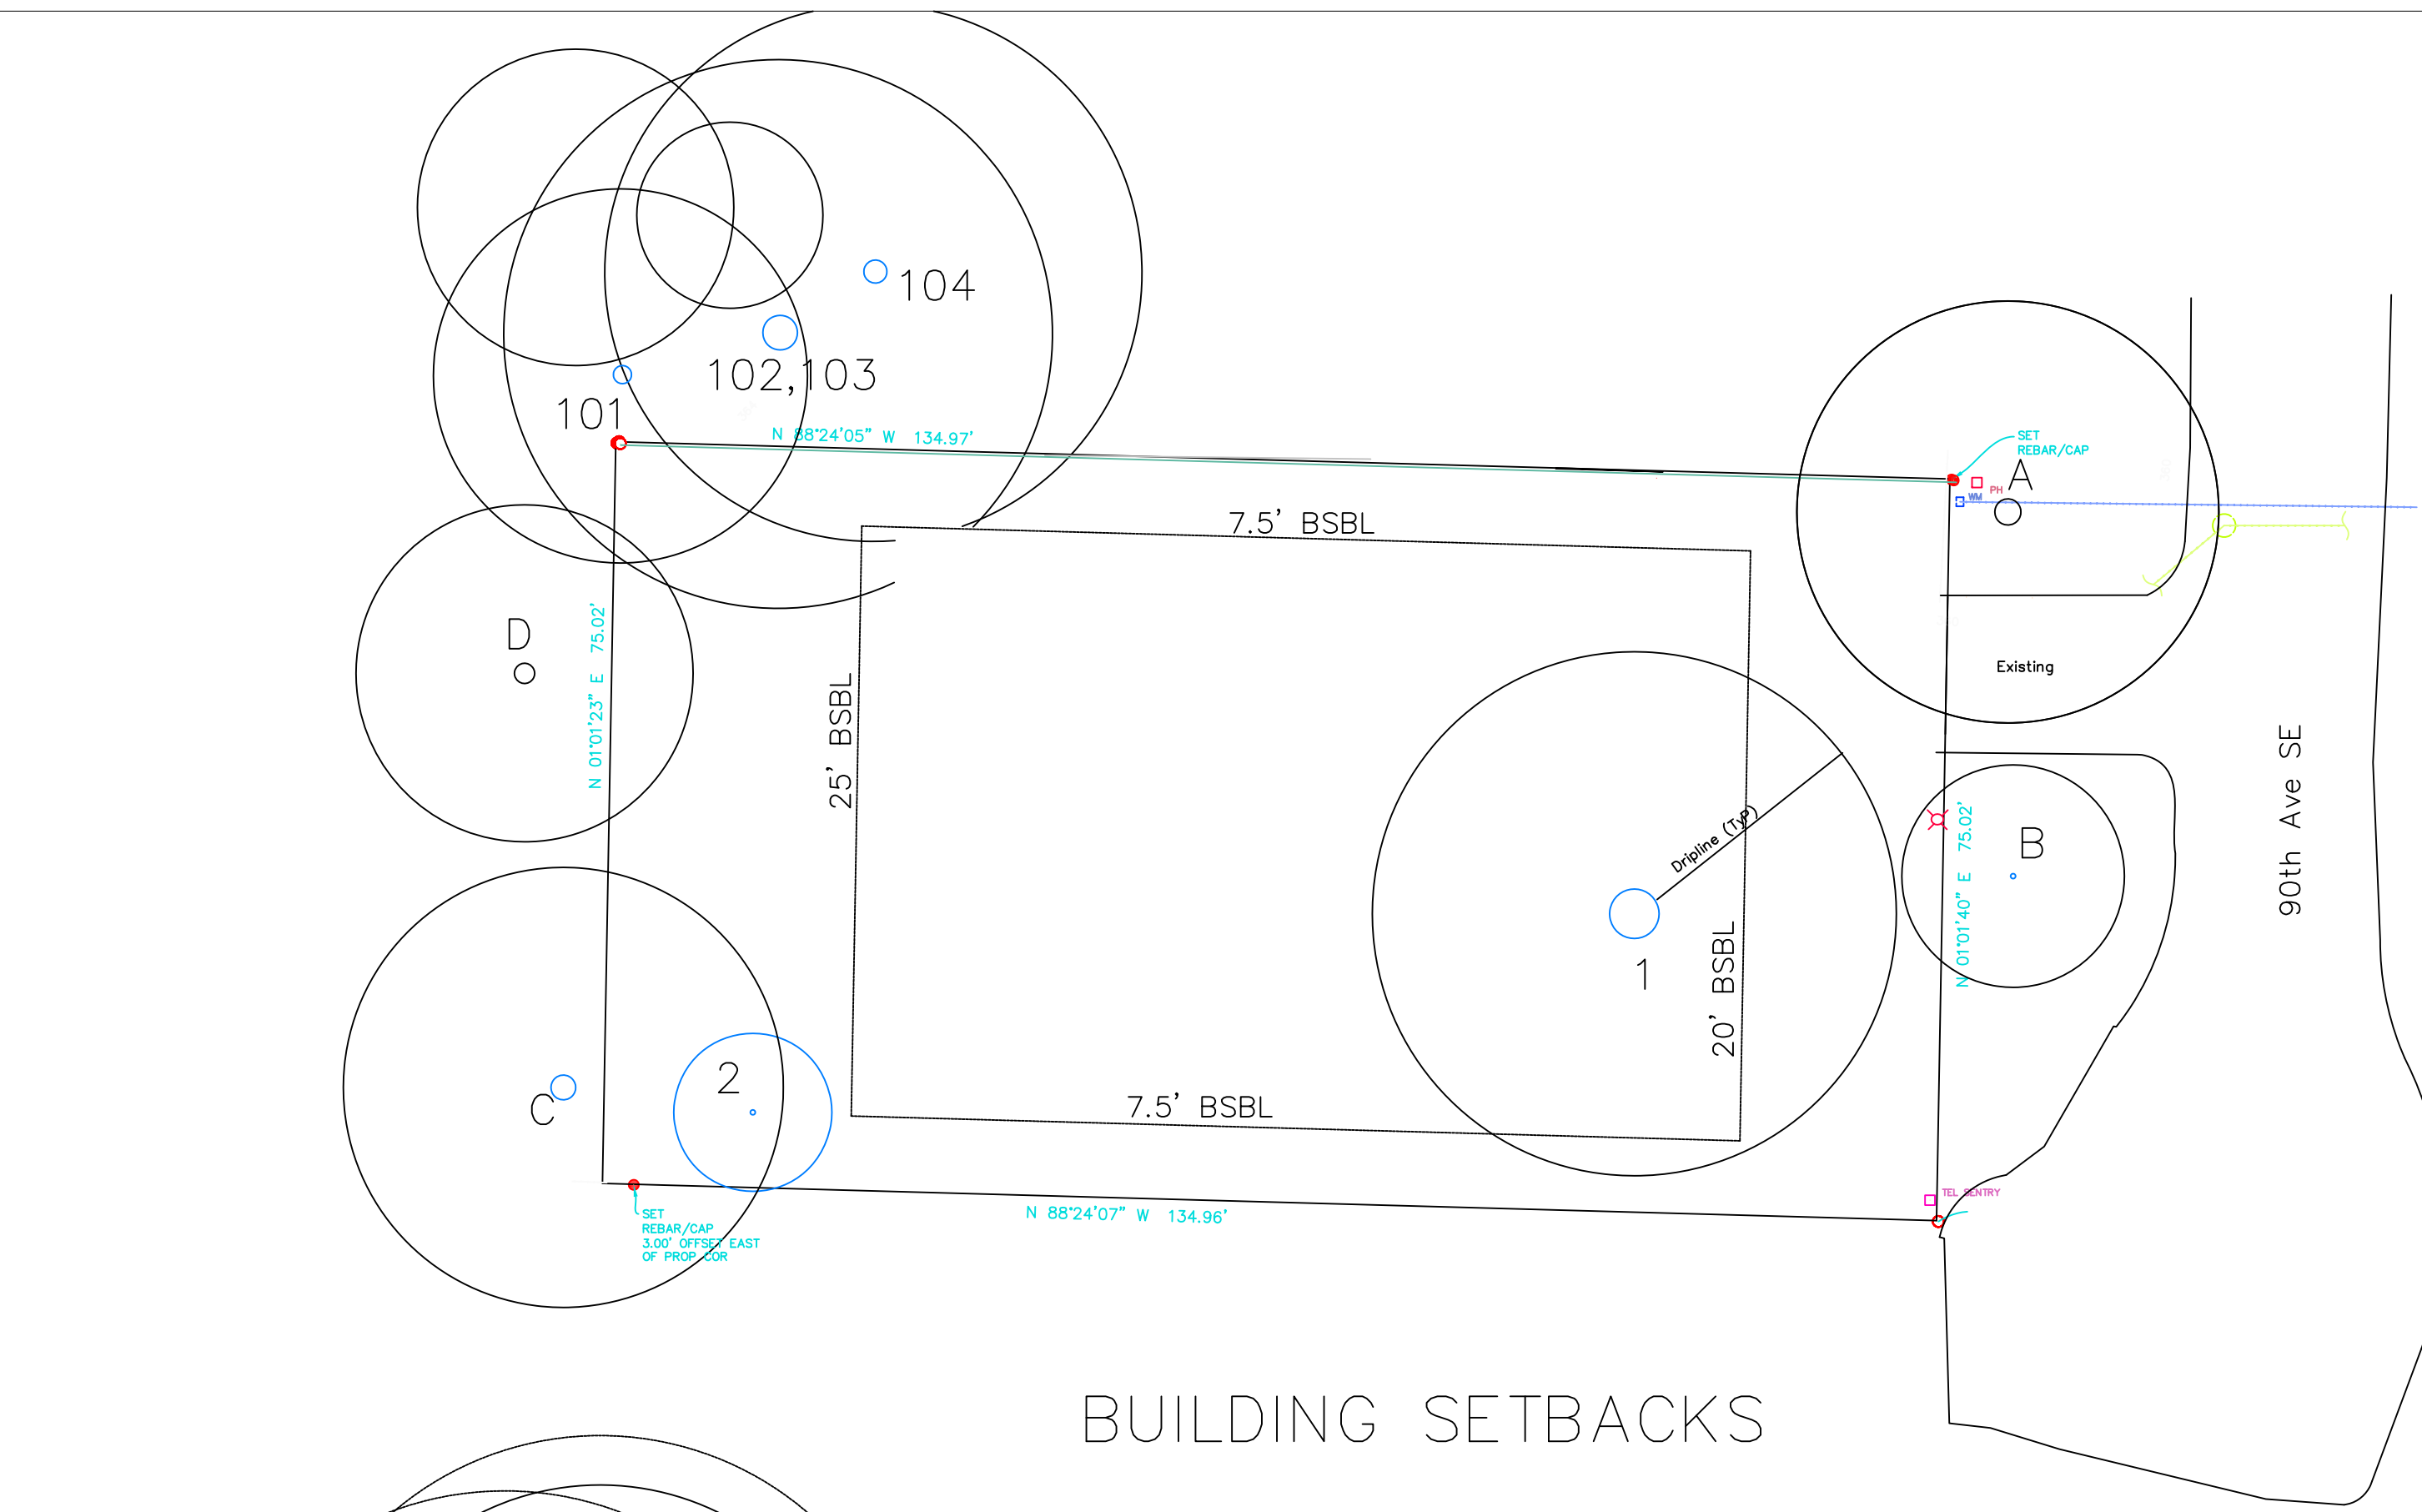

BUILDING SETBACKS

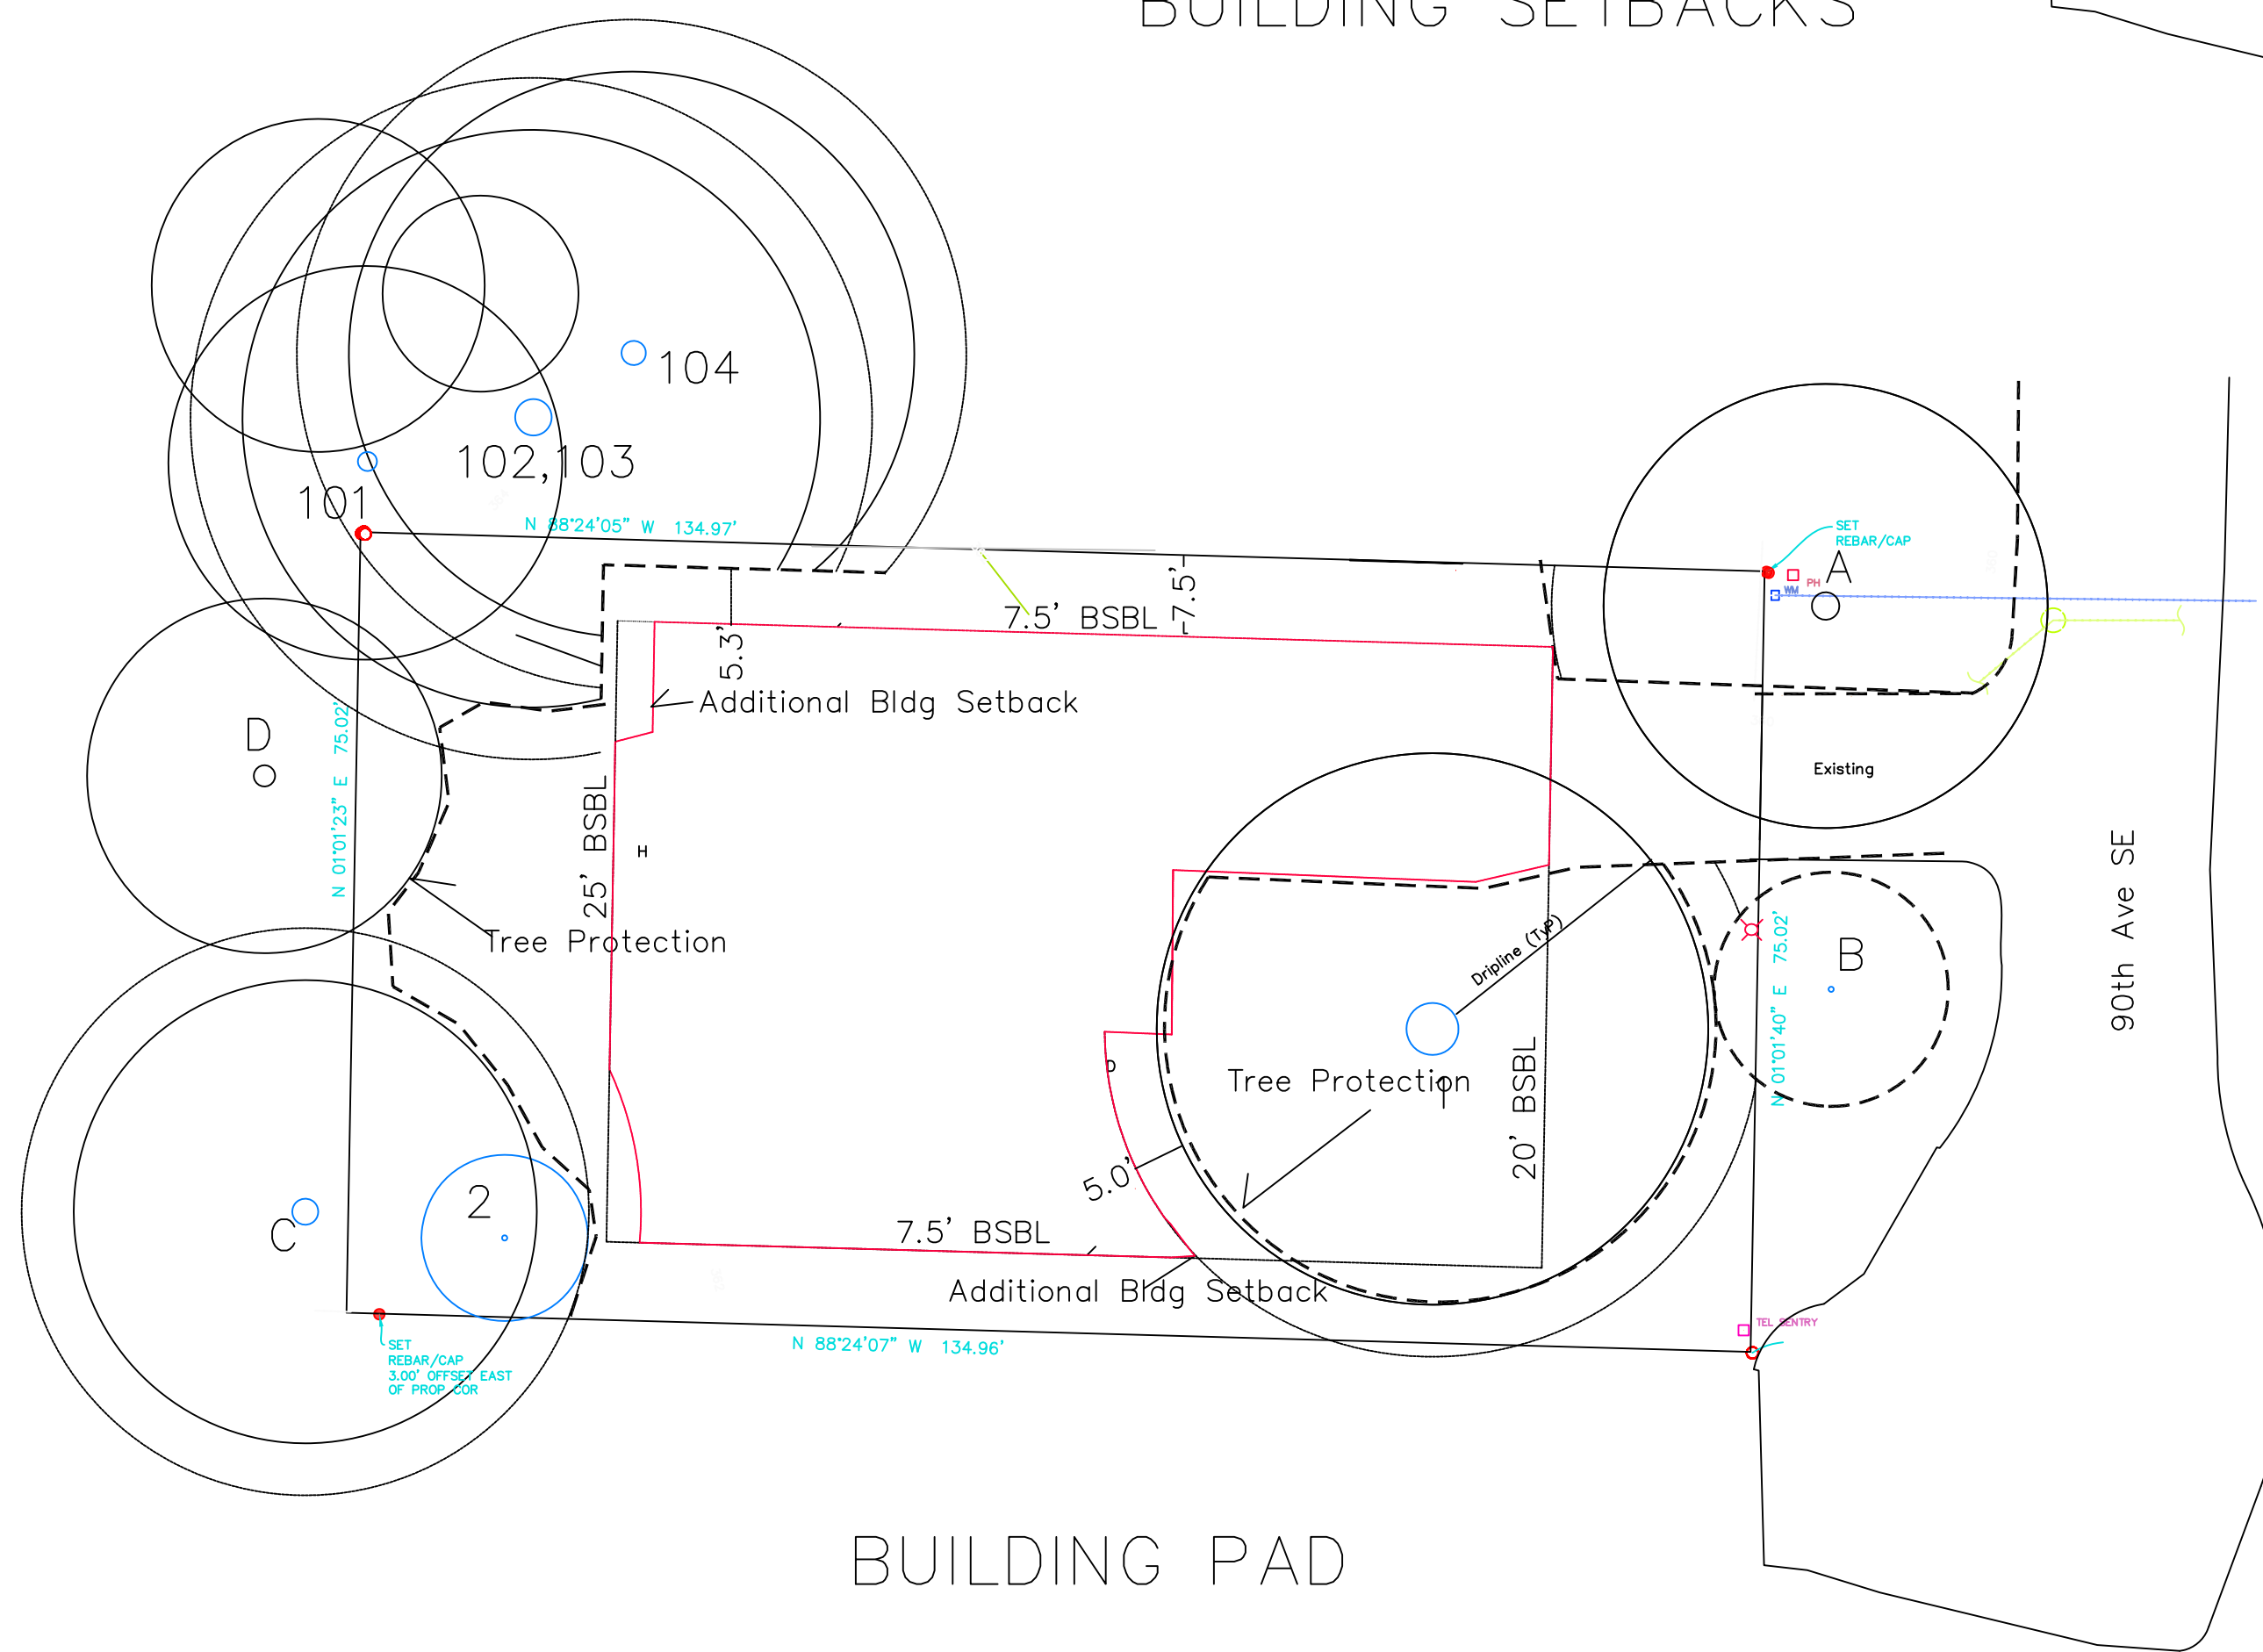

BUILDING PAD

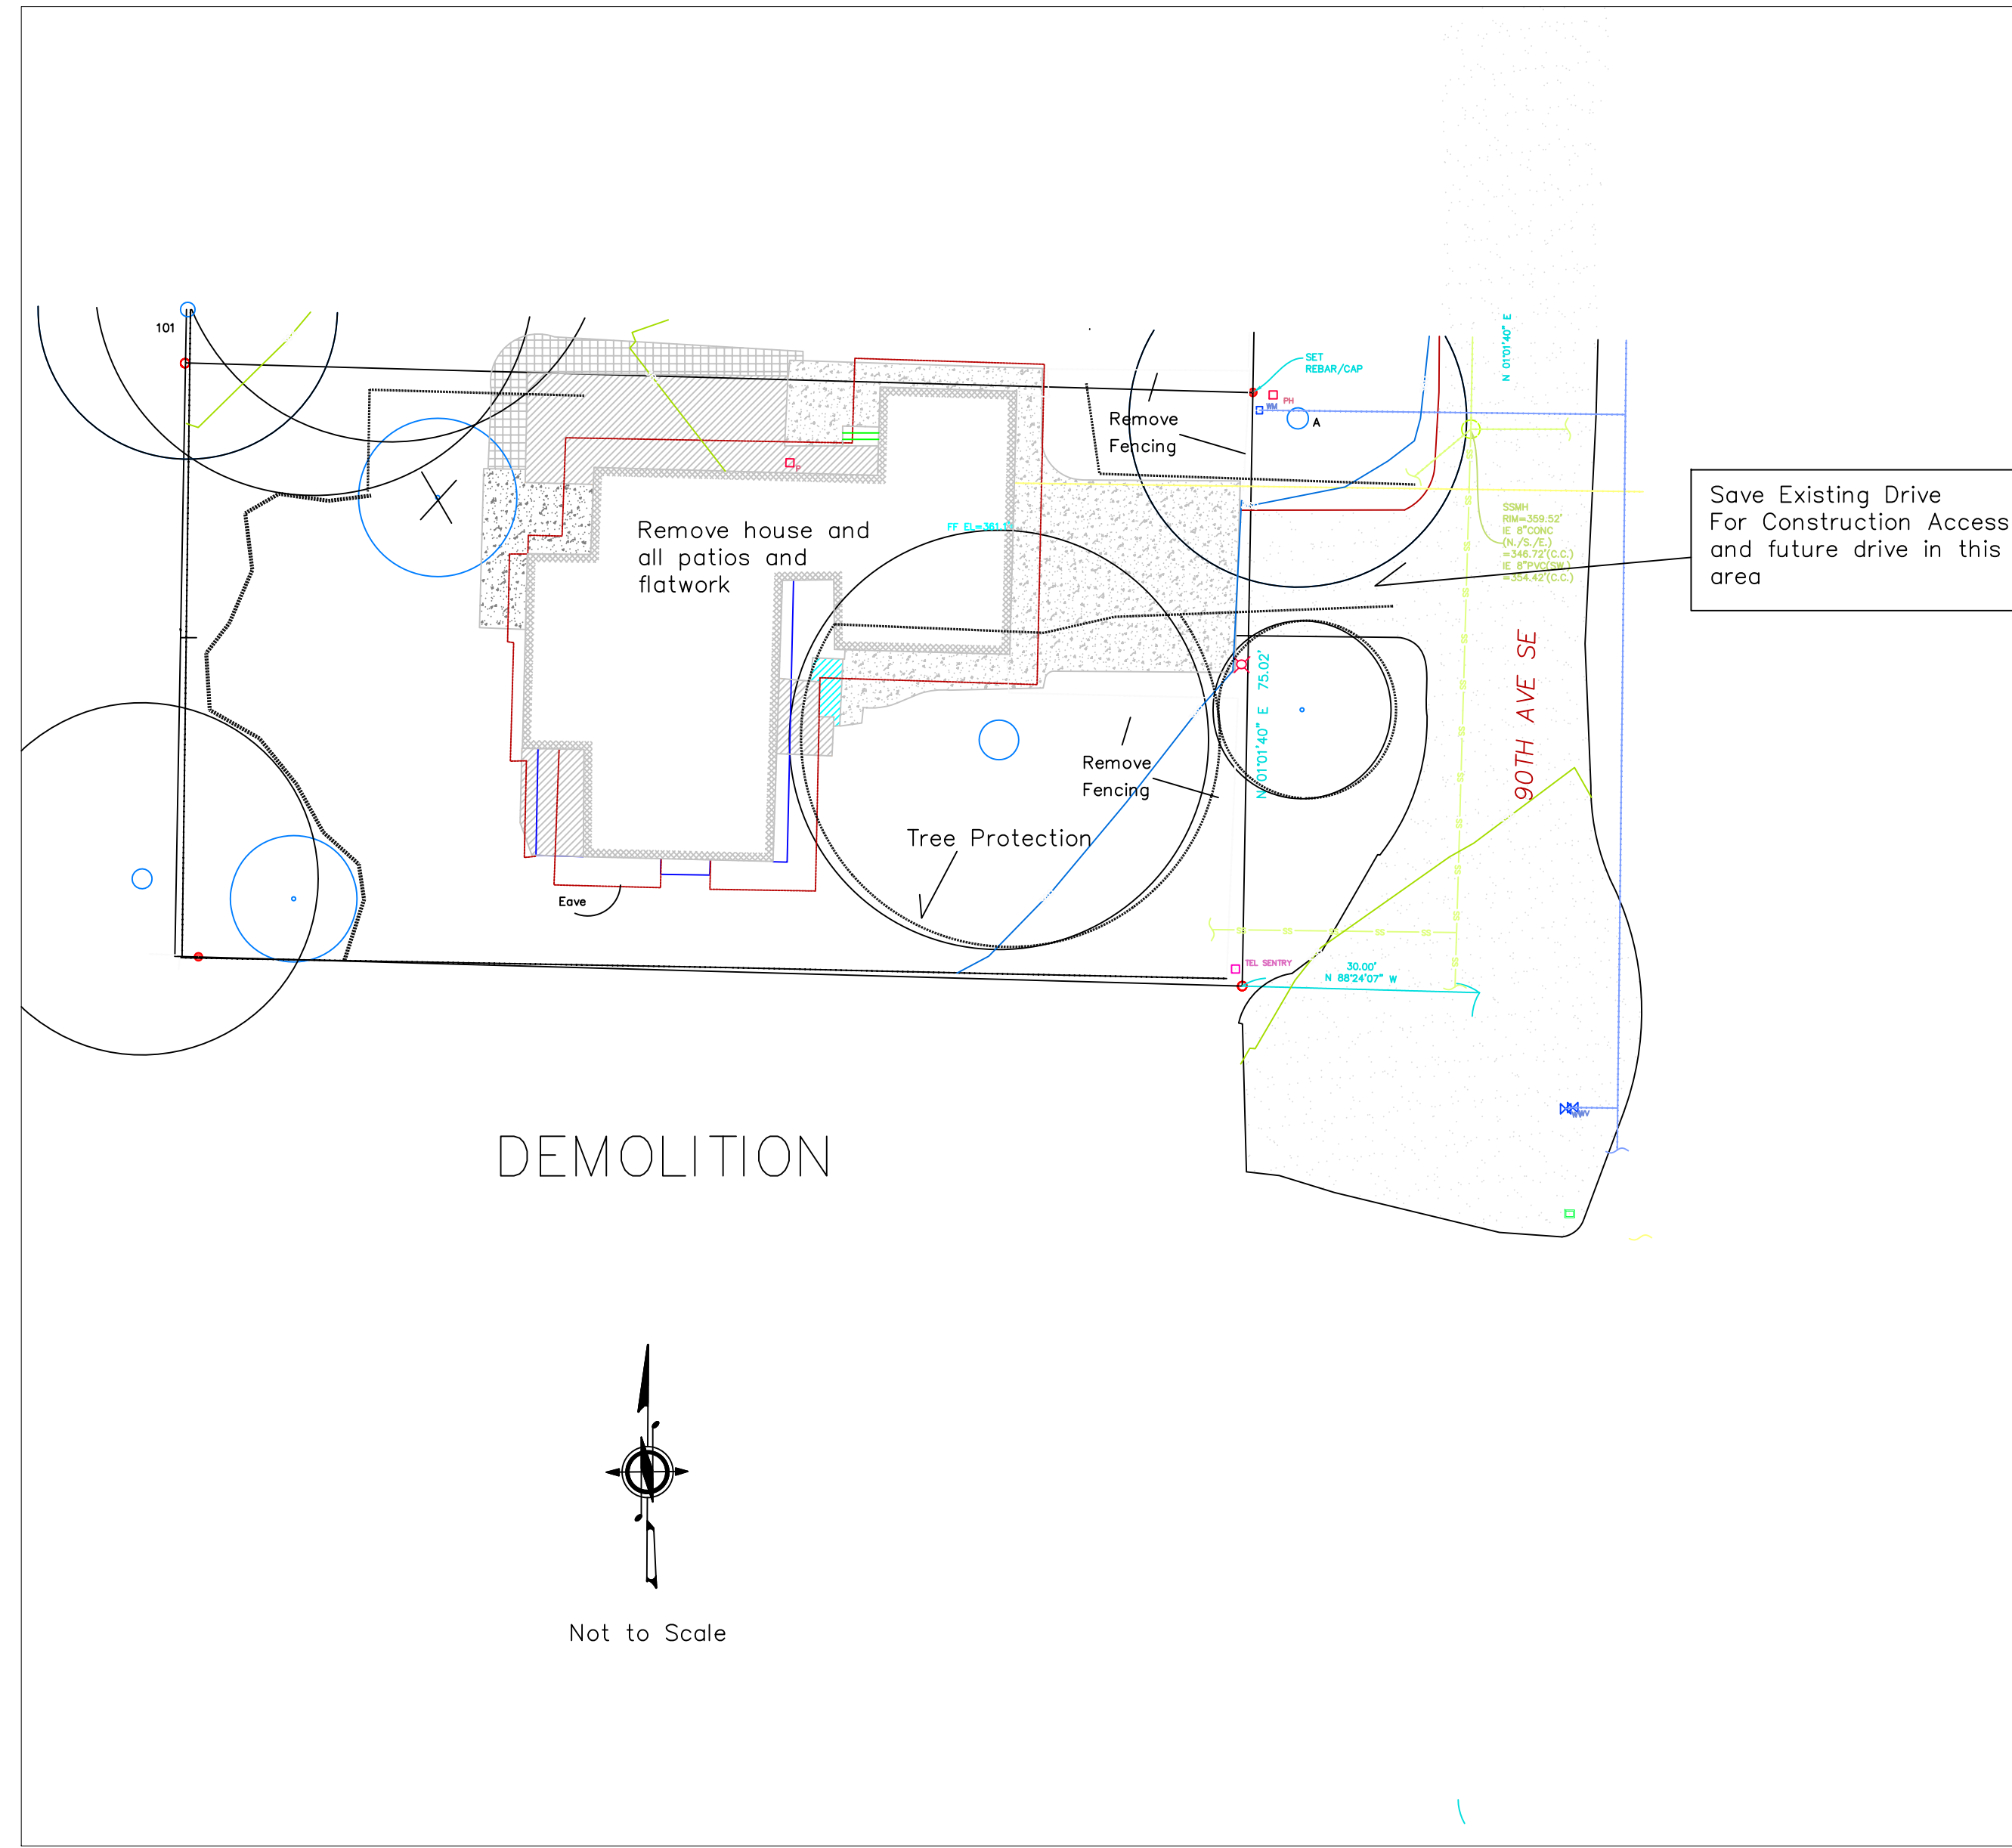


DEMOLITION

JayMarc Homes, LLC
 7525 SE 24th St, #487
 Mercer Island, WA 98040
 425 281 2706

Building Pad and Demolition
 4537 90th Ave SE
 Mercer Island, WA

Drawn by
 GU
 3-21-22

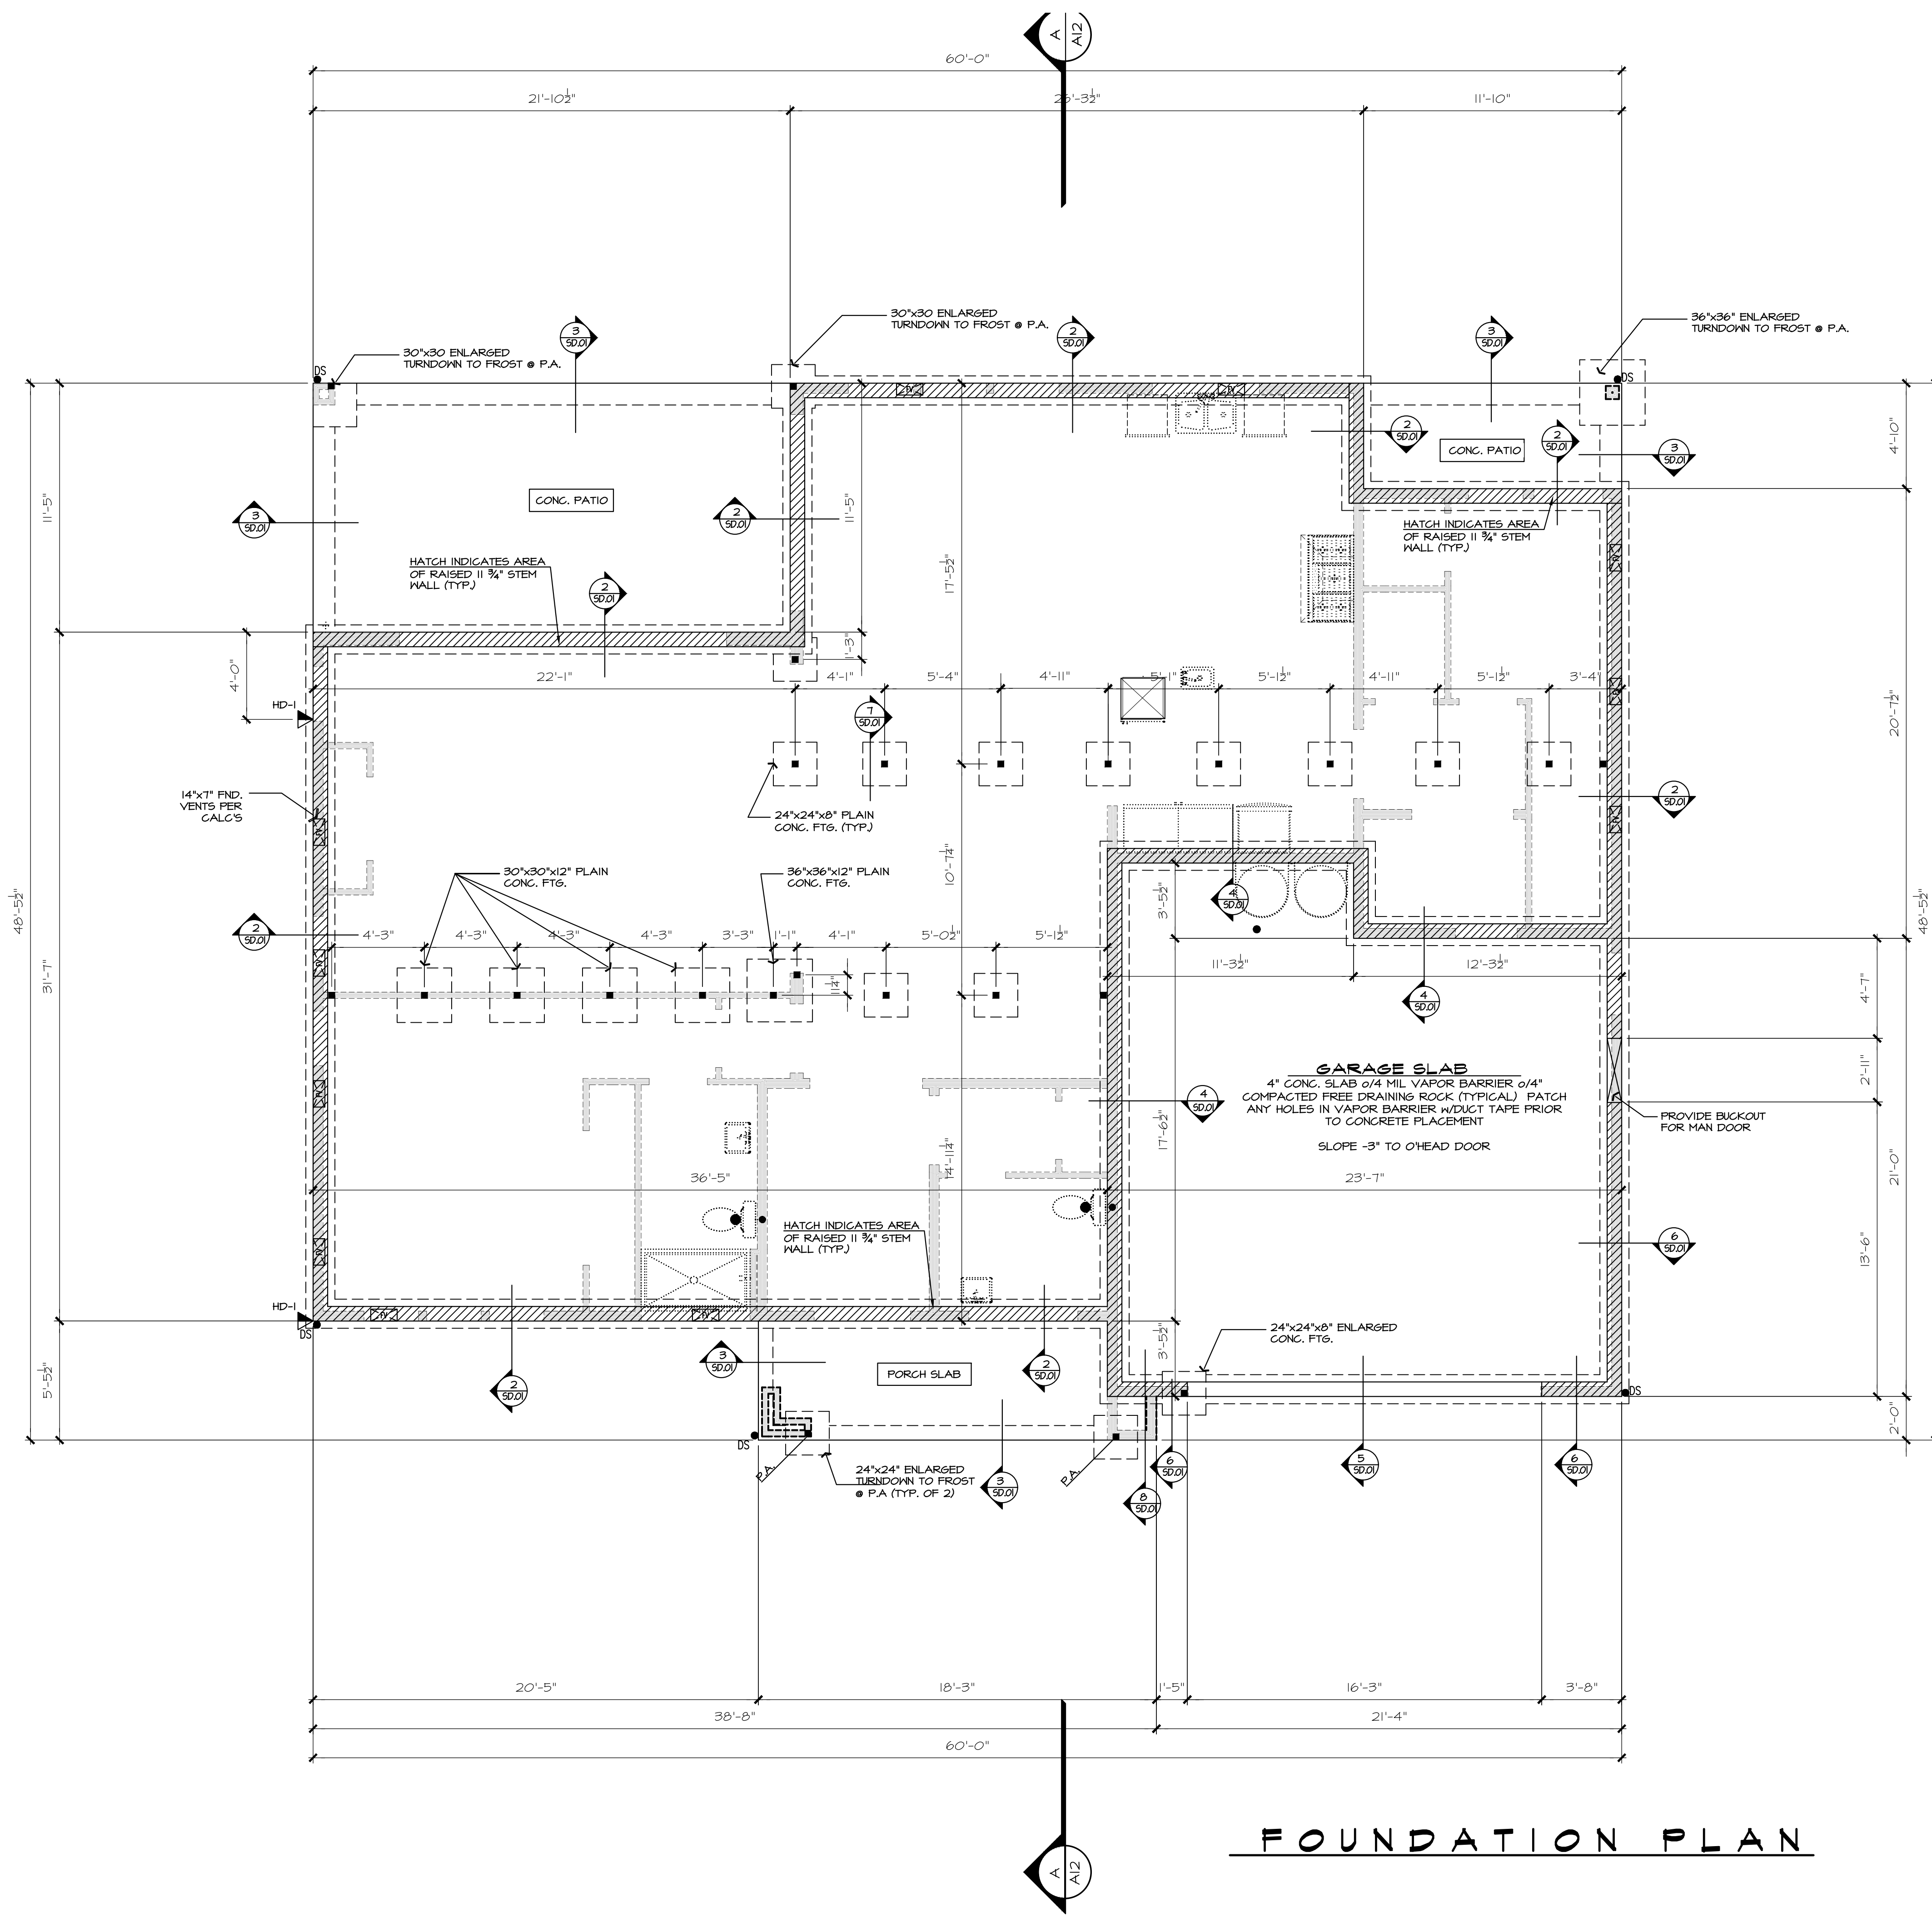

FOUNDATION PLAN

HOLD-DOWN SCHEDULE	
SYMBOL	SPECIFICATION
HD-1	SIMPSON STHD14 (R.J) HOLD-DOWN
HD-5	SIMPSON CSI6 STRAP TIE (14" END LENGTH)
HD-6	SIMPSON MSTC40 STRAP TIE (12" END LENGTH)
HD-7	SIMPSON MSTC66 STRAP TIE (24" END LENGTH)

LEGEND	
•	INTERIOR BEARING WALL
•	EXTERIOR WALL ABOVE
JL	METAL HANGER
*	INDICATES POST ABOVE. PROVIDE SOLID BLOCKING UNDER POST OR JAMB ABOVE.
▶	INDICATES HOLD-DOWN.

4x10 DROPPED CONT. BEAM (TYP. U.N.O.)

TYP. CRAWLSPACE POSTS:
 4x4 P.T. POST (4'-0" MAX. POST HEIGHT)
 W/2x4 CLEATS EA. SIDE + SIMPSON ABW44Z PLATE @ BASE OF POST ON ASPHALT SHINGLE ON 24"x24"x8" PLAIN CONC. FTG. (TYP. U.N.O.)

REFER TO S-O FOR TYPICAL STRUCTURAL NOTES & SCHEDULES


JAYMARC HOMES
 7525 SE 24th St., 487
 Mercer Island, WA
 98040
 425.266.9100

Issue	Issue Date	By	Description
△	07.11.22		CITY PLAN REVIEW COMMENTS

4537 90th AVE SE
Mercer Island, WA.
 Job Number:

plan name: -
 marketing name: XXXXXX
 plan number:
 mark sys. number: -

Conditions not specifically represented graphically or in writing or which conflict with the current International Residential Code (IRC.) or those of the local municipality then the current standards and requirements of each respectively shall govern.
 The drawings in this set are instruments of service and shall remain the property of JayMarc Homes, LLC.
 © 2017 JayMarc Homes, LLC; All rights reserved.

06.15.21
 Submittal Date

Sheet Title/Description
 JAYMARC HOMES
 Design Firm

R.R.
 Drawn by:

R.R./ S.K.
 Checked by:

Primary Scale

A3
 of .

Sheet Title/Description

HOLD-DOWN SCHEDULE	
SYMBOL	SPECIFICATION
HD-1	SIMPSON STHD14 (R.J.) HOLD-DOWN
HD-5	SIMPSON CSI6 STRAP TIE (14" END LENGTH)
HD-6	SIMPSON MSTC40 STRAP TIE (12" END LENGTH)
HD-7	SIMPSON MSTC66 STRAP TIE (24" END LENGTH)

LEGEND	
	J.L. METAL HANGER
	INDICATES POST ABOVE. PROVIDE SOLID BLOCKING UNDER POST OR JAMB ABOVE.
	INDICATES HOLD-DOWN.

07.11.22
CITY PLAN REVIEW COMMENTS

INDICATES 11-7/8" TJI FLOOR JOISTS @ 16" O.C. 210 SERIES (TYP. U.N.O.)

REFER TO S-O FOR TYPICAL STRUCTURAL NOTES & SCHEDULES

4x10 DROPPED CONT. BEAM (TYP. U.N.O.)

TYP. CRAWLSPACE POSTS:
4x4 P.T. POST (4'-0" MAX. POST HEIGHT) W/2x4 GLEATS EA. SIDE + SIMPSON ABW44Z PLATE @ BASE OF POST ON ASPHALT SHINGLE ON 24"x24"x8" PLAIN CONG. FTG. (TYP. U.N.O.)

FOUNDATION VENTILATION			
Crawlspace Area:	1821 s.f.		
Ventilation Required:	1821 s.f. / 300 =	874.08 s.i. Req'd	
Use:	14" x 7" Foundation Vents		
Vent Area =	98 s.i. - 25% reduct., 1/4" mesh =	73.5 s.i.	
Vents Required =	874.08 s.i. / Vent Area =	11.89 s.i.	
Provide:	12 14" x 7" Vents, Area =	882 s.i.	
Ventilation Provided =	882.00 s.i. is Greater than	874.08 s.i. Req'd	
Use:	12 14" x 7" Foundation Vents		
* FOUNDATION VENTS SHALL NOT INTERFERE WITH DIRECT LOAD PATH OF COLUMNS			
* INSTALL 6 MIL BLACK POLYETHYLENE VAPOR RETARDER GROUND COVER			
* LOCATE ONE VENT WITHIN 3 FEET OF EACH CORNER OF THE BUILDING, EXCEPT ONE SIDE OF THE BUILDING SHALL BE PERMITTED TO HAVE NO VENTS.			

Issue Issue Date By
Description

07.11.22
CITY PLAN REVIEW COMMENTS

4537 90th AVE SE
Mercer Island, WA.
Job Number:

plan name: -
marketing name: XXXXXX
plan number:
mark sys. number: -

Conditions not specifically represented graphically or in writing or which conflict with the current International Residential Code (IRC.) or those of the local municipality then the current standards and requirements of each respectively shall govern.

The drawings in this set are instruments of service and shall remain the property of JayMarc Homes, LLC.

© 2017 JayMarc Homes, LLC; All rights reserved.

06.15.21
Submittal Date

Sheet Title/Description
JAYMARC HOMES
Design Firm


R.R.
Drawn by:

R.R./ S.K.
Checked by:

Primary Scale

A4
of: .

Sheet Title/Description

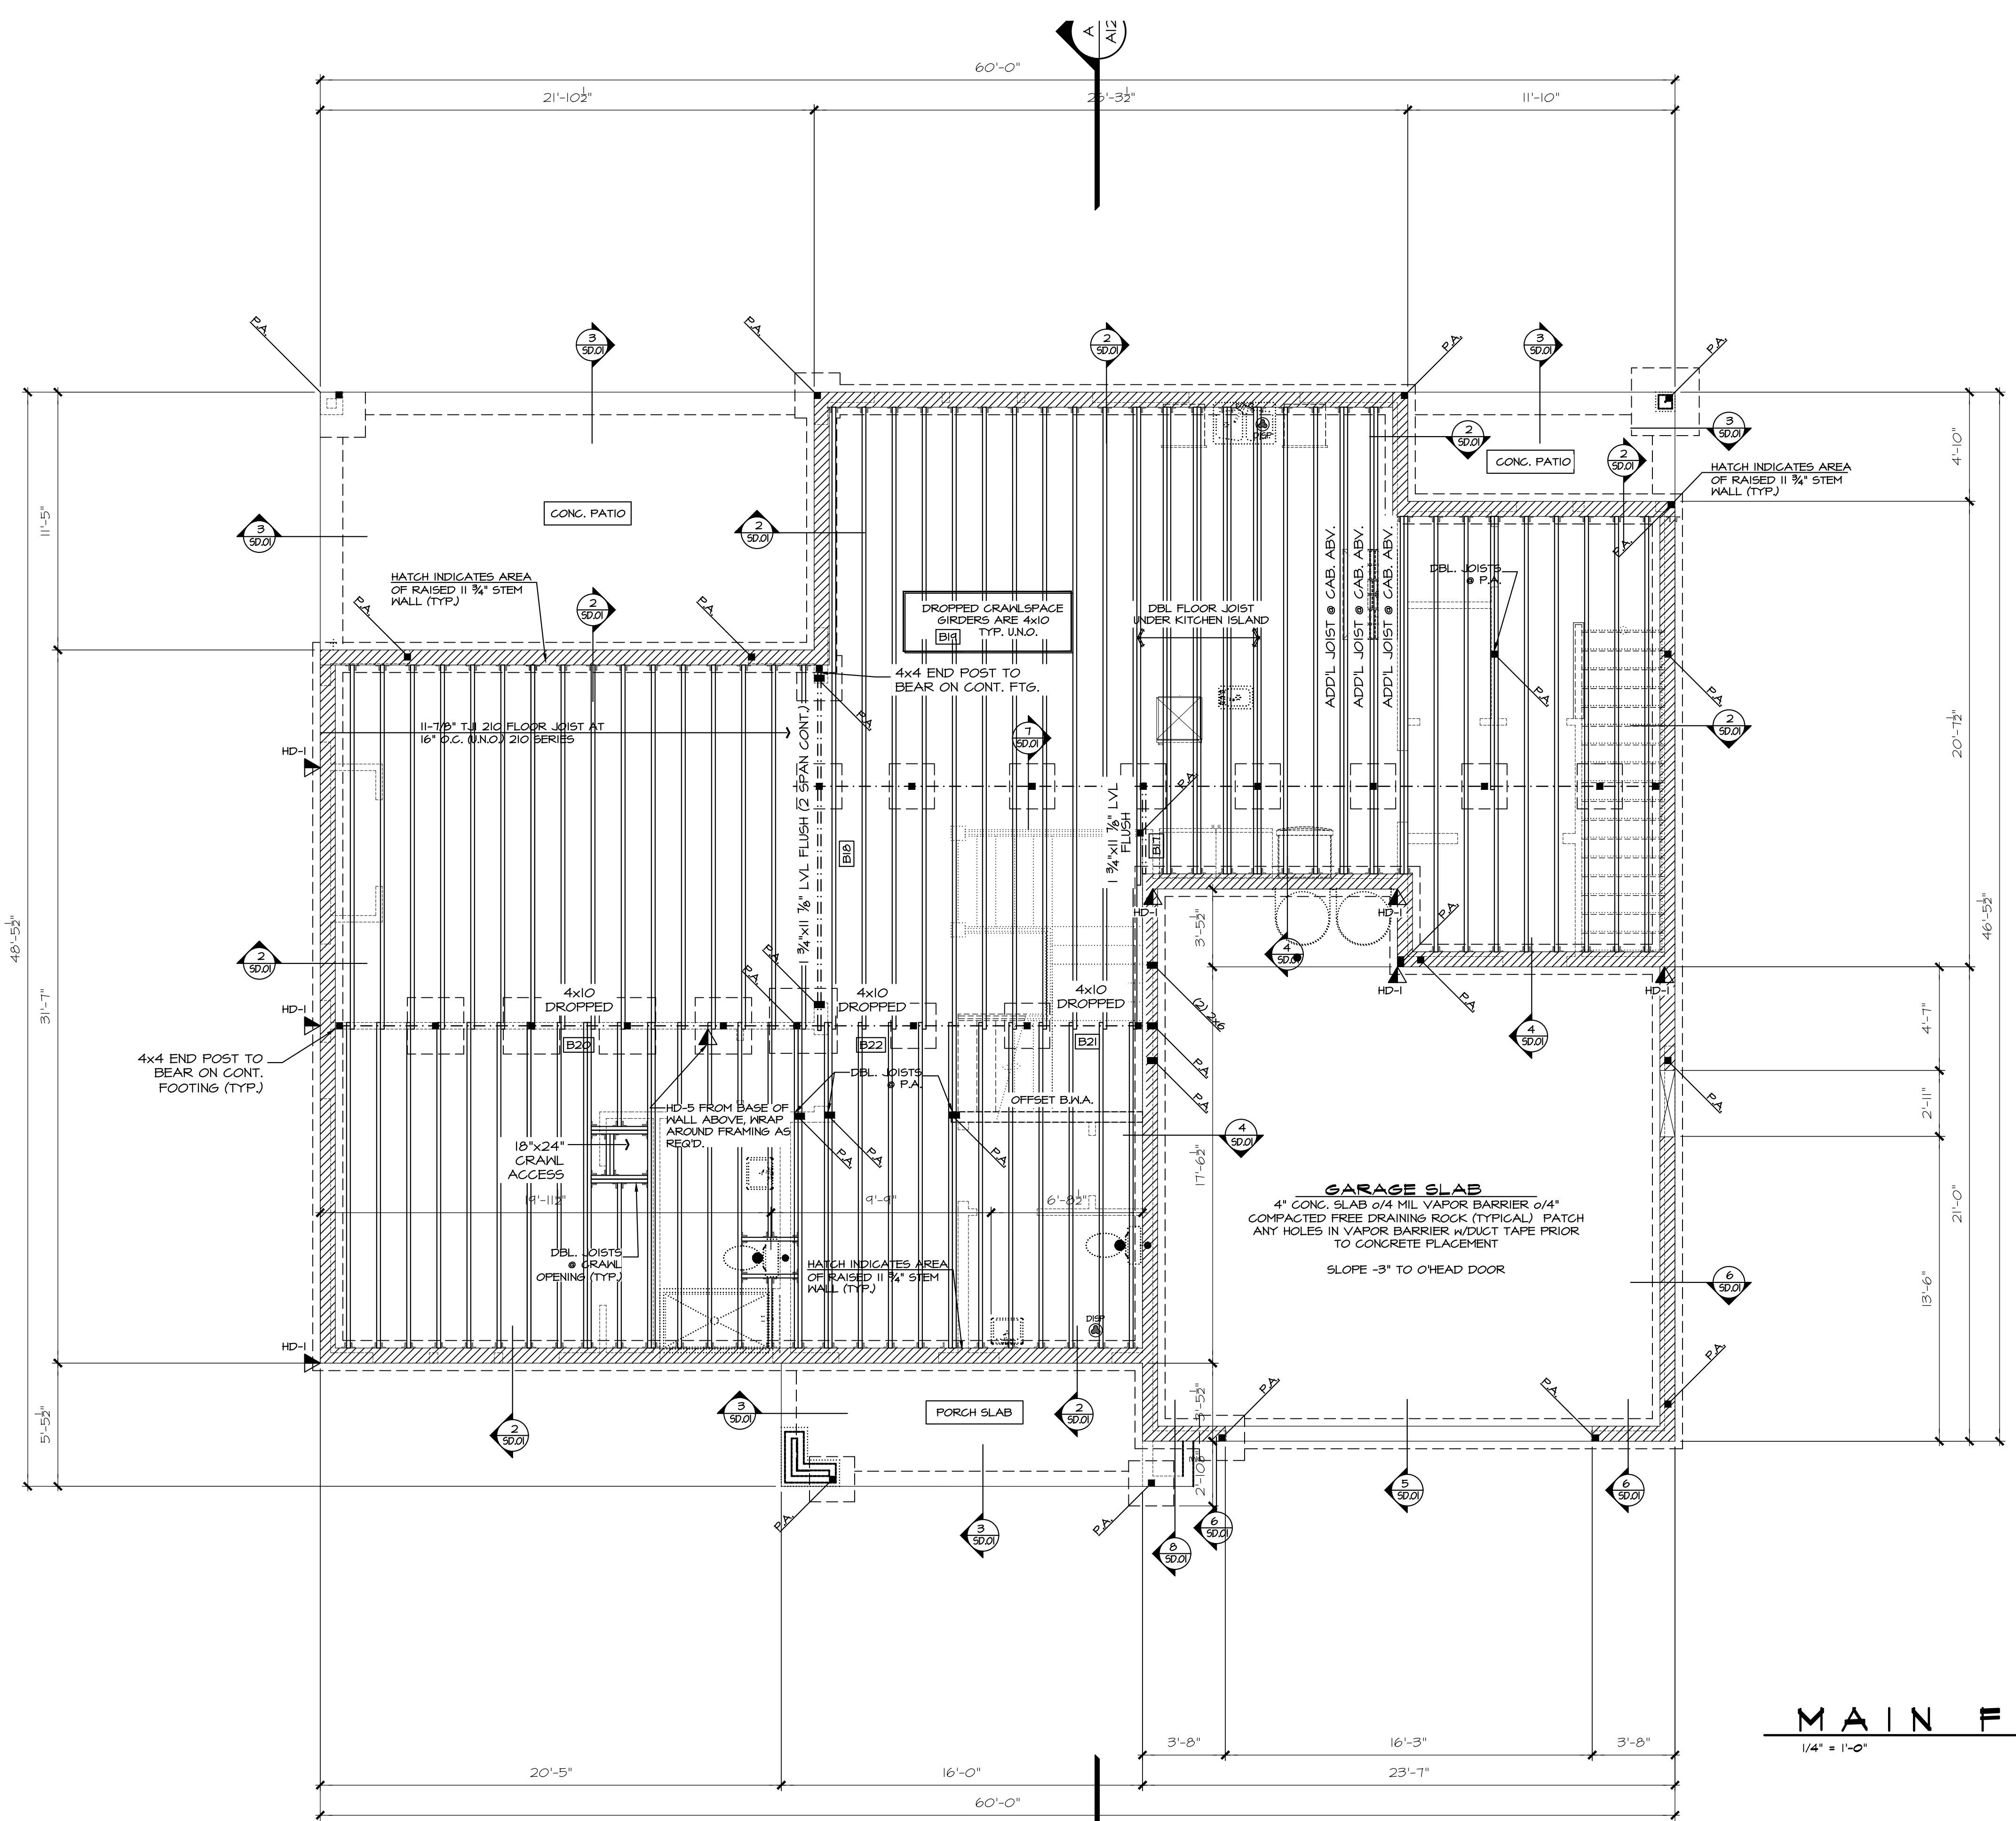

MAIN FLOOR FRAMING PLAN
1/4" = 1'-0"



7525 SE 24th St., 487
Mercer Island, WA
98040
425.266.9100

MAIN FLOOR PLAN NOTES

PLAN SPECIFIC 2018 INSEC. SECTION R06
R406.2 ADDITIONAL ENERGY EFFICIENCY REQUIREMENTS (MANDATORY). THIS RESIDENTIAL DWELLING SHALL COMPLY W/SUFFICIENT OPTIONS FROM TABLE R406.2 TO ACHIEVE THE FOLLOWING MIN. NUMBER OF CREDITS: 6 FOR A 1501sf TO 4,999sf HOME.
CREDITS PROVIDED IN THIS HOME AS FOLLOWS:
EFFICIENT BUILDING ENVELOPE OPT. 1.3: 0.5 CREDITS
PRESCRIPTIVE COMPLIANCE IS BASED ON TABLE R402.1.I WITH FOLLOWING MODIFICATIONS:
VERTICAL PENETRATION U = 0.28 WINDOWS
FLOORS TO BE R-38 and SLAB ON GRADE TO BE R-10 PERIMETER and UNDER ENTIRE SLAB BELOW GRADE.

HIGH EFFICIENCY HVAC EQUIPMENT OPT. 3.5a: 1.5 CREDITS
AIR-SOURCE, CENTRALLY DUCTED HEAT PUMP WITH MINIMUM HEFF OF 11.0. TO QUALIFY TO CLAIM THIS CREDIT, THE BUILDING PERMIT DRAWINGS SHALL SPECIFY THE OPTION BEING SELECTED AND SHALL SPECIFY THE HEATING EQUIPMENT EFFICIENCY. EXTERIOR LOCATED EQUIPMENT SHOULD ALSO BE REPRESENTED ON SITE PLAN.

HIGH EFFICIENCY HVAC DISTRIBUTION OPT. 4.2: 1.0 CREDITS
HVAC EQUIPMENT AND ASSOCIATED DUCT SYSTEM(S) SHALL COMPLY WITH THE REQUIREMENTS OF SECT R409.3.1. LOCATING SYSTEM COMPONENTS IN CONDITIONED CRACK SPACES IS NOT PERMITTED UNDER THIS OPTION. ELECTRIC RESISTANCE HEAT AND DUCTLESS HEAT PUMPS ARE NOT PERMITTED UNDER THIS OPTION. DIRECT COMBUSTION HEATING EQUIPMENT WITH AFUE LESS THAN 80% IS NOT PERMITTED UNDER THIS OPTION.
EFFICIENT WATER HEATING 5.5: 2.0 CREDITS

WATER HEATING SYSTEMS SHALL INCLUDE ONE OF THE FOLLOWING: ELECTRIC HEAT PUMP WATER HEATER MEETING THE STANDARDS FOR TIER III OF NEEA'S ADVANCED WATER HEATING SPECIFICATION. TO QUALIFY TO CLAIM THIS CREDIT, THE BUILDING PERMIT DRAWINGS SHALL SPECIFY THE OPTION BEING SELECTED AND SHALL SPECIFY THE WATER HEATER EQUIPMENT TYPE AND THE MINIMUM EQUIPMENT EFFICIENCY.

WHOLE HOUSE VENTILATION

PROVIDE WHOLE HOUSE VENTILATION per 2018 IRC, M1505.4.3(1) and IMC R403.8. THE WHOLE-HOUSE MECHANICAL VENTILATION SYSTEM SHALL PROVIDE OUTDOOR AIR AT A CONTINUOUS RATE AS DETERMINED IN ACCORDANCE WITH TABLE M1505.4.3(1) OR EQUATION 15.

SYMBOL	LOCATION	MIN. FAN REQUIREMENTS (ALL FANS VENT TO OUTSIDE)
50cfm+	BATH #1	Min. 50cfm. INTERMITTENT at .025mg per TABLE M1507.4
100cfm+	KITCHEN	Min. 100cfm. INTERMITTENT at .025mg per TBL. M1507.4
145cfm+	LAUNDRY ROOM	RANGE HOOD or DOWN DRAFT EXHAUST FAN RATED at min. 100cfm. at 0.10mg MAY BE USED FOR EXHAUST FAN RECYCLE. EXHAUST HOODS IN EXCESS OF 400cfm. SHALL BE INTERLOCKED AND PROVIDE MAKE UP AIR per M1503.4
145cfm+	WHF	MIN. 360cfm. INTERMITTENT at .025mg TO FUNCTION AS WHOLE HOUSE FAN (WHF) AS WHOLE HOUSE FAN (WHF)

MECHANICAL CONTRACTOR TO SIZE WHF, FAN and SET OPERATING TIMER per TABLE M1507.3(1) FOR A 4501-5000sf. DWELLING w/ 5 OR MORE BEDRMS. TO OPERATE INTERMITTENTLY and CONTINUOUSLY per TABLE M1507.3(2)
PROVIDE CONTROLS FOR WHF per M1507.3.2 AFFIX LABEL TO CONTROLS THAT READS "WHOLE HOUSE VENTILATION - SEE OPERATING INSTRUCTIONS"

Issue	Issue Date	By	Description
	07.11.22		CITY PLAN REVIEW COMMENTS

4537 90th AVE SE
Mercer Island, WA.
Job Number:

plan name: -
marketing name: XXXXXX
plan number:
mark sys. number:-

Conditions not specifically represented graphically or in writing or which conflict with the current International Residential Code (IRC) or those of the local municipality and requirements of each respectively shall govern.

The drawings in this set are instruments of service and shall remain the property of JayMarc Homes, LLC.

© 2017 JayMarc Homes, LLC; All rights reserved.

06.15.21
Submittal Date


Sheet Title/Description
JAYMARC HOMES
Design Firm

R.R.
Drawn by:

R.R./S.K.
Checked by:

Primary Scale

A5
of .

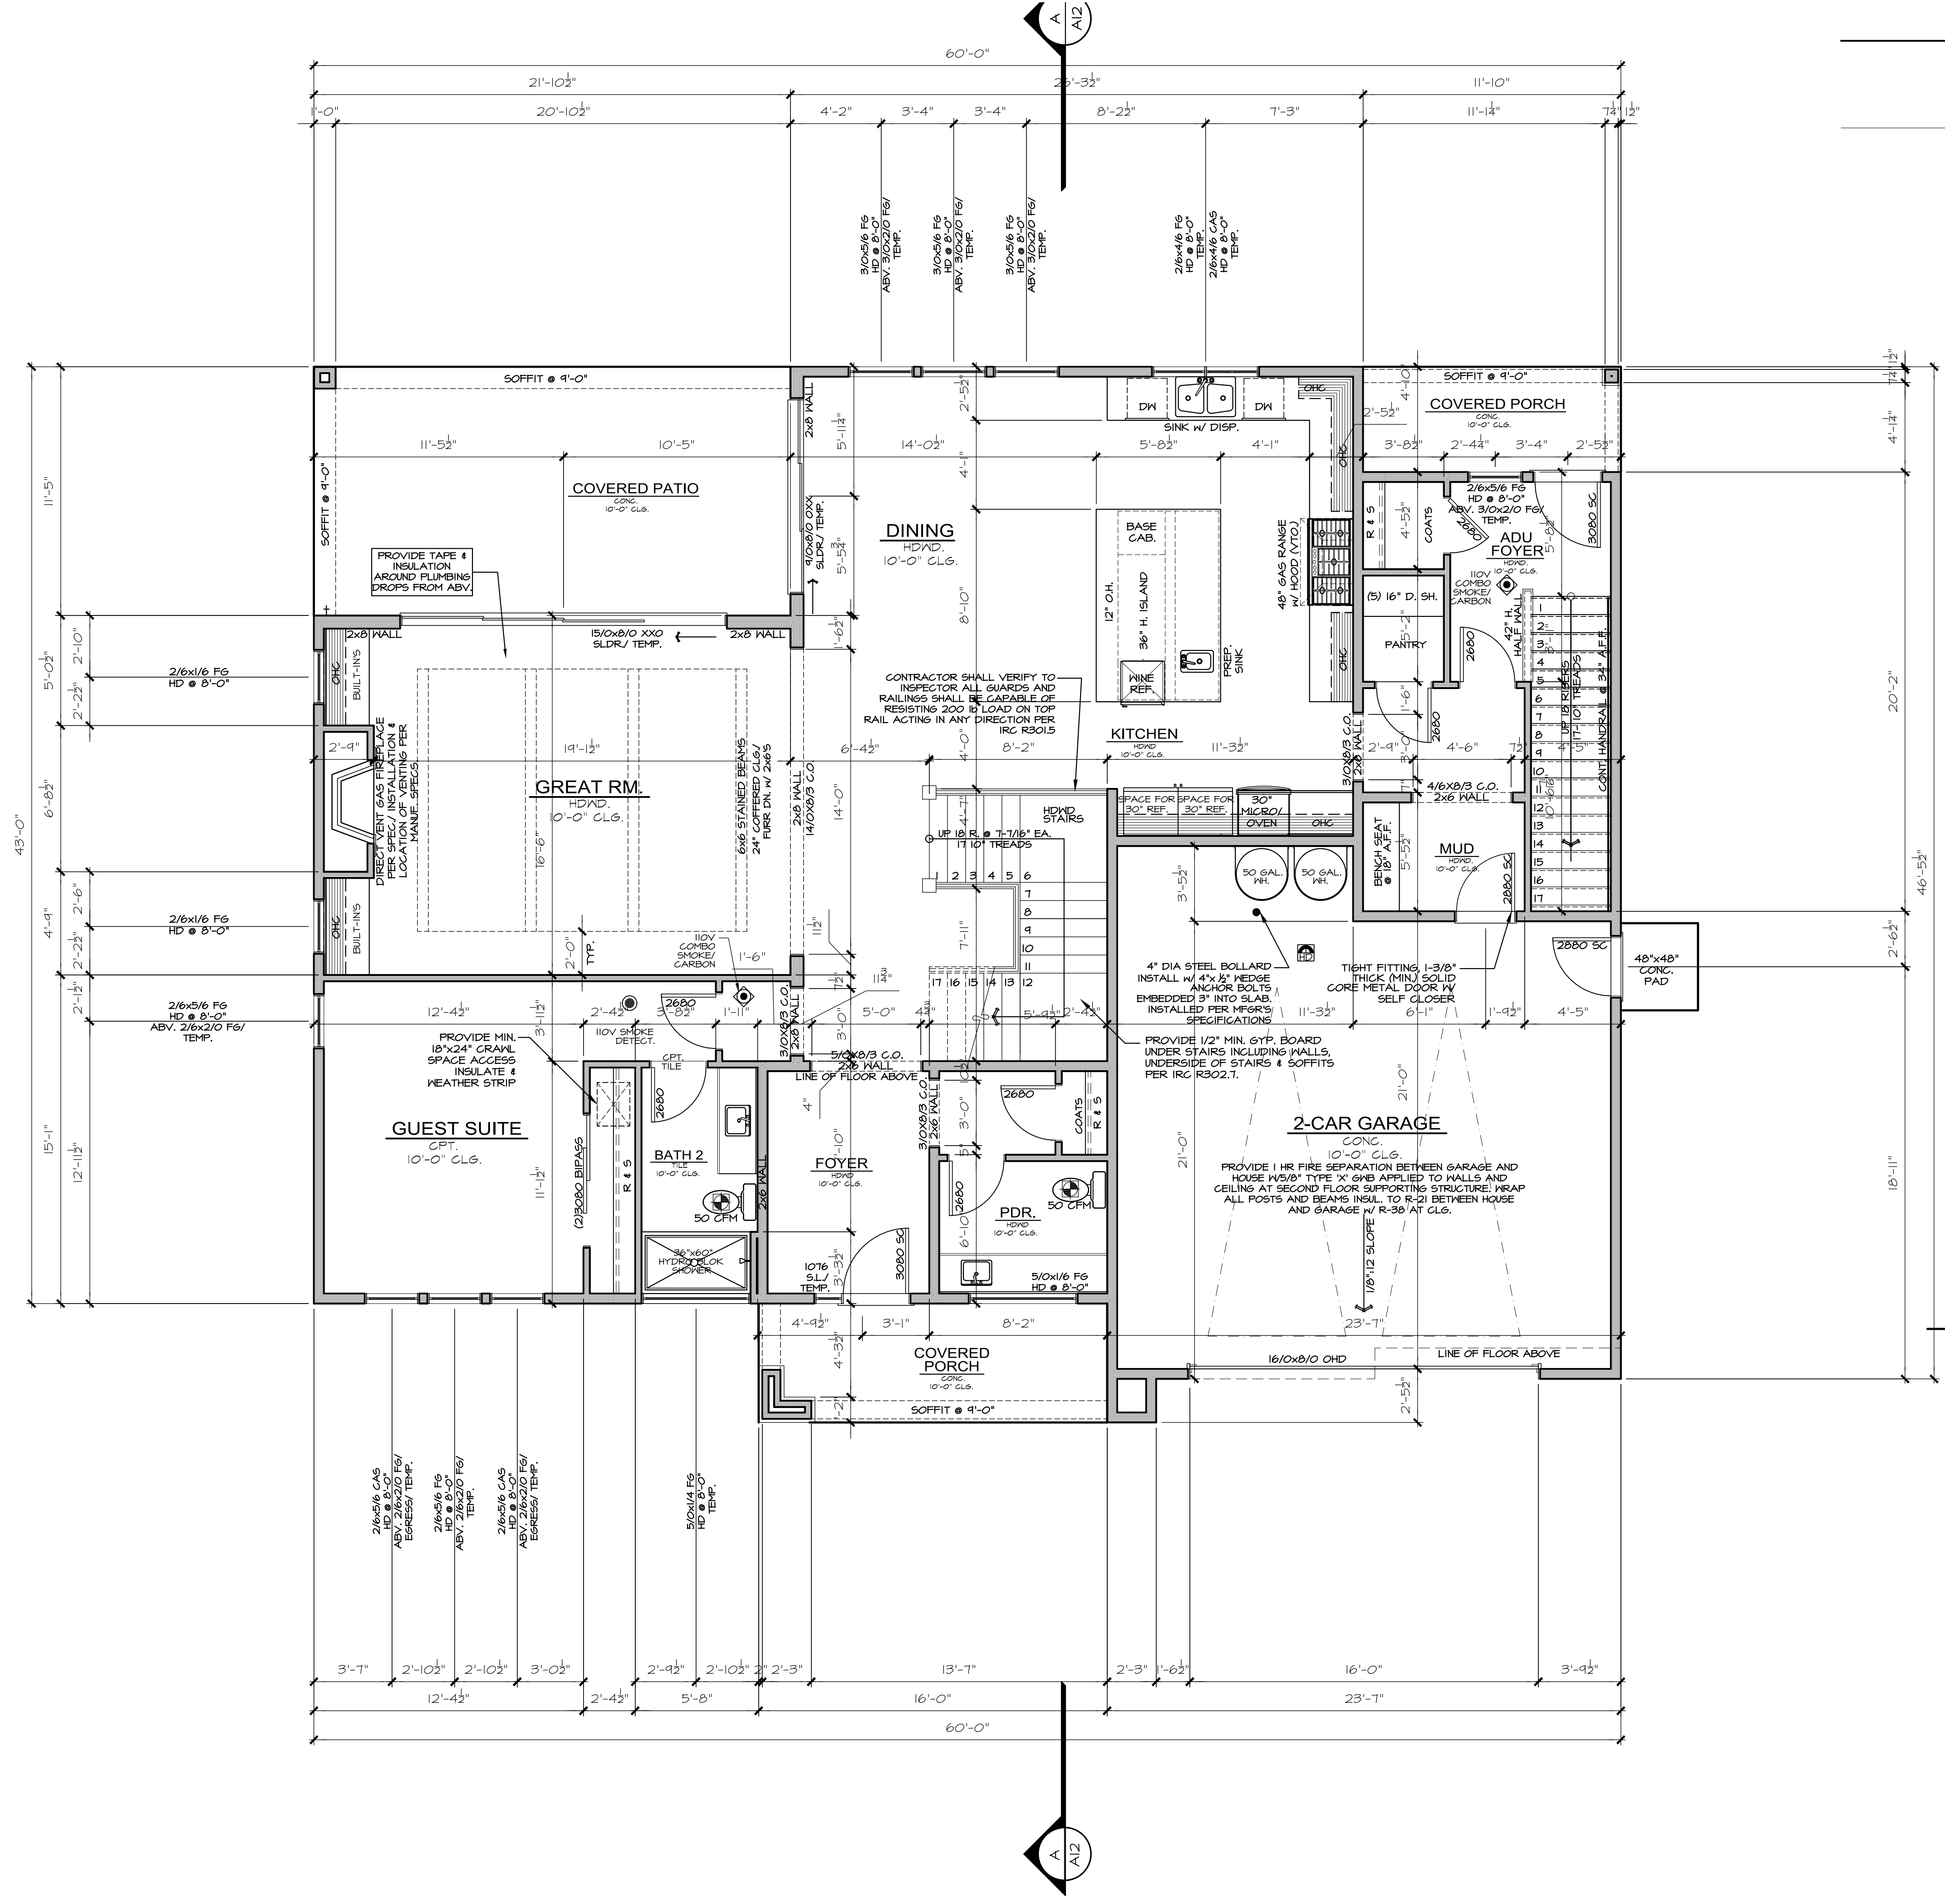

MAIN FLOOR PLAN


1/4" = 1'-0"

SQUARE FOOTAGE SUMMARY

MAIN FLOOR/ MAIN LIVING	1,691 S.F.
MAIN FLOOR A.D.U.	134 S.F.
GARAGE	525 S.F.
SUB TOTAL	2,355 S.F.
UPPER FLOOR/ MAIN LIVING	1,654 S.F.
UPPER FLOOR A.D.U.	685 S.F.
MINUS A.D.U. STAIRS	-54 S.F.
MINUS MAIN STAIRS	-100 S.F.
SUB TOTAL	2,185 S.F.
TOTAL G.F.A.	4,540 S.F.
ALLOWABLE F.A.R. 45%	4,556 S.F.
PROPOSED	34.4%
TOTAL NET AREA MAIN HOUSE	1,830 S.F.
GARAGE	525 S.F.
TOTAL NET A.D.U.	824 S.F.
SUB TOTAL	3,179 S.F.
COVD PATIO	250 S.F.
COVD PORCH	87 S.F.
OVERALL WIDTH	60'-0"
OVERALL DEPTH	48'-5 1/2"

Updated: 03/09/2018
Method for Calculating Square Footage - ANSI Z165-2013 except, no separate distinction of "above-grade or below-grade" areas and each level is measured to the outside of studs not the exterior finished surface.
Square Footage calculations for this house were made based on plan dimensions only and may vary from the finished square footage of the house as built.
See Sheet "CODES" for additional Zoning required Area Calculations

Sheet Title/Description

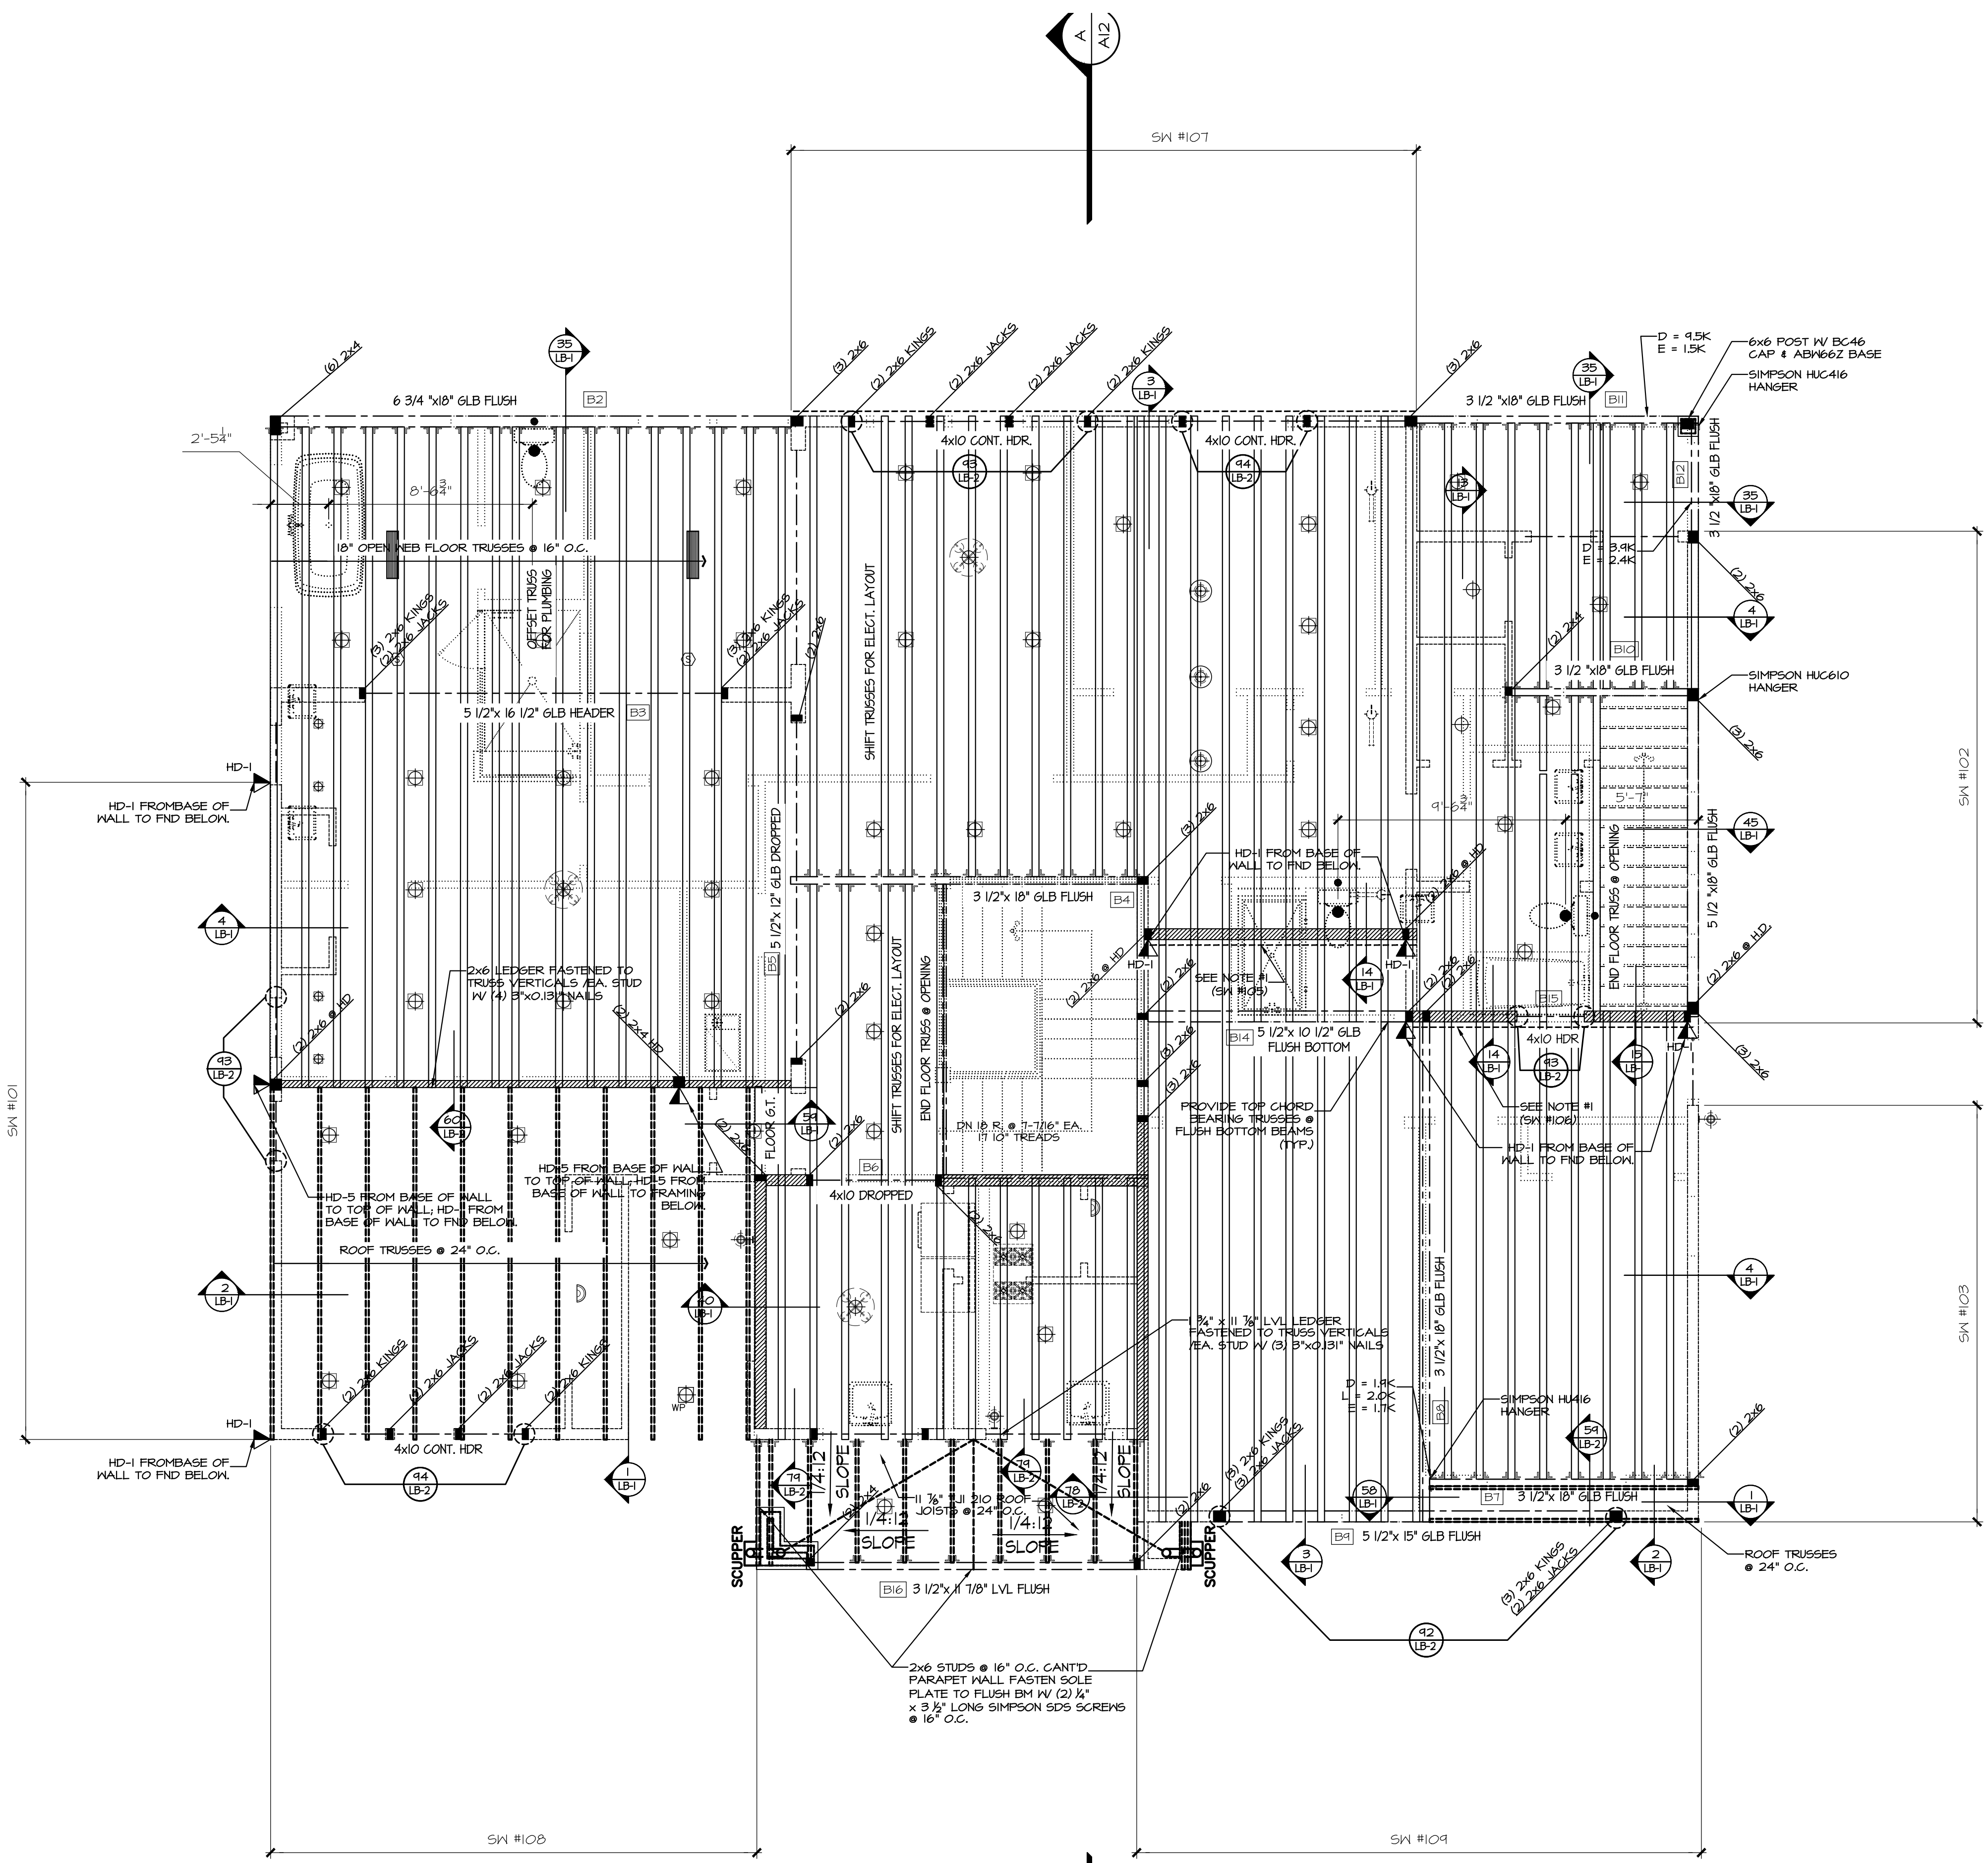

UPPER FLOOR & LOWER ROOF FRAMING PLAN
 1/4" = 1'-0"

HOLD-DOWN SCHEDULE	
SYMBOL	SPECIFICATION
HD-1	SIMPSON 5THD14 (R.L.) HOLD-DOWN
HD-5	SIMPSON CSI6 STRAP TIE (14" END LENGTH)
HD-6	SIMPSON MSTC40 STRAP TIE (12" END LENGTH)
HD-7	SIMPSON MSTC66 STRAP TIE (24" END LENGTH)

LEGEND	
	INTERIOR BEARING WALL
	BEAM / HEADER
	FLOOR TRUSS @ 16" O.C. (U.N.O.)
	INTERIOR SHEAR WALL PANEL OR EXTERIOR SHEAR WALL w/ 3" O.C. EDGE NAILING
	J.L. METAL HANGER
	* INDICATES POST ABOVE. PROVIDE SOLID BLOCKING UNDER POST OR JAMB ABOVE.
	◀ INDICATES HOLD-DOWN.

REFER TO S-O FOR TYPICAL STRUCTURAL NOTES & SCHEDULES

4x10 HDR @ ALL EXT. (B1) WINDOWS/DOORS (TYP. U.N.O.)

NOTE #1:
 PROVIDE 3/8" OSB/PLYWOOD SHTG. + FASTEN PER 3" O.C. EDGE NAILING SPECS. (SEE NOTES)



Issue	Issue Date	By	Description
	07.11.22		CITY PLAN REVIEW COMMENTS

**4537 90th AVE SE
 Mercer Island, WA.**
 Job Number:

plan name: -
 marketing name: XXXXXX
 plan number:
 mark sys. number: -

Conditions not specifically represented graphically or in writing or which conflict with the current International Residential Code (IRC), or those of the local municipality then the current standards and requirements of each respectively shall govern.
 The drawings in this set are instruments of service and shall remain the property of JayMarc Homes, LLC.
 © 2017 JayMarc Homes, LLC; All rights reserved.

06.15.21
 Submittal Date

Sheet Title/Description
 JAYMARC HOMES
 Design Firm

R.R.
 Drawn by:

R.R./S.K.
 Checked by:

Primary Scale

+ A6
 of .

Sheet Title/Description



7525 SE 24th St., 487
Mercer Island, WA
98040
425.266.9100

Issue	Issue Date	By
△		
△	07.11.22	

4537 90th AVE SE
Mercer Island, WA.
Job Number:

plan name: -
marketing name: XXXXXX
plan number:
mark sys. number:-

Conditions not specifically represented graphically or in writing or which conflict with the current International Residential Code (IRC) or those of the local municipality then the current standards and requirements of each respectively shall govern.

The drawings in this set are instruments of service and shall remain the property of JayMarc Homes, LLC.

© 2017 JayMarc Homes, LLC; All rights reserved.

06.15.21
Submittal Date

Sheet Title/Description
JAYMARC HOMES
Design Firm

R.R.
Drawn by:

R.R./S.K.
Checked by:

Primary Scale

A7
of .

UPPER FLOOR PLAN NOTES:

PLAN SPECIFIC 2018 NSEC, SECTION R06.
R406.2 ADDITIONAL ENERGY EFFICIENCY REQUIREMENTS (MANDATORY). THIS RESIDENTIAL DWELLING SHALL COMPLY W/SUFFICIENT OPTIONS FROM TABLE R406.2 TO ACHIEVE THE FOLLOWING MIN. NUMBER OF CREDITS: 6 FOR A 1501sf TO 4,999sf HOME.
CREDITS PROVIDED IN THIS HOME AS FOLLOWS:
EFFICIENT BUILDING ENVELOPE OPT. 1.3: 0.5 CREDITS
PRESCRIPTIVE COMPLIANCE IS BASED ON TABLE R402.1.1 WITH FOLLOWING MODIFICATIONS:
VERTICAL FENESTRATION U = 0.28 WINDOWS
FLOORS TO BE R-38 AND SLAB ON GRADE TO BE R-10 PERIMETER AND UNDER ENTIRE SLAB BELOW GRADE.

HIGH EFFICIENCY HVAC EQUIPMENT OPT. 3.5a: 1.5 CREDITS
AIR-SOURCE, CENTRALLY DUCTED HEAT PUMP WITH MINIMUM HSPF OF 11.0. TO QUALIFY TO CLAIM THIS CREDIT, THE BUILDING PERMIT DRAWINGS SHALL SPECIFY THE OPTION BEING SELECTED AND SHALL SPECIFY THE HEATING EQUIPMENT EFFICIENCY. EXTERIOR LOCATED EQUIPMENT SHOULD ALSO BE REPRESENTED ON SITE PLAN.

HIGH EFFICIENCY HVAC DISTRIBUTION OPT. 4.2: 1.0 CREDITS
HVAC EQUIPMENT AND ASSOCIATED DUCT SYSTEM(S) SHALL COMPLY WITH THE REQUIREMENTS OF SECT R403.3.1. LOCATING SYSTEM COMPONENTS IN CONDITIONED GRAVE SPACES IS NOT PERMITTED UNDER THIS OPTION. ELECTRIC RESISTANCE HEAT AND DUCTLESS HEAT PUMPS ARE NOT PERMITTED UNDER THIS OPTION. DIRECT COMBUSTION HEATING EQUIPMENT WITH AFUE LESS THAN 80% IS NOT PERMITTED UNDER THIS OPTION.

EFFICIENT WATER HEATING 5.5: 2.0 CREDITS
WATER HEATING SYSTEMS SHALL INCLUDE ONE OF THE FOLLOWING: ELECTRIC HEAT PUMP WATER HEATER MEETING THE STANDARDS FOR TIER III OF NEEA'S ADVANCED WATER HEATING SPECIFICATION. TO QUALIFY TO CLAIM THIS CREDIT, THE BUILDING PERMIT DRAWINGS SHALL SPECIFY THE OPTION BEING SELECTED AND SHALL SPECIFY THE WATER HEATER EQUIPMENT TYPE AND THE MINIMUM EQUIPMENT EFFICIENCY.

WHOLE HOUSE VENTILATION

PROVIDE WHOLE HOUSE VENTILATION per 2018 IRC, M1505.4.3(1) and IMC R403.9. THE WHOLE-HOUSE MECHANICAL VENTILATION SYSTEM SHALL PROVIDE OUTDOOR AIR AT A CONTINUOUS RATE AS DETERMINED IN ACCORDANCE WITH TABLE M1505.4.3(1) OR EQUATION 15.

SYMBOL	LOCATION	MIN. FAN REQUIREMENTS (ALL FANS VENT TO OUTSIDE)
	BATH #	Min. 50cfm, INTERMITTENT at .025kg per TABLE M1507.4
	KITCHEN	Min. 100cfm, INTERMITTENT at .025kg per TBL. M1507.4
	RANGE HOOD	or DOWN DRAFT EXHAUST FAN RATED at min. 100cfm, at 0.10kg may be used FOR EXHAUST FAN REQMT. EXHAUST HOODS IN EXCESS OF 400cfm, SHALL BE INTERLOCKED AND PROVIDED MAKE UP AIR per M1503.4
	LAUNDRY ROOM	MIN. 360cfm, INTERMITTENT at .025kg TO FUNCTION AS WHOLE HOUSE FAN (WHF)

MECHANICAL CONTRACTOR TO SIZE WHF, FAN AND SET OPERATING TIMER per TABLE M1507.3(1) FOR A 4501-5,000sf, DWELLING w/ 5 OR MORE BEDRMS, TO OPERATE INTERMITTENTLY AND CONTINUOUSLY per TABLE M1507.3(2)
PROVIDE CONTROLS FOR WHF per M1507.3.2 AFFIX LABEL TO CONTROLS THAT READS "WHOLE HOUSE VENTILATION - SEE OPERATING INSTRUCTIONS"


SQUARE FOOTAGE SUMMARY

MAIN FLOOR/ MAIN LIVING	1,641 S.F.
MAIN FLOOR A.D.U.	131 S.F.
GARAGE	525 S.F.
SUB TOTAL	2,297 S.F.
UPPER FLOOR/ MAIN LIVING	1,659 S.F.
UPPER FLOOR A.D.U.	685 S.F.
MINUS A.D.U. STAIRS	-54 S.F.
MINUS MAIN STAIRS	-100 S.F.
SUB TOTAL	2,185 S.F.
TOTAL G.F.A.	4,540 S.F.
ALLOWABLE F.A.R. 45%	4,556 S.F.
PROPOSED	34.4%
TOTAL NET AREA MAIN HOUSE	1,830 S.F.
GARAGE	525 S.F.
TOTAL NET A.D.U.	824 S.F.
SUB TOTAL	3,179 S.F.
COVID PATIO	250 S.F.
COVID PORCH	87 S.F.
OVERALL WIDTH	60'-0"
OVERALL DEPTH	48'-5 1/2"


Method for Calculating Square Footage - ANSI Z765-2013 except, no separate distinction of 'above-grade or below-grade' areas and each level is measured to the outside of studs not the exterior finished surface.
Square Footage calculations for this house were made based on plan dimensions only and may vary from the finished square footage of the house as built.
See Sheet "CODES" for additional Zoning required Area Calculations.

UPPER FLOOR PLAN

1/4" = 1'-0"

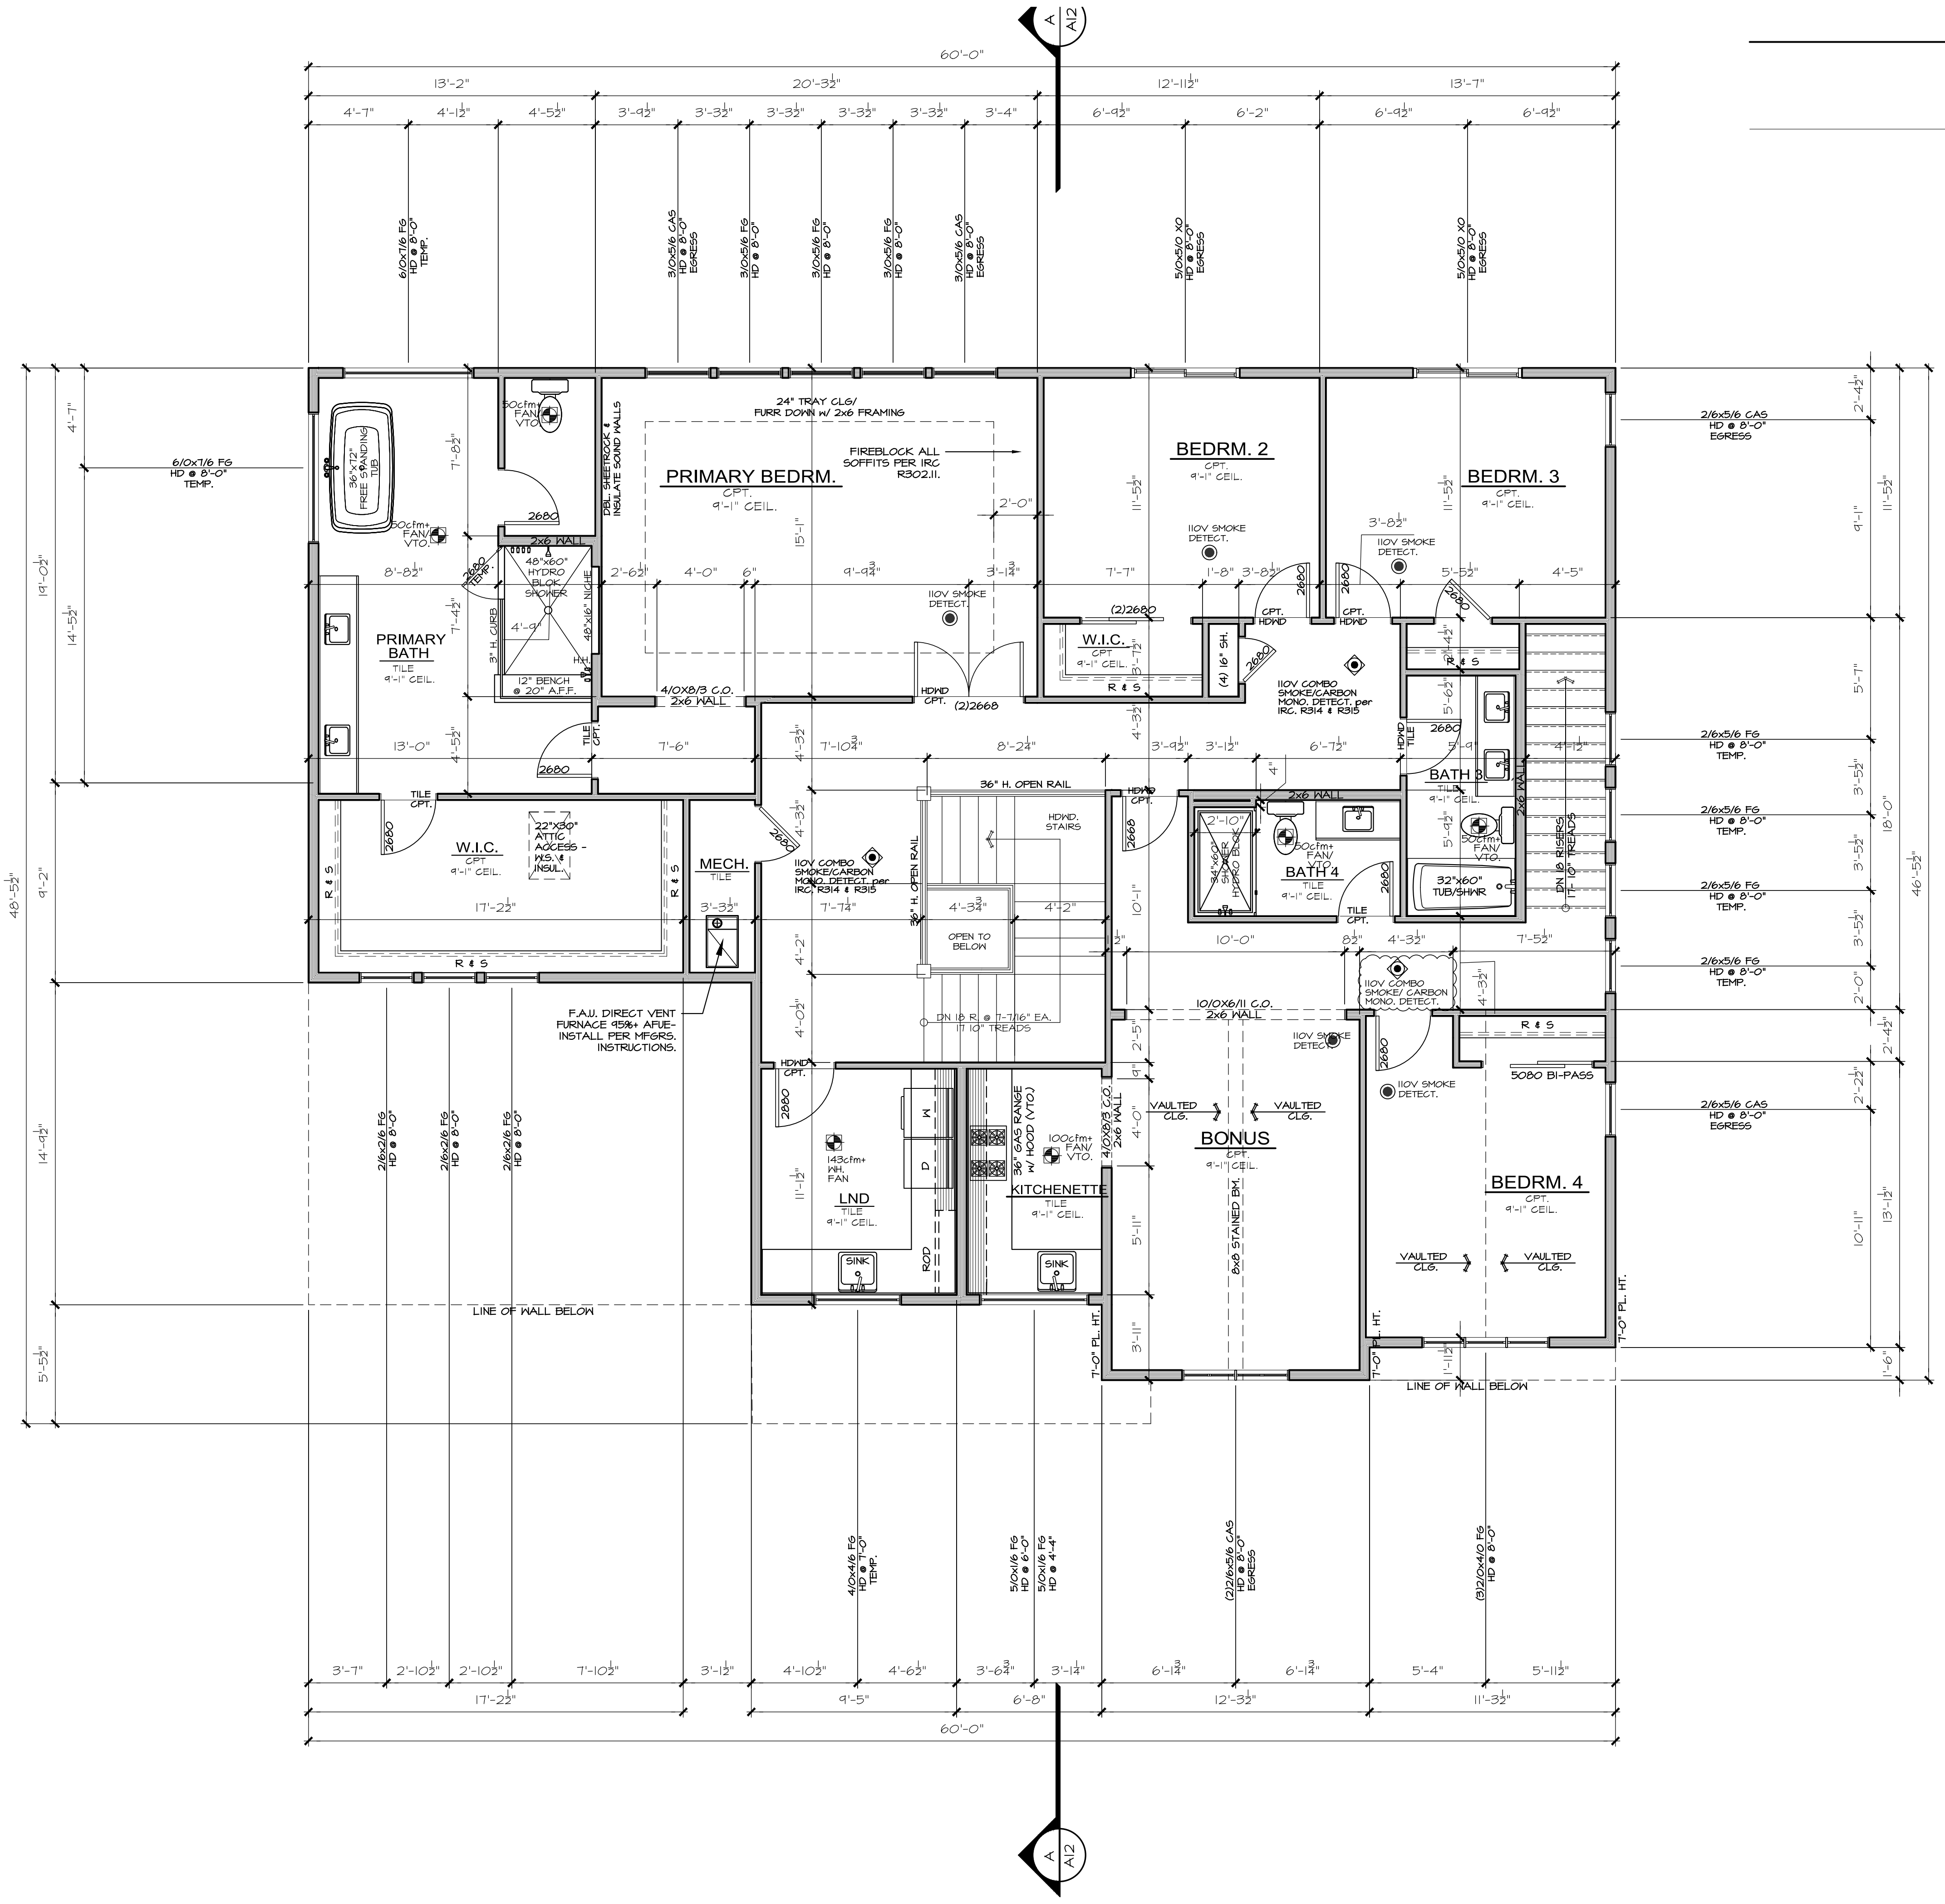

Sheet Title/Description

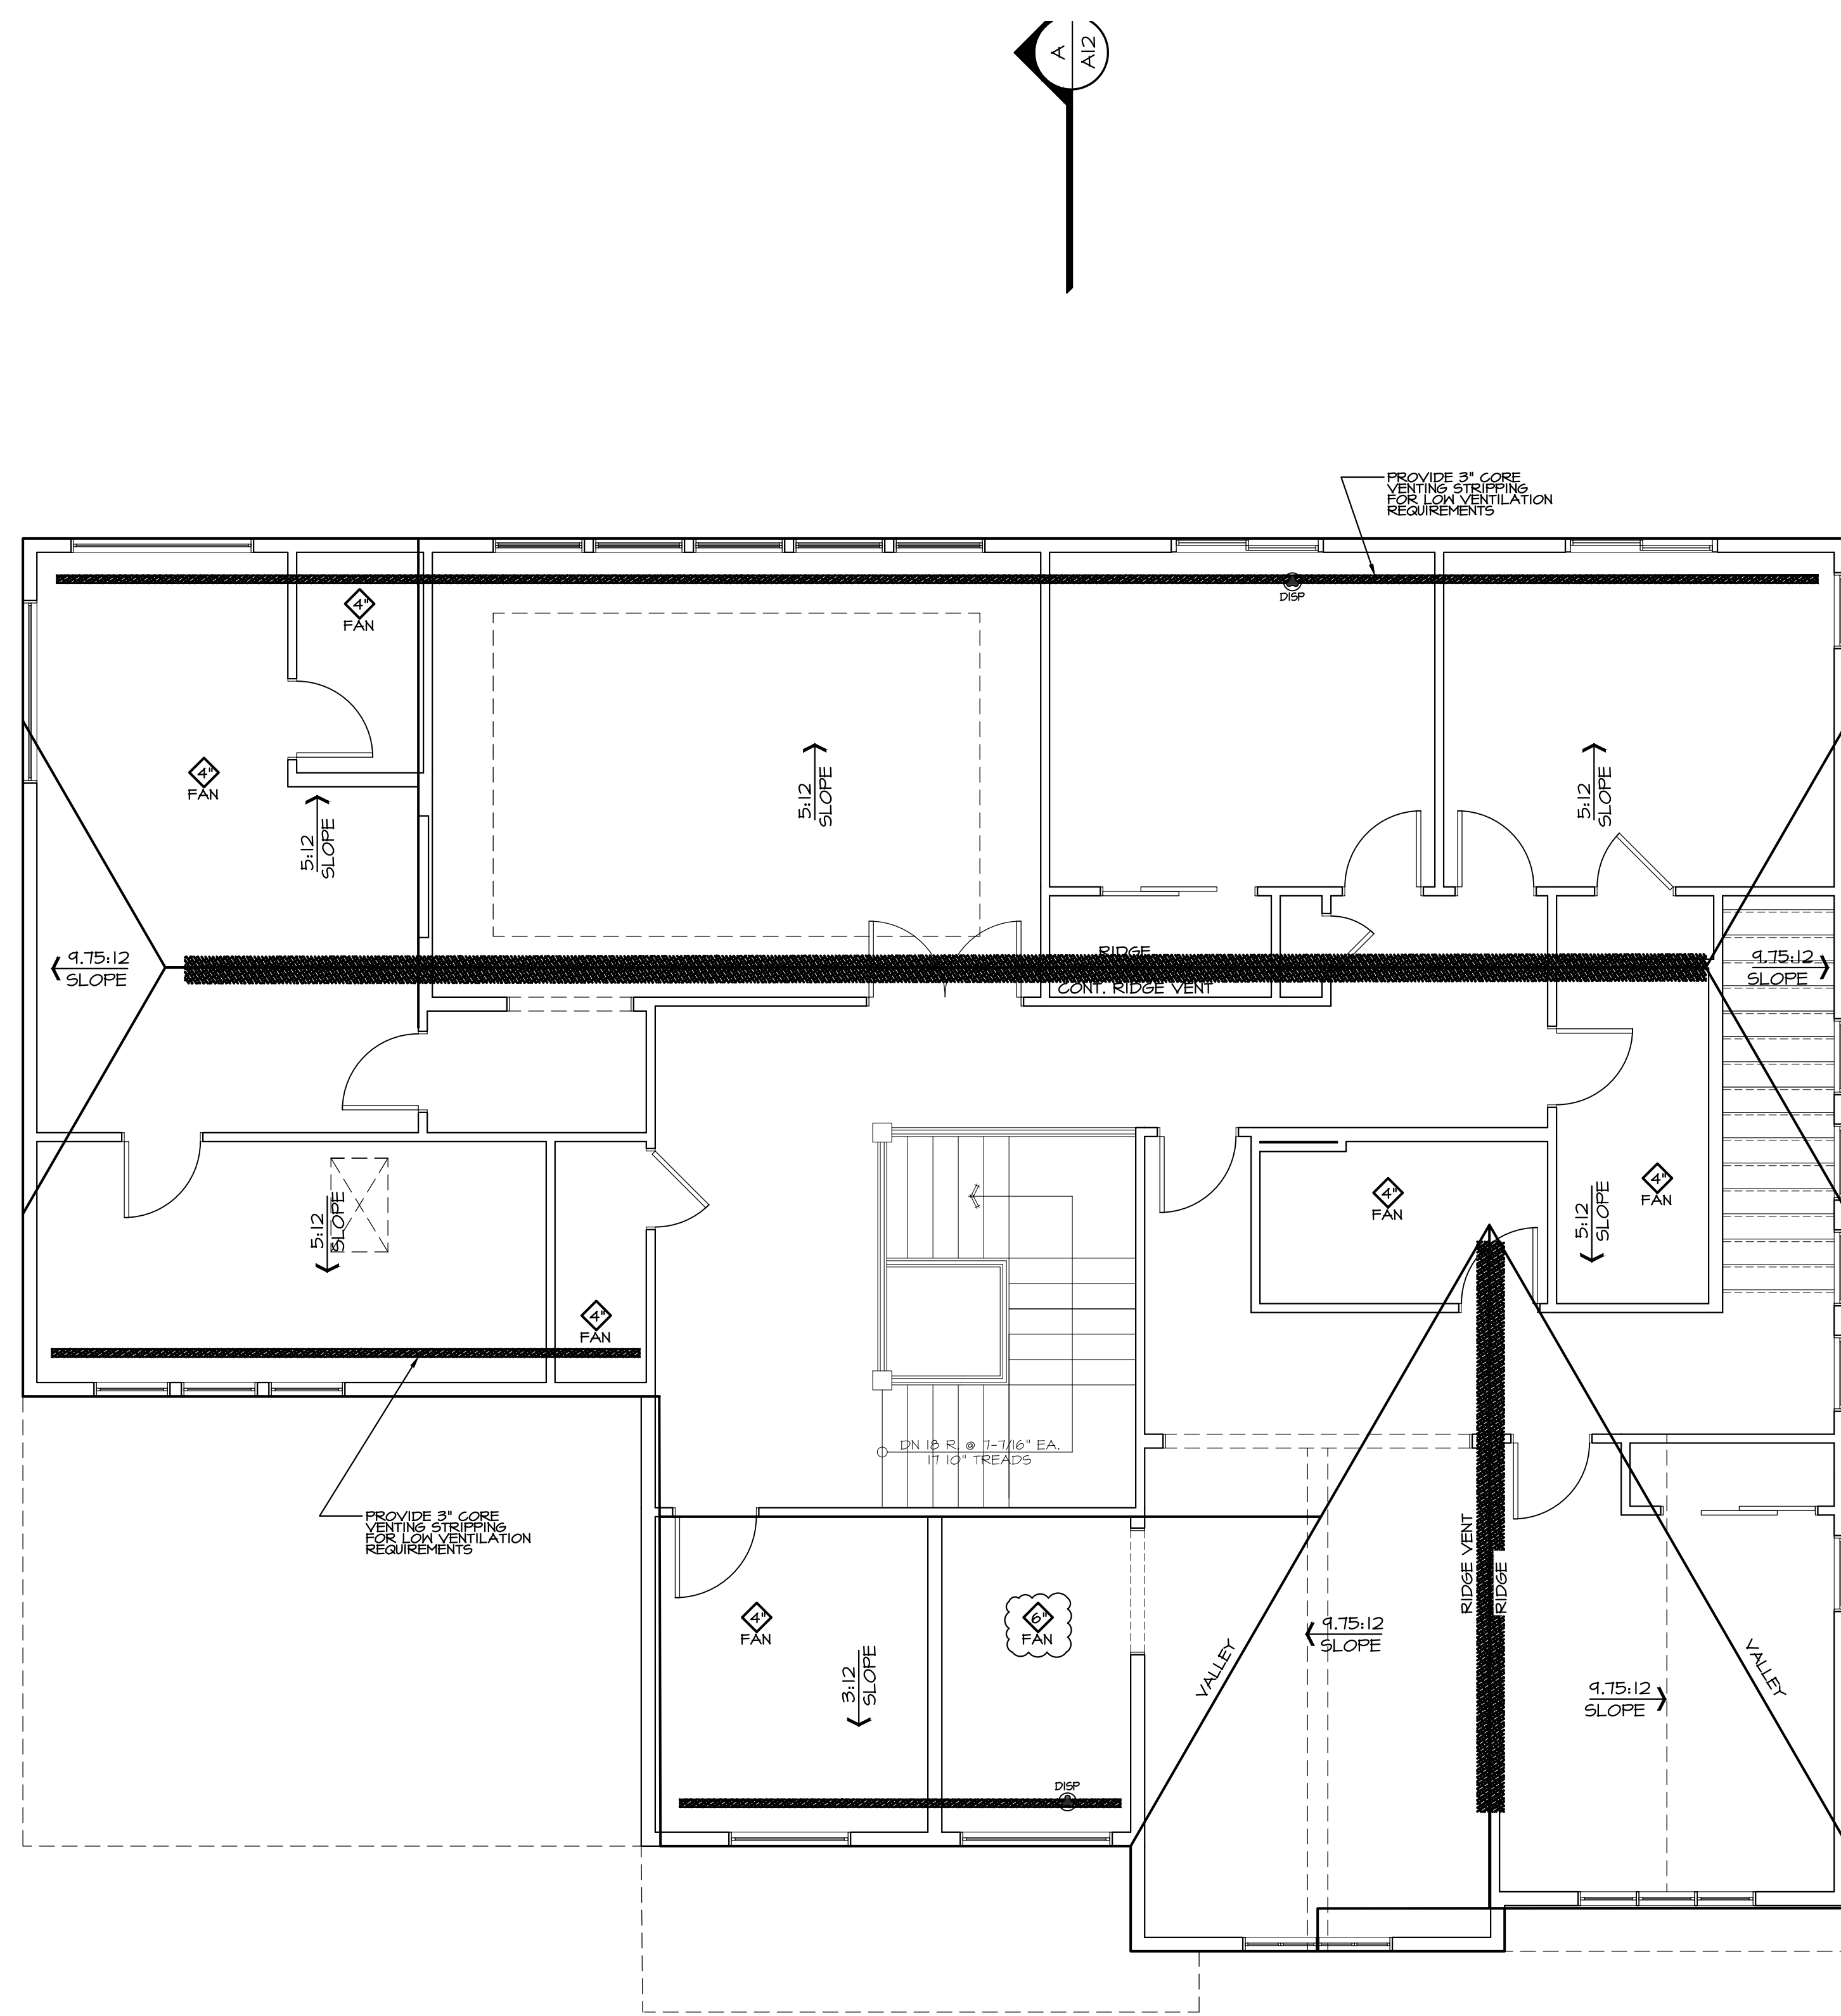

ROOF PLAN
1/4" = 1'-0"

ROOF VENTILATION		ZONE 1
Standard Truss / Scissor Truss Roof Framing Assembly:		
Roof Area :	2182 s.f.	
Ventilation Required:	2182 s.f. x 144 s.i. / s.f. / 300 =	1047.4 s.i. Req'd
Provide between 40% & 50% of the total required ventilation no more than 3 ft below the ridge or the highest point of the space. Remainder to be installed at eave vents.		
Ridge Ventilation: 50% of ventilation		523.68
Continuous Ridge Vent =		18.00 s.i. per l.f.
Upper Ventilation MIN. Req'd =	523.68 s.i. x 0.4 / s.i. per linear foot =	24 l.f.
Upper Ventilation MAX. Req'd =	523.68 s.i. x 0.5 / s.i. per linear foot =	29 l.f.
Provide:	28 l.f. ridge vent. Ventilation =	504.00 s.i.
Ventilation area remainder for AF50 vents =		19.68 s.i.
Upper Roof Ventilation: as needed to achieve 50% of ventilation		
AF50 Roof Jack (10" x 7") =		50.00 s.i. each.
Upper Ventilation Req'd TO GET 50% =	19.68 s.i. / s.i. of each vent =	1 vent
Provide:	0 -10"x7" roof jacks. Ventilation =	0.00 s.i.
Eave Ventilation:		
Birdblocking: (3/2" dia holes per bay =	4.71 s.i. / l.f. - 25% reduction =	3.53 s.i. / l.f.
Eave Ventilation Req'd =	523.68 s.i. / s.i. per l.f. =	19.68 l.f.
Provide Minimum:	214 l.f. birdblocking. Ventilation =	755.96 s.i.
Minimum Ventilation Provided =	1259.96 s.i. IS GREATER THAN :	1047.4 s.i. Req'd

JM
JAYMARC
HOMES

7525 SE 24th St., 487
Mercer Island, WA
98040
425.266.9100

Issue	Issue Date	Description
△	07.11.22	CITY PLAN REVIEW COMMENTS
△	08.16.22	CITY PLAN REVIEW COMMENTS

4537 90th AVE SE
Mercer Island, WA.
Job Number:

plan name: -
marketing name: XXXXXX
plan number:
mark sys. number: -

Conditions not specifically represented graphically or in writing or which conflict with the current International Residential Code (IRC.) or those of the local municipality then the current standards and requirements of each respectively shall govern.

The drawings in this set are instruments of service and shall remain the property of JayMarc Homes, LLC.

© 2017 JayMarc Homes, LLC; All rights reserved.

06.15.21
Submittal Date

Sheet Title/Description
JAYMARC HOMES
Design Firm

R.R.
Drawn by:

R.R./S.K.
Checked by:

Primary Scale

A8
of .

Sheet Title/Description

△	Issue	Issue Date By
	Description	
△		
	07.11.22	CITY PLAN REVIEW COMMENTS
	08.16.22	CITY PLAN REVIEW COMMENTS

4537 90th AVE SE
Mercer Island, WA
Job Number:

plan name: _____
marketing name: XXXXXX
plan number: _____
mark sys. number: _____

Conditions not specifically represented graphically or in writing or which conflict with the current International Residential Code (IRC), or those of the local municipality then the current standards and requirements of each respectively shall govern.

The drawings in this set are instruments of service and shall remain the property of JayMarc Homes, LLC.

© 2017 JayMarc Homes, LLC; All rights reserved.

06.15.21
Submittal Date

Sheet Title/Description
JAYMARC HOMES
Design Firm

R.R.
Drawn by:

R.R./S.K.
Checked by:

Primary Scale

A9
of .

LEGEND

- ▨ INTERIOR BEARING WALL
- ▬ BEAM / HEADER
- ▬ ROOF TRUSS @ 24" O.C. (U.N.O.)
- ▬ GIRDER TRUSS
- ▬ INTERIOR SHEAR WALL PANEL OR EXTERIOR SHEAR WALL w/ 3" o.c. EDGE NAILING
- JL METAL HANGER
- ⊗ INDICATES OVER FRAMED TRUSS AREA


REFER TO S-O FOR TYPICAL STRUCTURAL NOTES & SCHEDULES

4x10 HDR @ ALL EXT. [B1]
WINDOWS/DOORS (TYP. U.N.O.)

PROVIDE CONT. EXT. SHEATHING BEHIND LOW TRUSSES DOWN TO SECOND FLOOR SOLE PLATE (TYP. @ LOW ROOF)

ROOF VENTILATION

Standard Truss / Scissor Truss Roof Framing Assembly:		ZONE 1
Roof Area :	2182 s.f.	
Ventilation Required:	$2182 \text{ s.f.} \times 144 \text{ s.i.} / \text{s.f.} / 300 =$	1047.4 s.i. Req'd
Provide between 40% & 50% of the total required ventilation no more than 3 ft below the ridge or the highest point of the space. Remainder to be installed at eave vents.		
Ridge Ventilation: 50% of ventilation		523.68
Continuous Ridge Vent =		18.00 s.i. per l.f.
Upper Ventilation MIN. Req'd =	$523.68 \text{ s.i.} \times 0.4 / \text{s.i. per linear foot} =$	24 l.f.
Upper Ventilation MAX. Req'd =	$523.68 \text{ s.i.} \times 0.5 / \text{s.i. per linear foot} =$	29 l.f.
Provide:	28 l.f. ridge vent. Ventilation =	504.00 s.i.
Ventilation area remainder for AF50 vents =		19.68 s.i.
Upper Roof Ventilation: as needed to achieve 50% of ventilation		
AF50 Roof Jack (10" x 7") =		50.00 s.i. each.
Upper Ventilation Req'd TO GET 50%=	$19.68 \text{ s.i.} / \text{s.i. of each vent} =$	1 vent
Provide:	0 -10"x7" roof jacks. Ventilation =	0.00 s.i.
Eave Ventilation:		
Birdblocking: (3/2" dia holes per bay =	$4.71 \text{ s.i.} / \text{l.f.} - 25\% \text{ reduction} =$	3.53 s.i. / l.f.
Eave Ventilation Req'd =	$523.68 \text{ s.i.} / \text{s.i. per l.f.} =$	19.68 l.f.
Provide Minimum:	214 l.f. birdblocking. Ventilation =	755.96 s.i.
Minimum Ventilation Provided =	1259.96 s.i. IS GREATER THAN :	1047.4 s.i. Req'd

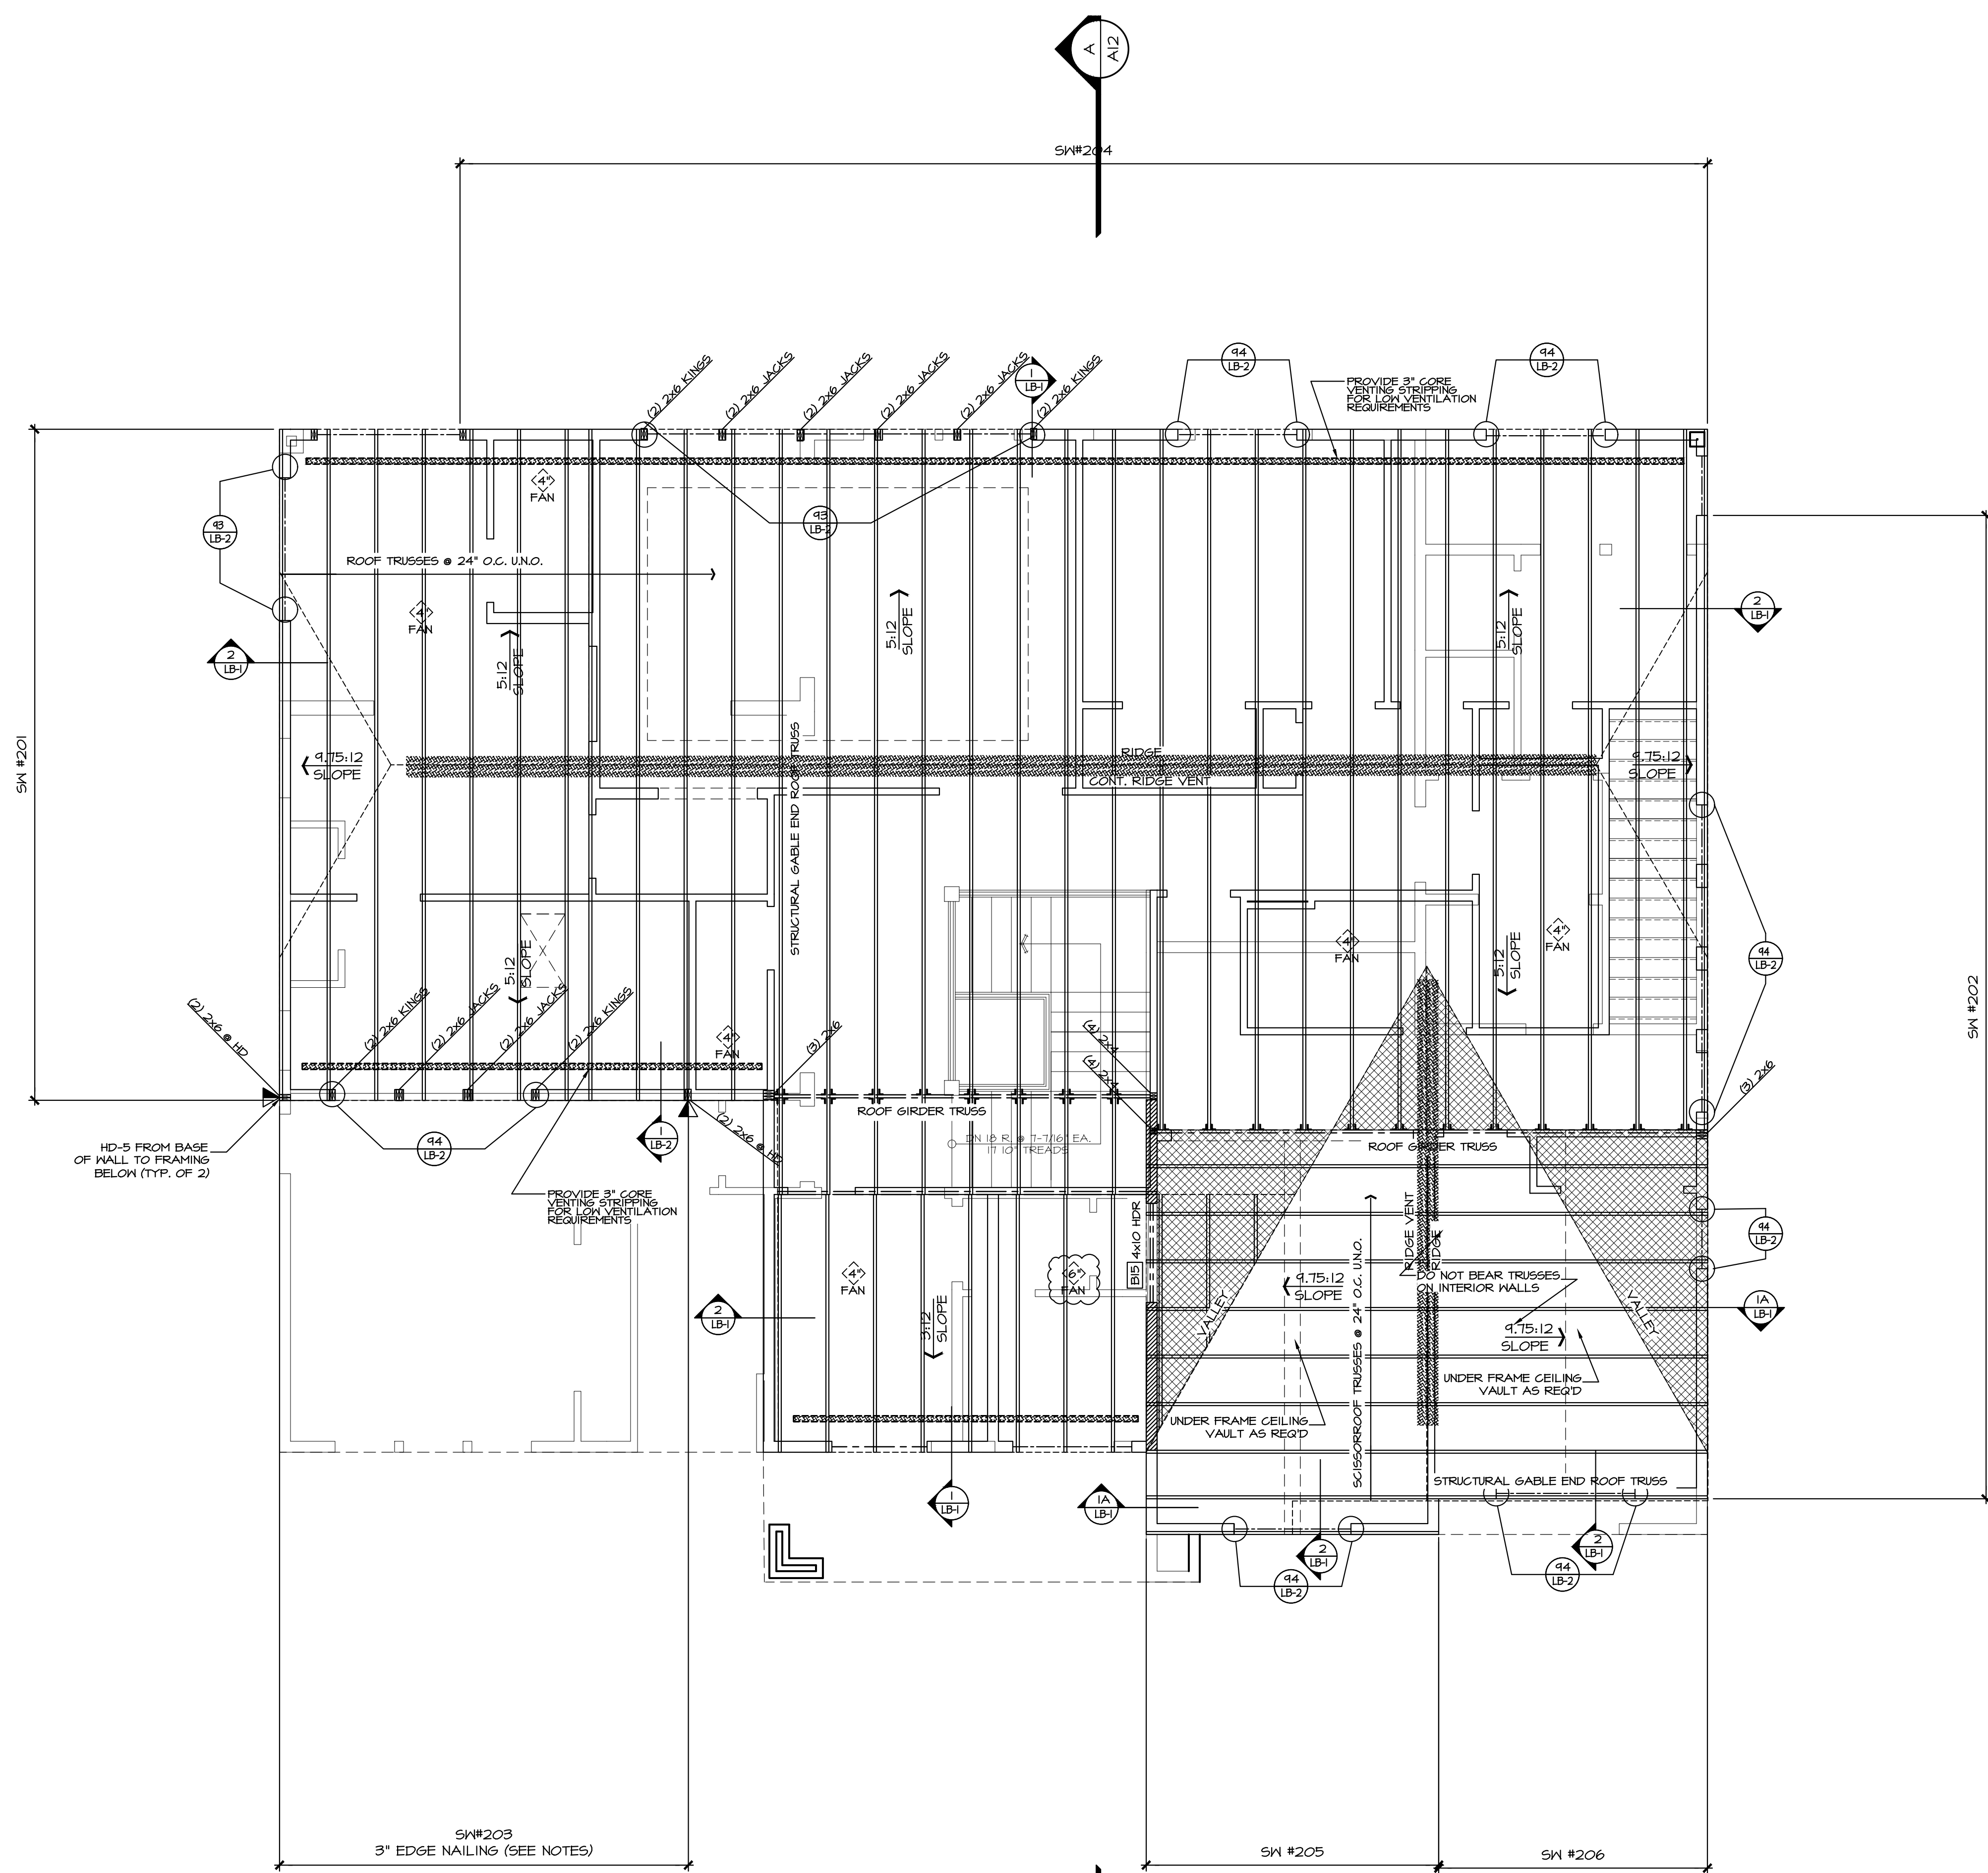

ROOF FRAMING PLAN

Sheet Title/Description

Issue	Issue Date	By	Description
△	07.11.22		CITY PLAN REVIEW COMMENTS
△	08.16.22		CITY PLAN REVIEW COMMENTS

4537 90th AVE SE
Mercer Island, WA.
Job Number:

plan name: -
marketing name: XXXXXX
plan number: -
mark sys. number: -

Conditions not specifically represented graphically or in writing or which conflict with the current International Residential Code (IRC), or those of the local municipality then the current standards and requirements of each respectively shall govern.

The drawings in this set are instruments of service and shall remain the property of JayMarc Homes, LLC.

© 2017 JayMarc Homes, LLC; All rights reserved.

06.15.21
Submission Date


Sheet Title/Description
JAYMARC HOMES
Design Firm

R.R.
Drawn by:


R.R./S.K.
Checked by:

Primary Scale


A10
of .

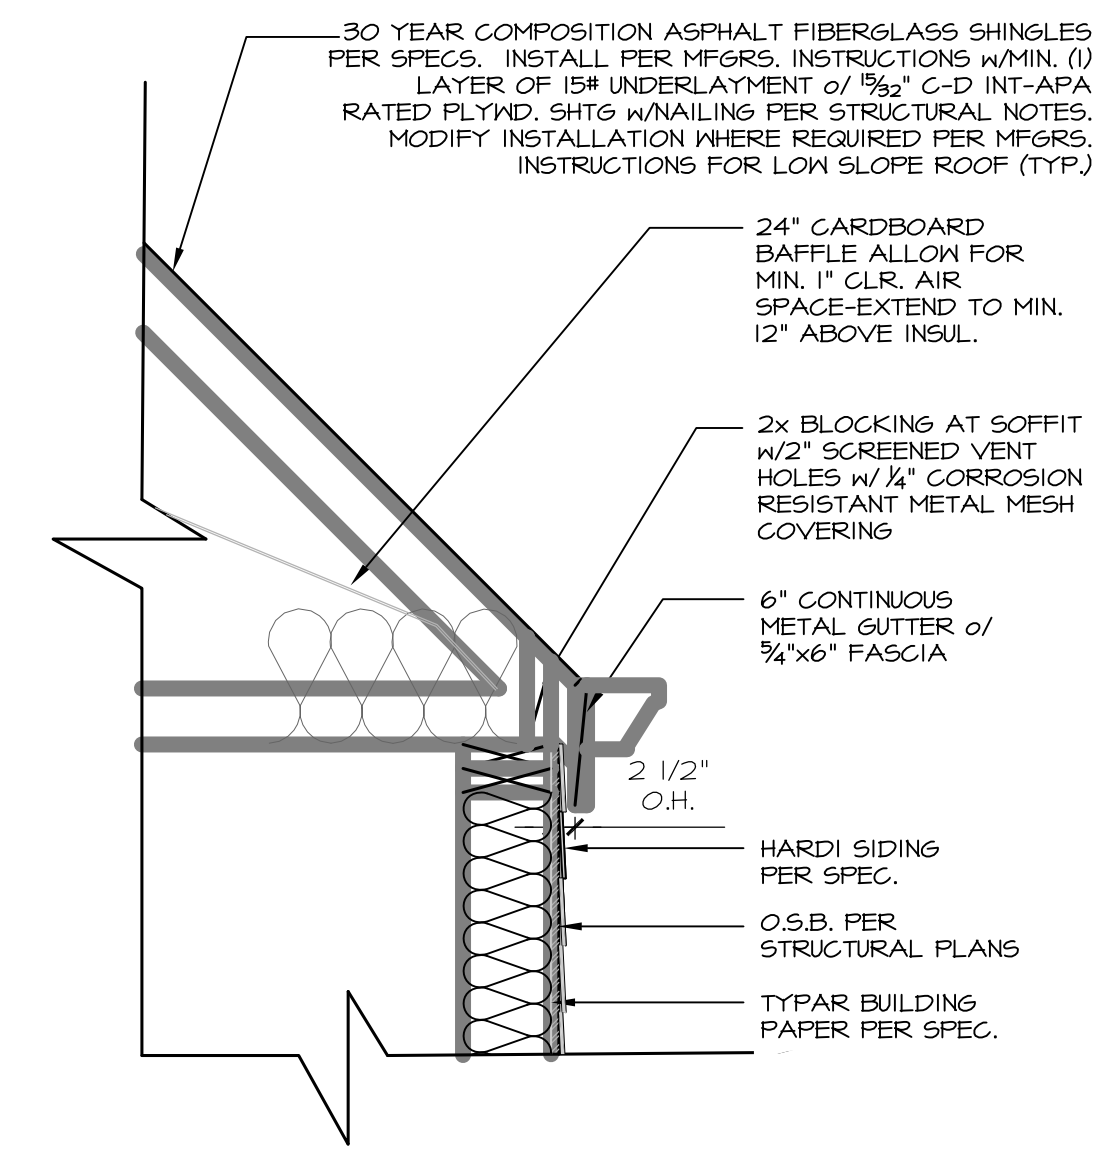

(A) OVERHANG DETAIL
1" = 1'-0"

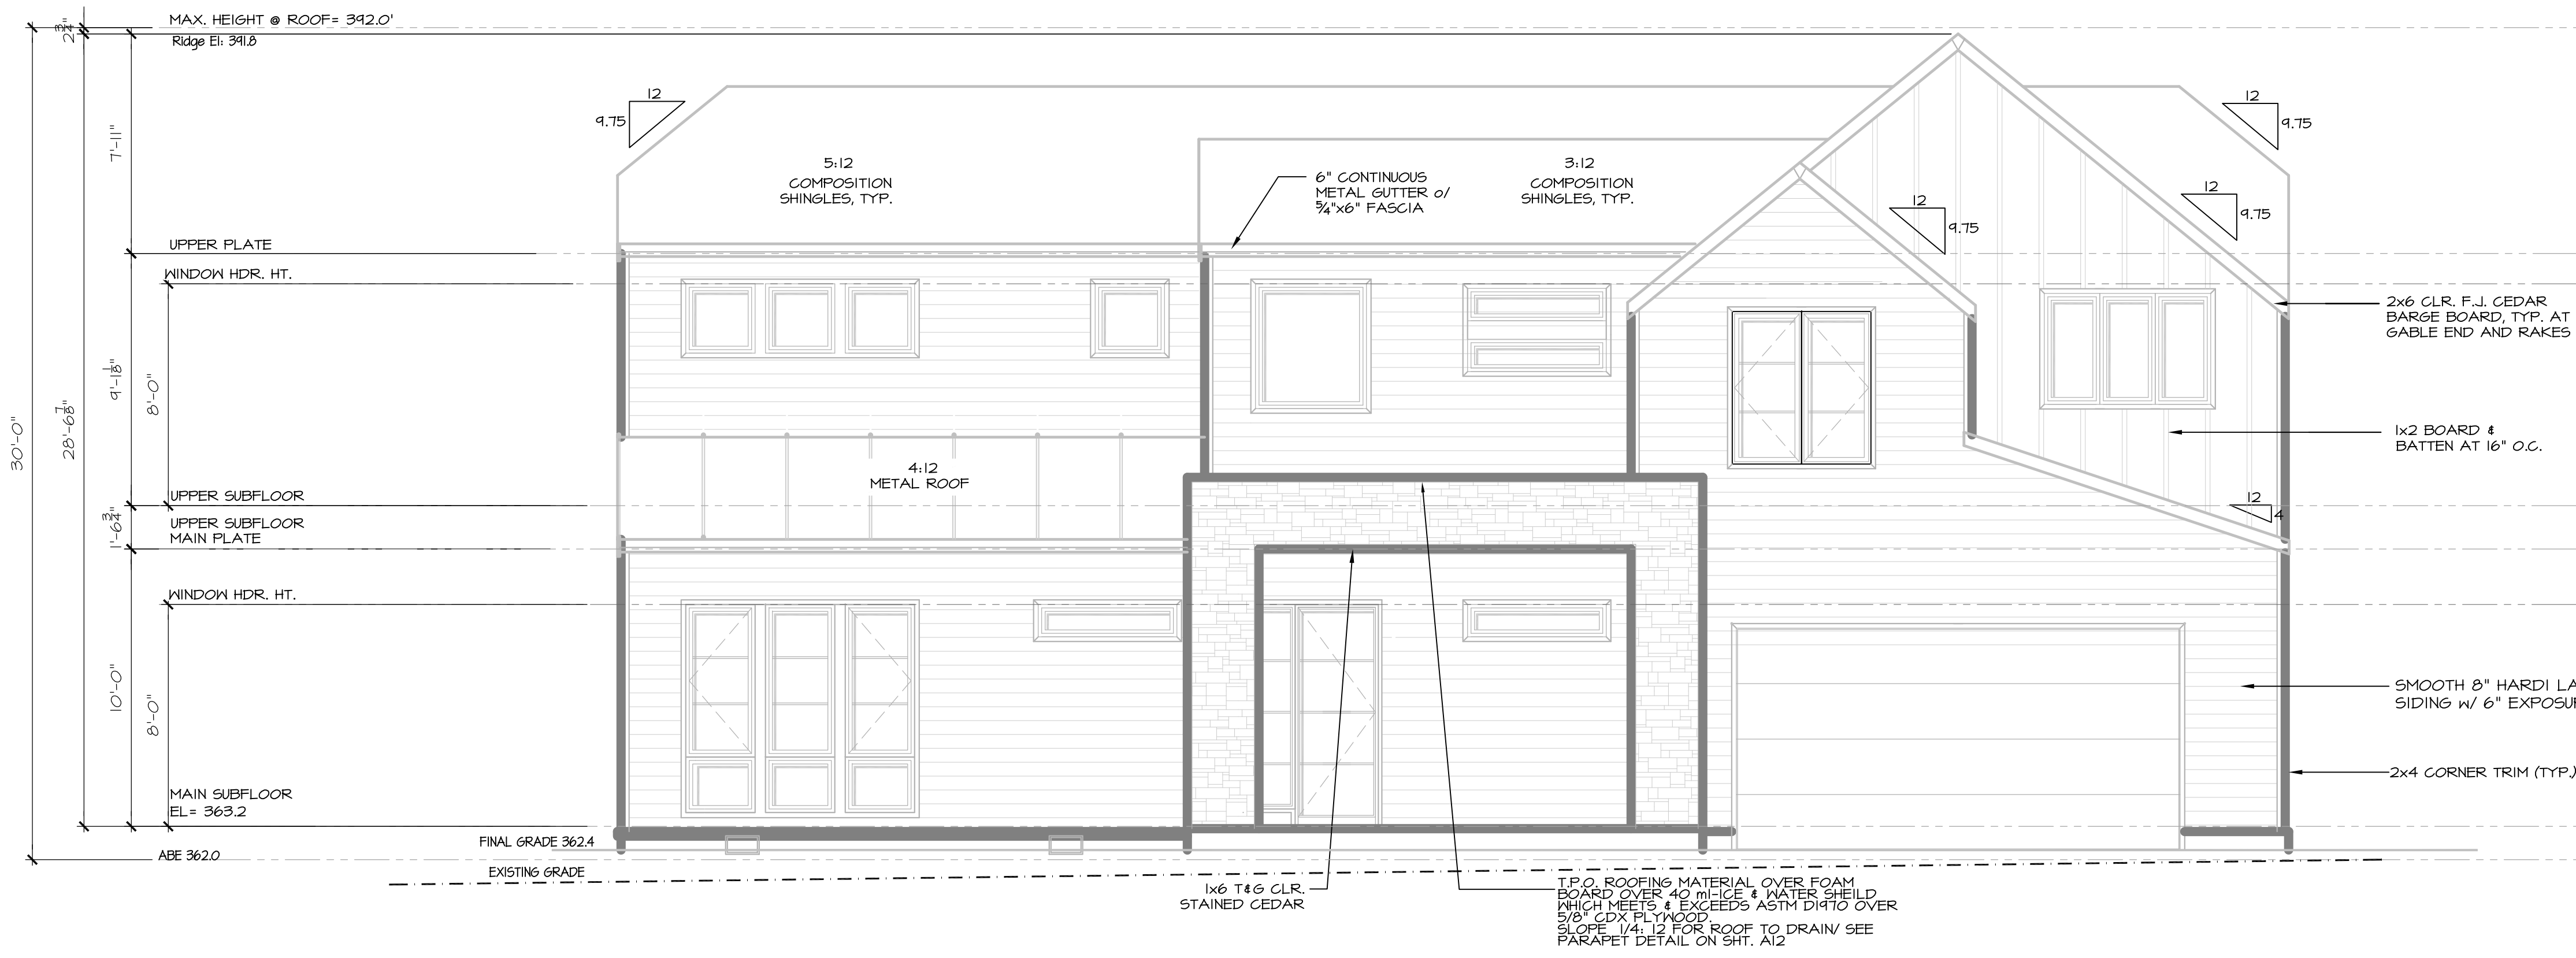

FRONT ELEVATION
1/4" = 1'-0"

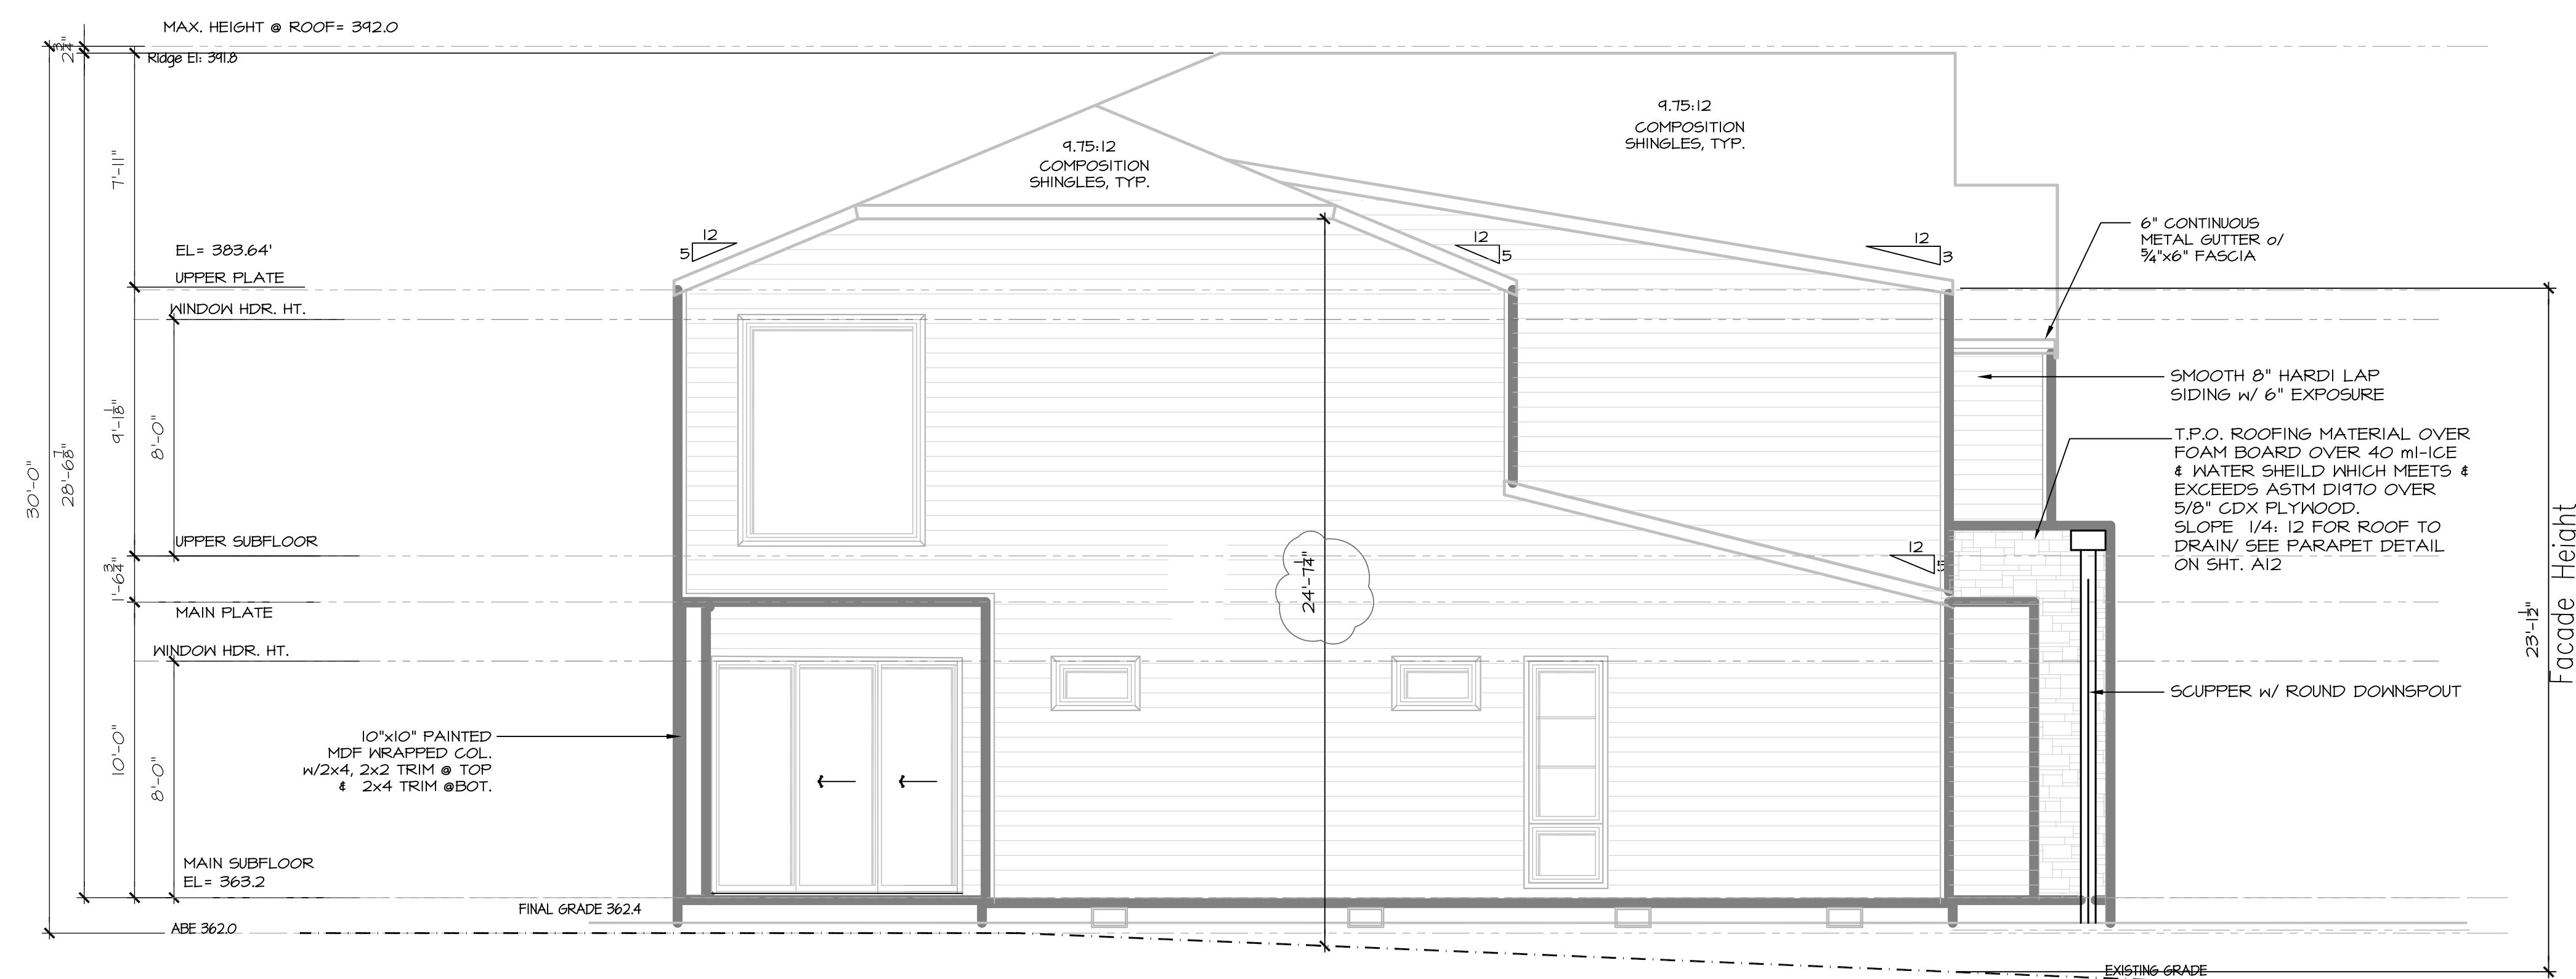

LEFT ELEVATION
1/4" = 1'-0"

Sheet Title/Description

Issue	Issue Date By	Description
△	07.11.22	CITY PLAN REVIEW COMMENTS
△	08.16.22	CITY PLAN REVIEW COMMENTS

4537 90th AVE SE
 Mercer Island, WA.
 Job Number:

plan name: -
 marketing name: XXXXXX
 plan number: -
 mark sys. number: -

Conditions not specifically represented graphically or in writing or which conflict with the current International Residential Code (IRC), or those of the local municipality then the current standards and requirements of each respectively shall govern.

The drawings in this set are instruments of service and shall remain the property of JayMarc Homes, LLC.

© 2017 JayMarc Homes, LLC; All rights reserved.

06.15.21
 Submittal Date

Sheet Title/Description
 JAYMARC HOMES
 Design Firm

R.R.
 Drawn by:

R.R./S.K.
 Checked by:


Primary Scale

A11
 of .



REAR ELEVATION

1/4" = 1'-0"

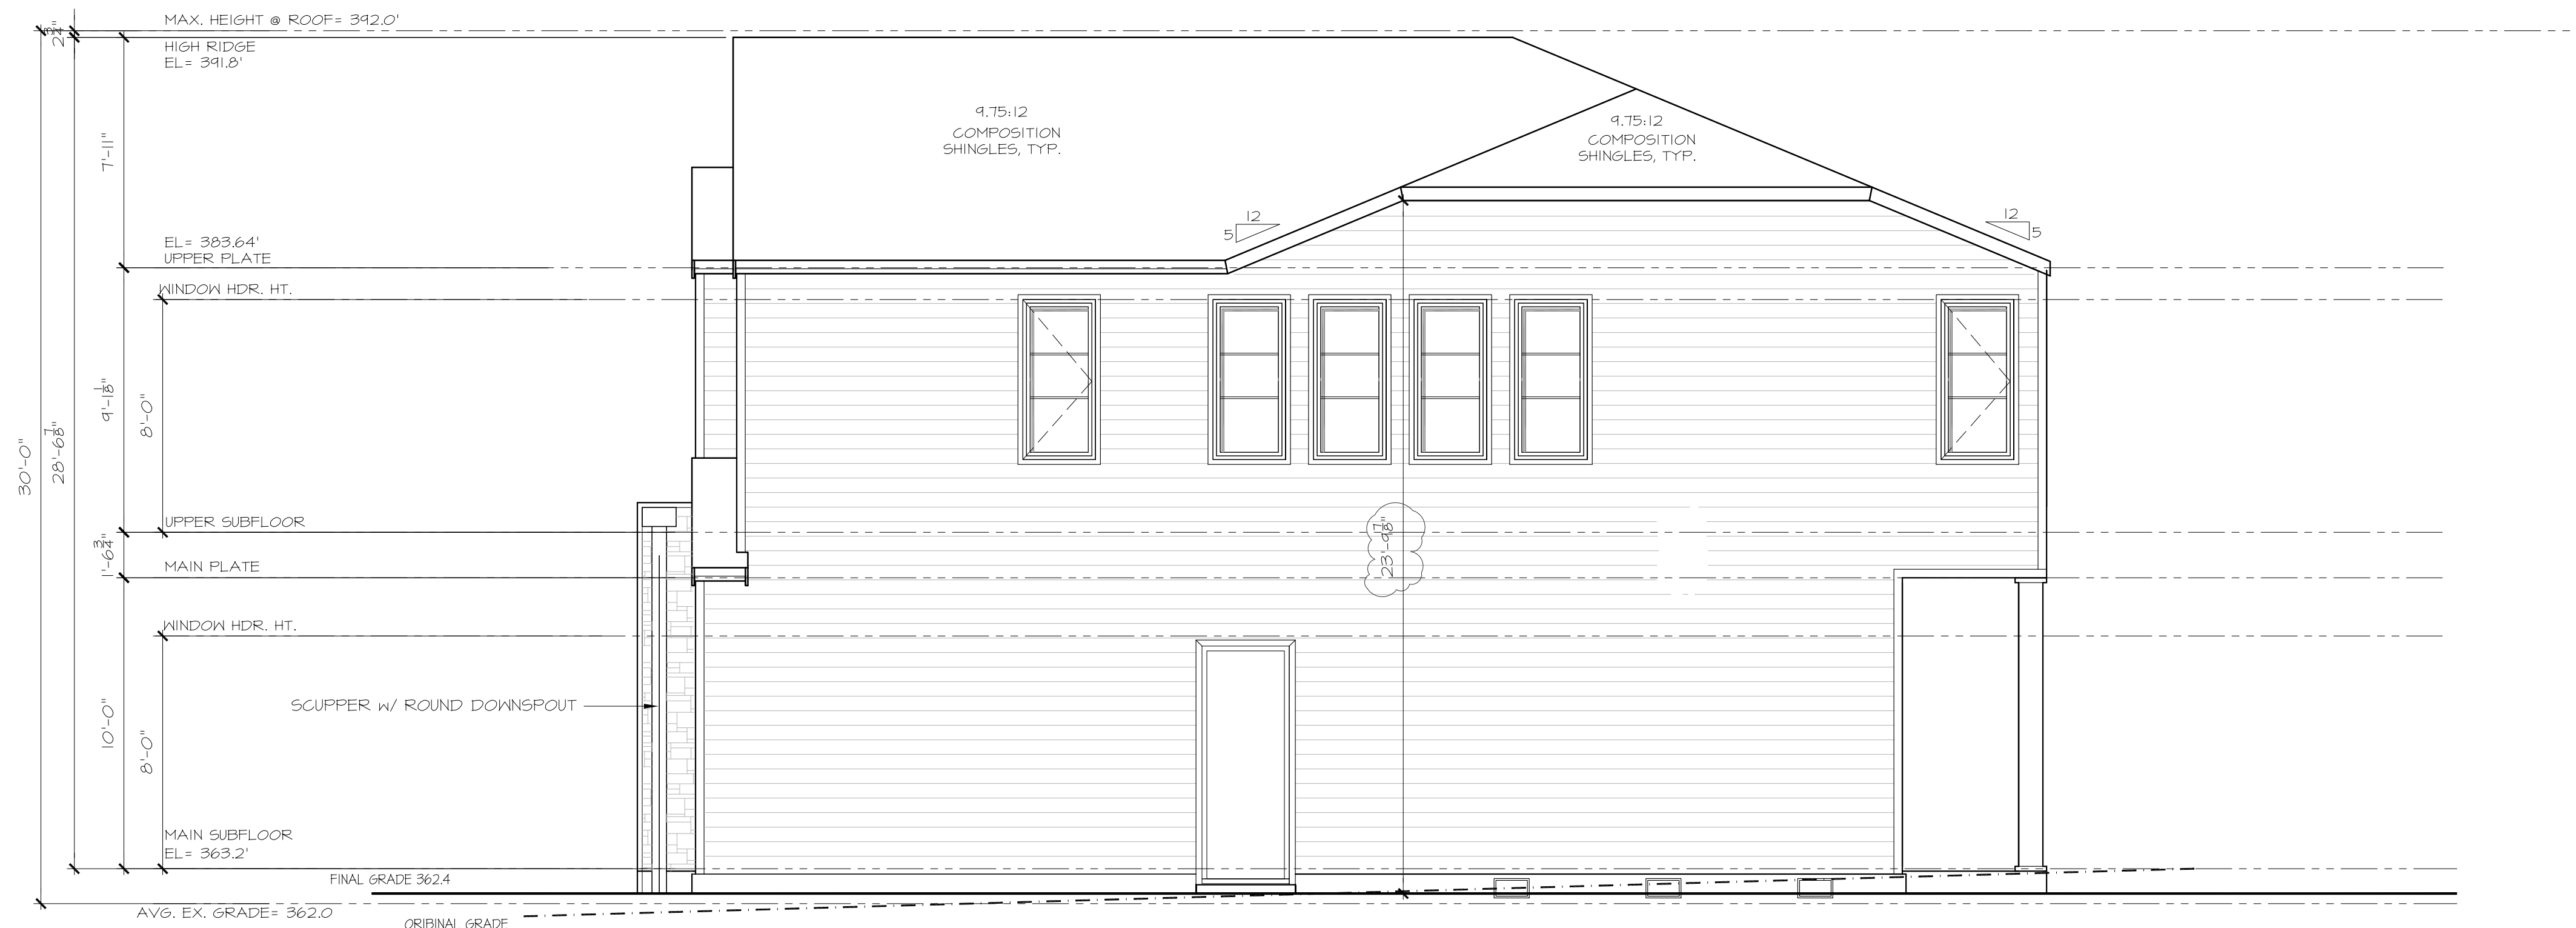

RIGHT ELEVATION


1/4" = 1'-0"

Sheet Title/Description


NOTES:




7525 SE 24th St., 487
Mercer Island, WA
98040
425.266.9100

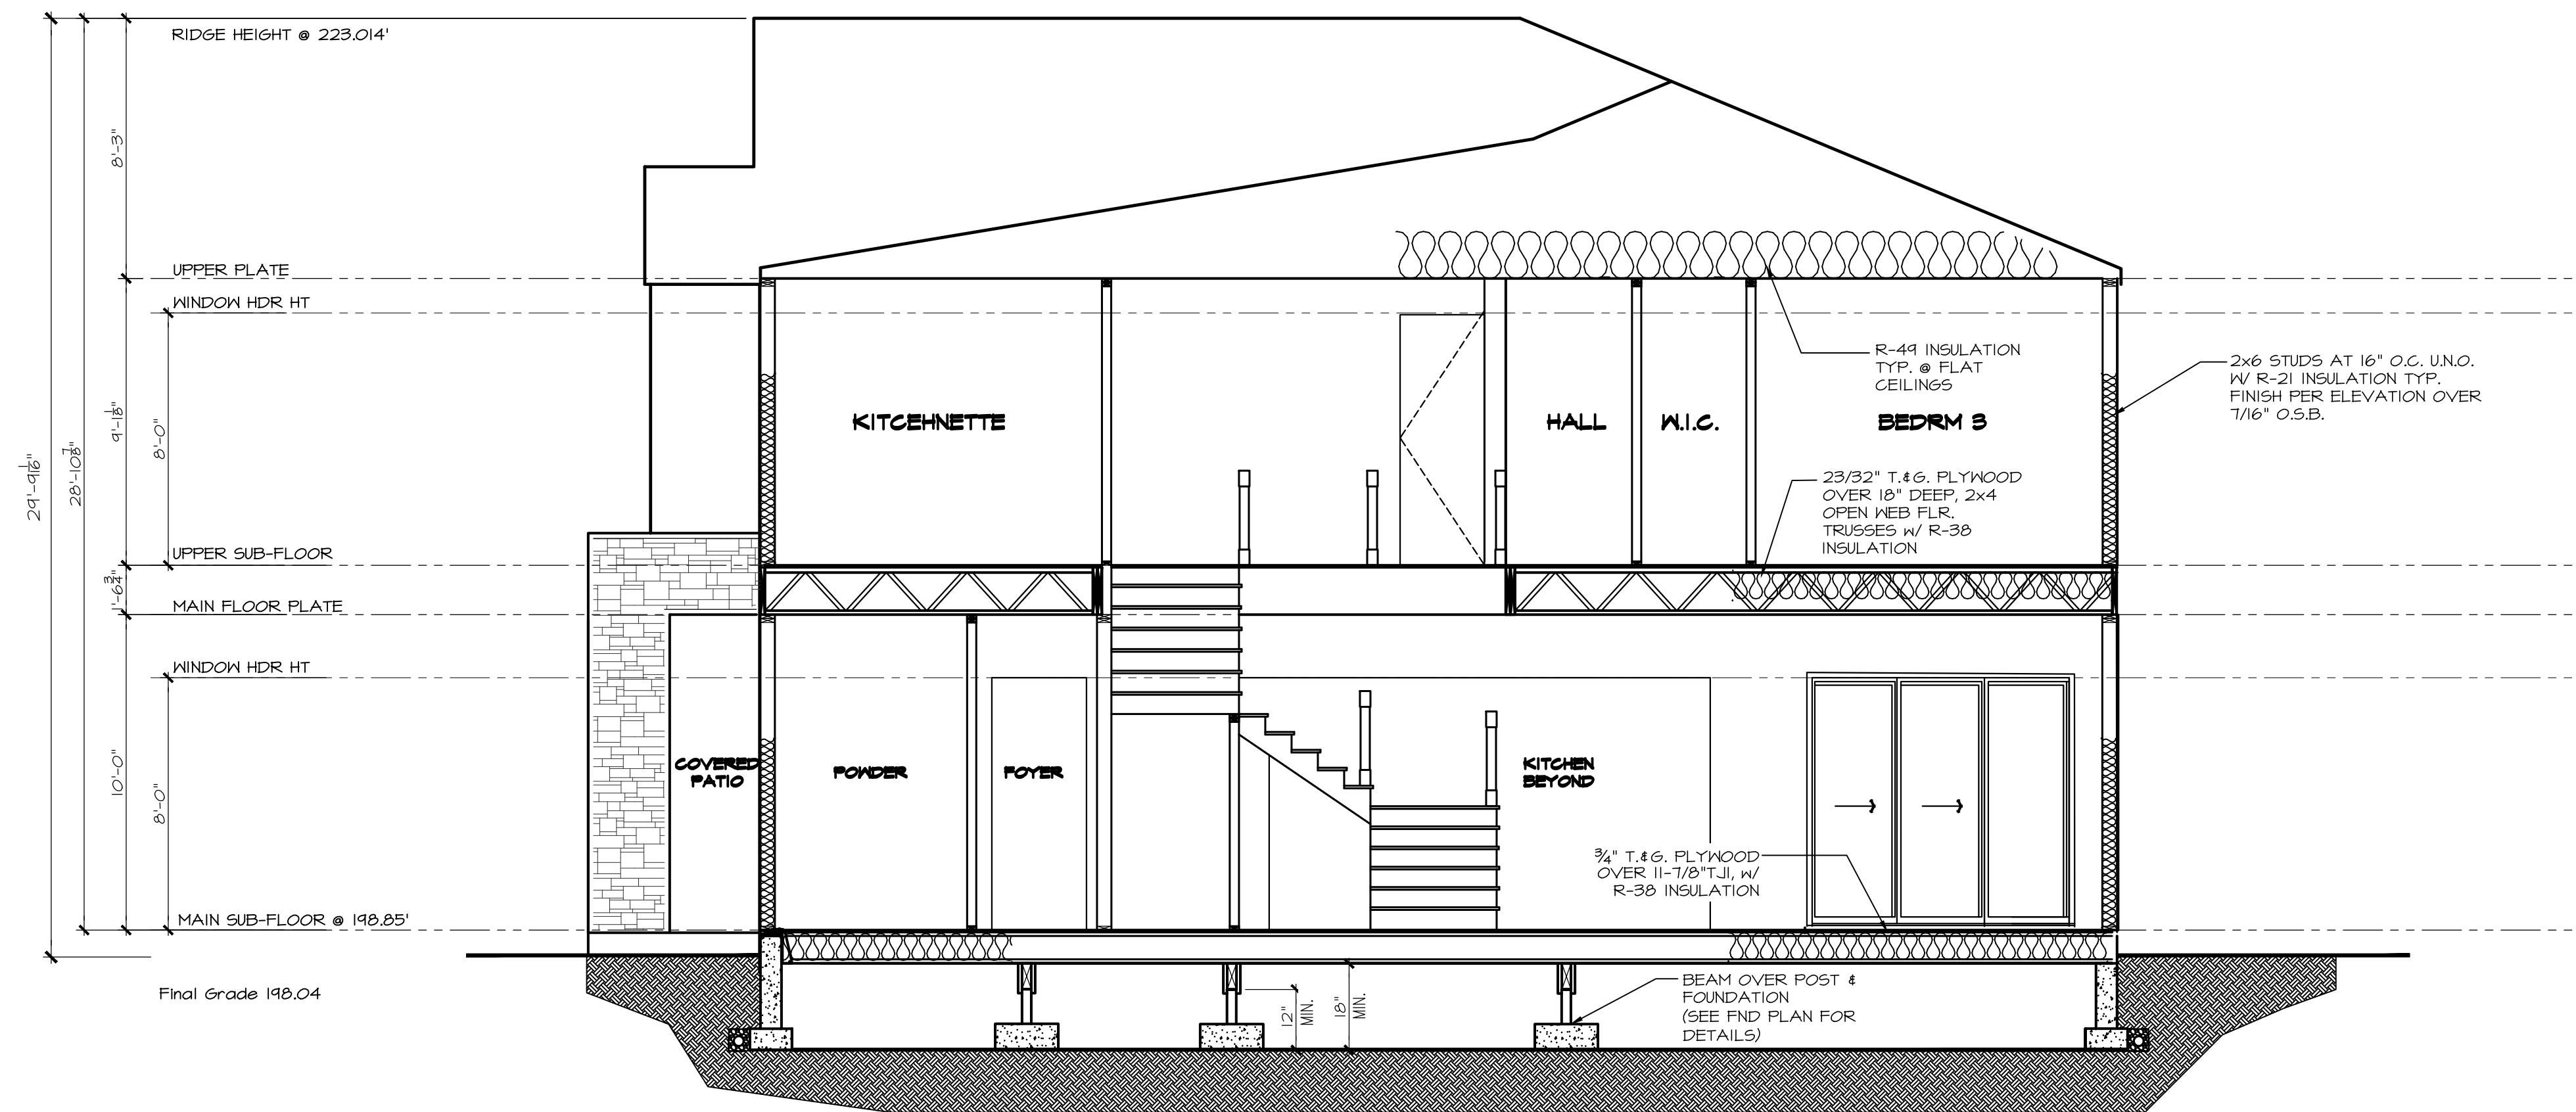

A BUILDING SECTION
1/4" = 1'-0"

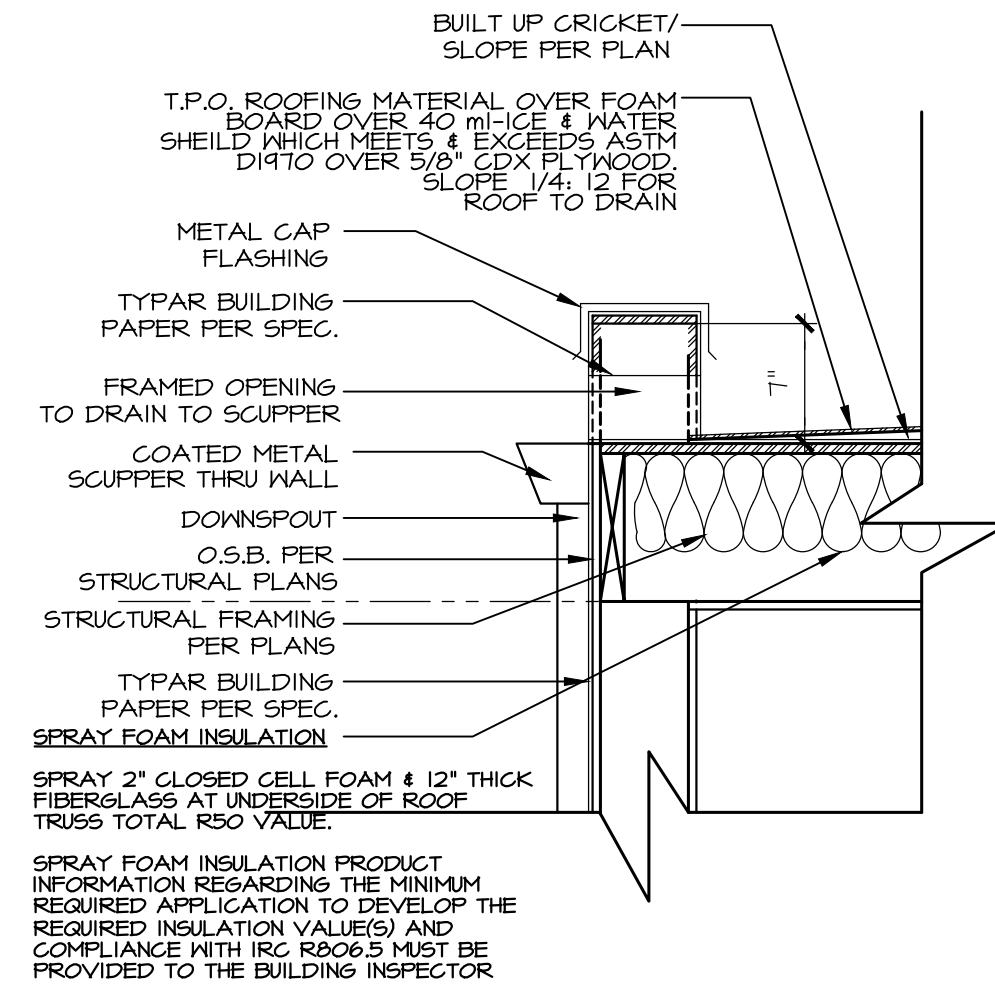

PARAPET DETAIL
1" = 1'-0"

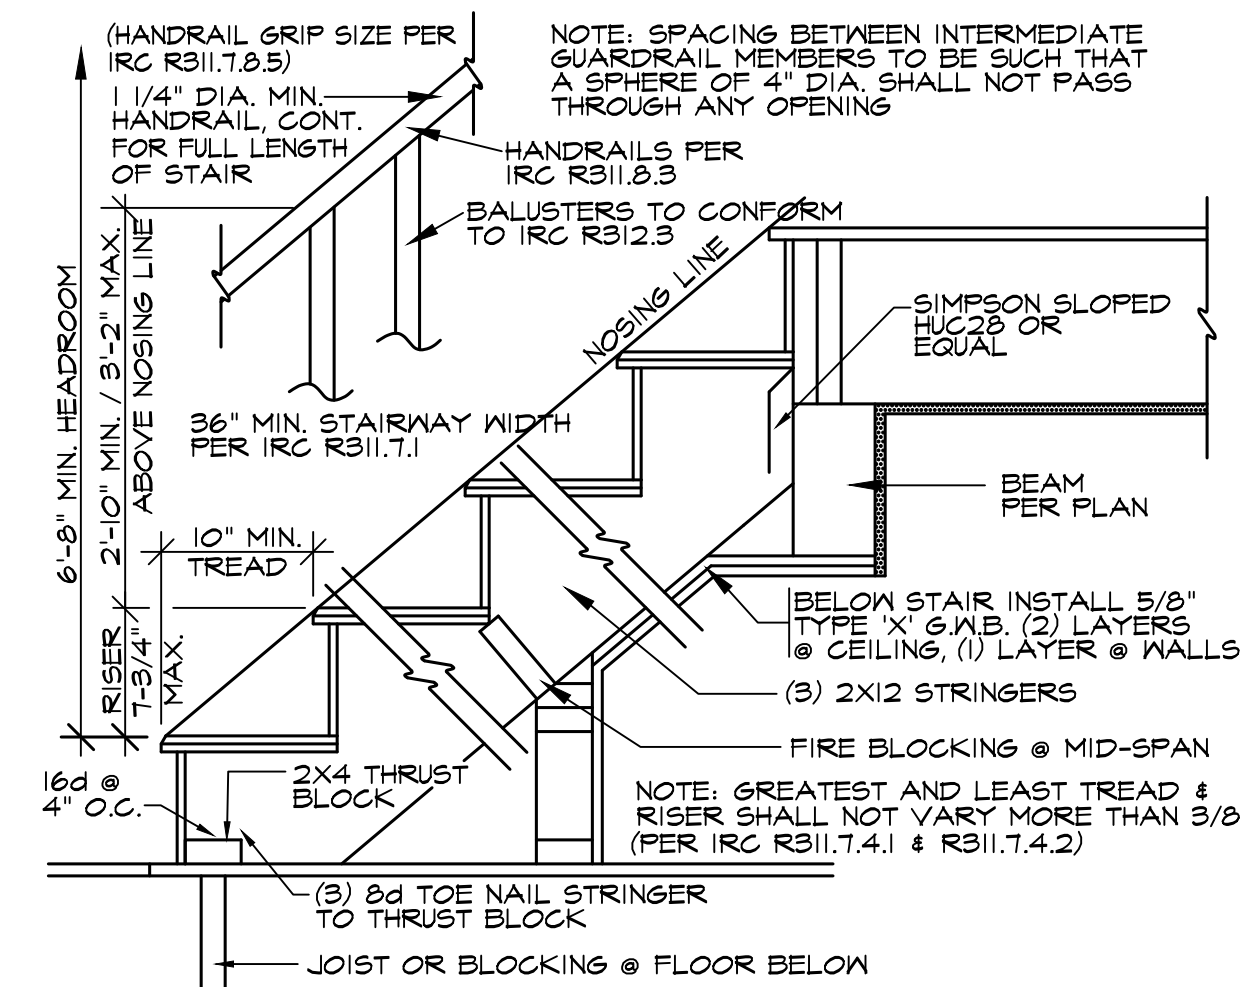

TYP. STAIR SECTION
1/4" = 1'-0"

Issue	Issue Date	Description
△	07.11.22	CITY PLAN REVIEW COMMENTS

4537 90th AVE SE
Mercer Island, WA.
Job Number:

plan name: -
marketing name: XXXXXX
plan number: -
mark sys. number: -

Conditions not specifically represented graphically or in writing or which conflict with the current international Residential Code (IRC.) or those of the local municipality then the current standards and requirements of each respectively shall govern.

The drawings in this set are instruments of service and shall remain the property of JayMarc Homes, LLC.

© 2017 JayMarc Homes, LLC; All rights reserved.

06.15.21
Submission Date

JAYMARC HOMES
Design Firm

R.R.
Drawn by:
R.R./ S.K.
Checked by:

Primary Scale

A12
of: .

Sheet Title/Description

BASEMENT SLAB

4" CONC. SLAB ON 6 MIL VAPOR BARRIER ON 4" MIN. GRANULAR FILL ON 95% COMPACTED FILL/VIRGIN SOIL

GARAGE SLAB

4" CONC. SLAB ON 4" MIN. GRANULAR FILL ON 95% COMPACTED FILL/VIRGIN SOIL

PORCH SLAB

4" CONC. SLAB ON GRADE ON 6 MIL VAPOR BARRIER ON 4" MIN. GRANULAR FILL ON 95% COMPACTED FILL/VIRGIN SOIL

GENERAL STRUCTURAL NOTES

FOUNDATION

- DESIGN IS BASED ON 2018 INTERNATIONAL RESIDENTIAL CODE & 2018 INTERNATIONAL BUILDING CODE
DESIGN LOADS: SOIL 2,000 PSF ALLOWABLE BEARING PRESSURE
CONCRETE SHALL ATTAIN THE FOLLOWING MINIMUM COMPRESSIVE STRENGTHS IN 28 DAYS, UNO
FOOTINGS: Fc = 2500 psi; FOUNDATION WALLS* Fc = 2500 psi; FOOTINGS* 2500 psi; INTERIOR SLABS ON GRADE 3500 psi; GARAGE & EXT. SLABS ON GRADE 4000 psi
UTILIZE 5/8" SACK 2500 PSI CONCRETE MIXES THAT ARE EQUIVALENT TO 3000 PSI CONCRETE FOR WEATHERING POTENTIAL
ALL CONCRETE EXPOSED TO THE WEATHER SHALL NOT HAVE LESS THAN 5% OR MORE THAN 7% AIR ENTRAINMENT.
FOUNDATION WALL DESIGN IS BASED ON BACKFILL SOIL CLASSIFICATIONS OF SG, ML-CL, OR CL (60 pcf) SOIL.
TYPICAL REINFORCEMENT DETAILS: LAP ALL REBAR 24" MIN; BEND BARS AND LAP AT CORNERS; PROVIDE 6" HOOK INTO SUPPORTING FOOTINGS WHEN FOOTINGS INTERSECT; PROVIDE 3" MINIMUM COVER AT THE BOTTOM BARS AND 1/2" COVER AT THE SIDES.
FOUNDATION WALLS SHALL BE BRACED, PRIOR TO BACKFILLING, BY EITHER ADEQUATE TEMPORARY BRACING OR INSTALLATION OF FIRST FLOOR DECK.
ALL FOOTINGS SHALL BEAR BELOW FROST LINE. CONSULT SOILS REPORT/ LOCAL MUNICIPALITY FOR MINIMUM DEPTH BELOW GRADE.
FOOTINGS AND SLABS ON GRADE SHALL BEAR ON VIRGIN SOIL OR 95% COMPACTED FILL.
PROVIDE CONTROL JOINTS AT ALL INSIDE CORNERS OF SLAB EDGES, AND OTHER LOCATIONS WHERE SLAB CRACKS ARE LIKELY TO DEVELOP. (5'-0" O.C.)
FASTEN SILL PLATES TO FOUNDATION WALLS WITH 5/8" DIA. ANCHOR BOLTS W/ MIN. 3"x2"x1/2" PLATE WASHERS (EDGE OF WASHER TO BE LOCATED WITHIN 1/2" OF EXTERIOR EDGE OF SILL PLATE) & NUTS @ 6'-0" O.C. @ 2-STORY & 4'-0" O.C. @ 3-STORY CONDITIONS W/ 7" MIN. EMBEDMENT INTO CONC. PROVIDE A MINIMUM OF 2 ANCHORS PER PLATE, 12" MAXIMUM FROM PLATE ENDS. UNO. (SEE DET. DETAILS).
ALL LUMBER EXPOSED TO WEATHER OR IN CONTACT W/ CONCRETE OR MASONRY FOUNDATION SHALL BE PRESERVATIVE TREATED HEM FIR #2.
BUILDER TO VERIFY CORROSION-RESISTANCE COMPATIBILITY OF HARDWARE & FASTENERS IN CONTACT W/ PRESERVATIVE-TREATED WOOD. CONTACT LUMBER & HARDWARE SUPPLIERS TO COORDINATE.
ARCH/BUILDER TO VERIFY ALL DIMENSIONS.

HOLD-DOWN SCHEDULE

Table with 2 columns: SYMBOL, SPECIFICATION. Rows include HD-1, HD-5, HD-6, HD-7.

MEANS & METHODS NOTES

THE STRUCTURE IS DESIGNED TO BE SELF SUPPORTING AND STABLE AFTER THE BUILDING IS FINISHED AND ALL PLAN, DETAIL, AND NOTE SPECIFICATIONS HAVE BEEN COMPLETED. IT IS THE CONTRACTOR'S SOLE RESPONSIBILITY TO DETERMINE THE ERECTION PROCEDURES AND SEQUENCE TO INSURE THE SAFETY OF THE BUILDING AND ITS COMPONENTS DURING CONSTRUCTION THIS INCLUDES, BUT IS NOT LIMITED TO, THE ADDITION OF NECESSARY SHORING, SHEETING, TEMPORARY BRACING, GUYS, AND TIE-DOWNS. CONTRACTOR SHALL BE RESPONSIBLE FOR ALL SHORING AND BRACING REQUIRED TO STABILIZE AND PROTECT EXISTING AND ADJACENT STRUCTURES AND SYSTEMS DURING COURSE OF DEMOLITION AND CONSTRUCTION OF THE PROJECT.

STRUCTURAL DESIGN AND SPECIFICATIONS ASSUME THAT ALL SUPPORTING AND NON-SUPPORTING ELEMENTS IN CONTACT WITH FLOOR FRAMING ARE LEVEL, INCLUDING, BUT NOT LIMITED TO; FOUNDATIONS, SLABS ON GRADE, BEAMS, WALLS, AND NON-BEARING ELEMENTS. IT IS THE CONTRACTOR'S RESPONSIBILITY TO VERIFY LEVELNESS AND MAKE ADJUSTMENTS AS NECESSARY, INCLUDING CONSIDERATION OF THOSE AREAS THAT MAY BE WITHIN CONTRACTUAL, INDUSTRY, OR WARRANTY TOLERANCES.

ADDITIONAL NOTES FOR TRUSS & I-JOIST MANUFACTURER

ROOF TRUSSES, FLOOR TRUSSES AND ENGINEERED JOISTS SHALL BE DESIGNED TO MEET THE DIFFERENTIAL DEFLECTION CRITERIA BELOW UNLESS NOTED OTHERWISE ON PLAN. MULHERN & KULP CANNOT BE HELD RESPONSIBLE FOR ANY STRUCTURAL ISSUES RELATED TO ANY BUILDING COMPONENT IF COMPONENT SHOP DRAWINGS ARE NOT SUBMITTED TO MKF FOR REVIEW PRIOR TO FABRICATION, DELIVERY, OR INSTALLATION.

TRUSSES SHALL BE DESIGNED SO THAT DIFFERENTIAL DEFLECTION BETWEEN ADJACENT PARALLEL TRUSSES OR GIRDER TRUSSES DOES NOT EXCEED THE FOLLOWING:
A. ROOF TRUSSES: 1/4" DEAD LOAD
B. FLOOR TRUSSES, ATTIC TRUSSES, & I-JOISTS: 1/8" DEAD LOAD
C. FLOOR TRUSSES & ATTIC TRUSSES ADJACENT TO FLOOR FRAMING BY OTHERS: LIMIT ABSOLUTE TRUSS DEFLECTION TO 3/16" DEAD LOAD. (NOT DIFFERENTIAL DEFLECTION)

LOADING AND DESIGN PARAMETERS

Tables for GRAVITY DESIGN LOADS, LIVE LOAD (PSF), SNOW LOAD, LATERAL DESIGN LOADS, and SEISMIC LOAD. Includes values for roof truss top/bottom chord, floor trusses, tile floors, residential living areas, and various wind speed/risk category parameters.

LATERAL BRACING NOTES

THIS HOME HAS BEEN ENGINEERED TO RESIST LATERAL FORCES RESULTING FROM: 100 MPH WIND SPEED, EXP. B (ASCE 7-16 WIND MAP, PER IRC R301.2.1.1) RISK CAT. 2 & SEISMIC CAT. D2.
110 MPH WIND IN 2018 IRC MAP
ENGINEERED DESIGN WAS COMPLETED PER 2018 IBC (SECTION 1609 & 1613) & ASCE 7-16, AS PERMITTED BY R301.1.3 OF THE 2018 IRC. ACCORDINGLY, THIS HOME, AS DOCUMENTED AND DETAILED HEREWITHIN, IS ADEQUATE TO RESIST THE CODE REQUIRED LATERAL FORCES, AND DOES NOT NEED TO CONFORM TO THE PRESCRIPTIVE PROVISIONS OF R602.10.

STANDARD EXTERIOR WALL SHEATHING SPECIFICATIONS


INTERIOR WALL SPECIFICATION WHERE NOTED ON PLANS

- 1/8" OSB OR 1/32" PLYWOOD: FASTEN SHEATHING W/ 2 1/2"x0.131" NAILS @ 6" O.C. AT ALL SUPPORTED PANEL EDGES AND 12" O.C. IN THE PANEL FIELD. ALL SHEATHING SHEET PANEL EDGES SHALL OCCUR OVER WALL FRAMING MEMBERS OR 2x HORIZONTAL BLOCKING SHALL BE PROVIDED TO SUPPORT PANEL EDGE. ALL EXTERIOR WALLS SHALL BE CONSTRUCTED PER THIS SPECIFICATION UNO. ON PLANS.
3" O.C. EDGE NAILING (WHERE NOTED ON PLANS)
1/8" OSB OR 1/32" PLYWOOD: ONLY AT LOCATIONS INDICATED ON PLANS - SHEATHED SHOWN WITH 1/8" OSB. FASTEN SHEATHING W/ 2 1/2"x0.131" NAILS @ 3" O.C. AT EDGES AND 12" O.C. AT CENTER. ALL SHEATHING SHEET PANEL EDGES SHALL OCCUR OVER WALL FRAMING MEMBERS OR 2x HORIZONTAL BLOCKING SHALL BE PROVIDED TO SUPPORT PANEL EDGE AND 3" O.C. FASTENING.

- NOTES: 1. LATERAL ANALYSIS ASSUMES STUD SPACING @ 16" O.C. 2. ALL SHEAR WALLS SHALL HAVE DOUBLE TOP PLATES FASTENED TOGETHER W/ 3"x0.131" NAILS @ 8" O.C. USE (12 1/2"x0.131" NAILS AT EACH LAP SPlice. (6) EACH SIDE OF JOINT (TYP. UNO.) 3. ALL EXTERIOR WALLS ARE CONTINUOUSLY SHEATHED. 4. ALL INTERIOR SHEAR WALLS AND EXTERIOR WALLS ARE SHEATHED ABOVE AND BELOW OPENINGS.

LEGEND

- Interior bearing wall
Bearing wall above (B.W.A.) OR SHEARNAIL ABOVE (S.W.A.)
Beam / Header
Interior shear wall panel OR EXTERIOR SHEAR WALL W/ 3" O.C. EDGE NAILING
Area of overframing
JL Metal hanger
* INDICATES POST ABOVE. PROVIDE SOLID BLOCKING UNDER POST OR JAMB ABOVE.
INDICATES HOLD-DOWN.

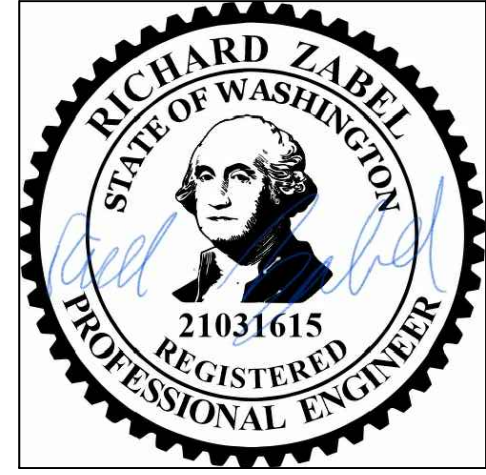

GENERAL STRUCTURAL NOTES

DESIGN PARAMETERS

- DESIGN IS BASED ON 2018 INTERNATIONAL RESIDENTIAL CODE & 2018 INTERNATIONAL BUILDING CODE
WOOD FRAME ENGINEERING IS BASED ON NDS, NATIONAL DESIGN SPECIFICATION FOR WOOD CONSTRUCTION - LATEST EDITION.

GENERAL FRAMING

- EXTERIOR BEARING WALLS SHALL BE 2x4 OR 2x6 (AS SHOWN ON PLANS) @ 16" O.C. W/ DOUBLE TOP PLATE HEM FIR (#F) #5UD GRADE LUMBER, OR BETTER, UNO.
INTERIOR BEARING WALLS SHALL BE 2x4 OR 2x6 (AS SHOWN ON PLANS) @ 16" O.C. W/ DOUBLE TOP PLATE HEM FIR (#F) #5UD GRADE LUMBER, OR BETTER, UNO.
NON-BEARING INTERIOR STUD WALLS SHALL BE CONSTRUCTED WITH 2x5 UD GRADE MEMBERS SPACED @ 24" O.C. (MAX.)
ALL WALLS TALLER THAN TYP. PLATE HEIGHT SHALL BE CONSIDERED BALLOON FRAMED & SHALL BE CONSTRUCTED FROM FLOOR TO UNDERSIDE OF FRAMING AT NEXT LEVEL. B.F. WALLS SHALL BE 2x4 OR 2x6 (AS SHOWN ON PLANS) HEM FIR (#F) #2 GRADE LUMBER, OR BETTER.
ALL HEADERS SHALL BE SUPPORTED BY (1)2x JACK STUD & (1)2x KING STUD, MINIMUM NUMBER OF STUDS SPECIFIED AT A SUPPORT INDICATES THE NUMBER OF JACK STUDS REQUIRED, UNO.
BUILT-UP POSTS SHALL BE 2x4 OR 2x6 HEM FIR (#F) #5UD GRADE LUMBER, OR BETTER, UNO. & SOLID WOOD COLUMNING SHALL BE SPRUCE PINE FIR (SPF) #2 GRADE LUMBER, OR BETTER, UNO.
2x6 AND LARGER SOLID SAWN BEAMS/HEADERS SHALL BE HEM FIR #2 (#F #2) OR BETTER. ALL 4x6 AND LARGER SOLID SAWN LUMBER SHALL BE DOUG FIR #2 (DF #2) OR BETTER.
ALL FRAMING LUMBER SHALL BE KILN DRIED TO 15% MC (KD-15).
ALL TYP. NAIL FASTENER REQUIREMENTS ARE NOTED IN GENERAL NOTES, IN DETAILS, OR ON PLANS. ALL NAILS SPECIFIED ARE MIN DIAMETER AND LENGTH REQUIRED FOR CONNECTION. ALL HANGER NAILS SHALL BE INSTALLED PER MANUFACTURER'S REQUIREMENTS FOR MAX CHARTED CAPACITY. NOTE: HANGERS USE COMMON NAIL DIAMETERS NOT TYPICAL FRAMING GUN NAILS.
FASTEN ALL BEAMS TO COLUMNING, OR FLASH BEAMS TO SUPPORTING BEAMS W/ (4) 3"x0.131" TORNAILS (MN), TYP. UNO.
PROVIDE SOLID BLOCKING IN FLOOR SYSTEM UNDER ALL POSTS & HOLD-DOWNS CONTINUOUS TO FOUNDATION/BEARING. BLOCKING TO MATCH POST ABOVE.
ENGINEERED LUMBER TO MEET OR EXCEED THE FOLLOWING:
LSL MEMBERS - Fb=2525 PSI; Fv=930 PSI; E=155x10^9 PSI
LVL MEMBERS - Fb=2400 PSI; Fv=285 PSI; E=1.2x10^9 PSI
GLB MEMBERS - Fb(A)=2400 PSI; Fv(A)=1850 PSI; Fv=265 PSI; E=1.8x10^9 PSI; Df/Df; 24F-V4 (UNO)
ENGINEERED LUMBER POSTS TO MEET OR EXCEED THE FOLLOWING:
LVL MEMBERS - Fb=2400 PSI; Fv=2500 PSI; E=1.8x10^9 PSI
FACE NAIL MULTI-PLY 2x BEAMS & HEADERS W/ 3-ROVRS OF 3"x0.131" NAILS (MN) @ 12" O.C. STAGGERED. APPLY NAILING FROM BOTH FACES @ 3-PLY OR MORE CONDITIONS. UTILIZE 2 ROVS OF NAILS FOR 2x6 & 2x8 MEMBERS.
ALL MEMBERS SPECIFIED AS MULTI-PLY (B) SHALL BE FASTENED TOGETHER PER MANUFACTURER. EQUIVALENT WIDTH SOLID MATERIAL MAY BE USED AS EQUAL.
2x FLOOR JOISTS HAVE BEEN DESIGNED TO MEET OR EXCEED L2400 LIVE LOAD DEFLECTION CRITERIA.
TYPICAL 2x JOIST HANGERS (UNO. ON PLANS): SINGLE PLY: SIMPSON LUS20 DOUBLES: SIMPSON LUS20-2
FLOOR SHEATHING SHALL BE 23/32" A.P.A. RATED #5UD-FLOOR 24" O.C. EXPOSURE 1 (OR APPROVED EQUAL) WITH TONGUE AND GROOVE EDGES. FASTEN TO FRAMING MEMBERS W/ GLUE AND 2 1/2" x 0.131" NAILS @ 6" O.C. @ PANEL EDGES & @ 12" O.C. FIELD.
ALL FLASH CONNECTIONS SHALL BE CONNECTED WITH HANGER APPROPRIATE FOR MEMBER SIZE. UNO.
FASTEN HANGERS TO SINGLE PLY FLASH BEAMS W/ 1/2" LONG NAILS.

FLOOR FRAMING

- I-JOISTS/TRUSSES SHALL BE DESIGNED BY MANUF. TO MEET OR EXCEED L/480 LIVE LOAD DEFLECTION CRITERIA AND SHALL RUN CONTINUOUS OVER SUPPORTS WHEREVER POSSIBLE. ALL LOADS SHOWN ON PLAN FOR MANUF. DESIGN ARE ASD LEVEL LOADS, UNO. (EXCLUDES STONE/MARBLE OR NET BED CONSTRUCTED FLOORS - CONTACT MKF FOR EXCLUDED DESIGN).
ALL METAL I-JOIST/TRUSS HANGERS SHALL BE SPECIFIED BY ARCHITECT AND ENGINEER FOR REVIEW AND APPROVAL PRIOR TO FABRICATION OR DELIVERY.
2x FLOOR JOISTS HAVE BEEN DESIGNED TO MEET OR EXCEED L2400 LIVE LOAD DEFLECTION CRITERIA.
TYPICAL 2x JOIST HANGERS (UNO. ON PLANS): SINGLE PLY: SIMPSON LUS20 DOUBLES: SIMPSON LUS20-2
FLOOR SHEATHING SHALL BE 23/32" A.P.A. RATED #5UD-FLOOR 24" O.C. EXPOSURE 1 (OR APPROVED EQUAL) WITH TONGUE AND GROOVE EDGES. FASTEN TO FRAMING MEMBERS W/ GLUE AND 2 1/2" x 0.131" NAILS @ 6" O.C. @ PANEL EDGES & @ 12" O.C. FIELD.
ALL FLASH CONNECTIONS SHALL BE CONNECTED WITH HANGER APPROPRIATE FOR MEMBER SIZE. UNO.
FASTEN HANGERS TO SINGLE PLY FLASH BEAMS W/ 1/2" LONG NAILS.


ROOF FRAMING

- FASTEN EACH ROOF TRUSS TO TOP PLATE W/ (4) 3"x0.131" TORNAILS (MIN) & (1) SIMPSON SDNG15600 SCREW @ ALL BEARING POINTS. PROVIDE (2) SIMPSON SDNG15600 SCREWS AT 2-PLY GIRDER TRUSSES, (3) SIMPSON SDNG15600 SCREWS AT 3-PLY GIRDER TRUSSES AT ALL BEARING POINTS.
FASTEN EACH ROOF RAFTER TO TOP PLATE WITH (1) SIMPSON SDNG15600 SCREW PROVIDE (2) SIMPSON SDNG15600 SCREWS AT FLASH BEAMS IN THE ROOF - AT ALL BEARING POINTS.
ROOF SHEATHING SHALL BE 7/8" A.P.A. RATED SHEATHING 24/16 EXPOSURE 1 (OR APPROVED EQUAL). FASTEN TO FRAMING MEMBERS W/ 2 1/2" x 0.131" NAILS @ 6" O.C. AT PANEL EDGES & @ 12" O.C. AT INTERMEDIATE SUPPORTS. ROOF SHEATHING SHALL EXTEND BELOW ALL INSTANCES OF OVERFRAMING. BLOCKING SHALL BE INSTALLED AS REQUIRED TO LIMIT ROOF SHEATHING SPANS TO 24" MAX.
WITHIN 48" OF ALL ROOF EDGES, RIDGES, & HIP'S FASTEN ROOF SHEATHING FIELDS PER EDGE NAILING SPEC.
ALL METAL HANGERS SHALL BE SPECIFIED BY THE TRUSS MANUFACTURER, UNLESS OTHERWISE NOTED.
ROOF TRUSS SHOP DRAWINGS SHALL BE SUBMITTED TO ARCHITECT AND ENGINEER FOR REVIEW AND APPROVAL PRIOR TO FABRICATION OR DELIVERY.
ROOF TRUSS SHOP DRAWINGS & CALCULATIONS SHALL BE PREPARED BY A WASHINGTON STATE LICENSED ENGINEER AND SHALL BE DESIGNED FOR UNBALANCED SNOW LOADING PER ASCE 7-16, SECTION 7.6.
ERECT AND INSTALL ROOF TRUSSES PER WTC & TP'S BC/S1 1-08 GUIDE TO GOOD PRACTICE FOR HANDLING, INSTALLING & BRACING OF METAL PLATE CONNECTED WOOD TRUSSES.
FASTEN OVER-FRAMED TRUSS SETS TO TRUSSES BELOW W/ (2) 3"x0.131" TORNAILS AT EA TRUSS.
SUPPORT PORCH & SHORT SPAN ROOF TRUSSES (UP TO 6' TRIB.) W/2x6 LEDGER FASTENED TO FRAMING W/ (3) 3"x0.131" NAILS @ 16" O.C.
FASTEN ALL INTERIOR NON-BEARING PARTITION WALLS TO TRUSS BOTTOM CHORD ABOVE WITH SIMPSON STC CLIPS AT 24" O.C. MAX. PROVIDE BLOCKING BETWEEN THE TRUSS BOTTOM CHORDS AS REQUIRED FOR THE PARALLEL CONDITIONS.

seal:

© copyright: MULHERN & KULP Structural Engineering, Inc.

MULHERN+KULP RESIDENTIAL STRUCTURAL ENGINEERING 7220 Trade Street, Suite 350, San Diego, CA 92121 p 619-660-0010 m+kulpmkf.com

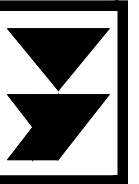

M&K project number:

154-22007

project mgr:

RJZ

drawn by:

ENW

issue date:

02-28-21

REVISIONS:

date:

initial:




STRUCTURAL NOTES

4537 90TH AVE SE MERCER ISLAND, WASHINGTON

sheat:

S-O.O

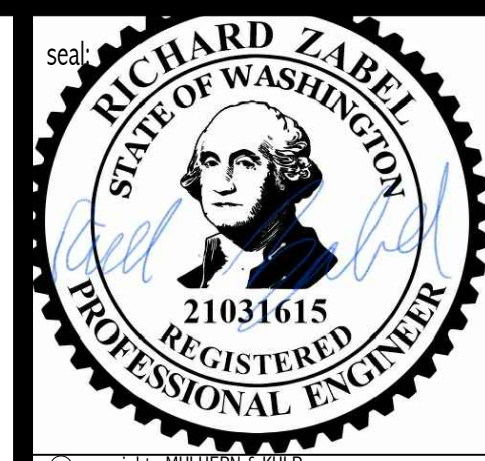

© copyright: MULHERN+KULP Structural Engineering, Inc.




M&K project number:
154-22007
project mgr: R.JZ
drawn by: ENW
issue date: 02-28-21

REVISIONS:
date: initial:




STRUCTURAL DETAILS
4537 90TH AVE SE
MERCER ISLAND, WASHINGTON


sheet:
LB-1

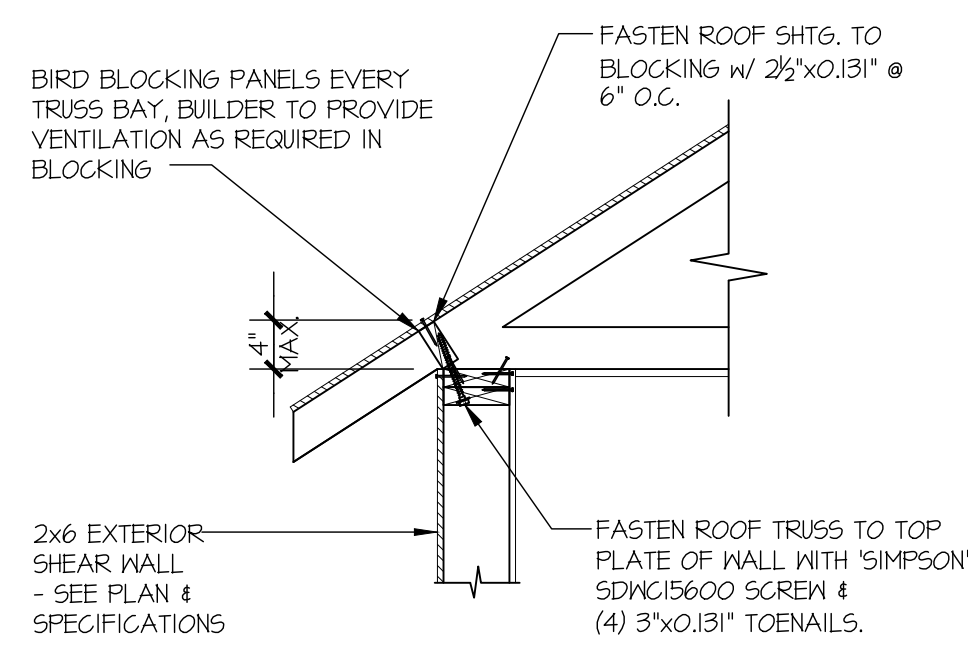


1 TYPICAL SHEAR TRANSFER DETAIL @ ROOF
SCALE: 3/4"=1'-0" HEEL HEIGHT LESS THAN 4"

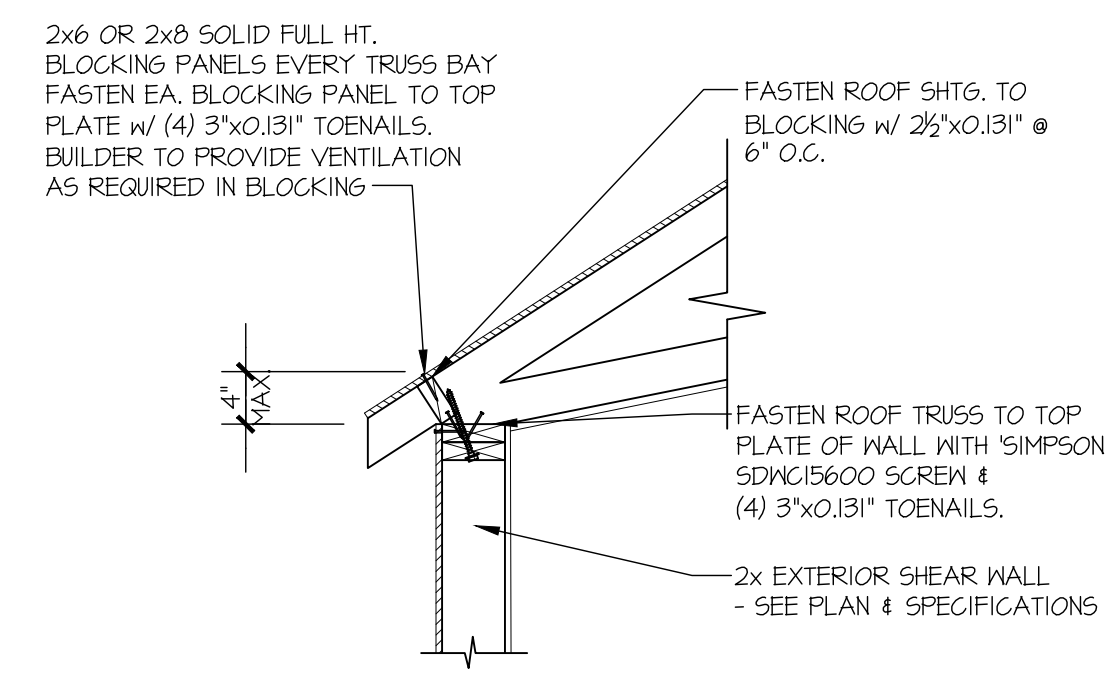


1A TYPICAL SHEAR TRANSFER DETAIL @ VAULTED CEILING
SCALE: 3/4"=1'-0"

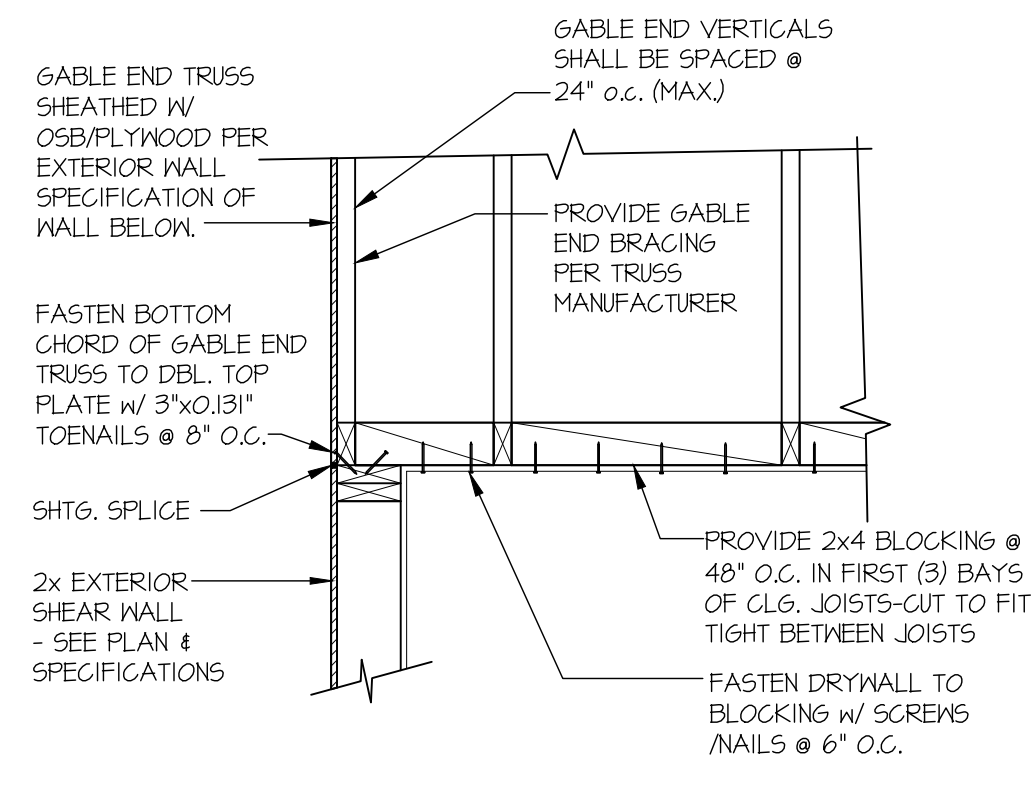


2 TYPICAL GABLE END DETAIL
SCALE: 3/4"=1'-0"

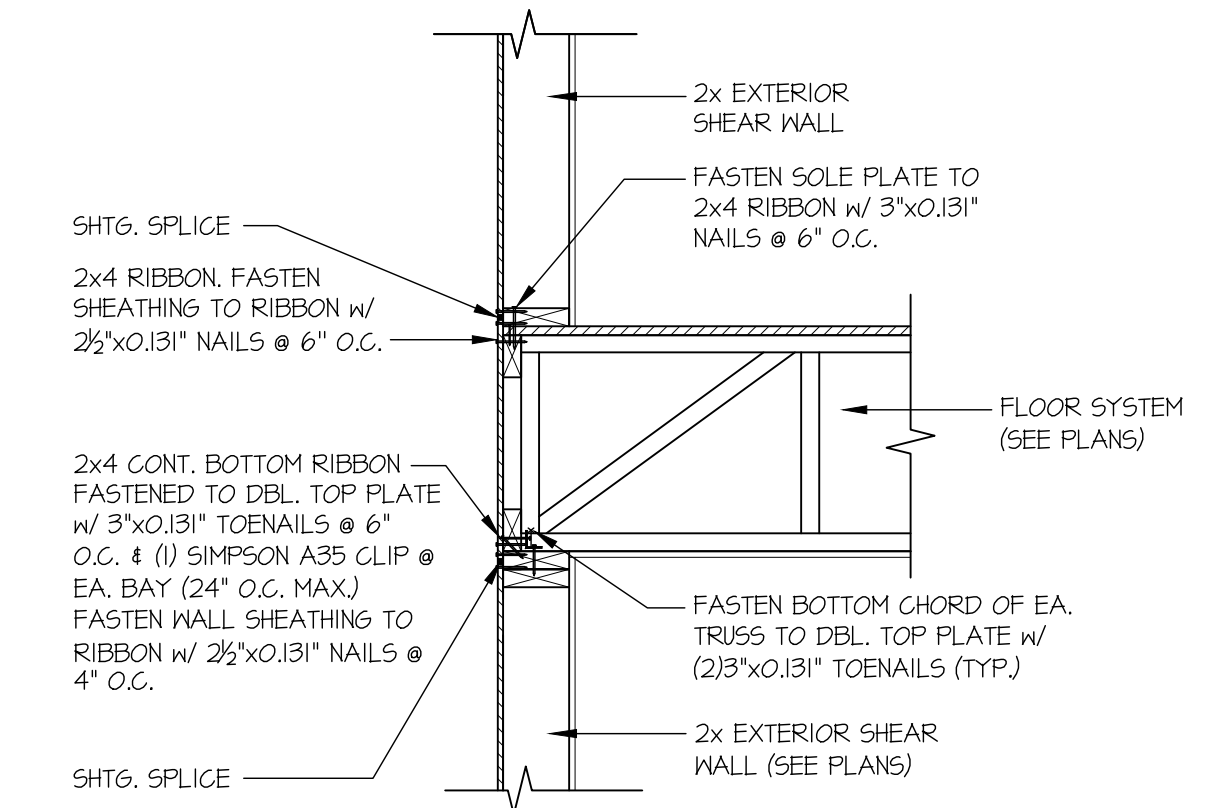


3 TYPICAL SHEAR TRANSFER DETAIL BETWEEN FLOORS @ EXTERIOR WALL
SCALE: 3/4"=1'-0" PERPENDICULAR FRAMING

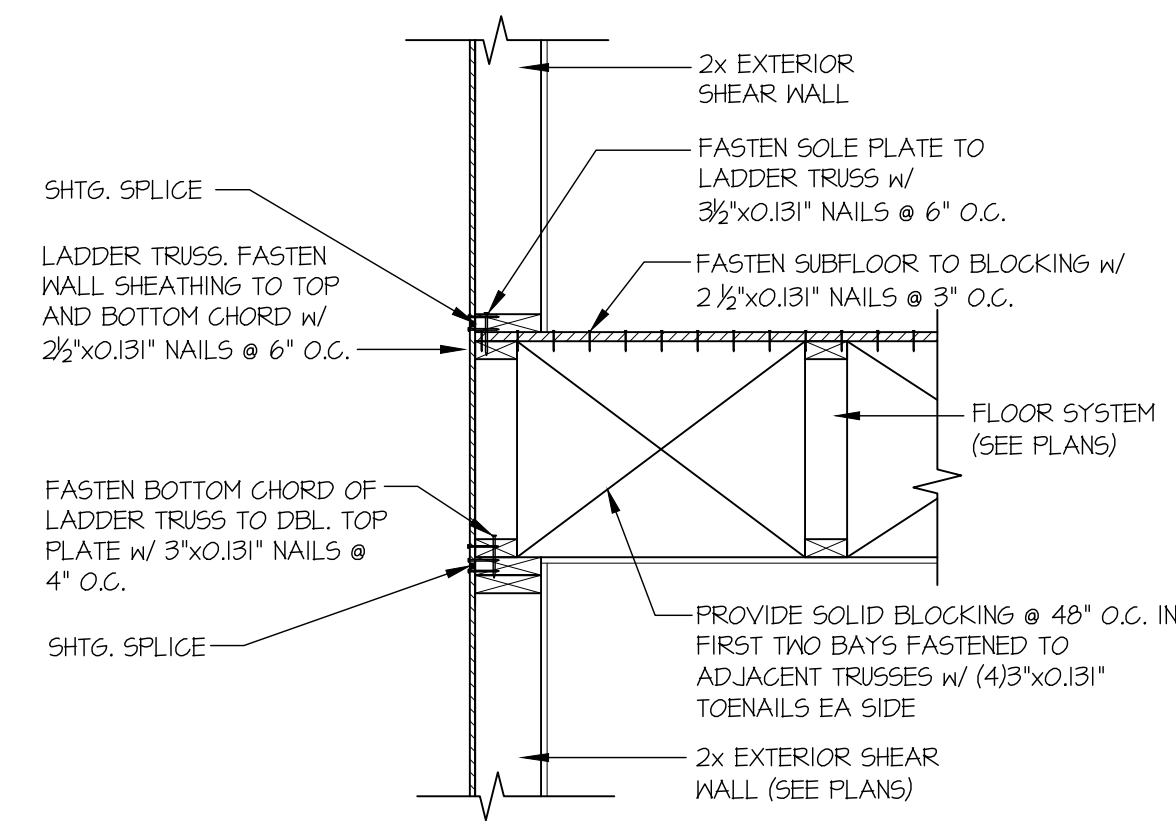


4 TYPICAL SHEAR TRANSFER DETAIL BETWEEN FLOORS @ EXTERIOR WALL
SCALE: 3/4"=1'-0" PARALLEL FRAMING

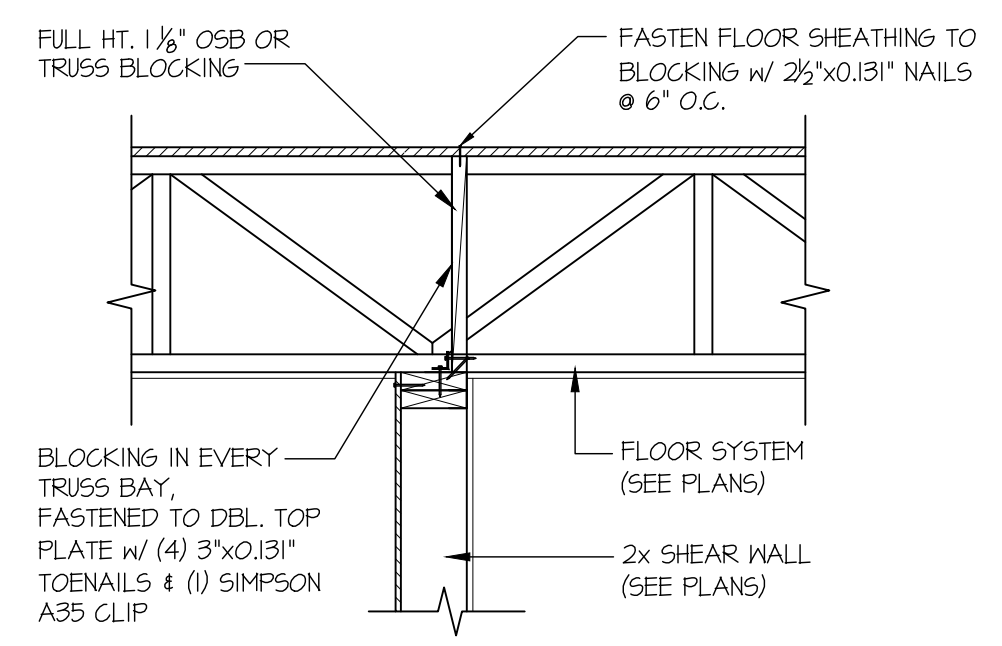


13 SHEAR TRANSFER DETAIL @ SHEAR WALL BELOW
SCALE: 3/4"=1'-0"

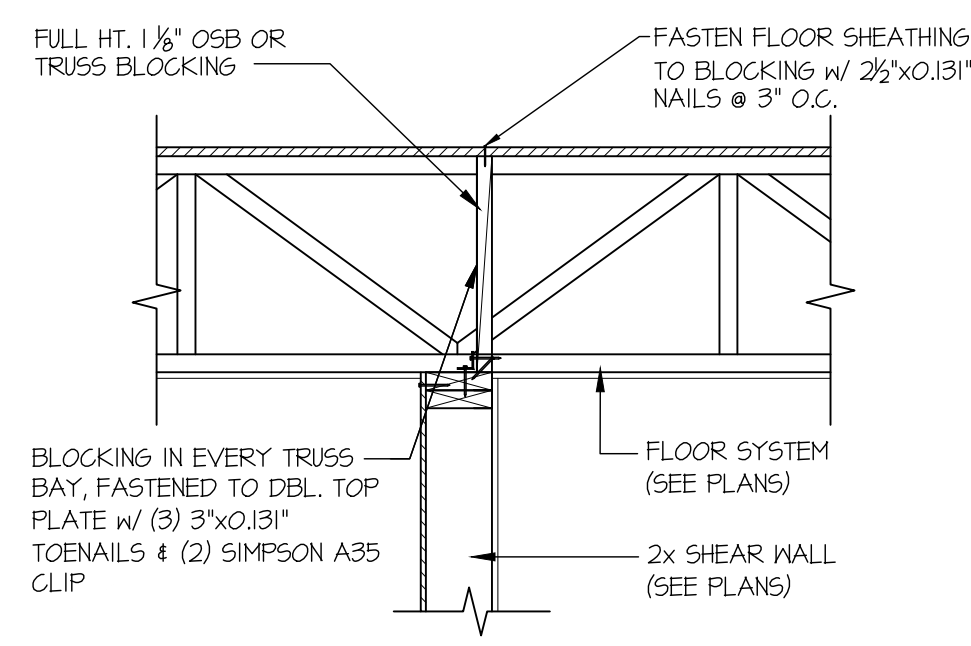


14 SHEAR TRANSFER DETAIL @ SHEAR WALL BELOW
SCALE: 3/4"=1'-0"

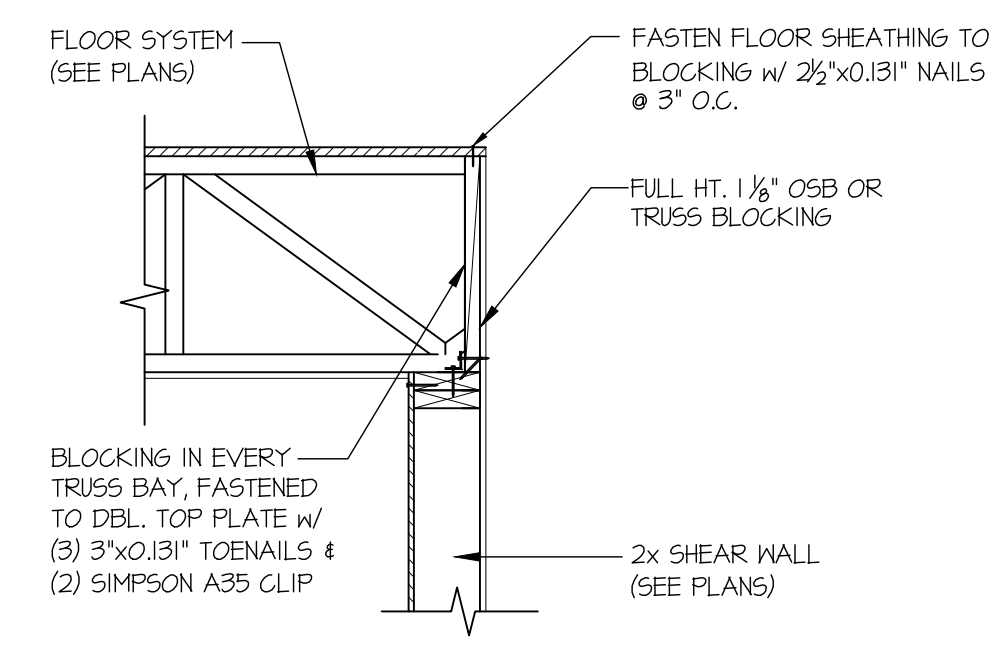


15 SHEAR TRANSFER DETAIL @ SHEAR WALL BELOW
SCALE: 3/4"=1'-0"

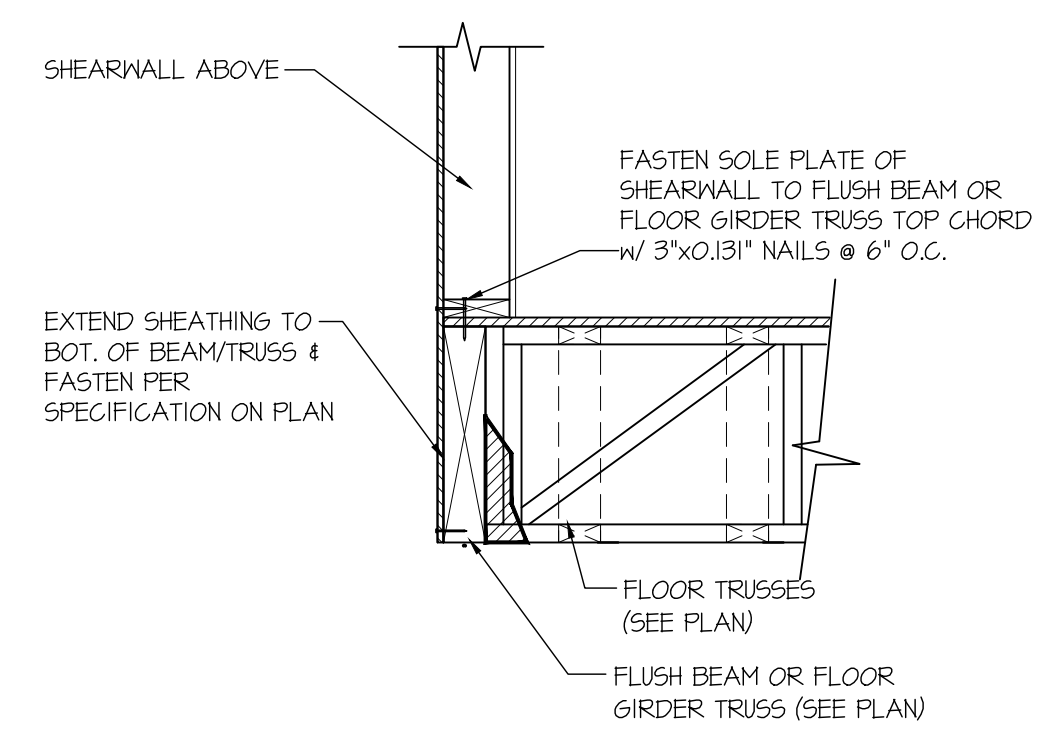


35 SHEAR TRANSFER DETAIL @ EXTERIOR SHEARWALL ABOVE
SCALE: 3/4"=1'-0"

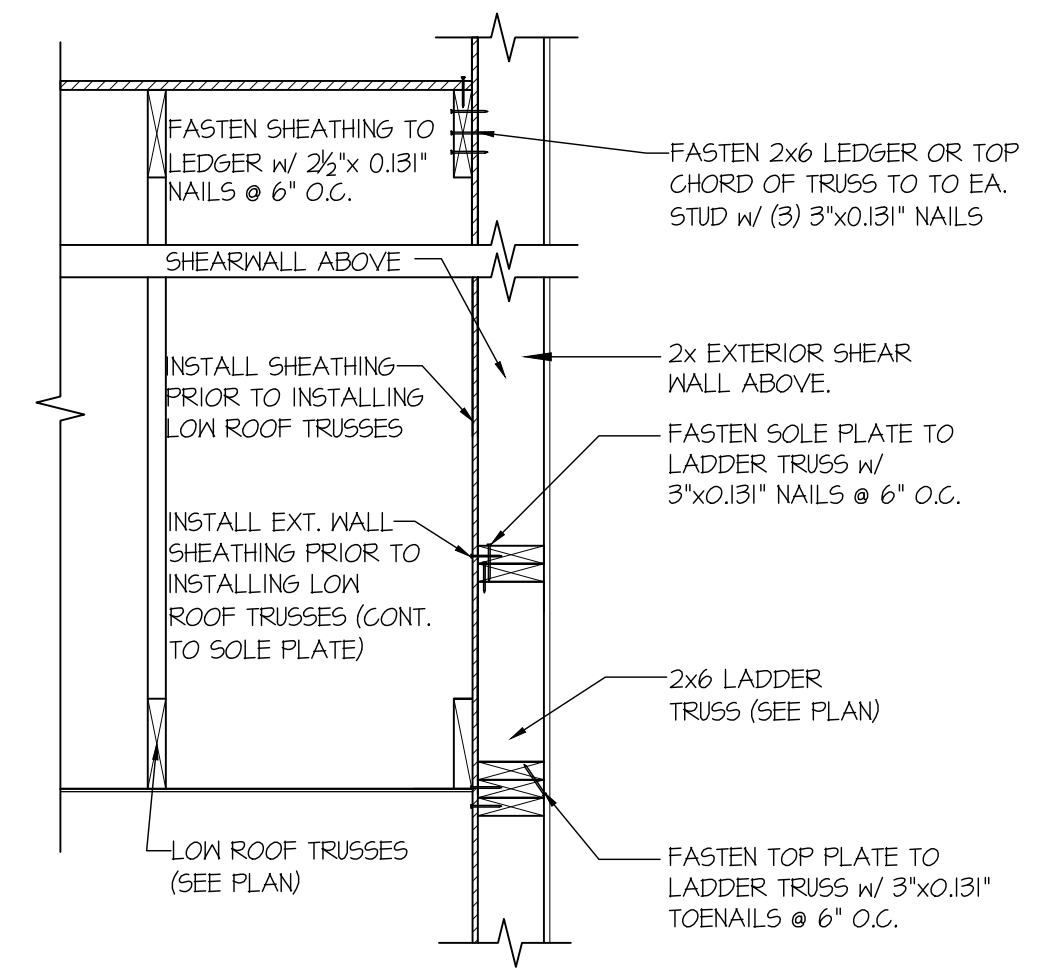


40 SECTION
SCALE: 3/4"=1'-0"

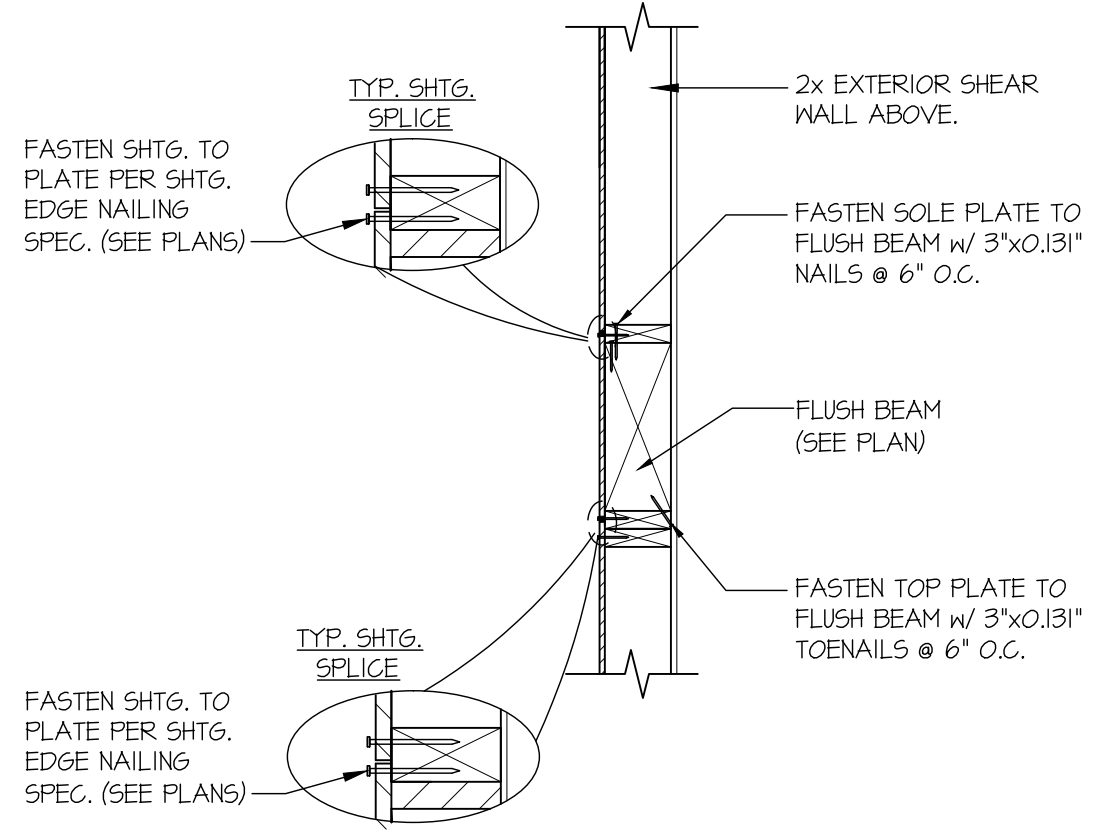

45 TYPICAL SHEAR TRANSFER DETAIL @ EXTERIOR WALL ABOVE FLUSH WIND BEAM
SCALE: 3/4"=1'-0"

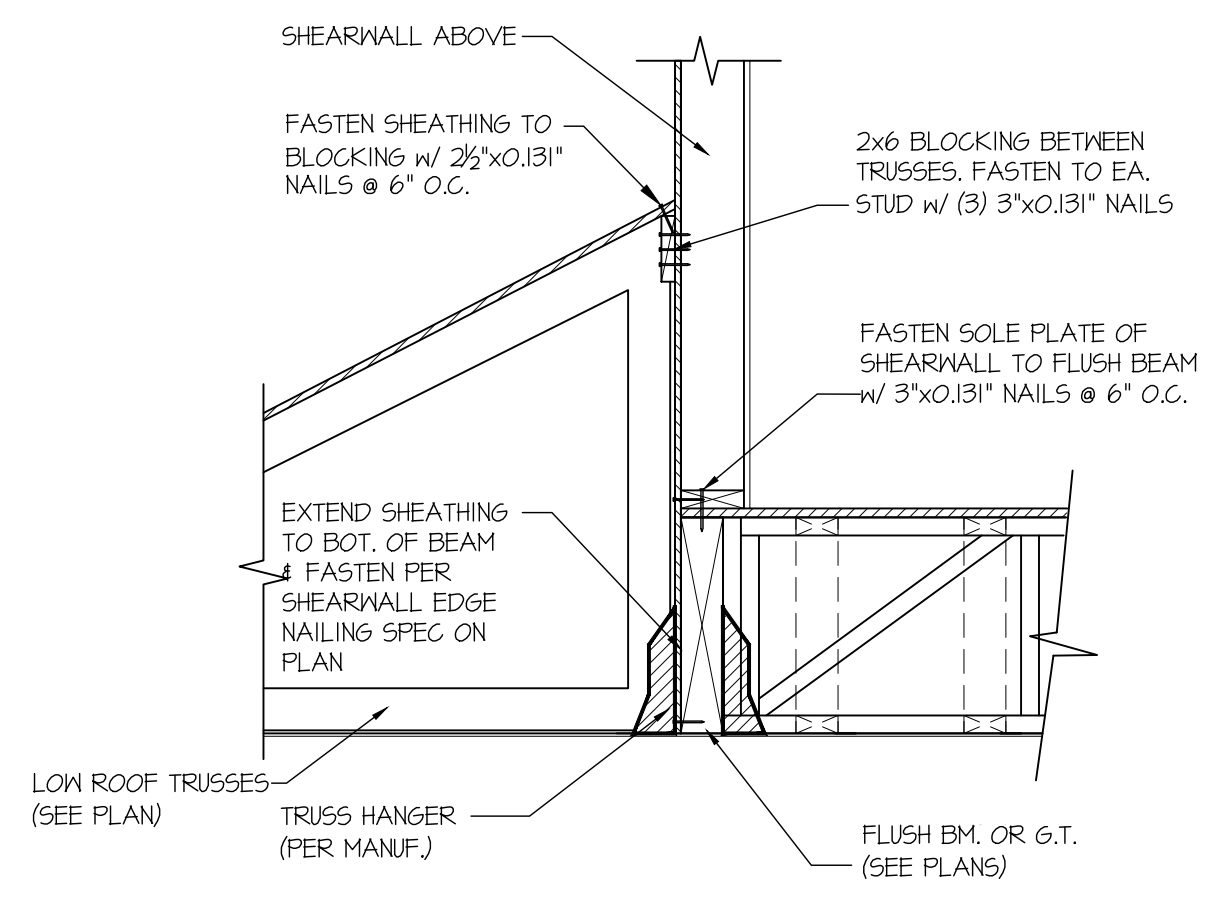

52 SHEAR TRANSFER DETAIL @ EXTERIOR SHEARWALL ABOVE
SCALE: 3/4"=1'-0"

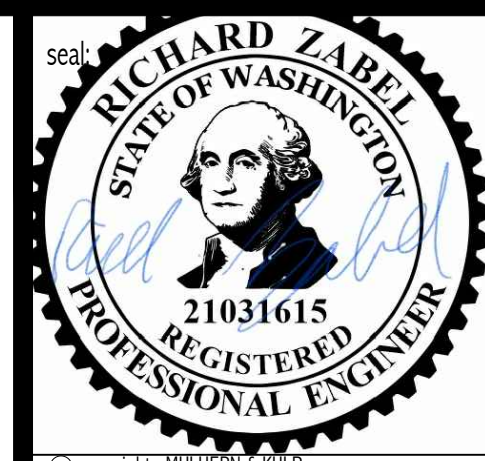

© copyright: MULHERN+KULP Structural Engineering, Inc.


MULHERN+KULP
RESIDENTIAL STRUCTURAL ENGINEERING
7220 Trade Street, Suite 350, San Diego, CA 92121
p 619-550-0010 • mulhernkulp.com

M&K project number:
154-22007
project mgr: R.JZ
drawn by: ENW
issue date: 02-28-21


REVISIONS:
date: initial:

STRUCTURAL DETAILS
4537 90TH AVE SE
MERCER ISLAND, WASHINGTON


sheet:
LB-2

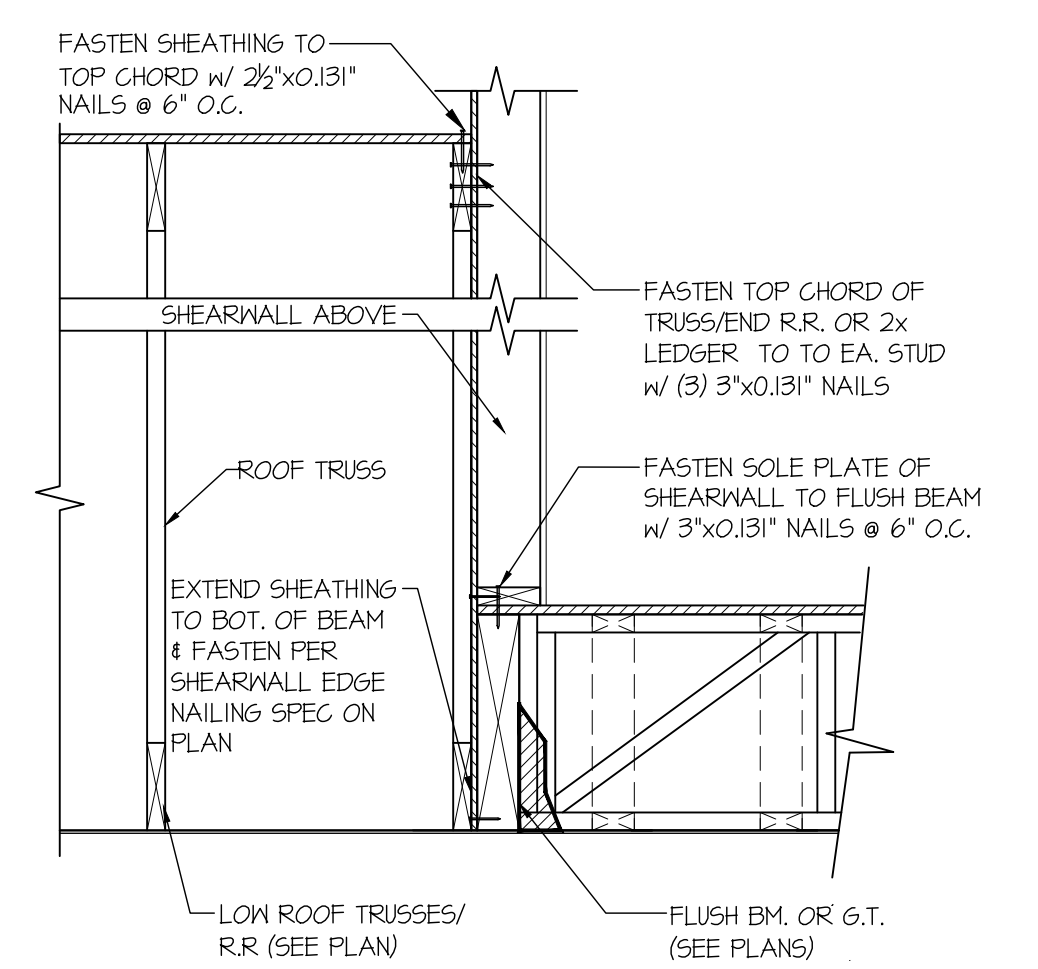


59 SHEAR TRANSFER DETAIL @ EXTERIOR SHEARWALL ABOVE
SCALE: 3/4"=1'-0"

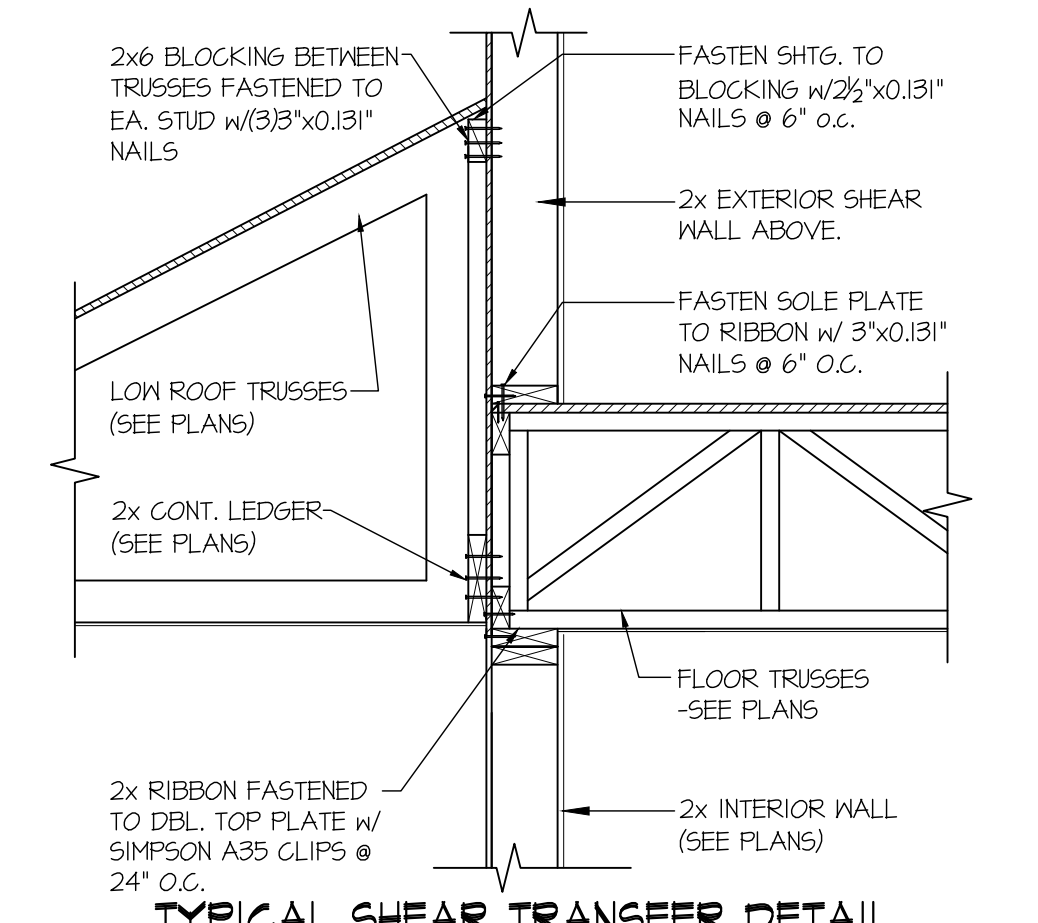


60 TYPICAL SHEAR TRANSFER DETAIL BETWEEN FLOORS
SCALE: 3/4"=1'-0" PERPENDICULAR FRAMING

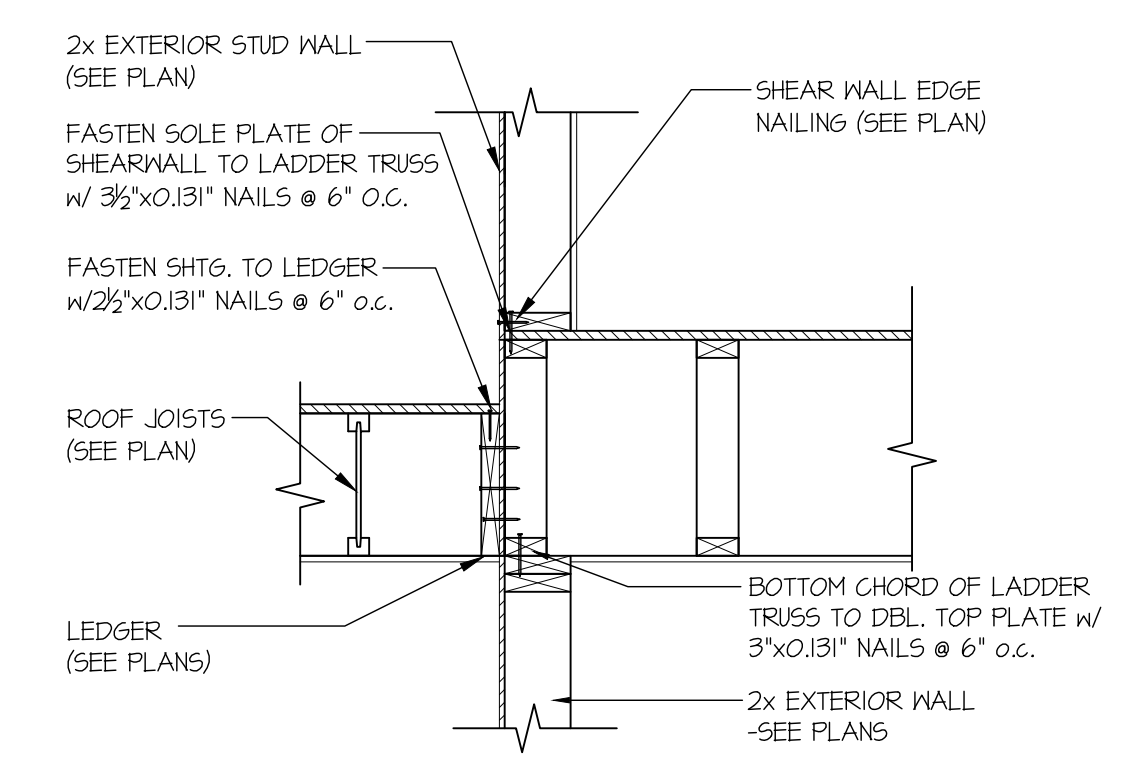

78 TYPICAL SHEAR TRANSFER DETAIL @ LOW ROOF
SCALE: 3/4"=1'-0"

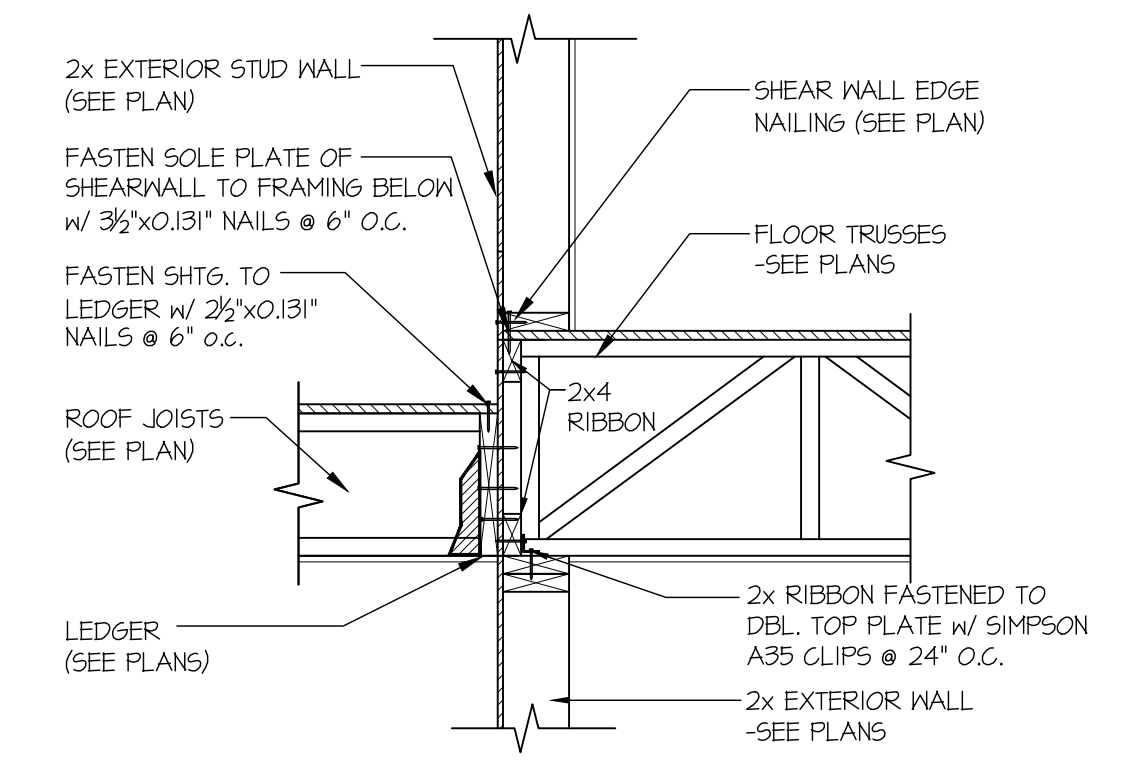


79 TYPICAL SHEAR TRANSFER DETAIL @ LOW ROOF
SCALE: 3/4"=1'-0"

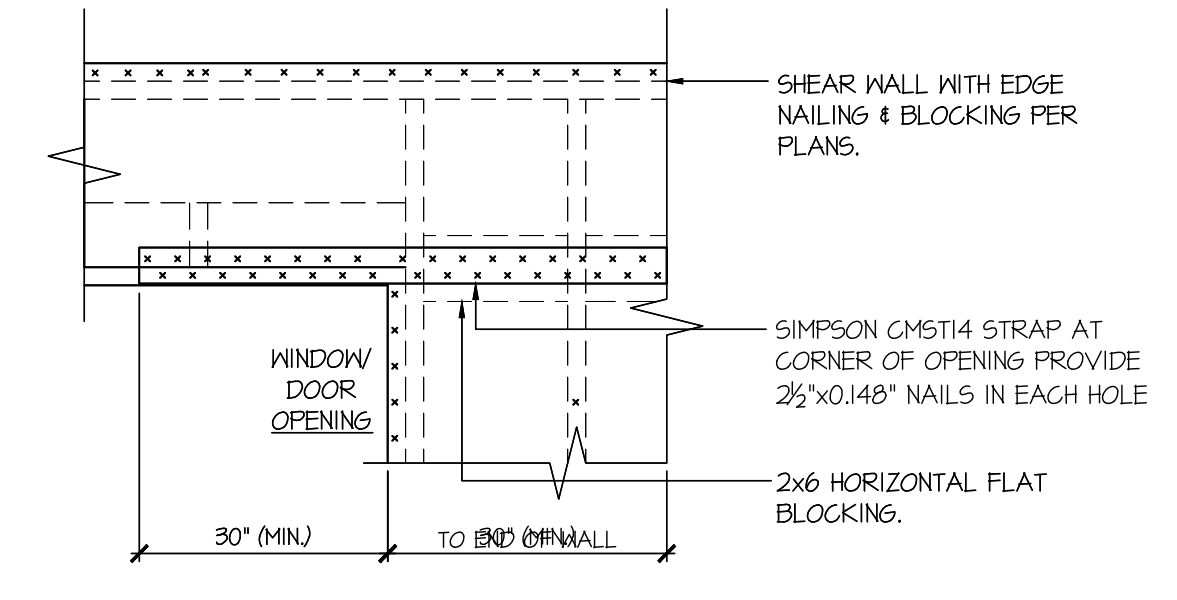


- NOT REQUIRED WHERE PORTAL FRAMES ARE SPECIFIED (SEE PLANS).
- ONLY REQUIRED WHERE SPECIFIED ON STRUCTURAL PLANS

92 EXT. WALL & INT. SHEARWALL OPENING ELEVATION
SCALE: NTS

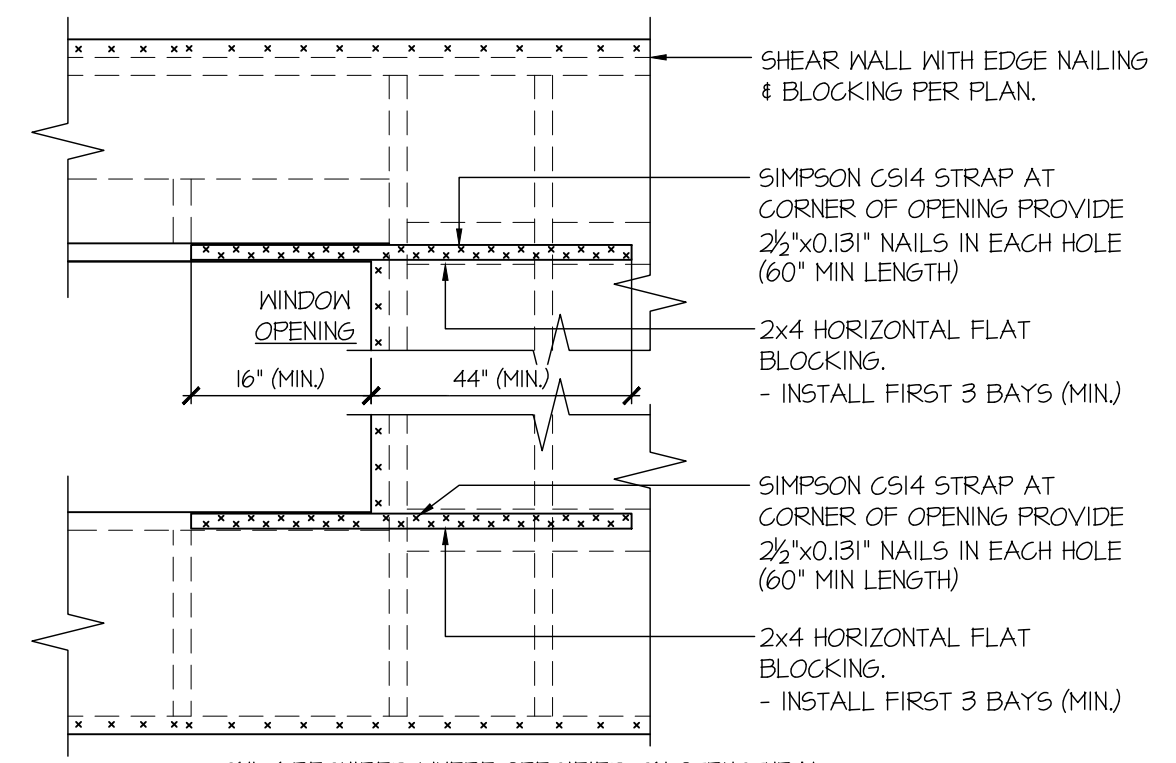


- ONLY REQUIRED WHERE SPECIFIED ON STRUCTURAL PLANS
- IF MIN LENGTH IS NOT PROVIDED RUN STRAP TO END OF WALL

93 EXT. WALL & INT. SHEARWALL OPENING ELEVATION
SCALE: NTS

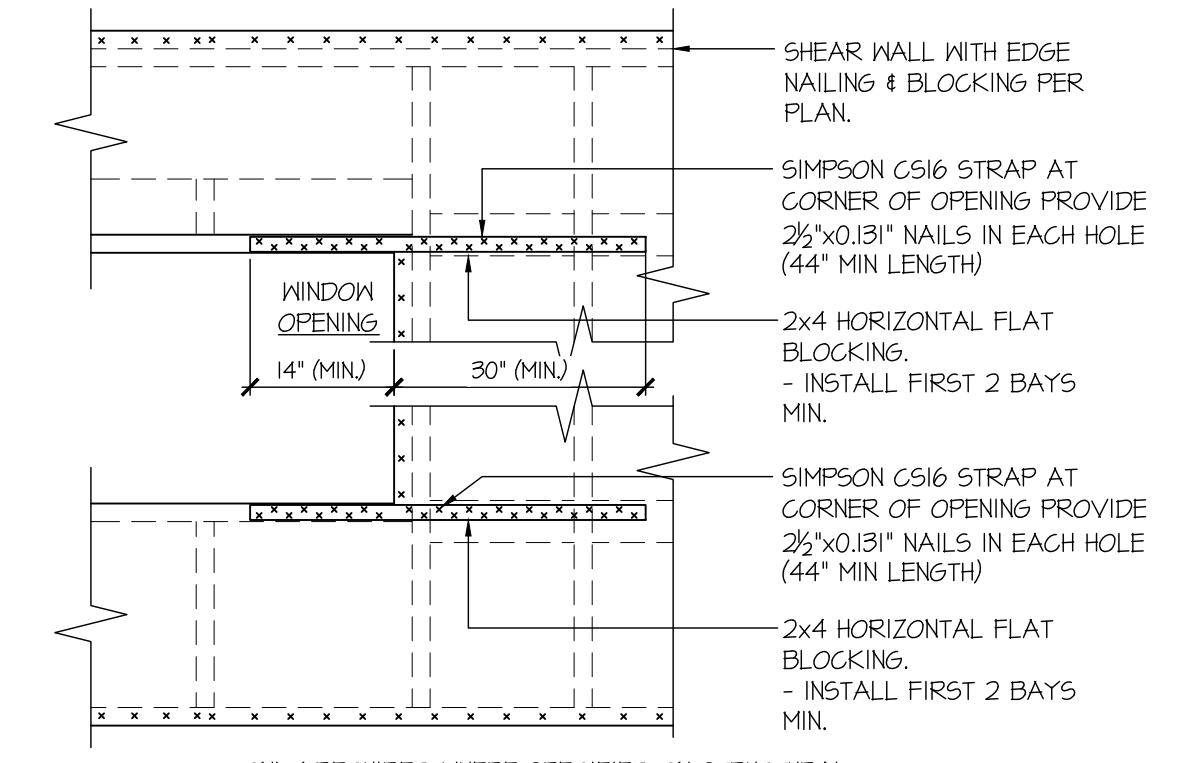


- ONLY REQUIRED WHERE SPECIFIED ON STRUCTURAL PLANS
- IF MIN LENGTH IS NOT PROVIDED RUN STRAP TO END OF WALL


94 EXT. WALL & INT. SHEARWALL OPENING ELEVATION
SCALE: NTS

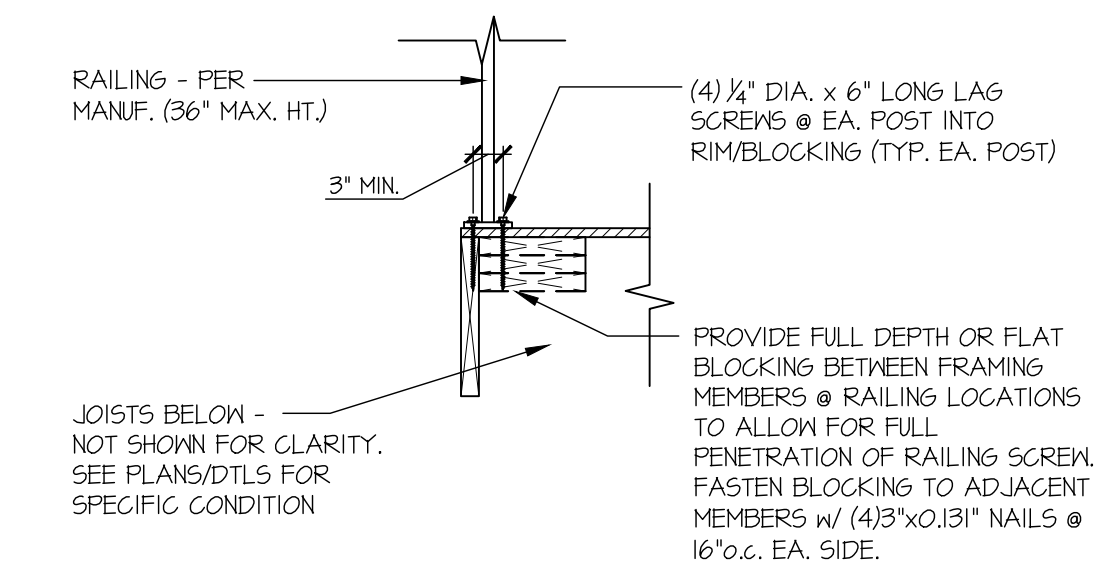


A TYP. RAILING CONNECTION
SCALE: 3/4"=1'-0" WOOD FRMS BELOW

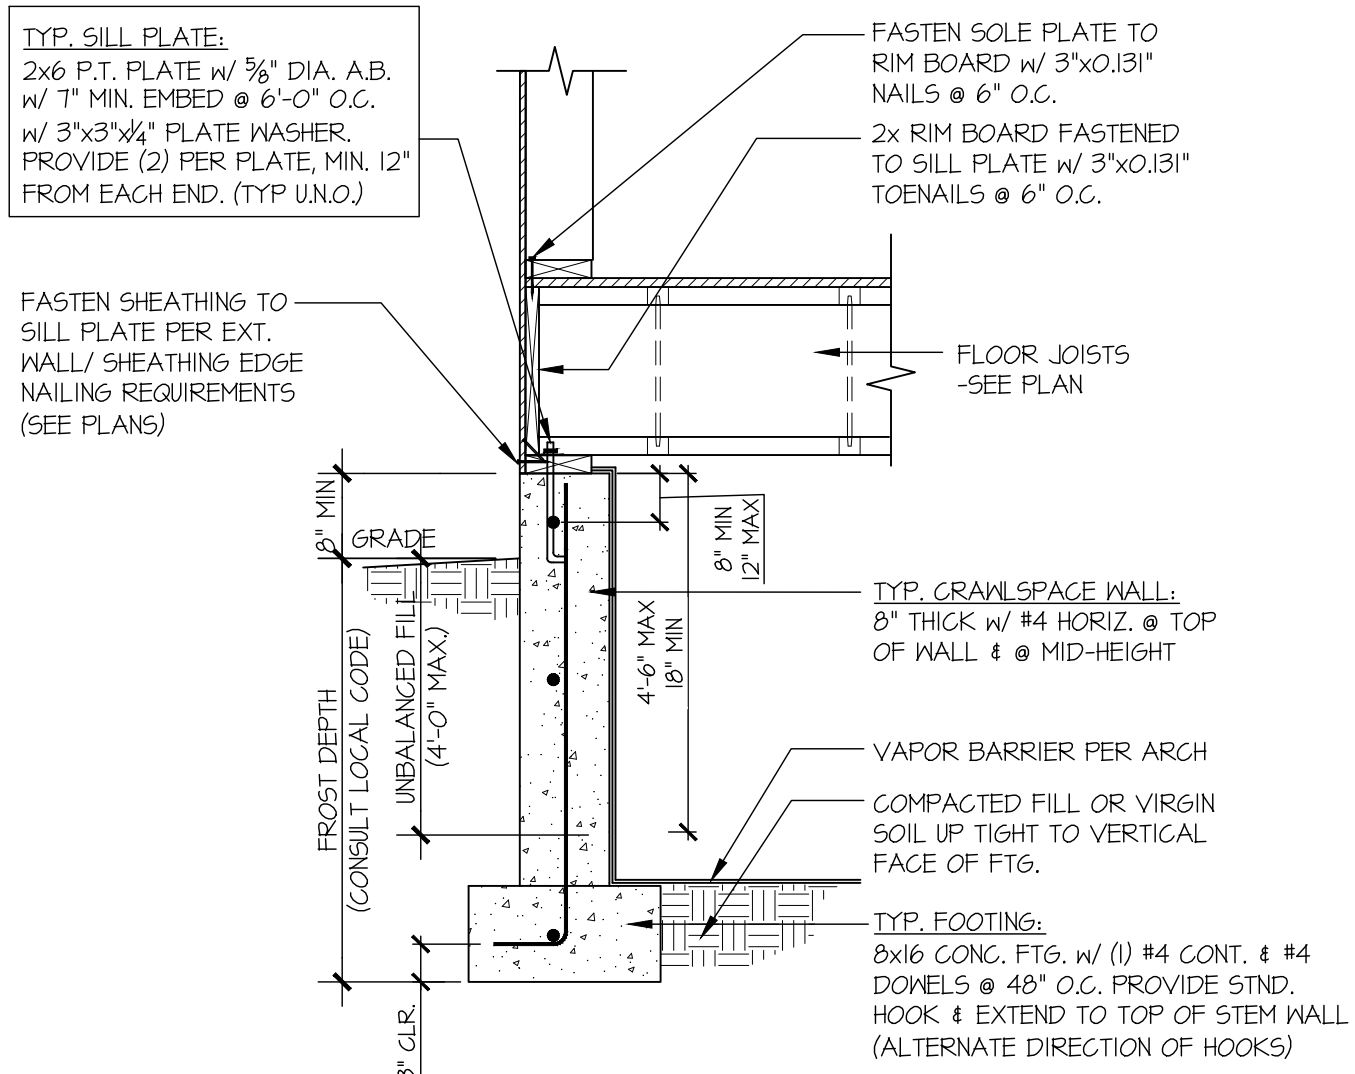


1 TYPICAL CRAWLSPACE FOUNDATION
SCALE: 3/4"=1'-0"

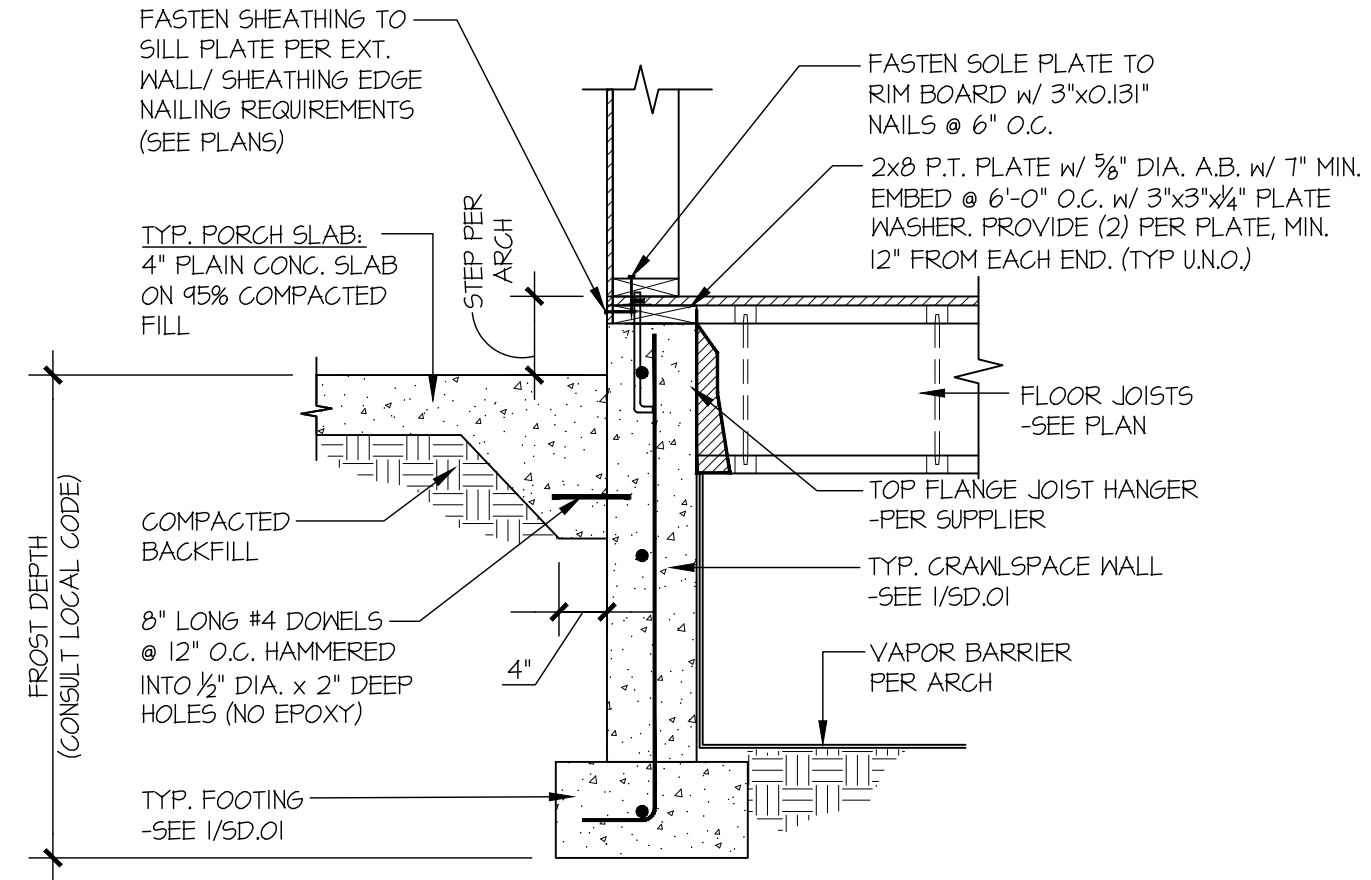


2 TYPICAL CRAWLSPACE FOUNDATION @ PORCH SLAB
SCALE: 3/4"=1'-0"

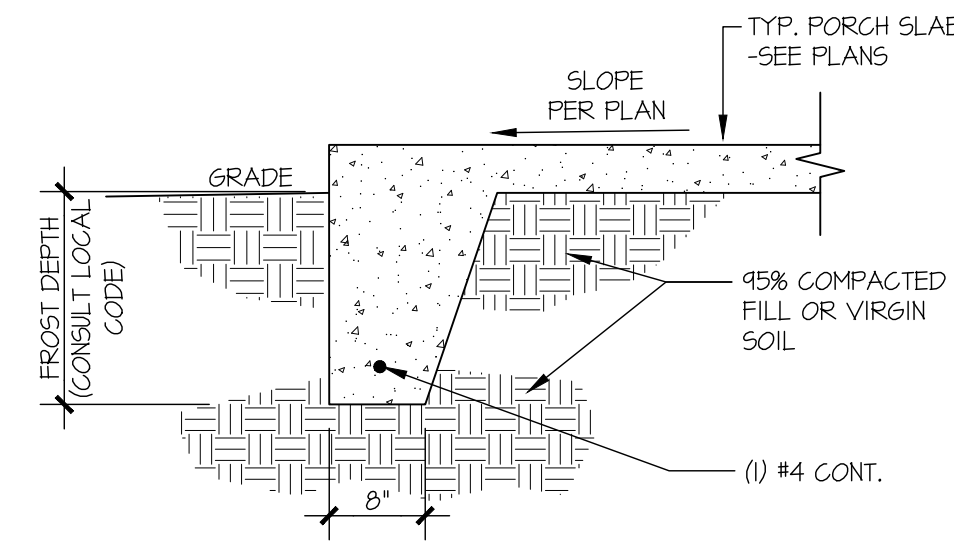


3 TYPICAL FOOTING @ PORCH SLAB
SCALE: 3/4"=1'-0"

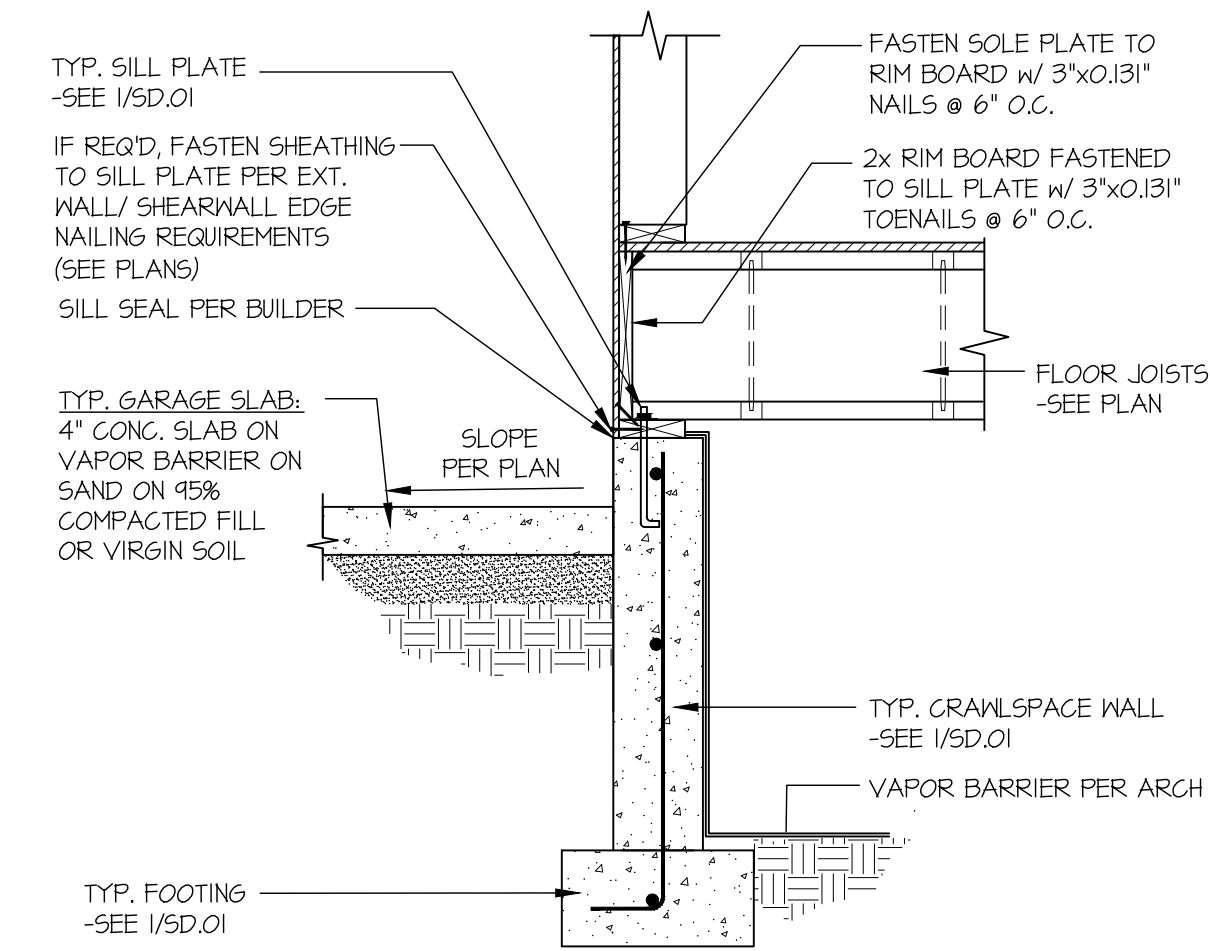


4 TYPICAL CRAWLSPACE FOUNDATION @ GARAGE
SCALE: 3/4"=1'-0"

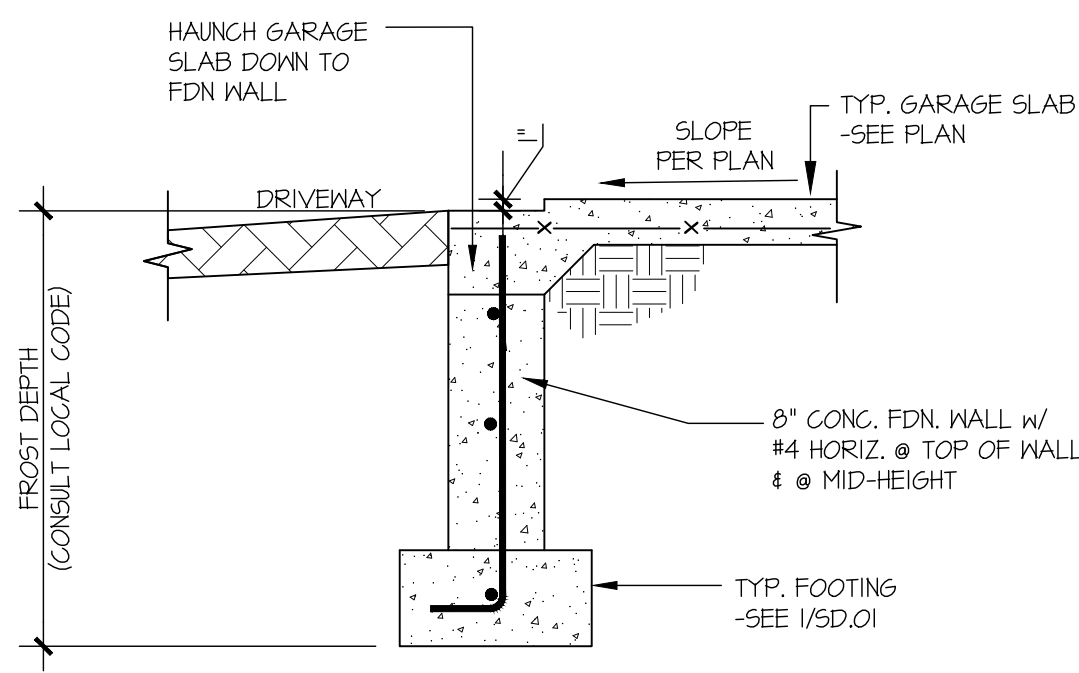


5 TYPICAL CONCRETE FOOTING @ GARAGE DOOR OPENING
SCALE: 3/4"=1'-0"

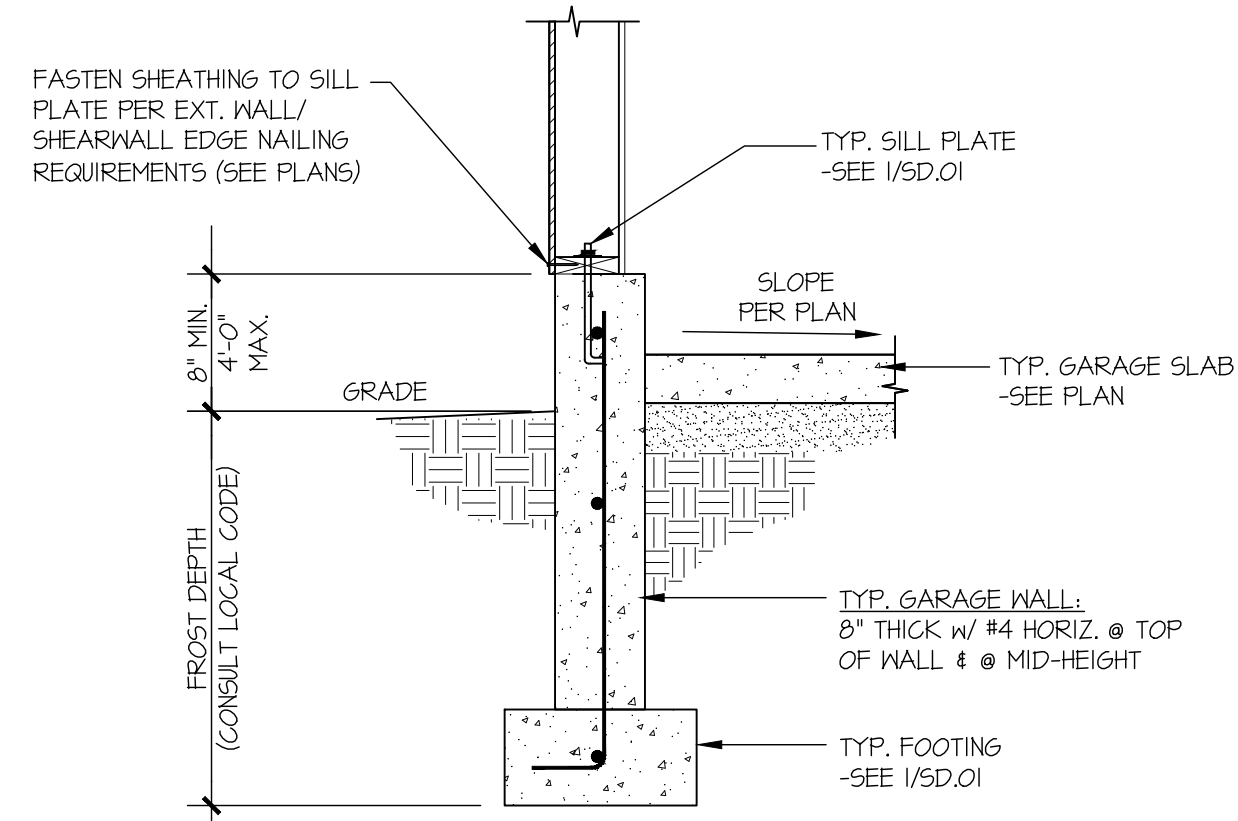


6 TYPICAL EXT. GARAGE FOUNDATION
SCALE: 3/4"=1'-0"

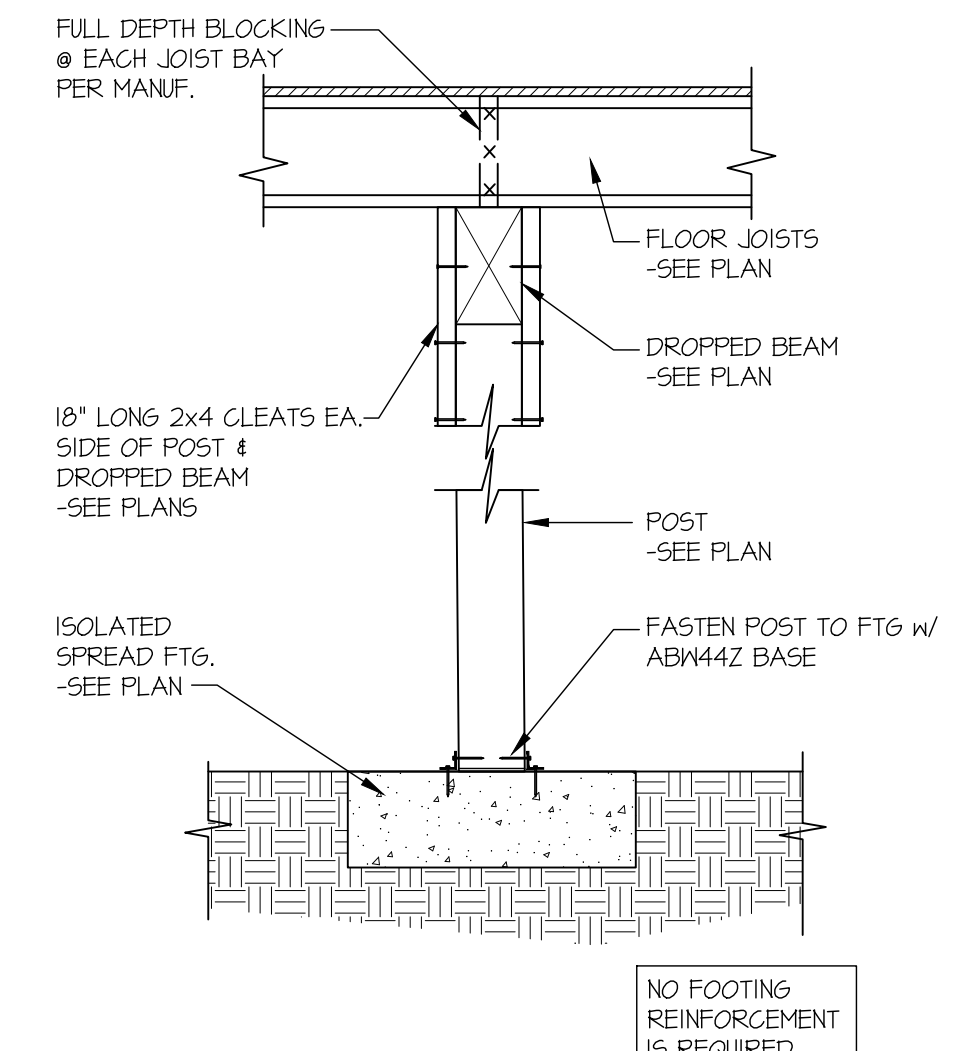


7 TYPICAL CRAWL SPACE FOOTING DETAIL
SCALE: 3/4"=1'-0"

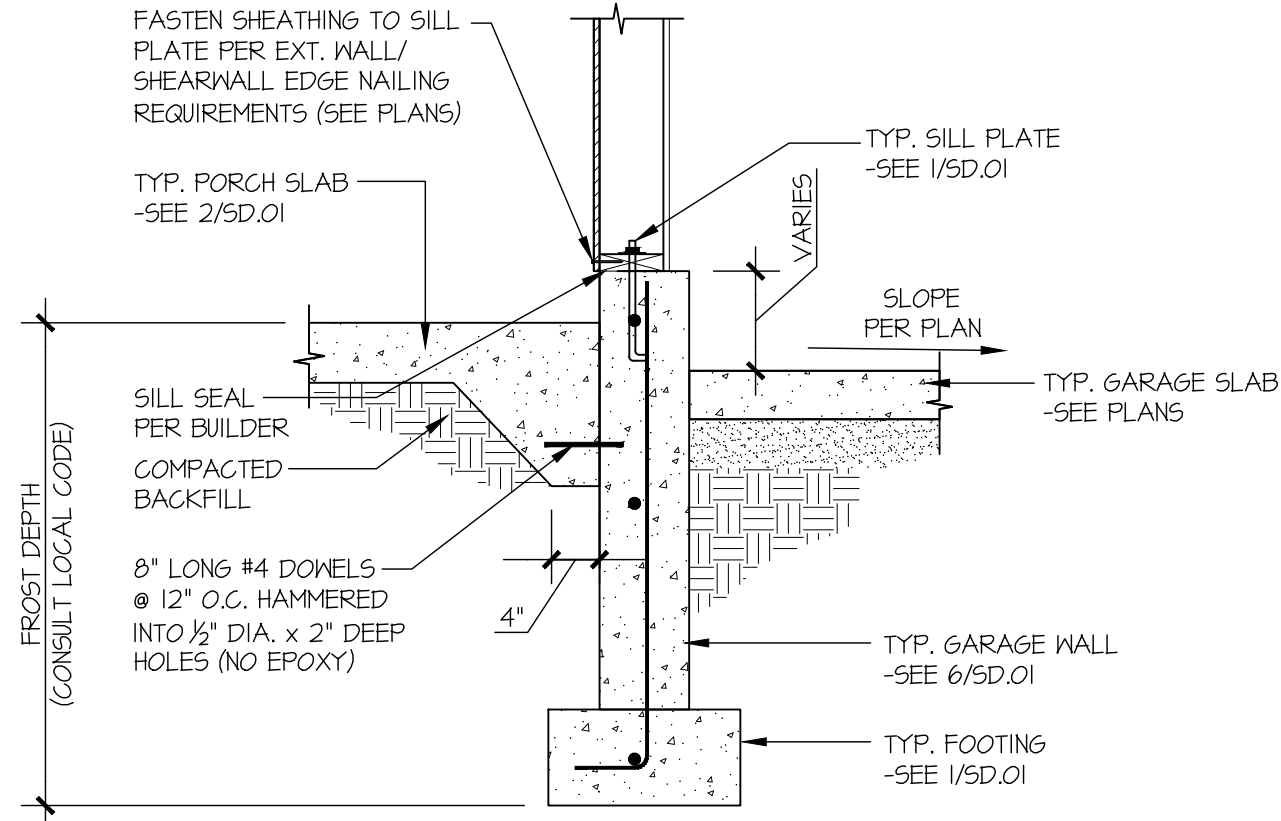

8 TYPICAL CRAWLSPACE FOUNDATION @ PORCH SLAB
SCALE: 3/4"=1'-0"

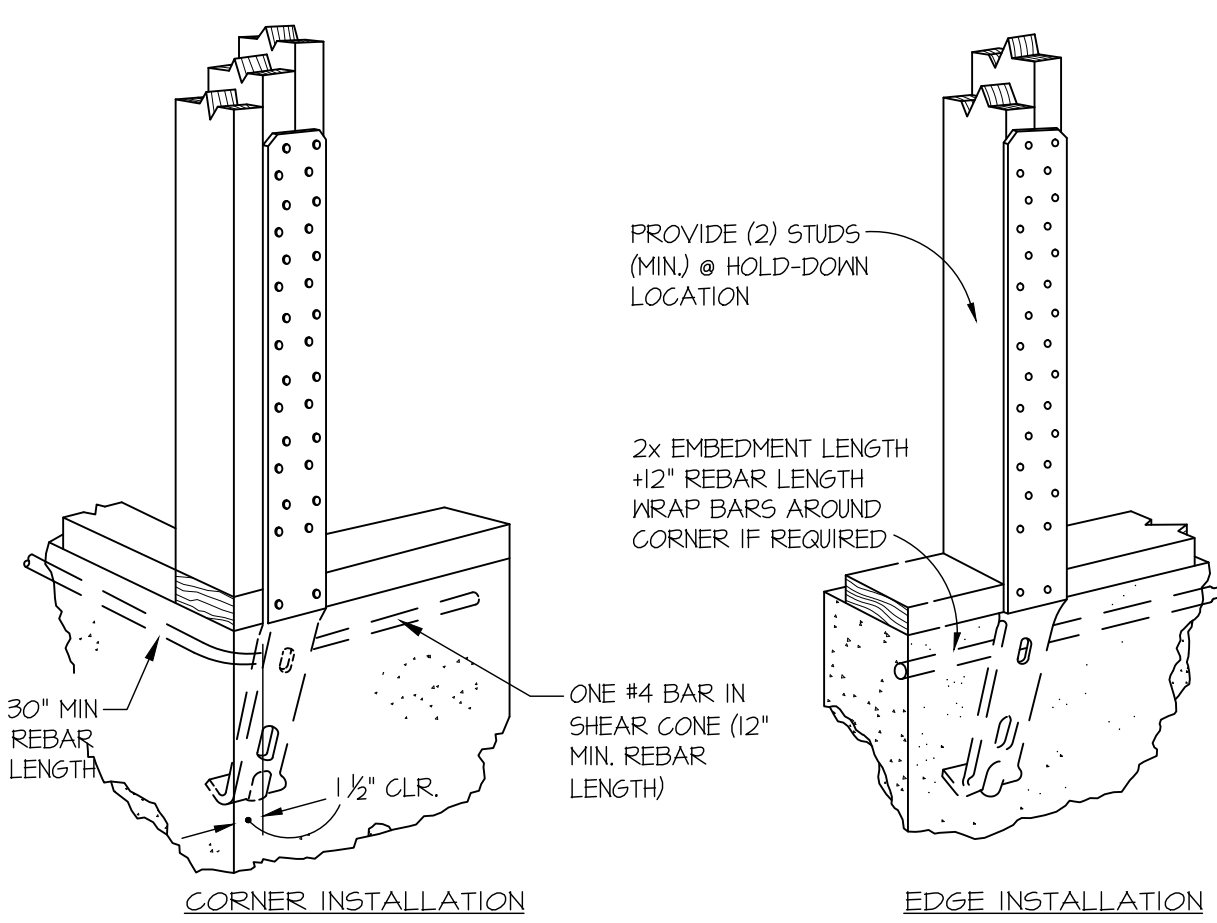


A TYPICAL HOLD-DOWN INSTALLATION
NOT TO SCALE
SIMPSON 5THD HD @ FOUNDATION

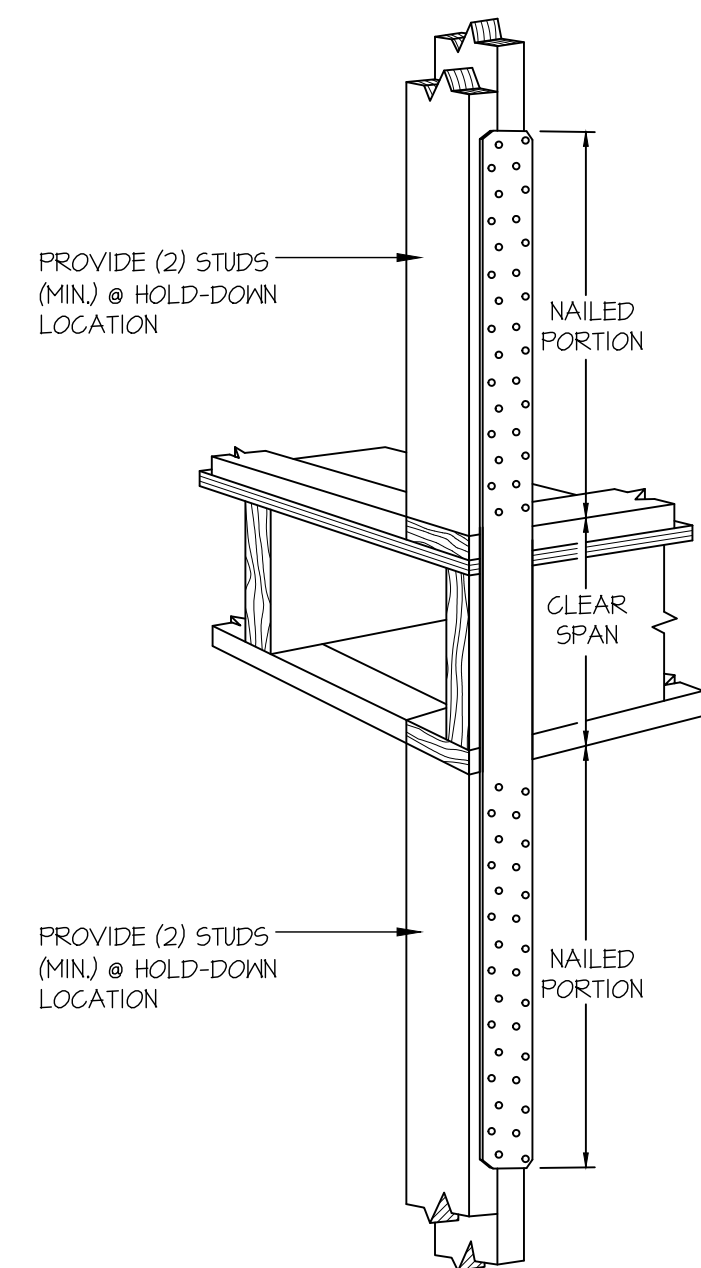

C TYPICAL HOLD-DOWN INSTALLATION
NOT TO SCALE
SIMPSON STRAP HD @ FLOOR FRAMING



MULHERN+KULP
RESIDENTIAL STRUCTURAL ENGINEERING
7220 Trade Street, Suite 350, San Diego, CA 92121
p 619-560-0010 • mulhernkulp.com

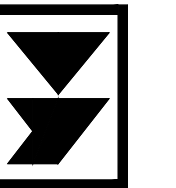

M&K project number:
154-22007
project mgr: R.JZ
drawn by: ENW
issue date: 02-28-21

REVISIONS:
date: initial:



STRUCTURAL DETAILS
4537 90TH AVE SE
MERCER ISLAND, WASHINGTON

sheet:
SD.01



Vertical wall Installation


Install TYPAR® HouseWrap over an approved exterior sheathing after the framing is complete and before the windows and doors have been installed. Plastic capped fasteners should be used and spaced at 32" OC (vertically and horizontally) when being applied over 7/16" OSB or 15/32" plywood. When installing over metal framing use screws with washers. If the windows and doors have already been installed, trim the TYPAR WRB close to the window frame and flash according to the TYPAR Flashing instructions.

STEP 1

Start at the bottom of one end of the wall with the printed side facing out. When starting at a corner, overlap by a minimum of 12".

Place the housewrap roll horizontally and roll out the first course evenly, covering rough window and door openings. A minimum of a 1" (25.4 mm) overlap on the sill plate is required; however, for maximum protection, a 2-4" (51-102 mm) overlap on the sill plate is recommended.

Pull the TYPAR snug and avoid wrinkles and creases. Ensure that the product is level.

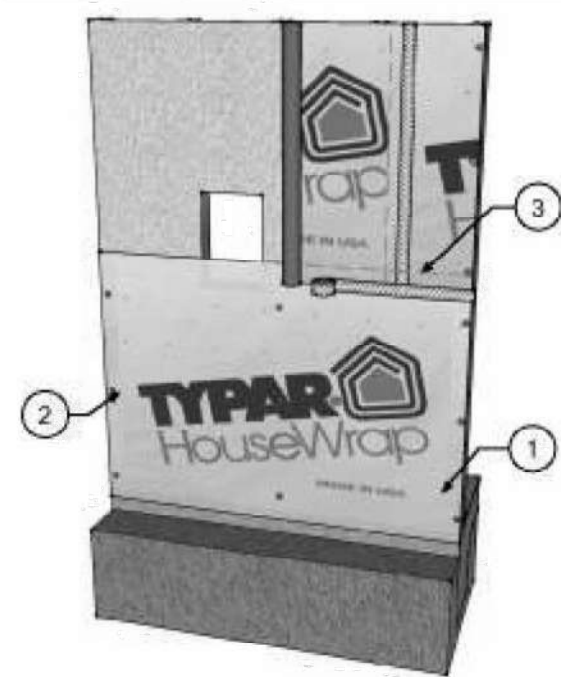

STEP 2

Fasten the TYPAR to the stud using plastic capped nails or plastic capped staples at 32" O.C. both horizontally and vertically.



STEP 3

The upper layer of TYPAR housewrap should overlap the bottom layer by a minimum of 6" (152 mm) vertically and horizontally. Ensure proper shingling throughout the installation to properly shed water. Once the structure is completely covered, tape all seams and penetrations using TYPAR® construction tape. (Please refer to the TYPAR® flashing instructions for more detailed instruction on penetrations and window flashing installation).

STEP 4

After the installation complete and before the exterior cladding is installed, inspect the TYPAR® for tears. Repair the issues with TYPAR Construction tape or TYPAR Flashing.



Window and Door Preparation

Preparing for Window Installation

STEP 1

After wrapping the structure and covering all rough openings. Cut a horizontal line across the top of the window opening. The cut should not extend past the rough opening.

STEP 2

Start at the top center and make a vertical cut running two-thirds of the way down the opening.

STEP 3


From that stopping point, cut diagonally to both lower left and right corners of the opening.

STEP 4

Pull each of the flaps tightly inside the rough opening and attach them to the frame with nails, staples, or tape.

STEP 5

At the window header, make a 6" diagonal cut at a 45 degree angle on both corners. Fold the material up exposing the sheathing. Now install the window or door according to the manufacturer instructions. The final step is to flash all seams and flanges securely (refer to TYPAR® Flashing instructions). TYPAR® flashing should also be installed in accordance with window manufacturer instructions and according to the ASTM 2112 standard.

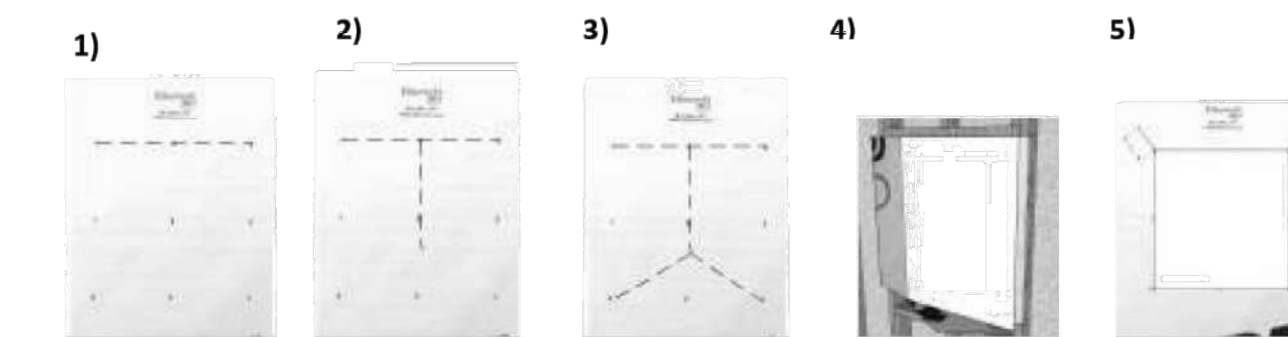

Typical Window Flashing

STEP 1

Install the window sill pan according to the manufacturer's instructions. Alternatively, you can create a sill pan using TYPAR Flashing Flex. Cut a piece that is 12" longer than the length of the rough opening window sill.

Carefully pull off the release liner. Center the Flashing in the center of the rough opening and work you way toward the corners and then up the sides. Note: the flex flashing should overlap to the outside of the wall by 2-3". Only stretch the flashing in the corners.

Alternatively to above, you can create a sill pan by installing TYPAR Straight Flashing along the bottom sill and installing TYPAR Flashing Flex on the corners only.

If needed, secure the fanned edges of the TYPAR Flashing Flex with a plastic capped nail/ plastic capped staple.

STEP 2

Apply a continuous bead of sealant to the back of the window or on the wall. Do not apply the sealant across the bottom of the sill or on the bottom of the window. This area is left open to allow for proper drainage.

Install the window according to the manufacturer's installation instructions.


STEP 3

Cut two pieces of TYPAR Flashing long enough to extend 1" above the window head flange and 1" below the window sill flange. Carefully peel off the release liner and apply the flashing on both sides of the window. Make sure to cover the entire window flange, press firmly either by hand or using a J-roller. Ensure there are no wrinkles or bubbles.

Cut a piece of TYPAR Flashing for the head flashing. Ensure that the piece is long enough to extend by 1" on both sides of the jamb flashing. Remove the release liner and carefully install the flashing. Cover the window flange and press firmly by hand or using a J-roller.

STEP 4

Release the upper flap of the WRB that you cut earlier. Tape the 45 degree cuts using TYPAR Construction Tape or TYPAR Flashing. DO NOT tape the WRB along the top of the window flange.

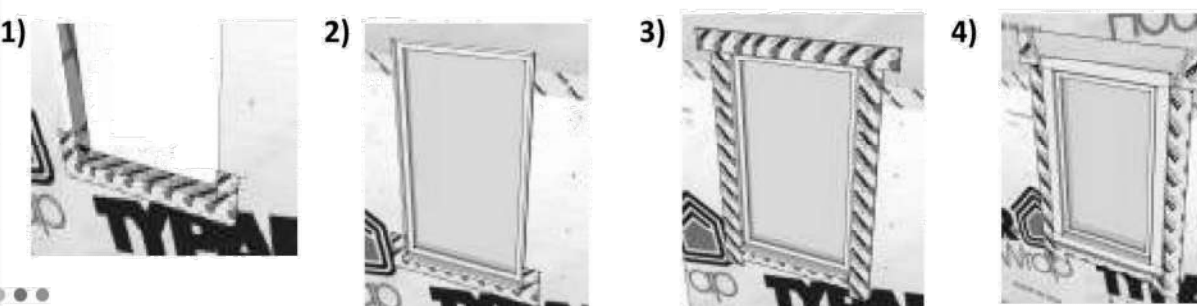


Flashing Penetrations

Penetrations such as exhaust fans, exterior electrical outlets, dryer vents, exterior lights, and gas outlets are a common entrance for bulk water into the wall cavity. Using TYPAR flashing will ensure proper water hold out and maintain the integrity of the structure.


The method is similar to the flashing a window. Start by flashing the bottom of the penetration. Ensure to shingle the upper tape over the bottom tape.

Some penetrations have flanges, such as dryer vents. These penetrations should be flashed according to the details below.


1)

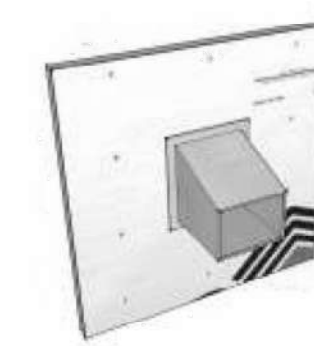

2)

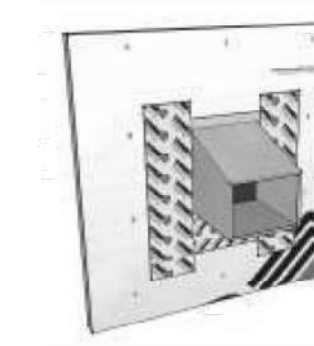

3)

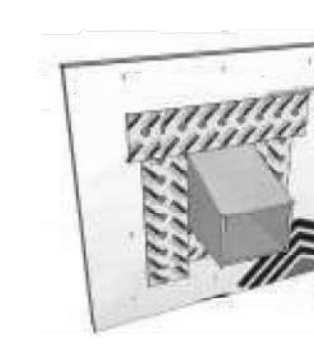

STEP 1

Install the vent according to the manufacturer's recommendations. Trim the housewrap as close as possible around the perimeter of the vent.

STEP 2

Flash the vent using the same method as windows. Starting at the bottom flange; cut the flashing so that it extends past the flanges by 1" on both sides. Now apply the flashing to the sides of the vent. Remember to extend the flashing 1" on both top and bottom. Make sure to smooth out wrinkles and air bubbles. The use of a J-roller is optional.

STEP 3

The Final step is to install the flashing across the top. Extend the flashing out at least 1" on both sides.

Note: This type of installation is suitable for several different penetrations. Always use the shingling method and ensure a tight seal around the flange/penetration.

TYPAR® HouseWrap is part of a complete Weather Protection System, which also includes TYPAR® Metro Wrap, TYPAR® Flashings and Construction tape

For more information, visit www.Typar.com



MADE IN USA. ICC #ESR-1404 • CCMC #12884-R • CCMC #12892-R
Please visit typar.com for installation instructions and warranty information



7525 SE 24th St., 487
Mercer Island, WA
98040
425.266.9100

Issue Description	Issue Date	By

Job Number:

plan name:	--
marketing name:	--
plan number:	--
mark sys. number:	--

Conditions not specifically represented graphically or in writing or which conflict with the current International Residential Code (IRC), or those of the local municipality then the current standards and requirements of each respectively shall govern.

The drawings in this set are instruments of service and shall remain the property of JayMarc Homes, LLC.

© 2017 JayMarc Homes, LLC; All rights reserved.

Submittal Date

Sheet Title/Description

Design Firm

Drawn by:

Checked by:

Primary Scale

D1 of .

Sheet Title/Description

Window, Skylight and Door Schedule

Project Information table with fields: NEW SFR, 4537 90th Ave SE, Mercer Island, WA.

Contact Information table with fields: JayMarc Homes, 7525 SE 24th St, Mercer Island, WA. 98040.

Table for Exempt Swinging Door and Exempt Glazed Fenestration with columns: Ref, U-factor, Width (Qt, Feet, Inch), Height (Feet, Inch), Area, UA.

Vertical Fenestration (Windows and doors)

Main table for Vertical Fenestration listing components like Powder - FG, Foyer - FG, Bath 2 - FG, etc., with columns for Ref, U-factor, Width, Height, Area, UA.

Summary table for Fenestration Area and UA with columns: Ref, U-factor, Width, Height, Area, UA.

Sum of Vertical Fenestration Area and UA
Vertical Fenestration Area Weighted U = UA/Area

Overhead Glazing (Skylights)

Table for Overhead Glazing with columns: Component, Description, Ref, U-factor, Width, Height, Area, UA.

Sum of Overhead Glazing Area and UA
Overhead Glazing Area Weighted U = UA/Area

Total Sum of Fenestration Area and UA (for heating system sizing calculations)

Simple Heating System Size: Washington State

This heating system sizing calculator is based on the Prescriptive Requirements of the 2018 Washington State Energy Code (WSEC) and ACCA Manuals J and S.

Please complete the green drop-downs and boxes that are applicable to your project. As you make selections in the drop-downs for each section, some values will be calculated for you.

Interactive heating system sizing calculator form with sections: Design Temperature, Area of Building, Glazing and Doors, Insulation, Location of Ducts, and a summary of heat loss calculations.

PROVIDE HEATING AND COOLING DESIGN LOADS CALCULATION FOR SIZING THE HVAC SYSTEM PER WSEC-R403.7

PER WSEC R402.4, THE BUILDING THERMAL ENVELOPE SHALL BE CONSTRUCTED TO LIMIT AIR LEAKAGE. THE RESULTS OF THE TEST SHALL BE SIGNED BY THE PARTY CONDUCTING THE TEST AND PROVIDED TO THE CODE OFFICIAL (R402.4.1.2).

PER WSEC R403.3.3, DUCTS, AIR HANDLERS, AND FILTER BOXES SHALL BE SEALED AND BE LEAK TESTED.

PER WSEC R404.1, A MINIMUM OF 90 PERCENT OF THE LAMPS IN PERMANENTLY INSTALLED LIGHTING FIXTURES SHALL BE HIGH EFFICIENCY LAMPS.

PROVIDE CERTIFICATE REPORT PER R405.4.2 IN 2018 WSEC.

2018 Washington State Energy Code - Residential Prescriptive Energy Code Compliance for All Climate Zones in Washington Single Family - New & Additions (effective February 1, 2021)

These requirements apply to all IRC building types, including detached one- and two-family dwellings and multiple single-family dwellings (townhouses).

Project Information and Contact Information summary table.

Instructions: This single-family project will use the requirements of the Prescriptive Path below and incorporate the minimum values listed.

Provide all information from the following tables as building permit drawings: Table R402.1 - Insulation and Fenestration Requirements by Component, Table R406.2 - Fuel Normalization Credits and 406.3 - Energy Credits.

Authorized Representative table with fields: Ryan Redman, Date: 03/07/2022.

All Climate Zones (Table R402.1.1) table listing R-values and U-factors for Fenestration U-Factor, Skylight U-Factor, Glazed Fenestration SHGC, etc.

2018 Washington State Energy Code - Residential Prescriptive Energy Code Compliance for All Climate Zones in Washington Single Family - New & Additions (effective February 1, 2021)

Each dwelling unit in a residential building shall comply with sufficient options from Table R406.2 (fuel normalization credits) and Table 406.3 (energy credits) to achieve the following minimum number of credits.

- 1. Small Dwelling Unit: 3 credits
2. Medium Dwelling Unit: 6 credits
3. Large Dwelling Unit: 7 credits
4. Additions less than 500 square feet: 1.5 credits

Before selecting your credits on this Summary table, review the details in Table 406.3 (Single Family), on page 4.

Summary of Table R406.2 table with columns: Heating Options, Fuel Normalization Descriptions, Credits - select ONE heating option, Energy Options, Energy Credit Option Descriptions, Credits - select ONE energy option from each category.

2018 Washington State Energy Code - Residential Prescriptive Energy Code Compliance for All Climate Zones in Washington Single Family - New & Additions (effective February 1, 2021)

Summary of Table R406.2 (cont.) table showing Energy Options, Energy Credit Option Descriptions (cont.), Credits - select ONE energy option from each category (cont.), and User Notes.

- a. An alternative heating source sized at a maximum of 0.5 W/sf (equivalent) of heated floor area or 500 W, whichever is bigger, may be installed in the dwelling unit.
b. Equipment listed in Table C403.3.2(4) or C403.3.2(5)
c. Equipment listed in Table C403.3.2(1) or C403.3.2(2)
d. You cannot select more than one option from any category EXCEPT in category 5. Option 5.1 may be combined with options 5.2 through 5.6. See Table 406.3.
e. 1.0 credit for each 1,200 kWh of electrical generation provided annually, up to 3 credits max.
f. Use the single radiobutton in the upper right of the second column to deselect radiobuttons in that group.

Please print only pages 1 through 3 of this worksheet for submission to your building official.



7525 SE 24th St., 487 Mercer Island, WA 98040 425.266.9100

Issue Issue Date By Description
07.11.22 CITY PLAN REVIEW COMMENTS

4537 90th AVE SE Mercer Island, WA. Job Number:

plan name:
marketing name: XXXXXX
plan number:
mark sys. number:-

Conditions not specifically represented graphically or in writing or which conflict with the current International Residential Code (IRC) or those of the local municipality then the current standards and requirements of each respectively shall govern.

The drawings in this set are instruments of service and shall remain the property of JayMarc Homes, LLC.

© 2017 JayMarc Homes, LLC; All rights reserved.

06.15.21
Submitted Date

Sheet Title/Description
JAYMARC HOMES
Design Firm

R.R.
Drawn by:
R.R./ S.K.
Checked by:

Primary Scale



EN1
of .

Sheet Title/Description

NE 1/4 OF THE SW 1/4 OF SECTION 18, TOWNSHIP 24 NORTH., RANGE 5 EAST, W.M., KING COUNTY, WA.

EXISTING UTILITY LOCATIONS SHOWN HEREON ARE APPROXIMATE ONLY. IT SHALL BE THE CONTRACTOR'S RESPONSIBILITY TO DETERMINE THE EXACT VERTICAL AND HORIZONTAL LOCATION OF ALL EXISTING UNDERGROUND UTILITIES PRIOR TO COMMENCING CONSTRUCTION. NO REPRESENTATION IS MADE THAT ALL EXISTING UTILITIES ARE SHOWN HEREON. THE ENGINEER ASSUMES NO RESPONSIBILITY FOR UTILITIES NOT SHOWN OR UTILITIES NOT SHOWN IN THEIR PROPER LOCATION.
CALL BEFORE YOU DIG: 811


- TREE PROTECTION NOTES:
 (A) TREE PROTECTION WITHIN R/W SHALL BE 3" ORANGE FENCING; ON PRIVATE PROPERTY TREE PROTECTION SHALL BE 6" CHAIN LINK FENCING ANCHORED TO THE GROUND
 (B) CERTIFIED ARBORIST TO OBSERVE EXCAVATION FOR THE NORTHWEST CORNER OF THE HOUSE FOUNDATION AND WALKWAYS; HAVE AIR EXCAVATION AVAILABLE IF NEEDED.

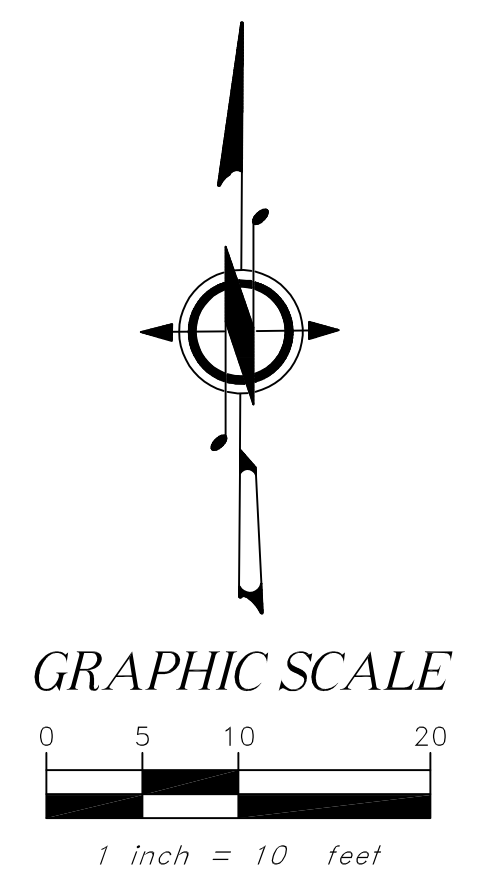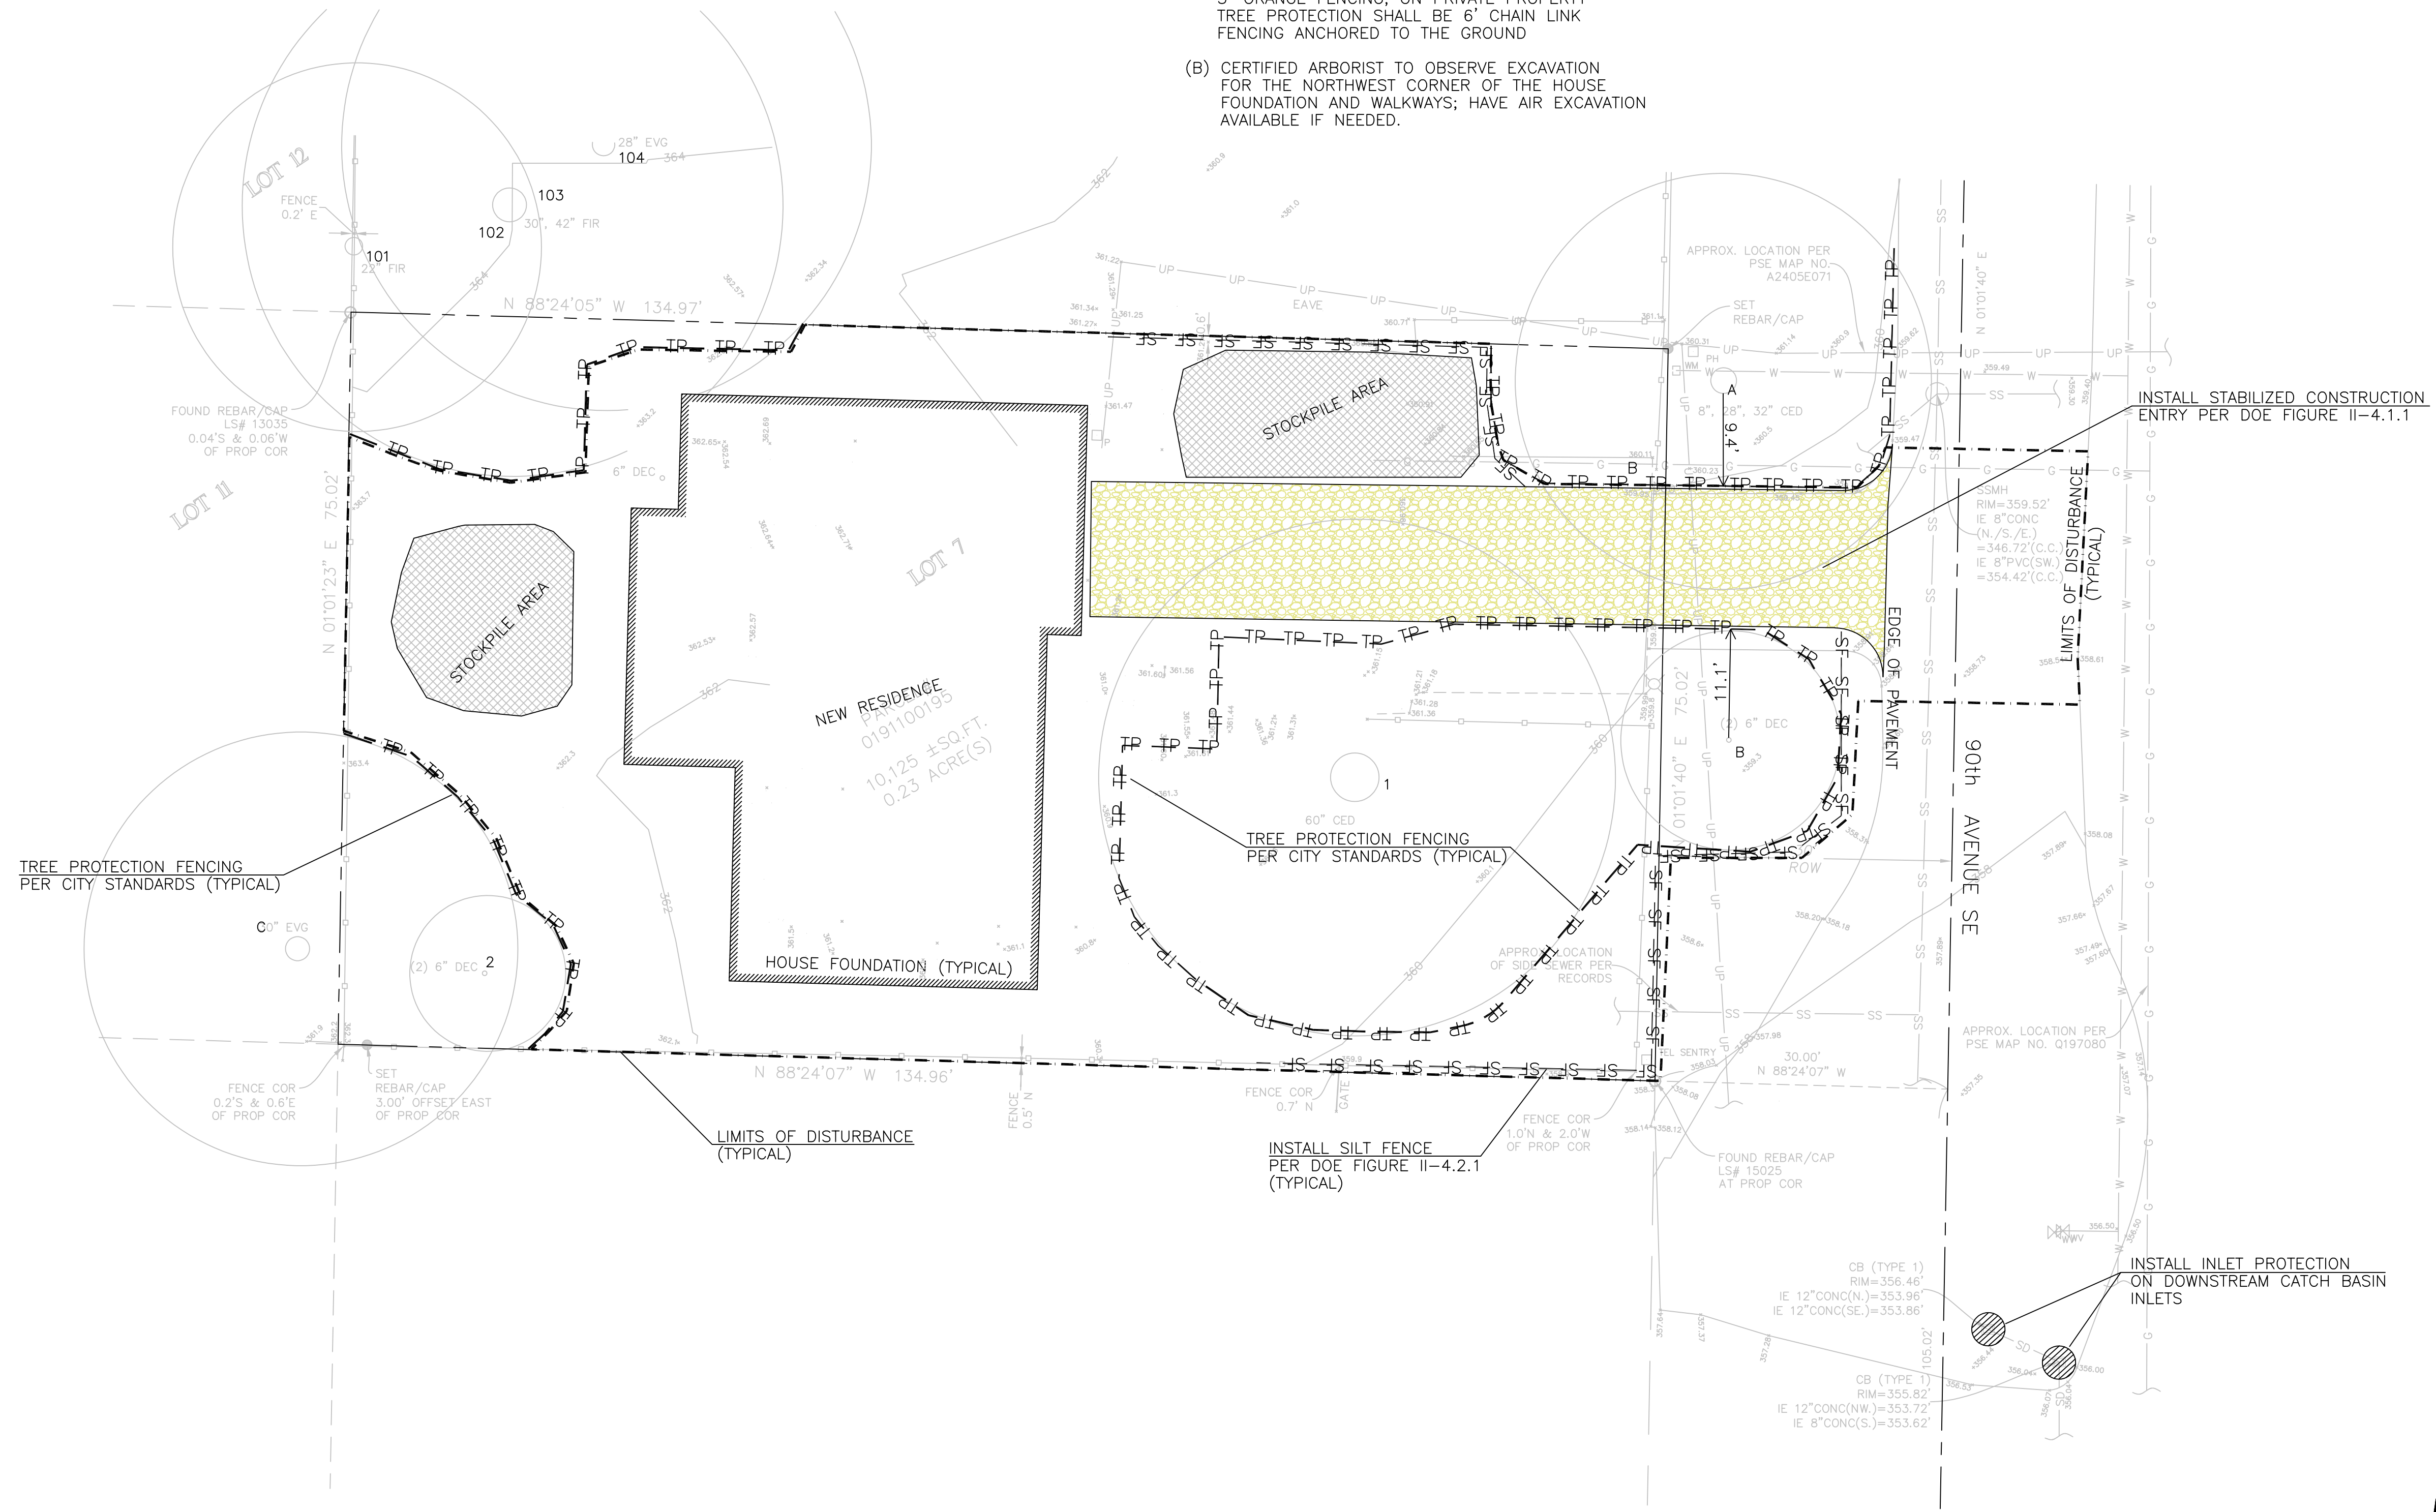

PERMIT #: 2203-197

REV. NO.	DATE	DESCRIPTION
1	07/25/2022	REVISED PER CITY COMMENTS 2202-197-SUB1

OFFE ENGINEERS
 13902 SOUTHEAST 159TH PLACE
 RENTON, WASHINGTON 98058
 PHONE: 425-260-3412
 CONTACT: DARRELL OFFE, P.E.

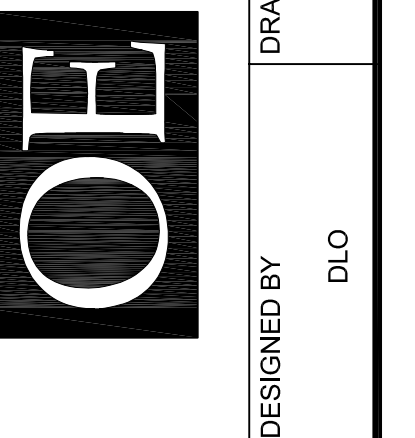

PROJECT	4537 90h Avenue SE
CLIENT	Marc Russo
SHEET CONTENT	Temp. Erosion & Sedimentation Control Plan
DESIGNED BY	DLO
DRAWN BY	VS
CHECKED BY	DLO
DATE	07/25/2022
JOB NO.	
DWG NO.	
SHEET	1
OF	3

NE 1/4 OF THE SW 1/4 OF SECTION 18, TOWNSHIP 24 NORTH., RANGE 5 EAST, W.M., KING COUNTY, WA.


NOTE: THE LAWN AND LANDSCAPE AREAS ARE REQUIRED TO PROVIDE POST-CONSTRUCTION SOIL QUALITY AND DEPTH IN ACCORDANCE WITH BMP T5.13. THE PROJECT CIVIL ENGINEER MUST PROVIDE A LETTER OF CERTIFICATION TO ENSURE THAT THE LAWN AND LANDSCAPE AREAS ARE MEETING THE POST-CONSTRUCTION SOIL QUALITY AND DEPTH REQUIREMENTS SPECIFIED ON THE APPROVED PLAN SET PRIOR TO FINAL INSPECTION OF THE PROJECT.

EXISTING UTILITY LOCATIONS SHOWN HEREON ARE APPROXIMATE ONLY. IT SHALL BE THE CONTRACTOR'S RESPONSIBILITY TO DETERMINE THE EXACT VERTICAL AND HORIZONTAL LOCATION OF ALL EXISTING UNDERGROUND UTILITIES PRIOR TO COMMENCING CONSTRUCTION. NO REPRESENTATION IS MADE THAT ALL EXISTING UTILITIES ARE SHOWN HEREON. THE ENGINEER ASSUMES NO RESPONSIBILITY FOR UTILITIES NOT SHOWN OR UTILITIES NOT SHOWN IN THEIR PROPER LOCATION.
CALL BEFORE YOU DIG: 811

TREE PROTECTION NOTES:
(A) TREE PROTECTION WITHIN R/W SHALL BE 3' ORANGE FENCING; ON PRIVATE PROPERTY TREE PROTECTION SHALL BE 6' CHAIN LINK FENCING ANCHORED TO THE GROUND
(B) CERTIFIED ARBORIST TO OBSERVE EXCAVATION FOR THE NORTHWEST CORNER OF THE HOUSE FOUNDATION AND WALKWAYS; HAVE AIR EXCAVATION AVAILABLE IF NEEDED.

SIDE SEWER NOTES

- S1 APPROXIMATE LOCATION OF EXISTING SANITARY SIDE SEWER, EXISTING SIDE SEWER TO BE ABANDONED INSIDE OF EXISTING MANHOLE. FLUG AND PATCH HOLE.
- S2 28LF., 6" PVC SIDE SEWER @ MIN. 2% SLOPE
- S3 60LF., 4" PVC SIDE SEWER @ MIN. 2% SLOPE

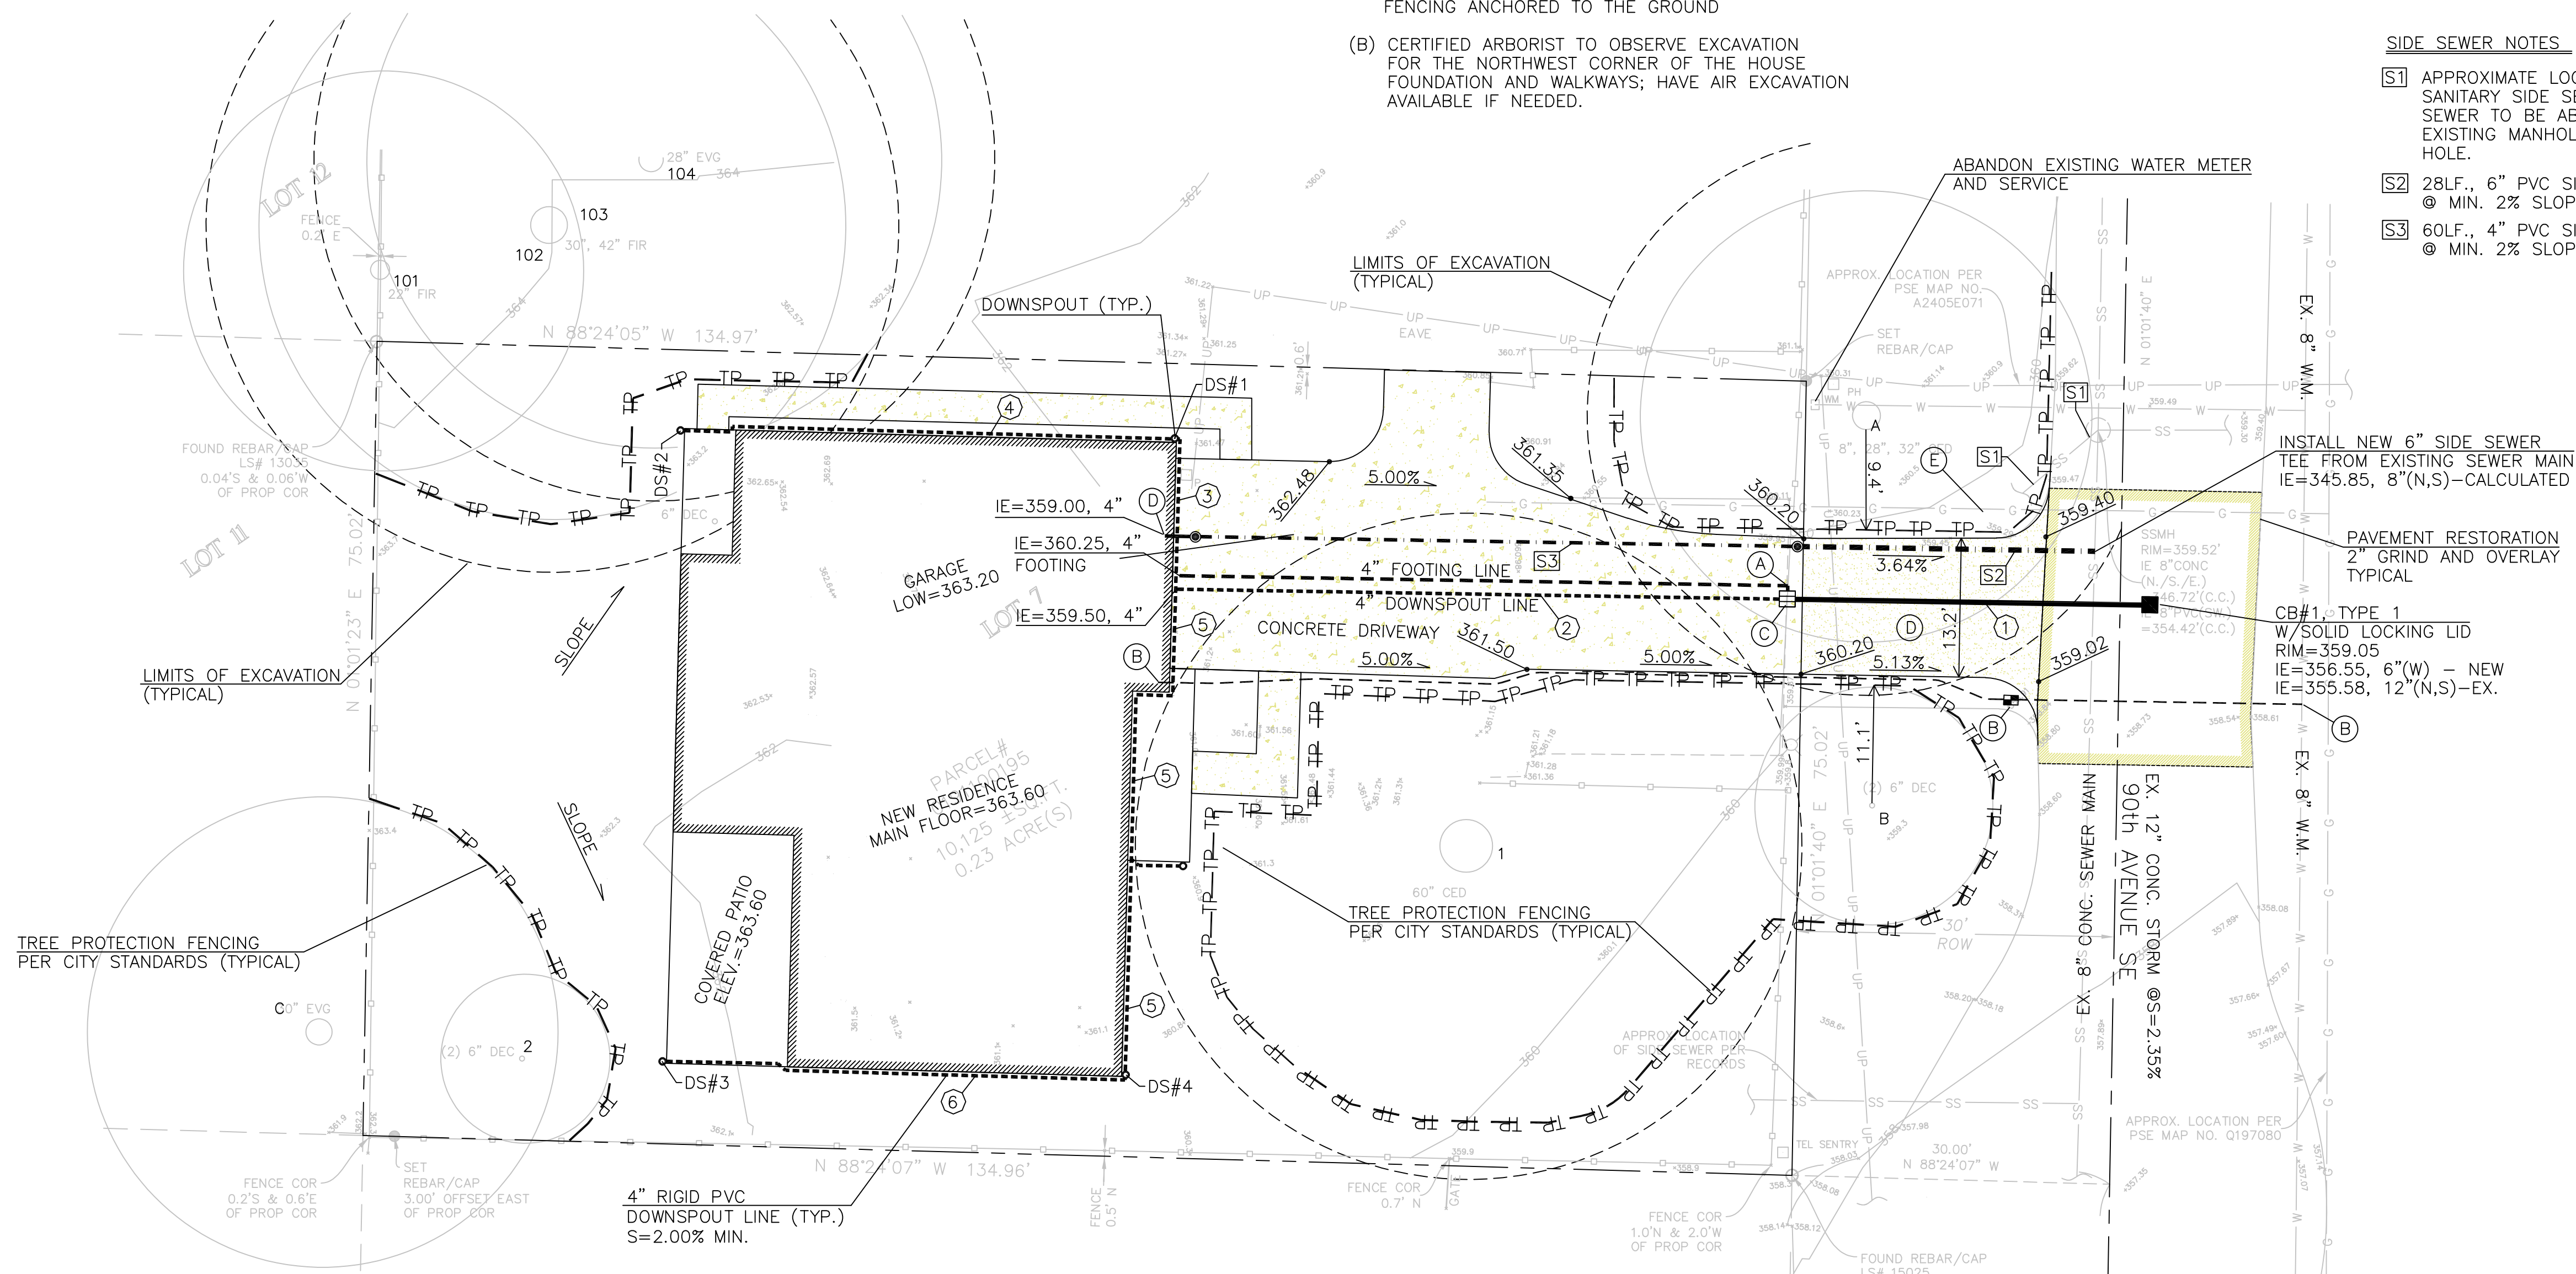

45XX TREE INVENTORY

Tree ID	species	DBH	DRIP	EXCEPTIONAL	SAVE	REMOVE
101	Doug Fir	24	18	yes, grove	yes	
102	Doug Fir	36.5	14	yes, grove	yes	
103	Doug Fir	40	26	yes, grove	yes	
104	Doug Fir	30.5	26	yes, grove	yes	
105	Doug Fir	11	9	yes, grove	yes	
108	Doug Fir	20	8	yes, grove	yes	
111	Doug Fir	33	22	yes, grove	yes	
112	Western red cedar	50	28	yes, grove		yes
113	Bitter Cherry	6	12			yes
114	Bitter Cherry	10	14	yes, grove	yes	
115	Western red cedar	13	17			yes
116	Western red cedar	18	17			yes
117	Western red cedar	15	17			yes
118	Western red cedar	28.8	15			yes
119	Western red cedar	21	19			yes
TOTALS		15			8	7

NON REGULATED TREES

106	Doug Fir	14	9	yes, grove		yes	Dying Tree
109	Bitter Cherry	4	12	Small Tree	yes		
110	Bitter Cherry	8	12	Small Tree	yes		
120	Orchard Apple	4	5	Small Tree		yes	

OFFSITE TREES

A	Western red cedar	41.6	20	Yes	Yes		
E	Doug Fir	30		yes, grove	yes		
F	Doug Fir	34		yes, grove	Yes		
G	Mountain Ash	6	7	Small tree		Yes	

NOTES:

- (A) FOOTING DRAIN CONNECTION, IE=358.00, 4"
- (B) INSTALL NEW WATER SERVICE & METER WITH TRAFFIC BEARING BOX AND LID
NOTE: CONTRACTOR TO COORDINATE FINAL LOCATION OF NEW METER WITH CITY OF MERCER ISLAND INSPECTOR AT TIME OF CONSTRUCTION
- (C) CB#2, TYPE 1 W/OIL WATER SEPARATOR GRATE=360.15 TOP OF TEE=359.90, 6" IE=357.87, 4"(N)-FOOTING IE=357.87, 4"(W)-DOWNSPOUTS IE=357.70, 6"(E) BOTTOM OF TEE=357.20, 6"
- (D) DRIVEWAY WITHIN R/W SHALL BE ASPHALTIC CONCRETE (HMA)
- (E) USE EXISTING DRIVEWAY AS TEMPORARY CONSTRUCTION ENTRY

STORM PIPE TABLE

①	34LF., 6" PVC SDR-35 @ S=3.38%
②	58LF., 4" PVC SDR-35 @ S=2.81%
③	12LF., 4" PVC SDR-35 @ S=15.8%
④	48LF., 4" PVC SDR-35 @ S=2.00%
⑤	52LF., 4" PVC SDR-35 @ S=2.00%
⑥	45LF., 4" PVC SDR-35 @ S=2.00%

DOWNSPOUT TABLE

DS#1	GROUND=363.20 DOWNSPOUT LINE=361.40, 4"
DS#2	GROUND=363.40 DOWNSPOUT LINE=362.40, 4"
DS#3	GROUND=362.40 DOWNSPOUT LINE=361.40, 4"
DS#4	GROUND=362.00 DOWNSPOUT LINE=360.50, 4"
DS#5	GROUND=362.80 DOWNSPOUT LINE=361.40, 4"

NOTE: 4" PERFORATED FOOTING DRAIN REQUIRED BUT NOT SHOWN ON PLAN, CONNECT WHERE SHOWN ON PLAN


STORM PIPE PVC SHALL BE SDR-35 PVC AT SLOPE=2.00% MINIMUM (TYPICAL) UNLESS OTHERWISE NOTED

IMPERVIOUS SURFACES:
ROOF AREA (UNDER EAVES) = 2,756 SQ. FEET
UNCOVERED DRIVEWAY AREA = 1,140 SQ. FEET
UNCOVERED WALKWAY = 241 SQ. FEET



TOTAL IMPERVIOUS AREAS = 4,137 SQ. FEET

LANDSCAPE AREAS NOTE:

DISTURBED LANDSCAPE AREAS SHALL BE TREATED AS AMENDED SOILS PER DOE FIGURE V-5.3.3, TYPICAL

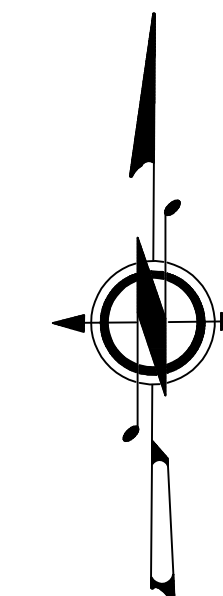

GRAPHIC SCALE

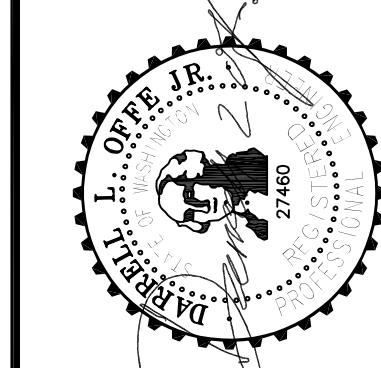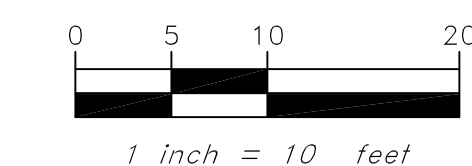

OFFE ENGINEERS
13902 SOUTHEAST 159TH PLACE
RENTON, WASHINGTON 98058
PHONE: 425-260-3412
CONTACT: DARRELL OFFE, P.E.



4537 90h Avenue SE

Marc Russo

Utility & Tree Plan

PROJECT: 4537 90h Avenue SE
CLIENT: Marc Russo

DATE: 07/25/2022

JOB NO.:





DWG NO.:

SHEET 2 OF 3

REV. NO.	DATE	DESCRIPTION
1	07/20/22	REVISED PER CITY COMMENTS 2202-197-SUB1


DESIGNED BY: DLO
DRAWN BY: VS
CHECKED BY: DLO

PERMIT #: 2203-197

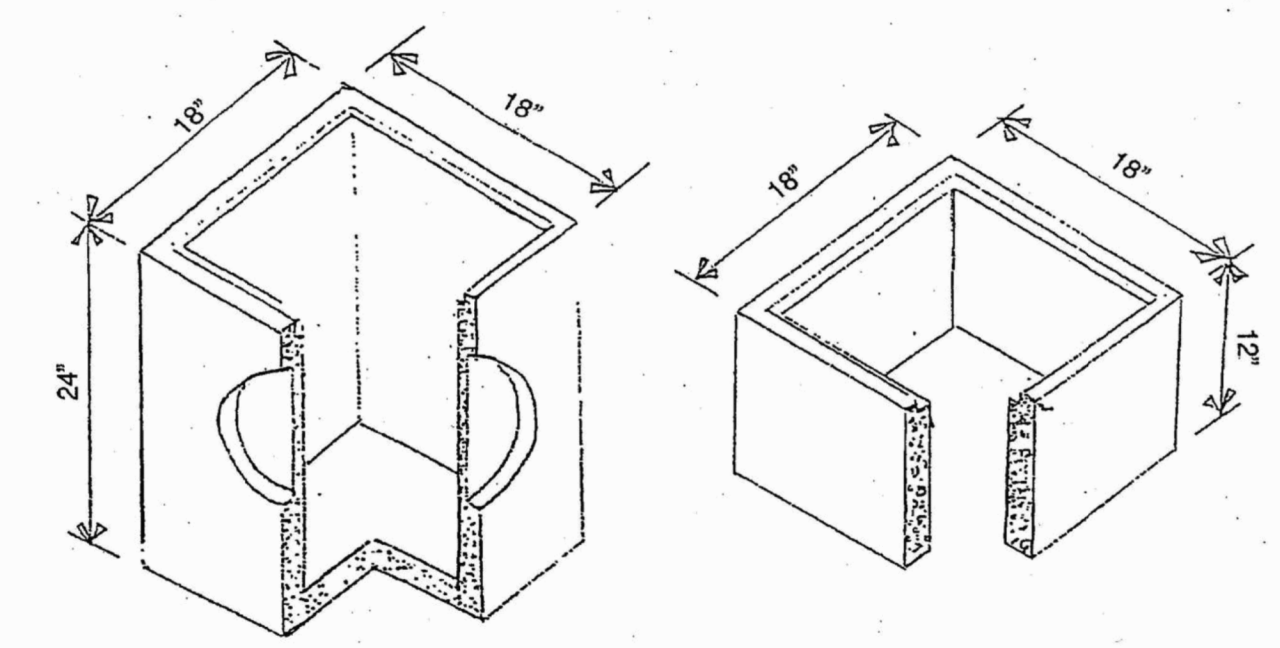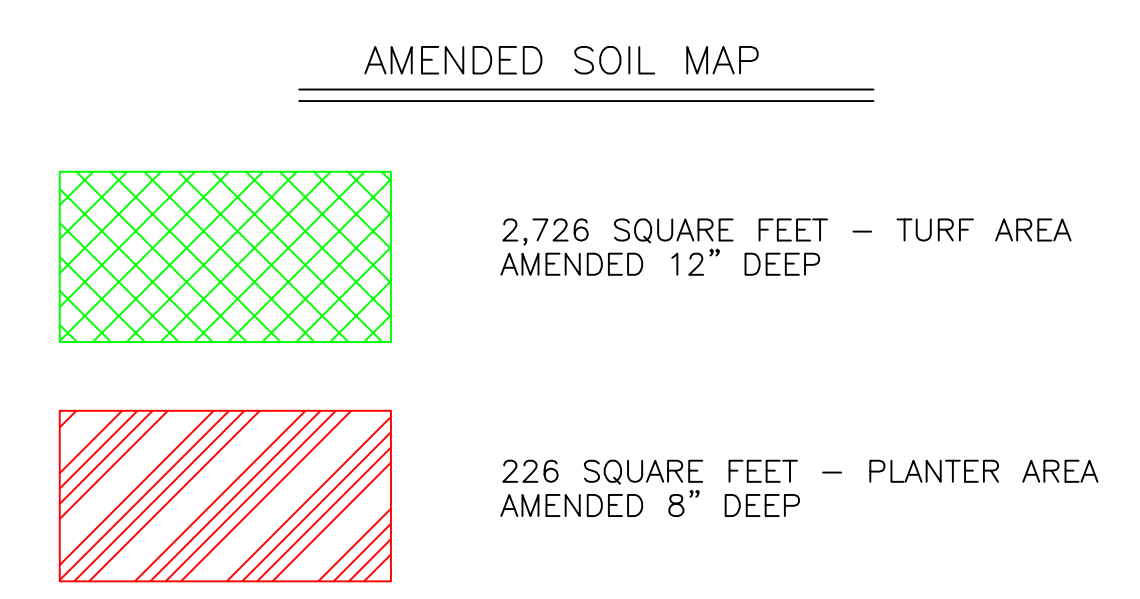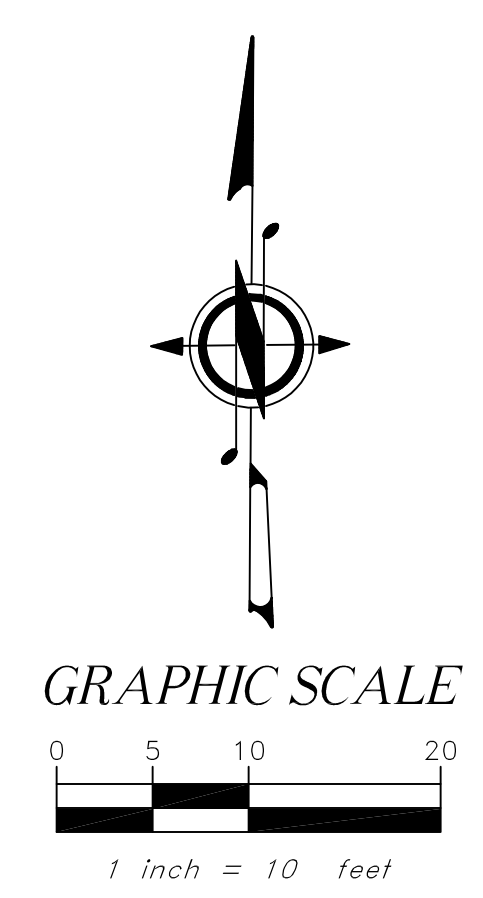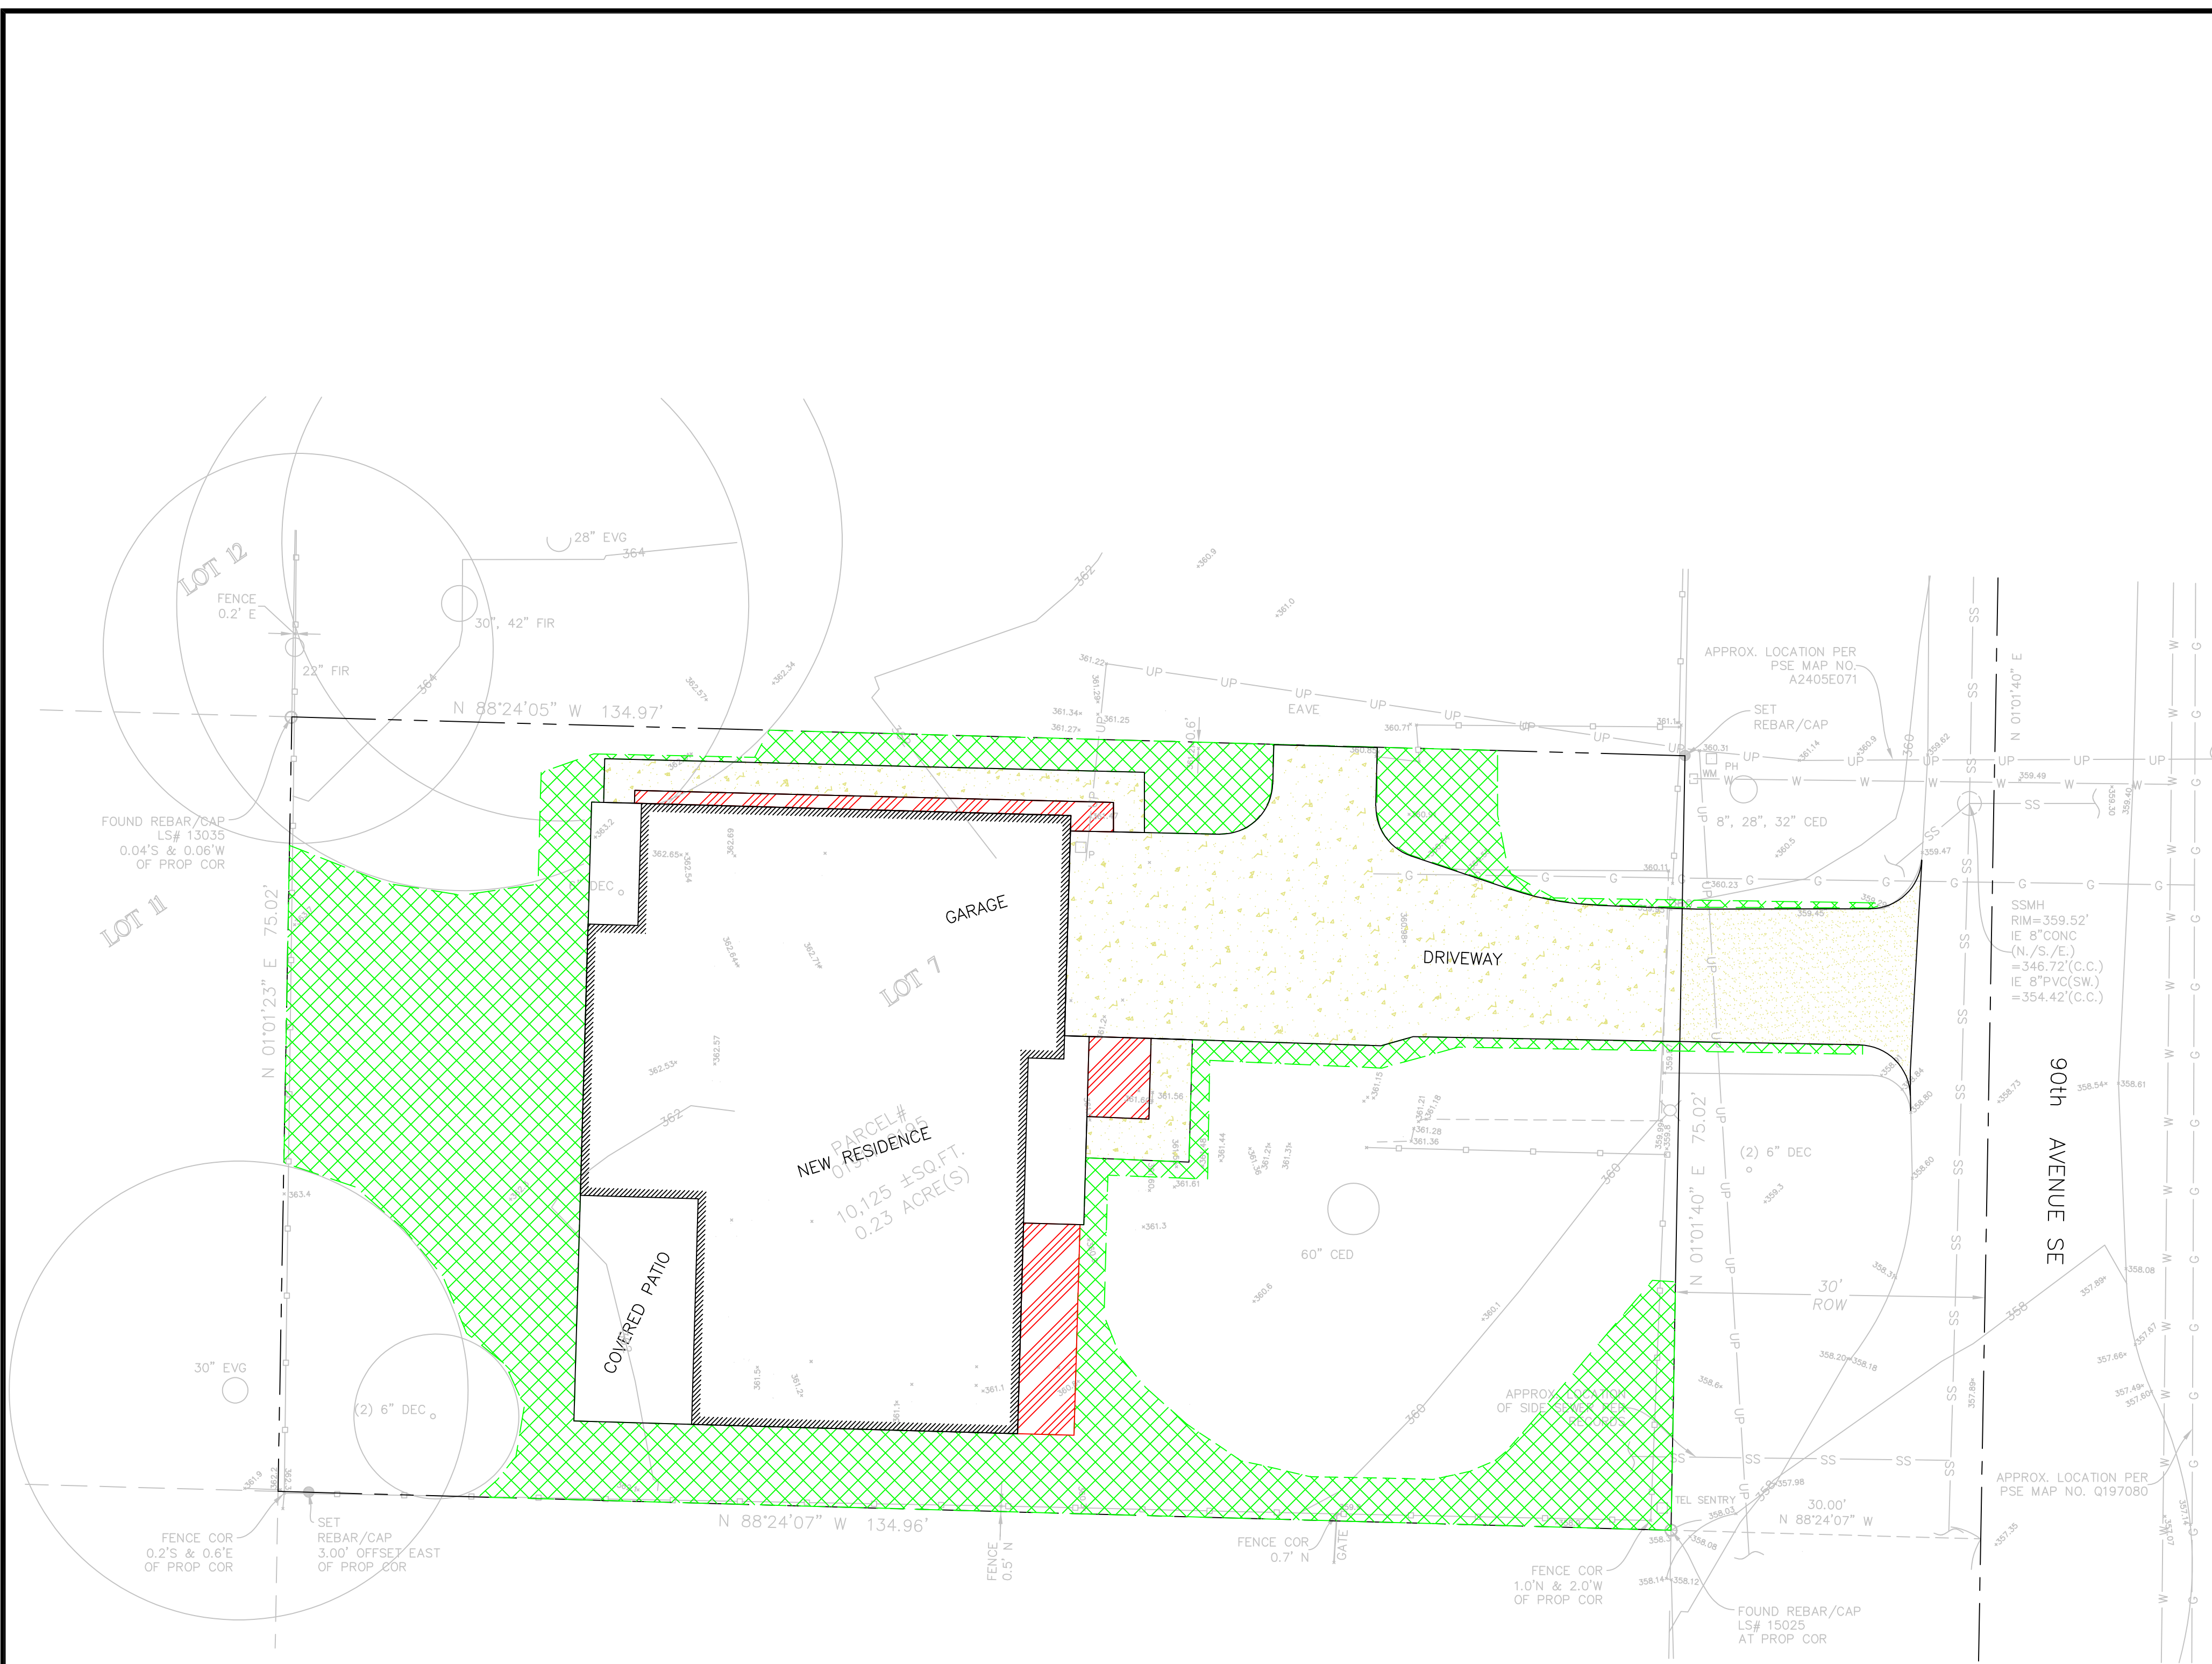

Catch Basin (C.B.)
Depth & Volume are Minimum Dimensions.
Minimum Volume = 24 gal.


6" & 12" Adjustment Riser

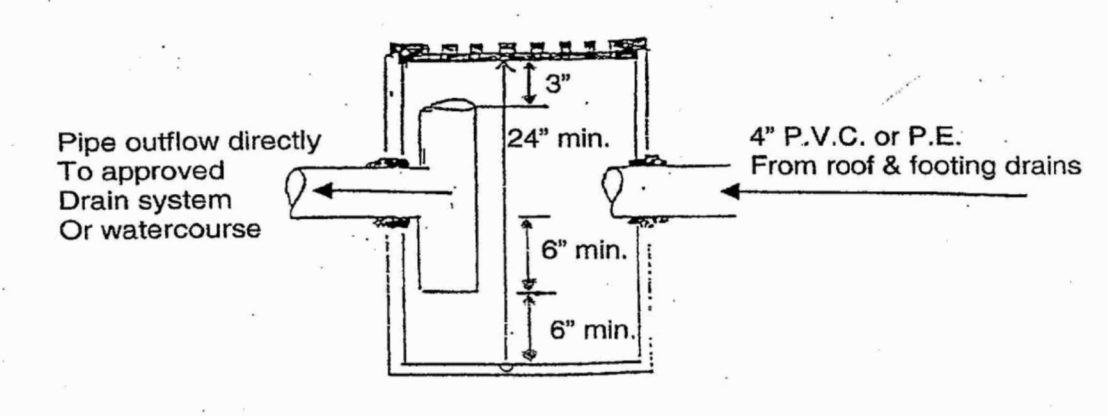


Catch Basin with Oil Separator

S:\DSG\FORMS\StormDrainageRequirements.doc 01/2010

Figure V-5.3.3 Planting bed Cross-Section

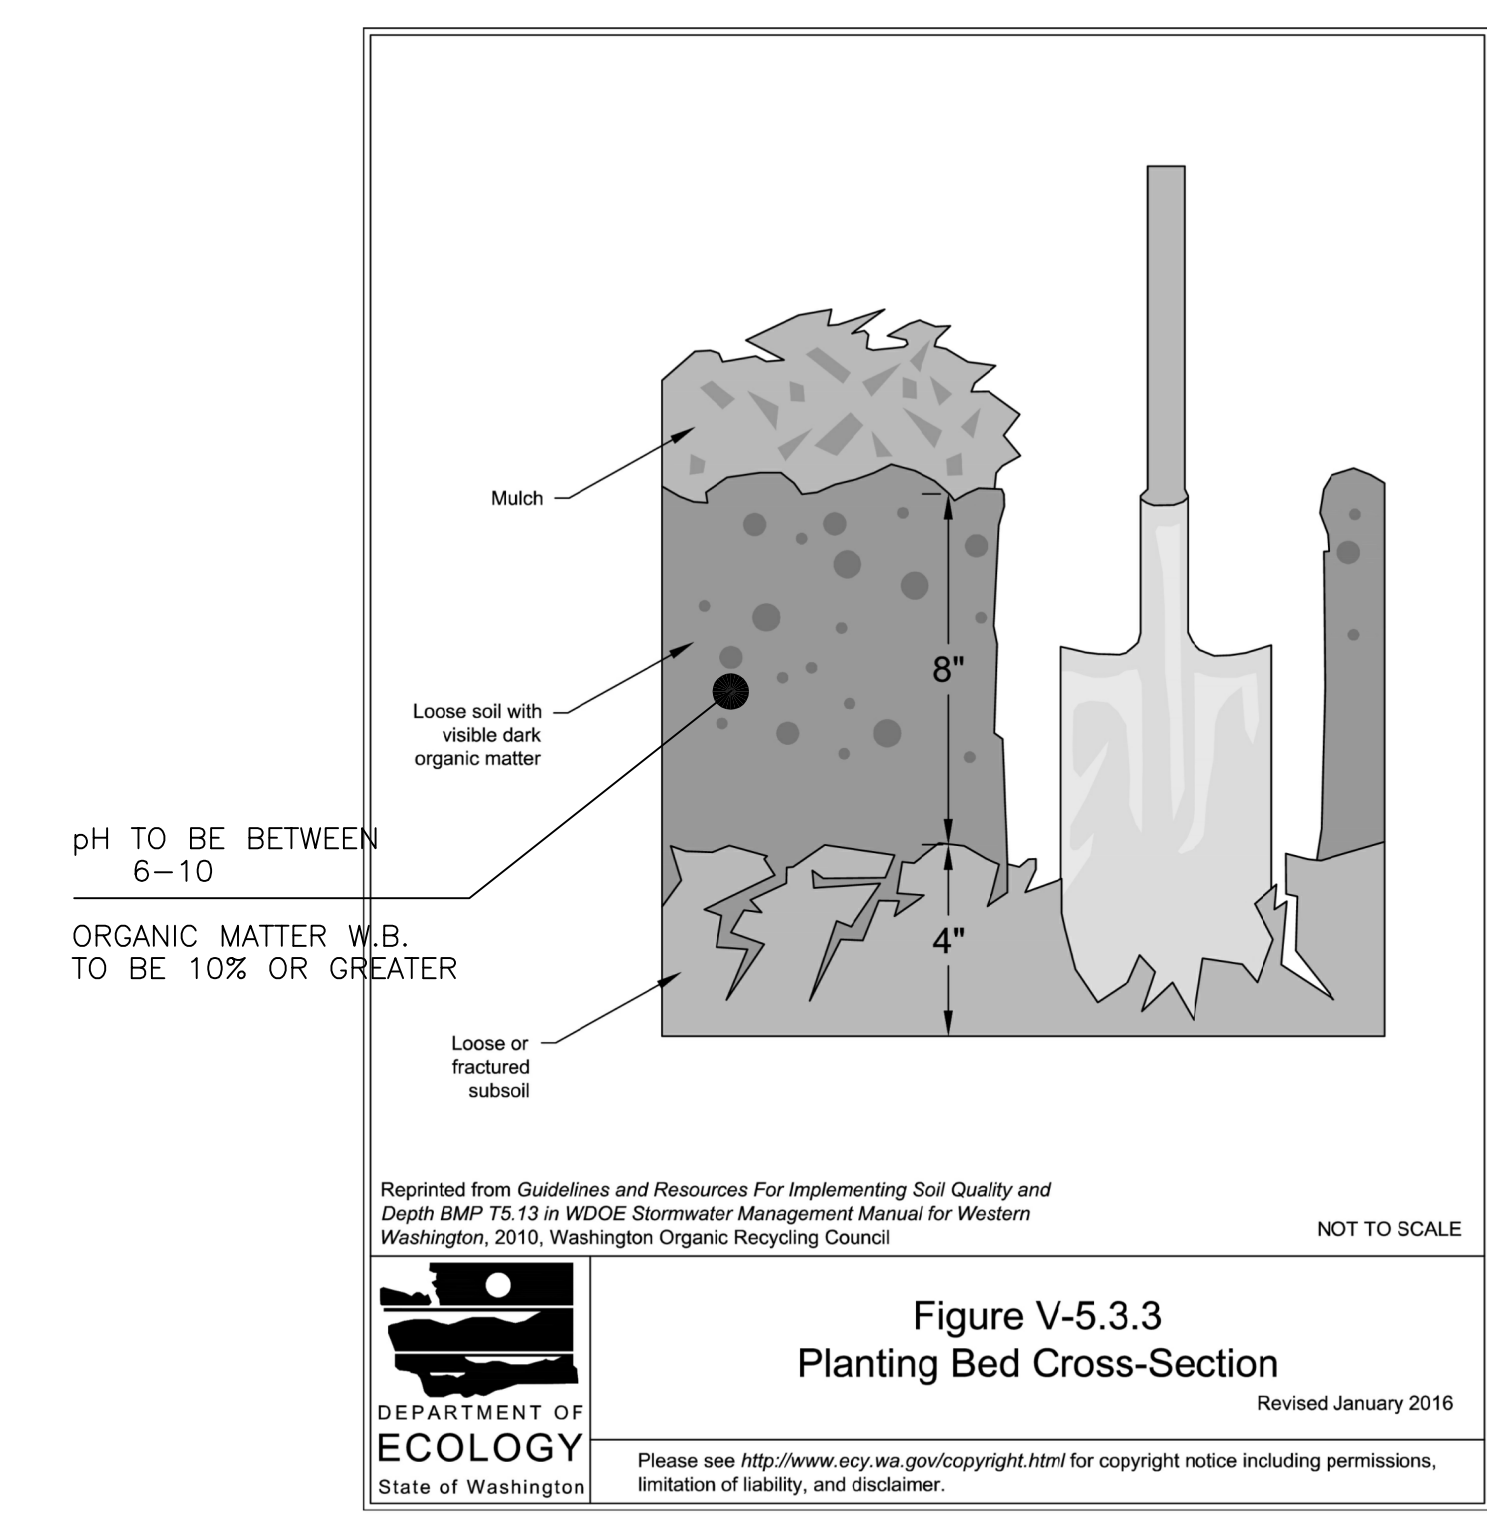

PROJECT	4537 90th Avenue SE		
	CLIENT	Marc Russo	
SHEET CONTENT	Amended Soil Map/Utility Details		
DATE	07/25/2022	DESIGNED BY	DLO
JOB NO.		DRAWN BY	VS
DWG NO.		CHECKED BY	DLO
3	OF	3	

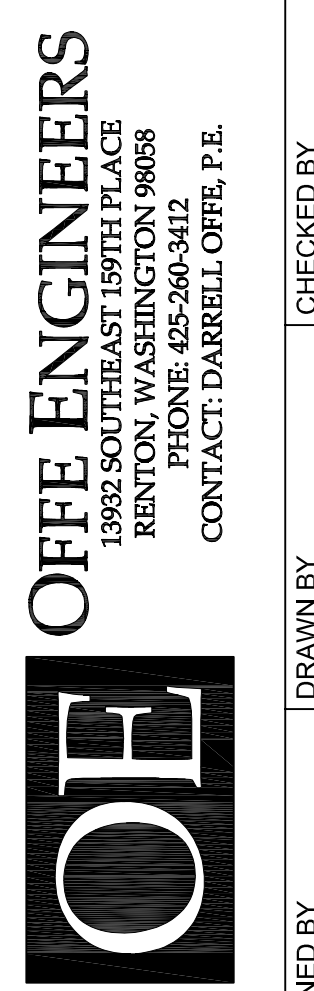


REV. NO.	DATE	DESCRIPTION
1	07/20/22	REVISED PER CITY COMMENTS 2202-197-SUB1
	07/25/2022	

TOPOGRAPHIC & BOUNDARY SURVEY

measure success

TOPOGRAPHIC & BOUNDARY SURVEY
PARCEL NO. 0191100190 & 0191100195
JAYMARC HOMES

4537 90TH AVE SE
MERCER ISLAND, WA 98040

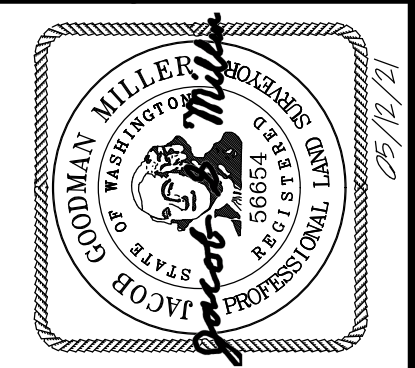

Terrane
10801 Main Street, Suite 102, Bellevue, WA 98004
phone 425.458.4498 support@terrane.net
www.terrane.net

JOB NUMBER:	210905
DATE:	05/12/21
DRAFTED BY:	IDV / GKD
CHECKED BY:	TBR / JGM
SCALE:	N.T.S.
REVISION HISTORY	
SHEET NUMBER	
1 OF 2	

LEGAL DESCRIPTION

FOR PARCEL# 0191100190
(PER PERSONAL REPRESENTATIVE'S DEED RECORDING# 20200115000188)
LOT 6, BLOCK 3, ALLVIEW HEIGHTS ADDITION TO SEATTLE, ACCORDING TO THE PLAT RECORDED IN VOLUME 16 OF PLATS, PAGE 20, IN KING COUNTY, WASHINGTON; TOGETHER WITH THE EAST VACATED ALLEY ADJOINING ON THE WEST, VACATED ON FEBRUARY 29 1960, IN VOLUME 64 OF COMMISSIONER'S RECORDS, PAGE 609.

FOR PARCEL# 0191100195
(PER PERSONAL REPRESENTATIVE'S DEED RECORDING# 20200115000187)
LOT 7, BLOCK 3, ALLVIEW HEIGHTS ADDITION TO SEATTLE, ACCORDING TO THE PLAT RECORDED IN VOLUME 16 OF PLATS, PAGE 20, IN KING COUNTY, WASHINGTON; TOGETHER WITH THE EAST VACATED ALLEY ADJOINING ON THE WEST, VACATED ON FEBRUARY 29 1960, IN VOLUME 64 OF COMMISSIONER'S RECORDS, PAGE 609.

BASIS OF BEARINGS

HELD N 01°01'40" E BETWEEN MONUMENTS FOUND ON THE CENTERLINE OF 90TH AVE SE PER GPS OBSERVATIONS, NAD83 WASHINGTON STATE PLANE, NORTH ZONE.

REFERENCES

R1. PLAT OF ALLVIEW HEIGHTS ADDITION, VOL. 16, PG. 20, RECORDS OF KING COUNTY, WASHINGTON.

VERTICAL DATUM


NAVD88, PER GPS OBSERVATIONS.

SURVEYOR'S NOTES

1. THE TOPOGRAPHIC SURVEY SHOWN HEREON WAS PERFORMED IN MAY OF 2021. THE FIELD DATA WAS COLLECTED AND RECORDED ON MAGNETIC MEDIA THROUGH AN ELECTRONIC THEODOLITE. THE DATA FILE IS ARCHIVED ON DISC OR CD. WRITTEN FIELD NOTES MAY NOT EXIST. CONTOURS ARE SHOWN FOR CONVENIENCE ONLY. DESIGN SHOULD RELY ON SPOT ELEVATIONS.
2. ALL MONUMENTS SHOWN HEREON WERE LOCATED DURING THE COURSE OF THIS SURVEY UNLESS OTHERWISE NOTED.
3. THE TYPES AND LOCATIONS OF ANY UTILITIES SHOWN ON THIS DRAWING ARE BASED ON INFORMATION PROVIDED TO US, BY OTHERS OR GENERAL INFORMATION READILY AVAILABLE IN THE PUBLIC DOMAIN INCLUDING, AS APPLICABLE, IDENTIFYING MARKINGS PLACED BY UTILITY LOCATE SERVICES AND OBSERVED BY TERRANE IN THE FIELD. AS SUCH, THE UTILITY INFORMATION SHOWN ON THESE DRAWINGS ARE FOR INFORMATIONAL PURPOSES ONLY AND SHOULD NOT BE RELIED ON FOR DESIGN OR CONSTRUCTION PURPOSES; TERRANE IS NOT RESPONSIBLE OR LIABLE FOR THE ACCURACY OR COMPLETENESS OF THIS UTILITY INFORMATION. FOR THE ACCURATE LOCATION AND TYPE OF UTILITIES NECESSARY FOR DESIGN AND CONSTRUCTION, PLEASE CONTACT THE SITE OWNER AND THE LOCAL UTILITY LOCATE SERVICE (800-424-5555).
4. SUBJECT PROPERTY TAX PARCEL NO. 019110-0190 & 019110-0195
5. SUBJECT TOTAL PROPERTY AREA PER THIS SURVEY IS 20,250 ±S.F. (0.46 ACRES)
FOR PARCEL# 019110-0190 AREA= 10,125 ±S.F. (0.23 ACRES)
FOR PARCEL# 019110-0195 AREA= 10,125 ±S.F. (0.23 ACRES)
6. THIS SURVEY WAS PERFORMED WITHOUT THE BENEFIT OF A TITLE REPORT. EASEMENTS AND OTHER ENCUMBRANCES MAY EXIST THAT ARE NOT SHOWN HEREON.
7. FIELD DATA FOR THIS SURVEY WAS OBTAINED BY DIRECT FIELD MEASUREMENTS WITH A CALIBRATED ELECTRONIC 5-SECOND TOTAL STATION AND/OR SURVEY GRADE GPS OBSERVATIONS. ALL ANGULAR AND LINEAR RELATIONSHIPS ARE ACCURATE AND MEET THE STANDARDS SET BY WAC 332-130-090.

LEGEND

	ASPHALT SURFACE		POWER HAND HOLE
	BUILDING		POWER METER
	CENTERLINE ROW		POWER (UNDERGROUND)
	CONCRETE SURFACE		POWER SENTRY
	RETAINING WALL		REBAR & CAP (SET)
	DECK		SEWER LINE
	FENCE LINE (WOOD)		SEWER MANHOLE
	GAS LINE		STORM DRAIN LINE
	INLET (TYPE 1)		TELEPHONE SENTRY
	NAIL AS NOTED		TREE (AS NOTED)
	MAILBOX (RESIDENTIAL)		WATER LINE
	PAVER SURFACE		WATER METER
	REBAR AS NOTED (FOUND)		WATER VALVE
	MONUMENT IN CASE (FOUND)		YARD LIGHT

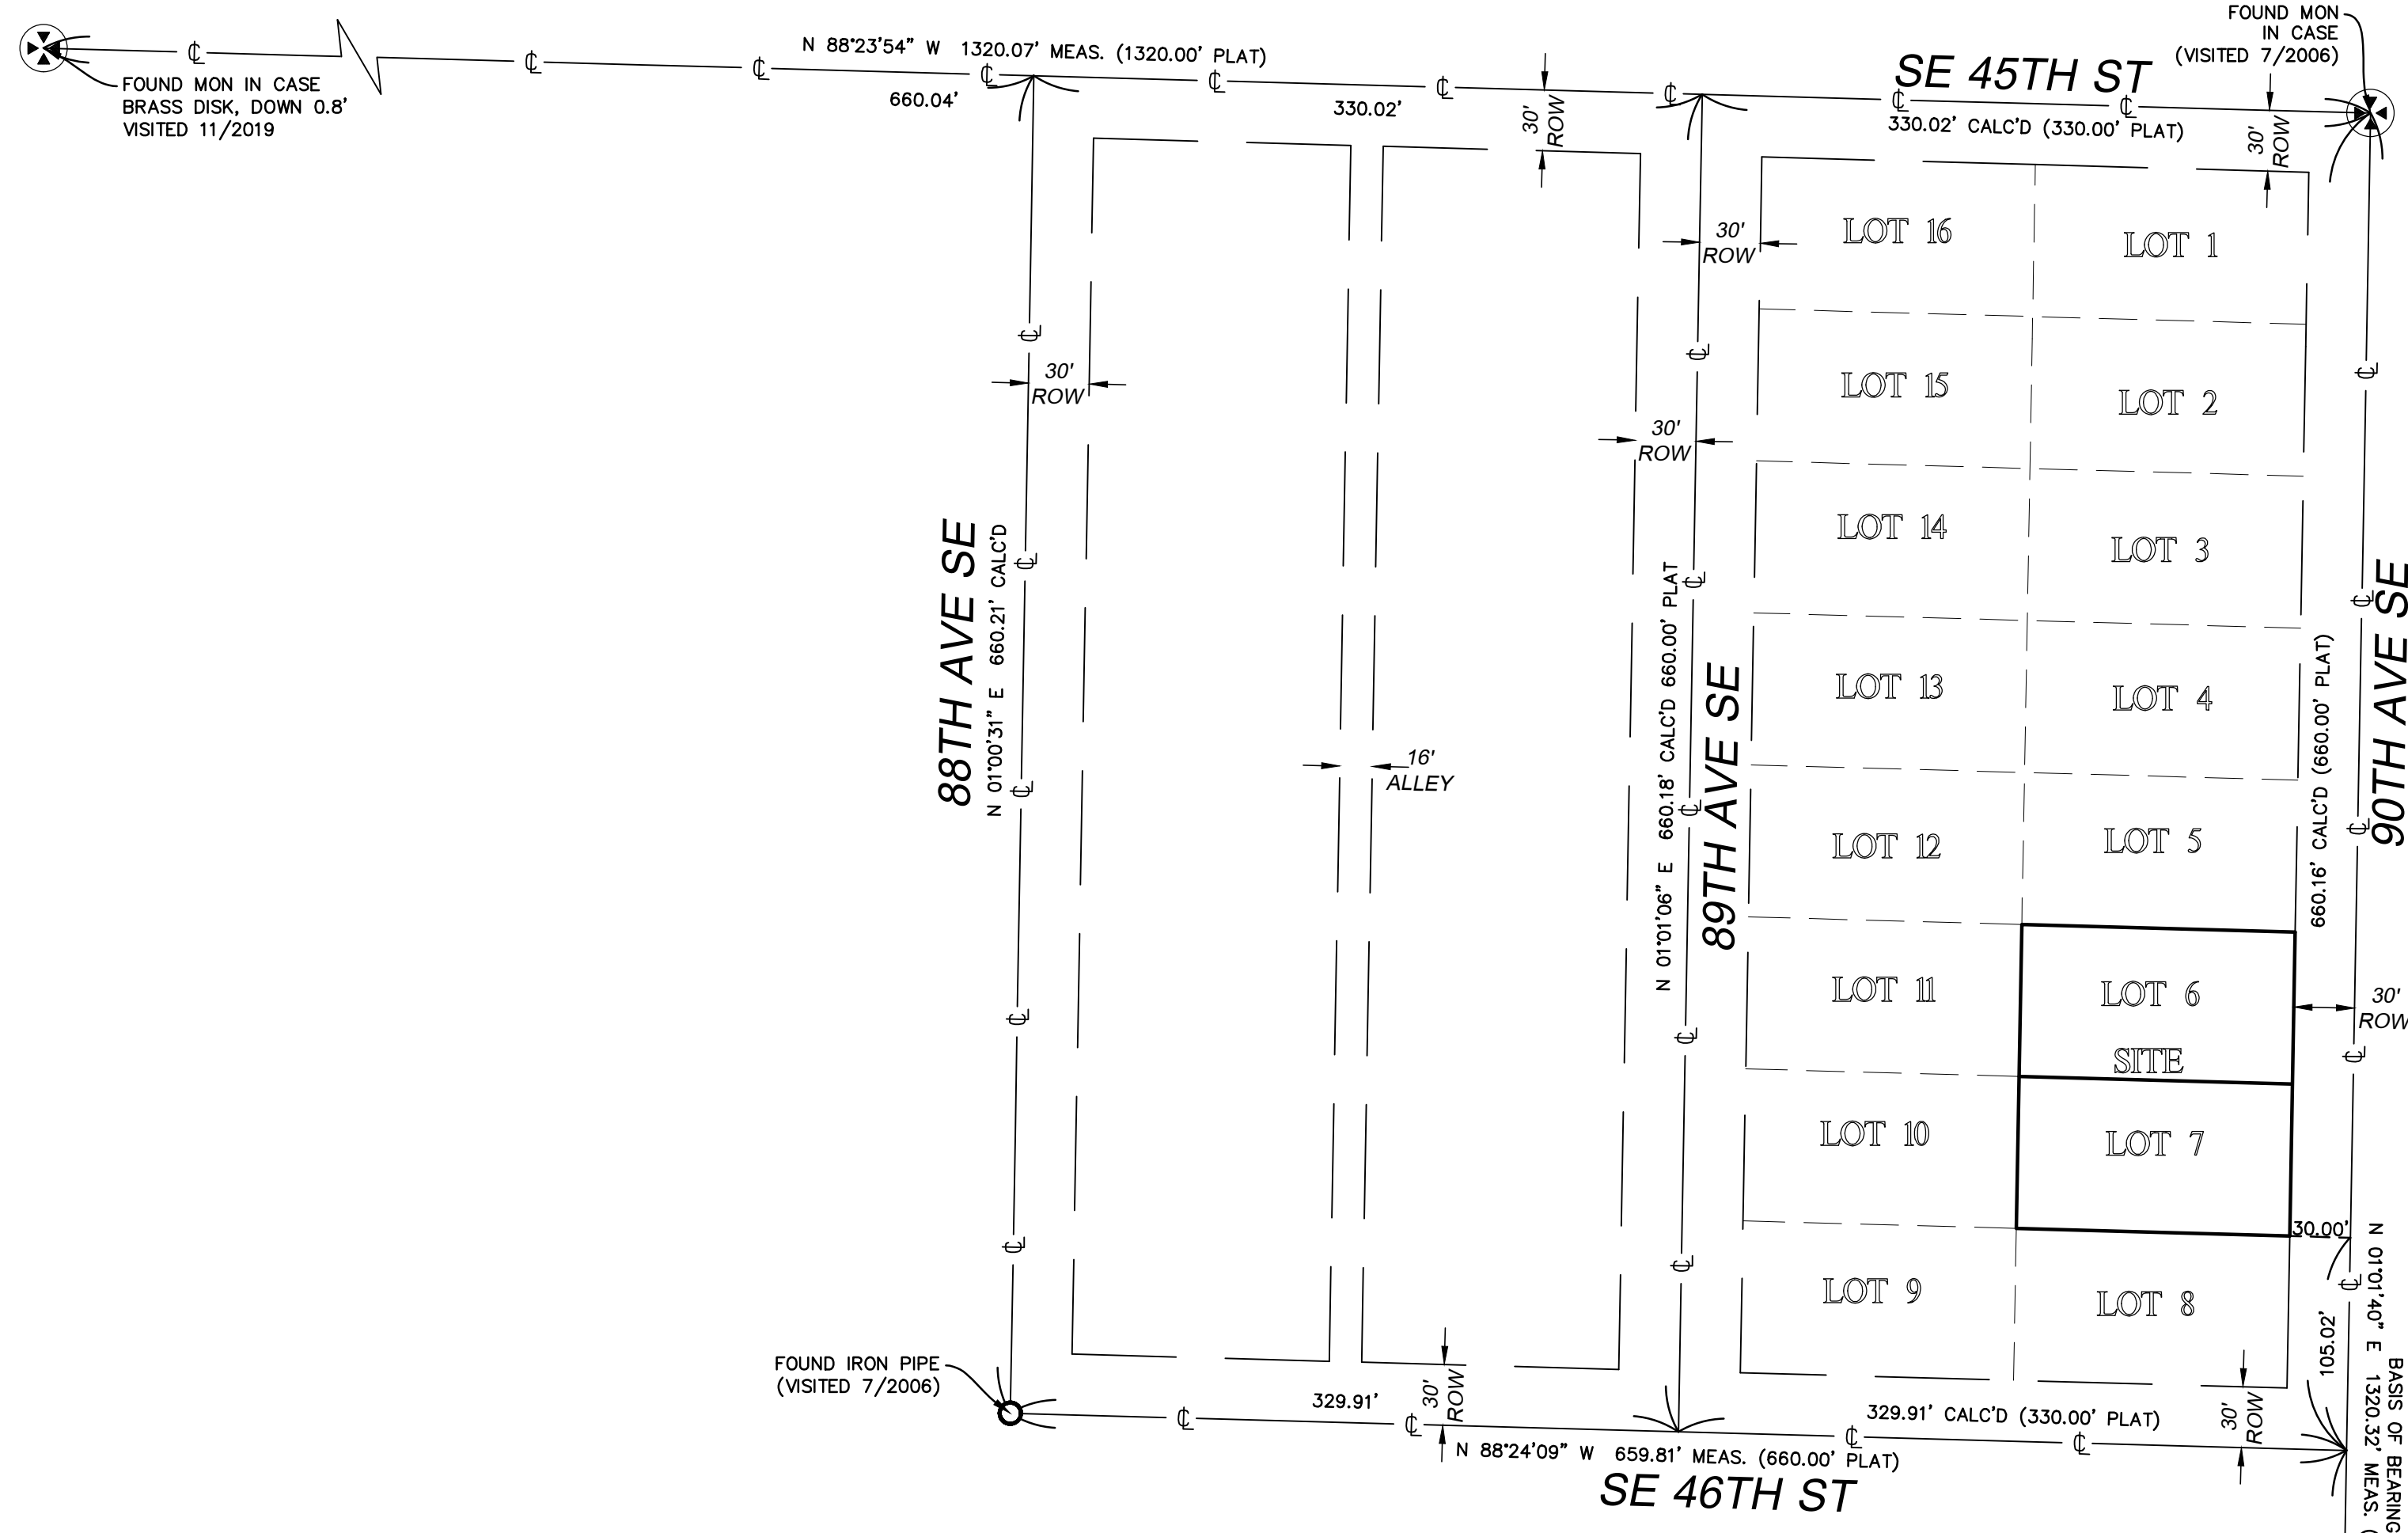



STEEP SLOPE/BUFFER DISCLAIMER:
THE LOCATION AND EXTENT OF STEEP SLOPES SHOWN ON THIS DRAWING ARE FOR INFORMATIONAL PURPOSES ONLY AND CANNOT BE RELIED ON FOR DESIGN AND/OR CONSTRUCTION. THE PITCH, LOCATION, AND EXTENT ARE BASED SOLELY ON OUR GENERAL OBSERVATIONS ON SITE AND OUR CURSORY REVIEW OF READILY AVAILABLE PUBLIC DOCUMENTS; AS SUCH, TERRANE CANNOT BE LIABLE OR RESPONSIBLE FOR THE ACCURACY OR COMPLETENESS OF ANY STEEP SLOPE INFORMATION. ULTIMATELY, THE LIMITS AND EXTENT OF ANY STEEP SLOPES ASSOCIATED WITH ANY SETBACKS OR OTHER DESIGN OR CONSTRUCTION PARAMETERS MUST BE DISCUSSED AND APPROVED BY THE REVIEWING AGENCY BEFORE ANY CONSTRUCTION CAN OCCUR.

INDEXING INFORMATION	
NE 1/4	SW 1/4
SECTION: 18	TOWNSHIP: 24N
RANGE: 05E, W.M.	COUNTY: KING

TOPOGRAPHIC & BOUNDARY SURVEY

LEGEND

	ASPHALT SURFACE		POWER HAND HOLE
	BUILDING		POWER METER
	CENTERLINE ROW		POWER (UNDERGROUND)
	CONCRETE SURFACE		POWER SENTRY
	RETAINING WALL		REBAR & CAP (SET)
	DECK		SEWER LINE
	FENCE LINE (WOOD)		SEWER MANHOLE
	GAS LINE		STORM DRAIN LINE
	INLET (TYPE 1)		TELEPHONE SENTRY
	NAIL AS NOTED		TREE (AS NOTED)
	MAILBOX (RESIDENTIAL)		WATER LINE
	PAVER SURFACE		WATER METER
	REBAR AS NOTED (FOUND)		WATER VALVE
	MONUMENT IN CASE (FOUND)		YARD LIGHT

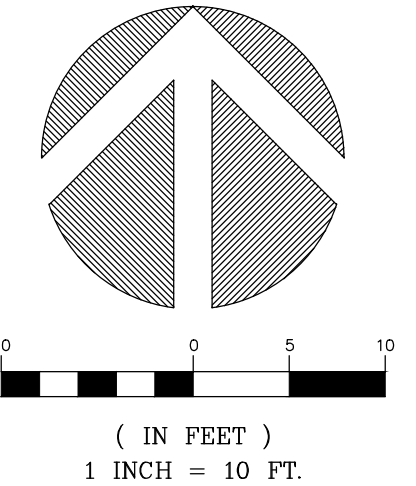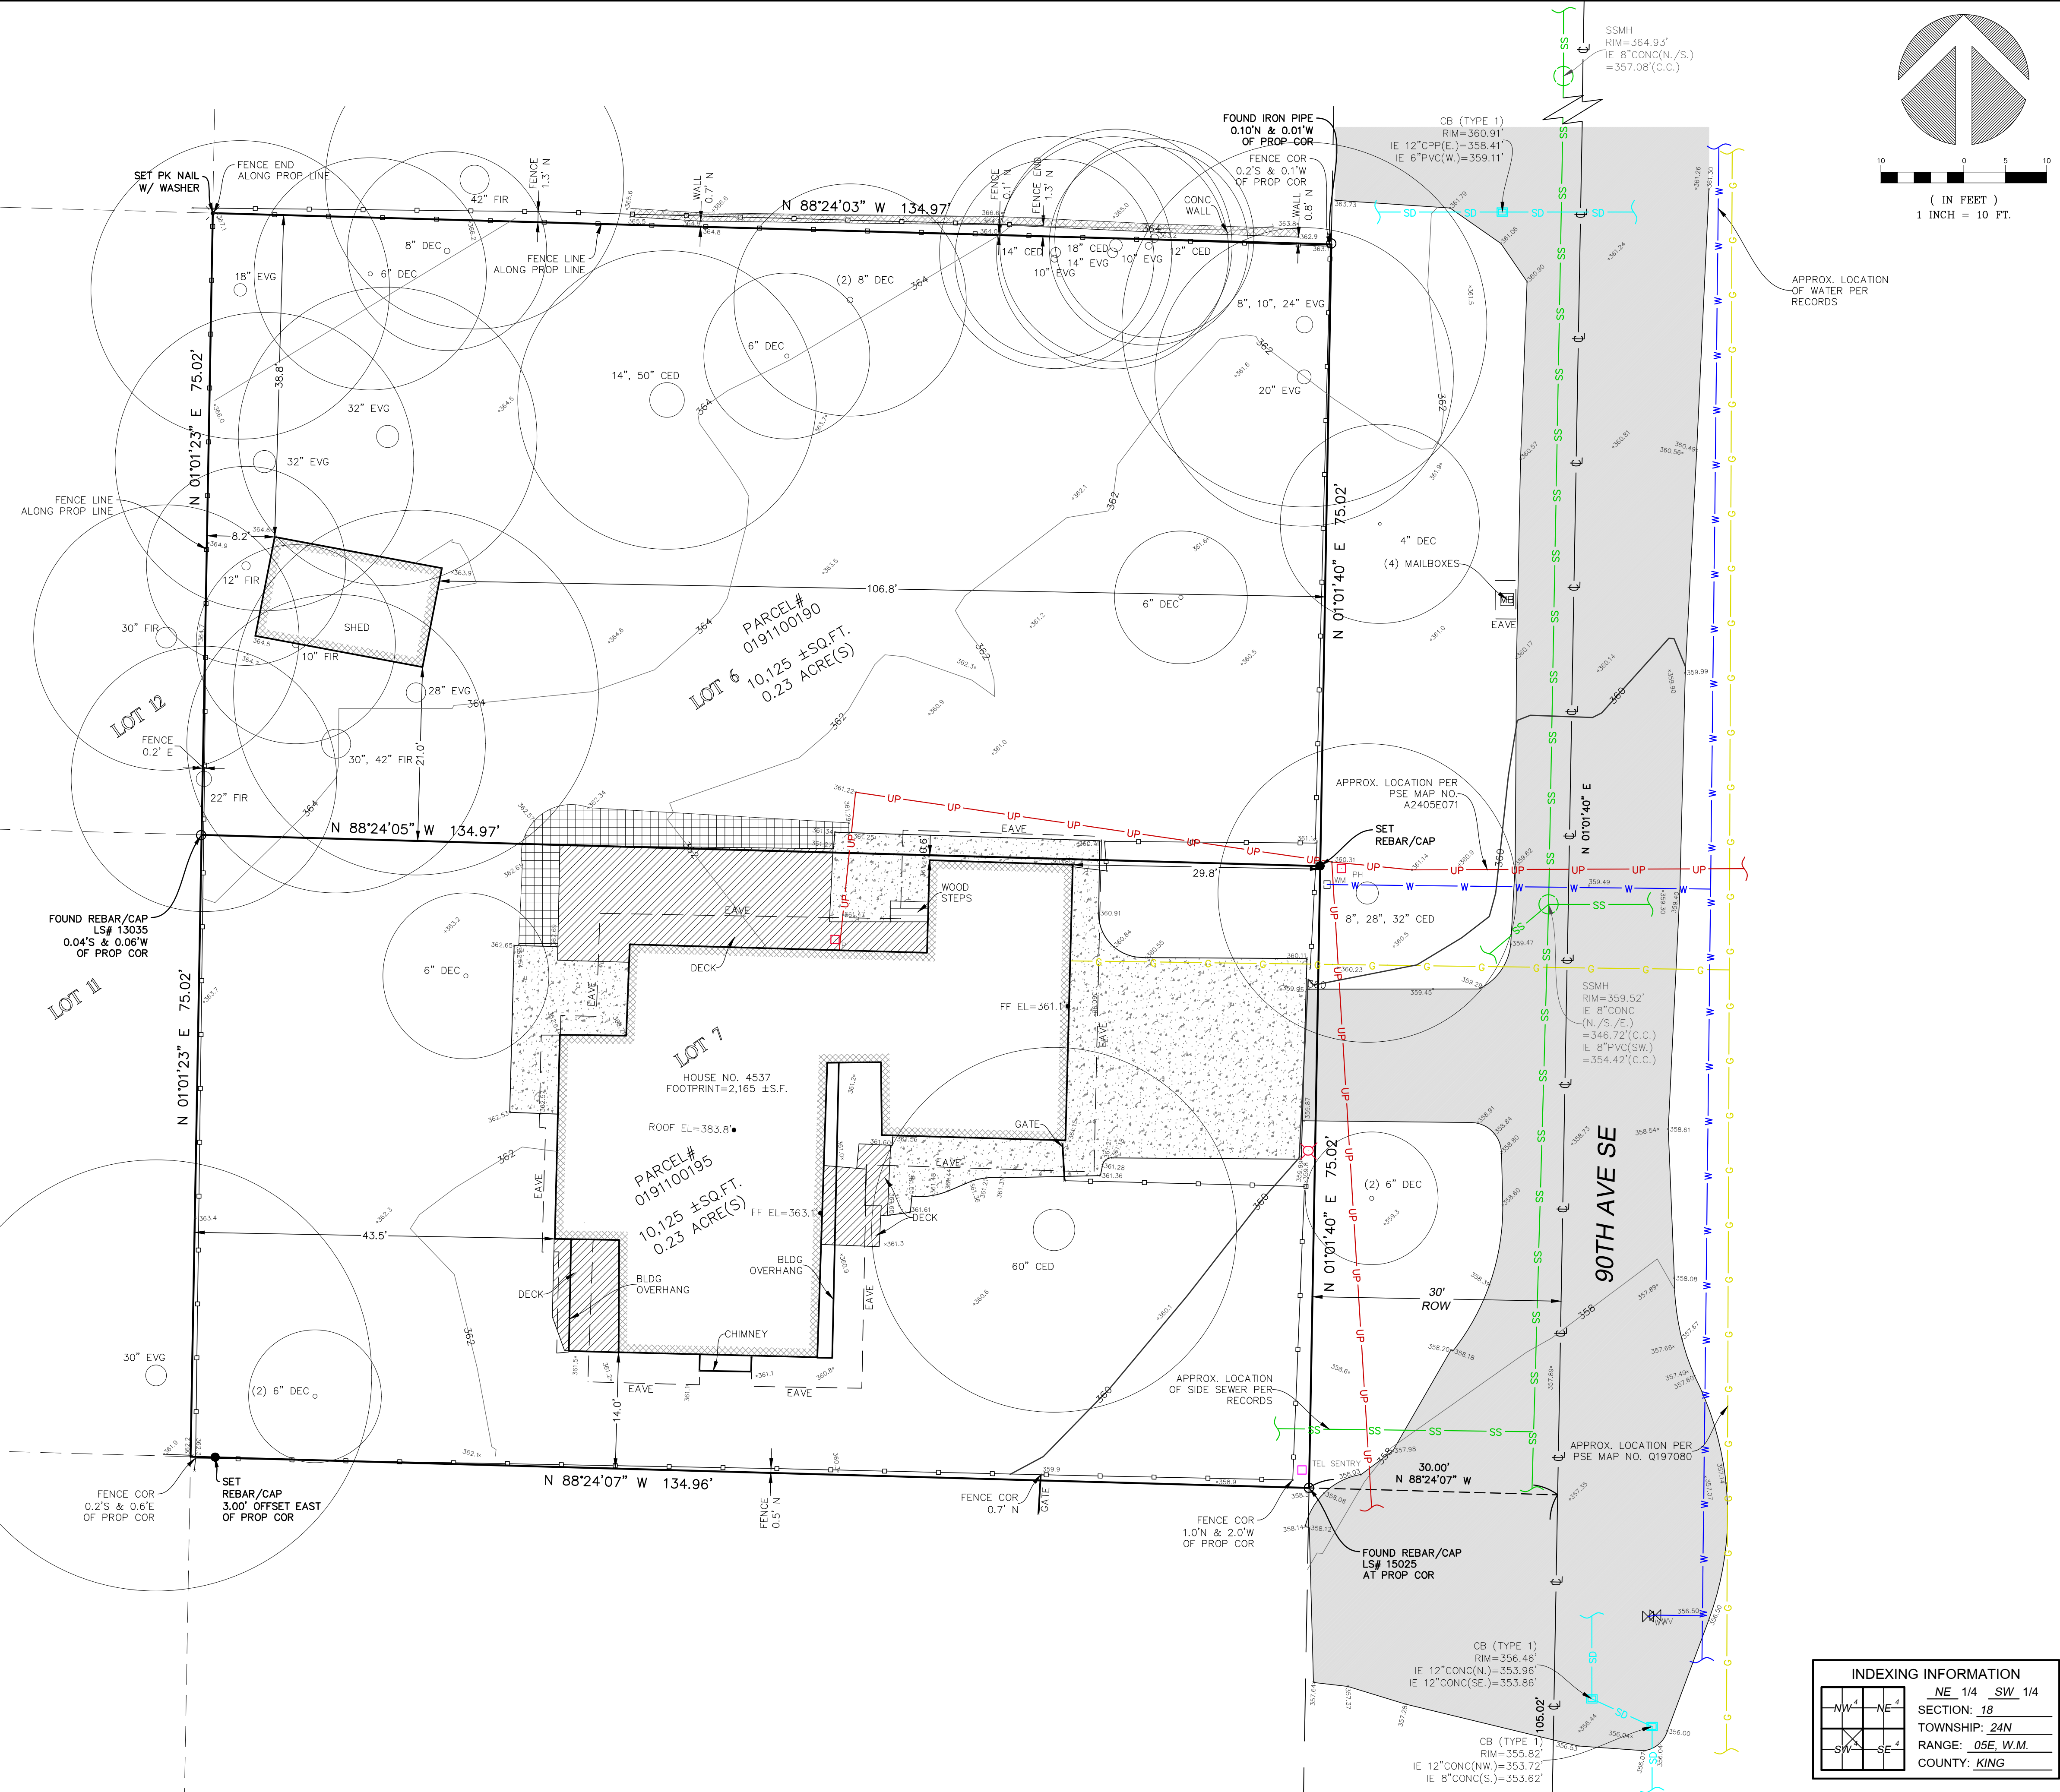

STEEP SLOPE/BUFFER DISCLAIMER:
 THE LOCATION AND EXTENT OF STEEP SLOPES SHOWN ON THIS DRAWING ARE FOR INFORMATIONAL PURPOSES ONLY AND CANNOT BE RELIED ON FOR DESIGN AND/OR CONSTRUCTION. THE PITCH, LOCATION, AND EXTENT ARE BASED SOLELY ON OUR GENERAL OBSERVATIONS ON SITE AND OUR CURSORY REVIEW OF READILY AVAILABLE PUBLIC DOCUMENTS; AS SUCH, TERRANE CANNOT BE LIABLE OR RESPONSIBLE FOR THE ACCURACY OR COMPLETENESS OF ANY STEEP SLOPE INFORMATION. ULTIMATELY, THE LIMITS AND EXTENT OF ANY STEEP SLOPES ASSOCIATED WITH ANY SETBACKS OR OTHER DESIGN OR CONSTRUCTION PARAMETERS MUST BE DISCUSSED AND APPROVED BY THE REVIEWING AGENCY BEFORE ANY CONSTRUCTION CAN OCCUR.

INDEXING INFORMATION			
NE	1/4	SW	1/4
SECTION:	18		
TOWNSHIP:	24N		
RANGE:	05E, W.M.		
COUNTY:	KING		

TOPOGRAPHIC & BOUNDARY SURVEY
 PARCEL NO. 0191100190 & 0191100195

JAYMARC HOMES
 4537 90TH AVE SE
 MERCER ISLAND, WA 98040



Terrane
 10801 Main Street, Suite 102, Bellevue, WA 98004
 phone 425.458.4488 support@terrane.net
 www.terrane.net

JOB NUMBER:	210905
DATE:	05/12/21
DRAFTED BY:	IDV / GKD
CHECKED BY:	TBR / JGM
SCALE:	1"=10'
REVISION HISTORY	
SHEET NUMBER	2 OF 2

measure success