

4537 90th AVE SE

MERCER ISLAND, WA - MISXXX

GENERAL INFORMATION
APPLIES FULL SET



7525 SE 24th St., 487
Mercer Island, WA
98040
425.266.9100

FLOOR PLAN GENERAL NOTES

GENERAL

A. ALL ANGLED WALLS (OTHER THAN 90°) SHALL BE CONSTRUCTED AS NOTED BY ANGLE (DEGREES) CALLOUT OR CONFIGURED AS DIMENSIONED. (UNO.)

B. ALL DIMENSIONS AT WALLS ARE TO THE FACE OF FRAMING STUDS.

C. ALL EXTERIOR WALLS ENCLOSING CONDITIONED SPACE SHALL BE 2x6 STUDS AT 16" OC, and INTERIOR WALLS TO BE 2x4 STUDS AT 16" OC, per IRC, R602.3.2 (UNO.)

D. ALL DIMENSIONS AT WINDOWS ARE TO THE CENTERLINE

E. WINDOW SIZES NOTED ON PLANS ARE NOMINAL SO CONTRACTOR MUST VERIFY EXACT ROUGH OPENINGS PRIOR TO FRAMING. WINDOW and DOOR HEAD HEIGHTS SHOULD BE COORDINATED SO THAT ALL WINDOW and DOOR TRIMS ALIGN.

F. PROVIDE WEATHER PROTECTION SYSTEM w/WATER-RESISTIVE BARRIERS IN COMBINATION w/FLASHINGS at EXT. WALLS, OPENINGS, PROJECTIONS, PENETRATIONS and INTERSECTIONS TO LOCK OUT ALL MOISTURE per IRC, R703.1-703.4

G. TILE INSTALLATION SHALL COMPLY w/APPLICABLE SECTIONS OF THE TILE COUNCIL OF AMERICA'S "HANDBOOK FOR CERAMIC TILE INSTALLATION" and ITS REFERENCED STANDARDS including IRC, R702.4.1

H. ALL COUNTERS, TUB DECKS & WALLS AT TUBS & SHOWERS SHALL HAVE SMOOTH, HARD, NON-ABSORBENT SURFACE w/CENTRITIOUS BACKER BOARD and MOISTURE RESISTANT UNDERLAYMENT per IRC, R702.4.2. NONABSORBENT AT TUB & SHOWER WALLS SHALL BE TO A HEIGHT OF +12" MIN. ABOVE DRAIN INLET per IRC, R307.2

I. ALL SHOWERS AND ALL SHOWER RECEPTORS SHALL COMPLY WITH THE 2018 INTERNATIONAL PLUMBING CODE.

J. CALCULATIONS and DETAILS FOR MOUNTING HEIGHTS & CONNECTION OF METAL GUARDRAILS (IF USED) SHALL BE PROVIDED FOR REVIEW and APPROVAL BY RAILING FABRICATOR PRIOR TO INSTALLATION FOR COMPLIANCE w/IRC R311 & R312

K. ALL REQUIREMENTS FOR BUILDING ENVELOPE TO COMPLY WITH THE 2018 WASHINGTON STATE ENERGY CODE (WSEC). SEE RESID ENERGY CREDITS ON THIS SHEET ALONG w/ ENI FOR PRESCRIPTIVE REQUIREMENTS and COMPLIANCE NOTES FOR SINGLE FAMILY RESIDENTIAL IN CLIMATE ZONE 5 and MARINE 4.

L. WSEC COMPLIANCE CERTIFICATE REQUIRED WITHIN 3' OF ELECTRICAL PANEL.

M. EXHAUST FANS LARGER THAN 50cfm MAY BE CONNECTED TO 4" SMOOTH WALL VENT PIPE IF RUNS DO NOT EXCEED 20' IN LENGTH, THE MINIMUM SIZE OF FLEX DUCT IS 5" DIAMETER WITH MAXIMUM RUN OF 15'.

N. COMBUSTION AIR REQUIRED FOR ALL FUEL BURNING APPLIANCES. ALL INTIION SOURCES TO BE MIN. 18" ABV. GARAGE FLOOR per IRC, M307.3

O. PROVIDE FIREBLOCKING TO CUT OFF DRAFT OPENINGS AT LOCATIONS w/MATERIALS per IRC, R302.11. PROVIDE DRAFT STOPPING AT FLOOR/CEILING ASSEMBLIES per IRC, R302.12

P. ALL WASTE PLUMBING DROPS TO BE ON INTERIOR WALLS or FURRED OUT EXTERIOR WALLS.

Q. PROVIDE ACOUSTICAL PIPE WRAP AT ALL UPPER LEVEL WASTE LINES

R. ALL OPENINGS MADE IN WALLS, FLOORS or CEILINGSS FOR THE PASSAGE OF PIPES, STRAINER PLATES ON DRAIN INLETS, TUB WASTE OPENINGS TO CRAWLSPACE and METER BOXES TO COMPLY w/THE CODE REQUIREMENTS OF THE GOVERNING UPC.

S. ENTRY STEPS SHALL HAVE SUFFICIENT GRADE BUILT UP AROUND THEM SO THE NUMBER OF STAIR RISERS DOES NOT EXCEED 3, w/MAX. RISER HEIGHT OF 7 3/4" - NOT REQUIRING A HANDRAIL per IRC, R311.7.8

T. ALL EXTERIOR HOSE BIBS TO HAVE NON-REMOVABLE VACUUM BREAKERS, MUST BE FROSTPROOF and BE CAULKED and SECURED AT EXT. WALLS.

U. INTERIOR CEILING HEIGHTS ARE AS FOLLOWS:
MAIN FLOOR 10'-0" (UNO.)
UPPER FLOOR 9'-1 1/8" (UNO.)

SAFETY GLAZING

SAFETY GLAZING INSTALLED IN HAZARDOUS LOCATIONS AS REQUIRED BY THIS SECTION SHALL HAVE MFG'S DESIGNATION w/TYPE, THICKNESS and SAFETY GLAZING STANDARD with WHICH IT COMPLIES MARKED BY PERMANENT MEANS THAT CANNOT BE REMOVED WITHOUT DESTROYING GLASS per IRC, R308.1

IRC, R308.4 REQUIRES THAT SAFETY GLAZING TO BE INSTALLED IN ALL HAZARDOUS LOCATIONS per DEFINED REQUIREMENTS and EXCEPTIONS SPECIFIED IN IRC, R308.4.1 through R308.4.7

- GLAZING IN DOORS.
- GLAZING ADJACENT TO DOORS.
- GLAZING IN WINDOWS MEETING ALL (4) CONDITIONS LISTED.
- GLAZING IN GUARDS and RAILINGS
- GLAZING IN and NEAR NET SURFACES.
- GLAZING ADJACENT TO STAIRS and RAMPS
- GLAZING ADJACENT TO THE BOTTOM STAIR LANDING.

SKYLIGHTS and SLOPED GLAZING SHALL COMPLY WITH

ALARMS per R314.5 and R315.4

BUILDING CODES FOR THIS SET

CITY OF MERCER ISLAND CODES AT THE DATE OF THIS DRAWING SET:

2018 INTERNATIONAL BUILDING CODE (IBC)
2018 INTERNATIONAL RESIDENTIAL CODE (IRC)
2018 WASHINGTON STATE ENERGY CODES
2018 ICC A117.1, BARRIER-FREE STANDARD
2018 INTERNATIONAL FIRE CODE (IFC)
2018 NATIONAL ELECTRIC CODE (NEC)
2018 UNIFORM PLUMBING CODE (UPC)
2018 INTERNATIONAL MECHANICAL CODE (IMC)
2018 INTERNATIONAL FUEL GAS CODE (IFGC)
2018 POOL AND SPA CODE

GUARDS SHALL BE PROVIDED IN ACCORDANCE w/REQUIREMENTS and EXCEPTIONS OF IRC, R312.1 through R312.2 INCLUDING:

- ALONG OPEN-SIDED WALKING SURFACES, INCLUDING STAIRS, RAMPS and LANDINGS LOCATED 30" or GREATER ABOVE ADJACENT FLOOR LEVEL per IRC, R312.1
- OPENINGS MUST PREVENT THE PASSAGE OF A 4" SPHERE or 4 3/4" AT OPEN SIDES OF STAIRS or 6" AT TRIANGLE OF TREAD, RISER & BOTTOM RAIL per R312.1.3
- GUARDS MUST BE PROVIDED AS WINDOW FALL PROTECTION AT LOW WINDOWS LOCATED GREATER THAN 12" ABV. FINISHED GRADE per IRC, R312.2

GUARDS and HANDRAILS MUST RESIST A SINGLE CONCENTRATED LOAD OF 200lbs. IN ANY DIRECTION ALONG THE TOP and GUARD INFILL MUST RESIST A 50lb. LOAD APPLIED HORIZ. OVER 1 sq.ft. per IRC, TABLE R301.5

ALARMS

SMOKE ALARMS and CARBON MONOXIDE ALARMS REQUIRED IN ALL NEW DWELLINGS SHALL MEET REQUIREMENTS and EXCEPTIONS OF NFPA 72, IRC, R314 and R315.

- SMOKE ALARMS TO BE LISTED and INSTALLED IN ACCORDANCE w/IRC, R314.1 and CARBON MONOXIDE ALARMS IN ACCORDANCE w/IRC, R315.1
- SMOKE ALARMS SHALL BE INSTALLED IN FOLLOWING LOCATIONS per R314.3:
 - IN EACH SLEEPING ROOM.
 - OUTSIDE EACH SEPARATE SLEEPING AREA.
 - ON EACH STORY OF THE DWELLING.
 - NOT LESS THAN 3' FROM A BATHROOM w/TUB or SHOWER.
 - NOT NEAR COOKING APPLIANCES per R314.3.1
- SMOKE ALARMS SHALL BE INTERCONNECTED per R314.4
- CARBON MONOXIDE ALARMS SHALL BE INSTALLED IN THE FOLLOWING LOCATIONS per R315.3:
 - ON EACH STORY OF THE DWELLING
 - ADJACENT TO EACH SEPARATE SLEEPING AREA.
 - WITHIN BEDROOMS WHERE A FUEL BURNING FIREPLACE IS LOCATED IN THE ROOM or ITS ATTACHED BATH.

ALL ALARMS SHALL RECEIVE THEIR PRIMARY POWER FROM BUILDING WIRING w/BATTERY BACKUP per R314.6 and R315.5

COMBINATION SMOKE and CARBON MONOXIDE ALARMS SHALL BE PERMITTED IN LIEU OF SEPARATE

ABBREVIATIONS

# Pound OR Number & And	ELEC Electrical ELEV Elevation EQ Equal EW Each Way EXC Excavate EXH Exhaust EXIST Existing EXT Exterior FBD Fiberboard FCB Fiber Cement Board FCO Floor clean out FDI Floor drain FMI Finish FIXT Fixture FLOR Fluorescent FLR Floor FLSH Flashing FND Foundation FOC Face Of FOM Face of Masonry FOS Face of Studs FOW Face of Wall FFL Fireplace FRM Frame(ing) FRFF Fireproof FT Fast FTG Footing FUR Furred G/G Gauge GALV Galvanized GFCI Ground Fault Circuit Interrupter GFI Ground Fault Interrupter GL Glass GLB Blue Laminated Beam GLBK Glass Block GYP Gypsum HB Hose Bib HC Hollow Core HDR Header HDWR Hardware HT Height HVAC Heat-Vent-Air Conditioning HW Hot water ID Inside Diameter ILO in Lieu Of IN Inch INCL Include INT Interior J=Box Junction box JNT Joint JST Joist KD Klin Dried KIT Kitchen LAM Laminated(d) LAV Lavatory LB Pound LF Lineal Feet LL Live Load LT Light LTV Lighting LVL Laminated Veneer LVR Louver MAS Masonry MAX Maximum MBR Member	MC Medicine Cabinet MDO Medium Density Overlay MECH Mechanical MED Medium MEMB Membrane MFR Manufacturer MIN Minimum MIR Mirror MSC Miscellaneous MLB Micro Laminated Beam MMB Membrane MTL Metal MWK Millwork NIC Not in Contract NO # NO Number NOM Nominal NTS Not to Scale O Non-Operable Window OBS Obscure OD Outside Diameter OH Overhang OP Opaque OPG Opening OPNG Opening or Rough Opening OSB Orientated Strand Board PBD Particle Board PBF Prefabricated PERFF Perforate(d) PL Property Line PLAM Plastic Laminated Plate Plywood PNT Paint or Painted PPF Pounds Per Square Foot PSI Pounds Per Square Inch PT Pressure Treated PVC Polyvinyl Chloride PWMT Pavement R Riser R&S Rod and Shelf RC Reinforced Concrete RD Rod RD Roof Drain RDL Roof drain leader REBAR Reinforcing Bar RETFR Retention REG Register RENF Reinforced REQ Required REQD Required REV Revision RFG Roofing RM Room RO Rough Opening ROW Right of way SA Supply Air SCH Schedule SCN Screen SD Smoke detector SECT Section SGD Sliding Glass Door SH Shelf SHH Sheathing SIM Similar SIM Similar	SLB Slab SPEC Specification SQ Square SQ IN Square inches SQFT Square feet STO Sound Transmission Coefficient STD Standard STL Steel STR Structural STRUCT Structure or Structural SY Square yard T Tread T&G Tongue and Groove TEL Telephone TME To Match Existing TOB Top of Beam TOC Top of curb / Top of Section TOF Top of footing TOJ Top of joint TOU Top of wall TP Toilet Paper Hanger TYP Typical UNO Unless Noted VERT Vertical VIF Verify in field W/ With W/O Without WC Toilet (water closet) WD Wood WDW Window WH Water Heater WIC Walk-in Closet WP Water Proofing WP Weatherproof WR Weather Resistant WRB Weather Resistive Barrier WWF Welded Wire Fabric X Operable Window Section
-------------------------	----------------------------------------------------------------------------------------------------------------------------------------------------------------------------------------------------------------------------------------------------------------------------------------------------------------------------------------------------------------------------------------------------------------------------------------------------------------------------------------------------------------------------------------------------------------------------------------------------------------------------------------------------------------------------------------------------------------------------------------------------------------------------------------------------------------------------------------------------------------------------------------------------------------------------------------------------------------------------------------	--------------------------------------------------------------------------------------------------------------------------------------------------------------------------------------------------------------------------------------------------------------------------------------------------------------------------------------------------------------------------------------------------------------------------------------------------------------------------------------------------------------------------------------------------------------------------------------------------------------------------------------------------------------------------------------------------------------------------------------------------------------------------------------------------------------------------------------------------------------------------------------------------------------------------------------------------------------------------------------------------------------------------------------------------------------------------------------------	---------------------------------------------------------------------------------------------------------------------------------------------------------------------------------------------------------------------------------------------------------------------------------------------------------------------------------------------------------------------------------------------------------------------------------------------------------------------------------------------------------------------------------------------------------------------------------------------------------------------------------------------------------------------------------------------------------

PROJECT TEAM

ARCHITECTURAL DESIGN - JAYMARC HOMES

ARCHITECTURAL DRAFTING
JAYMARC HOMES - 425.226.9100 - JAYMARCHOMES.COM
RYAN REDMAN - RYAN@JAYMARCHOMES.COM

M&K ENGINEERING
MULHERN & KULP - 215.646.8001 - MULHERNKULP.COM
RICHARD ZABEL - RZABEL@MULHERNKULP.COM

COVER SHEET

1/4" = 1'-0"

SHEET INDEX

SHEET #	DESCRIPTION
A1	COVERSHEET
A1.1	A.D.U. - FLOOR PLAN INFORMATION
A2	SITE PLAN
A3	FOUNDATION PLAN
A4	MAIN FLOOR FRAMING PLAN
A5	MAIN FLOOR PLAN
A6	UPPER FLOOR FRAMING PLAN
A7	UPPER FLOOR PLAN
A8	ROOF FRAMING PLAN
A9	ROOF PLAN
A10	EXTERIOR ELEVATIONS
A11	EXTERIOR ELEVATIONS
A12	BUILDING SECTIONS
S0.0	LATERAL - STRUCTURAL GENERAL NOTES
LB-1	LATERAL - DETAILS
LB-2	LATERAL - DETAILS
LB-3	LATERAL - DETAILS
SD.01	FOUNDATION DETAILS
D1	WATER INTRUSION DETAILS
E1	MAIN FLOOR ELECTRICAL LAYOUT
E2	UPPER FLOOR ELECTRICAL LAYOUT
EN1	2018 ENERGY CODE CALCULATIONS

F.A.R. CALCULATIONS: SQUARE FOOTAGE SUMMARY	
MAIN FLOOR/ MAIN LIVING	1,664 S.F.
MAIN FLOOR A.D.U.	134 S.F.
GARAGE	525 S.F.
SUB TOTAL	2,328 S.F.
UPPER FLOOR/ MAIN LIVING	1,636 S.F.
UPPER FLOOR A.D.U.	685 S.F.
MINUS MAIN STAIRS	-100 S.F.
SUB TOTAL	2,162 S.F.
TOTAL G.F.A.	4,490 S.F.
ALLOWABLE F.A.R. 45%	4,500 S.F.
PROPOSED	34.4%
TOTAL NET AREA MAIN HOUSE	3,200 S.F.
GARAGE	525 S.F.
TOTAL NET A.D.U.	765 S.F.
SUB TOTAL	4,490 S.F.
COVID PATIO	240 S.F.
COVID PORCH	87 S.F.
OVERALL WIDTH	54'-2"
OVERALL DEPTH	48'-5 1/2"

Updated: 03/04/2018

Method for Calculating Square Footage - ANSI Z769-2013 (except, no separate distinction of above-grade or below-grade areas and each level is measured to the outside of studs not the exterior finished surface.

Square footage calculations for this house were made based on plan dimensions only and may vary from the finished square footage of the house as built.

See Sheet "CODES" for additional Zoning required Area Calculations

Issue	Issue Date By
Description	
	07.11.22
	CITY PLAN REVIEW COMMENTS
	08.16.22
	CITY PLAN REVIEW COMMENTS
	12.15.22
	CITY PLAN REVIEW COMMENTS

4537 90th AVE SE
Mercer Island, WA.
Job Number:

plan name: -
marketing name: XXXXXX
plan number:
mark sys. number:-

Conditions not specifically represented graphically or in writing or which conflict with the current International Residential Code (IRC.) or those of the local municipality then the current standards and requirements of each respectively shall govern.

The drawings in this set are instruments of service and shall remain the property of JayMarc Homes, LLC.

© 2017 JayMarc Homes, LLC; All rights reserved.

06.15.21
Submission Date

Sheet Title/Description
JAYMARC HOMES
Design Firm

R.R.
Drawn by:
R.R./ S.K.
Checked by:

Primary Scale

A1
of .

Sheet Title/Description

Sheet Title/Description

Issue	Issue Date	By	Description
07.11.22			CITY PLAN REVIEW COMMENTS
08.16.22			CITY PLAN REVIEW COMMENTS
12.15.22			CITY PLAN REVIEW COMMENTS

4537 90th AVE SE
Mercer Island, WA.

Job Number:

plan name: -
marketing name: XXXXXX
plan number: -
mark sys. number: -

Conditions not specifically represented graphically or in writing or which conflict with the current International Residential Code (IRC.) or those of the local municipality then the current standards and requirements of each respectively shall govern.

The drawings in this set are instruments of service and shall remain the property of JayMarc Homes, LLC.

© 2017 JayMarc Homes, LLC. All rights reserved.

06.15.21
Submittal Date

Sheet Title/Description


JAYMARC HOMES
Design Firm

R.R.
Drawn by:

R.R./S.K.
Checked by:

Primary Scale


A1.1
of .

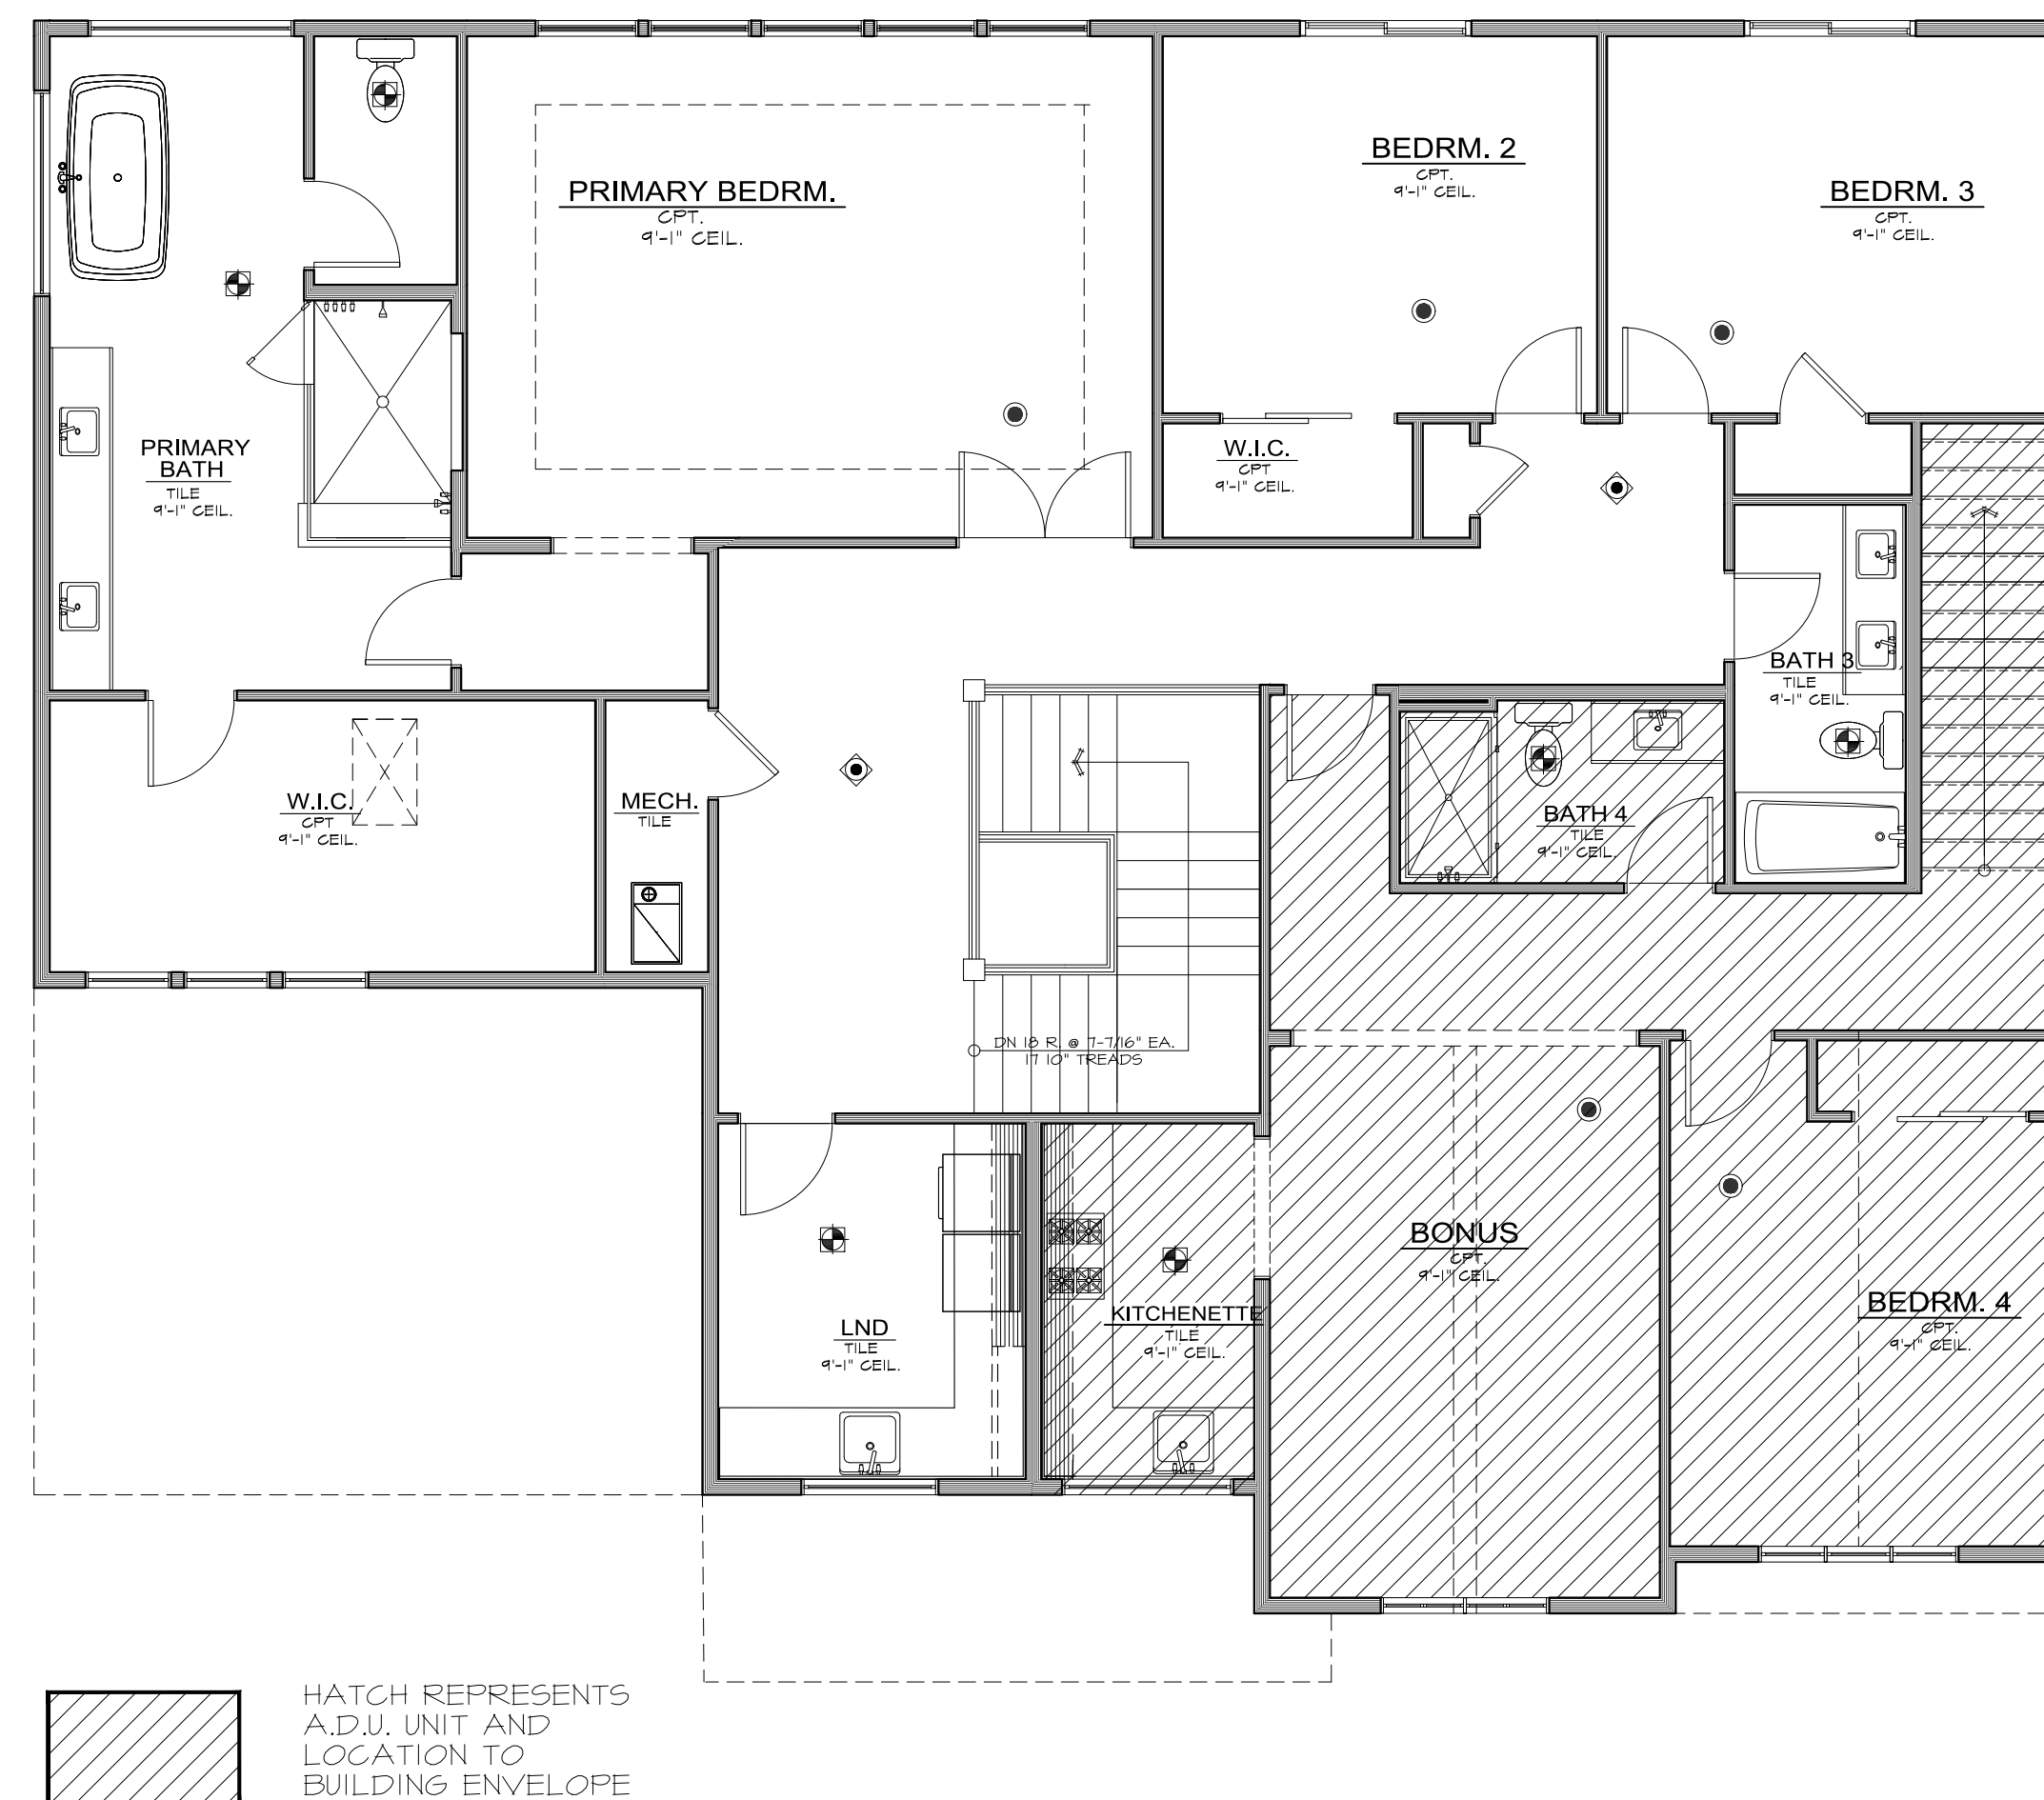

HATCH REPRESENTS A.D.U. UNIT AND LOCATION TO BUILDING ENVELOPE

UPPER FLOOR PLAN

1/4" = 1'-0"

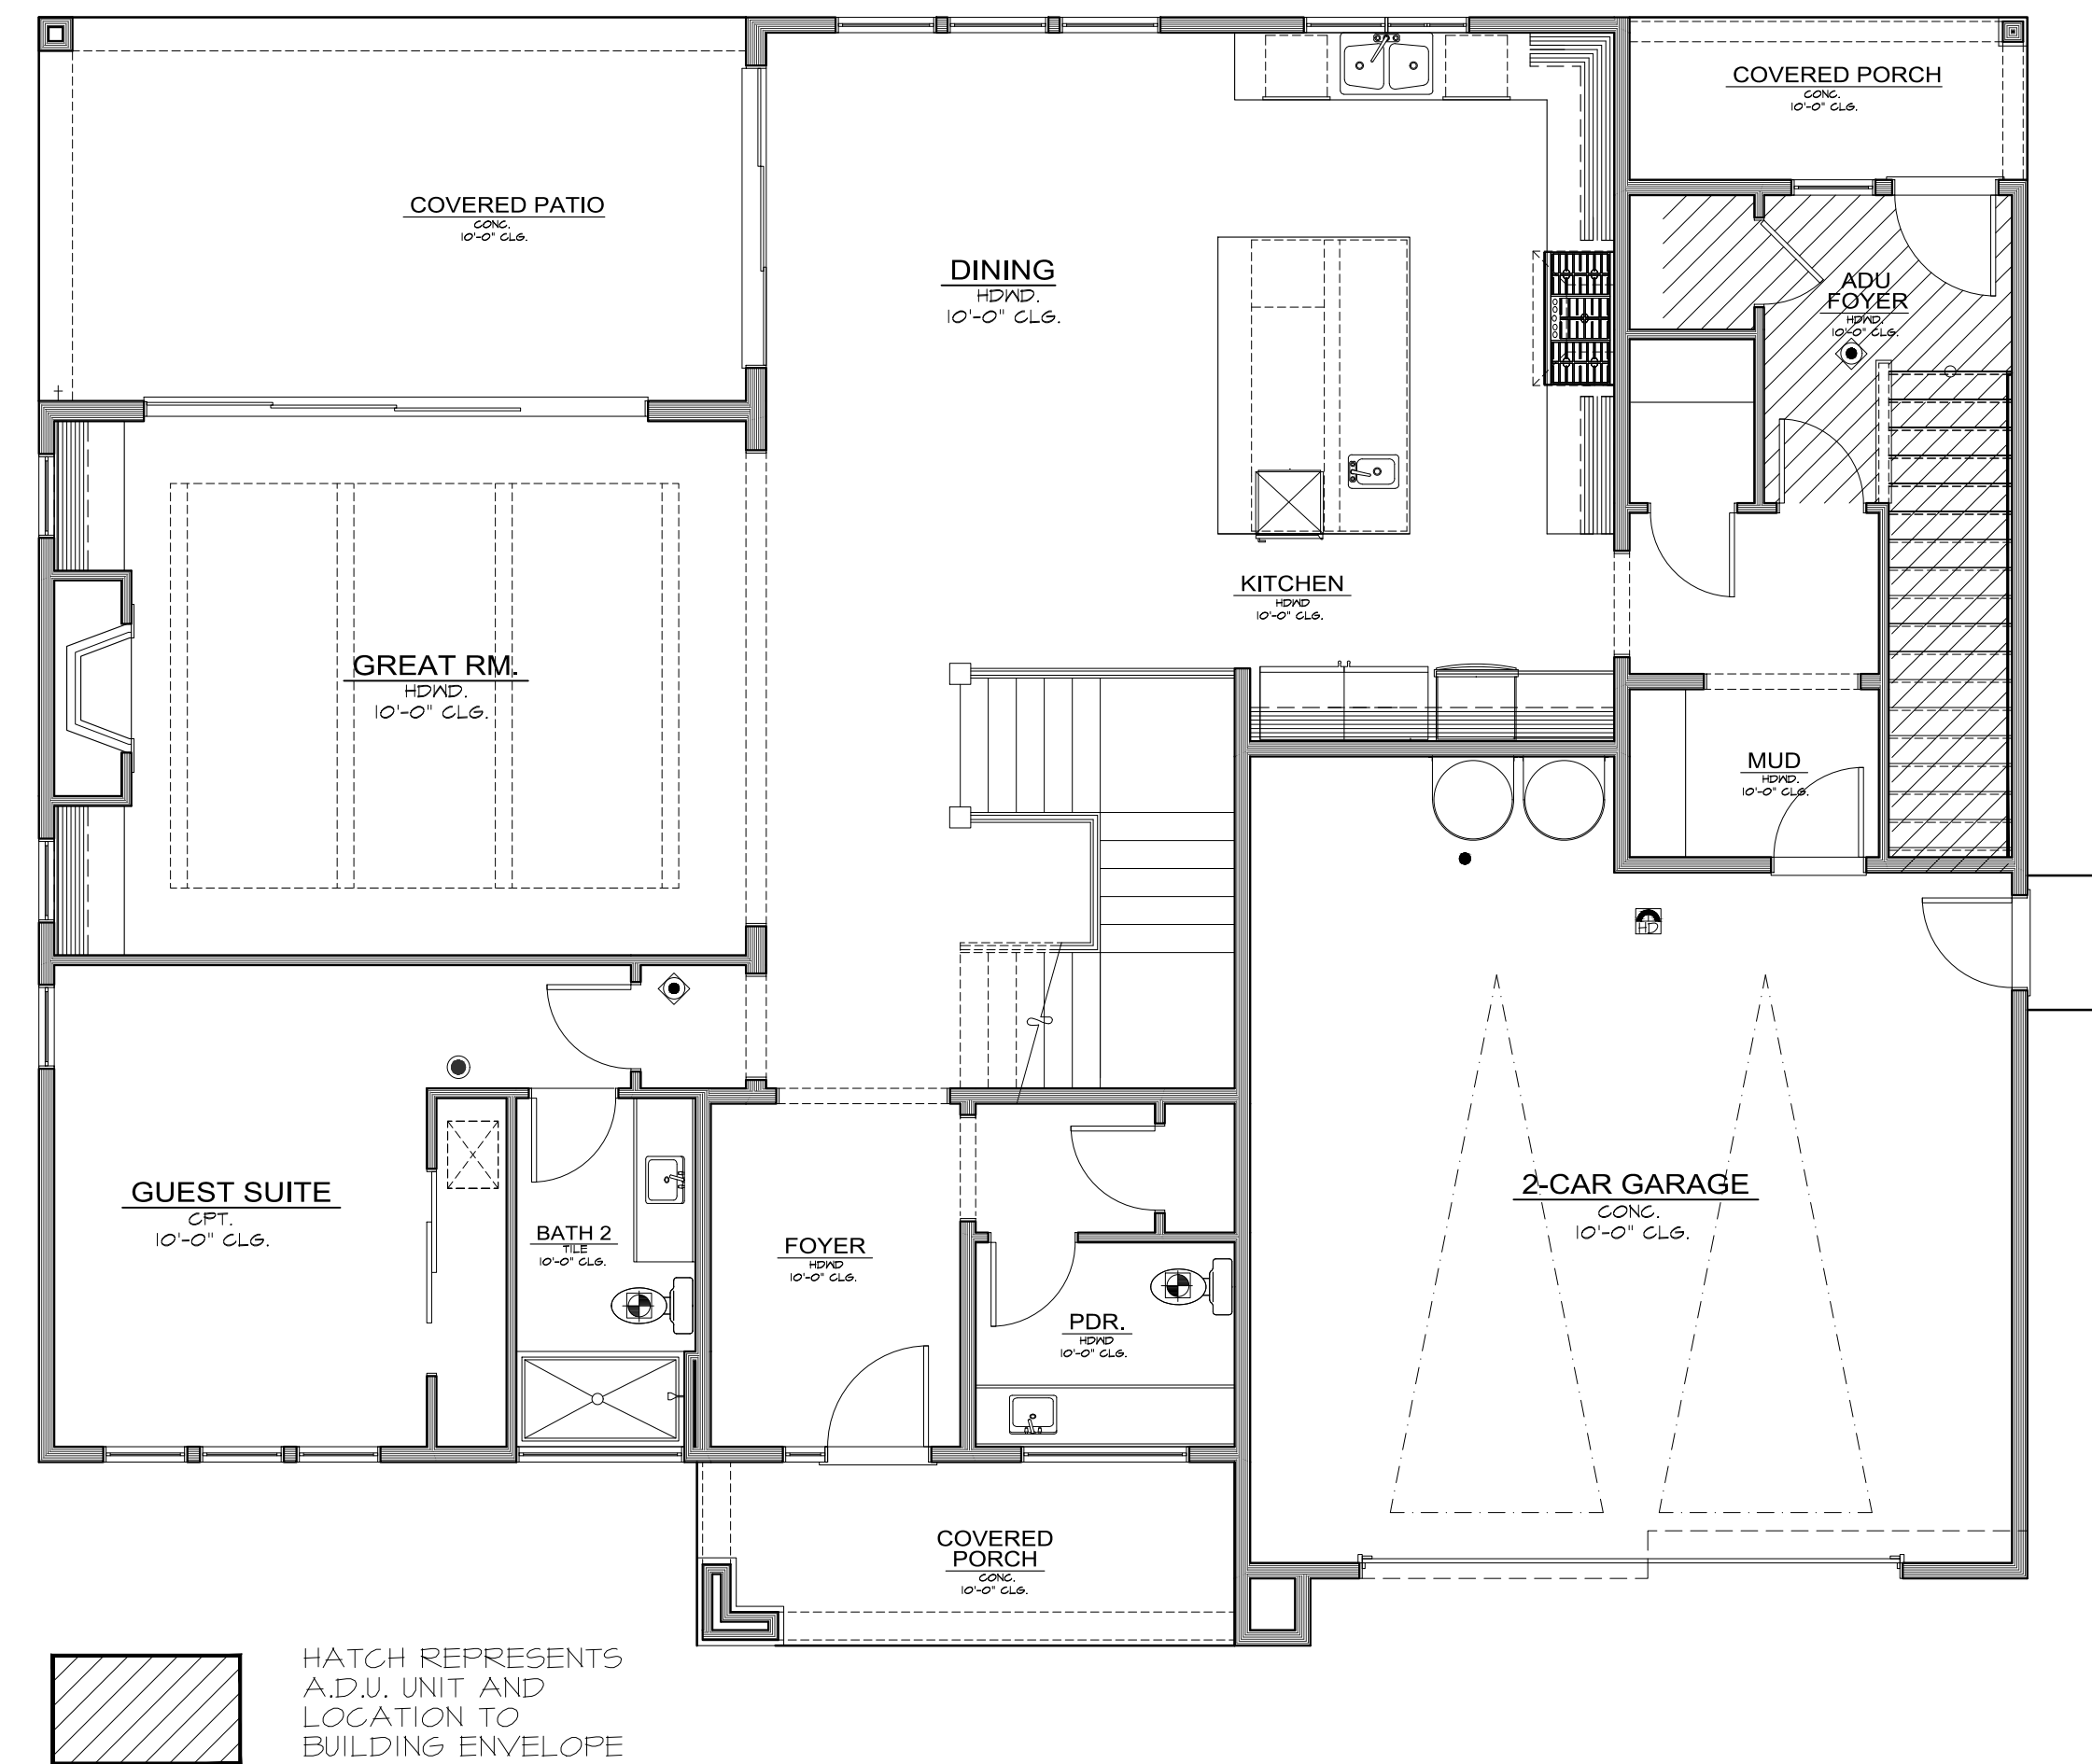

HATCH REPRESENTS A.D.U. UNIT AND LOCATION TO BUILDING ENVELOPE

MAIN FLOOR PLAN

1/4" = 1'-0"


ADU PLAN INFORMATION

1/4" = 1'-0"

F.A.R. CALCULATIONS:
SQUARE FOOTAGE SUMMARY

MAIN FLOOR/ MAIN LIVING	1,664	S.F.
MAIN FLOOR A.D.U.	194	S.F.
GARAGE	525	S.F.
SUB TOTAL	2,328	S.F.
UPPER FLOOR/ MAIN LIVING	1,696	S.F.
UPPER FLOOR A.D.U.	695	S.F.
MINUS A.D.U. STAIRS	-54	S.F.
MINUS MAIN STAIRS	-100	S.F.
SUB TOTAL	2,162	S.F.
TOTAL G.F.A.	4,490	S.F.
ALLOWABLE F.A.R. 45%	4,500	S.F.
PROPOSED	34.48	
TOTAL NET AREA MAIN HOUSE	3,200	S.F.
GARAGE	525	S.F.
TOTAL NET A.D.U.	165	S.F.
SUB TOTAL	4,490	S.F.
COVERD PATIO	240	S.F.
COVERD PORCH	87	S.F.
OVERALL WIDTH	54'-2"	
OVERALL DEPTH	48'-5 1/2"	

Method for Calculating Square Footage - ANSI Z90-2013 applied, no separate distinction of below-grade or semi-grade areas and shall be measured to the outside of studs not the exterior finished surface.
Square Footage calculations for this house were made based on plan dimensions only and may vary from the finished square footage of the house as built.
See Sheet "CODES" for additional Zoning required Area Calculations.

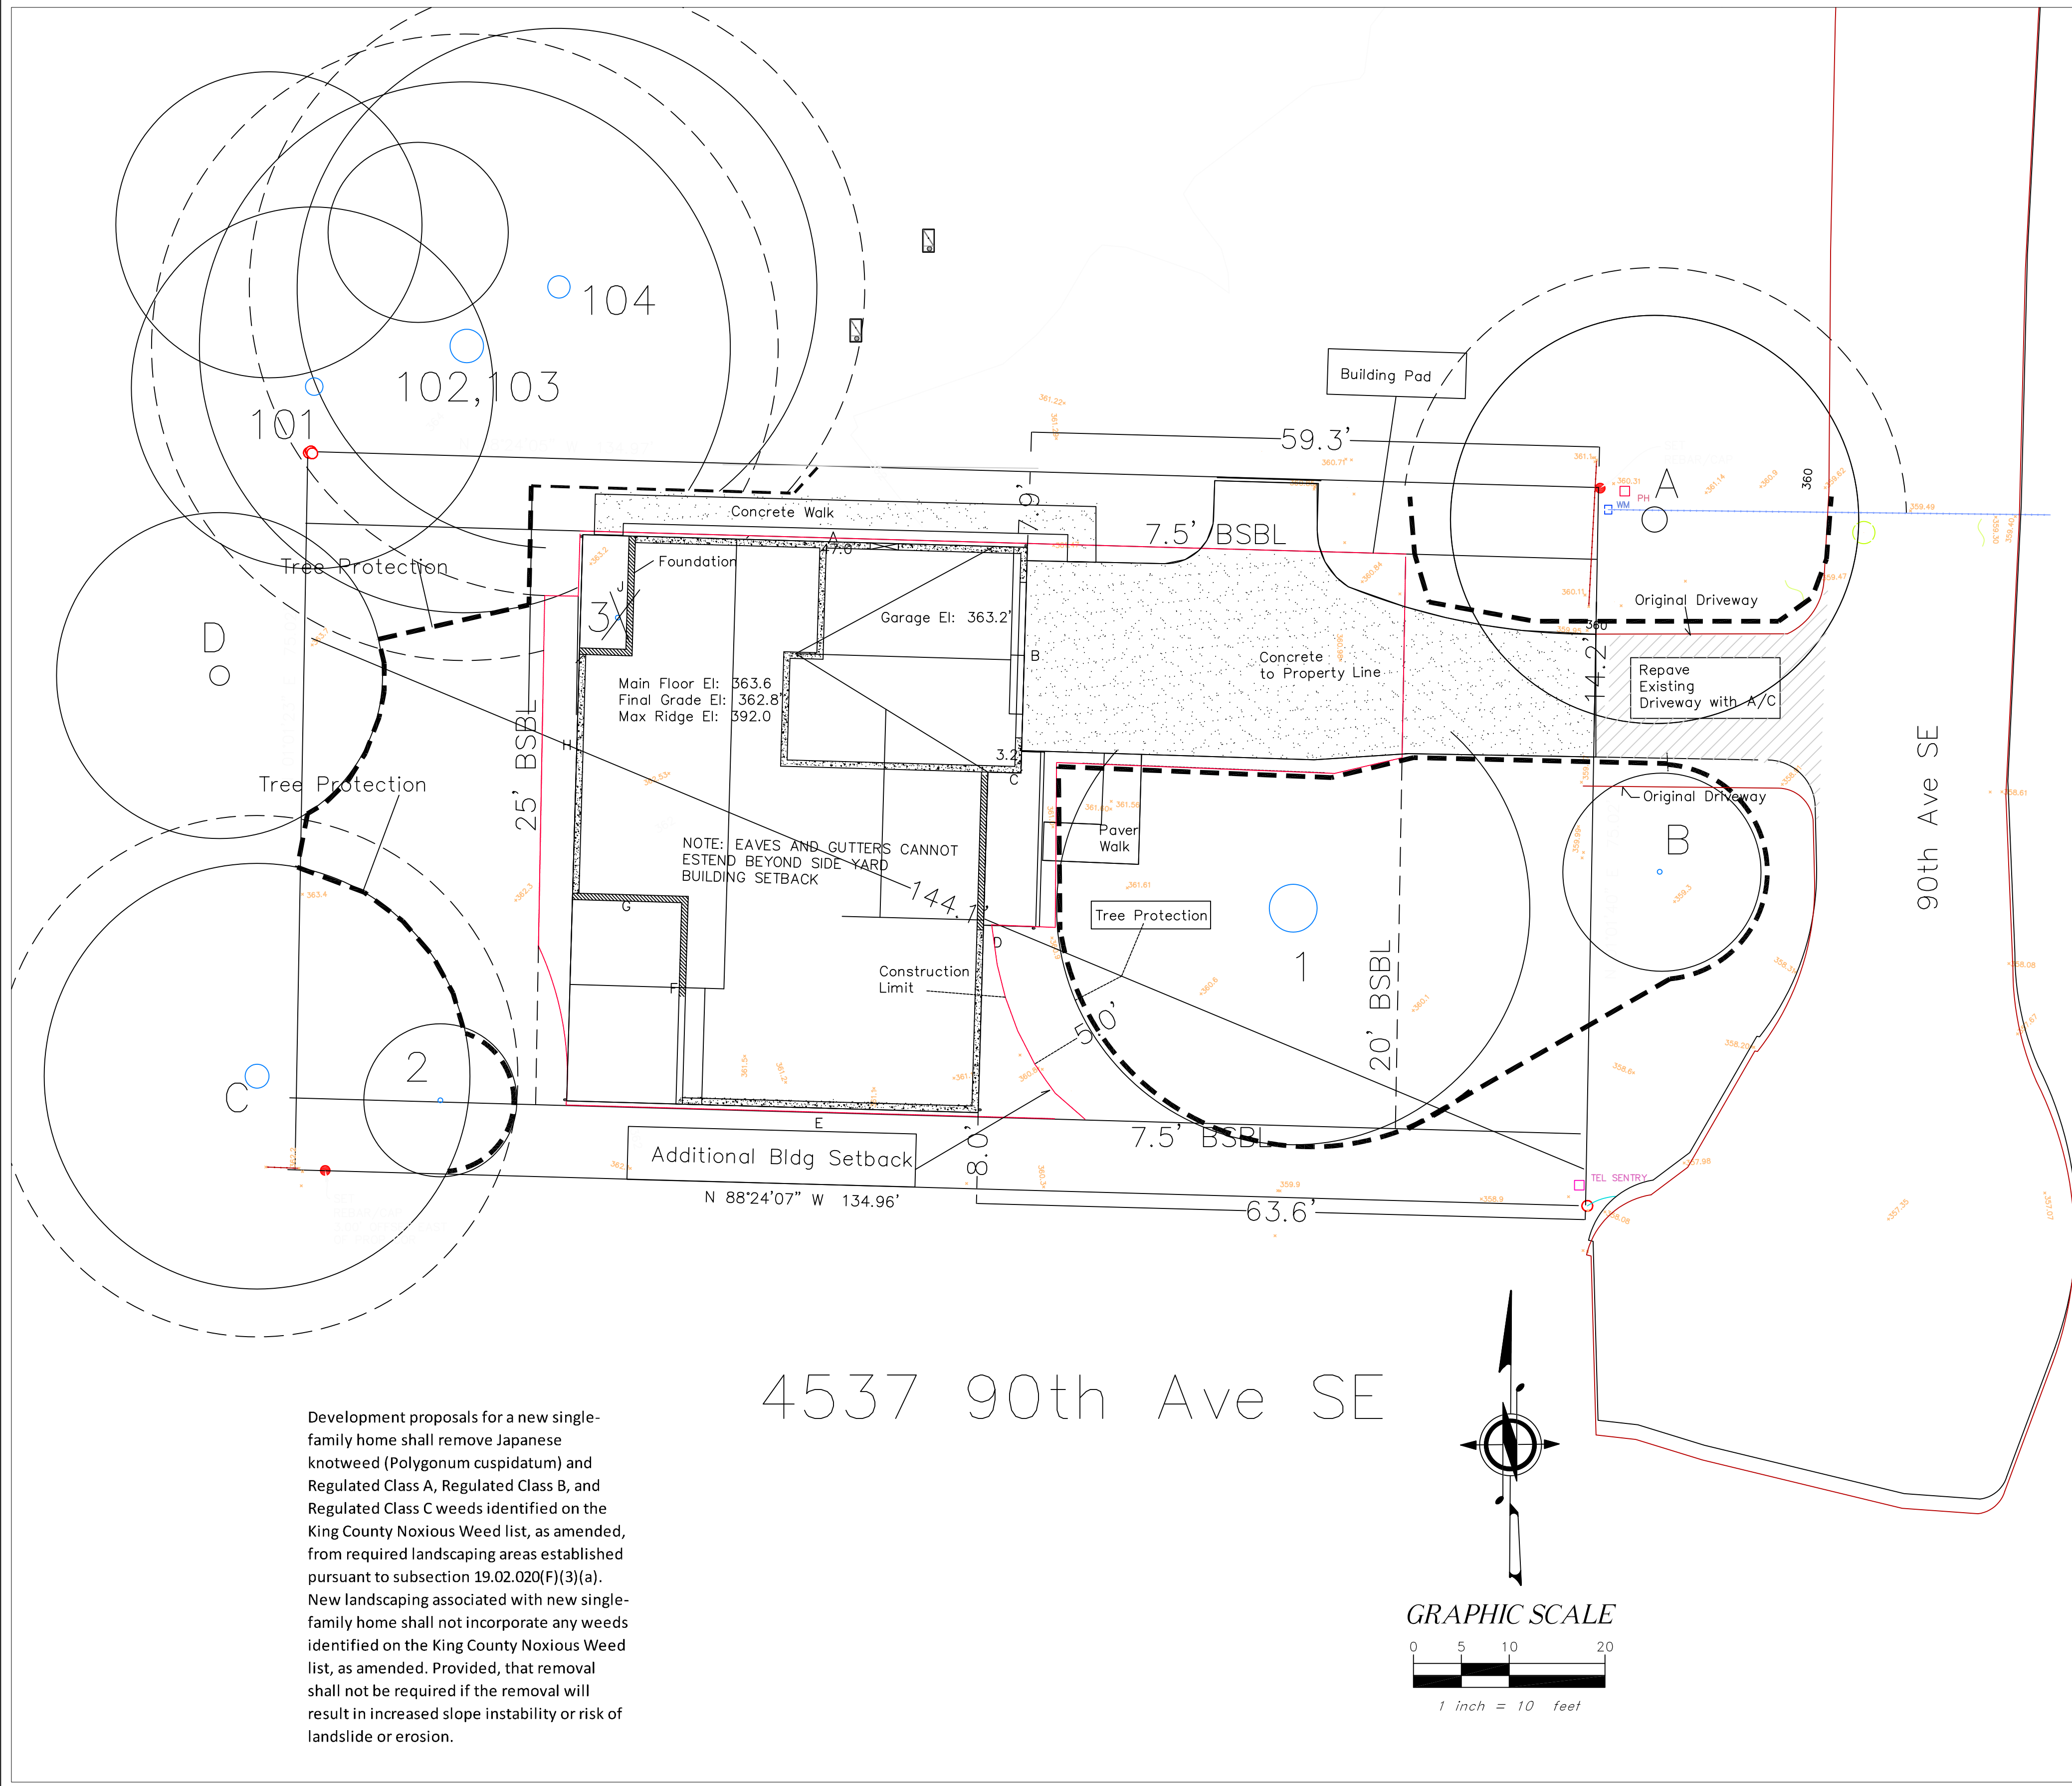

Development proposals for a new single-family home shall remove Japanese knotweed (*Polygonum cuspidatum*) and Regulated Class A, Regulated Class B, and Regulated Class C weeds identified on the King County Noxious Weed list, as amended, from required landscaping areas established pursuant to subsection 19.02.020(F)(3)(a). New landscaping associated with new single-family home shall not incorporate any weeds identified on the King County Noxious Weed list, as amended. Provided, that removal shall not be required if the removal will result in increased slope instability or risk of landslide or erosion.

4537 90th Ave SE



PROPERTY OWNER
 SABISABI, LLC
STREET ADDRESS
 4537 90th Ave SE, Mercer Island, WA 98040
PARCEL #
 191100195
LEGAL DESCRIPTION
 Lot 7, Block 3, Allview Heights Addition to Seattle, According to the plat recorded in Volume 16 of Plats, Page 20, King County Together with the east Half of the Vacated Alley Adjoining on the West.
ZONE: R-9.6
SETBACKS:
 Front Yard - 20'
 Rear Yard - 25'
 Side Yards - 7.5'/15'
HEIGHT LIMIT: 30' above ABE to roof peak
MAXIMUM LOT COVERAGE: 40%
MAXIMUM HARDSCAPE: 9%
MAXIMUM FAR: 40% + 5% ADU
PARKING SPACES PROVIDED: 3 GARAGE 2 DRIVEWAY
NO CRITICAL AREAS IMPACTED
No Onsite Utility Easements

Hardscape	
EXISTING	
Uncovered Patio	713
Total Existing	713
Existing Removed	-713
Net Existing Retained	0
NEW	
Walkways	239
Total New	239
Total New and Existing	239
Total Hardscape	2.36%

HEIGHT TABLE

Segment	Length	El:	
A	41	362.7	14870.7
B	24	361.5	8676
C	3	361.5	1084.5
D	36	361.3	13006.8
E	32	361.2	11558.4
F	22	362	7964
G	11.5	362.2	4165.3
H	26	362.7	9430.2
I	4.5	363	1633.5
J	11.5	363.2	4176.8
	211.5		76566.2
Average		362	
Height Limit		30	
Elevation Limit		392.0	
		391.5	

PARKING

Covered	2 ea.
Driveway	2 ea.

LOT SLOPE CALCULATION

High Point El:	363.7 ft
Low Point El:	358.3 ft
Elevation Difference	5.4 ft
Distance	144.1 ft
% Slope	3.75%

GROSS FLOOR AREA	
Main Floor/Main Living	1664 sf
Main Floor Garage	525 sf
Main Floor ADU	139 sf
Total Main Floor	2328 sf
Second Floor Main Living	1636 sf
Second Floor Stair Deduction	-100 sf
Second Floor ADU	685 sf
ADU Stair Deduction	-59 sf
Total Second Floor	2162 sf
Total GFA	4490 sf
Allowable GFA 45%/wADU	4500 sf
Proposed %	44.9 %

4537 TREE INVENTORY


ONSITE TREES							
Tree ID	species	DBH	DRIP	EXCEPTIONAL	SAVE	REMOVE	
1	Western red cedar	58.5	24	yes	yes		
2	Mountain Ash	6	6	small tree	yes		
3	Eastern Dogwood	6	16	small tree	No	YES	
OFFSITE TREES							
A	Western Red Cedar	41.6	20	yes			
B	Mountain Ash	9	11	small tree			
C	Douglas Fir	35	21	yes			
D	Douglas Fir	24	16	Large Tree			
101	Doug Fir	24	18	yes, grove			
102	Doug Fir	35.5	14	yes, grove			
103	Doug Fir	40	26	yes, grove			
104	Doug Fir	30.5	26	yes, grove			

JayMarc Homes, LLC
 7525 SE 24th St, #487
 Mercer Island, WA 98040
 425 281 2706

Site Plan
 4537 90th Ave SE
 Mercer Island, WA

Drawn by
 GU
 3-21-22
 8-19-22
 12-16-22

A2.0

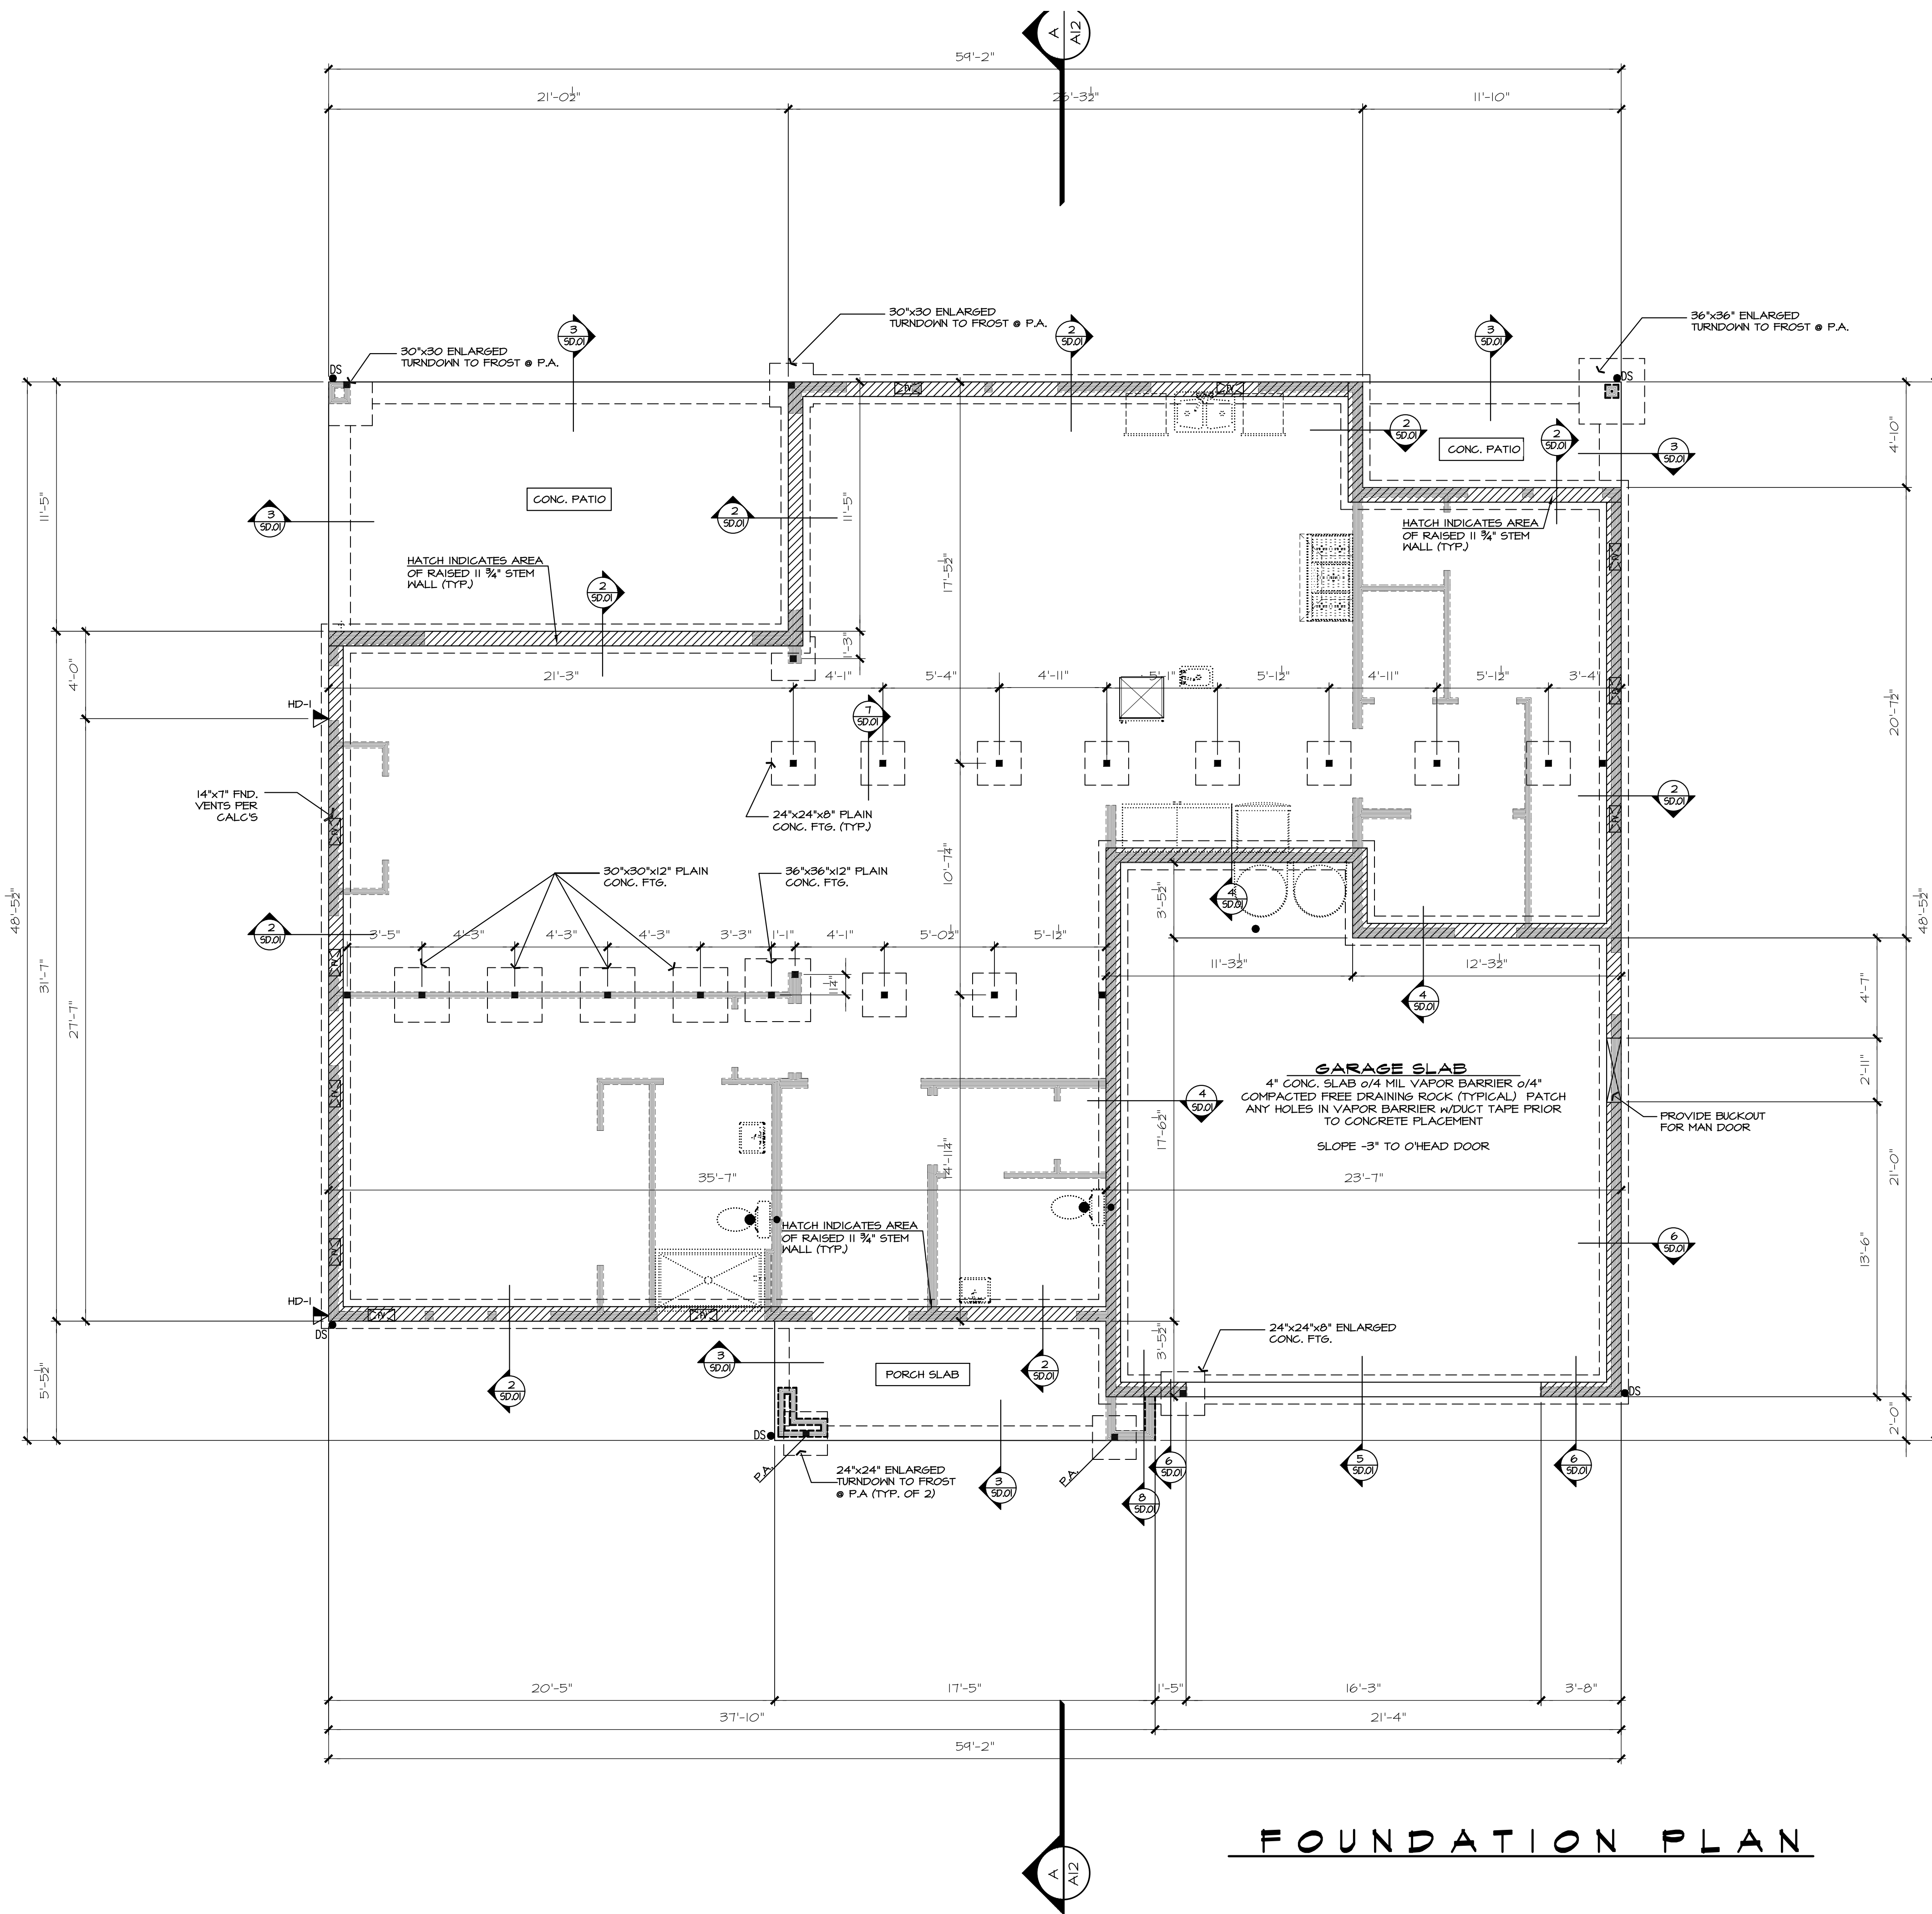

FOUNDATION PLAN

HOLD-DOWN SCHEDULE	
SYMBOL	SPECIFICATION
HD-1	SIMPSON STHD14 (R.J) HOLD-DOWN
HD-5	SIMPSON C516 STRAP TIE (14" END LENGTH)
HD-6	SIMPSON M5TC40 STRAP TIE (12" END LENGTH)
HD-7	SIMPSON M5TC66 STRAP TIE (24" END LENGTH)

LEGEND	
⋯	INTERIOR BEARING WALL
—	EXTERIOR WALL ABOVE
—	JL METAL HANGER
*	INDICATES POST ABOVE. PROVIDE SOLID BLOCKING UNDER POST OR JAMB ABOVE.
▶	INDICATES HOLD-DOWN.

4x10 DROPPED CONT. BEAM (TYP. U.N.O.)

TYP. CRAWLSPACE POSTS:
 4x4 P.T. POST (4'-0" MAX. POST HEIGHT)
 W/2x4 CLEATS EA. SIDE + SIMPSON ABW44Z PLATE @ BASE OF POST ON ASPHALT SHINGLE ON 24"x24"x8" PLAIN CONC. FTG. (TYP. U.N.O.)

REFER TO S-O FOR TYPICAL STRUCTURAL NOTES & SCHEDULES


JAYMARC HOMES
 7525 SE 24th St., 487
 Mercer Island, WA
 98040
 425.266.9100

Issue	Issue Date	By	Description
1	07.11.22		CITY PLAN REVIEW COMMENTS
2	08.16.22		CITY PLAN REVIEW COMMENTS
3	12.15.22		CITY PLAN REVIEW COMMENTS

4537 90th AVE SE
Mercer Island, WA.
 Job Number:


plan name: -
 marketing name: XXXXXX
 plan number:
 mark sys. number: -

Conditions not specifically represented graphically or in writing or which conflict with the current International Residential Code (IRC.) or those of the local municipality then the current standards and requirements of each respectively shall govern.
 The drawings in this set are instruments of service and shall remain the property of JayMarc Homes, LLC.

© 2017 JayMarc Homes, LLC; All rights reserved.

06.15.21
 Submittal Date

Sheet Title/Description
 JAYMARC HOMES
 Design Firm
 R.R.
 Drawn by:
 R.R./ S.K.
 Checked by:
 Primary Scale

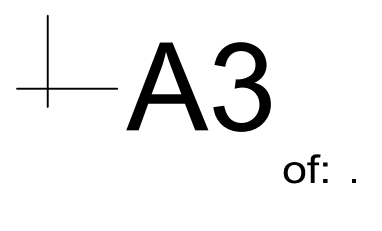
 A3
 of 100

Sheet Title/Description



7525 SE 24th St., 487
Mercer Island, WA
98040
425.266.9100

HOLD-DOWN SCHEDULE	
SYMBOL	SPECIFICATION
HD-1	SIMPSON STHD14 (R.J.) HOLD-DOWN
HD-5	SIMPSON CS16 STRAP TIE (14" END LENGTH)
HD-6	SIMPSON MSTC40 STRAP TIE (12" END LENGTH)
HD-7	SIMPSON MSTC66 STRAP TIE (24" END LENGTH)

LEGEND	
	J.L. METAL HANGER
	* INDICATES POST ABOVE. PROVIDE SOLID BLOCKING UNDER POST OR JAMB ABOVE.
	▶ INDICATES HOLD-DOWN.


INDICATES 11-7/8" TJI FLOOR JOISTS @ 16" O.C. 210 SERIES (TYP. U.N.O.)

REFER TO S-O FOR TYPICAL STRUCTURAL NOTES & SCHEDULES

4x10 DROPPED CONT. BEAM (TYP. U.N.O.)

TYP. CRAWLSPACE POSTS:
4x4 P.T. POST (4'-0" MAX. POST HEIGHT) W/2x4 GLEATS EA. SIDE + SIMPSON ABW44Z PLATE @ BASE OF POST ON ASPHALT SHINGLE ON 24"x24"x8" PLAIN CONG. FTG. (TYP. U.N.O.)

FOUNDATION VENTILATION		
Crawlspace Area:	1821 s.f.	
Ventilation Required:	1821 s.f. / 300 =	874.08 s.i. Req'd
Use:	14" x 7" Foundation Vents	
Vent Area =	98 s.i. - 25% reduct., 1/4" mesh =	73.5 s.i.
Vents Required =	874.08 s.i. / Vent Area =	11.89 s.i.
Provide:	12 14" x 7" Vents, Area =	882 s.i.
Ventilation Provided =	882.00 s.i. is Greater than	874.08 s.i. Req'd
Use:	12 14" x 7" Foundation Vents	
* FOUNDATION VENTS SHALL NOT INTERFERE WITH DIRECT LOAD PATH OF COLUMNS		
* INSTALL 6 MIL BLACK POLYETHYLENE VAPOR RETARDER GROUND COVER		
* LOCATE ONE VENT WITHIN 3 FEET OF EACH CORNER OF THE BUILDING, EXCEPT ONE SIDE OF THE BUILDING SHALL BE PERMITTED TO HAVE NO VENTS.		

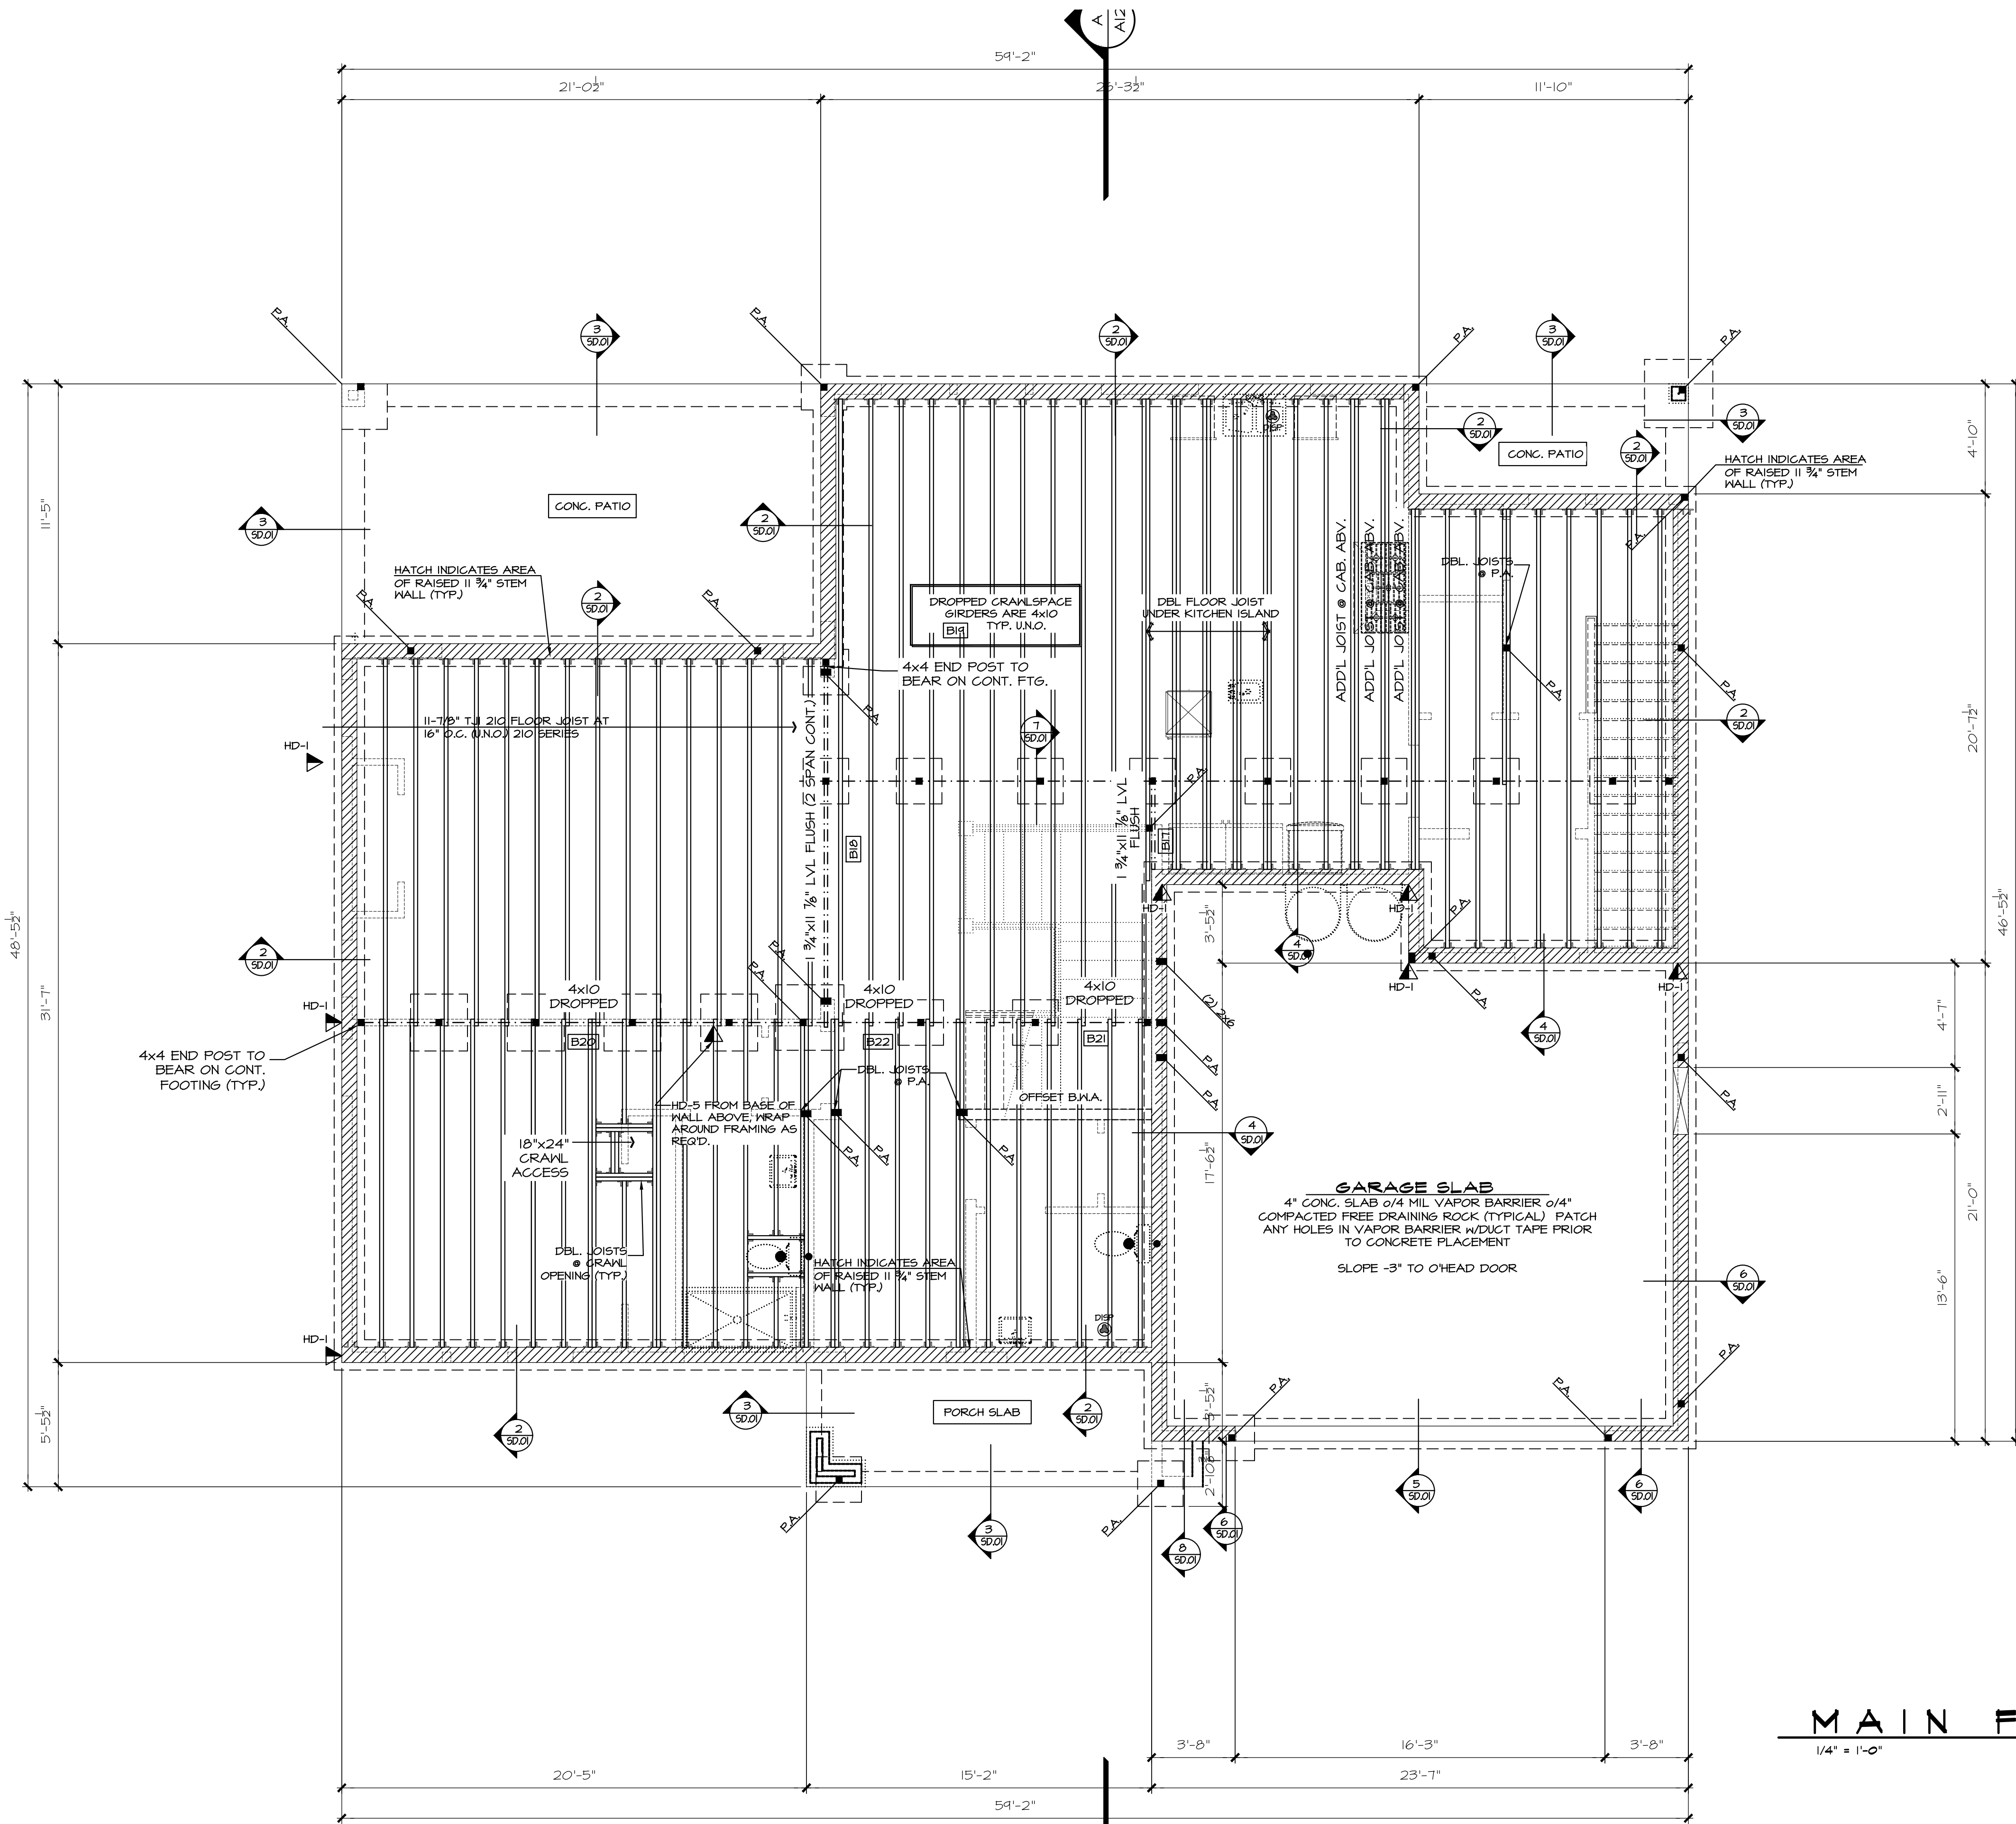

MAIN FLOOR FRAMING PLAN

1/4" = 1'-0"

Issue Description	Issue Date	By
	07.11.22	
CITY PLAN REVIEW COMMENTS	08.16.22	
CITY PLAN REVIEW COMMENTS	12.15.22	

4537 90th AVE SE
Mercer Island, WA.
Job Number:

plan name: -
marketing name: XXXXXX
plan number:
mark sys. number: -

Conditions not specifically represented graphically or in writing or which conflict with the current International Residential Code (IRC) or those of the local municipality then the current standards and requirements of each respectively shall govern.

The drawings in this set are instruments of service and shall remain the property of JoyMarc Homes, LLC.

© 2017 JoyMarc Homes, LLC; All rights reserved.

06.15.21
Submittal Date

Sheet Title/Description
JAYMARC HOMES
Design Firm

R.R.
Drawn by:
R.R./S.K.
Checked by:

Primary Scale

A4
of: .

Sheet Title/Description



7525 SE 24th St., 487
Mercer Island, WA
98040
425.266.9100

MAIN FLOOR PLAN NOTES

PLAN SPECIFIC 2018 INSEC. SECTION R06
R406.2 ADDITIONAL ENERGY EFFICIENCY REQUIREMENTS (MANDATORY). THIS RESIDENTIAL DWELLING SHALL COMPLY W/SUFFICIENT OPTIONS FROM TABLE R406.2 TO ACHIEVE THE FOLLOWING MIN. NUMBER OF CREDITS: 6 FOR A 1501sf TO 4499sf HOME.
CREDITS PROVIDED IN THIS HOME AS FOLLOWS:
EFFICIENT BUILDING ENVELOPE OPT. 1.3: 0.5 CREDITS
PRESCRIPTIVE COMPLIANCE IS BASED ON TABLE R402.1.1 WITH FOLLOWING MODIFICATIONS:
VERTICAL PENETRATION U = 0.28 WINDOWS
FLOORS TO BE R-38 and SLAB ON GRADE TO BE R-10 PERIMETER and UNDER ENTIRE SLAB BELOW GRADE.

HIGH EFFICIENCY HVAC EQUIPMENT OPT. 3.5a: 1.5 CREDITS
AIR-SOURCE, CENTRALLY DUCTED HEAT PUMP WITH MINIMUM HEFF OF 11.0. TO QUALIFY TO CLAIM THIS CREDIT, THE BUILDING PERMIT DRAWINGS SHALL SPECIFY THE OPTION BEING SELECTED AND SHALL SPECIFY THE HEATING EQUIPMENT EFFICIENCY. EXTERIOR LOCATED EQUIPMENT SHOULD ALSO BE REPRESENTED ON SITE PLAN.

HIGH EFFICIENCY HVAC DISTRIBUTION OPT. 4.2: 1.0 CREDITS
HVAC EQUIPMENT AND ASSOCIATED DUCT SYSTEM(S) SHALL COMPLY WITH THE REQUIREMENTS OF SECT R409.3.1. LOGGING SYSTEM COMPONENTS IN CONDITIONED CRANL SPACES IS NOT PERMITTED UNDER THIS OPTION. ELECTRIC RESISTANCE HEAT AND DUCTLESS HEAT PUMPS ARE NOT PERMITTED UNDER THIS OPTION. DIRECT COMBUSTION HEATING EQUIPMENT WITH AFUE LESS THAN 80% IS NOT PERMITTED UNDER THIS OPTION.

EFFICIENT WATER HEATING 5.5: 2.0 CREDITS
WATER HEATING SYSTEMS SHALL INCLUDE ONE OF THE FOLLOWING: ELECTRIC HEAT PUMP WATER HEATER MEETING THE STANDARDS FOR TIER III OF NEEA'S ADVANCED WATER HEATING SPECIFICATION. TO QUALIFY TO CLAIM THIS CREDIT, THE BUILDING PERMIT DRAWINGS SHALL SPECIFY THE OPTION BEING SELECTED AND SHALL SPECIFY THE WATER HEATER EQUIPMENT TYPE AND THE MINIMUM EQUIPMENT EFFICIENCY.

WHOLE HOUSE VENTILATION
PROVIDE WHOLE HOUSE VENTILATION per 2018 IRC, M505.4.3(1) and IMC R403.3. THE WHOLE-HOUSE MECHANICAL VENTILATION SYSTEM SHALL PROVIDE OUTDOOR AIR AT A CONTINUOUS RATE AS DETERMINED IN ACCORDANCE WITH TABLE M505.4.3(1) OR EQUATION 15.

SYMBOL	LOCATION	MIN. FAN REQUIREMENTS (ALL FANS VENT TO OUTSIDE)
	BATH 4 POWDER	Min. 50cfm, INTERMITTENT at .025mg per TABLE M501.4
	KITCHEN	Min. 100cfm, INTERMITTENT at .025mg per TBL. M501.4
	LAUNDRY ROOM	MIN. 36cfm, INTERMITTENT at .025mg TO FUNCTION AS WHOLE HOUSE FAN (WHF)

MECHANICAL CONTRACTOR TO SIZE WHF, FAN AND SET OPERATING TIMES per TABLE M501.3(3) FOR A 4501-5000sf. DWELLING w/ 5 OR MORE BEDRMS. TO OPERATE INTERMITTENTLY and CONTINUOUSLY per TABLE M501.3(2)
PROVIDE CONTROLS FOR WHF per M501.3.2 AFFIX LABEL TO CONTROLS THAT READS "WHOLE HOUSE VENTILATION - SEE OPERATING INSTRUCTIONS"

Issue	Issue Date By	Description
	07.11.22	CITY PLAN REVIEW COMMENTS
	08.16.22	CITY PLAN REVIEW COMMENTS
	12.15.22	CITY PLAN REVIEW COMMENTS

4537 90th AVE SE
Mercer Island, WA.
Job Number:

plan name: -
marketing name: XXXXXX
plan number:
mark sys. number:-

Conditions not specifically represented graphically or in writing or which conflict with the current International Residential Code (IRC.) or those of the local municipality and requirements of each respectively shall govern.
The drawings in this set are instruments of service and shall remain the property of JayMarc Homes, LLC.
© 2017 JayMarc Homes, LLC; All rights reserved.

06.15.21
Submittal Date


Sheet Title/Description
JAYMARC HOMES
Design Firm

R.R.
Drawn by:

R.R./ S.K.
Checked by:

Primary Scale

A5
of .

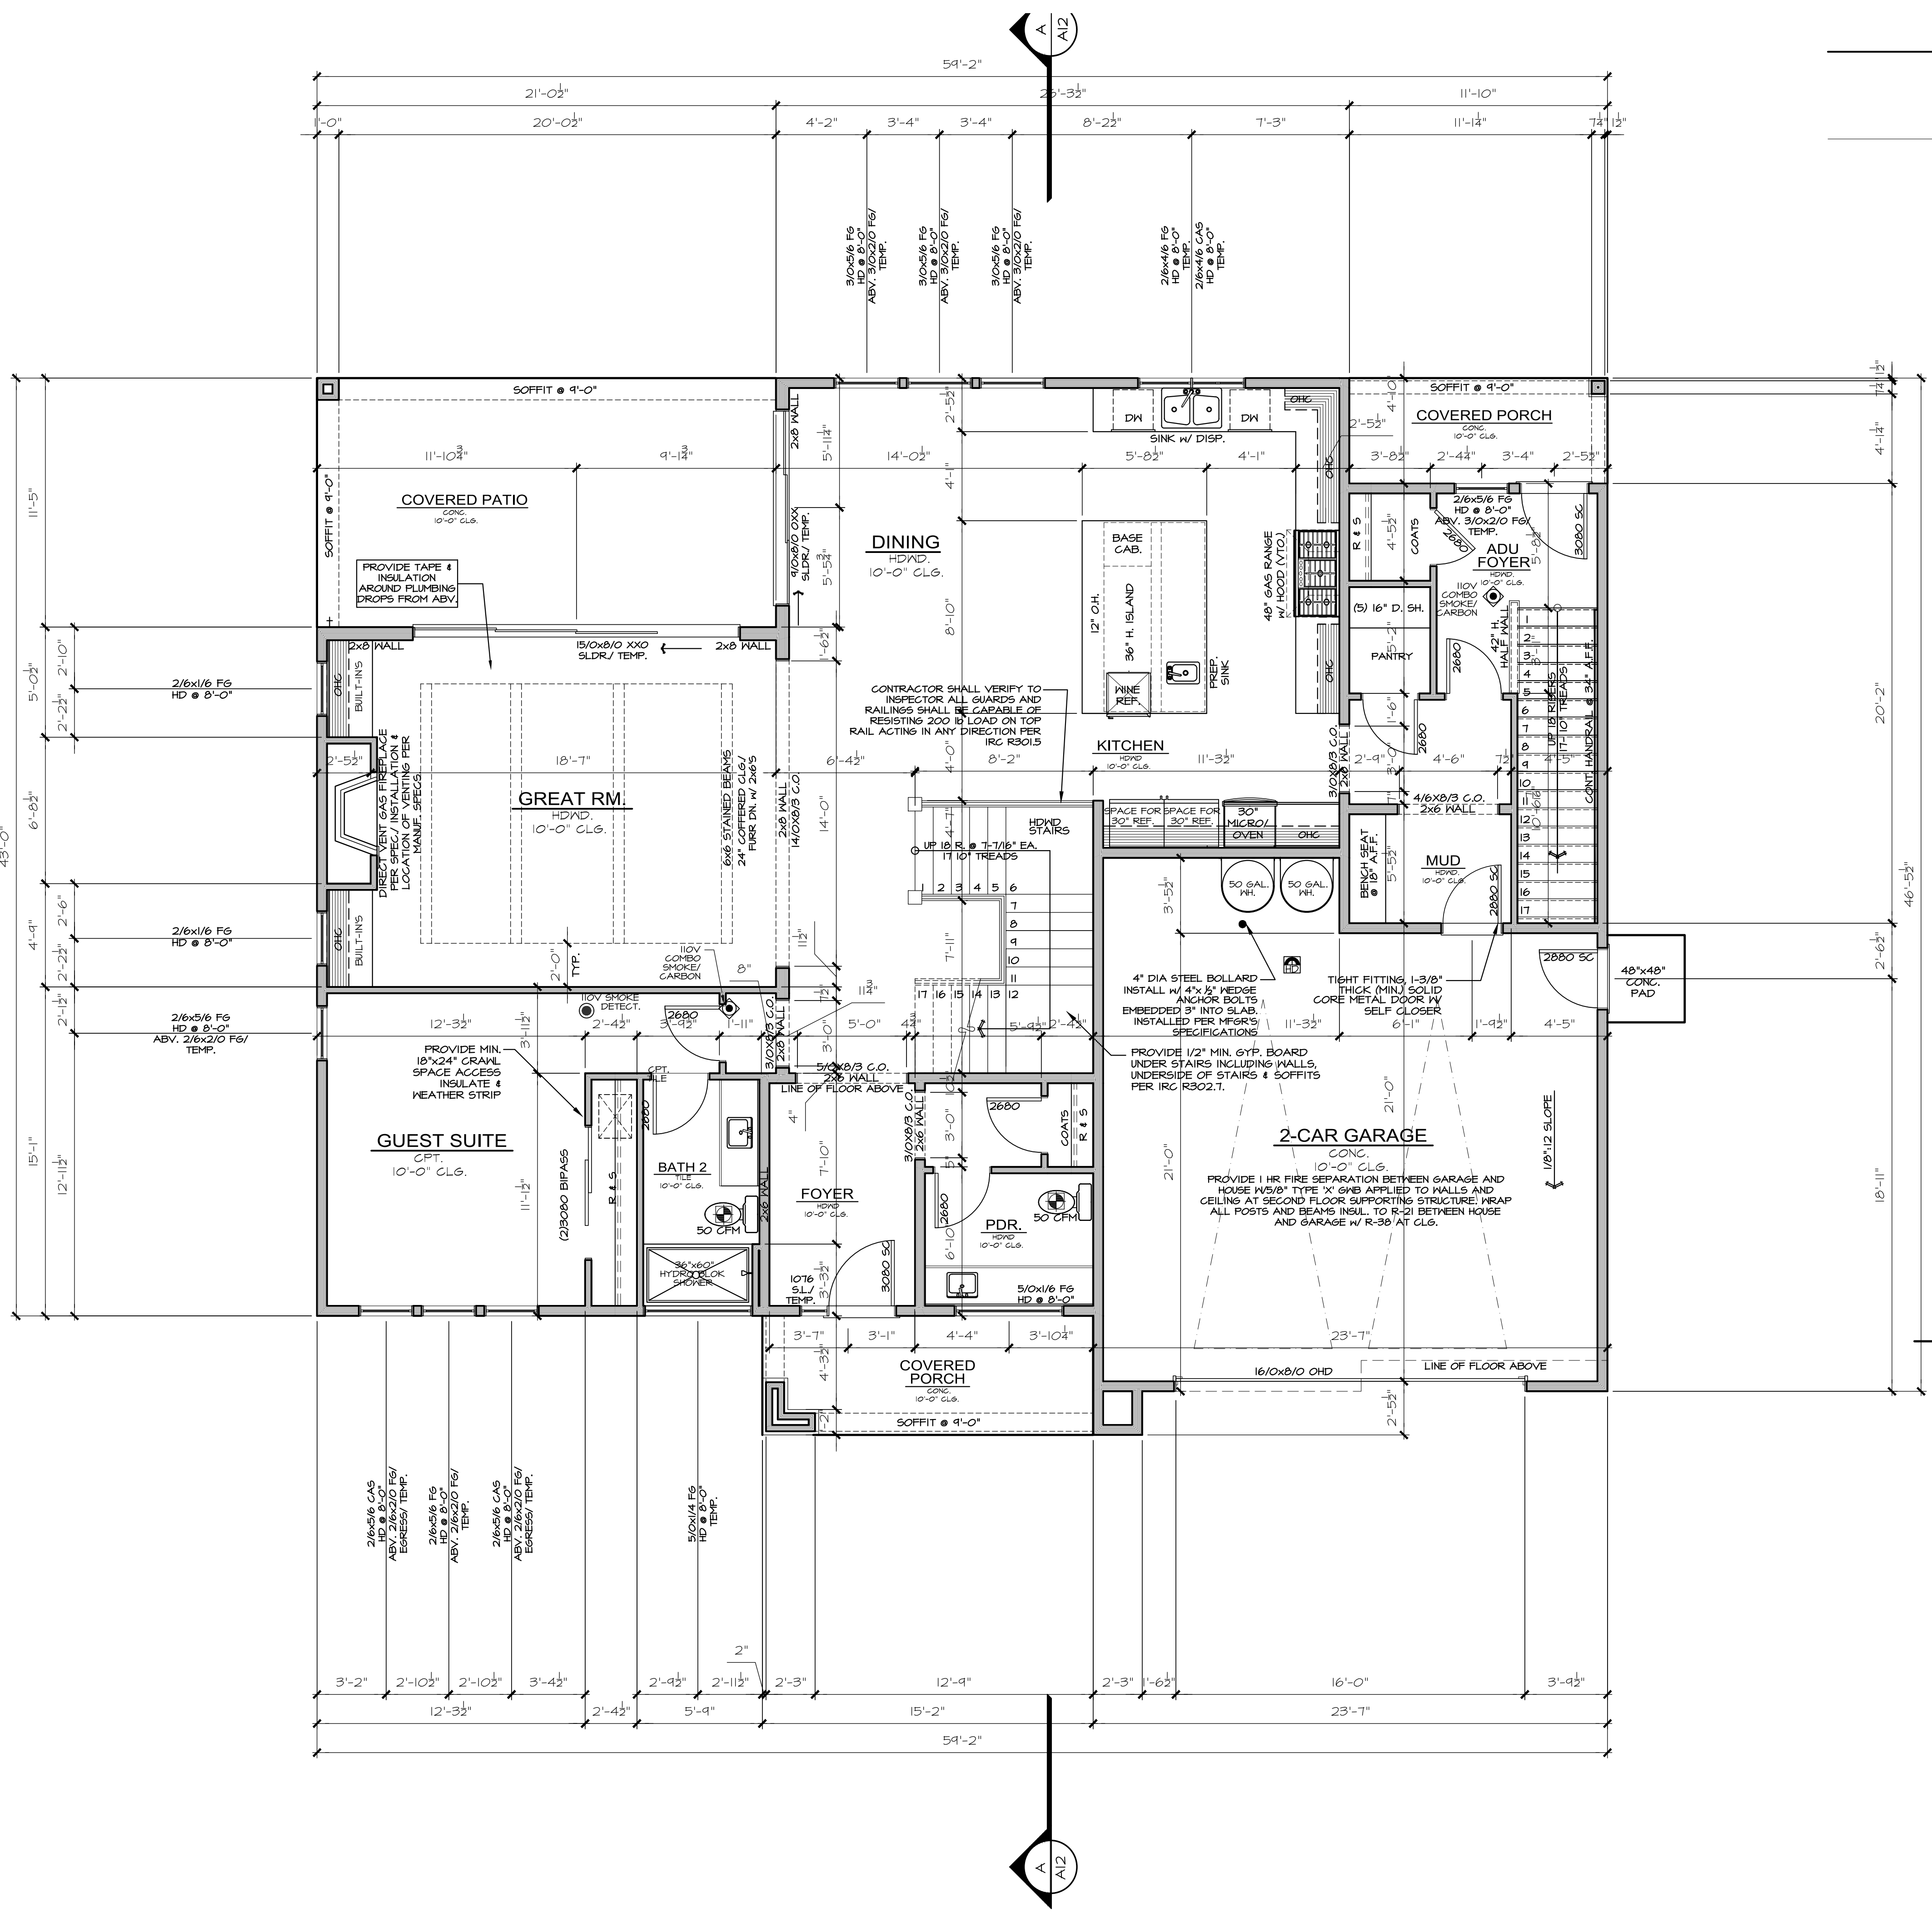

MAIN FLOOR PLAN

1/4" = 1'-0"

F.A.R. CALCULATIONS: SQUARE FOOTAGE SUMMARY

MAIN FLOOR/ MAIN LIVING	1,664 S.F.
MAIN FLOOR A.D.U.	134 S.F.
GARAGE	525 S.F.
SUB TOTAL	2,328 S.F.
UPPER FLOOR/ MAIN LIVING	1,636 S.F.
UPPER FLOOR A.D.U.	685 S.F.
MINUS A.D.U. STAIRS	-54 S.F.
MINUS MAIN STAIRS	-100 S.F.
SUB TOTAL	2,167 S.F.
TOTAL G.F.A.	4,490 S.F.
ALLOWABLE F.A.R. 45%	4,500 S.F.
PROPOSED	34.4%
TOTAL NET AREA MAIN HOUSE	3,200 S.F.
GARAGE	525 S.F.
TOTAL NET A.D.U.	165 S.F.
SUB TOTAL	4,490 S.F.
COVD PATIO	240 S.F.
COVD PORCH	87 S.F.
OVERALL WIDTH	54'-2"
OVERALL DEPTH	48'-5 1/2"

Updated: 03/09/2018
Method for Calculating Square Footage - ANSI Z165-2013 except, no separate distinction of "above-grade or below-grade" areas and each level is measured to the outside of studs not the exterior finished surface.
Square Footage calculations for this house were made based on plan dimensions only and may vary from the finished square footage of the house as built.
See Sheet "CODES" for additional Zoning required Area Calculations

Sheet Title/Description



7525 SE 24th St., 487
Mercer Island, WA
98040
425.266.9100

HOLD-DOWN SCHEDULE	
SYMBOL	SPECIFICATION
HD-1	SIMPSON 5THD14 (R.L.) HOLD-DOWN
HD-5	SIMPSON CSI6 STRAP TIE (14" END LENGTH)
HD-6	SIMPSON MSTC40 STRAP TIE (12" END LENGTH)
HD-7	SIMPSON MSTC66 STRAP TIE (24" END LENGTH)

LEGEND	
	INTERIOR BEARING WALL
	BEAM / HEADER
	18" FLOOR TRUSS @ 16" O.C. (U.N.O.)
	INTERIOR SHEAR WALL PANEL OR EXTERIOR SHEAR WALL w/ 3" O.C. EDGE NAILING
	J.L. METAL HANGER
	* INDICATES POST ABOVE. PROVIDE SOLID BLOCKING UNDER POST OR JAMB ABOVE.
	◀ INDICATES HOLD-DOWN.

REFER TO S-O FOR TYPICAL STRUCTURAL NOTES & SCHEDULES

4x10 HDR @ ALL EXT. [B1]
WINDOWS/DOORS (TYP. U.N.O.)

NOTE #1:
PROVIDE 1/8" OSB/PLYWOOD SHTG. + FASTEN PER 3" O.C. EDGE NAILING SPECS. (SEE NOTES)

Issue	Issue Date	By	Description
	07.11.22		CITY PLAN REVIEW COMMENTS
	08.16.22		CITY PLAN REVIEW COMMENTS
	12.15.22		CITY PLAN REVIEW COMMENTS

4537 90th AVE SE
Mercer Island, WA.
Job Number:

plan name: -
marketing name: XXXXXX
plan number:
mark sys. number: -

Conditions not specifically represented graphically or in writing or which conflict with the current International Residential Code (IRC), or those of the local municipality then the current standards and requirements of each respectively shall govern.

The drawings in this set are instruments of service and shall remain the property of JayMarc Homes, LLC.

© 2017 JayMarc Homes, LLC; All rights reserved.

06.15.21
Submittal Date


Sheet Title/Description
JAYMARC HOMES
Design Firm

R.R.
Drawn by:

R.R./S.K.
Checked by:

Primary Scale

A6
of .

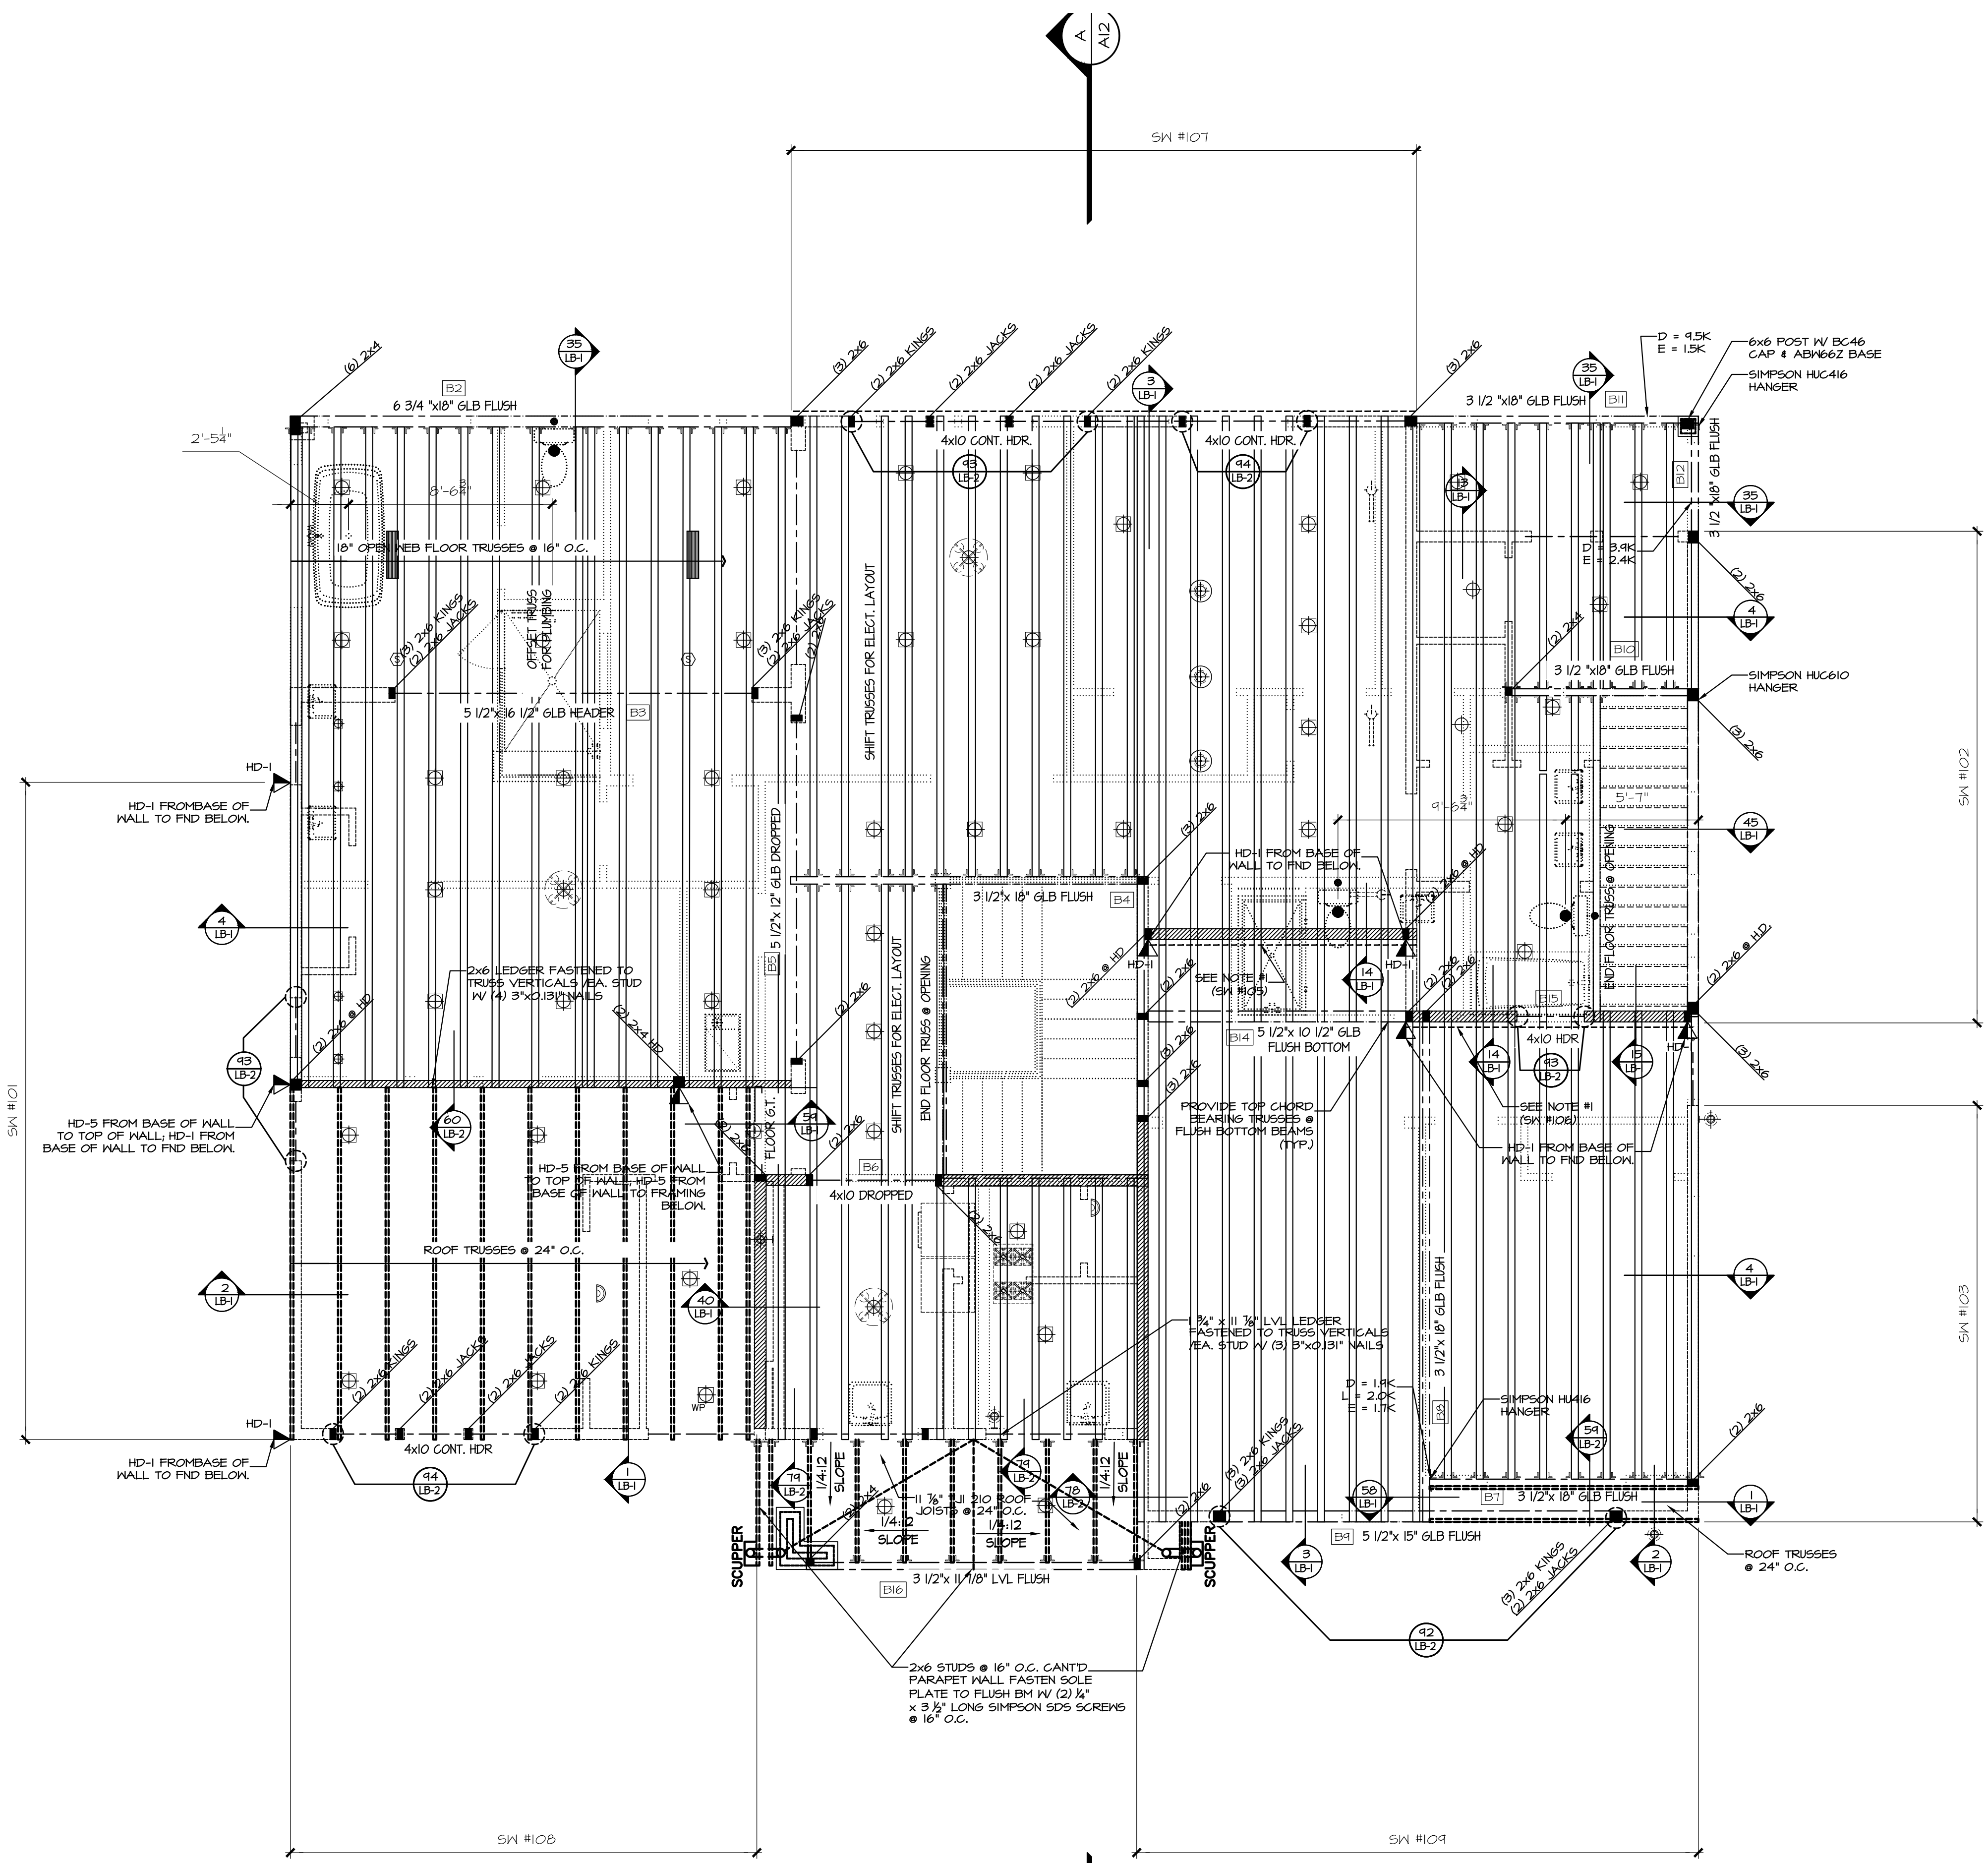

UPPER FLOOR & LOWER ROOF FRAMING PLAN

1/4" = 1'-0"

Sheet Title/Description



7525 SE 24th St., 487
Mercer Island, WA
98040
425.266.9100

Issue	Issue Date By	Description
07.11.22		CITY PLAN REVIEW COMMENTS
08.16.22		CITY PLAN REVIEW COMMENTS
12.15.22		CITY PLAN REVIEW COMMENTS

4537 90th AVE SE
Mercer Island, WA.
Job Number:

plan name: -
marketing name: XXXXXX
plan number:
mark sys. number: -

Conditions not specifically represented graphically or in writing or which conflict with the current International Residential Code (IRC) or those of the local municipality then the current standards and requirements of each respectively shall govern.

The drawings in this set are instruments of service and shall remain the property of JayMarc Homes, LLC.

© 2017 JayMarc Homes, LLC; All rights reserved.

06.15.21
Submittal Date

Sheet Title/Description
JAYMARC HOMES
Design Firm

R.R.
Drawn by:

R.R./S.K.
Checked by:

Primary Scale

A7
of .

UPPER FLOOR PLAN NOTES:

PLAN SPECIFIC 2018 NSEC, SECTION R06.
R406.2 ADDITIONAL ENERGY EFFICIENCY REQUIREMENTS (MANDATORY). THIS RESIDENTIAL DWELLINGS SHALL COMPLY w/SUFFICIENT OPTIONS FROM TABLE R406.2 TO ACHIEVE THE FOLLOWING MIN. NUMBER OF CREDITS:
6 FOR A 1501sf to 4,999sf HOME.
CREDITS PROVIDED IN THIS HOME AS FOLLOWS:
EFFICIENT BUILDING ENVELOPE OPT. 1.3: 0.5 CREDITS
PRESCRIPTIVE COMPLIANCE IS BASED ON TABLE R402.1.1 WITH FOLLOWING MODIFICATIONS:
VERTICAL FENESTRATION U = 0.28 WINDOWS
FLOORS TO BE R-38 and SLAB ON GRADE TO BE R-10 PERIMETER and UNDER ENTIRE SLAB BELOW GRADE.

HIGH EFFICIENCY HVAC EQUIPMENT OPT. 3.5a: 1.5 CREDITS
AIR-SOURCE, CENTRALLY DUCTED HEAT PUMP WITH MINIMUM HSPF OF 11.0. TO QUALIFY TO CLAIM THIS CREDIT, THE BUILDING PERMIT DRAWINGS SHALL SPECIFY THE OPTION BEING SELECTED AND SHALL SPECIFY THE HEATING EQUIPMENT EFFICIENCY. EXTERIOR LOCATED EQUIPMENT SHOULD ALSO BE REPRESENTED ON SITE PLAN.

HIGH EFFICIENCY HVAC DISTRIBUTION OPT. 4.2: 1.0 CREDITS
HVAC EQUIPMENT AND ASSOCIATED DUCT SYSTEM(S) SHALL COMPLY WITH THE REQUIREMENTS OF SECT R403.3.1. LOCATING SYSTEM COMPONENTS IN CONDITIONED GRAVEL SPACES IS NOT PERMITTED UNDER THIS OPTION. ELECTRIC RESISTANCE HEAT AND DUCTLESS HEAT PUMPS ARE NOT PERMITTED UNDER THIS OPTION. DIRECT COMBUSTION HEATING EQUIPMENT WITH AFUE LESS THAN 80% IS NOT PERMITTED UNDER THIS OPTION.

EFFICIENT WATER HEATING 5.5: 2.0 CREDITS
WATER HEATING SYSTEMS SHALL INCLUDE ONE OF THE FOLLOWING:
ELECTRIC HEAT PUMP WATER HEATER MEETING THE STANDARDS FOR TIER III OF NEEA'S ADVANCED WATER HEATING SPECIFICATION.
TO QUALIFY TO CLAIM THIS CREDIT, THE BUILDING PERMIT DRAWINGS SHALL SPECIFY THE OPTION BEING SELECTED AND SHALL SPECIFY THE WATER HEATER EQUIPMENT TYPE AND THE MINIMUM EQUIPMENT EFFICIENCY.

WHOLE HOUSE VENTILATION
PROVIDE WHOLE HOUSE VENTILATION per 2018 IRC, M505.4.3(1) and IMC R403.8. THE WHOLE-HOUSE MECHANICAL VENTILATION SYSTEM SHALL PROVIDE OUTDOOR AIR AT A CONTINUOUS RATE AS DETERMINED IN ACCORDANCE WITH TABLE M505.4.3(1) OR EQUATION 15.

SYMBOL	LOCATION	MIN. FAN REQUIREMENTS (ALL FANS VENT TO OUTSIDE)
	BATH # PONDERS	Min. 50cfm, INTERMITTENT at .025kg per TABLE M507.4
	KITCHEN	Min. 100cfm, INTERMITTENT at .025kg per TBL. M507.4
	RANGE HOOD	50cfm FAN VTO. EXHAUST HOODS IN EXCESS OF 400cfm SHALL BE INTERLOCKED AND PROVIDE MAKE UP AIR per M505.4
	LAUNDRY ROOM	Min. 360cfm, INTERMITTENT at .025kg TO FUNCTION AS WHOLE HOUSE FAN (WHF)
	MECHANICAL CONTRACTOR	TO SIZE WHF, FAN AND SET OPERATING TIMER per TABLE M507.3.2(1) FOR A 4501-5000sf DWELLING w/ 5 OR MORE BEDROOMS. TO OPERATE INTERMITTENTLY and CONTINUOUSLY per TABLE M507.3.2(2)
	PROVIDE CONTROLS	FOR WHF, per M507.3.2 AFFIX LABEL TO CONTROLS THAT READS "WHOLE HOUSE VENTILATION - SEE OPERATING INSTRUCTIONS"


UPPER FLOOR PLAN

1/4" = 1'-0"


F.A.R. CALCULATIONS: SQUARE FOOTAGE SUMMARY

MAIN FLOOR/ MAIN LIVING	1,664 S.F.
MAIN FLOOR A.D.U.	131 S.F.
GARAGE	525 S.F.
SUB TOTAL	2,320 S.F.
UPPER FLOOR/ MAIN LIVING	1,636 S.F.
UPPER FLOOR A.D.U.	689 S.F.
MINUS A.D.U. STAIRS	-51 S.F.
MINUS MAIN STAIRS	-100 S.F.
SUB TOTAL	2,162 S.F.
TOTAL G.F.A.	4,480 S.F.
ALLOWABLE F.A.R. 45%	4,500 S.F.
PROPOSED	34.9%
TOTAL NET AREA MAIN HOUSE	3,200 S.F.
GARAGE	525 S.F.
TOTAL NET A.D.U.	165 S.F.
SUB TOTAL	4,440 S.F.
COVID PATIO	240 S.F.
COVID PORCH	87 S.F.
OVERALL WIDTH	54'-2"
OVERALL DEPTH	48'-5 1/2"


Method for Calculating Square Footage - ANSI Z765-2013 except, no separate distinction of 'above-grade or below-grade' areas and each level is measured to the outside of studs not the exterior finished surface.
Square Footage calculations for this house were made based on plan dimensions only and may vary from the finished square footage of the house as built.
See Sheet "CODES" for additional Zoning required Area Calculations.

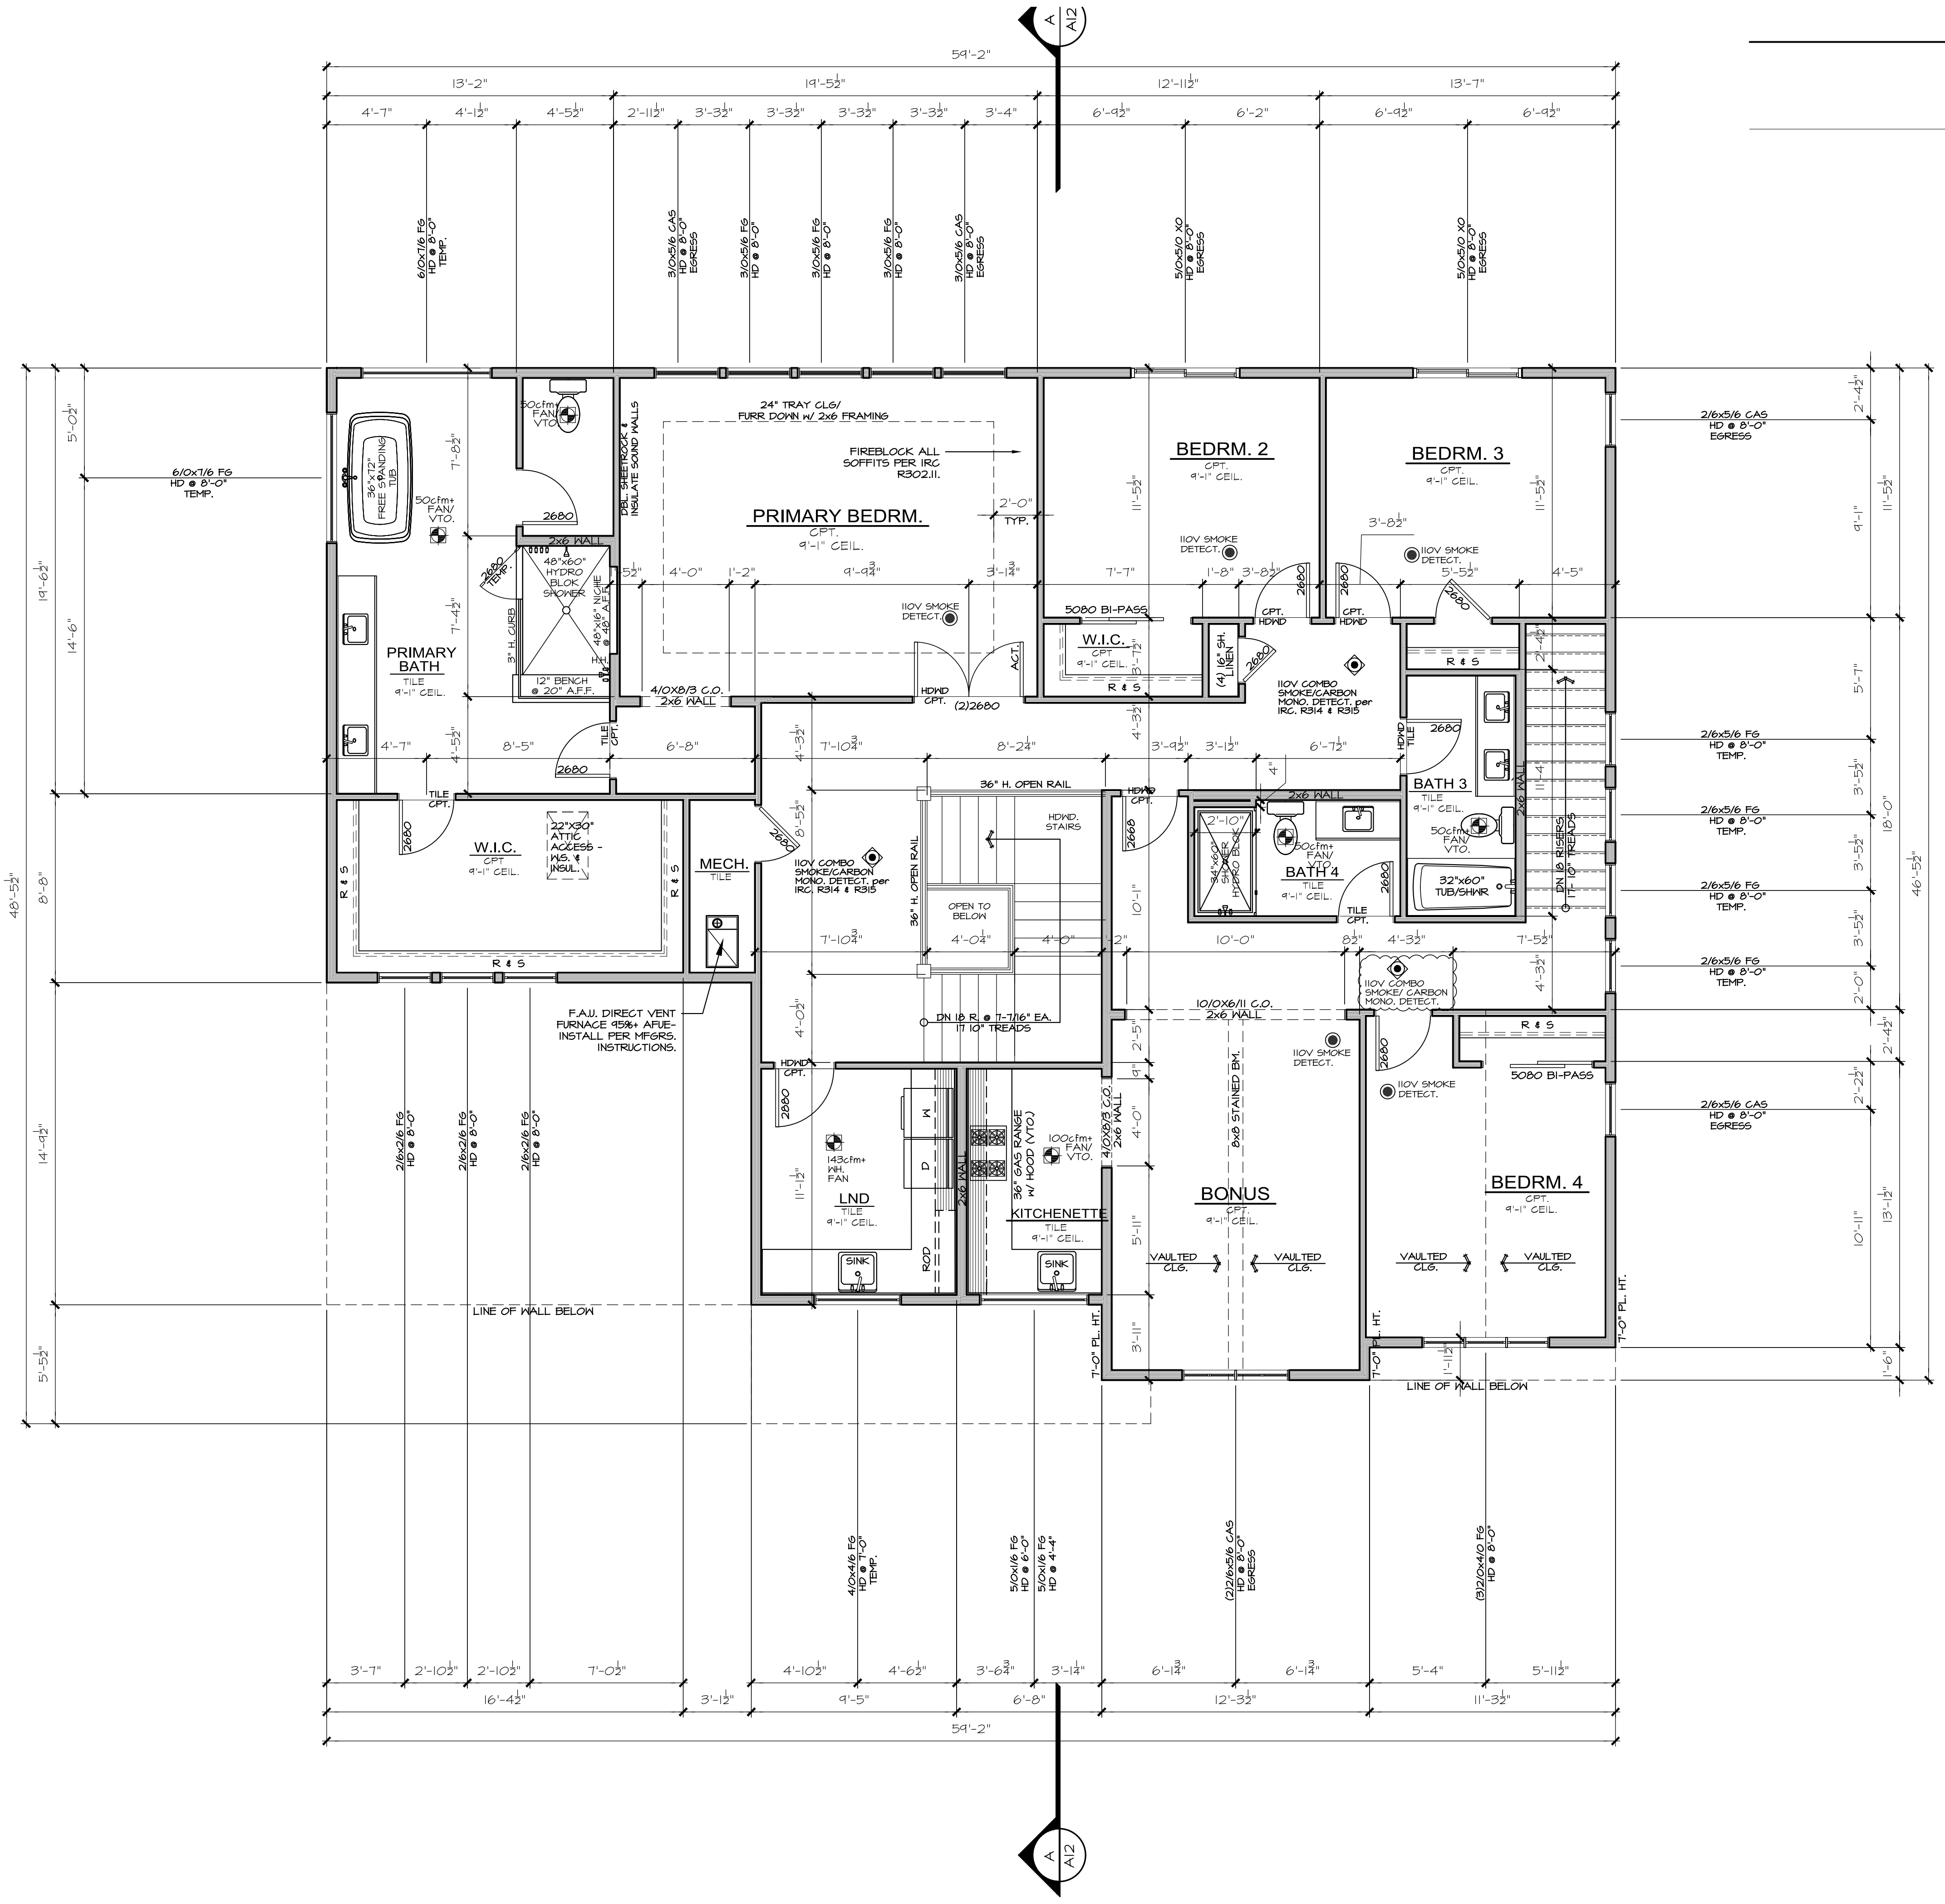

Sheet Title/Description

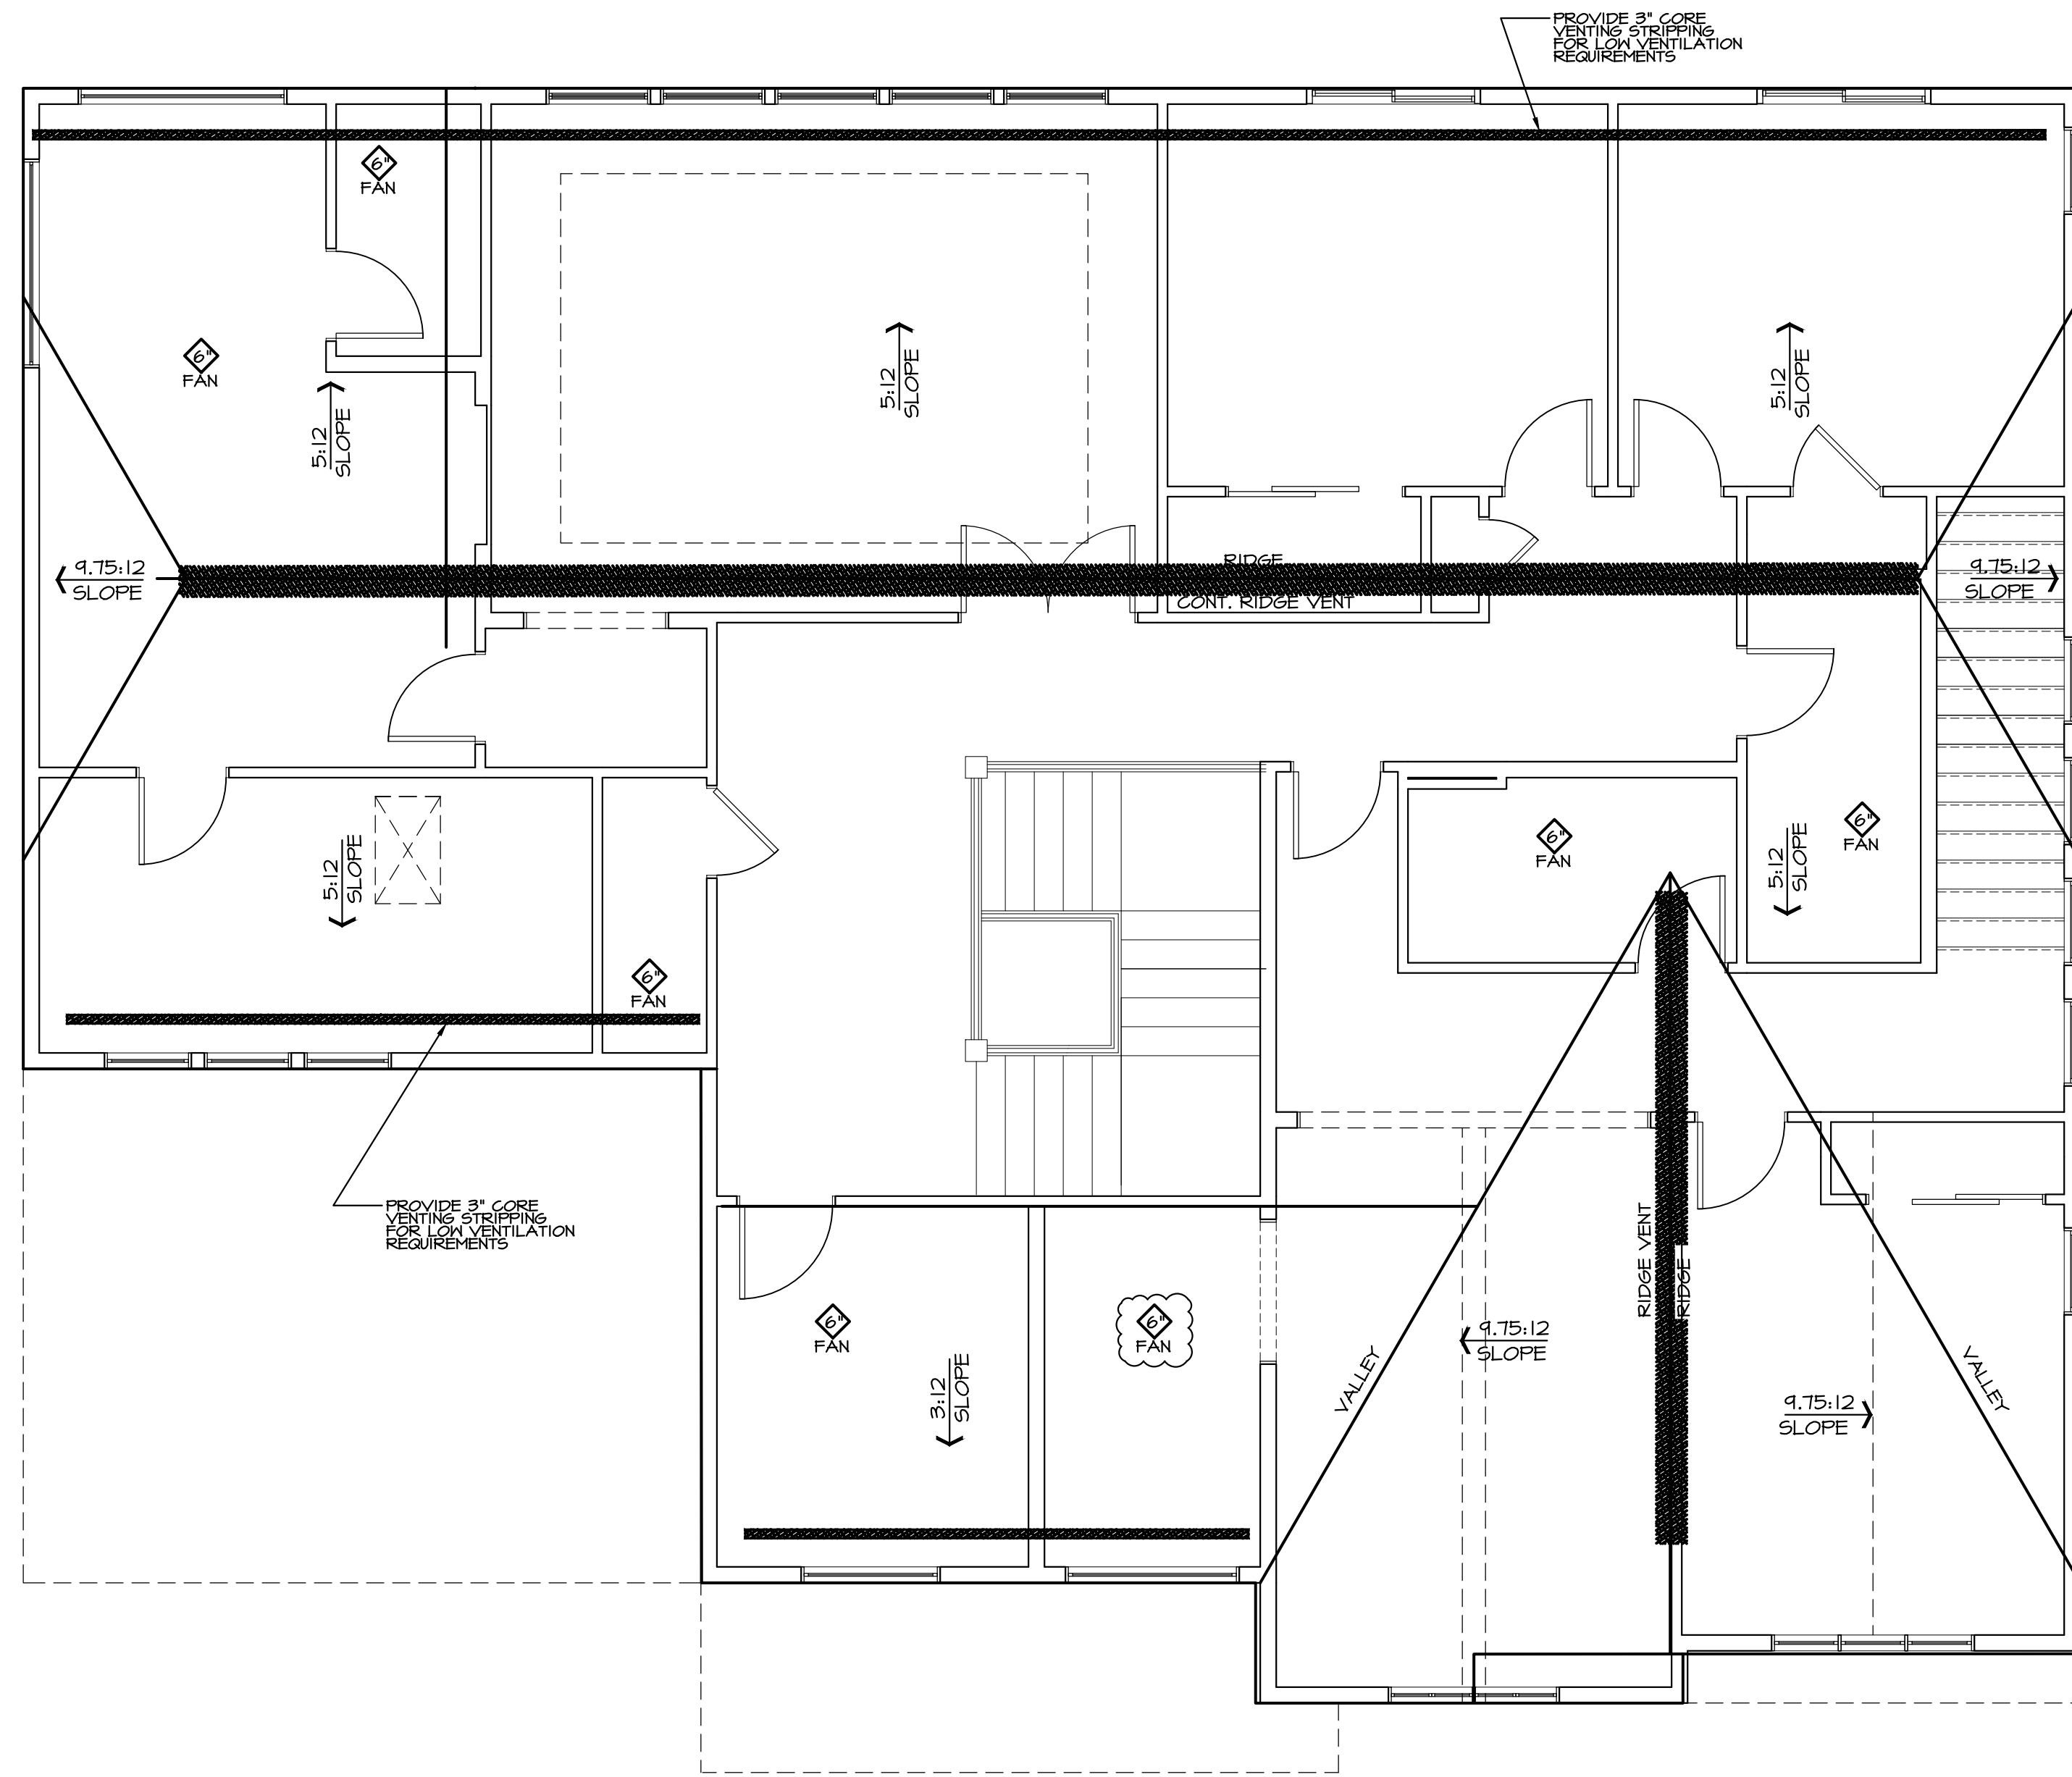

ROOF PLAN
1/4" = 1'-0"

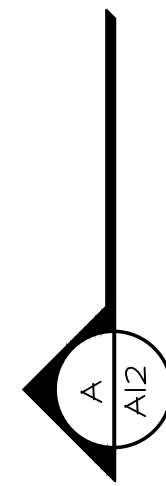

ROOF VENTILATION		ZONE 1
Standard Truss / Scissor Truss Roof Framing Assembly:		
Roof Area :	2182 s.f.	
Ventilation Required:	2182 s.f. x 144 s.i. / s.f. / 300 =	1047.4 s.i. Req'd
Provide between 40% & 50% of the total required ventilation no more than 3 ft below the ridge or the highest point of the space. Remainder to be installed at eave vents.		
Ridge Ventilation: 50% of ventilation		523.68
Continuous Ridge Vent =		18.00 s.i. per l.f.
Upper Ventilation MIN. Req'd =	523.68 s.i. x 0.4 / s.i. per linear foot =	24 l.f.
Upper Ventilation MAX. Req'd =	523.68 s.i. x 0.5 / s.i. per linear foot =	29 l.f.
Provide:	28 l.f. ridge vent. Ventilation =	504.00 s.i.
Ventilation area remainder for AF50 vents =		19.68 s.i.
Upper Roof Ventilation: as needed to achieve 50% of ventilation		
AF50 Roof Jack (10" x 7") =		50.00 s.i. each.
Upper Ventilation Req'd TO GET 50%=	19.68 s.i. / s.i. of each vent =	1 vent
Provide:	0 -10"x7" roof jacks. Ventilation =	0.00 s.i.
Eave Ventilation:		
Birdblocking: (3/2" dia holes per bay =	4.71 s.i. / l.f. - 25% reduction =	3.53 s.i. / l.f.
Eave Ventilation Req'd =	523.68 s.i. / s.i. per l.f. =	19.68 l.f.
Provide Minimum:	214 l.f. birdblocking. Ventilation =	755.96 s.i.
Minimum Ventilation Provided =	1259.96 s.i. IS GREATER THAN :	1047.4 s.i. Req'd



7525 SE 24th St., 487
Mercer Island, WA
98040
425.266.9100

Issue	Issue Date	Description
△	07.11.22	CITY PLAN REVIEW COMMENTS
△	08.16.22	CITY PLAN REVIEW COMMENTS
△	12.15.22	CITY PLAN REVIEW COMMENTS

4537 90th AVE SE
Mercer Island, WA
Job Number:

plan name: -
marketing name: XXXXXX
plan number:
mark sys. number: -

Conditions not specifically represented graphically or in writing or which conflict with the current International Residential Code (IRC.) or those of the local municipality then the current standards and requirements of each respectively shall govern.
The drawings in this set are instruments of service and shall remain the property of JayMarc Homes, LLC.
© 2017 JayMarc Homes, LLC; All rights reserved.

06.15.21
Submittal Date

Sheet Title/Description
JAYMARC HOMES
Design Firm

R.R.
Drawn by:

R.R./S.K.
Checked by:

Primary Scale

A8
of .

Sheet Title/Description

△	Issue	Issue Date By
	Description	
△		
	07.11.22	
	CITY PLAN REVIEW COMMENTS	
	08.16.22	
	CITY PLAN REVIEW COMMENTS	
	12.15.22	
	CITY PLAN REVIEW COMMENTS	

4537 90th AVE SE
Mercer Island, WA.
Job Number:

plan name: _____
marketing name: XXXXXX
plan number: _____
mark sys. number: _____

Conditions not specifically represented graphically or in writing or which conflict with the current International Residential Code (IRC), or those of the local municipality then the current standards and requirements of each respectively shall govern.

The drawings in this set are instruments of service and shall remain the property of JayMarc Homes, LLC.

© 2017 JayMarc Homes, LLC; All rights reserved.

06.15.21
Submittal Date

Sheet Title/Description
JAYMARC HOMES
Design Firm

R.R.
Drawn by:

R.R./S.K.
Checked by:

Primary Scale

A9
of .

LEGEND

- ▨ INTERIOR BEARING WALL
- ▬ BEAM / HEADER
- ▬ ROOF TRUSS @ 24" O.C. (U.N.O.)
- ▬ GIRDER TRUSS
- ▬ INTERIOR SHEAR WALL PANEL OR EXTERIOR SHEAR WALL w/ 3" o.c. EDGE NAILING
- J.L. METAL HANGER
- ⊗ INDICATES OVER FRAMED TRUSS AREA

REFER TO S-O FOR TYPICAL STRUCTURAL NOTES & SCHEDULES

4x10 HDR @ ALL EXT. [B1] WINDOWS/DOORS (TYP. U.N.O.)


PROVIDE CONT. EXT. SHEATHING BEHIND LOW TRUSSES DOWN TO SECOND FLOOR SOLE PLATE (TYP. @ LOW ROOF)

ROOF VENTILATION


Standard Truss / Scissor Truss Roof Framing Assembly:		ZONE 1
Roof Area :	2182 s.f.	
Ventilation Required:	$2182 \text{ s.f.} \times 144 \text{ s.i.} / \text{s.f.} / 300 =$	1047.4 s.i. Req'd
Provide between 40% & 50% of the total required ventilation no more than 3 ft below the ridge or the highest point of the space. Remainder to be installed at eave vents.		
Ridge Ventilation: 50% of ventilation		523.68
Continuous Ridge Vent =		18.00 s.i. per l.f.
Upper Ventilation MIN. Req'd =	$523.68 \text{ s.i.} \times 0.4 / \text{s.i. per linear foot} =$	24 l.f.
Upper Ventilation MAX. Req'd =	$523.68 \text{ s.i.} \times 0.5 / \text{s.i. per linear foot} =$	29 l.f.
Provide:	28 l.f. ridge vent. Ventilation =	504.00 s.i.
Ventilation area remainder for AF50 vents =		19.68 s.i.
Upper Roof Ventilation: as needed to achieve 50% of ventilation		
AF50 Roof Jack (10" x 7") =		50.00 s.i. each.
Upper Ventilation Req'd TO GET 50%=	$19.68 \text{ s.i.} / \text{s.i. of each vent} =$	1 vent
Provide:	0 -10"x7" roof jacks. Ventilation =	0.00 s.i.
Eave Ventilation:		
Birdblocking: (3/2" dia holes per bay =	$4.71 \text{ s.i.} / \text{l.f.} - 25\% \text{ reduction} =$	3.53 s.i. / l.f.
Eave Ventilation Req'd =	$523.68 \text{ s.i.} / \text{s.i. per l.f.} =$	19.68 l.f.
Provide Minimum:	214 l.f. birdblocking. Ventilation =	755.96 s.i.
Minimum Ventilation Provided =	1259.96 s.i. IS GREATER THAN :	1047.4 s.i. Req'd

ROOF FRAMING PLAN


1/4" = 1'-0"

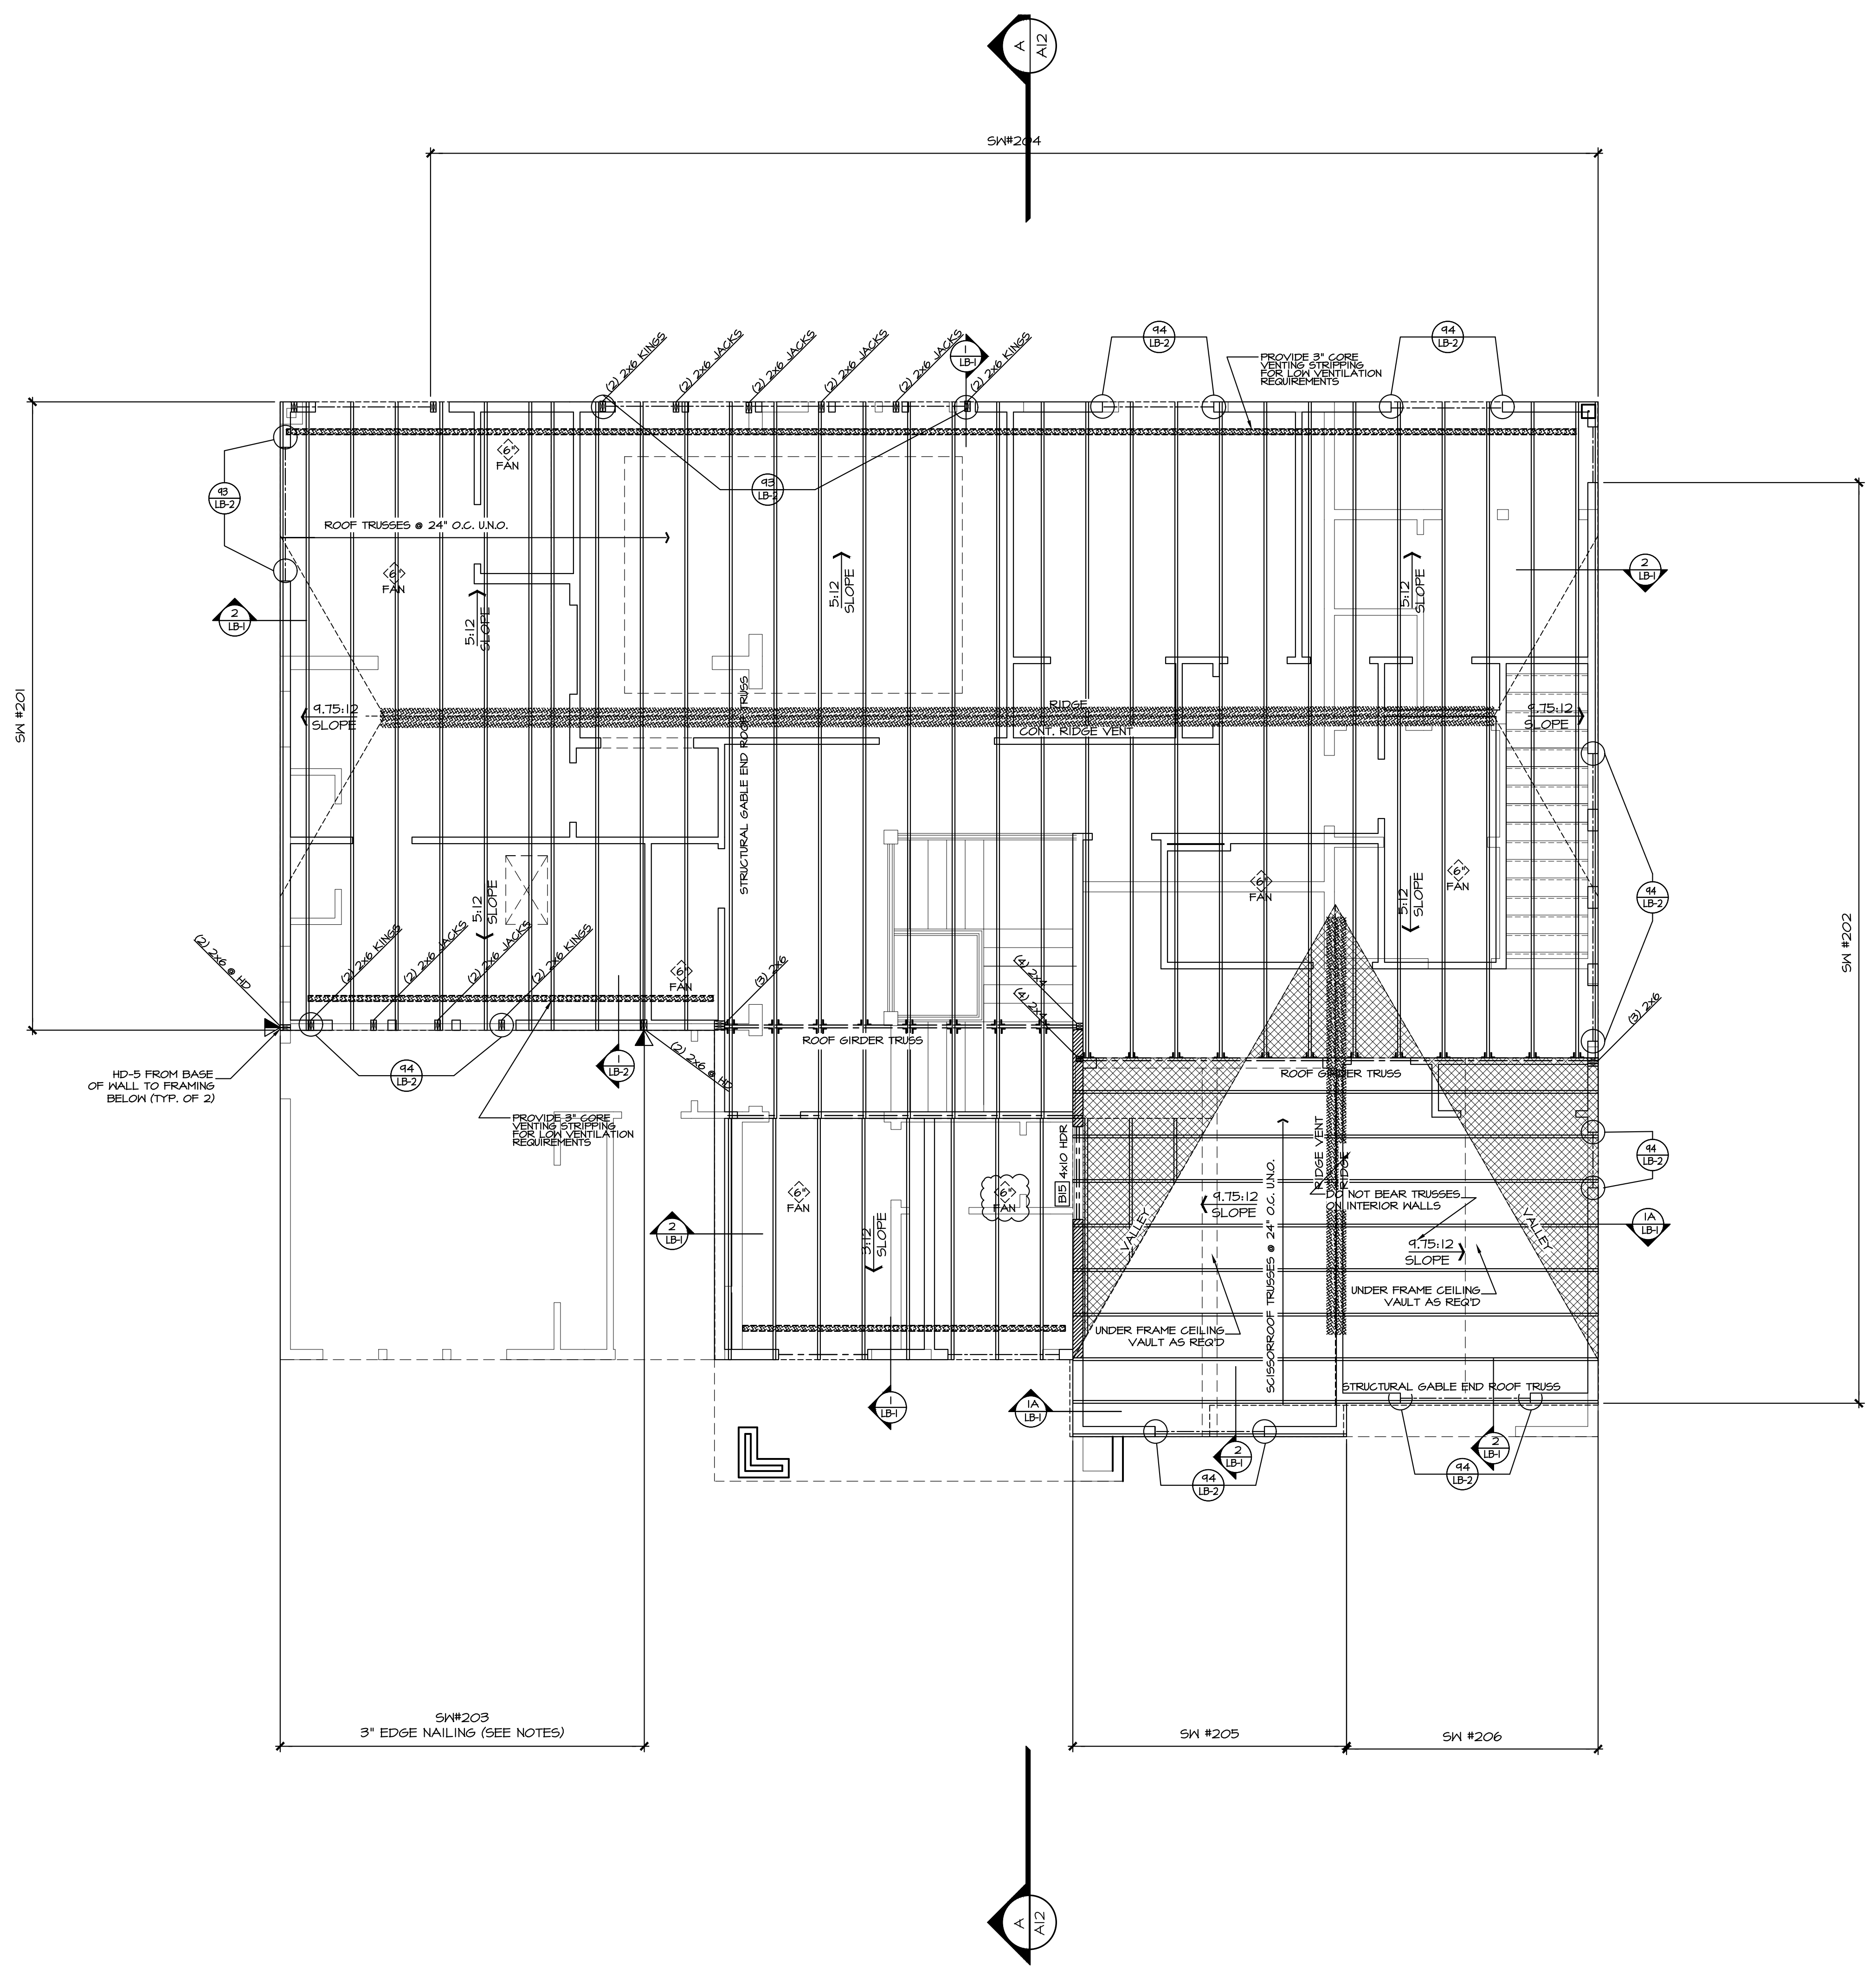

Sheet Title/Description

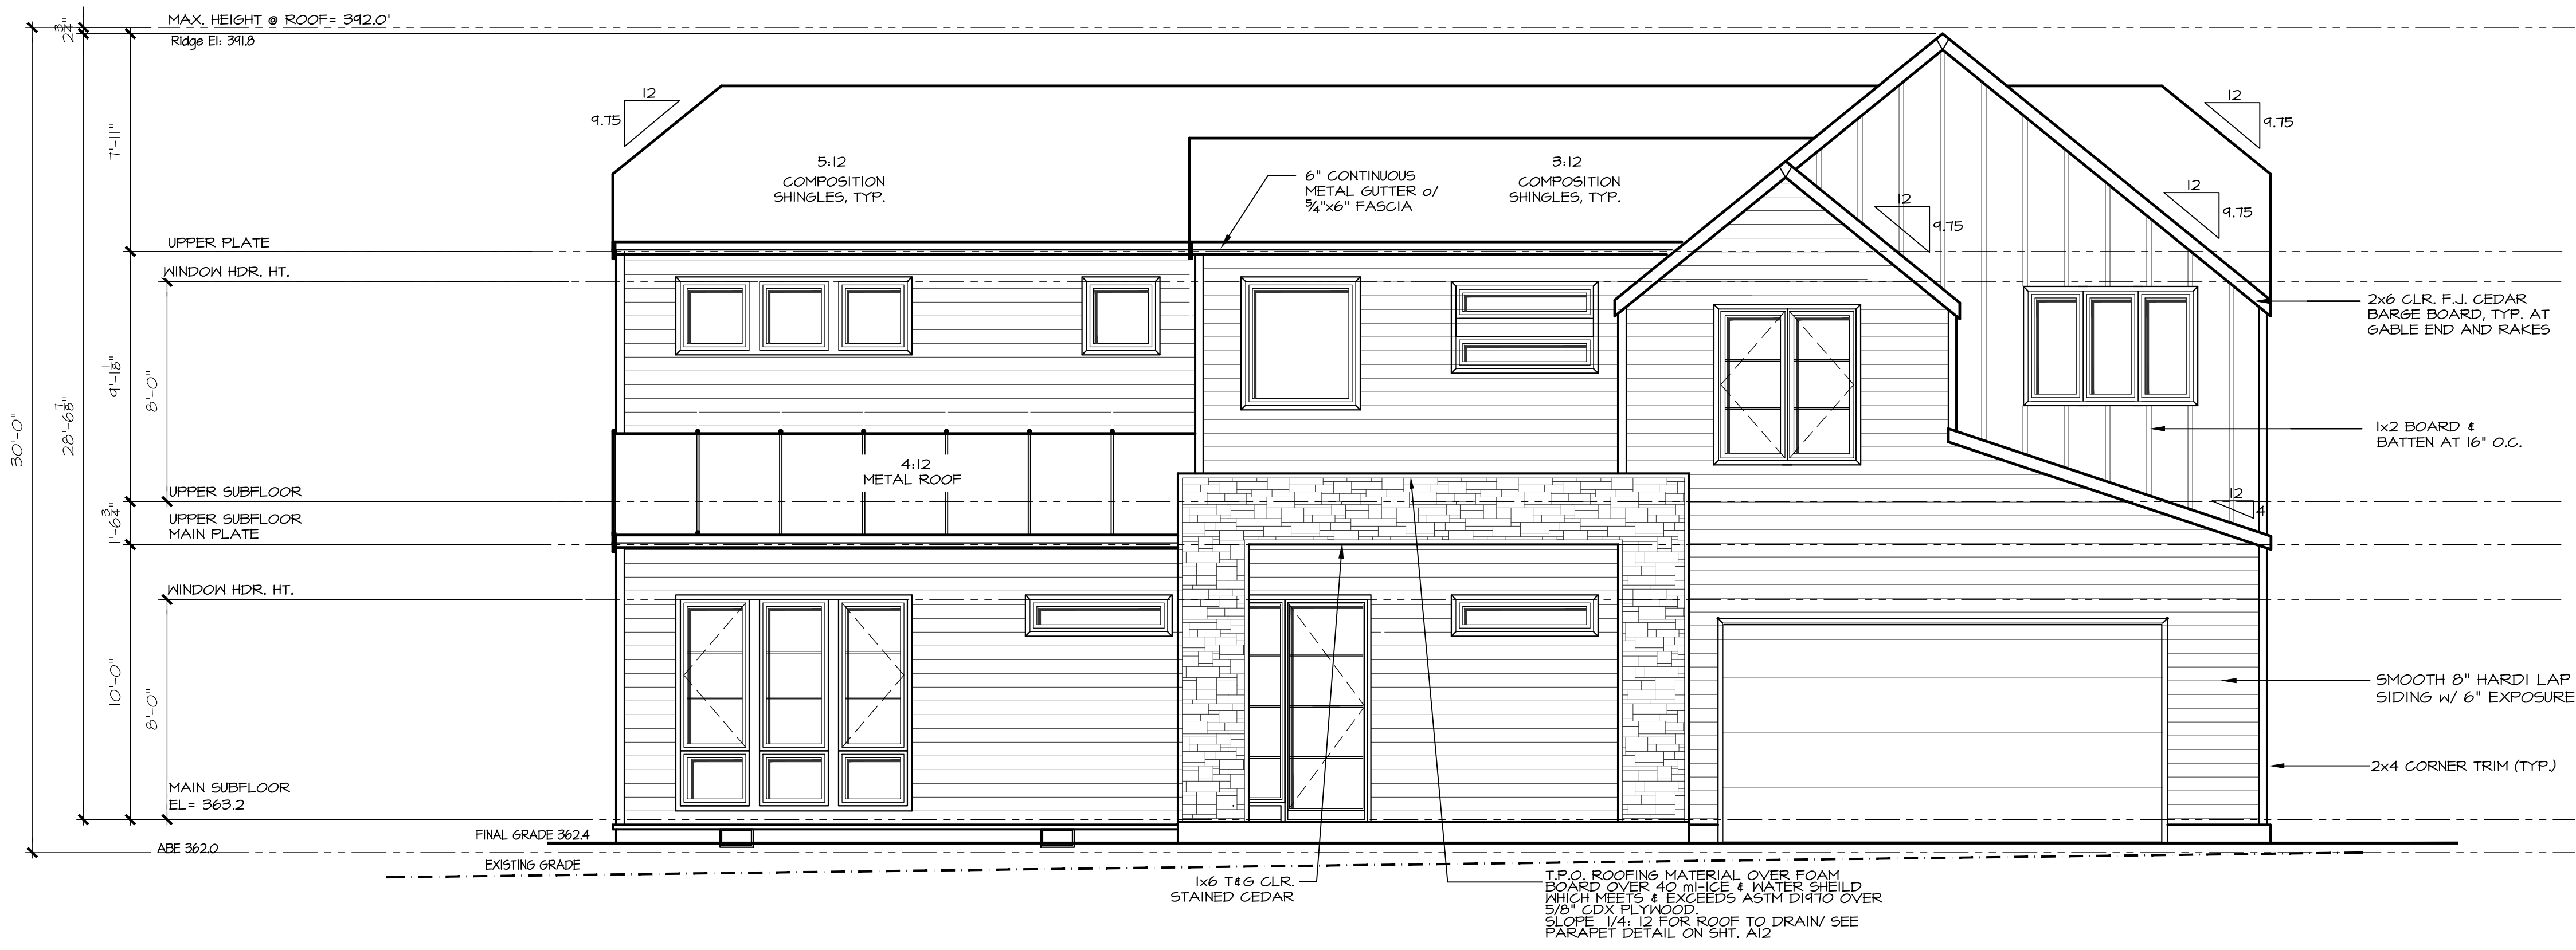


FRONT ELEVATION
 1/4" = 1'-0"

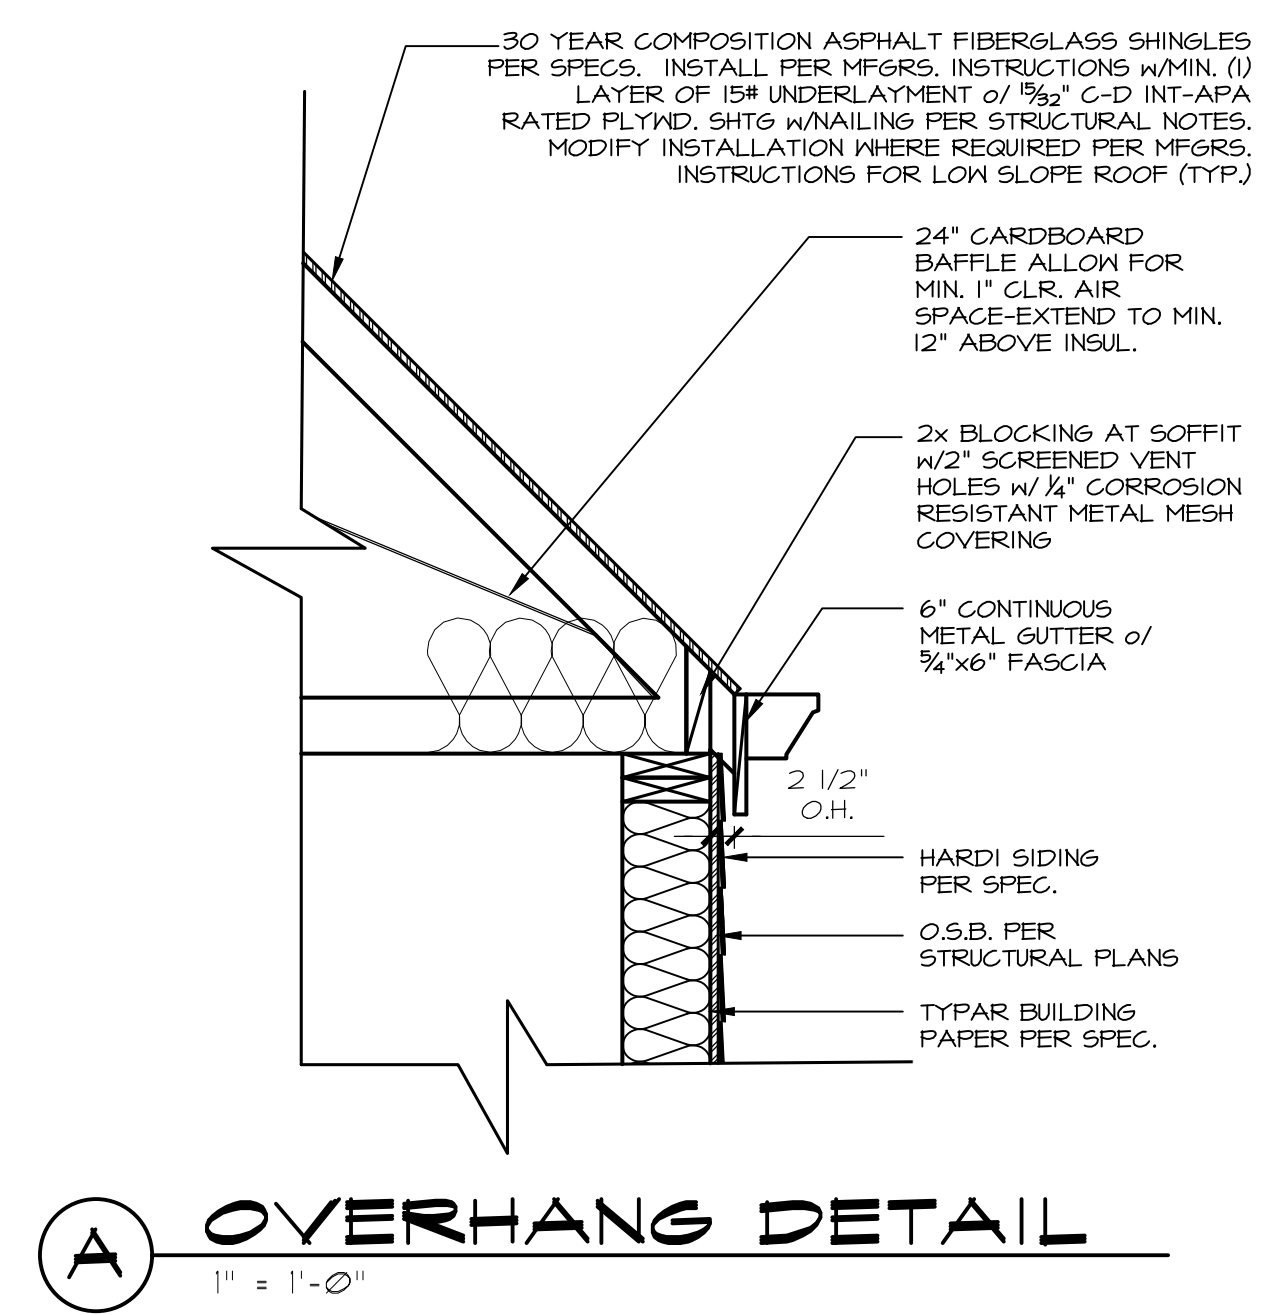

Issue Description	Issue Date	By
	07.11.22	
CITY PLAN REVIEW COMMENTS	08.16.22	
CITY PLAN REVIEW COMMENTS	12.15.22	
CITY PLAN REVIEW COMMENTS		

4537 90th AVE SE
 Mercer Island, WA.
 Job Number:

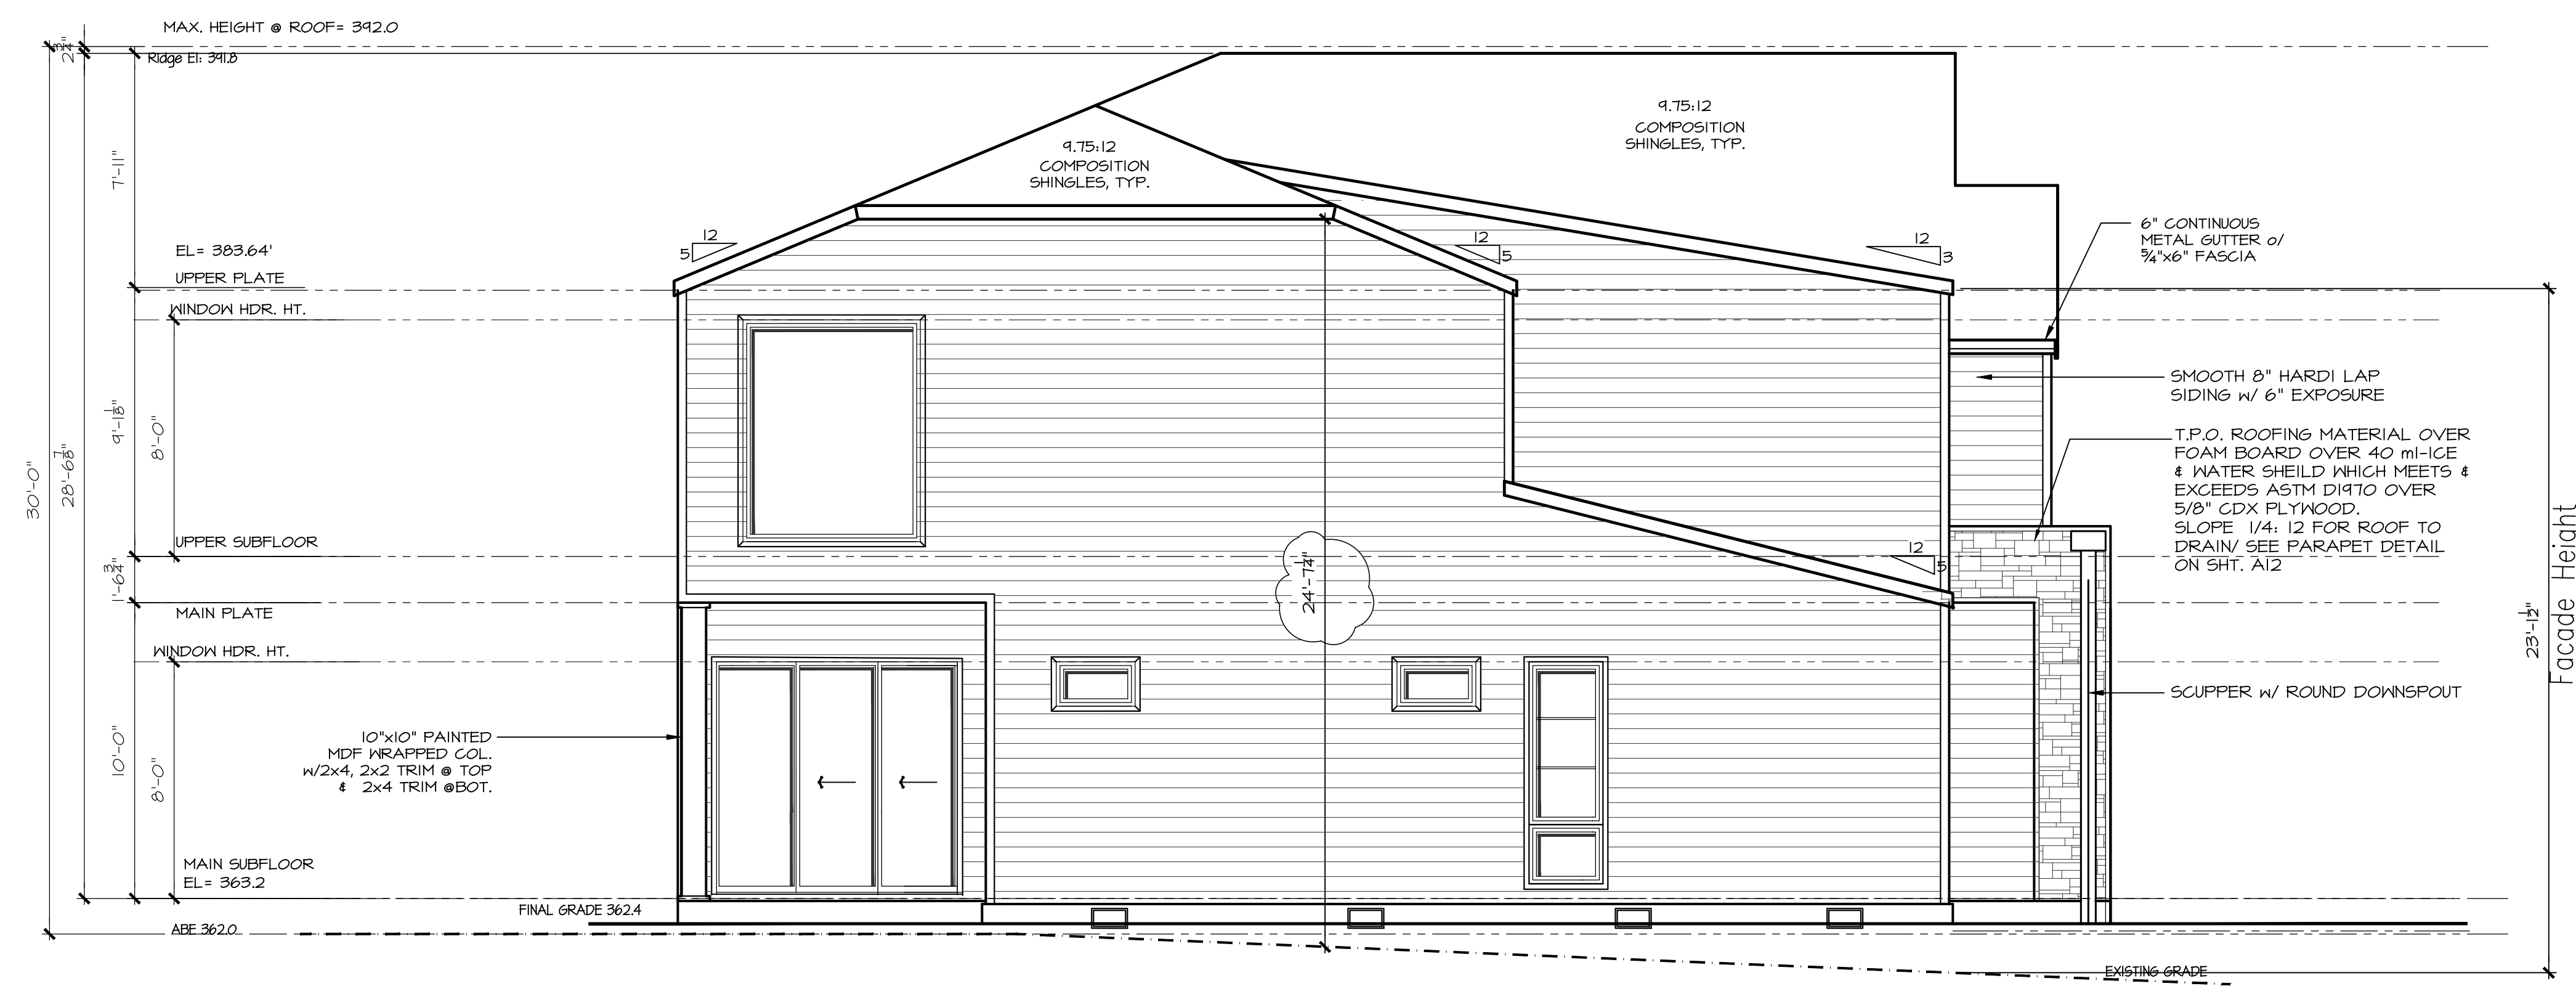

LEFT ELEVATION
 1/4" = 1'-0"

plan name: -
 marketing name: XXXXXX
 plan number: -
 mark sys. number: -

Conditions not specifically represented graphically or in writing or which conflict with the current International Residential Code (IRC.) or those of the local municipality then the current standards and requirements of each respectively shall govern.

The drawings in this set are instruments of service and shall remain the property of JayMarc Homes, LLC.

© 2017 JayMarc Homes, LLC; All rights reserved.

06.15.21
 Submittal Date

Sheet Title/Description
 JAYMARC HOMES
 Design Firm

R.R.
 Drawn by:

R.R./ S.K.
 Checked by:

Primary Scale

A10
 of .

Sheet Title/Description



Issue	Issue Date By	Description
△	07.11.22	CITY PLAN REVIEW COMMENTS
△	08.16.22	CITY PLAN REVIEW COMMENTS
△	12.15.22	CITY PLAN REVIEW COMMENTS

4537 90th AVE SE
 Mercer Island, WA.
 Job Number:

plan name: -
 marketing name: XXXXXX
 plan number: -
 mark sys. number: -

Conditions not specifically represented graphically or in writing or which conflict with the current International Residential Code (IRC), or those of the local municipality then the current standards and requirements of each respectively shall govern.

The drawings in this set are instruments of service and shall remain the property of JayMarc Homes, LLC.

© 2017 JayMarc Homes, LLC; All rights reserved.

06.15.21
 Submittal Date

JAYMARC HOMES
 Design Firm

R.R.
 Drawn by:

R.R./S.K.
 Checked by:

Primary Scale

A11
 of .

Sheet Title/Description

NOTES:

JM
JAYMARC
 HOMES

7525 SE 24th St., 487
 Mercer Island, WA
 98040
 425.266.9100

Issue	Issue Date By	Description
△	07.11.22	CITY PLAN REVIEW COMMENTS
△	08.16.22	CITY PLAN REVIEW COMMENTS
△	12.15.22	CITY PLAN REVIEW COMMENTS

4537 90th AVE SE
 Mercer Island, WA.
 Job Number:

plan name: -
 marketing name: XXXXXX
 plan number: -
 mark sys. number: -

Conditions not specifically represented graphically or in writing or which conflict with the current international Residential Code (IRC.) or those of the local municipality then the current standards and requirements of each respectively shall govern.

The drawings in this set are instruments of service and shall remain the property of JayMarc Homes, LLC.

© 2017 JayMarc Homes, LLC; All rights reserved.

06.15.21
 Submittal Date

Sheet Title/Description
 JAYMARC HOMES
 Design Firm


R.R.
 Drawn by:

R.R./S.K.
 Checked by:


Primary Scale

A12
 of .


Sheet Title/Description

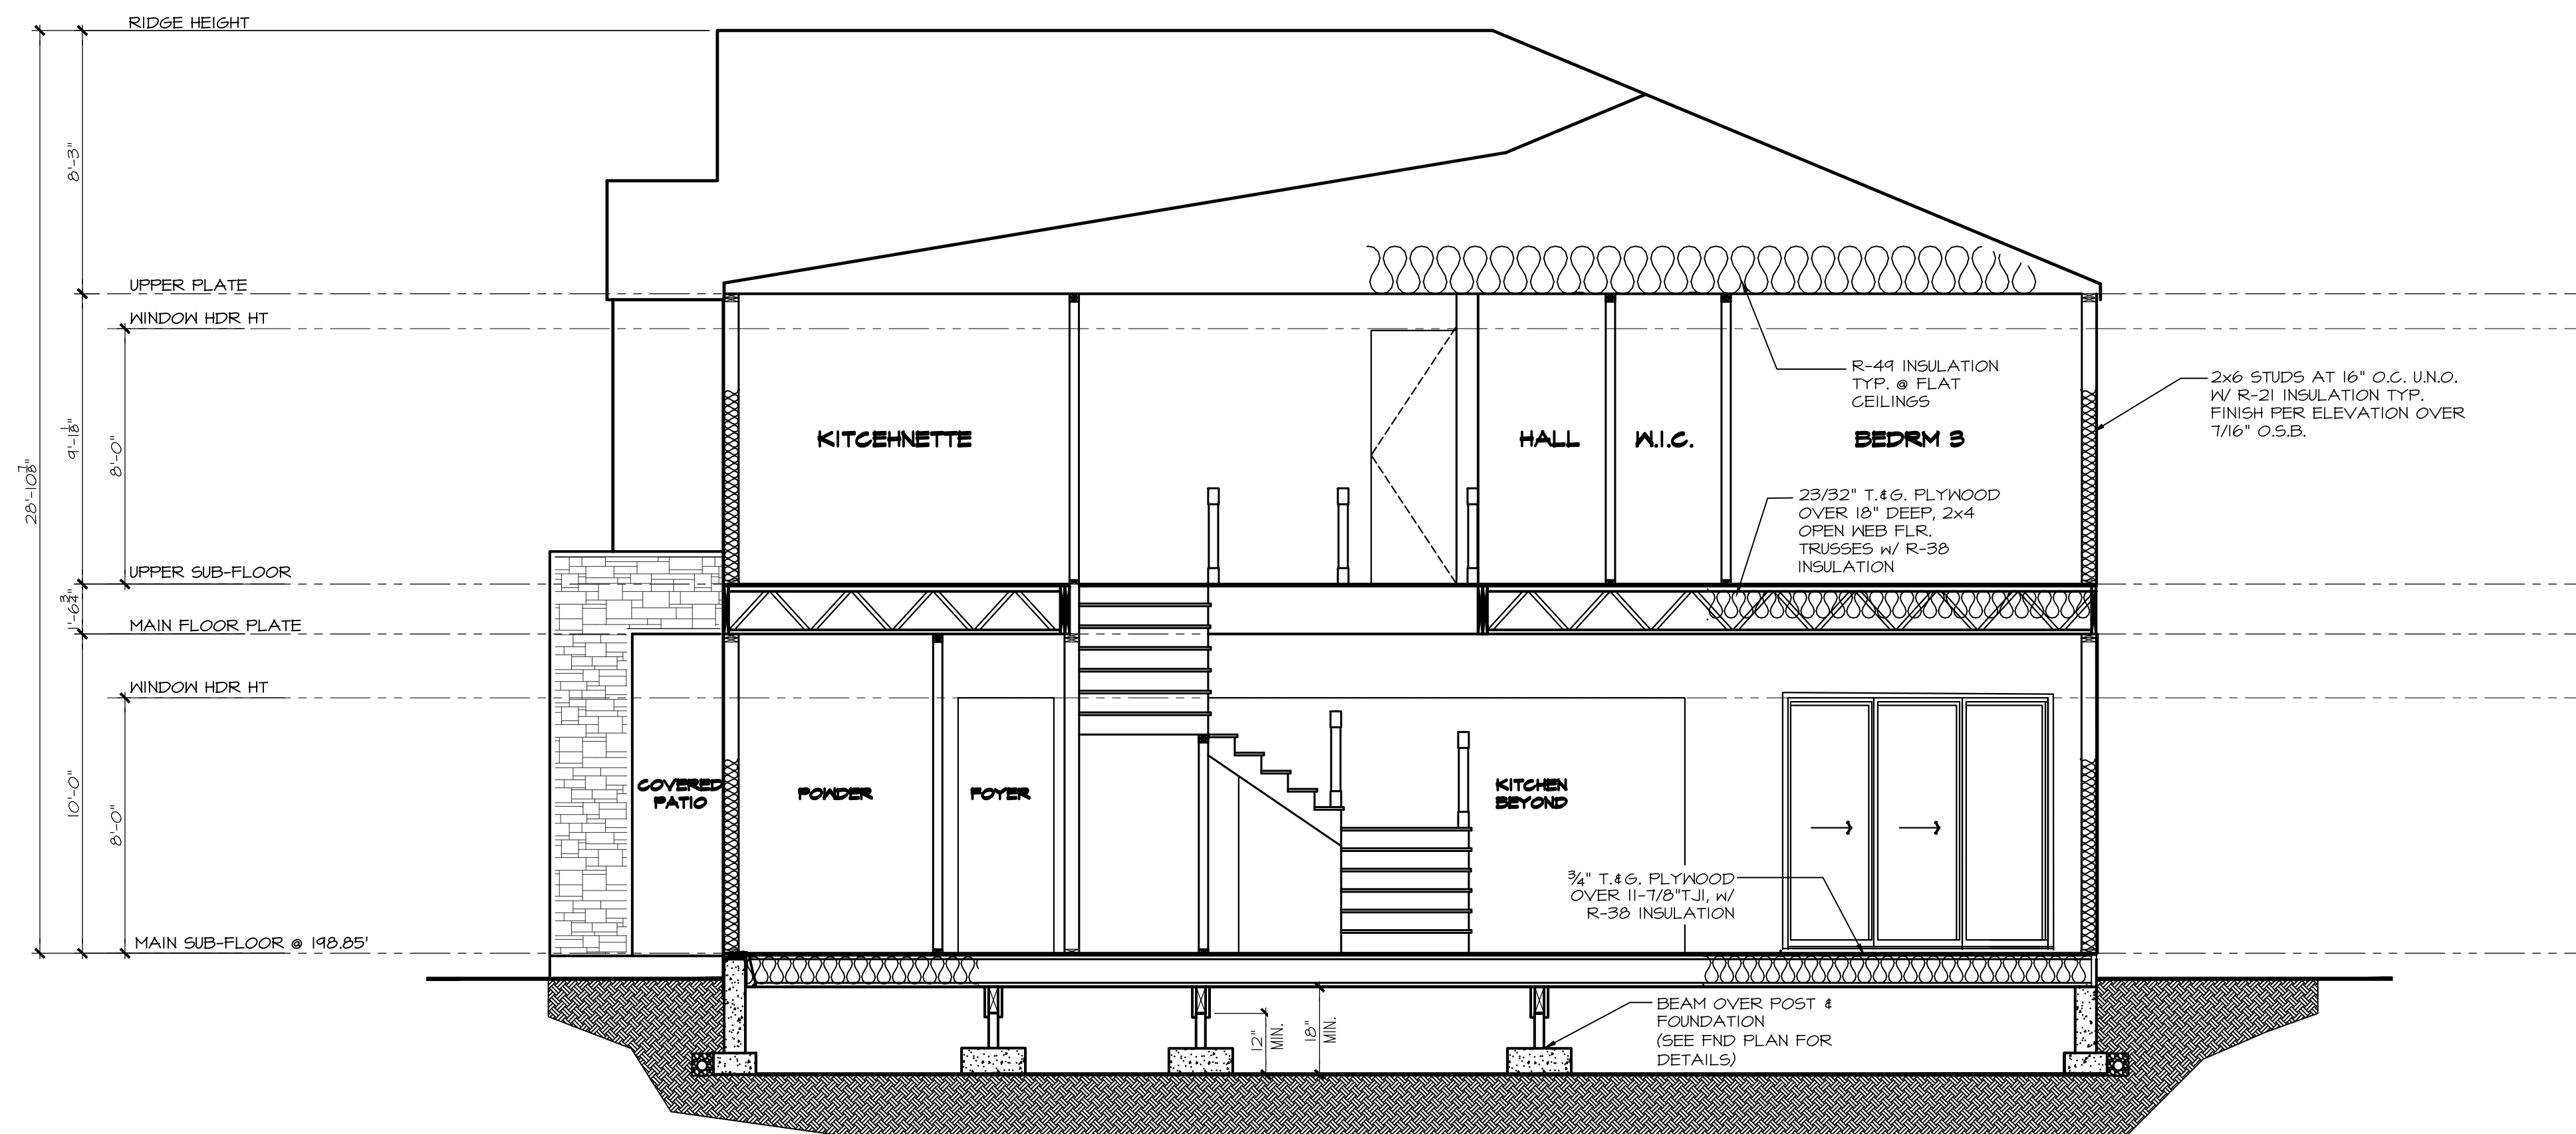

A BUILDING SECTION
 1/4" = 1'-0"

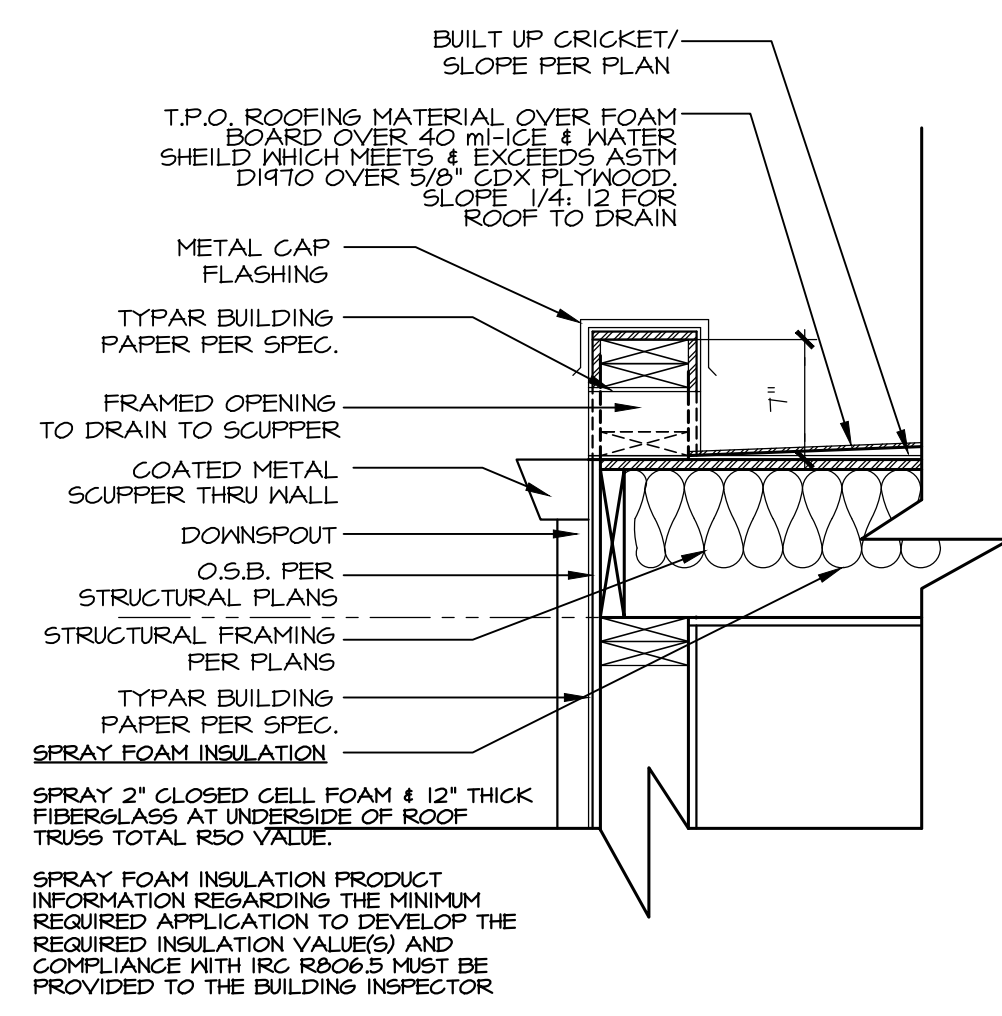

PARAPET DETAIL
 1" = 1'-0"

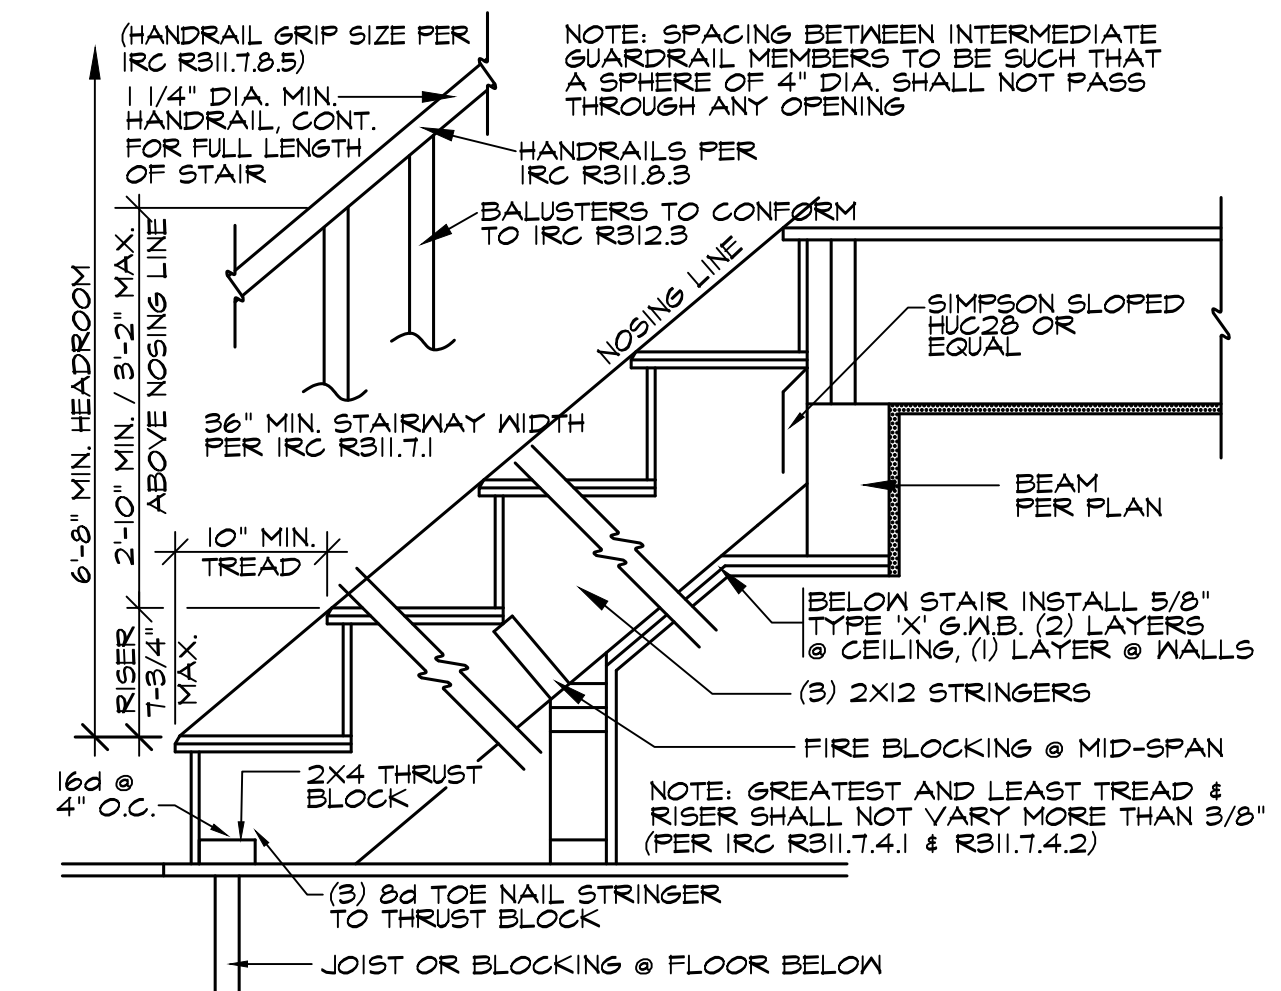

TYP. STAIR SECTION
 1/4" = 1'-0"

BASEMENT SLAB

4" CONC. SLAB ON 6 MIL VAPOR BARRIER ON 4" MIN. GRANULAR FILL ON 95% COMPACTED FILL/VIRGIN SOIL

GARAGE SLAB

4" CONC. SLAB ON 4" MIN. GRANULAR FILL ON 95% COMPACTED FILL/VIRGIN SOIL

PORCH SLAB

4" CONC. SLAB ON GRADE ON 6 MIL VAPOR BARRIER ON 4" MIN. GRANULAR FILL ON 95% COMPACTED FILL/VIRGIN SOIL

GENERAL STRUCTURAL NOTES

FOUNDATION

- DESIGN IS BASED ON 2018 INTERNATIONAL RESIDENTIAL CODE & 2018 INTERNATIONAL BUILDING CODE
DESIGN LOADS: SOIL 2,000 PSF ALLOWABLE BEARING PRESSURE
CONCRETE SHALL ATTAIN THE FOLLOWING MINIMUM COMPRESSIVE STRENGTHS IN 28 DAYS, UNO:
FC = 2500 psi: FOUNDATION WALLS*
2500 psi: FOOTINGS*
2500 psi: INTERIOR SLABS ON GRADE
3500 psi: GARAGE & EXT. SLABS ON GRADE
* UTILIZE 5% SACK 2500 PSI CONCRETE MIXES THAT ARE EQUIVALENT TO 3,000 PSI CONCRETE FOR WEATHERING POTENTIAL
ALL CONCRETE EXPOSED TO THE WEATHER SHALL NOT HAVE LESS THAN 5% OR MORE THAN 7% AIR ENTRAINMENT.
FOUNDATION WALL DESIGN IS BASED ON BACKFILL SOIL CLASSIFICATIONS OF SC, ML-CL, OR CL (60 pcf) SOIL.
TYPICAL REINFORCEMENT DETAILS: LAP ALL REBAR 24" MIN; BEND BARS AND LAP AT CORNERS; PROVIDE 6" HOOK INTO SUPPORTING FOOTINGS WHEN FOOTINGS INTERSECT; PROVIDE 3" MINIMUM COVER AT THE BOTTOM BARS AND 1 1/2" COVER AT THE SIDES.
FOUNDATION WALLS SHALL BE BRACED, PRIOR TO BACKFILLING, BY EITHER ADEQUATE TEMPORARY BRACING OR INSTALLATION OF FIRST FLOOR DECK.
ALL FOOTINGS SHALL BEAR BELOW FROST LINE. CONSULT SOILS REPORT/ LOCAL MUNICIPALITY FOR MINIMUM DEPTH BELOW GRADE.
FOOTINGS AND SLABS ON GRADE SHALL BEAR ON VIRGIN SOIL OR 95% COMPACTED FILL.
PROVIDE CONTROL JOINTS AT ALL INSIDE CORNERS OF SLAB EDGES, AND OTHER LOCATIONS WHERE SLAB CRACKS ARE LIKELY TO DEVELOP. (5'-0" O.C.)
FASTEN SILL PLATES TO FOUNDATION WALLS WITH 3/8" DIA. ANCHOR BOLTS W/ MIN. 3"x3"x1/2" PLATE WASHERS (EDGE OF WASHER TO BE LOCATED WITHIN 1/2" OF EXTERIOR EDGE OF SILL PLATE) & NUTS @ 6'-0" O.C. @ 2-STORY & 4'-0" O.C. @ 3-STORY CONDITIONS W/ 7" MIN. EMBEDMENT INTO CONC. PROVIDE A MINIMUM OF 2 ANCHORS PER PLATE, 12" MAXIMUM FROM PLATE ENDS, UNO. (SEE FIG. DETAILS).
ALL LUMBER EXPOSED TO WEATHER OR IN CONTACT W/ CONCRETE OR MASONRY FOUNDATION SHALL BE PRESERVATIVE TREATED HEM FIR #2.
BUILDER TO VERIFY CORROSION-RESISTANCE COMPATIBILITY OF HARDWARE & FASTENERS IN CONTACT W/ PRESERVATIVE-TREATED WOOD. CONTACT LUMBER & HARDWARE SUPPLIERS TO COORDINATE.
ARCH/BUILDER TO VERIFY ALL DIMENSIONS.

HOLD-DOWN SCHEDULE

Table with 2 columns: SYMBOL and SPECIFICATION. Includes items like HD-1 SIMPSON 5THD14 (RJ) HOLD-DOWN, HD-5 SIMPSON C616 STRAP TIE (14" END LENGTH), HD-6 SIMPSON MSTC40 STRAP TIE (CENTER STRAP ON FLOOR SYSTEM UNO.), HD-7 SIMPSON MSTC66 STRAP TIE (CENTER STRAP ON FLOOR SYSTEM UNO.).

MEANS & METHODS NOTES

THE STRUCTURE IS DESIGNED TO BE SELF SUPPORTING AND STABLE AFTER THE BUILDING IS FINISHED AND ALL PLAN, DETAIL, AND NOTE SPECIFICATIONS HAVE BEEN COMPLETED. IT IS THE CONTRACTOR'S SOLE RESPONSIBILITY TO DETERMINE THE ERECTION PROCEDURES AND SEQUENCE TO INSURE THE SAFETY OF THE BUILDING AND ITS COMPONENTS DURING CONSTRUCTION. THIS INCLUDES, BUT IS NOT LIMITED TO, THE ADDITION OF NECESSARY SHORING, SHEETING, TEMPORARY BRACING, GUYS, AND TIE-DOWNS. CONTRACTOR SHALL BE RESPONSIBLE FOR ALL SHORING AND BRACING REQUIRED TO STABILIZE AND PROTECT EXISTING AND ADJACENT STRUCTURES AND SYSTEMS DURING COURSE OF DEMOLITION AND CONSTRUCTION OF THE PROJECT.

STRUCTURAL DESIGN AND SPECIFICATIONS ASSUME THAT ALL SUPPORTING AND NON-SUPPORTING ELEMENTS IN CONTACT WITH FLOOR FRAMING ARE LEVEL, INCLUDING, BUT NOT LIMITED TO; FOUNDATIONS, SLABS ON GRADE, BEAMS, WALLS, AND NON-BEARING ELEMENTS. IT IS THE CONTRACTOR'S RESPONSIBILITY TO VERIFY LEVELNESS AND MAKE ADJUSTMENTS AS NECESSARY, INCLUDING CONSIDERATION OF THOSE AREAS THAT MAY BE WITHIN CONTRACTUAL, INDUSTRY, OR WARRANTY TOLERANCES.

ADDITIONAL NOTES FOR TRUSS & I-JOIST MANUFACTURER

ROOF TRUSSES, FLOOR TRUSSES AND ENGINEERED JOISTS SHALL BE DESIGNED TO MEET THE DIFFERENTIAL DEFLECTION CRITERIA BELOW UNLESS NOTED OTHERWISE ON PLAN. MULHERN & KULP CANNOT BE HELD RESPONSIBLE FOR ANY STRUCTURAL ISSUES RELATED TO ANY BUILDING COMPONENT IF COMPONENT SHOP DRAWINGS ARE NOT SUBMITTED TO MKF FOR REVIEW PRIOR TO FABRICATION, DELIVERY, OR INSTALLATION.

TRUSSES SHALL BE DESIGNED SO THAT DIFFERENTIAL DEFLECTION BETWEEN ADJACENT PARALLEL TRUSSES OR GIRDER TRUSSES DOES NOT EXCEED THE FOLLOWING:
A. ROOF TRUSSES: 1/4" DEAD LOAD
B. FLOOR TRUSSES, ATTIC TRUSSES, & I-JOISTS: 1/8" DEAD LOAD
C. FLOOR TRUSSES & ATTIC TRUSSES ADJACENT TO FLOOR FRAMING BY OTHERS: LIMIT ABSOLUTE TRUSS DEFLECTION TO 3/16" DEAD LOAD. (NOT DIFFERENTIAL DEFLECTION)

LOADING AND DESIGN PARAMETERS

Table listing design parameters: GRAVITY DESIGN LOADS (DEAD LOAD, ROOF TRUSS TOP CHORD, ROOF TRUSS BOTTOM CHORD, ROOF (I-JOISTS), FLOOR (TRUSSES), FLOOR (I-JOISTS), TILE FLOORS), LIVE LOAD (PSF) (ROOF, RESIDENTIAL LIVING AREAS, RESIDENTIAL SLEEPING AREAS, RESIDENTIAL HOOD DECKS, GARAGE), SNOW LOAD (GROUND SNOW LOAD, FLAT ROOF SNOW LOAD, SNOW EXPOSURE FACTOR, SNOW LOAD IMPORTANCE FACTOR, THERMAL FACTOR), LATERAL DESIGN LOADS (WIND LOAD, WIND RISK CATEGORY, IMPORTANCE FACTOR, EXPOSURE CATEGORY, INTERNAL PRESSURE COEFF, TOPOGRAPHIC FACTOR), SEISMIC LOAD (WIND SPEED, WIND RISK CATEGORY, IMPORTANCE FACTOR, SEISMIC IMPORTANCE FACTOR, MAPPED SPECTRAL RESPONSE, SITE CLASS, SPECTRAL RESPONSE COEFF), SEISMIC DESIGN CATEGORY, BASIC SEISMIC FORCE-RESISTING SYS., LIGHT FRAMED WALLS, WOOD STRUCTURAL PANELS, ULTIMATE BASE SHEAR, SEISMIC RESPONSE COEFF, TRANS, LONG, RESPONSE MODIFICATION FACTOR, TRANS, LONG, ANALYSIS PROCEDURE USED, EQUIVALENT LATERAL FORCE).

LATERAL BRACING NOTES

THIS HOME HAS BEEN ENGINEERED TO RESIST LATERAL FORCES RESULTING FROM: 100 MPH WIND SPEED, EXP. B (ASCE 7-16 WIND MAP, PER IRC R301.2.1.1) RISK CAT. 2 & SEISMIC CAT. D2.

110 MPH WIND IN 2018 IRC MAP ENGINEERED DESIGN WAS COMPLETED PER 2018 IBC (SECTION 1609 & 1613) & ASCE 7-16, AS PERMITTED BY R301.1.3 OF THE 2018 IRC. ACCORDINGLY, THIS HOME, AS DOCUMENTED AND DETAILED HEREWITHIN, IS ADEQUATE TO RESIST THE CODE REQUIRED LATERAL FORCES, AND DOES NOT NEED TO CONFORM TO THE PRESCRIPTIVE PROVISIONS OF R602.10.

STANDARD EXTERIOR WALL SHEATHING SPECIFICATIONS

INTERIOR WALL SPECIFICATION (WHERE NOTED ON PLANS)
1/8" OSB OR 1/2" PLYWOOD: FASTEN SHEATHING W/ 2 1/2"x0.131" NAILS @ 6" O.C. AT ALL SUPPORTED PANEL EDGES AND 12" O.C. IN THE PANEL FIELD. ALL SHEATHING SHEET PANEL EDGES SHALL OCCUR OVER WALL FRAMING MEMBERS OR 2x HORIZONTAL BLOCKING SHALL BE PROVIDED TO SUPPORT PANEL EDGE. ALL EXTERIOR WALLS SHALL BE CONSTRUCTED PER THIS SPECIFICATION UNO. ON PLANS.

3" O.C. EDGE NAILING (WHERE NOTED ON PLANS)


1/8" OSB OR 1/2" PLYWOOD: ONLY AT LOCATIONS INDICATED ON PLANS - SHEATHING SHOWN WITH 1/8" OSB. FASTEN SHEATHING W/ 2 1/2"x0.131" NAILS @ 3" O.C. AT EDGES AND 12" O.C. AT CENTER. ALL SHEATHING SHEET PANEL EDGES SHALL OCCUR OVER WALL FRAMING MEMBERS OR 2x HORIZONTAL BLOCKING SHALL BE PROVIDED TO SUPPORT PANEL EDGE AND 3" O.C. FASTENING.

NOTES:

- LATERAL ANALYSIS ASSUMES STUD SPACING @ 16" O.C.
ALL SHEAR WALLS SHALL HAVE DOUBLE TOP PLATES FASTENED TOGETHER W/ 3"x0.131" NAILS @ 8" O.C. USE (2) 3/8"x0.131" NAILS AT EACH LAP SPLICED (6) EACH SIDE OF JOINT (TYP. UNO.)
ALL EXTERIOR WALLS ARE CONTINUOUSLY SHEATHED.
ALL INTERIOR SHEAR WALLS AND EXTERIOR WALLS ARE SHEATHED ABOVE AND BELOW OPENINGS.

LEGEND

- INTERIOR BEARING WALL
BEARING WALL ABOVE (B.W.A.) OR SHEARNAIL ABOVE (S.W.A.)
BEAM / HEADER
INTERIOR SHEAR WALL PANEL OR EXTERIOR SHEAR WALL W/ 3" O.C. EDGE NAILING
AREA OF OVERFRAMING
METAL HANGER
INDICATES POST ABOVE. PROVIDE SOLID BLOCKING UNDER POST OR JAMB ABOVE.
INDICATES HOLD-DOWN.

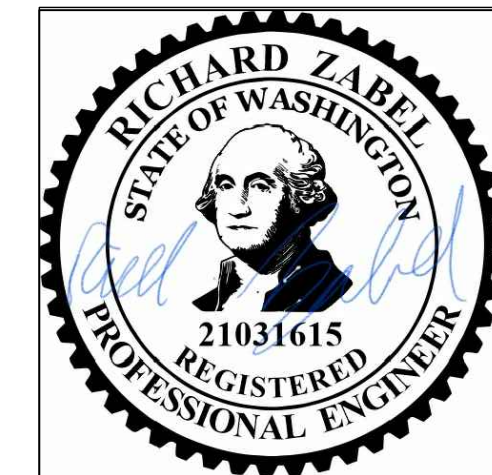

GENERAL STRUCTURAL NOTES

DESIGN PARAMETERS

- DESIGN IS BASED ON 2018 INTERNATIONAL RESIDENTIAL CODE & 2018 INTERNATIONAL BUILDING CODE
WOOD FRAME ENGINEERING IS BASED ON NDS, NATIONAL DESIGN SPECIFICATION FOR WOOD CONSTRUCTION - LATEST EDITION.

GENERAL FRAMING

- EXTERIOR BEARING WALLS SHALL BE 2x4 OR 2x6 (AS SHOWN ON PLANS) @ 16" O.C. (W/ DOUBLE TOP PLATE) HEM FIR (HF) #2 STUD GRADE LUMBER, OR BETTER, UNO.
INTERIOR BEARING WALLS SHALL BE 2x4 OR 2x6 (AS SHOWN ON PLANS) @ 16" O.C. (W/ DOUBLE TOP PLATE) HEM FIR (HF) #2 STUD GRADE LUMBER, OR BETTER, UNO.
ALL NON-BEARING INTERIOR STUD WALLS SHALL BE CONSTRUCTED WITH 2x4 STUD GRADE MEMBERS SPACED @ 24" O.C. (MAX.)
ALL WALLS TALLER THAN TYP. PLATE HEIGHT SHALL BE CONSIDERED BALLOON FRAMED & SHALL BE CONSTRUCTED FROM FLOOR TO UNDERSIDE OF FRAMING AT NEXT LEVEL. BF. WALLS SHALL BE 2x4 OR 2x6 (AS SHOWN ON PLANS) HEM FIR (HF) #2 GRADE LUMBER, OR BETTER.
ALL HEADERS SHALL BE SUPPORTED BY (1) 2x JACK STUD & (1) 2x KING STUD, MINIMUM. THE NUMBER OF STUDS SPECIFIED AT A SUPPORT INDICATES THE NUMBER OF JACK STUDS REQUIRED, UNO.
BUILT-UP POSTS SHALL BE 2x4 OR 2x6 HEM FIR (HF) #2 STUD GRADE LUMBER, OR BETTER, UNO. & SOLID WOOD COLUMN SHALL BE SPRUCE PINE FIR (SPF) #2 GRADE LUMBER, OR BETTER, UNO.
ALL 2x6 AND LARGER SOLID SAWN BEAMS/HEADERS SHALL BE HEM FIR #2 (HF #2) OR BETTER. ALL 4x6 AND LARGER SOLID SAWN LUMBER SHALL BE DOUG FIR #2 (DF #2) OR BETTER.
ALL FRAMING LUMBER SHALL BE KILN DRIED TO 15% MC (KD-15).
ALL TYP. NAIL FASTENER REQUIREMENTS ARE NOTED IN GENERAL NOTES, IN DETAILS, OR ON PLANS. ALL NAILS SPECIFIED ARE MIN DIAMETER AND LENGTH REQUIRED FOR CONNECTION. ALL HANGER NAILS SHALL BE INSTALLED PER MANUFACTURER'S REQUIREMENTS FOR MAX CHARTED CAPACITY. NOTE: HANGERS USE COMMON NAIL DIAMETERS NOT TYPICAL FRAMING GUN NAILS.
FASTEN ALL BEAMS TO COLUMN, OR FLUSH BEAMS TO SUPPORTING BEAMS W/ (4) 3"x0.131" TORNAILS (MN), TYP. UNO.
PROVIDE SOLID BLOCKING IN FLOOR SYSTEM UNDER ALL POSTS & HOLD-DOWNS CONTINUOUS TO FOUNDATION/BEARING. BLOCKING TO MATCH POST ABOVE.
ENGINEERED LUMBER TO MEET OR EXCEED THE FOLLOWING:
LVL MEMBERS - Fb=2525 PSI; Fv=910 PSI; E=155x10^6 PSI
LVL MEMBERS - Fb=2400 PSI; Fv=285 PSI; E=1.2x10^6 PSI
SLB MEMBERS - Fb=2400 PSI; Fv=1850 PSI; Fv=265 PSI; E=1.8x10^6 PSI; DF/DF; 24F-V4 (UNO)
ENGINEERED LUMBER POSTS TO MEET OR EXCEED THE FOLLOWING:
LVL MEMBERS - Fb=2400 PSI; Fv=2500 PSI; E=1.8x10^6 PSI
FACE NAIL MULTI-PLY 2x BEAMS & HEADERS W/ 3-RINGS OF 3"x0.131" NAILS (MN) @ 12" O.C. STAGGERED. APPLY NAILING FROM BOTH FACES @ 3-PLY OR MORE CONDITIONS. UTILIZE 2 RINGS OF NAILS FOR 2x6 & 2x8 MEMBERS.
ALL MEMBERS SPECIFIED AS MULTI-PLY (B) SHALL BE FASTENED TOGETHER PER MANUFACTURER. EQUIVALENT WIDTH SOLID MATERIAL MAY BE USED AS EQUAL.
FASTEN 2x WOOD PLATES TO TOP FLANGE OF STEEL BEAMS W/ PAFs (HILT) X-U PING OR EQUAL (0.151" DIA. x 2" LONG MIN.) @ 16" O.C. STAGGERED, OR 1/2" DIA. BOLTS @ 48" O.C., STAGGERED.
REFER TO IRC FASTENING SCHEDULE TABLE R602.3(1) FOR ALL CONNECTIONS, TYP. UNO.

FLOOR FRAMING

- I-JOISTS/TRUSSES SHALL BE DESIGNED BY MANUF. TO MEET OR EXCEED L/480 LIVE LOAD DEFLECTION CRITERIA AND SHALL RUN CONTINUOUS OVER SUPPORTS WHEREVER POSSIBLE. ALL LOADS SHOWN ON PLAN FOR MANUF. DESIGNS ARE ASD LEVEL LOADS, UNO. (EXCLUDES STONE/MARBLE OR NET BED CONSTRUCTED FLOORS - CONTACT MKF FOR EXCLUDED DESIGN).
ALL METAL I-JOIST/TRUSS HANGERS SHALL BE SPECIFIED BY ARCHITECT AND ENGINEER FOR REVIEW AND APPROVAL PRIOR TO FABRICATION OR DELIVERY.
2x FLOOR JOISTS HAVE BEEN DESIGNED TO MEET OR EXCEED L/260 LIVE LOAD DEFLECTION CRITERIA.
TYPICAL 2x JOIST HANGERS (UNO. ON PLANS): SINGLE PLY: SIMPSON LUS20 DOUBLES: SIMPSON LUS20-2
FLOOR SHEATHING SHALL BE 23/32" A.P.A. RATED #2/UD-FLOOR 24" O.C. EXPOSURE 1 (OR APPROVED EQUAL) WITH TONGUE AND GROOVE EDGES. FASTEN TO FRAMING MEMBERS W/ GLUE AND 2 1/2" x 0.131" NAILS @ 6" O.C. @ PANEL EDGES & @ 12" O.C. FIELD.
ALL FLUSH CONNECTIONS SHALL BE CONNECTED WITH HANGER APPROPRIATE FOR MEMBER SIZE, UNO.
FASTEN HANGERS TO SINGLE PLY FLUSH BEAMS W/ 1/2" LONG NAILS.

ROOF FRAMING

- FASTEN EACH ROOF TRUSS TO TOP PLATE W/ (4) 3"x0.131" TORNAILS (MN) & (1) SIMPSON SDNG15600 SCREW @ ALL BEARING POINTS. PROVIDE (2) SIMPSON SDNG15600 SCREWS AT 2-PLY GIRDER TRUSSES, (3) SIMPSON SDNG15600 SCREWS AT 3-PLY GIRDER TRUSSES AT ALL BEARING POINTS.
FASTEN EACH ROOF RAFTER TO TOP PLATE WITH (1) SIMPSON SDNG15600 SCREW PROVIDE (2) SIMPSON SDNG15600 SCREWS AT FLUSH BEAMS IN THE ROOF - AT ALL BEARING POINTS.
ROOF SHEATHING SHALL BE 7/16" A.P.A. RATED SHEATHING 24/16 EXPOSURE 1 (OR APPROVED EQUAL). FASTEN TO FRAMING MEMBERS W/ 2 1/2" x 0.131" NAILS @ 6" O.C. AT PANEL EDGES & @ 12" O.C. AT INTERMEDIATE SUPPORTS. ROOF SHEATHING SHALL EXTEND BELOW ALL INSTANCES OF OVERFRAMING. BLOCKING SHALL BE INSTALLED AS REQUIRED TO LIMIT ROOF SHEATHING SPANS TO 24" MAX. WITHIN 48" OF ALL ROOF EDGES, RIDGES, & HIPs FASTEN ROOF SHEATHING FIELDS PER EDGE NAILING SPEC.
ALL METAL HANGERS SHALL BE SPECIFIED BY THE TRUSS MANUFACTURER, UNLESS OTHERWISE NOTED.
ROOF TRUSS SHOP DRAWINGS SHALL BE SUBMITTED TO ARCHITECT AND ENGINEER FOR REVIEW AND APPROVAL PRIOR TO FABRICATION OR DELIVERY.
ROOF TRUSS SHOP DRAWINGS & CALCULATIONS SHALL BE PREPARED BY A WASHINGTON STATE LICENSED ENGINEER AND SHALL BE DESIGNED FOR UNBALANCED SNOW LOADING PER ASCE 7-16, SECTION 7.6.
ERECT AND INSTALL ROOF TRUSSES PER WTCA & TP15 BC51 I-08 GUIDE TO GOOD PRACTICE FOR HANDLING, INSTALLING & BRACING OF METAL PLATE CONNECTED WOOD TRUSSES.
FASTEN OVER-FRAMED TRUSS SEITS TO TRUSSES BELOW W/ (2) 3"x0.131" TORNAILS AT EA TRUSS.
SUPPORT PORCH & SHORT SPAN ROOF TRUSSES (UP TO 6' TRIB.) W/ 2x6 LEDGER FASTENED TO FRAMING W/ (3) 3"x0.131" NAILS @ 16" O.C.
FASTEN ALL INTERIOR NON-BEARING PARTITION WALLS TO TRUSS BOTTOM CHORD ABOVE WITH SIMPSON STC CLIPS AT 24" O.C. MAX. PROVIDE BLOCKING BETWEEN THE TRUSS BOTTOM CHORDS AS REQUIRED FOR THE PARALLEL CONDITIONS.

seal:

copyright: MULHERN & KULP Structural Engineering, Inc.

MULHERN+KULP RESIDENTIAL STRUCTURAL ENGINEERING 7720 Trade Street, Suite 350, San Diego, CA 92121 619-660-0010 mulhernkulp.com



M&K project number:

154-22007

project mgr:

R.JZ

drawn by:

ENW

issue date:

02-28-21

REVISIONS:

date:

initial:




STRUCTURAL NOTES

4537 90TH AVE SE MERCER ISLAND, WASHINGTON


sheat:

S-O.O

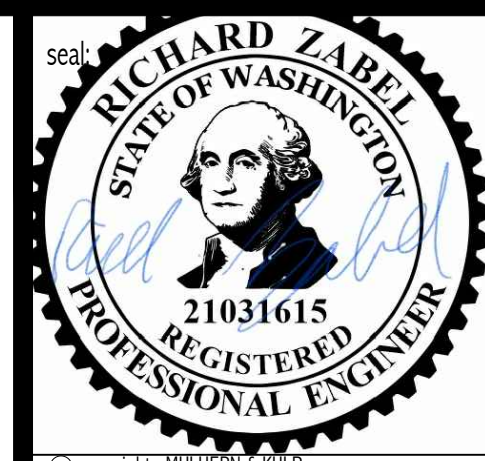

© copyright: MULHERN+KULP Structural Engineering, Inc.

MULHERN+KULP
RESIDENTIAL STRUCTURAL ENGINEERING
7220 Trade Street, Suite 350, San Diego, CA 92121
p 619-660-0010 • mulhernkulp.com

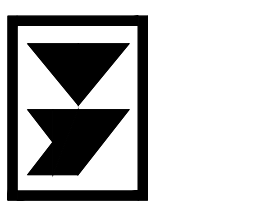


M&K project number:
154-22007
project mgr: **RJZ**
drawn by: **ENW**
issue date: **02-28-21**

REVISIONS:
date: _____ initial: _____




STRUCTURAL DETAILS
4537 90TH AVE SE
MERCER ISLAND, WASHINGTON


sheet:
LB-1

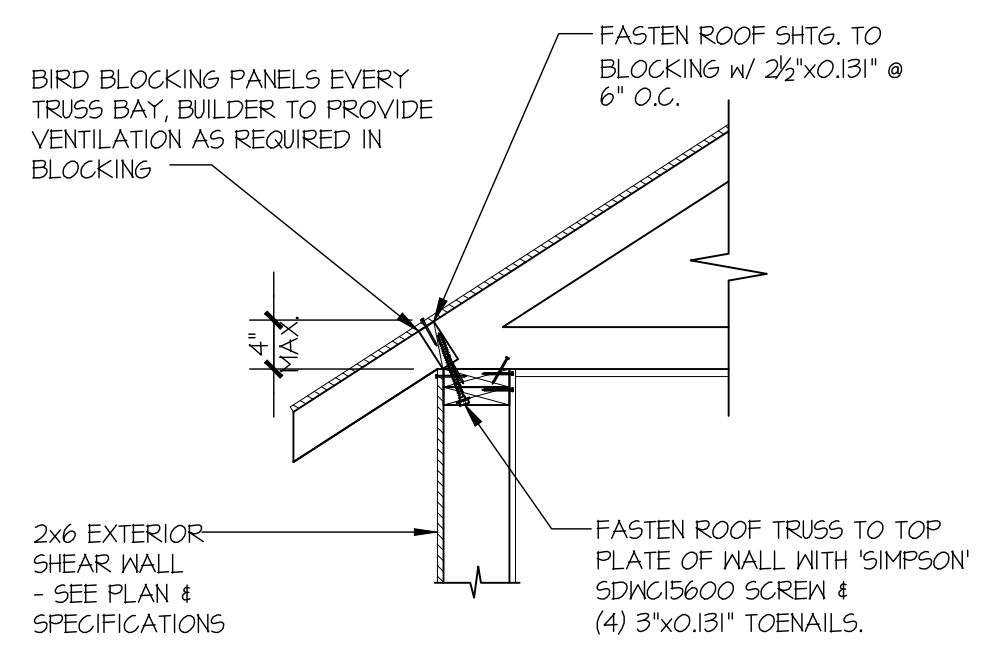


1 TYPICAL SHEAR TRANSFER DETAIL @ ROOF
SCALE: 3/4"=1'-0" HEEL HEIGHT LESS THAN 4"

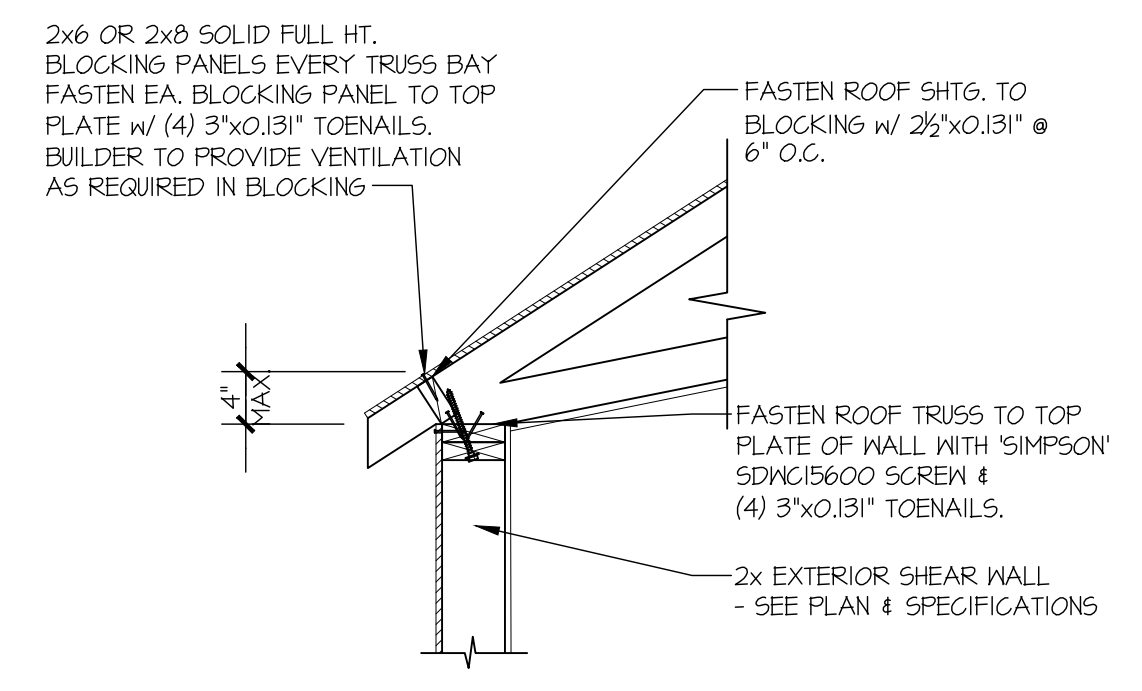


1A TYPICAL SHEAR TRANSFER DETAIL @ VAULTED CEILING
SCALE: 3/4"=1'-0"

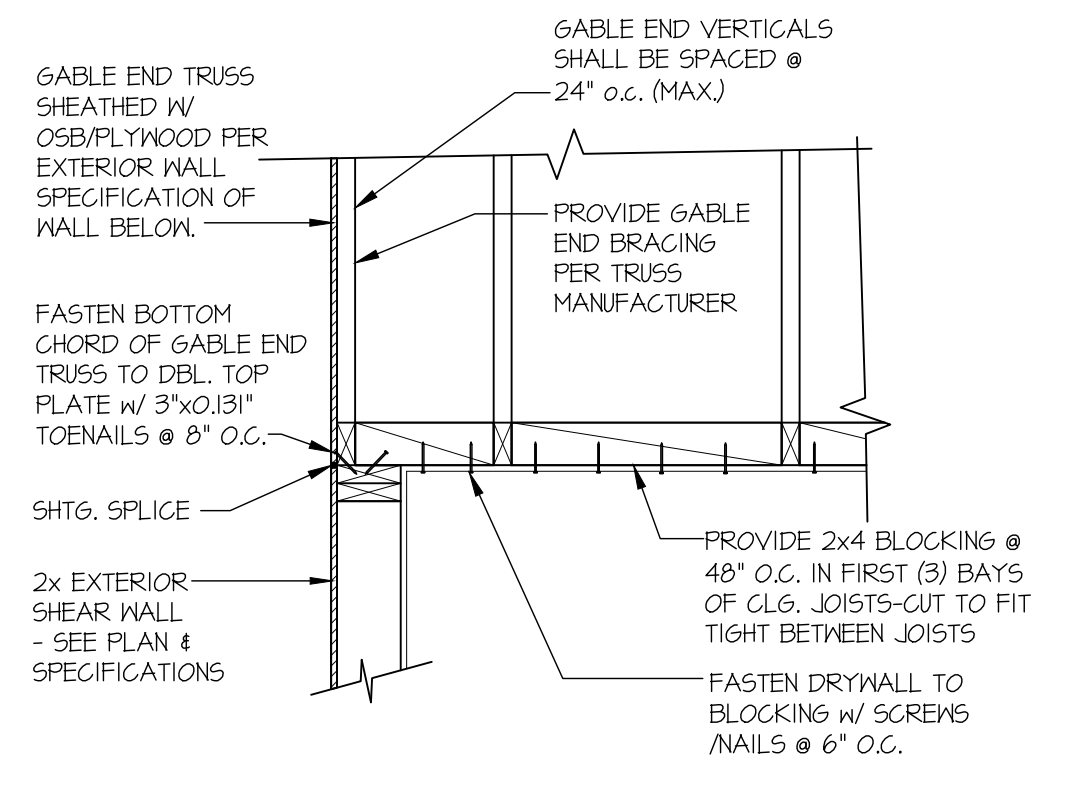


2 TYPICAL GABLE END DETAIL
SCALE: 3/4"=1'-0"

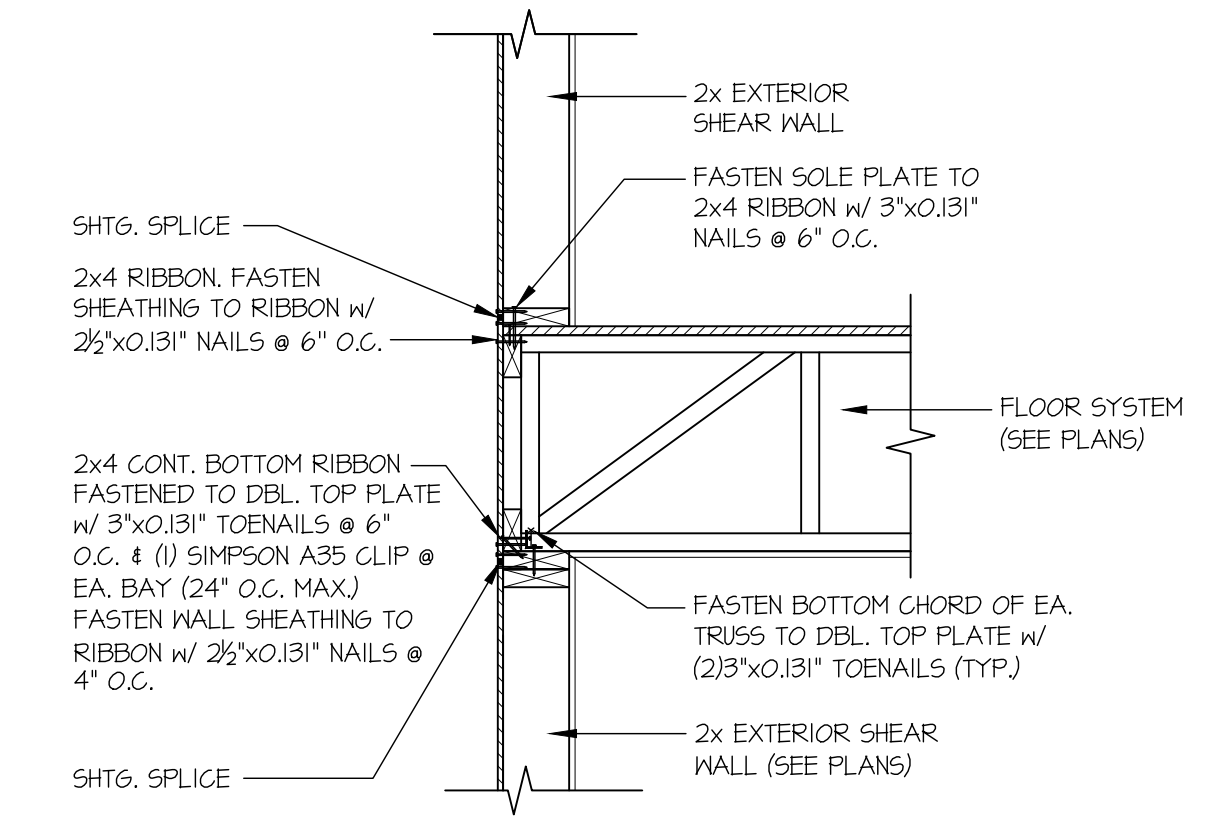


3 TYPICAL SHEAR TRANSFER DETAIL BETWEEN FLOORS @ EXTERIOR WALL
SCALE: 3/4"=1'-0" PERPENDICULAR FRAMING

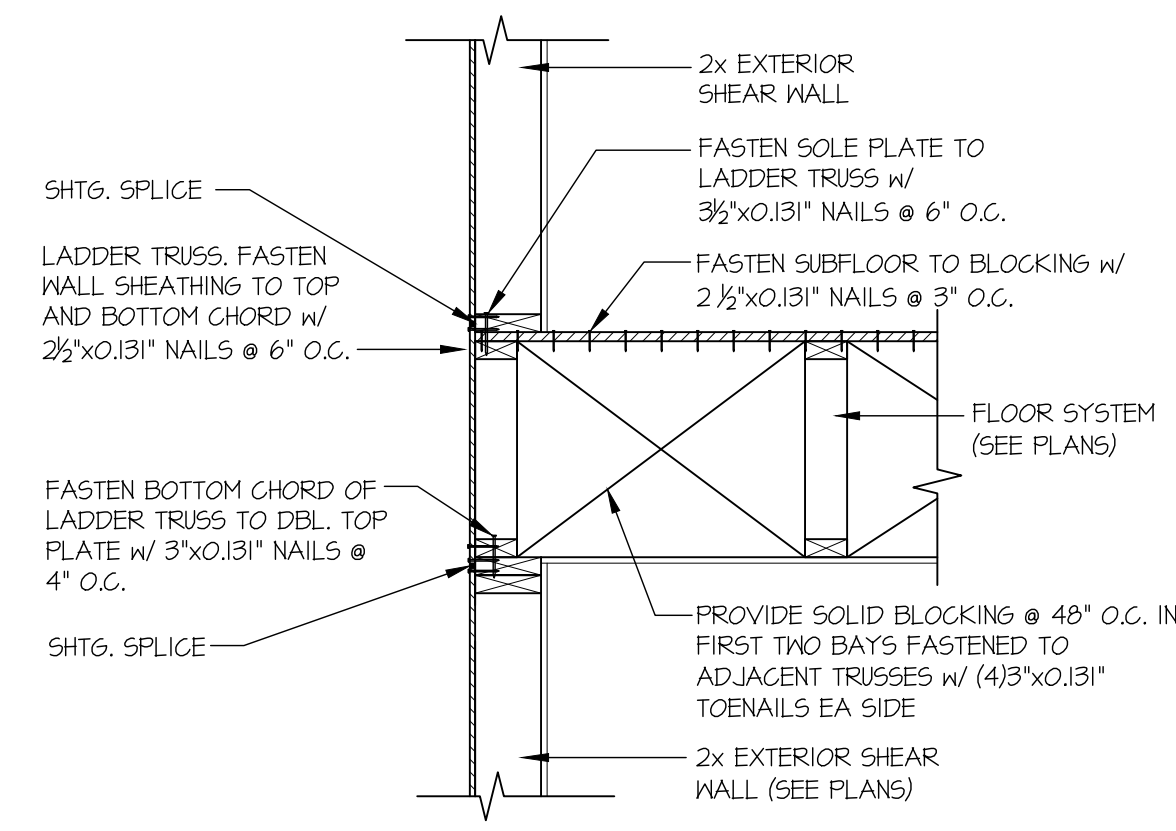


4 TYPICAL SHEAR TRANSFER DETAIL BETWEEN FLOORS @ EXTERIOR WALL
SCALE: 3/4"=1'-0" PARALLEL FRAMING

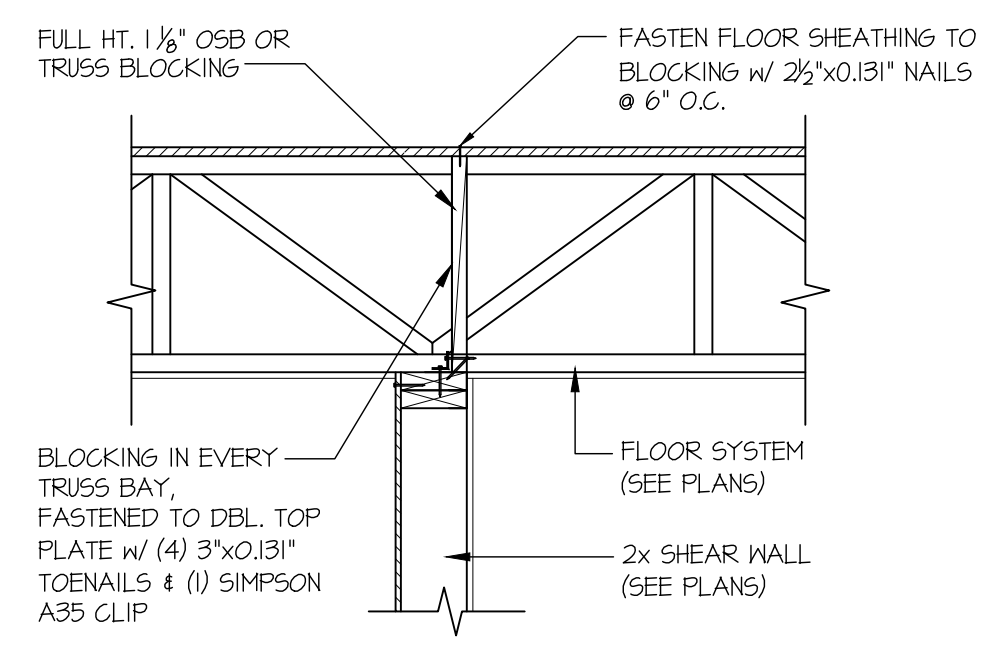


13 SHEAR TRANSFER DETAIL @ SHEAR WALL BELOW
SCALE: 3/4"=1'-0"

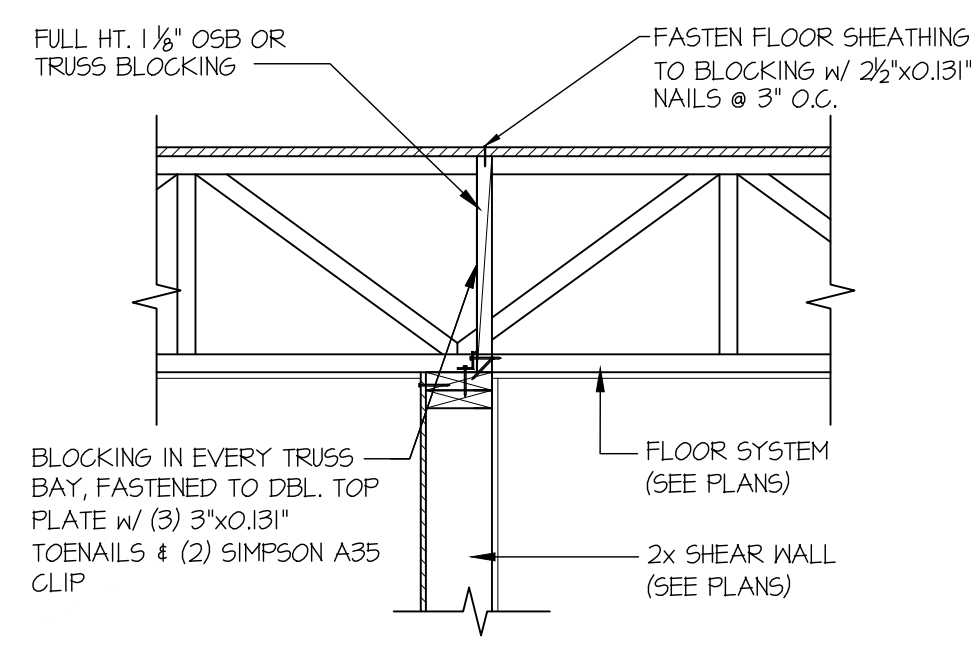


14 SHEAR TRANSFER DETAIL @ SHEAR WALL BELOW
SCALE: 3/4"=1'-0"

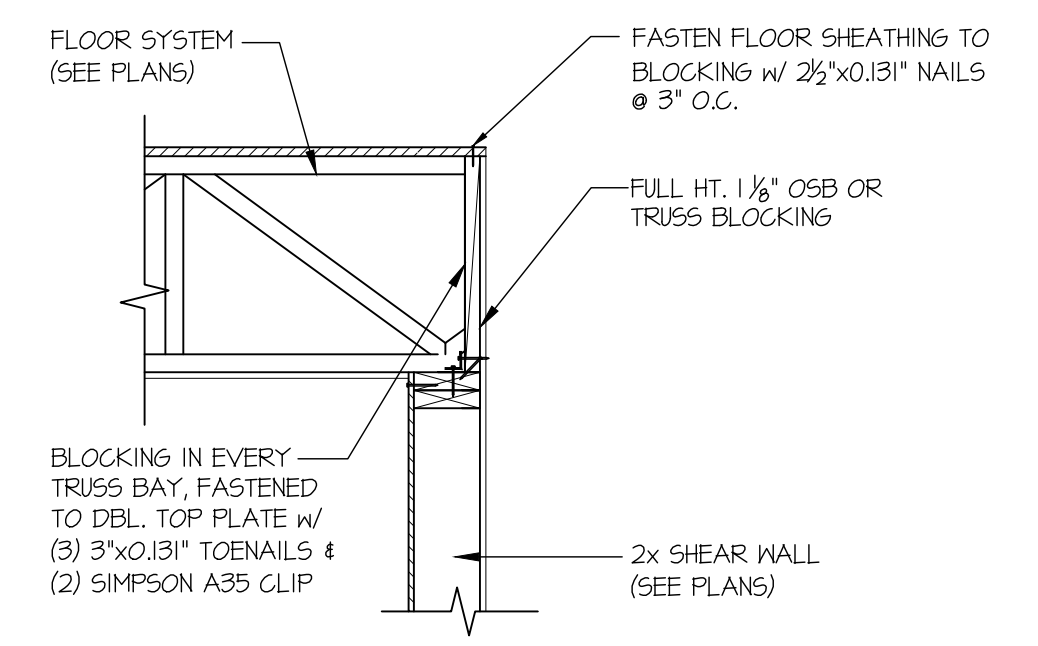


15 SHEAR TRANSFER DETAIL @ SHEAR WALL BELOW
SCALE: 3/4"=1'-0"

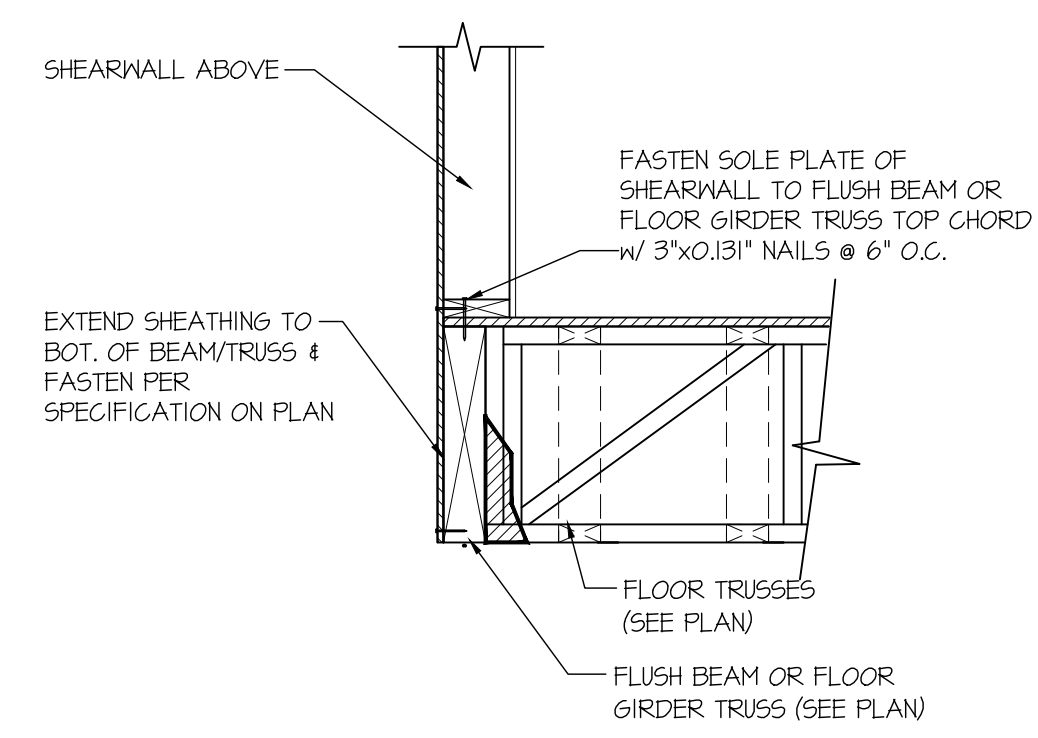


35 SHEAR TRANSFER DETAIL @ EXTERIOR SHEARWALL ABOVE
SCALE: 3/4"=1'-0"

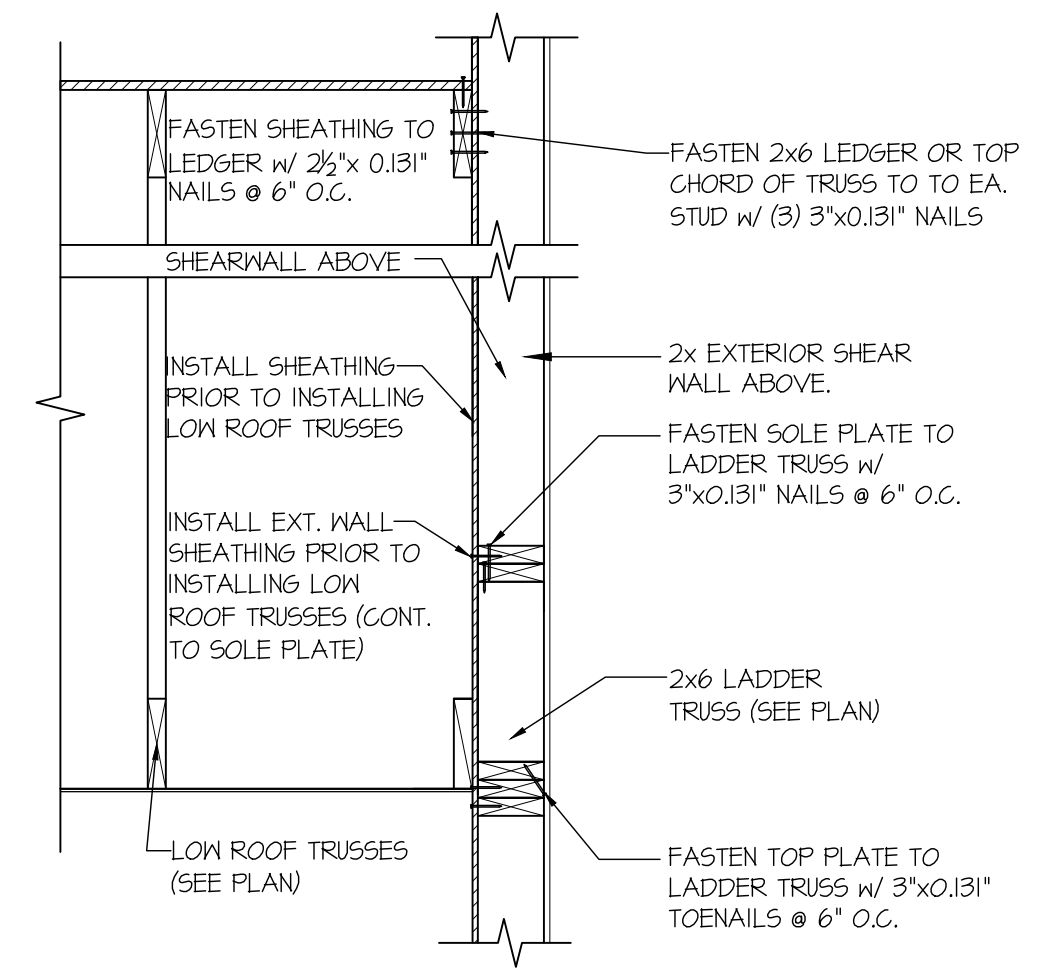


40 SECTION
SCALE: 3/4"=1'-0"

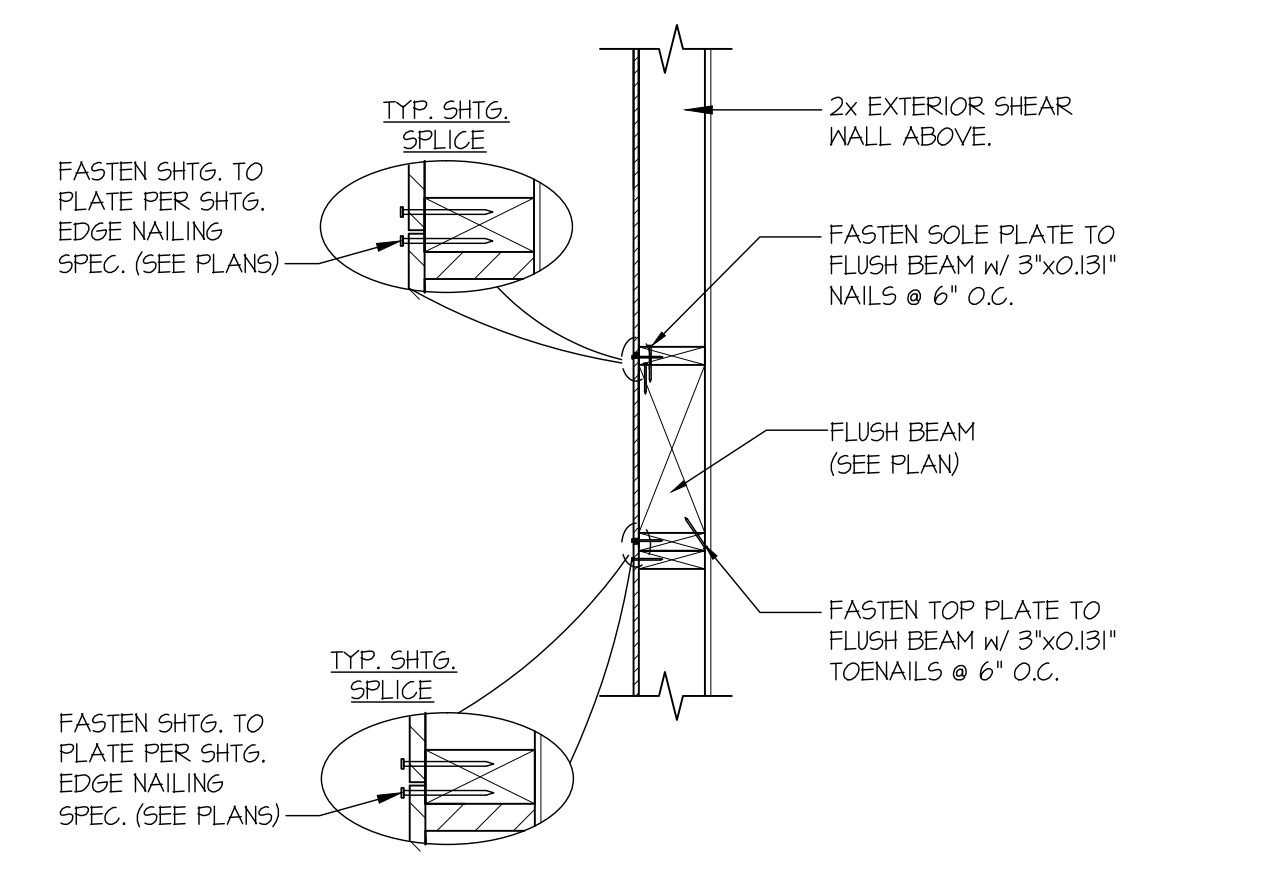

45 TYPICAL SHEAR TRANSFER DETAIL @ EXTERIOR WALL ABOVE FLUSH WIND BEAM
SCALE: 3/4"=1'-0"

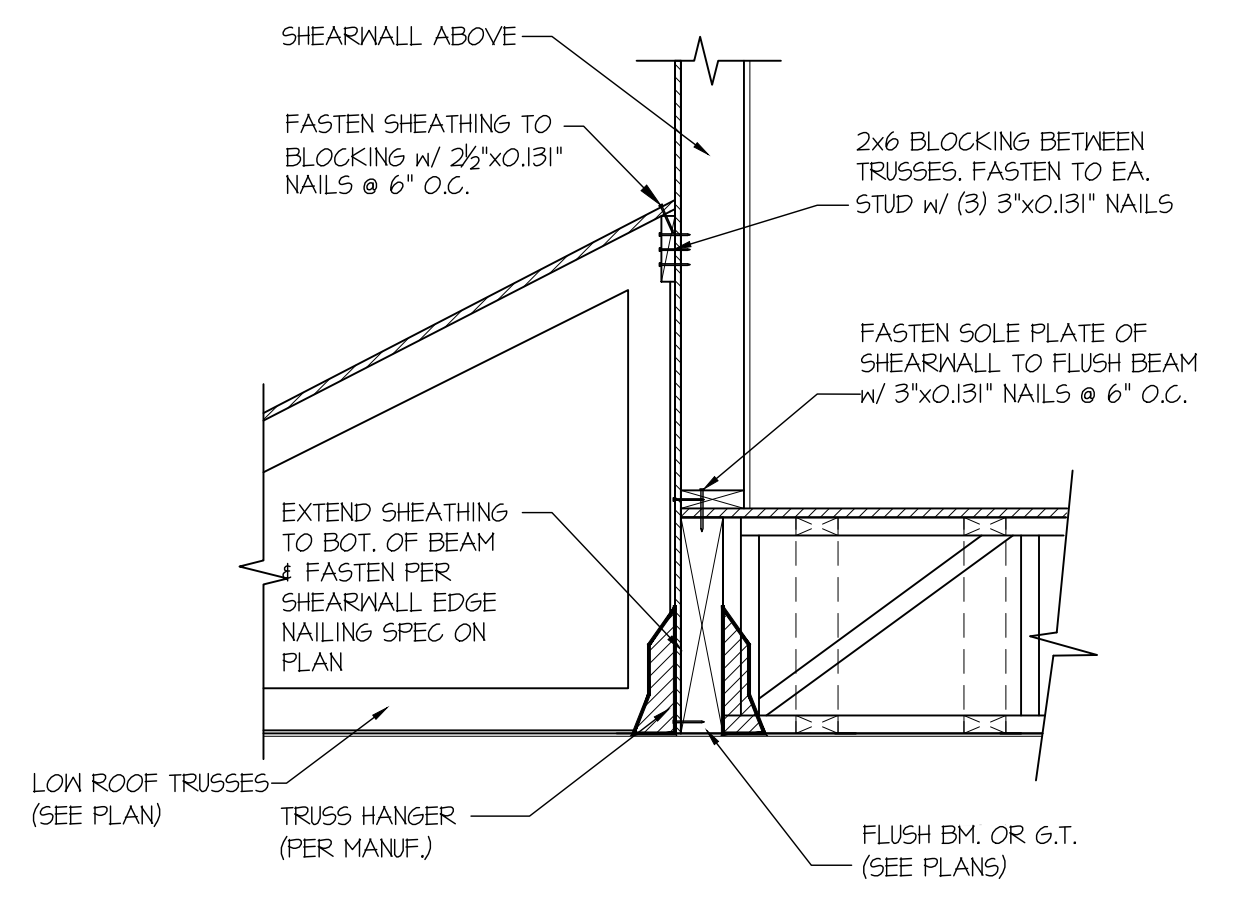

52 SHEAR TRANSFER DETAIL @ EXTERIOR SHEARWALL ABOVE
SCALE: 3/4"=1'-0"

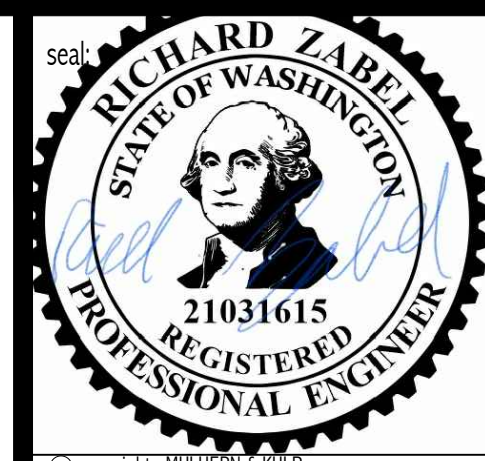

© copyright: MULHERN+KULP Structural Engineering, Inc.

MULHERN+KULP
RESIDENTIAL STRUCTURAL ENGINEERING
7220 Trade Street, Suite 350, San Diego, CA 92121
p 619-550-0010 • mulhernkulp.com


M&K project number:
154-22007
project mgr: **RJZ**
drawn by: **ENW**
issue date: **02-28-21**

REVISIONS:	
date:	initial:




STRUCTURAL DETAILS
4537 90TH AVE SE
MERCER ISLAND, WASHINGTON


sheet:
LB-2

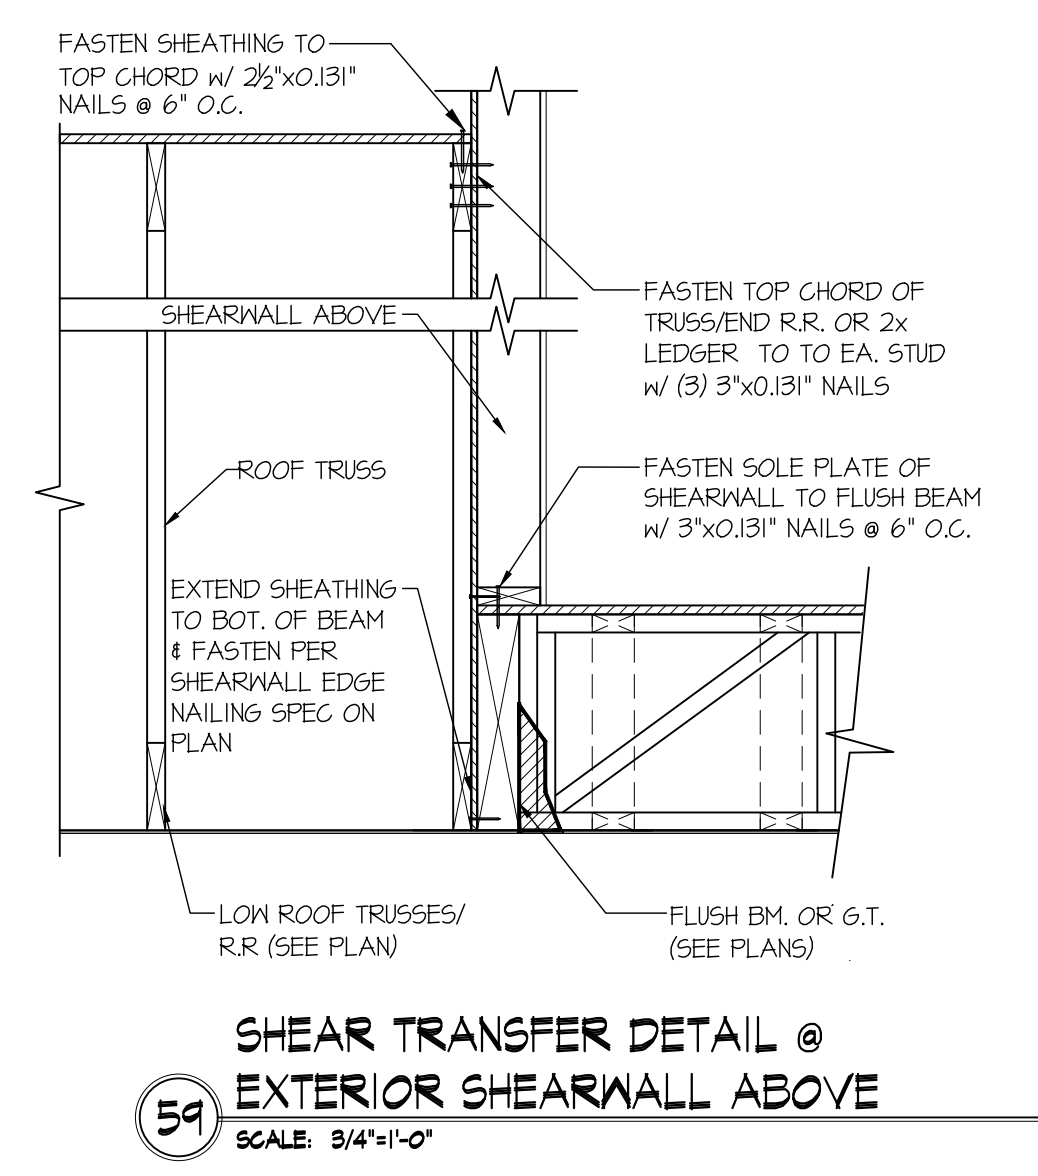


59 SHEAR TRANSFER DETAIL @ EXTERIOR SHEARWALL ABOVE
SCALE: 3/4"=1'-0"

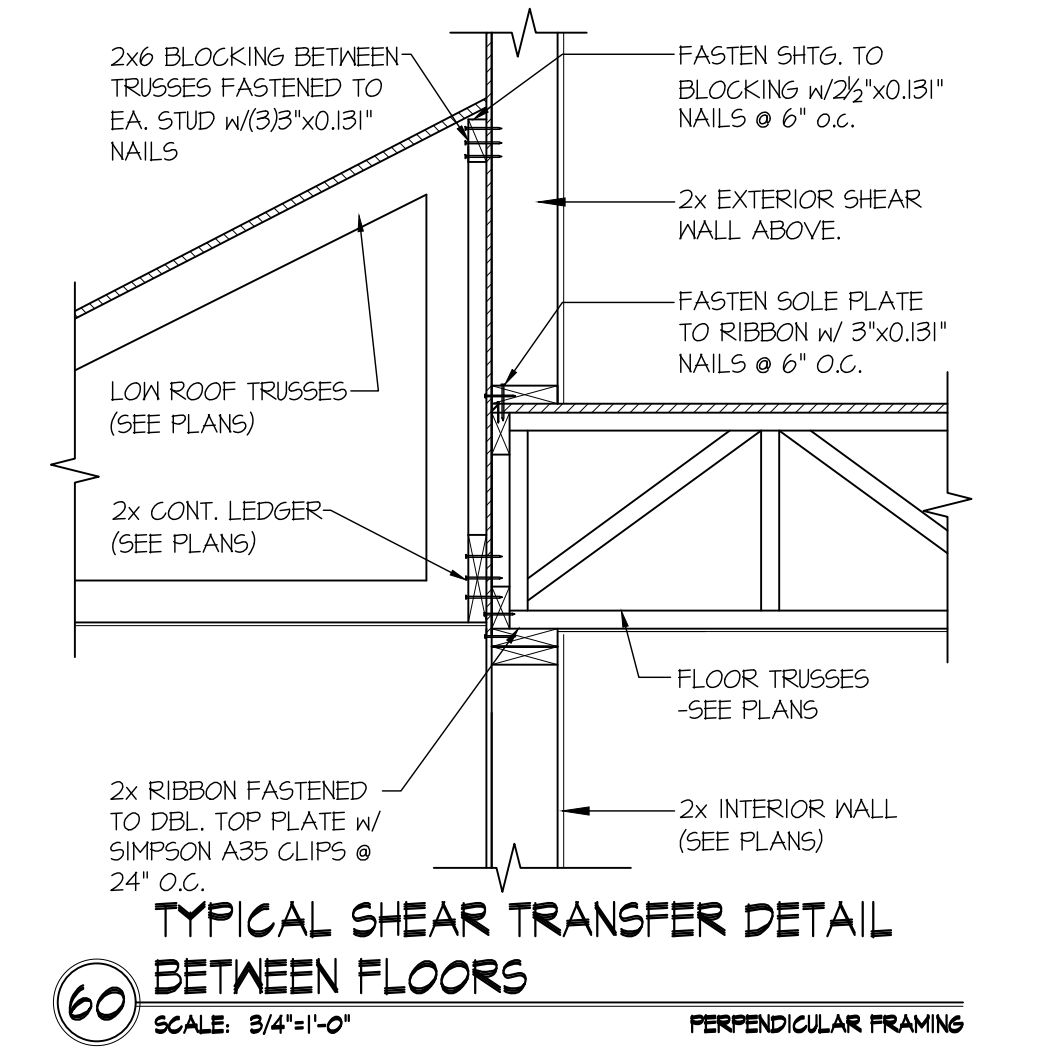


60 TYPICAL SHEAR TRANSFER DETAIL BETWEEN FLOORS
SCALE: 3/4"=1'-0" PERPENDICULAR FRAMING

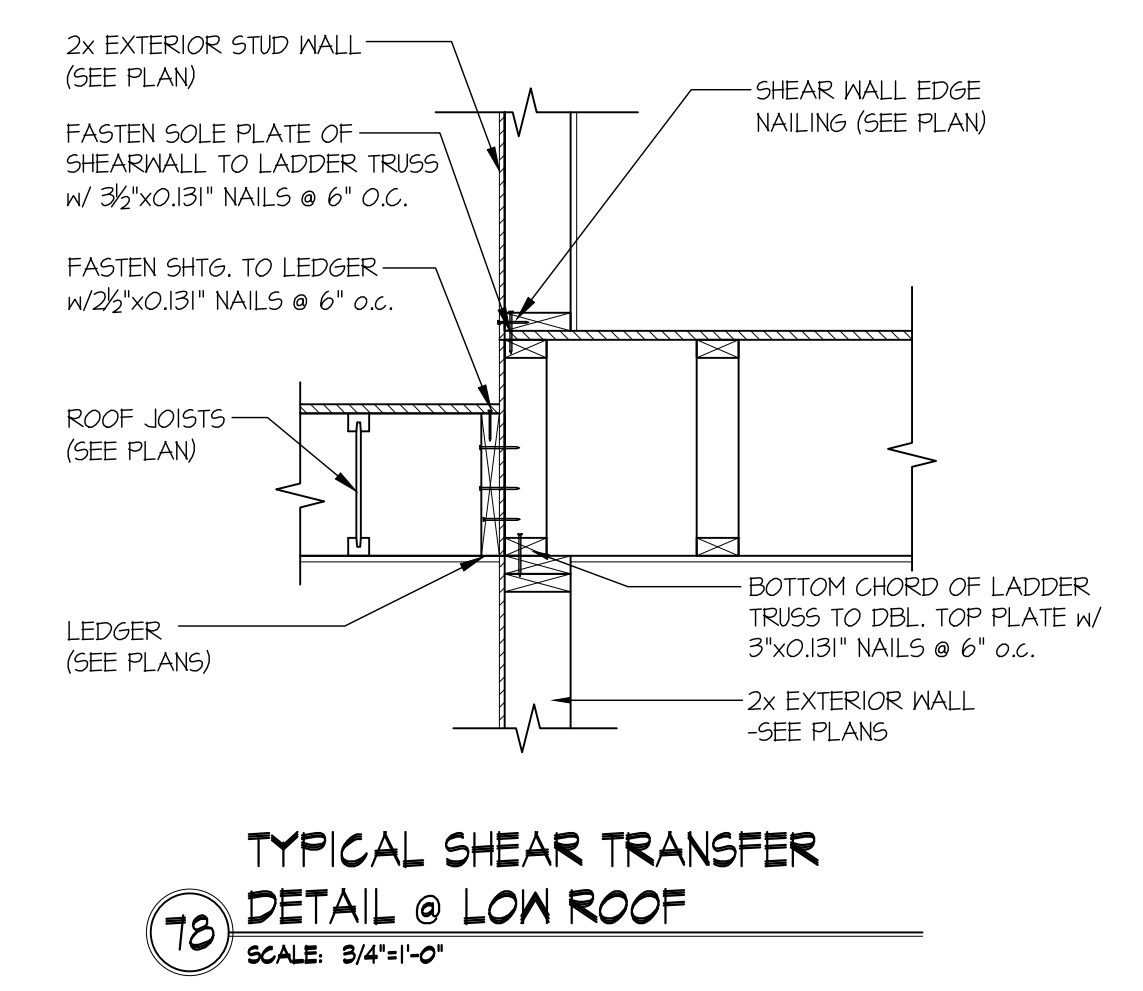

78 TYPICAL SHEAR TRANSFER DETAIL @ LOW ROOF
SCALE: 3/4"=1'-0"

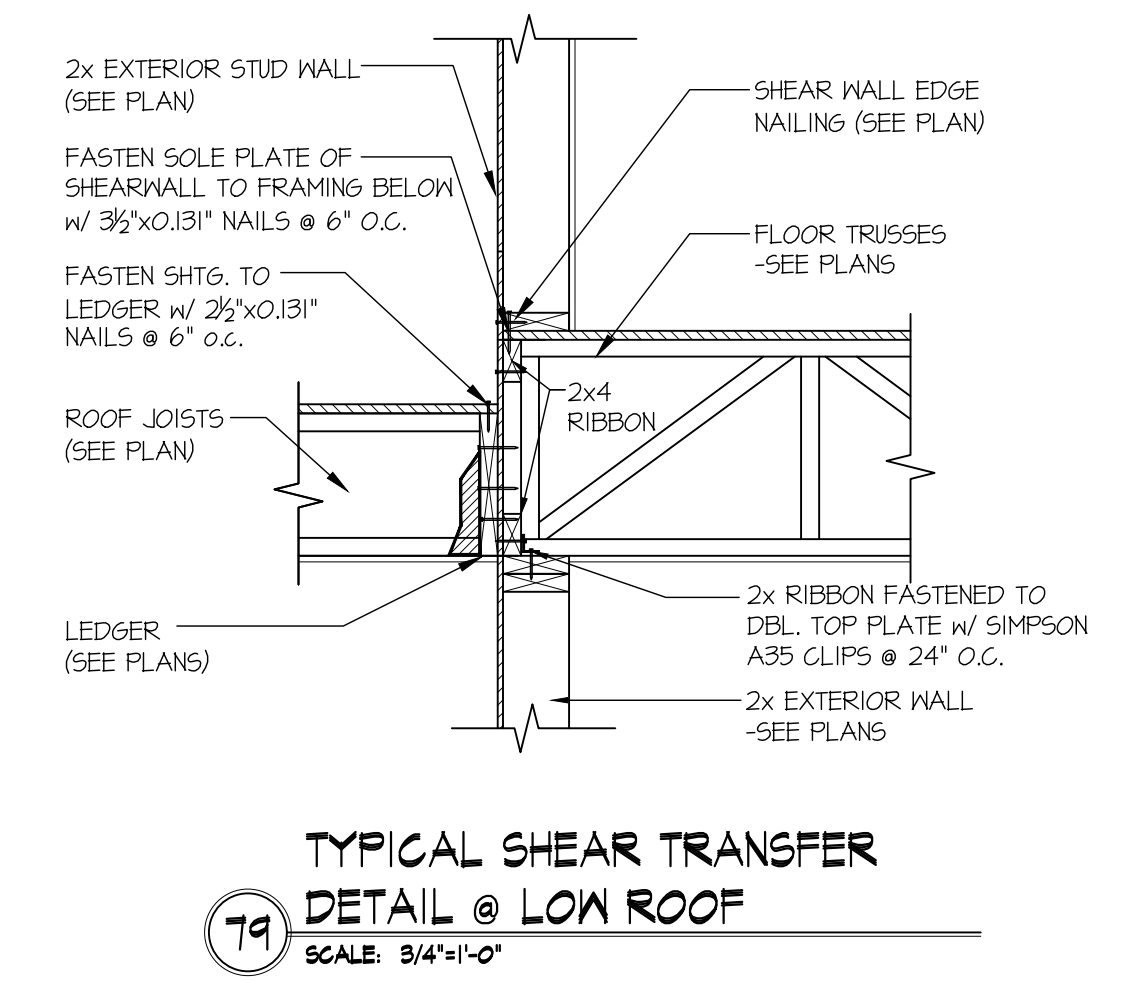


79 TYPICAL SHEAR TRANSFER DETAIL @ LOW ROOF
SCALE: 3/4"=1'-0"

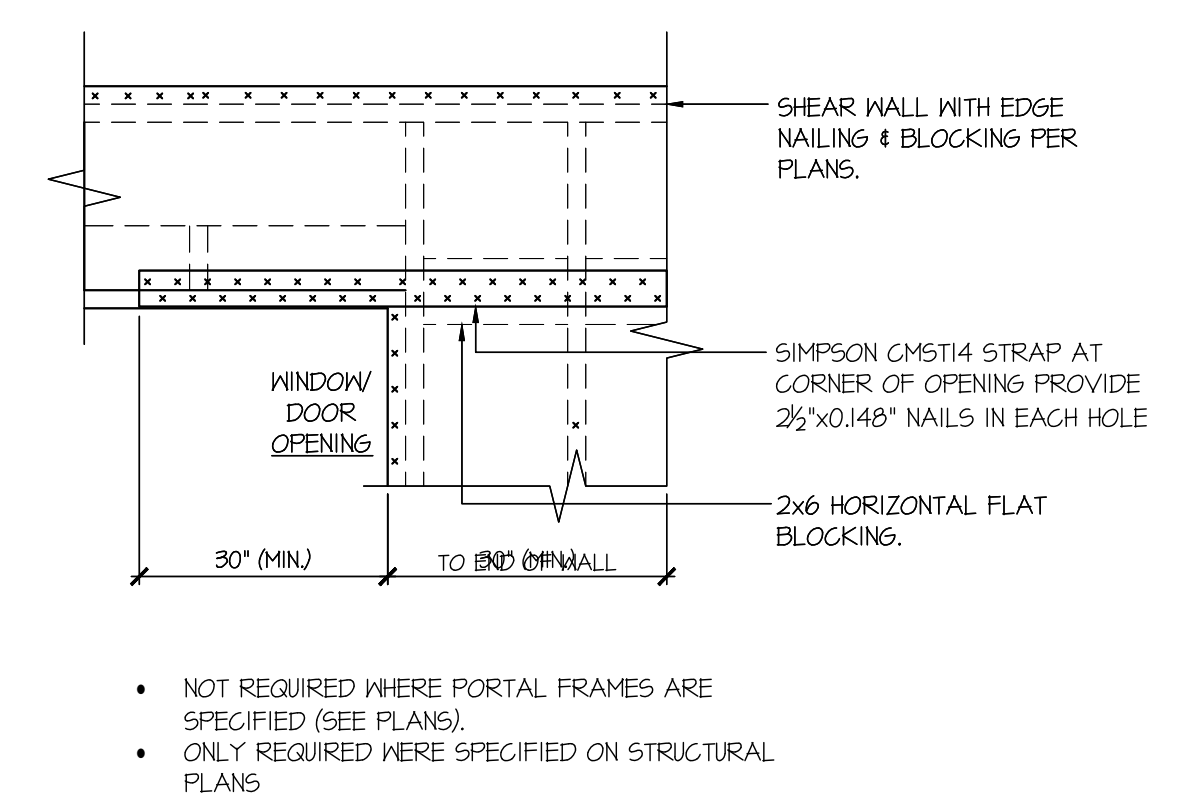


92 EXT. WALL & INT. SHEARWALL OPENING ELEVATION
SCALE: NTS

- NOT REQUIRED WHERE PORTAL FRAMES ARE SPECIFIED (SEE PLANS).
- ONLY REQUIRED WHERE SPECIFIED ON STRUCTURAL PLANS

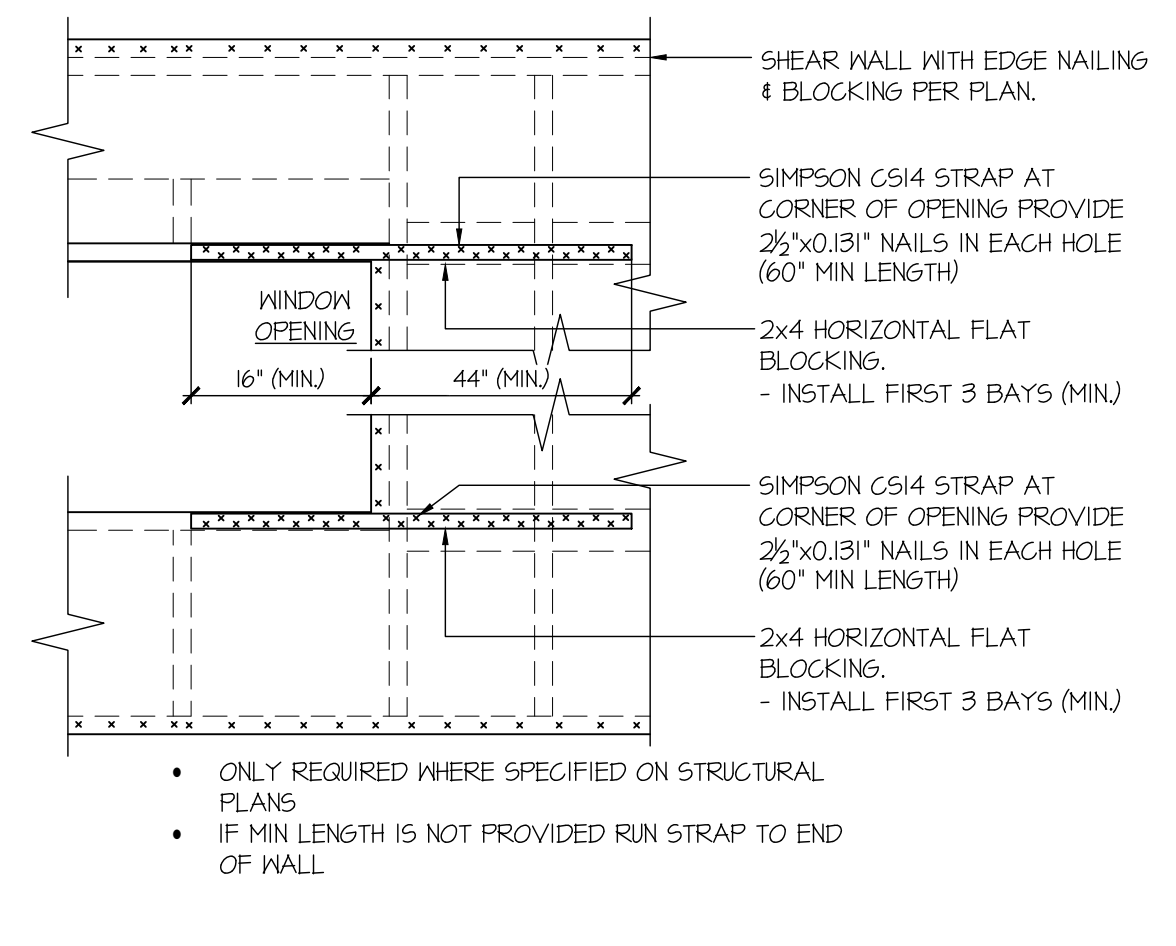


93 EXT. WALL & INT. SHEARWALL OPENING ELEVATION
SCALE: NTS

- ONLY REQUIRED WHERE SPECIFIED ON STRUCTURAL PLANS
- IF MIN LENGTH IS NOT PROVIDED RUN STRAP TO END OF WALL

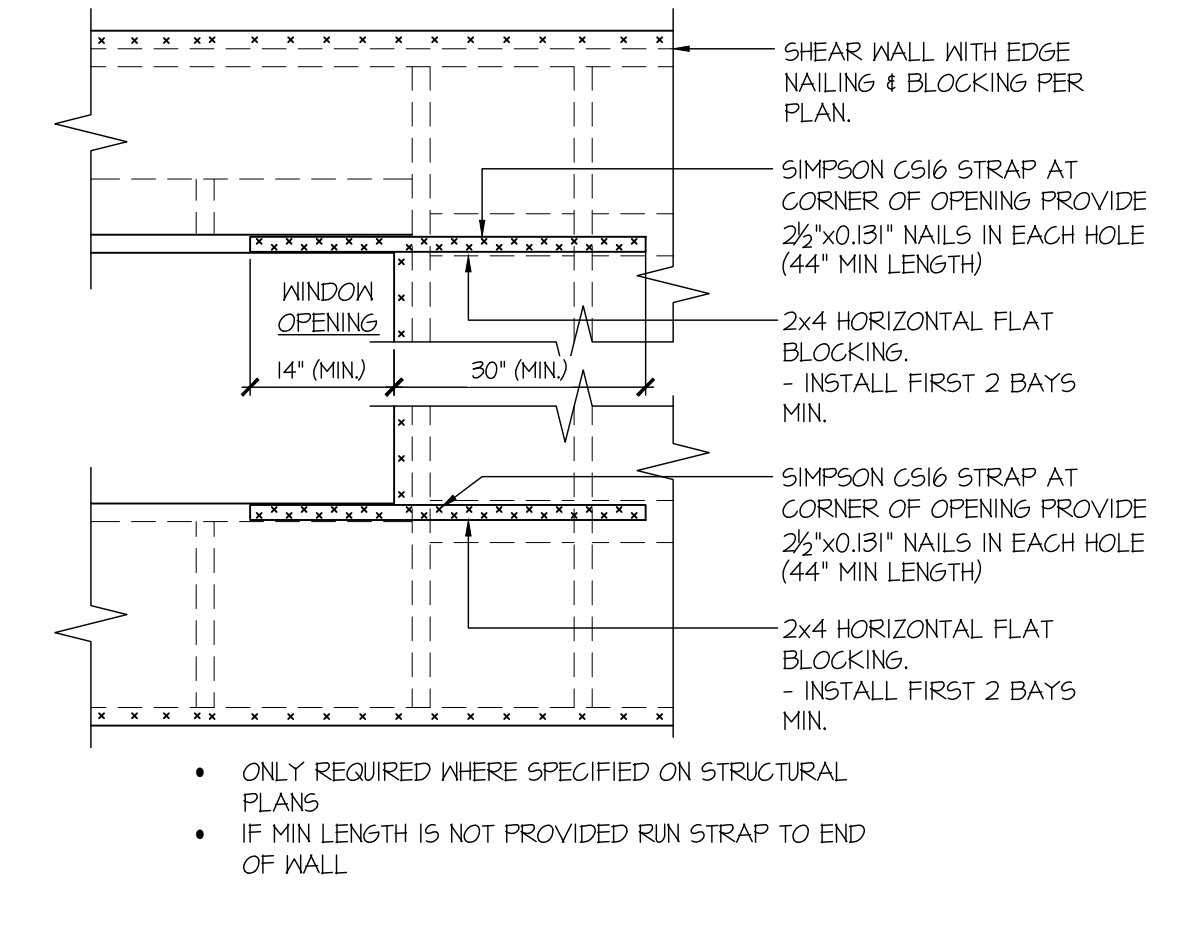


94 EXT. WALL & INT. SHEARWALL OPENING ELEVATION
SCALE: NTS


- ONLY REQUIRED WHERE SPECIFIED ON STRUCTURAL PLANS
- IF MIN LENGTH IS NOT PROVIDED RUN STRAP TO END OF WALL

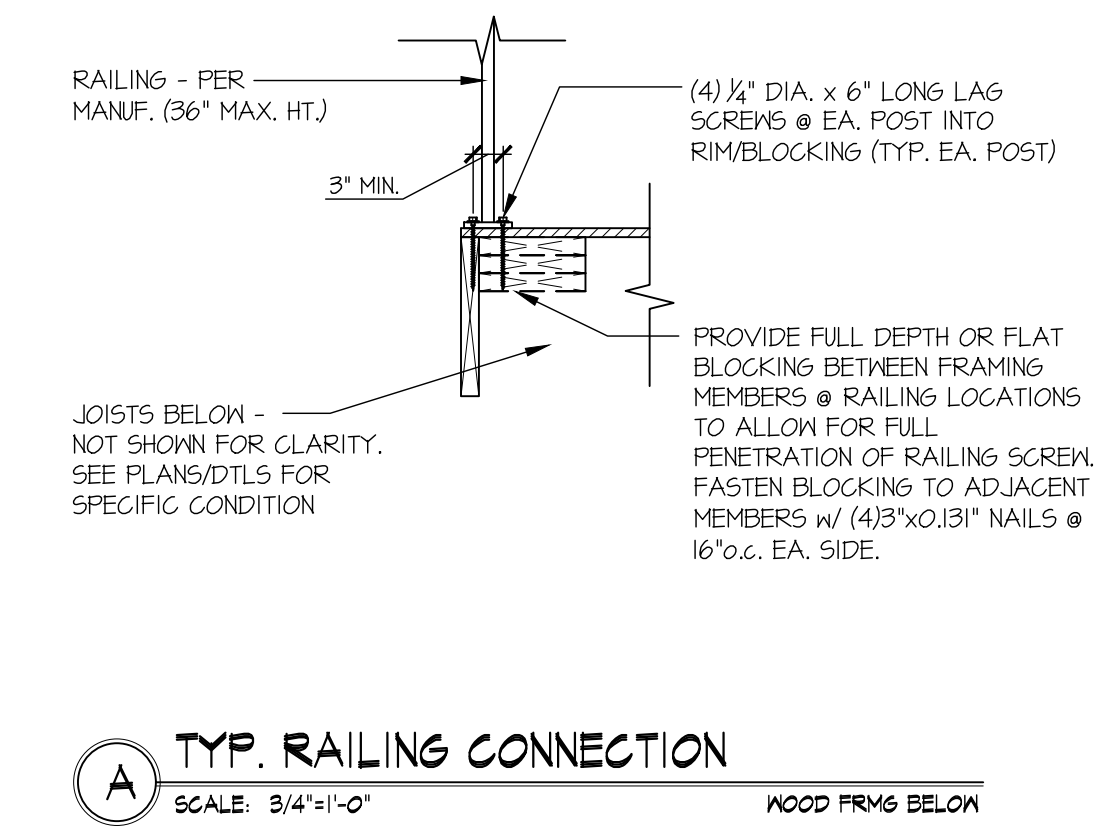


A TYP. RAILING CONNECTION
SCALE: 3/4"=1'-0" WOOD FRMS BELOW

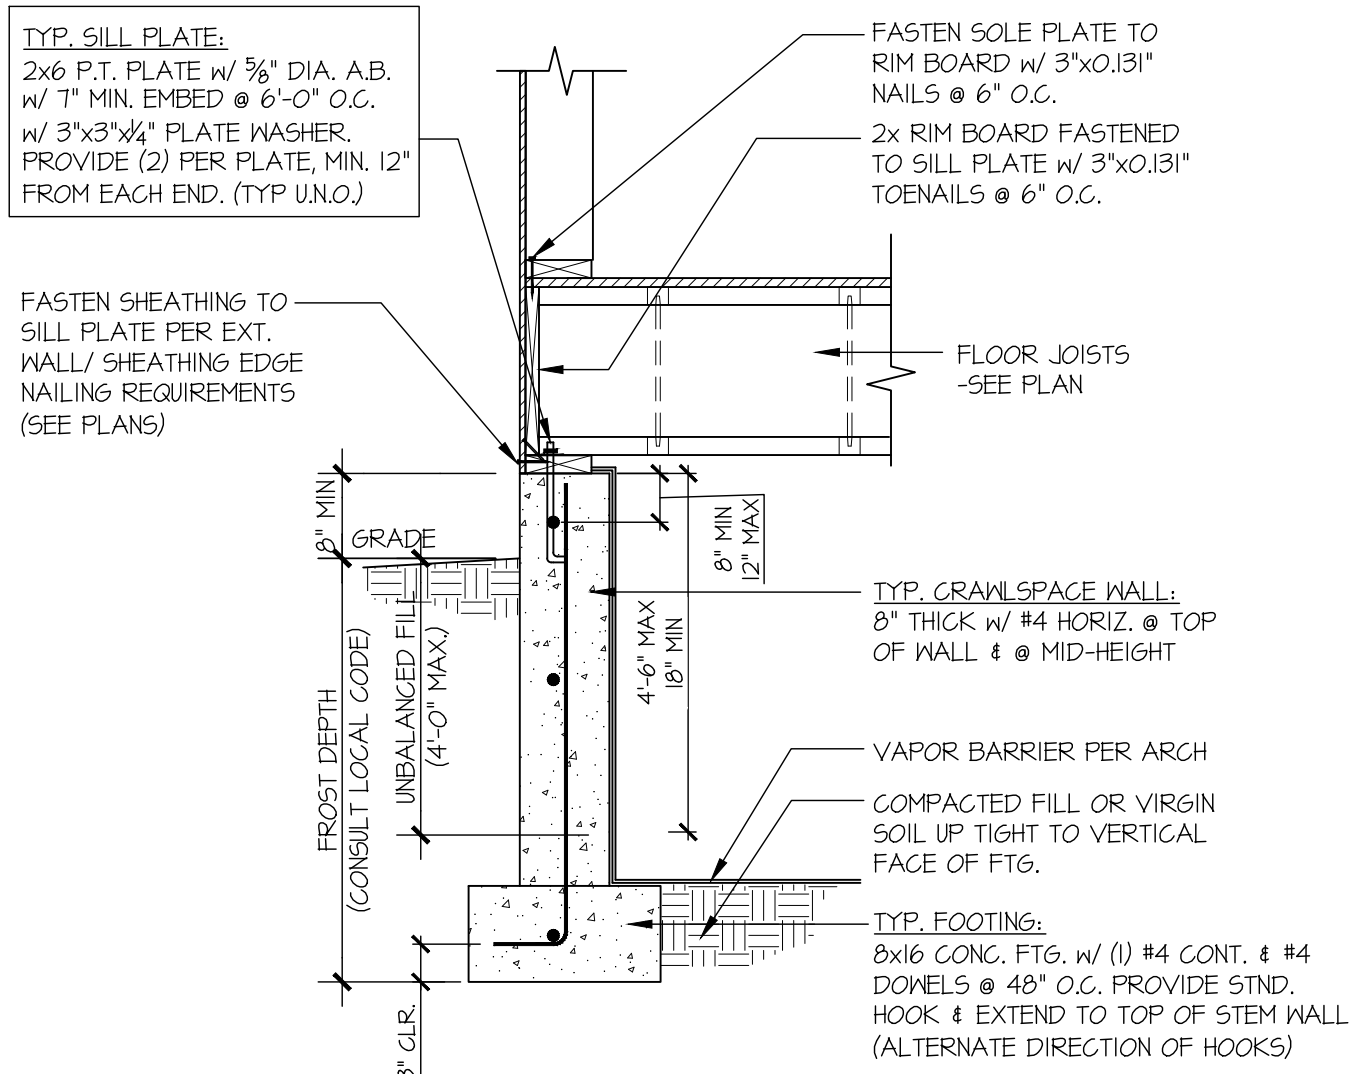


1 TYPICAL CRAWLSPACE FOUNDATION
SCALE: 3/4"=1'-0"

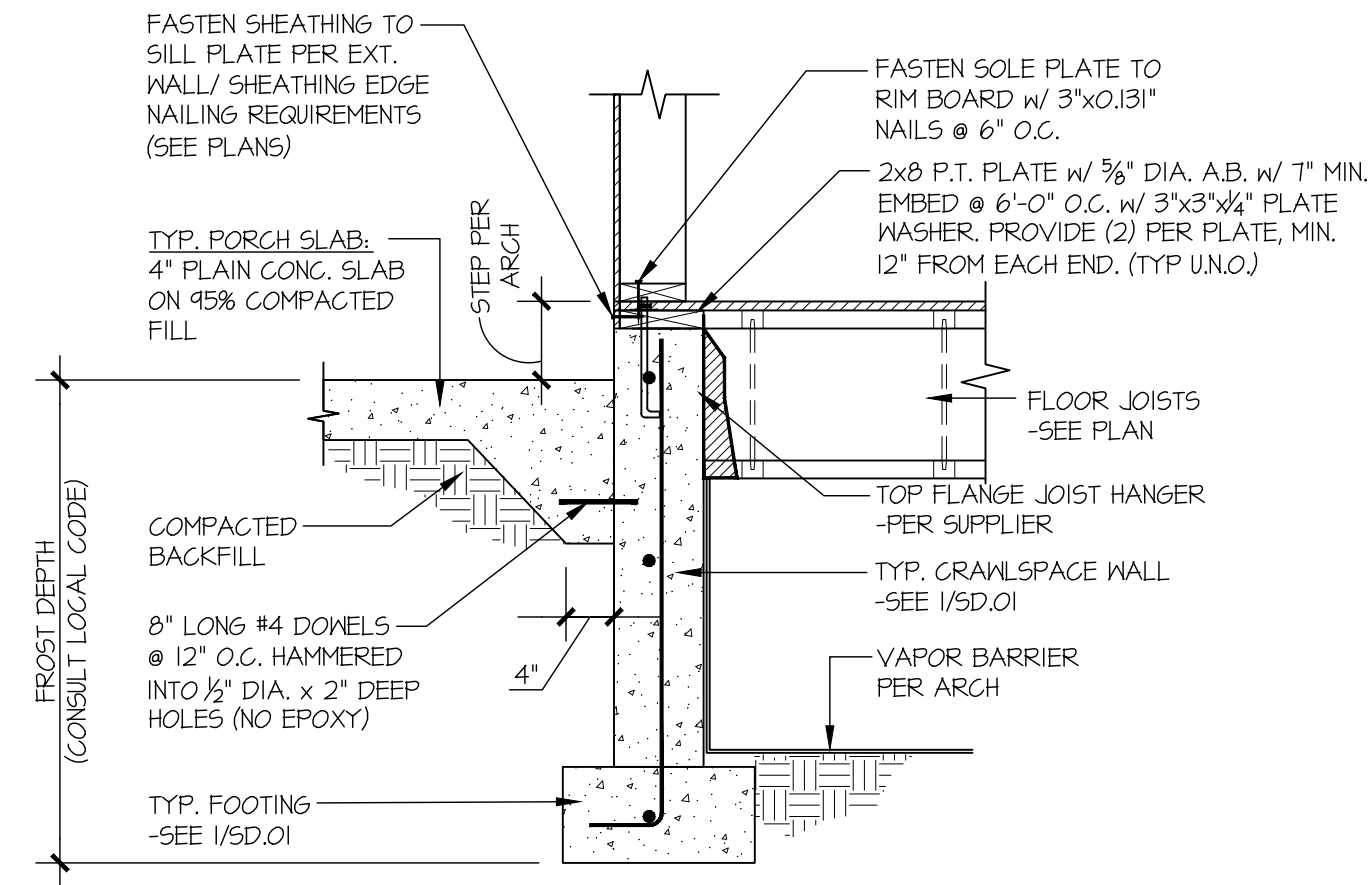


2 TYPICAL CRAWLSPACE FOUNDATION @ PORCH SLAB
SCALE: 3/4"=1'-0"

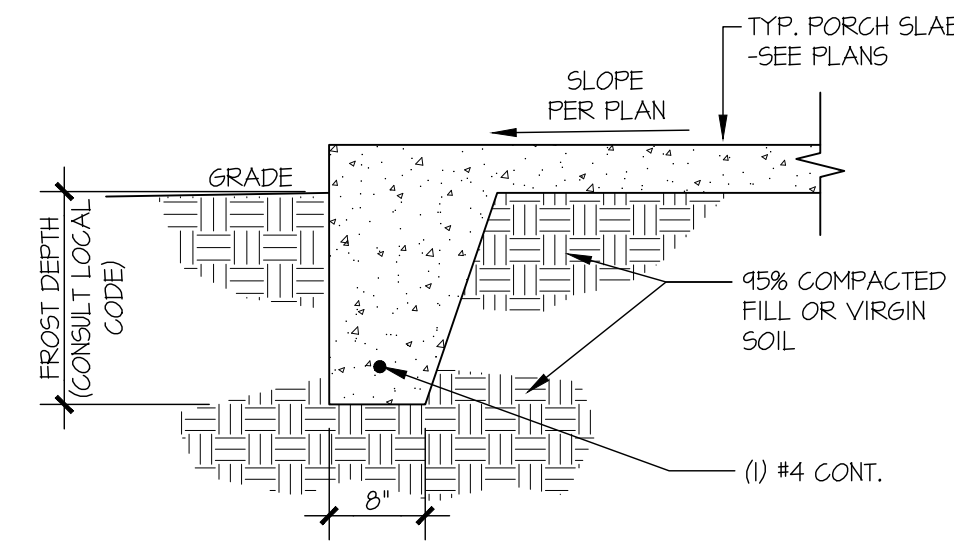


3 TYPICAL FOOTING @ PORCH SLAB
SCALE: 3/4"=1'-0"

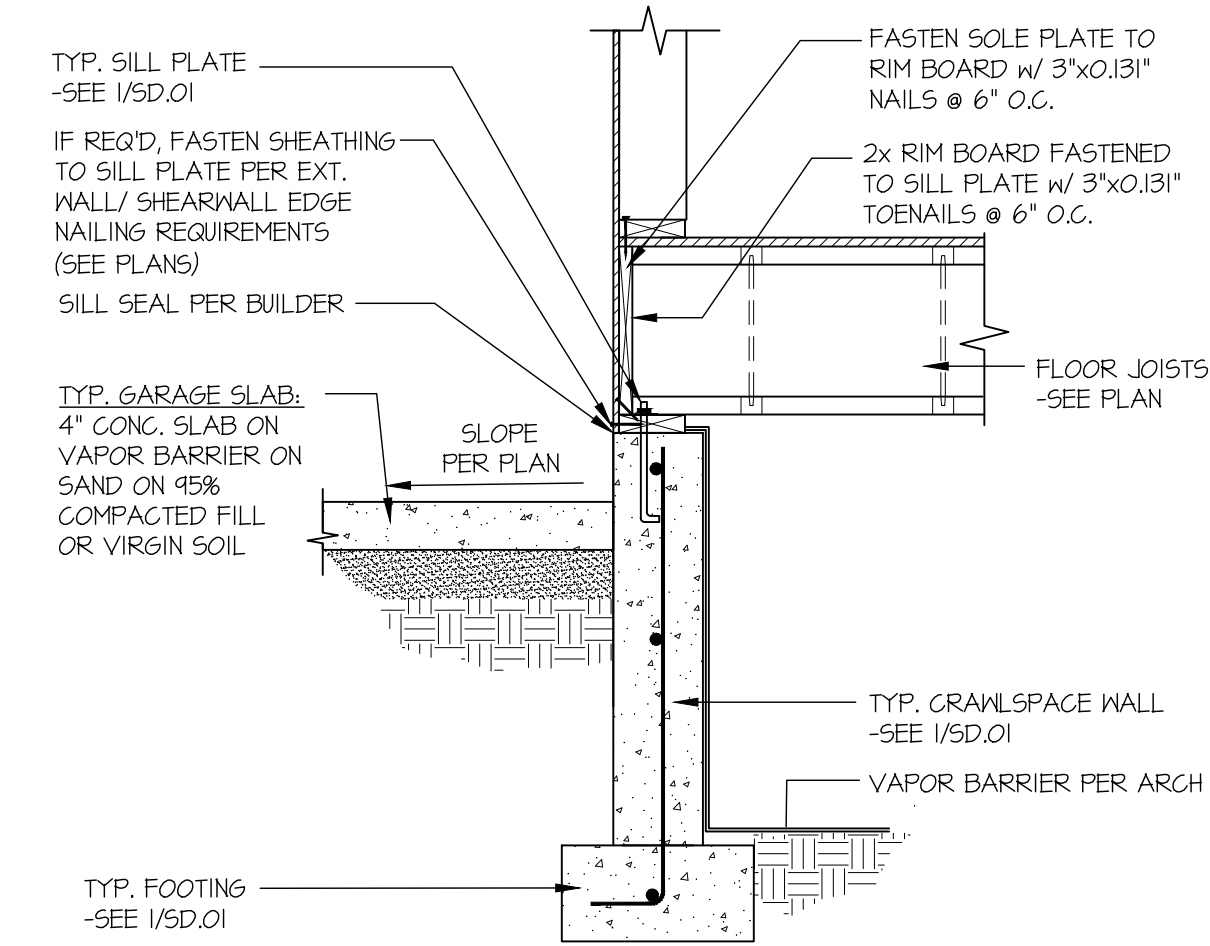


4 TYPICAL CRAWLSPACE FOUNDATION @ GARAGE
SCALE: 3/4"=1'-0"

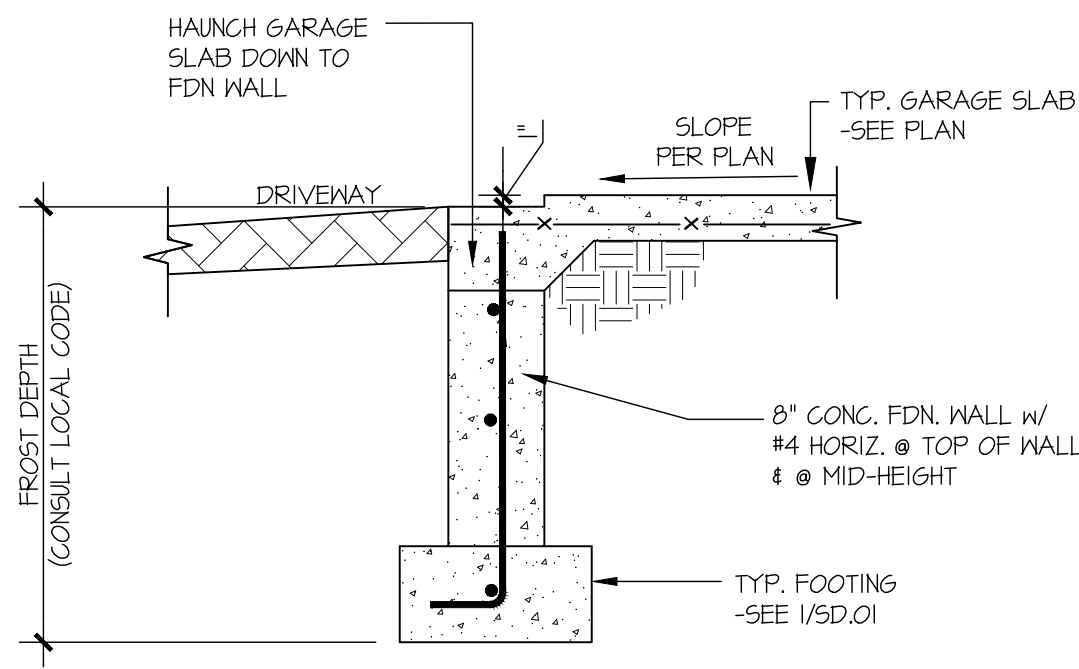


5 TYPICAL CONCRETE FOOTING @ GARAGE DOOR OPENING
SCALE: 3/4"=1'-0"

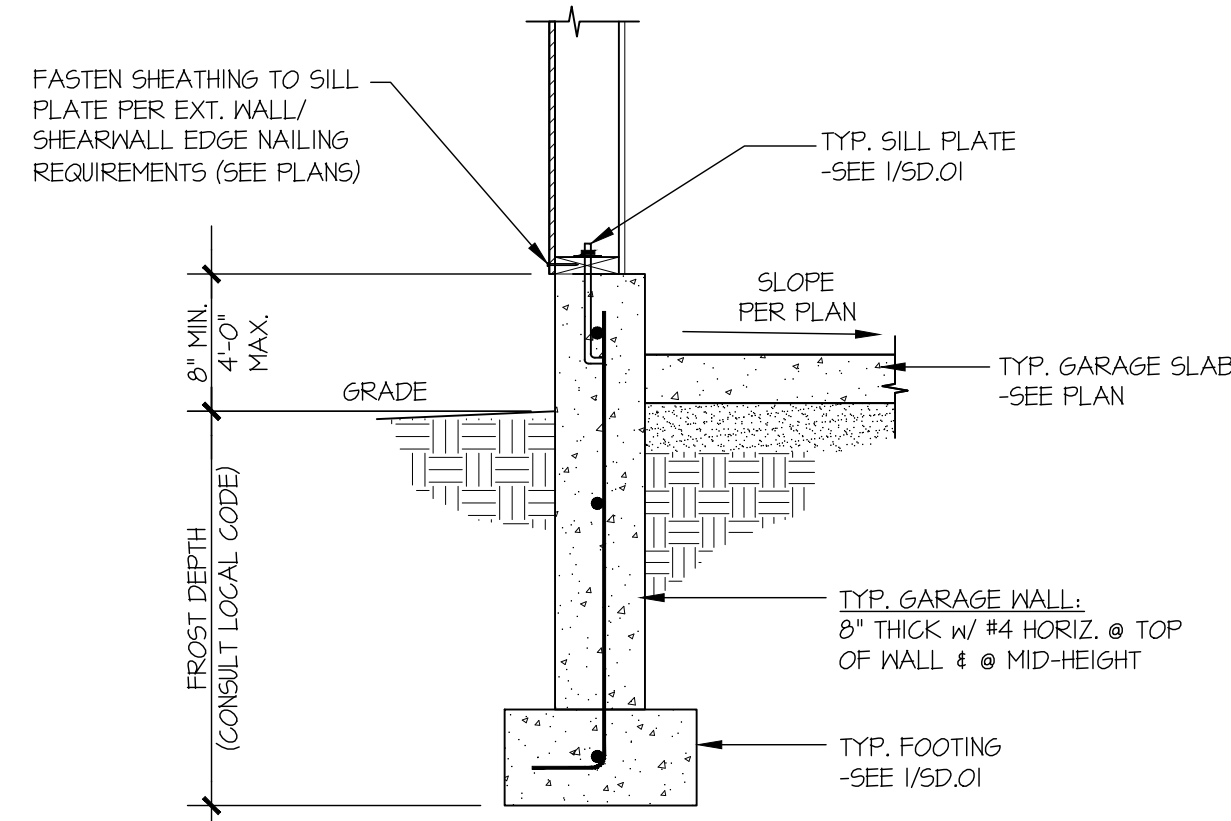


6 TYPICAL EXT. GARAGE FOUNDATION
SCALE: 3/4"=1'-0"

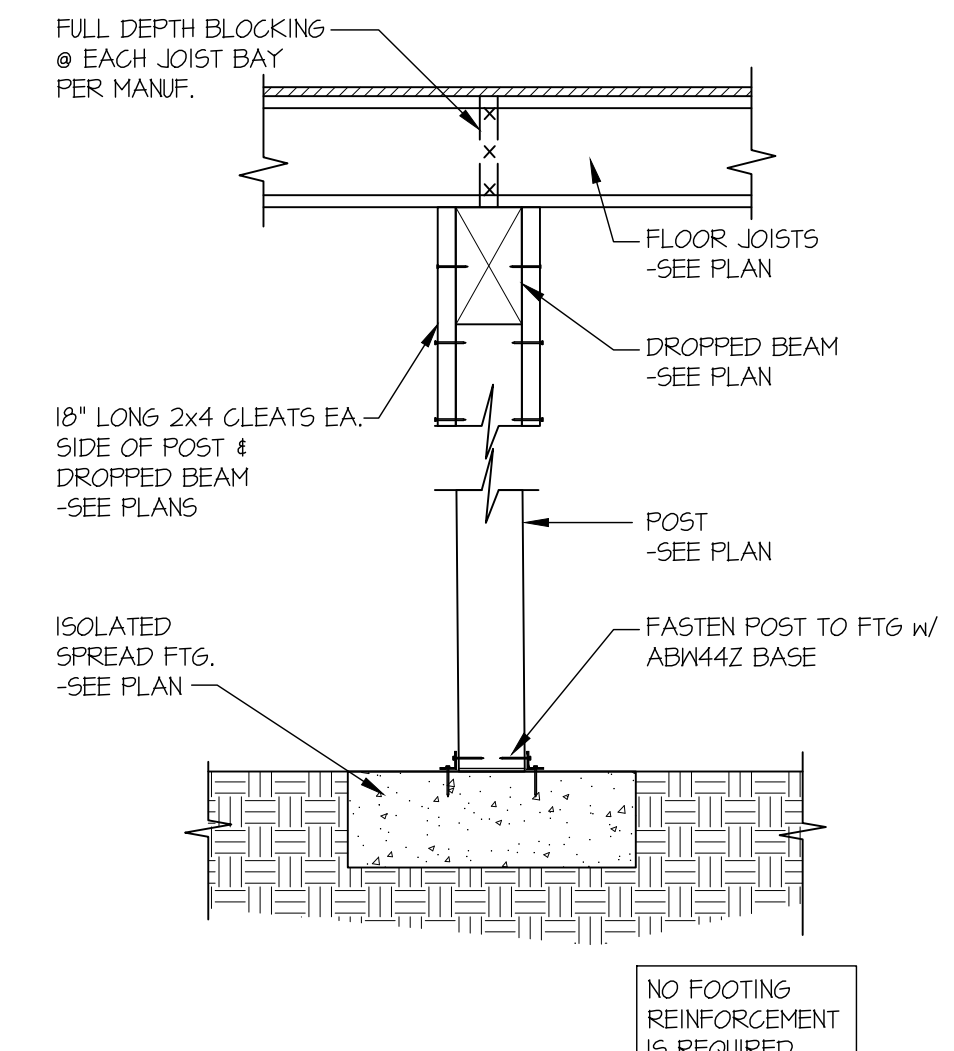


7 TYPICAL CRAWL SPACE FOOTING DETAIL
SCALE: 3/4"=1'-0"

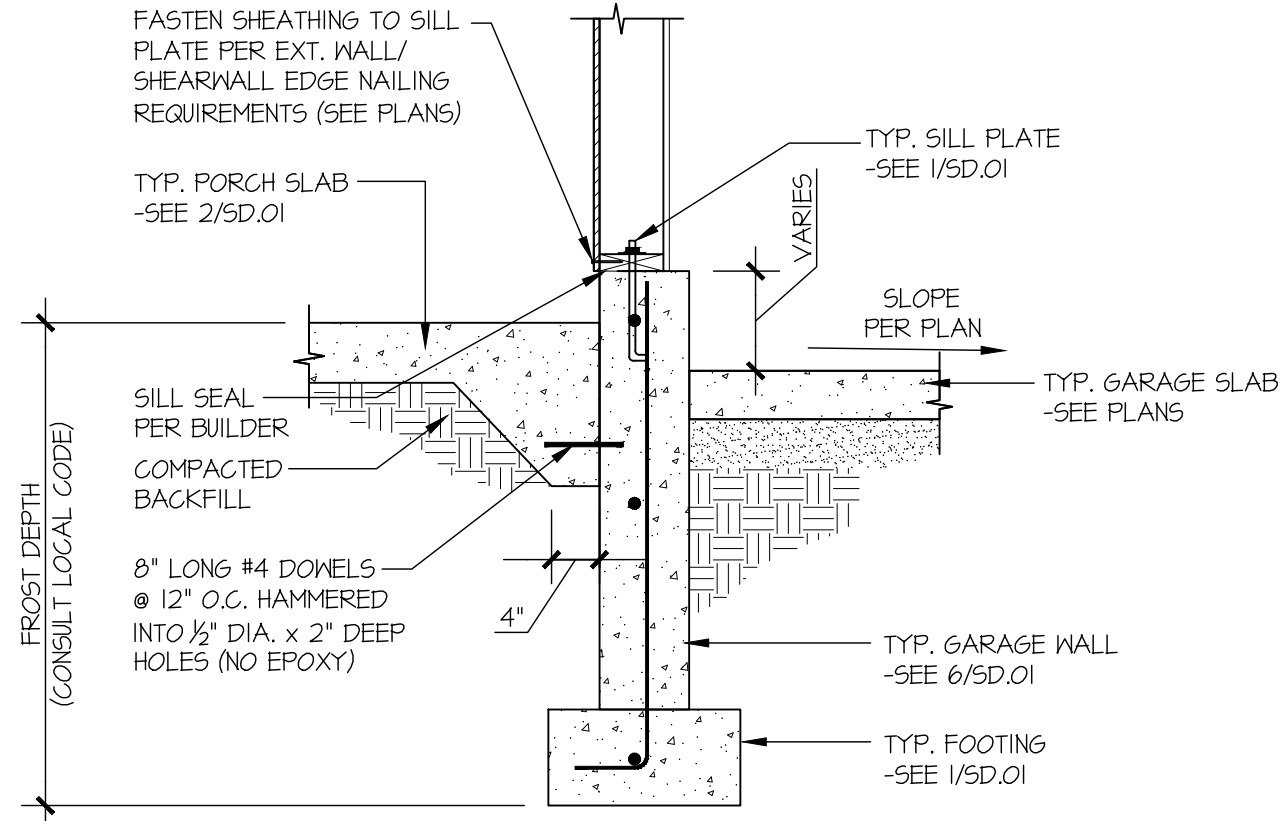

8 TYPICAL CRAWLSPACE FOUNDATION @ PORCH SLAB
SCALE: 3/4"=1'-0"

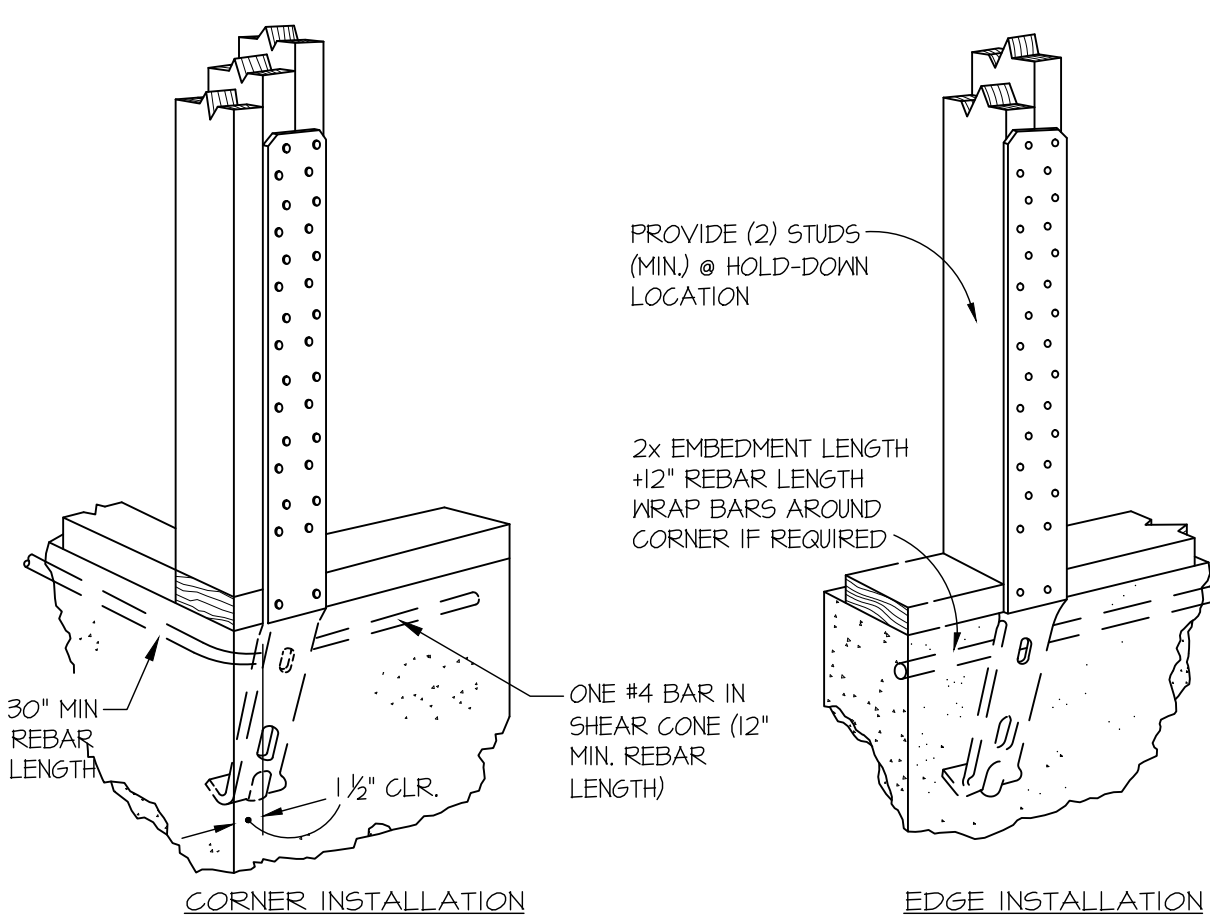

A TYPICAL HOLD-DOWN INSTALLATION
NOT TO SCALE
SIMPSON 5THD HD @ FOUNDATION

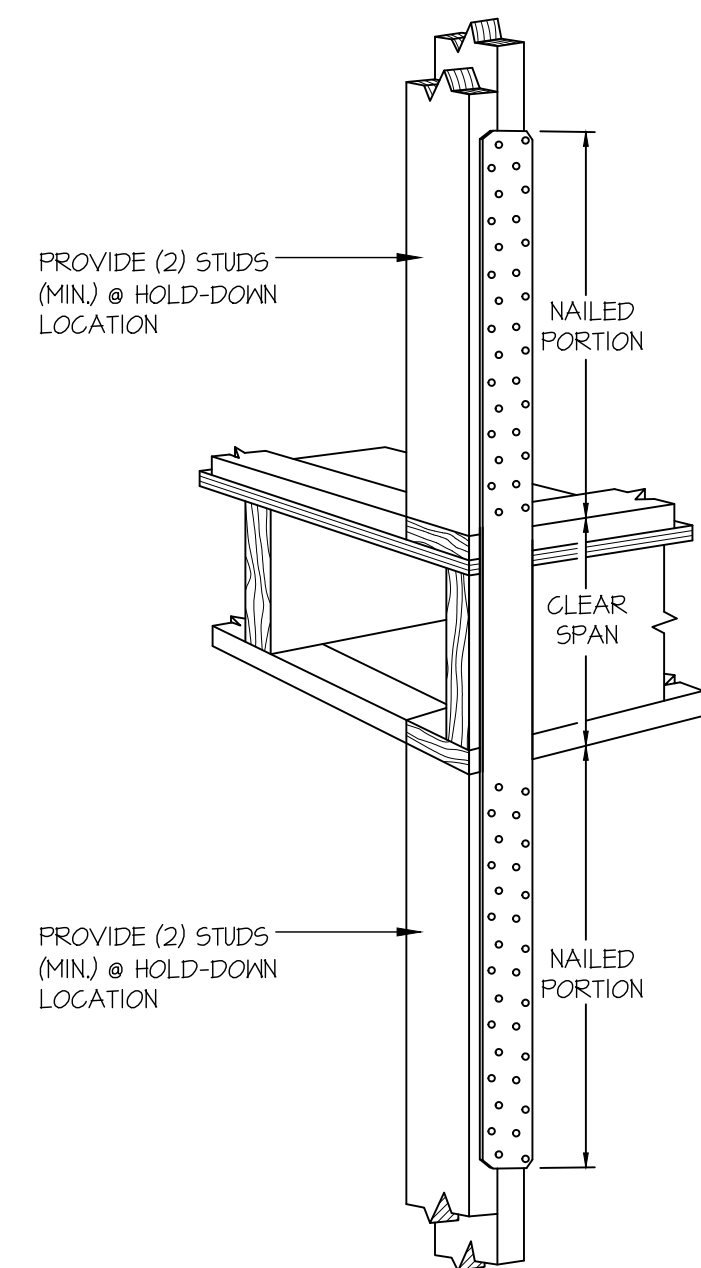

C TYPICAL HOLD-DOWN INSTALLATION
NOT TO SCALE
SIMPSON STRAP HD @ FLOOR FRAMING



MULHERN+KULP
RESIDENTIAL STRUCTURAL ENGINEERING
7220 Trade Street, Suite 350, San Diego, CA 92121
p 619-560-0010 • mulhernkulp.com



M&K project number:
154-22007
project mgr: R.JZ
drawn by: ENW
issue date: 02-28-21

REVISIONS:
date: initial:



STRUCTURAL DETAILS
4537 90TH AVE SE
MERCER ISLAND, WASHINGTON

sheet:
SD.01



Vertical wall Installation


Install TYPAR® HouseWrap over an approved exterior sheathing after the framing is complete and before the windows and doors have been installed. Plastic capped fasteners should be used and spaced at 32" OC (vertically and horizontally) when being applied over 7/16" OSB or 15/32" plywood. When installing over metal framing use screws with washers. If the windows and doors have already been installed, trim the TYPAR WRB close to the window frame and flash according to the TYPAR Flashing instructions.

STEP 1

Start at the bottom of one end of the wall with the printed side facing out. When starting at a corner, overlap by a minimum of 12".

Place the housewrap roll horizontally and roll out the first course evenly, covering rough window and door openings. A minimum of a 1" (25.4 mm) overlap on the sill plate is required; however, for maximum protection, a 2-4" (51-102 mm) overlap on the sill plate is recommended.

Pull the TYPAR snug and avoid wrinkles and creases. Ensure that the product is level.

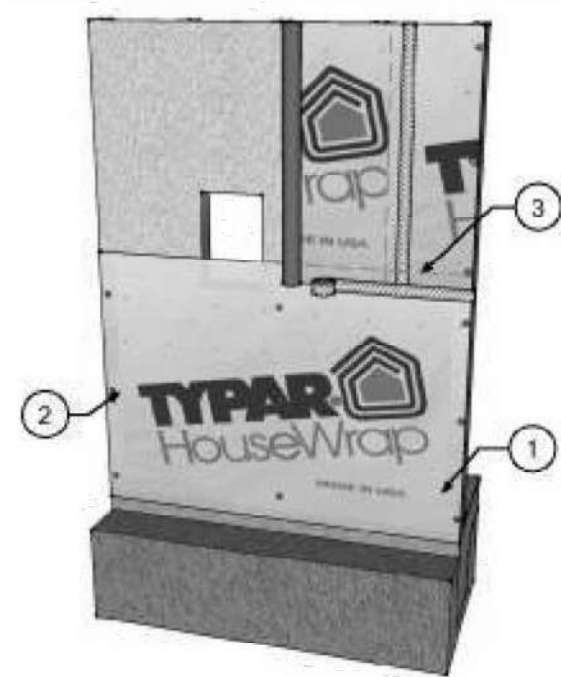

STEP 2

Fasten the TYPAR to the stud using plastic capped nails or plastic capped staples at 32" O.C. both horizontally and vertically.



STEP 3

The upper layer of TYPAR housewrap should overlap the bottom layer by a minimum of 6" (152 mm) vertically and horizontally. Ensure proper shingling throughout the installation to properly shed water. Once the structure is completely covered, tape all seams and penetrations using TYPAR® construction tape. (Please refer to the TYPAR® flashing instructions for more detailed instruction on penetrations and window flashing installation).

STEP 4

After the installation complete and before the exterior cladding is installed, inspect the TYPAR® for tears. Repair the issues with TYPAR Construction tape or TYPAR Flashing.



Window and Door Preparation

Preparing for Window Installation

STEP 1

After wrapping the structure and covering all rough openings. Cut a horizontal line across the top of the window opening. The cut should not extend past the rough opening.

STEP 2

Start at the top center and make a vertical cut running two-thirds of the way down the opening.

STEP 3


From that stopping point, cut diagonally to both lower left and right corners of the opening.

STEP 4

Pull each of the flaps tightly inside the rough opening and attach them to the frame with nails, staples, or tape.

STEP 5

At the window header, make a 6" diagonal cut at a 45 degree angle on both corners. Fold the material up exposing the sheathing. Now install the window or door according to the manufacturer instructions. The final step is to flash all seams and flanges securely (refer to TYPAR® Flashing instructions). TYPAR® flashing should also be installed in accordance with window manufacturer instructions and according to the ASTM 2112 standard.

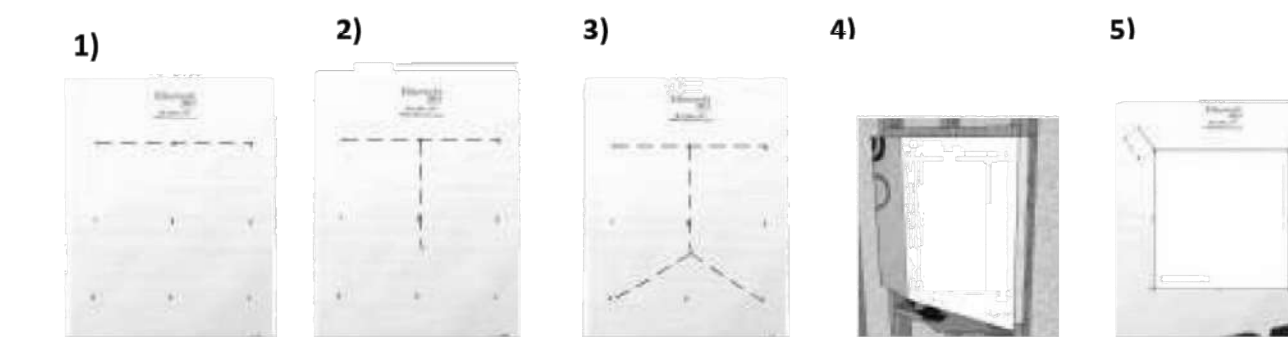

Typical Window Flashing

STEP 1

Install the window sill pan according to the manufacturer's instructions. Alternatively, you can create a sill pan using TYPAR Flashing Flex. Cut a piece that is 12" longer than the length of the rough opening window sill.

Carefully pull off the release liner. Center the Flashing in the center of the rough opening and work you way toward the corners and then up the sides. Note: the flex flashing should overlap to the outside of the wall by 2-3". Only stretch the flashing in the corners.

Alternatively to above, you can create a sill pan by installing TYPAR Straight Flashing along the bottom sill and installing TYPAR Flashing Flex on the corners only.

If needed, secure the fanned edges of the TYPAR Flashing Flex with a plastic capped nail/ plastic capped staple.

STEP 2

Apply a continuous bead of sealant to the back of the window or on the wall. Do not apply the sealant across the bottom of the sill or on the bottom of the window. This area is left open to allow for proper drainage.

Install the window according to the manufacturer's installation instructions.


STEP 3

Cut two pieces of TYPAR Flashing long enough to extend 1" above the window head flange and 1" below the window sill flange. Carefully peel off the release liner and apply the flashing on both sides of the window. Make sure to cover the entire window flange, press firmly either by hand or using a J-roller. Ensure there are no wrinkles or bubbles.

Cut a piece of TYPAR Flashing for the head flashing. Ensure that the piece is long enough to extend by 1" on both sides of the jamb flashing. Remove the release liner and carefully install the flashing. Cover the window flange and press firmly by hand or using a J-roller.

STEP 4

Release the upper flap of the WRB that you cut earlier. Tape the 45 degree cuts using TYPAR Construction Tape or TYPAR Flashing. DO NOT tape the WRB along the top of the window flange.

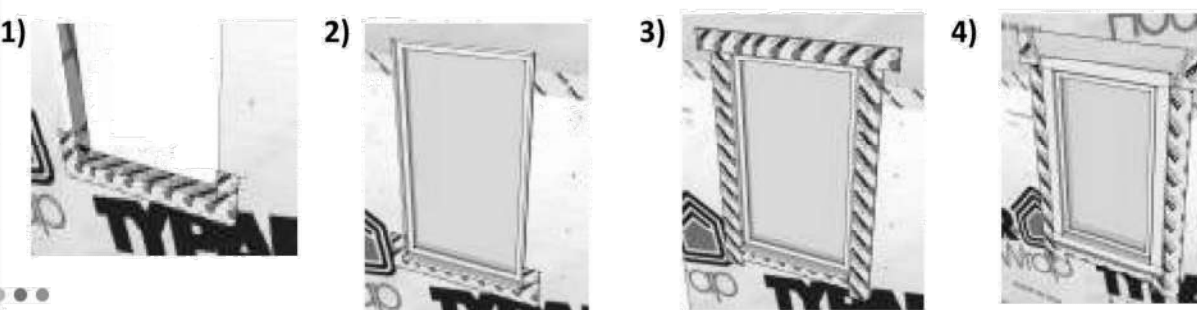


Flashing Penetrations

Penetrations such as exhaust fans, exterior electrical outlets, dryer vents, exterior lights, and gas outlets are a common entrance for bulk water into the wall cavity. Using TYPAR flashing will ensure proper water hold out and maintain the integrity of the structure.


The method is similar to the flashing a window. Start by flashing the bottom of the penetration. Ensure to shingle the upper tape over the bottom tape.

Some penetrations have flanges, such as dryer vents. These penetrations should be flashed according to the details below.


1)

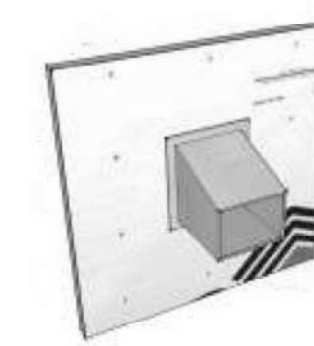

2)

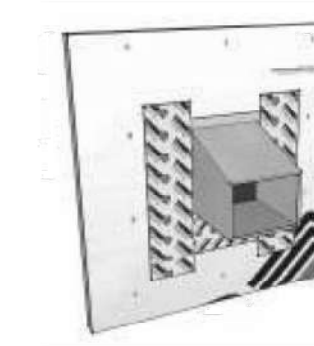

3)

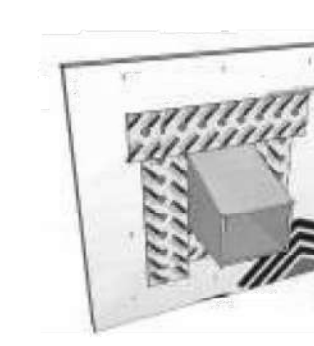

STEP 1

Install the vent according to the manufacturer's recommendations. Trim the housewrap as close as possible around the perimeter of the vent.

STEP 2

Flash the vent using the same method as windows. Starting at the bottom flange; cut the flashing so that it extends past the flanges by 1" on both sides. Now apply the flashing to the sides of the vent. Remember to extend the flashing 1" on both top and bottom. Make sure to smooth out wrinkles and air bubbles. The use of a J-roller is optional.

STEP 3

The Final step is to install the flashing across the top. Extend the flashing out at least 1" on both sides.

Note: This type of installation is suitable for several different penetrations. Always use the shingling method and ensure a tight seal around the flange/penetration.

TYPAR® HouseWrap is part of a complete Weather Protection System, which also includes TYPAR® Metro Wrap, TYPAR® Flashings and Construction tape

For more information, visit www.Typar.com



MADE IN USA. ICC #ESR-1404 • CCMC #12884-R • CCMC #12892-R
Please visit typar.com for installation instructions and warranty information



7525 SE 24th St., 487
Mercer Island, WA
98040
425.266.9100

Issue Description	Issue Date	By

Job Number: _____

plan name:	--
marketing name:	--
plan number:	--
mark sys. number:	--

Conditions not specifically represented graphically or in writing or which conflict with the current International Residential Code (IRC), or those of the local municipality then the current standards and requirements of each respectively shall govern.

The drawings in this set are instruments of service and shall remain the property of JayMarc Homes, LLC.

© 2017 JayMarc Homes, LLC; All rights reserved.

Submittal Date _____

Sheet Title/Description _____

Design Firm _____

Drawn by: _____

Checked by: _____

Primary Scale _____



D1 of .

Sheet Title/Description

NE 1/4 OF THE SW 1/4 OF SECTION 18, TOWNSHIP 24 NORTH., RANGE 5 EAST, W.M., KING COUNTY, WA.

EXISTING UTILITY LOCATIONS SHOWN HEREON ARE APPROXIMATE ONLY. IT SHALL BE THE CONTRACTOR'S RESPONSIBILITY TO DETERMINE THE EXACT VERTICAL AND HORIZONTAL LOCATION OF ALL EXISTING UNDERGROUND UTILITIES PRIOR TO COMMENCING CONSTRUCTION. NO REPRESENTATION IS MADE THAT ALL EXISTING UTILITIES ARE SHOWN HEREON. THE ENGINEER ASSUMES NO RESPONSIBILITY FOR UTILITIES NOT SHOWN OR UTILITIES NOT SHOWN IN THEIR PROPER LOCATION.
CALL BEFORE YOU DIG: 811

- TREE PROTECTION NOTES:
 (A) TREE PROTECTION WITHIN R/W SHALL BE 3" ORANGE FENCING; ON PRIVATE PROPERTY TREE PROTECTION SHALL BE 6" CHAIN LINK FENCING ANCHORED TO THE GROUND
 (B) CERTIFIED ARBORIST TO OBSERVE EXCAVATION FOR THE NORTHWEST CORNER OF THE HOUSE FOUNDATION AND WALKWAYS; HAVE AIR EXCAVATION AVAILABLE IF NEEDED.

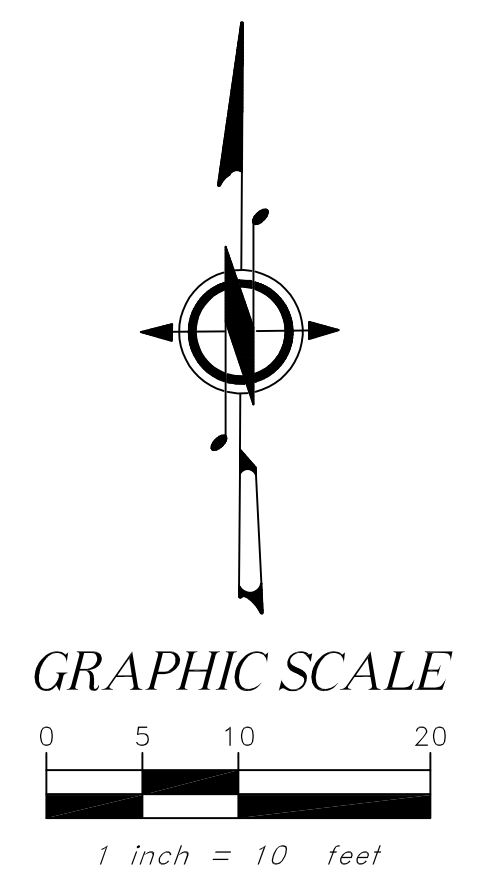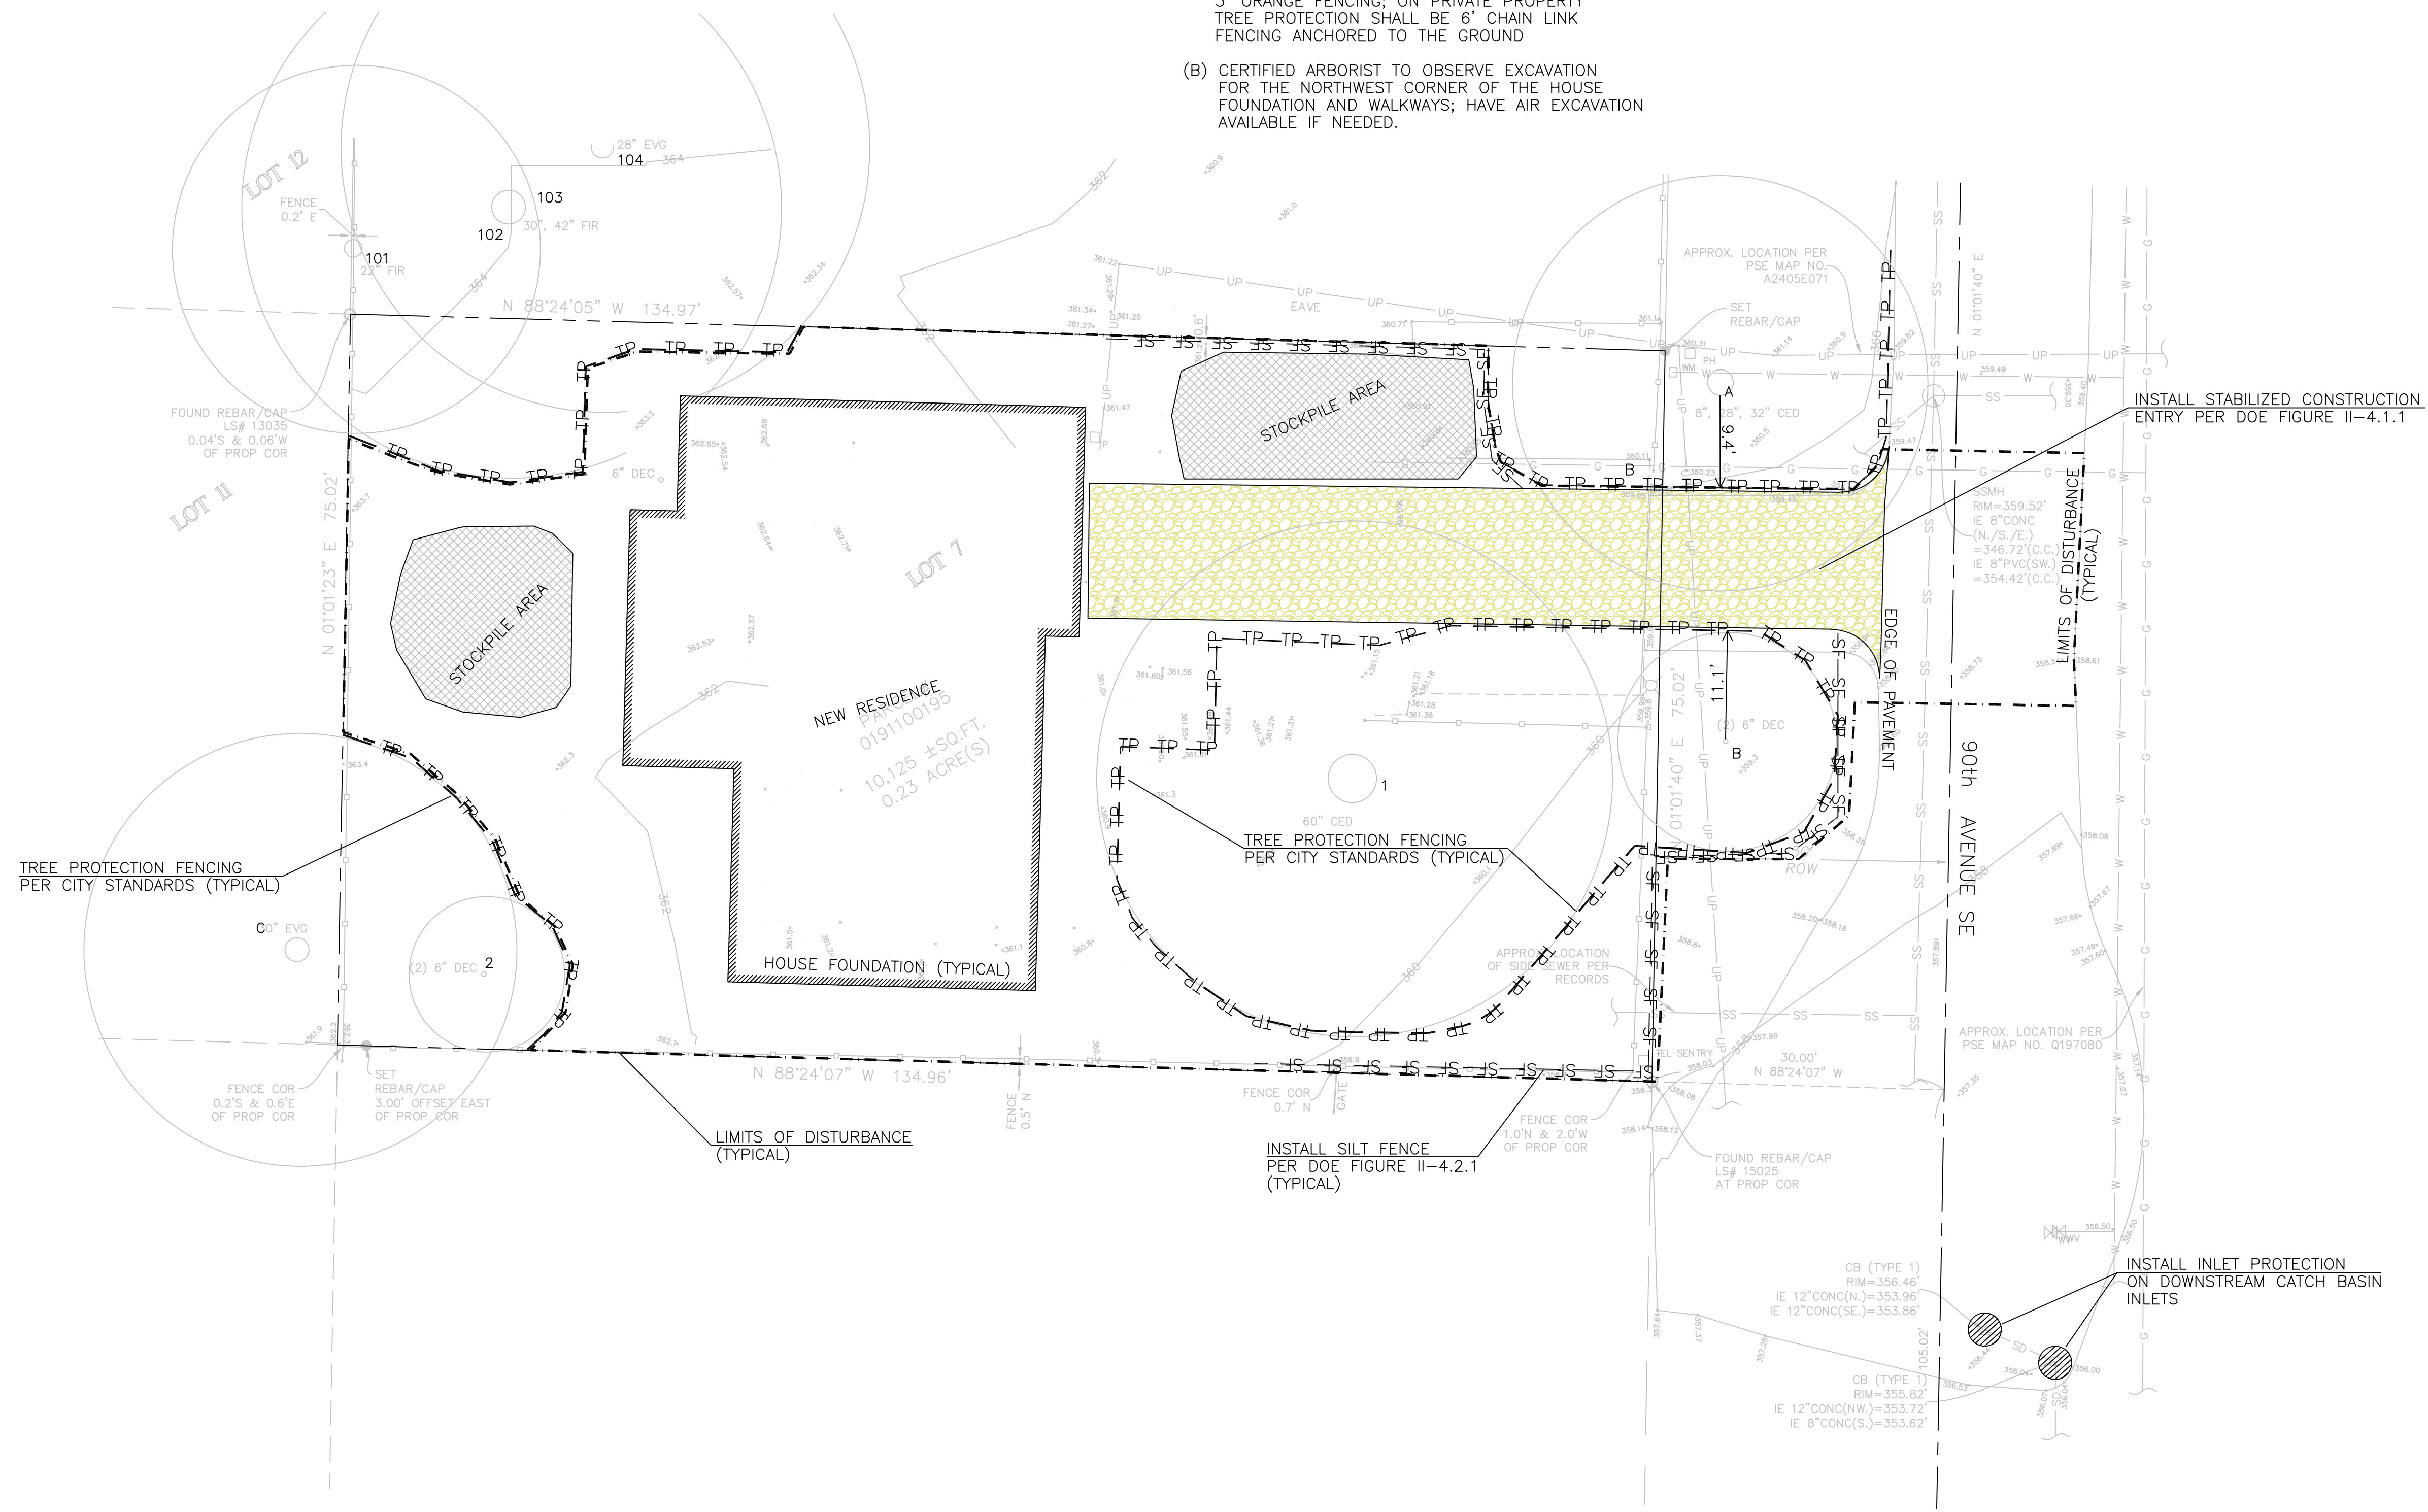

PERMIT #: 2203-197

<p>OFFE ENGINEERS 13902 SOUTHEAST 159TH PLACE RENTON, WASHINGTON 98058 PHONE: 425-260-3412 CONTACT: DARRELL OFFE, P.E.</p>	DESIGNED BY	DLO	DRAWN BY	VS	CHECKED BY	DLO
	PROJECT	4537 90h Avenue SE			CLIENT	Marc Russo
SHEET CONTENT	Temp. Erosion & Sedimentation Control Plan					
DATE	09/01/2022					
JOB NO.						
DWG NO.						
SHEET	1		OF		3	
REV. NO.	1	DATE	07/20/22	REVISED PER CITY COMMENTS	2202-197-SUB1	
DESCRIPTION						

NE 1/4 OF THE SW 1/4 OF SECTION 18, TOWNSHIP 24 NORTH., RANGE 5 EAST, W.M., KING COUNTY, WA.

NOTE: THE LAWN AND LANDSCAPE AREAS ARE REQUIRED TO PROVIDE POST-CONSTRUCTION SOIL QUALITY AND DEPTH IN ACCORDANCE WITH BMP 15.13. THE PROJECT CIVIL ENGINEER MUST PROVIDE A LETTER OF CERTIFICATION TO ENSURE THAT THE LAWN AND LANDSCAPE AREAS ARE MEETING THE POST-CONSTRUCTION SOIL QUALITY AND DEPTH REQUIREMENTS SPECIFIED ON THE APPROVED PLAN SET PRIOR TO FINAL INSPECTION OF THE PROJECT.

TREE PROTECTION NOTES:
 (A) TREE PROTECTION WITHIN R/W SHALL BE 3' ORANGE FENCING; ON PRIVATE PROPERTY TREE PROTECTION SHALL BE 6" CHAIN LINK FENCING ANCHORED TO THE GROUND
 (B) CERTIFIED ARBORIST TO OBSERVE EXCAVATION FOR THE NORTHWEST CORNER OF THE HOUSE FOUNDATION AND WALKWAYS; HAVE AIR EXCAVATION AVAILABLE IF NEEDED.

NOTE: A TV INSPECTION OF THE EXISTING SIDE SEWER TO THE CITY SEWER MAIN IN 90th AVENUE SE IS REQUIRED PRIOR TO ANY WORK RELATED TO THE SIDE SEWER. IF THE RESULT OF THE TV INSPECTION IS NOT IN SATISFACTORY CONDITION, AS DETERMINED BY THE CITY OF MERCER ISLAND INSPECTOR, THE REPLACEMENT OF THE EXISTING SIDE SEWER IS REQUIRED


EXISTING UTILITY LOCATIONS SHOWN HEREON ARE APPROXIMATE ONLY. IT SHALL BE THE CONTRACTOR'S RESPONSIBILITY TO DETERMINE THE EXACT VERTICAL AND HORIZONTAL LOCATION OF ALL EXISTING UNDERGROUND UTILITIES PRIOR TO COMMENCING CONSTRUCTION. NO REPRESENTATION IS MADE THAT ALL EXISTING UTILITIES ARE SHOWN HEREON. THE ENGINEER ASSUMES NO RESPONSIBILITY FOR UTILITIES NOT SHOWN OR UTILITIES NOT SHOWN IN THEIR PROPER LOCATION.
 CALL BEFORE YOU DIG: 811

SIDE SEWER NOTES

- S1 APPROXIMATE LOCATION OF EXISTING SANITARY SIDE SEWER.
- S2 INSTALL 60LF., 4" PVC SIDE SEWER @ MIN. 2% SLOPE

NOTE: SANITARY SEWER CLEANOUTS WITHIN DRIVEWAY AREA SHALL BE INSTALLED PER CITY OF MERCER ISLAND STD. DETAIL S-19, TYPICAL

INSTALL NEW 6" SIDE SEWER TEE FROM EXISTING SEWER MAIN IE=345.85, 8"(N,S)-CALCULATED

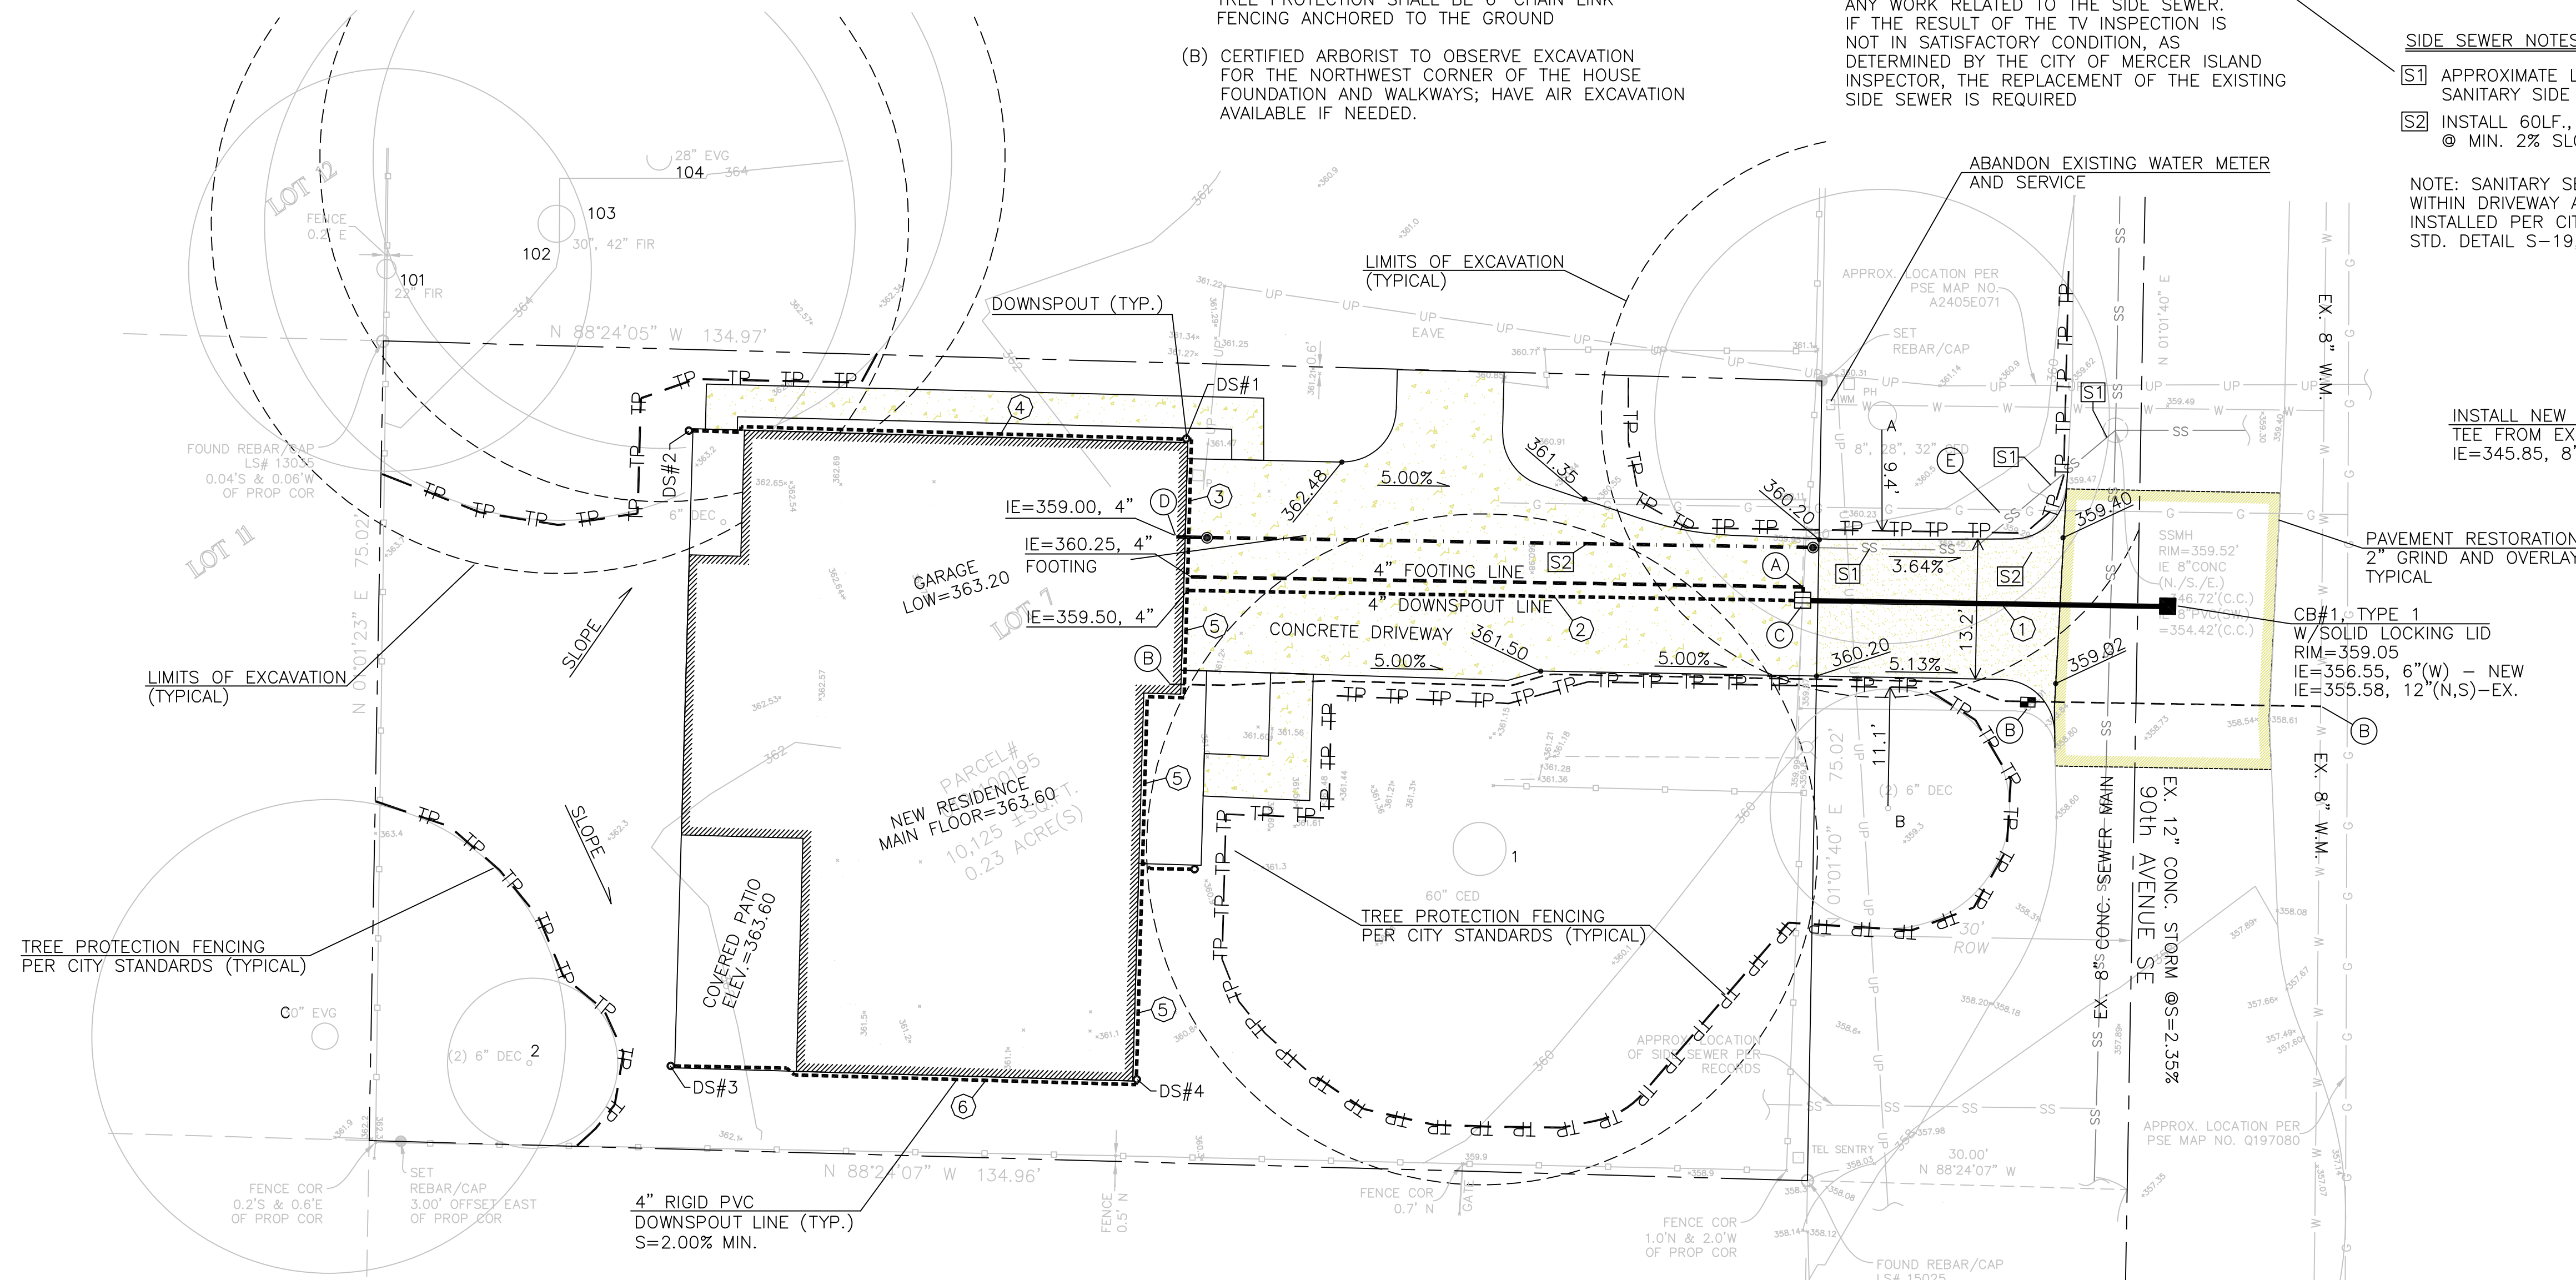

45XX TREE INVENTORY

Tree ID	species	DBH	DRIP	EXCEPTIONAL	SAVE	REMOVE
101	Doug Fir	24	18	yes, grove	yes	
102	Doug Fir	36.5	14	yes, grove	yes	
103	Doug Fir	40	26	yes, grove	yes	
104	Doug Fir	30.5	26	yes, grove	yes	
105	Doug Fir	11	9	yes, grove	yes	
108	Doug Fir	20	8	yes, grove	yes	
111	Doug Fir	33	22	yes, grove	yes	
112	Western red cedar	50	28	yes, grove		yes
113	Bitter Cherry	6	12			yes
114	Bitter Cherry	10	14	yes, grove	yes	
115	Western red cedar	13	17			yes
116	Western red cedar	18	17			yes
117	Western red cedar	15	17			yes
118	Western red cedar	28.8	15			yes
119	Western red cedar	21	19			yes
TOTALS		15			8	7

NON REGULATED TREES

106	Doug Fir	14	9	yes, grove		yes	Dying Tree
109	Bitter Cherry	4	12	Small Tree	yes		
110	Bitter Cherry	8	12	Small Tree	yes		
120	Orchard Apple	4	5	Small Tree		yes	

OFFSITE TREES

A	Western red cedar	41.6	20	Yes	Yes		
E	Doug Fir	30		yes, grove	yes		
F	Doug Fir	34		yes, grove	Yes		
G	Mountain Ash	6	7	Small tree		Yes	

NOTES:

- (A) FOOTING DRAIN CONNECTION, IE=358.00, 4"
- (B) INSTALL NEW WATER SERVICE & METER BOX PER CITY OF MERCER ISLAND STANDARD PLAN #W-17.
 NOTE: CONTRACTOR TO COORDINATE FINAL LOCATION OF NEW METER WITH CITY OF MERCER ISLAND INSPECTOR AT TIME OF CONSTRUCTION
- (C) CB#2, TYPE 1 W/OIL WATER SEPARATOR GRATE=360.15 TOP OF TEE=359.90, 6" IE=357.87, 4"(N)-FOOTING IE=357.87, 4"(W)-DOWNSPOUTS IE=357.70, 6"(E) BOTTOM OF TEE=357.20, 6"
- (D) NOT USED
- (E) USE EXISTING DRIVEWAY AS TEMPORARY CONSTRUCTION ENTRY

STORM PIPE TABLE

- ① 34LF., 6" PVC SDR-35 @ S=3.38%
- ② 58LF., 4" PVC SDR-35 @ S=2.81%
- ③ 12LF., 4" PVC SDR-35 @ S=15.8%
- ④ 48LF., 4" PVC SDR-35 @ S=2.00%
- ⑤ 52LF., 4" PVC SDR-35 @ S=2.00%
- ⑥ 45LF., 4" PVC SDR-35 @ S=2.00%

DOWNSPOUT TABLE

- DS#1 GROUND=363.20 DOWNSPOUT LINE=361.40, 4"
- DS#2 GROUND=363.40 DOWNSPOUT LINE=362.40, 4"
- DS#3 GROUND=362.40 DOWNSPOUT LINE=361.40, 4"
- DS#4 GROUND=362.00 DOWNSPOUT LINE=360.50, 4"
- DS#5 GROUND=362.80 DOWNSPOUT LINE=361.40, 4"

NOTE: 4" PERFORATED FOOTING DRAIN REQUIRED BUT NOT SHOWN ON PLAN, CONNECT WHERE SHOWN ON PLAN


STORM PIPE PVC SHALL BE SDR-35 PVC AT SLOPE=2.00% MINIMUM (TYPICAL) UNLESS OTHERWISE NOTED

IMPERVIOUS SURFACES:
 ROOF AREA (UNDER EAVES) = 2,756 SQ. FEET
 UNCOVERED DRIVEWAY AREA = 1,140 SQ. FEET
 UNCOVERED WALKWAY = 241 SQ. FEET


TOTAL IMPERVIOUS AREAS = 4,137 SQ. FEET

LANDSCAPE AREAS NOTE:


DISTURBED LANDSCAPE AREAS SHALL BE TREATED AS AMENDED SOILS PER DOE FIGURE V-5.3.3, TYPICAL

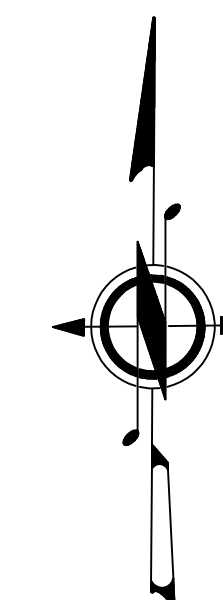

GRAPHIC SCALE

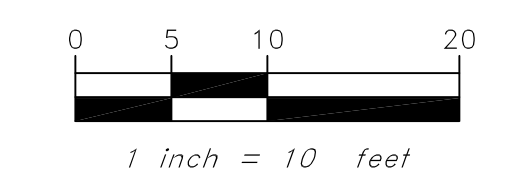

PERMIT #: 2203-197

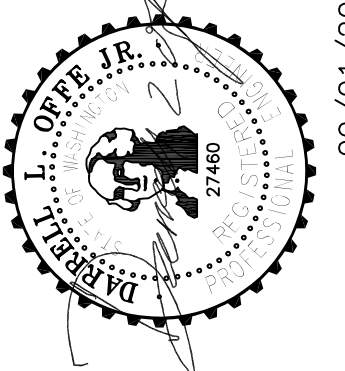

OFFE ENGINEERS
 13902 SOUTHEAST 19TH PLACE
 RENTON, WASHINGTON 98058
 PHONE: 425-260-3412
 CONTACT: DARRELL OFFE, P.E.



4537 90h Avenue SE

Marc Russo

Utility & Tree Plan

PROJECT: 4537 90h Avenue SE
 CLIENT: Marc Russo
 SHEET CONTENT: Utility & Tree Plan






DATE: 09/01/2022

JOB NO.:

DWG NO.:

2 SHEET OF 3

REV. NO.	DATE	DESCRIPTION
1	07/20/22	REVISED PER CITY COMMENTS 2202-197-SUB1
2	09/01/22	REVISED PER CITY COMMENTS 2202-197-SUB1

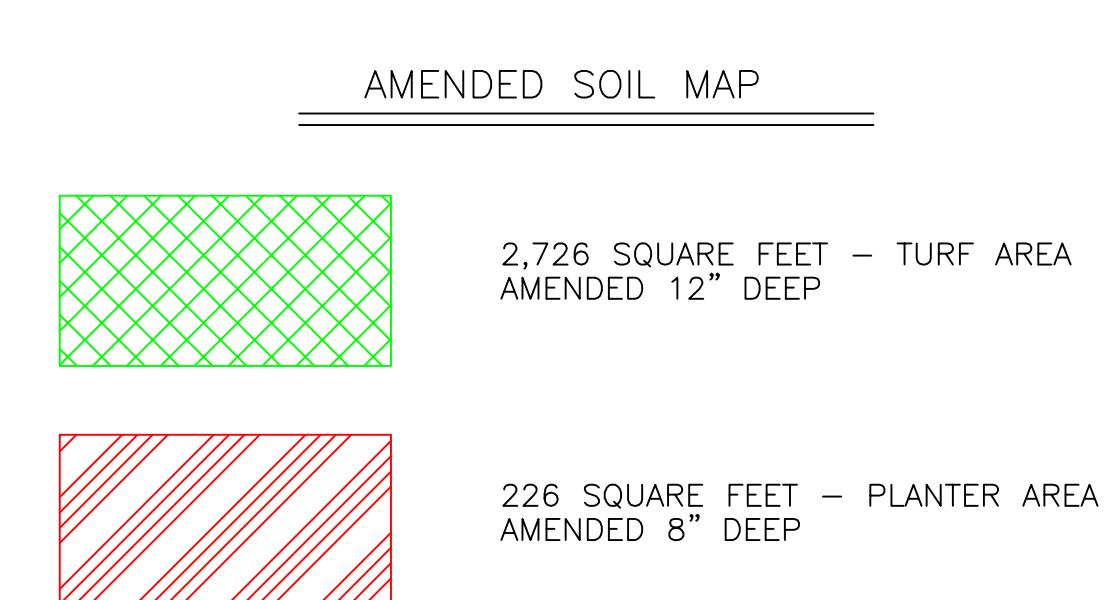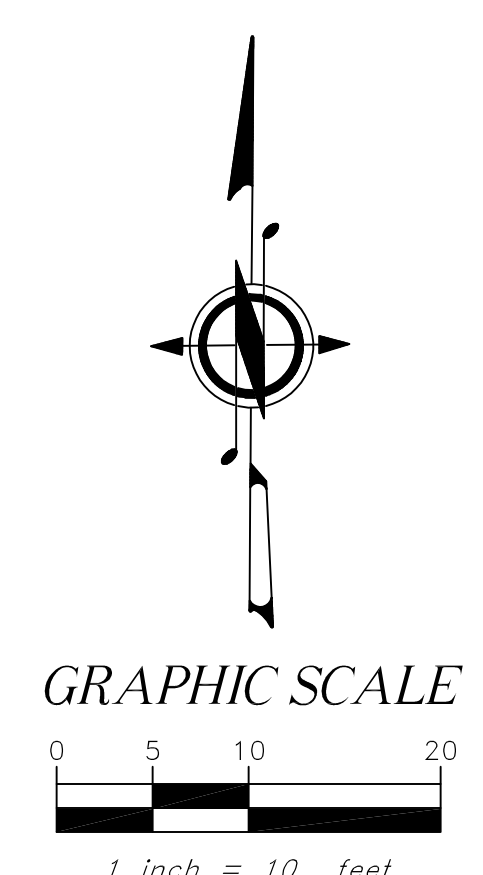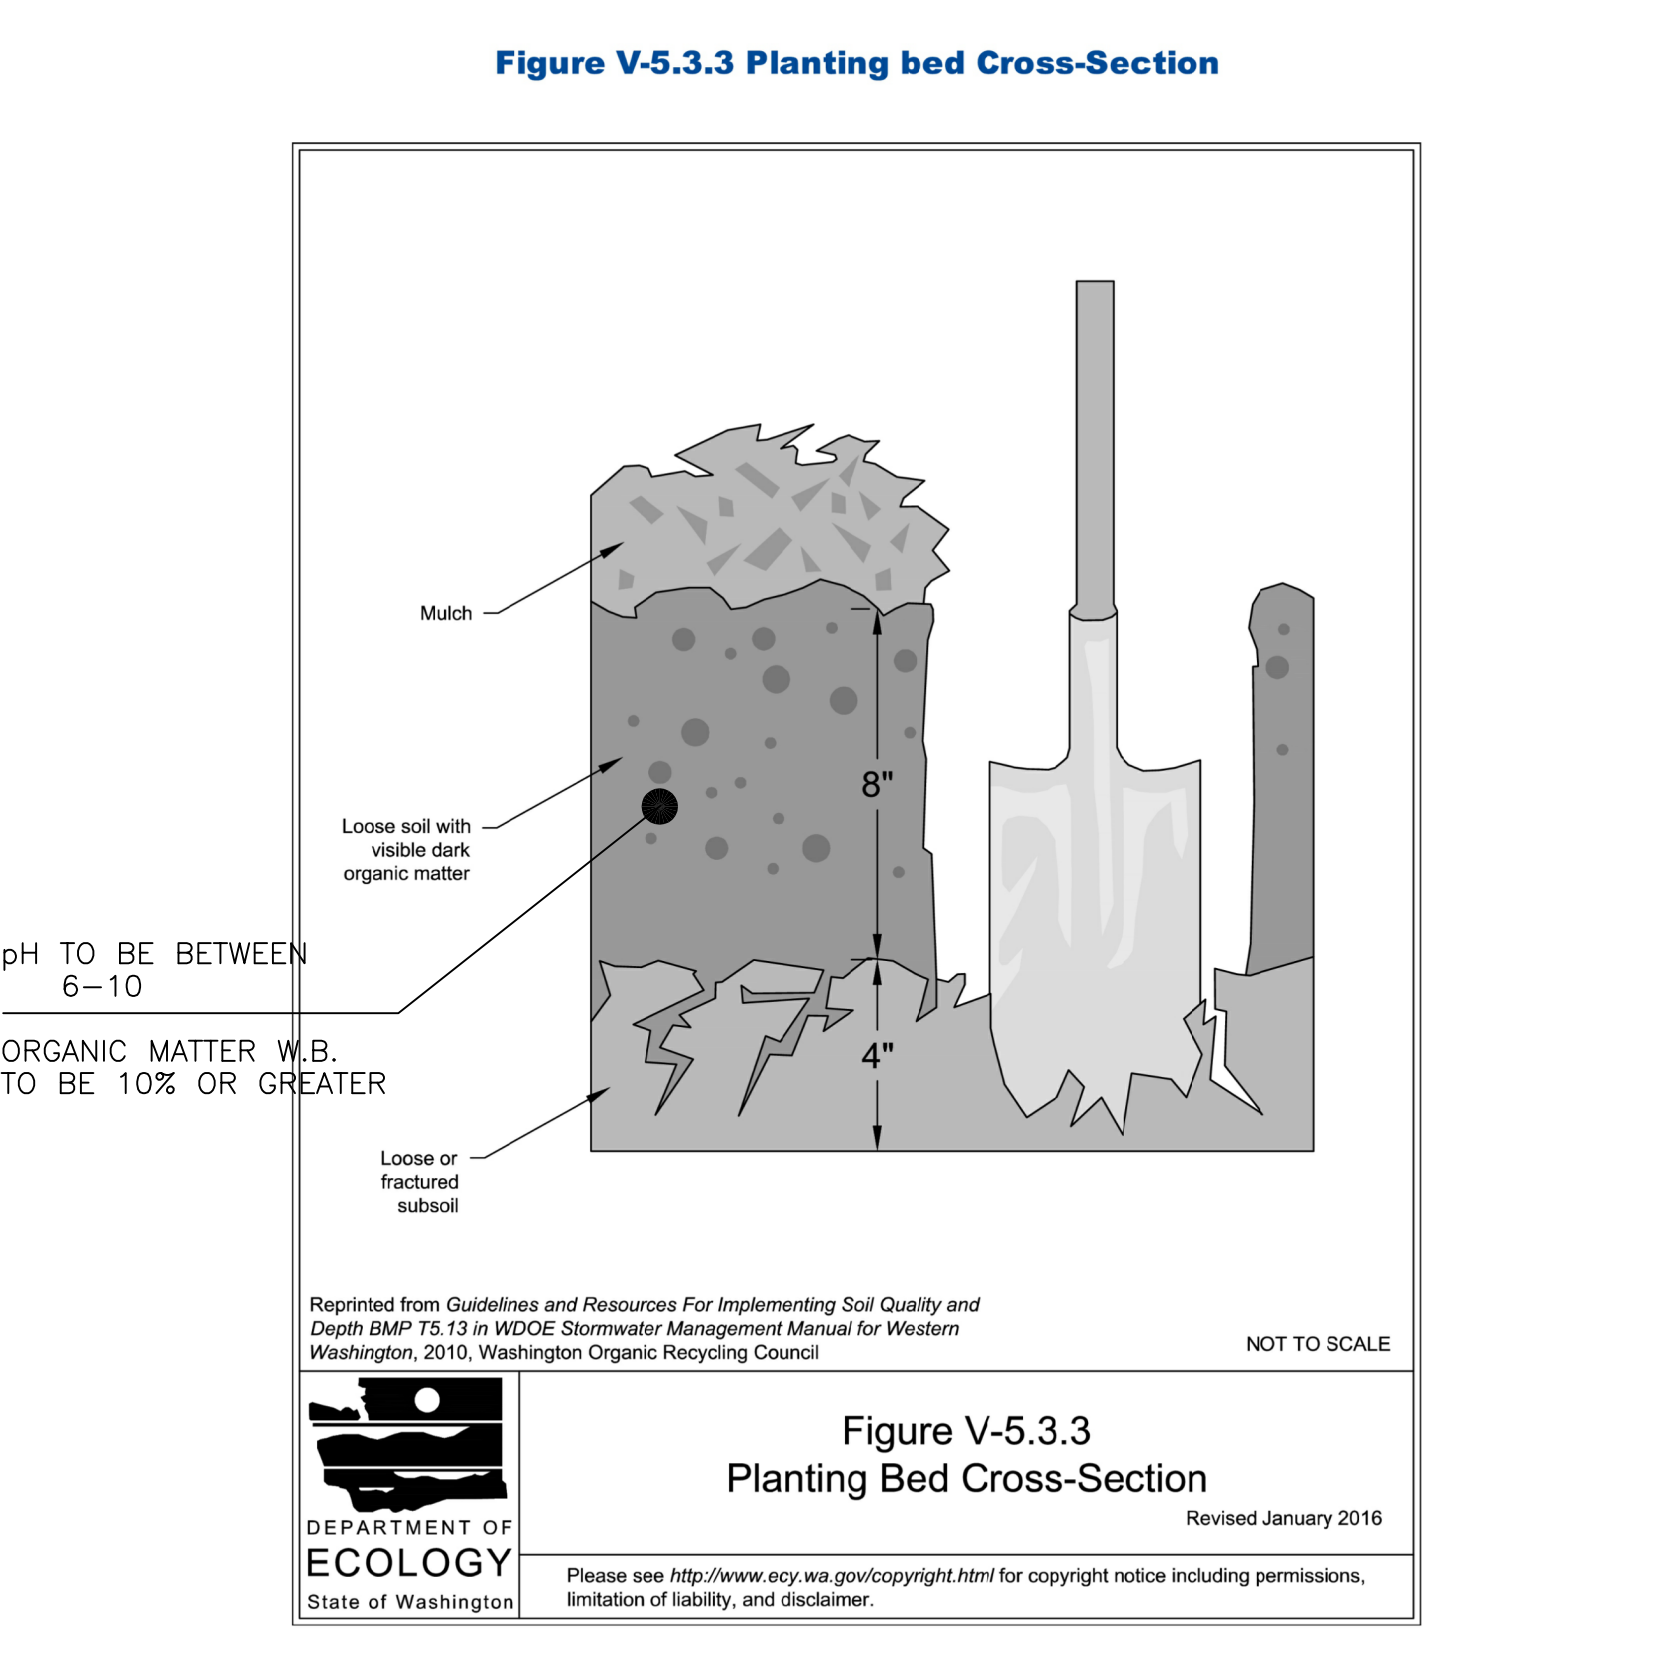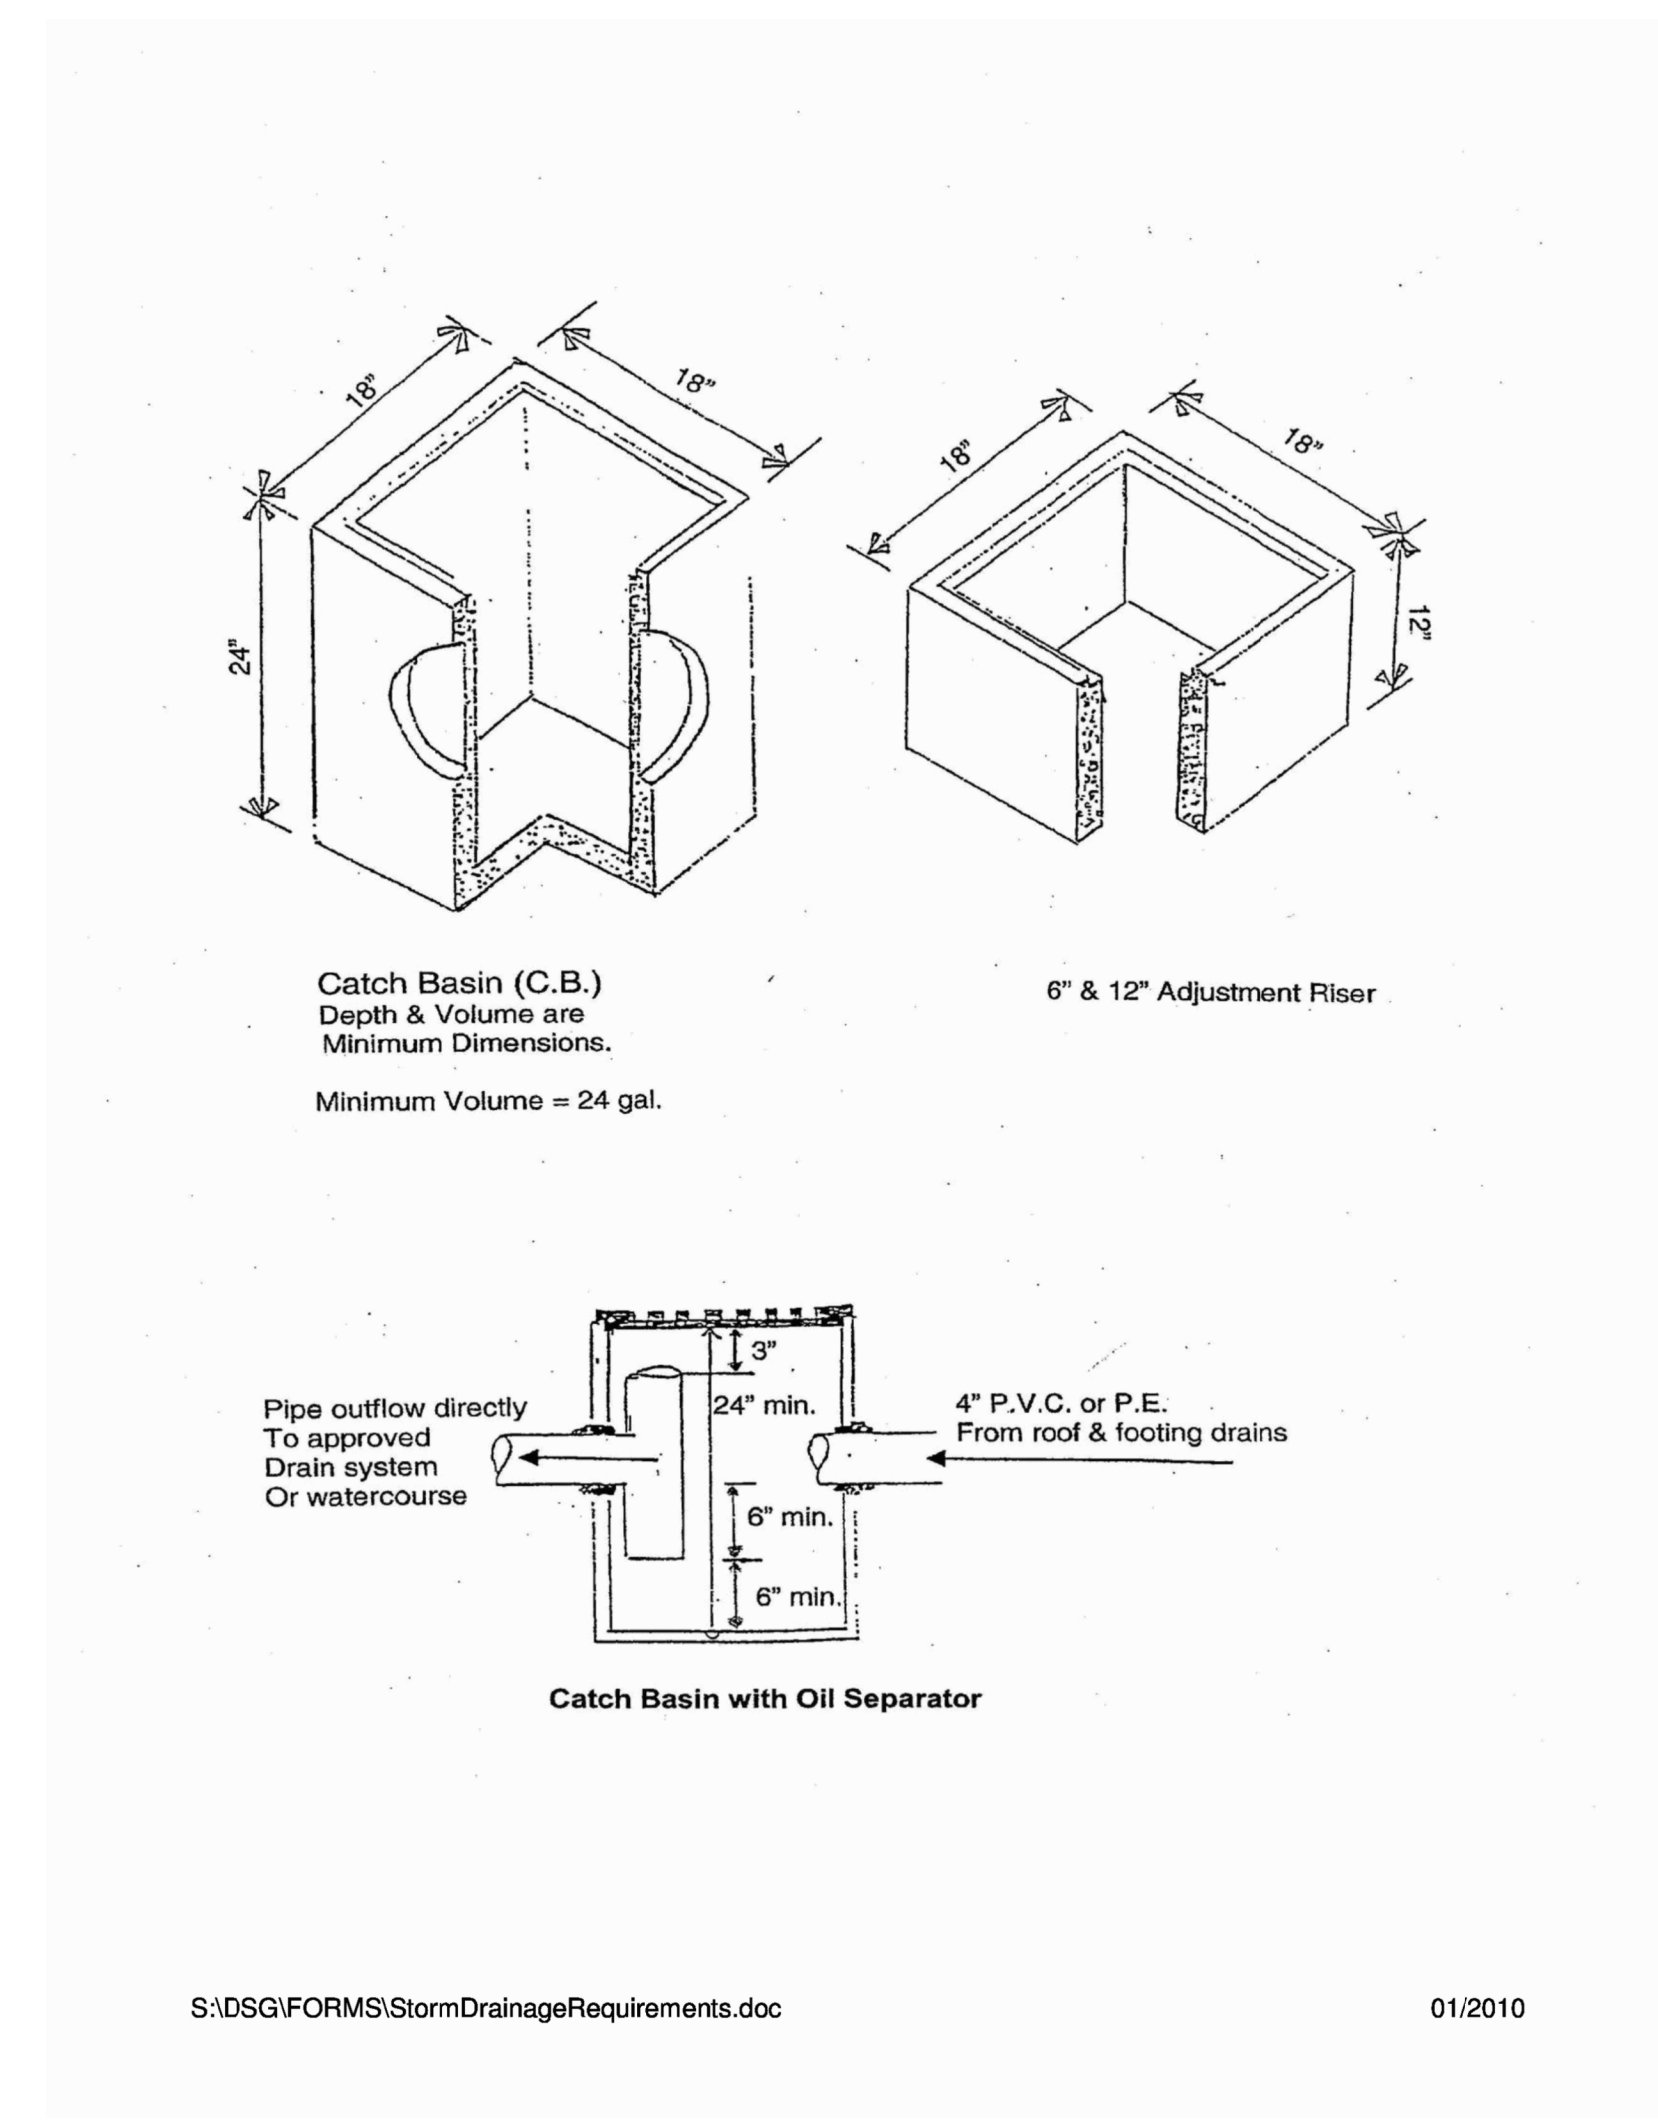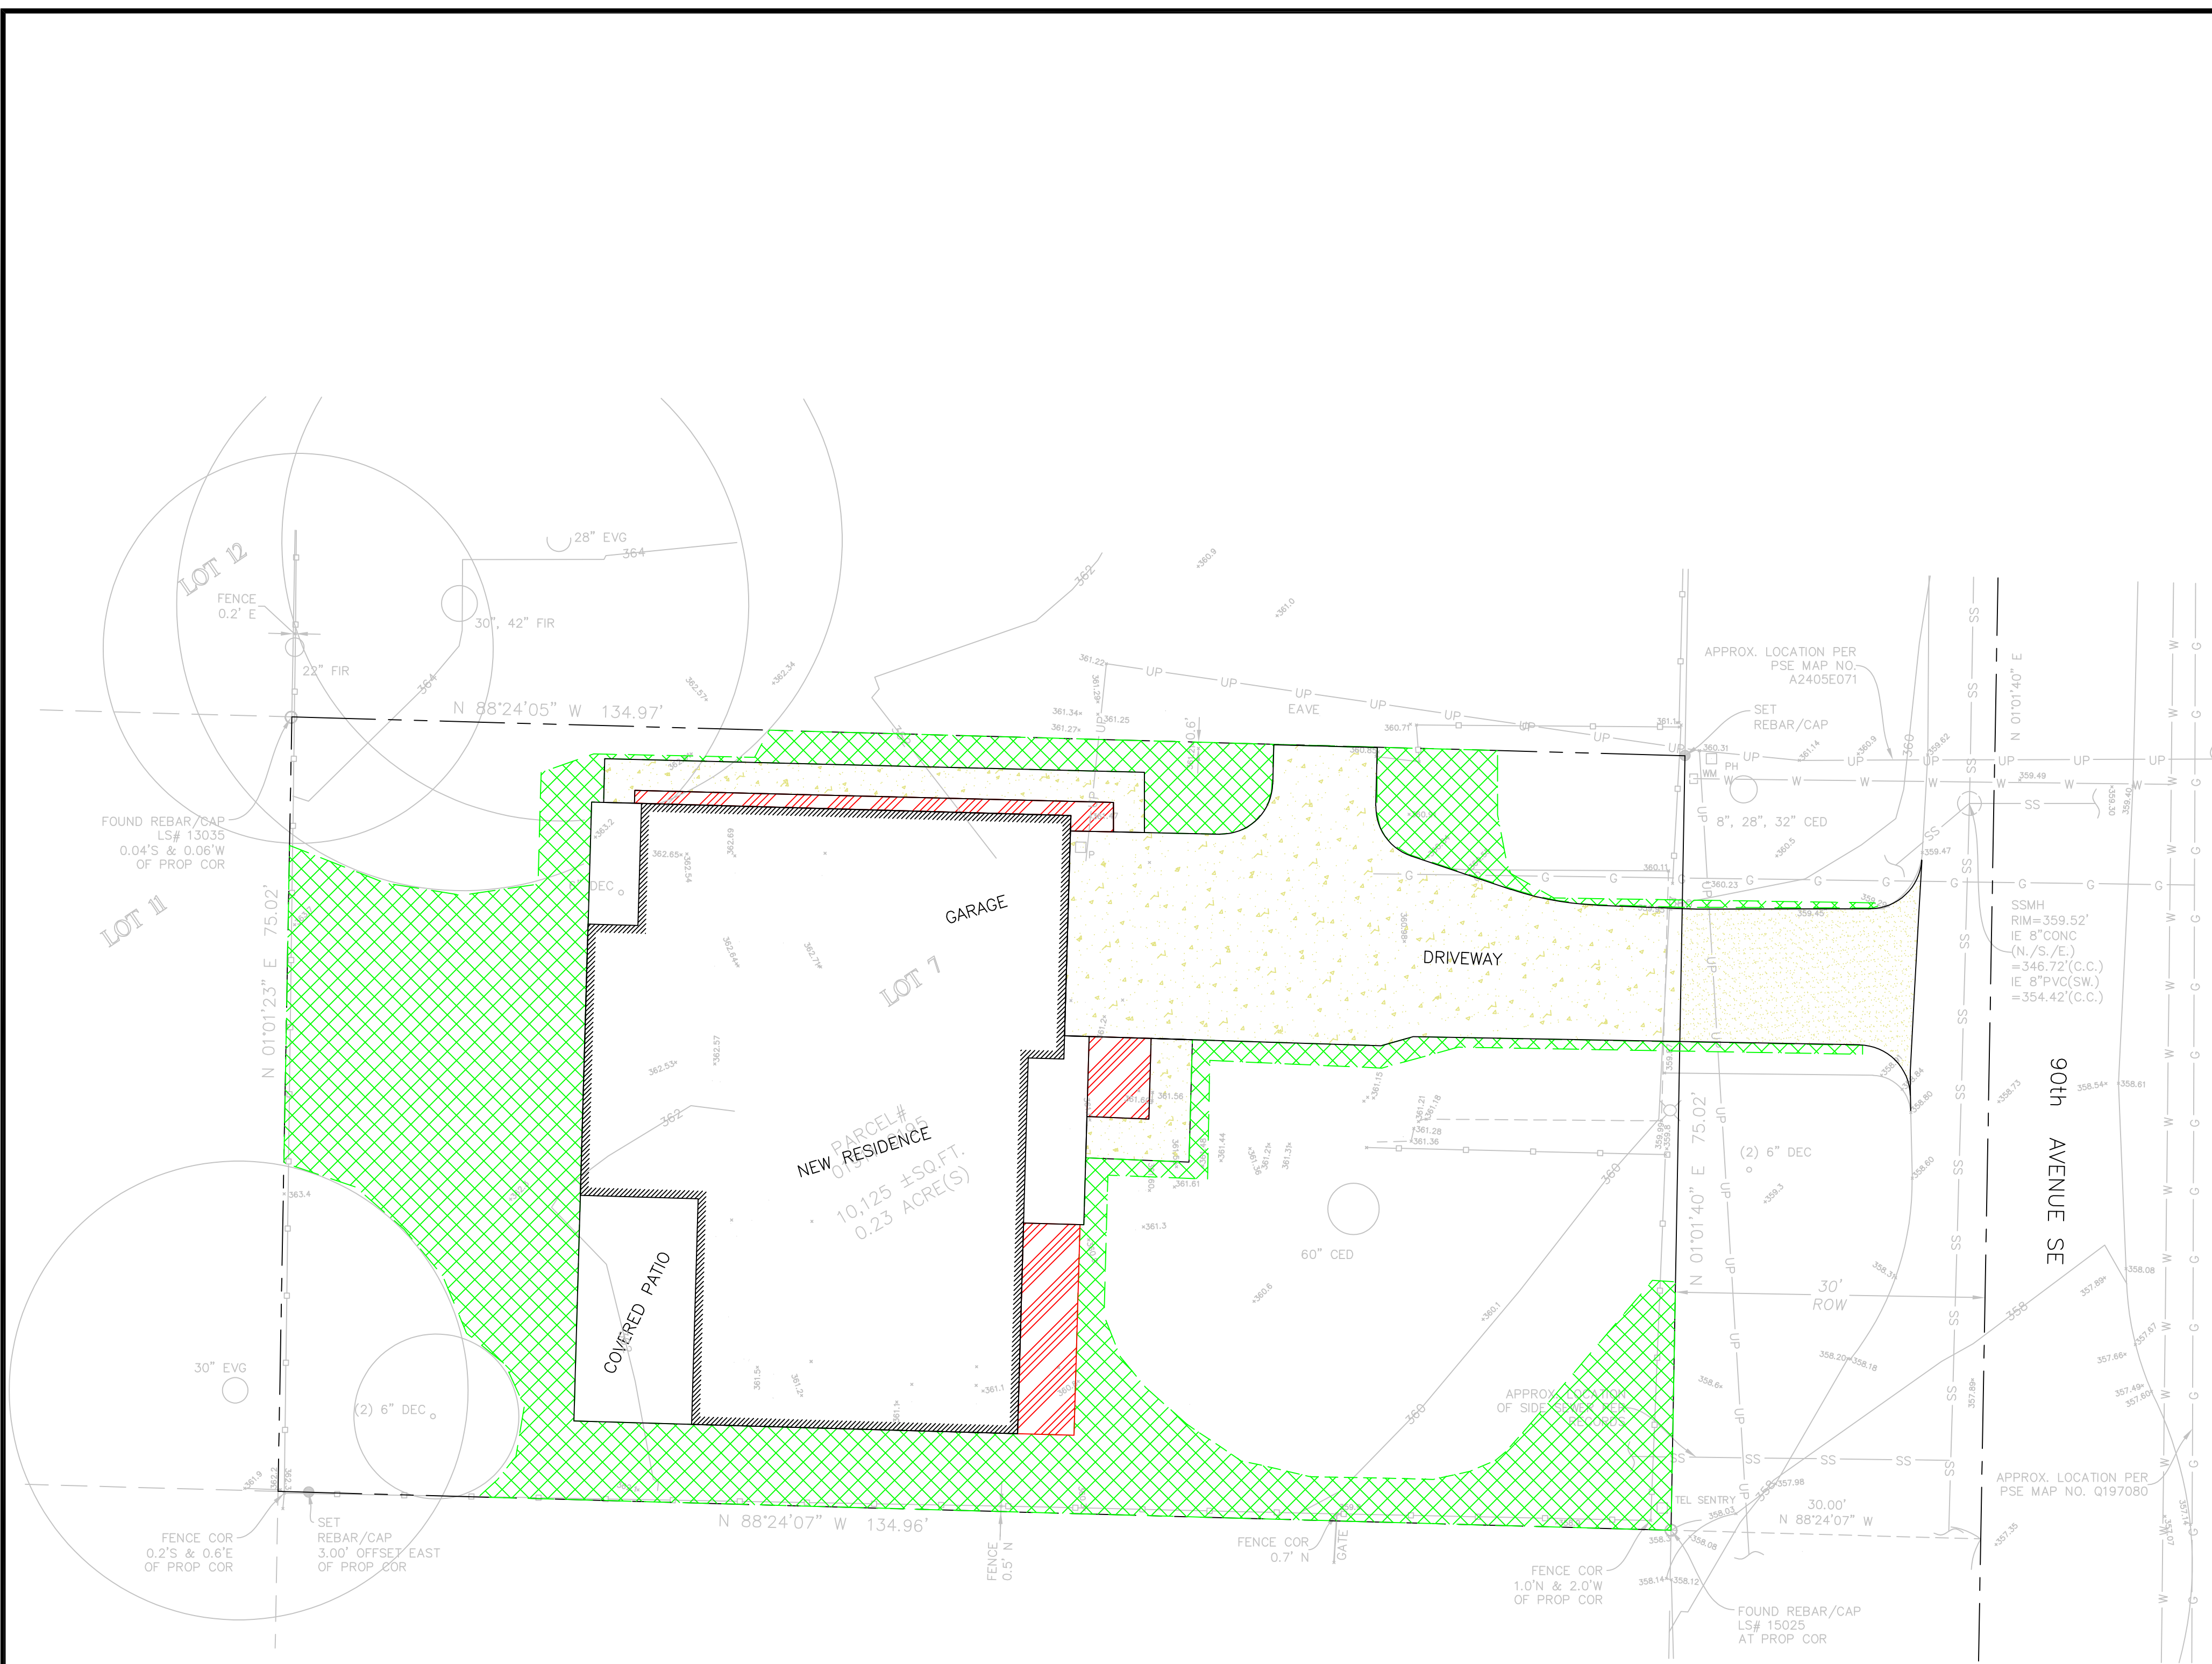


PROJECT	4537 90h Avenue SE		
	CLIENT		
SHEET CONTENT	Amended Soil Map/Utility Details		
	CLIENT		
DATE	09/01/2022		
JOB NO.			
DWG NO.			
SHEET	3	OF	3
DESIGNED BY	DLO	CHECKED BY	DLO
DRAWN BY	VS	DATE	09/01/2022
<p>OFFE ENGINEERS 13902 SOUTHEAST 159TH PLACE RENTON, WASHINGTON 98058 PHONE: 425-260-3412 CONTACT: DARRELL OFFE, P.E.</p>			
PERMIT #: 2203-197			

TOPOGRAPHIC & BOUNDARY SURVEY

measure success

TOPOGRAPHIC & BOUNDARY SURVEY
PARCEL NO. 0191100190 & 0191100195
JAYMARC HOMES

4537 90TH AVE SE
MERCER ISLAND, WA 98040

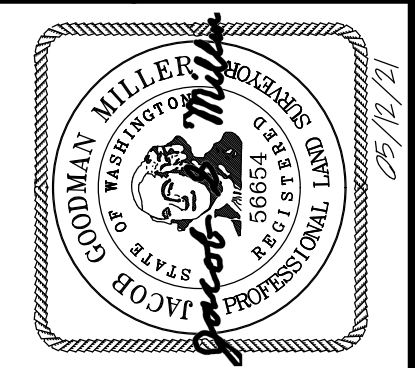

Terrane
10801 Main Street, Suite 102, Bellevue, WA 98004
phone 425.458.4498 support@terrane.net
www.terrane.net

JOB NUMBER:	210905
DATE:	05/12/21
DRAFTED BY:	IDV / GKD
CHECKED BY:	TBR / JGM
SCALE:	N.T.S.
REVISION HISTORY	
SHEET NUMBER	
1 OF 2	

LEGAL DESCRIPTION

FOR PARCEL# 0191100190
(PER PERSONAL REPRESENTATIVE'S DEED RECORDING# 20200115000188)
LOT 6, BLOCK 3, ALLVIEW HEIGHTS ADDITION TO SEATTLE, ACCORDING TO THE PLAT RECORDED IN VOLUME 16 OF PLATS, PAGE 20, IN KING COUNTY, WASHINGTON; TOGETHER WITH THE EAST VACATED ALLEY ADJOINING ON THE WEST, VACATED ON FEBRUARY 29 1960, IN VOLUME 64 OF COMMISSIONER'S RECORDS, PAGE 609.

FOR PARCEL# 0191100195
(PER PERSONAL REPRESENTATIVE'S DEED RECORDING# 20200115000187)
LOT 7, BLOCK 3, ALLVIEW HEIGHTS ADDITION TO SEATTLE, ACCORDING TO THE PLAT RECORDED IN VOLUME 16 OF PLATS, PAGE 20, IN KING COUNTY, WASHINGTON; TOGETHER WITH THE EAST VACATED ALLEY ADJOINING ON THE WEST, VACATED ON FEBRUARY 29 1960, IN VOLUME 64 OF COMMISSIONER'S RECORDS, PAGE 609.

BASIS OF BEARINGS

HELD N 01°01'40" E BETWEEN MONUMENTS FOUND ON THE CENTERLINE OF 90TH AVE SE PER GPS OBSERVATIONS, NAD83 WASHINGTON STATE PLANE, NORTH ZONE.

REFERENCES

R1. PLAT OF ALLVIEW HEIGHTS ADDITION, VOL. 16, PG. 20, RECORDS OF KING COUNTY, WASHINGTON.

VERTICAL DATUM


NAVD88, PER GPS OBSERVATIONS.

SURVEYOR'S NOTES

1. THE TOPOGRAPHIC SURVEY SHOWN HEREON WAS PERFORMED IN MAY OF 2021. THE FIELD DATA WAS COLLECTED AND RECORDED ON MAGNETIC MEDIA THROUGH AN ELECTRONIC THEODOLITE. THE DATA FILE IS ARCHIVED ON DISC OR CD. WRITTEN FIELD NOTES MAY NOT EXIST. CONTOURS ARE SHOWN FOR CONVENIENCE ONLY. DESIGN SHOULD RELY ON SPOT ELEVATIONS.
2. ALL MONUMENTS SHOWN HEREON WERE LOCATED DURING THE COURSE OF THIS SURVEY UNLESS OTHERWISE NOTED.
3. THE TYPES AND LOCATIONS OF ANY UTILITIES SHOWN ON THIS DRAWING ARE BASED ON INFORMATION PROVIDED TO US, BY OTHERS OR GENERAL INFORMATION READILY AVAILABLE IN THE PUBLIC DOMAIN INCLUDING, AS APPLICABLE, IDENTIFYING MARKINGS PLACED BY UTILITY LOCATE SERVICES AND OBSERVED BY TERRANE IN THE FIELD. AS SUCH, THE UTILITY INFORMATION SHOWN ON THESE DRAWINGS ARE FOR INFORMATIONAL PURPOSES ONLY AND SHOULD NOT BE RELIED ON FOR DESIGN OR CONSTRUCTION PURPOSES; TERRANE IS NOT RESPONSIBLE OR LIABLE FOR THE ACCURACY OR COMPLETENESS OF THIS UTILITY INFORMATION. FOR THE ACCURATE LOCATION AND TYPE OF UTILITIES NECESSARY FOR DESIGN AND CONSTRUCTION, PLEASE CONTACT THE SITE OWNER AND THE LOCAL UTILITY LOCATE SERVICE (800-424-5555).
4. SUBJECT PROPERTY TAX PARCEL NO. 019110-0190 & 019110-0195
5. SUBJECT TOTAL PROPERTY AREA PER THIS SURVEY IS 20,250 ±S.F. (0.46 ACRES)
FOR PARCEL# 019110-0190 AREA= 10,125 ±S.F. (0.23 ACRES)
FOR PARCEL# 019110-0195 AREA= 10,125 ±S.F. (0.23 ACRES)
6. THIS SURVEY WAS PERFORMED WITHOUT THE BENEFIT OF A TITLE REPORT. EASEMENTS AND OTHER ENCUMBRANCES MAY EXIST THAT ARE NOT SHOWN HEREON.
7. FIELD DATA FOR THIS SURVEY WAS OBTAINED BY DIRECT FIELD MEASUREMENTS WITH A CALIBRATED ELECTRONIC 5-SECOND TOTAL STATION AND/OR SURVEY GRADE GPS OBSERVATIONS. ALL ANGULAR AND LINEAR RELATIONSHIPS ARE ACCURATE AND MEET THE STANDARDS SET BY WAC 332-130-090.

LEGEND

	ASPHALT SURFACE		POWER HAND HOLE
	BUILDING		POWER METER
	CENTERLINE ROW		POWER (UNDERGROUND)
	CONCRETE SURFACE		POWER SENTRY
	RETAINING WALL		REBAR & CAP (SET)
	DECK		SEWER LINE
	FENCE LINE (WOOD)		SEWER MANHOLE
	GAS LINE		STORM DRAIN LINE
	INLET (TYPE 1)		TELEPHONE SENTRY
	NAIL AS NOTED		TREE (AS NOTED)
	MAILBOX (RESIDENTIAL)		WATER LINE
	PAVER SURFACE		WATER METER
	REBAR AS NOTED (FOUND)		WATER VALVE
	MONUMENT IN CASE (FOUND)		YARD LIGHT

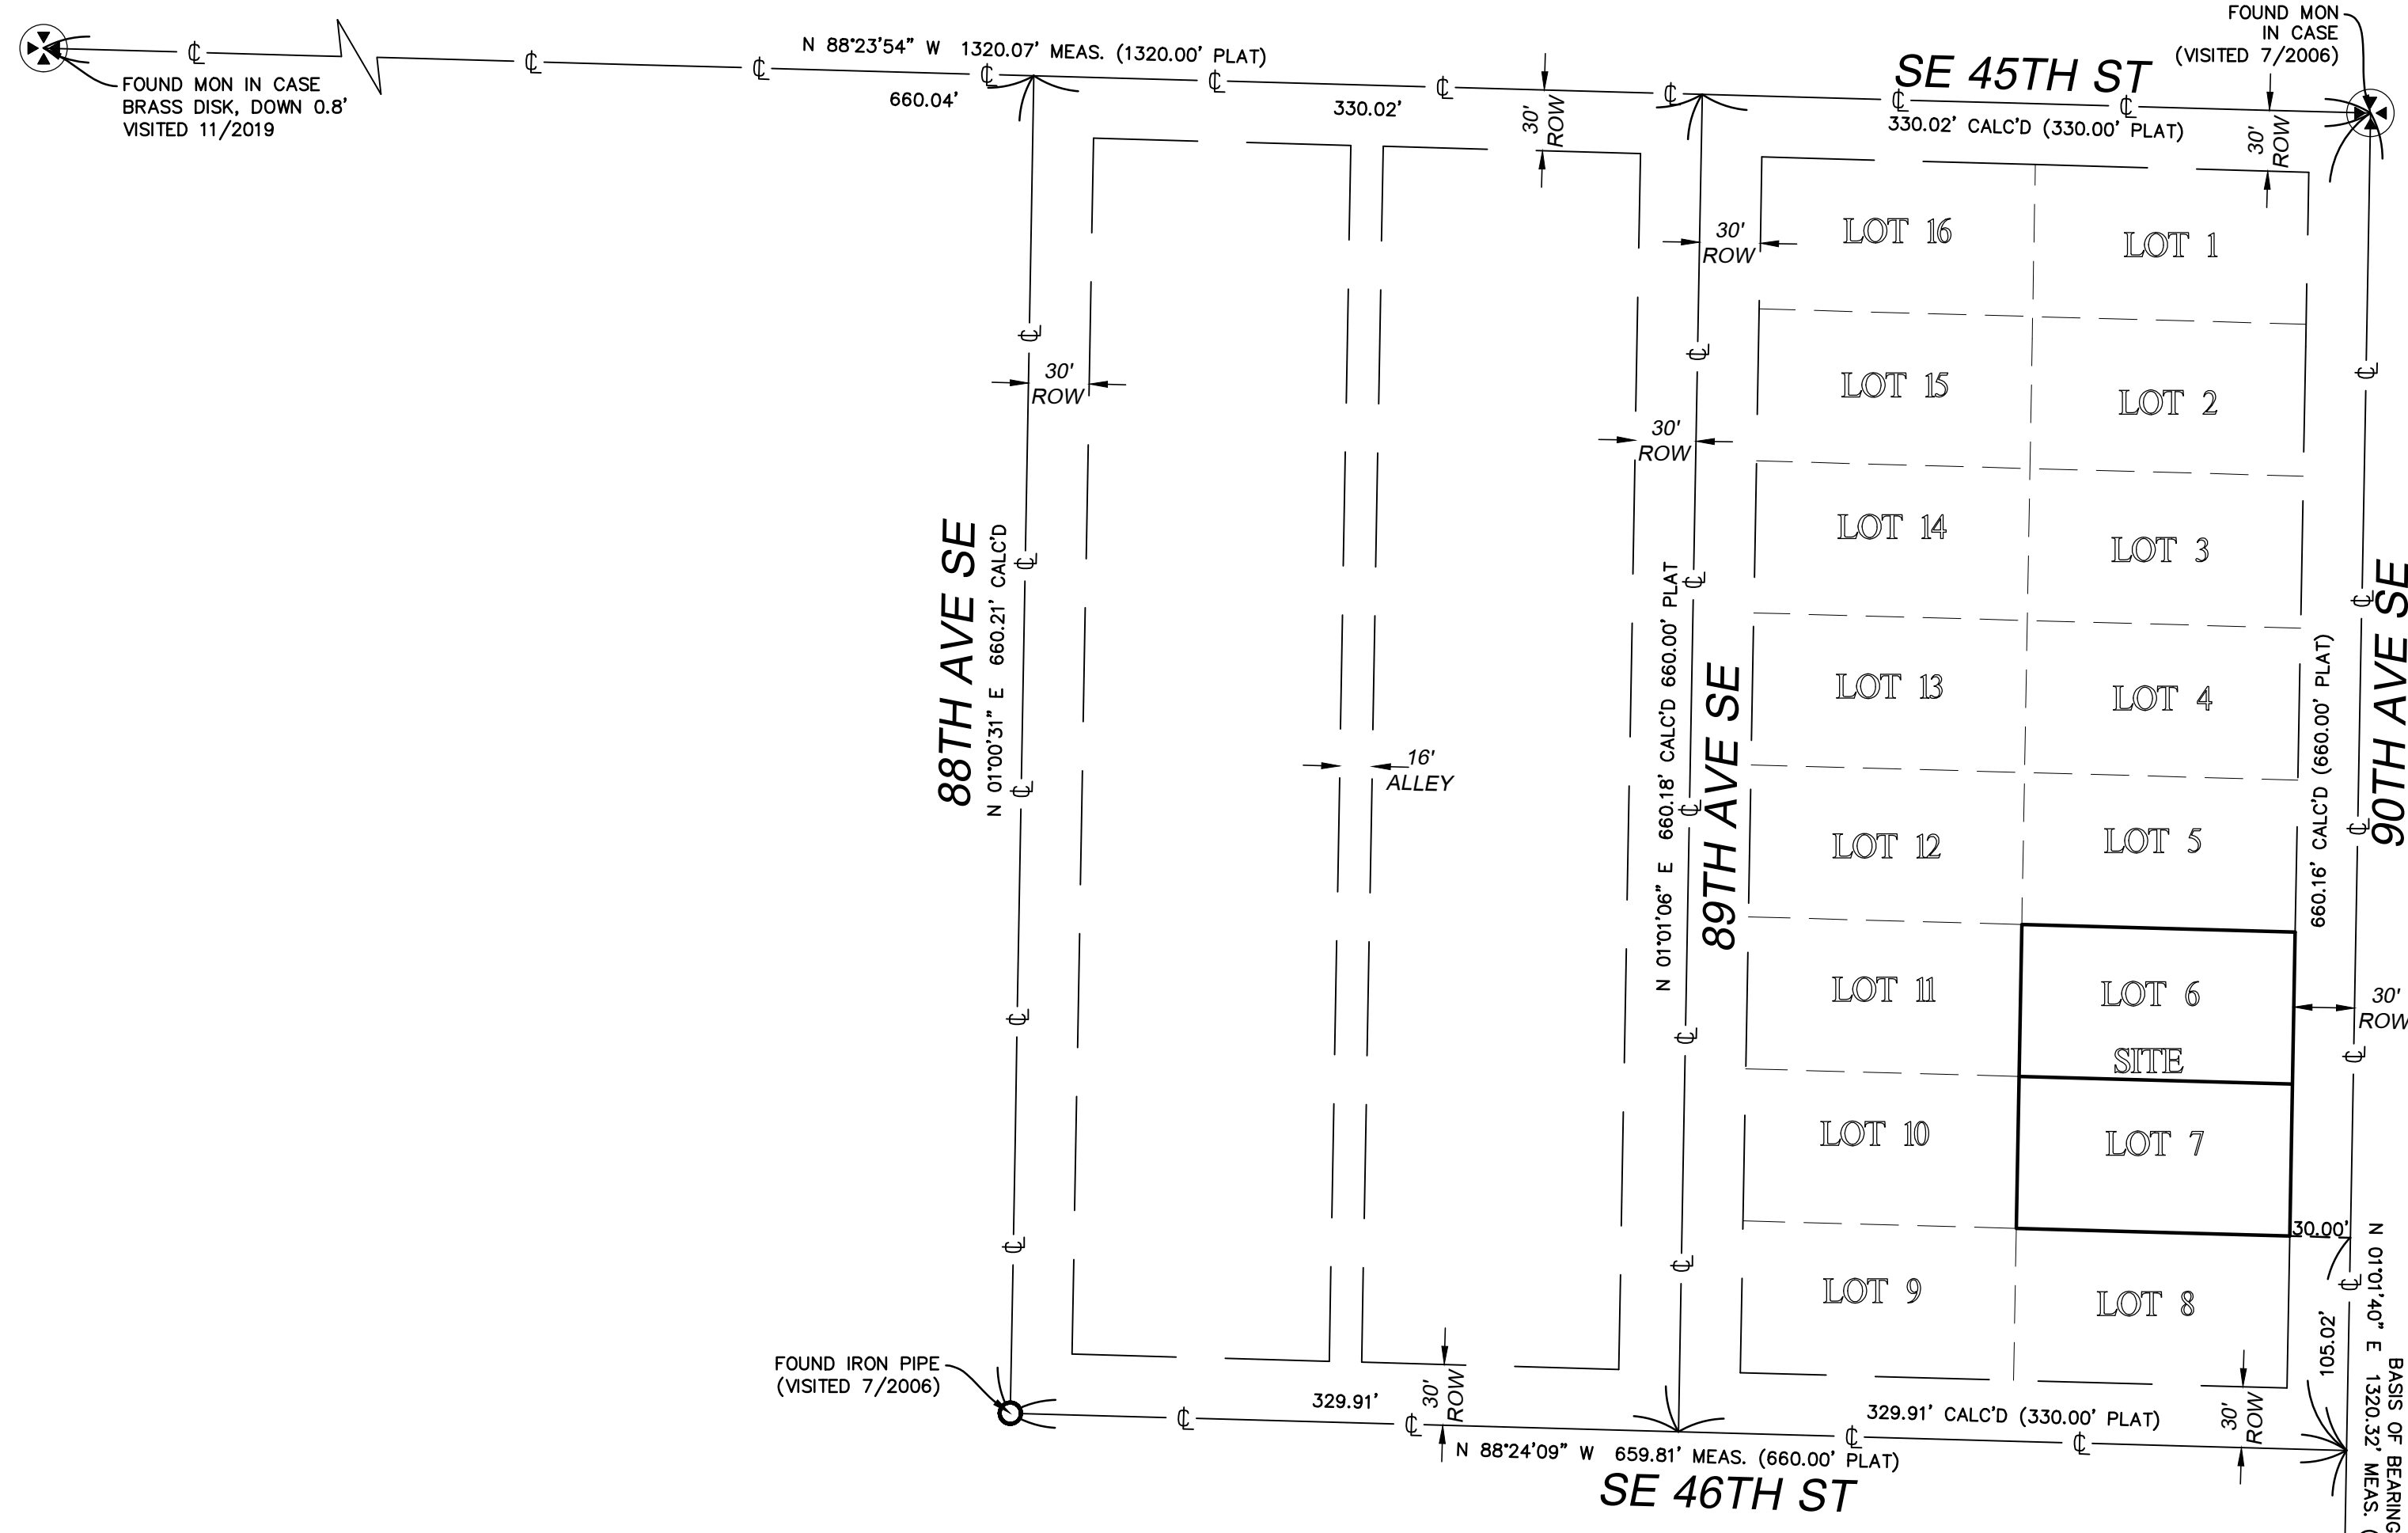

STEEP SLOPE/BUFFER DISCLAIMER:
THE LOCATION AND EXTENT OF STEEP SLOPES SHOWN ON THIS DRAWING ARE FOR INFORMATIONAL PURPOSES ONLY AND CANNOT BE RELIED ON FOR DESIGN AND/OR CONSTRUCTION. THE PITCH, LOCATION, AND EXTENT ARE BASED SOLELY ON OUR GENERAL OBSERVATIONS ON SITE AND OUR CURSORY REVIEW OF READILY AVAILABLE PUBLIC DOCUMENTS; AS SUCH, TERRANE CANNOT BE LIABLE OR RESPONSIBLE FOR THE ACCURACY OR COMPLETENESS OF ANY STEEP SLOPE INFORMATION. ULTIMATELY, THE LIMITS AND EXTENT OF ANY STEEP SLOPES ASSOCIATED WITH ANY SETBACKS OR OTHER DESIGN OR CONSTRUCTION PARAMETERS MUST BE DISCUSSED AND APPROVED BY THE REVIEWING AGENCY BEFORE ANY CONSTRUCTION CAN OCCUR.

INDEXING INFORMATION			
NE 1/4	SW 1/4	SECTION: 18	
TOWNSHIP: 24N		RANGE: 05E, W.M.	
COUNTY: KING			

