

*PLEASE REFERENCE 1/A1.3 FOR AVERAGE BUILDING CALCULATIONS.

**PLEASE REFERENCE 1/A0.2 FOR BASEMENT FLOOR AREA CALCULATIONS.

JULIAN WEBER ARCHITECTS, LTD

1257 S King St Seattle, WA 98144 203.953.1305

www.jwaseattle.com

9458 REGISTERED ARCHITECT

JULIAN R. WEBER STATE OF WASHINGTON

COOMBES DEVELOPMENT

4701 SW ADMIRAL WAY, SUITE 385 SEATTLE, WA 98116 P 206.420.7672

Coombes Residence

6221 83rd PI SE Mercer Island

#

 MUP #
 na

 BP #
 2207-110

 Δ
 Date
 Description

 06.02.2022
 Critical Area Submittal

 06.02.2022
 BP Submittal

 1
 08.07.2023
 PPR 1

06.02.2022 BP Submittal
1 08.07.2023 PPR 1

SITE PLAN

Scale 1/8" = 1'-0"

Date 06/01/2023


A0.1


Project Number


AU.I

JWA#611

N

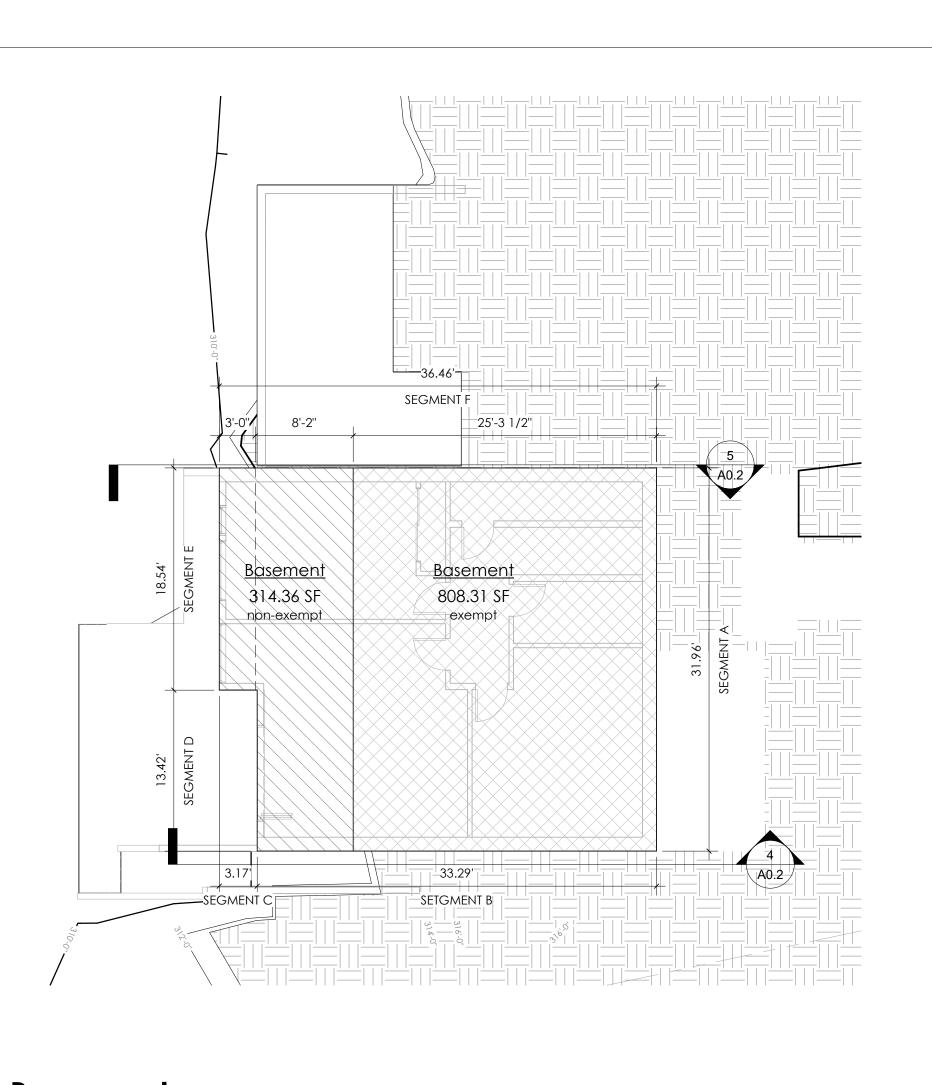

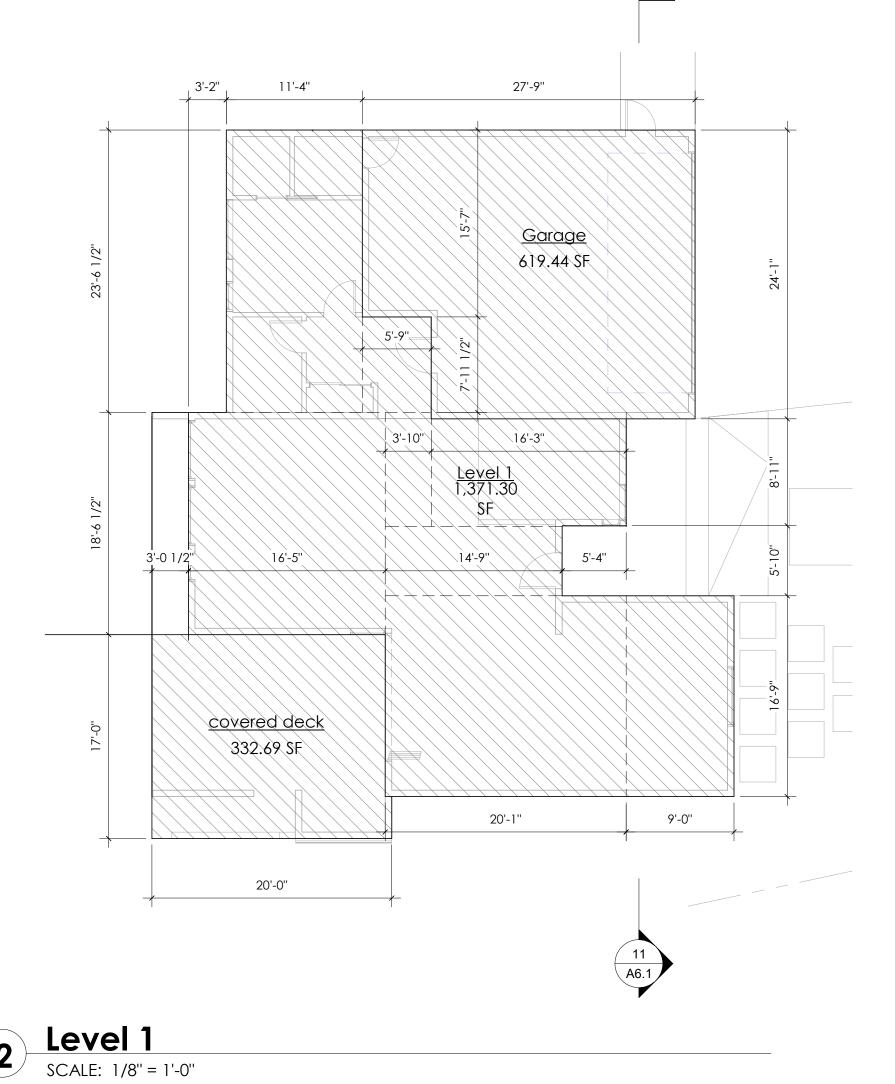

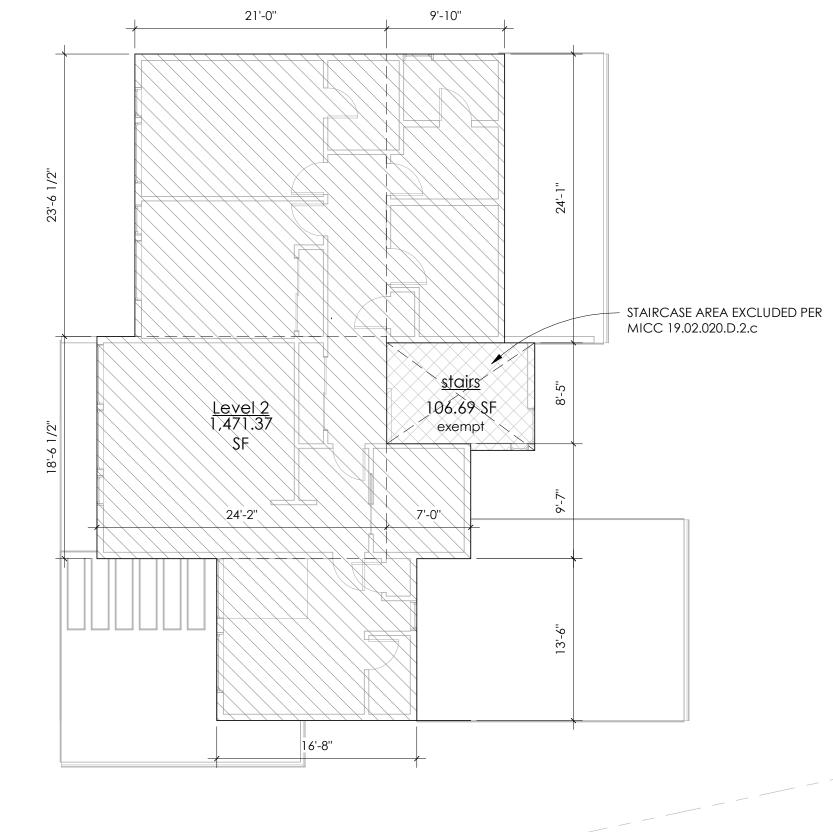




Level 2SCALE: 1/8" = 1'-0"


Basement SCALE: 1/8" = 1'-0" MICC TITLE 19 - UNIFIED LAND DEVELOPMENT APPENDICES APPENDIX B - BASEMENT FLOOR AREA CALCULATION STEP 2 - WALL SEGMENT COVERAGE A = 100% B = 7.92'/8.5' x 100 = 93.18 % C = 0 % D = 0 % E = 0 % F = 8.4'/8.5' x 100 = 98.82 % STEP 3 - (WALL LENGTH x %COVERAGE) SEGMENT B **SEGMENT B**SCALE: 1/8" = 1'-0" A = 31.96' x 100% = 3,196 B = 33.29' x 93.18 % = 3,101.96 C = 3.17 x 0 % = 0 $D = 13.42' \times 0 \% = 0$ $E = 18.54' \times 0\% = 0$ F = 36.46' x 98.82 % = 3,602.98 TOTAL WALL LENGTH= 136.84' TOTAL SUM = 9,900.94/100 = 99.01 crawlspace STEP 4 99.01/136.84' = 0.72 x 100 = <u>72% AREA EXCLUDED</u> BASEMENT TOTAL GROSS FLOOR AREA = 1,122.66 SF 1,122.66 x 0.72 = <u>808.31 SF AREA EXCLUDED</u> 36.46

SEGMENT F

SEGMENT FSCALE: 1/8" = 1'-0"

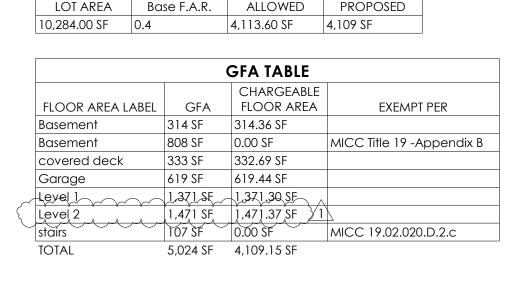

FAR CALCULATION

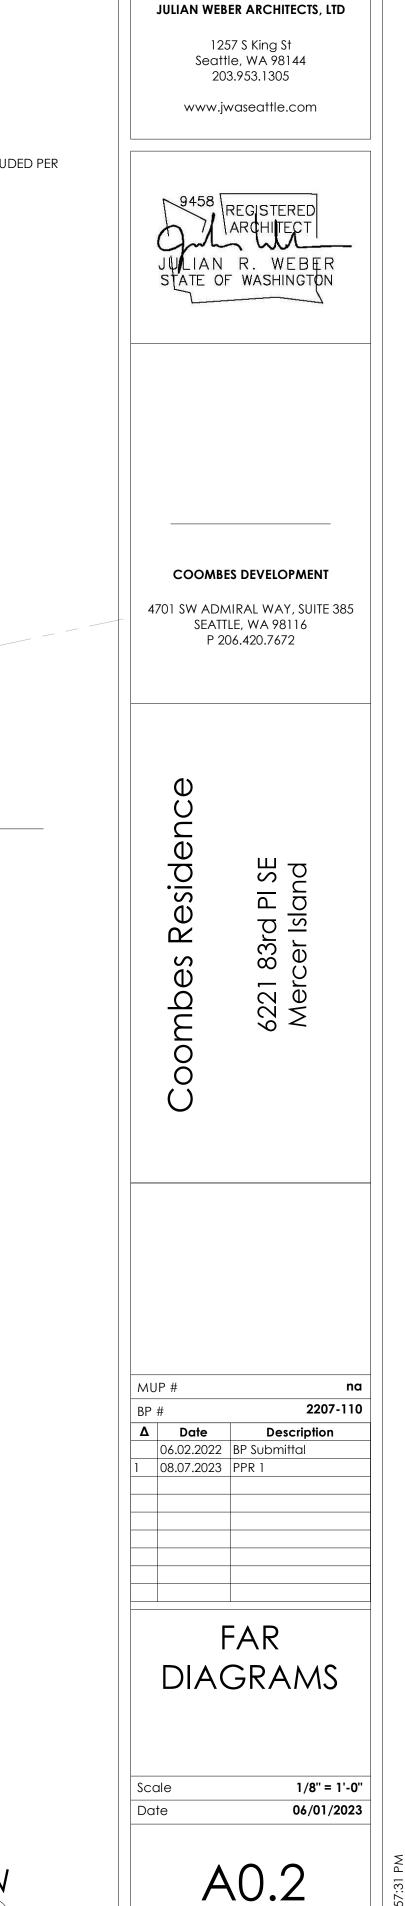




TOTAL EXISTING GFA = 4,477 SF REMOVED

Project Number

JWA#611

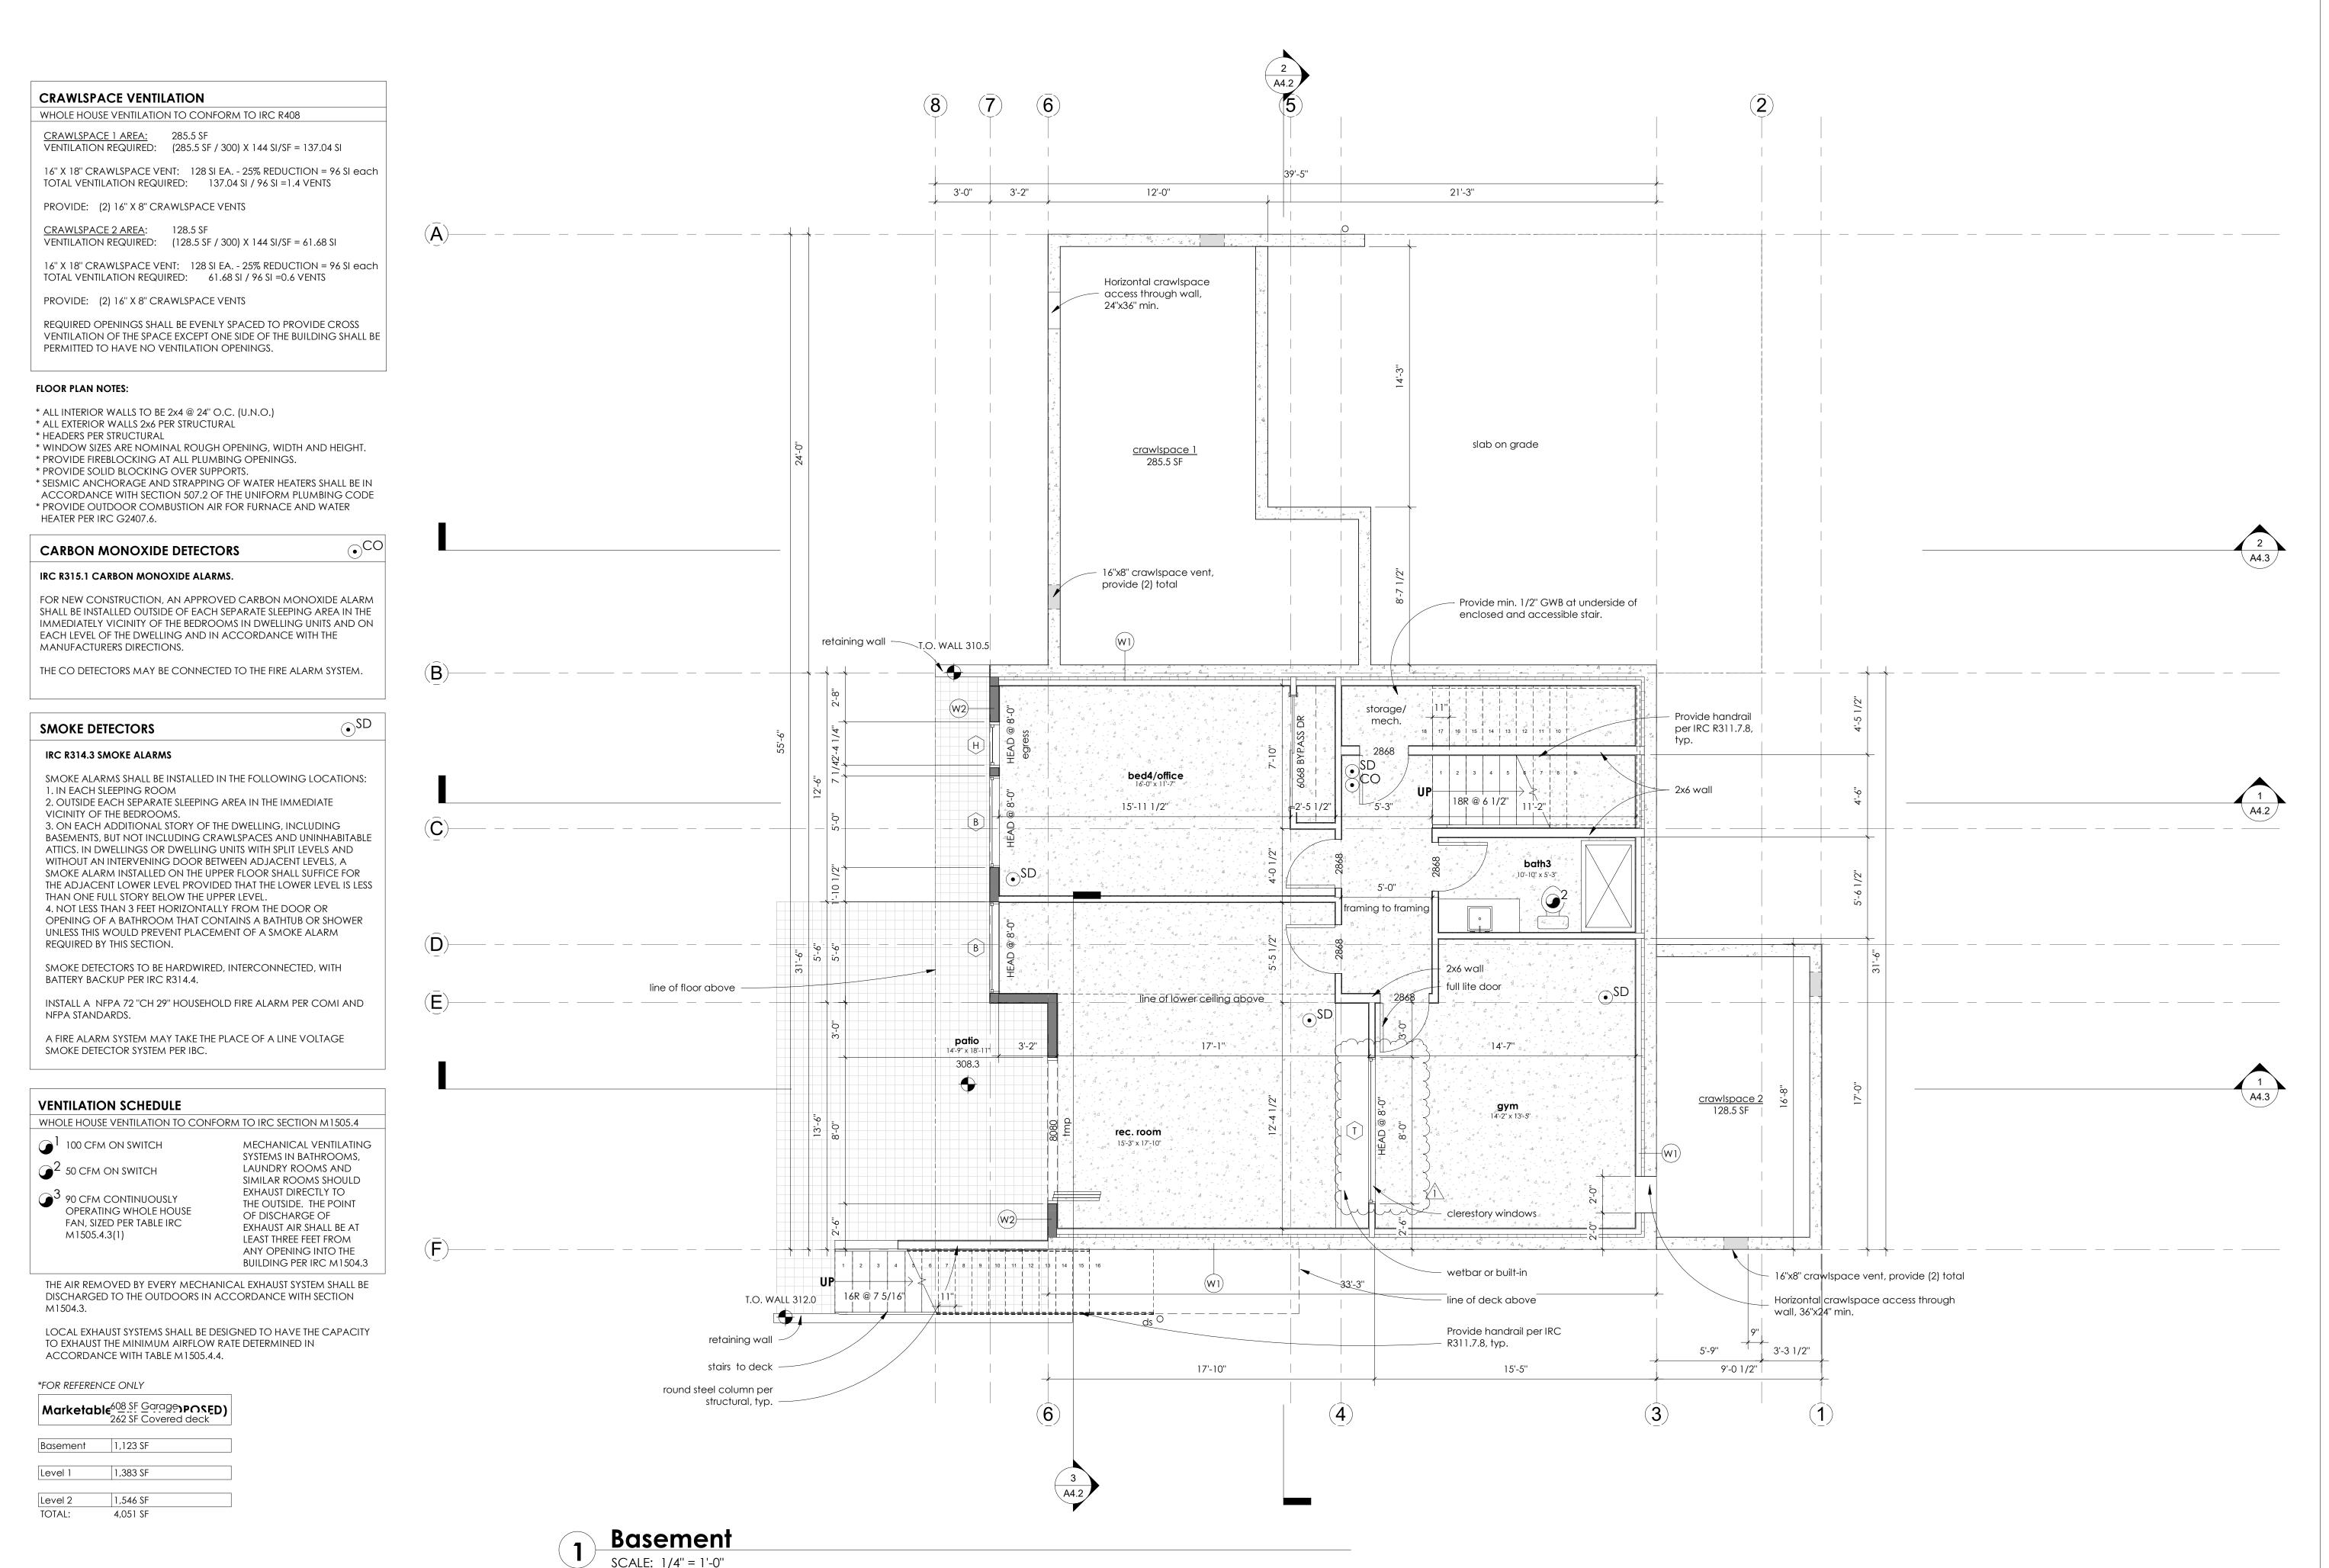

* NOT CEILING HEIGHT GREATER THAN 10 FT. PLEASE REFERENCE SECTIONS A4.2-3.

JULIAN WEBER ARCHITECTS, LTD Seattle, WA 98144

203.953.1305 www.jwaseattle.com

COOMBES DEVELOPMENT

4701 SW ADMIRAL WAY, SUITE 385 SEATTLE, WA 98116 P 206.420.7672

PI SE and

MUP# 2207-110 BP # Δ Date Description 06.02.2022 BP Submittal 08.07.2023 PPR 1

FLOOR PLANS

1/4" = 1'-0" Scale 06/01/2023

Project Number JWA#611

GARAGE NOTES:

* THE GARAGE SHALL BE SEPARATED FROM THE RESIDENCE AND ITS ATTIC AREA BY NOT LESS THAN 1/2" GWB APPLIED TO THE GARAGE SIDE. GARAGES BENEATH HABITABLE ROOMS SHALL BE SEPARATED FROM ALL HABITABLE ROOMS ABOVE BY NOT LESS THAN 5/8" TYPE X GYPSUM BOARD OR EQUIVALENT. WHERE THE SEPARATION IS A FLOOR-CEILING ASSEMBLY, THE STRUCTURE SUPPORTING THE SEPARATION SHALL ALSO BE PROTECTED BY NOT LESS THAN 1/2-INCH GYPSUM BOARD OR EQUIVALENT. SRC R302.6

* ...OPENINGS BETWEEN THE GARAGE AND RESIDENCE SHALL BE EQUIPPED WITH SOLID WOOD DOORS NOT LESS THAN 1 3/8" IN THICKNESS, SOLID OR HONEYCOMB CORE STEEL DOORS NOT LESS THAN 1 3/8" THICK, OR 20-MINUTE FIRE-RATED DOORS.SRC 302.5.1

* DUCTS IN THE GARAGE AND DUCTS PENETRATING THE WALLS OR CEILINGS SEPARATING THE DWELLING FROM THE GARAGE SHALL BE CONSTRUCTED OF A MINIMUM NO. 26 GAGE SHEET STEEL OR OTHER APPROVED MATERIALS AND SHALL HAVE NO OPENINGS INTO THE GARAGE. IRC R302.5.2

* SEISMIC ANCHORAGE AND STRAPPING OF WATER HEATERS SHALL BE IN ACCORDANCE WITH SECTION 507.2 OF THE UNIFORM PLUMBING CODE.

FLOOR PLAN NOTES:

- * ALL INTERIOR WALLS TO BE 2x4 @ 24" O.C. (U.N.O.)
- * ALL EXTERIOR WALLS 2x6 PER STRUCTURAL * HEADERS PER STRUCTURAL
- * WINDOW SIZES ARE NOMINAL ROUGH OPENING, WIDTH AND HEIGHT.
- * PROVIDE FIREBLOCKING AT ALL PLUMBING OPENINGS. * PROVIDE SOLID BLOCKING OVER SUPPORTS.
- * SEISMIC ANCHORAGE AND STRAPPING OF WATER HEATERS SHALL BE IN ACCORDANCE WITH SECTION 507.2 OF THE UNIFORM PLUMBING CODE * PROVIDE OUTDOOR COMBUSTION AIR FOR FURNACE AND WATER HEATER PER IRC G2407.6.

⊕CO CARBON MONOXIDE DETECTORS

IRC R315.1 CARBON MONOXIDE ALARMS.

FOR NEW CONSTRUCTION, AN APPROVED CARBON MONOXIDE ALARM SHALL BE INSTALLED OUTSIDE OF EACH SEPARATE SLEEPING AREA IN THE IMMEDIATELY VICINITY OF THE BEDROOMS IN DWELLING UNITS AND ON EACH LEVEL OF THE DWELLING AND IN ACCORDANCE WITH THE MANUFACTURERS DIRECTIONS.

THE CO DETECTORS MAY BE CONNECTED TO THE FIRE ALARM SYSTEM.

SMOKE DETECTORS

IRC R314.3 SMOKE ALARMS

SMOKE ALARMS SHALL BE INSTALLED IN THE FOLLOWING LOCATIONS: 1. IN EACH SLEEPING ROOM

2. OUTSIDE EACH SEPARATE SLEEPING AREA IN THE IMMEDIATE VICINITY OF THE BEDROOMS. 3. ON EACH ADDITIONAL STORY OF THE DWELLING, INCLUDING

BASEMENTS, BUT NOT INCLUDING CRAWLSPACES AND UNINHABITABLE ATTICS. IN DWELLINGS OR DWELLING UNITS WITH SPLIT LEVELS AND WITHOUT AN INTERVENING DOOR BETWEEN ADJACENT LEVELS, A SMOKE ALARM INSTALLED ON THE UPPER FLOOR SHALL SUFFICE FOR THE ADJACENT LOWER LEVEL PROVIDED THAT THE LOWER LEVEL IS LESS THAN ONE FULL STORY BELOW THE UPPER LEVEL.

4. NOT LESS THAN 3 FEET HORIZONTALLY FROM THE DOOR OR OPENING OF A BATHROOM THAT CONTAINS A BATHTUB OR SHOWER UNLESS THIS WOULD PREVENT PLACEMENT OF A SMOKE ALARM REQUIRED BY THIS SECTION.

SMOKE DETECTORS TO BE HARDWIRED, INTERCONNECTED, WITH BATTERY BACKUP PER IRC R314.4.

INSTALL A NFPA 72 "CH 29" HOUSEHOLD FIRE ALARM PER COMI AND NFPA STANDARDS.

A FIRE ALARM SYSTEM MAY TAKE THE PLACE OF A LINE VOLTAGE SMOKE DETECTOR SYSTEM PER IBC.

HEAT DETECTORS

(•)SD

A HEAT DETECTOR OR HEAT ALARM RATED FOR THE AMBIENT OUTDOOR TEMPERATURES AND HUMIDITY SHALL BE INSTALLED IN NEW GARAGES THAT ARE ATTACHED TO OR LOCATED UNDER NEW AND EXISTING DWELLINGS. HEAT DETECTORS AND HEAT ALARMS SHALL BE INSTALLED IN A CENTRAL LOCATION AND IN ACCORDANCE WITH THE MANUFACTURER'S INSTRUCTIONS.

HEAT DETECTORS AND HEAT ALARMS SHALL BE CONNECTED TO AN ALARM OR A SMOKE ALARM THAT IS INSTALLED IN THE DWELLING. ALARMS AND SMOKE ALARMS THAT ARE INSTALLED FOR THIS PURPOSE SHALL BE LOCATED IN A HALLWAY, ROOM, OR OTHER LOCATION THAT WILL PROVIDE OCCUPANT NOTIFICATION.

THE REQUIRED HEAT DETECTOR IN THE GARAGE MAY BE CONNECTED TO THE FIRE ALARM SYSTEM.

VENTILATION SCHEDULE

WHOLE HOUSE VENTILATION TO CONFORM TO IRC SECTION M1505.4

100 CFM ON SWITCH 50 CFM ON SWITCH

90 CFM CONTINUOUSLY OPERATING WHOLE HOUSE FAN, SIZED PER TABLE IRC M1505.4.3(1)

MECHANICAL VENTILATING SYSTEMS IN BATHROOMS, LAUNDRY ROOMS AND SIMILAR ROOMS SHOULD EXHAUST DIRECTLY TO THE OUTSIDE. THE POINT OF DISCHARGE OF EXHAUST AIR SHALL BE AT LEAST THREE FEET FROM ANY OPENING INTO THE BUILDING PER IRC M1504.3

SCALE: 1/4" = 1'-0"


* NOT CEILING HEIGHT GREATER THAN 10 FT. PLEASE REFERENCE SECTIONS A4.2-3.

THE AIR REMOVED BY EVERY MECHANICAL EXHAUST SYSTEM SHALL BE DISCHARGED TO THE OUTDOORS IN ACCORDANCE WITH SECTION M1504.3.

LOCAL EXHAUST SYSTEMS SHALL BE DESIGNED TO HAVE THE CAPACITY TO EXHAUST THE MINIMUM AIRFLOW RATE DETERMINED IN ACCORDANCE WITH TABLE M1505.4.4.

ROOF DECK VENTILATION

UNVENTED ASSEMBLY TO COMPLY WITH IRC R806.5

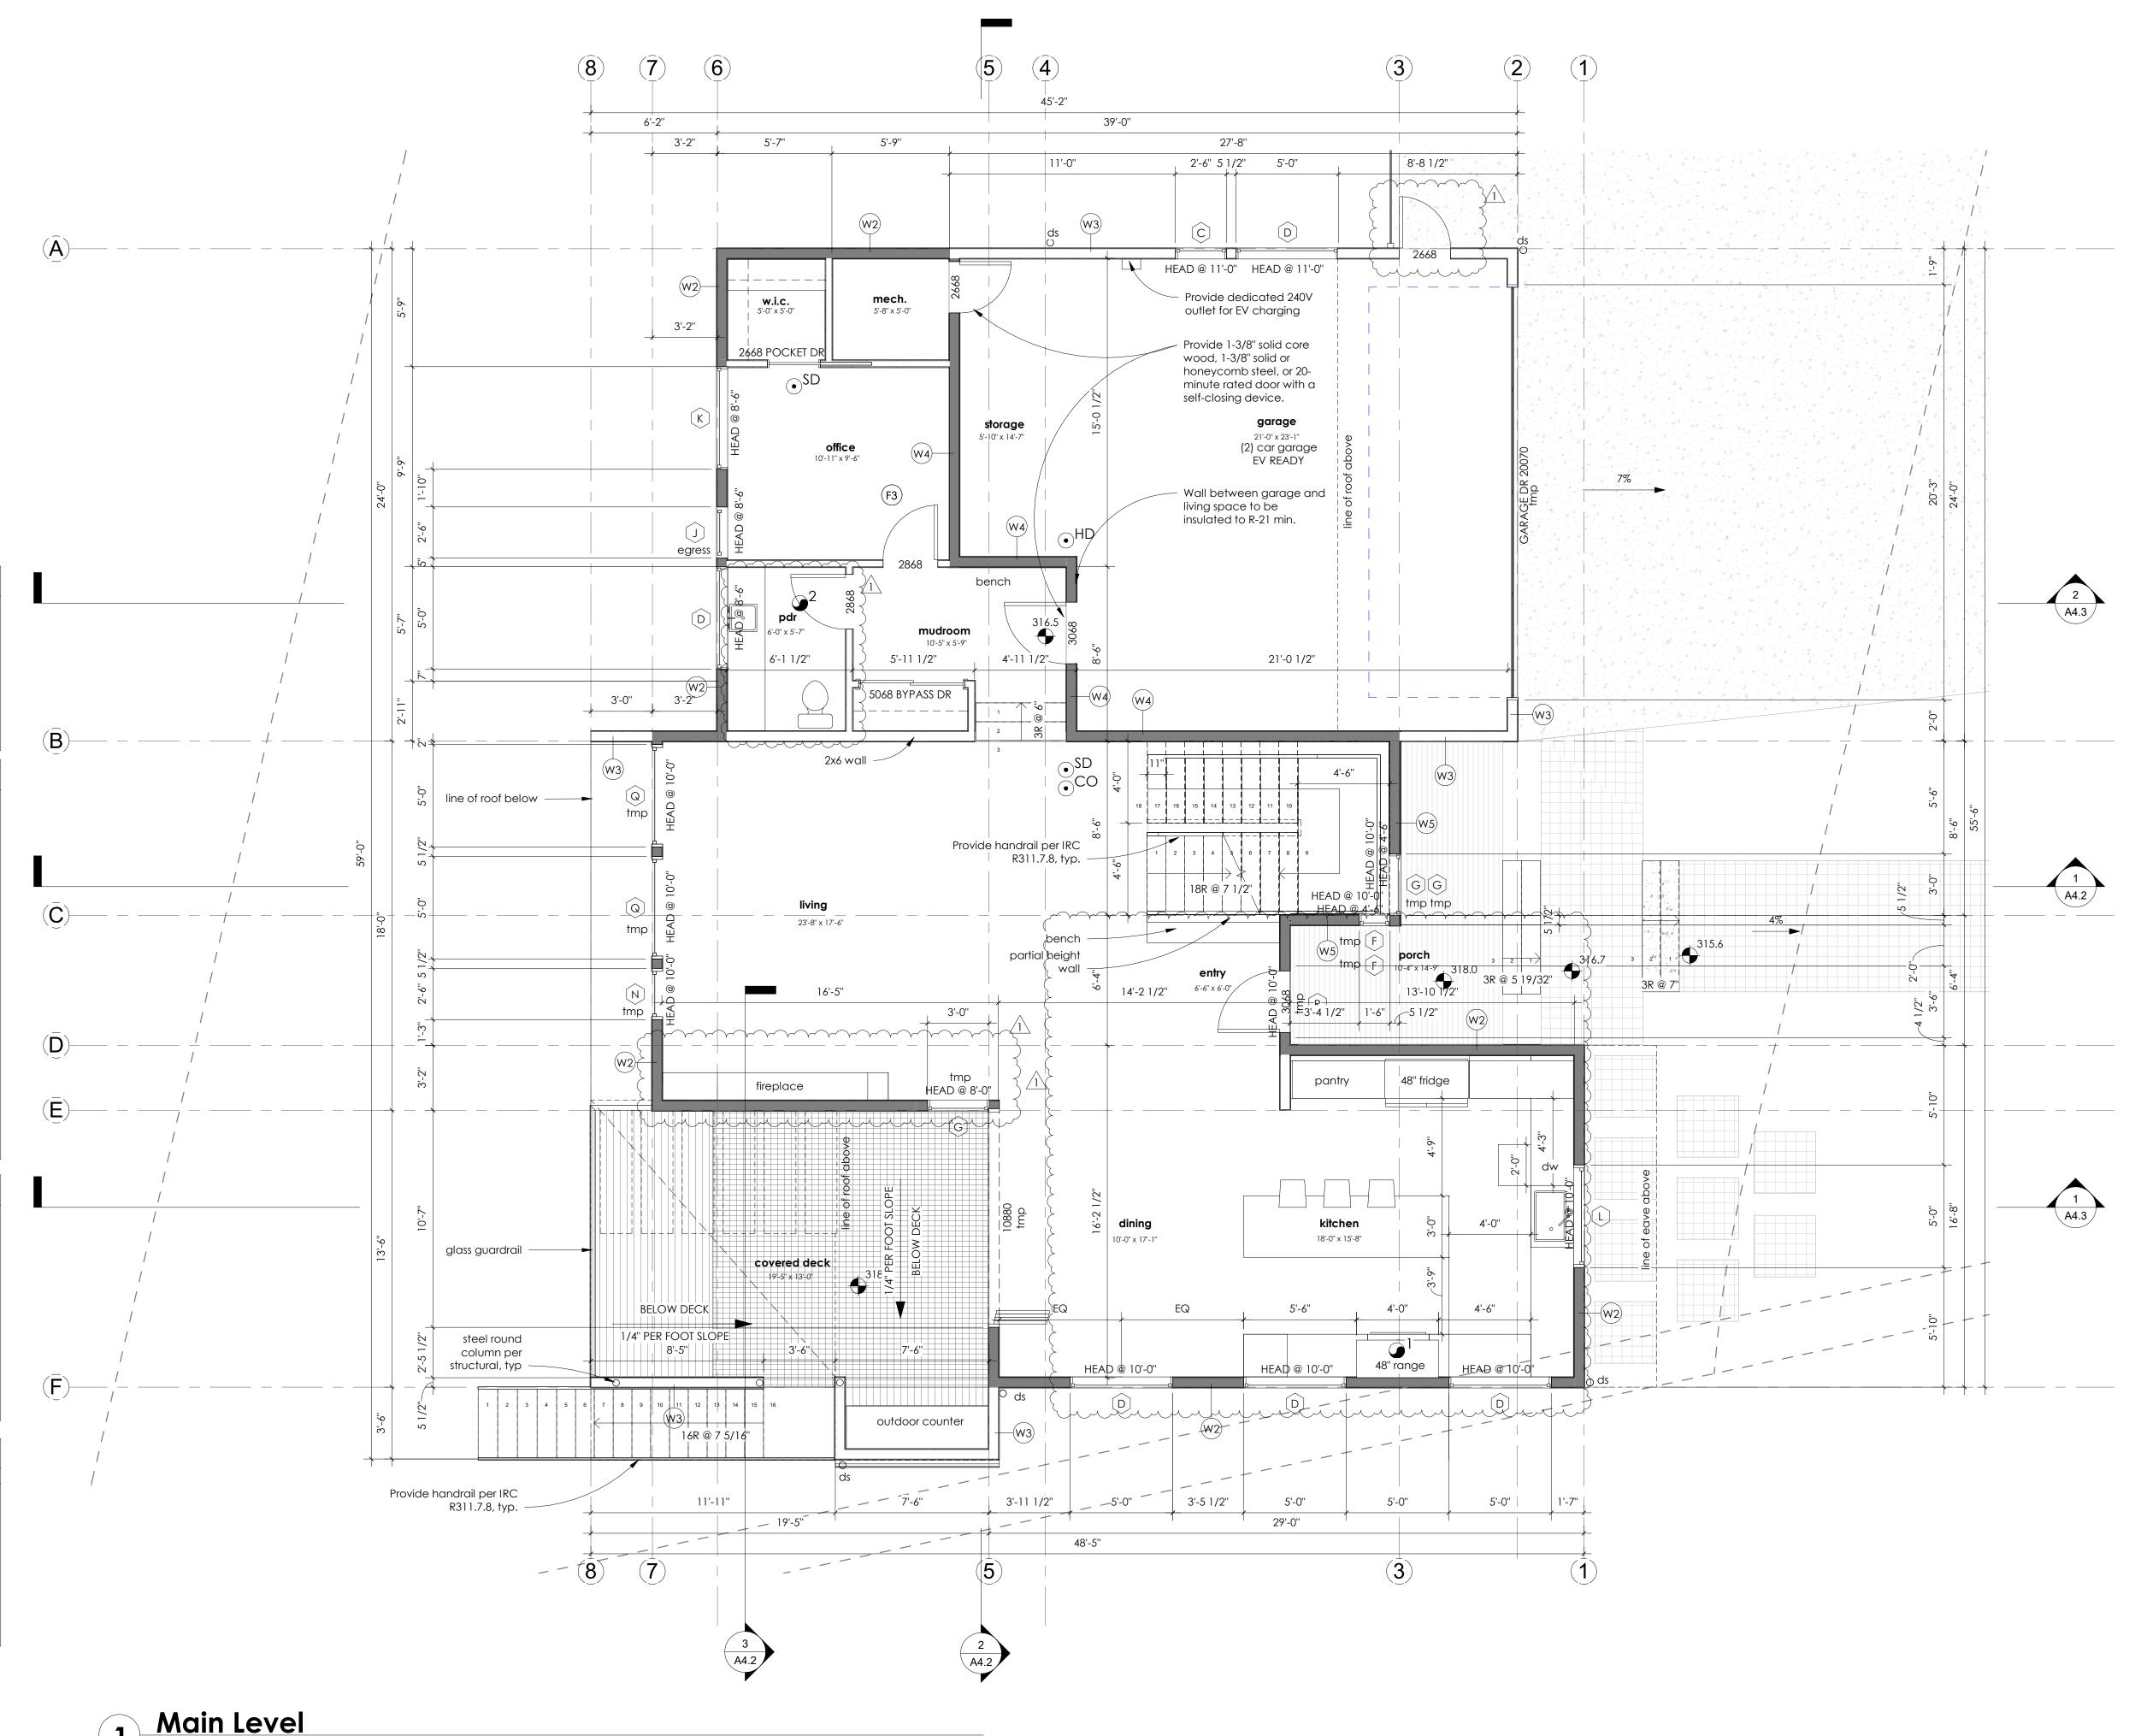

JULIAN WEBER ARCHITECTS, LTD

1257 S King St Seattle, WA 98144 203.953.1305

www.jwaseattle.com

COOMBES DEVELOPMENT

4701 SW ADMIRAL WAY, SUITE 385 SEATTLE, WA 98116 P 206.420.7672

PI SE and

MUP#


2207-110 BP # Δ Date Description 06.02.2022 BP Submittal 08.07.2023 PPR 1

FLOOR PLANS

1/4" = 1'-0" Scale 06/01/2023

Project Number

JWA#611

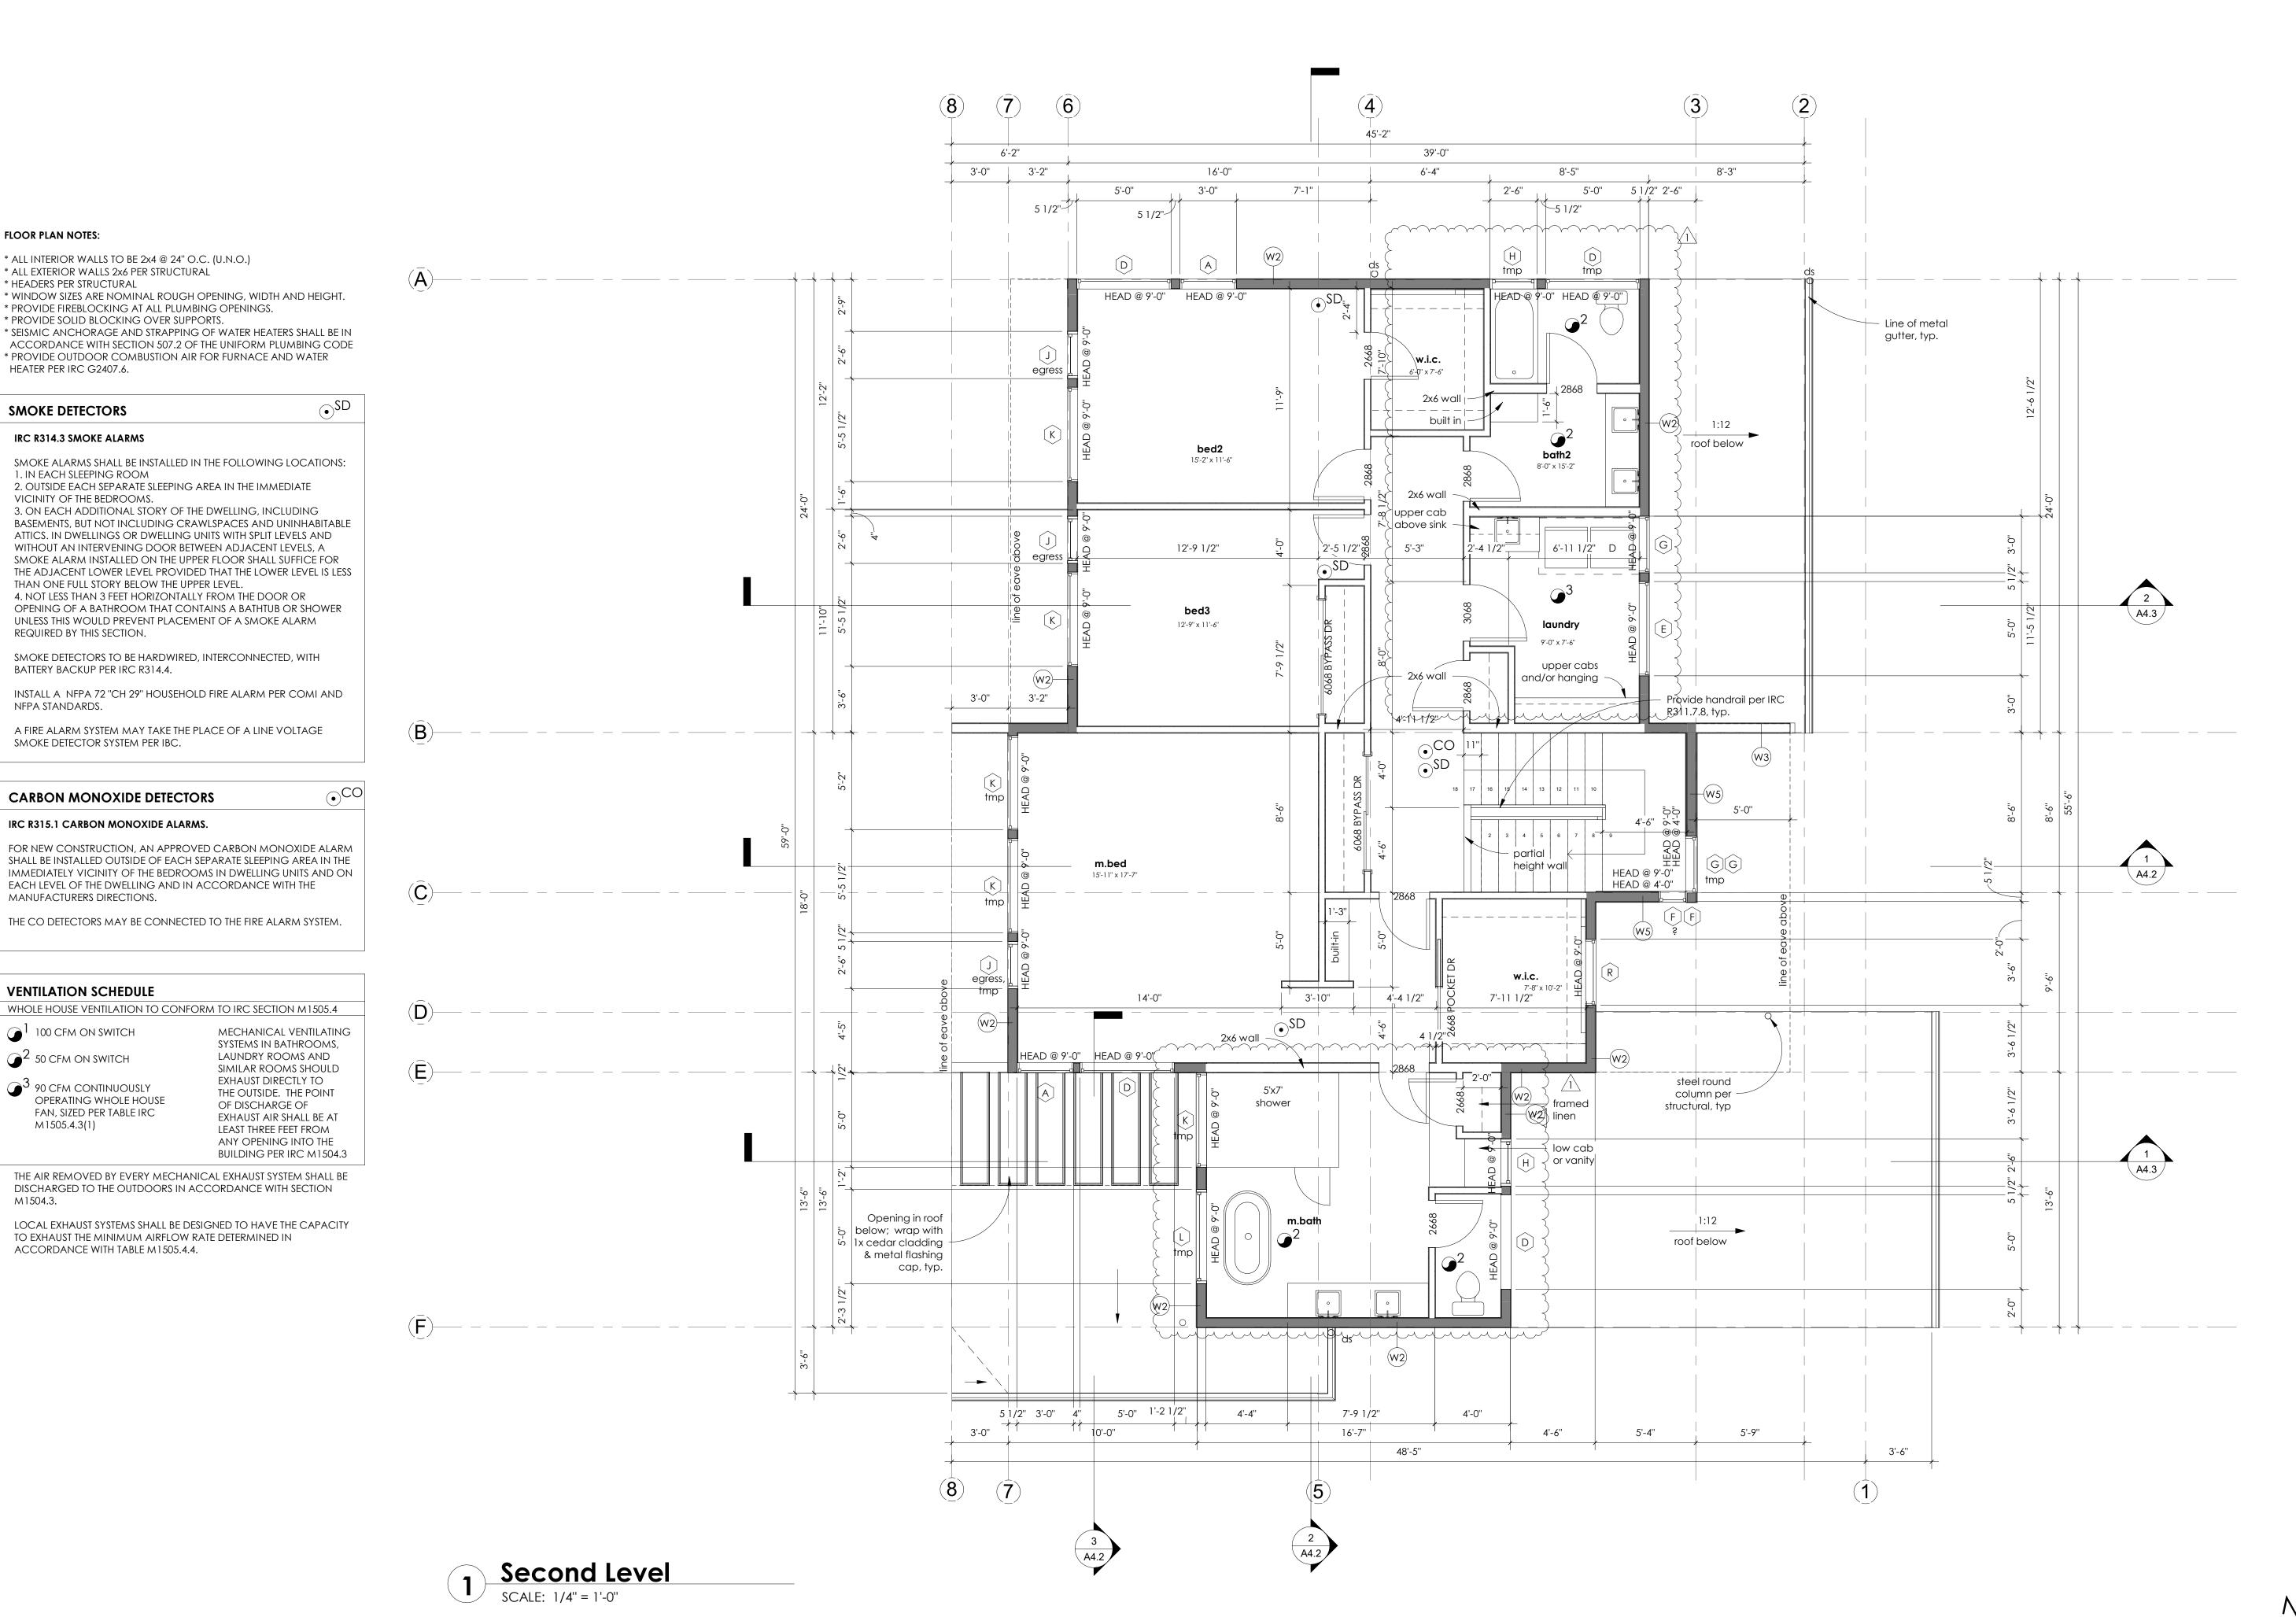

JULIAN WEBER ARCHITECTS, LTD 1257 S King St Seattle, WA 98144 203.953.1305

www.jwaseattle.com

COOMBES DEVELOPMENT

4701 SW ADMIRAL WAY, SUITE 385 SEATTLE, WA 98116 P 206.420.7672

PI SE and

MUP#

2207-110 BP # Δ Date Description 06.02.2022 BP Submittal 08.07.2023 PPR 1

FLOOR PLANS

1/4" = 1'-0" 06/01/2023

A2.3

Project Number JWA#611

* NOT CEILING HEIGHT GREATER THAN 10 FT. PLEASE REFERENCE SECTIONS A4.2-3.

FLOOR PLAN NOTES:

* HEADERS PER STRUCTURAL

HEATER PER IRC G2407.6.

SMOKE DETECTORS

IRC R314.3 SMOKE ALARMS

1. IN EACH SLEEPING ROOM

VICINITY OF THE BEDROOMS.

REQUIRED BY THIS SECTION.

NFPA STANDARDS.

BATTERY BACKUP PER IRC R314.4.

SMOKE DETECTOR SYSTEM PER IBC.

CARBON MONOXIDE DETECTORS

IRC R315.1 CARBON MONOXIDE ALARMS.

MANUFACTURERS DIRECTIONS.

VENTILATION SCHEDULE

100 CFM ON SWITCH

 2 50 CFM ON SWITCH

M1505.4.3(1)

M1504.3.

 \odot^3 90 CFM CONTINUOUSLY

OPERATING WHOLE HOUSE

ACCORDANCE WITH TABLE M 1505.4.4.

FAN, SIZED PER TABLE IRC

* ALL INTERIOR WALLS TO BE 2x4 @ 24" O.C. (U.N.O.)

* PROVIDE FIREBLOCKING AT ALL PLUMBING OPENINGS.

* PROVIDE OUTDOOR COMBUSTION AIR FOR FURNACE AND WATER

2. OUTSIDE EACH SEPARATE SLEEPING AREA IN THE IMMEDIATE

3. ON EACH ADDITIONAL STORY OF THE DWELLING, INCLUDING

WITHOUT AN INTERVENING DOOR BETWEEN ADJACENT LEVELS, A

4. NOT LESS THAN 3 FEET HORIZONTALLY FROM THE DOOR OR

UNLESS THIS WOULD PREVENT PLACEMENT OF A SMOKE ALARM

SMOKE DETECTORS TO BE HARDWIRED, INTERCONNECTED, WITH

A FIRE ALARM SYSTEM MAY TAKE THE PLACE OF A LINE VOLTAGE

EACH LEVEL OF THE DWELLING AND IN ACCORDANCE WITH THE

TO EXHAUST THE MINIMUM AIRFLOW RATE DETERMINED IN

LAUNDRY ROOMS AND

EXHAUST DIRECTLY TO


LEAST THREE FEET FROM

OF DISCHARGE OF

THAN ONE FULL STORY BELOW THE UPPER LEVEL.

* ALL EXTERIOR WALLS 2x6 PER STRUCTURAL

* PROVIDE SOLID BLOCKING OVER SUPPORTS.

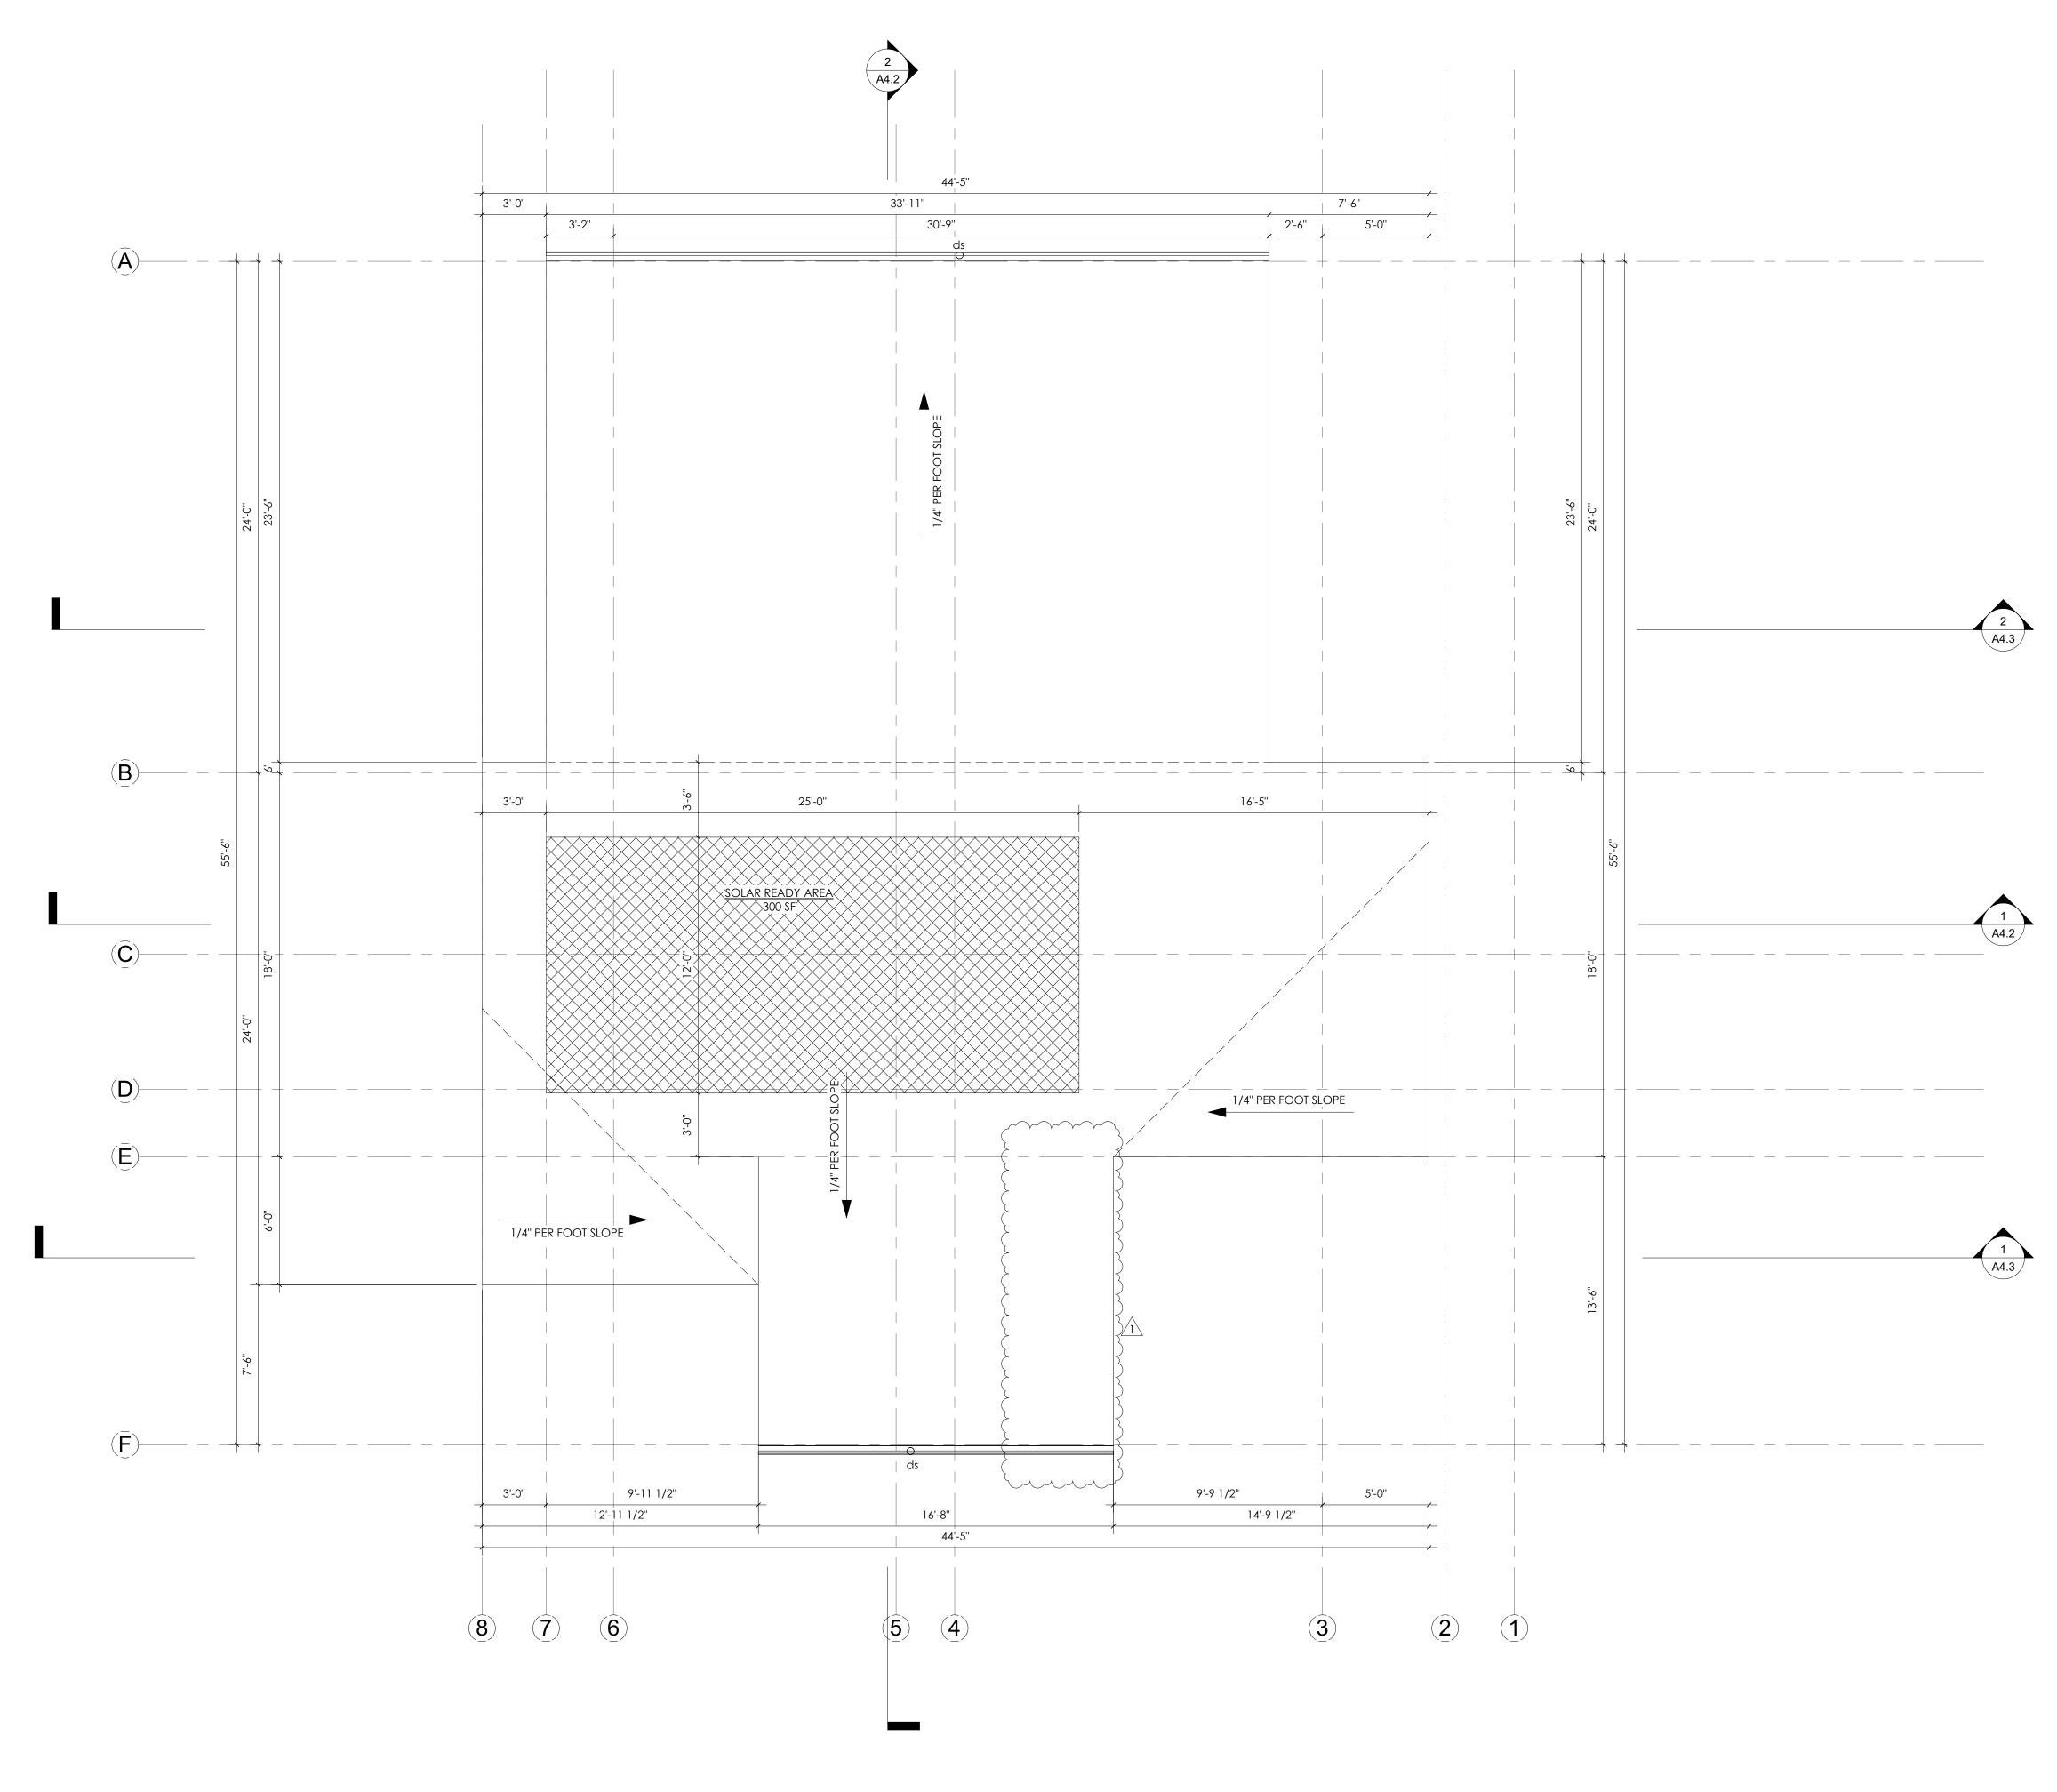

JULIAN WEBER ARCHITECTS, LTD

1257 S King St Seattle, WA 98144 203.953.1305 www.jwaseattle.com

9458 REGISTERED ARCHITECT

JULIAN R. WEBER
STATE OF WASHINGTON

4701 SW ADMIRAL WAY, SUITE 385 SEATTLE, WA 98116 P 206.420.7672

Mercer Island

MUP# n

BP # 2207-110

Δ Date Description

06.02.2022 BP Submittal

1 08.07.2023 PPR 1

06.02.2022 BP Submittal
08.07.2023 PPR 1

FLOOR PLANS

cale 1/4" = 1'-0"
rate 06/01/2023

A2.4

Project Number JWA#611

SOLAR-READY PROVISIONS

IRC T101: SOLAR-READY PROVISIONS

T101.1 NEW ONE AND TWO FAMILY DWELLINGS SHALL BE PROVIDED WITH A SOLAR-READY ZONE OF NOT LESS THAN 300 SQUARE FEET FOR EACH DWELLING UNIT. TOWNHOUSES SHALL BE PROVIDED WITH A SOLAR-READY ZONE OF NOT LESS THAN 150 SQUARE FEET FOR EACH DWELLING UNIT.

EXCEPTION: THE FOLLOWING DO NOT REQUIRE SOLAR-READY

ONES:

1. ONE AND TWO FAMILY DWELLING UNITS WITH LESS THAN 600
SF OF QUALIFYING ROOF AREA CONFORMING TO THE
REQUIREMENTS OF SECTION T101.1.1.

2. INDIVIDUAL UNITS WITHIN TOWNHOUSE BUILDINGS THAT HAVE LESS THAN 300 SQUARE FEET OF QUALIFYING ROOF AREA PER UNIT CONFORMING TO THE REQUIREMENTS OF SECTION T101.1.1.

3. BUILDINGS WITH PERMANENTLY INSTALLED ON-SITE RENEWABLE ENERGY SYSTEMS.

T101.1.1 QUALIFYING ROOF AREA INCLUDES ALL ROOF AREAS OTHER THAN THE FOLLOWING:

OTHER THAN THE FOLLOWING:

1.ROOF AREAS ORIENTED WITHINH 45 DEGREES OF TRUE NORTH


AND HAVING SLOPES GREATER THAN 2:12

2. ROOF AREAS SHADED BY EXISTING LANDFORMS, STRUCTURES OR TREES FOR MORE THAN 70 PERCENT OF THE DAYLIGHT HOURS ANNUALLY.

3. ROOF AREAS CONSISTING OF SKYLIGHTS, OCCUPIED DECKS, OR PLANTED AREAS
4. ACCESS OR SET-BACK AREAS REQUIRED BY THIS CODE OR

4. ACCESS OR SET-BACK AREAS REQUIRED BY THIS CODE OR THE APPLICABLE PROVISIONS OF THE IFC.

T103.1.1. SOLAR-READY ZONE AREA. NO SOLAR-READY ZONE MAY BE COMPRISED OF ONE SINGLE AREA OR OF MULTIPLE AREAS. NO SOLAR READY ZONE SHALL BE LESS THAN 5 FEET IN ANY DIMENSION NOR LESS THAN 80 SF OF CONTIGUOUS AREA

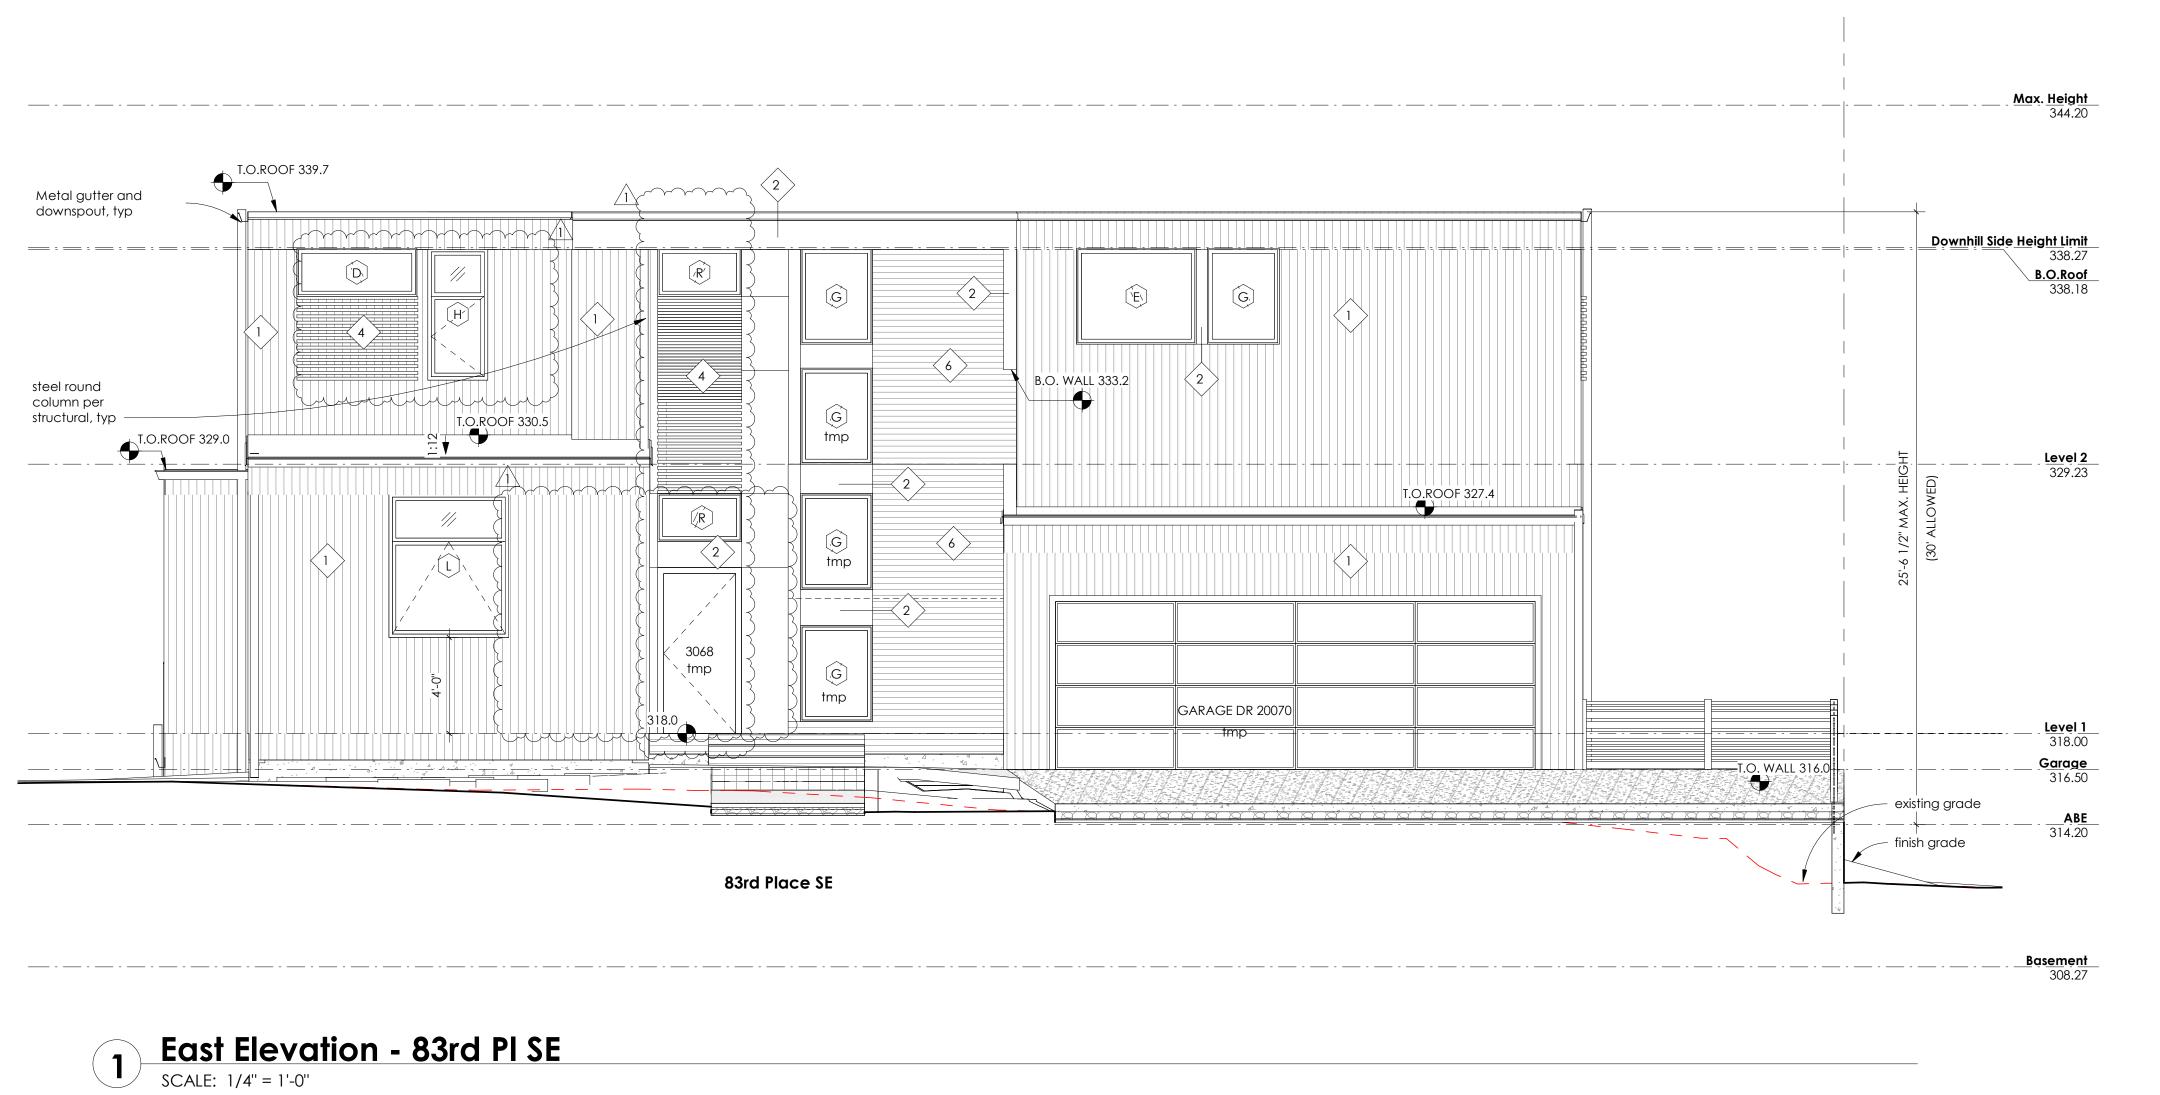



MATERIAL KEY

- 1. VERTICAL LAP SIDING 4" REVEAL PAINTED BLACK
- 2. 4X8 HARDIE PANEL PAINTED BLACK
- 3. VENEER STONE
- 4. OPEN JOINT TIMBER BOARDING RAINSCREEN
- 5. 8X4 HARDIE PANEL PAINTED WHITE
- 6. CEDAR T&G



JULIAN WEBER ARCHITECTS, LTD

1257 S King St Seattle, WA 98144 203.953.1305

www.jwaseattle.com

9458 REGISTERED
ARCHITECT

JULIAN R. WEBER
STATE OF WASHINGTON

COOMBES DEVELOPMENT

4701 SW ADMIRAL WAY, SUITE 385 SEATTLE, WA 98116 P 206.420.7672

Coombes Residence

6221 83rd PI SE Mercer Island

MUP # na
BP # 2207-110

Δ Date Description
06.02.2022 BP Submittal

ELEVATIONS

08.07.2023 PPR 1

Scale 1/4" = 1'-0"


Date 06/01/2023

A3.1

Project Number JWA#611

West Elevation

SCALE: 1/4" = 1'-0"

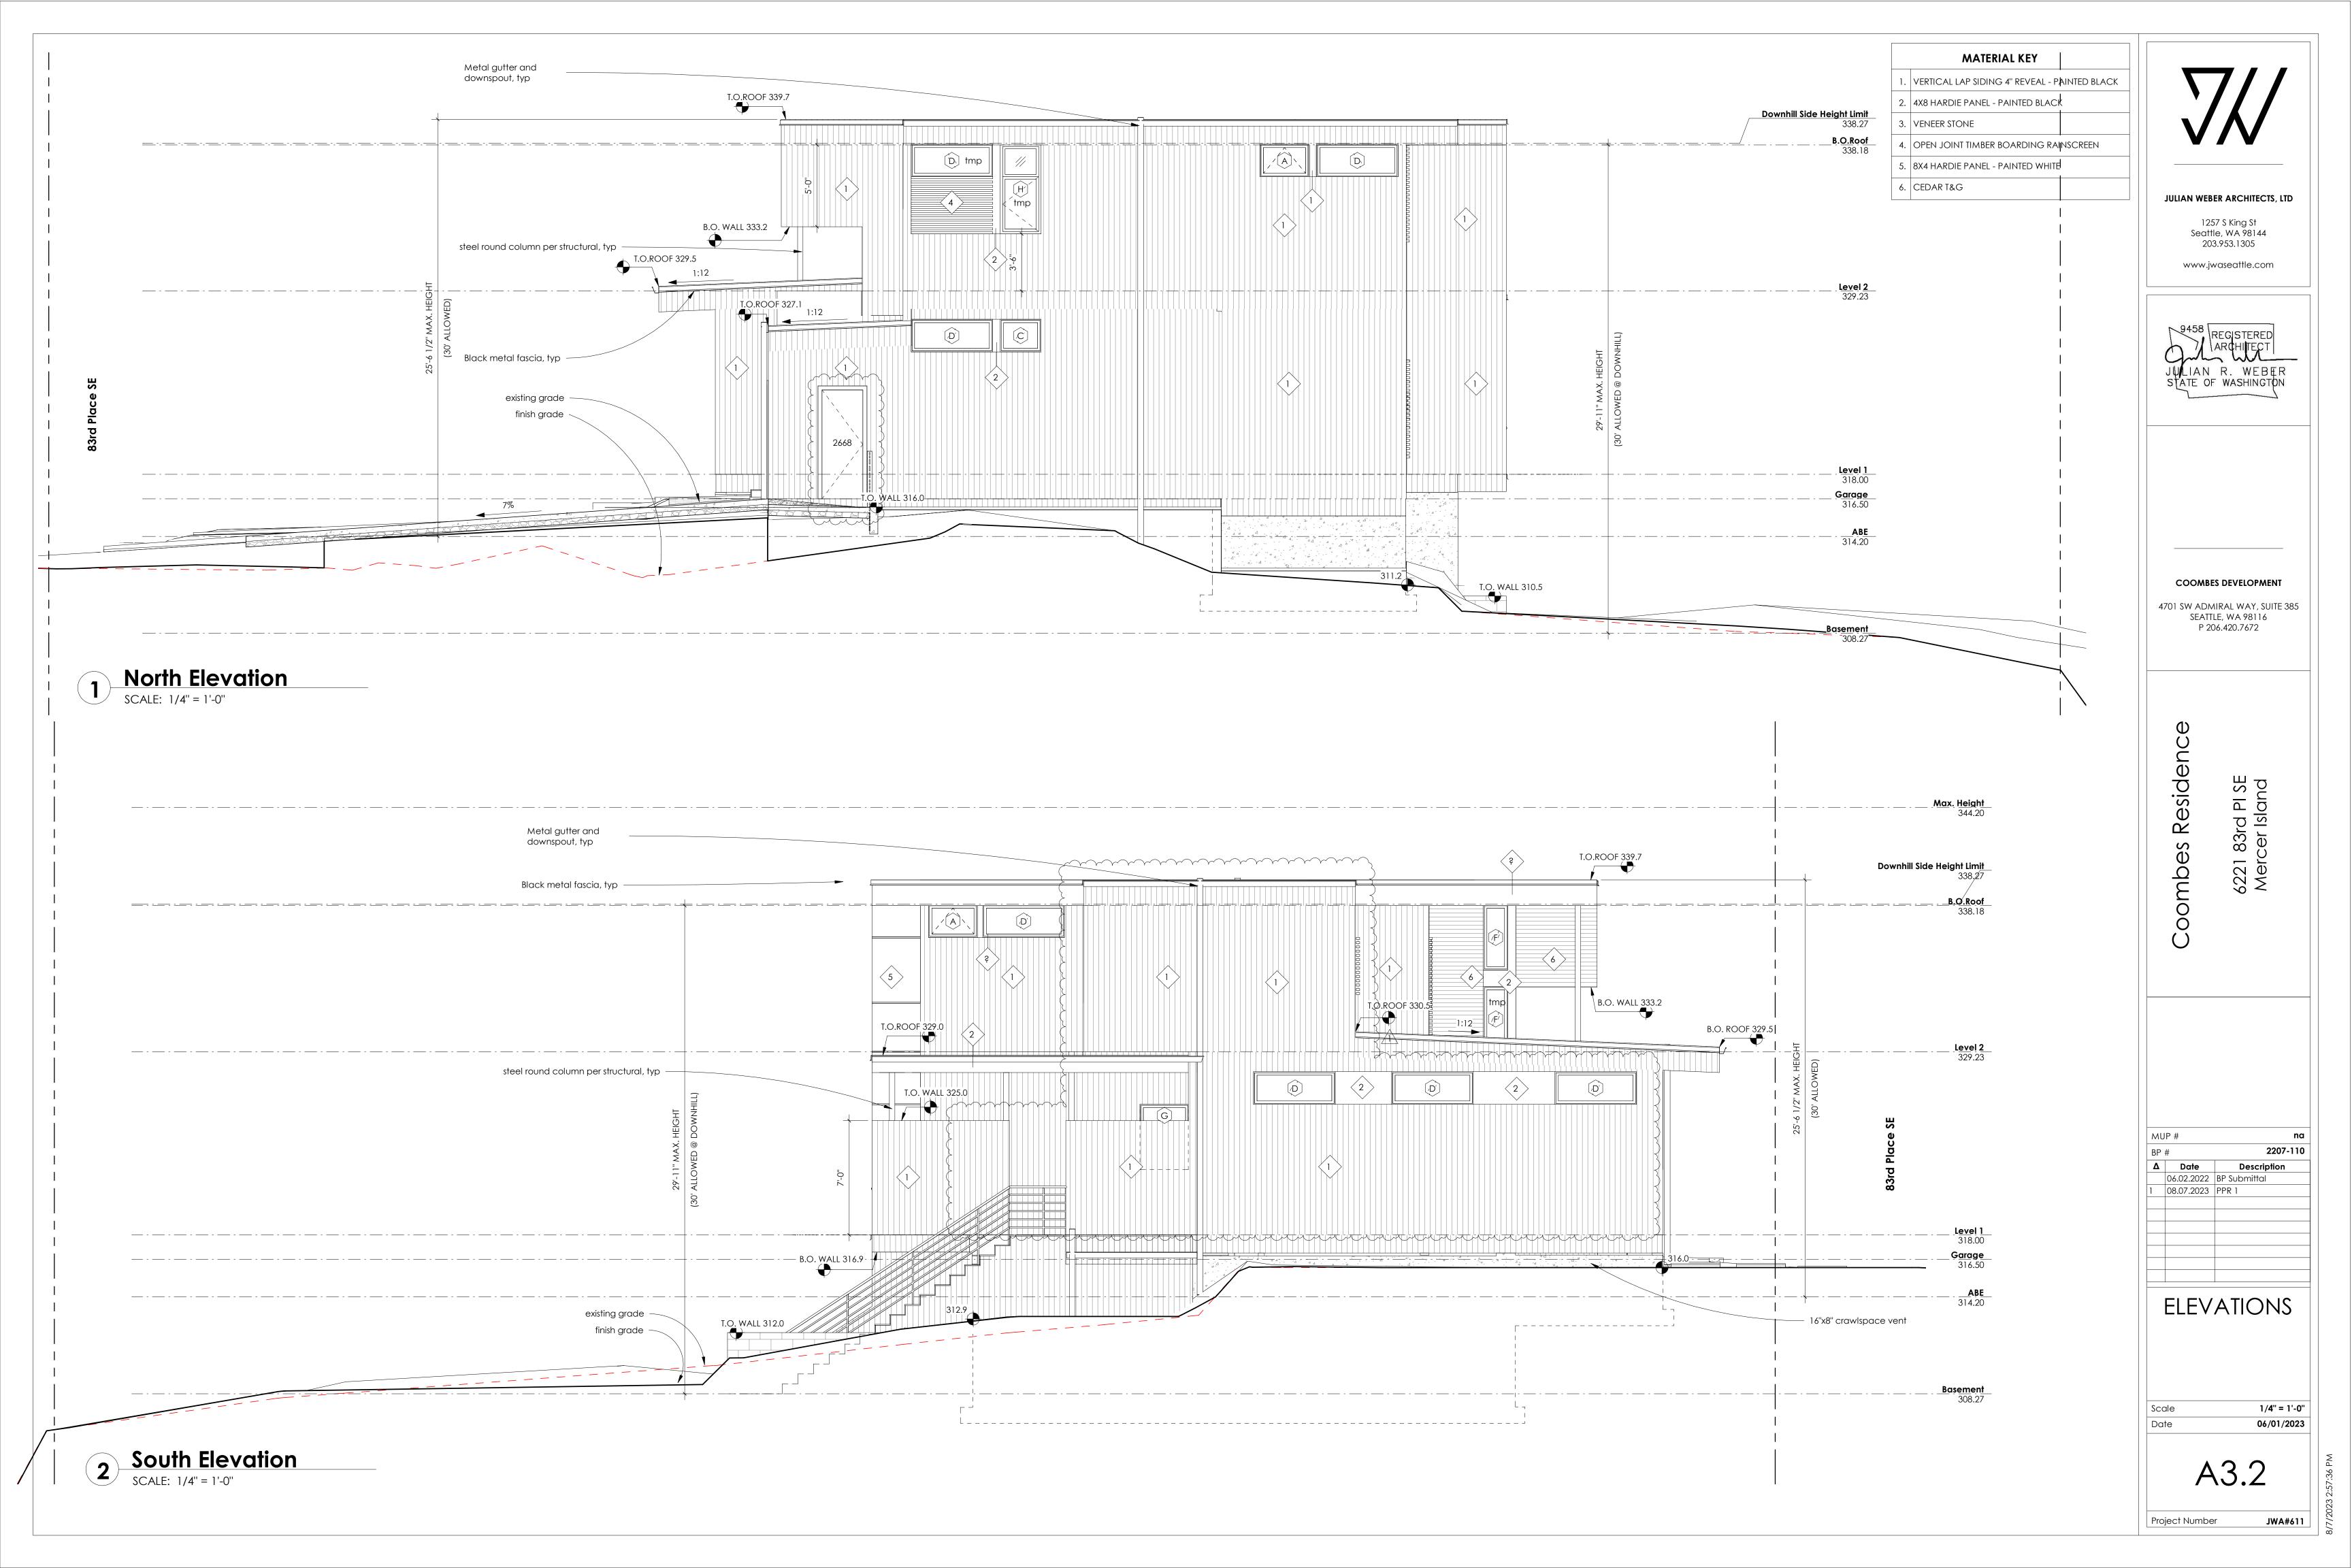

2018 WASHINGTON STATE ENERGY CODE (WSEC) NOTES

USE SYSTEM TYPE 2 FROM TABLE 406.2, AND USE OPTIONS (1.3, 3.5, 4.2, 5.5) FROM TABLE 406.3 FOR A TOTAL OF 6.0 CREDITS.

SYSTEM TYPE 2: (1.0 CREDITS) Heat pump

SELECTED OPTION 1.3: (0.5 CREDITS)

Prescriptive compliance is based on Table R402.1.1 with the following modifications: Vertical fenestration U = 0.28

Floor, R-38

Slab-on-grade, R-10 perimeter and under entire slab Below-grade slab, R-10 perimeter and under entire slab

SELECTED OPTION 3.5: (1.5 CREDITS)

Air-source, centrally ducted heat pump with minimum HSPF of 11.0.

SELECSELECTED OPTION 4.2: (1.0 CREDIT)

HVAC equipment and associated duct system(s) installation shall comply with the requirements of Section R403.3.7.

Electric resistance heat and ductless heat pumps are not permitted under this option.

SELECTED OPTION 5.5: (2.0 CREDITS)

Water heating system shall include one of the following: **Electric heat pump water** heater meeting the standards of Tier III of NEEA's advanced water heating specification.

A PERMANENT CERTIFICATE SHALL BE COMPLETED BY THE BUILDER OR OTHER APPROVED PARTY AND POSTED ON A WALL IN THE SPACE WHERE THE FURNANCE IS LOCATED, A UTILITY ROOM, OR AN APPROVED LOCATION INSIDE THE BUILDING. A SAMPLE CERTIFICATE IS AVAILABLE AT:

http://www.energy.wsu.edu/Documents/Compliance%20Certificate%202018% 20WESC.pdf


EACH DWELLING UNIT IS REQUIRED TO BE PROVIDED WITH AT LEAST ONE PROGRAMMABLE THERMOSTAT FOR THE REGULATION OF TEMPERATURE PER WSEC 403.1.1


DUCTS, AIR HANDLERS, AND FILTER BOXES SHALL BE SEALED. DUCT LEAKAGE SHALL BE LEAK TESTED IN ACCORDANCE WITH WSU RS-33 PER WSEC 403.2.2.

MECHANICAL SYSTEM PIPING CABLE OF CARRYING FLUIDS ABOVE 100 DEGREES FAHRENHEIT OR BELOW 55 DEGREES FAHRENHEIT SHALL BE INSULATED TO A MINIMUM OF R-6 PER WSEC R403.3.

A MINIMUM OF 90 PERCENT OF PERMANENTLY INSTALLED LAMPS IN LIGHTING FIXTURES SHALL BE HIGH-EFFICACY PER WSEC R404.1.

ALL NEW FENESTRATION TO BE NFRC CERTIFIED.

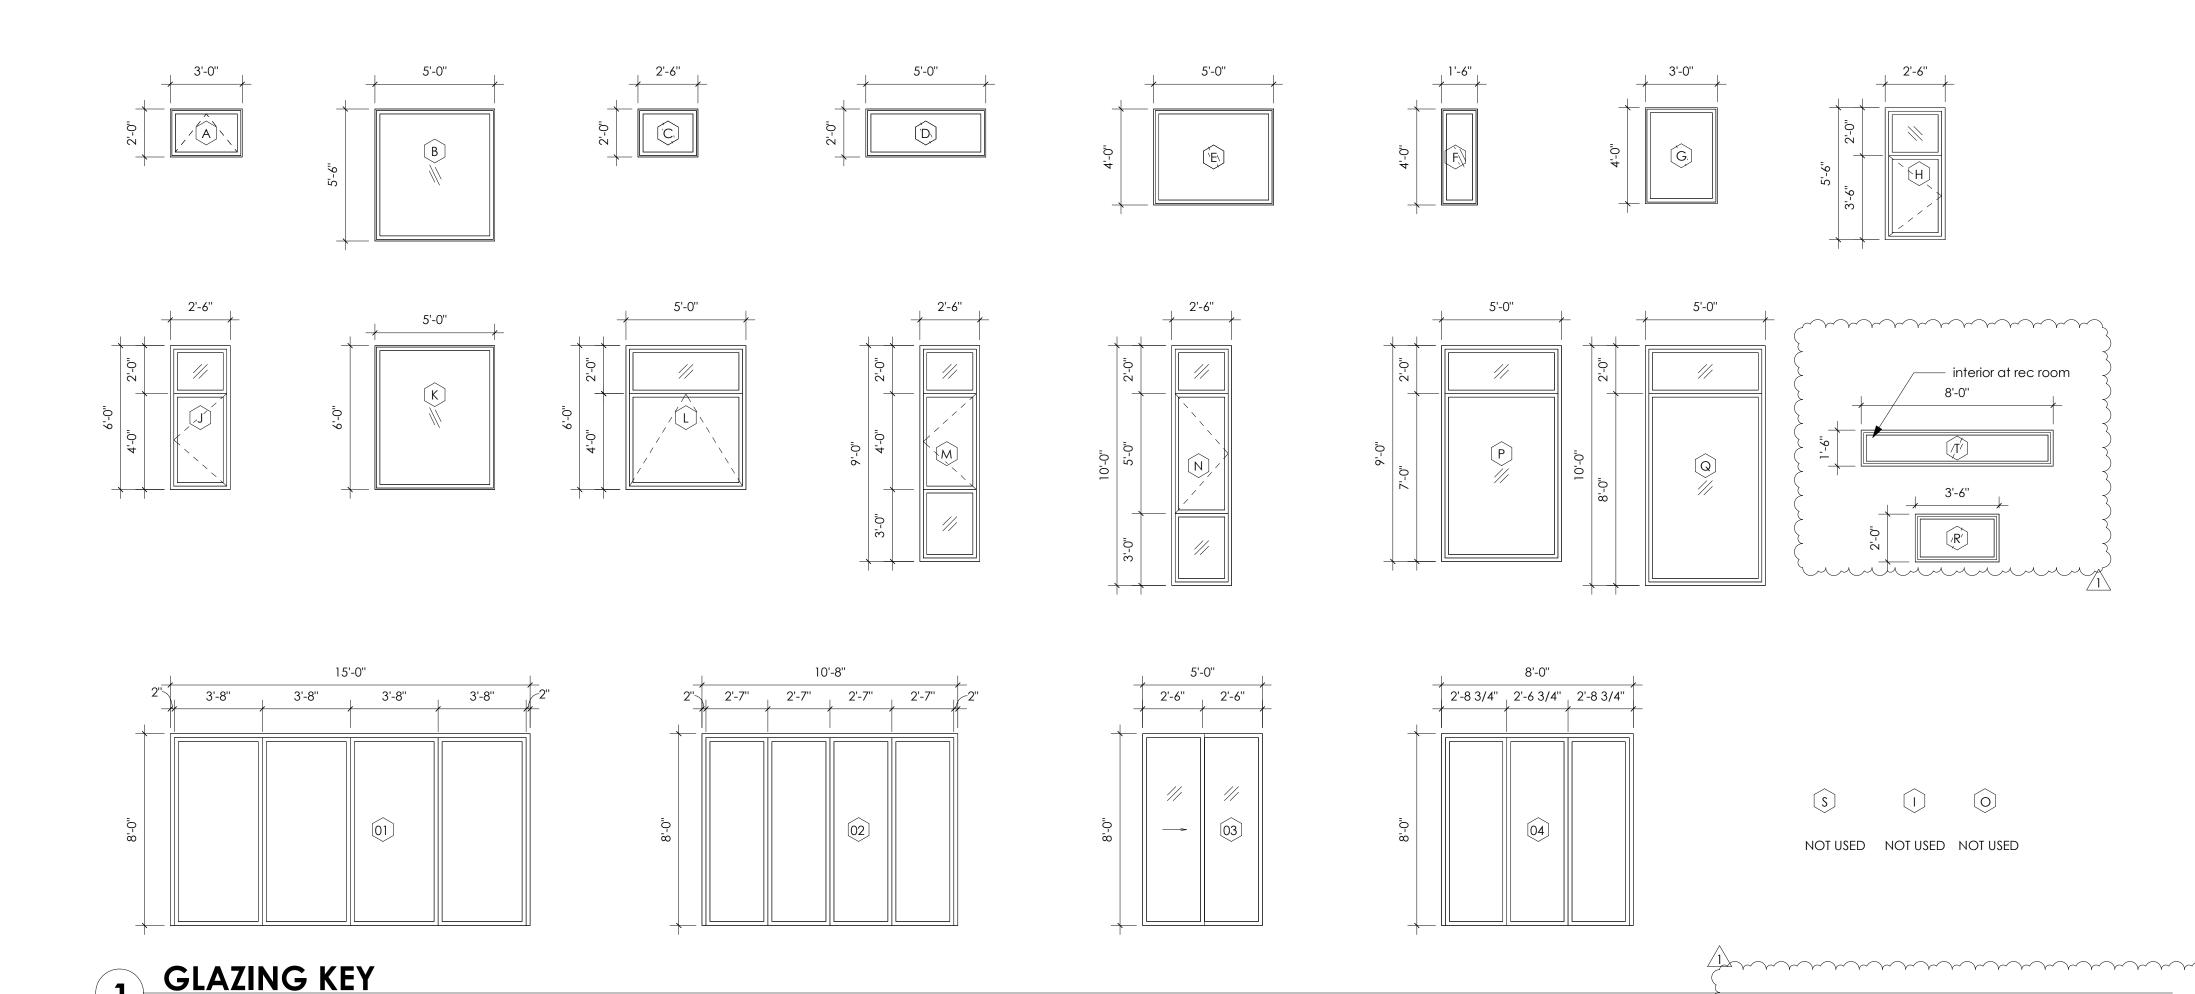

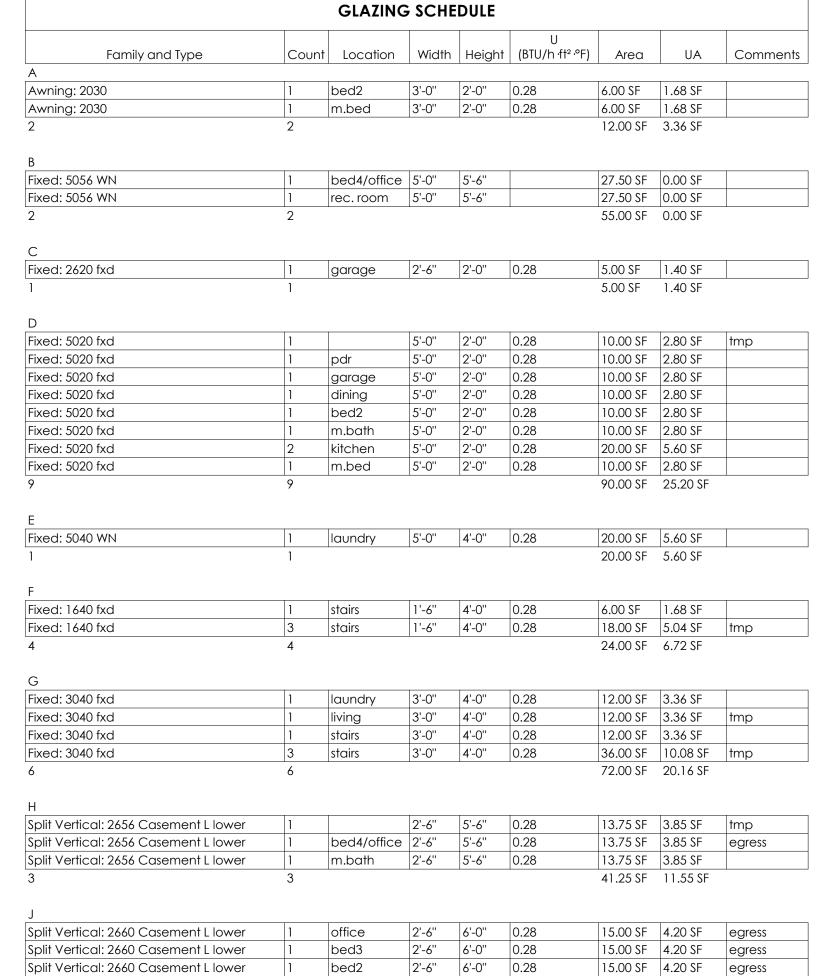

m.bed

office

2'-6" | 6'-0" | 0.28

5'-0" 6'-0"

5'-0" 6'-0"

Split Vertical: 2660 Casement L lower

Fixed: 5060 WN


Fixed: 5060 WN


15.00 SF | 4.20 SF | egress, tmp

60.00 SF 16.80 SF

30.00 SF 0.00 SF

30.00 SF 0.00 SF tmp

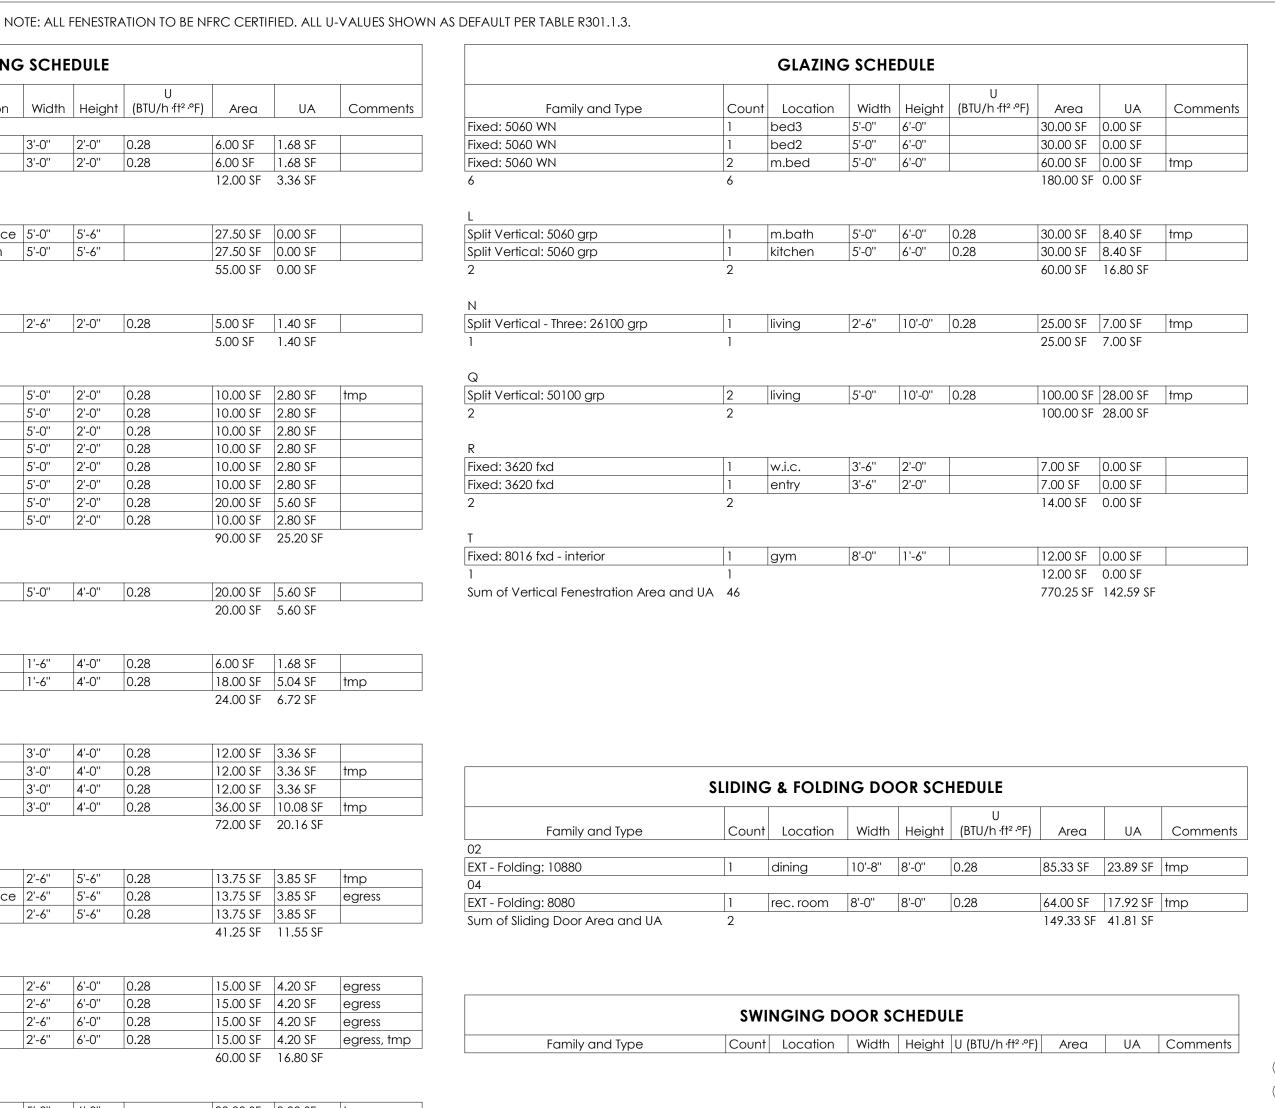

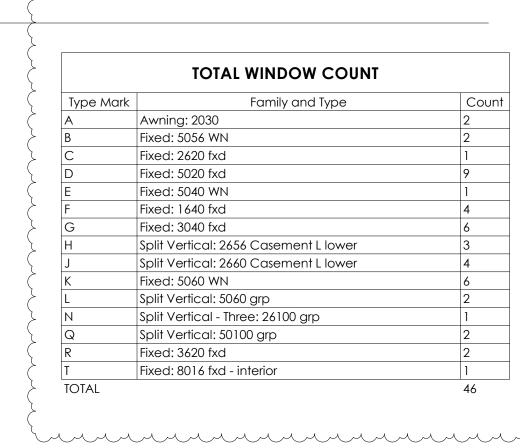

~~~~~~~~~~~~<del>~~</del>

TOTAL SUM OF FENESTRATION AREA AND UA: 963.08 SF 217.30



JULIAN WEBER ARCHITECTS, LTD

Seattle, WA 98144

203.953.1305

www.jwaseattle.com


STATE OF WASHINGTON

MUP# 2207-110 Δ Date Description 06.02.2022 BP Submittal 08.07.2023 PPR 1

> GLAZING SCHEDULE & **WSEC NOTES**


1/4" = 1'-0" Scale 06/01/2023 Date


Project Number JWA#611

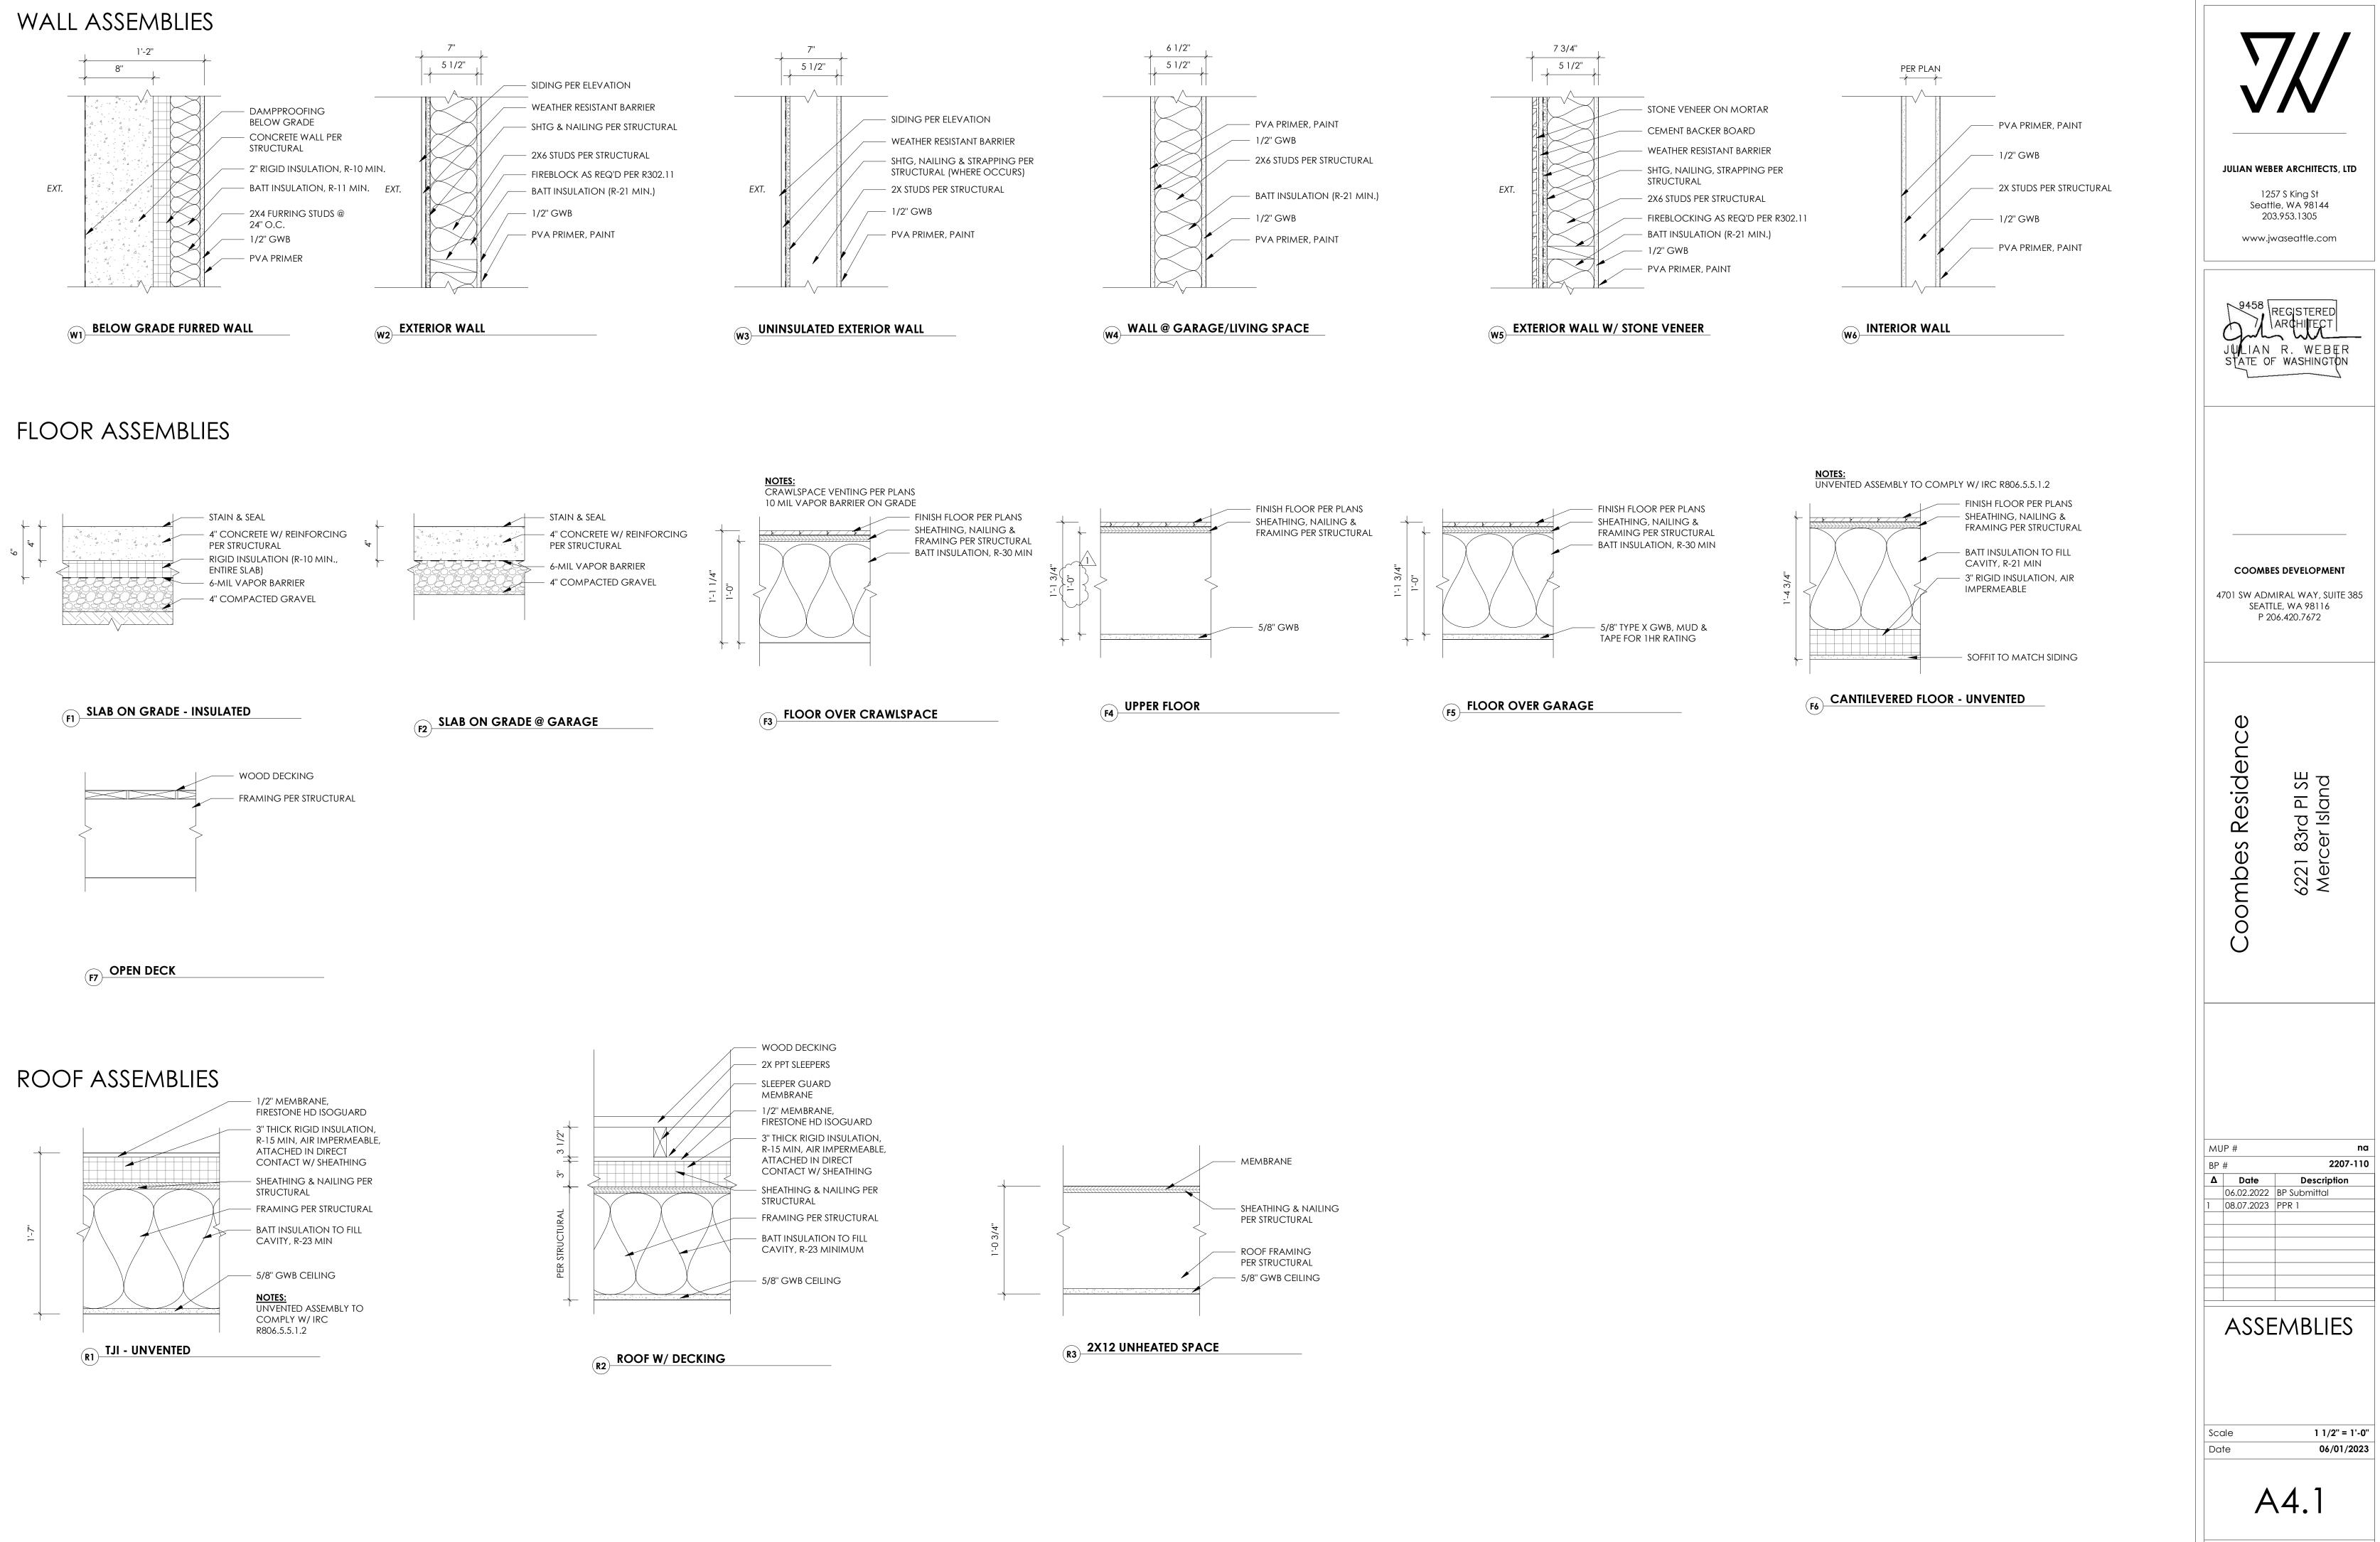

Project Number


JWA#611

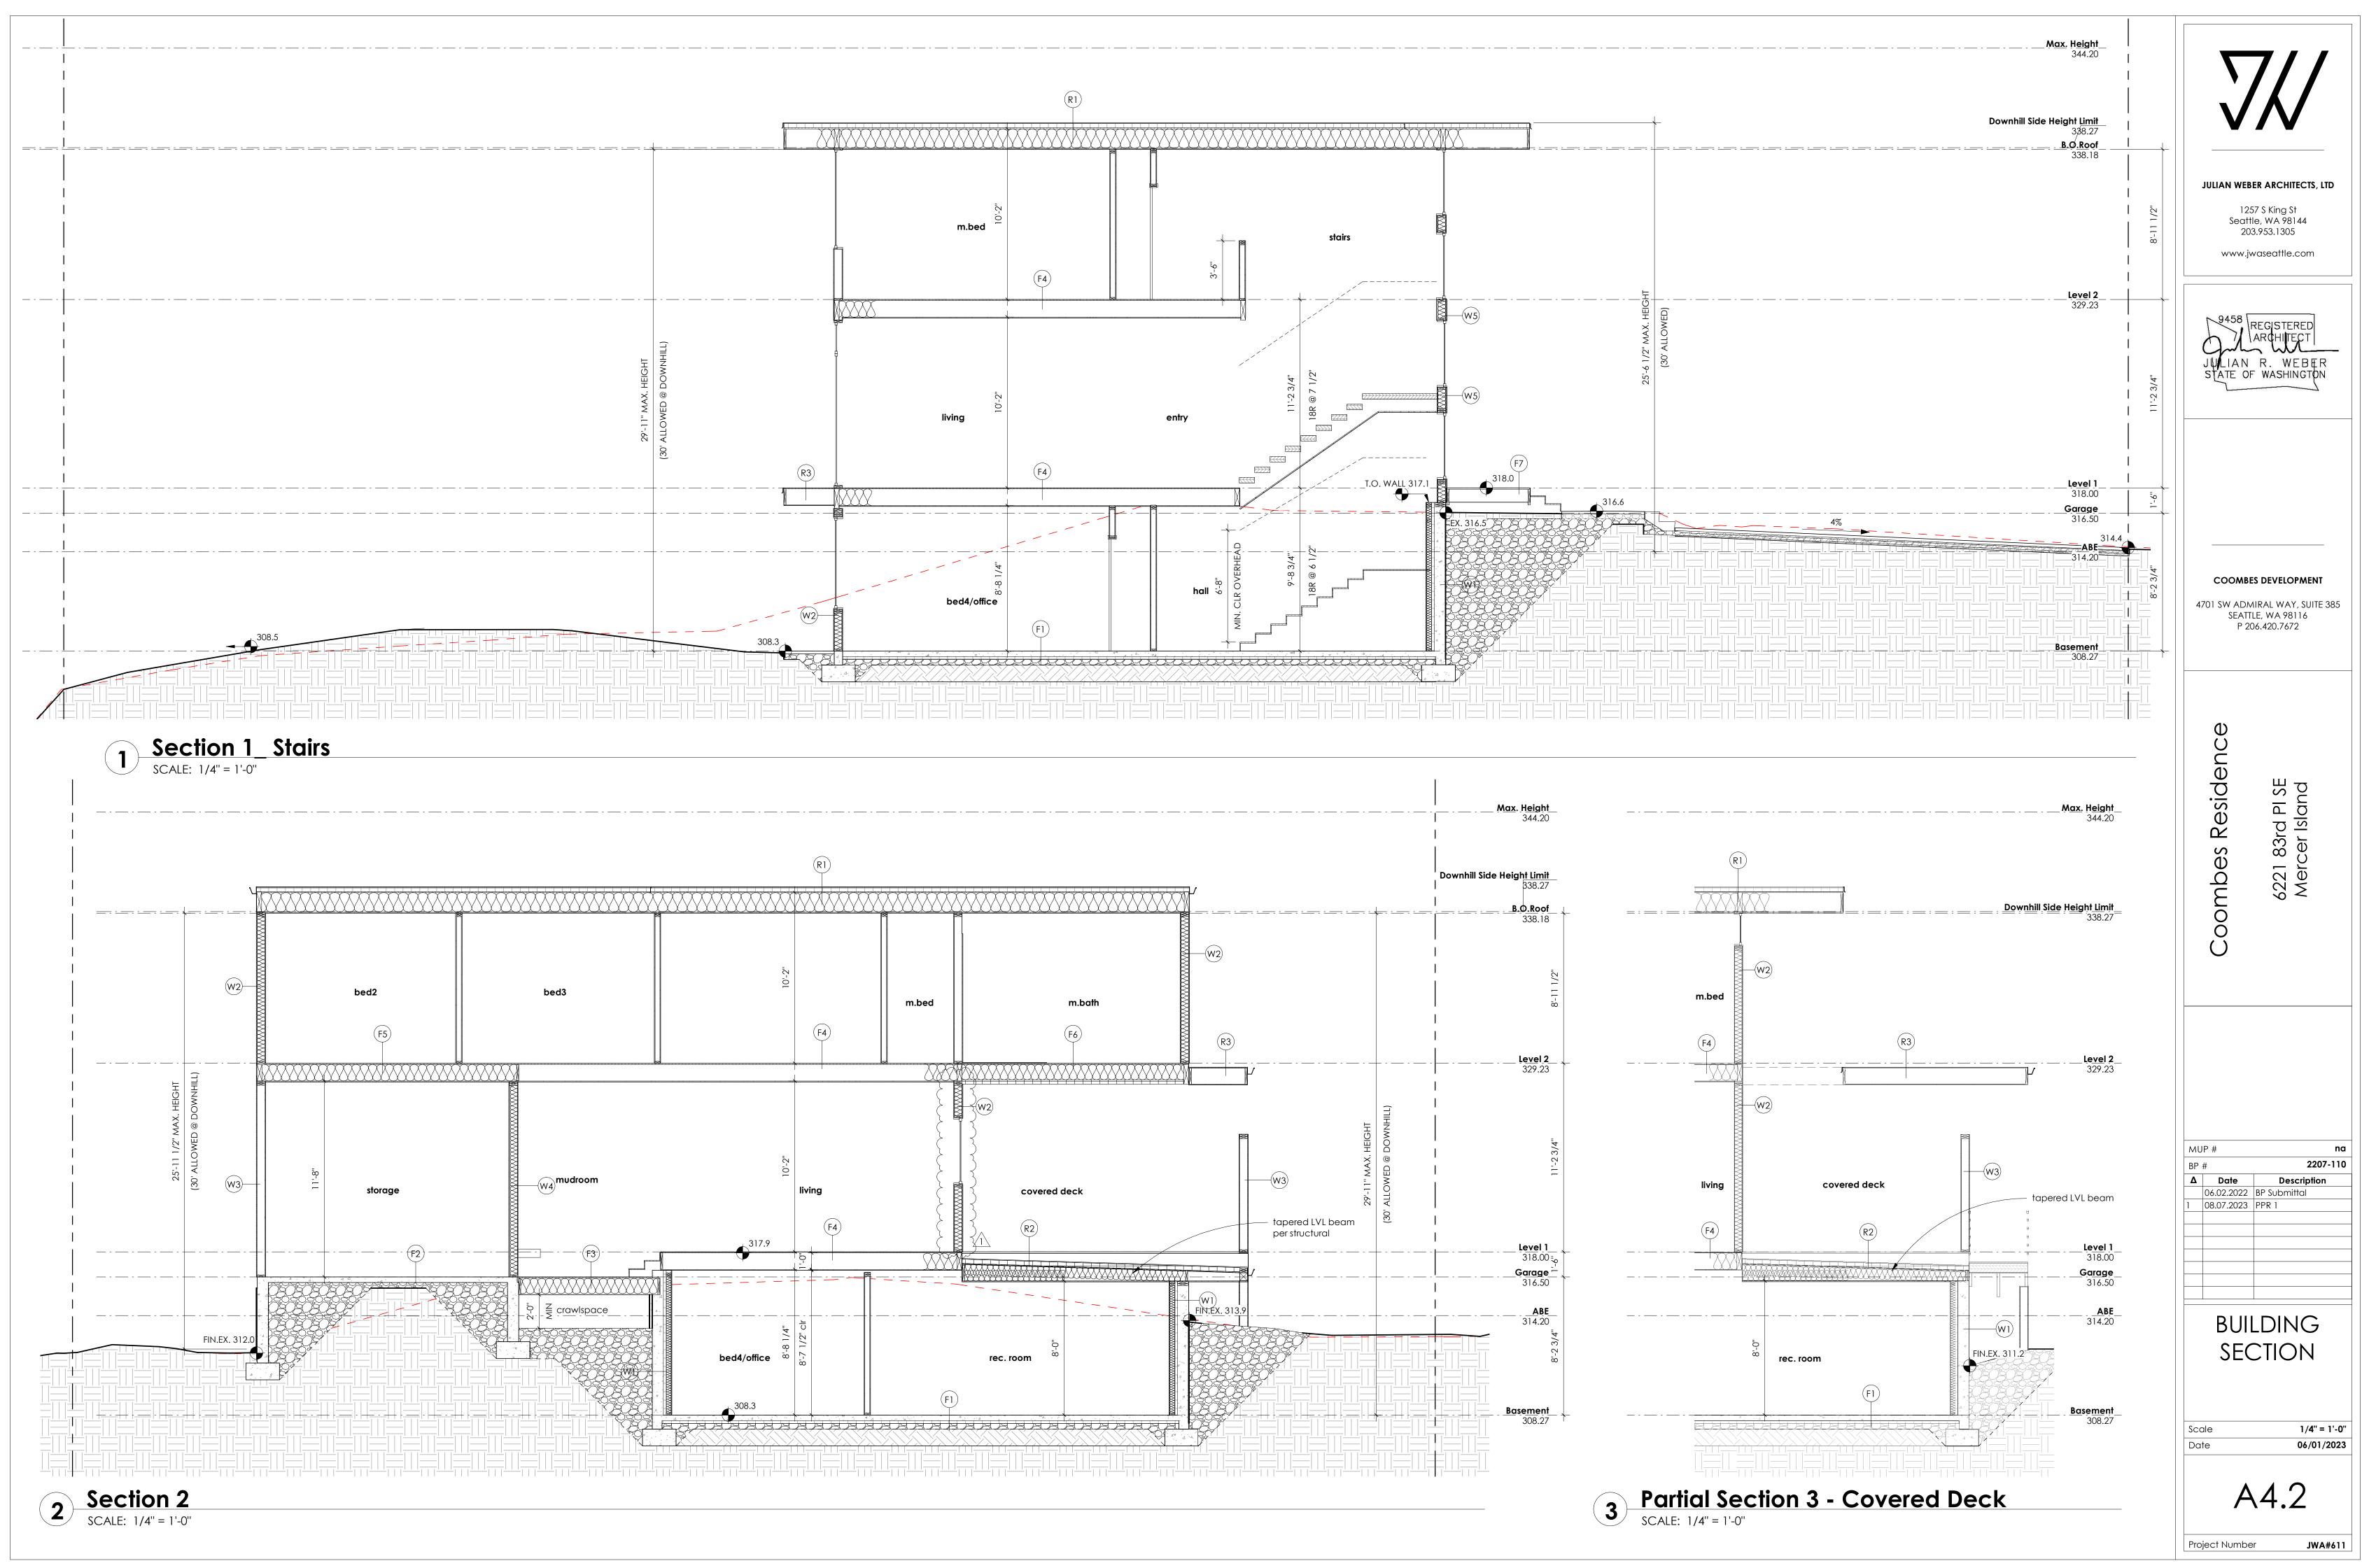

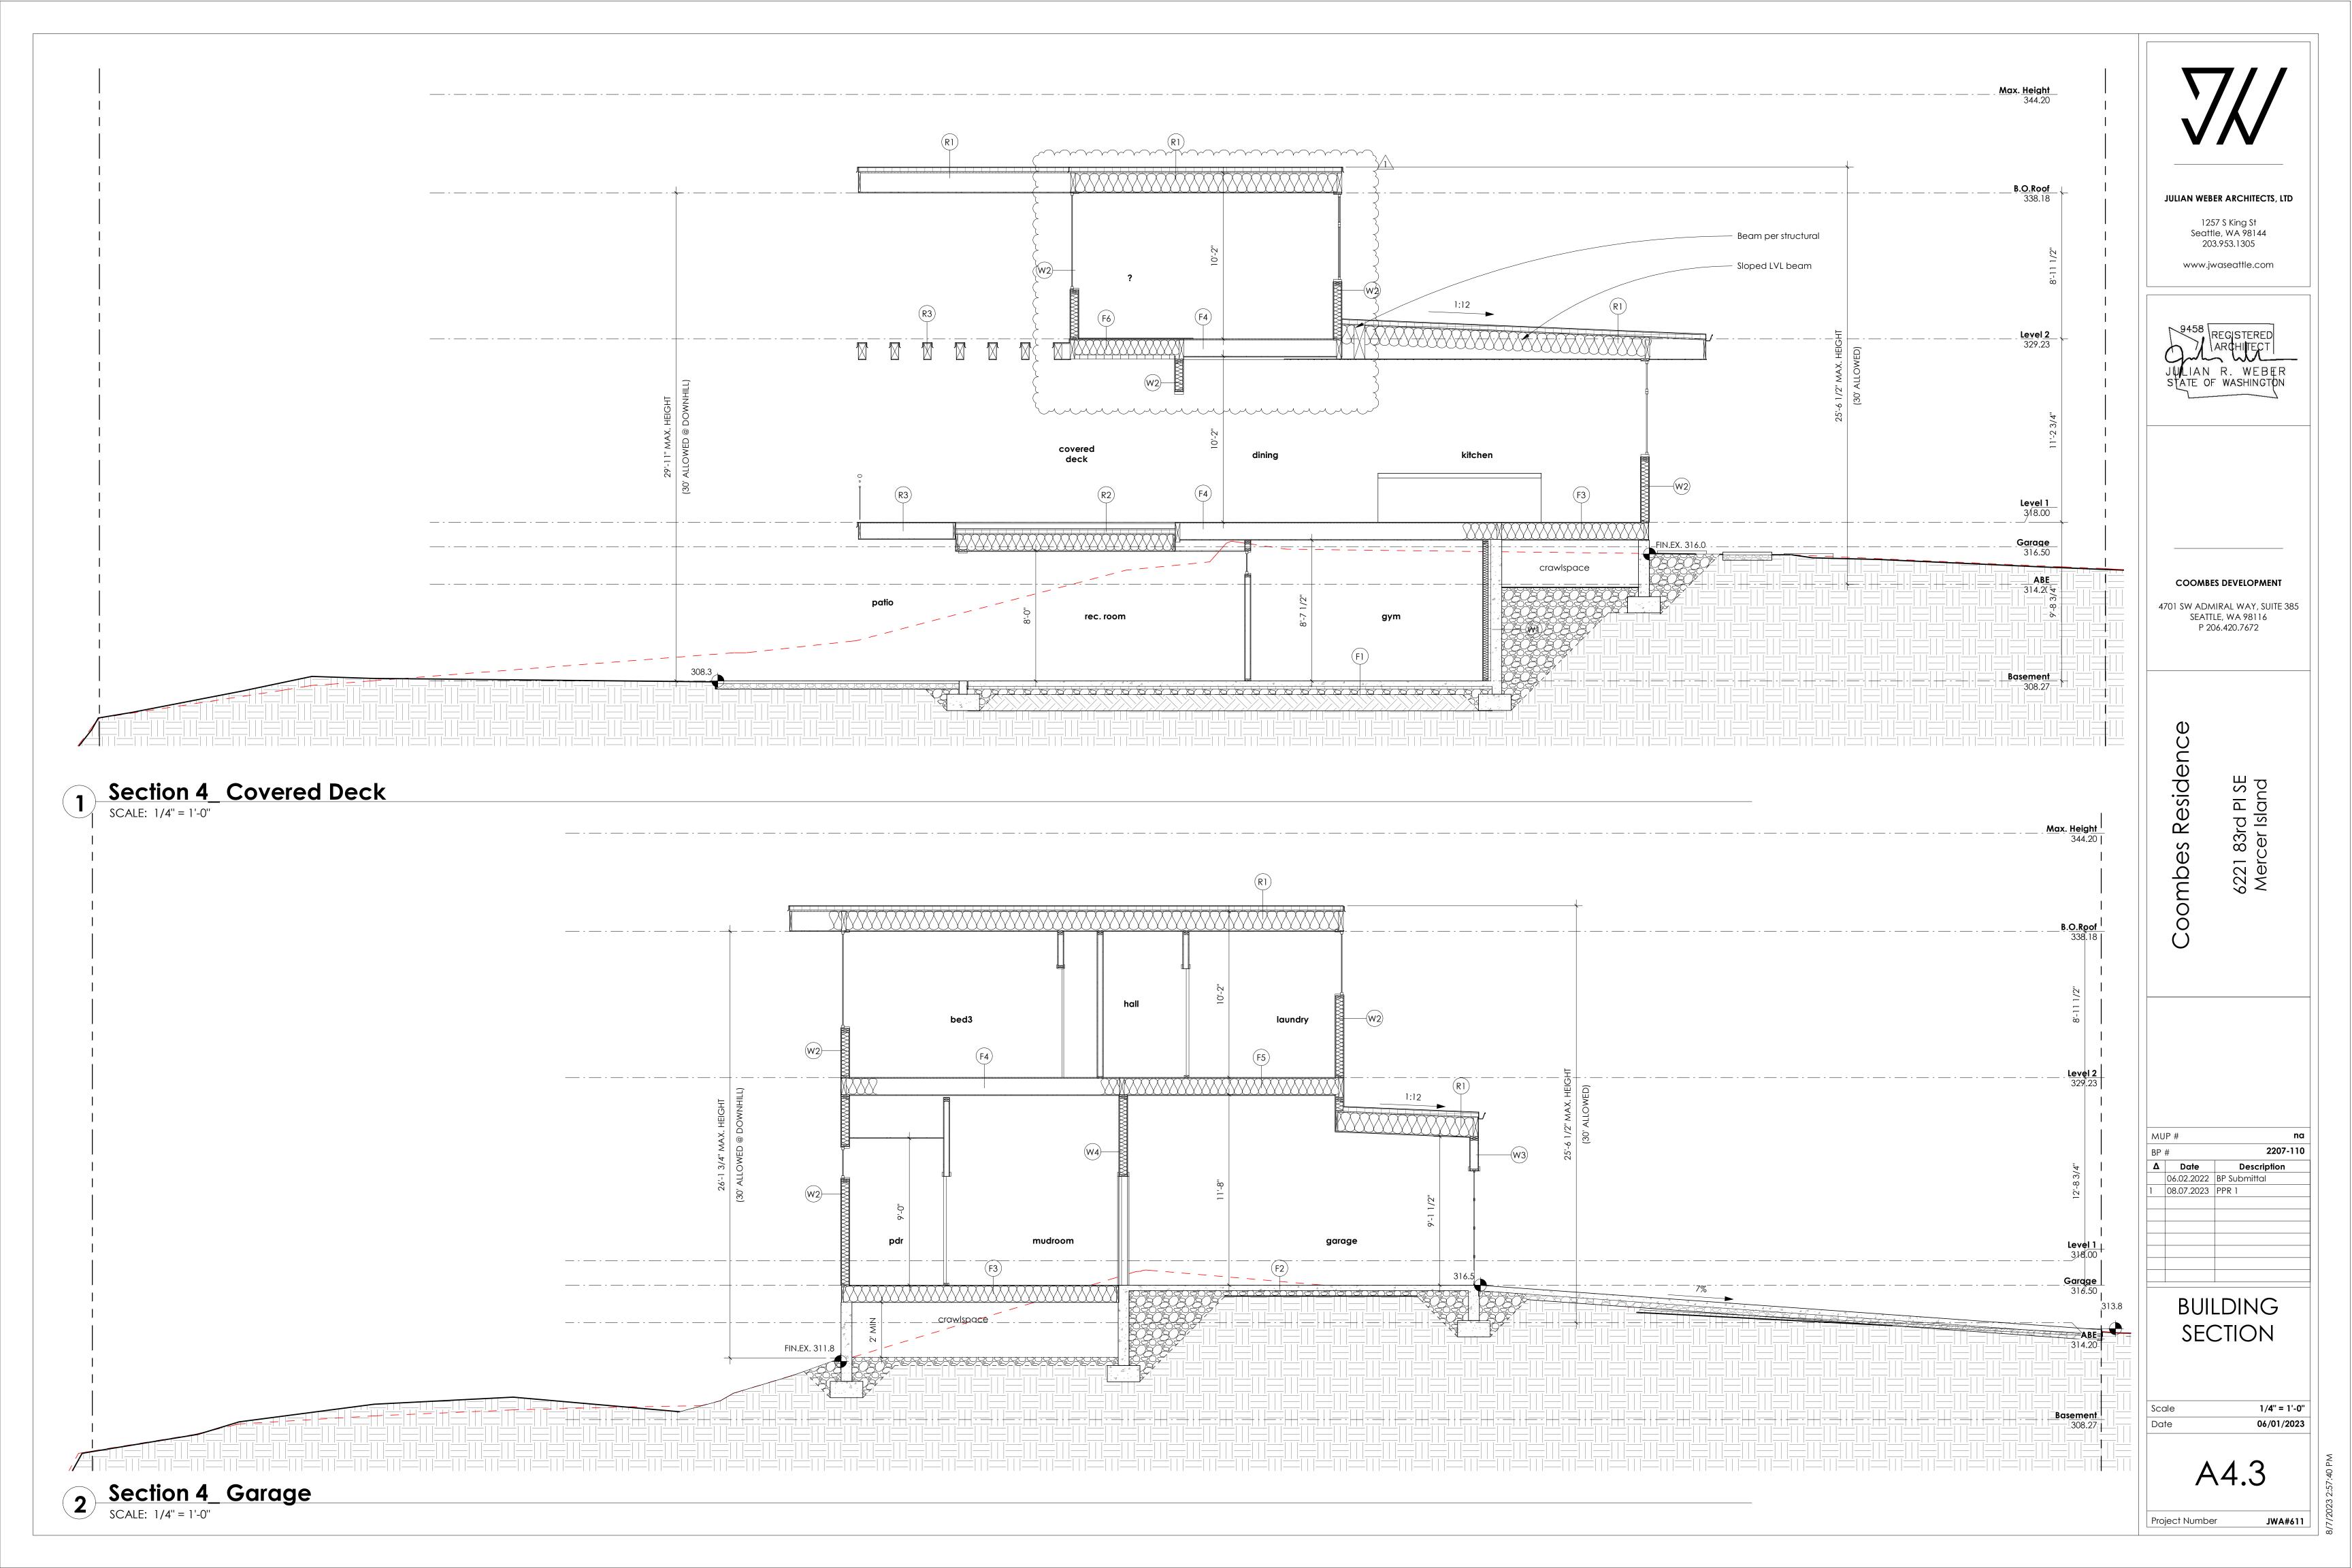

PLAN NOTES

DRAWINGS PROVIDED BY THE ARCHITECT AND SHOULD BE VERIFIED.

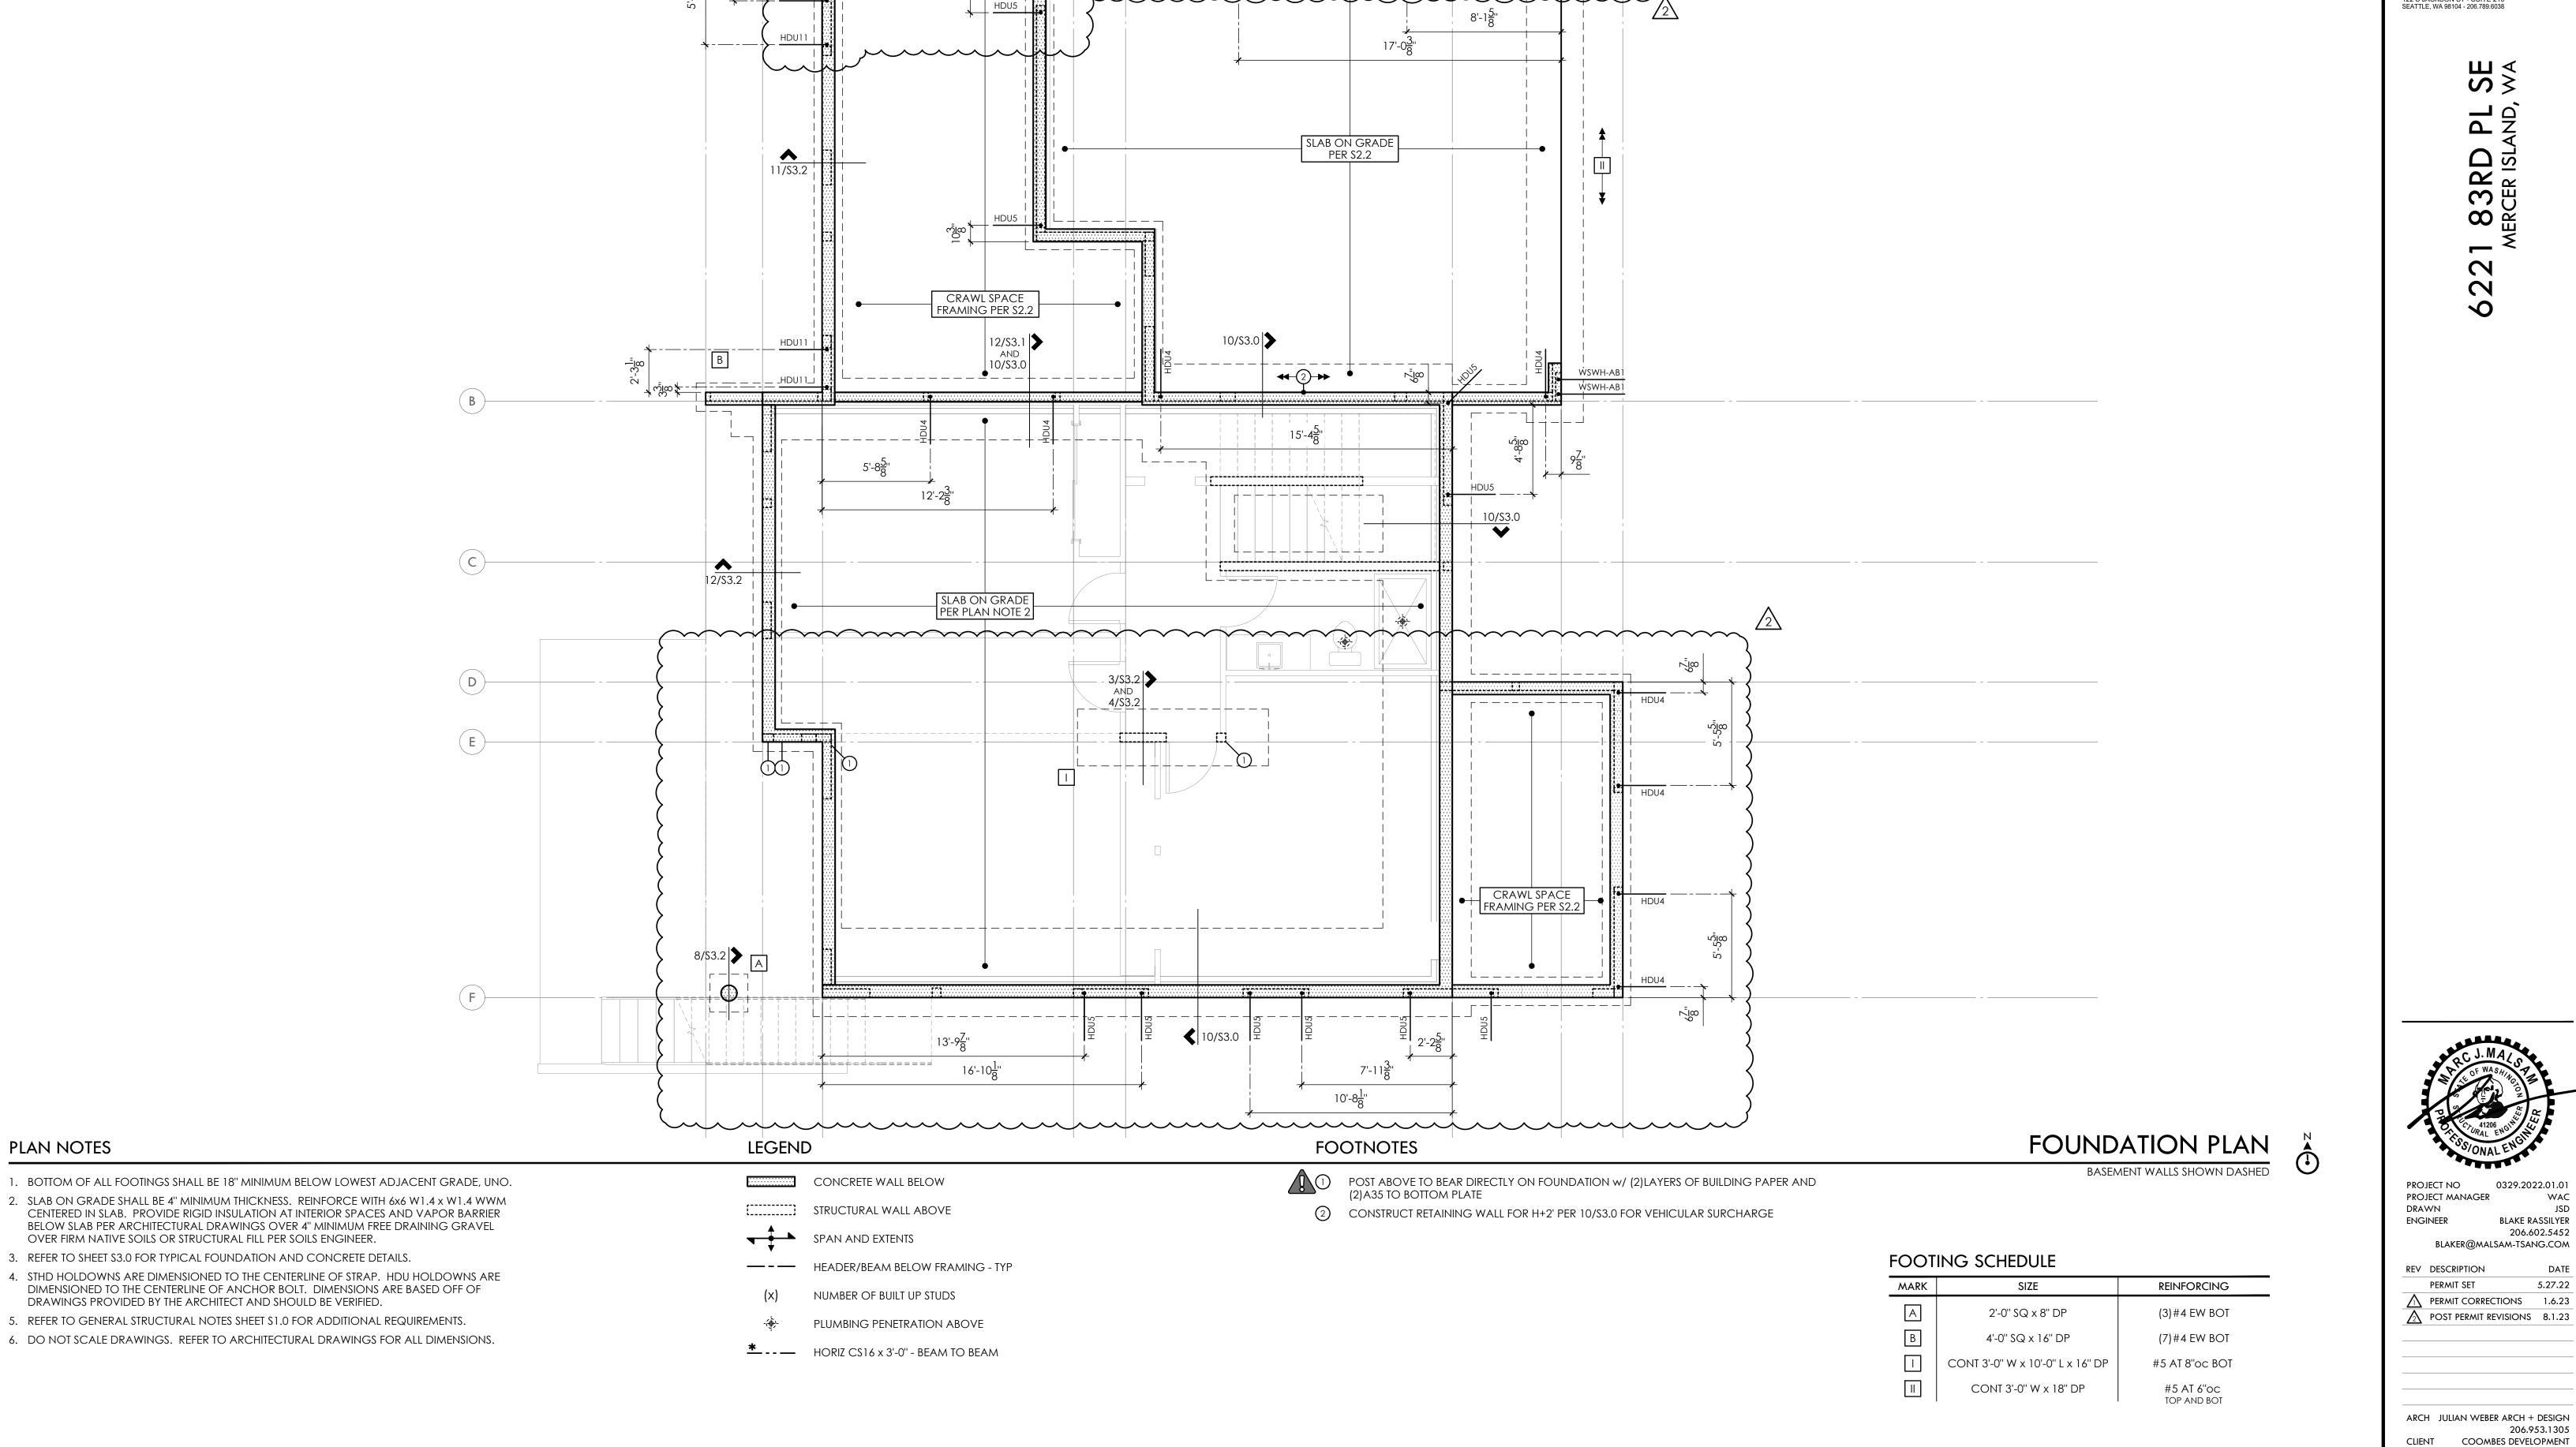



SCALE - 1/4" = 1'-0"

FOUNDATION PLAN


BLAKE RASSILYER

BLAKER@MALSAM-TSANG.COM

206.602.5452

206.953.1305

5.27.22

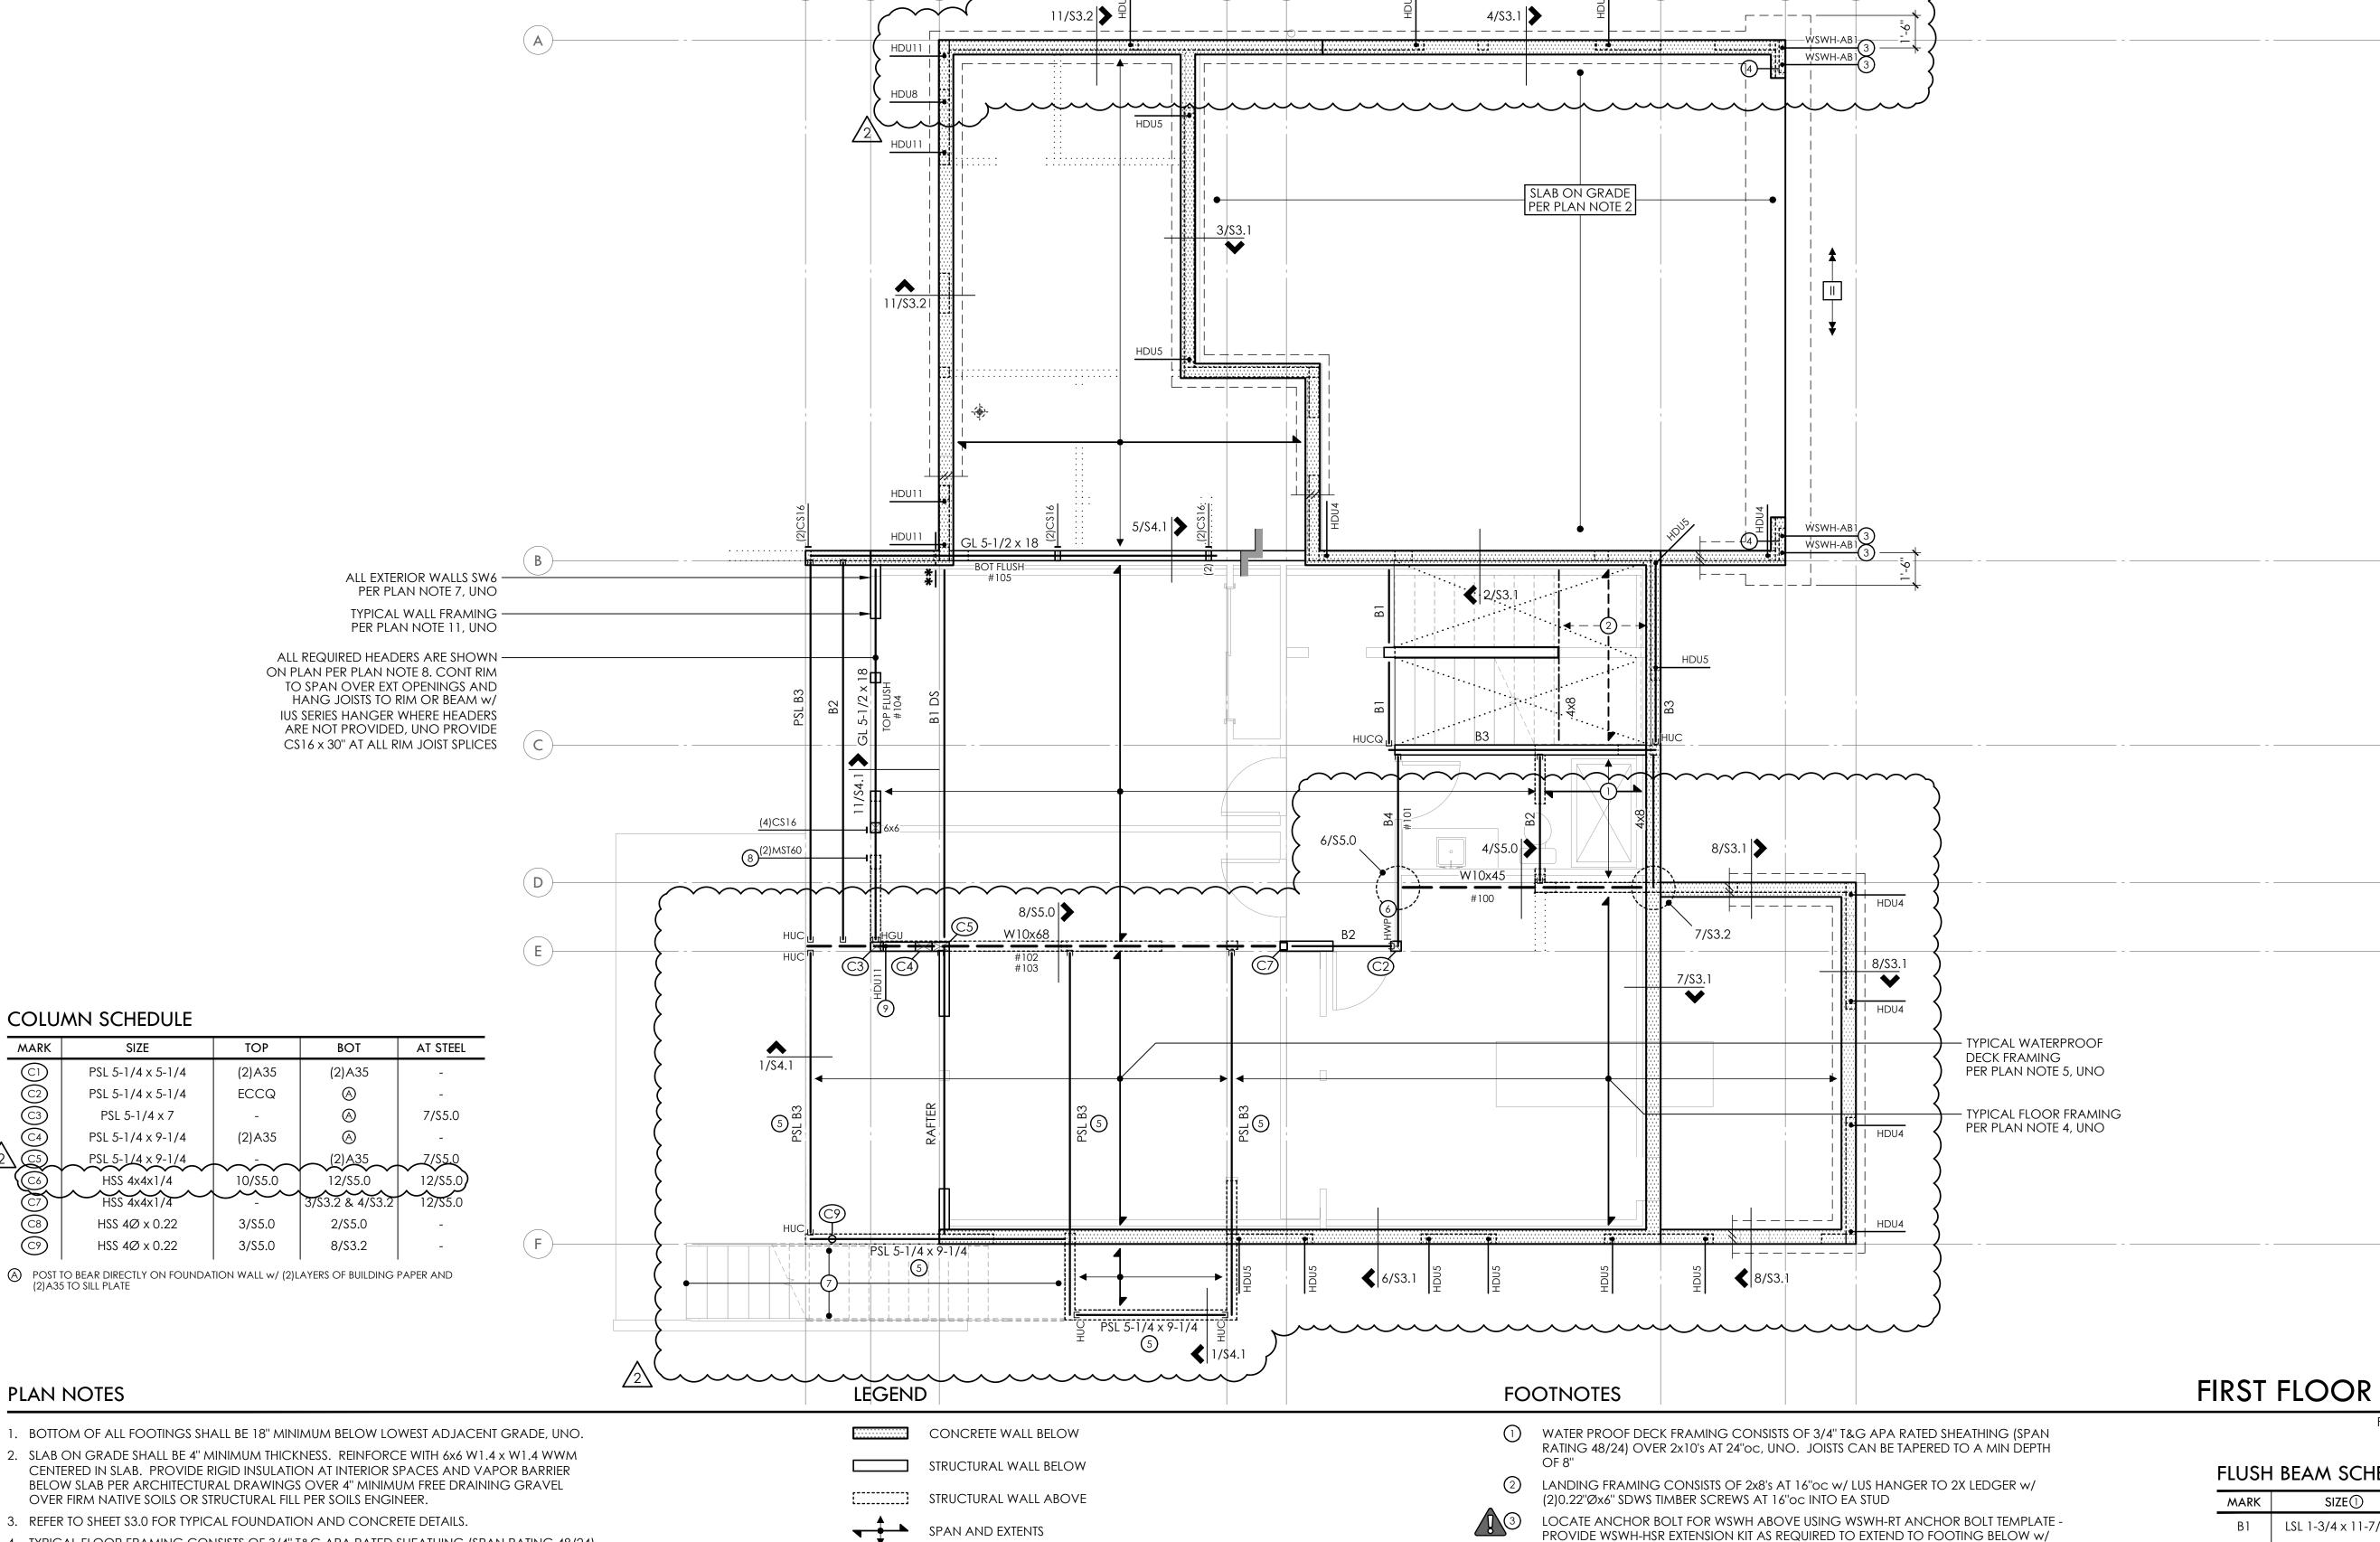

— - — HEADER/BEAM BELOW FRAMING - TYP

NUMBER OF BUILT UP STUDS

\*--- HORIZ CS16 x 3'-0" - BEAM TO BEAM

\*\*-- (2)HORIZ C\$16 x 3'-0" - BEAM TO BEAM

PLUMBING PENETRATION ABOVE

- 1. BOTTOM OF ALL FOOTINGS SHALL BE 18" MINIMUM BELOW LOWEST ADJACENT GRADE, UNO.
- 2. SLAB ON GRADE SHALL BE 4" MINIMUM THICKNESS. REINFORCE WITH 6x6 W1.4 x W1.4 WWM CENTERED IN SLAB. PROVIDE RIGID INSULATION AT INTERIOR SPACES AND VAPOR BARRIER BELOW SLAB PER ARCHITECTURAL DRAWINGS OVER 4" MINIMUM FREE DRAINING GRAVEL OVER FIRM NATIVE SOILS OR STRUCTURAL FILL PER SOILS ENGINEER.
- 3. REFER TO SHEET \$3.0 FOR TYPICAL FOUNDATION AND CONCRETE DETAILS.

**COLUMN SCHEDULE** 

SIZE

PSL 5-1/4 x 5-1/4

PSL 5-1/4 x 5-1/4

PSL 5-1/4 x 7

PSL 5-1/4 x 9-1/4

HSS 4x4x1/4

HSS 4Ø x 0.22

HSS 4Ø x 0.22

(2) A35 TO SILL PLATE

PLAN NOTES

MARK

- 4. TYPICAL FLOOR FRAMING CONSISTS OF 3/4" T&G APA RATED SHEATHING (SPAN RATING 48/24) OVER TJI'S PER JOIST SCHEDULE, UNO. PROVIDE DOUBLE JOISTS UNDER ALL PARALLEL PARTITIONS THAT EXTEND OVER MORE THAN HALF THE JOIST LENGTH.
- 5. TYPICAL WATER PROOF DECK FRAMING CONSISTS OF 3/4" T&G APA RATED SHEATHING (SPAN RATING 48/24) OVER LVL 1-3/4 x 11-7/8 AT 16"oc, UNO. JOISTS CAN BE TAPERED TO A MIN DEPTH
- 6. GLUE AND NAIL FLOOR SHEATHING W/8d AT 6"oc AT FRAMED PANEL EDGES AND AT 12"oc IN THE FIELD, UNO.
- 7. "SW\_" INDICATES SHEARWALL BELOW FRAMING SHOWN. REFER TO SHEARWALL SCHEDULE ON 4/\$4.0 FOR ADDITIONAL INFORMATION. ALL EXTERIOR WALLS ARE SW6, UNO.
- 8. ALL REQUIRED HEADERS ARE SHOWN ON PLAN AND SHALL BE (2)2x8, UNO. REFER TO DETAIL 8/S4.0 FOR ADDITIONAL REQUIREMENTS.
- 9. PROVIDE (2)BEARING (TRIMMER) STUDS AT EACH END OF ALL HEADERS AND BEAMS 6'-0" IN
- LENGTH AND OVER, UNO.
- 10. WHERE POSTS OCCUR, PROVIDE SOLID VERTICAL GRAIN BLOCKING THRU FLOOR TO MATCHING SUPPORTS BELOW, UNO.
- 11. TYPICAL WALL FRAMING CONSISTS OF 2x6's AT 16"oc AT EXTERIOR WALLS AND 2x4's or 2x6's AT 16"oc AT INTERIOR WALLS PER ARCH DRAWINGS, UNO.
- 12. REFER TO SHEET \$4.0 FOR TYPICAL WOOD FRAMING DETAILS.
- 13. STHD HOLDOWNS ARE DIMENSIONED TO THE CENTERLINE OF STRAP. HDU HOLDOWNS ARE DIMENSIONED TO THE CENTERLINE OF ANCHOR BOLT. DIMENSIONS ARE BASED OFF OF DRAWINGS PROVIDED BY THE ARCHITECT AND SHOULD BE VERIFIED.
- 14. REFER TO GENERAL STRUCTURAL NOTES SHEET \$1.0 FOR ADDITIONAL REQUIREMENTS.
- 15. DO NOT SCALE DRAWINGS. REFER TO ARCHITECTURAL DRAWINGS FOR ALL DIMENSIONS.

- 12" EMBEDMENT PROVIDE ADDITIONAL STEMWALL REINFORCEMENT AT WSWH PER MANUFACTURER'S
- REQUIREMENTS NOTCH AND TAPER BEAM TO MATCH JOIST DEPTH - 8" MIN, NO OVERCUTS
- OFFSET TOP FLANGE HANGER
- PREFABRICATED STAIR ASSEMBLY BY OTHERS BY DEFERRED SUBMITTAL
- 8 INSTALL HOLDOWN STRAP TO FACE OF BEAM FOR FULL DEPTH OF BEAM

  9 PROVIDE ALL-THREAD TO MATCH AB SIZE IN HOLDOWN SCHEDULE WELD TO TOP OF STEEL BEAM PER 1/S5.0

# FOOTING SCHEDULE

| MARK | SIZE                             | REINFORCING               |
|------|----------------------------------|---------------------------|
| A    | 2'-0" SQ x 8" DP                 | (3)#4 EW BOT              |
| В    | 4'-0" SQ x 16" DP                | (7)#4 EW BOT              |
|      | CONT 3'-0" W x 10'-0" L x 16" DP | #5 AT 8"oc BOT            |
| II   | CONT 3'-0" W x 18" DP            | #5 AT 6"OC<br>TOP AND BOT |

# FIRST FLOOR FRAMING PLAN

FIRST FLOOR WALLS SHOWN DASHED BASEMENT WALLS SHOWN SOLID

## FLUSH BEAM SCHEDULE

| MARK | SIZE ①                                     | BRG STUDS | HANGER                     |
|------|--------------------------------------------|-----------|----------------------------|
| В1   | LSL 1-3/4 x 11-7/8                         | 2         | HUS1.81/10                 |
| B2   | GL 3-1/2 x 11-7/8 OR<br>LSL 3-1/2 x 11-7/8 | 2<br>2    | HHUS410②<br>HHUS410        |
| В3   | GL 5-1/2 x 11-7/8 OR<br>PSL 5-1/4 x 11-7/8 | 3<br>3    | HGUS5.50/10<br>HGUS5.50/10 |
| B4   | PSL 7 x 11-7/8                             | 4         | HGUS7.25/10                |

1 ALL GLULAM BEAMS ARE 24F-V4 - UNO

2 PROVIDE HUC410 WHERE REQUIRED - UNO

### JOIST SCHEDULE 102


| <del></del>   | OCI IEDOLE OC   |         |                      |                      |
|---------------|-----------------|---------|----------------------|----------------------|
| MAX<br>LENGTH | SIZE            | SPACING | FACE MOUNT<br>HANGER | TOP FLANGE<br>HANGER |
| 18'-0''       | 11-7/8" TJI 110 | 16"oc   | IUS1.81/11.88        | ITS1.81/11.88        |
| 18'-9''       | 11-7/8" TJI 210 | 16"oc   | IUS2.06/11.88        | ITS2.06/11.88        |
| 19'-3"        | 11-7/8" TJI 230 | 16"oc   | IUS2.37/11.88        | ITS2.37/11.88        |
| 20'-0''       | 11-7/8" TJI 360 | 16"oc   | IUS2.37/11.88        | ITS2.37/11.88        |
| 22'-0''       | 11-7/8" TJI 560 | 16"oc   | IUS3.56/11.88        | ITS3.56/11.88        |

DESIGN BASED ON DL=15 PSF, LL=40 PSF,  $\triangle$ LL < L/480, TJ-PRO RATING OF 40

(2) SHEETROCK CEILING APPLIED TO BOTTOM FACE OF JOISTS



122 S JACKSON ST - SUITE 210 SEATTLE, WA 98104 - 206.789.6038

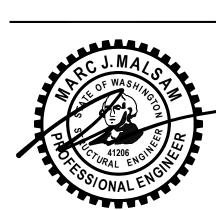

0329.2022.01.01 PROJECT MANAGER DRAWN **ENGINEER** BLAKE RASSILYER 206.602.5452 BLAKER@MALSAM-TSANG.COM

REV DESCRIPTION 5.27.22 PERMIT SET PERMIT CORRECTIONS 1.6.23 POST PERMIT REVISIONS 8.1.23

ARCH JULIAN WEBER ARCH + DESIGN 206.953.1305 COOMBES DEVELOPMENT

FIRST FLOOR FRAMING PLAN

**COLUMN SCHEDULE** 

SIZE

PSL 5-1/4 x 5-1/4

PSL 5-1/4 x 5-1/4

PSL 5-1/4 x 7

PSL 5-1/4 x 9-1/4

HSS 4x4x1/4

HSS 4Ø x 0.22

HSS 4Ø x 0.22

(2) A35 TO SILL PLATE

PLAN NOTES

TOP

(2)A35

**ECCQ** 

(2)A35

10/\$5.0

3/\$5.0

BOT


(2)A35


12/\$5.0

2/\$5.0

8/\$3.2

MARK

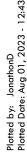

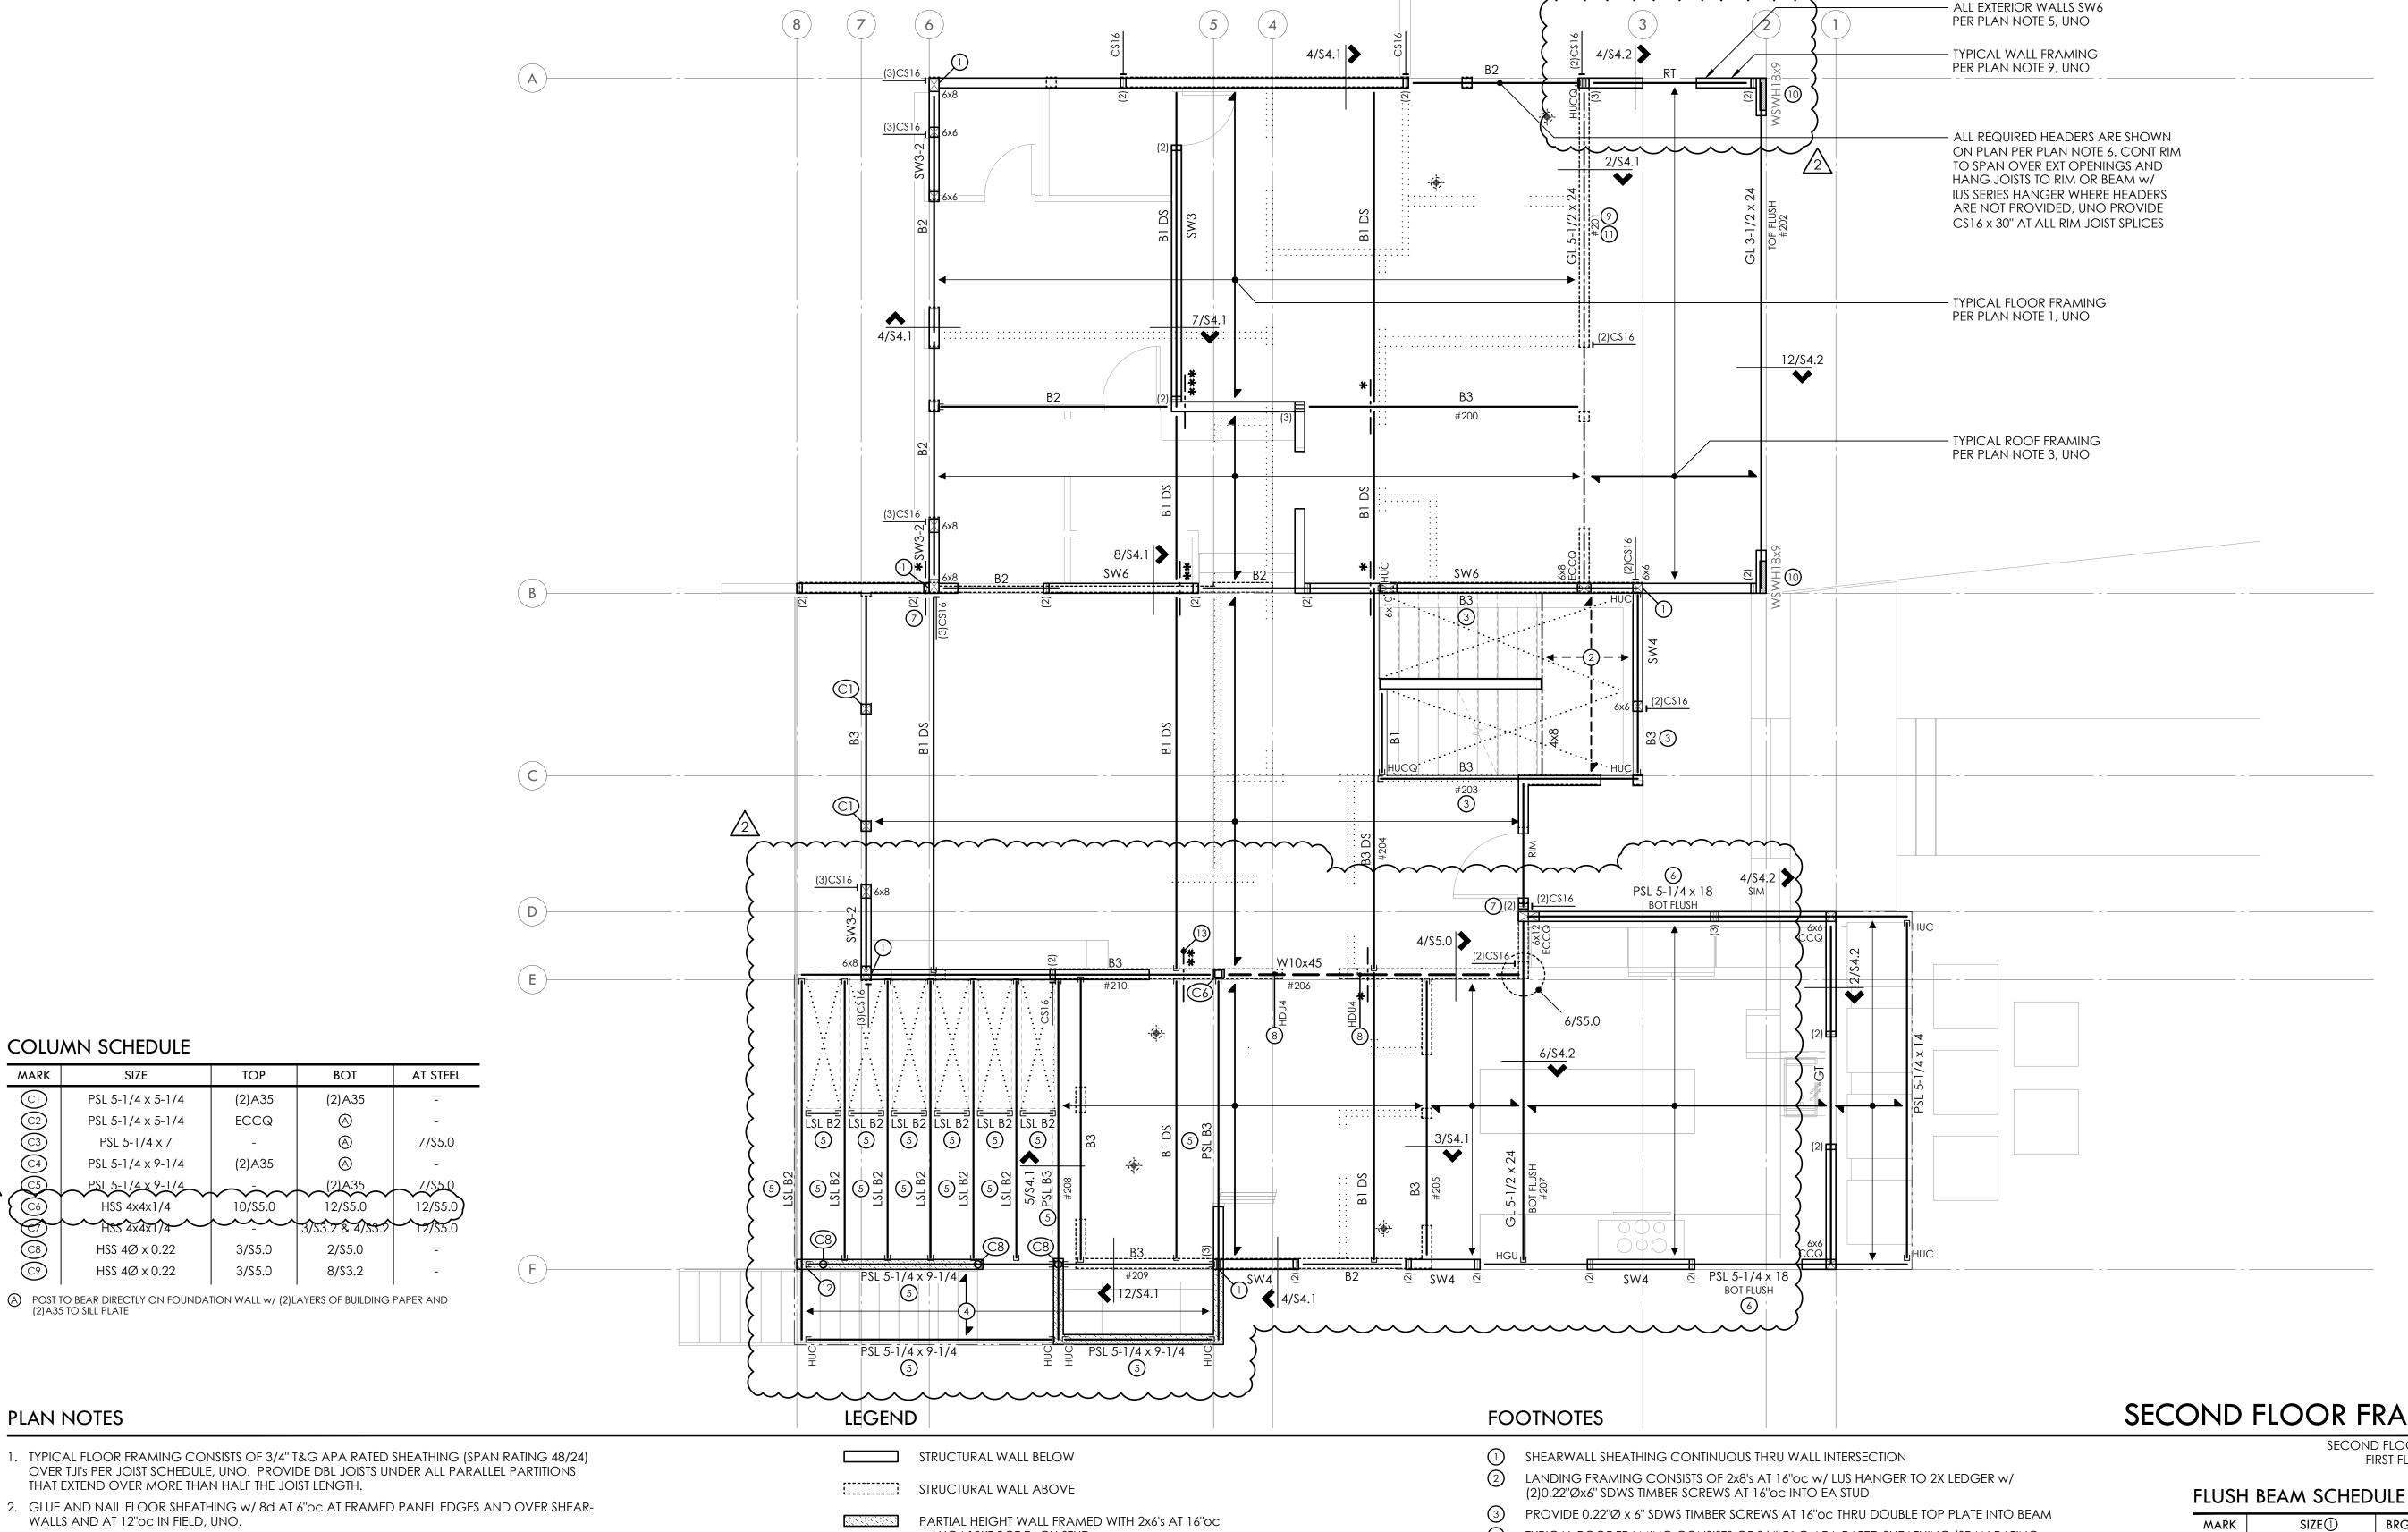

- 1. TYPICAL FLOOR FRAMING CONSISTS OF 3/4" T&G APA RATED SHEATHING (SPAN RATING 48/24) OVER TJI'S PER JOIST SCHEDULE, UNO. PROVIDE DBL JOISTS UNDER ALL PARALLEL PARTITIONS THAT EXTEND OVER MORE THAN HALF THE JOIST LENGTH.
- 2. GLUE AND NAIL FLOOR SHEATHING W/8d AT 6"OC AT FRAMED PANEL EDGES AND OVER SHEAR-WALLS AND AT 12"oc IN FIELD, UNO.
- 3. TYPICAL ROOF FRAMING CONSISTS OF 3/4" T&G APA RATED SHEATHING (SPAN RATING 48/24) OVER PRE-MANUFACTURED TRUSSES AT 24"oc, UNO. TOP CHORD OF TRUSS TO SLOPE A MIN OF 1/4" PER 1'-0". TRUSSES TO BE A MIN DEPTH OF 14". PROVIDE H2.5A AT EACH END OF ALL TRUSSES, AND H2.5A EACH SIDE OF ALL MULTIPLE TRUSSES, UNO. REFER TO ARCH DRAWINGS FOR TRUSS PROFILE.
- 4. NAIL ROOF SHEATHING W/8d AT 6"oc AT FRAMED PANEL EDGES AND OVER SHEARWALLS, AND AT 12"oc IN THE FIELD, UNO.
- 5. "SW\_" INDICATES SHEARWALL BELOW FRAMING SHOWN. REFER TO SHEARWALL SCHEDULE ON 4/S4.0 FOR ADDITIONAL INFORMATION. ALL EXTERIOR WALLS ARE SW6, UNO.
- 6. ALL REQUIRED HEADERS ARE SHOWN ON PLAN AND SHALL BE (2)2x8, UNO. REFER TO DETAIL 8/S4.0 FOR ADDITIONAL REQUIREMENTS.
- 7. PROVIDE (2)BEARING (TRIMMER) STUDS AT EACH END OF ALL HEADERS AND BEAMS 6'-0" IN LENGTH AND OVER, UNO.
- 8. WHERE POSTS OCCUR, PROVIDE SOLID VERTICAL GRAIN BLOCKING THRU FLOOR TO MATCHING SUPPORTS BELOW, UNO.
- 9. TYPICAL WALL FRAMING CONSISTS OF 2x6's AT 16"oc AT EXTERIOR WALLS AND 2x4's or 2x6's AT 16"oc AT INTERIOR WALLS PER ARCH DRAWINGS, UNO.
- 11. REFER TO GENERAL STRUCTURAL NOTES SHEET \$1.0 FOR ADDITIONAL REQUIREMENTS. 12. DO NOT SCALE DRAWINGS. REFER TO ARCH DRAWINGS FOR ALL DIMENSIONS.

10. REFER TO SHEET \$4.0 FOR TYPICAL WOOD FRAMING DETAILS.

W/ HGA10KT BOT EACH STUD

SPAN AND EXTENTS — - — HEADER/BEAM BELOW FRAMING - TYP

NUMBER OF BUILT UP STUDS

PLUMBING PENETRATION ABOVE \*--- HORIZ CS16 x 3'-0" - BEAM TO BEAM

\*\*-- (2)HORIZ CS16 x 3'-0" - BEAM TO BEAM \*\*\*- (3)HORIZ C\$16 x 3'-0" - BEAM TO BEAM

> DRAG STRUT - NAIL THRU SHEATHING w/ 8d AT 4"oc INTO ENTIRE LENGTH OF MEMBER

**GIRDER TRUSS** 

TYPICAL ROOF FRAMING CONSISTS OF 3/4" T&G APA RATED SHEATHING (SPAN RATING 48/24) OVER 2x12's AT 24"oc, UNO. RAFTERS CAN BE TAPERED TO A MIN DEPTH OF 8"

NOTCH AND TAPER BEAM TO MATCH JOIST DEPTH - 8" MIN, NO OVERCUTS

NOTCH AND TAPER BEAM TO MATCH JOIST DEPTH - 14" MIN, NO OVERCUTS PROVIDE 0.22"Ø x 6" SDWS TIMBER SCREWS AT 12"oc THRU DOUBLE STUDS INTO POST

PROVIDE ALL-THREAD TO MATCH AB SIZE IN HOLDOWN SCHEDULE - WELD TO TOP OF STEEL BEAM PER DETAIL 1/S5.0

BEAM BOTTOM FLUSH WITH ROOF FRAMING

FIELD TRIM SIMPSON STRONG WALL HIGH STRENGTH WOOD SHEARWALL AS REQUIRED AND CONNECT TO BEAM W/ WSWH-TP AND WSWH-PS PER MANUFACTURER'S REQUIREMENTS AND IN ACCORDANCE w/ ESR-2652 - REFER DETAIL 10/S4.1

INSTALL 2x PLATES w/ 10d AT 4"oc FOR ENTIRE LENGTH OF BEAM AS REQUIRED

INSTALL STRAPS TO TOP AND UNDERSIDE OF DRAG STRUTS

# SECOND FLOOR FRAMING PLAN

SECOND FLOOR WALLS SHOWN DASHED FIRST FLOOR WALLS SHOWN SOLID

| MARK | SIZE ①                                     | BRG STUDS | HANGER                     |
|------|--------------------------------------------|-----------|----------------------------|
| В1   | LSL 1-3/4 x 11-7/8                         | 2         | HUS1.81/10                 |
| B2   | GL 3-1/2 x 11-7/8 OR<br>LSL 3-1/2 x 11-7/8 | 2<br>2    | HHUS410②<br>HHUS410        |
| В3   | GL 5-1/2 x 11-7/8 OR<br>PSL 5-1/4 x 11-7/8 | 3<br>3    | HGUS5.50/10<br>HGUS5.50/10 |
| B4   | PSL 7 x 11-7/8                             | 4         | HGUS7.25/10                |

1 ALL GLULAM BEAMS ARE 24F-V4 - UNO

2 PROVIDE HUC410 WHERE REQUIRED - UNO

# JOIST SCHEDULE 102

|               | oci iedote oc   |         |                      |                      |
|---------------|-----------------|---------|----------------------|----------------------|
| MAX<br>LENGTH | SIZE            | SPACING | FACE MOUNT<br>HANGER | TOP FLANGE<br>HANGER |
| 18'-0''       | 11-7/8" TJI 110 | 16"oc   | IUS1.81/11.88        | ITS1.81/11.88        |
| 18'-9''       | 11-7/8" TJI 210 | 16"oc   | IUS2.06/11.88        | ITS2.06/11.88        |
| 19'-3"        | 11-7/8" TJI 230 | 16"oc   | IUS2.37/11.88        | ITS2.37/11.88        |
| 20'-0''       | 11-7/8" TJI 360 | 16"oc   | IUS2.37/11.88        | ITS2.37/11.88        |
| 22'-0''       | 11-7/8" TJI 560 | 16"oc   | IUS3.56/11.88        | ITS3.56/11.88        |

DESIGN BASED ON DL=15 PSF, LL=40 PSF,  $\triangle$ LL < L/480, TJ-PRO RATING OF 40

(2) SHEETROCK CEILING APPLIED TO BOTTOM FACE OF JOISTS



0329.2022.01.01 PROJECT MANAGER DRAWN **ENGINEER** BLAKE RASSILYER 206.602.5452 BLAKER@MALSAM-TSANG.COM


REV DESCRIPTION PERMIT SET 5.27.22 PERMIT CORRECTIONS 1.6.23 POST PERMIT REVISIONS 8.1.23


ARCH JULIAN WEBER ARCH + DESIGN 206.953.1305 COOMBES DEVELOPMENT

SECOND FLOOR FRAMING PLAN

SCALE - 1/4" = 1'-0"

PLAN NOTES

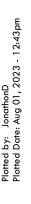

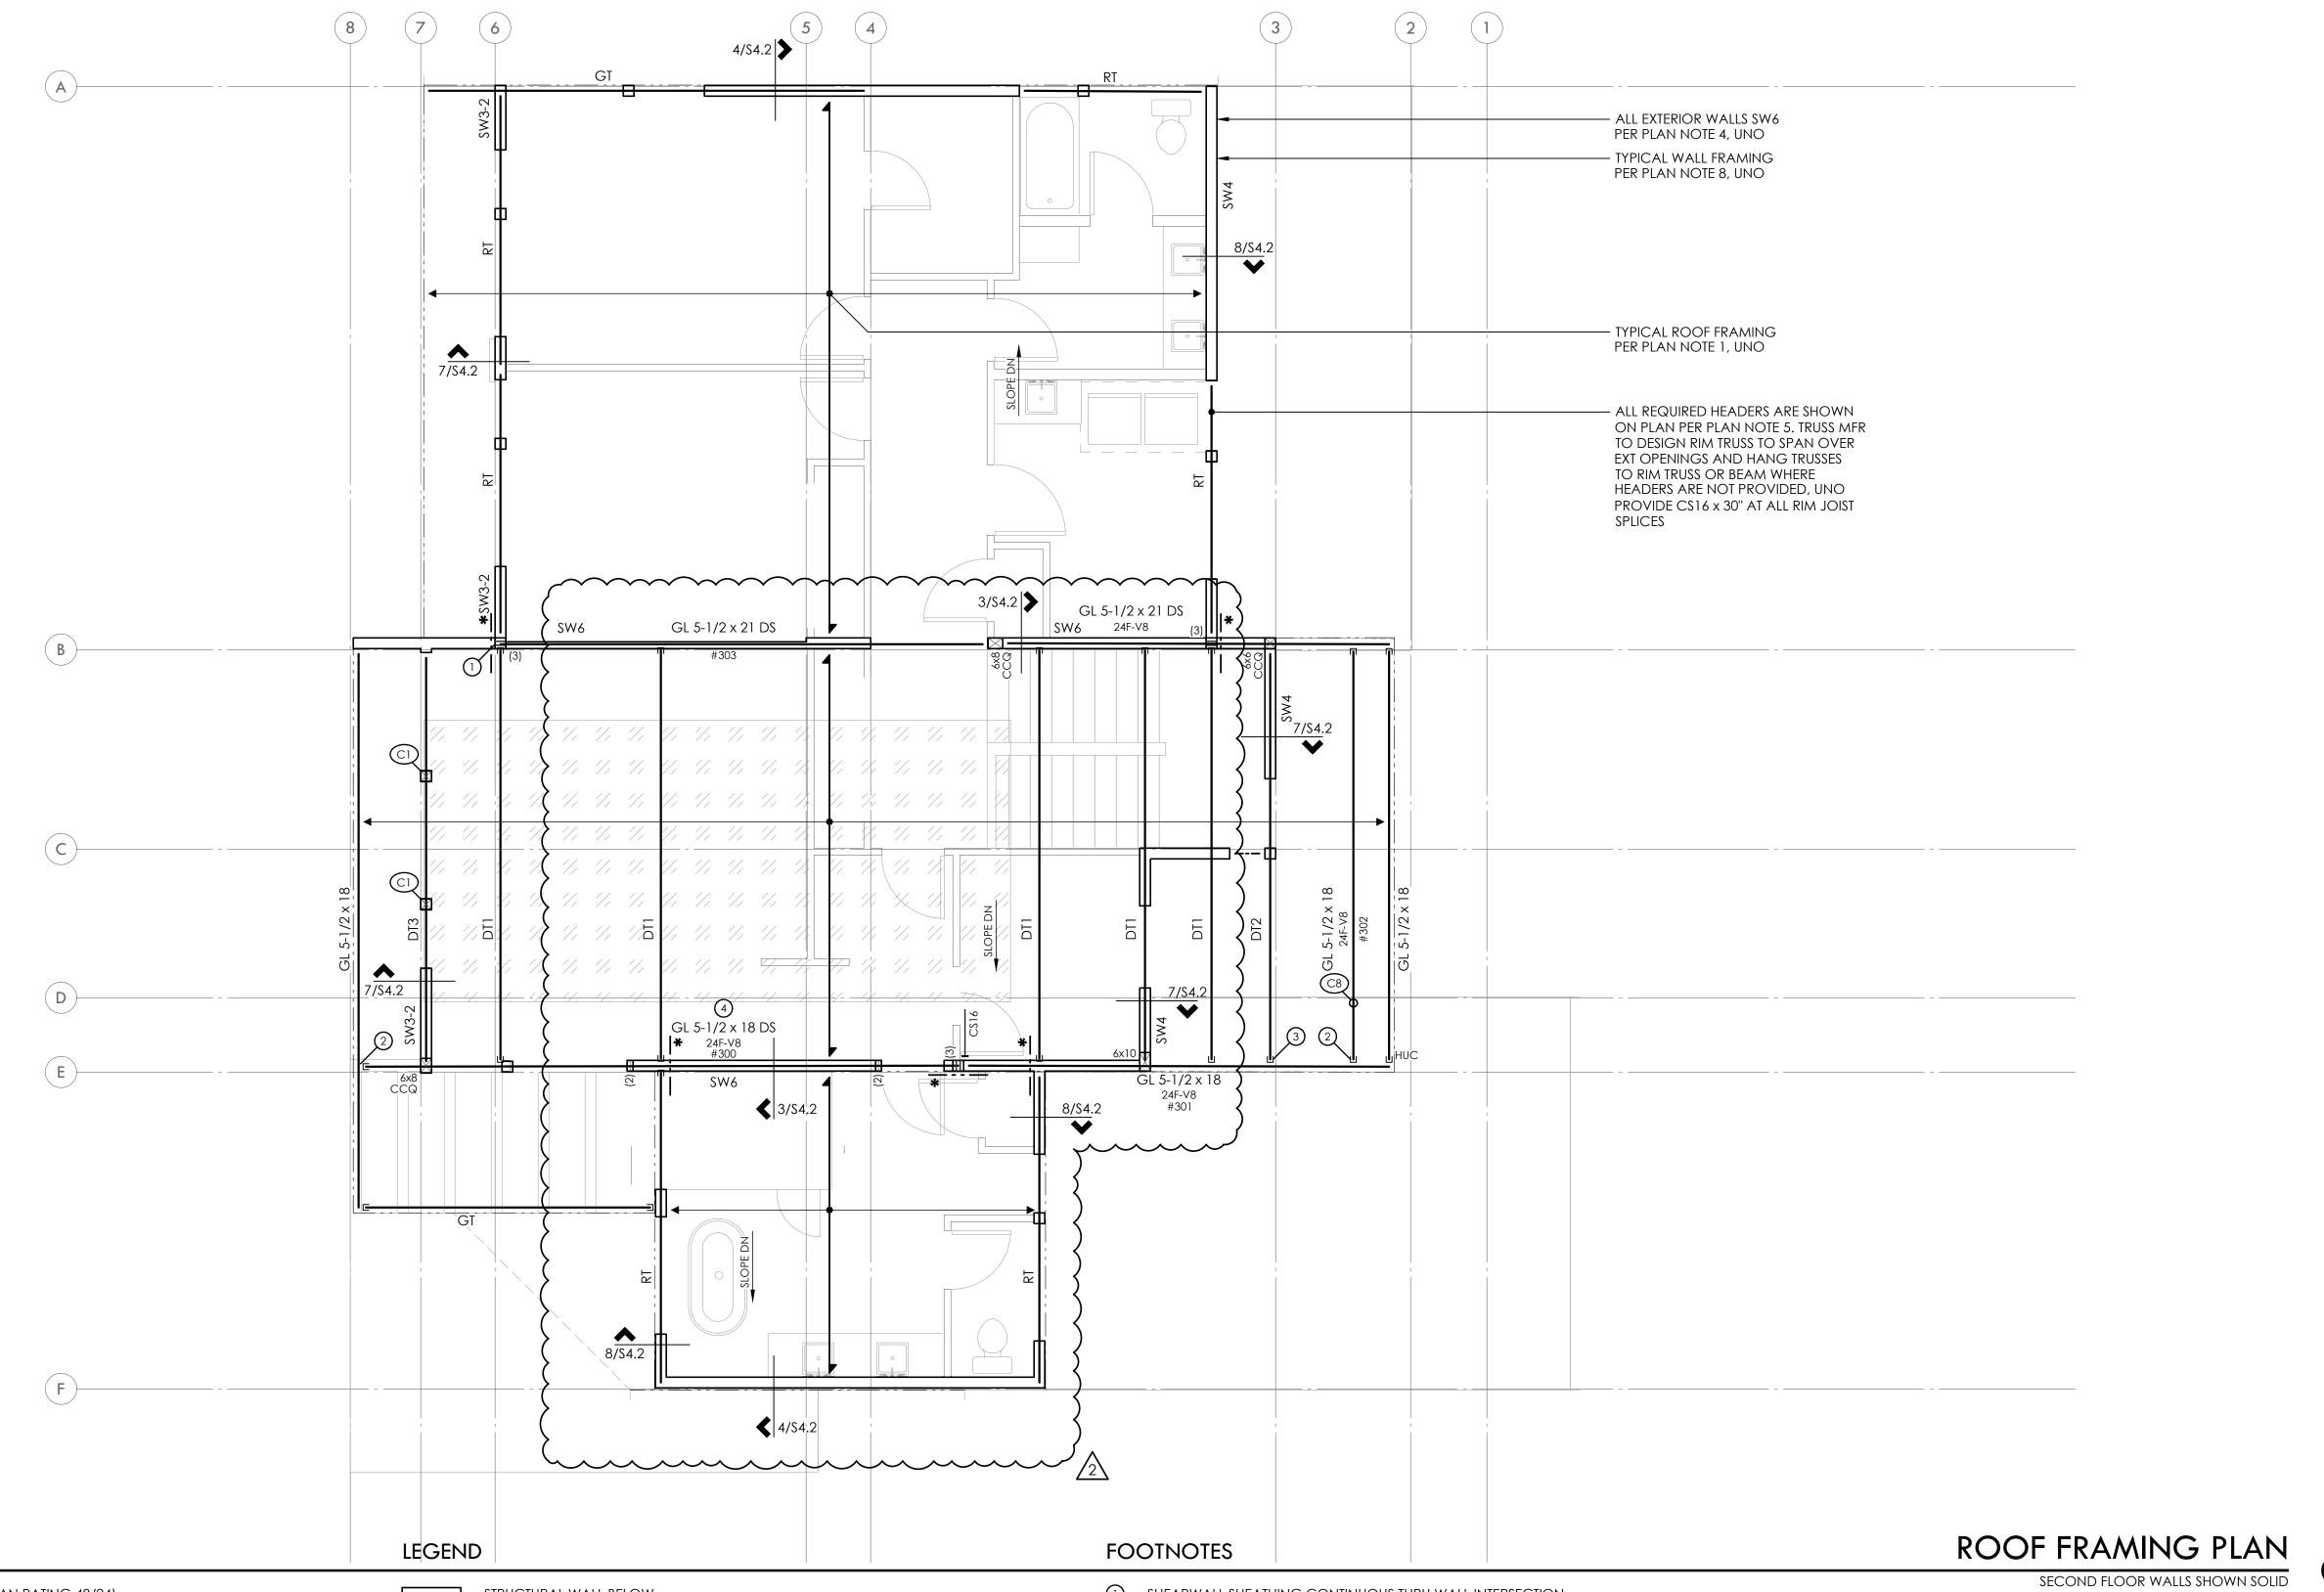

- 1. TYPICAL ROOF FRAMING CONSISTS OF 3/4" T&G APA RATED SHEATHING (SPAN RATING 48/24) OVER PRE-MANUFACTURED TRUSSES AT 24"OC, UNO. TOP CHORD OF TRUSS TO SLOPE A MIN OF 1/4" PER 1'-0". TRUSSES TO BE A MIN DEPTH OF 14". PROVIDE H2.5A AT EACH END OF ALL TRUSSES, AND H2.5A EACH SIDE OF ALL MULTIPLE TRUSSES, UNO. REFER TO ARCH DRAWINGS FOR TRUSS PROFILE.
- 2. TYPICAL CRICKET ROOF FRAMING CONSISTS OF 3/4" T&G APA RATED SHEATHING (SPAN RATING 48/24) OVER 2x SLEEPERS AT 24"oc. TOENAIL SLEEPERS w/ (2) 10d AT 24"oc OVER TYPICAL ROOF FRAMING. PROVIDE VENTING HOLES BELOW CRICKET ROOF FRAMING AS REQUIRED.
- 3. NAIL ROOF SHEATHING W/8d AT 6" OC AT FRAMED PANEL EDGES AND OVER SHEARWALLS, AND AT 12"oc IN FIELD, UNO.
- 4. "SW\_" INDICATES SHEARWALL BELOW FRAMING SHOWN. REFER TO SHEARWALL SCHEDULE ON 4/S4.0 FOR ADDITIONAL INFORMATION. ALL EXTERIOR WALLS ARE SW6, UNO.
- 5. ALL REQUIRED HEADERS ARE SHOWN ON PLAN AND SHALL BE (2)2x8, UNO. REFER TO DETAIL 8/S4.0 FOR ADDITIONAL REQUIREMENTS.
- 6. PROVIDE (2)BEARING (TRIMMER) STUDS AT EACH END OF ALL HEADERS, BEAMS, AND GIRDER TRUSSES 6'-0" IN LENGTH AND OVER, UNO.
- 7. WHERE POSTS OCCUR, PROVIDE SOLID VERTICAL GRAIN BLOCKING THRU FLOOR TO MATCHING SUPPORTS BELOW, UNO.
- 8. TYPICAL WALL FRAMING CONSISTS OF 2x6's AT 16"oc AT EXTERIOR WALLS AND 2x4's or 2x6's AT
- 9. REFER TO SHEET \$4.0 FOR TYPICAL WOOD FRAMING DETAILS.

16"oc AT INTERIOR WALLS PER ARCH DRAWINGS, UNO.

- 10. REFER TO GENERAL STRUCTURAL NOTES SHEET \$1.0 FOR ADDITIONAL REQUIREMENTS.
- 11. DO NOT SCALE DRAWINGS. REFER TO ARCH DRAWINGS FOR ALL DIMENSIONS.

- STRUCTURAL WALL BELOW
- SPAN AND EXTENTS
- - HEADER/BEAM BELOW FRAMING TYP
- SLOPE DN DIRECTION OF SLOPE
- NUMBER OF BUILT UP STUDS
- \*--- HORIZ CS16 x 3'-0" TRUSS TO TRUSS/TOP PLATE TO TOP PLATE
- DRAG STRUT NAIL THRU SHEATHING w/ 8d AT 4"oc INTO ENTIRE LENGTH OF MEMBER
- DRAG TRUSS NAIL THRU SHEATHING W/8d AT 4"oc
- INTO ENTIRE LENGTH OF TRUSS **GIRDER TRUSS**
- RIM TRUSS

- 1) SHEARWALL SHEATHING CONTINUOUS THRU WALL INTERSECTION
- INSTALL HUCQ HANGER UPSIDE DOWN HANGER PER TRUSS MANUFACTURER
- 3
- INSTALL 2x PLATES w/ 10d AT 4"oc FOR ENTIRE LENGTH OF BEAM AS REQUIRED TO FLUSH UNDERSIDE OF ROOF SHEATHING

### DRAG TRUSS SCHEDULE

|   | MARK | LOAD TRANSFER ①② |
|---|------|------------------|
| , | DT1  | 1.0 KIPS         |
|   | DT2  | 1.5 KIPS         |
|   | DT3  | 2.0 KIPS         |
|   | _    | ı                |

- TRUSS MFR TO DESIGN TRUSS TO TRANSFER LISTED LOAD FROM TOP TO BOT CHORD
- 2 NAIL THRU SHEATHING W/8d AT 4"OC INTO ENTIRE LENGTH OF MEMBER

# COLUMN SCHEDULE

|            | 0010       | ···· · · · · · · · · · · · · · · · · · |          |                 |          |
|------------|------------|----------------------------------------|----------|-----------------|----------|
| ·          | MARK       | SIZE                                   | TOP      | ВОТ             | AT STEEL |
| •          | C1         | PSL 5-1/4 x 5-1/4                      | (2)A35   | (2)A35          | -        |
|            | C2         | PSL 5-1/4 x 5-1/4                      | ECCQ     | (A)             | -        |
|            | <b>C</b> 3 | PSL 5-1/4 x 7                          | -        | (A)             | 7/\$5.0  |
| ^          | <u>C4</u>  | PSL 5-1/4 x 9-1/4                      | (2)A35   | (A)             | -        |
| $\sqrt{2}$ | C5         | PSL 5-1/4 x 9-1/4                      |          | (2)A35          | 7/\$5.0  |
|            | (C6)       | HSS 4x4x1/4                            | 10/\$5.0 | 12/\$5.0        | 12/\$5.0 |
|            |            | HSS 4x4x1/4                            |          | 3/53.2 & 4/53.2 | 12/\$5.0 |
|            | <u>C8</u>  | HSS 4Ø x 0.22                          | 3/\$5.0  | 2/\$5.0         | -        |
|            | <u>C9</u>  | HSS 4Ø x 0.22                          | 3/\$5.0  | 8/\$3.2         | -        |
|            |            | 1                                      | ı        |                 |          |

(2)A35 TO SILL PLATE



| MARK           | SIZE              | TOP      | ВОТ             | AT STEEL |
|----------------|-------------------|----------|-----------------|----------|
| Cl             | PSL 5-1/4 x 5-1/4 | (2)A35   | (2)A35          | -        |
| C2             | PSL 5-1/4 x 5-1/4 | ECCQ     | (A)             | -        |
| <b>C</b> 3     | PSL 5-1/4 x 7     | -        | (A)             | 7/\$5.0  |
| <u>C4</u>      | PSL 5-1/4 x 9-1/4 | (2)A35   | (A)             | -        |
| $\sqrt{C_{2}}$ | PSL 5-1/4 x 9-1/4 |          | (2)A35          | 7/\$5.0  |
| (C6)           | HSS 4x4x1/4       | 10/\$5.0 | 12/\$5.0        | 12/\$5.0 |
|                | HSS 4x4x1/4       |          | 3/53.2 & 4/53.2 | 12/\$5.0 |
| <u>C8</u>      | HSS 4Ø x 0.22     | 3/\$5.0  | 2/\$5.0         | -        |
| <u>C</u> 9     | HSS 4Ø x 0.22     | 3/\$5.0  | 8/\$3.2         | -        |



0329.2022.01.01

BLAKE RASSILYER

BLAKER@MALSAM-TSANG.COM

PERMIT CORRECTIONS 1.6.23

POST PERMIT REVISIONS 8.1.23

ARCH JULIAN WEBER ARCH + DESIGN

CLIENT COOMBES DEVELOPMENT

ROOF FRAMING PLAN

206.602.5452

206.953.1305

5.27.22


PROJECT MANAGER

REV DESCRIPTION

PERMIT SET

DRAWN


ENGINEER

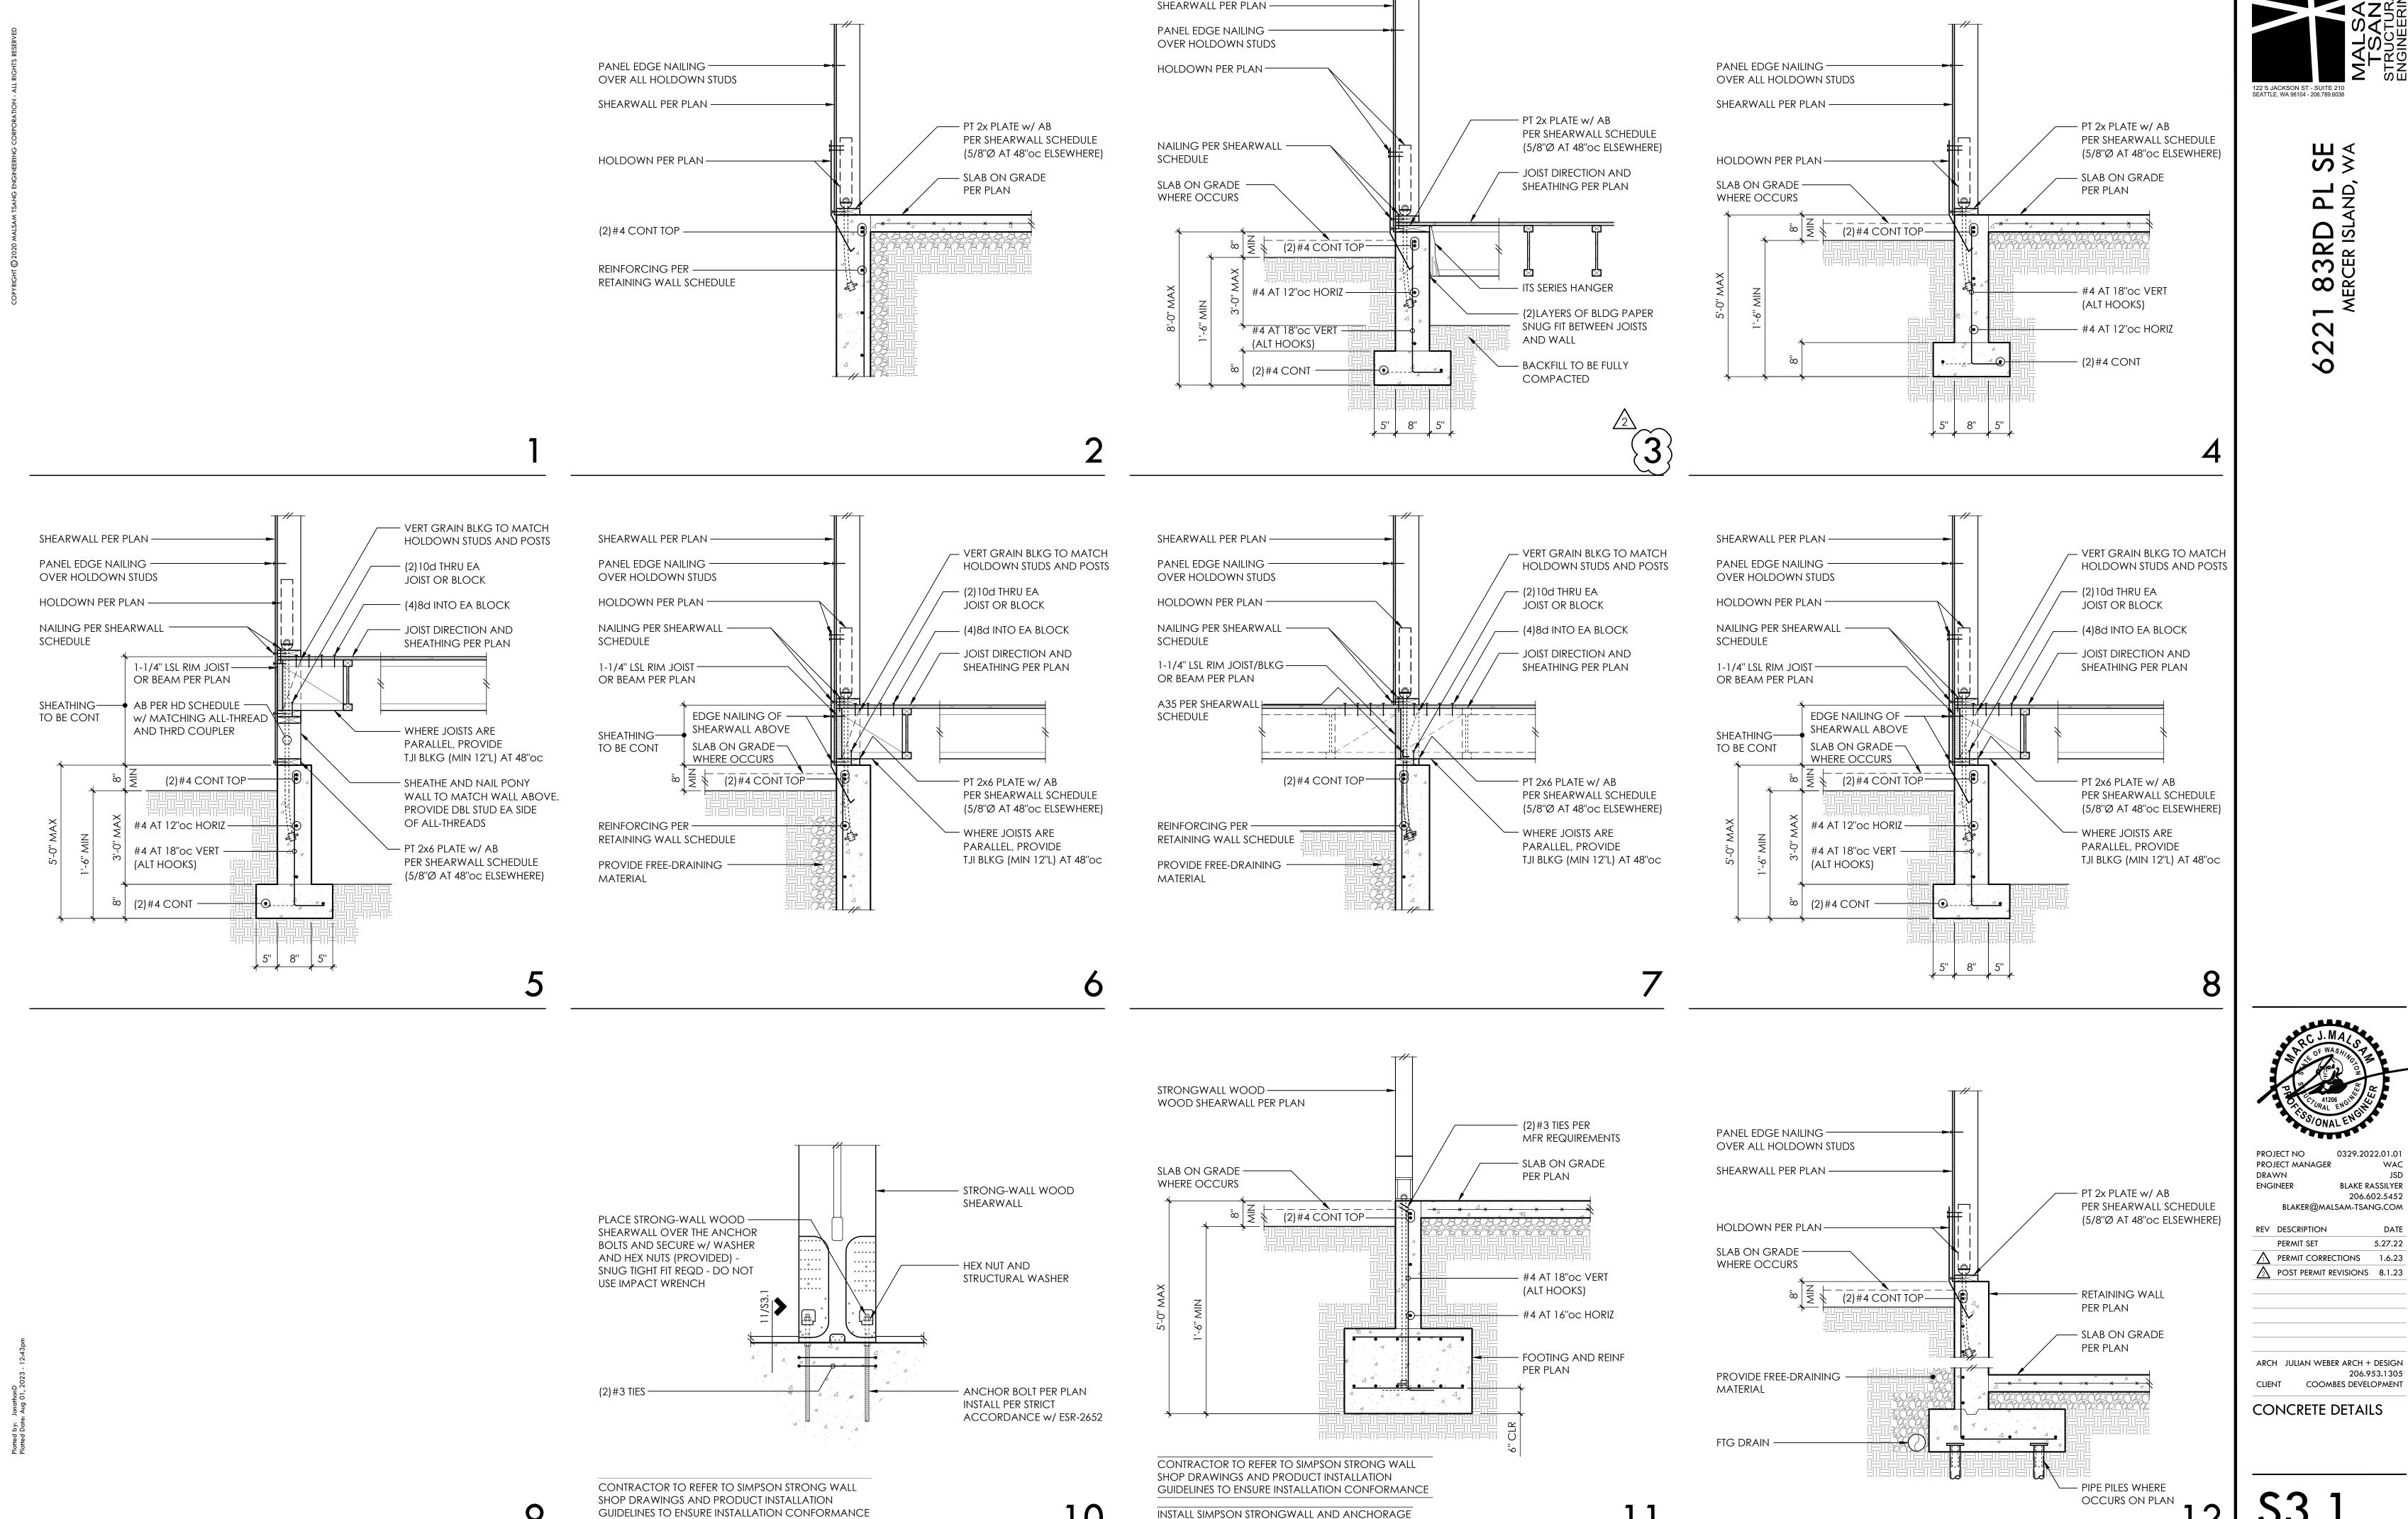

IN STRICT ACCORDANCE w/ ESR-2652

5.27.22

SCALE - 3/4" = 1'-0"

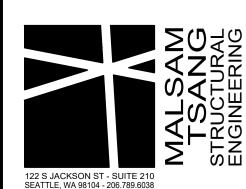

122 S JACKSON ST - SUITE 210 SEATTLE, WA 98104 - 206.789.6038

<u>\( \infty \)</u> ≥ 1 83RD MERCER ISLA ~

0329.2022.01.01

PROJECT MANAGER DRAWN ENGINEER BLAKE RASSILYER 206.602.5452 BLAKER@MALSAM-TSANG.COM

REV DESCRIPTION 5.27.22 PERMIT SET PERMIT CORRECTIONS 1.6.23 POST PERMIT REVISIONS 8.1.23

206.953.1305 COOMBES DEVELOPMENT

STEEL DETAILS

SCALE - 3/4" = 1'-0"

- BEAM PER PLAN

1 1/2"

POST PER PLAN -

WHERE OCCURS

9

- PL 1/2" BUCKET w/

PRE-DRILLED HOLES FOR

(2)3/4"Ø THRU BOLTS

5. MAXIMUM SIZES OF OPENINGS SHALL BE D/3 Ø OR D/3 x 2D/3 AS SHOWN.

6. NO OPENINGS SHALL OCCUR WITHIN 12" OF AN ADJACENT BEAM CONNECTION.

NOTE

BEARING PLATE THICKNESS SHALL BE 3/4" WHERE

DEPTH OF SUPPORTED MEMBER EXCEEDS 24"

7. REQUIRED OPENINGS NOT MEETING ABOVE CRITERIA SHALL BE SUBMITTED TO

ENGINEER FOR REINFORCING DESIGN.