
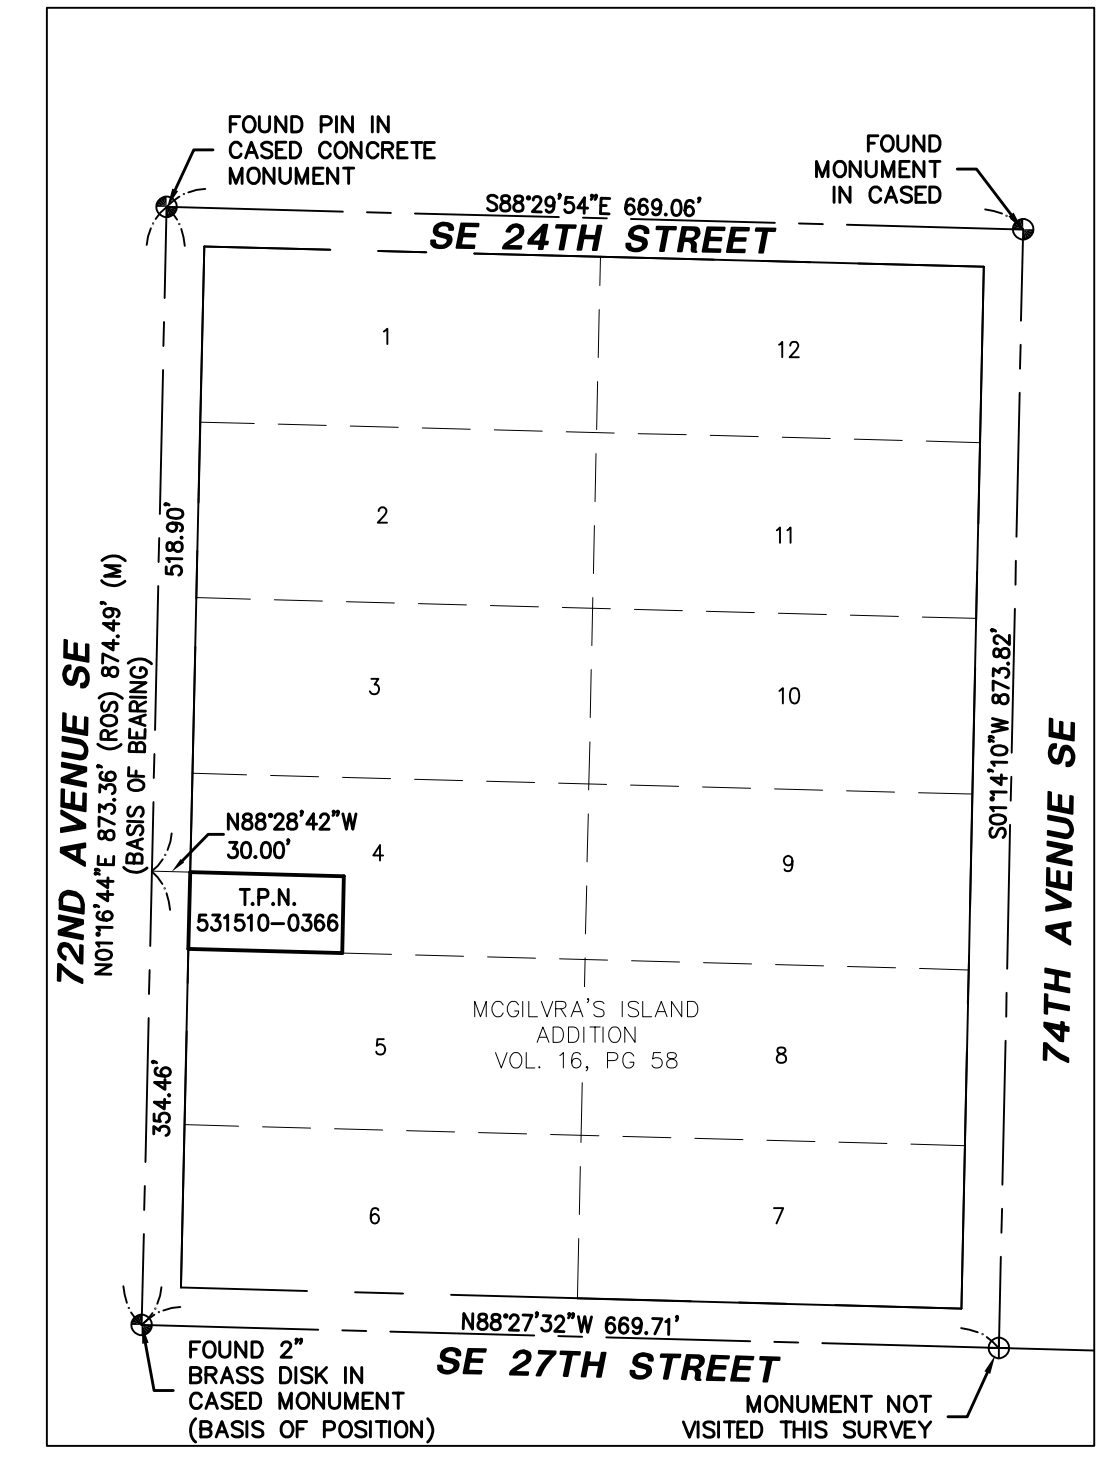
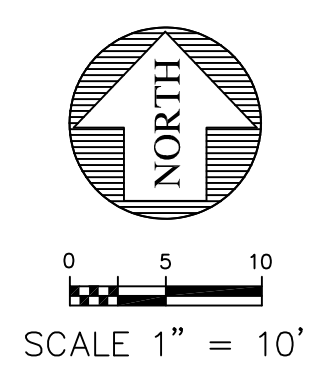


MU HU

A PORTION OF THE NE 1/4 OF THE NW 1/4 OF SEC. 12, T 24 N., R 04 W., W.M.
KING COUNTY, STATE OF WASHINGTON

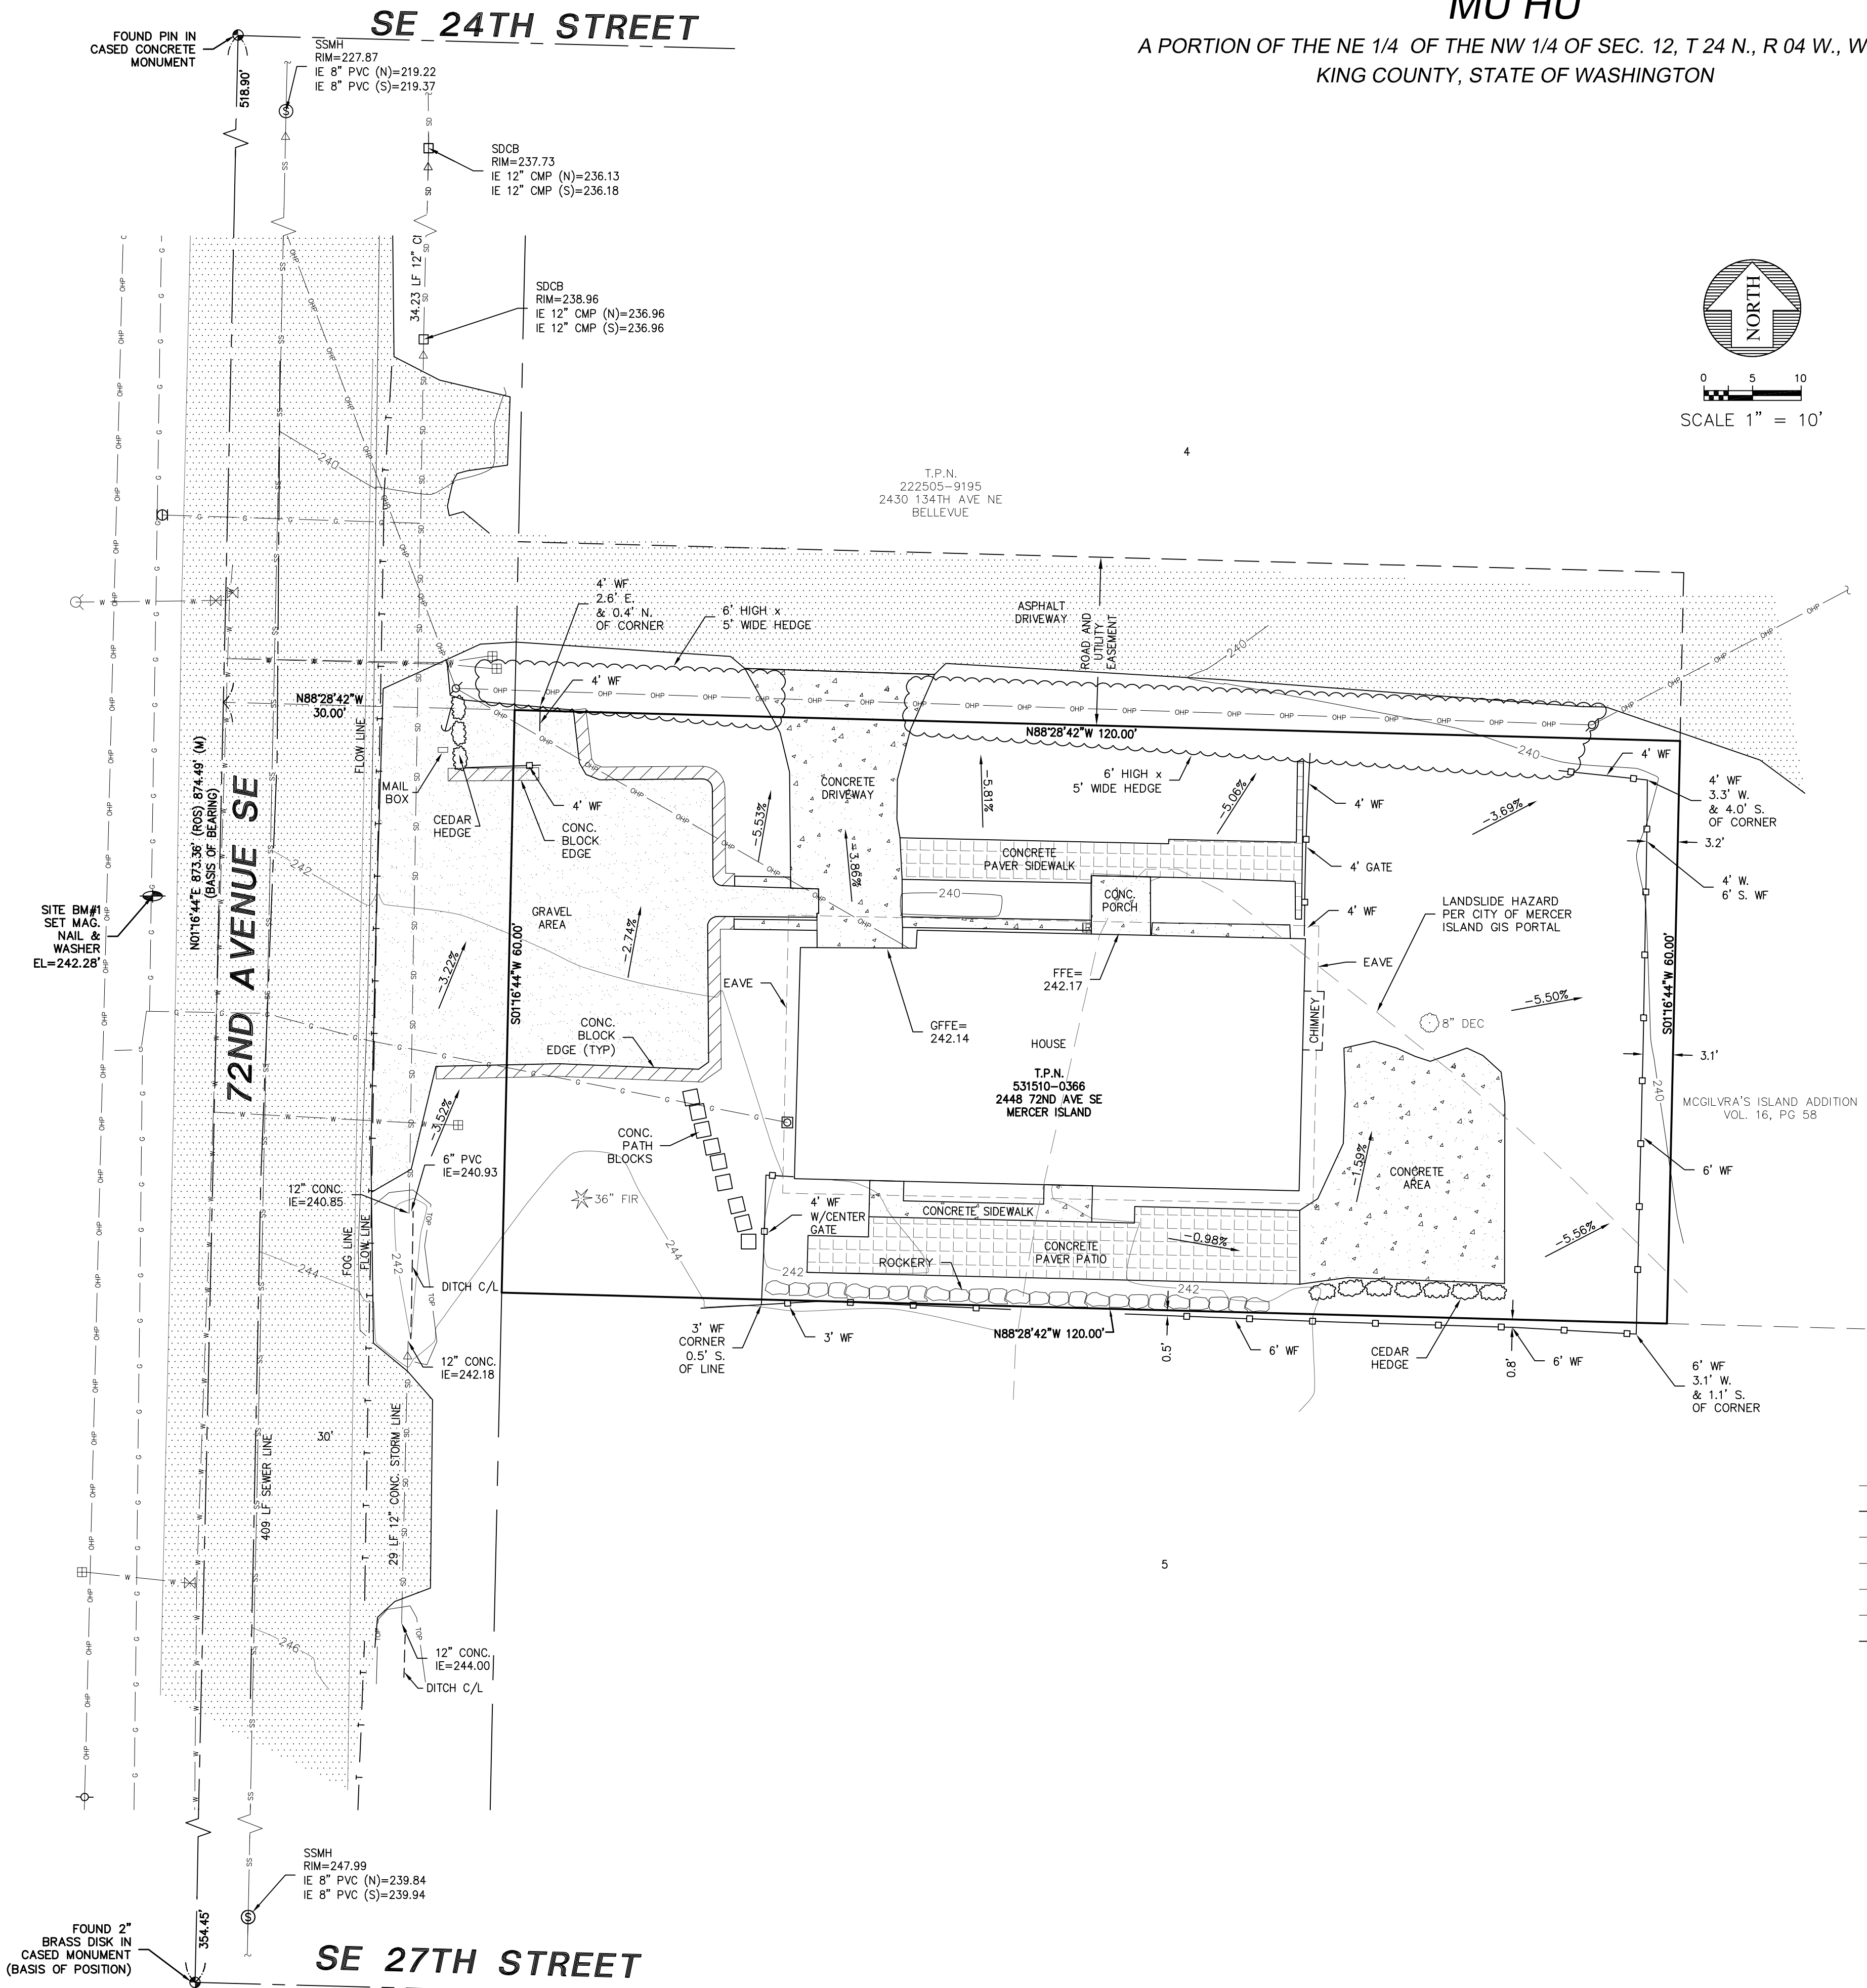

CONTROL DETAIL 1"-150'


LEGEND

- FOUND MONUMENT IN CASE
- MONUMENT NOT VISITED
- FOUND REBAR & CAP
- BENCHMARK
- RECORD OF SURVEY 449/13
- MEASURED
- WATER VALVE
- FIRE HYDRANT
- WATER METER
- IRRIGATION CONTROL VALVE
- SEWER MANHOLE
- CATCH BASIN
- GAS VALVE
- MAILBOX
- ROCKERY
- UTILITY POLE
- GUY ANCHOR
- GAS METER
- OVERHEAD POWER LINE
- FIBER OPTIC LINE
- WATER LINE
- STORM LINE
- SEWER LINE
- GAS LINE
- WOOD FENCE (WF)
- HEDGE LINE
- EVERGREEN TREE
- DECIDUOUS TREE
- CONCRETE
- ASPHALT
- GRAVEL

SURVEY NOTES:

1. HORIZONTAL DATUM: NAD83-2011 EPOCH 2010.00 ESTABLISHED BY OBSERVATIONS TO THE WASHINGTON STATE REFERENCE NETWORK.
2. BASIS OF POSITION: HELD THE FOUND CONCRETE MONUMENT WITH 2" BRASS DISK, IN CASE, AT THE CENTERLINE INTERSECTION OF SE 27TH STREET AND 72ND AVE SE. (SEE MAP FOR LOCATION)
3. BASIS OF POSITION: HELD THE BEARING OF N01°16'44"E BETWEEN THE ABOVE NOTED BASIS OF POSITION AND FOUND CONCRETE MONUMENT WITH BRASS PIN, IN CASE, AT THE CENTERLINE INTERSECTION OF SE 24TH ST AND 72ND AVE SE. (SEE MAP FOR LOCATION)
- THIS SURVEY HOLDS RECORD OF SURVEY RECORDED IN VOLUME 449 OF SURVEYS, PAGE 13, FOR THE BLOCK SHOWN HEREON.
- A ROTATION OF 00°00'10" WAS APPLIED TO THE SURVEY IN TO BE ON THE ABOVE NOTED DATUM
4. THE FOLLOWING INFORMATION WAS ALSO REFERENCED IN PREPARING THE BOUNDARY SHOWN HERE ON:
 - A) RECORD OF SURVEY AS RECORDED IN VOLUME 396 OF SURVEYS, PAGE 297, RECORDS OF KING COUNTY, WA.
 - B) MCGILVRA'S ISLAND ADDITION, ACCORDING TO THE PLAT THEREOF RECORDED IN VOLUME 16 OF PLATS, PAGE 58, RECORDS OF KING COUNTY, WASHINGTON.
 - C) KING COUNTY ASSESSOR'S MAP FOR THE NORTHWEST QUARTER OF SECTION 12, TOWNSHIP 24N, RANGE 4E, W.M.
5. VERTICAL DATUM: NAVD 88
- MASTER BENCHMARK: WASHINGTON STATE REFERENCE NETWORK. ELEVATION WAS DETERMINED BY GNSS OBSERVATIONS ON SITE BM #1.
- SITE BM #1: SET MAG NAIL WITH TAG IN ASPHALT 2.5 FEET WEST OF WEST FOG LINE ON 72ND AVE SE, +/- 30' SOUTHEAST OF FIRE HYDRANT. ELEVATION= 242.28 FEET
6. TRAVERSING AND DATA COLLECTION WERE PERFORMED USING A SPECTRA AND/OR TRIMBLE 5 SECOND TOTAL STATION. ALL FIELD WORK WAS PERFORMED, AND EQUIPMENT MAINTAINED, IN COMPLIANCE WITH WAC 332-130.
- ADDITIONAL FIELD WORK WAS PERFORMED USING SPECTRA SP-80 GNSS POSITIONING SYSTEMS, THE WASHINGTON STATE REFERENCE NETWORK, AND/OR THE NATIONAL GEODETIC SURVEY'S ONLINE POSITIONING USER SERVICE (OPUS).
7. ALL DISTANCES SHOWN HEREON ARE GROUND DISTANCES UNLESS OTHERWISE NOTED.
8. MONUMENTS SHOWN AS FOUND AND TOPOGRAPHIC INFORMATION SHOWN HEREON ARE THE RESULT OF A SURVEY BY ENCOMPASS, COMPLETED IN JANUARY 2022.
9. THIS SURVEY WAS PERFORMED WITHOUT THE BENEFIT OF A TITLE REPORT. OTHER EASEMENTS AND ENCUMBRANCES MAY EXIST ON THIS PROPERTY THAT ARE NOT SHOWN HEREON.
10. THE LEGAL DESCRIPTION SHOWN HEREON IS PER STATUTORY WARRANTY DEED AS RECORDED UNDER RECORDING NO. 20161129002481, RECORDS OF PIERCE COUNTY, WASHINGTON.
11. THE SUBJECT PROPERTY CONTAINS 7,200 SQUARE FEET OR 0.165 ACRES MORE OR LESS.
12. THE PURPOSE OF THIS EXHIBIT IS TO SHOW EXISTING CONDITIONS ON THE SUBJECT PROPERTY.
13. THE AVERAGE CONTOUR ELEVATION WITHIN THE VICINITY OF THE BUILDING FOOTPRINT IS ACCURATE WITHIN 6 INCHES VERTICALLY AND HORIZONTALLY FROM ACTUAL ELEVATIONS.


REVISIONS	DESCRIPTION	BY	DATE

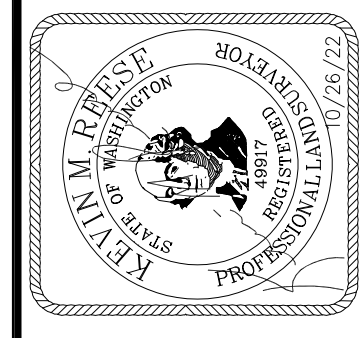

BOUNDARY TOPOGRAPHIC SURVEY
FOR
MU HU

Encompass
 ENGINEERING & SURVEYING
 Western Washington Division
 165 NE Juniper Street, Suite 201 • Issaquah, WA 98027 • Phone: (509) 674-7433 • Fax: (425) 391-3055
 Eastern Washington Division
 407 Stillwater Blvd. • Cle Elum, WA 98922 • Phone: (509) 674-7433 • Fax: (509) 674-7419


JOB NO.	21782
DATE	10/26/22
SCALE	1" = 10'
DESIGNED	N/A
DRAWN	LFM
CHECKED	JLS
APPROVED	KMR
SHEET	1 OF 1

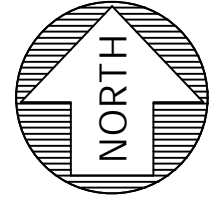

SCALE 1" = 10'

HU RESIDENCE

SE 1/4 OF SE 1/4 OF SECTION 12, T. 24 N., R. 04 E., W.M.
CITY OF MERCER ISLAND, KING COUNTY, STATE OF WASHINGTON

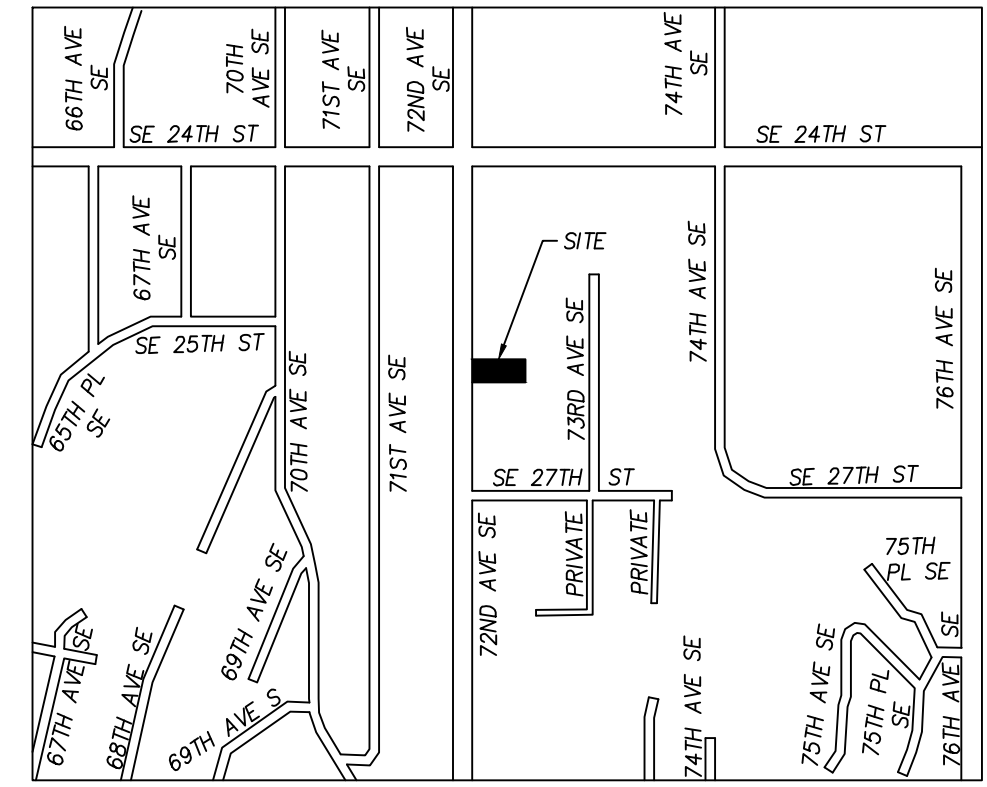

VICINITY MAP
NTS

PROJECT TEAM:

OWNER: HU MU
2448 72ND AVE SE
MERCER ISLAND, WA 98040
(469) 396-6167

**CIVIL ENGINEER/
SURVEYOR:** BRIANA BENNINGTON, PE / KEVIN REESE, PLS
ENCOMPASS ENGINEERING & SURVEYING
165 N.E. JUNIPER STREET, SUITE 201
ISSAQUAH, WA 98027
(425) 392-0250

ARCHITECT: PAUL MONSEF, RA
ATERA DESIGN STUDIO, LLC
451 DUVALL AVE NE, SUITE 115
RENTON, WA 98059
(425) 306-2758

**GEOTECHNICAL
ENGINEER:** MARC MCGINNIS, PE
GEOTECH CONSULTANTS, INC.
2401 10TH AVE E
SEATTLE, WA 98102
(425) 747-5618

SITE DATA:

SITE ADDRESS: 2448 72ND AVE SE
MERCER ISLAND, WA 98040

SITE AREA: 7,200 SF (0.165 AC) - AS SURVEYED

TAX PARCEL: 531510-0366

UTILITY DISTRICT INFORMATION:

WATER/SEWER: CITY OF MERCER ISLAND (206) 275-7608

FIRE DISTRICT: MERCER ISLAND FIRE DEPARTMENT (206) 275-7607

CABLE TV: COMCAST (800) 934-6489

GAS/ELECTRIC: PUGET SOUND ENERGY (888) 321-7779

ZONING INFORMATION:

ZONING: R-9.6

FRONT YARD SETBACK: 20'

SIDE YARD SETBACK: 10'

REAR YARD SETBACK: 25'

ON-SITE IMPERVIOUS COVERAGE:

HOUSE (ROOF): 2,383 SF

UNCOVERED PAVEMENT: 45 SF

UNCOVERED CONCRETE DRIVEWAY (ON-SITE): 444 SF

TOTAL: 2,872 SF (39.89%)

*NOTE: AN ADDITIONAL 312 SF OF PROPOSED ASPHALT DRIVEWAY IS LOCATED OFF-SITE IN THE PUBLIC ROW.

LEGAL DESCRIPTION:

THE SOUTH 60 FEET OF THE WEST 120 FEET OF LOT 4, BLOCK 5, MCGILVRA'S ISLAND ADDITION, ACCORDING TO THE PLAT THEREOF, RECORDED IN VOLUME 16 OF PLATS, PAGE 58, IN KING COUNTY, WASHINGTON;

TOGETHER WITH AN EASEMENT FOR ROAD AND UTILITY PURPOSES OVER THE SOUTH 17.33 FEET OF THE NORTH 77.33 FEET OF THE WEST 120 FEET OF SAID LOT 4, BLOCK 5, MCGILVRA'S ISLAND ADDITION.

EXISTING UTILITY NOTE:

ALL LOCATIONS OF EXISTING UTILITIES SHOWN HEREON HAVE BEEN ESTABLISHED BY FIELD SURVEY OR OBTAINED FROM AVAILABLE RECORDS AND SHOULD THEREFORE BE CONSIDERED APPROXIMATE ONLY AND NOT NECESSARILY COMPLETE. IT IS THE SOLE RESPONSIBILITY OF THE CONTRACTOR TO INDEPENDENTLY VERIFY THE ACCURACY OF ALL UTILITY LOCATIONS SHOWN AND TO FURTHER DISCOVER AND AVOID ANY OTHER UTILITIES NOT SHOWN HEREON WHICH MAY BE AFFECTED BY THE IMPLEMENTATION OF THIS PLAN.

CONTRACTOR RESPONSIBILITY:

CONTRACTOR AGREES THAT HE SHALL ASSUME SOLE AND COMPLETE RESPONSIBILITY FOR JOB SITE CONDITIONS, INCLUDING THE SAFETY OF ALL PERSONS AND PROPERTY, DURING THE COURSE OF CONSTRUCTION OF THIS PROJECT, AND THAT THIS REQUIREMENT SHALL APPLY CONTINUOUSLY AND NOT BE LIMITED TO NORMAL WORKING HOURS. THE CONTRACTOR SHALL DEFEND, INDEMNIFY AND HOLD THE OWNER AND THE ENGINEER HARMLESS FROM ANY AND ALL LIABILITY, REAL OR ALLEGED, IN CONNECTION WITH THE PERFORMANCE OF WORK ON THIS PROJECT, EXCEPTING FOR LIABILITY ARISING FROM THE SOLE NEGLIGENCE OF THE OWNER OR THE ENGINEER.

DISCREPANCIES:


IF THERE ARE ANY DISCREPANCIES BETWEEN DIMENSIONS IN DRAWINGS AND EXISTING CONDITIONS WHICH WILL AFFECT THE WORK, THE CONTRACTOR SHALL BRING SUCH DISCREPANCIES TO THE ATTENTION OF THE ENGINEER FOR ADJUSTMENT BEFORE PROCEEDING WITH THE WORK. THE CONTRACTOR SHALL BE RESPONSIBLE FOR THE PROPER FITTING OF ALL WORK AND FOR THE COORDINATION OF ALL TRADES, SUBCONTRACTORS, AND PERSONS ENGAGED UPON THIS CONTRACT.

GENERAL NOTES:

- SPECIAL INSPECTIONS BY CITY INSPECTOR ARE REQUIRED DURING CONSTRUCTION. GENERAL CONTRACTOR TO COORDINATE.
- ALL EXISTING ON-SITE STRUCTURES AND ASSOCIATED UTILITIES TO BE DEMOLISHED, REMOVED, AND/OR ABANDONED PER APPLICABLE JURISDICTIONAL REQUIREMENTS.
- DEFICIENCIES, WHETHER CAUSED BY CONTRACTOR OPERATIONS OR NOT CAUSED BY THE CONTRACTOR'S OPERATIONS SHALL BE REPAIRED IMMEDIATELY.
- THE CONTRACTOR SHALL MAINTAIN ROADS AND STREETS ADJACENT TO THE PROJECT LIMITS WHEN AFFECTED BY THE CONTRACTOR'S OPERATION. THE CONTRACTOR SHALL REMOVE OR REPAIR ANY CONDITION RESULTING FROM THE WORK THAT MIGHT IMPEDE TRAFFIC OR CREATE A HAZARD. PUBLIC ROADWAYS SHALL BE BROOMED CLEAN AT THE END OF EACH WORK DAY.
- THE CONTRACTOR SHALL BE RESPONSIBLE FOR PROVIDING ADEQUATE SAFEGUARDS, SAFETY DEVICES, PROTECTIVE EQUIPMENT, AND ANY OTHER DEEDED ACTIONS TO PROTECT THE LIFE, HEALTH, AND SAFETY OF THE PUBLIC AND PROTECT PROPERTY IN CONNECTION WITH THE PERFORMANCE OF THE WORK COVERED BY THE CONTRACT.
- ROCKERIES AND/OR RETAINING WALLS TO BE CONSTRUCTED PER GEOTECHNICAL AND/OR STRUCTURAL ENGINEER'S PLANS AND SPECIFICATIONS.
- ALL CONSTRUCTION TECHNIQUES AND MATERIALS SHALL BE PER CITY OF MERCER ISLAND STANDARDS/SPECIFICATIONS.

SITE IMPROVEMENT NOTES:

- THE PROPOSED PROJECT CONSISTS OF INSTALLING SITE UTILITIES, INSTALLING THE STRUCTURE FOUNDATIONS, BACKFILLING AND FINAL GRADING. THE WORK WILL REQUIRE THE CONSTRUCTION OF TEMPORARY EROSION AND SEDIMENTATION CONTROL MEASURES. ANY TEMPORARY SHORING AND/OR PERMANENT RETAINING WALLS THAT MAY BE REQUIRED SHALL BE ADDRESSED BY THE PROJECT STRUCTURAL AND GEOTECHNICAL ENGINEERS.
- EXISTING UTILITIES HAVE BEEN SHOWN FOR CONVENIENCE BASED ON SURVEY MAPPING OF THE PROJECT SITE AND ADJACENT CITY RIGHT-OF-WAY. THE CONTRACTOR SHALL LOCATE ALL PRIMARY AND SECONDARY UTILITIES (I.E.: SIDE SEWERS, GAS, ELECTRICAL, COMMUNICATIONS, WATER, STORM DRAINAGE, ETC.) VIA POT-HOLING PRIOR TO CONSTRUCTION. CONFLICTS WITH ANY PROPOSED CONSTRUCTION ELEMENTS SHALL BE RESOLVED PRIOR TO BEGINNING CONSTRUCTION. A CONFLICT IS GENERALLY DEFINED AS A UTILITY THAT IS LOCATED WITHIN A ZONE 3 FEET OR LESS BELOW OR BESIDE, OR 5 FEET OR LESS ABOVE ANY UTILITY.
- PROTECTION OF CITY IMPROVEMENTS WITHIN ROW SHALL TAKE PLACE AT ALL TIMES DURING CONSTRUCTION.
- ANY WORK BEYOND THE LIMITS OF THE PROPERTY LINES SHALL REQUIRE A CONSTRUCTION EASEMENT TO BE REVIEWED AND APPROVED BY THE CITY PRIOR TO BEGINNING CONSTRUCTION.
- SOIL SHALL BE AMENDED PER CITY STANDARDS. SEE SOIL AMENDMENT NOTES ON SHEET 2.
- THE CONTRACTOR SHALL HAVE APPROVED PLANS, STANDARD NOTES, STANDARD DETAILS AND SPECIFICATIONS AVAILABLE ON JOBSITE.

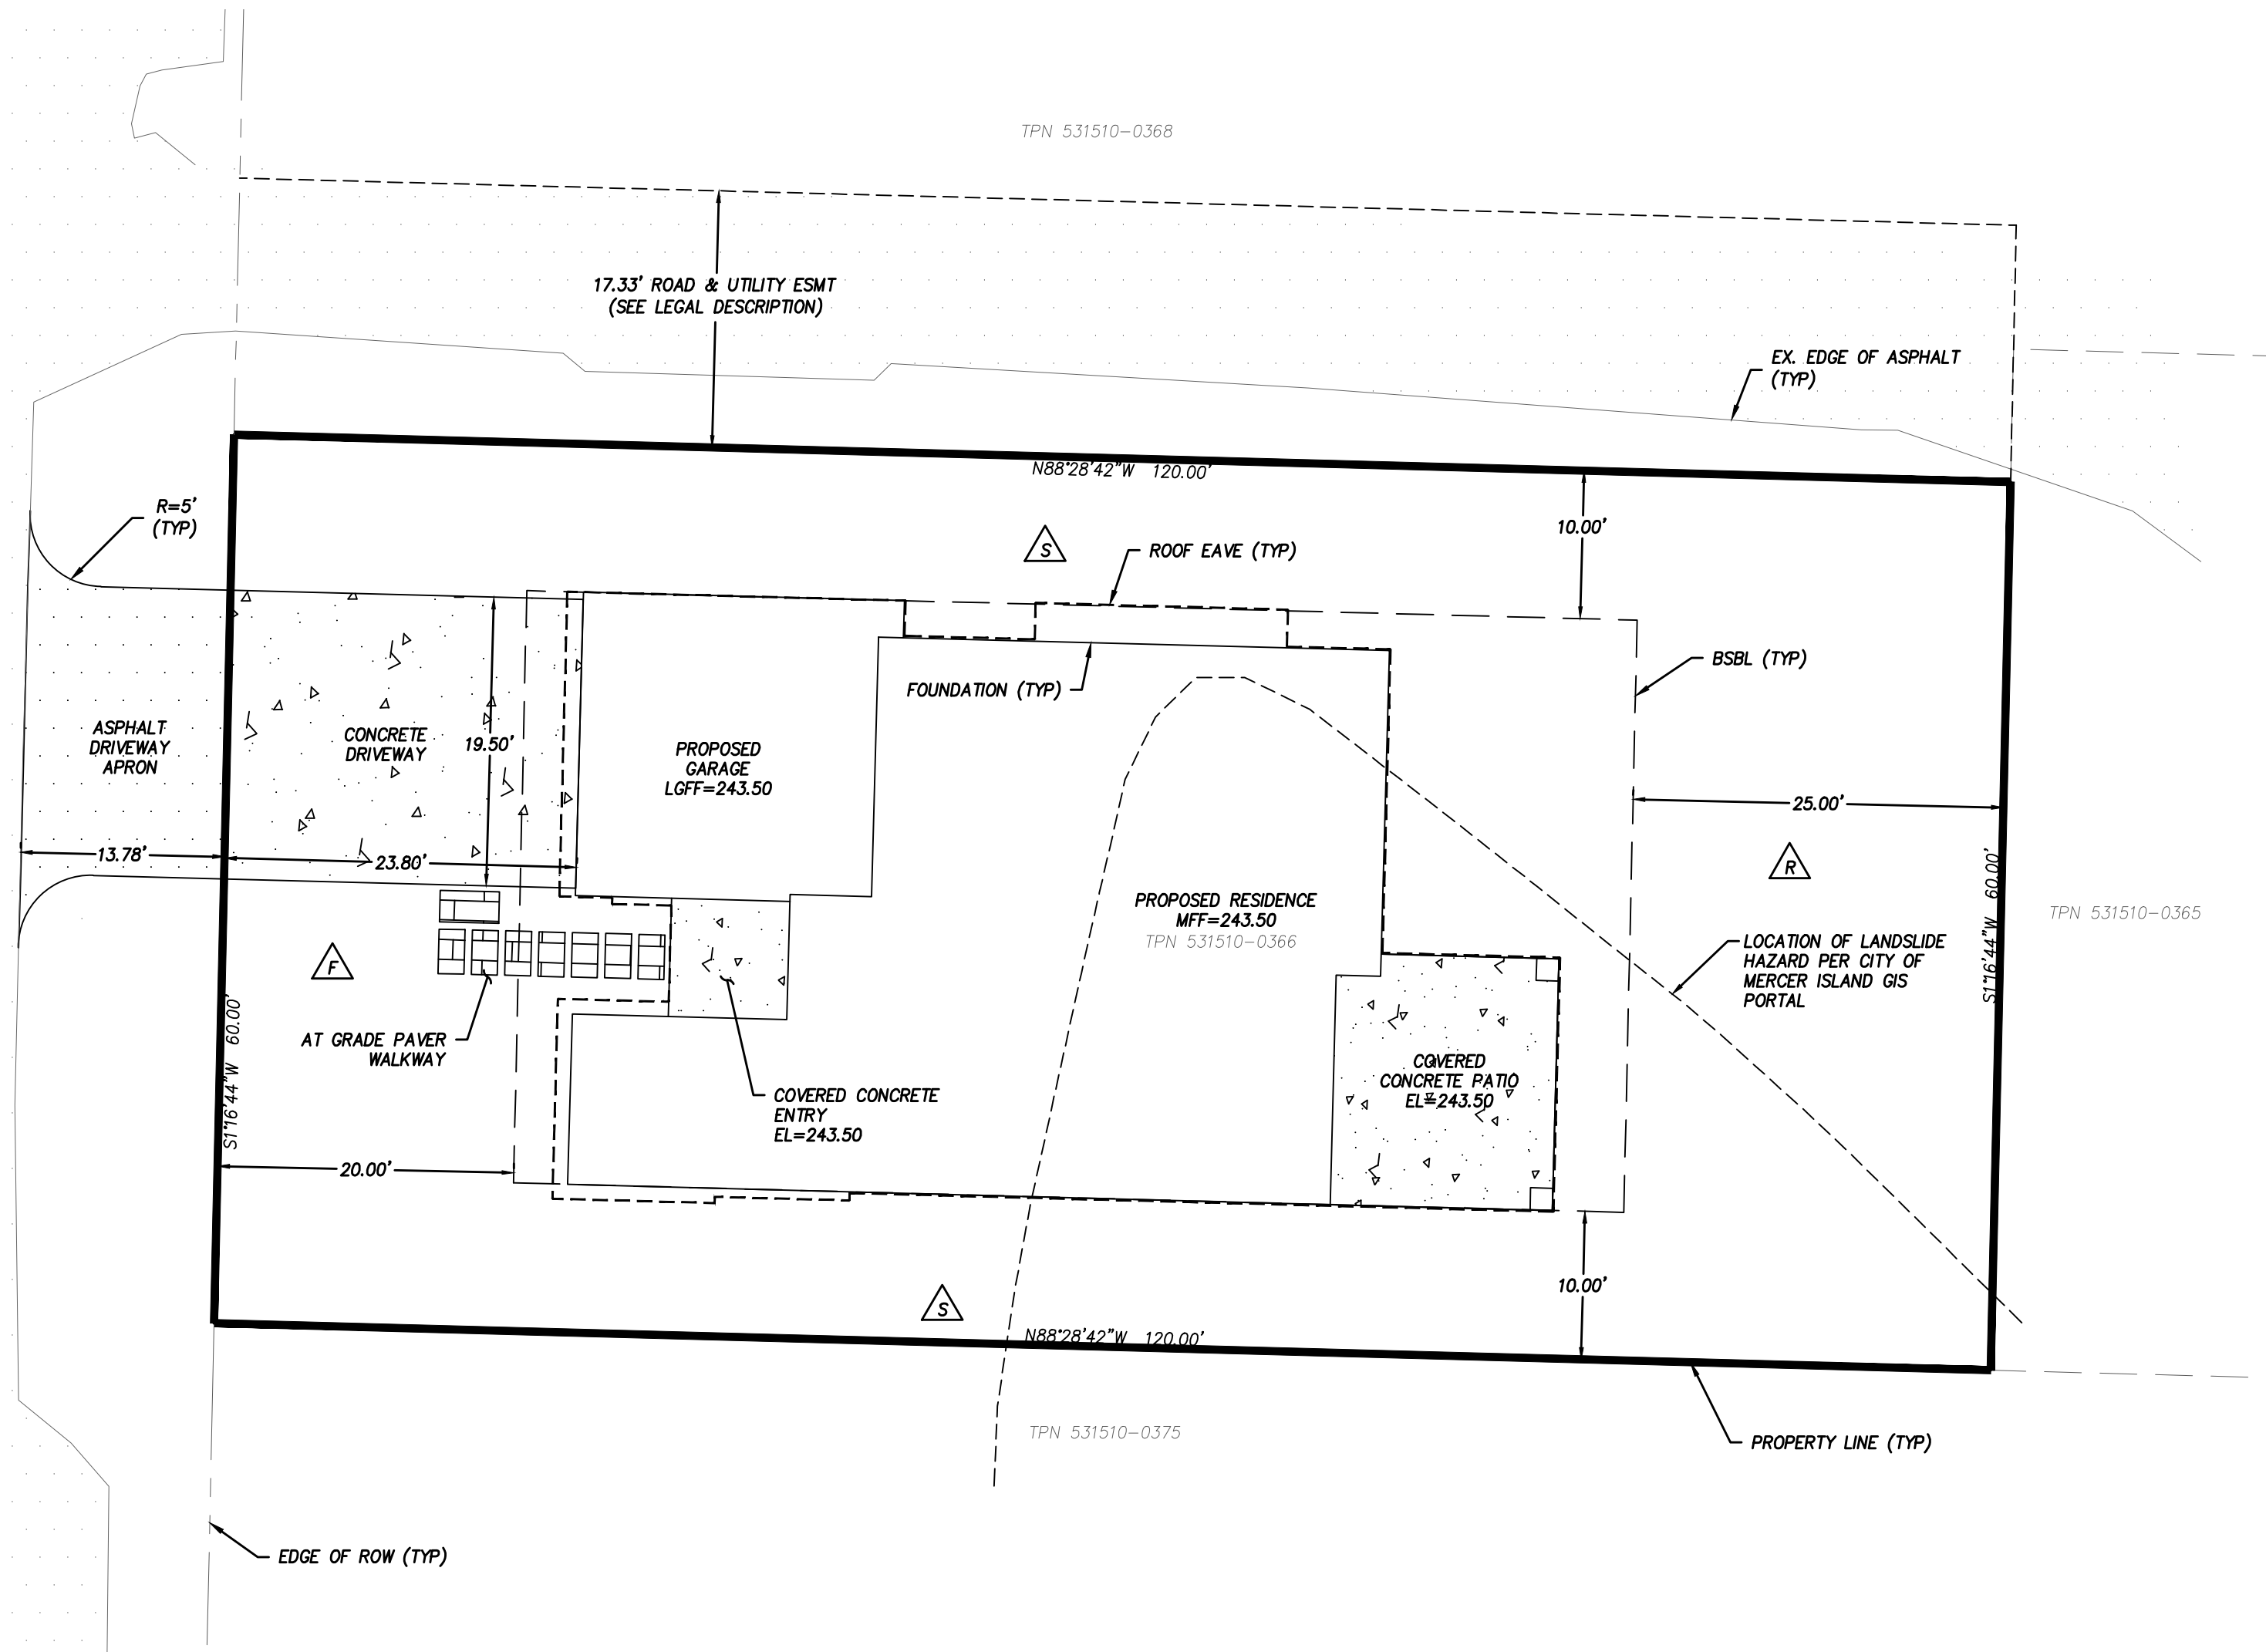

SHEET INDEX:

TITLE	NO.
COVER SHEET & SITE PLAN	1
TESC PLAN	2
TESC DETAILS	3
GRADING & UTILITY PLAN	4
CONSTRUCTION DETAILS	5



05/01/2023

HU RESIDENCE
2448 72ND AVE SE - MERCER ISLAND, WA 98040
COVER SHEET & SITE PLAN

Encompass
ENGINEERING & SURVEYING

Western Washington Division
165 NE Juniper Street, Suite 201 Issaquah, WA 98027 Phone: (425) 392-0250
Eastern Washington Division
407 Swiftwater Blvd. Cle Elum, WA 98922 Phone: (509) 674-7433

JOB NO.	21782
DATE	05/01/2023
SCALE	1"=10'
DESIGNED	BLB
DRAWN	PMS
CHECKED	CP
APPROVED	CP
SHEET	1 of 5




Know what's below.
Call before you dig.

FILENAME: J:\2171782 - HU HU\ENGINEERING\PLAN SHEETS\1 - COVER.DWG

HU RESIDENCE


SE 1/4 OF SE 1/4 OF SECTION 12, T. 24 N., R. 04 E., W.M.
CITY OF MERCER ISLAND, KING COUNTY, STATE OF WASHINGTON

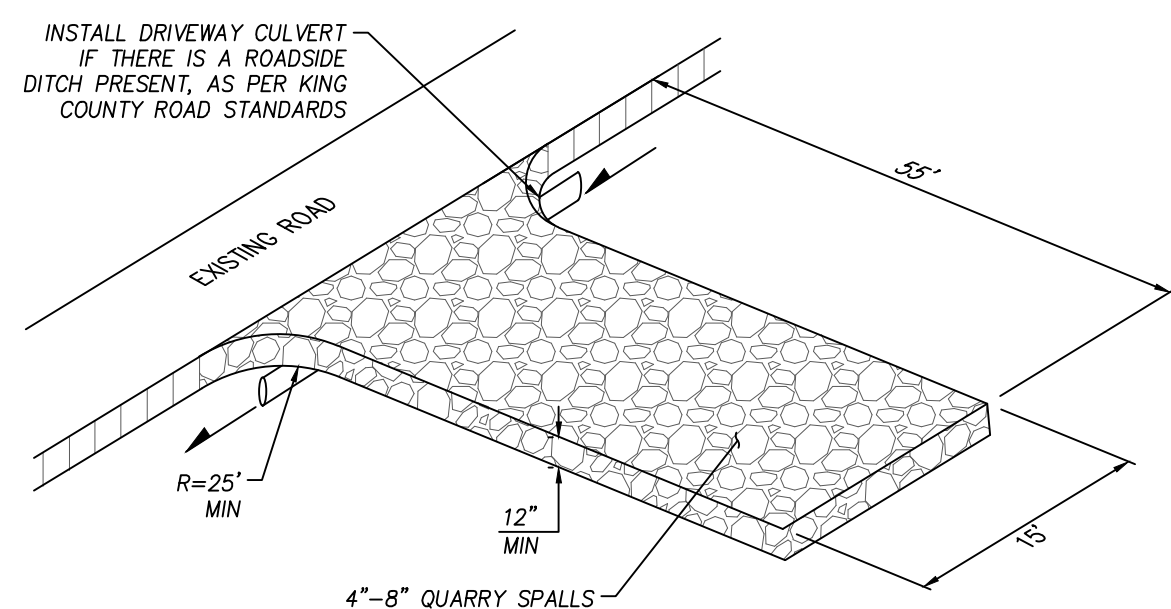

- MAINTENANCE:**
1. QUARRY SPALLS (OR HOG FUEL) SHALL BE ADDED IF THE PAD IS NO LONGER IN ACCORDANCE WITH THE SPECIFICATIONS.
 2. IF THE ENTRANCE IS NOT PREVENTING SEDIMENT FROM BEING TRACKED ONTO PAVEMENT, THEN ALTERNATIVE MEASURES TO KEEP THE STREETS FREE OF SEDIMENT SHALL BE USED. THIS MAY INCLUDE STREET SWEEPING, AN INCREASE IN THE DIMENSIONS OF THE ENTRANCE, OR THE INSTALLATION OF A WHEEL WASH. IF WASHING IS USED, IT SHALL BE DONE ON AN AREA COVERED WITH CRUSHED ROCK, AND WASH WATER SHALL DRAIN TO A SEDIMENT TRAP OR POND.
 3. ANY SEDIMENT THAT IS TRACKED ONTO PAVEMENT SHALL BE REMOVED IMMEDIATELY BY SWEEPING. THE SEDIMENT COLLECTED BY SWEEPING SHALL BE REMOVED OR STABILIZED ON SITE. THE PAVEMENT SHALL NOT BE CLEANED BY WASHING DOWN THE STREET, EXCEPT WHEN SWEEPING IS INEFFECTIVE AND THERE IS A THREAT TO PUBLIC SAFETY. IF IT IS NECESSARY TO WASH THE STREETS, A SMALL SUMP MUST BE CONSTRUCTED. THE SEDIMENT WOULD THEN BE WASHED INTO THE SUMP WHERE IT CAN BE CONTROLLED. WASH WATER MUST BE PUMPED BACK ONTO THE SITE AND CAN NOT DISCHARGE TO SYSTEMS TRIBUTARY TO SURFACE WATERS.
 4. ANY QUARRY SPALLS THAT ARE LOOSENED FROM THE PAD AND END UP ON THE ROADWAY SHALL BE REMOVED IMMEDIATELY.
 5. IF VEHICLES ARE ENTERING OR EXITING THE SITE AT POINTS OTHER THAN THE CONSTRUCTION ENTRANCE(S), FENCING SHALL BE INSTALLED TO CONTROL TRAFFIC.

CONSTRUCTION ENTRANCE DETAIL


NO SCALE

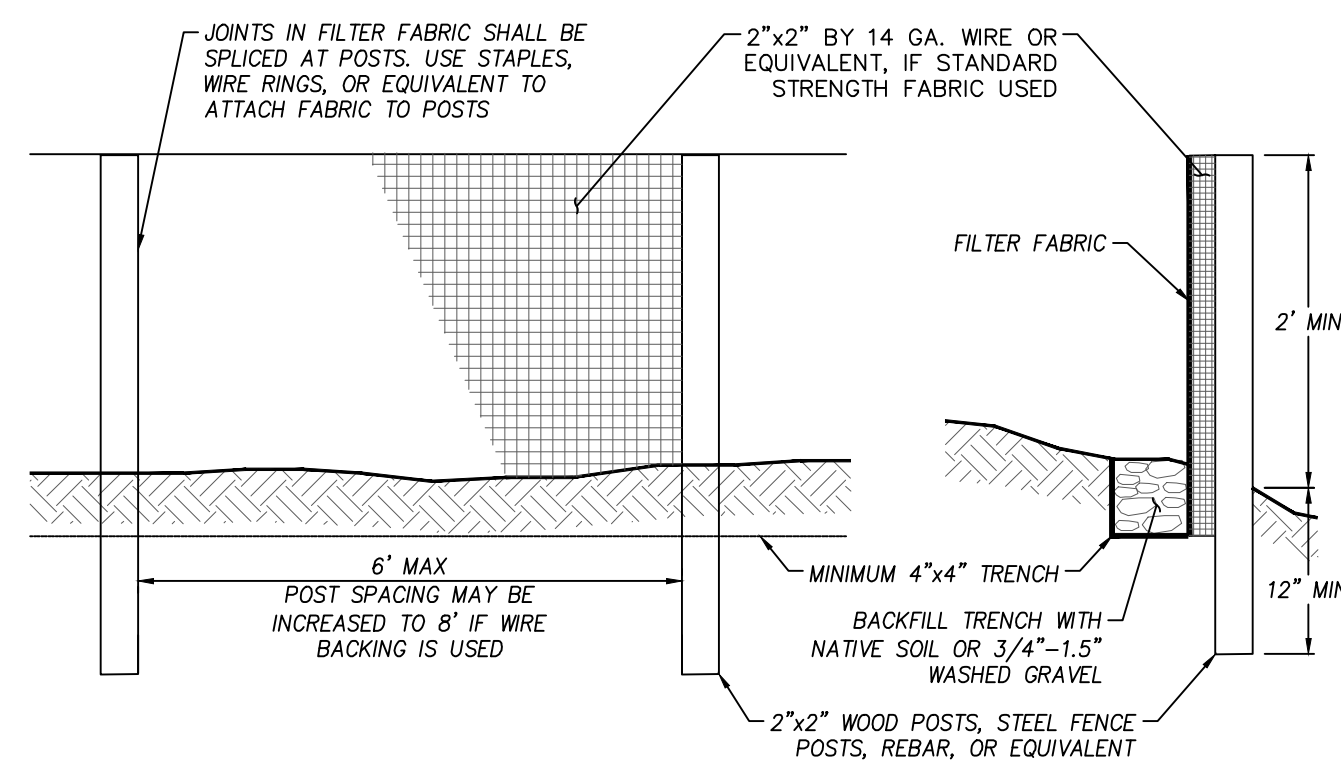

- MAINTENANCE:**
1. ANY DAMAGE SHALL BE REPAIRED IMMEDIATELY.
 2. IF CONCENTRATED FLOWS ARE EVIDENT UPHILL OF THE FENCE, THEY MUST BE INTERCEPTED AND CONVEYED TO A SEDIMENT TRAP OR POND.
 3. IT IS IMPORTANT TO CHECK THE UPHILL SIDE OF THE FENCE FOR SIGNS OF THE FENCE CLOGGING AND ACTING AS A BARRIER TO FLOW AND THEN CAUSING CHANNELIZATION OF FLOWS PARALLEL TO THE FENCE. IF THIS OCCURS, REPLACE THE FENCE OR REMOVE THE TRAPPED SEDIMENT.
 4. SEDIMENT MUST BE REMOVED WHEN THE SEDIMENT IS 6 INCHES HIGH.
 5. IF THE FILTER FABRIC (GEOTEXTILE) HAS DETERIORATED DUE TO ULTRAVIOLET BREAKDOWN, IT SHALL BE REPLACED.

SILT FENCE

NO SCALE

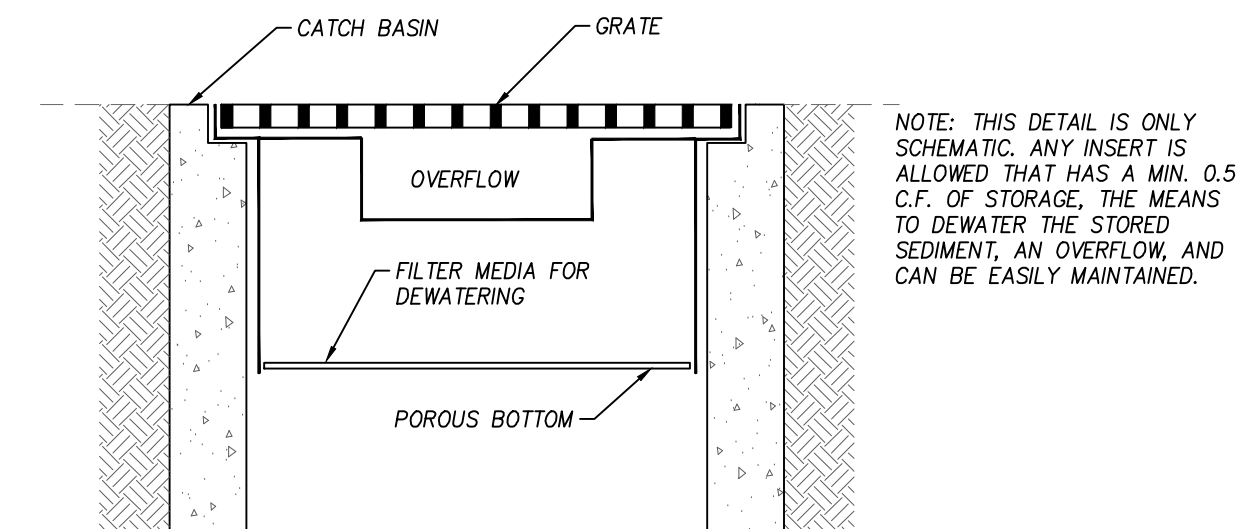


MAINTENANCE STANDARDS

1. ANY ACCUMULATED SEDIMENT ON OR AROUND THE FILTER FABRIC PROTECTION SHALL BE REMOVED IMMEDIATELY. SEDIMENT SHALL NOT BE REMOVED WITH WATER, AND ALL SEDIMENT MUST BE DISPOSED OF AS FILL ON-SITE OR HAULED OFF-SITE.
2. ANY SEDIMENT IN THE CATCH BASIN INSERT SHALL BE REMOVED WHEN THE INSERT HAS FILLED ONE-THIRD OF THE AVAILABLE STORAGE. THE FILTER MEDIA FOR THE INSERT SHALL BE CLEANED OR REPLACED AT LEAST MONTHLY.
3. REGULAR MAINTENANCE IS CRITICAL FOR BOTH FORMS OF CATCH BASIN PROTECTION. UNLIKE MANY FORMS OF PROTECTION THAT FAIL GRADUALLY, CATCH BASIN PROTECTION WILL FAIL SUDDENLY AND COMPLETELY IF NOT MAINTAINED PROPERLY.

CATCH BASIN PROTECTION DETAIL

NO SCALE

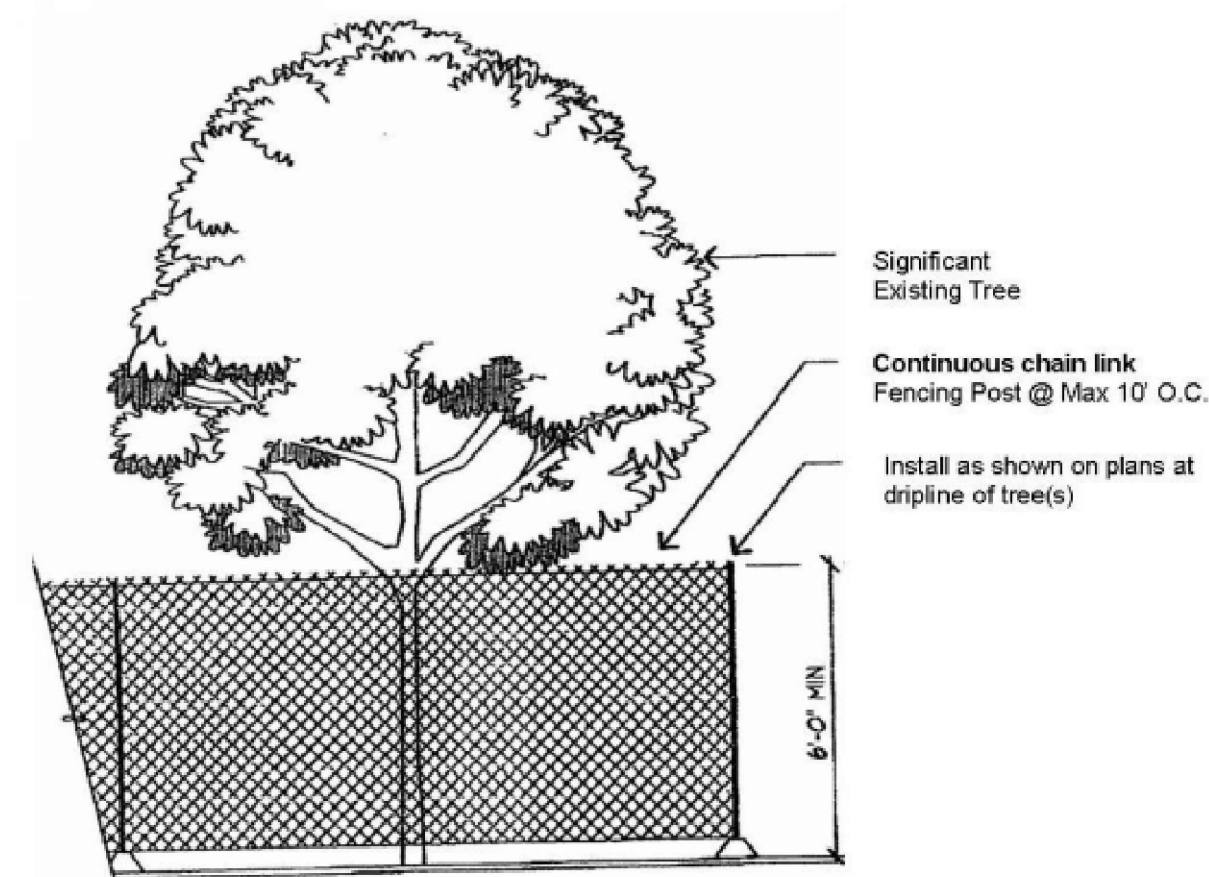

Six-foot high temporary chain link fence shall be placed as shown on plans. Fence shall completely encircle tree(s). Install fence posts using pier blocks only. Avoid driving posts or stakes into major roots.

Make a clean straight cut to remove damaged portion of root for all roots over 1" in diameter damaged during construction. All exposed roots shall be temporarily covered with damp burlap and covered with soils the same day, if possible, to prevent drying. If not possible, burlap must be kept moist at all times.

Work with the protection fencing shall be done manually. No stockpiling of materials, soil, debris, vehicle traffic, or storage of equipment or machinery shall be allowed within the limit of the fencing.


Cement trucks must not be allowed to deposit waste or wash out materials from their trucks within the Tree Protection Fences.

The area within the Tree Protection Fencing must be covered with wood chips, hog fuel, or similar materials to a depth of 8 to 10 inches. The materials should be placed prior to beginning construction and remain until the Tree Protection Fencing is taken down.

TREE PROTECTION FENCE DETAIL

NO SCALE

DESCRIPTION	BY	DATE
REVISED PER CITY COMMENTS #1	BLB	10/27/2022
REVISED PER CITY COMMENTS #2	BLB	03/06/2023
REVISED PER CITY COMMENTS #3	BLB	05/01/2023

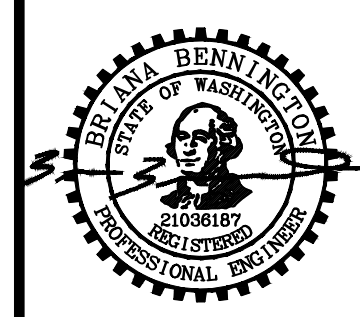

05/01/2023


HU RESIDENCE
2448 72ND AVE SE - MERCER ISLAND, WA 98040
TESC DETAILS

Encompass
ENGINEERING & SURVEYING

Western Washington Division
165 NE Juniper Street, Suite 201 Issaquah, WA 98027 Phone: (425) 407-8800
Eastern Washington Division
407 Swiftwater Blvd. Cle Elum, WA 98922 Phone: (509) 674-7433

JOB NO.	21782
DATE	05/01/2023
SCALE	NTS
DESIGNED	BLB
DRAWN	PMS
CHECKED	CP
APPROVED	CP
SHEET	3 of 5




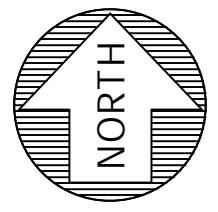

SCALE 1" = 10'

HU RESIDENCE

SE 1/4 OF SE 1/4 OF SECTION 12, T. 24 N., R. 04 E., W.M.
CITY OF MERCER ISLAND, KING COUNTY, STATE OF WASHINGTON

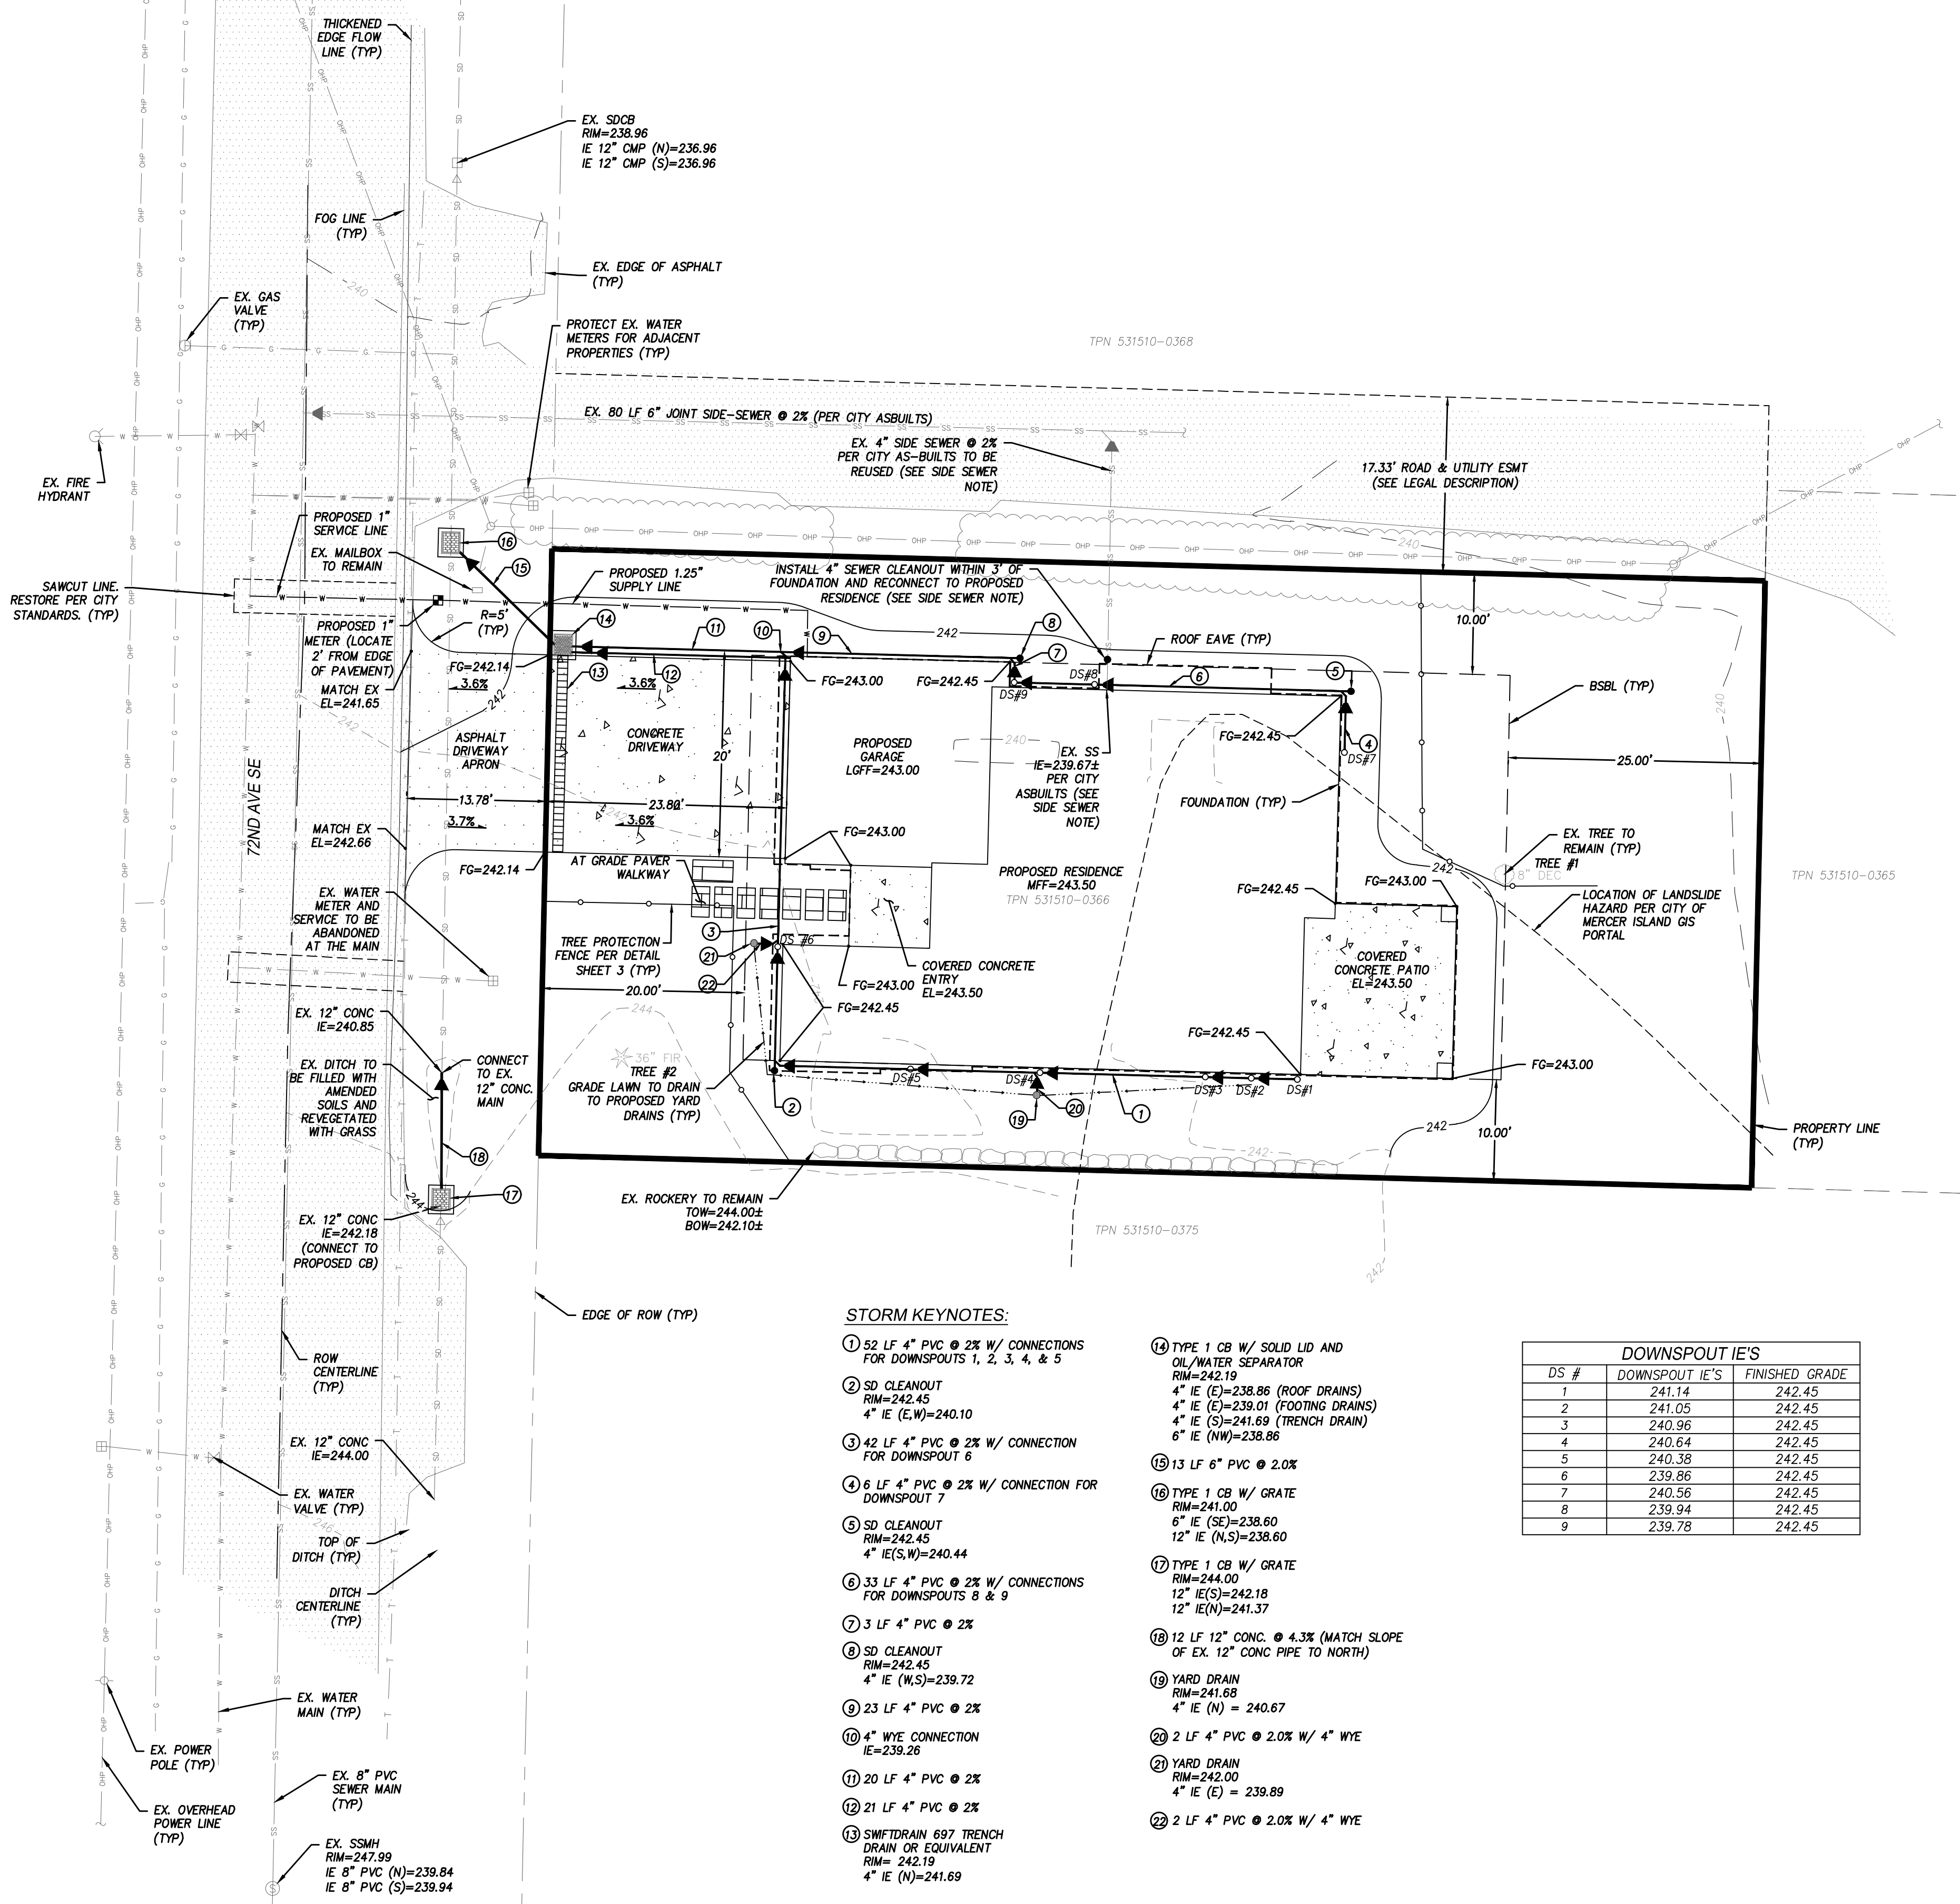

- ### ARCHITECTURAL, STRUCTURAL & GEOTECHNICAL NOTES
- THESE PLANS ARE APPROVED FOR STANDARD ROAD AND DRAINAGE IMPROVEMENTS ONLY. PLANS FOR STRUCTURES SUCH AS RETAINING WALLS REQUIRE A SEPARATE REVIEW AND APPROVAL PRIOR TO CONSTRUCTION.
 - SPECIAL INSPECTIONS FOR GEOTECHNICAL AND/OR STRUCTURAL ASPECTS OF THE PROJECT MAY BE REQUIRED DURING VARIOUS STAGES OF THE PROJECT. CONTRACTOR TO BE RESPONSIBLE FOR COORDINATION AND OBTAINING INSPECTIONS WHEN AND WHERE NECESSARY.
 - SEE ARCHITECTURAL PLANS FOR BUILDING SECTIONS AND ALL LOCATIONAL/DIMENSIONAL ASPECTS OF BUILDINGS.
 - SEE ARCHITECTURAL AND STRUCTURAL PLANS FOR ALL BUILDING AND RETAINING WALL DETAILS.
 - COORDINATE ALL SITE CIVIL CONSTRUCTION WITH ARCHITECTURAL, STRUCTURAL, MECHANICAL/PLUMBING AND LANDSCAPE PLANS AND IN ACCORDANCE WITH GEOTECHNICAL RECOMMENDATIONS.
 - PRIOR TO CONSTRUCTION THE EARTHWORK/GENERAL CONTRACTOR TO BE COMPLETELY FAMILIAR WITH THE GEOTECHNICAL REPORT AND RECOMMENDATIONS. PLEASE REVIEW GEOTECH CONSULTANTS, INC'S REPORT DATED JANUARY 12, 2022 AND CONTACT MARC MCGINNIS, PE ON ANY QUESTIONS OR CONCERNS REGARDING HIS RECOMMENDATIONS.

- ### STRUCTURAL NOTES
- THESE PLANS ARE APPROVED FOR STANDARD ROAD AND DRAINAGE IMPROVEMENTS ONLY. PLANS FOR STRUCTURES MAY REQUIRE A SEPARATE REVIEW AND APPROVAL.
 - ROCKERIES ARE CONSIDERED TO BE A METHOD OF BANK STABILIZATION AND EROSION CONTROL. ROCKERIES SHALL NOT BE CONSTRUCTED TO SERVE AS RETAINING WALLS. GEOTECHNICAL ENGINEERING MAY BE NECESSARY.

BUILDING STAKING NOTE:

CONTRACTOR TO USE ARCHITECTURAL PLANS FOR ACCURATE LOCATION & CONSTRUCTION STAKING OF ALL SITE IMPROVEMENTS SUCH AS BUILDINGS, DRIVEWAYS, WALLS, WALKS, PATIOS & OTHER APPURTENANCES ON THE PROPERTY.

- ### DRAINAGE NOTES:
- PROOF OF LIABILITY INSURANCE SHALL BE SUBMITTED TO THE CITY PRIOR TO THE PRECONSTRUCTION MEETING.
 - ALL PIPE AND APPURTENANCES SHALL BE LAID ON A PROPERLY PREPARED FOUNDATION IN ACCORDANCE WITH WSDOT 7-02.3(1). THIS SHALL INCLUDE LEVELING AND COMPACTING THE TRENCH BOTTOM, THE TOP OF THE FOUNDATION MATERIAL, AND ANY REQUIRED PIPE BEDDING, TO A UNIFORM GRADE SO THAT THE ENTIRE PIPE IS SUPPORTED BY A UNIFORMLY DENSE UNYIELDING BASE.
 - STEEL PIPE SHALL BE GALVANIZED AND HAVE ASPHALT TREATMENT #1 OR BETTER INSIDE AND OUTSIDE (KCRS 7.03).
 - ALL DRAINAGE STRUCTURES, SUCH AS CATCH BASINS AND MANHOLES, NOT LOCATED WITHIN A TRAVELED ROADWAY OR SIDEWALK, SHALL HAVE SOLID LOCKING LIDS. ALL DRAINAGE STRUCTURES ASSOCIATED WITH A PERMANENT RETENTION/DETENTION FACILITY SHALL HAVE SOLID LOCKING LIDS.
 - ALL CATCH BASIN GRATES SHALL BE STAMPED "OUTFALL TO STREAM, DUMP NO POLLUTANTS".
 - ALL DRIVEWAY CULVERTS LOCATED WITHIN RIGHT-OF-WAY SHALL BE OF SUFFICIENT LENGTH TO PROVIDE A MINIMUM 3:1 SLOPE FROM THE EDGE OF THE DRIVEWAY TO THE BOTTOM OF THE DITCH. CULVERTS SHALL HAVE BEVELED END SECTIONS TO MATCH THE SIDE SLOPE.
 - ROCK FOR EROSION PROTECTION OF ROADWAY DITCHES, WHERE REQUIRED, MUST BE OF SOUND QUARRY ROCK, PLACED TO A DEPTH OF 1 FOOT, AND MUST MEET THE FOLLOWING SPECIFICATIONS: 4" - 8" ROCK/40%-70% PASSING; 2" - 4" ROCK/30%-40% PASSING; AND -2" ROCK/10%-20% PASSING.

- ### GRADING NOTES:
- ALL CUT MATERIAL GENERATED DURING THE PROJECT THAT IS NOT ACCEPTABLE FOR USE AS COMPACTED FILL MATERIAL AT ANOTHER LOCATION ON-SITE MUST BE HAULED TO AN APPROVED LOCATION OFF-SITE.
 - THE ON-SITE TOPOGRAPHICAL MAPPING WAS PROVIDED BY ENCOMPASS ENGINEERING & SURVEYING.
 - ALL TEMPORARY OR PERMANENT SLOPES SHALL NOT EXCEED 2.5H:1V UNLESS APPROVED BY A GEOTECHNICAL ENGINEER.
 - FILL MATERIAL PLACED UNDER BUILDING FOUNDATIONS OR PAVEMENT SHALL BE CRUSHED BASE ROCK OR COMPACTED STRUCTURAL FILL IN ACCORDANCE TO WSDOT STANDARD SPECIFICATIONS.
 - ROCKERY AND/OR RETAINING WALLS GREATER THAN FOUR (4) FEET IN HEIGHT REQUIRES A BUILDING PERMIT.
 - IT WILL BE THE PERMITEE'S RESPONSIBILITY TO SUCCESSFULLY CAP AND ABANDON ALL EXISTING UTILITIES WITHIN THE DEVELOPMENT IN ACCORDANCE TO THE GOVERNING UTILITY AGENCY.

SIDE SEWER NOTE:

CCTV INSPECTION OF THE EXISTING 4" SIDE SEWER TO THE MAIN IS REQUIRED TO BE PROVIDED TO THE CITY PRIOR TO REUSE. IF THE RESULT OF THE INSPECTION IS NOT IN SATISFACTORY CONDITION, AS DETERMINED BY THE INSPECTOR, REPLACEMENT OF THE EXISTING SIDE SEWER IS REQUIRED.

GRADING QUANTITIES:

CUT= 5 CY
FILL= 30 CY
NET= 25 CY± (FILL)
*CONTRACTOR TO VERIFY

SOIL AMENDMENT NOTE:

SOIL AMENDMENT REQUIRED FOR ALL DISTURBED PERVIOUS SURFACES. (APPROXIMATELY 16.6 CY)


FOOTING DRAIN NOTE:

ALL FOOTING DRAINS AROUND THE FOUNDATION ARE TO BE 4" PERFORATED PIPE @ IE = 239.45. DO NOT CONNECT FOOTING DRAINS TO ROOF DRAIN SYSTEM. PIPE FOOTING DRAINS TO PROPOSED ON-SITE CATCH BASIN VIA SOLID 4" PVC @ 2% MINIMUM SLOPE (SEE STORM KEYNOTE 12).

- ### STORM KEYNOTES:
- 52 LF 4" PVC @ 2% W/ CONNECTIONS FOR DOWNSPOUTS 1, 2, 3, 4, & 5
 - SD CLEANOUT RIM=242.45 4" IE (E)=238.86 (ROOF DRAINS) 4" IE (E)=239.01 (FOOTING DRAINS) 4" IE (S)=241.69 (TRENCH DRAIN) 6" IE (NW)=238.86
 - 42 LF 4" PVC @ 2% W/ CONNECTION FOR DOWNSPOUT 6
 - 6 LF 4" PVC @ 2% W/ CONNECTION FOR DOWNSPOUT 7
 - SD CLEANOUT RIM=242.45 4" IE(S)=240.44
 - 33 LF 4" PVC @ 2% W/ CONNECTIONS FOR DOWNSPOUTS 8 & 9
 - 3 LF 4" PVC @ 2%
 - SD CLEANOUT RIM=242.45 4" IE (W,S)=239.72
 - 23 LF 4" PVC @ 2%
 - 4" WYE CONNECTION RIM=239.26
 - 20 LF 4" PVC @ 2%
 - 21 LF 4" PVC @ 2%
 - SMFT DRAIN 697 TRENCH DRAIN OR EQUIVALENT RIM= 242.19 4" IE (N)=241.69
 - TYPE 1 CB W/ SOLID LID AND OIL/WATER SEPARATOR RIM=242.19 4" IE (E)=238.86 (ROOF DRAINS) 4" IE (E)=239.01 (FOOTING DRAINS) 4" IE (S)=241.69 (TRENCH DRAIN) 6" IE (NW)=238.86
 - 13 LF 6" PVC @ 2.0%
 - TYPE 1 CB W/ GRATE RIM=241.00 6" IE (SE)=238.60 12" IE (N,S)=238.60
 - TYPE 1 CB W/ GRATE RIM=244.00 12" IE(S)=242.18 12" IE(N)=241.37
 - 12 LF 12" CONC. @ 4.3% (MATCH SLOPE OF EX. 12" CONC PIPE TO NORTH)
 - YARD DRAIN RIM=241.68 4" IE (N) = 240.67
 - 2 LF 4" PVC @ 2.0% W/ 4" WYE
 - YARD DRAIN RIM=242.00 4" IE (E) = 239.89
 - 2 LF 4" PVC @ 2.0% W/ 4" WYE

DS #	DOWNSPOUT IE'S	FINISHED GRADE
1	241.14	242.45
2	241.05	242.45
3	240.96	242.45
4	240.64	242.45
5	240.38	242.45
6	239.86	242.45
7	240.56	242.45
8	239.94	242.45
9	239.78	242.45

REVISIONS	DESCRIPTION	BY	DATE
REVISED PER CITY COMMENTS #1			10/17/2022
REVISED PER CITY COMMENTS #2			03/06/2023
REVISED PER CITY COMMENTS #3			05/01/2023

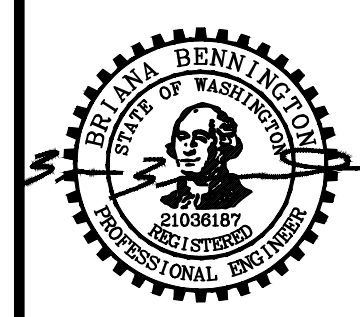

05/01/2023

HU RESIDENCE
2448 72ND AVE SE - MERCER ISLAND, WA 98040
GRADING & DRAINAGE PLAN

Encompass
ENGINEERING & SURVEYING
Western Washington Division
165 NE Juniper Street, Suite 201 Issaquah, WA 98027 Phone: (425) 407-1234
Eastern Washington Division
407 Swiftwater Blvd. Cle Elum, WA 98922 Phone: (509) 674-7433


JOB NO.	21782
DATE	05/01/2023
SCALE	1"=10'
DESIGNED	BLB
DRAWN	PMS
CHECKED	CP
APPROVED	CP
SHEET	4 of 5



FILENAME: J:\2171782 - HU HU\ENGINEERING\PLAN SHEETS\3 - UTILITING

HU RESIDENCE
SE 1/4 OF SE 1/4 OF SECTION 12, T. 24 N., R. 04 E., W.M.
CITY OF MERCER ISLAND, KING COUNTY, STATE OF WASHINGTON

DESCRIPTION	BY	DATE
REVISED PER CITY COMMENTS #1	BLB	10/27/2022
REVISED PER CITY COMMENTS #2	BLB	03/06/2023
REVISED PER CITY COMMENTS #3	BLB	05/01/2023

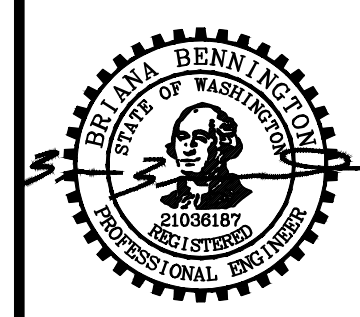


05/01/2023

HU RESIDENCE
2448 72ND AVE SE - MERCER ISLAND, WA 98040
CONSTRUCTION DETAILS

Encompass
ENGINEERING & SURVEYING
Western Washington Division
165 NE Juniper Street, Suite 201 Issaquah, WA 98027 Phone: (425) 407-4400
Eastern Washington Division
407 Swiftwater Blvd. Cle Elum, WA 98922 Phone: (509) 674-7433



JOB NO.	21782
DATE	05/01/2023
SCALE	NTS
DESIGNED	BLB
DRAWN	PMS
CHECKED	CP
APPROVED	CP
SHEET	5 of 5

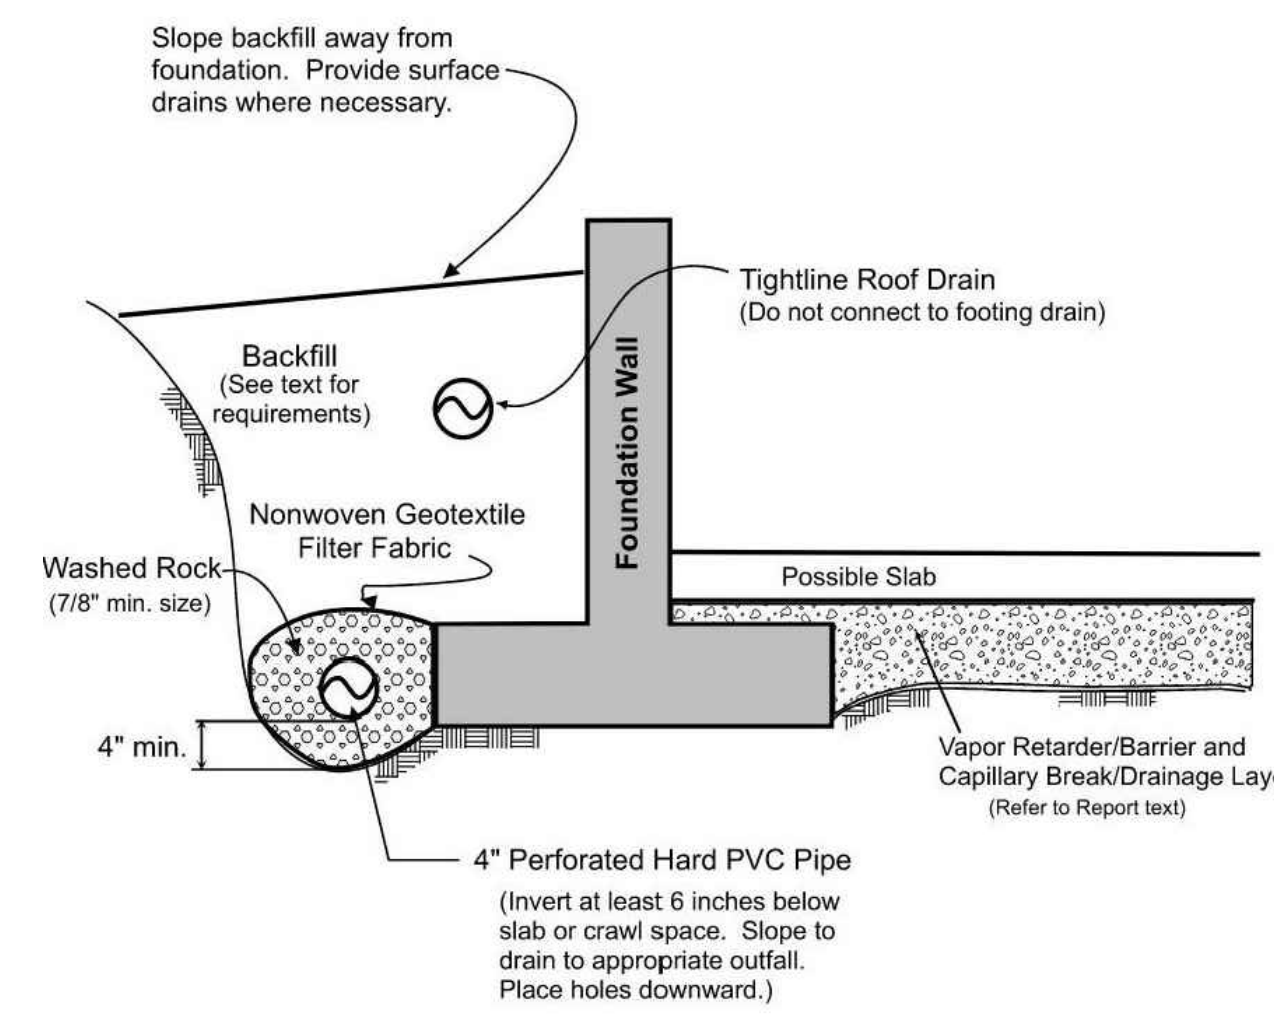

NOTES:

- In crawl spaces, provide an outlet drain to prevent buildup of water that bypasses the perimeter footing drains.
- Refer to report text for additional drainage, waterproofing, and slab considerations.

ROOF/FOOTING DRAIN DETAIL
NO SCALE

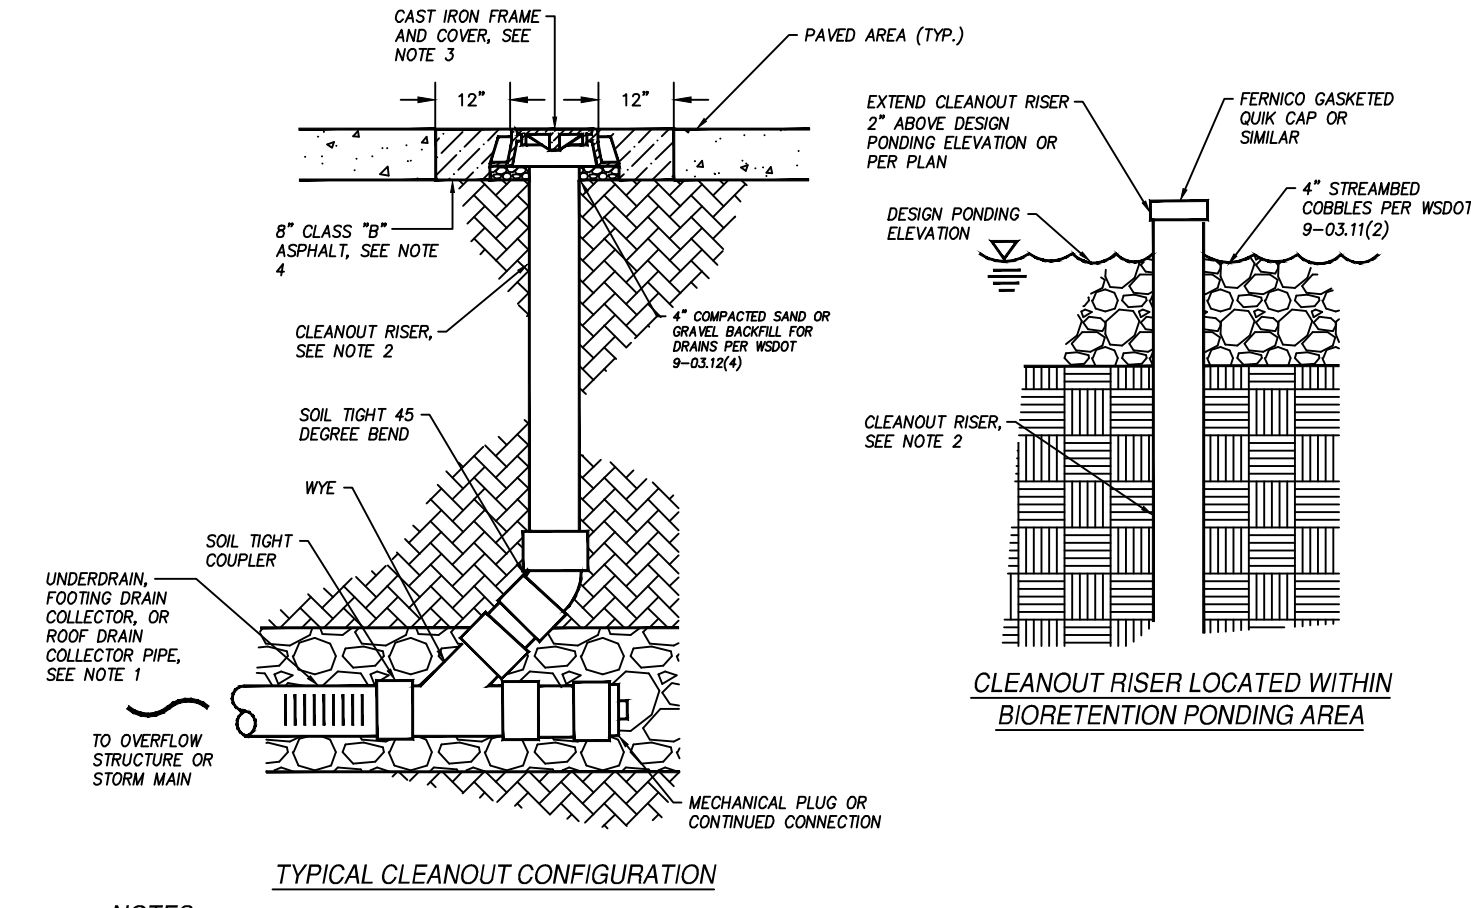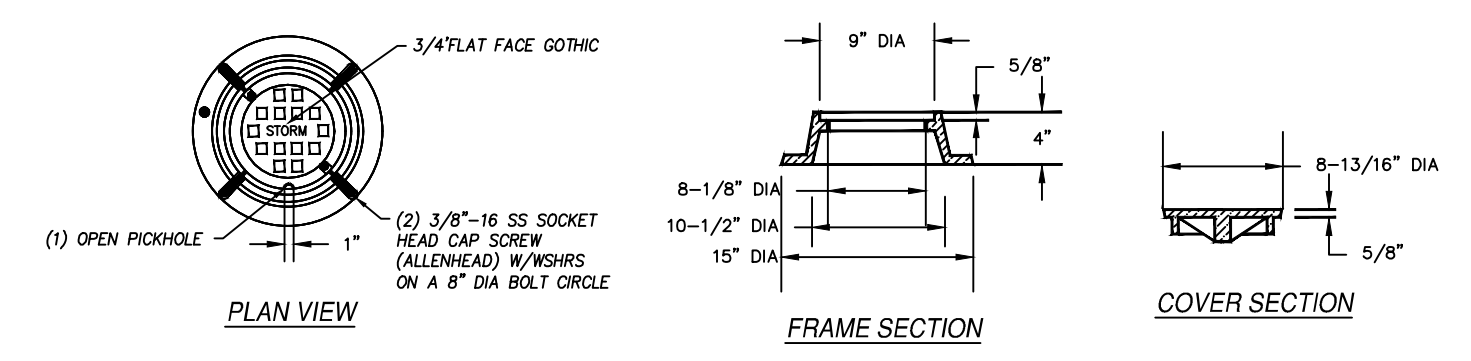


NOTES:

- DIAMETER TO BE 6-INCHES MINIMUM PRIVATE, 8-INCHES MINIMUM PUBLIC UNDERDRAIN PIPE.
- CLEANOUT RISER SHALL BE SAME SIZE AND MATERIAL AS CONNECTED UNDERDRAIN, FOOTING DRAIN COLLECTOR, OR ROOF DRAIN COLLECTOR PIPE.
- FRAME AND COVER SHALL BE E.J. PRODUCT NO. 00367549801 OR APPROVED EQUAL. COVER TO BE LOCKING WITH ALLEN HEAD BOLT, MARKED "STORM".
- FOR CLEANOUTS FULLY OR PARTIALLY WITHIN UNPAVED AREAS OUTSIDE OF BIOTENTION PONDING AREA, POUR 8" THICK, 2'X2' SQUARE CONCRETE COLLAR AROUND FRAME. CONCRETE COLLAR SHALL HAVE A MINIMUM COMPRESSIVE STRENGTH OF 3,000 PSI.

GENERAL NOTES:

- CLEANOUTS FOR UNDERDRAIN, FOOTING DRAIN COLLECTOR, AND ROOF DRAIN COLLECTOR PIPES SHALL BE INSTALLED AT A MINIMUM OF EVERY 100 FEET, AT EVERY 90 DEGREE OR SECOND 45 DEGREE BEND, AT THE END OF EVERY COLLECTOR PIPE, AND AT EACH END OF AN UNDERDRAIN PIPE NOT CONNECTED TO AN OVERFLOW STRUCTURE. CLEANOUTS SHALL BE INSTALLED TO ALLOW FOR MAINTENANCE ACCESS TO ALL PIPES.
- ALL FITTINGS SHALL BE SOIL TIGHT.
- CLEANOUT RISER SHALL BE LOCATED OUTSIDE OF BIOTENTION PONDING WHERE POSSIBLE.
- CLEANOUTS SHALL NOT BE LOCATED WITHIN THE STREET TRAVEL LANE, UNLESS OTHERWISE APPROVED BY THE CITY.

STORM CLEANOUT DETAIL
NO SCALE

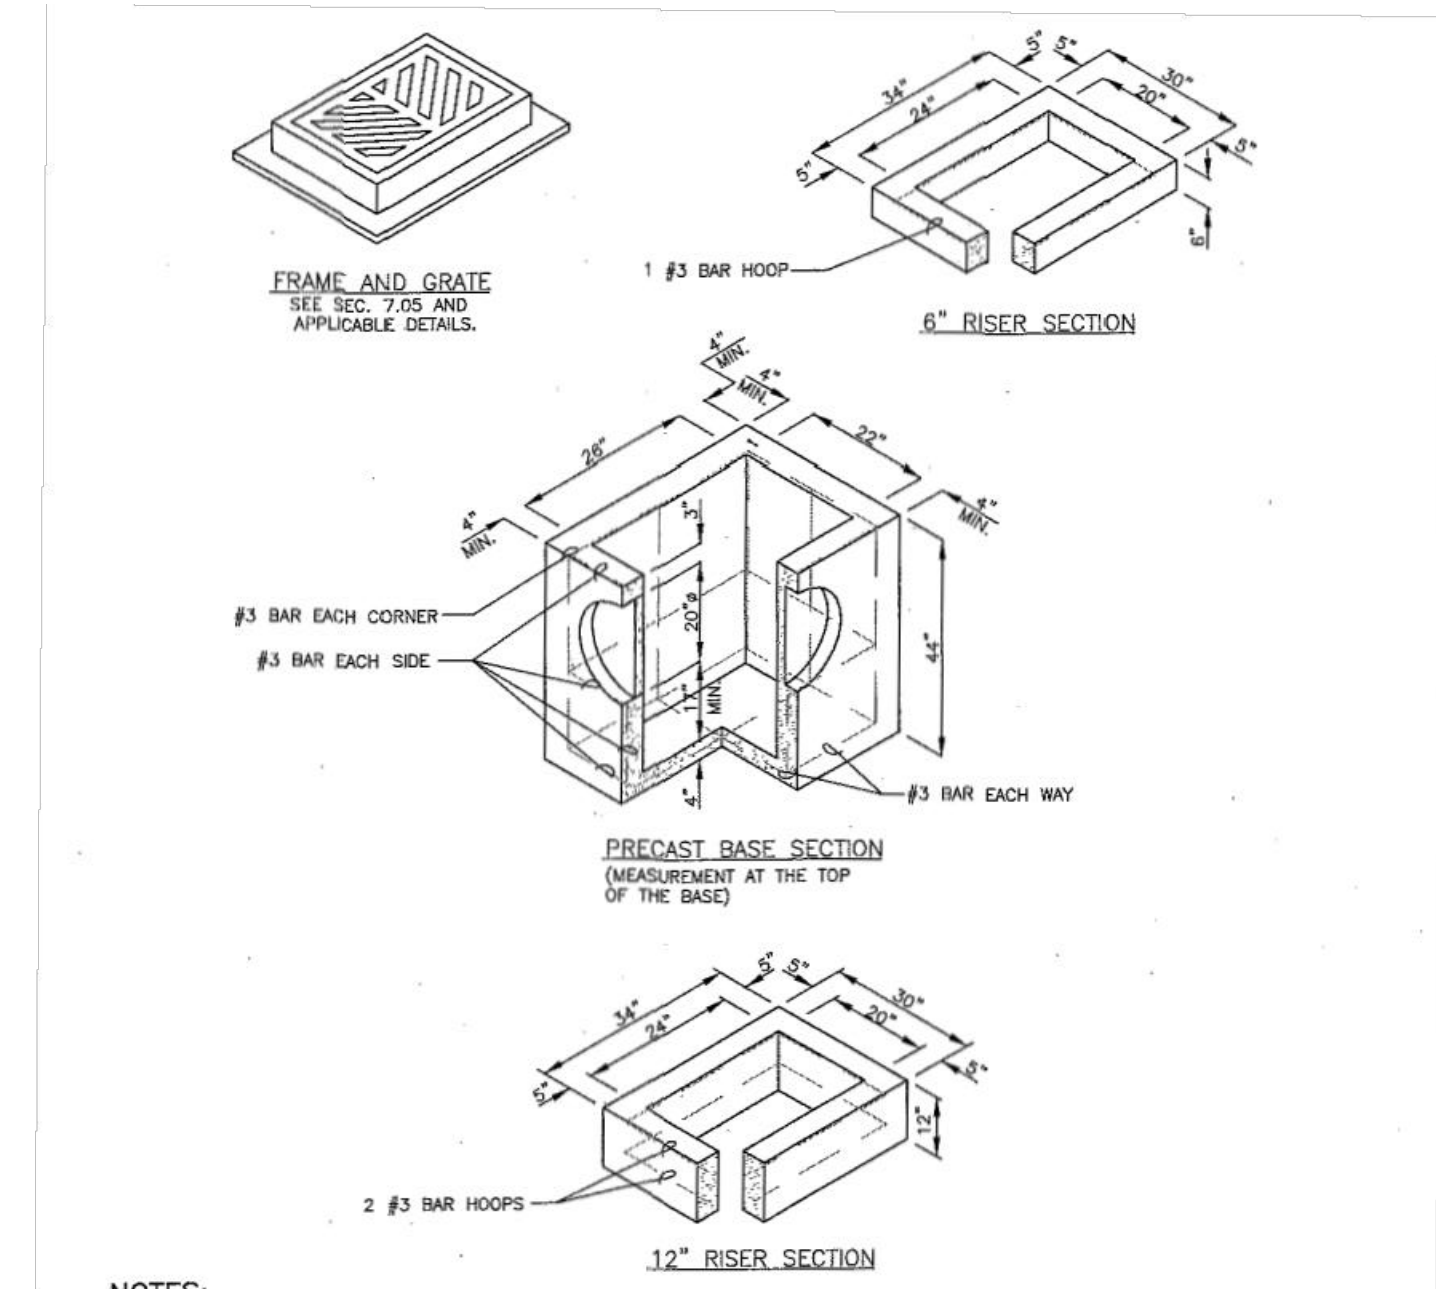

NOTES:


- CATCH BASINS SHALL BE CONSTRUCTED IN ACCORDANCE WITH WSDOT M 199 UNLESS OTHERWISE SHOWN ON PLANS OR NOTED IN THE WSDOT/APWA STANDARD SPECIFICATIONS.
- AS AN ACCEPTABLE ALTERNATIVE TO REBAR, WELDED WIRE FABRIC HAVING A MIN. AREA OF 0.12 SQ. IN. PER FT. MAY BE USED. WELDED WIRE FABRIC SHALL COMPLY TO ASTM A497 (ASTM M 221). WIRE FABRIC SHALL NOT BE PLACED IN KNOCKOUTS.
- ALL REINFORCED CAST-IN-PLACE CONCRETE SHALL BE CLASS 4000.
- PRECAST BASES SHALL BE FURNISHED WITH CUTOUPS OR KNOCKOUTS. KNOCKOUTS SHALL HAVE A WALL THICKNESS OF 2 IN. MIN. ALL PIPE SHALL BE INSTALLED IN FACTORY PROVIDED KNOCKOUTS. UNUSED KNOCKOUTS NEED NOT BE GROUTED IF WALL IS LEFT INTACT.
- KNOCKOUT OR CUTOUP HOLE SIZE IS EQUAL TO PIPE OUTER DIAM. PLUS CATCH BASIN WALL THICKNESS.
- ROUND KNOCKOUTS MAY BE ON ALL 4 SIDES, WITH MAX. DIAM. OF 20 IN. KNOCKOUTS MAY BE EITHER ROUND OR "D" SHAPE.
- THE MAX. DEPTH FROM THE FINISHED GRADE TO THE PIPE INVERT IS 9 FT.
- THE TAPER ON THE SIDES OF THE PRECAST BASE SECTION AND RISER SECTION SHALL NOT EXCEED 1/2" PER FT.
- CATCH BASIN FRAME AND GRATE SHALL BE IN ACCORDANCE WITH STANDARD SPECIFICATIONS AND MEET THE STRENGTH REQUIREMENTS OF FEDERAL SPECIFICATION RR-F-612E. MATING SURFACES SHALL BE FINISHED TO ASSURE NON-ROCKING FIT WITH ANY COVER POSITION.
- FRAME AND GRATE MAY BE INSTALLED WITH FLANGE DOWN OR CAST INTO RISER.
- FOR CATCH BASINS IN PARKING LOTS REFER TO WSDOT/APWA STANDARD DWG. B-5.60-01.
- EDGE OF RISER OR BRICK SHALL NOT BE MORE THAN 2 IN. FROM VERTICAL EDGE OF CATCH BASIN WALL.
- SEE THE WSDOT/APWA STANDARD SPECIFICATIONS SECTION 9-05.15 FOR METAL CASTINGS REQUIREMENTS.

TYPE 1 CATCH BASIN DETAIL
NO SCALE




FILENAME: J:\21782 - HU HU\ENGINEERING\PLAN SHEETS\3 - UTILITY.DWG

No.	Description	Date
1	Sub 2 City Comment Response	03/13/23

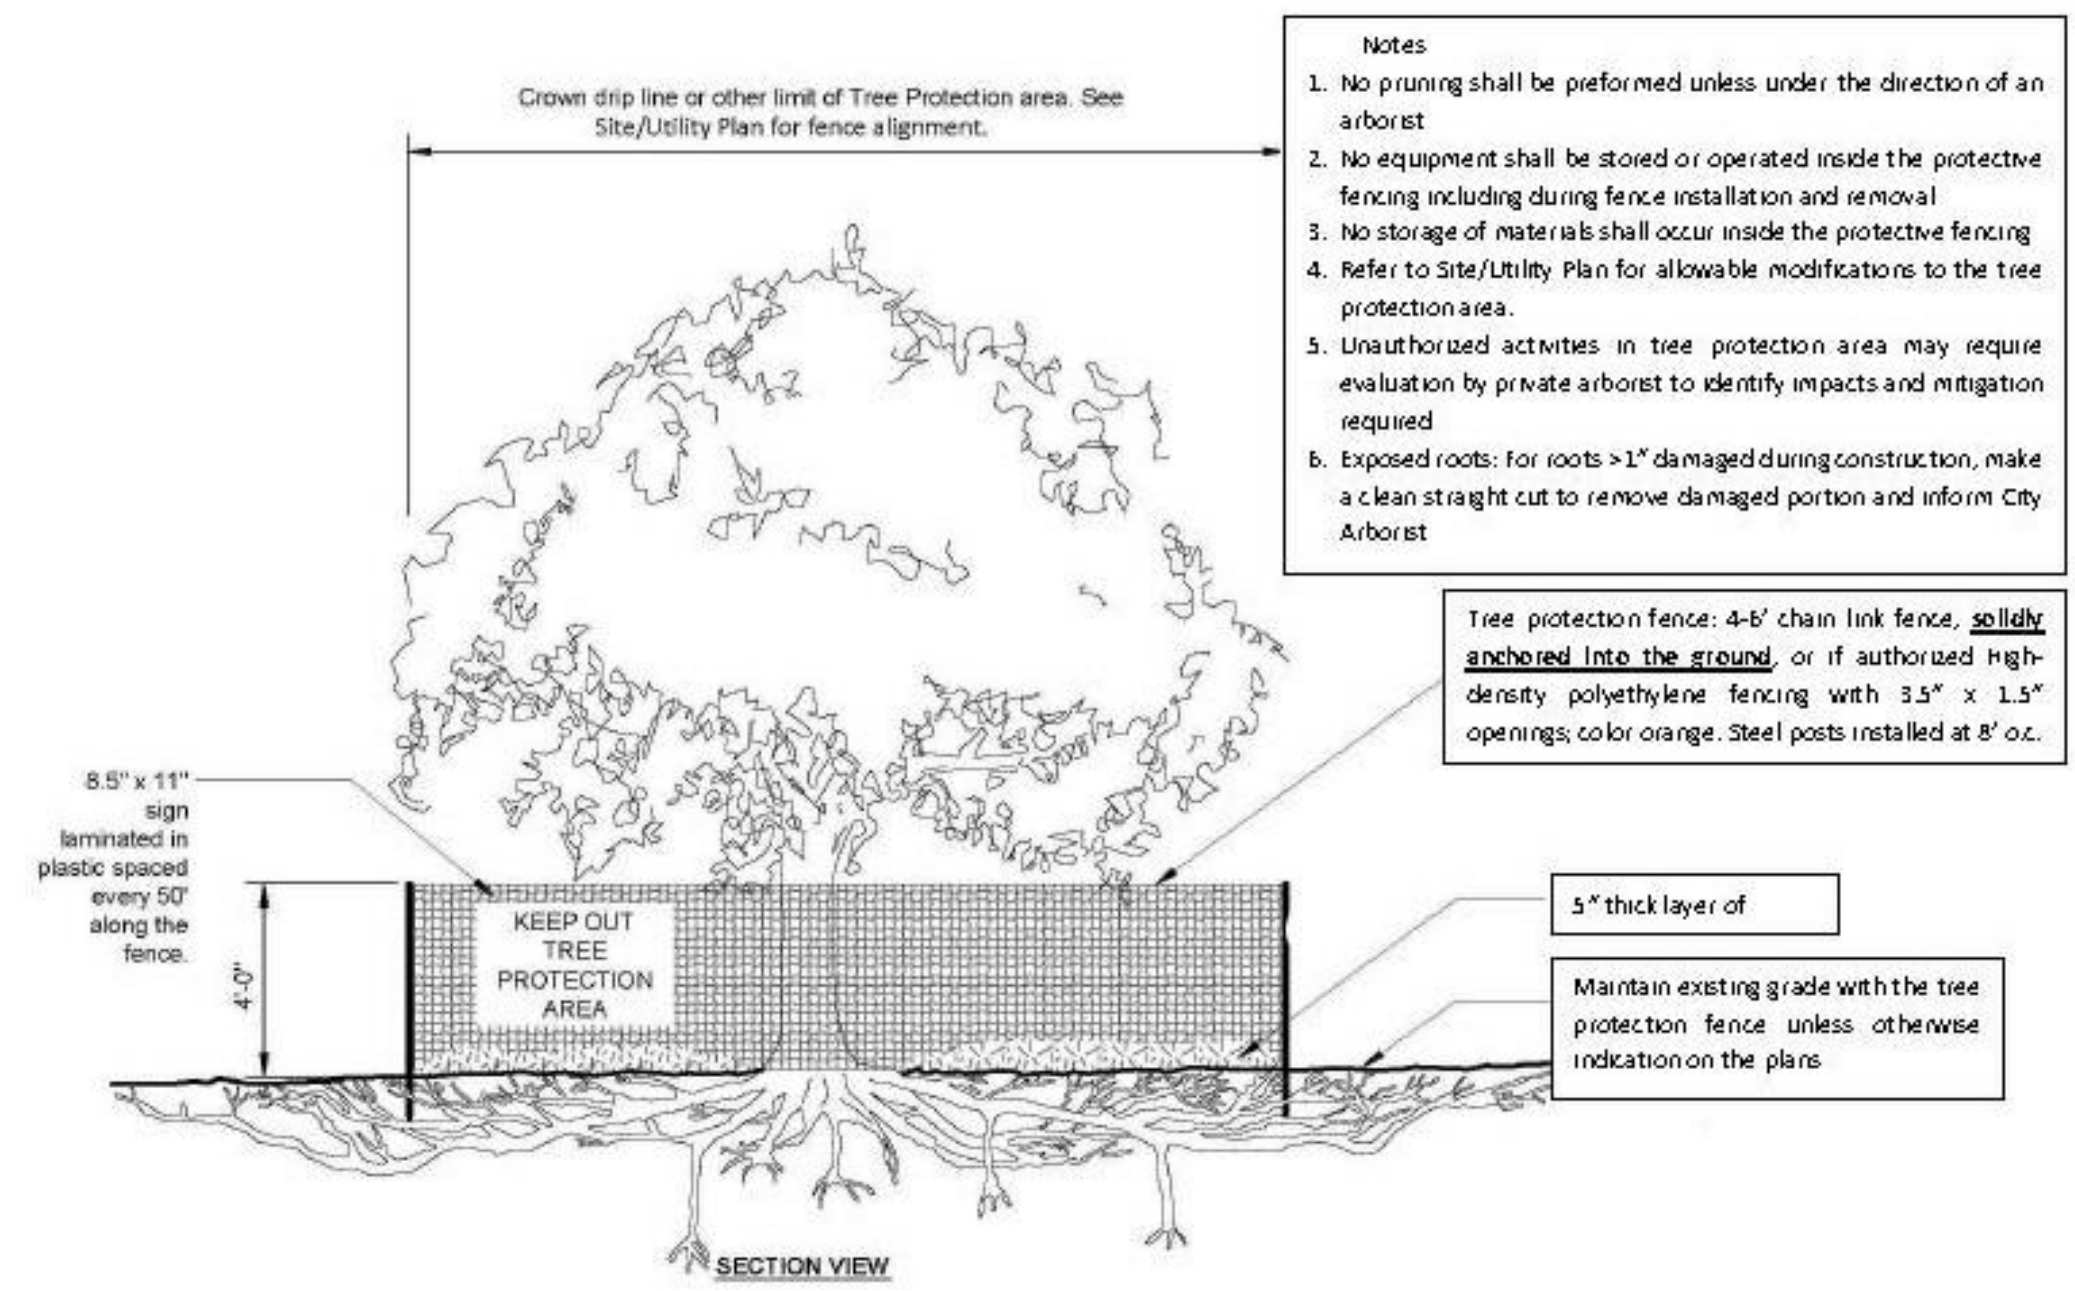

2 Mercer Island Tree Protection Detail
 1/4" = 1'-0"

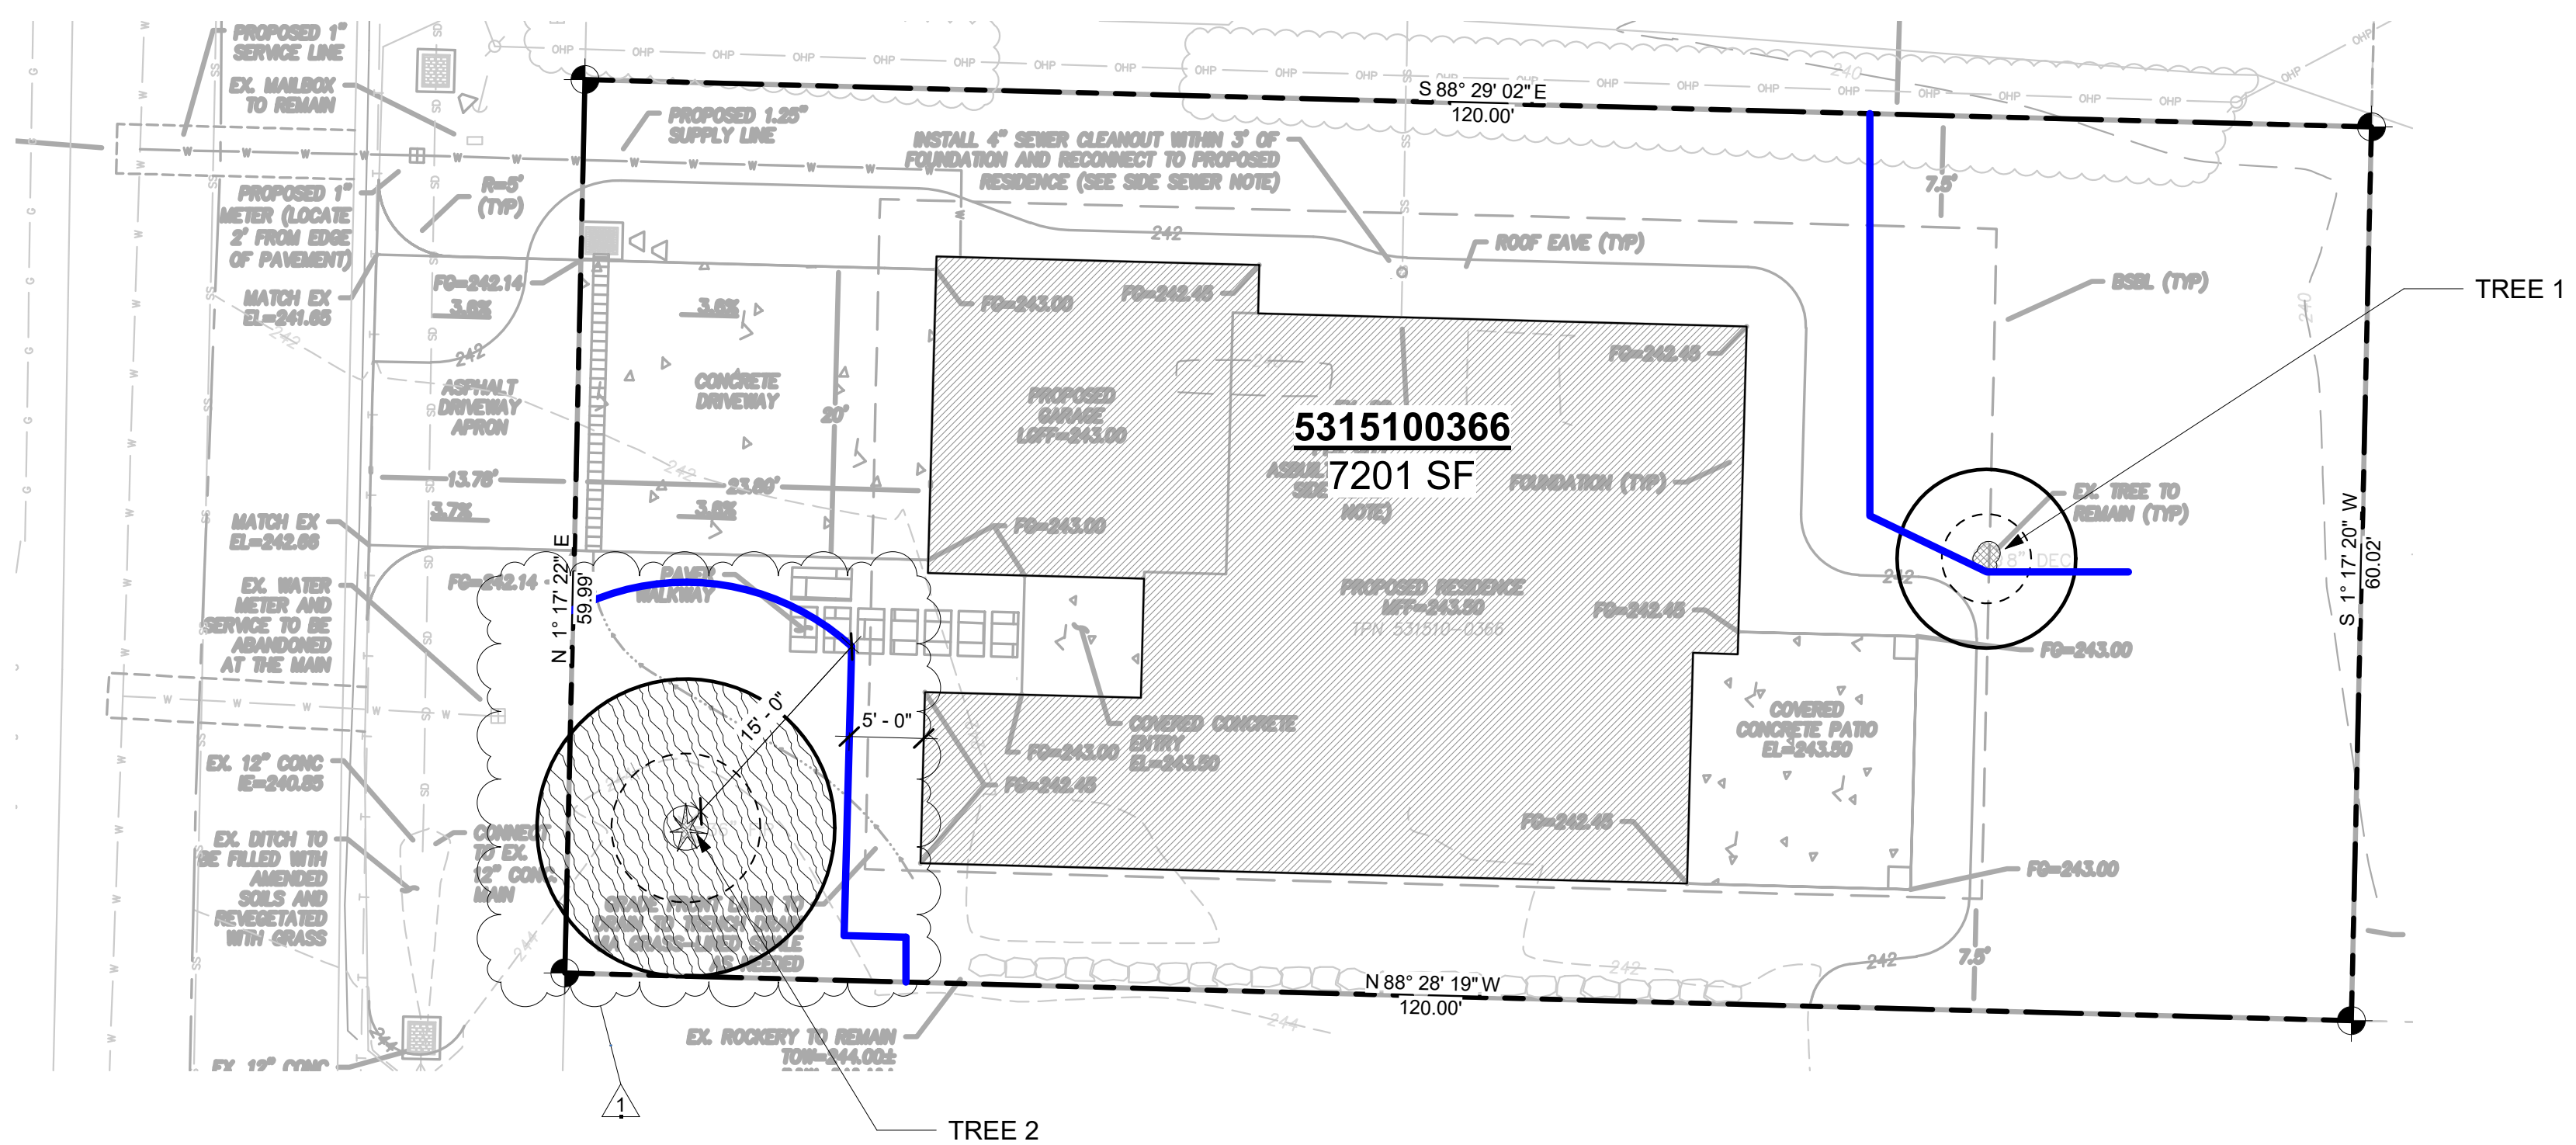

ARBORISTS SITE PLAN
 1" = 10'-0"



	TREE DRIP LINE (DL)
	DIAMETER STANDARD HEIGHT (DSH)
	EVERGREEN TREE
	DECIDUOUS TREE
	TREE TO BE REMOVED
	TREE PROTECTION FENCING
	NEW TREE
	MULCH COVER - 5"-6"

TREE #	TREE TYPE	DBH	DRILINE	CONDITION	RETAIN OR REMOVE
1.	JAPANESE MAPLE <i>ACER PALMATUM</i>	8.8	12'	GOOD	RETAIN
2.	DOUGLAS FIR <i>PSEUDOTSUGA MENZIESII</i>	32	20'	FAIR	RETAIN

PREPARED BY:
 NEAL BAKER
 ARBORISTS NW.COM
 ISA CERT. PN1075A
 TRAQ ISA (TREE RISK ASSESSMENT QUALIFIED)
 MEMBER AREA & SOCA
 PH: 206 779 2579

HU PROJECT

2448 72nd AVE SE Mercer Island, WA.

HU PROJECT

ARBORIST TREE PLAN

Project number	22021
Date	--
Drawn by	CW
Checked by	NB

X100

Scale As indicated

Area Schedule (Energy/Venting Calculations)				
Name	Area	Perimeter	Level	
FLOOR INSUL	1541 SF	180'-0"	Level 1	
CLG - FLAT	507 SF	118'-0"	Level 2	
CLG - FLAT	126 SF	39'-6"	Level 2	
CLG - FLAT	53 SF	25'-6"	Level 2	
FLOOR INSUL	42 SF	33'-0"	Level 2	
FLOOR INSUL	199 SF	64'-0"	Level 2	
CLG - FLAT	482 SF	97'-0"	T.O. PL LVL2	
CLG - VAULT	383 SF	76'-0"	T.O. PL LVL2	
CLG - VAULT	167 SF	48'-0"	T.O. PL LVL2	
CLG - VAULT	103 SF	36'-6"	T.O. PL LVL2	

CRAWL SPACE VENTING									
NAME	AREA	PERIMETER	AREA CALCULATIONS			VENTS REQUIRED		VENTING PROVIDED	
			NET AREA	NET FREE AREA	VENTING REQUIRED	VENT SIZE: 14" x 8" VENT AT .75 EFF	TOTAL VENTS REQUIRED	TOTAL VENTS SHOWN	TOTAL VENTING AREA PROVIDED
1	1404 SF	178'-8"	1404 SF	300	4.68 SF	0.583	8.03	16	9 SF

ROOF VENTING SCHEDULE											
NAME	GROSS AREA	AREA CALCULATIONS			EAVE/PARAPET VENTING			ROOF JACKS			NOTES
		NET VENTABLE AREA	REQUIRED VENTING	% AT EAVES	REQUIRED EAVE	LF OF VENT	PROVIDED	REQUIRED JACKS	# OF JACKS	AREA PROVIDED	
1A	437 SF	0 SF	0.00 SF	0%	0.00 SF	0	0.00 SF	0.00 SF	0	0.00 SF	SPRAY FOAM PER PLANS
1B	38 SF	0 SF	0.00 SF	0%	0.00 SF	0	0.00 SF	0.00 SF	0	0.00 SF	SPRAY FOAM PER PLANS
1C	97 SF	0 SF	0.00 SF	0%	0.00 SF	0	0.00 SF	0.00 SF	0	0.00 SF	SPRAY FOAM PER PLANS
2A	1013 SF	0 SF	0.00 SF	0%	0.00 SF	0	0.00 SF	0.00 SF	0	0.00 SF	SPRAY FOAM PER PLANS

SPRAY FOAM NOTES:

- WHERE SPRAY FOAM IS NOTED ON THE PLANS, NO VENTING IS REQUIRED: PROVIDE MIN 2" CLOSED CELL SPRAY FOAM INSULATION DIRECTLY TO THE UNDERSIDE OF THE ROOF/FLOOR SHEATHING.
- PROVIDE SOLID EAVE BLOCKING, TYP
- A COPY OF THE ICC-ES REPORT FOR THE INSULATION PRODUCT MUST BE PROVIDED ON SITE FOR THE FIELD INSPECTOR. THE APPLIED SPRAY FOAM MUST BE INSTALLED IN ACCORDANCE WITH THE MANUFACTURER'S INSTRUCTIONS BY A CERTIFIED INSTALLER

CRAWL SPACE VENTING NOTES:

- THE UNCONDITIONED, UNDER-FLOOR, SPACE BETWEEN THE BOTTOM OF THE FLOOR JOISTS AND THE EARTH UNDER ANY BUILDING SHALL HAVE VENTILATION OPENINGS THROUGH FOUNDATION WALLS OR EXTERIOR WALLS.
- A GROUND COVER OF SIX MIL (0.006 INCH THICK BLACK POLYETHYLENE OR APPROVED EQUAL SHALL BE LAID OVER THE GROUND WITHIN CRAWL SPACES. THE GROUND COVER SHALL BE OVERLAPPED SIX INCHES MINIMUM AT THE JOINTS AND SHALL EXTEND TO THE FOUNDATION WALL.
- THE MINIMUM NET AREA OF VENTILATION OPENINGS SHALL NOT BE LESS THAN 1 SQUARE FOOT FOR EACH 300 SQUARE FEET OF UNDER-FLOOR AREA. REQUIRED OPENINGS SHALL BE EVENLY PLACED TO PROVIDE CROSS VENTILATION OF THE SPACE EXCEPT ONE SIDE OF THE BUILDING SHALL BE PERMITTED TO HAVE NO VENTILATION OPENINGS.
- VENTILATION OPENINGS SHALL BE COVERED FOR THEIR HEIGHT AND WIDTH WITH ANY OF THE FOLLOWING MATERIALS PROVIDED THAT THE LEAST DIMENSION OF THE COVERING SHALL NOT EXCEED 1/4 INCH:
 - PERFORATED SHEET METAL PLATES NOT LESS THAN 0.070 INCH THICK.
 - EXPANDED SHEET METAL PLATES NOT LESS THAN 0.047 INCH THICK.
 - CAST-IRON GRILL OR GRATING.
 - EXTRUDED LOAD-BEARING BRICK VENTS.
 - HARDWARE CLOTH OF 0.035 INCH (0.89 MM) WIRE OR HEAVIER.
 - CORROSION-RESISTANT WIRE MESH, WITH THE LEAST DIMENSION BEING 1/8 INCH


AREA SCHEDULE ...

NAME	AREA
Garage	435 SF
Main Floor	1539 SF
Upper Floor	1022 SF
Covr'd Patio	246 SF
Covr'd Porch	61 SF
	308 SF
	3303 SF


F.A.R. COVERAGE CALCULATIONS:
 SITE AREA: 7,200.06 SF
 MAX LOT COVERAGE: 45% OF NET LOT AREA, OR 3,000 SF, WHICHEVER IS LESS, 19.02.020, D.3.A.
 PROPOSED FLOOR AREA: 2,996 SF
 PROPOSED F.A.R.: 41.6%




5 WSEC ENERGY CALCS - MAIN
SCALE: 1/16" = 1'-0"

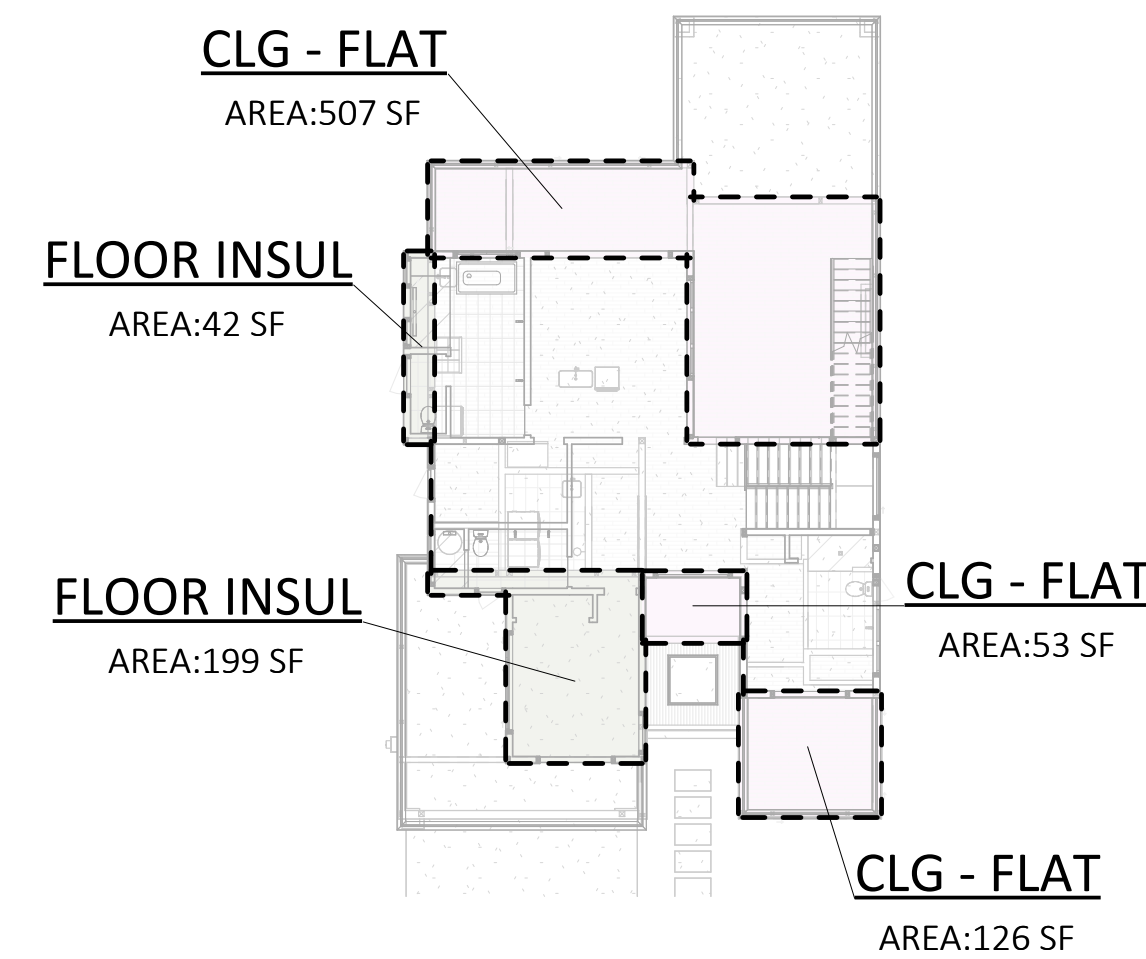


4 WSEC ENERGY CALCS - UPPER
SCALE: 1/16" = 1'-0"

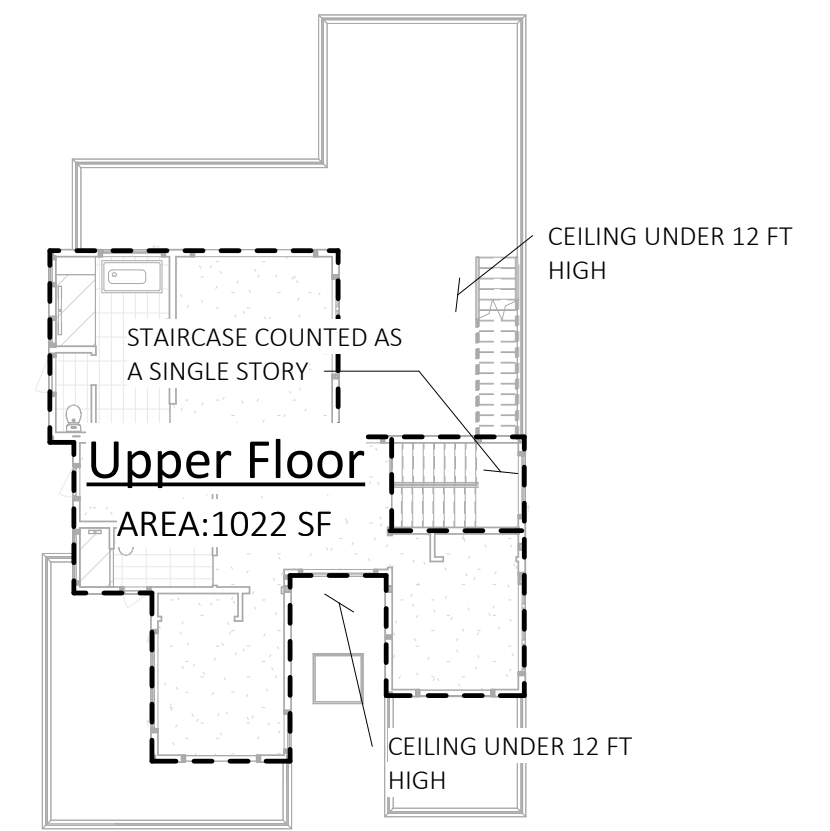


2 GROSS AREA PLAN - UPPER
SCALE: 1/16" = 1'-0"

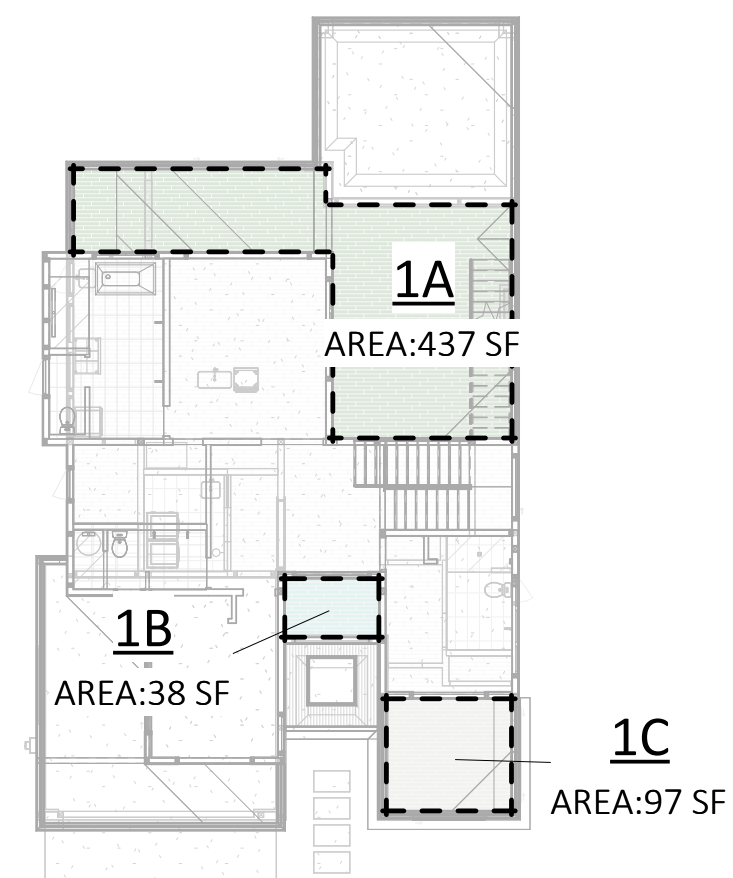


7 ROOF VENTING - MAIN
SCALE: 1/16" = 1'-0"

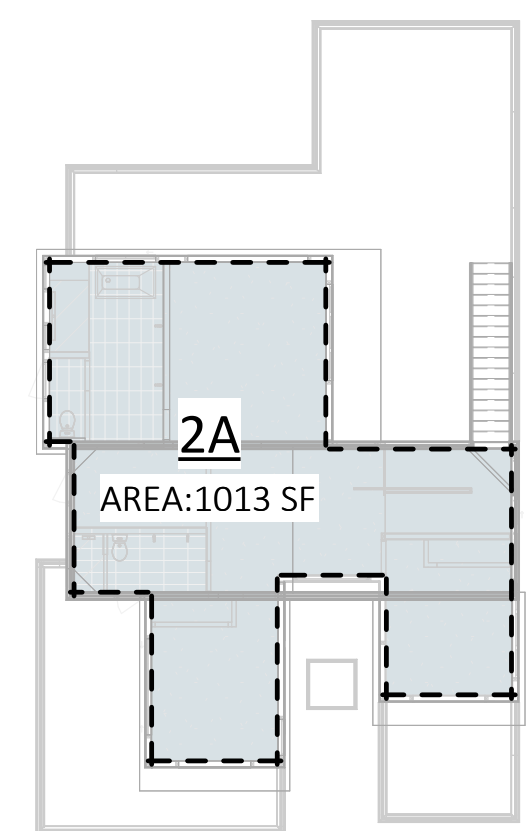


6 ROOF VENTING - UPPER
SCALE: 1/16" = 1'-0"

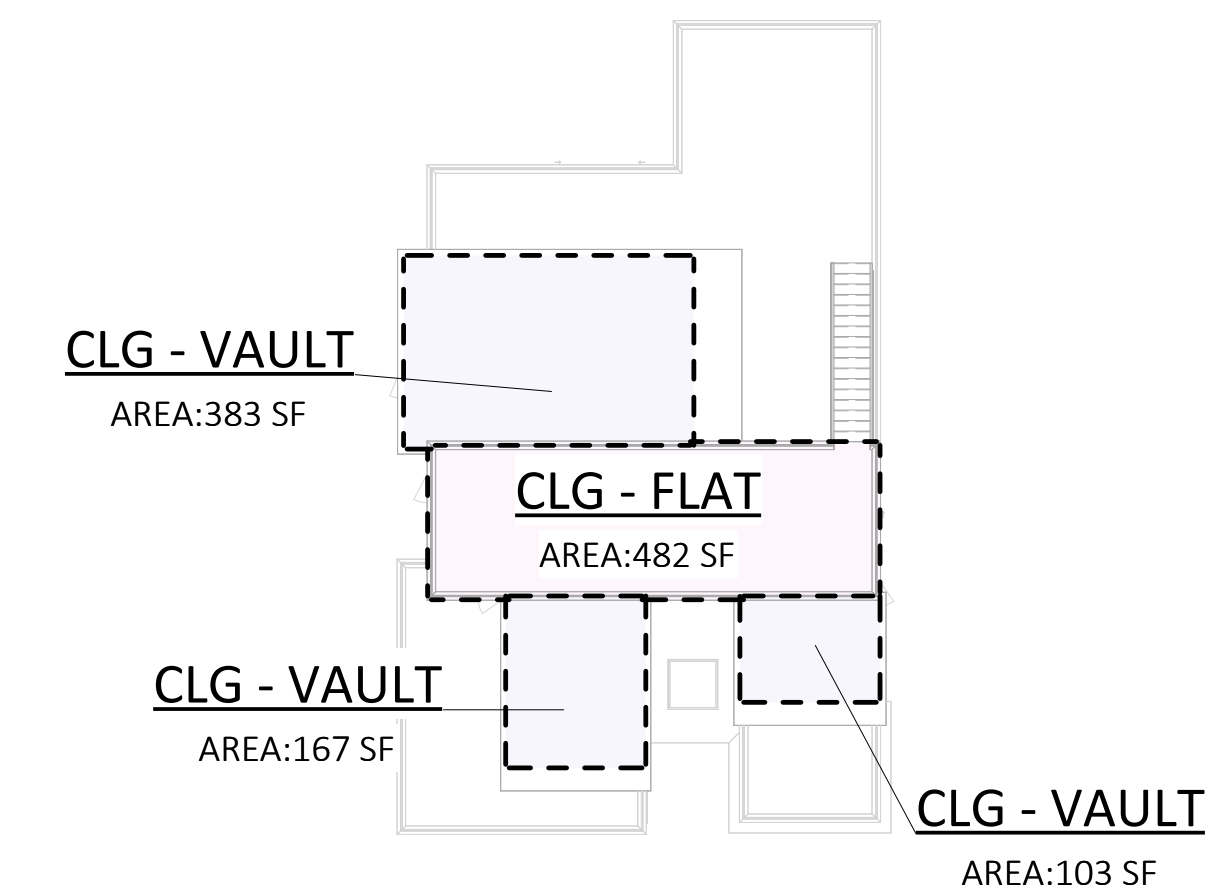

3 WSEC ENERGY CALCS - ROOF
SCALE: 1/16" = 1'-0"

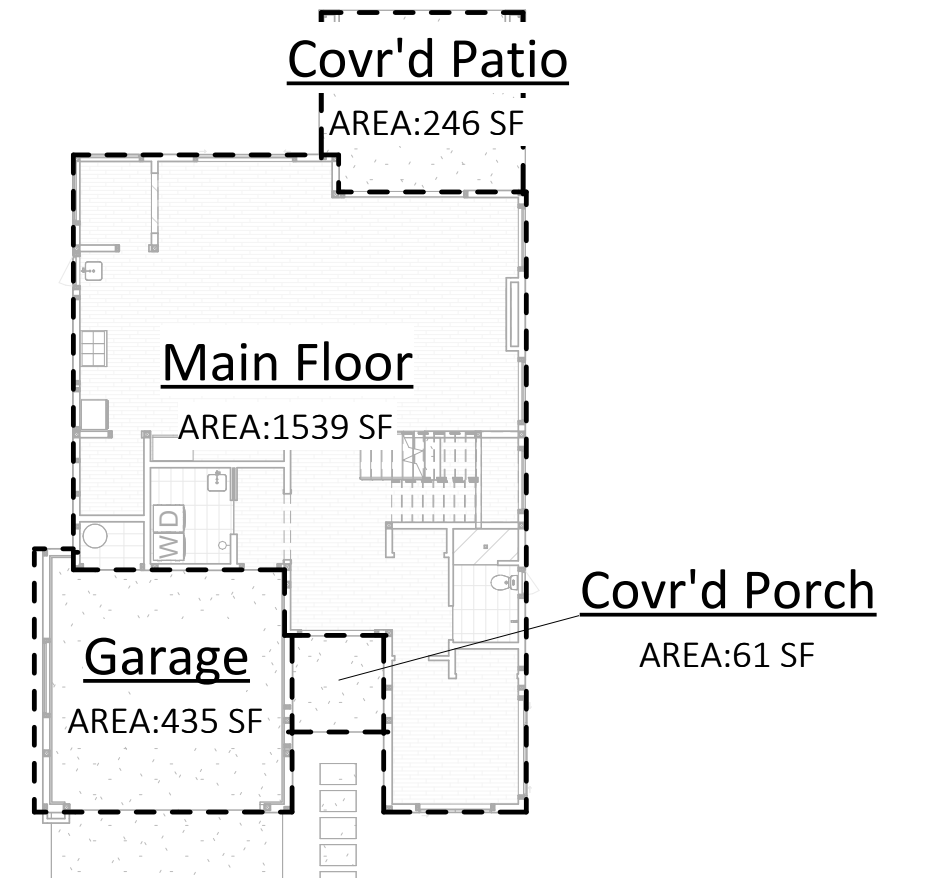

1 GROSS AREA PLAN - MAIN
SCALE: 1/16" = 1'-0"

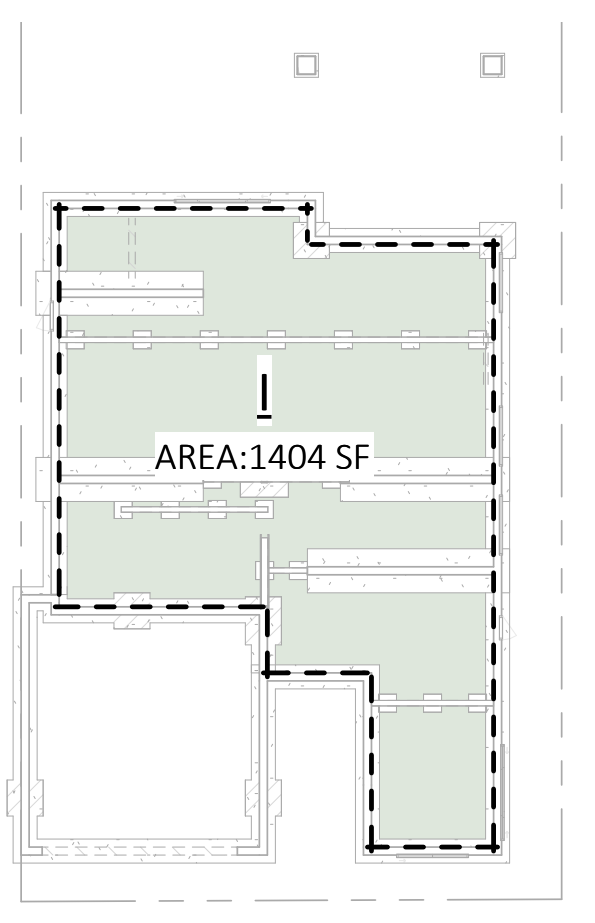

8 CRAWL SPACE VENTING CALCS
SCALE: 1/16" = 1'-0"

ATERA DESIGN STUDIO
451 DUVALL AVE NE
RENTON, WA 98059



HU RESIDENCE
2448 72nd AVE SE, Mercer Island

PERMIT SET

ENERGY/VENTING CALCULATIONS


PROJECT NO: 21014
ISSUE DATE: 2022/06/29

A003


SCALE 24X36: 1/16" = 1'-0"
* NOTE: 11X17 SETS ARE REDUCED 50% SCALE DRAWINGS ACCORDINGLY.

(C) ATERA DESIGN STUDIO LLC. PLANS AND DESIGNS (DRAWINGS) FORTHWITH REMAIN THE PROPERTY OF ATERA DESIGN STUDIO. REPRODUCTION WITHOUT PERMISSION IS PROHIBITED.




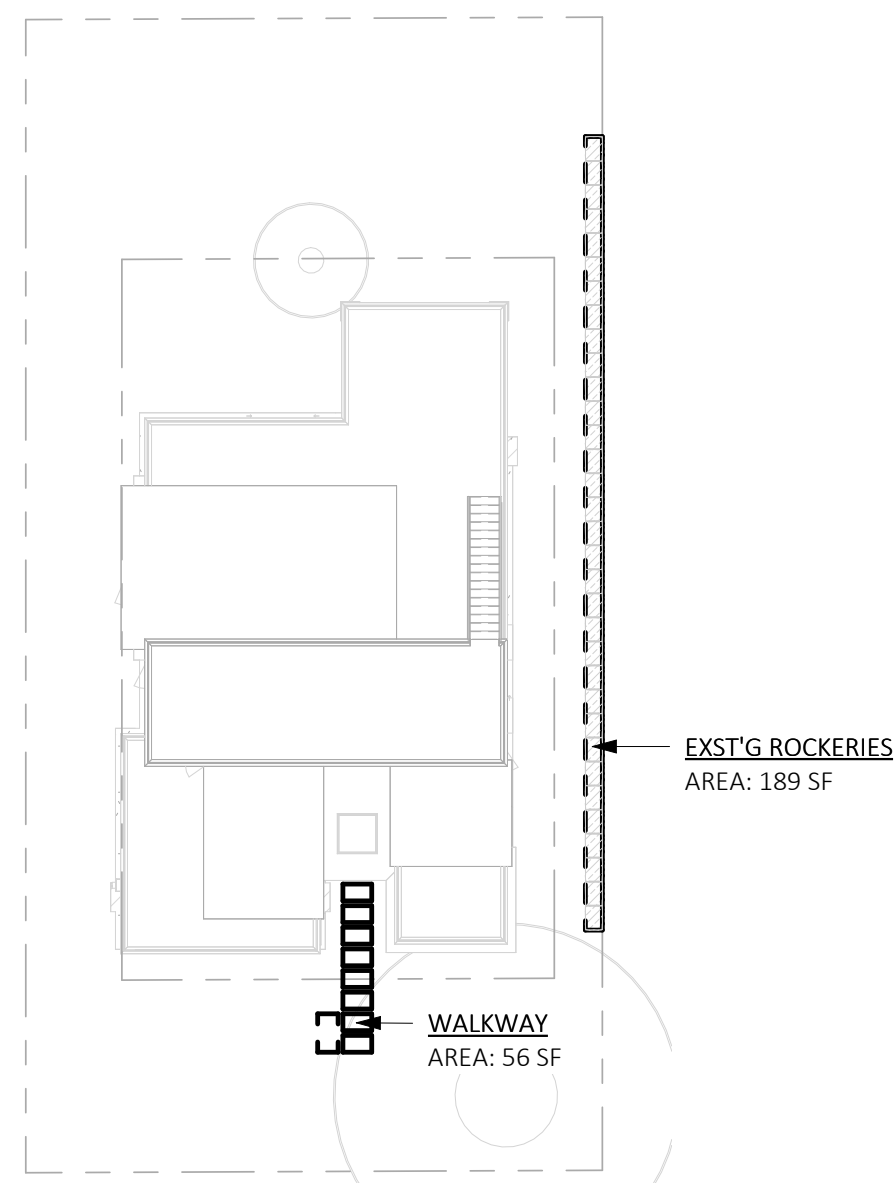

3 HARDSCAPE COVERAGE CALCS
 SCALE: 1" = 20'-0"

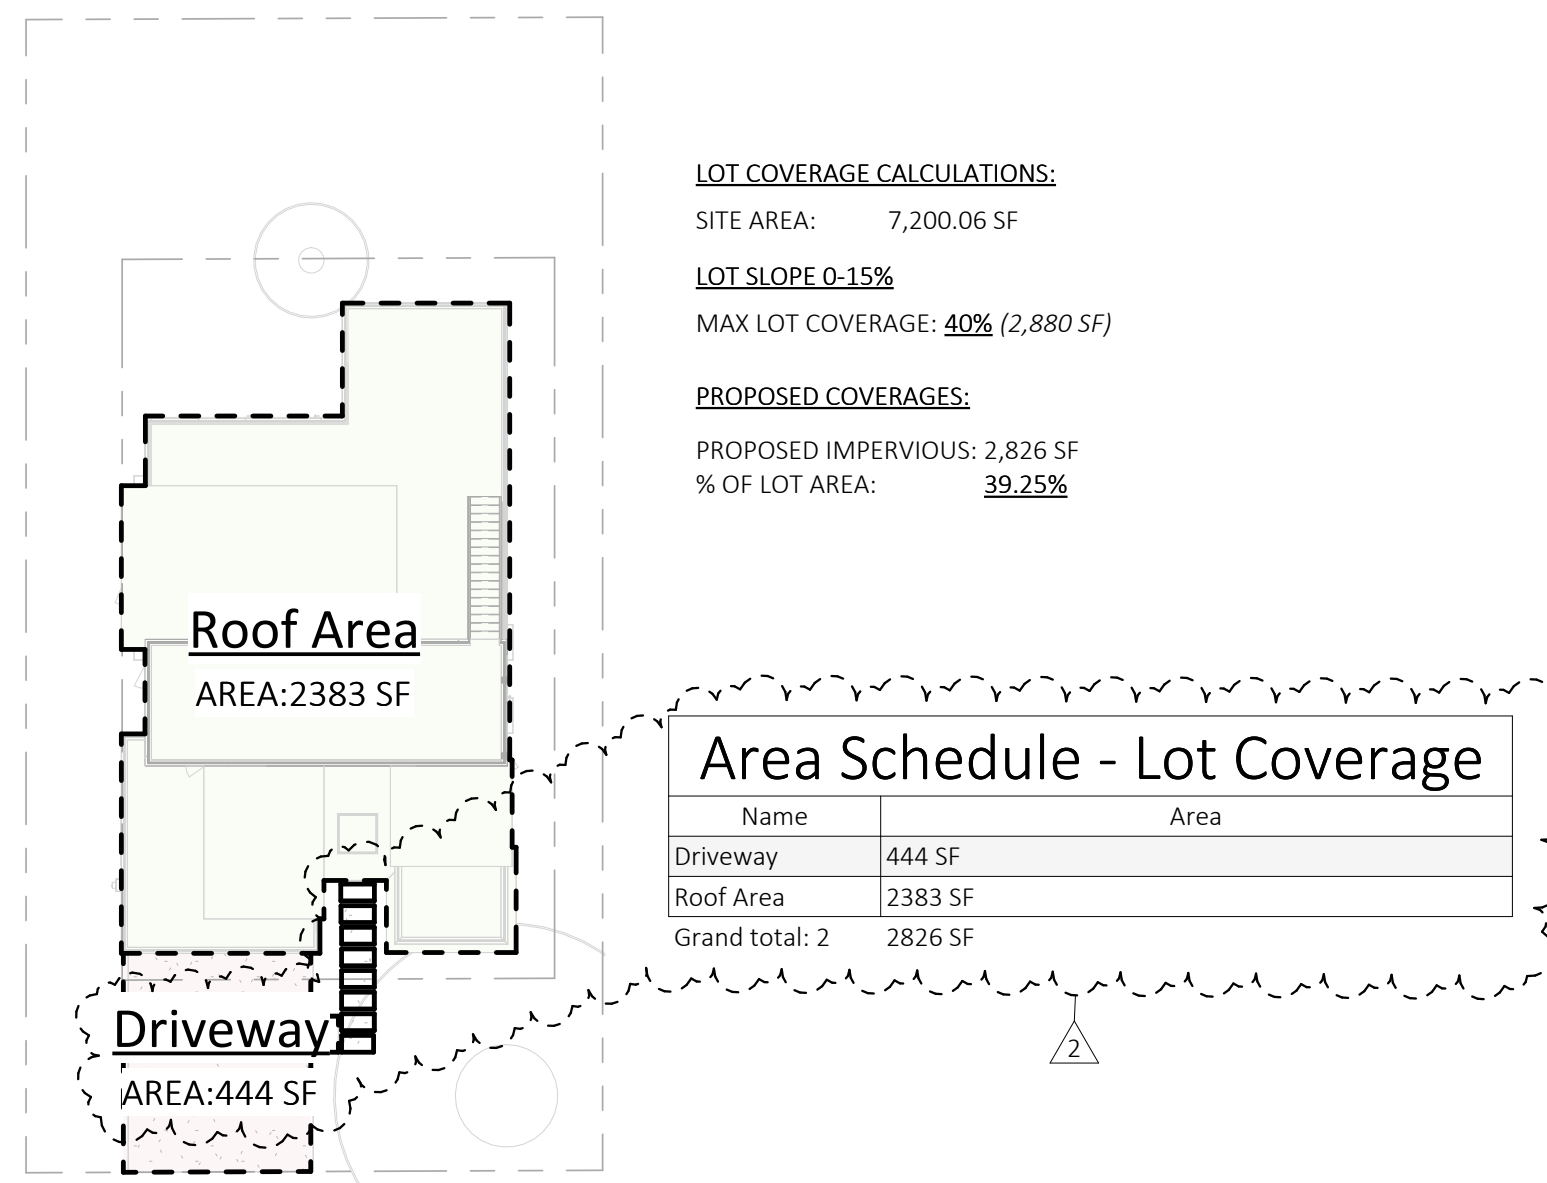

2 LOT COVERAGE CALCS
 SCALE: 1" = 20'-0"

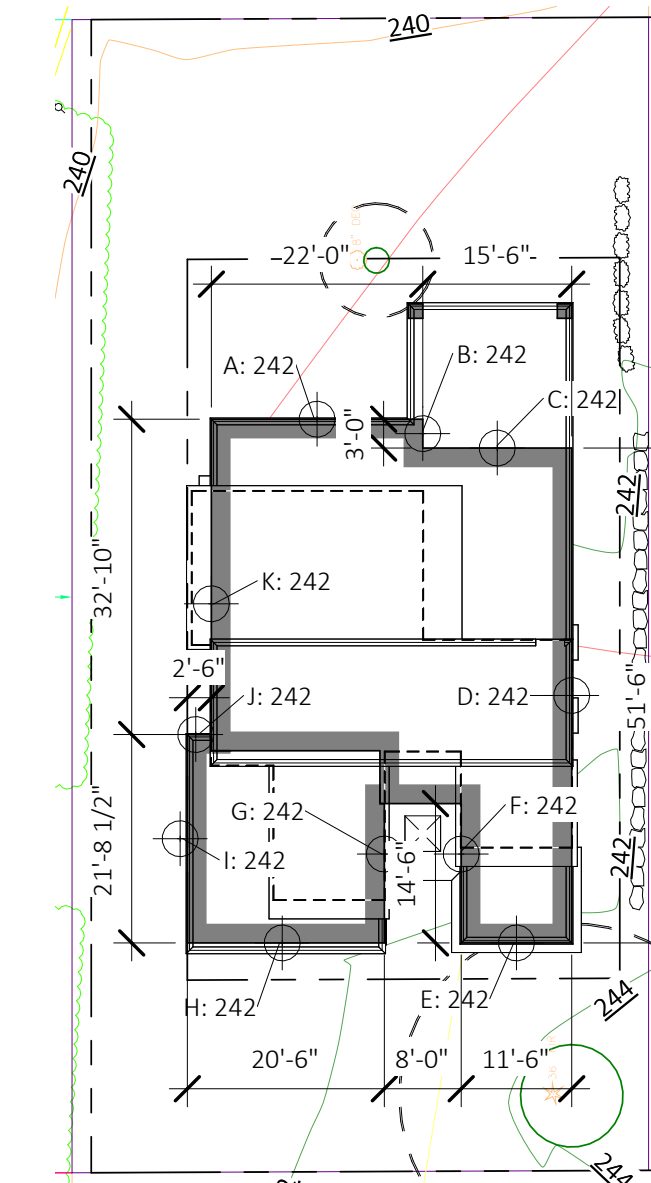

1 AVERAGE BLDG HT CALCULATIONS
 SCALE: 1" = 20'-0"

TREE RETENTION SCHEDULE

MARK	RETAINED	DIAMETER AT BREADTH HEIGHT		TYPE SPECIES
		EXISTING	RETAINED D.B.H.	
A	Yes	32"	32"	DOUGLAS FIR
B	Yes	8"	8"	JAPANESE MAPLE
2		40"	40"	


TREE RETENTION CALCS

TOTAL TREES RETAINED	40"
TOTAL TREES TO BE REMOVED	0"
PROPOSED TREE RETENTION %	100%


A.B.E. CHART

A.B.E. ID	A.B.E.	SEGMENT LENGTH	A.B.E. * LENGTH
A	242	22	5324
B	242	3	726
C	242	15.5	3751
D	242	51.5	12463
E	242	11.5	2783
F	242	14.5	3509
G	242	14.5	3509
H	242	21.25	5142.5
I	242	21.9	5299.8
J	242	3.25	786.5
K	242	32.9	7961.8
Grand total: 11	211.8	51255.6	

AVERAGE BLDG ELEVATION CALCULATIONS:
 51,255.6 / 211.8 = 242 A.B.E.

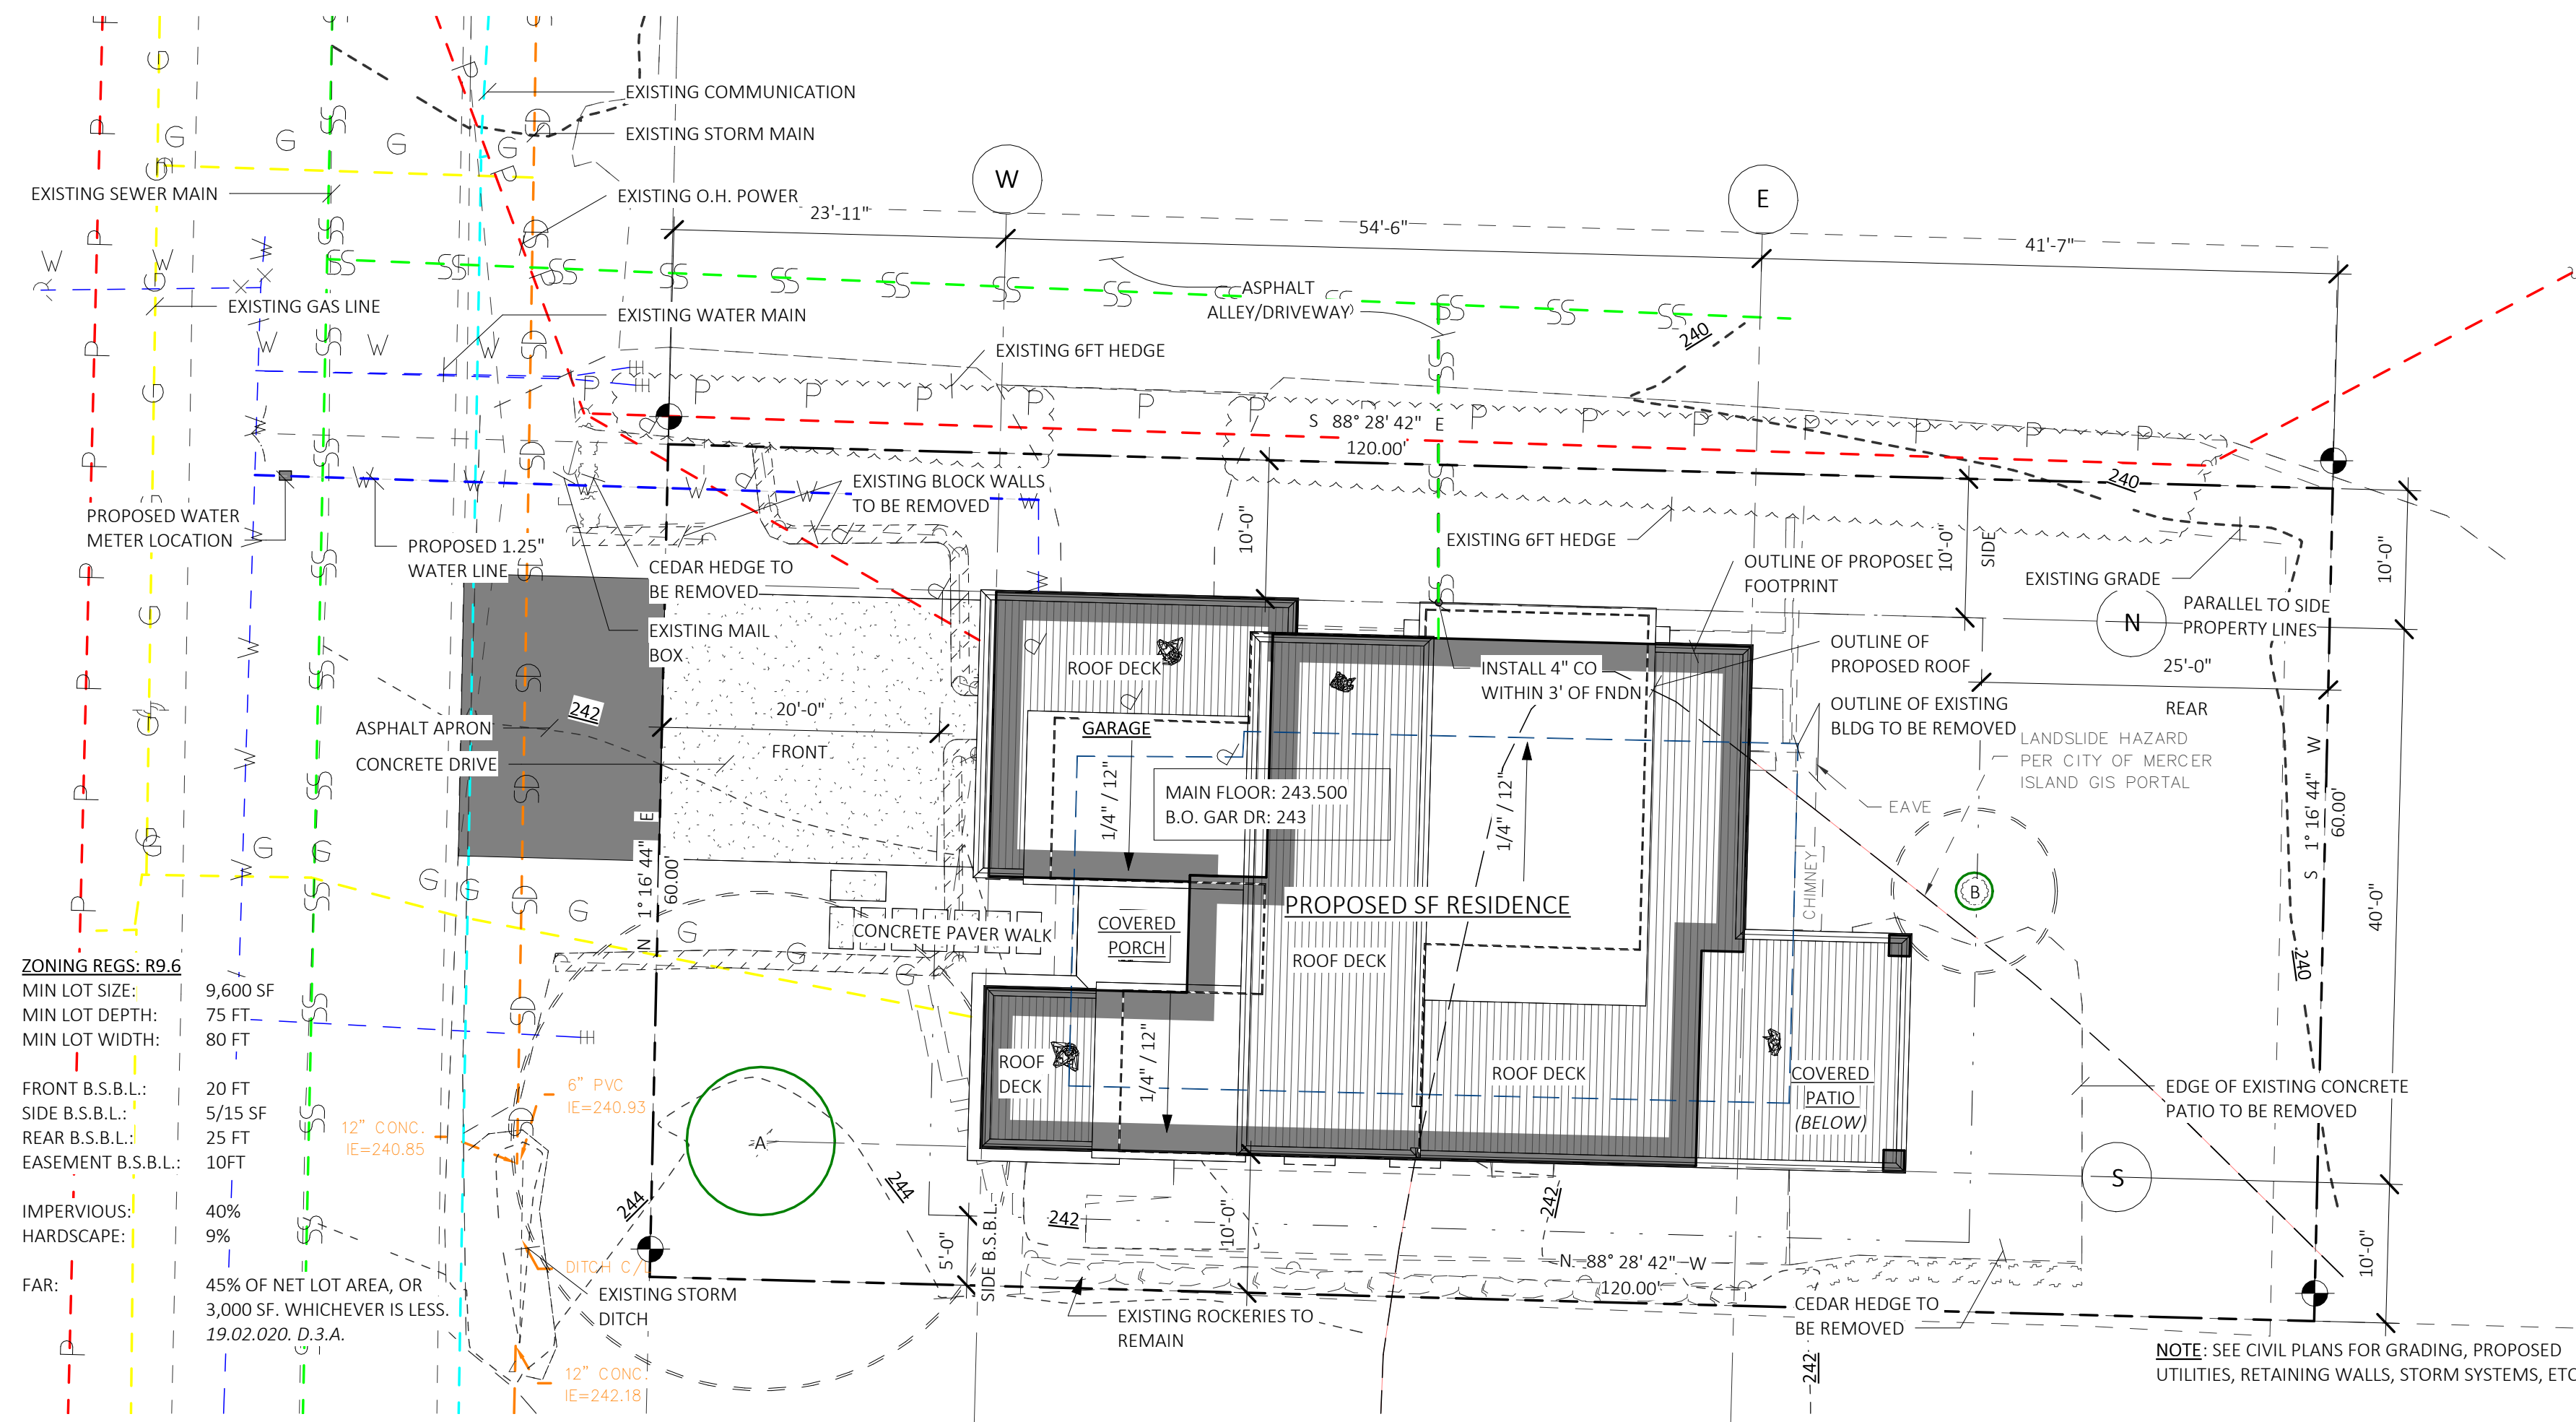

SEE SHEET A002 FOR F.A.R. CALCULATIONS

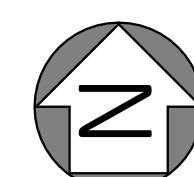


A101

SCALE 24X36: As indicated
 * NOTE: 1:1X17 SETS ARE REDUCED 50% SCALE DRAWINGS ACCORDINGLY.



DOOR SCHEDULE						
TYPE MARK	DESCRIPTION	SIZE		COUNT	DOOR PANEL	
		WIDTH	HT		CONSTRUCTION	GLAZING AREA
10	HINGED DOUBLE EXTERIOR - ENTRY	6'-0"	8'-0"	1	S.C.	0 SF
20	HINGED DOUBLE INTERIOR PANEL	4'-0"	8'-0"	1	S.C.	0 SF
21	HINGED DOUBLE INTERIOR PANEL	4'-8"	8'-0"	1	S.C.	0 SF
22	HINGED DOUBLE INTERIOR PANEL	5'-0"	8'-0"	1	S.C.	0 SF
30	HINGED - SINGLE - EXTERIOR - FULL LITE	3'-0"	8'-0"	1	S.C.	0 SF
40	HINGED - SINGLE - INTERIOR - FULL LITE	2'-4"	7'-0"	1	S.C.	0 SF
41	HINGED - SINGLE - INTERIOR - FULL LITE	2'-4"	8'-0"	1	S.C.	0 SF
42	HINGED - SINGLE - INTERIOR	2'-4"	8'-0"	4	S.C.	0 SF
43	HINGED - SINGLE - INTERIOR	2'-6"	8'-0"	2	S.C.	0 SF
44	HINGED - SINGLE - INTERIOR	2'-8"	8'-0"	3	S.C.	0 SF
50	LA CANTINA FOLDING DOOR	10'-0"	9'-11 1/2"	1		0 SF
60	2-PANEL SLIDING GLASS DOOR	6'-0"	8'-0"	2	VINYL	96 SF
61	3-PANEL SLIDING GLASS DOOR	10'-0"	7'-10"	1	VINYL	78 SF
70	OVERHEAD GARAGE DOOR	16'-0"	9'-0"	1		0 SF
80	SLIDING CLOSET - BI-PASS	5'-0"	8'-0"	1	H.C.	0 SF
81	SLIDING CLOSET - BI-PASS	6'-0"	8'-0"	2	H.C.	0 SF
90	SLIDING INTERIOR POCKET	2'-8"	8'-0"	1	S.C.	0 SF
Grand total: 25						174 SF

WINDOW SCHEDULE						
TYPE MARK	STYLE	SIZE			COUNT	IS EGRESS
		WIDTH	HT	AREA		
10	Double Casement + Picture	8'-0"	6'-0"	96 SF	2	No
20	Casement	2'-0"	4'-6"	18 SF	2	No
21	Casement	2'-6"	4'-6"	11 SF	1	Yes
22	Casement	2'-6"	6'-0"	15 SF	1	Yes
23	Casement	3'-0"	4'-6"	14 SF	1	Yes
30	Horz Sliding Dbl-Vent	8'-0"	5'-0"	80 SF	2	Yes
31	Horz Sliding Dbl-Vent	8'-0"	6'-0"	48 SF	1	Yes
32	Horz Sliding Half-Vent	5'-0"	5'-0"	25 SF	1	Yes
33	Horz Sliding Half-Vent	5'-0"	6'-0"	30 SF	1	Yes
34	Horz Sliding Half-Vent	6'-0"	5'-0"	30 SF	1	Yes
40	Picture	2'-0"	2'-0"	8 SF	2	No
41	Picture	2'-6"	1'-6"	8 SF	2	No
42	Picture	3'-0"	1'-6"	14 SF	3	No
43	Picture	3'-0"	5'-0"	15 SF	1	No
44	Picture	4'-0"	2'-0"	8 SF	1	No
45	Picture	5'-0"	1'-6"	30 SF	4	No
46	Picture	5'-0"	4'-0"	60 SF	3	No
47	Picture	5'-0"	6'-0"	90 SF	3	No
48	Picture	6'-0"	1'-6"	18 SF	2	No
49	Picture	6'-0"	4'-0"	24 SF	1	No
50	Picture	6'-0"	6'-0"	36 SF	1	No
51	Picture	6'-2"	1'-6"	9 SF	1	No
52	Picture	8'-0"	1'-6"	24 SF	2	No
80	Skylight	4'-0"	4'-0"	16 SF	1	
Grand total: 40						726 SF

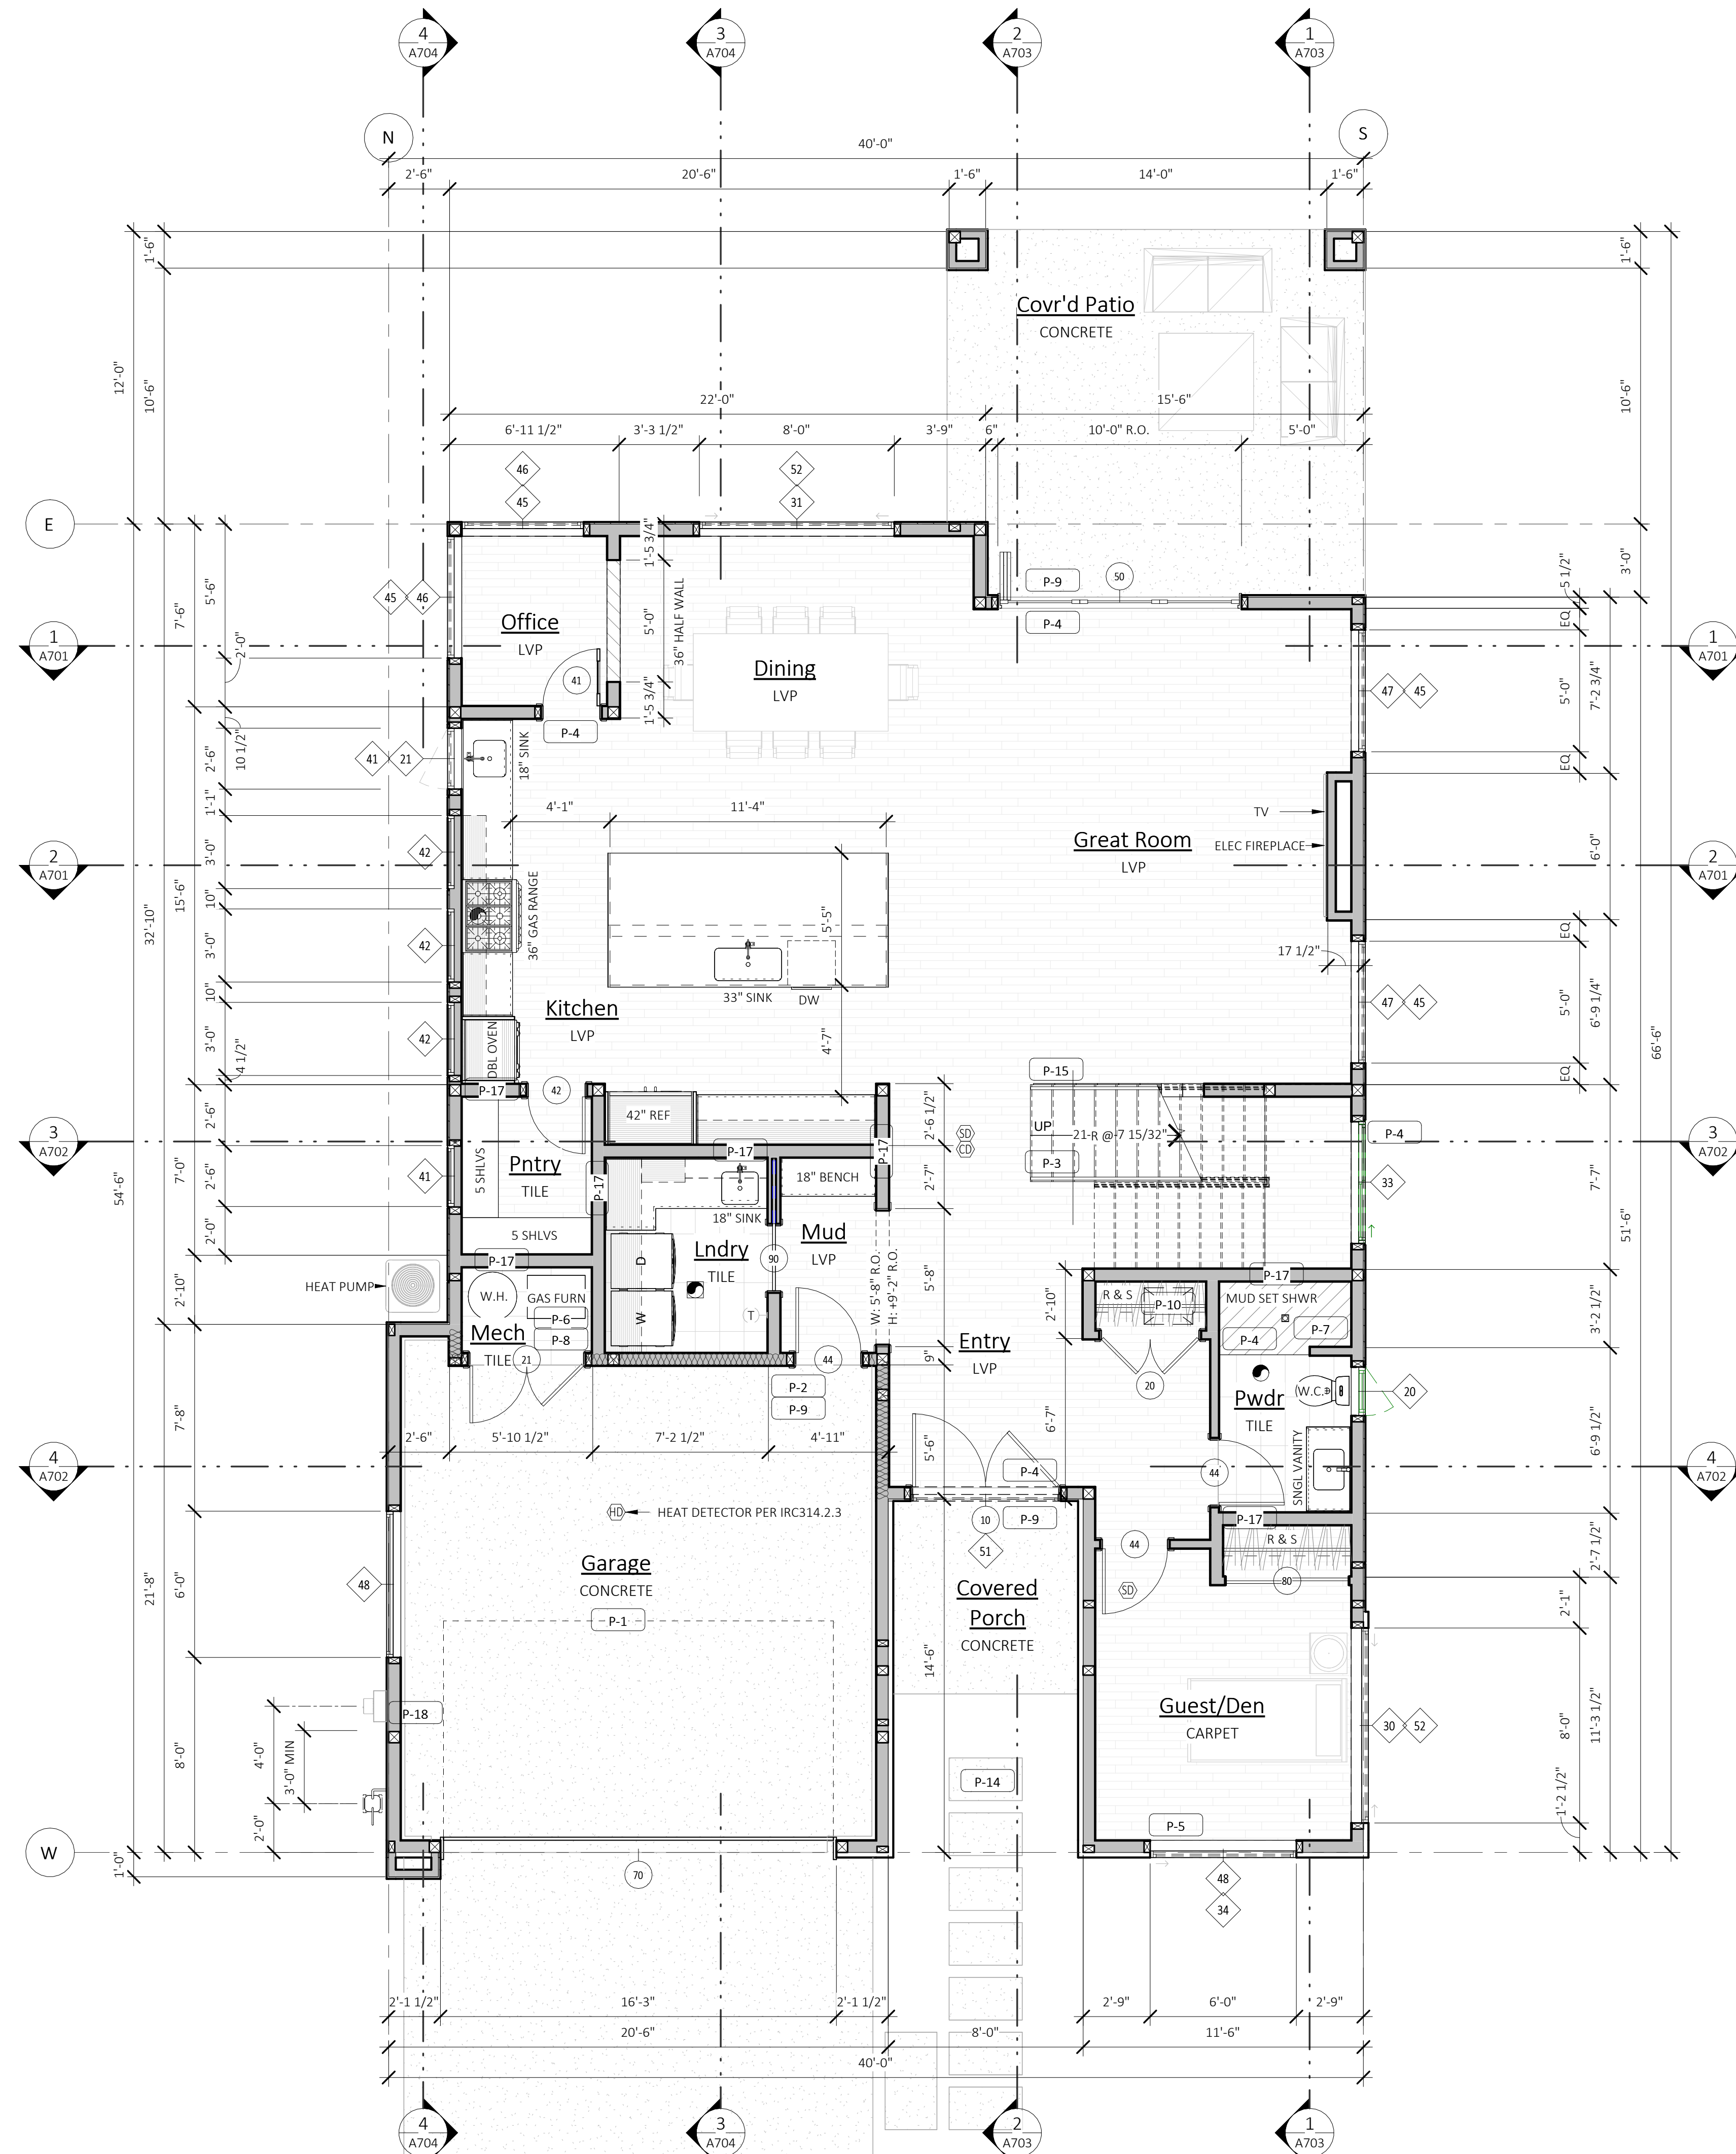

GENERAL PLAN NOTES:

- SEE SHEET A001 FOR GENERAL CONSTRUCTION SPECIFICATIONS.
- SEE BUILDING ELEVATIONS FOR WINDOW OPERATION.
- SEE "TYPICAL BUILDING MATERIALS" LIST ON THE ELEVATION SHEET(S).
- FOR THE SYMBOLS & LEGEND SEE SHEET A000.
- SEE STRUCTURAL SHEETS FOR SHEARWALL DESIGNATIONS & HOLD-DOWNS AND SHEET(S) S201-S203 FOR SHEARWALL DETAILS / SCHEDULE.
- SEE SHEET A201-A301 FOR WINDOWS SCHEDULE. SEE SHEET A201-A301 FOR DOOR SCHEDULE. SEE ELEVATIONS SHEETS FOR WINDOW OPERATION.
- WINDOW DIMENSIONS SHOWN ARE SUGGESTED NOMINAL/ROUGH OPENINGS, NET DIMENSIONS TO BE PER MANUFACTURER.

KEYNOTES - FLOORPLAN	
ID	DESCRIPTION
P-1	GARAGE/HOUSE OCCUPANCY SEPARATION. PER IRC R302.6 a) 1/2" GYP. AT GARAGE SIDE BETWEEN RESIDENCE AND ATTIC. b) 5/8" TYPE "X" GYP SEPARATING HABITABLE ROOMS ABOVE. c) 1/2" GYP. AT WALLS SUPPORTING HABITABLE ROOMS ABOVE."
P-2	DOOR BETWEEN GARAGE AND HOUSE SHALL BE EQUIPPED WITH A SELF-CLOSING DEVICE, AND BE A MIN 1 3/8" THICK SOLID WOOD DOOR OR 20 MIN. F.R. DOOR. PER IRC SECTION R302.5.1
P-3	STAIR ASSEMBLY: PER IRC SECTION R311.7.7 a) WIDTH 36" MIN., HEADROOM 6'-8" MIN. b) RISER 7-3/4" MAX.; TREAD 10" MIN. c) TOP OF HANDRAIL AT 34" MIN. AND 38" MAX ABOVE TREAD NOSING d) HANDRAIL WIDTH 1-1/4" MIN. AND 2" MAX. e) INSTALL FIRE BLOCKING IN CONCEALED SPACES BETWEEN STAIR STRINGERS AT THE TOP AND BOTTOM OF THE RUN. f) COVER USABLE SPACE UNDER STAIR WITH 1/2" GYP."
P-4	SAFETY GLAZING PER IRC SECTION R308.4
P-5	EGRESS WINDOW PER IRC SECTION R310. PROVIDE MIN NET CLEARANCE OF 5 SF AT GRADE FLOOR OPENINGS AND 5.7 SF ABOVE. MIN SILL HEIGHT TO BE 44" A.F.F.
P-6	IGNITERS: A) FOR GAS FIRED APPLIANCES IN GARAGE TO BE 18" MIN ABOVE TOP OF SLAB, PROVIDE (2) LAYERS OF FLOOR SHEATHING OVER FRAMING. PER IRC SECTION G2408. B) HEAT-PRODUCING EQUIPMENT AND APPLIANCES SHALL BE INSTALLED TO MAINTAIN THE REQUIRED CLEARANCES TO COMBUSTIBLE CONSTRUCTION AS SPECIFIED IN THE LISTING AND MANUFACTURER'S INSTRUCTIONS. PER IRC G2408.5
P-7	COVER WALLS ADJACENT TO TUBS AND SHOWERS WITH NONABSORBENT MATERIAL TO 72" ABOVE DRAIN INLETS. PER IRC SECTION R307.2. FOR GROUND FLR WASTE OPENING REQ SEE UPC NOTES ON SHT A001
P-8	HIGH EFFICIENCY GAS FURNACE. SIZE PER WSEC PRESCRIPTIVE ENERGY CODE COMPLIANCE FORMS. a) PROVIDE DUCT LEAKAGE, SEALING & TESTING PER WSEC 502 & 503. b) THERMOSTAT PER WSEC 503.8. c) SEE WSEC NOTES ON SHEET A001
P-9	7-3/4" MAX. RISER WITH 10" MIN. TREAD DEPTH. IF MORE THAN (4) RISERS HANDRAIL REQUIRED PER IRC SECTION R311.7.7. a) PROVIDE 36"x36" MIN. LANDING AT EXTERIOR DOORS PER IRC SECTION R311.3
P-10	PROVIDE CRAWL SPACE ACCESS, MIN. 18" X 24" UNOBSTRUCTED ACCESS. PER IRC SECTION R408.4
P-14	SEE SITE PLAN FOR EXTENT OF WALKS AND DRIVEWAYS.
P-15	36" MIN. GUARDRAIL. AT STAIRS SLOPES AT 36" ABOVE STAIR NOSINGS. PER SEE IRC SECTION 312
P-17	2x6 WALL FOR PLUMBING / HVAC.
P-18	A PERMANENT CERTIFICATE SHALL BE POSTED WITHIN 36" OF THE ELECTRICAL DISTRIBUTION PANEL. SEE SECTION M1505.4 ON SHEET A002 THE MAIN ELECTRICAL PANEL SHALL HAVE A RESERVED SPACE FOR FUTURE SOLAR ELECTRIC INSTALLATION PER IRC T103.9. A PERMANENT CERTIFICATE FOR SOLAR-READY ZONE IS TO BE POSTED PER IRC T103.10.

AREA SCHEDULE ...

NAME	AREA
Garage	435 SF
Main Floor	1539 SF
Upper Floor	1022 SF
	2996 SF
Cov'd Patio	246 SF
Cov'd Porch	61 SF
	308 SF
	3303 SF

(C) ATERA DESIGN STUDIO LLC. PLANS AND DESIGNS (DRAWINGS) FORTHWITH REMAIN THE PROPERTY OF ATERA DESIGN STUDIO. REPRODUCTION WITHOUT PERMISSION IS PROHIBITED.

Description
 No
 Date

ATERA DESIGN STUDIO
 451 DUVAL AVE NE
 RENTON, WA 98059

HU RESIDENCE
 2448 72nd AVE SE, Mercer Island

PERMIT SET
 MAIN FLOOR

PROJECT NO: 21014
 ISSUE DATE: 2022/06/29

A301


SCALE 24X36: 1/4" = 1'-0"
 * NOTE: 1:1 X 17 SETS ARE REDUCED 50% SCALE DRAWINGS ACCORDINGLY.



DOOR SCHEDULE						
TYPE MARK	DESCRIPTION	SIZE		COUNT	DOOR PANEL	
		WIDTH	HT		CONSTRUCTION	GLAZING AREA
10	HINGED DOUBLE EXTERIOR - ENTRY	6'-0"	8'-0"	1	S.C.	0 SF
20	HINGED DOUBLE INTERIOR PANEL	4'-0"	8'-0"	1	S.C.	0 SF
21	HINGED DOUBLE INTERIOR PANEL	4'-8"	8'-0"	1	S.C.	0 SF
22	HINGED DOUBLE INTERIOR PANEL	5'-0"	8'-0"	1	S.C.	0 SF
30	HINGED - SINGLE - EXTERIOR - FULL LITE	3'-0"	8'-0"	1	S.C.	0 SF
40	HINGED - SINGLE - INTERIOR - FULL LITE	2'-4"	7'-0"	1	S.C.	0 SF
41	HINGED - SINGLE - INTERIOR - FULL LITE	2'-4"	8'-0"	1	S.C.	0 SF
42	HINGED - SINGLE - INTERIOR	2'-4"	8'-0"	4	S.C.	0 SF
43	HINGED - SINGLE - INTERIOR	2'-6"	8'-0"	2	S.C.	0 SF
44	HINGED - SINGLE - INTERIOR	2'-8"	8'-0"	3	S.C.	0 SF
50	LA CANTINA FOLDING DOOR	10'-0"	9'-11 1/2"	1		0 SF
60	2-PANEL SLIDING GLASS DOOR	6'-0"	8'-0"	2	VINYL	96 SF
61	3-PANEL SLIDING GLASS DOOR	10'-0"	7'-10"	1	VINYL	78 SF
70	OVERHEAD GARAGE DOOR	16'-0"	9'-0"	1		0 SF
80	SLIDING CLOSET - BI-PASS	5'-0"	8'-0"	1	H.C.	0 SF
81	SLIDING CLOSET - BI-PASS	6'-0"	8'-0"	2	H.C.	0 SF
90	SLIDING INTERIOR POCKET	2'-8"	8'-0"	1	S.C.	0 SF
Grand total: 25						174 SF

WINDOW SCHEDULE						
TYPE MARK	STYLE	SIZE			COUNT	IS EGRESS
		WIDTH	HT	AREA		
10	Double Casement + Picture	8'-0"	6'-0"	96 SF	2	No
20	Casement	2'-0"	4'-6"	18 SF	2	No
21	Casement	2'-6"	4'-6"	11 SF	1	Yes
22	Casement	2'-6"	6'-0"	15 SF	1	Yes
30	Casement	3'-0"	4'-6"	14 SF	1	Yes
23	Horz Sliding Dbl-Vent	8'-0"	5'-0"	80 SF	2	Yes
31	Horz Sliding Dbl-Vent	8'-0"	6'-0"	48 SF	1	Yes
32	Horz Sliding Half-Vent	5'-0"	5'-0"	25 SF	1	Yes
33	Horz Sliding Half-Vent	5'-0"	6'-0"	30 SF	1	Yes
34	Horz Sliding Half-Vent	6'-0"	5'-0"	30 SF	1	Yes
40	Picture	2'-0"	2'-0"	8 SF	2	No
41	Picture	2'-6"	1'-6"	8 SF	2	No
42	Picture	3'-0"	1'-6"	14 SF	3	No
43	Picture	3'-0"	5'-0"	15 SF	1	No
44	Picture	4'-0"	2'-0"	8 SF	1	No
45	Picture	5'-0"	1'-6"	30 SF	4	No
46	Picture	5'-0"	4'-0"	60 SF	3	No
47	Picture	5'-0"	6'-0"	90 SF	3	No
48	Picture	6'-0"	1'-6"	18 SF	2	No
49	Picture	6'-0"	4'-0"	24 SF	1	No
50	Picture	6'-0"	6'-0"	36 SF	1	No
51	Picture	6'-2"	1'-6"	9 SF	1	No
52	Picture	8'-0"	1'-6"	24 SF	2	No
80	Skylight	4'-0"	4'-0"	16 SF	1	
Grand total: 40						726 SF

NOTE:
SPECIAL INSPECTION OF THE ROOF MEMBRANE AND PEDESTAL DECKING INSTALLATION REQUIRED.
SEE SHEETD401 FOR WATERPROOF DECKING CUT SHEETS AND DETAILS. INSTALL PER MFR RECOMMENDATIONS

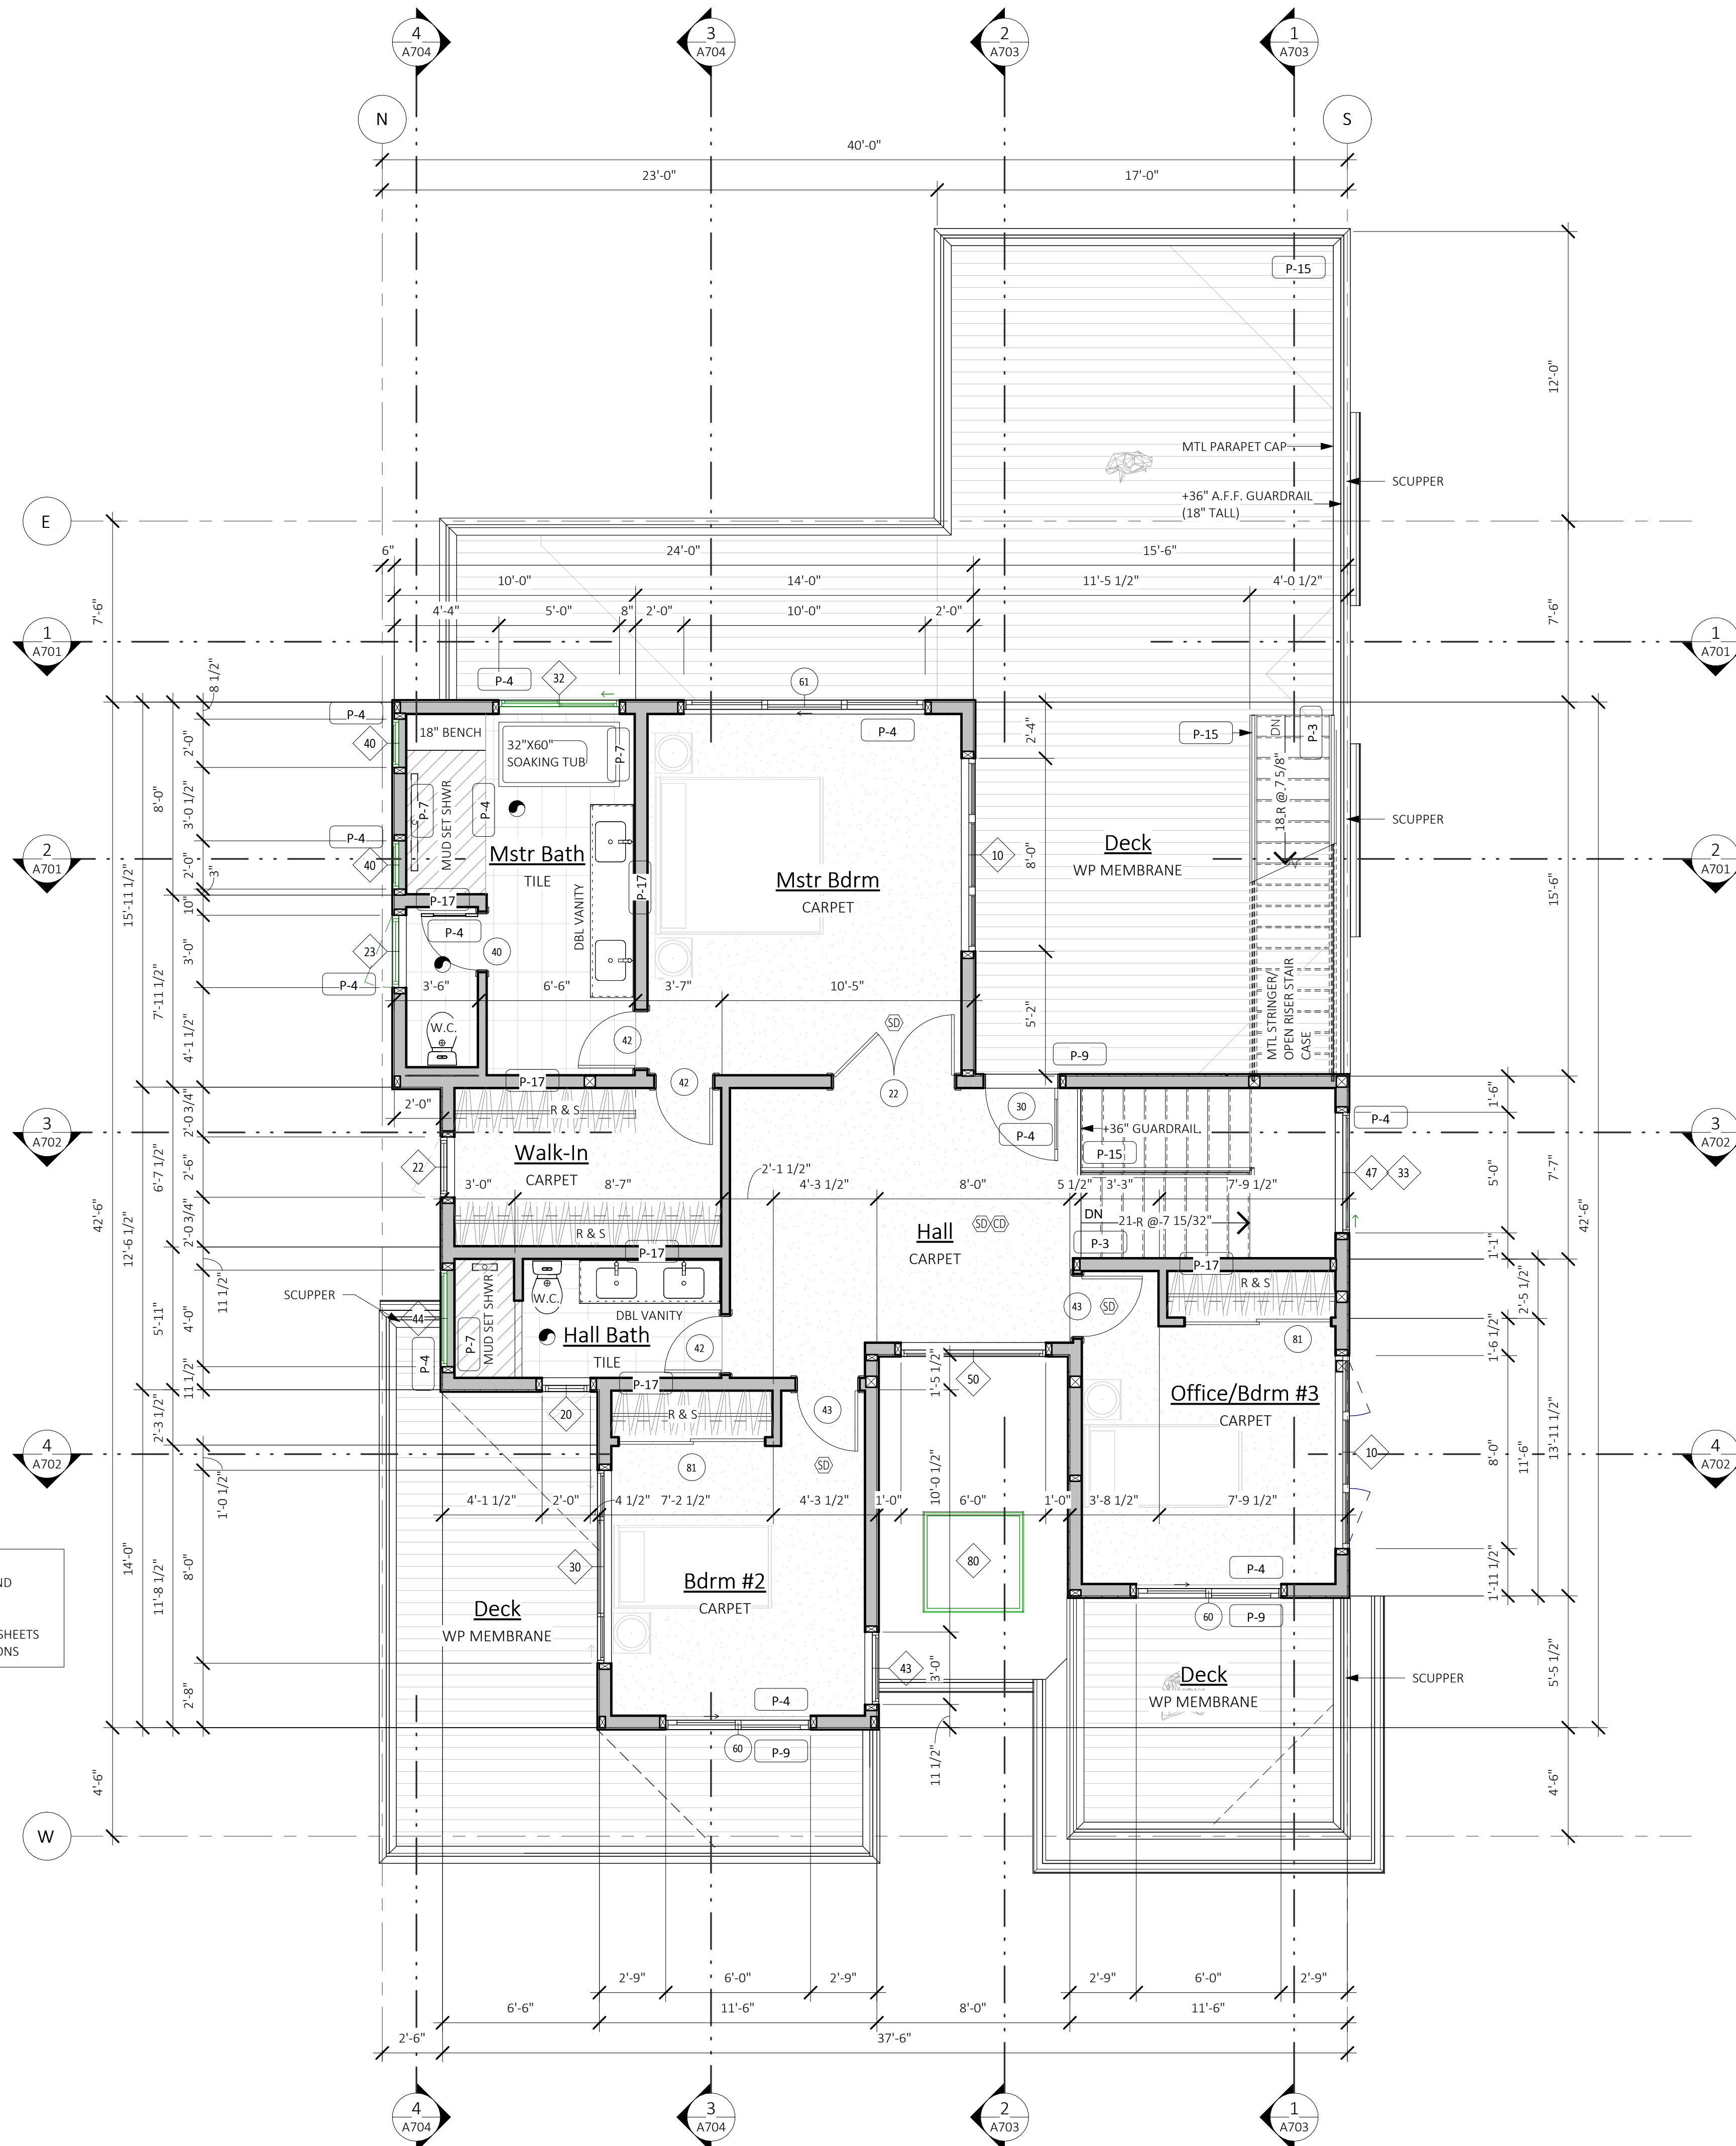

GENERAL PLAN NOTES:

- SEE SHEET A001 FOR GENERAL CONSTRUCTION SPECIFICATIONS.
- SEE BUILDING ELEVATIONS FOR WINDOW OPERATION.
- SEE "TYPICAL BUILDING MATERIALS" LIST ON THE ELEVATION SHEET(S).
- FOR THE SYMBOLS & LEGEND SEE SHEET A000.
- SEE STRUCTURAL SHEETS FOR SHEARWALL DESIGNATIONS & HOLDDOWNS AND SHEET(S) S201-S203 FOR SHEARWALL DETAILS/SCHEDULE.
- SEE SHEET A201-A301 FOR WINDOWS SCHEDULE. SEE SHEET A201-A301 FOR DOOR SCHEDULE. SEE ELEVATIONS SHEETS FOR WINDOW OPERATION.
- WINDOW DIMENSIONS SHOWN ARE SUGGESTED NOMINAL/ROUGH OPENINGS, NET DIMENSIONS TO BE PER MANUFACTURER.

KEYNOTES - FLOORPLAN

ID	DESCRIPTION
P-1	GARAGE/HOUSE OCCUPANCY SEPARATION. PER IRC R302.6 a) 1/2" GYP. AT GARAGE SIDE BETWEEN RESIDENCE AND ATTIC. b) 5/8" TYPE 'X' GYP SEPARATING HABITABLE ROOMS ABOVE. c) 1/2" GYP. AT WALLS SUPPORTING HABITABLE ROOMS ABOVE."
P-2	DOOR BETWEEN GARAGE AND HOUSE SHALL BE EQUIPED WITH A SELF-CLOSING DEVICE, AND BE A MIN 1 3/8" THICK SOLID WOOD DOOR OR 20 MIN. F.R. DOOR. PER IRC SECTION R302.5.1
P-3	STAIR ASSEMBLY: PER IRC SECTION R311.7.3) a) WIDTH 36" MIN.; HEADROOM 6'-8" MIN. b) RISER 7-3/4" MAX.; TREAD 10" MIN. c) TOP OF HANDRAIL AT 34" MIN. AND 38" MAX ABOVE TREAD NOSING d) HANDRAIL WIDTH 1-1/4" MIN. AND 2" MAX. e) INSTALL FIRE BLOCKING IN CONCEALED SPACES BETWEEN STAIR STRINGERS AT THE TOP AND BOTTOM OF THE RUN. f) COVER USABLE SPACE UNDER STAIR WITH 1/2" GYP."
P-4	SAFETY GLAZING PER IRC SECTION R308.4
P-5	EGRESS WINDOW PER IRC SECTION R310. PROVIDE MIN NET CLEARANCE OF 5 SF AT GRADE FLOOR OPENINGS AND 5.7 SF ABOVE. MIN SILL HEIGHT TO BE 44" A.F.F.
P-6	IGNITERS: a) FOR GAS FIRED APPLIANCES IN GARAGE TO BE 18" MIN ABOVE TOP OF SLAB, PROVIDE (2) LAYERS OF FLOOR SHEATHING OVER FRAMING. PER IRC SECTION G2408. b) HEAT-PRODUCING EQUIPMENT AND APPLIANCES SHALL BE INSTALLED TO MAINTAIN THE REQUIRED CLEARANCES TO COMBUSTIBLE CONSTRUCTION AS SPECIFIED IN THE LISTING AND MANUFACTURER'S INSTRUCTIONS. PER IRC G2408.5
P-7	COVER WALLS ADJACENT TO TUBS AND SHOWERS WITH NONABSORBENT MATERIAL TO 72" ABOVE DRAIN INLETS. PER IRC SECTION R307.2. FOR GROUND FLR WASTE OPENING REQ SEE UPC NOTES ON SHT A001
P-8	HIGH EFFICIENCY GAS FURNACE, SIZE PER WSEC PRESCRIPTIVE ENERGY CODE COMPLIANCE FORMS. a) PROVIDE DUCT LEAKAGE, SEALING & TESTING PER WSEC 502 & 503. b) THERMOSTAT PER WSEC 503.8. c) SEE WSEC NOTES ON SHEET A001
P-9	7-3/4" MAX. RISER WITH 10" MIN. TREAD DEPTH. IF MORE THAN (4) RISERS. HANDRAIL REQUIRED PER IRC SECTION R311.7.7. a) PROVIDE 36"x36" MIN. LANDING AT EXTERIOR DOORS PER IRC SECTION R311.3
P-10	PROVIDE CRAWL SPACE ACCESS, MIN. 18" X 24" UNOBSTRUCTED ACCESS. PER IRC SECTION R408.4
P-14	SEE SITE PLAN FOR EXTENT OF WALKS AND DRIVEWAYS.
P-15	36" MIN. GUARDRAIL. AT STAIRS SLOPES AT 36" ABOVE STAIR NOSINGS. PER SEE IRC SECTION 312
P-17	2x6 WALL FOR PLUMBING / HVAC.
P-18	A PERMANENT CERTIFICATE SHALL BE POSTED WITHIN 36" OF THE ELECTRICAL DISTRIBUTION PANEL. SEE SECTION M1505.4 ON SHEET A002 THE MAIN ELECTRICAL PANEL SHALL HAVE A RESERVED SPACE FOR FUTURE SOLAR ELECTRIC INSTALLATION PER IRC T103.9. A PERMANENT CERTIFICATE FOR SOLAR-READY ZONE IS TO BE POSTED PER IRC T103.10.

AREA SCHEDULE ...

NAME	AREA
Garage	435 SF
Main Floor	1539 SF
Upper Floor	1022 SF
	2996 SF
Covr'd Patio	246 SF
Covr'd Porch	61 SF
	308 SF
	3303 SF

A401

SCALE 24X36: 1/4" = 1'-0"
* NOTE: 1:1 X 17 SETS ARE REDUCED 50% SCALE DRAWINGS ACCORDINGLY.

UPPER FLOOR

PROJECT NO: 21014
ISSUE DATE: 2022/06/29

PERMIT SET

HU RESIDENCE
2448 72nd AVE SE, Mercer Island




ATERA DESIGN STUDIO
451 DUVALLE AVE NE
RENTON, WA 98059

Date: 2023/07/25
No: 1
Description: SUB2 City Comment Submittal

© ATERA DESIGN STUDIO LLC. PLANS AND DESIGNS (DRAWINGS) FORTHWITH REMAIN THE PROPERTY OF ATERA DESIGN STUDIO. REPRODUCTION WITHOUT PERMISSION IS PROHIBITED.



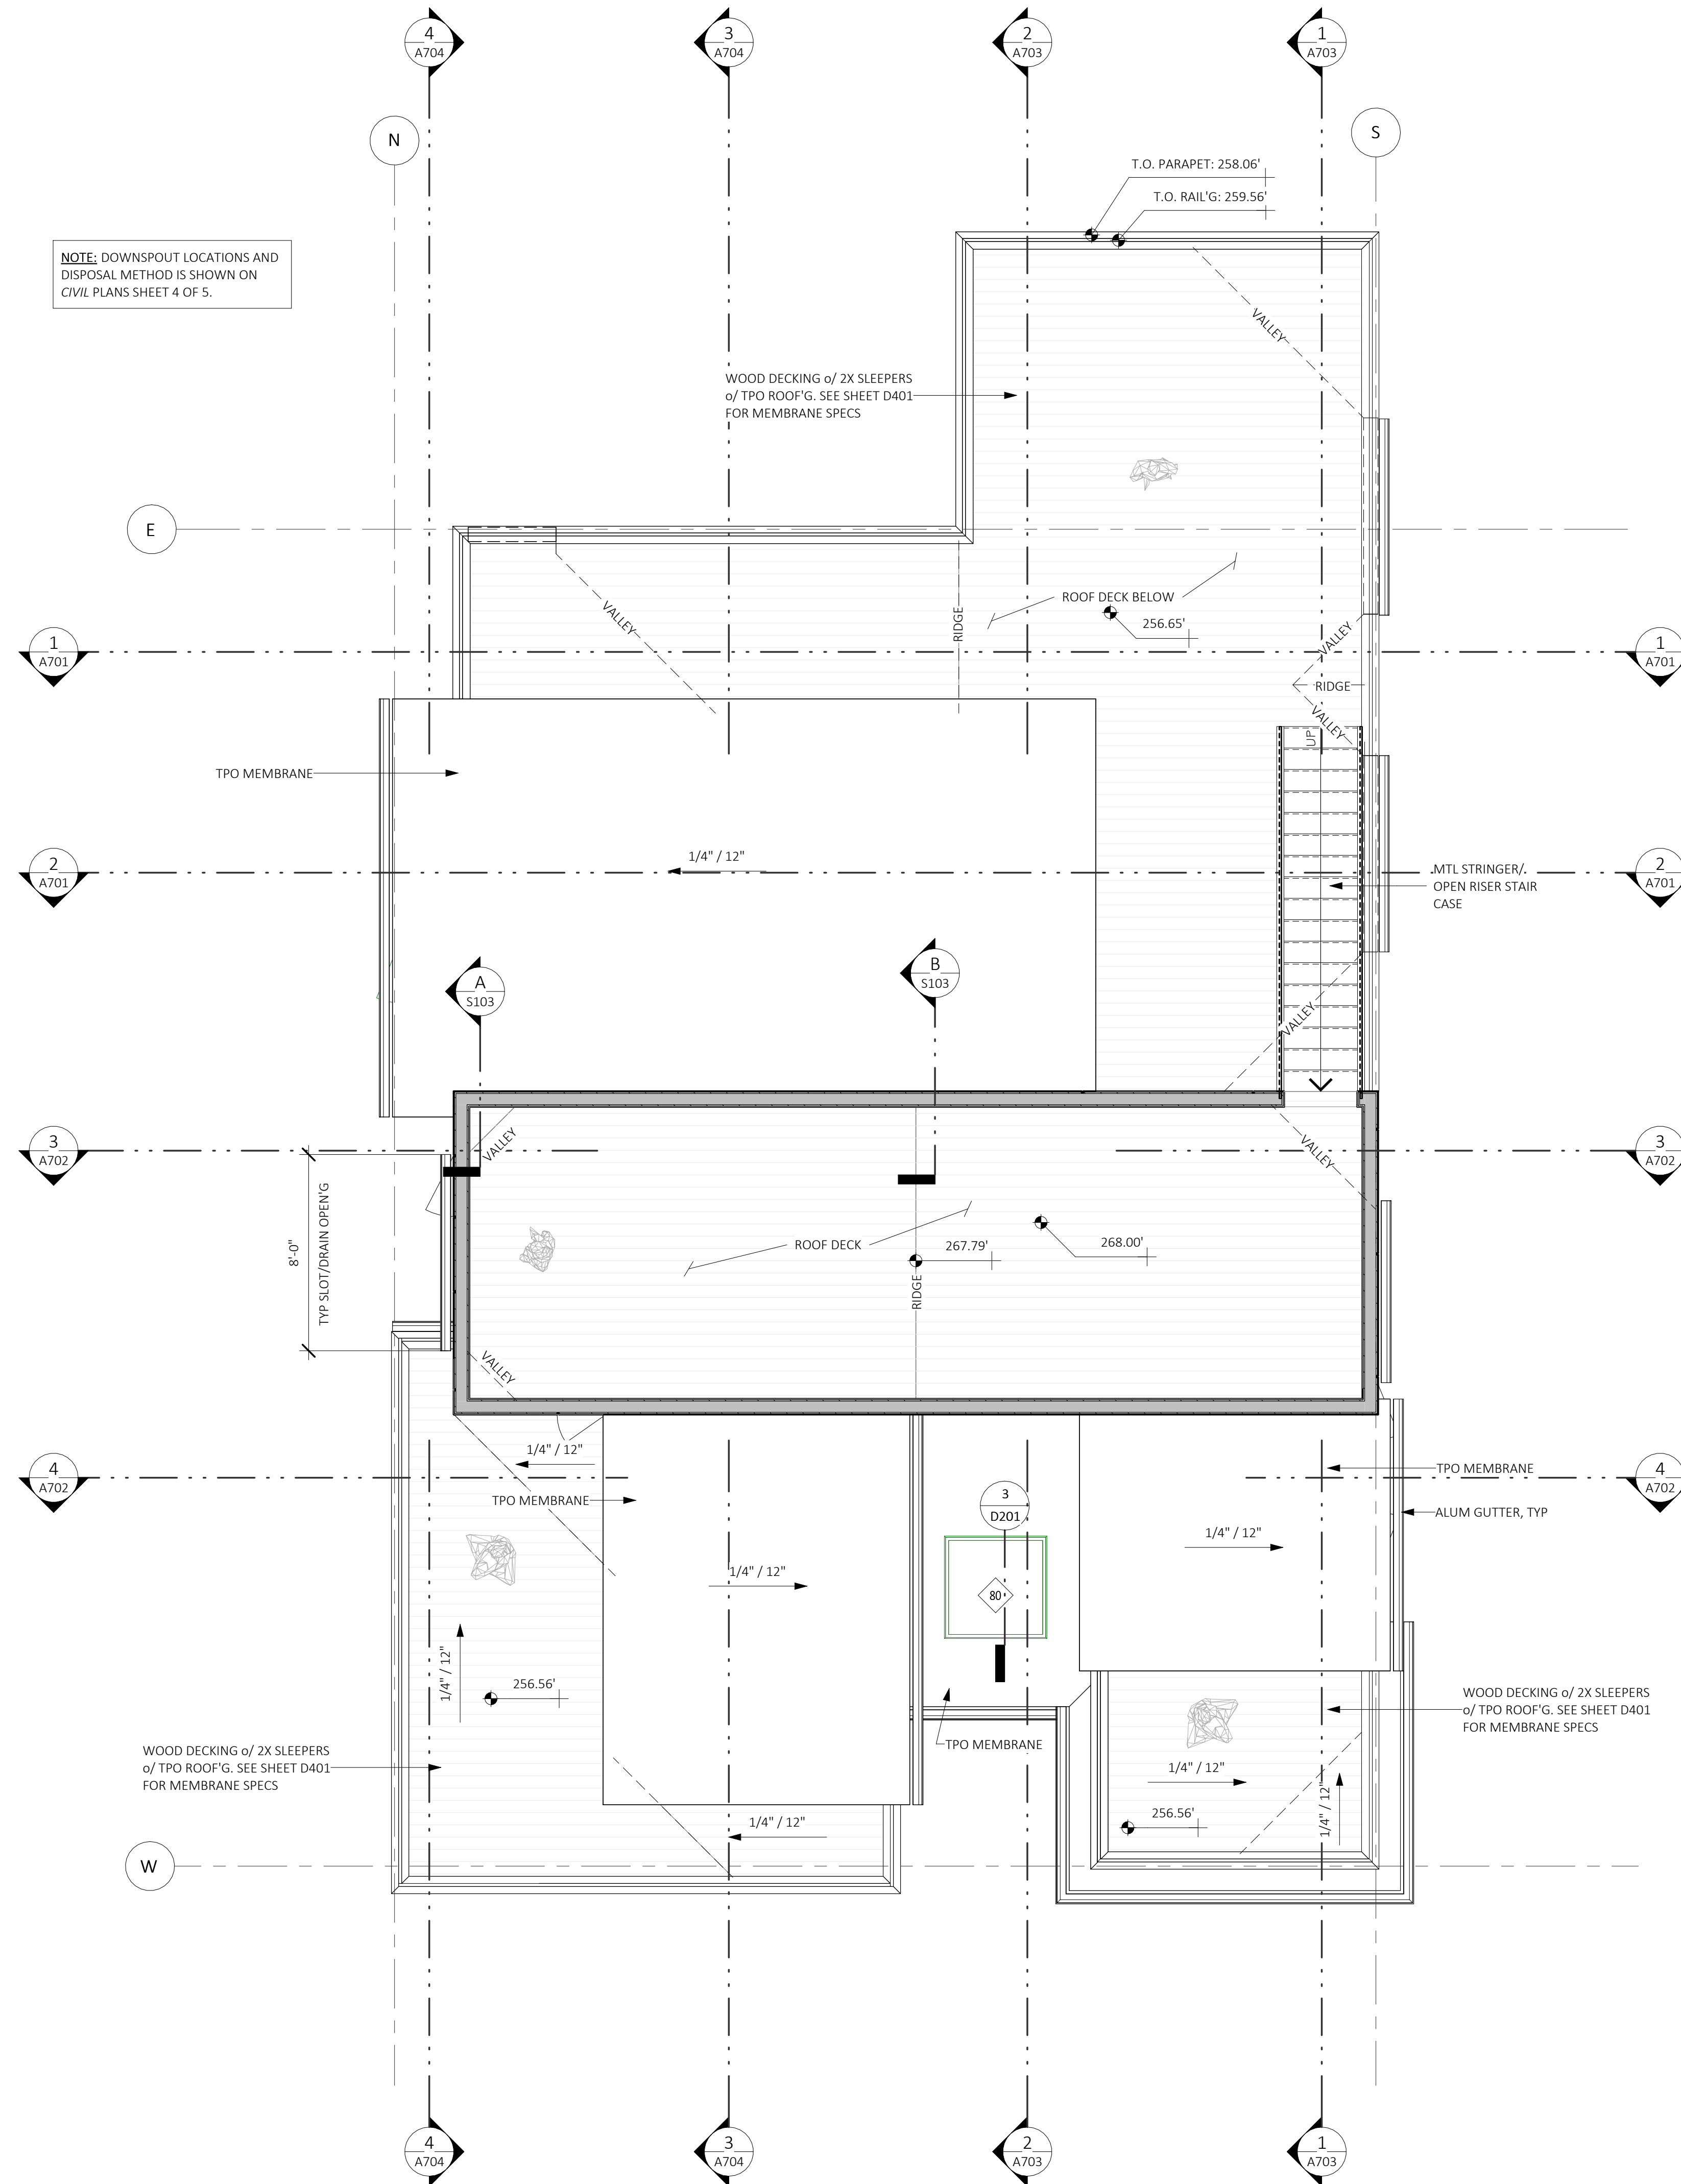

NOTE: DOWNSPOUT LOCATIONS AND DISPOSAL METHOD IS SHOWN ON CIVIL PLANS SHEET 4 OF 5.

WOOD DECKING o/ 2X SLEEPERS o/ TPO ROOF'G. SEE SHEET D401 FOR MEMBRANE SPECS

WOOD DECKING o/ 2X SLEEPERS o/ TPO ROOF'G. SEE SHEET D401 FOR MEMBRANE SPECS

T.O. PARAPET: 258.06'
T.O. RAIL'G: 259.56'

ROOF DECK BELOW
256.65'

ROOF DECK
267.79' / 268.00'

TPO MEMBRANE
ALUM GUTTER, TYP

WOOD DECKING o/ 2X SLEEPERS o/ TPO ROOF'G. SEE SHEET D401 FOR MEMBRANE SPECS

GENERAL FRAMING NOTES:

- 1. SEE SECTION R301, SHEET A001 FOR GENERAL DESIGN CRITERIA.
2. SEE STRUCTURAL SHEETS FOR SHEARWALL DESIGNATIONS & HOLD-DOWNS AND SHEETS(S) S201-S203 FOR SHEARWALL DESIGNATIONS/ SCHEDULE.
3. TRUSS DESIGN BY MANUFACTURER. TRUSS DESIGN DRAWINGS SHALL BE PREPARED PER IRC SECTION R802.10.1 AND SHALL BE PROVIDED TO THE BUILDING OFFICIAL AND APPROVED PRIOR TO INSTALLATION.
...
11. SEE SHT A003 FOR ROOF & CRAWL SPACE AREA VENTILATION CALCULATIONS

SPRAY FOAM NOTES:

- 1. WHERE SPRAY FOAM IS NOTED ON THE PLANS, NO VENTING IS REQUIRED: PROVIDE MIN 2" CLOSED CELL SPRAY FOAM INSULATION DIRECTLY TO THE UNDERSIDE OF THE ROOF/FLOOR SHEATHING.
2. PROVIDE SOLID EAVE BLOCKING, TYP
3. A COPY OF THE ICC-ES REPORT FOR THE INSULATION PRODUCT MUST BE PROVIDED ON SITE FOR THE FIELD INSPECTOR.
4. THE APPLIED SPRAY FOAM MUST BE INSTALLED IN ACCORDANCE WITH THE MANUFACTURER'S INSTRUCTIONS BY A CERTIFIED INSTALLER

ROOF VENTING NOTES:

- 1. (4) 2" DIA EAVE VENTS PER BLOCK= 5.024 SQ. IN. / L.F. (80% NET FREE AREA)
2. ROOF JACKS - 50 SQ. IN. EACH
3. INSTALL ONE LOW ROOF JACK, WITHIN 36" OF EAVE, FOR EVERY 12 LF OF EAVE WITHIN 60" OF PROPERTY LINE
4. MINIMUM NET AREA SHALL BE NOT LESS THAN 1 S.F. PER 150 S.F. OF ATTIC AREA OR 1 S.F. PER 300 S.F. OF ATTIC AREA IF NOT LESS THAN 40 PERCENT, BUT NOT MORE THAN 50 PERCENT, OF THE REQUIRED VENTILATING AREA IS PROVIDED BY VENTILATORS LOCATED NOT MORE THAN 3 FEET BELOW THE RIDGE OR HIGHEST POINT OF THE SPACE, MEASURED VERTICALLY.
A. THE BALANCE OF THE REQUIRED VENTILATION PROVIDED SHALL BE LOCATED IN THE BOTTOM ONE-THIRD OF THE ATTIC SPACE.
5. AS AN ALTERNATIVE, THE NET FREE CROSS-VENTILATION AREA MAY BE REDUCED TO 1/300 WHEN A CLASS I OR II VAPOR BARRIER IS INSTALLED ON THE WARM-IN-WINTER SIDE OF THE CEILING.

KEYNOTES - FRAMING

Table with 2 columns: ID, DESCRIPTION. Rows include FR-4 (UPSET - BOTTOM OF BEAM EVEN w/ BOTTOM OF JOISTS), FR-5 (TOP OF BEAM IS FLUSH w/ BOTTOM OF JOISTS), FR-9 (TOP OF BEAM 5" BELOW TOP OF JOISTS TO ALLOW FOR HVAC).

(C) ATERA DESIGN STUDIO LLC. PLANS AND DESIGNS (DRAWINGS) FORTHWITH REMAIN THE PROPERTY OF ATERA DESIGN STUDIO. REPRODUCTION WITHOUT PERMISSION IS PROHIBITED.

Table with 3 columns: No., Date, Description. Row 1: 1, 2023/07/25, SUB2 City Comment Submittal

ATERA DESIGN STUDIO logo and address: 451 DUVALL AVE NE, RENTON, WA 98059

HU RESIDENCE
2448 72nd AVE SE, Mercer Island

PERMIT SET


ROOF PLAN

PROJECT NO: 21014
ISSUE DATE: 2022/06/29


A501

SCALE 24X36: 1/4" = 1'-0"
* NOTE: 11X17 SETS ARE REDUCED 50% SCALE DRAWINGS ACCORDINGLY.




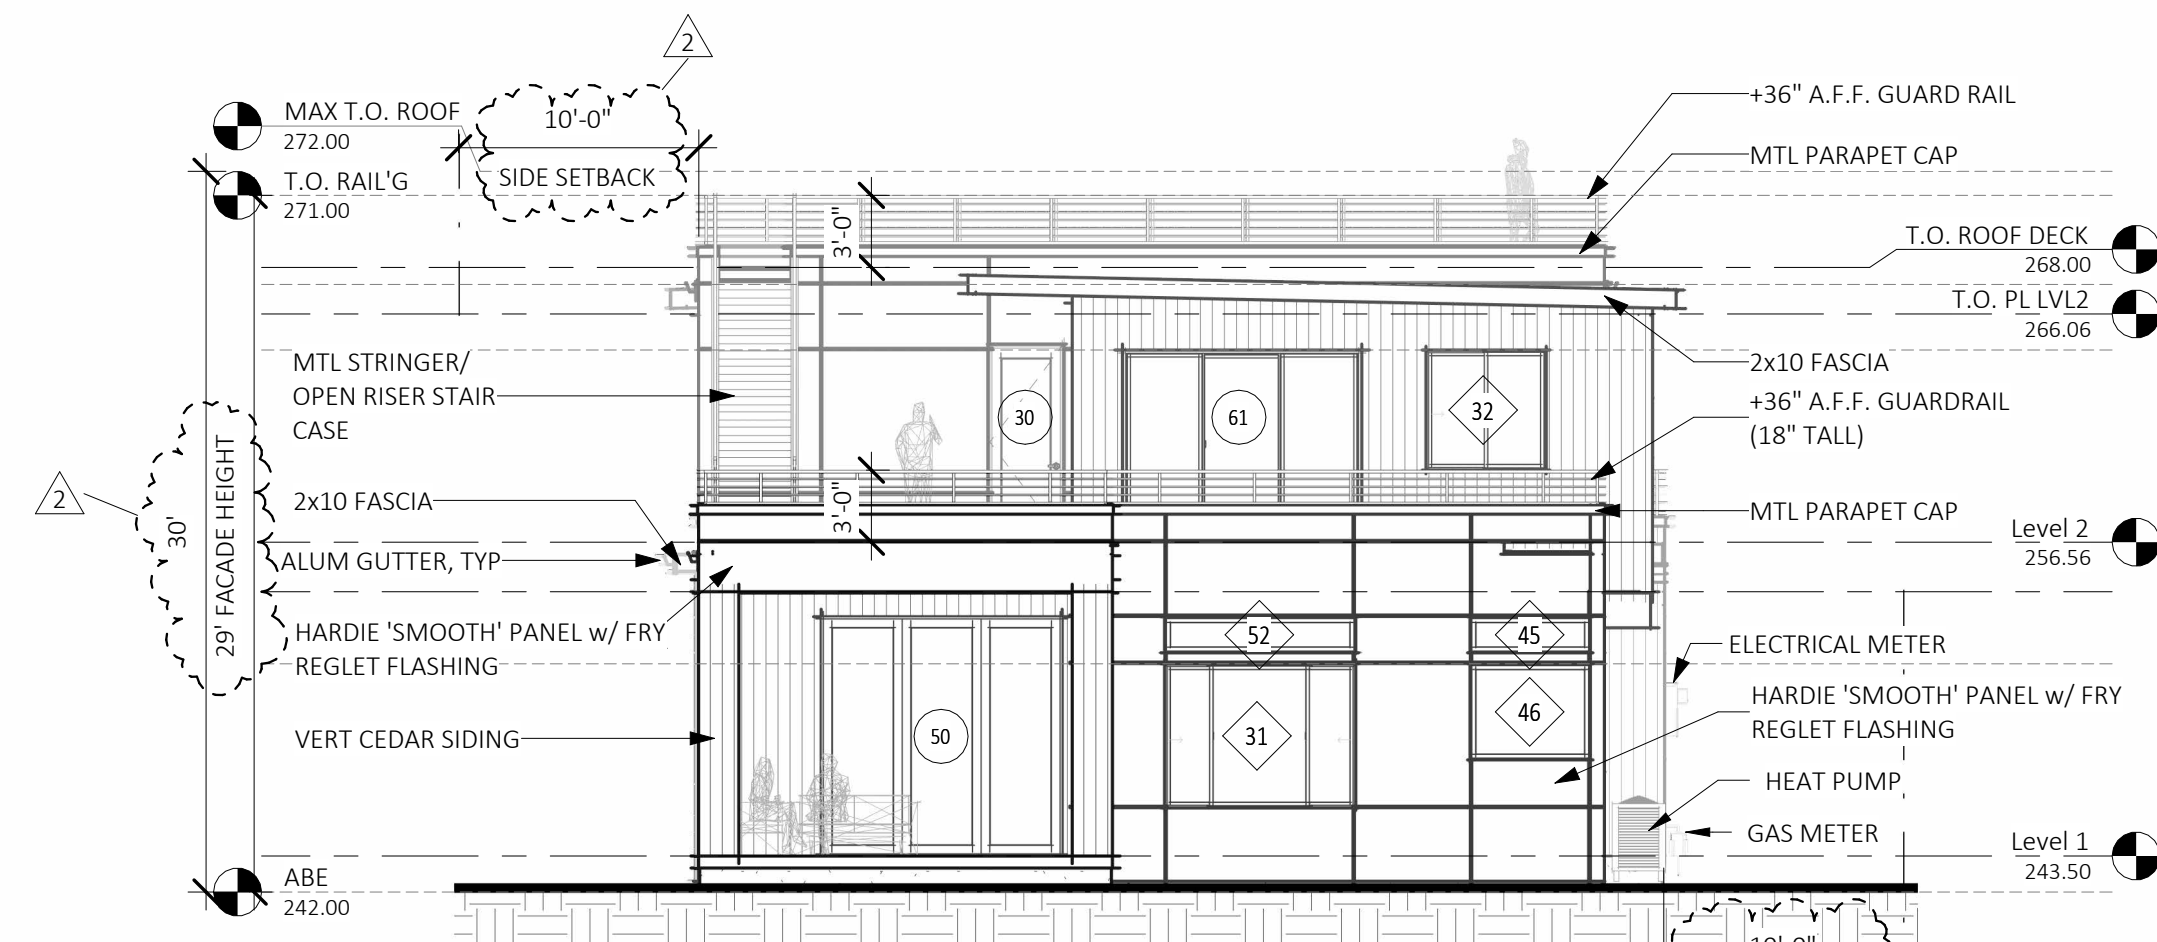


2 EAST ELEVATION
SCALE: 1/8" = 1'-0"

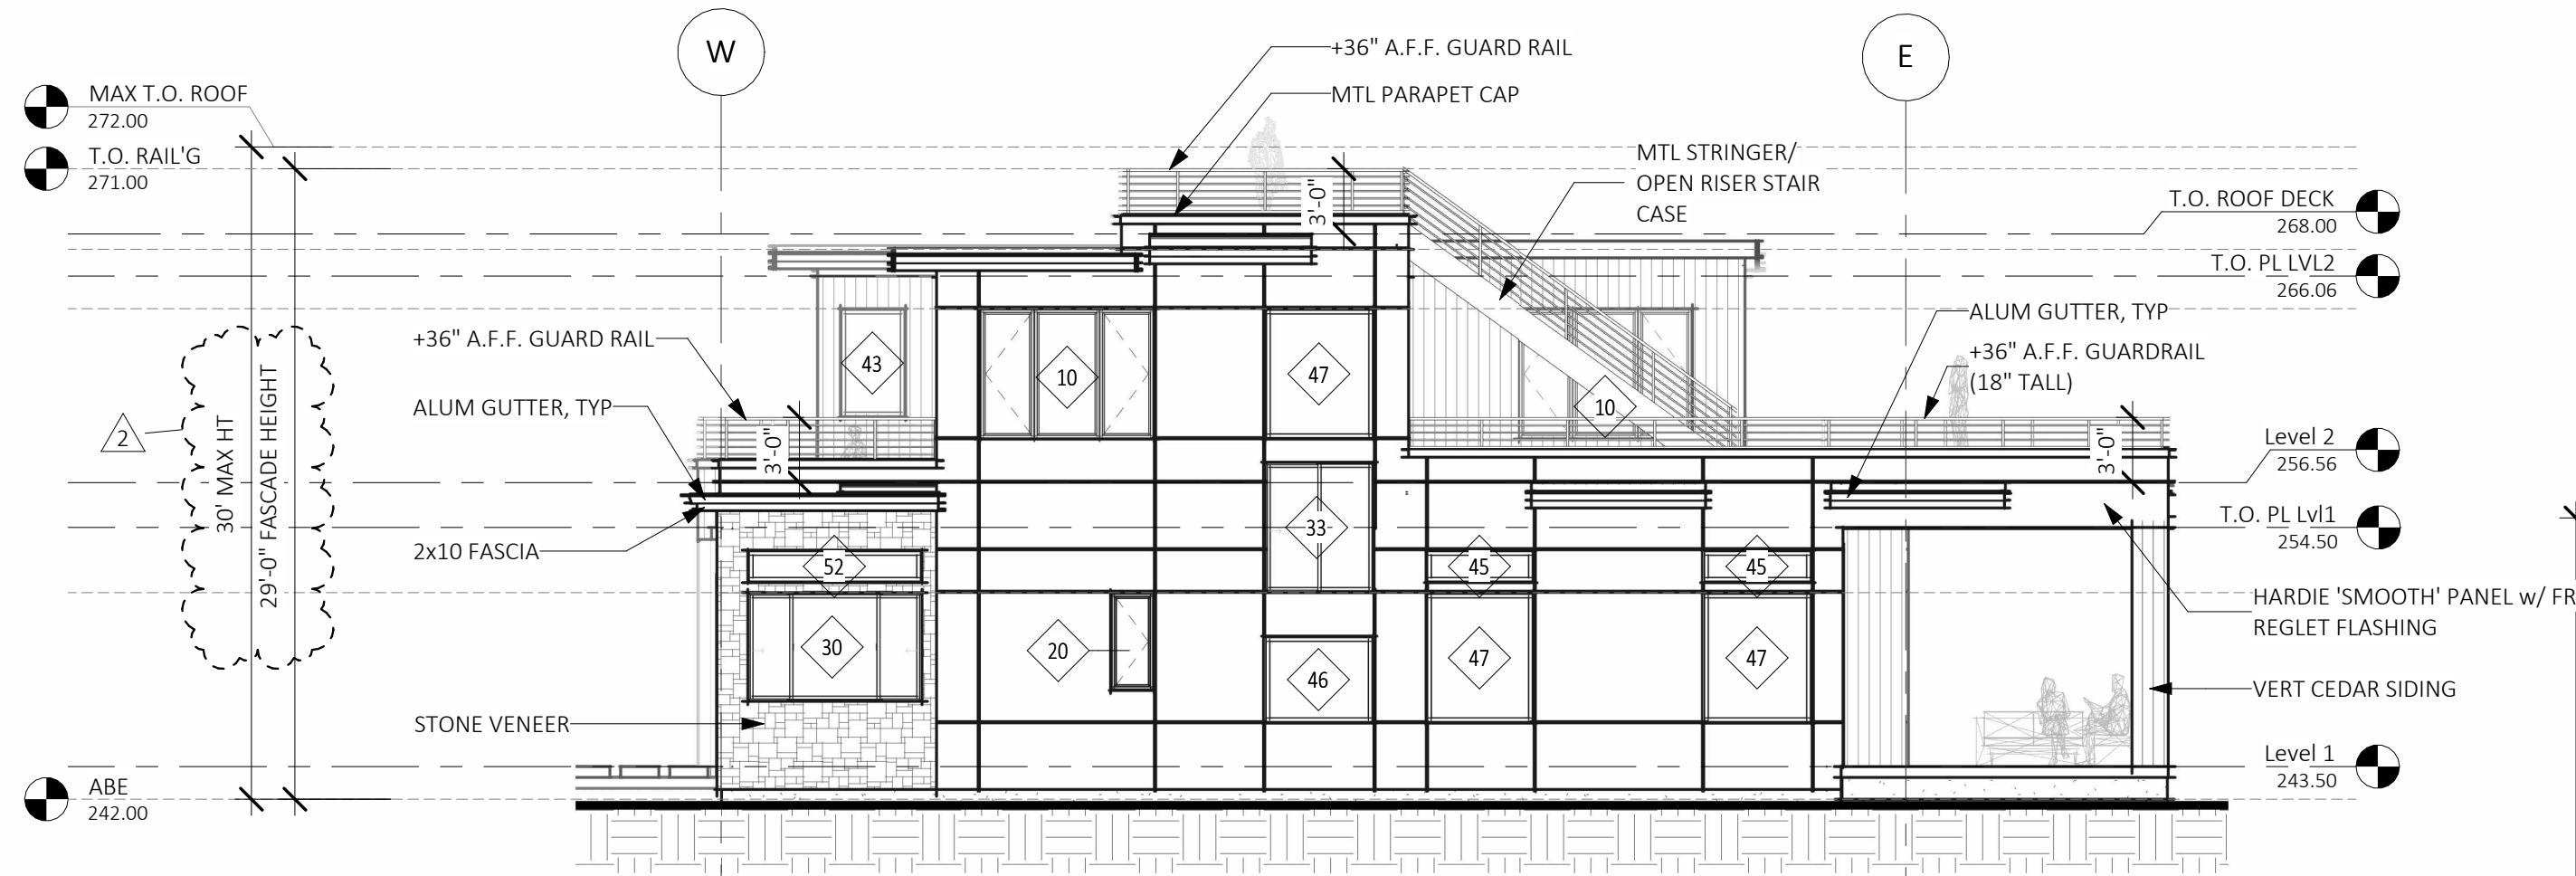

4 SOUTH ELEVATION
SCALE: 1/8" = 1'-0"

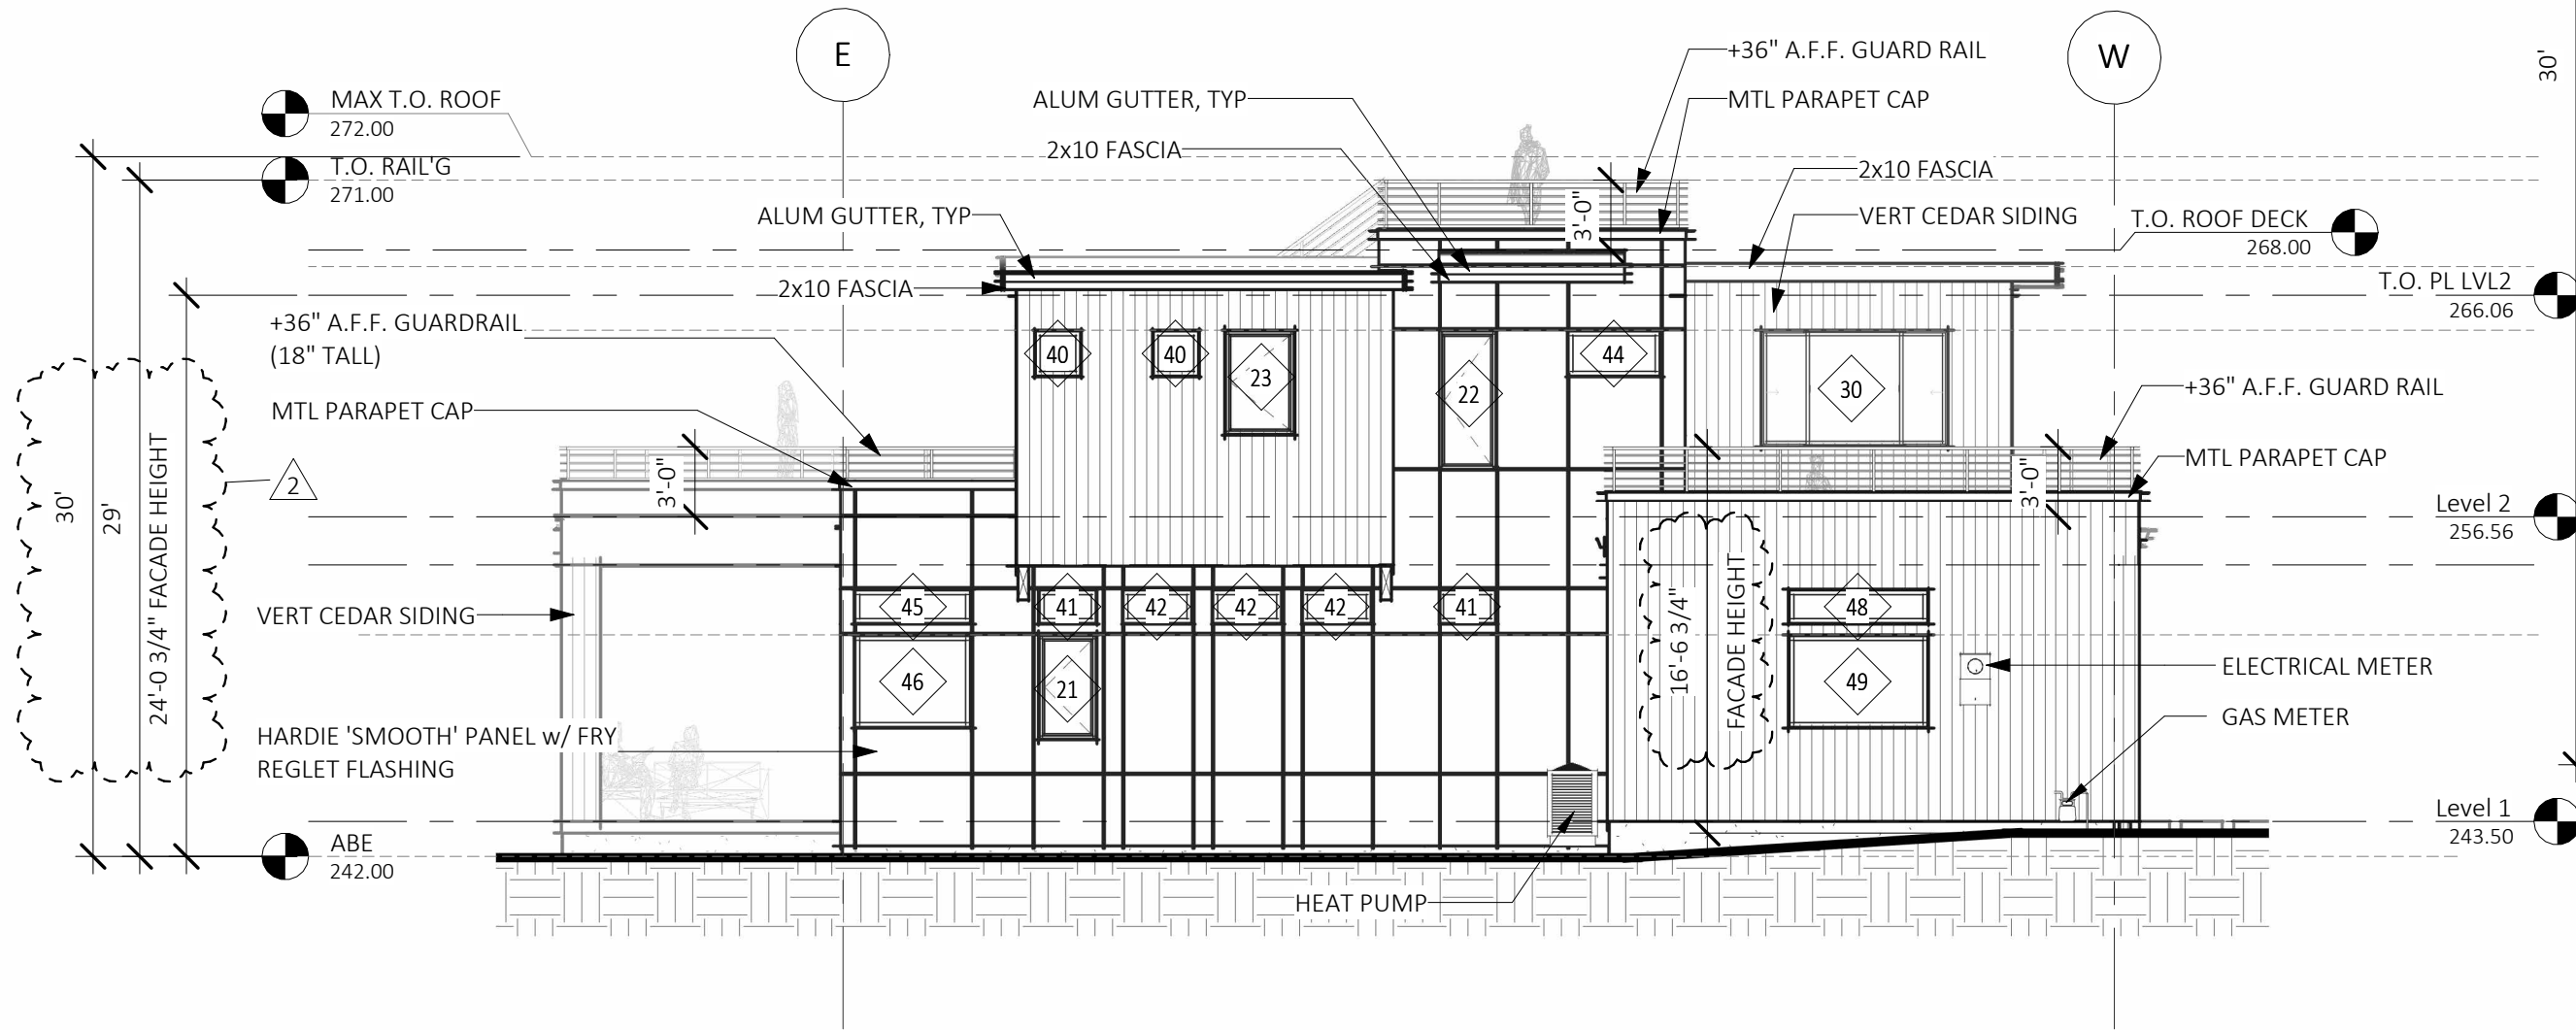

3 NORTH ELEVATION
SCALE: 1/8" = 1'-0"

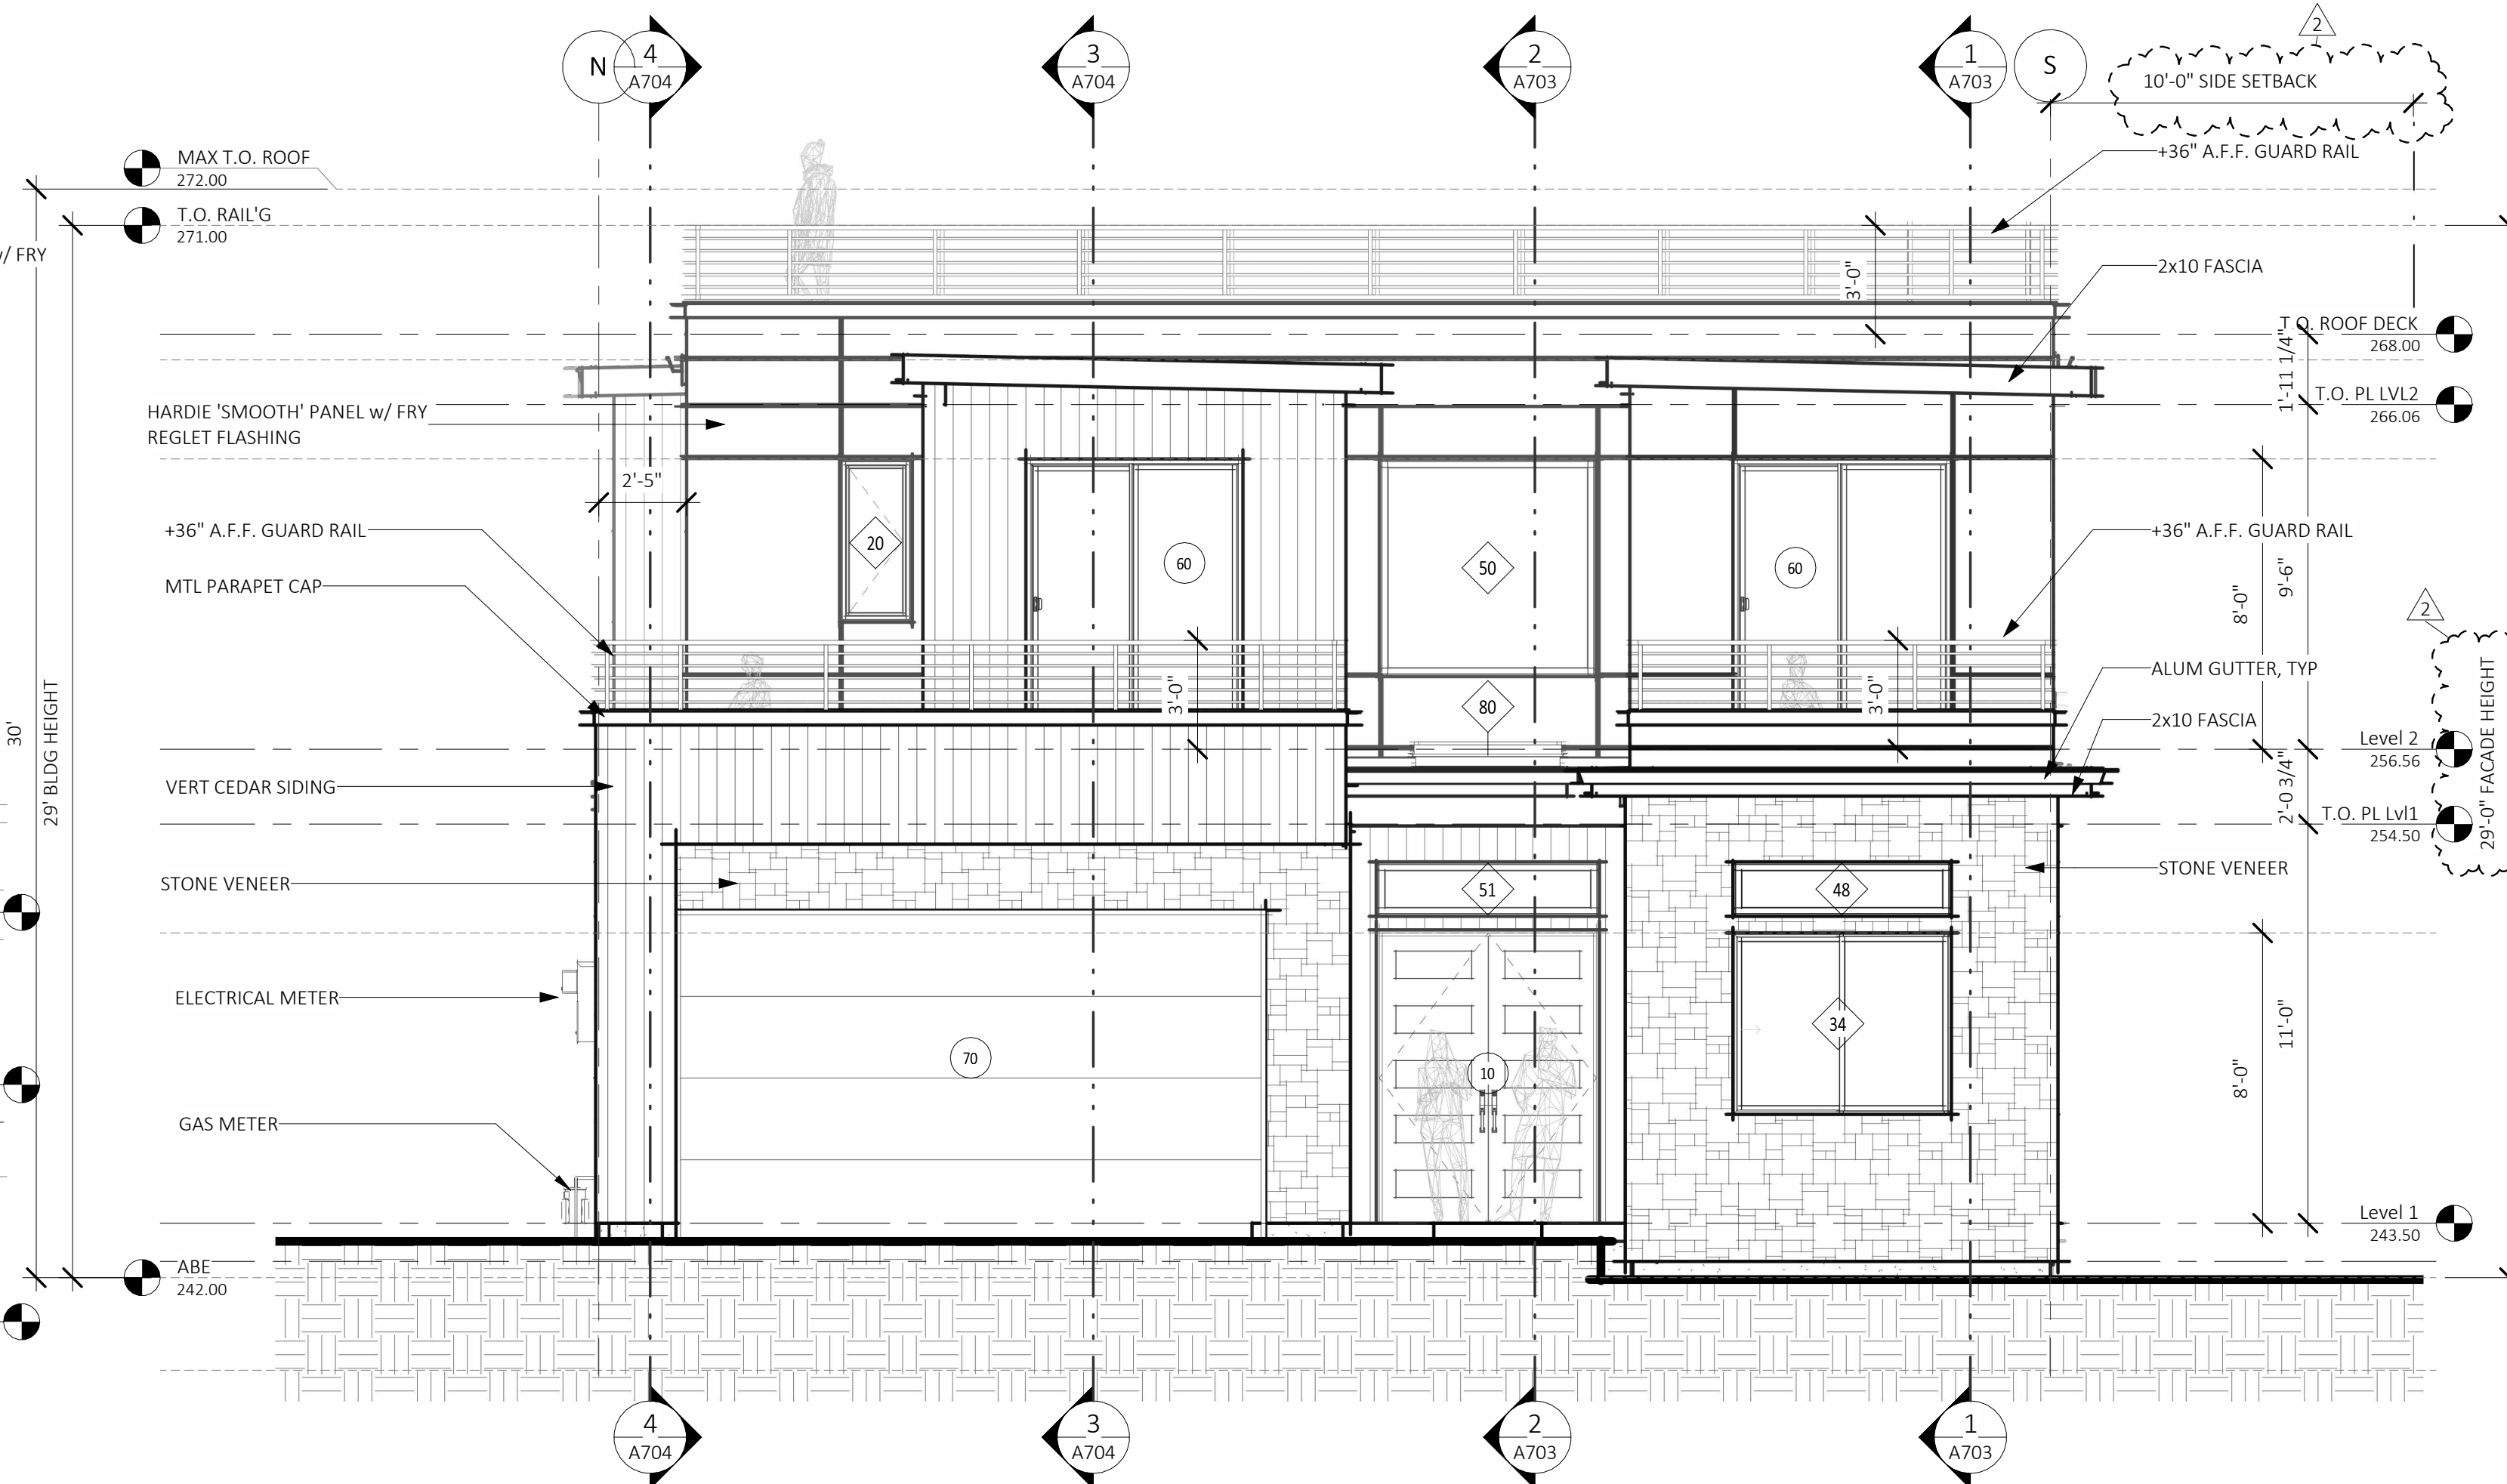

1 WEST ELEVATION
SCALE: 1/4" = 1'-0"

TYPICAL BUILDING MATERIALS:

ROOF CONSTRUCTION

ROOFING: TPO MEMBRANE
 BUILDING PAPER: PER MFR
 SHEATHING: PER SHEARWALL SCHEDULE
 FRAMING: PER PLANS
 INSULATION: R-49 BLOWN IN (R-38 VAULTED)
 SOFFIT: T&G WHERE NOTED
 GWB: 5/8" GWB

FLOOR CONSTRUCTION

FLOORING: FINISH PER PLANS
 SUBFLOOR: 3/4" T&G (PLYWOOD, COMPLY OR EQUAL)
 FRAMING: PER PLANS
 INSULATION: R-38 BATT
 SOFFIT: HARDIA PANEL WHERE NOTED

EXTERIOR WALL CONSTRUCTION

SIDING MATERIAL: PER ELEVATIONS
 BUILDING PAPER: 15# BUILDING PAPER
 SHEATHING: PER SHEARWALL SCHEDULE
 FRAMING: 2x6 STUDS AT 16" oc U.N.O.
 INSULATION: R-21 BATT w/ INTEGRAL VAPOR BARRIER
 GWB: 1/2" GWB

TRIM

WINDOW: (WITH NO BRICK MOLD) 1/2" FLASHING
 CORNER BOARDS: INSIDE: 2x2
 OUTSIDE: 'X' FLASHING

FASCIA: 2x8 (PER DETAILS) U.N.O.

ELEVATION NOTES:

- INSTALL APPROVED CORROSION-RESISTANT FLASHING, TO PREVENT ENTRY OF WATER INTO THE WALL CAVITY OR PENETRATION OF WATER TO THE BUILDING STRUCTURAL FRAMING COMPONENTS PER R708.3. SELF-ADHERED MEMBRANES USED AS FLASHING SHALL COMPLY WITH AAMA 711. THE FLASHING SHALL EXTEND TO THE SURFACE OF THE EXTERIOR WALL FINISH. APPROVED CORROSION-RESISTANT FLASHINGS SHALL BE INSTALLED AT ALL OF THE FOLLOWING LOCATIONS:
 - EXTERIOR WINDOW AND DOOR OPENINGS. FLASHING AT EXTERIOR WINDOW AND DOOR OPENINGS SHALL EXTEND TO THE SURFACE OF THE EXTERIOR WALL FINISH OR TO THE WATER-RESISTIVE BARRIER FOR SUBSEQUENT DRAINAGE.
 - AT THE INTERSECTION OF CHIMNEYS OR OTHER MASONRY CONSTRUCTION WITH FRAME OR STUCCO WALLS, WITH PROJECTING LIPS ON BOTH SIDES UNDER STUCCO COPINGS.
 - UNDER AND AT THE ENDS OF MASONRY, WOOD OR METAL COPINGS AND SILLS.
 - CONTINUOUSLY ABOVE ALL PROJECTING WOOD TRIM.
 - WHERE EXTERIOR PORCHES, DECKS OR STAIRS ATTACH TO A WALL OR FLOOR ASSEMBLY OF WOOD-FRAME CONSTRUCTION.
 - AT WALL AND ROOF INTERSECTIONS.
 - AT BUILT-IN GUTTERS.
- PER IRC R703.12.1, ADHERED MASONRY VENEER IS REQUIRED TO HAVE THE FOLLOWING CLEARANCES:
 - 4" MINIMUM ABOVE THE EARTH
 - 2" MINIMUM ABOVE PAVED AREAS, AND
 - 1/2" MINIMUM ABOVE EXTERIOR WALKING SURFACES WHICH ARE SUPPORTED BY THE SAME FOUNDATION THAT SUPPORTS THE EXTERIOR WALL.
- STONE VENEER TO BE SUPPLIED BY ELDERADO STONE OR APPROVED EQUAL. STONE VENEER MAXIMUM WEIGHT 15 psf.

3/15/2023 8:46:13 AM Autocad2023 Docx/21014 HU Residence, Mercer Island/21014 OS/CD, HU Residence, Mercer Island.rvt

REPRODUCTION WITHOUT PERMISSION IS PROHIBITED. PLANS AND DESIGNS (DRAWINGS) FORTHWITH REMAIN THE PROPERTY OF ATERA DESIGN STUDIO.

No.	Date	Description
1	2023/07/25	SUB2 City Comment Submittal
2		SUB2 City Comment Submittal

ATERA DESIGN STUDIO
 451 DUVALL AVE. NE
 RENTON, WA 98059

HU RESIDENCE
 2448 72nd AVE SE, Mercer Island

PERMIT SET
 ELEVATIONS


PROJECT NO: 21014
 ISSUE DATE: 2022/06/29

A601


SCALE 24X36: As indicated
 *NOTE: 11X17 SETS ARE REDUCED 50% SCALE DRAWINGS ACCORDINGLY.



3/15/2023 8:48:20 AM Autodesk Docs/21014 HU Residence, Mercer Island/21014 05CD, HU Residence, Mercer Island.rvt

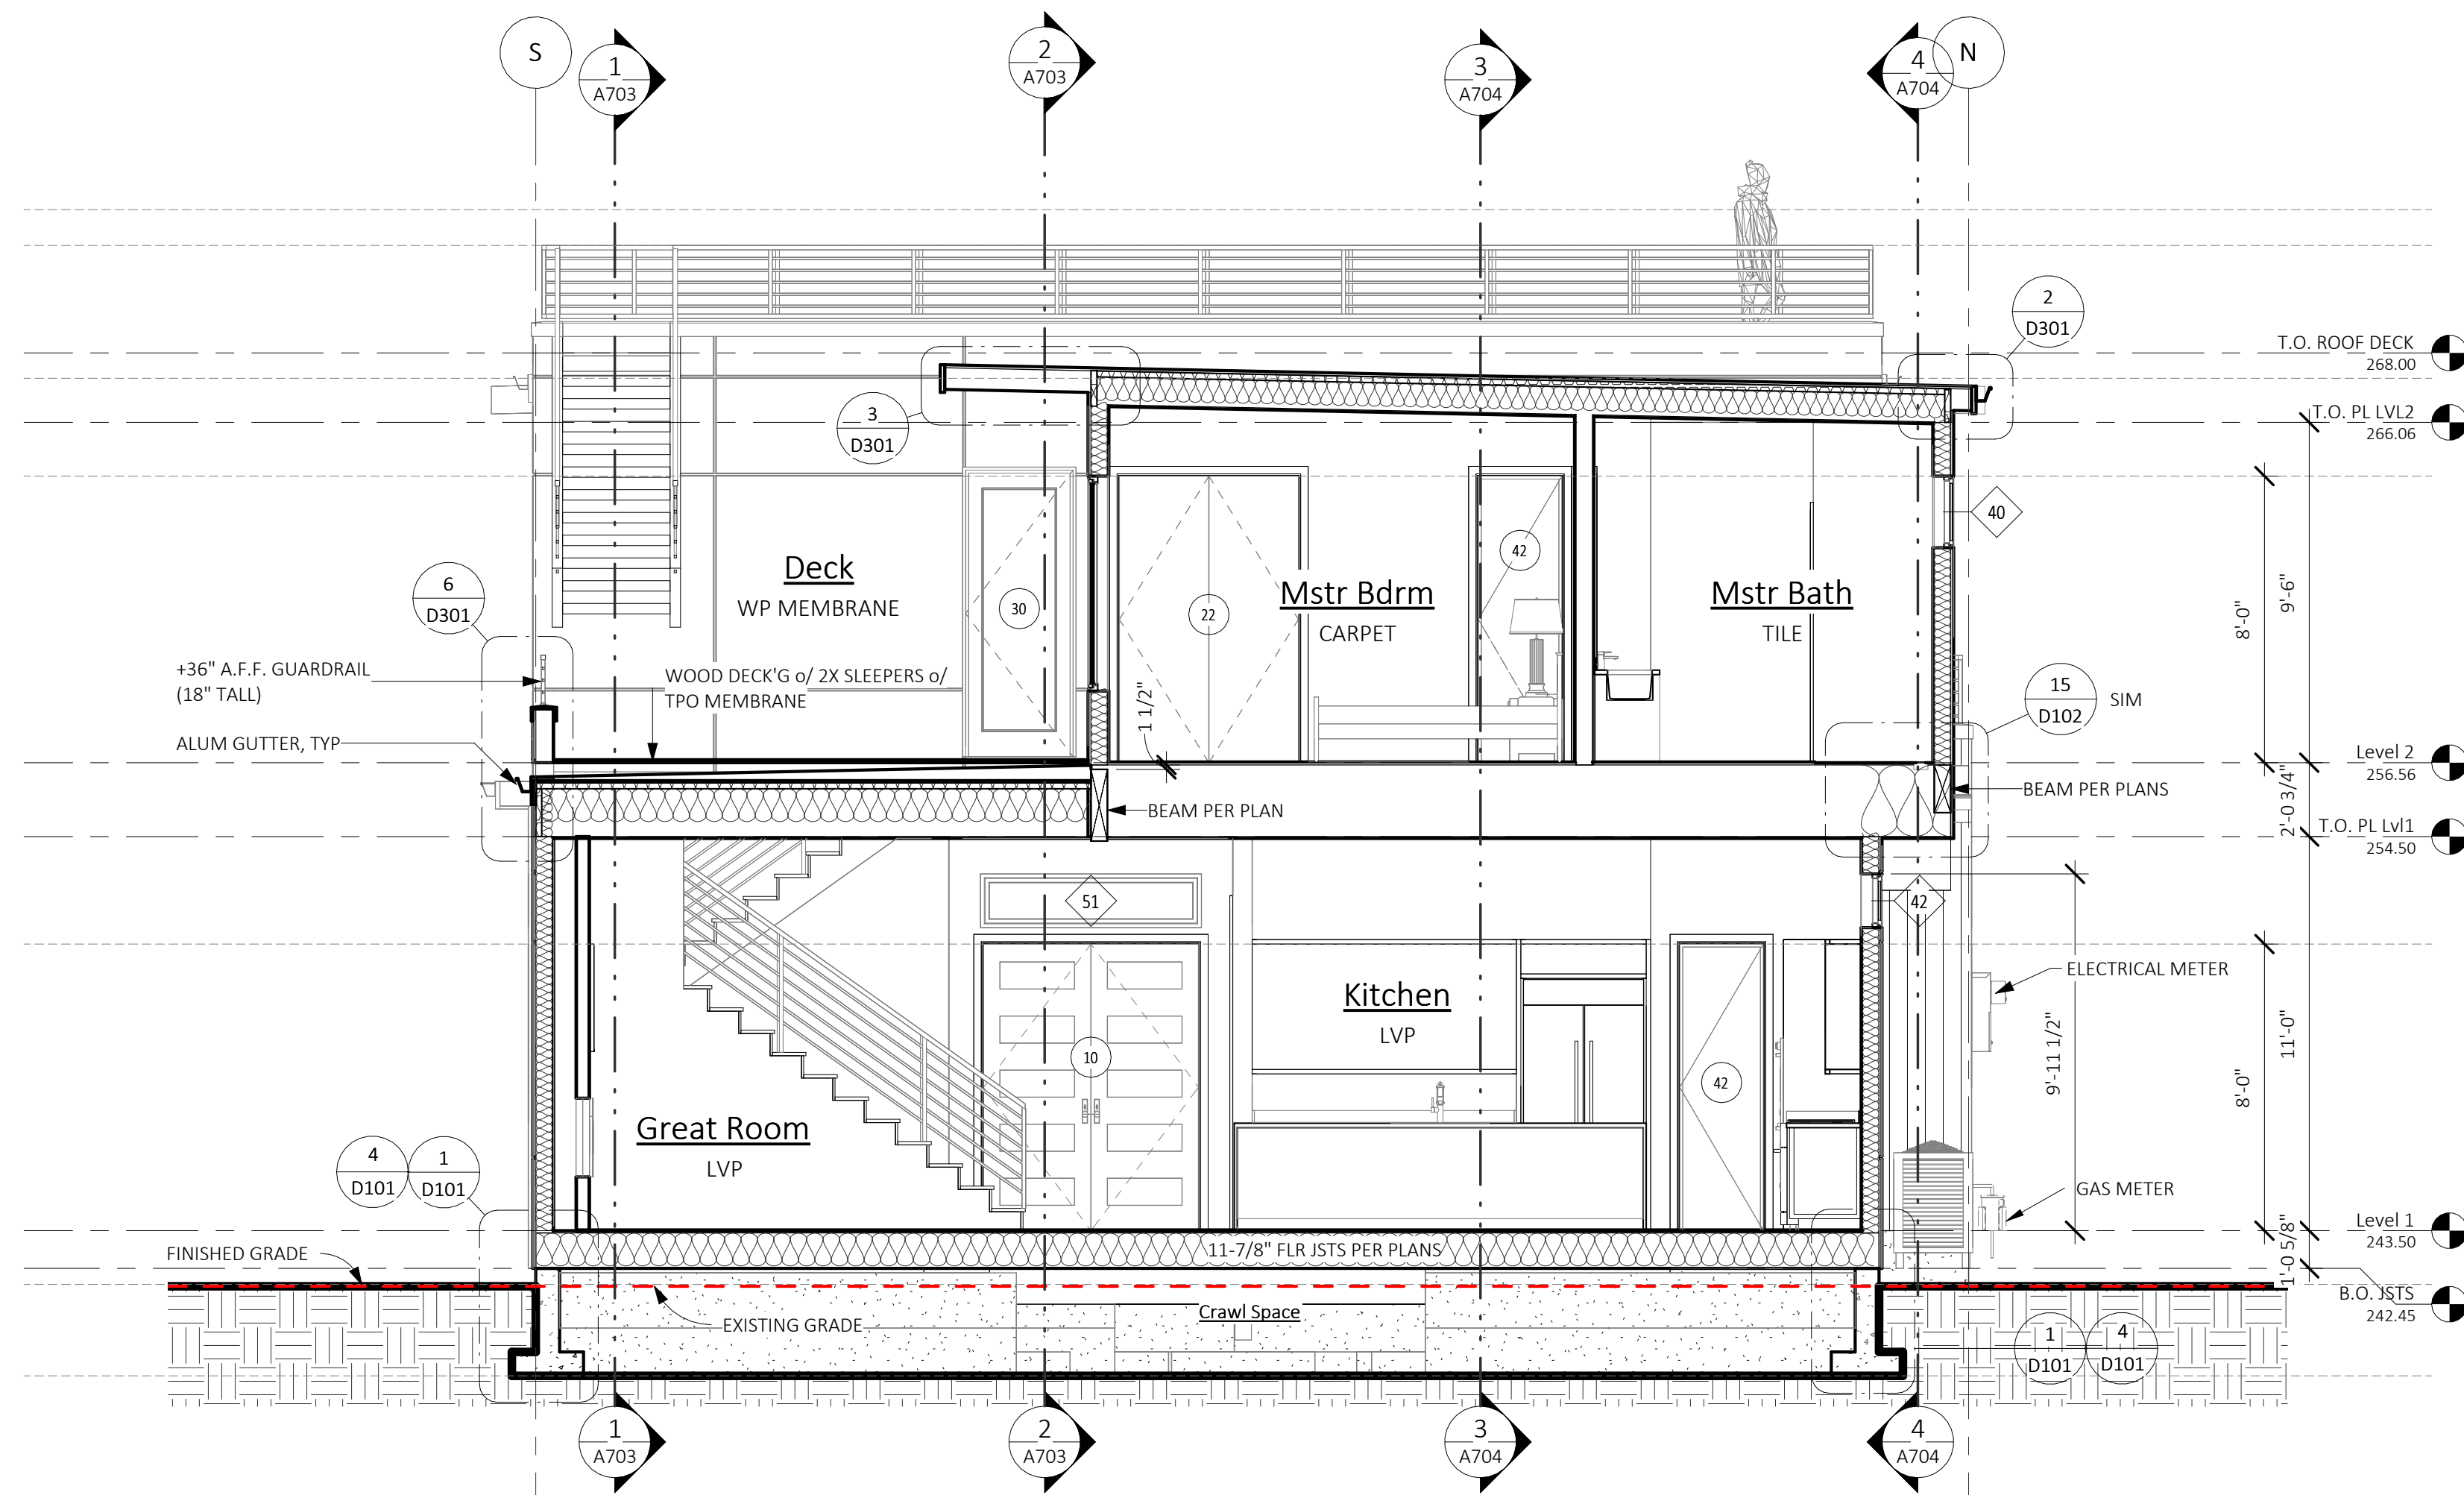

2 Section E/W 2
SCALE: 1/4" = 1'-0"

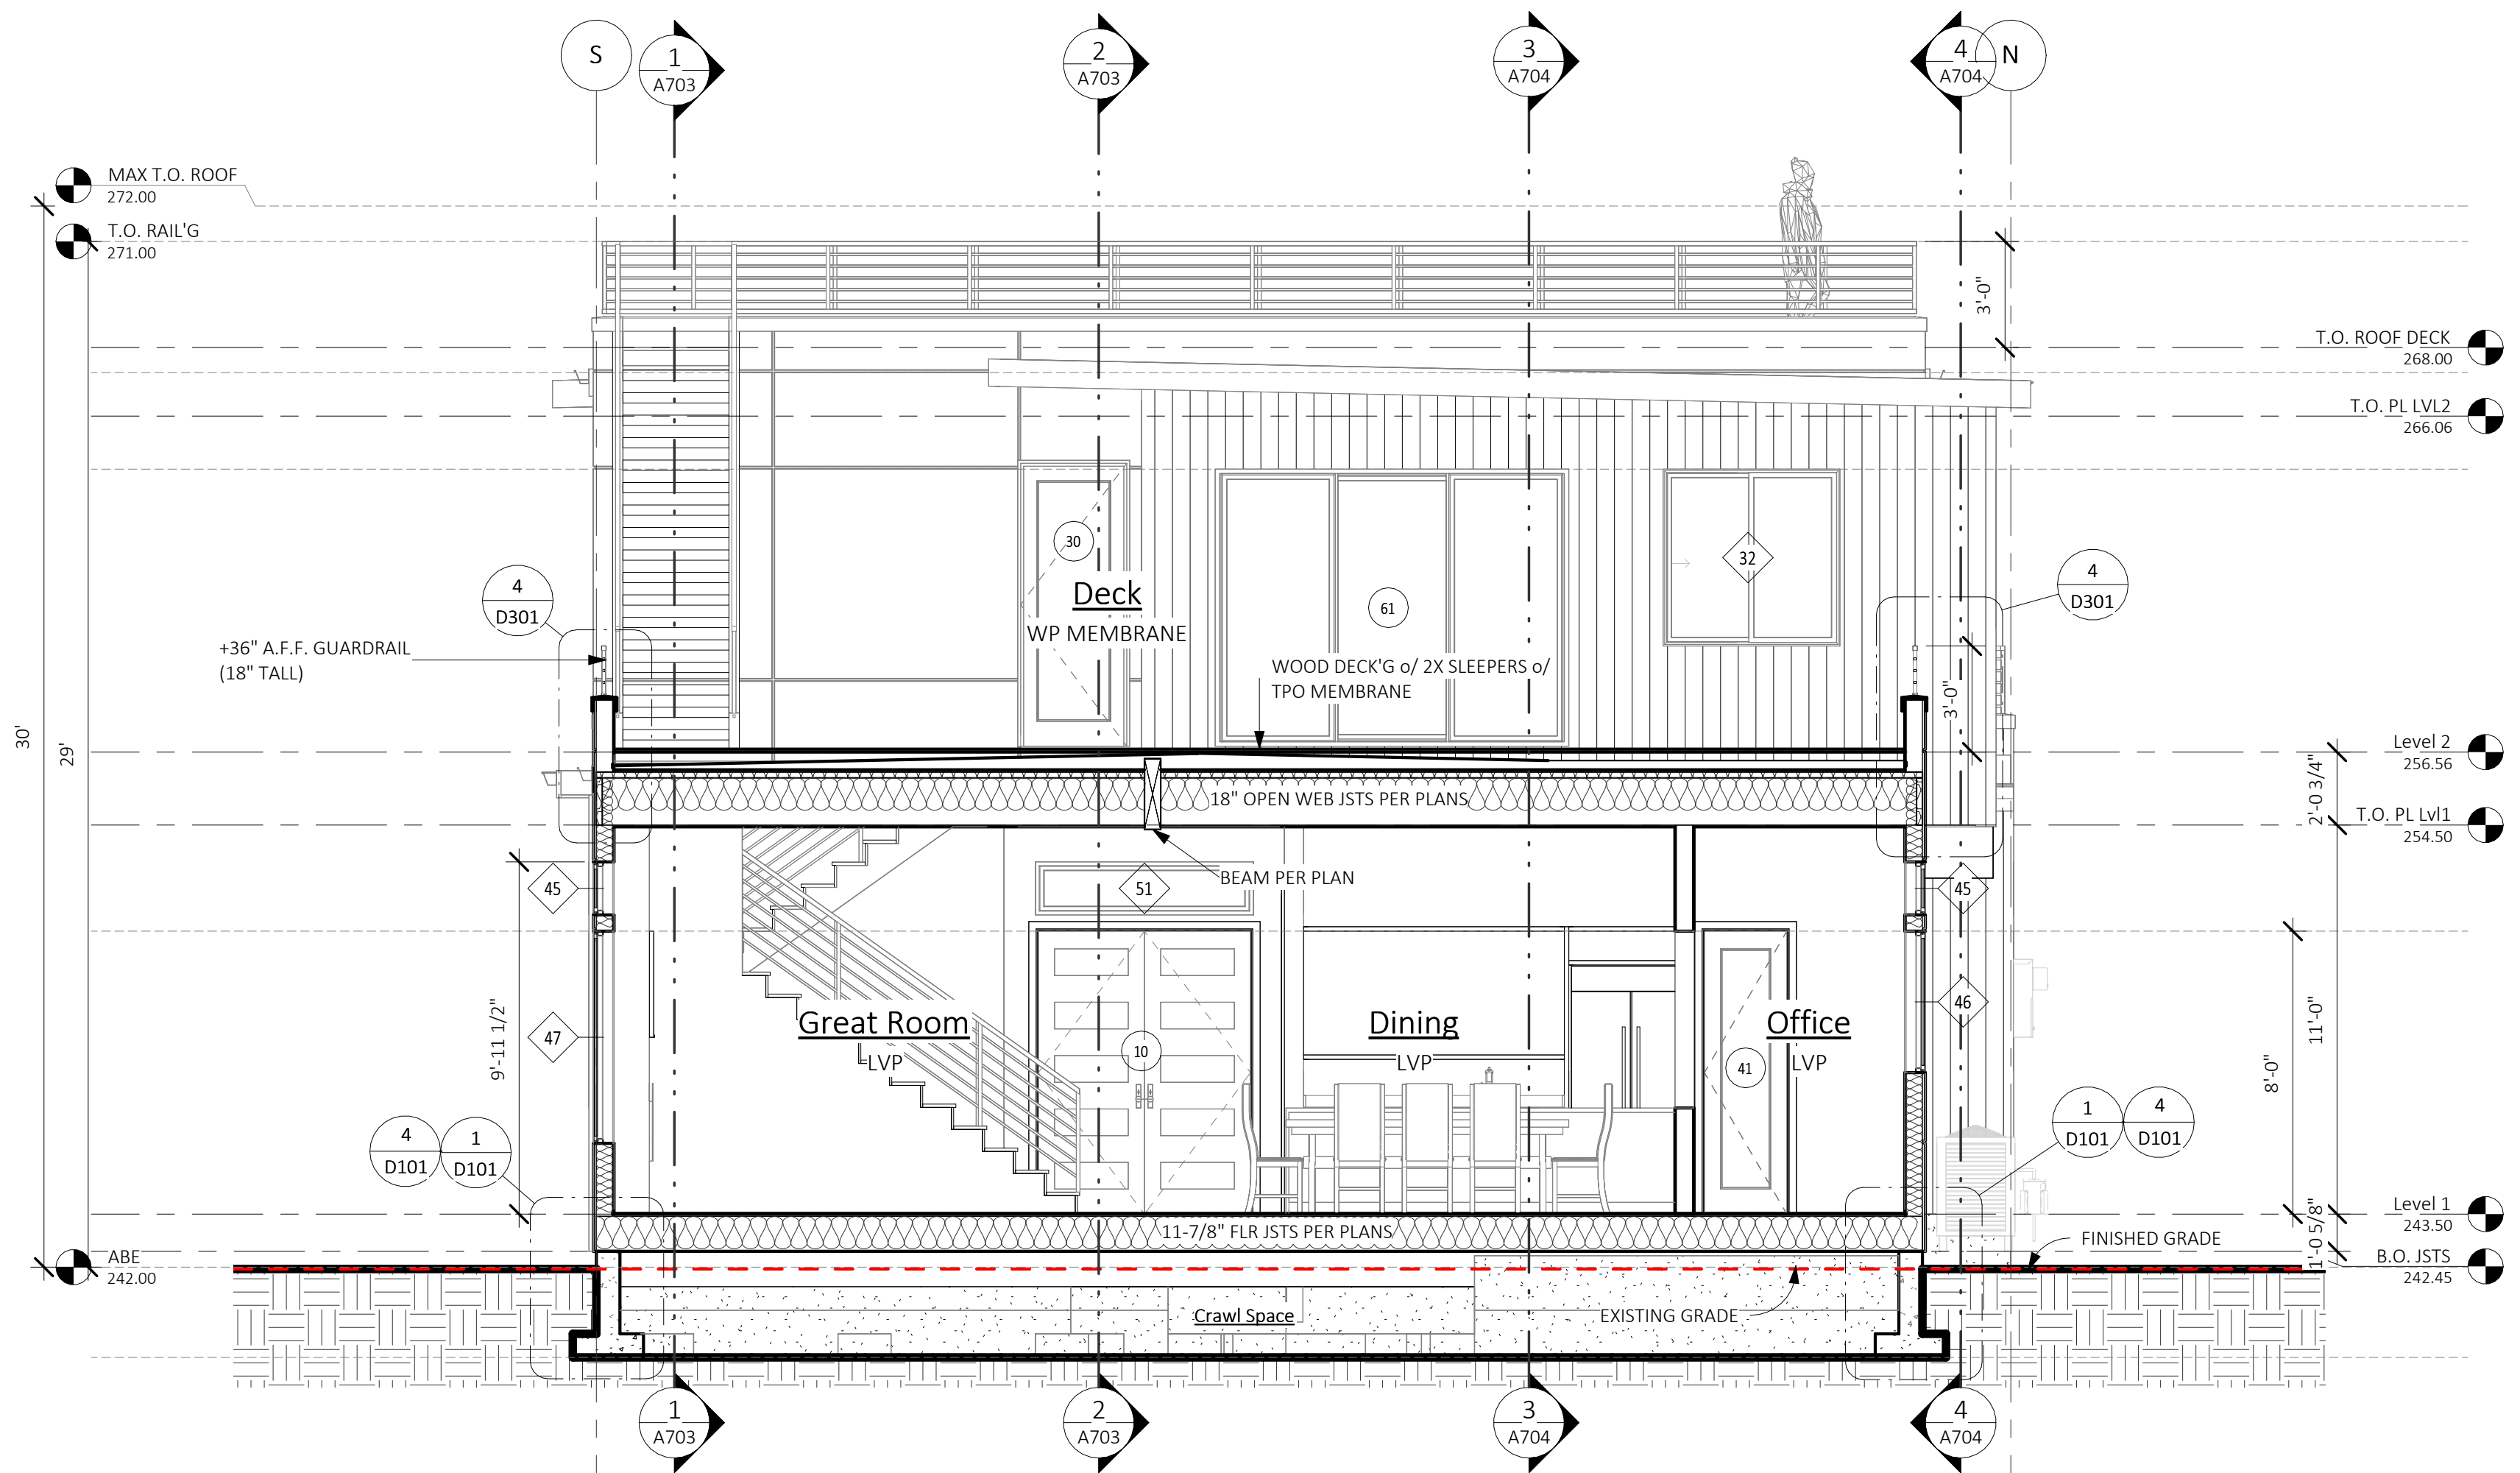

1 Section E/W 1
SCALE: 1/4" = 1'-0"

TYPICAL BUILDING MATERIALS:

ROOF CONSTRUCTION

ROOFING: TPO MEMBRANE
 BUILDING PAPER: PER MFR
 SHEATHING: PER SHEARWALL SCHEDULE
 FRAMING: PER PLANS
 INSULATION: R-49 BLOWN IN (R-38 VAULTED)
 SOFFIT: T&G WHERE NOTED
 GWB: 5/8" GWB

FLOOR CONSTRUCTION

FLOORING: FINISH PER PLANS
 SUBFLOOR: 3/4" T&G (PLYWOOD, COMPLY OR EQUAL)
 FRAMING: PER PLANS
 INSULATION: R-38 BATT
 SOFFIT: HARDIA PANEL WHERE NOTED

EXTERIOR WALL CONSTRUCTION

SIDING MATERIAL: PER ELEVATIONS
 BUILDING PAPER: 15# BUILDING PAPER
 SHEATHING: PER SHEARWALL SCHEDULE
 FRAMING: 2x6 STUDS AT 16" oc U.N.O.
 INSULATION: R-21 BATT w/ INTEGRAL VAPOR BARRIER
 GWB: 1/2" GWB
TRIM
 WINDOW: (WITH NO BRICK MOLD) 2" FLASHING
 CORNER BOARDS: INSIDE: 2x2
 OUTSIDE: 'X' FLASHING
 FASCIA: 2x8 (PER DETAILS) U.N.O.

No.	Date	Description
1	2023/07/25	SUB2 City Comment Submittal

ATERA DESIGN STUDIO
 451 DUVALL AVE. NE
 RENTON, WA 98059



HU RESIDENCE
 2448 72nd AVE SE, Mercer Island

PERMIT SET

SECTIONS

PROJECT NO: 21014
 ISSUE DATE: 2022/06/29


A701

SCALE 24X36: 1/4" = 1'-0"
 * NOTE: 11X17 SETS ARE REDUCED 50% SCALE DRAWINGS ACCORDINGLY.


(C) ATERA DESIGN STUDIO LLC. PLANS AND DESIGNS (DRAWINGS) FORTHWITH REMAIN THE PROPERTY OF ATERA DESIGN STUDIO. REPRODUCTION WITHOUT PERMISSION IS PROHIBITED.



3/15/2023 8:48:43 AM Autodesk Docs/21014 HU Residence, Mercer Island/21014 05CD, HU Residence, Mercer Island.rvt

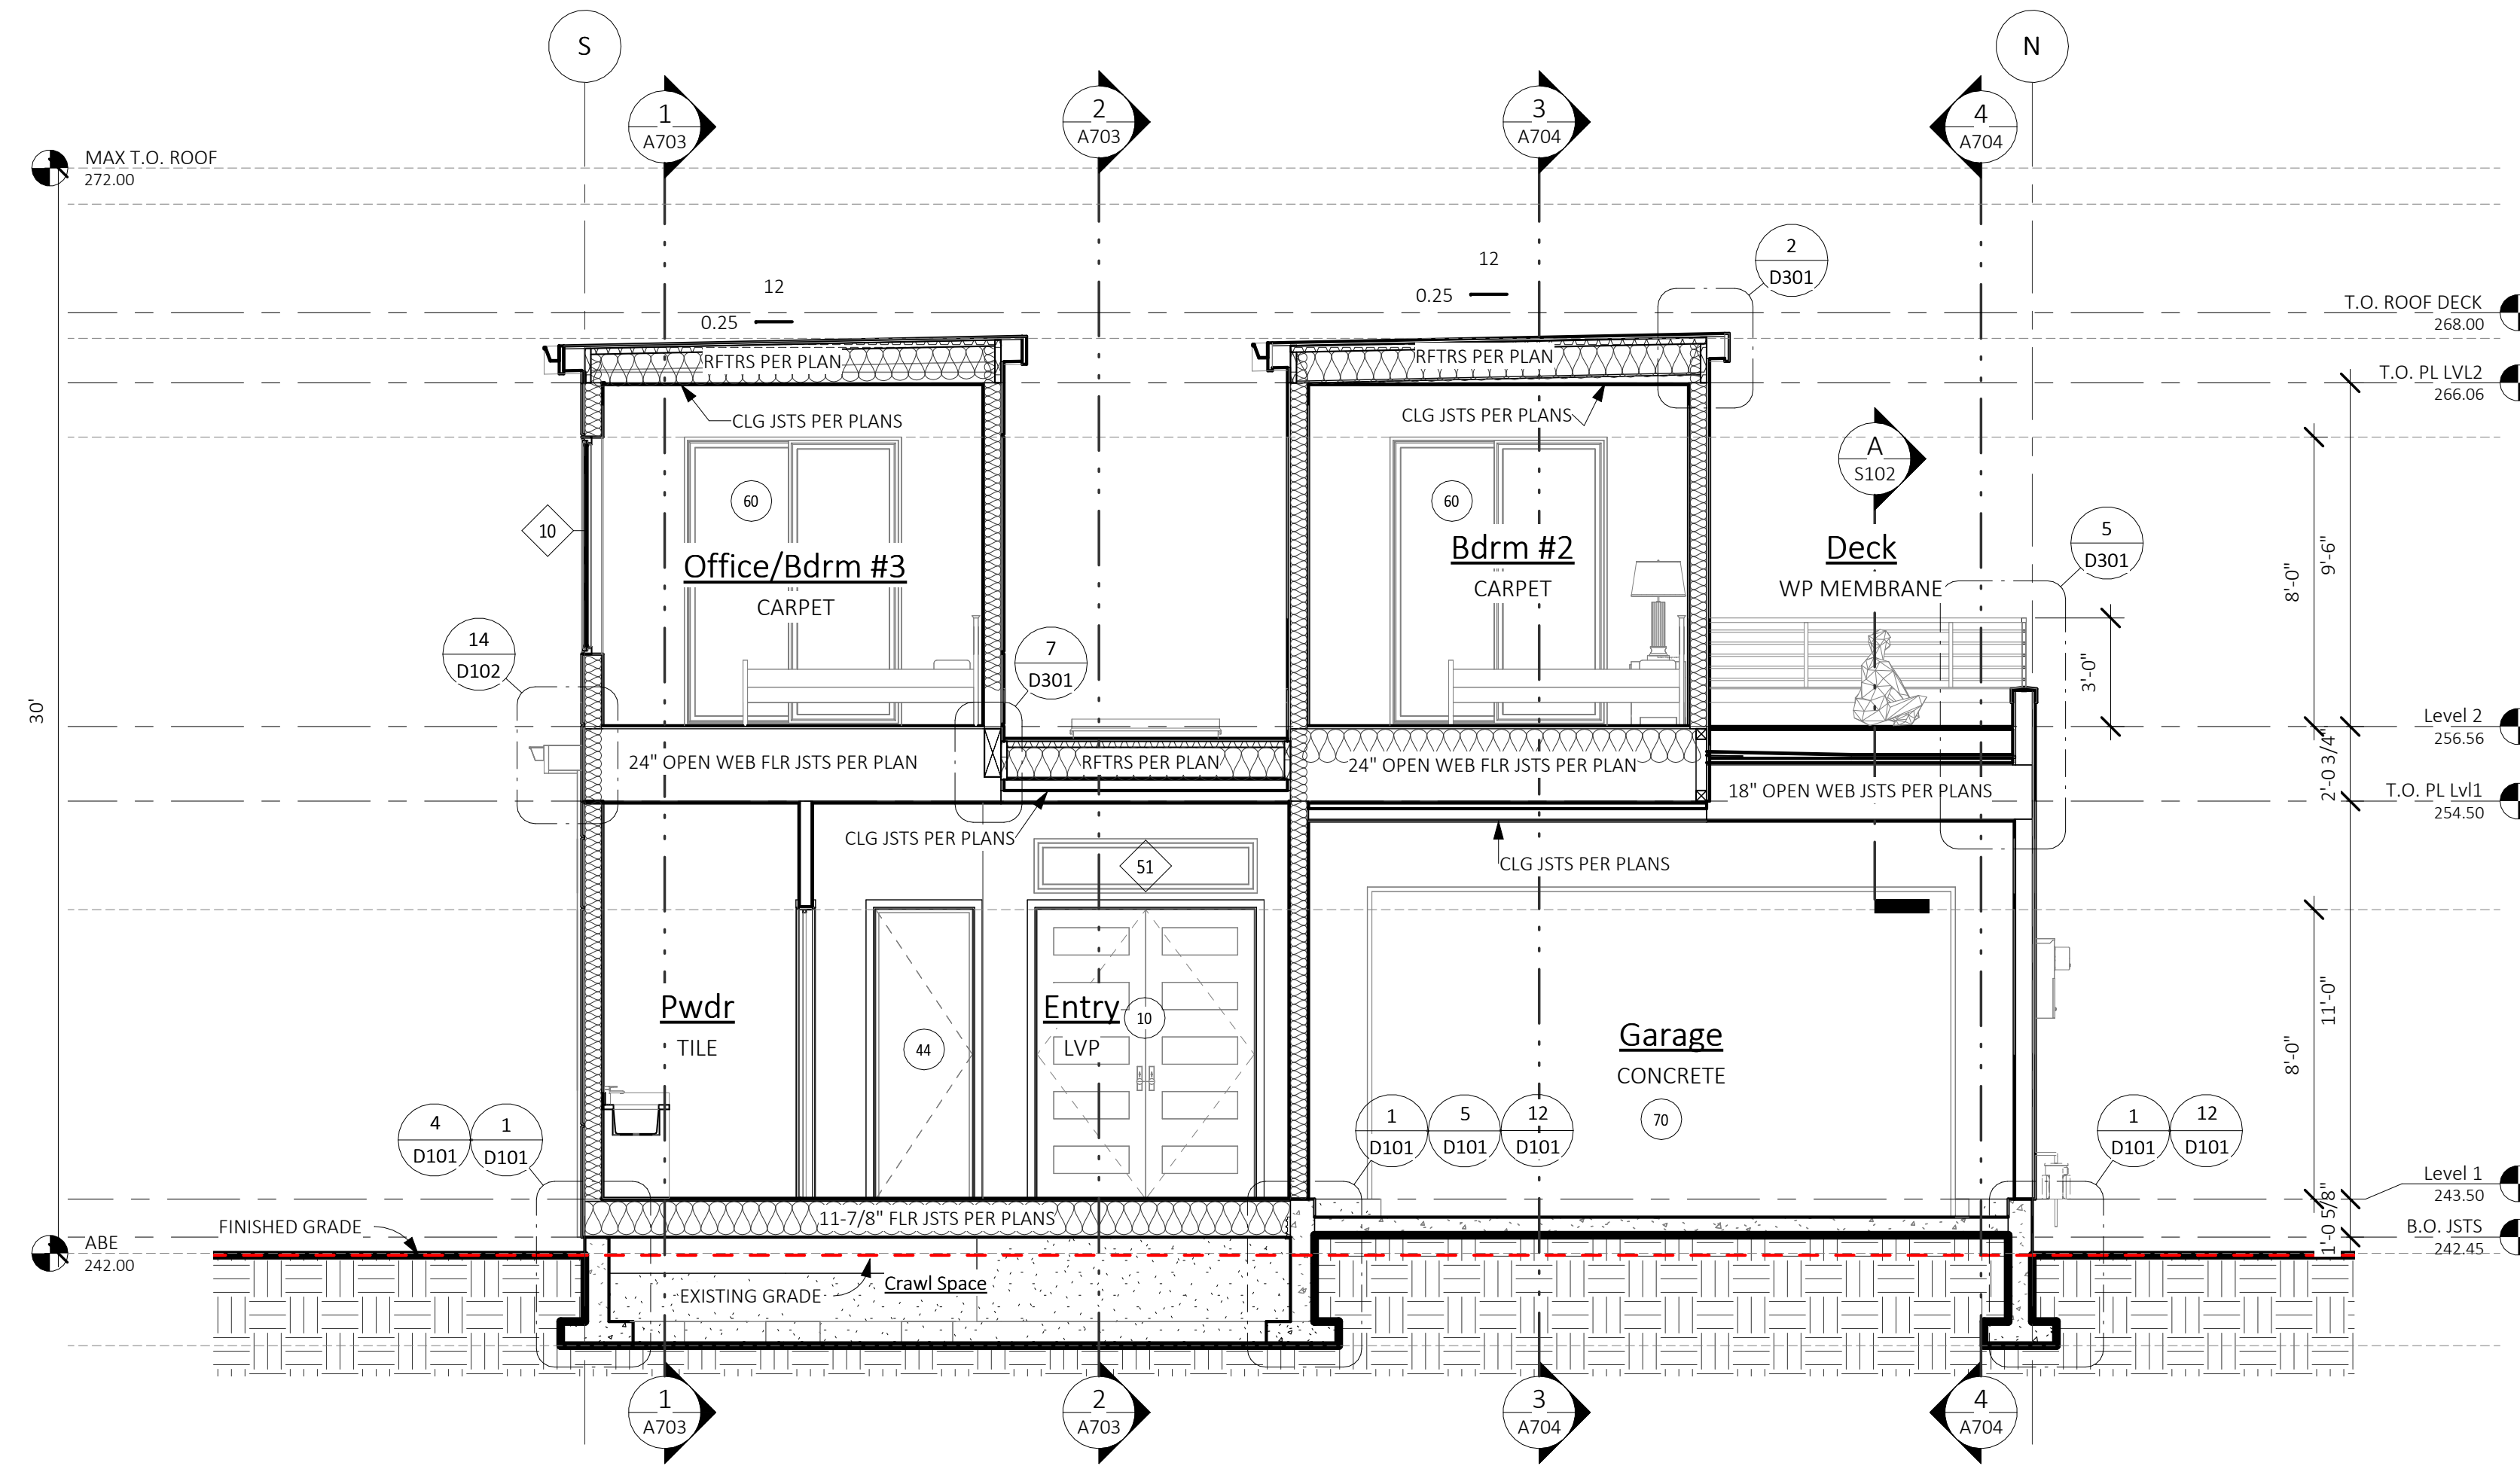

4 Section E/W 4
SCALE: 1/4" = 1'-0"

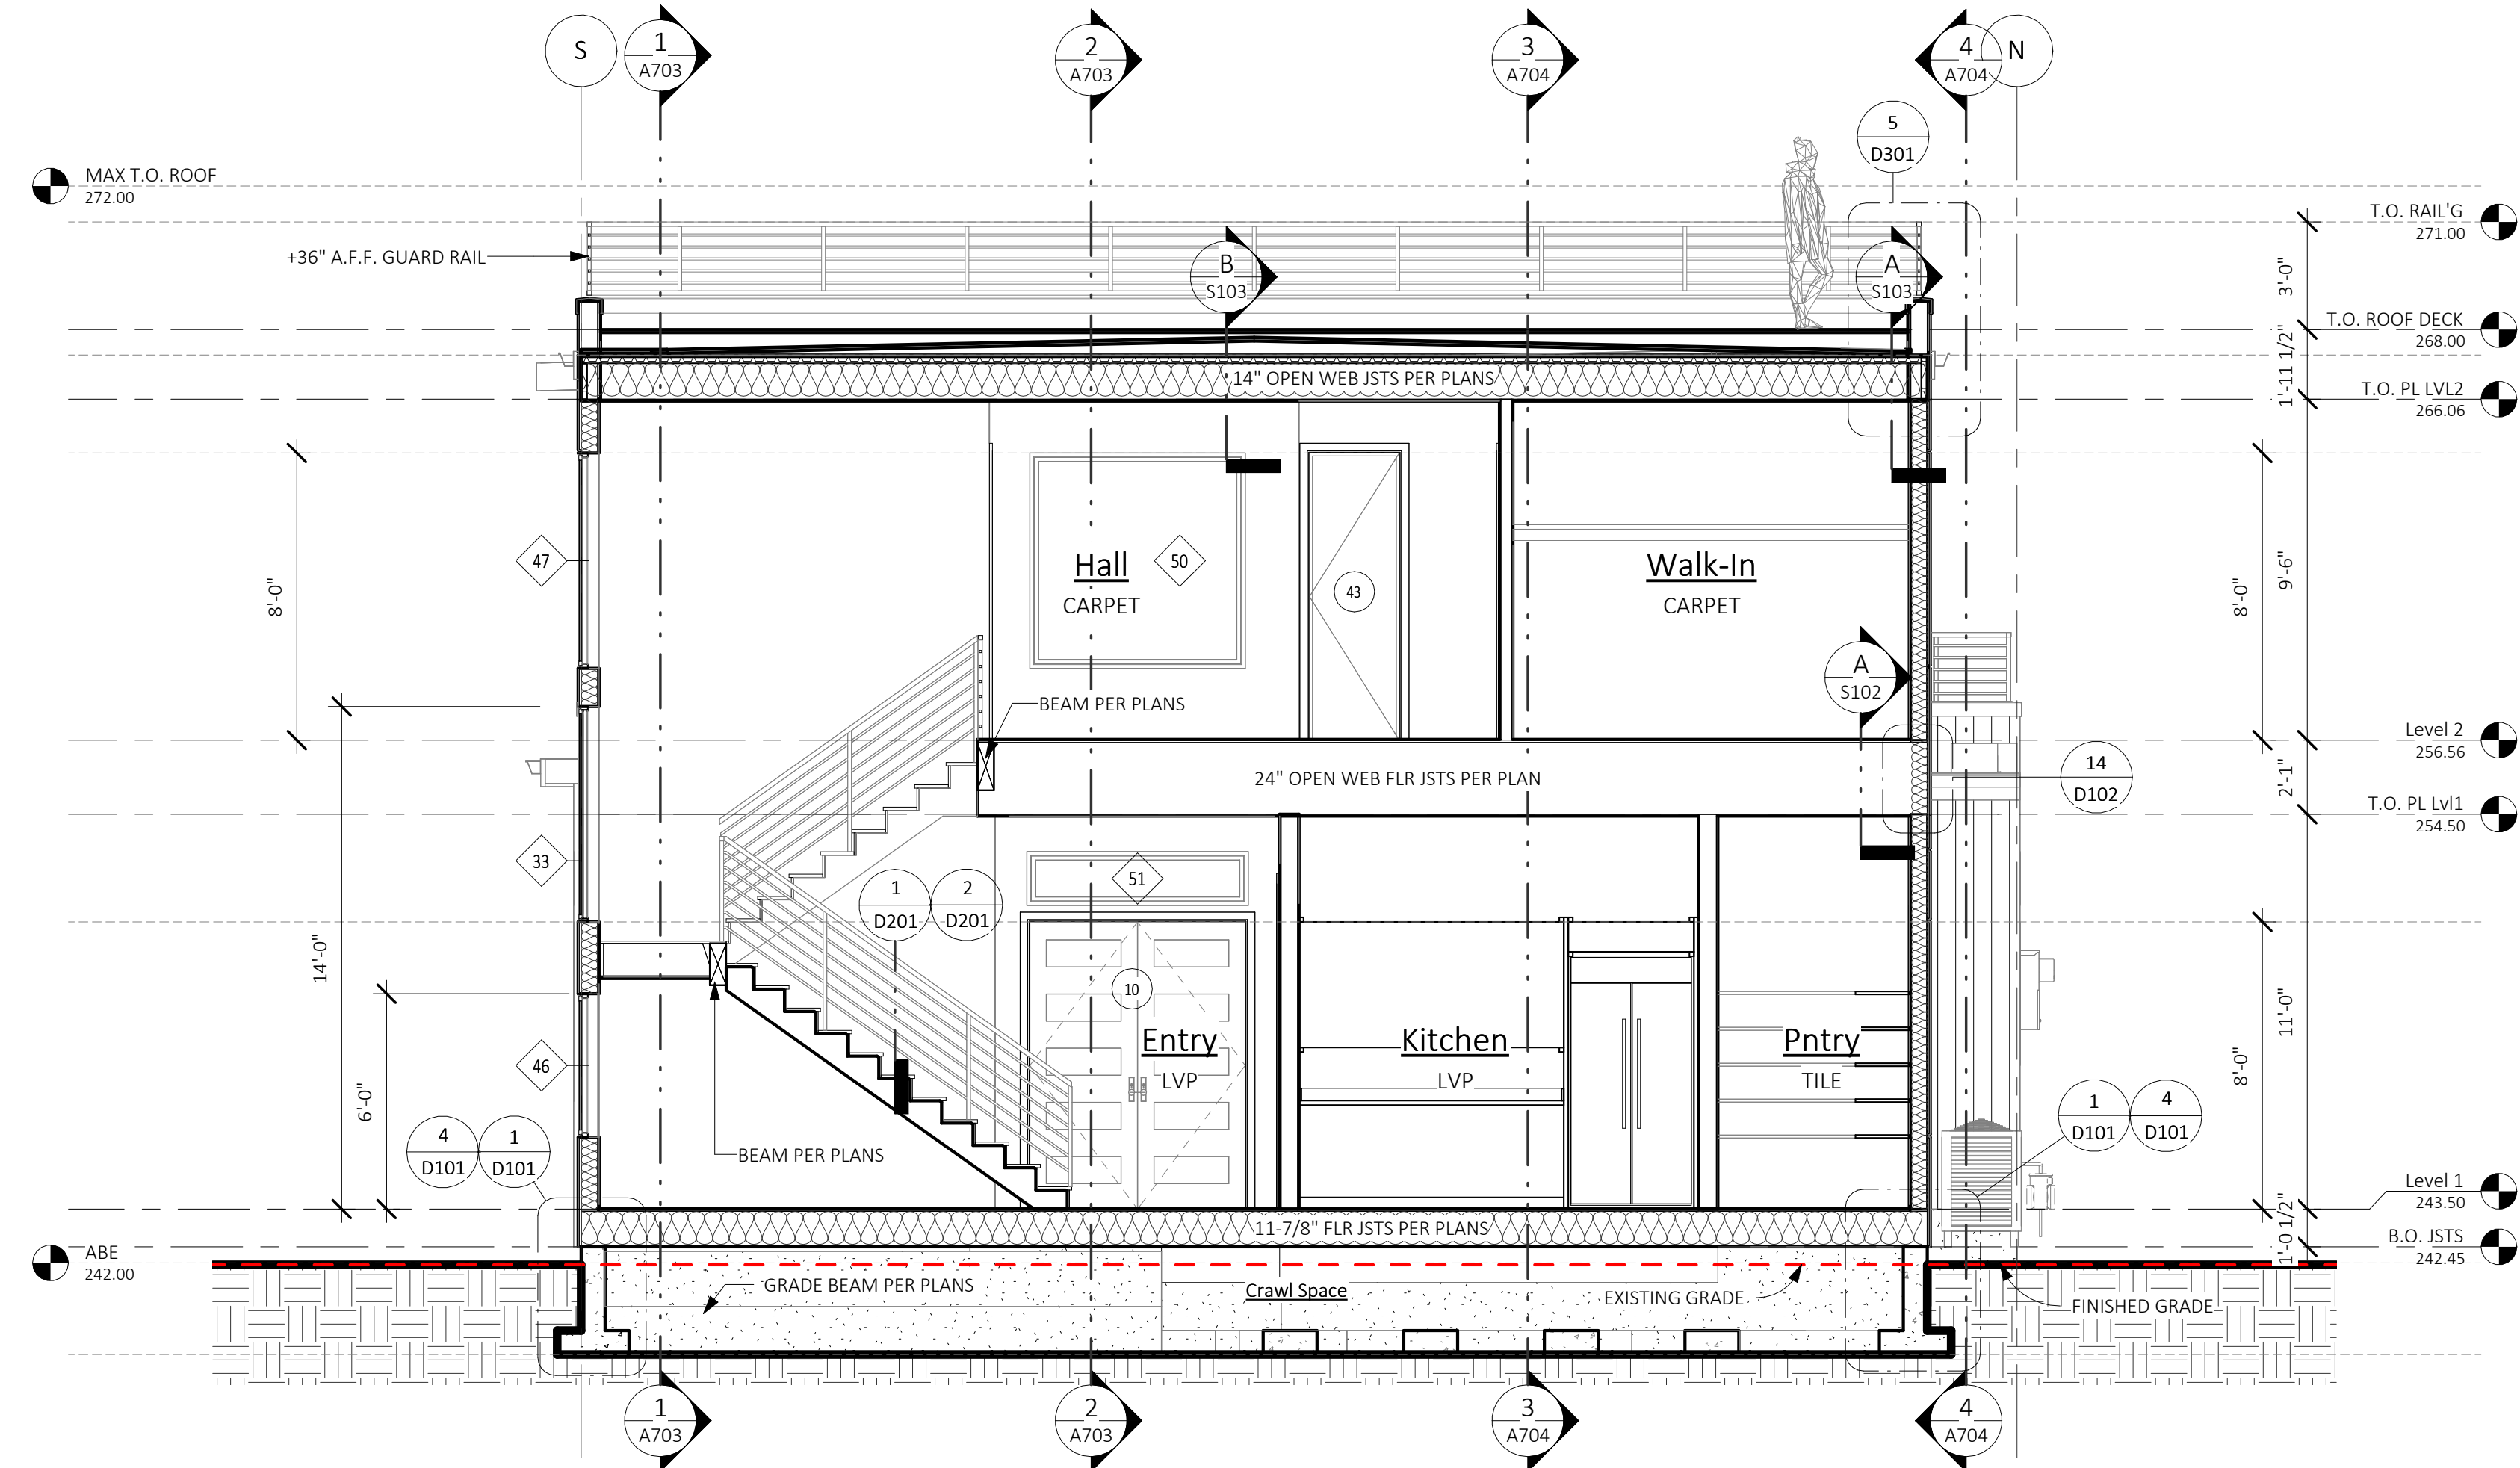

3 Section E/W 3
SCALE: 1/4" = 1'-0"

TYPICAL BUILDING MATERIALS:

ROOF CONSTRUCTION

ROOFING: TPO MEMBRANE
 BUILDING PAPER: PER MFR
 SHEATHING: PER SHEARWALL SCHEDULE
 FRAMING: PER PLANS
 INSULATION: R-49 BLOWN IN (R-38 VAULTED)
 SOFFIT: T&G WHERE NOTED
 GWB: 5/8" GWB

FLOOR CONSTRUCTION

FLOORING: FINISH PER PLANS
 SUBFLOOR: 3/4" T&G (PLYWOOD, COMPLY OR EQUAL)
 FRAMING: PER PLANS
 INSULATION: R-38 BATT
 SOFFIT: HARDIA PANEL WHERE NOTED

EXTERIOR WALL CONSTRUCTION

SIDING MATERIAL: PER ELEVATIONS
 BUILDING PAPER: 15# BUILDING PAPER
 SHEATHING: PER SHEARWALL SCHEDULE
 FRAMING: 2x6 STUDS AT 16" oc U.N.O.
 INSULATION: R-21 BATT w/ INTEGRAL VAPOR BARRIER
 GWB: 1/2" GWB

TRIM

WINDOW: (WITH NO BRICK MOLD) 'Z' FLASHING
 INSIDE: 2x2
 OUTSIDE: 'X' FLASHING
 FASCIA: 2x8 (PER DETAILS) U.N.O.

No.	Date	Description
1	2023/07/25	SUB2 City Comment Submittal



HU RESIDENCE
 2448 72nd AVE SE, Mercer Island

PERMIT SET

SECTIONS

PROJECT NO: 21014
 ISSUE DATE: 2022/06/29

A702

SCALE 24X36: 1/4" = 1'-0"
 * NOTE: 11X17 SETS ARE REDUCED 50% SCALE DRAWINGS ACCORDINGLY.

(C) ATERA DESIGN STUDIO LLC. PLANS AND DESIGNS (DRAWINGS) FORTHWITH REMAIN THE PROPERTY OF ATERA DESIGN STUDIO. REPRODUCTION WITHOUT PERMISSION IS PROHIBITED.



TYPICAL BUILDING MATERIALS:

ROOF CONSTRUCTION

ROOFING:	TPO MEMBRANE
BUILDING PAPER:	PER MFR
SHEATHING:	PER SHEARWALL SCHEDULE
FRAMING:	PER PLANS
INSULATION:	R-49 BLOWN IN (R-38 VAULTED)
SOFFIT:	T&G WHERE NOTED
GWB:	5/8" GWB

FLOOR CONSTRUCTION


FLOORING:	FINISH PER PLANS
SUBFLOOR:	3/4" T&G (PLYWOOD, COMPLY OR EQUAL)
FRAMING:	PER PLANS
INSULATION:	R-38 BATT
SOFFIT:	HARDIA PANEL WHERE NOTED

EXTERIOR WALL CONSTRUCTION


SIDING MATERIAL:	PER ELEVATIONS
BUILDING PAPER:	15# BUILDING PAPER
SHEATHING:	PER SHEARWALL SCHEDULE
FRAMING:	2x6 STUDS AT 16" oc U.N.O.
INSULATION:	R-21 BATT w/ INTEGRAL VAPOR BARRIER
GWB:	1/2" GWB

TRIM

WINDOW:	'Z' FLASHING
(WITH NO BRICK MOLD)	
CORNER BOARDS:	INSIDE: 2x2
	OUTSIDE: 'X' FLASHING
FASCIA:	2x8 (PER DETAILS) U.N.O.

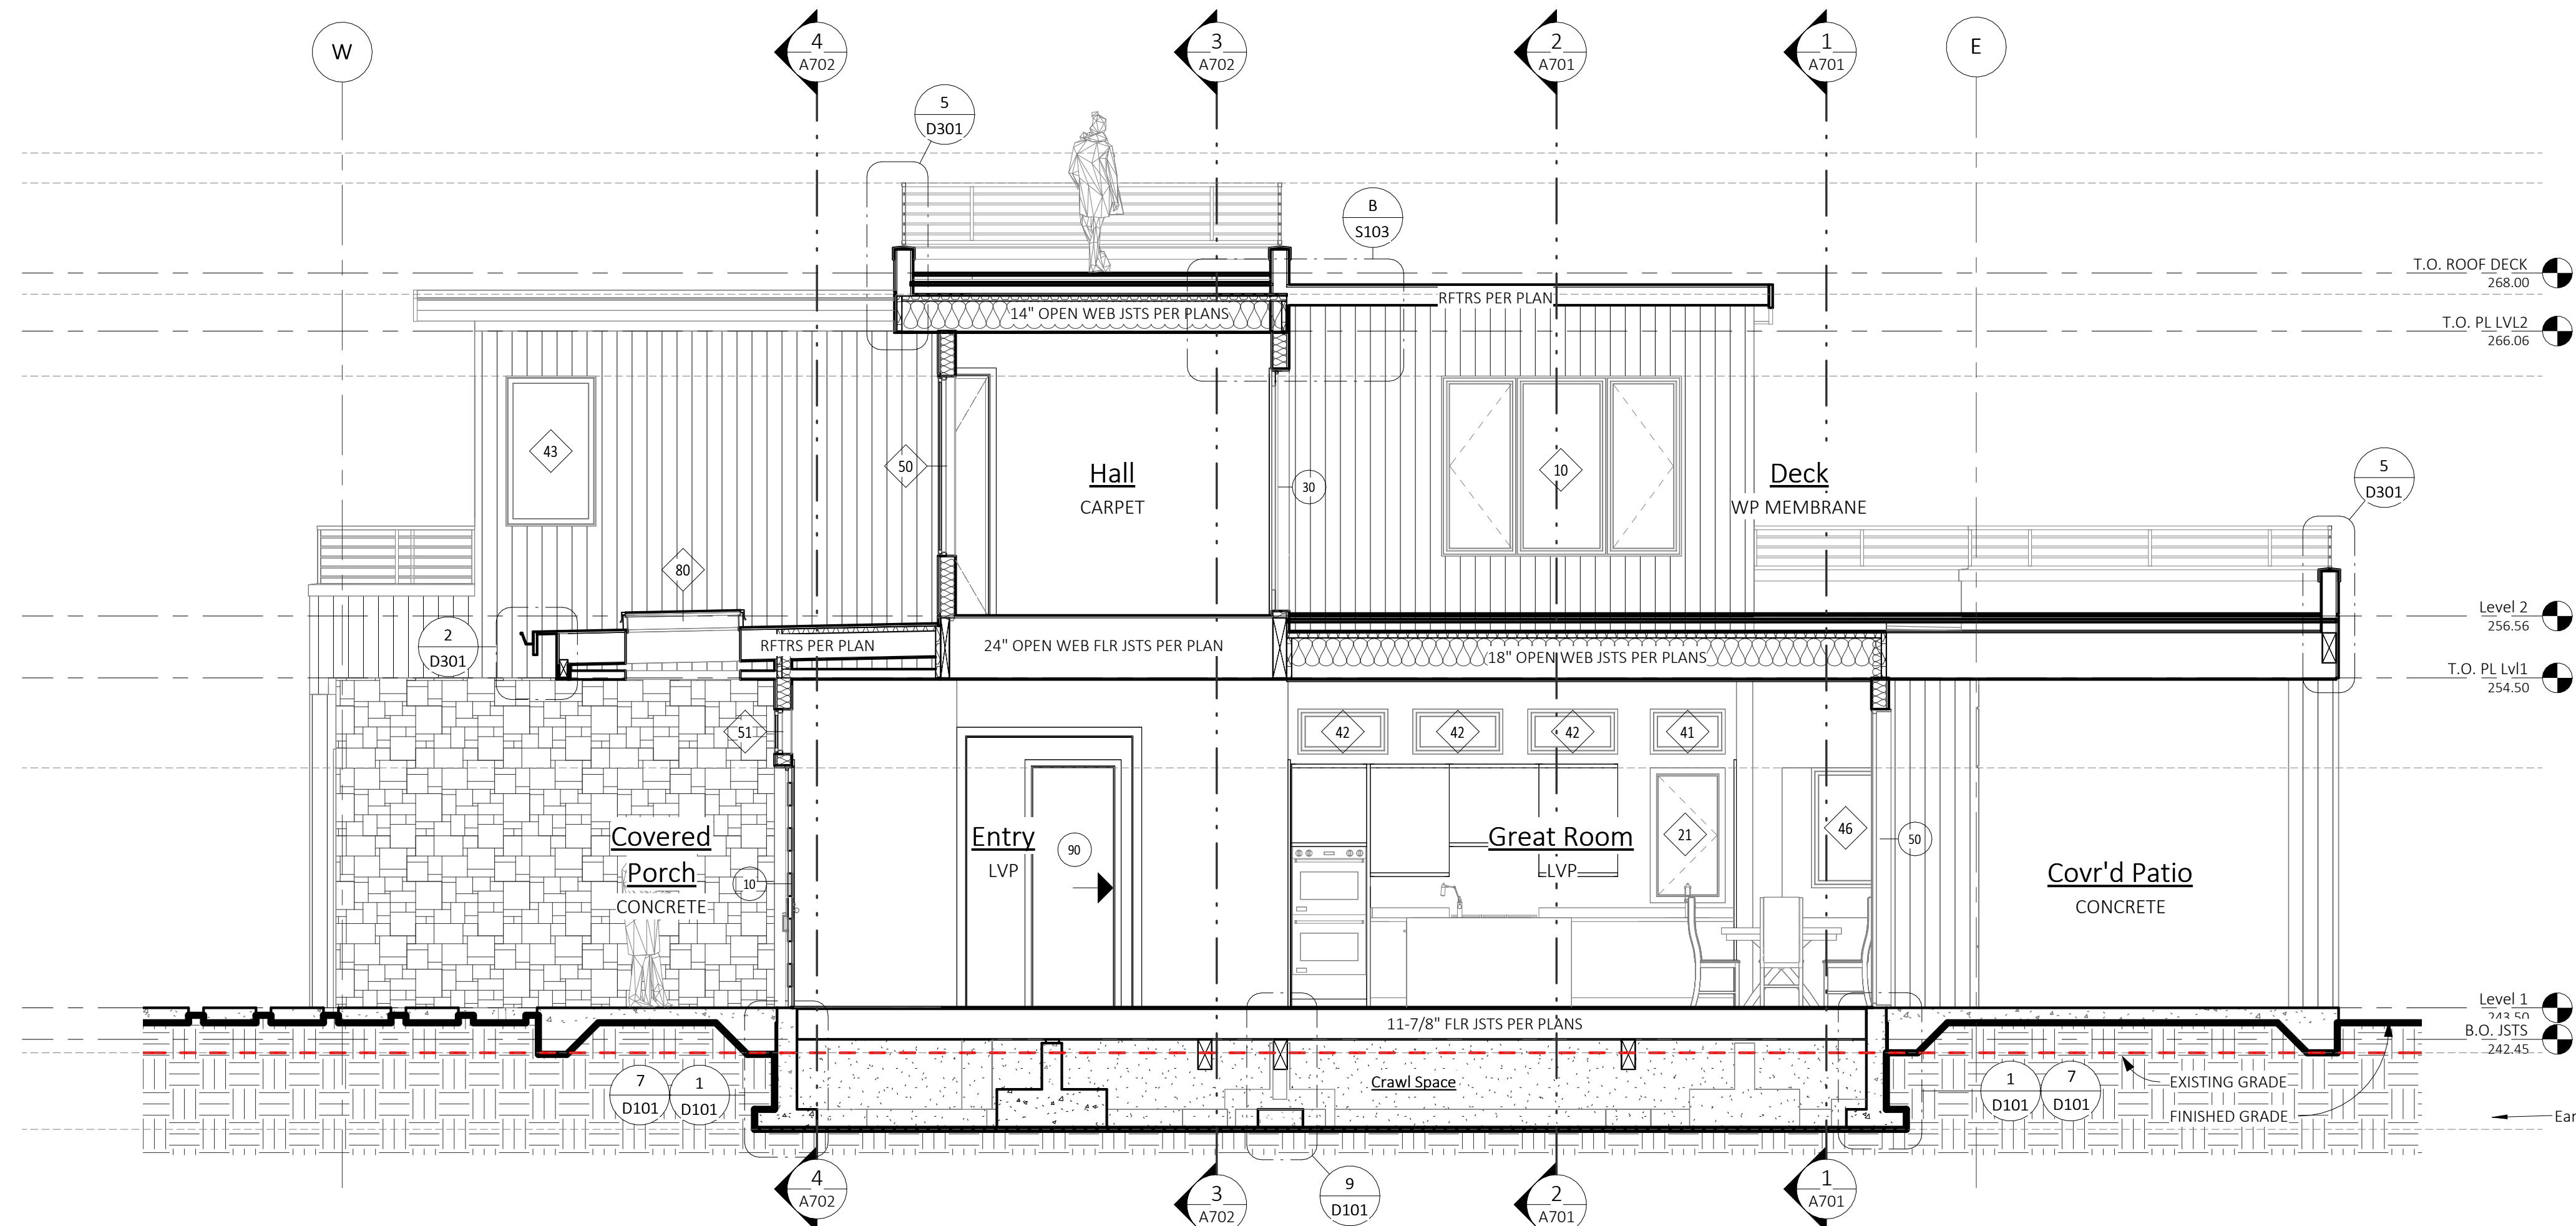

2 Section N/S 2
SCALE: 1/4" = 1'-0"

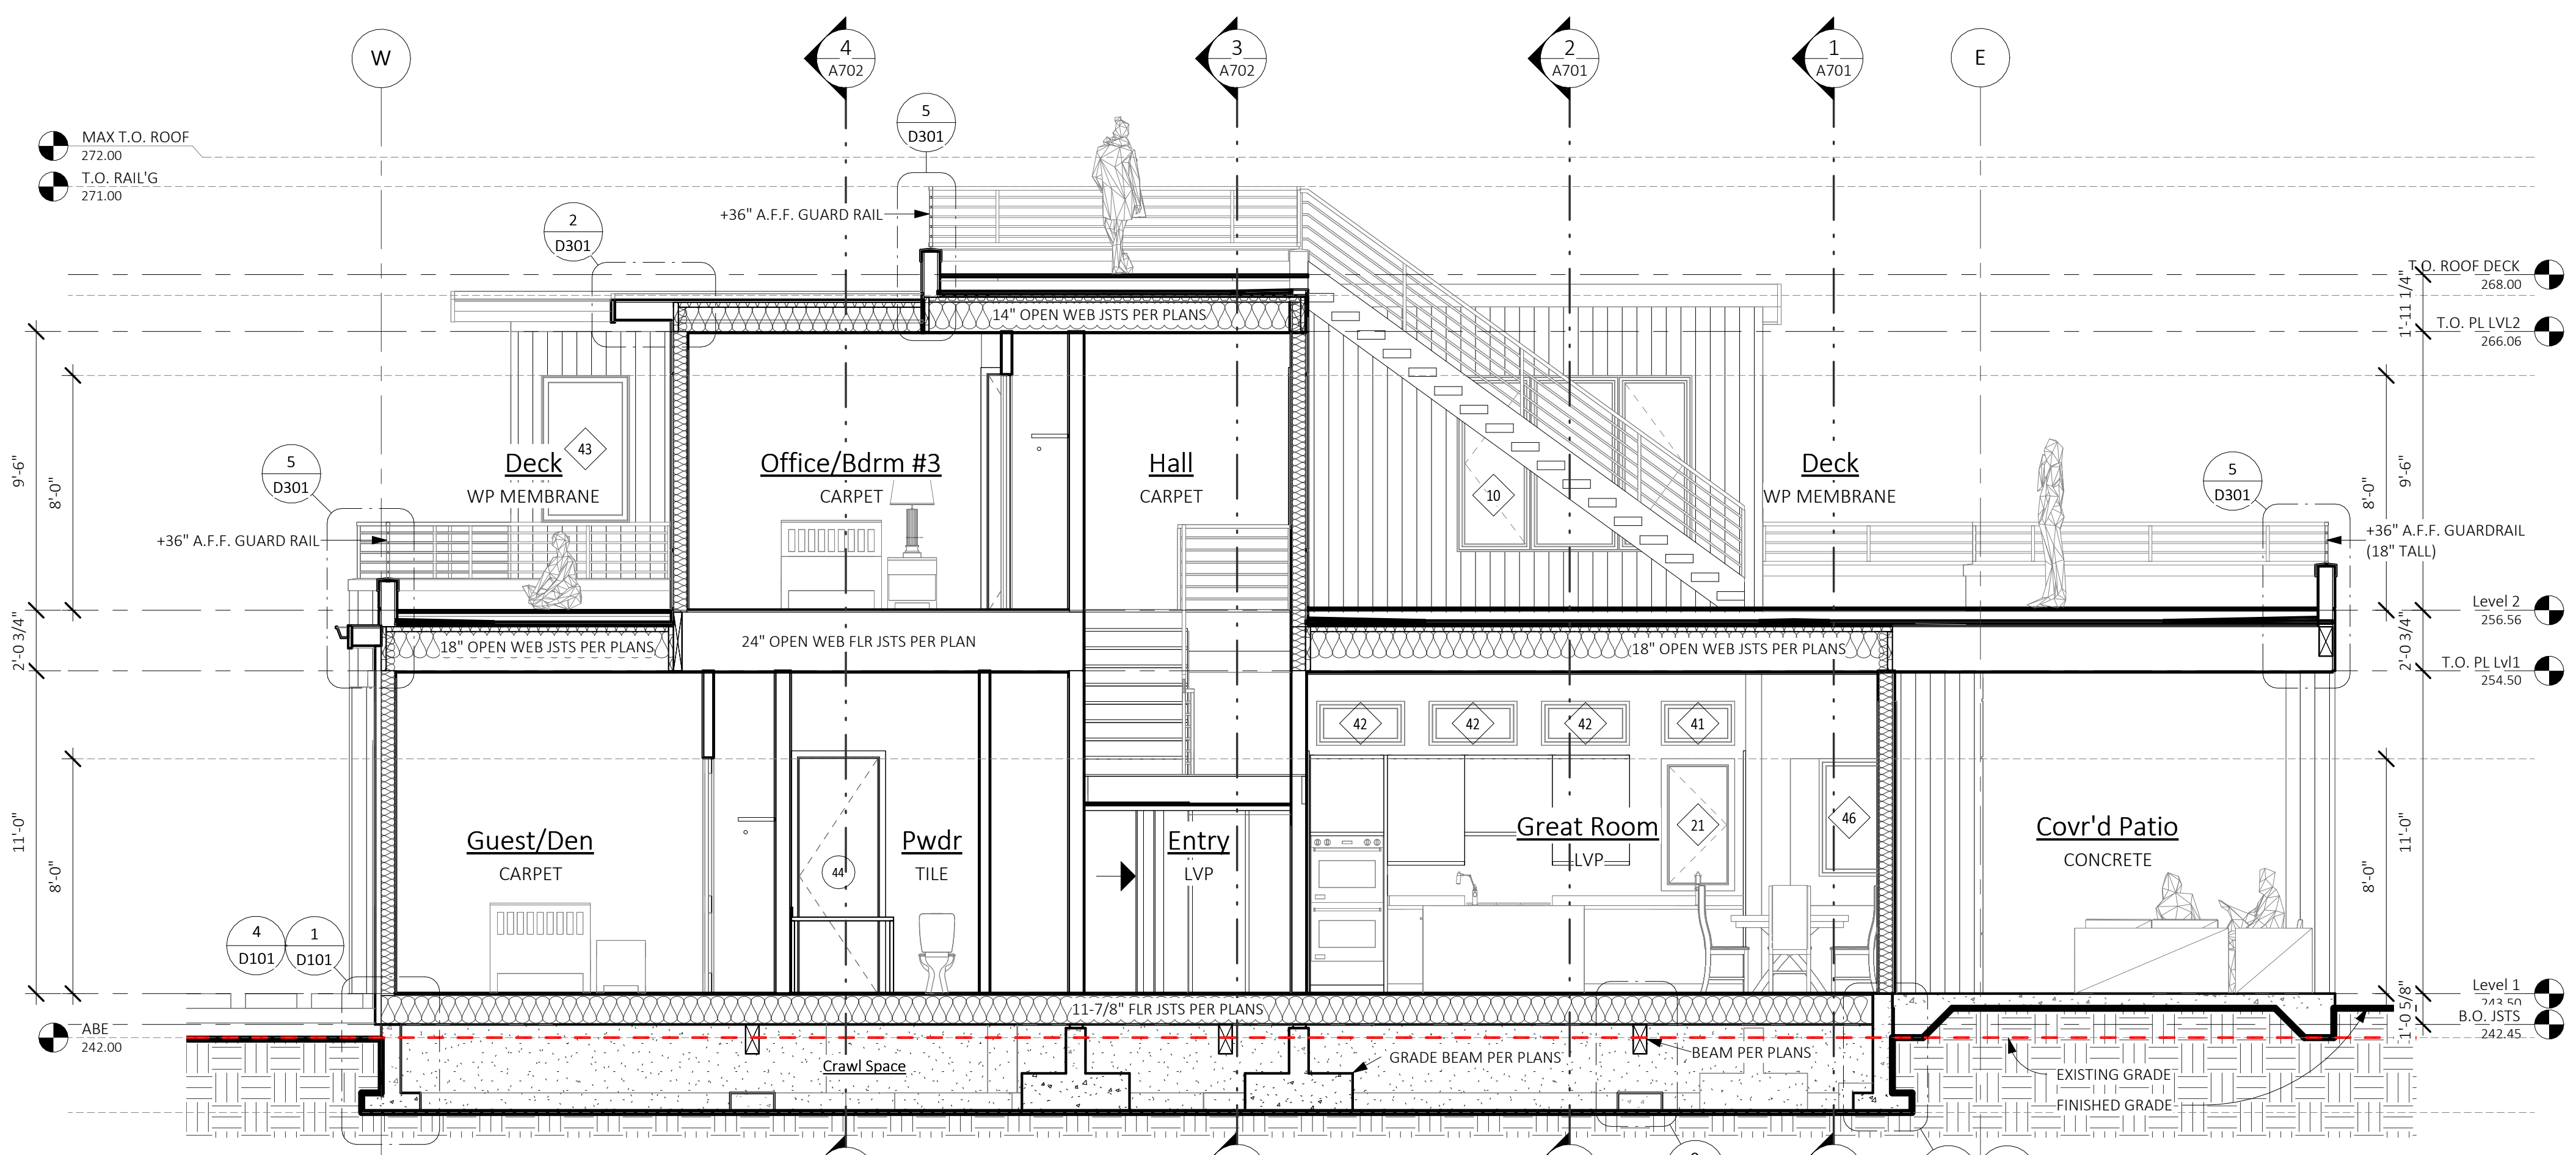

1 Section N/S 1
SCALE: 1/4" = 1'-0"

(C) ATERA DESIGN STUDIO LLC. PLANS AND DESIGNS (DRAWINGS) FORTHWITH REMAIN THE PROPERTY OF ATERA DESIGN STUDIO. REPRODUCTION WITHOUT PERMISSION IS PROHIBITED.

No.	Date	Description
1	2023/07/25	SUB2 City Comment Submittal

ATERA DESIGN STUDIO
 451 DUVALL AVE. NE
 RENTON, WA 98059

HU RESIDENCE
 2448 72nd AVE SE, Mercer Island

PERMIT SET

SECTIONS


PROJECT NO: 21014
ISSUE DATE: 2022/06/29

A703


SCALE 24X36: 1/4" = 1'-0"
 *NOTE: 11X17 SETS ARE REDUCED 50% SCALE DRAWINGS ACCORDINGLY.

3/15/2023 8:48:41 AM Autodesk Docs/21014 Hu Residence, Mercer Island/21014 OSD, Hu Residence, Mercer Island.rvt



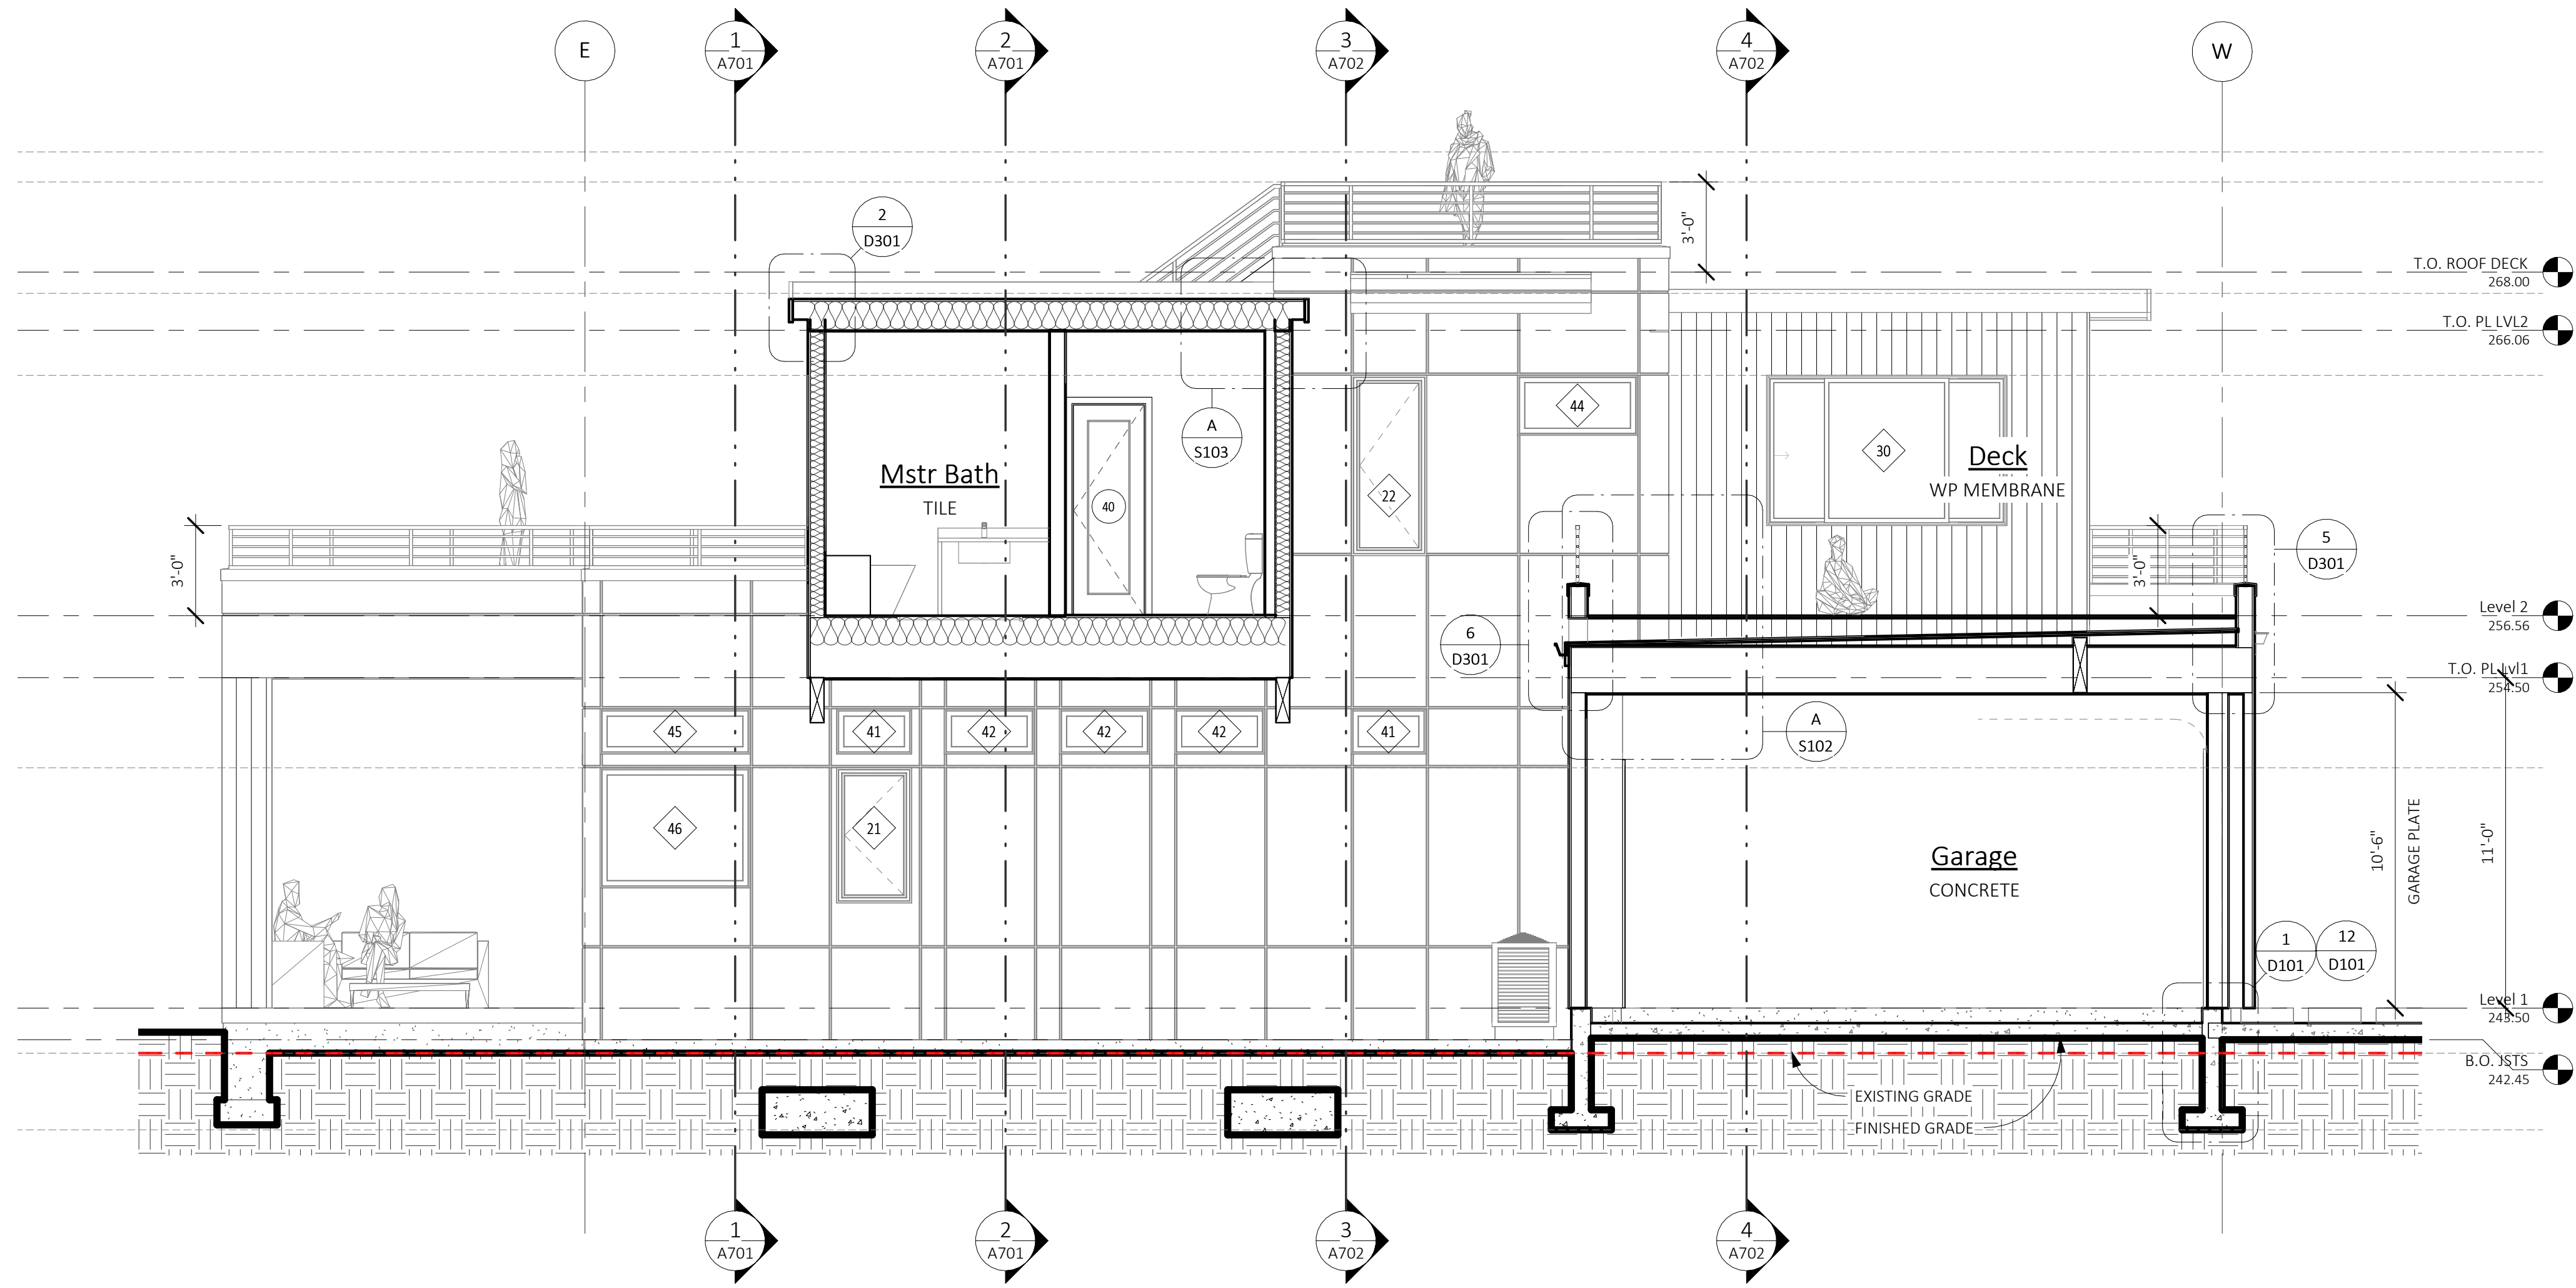

4 Section N/S 4
SCALE: 1/4" = 1'-0"

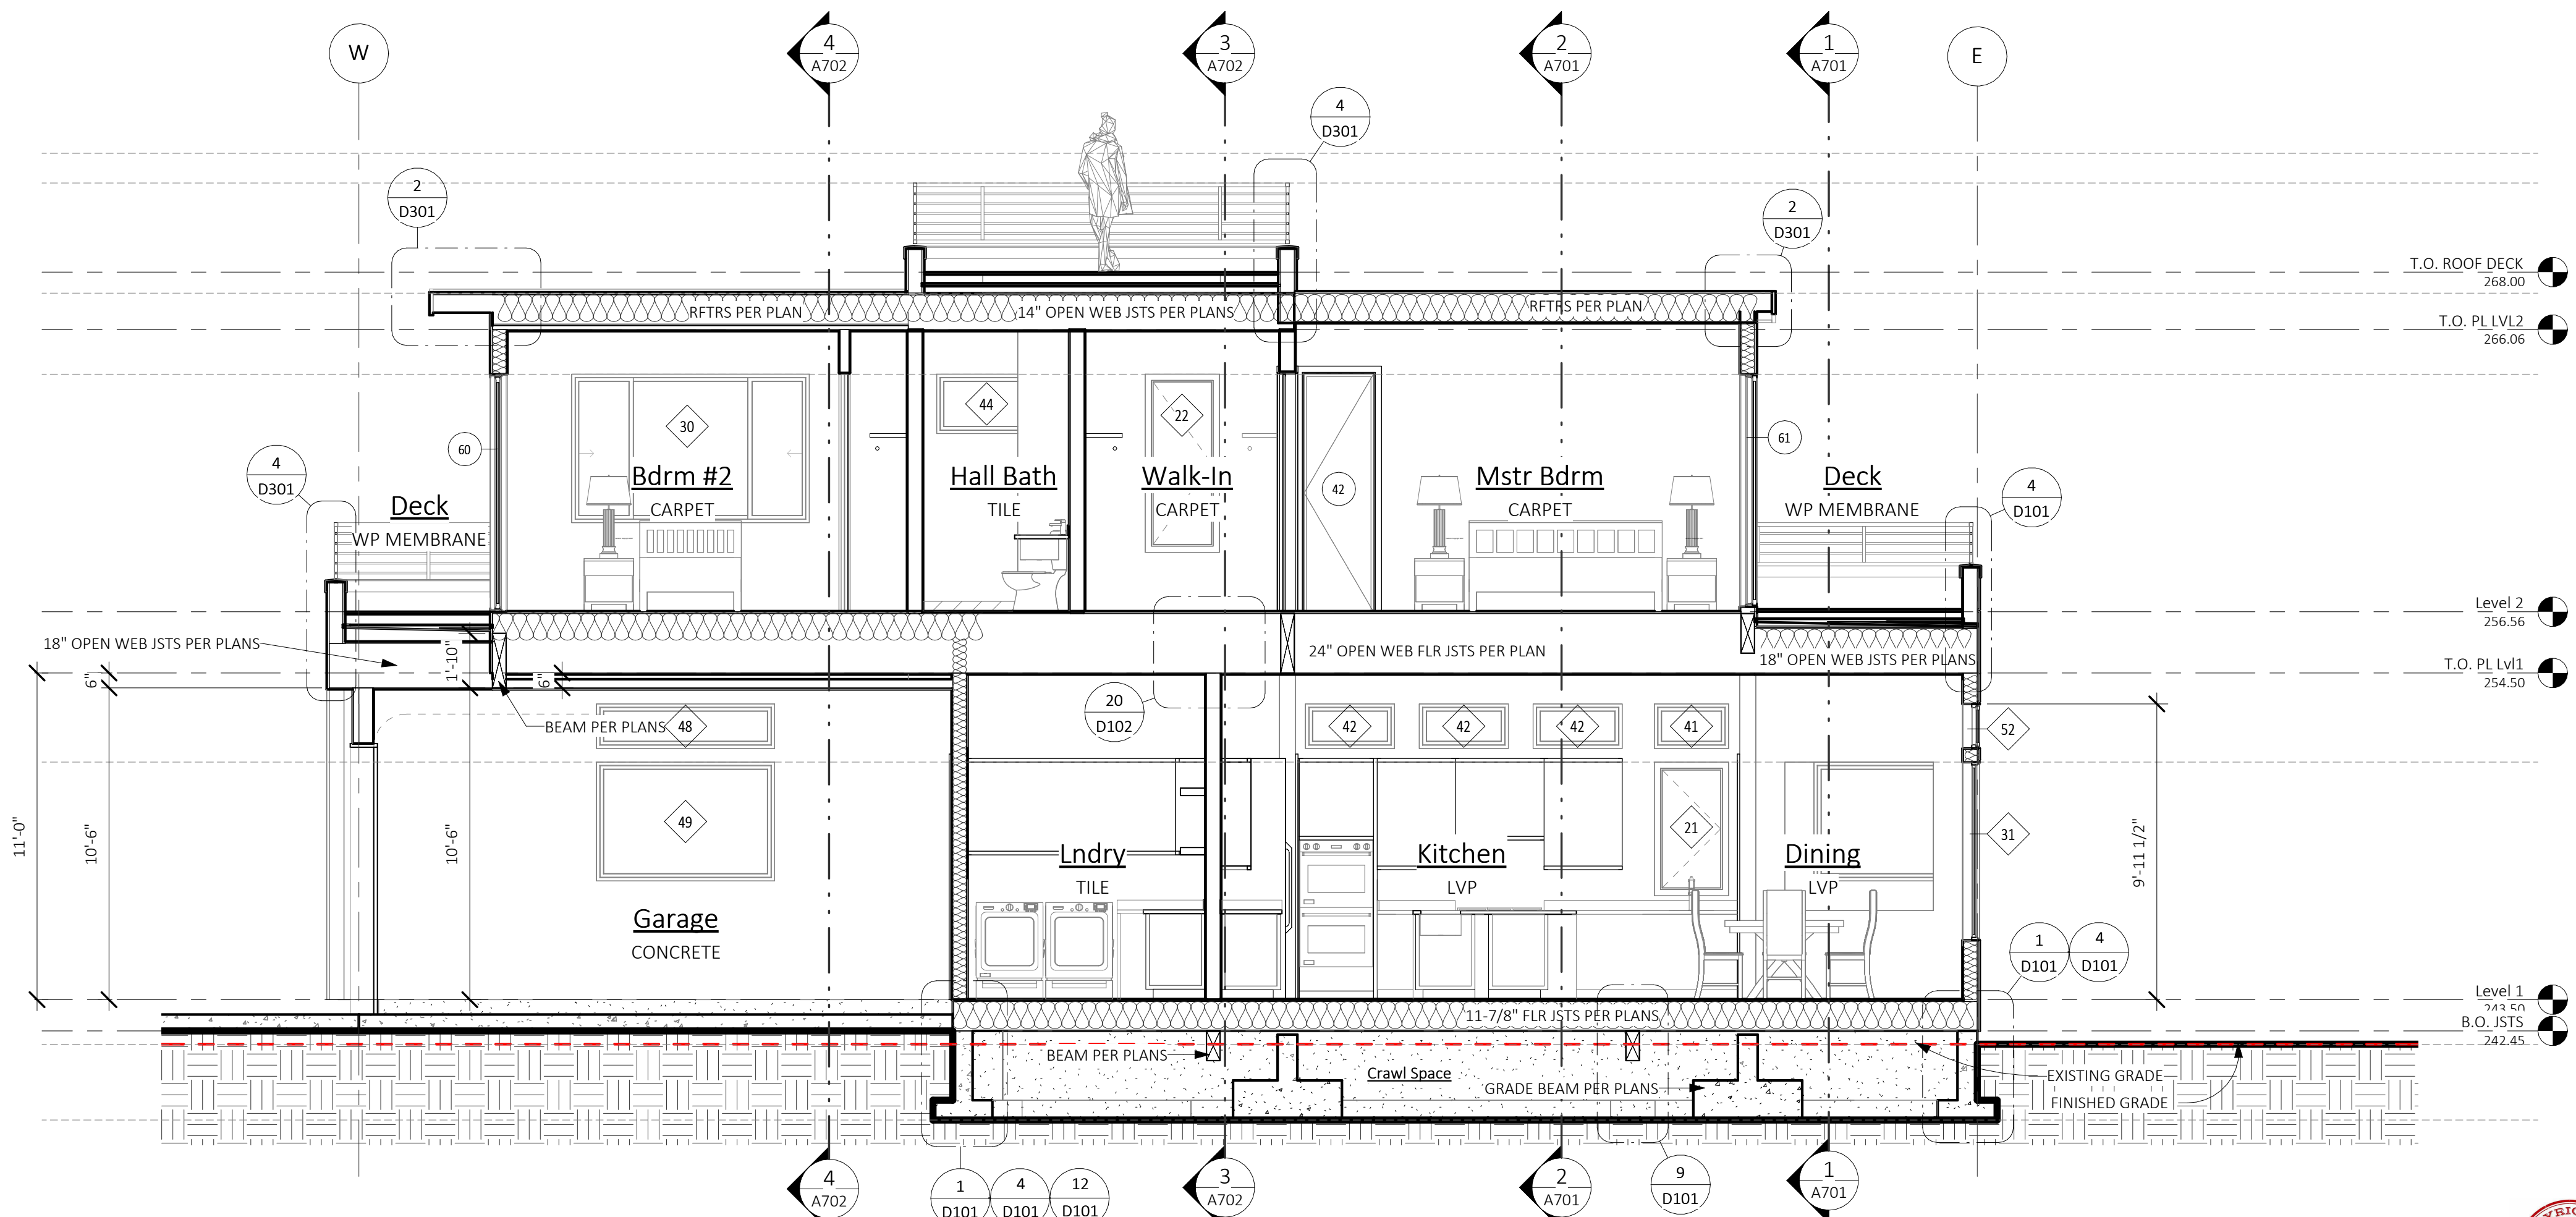

3 Section N/S 3
SCALE: 1/4" = 1'-0"

TYPICAL BUILDING MATERIALS:

ROOF CONSTRUCTION	
ROOFING:	TPO MEMBRANE
BUILDING PAPER:	PER MFR
SHEATHING:	PER SHEARWALL SCHEDULE
FRAMING:	PER PLANS
INSULATION:	R-49 BLOWN IN (R-38 VAULTED)
SOFFIT:	T&G WHERE NOTED
GWB:	5/8" GWB
FLOOR CONSTRUCTION	
FLOORING:	FINISH PER PLANS
SUBFLOOR:	3/4" T&G (PLYWOOD, COMPLY OR EQUAL)
FRAMING:	PER PLANS
INSULATION:	R-38 BATT
SOFFIT:	HARDIA PANEL WHERE NOTED
EXTERIOR WALL CONSTRUCTION	
SIDING MATERIAL:	PER ELEVATIONS
BUILDING PAPER:	15# BUILDING PAPER
SHEATHING:	PER SHEARWALL SCHEDULE
FRAMING:	2x6 STUDS AT 16" oc U.N.O.
INSULATION:	R-21 BATT w/ INTEGRAL VAPOR BARRIER
GWB:	1/2" GWB
TRIM	
WINDOW: (WITH NO BRICK MOLD)	2" FLASHING
CORNER BOARDS:	INSIDE: 2x2 OUTSIDE: 1" FLASHING
FASCIA:	2x8 (PER DETAILS) U.N.O.

3/15/2023 8:48:40 AM Autodesk Docs/21/0/14 HU Residence, Mercer Island/21/0/14 OS/CD, HU Residence, Mercer Island.rvt

(C) ATERA DESIGN STUDIO LLC. PLANS AND DESIGNS (DRAWINGS) FORTHWITH REMAIN THE PROPERTY OF ATERA DESIGN STUDIO. REPRODUCTION WITHOUT PERMISSION IS PROHIBITED.

No.	Date	Description
1	2023/07/25	SUB2 City Comment Submittal

ATERA DESIGN STUDIO
451 DUVALL AVE NE
RENTON, WA 98059

HU RESIDENCE
2448 72nd AVE SE, Mercer Island

PERMIT SET

SECTIONS


PROJECT NO: 21014
ISSUE DATE: 2022/06/29

A704


SCALE 24X36: 1/4" = 1'-0"
* NOTE: 11X17 SETS ARE REDUCED 50% SCALE DRAWINGS ACCORDINGLY.




3/15/2023 8:48:47 AM Autodesk Docs//71014 Hu Residence, Mercer Island//21014.05CD, Hu Residence, Mercer Island.rvt

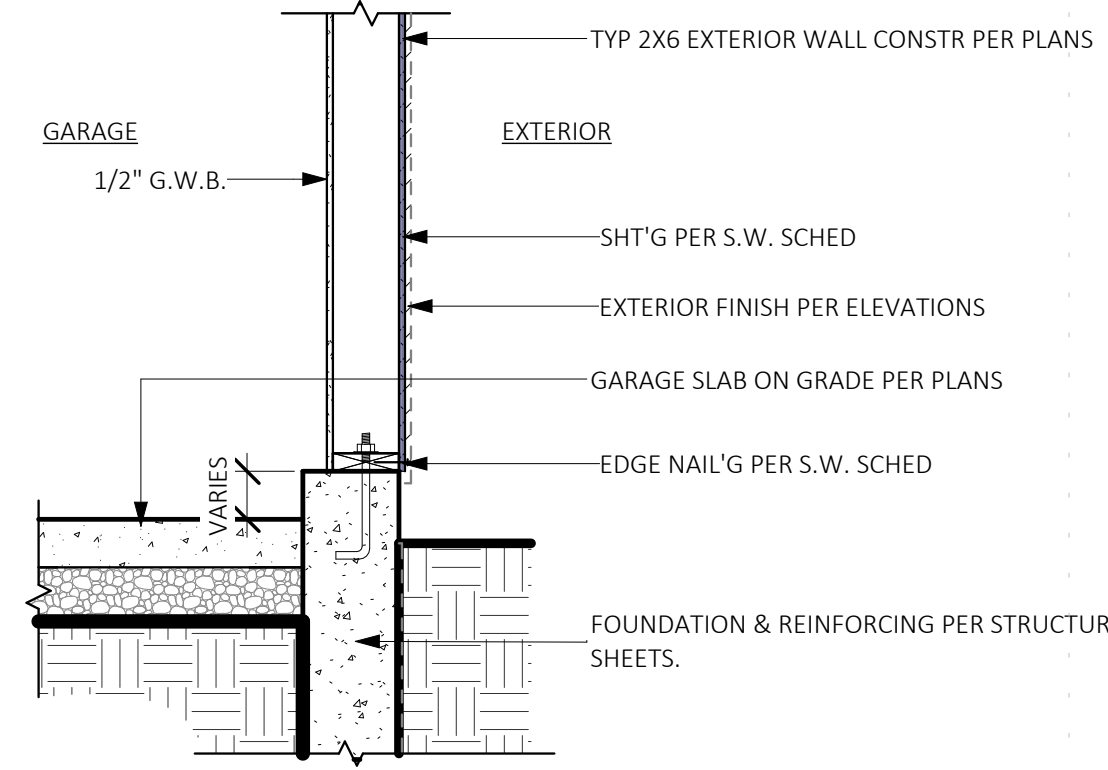

12 SLAB AT STEM WALL
SCALE: 3/4" = 1'-0"

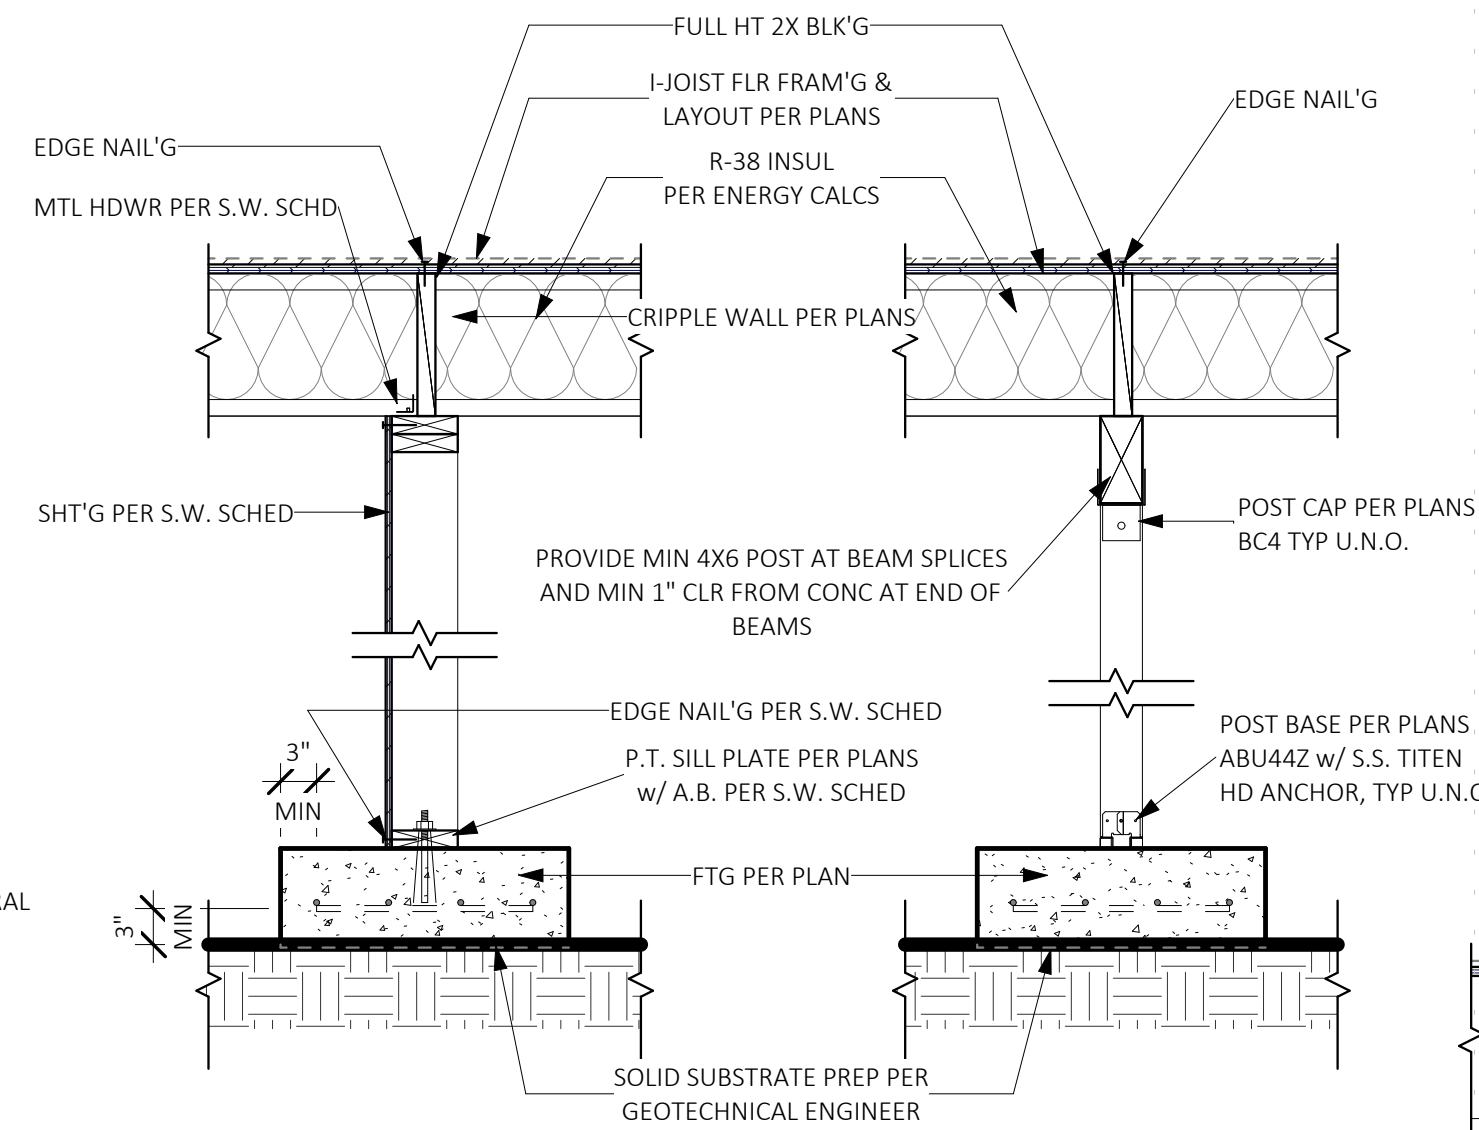


9 FRAM'G / FNDN - JOIST OVER
SCALE: 3/4" = 1'-0"

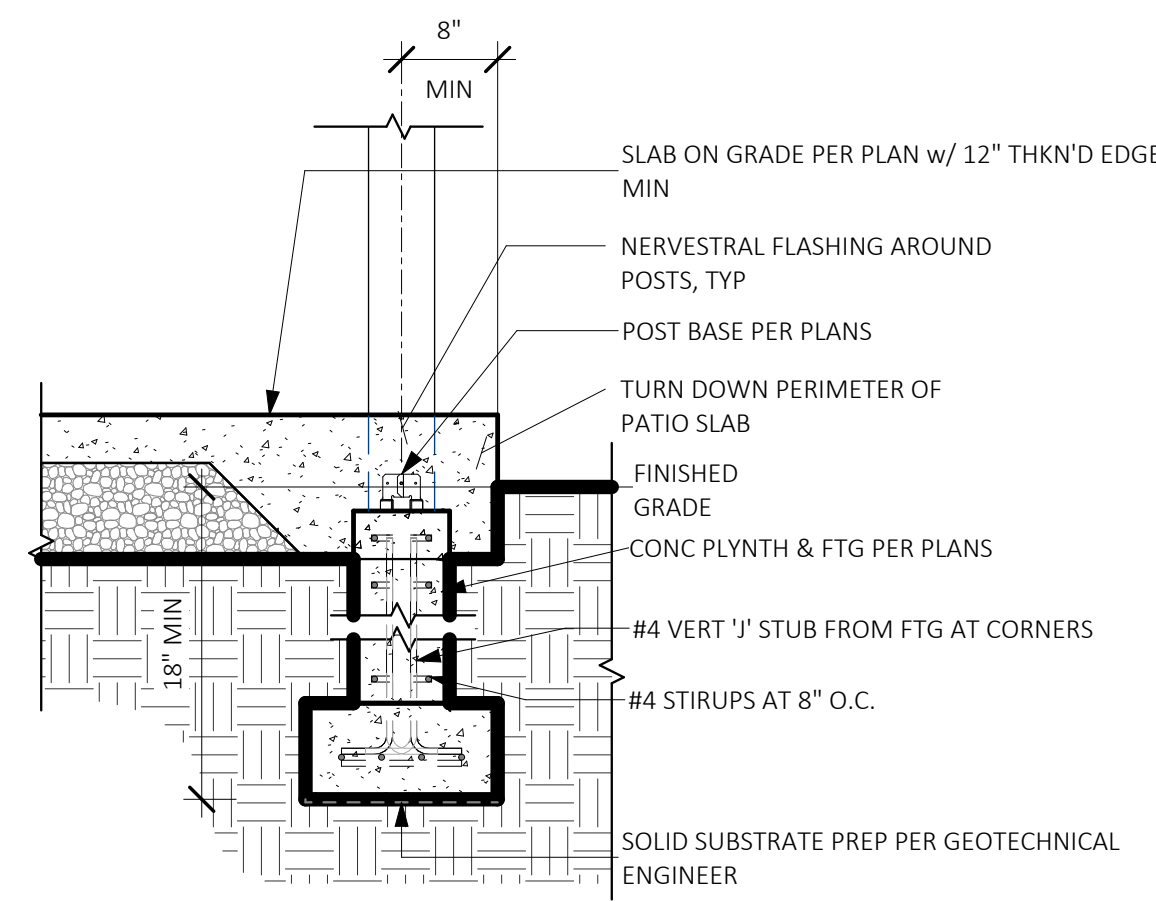


11 FRAM'G / FNDN - JOIST OVER
SCALE: 3/4" = 1'-0"


7 FRAM'G / FNDN - DROPPED JOISTS
SCALE: 3/4" = 1'-0"

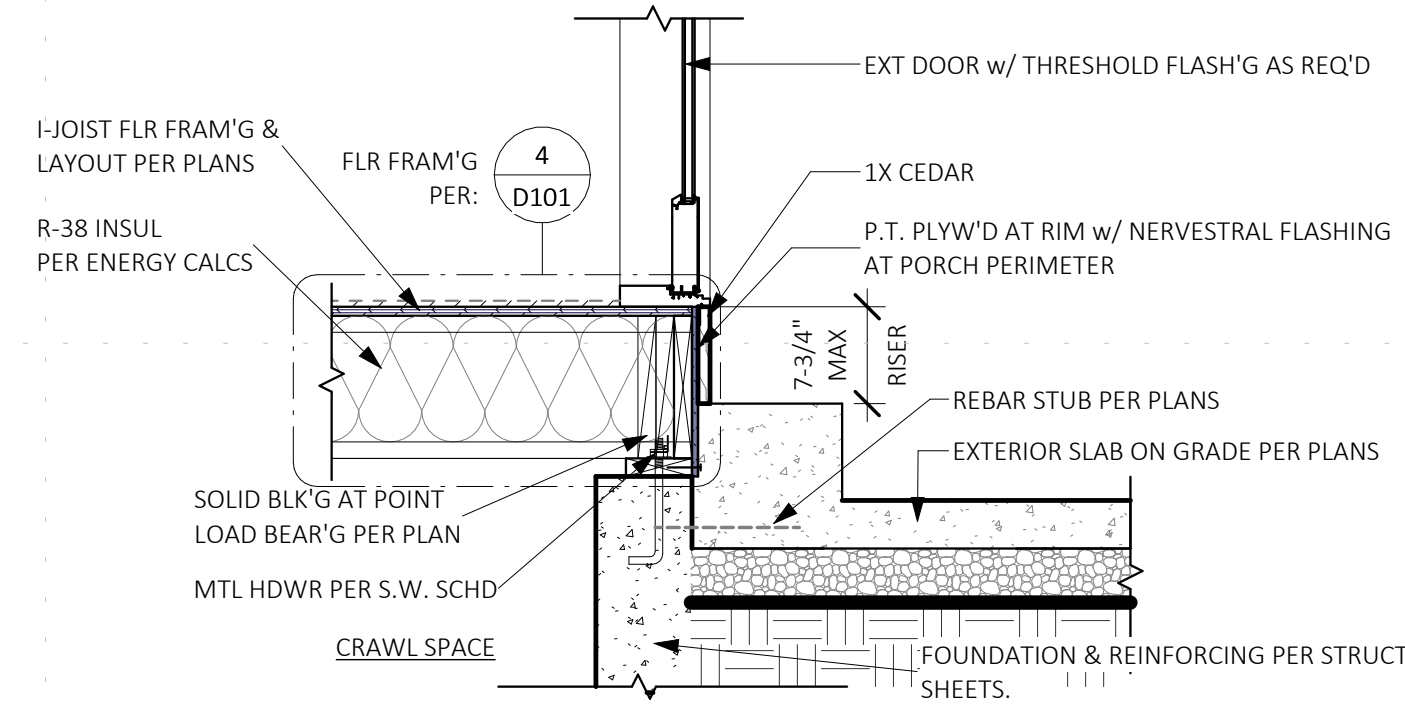

6 FRAM'G / FNDN - JOIST OVER
SCALE: 3/4" = 1'-0"

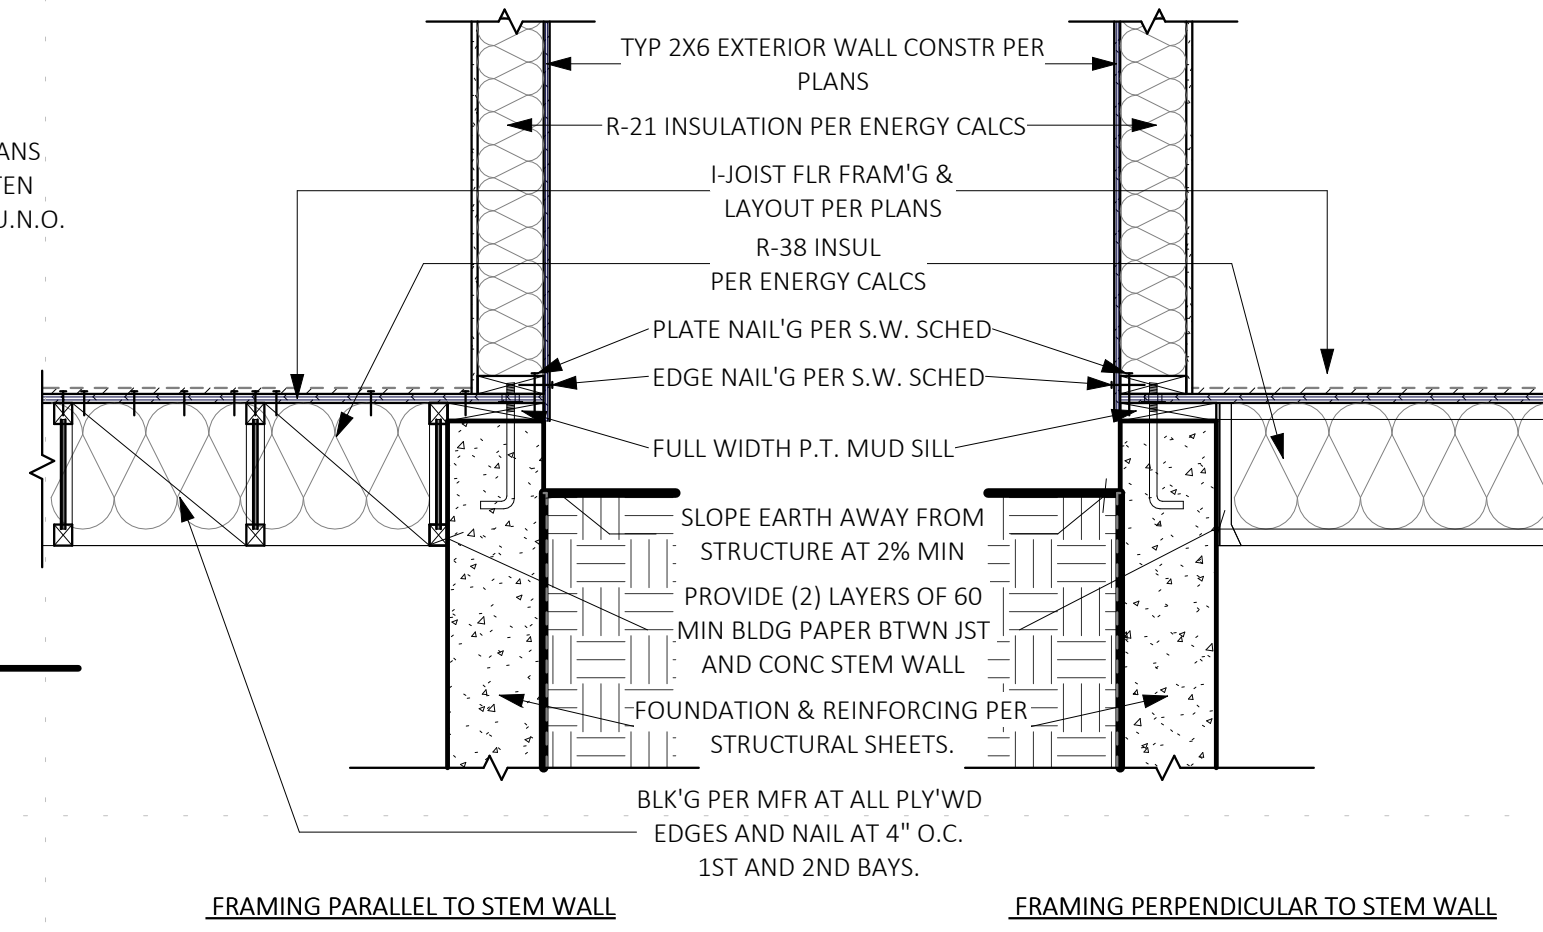


5 FRAM'G / FNDN - DROPPED JOISTS
SCALE: 3/4" = 1'-0"

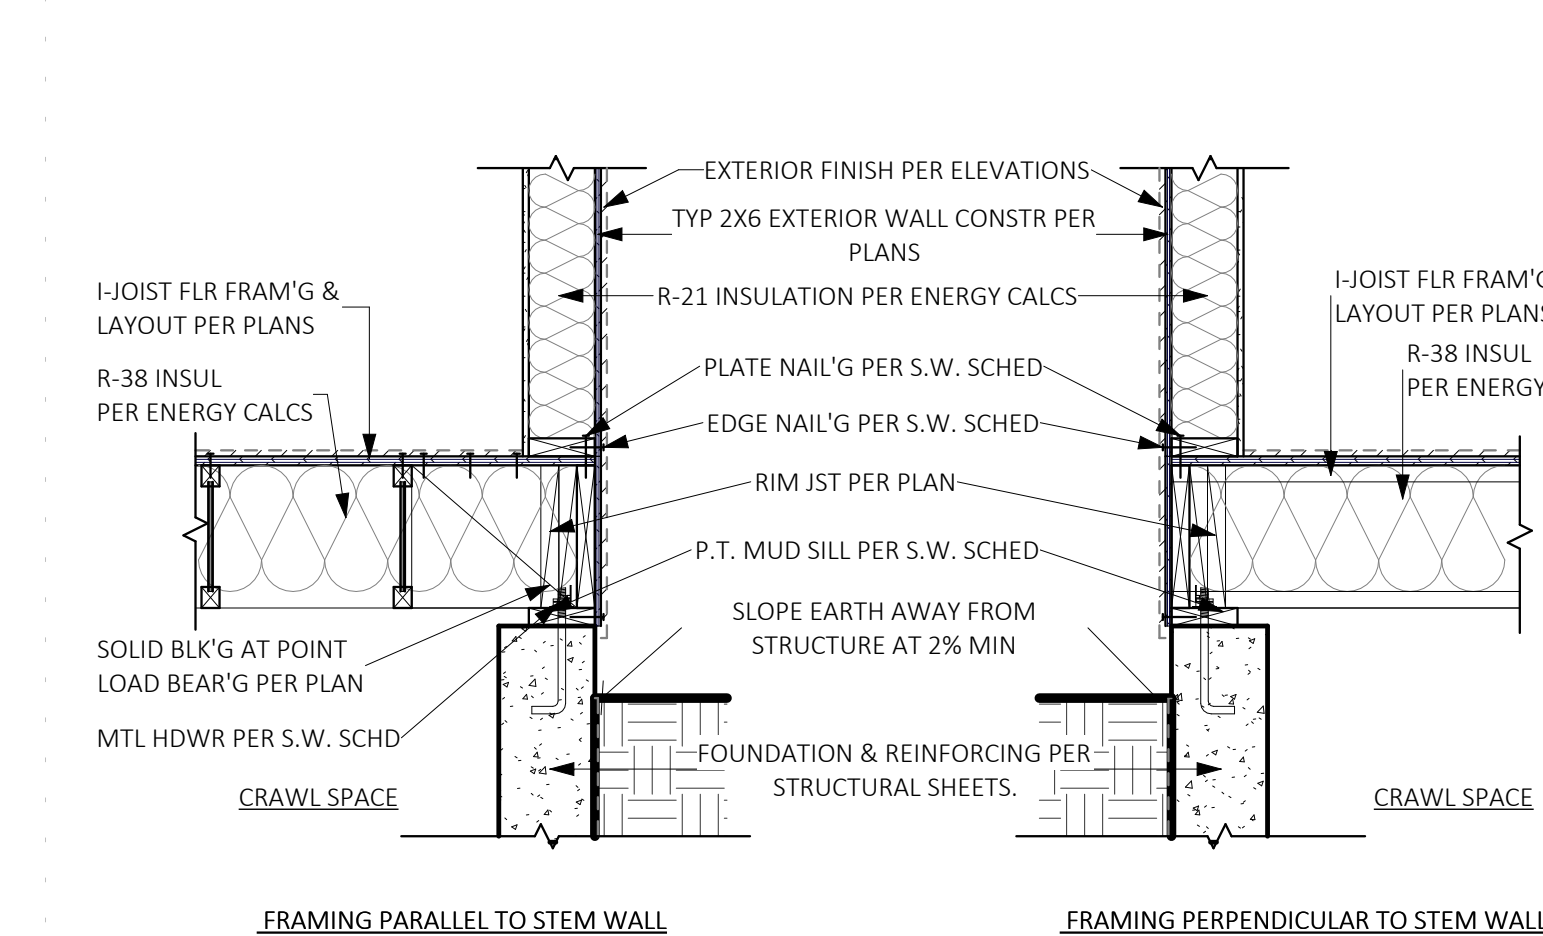

4 FRAM'G / FNDN - JOIST OVER
SCALE: 3/4" = 1'-0"

FNDN SCHEDULE - TYP									
MAX UNBAL FILL	FOOTING					STEM WALL			
	DEPTH	WIDT H	TOE	HEEL	LONGITUDAL BAR	TRANSVERSE BAR	WIDTH	HORIZONTAL REINFORCING	VERTICAL REINFORCING
2'-6"	8"	1'-6"	5"	5"	(3) #4 BAR CONT BOT	#4 AT 8" O.C.	8"	#4 HORZ BAR CENTERED AT 12" O.C.	#4 VERT BAR CENTERED AT 12" O.C.
4'-0"	11"	2'-8"	8"	1'-4"	(2) #4 BAR CONT TOP & BOT	PER DETAILS	8"	#4 HORZ BAR CENTERED AT 12" O.C.	#4 VERT BAR CENTERED AT 12" O.C.

1 FOUNDATION DETAIL - TYP
SCALE: 3/4" = 1'-0"

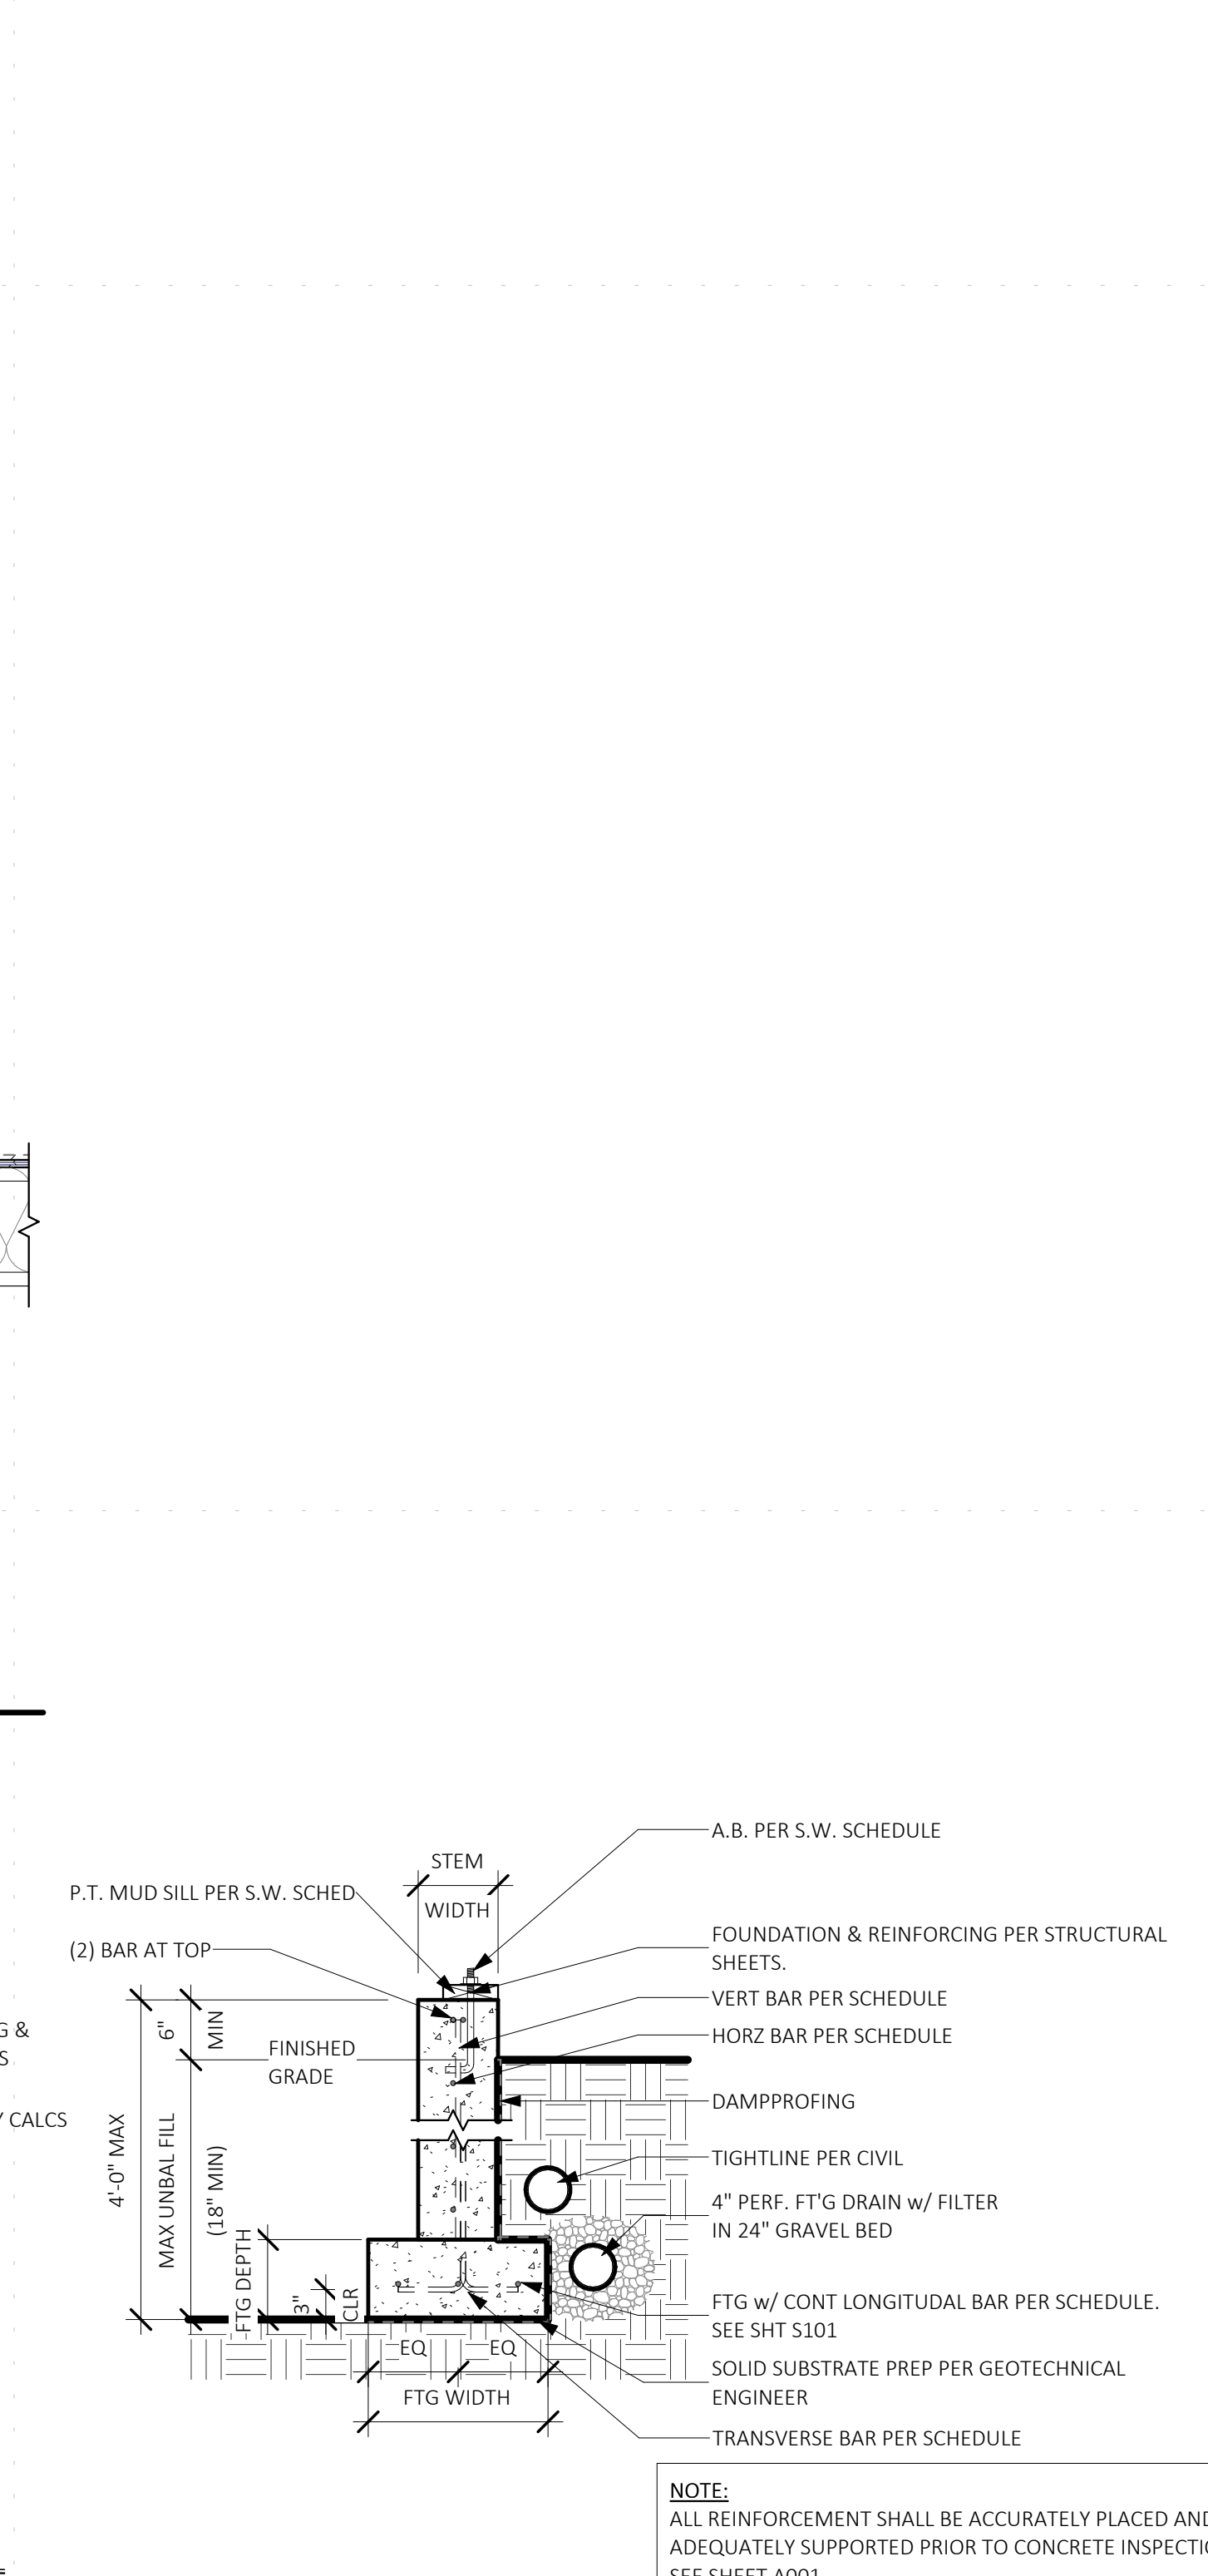

1 FOUNDATION DETAIL - TYP
SCALE: 3/4" = 1'-0"

NOTE: THIS IS A STANDARD DETAILS SHEET PREPARED FOR SINGLE FAMILY HOUSING TYPE V NONRATED CONSTRUCTION. THESE DETAILS HAVE BEEN PREPARED TO COVER GENERAL CONSTRUCTION CONDITIONS. NOT ALL DETAILS ON THIS SHEET ARE NECESSARILY INCORPORATED INTO THIS PROJECT. COORDINATE WITH PLANS.

STANDARD DETAIL SHEET
(C) ATERA DESIGN STUDIO LLC. PLANS AND DESIGNS (DRAWINGS) FORTHWITH REMAIN THE PROPERTY OF ATERA DESIGN STUDIO. REPRODUCTION WITHOUT PERMISSION IS PROHIBITED.

L2 ENGINEERS
17848 NE 198TH PLAVE
WOODINVILLE, WA 98072

ATERA DESIGN STUDIO
451 DUVALL AVE NE,
RENTON, WA 98059

01/13/2023

HU RESIDENCE
2448 72nd AVE SE, Mercer Island

PERMIT SET

FOUNDATION & FRAM'G DETAILS

PROJECT NO: 21014
ISSUE DATE: 2022/06/29
DRAWN BY: SPM


D101

SCALE 24X36: 3/4" = 1'-0"
* NOTE: 11X17 SETS ARE REDUCED 50% SCALE DRAWINGS ACCORDINGLY.

3/15/2023 8:48:48 AM Autodesk Docs//721014 Hu Residence, Mercer Island/21014.05CD_Hu Residence, Mercer Island.rvt


23

FORCE TRANSFER AT OPENING
SCALE: 3/4" = 1'-0"

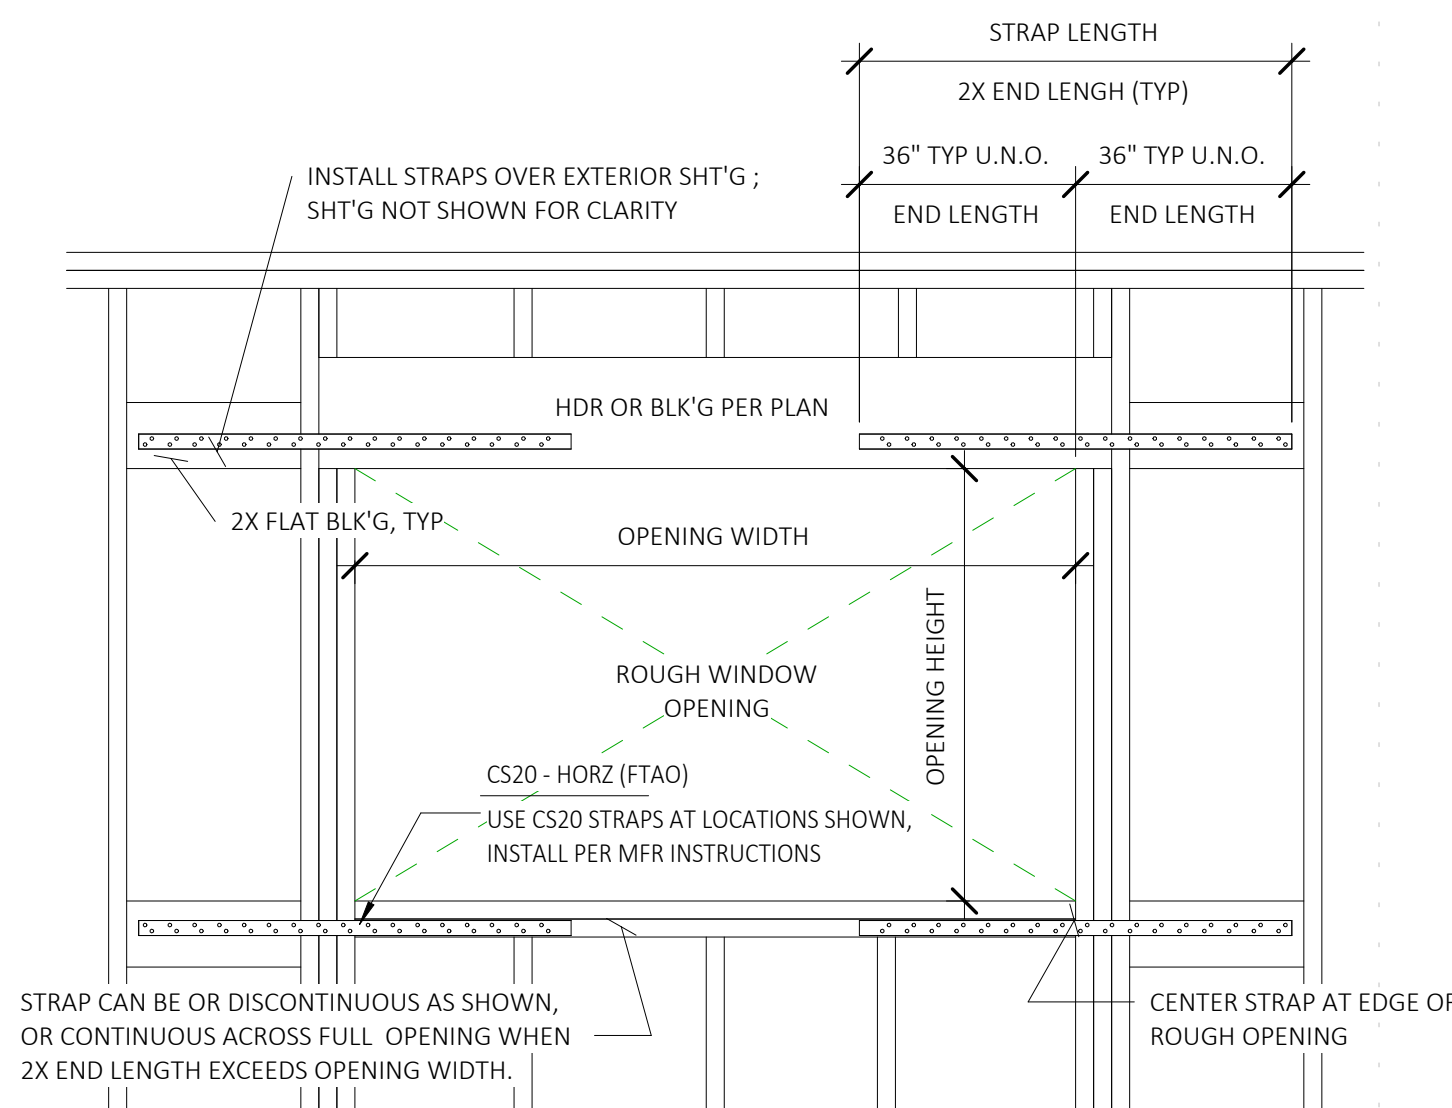


22

INT/EXT WALL FRAMING DETAIL
SCALE: 3/4" = 1'-0"

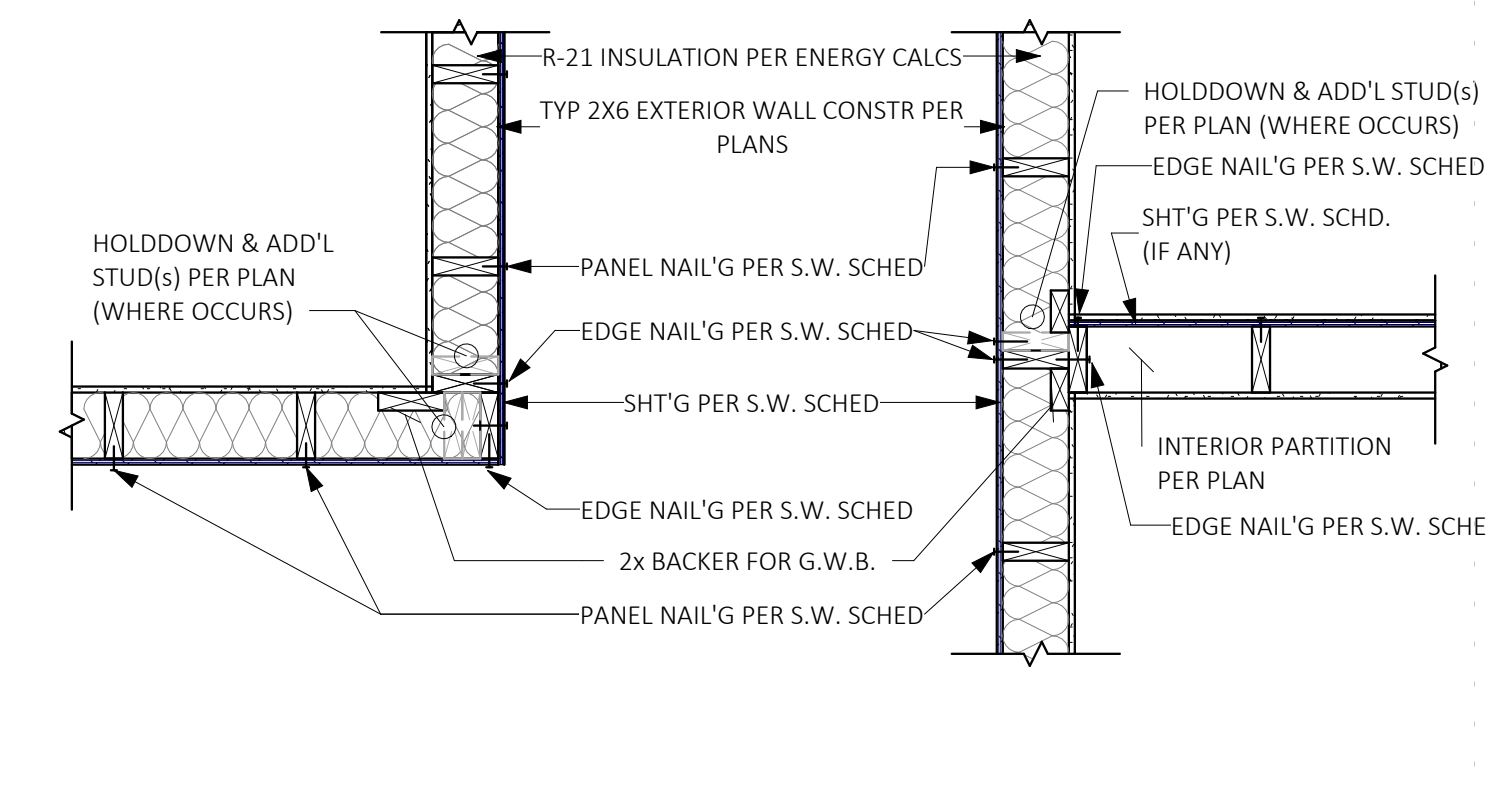


17

INTERIOR WALL/FLOOR JOISTS - STACKED
SCALE: 3/4" = 1'-0"

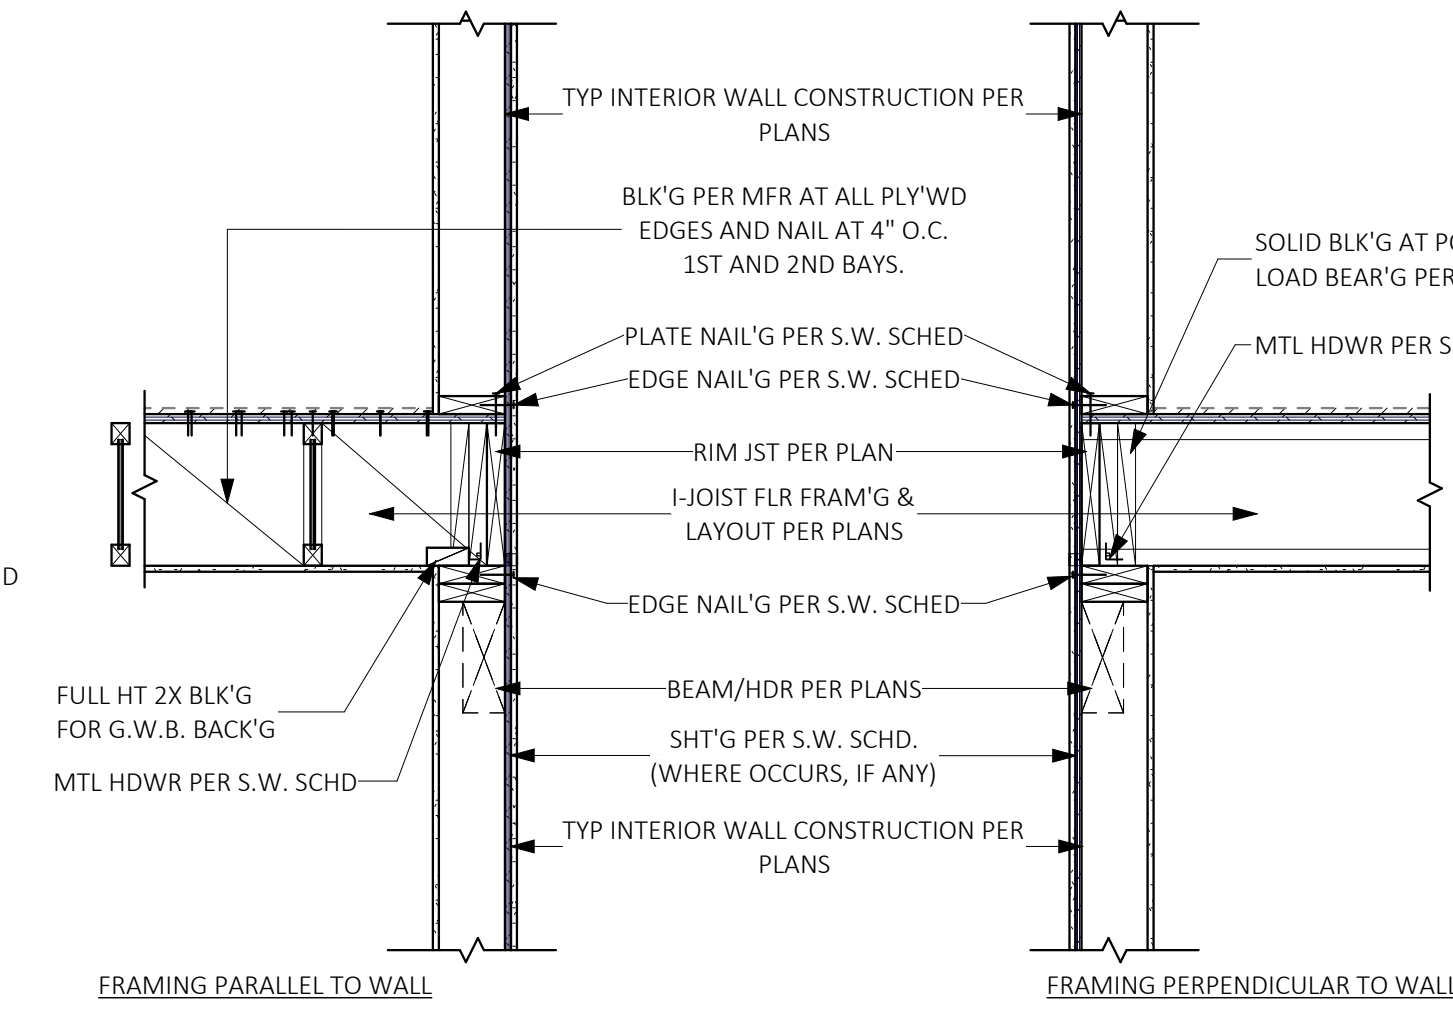


14

EXTERIOR WALL TO FLOOR JOISTS
SCALE: 3/4" = 1'-0"

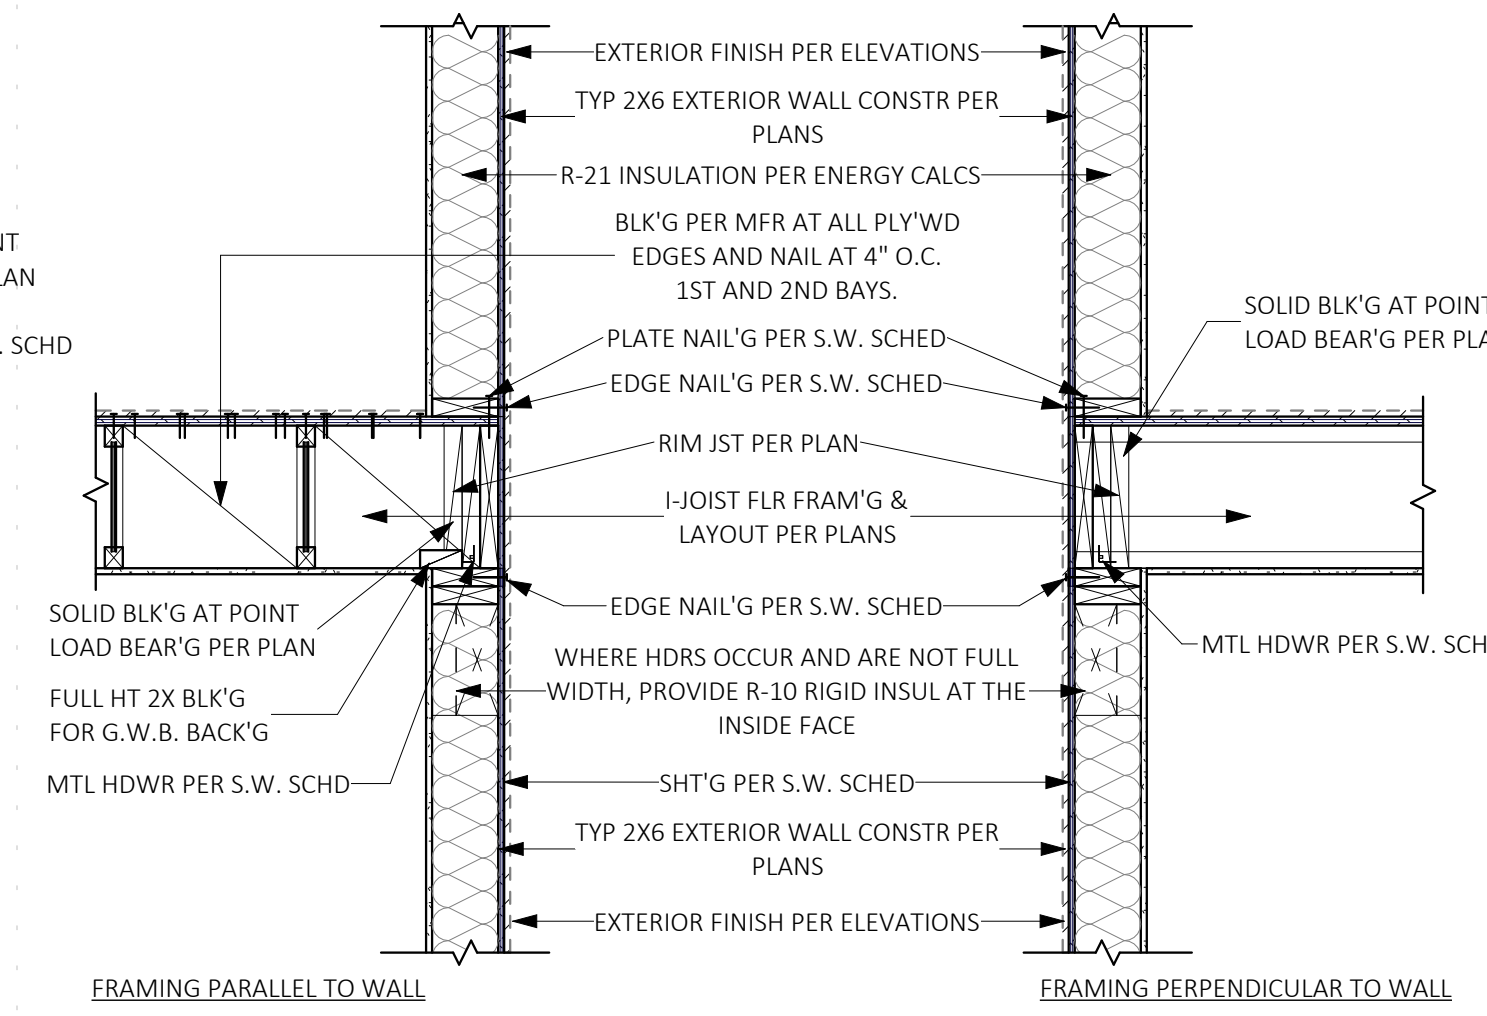

15

CANTILEVERED FRM'G AT EXT WALL
SCALE: 3/4" = 1'-0"

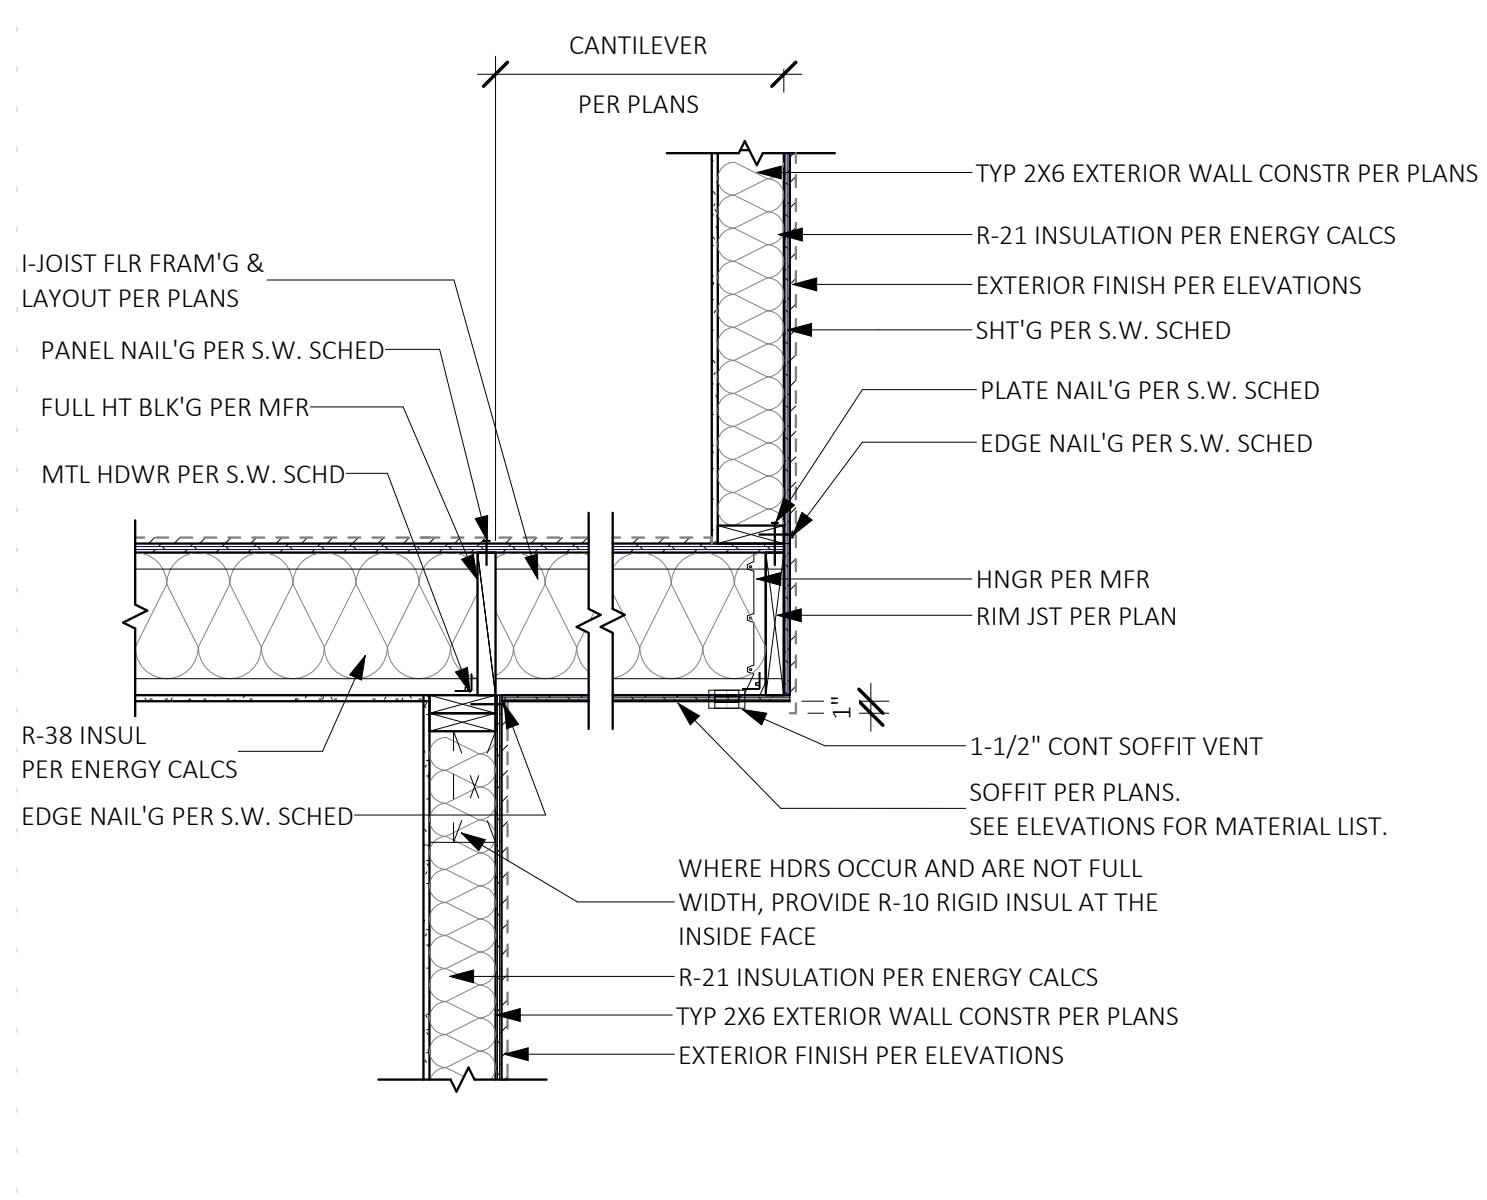

NOTE: THIS IS A STANDARD DETAILS SHEET PREPARED FOR SINGLE FAMILY HOUSING TYPE V NONRATED CONSTRUCTION. THESE DETAILS HAVE BEEN PREPARED TO COVER GENERAL CONSTRUCTION CONDITIONS. NOT ALL DETAILS ON THIS SHEET ARE NECESSARILY INCORPORATED INTO THIS PROJECT. COORDINATE WITH PLANS.


STANDARD DETAIL SHEET (C) ATERA DESIGN STUDIO LLC. PLANS AND DESIGNS (DRAWINGS) FORTHWITH REMAIN THE PROPERTY OF ATERA DESIGN STUDIO. REPRODUCTION WITHOUT PERMISSION IS PROHIBITED.

No. _____ Date _____

01/13/2023

L2 ENGINEERS
17848 NE 198TH PLAVE
WOODINVILLE, WA 98072

ATERA DESIGN STUDIO
451 DUVALL AVE NE,
RENTON, WA 98059

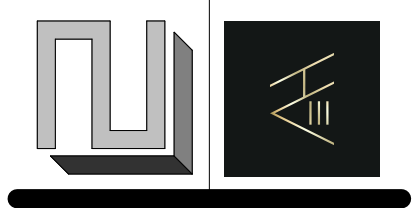

HU RESIDENCE
2448 72nd AVE SE, Mercer Island

PERMIT SET


FRAMING DETAILS

PROJECT NO: 21014
ISSUE DATE: 2022/06/29
DRAWN BY: SPM


D102

SCALE 24X36: 3/4" = 1'-0"
* NOTE: 11X17 SETS ARE REDUCED 50% SCALE DRAWINGS ACCORDINGLY.




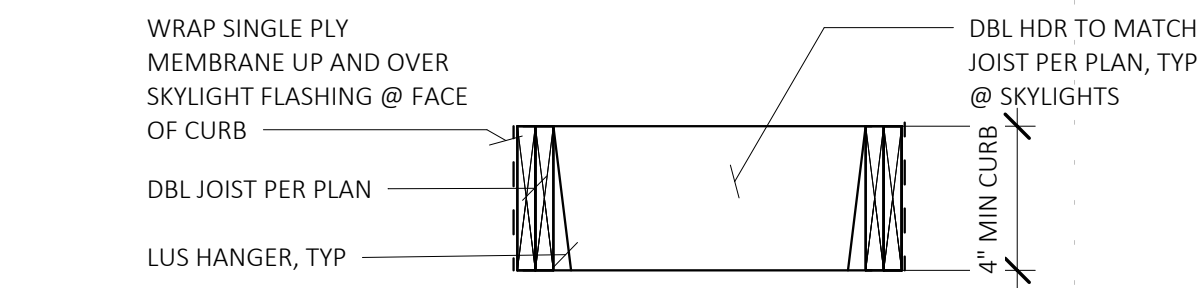


4 ROOF - SKYLIGHT CURB
 SCALE: 3/4" = 1'-0"

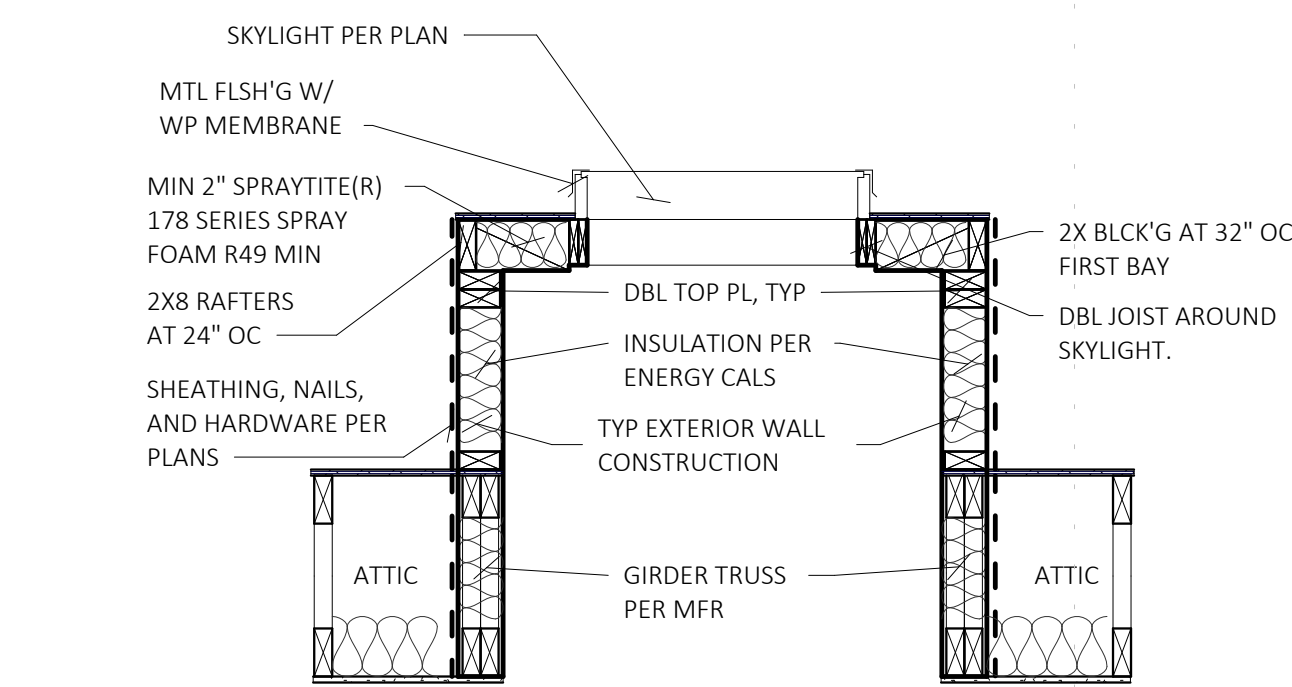

3 ROOF - SKYLIGHT
 SCALE: 3/4" = 1'-0"

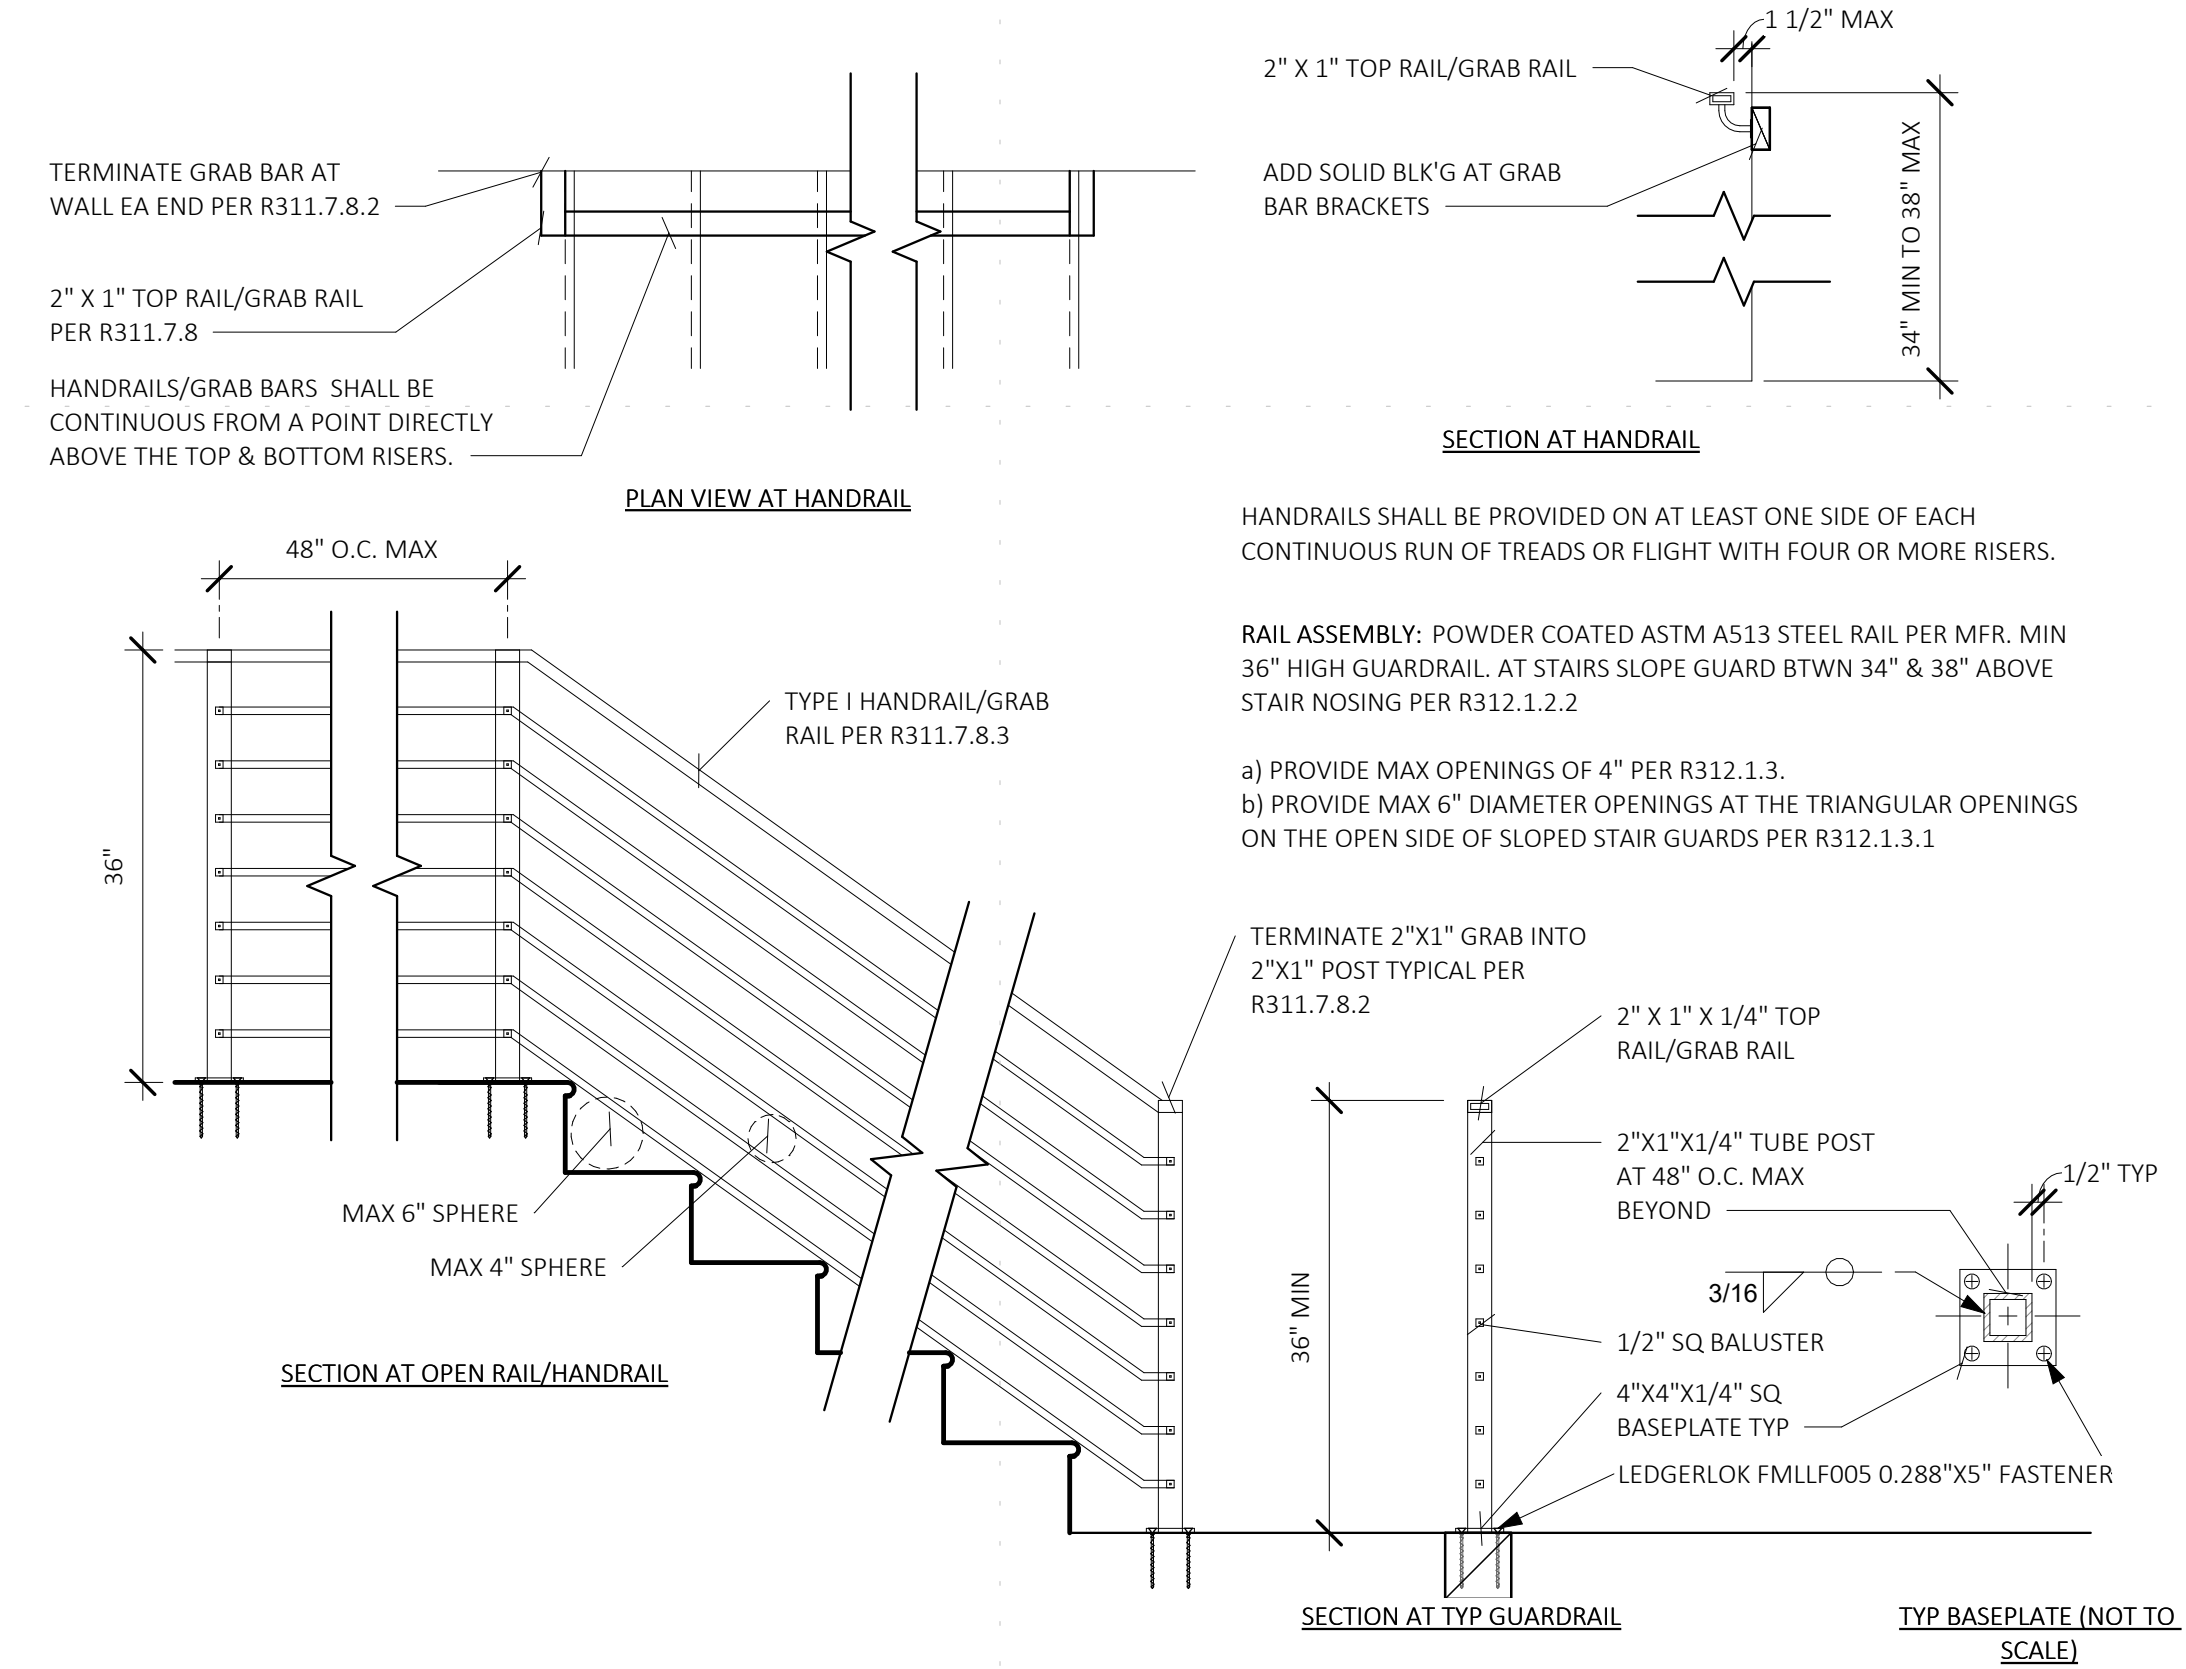


2 TYP RAILING/GRAB BAR DETAIL
 SCALE: 3/4" = 1'-0"

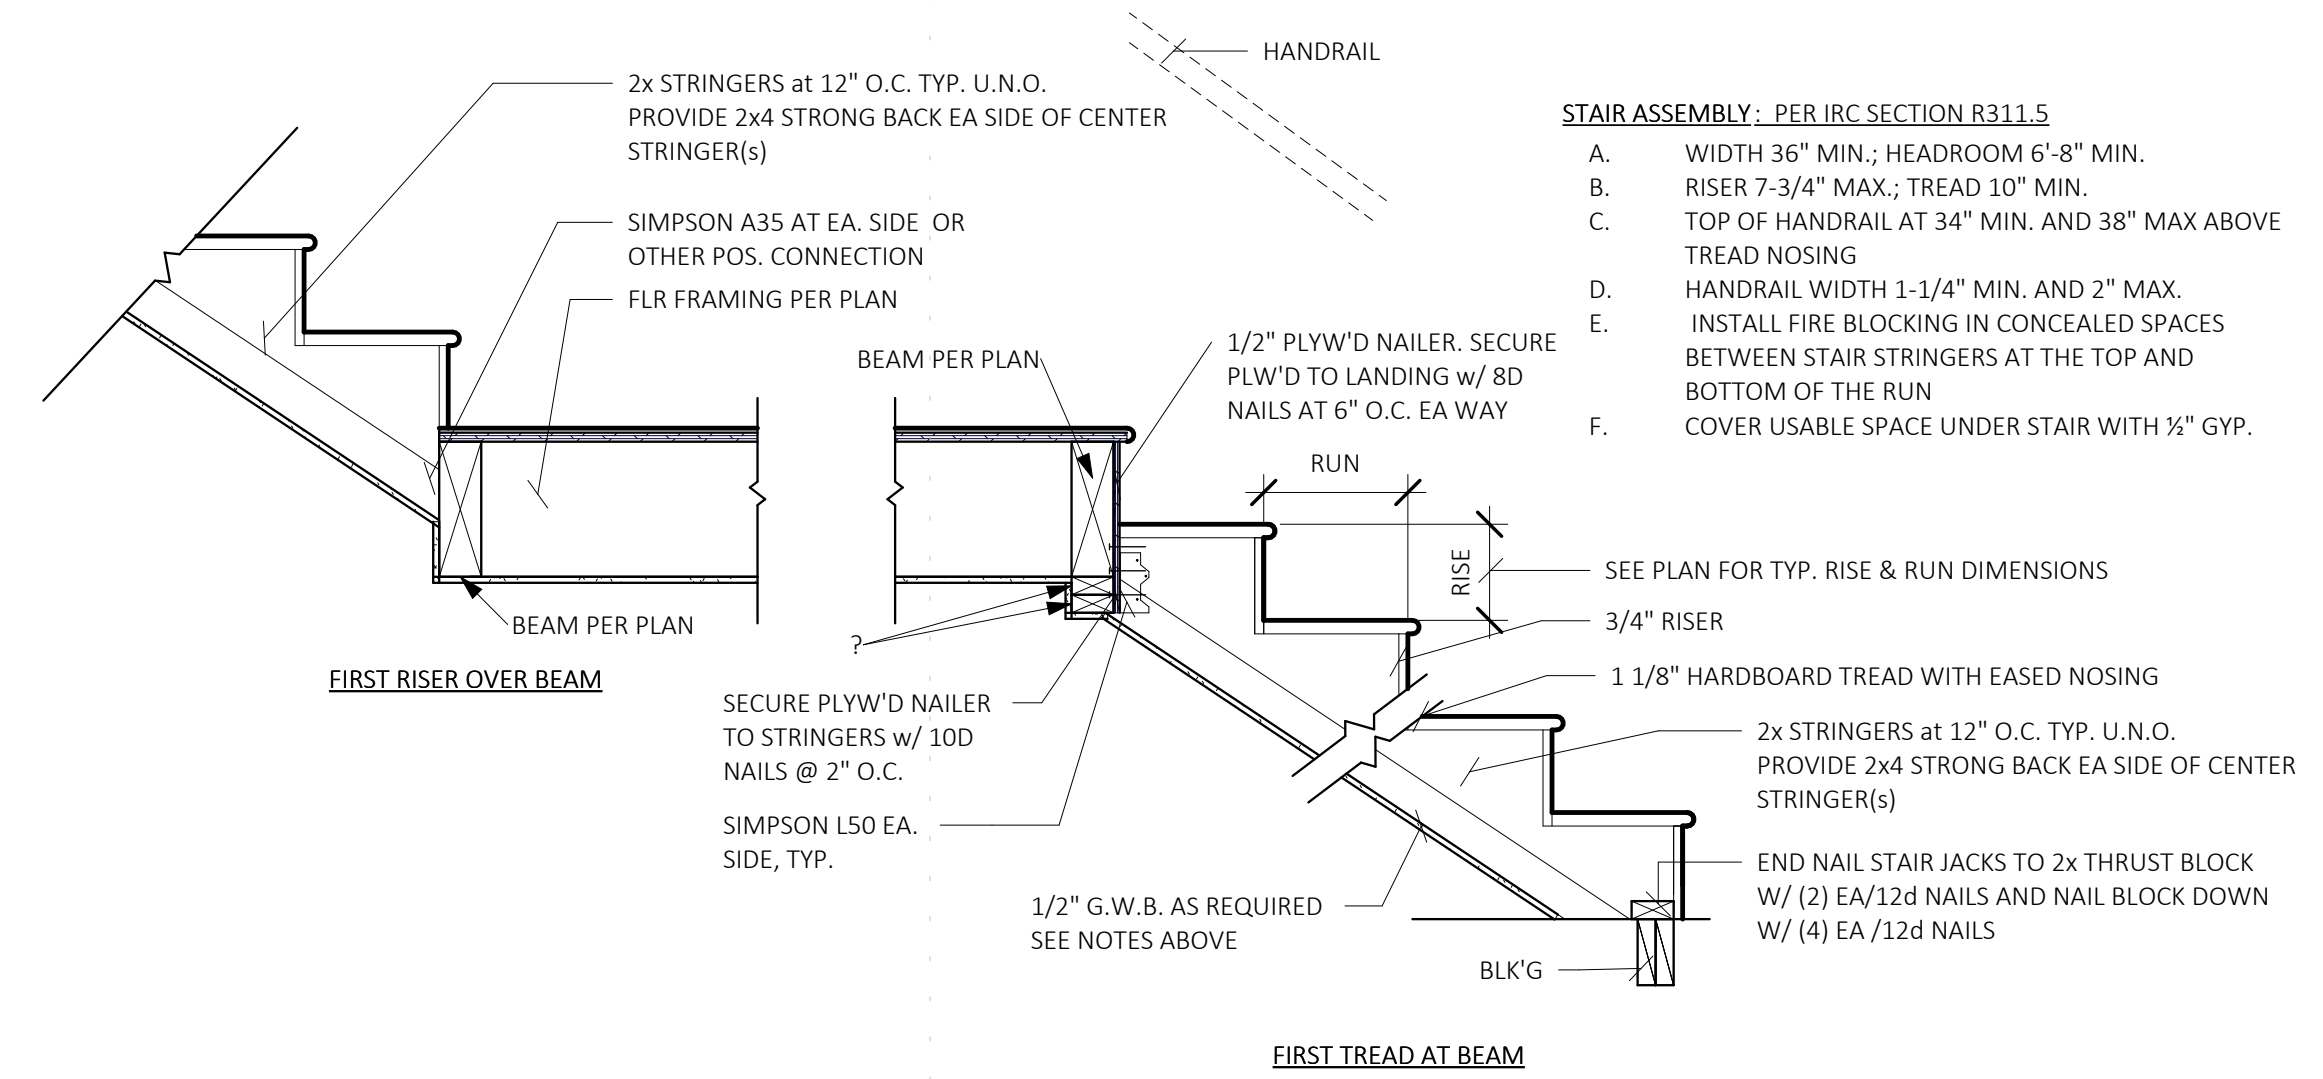


1 STAIR SECTION DETAIL
 SCALE: 3/4" = 1'-0"

NOTE: THIS IS A STANDARD DETAILS SHEET PREPARED FOR SINGLE FAMILY HOUSING TYPE V NONRATED CONSTRUCTION. THESE DETAILS HAVE BEEN PREPARED TO COVER GENERAL CONSTRUCTION CONDITIONS. NOT ALL DETAILS ON THIS SHEET ARE NECESSARILY INCORPORATED INTO THIS PROJECT. COORDINATE WITH PLANS.

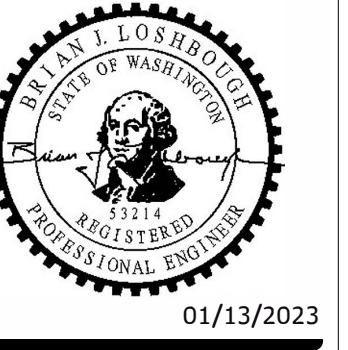

L2 ENGINEERS
 17848 NE 198TH PLAVE
 WOODINVILLE, WA 98072
ATERA DESIGN STUDIO
 451 DUVALL AVE NE,
 RENTON, WA 98059

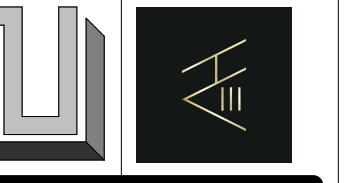

HU RESIDENCE
 2448 72nd AVE SE, Mercer Island

PERMIT SET

STAIR & RAILING DETAILS

PROJECT NO: 21014
 ISSUE DATE: 2022/06/29
 DRAWN BY: SPM







D201

SCALE 24X36: 3/4" = 1'-0"
 * NOTE: 11x17 SETS ARE REDUCED 50%; SCALE DRAWINGS ACCORDINGLY.



No.	Date	Description
1	2023/01/25	SUB2 City Comment Submittal




REPRODUCTION WITHOUT PERMISSION IS PROHIBITED.

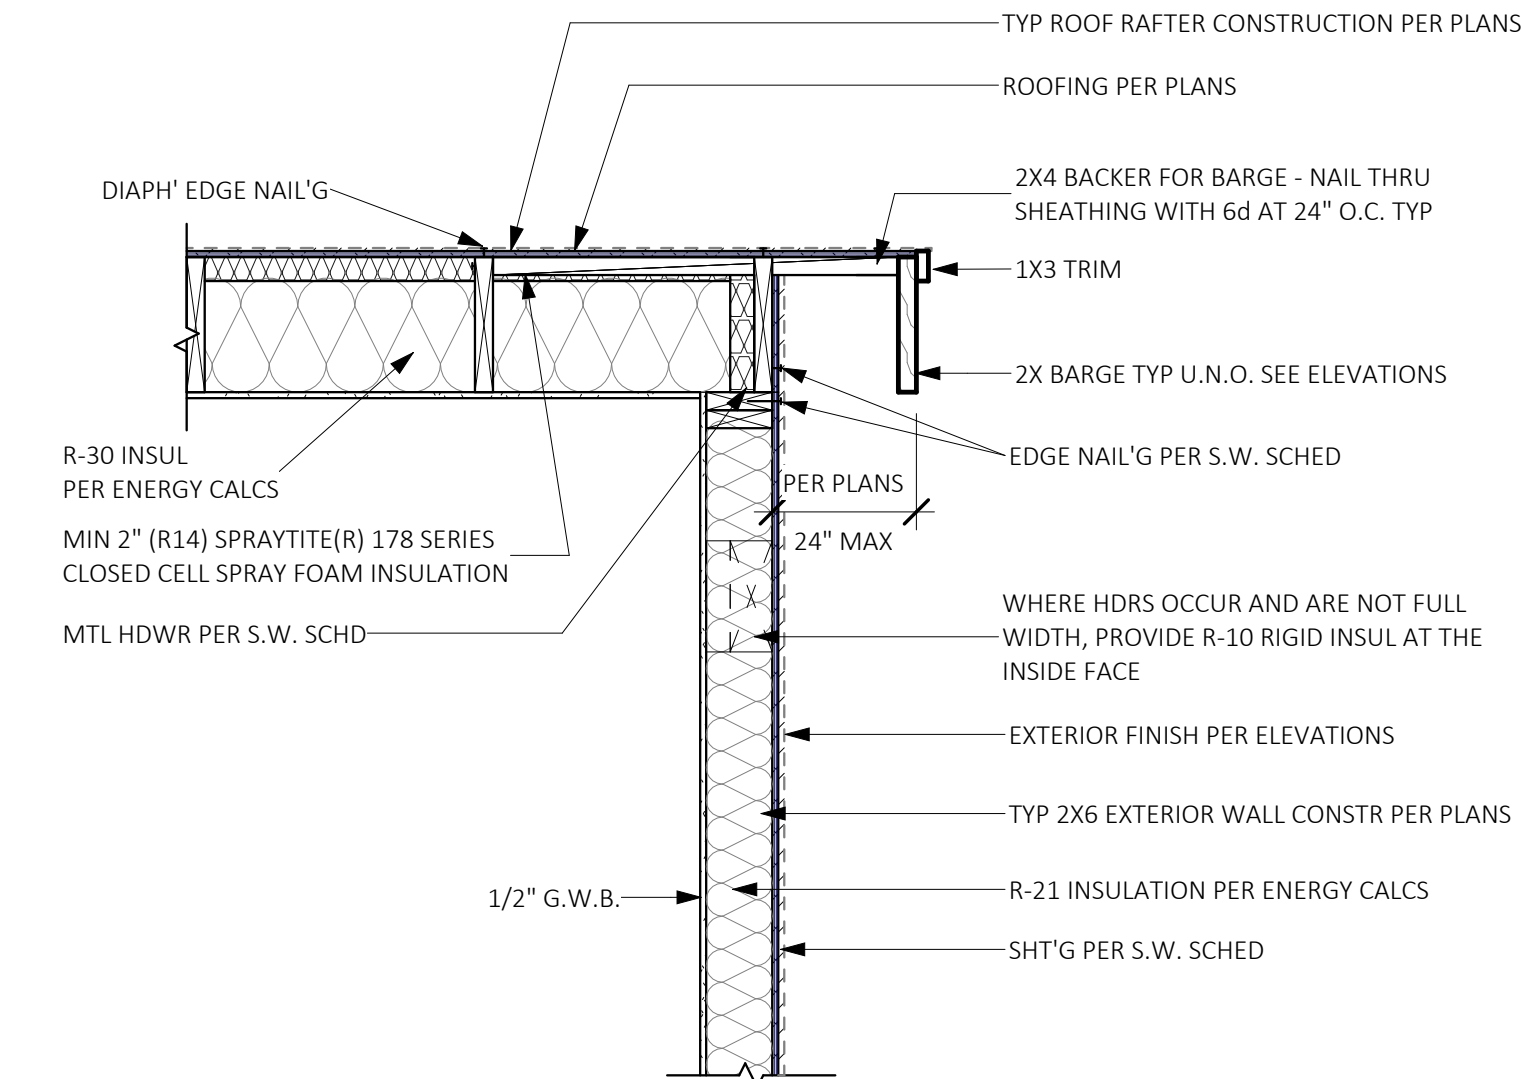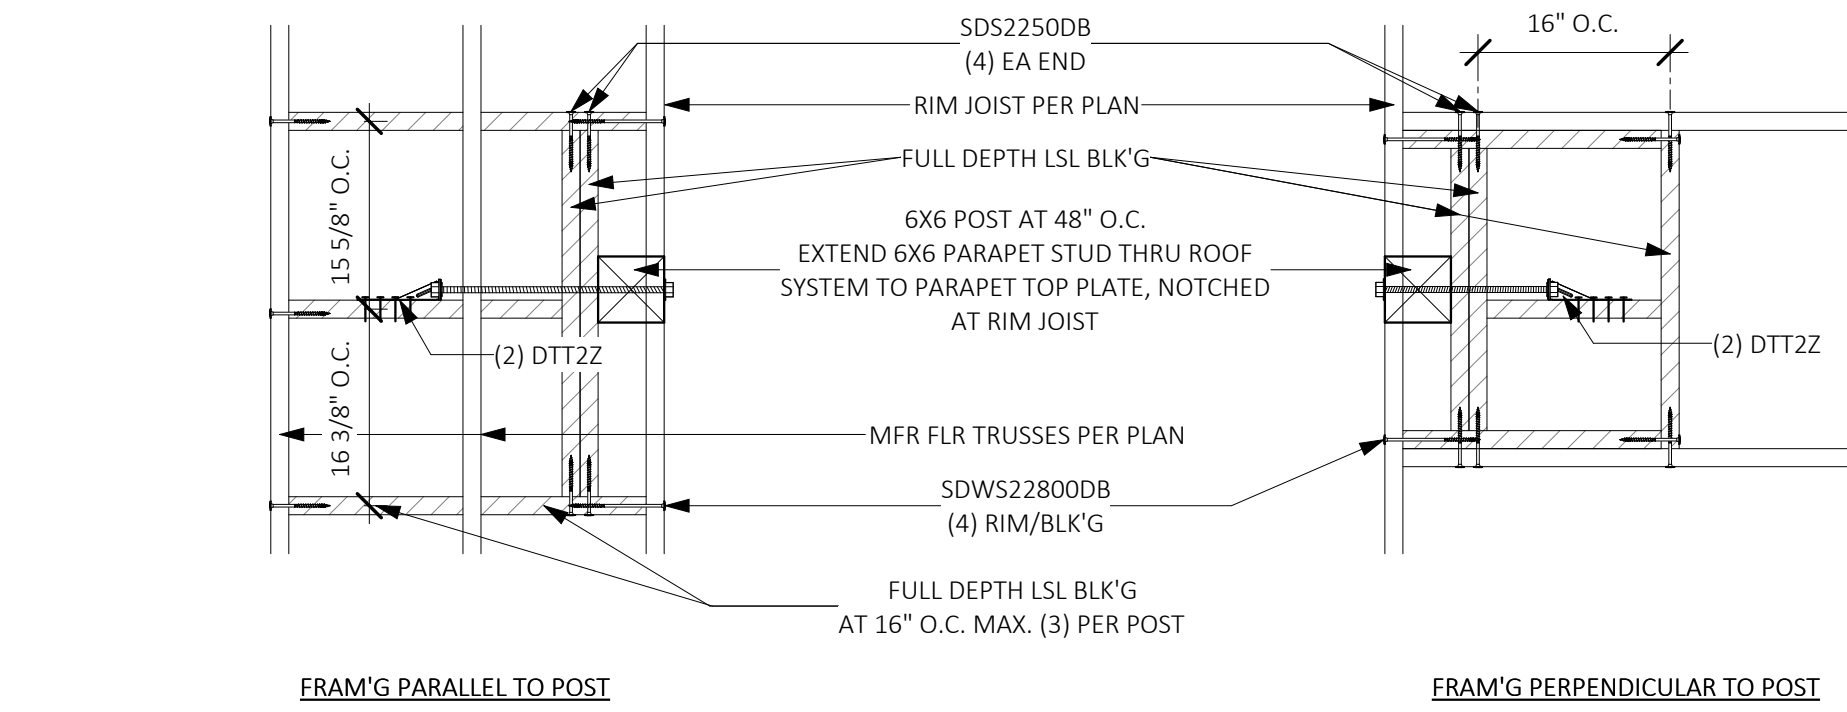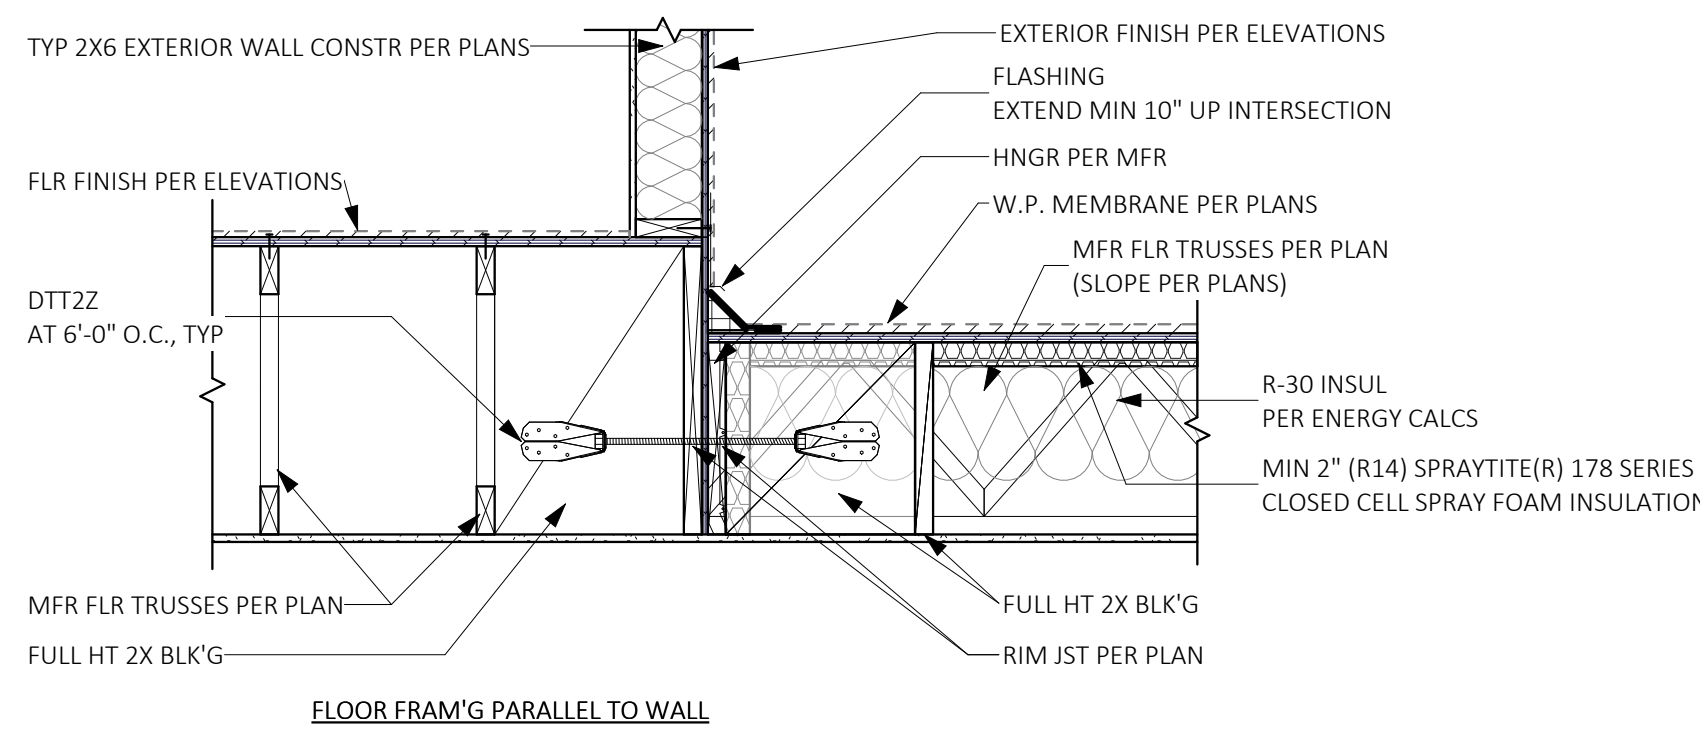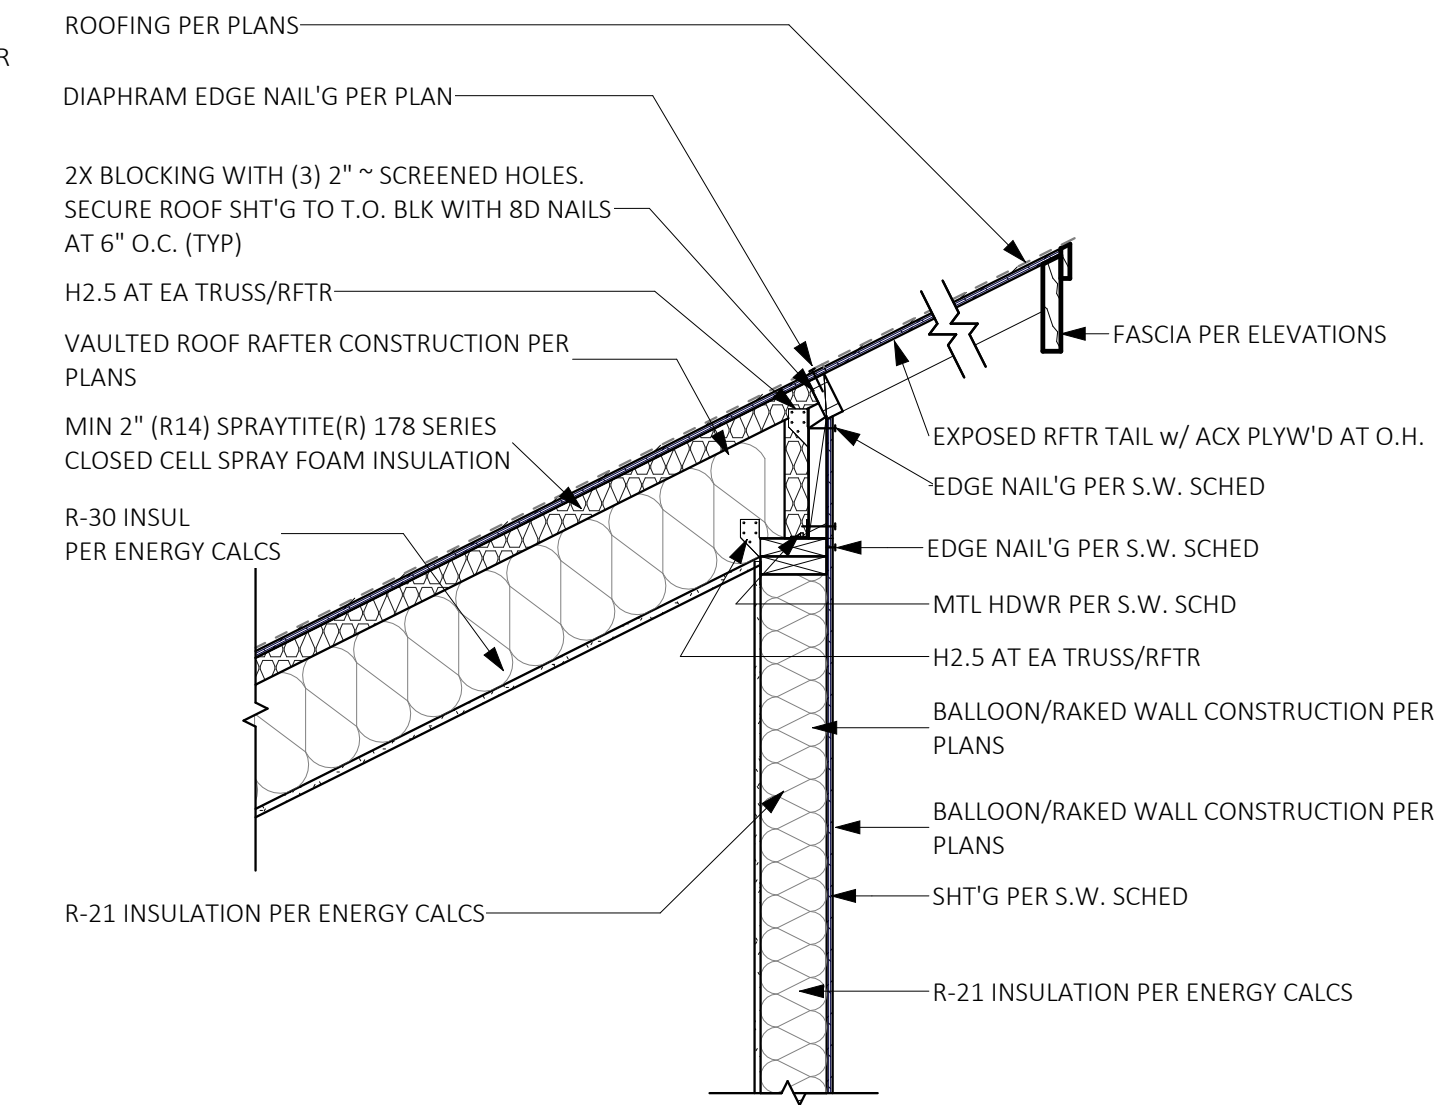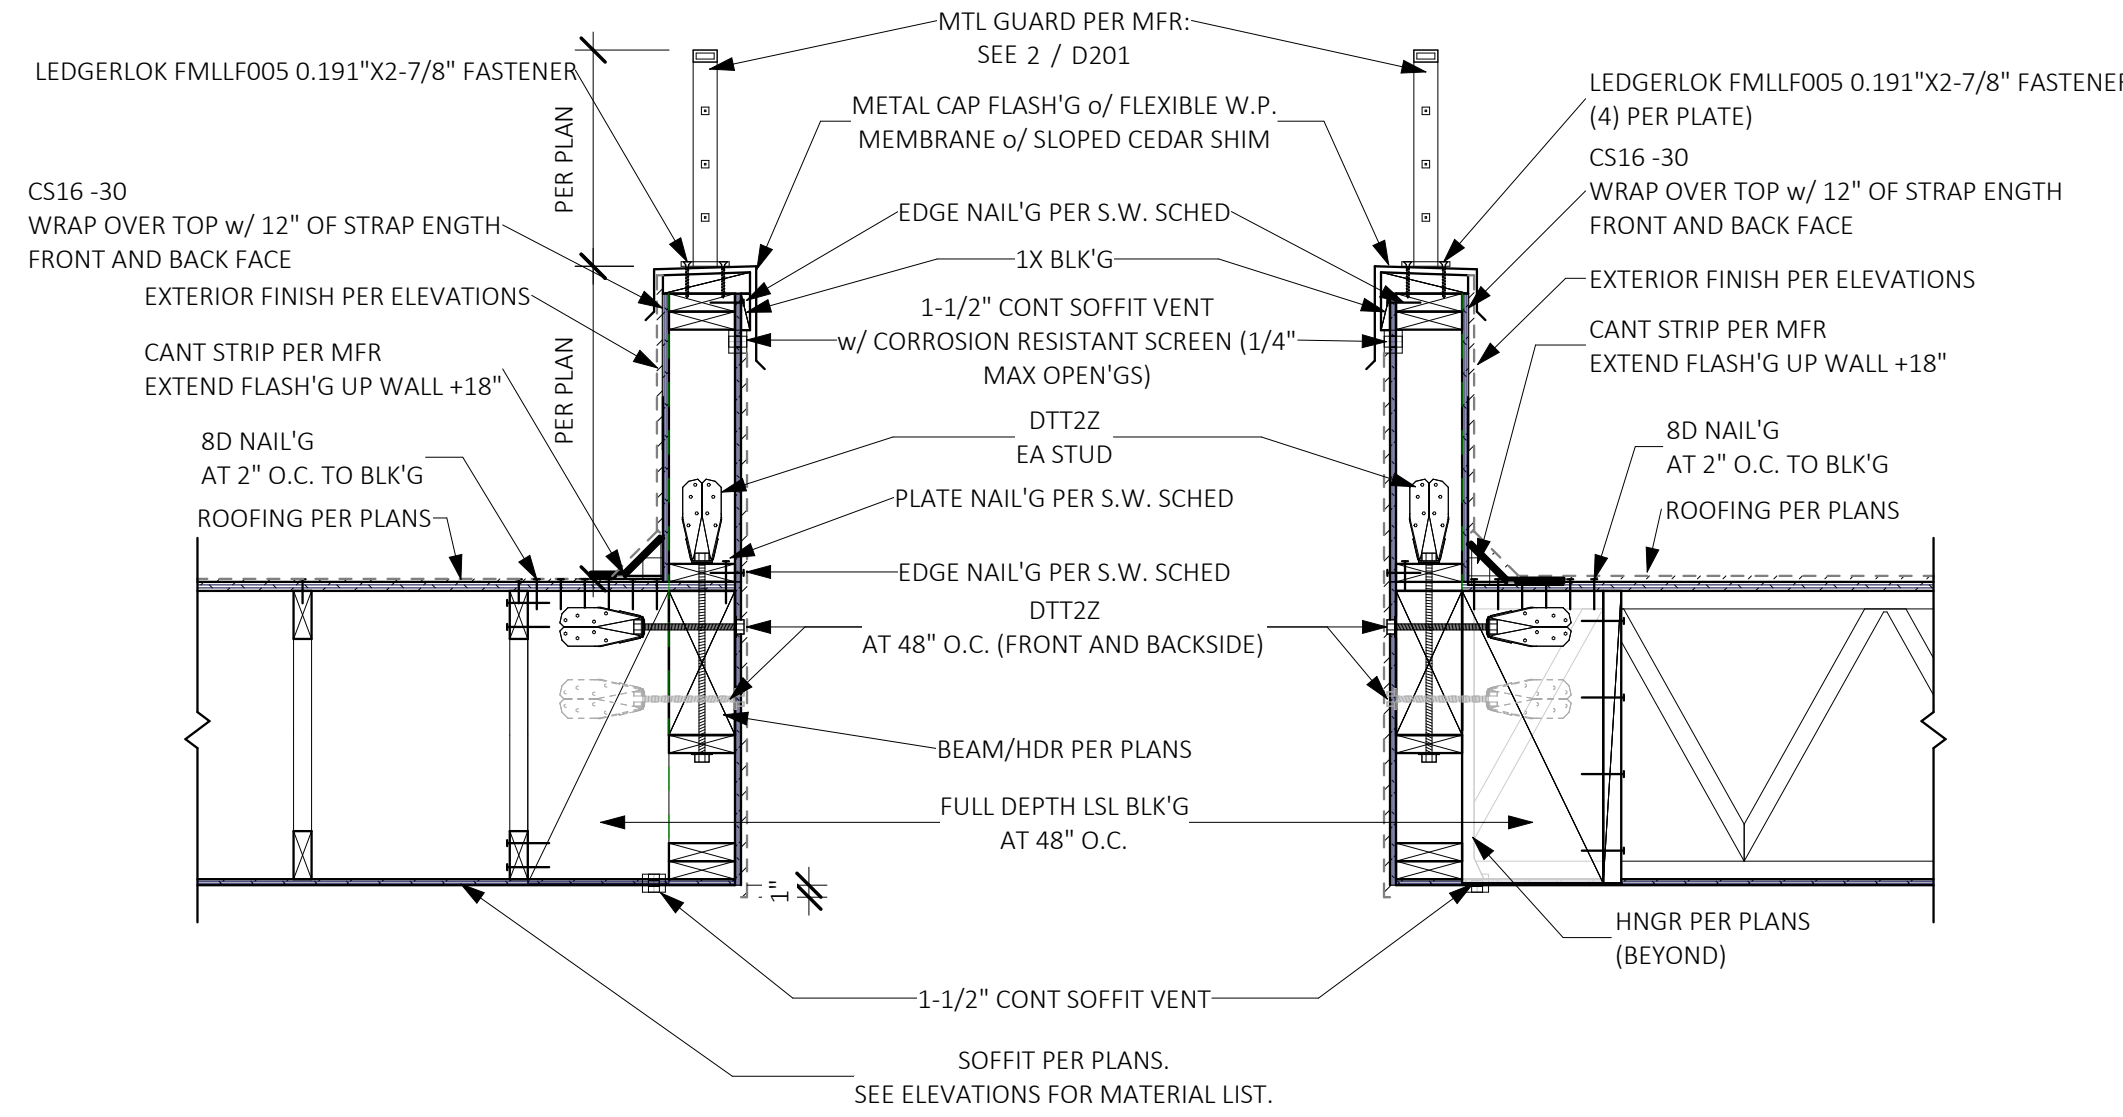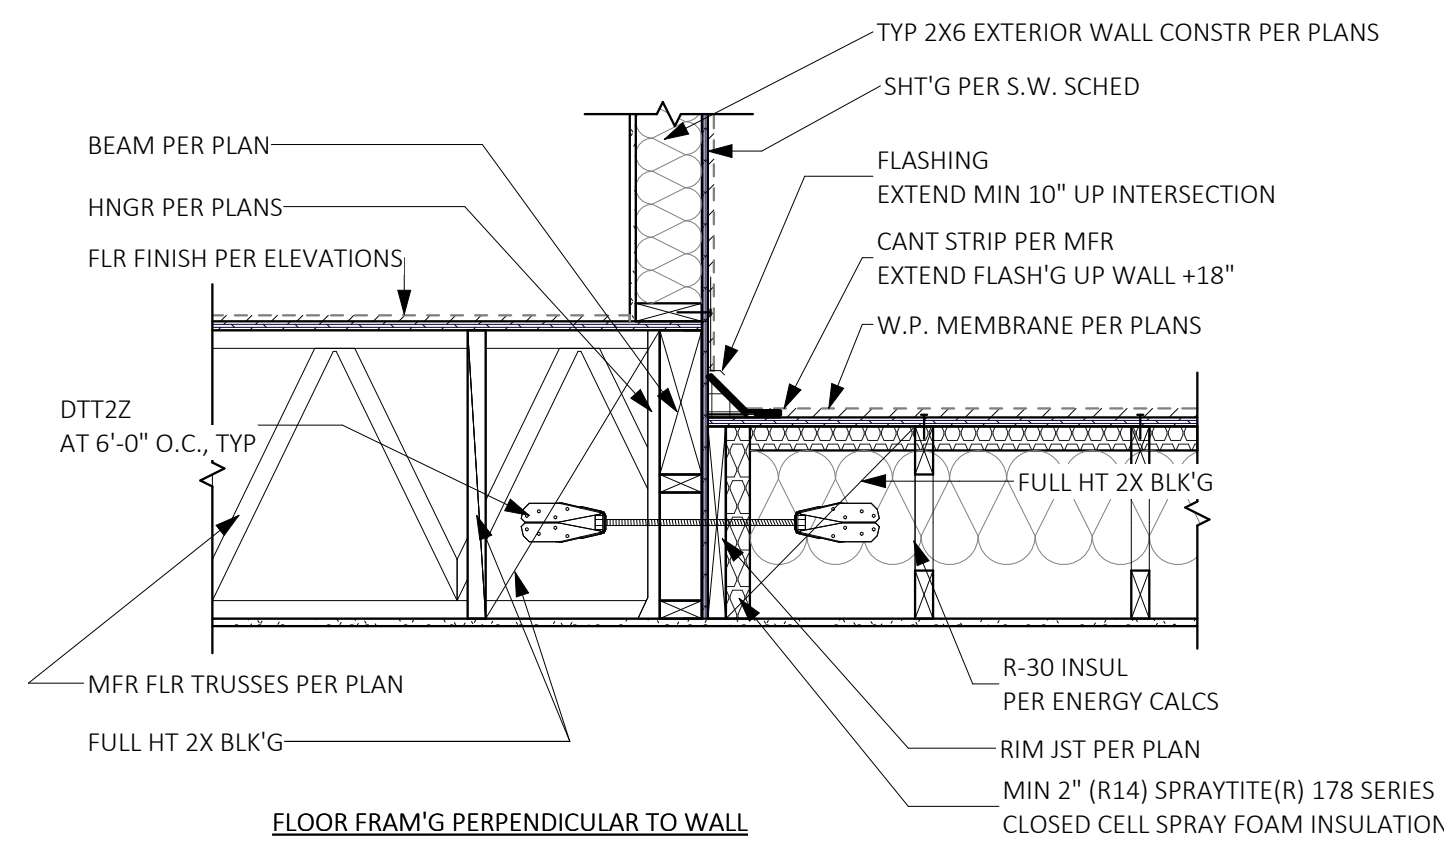

7 BALCONY/WALL CONNECTION
SCALE: 3/4" = 1'-0"

8 PLAN VIEW AT PARAPET STUD
SCALE: 3/4" = 1'-0"

2 GABLE END DETAIL- VAULT'D RFR
SCALE: 3/4" = 1'-0"

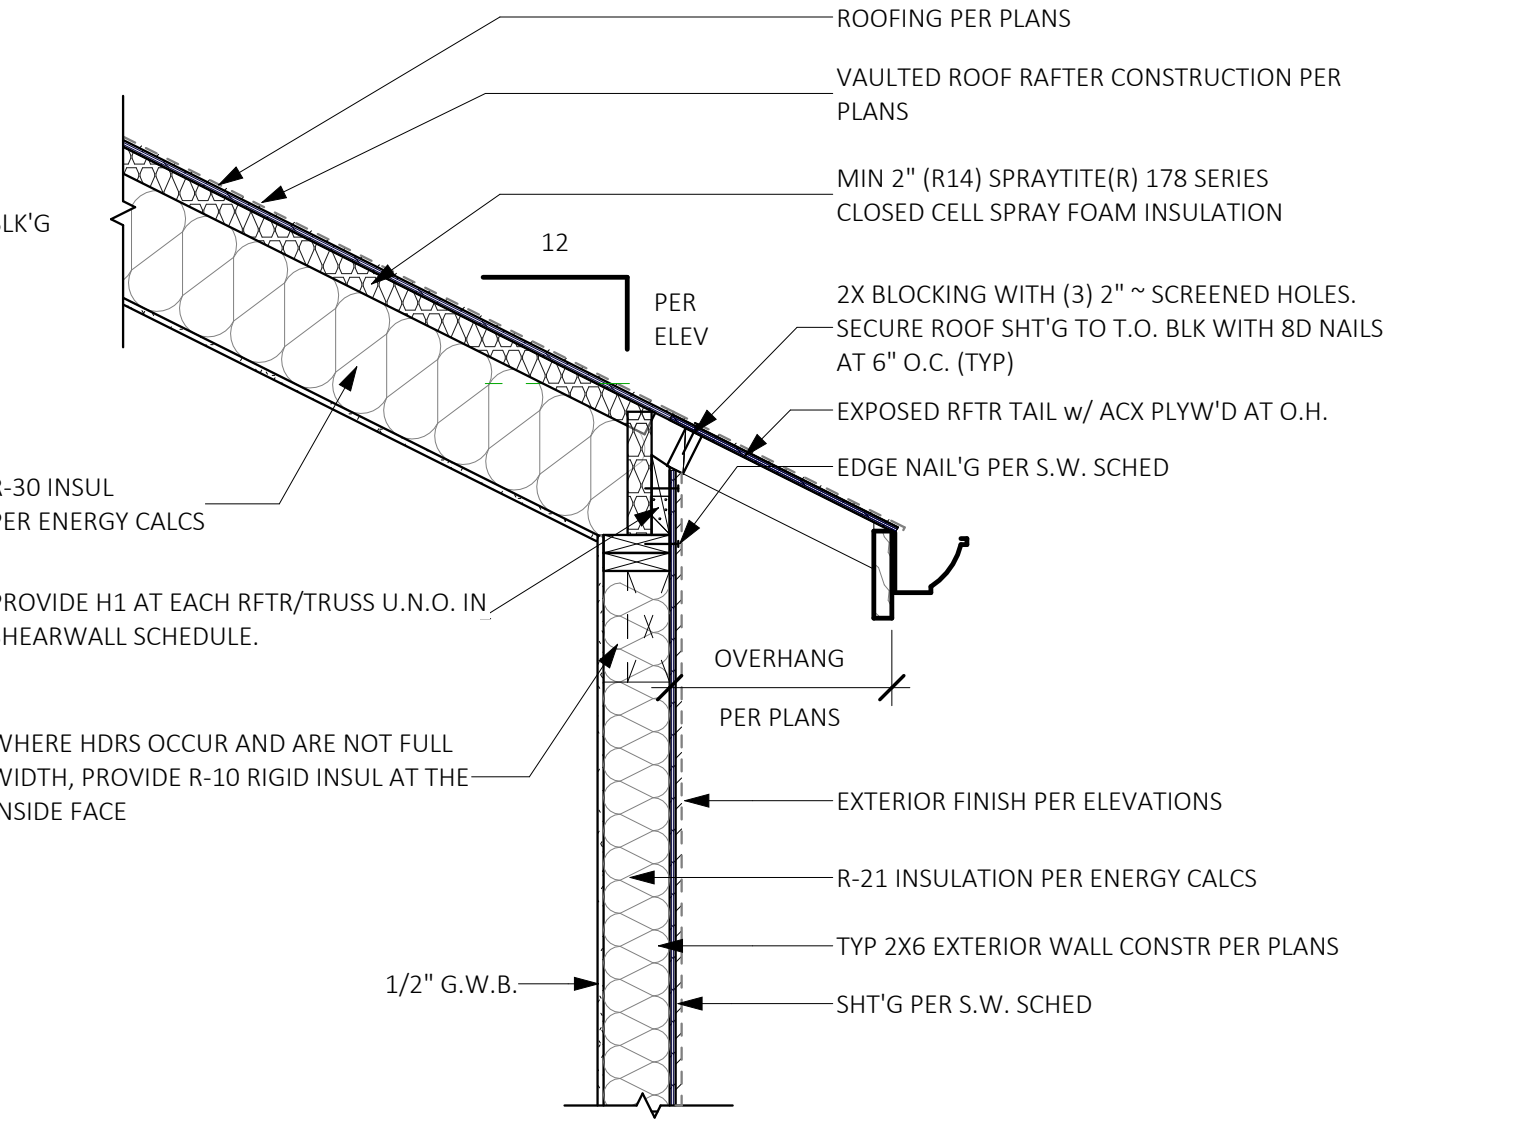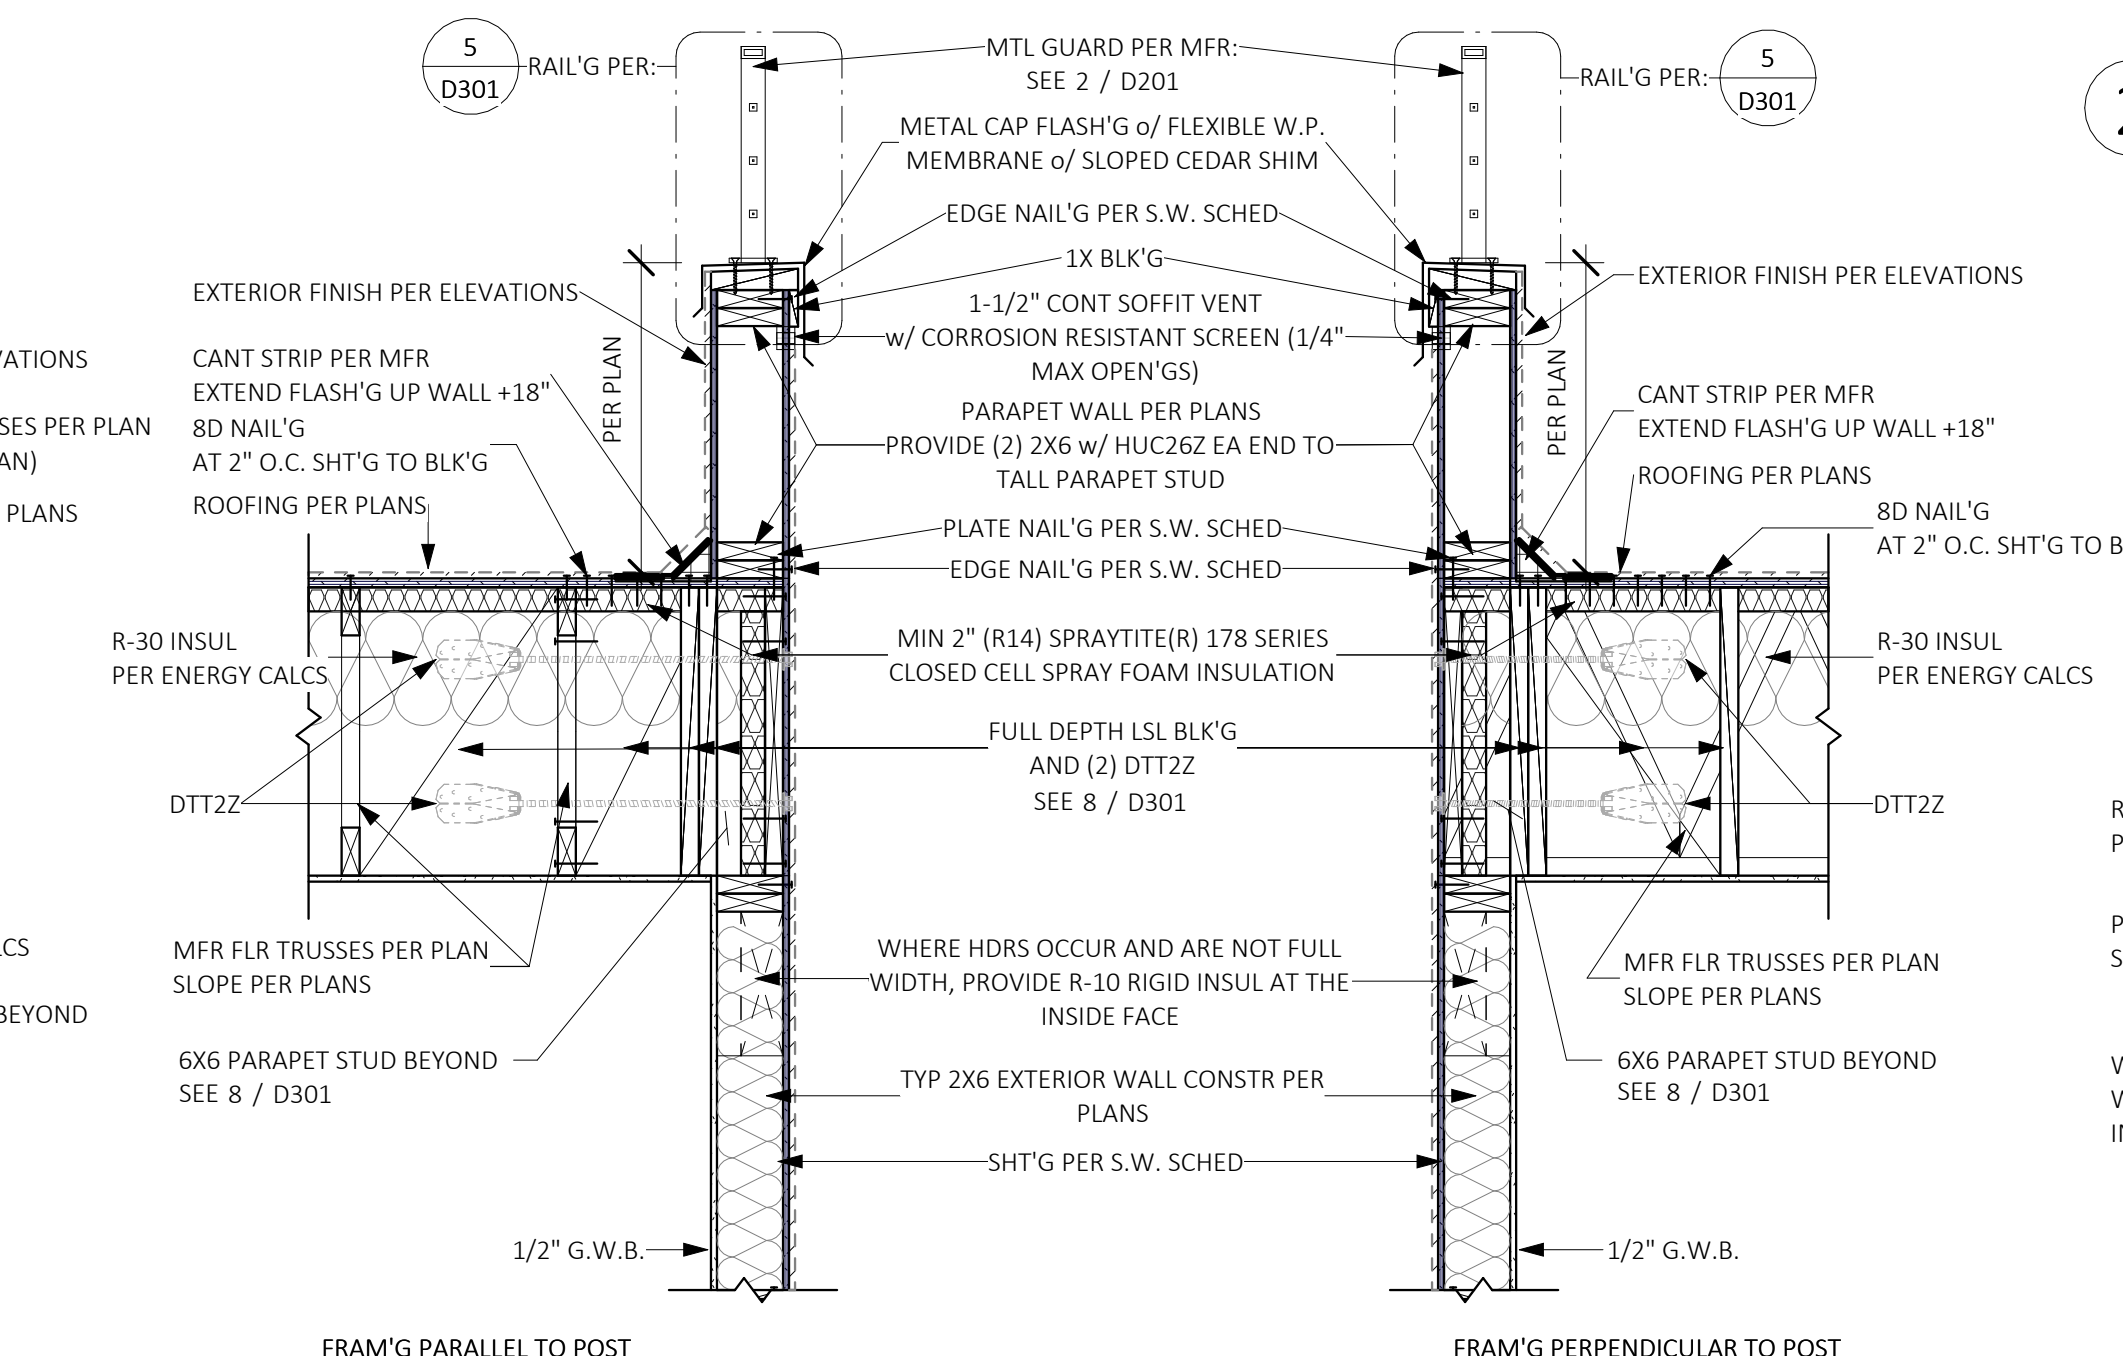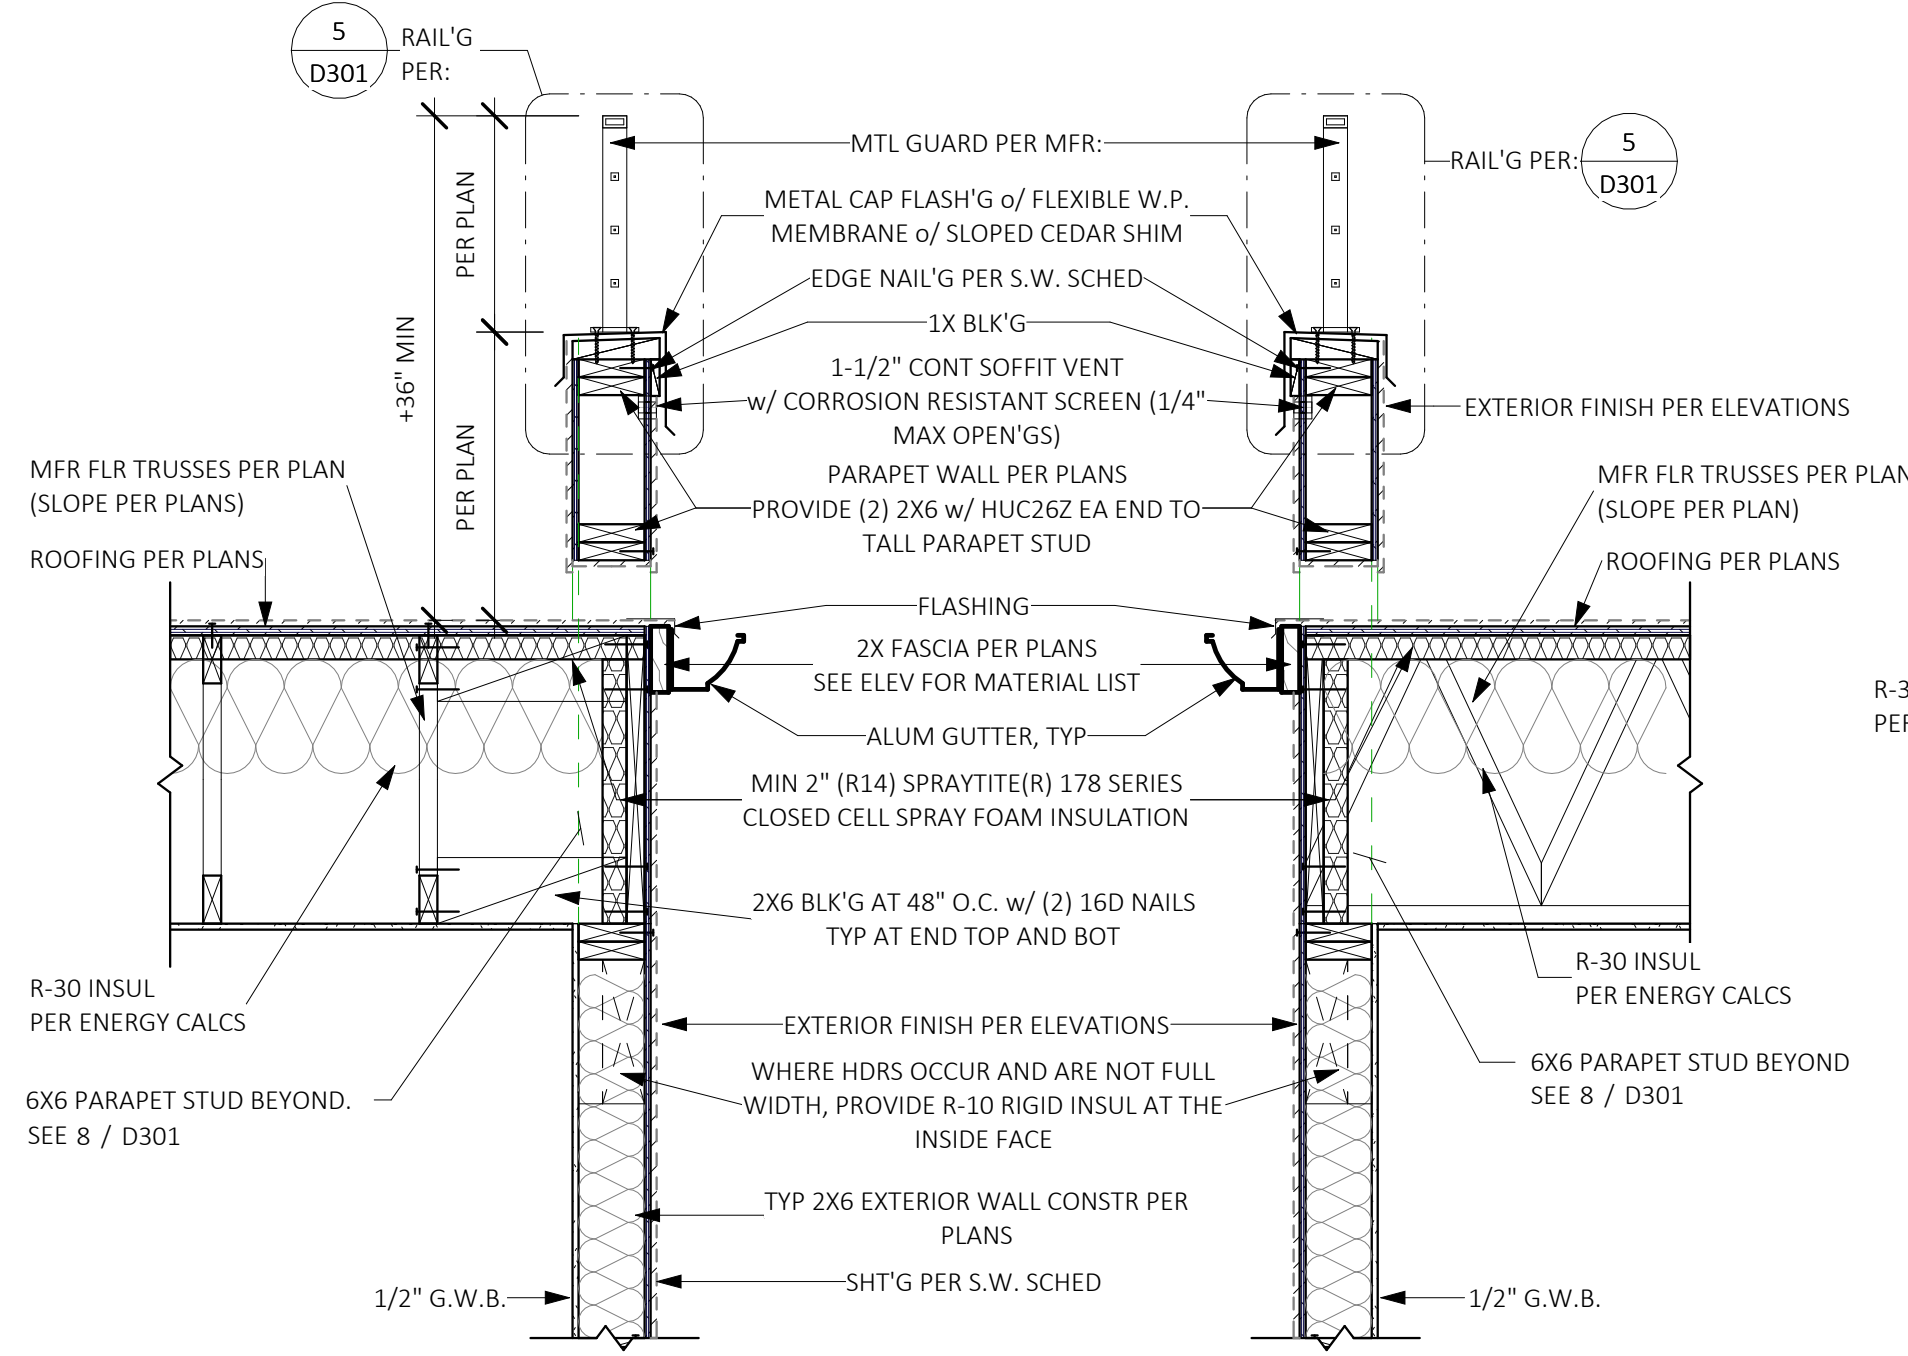

6 PARAPET DETAIL w/ GUTTER
SCALE: 3/4" = 1'-0"

4 PARAPET DETAIL
SCALE: 3/4" = 1'-0"

1 EAVE DETAIL - VAULTED RAFTER
SCALE: 3/4" = 1'-0"

NOTE: THIS IS A STANDARD DETAIL SHEET PREPARED FOR SINGLE FAMILY HOUSING TYPE V NONRATED CONSTRUCTION. THESE DETAILS HAVE BEEN PREPARED TO COVER GENERAL CONSTRUCTION CONDITIONS. NOT ALL DETAILS ON THIS SHEET ARE NECESSARILY INCORPORATED INTO THIS PROJECT. COORDINATE WITH PLANS.

STANDARD DETAIL SHEET (C) ATERA DESIGN STUDIO LLC. PLANS AND DESIGNS (DRAWINGS) FORTHWITH REMAIN THE PROPERTY OF ATERA DESIGN STUDIO. REPRODUCTION WITHOUT PERMISSION IS PROHIBITED.

L2 ENGINEERS
17848 NE 198TH PLAVE
WOODINVILLE, WA 98072

ATERA DESIGN STUDIO
451 DUVALLE AVE. NE,
RENTON, WA 98059

01/13/2023

HU RESIDENCE

2448 72nd AVE SE, Mercer Island

PERMIT SET

ROOF DETAILS


PROJECT NO: 21014
ISSUE DATE: 2022/06/29
DRAWN BY: SPM

D301

SCALE 24X36: 3/4" = 1'-0"
* NOTE: 11X17 SETS ARE REDUCED 50% SCALE DRAWINGS ACCORDINGLY.

No.	Date	Description



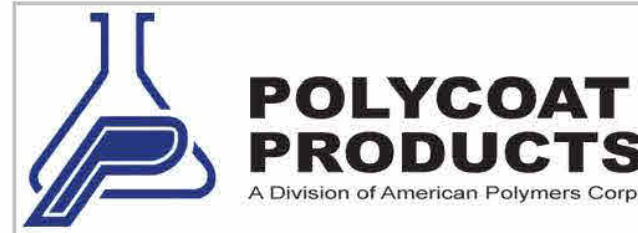

POLYCOAT-AQUASEAL® 5000
Single Component, Bitumen Modified
Waterproofing Membrane System

Technical Data Sheet

System Description:

Polycoat-Aquaseal® 5000 is a single component, liquid applied, bitumen modified, coal tar free, moisture cured polyurethane waterproofing membrane. It is available in three application versions: Horizontal (H), Vertical (V), and Water Catalyzing (WC) – available only in horizontal. Polycoat-Aquaseal® 5000 is in complete compliance with SCAQMD air quality standards, and has VOC levels equal to or less than 100 grams per liter.

- FEATURES**
- Economical
 - Labor Saving
 - Meets the Criteria of ASTM C-836 and E-96
 - User Friendly
 - Resistant to Bacteria

- TYPICAL USES**
- Bridges
 - Planters
 - Between Slabs
 - Shower Pans
 - Tunnels
 - Basements
 - Foundation Walls
 - Water Storage Tanks

Approved City of Los Angeles RR# 25935

Color: Black

Packaging: 5 gallon (18.9 liter) pail, 55 gallon drum, net fill 50 gallons (189 liters)

Mixing For Polycoat-Aquaseal® 5000H / 5000V

Before application, Polycoat-Aquaseal® 5000 should be thoroughly mixed using a mechanical mixer at slow speed to ensure a homogeneous material. Take care not to allow entrapment of air into the material.

Mixing For Polycoat-Aquaseal® 5000WC-H:

Before application, mix Polycoat-Aquaseal® 5000WC using a mechanical mixer at slow speed. Mix Polycoat-Aquaseal® 5000WC with water (water must be added) at a ratio of one quart of water to five gallons of Polycoat-Aquaseal® 5000WC. This will yield 5 1/2 gallons of membrane. The mixing ratio is 20 parts Polycoat-Aquaseal® 5000WC membrane to 1 part of water (20:1). Use care not to allow the entrapment of air into the mixture.

Polycoat-Aquaseal® 5000 (100 VOC) Properties:

Based on Drawn Down Film	5000H Horizontal	5000V Vertical	5000WC-H Water Catalyzed	Green Concrete
Hardness, ASTM D-2240	50 ± 5 Shore A	45 ± 5 Shore A	25 ± 5 Shore A	Polycoat-Aquaseal® 5000 May be applied to Green Concrete. (1) Prime the wall with a thin (5 mil) application of Aquaseal 5000V diluted with a manufacturer approved and AQMD compliant solvent at a ratio of 1 quart of solvent per 5 gallons of Aquaseal 5000. The coverage rate for this prime coat should be around 200 square feet per gallon. This should fill all of the bug holes in a poured wall that typically cause outgassing resulting in pin holing in the coating. (2) Follow Step 1 with a standard two to three coat application of Aquaseal 5000V at 30 mils per coat (50 square feet per gallon) depending on whether a 60 or 90 mil application is desired. The standard Aquaseal 5000 may be applied to both fully cured (28 days for poured in place and 10 days after grouting for block) and green concrete.
Tear Resistance, Die C, ASTM D-624	40 ± 20 pli 21 ± 3.5 kNm	35 ± 10 pli 14 ± 2 kNm	50 ± 5 pli 8.8 ± 0.9 kNm	
Tensile Strength, ASTM D-412	350 ± 50 psi 3.45 ± 0.3 Mpa	350 ± 50 psi 2.1 ± 0.3 Mpa	300 ± 50 psi 2.1 ± 0.3 Mpa	
Ultimate Elongation, ASTM D-412	300 ± 50%	300 ± 50%	650 ± 50%	
Specific Gravity	1.32	1.23	1.12	
Total Solids by Weight, ASTM D-236	92 ± 3%	92 ± 3%	95 ± 1%	
Total Solids by Volume, ASTM D-2697	90 ± 3%	90 ± 3%	94 ± 1%	
Viscosity at 80°F (27°C)	5000 ± 2000 cps -25°F to 200°F -31.7°C to 93.3°C	40,000 ± 20,000 cps -25°F to 200°F -31.7°C to 93.3°C	-	
Service Temperature	-25°F to 200°F -31.7°C to 93.3°C	-25°F to 200°F -31.7°C to 93.3°C	-	
Volatile Organic Compounds, ASTM D-2369-81	0.83 lb/gal 100 gm/liter	0.83 lb/gal 100 gm/liter	<0.5 lb/gal <60 gm/liter	

Polycoat-Aquaseal® 5000 Waterproofing Membrane System

Page 1 of 2

14722 Spring Ave • Santa Fe Springs, CA 90670-5108 USA • Tel: 562-802-8634 • Fax: 562-921-7363 • www.polycoatusa.com

Joints, Cracks and Flashing:

Apply a stripe coat of Polycoat-Aquaseal® 5000 over all cracks up to 1/16" in width. All cracks over 1/16" in width must be caulked with a polyurethane sealant.

All metal flashings must be primed with manufacturer's recommended primer.

Application:

Polycoat-Aquaseal® 5000 may be applied with a brush, squeegee, trowel, roller or airless sprayer. Over smooth surfaces, such as poured-in-place concrete, apply Polycoat-Aquaseal® 5000 evenly in two 30 mil coats.

Polycoat-Aquaseal® 5000WC-H (Water Catalyzed) can be applied at any thickness.

Curing:

At 75°F (24°C) and 50% relative humidity, allow each coat of Polycoat-Aquaseal® 5000 Vertical, Horizontal and Green Concrete to cure 16 hours minimum.

Cure time will vary depending on temperature and humidity. If more than 48 hours pass between coats the surface must be re-primed.

For Polycoat-Aquaseal® 5000 WC applications, at 75°F (24°C) and 50% relative humidity, allow coating to cure a minimum of 2-4 hours before proceeding to subsequent coats. Cure time will vary depending on temperature and humidity. If more than 48 hours pass between coats the surface must be re-primed.

Polycoat-Aquaseal® 5000 is very sensitive to heat and moisture. Higher temperatures and/or high humidity will accelerate the cure time. Use caution in thickness of application. Limit single coat thickness to 30-40 wet mils.

Equipment Cleanup:

Equipment should be cleaned with an environmentally safe solvent, as permitted under local regulations, immediately after use.

Storage:

Polycoat-Aquaseal® 5000 has a shelf life of one (1) year from date of manufacture in original, factory-sealed containers when stored indoors at a temperature between 60-95°F (15-35°C).

Limitations:

Surfaces must be dry, clean and free of foreign matter.

Not UV stable.

Cannot withstand direct wear or abrasion.

Containers that have been opened must be used as soon as possible.

Do not dilute under any circumstance.

The following conditions must not be coated with Polycoat Products deck coating systems or products: on grade slabs, split slabs with a between slab membrane, sandwich slabs with insulation, and slabs over unvented metal pan.

Warning:

This product contains Aromatic Hydrocarbons, Isocyanates and Solvent.

Limited Warranty:

Please read all information in the general guidelines, product data sheets, guide specifications and material safety data sheets (MSDS) before applying material. Published technical data and instructions are subject to change without notice. Contact your local Polycoat Products representative or visit our website for current technical data and instructions.

Polycoat Products warrants its products to be free of manufacturing defects and that they will meet Polycoat Products current published physical properties. Polycoat Products warrants that its products, when properly installed by a state licensed waterproofing contractor according to Polycoat Products guide specifications and product data sheets over a sound, properly prepared substrate, will not allow water migration for a period of one (1) year. Seller's and manufacturer's sole responsibility shall be to replace that portion of the product of this manufacturer which proves to be defective. There are no other warranties by Polycoat Products of any nature whatsoever expressed or implied, including any warranty of merchantability or fitness for a particular purpose in connection with this product. Polycoat Products shall not be liable for damages of any sort, including remote or consequential damages resulting from any claimed breach of any warranty whether expressed or implied. Polycoat Products shall not be responsible for use of this product in a manner to infringe on any patent held by others. In addition, no warranty or guarantee is being issued with respect to appearance, color, fading, chalking, staining, shrinkage, peeling, normal wear and tear or improper application by the applicator. Damage caused by abuse, neglect and lack of proper maintenance, acts of nature and/or physical movement of the substrate or structural defects are also excluded from the limited warranty. Polycoat Products reserves the right to conduct performance tests on any material claimed to be defective prior to any repairs by owner, general contractor, or applicator.


Disclaimer:

All guidelines, recommendations, statements, and technical data contained herein are based on information and tests we believe to be reliable and correct, but accuracy and completeness of said tests are not guaranteed and are not to be construed as a warranty, either expressed or implied. It is the user's responsibility to satisfy himself, by his own information and test, to determine suitability of the product for his own intended use, application and job situation and user assumes all risk and liability resulting from his use of the product. We do not suggest or guarantee that any hazard listed herein are the only ones which may exist. Neither seller nor manufacturer shall be liable to the buyer or any third person for any injury, loss or damage directly or indirectly resulting from use of, or inability to use, the product. Recommendations or statements, whether in writing or oral, other than those contained herein shall not be binding upon the manufacturer, unless in writing and signed by a corporate officer of the manufacturer. Technical and application information is provided for the purpose of establishing a general profile of the material and proper application procedures. Test performance results were obtained in a controlled environment and Polycoat Products makes no claim that these tests or any other tests, accurately represent all environments.

Rev. 8/1/13

Polycoat-Aquaseal® 5000 Waterproofing Membrane System

Page 2 of 2

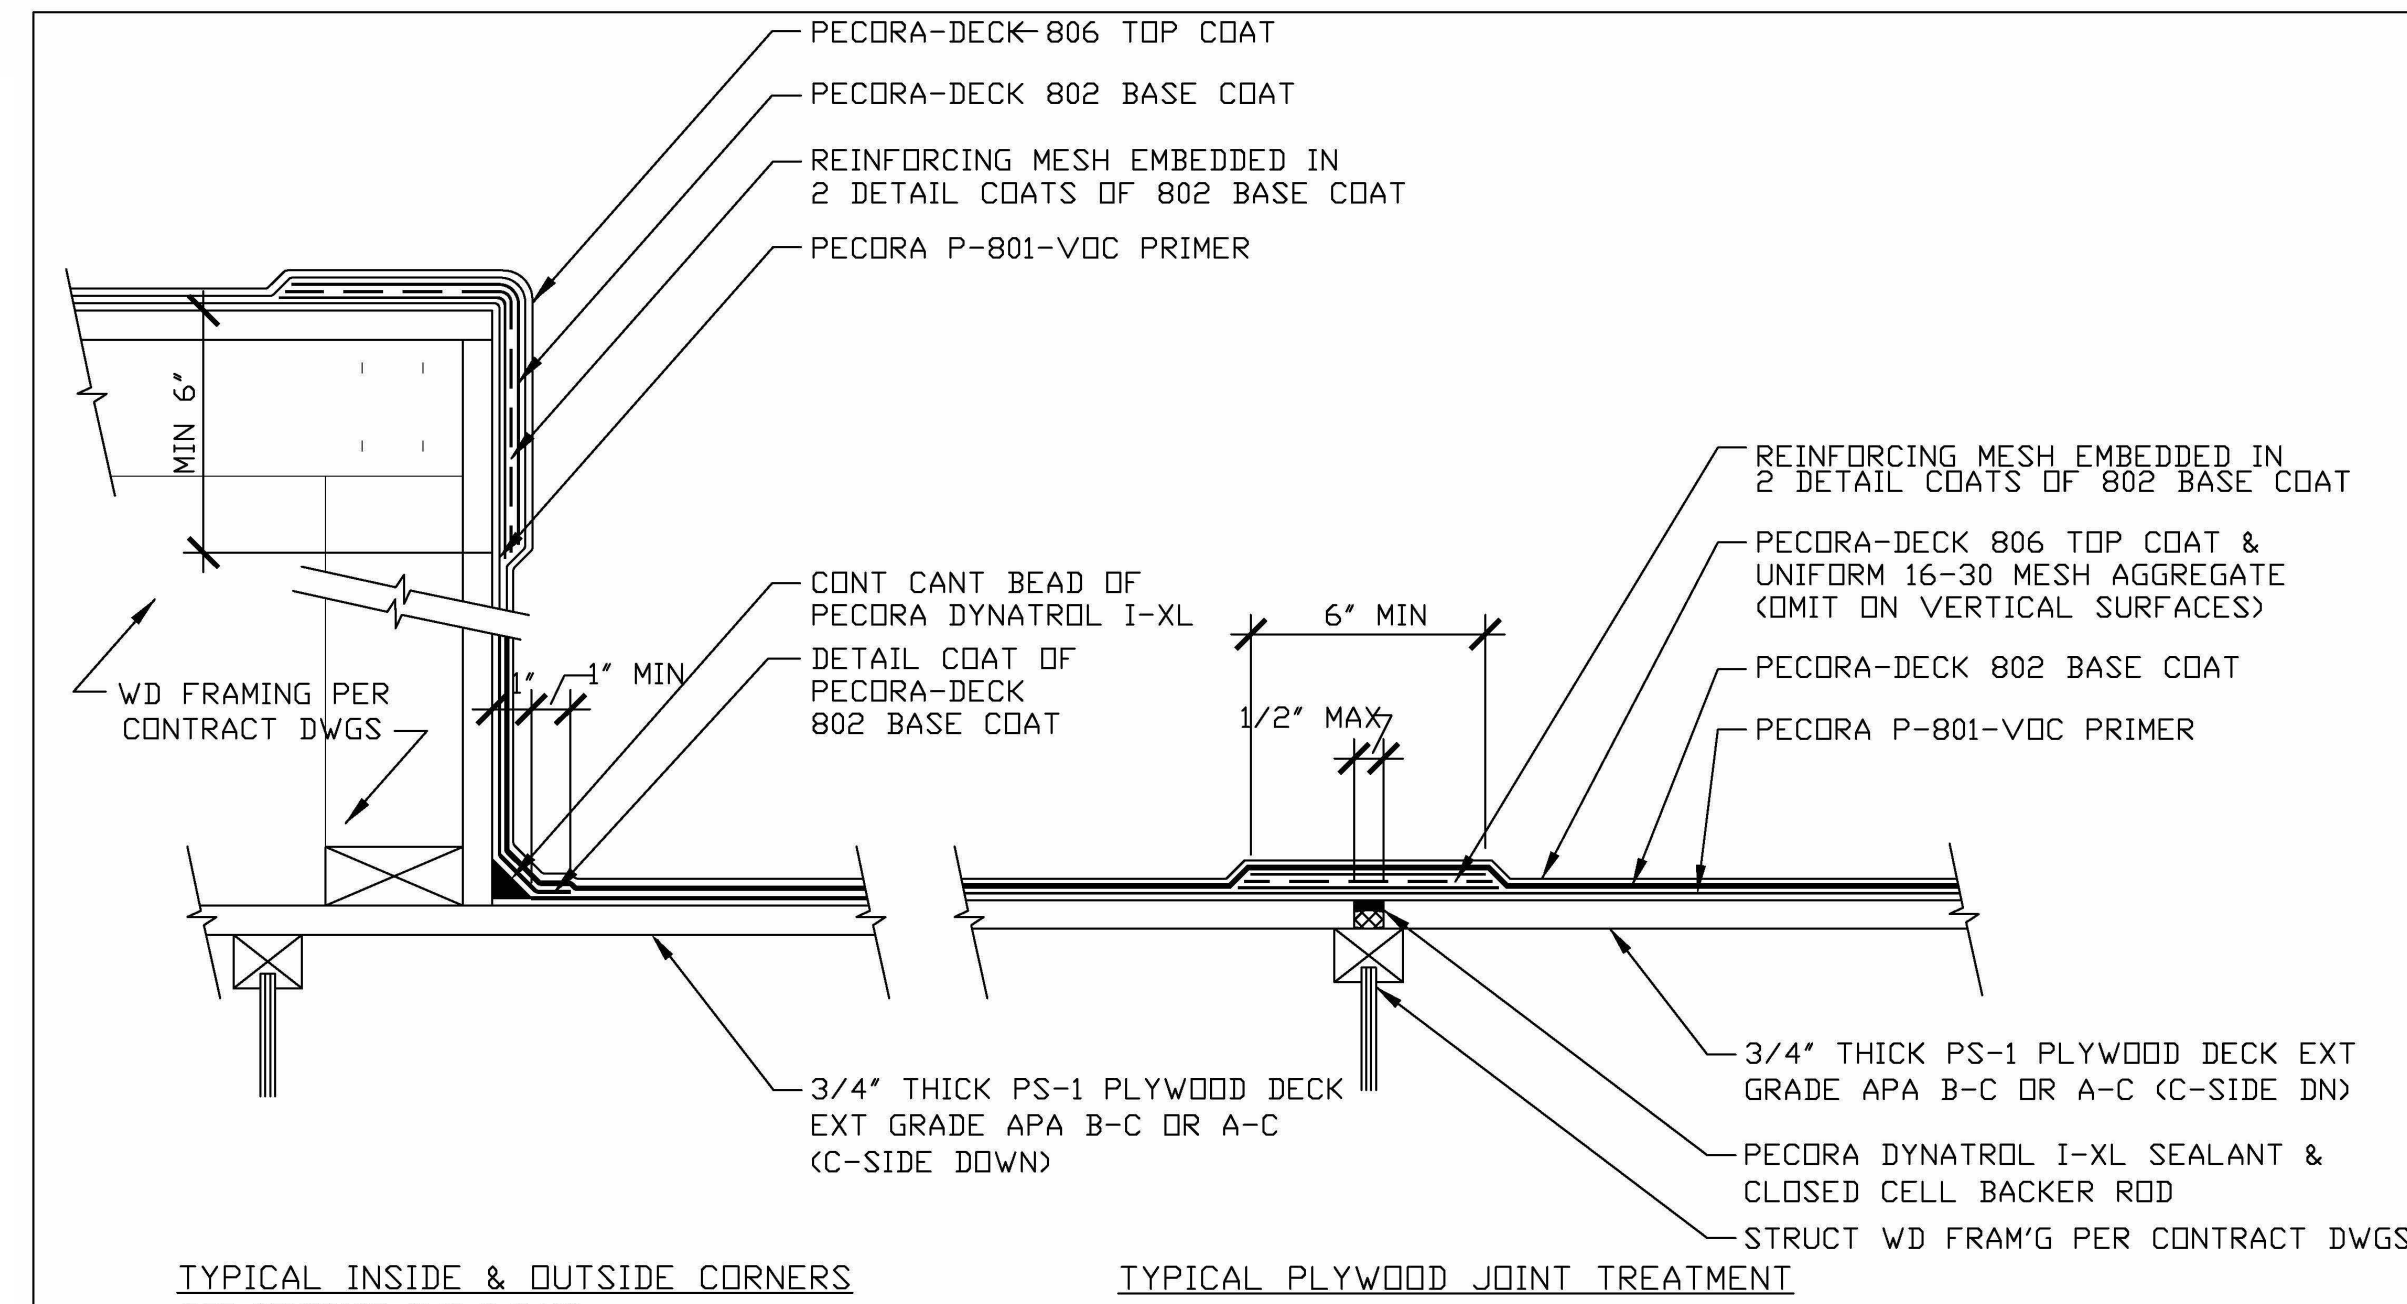

- NOTES:**
- WHERE PECDRA 800 WATERPROOF MEMBRANE IS NOTED ON CONTRACT DWGS., PROVIDE PECDRA-DECK 8313 PLYWOOD DECK PEDESTRIAN DECK COATING SYSTEM AS DETAILED.
 - THE FOLLOWING REINFORCING MESH PRODUCTS ARE ACCEPTABLE TO PECORA CORP. FOR PLYWOOD JOINT & CORNER REINFORCEMENT:
 TIE TEX T-272 BY TIE TEX INTERNATIONAL
 PERMAGLAS MESH PG-242 BT SAINT GOBAIN
 WEB SEAL TAPE BY ETRNABOND
 - PECORA CORP IS NOT A LICENSED DESIGN PROFESSIONAL IN THE STATE OF WASHINGTON AND IS THEREFORE NOT RESPONSIBLE FOR THE ROOF DECK DESIGN, INCLUDING STRUCTURAL FRAMING & SHEATHING.

BERINGER RESIDENCE, 7916 E MERCER WAY, MERCER ISLAND, WA
 WALKING DECK COATING DETAILS
 PECDRA-DECK 8313, PLYWOOD DECK

NO SCALE MAY 3, 2019 DRAWING NO: 050319.01

PECORA CORPORATION
 Architectural Waterproofing Products
 U.S.A. • Since 1882

No.	Date	Description
1	2023/07/25	SUB2 City Comment Submittal
2	2023/07/25	SUB2 City Comment Submittal

ATERA DESIGN STUDIO
 451 DUVALL AVE NE
 RENTON, WA 98059

HU RESIDENCE
 2448 72nd AVE SE, Mercer Island

PERMIT SET

SPECIALTY DETAILS

PROJECT NO: 21014
 ISSUE DATE: 2022/06/29




D401

SCALE 24X36:
 * NOTE: 1/1 X 1/7 SETS ARE REDUCED 50% SCALE DRAWINGS ACCORDINGLY.

(C) ATERA DESIGN STUDIO LLC. PLANS AND DESIGNS (DRAWINGS) FORTHWITH REMAIN THE PROPERTY OF ATERA DESIGN STUDIO. REPRODUCTION WITHOUT PERMISSION IS PROHIBITED.

FOOTING SCHEDULE			
MARK	SIZE	REINFORCING	DETAIL
181810	18" X 18" X 10" THK	(3) #4 BOT BAR EA WAY	DTL 9/D101
363612	36" X 36" X 12" THK	(4) #4 BAR EA WAY TOP & BOT	DTL 9/D101
364812	36" X 48" X 12" THK	#4 BAR AT 10" O.C. EA WAY TOP & BOT	DTL 9/D101
Footing-MAT-Rectangular: Z5			
242410-18X18	24" X 24" X 10" THK	(3) #4 BAR EA WAY TOP & BOT. PROVIDE 18" SQ PLYNTH w/ (4) #4 BAR VERT	DTL 11/D101
Footing-MAT-Rectangular w Plynth: 2			

BEAM SCHEDULE - MAIN...	
ID	SIZE
1.1	4X8, TYP
1.3	5-1/2"X9-1/4" PSL

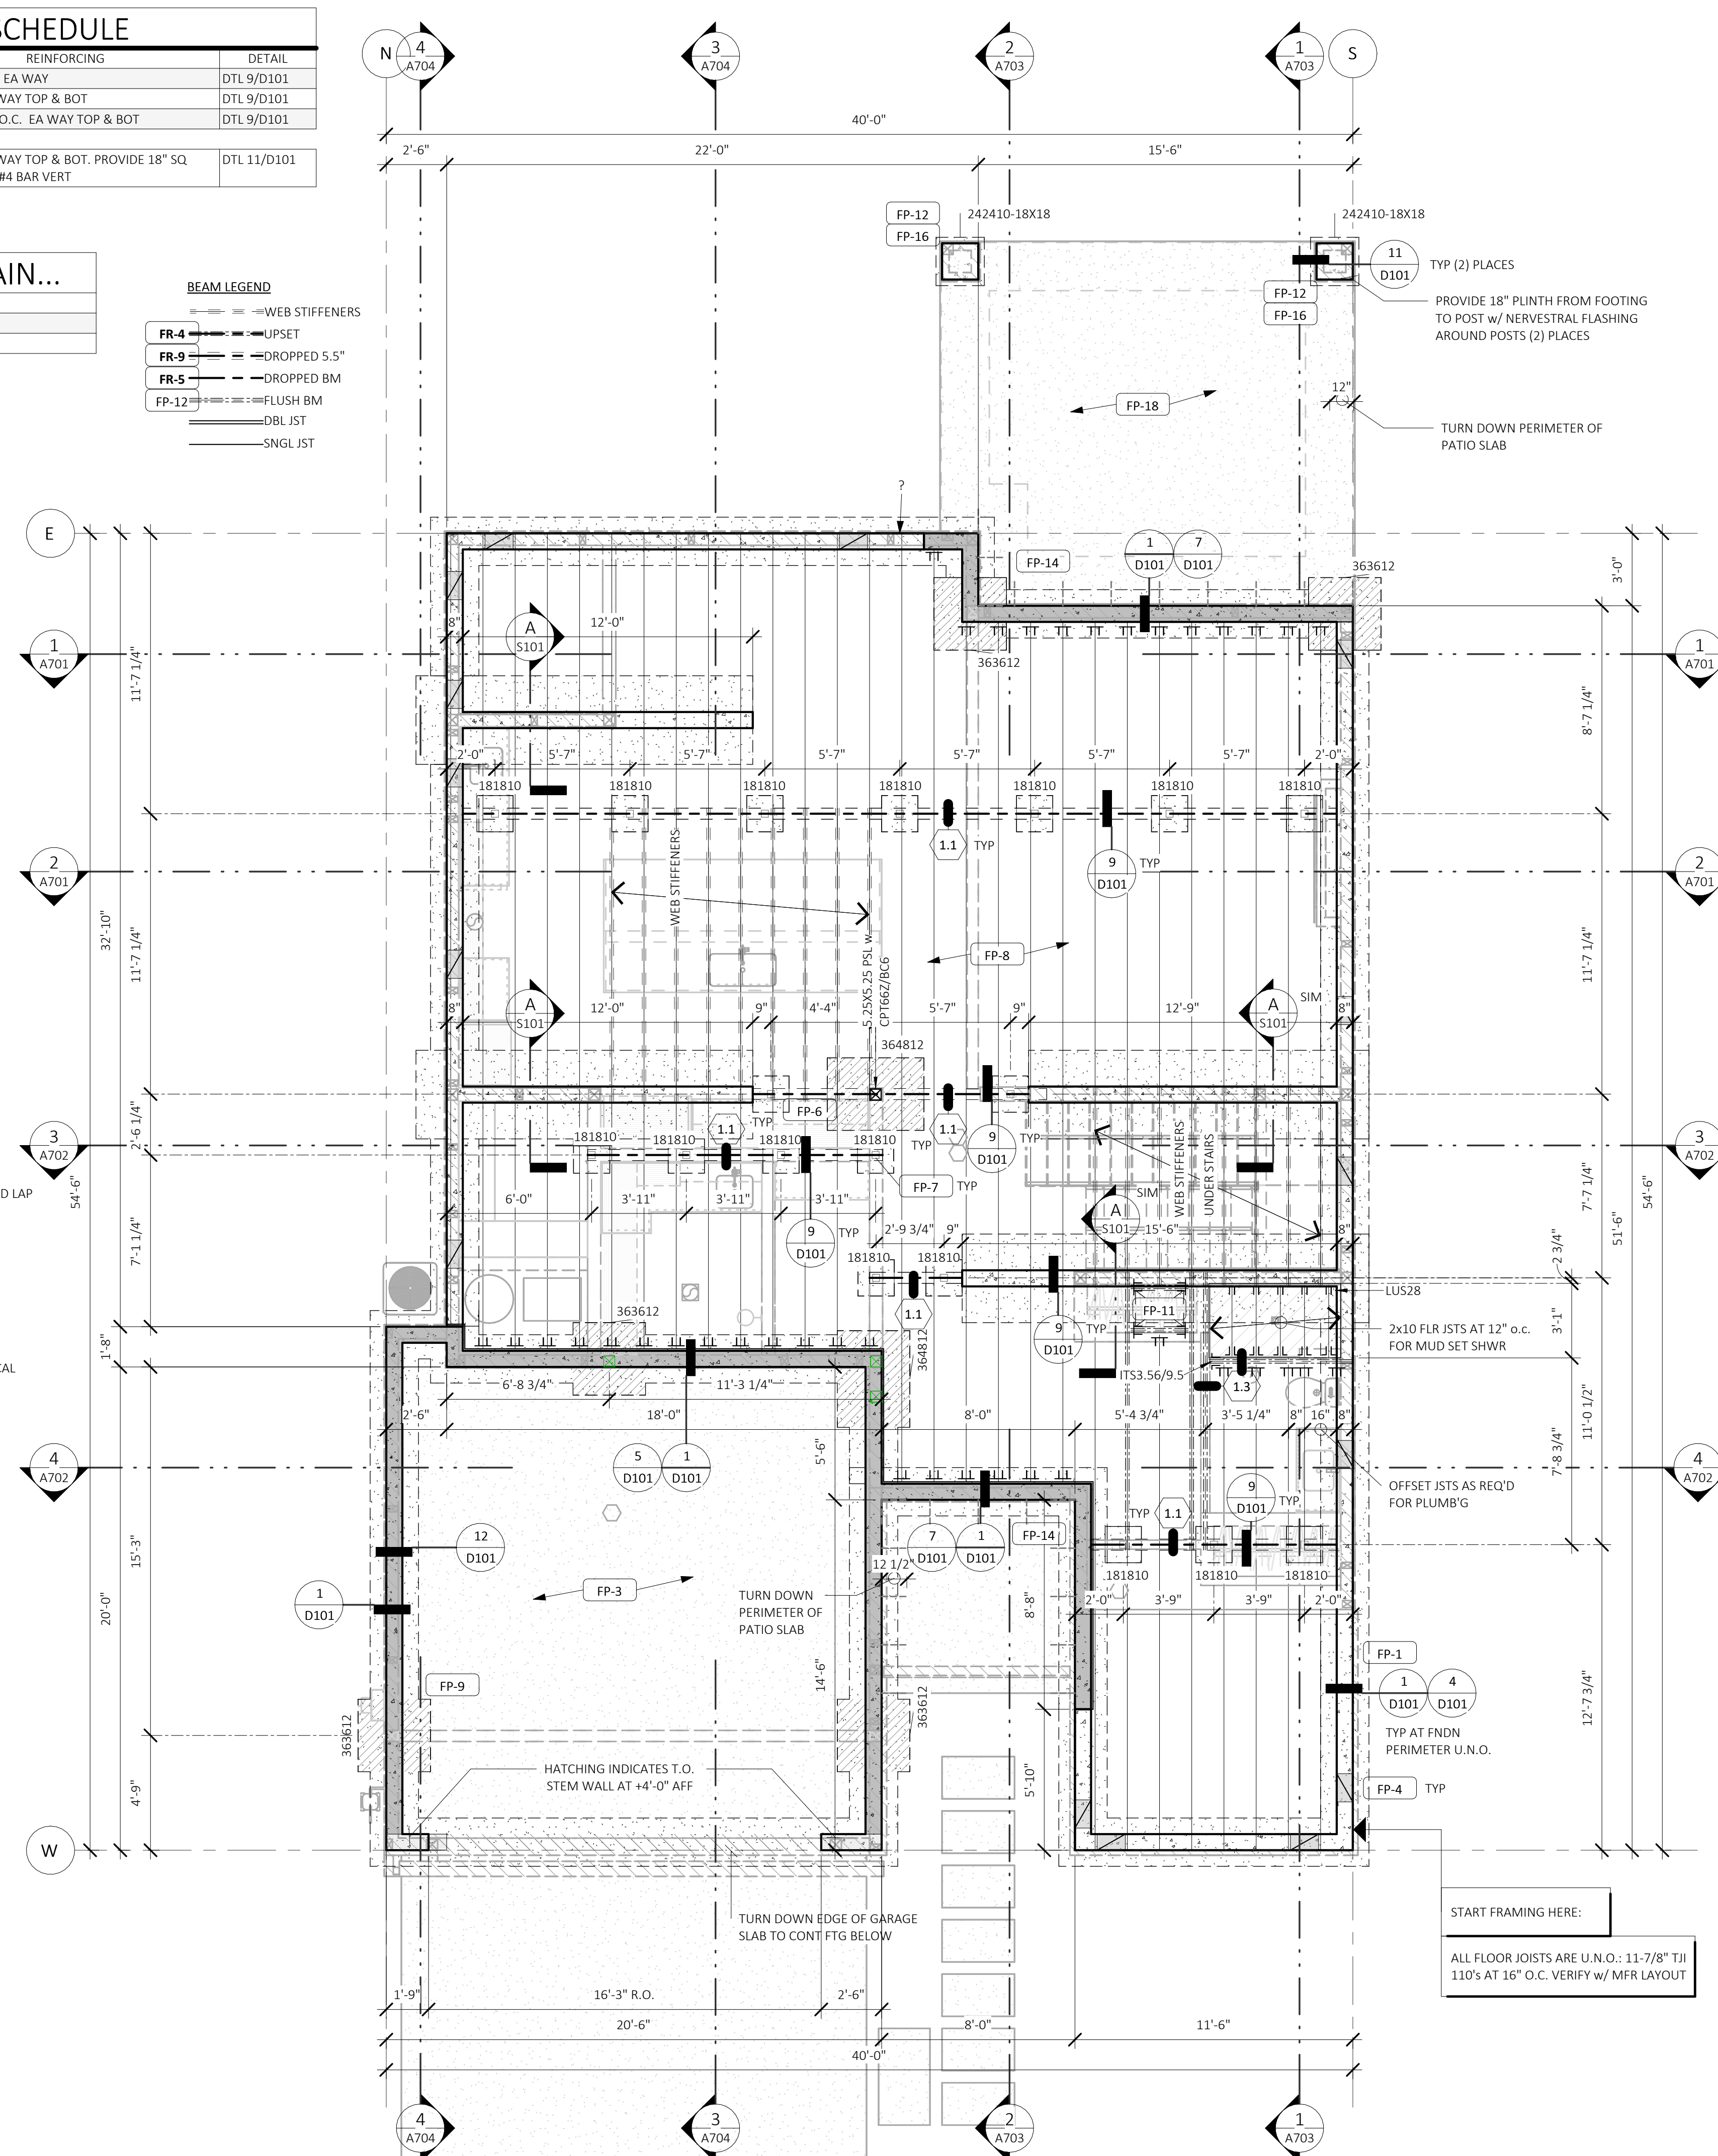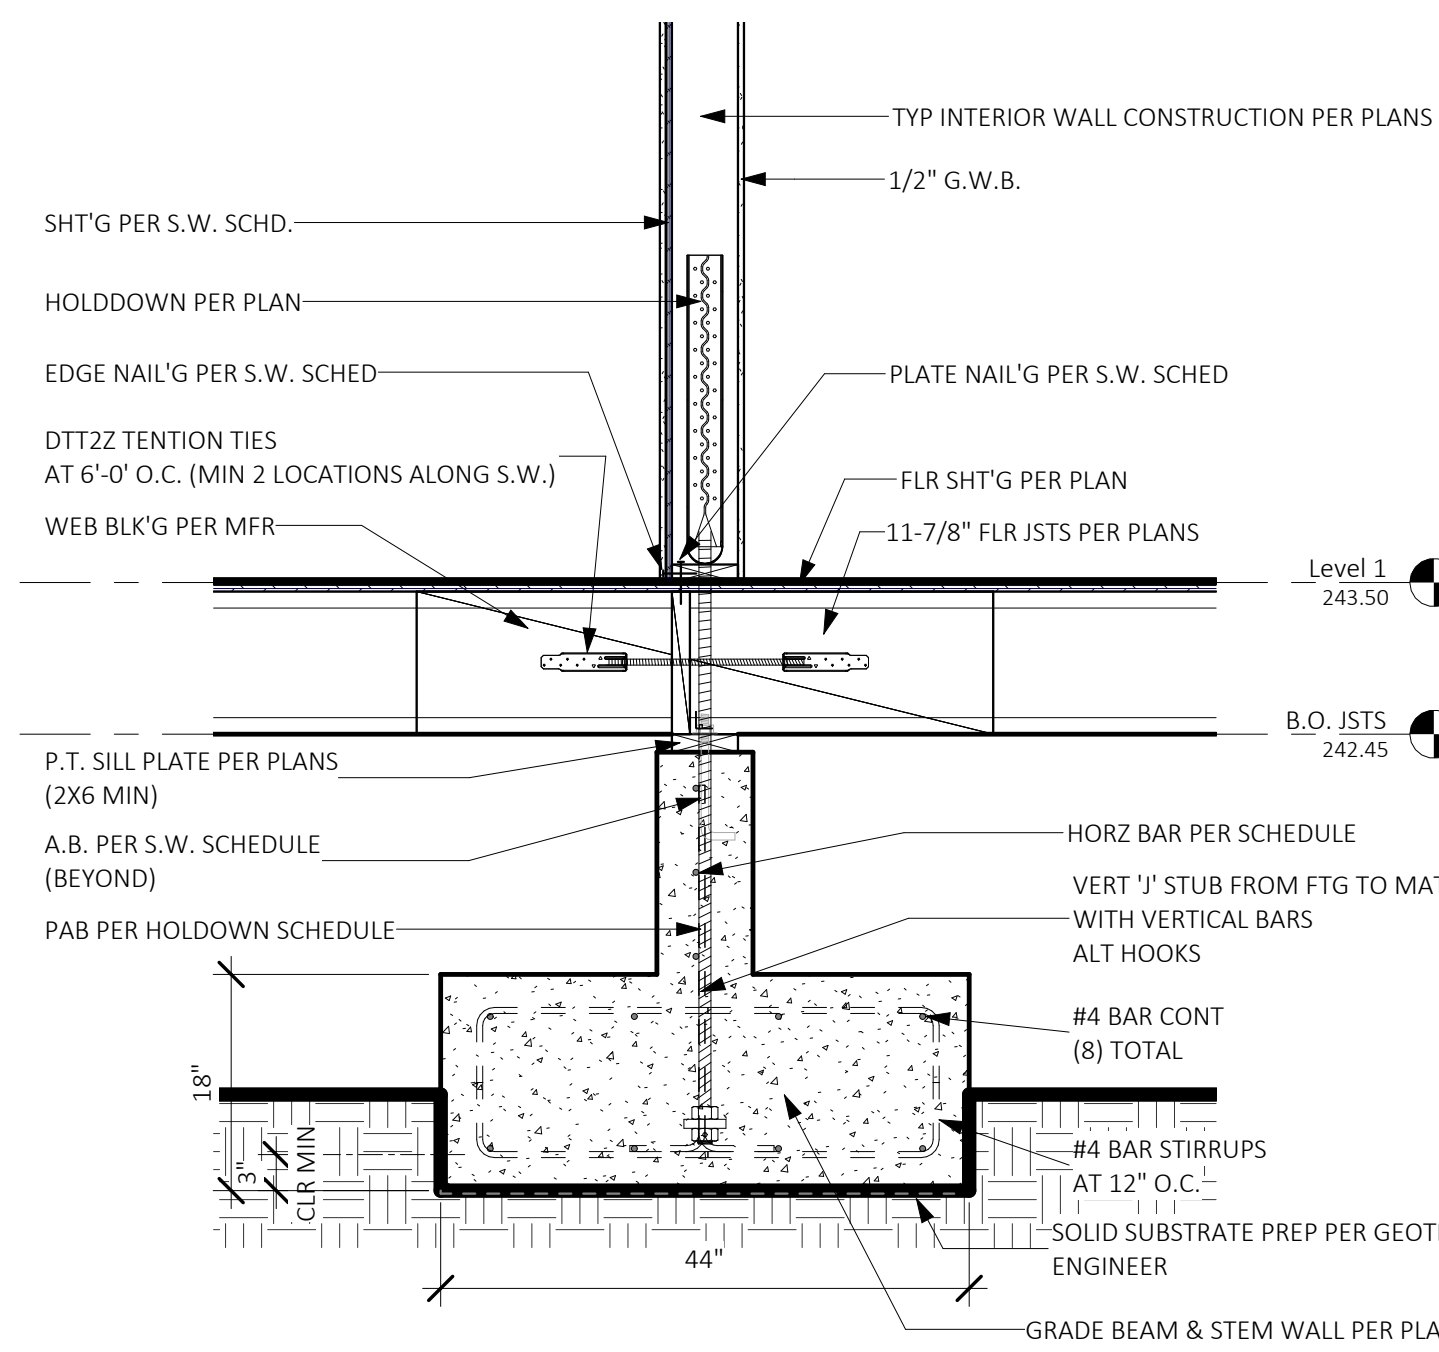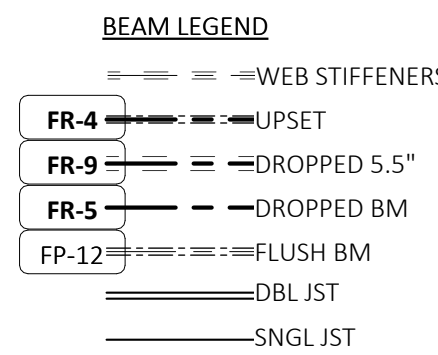

SYMBOLS & LEGEND:

- POINT LOAD FROM ABOVE. PROVIDE SOLID BLK'G THROUGH JOIST SYSTEM
- (1) 2x STUD
- (2) 2x STUD, TYP. LARGER MEMBERS AS NOTED ON PLANS
- SIMPSON OR OTHER APPROVED ALTERNATE HANGER. USE ALL REQUIRED FASTENERS
- INDICATES BEAM CALCULATION WITH INDEXED NUMBER
- WALL ABOVE
- BEARING WALL BELOW
- NON BEARING WALL BELOW
- SHEARWALL BELOW
- BEARING WALL ABOVE

GENERAL FRAMING NOTES:

- SEE SHEET S001 FOR GENERAL DESIGN CRITERIA.
- SEE SHEET(S) S201-203 FOR SHEARWALL DESIGNATIONS, HOLDDOWNS, AND SHEARWALL SCHEDULE.
- U.N.O. ALL HEADERS ARE: 4x8 DF #2 (UP TO 8' SPAN) TRIMMER STUD UP TO 6'-0" SPAN AND PROVIDE (2) TRIMMER STUDS OVER 6'-0" U.N.O.
- TRUSS DESIGN BY MANUFACTURER. TRUSS DESIGN DRAWINGS SHALL BE PREPARED PER IRC SECTION R802.10.1 AND SHALL BE PROVIDED TO THE BUILDING OFFICIAL AND APPROVED PRIOR TO INSTALLATION.
 - * TRUSS DESIGN PER IRC SECTION R802.10.2
 - * FIELD ALTERATIONS MUST BE DESIGNED BY MFR. PER IRC SECTION R802.10.4
 - * SEE SHEET(S) S001 FOR DESIGN LOADS.
 - * TRUSS MFR TO PROVIDE ADEQUATE BEARING AREA TO RESOLVE REACTION (PERPENDICULAR TO GRAIN) AT ALL HIGHLY LOADED GIRDER TRUSSES.
- PROVIDE 2x4 RAFTER/TRUSS TAIL - TYP. U.N.O.
- ROOF PITCH: EXTERIOR PER ELEVATIONS & INTERIOR PER SECTIONS.
- ROOF FRAMING SPACING, 24" o.c. U.N.O.
- SEE ELEVATIONS AND/OR SECTIONS FOR ROOF PITCH, PLATE HEIGHT AND HEADER HEIGHT.
- FRAMING LUMBER: FRAMING LUMBER SHALL BE MARKED IN ACCORDANCE TO W.C.L.B. STANDARD GRADING RULES FOR WEST COAST LUMBER #16, LATEST EDITION. ALL KILN DRIED MIN. 19.
 - a) JOIST AND RAFTERS: SEE SHT S002
 - b) BEAMS AND STRINGERS: SEE SHT S002
 - c) POST AND TIMBERS: SEE SHT S002
 - d) STUDS, PLATES, AND MISC. LIGHT FRAMING: SEE SHT S002
 - e) TJS AND MICROLUMS: PER MANUFACTURER.
 - f) GLUE LAMINATED TIMBER: SEE SHT S002
 - g) ALL OTHER LUMBER: HEM-FIR STANDARD OR BETTER.
 - h) PLYWOOD/ORIENTED STRAND BOARD (OSB): SEE SHT S002
 - i) WALL SHEATHING: SEE SHT S002
 - j) FLOOR SHEATHING: 23/32" APA RATED STRUCTURAL SHT'G FACE GRAIN PERP TO FLR FRAM'G W/ 10d @ 6" OC PANEL EDGES, & 12" O.C. FIELD, UNBLOCKED, TYP. U.N.O.
 - k) ROOF SHEATHING: 15/32" APA RATED STRUCTURAL SHT'G FACE GRAIN PERP TO FLR FRAM'G W/ 10d @ 6" OC PANEL EDGES, & 12" O.C. FIELD, UNBLOCKED, TYP.
 - l) OTHER: AS NOTED ON DRAWINGS. SEE SHT S002
- FASTENERS: ALL FRAMING SHALL BE NAILED IN ACCORDANCE WITH TABLE R602.3.1(3) OF THE IRC. SEE SHEET A001
 - * POSITIVE CONNECTIONS SHALL BE PROVIDED WHERE POSTS AND BEAM OR GIRDER CONSTRUCTION IS USED TO SUPPORT FLOOR FRAMING.
- INSTALL 2X FIRELOCKING PER R302.11 AS FOLLOWS:
 - a) IN CONCEALED SPACES OF STUD WALLS AND PARTITIONS, INCLUDING FURRED SPACES AND PARALLEL ROWS OF STUDS OR STAGGERED STUDS, AS FOLLOWS, VERT AT THE CLG AND FLR LEVELS AND HORIZ AT INTERVALS NOT EXCEEDING 10 FEET.
 - b) AT ALL INTERCONNECTIONS BETWEEN CONCEALED VERT AND HORIZ SPACES SUCH AS OCCUR AT SOFFITS, DROP CLGS AND COVE CLGS.
 - c) IN CONCEALED SPACES BTWN STAIR STRINGERS AT THE TOP AND BOTTOM OF THE RUN. ENCLOSED SPACES UNDER STAIRS SHALL COMPLY WITH SECTION R302.7.
 - d) AT OPENINGS AROUND VENTS, PIPES, DUCTS, CABLES AND WIRES AT CEILING AND FLOOR LEVEL, WITH AN APPROVED MATERIAL TO RESIST THE FREE PASSAGE OF FLAME AND PRODUCTS OF COMBUSTION. THE MATERIAL FILLING THIS ANNULAR SPACE SHALL NOT BE REQUIRED TO MEET THE ASTM E 136 REQUIREMENTS. THE INTEGRITY OF ALL FIREBLOCKS SHALL BE MAINTAINED.
- SEE SHT A002 FOR ROOF & CRAWL SPACE AREA VENTILATION CALCULATIONS

KEYNOTES - FOUNDATION

ID	DESCRIPTION
FP-1	CONCRETE STEM WALL 8" WIDE w/ FTG PER DETAILS.
FP-3	CONCRETE SLAB ON GRADE SHALL BE 4" THICK STEEL TROWLED FINISH w/ W1.4xW1.4 WWF ON 4" GRANULAR FILL. SLOPE TO AND PROVIDE THICKENED EDGE AT O.H. GAR DOOR. PER IRC SECTION R506
FP-4	14"x8" CRAWL SPACE VENT INSTALLED IN RIM JOIST. SEE CRAWL SPACE CALCULATIONS ON SHEET A003.
FP-6	BEAM LINE PER PLAN w/ SOLID BLK'G OVER. PROVIDE MIN 1" CLEARANCE FROM CONCRETE AT ENDS OF BEAM.
FP-7	4x4 POST - TYP. U.N.O. PROVIDE 4x6 AT BEAM SPLICES AND PROVIDE POSITIVE CONNECTION PER IRC SECTION R407.3
FP-8	6 MIL BLACK POLYETHYLENE GROUND COVER OR APPROVED EQ. OVERLAP EDGES 12" MIN AT JOINTS AND EXTEND UP FOUNDATION WALL. PER WSEC 502.1.6.7.
FP-9	ELECTRICAL SERVICE: VERIFY LOCATION WITH SITE CONDITIONS
FP-11	PROVIDE CRAWL SPACE ACCESS, MINIMUM 18" X 24" UNOBSTRUCTED ACCESS PER IRC SECTION R408.3. INSULATE AND WEATHER-STRIP PER ENERGY REQUIREMENTS (WSEC 502.1.4.4). ALLOW 18" MINIMUM SPACE UNDER WOOD JOISTS AND 12" MINIMUM SPACE UNDER WOOD GIRDERS.
FP-12	MAT FOOTING PER FTG SCHEDULE. SEE DETAILS FOR ADDITIONAL INFORMATION.
FP-14	#4 REBAR STUB-OUT AT 24" O.C. AROUND PERIMETER OF CONC. PORCH/PATIO.
FP-16	EXTEND PIER MIN. 18" BELOW SURROUNDING GRADE. PER IRC TABLE R301.2.
FP-18	CONCRETE SLAB ON GRADE SHALL BE 4" THICK STEEL BRUSHED FINISH w/ W1.4xW1.4 WWF ON 4" GRANULAR FILL. AT EXTERIOR PATIOS, SLOPE AWAY FROM BLDG 2% MIN. PER IRC SECTION R506.

(C) ATERA DESIGN STUDIO LLC. PLANS AND DESIGNS (DRAWINGS) FORTHWITH REMAIN THE PROPERTY OF ATERA DESIGN STUDIO. REPRODUCTION WITHOUT PERMISSION IS PROHIBITED.

Description: L2 ENGINEERS
 17848 NE 198TH PLACE
 WOODINVILLE, WA 98072
 ATERA DESIGN STUDIO
 451 DUVAL AVE NE
 RENTON, WA 98059

Date: 01/13/2023




No.: HJ RESIDENCE
 2448 72nd AVE SE, Mercer Island

PERMIT SET
 FOUNDATION/MAIN FLOOR FRAMING PLAN

PROJECT NO: 21014
 ISSUE DATE: 2022/06/29
 DRAWN BY: SPM

S101
 SCALE 24X36: As Indicated
 * NOTE: 11x17 SETS ARE REDUCED 50%; SCALE DRAWINGS ACCORDINGLY.

BEAM SCHEDULE - UPPER FRAMING		
ID	SIZE	
2.2	5-1/2" X 12" GLB	
2.3	5-1/2" X 16" GLB (3-SPAN)	
2.4	5-1/4" X 24" PSL	
2.5	5-1/2" X 16" GLB	
2.6	3-1/2" X 9" GLB	
2.7	5-1/2" X 20" GLB (3-SPAN)	
2.8	5-1/2" X 20" GLB	
2.9	6X14	
2.10	5-1/4" X 22" PSL	
2.11	5-1/2" X 12" GLB	
2.12	5-1/2" X 12" GLB (2-SPAN)	
2.13	5-1/2" X 14" GLB (2-SPAN)	
2.14	4X8	
2.15	3-1/2" X 10-1/2" GLB	
2.16	3-1/2" X 9" GLB	
2.17	5-1/2" X 12" GLB	
2.18	3-1/2" X 18" PSL RIM	

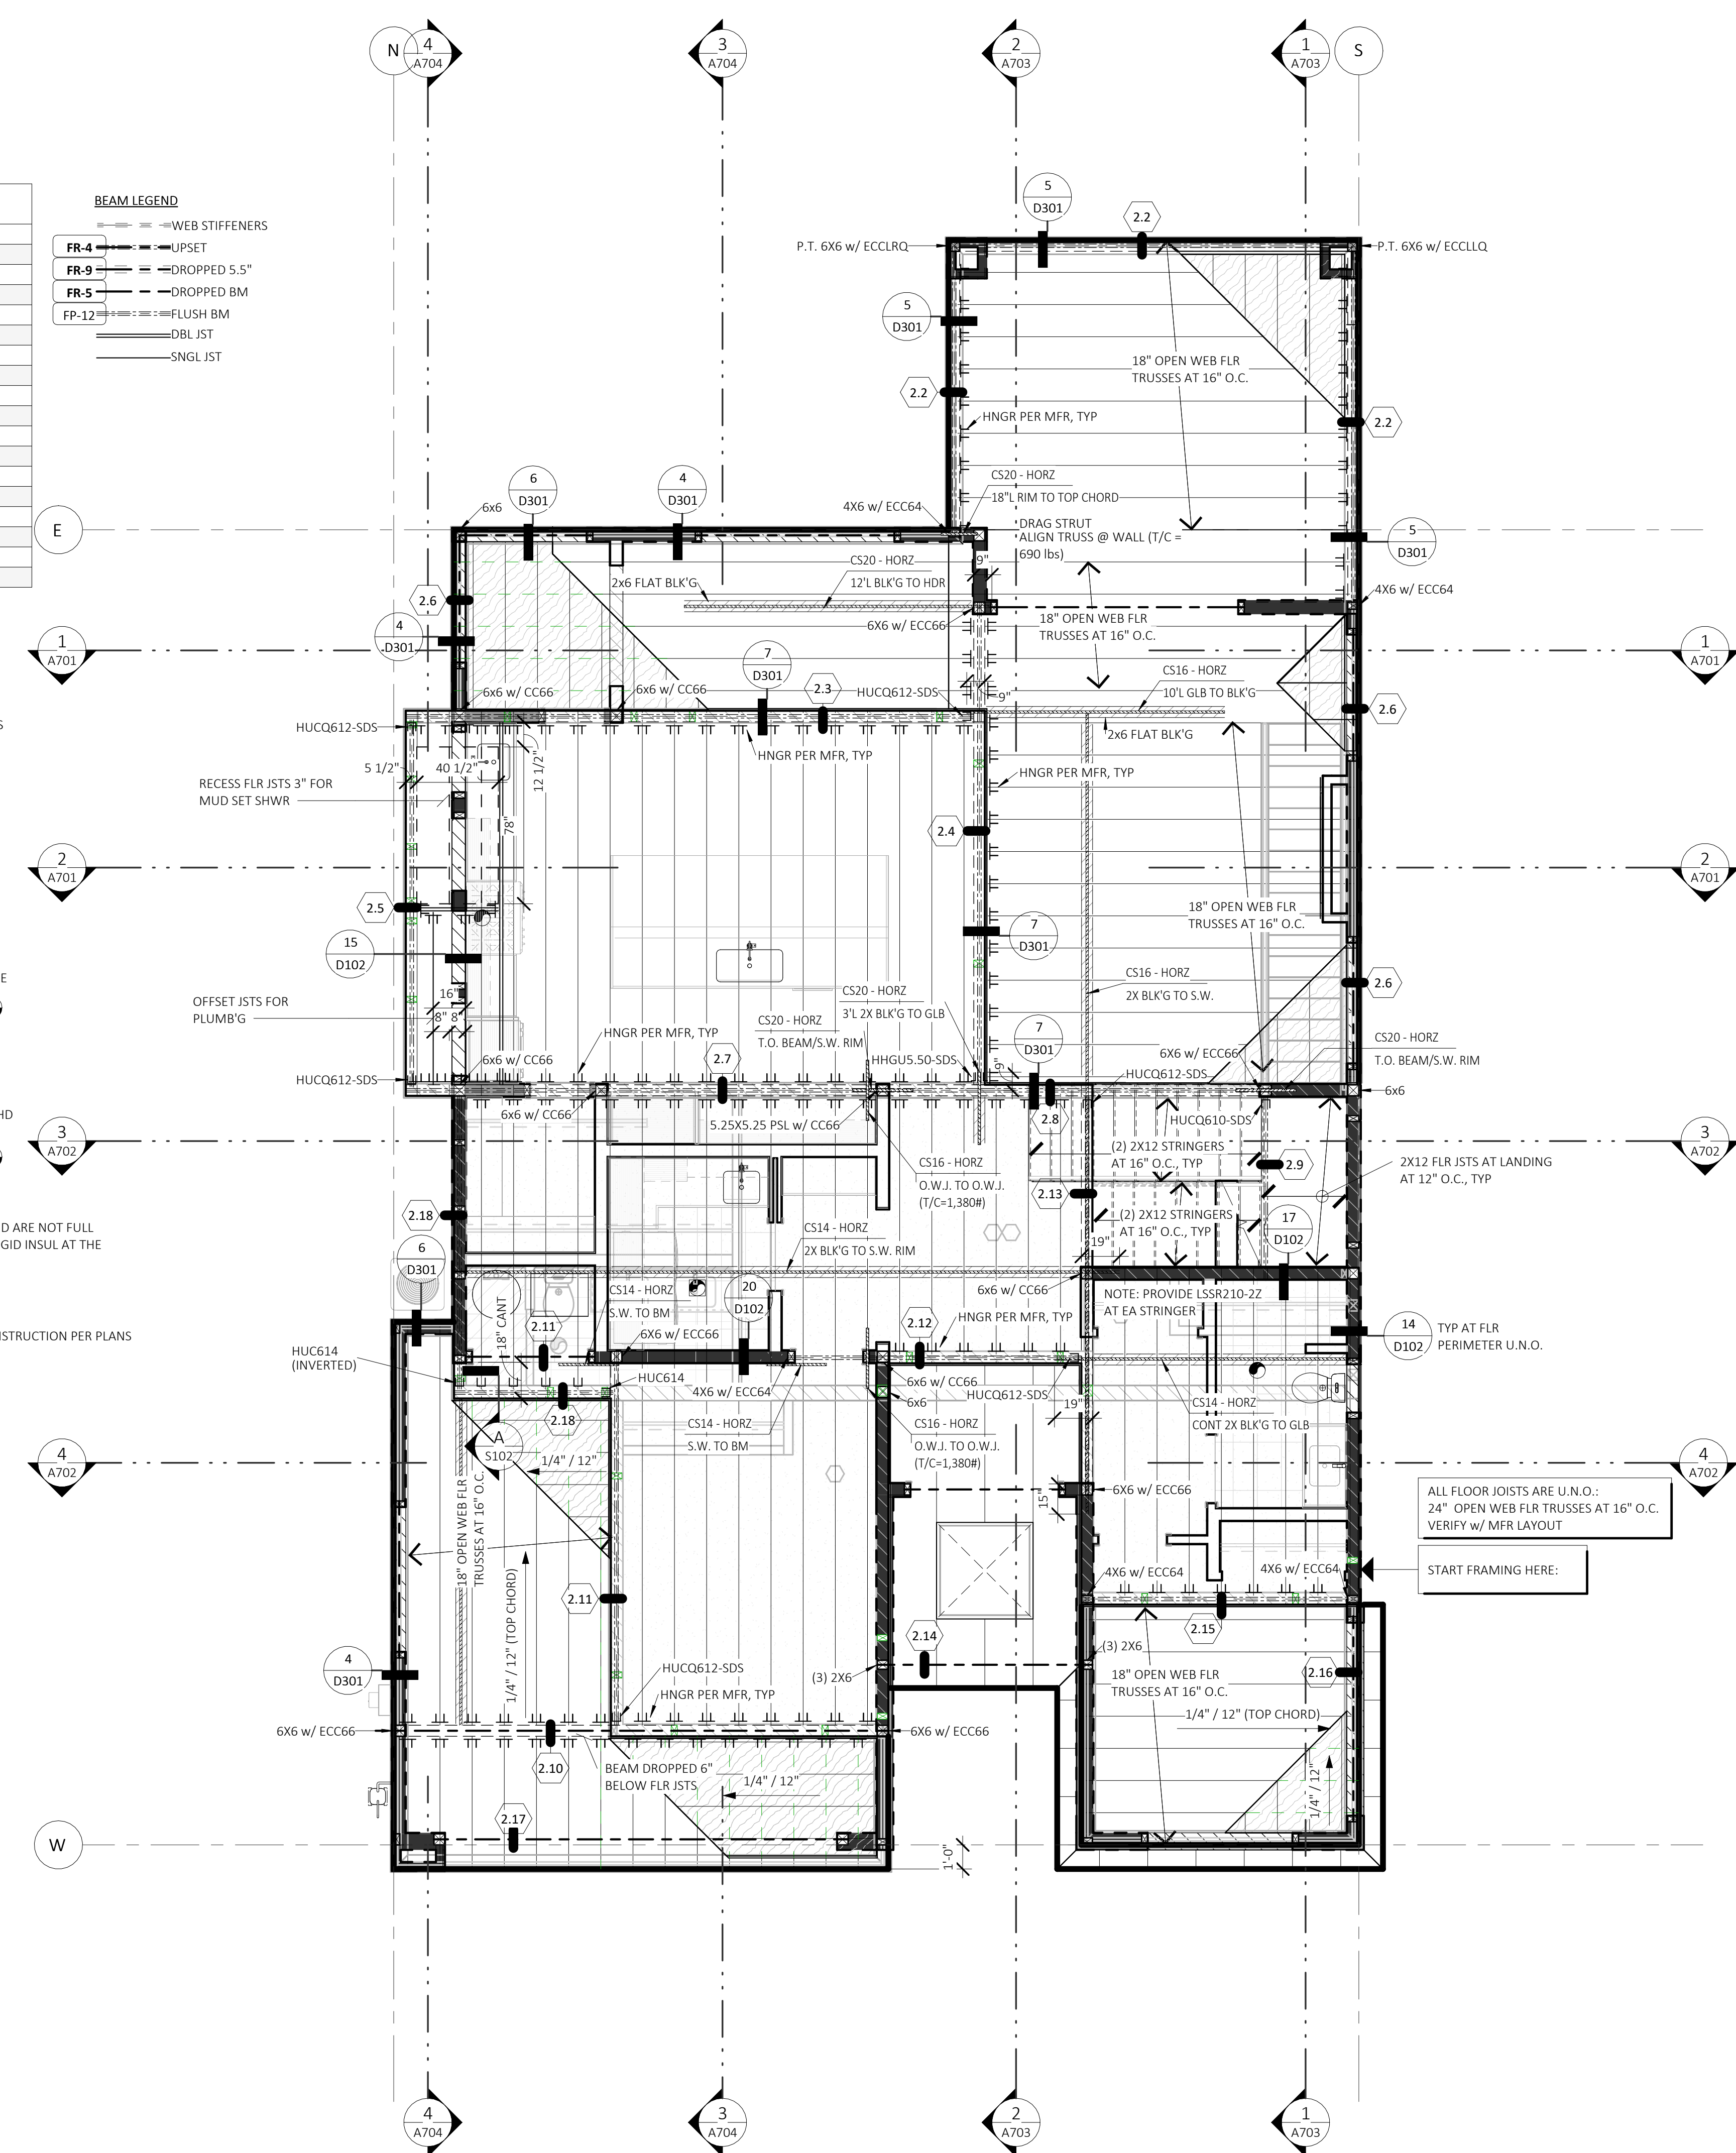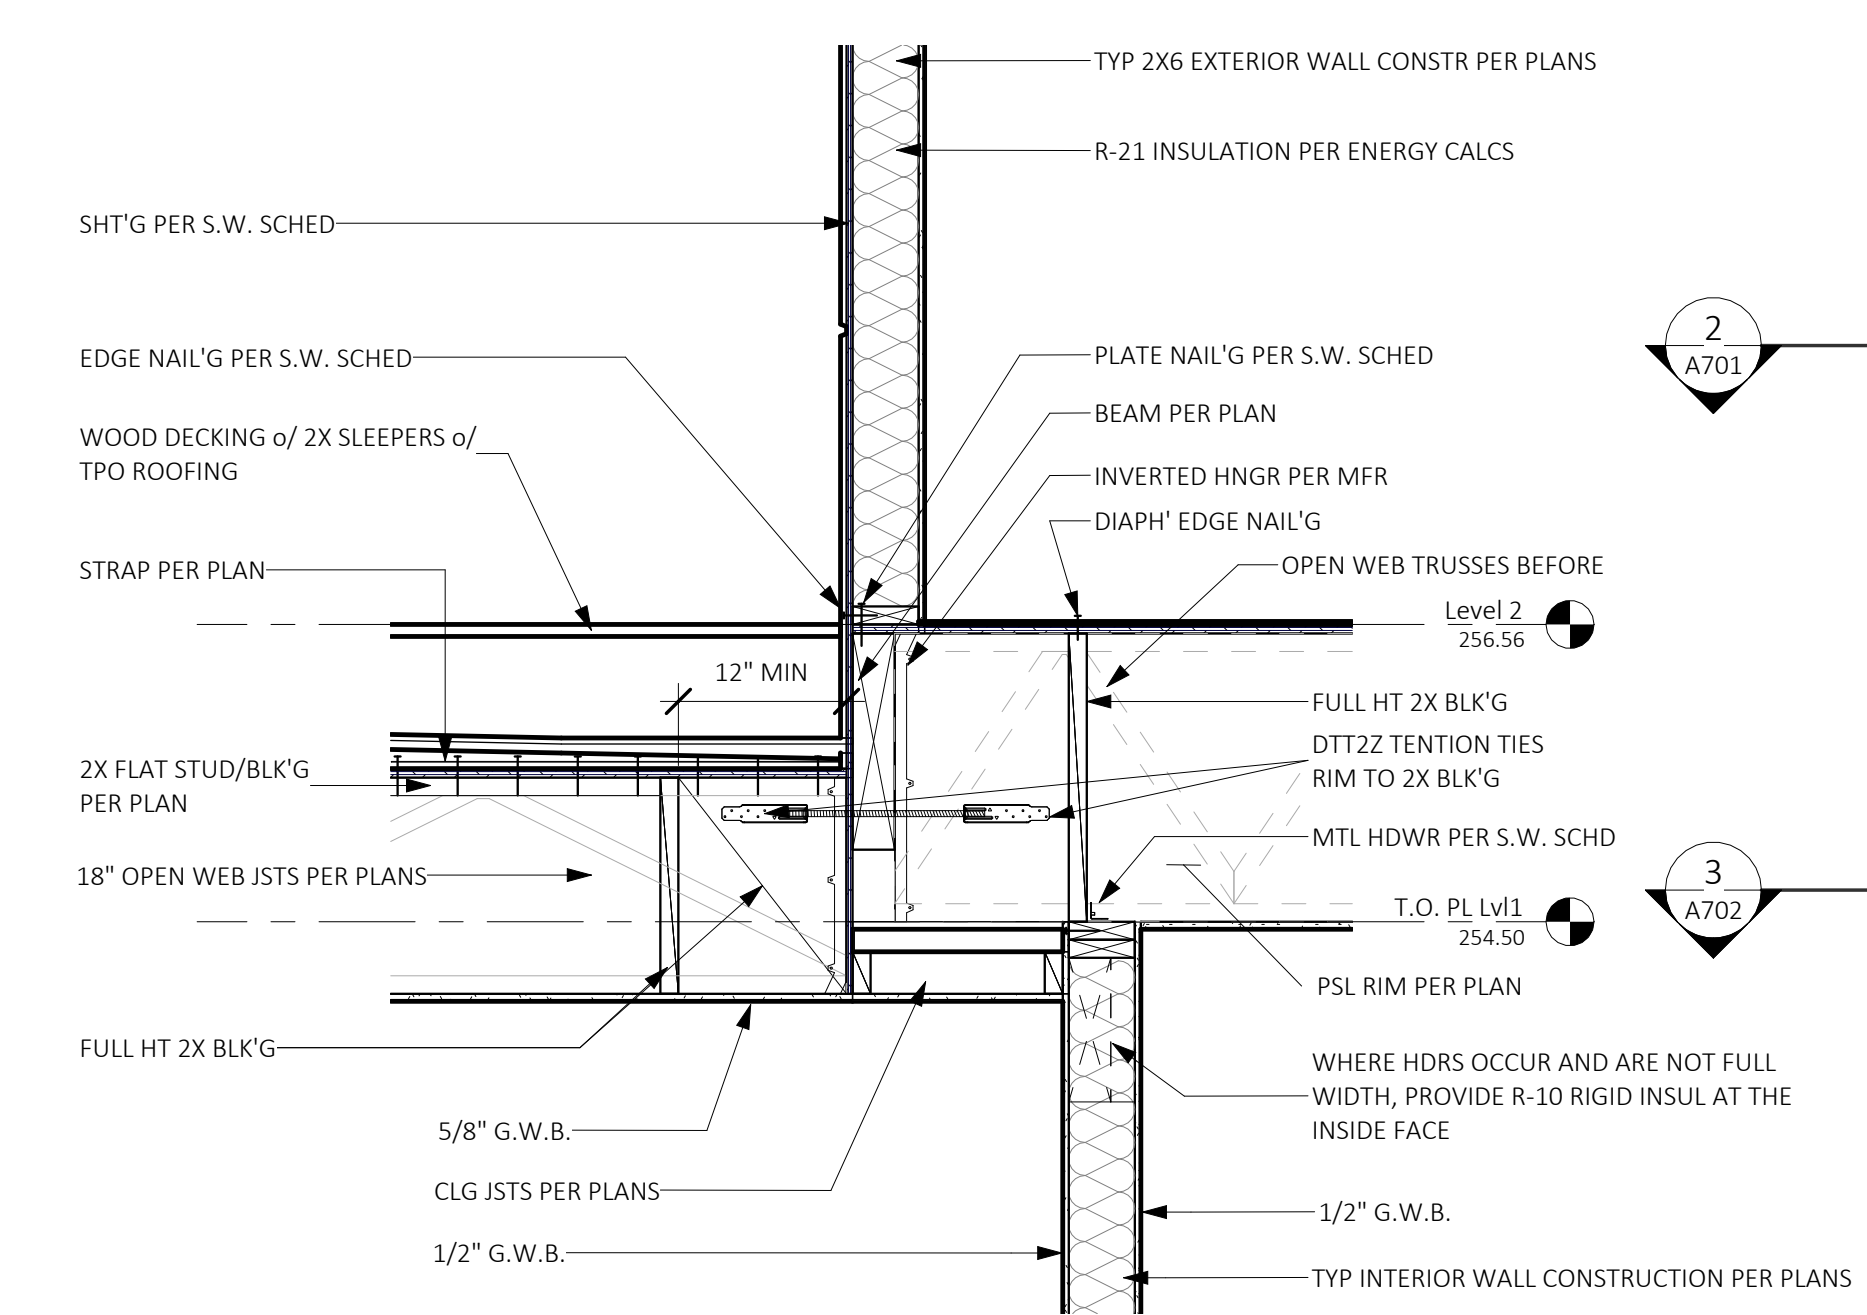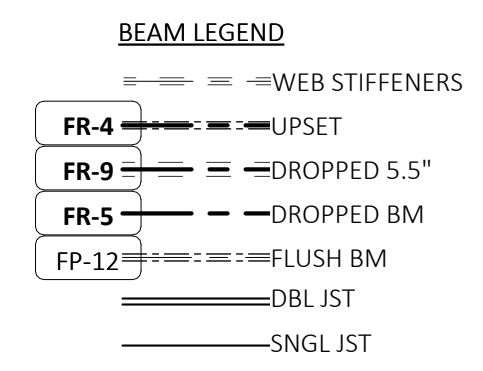

- SYMBOLS & LEGEND:**
- POINT LOAD FROM ABOVE. PROVIDE SOLID BLK'G THROUGH JOIST SYSTEM (1) 2x STUD
 - (2) 2x STUD, TYP. LARGER MEMBERS AS NOTED ON PLANS
 - SIMPSON OR OTHER APPROVED ALTERNATE HANGER. USE ALL REQUIRED FASTENERS
 - INDICATES BEAM CALCULATION WITH INDEXED NUMBER
 - WALL ABOVE BEARING WALL BELOW
 - NON BEARING WALL BELOW
 - BEARING WALL BELOW
 - SHEARWALL BELOW
 - BEARING WALL ABOVE

GENERAL FRAMING NOTES:

- SEE SHEET S001 FOR GENERAL DESIGN CRITERIA.
- SEE SHEET(S) S201-203 FOR SHEARWALL DESIGNATIONS, HOLDDOWNS, AND SHEARWALL SCHEDULE.
- U.N.O. ALL HEADERS ARE: 4X8 DF #2 (UP TO 8' SPAN) TRIMMER STUD UP TO 6'-0" SPAN AND PROVIDE (2) TRIMMER STUDS OVER 6'-0" U.N.O.
- TRUSS DESIGN BY MANUFACTURER. TRUSS DESIGN DRAWINGS SHALL BE PREPARED PER IRC SECTION R802.10.1 AND SHALL BE PROVIDED TO THE BUILDING OFFICIAL AND APPROVED PRIOR TO INSTALLATION.
 - * TRUSS DESIGN PER IRC SECTION R802.10.2
 - * FIELD ALTERATIONS MUST BE DESIGNED BY MFR. PER IRC SECTION R802.10.4
 - * SEE SHEET(S) S001 FOR DESIGN LOADS.
 - * TRUSS MFR TO PROVIDE ADEQUATE BEARING AREA TO RESOLVE REACTION (PERPENDICULAR TO GRAIN) AT ALL HIGHLY LOADED GIRDER TRUSSES.
- PROVIDE 2x4 RAFTER/TRUSS TAIL - TYP. U.N.O.
- ROOF PITCH: EXTERIOR PER ELEVATIONS & INTERIOR PER SECTIONS.
- ROOF FRAMING SPACING, 24" o.c. U.N.O.
- SEE ELEVATIONS AND/OR SECTIONS FOR ROOF PITCH, PLATE HEIGHT AND HEADER HEIGHT.
- FRAMING LUMBER: FRAMING LUMBER SHALL BE MARKED IN ACCORDANCE TO W.C.L.B. STANDARD GRADING RULES FOR WEST COAST LUMBER #16, LATEST EDITION. ALL KILN DRIED MIN. 19.
 - a) JOIST AND RAFTERS: SEE SHT S002
 - b) BEAMS AND STRINGERS: SEE SHT S002
 - c) POST AND TIMBERS: SEE SHT S002
 - d) STUDS, PLATES, AND MISC. LIGHT FRAMING: SEE SHT S002
 - e) TJI'S AND MICROLAMS: PER MANUFACTURER
 - f) GLUE LAMINATED TIMBER: SEE SHT S002
 - g) ALL OTHER LUMBER: HEM-FIR STANDARD OR BETTER
 - h) PLYWOOD/ORIENTED STRAND BOARD (OSB): SEE SHT S002
 - i) WALL SHEATHING: SEE SHT S002
 - j) FLOOR SHEATHING: 23/32" APA RATED STRUCTURAL SHIT'G FACE GRAIN PER TO FLR FRAM'G W/ 10d @ 6" OC PANEL EDGES, & 12" O.C. FIELD, UNBLOCKED, TYP U.N.O.
 - k) ROOF SHEATHING: 15/32" APA RATED STRUCTURAL SHIT'G FACE GRAIN PER TO FLR FRAM'G W/ 10d @ 6" OC PANEL EDGES, & 12" O.C. FIELD, UNBLOCKED, TYP
 - l) OTHER: AS NOTED ON DRAWINGS. SEE SHT S002
- FASTENERS: ALL FRAMING SHALL BE NAILED IN ACCORDANCE WITH TABLE R602.3(1) OF THE IRC. SEE SHEET A001
 - * POSITIVE CONNECTIONS SHALL BE PROVIDED WHERE POSTS AND BEAM OR GIRDER CONSTRUCTION IS USED TO SUPPORT FLOOR FRAMING.
 - a) IN CONCEALED SPACES BETWEEN STUD WALLS AND PARTITIONS, INCLUDING FURRED SPACES AND PARALLEL ROWS OF STUDS OR STAGGERED STUDS, AS FOLLOWS, VERT AT THE CLG AND FLR LEVELS AND HORZ AT INTERVALS NOT EXCEEDING 10 FEET.
 - b) AT ALL INTERCONNECTIONS BETWEEN CONCEALED VERT AND HORZ SPACES SUCH AS OCCUR AT SOFFITS, DROP CLGS AND COVE CLGS.
 - c) IN CONCEALED SPACES BTWN STAIR STRINGERS AT THE TOP AND BOTTOM OF THE RUN. ENCLOSED SPACES UNDER STAIRS SHALL COMPLY WITH SECTION R302.7.
 - d) AT OPENINGS AROUND VENTS, PIPES, DUCTS, CABLES AND WIRES AT CEILING AND FLOOR LEVEL, WITH AN APPROVED MATERIAL TO RESIST THE FREE PASSAGE OF FLAME AND PRODUCTS OF COMBUSTION. THE MATERIAL FILLING THIS ANNULAR SPACE SHALL NOT BE REQUIRED TO MEET THE ASTM E 136 REQUIREMENTS. THE INTEGRITY OF ALL FIREBLOCKS SHALL BE MAINTAINED.
- SEE SHT A002 FOR ROOF & CRAWL SPACE AREA VENTILATION CALCULATIONS

KEYNOTES - FRAMING	
ID	DESCRIPTION
FR-4	UPSET - BOTTOM OF BEAM EVEN w/ BOTTOM OF JOISTS. TOP OF BEAM EXTENDS ABOVE JOISTS.
FR-5	TOP OF BEAM IS FLUSH w/ BOTTOM OF JOISTS w/ NO TOP PLATE. CUT ADJACENT FRAMING MEMBERS INTO BEAM FOR ADEQUATE SUPPORT.
FR-9	TOP OF BEAM 5" BELOW TOP OF JOISTS TO ALLOW FOR HVAC.

(C) ATERA DESIGN STUDIO LLC. PLANS AND DESIGNS (DRAWINGS) FORTHWITH REMAIN THE PROPERTY OF ATERA DESIGN STUDIO. REPRODUCTION WITHOUT PERMISSION IS PROHIBITED.



L2 ENGINEERS
17848 NE 198TH PLAVE
WOODINVILLE, WA 98072

ATERA DESIGN STUDIO
451 DUVALL AVE NE,
RENTON, WA 98059

HU RESIDENCE
2448 72nd AVE SE, Mercer Island

PERMIT SET

UPPER FLOOR/MAIN ROOF FRAMING PLAN

PROJECT NO: 21014
ISSUE DATE: 2022/06/29
DRAWN BY: SPM

S102

SCALE 24X36: As indicated
* NOTE: 11x17 SETS ARE REDUCED 50% SCALE DRAWINGS ACCORDINGLY.




BEAM SCHEDULE - UPPER ROOF


ID	SIZE
3.1	4X8
3.2	5-1/2" X 7-1/2" GLB

BEAM LEGEND


---	WEB STIFFENERS
FR-4	UPSET
FR-9	DROPPED 5.5"
FR-5	DROPPED BM
FP-12	FLUSH BM
---	DBL IJT
---	SINGL IJT

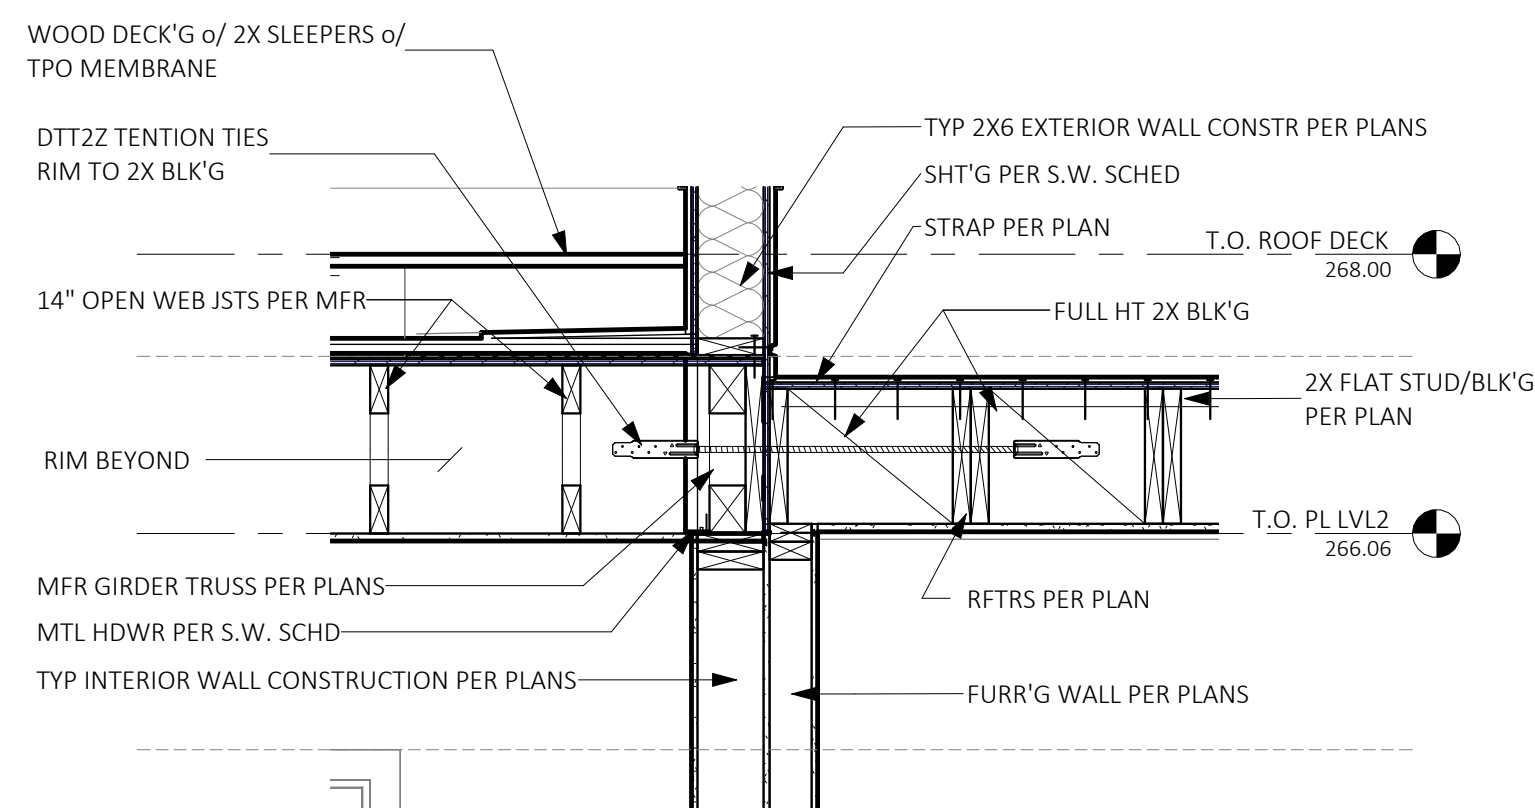

A DTTZ AT ROOF
SCALE: 3/4" = 1'-0"

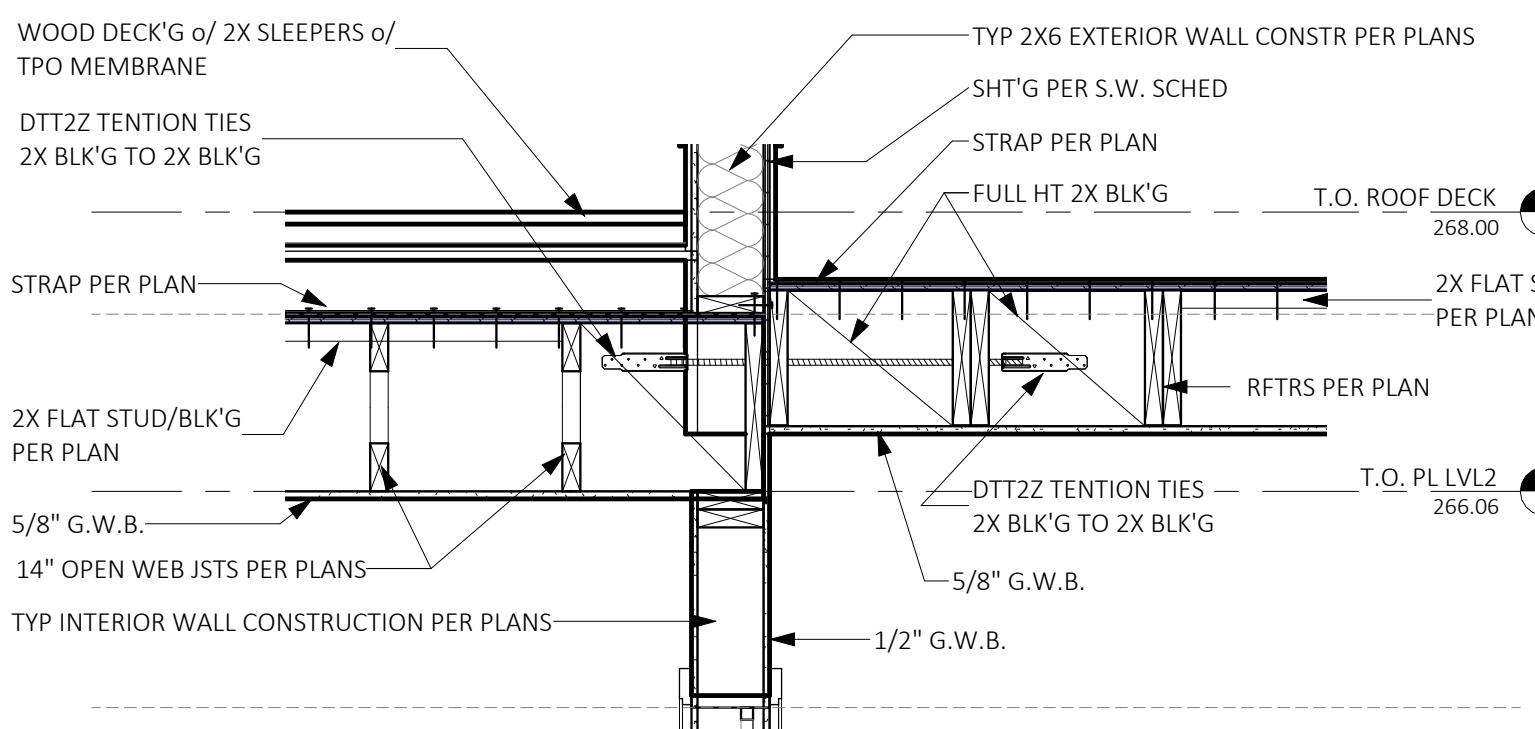

B DTTZ AT ROOF
SCALE: 3/4" = 1'-0"

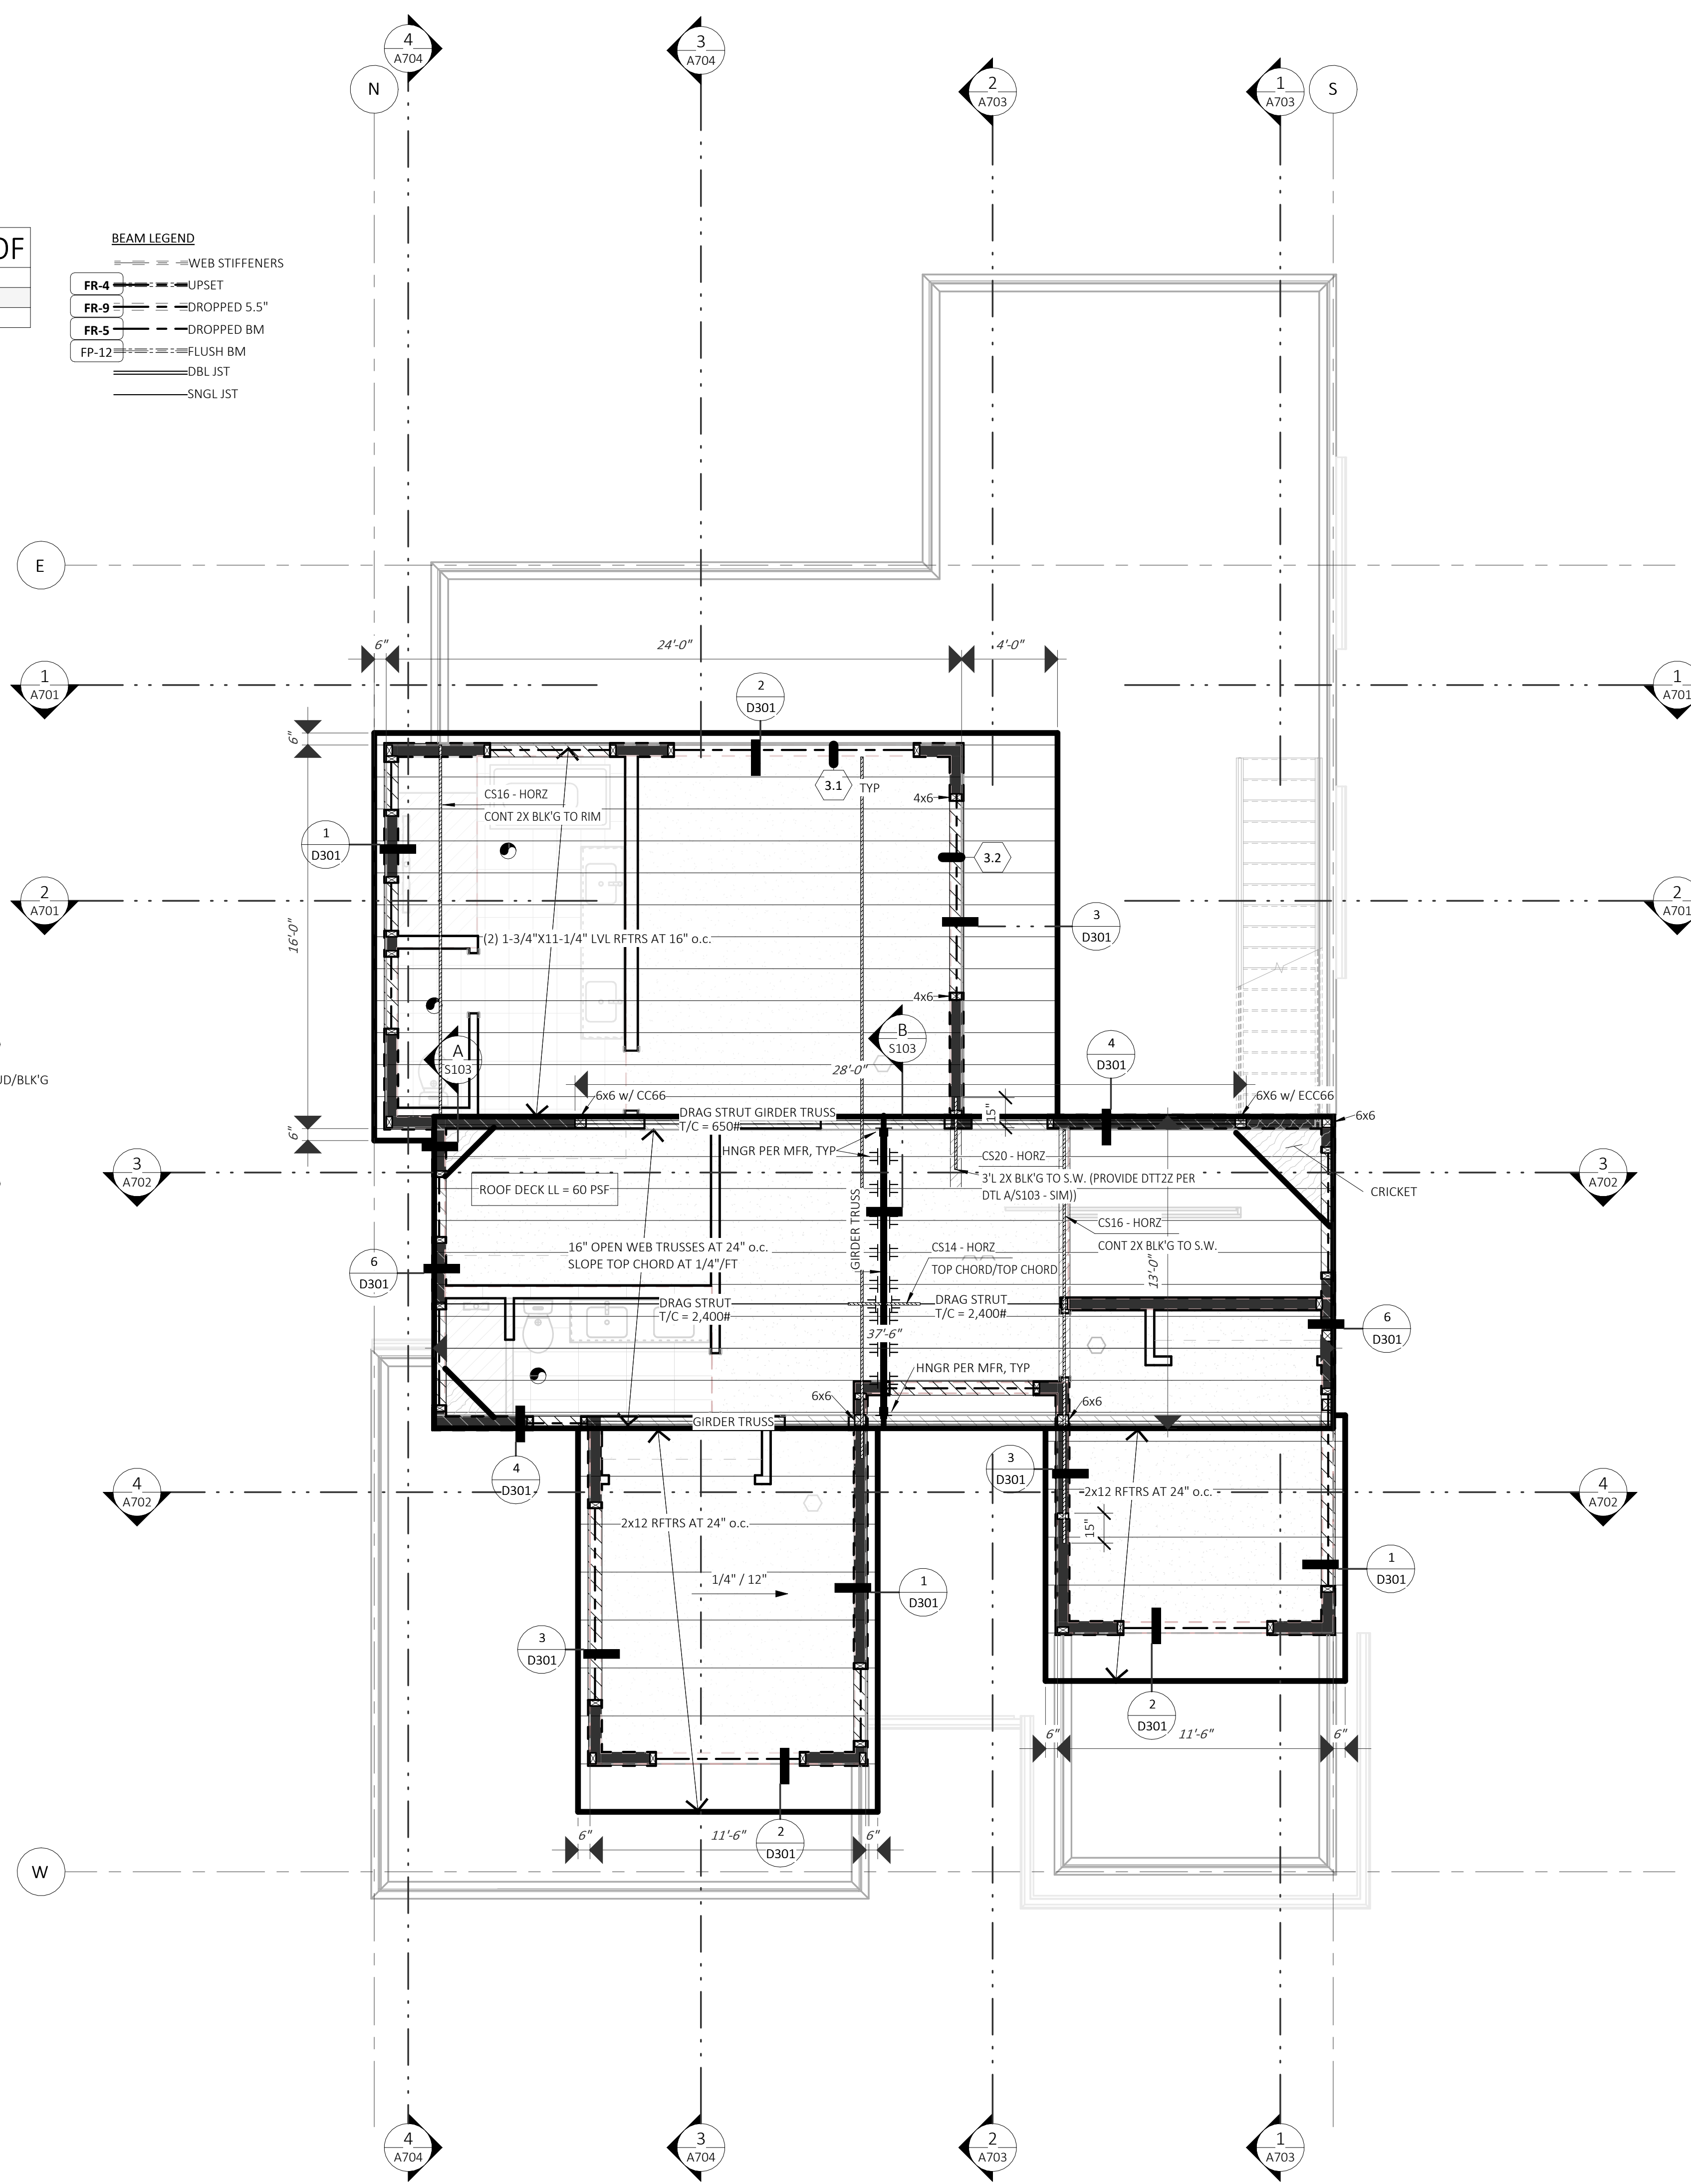

SYMBOLS & LEGEND:

- POINT LOAD FROM ABOVE. PROVIDE SOLID BLK'G THROUGH JOIST SYSTEM
(1) 2x STUD
- (2) 2x STUD, TYP. LARGER MEMBERS AS NOTED ON PLANS
- SIMPSON OR OTHER APPROVED ALTERNATE HANGER. USE ALL REQUIRED FASTENERS
- INDICATES BEAM CALCULATION WITH INDEXED NUMBER
- WALL ABOVE
- BEARING WALL BELOW
- NON BEARING WALL BELOW
- SHEARWALL BELOW
- BEARING WALL ABOVE

GENERAL FRAMING NOTES:

- SEE SHEET S001 FOR GENERAL DESIGN CRITERIA.
- SEE SHEET(S) S201-203 FOR SHEARWALL DESIGNATIONS, HOLDDOWNS, AND SHEARWALL SCHEDULE.
- U.N.O. ALL HEADERS ARE: **4x8 DF #2 (UP TO 8' SPAN)** TRIMMER STUD UP TO 6'-0" SPAN AND PROVIDE (2) TRIMMER STUDS OVER 6'-0" U.N.O.
- TRUSS DESIGN BY MANUFACTURER. TRUSS DESIGN DRAWINGS SHALL BE PREPARED PER IRC SECTION R802.10.1 AND SHALL BE PROVIDED TO THE BUILDING OFFICIAL AND APPROVED PRIOR TO INSTALLATION.
 - * TRUSS DESIGN PER IRC SECTION R802.10.2
 - * FIELD ALTERATIONS MUST BE DESIGNED BY MFR. PER IRC SECTION R802.10.4
 - * SEE SHEET(S) S001 FOR DESIGN LOADS.
 - * TRUSS MFR TO PROVIDE ADEQUATE BEARING AREA TO RESOLVE REACTION (PERPENDICULAR TO GRAIN) AT ALL HIGHLY LOADED GIRDER TRUSSES.
- PROVIDE 2x4 RAFTER/TRUSS TAIL - TYP. U.N.O.
- ROOF PITCH: EXTERIOR PER ELEVATIONS & INTERIOR PER SECTIONS.
- ROOF FRAMING SPACING, 24" o.c. U.N.O.
- SEE ELEVATIONS AND/OR SECTIONS FOR ROOF PITCH, PLATE HEIGHT AND HEADER HEIGHT.
- FRAMING LUMBER: FRAMING LUMBER SHALL BE MARKED IN ACCORDANCE TO W.C.L.B. STANDARD GRADING RULES FOR WEST COAST LUMBER #16, LATEST EDITION. ALL KILN DRIED MIN. 19.
 - a) JOIST AND RAFTERS: SEE SHT S002
 - b) BEAMS AND STRINGERS: SEE SHT S002
 - c) POST AND TIMBERS: SEE SHT S002
 - d) STUDS, PLATES, AND MISC. LIGHT FRAMING: SEE SHT S002
 - e) TJI'S AND MICROLAMS: PER MANUFACTURER
 - f) GLUE LAMINATED TIMBER: SEE SHT S002
 - g) ALL OTHER LUMBER: **HEM-FIR STANDARD OR BETTER**.
 - h) PLYWOOD/ORIENTED STRAND BOARD (OSB): SEE SHT S002
 - i) WALL SHEATHING: SEE SHT S002
 - j) FLOOR SHEATHING: 23/32" APA RATED STRUCTURAL SHT'G FACE GRAIN PERP TO FLR FRAM'G W/ 10d @ 6" OC PANEL EDGES, & 12" O.C. FIELD, UNBLOCKED, TYP. U.N.O.
 - k) ROOF SHEATHING: 15/32" APA RATED STRUCTURAL SHT'G FACE GRAIN PERP TO FLR FRAM'G W/ 10d @ 6" OC PANEL EDGES, & 12" O.C. FIELD, UNBLOCKED, TYP.
 - l) OTHER: AS NOTED ON DRAWINGS. SEE SHT S002
- FASTENERS: ALL FRAMING SHALL BE NAILED IN ACCORDANCE WITH TABLE R602.3(1) OF THE IRC. SEE SHEET A001
 - * POSITIVE CONNECTIONS SHALL BE PROVIDED WHERE POSTS AND BEAM OR GIRDER CONSTRUCTION IS USED TO SUPPORT FLOOR FRAMING.
- INSTALL 2X FIREBLOCKING PER R302.11 AS FOLLOWS:
 - a) IN CONCEALED SPACES OF STUD WALLS AND PARTITIONS, INCLUDING FURRED SPACES AND PARALLEL ROWS OF STUDS OR STAGGERED STUDS, AS FOLLOWS, VERT AT THE CLG AND FLR LEVELS AND HORZ AT INTERVALS NOT EXCEEDING 10 FEET.
 - b) AT ALL INTERCONNECTIONS BETWEEN CONCEALED VERT AND HORZ SPACES SUCH AS OCCUR AT SOFFITS, DROP CLGS AND COVE CLGS.
 - c) IN CONCEALED SPACES BTWN STAIR STRINGERS AT THE TOP AND BOTTOM OF THE RUN. ENCLOSED SPACES UNDER STAIRS SHALL COMPLY WITH SECTION R302.7.
 - d) AT OPENINGS AROUND VENTS, PIPES, DUCTS, CABLES AND WIRES AT CEILING AND FLOOR LEVEL, WITH AN APPROVED MATERIAL TO RESIST THE FREE PASSAGE OF FLAME AND PRODUCTS OF COMBUSTION. THE MATERIAL FILLING THIS ANNULAR SPACE SHALL NOT BE REQUIRED TO MEET THE ASTM E 136 REQUIREMENTS. THE INTEGRITY OF ALL FIREBLOCKS SHALL BE MAINTAINED.
- SEE SHT A002 FOR ROOF & CRAWL SPACE AREA VENTILATION CALCULATIONS

KEYNOTES - FRAMING


ID	DESCRIPTION
FR-4	UPSET - BOTTOM OF BEAM EVEN W/ BOTTOM OF JOISTS. TOP OF BEAM EXTENDS ABOVE JOISTS.
FR-5	TOP OF BEAM IS FLUSH W/ BOTTOM OF JOISTS w/ NO TOP PLATE. CUT ADJACENT FRAMING MEMBERS INTO BEAM FOR ADEQUATE SUPPORT.
FR-9	TOP OF BEAM 5" BELOW TOP OF JOISTS TO ALLOW FOR HVAC.

(C) ATERA DESIGN STUDIO LLC. PLANS AND DESIGNS (DRAWINGS) FORTHWITH REMAIN THE PROPERTY OF ATERA DESIGN STUDIO. REPRODUCTION WITHOUT PERMISSION IS PROHIBITED.



L2 ENGINEERS
17848 NE 198TH PLAVE
WOODINVILLE, WA 98072

ATERA DESIGN STUDIO
451 DUVAL AVE NE,
RENTON, WA 98059

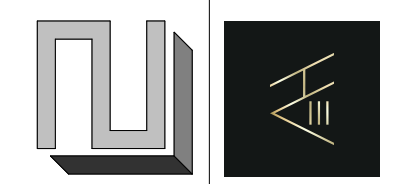

HU RESIDENCE
2448 72nd AVE SE, Mercer Island

PERMIT SET

ROOF FRAMING PLAN

PROJECT NO: 21014
ISSUE DATE: 2022/06/29
DRAWN BY: SPM

S103

SCALE 24X36: As indicated
* NOTE: 11x17 SETS ARE REDUCED 50%; SCALE DRAWINGS ACCORDINGLY.



Holdowns and Tension Tie SCHEDULE

TYPE	MIN END STUD	FASTENERS			DETAIL	Count	Manufacturer	ALLOWABLE UPLIFT (DF / HF)
		ANCHOR BOLT	NAILS/SCREWS	CONCRETE ANCHOR				
CS16-11"			(22) 10d		DTL 272/S303	4	Simpson Strong Tie or EQ.	1705 / --
CS14-15"			(30) 10d		DTL 272/S303	2	Simpson Strong Tie or EQ.	2490 / --
CMSTC16-20"			(58) 16d SINKER		DTL 272/S303	8	Simpson Strong Tie or EQ.	4960 / --
(2) HDU11-SDS2.5 2	4X	1"	(30) SDS 1/4"x2 1/2"		DTL 52/S302	2	Simpson Strong Tie or EQ.	9535 / --
FLOOR TO FLOOR								
LSTHD8/LSTHD8RJ	(2) 2X		(20) 0.148 X 3-1/4"		DTL 58/S301	6	Simpson Strong Tie or EQ.	1610 / --
STHD10/STHD10RJ	(2) 2X		(28) 0.148 X 3-1/4"		DTL 58/S301	2	Simpson Strong Tie or EQ.	2175 / --
STHD14/STHD14RJ	(2) 2X		(30) 0.148 X 3-1/4"		DTL 58/S301	5	Simpson Strong Tie or EQ.	3500 / --
HDU8-SDS2.5	4X6	7/8"	(20) SDS 1/4"x2 1/2"	PAB6	DTL 52/S302	8	Simpson Strong Tie or EQ.	7870 / 6580
HDU11-SDS2.5	4X8	1"	(30) SDS 1/4"x2 1/2"	PAB7	DTL 52/S302	11	Simpson Strong Tie or EQ.	11175 / 9610
HDU14-SDS2.5	6X6	1"	(36) SDS 1/4"x2 1/2"	PAB8	DTL 52/S302	3	Simpson Strong Tie or EQ.	14445 / 12425
HD19	6X6	1-1/4"	(5) 1" BOLTS	PAB10	DTL 56/S301	2	Simpson Strong Tie or EQ.	19070 / 16210
HOLDDOWN								
MSTC48B3	(2) 2X		REF DETAIL		DTL 269/S303	9	Simpson Strong Tie or EQ.	3795 / 3900
MSTC66B3Z	4X		REF DETAIL		DTL 269/S303	1	Simpson Strong Tie or EQ.	4490 / --
OVERHANG								

WOOD FRAMED SHEARWALL SCHEDULE


SHEARWALL TYPE	WALL SHT'G APA RATED	EDGE NAIL'G	BOT PLATE CONNECTION	FRAM'G CONNECTION AT WALL BELOW	MIN RIM THICKNESS	FRAM'G AT PANEL EDGES	BLK'G AT PANEL EDGES	P.T. 2X SILL		P.T. 3X SILL	
								ANCHOR BOLT	SHEAR CAPACITY (WIND/SEISMIC)	ANCHOR BOLT	SHEAR CAPACITY (WIND/SEISMIC)
sw6	15/32"	8D AT 6" O.C.	(2) ROWS 16D COMMON AT 6" O.C. STAGGERED	LPTS'S AT 18" O.C.	1-1/4"	2X	2X	5/8" DIA AT 48" O.C.	242 / 339	5/8" DIA AT 60" O.C.	242 / 339
sw4	15/32"	8D AT 4" O.C.	(2) ROWS 16D COMMON AT 6" O.C. STAGGERED	LPTS'S AT 12" O.C.	1-3/4"	3X OR (2) 2X	3X OR FLAT 2X	5/8" DIA AT 32" O.C.	353/495	5/8" DIA AT 40" O.C.	353/495
sw3	15/32"	8D AT 3" O.C.	(2) ROWS 16D COMMON AT 6" O.C. STAGGERED	LPTS'S AT 10" O.C.	1-3/4"	3X OR (2) 2X	3X OR FLAT 2X	5/8" DIA AT 24" O.C.	456 / 637	5/8" DIA AT 32" O.C.	456 / 637
sw2	15/32"	8D AT 2" O.C.	(2) ROWS 16D COMMON AT 4" O.C. STAGGERED	LPTS'S AT 6" O.C.	3-1/2"	3X OR (2) 2X	3X OR FLAT 2X	5/8" DIA AT 18" O.C.	595 / 832	5/8" DIA AT 24" O.C.	595 / 832
2sw4	15/32" BOTH SIDES	8D AT 4" O.C.	(3) ROWS 16D COMMON AT 6" O.C. STAGGERED	LPTS'S AT 5" O.C.	3-1/2"	3X	3X	5/8" DIA AT 24" O.C.	707 / 990	5/8" DIA AT 24" O.C.	707 / 990
2sw3	15/32" BOTH SIDES	8D AT 3" O.C.	(3) ROWS 16D COMMON AT 4" O.C. STAGGERED	LPTS'S AT 8" O.C. AND A35 AT 8" O.C.	3-1/2"	3X	3X	5/8" DIA AT 16" O.C.	911 / 1274	5/8" DIA AT 16" O.C.	911 / 1274
2sw2	15/32" BOTH SIDES	8D AT 2" O.C.	(3) ROWS 16D COMMON AT 4" O.C. STAGGERED	LPTS'S AT 6" O.C. AND A35 AT 6" O.C.	3-1/2"	3X	3X	5/8" DIA AT 12" O.C.	1190 / 1469	5/8" DIA AT 12" O.C.	1190 / 1469

SHEARWALL LEGEND:

- # SHEARWALL TAG: SEE SHEARWALL SCHEDULE AND STRUCTURAL NOTES ON THIS SHEET.
- ALL EXTERIOR WALLS TO BE SW6 SHEAR WALLS U.N.O.
- FOR WALL CONSTRUCTION FOR WALLS THAT EXTEND THRU WINDOWS SHEATH ABV AND BELOW WINDOW & STRAP PER DETAIL ON SHEET D101
- HDN INDICATES STRUCTURAL KEYNOTE FOR HOLDOWN WITH INDEXED NUMBER. SEE STRUCTURAL KEYNOTE SCHEDULE THIS SHEET. SEE STRUCTURAL NOTES ON SHEET S101
- - - EXTENT OF SHEARWALL
- - - SHEARWALL BELOW

SHEAR WALL NOTES

1. ALL NAILS ARE COMMON. UNO. REFERENCE GENERAL STRUCTURAL NOTES FOR NAIL DIAMETER AND LENGTH. REFERENCE SHEAR WALL KEY DETAIL FOR DESCRIPTION OF TERMS.
2. PROVIDE SHEAR WALL SHEATHING AND NAILING FOR ENTIRE LENGTH OF THE WALLS INDICATED ON THE PLANS. ENDS OF SHEAR WALLS ARE TYPICALLY AT WINDOWS, DOORWAYS OR AS SHOWN ON PLAN.
3. EDGE NAILING IS REQUIRED AT ALL HOLDDOWN POS. EDGE NAILING IS REQUIRED TO EACH STUD USED IN BUILT-UP HOLDDOWN POS. REFERENCE HOLDOWN SCHEDULE & DETAILS FOR ADDITIONAL INFORMATION.
4. INTERMEDIATE FRAMING TO BE 2x MINIMUM MEMBERS UNO IN SCHEDULE. ATTACH SHEATHING TO INTERMEDIATE FRAMING WITH EDGE NAILING AT 12"OC WHERE STUDS ARE SPACED AT 16"OC AND EDGE NAILING AT 6"OC WHERE STUDS ARE SPACED AT 24"
5. SIMPSON STRONG-TIE "A35" MAY BE USED IN LIEU OF "LTP5." "LTP2" CLIPS SHALL BE ORIENTED LENGTHWISE 1 (HORIZONTAL) AT PLATE TO RIM. USE 0.131" x1. NAILS WHERE CLIPS ARE ATTACHED DIRECTLY TO FRAMING. USE Ø 2 1 0.131" x2 WHERE CLIPS ARE INSTALLED OVER SHEATHING. Ø 2
6. 2x STUDS NAILED TOGETHER MAY BE USED IN PLACE OF SINGLE 3x STUD. DOUBLE 2x STUDS SHALL BE SECURED TOGETHER WITH FASTENERS OF THE SAME DIAMETER AND SPACING AS THE BOTTOM PLATE ATTACHMENT PER SCHEDULE. WHERE SHEATHING IS APPLIED ON BOTH SIDES OF A SHEAR WALL AND NAIL SPACING IS LESS THAN 6"OC ON EITHER SIDE, THE WIDTH OF THE NAILED FACE OF THE FRAMING MEMBER SHALL BE 3" NOMINAL OR GREATER AT ADJOINING PANEL EDGES AND NAILS AT ALL PANEL EDGES SHALL BE STAGGERED. ALTERNATIVELY, PANELS SHALL BE STAGGERED SO THAT EDGE JOINTS ON OPPOSITE SIDES ARE NOT LOCATED ON THE SAME STUD.
7. ANCHOR BOLTS SHALL BE PROVIDED WITH MINIMUM 0.229"x 3"x 3" HOT-DIPPED GALVANIZED STEEL PLATE WASHERS PER DETAILS ON DRAWINGS. EMBED ANCHOR BOLTS 7" MINIMUM INTO THE CONCRETE PROVIDE AN ANCHOR BOLT AT EACH END OF EACH PLATE AND SHALL BE AT LEAST 7 TIMES THE ANCHOR BOLT DIAMETER FROM THE ENDS OF THE PLATE, BUT NOT MORE THAN 1 THE TABULATED ANCHOR BOLT SPACING OR 12", WHICHEVER IS LESS. SEE ANCHOR BOLT DETAIL FOR PLATE 2 5 WASHER REQUIREMENTS. [ALT: " 8 Øx8" TITEN HD ANCHOR SCREWS MAY BE USED IN LIEU OF ANCHOR BOLTS AT EXISTING CONCRETE, WITH PLATE WASHER & SPACING REQUIREMENTS PER SCHEDULE.]
8. PROVIDE HOT-DIPPED GALVANIZED NAILS AND CONNECTOR PLATES (FRAMING ANGLES, ETC.) AT ALL PRESSURE TREATED LUMBER. REFERENCE GENERAL STRUCTURAL NOTES FOR ADDITIONAL INFORMATION.
9. PANELS MAY BE INSTALLED HORIZONTALLY IF STUDS ARE SPACED AT 16"OC MAX.
10. STAGGER EDGE NAILING.
11. THE TOP EDGE OF THE WOOD STRUCTURAL PANEL SHALL BE ATTACHED TO THE UPPER TOP PLATE. ROOF OR UPPER LEVEL UPLIFT CONNECTORS SHALL BE ON THE SAME SIDE OF THE WALL AS THE SHEATHING.
12. THE BOTTOM EDGE OF THE WOOD STRUCTURAL PANEL SHALL EXTEND TO AND BE ATTACHED TO THE BOTTOM OR SILL PLATE. REFERENCE DETAIL BELOW FOR STAGGERED NAIL AND SCREW SPACING AT RIM BOARDS.
13. WALL TYPE ACCEPTABLE WITH TRUSJOIST AND BOISE CASCADE RIM JOIST AND BLOCKING.

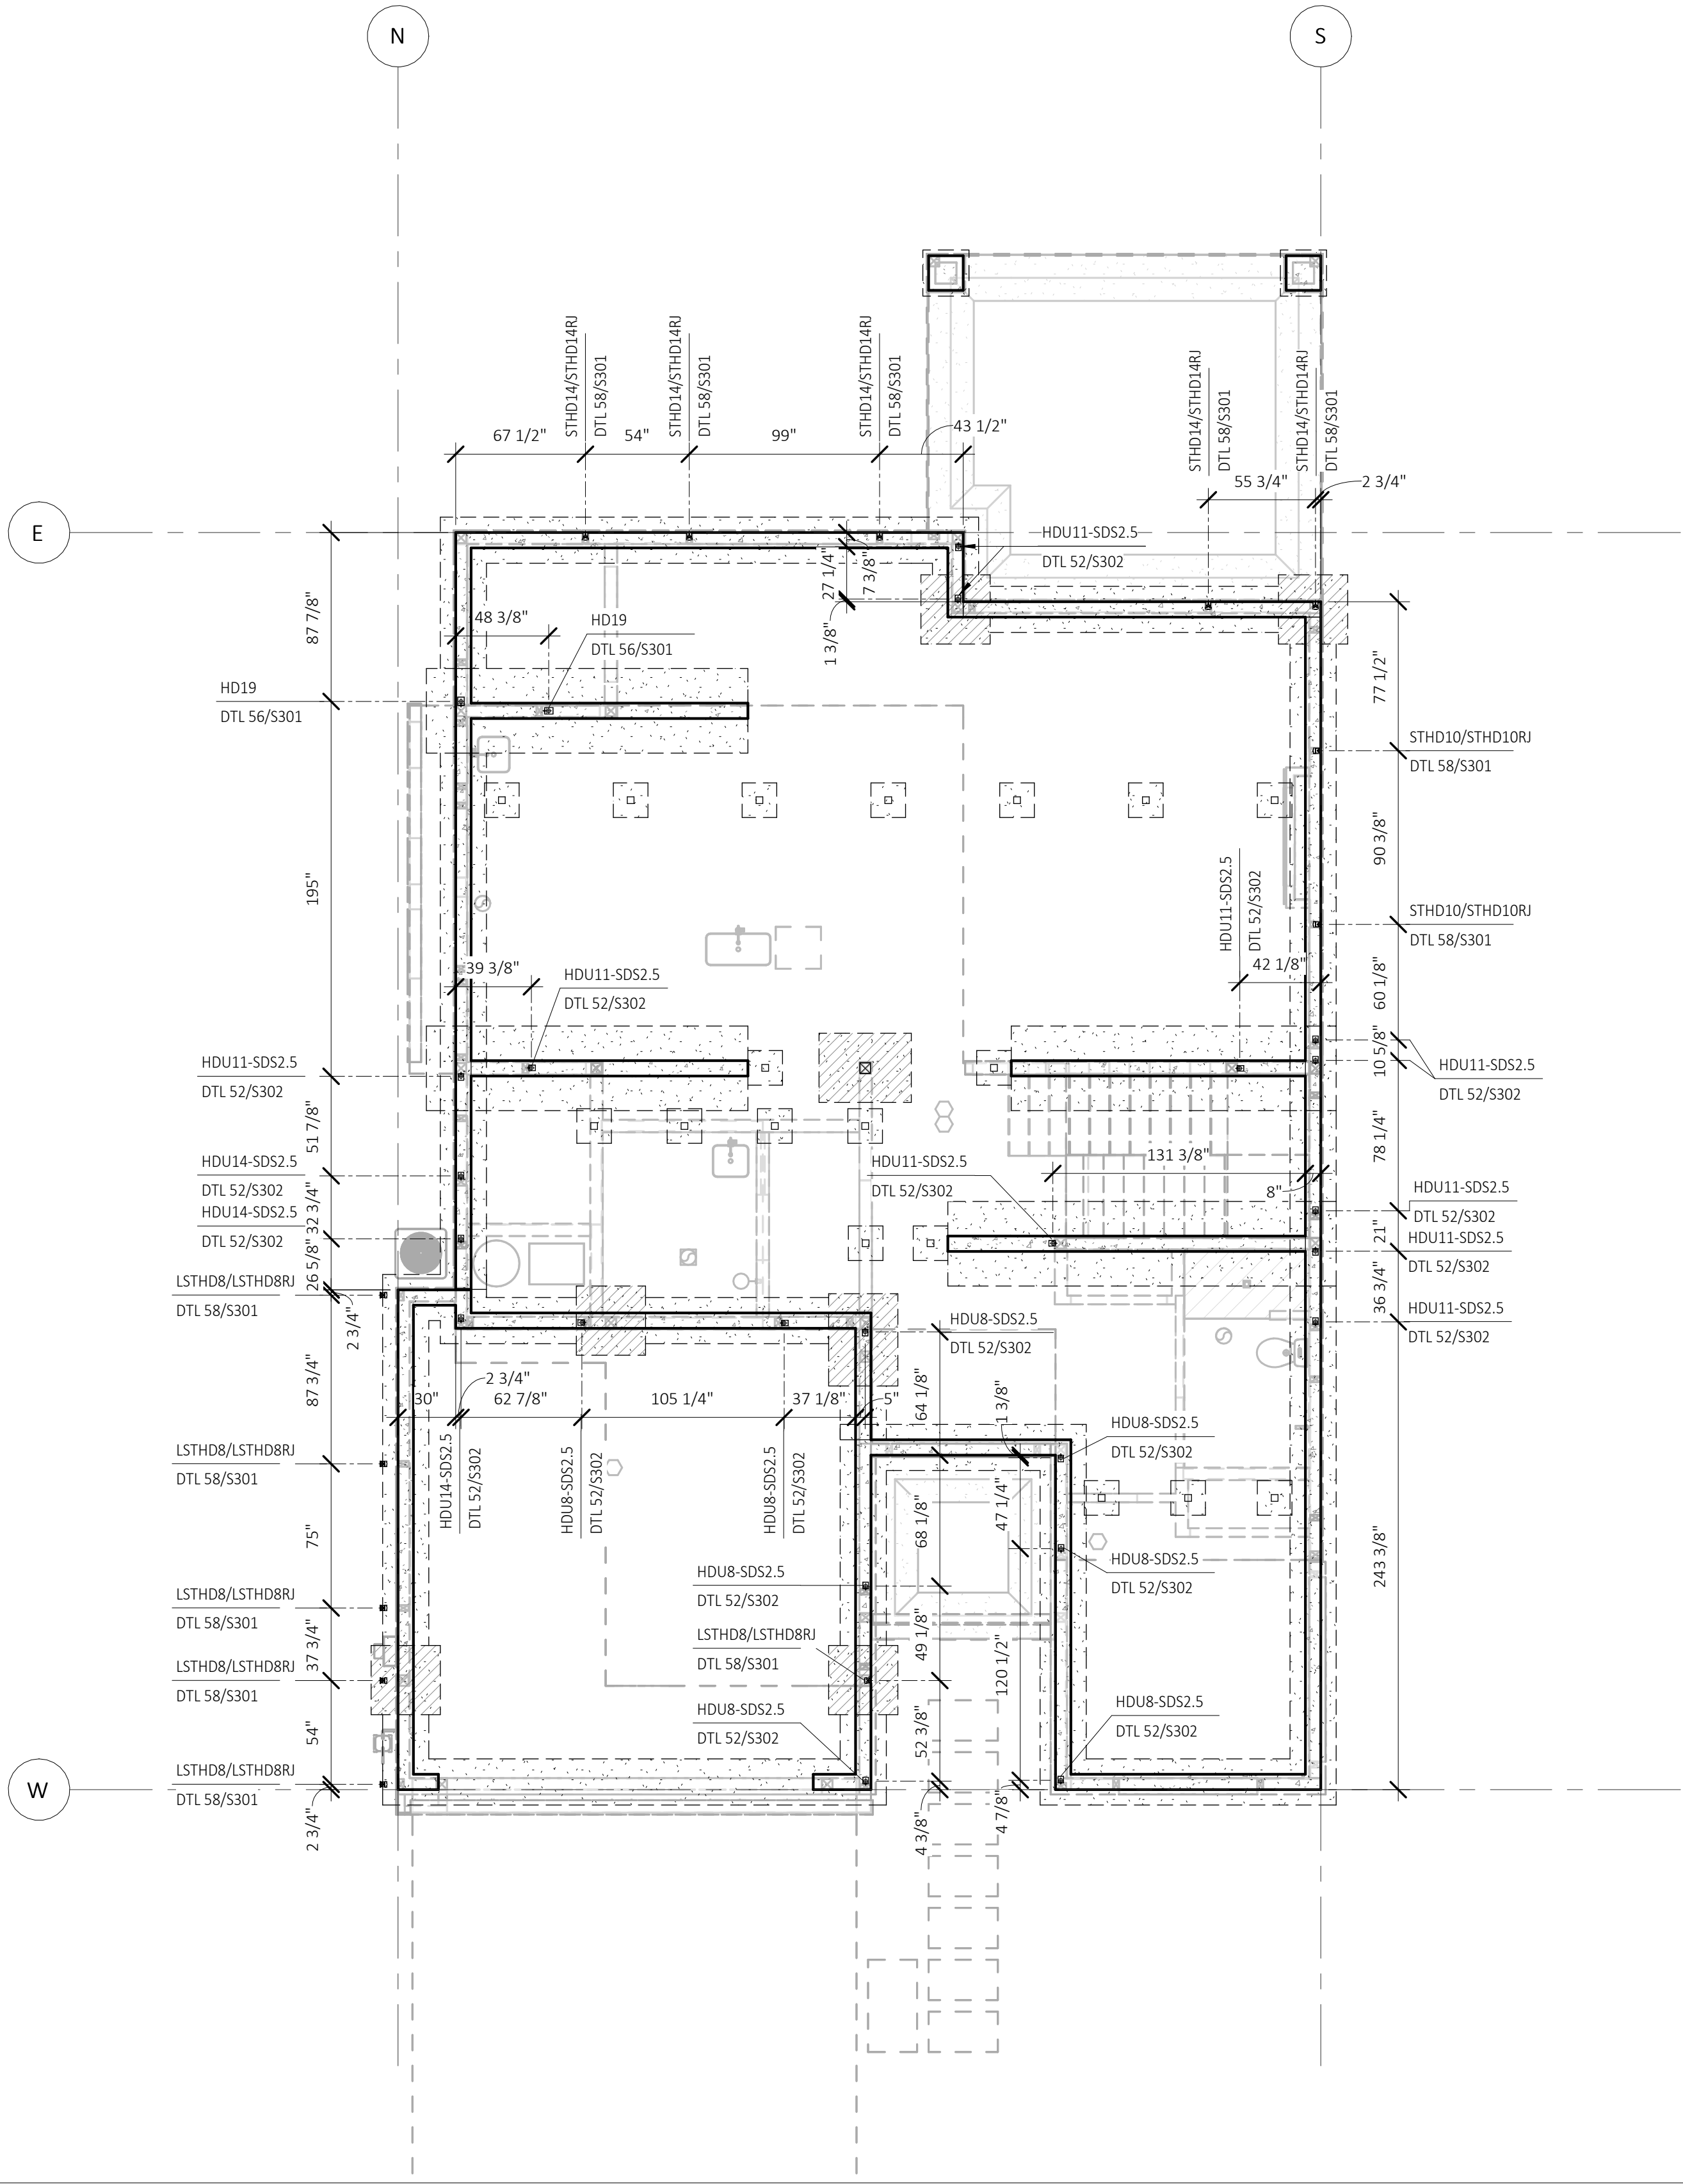

Description

Date

No.

L2 ENGINEERS

17848 NE 198TH PLAVE
WOODINVILLE, WA 98072

ATERA DESIGN STUDIO

451 DUVAL AVE NE,
RENTON, W A 98059

HU RESIDENCE

2448 72nd AVE SE, Mercer Island

PERMIT SET

FOUNDATION
HOLDDOWNS

PROJECT NO: 21014
ISSUE DATE: 2022/06/29
DRAWN BY: SPM

S201

SCALE 24X36: 3/16" = 1'-0"
* NOTE: 11X17 SETS ARE
REDUCED 50%; SCALE
DRAWINGS ACCORDINGLY.

COPYRIGHT
COPYRIGHT

Holdowns and Tension Tie SCHEDULE

TYPE	MIN END STUD	FASTENERS			DETAIL	Count	Manufacturer	ALLOWABLE UPLIFT (DF / HF)
		ANCHOR BOLT	NAILS/SCREWS	CONCRETE ANCHOR				
CS16-11"			(22) 10d		DTL 272/S303	4	Simpson Strong Tie or EQ.	1705 / --
CS14-15"			(30) 10d		DTL 272/S303	2	Simpson Strong Tie or EQ.	2490 / --
CMSTC16-20"			(58) 16d SINKER		DTL 272/S303	8	Simpson Strong Tie or EQ.	4960 / --
(2) HDU11-SDS2.5 2	4X	1"	(30) SDS 1/4"x2 1/2"		DTL 52/S302	2	Simpson Strong Tie or EQ.	9535 / --
FLOOR TO FLOOR								
LSTHD8/LSTHD8RJ	(2) 2X		(20) 0.148 X 3-1/4"		DTL 58/S301	6	Simpson Strong Tie or EQ.	1610 / --
STHD10/STHD10RJ	(2) 2X		(28) 0.148 X 3-1/4"		DTL 58/S301	2	Simpson Strong Tie or EQ.	2175 / --
STHD14/STHD14RJ	(2) 2X		(30) 0.148 X 3-1/4"		DTL 58/S301	5	Simpson Strong Tie or EQ.	3500 / --
HDU8-SDS2.5	4X6	7/8"	(20) SDS 1/4"x2 1/2"	PAB6	DTL 52/S302	8	Simpson Strong Tie or EQ.	7870 / 6580
HDU11-SDS2.5	4X8	1"	(30) SDS 1/4"x2 1/2"	PAB7	DTL 52/S302	11	Simpson Strong Tie or EQ.	11175 / 9610
HDU14-SDS2.5	6X6	1"	(36) SDS 1/4"x2 1/2"	PAB8	DTL 52/S302	3	Simpson Strong Tie or EQ.	14445 / 12425
HD19	6X6	1-1/4"	(5) 1" BOLTS	PAB10	DTL 56/S301	2	Simpson Strong Tie or EQ.	19070 / 16210
HOLDDOWN								
MSTC4883	(2) 2X		REF DETAIL		DTL 269/S303	9	Simpson Strong Tie or EQ.	3795 / 3900
MSTC6683Z	4X		REF DETAIL		DTL 269/S303	1	Simpson Strong Tie or EQ.	4490 / --
OVERHANG								

WOOD FRAMED SHEARWALL SCHEDULE


SHEARWALL TYPE	WALL SHT'G APA RATED	EDGE NAIL'G	BOT PLATE CONNECTION	FRAM'G CONNECTION AT WALL BELOW	MIN RIM THICKNESS	FRAM'G AT PANEL EDGES	BLK'G AT PANEL EDGES	P.T. 2X SILL		P.T. 3X SILL	
								ANCHOR BOLT	SHEAR CAPACITY (WIND/SEISMIC)	ANCHOR BOLT	SHEAR CAPACITY (WIND/SEISMIC)
sw6	15/32"	8D AT 6" O.C.	(2) ROWS 16D COMMON AT 6" O.C. STAGGERED	LPTS'S AT 18" O.C.	1-1/4"	2X	2X	5/8" DIA AT 48" O.C.	242 / 339	5/8" DIA AT 60" O.C.	242 / 339
sw4	15/32"	8D AT 4" O.C.	(2) ROWS 16D COMMON AT 6" O.C. STAGGERED	LPTS'S AT 12" O.C.	1-3/4"	3X OR (2) 2X	3X OR FLAT 2X	5/8" DIA AT 32" O.C.	353/495	5/8" DIA AT 40" O.C.	353/495
sw3	15/32"	8D AT 3" O.C.	(2) ROWS 16D COMMON AT 6" O.C. STAGGERED	LPTS'S AT 10" O.C.	1-3/4"	3X OR (2) 2X	3X OR FLAT 2X	5/8" DIA AT 24" O.C.	456 / 637	5/8" DIA AT 32" O.C.	456 / 637
sw2	15/32"	8D AT 2" O.C.	(2) ROWS 16D COMMON AT 4" O.C. STAGGERED	LPTS'S AT 6" O.C.	3-1/2"	3X OR (2) 2X	3X OR FLAT 2X	5/8" DIA AT 18" O.C.	595 / 832	5/8" DIA AT 24" O.C.	595 / 832
2sw4	15/32" BOTH SIDES	8D AT 4" O.C.	(3) ROWS 16D COMMON AT 6" O.C. STAGGERED	LPTS'S AT 5" O.C.	3-1/2"	3X	3X			5/8" DIA AT 24" O.C.	707 / 990
2sw3	15/32" BOTH SIDES	8D AT 3" O.C.	(3) ROWS 16D COMMON AT 4" O.C. STAGGERED	LPTS'S AT 8" O.C. AND A35 AT 8" O.C.	3-1/2"	3X	3X			5/8" DIA AT 16" O.C.	911 / 1274
2sw2	15/32" BOTH SIDES	8D AT 2" O.C.	(3) ROWS 16D COMMON AT 4" O.C. STAGGERED	LPTS'S AT 6" O.C. AND A35 AT 6" O.C.	3-1/2"	3X	3X			5/8" DIA AT 12" O.C.	1190 / 1469

SHEARWALL LEGEND:

- # SHEARWALL TAG: SEE SHEARWALL SCHEDULE AND STRUCTURAL NOTES ON THIS SHEET.
- ALL EXTERIOR WALLS TO BE SW6 SHEAR WALLS U.N.O.
- FOR WALL CONSTRUCTION FOR WALLS THAT EXTEND THRU WINDOWS SHEATH AND BELOW WINDOW & STRAP PER DETAIL ON SHEET D101
- INDICATES STRUCTURAL KEYNOTE FOR HOLDDOWN WITH INDEXED NUMBER. SEE STRUCTURAL KEYNOTE SCHEDULE THIS SHEET. SEE STRUCTURAL NOTES ON SHEET S101
- - - EXTENT OF SHEARWALL
- - - SHEARWALL BELOW

SHEAR WALL NOTES

1. ALL NAILS ARE COMMON. UNO. REFERENCE GENERAL STRUCTURAL NOTES FOR NAIL DIAMETER AND LENGTH. REFERENCE SHEAR WALL KEY DETAIL FOR DESCRIPTION OF TERMS.
2. PROVIDE SHEAR WALL SHEATHING AND NAILING FOR ENTIRE LENGTH OF THE WALLS INDICATED ON THE PLANS. ENDS OF SHEAR WALLS ARE TYPICALLY AT WINDOWS, DOORWAYS OR AS SHOWN ON PLAN.
3. EDGE NAILING IS REQUIRED AT ALL HOLDDOWN POSTS. EDGE NAILING IS REQUIRED TO EACH STUD USED IN BUILT-UP HOLDDOWN POSTS. REFERENCE HOLDDOWN SCHEDULE & DETAILS FOR ADDITIONAL INFORMATION.
4. INTERMEDIATE FRAMING TO BE 2x MINIMUM MEMBERS UNO IN SCHEDULE. ATTACH SHEATHING TO INTERMEDIATE FRAMING WITH EDGE NAILING AT 12" O.C. WHERE STUDS ARE SPACED AT 16" O.C. AND EDGE NAILING AT 6" O.C. WHERE STUDS ARE SPACED AT 24"
5. SIMPSON STRONG-TIE "A35" MAY BE USED IN LIEU OF "LTP5." "LT2P" CLIPS SHALL BE ORIENTED LENGTHWISE 1 (HORIZONTAL) AT PLATE TO RIM. USE 0.131" x 1" NAILS WHERE CLIPS ARE ATTACHED DIRECTLY TO FRAMING. USE Ø 2 1 0.131" x 2" WHERE CLIPS ARE INSTALLED OVER SHEATHING. Ø 2
6. (2) 2x STUDS NAILED TOGETHER MAY BE USED IN PLACE OF SINGLE 3x STUD. DOUBLE 2x STUDS SHALL BE SECURED TOGETHER WITH FASTENERS OF THE SAME DIAMETER AND SPACING AS THE BOTTOM PLATE ATTACHMENT PER SCHEDULE. WHERE SHEATHING IS APPLIED ON BOTH SIDES OF A SHEAR WALL AND NAIL SPACING IS LESS THAN 6" O.C. ON EITHER SIDE, THE WIDTH OF THE NAILED FACE OF THE FRAMING MEMBER SHALL BE 3" NOMINAL OR GREATER AT ADJOINING PANEL EDGES AND NAILS AT ALL PANEL EDGES SHALL BE STAGGERED. ALTERNATIVELY, PANELS SHALL BE STAGGERED SO THAT EDGE JOINTS ON OPPOSITE SIDES ARE NOT LOCATED ON THE SAME STUD.
7. ANCHOR BOLTS SHALL BE PROVIDED WITH MINIMUM 0.229" x 3" x 3" HOT-DIPPED GALVANIZED STEEL PLATE WASHERS PER DETAILS ON DRAWINGS. EMBED ANCHOR BOLTS 7" MINIMUM INTO THE CONCRETE PROVIDE AN ANCHOR BOLT AT EACH END OF EACH PLATE AND SHALL BE AT LEAST 7 TIMES THE ANCHOR BOLT DIAMETER FROM THE ENDS OF THE PLATE, BUT NOT MORE THAN 1 THE TABULATED ANCHOR BOLT SPACING OR 12", WHICHEVER IS LESS. SEE ANCHOR BOLT DETAIL FOR PLATE 2 5 WASHER REQUIREMENTS. [ALT: " 8 ØX8" TITEN HD ANCHOR SCREWS MAY BE USED IN LIEU OF ANCHOR BOLTS AT EXISTING CONCRETE, WITH PLATE WASHER & SPACING REQUIREMENTS PER SCHEDULE.]
8. PROVIDE HOT-DIPPED GALVANIZED NAILS AND CONNECTOR PLATES (FRAMING ANGLES, ETC.) AT ALL PRESSURE TREATED LUMBER. REFERENCE GENERAL STRUCTURAL NOTES FOR ADDITIONAL INFORMATION.
9. PANELS MAY BE INSTALLED HORIZONTALLY IF STUDS ARE SPACED AT 16" O.C. MAX.
10. STAGGER EDGE NAILING.
11. THE TOP EDGE OF THE WOOD STRUCTURAL PANEL SHALL BE ATTACHED TO THE UPPER TOP PLATE. ROOF OR UPPER LEVEL UPLIFT CONNECTORS SHALL BE ON THE SAME SIDE OF THE WALL AS THE SHEATHING.
12. THE BOTTOM EDGE OF THE WOOD STRUCTURAL PANEL SHALL EXTEND TO AND BE ATTACHED TO THE BOTTOM OR SILL PLATE. REFERENCE DETAIL BELOW FOR STAGGERED NAIL AND SCREW SPACING AT RIM BOARDS.
13. WALL TYPE ACCEPTABLE WITH TRUSIOIST AND BOISE CASCADE RIM JOIST AND BLOCKING.

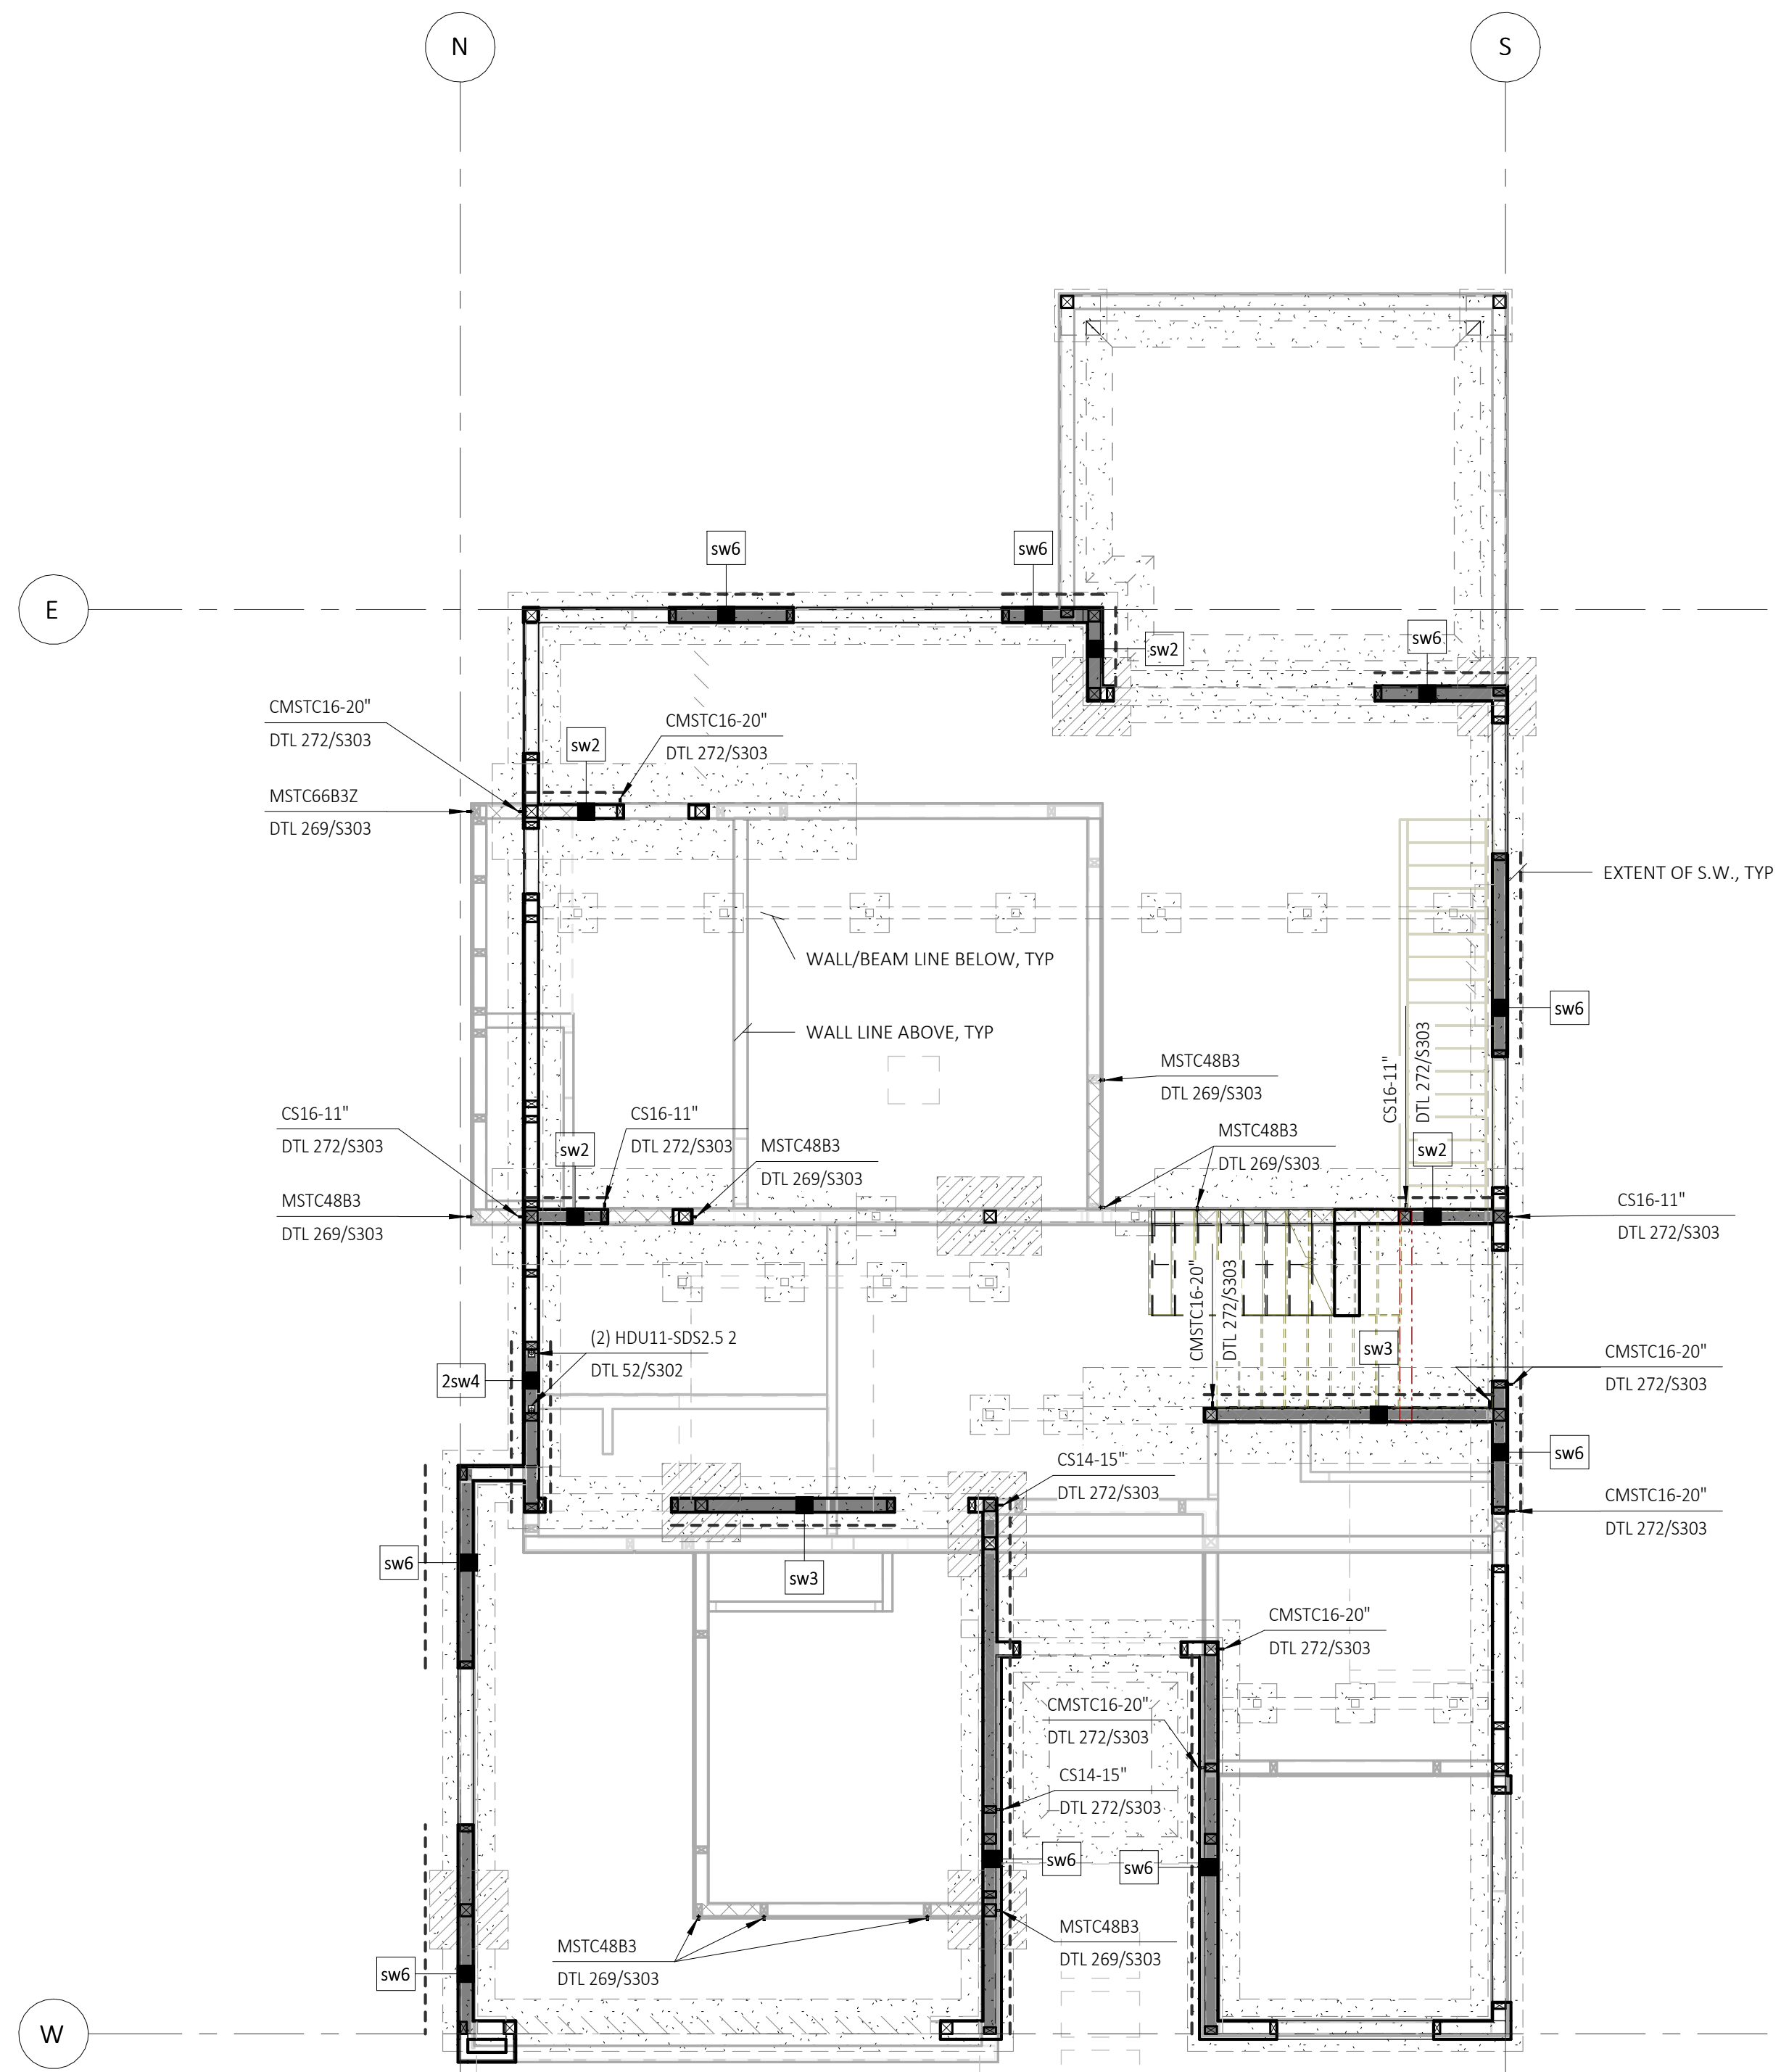


Description
Date
No.



L2 ENGINEERS
17848 NE 198TH PLAVE
WOODINVILLE, WA 98072

ATERA DESIGN STUDIO
451 DUVALL AVE. NE,
RENTON, W A 98059

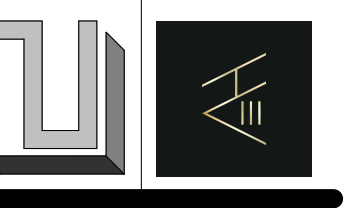

HU RESIDENCE
2448 72nd AVE SE, Mercer Island

PERMIT SET

MAIN FLOOR
SHEARWALLS &
UPPER FLOOR
HOLDDOWNS

PROJECT NO: 21014
ISSUE DATE: 2022/06/29
DRAWN BY: SPM

S202

SCALE 24X36: 3/16" = 1'-0"
* NOTE: 11x17 SETS ARE
REDUCED 50%; SCALE
DRAWINGS ACCORDINGLY.



COPYRIGHTS REMAIN THE PROPERTY OF ATERA DESIGN STUDIO. REPRODUCTION WITHOUT PERMISSION IS PROHIBITED.

Holdowns and Tension Tie SCHEDULE

TYPE	MIN END STUD	FASTENERS			DETAIL	Count	Manufacturer	ALLOWABLE UPLIFT (DF / HF)
		ANCHOR BOLT	NAILS/SCREWS	CONCRETE ANCHOR				
CS16-11"			(22) 10d		DTL 272/S303	4	Simpson Strong Tie or EQ.	1705 / --
CS14-15"			(30) 10d		DTL 272/S303	2	Simpson Strong Tie or EQ.	2490 / --
CMSTC16-20"			(58) 16d SINKER		DTL 272/S303	8	Simpson Strong Tie or EQ.	4960 / --
(2) HDU11-SDS2.5 2	4X	1"	(30) SDS 1/4"x2 1/2"		DTL 52/S302	2	Simpson Strong Tie or EQ.	9535 / --
FLOOR TO FLOOR								
LSTHD8/LSTHD8RJ	(2) 2X		(20) 0.148 X 3-1/4"		DTL 58/S301	6	Simpson Strong Tie or EQ.	1610 / --
STHD10/STHD10RJ	(2) 2X		(28) 0.148 X 3-1/4"		DTL 58/S301	2	Simpson Strong Tie or EQ.	2175 / --
STHD14/STHD14RJ	(2) 2X		(30) 0.148 X 3-1/4"		DTL 58/S301	5	Simpson Strong Tie or EQ.	3500 / --
HDU8-SDS2.5	4X6	7/8"	(20) SDS 1/4"x2 1/2"	PAB6	DTL 52/S302	8	Simpson Strong Tie or EQ.	7870 / 6580
HDU11-SDS2.5	4X8	1"	(30) SDS 1/4"x2 1/2"	PAB7	DTL 52/S302	11	Simpson Strong Tie or EQ.	11175 / 9610
HDU14-SDS2.5	6X6	1"	(36) SDS 1/4"x2 1/2"	PAB8	DTL 52/S302	3	Simpson Strong Tie or EQ.	14445 / 12425
HD19	6X6	1-1/4"	(5) 1" BOLTS	PAB10	DTL 56/S301	2	Simpson Strong Tie or EQ.	19070 / 16210
HOLDDOWN								
MSTC48B3	(2) 2X		REF DETAIL		DTL 269/S303	9	Simpson Strong Tie or EQ.	3795 / 3900
MSTC68B3Z	4X		REF DETAIL		DTL 269/S303	1	Simpson Strong Tie or EQ.	4490 / --
OVERHANG								

WOOD FRAMED SHEARWALL SCHEDULE


SHEARWALL TYPE	WALL SHT'G APA RATED	EDGE NAIL'G	BOT PLATE CONNECTION	FRAM'G CONNECTION AT WALL BELOW	MIN RIM THICKNESS	FRAM'G AT PANEL EDGES	BLK'G AT PANEL EDGES	P.T. 2X SILL		P.T. 3X SILL	
								ANCHOR BOLT	SHEAR CAPACITY (WIND/SEISMIC)	ANCHOR BOLT	SHEAR CAPACITY (WIND/SEISMIC)
sw6	15/32"	8D AT 6" O.C.	(2) ROWS 16D COMMON AT 6" O.C. STAGGERED	LPTS'S AT 18" O.C.	1-1/4"	2X	2X	5/8" DIA AT 48" O.C.	242 / 339	5/8" DIA AT 60" O.C.	242 / 339
sw4	15/32"	8D AT 4" O.C.	(2) ROWS 16D COMMON AT 6" O.C. STAGGERED	LPTS'S AT 12" O.C.	1-3/4"	3X OR (2) 2X	3X OR FLAT 2X	5/8" DIA AT 32" O.C.	353/495	5/8" DIA AT 40" O.C.	353/495
sw3	15/32"	8D AT 3" O.C.	(2) ROWS 16D COMMON AT 6" O.C. STAGGERED	LPTS'S AT 10" O.C.	1-3/4"	3X OR (2) 2X	3X OR FLAT 2X	5/8" DIA AT 24" O.C.	456 / 637	5/8" DIA AT 32" O.C.	456 / 637
sw2	15/32"	8D AT 2" O.C.	(2) ROWS 16D COMMON AT 4" O.C. STAGGERED	LPTS'S AT 6" O.C.	3-1/2"	3X OR (2) 2X	3X OR FLAT 2X	5/8" DIA AT 18" O.C.	595 / 832	5/8" DIA AT 24" O.C.	595 / 832
2sw4	15/32" BOTH SIDES	8D AT 4" O.C.	(3) ROWS 16D COMMON AT 6" O.C. STAGGERED	LPTS'S AT 5" O.C.	3-1/2"	3X	3X	5/8" DIA AT 24" O.C.	707 / 990	5/8" DIA AT 32" O.C.	707 / 990
2sw3	15/32" BOTH SIDES	8D AT 3" O.C.	(3) ROWS 16D COMMON AT 4" O.C. STAGGERED	LPTS'S AT 8" O.C. AND A35 AT 8" O.C.	3-1/2"	3X	3X	5/8" DIA AT 16" O.C.	911 / 1274	5/8" DIA AT 24" O.C.	911 / 1274
2sw2	15/32" BOTH SIDES	8D AT 2" O.C.	(3) ROWS 16D COMMON AT 4" O.C. STAGGERED	LPTS'S AT 6" O.C. AND A35 AT 6" O.C.	3-1/2"	3X	3X	5/8" DIA AT 12" O.C.	1190 / 1469	5/8" DIA AT 12" O.C.	1190 / 1469

SHEARWALL LEGEND:

- # SHEARWALL TAG: SEE SHEARWALL SCHEDULE AND STRUCTURAL NOTES ON THIS SHEET.
 - ALL EXTERIOR WALLS TO BE SW6 SHEAR WALLS U.N.O.
 - FOR WALL CONSTRUCTION FOR WALLS THAT EXTEND THRU WINDOWS SHEATH ABV AND BELOW WINDOW & STRAP PER DETAL ON SHEET D101
- HHDN INDICATES STRUCTURAL KEYNOTE FOR HOLDOWN WITH INDEXED NUMBER. SEE STRUCTURAL KEYNOTE SCHEDULE THIS SHEET. SEE STRUCTURAL NOTES ON SHEET S101
- DET #/# -- -- EXTENT OF SHEARWALL
- SHEARWALL BELOW

SHEAR WALL NOTES

1. ALL NAILS ARE COMMON. UNO. REFERENCE GENERAL STRUCTURAL NOTES FOR NAIL DIAMETER AND LENGTH. REFERENCE SHEAR WALL KEY DETAIL FOR DESCRIPTION OF TERMS.
2. PROVIDE SHEAR WALL SHEATHING AND NAILING FOR ENTIRE LENGTH OF THE WALLS INDICATED ON THE PLANS. ENDS OF SHEAR WALLS ARE TYPICALLY AT WINDOWS, DOORWAYS OR AS SHOWN ON PLAN.
3. EDGE NAILING IS REQUIRED AT ALL HOLDDOWN POSTS. EDGE NAILING IS REQUIRED TO EACH STUD USED IN BUILT-UP HOLDDOWN POSTS. REFERENCE HOLDDOWN SCHEDULE & DETAILS FOR ADDITIONAL INFORMATION.
4. INTERMEDIATE FRAMING TO BE 2x MINIMUM MEMBERS UNO IN SCHEDULE. ATTACH SHEATHING TO INTERMEDIATE FRAMING WITH EDGE NAILING AT 12"OC WHERE STUDS ARE SPACED AT 16"OC AND EDGE NAILING AT 6"OC WHERE STUDS ARE SPACED AT 24"
5. SIMPSON STRONG-TIE "A35" MAY BE USED IN LIEU OF "LTP5." "LTP5" CLIPS SHALL BE ORIENTED LENGTHWISE 1 (HORIZONTAL) AT PLATE TO RIM. USE 0.131" x 1" NAILS WHERE CLIPS ARE ATTACHED DIRECTLY TO FRAMING. USE Ø 2 1/8" x 2 WHERE CLIPS ARE INSTALLED OVER SHEATHING. Ø 2
6. (2) 2x STUDS NAILED TOGETHER MAY BE USED IN PLACE OF SINGLE 3x STUD. DOUBLE 2x STUDS SHALL BE SECURED TOGETHER WITH FASTENERS OF THE SAME DIAMETER AND SPACING AS THE BOTTOM PLATE ATTACHMENT PER SCHEDULE. WHERE SHEATHING IS APPLIED ON BOTH SIDES OF A SHEAR WALL AND NAIL SPACING IS LESS THAN 6"OC ON EITHER SIDE, THE WIDTH OF THE NAILED FACE OF THE FRAMING MEMBER SHALL BE 3" NOMINAL OR GREATER AT ADJOINING PANEL EDGES AND NAILS AT ALL PANEL EDGES SHALL BE STAGGERED. ALTERNATIVELY, PANELS SHALL BE STAGGERED SO THAT EDGE JOINTS ON OPPOSITE SIDES ARE NOT LOCATED ON THE SAME STUD.
7. ANCHOR BOLTS SHALL BE PROVIDED WITH MINIMUM 0.229" x 3" x 3" HOT-DIPPED GALVANIZED STEEL PLATE WASHERS PER DETAILS ON DRAWINGS. EMBED ANCHOR BOLTS 7" MINIMUM INTO THE CONCRETE PROVIDE AN ANCHOR BOLT AT EACH END OF EACH PLATE AND SHALL BE AT LEAST 7 TIMES THE ANCHOR BOLT DIAMETER FROM THE ENDS OF THE PLATE, BUT NOT MORE THAN 1 THE TABULATED ANCHOR BOLT SPACING OR 12", WHICHEVER IS LESS. SEE ANCHOR BOLT DETAIL FOR PLATE 2 5 WASHER REQUIREMENTS. [ALT: " 8 ØX8" TITEN HD ANCHOR SCREWS MAY BE USED IN LIEU OF ANCHOR BOLTS AT EXISTING CONCRETE, WITH PLATE WASHER & SPACING REQUIREMENTS PER SCHEDULE.]
8. PROVIDE HOT-DIPPED GALVANIZED NAILS AND CONNECTOR PLATES (FRAMING ANGLES, ETC.) AT ALL PRESSURE TREATED LUMBER. REFERENCE GENERAL STRUCTURAL NOTES FOR ADDITIONAL INFORMATION.
9. PANELS MAY BE INSTALLED HORIZONTALLY IF STUDS ARE SPACED AT 16"OC MAX.
10. STAGGER EDGE NAILING.
11. THE TOP EDGE OF THE WOOD STRUCTURAL PANEL SHALL BE ATTACHED TO THE UPPER TOP PLATE. ROOF OR UPPER LEVEL UPLIFT CONNECTORS SHALL BE ON THE SAME SIDE OF THE WALL AS THE SHEATHING.
12. THE BOTTOM EDGE OF THE WOOD STRUCTURAL PANEL SHALL EXTEND TO AND BE ATTACHED TO THE BOTTOM OR SILL PLATE. REFERENCE DETAIL BELOW FOR STAGGERED NAIL AND SCREW SPACING AT RIM BOARDS.
13. WALL TYPE ACCEPTABLE WITH TRUSJOIST AND BOISE CASCADE RIM JOIST AND BLOCKING.

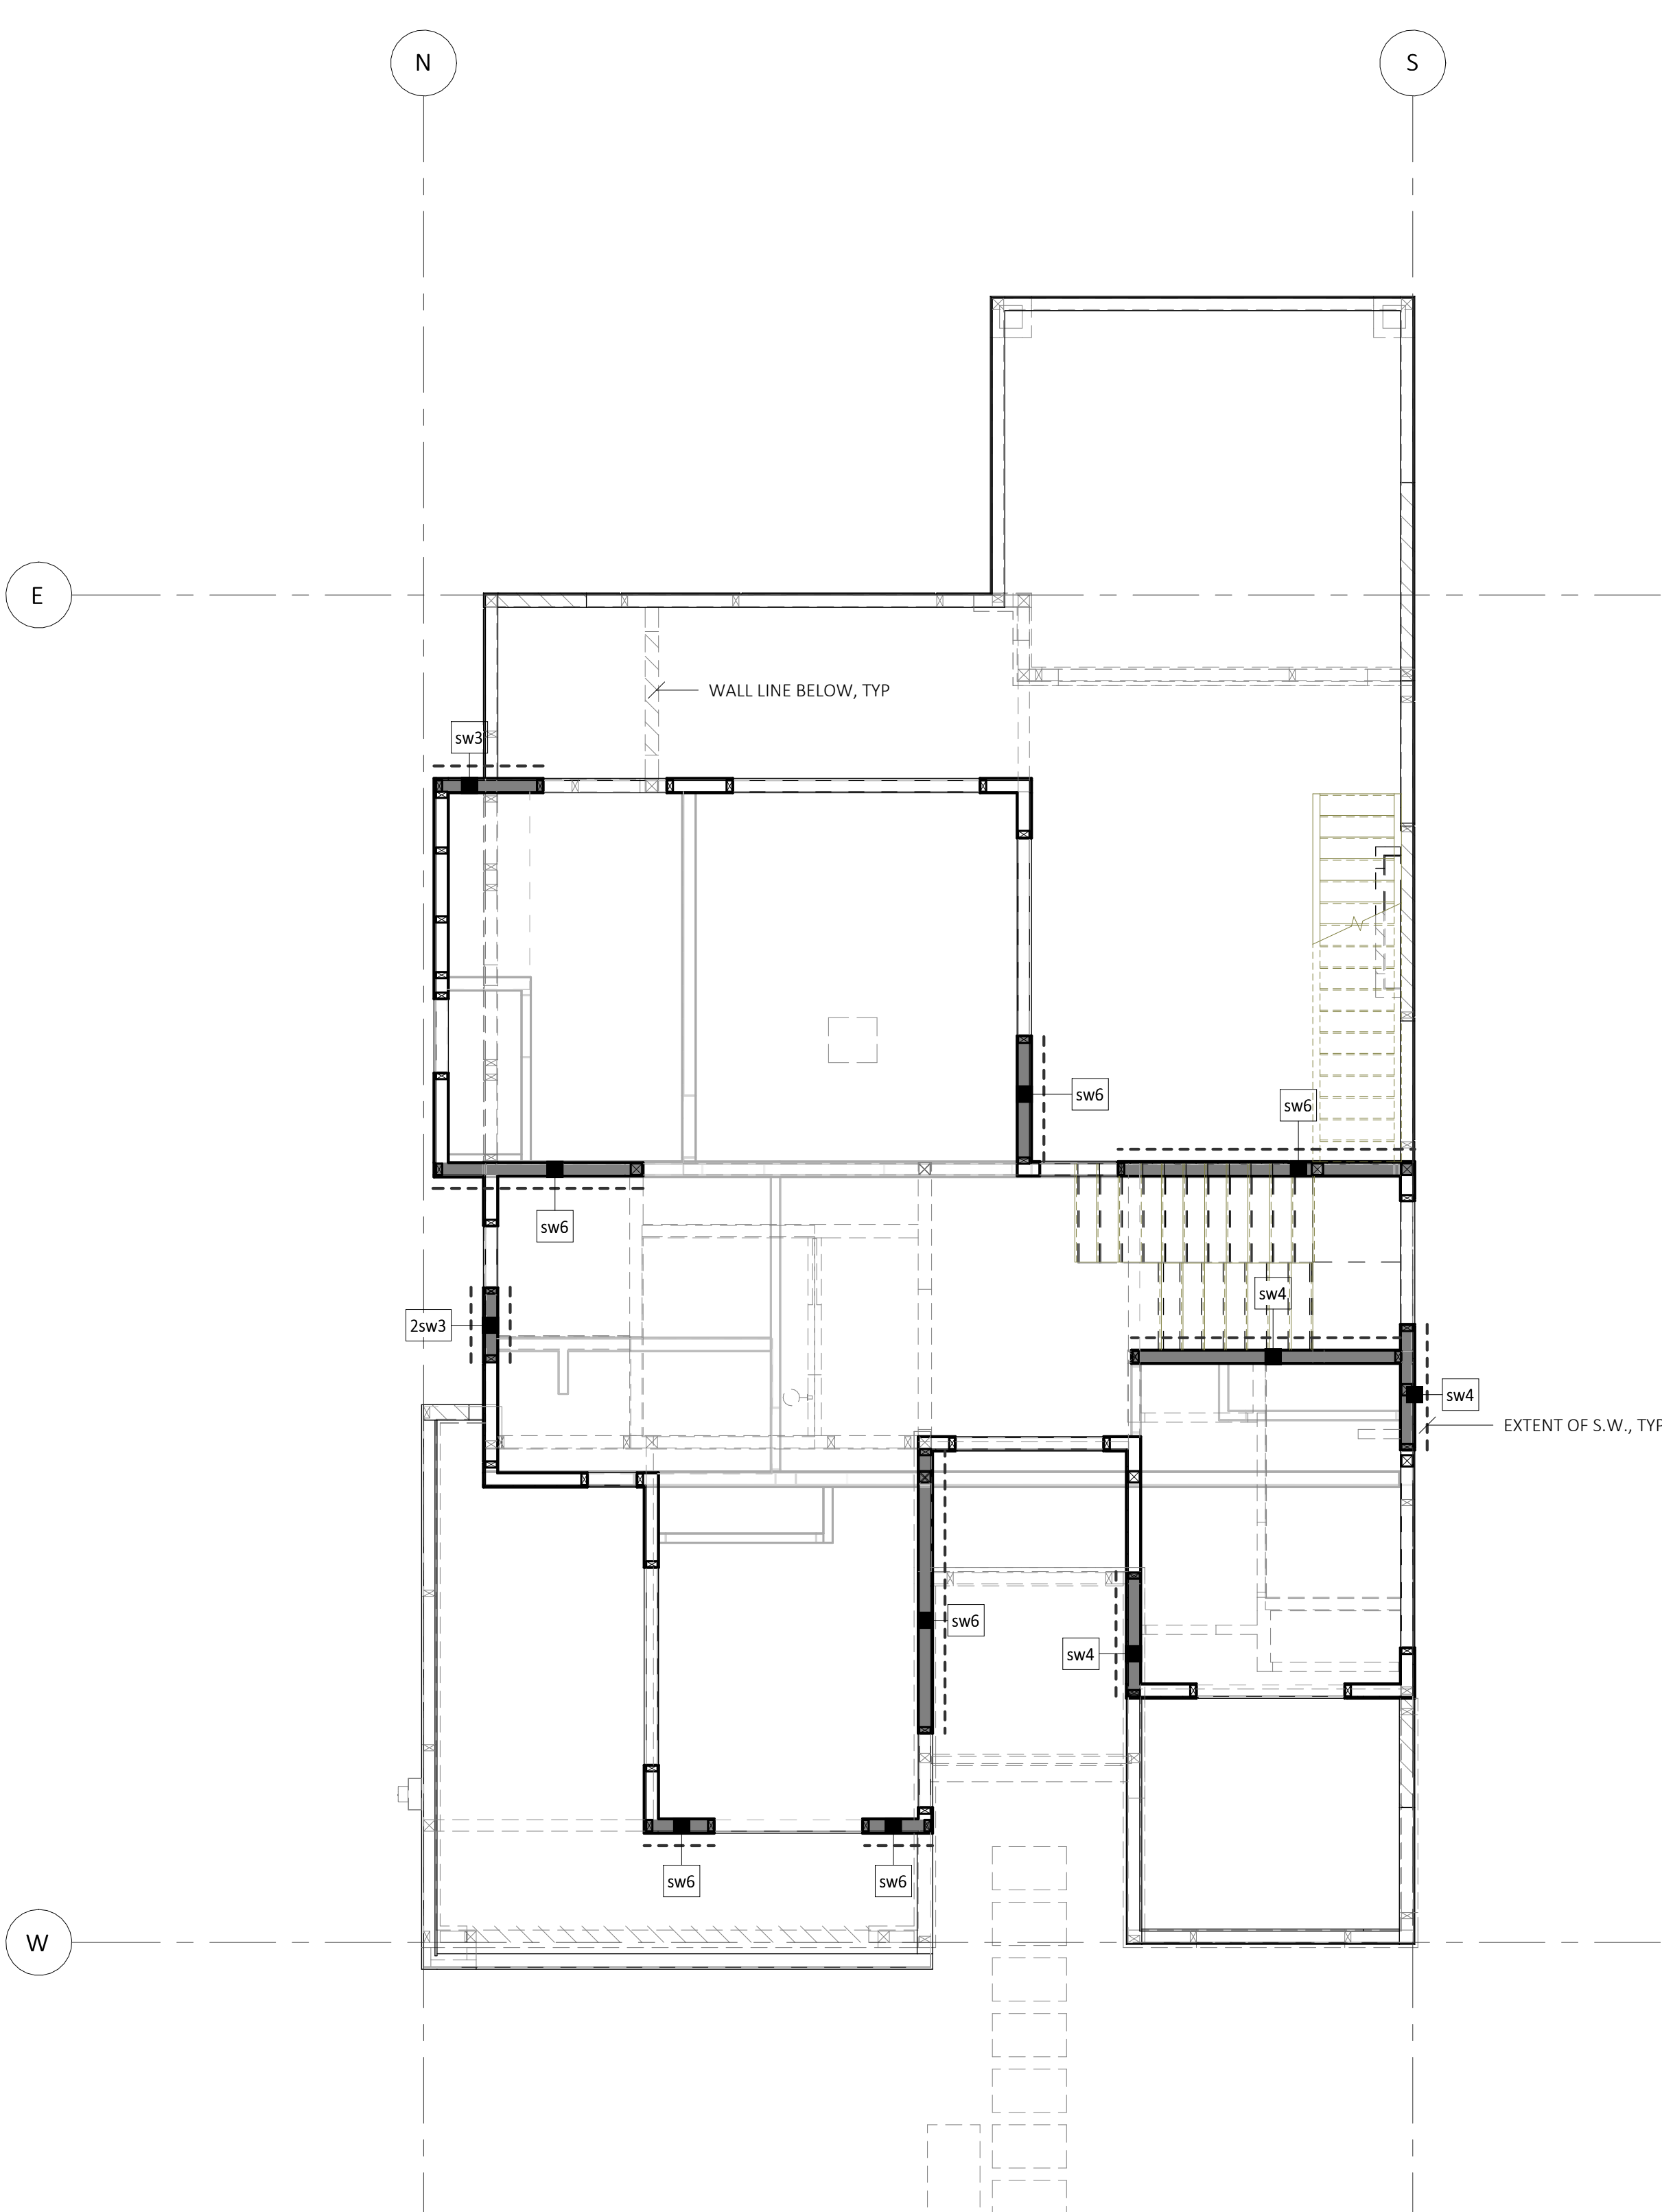

Description

Date


No.



01/13/2023

L2 ENGINEERS
17848 NE 198TH PLAVE
WOODINVILLE, WA 98072

ATERA DESIGN STUDIO
451 DUVAL AVE NE,
RENTON, W A 98059

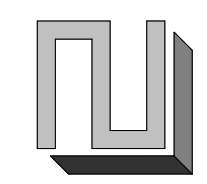

HU RESIDENCE

2448 72nd AVE SE, Mercer Island

PERMIT SET

UPPER FLOOR
SHEARWALLS

PROJECT NO: 21014
ISSUE DATE: 2022/06/29
DRAWN BY: SPM


S203

SCALE 24X36: 3/16" = 1'-0"
* NOTE: 11X17 SETS ARE REDUCED 50% SCALE DRAWINGS ACCORDINGLY.



LSTHD/STHD

Strap-Tie Holdowns (cont.)

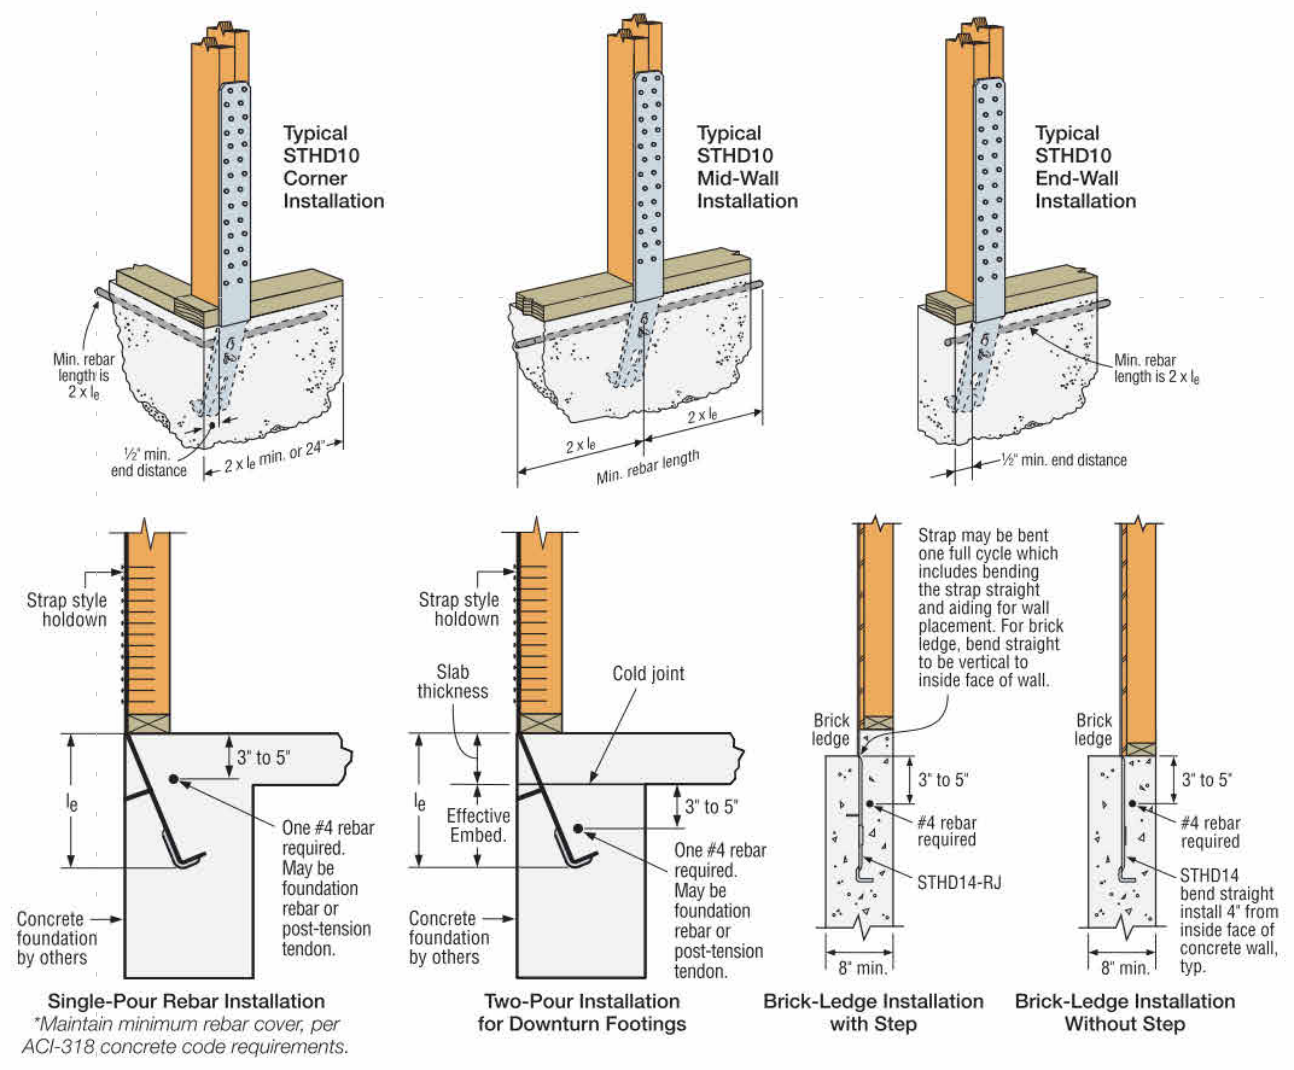

StrapMate® Strap Holder

The StrapMate is designed to keep the STHD and LSTHD straps vertically aligned during the concrete pour to minimize possibility of spalling. The friction fit allows for quick and easy installation.

Table with 2 columns: Model No., Nails (in.)


LSTHD/STHD

Strap-Tie Holdowns (cont.)

Table titled 'Tension Loads for STHD Installations' with columns for Model No., Strap Length (in.), Lc (in.), Required Nails (n), and various load values.

- 1. Allowable loads have been increased for wind or earthquake loading with no further increase allowed. Reduce where other loads govern.
2. Concrete shall have a minimum compressive strength of Fc = 2,000 psi.

Spall Reduction System for STHD Holdown

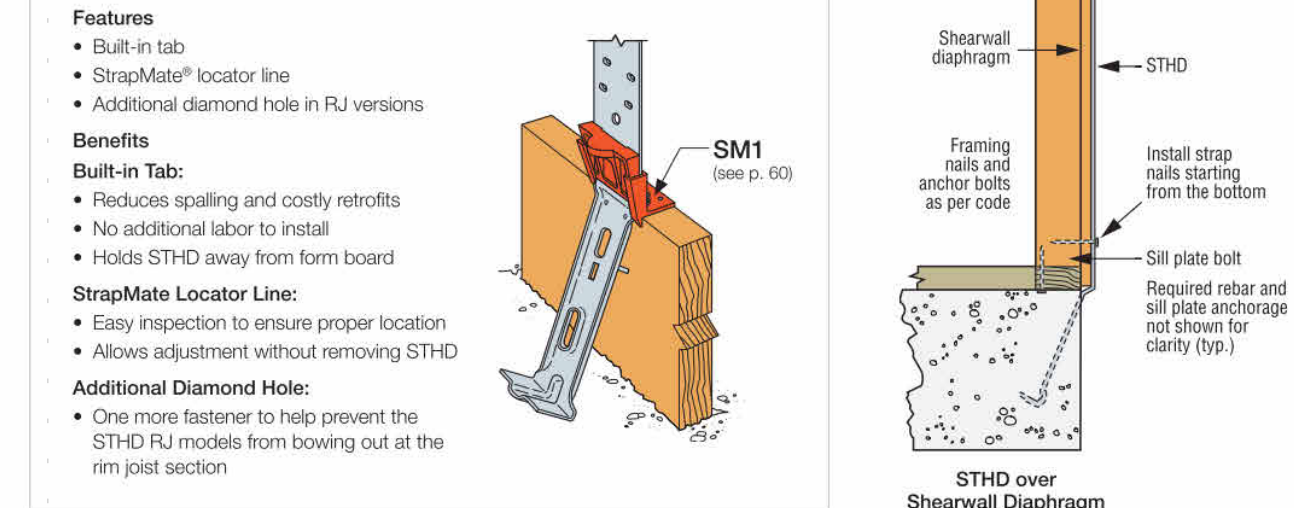


HDB/HD

Holdowns

Simpson Strong-Tie offers a wide variety of bolted holdowns offering low-deflection performance for a range of load requirements. The HD3B is a light-duty holddown designed for use in shearnails and braced-wall panels, as well as other lateral applications.

- Material: See table
Finish: HD3B/HD7B/HD7B/HD9B — Galvanized
HD — Simpson Strong-Tie gray paint, HDG available.



Codes: See p. 11 for Code Reference Key Chart

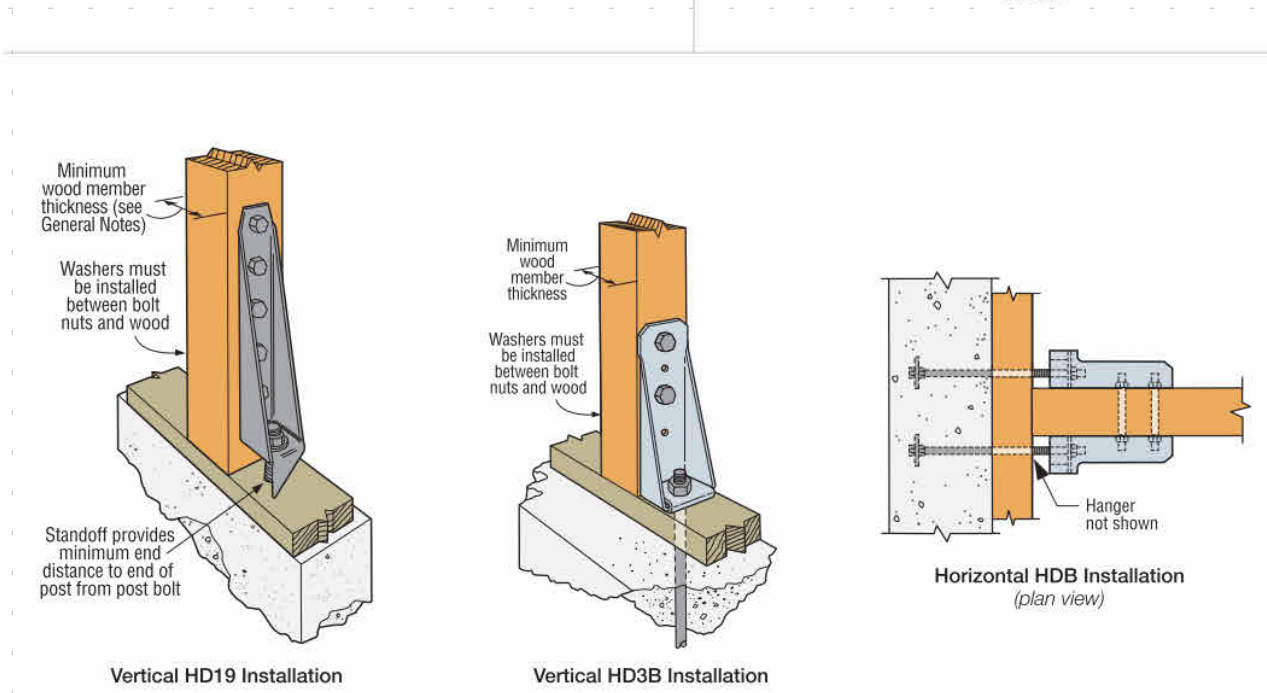

General Information and Notes

Holdowns and tension ties represent key components that comprise a continuous load path. In light-frame construction, holdowns are typically used to resist uplift due to shearnail overturning or wind uplift forces. In paneled roof construction, holdowns are used to anchor the concrete or masonry walls to the roof framing.

Holdowns can be separated into two categories — post-installed or cast-in-place. Cast-in-place holdowns, such as the STHD holdowns or the PA purin anchors are installed at the time of concrete placement and attached to wood framing with nails.

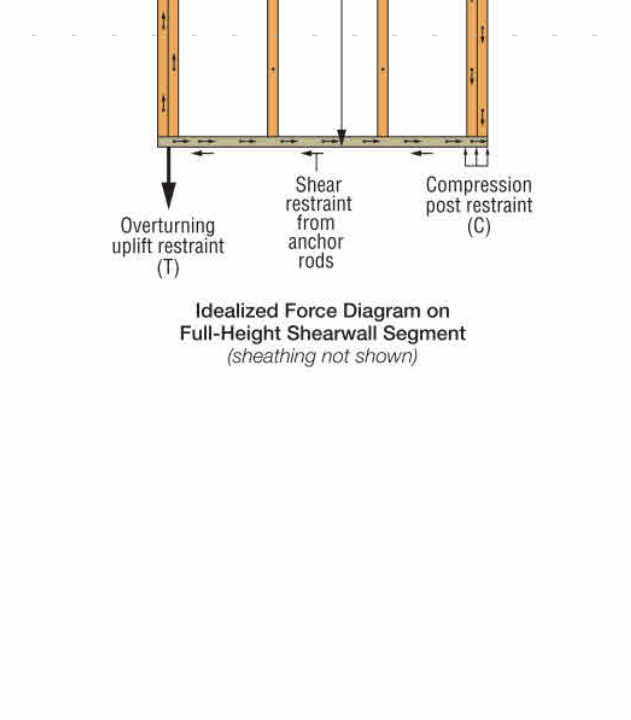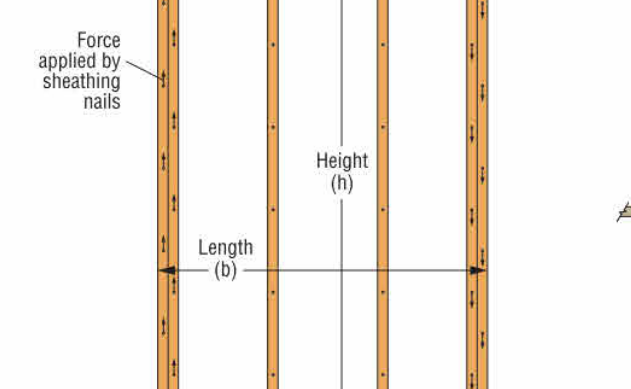

After the concrete has been placed, post-installed holdowns are attached to anchor bolts during wall framing. They are attached to the wood framing with nails. Strong Drive® SD Connector screws and Strong-Drive SDS Heavy-Duty Connector screws or bolts. Post-installed holdowns have allowable loads ranging from about 850 lb. up to nearly 20,000 lb.

The Post-to-Foundation Designer is a quick way to specify a holddown and the applicable anchorage to meet your project design requirements. Visit app.strongtie.com/pfd

Software interface for Post-to-Foundation Designer and Site-Built Shearwall Designer.

HDB/HD

Holdowns (cont.)

Table with columns for Model No., Material, Dimensions (in.), Fasteners (in.), Minimum Wood Member Size (in.), Allowable Tension Loads (lb), and Deflection at Highest Allowable Load.

- 1. To achieve published loads, machine bolts shall be installed with the nut on the opposite side of the holddown.
2. All references to bolts are for structural quality through bolts (not lag screws or carriage bolts) equal to or better than ASTM A307, Grade 3.

General Information and Notes (cont.)

Holddown and Tension Tie General Notes:

- a. Allowable loads have been increased for earthquake or wind load durations with no further increase allowed. Reduce where other loads govern.
b. To obtain LPFD values for cast-in-place holdowns (STHD and PA), multiply ASD seismic load values by 1.43 and wind load values by 1.67.

HU RESIDENCE

2448 72nd AVE SE, Mercer Island

PERMIT SET

SIMPSON HOLDOWN & TENSION TIES STANDARD DTLS

PROJECT NO: 21014
ISSUE DATE: 2022/06/29
DRAWN BY: SPM

S301

SCALE 24X36:
NOTE: 11X17 SETS ARE REDUCED 50% SCALE DRAWINGS ACCORDINGLY.

NOTE: THIS IS A STANDARD DETAIL SHEET PREPARED FOR SINGLE FAMILY HOUSING TYPE V NONRATED CONSTRUCTION. THESE DETAILS HAVE BEEN PREPARED TO COVER GENERAL CONSTRUCTION CONDITIONS. NOT ALL DETAILS ON THIS SHEET ARE NECESSARILY INCORPORATED INTO THIS PROJECT. COORDINATE WITH PLANS.

Description

No.

Date



L2 ENGINEERS
17848 NE 198TH PLACE
WOODINVILLE, WA 98072
ATERA DESIGN STUDIO
451 DUVALL AVE NE
RENTON, WA 98059

