





2S DESIGN 5454 DELRIDGE WAY SW, SEATTLE TEL.(206) 778-1032 WWW.2SDESIGNBUILD.COM



CONTACT@GODESIGN.STUDIO WWW.GODESIGN.STUDIO TEL.: (425) 595-0691

KAHN RESIDENCE

4205 85TH AVE SE, MERCER ISLAND, WA 98040

THE STATE OF THE S

LOWER FLOOR PLAN

A1. CODE NOTES

A1.1.SITE PLAN

A2. (E) LOWER FLOOR PLAN A3. (E) MAIN FLOOR PLAN

A5. (P) MAIN FLOOR PLAN

A6. (P) ARCH. ROOF PLAN

A7. (E) ELEVATIONS

A8. (P) ELEVATIONS

A8.1(P) ELEVATIONS

A9. (P) SECTION

DECK

D1. STANDARD DETAILS


1,722 SF LOWER FLOOR _<u>1,862</u>_sf/ MAIN FLOOR 3,584 SF TOTAL 562 SF CARPORT 24 SF PORCH 324 SF PATIO

299 SF


S1.1. STRUCTURAL NOTES S1.2. FOUNDATION PLAN S1.3. LOWER FLOOR WALL PLAN S1.4. MAIN FLOOR FRAMING PLAN A4. (P) LOWER FLOOR PLAN S1.5. MAIN FLOOR WALL PLAN S1.6. ROOF FRAMING PLAN S2.1. STRUCTURAL DETAILS S2.2. STRUCTURAL DETAILS S3.1. STRUCTURAL DETAILS S3.2. STRUCTURAL DETAILS S3.3. STRUCTURAL DETAILS S3.4. STRUCTURAL DETAILS

ADDITIONAL SQ FTG LOWER FLOOR +0_SF +0 SF MAIN FLOOR +0_sf TOTAL +0 sF (N)ATTACHED GÁRAGE

(E)CAR PORT

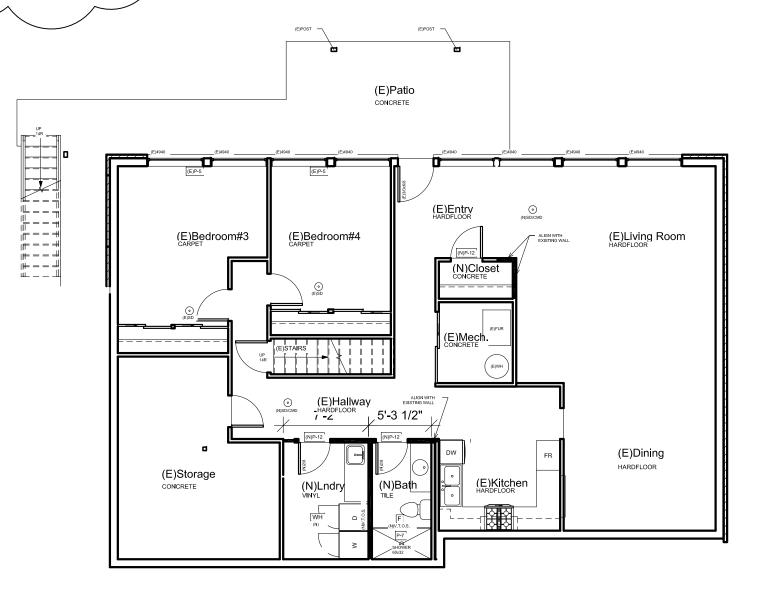

PROPOSED LOWER FLOOR PLAN

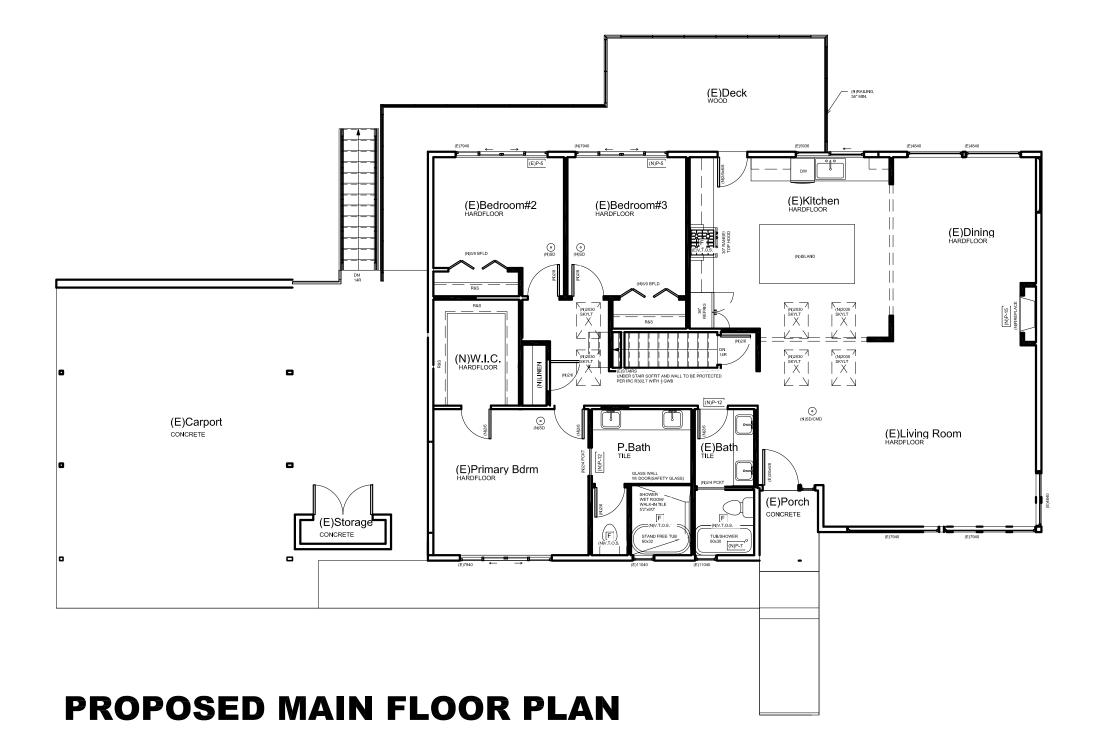

KAHN RESIDENCE

KAHN MICHAEL A

4205 85th AVE SE, MERCER ISLAND, WA 98040

writing	from 2SDESIG	N BUILD, Inc.
\triangle	DATE	DESCRIPTION

#22001

DRAWN BY: 2S DESIGN

COVER SHEET

1CS

01002 MISCELLANEOUS ASSEMBLY REQUIREMENTS CONT. 12. Prefabricated Fireplaces and Solid Fuel Burning Appliances per I.M.C. and I.R.C. Chapter 101; A) Solid fuel burning appliances include airtight stoves, fireplace stoves, room heaters/fireplace stoves, factory built fireplaces, and fireplace inserts, and all shall comply with the provisions of I.M.C. B) Metal Chimneys shall be enclosed above the story in which the appliance served is located, in walls having one hour fire resistance rating, and with a space on all sides between chimney and enclosing walls sufficient for examination and repair for entire chimney. Walls shall be without openings per I.M.C C) Provide fireblocking at chimney per I.R.C. section R302.11) Install metal fireplace with hearth and surrounds per manufacturers specifications. E) Prefabricated fireplaces, chimneys, and related components to bear U.L. or ICBO seal of approval and be installed per manufacturers requirements. 13. Fireblocking per I.R.C. sections R302.11 01060 REGULATORY REQUIREMENTS . All construction shall conform to the 2018 International Residential Code (I.R.C.), 2018 International Building Code (I.B.C.), 2018 International Fire Code (I.F.C.) 2018 International Mechanical Code (I.M.C.), 2018 Uniform Plumbing Code (U.P.C.) 2018 Washington State Energy Code (W.S.E.C.) and be in accordance with all State Laws and Regulations and various codes mposed by jurisdictional requirements and local authorities. Arrangé inspections that are mandatory due to jurisdictional requirements. 01500 CONSTRUCTION FACILITIES AND TEMPORARY CONTROLS Provide Temporary Facilities - including electricity, water, and temporary toilet, per jurisdictional requirements 2. Provide Contemporary Controls - including erosion sediment and surface water control and entrapment during construction per jurisdictional requirements. END DIVISION 1 02200 EARTHWORK . Rough grading: 4" below finish grading unless otherwise specified. Finish grading: Landscaping division 02900. Excavation, backfilling, and compacting for structures as needed. Excavation, backfilling, and compacting for pavement as needed. 5. Hauling and disposal of excavated material as needed. Importing of material as needed. 7. Rock removal as needed. 02500 PAVING AND SURFACING Part 2 - Product Walk, road, and parking paving: A. Asphalt 2", class B, over 3" crushed rock or 2" ATB. B. Crushed rock 5/8" minus. C. Concrete per Division 3: Finish and color: Coordinate with materials finish selection schedule. Unit Pavers: 1. Coordinate with materials finish selection schedule. vement marking: 1. Coordinate with materials finish selection schedule. 02700 SEWAGE AND DRAINAGE Subdrainage systems: A. Foundation drainage 4" SDR 35 or sched. 40 rigid PVC perforated pipe embedded impea gravel or clean crushed rock and wrapped in filter fabric. Storm sewage systems: A. Exterior catch basins, grates, and frames: 1. Coordinate with materials finish selection schedule. 1. Coordinate with materials finish selection schedule C. Drain pipe: 4" ADS non-perforated tight line. Sanitary sewage systems: A. Sewage collection lines 8" PVC unless cast iron is noted B. Septic system: Per drawings of bidders designer. Part 3 - Execution Subdrainage system: A. Slope to drain and surround in well draining material per details. 2. Surface drainage per I.R.C. section R401.3. 02800 SITE IMPROVEMENTS Irrigation system: Bidder design Coordinate with materials finish selection schedule Fences and gates: 1. Coordinate with materials finish selection schedule. 02900 LANDSCAPING Part 2 - Produc Bidder Design **END DIVISION 2** CONCRETE 03100 CONCRETE FORMWORK Part 3 - Execution Formwork and bracing for structural cast-in place concrete shall be by subcontractor and meet the requirements of the 2. All formwork shall be placed in such a manner as to allow cast-in place concrete to be placed on solid substrate and to allow structural support members to sit below the frost line 03200 CONCRETE REINFORCING . Reinforcing steel: Deformed bar sizes and locations per plans and details. Grade 60, Fy'

= 60ksi per I.R.C. section R404.1.3.3.7.1. Unless otherwise noted per Engineer

2. Welded wire fabric: at locations per plans and details: 6x6, W1.4x1.4WWF

reinforcement. Minimum coverage per details and I.R.C. section R404.1.3.3.7.4.

washers per I.R.C. section R602.11.1. Unless otherwise noted per Engineer.

R402.2. Special inspection not required unless noted otherwise per Engineer.

A. All concrete shall have water reducing admixtures except for footings.

1. Coordinate with materials finish selection schedule.

B. Air entrainment shall be 5-7% in all concrete exposed to weather, I.R.C. Table R402.2

03300 CAST-IN-PLACE CONCRETE

03300 CAST-IN-PLACE CONCRETE (cont.)

C. Coloring agent:

Part 3 - Execution

END DIVISION 3

ninimum 7" embedment, per I.R.C. section R403.1.6., unless otherwise noted per Engineer.

. Structural concrete: Design fc = 2500 psi min 5-1/2 sacks of cement per cubic yard of concrete and a maximum of 6.0

gallons of water per 94lb sack of cement at 28 days. Max slump is 4", segregation of materials to be prevented. Use fc =

8000 psi concrete at 28 days with air entrainment only for concrete exposed to weather, in accordance with I.R.C. Table

2. Architectural concrete: for exposed aggregate finish (washed), f'c = 2000 psi at 28 days, with 3/8" round aggregate.

DIVISION 5 METALS

Part 2 - Product Anchors and Ties: To be corrosion-resistant metal ties per I.R.C. section R703.8.4. 2. Joint reinforcement: Standard strand no. 9 U.S. gage wire per I.R.C. section R703.8. Part 3 - Execution 1. Per I.R.C. Chapter 7. 04200 UNIT MASONRY Part 2 - Product Brick masonry: A. Exterior locations: name/mfg: . Coordinate with materials finish selection schedule (by others). B. Interior locations: name/mfg 1. Coordinate with materials finish selection schedule (by others). C. Pavers/planters: name/mfg: 1. Coordinate with materials finish selection schedule (by others). 2. Concrete masonry units: grade N-1 CMU, unless otherwise indicated sizes per drawings. A. Special units: 1. Coordinate with materials finish selection schedule (by others). 3. Glass masonry units: (glass block) Per I.R.C. section R607. A. Exterior locations: name/mfg: 1. Coordinate with materials finish selection schedule (by others). B. Interior locations: name/mfg: 1. Coordinate with materials finish selection schedule (by others). Part 3 Execution Brick and Veneer A. Brick veneer shall be supported on footings, foundation, or other non-combustible supports. It shall have 15# felt backing and No. 9 gauge, non corrosive ties at 1 per each 2 s.f. of veneer. Provide 1" minimum air space between veneer and Part 2 - Product backing. Provide approved flashing at base of veneer with 3/16" min, round weepholes at 33" o.c. max., located immediately above the flashing, extending from the air space to the exterior. Veneer shall support no load other than its own weight and the vertical dead lead of veneer above. Provide angle iron support at doors, windows, and other openings per R606.10. Concrete masonry unit (CMU) A. Concrete masonry unit walls shall be constructed to conform to ASTM C90. It shall be laid up, reinforced, and anchored Part 3 - Execution as shown on drawings. 04400 STONE Part 2 - Product As shown on drawings. A. Exterior locations: name/mfg; 1. Coordinate with materials finish selection schedule (by others). B. Interior locations: name/mfg. 1. Coordinate with materials finish selection schedule (by others). Part 3 Execution 1. Stone Veneer:Adhered per manufacturer's installation instructions and in accordance with I.R.C. R703.12.1 A. On exterior stud walls, adhered masonry veneer shall be installed: 1. Minimum of 4 inches above the earth. 2. Minimum of 2 inches above paved areas. or 3. Minimum of 1/2 inch above exterior walking surfaces which are supported by the same foundation that supports the B. Flashing at foundation: 1. A corrosion-risistant screed or flashing of a minimum 0.019-inch or 26-gage galvanizedor plastic with a minimum vertical attachment flange of 3\ inches shall be installed. **END DIVISION 4** 05050 METAL FASTENINGS 1. Bolts: Use sizes and shapes per dwgs, or as needed for intended purposes. Bolts, nuts and cut washers in contact with treated wood to be triple zinc ZMAX (G185 per ASTM A653) hot dipped galvanized steel (ASTM 153 for Anchors). 05500 METAL FABRICATION Part 2 - Product Handrails and guardrails: Provide in sizes and locations as shown per dwg. END DIVISION 5 WOOD AND PLASTICS 06100 ROUGH CARPENTRY Part 2 - Product 1. Framing Lumber: Framing lumber shall be marked in conformance with the United States Dept. of Commerce, Standard Reference No. PS 20 (DOC PS 20) standards. All Kiln dried minimum 19%. A. Joist and rafters: (2x6 and larger) Hem-Fir #2 or better B. Beams and stringers: (4x and larger) Doug-Fir #2 or better. C Post and timbers: Doug-Fir #1.). Studs, plates, and misc. light framing: Hem-Fir #2 or better. E. "I" Joists and Engineered beams: Per manufacturer. Glue laminated timber: 1. Simple span: 24F V4 DF/N3WN 2. Continuous or cantilever: 24F V8 DF/DF G. All other lumber: Hem-Fir Standard or better. H. Plywood/oriented strand board (O.S.B.); APA graded I. Wall sheathing: see "TYPICAL BUILDING MATERIALS" list on the dwgs. J. Floor sheathing; see "TYPICAL BUILDING MATERIALS LIST"on the dwg. K. Other: As noted on drawings. L. All wood members in contact with exposed concrete to be pressure treated members 2. Particle Board: A.P.A. graded A. Underlayment Floors: 5/8" (U.N.O.) 2. Sheet vinyl: 1/4" (U.N.O.) see division 9 3. Cabinet surfaces 3/4" (U.N.O.) . A minimum lap for all bars shall be 40 diameters taken from the smallest bar. Provide corner bars to match horizontal A. Prefabricated connector plate wood roof trusses shall be designed and stamped by the manufacturer in accordance with the "design specification for metal plate connected wood trusses". Design drawings and details to be available upon request. B. See "Roof Framing Notes" on drawings. C. Roof design, layout, loading, and bracing shall be by manufacturer. D. Field alterations of truss must be designed by manufacturer 4. Fasteners and adhesives: All nails shall be common wire of sizes for intended purpose per I.R.C. table R602.3(1). Attach timber joists to flush headers and beams with Simpson "U" hanger series or equal to suit intended purpose. Simpson 1. Anchor bolts: 1/2"~ triple zinc ZMAX (G185 per ASTM A653) hot dipped galvanized steel (ASTM 153 for Anchors), with a connectors at other locations as outlined per drawings. Bolt heads, nuts, and cut washers per Division 5. Connectors and fasteners in contact with treated wood to be triple zinc ZMAX (G185 per ASTM A653) hot dipped galv. steel (ASTM 153 for 2. Washers: 3"x3"x1/4" sq. triple zinc ZMAX (G185 per ASTM A653) hot dipped galv. steel (ASTM 153 for Anchors), plate Fasteners), stainless steel, silicone bronze, or copper as required per dwgs. 5. Post to mat footing connection. Provide pressure treated post and positive connection to footing per I.R.C. section 502.9. . Anchor bolts at 6'-0" o.c. max. for one story & 4'-0" o.c. for buildings over two stories in height, 12" from corners and 6. All exposed glue laminated wood, if not protected by a roof or eave, must be preservative-treated. joints, with a minimum embedment of 7". Provide a minimum of (2) bolts per plate section per I.R.C. section R403.1.6. Part 3 - Execution 1. The following will apply unless shown on drawings. All wood framing details shall be constructed to the minimum standards in the I.R.C. All framing shall conform to the requirements of Chapters 5,6, and 8 of the I.R.C. Minimum nailing shall conform to table R602.3(1) of the I.R.C. Height and spacing of study shall conform to table R602.3(5) of the I.R.C.

06200 FINISH CARPENTRY

4. Stair and handrail by:

5. Bookcases and built-in shelves:

6. Plastic laminate and solid surface material:

A. Coordinate with materials finish selection schedule (by others).

A. Coordinate with materials finish selection schedule (by others).

B. See division 01002.7 misc. assembly requirements.

Part 2 - Product

END DIVISION 6

Type "M" or "S" mortar with integral waterproofing agent per I.R.C. section R606.2.7

Part 3 - Execution

1. Per I.R.C. section R606.2

04150 MASONRY ACCESSORIES

HERMAL AND MOISTURE PROTECTION 07150 WATER PROOFING & DAMP PROOFING 09250 GYPSUM WALLBOARD 1. Walls; See the "TYPICAL BUILDING MATERIALS" list on the drawings. A. Finish: 1. Coordinate with Contractor/Owner material selections. 2. Ceiling: See the "TYPICAL BUILDING MATERIALS" list on the drawings. A, Finish; 1, Coordinate with materials finish selection schedule, greater than 450 per I.R.C. R302.9. 1. Ground cover: 6 mil polyethylene: black, with 12" minimum lap. 4. Code required areas: 2. Building wrap: see the "TYPICAL BUILDING MATERIALS" list on the drawings. A. Type "X: GWB as required. 5. Wonderboard or duroc at all tile locations (U.N.O.) 6. Metal corner bead profile: 1. Fiberglass or mineral wood batts, bloom mineral wool, and extruded polystyrene: Part 3 - Execution A. Walls: 1. See the "TYPICAL BUILDING MATERIALS" list on the dwgs. B. Ceiling: 1. See the "TYPICAL BUILDING MATERIALS" list on the dwas. C. Floor: 1. See the "TYPICAL BUILDING MATERIALS" list on the dwgs 09300 TILE Part 2 - Product D. Slab on Grade: R-10 (per W.S.E.C. Table R402.1.1). 1. Ceramic, quarry, and marble tiles: 2. Insulating foam: A. Standard sealant foam. A. Coordinate with materials finish selection schedule (by others). Part 3 - Execution 1. Refer to manufacturer's recommendations 2. Provide insulation markers for blown-in or sprayed insulation every 300 sq ft. Markers shall face the attic access per IECC Sec 303.1.1.1 09550 WOOD FLOORING
Part 2 - Products 1, Type: 3. Crawl Space/Cantilevered floors: Insulation shall be installed to maintain permanent contact with the underside of the sub-floor decking. Insulation supports shall be installed so spacing is no more than 24" on A. Coordinate with materials finish selection schedule (by others). center. Cantilevered floor vents shall be placed below the lower surface of the floor insulation. A. See the "TYPICAL BUILDING MATERIALS" list on the drawings Membrane roofing: A. 3-ply hot mopped. 1. Install per manufacturer's recommendation and Chapter 9 of the I.R.C. Siding: A. See the "TYPICAL BUILDING MATERIALS" list on the drawings. 2. Trim: A. See the "TYPICAL BUILDING MATERIALS" list on the drawings. 3. Soffits: A. See the "TYPICAL BUILDING MATERIALS" list on the drawings. 4. Other: A. See the "TYPICAL BUILDING MATERIALS" list on the drawings. 1. Install per manufacturer's recommendation and Chapter 7 of the I.R.C. 07600 FLASHING AND SHEET METAL A) Flashing against a vertical sidewall shall be by the step-flashing method. The flashing shall be a minimum of 4" high and 4" wide. At the end of the vertical sidewall the step flashing shall be turned out in a manner that directs water away from the wall and onto the roof and/or gutter, Per I.R.C. R903.2. . Coordinate with materials finish selection schedule (by others). Coordinate with materials finish selection schedule (by others). Skylights to conform with I.R.C. section R308.6. 2. Manufacturer: A. Coordinate with materials finish selection schedule (by others). 1. Caulking A. Styrene butadene caulking (SBR) 1. Color: Match siding 08200 WOOD DOORS (Lower Level, Main Level, Upper Level) . Panel wood doors: A. Coordinate with materials finish selection schedule (by others). . Flush wood doors: A. Coordinate with materials finish selection schedule (by others). Stile and rail(store door): A. Coordinate w/materials finish selection schedule (by others) 4. Patio door: A. Coordinate with materials finish selection schedule (by others). 5. Other: A. Coordinate with materials finish selection schedule (by others). A. Coordinate with materials finish selection schedule (by others). Garage door: (make/style): (see division 11450) A. Coordinate with materials finish selection schedule (by others). A. Every sleeping room shall have at least one operable window with a net clear opening of 5.7 s.f. The net clear opening height shall be a minimum of 24", with a minimum net clear width of 20", and a finished sill height of not more than 44" above the floor, per I.R.C. section R310.

Part 2 - Product 1. Per I.R.C. section R406.

1. Per I.R.C. section R406.

07190 VAPOR AND AIR RETARDER

1. See Division 17, Energy Requirements.

1. See division 17: energy requirements

07300 ROOFING MATERIAL

Shingles and roofing tiles:

07460 SIDING MATERIAL

Part 2 - Product

Part 3 - Execution

Part 2 - Product

Part 3 - Execution

Part 2 - Product

Min. 26 Gauge galvanized, prefinished.

1. Install per Chapter 7 and 9 of the I.R.C

07700 ROOFING SPECIALTIES

A. Ridge vent: manufactured by

Gutters:
 A. Continuous alum. precoated:

2. Color: Match fascia

Style: K profile

B. Tie to 1 drain system.

07800 SKYLIGHTS

Part 2 - Product

END DIVISION 7

DOORS AND WINDOWS

08300 SPECIALTY DOORS

08600 WOOD/VINYL WINDOWS

Safety glaze per I.R.C. section R308

. See plans for egress and operation.

Safety glaze per I.R.C. section R308

3. Mirrors to be silvered 1/4" float plate glass

A. Color: 1. Coordinate with materials finish selection schedule (by others)

B. Style: 1. Coordinate with materials finish selection schedule (by others).

Type: A. Coordinate with materials finish selection schedule (by others).

Sliding glass door;

Part 2 - Product

Note: Egress -

Manufactured by:

08800 GLAZING

Part 2 - Product

END DIVISION 8

B. Mushroom vent: manufactured by:

A. 2x3 rectangular aluminum precoated

Color: Match fascia & trim

07900 SEALANTS AND CAULKING

Part 3 - Execution

Part 2 - Product

07200 INSULATION

Part 2 - Product

Part 3 - Execution

09650 RESILIENT FLOORING
Part 2 - Products 1. Type: A. Coordinate with materials finish selection schedule (by others). 09680 CARPETING
Part 2 - Products 1. Carpet and Pad: A. Coordinate with materials finish selection schedule (by others). 09900 PAINTING
Part 2 - Products 1. Painting over prepared surface per manufacturer's recommendations A. Coordinate with materials finish selection schedule (by others). 09950 WALL COVERINGS 1. Type: A. Coordinate with materials finish selection schedule (by others). END DIVISION 9 Division 10 SPECIALTIES 10200 LOUVERS AND VENTS Part 2 - Products . Hardware cloth screen 1/4" x 1/4" on soffit vents as detailed. . Continuous 2" performed metal soffit vent as detailed. Roof vent (See Division 07700 Other vents as noted per plans. 10300 PREFABRICATED FIREPLACES Part 2 - Products Location/Model/Accessories A. Coordinate with materials finish selection schedule (by others). 1. See division 01002.12 for misc. assembly requirements for fireplaces. 10400 IDENTIFYING DEVICES Part 2 - Products Building numbers: A. Coordinate with materials finish selection schedule (by others). Part 3 - Execution 1. Install in location per jurisdictional requirements. 10800 TOILET AND BATH ACCESSORIES Part 2 - Products 1. Toilet and bath accessories: A. Coordinate with materials finish selection schedule (by others). 10900 WARDROBE AND CLOSET SPECIALTIES Part 2 - Products A. Coordinate with materials finish selection schedule (by others). A. Coordinate with materials finish selection schedule (by others). END DIVISION 10 Division 11 EQUIPMENT 11010 MAINTENANCE EQUIPMENT . Vacuum cleaning system: A. Coordinate with materials finish selection schedule (by others). 11450 RESIDENTIAL EQUIPMENT Garage door opener(s). A. Coordinate with materials finish selection schedule (by others). Ironing board cabinet (or drawer). A. Coordinate with materials finish selection schedule (by others). Free-standing appliances: A. Coordinate with materials finish selection schedule (by others). **END DIVISION 11** Division 12 FURNISHINGS 12500 WINDOW TREATMENT . Window treatment: A. Coordinate with materials finish selection schedule (by others). END DIVISION 12 SPECIAL CONSTRUCTION 13150 POOLS Part 2 - Products 1. Bidder design 13156 HOT TUB Weather Stripping: A. Coordinate with materials finish selection schedule (by others). Part 2 - Products 3. Thresholds: A. Coordinate with materials finish selection schedule (by others). A. Coordinate with materials finish selection schedule (by others). END DIVISION 13 Glass thickness to be determined by size and wind loading per I.R.C. section R308. Division 14 CONVEYING SYSTEMS 14100 DUMBWAITER Part 2 - Products . Dumbwaiter: A. Manufacturer/model number: 1. Coordinate with materials finish selection schedule (by others). END DIVISION 14

1. See division 01002 misc. assembly requirements.

1. Coordinate with materials finish selection schedule.

Division 15 MECHANICAL Part 1 - General Mechanical system to be bidder design. Regulatory requirements: A. Refer to Division 1 General Requirements. B. See plans for total maximum Btu. C. Heating and cooling equipment shall be sized based on building loads calculated in accordance with ACCA manual J 3. Wall and ceiling finishes shall have a flame spread index of not greater than 200, and a smoke-developed index of not or other approved heating and cooling calculation methodologies. Per M1401.3 Contractor work out plumbing and HVAC diagram layout. A. Coordinate with other trades B. Waterproof GWB as req'd at wet or damp locations per I.R.C. section R702.4.2. A. Waste & soil: ABS plastic of sizes req'd for the intended purpose. 1. Provide cast iron with compression neoprene joints per locations shown on the drawings. 2. Provide clean-outs at bends. 1. Apply as required in I.R.C. Chapter 7 and Table R702.1(3). Nail or screw in place per table. Gas: Per code, verify location of appliances.
 Provide an approved earthquake shutoff valve installed in the building supply line immediately after the gas meter. The valve shall be located outside of the structure and be accessible. 1. Below Grade: 1 1/4" type K with/hard solder 2. Above Grade: Type L w/soft solder Plumbing equipment. A. Hot water heater: (Duals in tandem) 1. Size per U.P.C. 501 and Table 501.1 and jurisdictional amendments. Coordinate with owner's material selection (by others) B. Hose bib, frost proof type: Mansfield units . Main shut-off valve in garage. D. Plumbing fixtures 1. Coordinate with owners material selection (by others). Irrigation: (bidder design A. Provide "T" connection in main line in garage by main shut-off valve with separate shut-off and drain valve. 15400 PLUMBING (cont.) 4. Automatic Sprinkler System: (bidder design 1. The installer to design the system to appropriate jurisdictional requirements and function in a manner consistent with industry standards. Refer to general requirements. 15500 HVAC Part 2 - Product 1. Forced Air: A. Furnace system: 1. Coordinate with materials finish selection schedule (by others). B. Duct work and insulation . Coordinate with materials finish selection schedule (by others). C. Air cleaner: 1. Coordinate with materials finish selection schedule (by others). D. Controls: 1. Coordinate with materials finish selection schedule (by others). E. Registers with adjustable supply: 1. Coordinate with materials finish selection schedule (by others). F. Provide firestopping at 'B' vent location per I.R.C. sections R302.13 2. Fans, see division 17 energy requirements. 3. See floor plans for Whole House Ventilation requirements. 1. Coordinate with materials finish selection schedule (by others). Exhaust Ducts: A. Terminate outside building and equip with backdraft dampers per I.R.C. section M1507.3.3. Dryer Ducts: A. Cloths Dryers shall be exhausted in accordance with manufactures instructions & I.R.C. M1502. B. Protective shield plates shall be placed per I.R.C. M1502.5. Part 3 - Execution 1. The installer to design the system to appropriate jurisdictional requirements and function in a manner consistent with industry standards. Refer to general requirements. END DIVISION 15 ELECTRICAL 16000 GENERAL Part 1 - General Electrical systems to be bidder designed.
 Regulatory requirements: refer to Division 1 - General Requirements. $Contractor\ to\ provide\ electrical\ diagramming\ layouts,\ design\ circuitry.\ follow\ lighting\ plan\ if\ provided.$ A. Coordinate with other trades. 16200 POWER Part 2 - Product Wire and Boxes. A. Volt. 12 6A (3) Wire GFI @ Damp Locations B. Low voltage: standard type 2. Panels: Circuit breaker box fully labeled A. Capacity: Bidder Design B. Circuitry: Bidder Design A. Provide (1) 2 1/2" schedule 80 PVC conduit at concrete stem wall for electrical service and (1) 5/8" diameter x 8'0" long galvanized rod (& Ufer ground) for electrical grounding. A. Provide and install per I.R.C. section R314. A. Provide and install per N.E.C. and as required by governing fire marshal. Part 3 - Execution 1. The installer to design the system to appropriate jurisdictional requirements and function in a manner consistent with the industry standards. Refer to general requirements and I.R.C. 16200 COMMUNICATIONS 1. Intrusion alarm and security detection systems: A. Coordinate with materials finish selection schedule (by others). Phone system: A. Coordinate with materials finish selection schedule (by others). A. Coordinate with materials finish selection schedule (by others). Stereo system: A. Coordinate with materials finish selection schedule (by others). 16500 LIGHTING Part 2 - Product

1. Fixtures: 1. Coordinate with materials finish selection schedule (by others).

2. Control: A. Switches: 1. Coordinate with materials finish selection schedule.

3. Dimmers: 1. Coordinate with materials finish selection schedule (by others)

4. Boxes: 1. Coordinate with materials finish selection schedule (by others).

5. Other: 1. Coordinate with materials finish selection schedule (by others).

3. Per WSEC R403.3.2. ducts, air handlers, and filter boxes shall be sealed.

the industry standards. Refer to general requirements.

Part 3 - Execution

END DIVISION 16

General Notes:

(R402.4.1.2).

Division 17 ENERGY REQUIREMENTS

system on a daily schedule.

WASHINGTON STATE ENERGY CODE:

Note: A minimum of 90% of all luminaries shall be high efficiency per W.S.E.C. R404.1.

1. The installer to design the system to appropriate jurisdictional requirements and function in a manner consistent with

1. Per WSEC R402.4. The building Envelope shall be constructed to limit the air leakage rate not to exceed 5 air changes

per hour. The results of the test shall be signed by the party conducting the test and provided to the code official

2. Per WSEC R403.1.1. at least one thermostat per dwelling unit shall be capable of controlling the heating and cooling

KAHN MICHAEL A 4205 85th AVE SE, MERCER ISLAND, WA 98040 © 2SDESIGN BUILD, Inc. All rights reserved. No part of this document may be reproduced in any form or by any means without permission in writing from 2SDESIGN BUILD, Inc. riangle date description DRAWN BY: 2S DESIGN

2S DESIGN

GO DESIGN

CONTACT@GODESIGN.STUDIO

WWW.GODESIGN.STUDIO


TEL.: (425) 595-0691

SW, SEATTLE

5454 DELRIDGE WAY

TEL.(206) 778-1032

WWW.2SDESIGNBUILD.COM

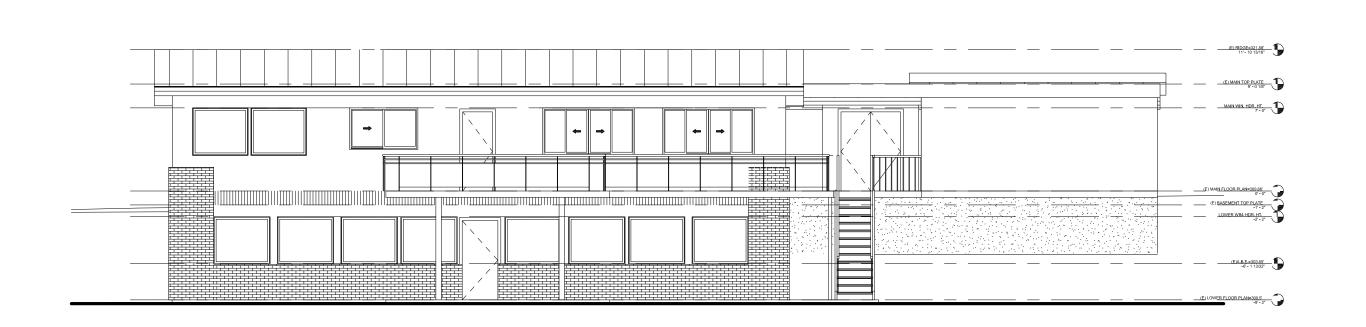

MAX ALLOWABLE HEIGHT=333.55'

LEGENDS:


- - - PROPERTY LINE


INTERIOR RENOVATIONS


EXISTING PORCH / DECK

EXISTING TREES WILL REMAIN


EXISTING BUILDING

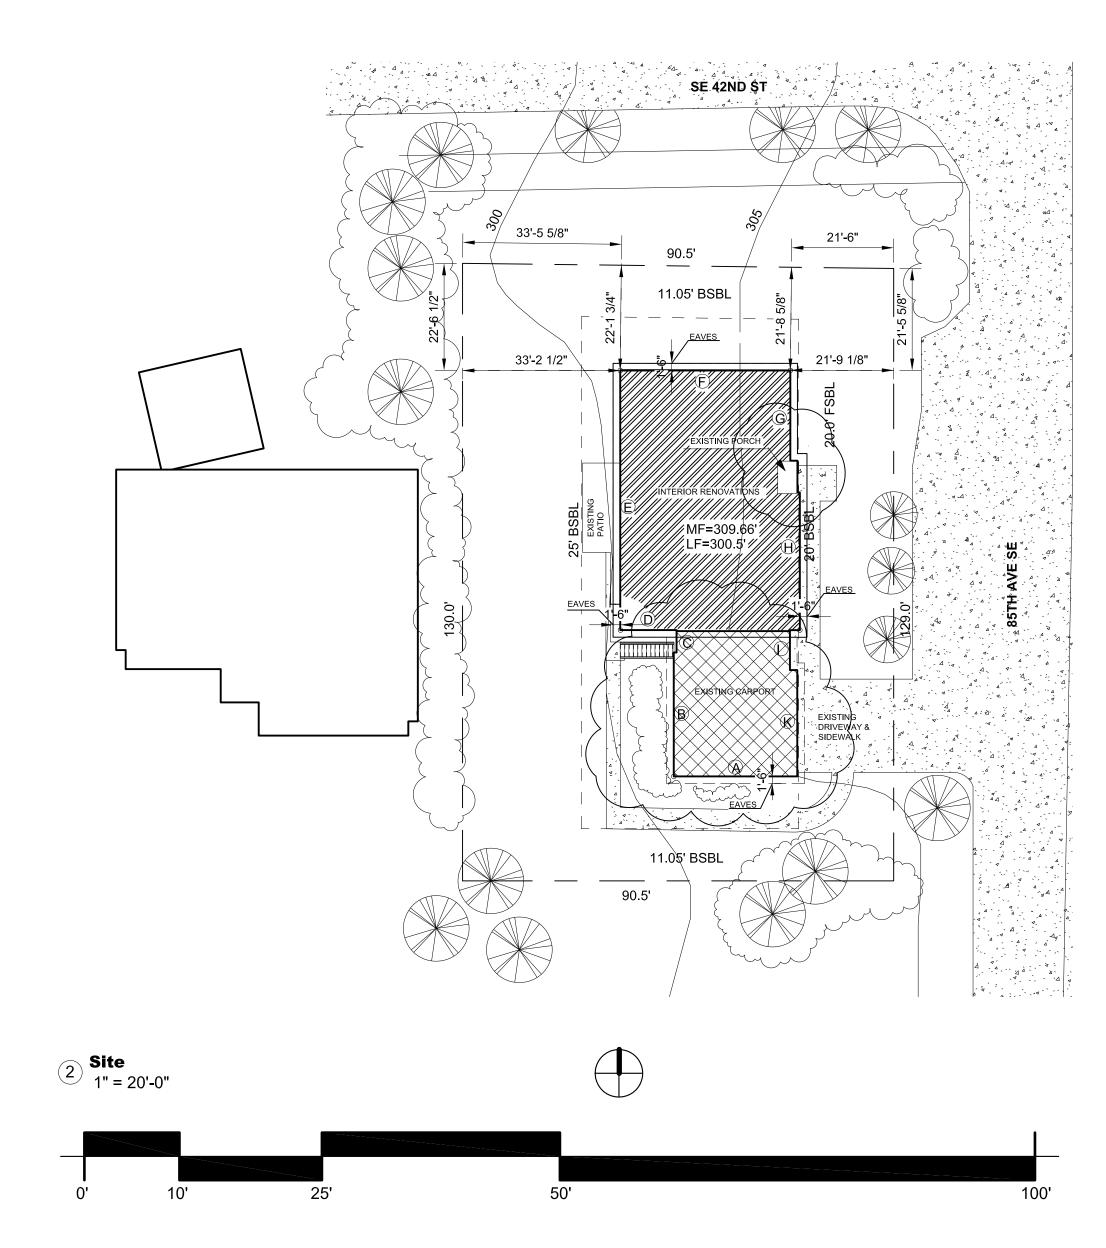


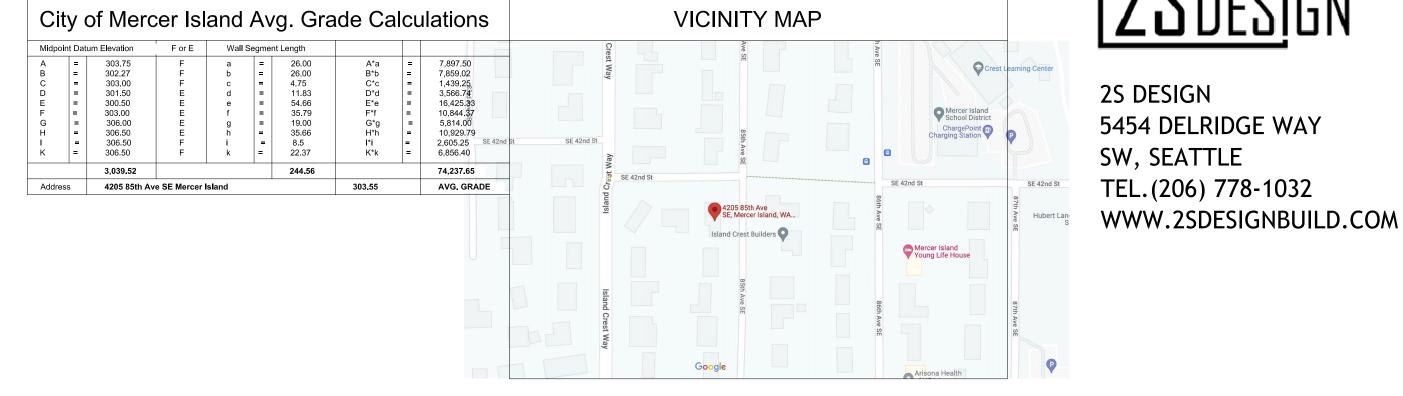

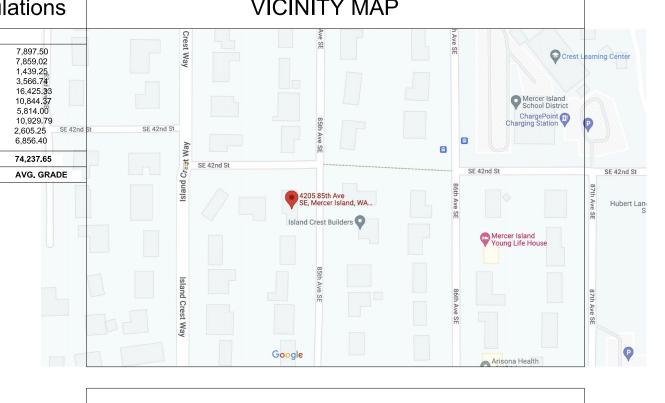



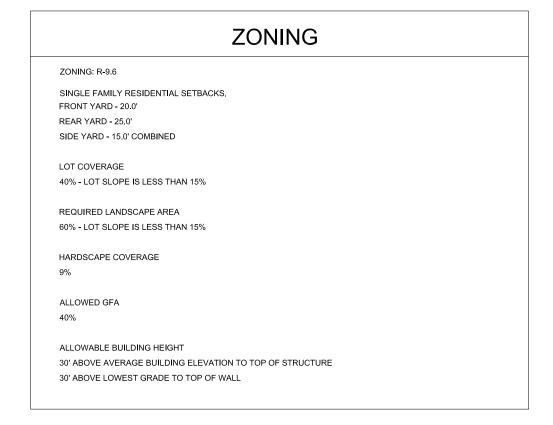

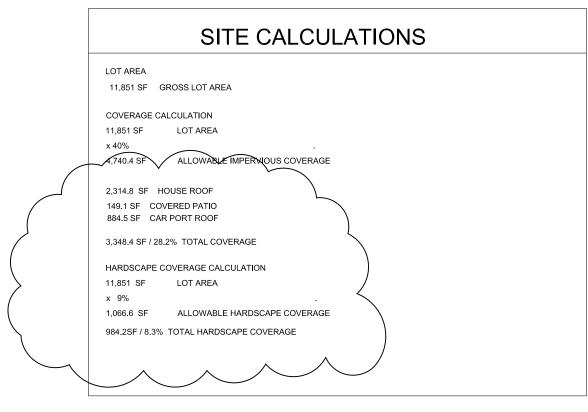

ALL TREES WILL BE RETAIN






GO DESIGN CONTACT@GODESIGN.STUDIO WWW.GODESIGN.STUDIO TEL.: (425) 595-0691

KAHN RESIDENCE

KAHN MICHAEL A

4205 85th AVE SE, MERCER ISLAND, WA 98040


© 2SDESIGN BUILD,Inc.All rights reserved. No part of this document may be reproduced in any form or by any means without permission in writing from 2SDESIGN BUILD, Inc.

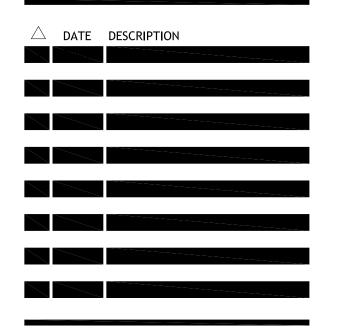

#22001

DRAWN BY: GO DESIGN

SITE PLAN

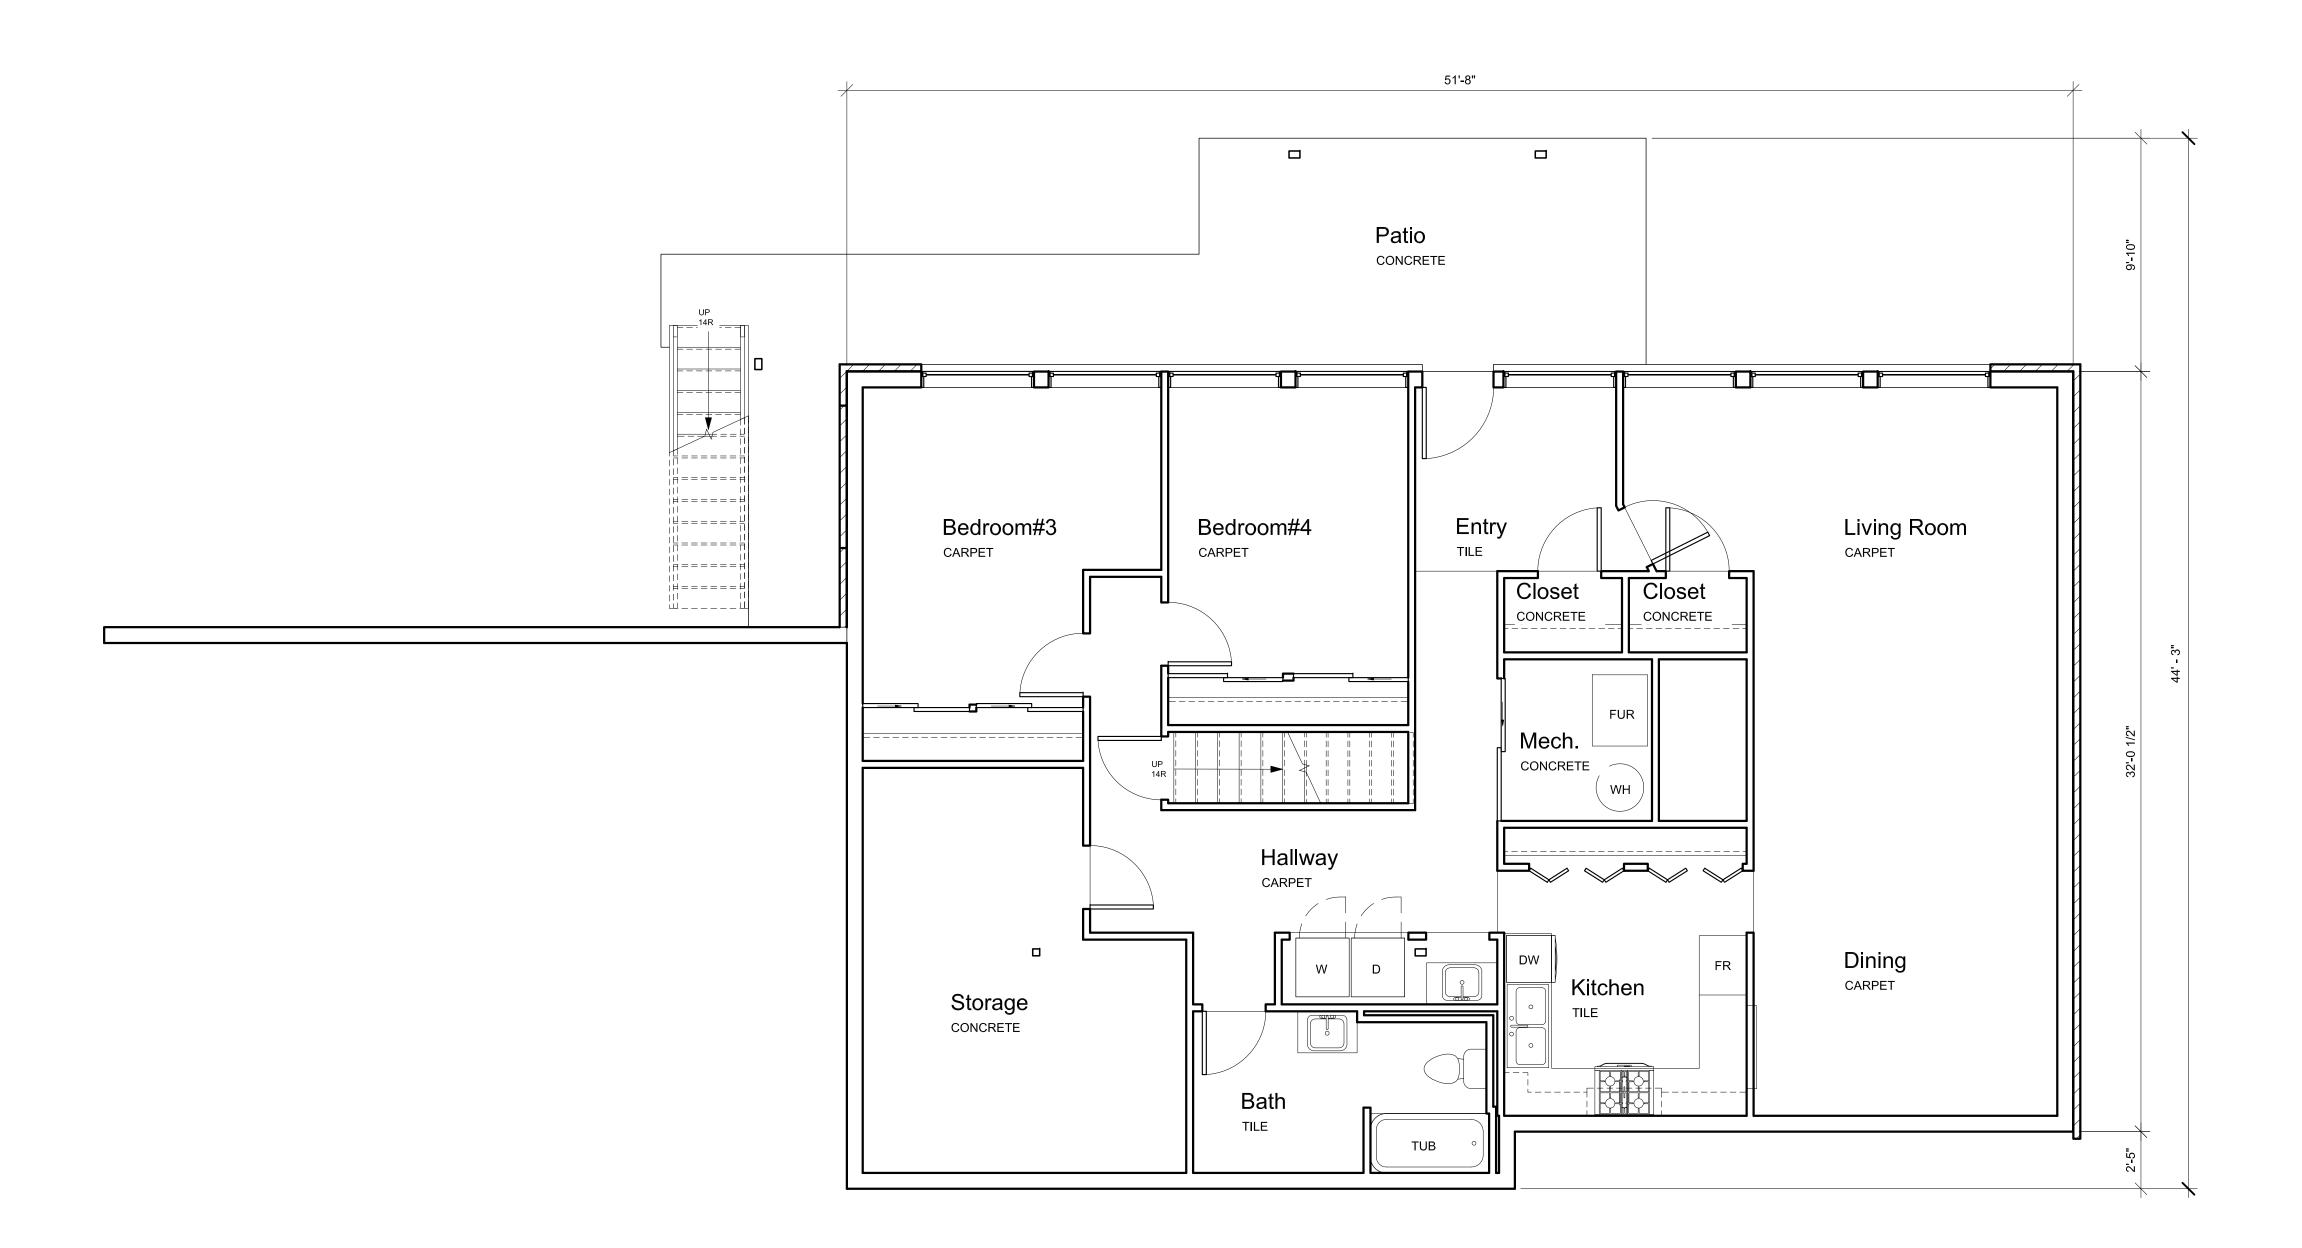





2S DESIGN
5454 DELRIDGE WAY
SW, SEATTLE
TEL.(206) 778-1032
WWW.2SDESIGNBUILD.COM




GO DESIGN
CONTACT@GODESIGN.STUDIO
WWW.GODESIGN.STUDIO
TEL.: (425) 595-0691

KAHN RESIDENCE

KAHN MICHAEL A

4205 85th AVE SE, MERCER ISLAND, WA 98040

© 2SDESIGN BUILD, Inc. All rights reserved. No part of this document may be reproduced in any form or by any means without permission in writing from 2SDESIGN BUILD, Inc.

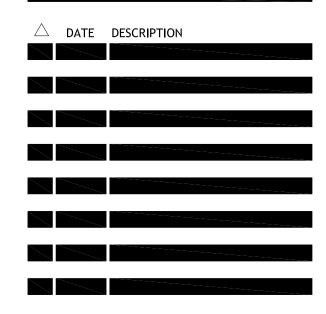


#22001

DRAWN BY: GO DESIGN

(E) LOWER FLOOR PLAN

12

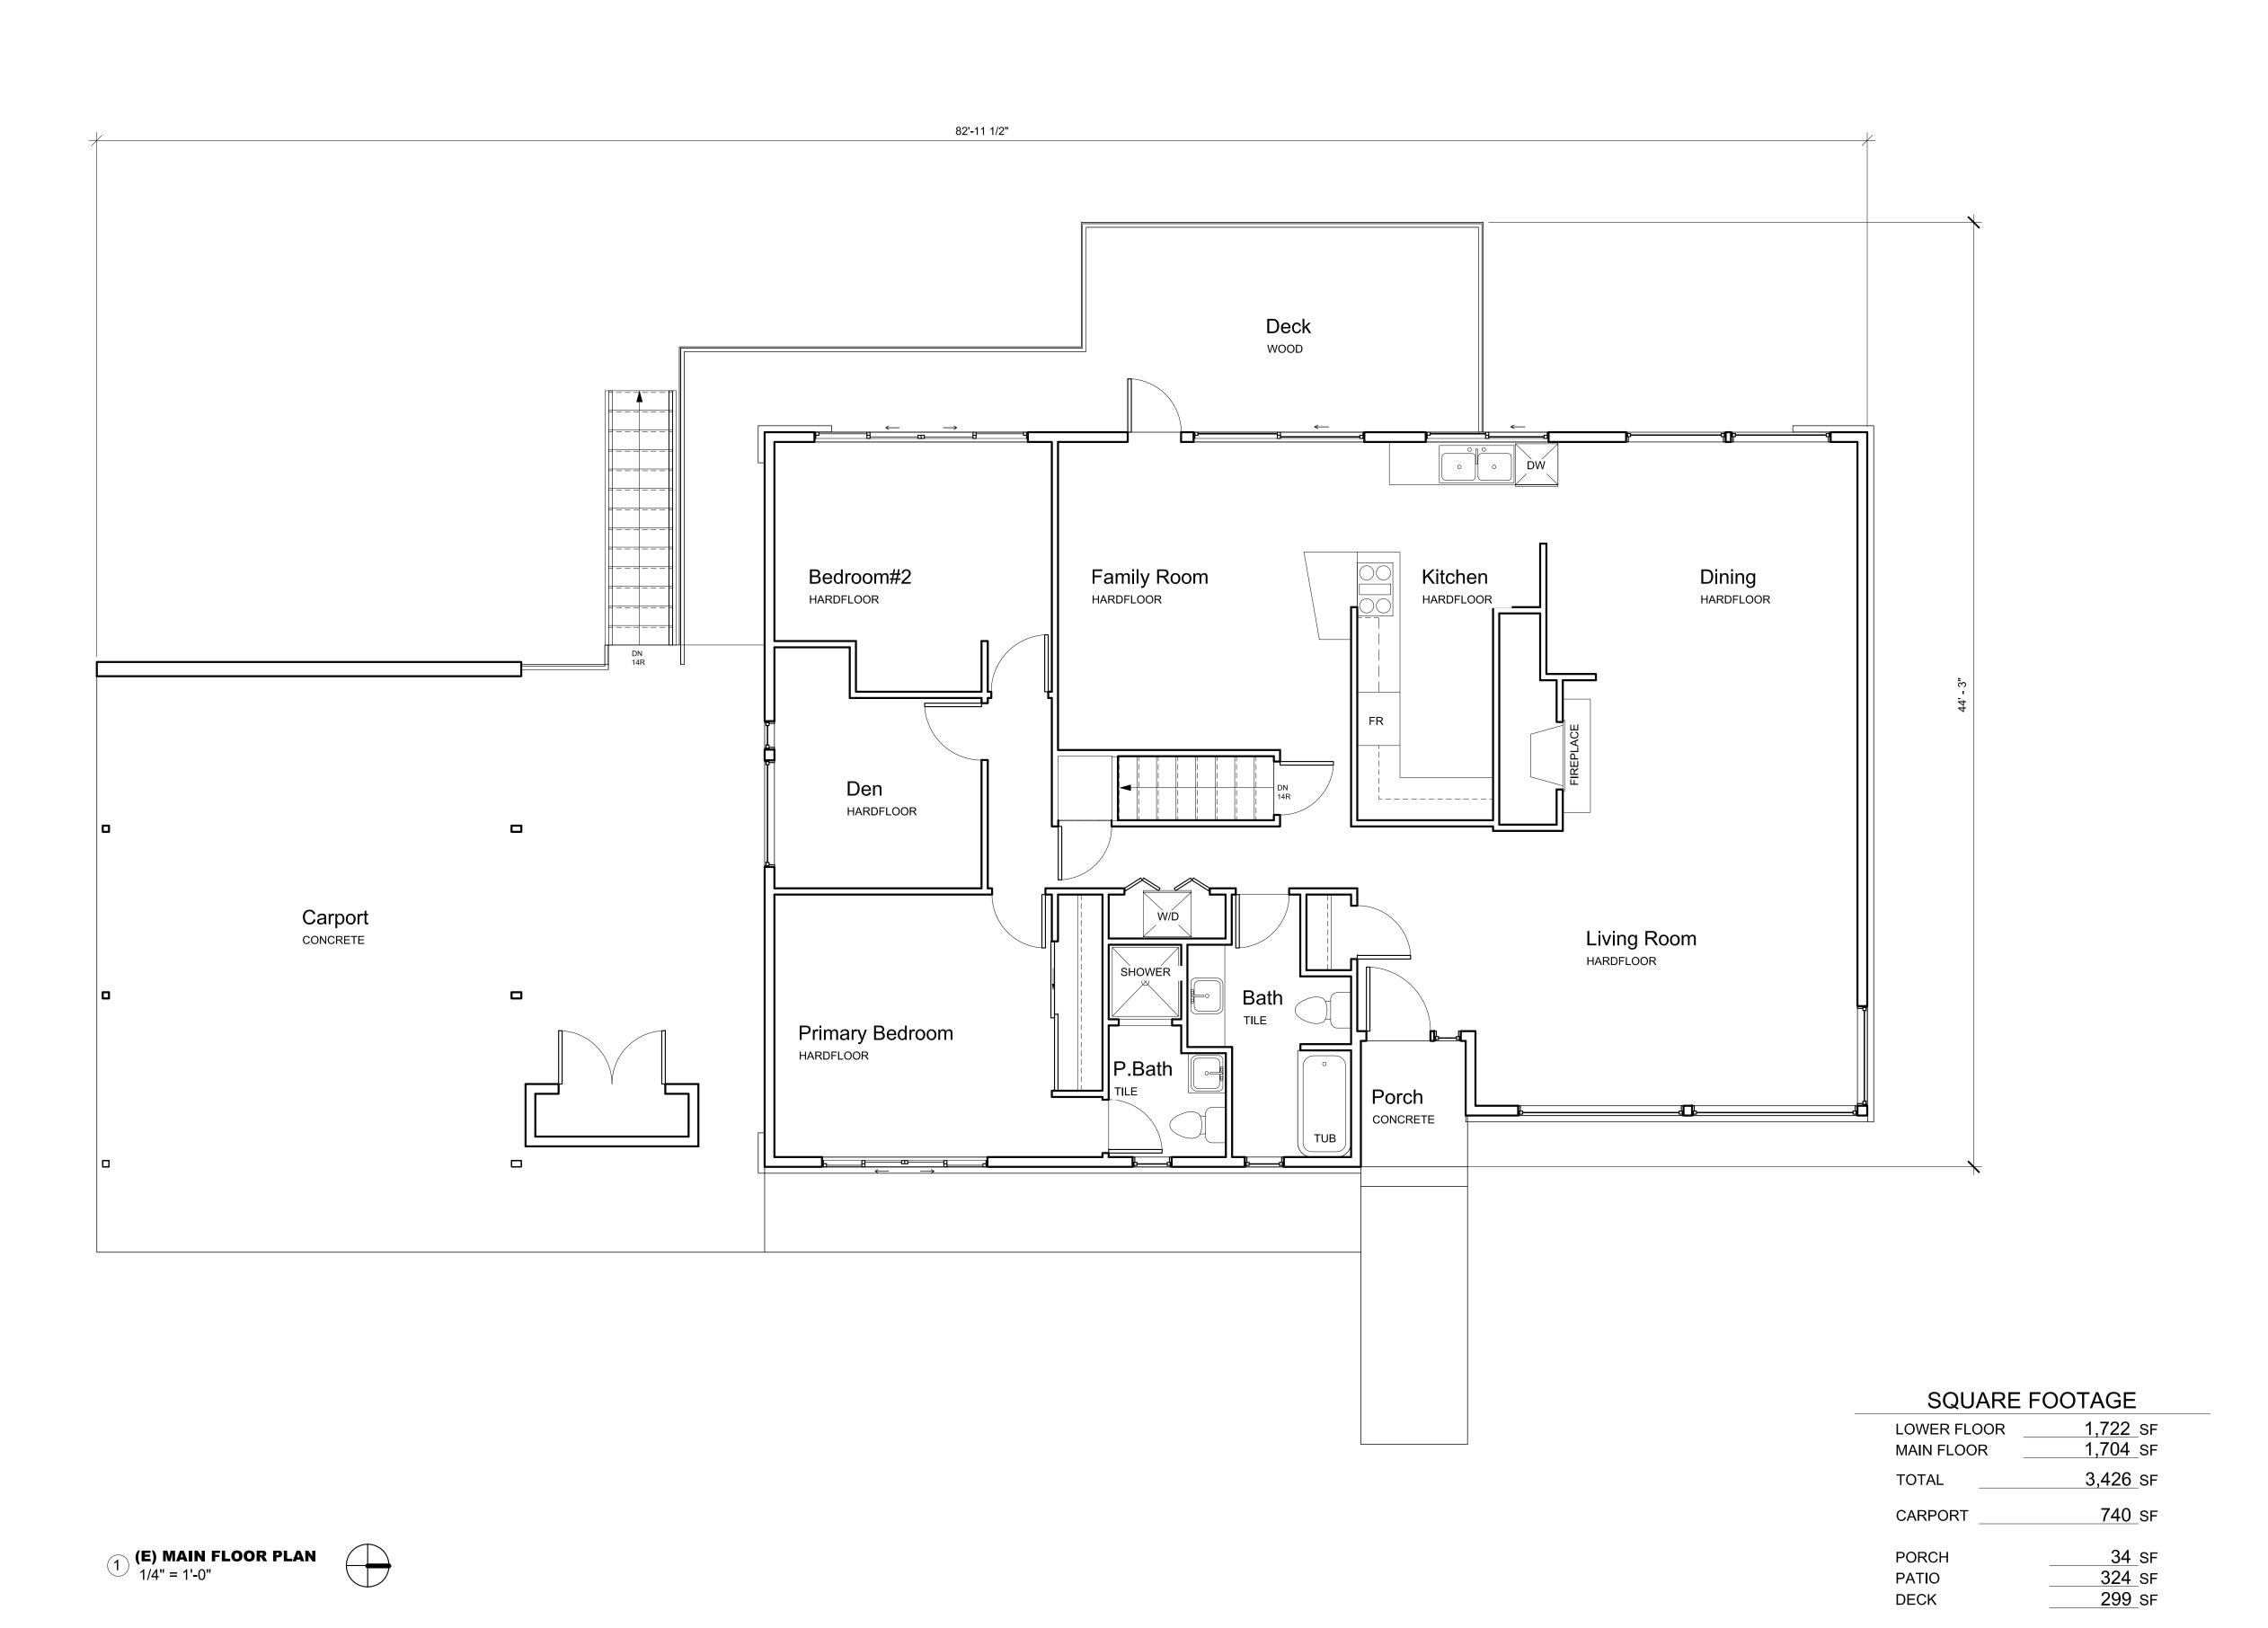

 3 1 5 1



2S DESIGN
5454 DELRIDGE WAY
SW, SEATTLE
TEL.(206) 778-1032
WWW.2SDESIGNBUILD.COM




GO DESIGN
CONTACT@GODESIGN.STUDIO
WWW.GODESIGN.STUDIO
TEL.: (425) 595-0691

KAHN RESIDENCE

KAHN MICHAEL A

4205 85th AVE SE, MERCER ISLAND, WA 98040


© 2SDESIGN BUILD, Inc. All rights reserved. No part of this document may be reproduced in any form or by any means without permission in writing from 2SDESIGN BUILD, Inc.

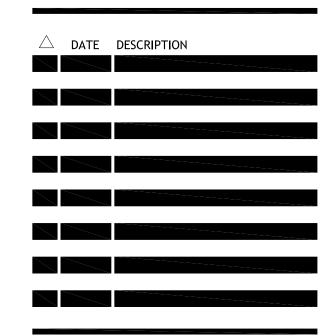

#22001

DRAWN BY: GO DESIGN

(E) MAIN FLOOR PLAN

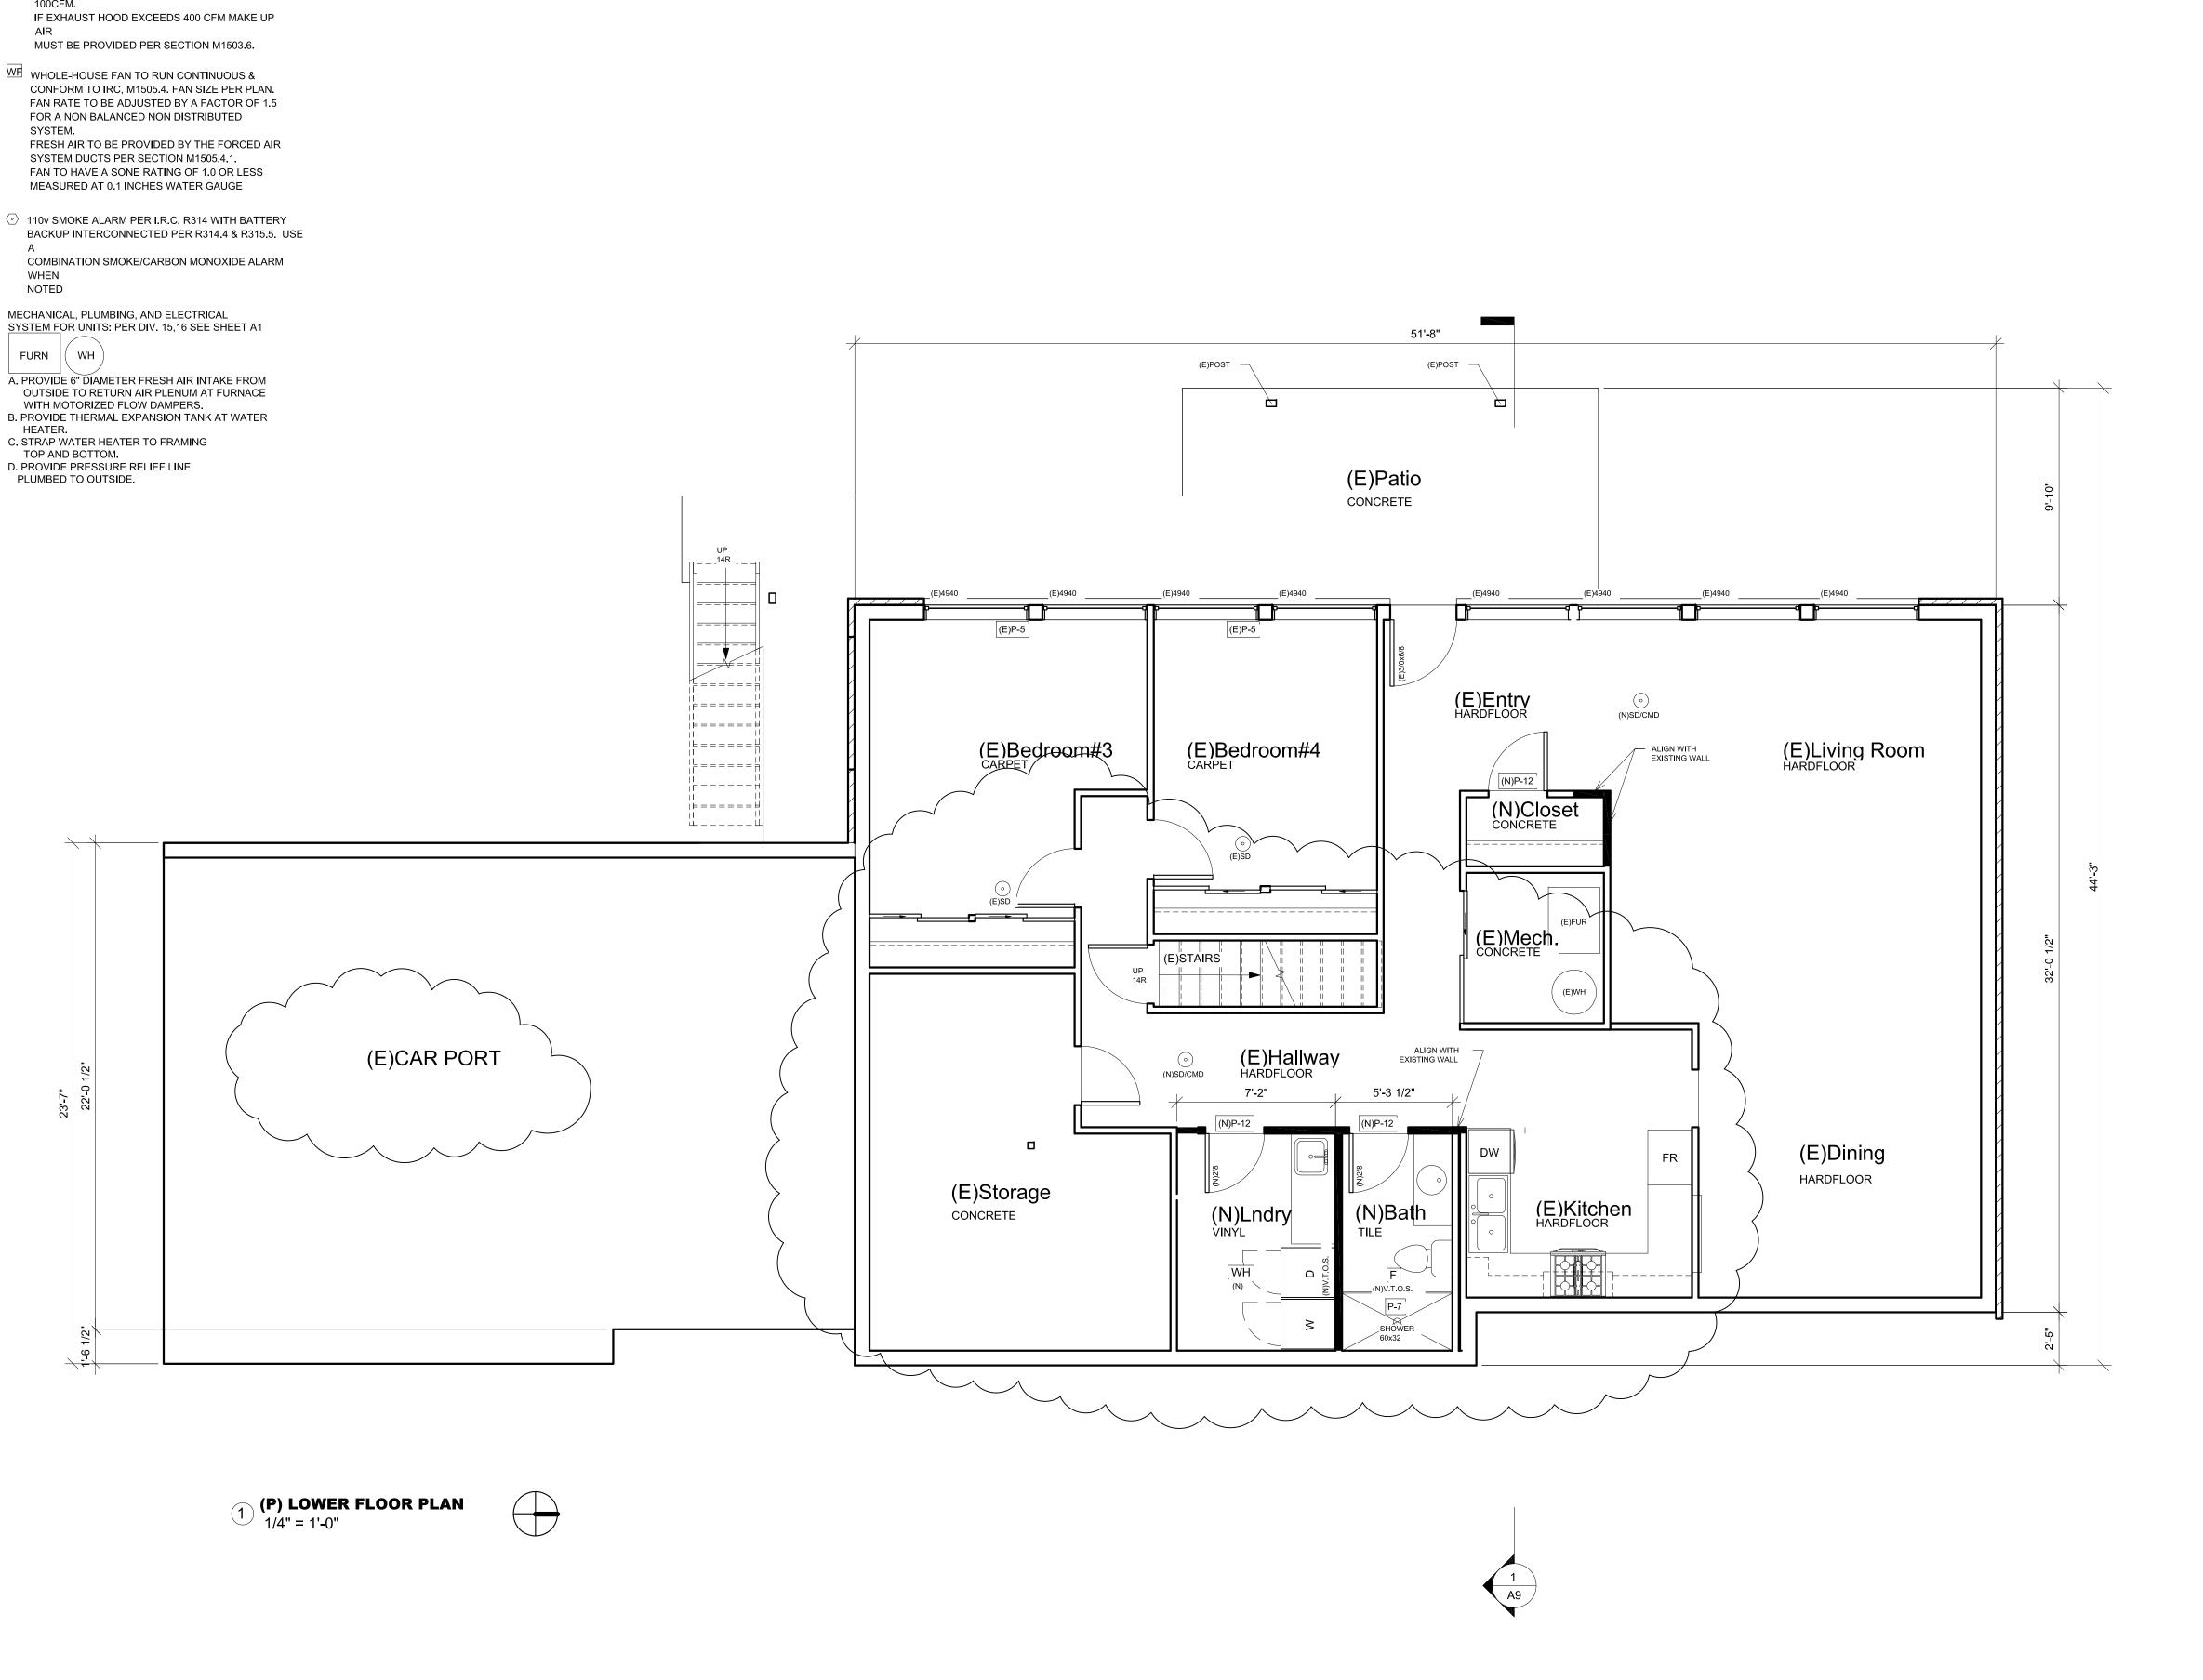

SYMBOLS AND LEGEND

-BATHROOMS/LAUNDRY 50 CFM MIN.

-KITCHEN EXHAUST HOOD TO BE MIN. OF

F FAN- DIRECT VENT TO OUTSIDE

GENERAL PLAN NOTES

- 1. SEE SHEET A-1 FOR ALL GENERAL NOTES AND REQUIREMENTS.
- 2. ENERGY AND AIR QUAILITY INFORMATION

SEE DIV. 17 SHEET A-1

- 3. SEE BUILDING ELEVATION FOR WINDOW
- OPERATION SEE DIV. 8 SHEET A-1
- 4. SEE TYP. MATERIALS LIST ON SECTION SHEET
- 5. SEE SHEET A-1 FOR ALL NOTES AND REQUIREMENTS CONCERNING MECHANICAL, PLUMBING, AND ELECTRICAL.

2S DESIGN 5454 DELRIDGE WAY SW, SEATTLE TEL.(206) 778-1032 WWW.2SDESIGNBUILD.COM

FLOOR PLAN KEY NOTES

- P-1 OCCUPANCY SEPARATION:
 APPLY (1) LAYER OF \" G.W.B. TO GARAGE SIDE OF
 RESIDENCE, ATTIC SPACES, AND TO ALL BEAMS AND POSTS SUPPORTING A FLOOR-CEILING ASSEMBLY. APPLY (1) LAYER OF }" TYPE 'X' G.W.B. TO GARAGE CEILING WHEN UNDER HABITABLE ROOMS. DUCTS THROUGH WALL OR CEILING COMMON TO HOUSE SHALL HAVE MINIMUM 26 GAUGE STEEL SEE DIV. 01002.6.A. SHEET A-1.
- P-2 1{" MIN. SELF CLOSING SOLID WOOD CORE, HONEY-COMB CORE STEEL, OR 20-MINUTE FIRE RATED DOOR. SEE DIV. 01002.6.B. SHEET A-1
- STAIR ASSEMBLY NOTES: PER I.R.C. SECTION R311.5 A. HEADROOM MIN. 6'-8", WIDTH MIN. 3'-0". B. TREADS 10" MIN. DEPTH AND MIN. WIDTH OF 36" ABOVE HANDRAIL HEIGHT, RISERS 7[" MAX, HT, TREAD NOSING TO BE MINIMUM 3/4" AND A MAXIMUM OF 1 1/4" ON STAIRS WITH SOLID RISERS. C. HANDRAIL MIN. 34" TO MAX 38" ABOVE TREAD NOSING. HANDRAIL TYPE 1 CIRCULAR TO HAVE 11" MIN. TO 2" MAX. CROSS SECTION DIMENSION AND 1 1/2" MIN. CLEAR FROM WALL, RETURN RAIL ENDS. HANDRAILS SHALL BE
 - STRONG ENOUGH TO RESIST A 200 POUND POINT LOAD IN ANY DIRECTION PER I.R.C. TABLE R301.5 D. INSTALL FIRE BLOCKING BETWEEN STRINGERS AT THE TOP AND BOTTOM OF EACH RUN PER I.R.C. SECTION R302.11.
- E. COVER USABLE SPACE UNDER STAIR W/ \" G.W.B. PER I.R.C. SECTION R302.7. F. INTERMEDIATE BALUSTERS SHALL BE SPACED W/ LESS THAN 4" BETWEEN BALUSTERS. G. PROVIDE STAIRWAY ILLUMINATION PER I.R.C. SECTION R303.7. SEE DIV. 01002.7 SHEET A-1.
- SAFETY GLAZING PER I.R.C., SECTION R308 A. WINDOWS WITHIN 18" OF FLOOR B. WINDOWS WITHIN A 24" ARC OF DOORS C. WINDOWS AT TUBS AND SHOWERS D. GLAZING IN DOORS E. LESS THAN 60" HORIZ. FROM THE BOT. STAIR TREAD NOSING, & BOT. EDGE OF GLAZING IS LESS THAN 36" ABV. LANDING/WALKING SURFACE SEE DIV. 08800 SHEET A-1
- EGRESS WINDOW PER I.R.C., SECTION R310 SEE DIV. 08600 SHEET A-1
- IGNITERS FOR GAS FIRED APPLIANCES IN GARAGE TO BE 18" MIN, ABOVE TOP OF SLAB. SEE DIV. 15 SHEET A-1
- COVER WALLS ADJACENT TO TUBS AND SHOWERS WITH NON-ABSORBENT MATERIAL TO 72" ABOVE DRAIN INLETS, PER I.R.C. SECTION 307.2. SEE DIV. 09250 SHEET A-1
- (2) LAYERS OF FLOOR SHEATHING OVER
- 7[" MAX. RISER WITH 10" MIN. RUN, IF MORE THAN SECTION R311.7.8. SEE DIV. 01002.7 SHEET A-1 18"x24" CRAWL SPACE ACCESS. INSULATE AND
- WEATHER STRIP. SEE DIV. 01002.1 SHEET A-1 22"x30" ATTIC SPACE ACCESS W/ 30" HEAD CLEARANCE. INSULATE AND WEATHER STRIP.
- SEE DIV. 01002.2 SHEET A-1 FLOOR MATERIAL BREAK LINE P-12
- WALL LINE ABOVE P-13
- WALL LINE BELOW
- FIREPLACE ASSEMBLY NOTES: A. DIRECT VENT GAS FIREPLACES, MUST BE LISTED, LABELED &INSTALLED PER MFG. SPECIFICATIONS, SHALL CONFORM TO I.R.C.REQUIREMENTS.
 - SEE DIV. 01002.12 SHEET A-1 B. ZERO CLEARANCE FIREPLACES SHALL CONFORM TO I.R.C. REQUIREMENTS, SEE DIV. 01002.12 SHT A-1 C. HEARTH SHALL CONFORM TO I.R.C REQUIREMENT
- D. FIREBLOCK OPENINGS AROUND PENETRATIONS @ EACH FLOOR PER I.R.C. SECTION R1003.19. E. FIREPLACE MUST COMPLY WITH UL 127 TESTING
- P-16 SEE SITE PLAN FOR EXTENT OF WALKS & DRIVEWAYS
- 3" DIAMETER STEEL POST

SEE DIV. 01002.12

- 36" GUARDRAIL PER I.R.C. SECTION R312 & TABLE R301.5 CONTRACTOR TO VERIFY TO INSPECTOR THAT ALL GUARDS & RAILINGS ARE CAPABLE OF RESISTING 200lb LOAD ON TOP RAIL ACTING IN ANY DIRECTION.
- 'B' VENT FOR MECHANICAL. 1" CLEARANCE ALL SIDES PER
- SECTION R302.11. SEE DIV. 15 SHEET A-1
 PROVIDE A HEAT DETECTOR OR HEAT ALARM
 RATED FOR THE AMBIENT OUTDOOR TEMPERATURES & HUMIDITY. INSTALL IN A CENTRAL LOCATION AND IN ACCORDANCE W/ THE MANF. INSTRUCTIONS. CONNECT TO ALARM OR SMOKE ALARM IN THE DWELLING IN A LOCATION THAT WILL PROVIDE OCCUPANT NOTIFICATION.
- P-21 2x6 STUDS W/ R-21 INSULATION MIN.



GO DESIGN CONTACT@GODESIGN.STUDIO WWW.GODESIGN.STUDIO TEL.: (425) 595-0691

KAHN RESIDENCE

KAHN MICHAEL A

4205 85th AVE SE, MERCER ISLAND, WA 98040


© 2SDESIGN BUILD, Inc. All rights reserved. No part of this document may be reproduced in any form or by any means without permission in writing from 2SDESIGN BUILD, Inc.

DATE	DESCRIPTION


#22001

DRAWN BY: GO DESIGN

(P) LOWER FLOOR PLAN

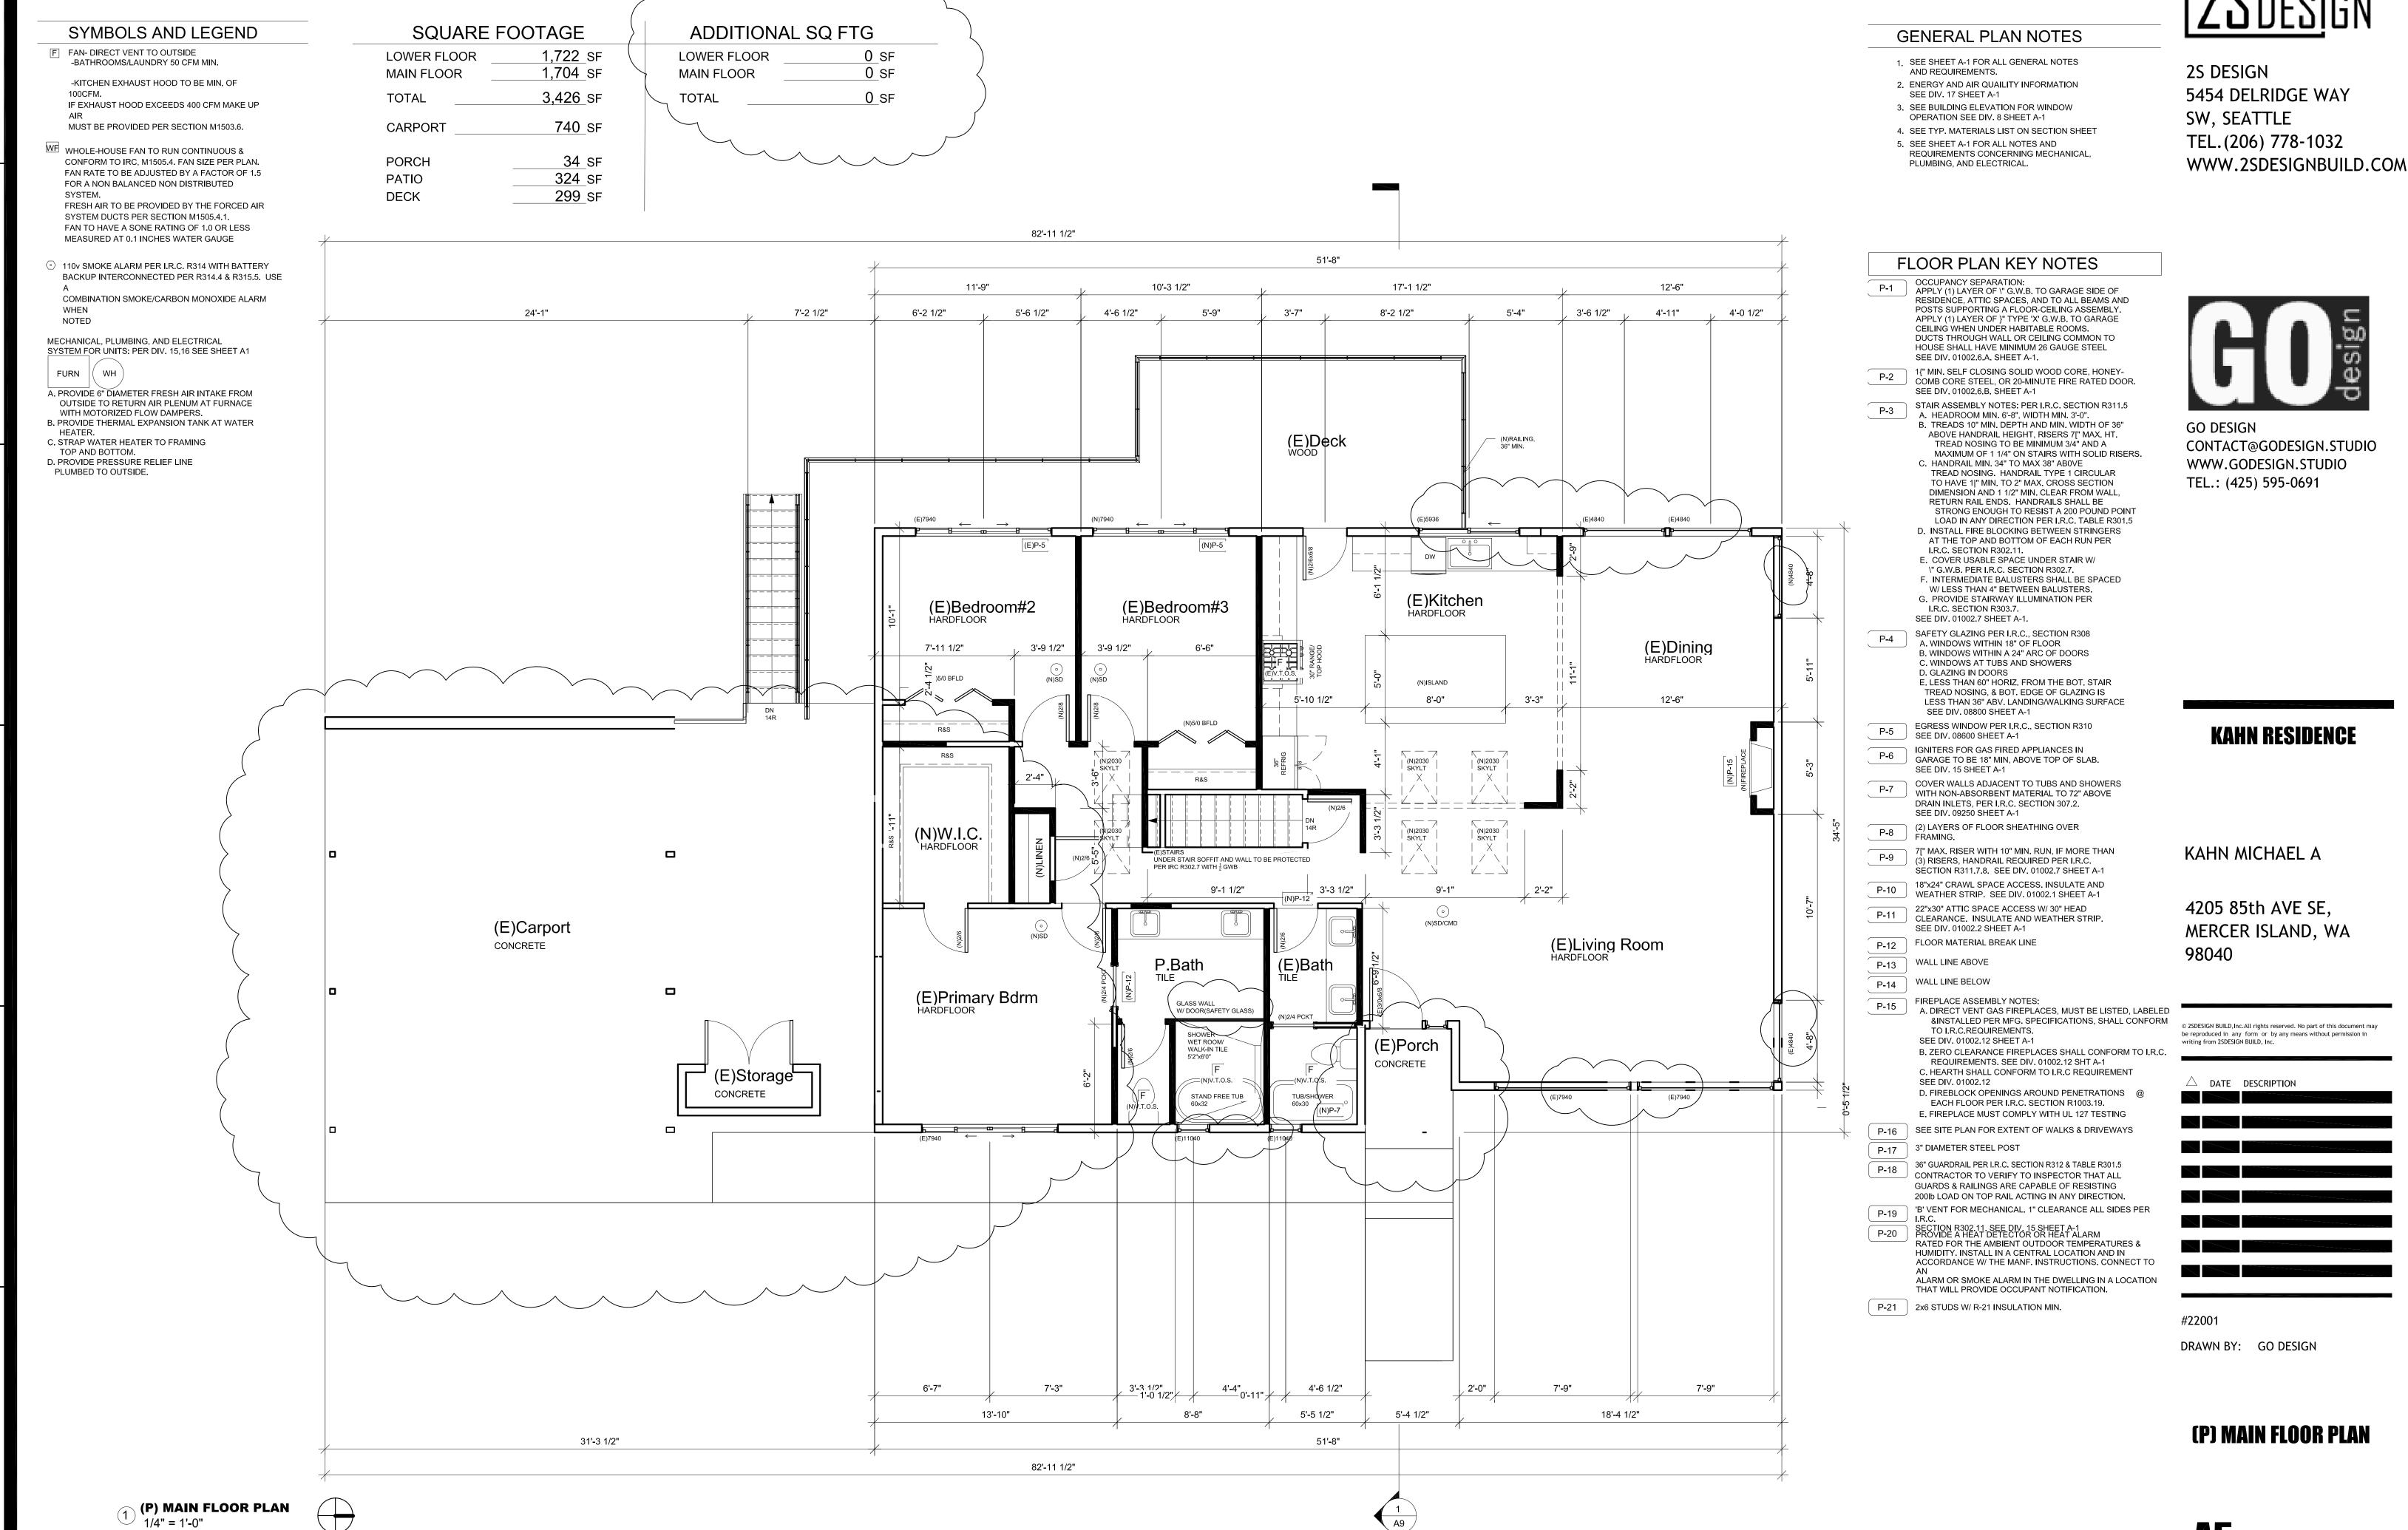

© 2SDESIGN BUILD,Inc.All rights reserved. No part of this document may

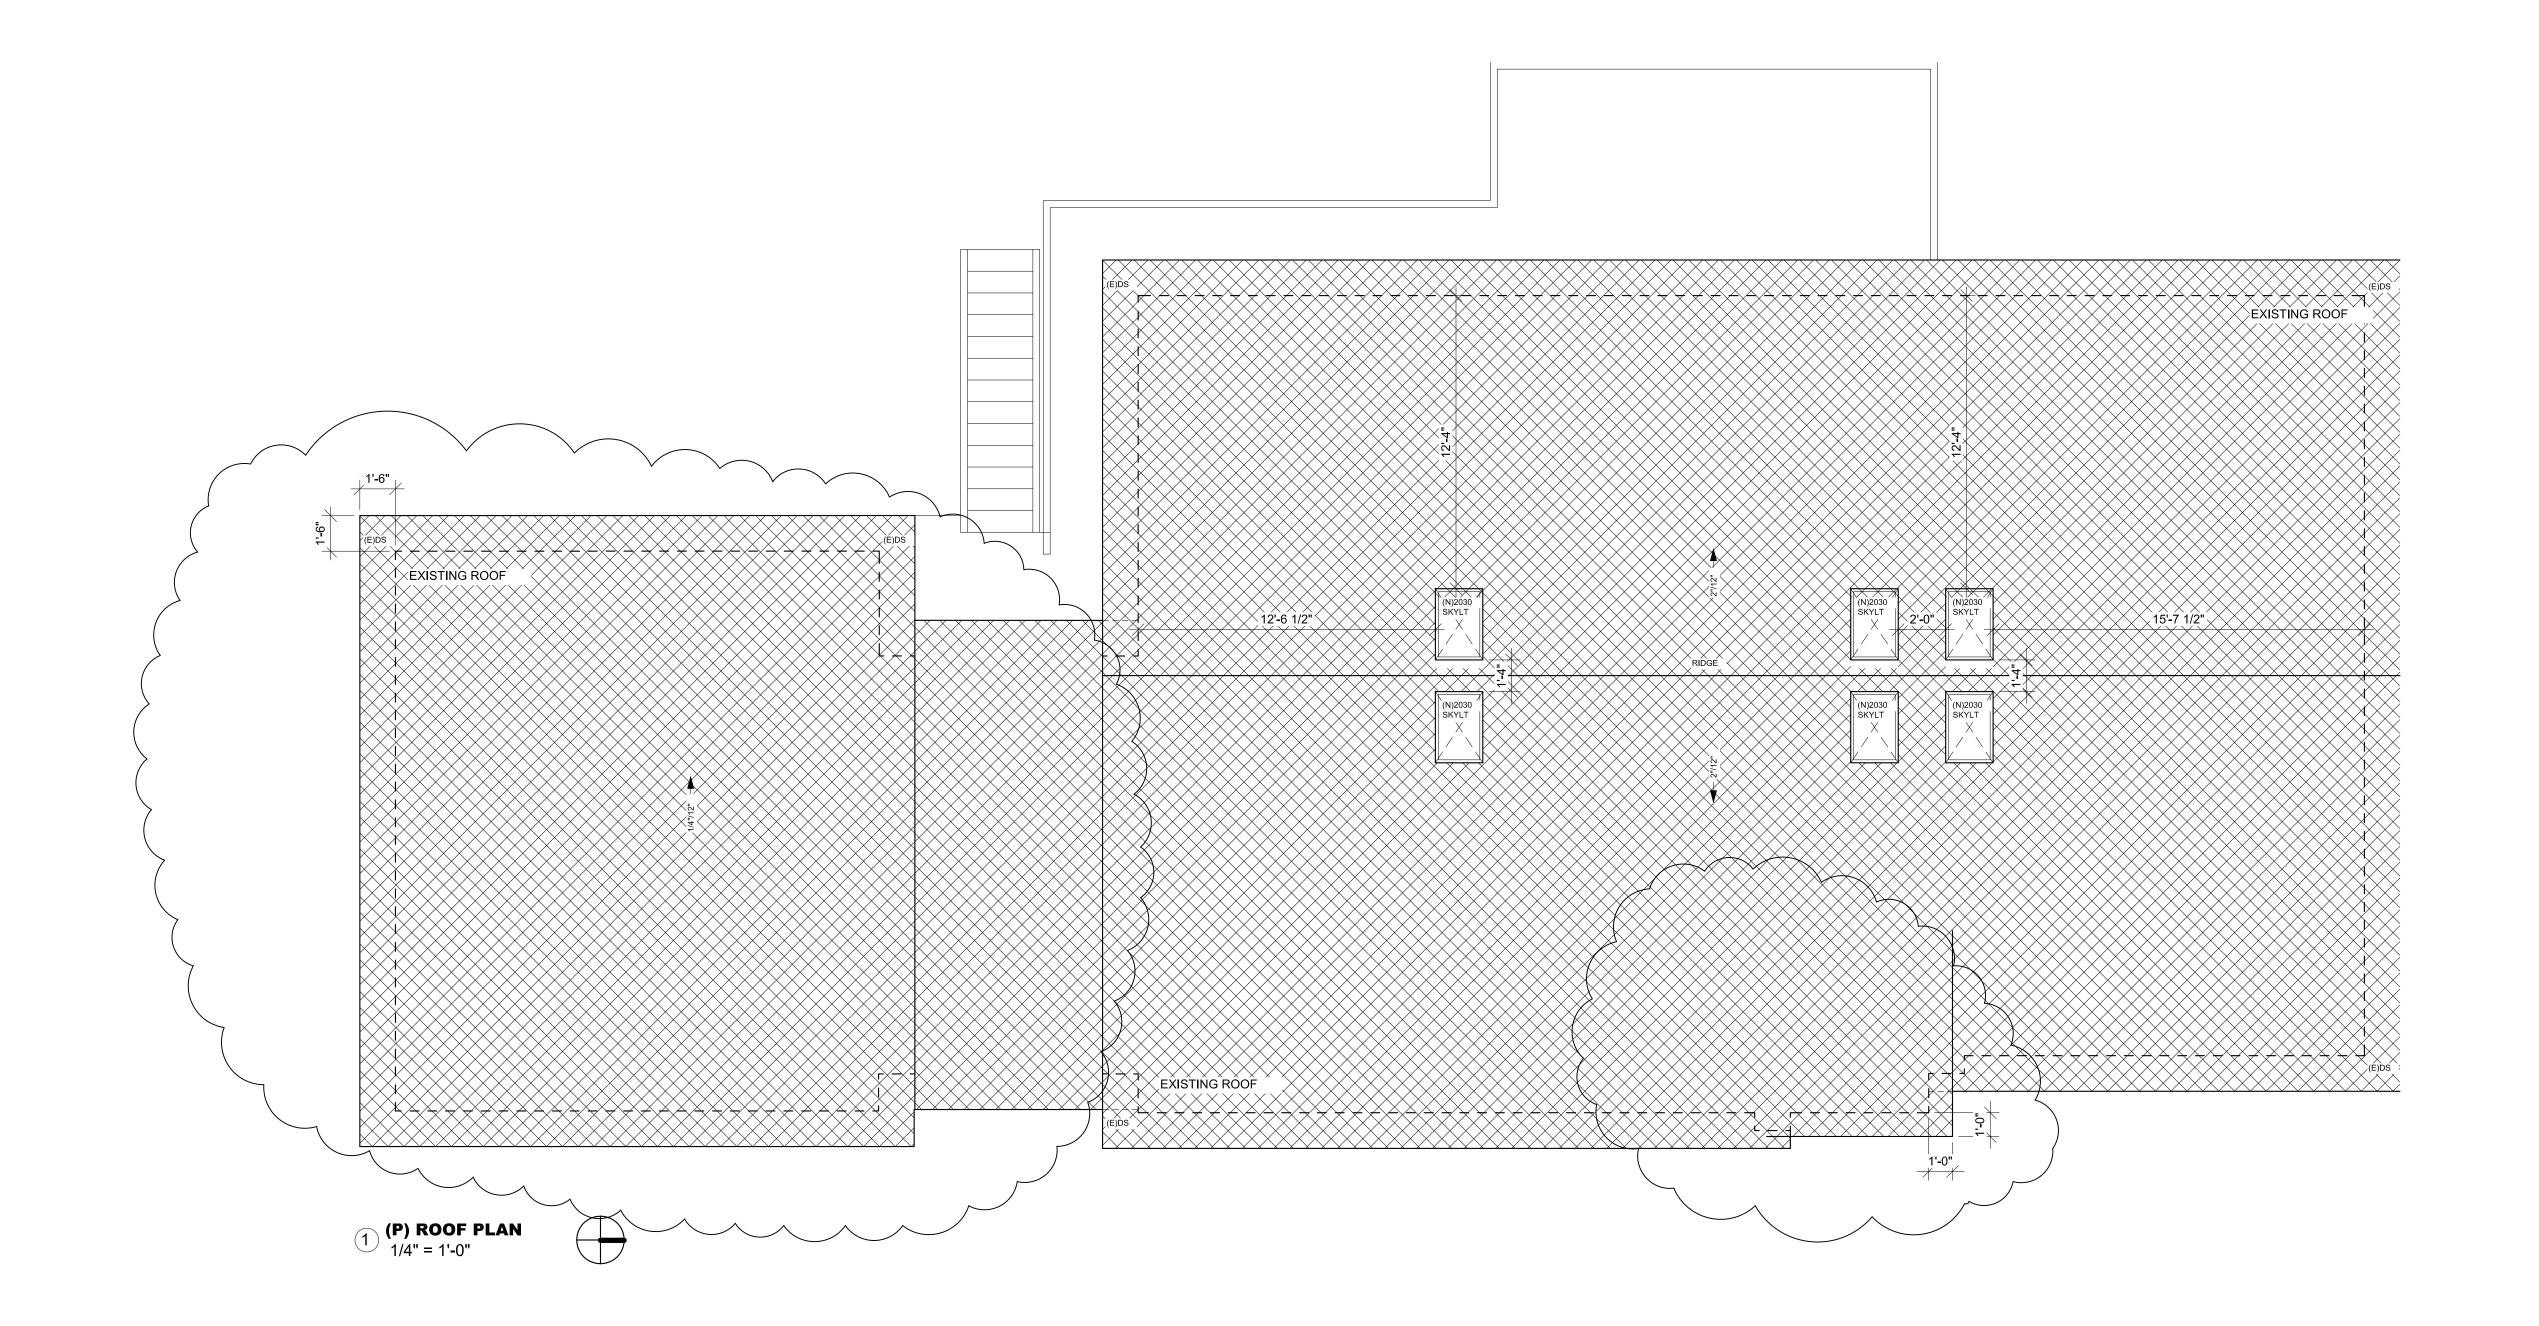



2S DESIGN
5454 DELRIDGE WAY
SW, SEATTLE
TEL.(206) 778-1032
WWW.2SDESIGNBUILD.COM




GO DESIGN CONTACT@GODESIGN.STUDIO WWW.GODESIGN.STUDIO TEL.: (425) 595-0691

KAHN RESIDENCE

KAHN MICHAEL A

4205 85th AVE SE, MERCER ISLAND, WA 98040


© 2SDESIGN BUILD, Inc. All rights reserved. No part of this document may be reproduced in any form or by any means without permission in writing from 2SDESIGN BUILD, Inc.

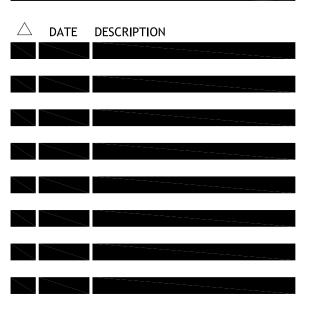

#22001

DRAWN BY: GO DESIGN

(P) ROOF PLAN

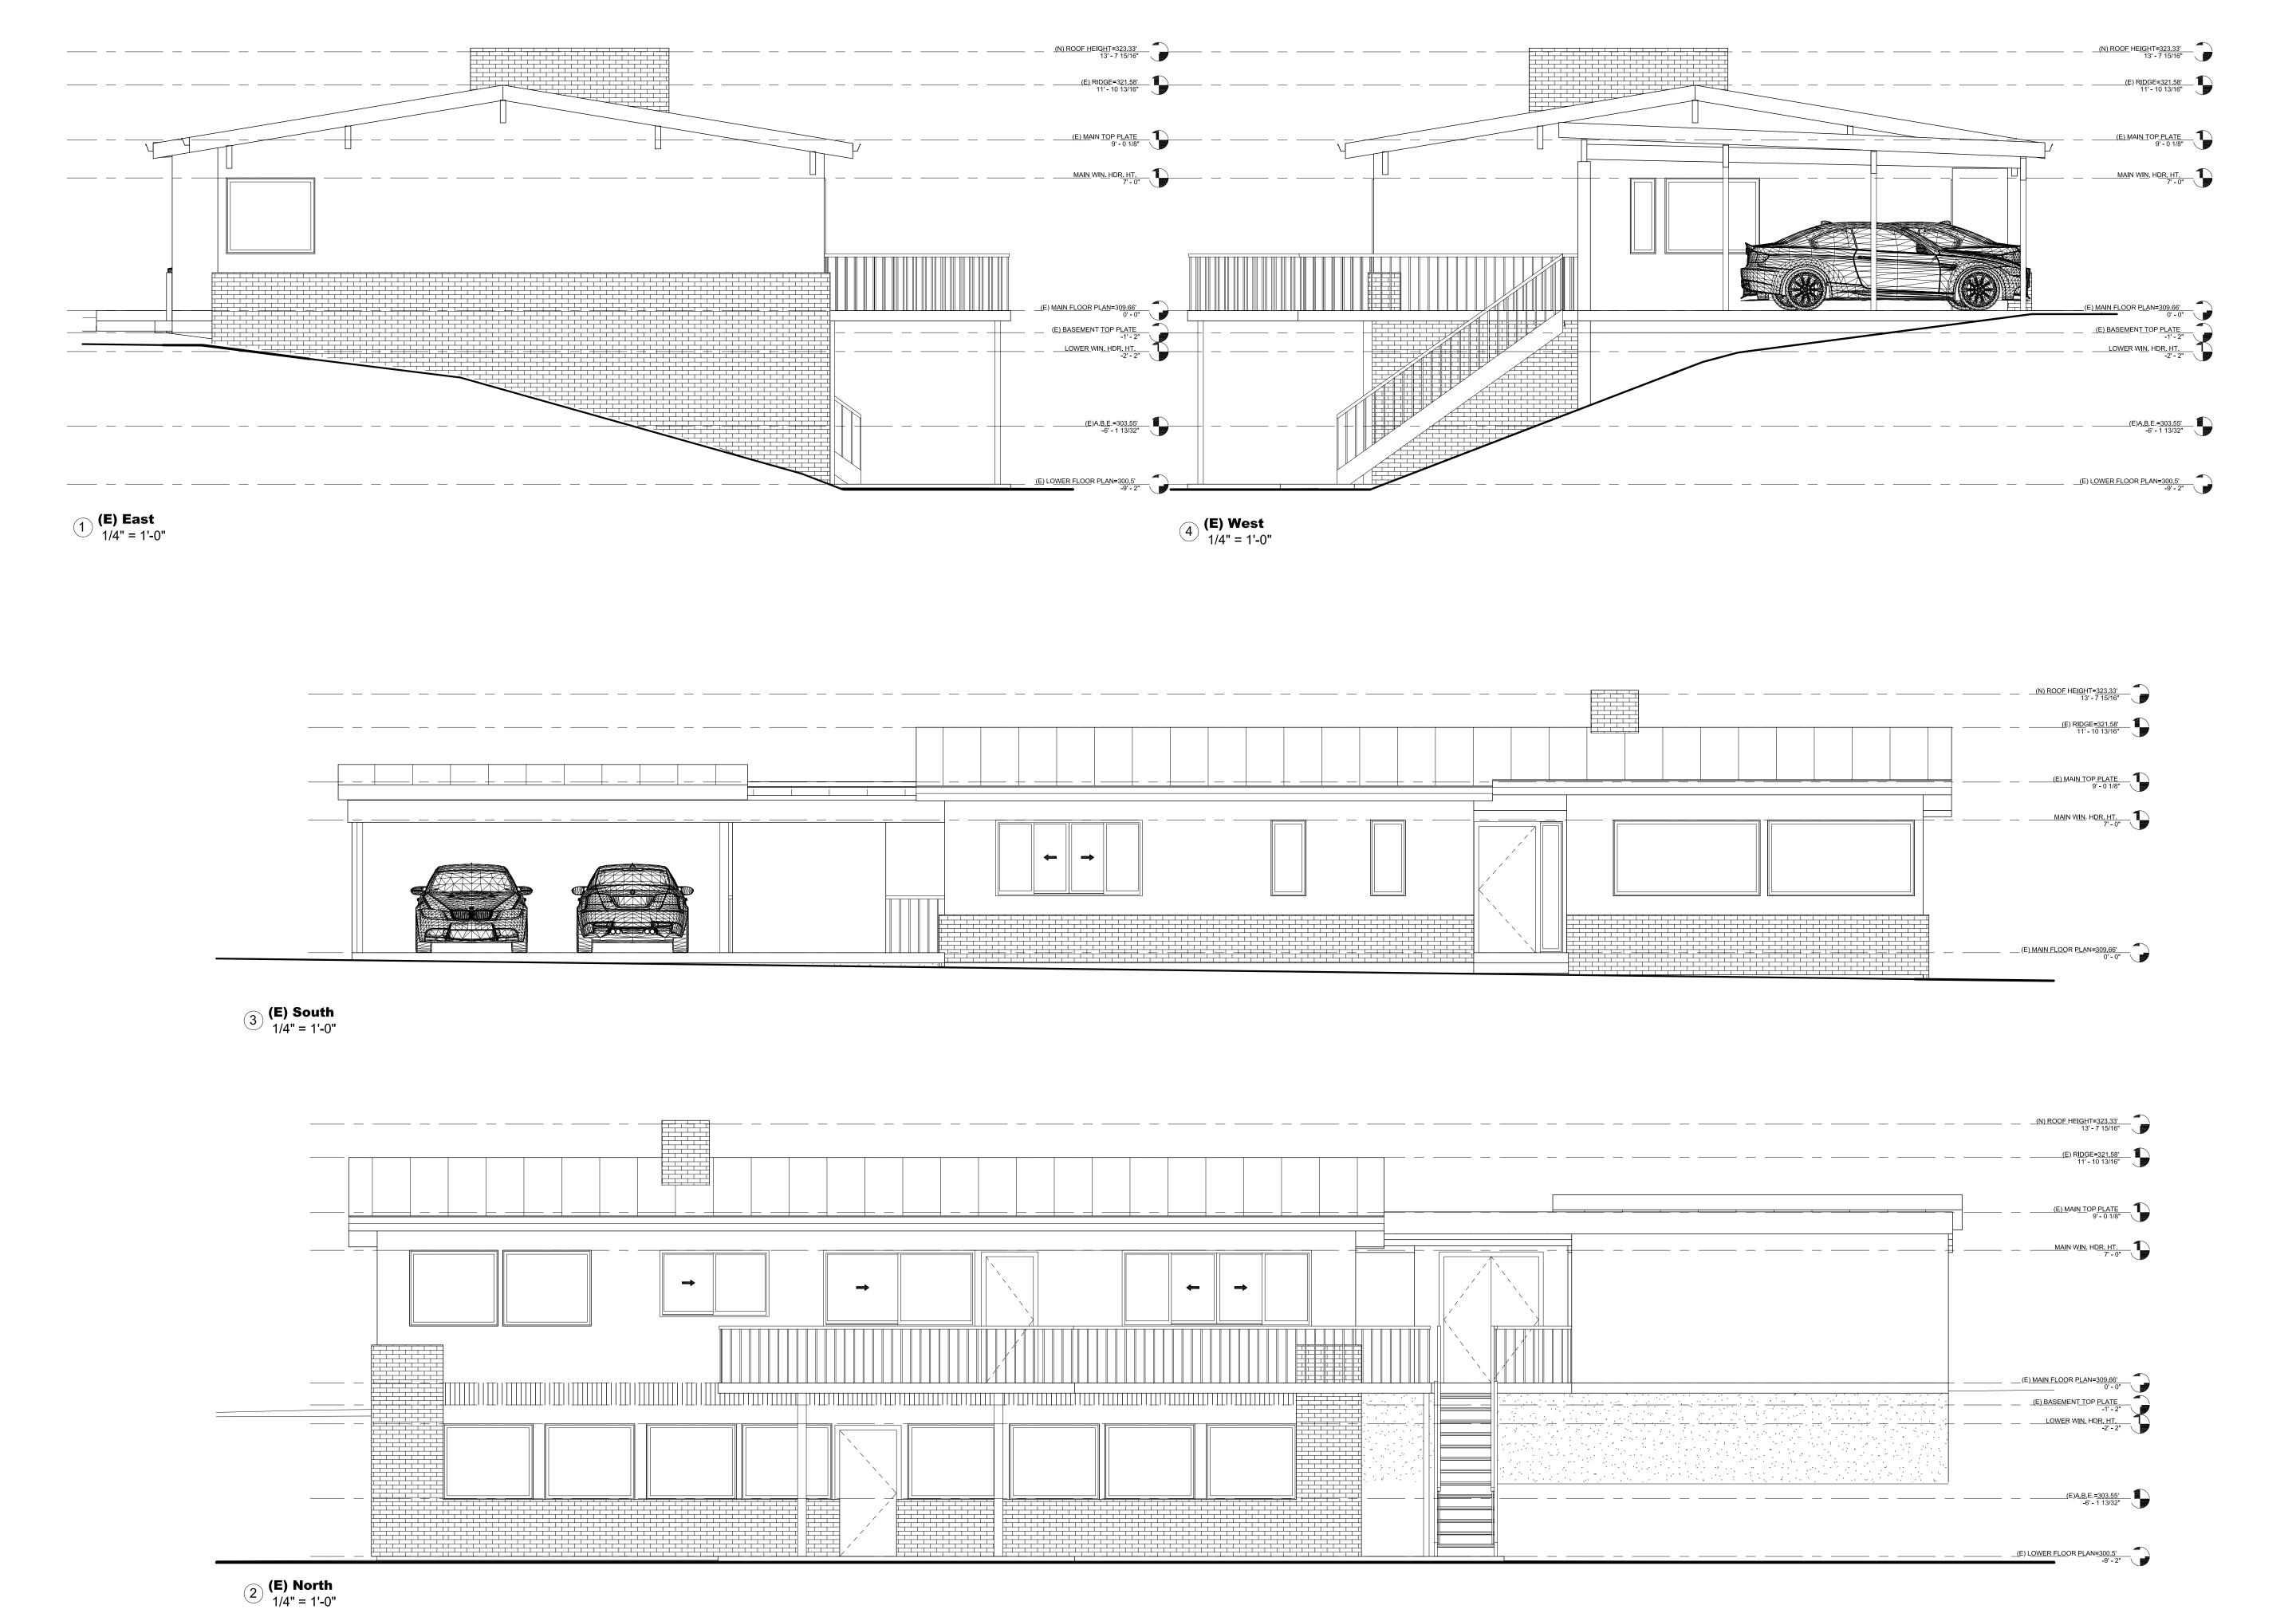



2S DESIGN
5454 DELRIDGE WAY
SW, SEATTLE
TEL.(206) 778-1032
WWW.2SDESIGNBUILD.COM



GO DESIGN CONTACT@GODESIGN.STUDIO WWW.GODESIGN.STUDIO TEL.: (425) 595-0691

KAHN RESIDENCE

KAHN MICHAEL A

4205 85th AVE SE, MERCER ISLAND, WA 98040

© 2SDESIGN BUILD, Inc.All rights reserved. No part of this document may be reproduced in any form or by any means without permission in writing from 2SDESIGN BUILD, Inc.




#22001

DRAWN BY: GO DESIGN

(E) ELEVATIONS

MAX ALLOWABLE HEIGHT=333.55'

2S DESIGN
5454 DELRIDGE WAY
SW, SEATTLE
TEL.(206) 778-1032
WWW.2SDESIGNBUILD.COM

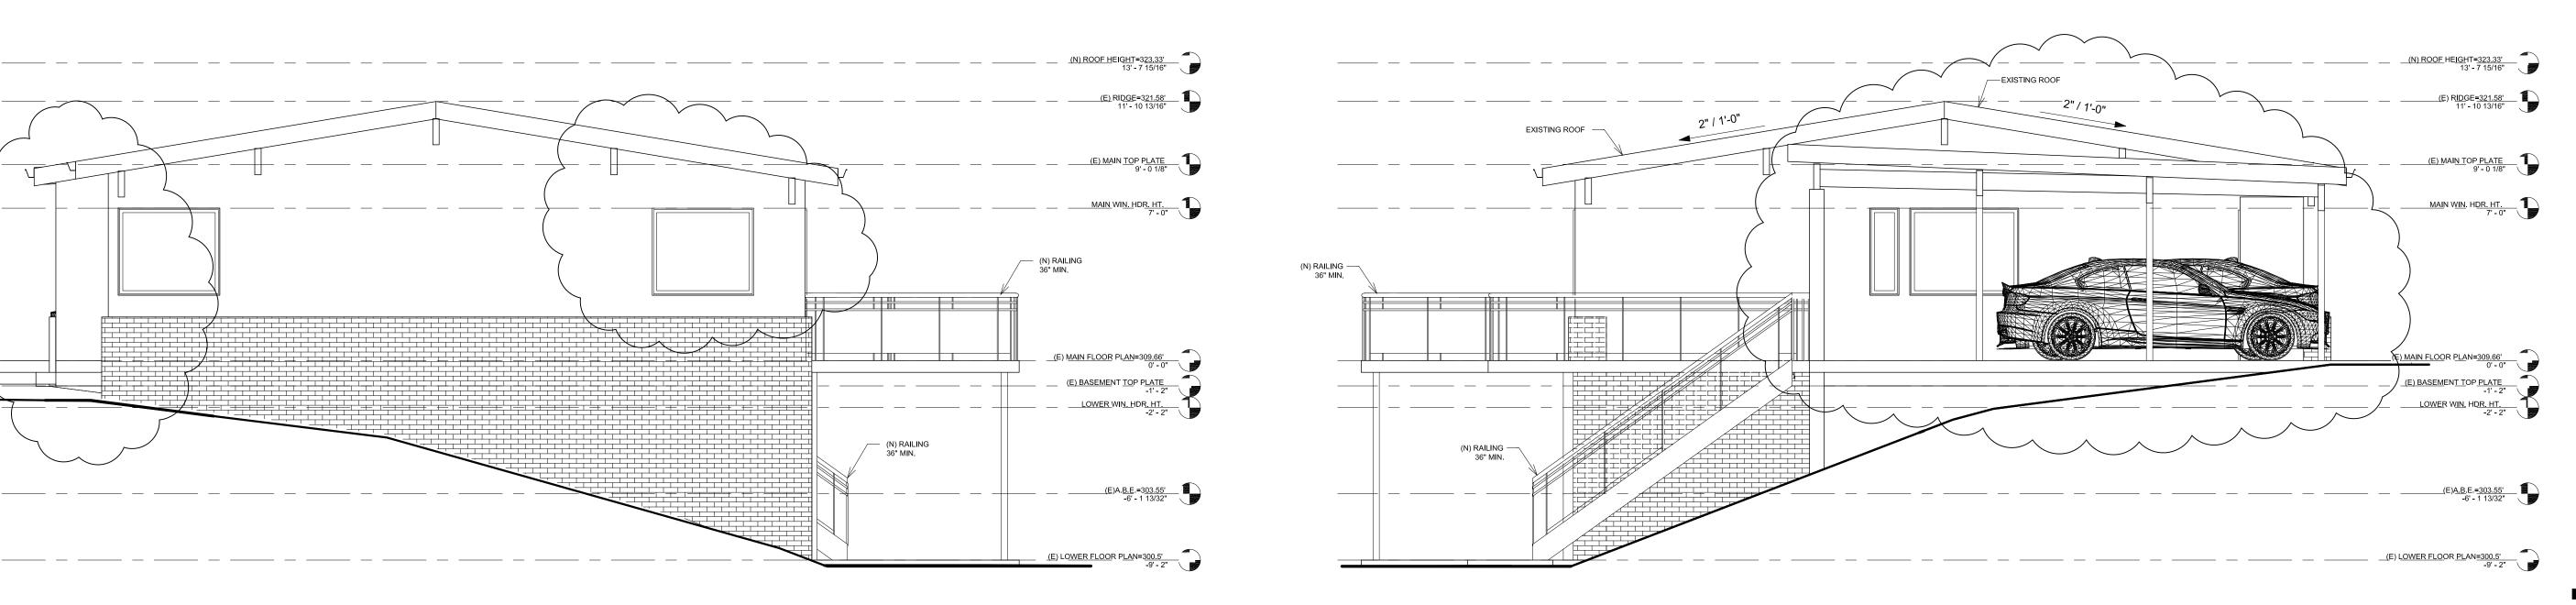

(P) WEST 1/4" = 1'-0"

___ EXISTING ROOF

Gesign

GO DESIGN
CONTACT@GODESIGN.STUDIO
WWW.GODESIGN.STUDIO
TEL.: (425) 595-0691


KAHN RESIDENCE

MAX ALLOWABLE HEIGHT=333.55'

KAHN MICHAEL A

4205 85th AVE SE, MERCER ISLAND, WA 98040

© 2SDESIGN BUILD, Inc. All rights reserved. No part of this document may be reproduced in any form or by any means without permission in writing from 2SDESIGN BUILD, Inc.

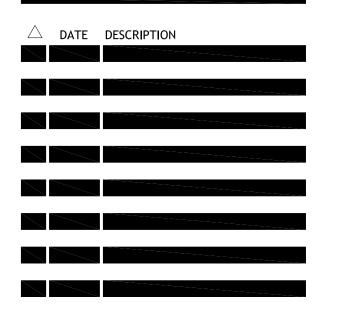

#22001

DRAWN BY: GO DESIGN


(P) **ELEVATIONS**


(P) North
1/4" = 1'-0"

(P) EAST 1/4" = 1'-0"

(E) LOWER FLOOR PLAN=300.5'
-9' - 2"

MAN WIN FOR PLANSAGE PLANSAGE

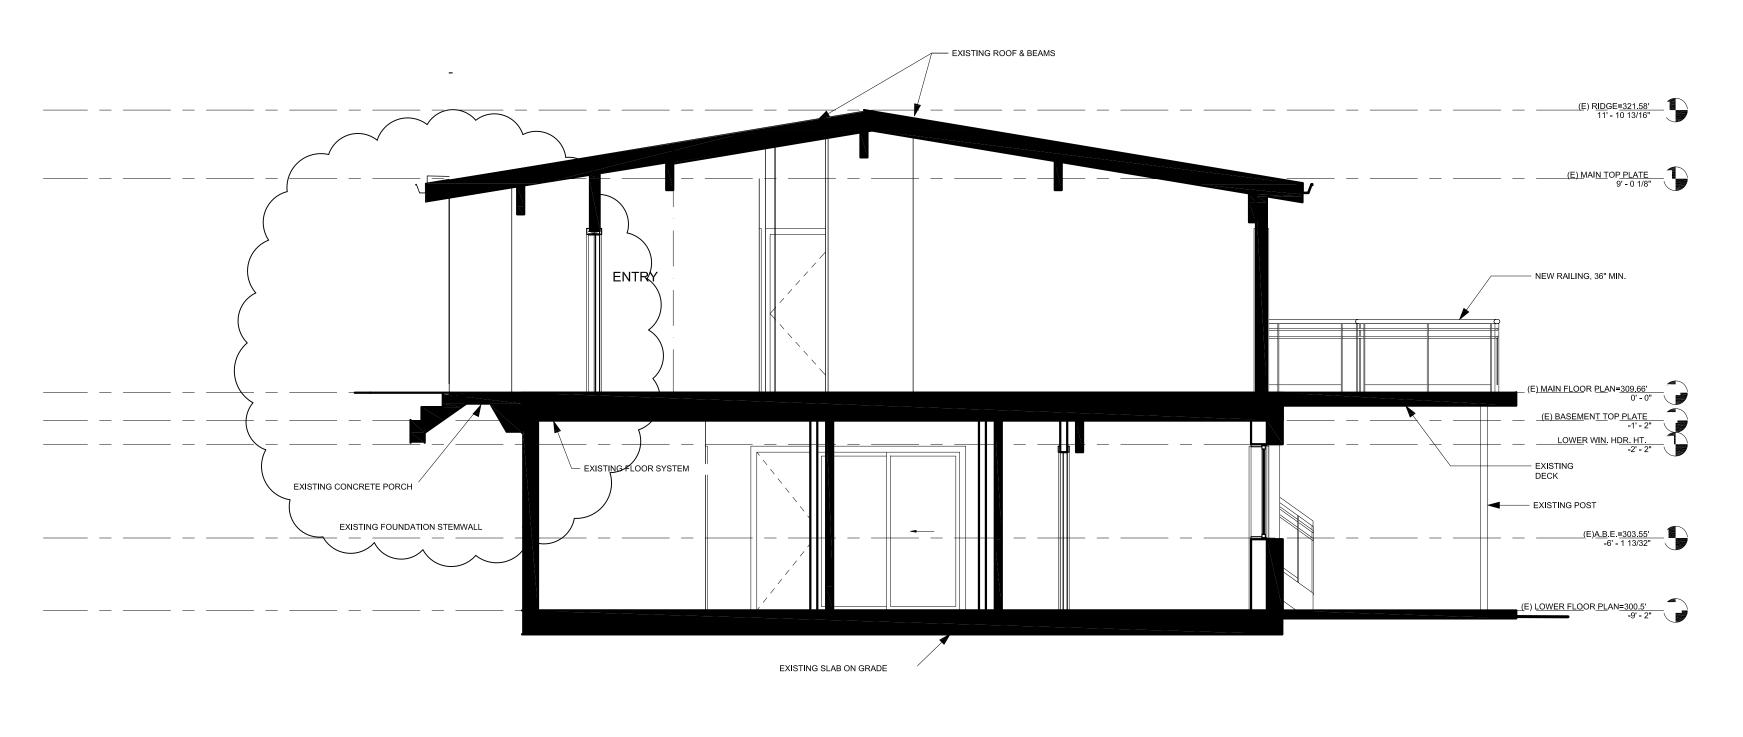

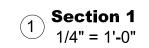

2S DES GN

2S DESIGN
5454 DELRIDGE WAY
SW, SEATTLE
TEL.(206) 778-1032
WWW.2SDESIGNBUILD.COM




CONTACT@GODESIGN.STUDIO WWW.GODESIGN.STUDIO TEL.: (425) 595-0691

KAHN RESIDENCE

KAHN MICHAEL A

4205 85th AVE SE, MERCER ISLAND, WA 98040


© 2SDESIGN BUILD, Inc. All rights reserved. No part of this document may be reproduced in any form or by any means without permission in writing from 2SDESIGN BUILD, Inc.

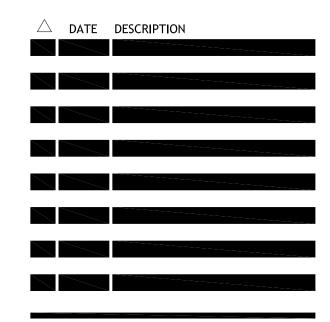

#22001

DRAWN BY: GO DESIGN

(P) BUILDING SECTION

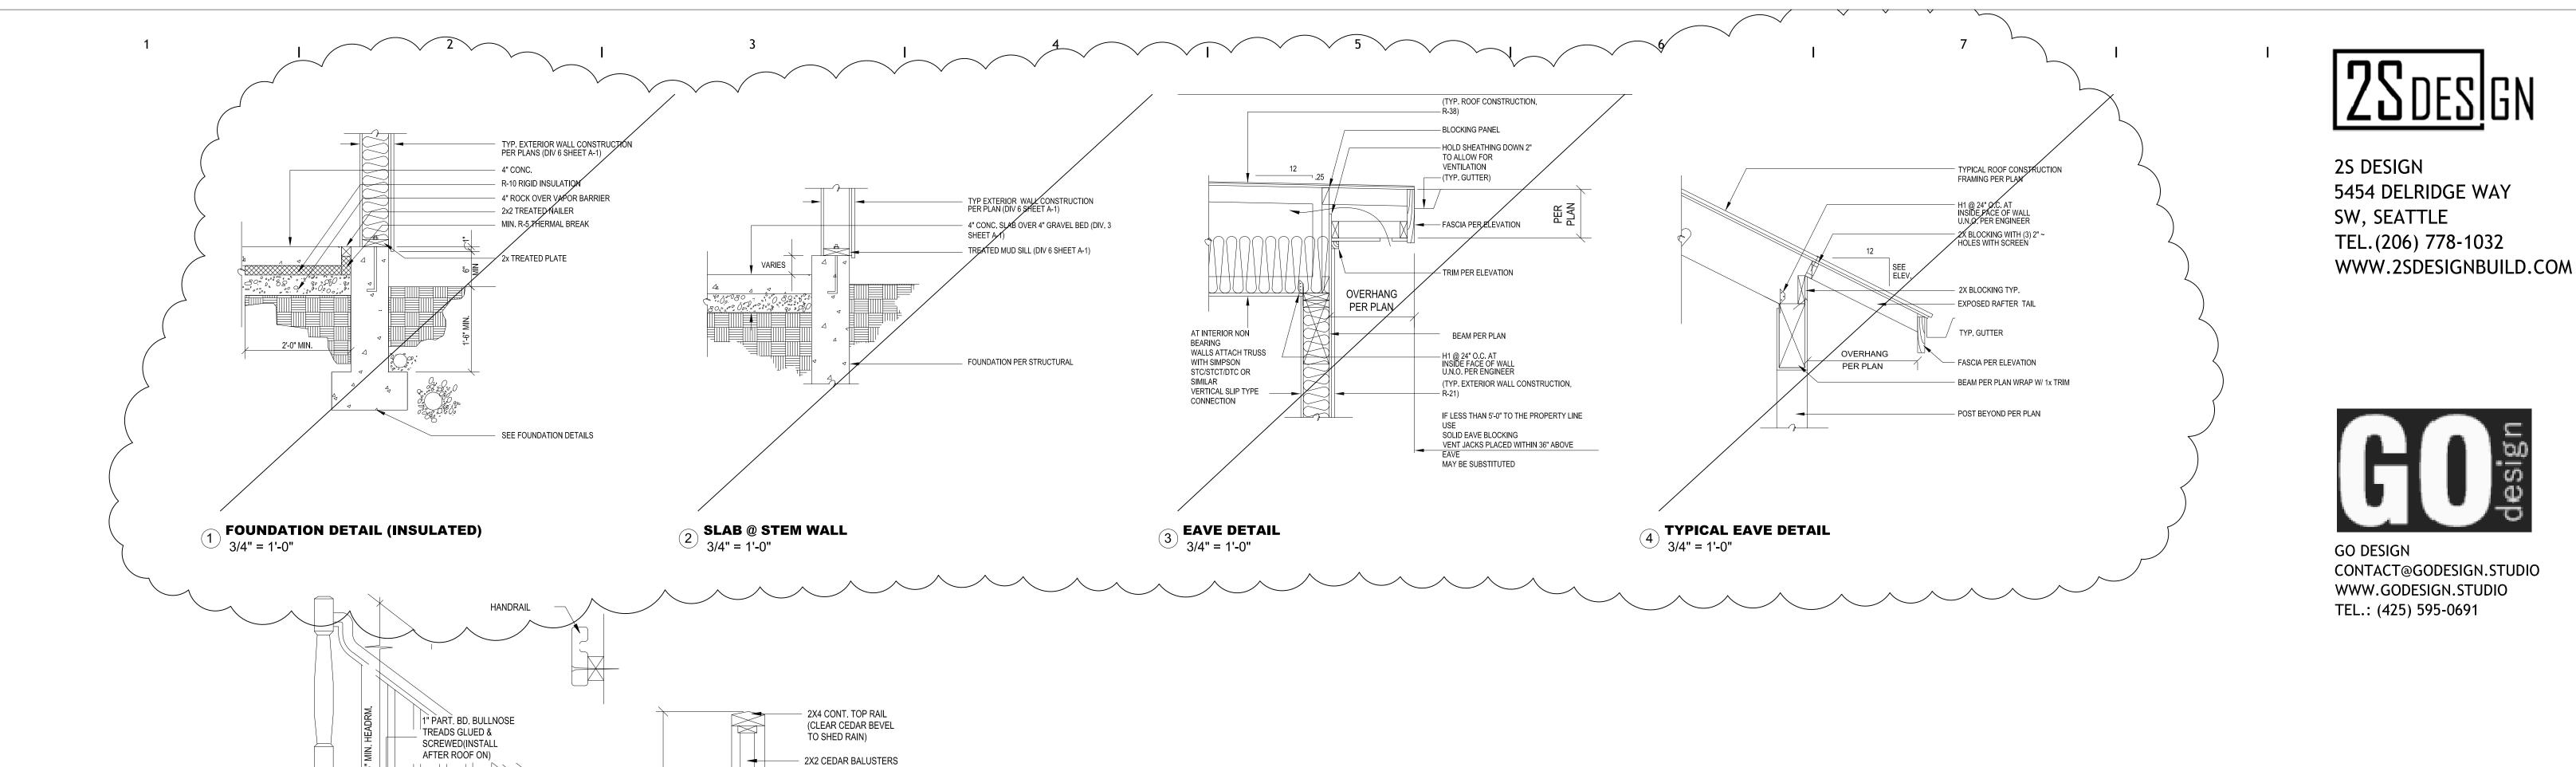

SPACED TO PREVENT PASSAGE OF 4" SPHERE

1X3 CONTINIOUS CEDAR -

- 4X4 CLEAR CEDAR POSTS @ 6' O/C (MAX.) BOLT BTWN DBL DECK JSTS W/ \" BOLTS. (2 EA. POST)

- 4X4 CLEAR CEDAR BOTTOM RAIL

TOP & BOTT.

"SIMPSON" LS50

PLYWOOD RISERS

TYPE "X" G.W.B. TYP UNDER STAIR

RAILING DETAIL 3/4" = 1'-0"

(3) 2X12 STRINGERS

PROVIDE MIN 36" CLEAR

WIDTH AT STAIRWAYS

EA SIDE

KAHN RESIDENCE

KAHN MICHAEL A

4205 85th AVE SE, MERCER ISLAND, WA 98040

© 2SDESIGN BUILD, Inc. All rights reserved. No part of this document may be reproduced in any form or by any means without permission in writing from 2SDESIGN BUILD, Inc.



#22001

DRAWN BY: GO DESIGN

STANDARD DETAILS

01

AND SHORING NECESSARY FOR THE CONSTRUCTION OF THE STRUCTURE AND ITS COMPONENTS UNTIL ALL FINAL CONNECTIONS HAVE BEEN COMPLETED. THE CONTRACTOR SHALL BE RESPONSIBLE FOR ALL REQUIRED SAFETY PRECAUTIONS AND THE METHODS, TECHNIQUES, SEQUENCING OF OR PROCEDURES REQUIRED TO PERFORM THE WORK. ALL CONTRACTOR INITIATED CHANGES SHALL BE SUBMITTED IN WRITING TO THE DESIGNER OR THE ENGINEER FOR APPROVAL PRIOR TO FABRICATION OR CONSTRUCTION. THESE STRUCTURAL DRAWINGS SHALL BE USED IN CONJUNCTION WITH THE ARCHITECTURAL DRAWINGS FOR BIDDING AND CONSTRUCTION. ALL STRUCTURAL SYSTEMS WHICH ARE TO BE COMPOSED OF COMPONENTS TO BE FIELD ERECTED SHALL BE SUPERVISED BY THE SUPPLIER DURING MANUFACTURING, DELIVERY, HANDLING, STORAGE AND ERECTION IN

APPLICABLE CODES AND STANDARDS

ACCORDANCE WITH INSTRUCTIONS PREPARED BY THE SUPPLIER.

THE STRUCTURAL DESIGN HAS BEEN PREPARED IN ACCORDANCE WITH THE LATEST EDITION OF THE FOLLOWING: CODES AND STANDARDS.

AMERICAN CONCRETE INSTITUTE ACI 318-11 BUILDING CODE REQUIREMENTS FOR STRUCTURAL CONCRETE ACI-301-10 SPECIFICATIONS FOR STRUCTURAL CONCRETE-SP 66-04 CONCRETE DETAILING MANUAL AMERICAN INSTITUTE OF STEEL. CONSTRUCTION - ANSI/AISC 360 SPECIFICATION FOR THE DESIGN,

FABRICATION AND ERECTION OF STRUCTURAL STEEL

AMERICAN WELDING SOCIETY - AWS STRUCTURAL WELDING CODE.

STEEL STRUCTURE PAINTING COUNCIL - SSPC STEEL STRUCTURE PAINTING MANUAL

U.S. PRODUCT STANDARDS - PS - 1- 74.

INTERNATIONAL BUILDING CODE (IBC) 2018 EDITION.+ 2018 IRC
NATIONAL DESIGN SPECS FOR WOOD CONSTRUCTION (NDS) 2018 EDITION. NDS FOR WOOD CONSTR. W/ 2018 SUPPLEMENT
SD PWS 2011 SPECIAL DESIGN PROVISIONS FOR WIND AND SEISMIC.

WESTERN WOOD PRODUCTS ASSOCIATION - WWPA GRADING RULES FOR LUMBER AND PLYWOOD AMERICAN SOCIETY OF CIVIL ENGINEERSASCE/SEI 7-10 MIN. DESIGN LOADS FOR BLDGS + OTHER STRUCTURES.

DESIGN CHITEMA

IN ADDITION TO THE DEAD LOADS, THE FOLLOWING LOADS WERE USED IN THE PREPARATION OF THIS DESIGN AS REQUIRED BY CHAPTER 16 OF THE INTERNATIONAL BUILDING CODE.

LIVE LOADS SOIL PRESSURE 90IL BEARING 1500 PSF (ASSUMED) ACTIVE PRESSURE?CANTILEVER PCF (ASSUMED) ACTIVE PRESSURE?BASEMENSS PCF (ASSUMED) CEILING 300 PCF (ASSUMED EXTERIOR BALCONY BASE FRICTION COEFF. 0.40 PCF (ASSUMED) STAIR + CORRIDOR

ls **-**1.0

ROOF SNOW LOAD

GROUND SNOW LOAD,pg ROOF SNOW LOAD,Pf 2. SNOW EXPOSURE FACTOR CE -1.0

3. SNOW LOAD IMPORTANCE FACTOR 4. THERMAL FACTOR Ct =1.1 **EARTHQUAKE DESIGN DATA:**

1. RISK CATEGORY 2. SESMIC IMPORTANCE FACTOR

3. MAPPED SPECTRAL ACCELERATION, SHORT PERIOD MAPPED SPECTRAL ACCELERATION, 1 SECOND PERIOD 4. SITE CLASS 5. SPECTRAL RESPONSE COEFFICIENT, SHORT PERIOD

SPECTRAL RESPONSE COEFFICIENT, 1-SECOND PERIOD SD1+0.542g 6. TOPOGRAPHICAL FACTOR 6. SEISMIC DESIGN CATEGORY 7. BASIC SEISMIC FORCE RESISTANCE B. DESIGN BASE SHEAR

. SEISMIC RESPONSE COEFFICIENT 10. RESPONSE MODIFICATION FACTOR 1. ANALYSIS PROCEDURE USED

-OUNDATIONS

ALL FOOTINGS AND FOUNDATIONS SHALL BEAR ON SOLID, UNDISTURBED FIRM NATURAL EARTH OR COMPACTED SOIL, AT LEAST 18' BELOW FINISHED GRADE AND FREE OF ORGANIC MATERIALS. FOOTING AND FOUNDATION EXCAVATION SHALL BE FREE OF LOOSE SOILS, SLOUGHS, DEBRIS, AND FREE OF WATER AT ALL TIMES. FOUNDATIONS SUPPORTING WOOD SHALL EXTEND AT LEAST 6" ABOVE FINISH GRADE. FOUNDATION WALL BACKFILL SHALL BE PLACED SIMULTANEOUSLY ON BOTH SIDES OF WALL. PROVIDE 4" PERFORATED PIPE (AS REQUIRED) FOR SUBSURFACE DRAINAGE. FOOTING SIZE SHALL BE AS INDICATED ON DRAWINGS OR MINIMUM AS PER IBC SECTION 1806. WHERE THE SURFACE IS SLOPED MORE THAN ONE (1) FOOT IN TEN(10) FEET THE FOUNDATION SHALL BE LEVEL OR BE STEPPED SO THAT BOTH TOP AND BOTTOM OF SUCH FOUNDATION ARE LEVEL PER IBC. WHERE STRUCTURAL COLUMNS AND POSTS ARE EXPOSED TO WATER SPLASH ABOVE A CONCRETE SURFACE OR TO THE WEATHER, PROVIDE A MINIMUM PLINTH OF 1' ABOVE THE CONCRETE SURFACE, OR 6 ' ABOVE THE EXPOSED EARTH PER UBC. FOUNDATION SILL PLATES SHALL BE BOLTED TO THE FOUNDATION OR THE FOUNDATION WALL WITH A STEEL ANCHOR BOLT HAVING A MINIMUM NOMINAL DIAMETER OF 5/8". BOLTS SHALL BE EMBEDDED A MINIMUM OF 7" INTO THE CONCRETE AND SHALL BE SPACED NOT MORE THAN 4 FEET APART. THERE SHALL BE A MINIMUM OF TWO BOLTS PER PIECE WITH ONE BOLT LOCATED NOT MORE THAN 12" OR LESS THAN 7 BOLT DIAMETERS FROM EACH END OF THE PIECE. ANCHOR BOLTS SHALL BE A STANDARD 'J-BOLT' WITH A 4d RETURN, OR A STANDARD 'L-BOLT' WITH 12d EXTENSION. ANCHOR BOLTS SHALL BE A36 STEEL OR BETTER. ALL ANCHOR BOLTS AT FOUNDATION SILL PLATES SHALL BE PROVIDED WITH 3"x3"x1/4" PLATE WASHERS PER SHEAR WALL SCHEDULE AT SHEAR WALLS AND OTHER STANDARD WALLS DEFAULTING TO PI-6. SEE SHEARWALL SCHEDULE ON THIS SHEET FOR SPECIFIC ANCHOR BOLT REQUIREMENTS AT ALL SHEARWALL LOCATIONS.

PLYWOOD SHEAR PANELS

V-SEE CALCS

(ASCE7-10.12.8)

EQ.LATERAL FORCE

CS=0.13

WIND DESIGN DATA:

S1-0.494g 4. INTERNAL PRESSURE COEFFICIENT N/A

le =1.0 2. RISK CATEGORY

SS=1.420g 3. WIND EXPOSURE

(ANSI/AF+PA WFCM-2018)

SD9-0.947g 5. COMPONENTS AND CLADDING REFER TO DRAWINGS

1. ULTIMATE WIND SPEED (3 SECOND GUST) VULT =110 MPH

CONCRETE SHALL ATTAIN A 28 DAY STRENGTH OF 1'7c ? AS INDICATED BELOW. CONCRETE SHALL CONFORM TO AMERICAN CONCRETE INSTITUTE STANDARD 301, 'SPECIFICATIONS FOR STRUCTURAL CONCRETE FOR BUILDING'. AN AIR ENTRAINING ADMIXTURE CONFORMING TO BC STANDARDS SHALL BE ADDED TO ALL CONCRETE EXPOSED TO EARTH OR WEATHER. PROVIDE 5% ± 1.5% ENTRANED AIR MAXIMUM. MAXIMUM SLUMP SHALL BE 4' AT TIME OF PLACING, COMPRESSIVE STRENGHT OF 3,000 pei IS REQUIRED FOR ALL EXTERIOR AND EXPOSED CONDITIONS PER PER IBC AND/ORTIRC GOVERNING CODES.

-	MIN. SACKS OF CEMENT PER C.Y. OF CONC	SPECIAL INSP.	USE
5000 pel	6 1/2	YES	SLABS ON GRADE, FOUNDATIONS + FOOTINGS
E FOR POST OF ADMO			COLOREDONE OTTENOTALO

GROUT FOR POST BEARING PLATES SHALL BE NON-SHRINK TYPE WITH MINIMUM COMPRESSIVE STRENGTH OF 8,000 PSI AT 28 DAYS.

REINFORCING STEEL

NEW, CLEAN AND FREE FROM DIRT, CONCRETE REINFORCING STEEL SHALL CONFORM TO ASTM -A615-76A, GRADE 60 (1797-60,000 PSI.) FOR \$\frac{1}{2}\$ 4 BARS AND SMALLER GRADE 60 (1797-60,000 PSI.) FOR \$\frac{1}{2}\$ 5 BARS AND LARGER

UNLESS NOTED OR SHOWN OTHERWISE, ALL REINFORCING BARS SHALL BE CONTINUOUS WITH ALL SPLICES STAGGERED. ALL STEEL SHALL BE ACCURATELY LOCATED IN THE FORMS AND SECURED BY FORM TIES TO PREVENT DISPLACEMENT DURING CONSTRUCTION. PROVIDE ALL HORIZONTAL BARS ON 15 COPPORT AND WALL INTERSECTIONS. MALLER A CONCRETE WALL END DOES AND INTERSECT WITH ANOTHER AT ALL CORNERS AND WALL INTERSECTIONS. WHERE A CONCRETE WALL END DOES NOT INTERSECT WITH ANOTHER WALL, HOOK HORIZONTAL BARS 90 DEGREES AND PROVIDE AN EXTENSION OF 6 BAR DIAMETERS. AT CONCRETE WALLS LAP VERTICAL REINFORCEMENT A MINIMUM OF 48 BAR DIAMETERS TO FOOTING DOWELS. LAP ALL REINFORCING BAR SPLICES A MINIMUM OF 48 BAR DIAMETERS. REINFORCING STEEL SHALL BE DETAILED (INCLUDING HOOK AND BENDS) IN ACCORDANCE WITH ACI 315 AND 318 - (LATEST EDITION).

CONCRETE PROTECTION (COVER) FOR REINFORCING STEEL SHALL BE AS FOLLOWS: FOOTINGS AND OTHER UNFORMED SURFACES, EARTH FACE FORMED SURFACES EXPOSED TO EARTH OR WEATHER

#5 BARS OR SMALLER #6 BARS OR LARGER

BLABS AND WALLS (INTERIOR FACE)

WELDED WIRE FABRIC SHALL CONFORM TO ASTM-185. LAP FABRIC 1'-O' MINIMUM AT SPUCES. LAP ADJACENT MATS OF WELDED WIRE MESH ONE FULL MESH AT SIDES AND ENDS.

STRUCTURAL STEEL

STRUCTURAL STEEL STANDARD SHAPES AND PLATES SHALL CONFORM TO ASTM A36 STEEL (17y? = 36,000 PSI) STRUCTURAL TUBING SHALL CONFORM TO ASTM A500, GRADE B (17)? - 46,000 PSI).
ALL MACHINE BOLTS AND ANCHOR BOLTS SHALL CONFORM TO ASTM A 307. USE E70XX ELECTRODES FOR WELDING. ALL FILLET WELDS SHALL BE MINIMUM 3/16" OR EQUAL TO MINIMUM THICKNESS OF MEMBER BEING WELDED, WHICHEVER IS LESS, UNLESS OTHERWISE SHOWN, ALL WELDING SHALL BE PERFORMED BY WELDERS CERTIFIED IN ACCORDANCE WITH AWS AND WABO, ALL STEEL ITEMS SHALL HAVE ONE COAT OF RED LEAD CONFORMING TO TT-P-00615C TYPE II, 2-3 MILL COATING.
SHOP DRAWINGS FOR STRUCTURAL STEEL SHALL BE SUBMITTED TO THE DESIGNER AND THE ENGINEER FOR

METAL WOOD TO WOOD CONNECTORS

METAL WOOD TO WOOD CONNECTORS REFERENCED BY LETTERS AND NUMBERS SHALL BE MANUFACTURED BY SIMPSON STRONG TIE AS SPECIFIED IN THEIR FULL LINE CATALOG' CURRENT EDITION. EQUIVALENT DEVICES BY OTHER MANUFACTURERS MAY BE SUBSTITUTED, PROVIDED THEY HAVE ICC APPROVAL FOR EQUAL OR GREATER LOAD CAPACITIES. PROVIDE NUMBER AND SIZE OF FASTENERS AS SPECIFIED BY MANUFACTURER. CONNECTORS SHALL BE INSTALLED IN ACCORDANCE WITH THE MANUFACTURER'S RECOMMENDATIONS. WHERE CONNECTOR STRAPS CONNECT TWO MEMBERS, PLACE ONE-HALF OF THE NAILS OR BOLTS IN EACH MEMBER.

SOLID SAWN LUMBER

ALL FRAMING LUMBER SHALL KILN DRIED OR MC-19 AND BE GRADED AND MARKED IN CONFORMANCE WITH GLB STANDARD GRADING RULES FOR WEST COASTLUMBER NO 17 OR WPA WESTERN LUMBER GRADING RULES MOST CURRENT EDITION.

FURNISH TO THE FOLLOWING MINIMUM STANDARDS: 1. 4' X 6' STUDS (2x AND 3x MEMBERS): HEM FIR OR SPF STUD GRADE DESIGN VALUES Fb= 675 pei Fv= 150 pei Fcf 425 psi Fc = 675 psi E = 1,200,000 2. 4' X 6' PLATES AND MISC. (2x AND 3x MEMBERS): HEM-FIR NO. 2 DESIGN VALUES Fb= 850 psi Fv= 150 psi Fc? 405 psi Fc- 1250 pei E = 1,300,000 3. JOISTS AND RAFTERS (2x AND 3x MEMBERS): HEM-FIR NO. 2 DESIGN VALUES Fb= 900 psi Fv= 150 psi Fct 405 pei Fct 1250 pei E = 1,300,000 4. 4x BEAMS: DOUGLAS FIR-LARCH NO. 2 DESIGN VALUES Fb= 950 pei E = 1,600,000 Fcf 625 pei Fc- 1300 pai DOUGLAS FIR-LARCH NO. 2 5. 4x POSTS: DESIGN VALUES Fb= 875 psi Fv= 180 psi Fc? 625 pei Fc- 1300 pai E = 1,600,000 6. TIMBER BEAMS (RECTANGULAR 6x AND LARGER): DOUGLAS FIR-LARCH NO. 2 DESIGN VALUES Fb= 875 pai Fv= 170 pai Fc?= 625 pei Fc = 600 pei 7. TIMBER POSTS (SQUARE 6x AND LARGER): DOUGLAS FIR-LARCH NO. 2

DESIGN VALUES Fb= 700 pei Fv= 180 pei STRUCTURAL CILIED LAMINATED TIMBERS

STRUCTURAL GLUED LAMINATED TIMBERS SHALL BE FABRICATED IN CONFORMANCE WITH ANSI/AITC STANDARD A190.1 AND ASTM D 3737. EACH MEMBER SHALL BEAR AN A.I.T.C. IDENTIFICATION MARK AND SHALL BE ACCOMPANIED BY AN A.I.T.C. CERTIFICATE OF CONFORMANCE. ALL BEAMS SHALL BE DOUGLAS FIR COMBINATION (24F-V4/DF OR 24F-V8/DF, AS INDICATED) WITH A STANDARD CAMBER (3500 FT. RADIUS), UNLESS OTHERWISE NOTED ON PLANS. ONE COAT OF END SEALER SHALL BE APPLIED IMMEDIATELY AFTER TRIMMING IN EITHER SHOP OR FIELD, GLUE LAMINATED MEMBERS EXPOSED TO WEATHER OR MOISTURE SHALL BE TREATED WITH AN APPROVED PRESERVATIVE.

Fc9 625 psi Fc= 475 psi

E = 1,300,000

DESIGN VALUES E = 1.800,000 DESIGN VALUES Fc = 1600 pei E = 1,800,000

STRUCTURAL COMPOSITE LUMBER ENGINEERED WOOD SHOWN ON THE DRAWINGS IS BASED ON PRODUCT MANUFACTURED BY WEYERHAUSER IN ACCORDANCE WITH ICC REPORT NO. ES ESR-1387. EACH PIECE SHALL BEAR A STAMP OR STAMPS NOTING THE NAME PLANT NUMBER OF THE MANUFACTURER, THE GRADE, THE ICC REPORT NUMBER AND THE QUALITY CONTROL AGENCY, AND SHALL BE FURNISHED TO THE FOLLOWING MINIMUM STANDARDS.

1.3 E ILEVEL TRUS JOIST: TIMBERSTRAND LSL (BEAM / COLUMN) Fc = 1400 pei DESIGN VALUES Fb= 1700 pei Fv= 400 pei Fc?= 680 psi E = 1,300,000 1.55 E ILEVEL TRUS JOIST: TIMBERSTRAND LSL (BEAM) DESIGN VALUES Fb= 2325 pei Fv= 310 pei Fc = 2050 pel E = 1,550,000 1.9 E LEVEL TRUS JOIST: MICROLLAM LVL (BEAM) Fc?= 750 pei DESIGN VALUES Fb= 2600 pei Fv= 285 pei Fc = 2510 pei E = 1,900,000 1.8 E ILEVEL TRUS JOIST: PARALLAM PSL. (COLUMN) DESIGN VALUES Fb= 2400 pei Fv= N.A. Fc = 2500 psi E = 1,800,000 20 E ILEVEL TRUS JOIST: PARALLAM PSL (BEAM) DESIGN VALUES Fb= 2900 pai Fv= 290 pai Fe?750 psi Fc = 2900 psi E = 2,000,000

PRE-MANUFACTURED WOOD FLOOR JOISTS ILL WOOD I-JOISTS SHALL BE TJI SERIES JOISTS MANUFACTURED BY WEYERHAEUSER I ACCORDANCE WITH ICC ES ESR-1153

ALL WOOD OPEN WEB JOISTS SHALL BE TJLX SERIES JOISTS MANUFACTURED BY WEYERHAEUSEF PRE-MANUFACTURED WOOD JOISTS SHALL BE OF THE SIZE, SPACING AND PROFILE SHOWN ON THE DRAWINGS. THE JOISTS SHALL BE COMPATIBLE WITH THE LOAD, DIMENSIONAL AND FIRE RATING REQUIREMENTS OF THE PROJECT. INSTALLATION SHALL COMPLY WITH MANUFACTURERS SPECIFICATIONS, LAYOUT AND CONSTRUCTION DETAILING DRAWINGS PREPARED AND FURNISHED BY MANUFACTURERS AUTHORIZED REPRESENTATIVE. ALL JOIST HANGERS AND OTHER HARDWARE SHALL BE COMPATIBLE IN SIZE WITH MEMBERS

PRE-MANUFACTURED ROOF TRUSSES

ROOF TRUSS MANUFACTURER IS RESPONSIBLE FOR THE DESIGN, FABRICATION AND INSTALLATION QUIDELINES OF ALL ROOF TRUSSWS. ROOF TRUSSES SHALL BE COMPATIBLE WITH THE LOAD, DIMENSIONAL AND FIRE RATING REQUIREMENTS OF THE PROJECT ROOF TRUSS LAYOUT AND SPACING SHALL CONFORM TO THE LOCATIONS AND SPACING SHOWN ON THE ROOF FRAMING PLAN DESCRIBED HEREIN PREFABRICATED CONNECTOR PLATE WOOD ROOF TRUSSES SHALL BE DESIGNED BY THE MANUFACTURER IN ACCORDANCE WITH TPI-2007 FOR THE SPANS AND CONDITIONS SHOWN ON THE DRAWINGS BY A STRUCTURAL ENGINEER LICENSED IN THE STATE OF WASHINGTON EXPERIENCED WITH THE DESIGN OF WOOD ROOF TRUSSES. WOOD TRUSSES SHALL UTILIZE APPROVED CONNECTOR PLATES (MITEK, ITW, OR APPROVED TRUSS PLATE MANUFACTURER TRUSSES SHALL BE SUPPLIED WITH THE NECESSARY BRACING TO PROVIDE LATERAL STABILITY OF ALL TRUSS MEMBERS AND TIE-DOWN CONNECTIONS FROM TRUSS MEMBERS TO THE TOP OF WALLS AND BEAMS TO FORM AN INTEGRAL PART OF THE WHOLE

STRUCTURAL WOOD PANEL SHEATHING

all structural wood panel sheathing (roof, floor, and wall sheathing shall be apa rated, exterior or with EXPOSURE (1) CLASSIFICATION PLYWOOD OR OSB. EACH PIECE SHALL BEAR THE GRADE TRADEMARK OF APA AND SHALL BE MANUFACTURED UNDER THE PROVISIONS OF VOLUNTRY PRODUCT STANDARDS DOC PS-1, DOC PS-2 OR APA PRP-108

PERFORMANCE STANDARDS AND POLICIES FOR STRUCTURAL WOOD PANELS
ROOF SHEATHING SHALL BE 7/16' PLYWOOD (OR OSB.) WITH AN APA SPAN RATING OF 24/0 FLOOR SHEATHING
SHALL BE 3/4' TONGUE AND GROOVE PLYWOOD WITH AN APA SPAN RATING OF 48/24 ALL FLOOR SHEATHING SHALL BE NAILED AND GLUED. ADHESVE SHALL CONFORM TO APA SPECIFICATION AFG 01. WALL SHEATHING SHALL BE 7/16" PLYWOOD (OR OSB) WITH AN APA SPAN RATING OF 24/0 . INSTALL WITH A MINIMUM GAP OF 1/8" CLEAR SPACE BETWEEN PANEL JOINTS TO ALLOW FOR EXPANSION. NAILS SHALL BE DRIVEN FLUSH BUT NOT FRACTURE THE SURFACE OF THE SHEATHING. REFER TO WOOD FRAMING NOTES BELOW FOR TYPICAL NAILING REQUIREMENTS.

WOOD FRAMING

THE FOLLOWING SHALL APPLY UNLESS OTHERWISE SHOWN ON THE PLANS:

ALL WOOD FRAMING COMPONENTS NOT SPECIFICALLY ENGINEERED AND DETAILED ON PLANS SHALL BE CONSTRUCTED TO COMPLY WITH IBC CHAPTER 23. THE NUMBER AND SIZE OF NAILS CONNECTING WOOD MEMBERS, UNLESS OTHERWISE NOTED. SHALL COMPLY WITH TABLE 2304.9.1 OF THE INTERNATIONAL BLDG. CODE. ALL NAILS SHALL BE COMMON. UNLESS OTHERWISE INDICATED. COORDINATE THE SIZE AND LOCATION OF ALL OPENINGS WITH MECHANICAL AND ARCHITECTURAL DRAWINGS. ALL BOLT HEADS AND NUTS BEARING AGAINST WOOD SURFACES SHALL BE PROVIDED WITH STANDARD FLAT CUT WASHERS. INSTALLATION OF LAG BOLTS SHALL CONFORM TO THE NATIONAL DESIGN SPECIFICATION FOR WOOD CONSTRUCTION ALL SHIMS SHALL BE SEASONED AND DRIED AND OF THE SAME GRADE (MINIMUM) AS MEMBERS CONNECTED.

WALL FRAMING:

ALL STUD WALLS SHOWN AND NOT OTHERWISE NOTED SHALL BE 2x4 STUDS • 16" o.c. AT INTERIOR WALLS AND 2x6 STUDS • 16" O.C. AT EXTERIOR WALLS AND WALLS SEPERATING HEATED AND UNHEATED SPACES. A MINIMUM OF THREE STUDS SHALL BE PROVIDED AT THE CORNERS AND INTERSECTIONS OF ALL WALLS AND A MINIMUM OF ONE TRIMMER STUD PLUS A SINGLE KING. STUD SHALL BE PROVIDED AT EACH SIDE OF ALL OPENINGS NOT OTHERWISE NOTED ON PLANS.

TRIMMERS AT WINDOW AND DOOR OPENING INDICATED ON PLANS ARE AS FOLLOWS: (1) 2x - ONE TRIMMER STUD PLUS A SINGLE KING STUD.

(2) 2x - TWO TRIMMER STUDS PLUS A SINGLE KING STUD. (3) 2x - THREE TRIMMER STUDS PLUS A SINGLE KING STUD.

THE TRIMMER/KING STUD ASSEMBLY SHALL BE FASTENED TOGETHER IN ACCORDANCE WITH TABLE 2304.9.1 AS DOUBLE STUDS. A SINGLE 4x8 HEADER SHALL BE PROVIDED OVER ALL OPENINGS NOT OTHERWISE NOTED. PROVIDE CONTINUOUS SOLID BLOCKING AT MID-HEIGHT OF ALL UNSHEATHED STUD WALLS OVER 8'-0" IN HEIGHT. ALL WALLS SHALL HAVE A SINGLE BOTTOM PLATE AND A DOUBLE TOP PLATE. ALL WOOD PLATES AND BLOCKING IN DIRECT CONTACT WITH CONCRETE SHALL BE PRESSURE TREATED, OR PROVIDE 2 LAYERS OF ASPHALT IMPREGNATED BUILDING PAPER BETWEEN UNTREATED WOOD AND CONCRETE. END NAIL TOP PLATE TO EACH STUD AND TOENAIL OR END NAIL EACH STUD TO BOTTOM PLATE IN ACCORDANCE WITH TABLE 2304.9.1. FACE NAIL DOUBLE TOP PLATES IN ACCORDANCE WITH TABLE 2304.9.1. END JOINTS AT DOUBLE TOP PLATE SPLICES SHALL BE OFFSET A MINIMUM OF 48" AND NAILED PER TABLE 2304.9.1. ALL STUD WALLS SHALL HAVE THEIR LOWER WOOD PLATES ATTACHED TO WOOD FRAMING BELOW PER TABLE 2304.9.1 OR BOLTED TO CONCRETE WITH 1/2" DIAMETER ANCHOR BOLTS (WITH 7' MINIMUM EMBEDMENT) • 4'-0' O.C. UNLESS INDICATED OTHERWISE. ALL POSTS WITH-IN THE WALL FRAME ASSEMBLY NOT OTHERWISE NOTED ON PLANS SHALL BE SPIKE LAMINATED COLUMNS, CONSISTING OF DOUBLED STUDS. INDMIDUAL MEMBERS OF BUILT-UP POSTS SHALL BE NAILED TO EACH OTHER PER TABLE 2304.9.1. REFER TO THE PLANS AND SHEARWALL SCHEDULE FOR REQUIRED SHEATHING AND NAILING. WHEN NOT OTHERWISE NOTED, PROVIDE GYPSUM WALLBOARD ON INTERIOR SURFACES NAILED TO ALL STUDS, TOP AND BOTTOM PLATES, AND BLOCKING WITH NAILS • 7" o.c. USE 5d COOLER NAILS FOR 1/2" GWB AND 6d COOLER NAILS FOR 5/8" GWB. PROVIDE 7/16" (NOMINAL) APA RATED SHEATHING SPAN RATING 24/0) ON EXTERIOR SURFACES NAILED AT ALL PANEL EDGES (BLOCK UN-SUPPORTED EDGES), AND TOP AND BOTTOM PLATES WITH 8d • 6" o.c. AND TO ALL INTERMEDIATE STUDS AND BLOCKING WITH 8d • 12" o.c. ALLOW 1/8" SPACING AT ALL PANEL EDGES AND ENDS. NON-BEARING WALLS SHALL BE HELD AWAY FROM THE TRUSS BOTTOM CHORD WITH APPROVED FASTENERS TO INSURE THAT THE TRUSS BOTTOM CHORD WILL NOT BEAR ON THE WALL

FLOOR AND ROOF FRAMING:

REFER TO FRAMING PLANS FOR ALL JOIST, RAFTER AND BEAM LAYOUTS. DIRECTION, SPACING, TYPE AND SIZE SHALL BE AS INDICATED ON PLANS. PROVIDE DOUBLE JOISTS UNDER ALL BEARING PARTITIONS THAT EXTEND OVER MORE THAN HALF OF THE JOIST LENGTH AND AROUND ALL OPENINGS UNLESS OTHERWISE NOTED. PROVIDE SOLID BLOCKING AT ALL BEARING POINTS. TOENAIL JOISTS TO SUPPORTS IN ACCORDANCE WITH TABLE 2304.9.1. ATTACH WOOD JOISTS TO FLUSH HEADERS OR BEAMS WITH METAL JOIST HANGERS IN ACCORDANCE WITH NOTES ABOVE. NAIL ALL MULTI-JOIST BEAMS TOGETHER IN ACCORDANCE WITH TABLE 2304.9.1. UNLESS OTHERWISE NOTED ON THE PLANS, PLYWOOD ROOF AND FLOOR SHEATHING SHALL BE LAID UP W/ FACE GRAIN PERPENDICULAR TO SUPPORTS AND END JOINTS STAGGERED 4'-0'. ALL PLYWOOD SHALL BE INSTALLED PER APA STANDARDS, SHEATHING SHALL BE FASTENED IN ACCORDANCE WITH TABLE 2304,9.1. PROVIDE APPROVED PLYWOOD EDGE CLIPS CENTERED BETWEEN RAFTER/TRUSSES AT UNBLOCKED ROOF SHEATHING EDGES. ALL FLOOR SHEATHING EDGES SHALL HAVE APPROVED TONGUE-AND-GROOVE JOINTS OR SHALL BE SUPPORTED WITH SOLID BLOCKING. ALLOW 1/8" SPACING AT ALL PANEL EDGES AND ENDS OF FLOOR AND ROOF SHEATHING. TOENAIL BLOCKING TO SUPPORTS IN ACCORDANCE WITH TABLE 2304.9.1 UNLESS OTHERWISE NOTED. AT BLOCKED FLOOR AND ROOF DIAPHRAGMS PROVIDE FLAT 2x BLOCKING AT ALL UNFRAMED PANEL EDGES AND NAIL WITH EDGE NAILING PER NAILING SCHEDULE THIS SHEET. SOLID BLOCKING FOR WOOD COLUMNS SHALL BE PROVIDED THROUGH FLOORS TO SUPPORTS BELOW. SOLID BLOCKING SHALL BE PROVIDED AT ALL HOLDOWN LOCATIONS AND POINT LOADS BEARING DIRECTLY ON THE FLOOR DIAPHRAGM FROM ABOVE. BLOCKING SHALL BE OF THE SAME SIZE AS THE POST OR COLUMN ABOVE. OR SHALL BE CONSTRUCTED OF MULTIPLE STUDS PROVIDING AN AREA

DIAPHRAGM AND HOLDOWN SCHEDULES

SHEA	AR WALL SCH	EDULE? 1?	(VERTICAL DIA	PHRAGM)							4		
SHEARWALL TYPE	WALL SHEATHING (PANEL) THICKNESS AND GRADE	WALL STUD GRADE AND SPACING	NAIL TYPE	EDGE NAILING	FIELD NAILING	BLOCKING REQ'D	BLOCK SIZE	ABUTTING PLYWOOD PANEL EDGE MEMBER SIZE	TOP PLATE NAILING SIZE AND SPACING	SOLE PLATE NAILING SIZE AND SPACING	FOUNDATION ANCHOR BOLTS SIZE AND SPACING	FRAMING ANCHOR TYPE AND SPACING	LOAD ³
P1-6	7/16" APA RATED OR 15/32" PLYWOOD ONE FACE	HEM-FIR @ 16" o.c.	8d COMMON	6" o.c.	12" o.c.	YES	2x	2x	16d @ 5"	16d @ 5"	5/8" @ 48" o.c.	A35 @ 24" o.c.	240 PLF/336 PLF
P1-4	7/16" APA RATED OR 15/32" PLYWOOD ONE FACE	HEM-FIR @ 16" o.c.	8d COMMON	4" o.c.	12" o.c.	YES	2x	2x	16d @ 3"	16d @ 3"	5/8" @ 32" o.c.	A35 @ 12" o.c.	350 PLF/400 PLF
P1-3 ²	7/16" APA RATED OR 15/32" PLYWOOD ONE FACE	HEM-FIR @ 16" o.c.	8d COMMON	3" o.c.	12" o.c.	YES	3x	3x	(2) ROWS 16d @ 4"	(2) ROWS 16d @ 4"	5/8" @ 24" o.c.	A35 @ 12" o.c.	450 PLF/630 PLF
P1-2 ^{2,6}	7/16" APA RATED OR 15/32" PLYWOOD ONE FACE	HEM-FIR @ 16" o.c.	8d COMMON	2" o.c.	12" o.c.	YES	3x	3x	(2) ROWS 16d @ 3"	(2) ROWS 16d @ 3"	5/8" @ 12" o.c.	A35 @ 8" o.c.	590 PLF/820 PLF
P2-4 ^{2,8}	7/16" APA RATED OR 15/32" PLYWOOD TWO FACES	HEM-FIR @ 16" o.c.	8d COMMON	4" o.c.	12" o.c.	YES	3x	3x	(2) ROWS 16d @ 3"	(2) ROWS 16d @ 3"	5/8" @ 12" o.c.	A35 @ 6" o.c.	700 PLF / 1050 PLF
P2-3 ^{2,6}	7/16" APA RATED OR 15/32"	HEM-FIR @ 16" o.c.	8d COMMON	3" o.c.	12" o.c.	YES	3x	3x	(2) ROWS 16d @ 3"	(2) ROWS 16d @ 3"	5/8" @ 12" o.c.	A35 @ 6" o.c.	900 PLF / 1260 PLF
P2-2 ²⁶	7/16" APA RATED OR 15/32" TWO FACES	HEM-FIR @ 16" o.c.	8d COMMON	2" o.c.	12" o.c.	YES	3x	3x	(2) ROWS 16d @ 2"	(2) ROWS 16d @ 2"	5/8" @ 8" o.c.	A35 (2) ROWS @ 9" o.c.	1180 PLF / 1640 PLF

ALL SHEAR WALLS SHALL COMFORM TO IBC SECTION 23 REQ'MNTS. APPLY NAILING TO ALL STUDS, TOP AND BOTTOM PLATES AND BLOCKING. SHEATHING SHALL BE INSTALLED VERTICALLY WITH 4x10 SHEETS EXTENDING FROM THE SILL PLATE AT THE FOUNDATION TO THE LOWER OF THE DOUBLED TOP PLATES AT THE MAIN LEVEL AND FROM THE UPPER OF THE DOUBLED TOP PLATES AT THE LOWER WALL TO THE TOP OF THE DOUBLED TOP PLATES AT THE ALLOWABLE LOADS ARE NOT ADJUSTED BY

. WHERE APA SHEATHING IS APPUED ON BOTH FACES OF A WALL AND NAIL SPACING IS LESS THAN 6" O.C. ON EITHER SIDE, PANEL JOINTS SHALL BE OFFSET TO FALL ON DIFFERENT FRAMING MEMBER, OR FRAMING SHALL BE 3x NOMINAL AND NAILS ON EACH SIDE SHALL BE STAGGERED. WHERE ALLOWABLE SHEAR VALUES EXCEED 350 PLF (NAIL SPACING 3" OR LESS, OR SHEAR WALLS WITH PLYWOOD APPUED ON EACH SIDE OF STUD WALL) FOUNDATION SILL PLATES AND FRAMING FOR ABUTTING PANEL EDGES SHALL BE 3x NOMINAL

. ABOVE ALLOWABLE SHEAR CAPACITIES APPUES FOR 2x SPRUCE-PINE-FIR FRAMING SPACED NO MORE THAN 16" O.C. AND SHEATHING APPLIED DIRECTLY TO FRAMING MEMBERS. -. 14 GAUGE STAPLES W/ 7/16" CROWN AND 2" NOMINAL LEG LENGTH OR 0.131 DIAM. P-NAILS W/ 2" NOMINAL LENGTH CAN BE SUBSTITUTED FOR 8d COMMON NAILS WITH REDUCED SHEAR CAPACITIES TO USE STAPLES. VERIFY WITH ENGINEER

O. ALL FASTENERS SHALL BE DRIVEN FLUSH WITH SURFACE OF SHEATHING. FOR FASTENER DIAMETER AND LENGTH, REFER TO FASTENER SCHEDULE BELOW. . PROVIDE A SINGLE JOIST OR MIN. 2x SOLID BLOCKING BELOW AND AT THE TOP OF ALL SHEARWALLS. FOR SHEARWALLS DESIGNATED P1-2, P2-4, P2-3, AND P2-2 SUCH JOISTS AND OR BLOCKING AT SHEARWALLS SHALL BE DOUBLED. WHERE JOISTS OR BLOCKING CONSIST OF DOUBLED SOLID SAWN MEMBERS, METAL FRAMING CLIPS SHALL BE INSTALLED

SYMBOL	MODEL NUMBER ²	DBL STUD NAILING ⁵	ALLOWABLE LOAD (LBS) ³
1	HDU4-SDS2.5 w/ SSTB-24 5/8" ANCHOR BOLT w/ 21" MIN. EMBED AND (10) SDS 1/4"x2 1/2" LONG SCREWS (SYMBOL 1) TO DBL STUDS	(20) 16d	2100
\$	HDU5-SDS2.5 w/ SSTB-34 7/8" ANCHOR BOLT w/ 29" MIN. EMBED AND (14) SDS 1/4"x2 1/2" LONG SCREWS (SYMBOL 2) TO DBL STUDS	(24) 16d	3700
\$	HDU8-SDS2.5 w/ SSTB-34 7/8" ANCHOR BOLT w/ 29"" MIN. EMBED AND (20) SDS 1/4"x2 1/2" LONG SCREWS (SYMBOL 3)TO TRIPLE STUDS	(30) 16d	4000
(4)	HDU11-SDS2.5 w/ SB1-30 ANCHOR BOLT w/ 24" MIN. EMBED AND (30) SDS 1/4"x2 1/2" LONG SCREWS (SYMBOL 4)TO TRIPLE STUDS	(34) 16d	5200
\$	STHD14/STHD14RJ STRAP TIE DOWN	(20) 16d	3800
6	SINGLE 1 1/4" COIL STRAP ⁴ (CLEAR SPAN + 24")	N.A.	1462
\Diamond	DOUBLE 1 1/4" COIL STRAP4 (CLEAR SPAN + 24")	(16) 16d	2924
8	3" x 16 GUAGE COIL STRAP⁴ (CLEAR SPAN + 50")	(18) 16d	4343
\$	3" x 16 GUAGE COIL STRAP ⁴ (CLEAR SPAN + 50") + 1 1/4" COIL STRAP ⁴ (CLEAR SPAN + 24")	(30) 16d	5805

SEE STRUCTURAL NOTES FOR SPECIFICATION OF METAL CONNECTORS 2. ALL METAL HOLDOWNS SHALL BE INSTALLED PER MANUFACTURES INSTALLATION

3. ALLOWABLE LOADS INDICATES 133% WIND LOADING INCREASE, SEE MANUFACTURERS DATA FOR ADDITIONAL LOADING AND OR LIMITATIONS. LOADS REFLECT AN ADJUSTMENT FOR SPRUCE-PINE-FIR FRAMING MEMBERS PER MANUFACTURER'S REQUIREMENTS.

4. ALL 1 1/4" STRAPS SHALL BE CSI6 BY SIMPSON OR EQUAL, ALL 3" STRAPS SHALL BE CMSTC16 BY SIMPSON OR EQUAL. 5. THE DOUBLE 2x STUDS (STUD GROUP BOUNDARY ELEMENT) ARE TO BE NAILED

TOGETHER (IN TWO STAGGERED ROWS) WITH EVENLY SPACED NAILING, SEE PLANS FOR

TYP. FLOOR SHEATHING: 3/4" CDX T+G APA RATED PLYWOOD (48/24) NAILED AND GLUED. ADHESIVE SHALL CONFORM TO APA SPECIFICATION AFG 01. PROVIDE T+G EDGES AT LONG PANEL EDGES. NAILING SHALL BE 10d AT 6' O.C. AT PANEL EDGES AND 10' O.C. AT INTERMEDIATE SUPPORTS. ALLOWABLE DIAPHRAGM SHEAR = 215X0.82=777 plf. FLOOR DIAPHRAGM 23/32° 2x FRAMING - H.F. @ 16" O.C.

IFLOOR NAILING (HORIZONTAL DIAPHRAGM)

TYPE	NAILS	BOUNDARY NAILING	SUPPORTED EDGES	BLOCKED EDGE NAILING	BLOCKING	ALLOWABLE LOAD ²
F1	10d	6" O.C.	6" O.C.	6" O.C.	YES	290 PLF
F2	10d	4" O.C.	4" O.C.	4" O.C.	YES	390 PLF
F3 ¹	10d	2.5" O.C.	2.5" O.C.	2.5" O.C.	YES	590 PLF
1. WHE	RE NAILS	ARE SPACE	D 2.5" o.c. AND	LESS, FRAMING A	ND BLOCKING	AT

AD JOINING PANEL EDGES SHALL BE 3x AND SHALL BE STAGGERED 2 ABOYE ALLOWARIES SHEAR CAPACITIES HAVE BEEN ADJUSTED FOR 2x HEM-FIR

TYP. ROOF SHEATHING: 7/16" OSB APA RATED SHEATHING (24/0) EXP. 1 EXT. BOND NEROA397, RP.0108. LAY UP W/ MINIMUM 1/8" CLEAR BETWEEN PANELS TO ALLOW FOR

EXPANSION. NAILING SHALL BE 10d AT 6" O.C. AT PANEL EDGES AND 12" O.C. AT INTERMEDIATE SUPPORTS. PROVIDE EDGE CLIPS • 24" O.C. AT ALL UNSUPPORTED EDGES. ALLOWABLE DIAPHRAGM SHEAR = 190 x 0.93 = 176 PLF ROOF DIAPHRAGM 15/32" 2x FRAMING - H.F. @ 24" O.C.

ROOF DIA	PHRAGM	15/32" 2	2X FRAMING - H.F. @ 24" U.C.			
TYPE	NAILS	BOUNDARY NAILING	SUPPORTED EDGES	BLOCKED EDGE NAILING	BLOCKING	ALLOWABLE LOAD ²
R1	10d	6" O.C.	6" O.C.	6" O.C.	YES	260 PLF
R2	10d	4" O.C.	4" O.C.	4" O.C.	YES	350 PLF
R3 ¹	10d	2.5" O.C.	2.5" O.C.	6" O.C.	YES	530 PLF

1. WHERE NAILS ARE SPACED 2.5" o.c. AND LESS. FRAMING AND BLOCKING AT ADJOINING PANEL EDGES SHALL BE 3x AND SHALL BE STAGGERED. 2. ABOVE ALLOWABLE SHEAR CAPACITIES HAVE BEEN ADJUSTED FOR 2x HEM-FIR FRAMING IN ACCORDANCE WITH TABLE 2306.3.1 I.B.C.

FASTENER SCHEDULE

(FOR ALL VERTICAL + HORIZONTAL DIAPHRAMS)

METAL CONNECTORS + FASTENER'S USED w/ PRESSURE TREATED LUMBER

ALL METAL CONNECTORS AND FASTENERS IN DIRECT CONTACE WITH PRESSURE TREATED LUMBER SHALL BE HOT-DIP GALVANIZED IN ACCORDANCE WITH THE FOLLOWING REQUIREMENTS:

GROUP ONE: CHROMATED COPPER ARSENATE (CCA) AND SODIUM BORATE (SBX) FFIESSURE TREATED LUMBER MANAGE CONTROLL PROTECTIONS

1. ALL METAL CONNECTORS, HANGERS, STRAPS, ETC. SHALL BE HOT-DIP GALVANIZED IN ACCORDANCE WITH ASTM A-123 STANDARDS WITH MINIMUM ZINC THICKNESS THAT MEET Q-90 STANDARDS. 2. ALL FASTENERS INCLUDING NAILS, SCREW, ETC. SHALL BE HOT-DIP GALVANIZED IN ACCORDANCE WITH ASTM A-153 STANDARDS.

GROUP TWO ALKAUNE COPPER QUAT (ACQ AND CAO-D AND COPPER AZOLE (CBA-A AND CA-B) PRESSURE TREATED LUMBER MINIMUM CORROSION PROTECTION:

1. ALL METAL CONNECTORS, HANGERS, STRAPS, ETC. SHALL BE HOT-DIP GALVANIZED IN ACCORDANCE WITH ASTM A-653 STANDARDS WITH MINIMUM ZINC THICKNESS THAT MEET G-185 STANDARDS. 2. ALL FASTENER'S INCLUDING NAILS, SCREW, ETC. SHALL BE HOT-DIP GALVANIZED IN ACCORDANCE WITH ASTM A-153 STANDARDS.

1_SOME PRESERVATIVE PRESSURE TREATED WOOD REQUIRE ADDITIONAL COPPOSION PROTECTION FOR STEEL CONNECTORS. AND FASTENERS. ALWAYS CONSULT WITH PRESSURE TREATED WOOD MANUFACTURER FOR SPECIAL CORROSION

2. STAINLESS STEEL FASTENERS ARE TO BE USED WITH STAINLESS STEEL CONNECTORS ONLY

AND USE HOT-DIP GALVANIZED FASTENERS WITH HOT-DIP CONNECTORS ONLY.

TYPICAL SHEAR WALL CONSTRUCTION DETAIL

3. FOR ALL OTHER PRESSURE TREATED WOOD NOT LISTED IN THE ABOVE GROUPS ONE OR TWO, CONSULT WITH PRESSURE TREATED WOOD MANUFACTURER FOR SPECIAL CORROSION PROTECTION REQUIREMENTS.

DIAPHRAGM BLOCKING

- PROVIDE SOLID BLOCKING . HOLDOWNS AND POINT LOADS ABOVE, USE SAME SIZE (1) AS POST OR MULTIPLE STUDS ABOVE FOR BLOCKING. WHEN MULTIPLE STUDS ARE USED,
- ORIENT GRAINS VERTICALLY. (FOR 6X6 POST ABOVE, USE 4X8 POST BLOCKING RIM). RUN POST TO BOTTOM OF FLOOR PLYWOOD DIAPHRAGM. PROVIDE POSITIVE CONNECTION (MTL STRAP - MIN. (2) CS16-48. NAIL ONE ON THE OPPOSING FACE OF THE OTHER).
- PROVIDE SOLID BLOCKING BETWEEN TOP OF BEAM AND BOTTOM OF PLYWOOD FLOOR DIAPHRAGM. USE SAME SIZE AS POST OR MULTIPLE STUDS ABOVE FOR BLOCKING, WHEN MULTIPLE STUDS ARE USED,

NAIL | DIAMETER | LENGTH SPECIFICATIONS IN INCHES IN INCHES COMMON NAIL ASTM A36 COATED SMOOTH COMMON NAIL ASTM A36 COATED SMOOTH COMMON NAIL ASTM A36 COATED SMOOTH

COMMON NAIL ASTM A36 COATED SMOOTH

DISCLAMER


FUNAUTHORIZED ALTERATION OF ANY INFORMATION ON PLANS PREPARED BY SAZEI DESIGN GROUP, LLC WILL INVALIDATE THE DOCUMENT, MY CERTIFICATION AND SIGNATURE. THE IDEAS AND DESIGNS INCORPORATED HEREIN, AS AN INSTRUMENT OF PROPESSIONAL SERVICE, IS THE PROPERTY OF SAZEI DESIGN GROUP, LLC AND IS NOT TO BE USED IN WHOLE OR IN PART WITHOUT WRITTEN AUTHORIZATION FROM SAZEI DESIGN GROUP, LLC, Furthermore any or all initiated changes by the contractor, architect, owner, etc. shall be submitted to the engineer of record for review and approval prior to construction; changes made to this plan/building in whole or in part without the consent of the engineer shall invalidate the entire document; therefore plans are no longer certified by SAZEI DESIGN GROUP, LLC and shall NOT be used for inspection, or any further construction on this project used by the contractor or other consultants.

2-COPYRIGHT: The drawings, specifications and other documents prepared by the SAZEI DESIGN GROUP, LLC for this project are instruments of the Consultant's services for use solely with respect to this project "ONLY", and SAZEI DESIGN GROUP, LLC shall be deemed the author of these documents and shall retain all common law, statutory and other reserved rights, including the copyright. The Consultant's (SAZEI DESIGN GROUP, LLC) drawings, specifications or other documents shall not be used by others on this project, for additions to this project or for completion of this project by others, except by agreement in writing and with appropriate compensation to the Consultant. Drawings, specifications shall only be used for the project indicated in the title block.

3-OWNERSHIP OF DRAWINGS AND CALCULATIONS: All drawings, calculations, specifications and other documents, including those in electronic form, prepared by SAZEI Design Group, LLC are Instruments of service for use solely with respect to this project and shall remain the property of the SAZEI Design Group, LLC, whether executed or not. Documents shall not be used for any other project or extensions by other consultants of this project without agreement in writing from SAZEI Design Group, LLC.

GROUP,

JLY 18, 2022

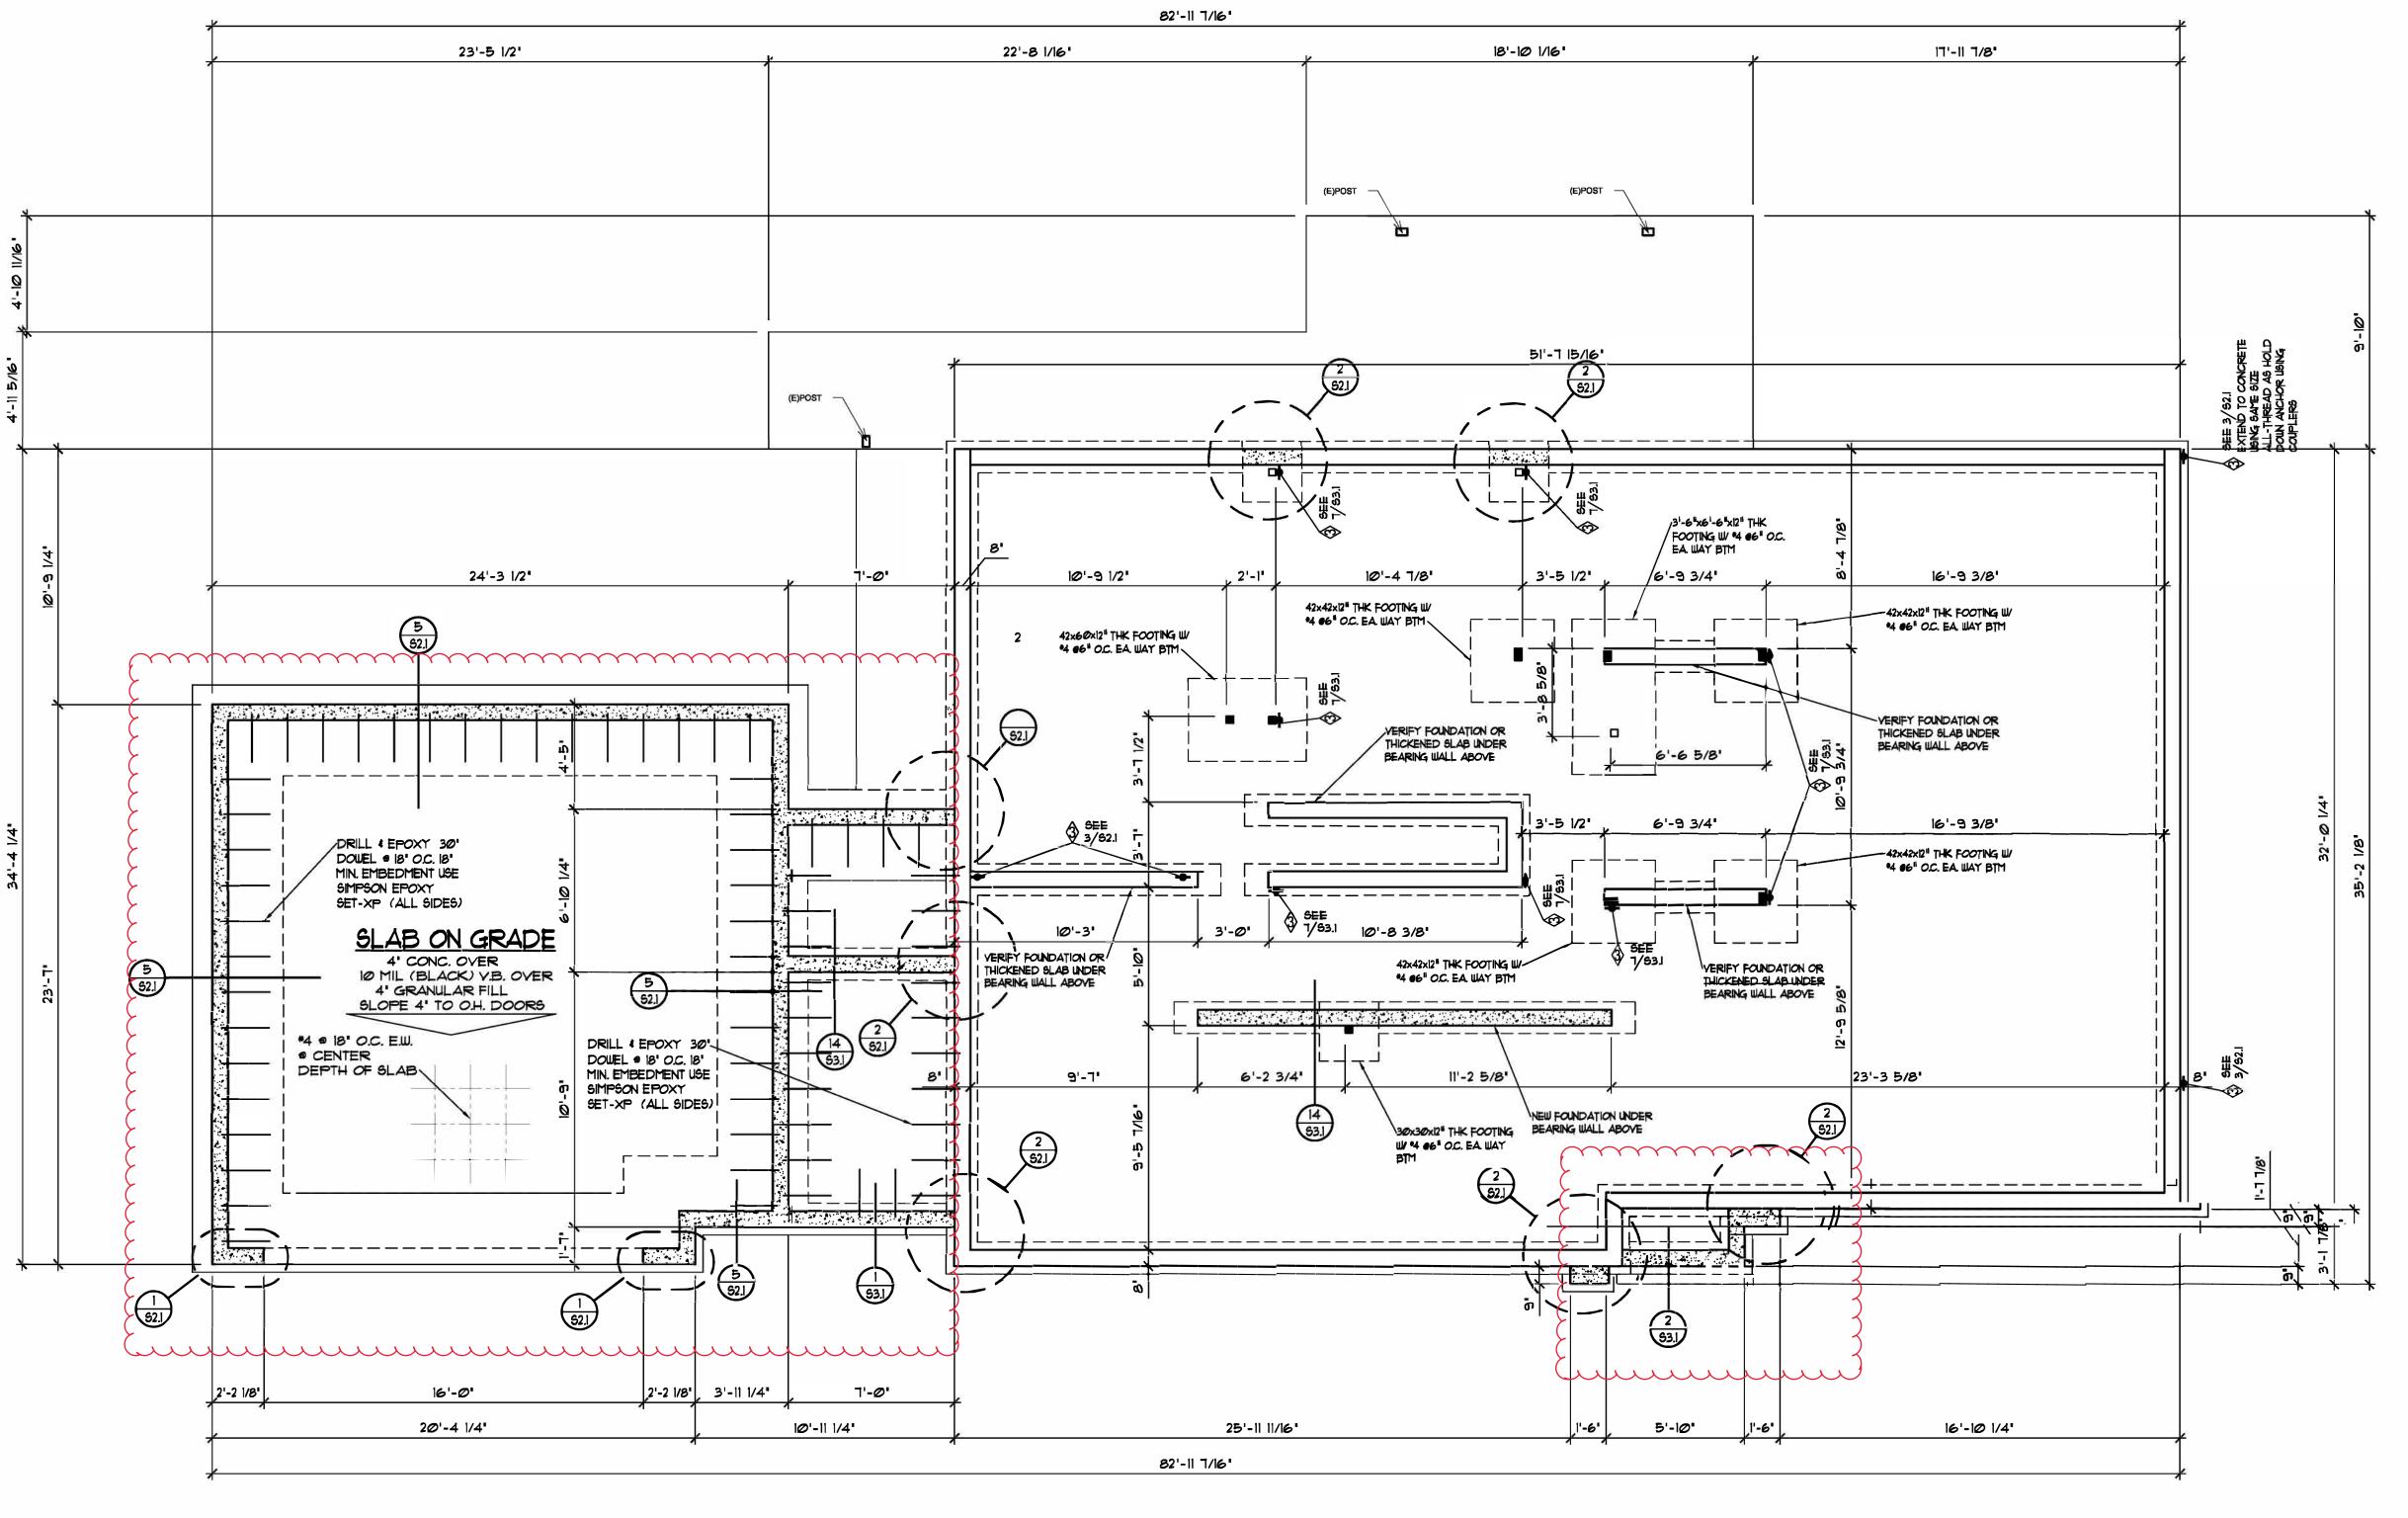

FOUNDATION NOTES:

<u>Structural Legend</u>

SHEAR WALLS

 WRITTEN DIMENSIONS TAKE PRECEDENCE OVER SCALED DIMENSIONS.

-DENOTES LOCATION AND EXTENT OF

DENOTES HOLDOWN LOCATION SEE HOLD DOWN SCHEDULE LOCATE HOLDOWNS MIN. 3"

PI-6 DENOTES TYPE OF SHEAR WALLS SEE

FROM FOUNDATION VENTS

CONTRACTOR TO VERIFY ALL DIMENSIONS AND FIELD CONDITIONS.

3. ALL FOOTINGS TO HAVE A MINIMUM DEPTH OF 18" BELOW FINISH GRADE

- 4. STEP FOUNDATIONS PER SITE CONDITIONS
- 5. ALL POSTS SHALL BE TREATED 4x4 (4x6 @ BM SPLICE) ON TYPE-90 FELT ON CONCRETE FOOTING AS INDICATED PER PLAN.
- ALL GIRDERS SHALL BE 12 DOUG!/FIR (SIZE AS INDICATED PER PLAN).
- 7. GROUND COVER SHALL BE 6 mil. (0006")
 POLYETHYLENE FILM WITH AT LEAST A 12" LAP
 AT ALL SEAMS AND EXTENDED UP THE
 FOUNDATION WALL TO AT LEAST THE OUTSIDE
 FINISHED GRADE LINE.
- 6. ALL WOOD IN CONTACT WITH EARTH, MASONRY OR CONCRETE SHALL BE TREATED OR BE OF WOOD WITH A NATURAL RESISTANCE TO DECAY.

FOUNDATION PLAN 1/4" = 1'-0"

CONTRACTOR SHALL VERIFY ALL CONDITIONS DURING DEMOLITION AND INSPECTION, AND REPORT TO ARCHITECT AND ENGINEER OF RECORD FOR REVIEW AND APPROVAL

REMODEL
LEGEND

NEW FOUNDATION

EXISTING FOUNDATION TO REMAIN

EXISTING FOUNDATION TO BE REMOVED

Revisions

1 - 2 - 3 - 3 - 4 - 5 - 5 - Checked


Date 14 16, 222

Sheet

S12

TYPICAL HEADER

N.T.S.

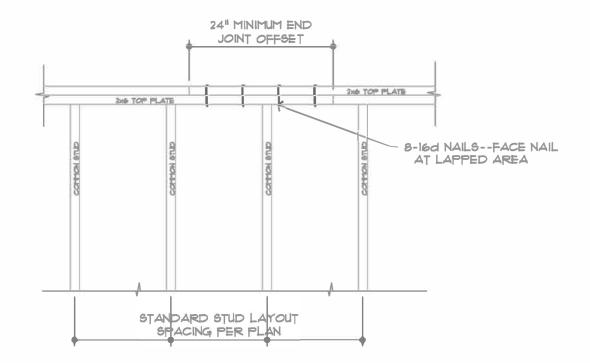

DOUBLE TOP PLATE SPLICE


 $1/2^{11} = 1^1 - \emptyset^{11}$

STRUCTURAL LEGEND

-DENOTES LOCATION AND EXTENT OF SHEAR WALLS

PI-6 DENOTES TYPE OF SHEAR WALLS SEE

2 DENOTES HOLDOWN LOCATION SEE HOLD DOWN SCHEDULE LOCATE HOLDOWNS MIN. 9" FROM FOUNDATION VENTS

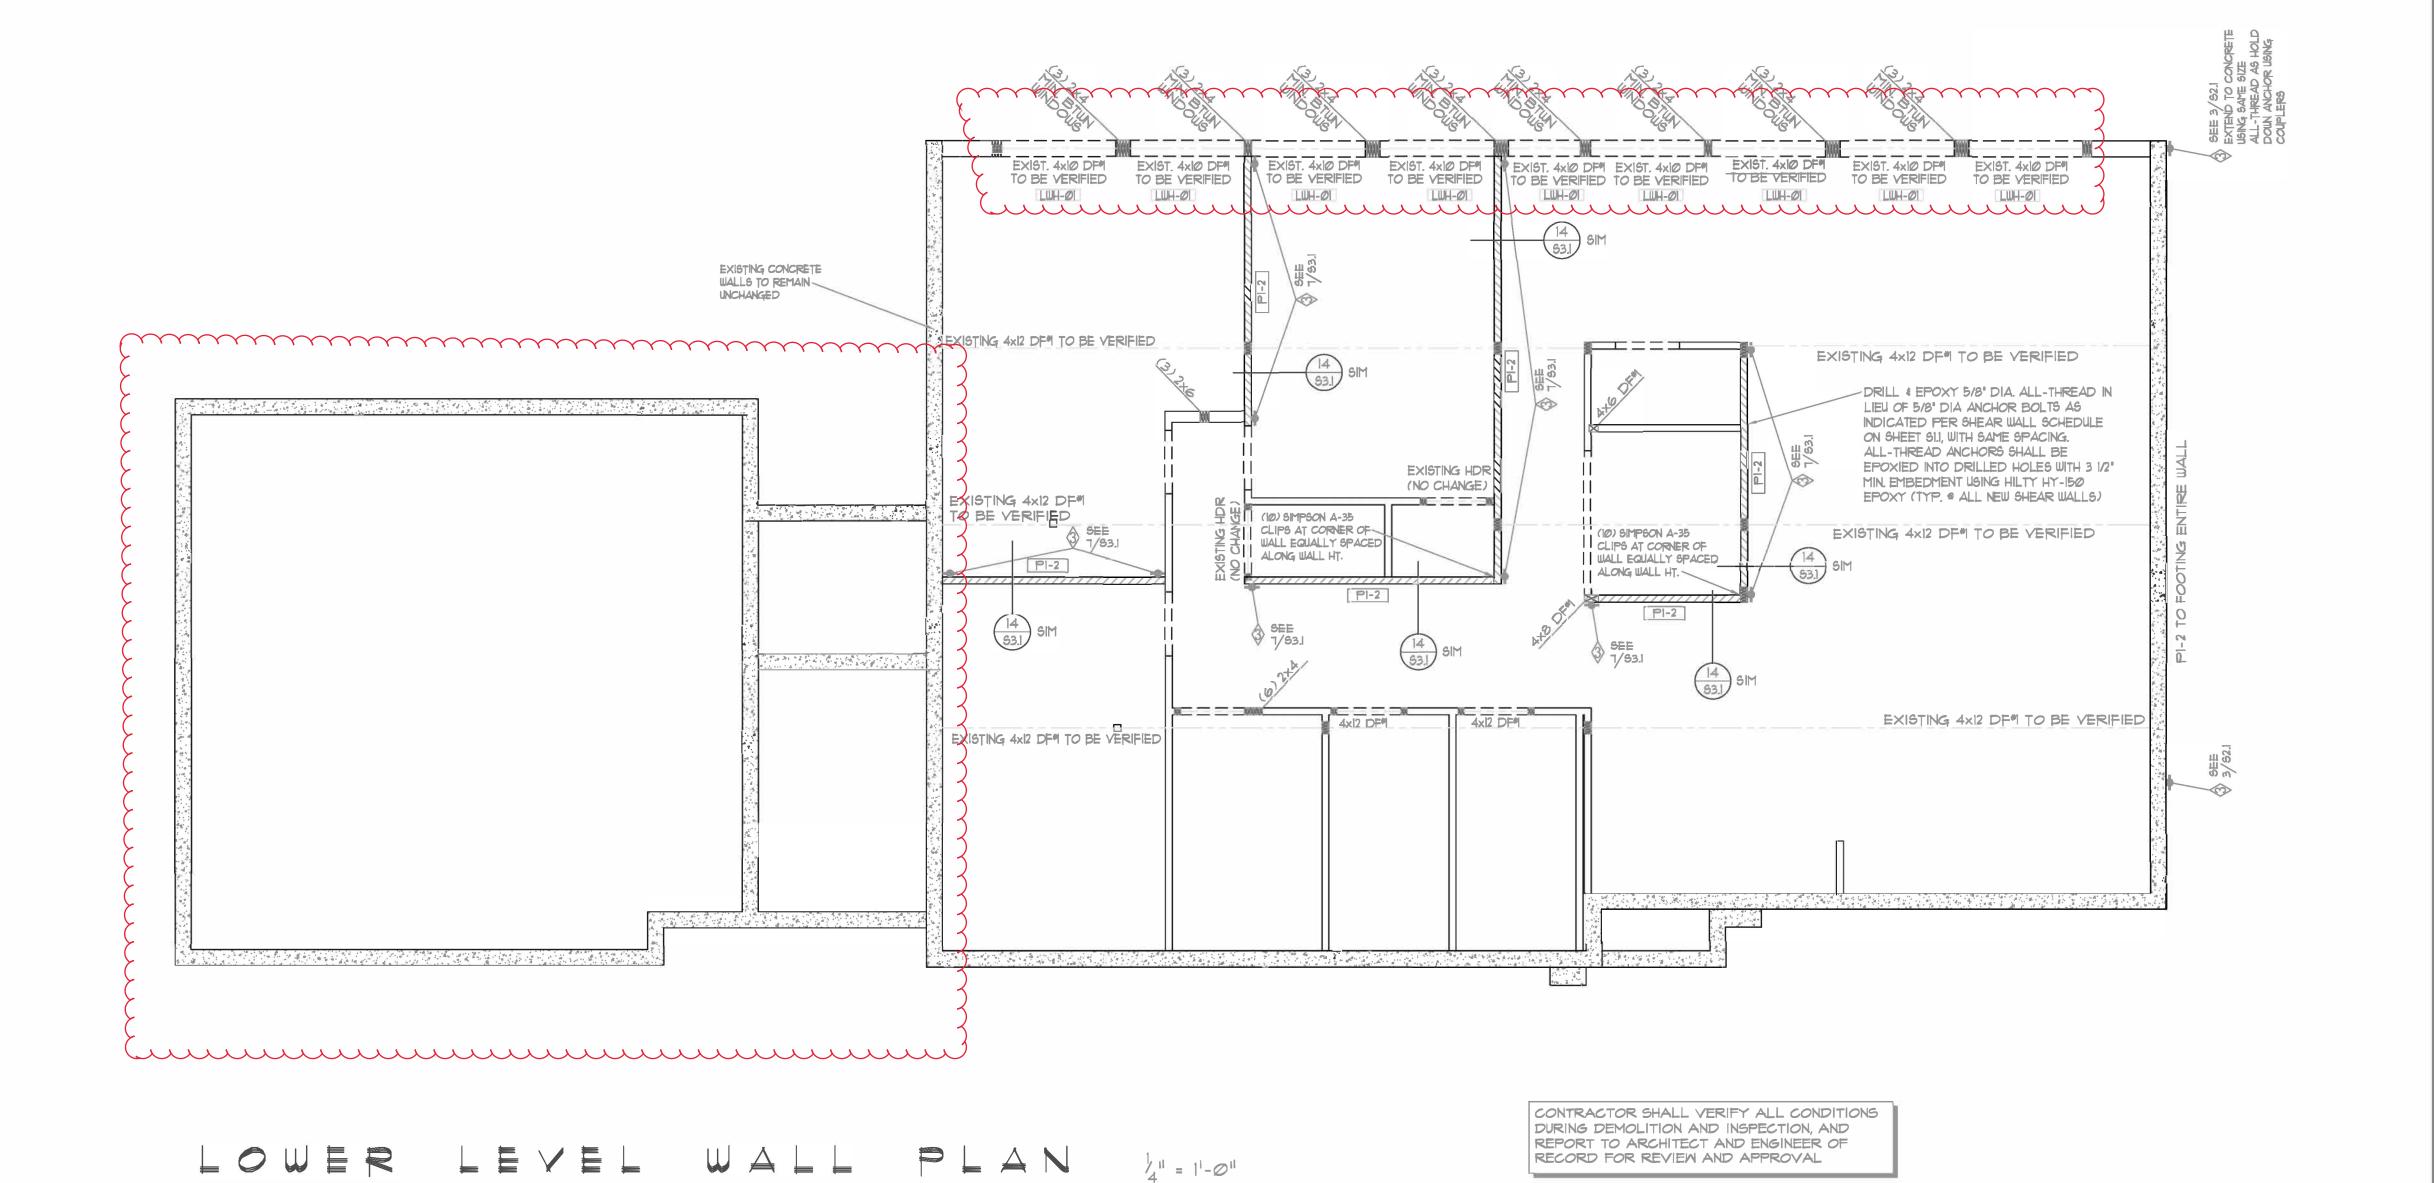


Drawn DSF

JULY 18, 2022





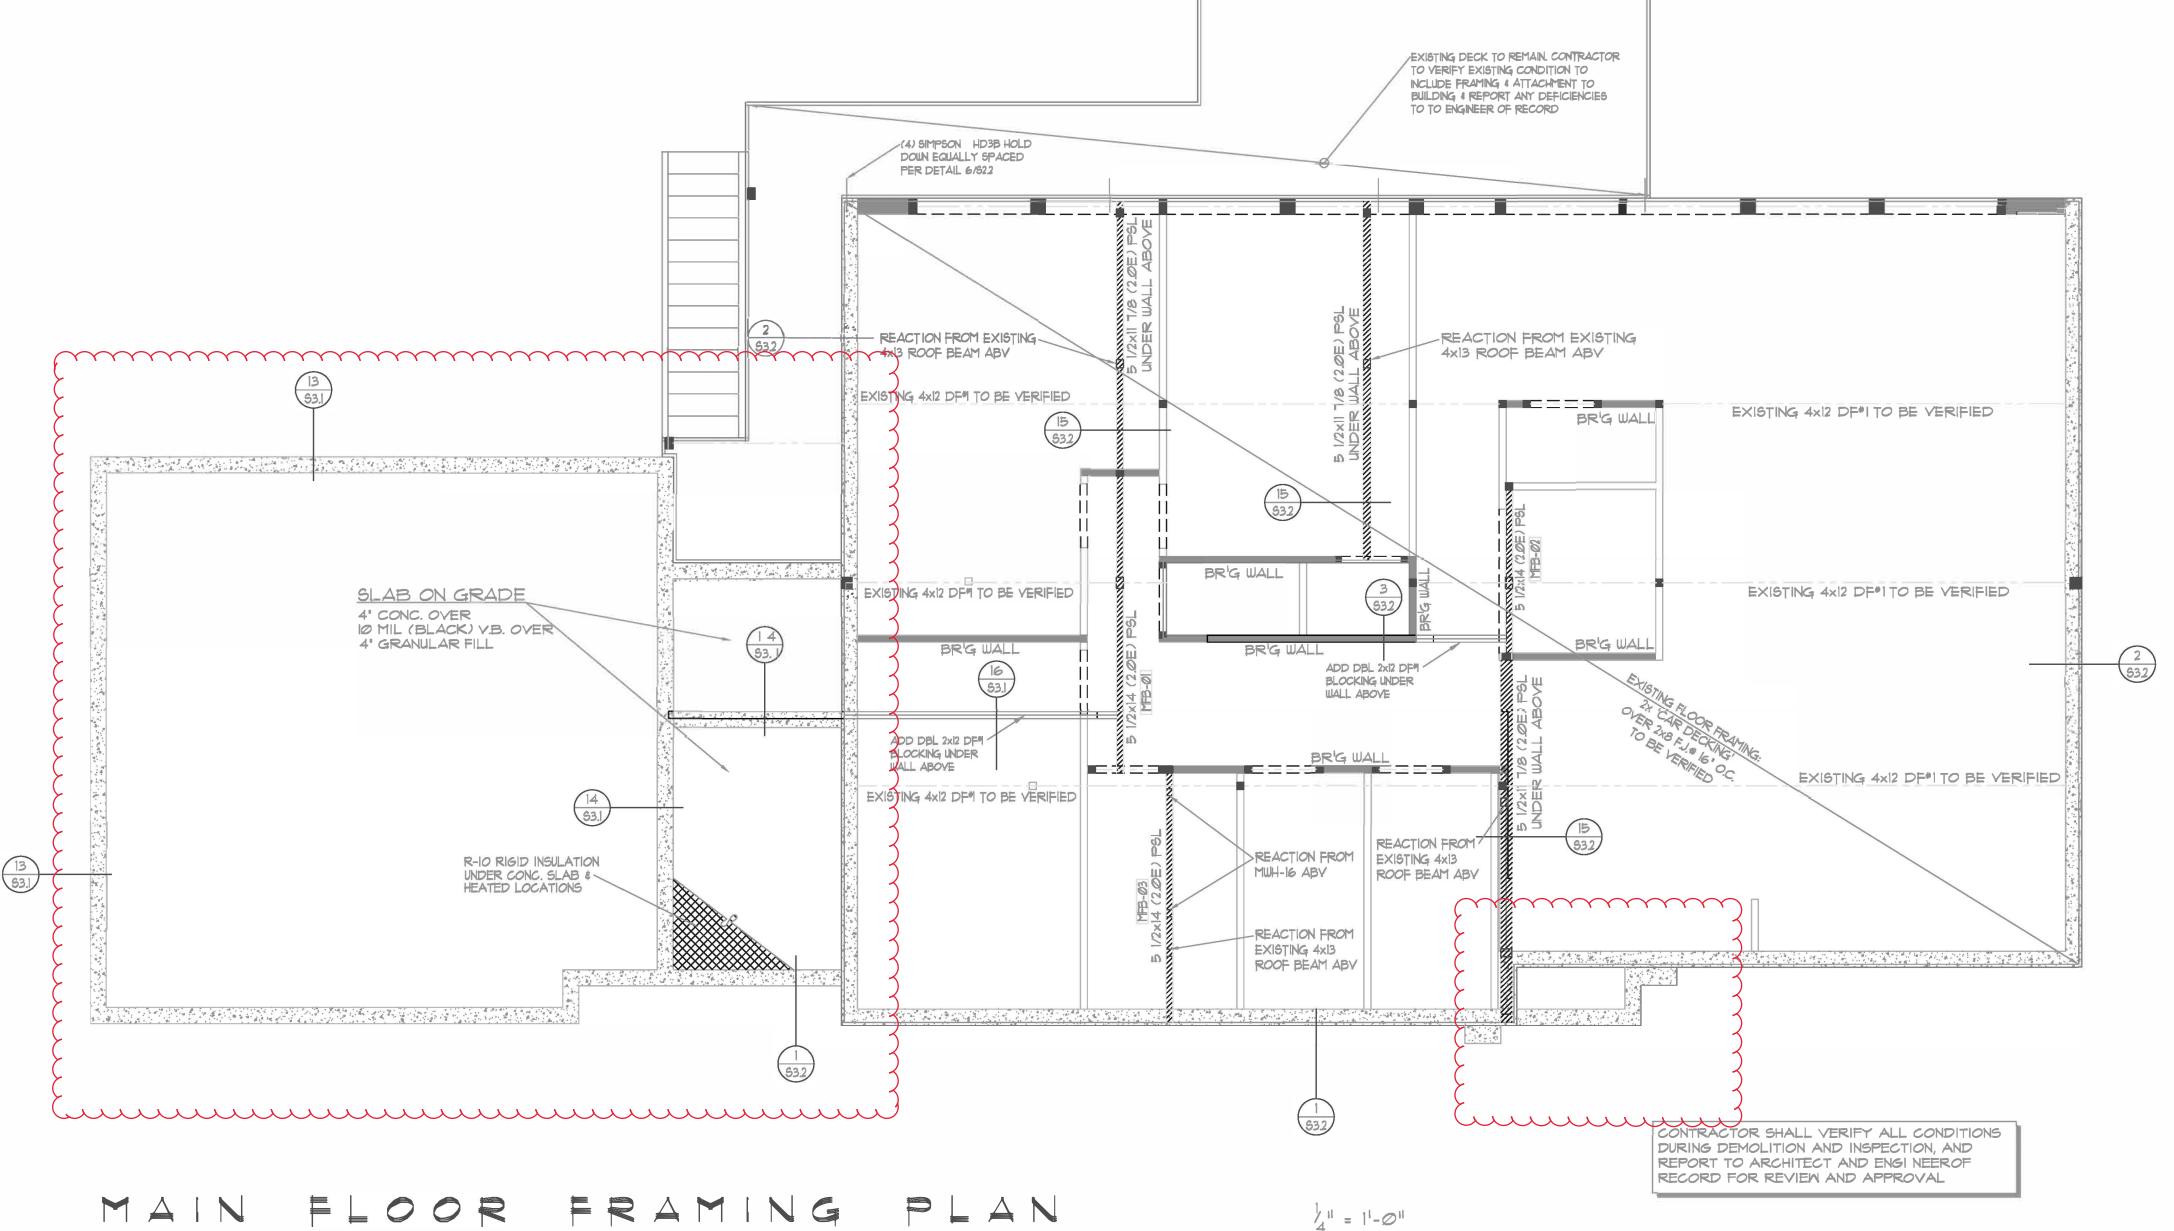

MAIN LEVEL FRAMING NOTES:

- CONTRACTOR SHALL VERIFY ALL NOTES, DIMENSIONS & CONDITIONS PRIOR TO CONSTRUCTION.
- 2. ALL FLOOR JOISTS @ THIS LEVEL SHALL BE 14" TJI 230 FJ. @ 16" O.C. UNLESS OTHERWISE INDICATED PER PLAN.
- 3. ALL EXTERIOR RIMS TO BE I 3/4xI4" (1.55E) LSL UN.O.
- 4. ALL HEADERS @ WINDOW AND DOOR OPENINGS SUPPORTING THIS LEVEL SHALL BE 4x12 * 2 DOUG/FIR, UNLESS OTHERWISE INDICATED PER PLAN.
- 5. PROVIDE SOLID BLOCKING OVER SUPPORTS. 6. PROVIDE FIRE BLOCKING @ ALL PLUMBING
- PENETRATIONS.
- 7. BEARING WALLS ARE SHADED.
- 8. PLUMBING AND MECHANICAL FIXTURES ARE DASHED.
- 9. INDICATES POINT LOAD SUPPORTED BY (2) STUDS, UN.O.
- 10. ALL WOOD IN CONTACT WITH CONCRETE TO BE PRESSURE TREATED.
- II. ALL METAL JOIST HANGERS SHALL BE "SIMPSON STRONG-TIE" U-SERIES JOIST HANGERS OR APPROVED

EQUAL UNLESS NOTED OTHERWISE.

 $\frac{1}{4}II = II - \emptyset II$

DSF JULY 18, 2022

TYPICAL HEADER

24" MINIMUM END
JOINT OFFSET

200 TOP PLATE

N.T.S.

8 TYPICAL FRAMING DETAIL

© DOUBLE TOP PLATE SPLICE 1/2" = 1'-0"


STANDARD STUD LAYOUT SPACING PER PLAN

STRUCTURAL LEGEND

-DENOTES LOCATION AND EXTENT OF SHEAR WALLS

PI-6 DENOTES TYPE OF SHEAR WALLS SEE

DENOTES HOLDOWN LOCATION SEE HOLD
DOWN SCHEDULE LOCATE HOLDOWNS MIN. 9"
FROM FOUNDATION VENTS

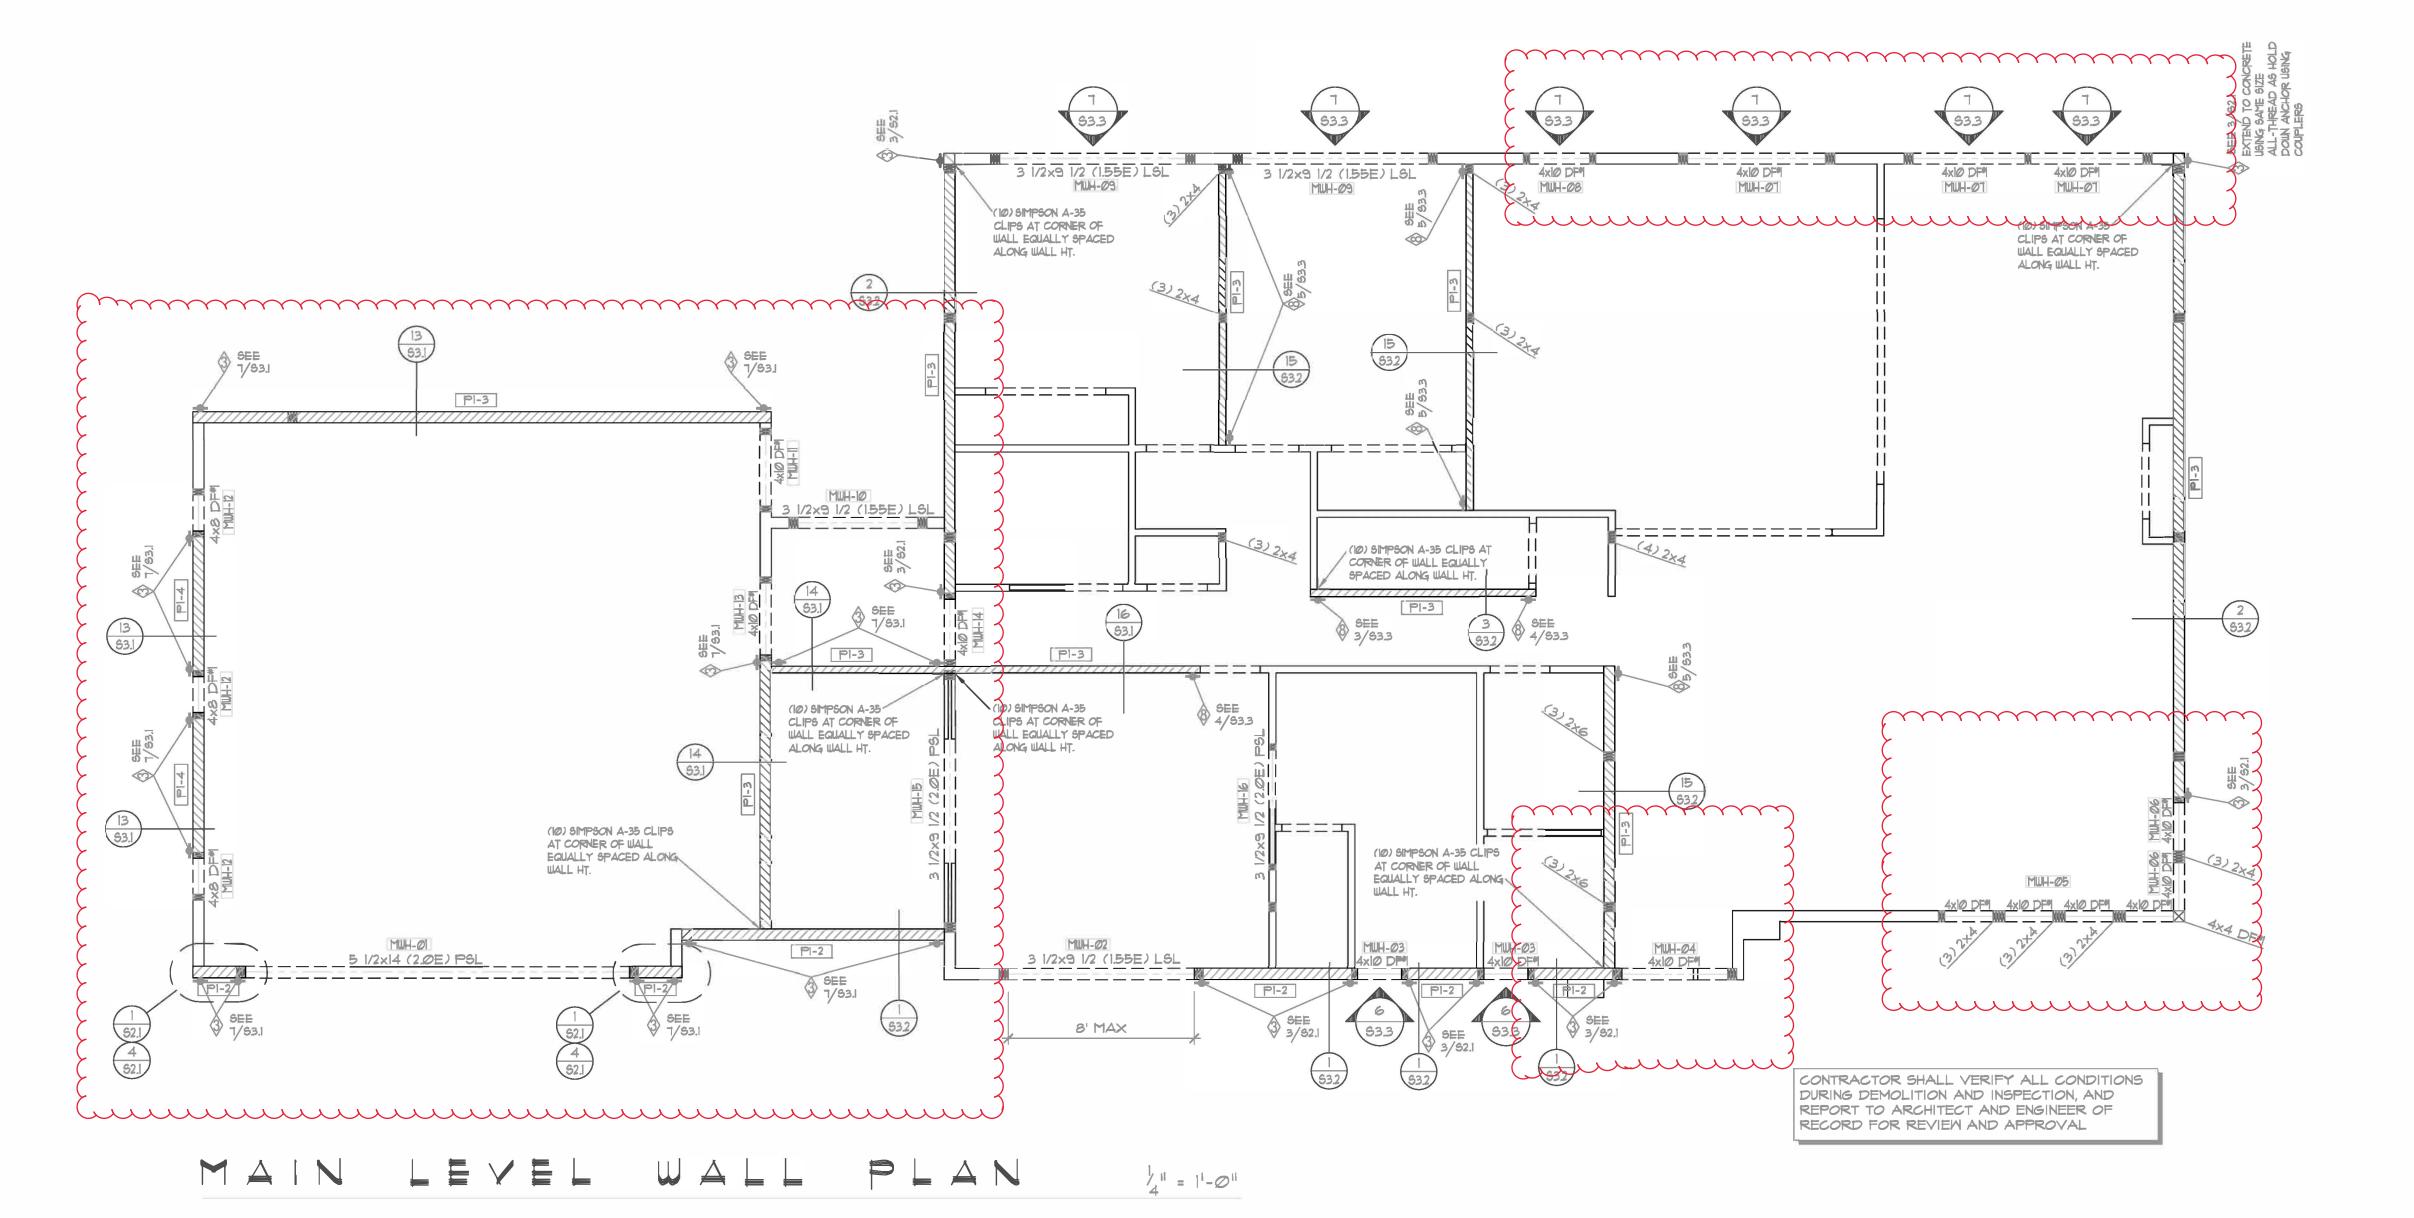

07/18/2022

SAZEI DESIGN GROUP, L 3608 110TH AVE. N.E. (IRKLAND, WA. 98033

KAHN RESID
4205 85TH AVE SE, MERCER ISLAN

Revisions

1 2 3 4 5
Drawn
DSF

Date

Duly 18, 2022

Sheet

S1.5

Scale Jo

- 2. BEARING WALLS ARE SHADED.
- 3. PROVIDE VENTED BLOCKING OVER SUPPORTS.
- 4. ALL HEADERS SUPPORTING ROOF . MAIN LEVEL OPENINGS SHALL BE 4x10 12 DOUG FIR UNLESS OTHERWISE INDICATED PER PLAN.
- 5. CONTRACTOR TO VERIFY LOCATION OF ALL ROOF SUPPORT BRACING OR POSTING AND PROVIDE ADEQUATE BEARING TO FOUNDATION.
- 6. DENOTES CONCENTRATED LOADS SUPPORTED BY (2) STUDS, UNO.
- 1. ALL METAL HANGERS SHALL BE "SIMPSON STRONG-TIE" LSSR-SERIES JOIST HANGERS OR APPROVED EQUAL.
- 8. ALL FALSE VALLEYS SHALL BE FRAMED W/ A FLAT 2XIO LAID DIRECTLY ON RAFTERS BELOW, OR W/ A FLAT KIO LAID ON 3/4" SOLID SHEATH'G.
- 9. ALL CEILING JOISTS SHALL BE 2x8 12 HEM/FIR FRAMED • 24" O.C. UNLESS OTHERWISE INDICATED PER PLAN. SEE PLAN JOIST DIRECTION.
- 10. WHERE CEILING JOISTS ARE PERPENDICULAR TO RAFTER FRAMING, PROVIDE METAL STRAP TIES • 48" O.C. ACROSS THE FIRST THREE ADJACENT JOIST SPACES AND SOLID FULL DEPTH BLK'G . EA. TIE.
- II. INSTALL SHEAR WALLS 4/OR BLOCKING IN ROOF STRUCTURE BEFORE INSTALLING FINISH ROOFING.


ROOF LOAD:


LIVE (SNOW)- 25 PSF DEAD-15 PSF 40 PSF


ROOF SHEATHING

ENTIRE UPPER & LOWER ROOF TO BE 3/4" CDX PLYWOOD NAILED PER R-I ROOF NAILING PER ROOF NAILING SCHEDULE ON SHEET SI.I

INTERMEDIATE BEARING Blocking panels or shear blocking may be specified for joist stability at intermediate supports

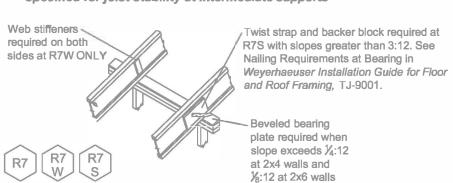


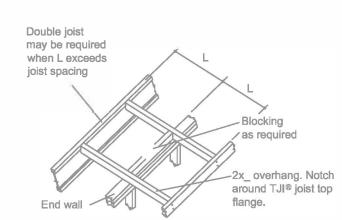

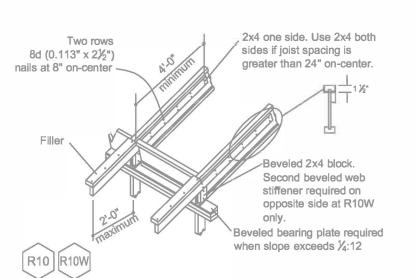

ROOF FRAMING

ROOF FRAMING PLAN

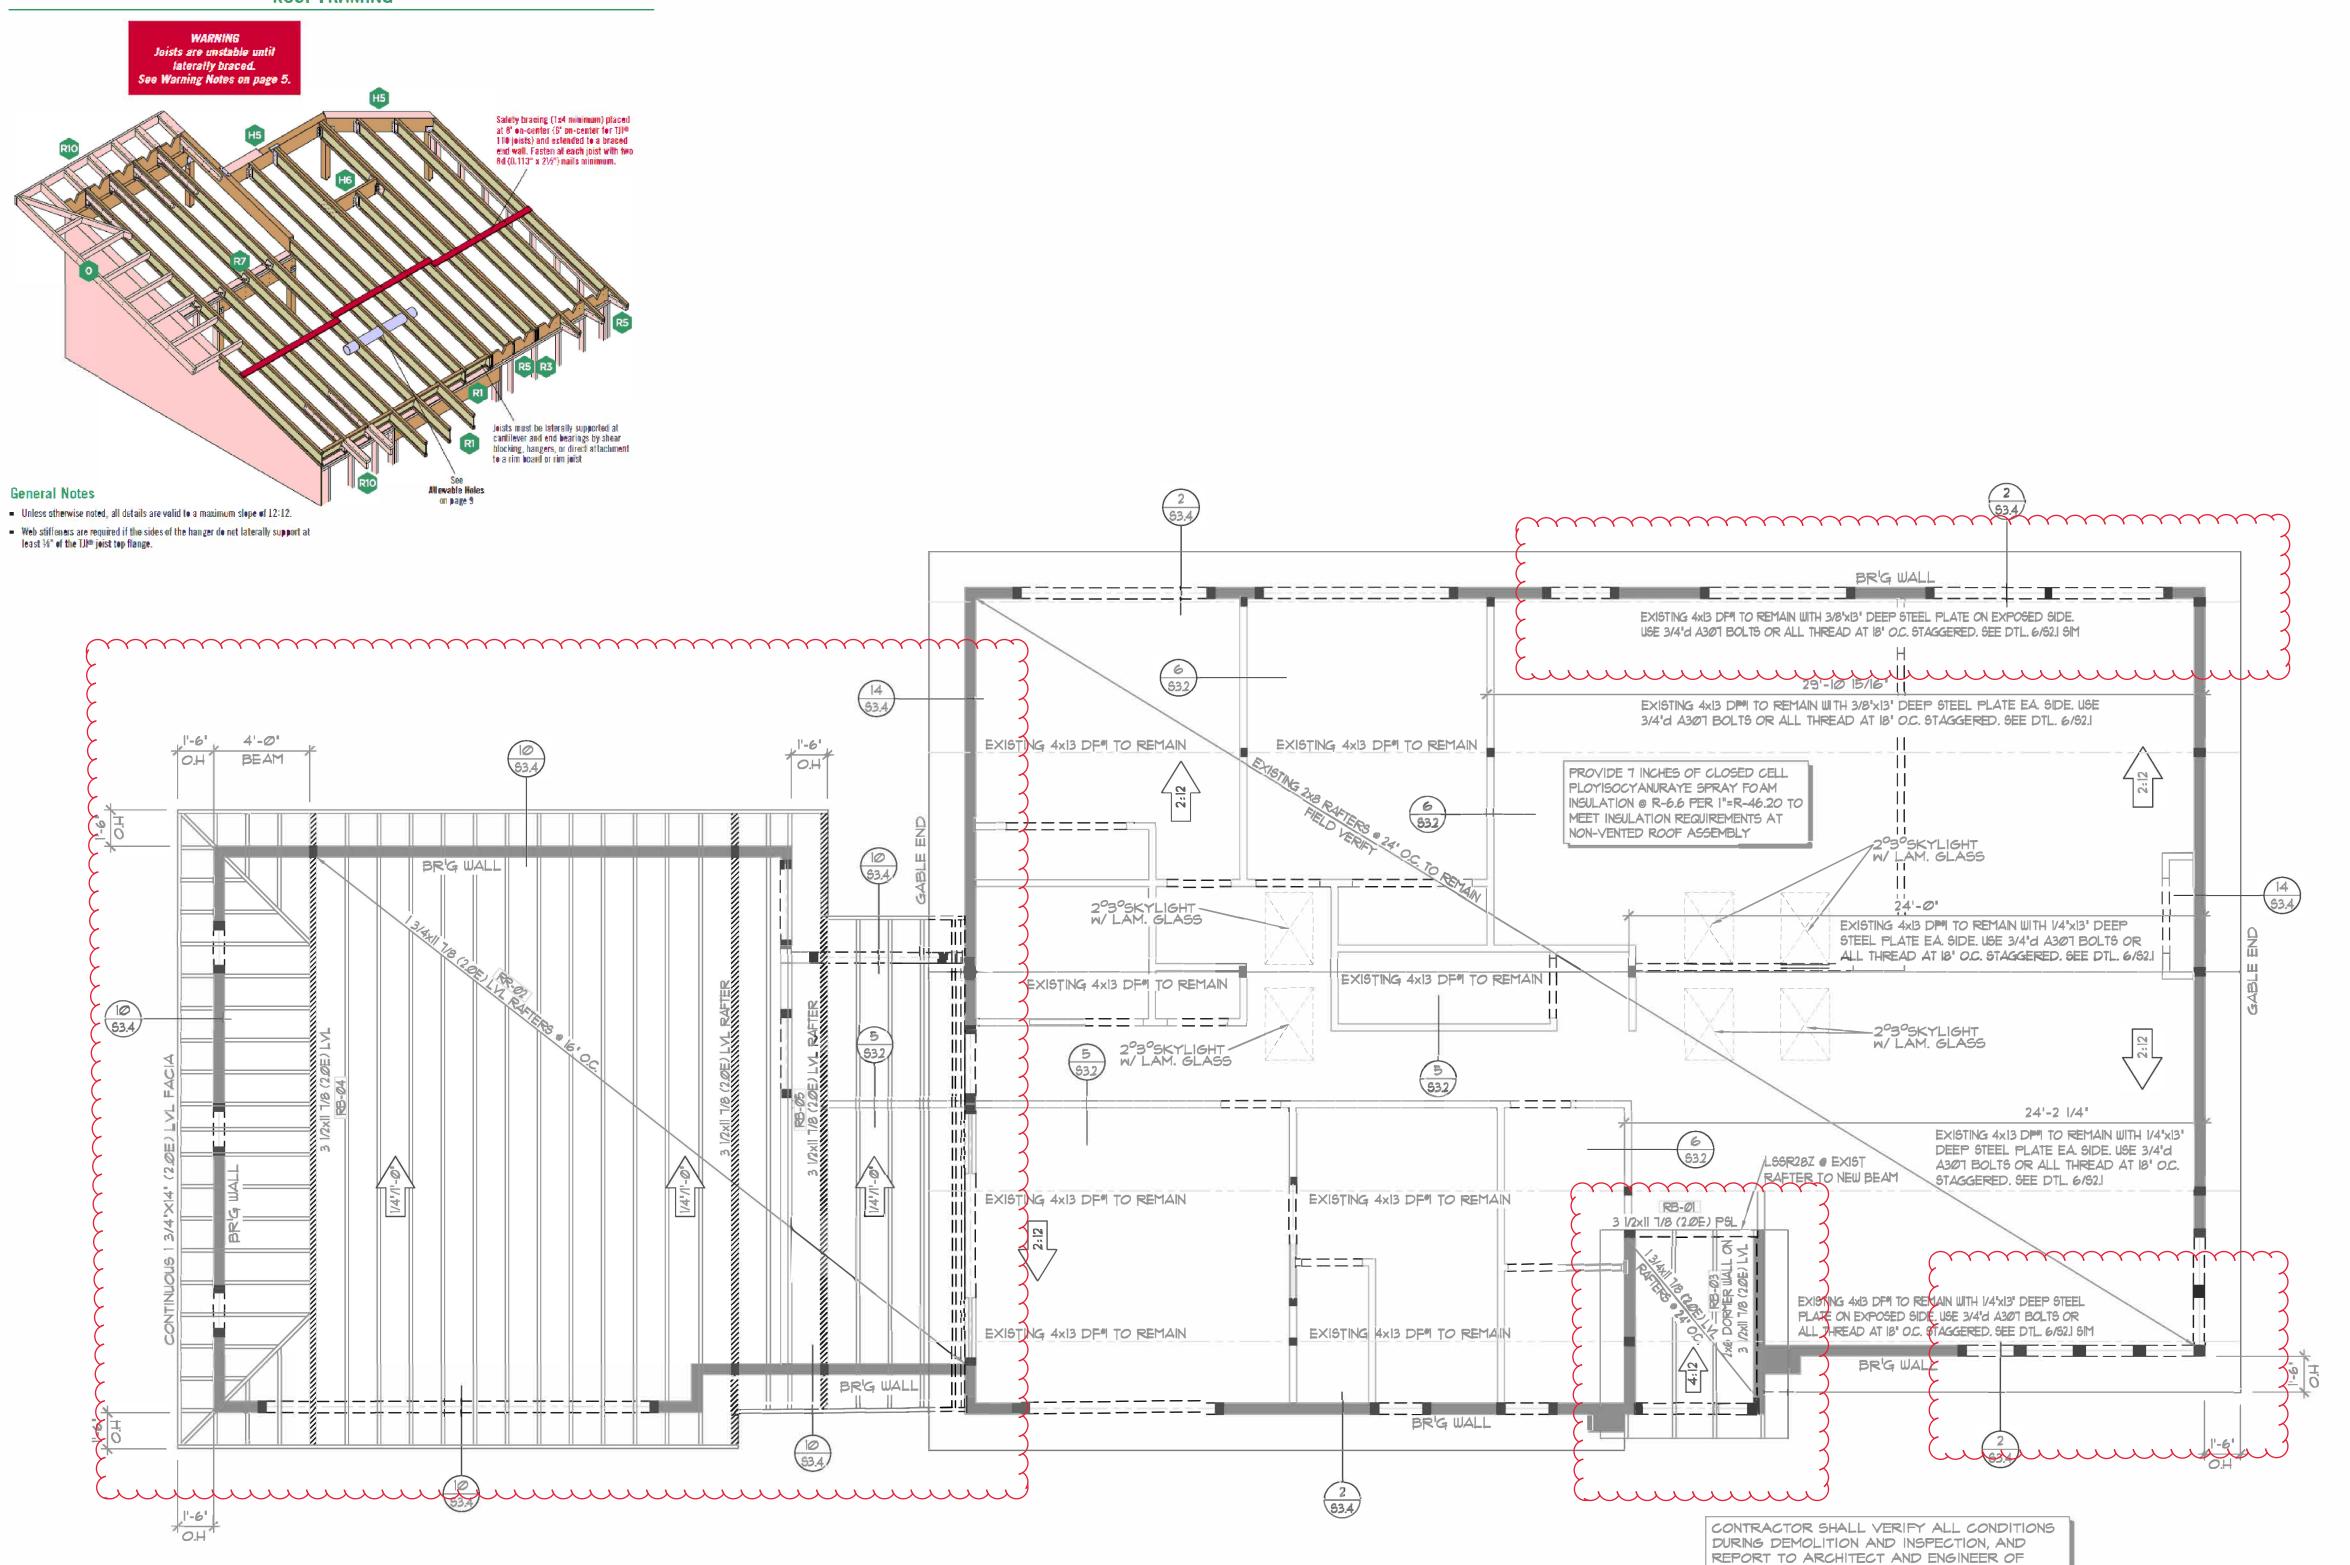



 $\frac{1}{2} = 1 - 0$

DSF

RECORD FOR REVIEW AND APPROVAL

JULY 18, 2022

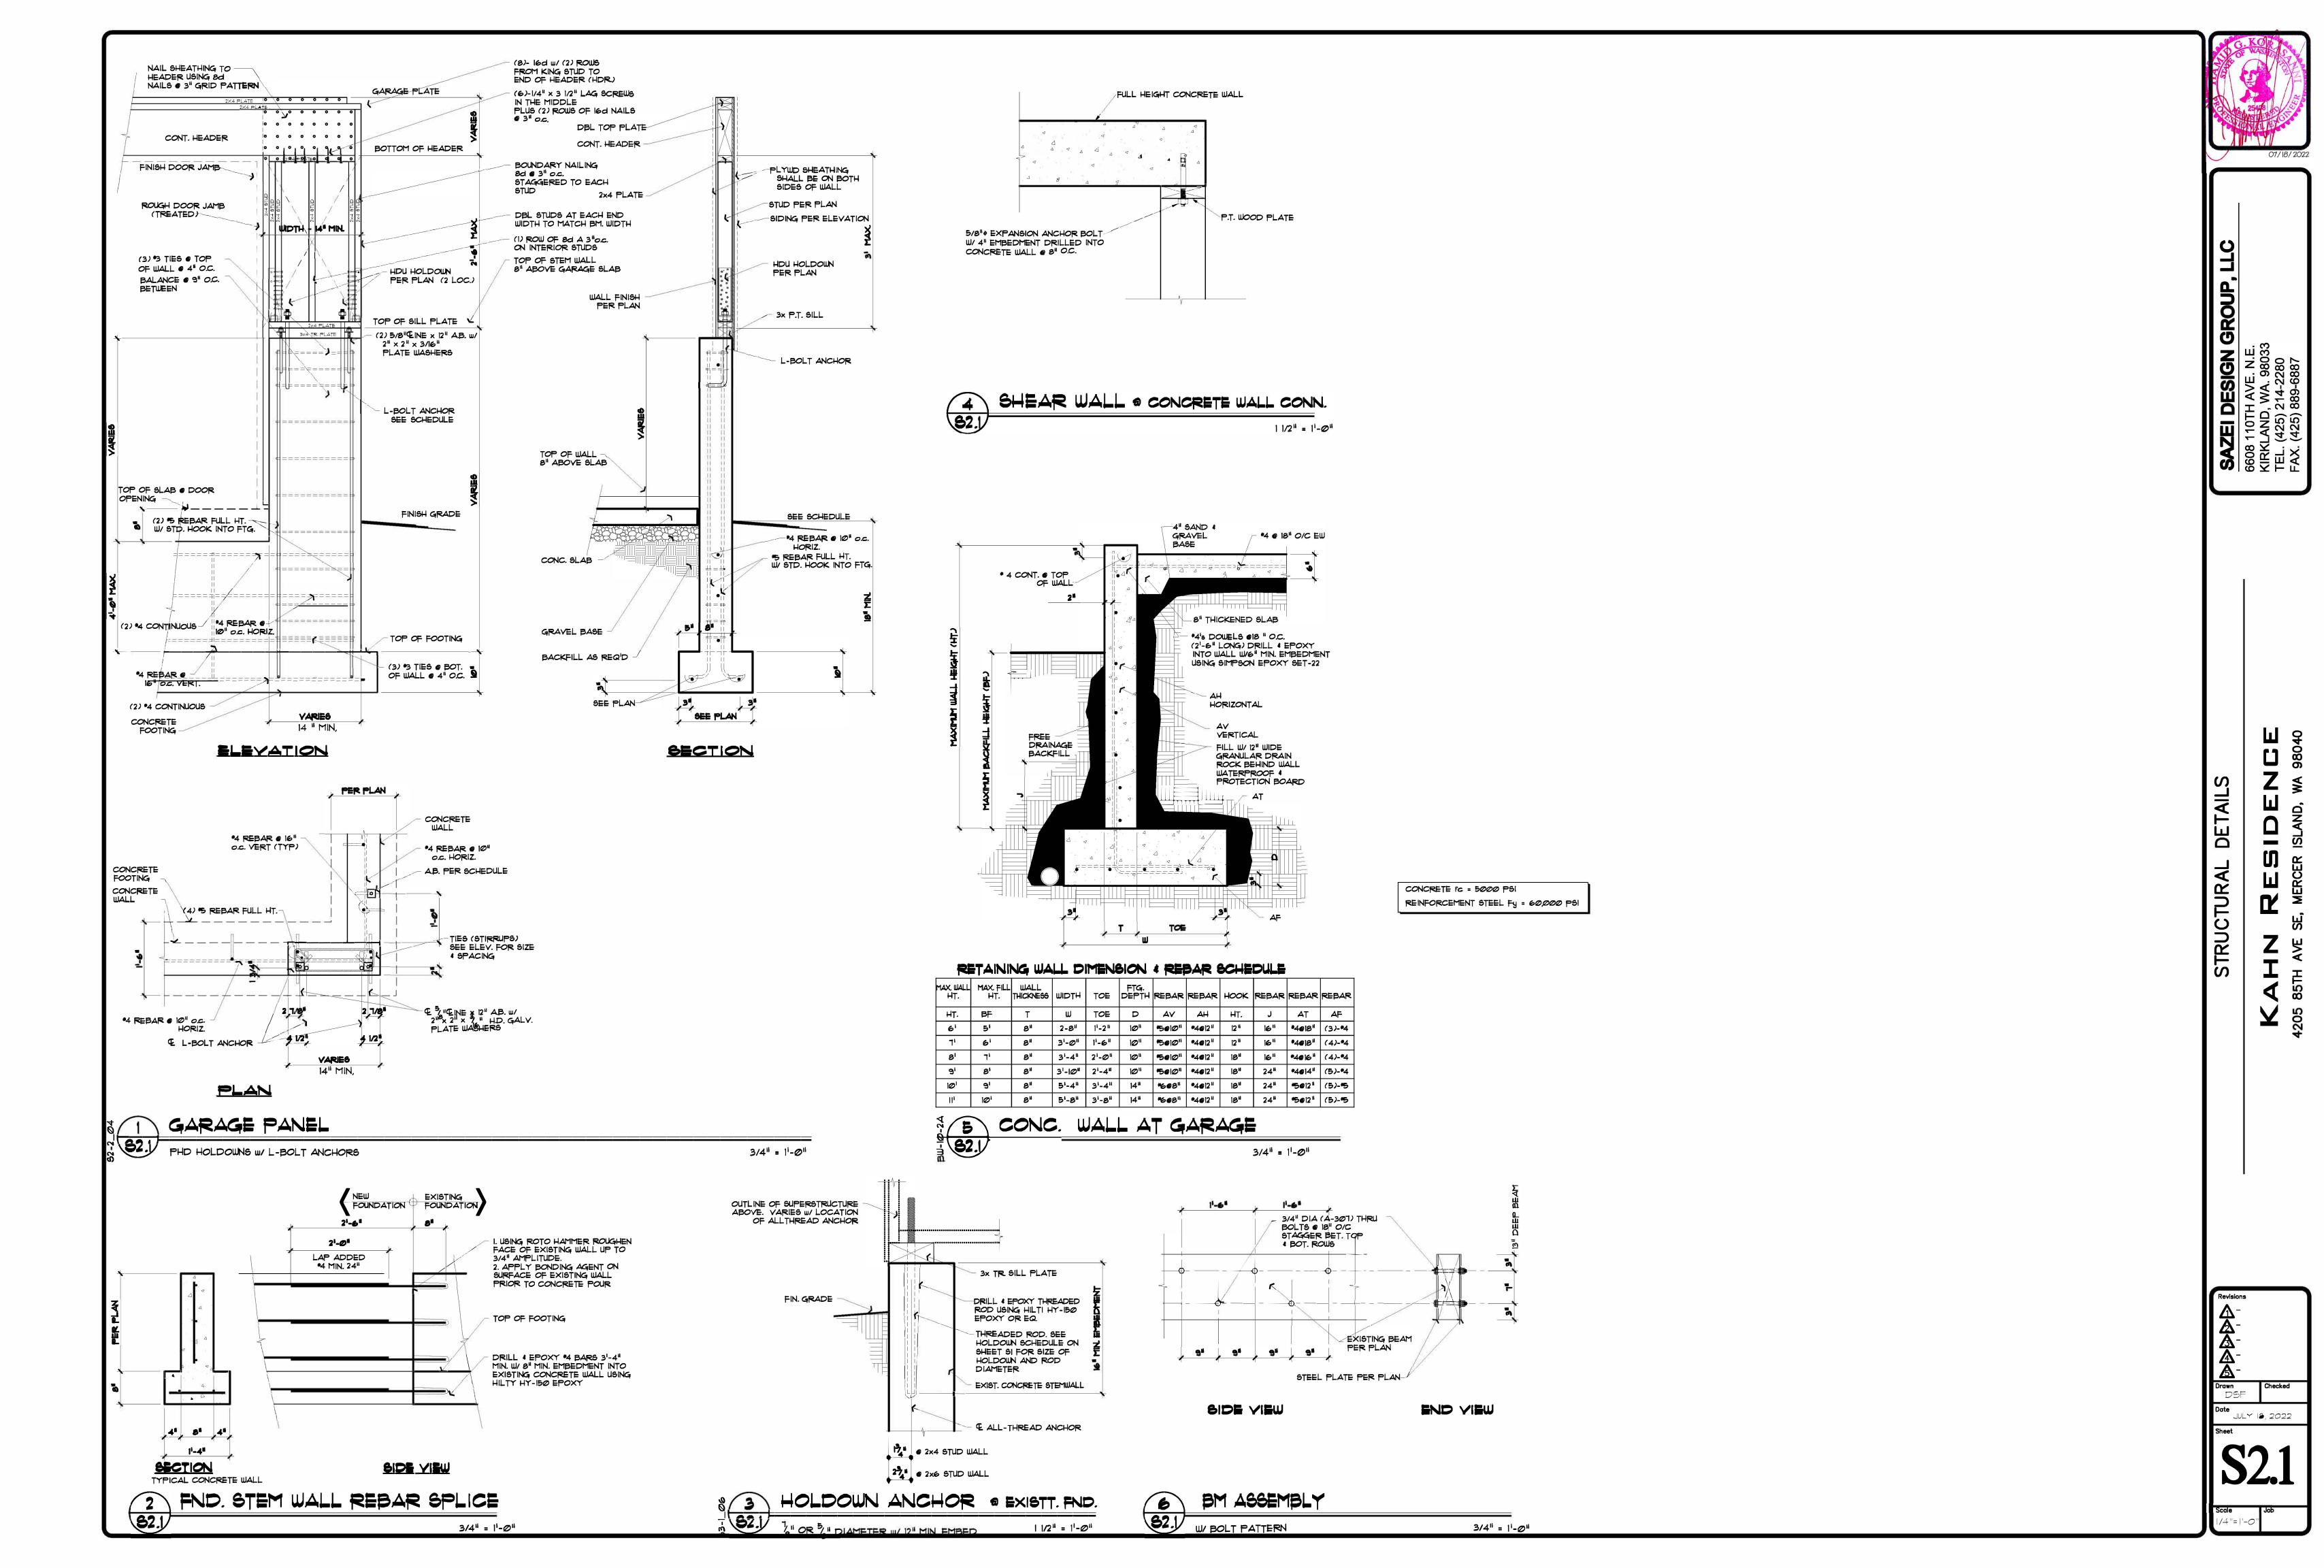

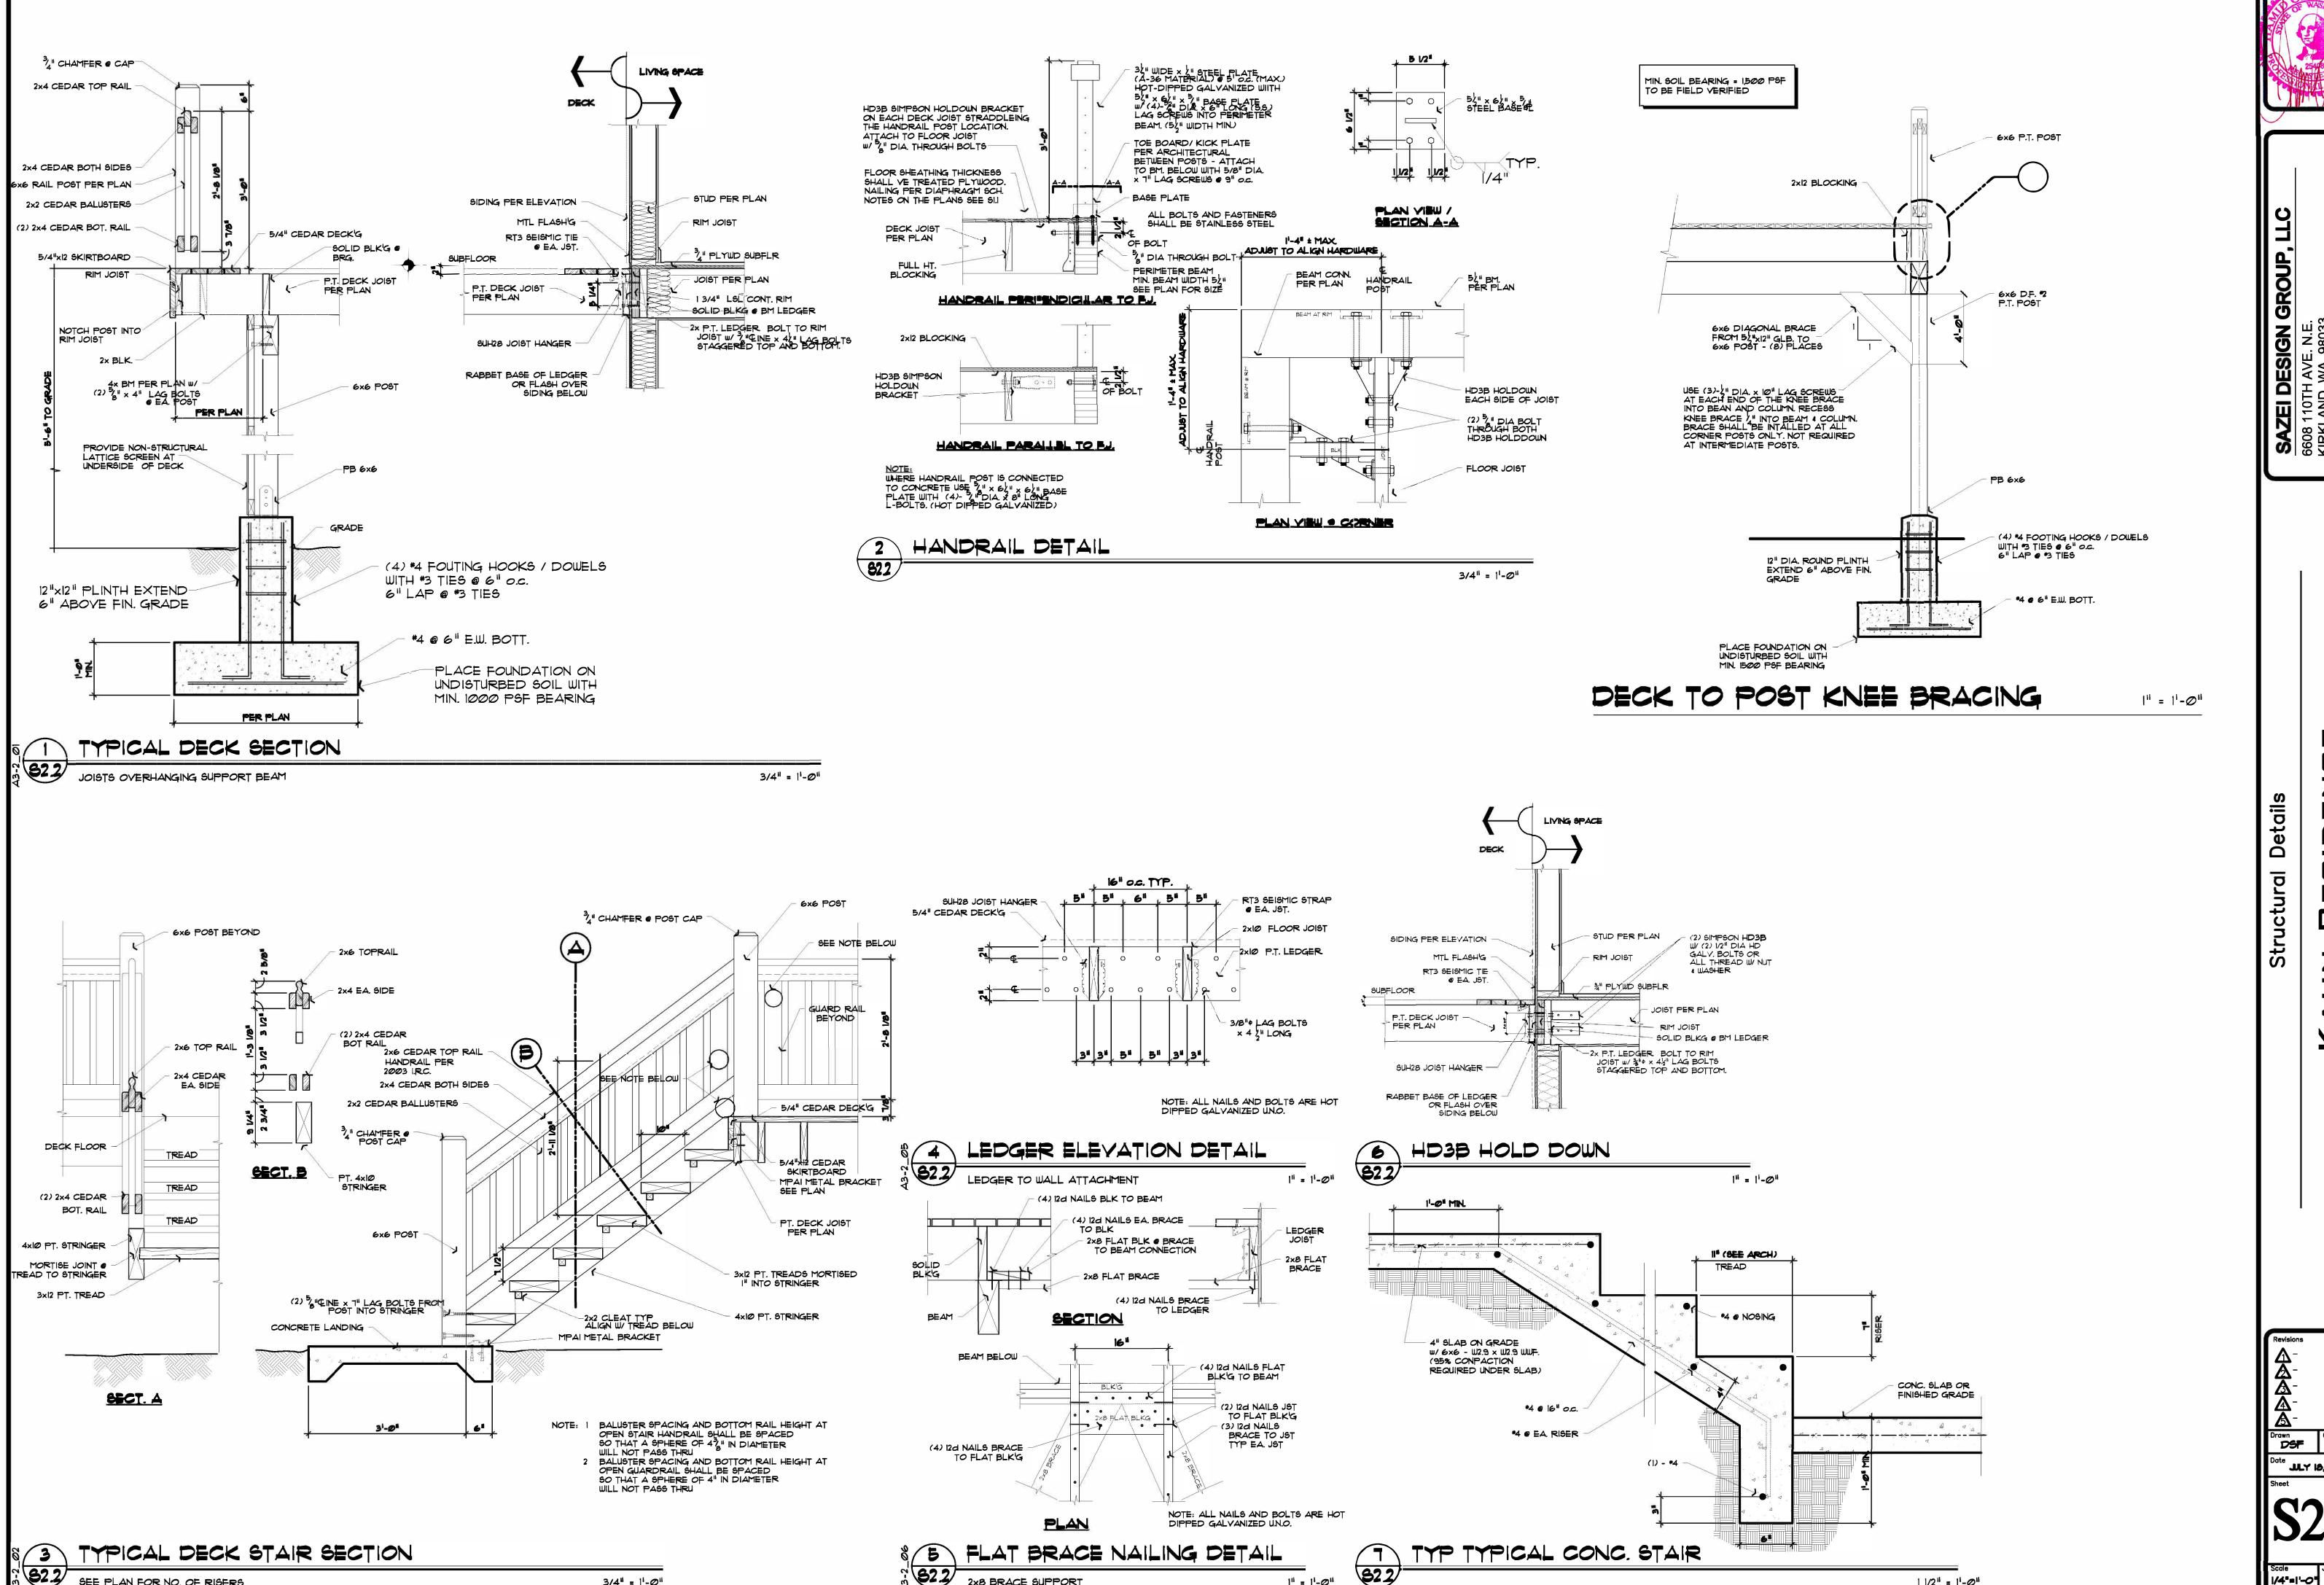

2x8 BRACE SUPPORT


1" = 1'-0"


3/4" = 1'-0"

SEE PLAN FOR NO. OF RISERS

dsf JLY 18, 2022

1 1/2" = 1'-0"

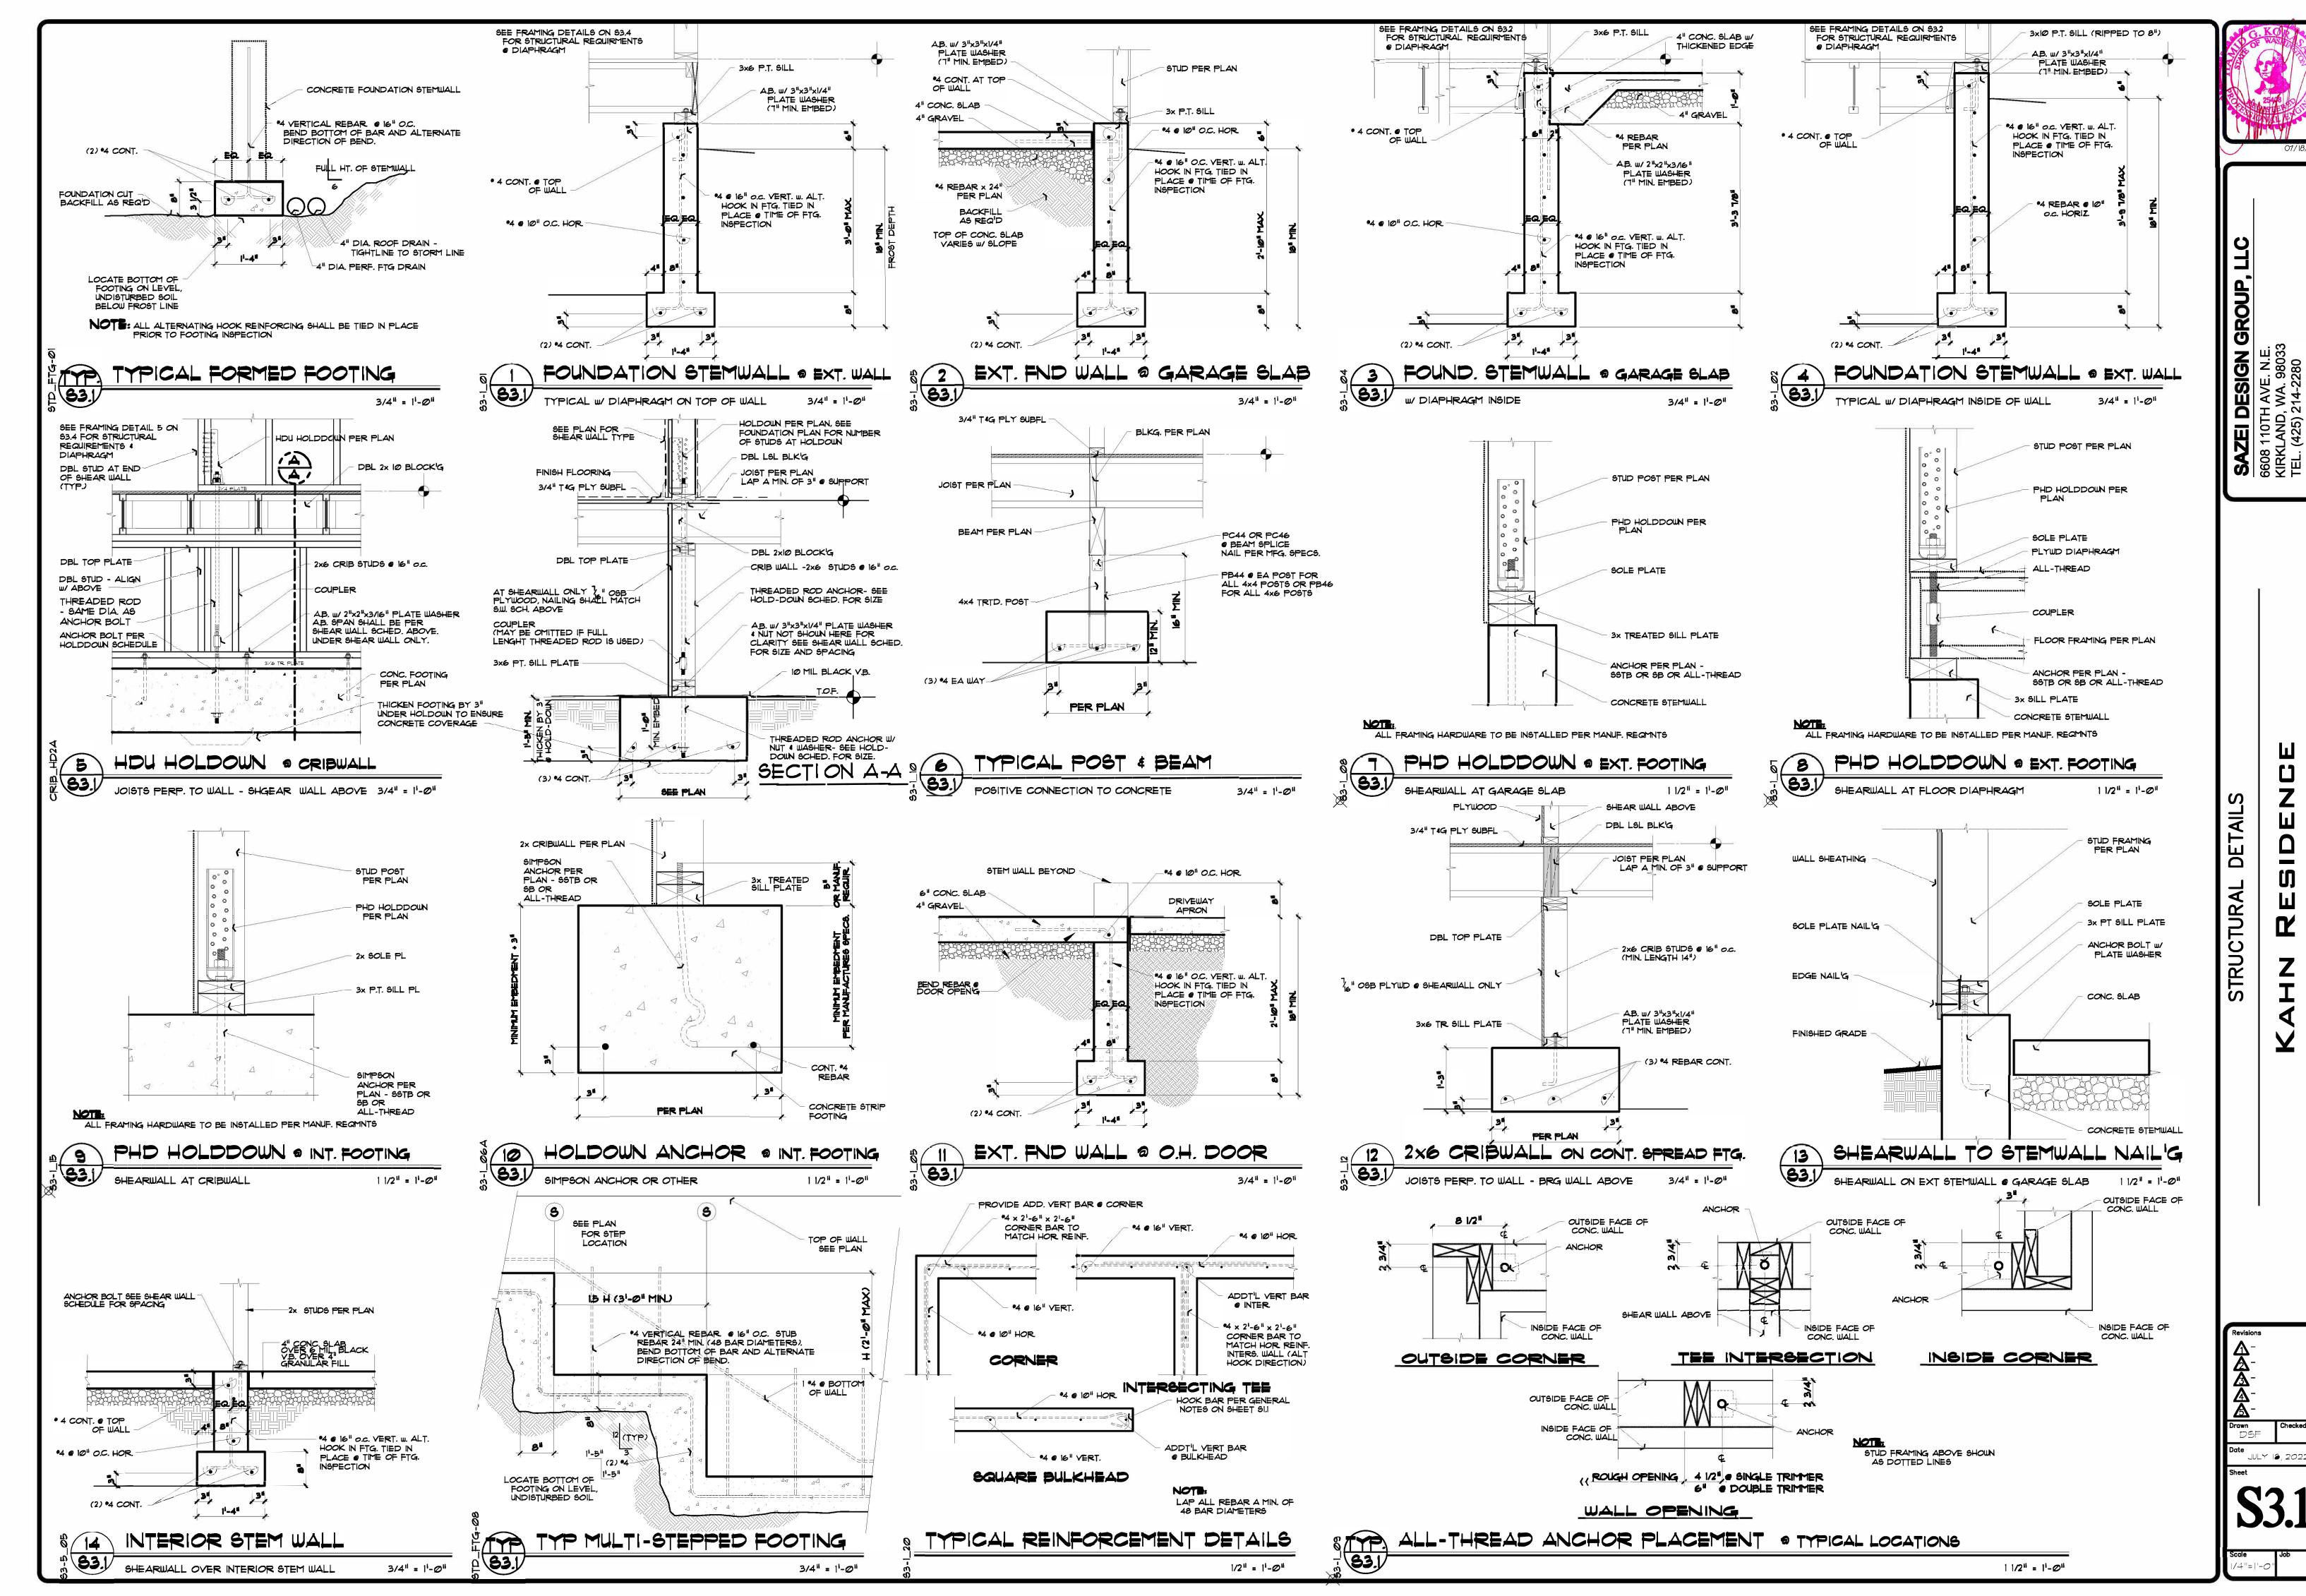

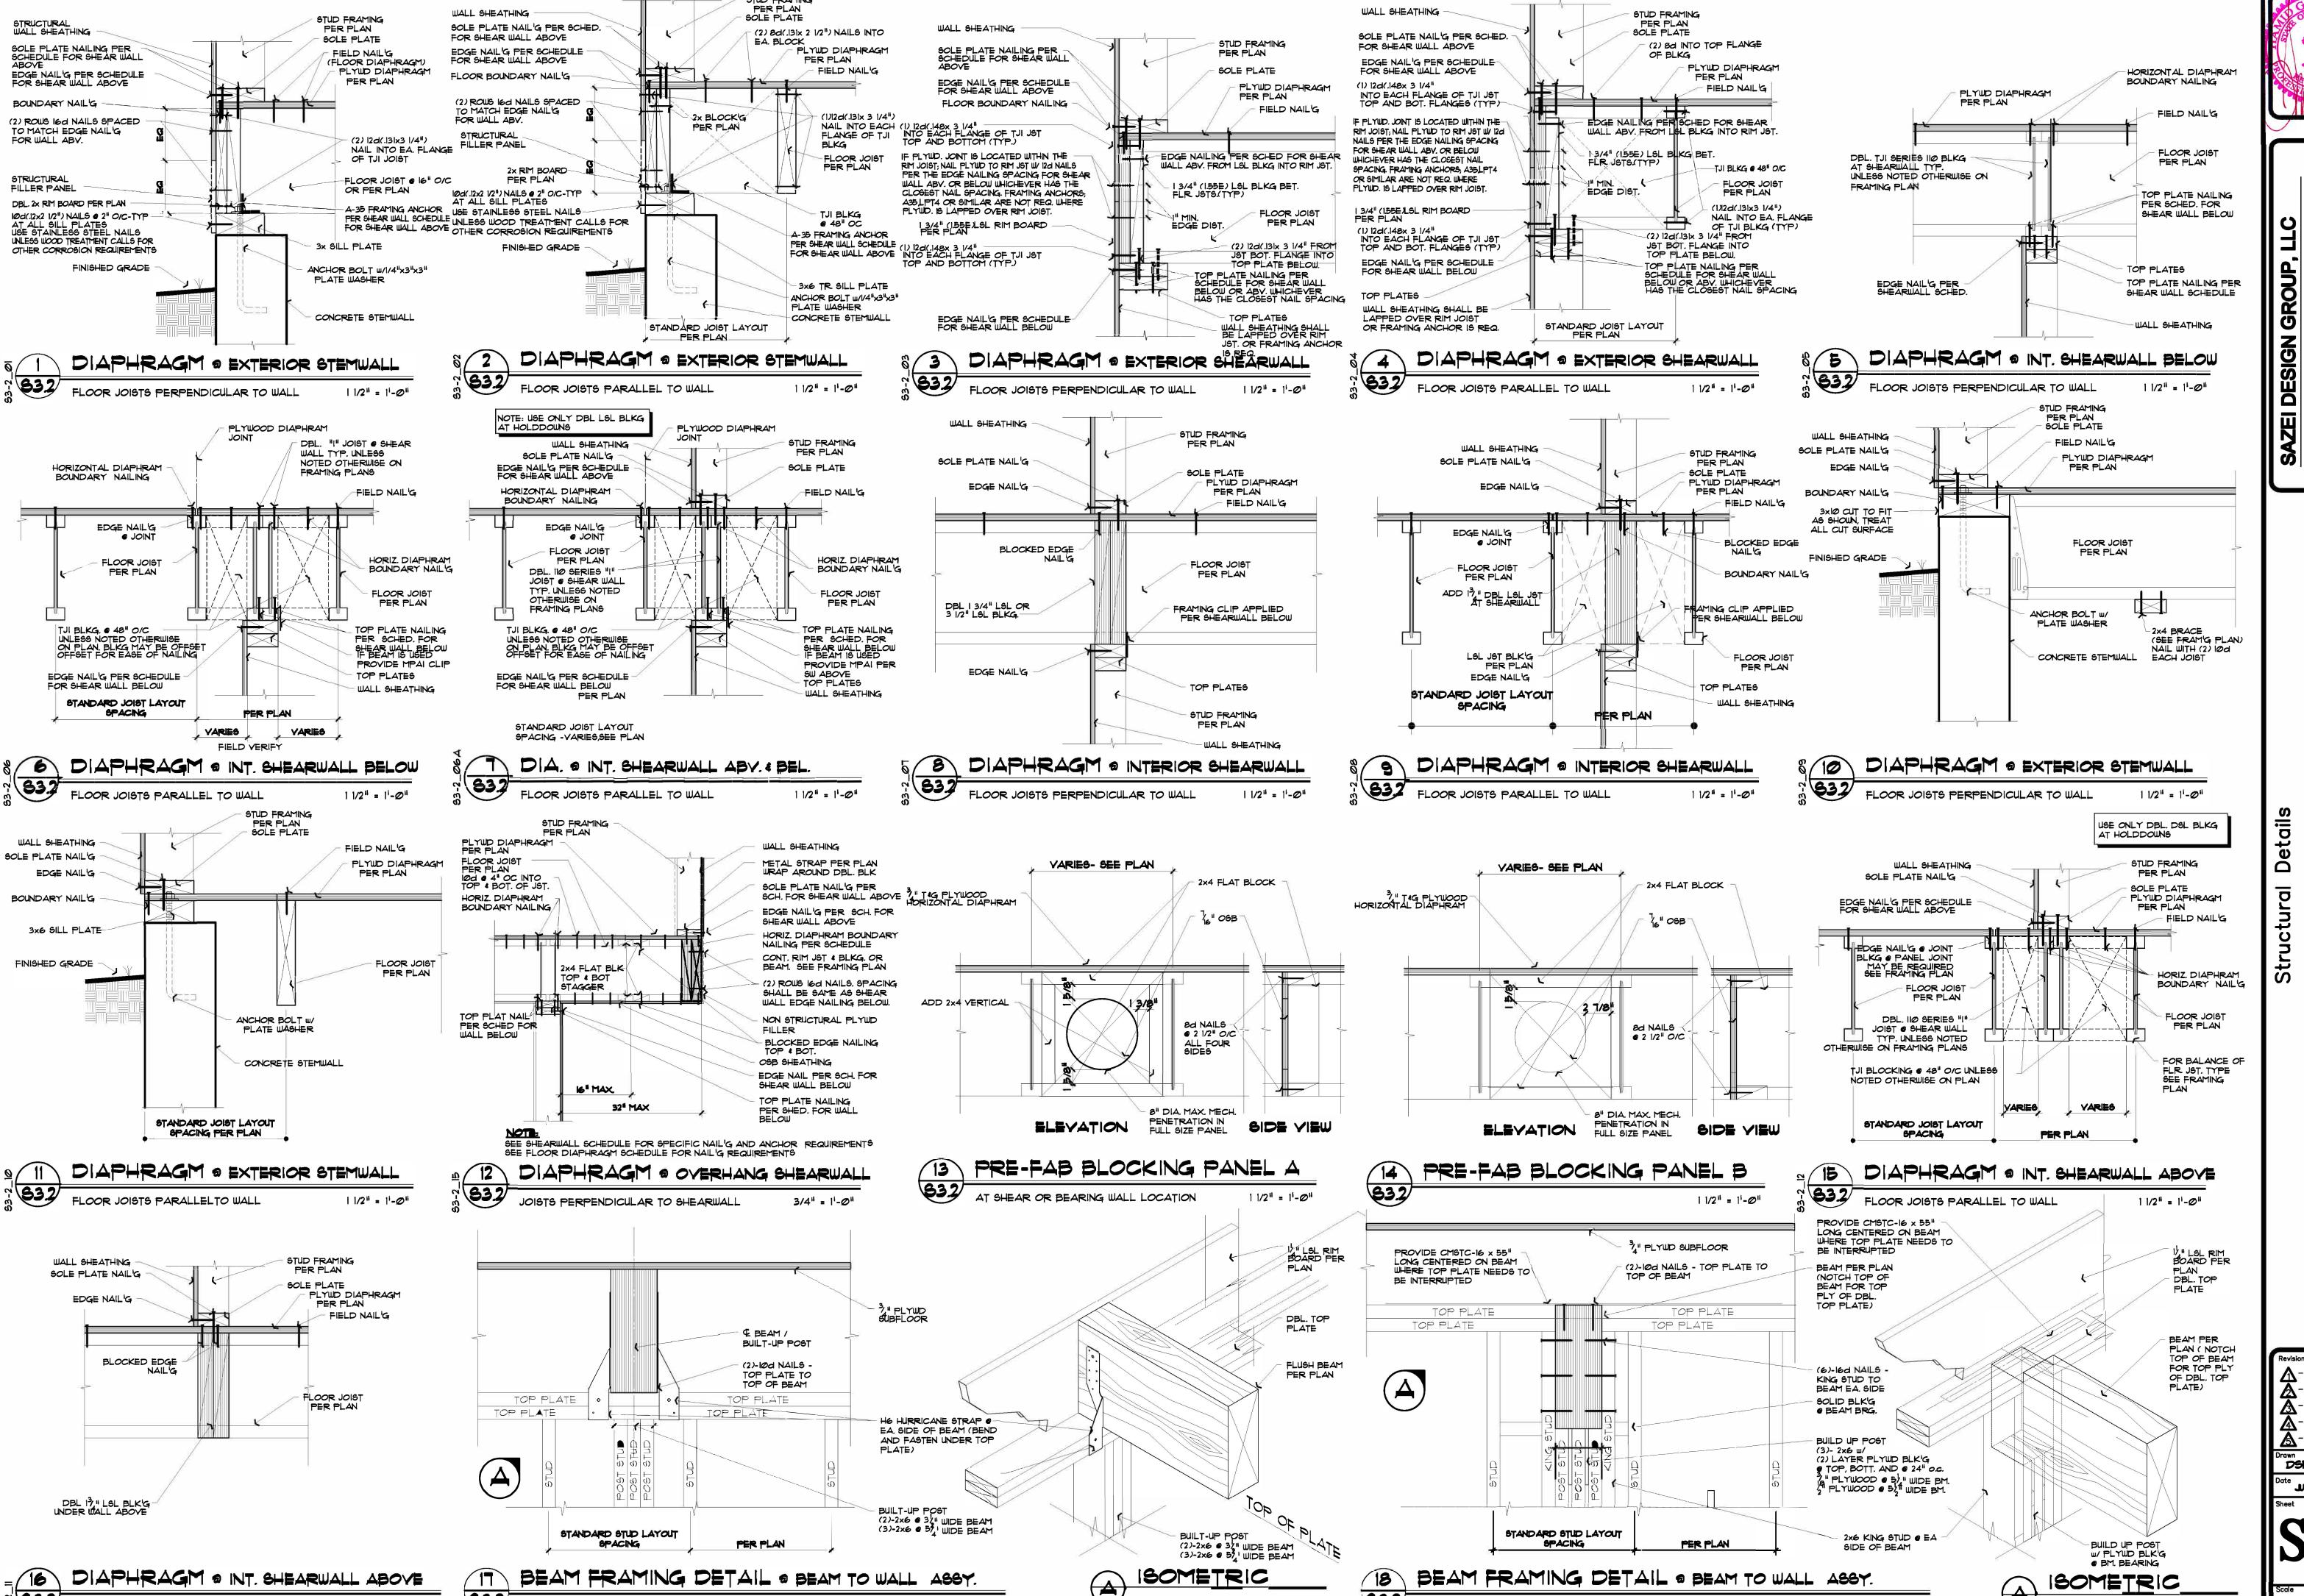

TOP OF BEAM FLUSH W/ TOP OF JOIST-BEAM BEARING ON TOP OF PLATE 11/2" = 11-01


TOP OF BEAM FLUSH W/ TOP OF PLATE

| 1/2" = 11-0"


FLOOR JOISTS PERPENDICULAR TO WALL

1 1/2" = 1'-0"

DSF JLY 18, 2022 227 |/4"=|'-O"

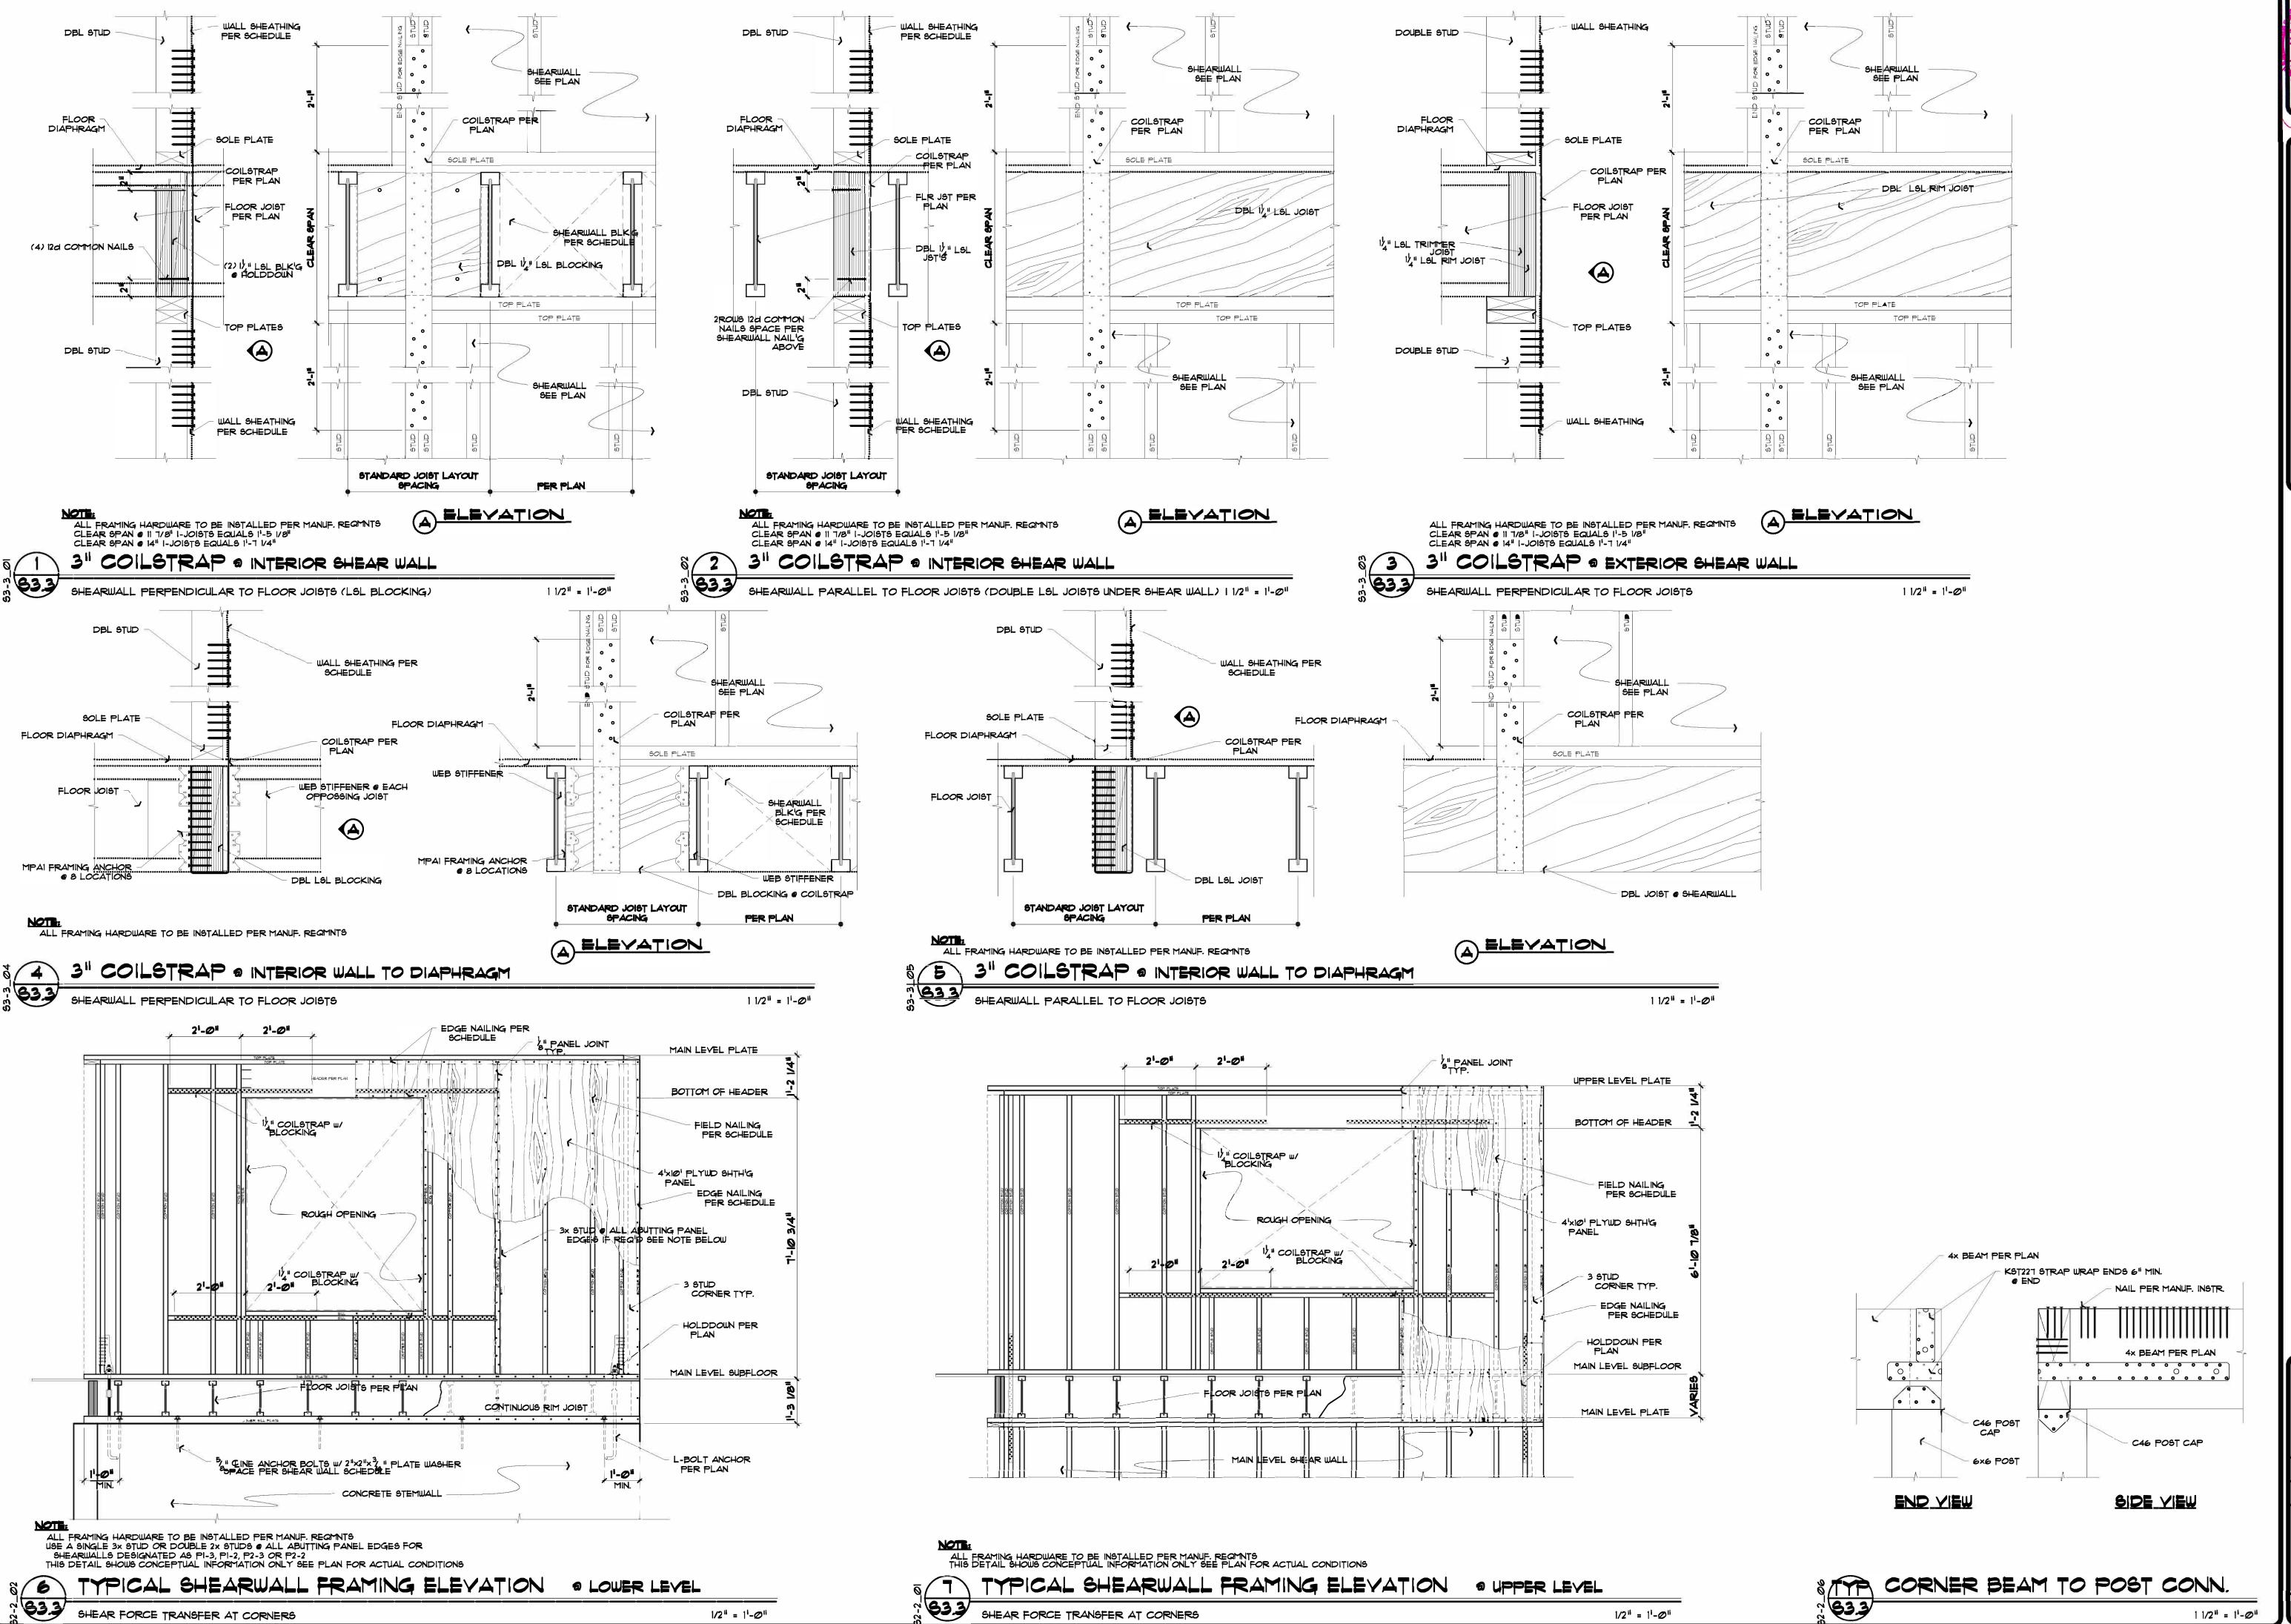

AILS DET STRUCTURAL

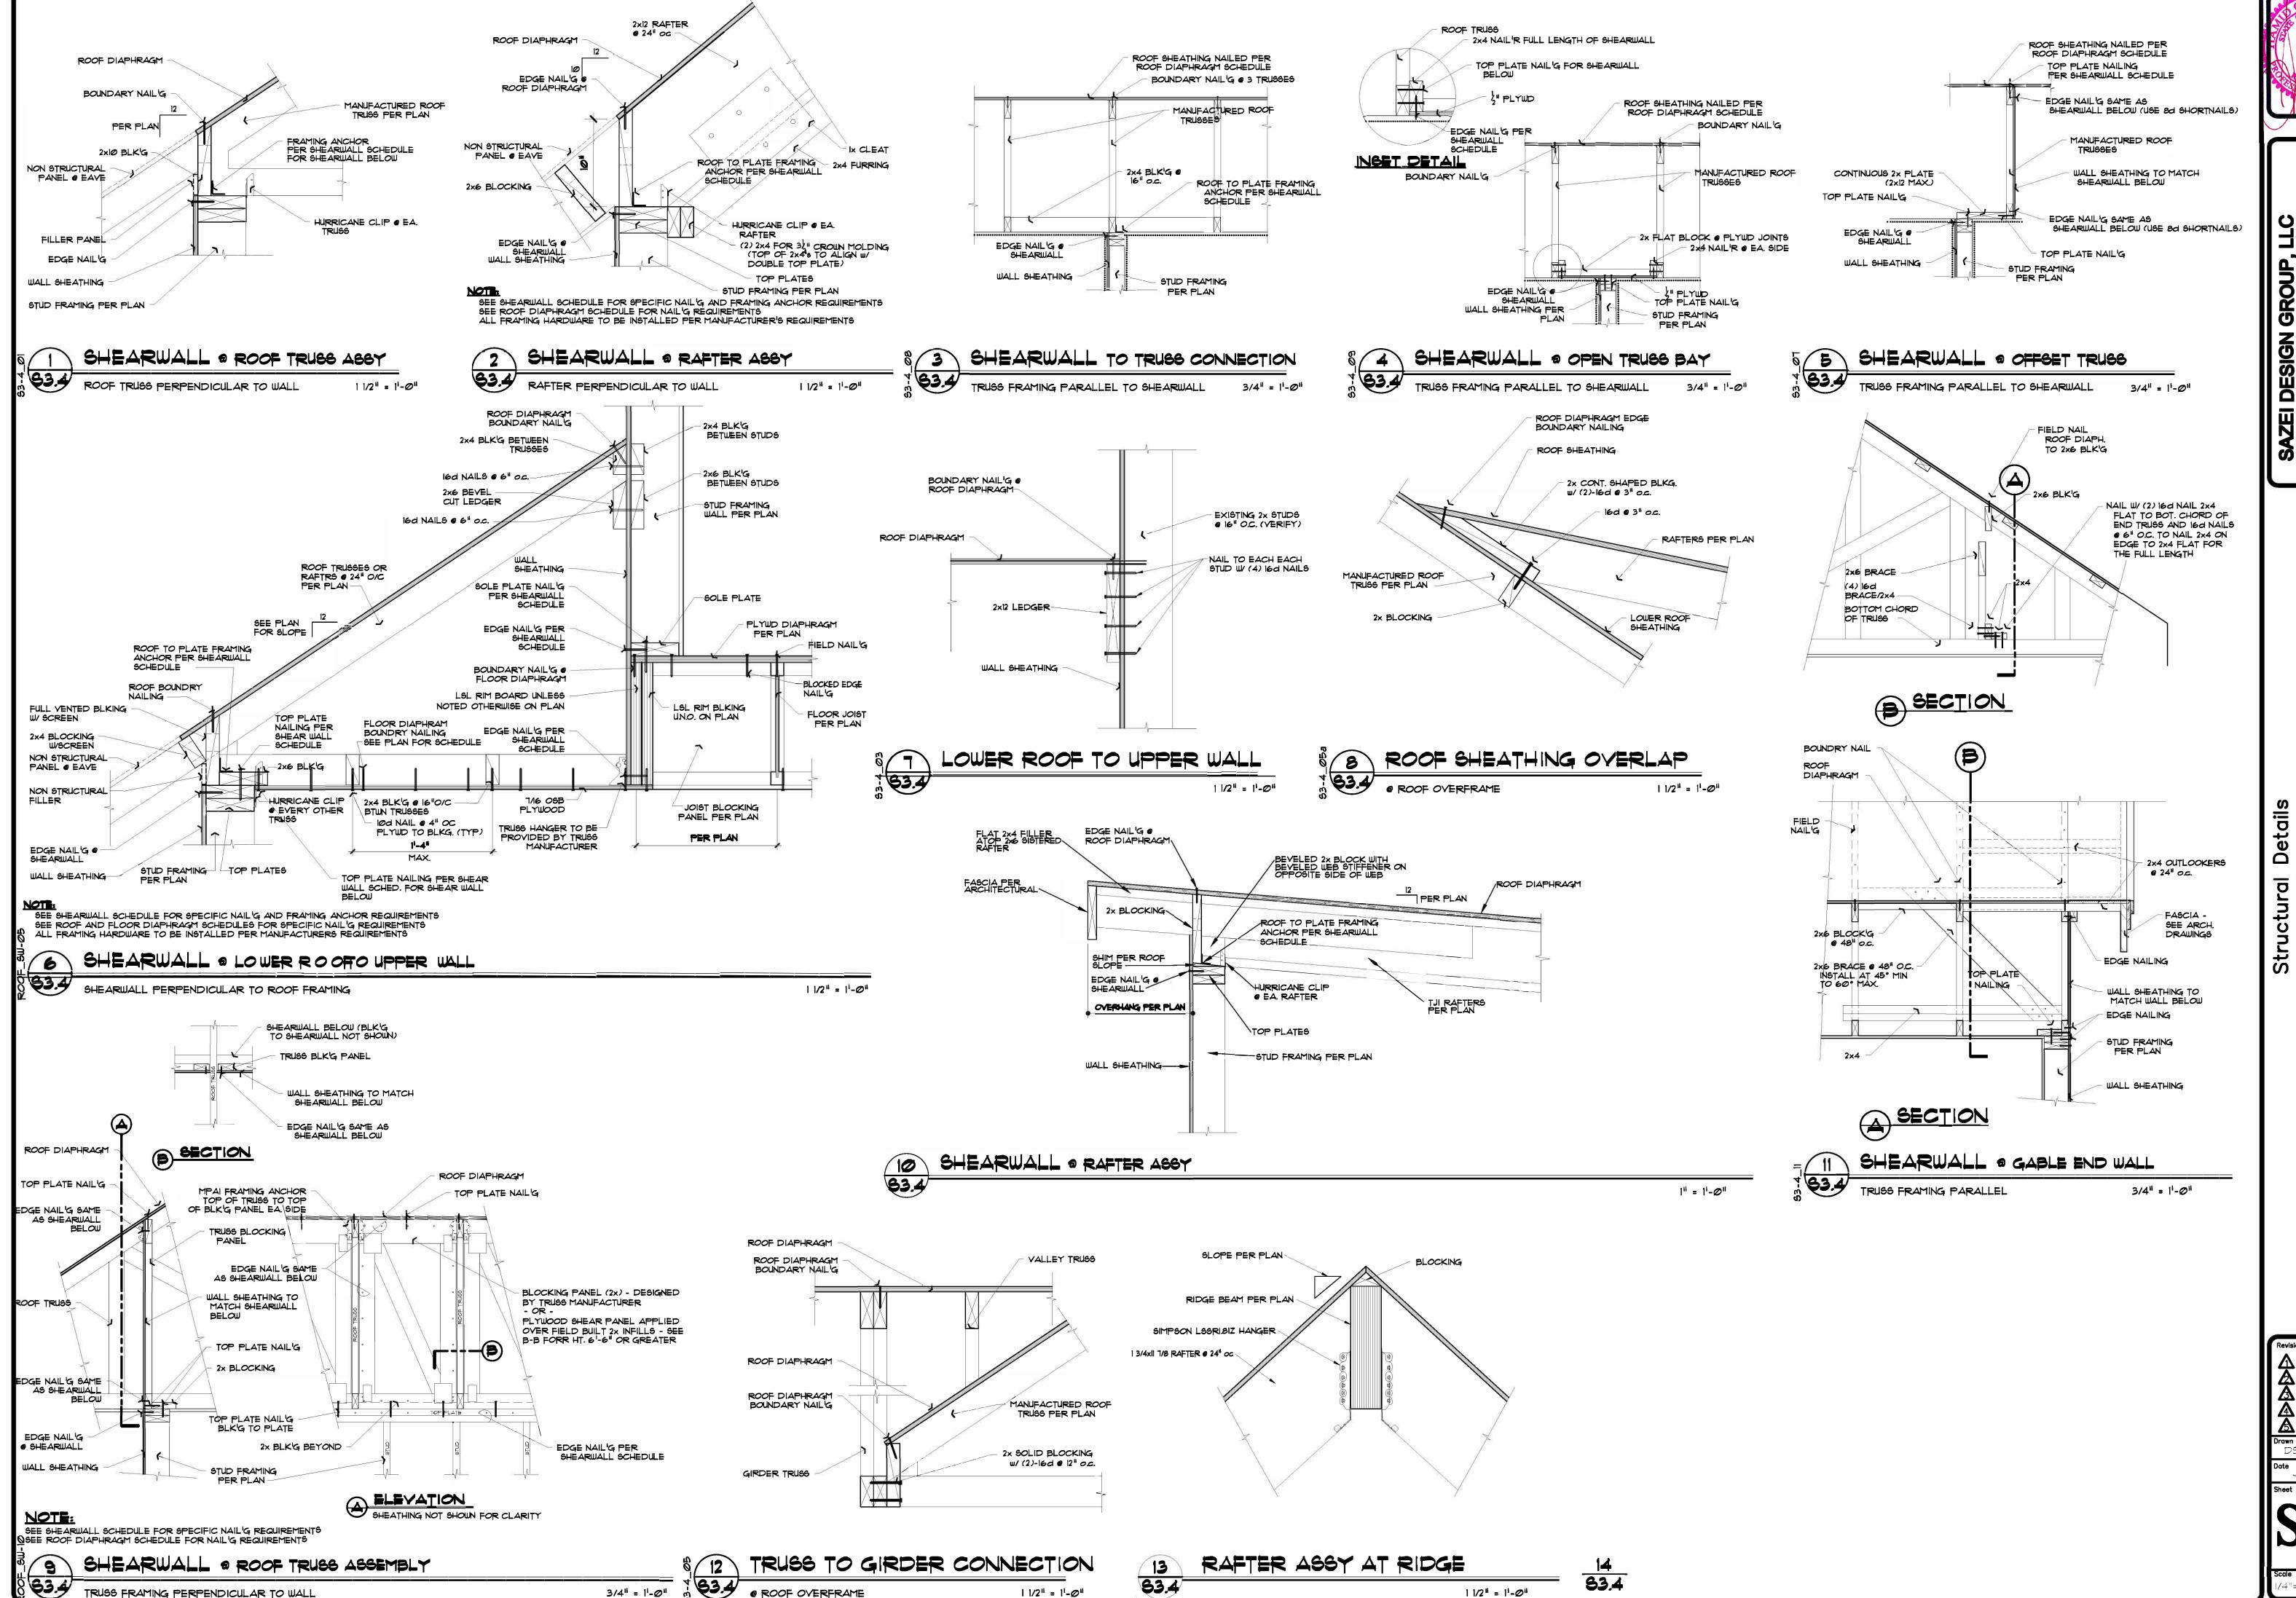

1 1/2" = 1'-0"

1 1/2" = 1'-0"

TRUSS FRAMING PERPENDICULAR TO WALL

GROUP,