


Project Title
JAFFE RESIDENCE
 8455 SE 83RD STREET
 MERCER ISLAND, WA 98040

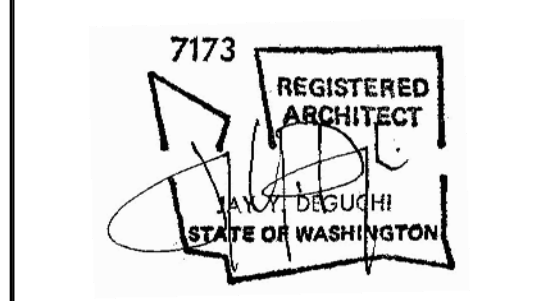

Drawing Title
SITE PLAN







Date
 08/08/2022
 Job No.
 210

ISSUE	DATE
PERMIT CORRECTIONS #1	03/31/2023
PERMIT CORRECTIONS #2	05/31/2023

SITE PLAN LEGEND:


[Hatched Box]	EXISTING HOUSE TO REMAIN
[Dotted Box]	ADDITION AREA
[Cross-hatched Box]	REPAIRED DECK
[Stippled Box]	EXISTING & NEW PAVING
[Solid Box]	NEW DECK AREA

NOTE: REFER TO PLAN C10 FOR TREE PROTECTION FENCING INFORMATION, AND DIAGRAM 5/TS-4 FOR TREE PLANTING PLAN

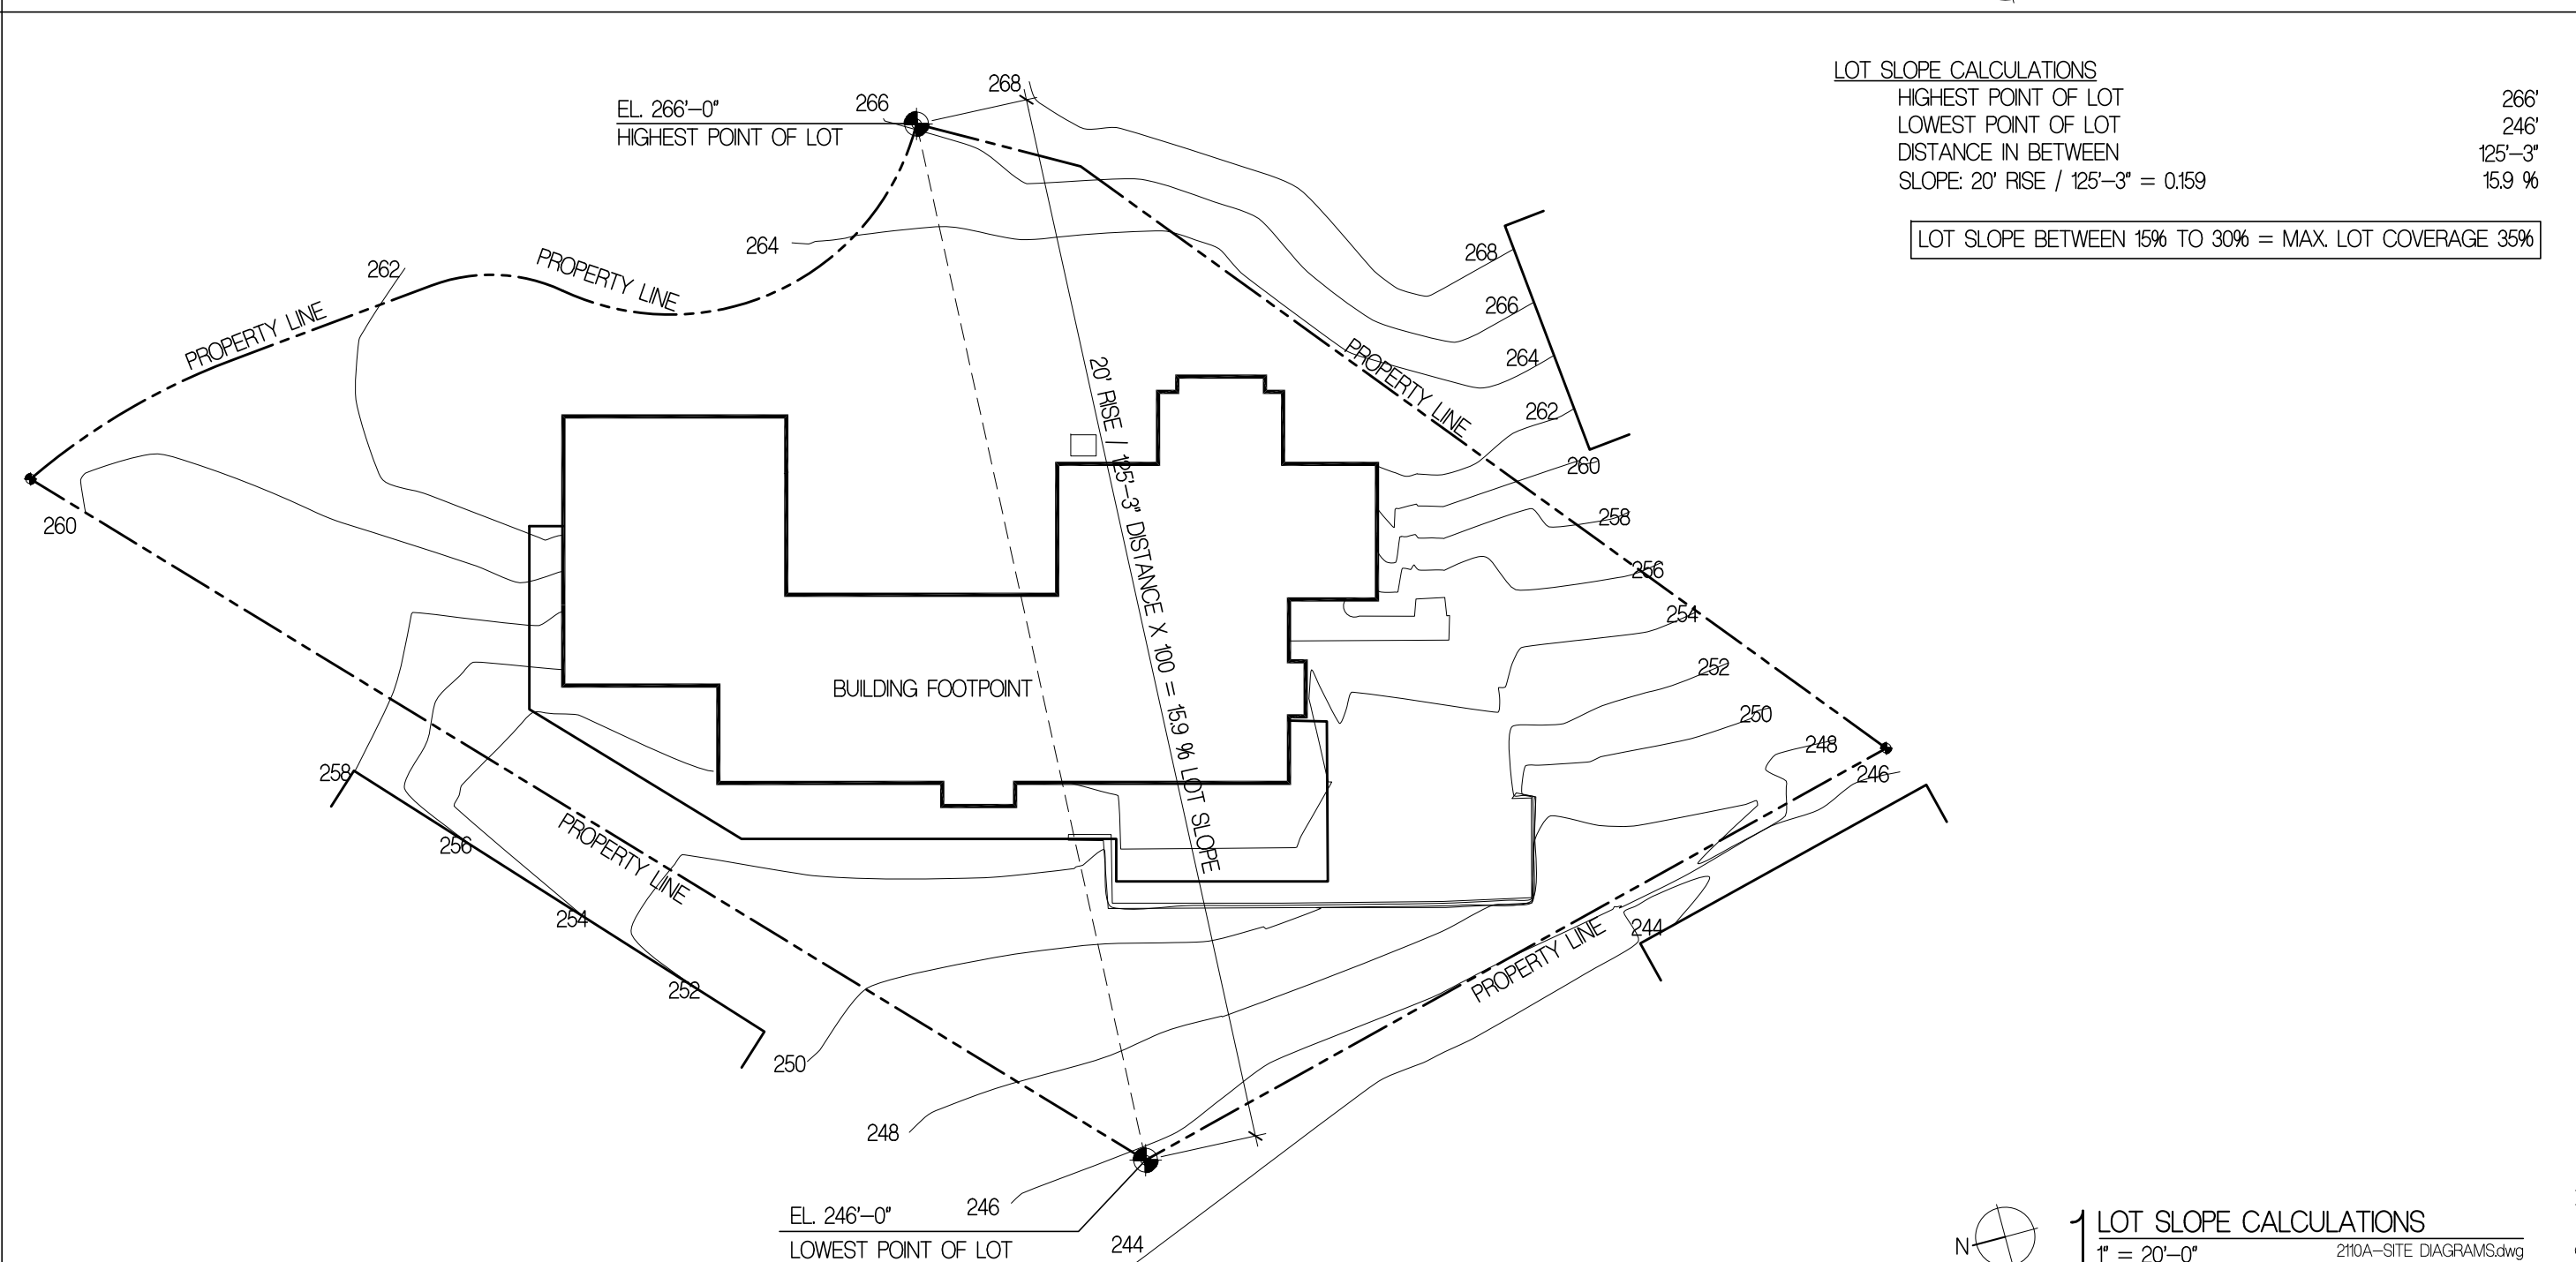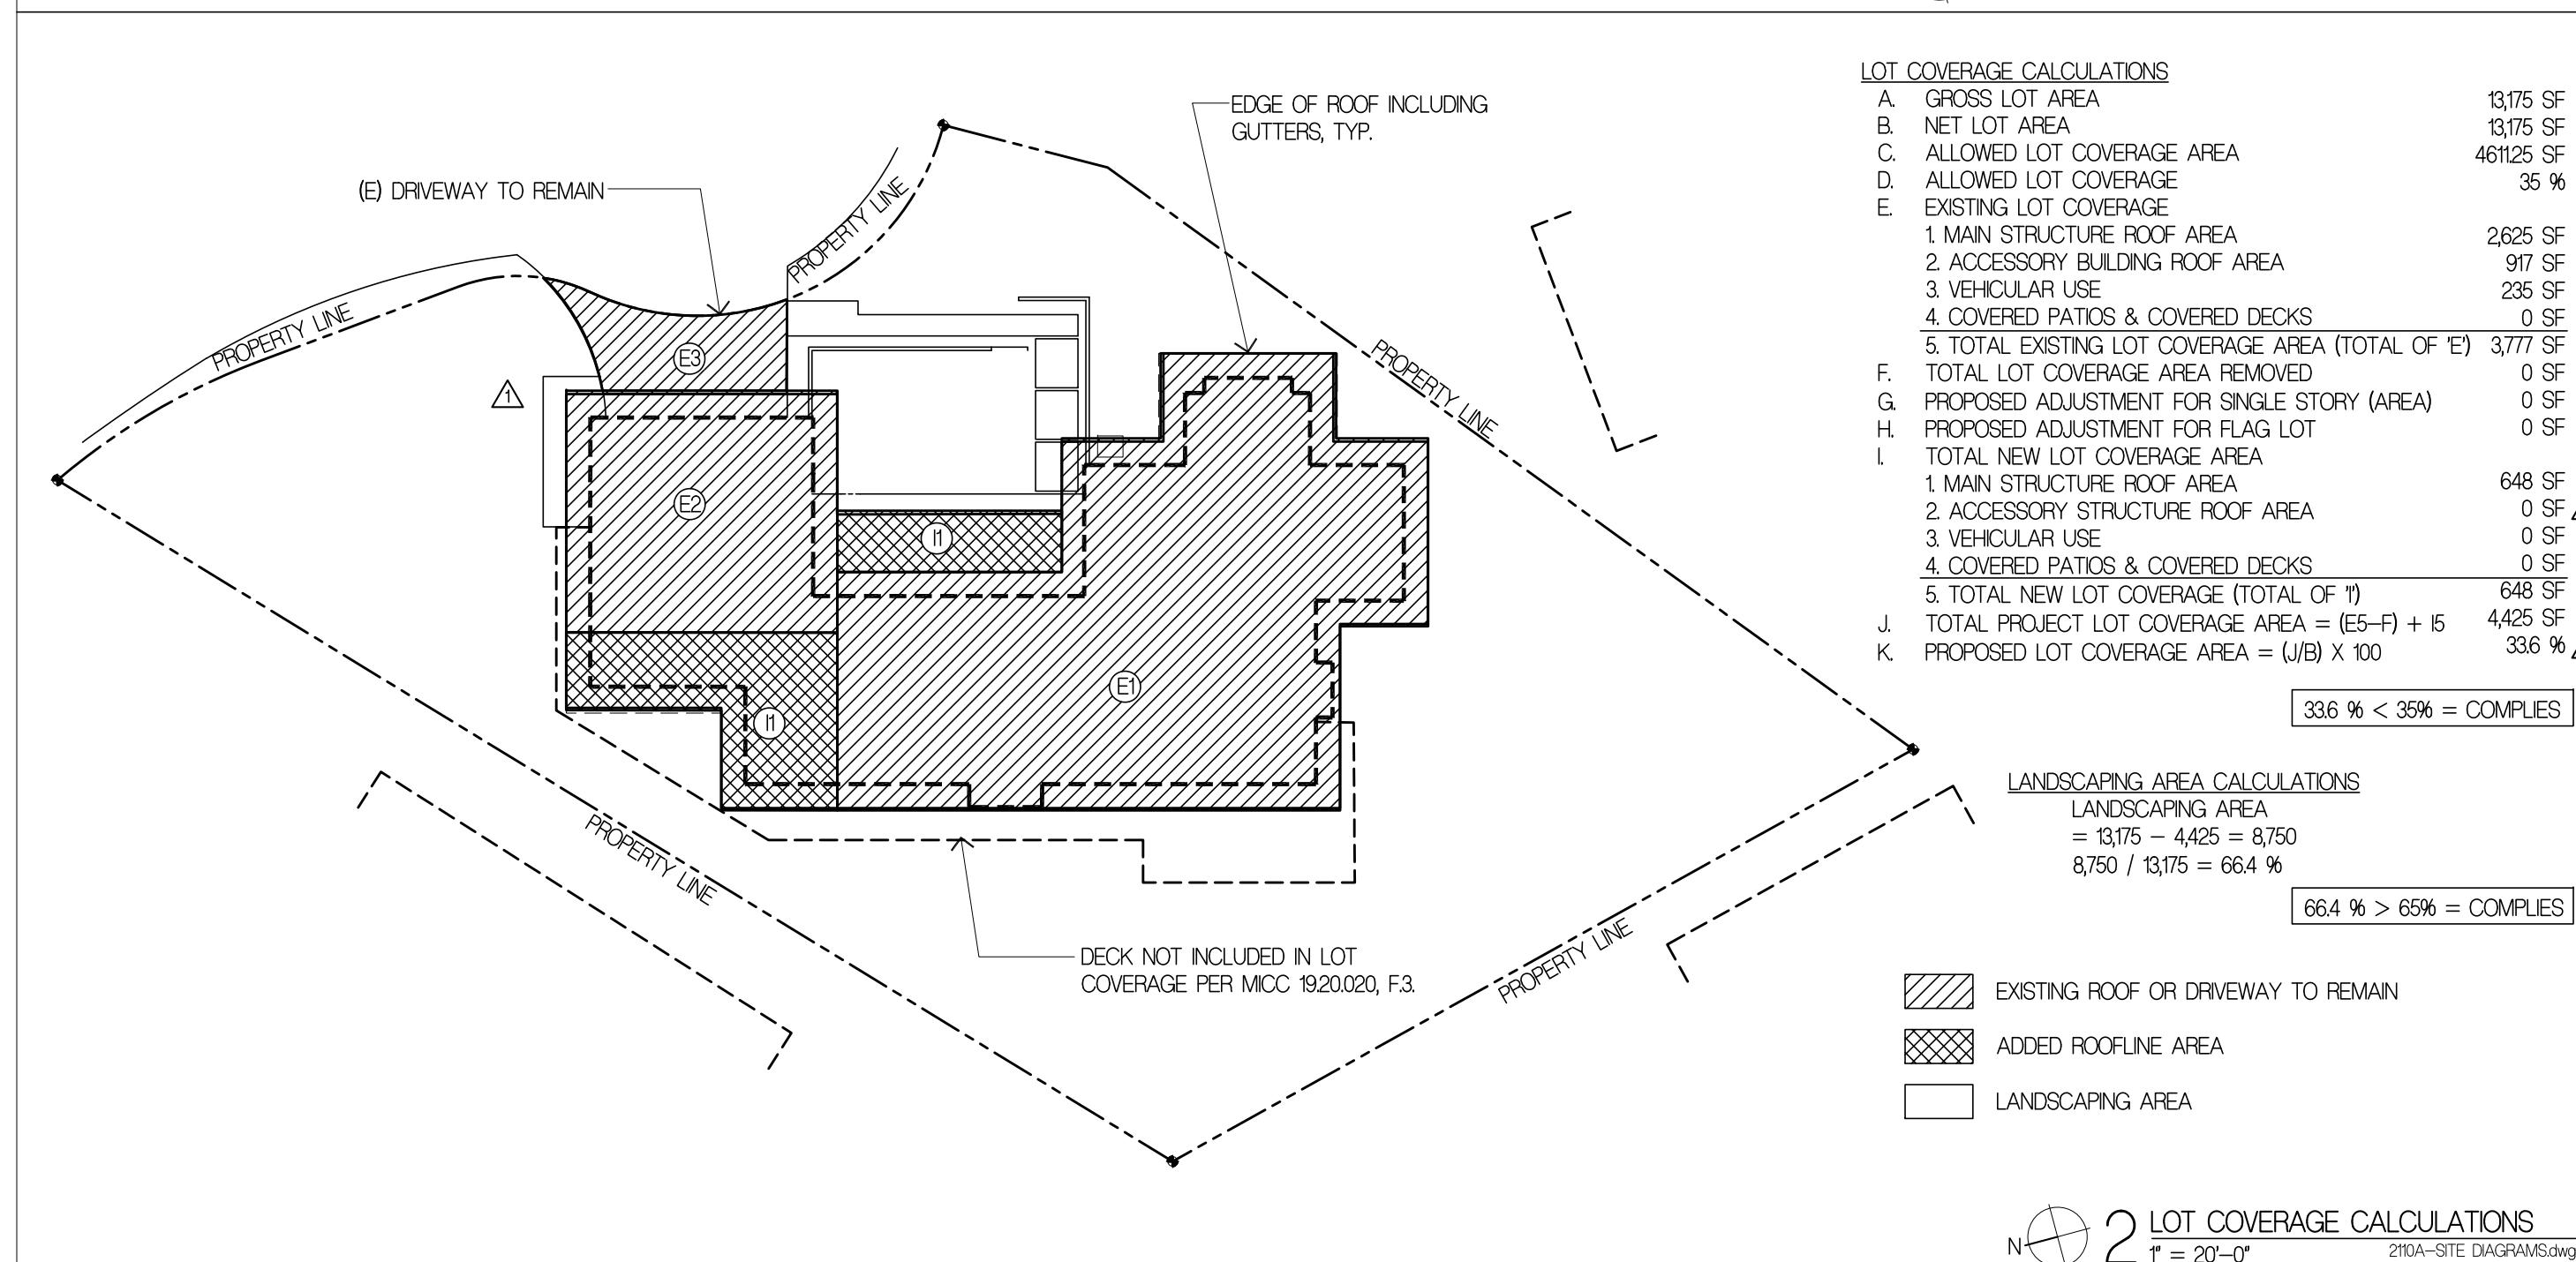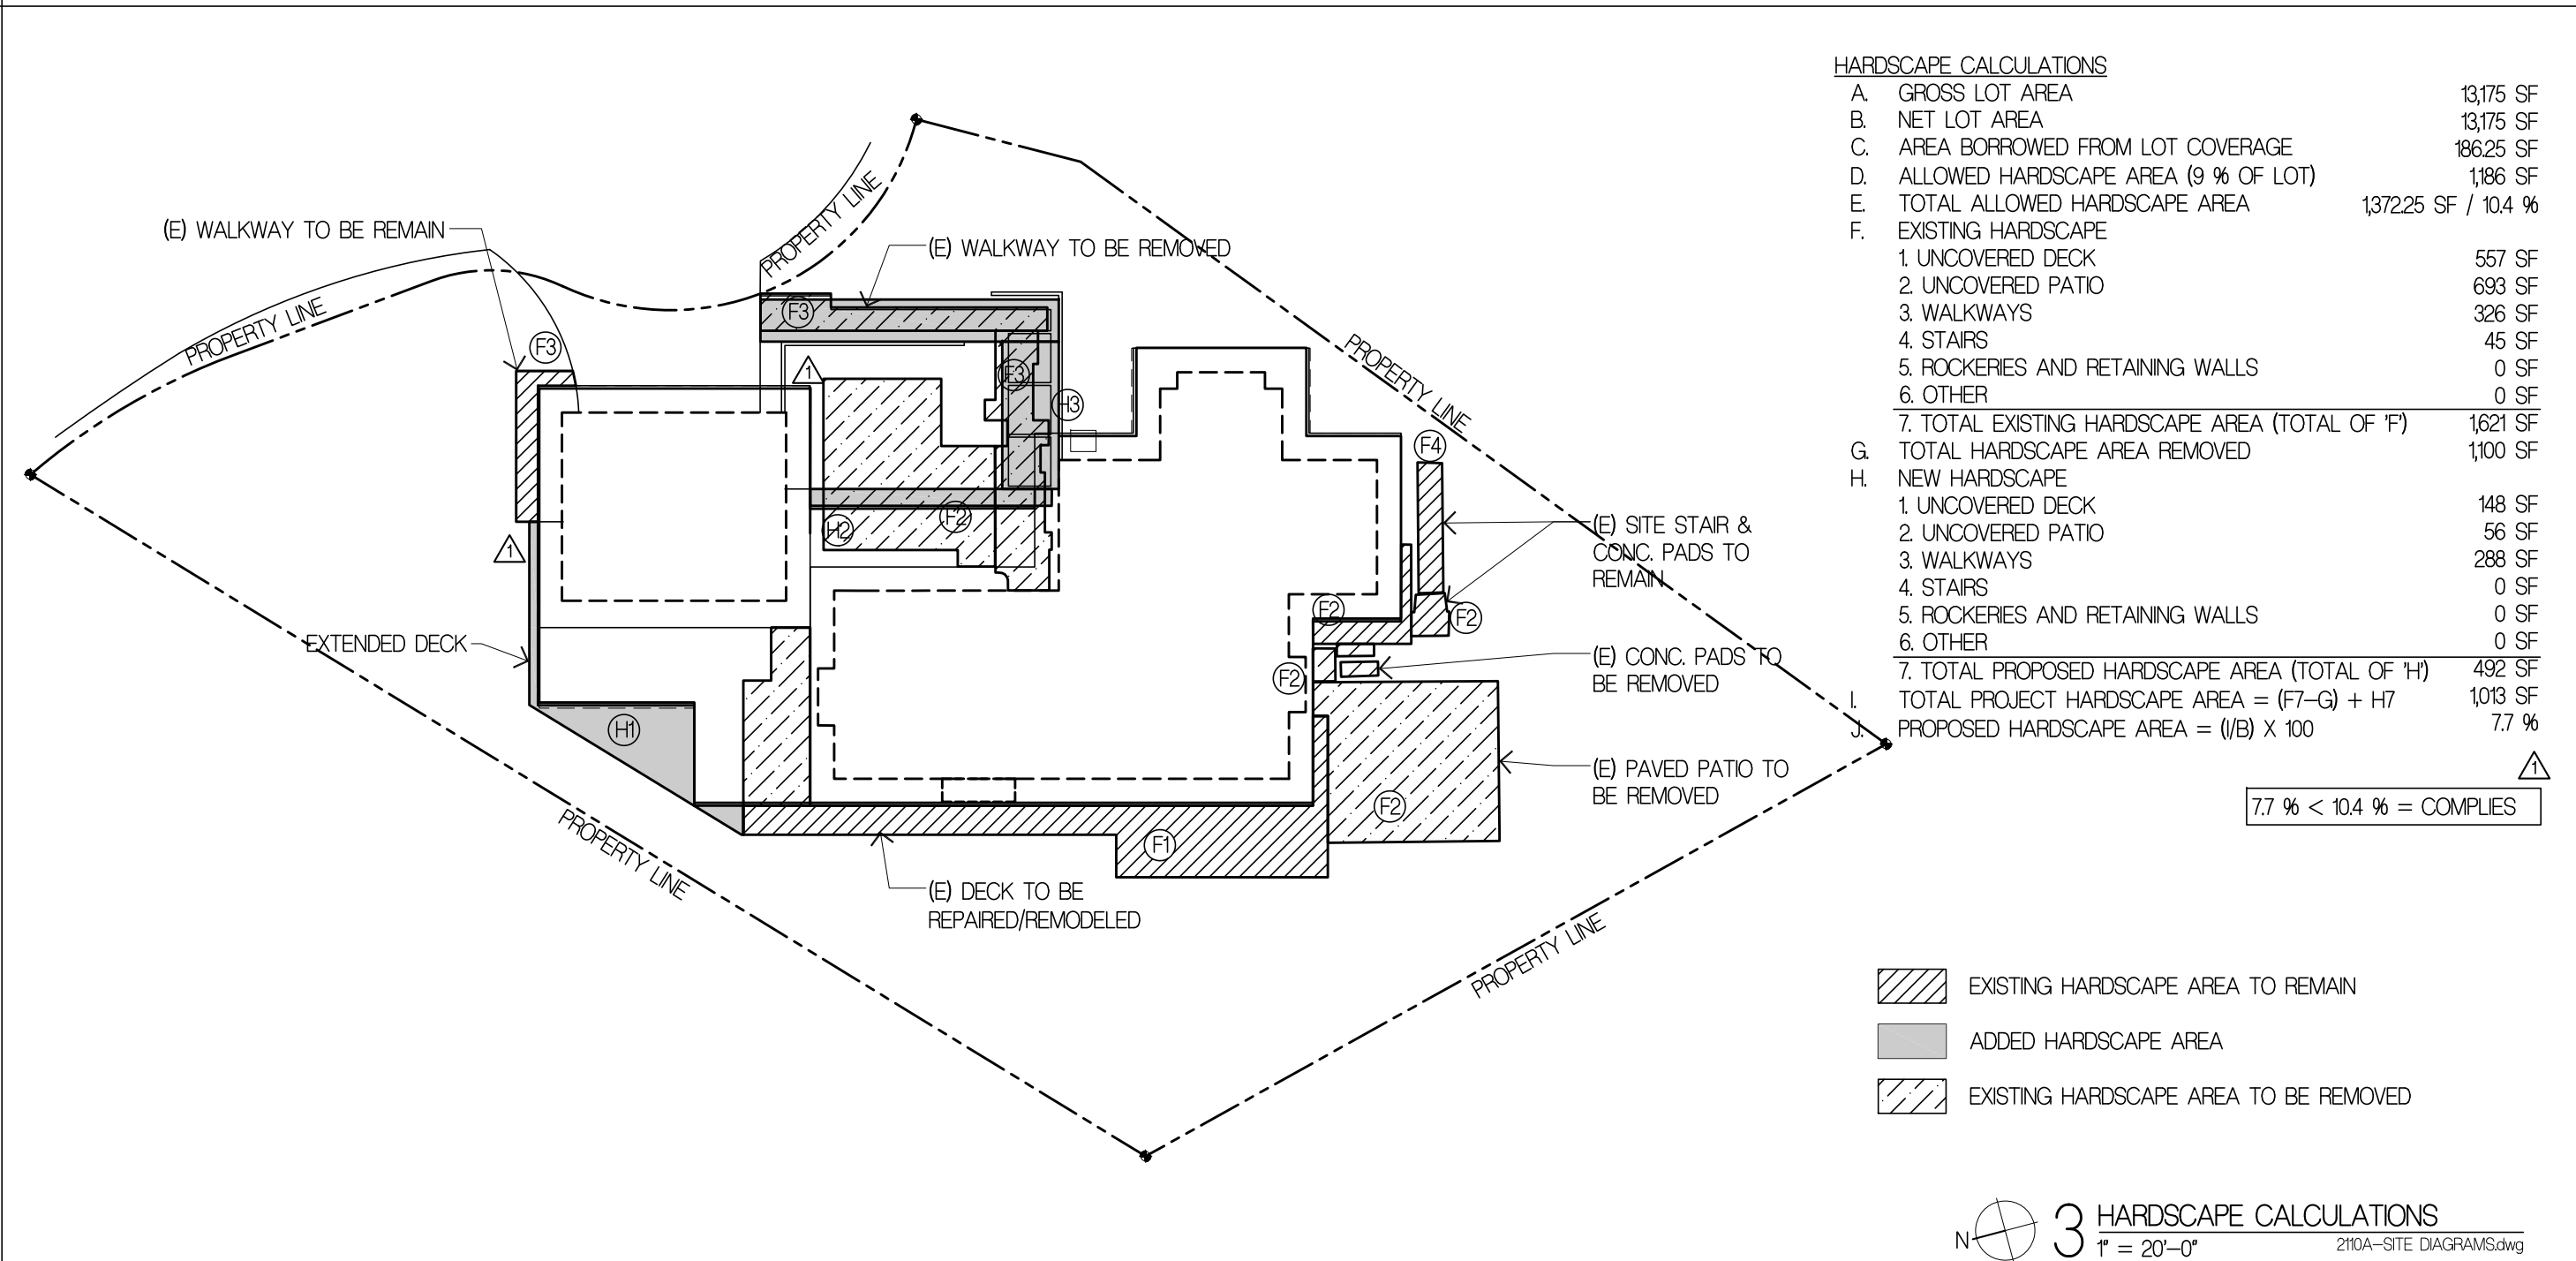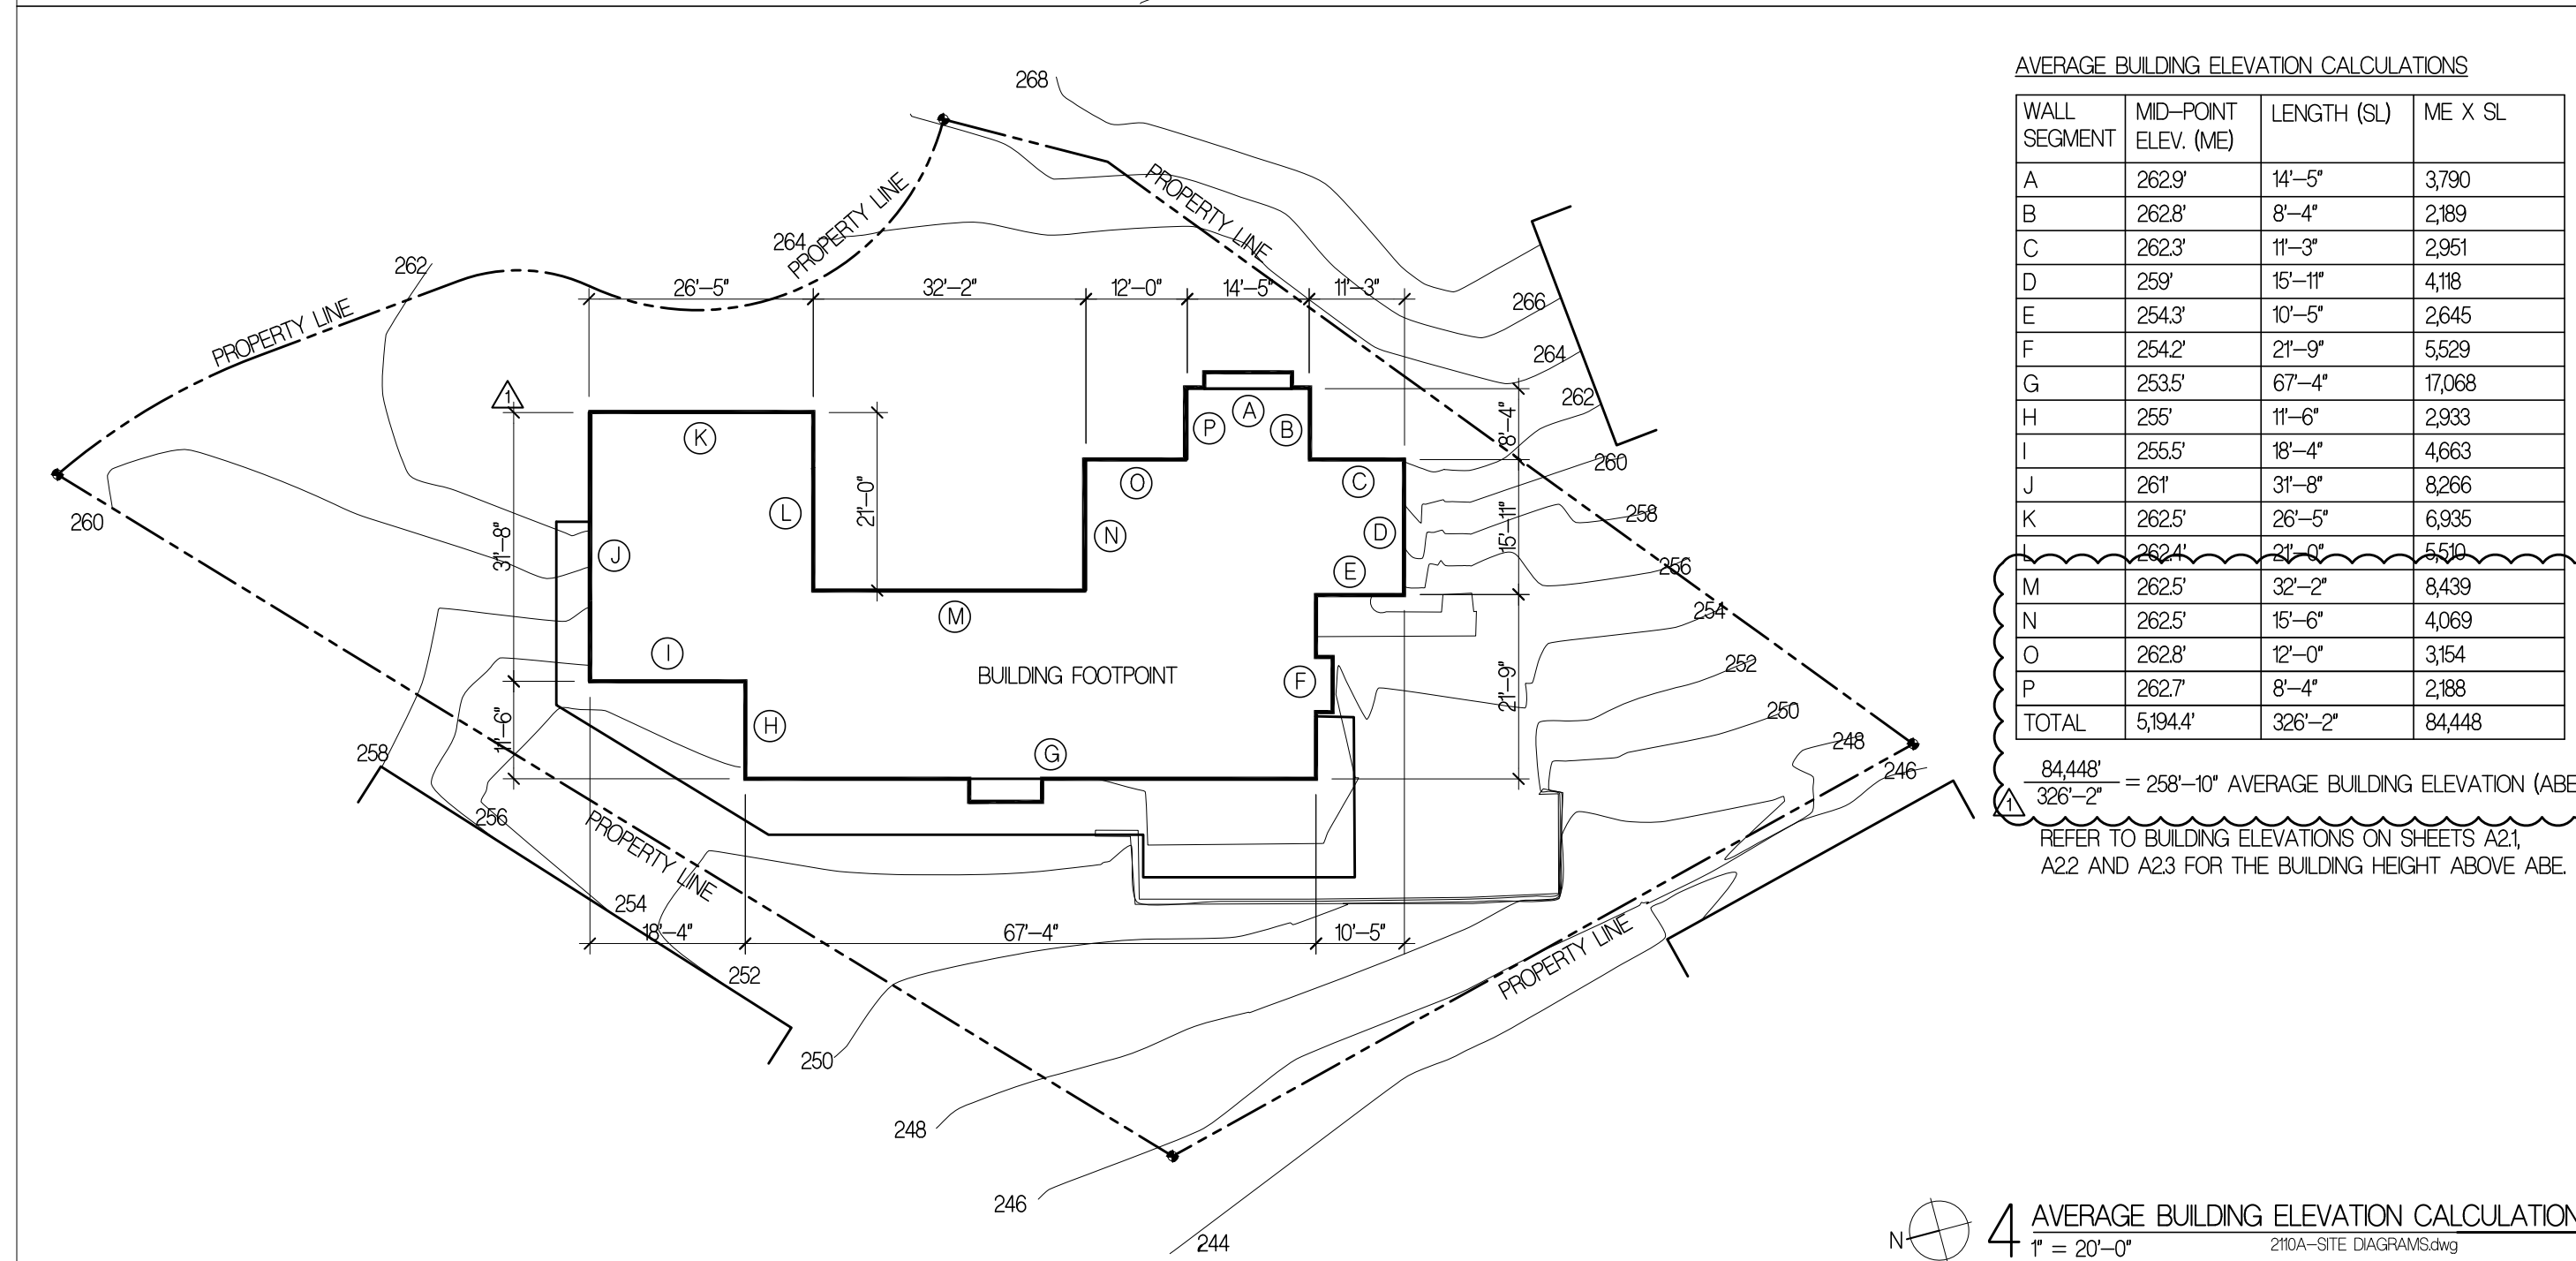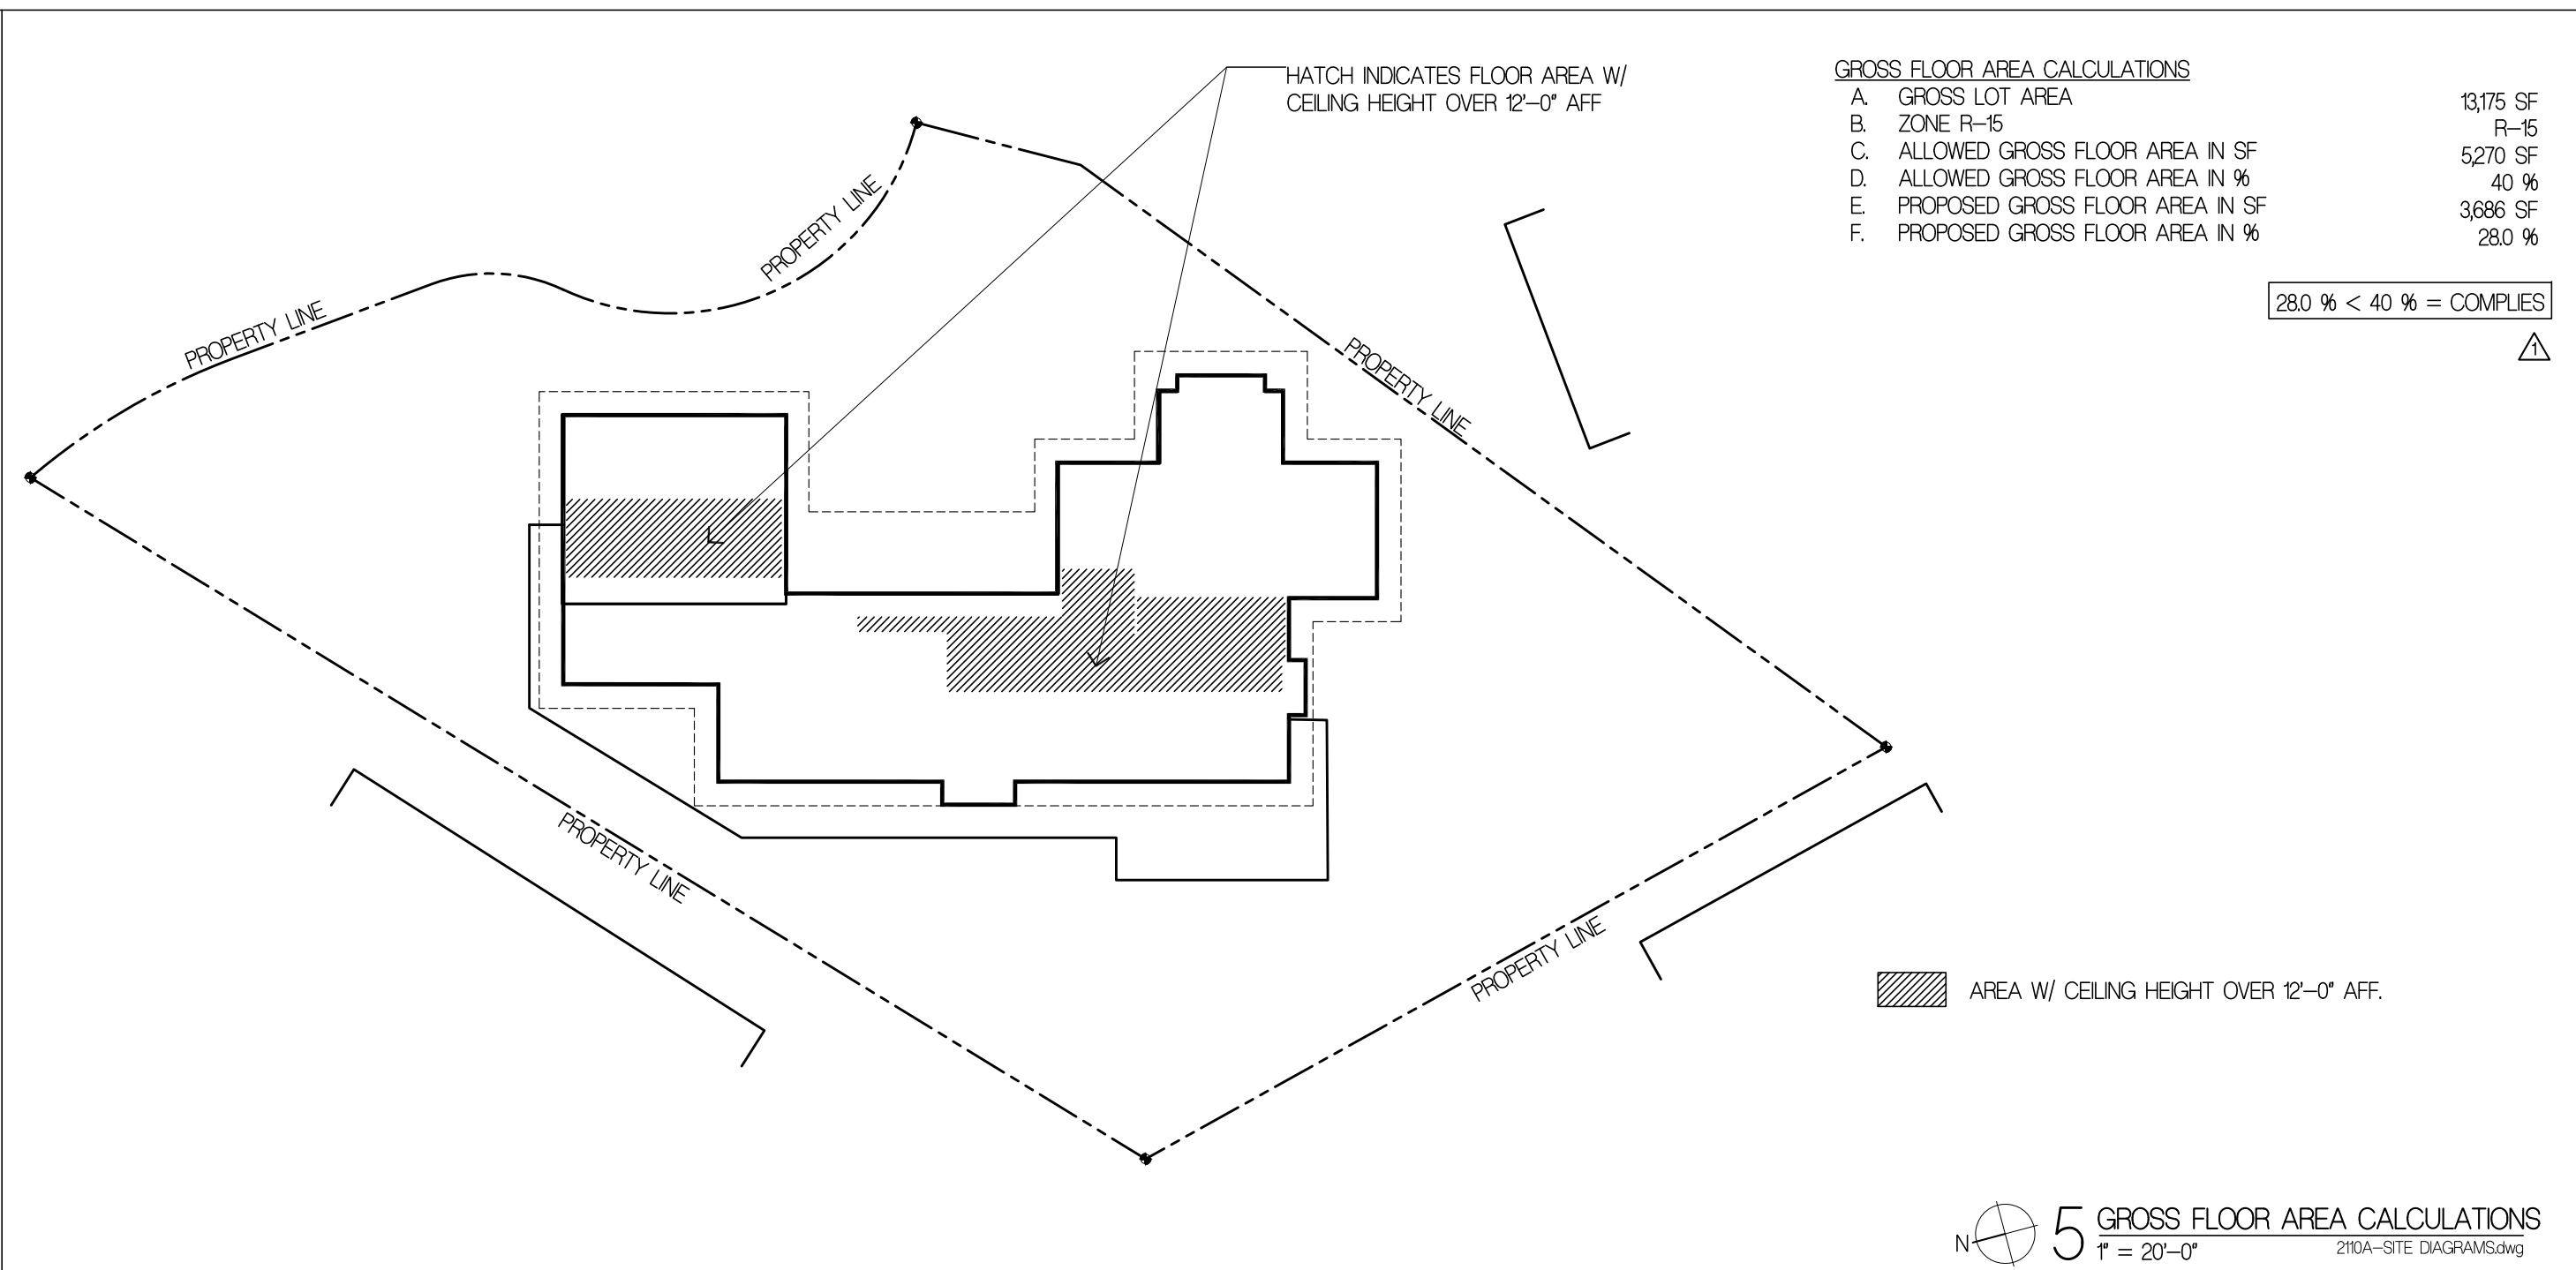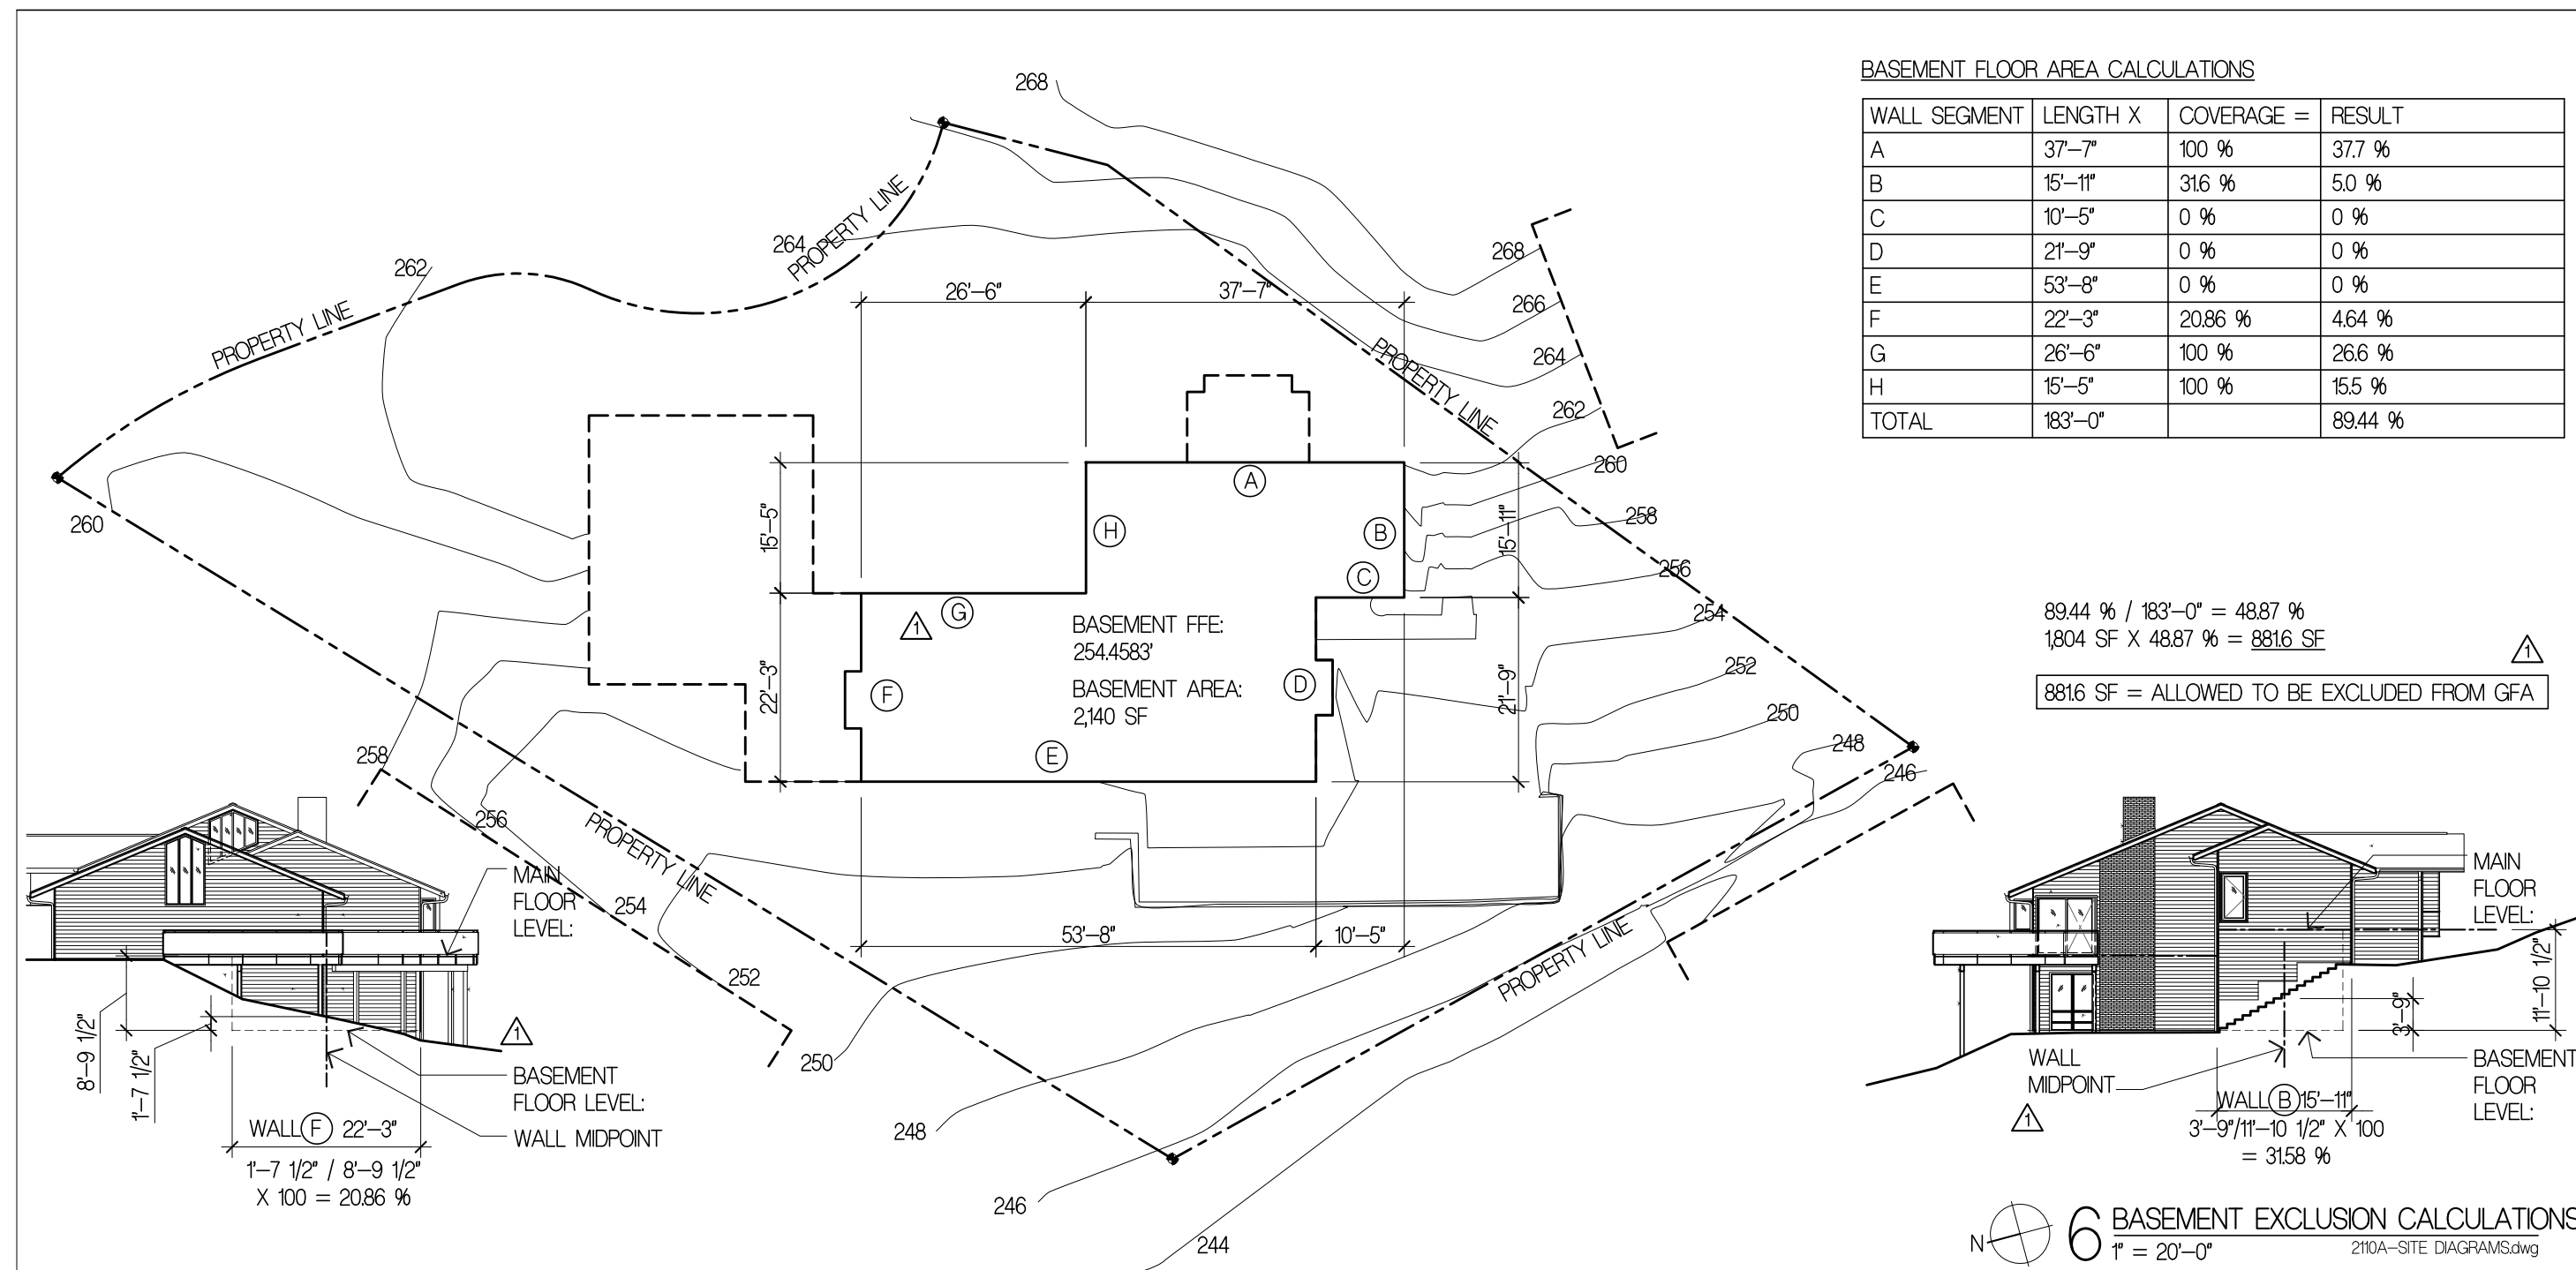

Suyama Peterson Deguchi
 8601 8th Avenue South Seattle, Washington 98108
 P 206.256.0809

Project Title
JAFFE RESIDENCE
 8455 SE 83RD STREET
 MERCER ISLAND, WA 98040

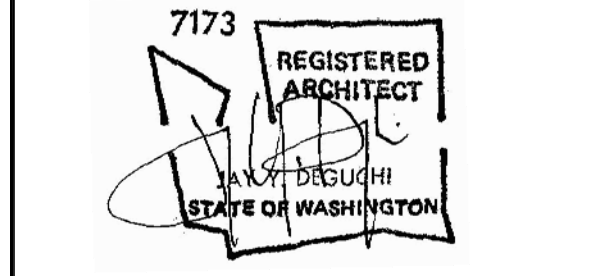


Drawing Title
SITE DIAGRAMS

Date
 08/08/2022
 Job No.
 2110

ISSUE DATE
 PERMIT CORRECTIONS #1 03/31/2023
 PERMIT CORRECTIONS #2 05/31/2023

PERMIT CORRECTIONS
 Sheet No.

TS-3

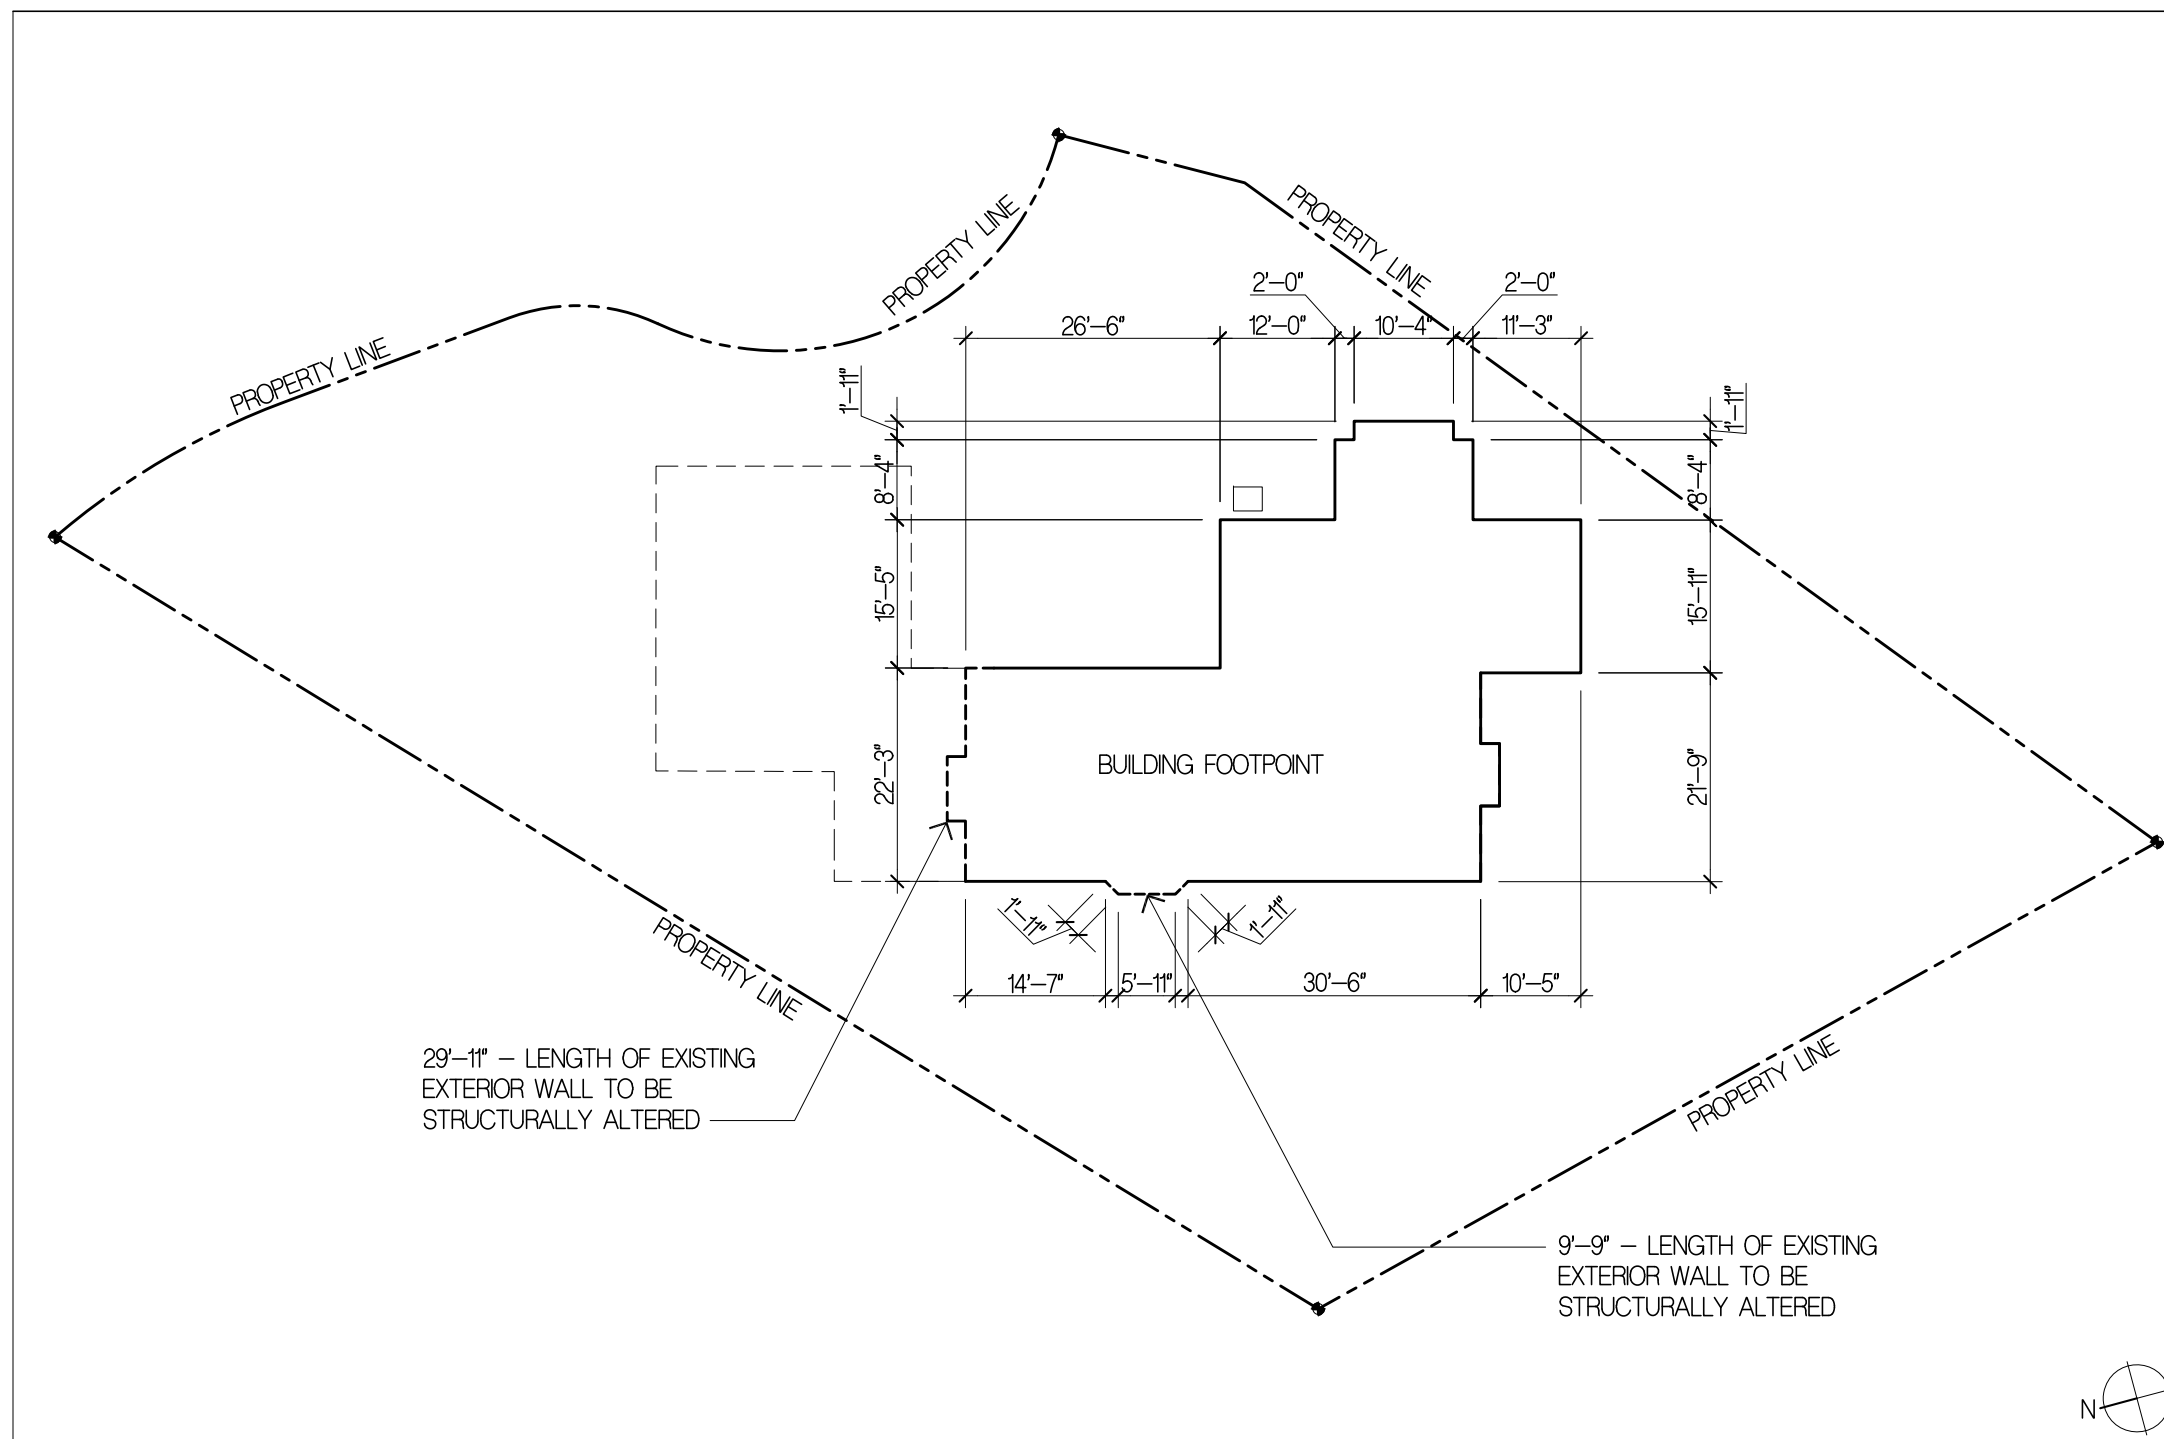


EXTERIOR ALTERATION WALL SEGMENT CALCULATION FOR NONCONFORMING STRUCTURE

CALCULATION FORMULA PER MCC 19.01.050 (D):
 $\% \text{ OF EXTERIOR WALL ALTERED} = (29'-11" + 9'-9") / 232'-10"$
 $= 37'-8" / 232'-10"$
 $= 0.16$

13 % < 40 % = COMPLES

6 EXTERIOR ALTERATION WALL CALCULATIONS
 T = 20'-0" 210A-SITE DIAGRAMS.dwg

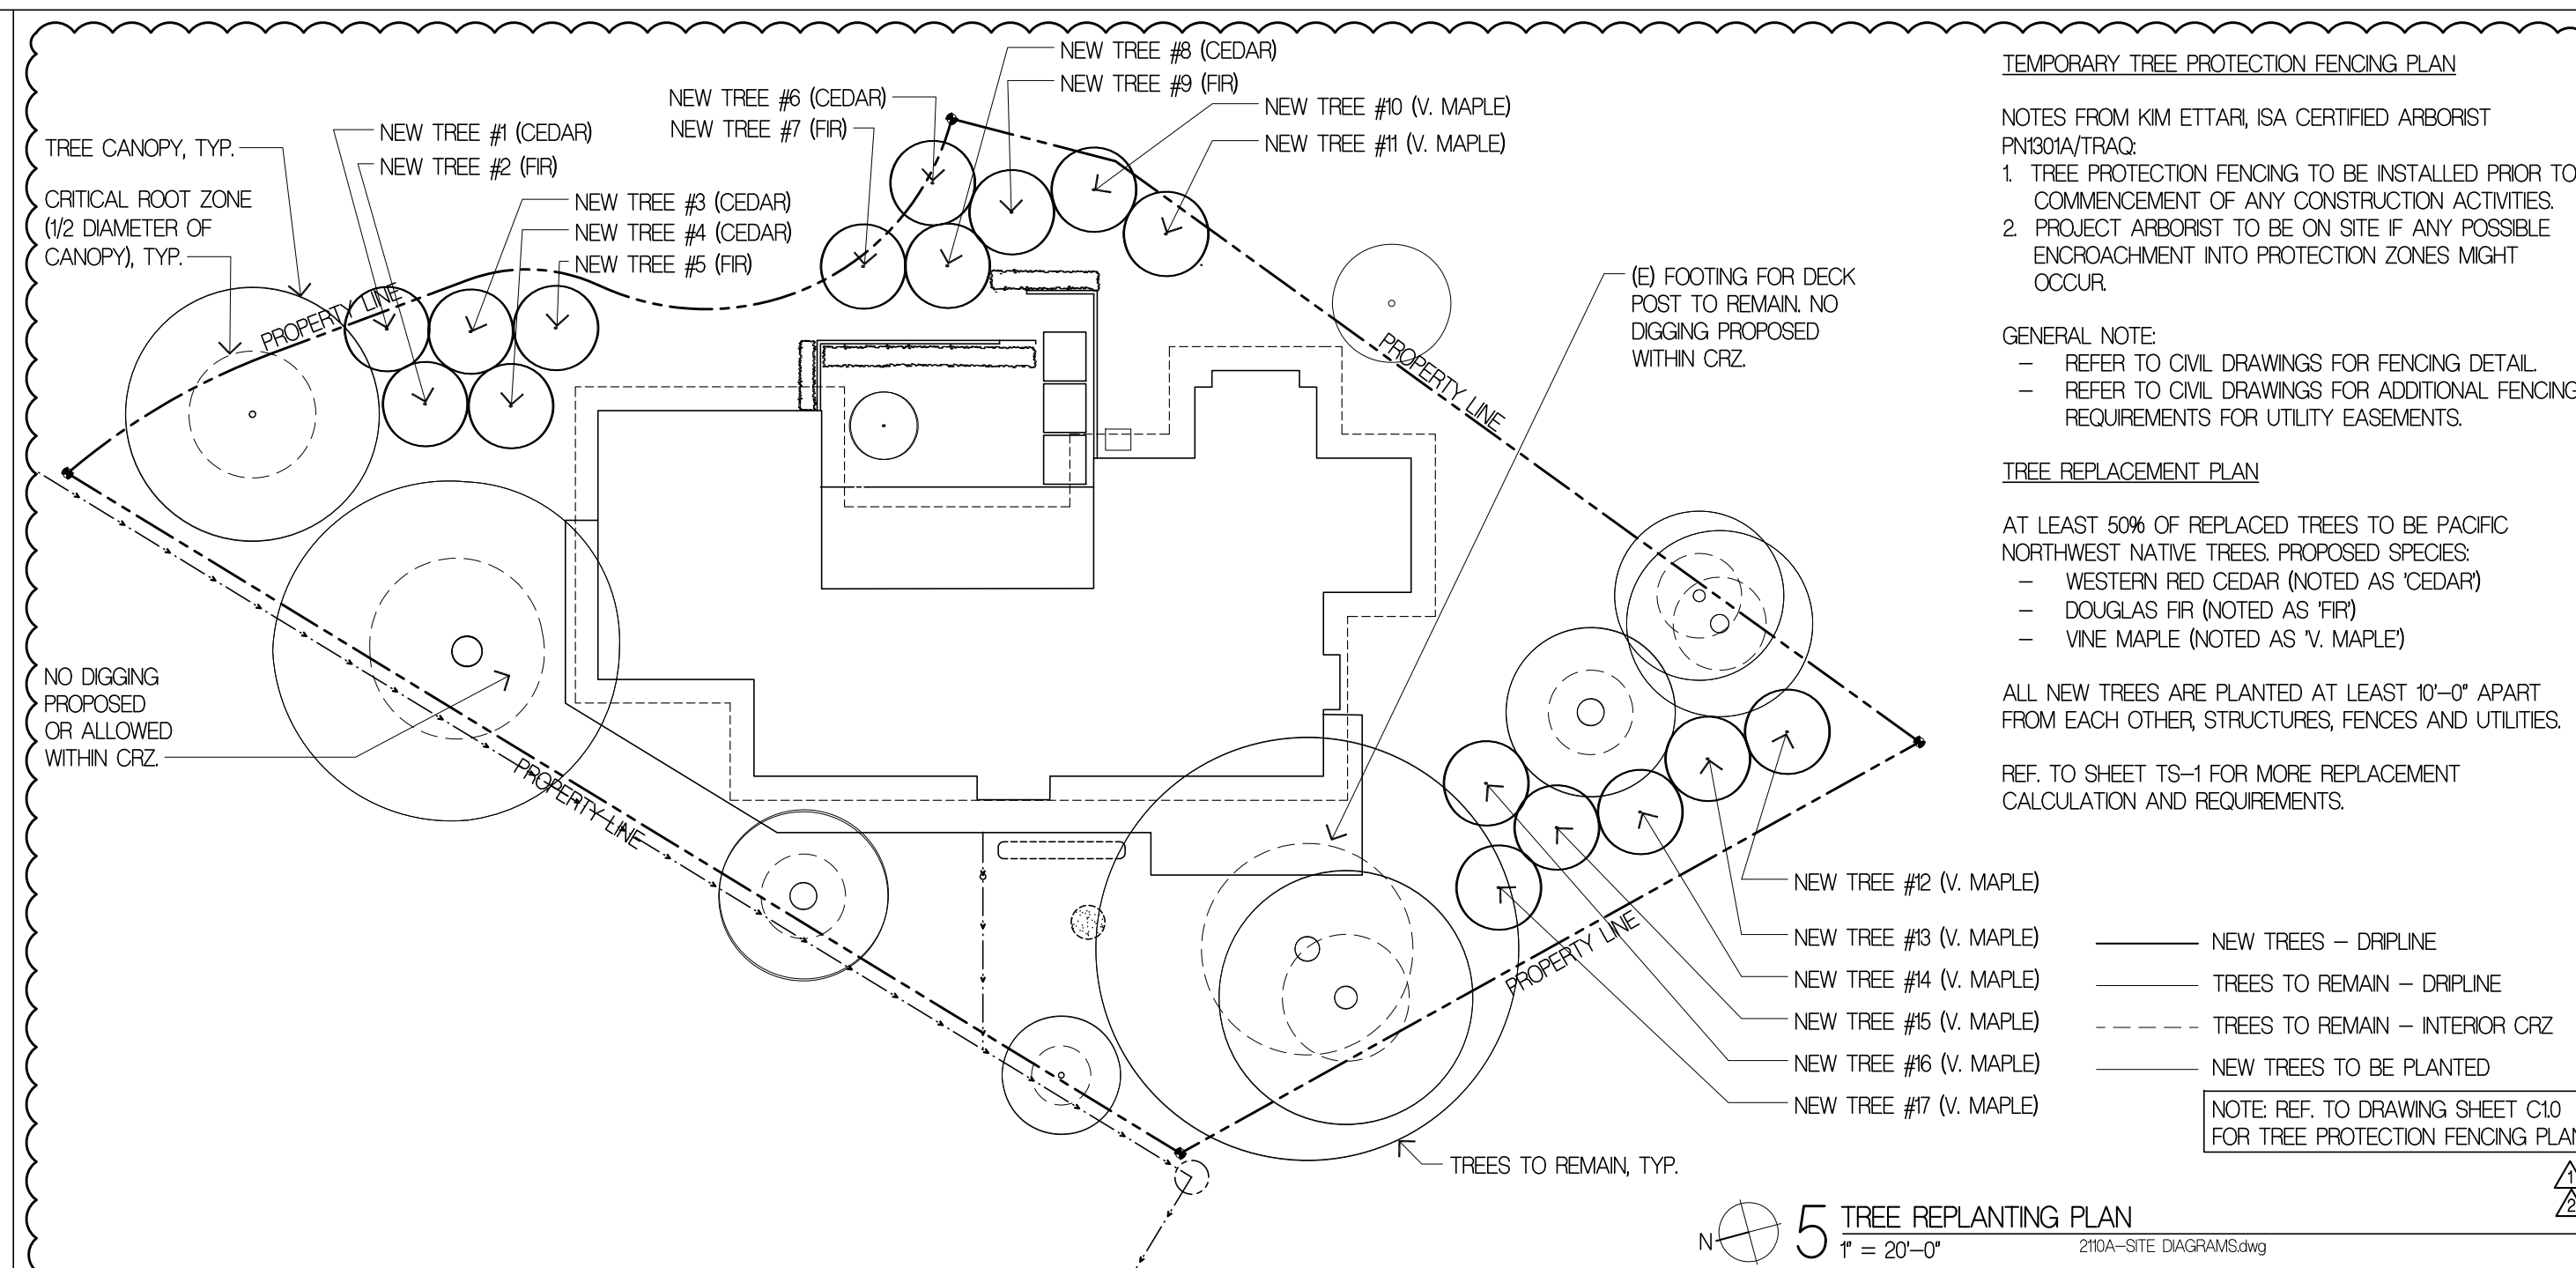

TEMPORARY TREE PROTECTION FENCING PLAN

NOTES FROM KIM ETTARI, ISA CERTIFIED ARBORIST
 PN801A/TRAQ.

1. TREE PROTECTION FENCING TO BE INSTALLED PRIOR TO COMMENCEMENT OF ANY CONSTRUCTION ACTIVITIES.
2. PROJECT ARBORIST TO BE ON SITE IF ANY POSSIBLE ENCROACHMENT INTO PROTECTION ZONES MIGHT OCCUR.

GENERAL NOTE:
 - REFER TO CIVIL DRAWINGS FOR FENCING DETAIL.
 - REFER TO CIVIL DRAWINGS FOR ADDITIONAL FENCING REQUIREMENTS FOR UTILITY EASEMENTS.

TREE REPLACEMENT PLAN

AT LEAST 50% OF REPLACED TREES TO BE PACIFIC NORTHWEST NATIVE TREES. PROPOSED SPECIES:
 - WESTERN RED CEDAR (NOTED AS CEDAR)
 - DOUGLAS FIR (NOTED AS FR)
 - VINE MAPLE (NOTED AS V. MAPLE)


ALL NEW TREES ARE PLANTED AT LEAST 10'-0" APART FROM EACH OTHER, STRUCTURES, FENCES AND UTILITIES.

REF. TO SHEET TS-1 FOR MORE REPLACEMENT CALCULATION AND REQUIREMENTS.

- NEW TREES - DRIPLINE
- TREES TO REMAIN - DRIPLINE
- TREES TO REMAIN - INTERIOR CRZ
- NEW TREES TO BE PLANTED

NOTE: REF. TO DRAWING SHEET C10 FOR TREE PROTECTION FENCING PLAN

5 TREE REPLANTING PLAN
 T = 20'-0" 210A-SITE DIAGRAMS.dwg

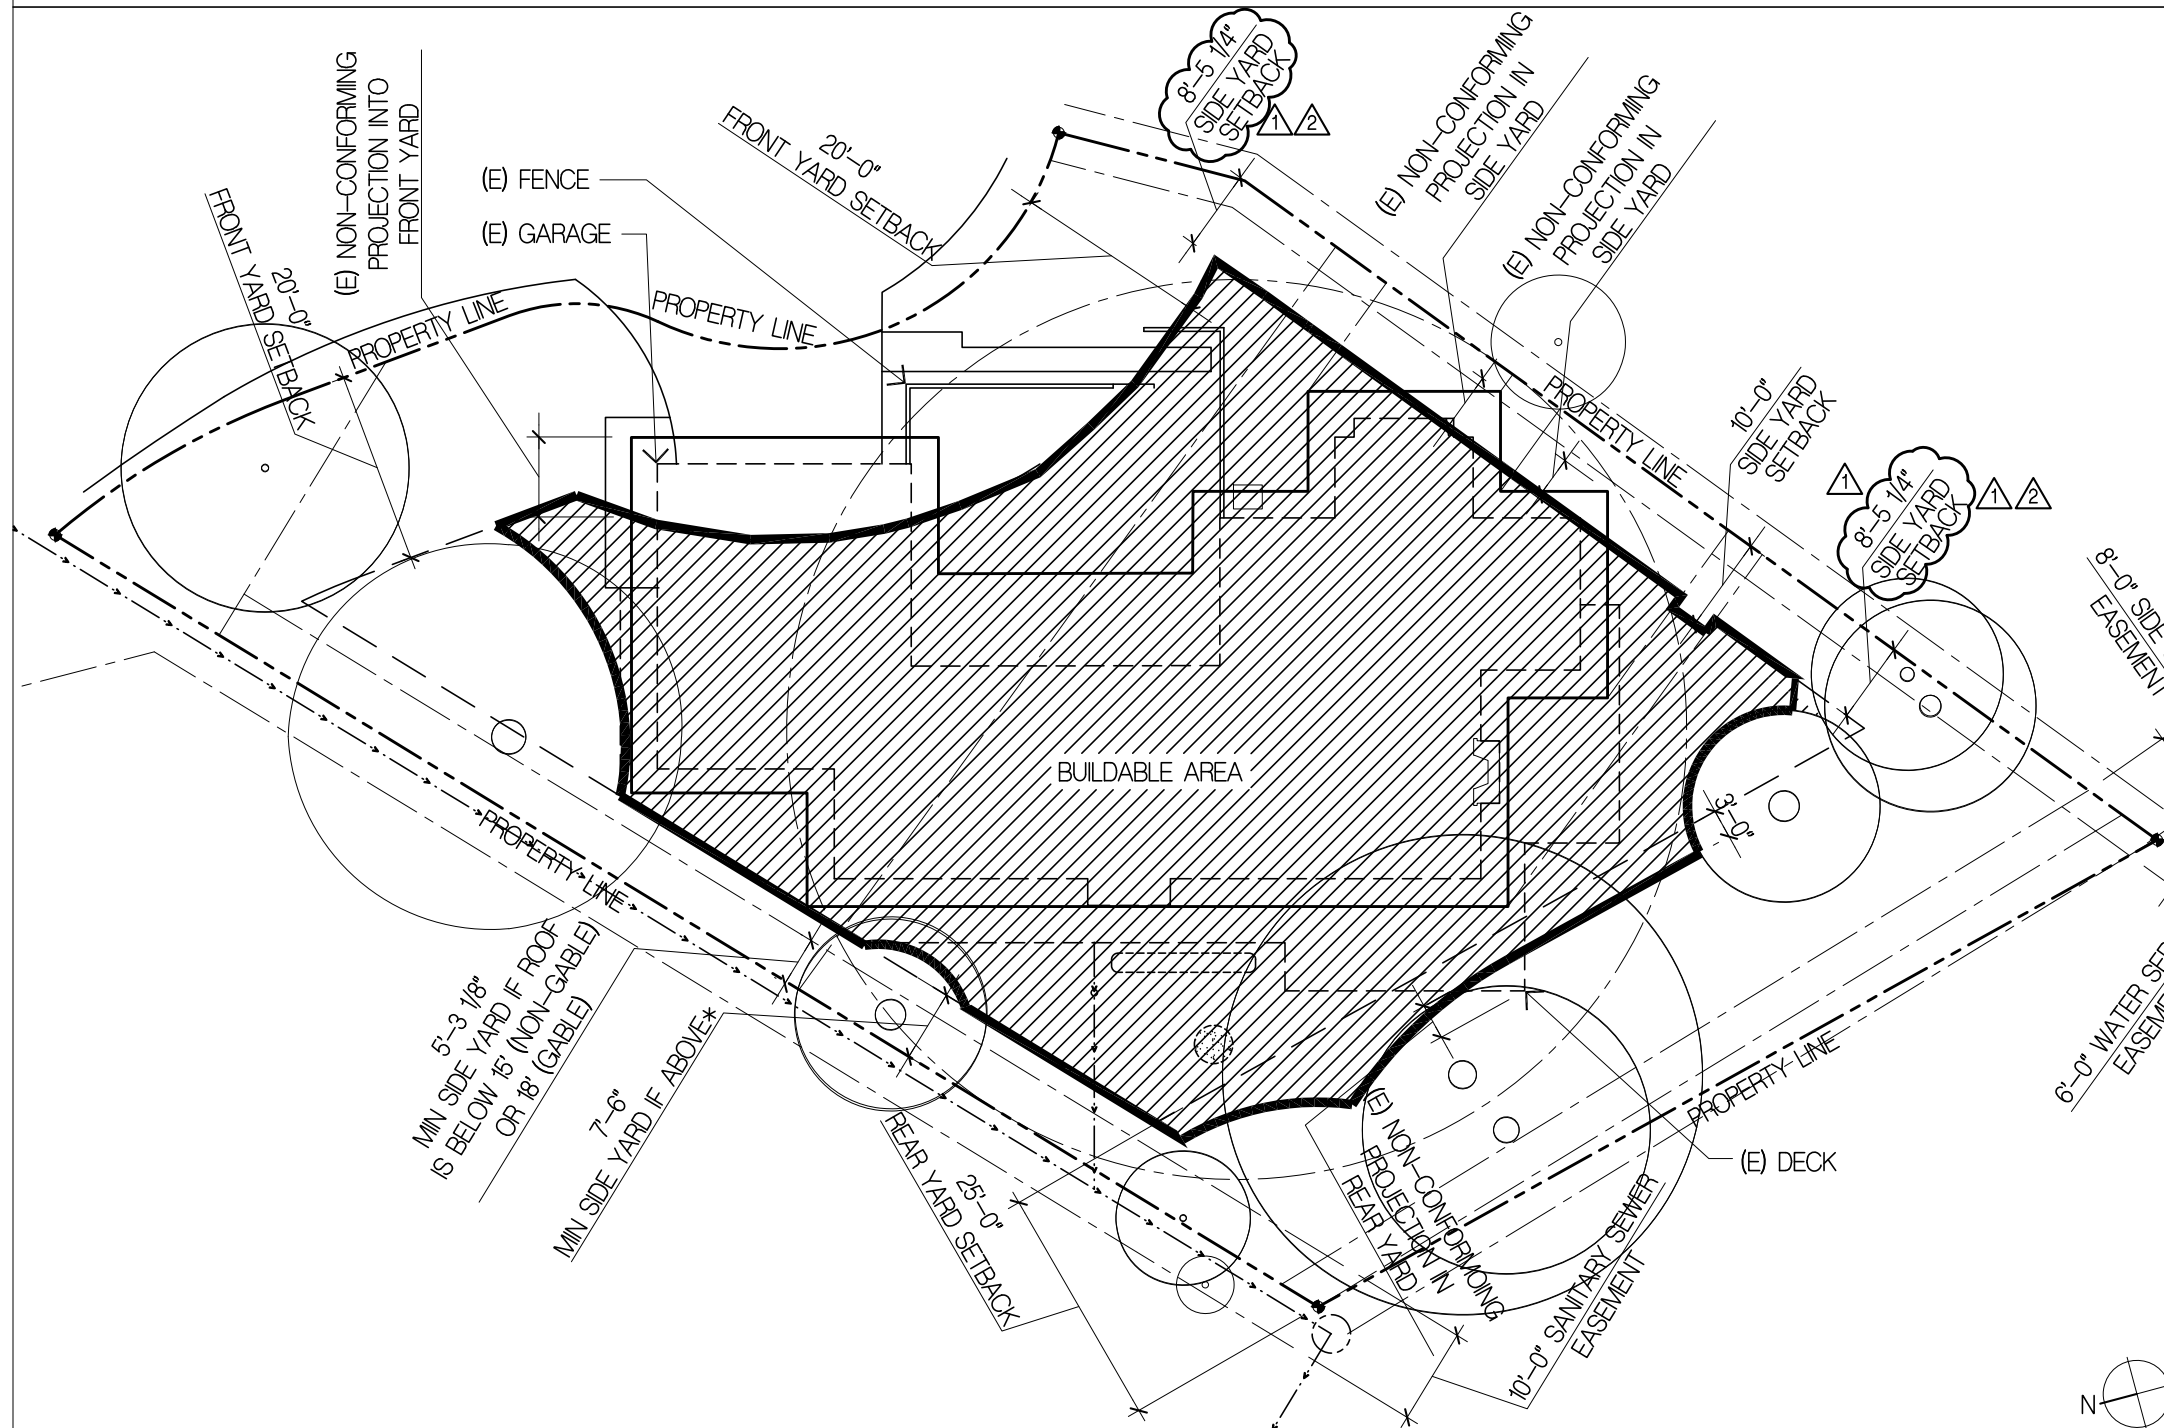

PROPERTY LINE SETBACKS

FRONT YARD = 20'-0"
 REAR YARD = 25'-0"
 SIDE YARD SETBACKS:
 1. MIN REQUIRED SIDE YARD:
 LARGEST DIA. CIRCLE FIT BETWEEN PROP LINES
 $= 93'-9" \times 17 = 15'-11 \frac{1}{4}"$
 MIN. SIDE YARD (FOR BOTH SIDES)
 $= 15'-11 \frac{1}{4}" \times 33 = 5'-3 \frac{1}{8}"$


AND

2. IF GABLED ROOF > 18'; SIDE YARD = 75'
 IF NON-GABLE ROOF > 6'; SIDE YARD = 75'

PROPOSED SIDE YARD SETBACKS:
 AT NORTH-WEST PROPERTY LINE: 7'-6"
 AT SOUTH-EAST PROPERTY LINE: 15'-11 1/4" - 7'-6" = 8'-5 1/4"

YARD LIMITATIONS PROJECTIONS (MINOR ELEMENTS) INTO REAR YARD = NO MORE THAN 3'-0"
 FRONT YARD - GARAGES ARE NOT ALLOWED IN REAR YARD UNLESS THE ENTRANCE TO THE GARAGE IS 4' LOWER THAN THE GRADE ELEVATION OF THE DRIVEWAY AT THE FRONT PROPERTY LINE.

4 BUILDABLE AREA DIAGRAM
 T = 20'-0" 210A-SITE DIAGRAMS.dwg

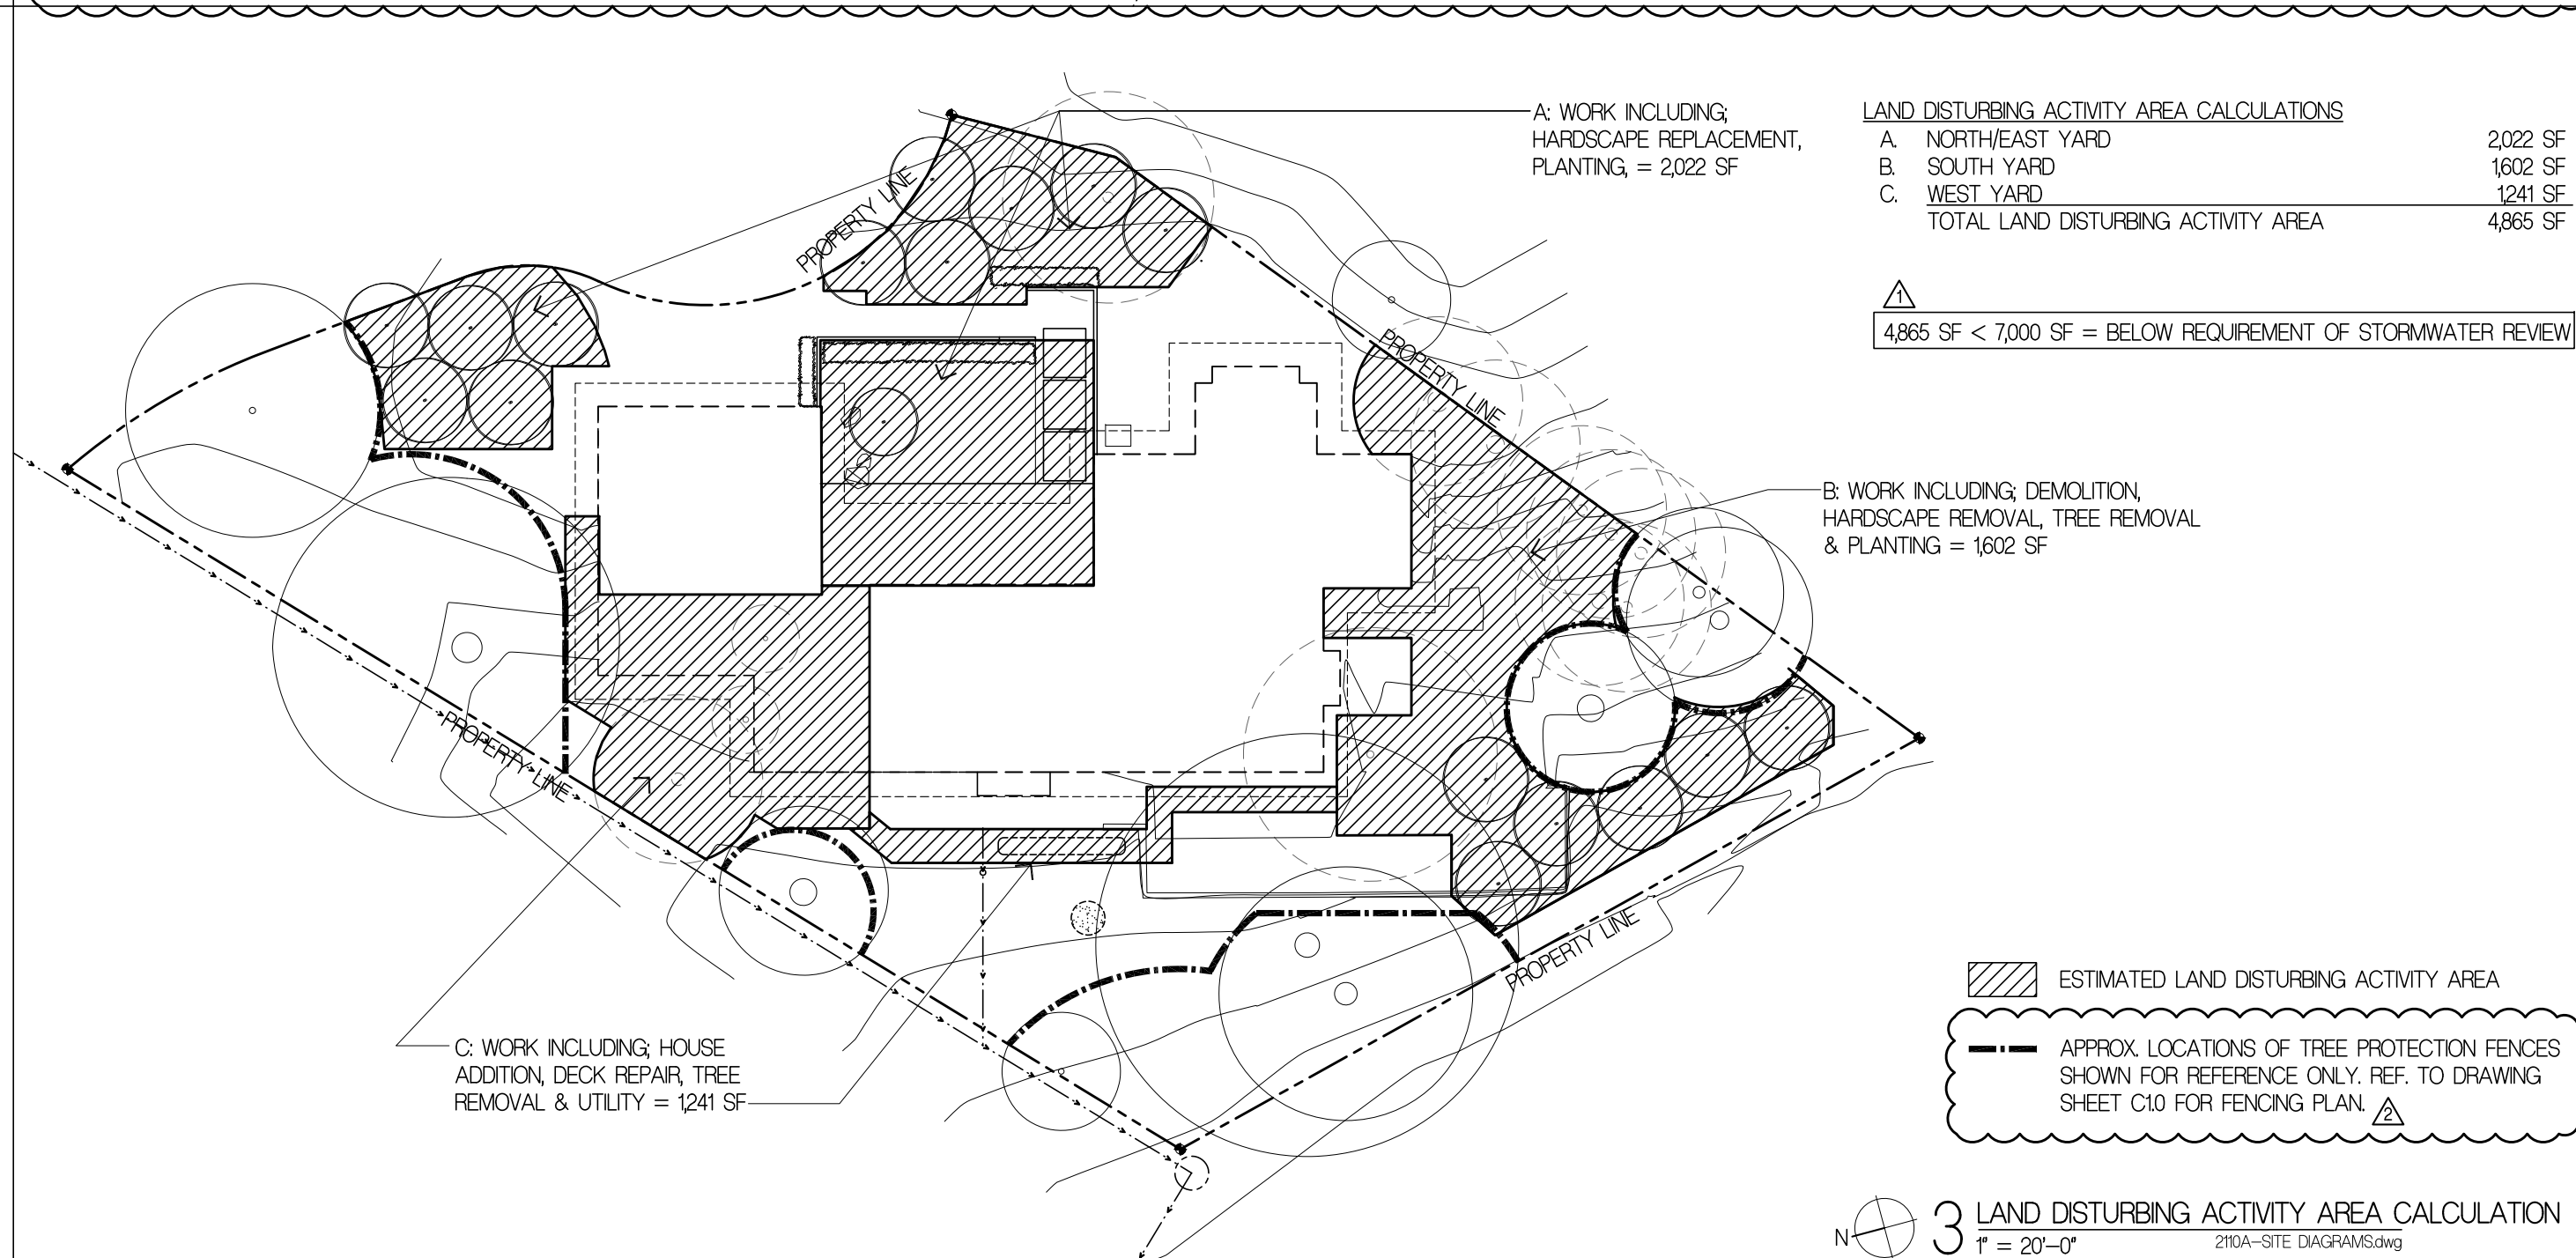

LAND DISTURBING ACTIVITY AREA CALCULATIONS


A. NORTH-EAST YARD	2022 SF
B. SOUTH YARD	1602 SF
C. WEST YARD	1241 SF
TOTAL LAND DISTURBING ACTIVITY AREA	4865 SF

4865 SF < 7000 SF = BELOW REQUIREMENT OF STORMWATER REVIEW

ESTIMATED LAND DISTURBING ACTIVITY AREA

APPROX. LOCATIONS OF TREE PROTECTION FENCES SHOWN FOR REFERENCE ONLY. REF. TO DRAWING SHEET C10 FOR FENCING PLAN.

3 LAND DISTURBING ACTIVITY AREA CALCULATION
 T = 20'-0" 210A-SITE DIAGRAMS.dwg

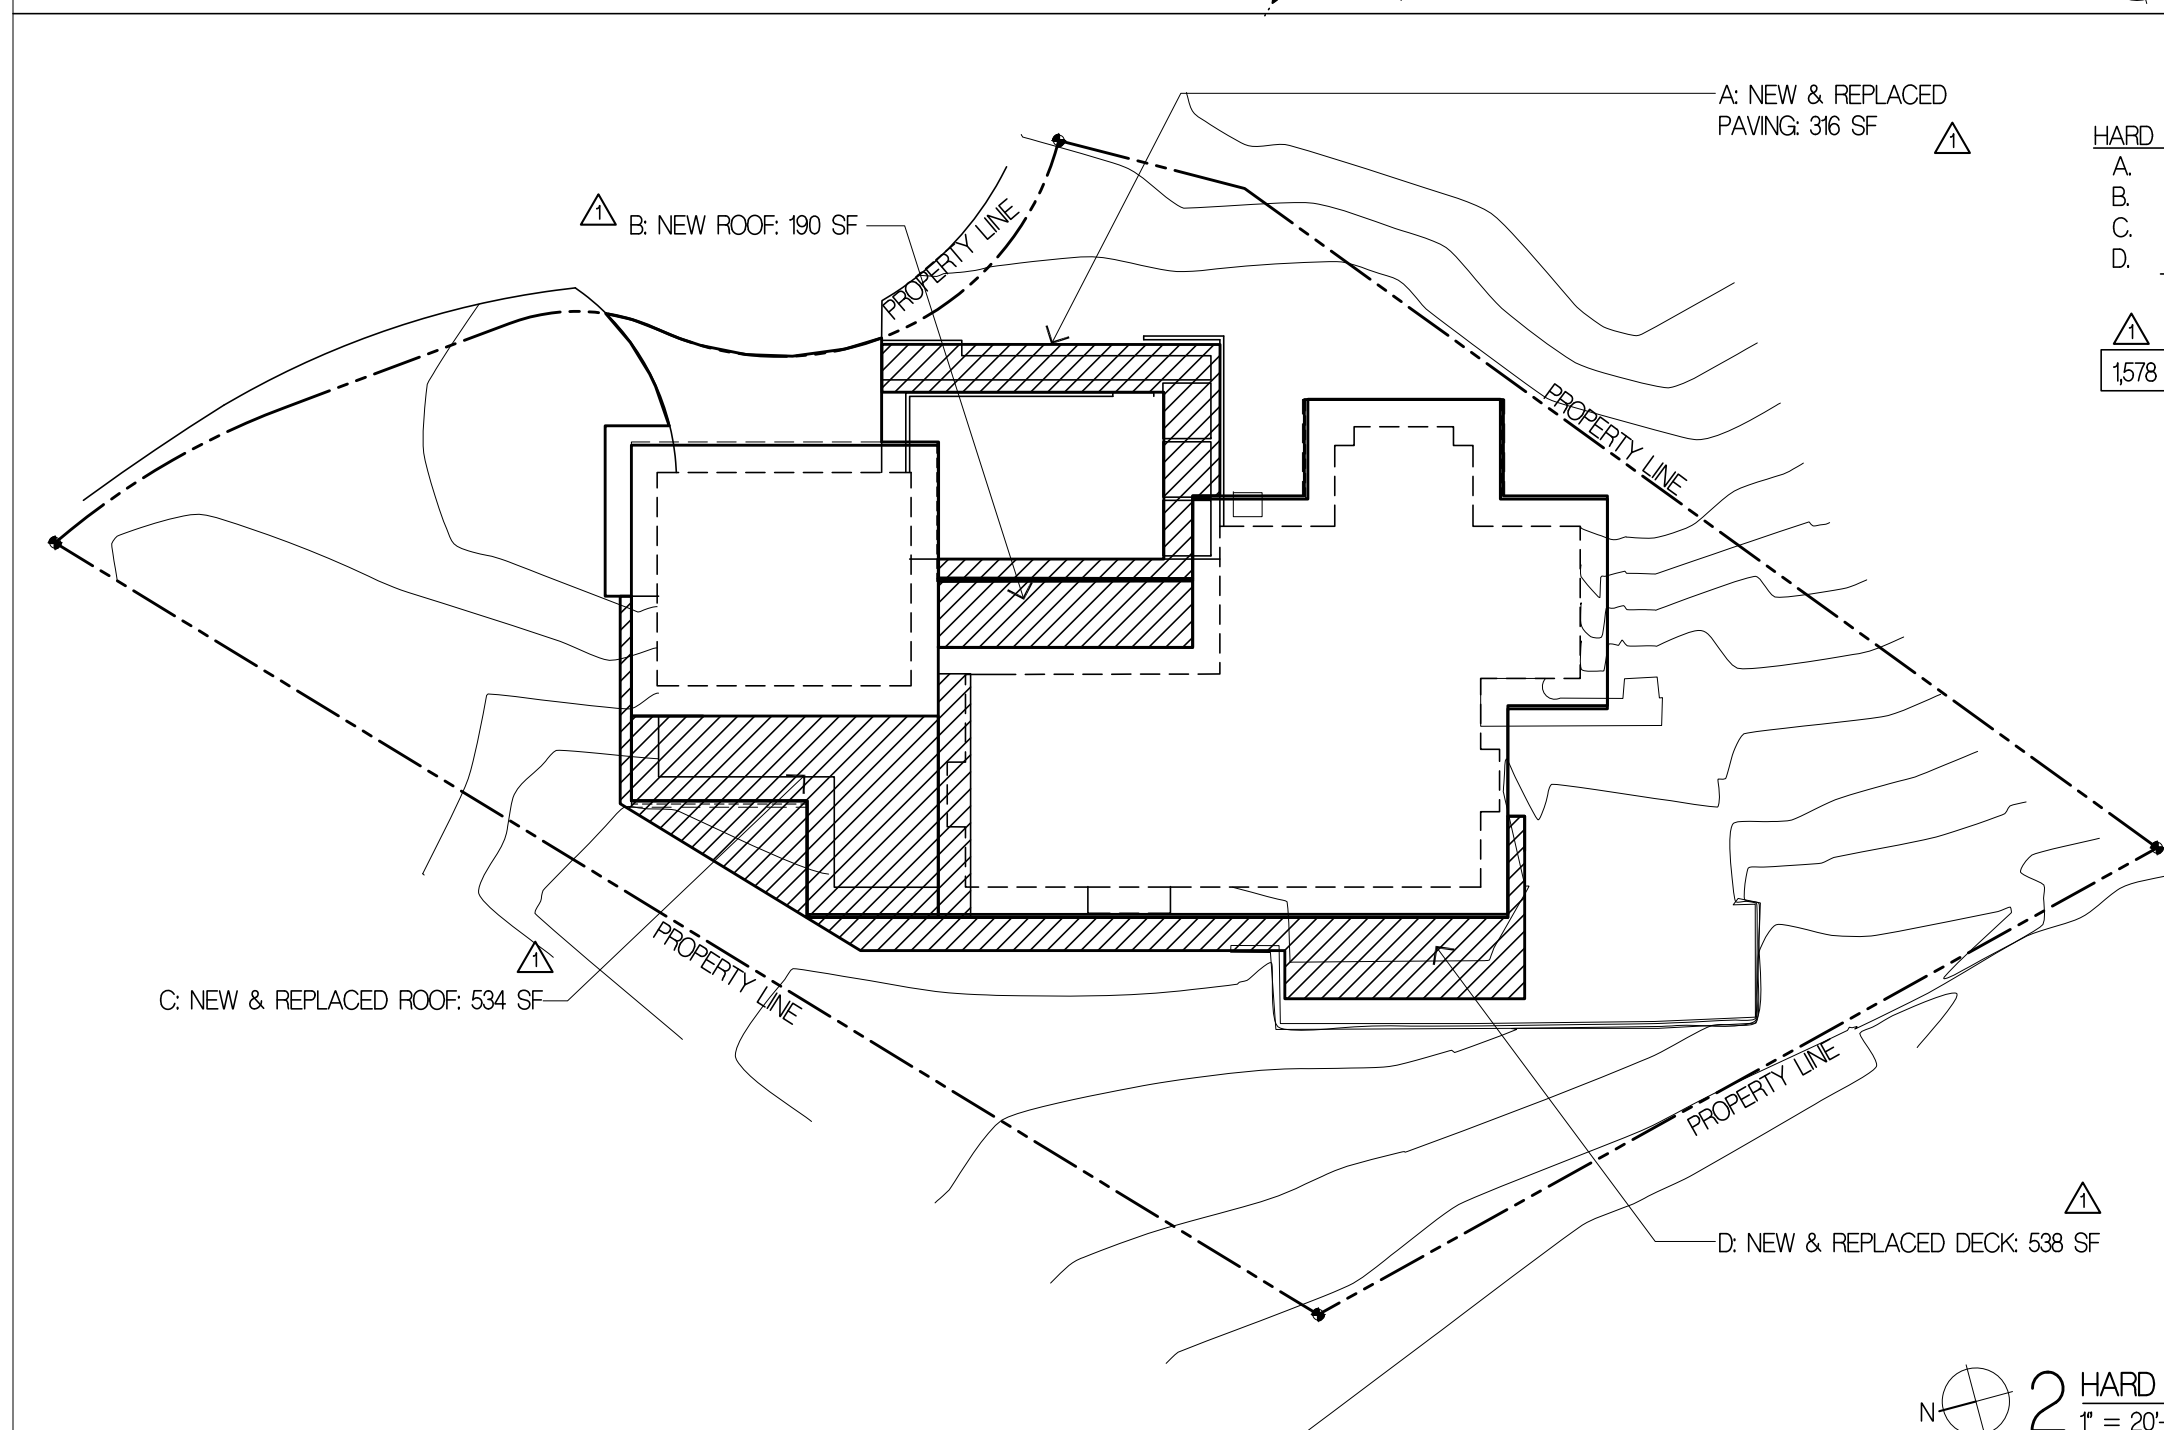


HARD SURFACE CALCULATIONS

A. FRONT YARD	316 SF
B. ROOF - NEW	190 SF
C. ROOF - NEW & REPLACED	534 SF
D. DECK - NEW & REPLACED	538 SF
TOTAL NEW & REPLACED HARD SURFACE	1578 SF

1578 SF < 2000 SF = BELOW REQUIREMENT FOR STORMWATER REVIEW

NEW & REPLACED HARD SURFACE

2 HARD SURFACE CALCULATION
 T = 20'-0" 210A-SITE DIAGRAMS.dwg

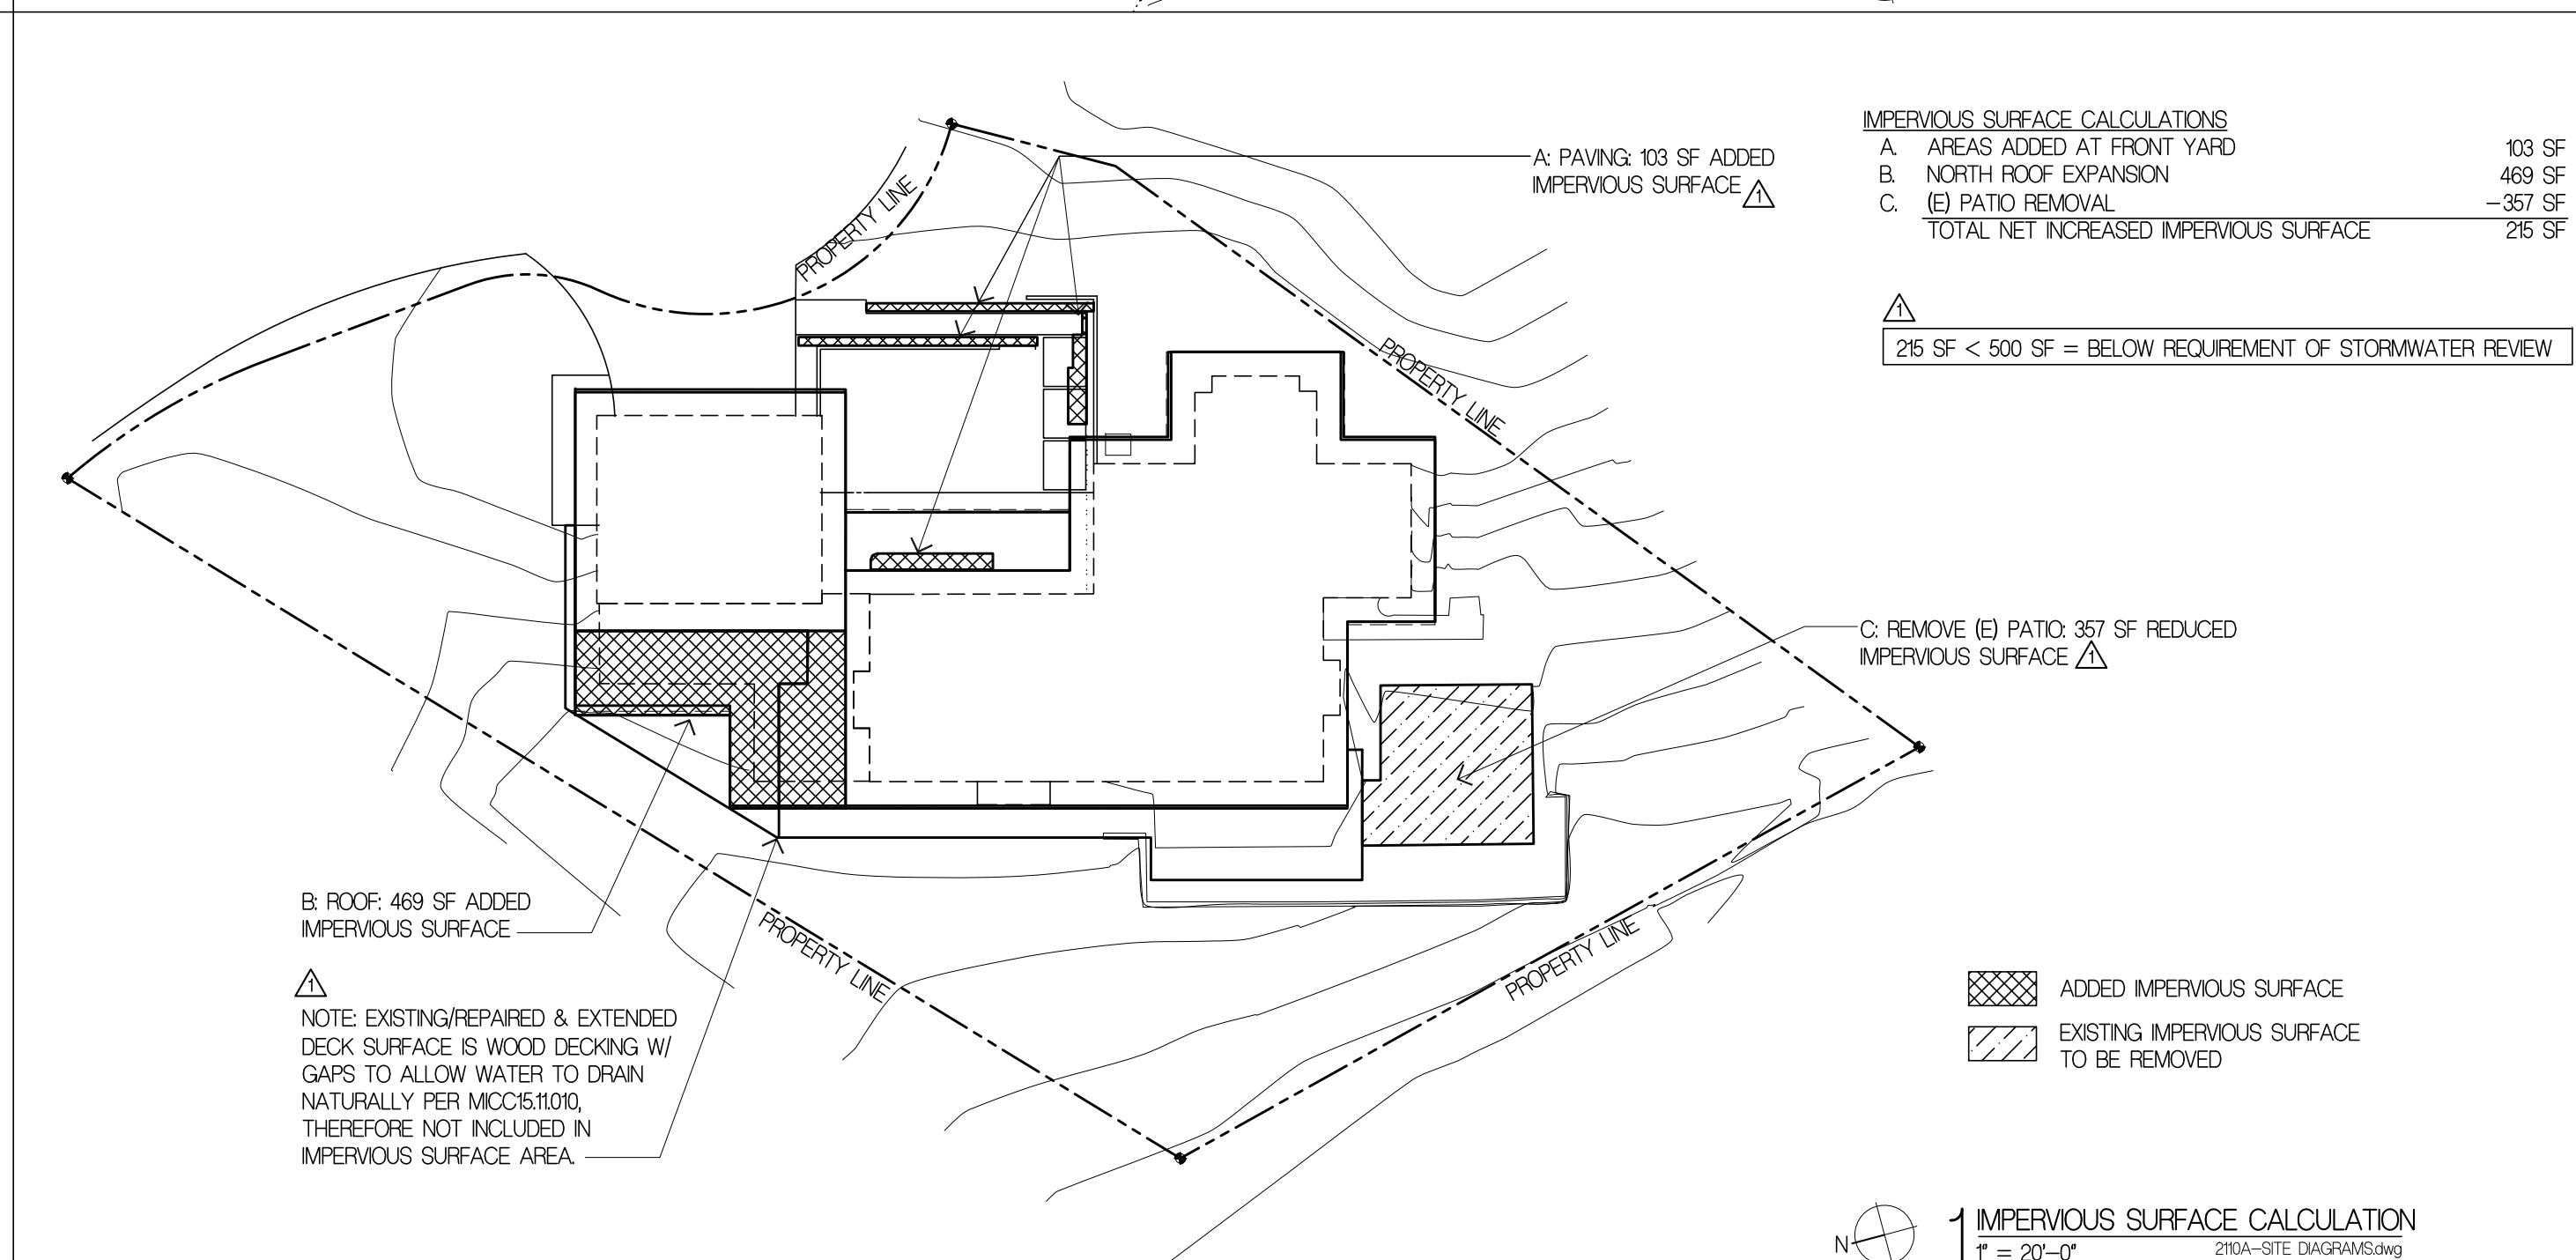

IMPERVIOUS SURFACE CALCULATIONS

A. AREAS ADDED AT FRONT YARD	103 SF
B. NORTH ROOF EXPANSION	469 SF
C. (E) PATIO REMOVAL	-357 SF
TOTAL NET INCREASED IMPERVIOUS SURFACE	215 SF


215 SF < 500 SF = BELOW REQUIREMENT OF STORMWATER REVIEW

ADDED IMPERVIOUS SURFACE
 EXISTING IMPERVIOUS SURFACE TO BE REMOVED

1 IMPERVIOUS SURFACE CALCULATION
 T = 20'-0" 210A-SITE DIAGRAMS.dwg

Suyama Peterson Deguchi
 8601 8th Avenue South Seattle, Washington 98108
 P 206.256.0809

Project Title
JAFFE RESIDENCE
 8455 SE 83RD STREET
 MERCER ISLAND, WA 98040

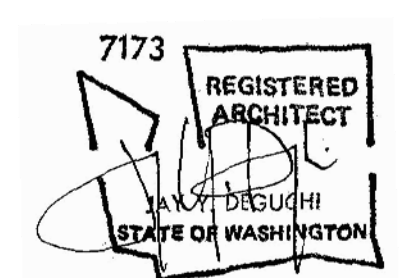

Drawing Title
SITE DIAGRAMS

Date
 08/08/2022
 Job No.
 210

ISSUE DATE
 PERMIT CORRECTIONS #1 03/31/2023
 PERMIT CORRECTIONS #2 05/31/2023

PERMIT CORRECTIONS
 Sheet No.

TS-4



ARBORIST REPORT

DATE:
June 3, 2023

PREPARED FOR:
Eric & Tricia Jaffe

SITE ADDRESS:
8455 SE 83rd St Mercer Island, WA 98040 / Lot # 3625700150

PREPARED BY:
Kim Ettari - ISA Certified Arborist PN1301A / TRAQ
Laughing Trees Landscapes
5670 40th Ave NE Seattle, WA 98105
828-318-6088 / laughingtreeslandscapes@gmail.com

NARRATIVE

SCOPE OF WORK
You have asked me to complete a tree retention and replacement plan in preparation for the proposed construction project that will include 1) an addition to the northwest corner of the residence end 2) the rebuilding of the upper decks that surround the north and west sides of the residence.
METHODODOLOGY
The methods used for this assessment are as outlined in Tree Risk Assessment by Julian Dunster and as adopted by the International Society of Arboriculture (ISA). The end goal of most assessments is to provide the owner or manager of the tree(s) with factual information, enabling them to make decisions about the management of the tree(s). For this particular assessment, I used a Level II Assessment that includes inspection of the root collar, lower trunk, upper limbs and canopy of the trees as can be seen from the ground. Basic assessment does not include climbing the tree or excavation of soils to inspect root structure or condition.

I measured sixteen (16) significant trees (10" diameter or greater) for their diameter at breast height (DBH), an industry standard of measuring trees at 4.5' above grade. Trees that were multi-stemmed or branched below the standard 4.5' point of measurement were measured using an alternative method and noted as such. Each tree was tagged with a round metal tag with a number that corresponds to the inventory.

A tree inventory was created that details the tree by reference number, species/common name, size (DBH), drip line or canopy extension and condition with remarks as needed. Any recommended action items are also included on said sheet. (See attached inventory.)

A tree map was created indicating the location of the trees, their canopy extensions and the locations of required tree protection fencing. (See attached CAD site plan marked with notes.)

A tree replacement plan was created by the architect, Suyama Peterson Deguchi, with my input and approval of the final species choices and rendering. (See attached CAD tree replacement plan.)

FINDINGS & OBSERVATIONS
The subject site is a residential property with an existing home in an established neighborhood on Mercer Island, WA. The following significant trees (10" or greater) were located on the site for a total of 393 caliper inches.

1. Tree #347 - Pseudotsuga menziesii / Douglas Fir - 43" DBH (exceptional) - GOOD CONDITION / LOW RISK - RETAIN
This tree is approximately 80' tall with a 20' drip line in all directions. The trunk has a small corrected lean to the north but shows good vigor and a healthy balanced crown.

2. Tree #348 - Tsuga heterophylla / Western Hemlock - 18" DBH - POOR CONDITION / LOW RISK - REMOVE
This tree is 50' tall with a slight uncorrected lean to the NE. Bark splitting is present between 10' - 20' on the south side of the trunk. The tree has chlorotic needles, a woolly adelgid infestation and extremely poor vigor. *Slated for removal due to poor health.

3. Tree #351 - Pseudotsuga menziesii / Douglas Fir - 38" DBH (exceptional) - GOOD CONDITION / LOW RISK - RETAIN
This tree is 100' tall with a slight corrected lean to the north. There is oozing sap on the west side of the trunk at 10'. There are a few small dead hanging branches and surface roots at base.

4. Tree #352 - Pseudotsuga menziesii / Douglas Fir - 35" DBH (exceptional) - GOOD CONDITION / LOW RISK - RETAIN
This tree is 80' tall with a 50' canopy spread. The tree shows good vigor with a slight, smaller canopy. There is a small section of dead bark on the base on the north side of the trunk. This tree is close to Tree #353.

5. Tree #353 - Pseudotsuga menziesii / Douglas Fir - 32" DBH (exceptional) - GOOD CONDITION / LOW RISK - RETAIN
This tree is 80' tall with a canopy spread of 40' running east to west. There is a small section of dead bark at the base but the tree shows good vigor. Close to Tree #352.

6. Tree #354 - Prunus species / Flowering Cherry - 10" DBH - POOR CONDITION / MODERATE RISK - REMOVE
This tree is approximately 25' tall with a 30' spread. There is evidence of decay in several previous pruning cuts with dead branches and previous branch failures. This tree shows poor vigor. *Slated for removal due to poor health.

7. Tree #355 - Pseudotsuga menziesii / Douglas Fir - 38" DBH (exceptional) - FAIR CONDITION / LOW RISK - RETAIN
This tree is approximately 80' tall with a crown spread of 30' mostly north and south. It has sparse foliage on the lower branches and is crowded with Trees #356 & 357.

8. Tree #356 - Tsuga heterophylla / Western Hemlock - 16" DBH - POOR CONDITION / MODERATE RISK - REMOVE
This tree is approximately 60' tall with a small, unbalanced crown 20' to the north, south and west. The canopy is intertwined with Tree #357. There is a woolly adelgid infestation with slightly chlorotic needles, low vigor and poor inside growth. *Slated for removal due to poor health.

9. Tree #357 - Pseudotsuga menziesii / Douglas Fir - 22" DBH - FAIR CONDITION / LOW RISK - REMOVE
This tree is approximately 70' tall with a canopy spread of 20'. The canopy is weighted to the north towards the residence and is intertwined with Tree #356 and shows poor vigor. *Slated for removal due to poor health.

10. Tree #358 - Thuja plicata / Western Red Cedar - 26" DBH (exceptional) - GOOD CONDITION / LOW RISK - RETAIN
This tree is part of a row of trees (Tree #358 - 364) planted together. It is 70' tall with a 20' spread. Good vigor.

11. Tree #359 - Thuja plicata / Western Red Cedar - 17" DBH - GOOD CONDITION / LOW RISK - RETAIN
This tree is part of a row of trees (Tree #358 - 364) planted together. It is 70' tall with a 20' spread. Good vigor.

12. Tree #360 - Thuja plicata / Western Red Cedar - 17" DBH - GOOD CONDITION / LOW RISK - REMOVE
This tree is part of a row of trees (Tree #358 - 364) planted together. It is 70' tall with a 20' spread. Good vigor. *This overgrown "hedge" planting slated for removal to allow light to south side of house.

13. Tree #361 - Thuja plicata / Western Red Cedar - 15" DBH - GOOD CONDITION / LOW RISK - REMOVE
This tree is part of a row of trees (Tree #358 - 364) planted together. It is 70' tall with a 20' spread. Good vigor. *This overgrown "hedge" planting slated for removal to allow light to south side of house.

14. Tree #362 - Thuja plicata / Western Red Cedar - 17" DBH - GOOD CONDITION / LOW RISK - REMOVE
This tree is part of a row of trees (Tree #358 - 364) planted together. It is 70' tall with a 20' spread. Good vigor. *This overgrown "hedge" planting slated for removal to allow light to south side of house.

15. Tree #363 - Thuja p. / Western Red Cedar - 25" DBH (exceptional) - FAIR CONDITION / MOD RISK - REMOVE
This tree is part of a row of trees (Tree #358 - 364) planted together. It is 70' tall with a 20' spread. There are many surface roots at the base. Good vigor. *Slated for removal for tripping hazard from large surface roots making access to south side of house treacherous.

16. Tree #364 - Thuja p. / Western Red Cedar - 29" DBH (exceptional) - FAIR CONDITION / MOD RISK - REMOVE
This tree is part of a row of trees (Tree #358 - 364) planted together. It is 70' tall with a 20' spread. There are many surface roots at the base. Good vigor. *Slated for removal for tripping hazard from large surface roots making access to south side of house treacherous.

Suyama Peterson Deguchi
8601 8th Avenue South Seattle, Washington 98108
P. 206.256.0809

Table with 10 columns: Tree #, Botanical Name, Common Name, DBH, CRZ, Condition, Condition / Notes, Action. Lists trees 347-364 with details on species, size, and status.

RECOMMENDATIONS & CONSIDERATIONS
TREE REMOVAL
As per the tree retention requirements in Mercer Island Municipal Code (19.10.06) (2.a) a "minimum of 30 percent of trees with a diameter of 10 inches or greater, or that otherwise meet the definition of large trees, shall be retained over a rolling five-year period."

REMOVAL CALCULATION - The proposed construction project will require the removal of trees #348, #354, #356, #357, #360, #361, #362, #363, #364 for the reasons listed in each tree's description. These trees represent 169 caliper inches or 42.5% of the caliper inches and 58% of the significant trees on the property.

TREE RETENTION
RETENTION CALCULATION - The remaining trees #347(E), #351(E), #352(E), #353(E), #355(E), #358(E), and #359 represent 229 caliper inches or 57.5% of the caliper inches and 44% of the significant trees on the property. As per MICC this percentage meets the 30% tree retention requirement.

PROTECTION OF RETAINED TREES
Tree #347 - Pseudotsuga menziesii / Douglas Fir - 43" DBH (exceptional)
Exploratory hand trenching was completed in December 2021 to determine what and where, if any significant roots were located. Only one 1.5" root was found near the northwest corner of the residence. (See attached trenching report with photos.)

The 7.2' eastern and northern limits of disturbance on this tree were calculated using the trenching information and the construction requirements in this portion of the property. Tree protection fencing should be placed at that line. Due to the narrow access on this side of the residence the fencing will be slightly less than 5' from the structure.

Tree #351 - Pseudotsuga menziesii / Douglas Fir - 38" DBH (exceptional)
Exploratory hand trenching was completed in December 2021 to determine what and where, if any significant roots were located. One 8" and one 1.5" root were found between the trunk and the base of the deck to the east. (See attached trenching report with photos.)

The 3.5' eastern limit of disturbance on this tree was calculated using the trenching information and the construction requirements in this portion of the property. Tree protection fencing should be placed at that line. Due to the narrow access on this side of the residence the fencing will be slightly less than 5' from the structure.

Tree #352 - Pseudotsuga menziesii / Douglas Fir - 35" DBH (exceptional)
This tree grows at the base of a 3.5' high railroad tie retaining wall. Root excavation was unnecessary as all construction to the deck under the critical root zone will be conducted at the top of the wall and will not impact these roots. (See attached photo.) The limits of disturbance on this tree were calculated based on the usable ground level space. Fencing is to be

installed at the base of the retaining wall between the laurel hedge and the trunk. Absolutely no mechanized equipment is permitted inside the ground level tree protection zone. (See attached tree protection plan for location of protection fencing.)

Tree #352 - Pseudotsuga menziesii / Douglas Fir - 35" DBH (exceptional)
This tree grows at the base of a 3.5' high railroad tie retaining wall. Root excavation was unnecessary as all construction to the deck under the critical root zone will be conducted at the top of the wall and will not impact these roots. (See attached photo.) The limits of disturbance on this tree were calculated based on the usable ground level space. Fencing is to be installed at the base of the retaining wall between the laurel hedge and the trunk. Absolutely no mechanized equipment is permitted inside the ground level tree protection zone. (See attached tree protection plan for location of protection fencing.)



Tree #355 - Pseudotsuga menziesii / Douglas Fir - 38" DBH (exceptional)
This exceptional tree grows near the southernmost point of the property. The limits of disturbance on this tree is the critical root zone at 15' radius in all directions, Tree protection fencing to be installed at this measurement.


Tree #358 - Thuja plicata / Western Red Cedar - 26" DBH
This tree grows at the southwestern end of row of Cedars that were apparently planted as a screen many years ago. The row of trees have become crowded together and cast deep shade over the southern part of the residence. This tree along with Tree #359 are more exposed to wind and sun at the end away from the house and should not be greatly impacted by the

removed of the trees to the east. The limits of disturbance for this tree is its dripline of 10 N and 10 SE and tree protection fencing should be installed at the point.


Tree #359 - Thuja plicata / Western Red Cedar - 17" DBH
This tree grows at the southwestern end of row of Cedars that were apparently planted as a screen many years ago. The row of trees have become crowded together and cast deep shade over the southern part of the residence. This tree along with Tree #358 are more exposed to wind and sun at the end away from the house and should not be greatly impacted by the removed of the trees to the east. The limits of disturbance for this tree is its dripline of 10 N and 10 SE and tree protection fencing should be installed at the point.

TREE PROTECTION NOTES:
I recommend that steel plates be installed in the 4-5' gap between the tree protection zones of Tree #347 and Tree #351 and the structure. This will reduce foot traffic compaction in those critical areas. (See tree protection plan for locations of plates.)

3-4" of bark mulch is to be installed inside the tree protection zones of all other retained trees. Mercer Island approved tree protection signage is to be used on all tree protection fences.

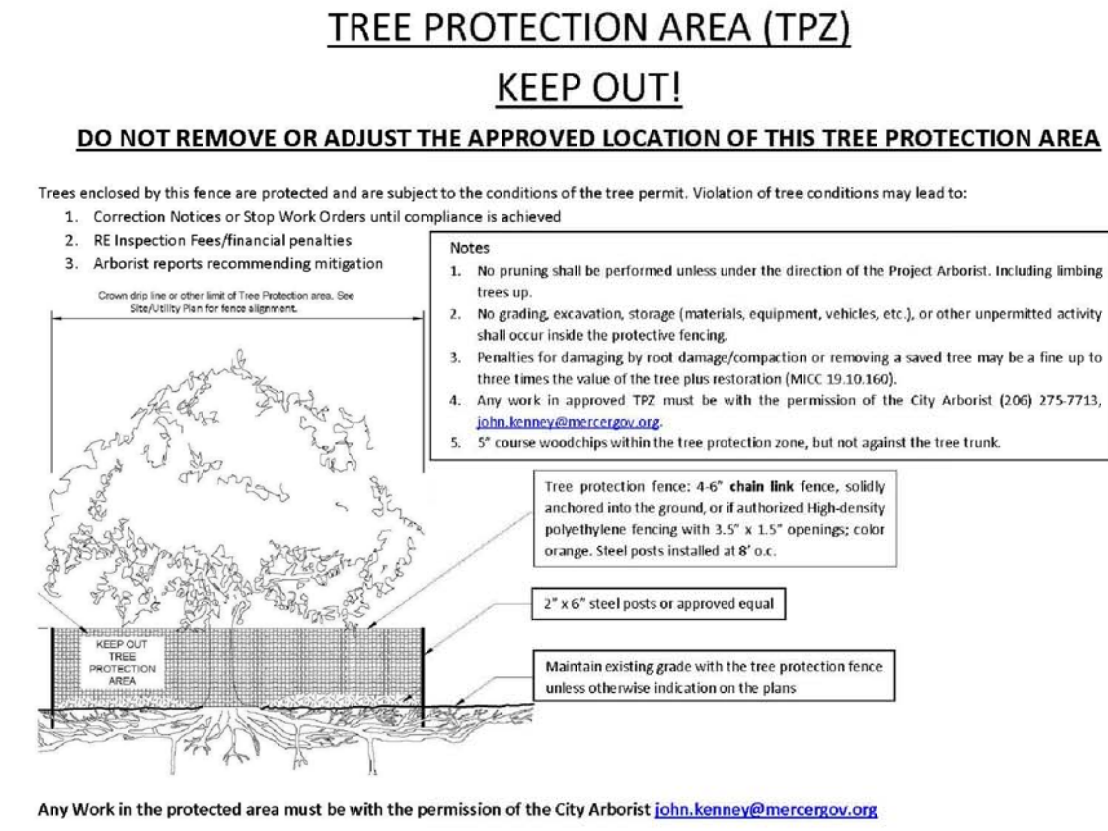

Project Title
JAFFE RESIDENCE
8455 SE 83RD STREET
MERCER ISLAND, WA 98040

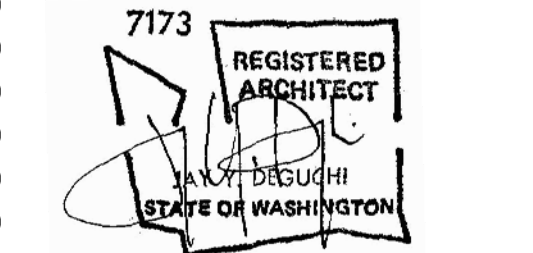

Drawing Title
ARBORIST EXCAVATION REPORT

Date
08/08/2022
Job No.
210

ISSUE DATE
PERMIT CORRECTIONS #1 03/31/2023
PERMIT CORRECTIONS #2 05/31/2023

PERMIT CORRECTIONS
Sheet No.

TREE REPLACEMENT

The following tree replacements are proposed and will be a mixture of Vine Maple, Douglas Fir and Western Red Cedar to satisfy MICC requirements that 50% of replacement trees be PNW natives. (See attached tree replanting plan.)

In my earlier report submitted John Kenney, city arborist of Mercer Island, calculated the number of required tree replacements at 17 total trees so I have used that number here.

NOTE REGARDING FEE-IN-LIEU: Eric and Tricia Jaffe would like the option to either a) install all of the required replacement trees as proposed or b) pay a full or partial fee-in-lieu of some of the replantings.

WATERING PLAN FOR REPLACEMENT TREES

- Above ground soaker hoses to be installed around each replacement tree. Smaller diameter trees to have hose looped around them once and larger diameter trees to have hose looped around them twice. If using hoses with emitters then multiple emitters are required for larger trees.
- Watering times will depend on soaker hose system but deeper, less frequent waterings is ideal (possibly a couple of hours once or twice per week). Check soil periodically to determine how deeply the water is soaking in. Trees that are planted near other large, established trees will likely need more water.
- Watering to be applied for at least two full seasons (April - October or longer if little rainfall.)
- 2-3" mulch to be applied over soaker hoses to aid water retention. Care should be taken to keep soaker hose and mulch away from the trunks.

LIMITATIONS

This report was based on the conditions of the trees and site at the time the report was written. Weather and site changes can alter the conditions at any time. Trees inherently pose a certain degree of hazard and risk from breakage, failure or other causes and conditions. Recommendations that are made by Laughing Trees Landscapes are intended to minimize or reduce hazardous conditions that may be associated with trees. However, there is and there can be no guarantee or certainty that efforts to correct unsafe conditions will prevent breakage or failure of the tree. Any recommendations made should reduce the risk of tree failure but they cannot eliminate such risk, especially in the event of a storm or any act of God. There can be no guarantee or certainty that all hazardous conditions will be detected.



ARBORIST / TRENCHING REPORT

DATE:

December 11, 2021

PREPARED FOR:

Eric Jaffe

SITE ADDRESS:

8455 SE 83rd St Mercer Island, WA 98040

PREPARED BY:

Kim Ettari, ISA Certified Arborist PN1301A

Laughing Trees Landscapes

5607 40th Ave NE Seattle, WA 98105

828-318-6088 / laughingtreeslandscapes@gmail.com

NARRATIVE


SCOPE OF WORK

- Dig a 10' exploratory trench (24" deep) to determine the locations of any significant roots of regulated exceptional Tree #351 - 38" Douglas Fir that may be impacted by the proposed rebuilding of the upper deck.
- Dig a 25' exploratory trench (24" deep) to determine the locations of any significant roots of regulated exceptional Tree #347 - 43" Douglas Fir that may be impacted by the proposed northwest addition to the garage.

FINDINGS AND RECOMMENDATIONS




Trench #1 - Tree #351 - The trench was located on the north east corner of the existing deck between Tree #351 and the footing on that corner and running north to south. One 8" diameter root and one 1.5" diameter root were found in the 10' long trench at approximately 20" deep. The proposed rebuilding of the deck will require no excavation as the existing footings will be used but will require disturbance from foot traffic to the outer half of the critical root zone on the east side of the tree.

I recommend that steel plates be placed prior to the commencement of construction along the western edge of the deck between Tree #351 and the pylons to alleviate compaction from construction foot traffic while the deck is rebuilt. Absolutely no mechanized equipment is to be used in this area.

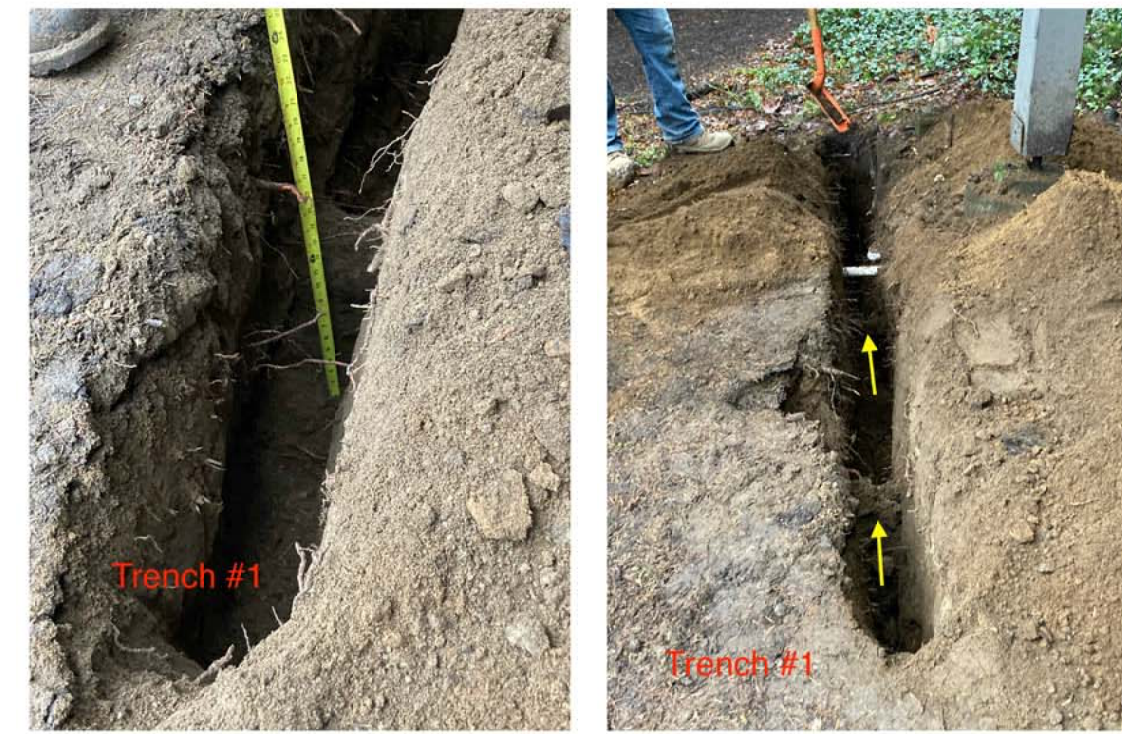

Trench #2 - Tree #347 - This 25' trench was located approximately 8' from the trunk running north to south. Only one 1.5" diameter root was found at approximately 18" deep close to the north west corner of the residence. No other significant roots were found. The proposed building of a small deck and the cantilevered addition to the garage will require the installation of one pylon. No significant roots should be impacted although this activity will occur in the outer half of the critical root zone on the south side of the tree.

I recommend that steel plates be placed prior to the commencement of construction along the northern edge of the garage and westward 5' past the boundary of the garage expansion. Absolutely no mechanized equipment is to be used in this area after the pylon is installed.

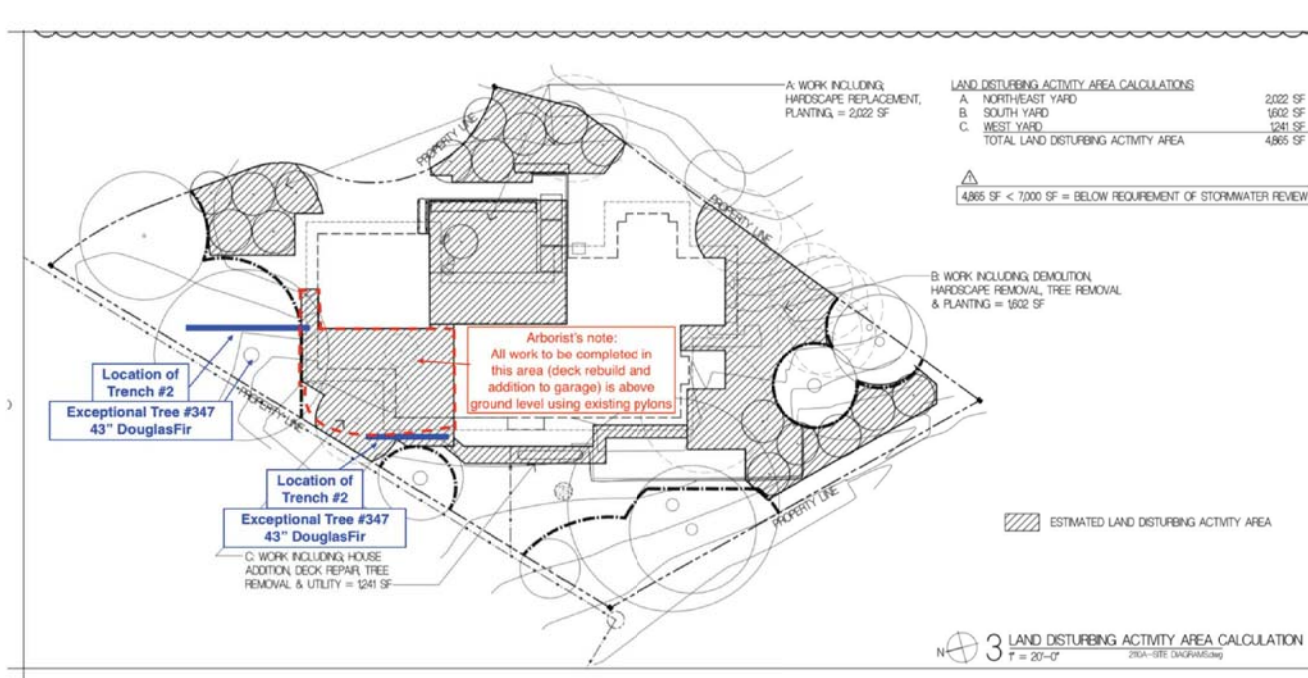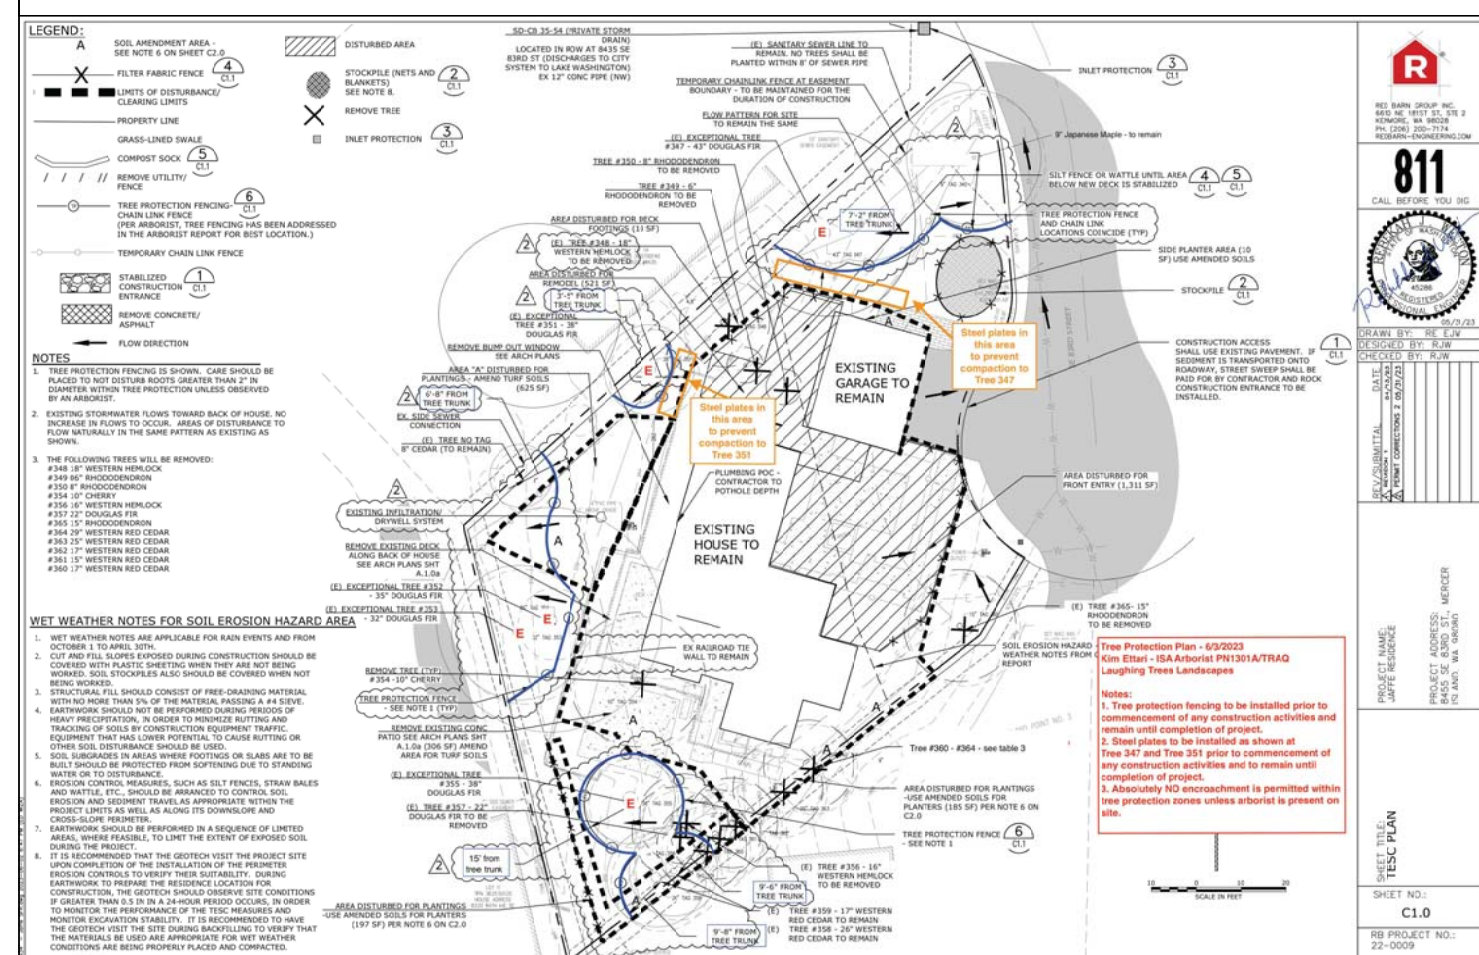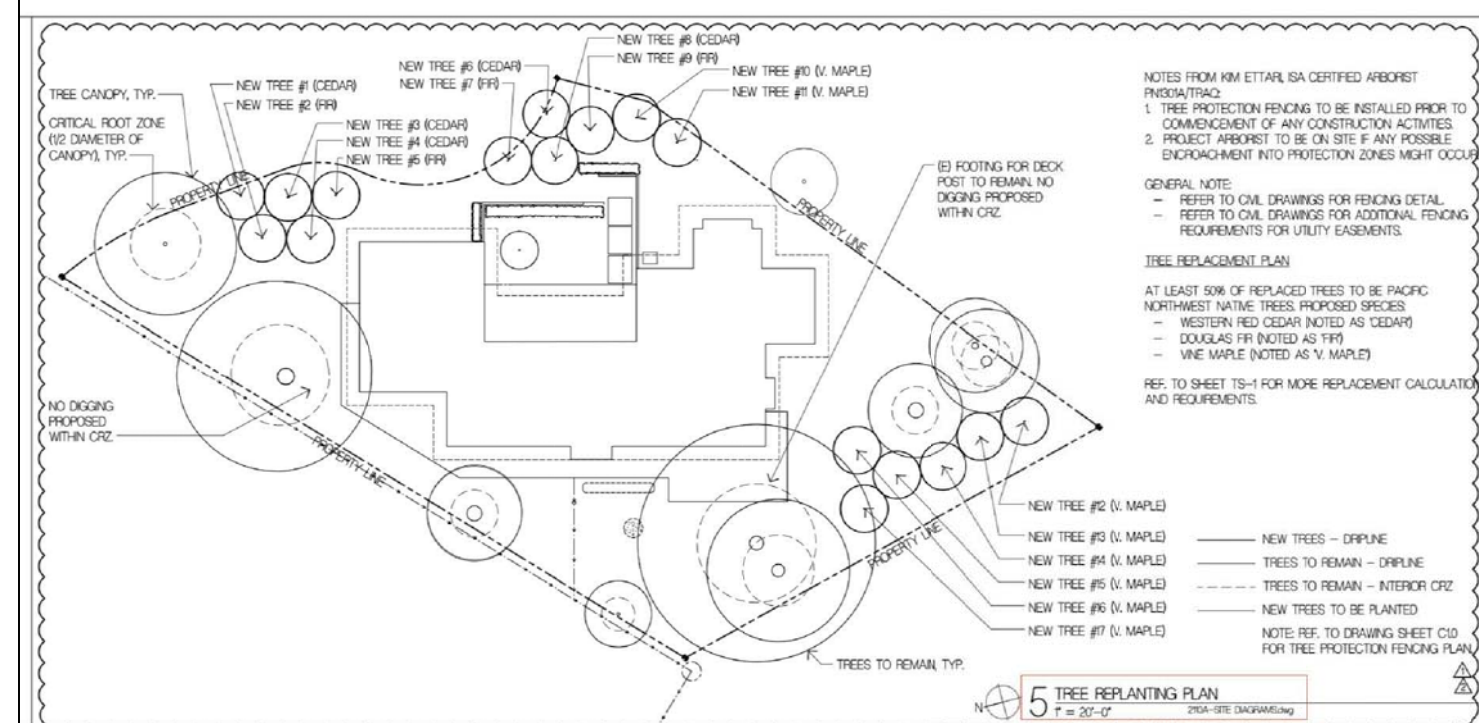

Eric & Tricia Jaffe Trenching Map

CITY OF MERCER ISLAND

COMMUNITY PLANNING & DEVELOPMENT
9611 SE 36TH STREET | MERCER ISLAND, WA 98040
PHONE: 206.275.7605 | www.mercer.gov



MERCER ISLAND TREE INVENTORY & REPLACEMENT SUBMITTAL INFORMATION

PROJECT INFORMATION

Property Owner Name: ERIC & TRICIA JAFFE

Site Address or Parcel Number: 8455 SE 83RD ST.

Project Contact Name: CHRIS HADDAD

Contact Email Address: CHRIS@S-PD.COM

Contact Phone Number: 206-256-0809

EXCEPTIONAL TREES

Exceptional Trees: means a tree or group of trees that because of its unique historical, ecological or aesthetic value constitutes an important community resource. A tree that is rare or exceptional by virtue of its size, species, condition, cultural/historical importance, age, and/or contribution as part of a tree grove. Trees with a diameter of more than 36 inches, or with a diameter that is equal to or greater than the diameter listed in the Exceptional Tree Table shown in MICC 19.16 under Tree, Exceptional.

List the total number of trees for each category and the tree identification numbers from the arborist report.

Number of trees 36" or greater	3
List tree numbers: 347, 351, 355	
Number of trees 24" or greater (including 36" or greater)	8
List tree numbers: 347, 351, 352, 353, 355, 358, 363, 364	
Number of trees from Exceptional Tree Table (MICC 19.16)	5
List tree numbers: 347, 351, 352, 353, 355	

LARGE REGULATED TREES

Large Regulated Trees: means any tree with a diameter of 10 inches or more, and any tree that meets the definition of an Exceptional Tree.

Number of Large Regulated Trees on site	16
List tree numbers: 347,348,351,352,353,354,355,356,357,358,359,360,361,362,363,364,	
Number of Large Regulated Trees on site proposed for removal	9
List tree numbers: 348,354,358,359,360,361,362,363,364,	
Percentage of trees to be retained ((A-B)/Ax100) note: must be at least 30%	44

RIGHT OF WAY TREES

Right of Way Trees: means a tree that is located in the street right of way adjacent to the project property.

Number of Large Regulated Trees in right of way

List tree numbers:

Number of Large Regulated Trees in right of way proposed for removal

List tree numbers:

Reason for removal:

TREE REPLACEMENT


Tree replacement: removed trees must be replaced based on the ratio in the table below. Replacement trees shall be conifers at least six feet tall and deciduous at least one and one-half inches in diameter at base.

Diameter of Removed Tree (measured 4.5' above ground)	Tree replacement Ratio	Number of Trees Proposed for Removal	Number of Tree Required for Replacement Based on Site/Type
Less than 10"	1		
10" up to 24"	2		
Greater than 24" up to 36"	3		
Greater than 36" and any Exceptional Tree	6		
TOTAL TREE REPLACEMENTS			17

*no replacement tree is needed if the tree fits all of the following:
Less than 10 inches in diameter, not an exceptional tree, and not a replacement tree from another tree permit. *

Suyama Peterson Deguchi
8601 8th Avenue South Seattle, Washington 98108
P 206.256.0809

Project Title
JAFFE RESIDENCE
8455 SE 83RD STREET
MERCER ISLAND, WA 98040

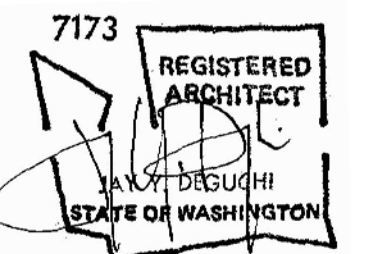

Drawing Title
ARBORIST EXCAVATION REPORT

Date
08/08/2022
Job No.
210

ISSUE DATE
PERMIT CORRECTIONS #1 03/31/2023
PERMIT CORRECTIONS #2 05/31/2023

PERMIT CORRECTIONS
Sheet No.



TOPOGRAPHIC SURVEY

THE NE 1/4 OF THE NE 1/4 OF SECTION 36, TOWNSHIP 24 NORTH, RANGE 4 EAST, W.M.
KING COUNTY, WASHINGTON

LEGAL DESCRIPTION

PER CHICAGO TITLE COMPANY OF WASHINGTON COMMITMENT FOR TITLE INSURANCE NO. 0208125-ETV DATED APRIL 1, 2021

LOT 15, ISLAND POINT NO. 3, ACCORDING TO THE PLAT THEREOF RECORDED IN VOLUME 82 OF PLATS, PAGES 71 AND 72, RECORDS OF KING COUNTY, WASHINGTON.

SITUATE IN THE COUNTY OF KING, STATE OF WASHINGTON.

HORIZONTAL DATUM


WASHINGTON STATE PLANE COORDINATE SYSTEM, NORTH ZONE (NAD 83/2011) BASED ON RTK GPS MEASUREMENTS CONSTRAINED TO THE WASHINGTON STATE REFERENCE NETWORK.

VERTICAL DATUM

NAVD 88 BASED ON RTK GPS MEASUREMENTS CONSTRAINED TO THE WASHINGTON STATE REFERENCE NETWORK.


SURVEY NOTES

- DATA FOR THIS SURVEY WAS GATHERED BY FIELD TRAVERSE UTILIZING ELECTRONIC DATA COLLECTION, AND MEETS OR EXCEEDS ACCURACY REQUIREMENTS CONTAINED IN W.A.C. 332.130.090. ALL MEASURING INSTRUMENTS EMPLOYED IN THIS SURVEY HAVE BEEN MAINTAINED IN ACCORDANCE WITH MANUFACTURER'S SPECIFICATIONS.
- THIS MAP GRAPHICALLY REPRESENTS CONDITIONS AND FEATURES EXISTING AT THE TIME OF THIS SURVEY ONLY, WHICH WAS PERFORMED DURING NOVEMBER OF 2021.
- THE CERTIFICATION OF THIS SURVEY AND MAP IS EXCLUSIVE TO THE NAMED CLIENT WHO REQUESTED THIS SURVEY. IT WAS SPECIFICALLY DESIGNED TO MEET THEIR STATED NEED(S). THAT CERTIFICATION DOES NOT EXTEND TO ANY OTHER PARTIES OR FOR ANY ALTERNATIVE USE OF THIS MAP WITHOUT THE EXPRESS RECERTIFICATION BY THE SURVEYOR NAMING THOSE PARTIES.
- THE PURPOSE OF THIS SURVEY IS TO PROVIDE A TOPOGRAPHIC MAP OF THE EXISTING CONDITIONS WITHIN KING COUNTY PARCEL #3625700150 FOR PLANNING, DESIGN AND CONSTRUCTION.
- UTILITIES OTHER THAN SHOWN MAY EXIST ON THE SITE. THE SURVEYOR DOES NOT WARRANT THAT THE UNDERGROUND UTILITIES SHOWN ARE IN THE EXACT LOCATION INDICATED. LACKING EXCAVATION, THE EXACT LOCATION OF UNDERGROUND FEATURES CANNOT BE ACCURATELY, COMPLETELY, AND RELIABLY DEPICTED. WHERE ADDITIONAL OR MORE DETAILED INFORMATION IS REQUIRED, THE CLIENT IS ADVISED THAT EXCAVATION MAY BE NECESSARY. THE SURVEYOR DOES CERTIFY THAT THEY ARE SHOWN AS ACCURATELY AS POSSIBLE FROM FIELD SURVEY INFORMATION.
- PARCEL AREA: 13,175 ± SQ.FT. (0.30 ACRES)
- ALL DISTANCES AND DIMENSIONS SHOWN ARE U.S. SURVEY FEET GROUND MEASUREMENTS.
- CONTOUR INTERVALS ARE 2-FOOT AND ARE COMPUTER GENERATED FROM GROUND FIELD TOPOGRAPHY GATHERED FOR THIS SURVEY UTILIZING ELECTRONIC DATA COLLECTION.
- THE PROPERTY AND RIGHT-OF-WAY LINES SHOWN HEREON ARE BASED ON FIELD TIES TO SEVERAL OF THE ORIGINAL PLAT MONUMENTS, FROM WHICH WE CONDUCTED A MATHEMATICAL CALCULATION OF THE PARCEL BASED ON THE GEOMETRY OF THE RECORDED PLAT MAP. NO PROPERTY CORNERS WERE FOUND NOR ESTABLISHED DURING THIS SURVEY.
- WE HAVE USED GRAPHIC SYMBOLS TO REPRESENT SOME FEATURES ON THIS MAP, SUCH AS UTILITIES, TREES AND FENCES. THE DEFAULT SIZE OF THOSE SYMBOLS MAY NOT REFLECT THE TRUE SIZE OF THE FEATURE THAT WAS MAPPED.

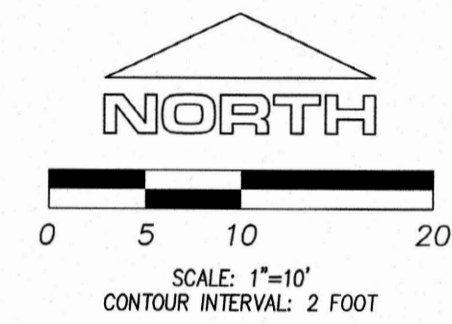

LEGEND

- TPN TAX PARCEL NUMBER
- SET MAG NAIL, AS NOTED
- BOUNDARY LINE
- - - ADJOINER PROPERTY BOUNDARY
- RIGHT OF WAY LINE
- ROAD CENTERLINE
- - - EASEMENT LINE
- - - BUILDING SET BACK LINE
- DECIDUOUS TREE
- MAPLE TREE
- CEDAR TREE
- FIR TREE
- HEMLOCK TREE
- PINE TREE
- TREE DIAMETERS ARE NOTED AND DRILLINES SHOWN
- NOTE: PLEASE REFER TO ARBORIST REPORT FOR TAGGED TREES.
- EXC. EXCEPTIONAL
- BUILDING COLUMN
- WOOD FENCE (AS NOTED)
- BASKETBALL HOOP
- SANITARY SEWER CLEANOUT
- TRANSFORMER
- TELEPHONE RISER
- GAS METER
- WATER VALVE
- WATER METER
- WATER HOSE BIB
- IRRIGATION CONTROL VALVE
- E — E — BURIED POWER LINE
- G — G — BURIED GAS LINE
- W — W — BURIED WATER LINE
- ASPHALT SURFACE
- CONCRETE SURFACE

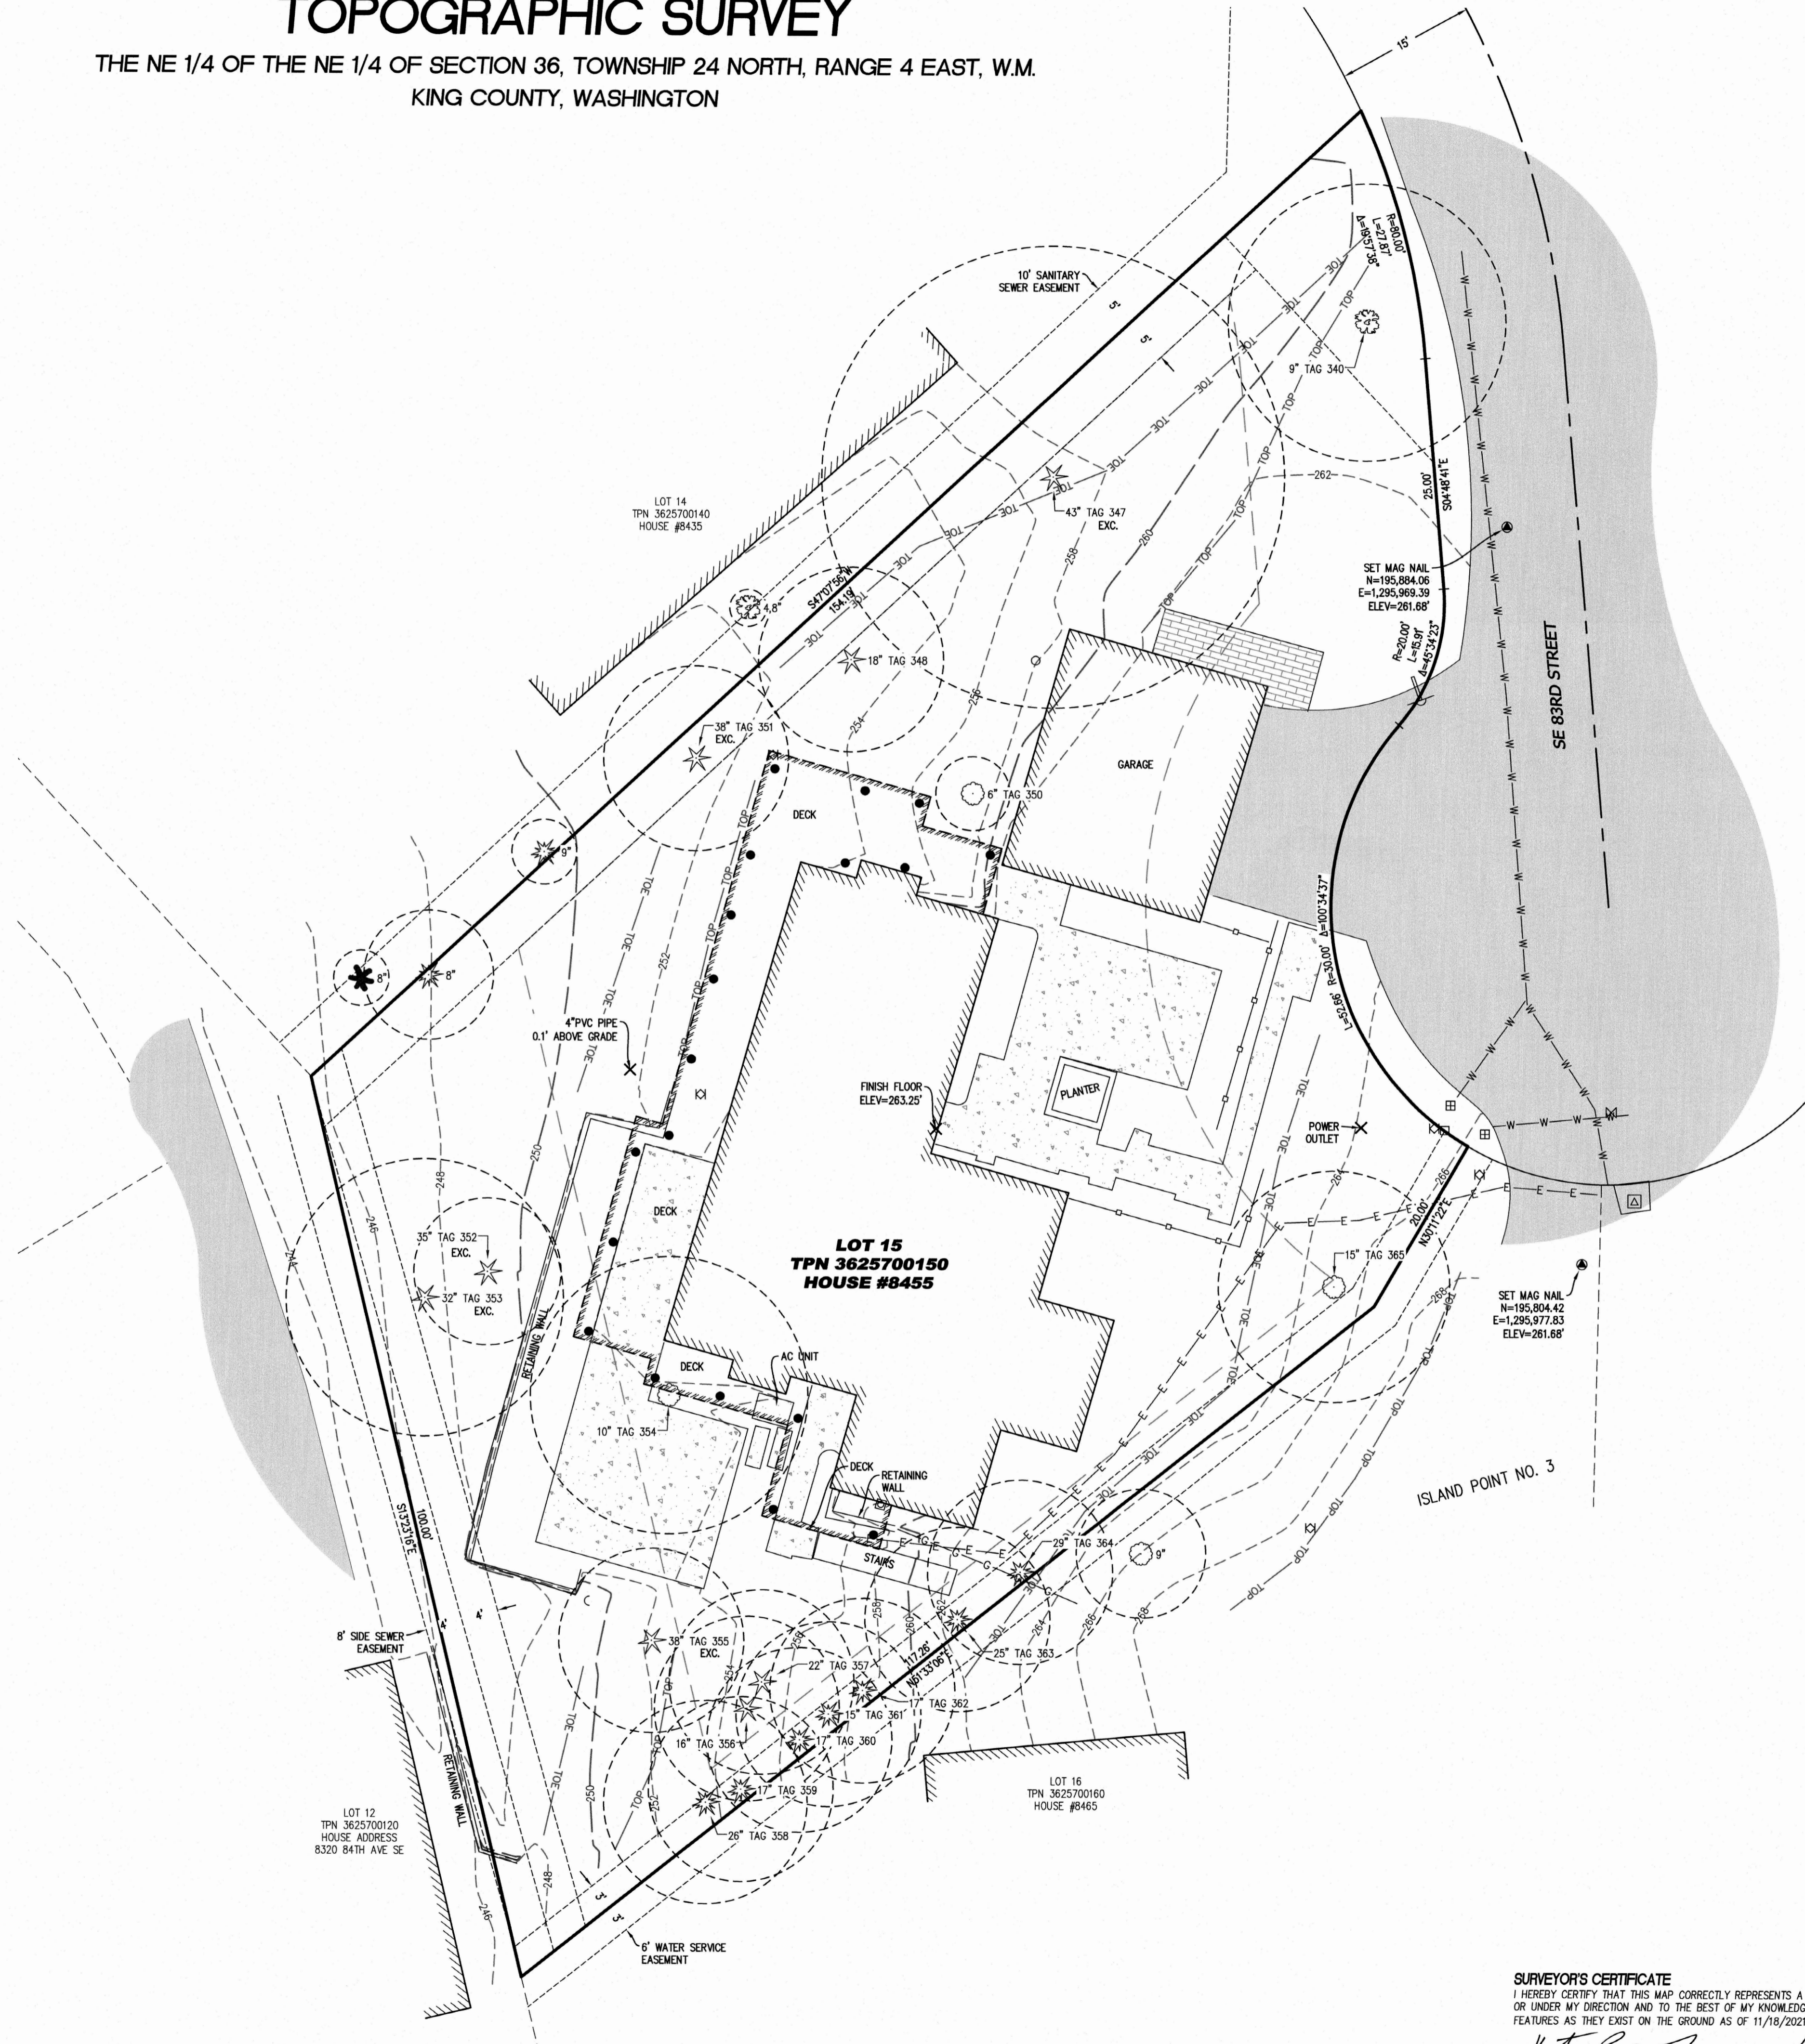

REV NO	REVISION DESCRIPTION	DATE BY
1	ADDED INFORMATION FROM ARBORIST REPORT	12/21/21 BPM

Apex Engineering
 2801 South 35th Street, Suite 200
 Tacoma, Washington 98409-7479
 (253) 473-4494 FAX: (253) 473-0599

TOPOGRAPHIC SURVEY
ERIC AND TRICIA JAFFE
 8544 SE 83RD STREET
 MERCER ISLAND, WASHINGTON 98040

TITLE
CLIENT
 DATE SEALED 12/21/2021



PROJECT MANAGER
KAP


DESIGN
DRAWN **BPM**
CHECKED **KAP**
SEC **36** T 24 N R 4 E
FILE NO **35957**
DATE **12/17/2021**
SCALE **1"=10'**

SHEET 1 OF 1
FILE NO **35957**
DATE

©APEX ENGINEERING LLC 2021


SURVEYOR'S CERTIFICATE
 I HEREBY CERTIFY THAT THIS MAP CORRECTLY REPRESENTS A TOPOGRAPHIC SURVEY MADE BY ME OR UNDER MY DIRECTION AND TO THE BEST OF MY KNOWLEDGE REPRESENTS THE TOPOGRAPHIC FEATURES AS THEY EXIST ON THE GROUND AS OF 11/18/2021.
 Kurt A. Parcher 12/21/2021
 KURT A. PARCHER P.L.S. NO. 49286 DATE

JAFFE RESIDENCE

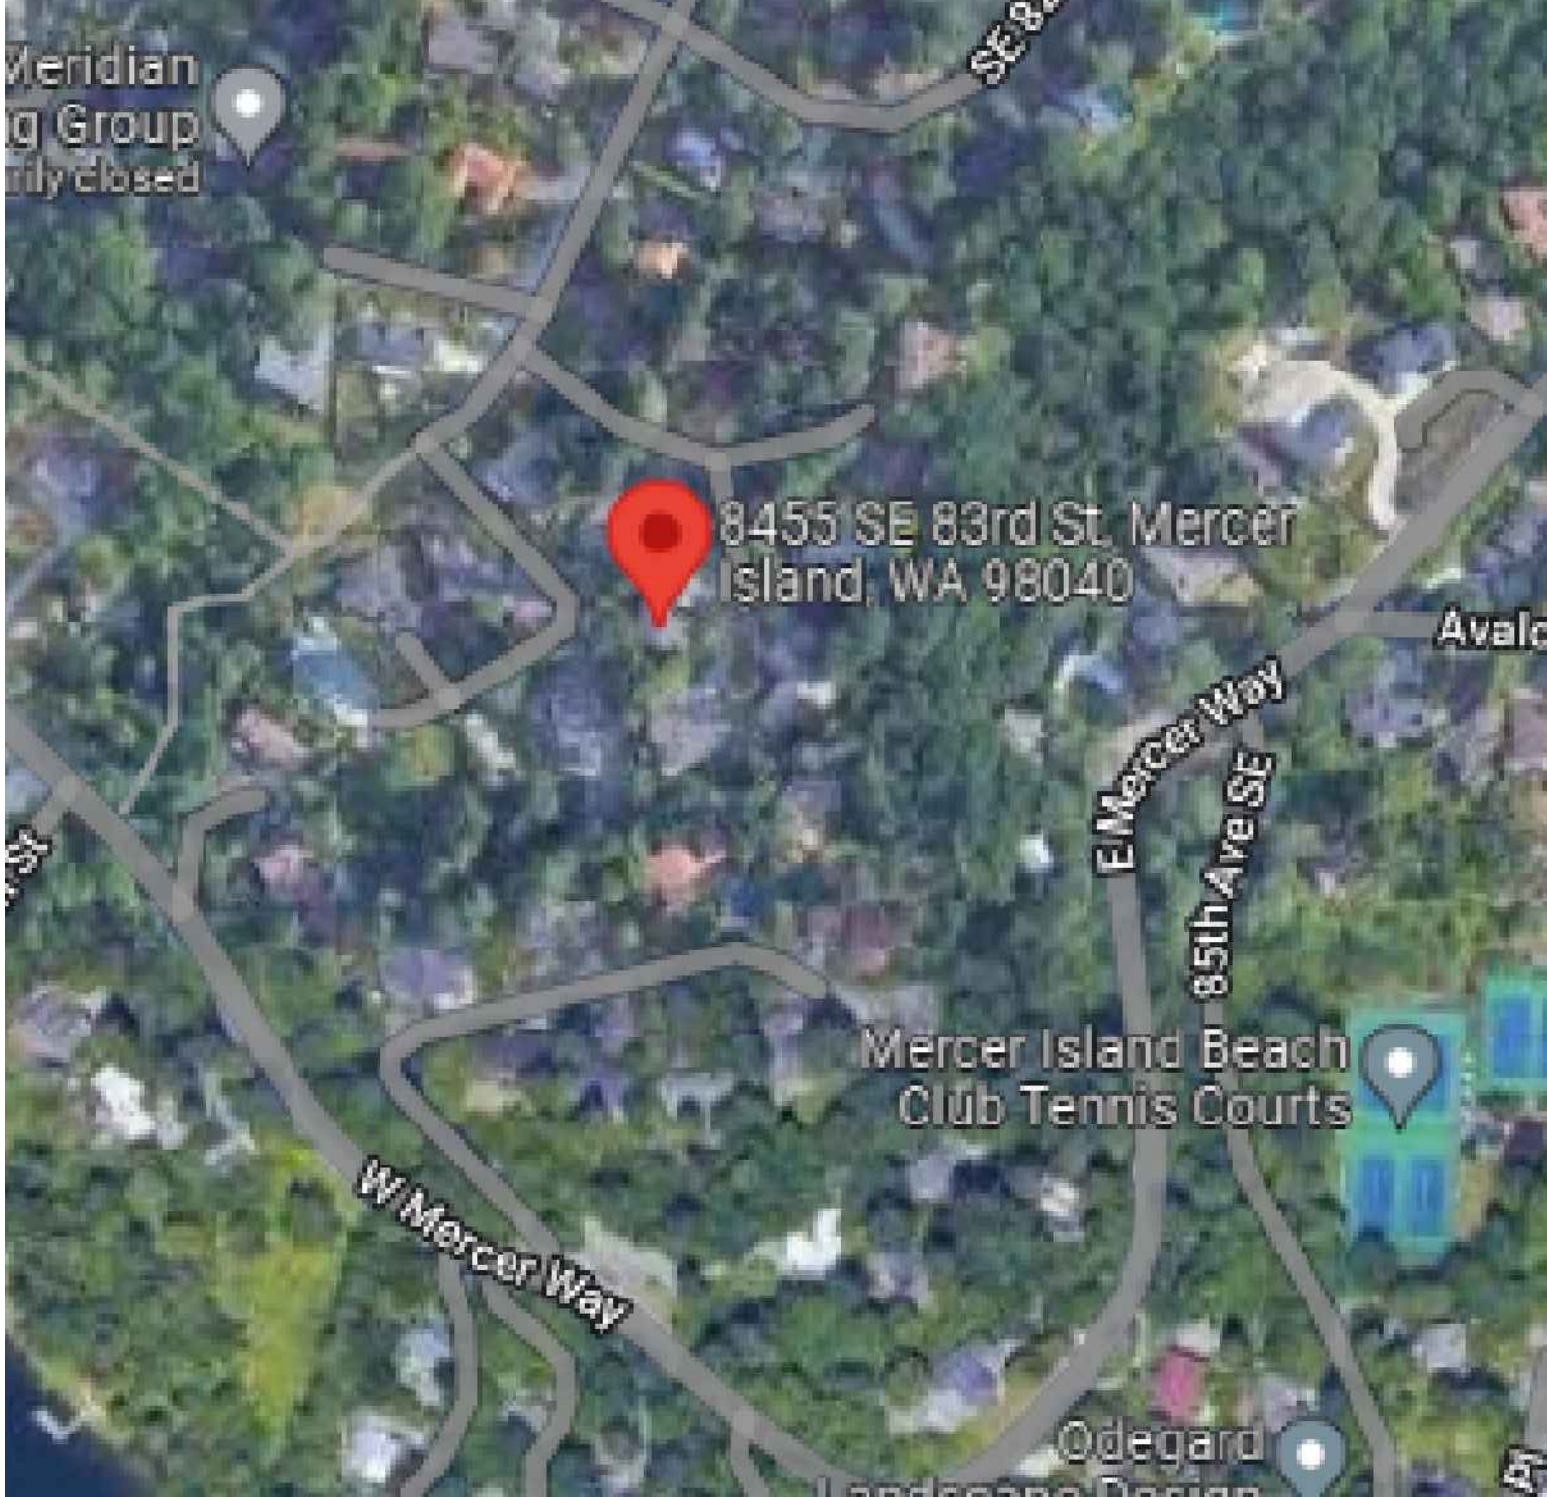

VICINITY MAP

SCALE: 1" = 1,000' APPROX.

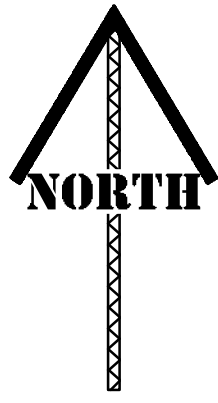

LEGEND AND ABBREVIATIONS

PROPOSED

	COMM MANHOLE		HYDRANT
	COMM BOX		METER
	COMM POLE		MANHOLE
	ANCHOR		POST INDICATOR
	GUY POLE		THRUST BLOCK
	ELEC BOX		VAULT
	LIGHT		VALVE
	YARD LIGHT		WELL
	LUMINAIRE		IRR METER
	METER		SPRINKLER
	ELEC MANHOLE		IRR VALVE
	POLE		PUMP
	TRANSFORMER		INLET PROTECTION
	GAS METER		REMOVE TREE
	GAS VALVE		COMPOST SOCK
	SEWER MANHOLE		FLAG
	CLEANOUT		MONITOR WELL
	CB MANHOLE		SIGN
	STORM MANHOLE		TEST PIT
	CATCH BASIN (CB)		WETLAND FLAG
	CULVERT		BUSH
	CLEANOUT		SHRUB
	YARD DRAIN		CONIFER TREE
	AIR RELEASE		DECIDUOUS TREE
	BLOW OFF		STOCK PILE
	FIRE DEPT CONN (FDC)		

SURVEY LINE LEGEND

	SANITARY SEWER LINE	SS
	STORM DRAIN LINE	SD
	WATER LINE	W
	GAS LINE	G
	OVER HEAD ELECTRICAL LINE	OHE
	OVER HEAD COMMUNICATION LINE	OHT
	OVER HEAD GUY WIRE	OHW
	BURIED ELECTRICAL CONDUIT	ECG
	BURIED COMMUNICATION CONDUIT	BCG
	BURIED FIBER OPTIC CONDUIT	FOD
	STEAM LINE	STM
	ROCKERY	
	GUARD RAIL	
	STOCKADE FENCE	
	BARB WIRE FENCE	
	CHAIN LINK FENCE	

SURVEY LEGEND

	SET REBAR & CAP PLS No. 29536
	FOUND REBAR & CAP LSF 34144 AT PROPERTY CORNER
	FOUND TACK IN CONCRETE MONUMENT
	FOUND STONE MONUMENT WITH BRASS TACK
	FOUND MAGNETIC NAIL
	SET LINE HUB, TACK & DISC PLS No. 29536
	SET LEAD & TACK WITH DISC PLS No. 29536
	CALCULATION POINT

ABBREVIATIONS

@	AT
AC	ACRES
ADA	AMERICANS W/ DISABILITIES ACT
BC	BACK OF CURB
BW	BOTTOM OF WALL
CC	CURB CUT
CL	CENTERLINE
CO	CLEAN OUT
COMI	CITY OF MERCER ISLAND
CY	CUBIC YARDS
DS	DOWNSPOUT
E	EAST
ESC	EROSION AND SEDIMENT CONTROL
EX	EXISTING
FDCO	FOUNDATION DRAIN CLEAN OUT
FH	FIRE HYDRANT
FL	FLOWLINE
FM	FORCE MAIN
N	NORTH
NTS	NOT TO SCALE
OHWM	ORDINARY HIGH WATER MARK
PC	POINT OF CURVATURE
PCC	POINT OF COMPOUND CURVATURE
PRC	POINT OF REVERSE CURVATURE
PT	POINT OF TANGENCY
PVC	POLYVINYL CHLORIDE PIPE
ROW	RIGHT OF WAY
S	SOUTH
SCH	SCHEDULE
SD	STORM DRAIN
SDCO	STORM DRAIN CLEAN OUT
SL	SLOPE
SSCO	SANITARY SEWER CLEAN OUT
STD	STANDARD
S/W	SIDEWALK
TC	TOP OF CURB
TS	TOP OF STAIRS
TW	TOP OF WALL
W	WEST

SHEET INDEX	
SHEET #	SHEET TITLE
C0.0	COVER SHEET
C0.1	TESC NOTES
C1.0	TESC PLAN
C1.1	TESC DETAIL
C2.0	DRAINAGE OVERALL
C2.1	DRAINAGE DETAILS

OWNER/APPLICANT:
ERIC AND TRICIA JAFFE
8455 SE 83RD ST.
MERCER ISLAND, WA 98040

CIVIL ENGINEER/CONTACT:
RED BARN GROUP INC.
6610 NE 181ST ST STE 2
KENMORE, WA 98028
CONTACT: REBEKAH WESTON, PE
REBEKAH@REDBARN-ENGINEERING.COM
206-200-7174

ARCHITECT:
CHRIS HADDAD, ARCHITECT
8601 8TH AVE S
SEATTLE, WA 98108
CHRIS@SUYAMAPETERSONDEGUCHI.COM
206-256-0809

PARCEL #: 3625700150
LOT SIZE: 13,175 SF

TOTAL NEW AND REPLACED IMPERVIOUS AREA: 1,578 SF
DISTURBED AREA: 4,865 SF

HORIZONTAL DATUM:
WASHINGTON STATE PLANE COORDINATE SYSTEM, NORTH ZONE (NAD 83/2011) BASED ON RTK GPS MEASUREMENTS CONTAINED TO THE WASHINGTON STATE REFERENCE NETWORK.

VERTICAL DATUM:
NAVD 88 BASED ON RTK GPS MEASUREMENTS CONSTRAINED TO THE WASHINGTON STATE REFERENCE NETWORK

BENCH MARK:
TBM MAG NAILS SET IN/NEAR CUL DE SAC
ELEVATION = 261.68'

FLOODPLAIN DESIGNATION:
PROPERTY IS ZONED X PER FEMA PANEL 53033C0663G

WATER DISTRICT:
CITY OF MERCER ISLAND

- CONSTRUCTION SEQUENCE:**
1. INSTALL TESC
 2. CONSTRUCT REMODEL
 3. CONNECT ROOF DOWNSPOUTS TO DRAINAGE SYSTEM
 4. PLANT DISTURBED AREAS
 5. REMOVE TESC

QUANTITIES (FOR PERMITTING ONLY)	CY
CUT	2
FILL	0
NET CUT/FILL	2


DISCLAIMER:
RED BARN GROUP INC. SHALL NOT BE HELD RESPONSIBLE FOR DISCREPANCIES IN THE SITE DIMENSIONS AND ELEVATIONS PREPARED BY OTHERS. IN THE EVENT THAT A DISCREPANCY OCCURS THAT AFFECTS THE DESIGN, CONTACT RED BARN GROUP INC. TO PROVIDE A SITE VISIT AND DESIGN UPDATE.



RED BARN GROUP INC.
6610 NE 181ST ST, STE 2
KENMORE, WA 98028
PH. (206) 200-7174
REDBARN-ENGINEERING.COM

811

CALL BEFORE YOU DIG

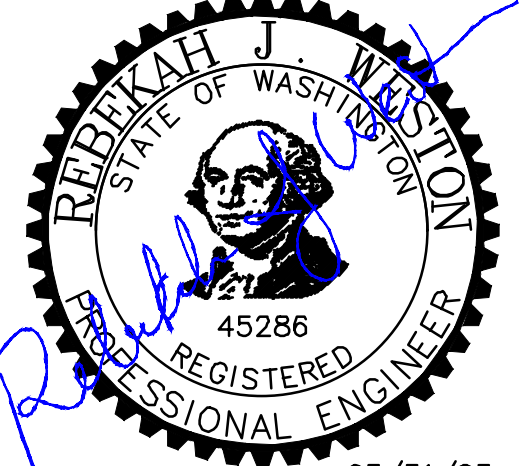

DRAWN BY: RE EJW
DESIGNED BY: RJW
CHECKED BY: RJW

REV/SUBMITTAL	DATE
REVISION 1	04/13/23
PERMIT CORRECTIONS 2	05/31/23

PROJECT NAME:
JAFFE RESIDENCE

PROJECT ADDRESS:
8455 SE 83RD ST., MERCER ISLAND, WA 98080

SHEET TITLE:
COVER

SHEET NO.:
C0.0

RB PROJECT NO.:
22-0009

Clearing / Grading Approval	Engineering/ Drainage Approval
Signature: _____	Signature: _____
Date: _____	Date: _____

PROJECT SPECIFIC TESC NOTES:

1. MARK CLEARING LIMITS AND ENVIRONMENTALLY CRITICAL AREAS. WITHIN THE BOUNDARIES OF THE PROJECT SITE AND PRIOR TO BEGINNING LAND DISTURBING ACTIVITIES, CLEARLY MARK ALL CLEARING LIMITS, EASEMENTS, SETBACKS, ALL ENVIRONMENTALLY CRITICAL AREAS AND THEIR BUFFERS, AND ALL TREES, AND DRAINAGE COURSES THAT ARE TO BE PRESERVED WITHIN THE CONSTRUCTION AREA.
2. RETAIN TOP LAYER AND/OR AMEND ALL DISTURBED SOILS. WITHIN THE BOUNDARIES OF THE PROJECT SITE, THE DUFF LAYER, TOP SOIL, AND NATIVE VEGETATION, IF THERE IS ANY, SHALL BE RETAINED IN AN UNDISTURBED STATE TO THE MAXIMUM EXTENT FEASIBLE. IF IT IS NOT FEASIBLE TO RETAIN THE TOP LAYER IN PLACE, IT SHALL BE STOCKPILED ON-SITE AND COVERED TO PREVENT EROSION. SOIL SHALL THEN BE AMENDED AND REPLACED IMMEDIATELY UPON COMPLETION OF THE GROUND DISTURBING ACTIVITIES.
3. ESTABLISH CONSTRUCTION ENTRANCE. LIMIT CONSTRUCTION VEHICLE ACCESS TO ONE ROUTE. STABILIZE ACCESS POINTS AND PREVENT TRACKING SEDIMENT ONTO PUBLIC ROADS. PROMPTLY REMOVE ANY SEDIMENT TRACKED OFFSITE.
4. PROTECT DOWNSTREAM PROPERTIES AND RECEIVING WATERS. PROTECT PROPERTIES AND RECEIVING WATERS DOWNSTREAM FROM THE DEVELOPMENT SITES FROM EROSION DUE TO INCREASES IN THE VOLUME, VELOCITY, AND PEAK FLOW RATE OF DRAINAGE WATER FROM THE PROJECT SITE.
5. PREVENT EROSION AND SEDIMENT TRANSPORT FROM THE SITE. PASS ALL DRAINAGE WATER FROM DISTURBED AREAS THROUGH A SEDIMENT TRAP OR OTHER APPROPRIATE SEDIMENT REMOVAL BEST MANAGEMENT PRACTICES BEFORE DISCHARGING FROM THE SITE. SEDIMENT CONTROLS INTENDED TO TRAP SEDIMENT ON-SITE SHALL BE CONSTRUCTED AS ONE OF THE FIRST STEPS IN GRADING AND SHALL BE FUNCTIONAL BEFORE OTHER LAND DISTURBING ACTIVITIES TAKE PLACE. ONE OF THE FOLLOWING SHALL BE USED TO PREVENT THE TRANSPORT OF SEDIMENT FROM THE SITE: COMPOST SOCKS, BERMS OR BLANKETS, FILTER FENCE, STRAW BALE BARRIER, BRUSH BARRIER, GRAVEL FILTER BERM, SEDIMENT POND OR SEDIMENT TRAP. SANDBAGS MAY ALSO BE UTILIZED TO PREVENT SEDIMENT FROM BEING DISCHARGED OFFSITE. RETAINING NATURAL VEGETATION AND BUFFER ZONES ARE ENCOURAGED, BUT MAY NOT BE USED AS A SUBSTITUTE.
6. PREVENT EROSION AND SEDIMENT TRANSPORT FROM THE SITE BY VEHICLES. LIMIT CONSTRUCTION VEHICLE ACCESS, WHENEVER POSSIBLE, TO ONE LOCATION. STABILIZE ALL ACCESS POINTS. PROVIDE PERIODIC STREET CLEANING BY SWEEPING OR SHOVELING ANY SEDIMENT THAT MAY HAVE BEEN TRACKED OUT. PLACE SEDIMENT IN A SUITABLE DISPOSAL AREA WHERE IT WILL NOT ERODE ANY FURTHER.
7. STABILIZE SOILS. PREVENT ON-SITE EROSION BY STABILIZING ALL EXPOSED AND UNWORKED SOILS, INCLUDING STOCK PILES. FROM OCTOBER 1 TO APRIL 30, NO SOILS SHALL REMAIN EXPOSED AND UNWORKED FOR MORE THAN TWO DAYS. FROM MAY 1 TO SEPTEMBER 30, NO SOILS SHALL REMAIN EXPOSED FOR MORE THAN SEVEN DAYS. SOILS SHALL BE STABILIZED AT THE END OF THE SHIFT BEFORE A HOLIDAY OR WEEKEND IF NEEDED BASED ON THE WEATHER FORECAST. SOIL STOCKPILES SHALL BE STABILIZED FROM EROSION, PROTECTED WITH SEDIMENT TRAPPING MEASURES, AND BE LOCATED AWAY FROM STORM DRAIN INLETS, WATERWAYS, AND DRAINAGE CHANNELS. BEFORE THE COMPLETION OF THE PROJECT, PERMANENTLY STABILIZE ALL EXPOSED SOILS THAT HAVE BEEN DISTURBED DURING CONSTRUCTION. SOME EXAMPLES OF BMPS TO USE TO STABILIZE SOILS, INCLUDING STOCKPILES ARE: COMPOST BLANKETS, SEEDING AND MULCHING, OR MATTING/ROLLED EROSION CONTROL PRODUCTS. COMPOST BLANKETS CAN BE USED AS TEMPORARY EROSION CONTROL AND THEN BE MIXED INTO THE SOIL TO HELP MEET THE POST CONSTRUCTION SOIL AMENDMENT REQUIREMENTS.
8. PROTECT SLOPES. EROSION FROM SLOPES SHALL BE MINIMIZED. CUT AND FILL SLOPES SHALL BE DESIGNED AND CONSTRUCTED IN A MANNER THAT WILL MINIMIZE EROSION. OFFSITE STORMWATER RUN-ON OR GROUNDWATER SHALL BE DIVERTED AWAY FROM SLOPES AND UNDISTURBED AREAS.
9. PROTECT STORM DRAINS. PREVENT SEDIMENT FROM ENTERING ALL STORM DRAINS, INCLUDING DITCHES, THAT RECEIVE DRAINAGE WATER FROM THE PROJECT. STORM DRAIN INLET PROTECTION DEVICES SHALL BE CLEANED OR REMOVED AND REPLACED AS RECOMMENDED BY THE PRODUCT MANUFACTURER, OR MORE FREQUENTLY IF REQUIRED TO PREVENT FAILURE OF THE DEVICE OR FLOODING. STORM DRAIN INLETS MADE OPERABLE DURING CONSTRUCTION SHALL BE PROTECTED SO THAT DRAINAGE WATER DOES NOT ENTER THE DRAINAGE SYSTEM WITHOUT FIRST BEING FILTERED OR TREATED TO REMOVE SEDIMENTS. STORM DRAIN INLET PROTECTION DEVICES SHALL BE REMOVED AT THE CONCLUSION OF THE PROJECT.
10. STABILIZE CHANNELS AND OUTLETS. ALL TEMPORARY ON-SITE DRAINAGE SYSTEMS SHALL BE DESIGNED, CONSTRUCTED, AND STABILIZED TO PREVENT EROSION. STABILIZATION SHALL BE PROVIDED AT THE OUTLETS OF ALL DRAINAGE SYSTEMS THAT IS ADEQUATE TO PREVENT EROSION OF OUTLETS, ADJACENT STREAM BANKS, SLOPES, AND DOWNSTREAM REACHES.
11. CONTROL POLLUTANTS. MEASURES SHALL BE TAKEN TO CONTROL POTENTIAL POLLUTANTS. COMPLY WITH THE REQUIREMENTS OF WASHINGTON STATE DEPARTMENT OF ECOLOGY'S 2014 STORMWATER MANAGEMENT MANUAL FOR WESTERN WASHINGTON (SWMMWW) VOLUME IV FOR EACH OF THE FOLLOWING CONSTRUCTION RELATED ACTIVITIES: POLLUTANT DISPOSAL (INCLUDING SEDIMENT, WASTE MATERIALS, AND DEMOLITION DEBRIS); CHEMICAL STORAGE; ON-SITE FUELING; MAINTENANCE, FUELING AND REPAIR OF HEAVY EQUIPMENT AND VEHICLES; CLEANUP OF CONTAMINATED SURFACES; DISCHARGE OF WHEEL WASH WASTEWATER; FERTILIZER AND PESTICIDE APPLICATION; PH-MODIFYING SOURCES.


12. CONTROL DEWATERING. WHEN DEWATERING DEVICES DISCHARGE ON-SITE OR TO A PUBLIC DRAINAGE SYSTEM, DEWATERING DEVICES SHALL DISCHARGE INTO A SEDIMENT TRAP TO REMOVE SEDIMENT CONTAMINATION, OR OTHER SEDIMENT REMOVAL BMP.
13. MAINTAIN AND INSPECT BMPS. ALL TEMPORARY AND PERMANENT EROSION AND SEDIMENT CONTROL BMPS SHALL BE INSPECTED, MAINTAINED, AND REPAIRED AS NEEDED TO ASSURE CONTINUED PERFORMANCE OF THEIR INTENDED FUNCTION. ALL TEMPORARY EROSION AND SEDIMENT CONTROLS SHALL BE REMOVED WITHIN FIVE (5) DAYS AFTER FINAL SITE STABILIZATION IS ACHIEVED OR AFTER THE TEMPORARY CONTROLS ARE NO LONGER NEEDED, WHICHEVER IS LATER. TRAPPED SEDIMENT SHALL BE REMOVED OR STABILIZED ON-SITE. DISTURBED SOIL AREAS RESULTING FROM REMOVAL SHALL BE PERMANENTLY STABILIZED.
14. EXECUTE CONSTRUCTION STORMWATER CONTROL PLAN. CONSTRUCTION SITE OPERATORS SHALL MAINTAIN, UPDATE, AND IMPLEMENT THEIR CONSTRUCTION STORMWATER CONTROL PLAN. CONSTRUCTION SITE OPERATORS SHALL MODIFY THEIR CONSTRUCTION STORMWATER CONTROL PLAN TO MAINTAIN COMPLIANCE.
15. MINIMIZE OPEN TRENCHES. IN THE CONSTRUCTION OF UNDERGROUND UTILITY LINES, WHERE FEASIBLE, NO MORE THAN ONE HUNDRED FIFTY (150) FEET OF TRENCH SHALL BE OPENED AT ONE TIME.
16. PHASE THE PROJECT. DEVELOPMENT PROJECTS SHALL BE PHASED IN ORDER TO MINIMIZE THE AMOUNT OF LAND DISTURBING ACTIVITY OCCURRING AT THE SAME TIME AND SHALL TAKE INTO ACCOUNT SEASONAL WORK LIMITATIONS.
17. INSTALL PERMANENT FLOW CONTROL FACILITIES. AFTER CONSTRUCTION BUT BEFORE THE PROJECT IS CONSIDERED COMPLETED, PERMANENTLY STABILIZE ALL EXPOSED SOILS THAT HAVE BEEN DISTURBED DURING CONSTRUCTION. USE ONE OF THE FOLLOWING TO PERMANENTLY STABILIZE SOILS: PERMANENT SEEDING, PLANTING, OR SODDING.



RED BARN GROUP INC.
6610 NE 181ST ST, STE 2
KENMORE, WA 98028
PH. (206) 200-7174
REDBARN-ENGINEERING.COM

811

CALL BEFORE YOU DIG

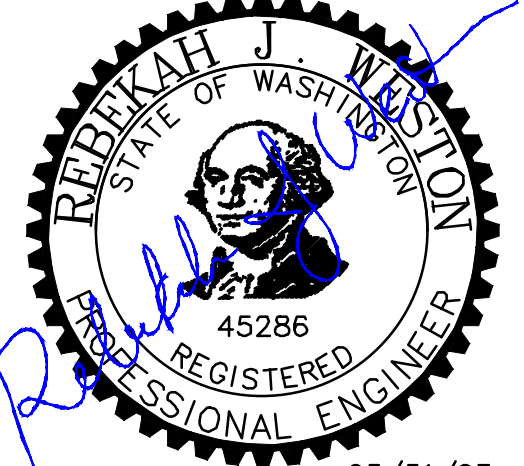

05/31/23

DRAWN BY: RE EJW

DESIGNED BY: RJW

CHECKED BY: RJW

REV/SUBMITTAL	DATE
REVISION 1	04/13/23
PERMIT CORRECTIONS 2	05/31/23

PROJECT NAME:
JAFFE RESIDENCE

PROJECT ADDRESS:
8455 SE 83RD ST., MERCER ISLAND, WA 98080

SHEET TITLE:
NOTES

SHEET NO.:
C0.1

RB PROJECT NO.:
22-0009

LEGEND:



- A** SOIL AMENDMENT AREA - SEE NOTE 6 ON SHEET C2.0
- X** FILTER FABRIC FENCE
- █ █ █** LIMITS OF DISTURBANCE/CLEARING LIMITS
- PROPERTY LINE
- GRASS-LINED SWALE
- 5** COMPOST SOCK
- /// ///** REMOVE UTILITY/FENCE
- TP** TREE PROTECTION FENCING - CHAIN LINK FENCE (PER ARBORIST, TREE FENCING HAS BEEN ADDRESSED IN THE ARBORIST REPORT FOR BEST LOCATION.)
- TEMPORARY CHAIN LINK FENCE
- 1** STABILIZED CONSTRUCTION ENTRANCE
- █ █ █** REMOVE CONCRETE/ ASPHALT
- ←** FLOW DIRECTION
- 2** DISTURBED AREA
- 2** STOCKPILE (NETS AND BLANKETS) SEE NOTE 8.
- X** REMOVE TREE
- 3** INLET PROTECTION
- 4** INLET PROTECTION
- 5** INLET PROTECTION
- 6** INLET PROTECTION

NOTES

1. TREE PROTECTION FENCING IS SHOWN. CARE SHOULD BE PLACED TO NOT DISTURB ROOTS GREATER THAN 2" IN DIAMETER WITHIN TREE PROTECTION UNLESS OBSERVED BY AN ARBORIST.
2. EXISTING STORMWATER FLOWS TOWARD BACK OF HOUSE. NO INCREASE IN FLOWS TO OCCUR. AREAS OF DISTURBANCE TO FLOW NATURALLY IN THE SAME PATTERN AS EXISTING AS SHOWN.
3. THE FOLLOWING TREES WILL BE REMOVED:
 #348 18" WESTERN HEMLOCK
 #349 06" RHODODENDRON
 #350 8" RHODODENDRON
 #354 10" CHERRY
 #356 16" WESTERN HEMLOCK
 #357 22" DOUGLAS FIR
 #365 15" RHODODENDRON
 #364 29" WESTERN RED CEDAR
 #363 25" WESTERN RED CEDAR
 #362 17" WESTERN RED CEDAR
 #361 15" WESTERN RED CEDAR
 #360 17" WESTERN RED CEDAR

WET WEATHER NOTES FOR SOIL EROSION HAZARD AREA

1. WET WEATHER NOTES ARE APPLICABLE FOR RAIN EVENTS AND FROM OCTOBER 1 TO APRIL 30TH.
2. CUT AND FILL SLOPES EXPOSED DURING CONSTRUCTION SHOULD BE COVERED WITH PLASTIC SHEETING WHEN THEY ARE NOT BEING WORKED. SOIL STOCKPILES ALSO SHOULD BE COVERED WHEN NOT BEING WORKED.
3. STRUCTURAL FILL SHOULD CONSIST OF FREE-DRAINING MATERIAL WITH NO MORE THAN 5% OF THE MATERIAL PASSING A #4 SIEVE.
4. EARTHWORK SHOULD NOT BE PERFORMED DURING PERIODS OF HEAVY PRECIPITATION, IN ORDER TO MINIMIZE RUTTING AND TRACKING OF SOILS BY CONSTRUCTION EQUIPMENT TRAFFIC. EQUIPMENT THAT HAS LOWER POTENTIAL TO CAUSE RUTTING OR OTHER SOIL DISTURBANCE SHOULD BE USED.
5. SOIL SUBGRADES IN AREAS WHERE FOOTINGS OR SLABS ARE TO BE BUILT SHOULD BE PROTECTED FROM SOFTENING DUE TO STANDING WATER OR TO DISTURBANCE.
6. EROSION CONTROL MEASURES, SUCH AS SILT FENCES, STRAW BALES AND WATTLE, ETC., SHOULD BE ARRANGED TO CONTROL SOIL EROSION AND SEDIMENT TRAVEL AS APPROPRIATE WITHIN THE PROJECT LIMITS AS WELL AS ALONG ITS DOWNSLOPE AND CROSS-SLOPE PERIMETER.
7. EARTHWORK SHOULD BE PERFORMED IN A SEQUENCE OF LIMITED AREAS, WHERE FEASIBLE, TO LIMIT THE EXTENT OF EXPOSED SOIL DURING THE PROJECT.
8. IT IS RECOMMENDED THAT THE GEOTECH VISIT THE PROJECT SITE UPON COMPLETION OF THE INSTALLATION OF THE PERIMETER EROSION CONTROLS TO VERIFY THEIR SUITABILITY. DURING EARTHWORK TO PREPARE THE RESIDENCE LOCATION FOR CONSTRUCTION, THE GEOTECH SHOULD OBSERVE SITE CONDITIONS IF GREATER THAN 0.5 IN IN A 24-HOUR PERIOD OCCURS, IN ORDER TO MONITOR THE PERFORMANCE OF THE TESC MEASURES AND MONITOR EXCAVATION STABILITY. IT IS RECOMMENDED TO HAVE THE GEOTECH VISIT THE SITE DURING BACKFILLING TO VERIFY THAT THE MATERIALS BE USED ARE APPROPRIATE FOR WET WEATHER CONDITIONS ARE BEING PROPERLY PLACED AND COMPACTED.

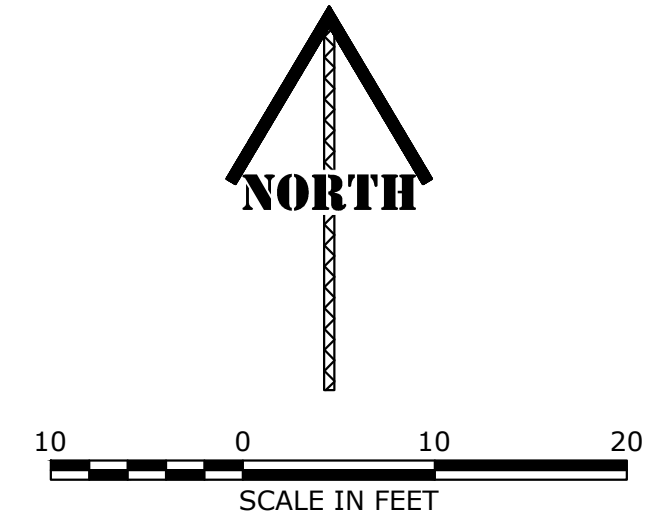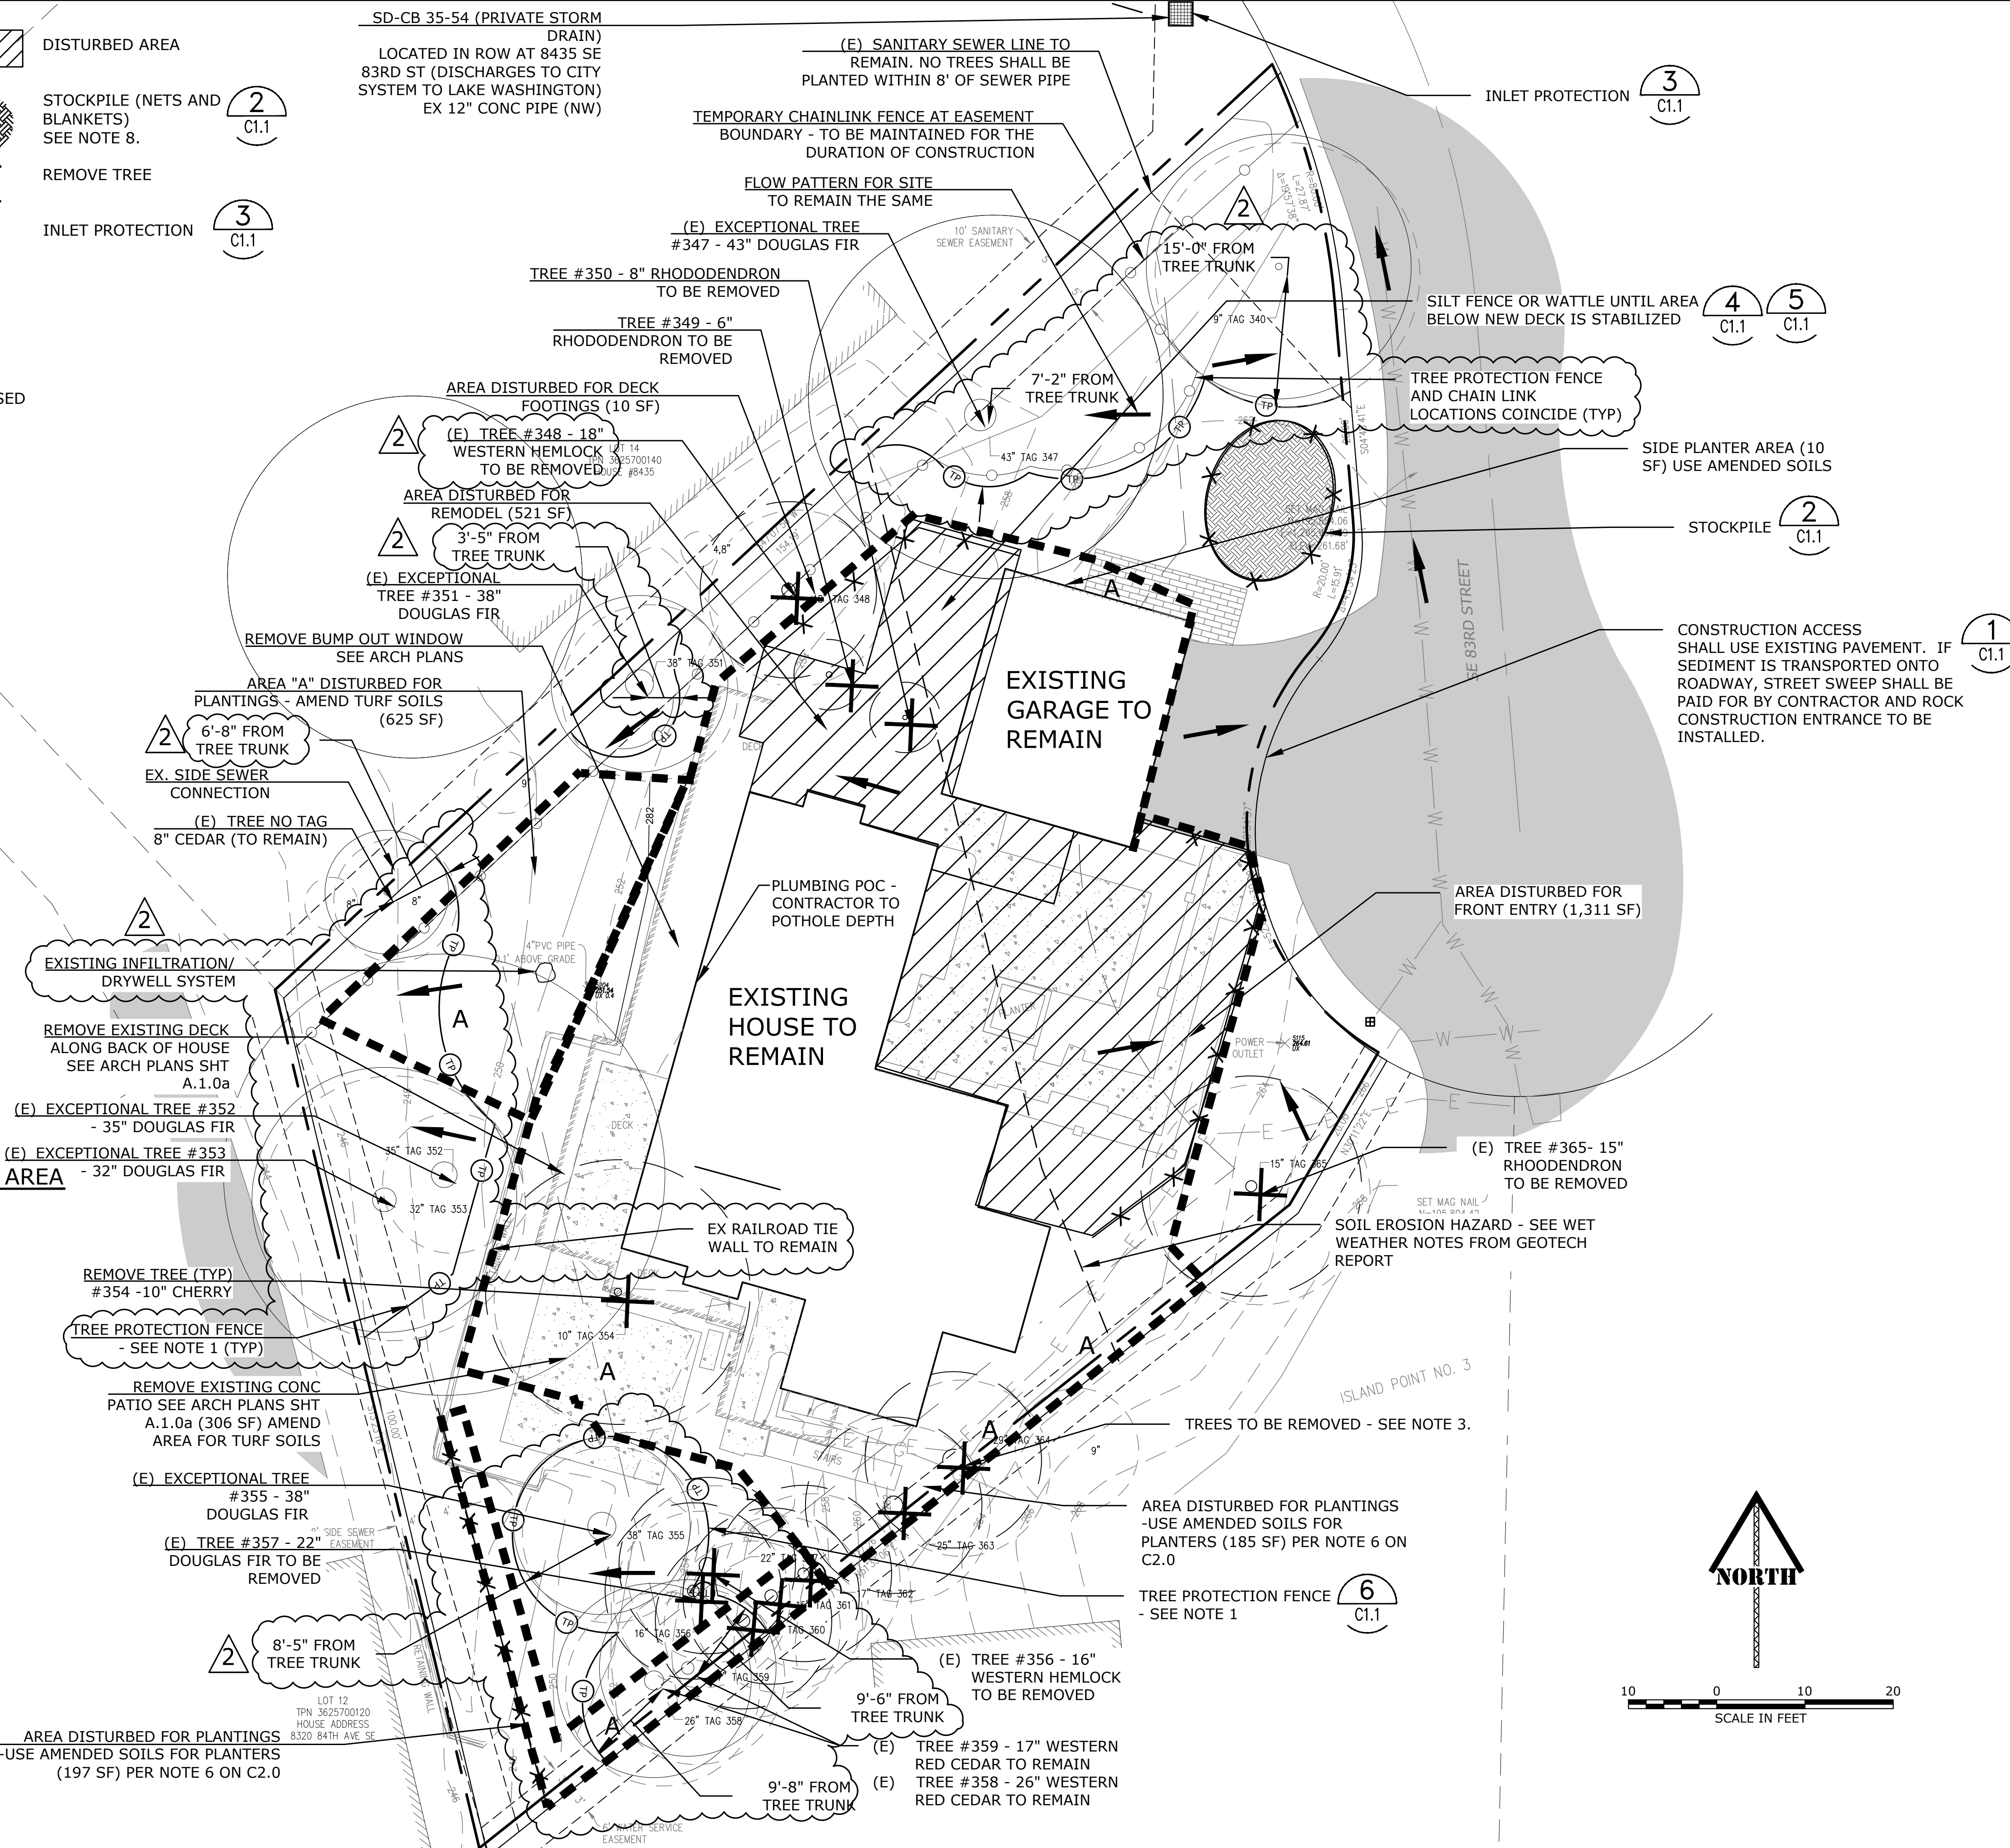

RED BARN GROUP INC.
 6610 NE 181ST ST, STE 2
 KENMORE, WA 98028
 PH. (206) 200-7174
 REDBARN-ENGINEERING.COM

811
 CALL BEFORE YOU DIG

REBEKAH J. WASHINGTON
 REGISTERED PROFESSIONAL ENGINEER
 45286
 05/31/23

DRAWN BY: RE EJW
 DESIGNED BY: RJW
 CHECKED BY: RJW

REV/SUBMITTAL	DATE
REVISION 1	04/13/23
PERMIT CORRECTIONS 2	05/31/23


PROJECT NAME:
 JAFFE RESIDENCE

PROJECT ADDRESS:
 8455 SE 83RD ST., MERCER ISLAND, WA 98080

SHEET TITLE:
TESC PLAN


SHEET NO.:
C1.0

RB PROJECT NO.:
 22-0009

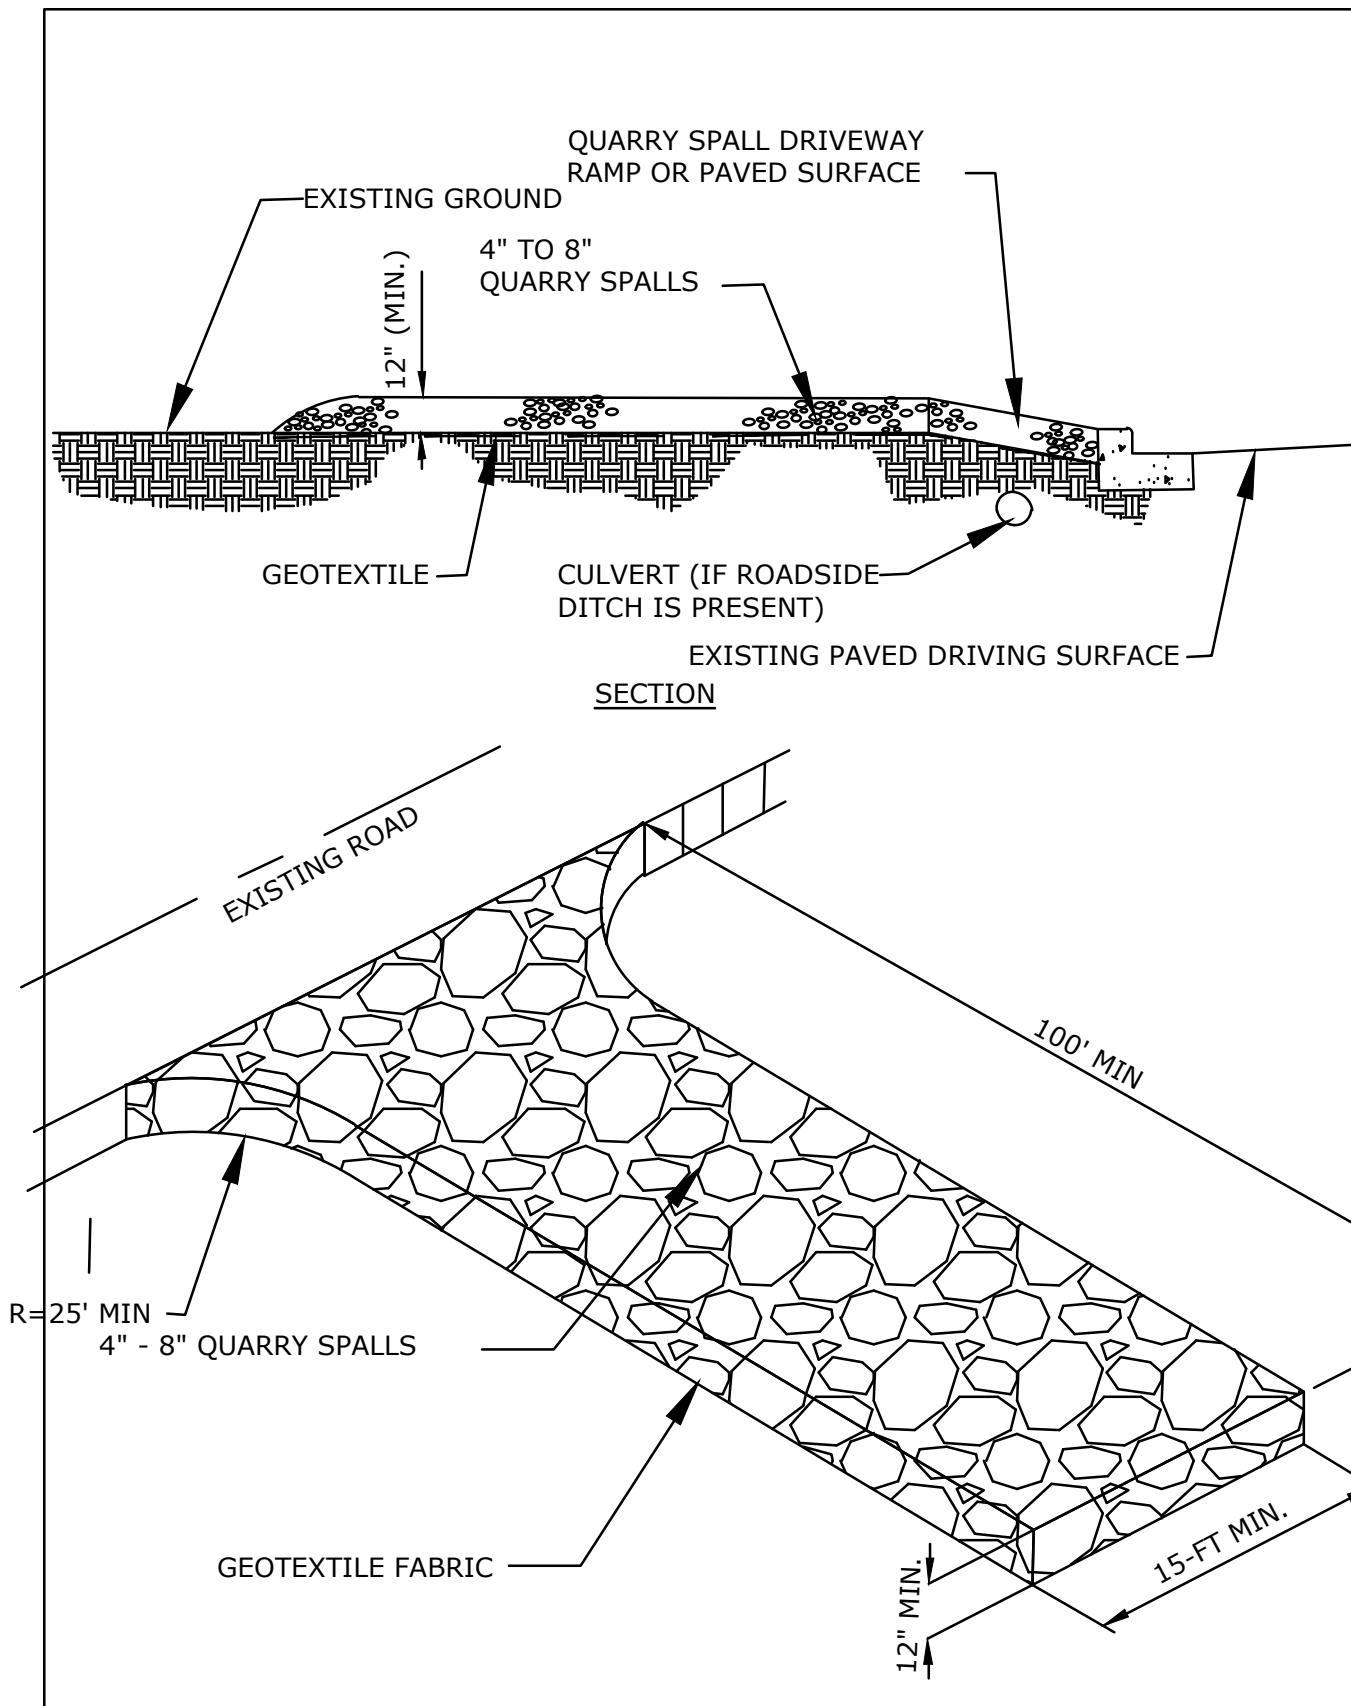

NOTE: THE EXISTING DVWY APRON TO BE USED. THIS DETAIL IS ONLY FOR IF SEDIMENT NEEDS TO BE CONTROLLED AS THE PROJECT IS FOR A REMODEL.

1 STABILIZED CONSTRUCTION ENTRANCE
NTS

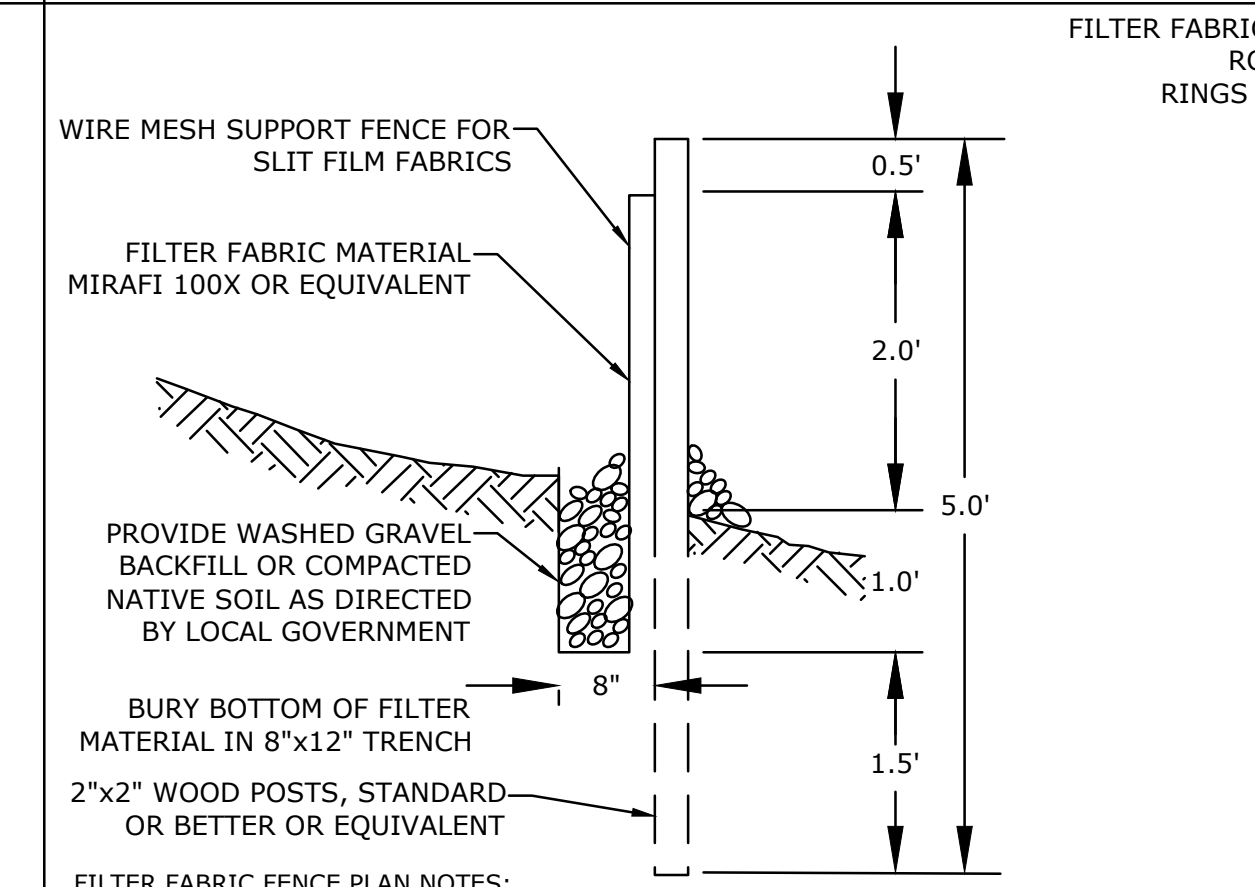

FILTER FABRIC FENCE PLAN NOTES:

1. THE CONTRACTOR SHALL INSTALL AND MAINTAIN TEMPORARY SILT FENCES AT THE LOCATIONS SHOWN IN THE PLANS.
2. CONSTRUCT SILT FENCES IN AREAS OF CLEARING, GRADING, OR DRAINAGE PRIOR TO STARTING THOSE ACTIVITIES.
3. THE SILT FENCE SHALL HAVE A 2-FOOT MIN. AND A 2½-FOOT MAX. HEIGHT ABOVE THE ORIGINAL GROUND SURFACE.
4. THE FILTER FABRIC SHALL BE SEWN TOGETHER AT THE POINT OF MANUFACTURE TO FORM FILTER FABRIC LENGTHS AS REQUIRED. LOCATE ALL SEWN SEAMS AT SUPPORT POSTS. ALTERNATIVELY, TWO SECTIONS OF SILT FENCE CAN BE OVERLAPPED, PROVIDED THE CONTRACTOR CAN DEMONSTRATE, TO THE SATISFACTION OF THE ENGINEER, THAT THE OVERLAP IS LONG ENOUGH AND THAT THE ADJACENT FENCE SECTIONS ARE CLOSE ENOUGH TOGETHER TO PREVENT SILT LADEN WATER FROM ESCAPING THROUGH THE FENCE AT THE OVERLAP.
5. ATTACH THE FILTER FABRIC ON THE UP-SLOPE SIDE OF THE POSTS AND SECURE WITH STAPLES, WIRE, OR IN ACCORDANCE WITH THE MANUFACTURER'S RECOMMENDATIONS. ATTACH THE FILTER FABRIC TO THE POSTS IN A MANNER THAT REDUCES THE POTENTIAL FOR TEARING.
6. SUPPORT THE FILTER FABRIC WITH WIRE OR PLASTIC MESH, DEPENDENT ON THE PROPERTIES OF THE GEOTEXTILE SELECTED FOR USE. IF WIRE OR PLASTIC MESH IS USED, FASTEN THE MESH SECURELY TO THE UP-SLOPE SIDE OF THE POSTS WITH THE FILTER FABRIC UP-SLOPE OF THE MESH.
7. MESH SUPPORT, IF USED, SHALL CONSIST OF STEEL WIRE WITH A MAXIMUM MESH SPACING OF 2-INCHES, OR A PREFABRICATED POLYMERIC MESH. THE STRENGTH OF THE WIRE OR POLYMERIC MESH SHALL BE EQUIVALENT TO OR GREATER THAN 180 LBS. GRAB TENSILE STRENGTH. THE POLYMERIC MESH MUST BE AS RESISTANT TO THE SAME LEVEL OF ULTRAVIOLET RADIATION AS THE FILTER FABRIC IT SUPPORTS.
8. BURY THE BOTTOM OF THE FILTER FABRIC 4-INCHES MIN. BELOW THE GROUND SURFACE. BACKFILL AND TAMP SOIL IN PLACE OVER THE BURIED PORTION OF THE FILTER FABRIC, SO THAT NO FLOW CAN PASS BENEATH THE FENCE AND SCOURING CANNOT OCCUR. WHEN WIRE OR POLYMERIC BACK-UP SUPPORT MESH IS USED, THE WIRE OR POLYMERIC MESH SHALL EXTEND INTO THE GROUND 3-INCHES MIN.
9. DRIVE OR PLACE THE FENCE POSTS INTO THE GROUND 18-INCHES MIN. A 12-INCH MIN. DEPTH IS ALLOWED IF TOPSOIL OR OTHER SOFT SUBGRADE SOIL IS NOT PRESENT AND 18-INCHES CANNOT BE REACHED. INCREASE FENCE POST MIN. DEPTHS BY 6 INCHES IF THE FENCE IS LOCATED ON SLOPES OF 3H:1V OR STEEPER AND THE SLOPE IS PERPENDICULAR TO THE FENCE. IF REQUIRED POST DEPTHS CANNOT BE OBTAINED, THE POSTS SHALL BE ADEQUATELY SECURED BY BRACING OR GUYING TO PREVENT OVERTURNING OF THE FENCE DUE TO SEDIMENT LOADING.

4 FILTER FABRIC FENCE
NTS


FILTER FABRIC SPECIFICATIONS	
AOS (ASTM D4751)	30-100 SIEVE SIZE (0.60-0.15 mm) FOR SLIT FILM 50-100 SIEVE SIZE (0.30-0.15 mm) FOR OTHER FABRIC
WATER PERMITTIVITY (ASTM D4491)	0.02 SEC ⁻¹ MINIMUM
GRAB TENSILE STRENGTH (ASTM D4632)	180 LBS MIN. FOR EXTRA STRENGTH 100 LBS MIN. FOR STD. STRENGTH FABRIC
GRAB TENSILE ELONGATION (ASTM D4632)	30% MAX.
ULTRAVIOLET RESISTANCE (ASTM D4355)	70% MAX.

MAINTENANCE STANDARD:

1. QUARRY SPALLS SHALL BE ADDED IF THE PAD IS NO LONGER IN ACCORDANCE WITH THE SPECIFICATIONS.
2. IF THE ENTRANCE IS NOT PREVENTING SEDIMENT FROM BEING TRACKED ONTO PAVEMENT, THEN ALTERNATIVE MEASURES TO KEEP THE STREETS FREE OF SEDIMENT SHALL BE USED. THIS MAY INCLUDE STREET SWEEPING, AN INCREASE IN THE DIMENSIONS OF THE ENTRANCE, OR THE INSTALLATION OF A WHEEL WASH. IF WASHING IS USED, IT SHALL BE DONE ON AN AREA COVERED WITH CRUSHED ROCK AND WASH WATER SHALL DRAIN TO A SEDIMENT TRAP OR POND.
3. ANY SEDIMENT THAT IS TRACKED ONTO PAVEMENT SHALL BE REMOVED IMMEDIATELY BY SWEEPING. THE SEDIMENT COLLECTED BY SWEEPING SHALL BE REMOVED OR STABILIZED ON-SITE. THE PAVEMENT SHALL NOT BE CLEANED BY WASHING DOWN THE STREET. EXCEPT WHEN SWEEPING IS INEFFECTIVE AND THERE IS A THREAT TO PUBLIC SAFETY. IF IT IS NECESSARY TO WASH THE STREETS, THE CONSTRUCTION OF A SMALL SUMP SHALL BE CONSIDERED. THE SEDIMENT WOULD THEN BE WASHED INTO THE SUMP.
4. ANY QUARRY SPALLS THAT ARE LOOSENED FROM THE PAD AND END UP ON THE ROADWAY SHALL BE REMOVED IMMEDIATELY.
5. IF VEHICLES ARE ENTERING OR EXITING THE SITE AT POINTS OTHER THAN THE CONSTRUCTION ENTRANCE(S), FENCING SHALL BE INSTALLED TO CONTROL TRAFFIC.

NOTES:

1. STABILIZED ACCESS SHALL BE USED IN ALL AREAS OF THE SITE WITH VEHICLE TRAFFIC AND PARKING, INCLUDING PLANTING STRIPS.
2. SEE SECTION 9-37.2 (TABLE 3) FOR GEOTEXTILE REQUIREMENTS. GEOTEXTILE MODIFICATIONS BASED ON SPECIFIC PROJECT SITE CONDITIONS MUST BE APPROVED BY THE ENGINEER.
3. 100-FT MIN FOR LARGE SITES. UPON INSPECTOR APPROVAL LENGTH FOR SMALL SITES MAY BE REDUCED TO 50-FT OR LESS.

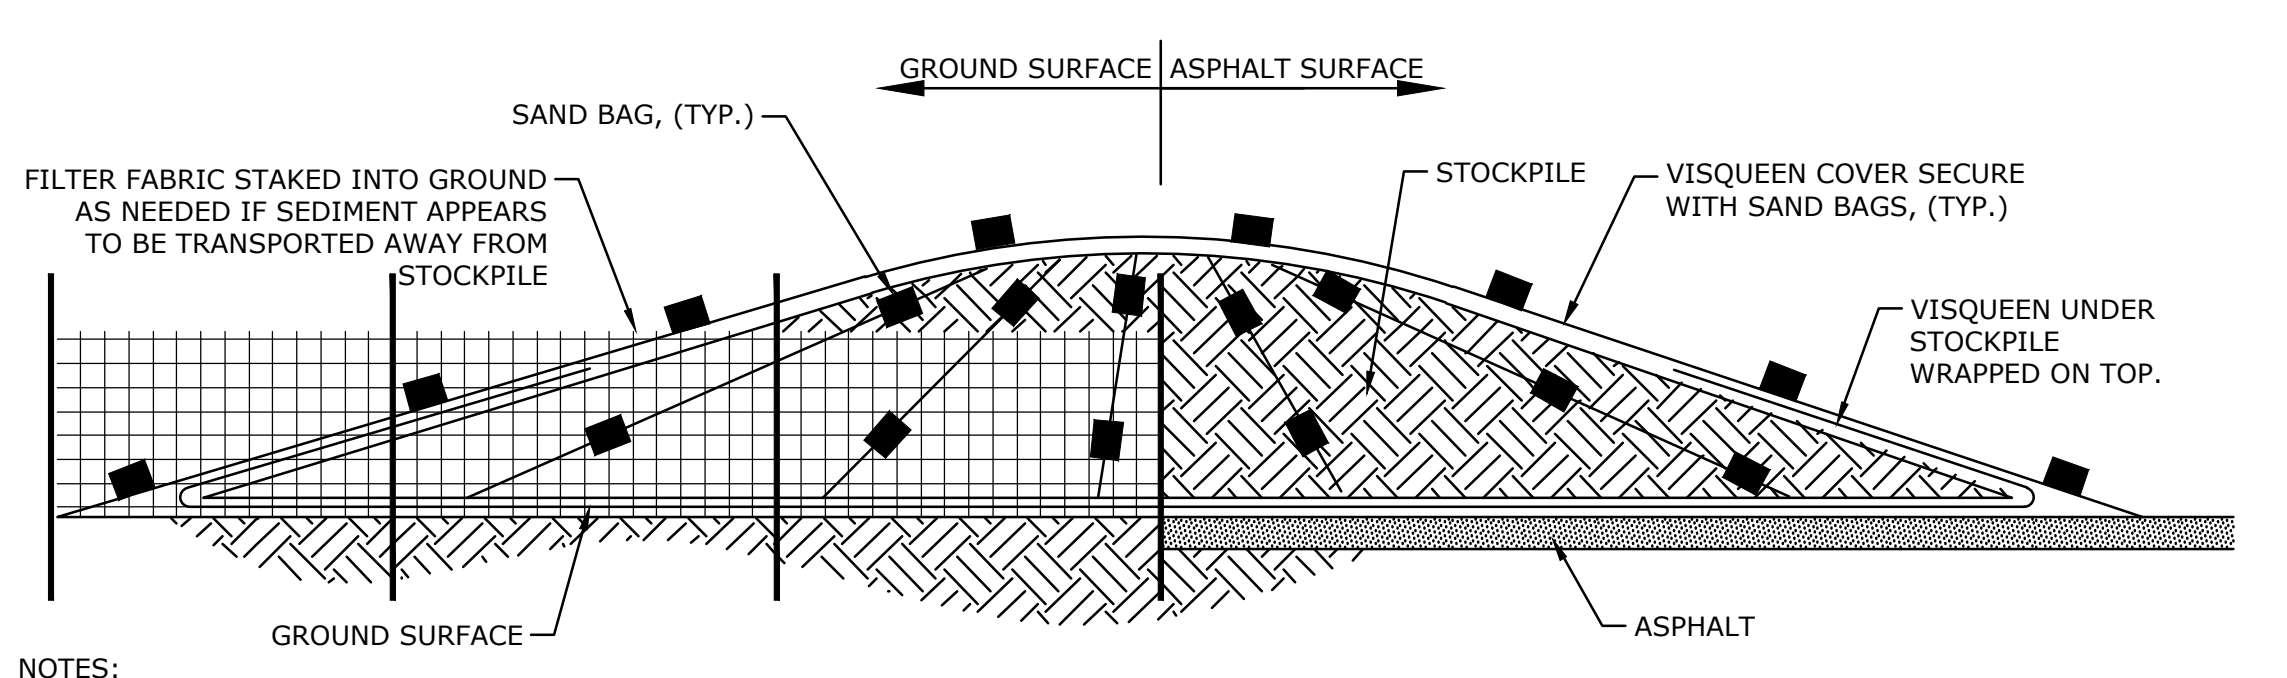


NOTES:


1. CLEAR PLASTIC SHEETING SHALL HAVE A MINIMUM THICKNESS OF 6 MIL AND SHOULD MEET THE REQUIREMENTS OF THE SDOT STANDARD SPECIFICATIONS SECTION 9-14.5.
2. PLACE PLASTIC INTO A SMALL (12-INCH WIDE BY 6-IN DEEP) SLOT TRENCH AT THE TOP OF THE SLOPE AND BACKFILL WITH SOIL TO KEEP WATER FROM FLOWING UNDERNEATH.
3. INSTALL COVERING AND MAINTAIN TIGHTLY IN PLACE BY USING SANDBAGS OR TIRES ON ROPES WITH A MAXIMUM 10 FOOT GRID SPACING IN ALL DIRECTIONS. TAPE OR WEIGH DOWN ALL SEAMS FULL LENGTH WITH AT LEAST A 1- TO 2-FT OVERLAP OF ALL SEAMS. THEN ROLL, STAKE OR TIE ALL SEAMS.
4. IMMEDIATELY INSTALL COVERING ON AREAS SEEDED FROM NOVEMBER 1 TO MARCH 1, AND KEEP COVERING IN PLACE UNTIL VEGETATION IS FIRMLY ESTABLISHED.
5. WHEN THE COVERING IS USED ON UNSEEDED SLOPES, LEAVE IN PLACE UNTIL THE NEXT SEEDING PERIOD.
6. TOE IN SHEETING AT THE TOP OF THE SLOPE TO PREVENT SURFACE FLOW BENEATH THE PLASTIC. IF EROSION AT THE TOP OF SLOPE IS LIKELY, INSTALL A GRAVEL BERM, RIPRAP, OR OTHER SUITABLE PROTECTION AT THE TOE OF THE SLOPE IN ORDER TO REDUCE THE VELOCITY OF RUNOFF.
7. REMOVE SHEETING AS SOON AS IS POSSIBLE ONCE VEGETATION IS WELL GROWN TO PREVENT BURNING THE VEGETATION THROUGH THE PLASTIC SHEETING, WHICH ACTS AS A GREENHOUSE.

MAINTENANCE:
CHECK REGULARLY FOR RIPS AND PLACES WHERE THE PLASTIC MAY BE DISLODGED. CONTACT BETWEEN THE PLASTIC AND THE GROUND SHOULD ALWAYS BE MAINTAINED. ANY AIR BUBBLES FOUND SHOULD BE REMOVED IMMEDIATELY OR THE PLASTIC MAY RIP DURING THE NEXT WINDY PERIOD. RE-ANCHOR OR REPLACE THE PLASTIC AS NECESSARY.

2 STOCKPILE AND PLASTIC COVERING
NTS

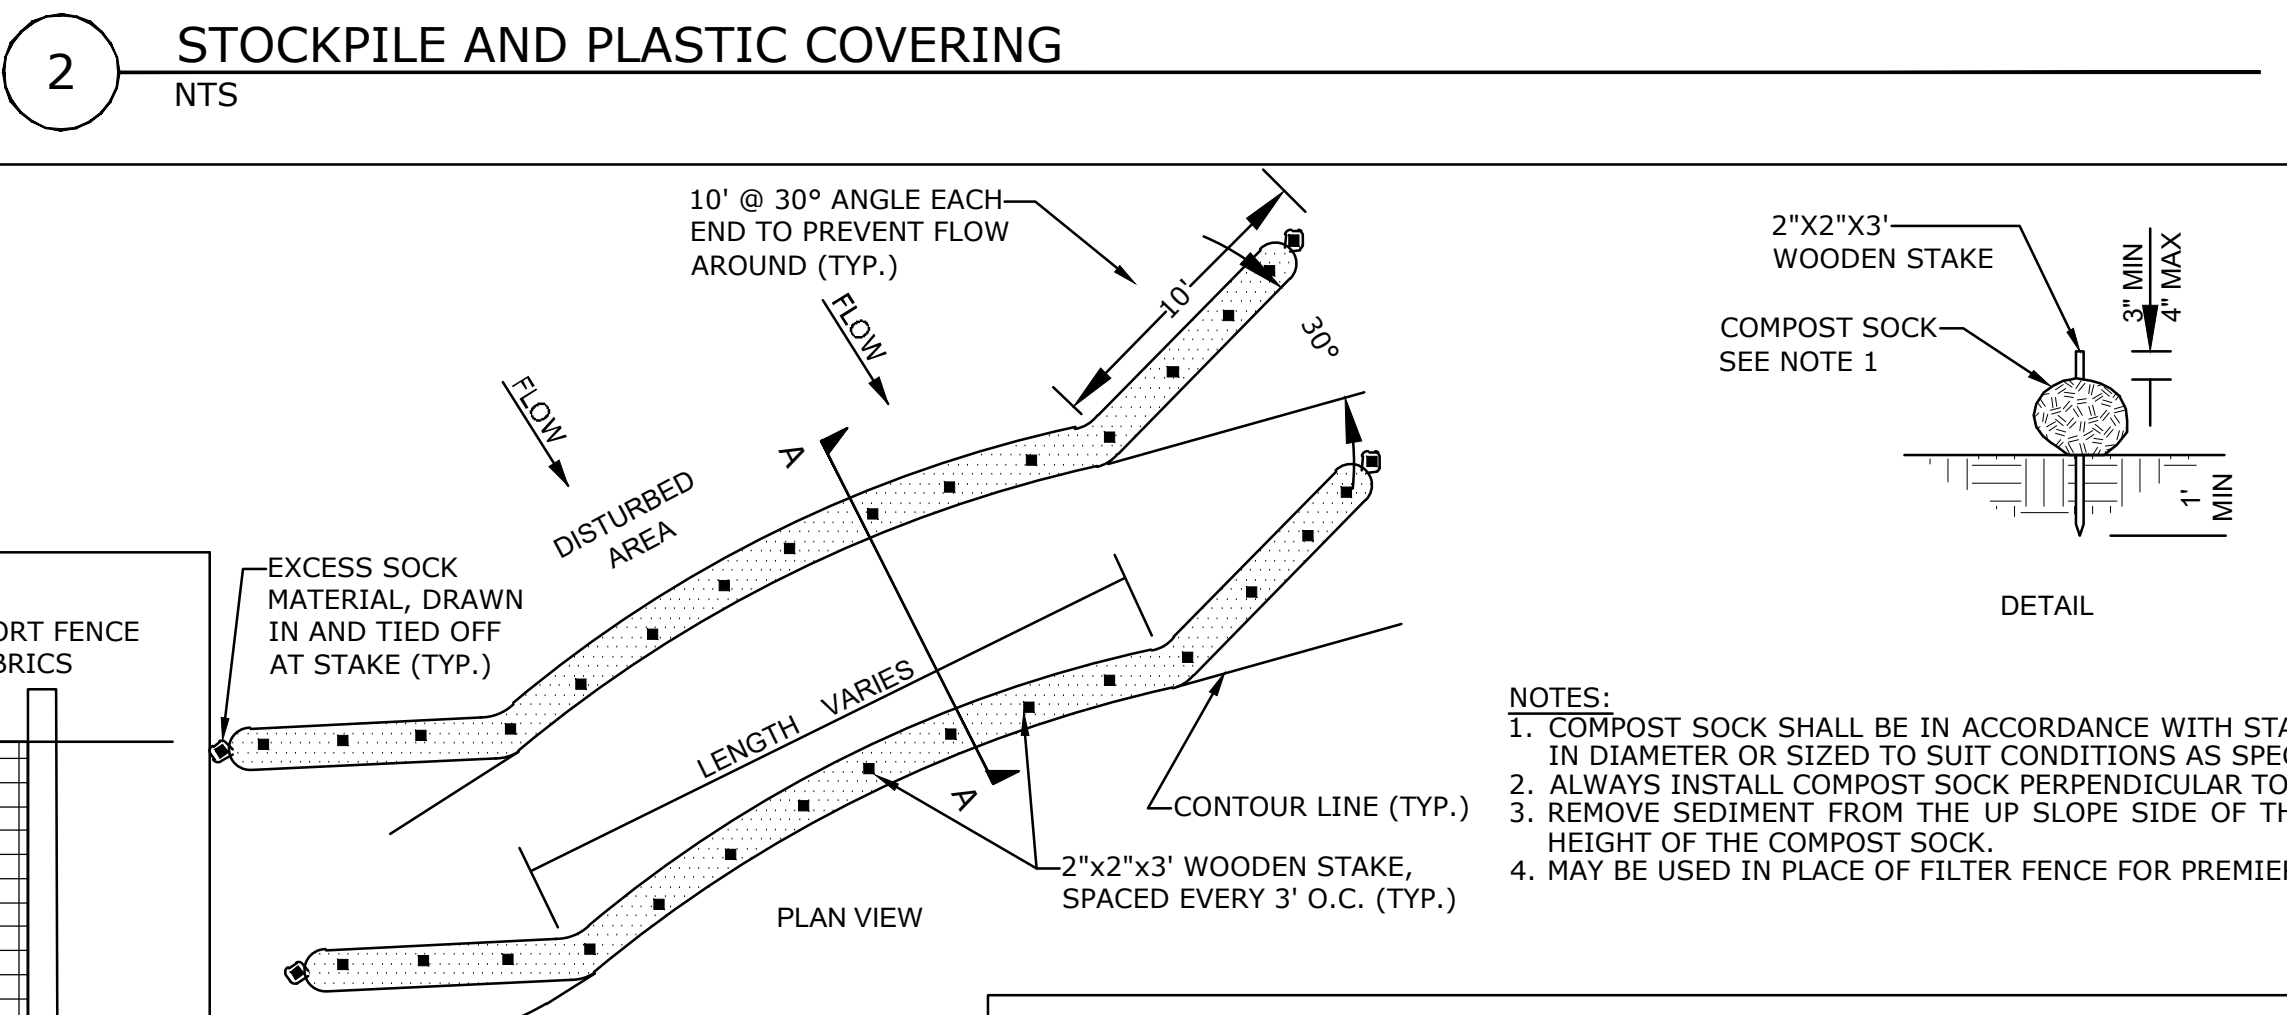

5 COMPOST SOCK
NTS

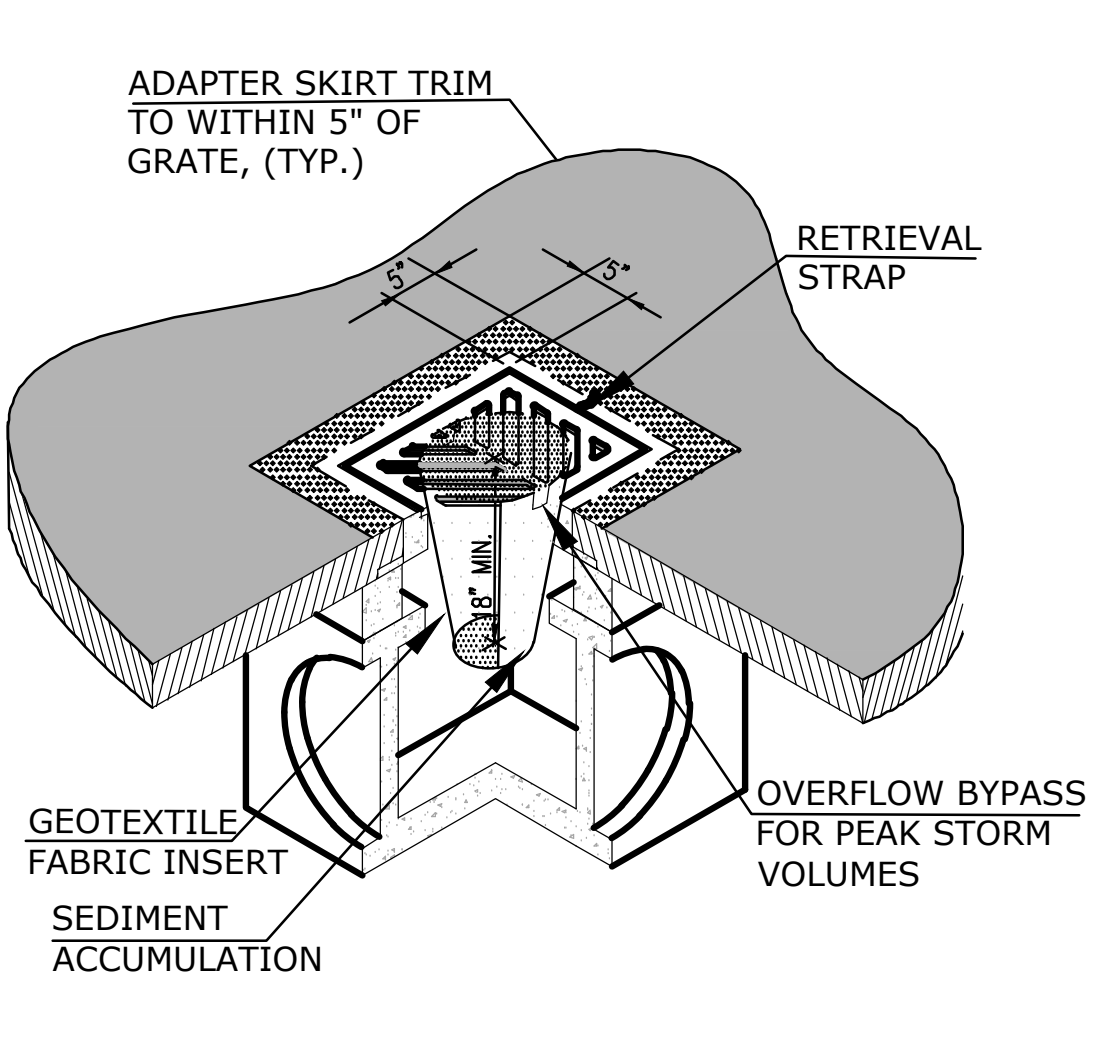

NOTES:


1. INSERT SHALL BE INSTALLED PRIOR TO CLEARING AND GRADING ACTIVITY, OR UPON PLACEMENT OF A NEW CATCH BASIN.
2. SEDIMENT SHALL BE REMOVED FROM THE UNIT WHEN IT BECOMES HALF FULL.
3. SEDIMENT REMOVAL SHALL BE ACCOMPLISHED BY REMOVING THE INSERT, EMPTYING, AND REINSERTING IT INTO THE CATCH BASIN.

3 INLET PROTECTION
NTS

DO NOT REMOVE OR ADJUST THE APPROVED LOCATION OF THIS TREE PROTECTION AREA

Trees enclosed by this fence are protected and are subject to the conditions of the tree permit. Violation of tree conditions may lead to:

1. Correction Notices or Stop Work Orders until compliance is achieved
2. RE Inspection Fees
3. Arborist reports recommending mitigation

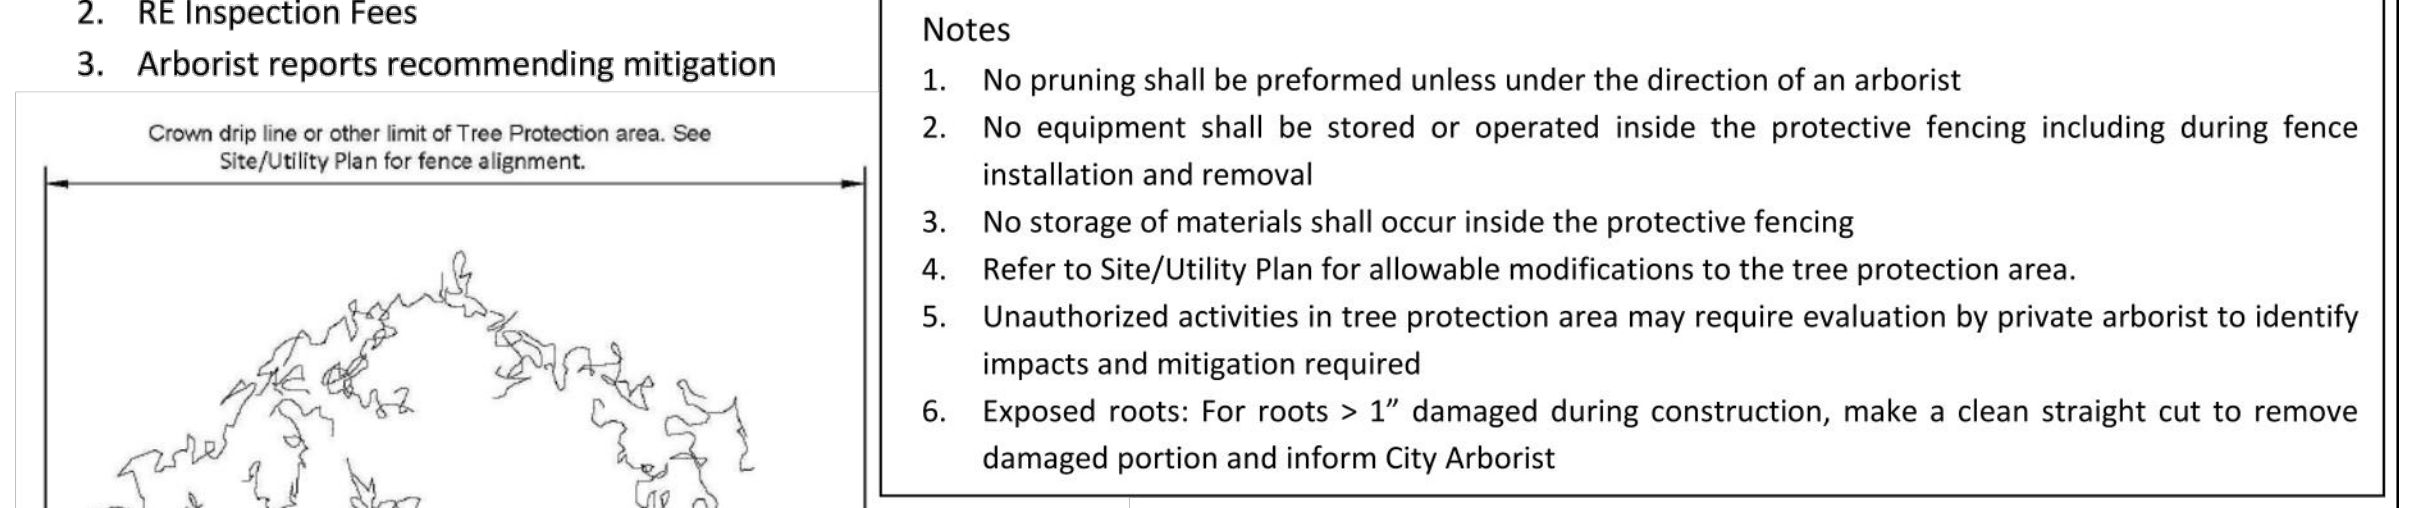

Notes

1. No pruning shall be performed unless under the direction of an arborist
2. No equipment shall be stored or operated inside the protective fencing including during fence installation and removal
3. No storage of materials shall occur inside the protective fencing
4. Refer to Site/Utility Plan for allowable modifications to the tree protection area.
5. Unauthorized activities in tree protection area may require evaluation by private arborist to identify impacts and mitigation required
6. Exposed roots: For roots > 1\"/>

2\"/>

Maintain existing grade with the tree protection fence unless otherwise indication on the plans

Any Work in the protected area must be with the permission of the City Arborist john.kenney@mercergov.org

6 TREE PROTECTION
NTS



811
CALL BEFORE YOU DIG



DRAWN BY: RE EJW
DESIGNED BY: RJW
CHECKED BY: RJW

REV/SUBMITTAL	DATE
REVISION 1	04/13/23
PERMIT CORRECTIONS 2	05/31/23


PROJECT NAME:
JAFFE RESIDENCE

PROJECT ADDRESS:
8455 SE 83RD ST., MERCER ISLAND, WA 98080

SHEET TITLE:
TESC DETAILS

SHEET NO.:
C1.1

RB PROJECT NO.:
22-0009

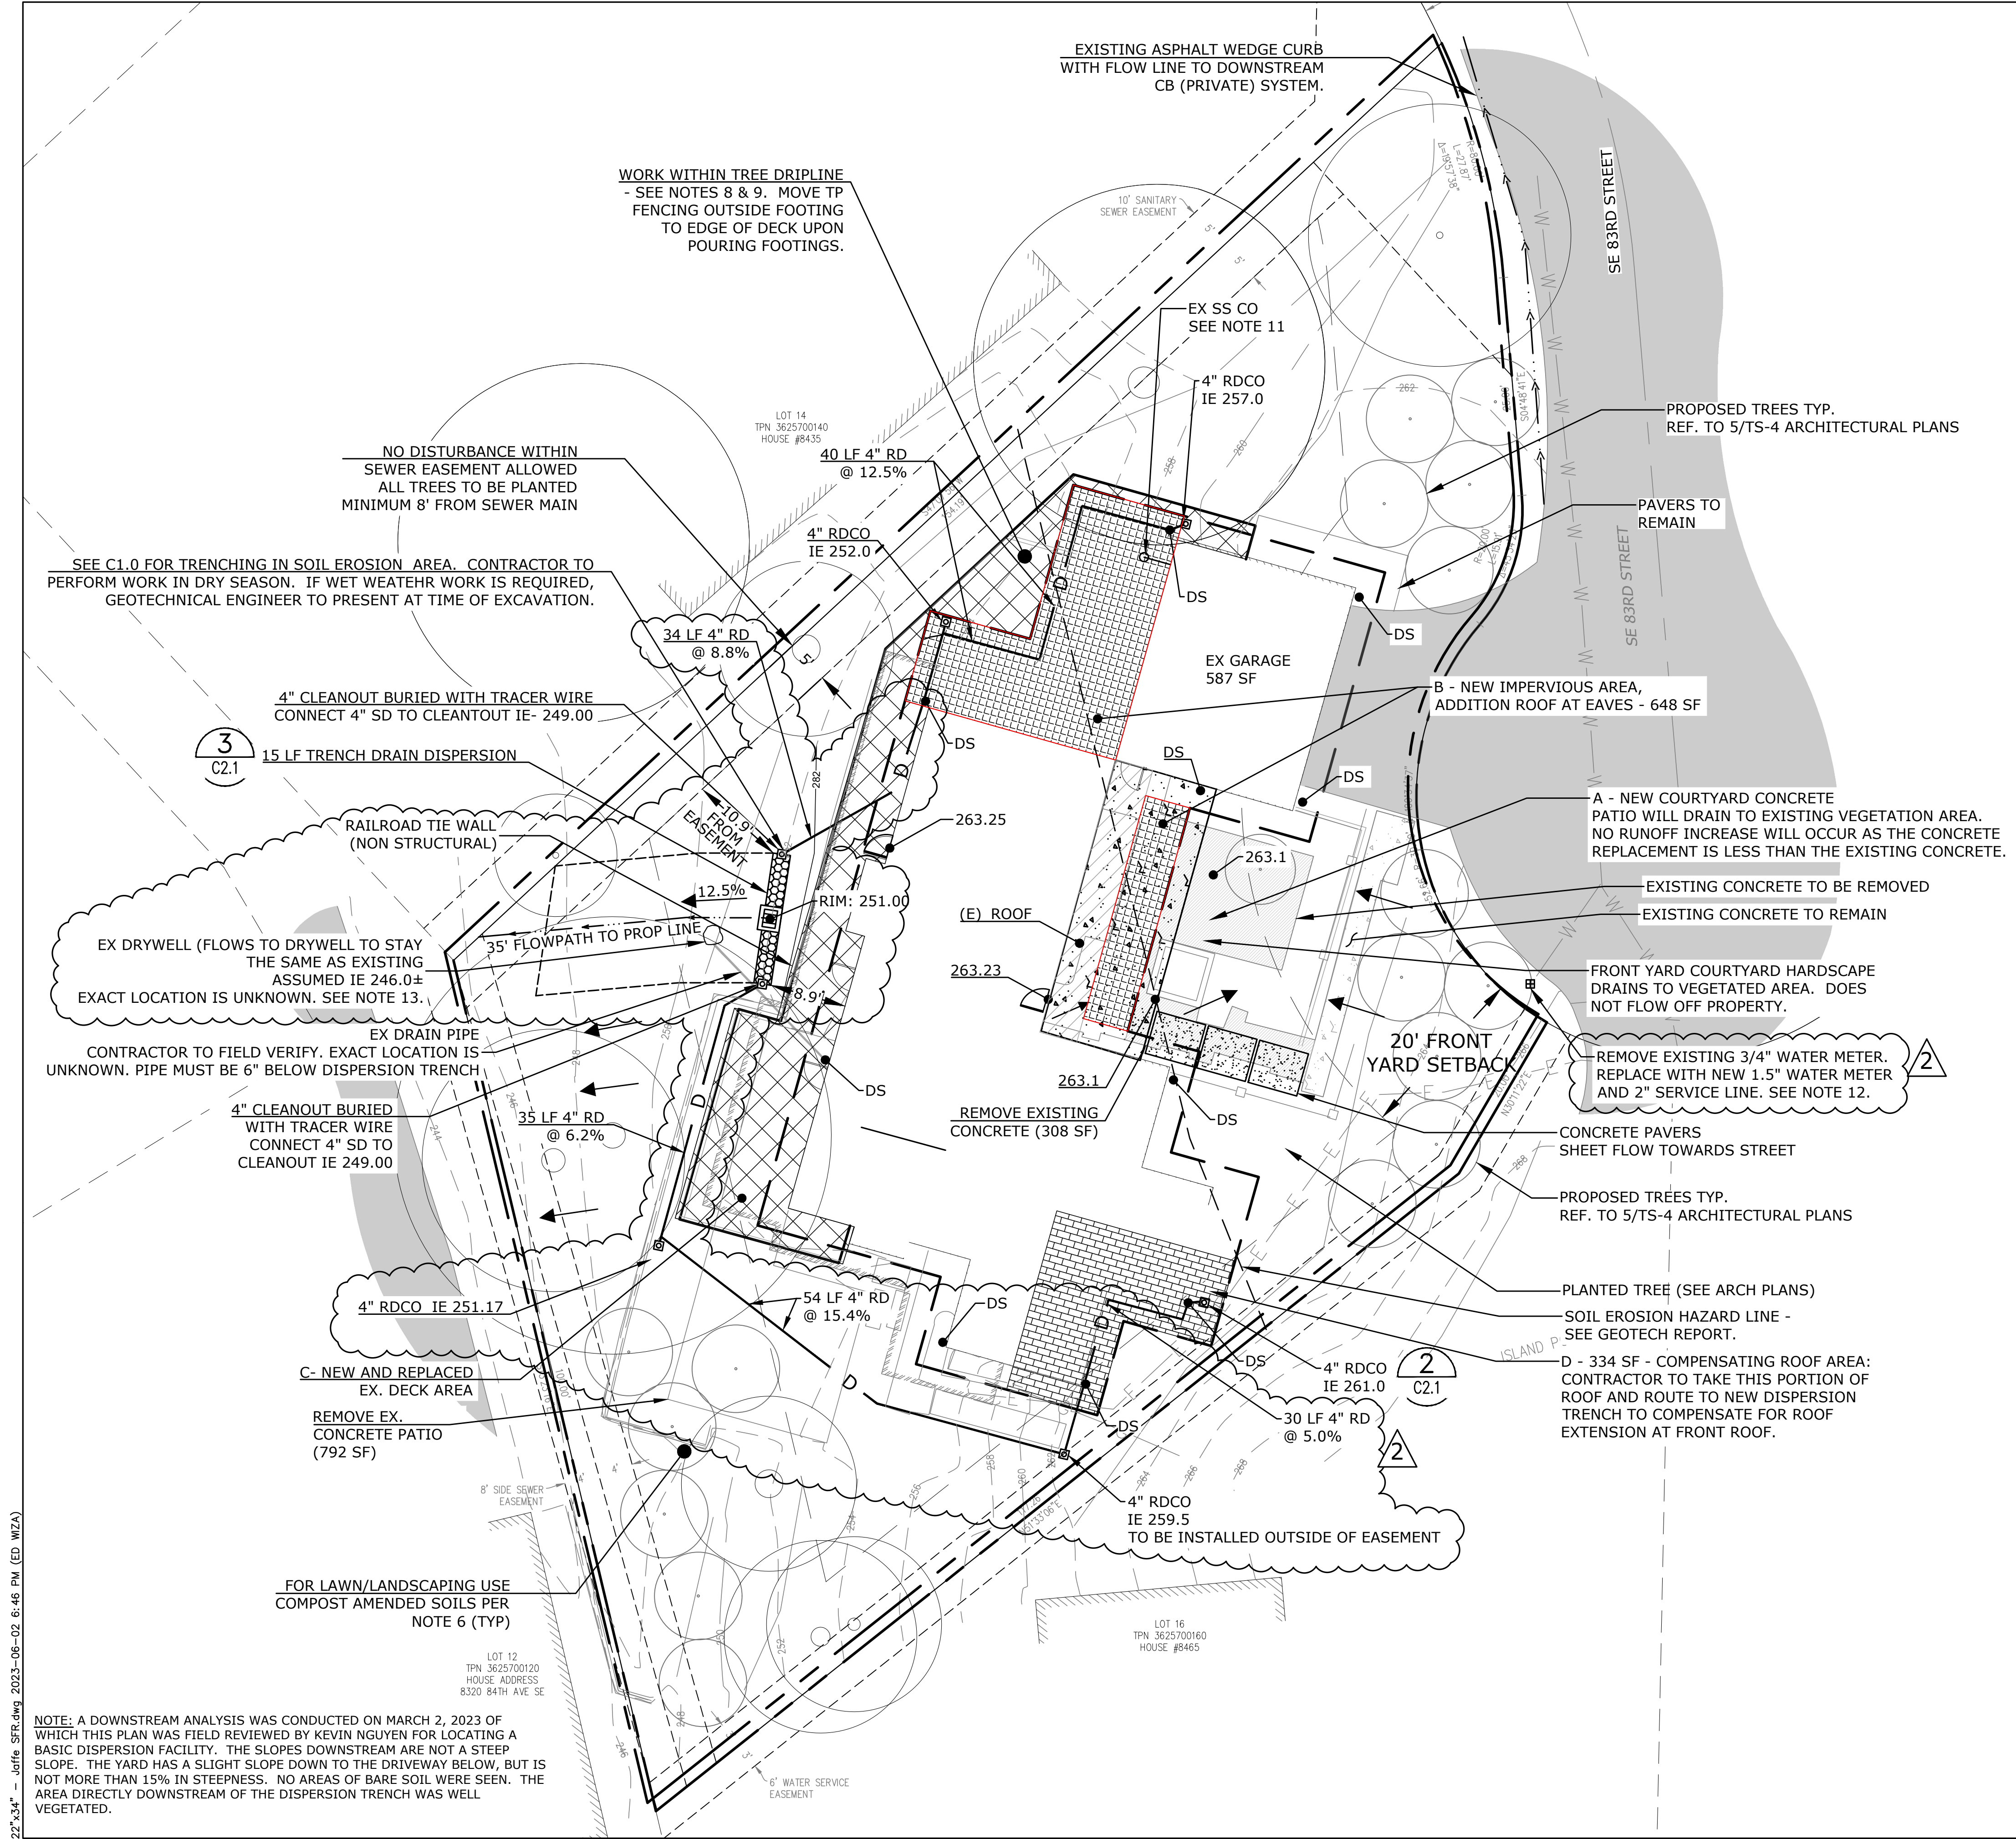


LEGEND:

- STORM DRAIN CLEANOUT
- DOWNSPOUT (DS) PER ARCH PLANS
- RD ROOF DRAIN (SMOOTH-WALLED PVC ASTM 3034 SDR 35)
- NEW ROOF (ABOVE)
- TREE PROTECTION
- EXISTING CONCRETE TO BE REMOVED
- NEW COURTYARD CONCRETE
- CONCRETE PAVERS
- COMPENSATING ROOF AREA
- NEW ROOF AREA
- NEW AND REPLACED DECK

NOTES

1. ALL WORK SHALL BE DONE IN ACCORDANCE WITH THE CITY OF MERCER ISLAND CURRENT STANDARD SPECIFICATIONS.
2. STORM DRAIN SYSTEM SHALL NOT BE TIED INTO FOOTING DRAIN (FD) SYSTEM. SEE NOTE 7.
3. CONTRACTOR TO AS-BUILT STORM AND ANY CHANGES TO SAN. SEWER SYSTEM UPON COMPLETION.
4. UNLESS OTHERWISE NOTED, SD SHALL BE 6" PE PIPE RIGID W/ SMOOTH WALL INTERIOR. SD SHALL BE AT 2.0% MINIMUM.
5. CONTRACTOR TO CLEAN EXISTING DRYWELL AND REPLACE GRAVEL AS NEEDED.
6. THE LAWN AND LANDSCAPE AREAS ARE REQUIRED TO PROVIDE POST-CONSTRUCTION SOIL QUALITY AND DEPTH IN ACCORDANCE WITH BMP T5.13. THE PROJECT CIVIL ENGINEER MUST PROVIDE A LETTER OF CERTIFICATION TO ENSURE THAT THE LAWN AND LANDSCAPE AREAS ARE MEETING THE POST-CONSTRUCTION SOIL QUALITY AND DEPTH REQUIREMENTS SPECIED ON THE APPROVED PLAN AND BMPT5.13 (2014 DOE MANUAL) SET PRIOR TO FINAL INSPECTION OF THE PROJECT.
7. SD SHALL BE SDR 35 ASTM 3034 SMOOTH-WALLED PIPE. SS SHALL BE SCH 40 PVC. FD SHALL BE 4" PERF SCH 40 PVC. FD SHALL ENTER AREA DRAIN 1-FT HIGHER THAN ROOF DRAIN LINE. CONNECT DS TO TIGHTLINE.
8. CONTRACTOR TO ENGAGE ARBORIST WHILE PERFORMING GRADING WITHIN DRIPLINE OF TREES.
9. ANY ROOT GREATER THAN 2" IN DIAMETER TO BE CUT SHOULD BE SUPERVISED BY ARBORIST.
10. DOWNSPOUT TIGHTLINE TO BE VIDEO INSPECTED BY ENGINEER PRIOR TO BURYING PIPE. GEOTECHNICAL ENGINEER TO INSPECT DRYWELL AT TIME OF MAINTENANCE.
11. SIDE SEWER CLEANOUT TO BE RELOCATED OUTSIDE OF BUILDING FOOTPRINT. CONTRACTOR TO LOCATE BASED ON FIELD CONDITIONS/OBSERVATIONS. THE TV INSPECTION OF THE EXISTING SIDE SEWER TO THE CITY SEWER MAIN IS REQUIRED PRIOR TO ANY WORK RELATED TO THE SIDE SEWER. IF THE RESULT OF THE TV INSPECTION IS NOT IN SATISFACTORY CONDITION, AS DETERMINED BY THE CITY OF MERCER ISLAND INSPECTOR, THE REPLACEMENT OF THE EXISTING SIDE SEWER IS REQUIRED.
12. CONTRACTOR TO VERIFY THE SERVICE ADDRESS TO THE EXISTING WATER METER PRIOR TO ABANDONING THE EXISTING WATER METER AND SERVICE LINE. REFER TO WATER SERVICE PERMIT FOR ACTUAL LOCATION OF NEW WATER METER AND SERVICE LINE DETERMINED BY MERCER ISLAND WATER DEPARTMENT.
13. CONTRACTOR TO LOCATE DRYWELL LOCATION, AND CONTACT CIVIL ENGINEER IF LOCATION IS WITHIN DISPERSION FLOWPATH.

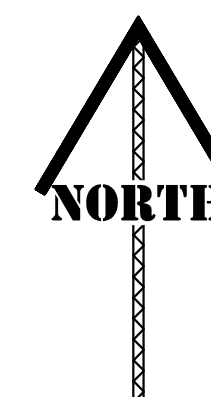

EXCEPTIONAL TREE LIST
SEE ARBORIST REPORT AND SHEET TS-2



RED BARN GROUP INC.
6610 NE 181ST ST, STE 2
KENMORE, WA 98028
PH. (206) 200-7174
REDBARN-ENGINEERING.COM

811

CALL BEFORE YOU DIG



05/31/23

DRAWN BY: RE EJW

DESIGNED BY: RJW

CHECKED BY: RJW

REV/SUBMITTAL	DATE
REVISION 1	04/13/23
PERMIT CORRECTIONS 2	05/31/23

PROJECT NAME:
JAFFE RESIDENCE

PROJECT ADDRESS:
8455 SE 83RD ST., MERCER ISLAND, WA 98080


SHEET TITLE:
OVERALL DRAINAGE PLAN

SHEET NO.:

C2.0



RB PROJECT NO.:

22-0009

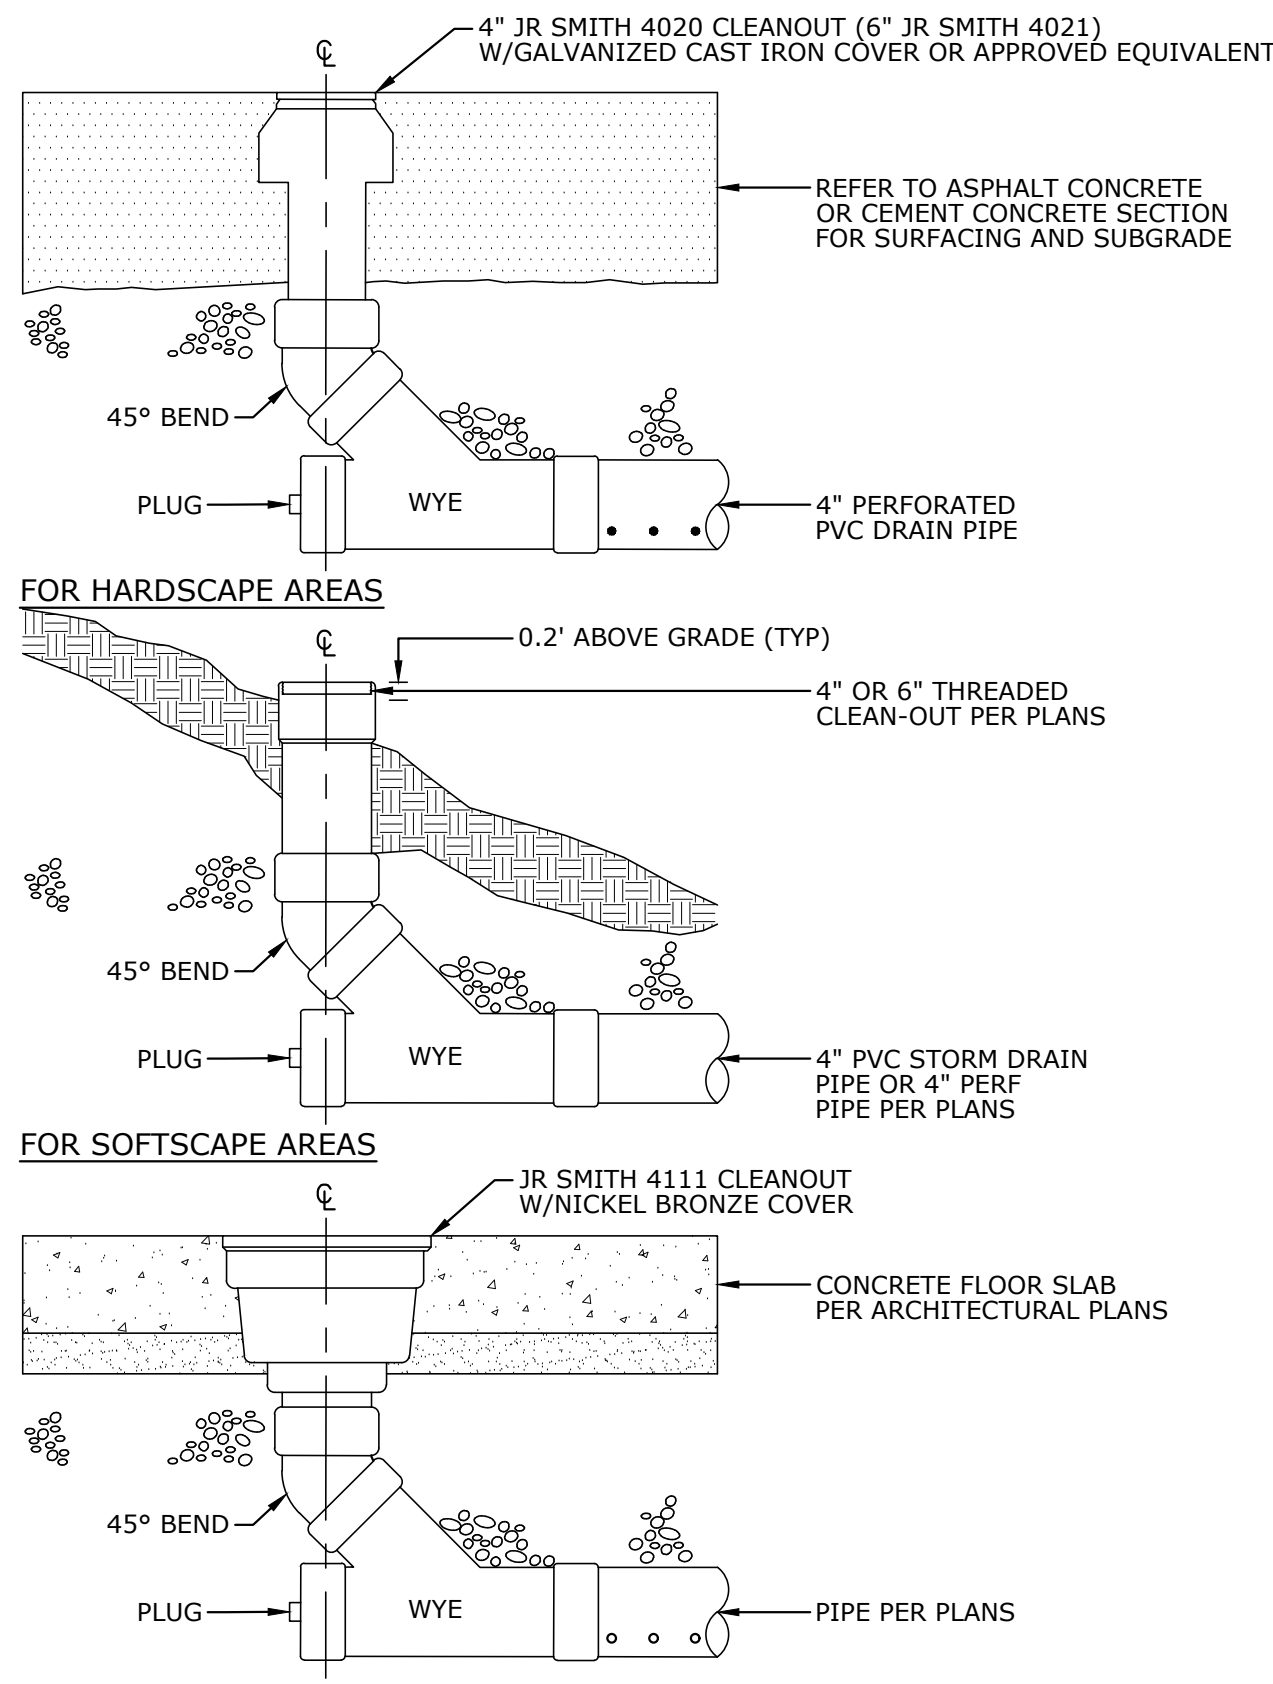

2 CLEANOUT
NTS

1 NOT USED

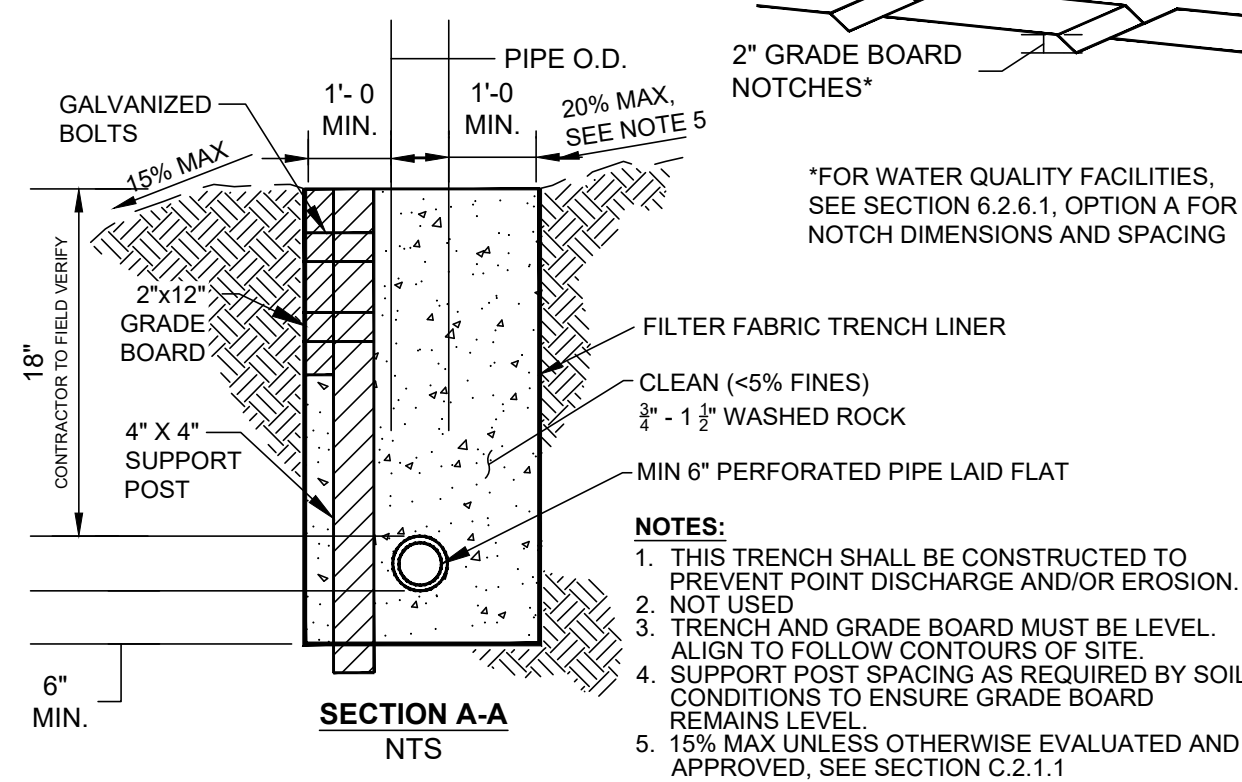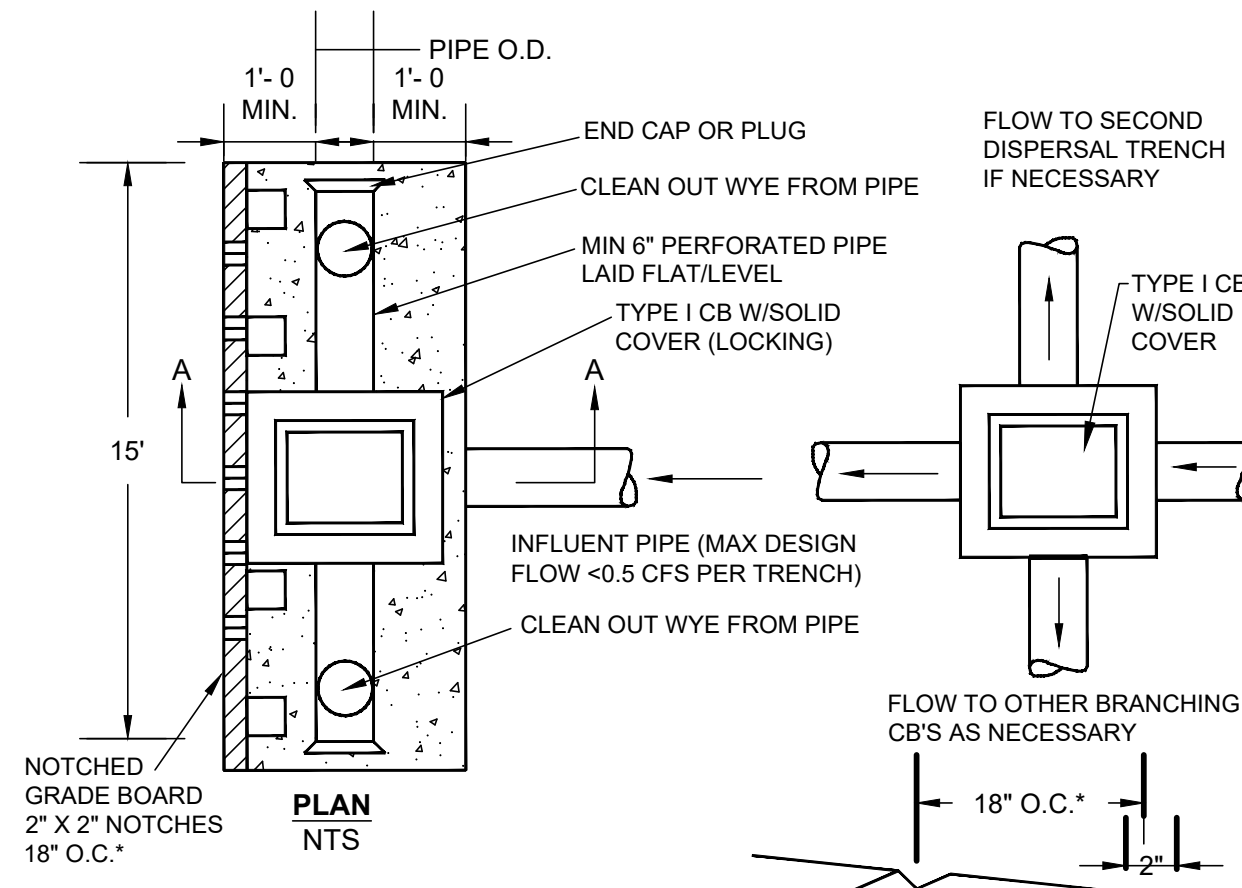

- NOTES:**
1. THIS TRENCH SHALL BE CONSTRUCTED TO PREVENT POINT DISCHARGE AND/OR EROSION.
 2. NOT USED
 3. TRENCH AND GRADE BOARD MUST BE LEVEL. ALIGN TO FOLLOW CONTOURS OF SITE.
 4. SUPPORT POST SPACING AS REQUIRED BY SOIL CONDITIONS TO ENSURE GRADE BOARD REMAINS LEVEL.
 5. 15% MAX UNLESS OTHERWISE EVALUATED AND APPROVED, SEE SECTION C.2.1.1


3 DISPERSION TRENCH DETAIL
NTS

AREA	DESC.	NEW IMPERVIOUS AREA (SF)	DRAINAGE DISCUSSION	IMPERVIOUS AREA TO EXISTING DRAINAGE SYSTEM
A	WALKWAYS & UNCOVERED PATIO	288	THE AREA IS LOCATED NEAR THE FRONT ENTRY AND DOES NOT DRAIN OFF-SITE. (SEE ARCH PLANS TS-3)	0
B1	ROOF	190	THIS AREA WILL BE ROUTED TO THE BASIC DISPERSION TRENCH (SEE ARCH PLANS TS-3)	0
B2	ROOF	(COVER EX. CONCRETE)	THE ROOF EXTENSION IS OVER THE EXISTING CONCRETE. THEREFORE IT DOES NOT COUNT AS "NEW IMPERVIOUS". IT IS COUNTED ONLY FOR MAKING SURE FEWER FLOWS GO TO THE EXISTING TIGHTLINE SYSTEM. (SEE ARCH PLANS TS-3, AREA H2)	CURRENTLY, 193 SF GOES TO THE EXISTING SYSTEM. THE EXTENSION OF 2 FEET ADDS 100 SF OF IMPERVIOUSNESS. WE ARE REROUTING AREA D TO THE BASIC DISPERSION TRENCH IN ORDER TO NOT ADD OR COMPENSATE FOR THE ADDITIONAL 100 SF.
C	UNCOVERED DECK		FLOWS THROUGH BOARDS TO MULCH AREA BELOW DECK AND FLOWS WITH NATURAL FLOW PATTERN.	THE ARCH PLANS CALL FOR 148 SF. PER DRAINAGE CODE IT HAS FLOW-THROUGH BOARDS AND IS THEREFORE PERVIOUS PER MICC.
D	COMPENSATING ROOF		334 SF OF THE SOUTHEAST ROOF IS ROUTED TO THE BASIC DISPERSION TRENCH TO ACCOMMODATE THE B2 ROOF EXTENSION AND THE ADDITIONAL 100 SF TO THE EXISTING SYSTEM.	THE EXISTING SYSTEM WILL HAVE 100 SF - 334 SF = -234 SF (SO 234 FEWER SQUARE FEET GOING TO THE EXISTING SYSTEM)
R	REMOVED IMPERVIOUS SURFACE	(1,100)	PER ARCH PLANS TS-3 THERE IS 1,100 SF OF REMOVED IMPERVIOUS SURFACE	
NET		743-1,100=-357	A REDUCTION IN TOTAL IMPERVIOUS AREA OCCURS PER THE EXISTING PLAN	

AREA	DESCRIPTION	NEW PERVIOUS AREA (SF)	DRAINAGE DISCUSSION
P	LANDSCAPING	90	FOLLOWS EXISTING FLOW PATTERN



811
CALL BEFORE YOU DIG

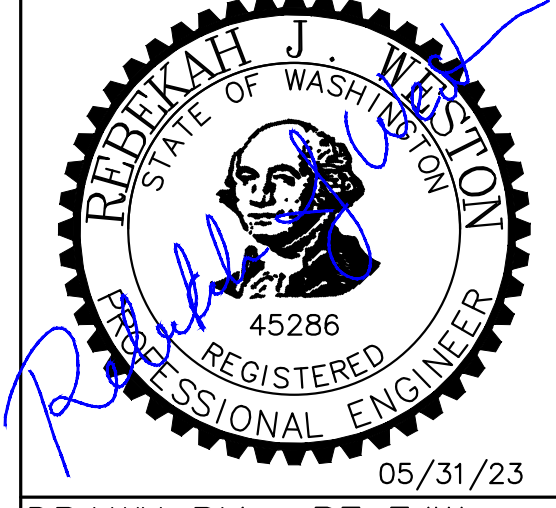

DRAWN BY: RE EJW
DESIGNED BY: RJW
CHECKED BY: RJW

REV/SUBMITTAL	DATE
REVISION 1	04/13/23
PERMIT CORRECTIONS 2	05/31/23


PROJECT NAME:
JAFFE RESIDENCE

PROJECT ADDRESS:
8455 SE 83RD ST., MERCER ISLAND, WA 98080


SHEET TITLE:
DRAINAGE DETAILS

SHEET NO.:
C2.1


RB PROJECT NO.:
22-0009

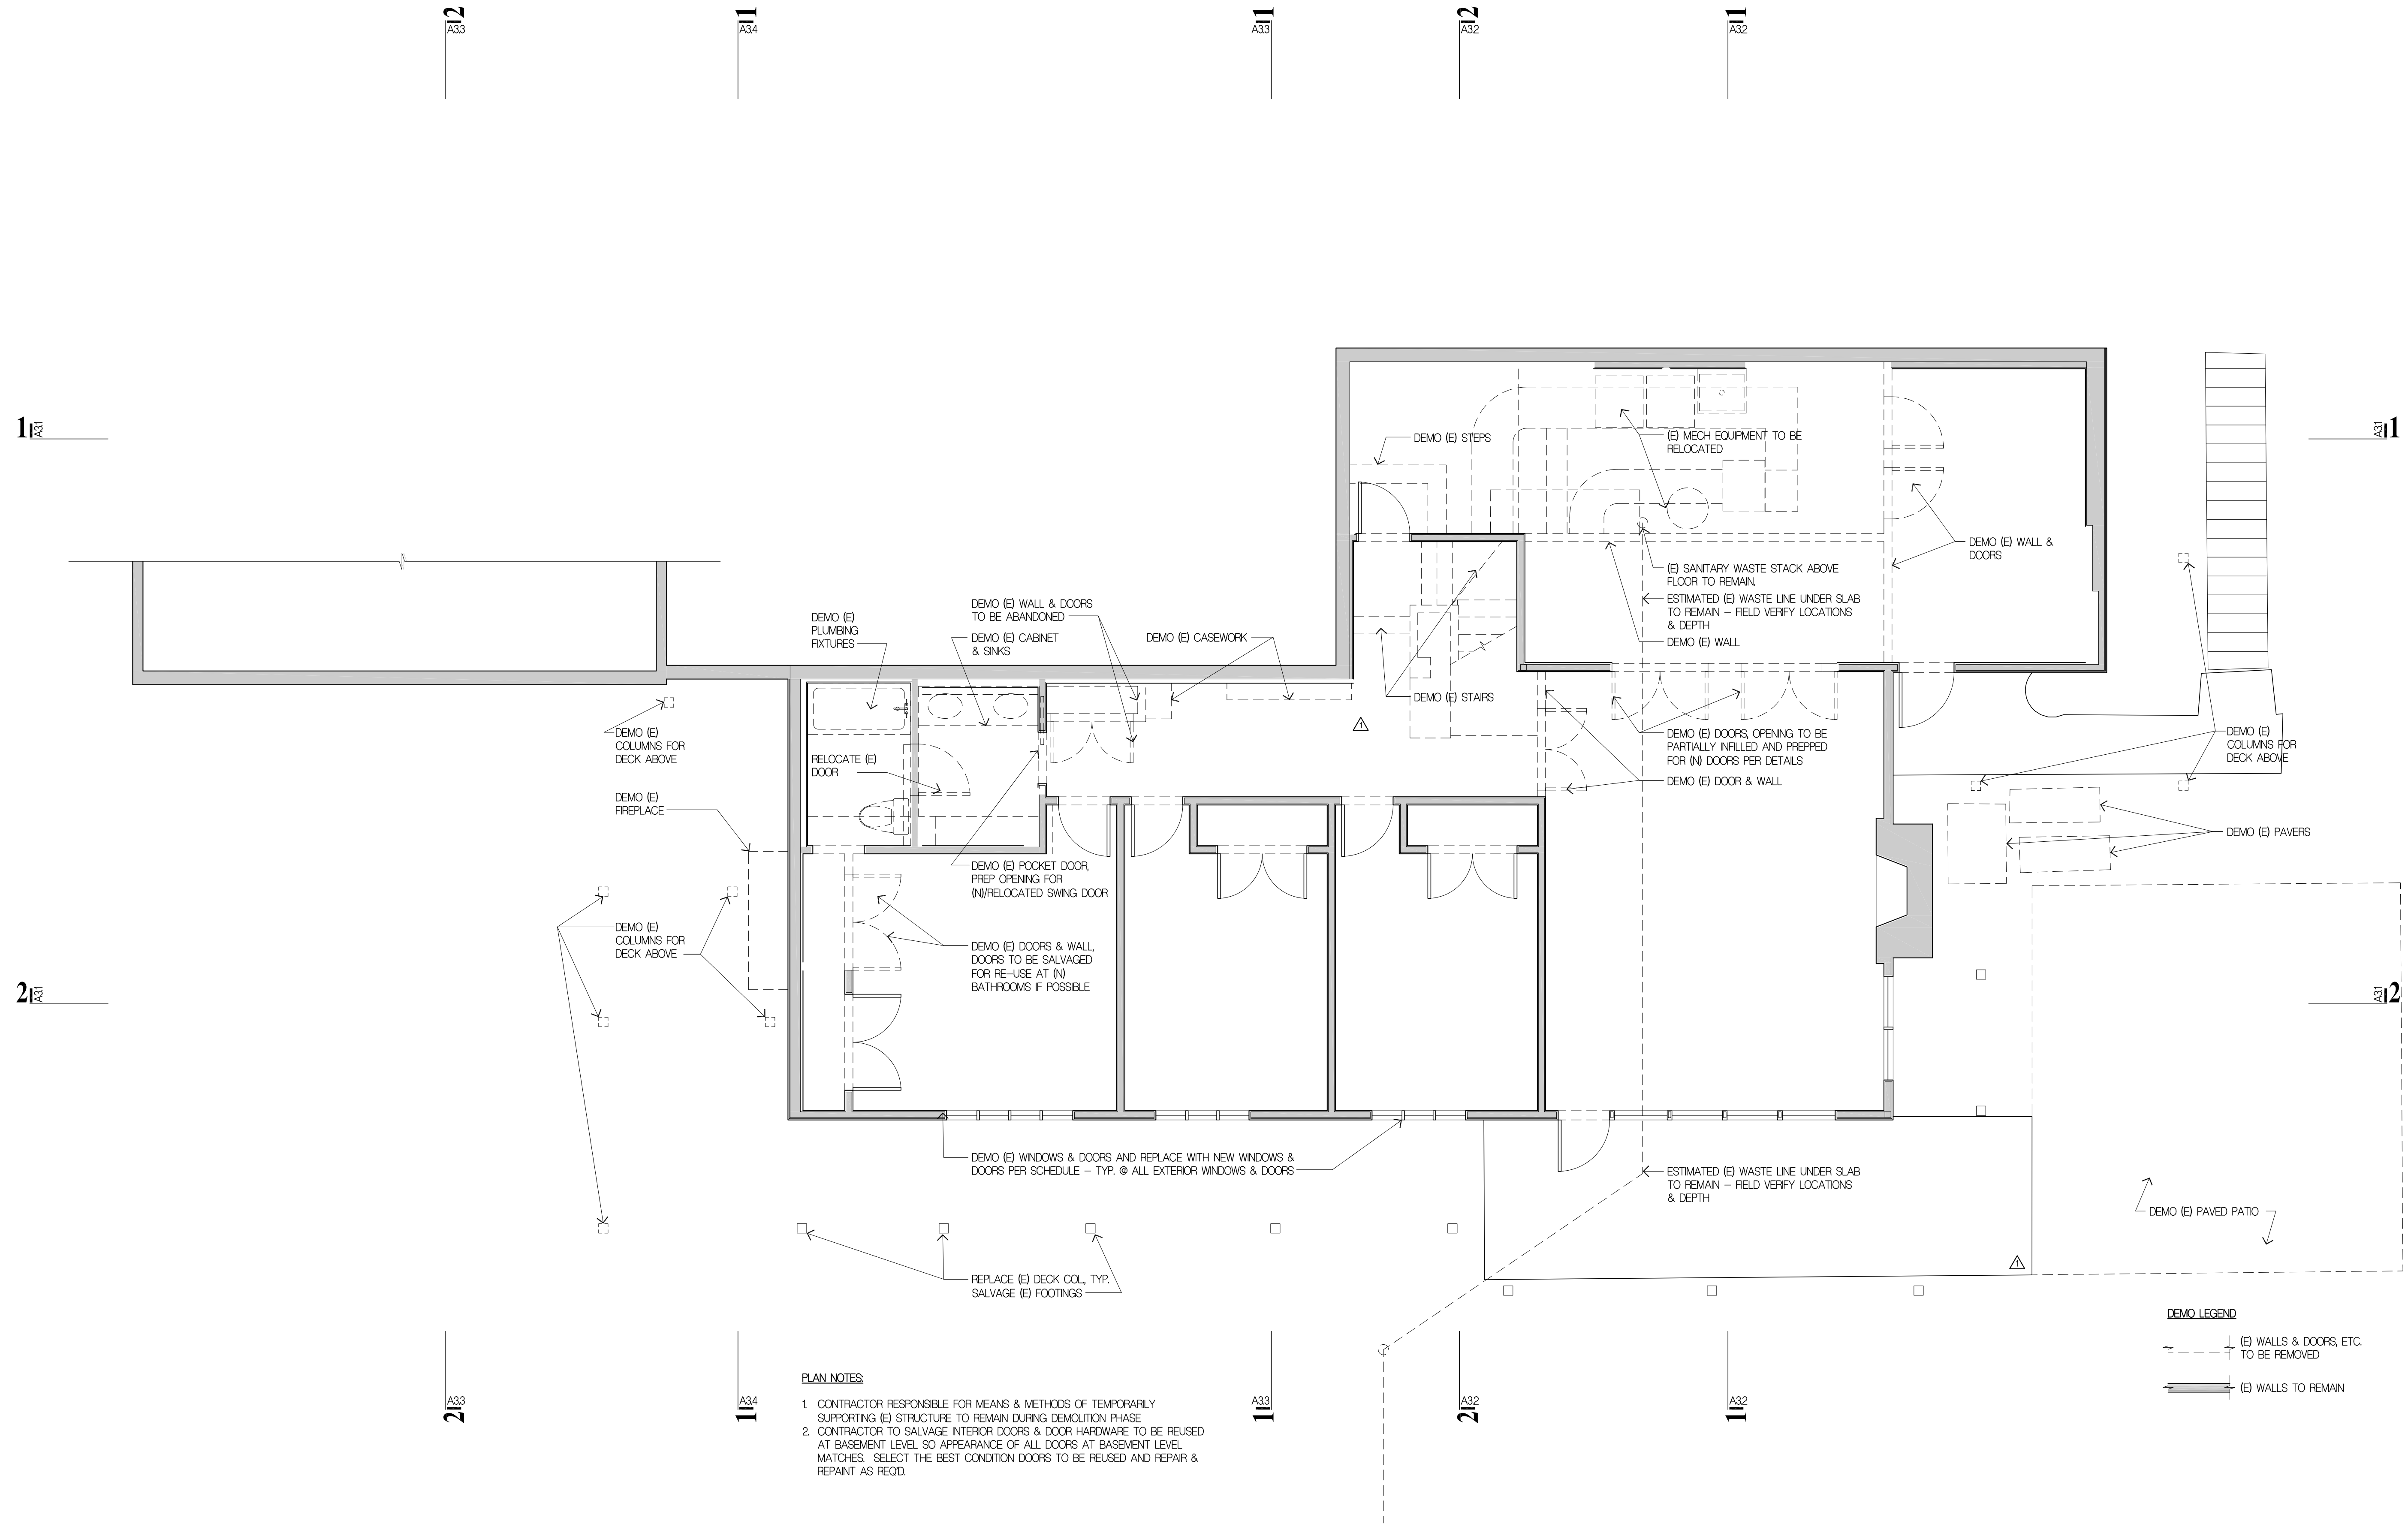

- PLAN NOTES**
- CONTRACTOR RESPONSIBLE FOR MEANS & METHODS OF TEMPORARILY SUPPORTING (E) STRUCTURE TO REMAIN DURING DEMOLITION PHASE
 - CONTRACTOR TO SALVAGE INTERIOR DOORS & DOOR HARDWARE TO BE REUSED AT BASEMENT LEVEL SO APPEARANCE OF ALL DOORS AT BASEMENT LEVEL MATCHES. SELECT THE BEST CONDITION DOORS TO BE REUSED AND REPAIR & REPAINT AS REQD.

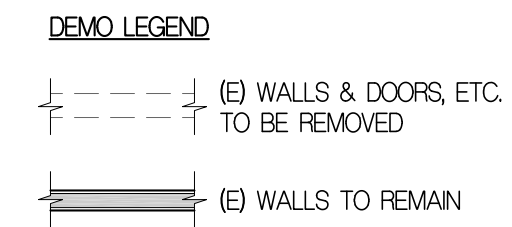

Project Title
JAFFE RESIDENCE
 8455 SE 83RD STREET
 MERCER ISLAND, WA 98040

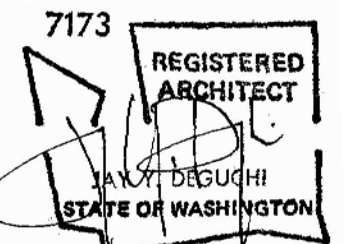


Drawing Title
BASEMENT DEMO PLAN

Date
 08/08/2022


Job No.
 210

ISSUE	DATE
PERMIT CORRECTIONS #1	03/31/2023
PERMIT CORRECTIONS #2	05/31/2023


PERMIT CORRECTIONS
 Sheet No.

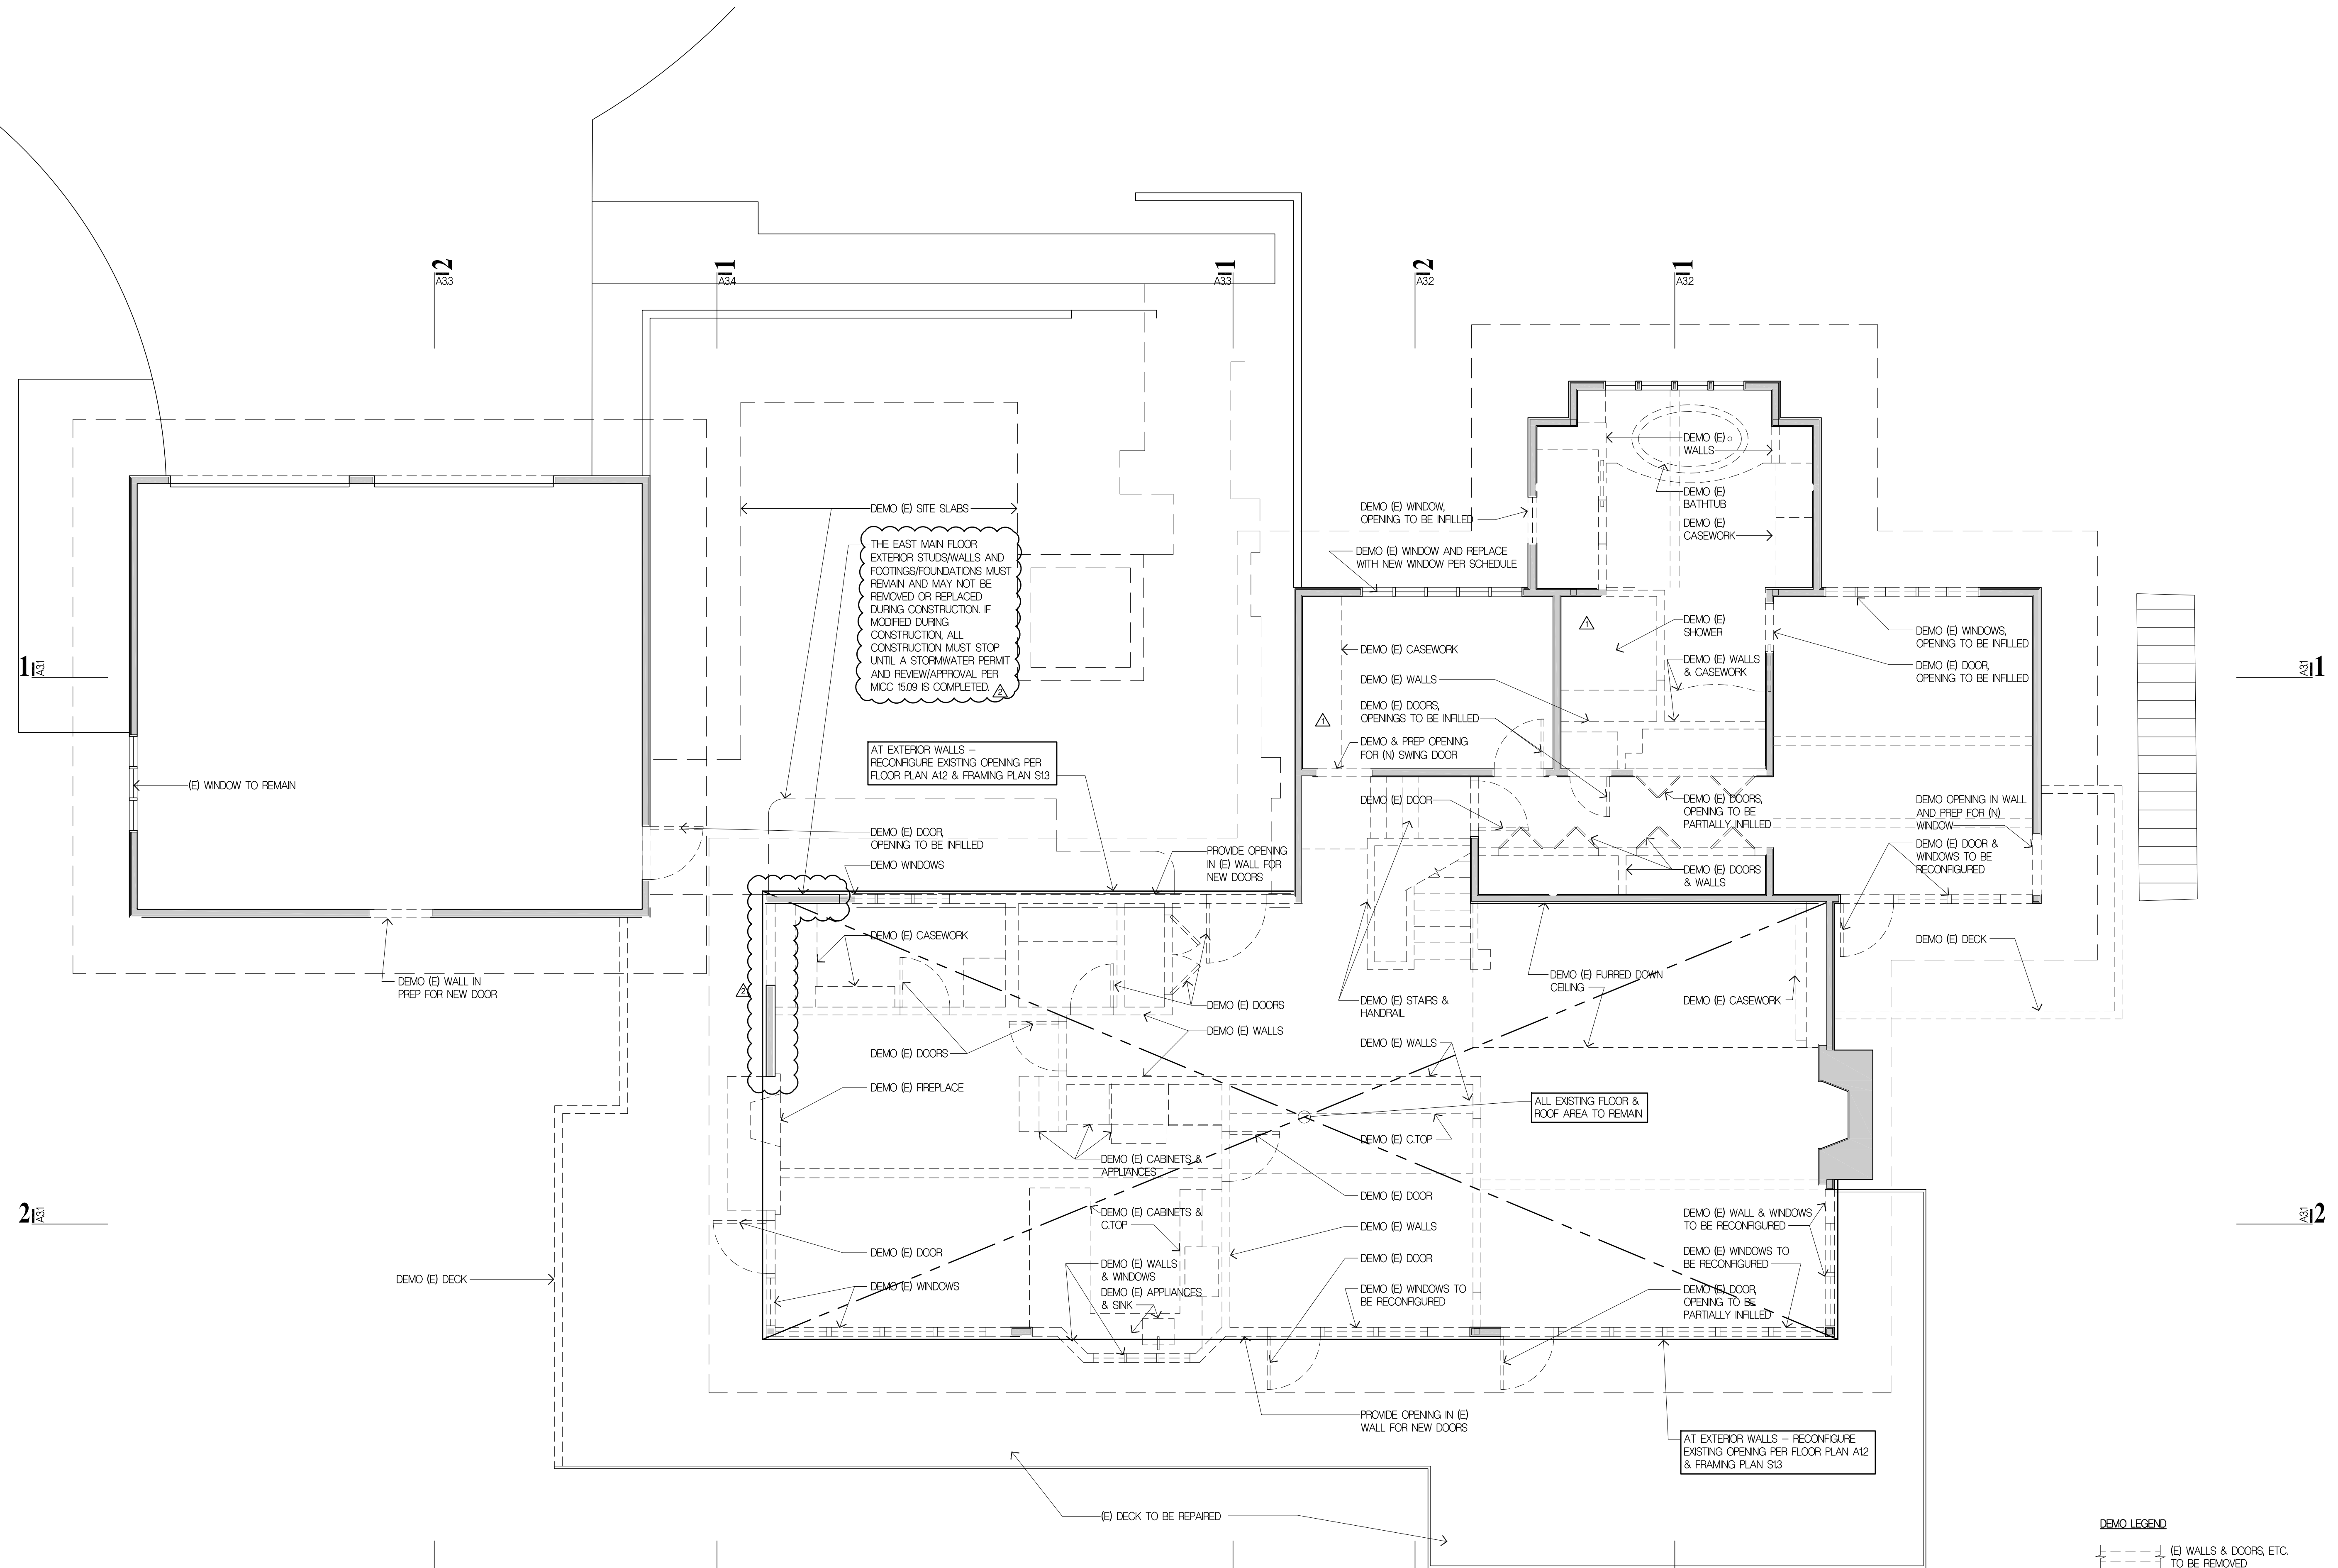

- PLAN NOTES**
1. CONTRACTOR RESPONSIBLE FOR MEANS & METHODS OF TEMPORARILY SUPPORTING (E) STRUCTURE TO REMAIN DURING DEMOLITION PHASE.
 2. CONTRACTOR TO SALVAGE INTERIOR DOORS & DOOR HARDWARE TO BE REUSED AT BASEMENT LEVEL SO APPEARANCE OF ALL DOORS AT BASEMENT LEVEL MATCHES. SELECT THE BEST CONDITION DOORS TO BE REUSED AND REPAIR & REPAINT AS REQD.

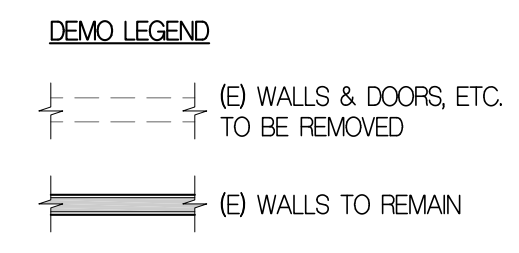

Project Title
JAFFE RESIDENCE
 8455 SE 83RD STREET
 MERCER ISLAND, WA 98040

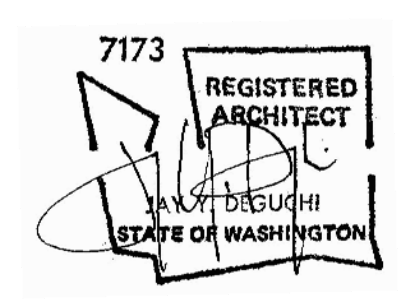


Drawing Title
MAIN LEVEL DEMO PLAN


Date
 08/08/2022
 Job No.
 2110

ISSUE	DATE
PERMIT CORRECTIONS #1	03/31/2023
PERMIT CORRECTIONS #2	05/31/2023

PERMIT CORRECTIONS
 Sheet No.

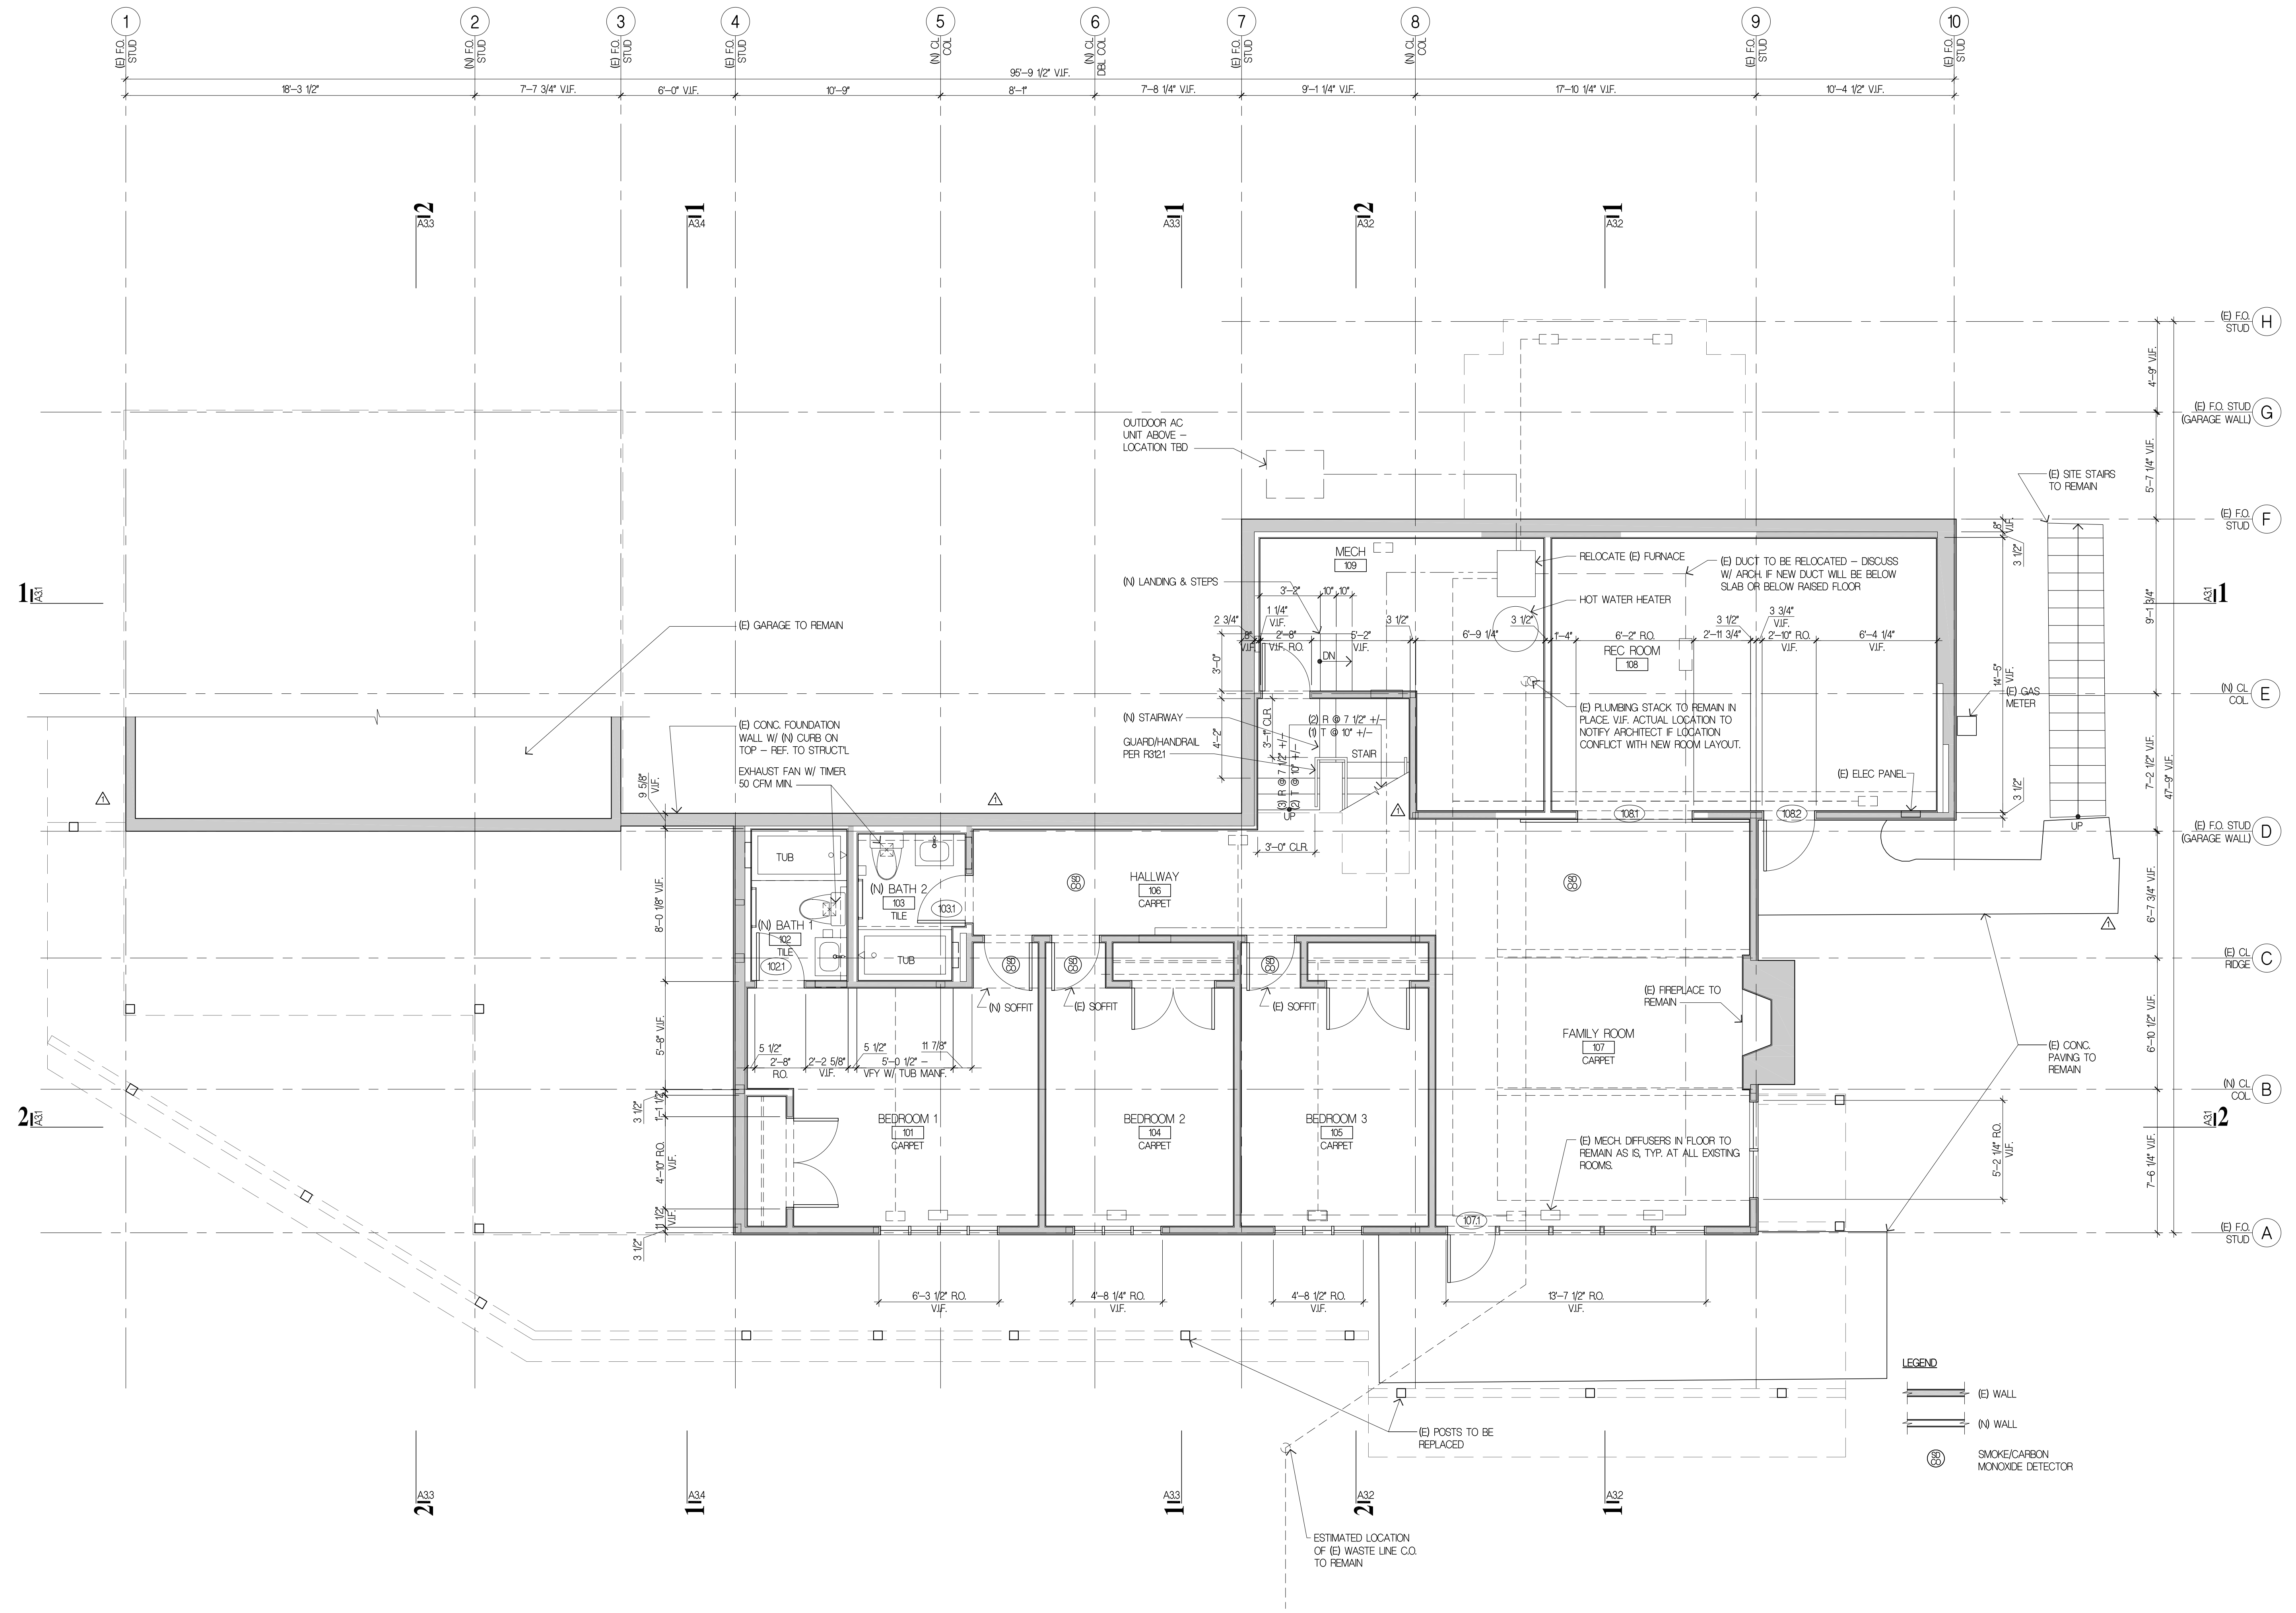

Project Title
JAFFE RESIDENCE
 8455 SE 83RD STREET
 MERCER ISLAND, WA 98040

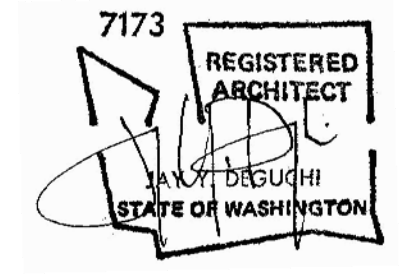


Drawing Title
BASEMENT FLOOR PLAN

Date
 08/08/2022
 Job No.
 2110


ISSUE	DATE
(E) PERMIT CORRECTIONS #1	03/31/2023
(N) PERMIT CORRECTIONS #2	05/31/2023

- LEGEND**
- (E) WALL
 - (N) WALL
 - (S) SMOKE/CARBON MONOXIDE DETECTOR

PERMIT CORRECTIONS
 Sheet No.

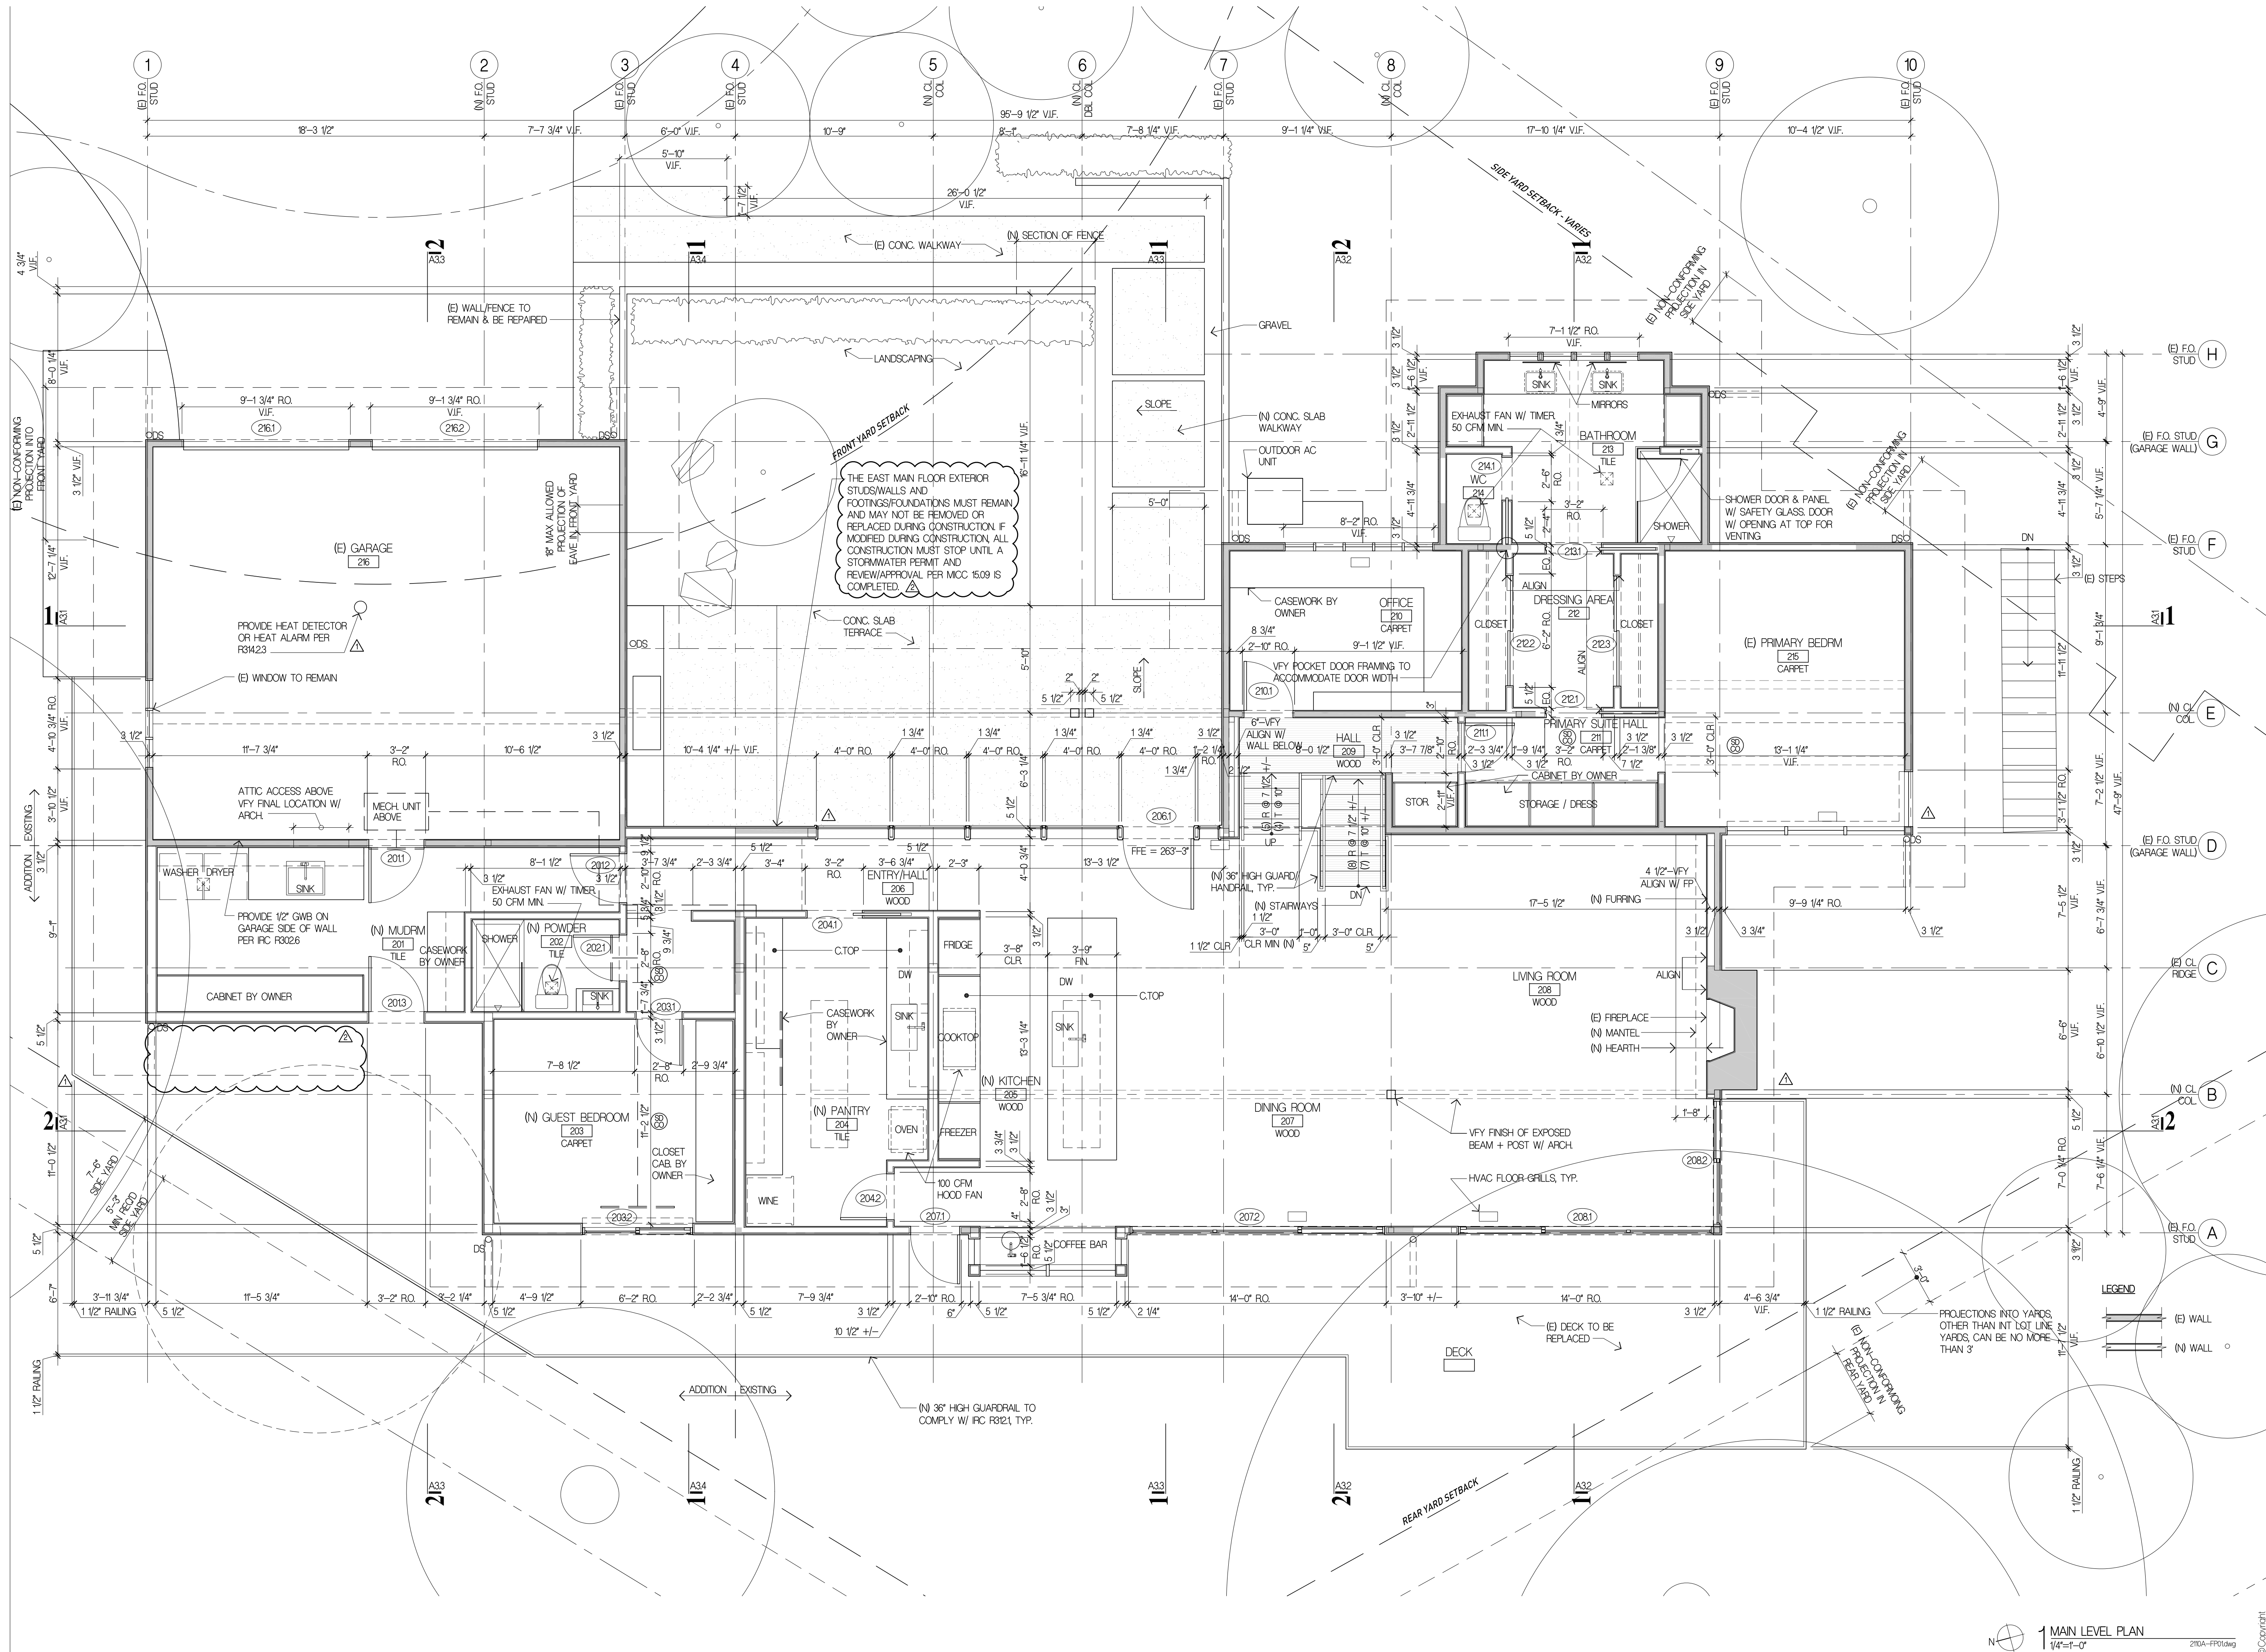

Project Title
JAFFE RESIDENCE
 8455 SE 83RD STREET
 MERCER ISLAND, WA 98040

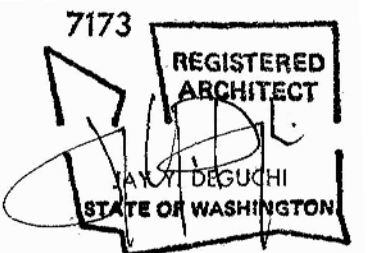


Drawing Title
MAIN LEVEL FLOOR PLAN

Date
 08/08/2022
 Job No.
 210


ISSUE	DATE
△ PERMIT CORRECTIONS #1	03/31/2023
△ PERMIT CORRECTIONS #2	05/31/2023

PERMIT CORRECTIONS
 Sheet No.

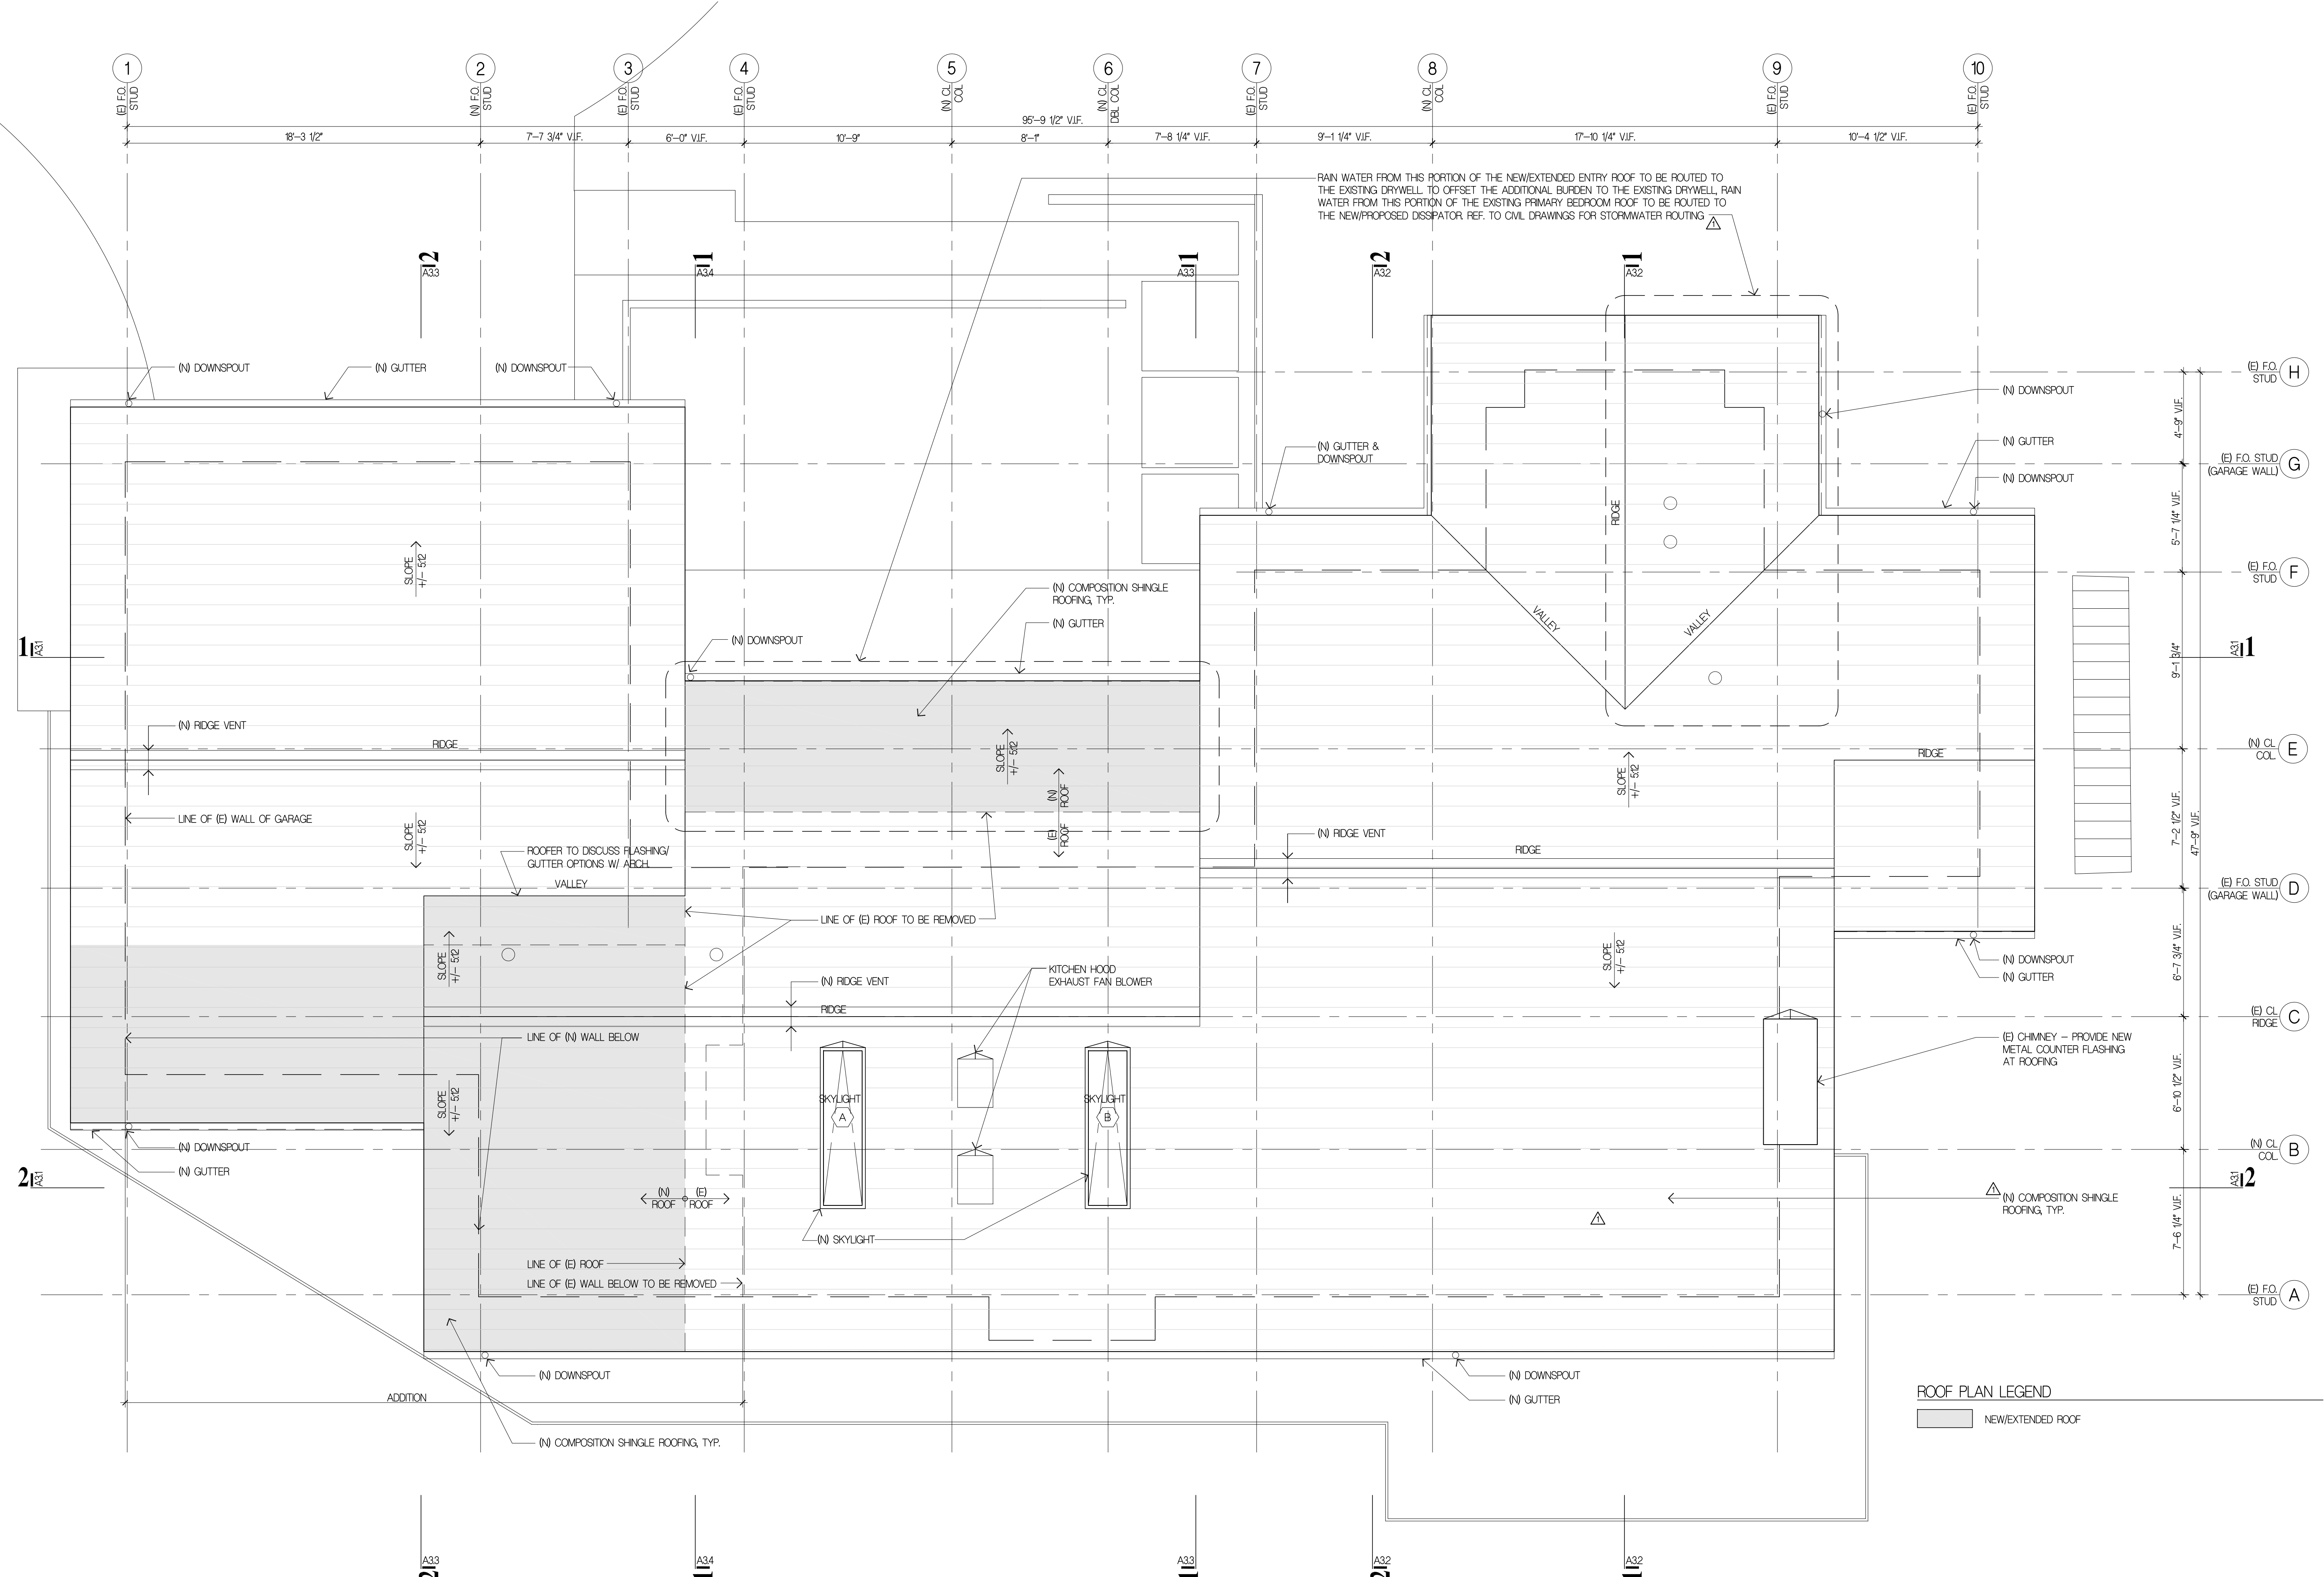

ROOF PLAN LEGEND
 [Shaded Area] NEW/EXTENDED ROOF

Project Title
JAFFE RESIDENCE
 8455 SE 83RD STREET
 MERCER ISLAND, WA 98040


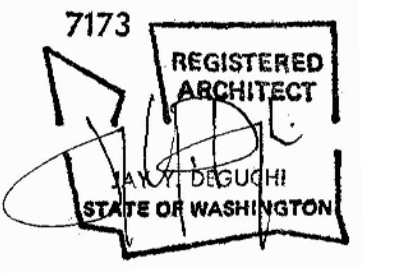


Drawing Title
ROOF PLAN


Date
 08.08.2022
 Job No.
 2110

ISSUE DATE
 △ PERMIT CORRECTIONS #1 03/31/2023
 ▲ PERMIT CORRECTIONS #2 05/31/2023

PERMIT CORRECTIONS
 Sheet No.

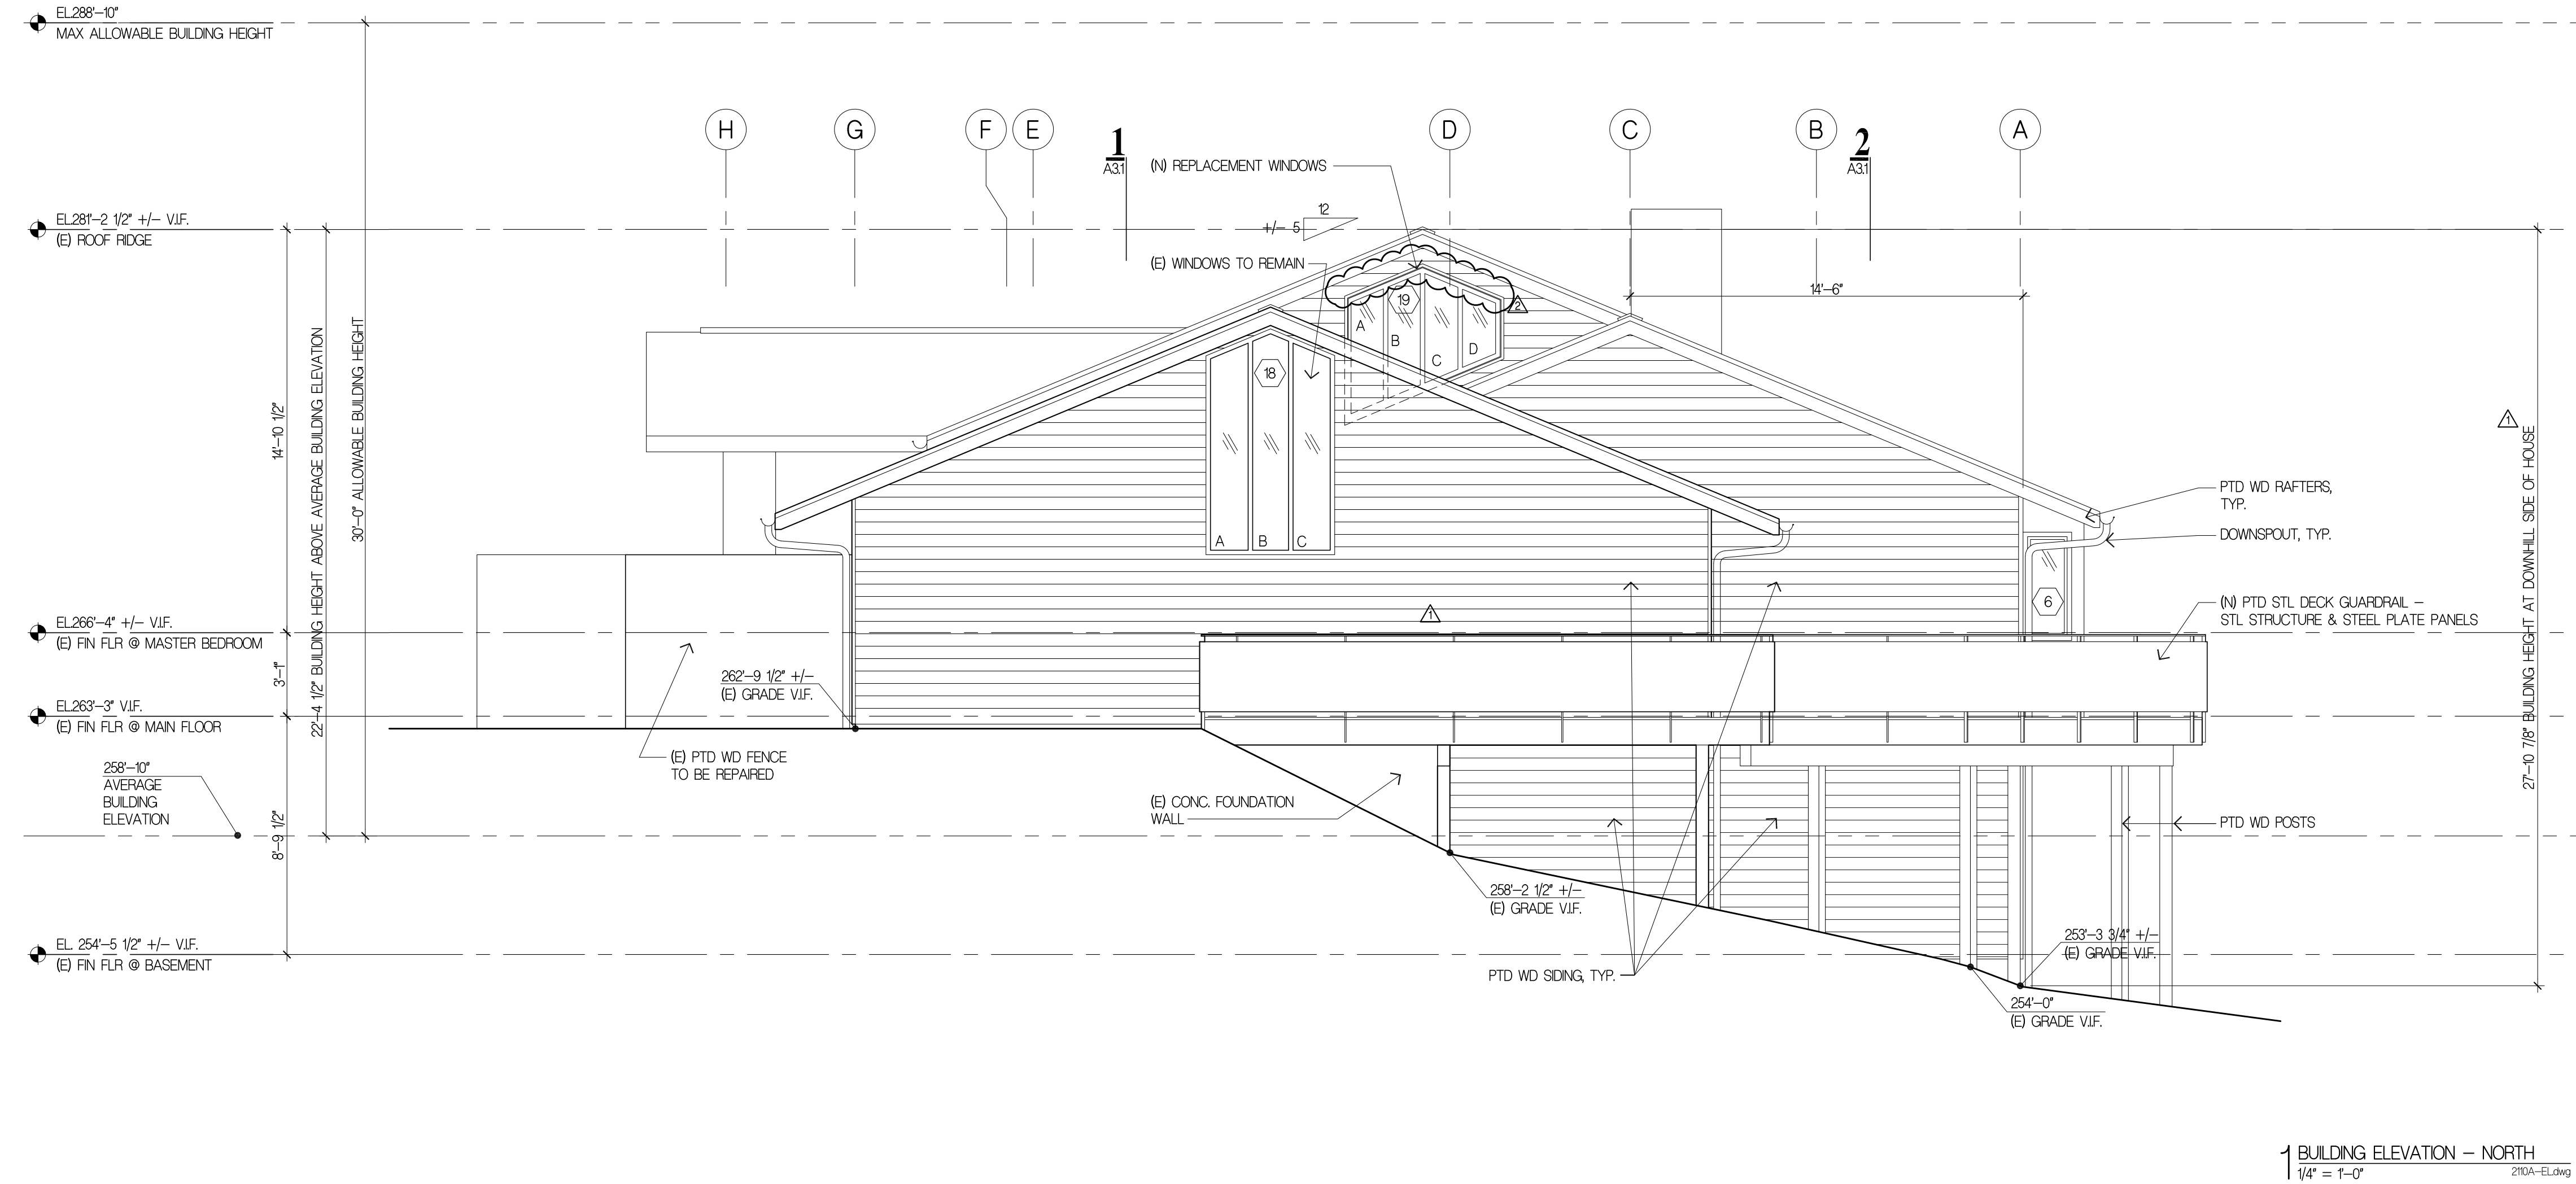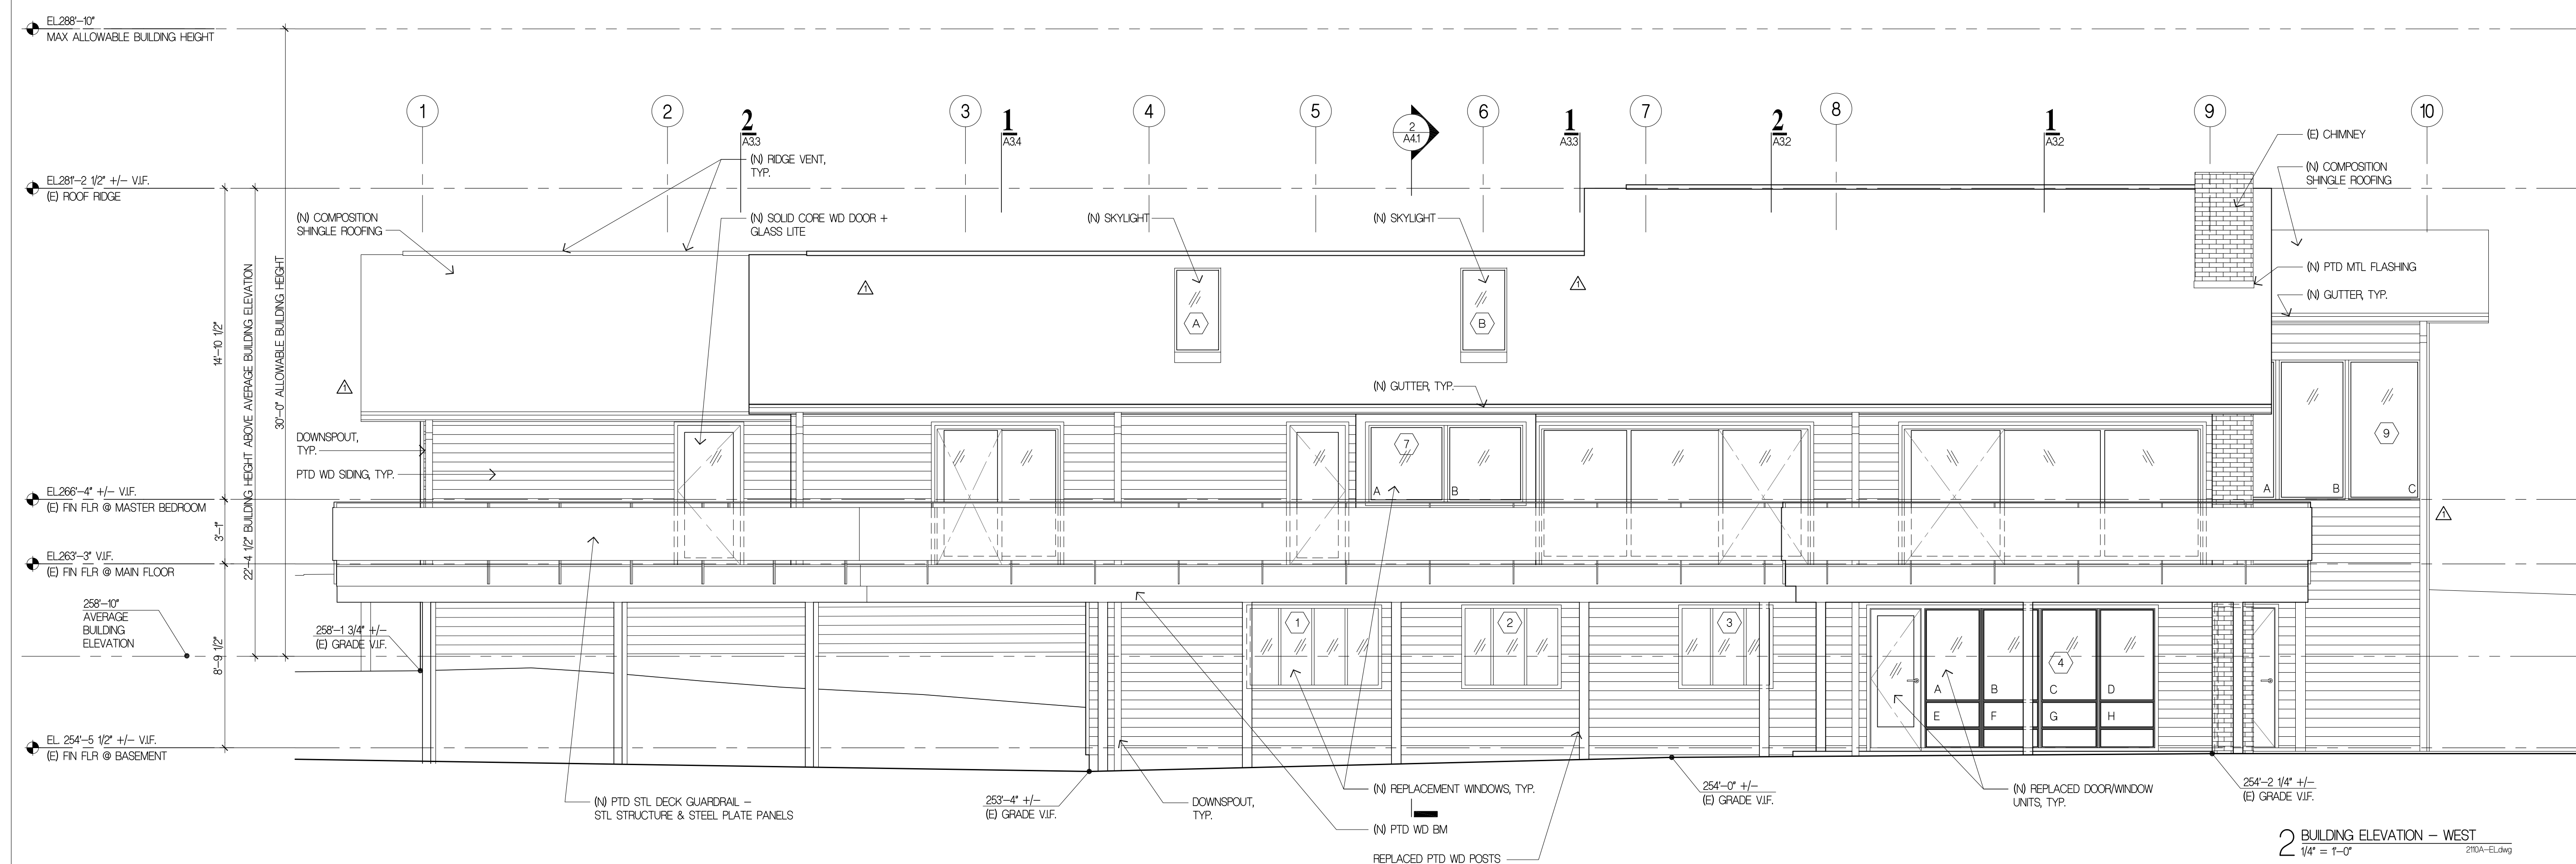

Project Title
JAFFE RESIDENCE
 8455 SE 83RD STREET
 MERCER ISLAND, WA 98040

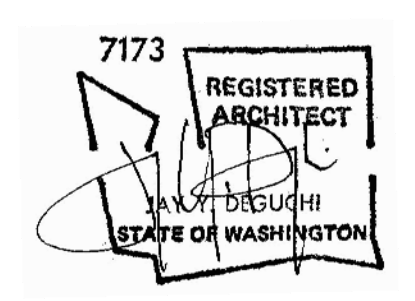


Drawing Title
BUILDING ELEVATIONS
 Date
 08.08.2022
 Job No.
 210


ISSUE	DATE
PERMIT CORRECTIONS #1	03/31/2023
PERMIT CORRECTIONS #2	05/31/2023

PERMIT CORRECTIONS
 Sheet No.


A2.1

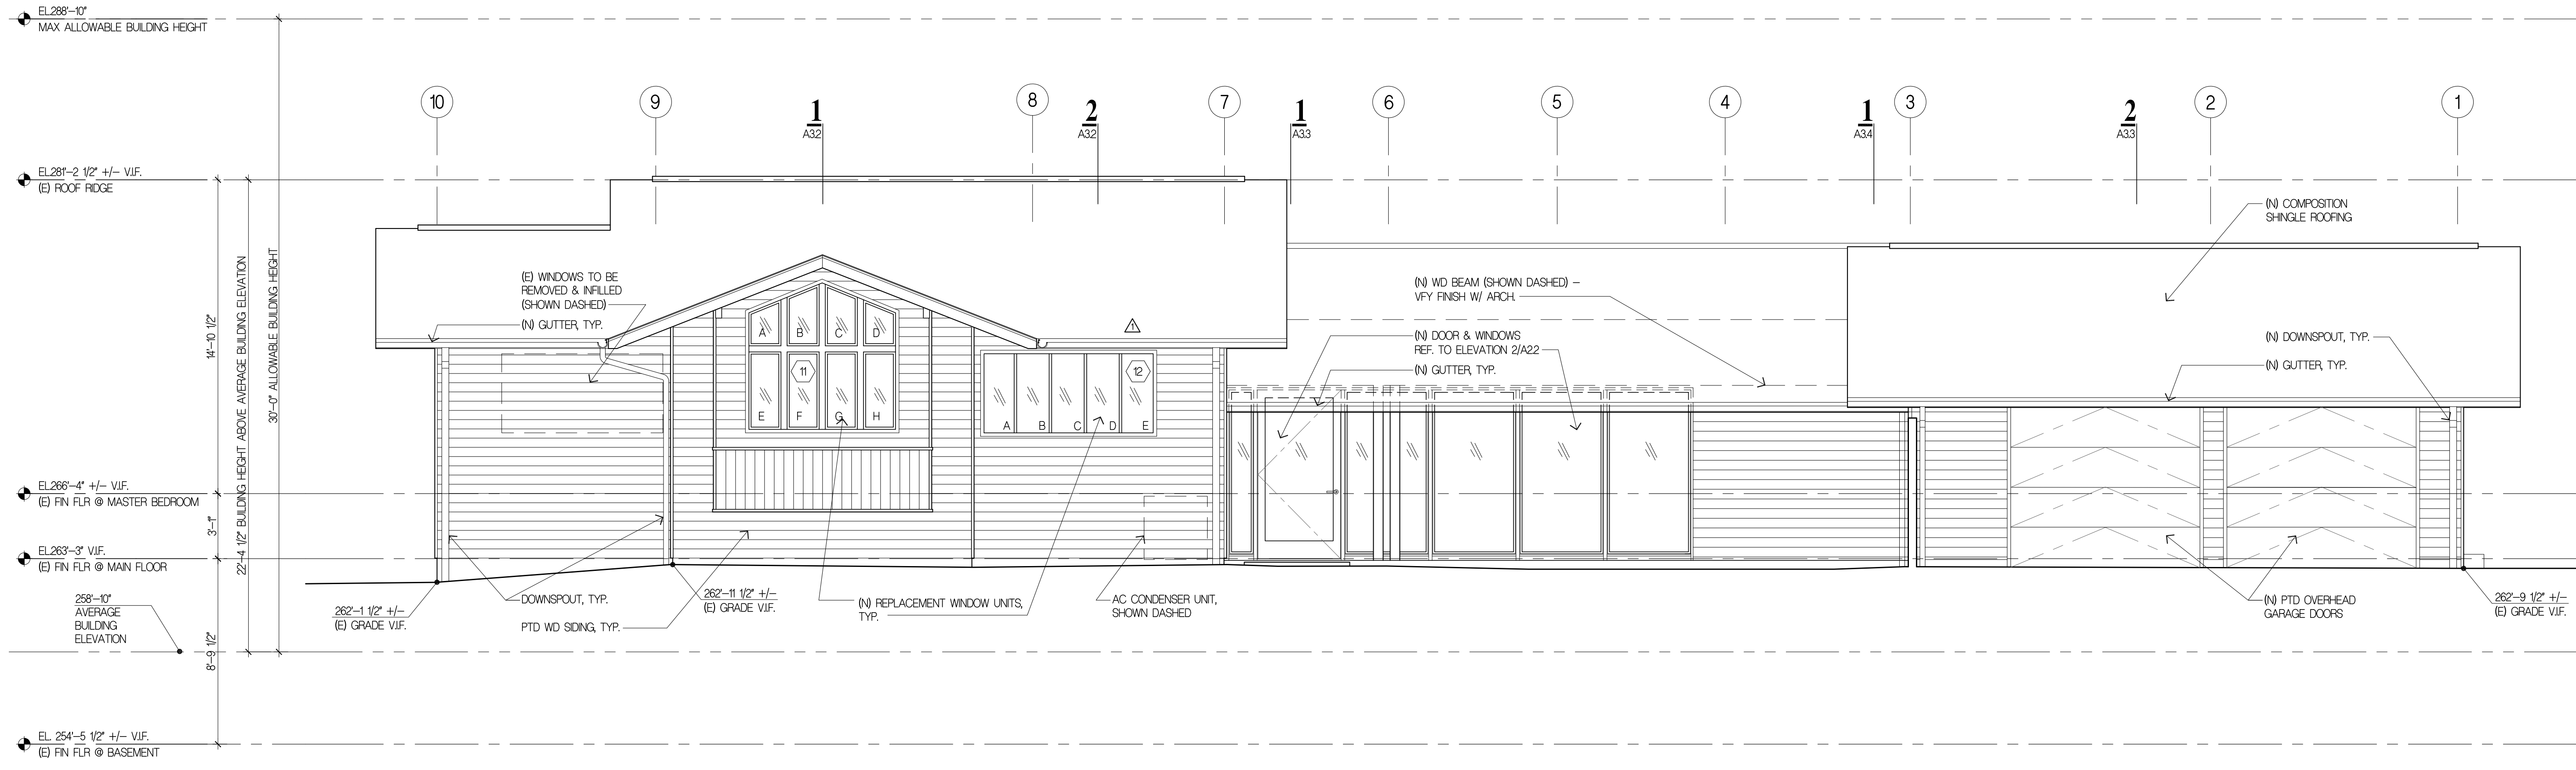

3 BUILDING ELEVATION - EAST
 1/4" = 1'-0" 210A-EL.dwg

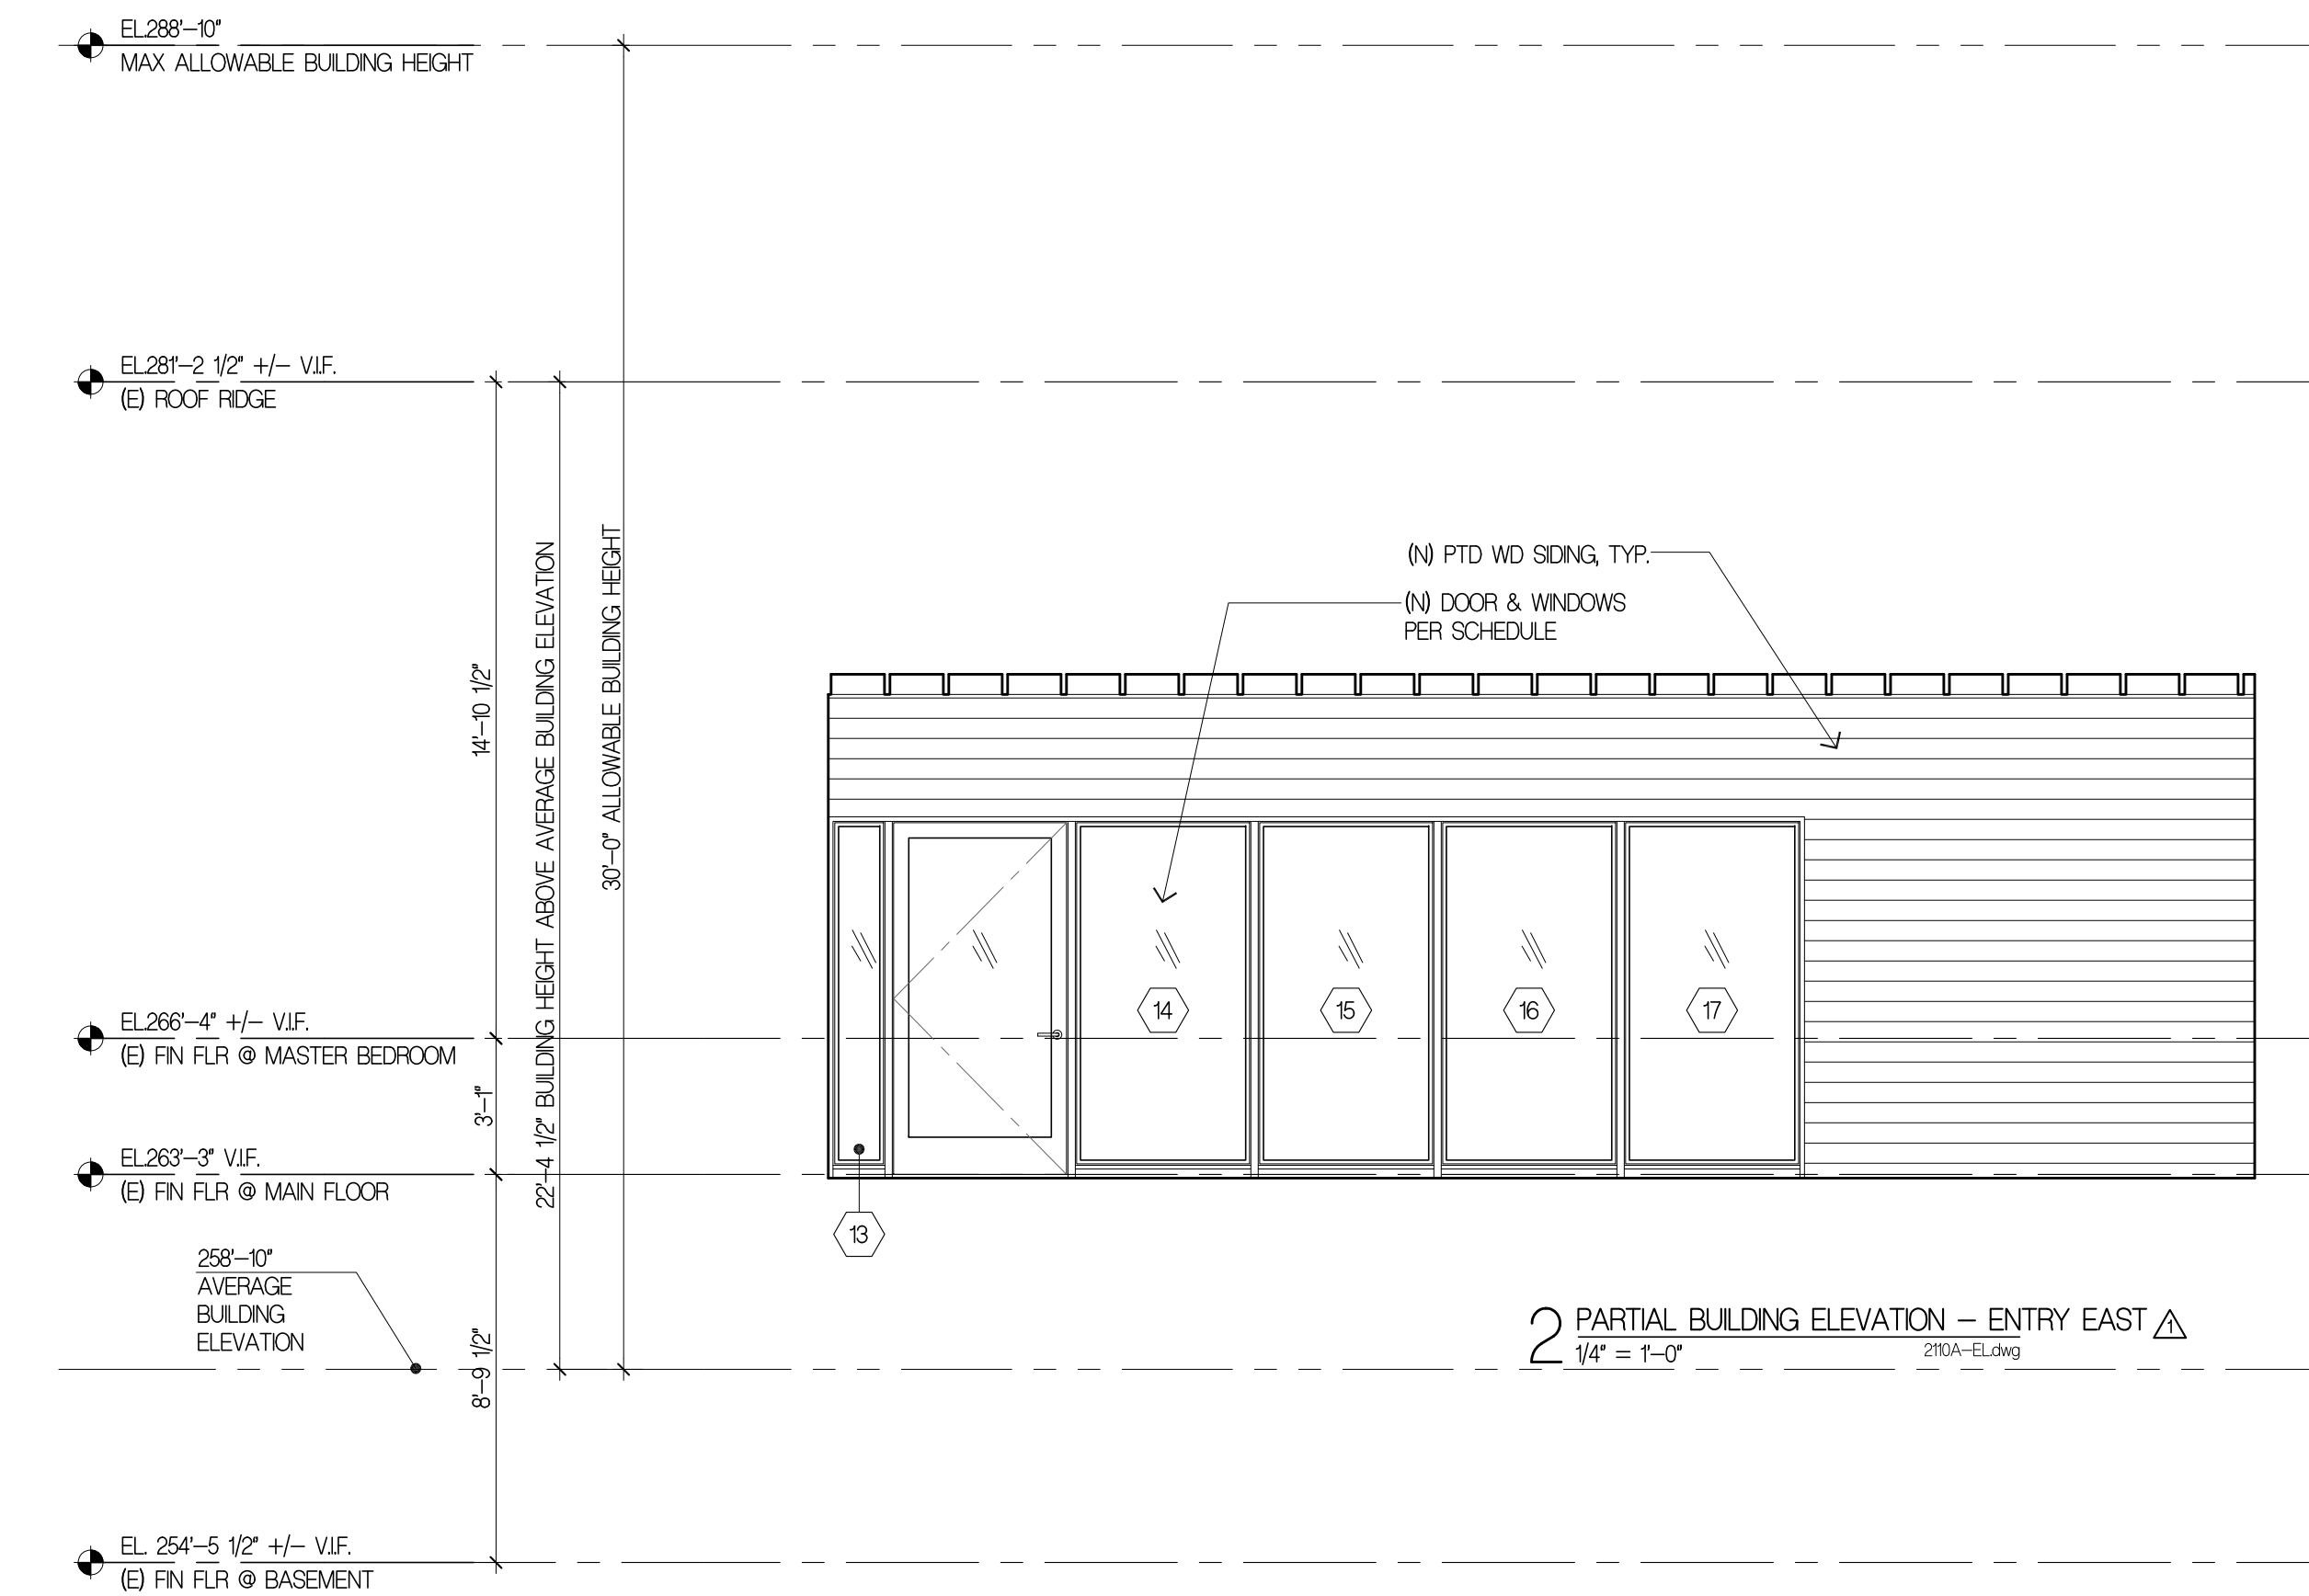


2 PARTIAL BUILDING ELEVATION - ENTRY EAST
 1/4" = 1'-0" 210A-EL.dwg

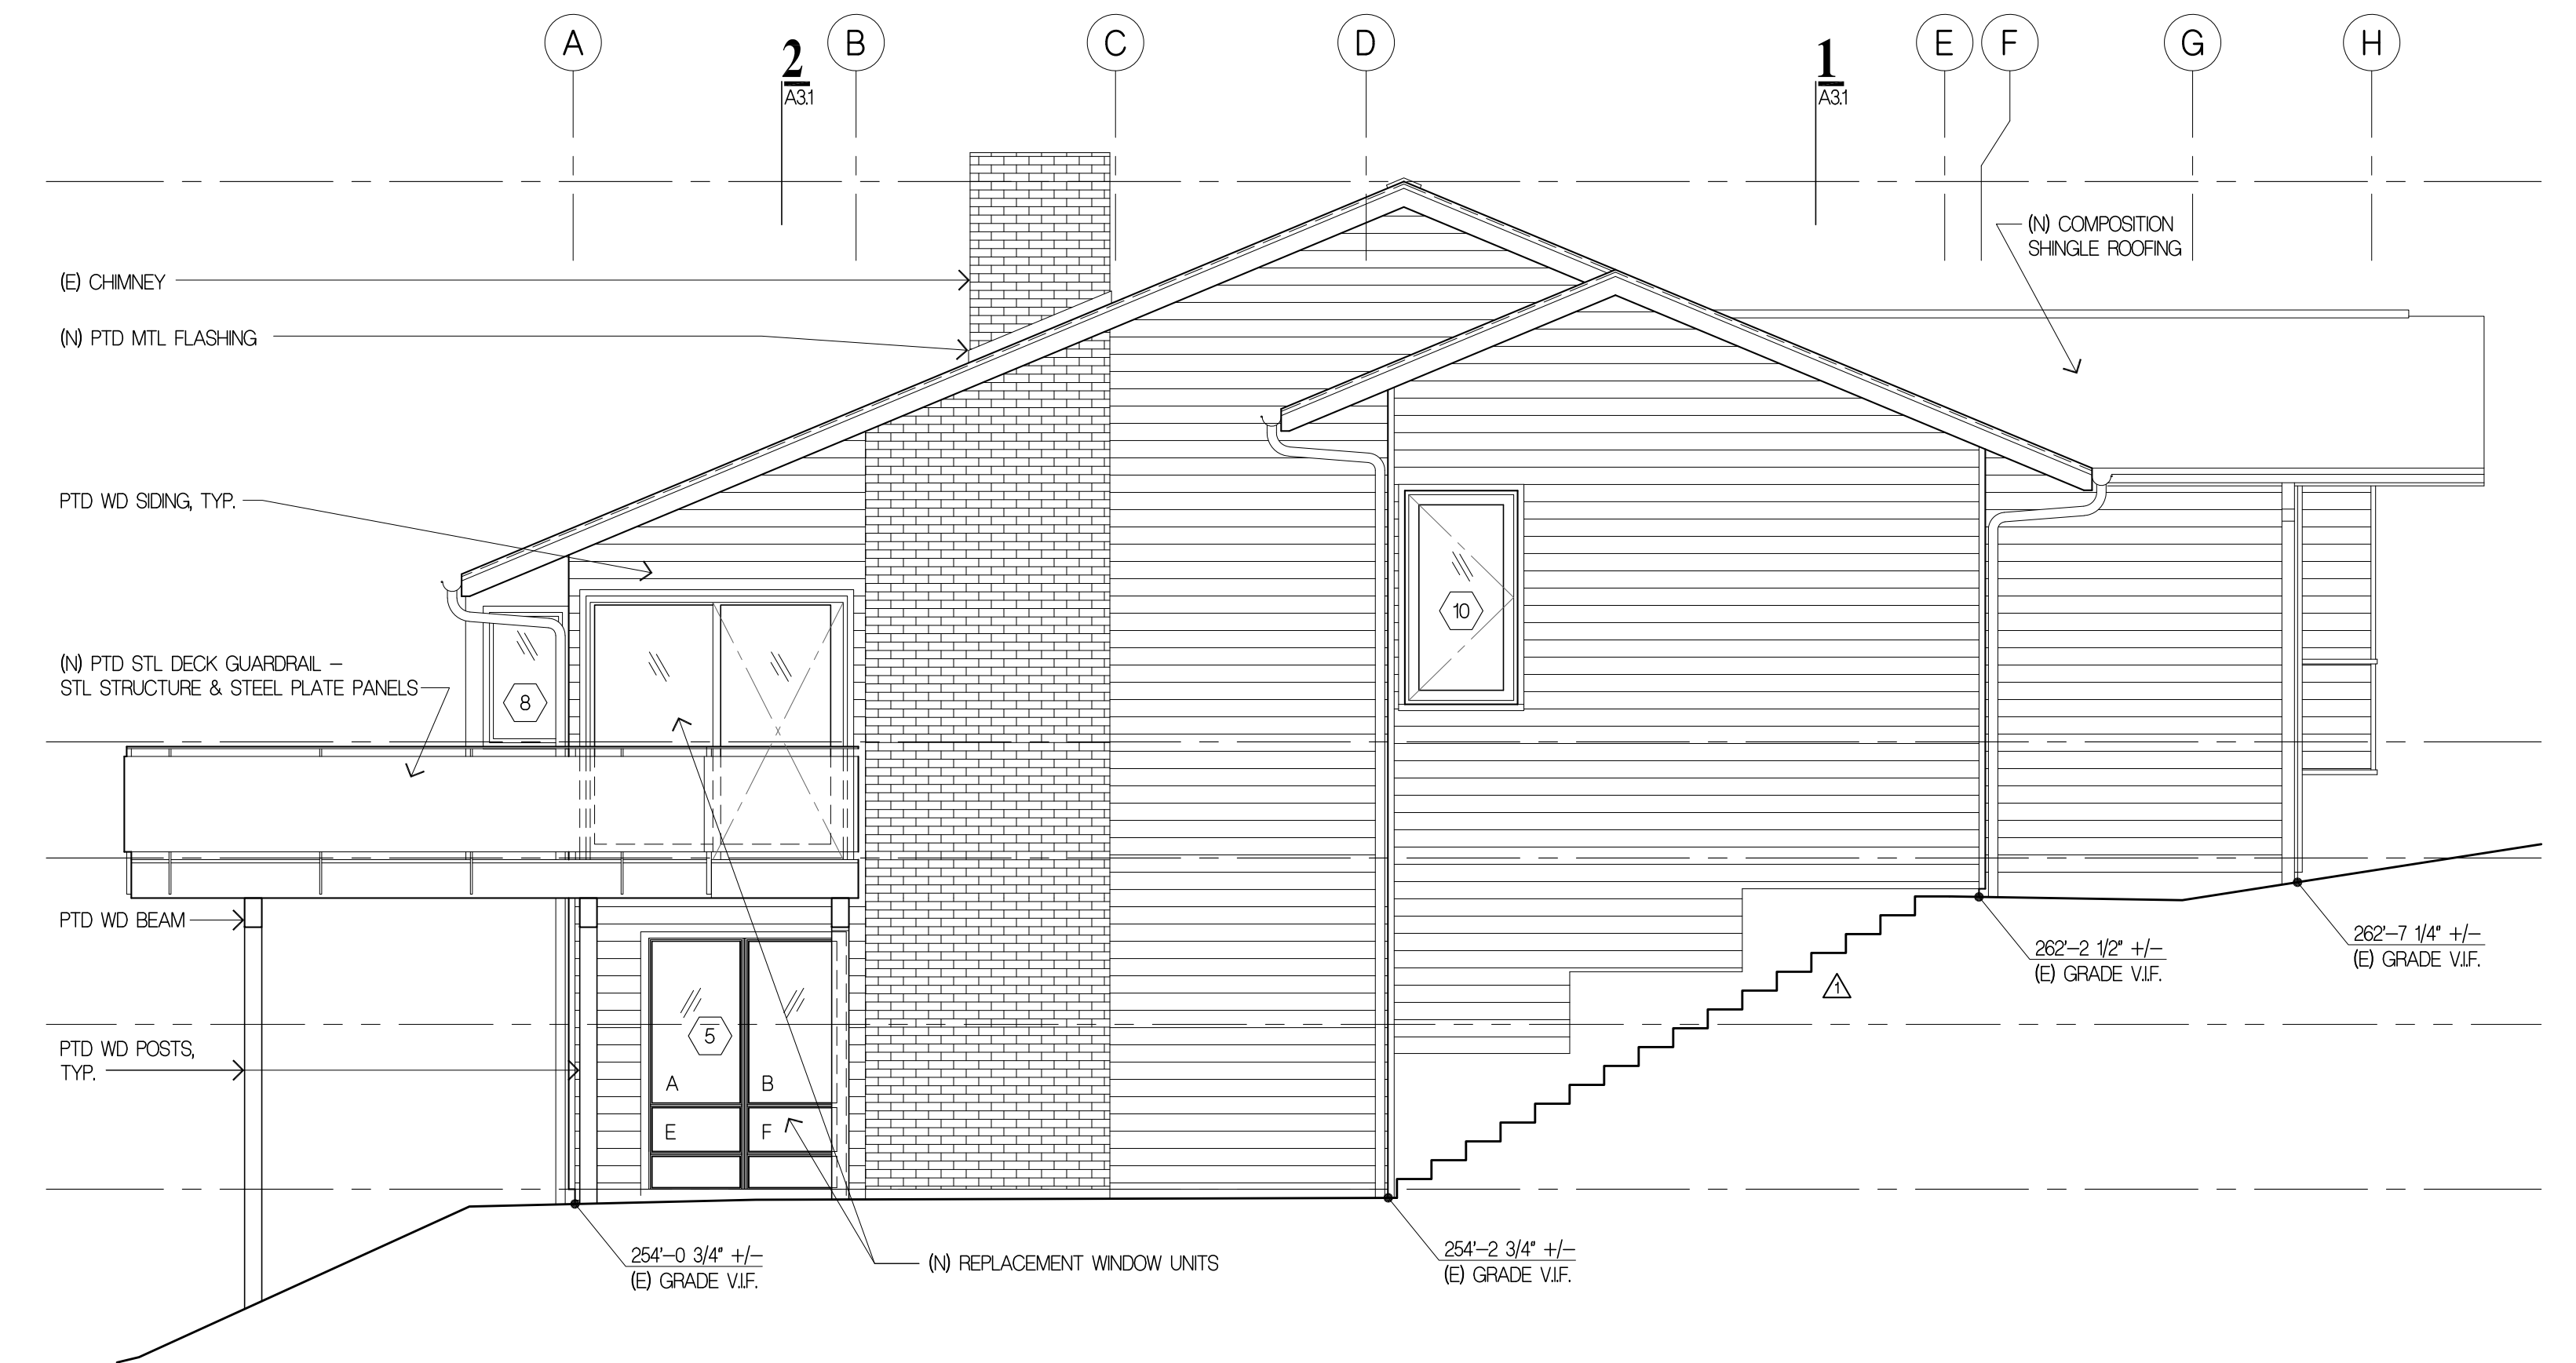

1 BUILDING ELEVATION - SOUTH
 1/4" = 1'-0" 210A-EL.dwg

Project Title
JAFFE RESIDENCE
 8455 SE 83RD STREET
 MERCER ISLAND, WA 98040

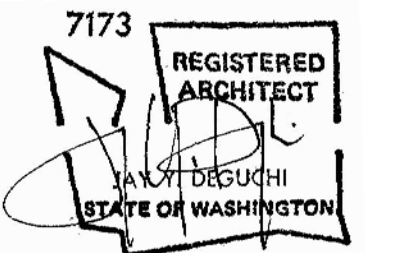


Drawing Title
BUILDING ELEVATIONS

Date
 08/08/2022
 Job No.
 210


ISSUE	DATE
△ PERMIT CORRECTIONS #1	03/31/2023
△ PERMIT CORRECTIONS #2	05/31/2023

PERMIT CORRECTIONS
 Sheet No.

A2.2

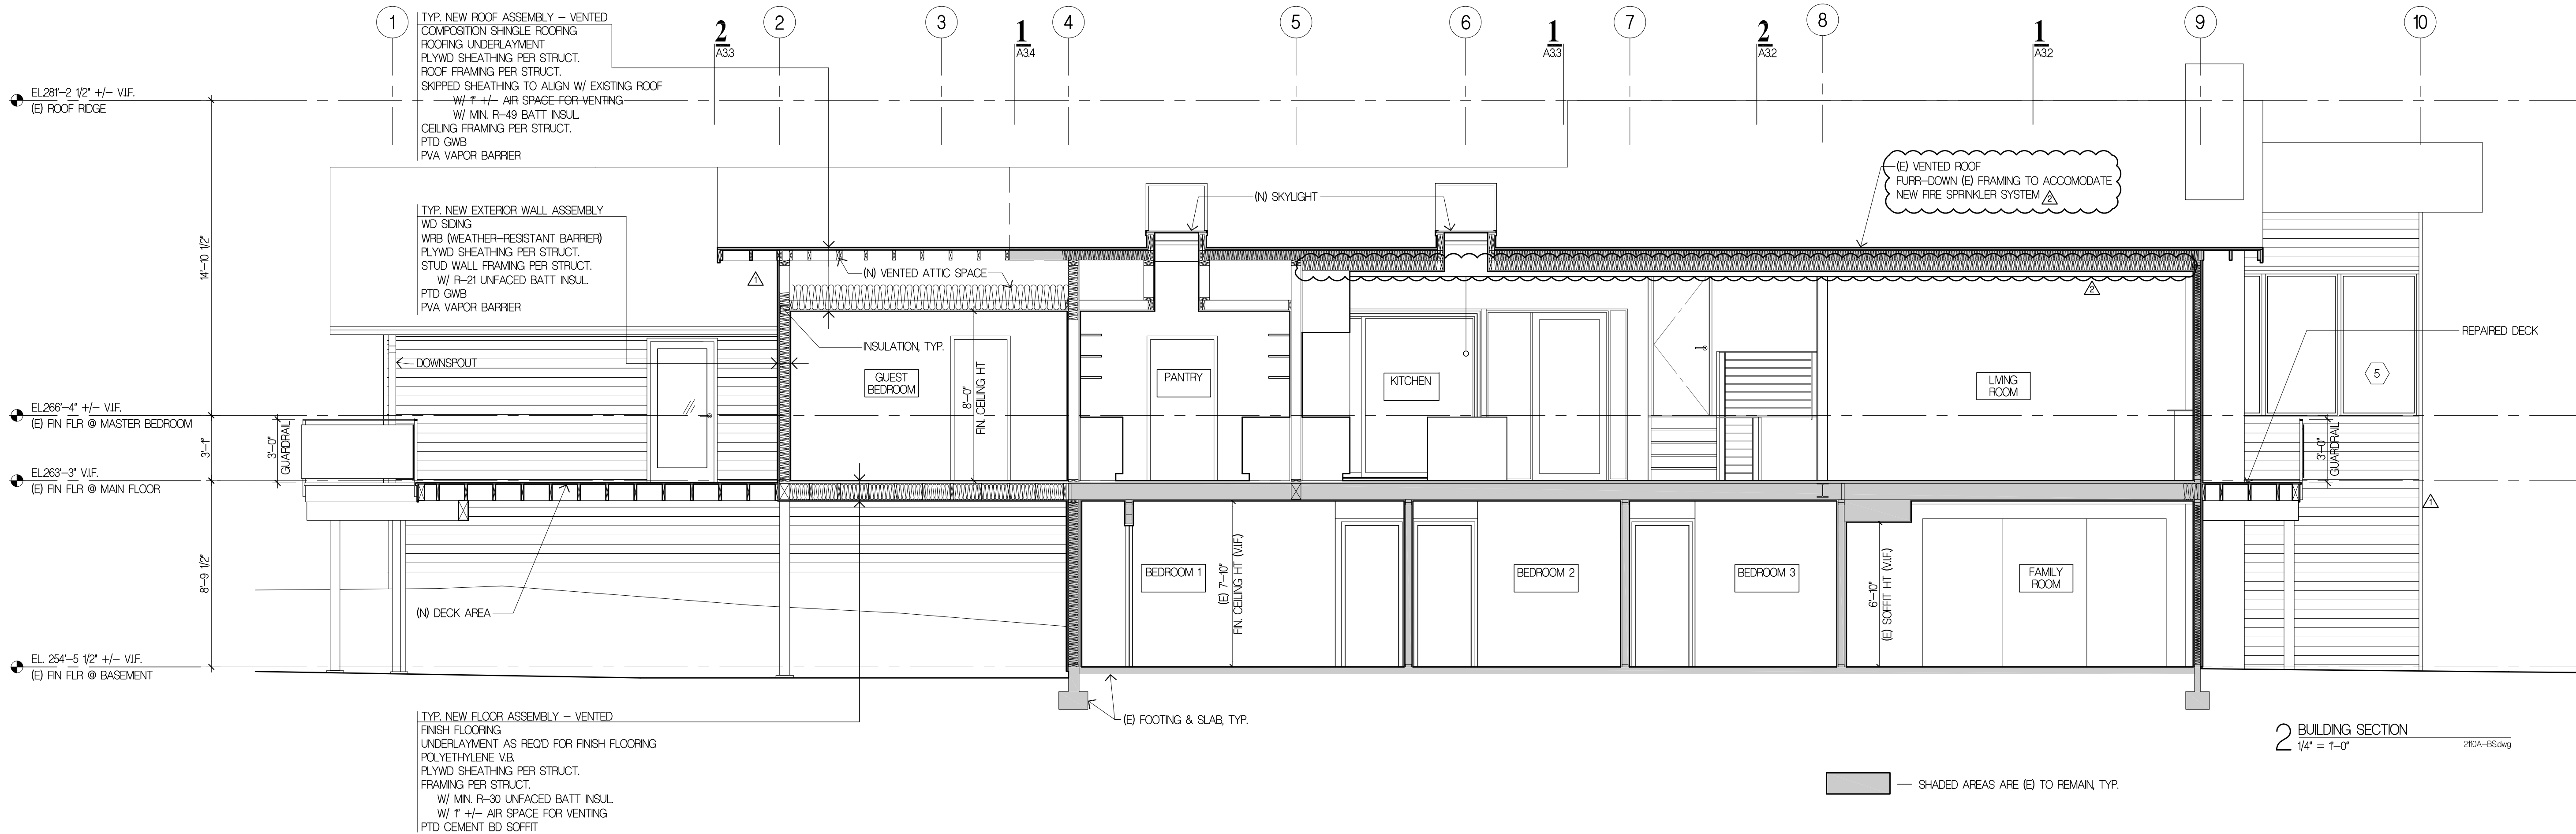


2 BUILDING SECTION
 1/4" = 1'-0" 210A-BSDwg

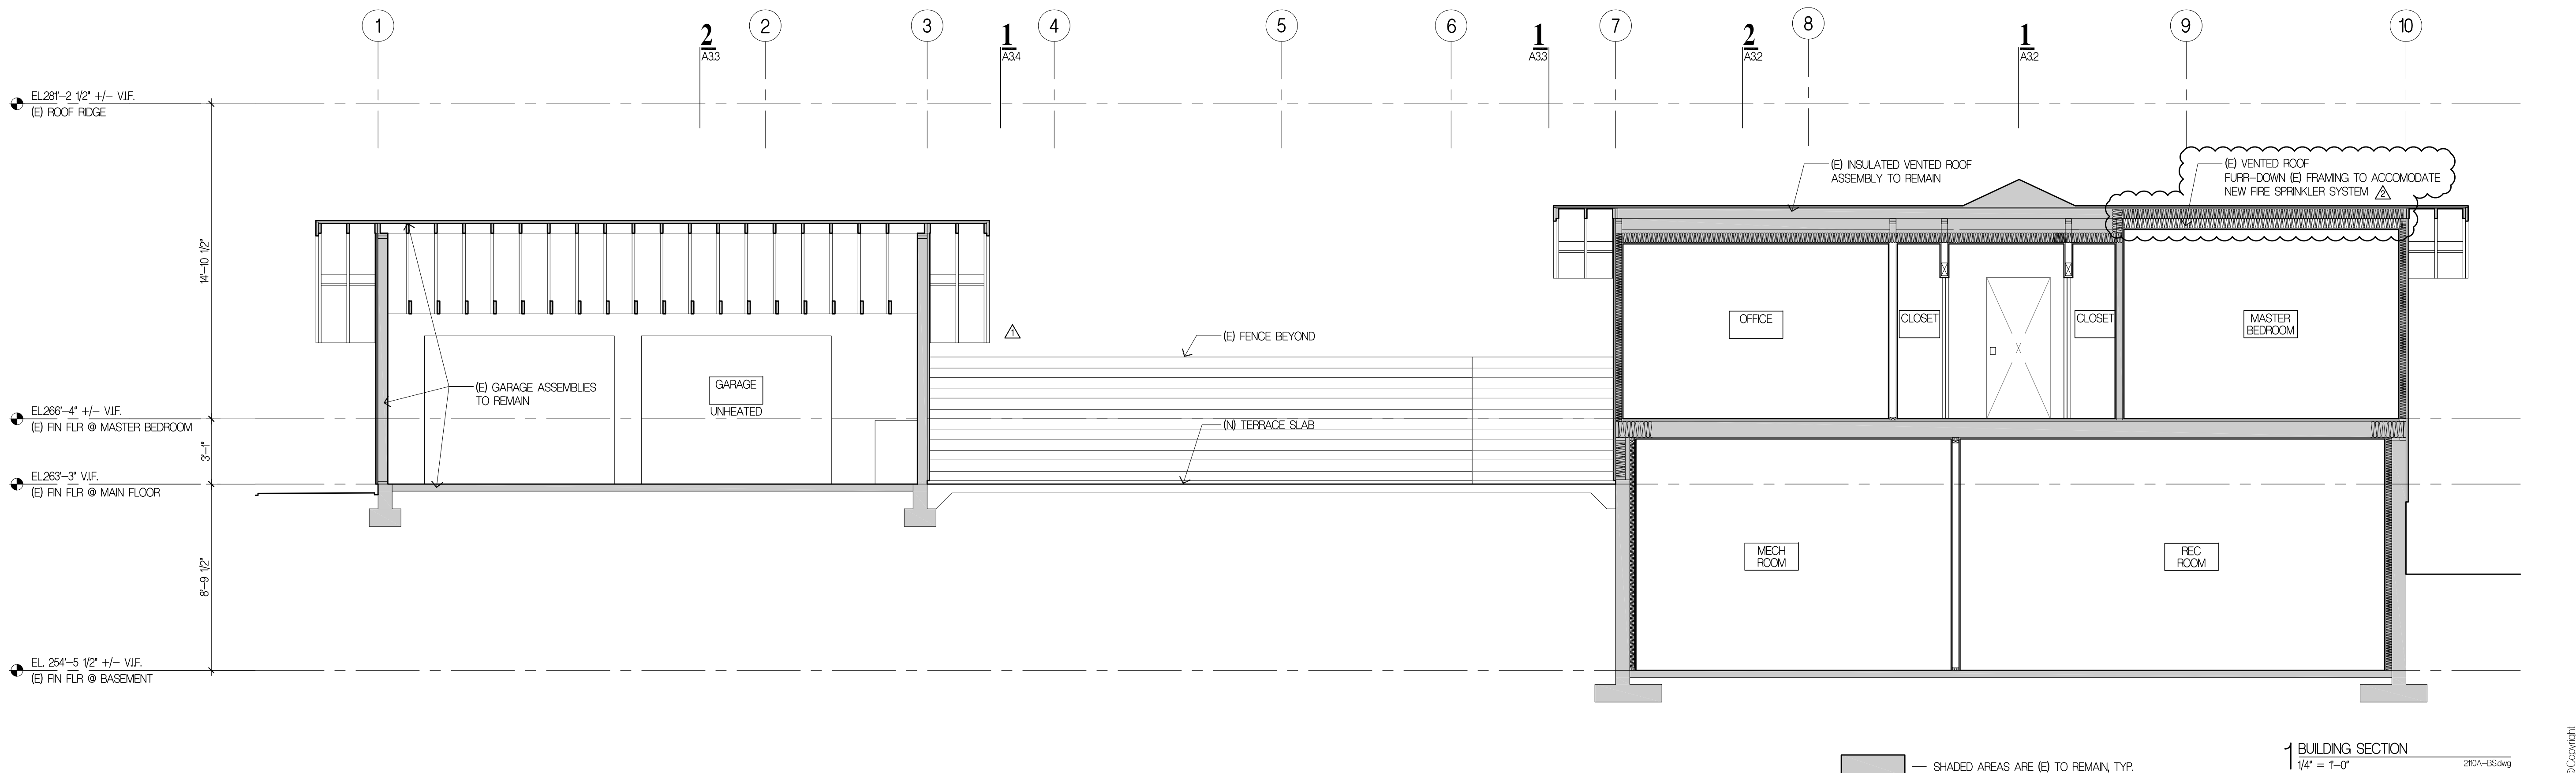

1 BUILDING SECTION
 1/4" = 1'-0" 210A-BSDwg

Project Title
JAFFE RESIDENCE
 8455 SE 83RD STREET
 MERCER ISLAND, WA 98040

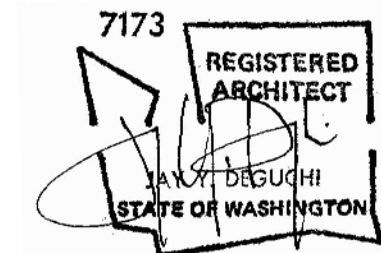


Drawing Title
BUILDING SECTIONS

Date
 08/08/2022
 Job No.
 210


ISSUE DATE
 PERMIT CORRECTIONS #1 03/31/2023
 PERMIT CORRECTIONS #2 05/31/2023

PERMIT CORRECTIONS
 Sheet No.

A3.1

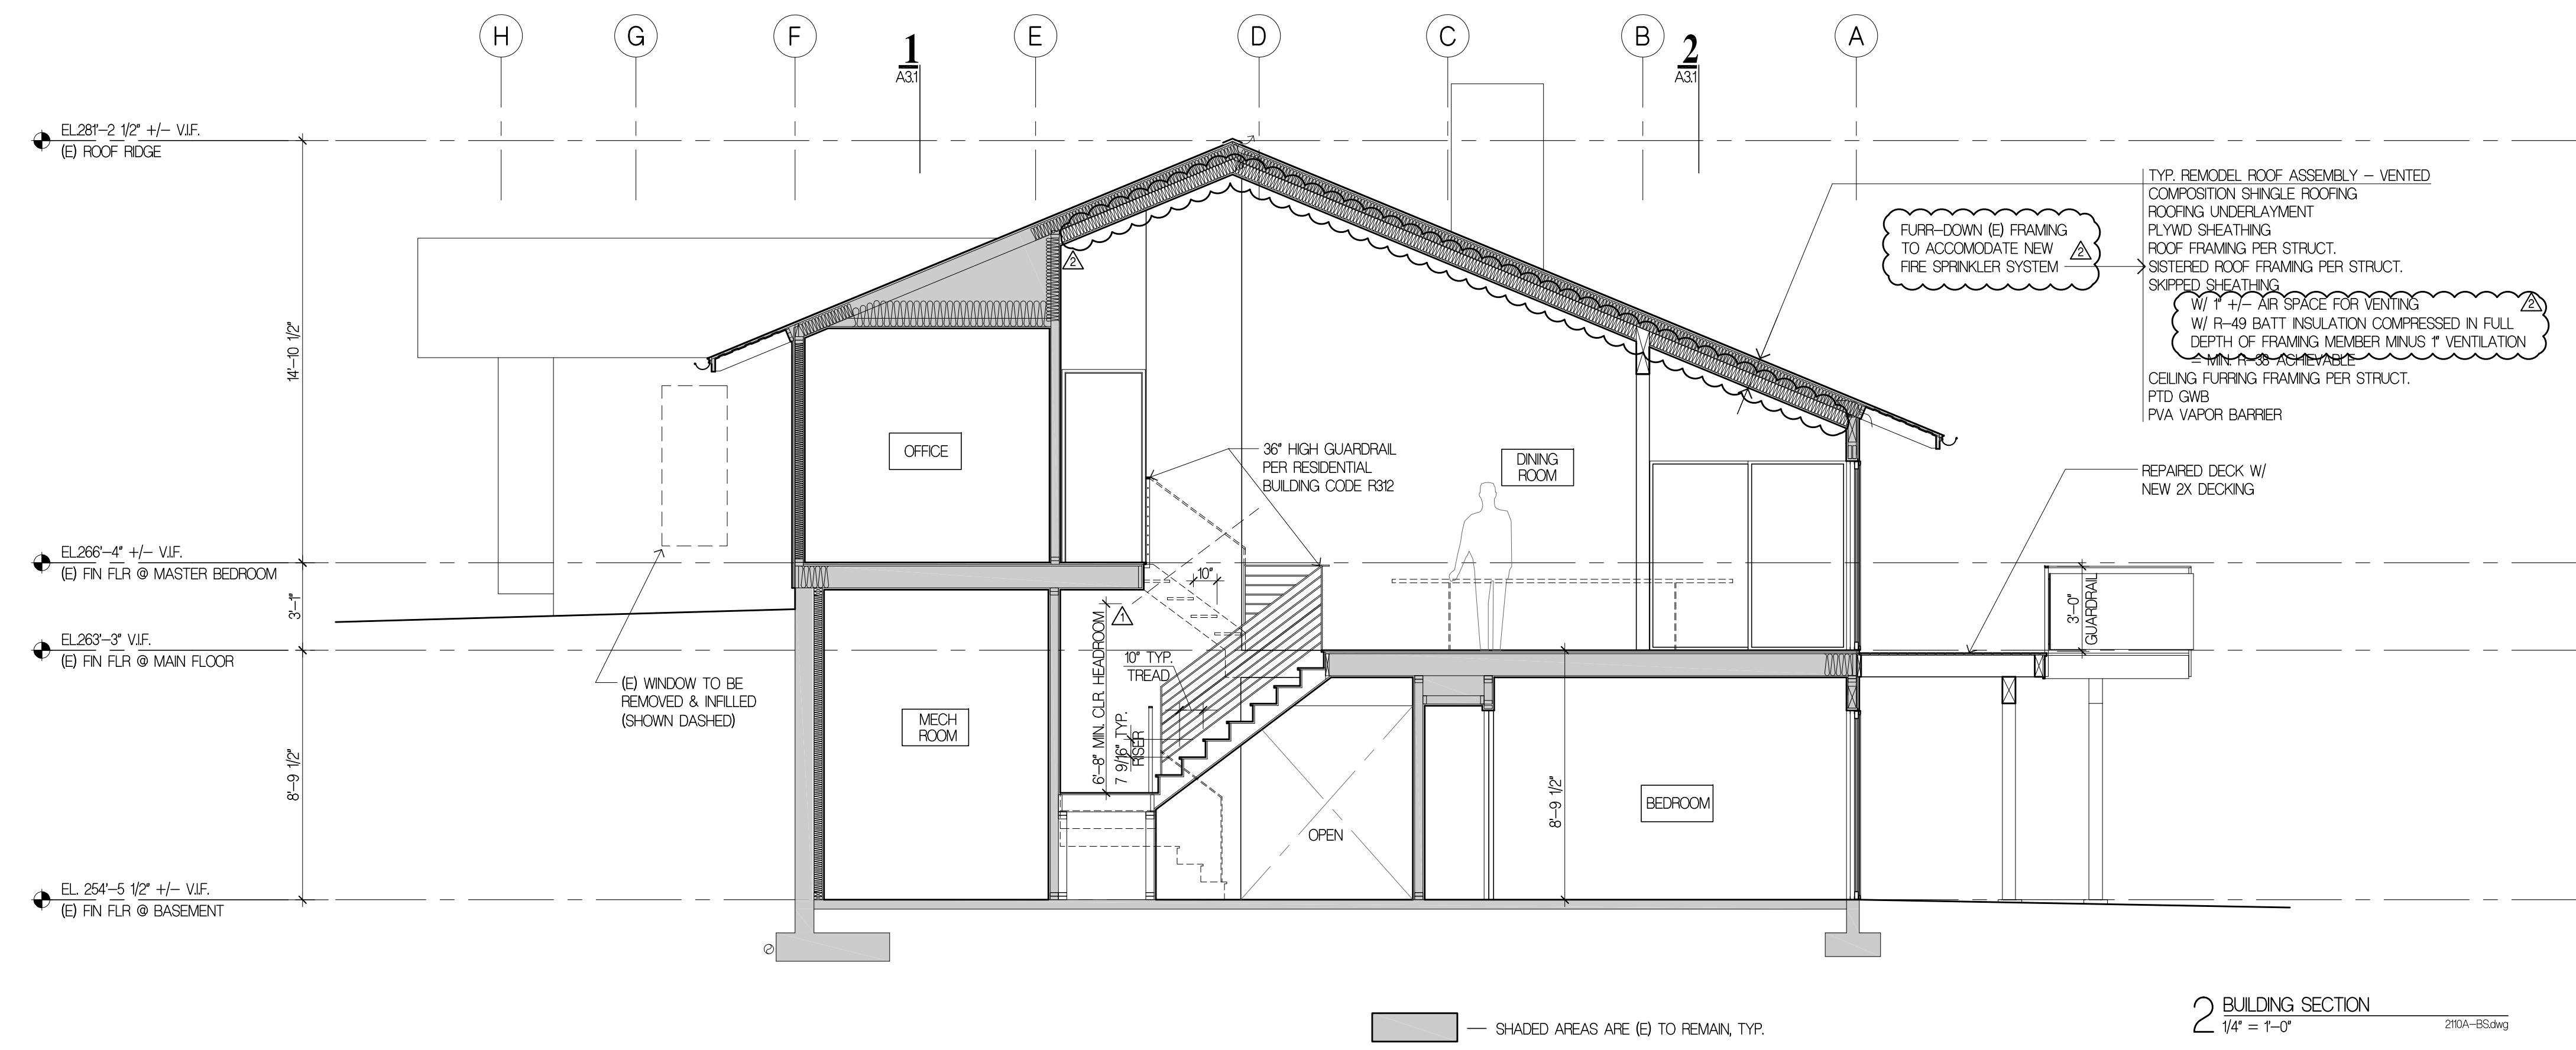


2 BUILDING SECTION
 1/4" = 1'-0"
 210A-BS.dwg

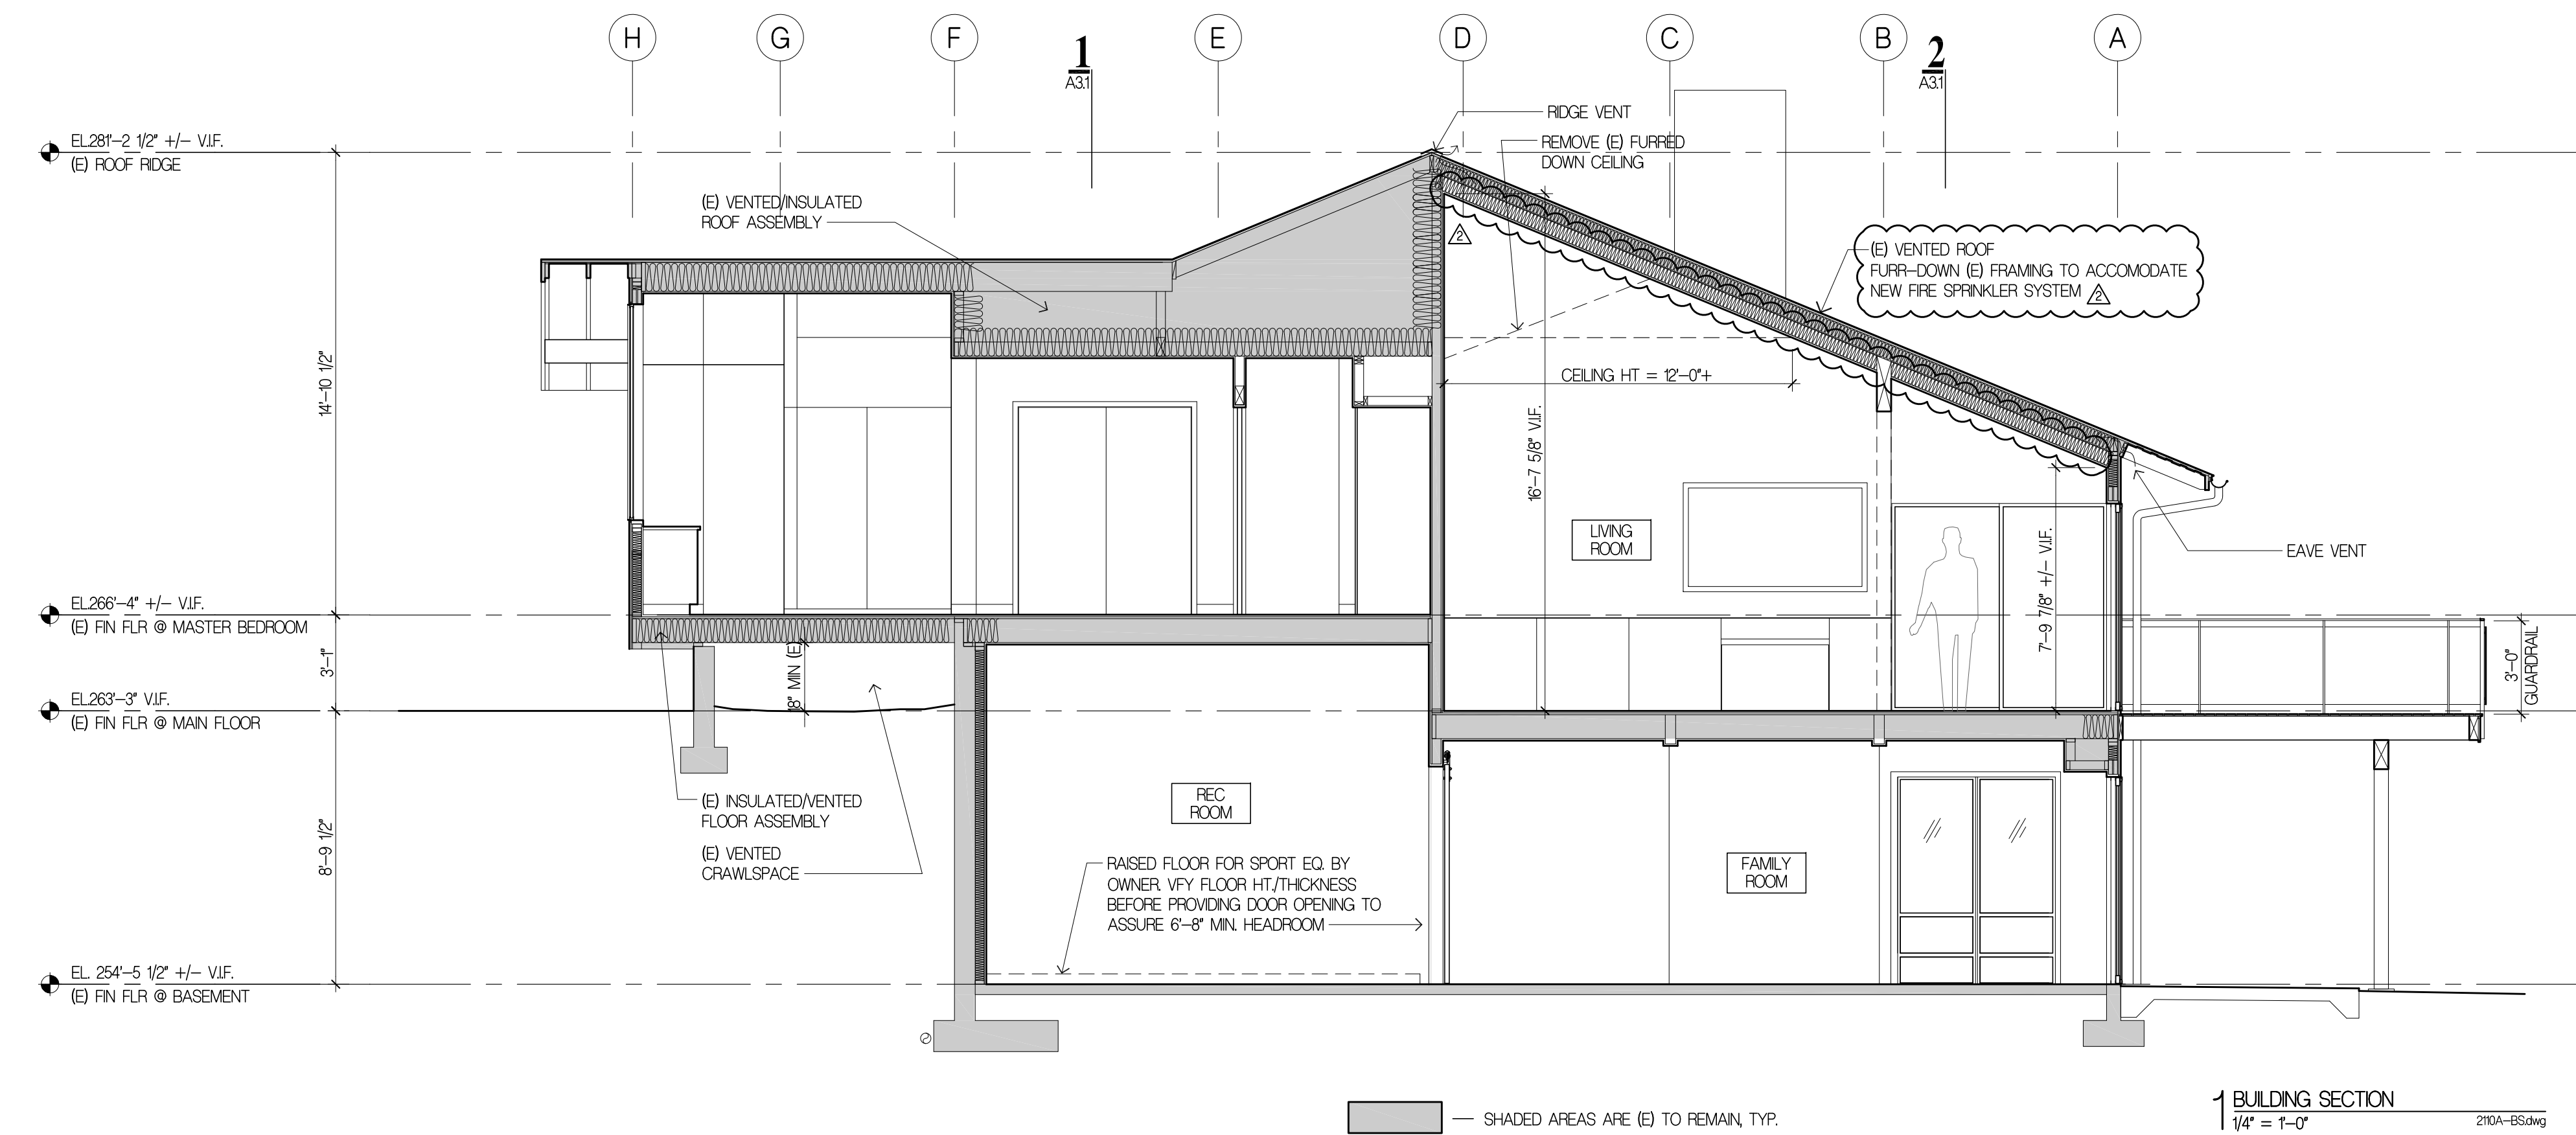

1 BUILDING SECTION
 1/4" = 1'-0"
 210A-BS.dwg

Project Title
JAFFE RESIDENCE
 8455 SE 83RD STREET
 MERCER ISLAND, WA 98040

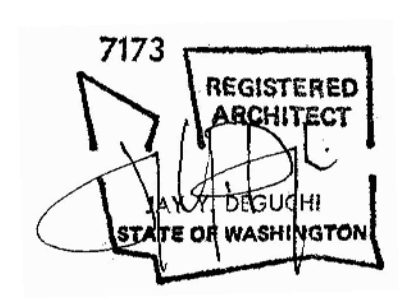


Drawing Title
BUILDING SECTIONS

Date
 08.08.2022
 Job No.
 2110


ISSUE DATE
 △ PERMIT CORRECTIONS #1 03/31/2023
 △ PERMIT CORRECTIONS #2 05/31/2023

PERMIT CORRECTIONS
 Sheet No.

A3.2

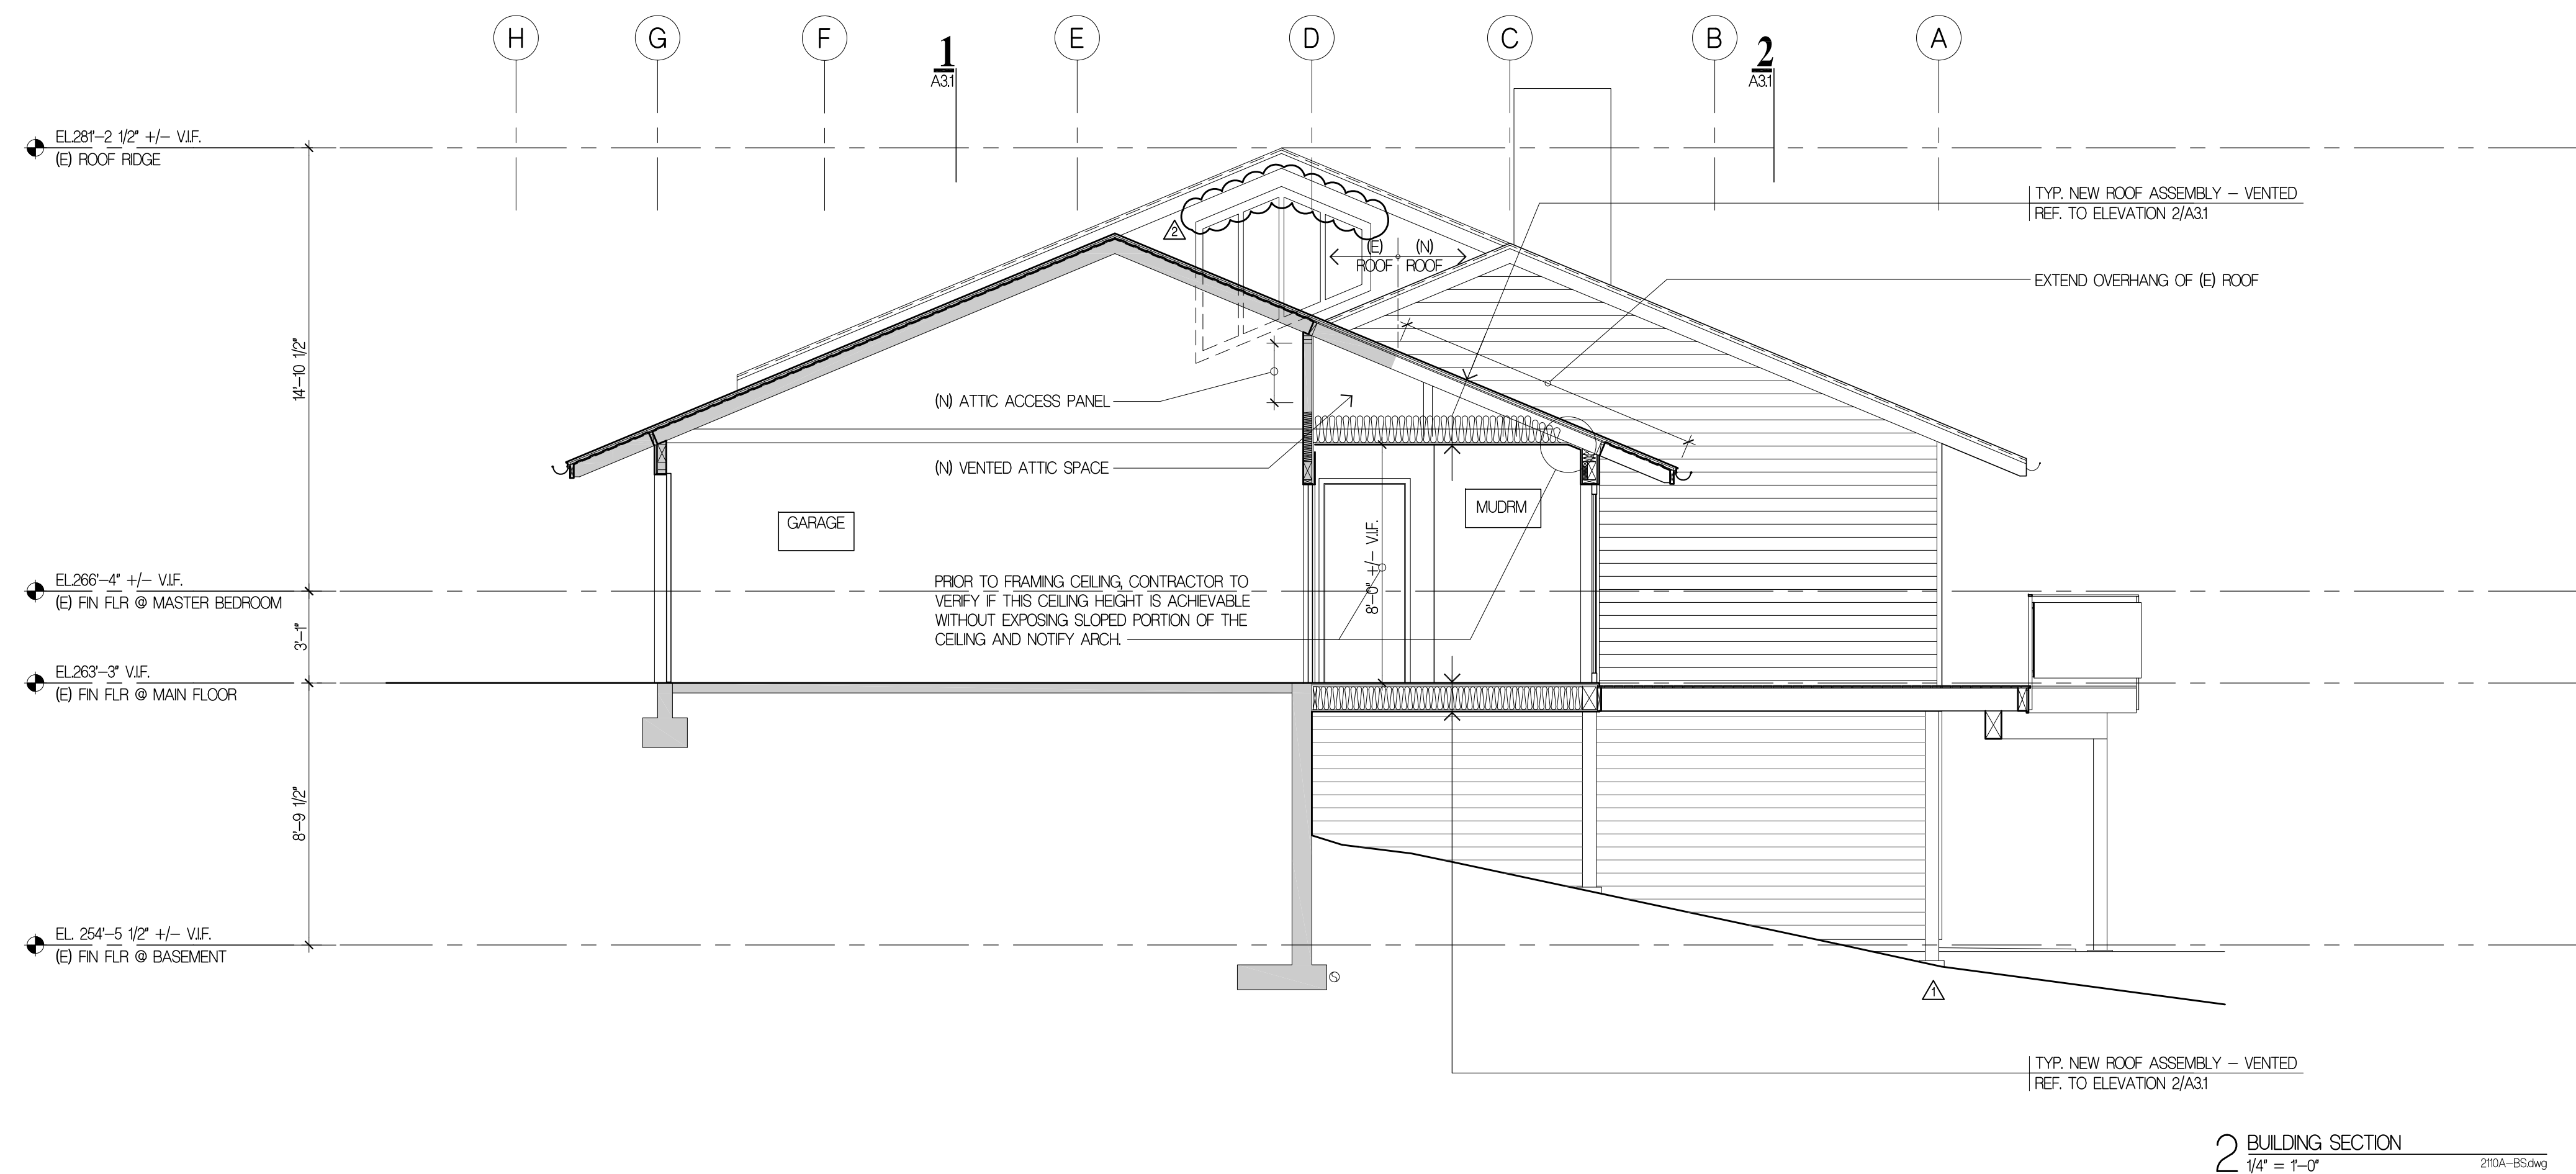


2 BUILDING SECTION
 1/4" = 1'-0" 210A-BS.dwg

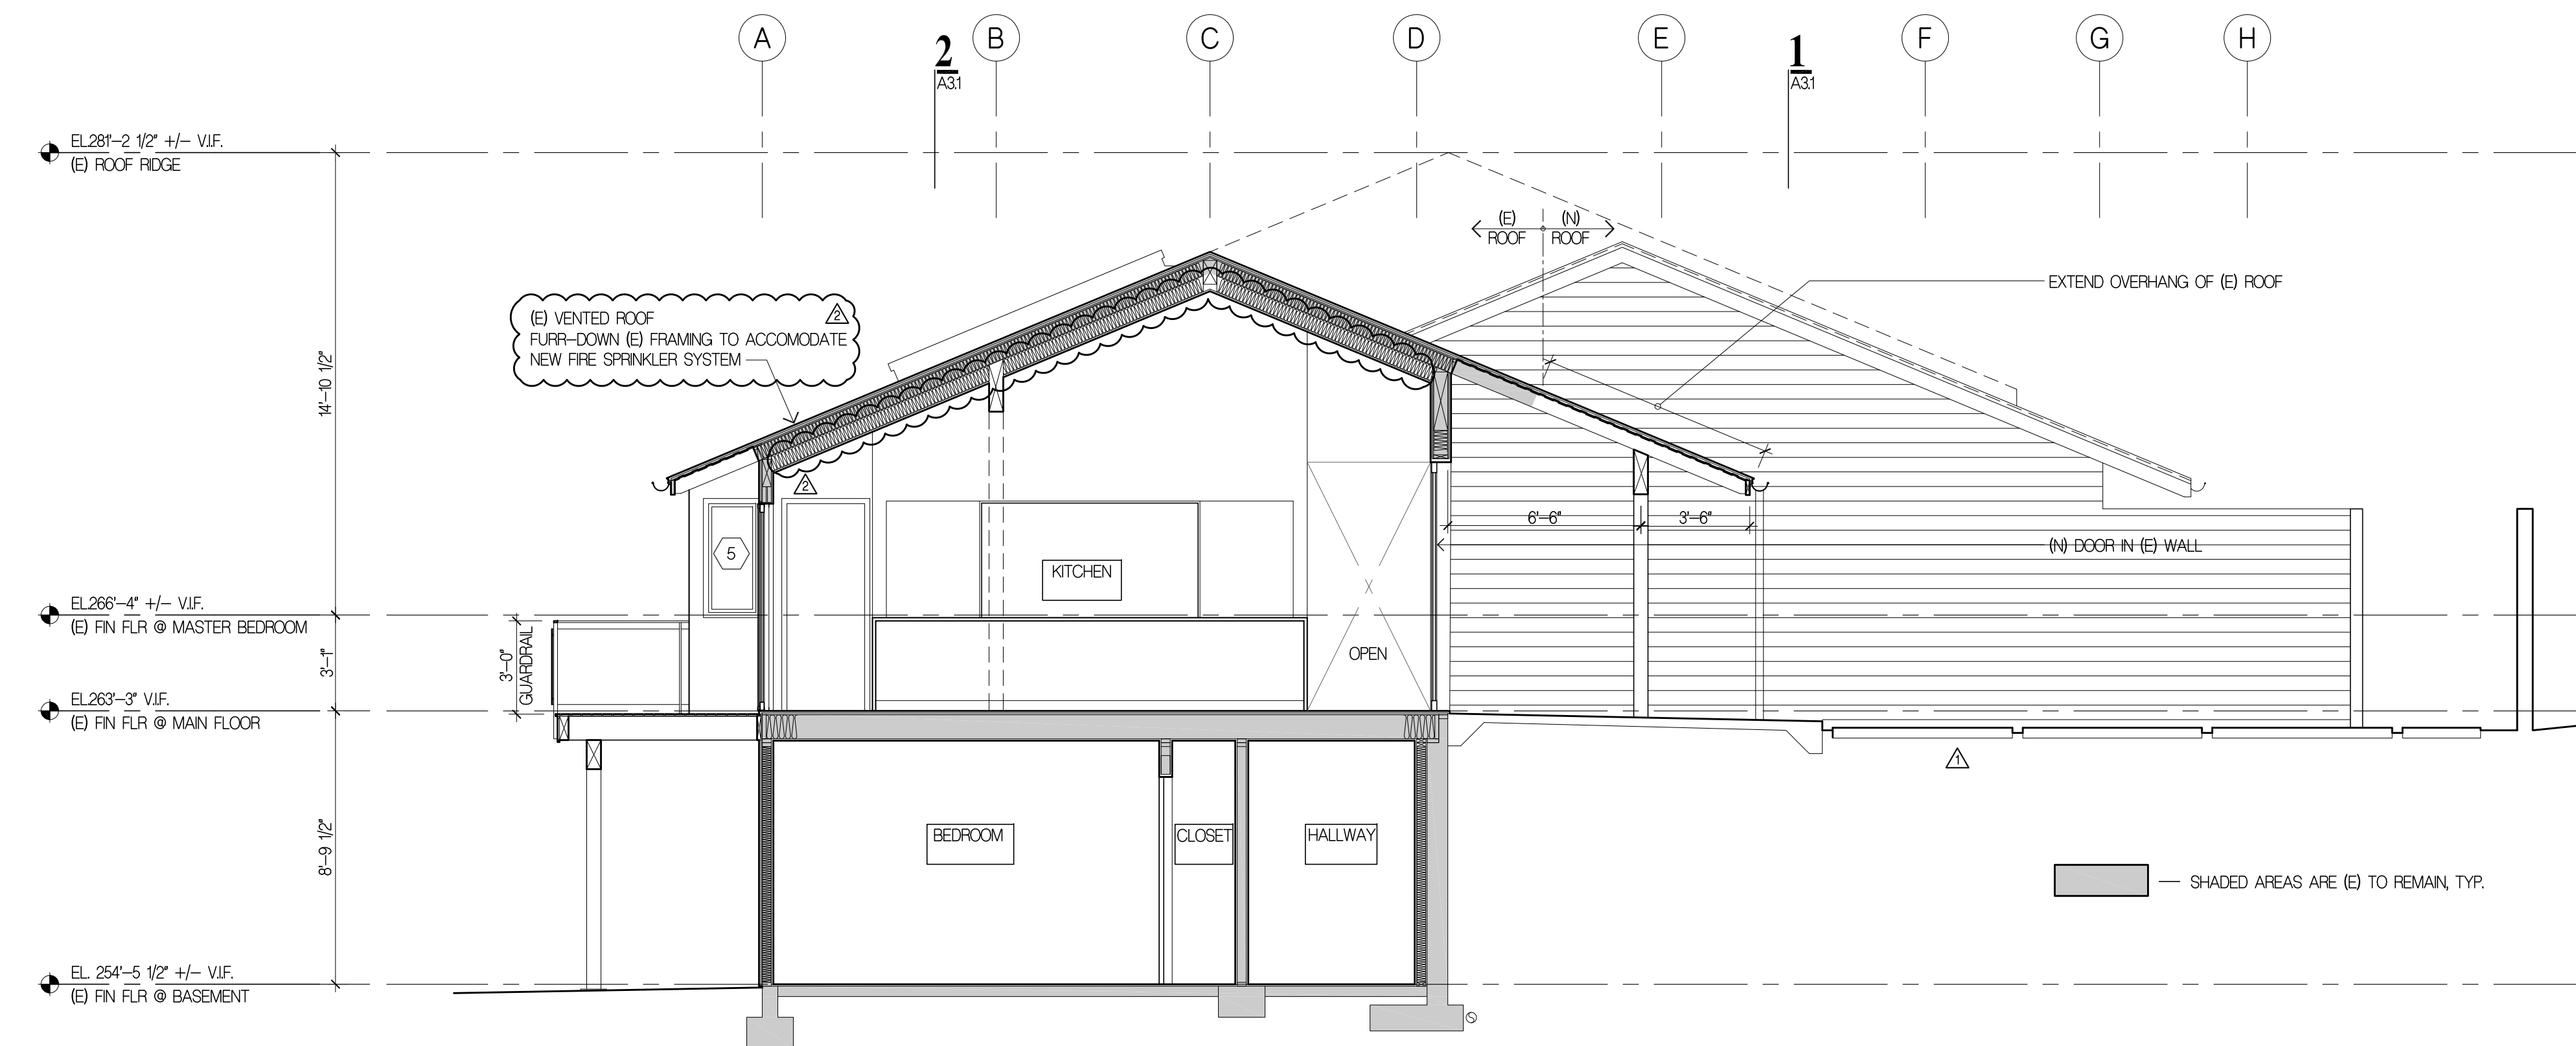

1 BUILDING SECTION
 1/4" = 1'-0" 210A-BS.dwg

Project Title
JAFFE RESIDENCE
 8455 SE 83RD STREET
 MERCER ISLAND, WA 98040

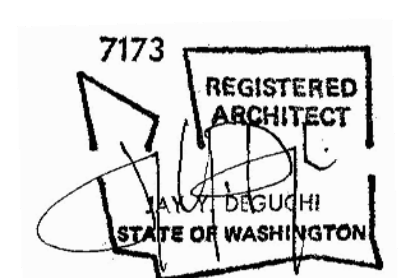

Drawing Title
BUILDING SECTIONS


Date
 08.08.2022
 Job No.
 2110

ISSUE DATE
 △ PERMIT CORRECTIONS #1 03/31/2023
 △ PERMIT CORRECTIONS #2 05/31/2023


PERMIT CORRECTIONS
 Sheet No.

A3.3

© Copyright

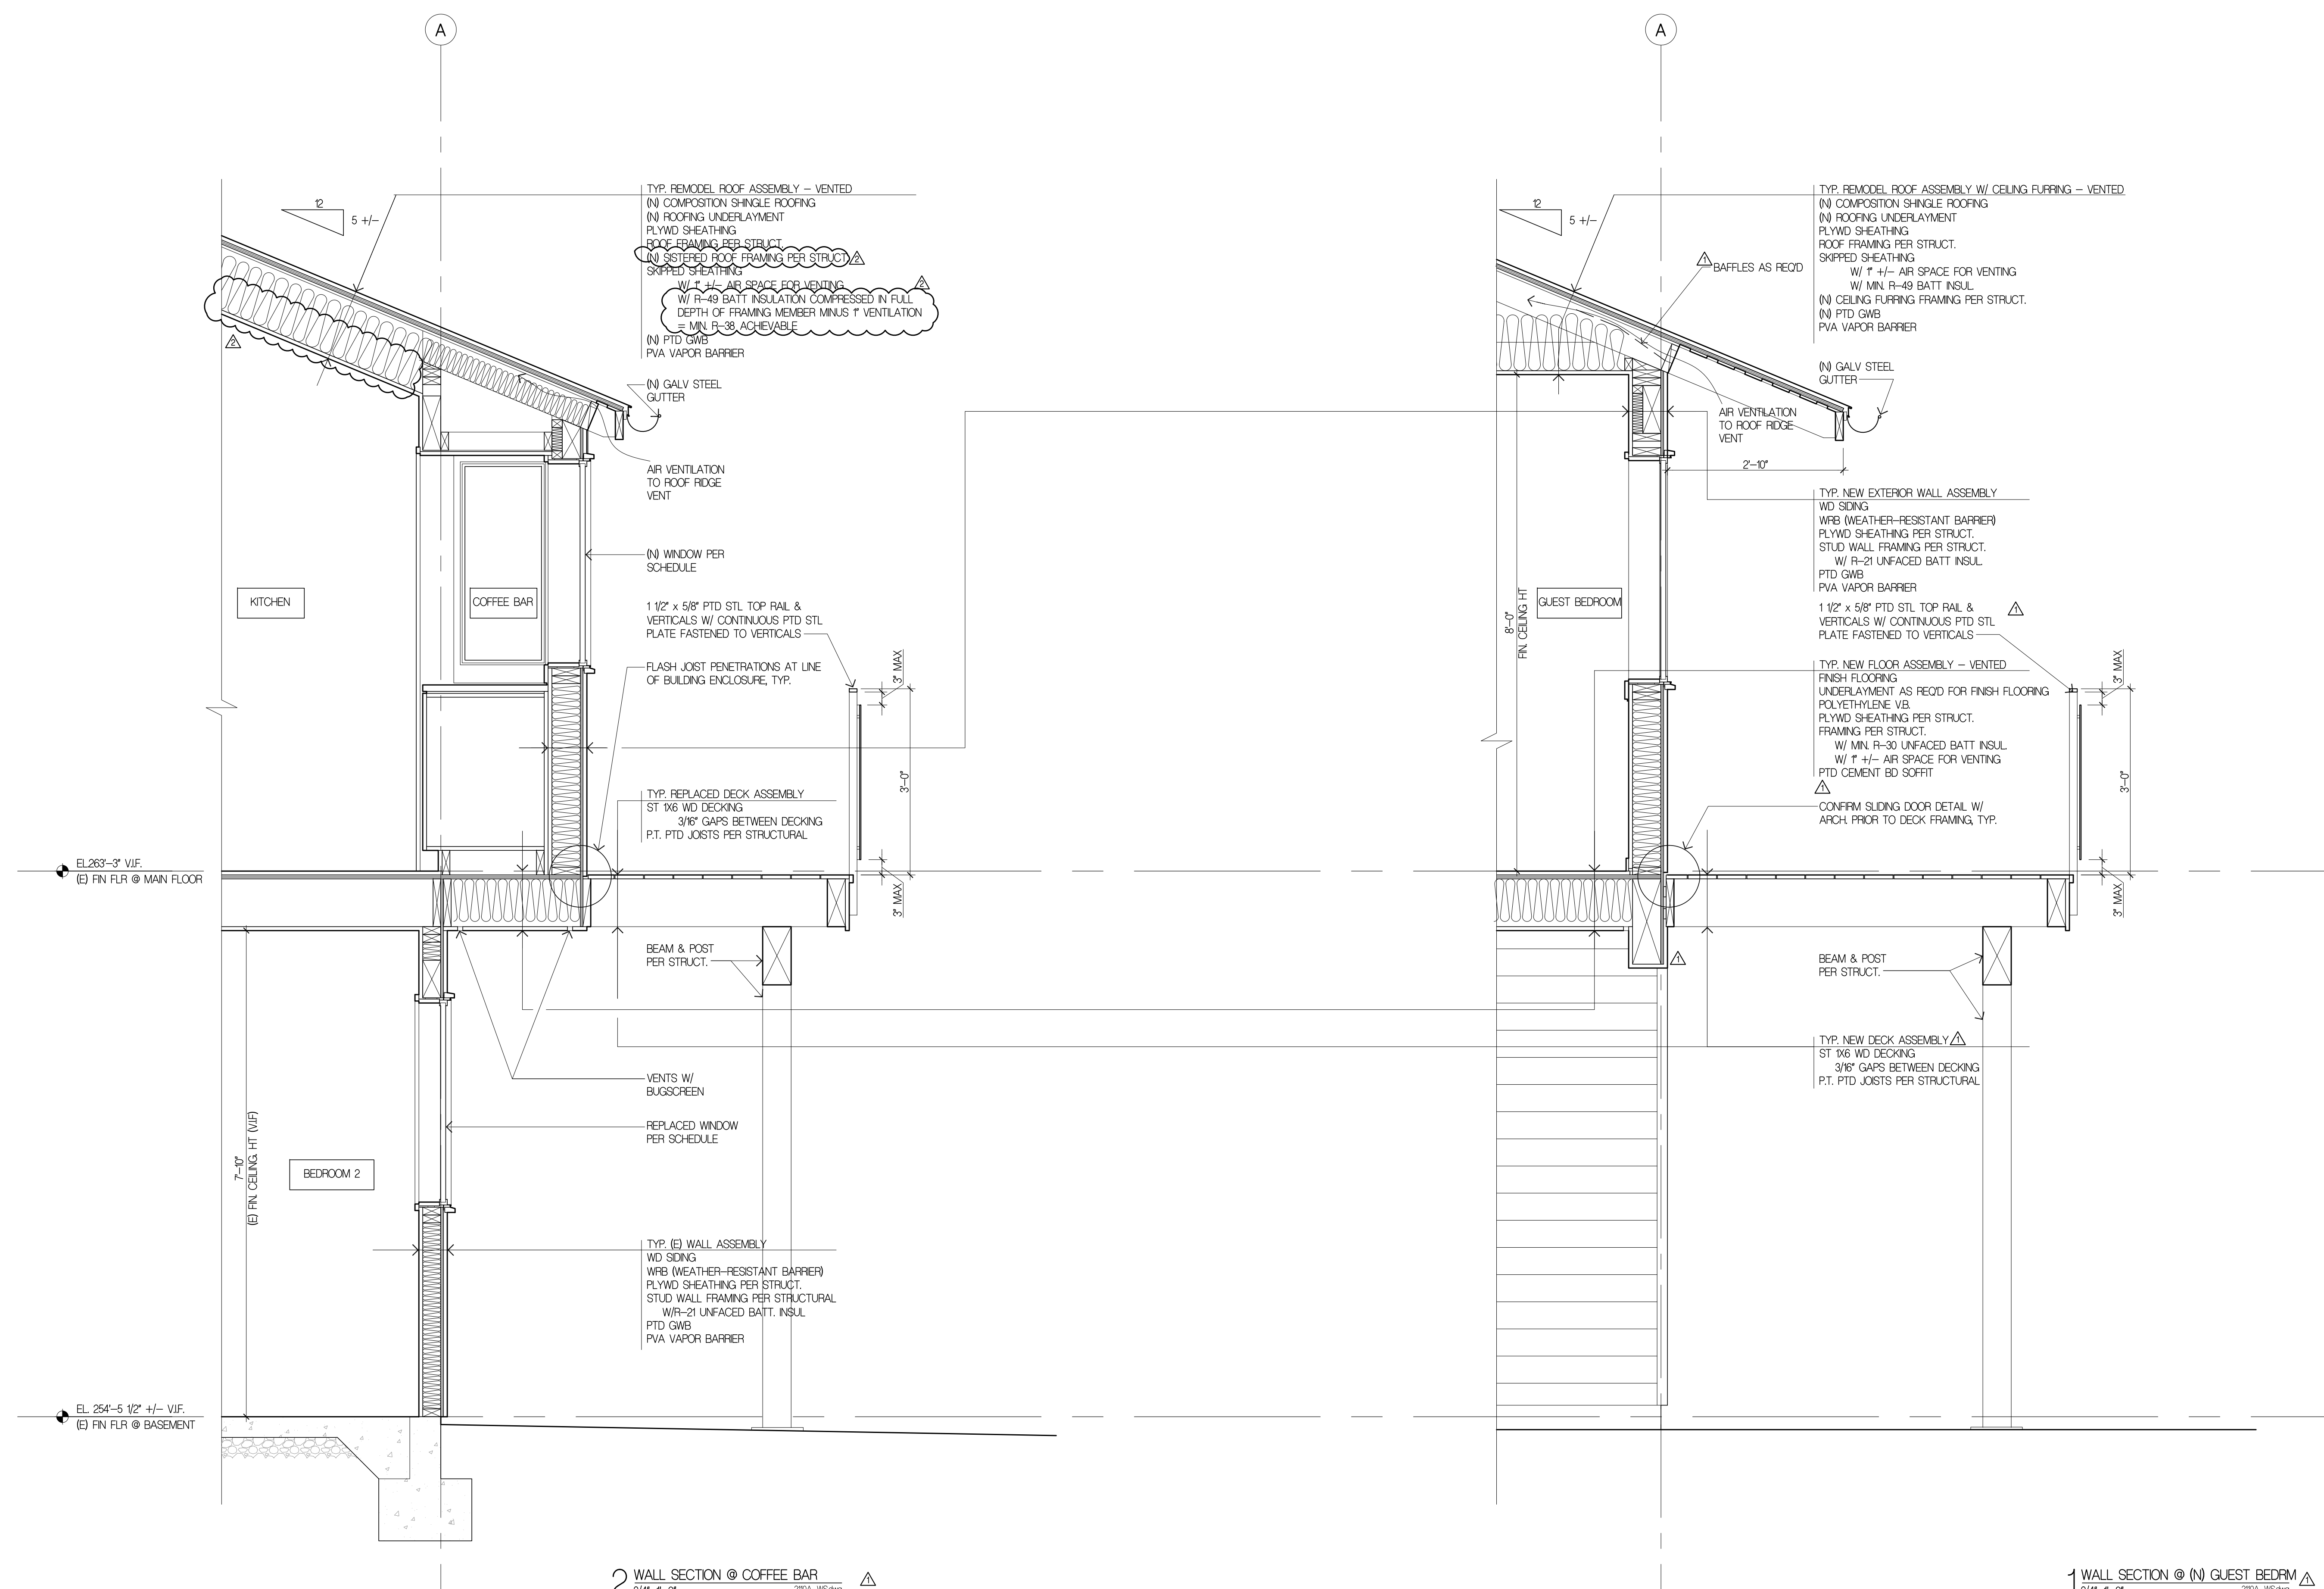

Project Title
JAFFE RESIDENCE
 8455 SE 83RD STREET
 MERCER ISLAND, WA 98040

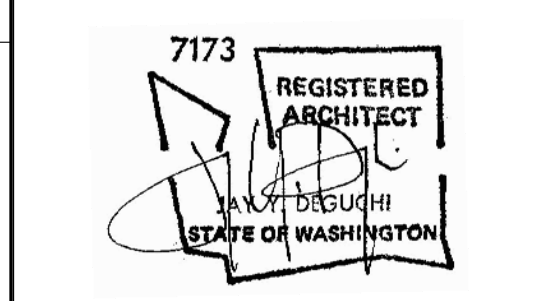

Drawing Title
WALL SECTIONS

Date
 08.08.2022
 Job No.
 210


ISSUE	DATE
PERMIT CORRECTIONS #1	03/31/2023
PERMIT CORRECTIONS #2	05/31/2023

PERMIT CORRECTIONS
 Sheet No.

2 WALL SECTION @ COFFEE BAR
 3/4"=1'-0" 210A-WS.dwg

1 WALL SECTION @ (N) GUEST BEDRM
 3/4"=1'-0" 210A-WS.dwg

A4.1

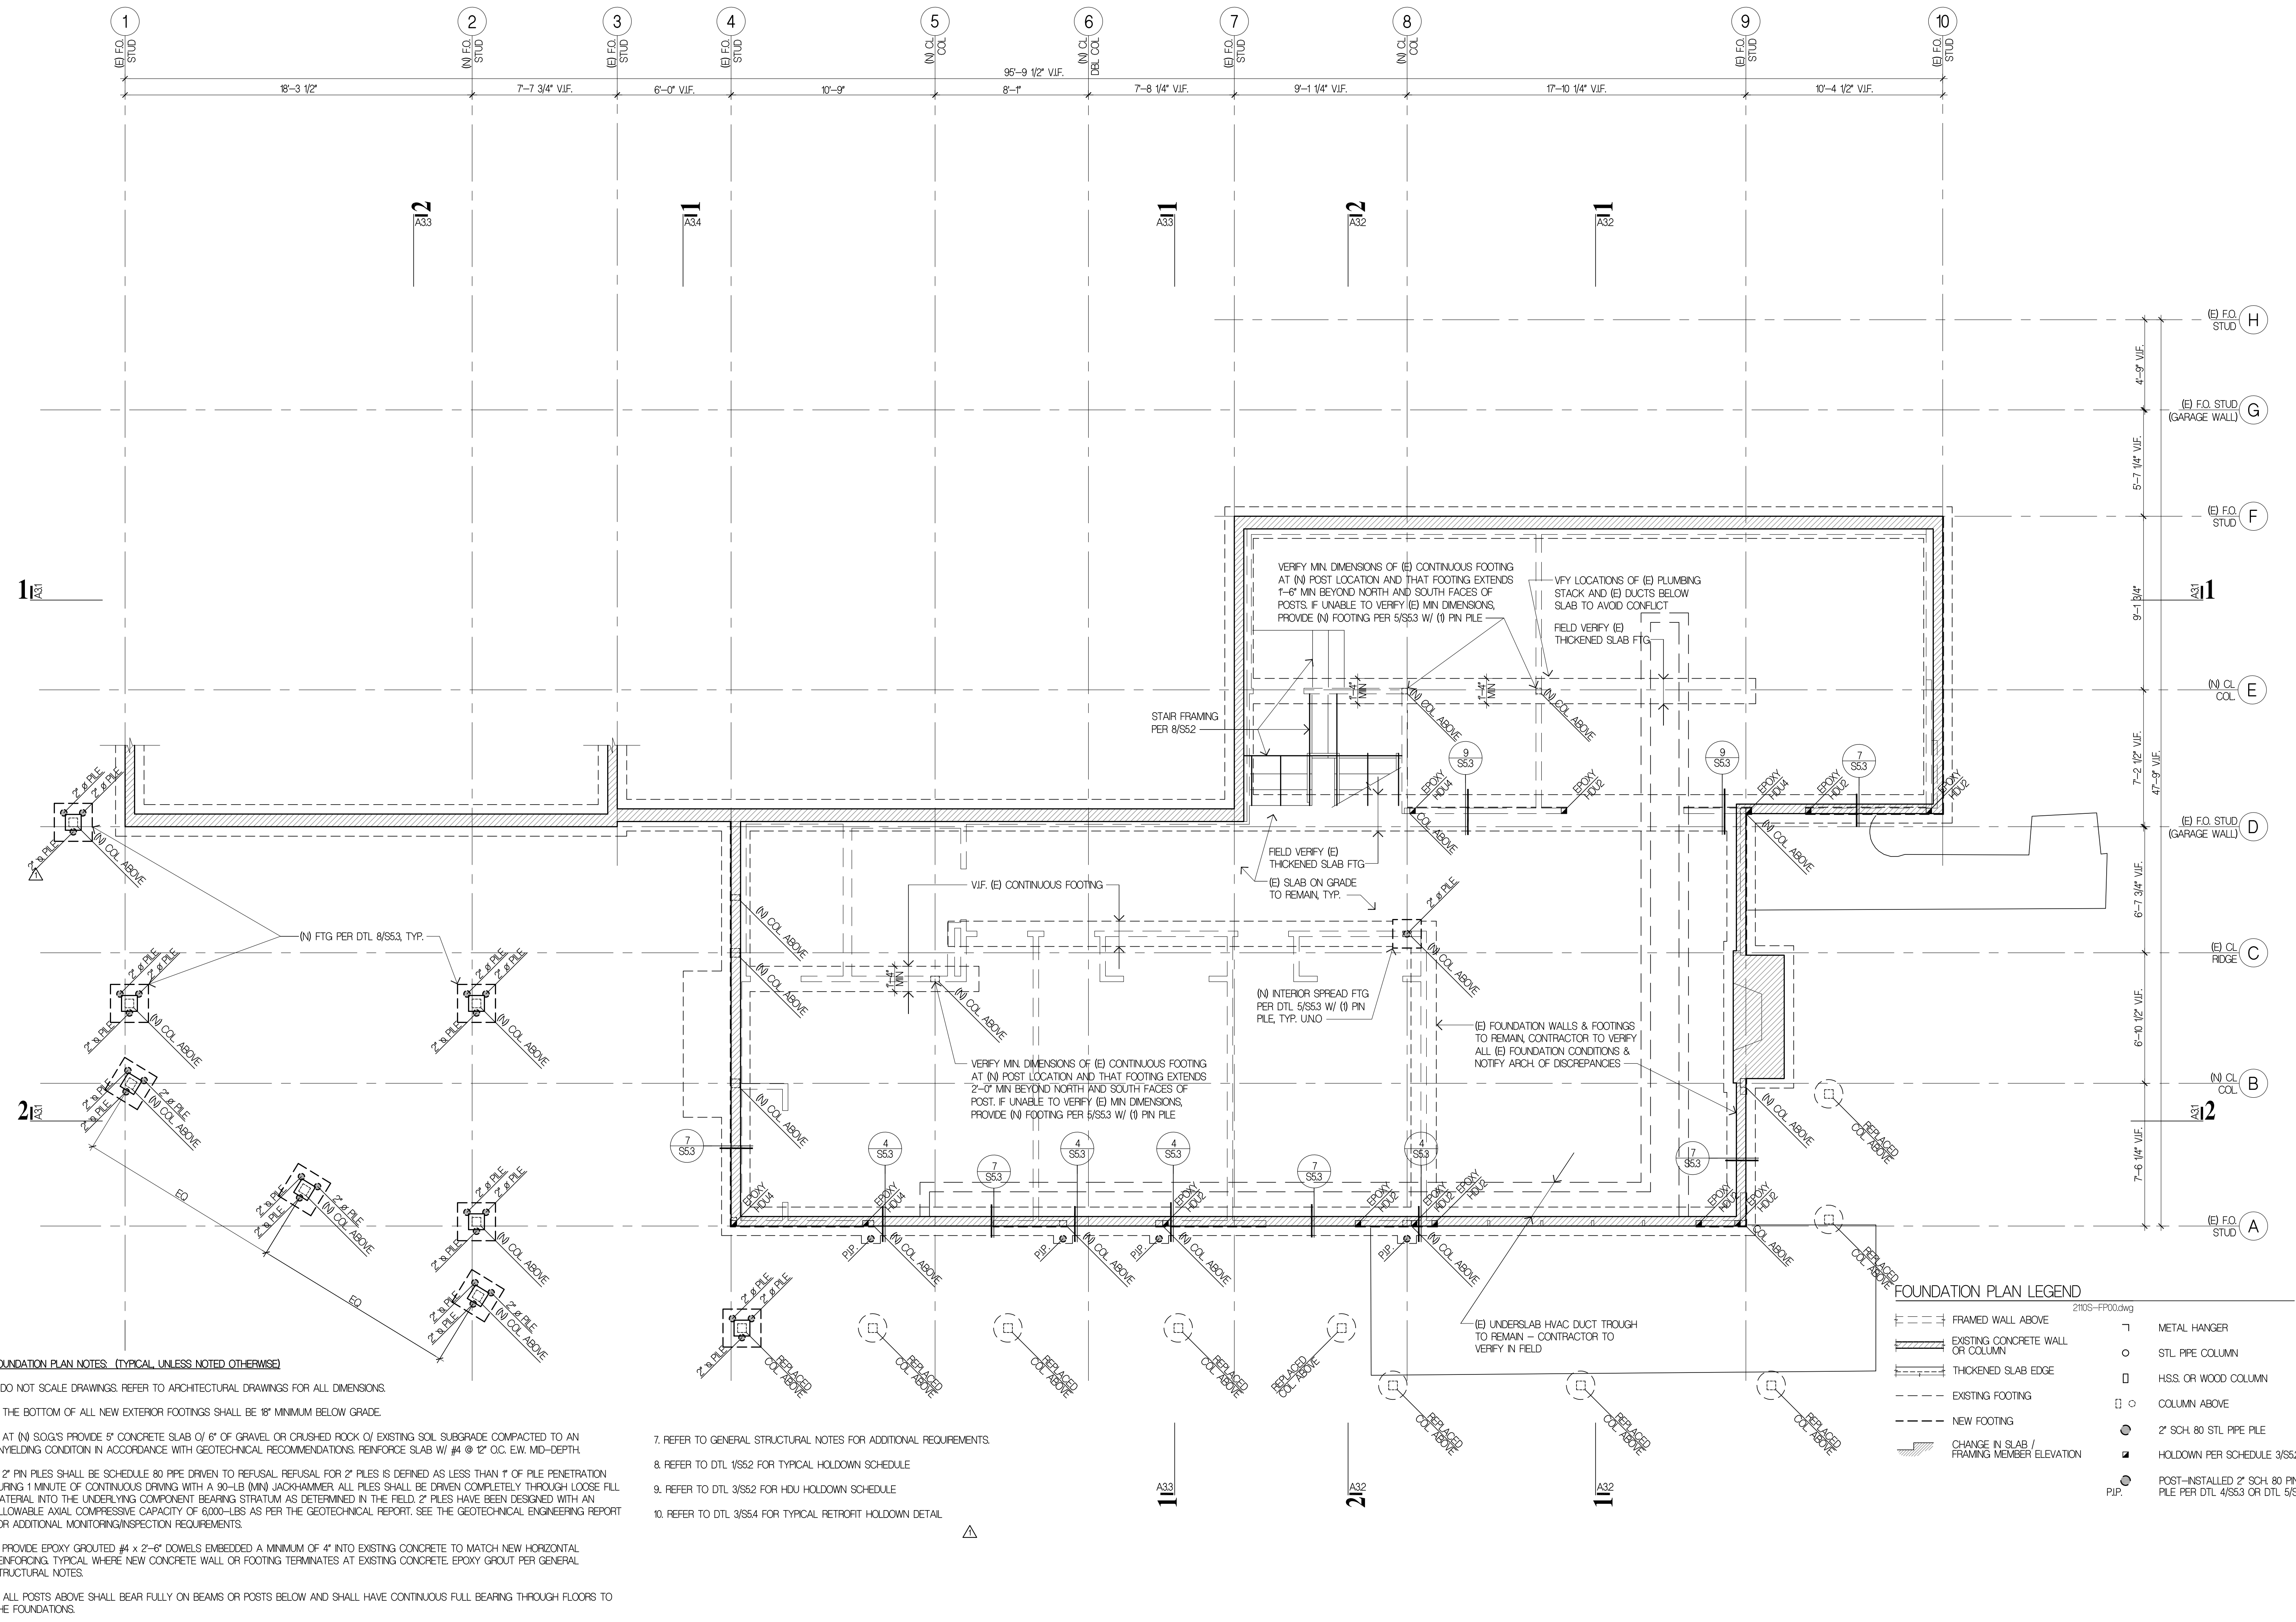


FOUNDATION PLAN NOTES. (TYPICAL UNLESS NOTED OTHERWISE)

- DO NOT SCALE DRAWINGS. REFER TO ARCHITECTURAL DRAWINGS FOR ALL DIMENSIONS.
- THE BOTTOM OF ALL NEW EXTERIOR FOOTINGS SHALL BE 18" MINIMUM BELOW GRADE.
- AT (N) SOG'S PROVIDE 5" CONCRETE SLAB (1' 6" OF GRAVEL OR CRUSHED ROCK (1) EXISTING SOIL SUBGRADE COMPACTED TO AN UNYIELDING CONDITION IN ACCORDANCE WITH GEOTECHNICAL RECOMMENDATIONS. REINFORCE SLAB W/ #4 @ 12" O.C. E.W. MD-DEPTH.
- 2" PN PILES SHALL BE SCHEDULE 80 PPE DRIVEN TO REFUSAL. REFUSAL FOR 2" PILES IS DEFINED AS LESS THAN 1' OF PILE PENETRATION DURING 1 MINUTE OF CONTINUOUS DRIVING WITH A 90-LB (MIN) JACKHAMMER. ALL PILES SHALL BE DRIVEN COMPLETELY THROUGH LOOSE FILL MATERIAL INTO THE UNDERLYING COMPONENT BEARING STRATUM AS DETERMINED IN THE FIELD. 2" PILES HAVE BEEN DESIGNED WITH AN ALLOWABLE AXIAL COMPRESSIVE CAPACITY OF 6000-LBS AS PER THE GEOTECHNICAL REPORT. SEE THE GEOTECHNICAL ENGINEERING REPORT FOR ADDITIONAL MONITORING/INSPECTION REQUIREMENTS.
- PROVIDE EPOXY GROUTED #4 x 2'-6" DOWELS EMBEDDED A MINIMUM OF 4" INTO EXISTING CONCRETE TO MATCH NEW HORIZONTAL REINFORCING. TYPICAL WHERE NEW CONCRETE WALL OR FOOTING TERMINATES AT EXISTING CONCRETE. EPOXY GROUT PER GENERAL STRUCTURAL NOTES.
- ALL POSTS ABOVE SHALL BEAR FULLY ON BEAMS OR POSTS BELOW AND SHALL HAVE CONTINUOUS FULL BEARING THROUGH FLOORS TO THE FOUNDATIONS.

- REFER TO GENERAL STRUCTURAL NOTES FOR ADDITIONAL REQUIREMENTS.
- REFER TO DTL 1/SS2 FOR TYPICAL HOLDOWN SCHEDULE.
- REFER TO DTL 3/SS2 FOR HDU HOLDOWN SCHEDULE.
- REFER TO DTL 3/SS4 FOR TYPICAL RETROFIT HOLDOWN DETAIL.

Project Title
JAFFE RESIDENCE
 8455 SE 83RD STREET
 MERCER ISLAND, WA 98040

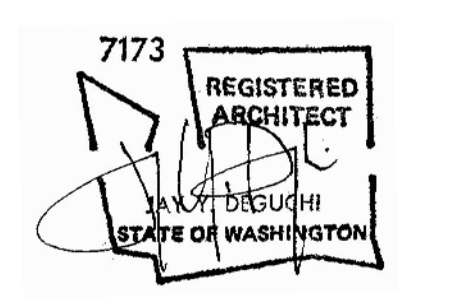

Drawing Title
FOUNDATION PLAN

Date
 08/08/2022
 Job No.
 2110

ISSUE DATE
 PERMIT CORRECTIONS #1 03/31/2023
 PERMIT CORRECTIONS #2 05/31/2023

PERMIT CORRECTIONS
 Sheet No.

FLOOR FRAMING FOUNDATION PLAN NOTES. (TYPICAL UNLESS NOTED OTHERWISE)

1. DO NOT SCALE DRAWINGS. REFER TO ARCH. DRAWINGS FOR ALL DIMENSIONS.

2. NEW FLOOR SHEATHING SHALL BE 3/4" APA RATED PANELS (EXPOSURE 1, SPAN RATING 4R24). NAIL AT ALL FRAMED PANEL EDGES W/ 10d @ 6" O.C. AND TO ALL INTERMEDIATE FRAMING AT 12" O.C.

3. HEADERS OVER DOOR AND WINDOW OPENINGS SHALL BE 4x8 MINIMUM PROVIDE (2) TRIMMER STUDS (MINIMUM) @ EA END OF ALL HEADERS UNLESS NOTED OTHERWISE ON PLANS. SEE DETAIL 4/SS2 FOR TYPICAL INSTALLATION.

4. PROVIDE (2) STUDS MINIMUM @ EA END OF ALL BEAMS UNLESS NOTED OTHERWISE ON PLANS. BEAR BEAMS FULLY ON BUILT UP COLUMN AND PROVIDE AC, PC, OR LFC CAP.

5. MANUFACTURED LUMBER PRODUCTS (LSL, LVL, PSL, GL) SHALL BE INSTALLED WITH A MOISTURE CONTENT OF 12% OR LESS. THE CONTRACTOR SHALL MAKE PROVISIONS DURING CONSTRUCTION TO PREVENT THE MOISTURE CONTENT OF INSTALLED BEAMS FROM EXCEEDING 12%.

6. ALL POSTS ABOVE SHALL BEAR FULLY ON BEAMS OR POSTS BELOW AND SHALL HAVE CONTINUOUS VERTICAL GRAIN BLOCKING TO MATCH POST ABOVE FOR FULL BEARING THROUGH FLOORS TO THE FOUNDATION.

7. SPLICE ALL TOP PLATE SPLICES PER DET. 7/SS2

8. THE BOTTOM OF ALL NEW EXTERIOR FOOTINGS SHALL BE 18" MINIMUM BELOW GRADE.

9. 5" CONC. SLAB ON 6" OF GRAVEL OR CRUSHED ROCK (1) EXISTING SOIL SUBGRADE COMPACTED TO AN UNYIELDING CONDITION IN ACCORDANCE W/ GEOTECHNICAL RECOMMENDATIONS. REINFORCE SLAB W/ #4 @ 12" O.C. E.W. MID-DEPTH.

10. 2" PIN PILES SHALL BE SCHEDULE 80 PIPE DRIVEN TO REFUSAL. REFUSAL FOR 2" PILES IS DEFINED AS LESS THAN 1" OF PILE PENETRATION DURING 1 MINUTE OF CONTINUOUS DRIVING WITH A 90-LB (MIN) JACKHAMMER. ALL PILES SHALL BE DRIVEN COMPLETELY THROUGH LOOSE FILL MATERIAL INTO THE UNDERLYING COMPACT BEARING STRATUM AS DETERMINED IN FIELD. 2" PILES SHALL HAVE BEEN DESIGNED W/ AN ALLOWABLE AXIAL COMPRESSIVE CAPACITY OF 6000-LBS AS PER THE GEOTECHNICAL REPORT. SEE THE GEOTECHNICAL ENGINEERING REPORT FOR ADDITIONAL MONITORING/INSPECTION REQUIREMENTS.


11. PROVIDE EPOXY GROUTED #4 x 2'-6" DOWELS EMBEDDED A MINIMUM OF 4" IN TO EXISTING CONCRETE TO MATCH NEW HORIZONTAL REINFORCING. TYPICAL WHERE NEW CONCRETE WALL OR FOOTING TERMINATES AT EXISTING CONCRETE. EPOXY GROUT PER GENERAL STRUCTURAL NOTES.

12. REFER TO GENERAL STRUCTURAL NOTES FOR ADDITIONAL REQUIREMENTS.

13. HATCHED AREA REPRESENTS EXTENTS OF BLOCKED FLOOR DIAPHRAGM. PROVIDE 2x4 FLAT BLOCKING AT ALL UNFRAMED PANEL EDGES. NAIL SHEATHING TO BLOCKING W/ 8d @ 4" O.C. PANEL EDGE NAILING.

14. REFER TO DET. 6/SS2 FOR TYPICAL SHEARWALL CONSTRUCTION.

Suyama Peterson Deguchi
8601 8th Avenue South
Seattle, Washington 98108
P. 206.256.0809

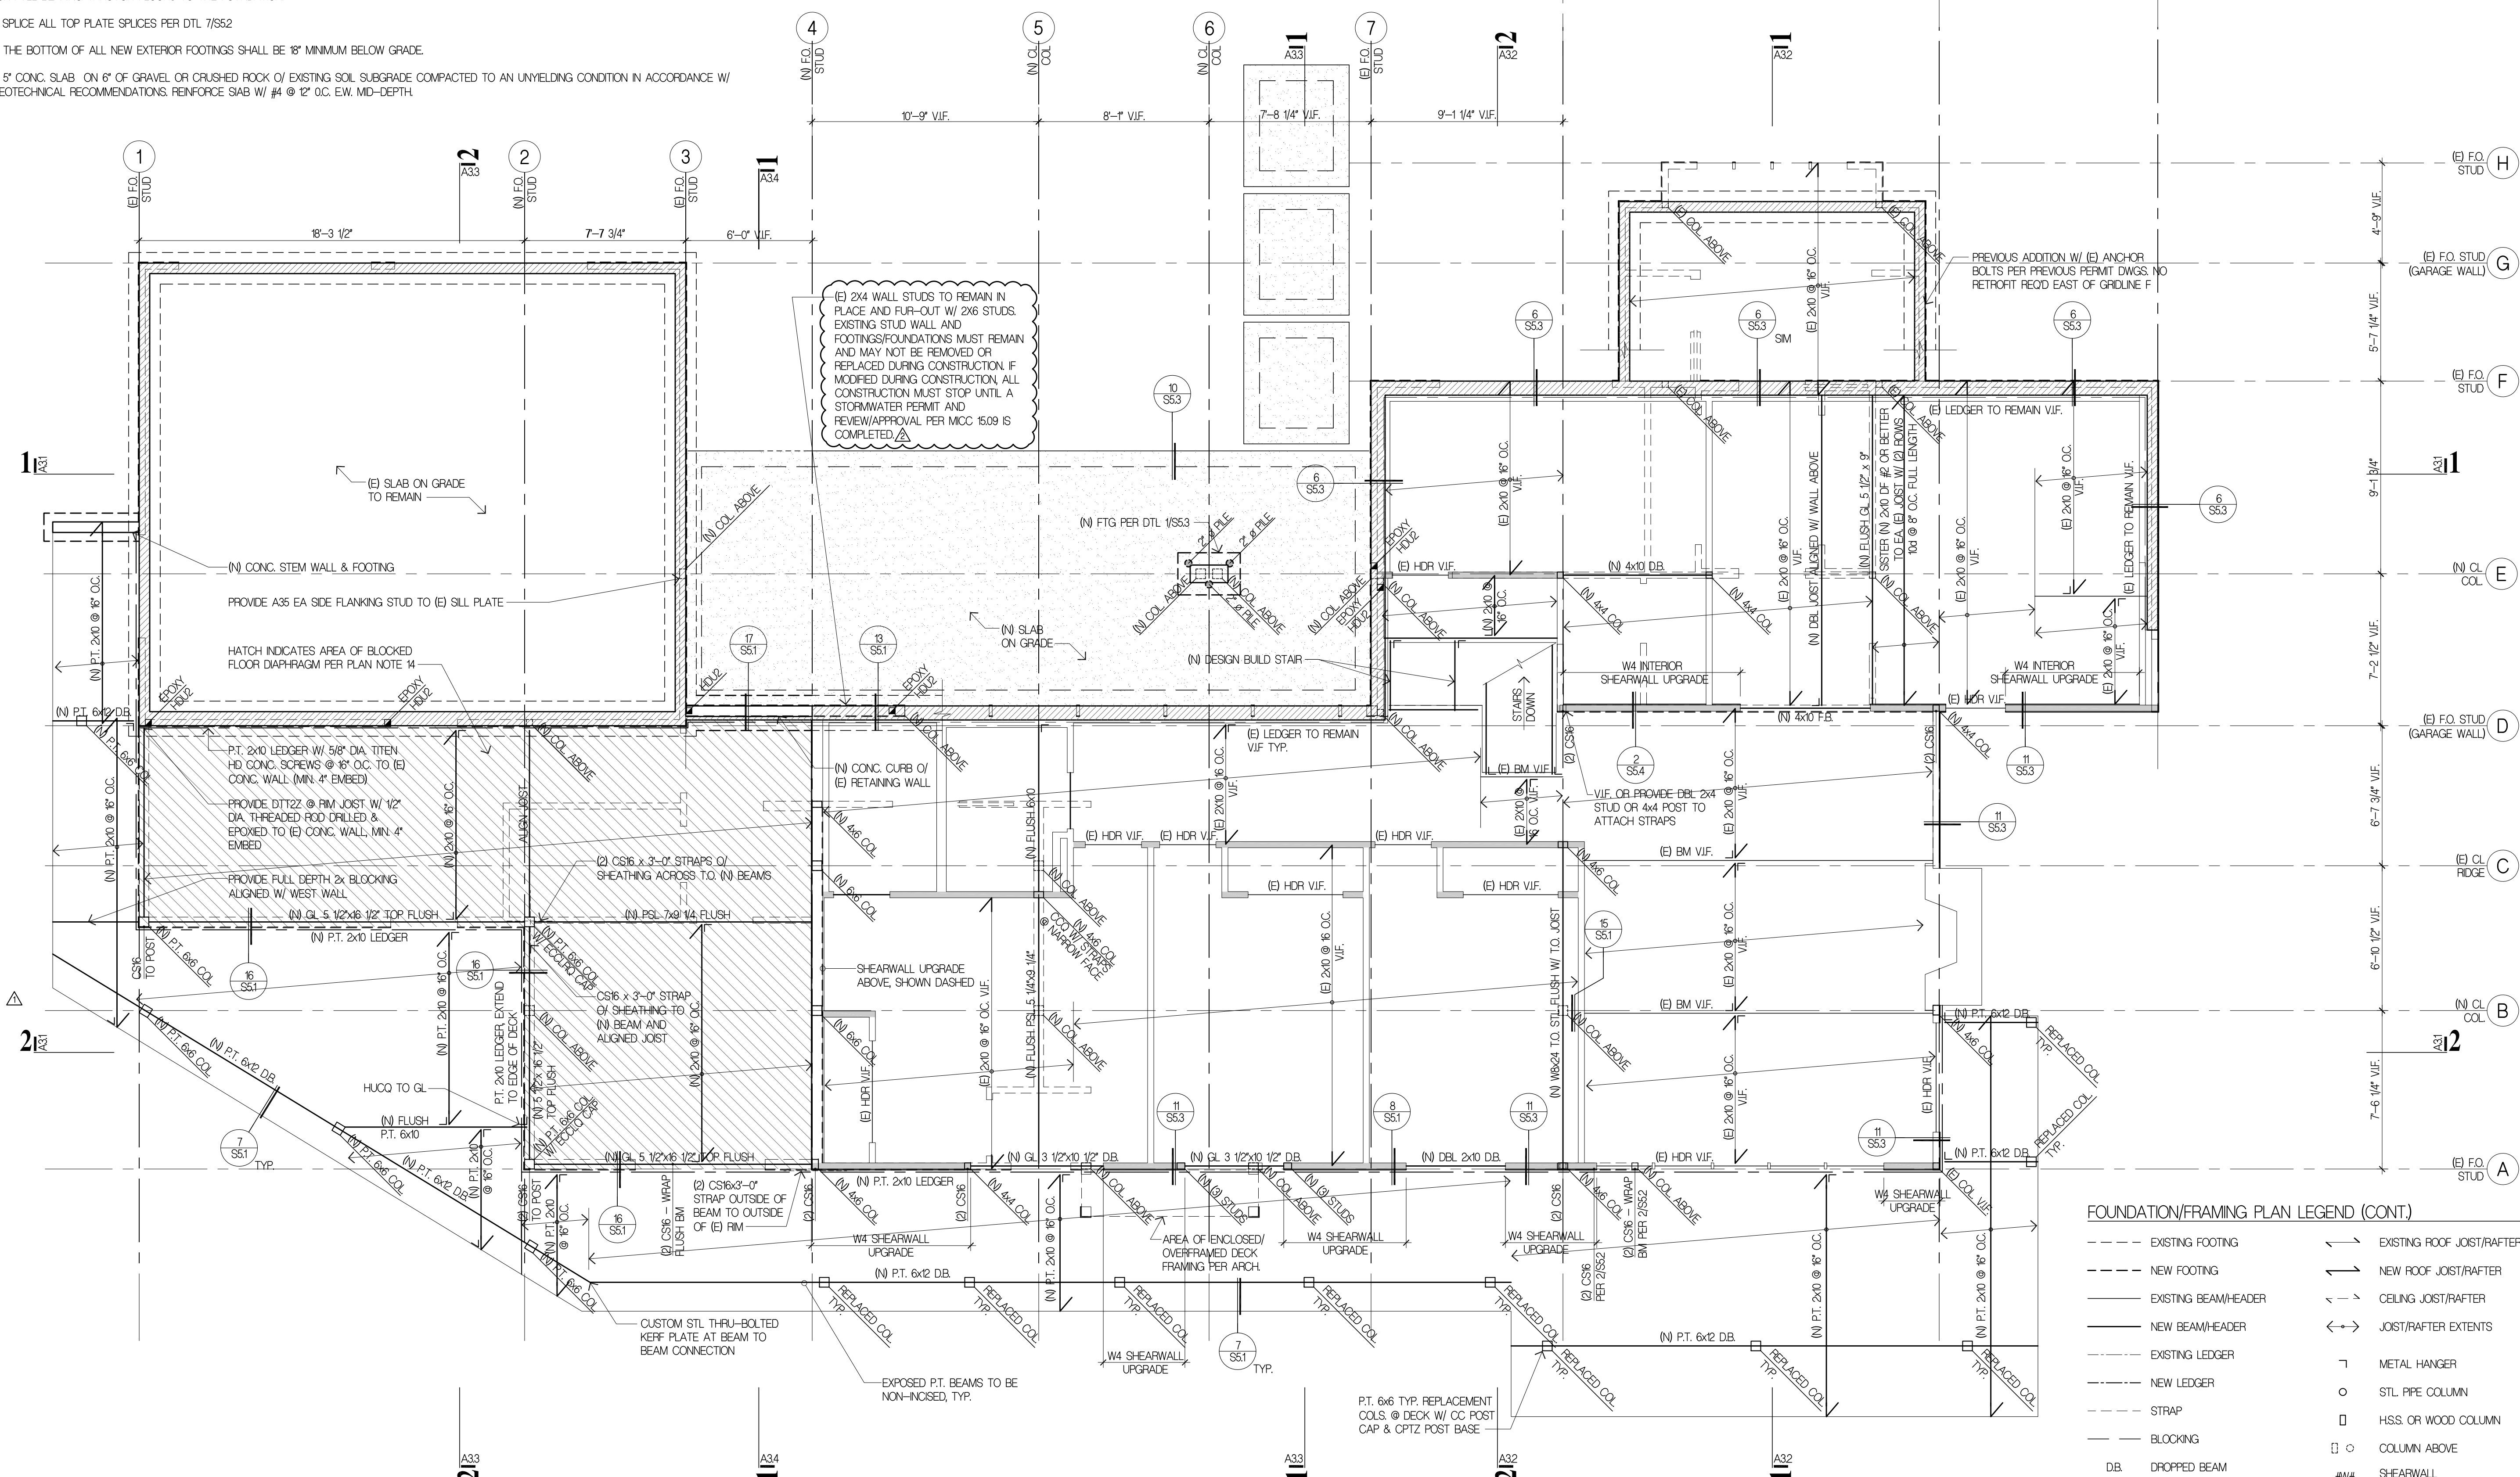


FOUNDATION/FRAMING PLAN LEGEND (CONT.)

---	EXISTING FOOTING	←	EXISTING ROOF JOIST/RAFTER
---	NEW FOOTING	→	NEW ROOF JOIST/RAFTER
---	EXISTING BEAM/HEADER	↔	CEILING JOIST/RAFTER
---	NEW BEAM/HEADER	↔	JOIST/RAFTER EXTENTS
---	EXISTING LEDGER	┌	METAL HANGER
---	NEW LEDGER	└	STL. PIPE COLUMN
---	STRAP	□	H.S.S. OR WOOD COLUMN
---	BLOCKING	□	COLUMN ABOVE
DB	DROPPED BEAM	#/#	SHEARWALL SEE SCHEDULE, 5/SS2
FB	FLUSH BEAM	DS	DEAG. STRUT. NAIL SHEATHING TO DS W/ 10d @ 4" O.C. UNCL.
---	CHANGE IN SLAB / FRAMING MEMBER ELEVATION	---	NI SOG
---	2" SCH. 80 STL. PIPE PILE	---	AREA OF BLOCKED FLOOR DIAPHRAGM PER PLAN NOTE 14
---	HOLDOWN PER SCHEDULE 3/SS2		

FOUNDATION/FRAMING PLAN LEGEND

---	NON-STRUCTURAL WALL	---	EXISTING CONCRETE WALL OR COLUMN
---	WOOD BEARING WALL	---	THICKENED SLAB EDGE
---	NEW CONCRETE WALL	---	SHEAR WALL (HEAVIEST LINE INDICATES PANEL SIDE)
---		---	FRAMED WALL ABOVE

Project Title
**JAFFE
RESIDENCE**
8455 SE 83RD STREET
MERCER ISLAND, WA 98040

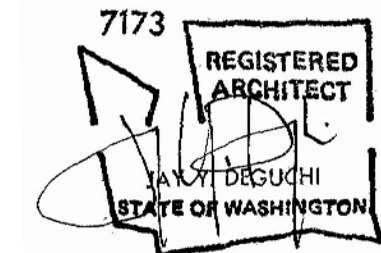

Drawing Title
FLOOR FRAMING PLAN


Date
08/08/2022
Job No.
2110

ISSUE DATE
△ PERMIT CORRECTIONS #1 03/31/2023
△ PERMIT CORRECTIONS #2 05/31/2023


PERMIT CORRECTIONS
Sheet No.

S1.2

1 MAIN FLOOR FRAMING & FDN PLAN
14'-1'-0"

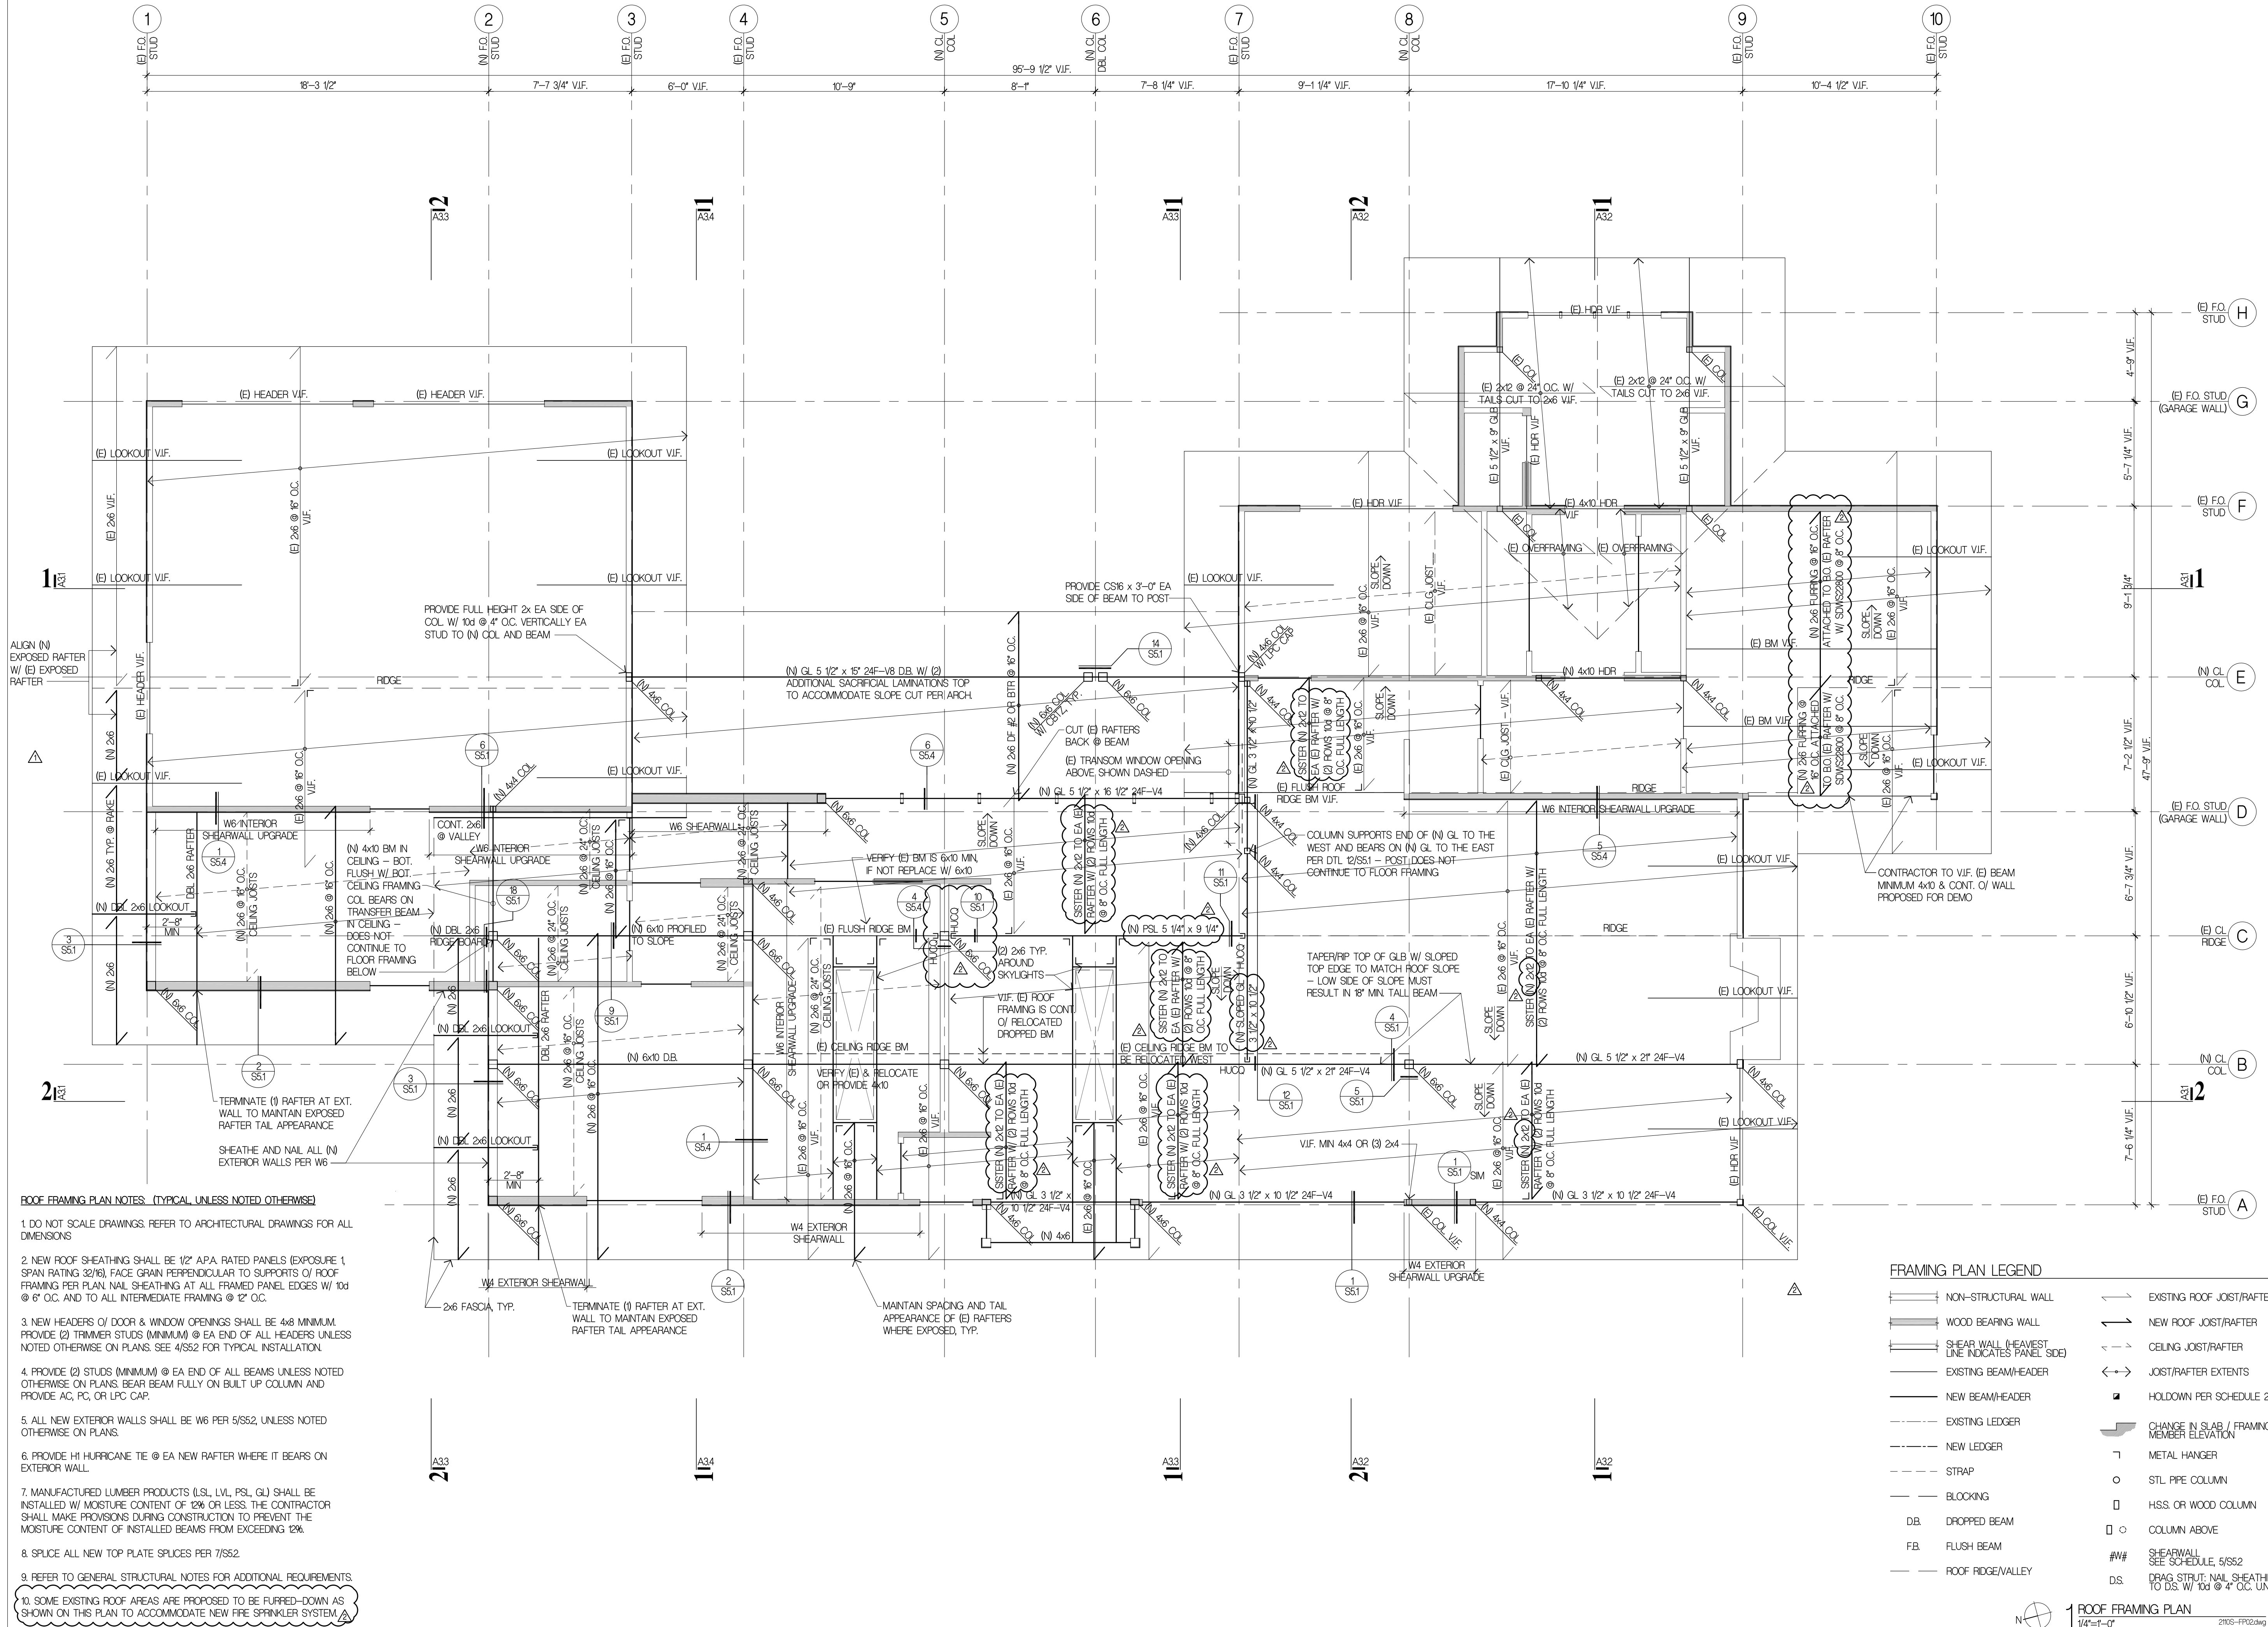

Project Title
JAFFE RESIDENCE
 8455 SE 83RD STREET
 MERCER ISLAND, WA 98040

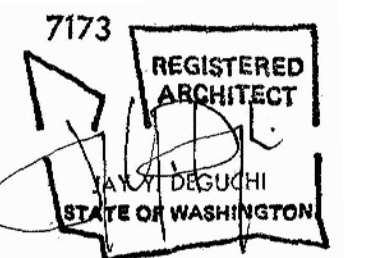

Drawing Title
ROOF FRAMING PLAN


Date
 08/08/2022

Job No.
 210


ISSUE DATE
 PERMIT CORRECTIONS #1 03/31/2023
 PERMIT CORRECTIONS #2 05/31/2023

PERMIT CORRECTIONS
 Sheet No.


S1.3

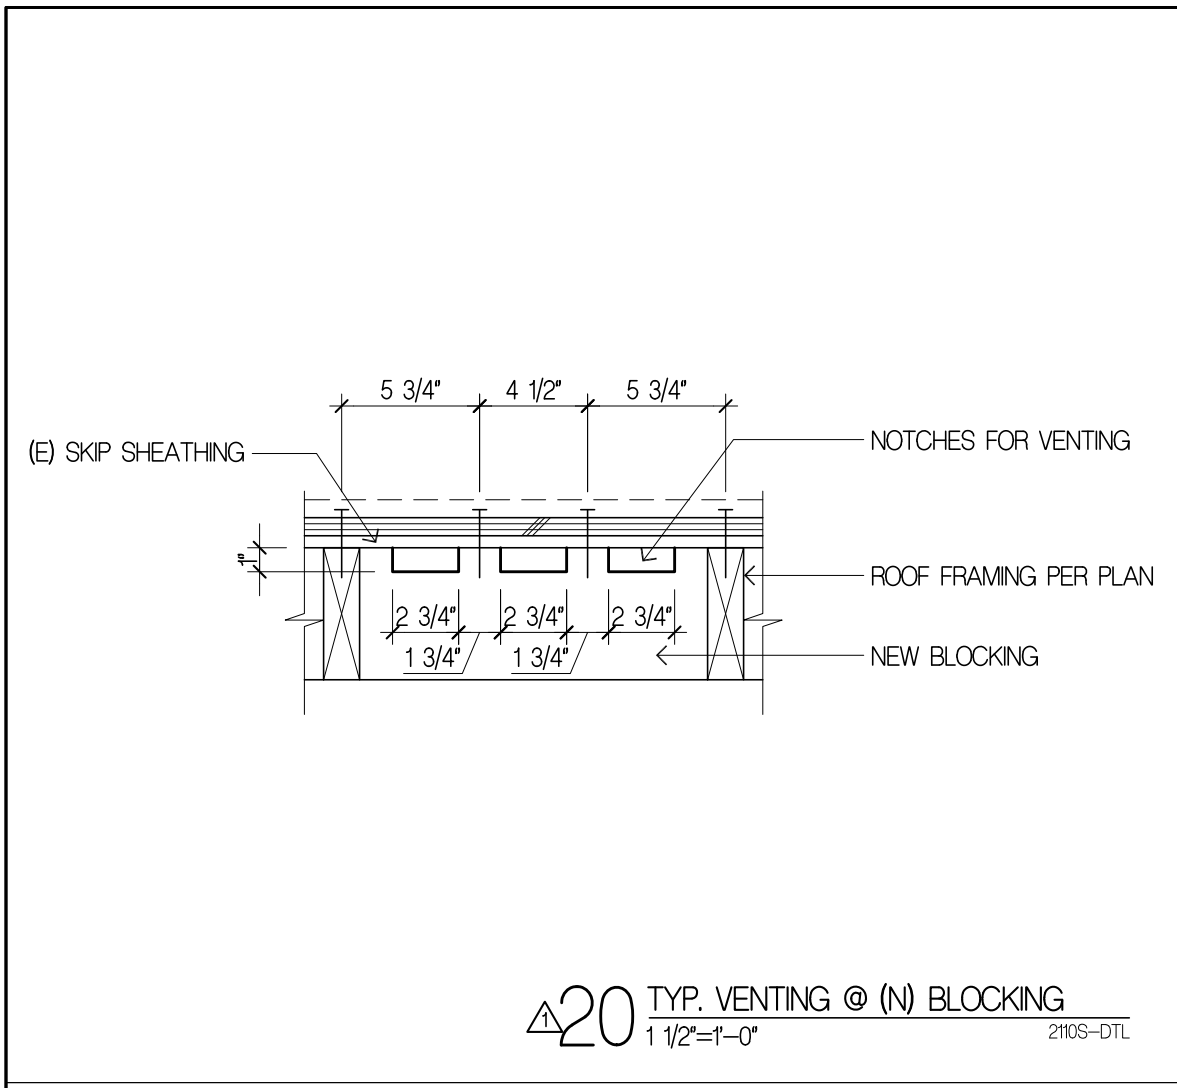


20 TYP. VENTING @ (N) BLOCKING
1 1/2'-1'-0"

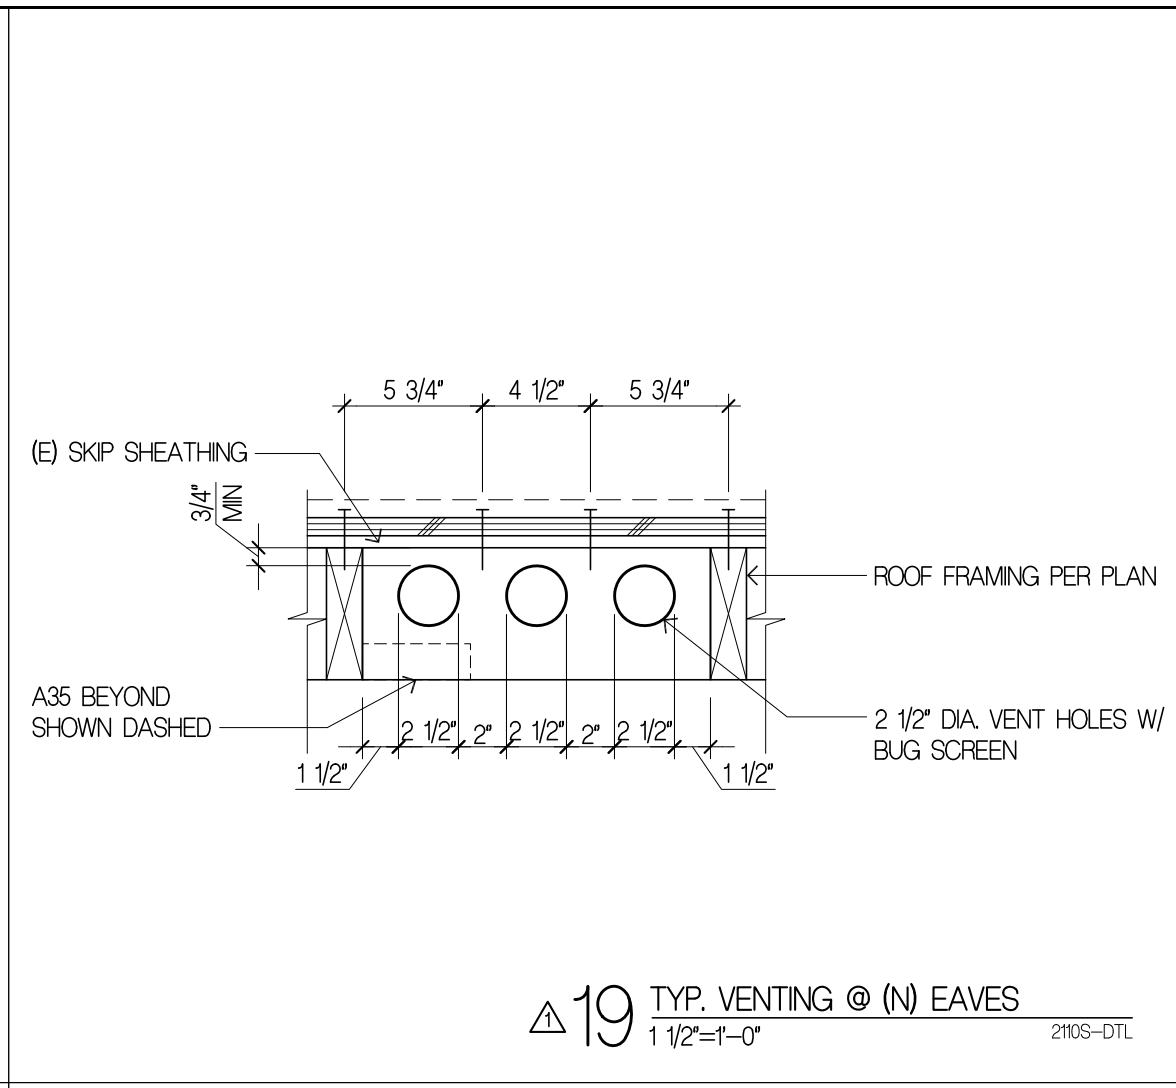


19 TYP. VENTING @ (N) EAVES
1 1/2'-1'-0"

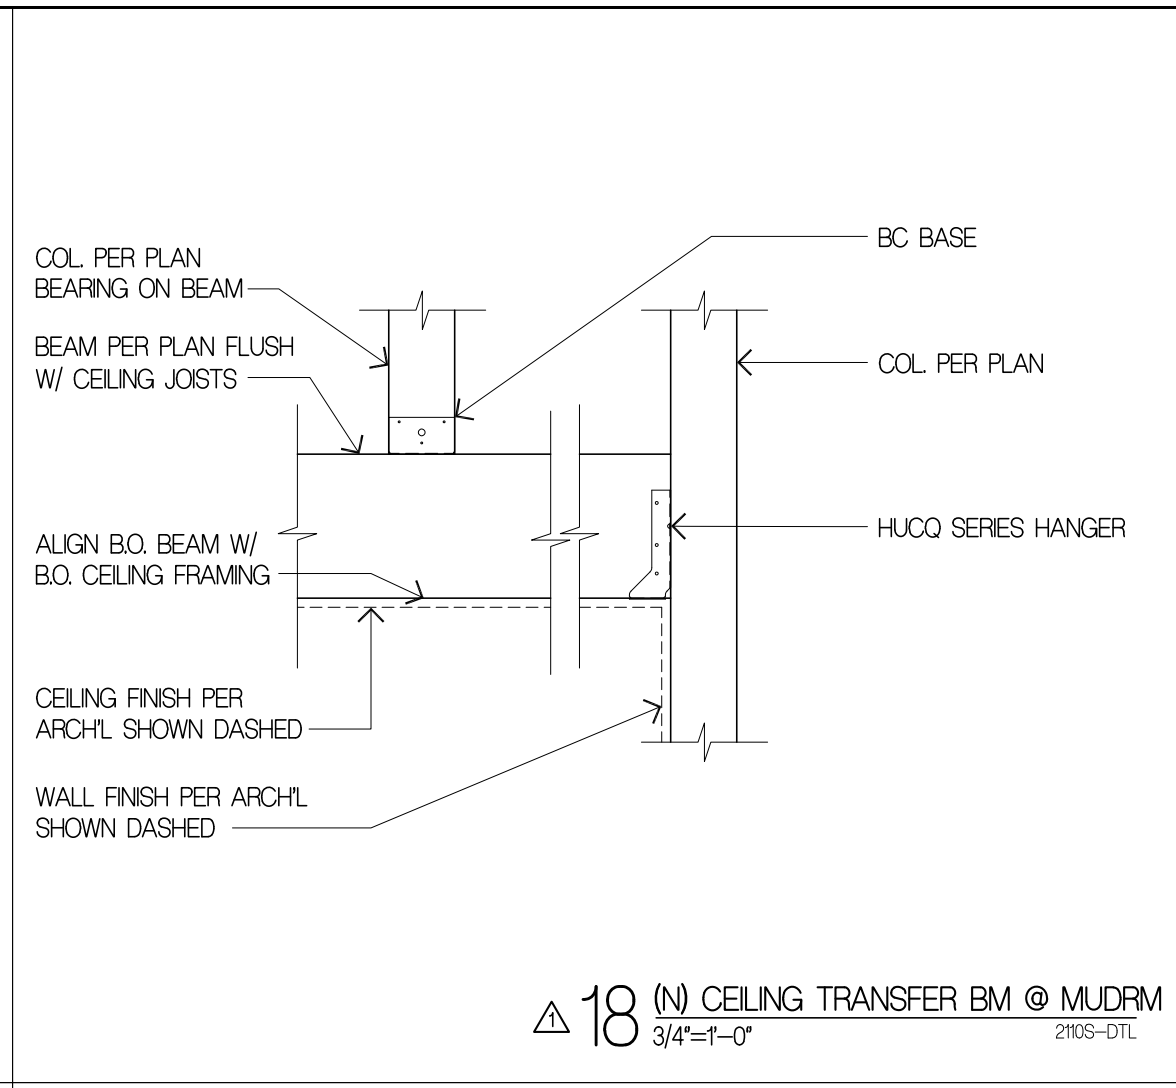


18 (N) CEILING TRANSFER BM @ MUDRM
3/4'-1'-0"

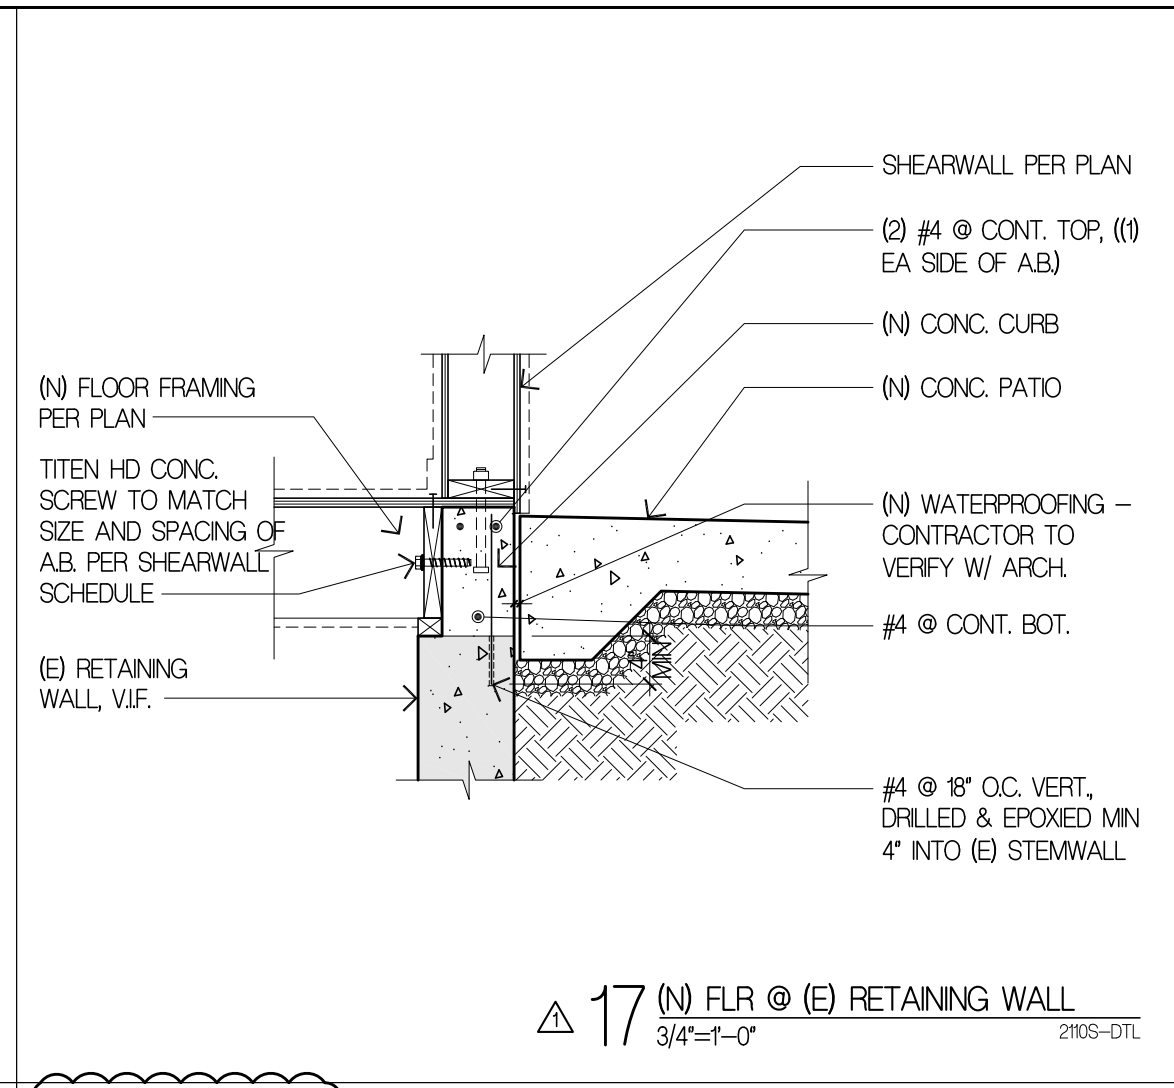


17 (N) FLR @ (E) RETAINING WALL
3/4'-1'-0"

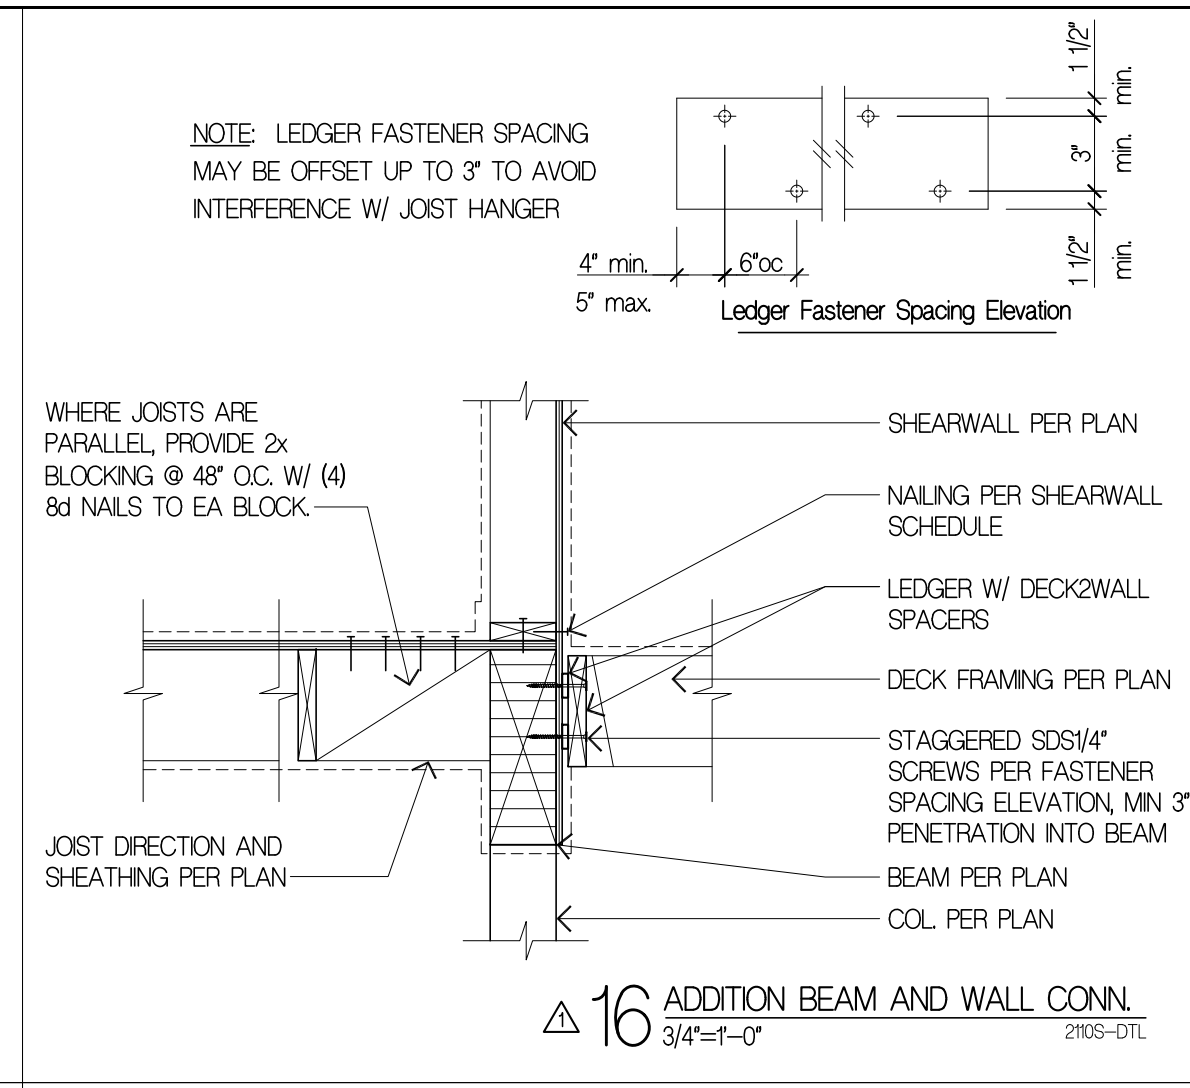


16 ADDITION BEAM AND WALL CONNL.
3/4'-1'-0"

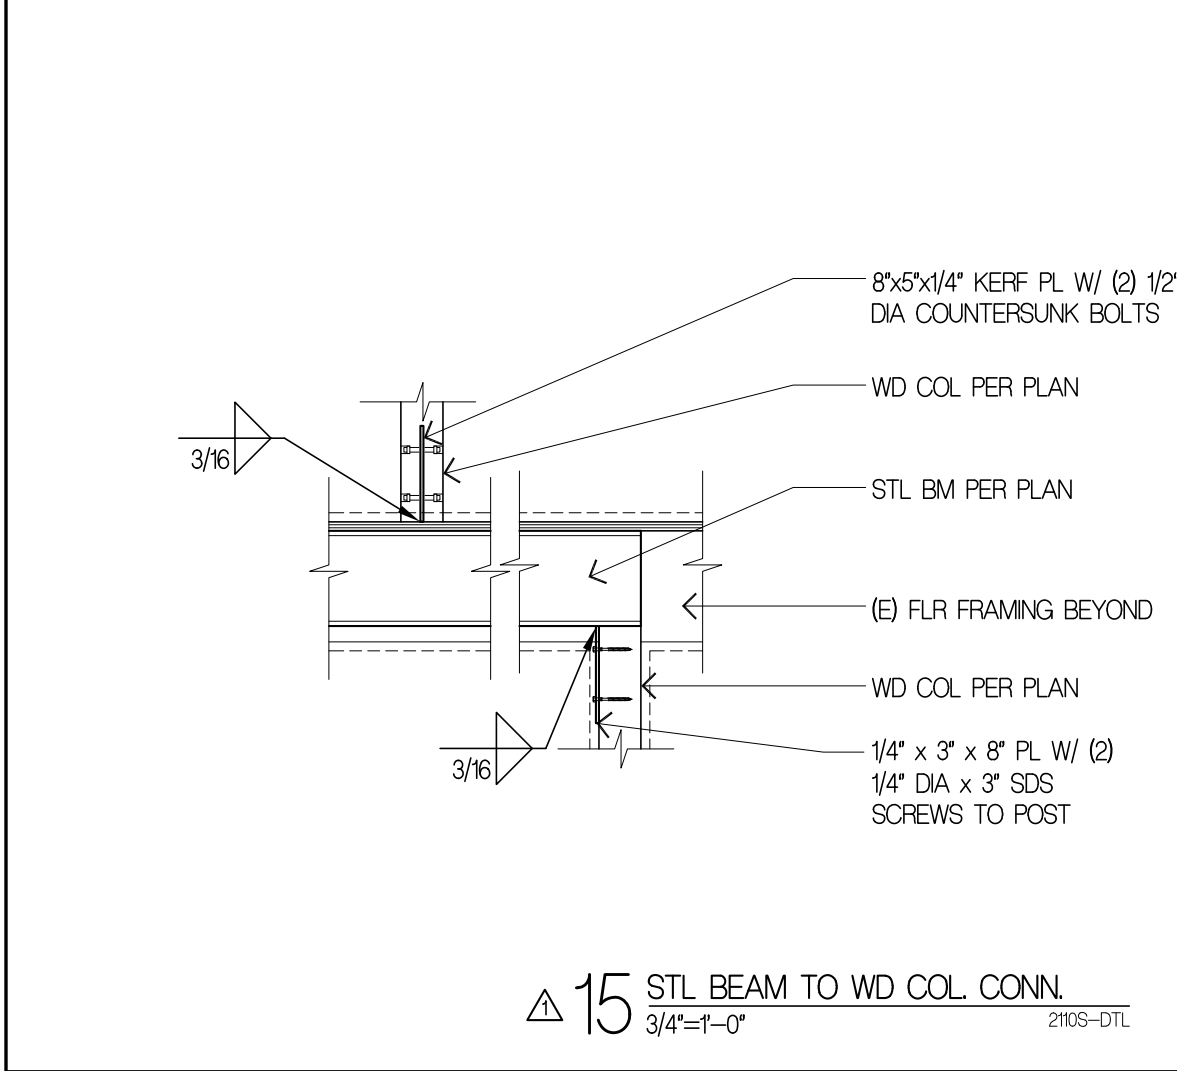


15 STL BEAM TO WD COL. CONNL.
3/4'-1'-0"

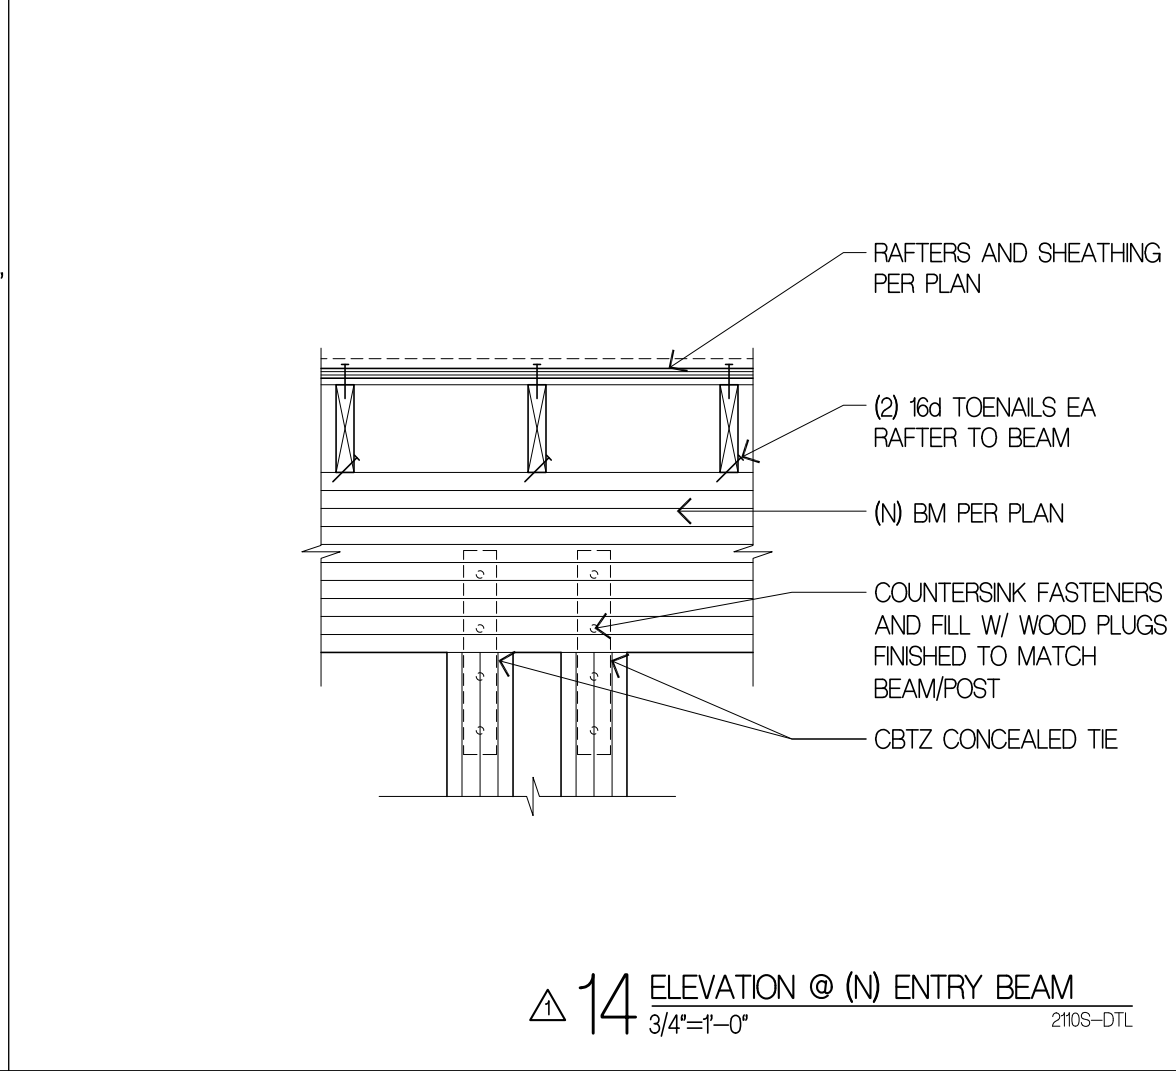


14 ELEVATION @ (N) ENTRY BEAM
3/4'-1'-0"

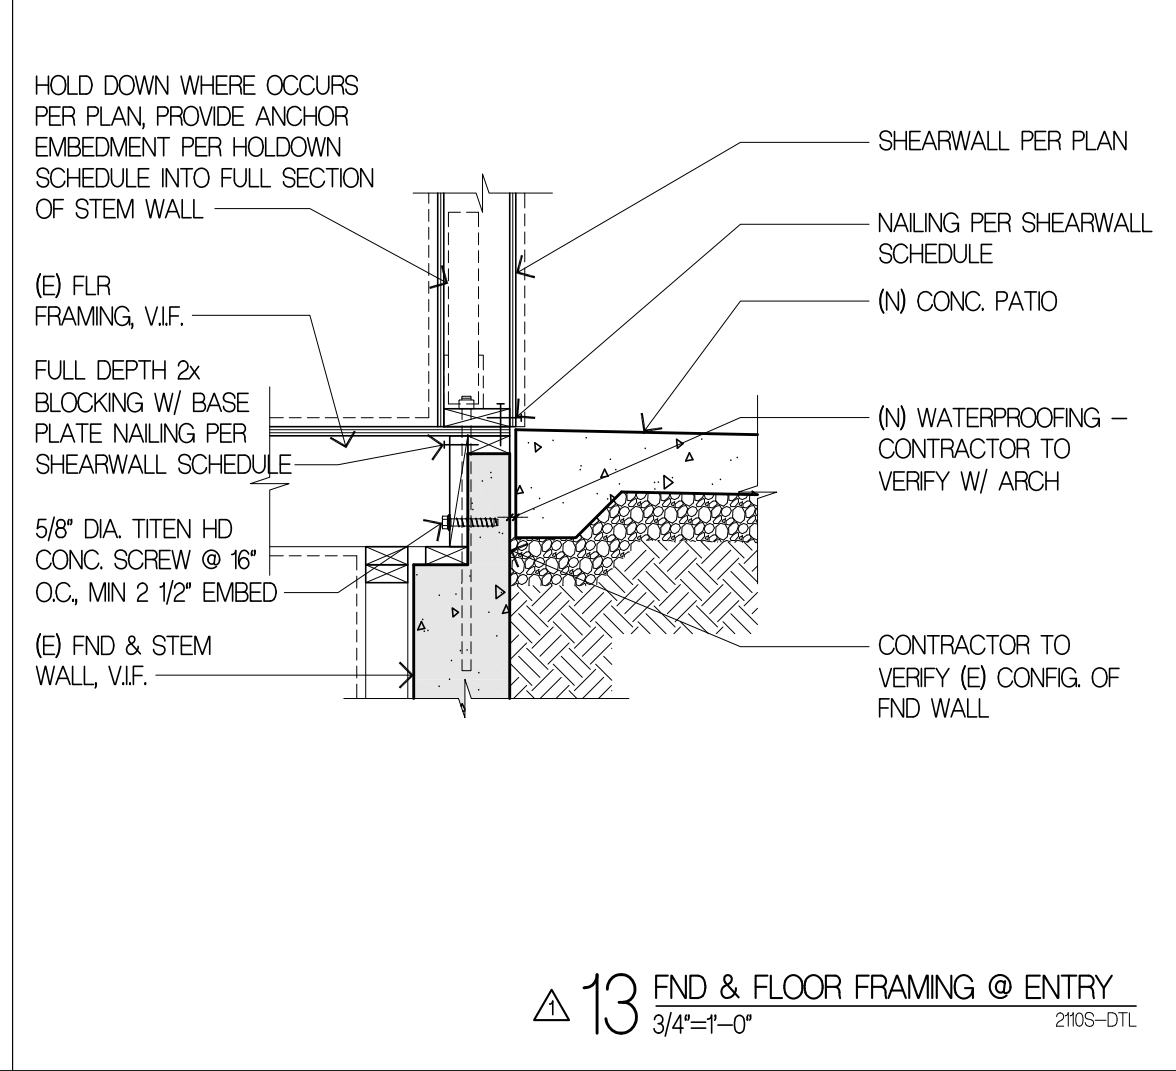


13 FND & FLOOR FRAMING @ ENTRY
3/4'-1'-0"

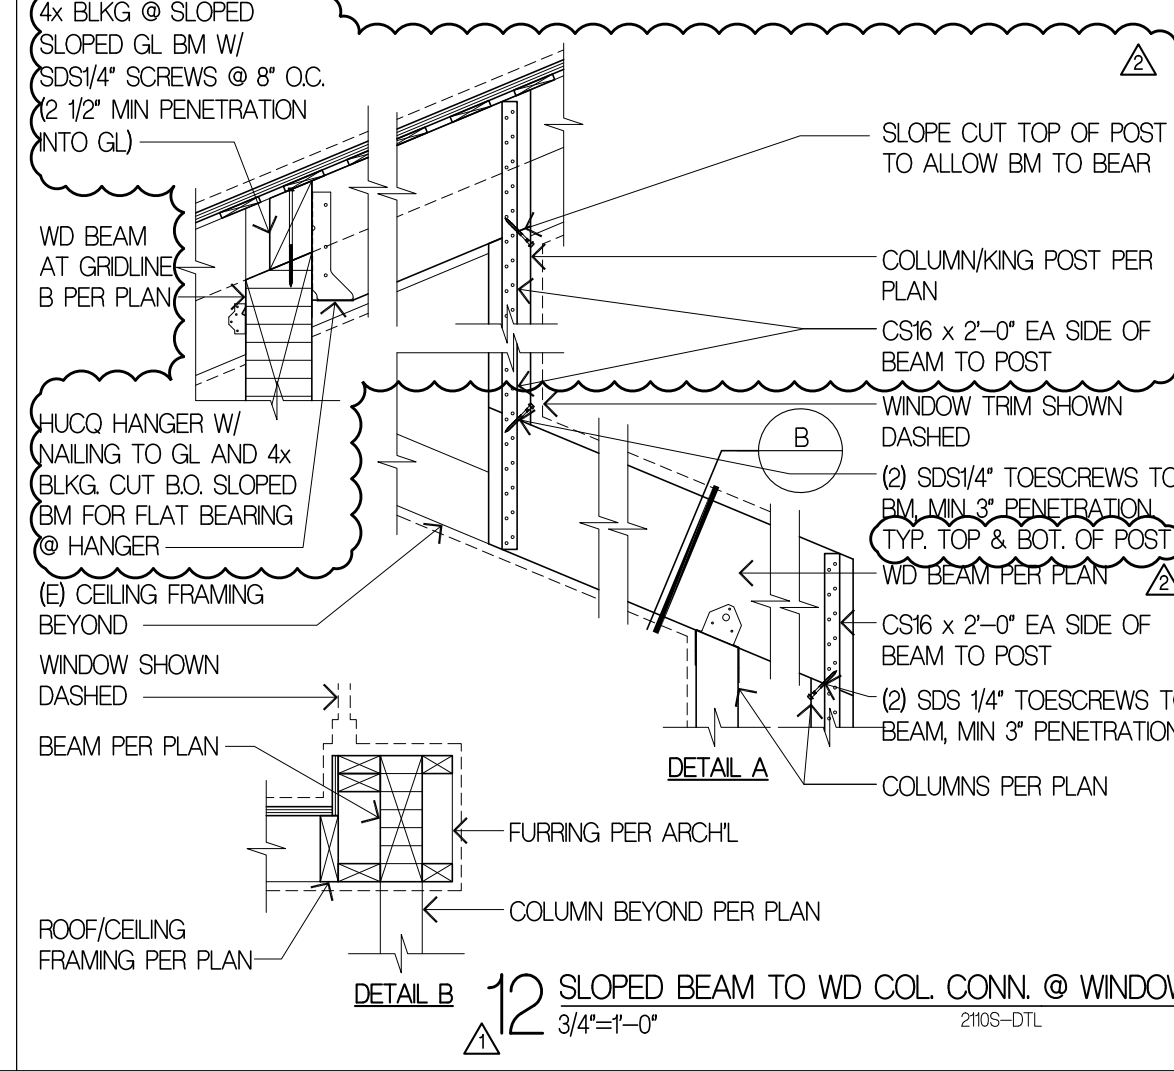


12 SLOPED BEAM TO WD COL. CONNL. @ WINDOW
3/4'-1'-0"

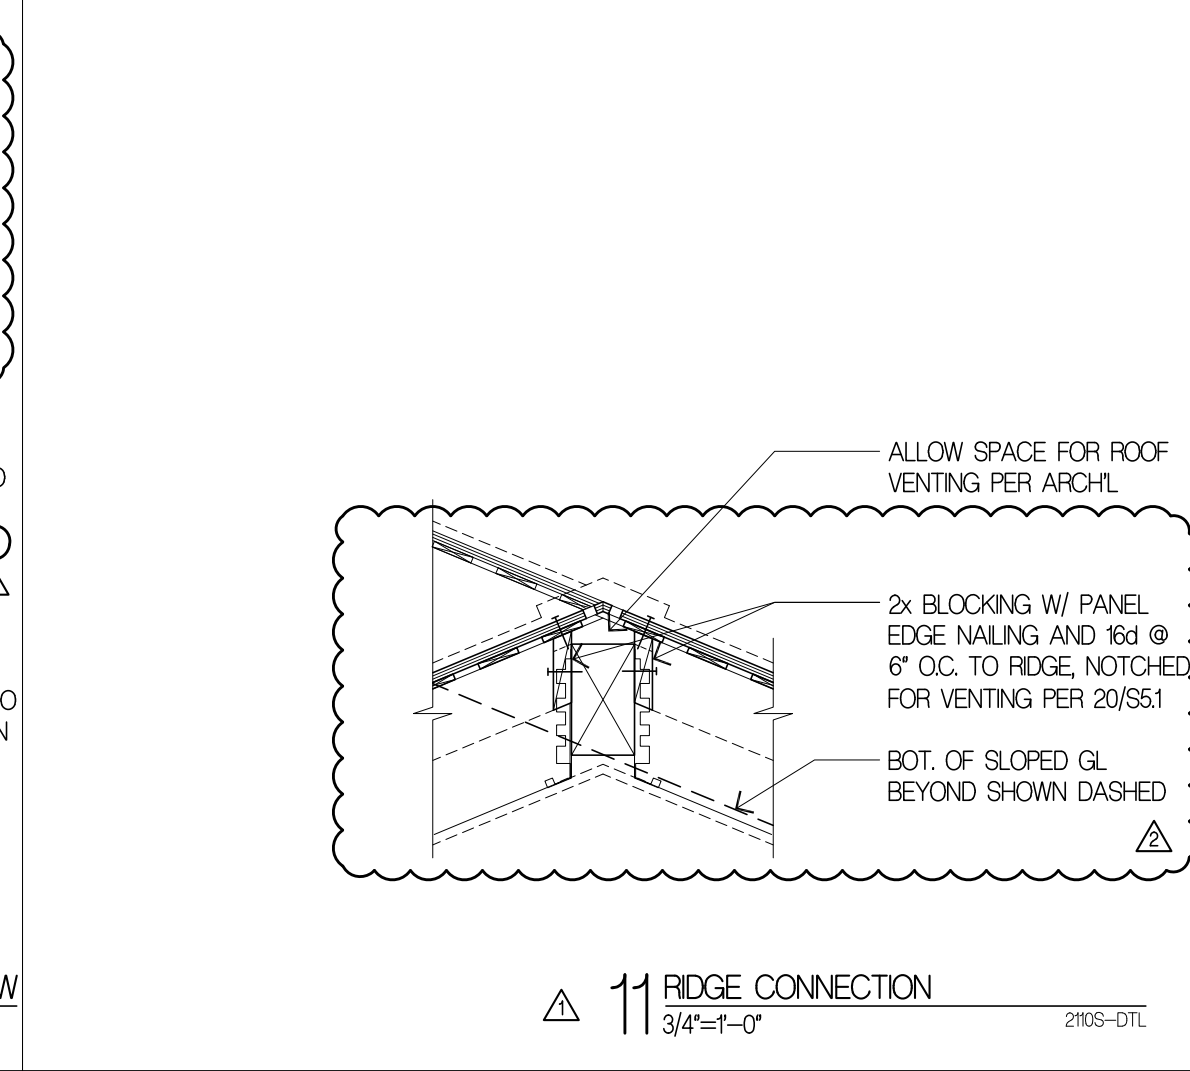


11 RIDGE CONNECTION
3/4'-1'-0"

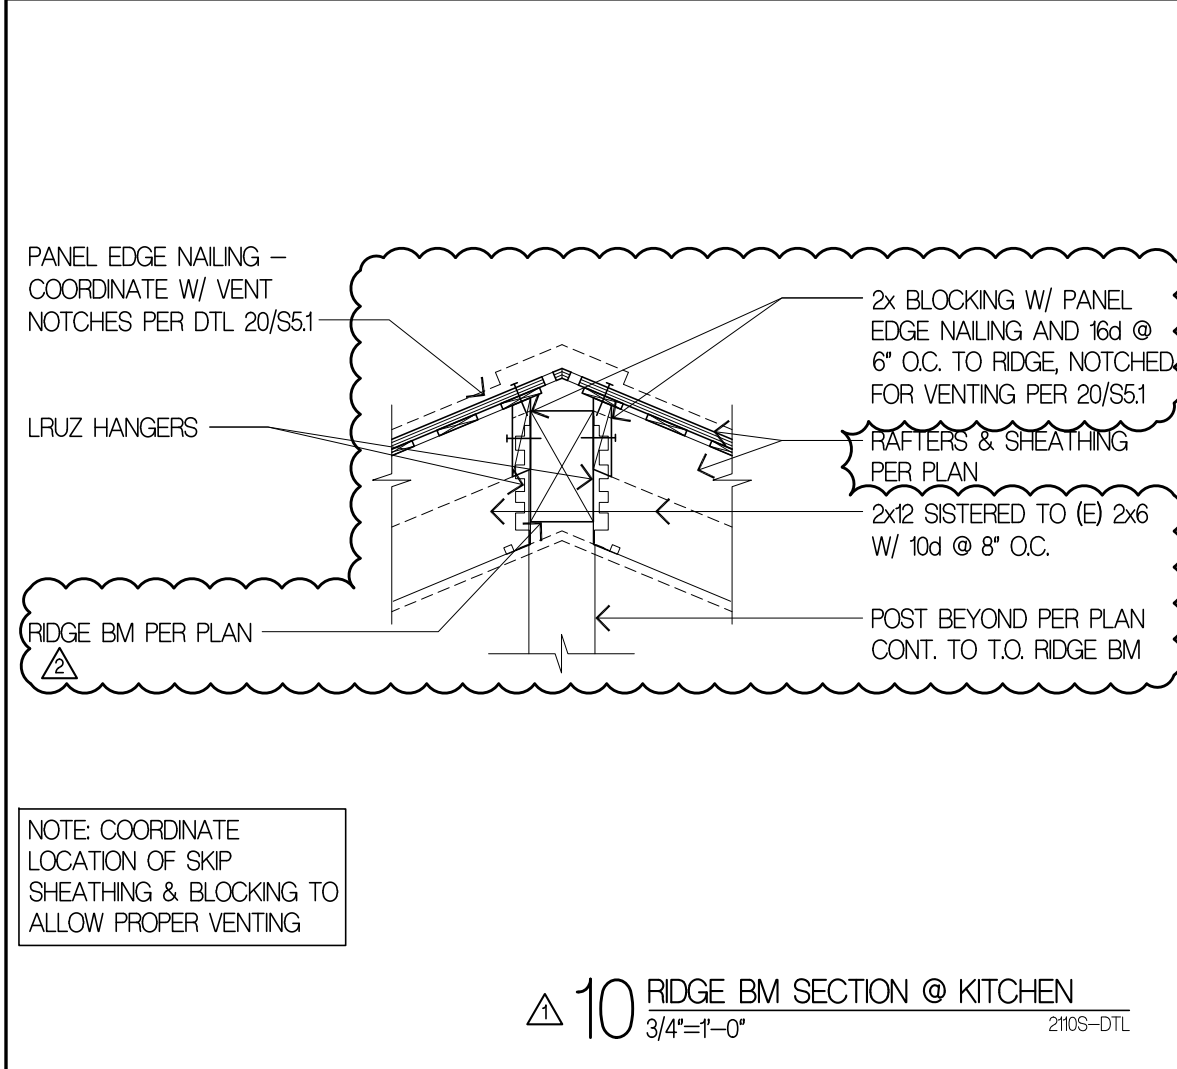


10 RIDGE BM SECTION @ KITCHEN
3/4'-1'-0"

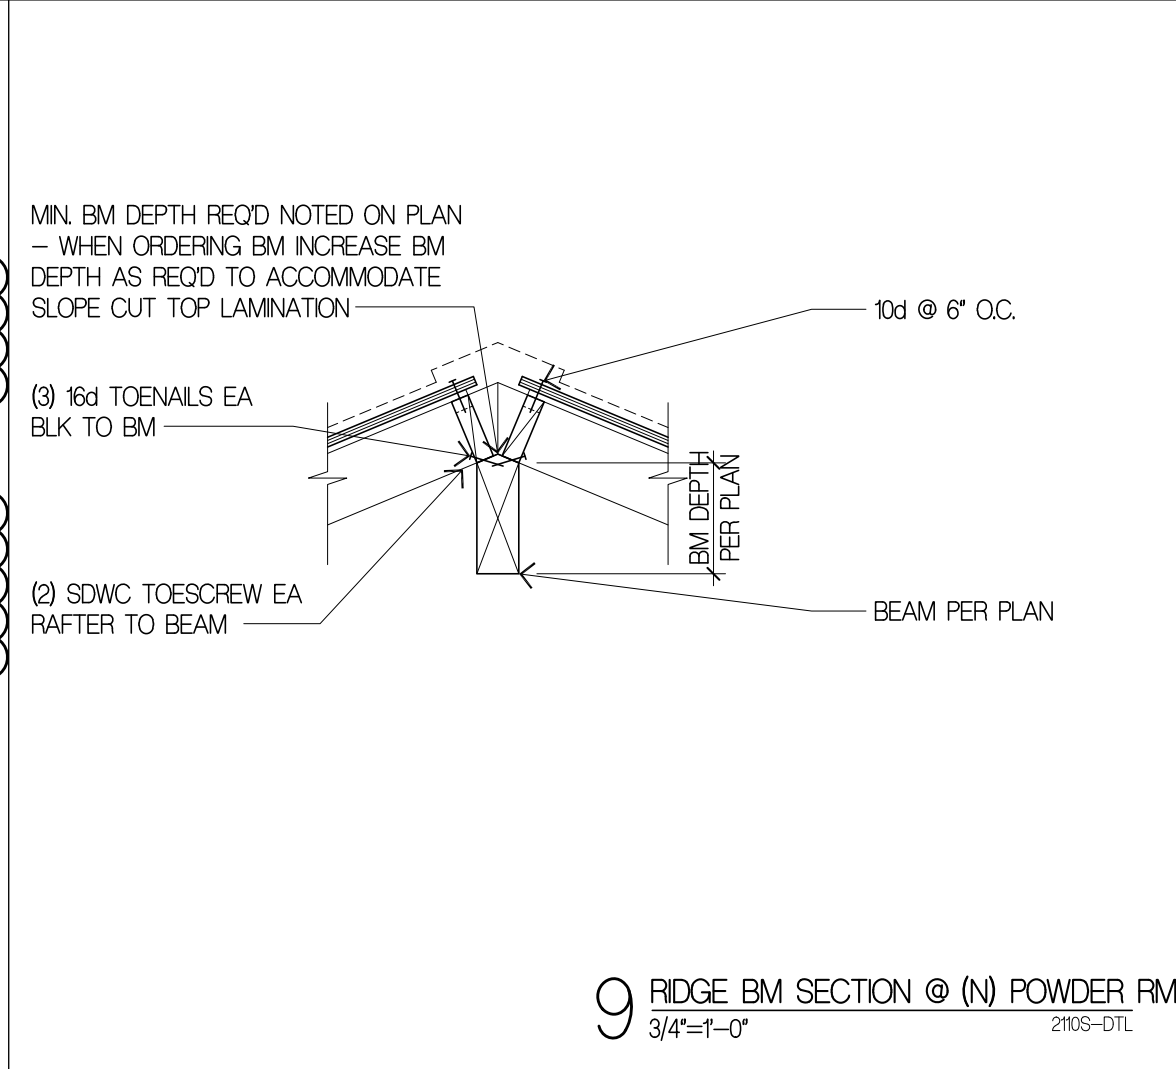


9 RIDGE BM SECTION @ (N) POWDER RM
3/4'-1'-0"

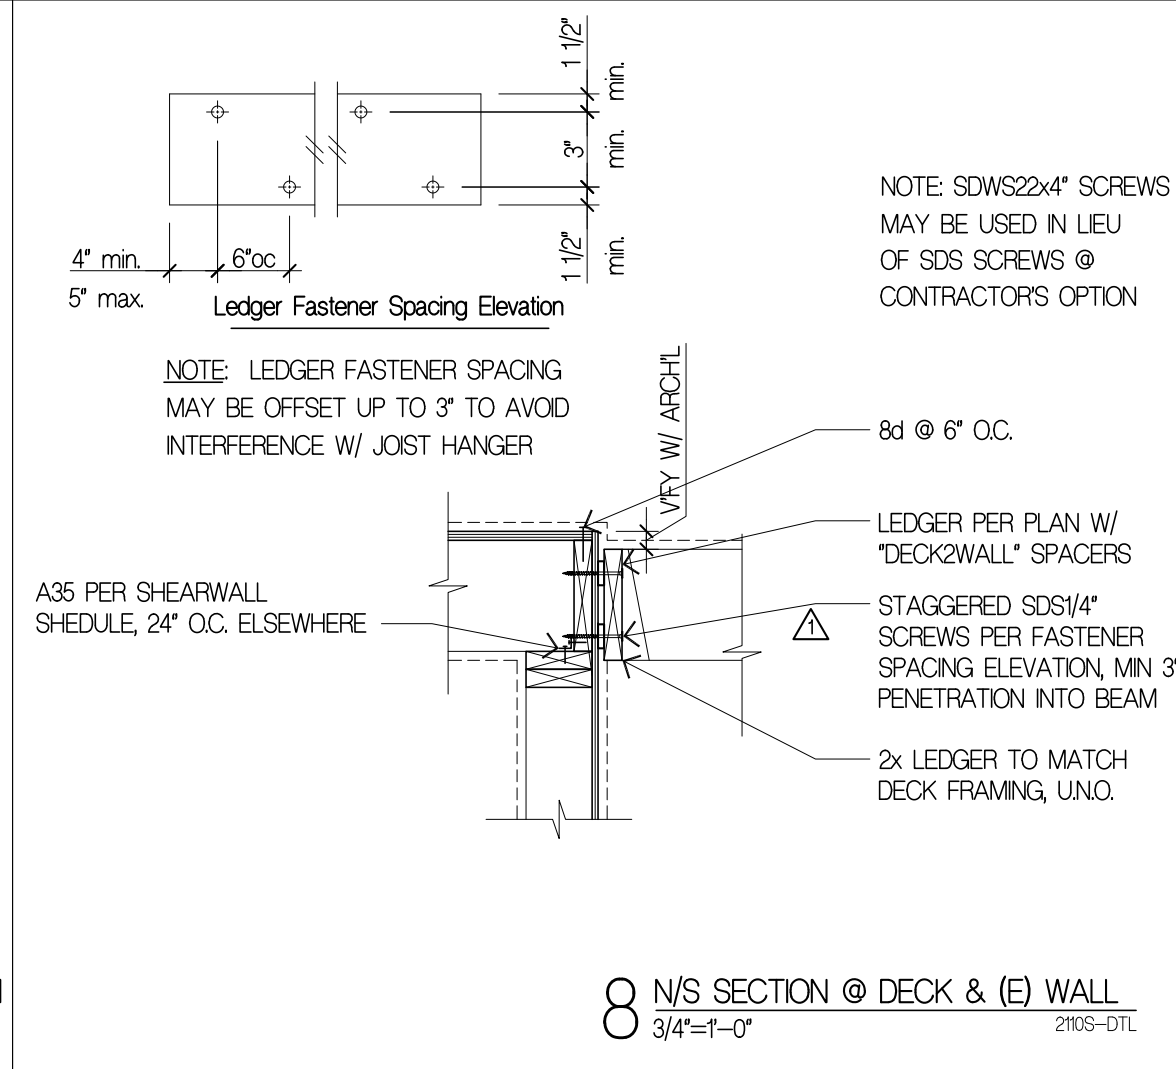


8 N/S SECTION @ DECK & (E) WALL
3/4'-1'-0"

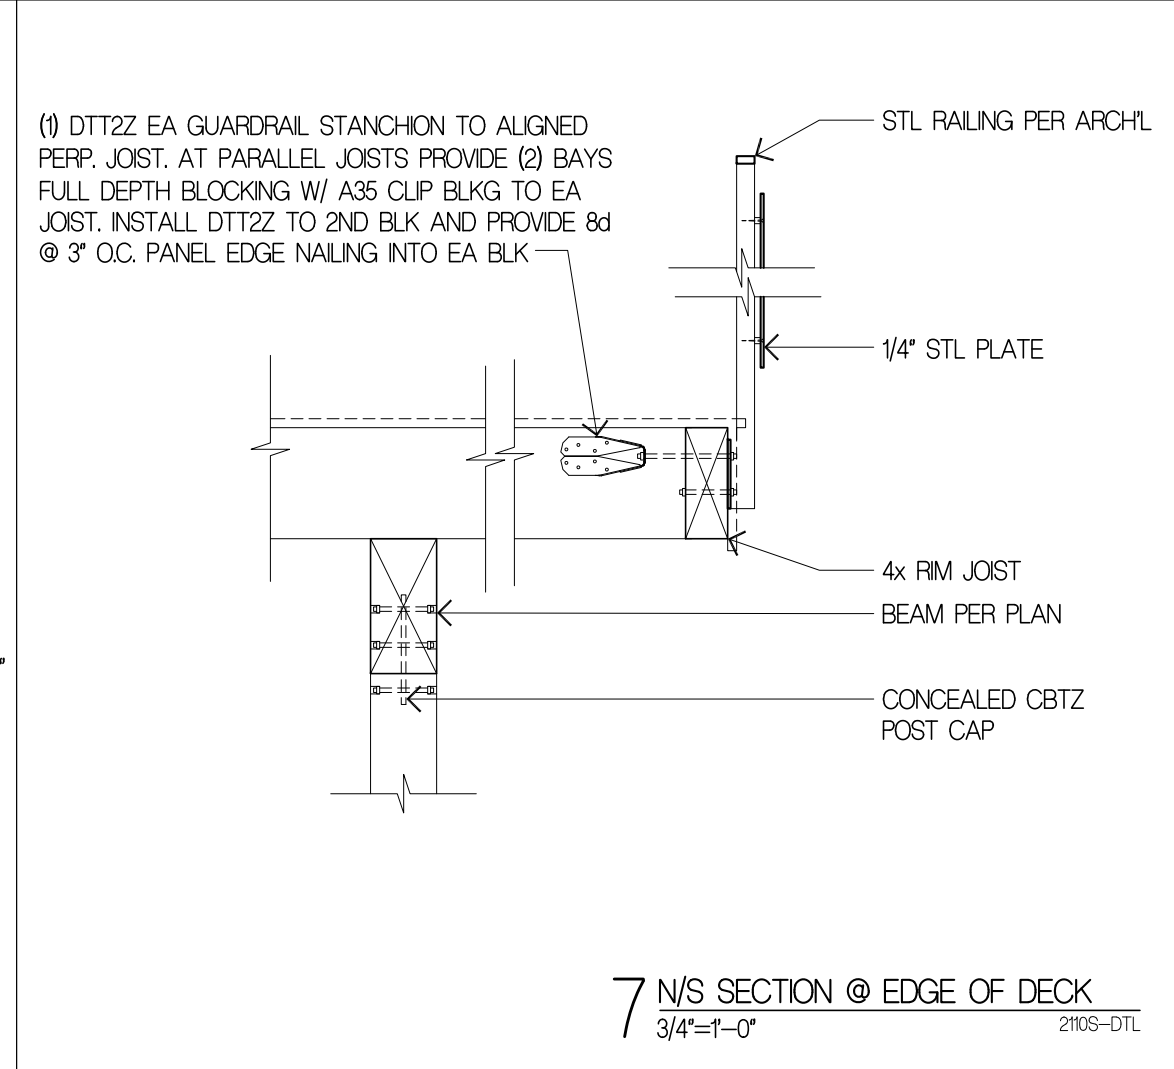


7 N/S SECTION @ EDGE OF DECK
3/4'-1'-0"

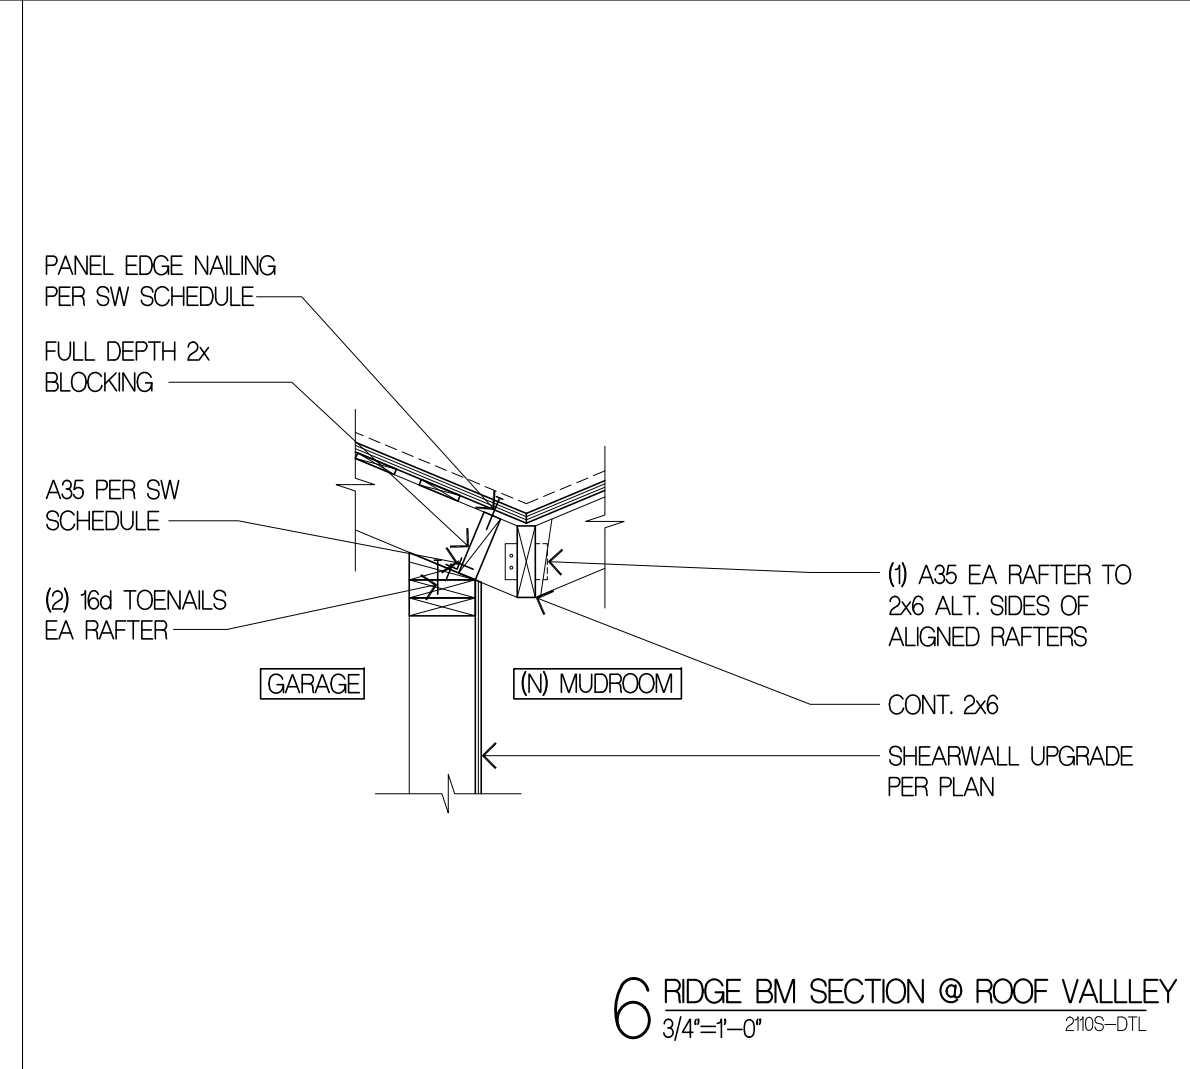


6 RIDGE BM SECTION @ ROOF VALLEY
3/4'-1'-0"

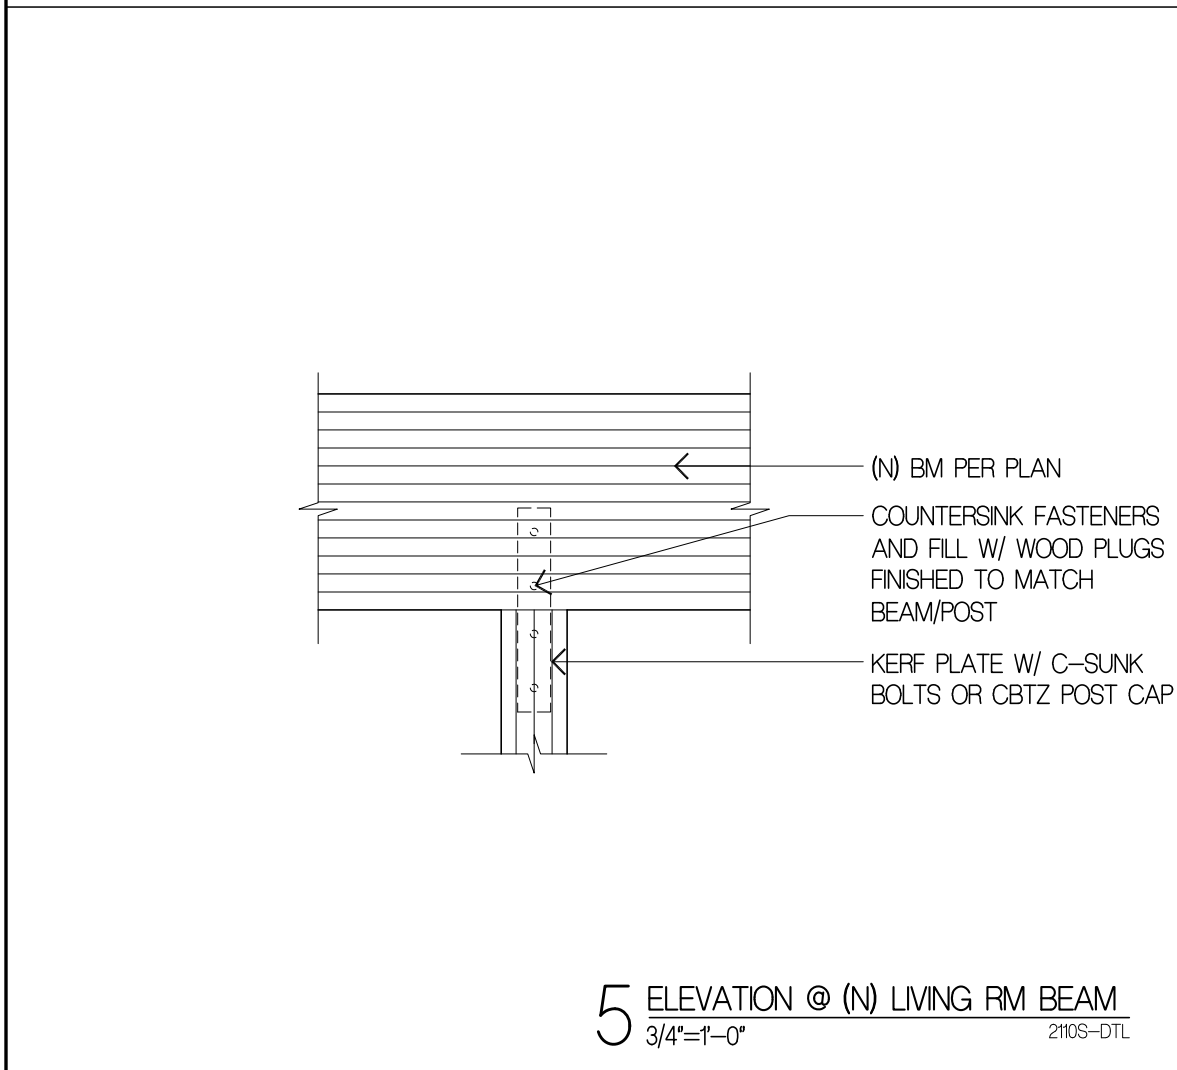


5 ELEVATION @ (N) LIVING RM BEAM
3/4'-1'-0"

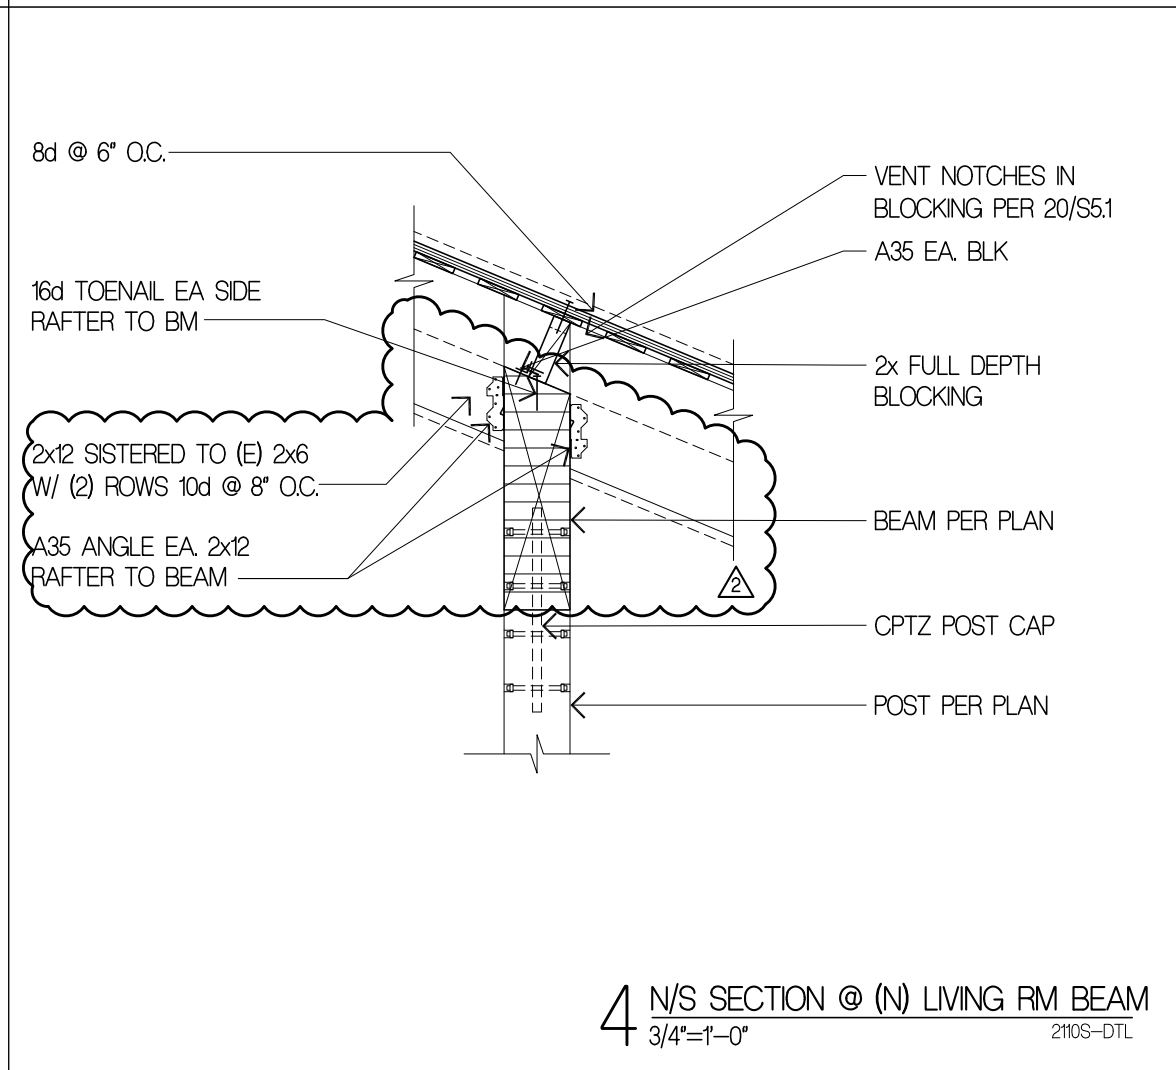


4 N/S SECTION @ (N) LIVING RM BEAM
3/4'-1'-0"

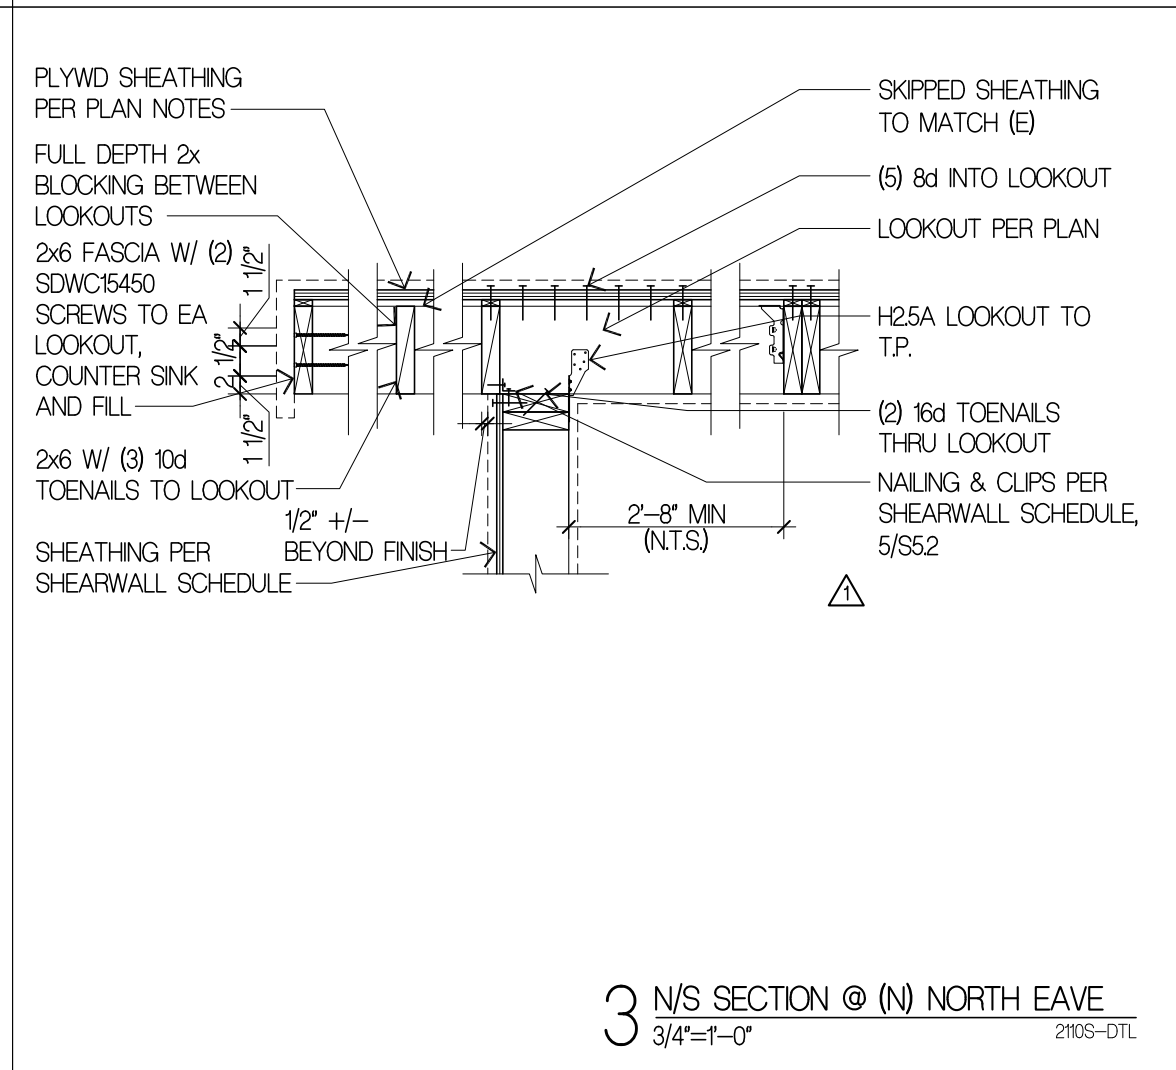

3 N/S SECTION @ (N) NORTH EAVE
3/4'-1'-0"

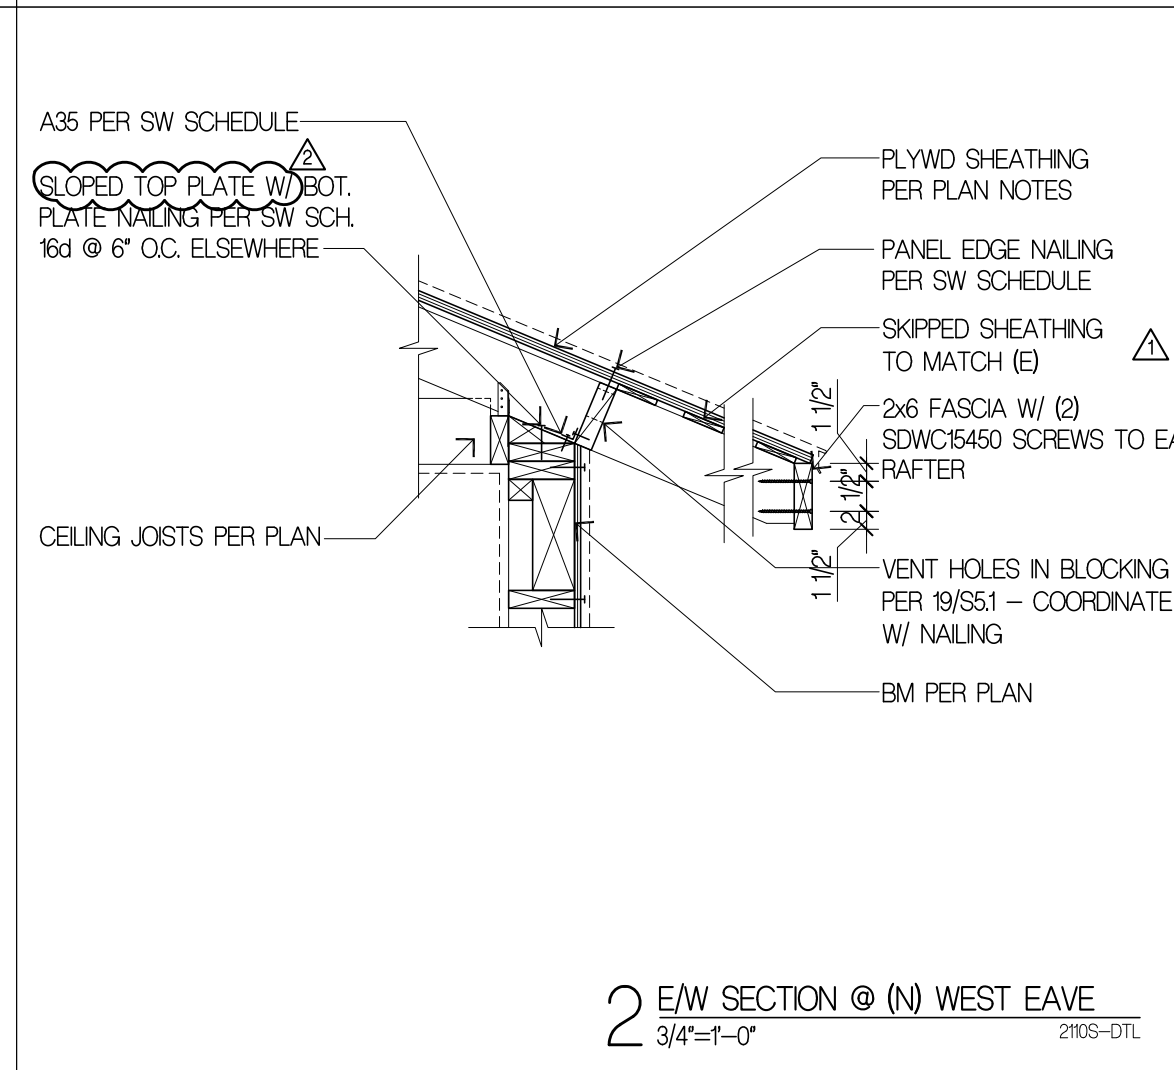


2 E/W SECTION @ (N) WEST EAVE
3/4'-1'-0"

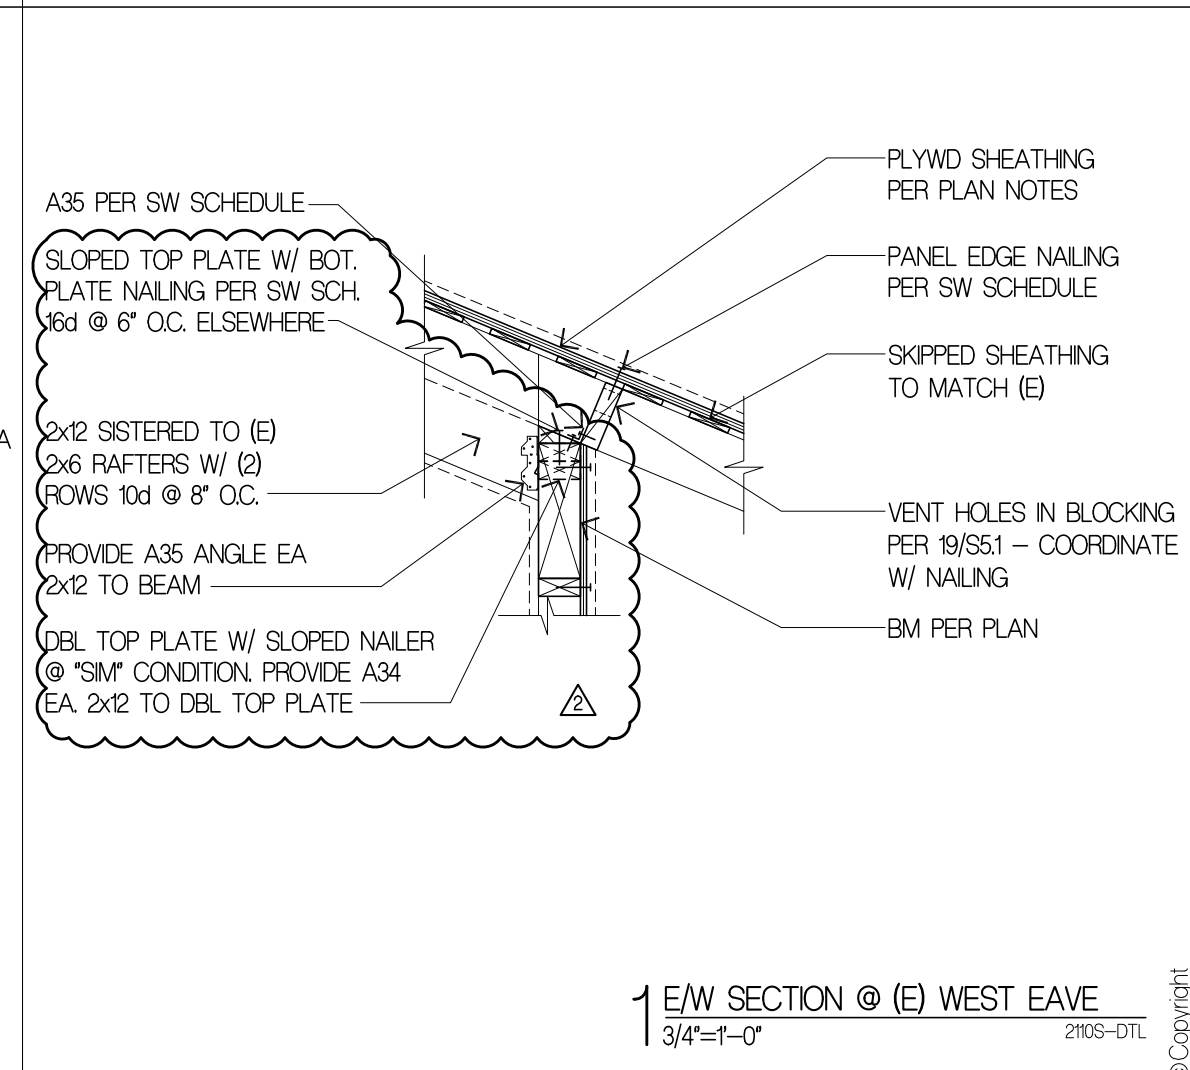

1 E/W SECTION @ (E) WEST EAVE
3/4'-1'-0"

Suyama Peterson Deguchi
8601 8th Avenue South Seattle, Washington 98108
P 206.256.0809

Project Title
JAFFE RESIDENCE
8455 SE 83RD STREET
MERCER ISLAND, WA 98040

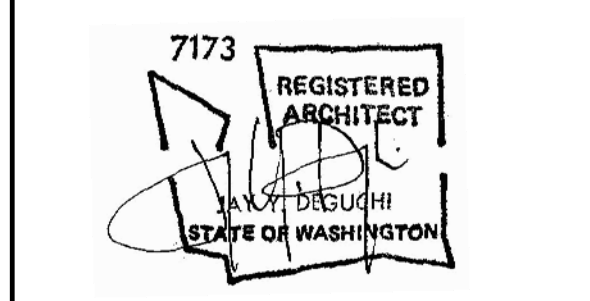

Drawing Title
STRUCTURAL DETAILS

Date
08/08/2022
Job No.
210





ISSUE DATE
PERMIT CORRECTIONS #1 03/31/2023
PERMIT CORRECTIONS #2 05/31/2023

PERMIT CORRECTIONS
Sheet No.

S5.1

10 NOT USED
 2105-DTL





9 NOT USED
 2105-DTL

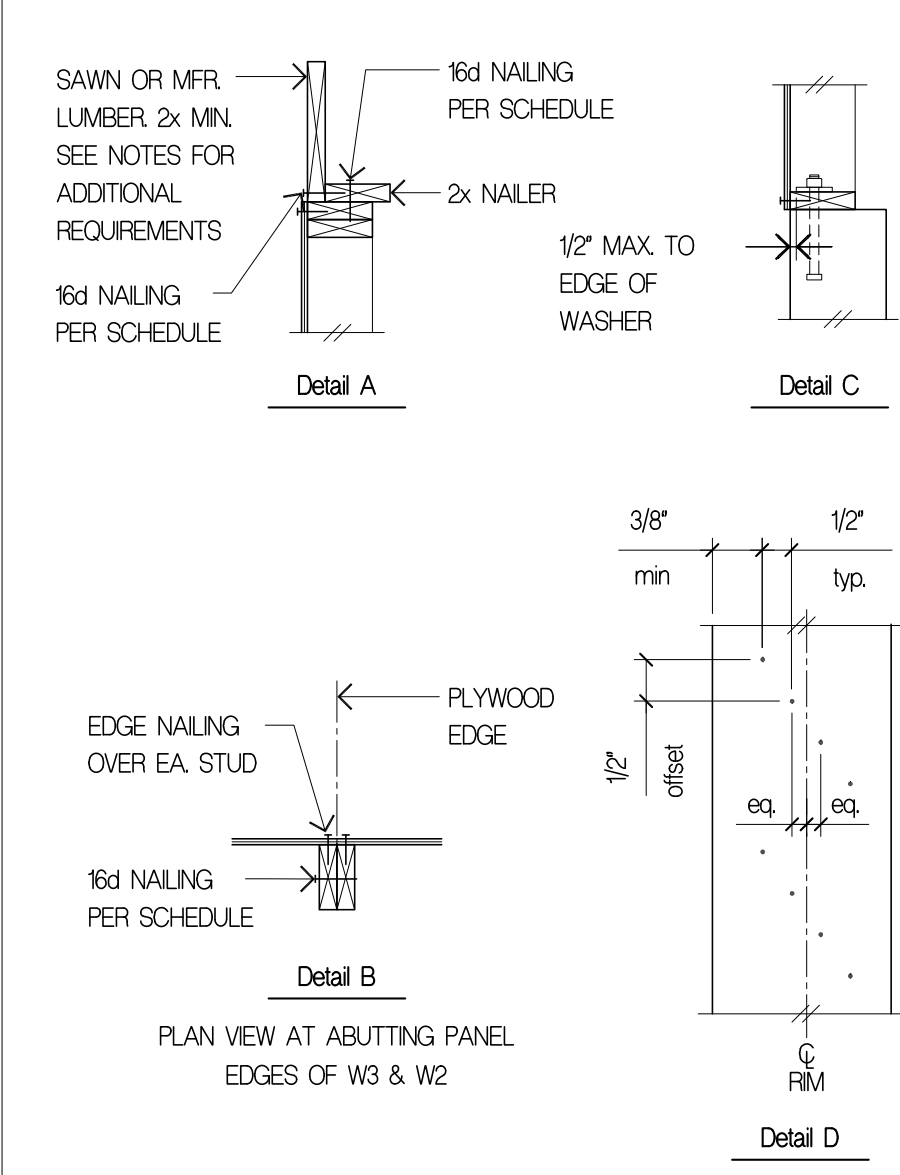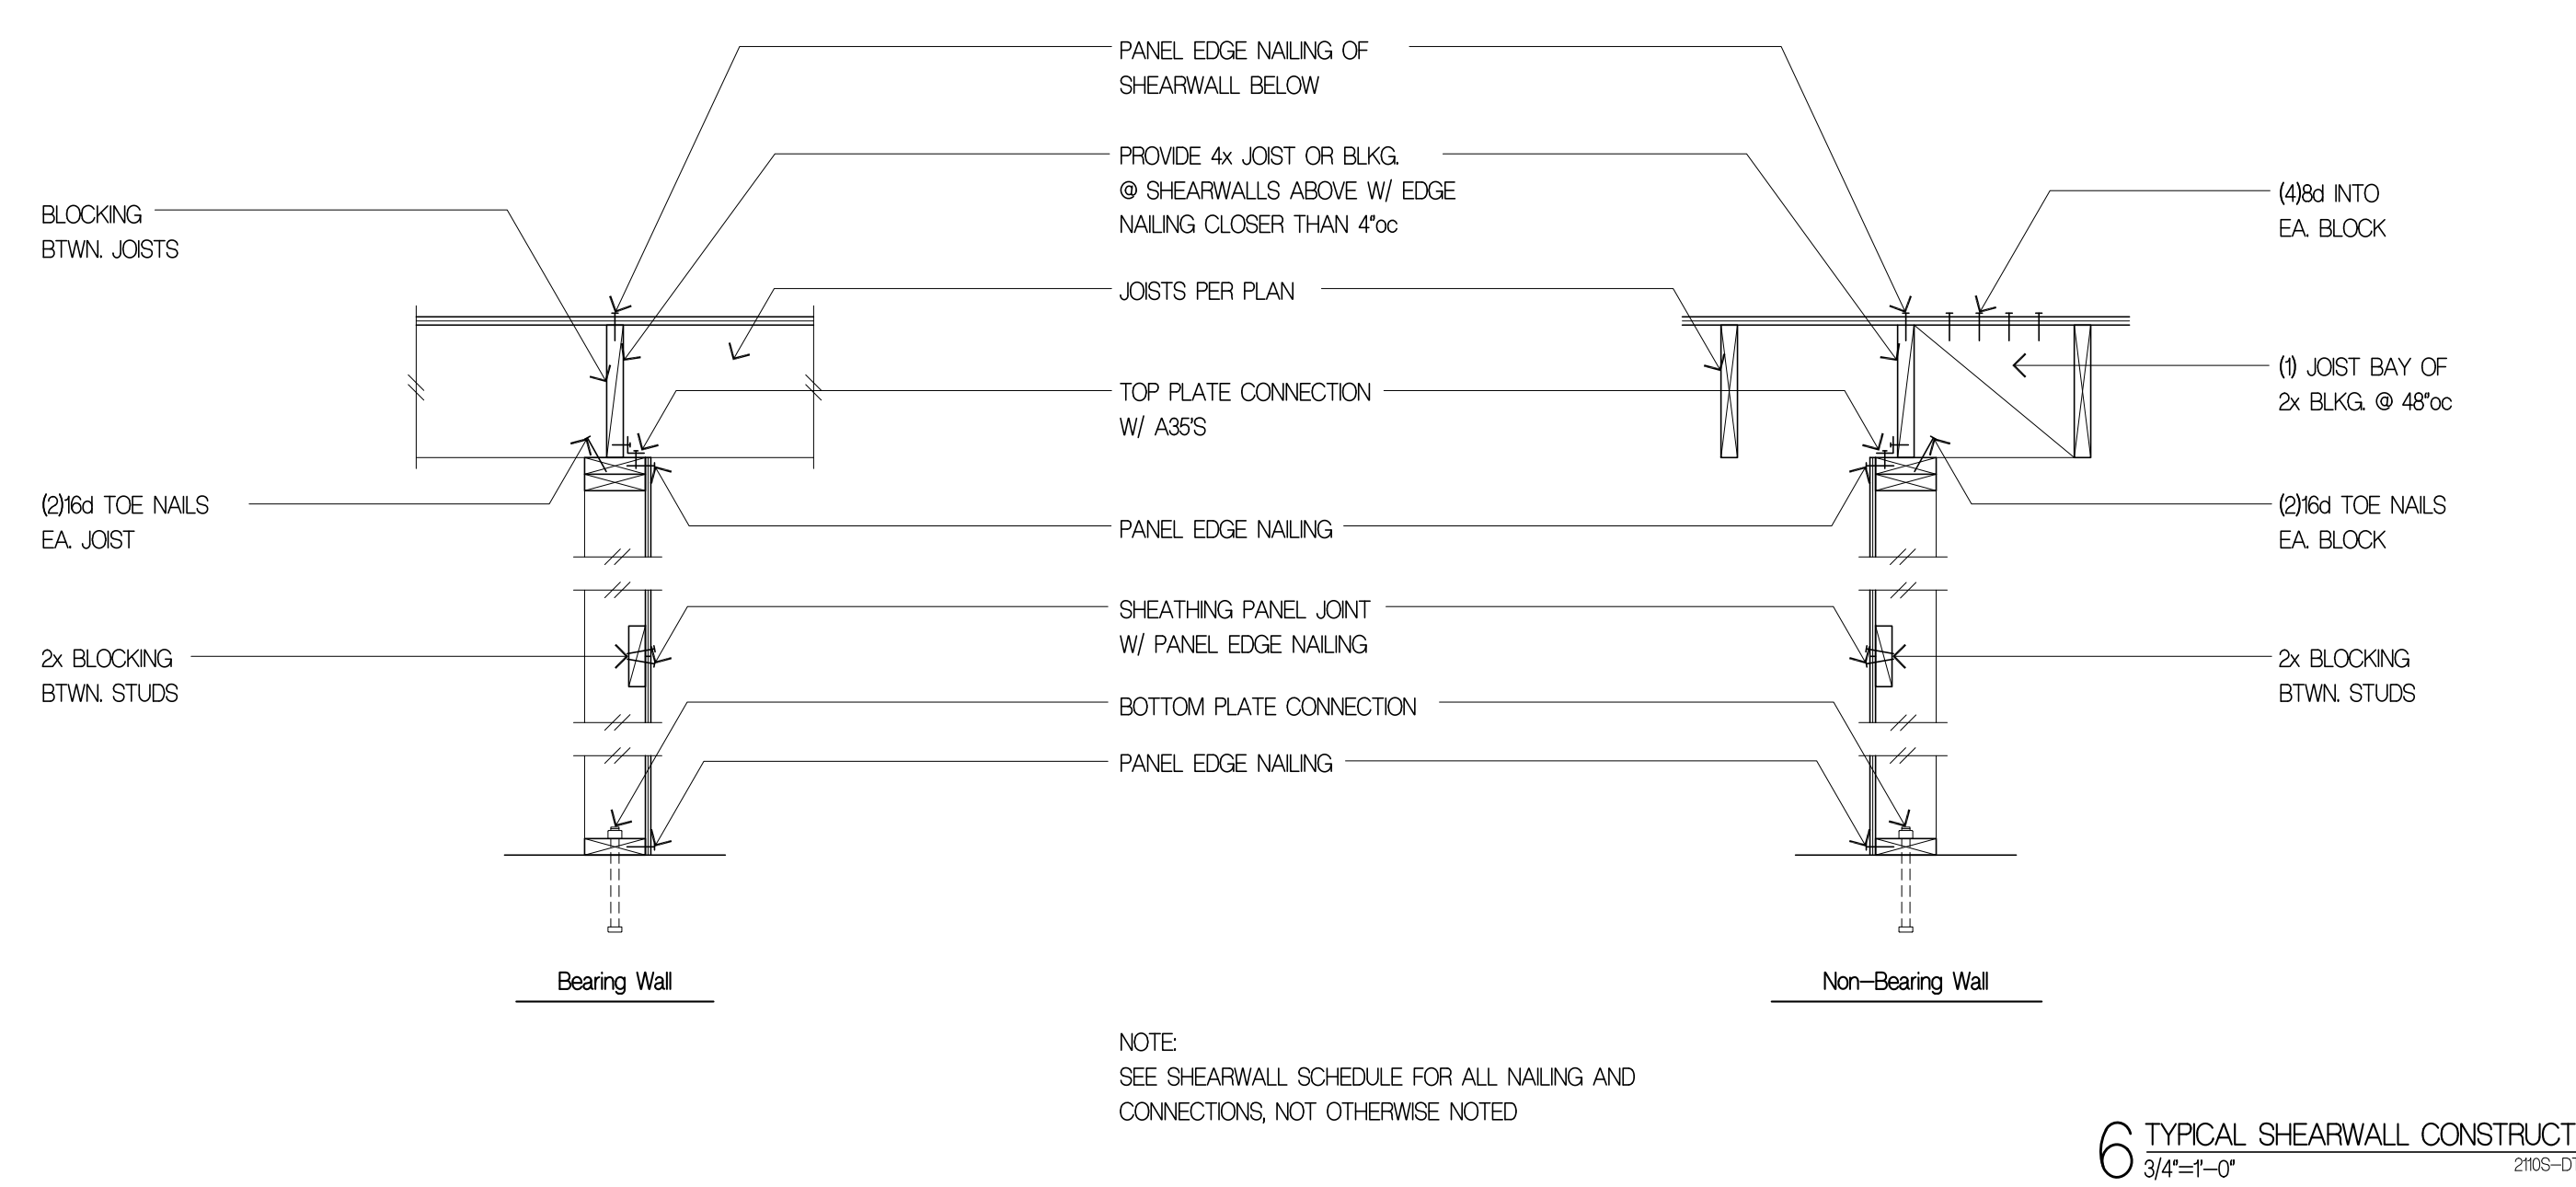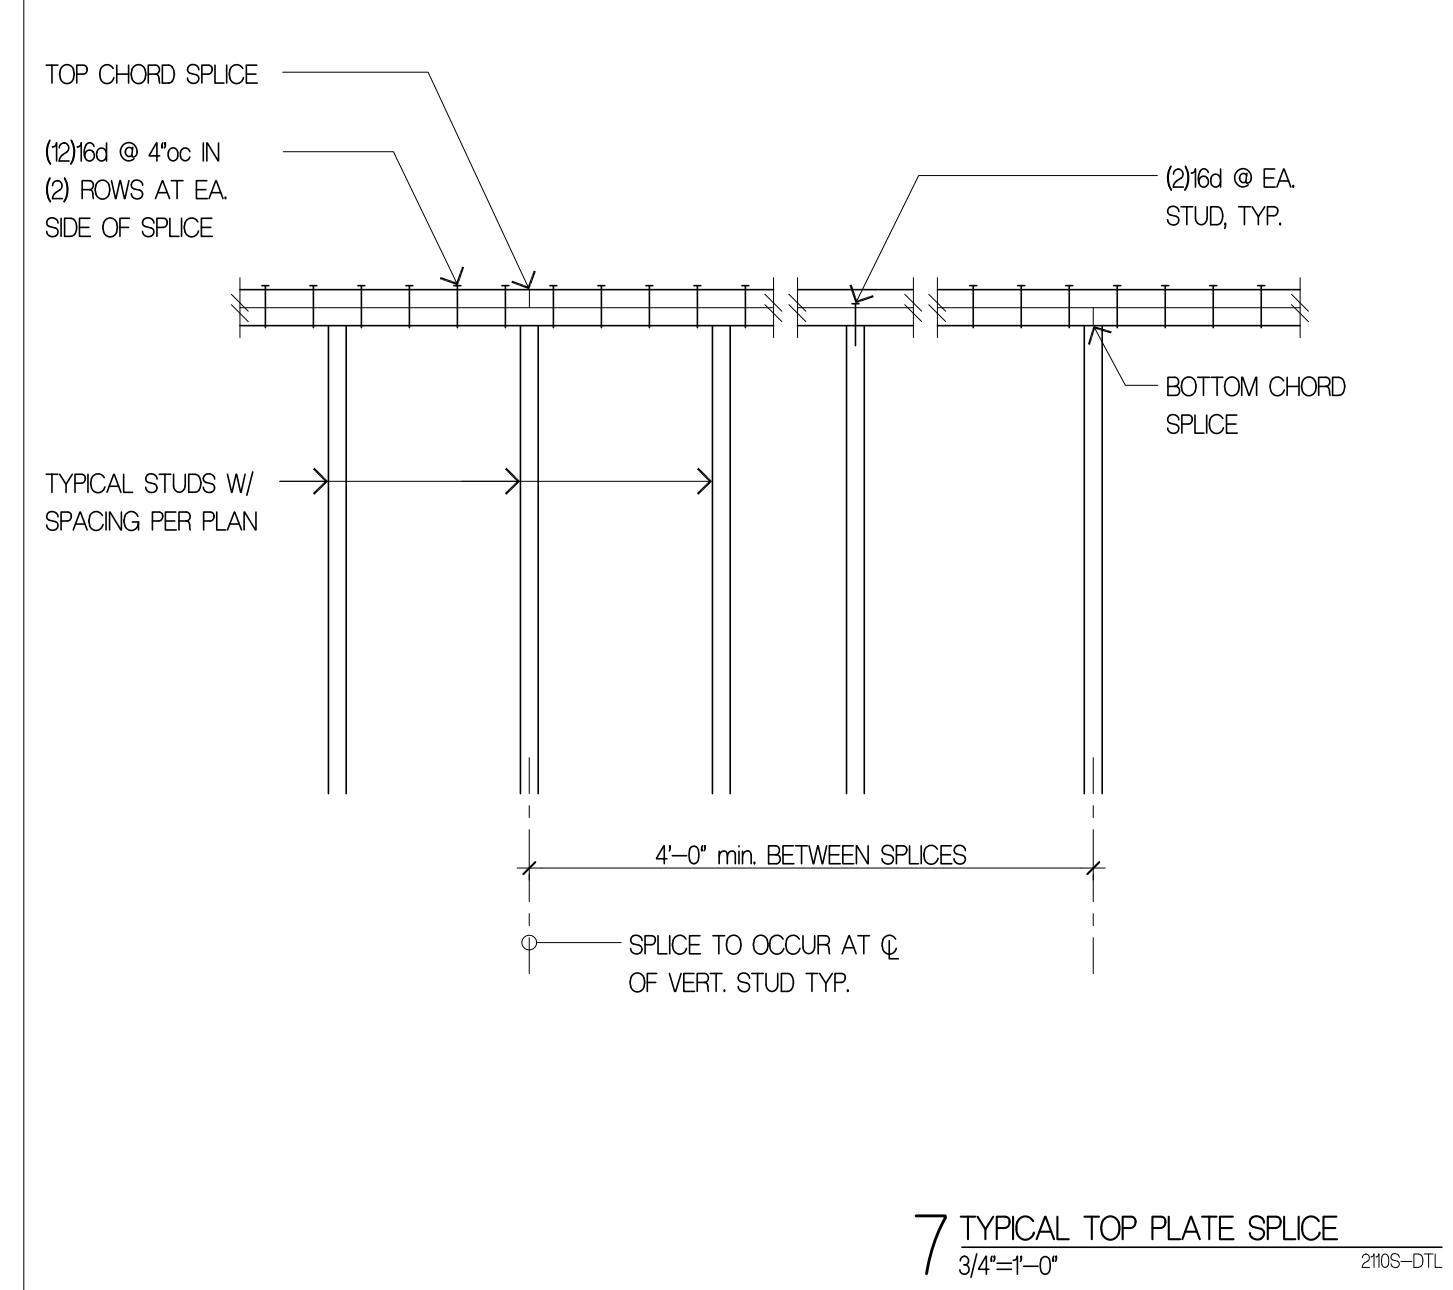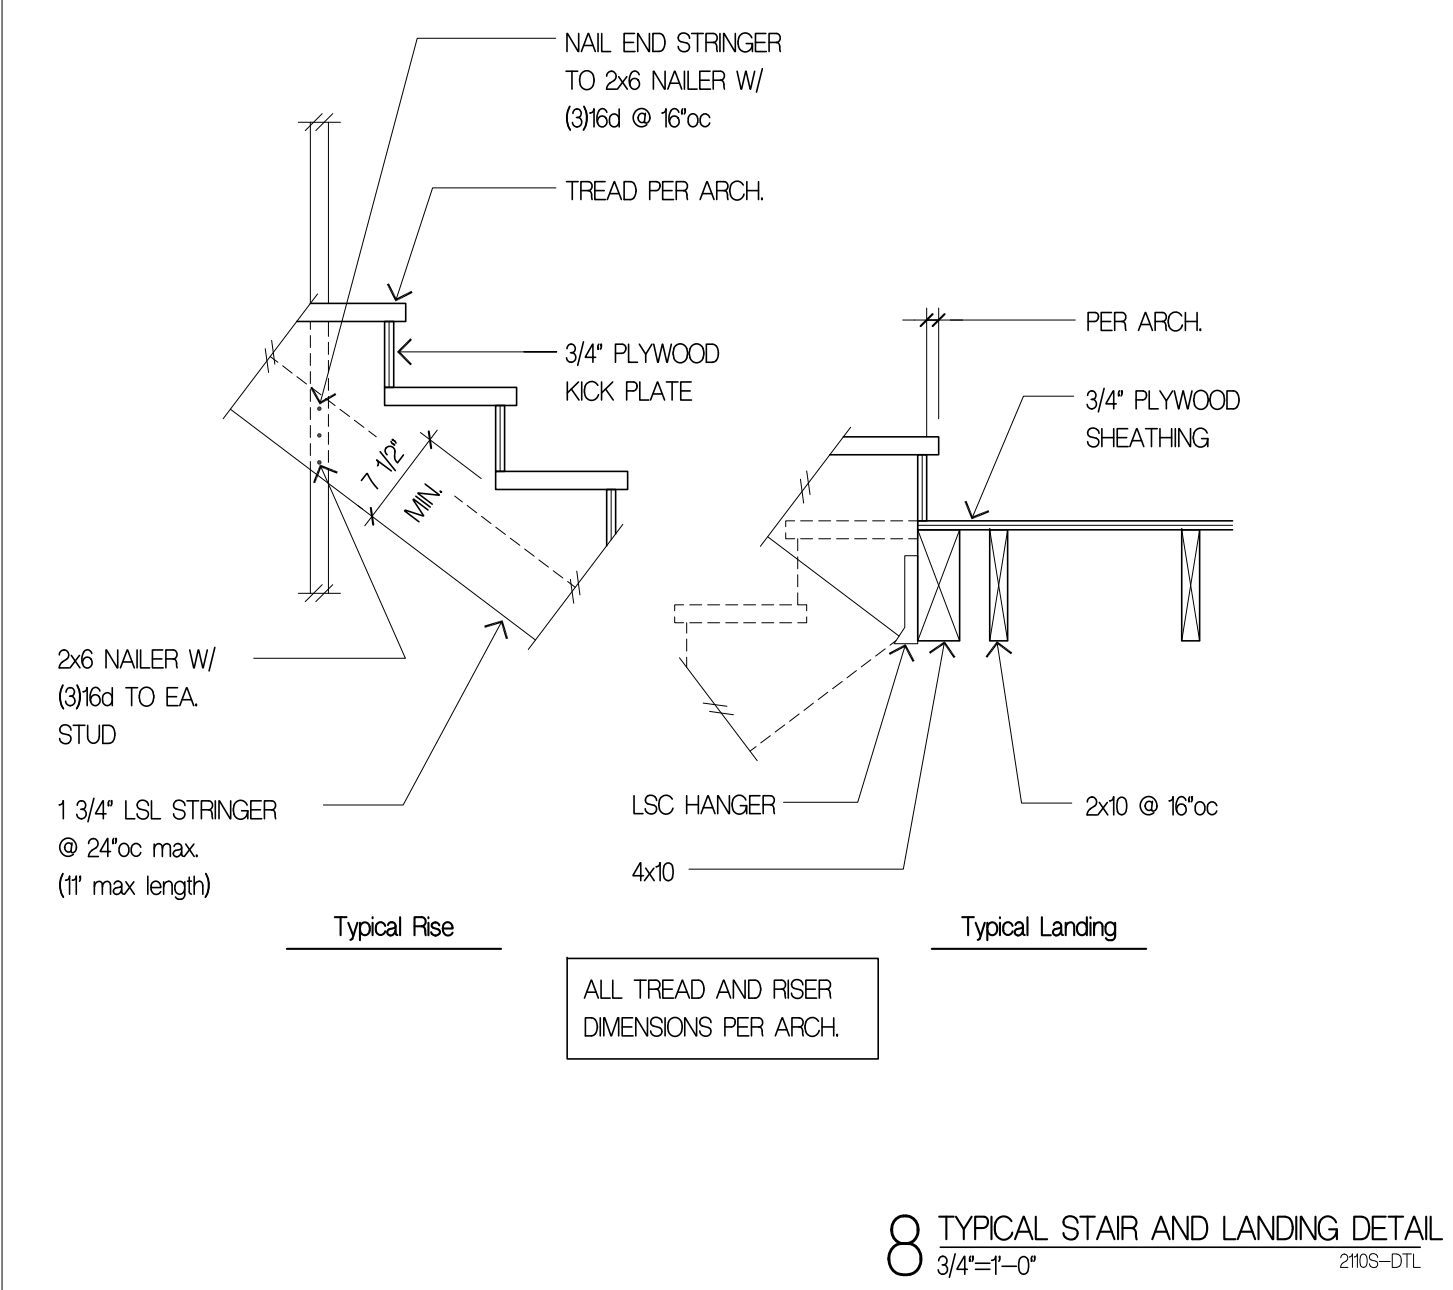


Shearwall Schedule ①②③④⑤⑥

Mark	Sheathing	Panel Edge Nailing	Top Plate Connection		Base Plate Connection	
			if T/J	if Wood ⑦	at Wood ⑧	at Concrete
W6	15/32" CDX PLYWOOD	8d @ 6"oc	16d @ 6"oc	A35 @ 24"oc	16d @ 6"oc	5/8" AB @ 48"oc
W4	15/32" CDX PLYWOOD	8d @ 4"oc	16d @ 4"oc	A35 @ 16"oc	(2)rows 16d @ 6"oc	5/8" AB @ 32"oc
W3 ④	15/32" CDX PLYWOOD	8d @ 3"oc	(2)rows 16d @ 4"oc	A35 @ 12"oc	(2)rows 16d @ 6"oc	5/8" AB @ 24"oc
W2 ⑤	15/32" CDX PLYWOOD	8d @ 2"oc	(2)rows 16d @ 4"oc	A35 @ 9"oc	(2)rows 16d @ 4"oc ⑩	5/8" AB @ 16"oc

- BLOCK PANEL EDGES WITH 2x MIN. LAID FLAT AND NAIL PANELS TO INTERMEDIATE SUPPORTS WITH 8d @ 12"oc.
- 8d NAILS SHALL BE 0.131" x 2 1/2" (common) - 16d NAILS SHALL BE 0.165" x 3 1/2" (box)
- EMBED ANCHOR BOLTS AT LEAST 7". DRILLED AND EPOXIED THREADED ROD MAY BE SUBSTITUTED FOR ANCHOR BOLTS WITH 6" EMBEDMENT. TITEN HD SCREW ANCHORS MAY BE SUBSTITUTED FOR ANCHOR BOLTS W/ 4" EMBEDMENT. ALL BOLTS SHALL HAVE 3" x 3" x 1/4" MIN. PLATE WASHERS. PLATE WASHERS SHALL EXTEND TO WITHIN 1/2" OF THE EDGE OF THE BOTTOM PLATE ON THE SIDE WITH SHEATHING. SEE DETAIL C.
- 3x STUDS OR DOUBLE STUDS NAILED TOGETHER W/ BASE PLATE NAILING ARE REQUIRED AT ABUTTING PANEL EDGES OF W3 AND W2. SEE DETAIL B. WHERE 3x STUDS ARE USED FOR W2, STAGGER NAILS AT ADJOINING PANEL EDGES.
- TWO STUDS MINIMUM ARE REQUIRED AT EACH END OF ALL SHEARWALLS AND ALL END STUDS SHALL RECEIVE PANEL EDGE NAILING. SEE PLANS AND HOLDOWN SCHEDULE FOR ALTERNATE REQUIREMENTS.
- ALL EXTERIOR WALLS SHALL BE W6, UNLESS NOTED OTHERWISE.
- LTP4s (HORIZONTAL ORIENTATION) W/ 8d COMMON MAY BE SUBSTITUTED FOR A35s AT CONTRACTORS OPTION.
- A 2x NAILER ATTACHED W/ BASE PLATE NAILING PER DETAIL A MAY BE SUBSTITUTED FOR A35s AT CONTRACTORS OPTION.
- AT MULTI-ROW NAILING, MINIMUM OFFSET BETWEEN ROWS AND ROW SPACING 1/2", SEE DETAIL D.
- PROVIDE (3) ROWS 16d @ 6"oc AT LVL RIMS.

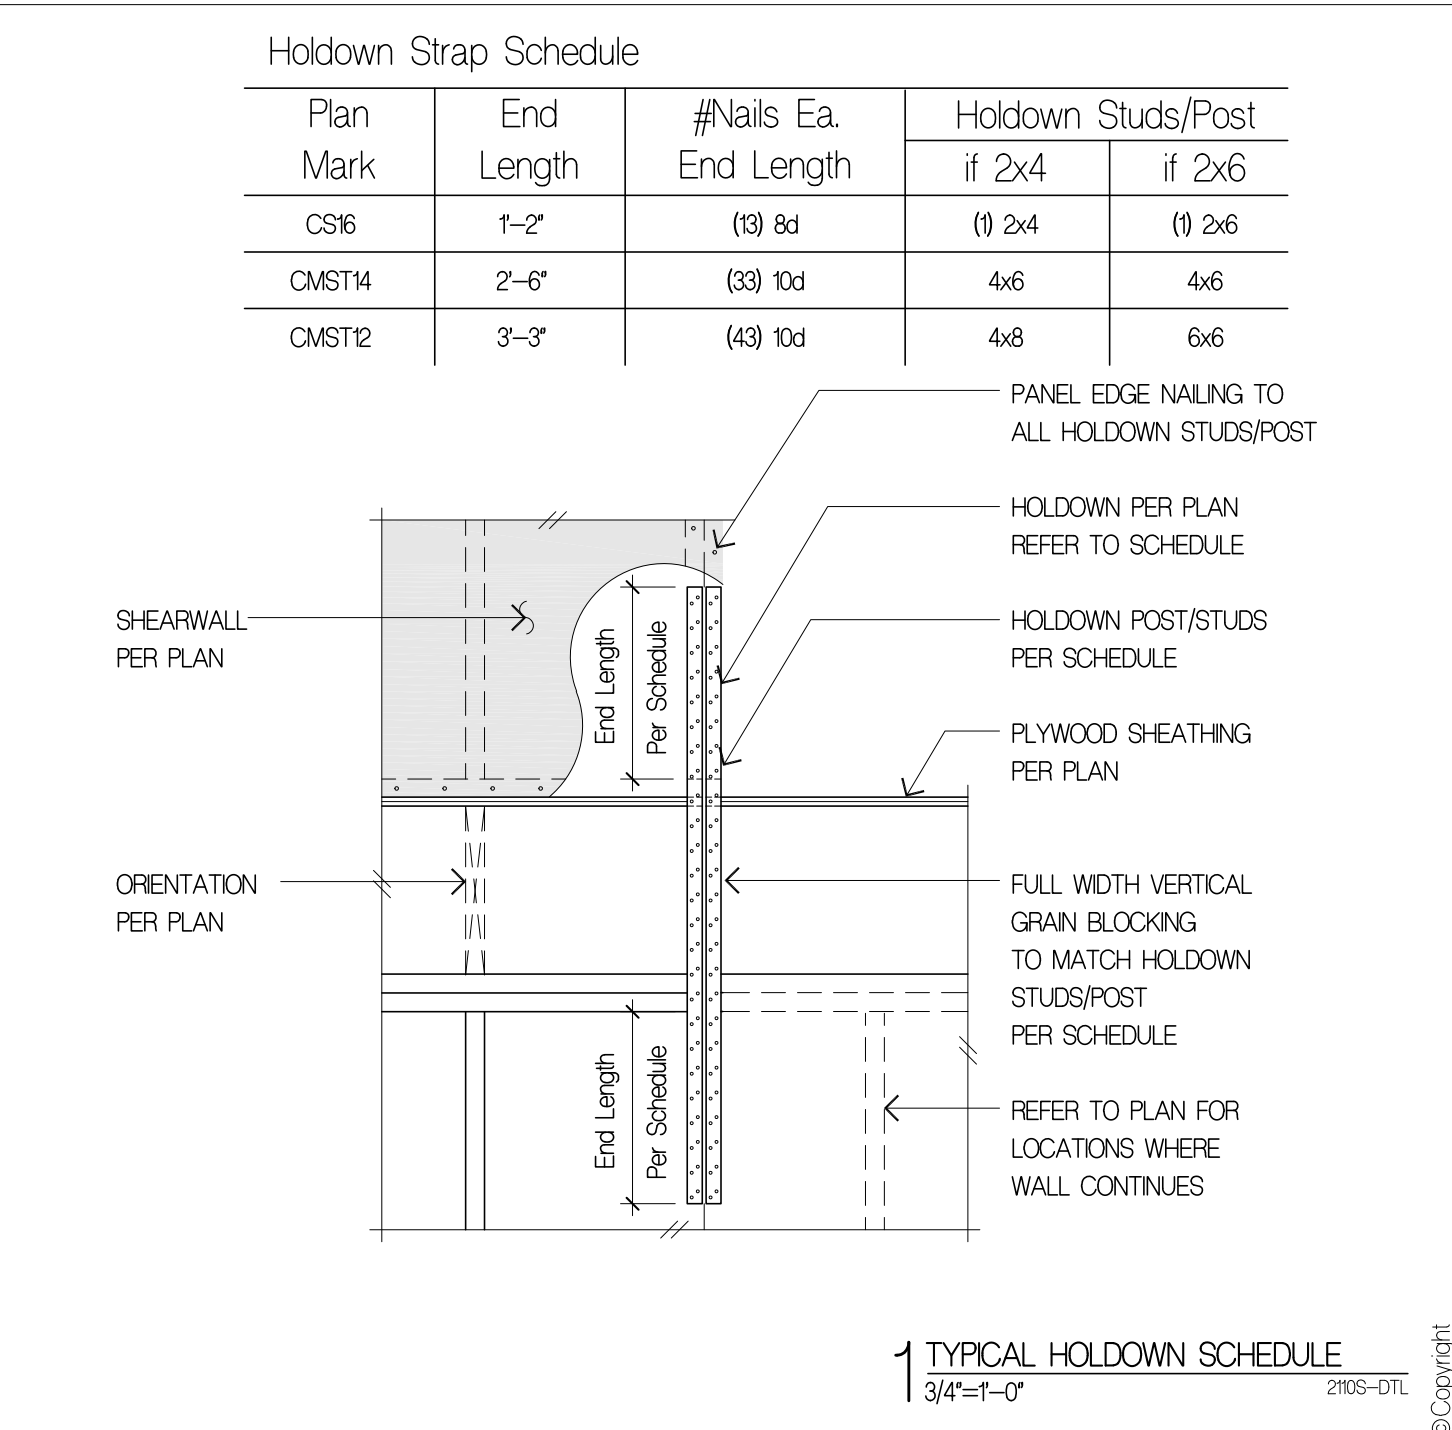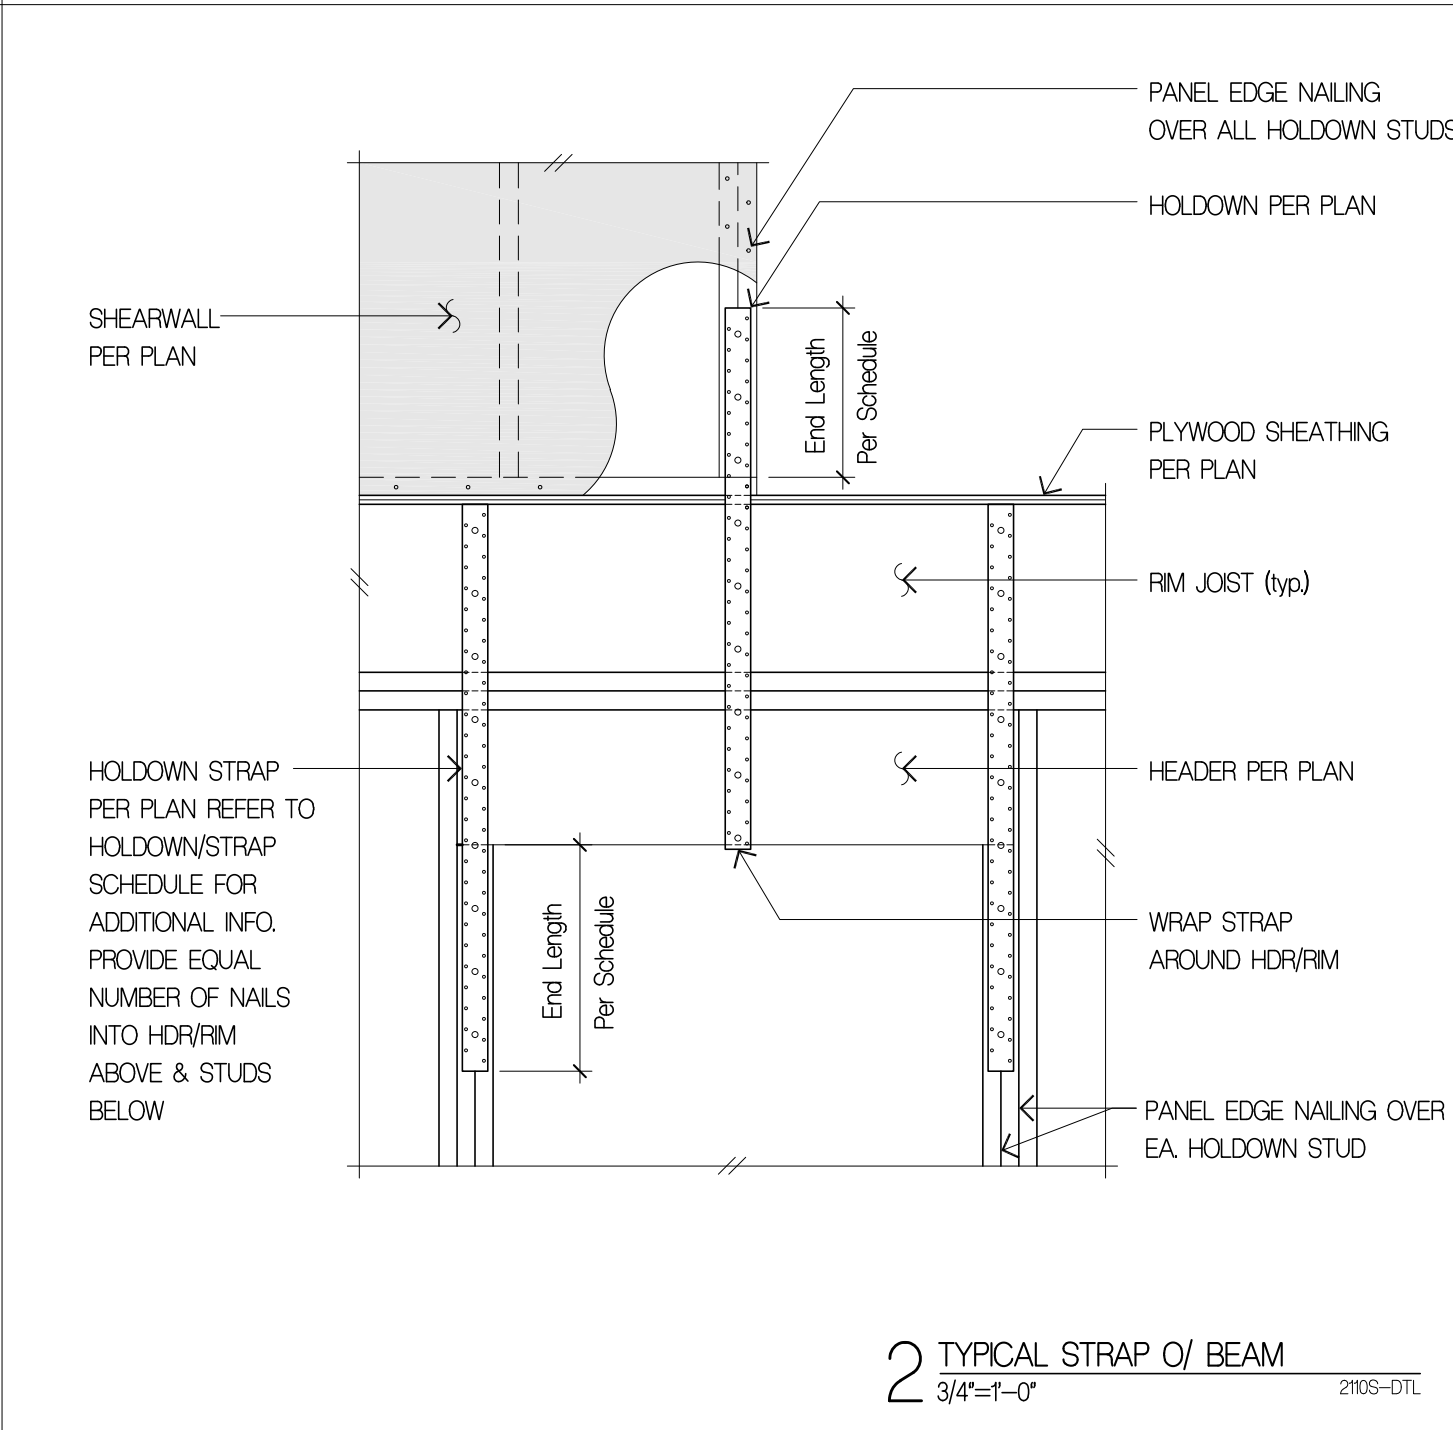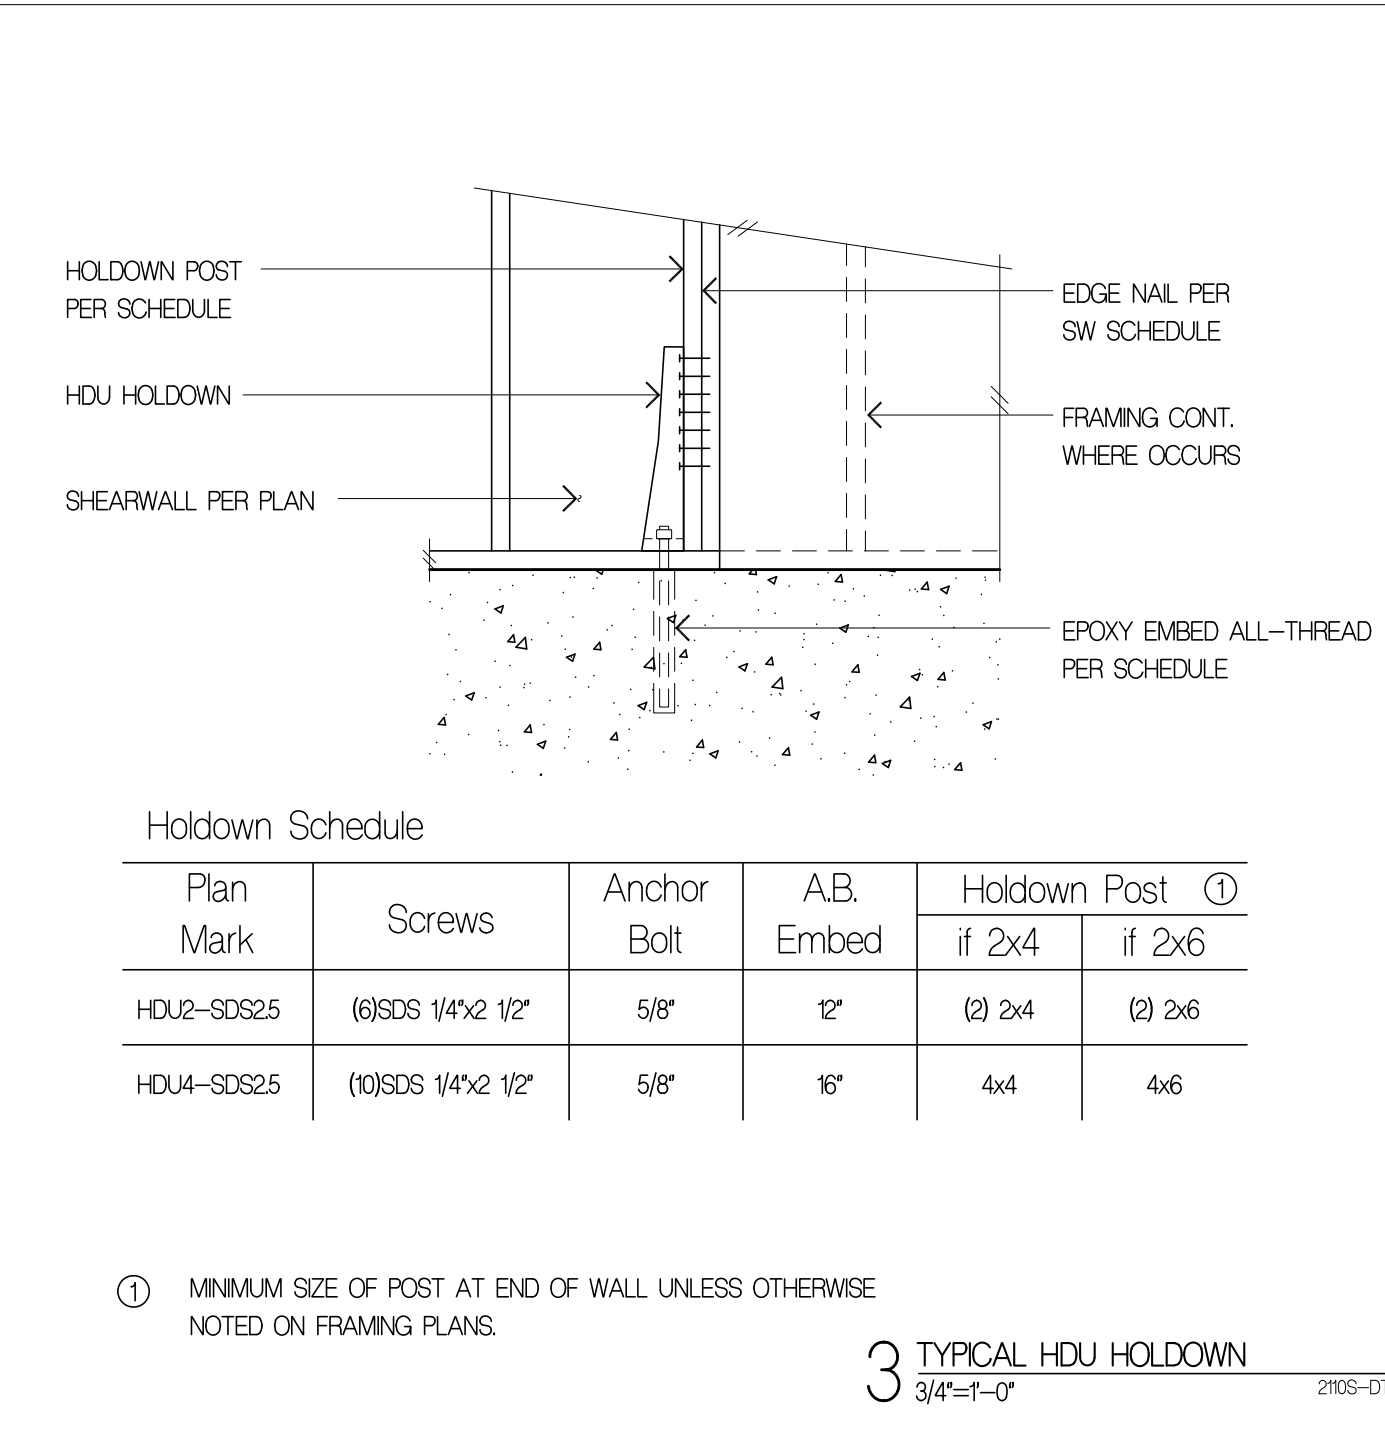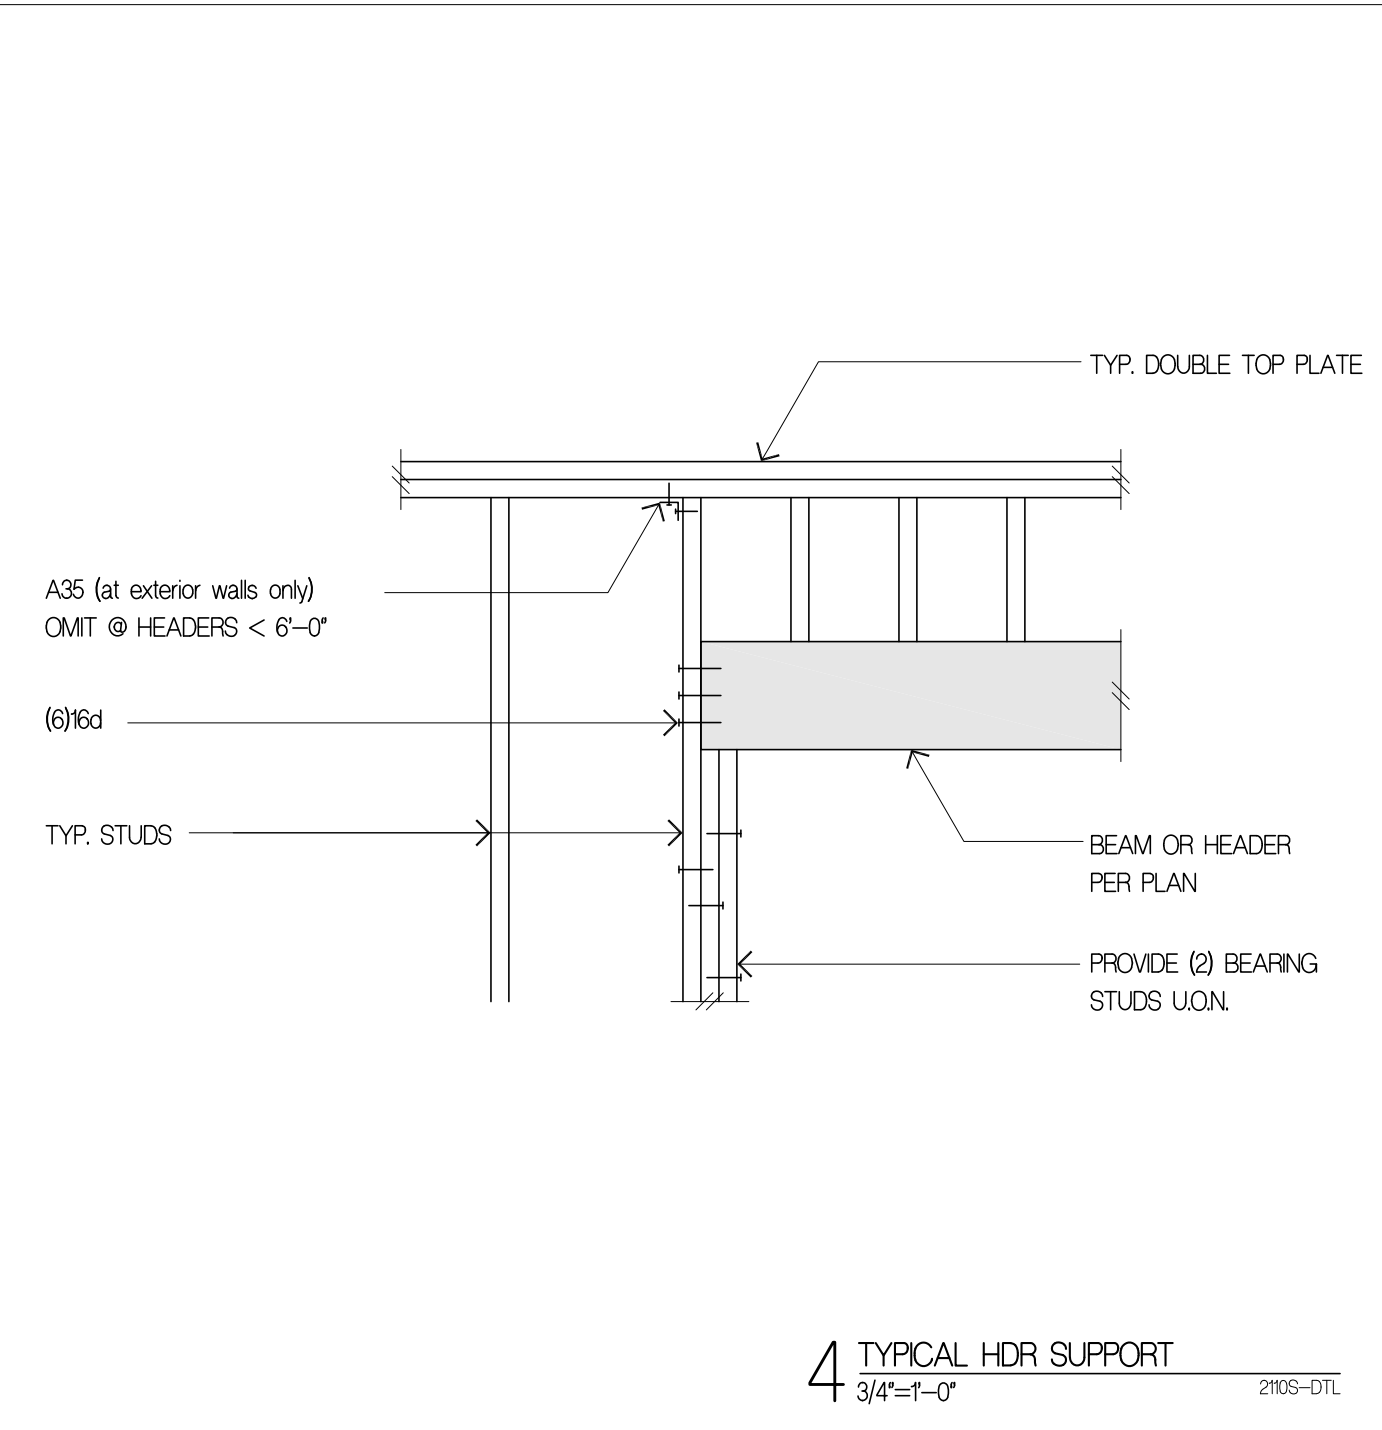

Project Title
JAFFE RESIDENCE
 8455 SE 83RD STREET
 MERCER ISLAND, WA 98040

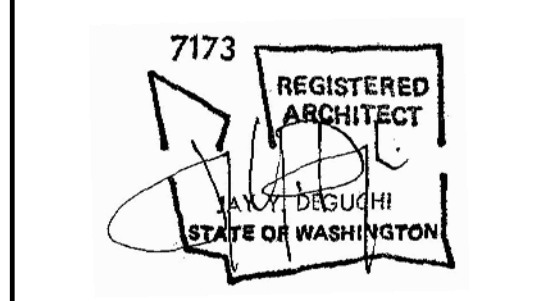


Drawing Title
STRUCTURAL DETAILS


Date
 08/08/2022
 Job No.
 210

ISSUE DATE
 PERMIT CORRECTIONS #1 03/31/2023
 PERMIT CORRECTIONS #2 05/31/2023


PERMIT CORRECTIONS
 Sheet No.

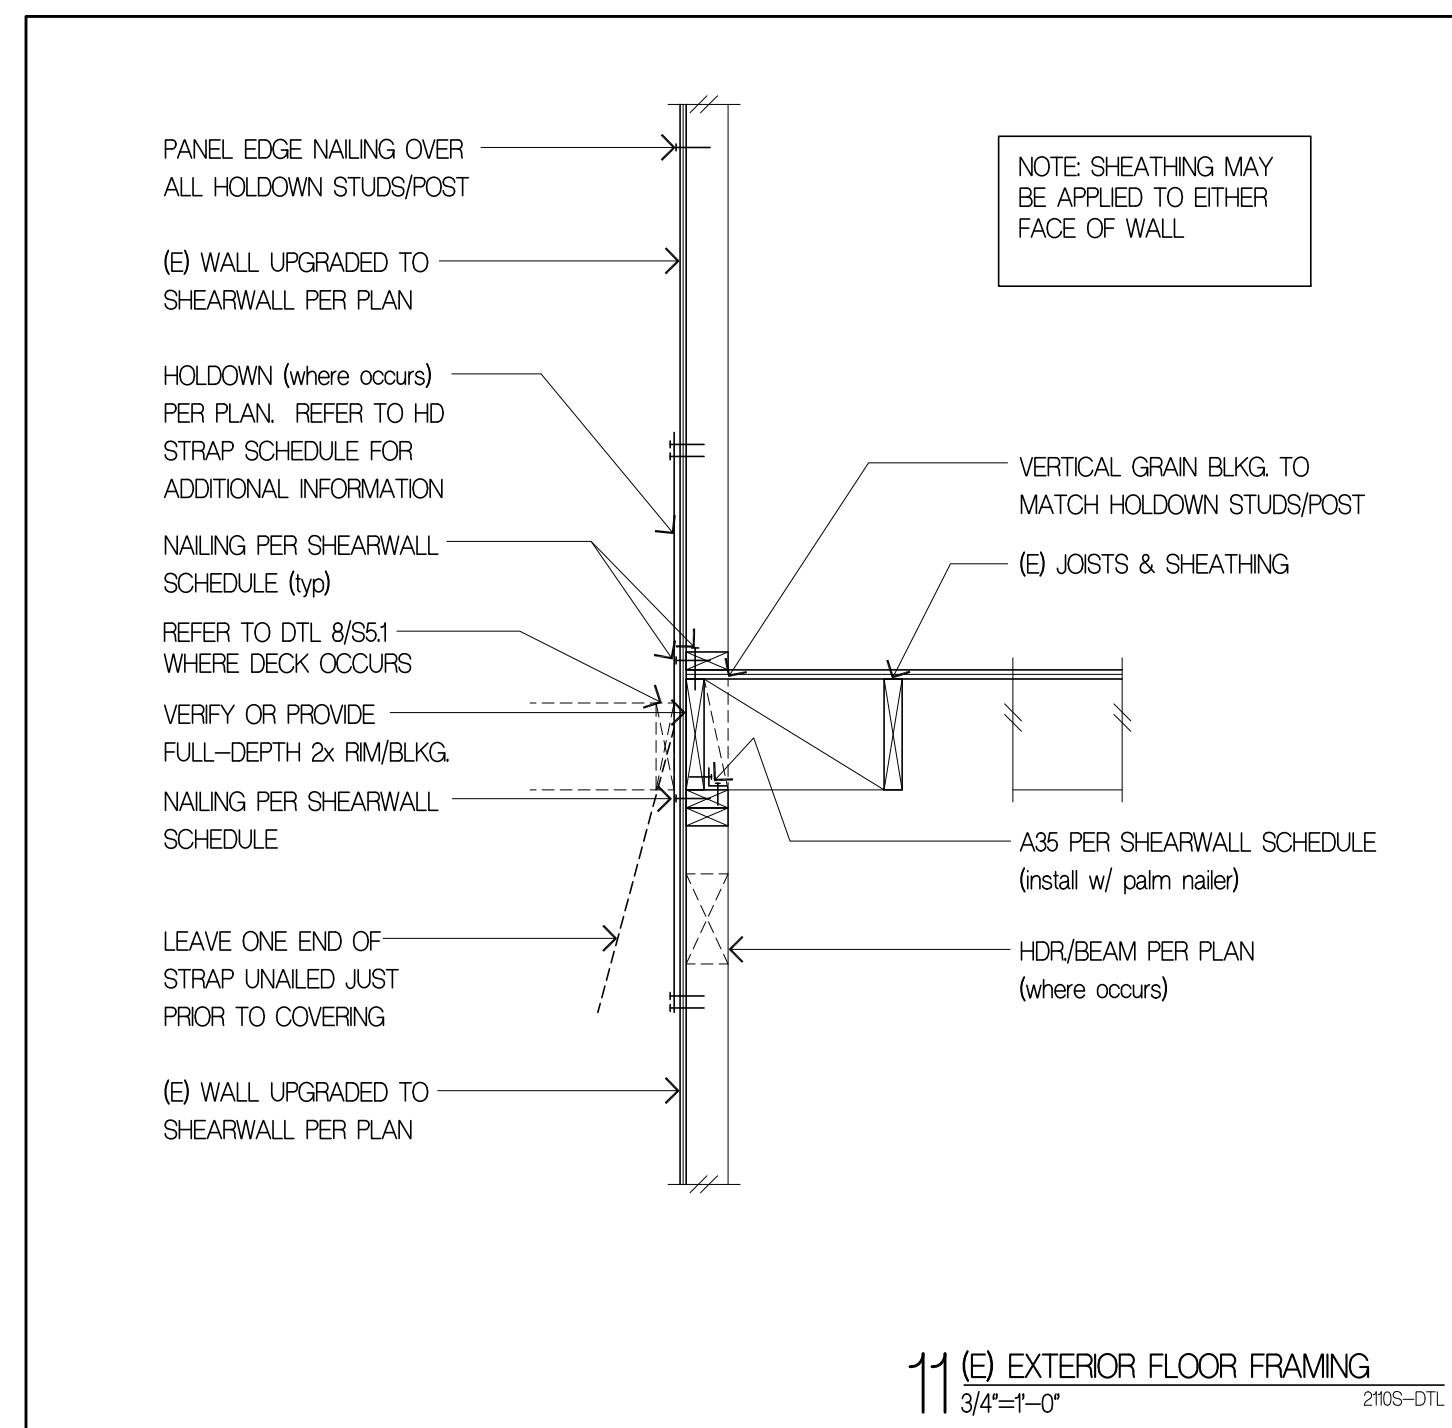


11 (E) EXTERIOR FLOOR FRAMING
 3/4"-1'-0" 2105-DTL

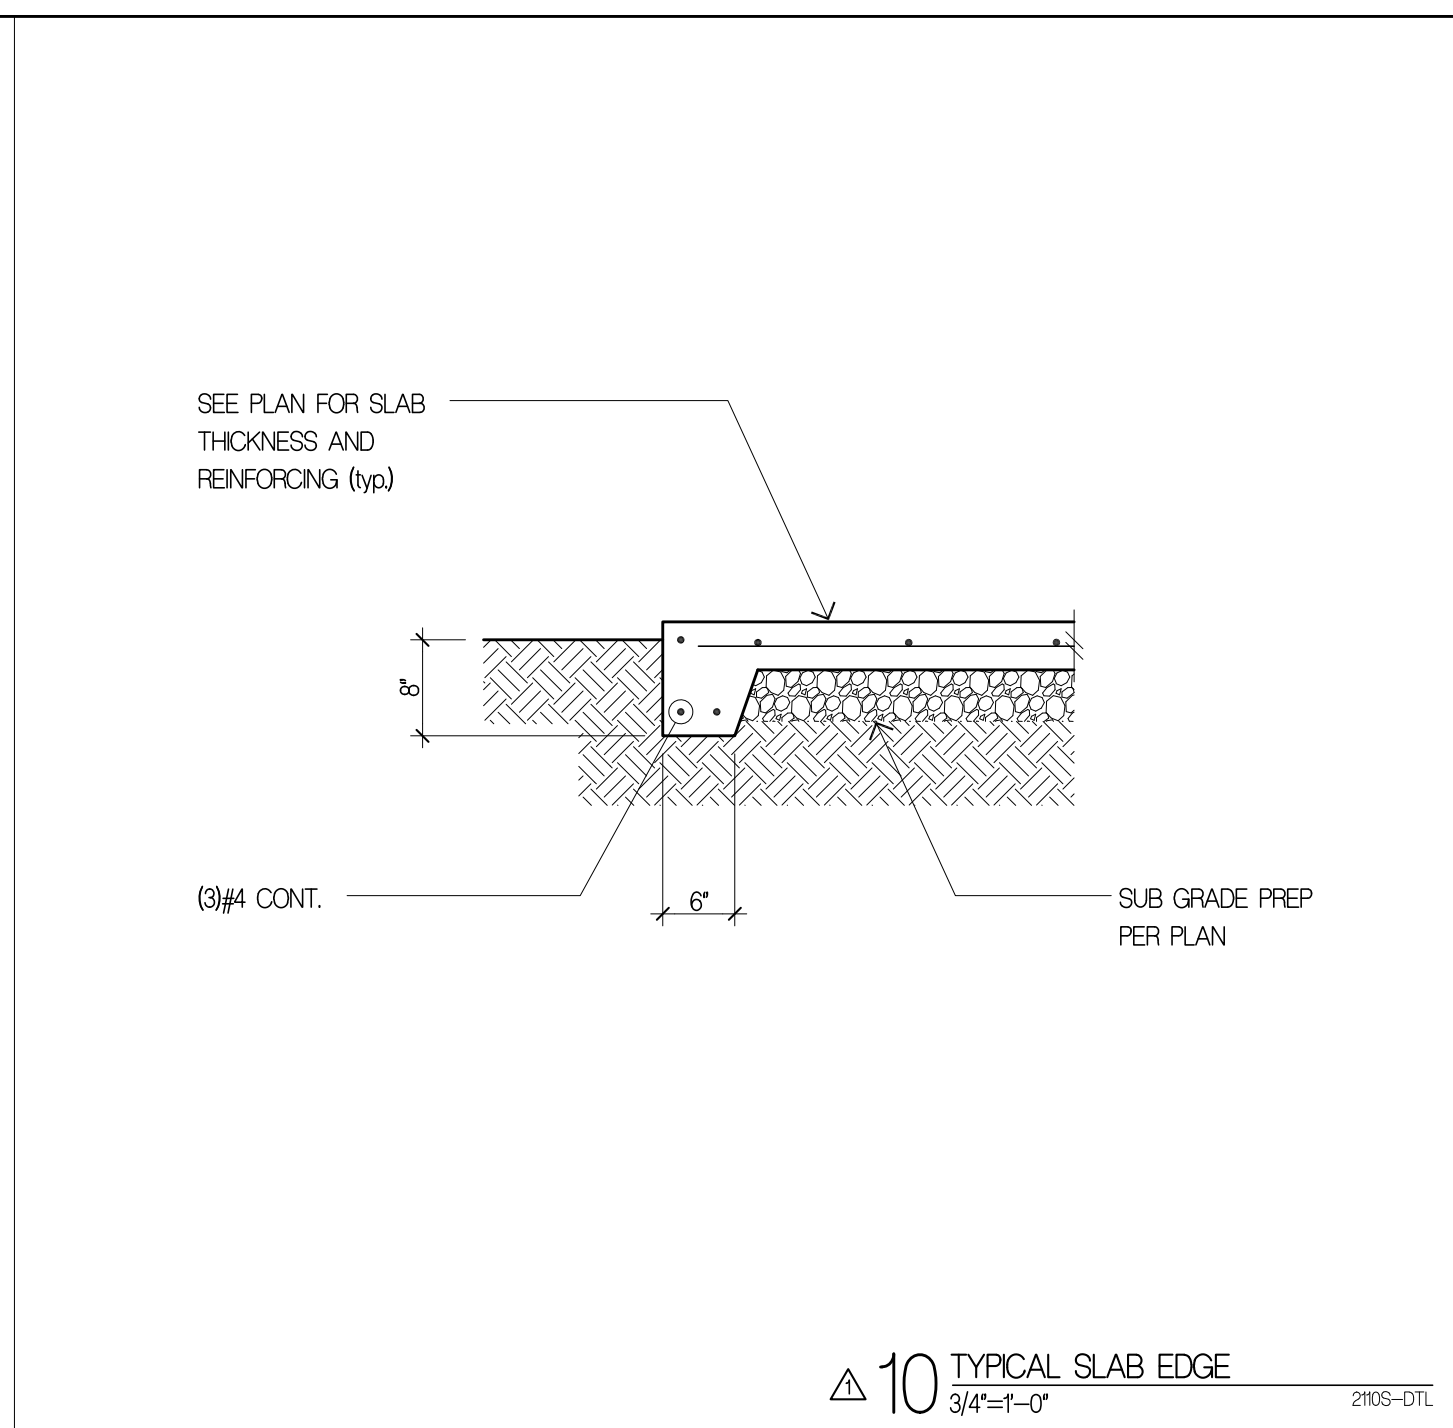


10 TYPICAL SLAB EDGE
 3/4"-1'-0" 2105-DTL

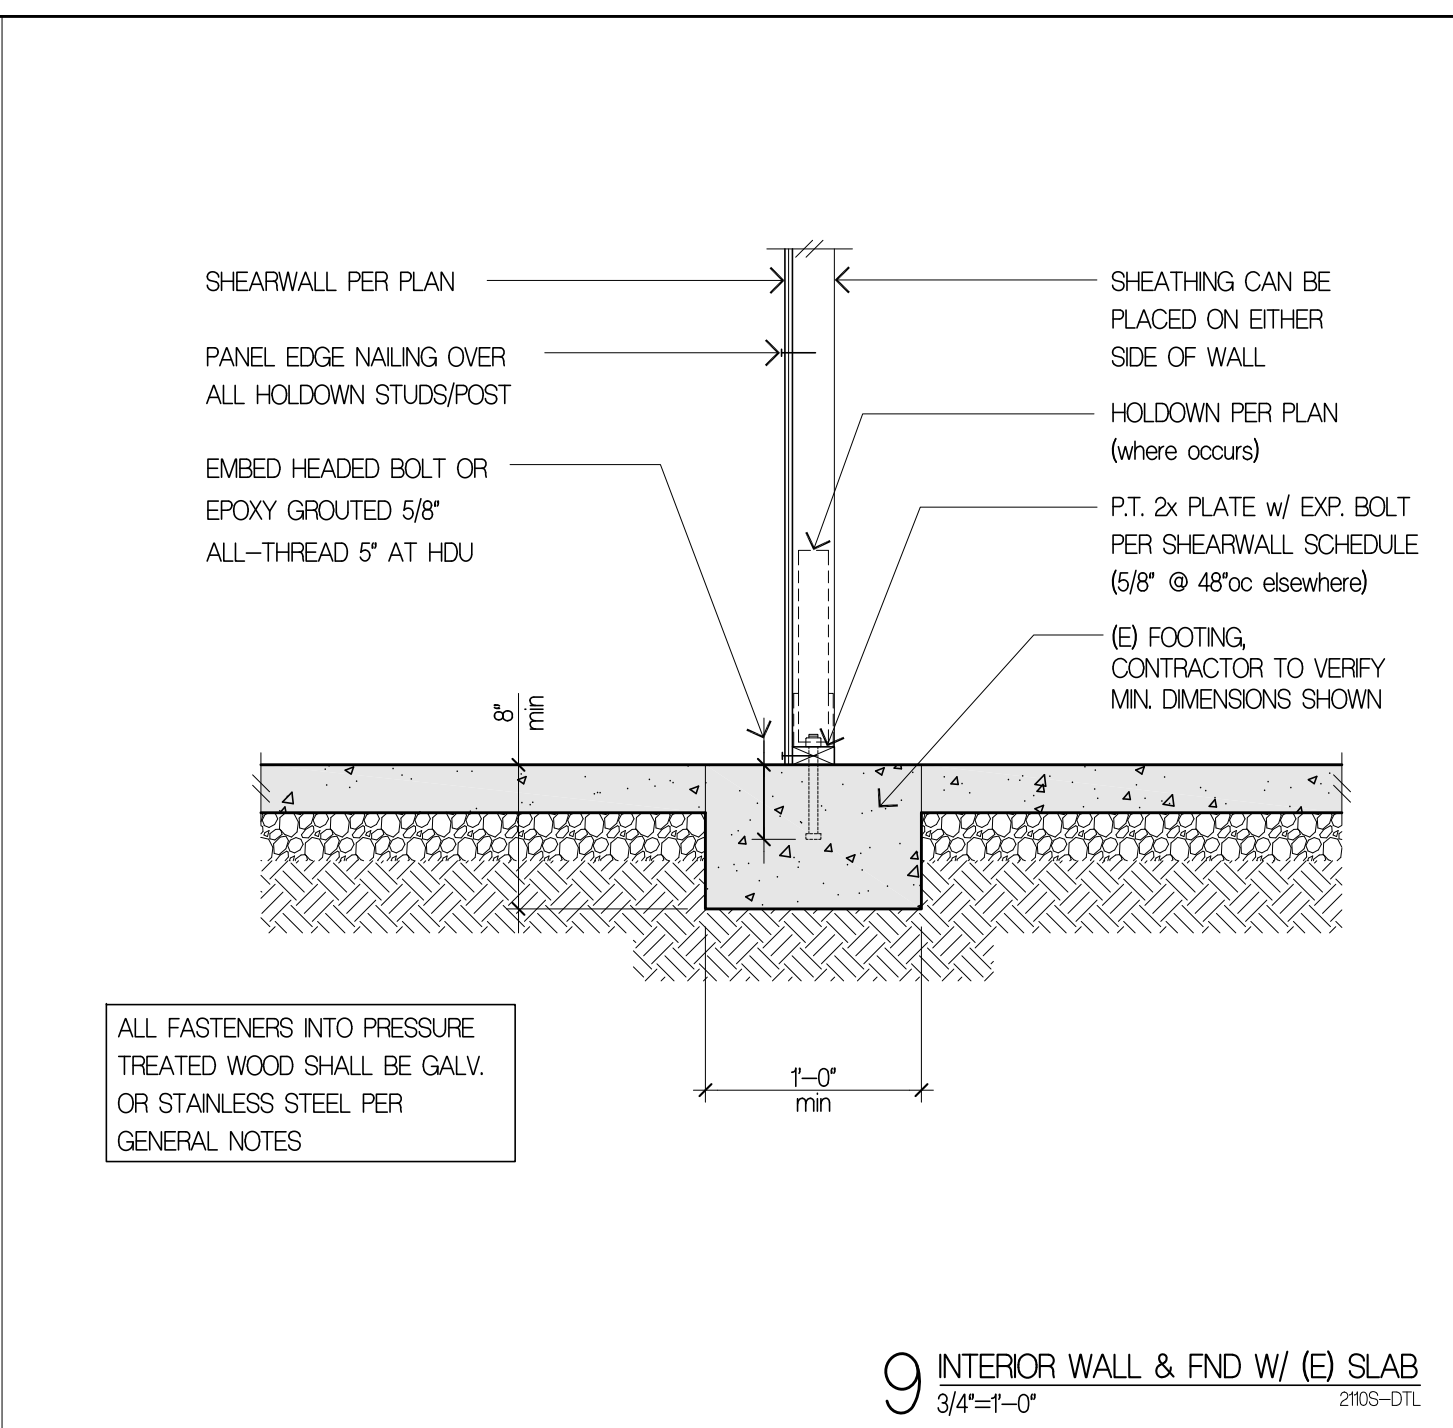


9 INTERIOR WALL & FND W/ (E) SLAB
 3/4"-1'-0" 2105-DTL

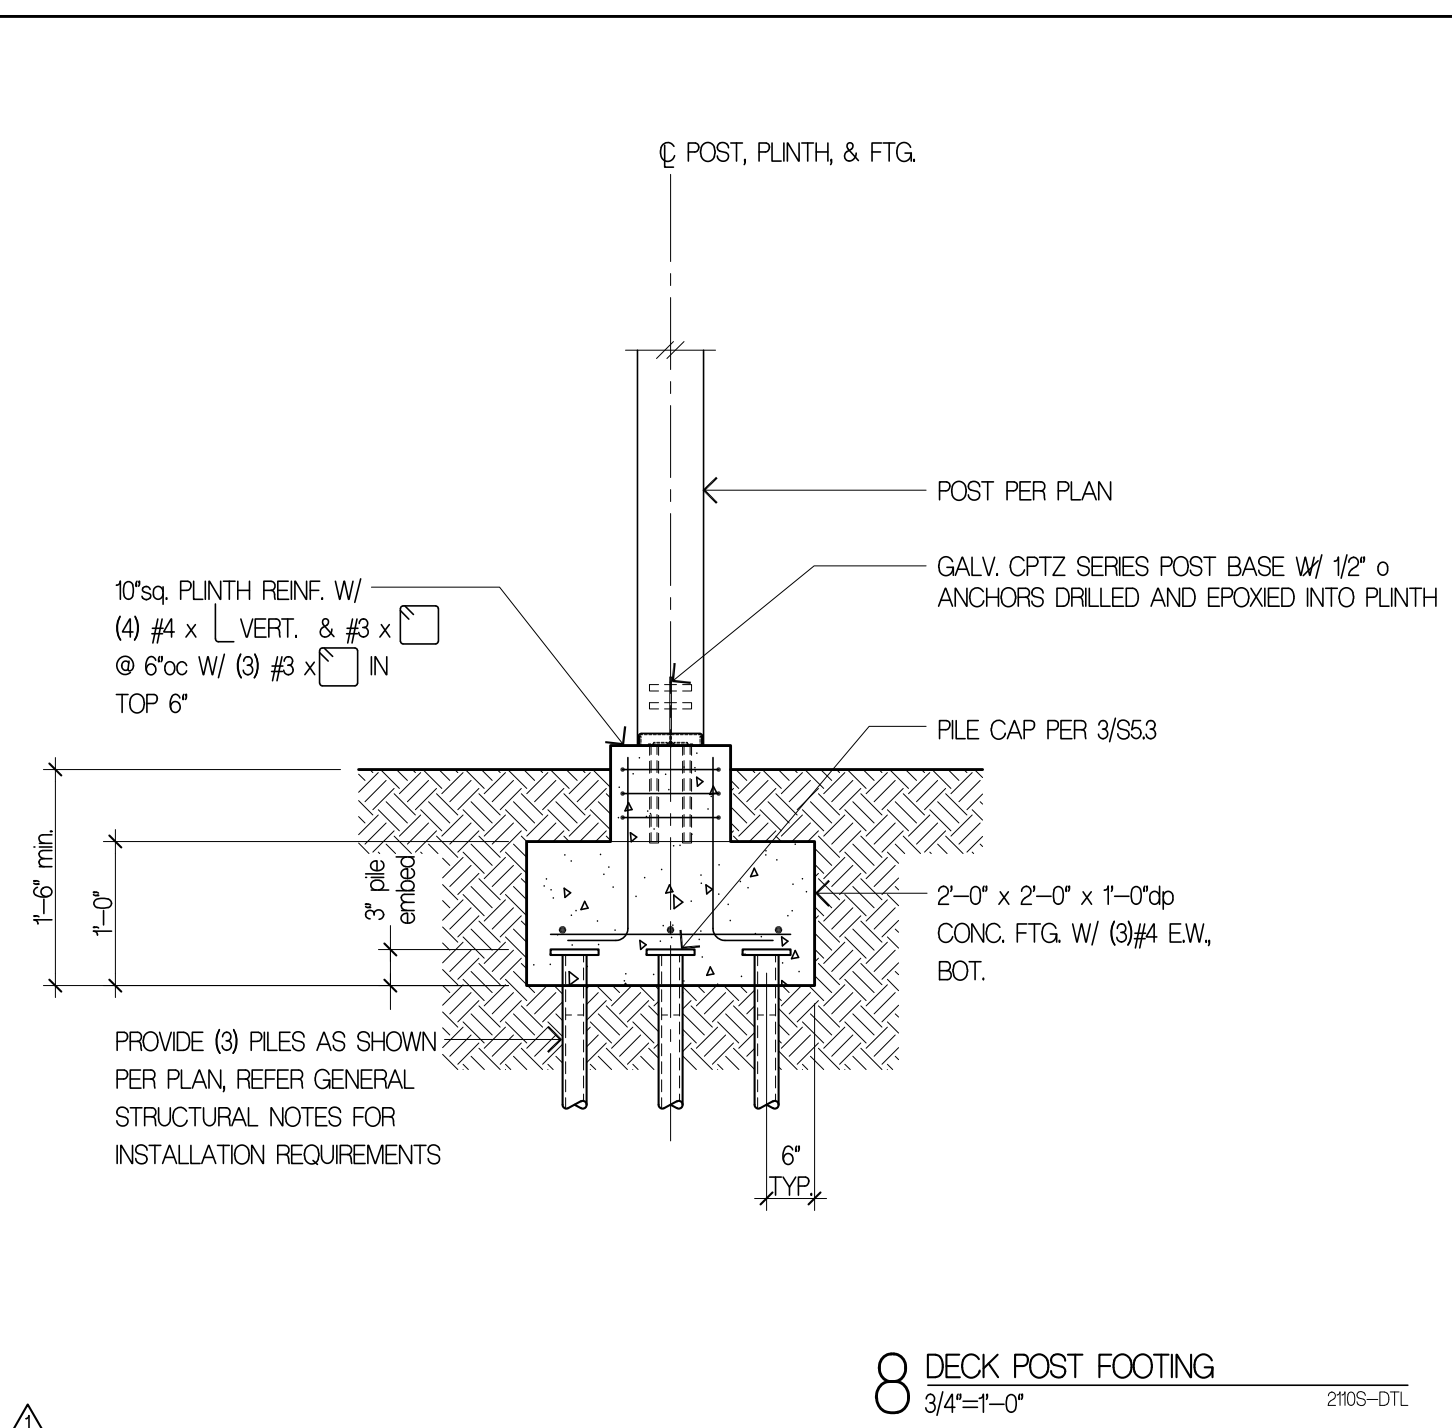


8 DECK POST FOOTING
 3/4"-1'-0" 2105-DTL

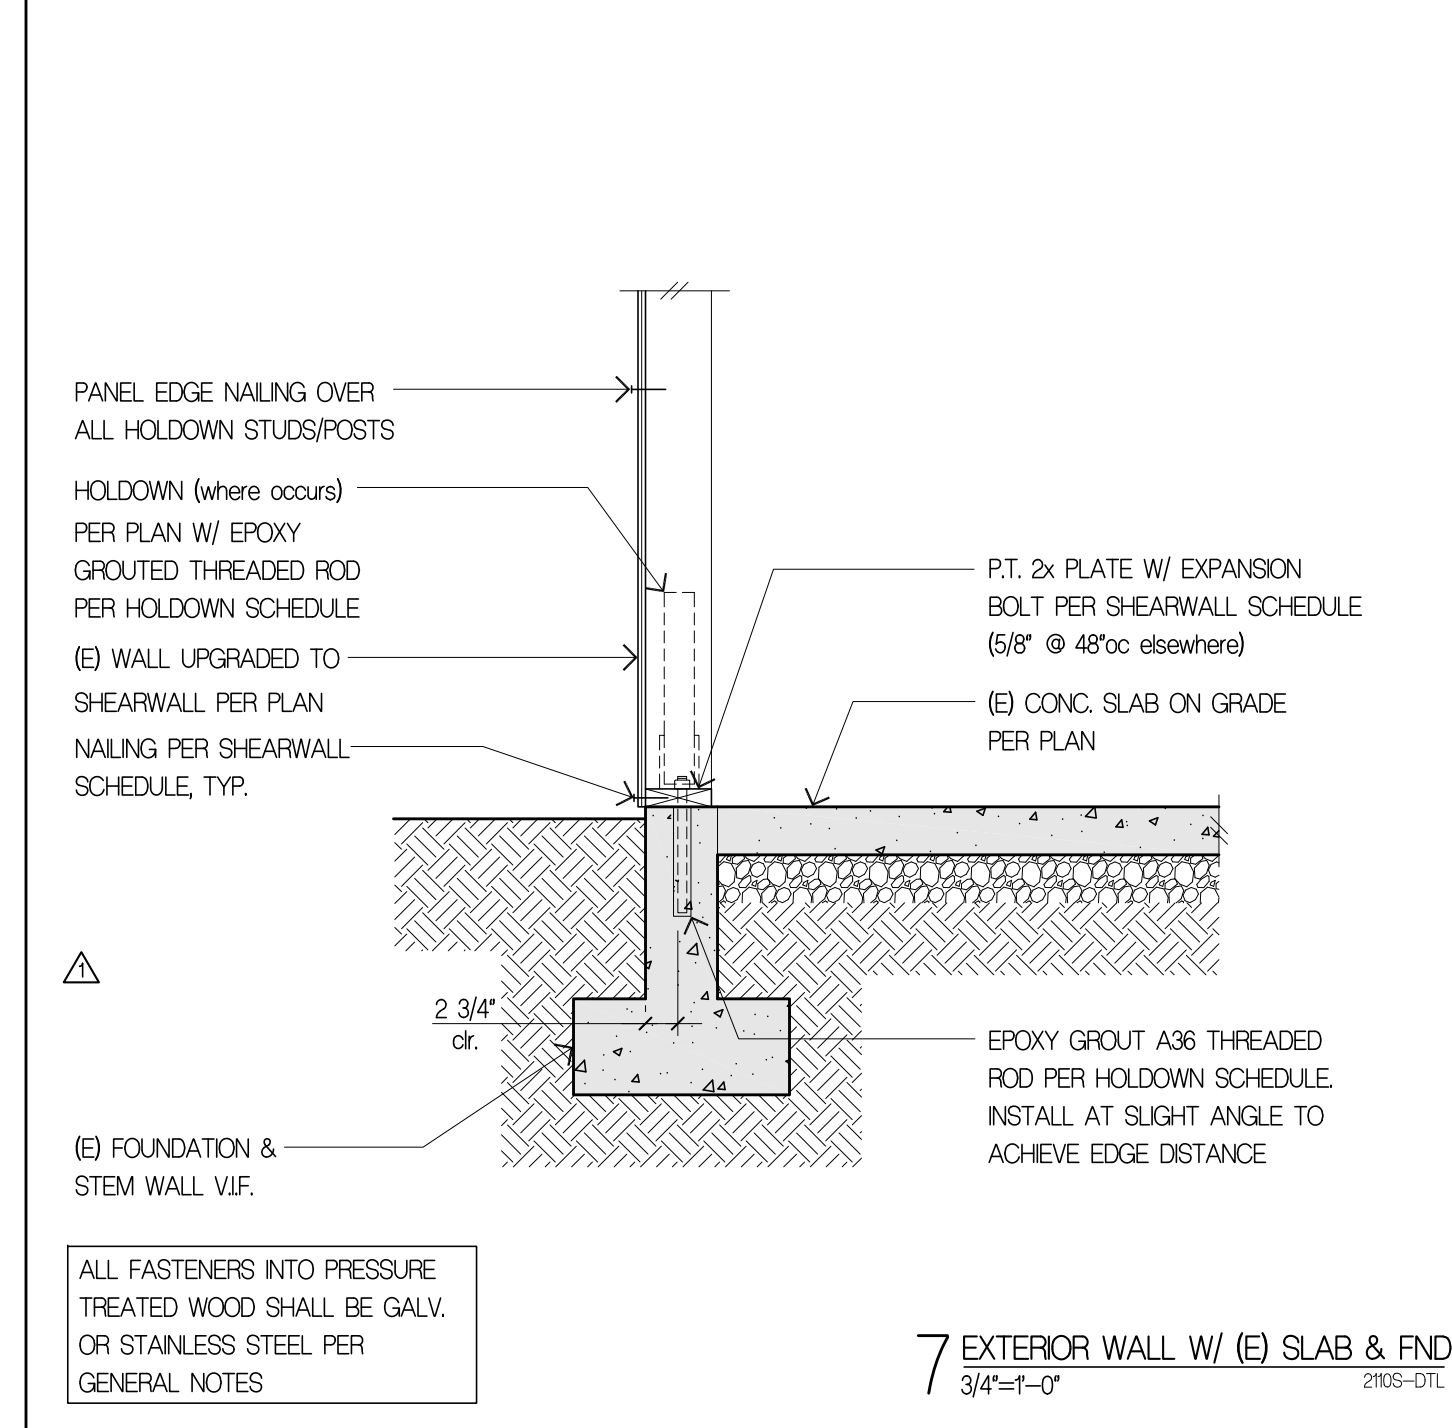


7 EXTERIOR WALL W/ (E) SLAB & FND
 3/4"-1'-0" 2105-DTL

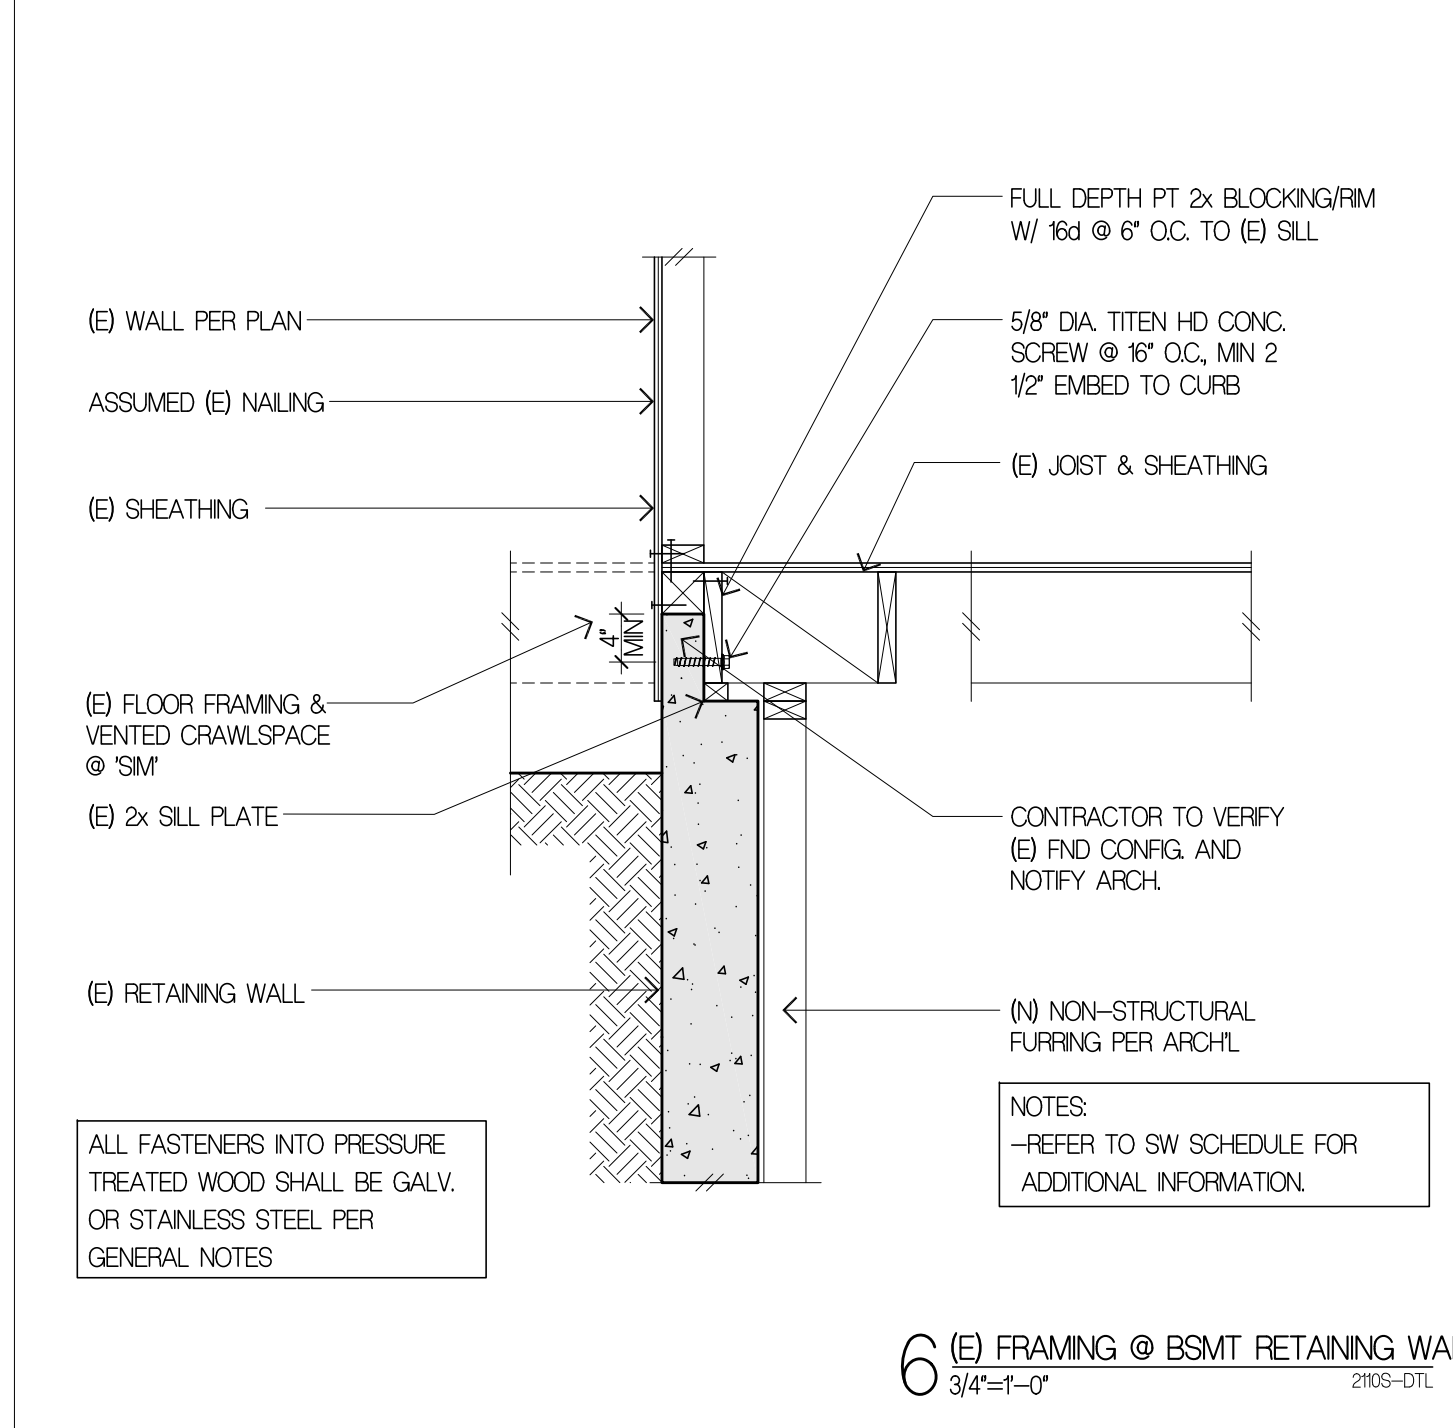


6 (E) FRAMING @ BSMT RETAINING WALL
 3/4"-1'-0" 2105-DTL

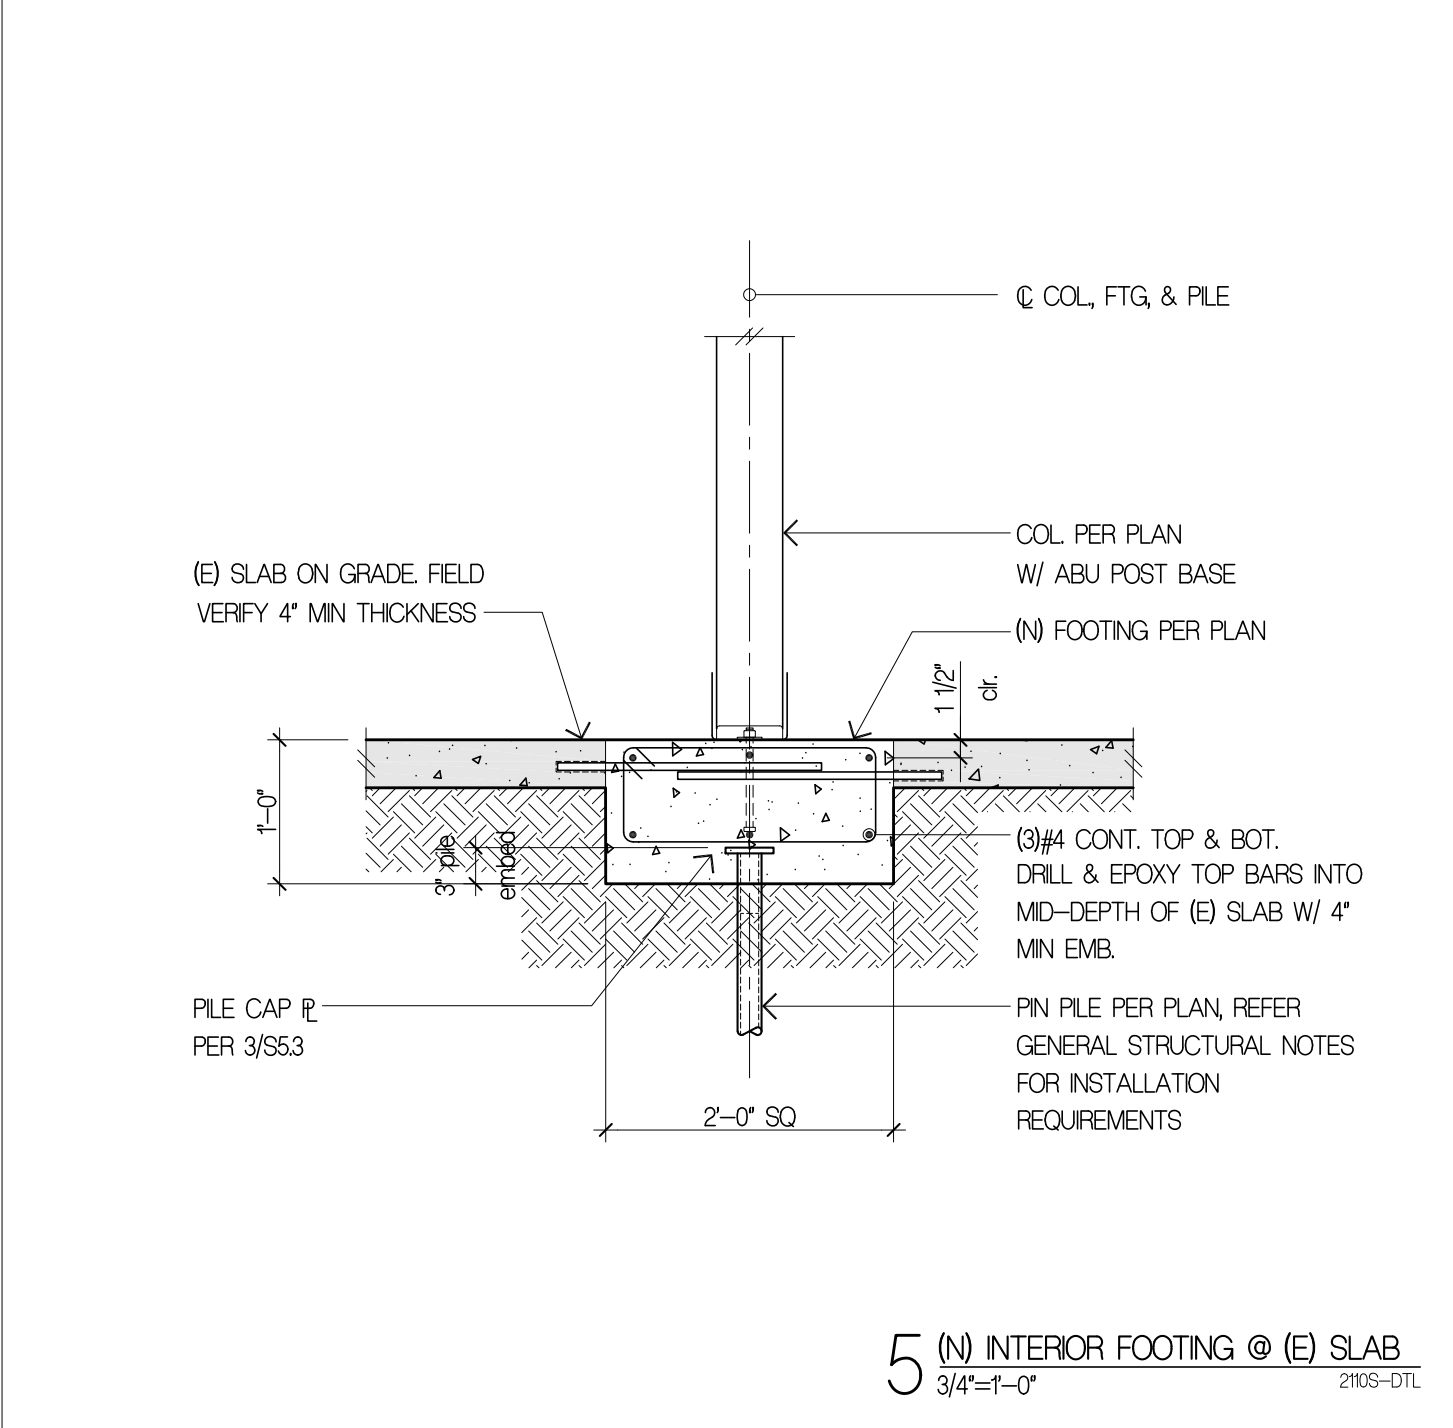

5 (N) INTERIOR FOOTING @ (E) SLAB
 3/4"-1'-0" 2105-DTL

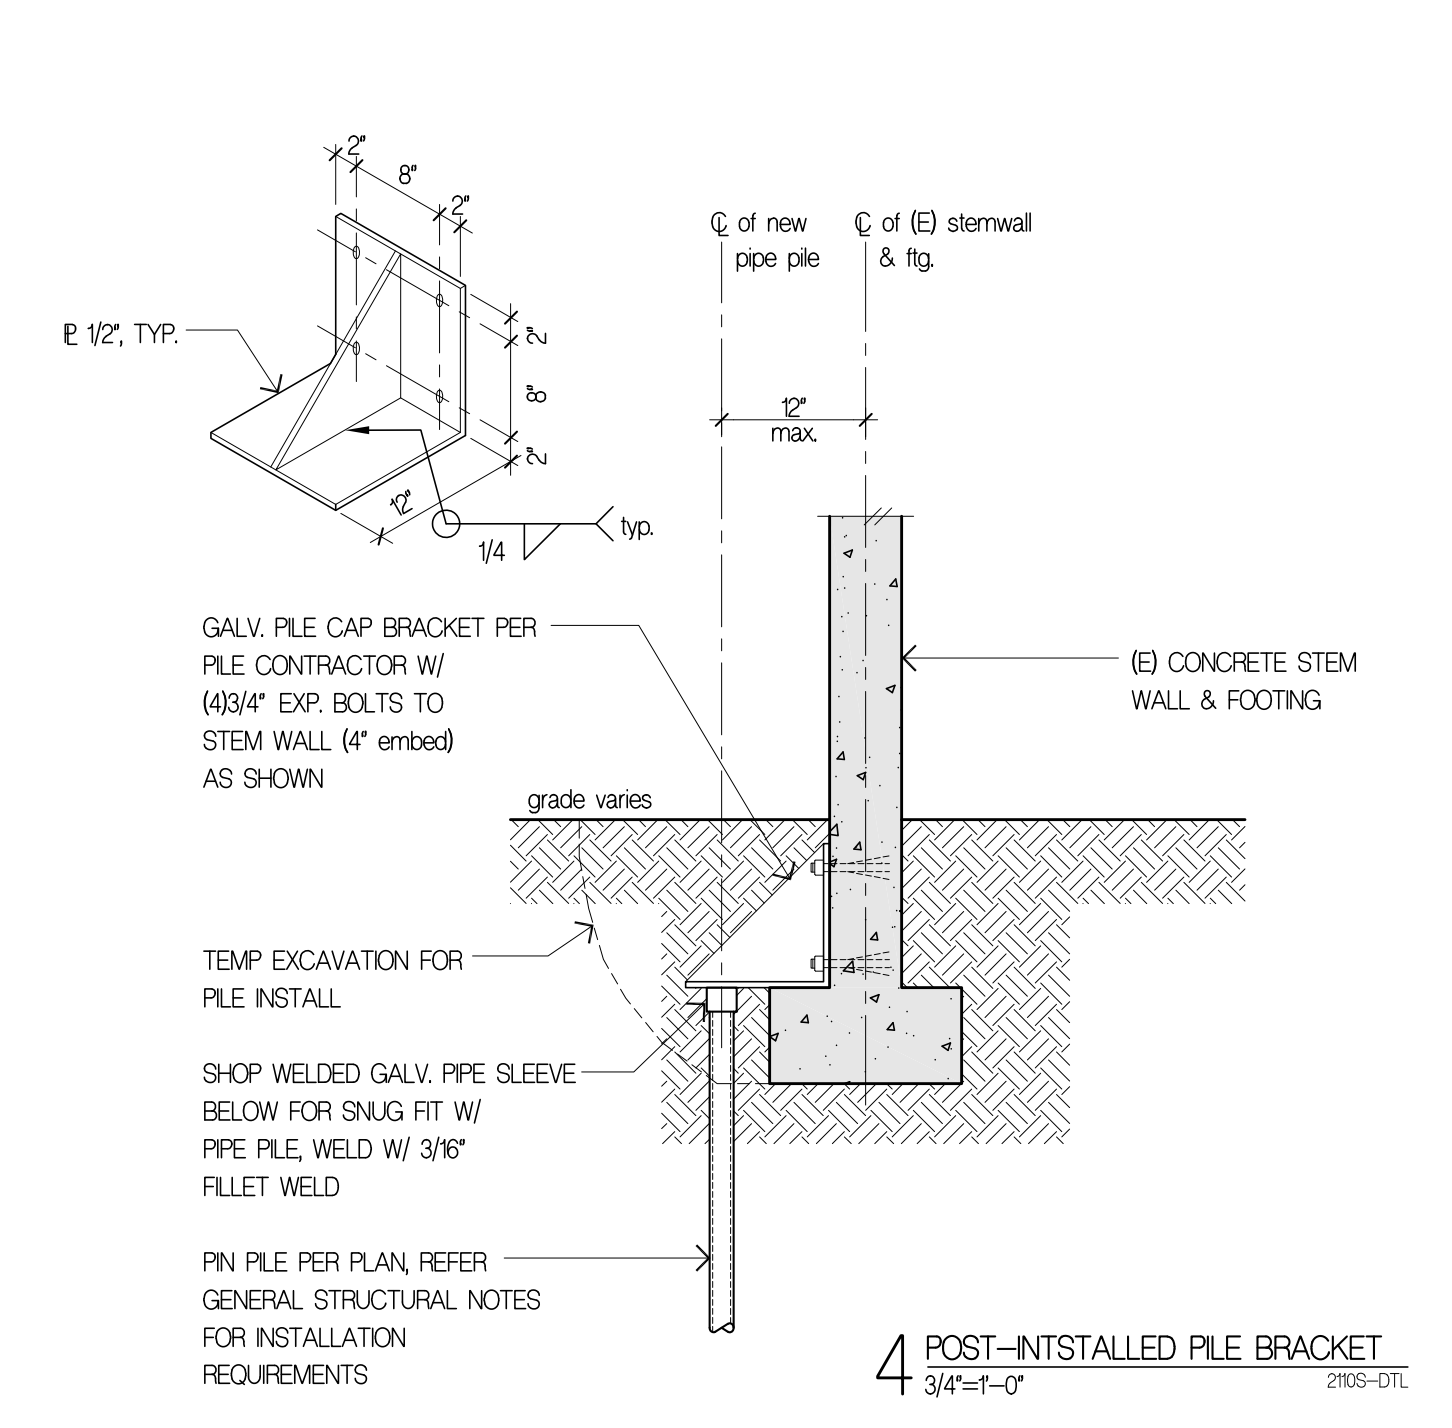


4 POST-INSTALLED PILE BRACKET
 3/4"-1'-0" 2105-DTL

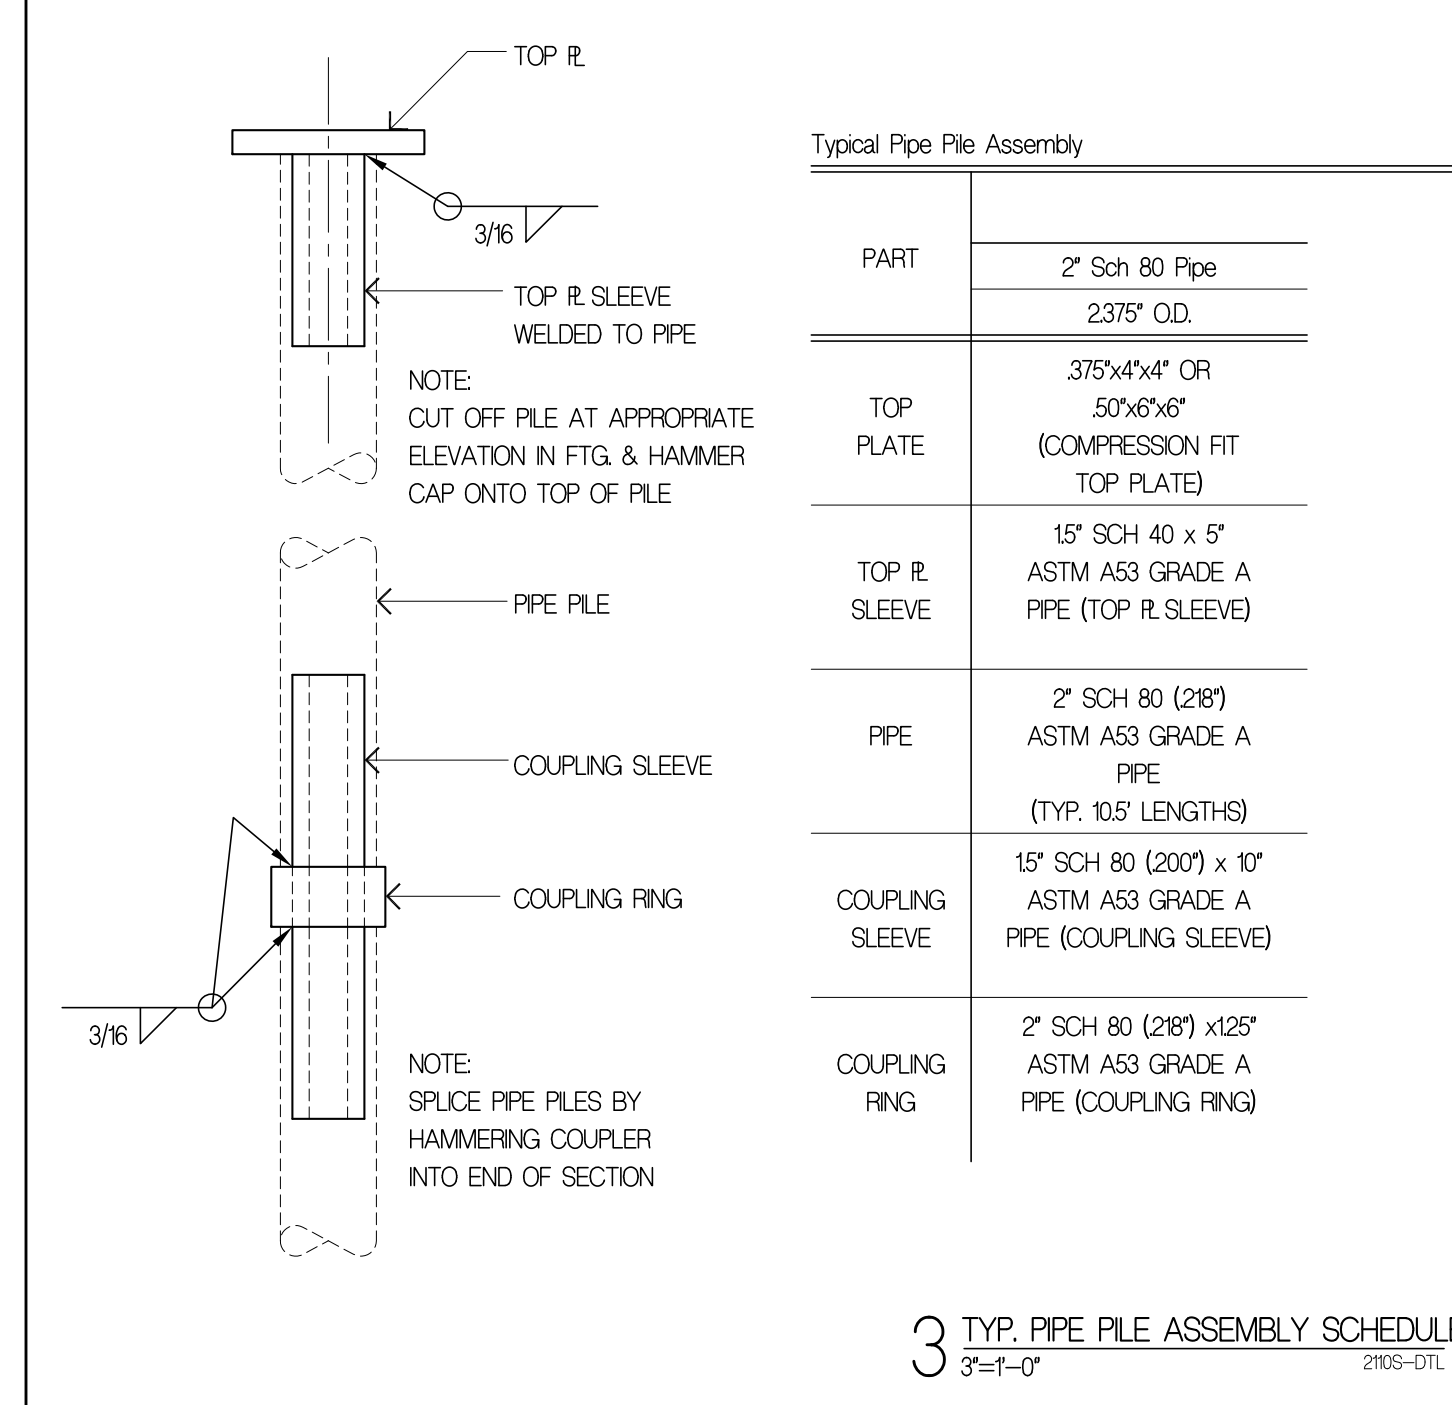

3 TYP. PIPE PILE ASSEMBLY SCHEDULE
 3'-1'-0" 2105-DTL




2 NOT USED
 3/4"-1'-0" 2105-DTL

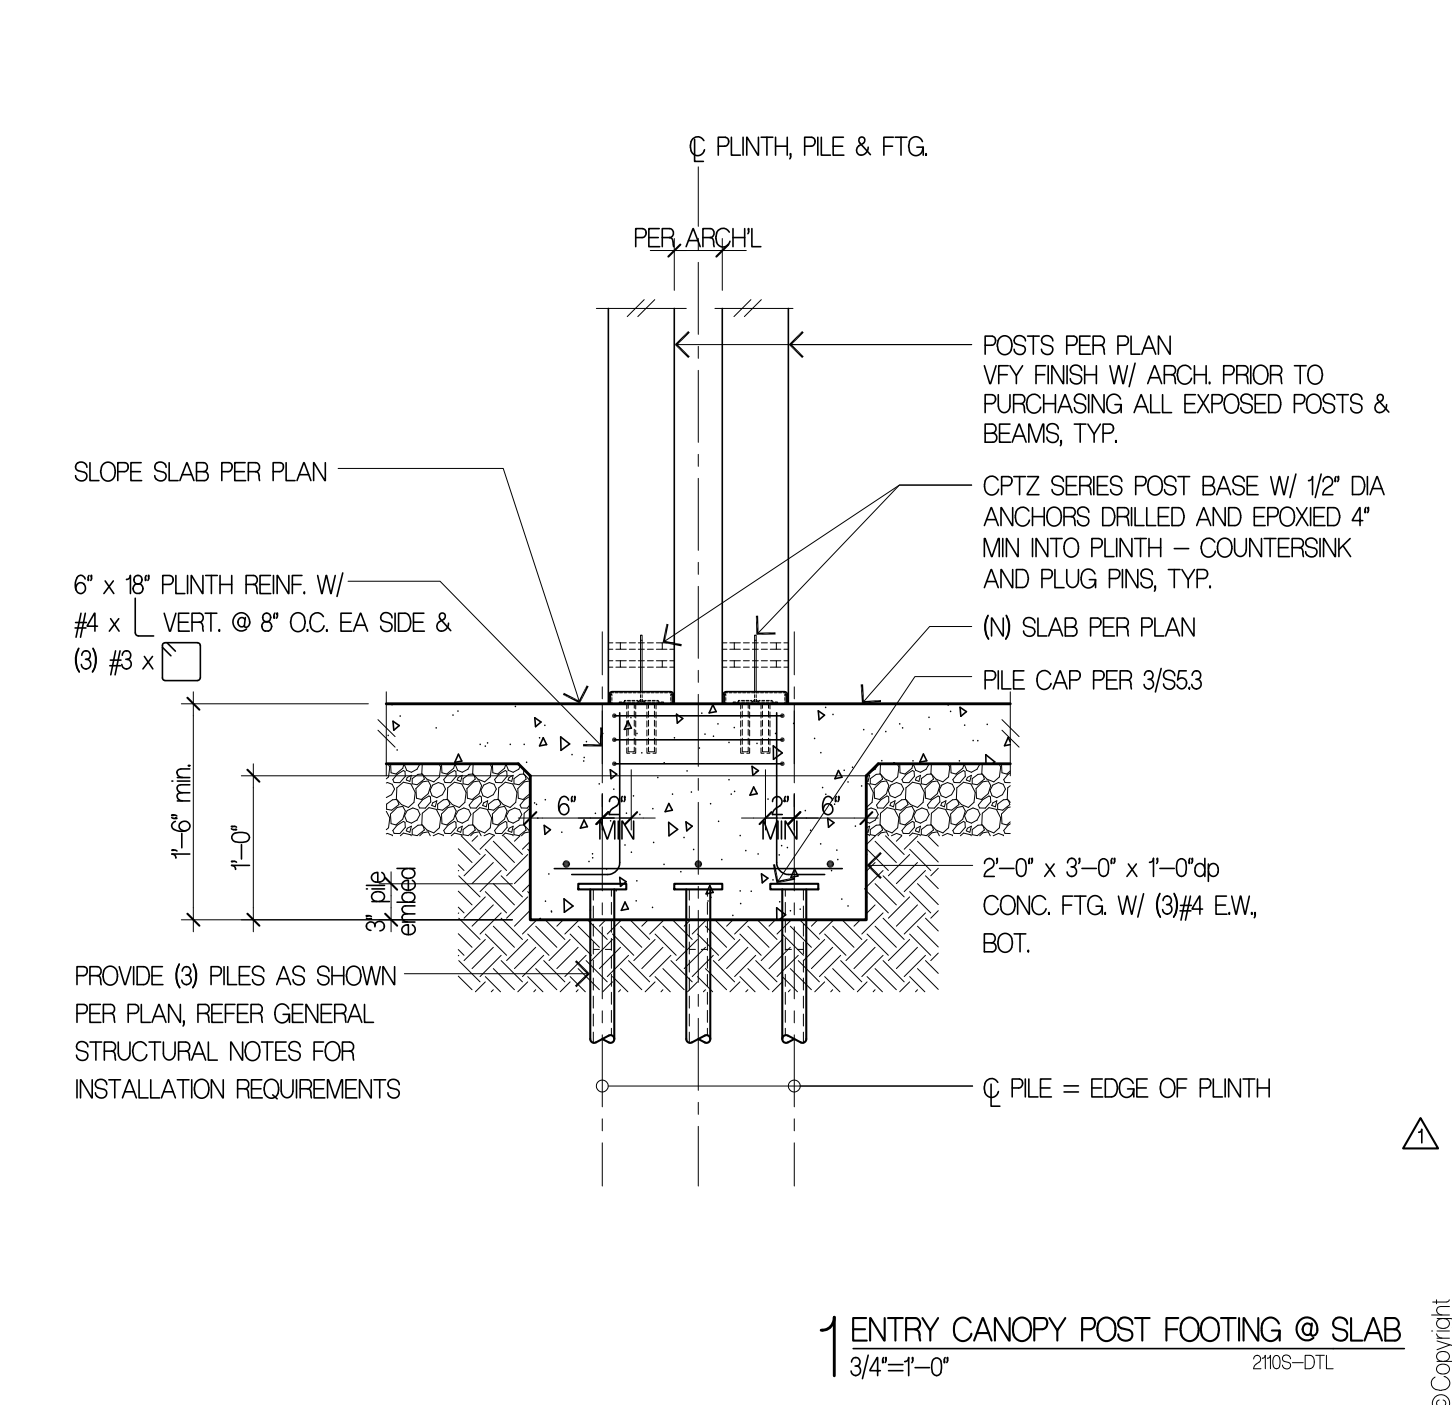

1 ENTRY CANOPY POST FOOTING @ SLAB
 3/4"-1'-0" 2105-DTL

Project Title
JAFFE RESIDENCE
 8455 SE 83RD STREET
 MERCER ISLAND, WA 98040

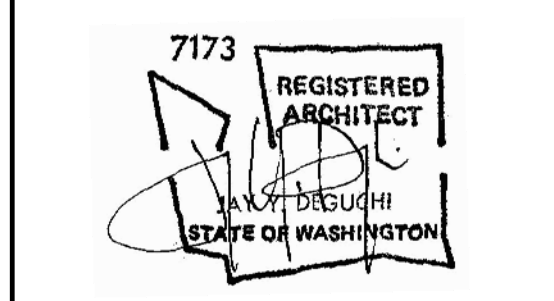

Drawing Title
STRUCTURAL DETAILS


Date
 08/08/2022
 Job No.
 210

ISSUE DATE
 PERMIT CORRECTIONS #1 03/31/2023
 PERMIT CORRECTIONS #2 05/31/2023

PERMIT CORRECTIONS
 Sheet No.

S5.3

Project Title
JAFFE RESIDENCE
 8455 SE 83RD STREET
 MERCER ISLAND, WA 98040

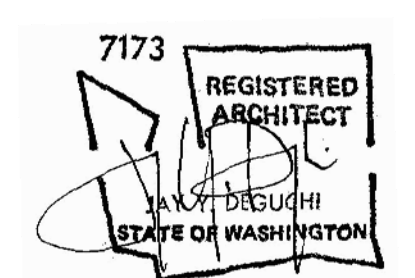


Drawing Title
STRUCTURAL DETAILS

Date
 08/08/2022
 Job No.
 210


ISSUE DATE
 PERMIT CORRECTIONS #1 03/31/2023
 PERMIT CORRECTIONS #2 05/31/2023

PERMIT CORRECTIONS
 Sheet No.


S5.4

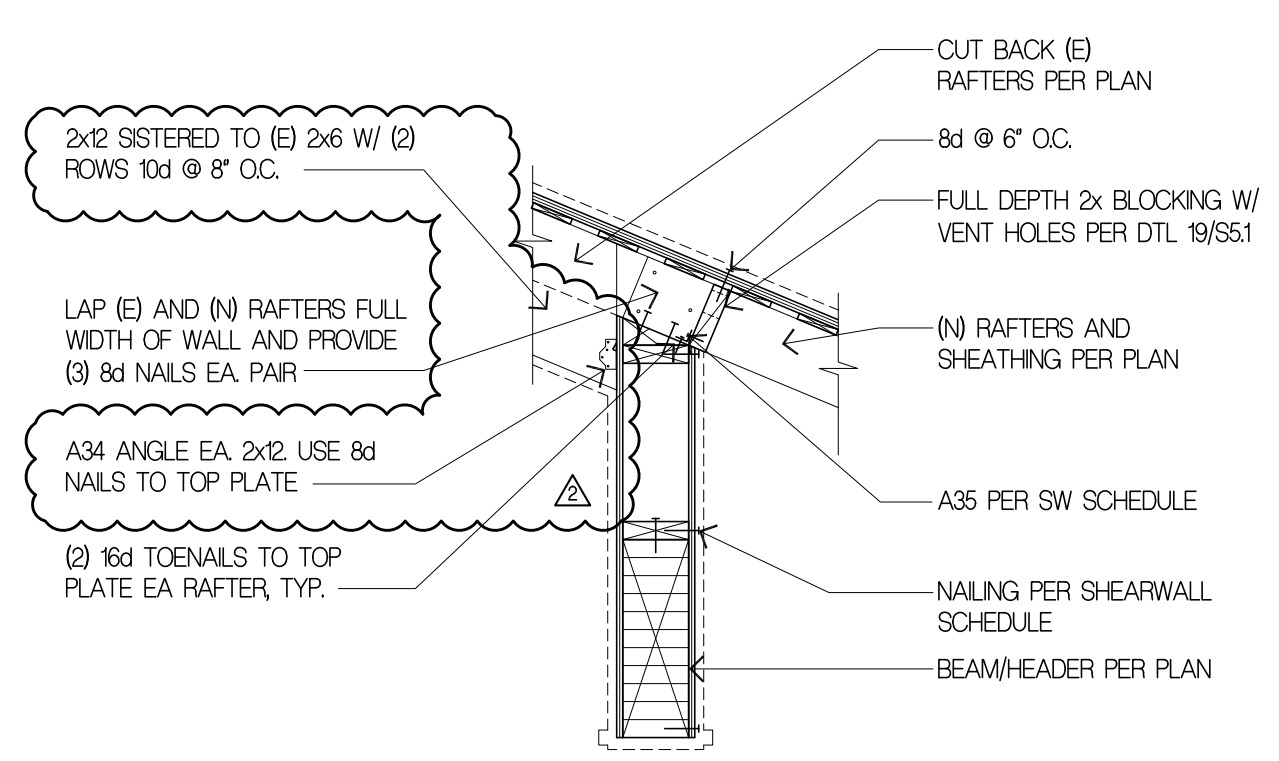


6 ROOF TRANSITION @ ENTRY CANOPY
 3/4"=1'-0" 2105-DTL

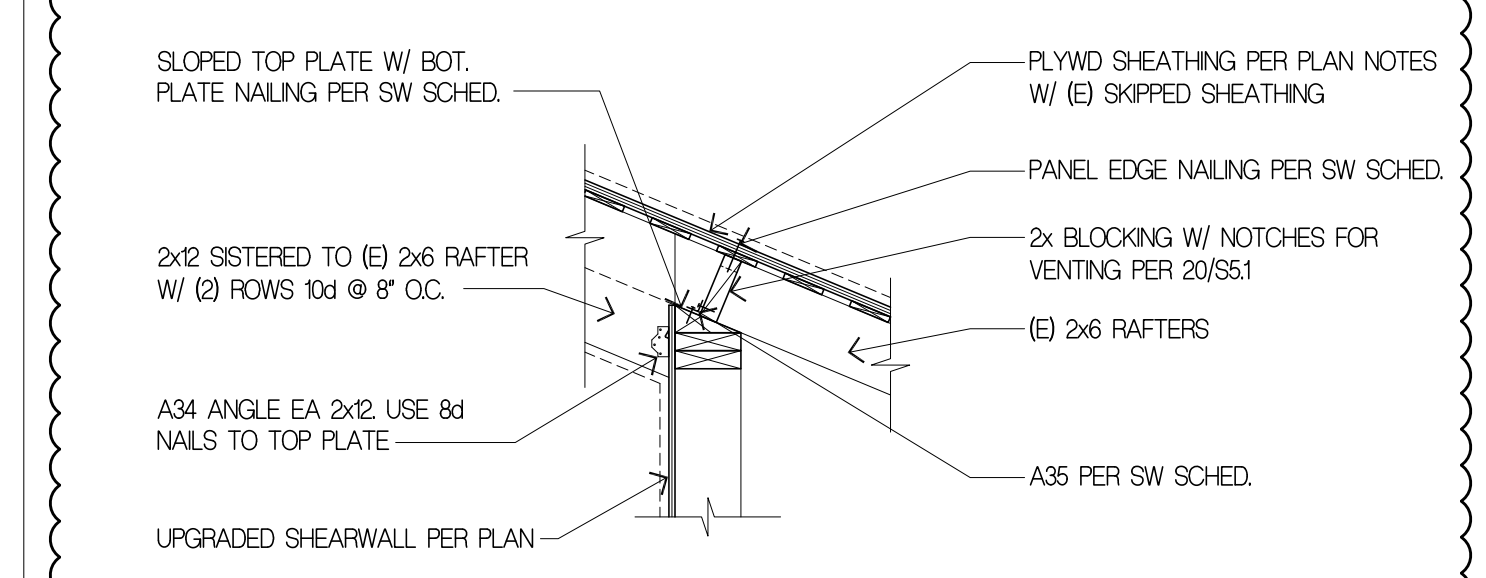


5 ROOF FRAMING @ INT. SW UPGRADE
 3/4"=1'-0" 2105-DTL

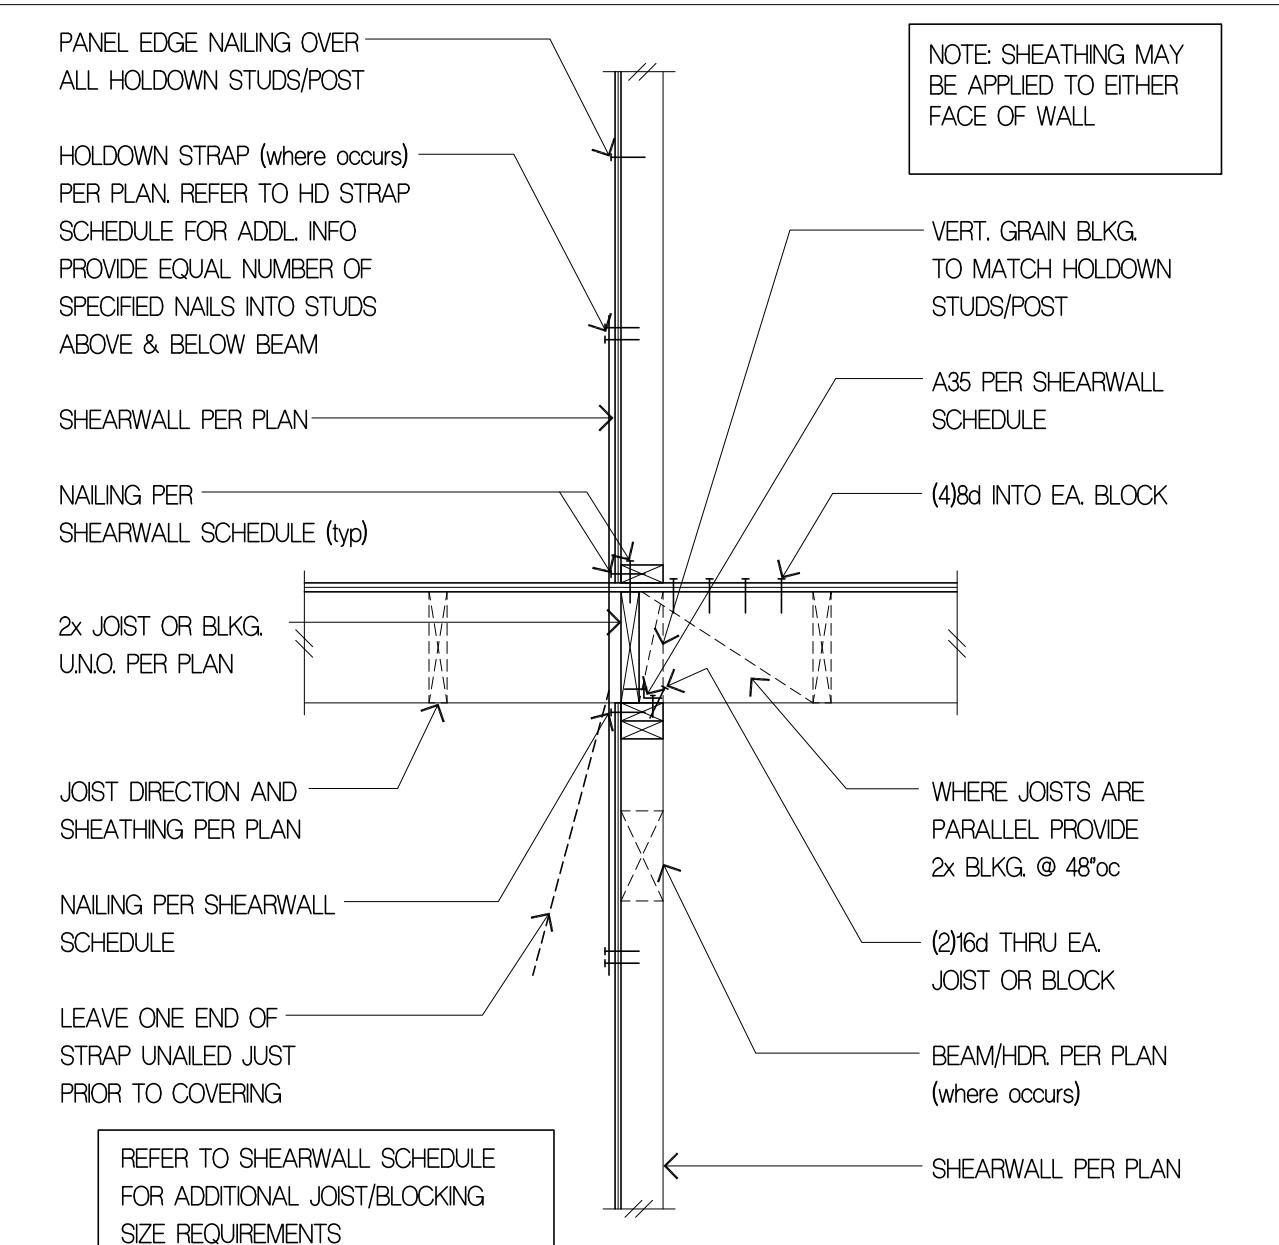


2 INTERIOR SHEARWALL
 3/4"=1'-0" 2105-DTL

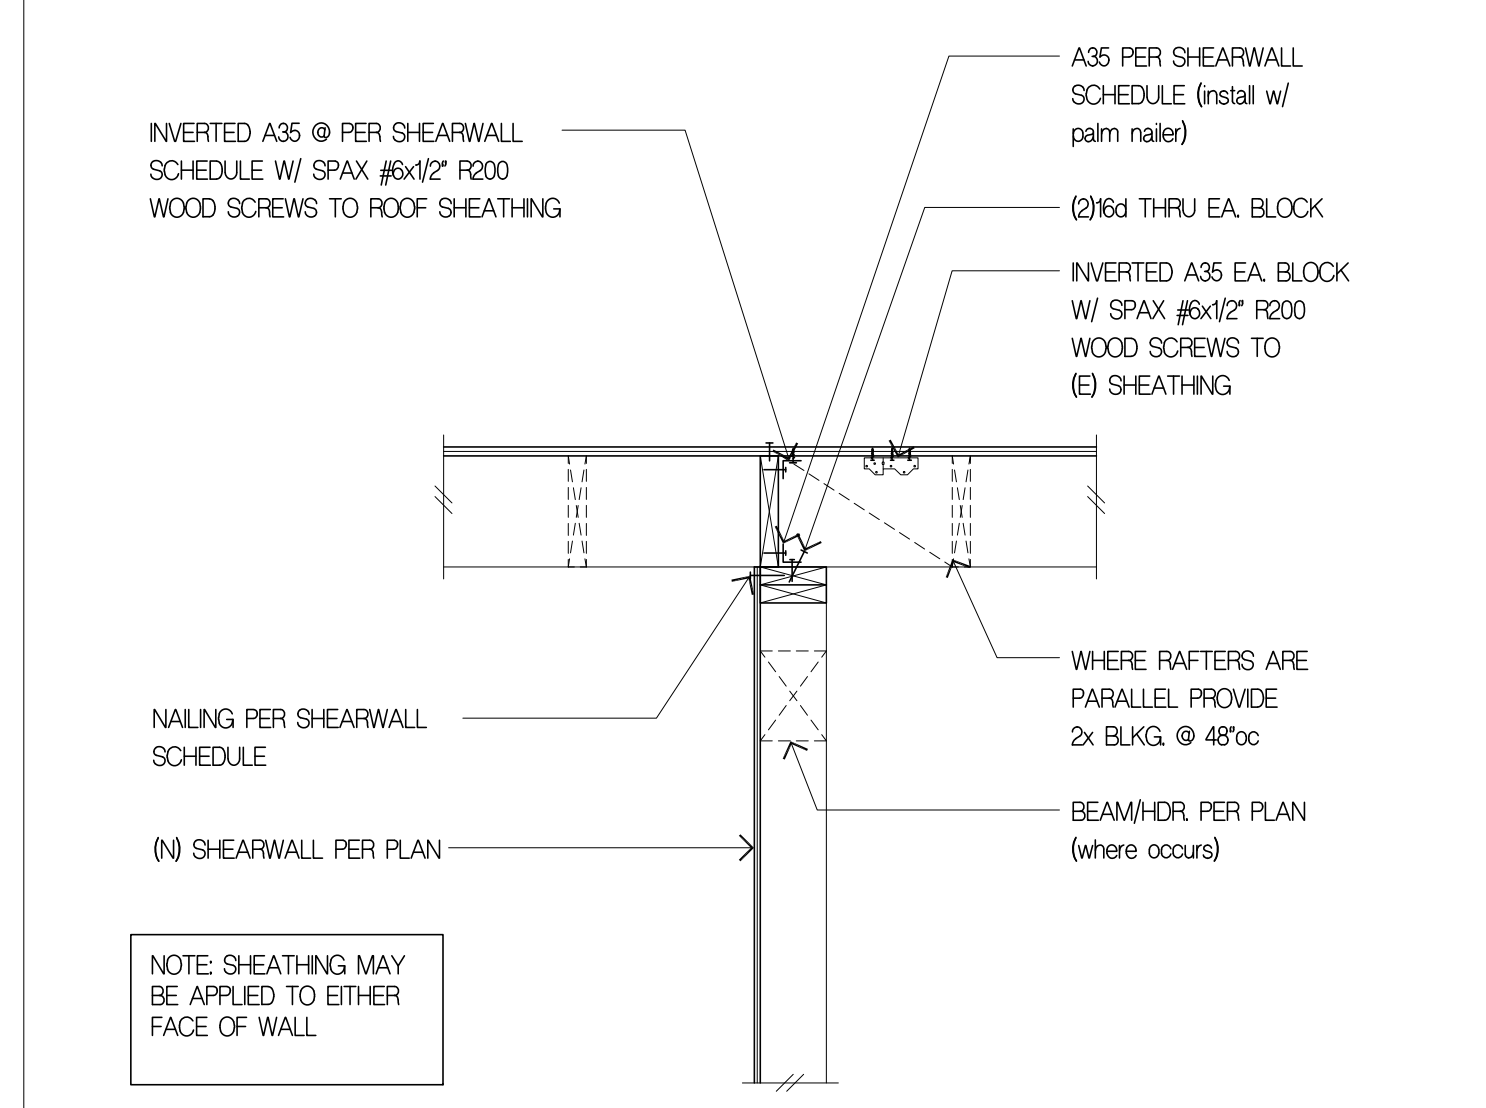

1 INTERIOR SW BELOW (E) ROOF
 3/4"=1'-0" 2105-DTL

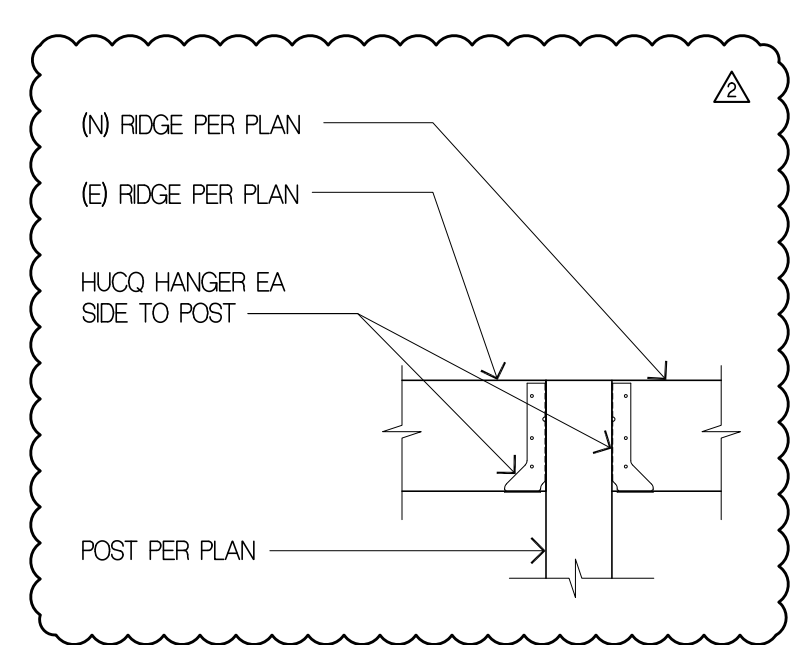

4 (N) TO (E) RIDGE CONNECTION
 3/4"=1'-0" 2105-DTL

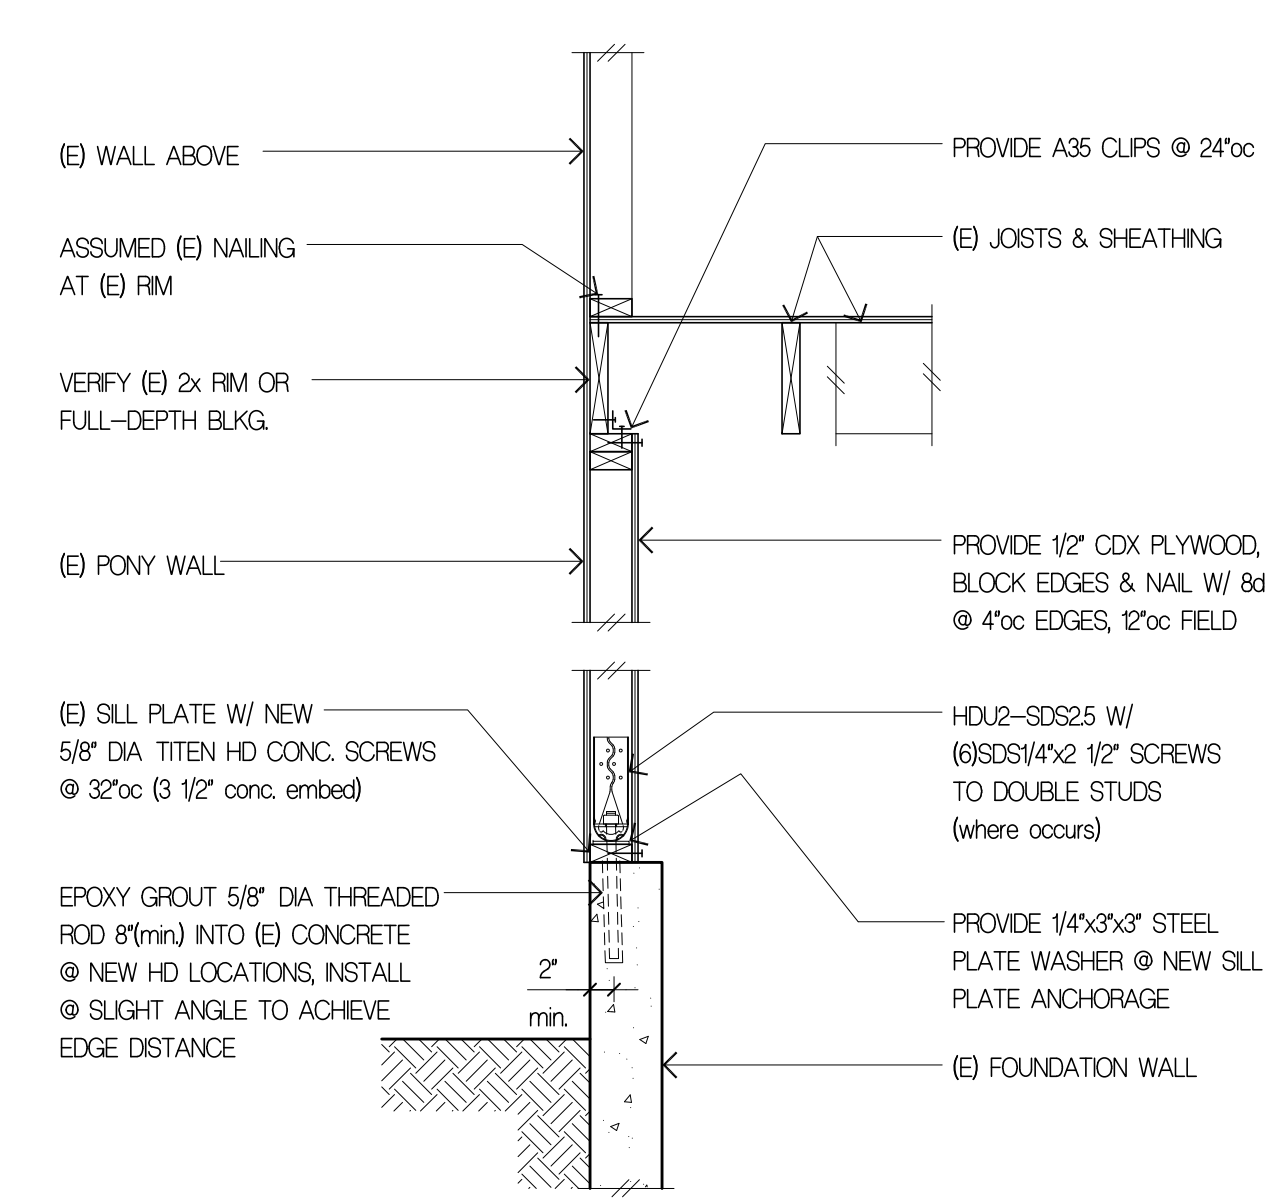

3 RETROFIT HOLDOWN DETAIL
 3/4"=1'-0" 2105-DTL