

4740 W. MERCER WAY

MERCER ISLAND, WA - 98040 - SPRING RESIDENCE

GENERAL INFORMATION
APPLIES FULL SET



7525 SE 24th St., 487
Mercer Island, WA
98040
425.266.9100

FLOOR PLAN GENERAL NOTES

GENERAL

- ALL ANGLED WALLS (OTHER THAN 90°) SHALL BE CONSTRUCTED AS NOTED BY ANGLE (DEGREES) CALLOUT OR CONFIGURED AS DIMENSIONED. (I.N.O.)
- ALL DIMENSIONS AT WALLS ARE TO THE FACE OF FRAMING STUDS.
- ALL EXTERIOR WALLS ENCLOSING CONDITIONED SPACE SHALL BE ADVANCED FRAMING w/2x6 STUDS AT 16" OC. and INTERIOR WALLS TO BE 2x4 STUDS AT 16" OC. per IRC, R602.3.2 (I.N.O.)
- ALL DIMENSIONS AT WINDOWS ARE TO THE CENTERLINE
- WINDOW SIZES NOTED ON PLANS ARE NOMINAL SO CONTRACTOR MUST VERIFY EXACT ROUGH OPENINGS PRIOR TO FRAMING. WINDOW and DOOR HEAD HEIGHTS SHOULD BE COORDINATED SO THAT ALL WINDOW and DOOR TRIMS ALIGN.
- PROVIDE WEATHER PROTECTION SYSTEM w/WATER-RESISTIVE BARRIERS IN COMBINATION w/FLASHINGS at EXT. WALLS, OPENINGS, PROJECTIONS, PENETRATIONS and INTERSECTIONS TO LOCK OUT ALL MOISTURE per IRC, R103.1-103.4
- TILE INSTALLATION SHALL COMPLY w/APPLICABLE SECTIONS OF THE TILE COUNCIL OF AMERICA'S "HANDBOOK FOR CERAMIC TILE INSTALLATION" and ITS REFERENCED STANDARDS including IRC, R102.4.1
- ALL COUNTERS, TUB DECKS & WALLS AT TUBS & SHOWERS SHALL HAVE SMOOTH, HARD, NON-ABSORBENT w/CEMENTITIOUS BACKER BOARD and MOISTURE RESISTANT UNDERLAYMENT per IRC, R102.4.2 UNDERLAYMENT AT TUB & SHOWER WALLS SHALL BE TO A HEIGHT OF +12" MIN. ABOVE DRAIN INLET per IRC, R301.2
- ALL SHOWERS TO COMPLY w/IRC, P2100.1 through P2100.5 ALL SHOWER RECEPTORS TO COMPLY w/IRC, P2104.1 through P2104.4
- CALCULATIONS AND DETAILS FOR MOUNTING HEIGHTS & CONNECTION OF METAL GUARDRAILS (IF USED) SHALL BE PROVIDED FOR REVIEW AND APPROVAL BY RAILING FABRICATOR PRIOR TO INSTALLATION FOR COMPLIANCE w/IRC, R311.1 & R312
- ALL REQUIREMENTS FOR BUILDING ENVELOPE TO COMPLY WITH THE 2015 WASHINGTON STATE ENERGY CODE (WSEC). SEE REQ'D ENERGY CREDITS ON THIS SHEET ALONG w/SHEETS A11 & A12 FOR PRESCRIPTIVE REQUIREMENTS and COMPLIANCE NOTES FOR SINGLE FAMILY RESIDENTIAL IN CLIMATE ZONE 5 and MARINE 4.
- WSEC COMPLIANCE CERTIFICATE REQUIRED WITHIN 3' OF ELECTRICAL PANEL.
- EXHAUST FANS LARGER THAN 50cfm. MAY BE CONNECTED TO 4" SMOOTH WALL VENT PIPE IF RUNS DO NOT EXCEED 20' IN LENGTH, THE MINIMUM SIZE OF FLEX DUCT IS 5" DIAMETER WITH MAXIMUM RUN OF 15'.
- COMBUSTION AIR REQUIRED FOR ALL FUEL BURNING APPLIANCES. ALL INTAKE SOURCES TO BE MIN. 18" ABV. GARAGE FLOOR per IRC, M301.3
- PROVIDE FIREBLOCKING TO CUT OFF DRAFT OPENINGS AT LOCATIONS w/MATERIALS per IRC, R302.11 PROVIDE DRAFTSTOPPING AT FLOOR/CEILING ASSEMBLIES per IRC, R302.12
- ALL WASTE PLUMBING DROPS TO BE ON INTERIOR WALLS or FURRED OUT EXTERIOR WALLS.
- PROVIDE ACOUSTICAL PIPE WRAP AT ALL UPPER LEVEL WASTE LINES
- ALL OPENINGS MADE IN WALLS, FLOORS or CEILINGSS FOR THE PASSAGE OF PIPES, STRAINER PLATES ON DRAIN INLETS, TUB WASTE OPENINGS TO CRAWLSPACE and METER BOXES TO COMPLY w/THE CODE REQUIREMENTS OF THE GOVERNING UPC.
- ENTRY STEPS SHALL HAVE SUFFICIENT GRADE BUILT UP AROUND THEM SO THE NUMBER OF STAIR RISERS DOES NOT EXCEED 3, w/MAX. RISER HEIGHT OF 7 7/8" - NOT REQUIRING A HANDRAIL per IRC, R311.1.8
- ALL EXTERIOR HOSE BIBS TO HAVE NON-REMOVABLE VACUUM BREAKERS, MUST BE FROSTPROOF and BE CAULKED and SECURED AT EXT. WALLS.
- INTERIOR CEILING HEIGHTS ARE AS FOLLOWS:
MAIN FLOOR 10'-0" (I.N.O.)
UPPER FLOOR 9'-1 1/8" (I.N.O.)

SAFETY GLAZING

SAFETY GLAZING INSTALLED IN HAZARDOUS LOCATIONS AS REQUIRED BY THIS SECTION SHALL HAVE MFG'S DESIGNATION w/TYPE, THICKNESS and SAFETY GLAZING STANDARD w/WHICH IT COMPLIES MARKED BY PERMANENT MEANS THAT CANNOT BE REMOVED WITHOUT DESTROYING GLASS per IRC, R308.1

IRC, R308.4 REQUIRES THAT SAFETY GLAZING TO BE INSTALLED IN ALL HAZARDOUS LOCATIONS per DEFINED REQUIREMENTS and EXCEPTIONS SPECIFIED IN IRC, R308.4.1 through R308.4.7

- GLAZING IN DOORS.
- GLAZING ADJACENT TO DOORS.
- GLAZING IN WINDOWS MEETING ALL (4) CONDITIONS LISTED.
- GLAZING IN GUARDS and RAILINGS
- GLAZING IN and NEAR NET SURFACES.
- GLAZING ADJACENT TO STAIRS and RAMPS
- GLAZING ADJACENT TO THE BOTTOM STAIR LANDING.

SKYLIGHTS and SLOPED GLAZING SHALL COMPLY WITH THE MATERIALS and REQUIREMENTS OF IRC, R308.6.1 through R308.6.4

EGRESS WINDOWS

WINDOWS PROVIDING EMERGENCY ESCAPE and RESCUE OPENING REQUIRED AT BASEMENTS, HABITABLE ATTICS and ALL SLEEPING ROOMS and SHALL OPEN DIRECTLY INTO A PUBLIC WAY or YARD TO SAME per IRC, R310.1

- WINDOW CANNOT REQUIRE KEYS, TOOLS or SPECIAL KNOWLEDGE TO OPEN per IRC, R310.1.1
- MUST HAVE AN OPENING AREA OF NOT LESS THAN 5.7 Sq.Ft. with 20" min. WIDTH and 24" min. HEIGHT per IRC, R312.2.1
- MUST HAVE A SILL HEIGHT OF NOT MORE THAN 44" ABV. FLOOR per IRC, R310.2.2
- GUARDS MUST BE PROVIDED AS WINDOW FALL PROTECTION AT LOW WINDOWS LOCATED GREATER THAN 12" ABV. FINISHED GRADE per IRC, R312.2

STAIRWAYS PROVIDING EGRESS FROM HABITABLE LEVELS NOT PROVIDED w/EGRESS DOOR per IRC, R311.2 SHALL MEET THE REQUIREMENTS and EXCEPTIONS OF IRC, R311.1.1 through R311.1.4 INCLUDING:

STAIRS and HANDRAILS

SHALL PROVIDE A MIN. CLEAR WIDTH OF 36" ABOVE HANDRAIL w/MAX. HANDRAIL PROJECTION INTO STAIRWAY OF 4 1/2" ON EITHER SIDE per R311.1.1

SHALL PROVIDE A MIN. HEADROOM OF 6'-8" MEASURED VERTICALLY FROM THE NOSE OF TREADS or LANDINGS per R311.1.2

SHALL HAVE A VERTICAL RISE GREATER THAN 14" BTWN. FLOOR LEVELS or LANDINGS per R311.1.3

SHALL MEET THE WALKLINE REQUIREMENTS AT WINDER TREADS per R311.1.4

SHALL HAVE A MAX. RISER HEIGHT OF 7 7/8" and HAVE A MIN. TREAD DEPTH OF 10" THE GREATEST DIMENSION OF ANY RISER or TREAD MUST NOT EXCEED THE SMALLEST DIMENSION BY MORE THAN 3/8". TREADS LESS THAN 11" SHALL MEET NOSING REQUIREMENTS. THE OPENINGS AT OPEN RISERS SHALL NOT PERMIT THE PASSAGE OF A 4"ø SPHERE per R311.5.1 through R311.5.4

LANDINGS AT TOP and BOTTOM OF STAIRS SHALL MEET THE REQUIREMENTS OF R311.7.6

THE WALKING SURFACE OF TREADS and LANDINGS SHALL NOT BE SLOPED MORE THAN 2% PER R311.7.7

HANDRAILS SHALL BE PROVIDED ON AT LEAST ONE SIDE OF EACH CONTINUOUS RUN OF TREADS w/(4) or MORE RISERS. THE TOP OF HANDRAIL SHALL BE 34-38" ABV. LINE CONNECTING NOSINGS. HAVE MIN. 1 1/2" SPACE BETWN. RAIL and WALL. HANDRAIL MUST RUN CONTINUOUS FOR FULL LENGTH OF EACH FLIGHT and MEET APPROVED GRIP-SIZE per IRC, R311.7.8

SHALL BE PROVIDED w/ILLUMINATION per IRC, R303.7 AT INTERIOR STAIRWAYS and R303.8 at EXTERIOR STAIRWAYS.

GUARDS

GUARDS SHALL BE PROVIDED IN ACCORDANCE w/REQUIREMENTS and EXCEPTIONS OF IRC, R312.1 through R312.2 INCLUDING:

ALONG OPEN-SIDED WALKING SURFACES, INCLUDING STAIRS, RAMPS and LANDINGS LOCATED 30" or GREATER ABOVE ADJACENT FLOOR LEVEL per IRC, R312.1.1

OPENINGS MUST PREVENT THE PASSAGE OF A 4" SPHERE or 4 1/8" AT OPEN SIDES OF STAIRS or 6" AT TRIANGLE OF TREAD, RISER & BOTTOM RAIL per R312.1.3

GUARDS MUST BE PROVIDED AS WINDOW FALL PROTECTION AT LOW WINDOWS LOCATED GREATER THAN 12" ABV. FINISHED GRADE per IRC, R312.2

GUARDS and HANDRAILS MUST RESIST A SINGLE CONCENTRATED LOAD OF 200lbs. IN ANY DIRECTION ALONG THE TOP and GUARD INFILL MUST RESIST A 50lb. LOAD APPLIED HORIZ. OVER 1 Sq.Ft. per IRC, TABLE R301.5

ALARMS

SMOKE ALARMS and CARBON MONOXIDE ALARMS REQUIRED IN ALL NEW DWELLINGS SHALL MEET REQUIREMENTS and EXCEPTIONS OF NFPA 72, IRC, R314 and R315.

SMOKE ALARMS TO BE LISTED and INSTALLED IN ACCORDANCE w/IRC, R314.1.1 and CARBON MONOXIDE ALARMS IN ACCORDANCE w/IRC, R315.1.1

SMOKE ALARMS SHALL BE INSTALLED IN FOLLOWING LOCATIONS per R314.3.1:

- IN EACH SLEEPING ROOM.
- OUTSIDE EACH SEPARATE SLEEPING AREA.
- ON EACH STORY OF THE DWELLINGS.
- NOT LESS THAN 3' FROM A BATHROOM w/TUB or SHOWER.
- NOT NEAR COOKING APPLIANCES per R314.3.1

SMOKE ALARMS SHALL BE INTERCONNECTED per R314.4

CARBON MONOXIDE ALARMS SHALL BE INSTALLED IN THE FOLLOWING LOCATIONS per R315.3.1:

- ON EACH STORY OF THE DWELLINGS
- ADJACENT TO EACH SEPARATE SLEEPING AREA.
- WITHIN BEDROOMS WHERE A FUEL BURNING FIREPLACE IS LOCATED IN THE ROOM or ITS ATTACHED BATH.

ALL ALARMS SHALL RECEIVE THEIR PRIMARY POWER FROM BUILDING WIRING w/BATTERY BACKUP per R314.6 and R315.5

COMBINATION SMOKE and CARBON MONOXIDE

A NFPA 13R FIRE SPRINKLER SYSTEM INSTALLED PER CoMI and NFPA 13R STANDARDS IS REQUIRED. THIS WILL REQUIRE A 1.5" METER AND 2" SUPPLY LINE.

ALARMS SHALL BE PERMITTED IN LIEU OF SEPARATE ALARMS per R314.5 and R315.4
FIRE PROTECTION

ABBREVIATIONS

# Pound OR Number	ELEC Electrical	MC Medicine Cabinet	SLB Slab
& And	ELEV Elevation	MDO Medium Density	SPEC Specification
@ At	EQ Equal	OV Overlay	SQ Square
A/C Air Conditioner	EW Each Way	MECH Mechanical	SQ IN Square inches
AB Anchor Bolt	EXC Excavate	MED Medium	SQFT Square feet
ABV Above	EXH Exhaust	MEMB Membrane	STC Sound Transmission
AD Area Drain	EXIST Existing	MFR Manufacturer	Coefficient
ADL Additional	EXT Exterior	MIN Minimum	STD Standard
ADH Adhesive	FBD Fiberboard	MIR Mirror	STL Steel
ADJ Adjustable	FCB Fiber Cement Board	MISC Miscellaneous	STR Structural
AFF Above Finish Floor	FCC Floor clean out	MLB Micro Laminate Beam	STRUCT Structure or
AGG Aggregate	FD Floor drain	MMB Membrane	Structural
ALT Alternate	FLR Floor	NO #	SY Square yard
ALUM Aluminum	FLX Flashing	NO Number	T Tread
ANC Anchor	FND Foundation	NOM Nominal	T&O Tongue and Groove
APX Approximate	FO Face Of	NTS Not to Scale	TEL Telephone
ASPH Asphalt	FOC Face of Concrete	O Non-Operable Window	TEMP Tempered
AUTO Automatic	FOM Face of Masonry	OB Section	TK Tight Knot
AVR Average	FOS Face of Studs	OBS Obscure	T&M To Match Existing
AWG American Wire Gauge	FOW Face of Wall	OD Outside Diameter	TO Top Of
AWN Awning	FPL Fireplace	OH Overhang	TOB Top of Beam
B/O By Others	FRM Frame(ing)	OP Opening or	TOC Top of curb / Top of
BJ Board	FRFF Fireproof	OPG Opening	Concrete
BLDG Building	FT Fast	OSB Oriented Strand	TP Toilet Paper Hanger
BLK Blocking	FTG Footing	Board	TYP Typical
BLW Below	FUR Furred	PBD Particle Board	UNO Unless Noted
BM Beam	GA Gauge	PBF Prefabricated	Otherwise
BOF Bottom of footing	GALV Galvanized	PERF Perforate(d)	VB Vapor barrier
BOT Bottom	GFCI Ground Fault Circuit	Interrupt	VERT Vertical
BOW Bottom of wall	INT Interrupt	QFI Ground Fault	W/F With
BR Bedroom	INT Interrupt	PL Property Line	W/O Without
BMT Basement	INT Interrupt	PLAM Plastic Laminate	WC Toilet (water closet)
BTW Between	INT Interrupt	PLT Plate	WD Wood
BYND Beyond	INT Interrupt	PLYWD Plywood	WH Window
CAB Cabinet	INT Interrupt	PNT Paint or Painted	WH Water Heater
CAS Casement	INT Interrupt	PSF Pounds Per Square	WC Walk-in Closet
CS Catch Basin	INT Interrupt	PSI Pounds Per Square	WP Water Proofing
CV Venting	INT Interrupt	INCH Inch	WR Weatherproof
CC Center to Center	INT Interrupt	INCL Include	WR Weather Resistant
CCP cast-in-place	INT Interrupt	INS Insulate(ion)	WRB Weather Resistive
CJ Control Joint	INT Interrupt	INSUL Insulation	Barrier
CL Centerline	INT Interrupt	INT Interior	WWF Welded Wire Fabric
CLG Ceiling	INT Interrupt	J-Box Junction box	X Operable Window
CLR Clear	INT Interrupt	INT Joint	Section
CMU Concrete Masonry	INT Interrupt	KIT Kitchen	
CO Clean Out	INT Interrupt	LAM Laminated(d)	
COL Column	INT Interrupt	LAV Lavatory	
CONC Concrete	INT Interrupt	LB Pound	
CONT Continuous	INT Interrupt	LF Lineal Feet	
CRPT Carpet	INT Interrupt	LL Live Load	
CT Ceramic Tile	INT Interrupt	LT Light	
CTYD Courtyard	INT Interrupt	LV Laminated Veneer	
CU FT Cubic Feet	INT Interrupt	LVR Louver	
CU YD Cubic Yard	INT Interrupt	MAS Masonry	
DBL Double	INT Interrupt	MAX Maximum	
DEMO Demolish or	INT Interrupt	MBR Member	
Demolition	INT Interrupt		
DH Double Hung	INT Interrupt		
DIA Diameter	INT Interrupt		
DM Dimension	INT Interrupt		
DN Down	INT Interrupt		
DP Damp proofing	INT Interrupt		
DR Door	INT Interrupt		
DRWR Drawer	INT Interrupt		
DS Downspout	INT Interrupt		
DT Drain Tile	INT Interrupt		
DW Dishwasher	INT Interrupt		
DWG Drawing	INT Interrupt		
EA Each	INT Interrupt		
EF Exhaust fan	INT Interrupt		
EJ Expansion Joint	INT Interrupt		
EL Elevation	INT Interrupt		

SHEET INDEX

SHEET #	DESCRIPTION
A1	COVERSHEET
A2	SITE PLAN
A2.1	SITE PLAN
A3	FOUNDATION PLAN
A4	MAIN FLOOR FRAMING PLAN
A5	MAIN FLOOR PLAN
A6	UPPER FLOOR FRAMING PLAN
A7	UPPER FLOOR PLAN
A8	ROOF FRAMING PLAN
A9	ROOF PLAN
A10	EXTERIOR ELEVATIONS
A11	EXTERIOR ELEVATIONS
A12	BUILDING SECTIONS
A13	STAIR SECTION
SO.0	LATERAL - STRUCTURAL GENERAL NOTES
LB-1	LATERAL - DETAILS
LB-2	LATERAL - DETAILS
SD.01	FOUNDATION DETAILS
EN1	ENERGY CODE
EN2	ENERGY CODE
EN3	ENERGY CODE
1 OF 4	TESCP
2 OF 4	UTILITY & TREE PLAN
3 OF 4	UTILITY DETAILS
4 OF 4	AMENDED SOILS MAP
TOPO	TOPOGRAPHIC SURVEY

PROJECT TEAM

ARCHITECTURAL DESIGN -
JAYMARCH HOMES

ARCHITECTURAL DRAFTING
JAYMARC HOMES - 425.226.9100 - JAYMARCHOMES.COM
RANDY NEWTON - RANDYNEWTON@JAYMARCHOMES.COM

M&K ENGINEERING
MULHERN & KULP - 215.646.8001 - MULHERNKULP.COM
RICHARD ZABEL - RZABEL@MULHERNKULP.COM

SQUARE FOOTAGE SUMMARY

SQUARE FOOTAGE SUMMARY	
LOWER FLOOR AREA	0 S.F.
MAIN FLOOR AREA	2,141 S.F.
UPPER FLOOR AREA	2,644 S.F.
TOTAL CONDITIONED AREA	4840 S.F.
2 CAR GARAGE	702 S.F.
COVID PATIO	815 S.F.
COVID PORCH	97 S.F.
TOTAL AREA UNDER ROOF	6,414 S.F.
OVERALL WIDTH	45'-0"
OVERALL DEPTH	44'-8"

Method for Calculating Square Footage - ANSI Z390-2015 (except, no separate distinction of 'above-grade' or 'below-grade' areas and each level is measured to the outside of studs not the exterior finished surface.)

Square footage calculations for this house were made based on plan dimensions only and may vary from the finished square footage of the house as built.

See Sheet "CODES" for additional Zoning required Area Calculations

BUILDING CODES FOR THIS SET

CITY OF MERCER ISLAND CODES AT THE DATE OF THIS DRAWING SET:

- 2018 INTERNATIONAL BUILDING CODE (IBC)
- 2018 INTERNATIONAL RESIDENTIAL CODE (IRC)
- 2018 WASHINGTON STATE ENERGY CODES
- 2018 INTERNATIONAL FIRE CODE (IFC)
- 2018 NATIONAL ELECTRIC CODE (NEC)
- 2018 UNIFORM PLUMBING CODE (UPC)
- 2018 INTERNATIONAL MECHANICAL CODE (IMC)
- 2018 INTERNATIONAL FUEL GAS CODE (IFGC)



COVER SHEET

1/4" = 1'-0"

4.21.23 RKN
M.I. BUILDING COMMENTS

Spring Residence
4740 W. Mercer Way
Mercer Island, WA.
Job Number: Spring
JMC011

plan name: -
marketing name: -
plan number: -
mark sys. number: -

Conditions not specifically represented graphically or in writing or which conflict with the current International Residential Code (IRC.) or those of the local municipality then the current standards and requirements of each respectively shall govern.

The drawings in this set are instruments of service and shall remain the property of JayMarc Homes, LLC.

© 2017 JayMarc Homes, LLC; All rights reserved.

03.21.23
Submission Date

Sheet Title/Description

JAYMARC HOMES
Design Firm

R.K.N.
Drawn by:


S.K.
Checked by:

Primary Scale

A1
of .

Sheet Title/Description

Sheet Title/Description

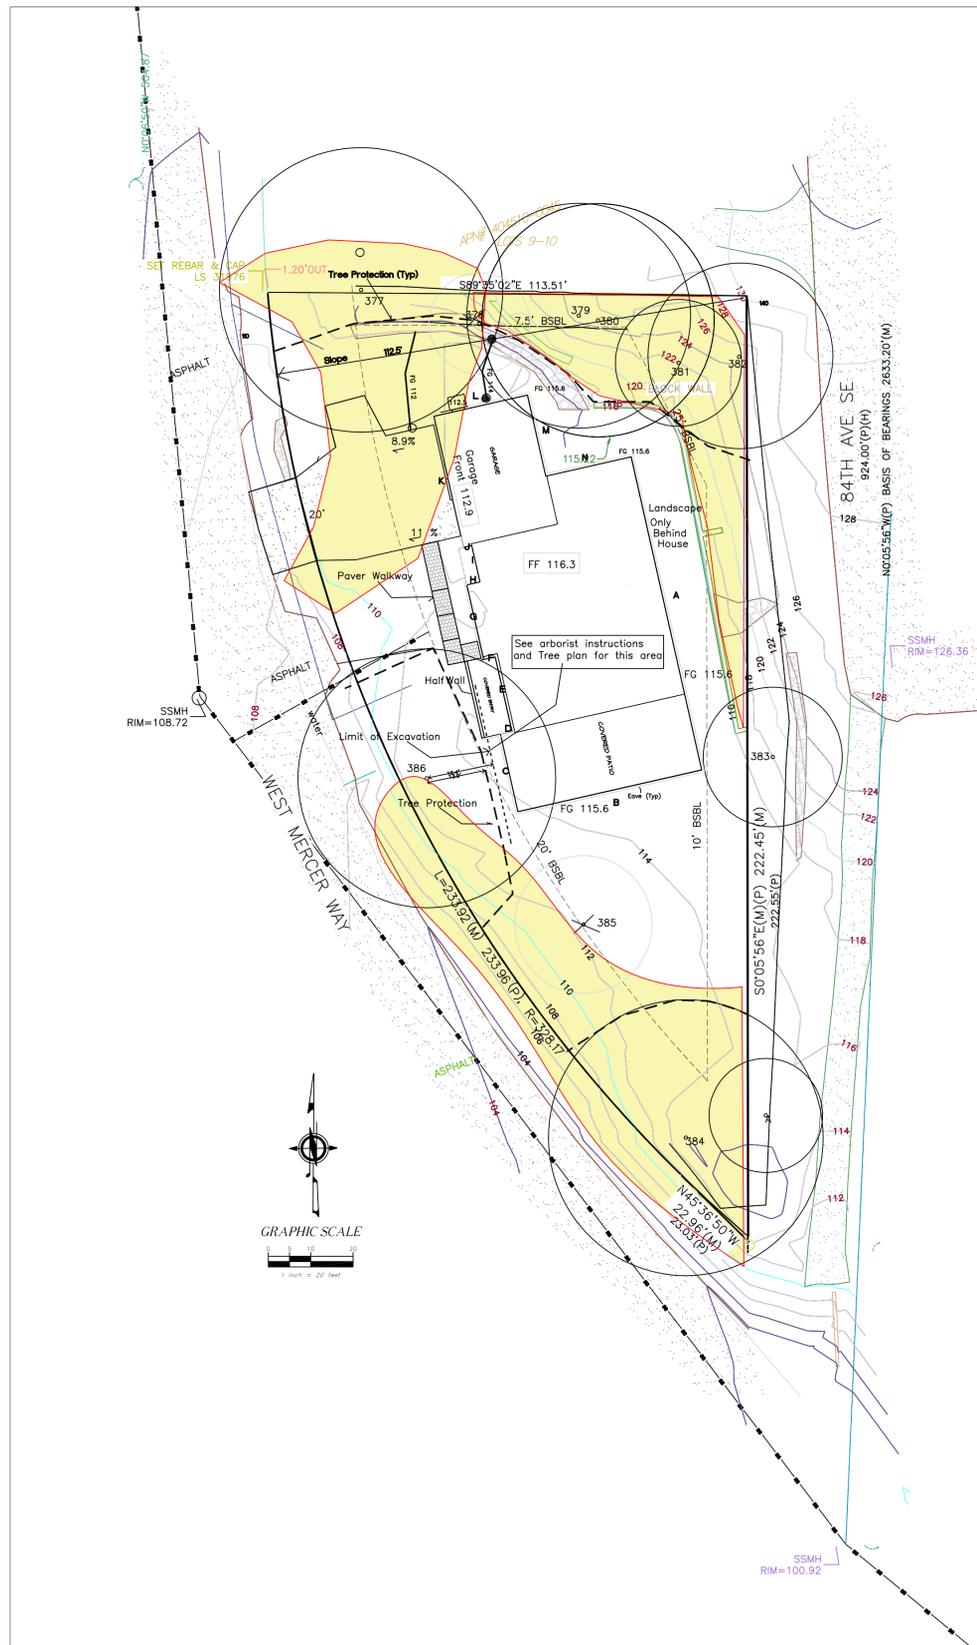

LOT COVERAGE	
Lot Area	16,710
Allowed	35%
Allowed sf	5,849
New	
Main Structure Roof Area	3,991
Driveway	997
New sf	4,988
Existing	
Main Structure Roof Area	2,070
Driveway	2,377
Auxiliary Bldg	38
Total Existing	4,485
Existing Removed	(4,485)
Total New and Existing	4,988
% 29.9%	

PARKING	
Covered	3 ea
Driveway	3 ea.

Gross Floor Area	
Lot Size 16,710	
Main Floor Living	2,191 sf
Garage	702 sf
Second Floor Living	2,649 sf
Less Second Floor Stairs	-122 sf
Total	5,420 sf
Max Allowed: 40% 6,684 sf	
This Proposal 32.4%	

PROPERTY OWNER
Erik and Katie Spring

STREET ADDRESS
4740 West Mercer Way

PARCEL #
4045100055

LEGAL DESCRIPTION
LOTS 11, 12 AND 13 OF A PORTION OF LAKE ISLE, ACCORDING TO THE PLAT THEREOF, VOL. 28, P13 BOOK OF PLATS, KING COUNTY, WA

ZONE: R-15

SETBACKS:
Front Yard - 20'
Rear Yard - 25'
Side Yards - 7.5'/15'

HEIGHT LIMIT; 30' above ABE to roof peak

MAXIMUM LOT COVERAGE: 35%

MAXIMUM HARDSCAPE: 9%

MAXIMUM FAR: 40%


PARKING SPACES PROVIDED: 3 GARAGE 3DRIVEWAY

4740 West Mercer Way TREE INVENTORY														
Tree ID	Common Name	DSH	Multi	Health	Condition	Dripline				Exceptional Threshold	Exceptional Above 24"	Retain?		
						N	E	S	W					
377	Bigleaf Maple	34.7	24,25	Good	Good	26.4	26.4	33.4	31.4	30"	Size	Yes	Yes	
378	Lodgepole Pine	11.5		Good	Fair	0.5	13.5	24.5	12.5	6	Size	No	No	
379	Austrian Black Pine	26.7		Good	Fair	17.1	9.1	26.1	21.1	24	Size	Yes	Yes	
380	Austrian Black Pine	28.3		Good	Fair	19.2	21.2	27.2	9.2	24	Size	Yes	Yes	
381	Western Red Cedar	12.9		Good	Good	14.5	14.5	14.5	14.5	30	No	No	Yes	
382	Western Red Cedar	32.5		Good	Good	21.4	21.4	21.4	21.4	30	Size	Yes	Yes	
384	Western Red Cedar	45.4		Good	Good	31.9	21.9	26.9	21.9	30	Size	Yes	Yes	
385	Doug-Fir	20.3		Good	Good	15.8	15.8	15.8	15.8	30	No	No	No	
386	Doug-Fir	42		Good	Excellent	25.8	25.8	25.8	23.8	30	Size	Yes	Yes	
10	TOTALS	9										7	6	7
OFFSITE														
A	Red Alder	12		Poor	Fair	15.5	17.5	10.5	16.5			No	Yes	
383	Flowering Cherry	10.2	6,5,7,1,3,3	Good	Good	16.4	8.4	12.4	16.4	23	No	No	Yes	

4740 W Mercer Way Height Table				
Segment	Midpoint Elevation	Length	Product	
A	115.2	76.5	8,812.8	
B	114.3	45	5,143.5	
C	114.2	18.75	2,141.3	
D	114.3	2.75	314.3	
E	114.1	18	2,053.8	
F	113.9	2.75	313.2	
G	112	18	2,016.0	
H	112.2	3.1	347.8	
I	114	8.7	991.8	
J	113	3.1	350.3	
K	112.1	31.6	3,542.4	
L	112.1	24	2,690.4	
M	113	19.5	2,203.5	
N	114.5	20.6	2,358.7	
Sub Totals		292.4	33,279.8	
ABE			113.8	
Max Height			30.0	
Max Elevation			143.84	

Lot Slope Calculations	
High Point	130 ft
Low Point	110 ft
Elevation Difference	20 ft
Distance	112.6 ft
Slope%	17.8%

Hardscape	
Lot Size	16,710
EXISTING	
Uncovered Patio	1420
Walkways	140
Stairs	0
Rockery/Retaining Walls	251
Total Existing	1811
Existing Removed	1560
Net Existing Retained	251
NEW	
Uncovered Patio	
Walk	131
Total New	131
Total Project	382
Project %	2.30%

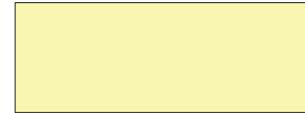

Hatch denotes landslide and Steep Slope mapped area

JayMarc Homes, LLC
7525 SE 24th St, #487
Mercer Island, WA 98040
425 281 2706

Spring Residence
4740 W Mercer Way

Drawn by
Gary Upper


12/8/22

12/19/22

1/11/232

4/19/23

A2.0

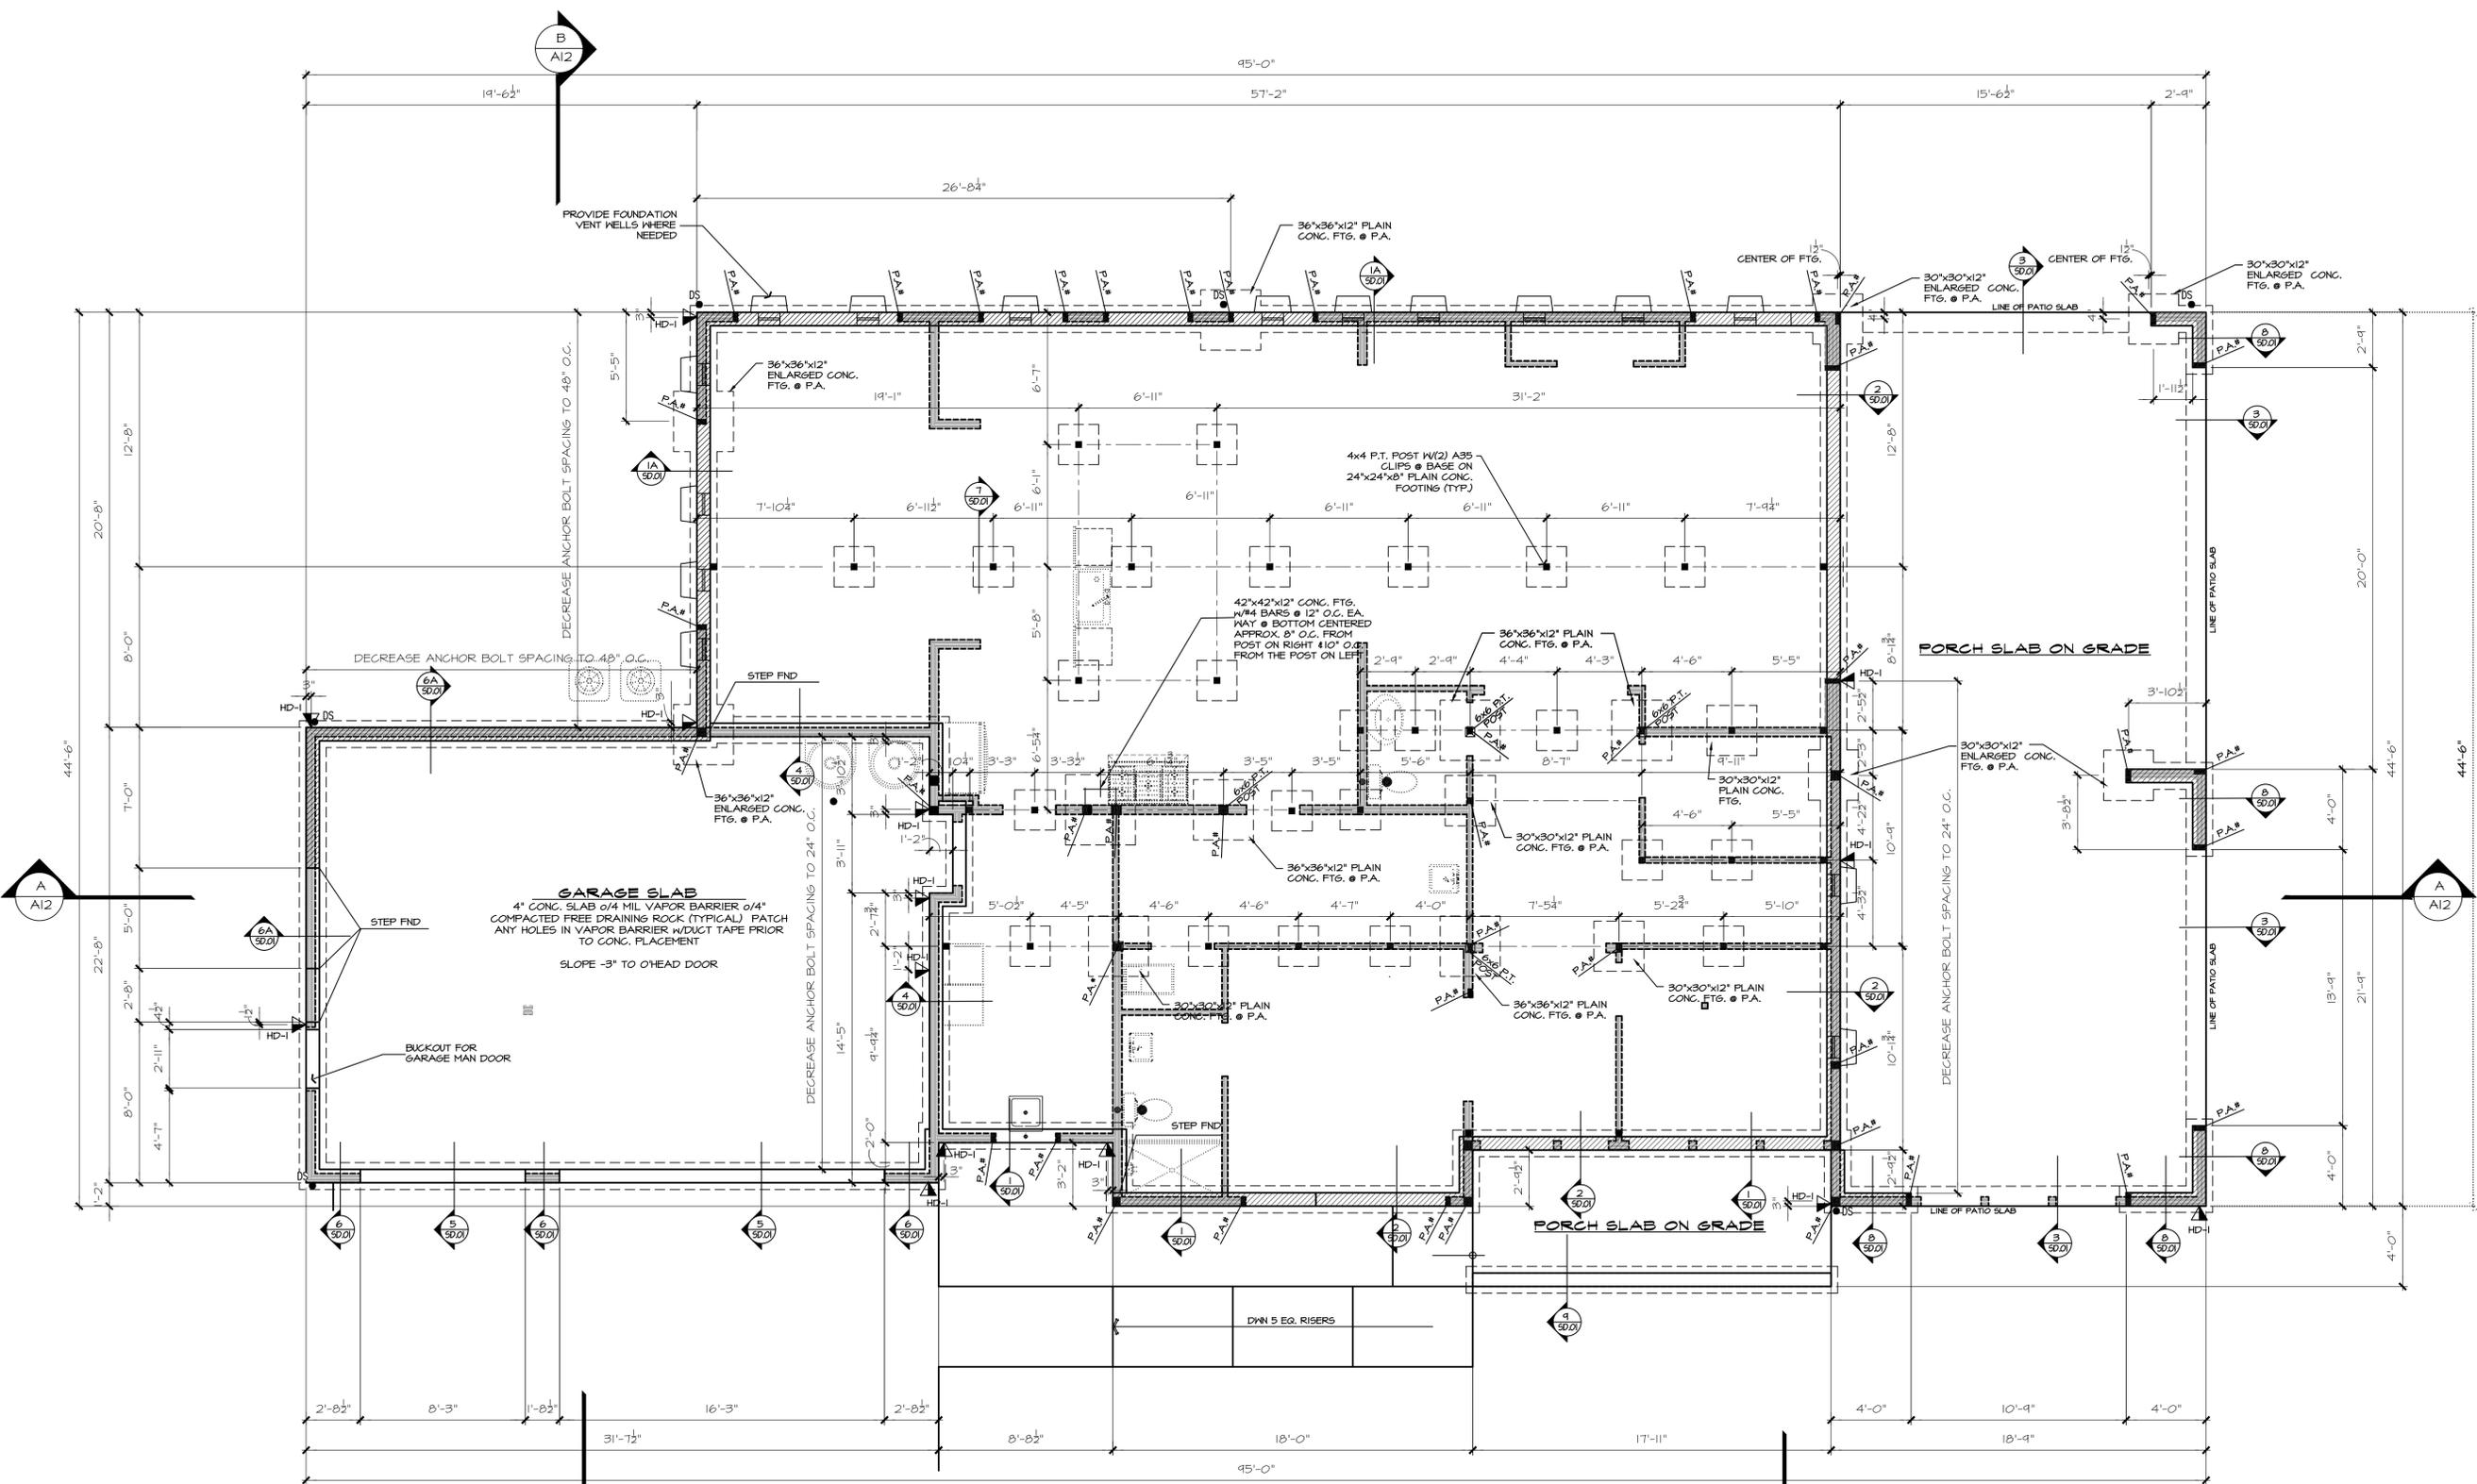

4x10 DROPPED CONT. BEAM (TYP. U.N.O.)

TYP. CRAWLSPACE POSTS:
4x4 P.T. POST W/2x4 CLEATS EA. SIDE + (2) A35 CLIPS @ BASE OF POST W/O.131"x1-1/2" LONG REDHEAD NAILS (4'-0" MAX. POST HEIGHT) ON ASPHALT SHINGLE ON 24"x24"x8" PLAIN CONC. FTG. (TYP. U.N.O.)

FOUNDATION VENTILATION

crawl space Area:	2197 s.f.	
ventilation Required:	2197 s.f. / 300 =	1054 s.i. Req'd
14" x 7" Foundation Vents		
vent Area =	98 s.i. - 25% reduct., 1/4" mesh =	73.5 s.i.
vents Required =	1054 s.i. / Vent Area =	14.34 s.i.
provide:	15 14" x 7" Vents, Area =	1103 s.i.
ventilation Provided =	1103.00 s.i. is Greater than	1054 s.i. Req'd
15 14" x 7" Foundation Vents		

FOUNDATION VENTS SHALL NOT INTERFERE WITH DIRECT LOAD PATH OF COLUMNS
INSTALL 6 MIL BLACK POLYETHYLENE VAPOR RETARDER GROUND COVER
LOCATE ONE VENT WITHIN 3 FEET OF EACH CORNER OF THE BUILDING, EXCEPT ONE SIDE IF THE BUILDING SHALL BE PERMITTED TO HAVE NO VENTS.

LEGEND

- INTERIOR BEARING WALL
- ===== EXTERIOR WALL ABOVE
- JL METAL HANGER
- * INDICATES POST ABOVE. PROVIDE SOLID BLOCKING UNDER POST OR JAMB ABOVE.
- ▲ INDICATES HOLD-DOWN.

REFER TO S-O FOR TYPICAL STRUCTURAL NOTES & SCHEDULES


HOLD-DOWN SCHEDULE

SYMBOL	SPECIFICATION
HD-1	SIMPSON STHD14 (RJ) HOLD-DOWN
HD-5	SIMPSON CSI6 STRAP TIE (14" END LENGTH)
HD-6	SIMPSON MSTC40 STRAP TIE (12" END LENGTH)
HD-7	SIMPSON MSTC66 STRAP TIE (24" END LENGTH)

FOUNDATION PLAN

1/4" = 1'-0"

Sheet Title/Description

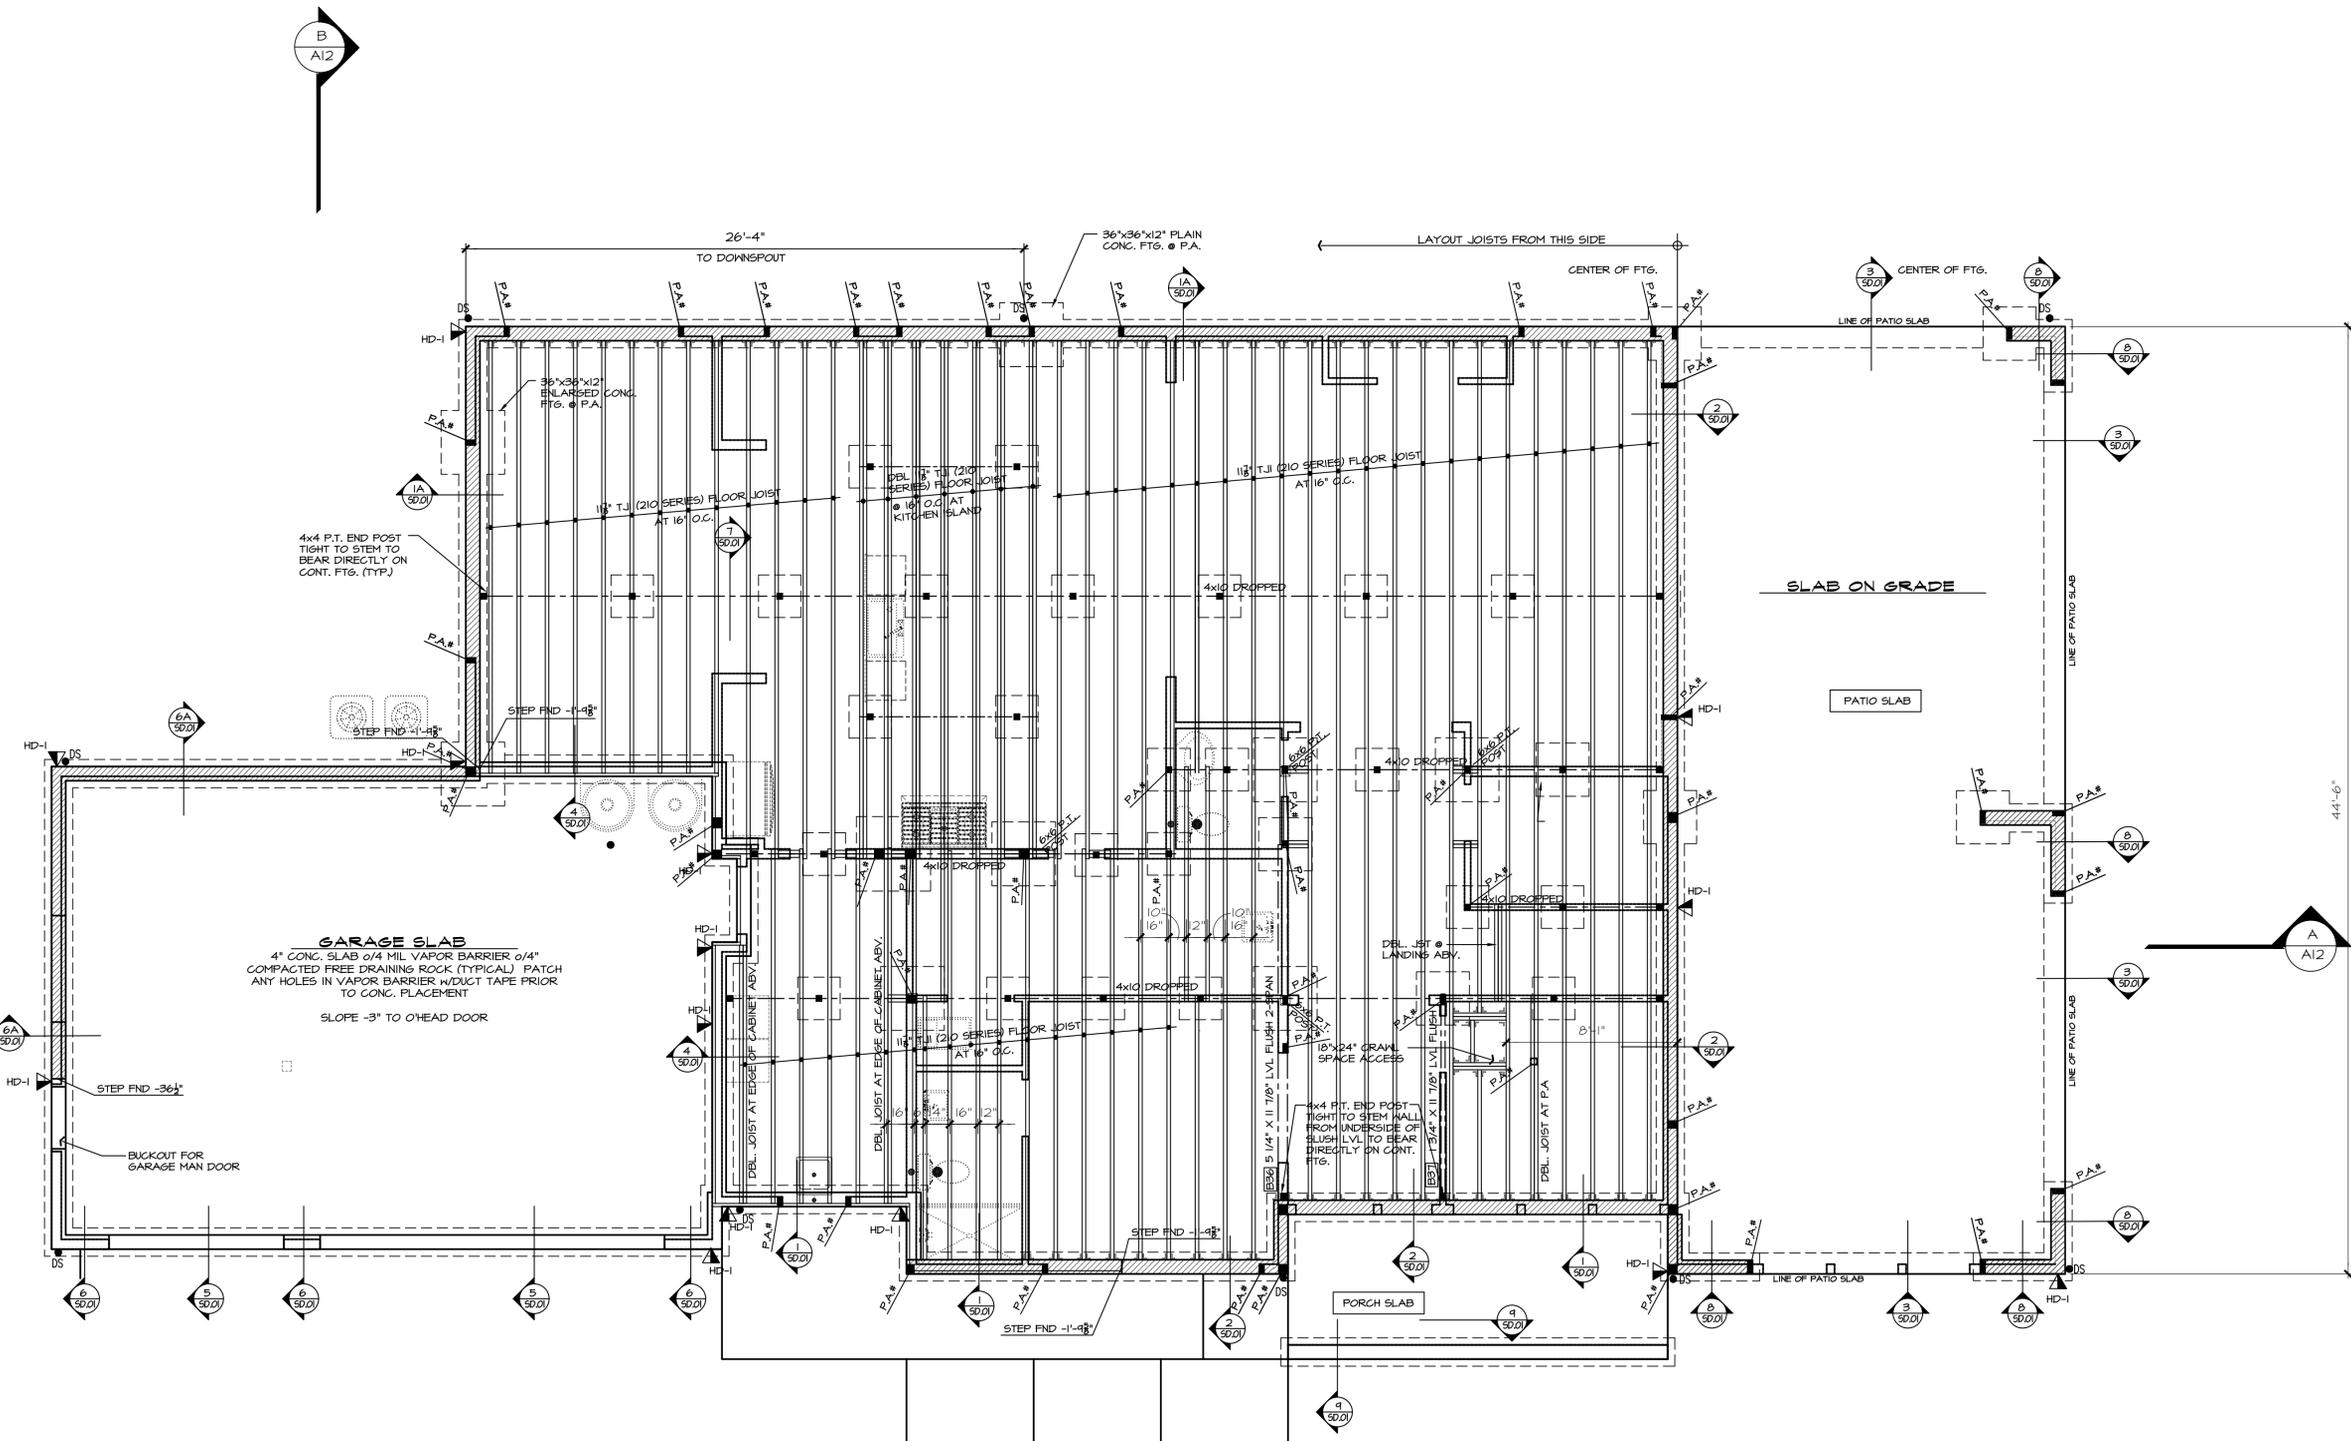

B35 4x10 DROPPED CONT. BEAM (TYP. U.N.O.)

TYP. CRAWLSPACE POSTS:
4x4 P.T. POST W/2x4 CLEATS EA. SIDE + (2) A35 CLIPS ON EA. SIDE @ BASE OF POST W/O.131"x1-1/2" LONG REDHEAD NAILS (4'-0" MAX. POST HEIGHT) ON ASPHALT SHINGLE ON 24"x24"x8" PLAIN CONC. FTG. (TYP. U.N.O.)

INDICATES 11-7/8" TJI FLOOR JOISTS @ 16" O.C. (TYP. U.N.O.)

REFER TO S-O FOR TYPICAL STRUCTURAL NOTES & SCHEDULES

LEGEND

- INTERIOR BEARING WALL
- BEARINGS WALL ABOVE (B.W.A.), OR SHEARWALL ABOVE (S.W.A.)
- BEAM / HEADER
- INTERIOR SHEAR WALL PANEL OR EXTERIOR SHEAR WALL w/ 3" o.c. EDGE NAILING
- AREA OF FLOOR SYSTEM DESIGNED FOR TILE
- JL METAL HANGER
- INDICATES POST ABOVE. PROVIDE SOLID BLOCKING UNDER POST OR JAMB ABOVE.
- INDICATES HOLD-DOWN.

HOLD-DOWN SCHEDULE

SYMBOL	SPECIFICATION
HD-1	SIMPSON STHD14 (R.J.) HOLD-DOWN
HD-5	SIMPSON CS16 STRAP TIE (14" END LENGTH)
HD-6	SIMPSON MSTC40 STRAP TIE (12" END LENGTH)
HD-7	SIMPSON MSTC66 STRAP TIE (24" END LENGTH)

SQUARE FOOTAGE SUMMARY


Category	Area (S.F.)
LOWER FLOOR AREA	0
MAIN FLOOR AREA	2,141
UPPER FLOOR AREA	2,644
TOTAL CONDITIONED AREA	4840
2 CAR GARAGE	702
COVID PATIO	815
COVID PORCH	97
TOTAL AREA UNDER ROOF	6,414
OVERALL WIDTH	45'-0"
OVERALL DEPTH	44'-8"

Updated: 12.03.20
Method for Calculating Square Footage - ANSI Z165-2013 except, no separate distribution of above-grade or below-grade areas and each level is measured to the outside of studs not the exterior finished surface.
Square Footage calculations for this house were made based on plan dimensions only and may vary from the finished square footage of the house as built.
See sheet CODES for additional zoning required Area Calculations

MAIN FLOOR FRAMING PLAN

1/4" = 1'-0"

Sheet Title/Description

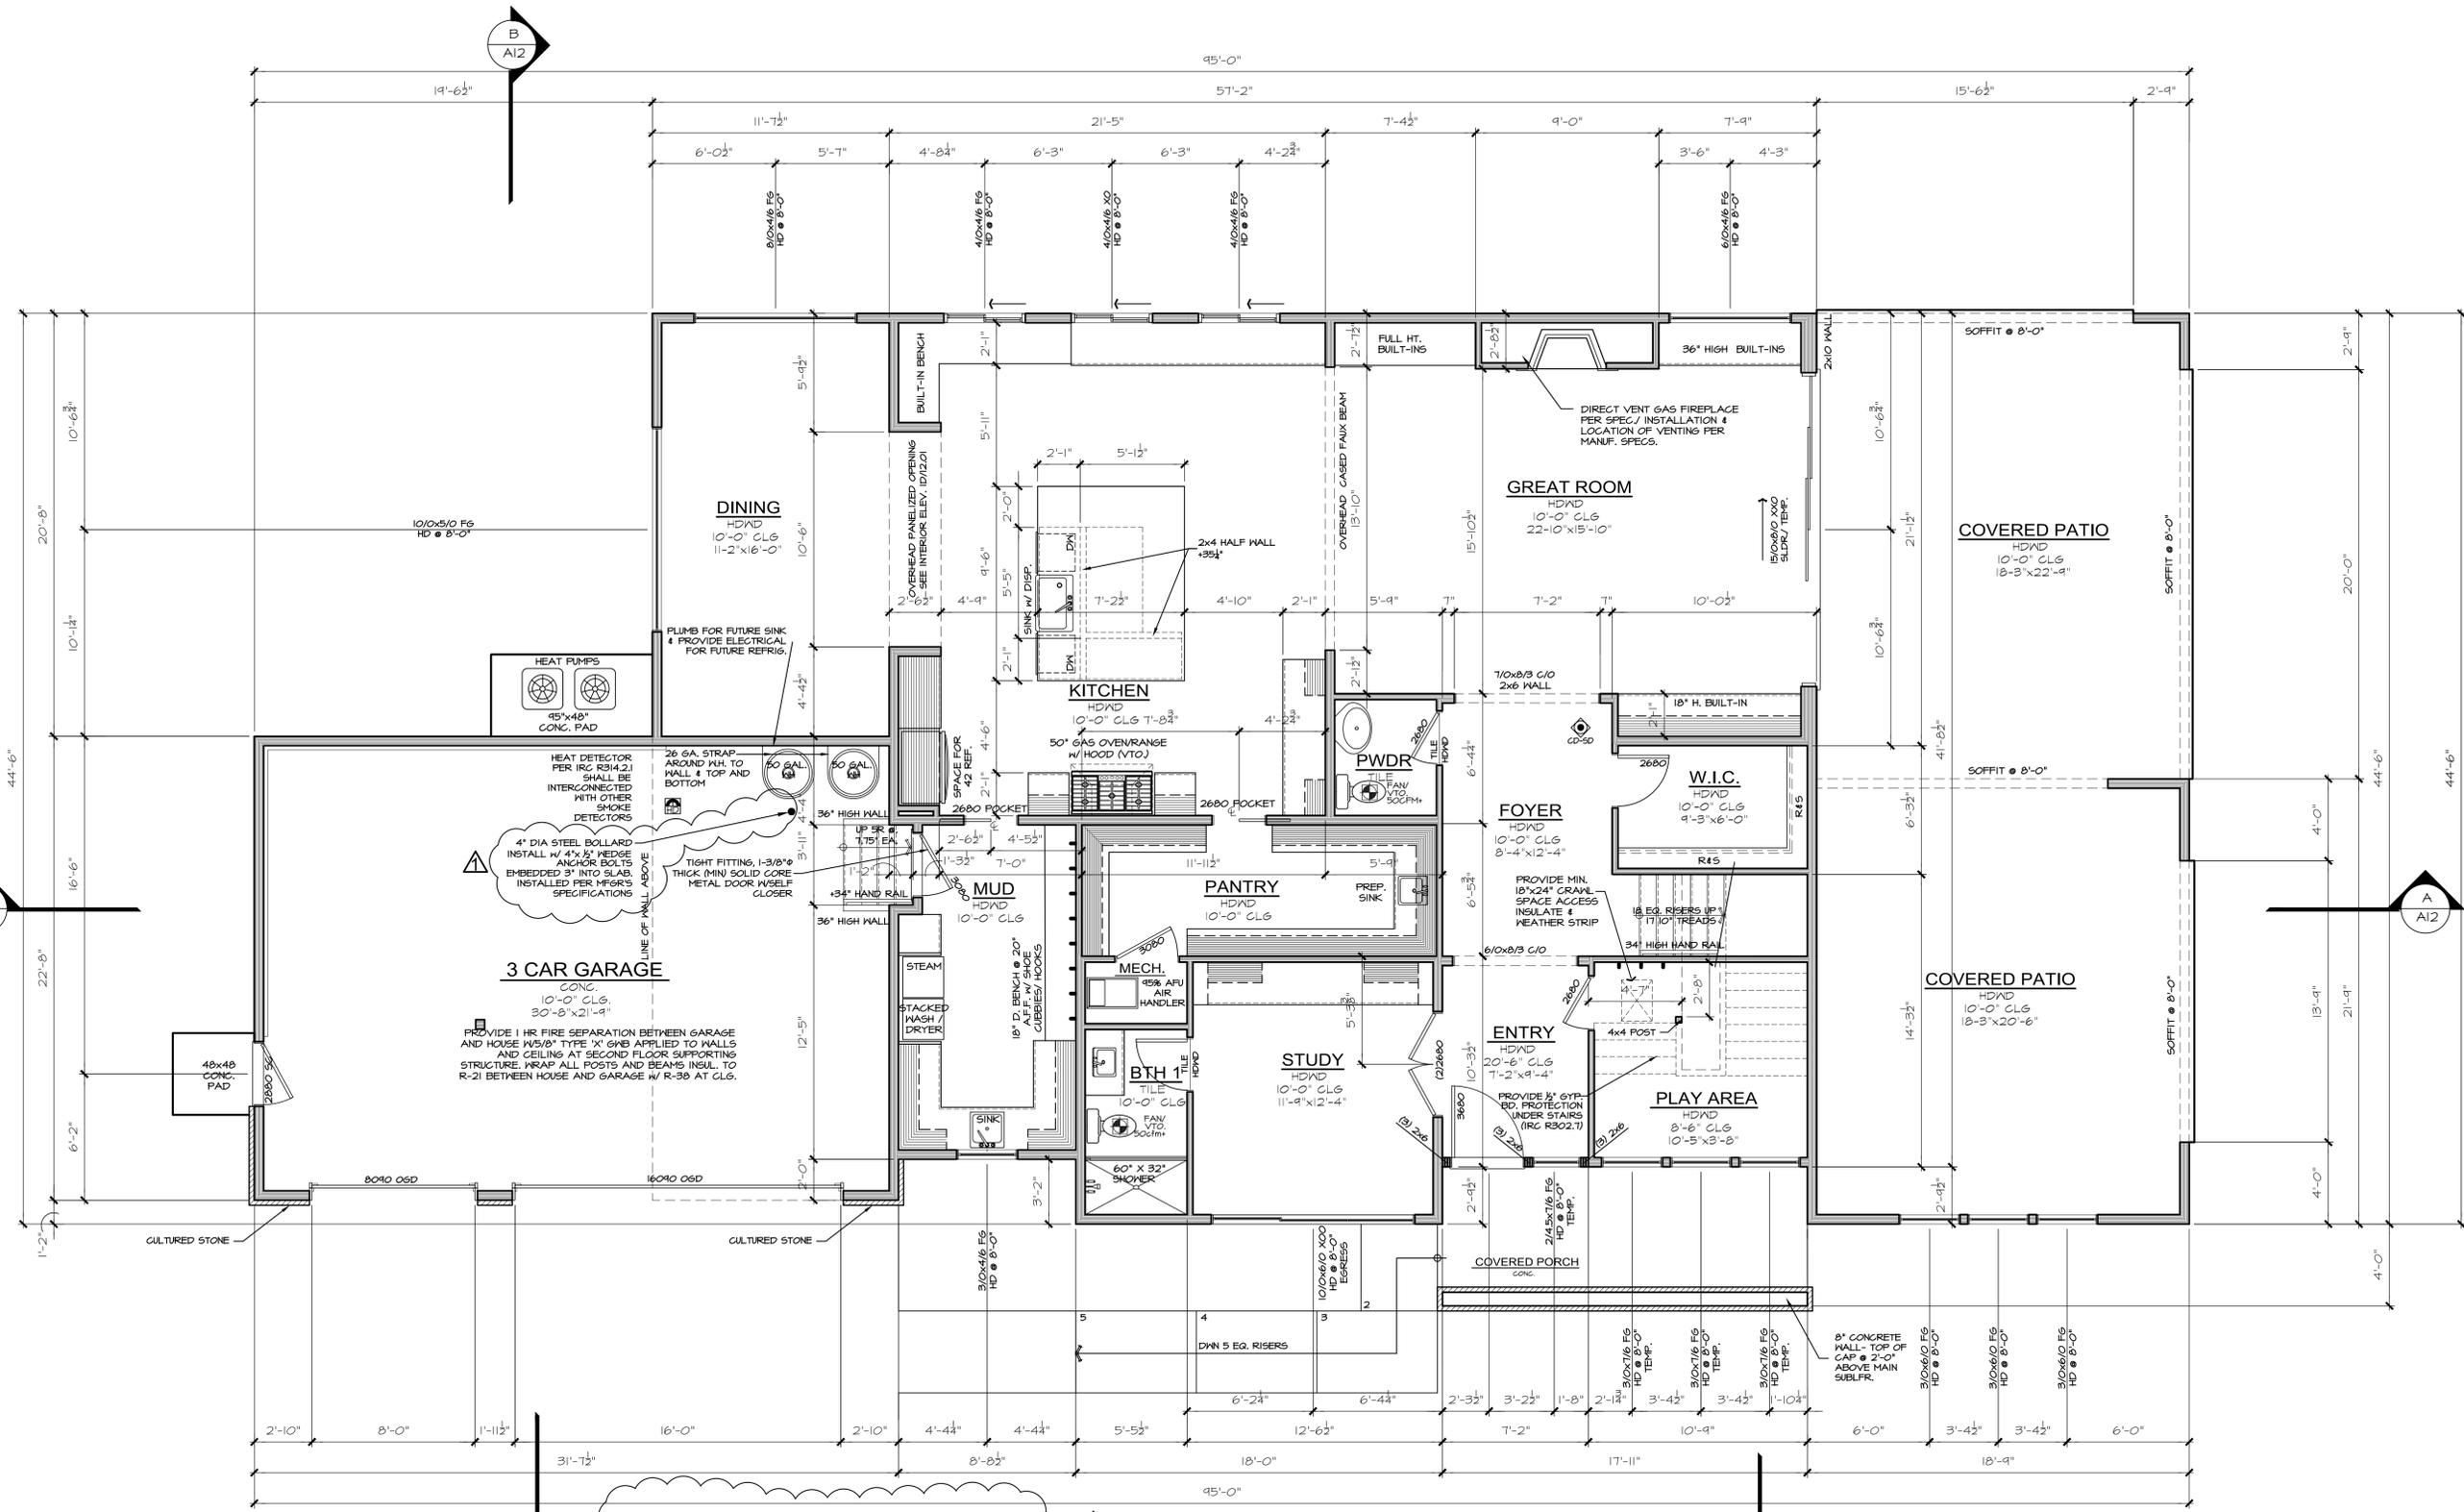

WHOLE HOUSE VENTILATION
PROVIDE WHOLE HOUSE VENTILATION per 2018 IRC, M1505.4.3(1), M1505.4.3(2), & M1505.4.3(3) USING WHOLE HOUSE VENTILATION SYSTEM USING CENTRAL EXHAUST FAN. CONTINUOUSLY OPERATING - WALL SWITCH LABELED "WHOLE HOUSE FAN. LEAVE ON UNLESS OUTDOOR AIR QUALITY IS POOR".

SYMBOL	LOCATION	MIN. FAN REQUIREMENTS (ALL FANS VENT TO OUTSIDE)
	BATH & POWDER	Min. 50cfm, INTERMITTENT at 0.25wg per TABLE M1505.4.4
	KITCHEN	Min. 100cfm, INTERMITTENT at 0.25wg per TBL. M1505.6
	LAUNDRY ROOM	FINAL ADJUSTED RATE = 180 CFM (120 CFM PER TABLE 1505.4.3(1), ADJUSTED BY FACTOR OF 1.5 PER TABLE M1505.4.3(2) FOR NON-BALANCED, NOT DISTRIBUTED SYSTEM.

MAIN FLOOR PLAN NOTES

PLAN SPECIFIC 2018 WSEC SECTION R06
R406.2 ADDITIONAL ENERGY EFFICIENCY REQUIREMENTS (MANDATORY). THIS RESIDENTIAL DWELLING SHALL COMPLY W/SUFFICIENT OPTIONS FROM TABLE R406.2 TO ACHIEVE THE FOLLOWING MIN. NUMBER OF CREDITS:
3.5 FOR A 1501sf to 4999sf HOME.
CREDITS PROVIDED IN THIS HOME AS FOLLOWS:
EFFICIENT BUILDING ENVELOPE 1a. 0.5 CREDITS
PRESCRIPTIVE COMPLIANCE IS BASED ON TABLE R402.1.1 WITH FOLLOWING MODIFICATIONS:
VERTICAL PENETRATION U = 0.28 WINDOWS
FLOORS TO BE R-38 and SLAB ON GRADE TO BE R-10 PERIMETER and UNDER ENTIRE SLAB BELOW GRADE.


HIGH EFFICIENCY HVAC EQUIPMENT 3a. 1.0 CREDITS
GAS FURNACE WITH MINIMUM AFUE OF 94%
EFFICIENT WATER HEATING 5a. 0.5 CREDITS
ALL SHOWERHEAD and KITCHEN SINK FAUCETS INSTALLED IN THE HOUSE SHALL BE RATED AT 1.75 GPM or LESS.
ALL OTHER LAVATORY FAUCETS SHALL BE RATED AT 1.0 GPM or LESS.
EFFICIENT WATER HEATING 5c. 1.5 CREDITS
WATER HEATING SYSTEM SHALL BE:
GAS WATER HEATER WITH A MINIMUM EF OF 0.91

SUMMARY

SQUARE FOOTAGE SUMMARY	
LOWER FLOOR AREA	0 S.F.
MAIN FLOOR AREA	2,141 S.F.
UPPER FLOOR AREA	2,644 S.F.
TOTAL CONDITIONED AREA	4840 S.F.
2 CAR GARAGE	702 S.F.
COVERED PATIO	815 S.F.
COVERED PORCH	97 S.F.
TOTAL AREA UNDER ROOF	6,414 S.F.
OVERALL WIDTH	95'-0"
OVERALL DEPTH	44'-8"

Method for Calculating Square Footage - ANSI Z165-2013 except, no separate distinction of "above-grade or below-grade" areas and each level is measured to the outside of studs not the exterior finished surface.
Square Footage calculations for this house were made based on plan dimensions only and may vary from the finished square footage of the house as built.
See Sheet "CODES" for additional Zoning required Area Calculations

Sheet Title/Description

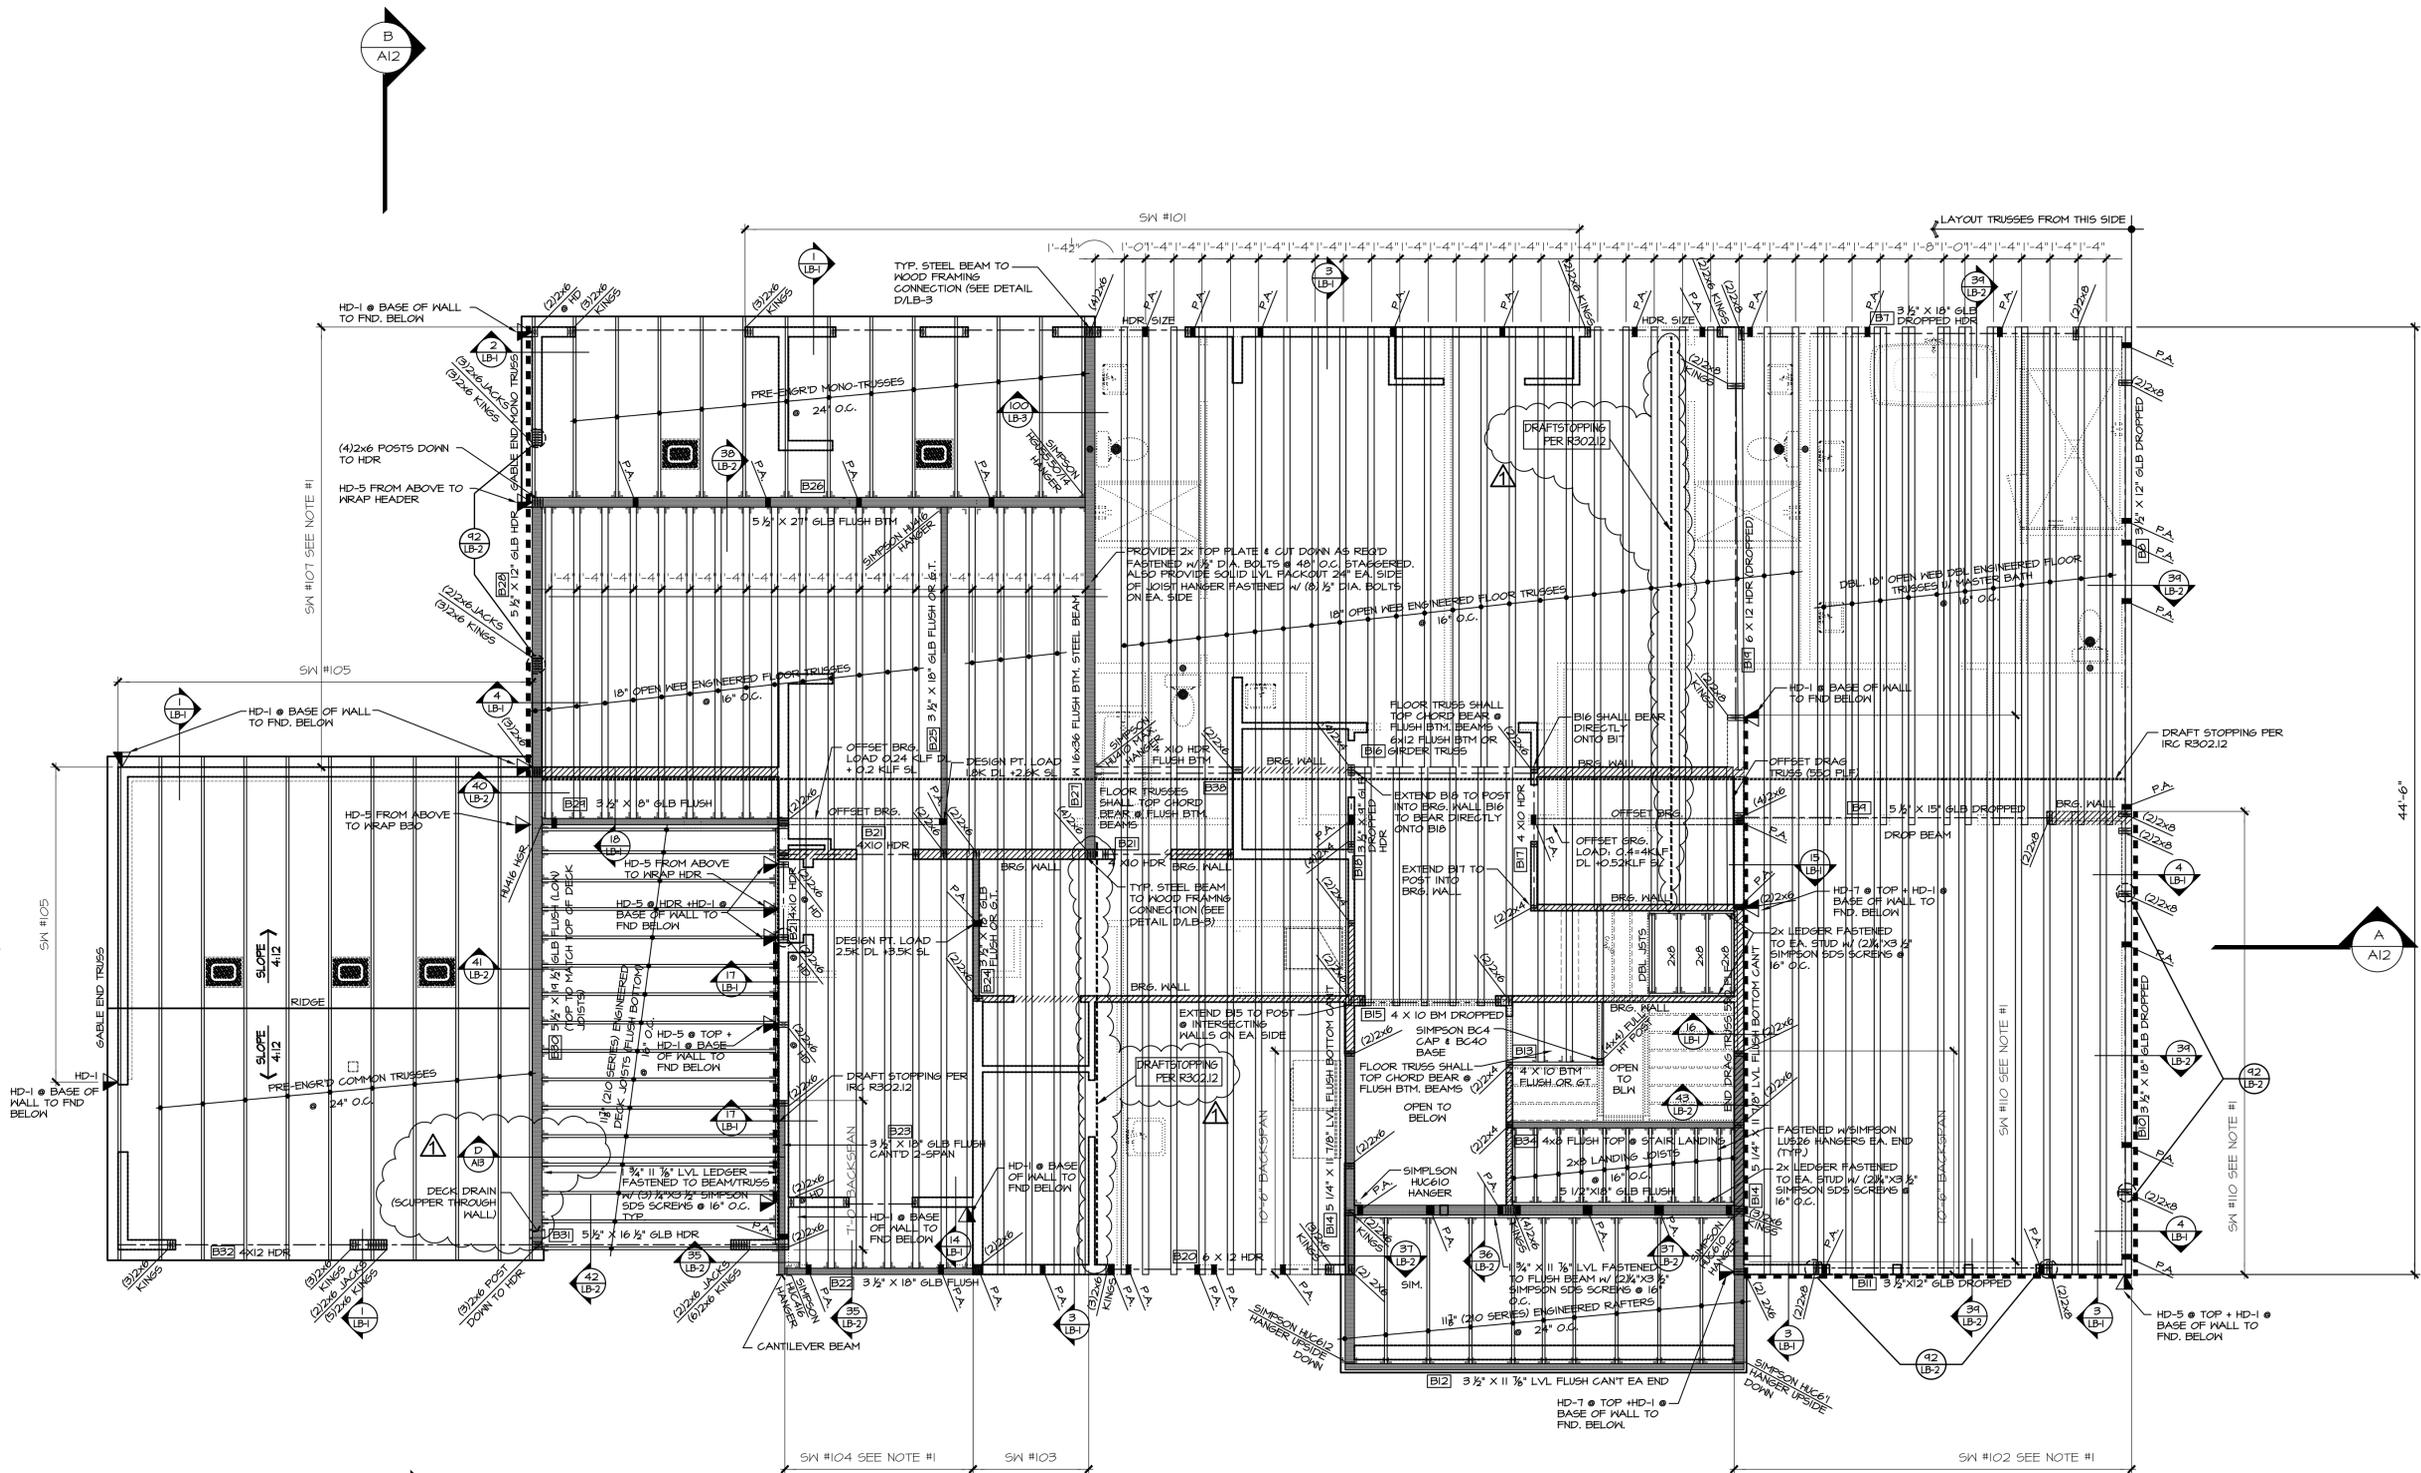

NOTE #1:
PROVIDE 3/8" OSB OR PLYWOOD FASTENED PER 3" O.C. EDGE NAILING (SEE S-O.O)

REFER TO S-O FOR TYPICAL STRUCTURAL NOTES & SCHEDULES

4x10 HDR @ ALL EXT. B33 WINDOWS/DOORS (TYP. U.N.O.)

LEGEND


- ▨ INTERIOR BEARING WALL
- ▤ BEAM/HEADER
- ▧ FLOOR TRUSS @ 24" O.C. (U.N.O.)
- ▩ INTERIOR SHEAR WALL PANEL OR EXTERIOR SHEAR WALL w/ 3" o.c. EDGE NAILING
- JL METAL HANGER
- * INDICATES POST ABOVE. PROVIDE SOLID BLOCKING UNDER POST OR JAMB ABOVE.
- ◁ INDICATES HOLD-DOWN.

HOLD-DOWN SCHEDULE

SYMBOL	SPECIFICATION
HD-1	SIMPSON STD14 (R.J) HOLD-DOWN
HD-5	SIMPSON C516 STRAP TIE (14" END LENGTH)
HD-6	SIMPSON MSTC40 STRAP TIE (12" END LENGTH)
HD-7	SIMPSON MSTC66 STRAP TIE (24" END LENGTH)

UPPER FLOOR & LOWER ROOF FRAMING PLAN

1/4" = 1'-0"

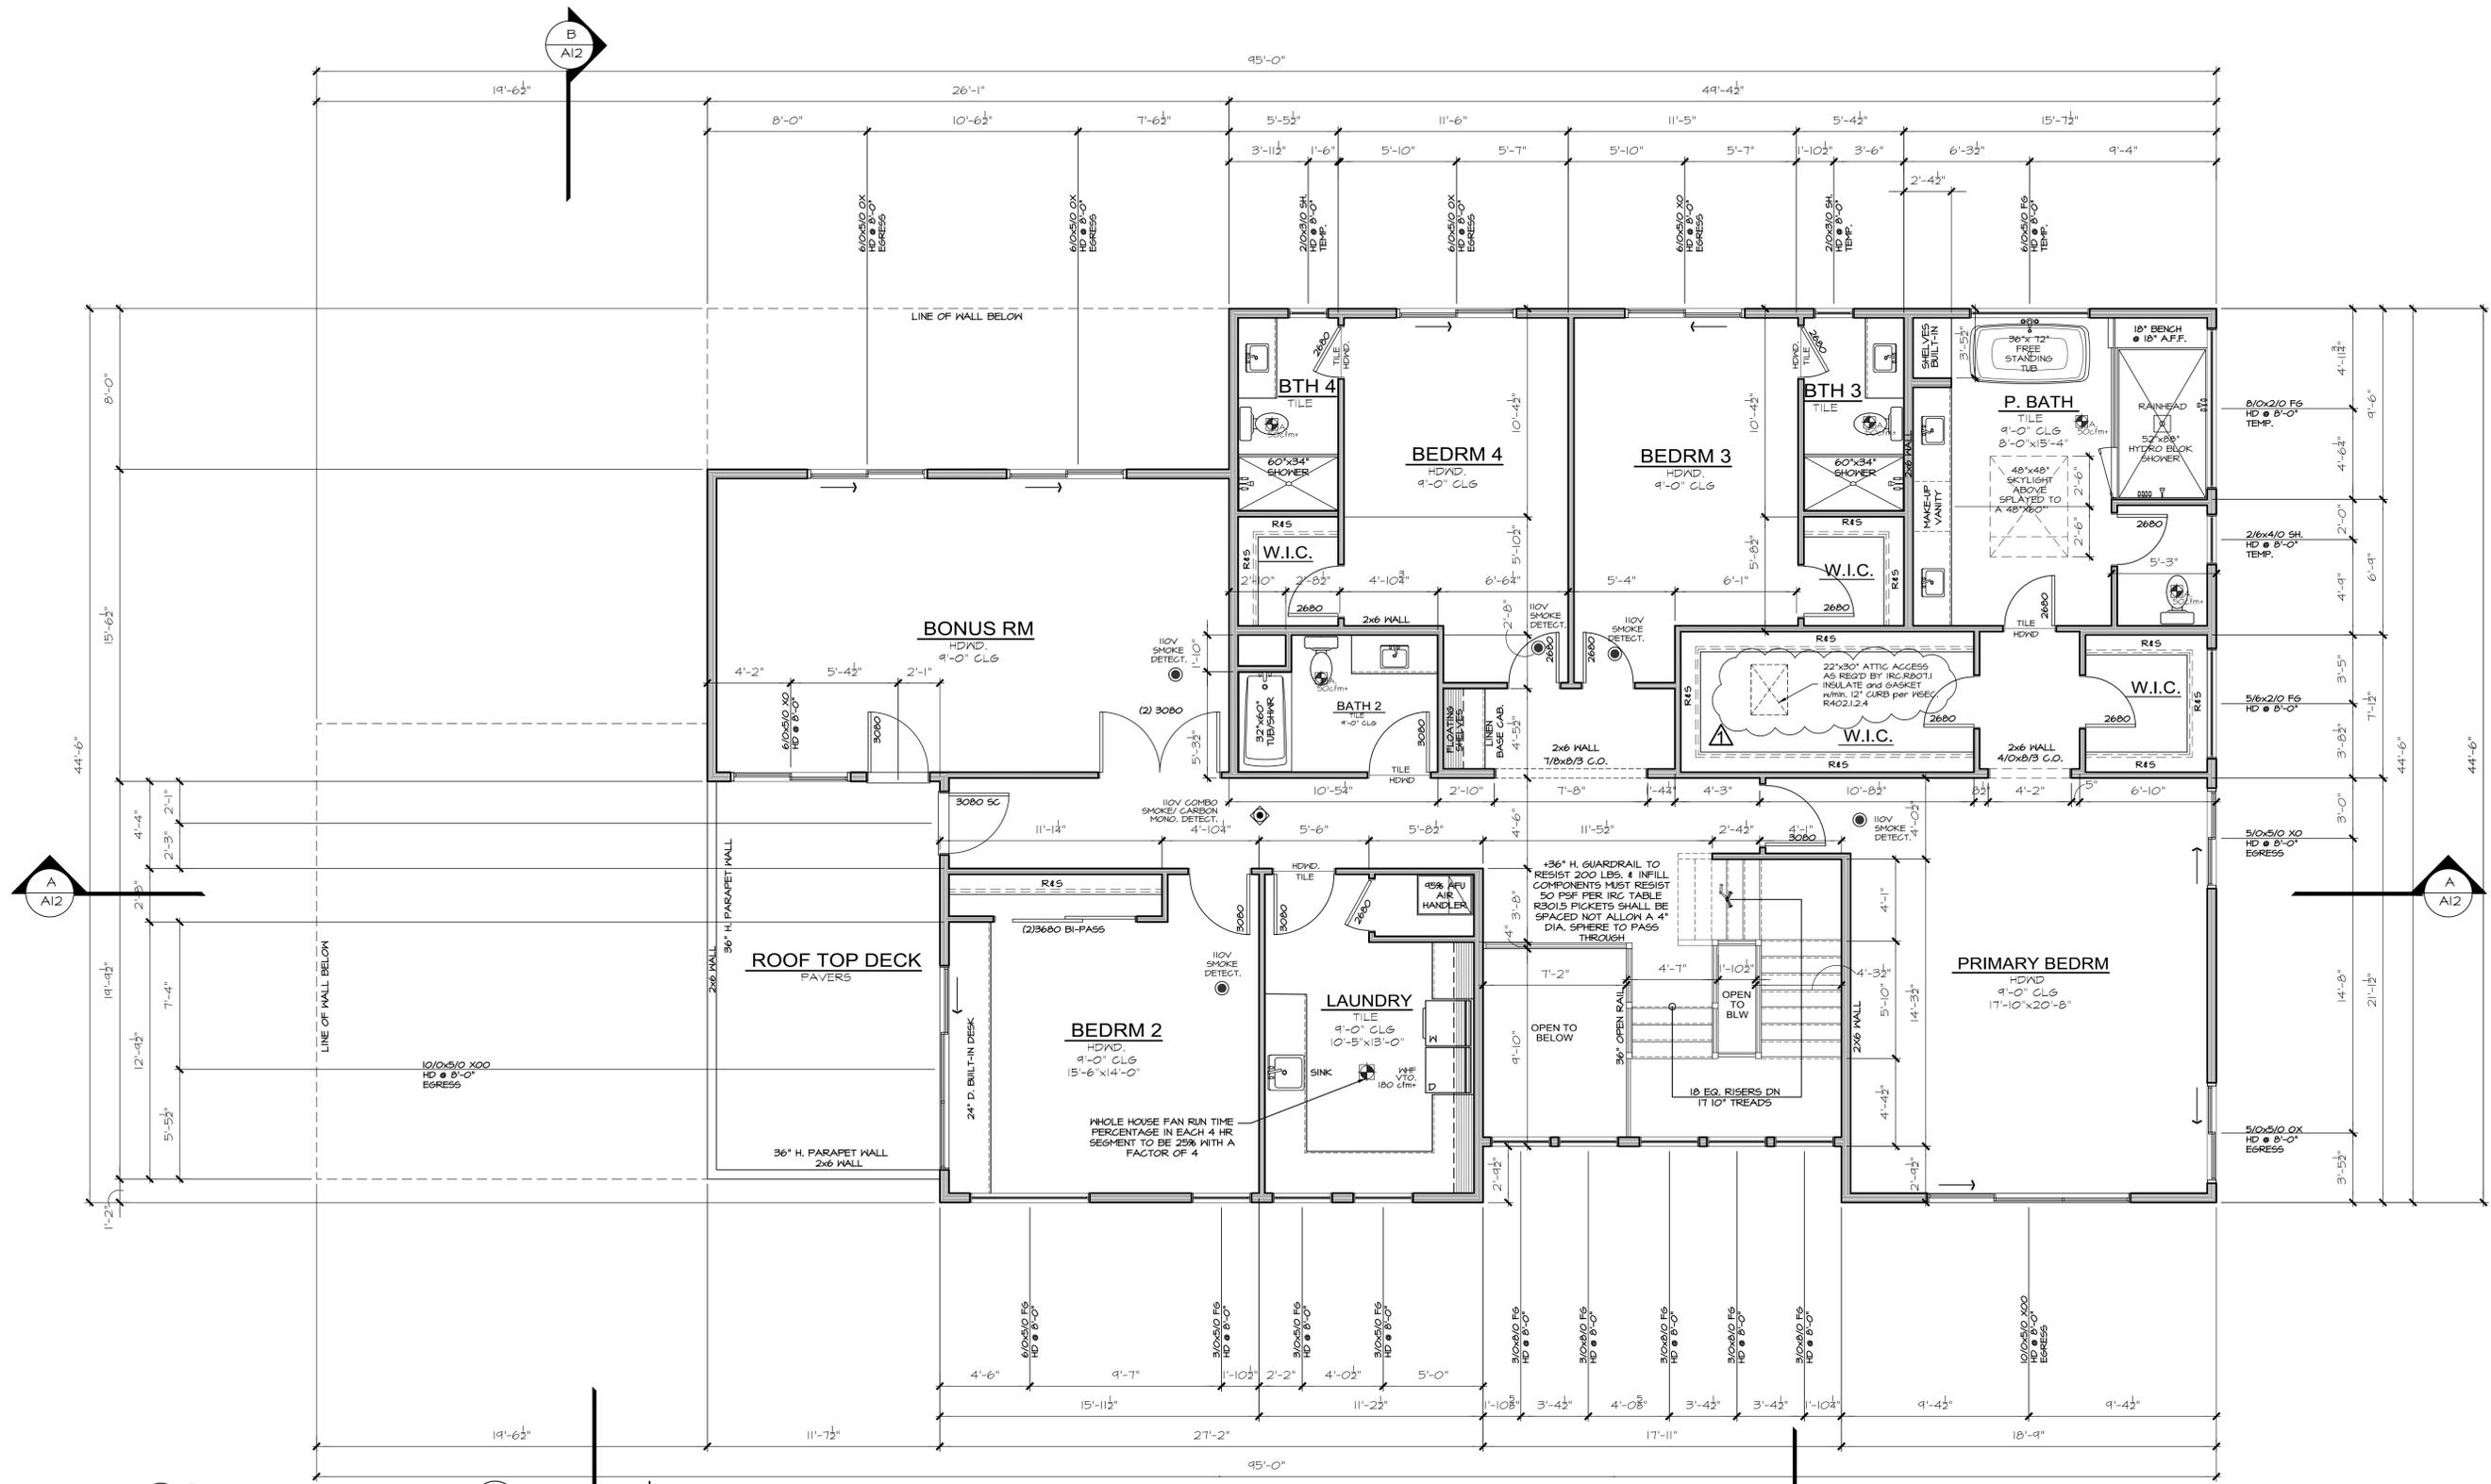

WHOLE HOUSE VENTILATION

PROVIDE WHOLE HOUSE VENTILATION per 2018 IRC, M1505.4.3(1), M1505.4.3(2), & M1505.4.3(3) USING WHOLE HOUSE VENTILATION SYSTEM USING CENTRAL EXHAUST FAN, CONTINUOUSLY OPERATING - WALL SWITCH LABELED "WHOLE HOUSE FAN, LEAVE ON UNLESS OUTDOOR AIR QUALITY IS POOR".

SYMBOL	LOCATION	MIN. FAN REQUIREMENTS (ALL FANS VENT TO OUTSIDE)
	BATH #1 PONDOR	Min. 50cfm, INTERMITTENT at .025mg per TABLE M1505.4.4
	KITCHEN	Min. 100cfm, INTERMITTENT at .025mg per TBL. M1509.6
	LAUNDRY ROOM	FINAL ADJUSTED RATE = 180 CFM (120 CFM PER TABLE M1505.4.3(1)), ADJUSTED BY FACTOR OF 1.5 PER TABLE M1505.4.3(2) FOR NON-BALANCED, NOT DISTRIBUTED SYSTEM.

UPPER FLOOR PLAN NOTES:

PLAN SPECIFIC 2018 WSEC, SECTION R406

R406.2 ADDITIONAL ENERGY EFFICIENCY REQUIREMENTS (MANDATORY). THIS RESIDENTIAL DWELLING SHALL COMPLY W/SUFFICIENT OPTIONS FROM TABLE R406.2 TO ACHIEVE THE FOLLOWING MIN. NUMBER OF CREDITS: 3.5 FOR a 150sqft to 4,999sqft HOME.

EFFICIENT BUILDING ENVELOPE (a) - 0.5 CREDITS

PRESCRIPTIVE COMPLIANCE IS BASED ON TABLE R402.1.1 WITH FOLLOWING MODIFICATIONS:

- VERTICAL PENETRATION U = 0.28 WINDOWS
- FLOORS TO BE R-38 and SLAB ON GRADE TO BE R-10 PERIMETER and UNDER ENTIRE SLAB BELOW GRADE.

EFFICIENT WATER HEATING (a) - 0.5 CREDITS

WATER HEATING SYSTEM SHALL BE: GAS WATER HEATER WITH A MINIMUM EF OF 0.91

EFFICIENT WATER HEATING (b) - 1.5 CREDITS

ALL SHOWERHEAD AND KITCHEN SINK FAUCETS INSTALLED IN THE HOUSE SHALL BE RATED AT 1.75 GPM or LESS.

ALL OTHER LAVATORY FAUCETS SHALL BE RATED AT 1.0 GPM or LESS.

SUMMARY



SQUARE FOOTAGE SUMMARY

LOWER FLOOR AREA	0 S.F.
MAIN FLOOR AREA	2,191 S.F.
UPPER FLOOR AREA	2,644 S.F.
TOTAL CONDITIONED AREA	4840 S.F.
2 CAR GARAGE	702 S.F.
COVID PATIO	915 S.F.
COVID PORCH	57 S.F.
TOTAL AREA UNDER ROOF	6,414 S.F.
OVERALL WIDTH	45'-0"
OVERALL DEPTH	44'-8"

Updated: 12.09.20

Method for Calculating Square Footage - ANSI Z765-2019 excludes no separate distinction of above-grade or below-grade areas and each level is measured to the outside of studs not the exterior finished surface.

Square footage calculations for this house were made based on plan dimensions only and may vary from square footage measurements on the house site.

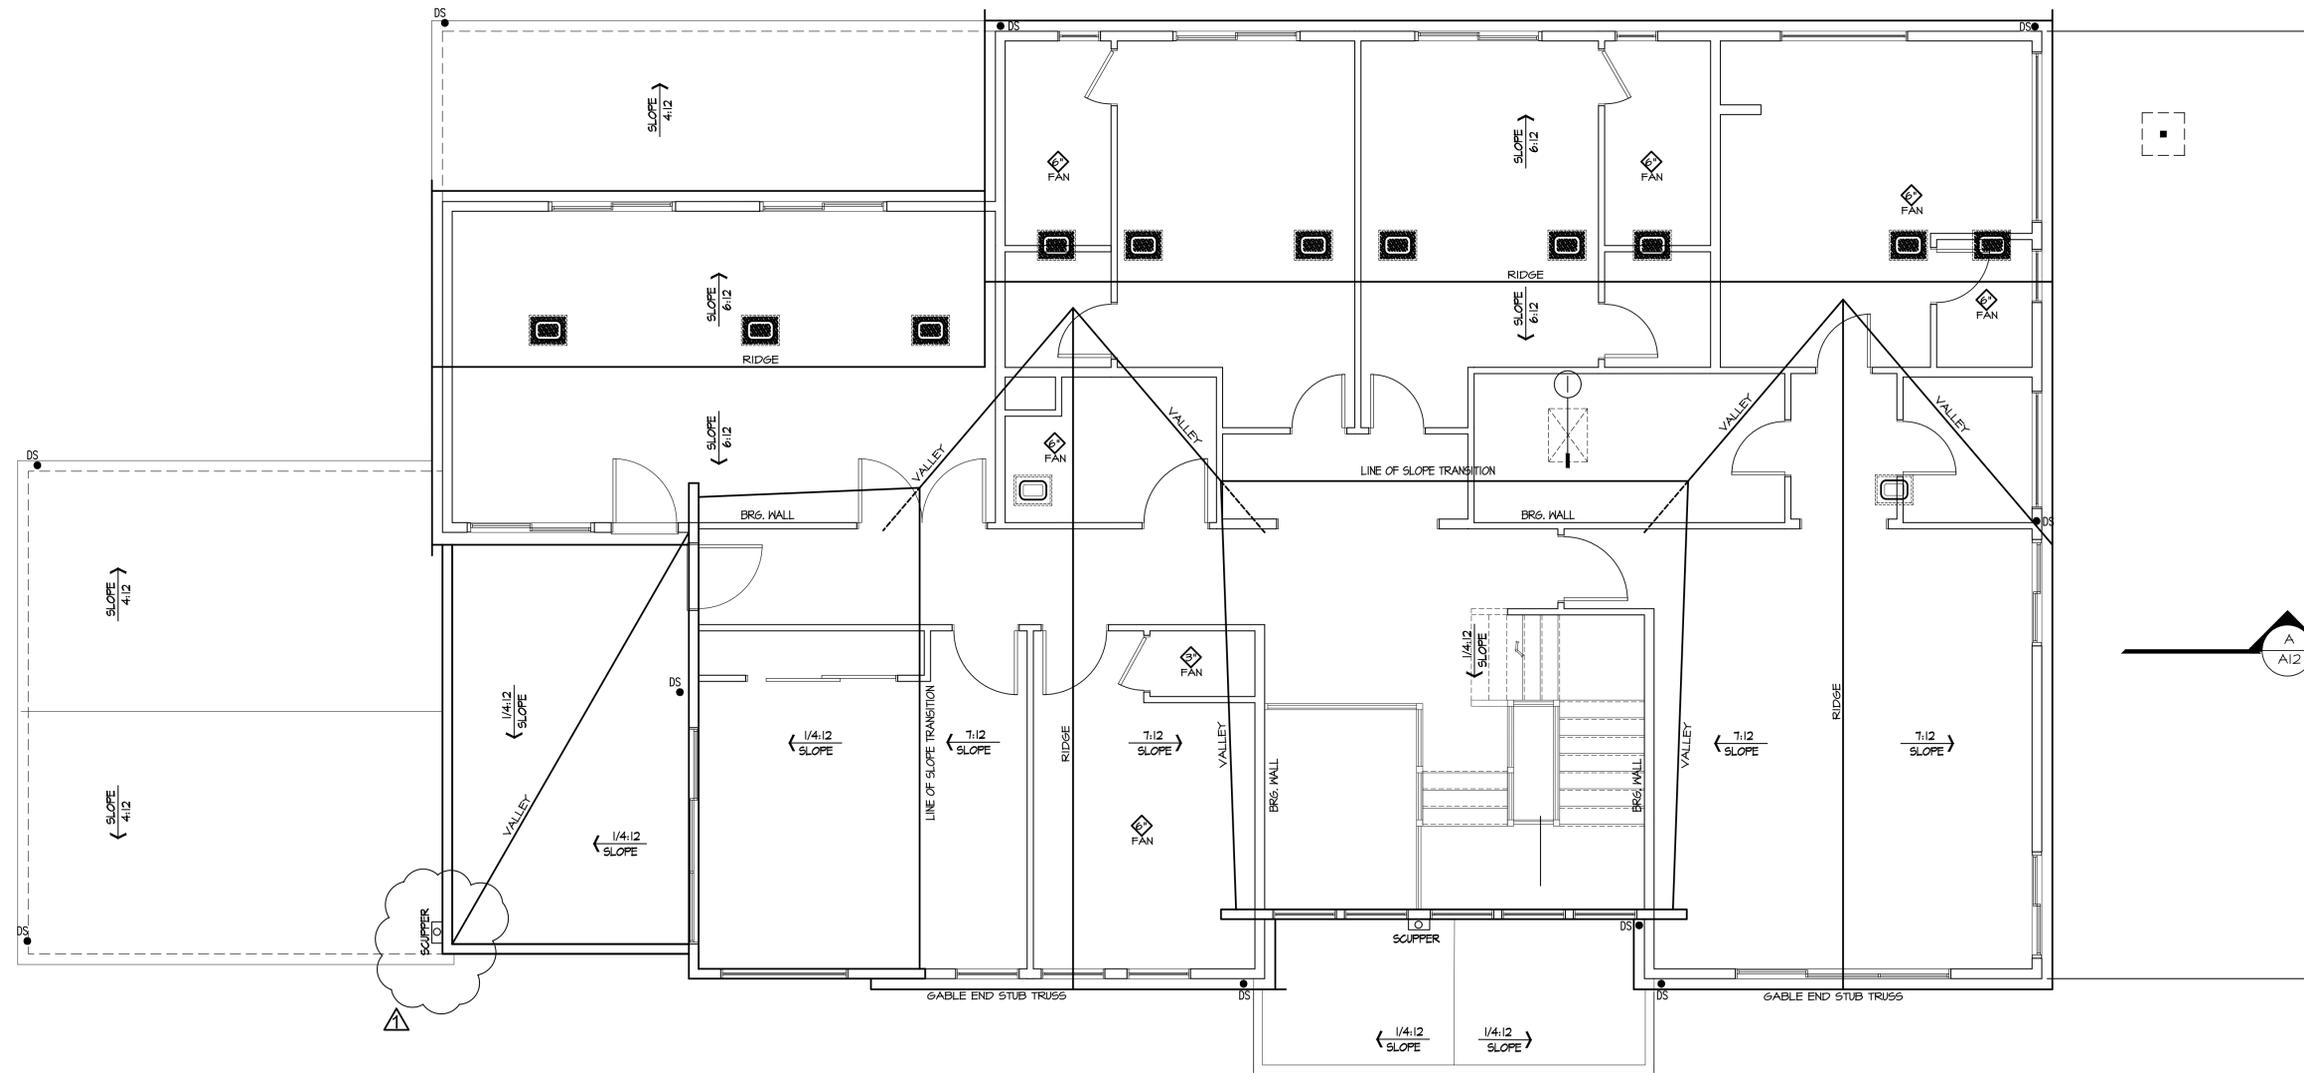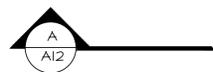

ROOF PLAN

1/4" = 1'-0"

JAYMARC HOMES
 7525 SE 24th St., 487
 Mercer Island, WA
 98040
 425.266.9100

4.21.23 RKN
 M.I. BUILDING COMMENTS

Spring Residence
 4740 W. Mercer Way
 Mercer Island, WA.
 Job Number: Spring JMC011

plan name: -
 marketing name: -
 plan number: -
 mark sys. number: -

Conditions not specifically represented graphically or in writing or which conflict with the current International Residential Code (IRC.) or those of the local municipality then the current standards and requirements of each respectively shall govern.

The drawings in this set are instruments of service and shall remain the property of JayMarc Homes, LLC.

© 2017 JayMarc Homes, LLC; All rights reserved.

03.21.23
 Submittal Date

Sheet Title/Description
 JAYMARC HOMES
 Design Firm

R.K.N.
 Drawn by:

S.K.
 Checked by:


Primary Scale

A8
 of .

Sheet Title/Description

LOWER ROOF VENTILATION @ GARAGE	
Standard Truss / Scissor Truss Roof Framing Assembly: ZONE 1	
Roof Area:	443 s.f.
Ventilation Required:	443 s.f. x 144 s.i. / s.f. / 300 = 212.64 s.i. Req'd
Provide between 40% & 50% of the total required ventilation no more than 3 ft below the ridge or the highest point of the space. Remainder to be installed at eave vents.	
Ridge Ventilation: 50% of ventilation	50.16
Continuous Ridge Vent =	18.00 s.i. per l.f.
Upper Ventilation MIN. Req'd =	106.32 s.i. x 0.4 / s.i. per linear foot = 5 l.f.
Upper Ventilation MAX. Req'd =	106.32 s.i. x 0.5 / s.i. per linear foot = 5 l.f.
Provide:	0 l.f. ridge vent. Ventilation = 0.00 s.i.
Ventilation area remainder for AF50 vents =	50.16 s.i.
Upper Roof Ventilation: as needed to achieve 50% of ventilation	
AF50 Roof Jack (10" x 7") =	50.00 s.i. each.
Upper Ventilation Req'd TO GET 50% =	50.16 s.i. / s.i. of each vent = 2 vents
Provide:	3 -10"x7" roof jacks. Ventilation = 150.00 s.i.
Eave Ventilation:	
Birdblocking: (3/2" dia holes per bay =	4.71 s.i. / l.f. - 25% reduction = 3.53 s.i. / l.f.
Eave Ventilation Req'd =	106.32 s.i. / s.i. per l.f. = 92.62 l.f.
Provide Minimum:	20 l.f. birdblocking. Ventilation = 70.85 s.i.
Minimum Ventilation Provided =	220.65 s.i. IS GREATER THAN : 212.64 s.i. Req'd

LOWER ROOF VENTILATION @ KITCHEN & DINING	
Standard Truss / Scissor Truss Roof Framing Assembly: ZONE 1	
Roof Area:	209 s.f.
Ventilation Required:	209 s.f. x 144 s.i. / s.f. / 300 = 100.32 s.i. Req'd
Provide between 40% & 50% of the total required ventilation no more than 3 ft below the ridge or the highest point of the space. Remainder to be installed at eave vents.	
Ridge Ventilation: 50% of ventilation	50.16
Continuous Ridge Vent =	18.00 s.i. per l.f.
Upper Ventilation MIN. Req'd =	50.16 s.i. x 0.4 / s.i. per linear foot = 3 l.f.
Upper Ventilation MAX. Req'd =	50.16 s.i. x 0.5 / s.i. per linear foot = 2 l.f.
Provide:	0 l.f. ridge vent. Ventilation = 0.00 s.i.
Ventilation area remainder for AF50 vents =	50.16 s.i.
Upper Roof Ventilation: as needed to achieve 50% of ventilation	
AF50 Roof Jack (10" x 7") =	50.00 s.i. each.
Upper Ventilation Req'd TO GET 50% =	50.16 s.i. / s.i. of each vent = 2 vents
Provide:	2 -10"x7" roof jacks. Ventilation = 100.00 s.i.
Eave Ventilation:	
Birdblocking: (3/2" dia holes per bay =	4.71 s.i. / l.f. - 25% reduction = 3.53 s.i. / l.f.
Eave Ventilation Req'd =	50.16 s.i. / s.i. per l.f. = 78.47 l.f.
Provide Minimum:	15 l.f. birdblocking. Ventilation = 52.99 s.i.
Minimum Ventilation Provided =	152.99 s.i. IS GREATER THAN : 100.32 s.i. Req'd

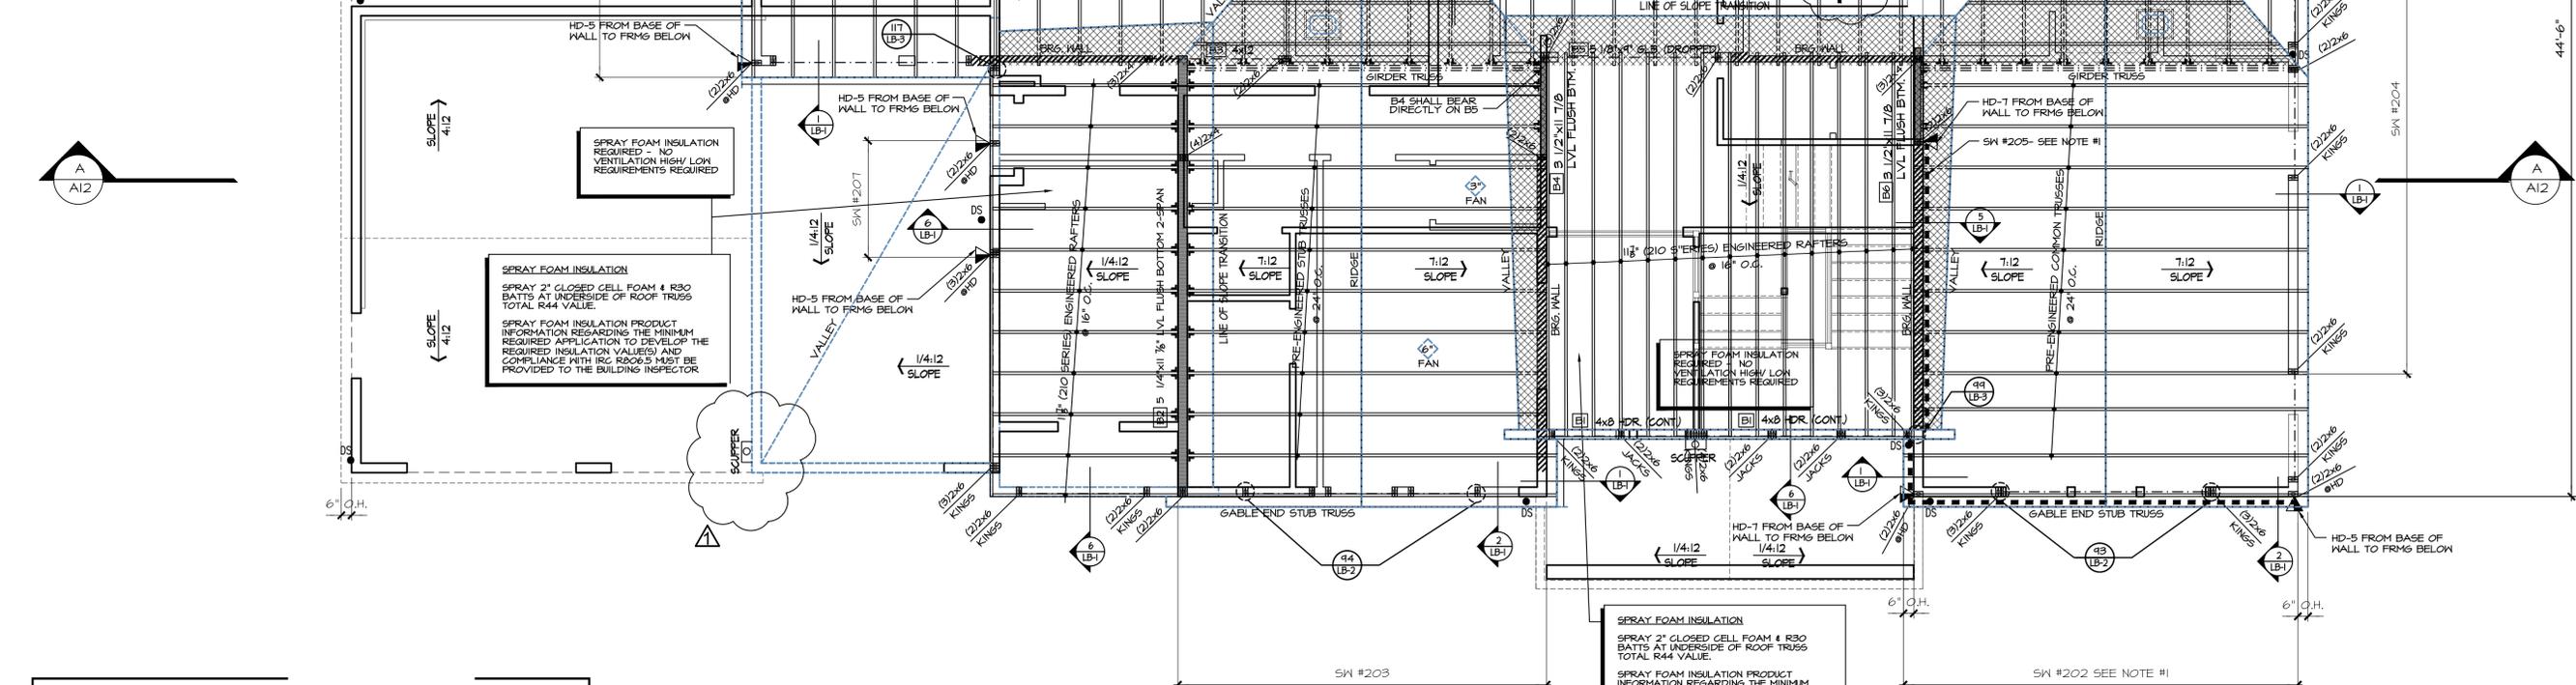

Upper Roof Ventilation: as needed to achieve 50% of ventilation	
Standard Truss / Scissor Truss Roof Framing Assembly: ZONE 1	
Roof Area:	2477 s.f.
Ventilation Required:	2477 s.f. x 144 s.i. / s.f. / 300 = 1189 s.i. Req'd
Provide between 40% & 50% of the total required ventilation no more than 3 ft below the ridge or the highest point of the space. Remainder to be installed at eave vents.	
Ridge Ventilation: 50% of ventilation	50.16
Continuous Ridge Vent =	18.00 s.i. per l.f.
Upper Ventilation MIN. Req'd =	594.48 s.i. x 0.4 / s.i. per linear foot = 27 l.f.
Upper Ventilation MAX. Req'd =	594.48 s.i. x 0.5 / s.i. per linear foot = 33 l.f.
Provide:	0 l.f. ridge vent. Ventilation = 0.00 s.i.
Ventilation area remainder for AF50 vents =	50.16 s.i.
Upper Roof Ventilation: as needed to achieve 50% of ventilation	
AF50 Roof Jack (10" x 7") =	50.00 s.i. each.
Upper Ventilation Req'd TO GET 50% =	50.16 s.i. / s.i. of each vent = 2 vents
Provide:	13 -10"x7" roof jacks. Ventilation = 650.00 s.i.
Eave Ventilation:	
Birdblocking: (3/2" dia holes per bay =	4.71 s.i. / l.f. - 25% reduction = 3.53 s.i. / l.f.
Eave Ventilation Req'd =	594.48 s.i. / s.i. per l.f. = 234.17 l.f.
Provide Minimum:	153 l.f. birdblocking. Ventilation = 540.47 s.i.
Minimum Ventilation Provided =	1190.47 s.i. IS GREATER THAN : 1189 s.i. Req'd

NOTE #2:
 PROVIDE SIMPSON CSI6 STRAP FROM DBL. TOP PLATE (13" END LENGTH) TO UNDERSIDE OF 2X BLOCKING BETWEEN TRUSS BOT. CHORDS FOR (3) TRUSS BAYS (6'-0" MIN.) PROVIDE 2X BLOCKING @ TOP CHORDS OF TRUSSES + SHTG. BETWEEN TOP CHORD @ BOT. CHORD BLOCKING FASTENED W/ 2 1/2"x0.131" NAILS @ 6" O.C. @ SHTG. EDGES. FASTEN ROOF SHTG. TO BLOCKING W/ 2 1/2"x0.131" NAILS @ 6" O.C.

REFER TO S-O FOR TYPICAL STRUCTURAL NOTES & SCHEDULES

PROVIDE CONT. EXT. SHEATHING BEHIND LOW TRUSSES DOWN TO SECOND FLOOR SOLE PLATE (TYP. @ LOW ROOF)

NOTE #1:
 PROVIDE 3/8" OSB OR PLYWOOD FASTENED PER 3" O.C. EDGE NAILING (SEE S-O)

4x8 HDR @ ALL EXT. WINDOWS/DOORS (TYP. U.N.O.)

LEGEND	
	INTERIOR BEARING WALL
	BEAM / HEADER
	ROOF TRUSS @ 24" O.C. (U.N.O.)
	GIRDER TRUSS
	INTERIOR SHEAR WALL PANEL OR EXTERIOR SHEAR WALL W/ 3" O.C. EDGE NAILING
	J.L. METAL HANGER
	INDICATES OVER FRAMED TRUSS AREA

JAYMARC HOMES
 7525 SE 24th St., 487
 Mercer Island, WA
 98040
 425.266.9100

4.21.23 RKN
 M.I. BUILDING COMMENTS

Spring Residence
 4740 W. Mercer Way
 Mercer Island, WA.
 Job Number: Spring JMC011

plan name: ---
 marketing name: ---
 plan number: ---
 mark sys. number: ---

Conditions not specifically represented graphically or in writing or which conflict with the current International Residential Code (IRC.) or those of the local municipality then the current standards and requirements of each respectively shall govern.

The drawings in this set are instruments of service and shall remain the property of JayMarc Homes, LLC.

© 2017 JayMarc Homes, LLC. All rights reserved.

03.21.23
 Submittal Date

Sheet Title/Description
 JAYMARC HOMES
 Design Firm

R.K.N.
 Drawn by:

S.K.
 Checked by:


Primary Scale

A9
 of .


ROOF FRAMING PLAN

1/4" = 1'-0"


Sheet Title/Description

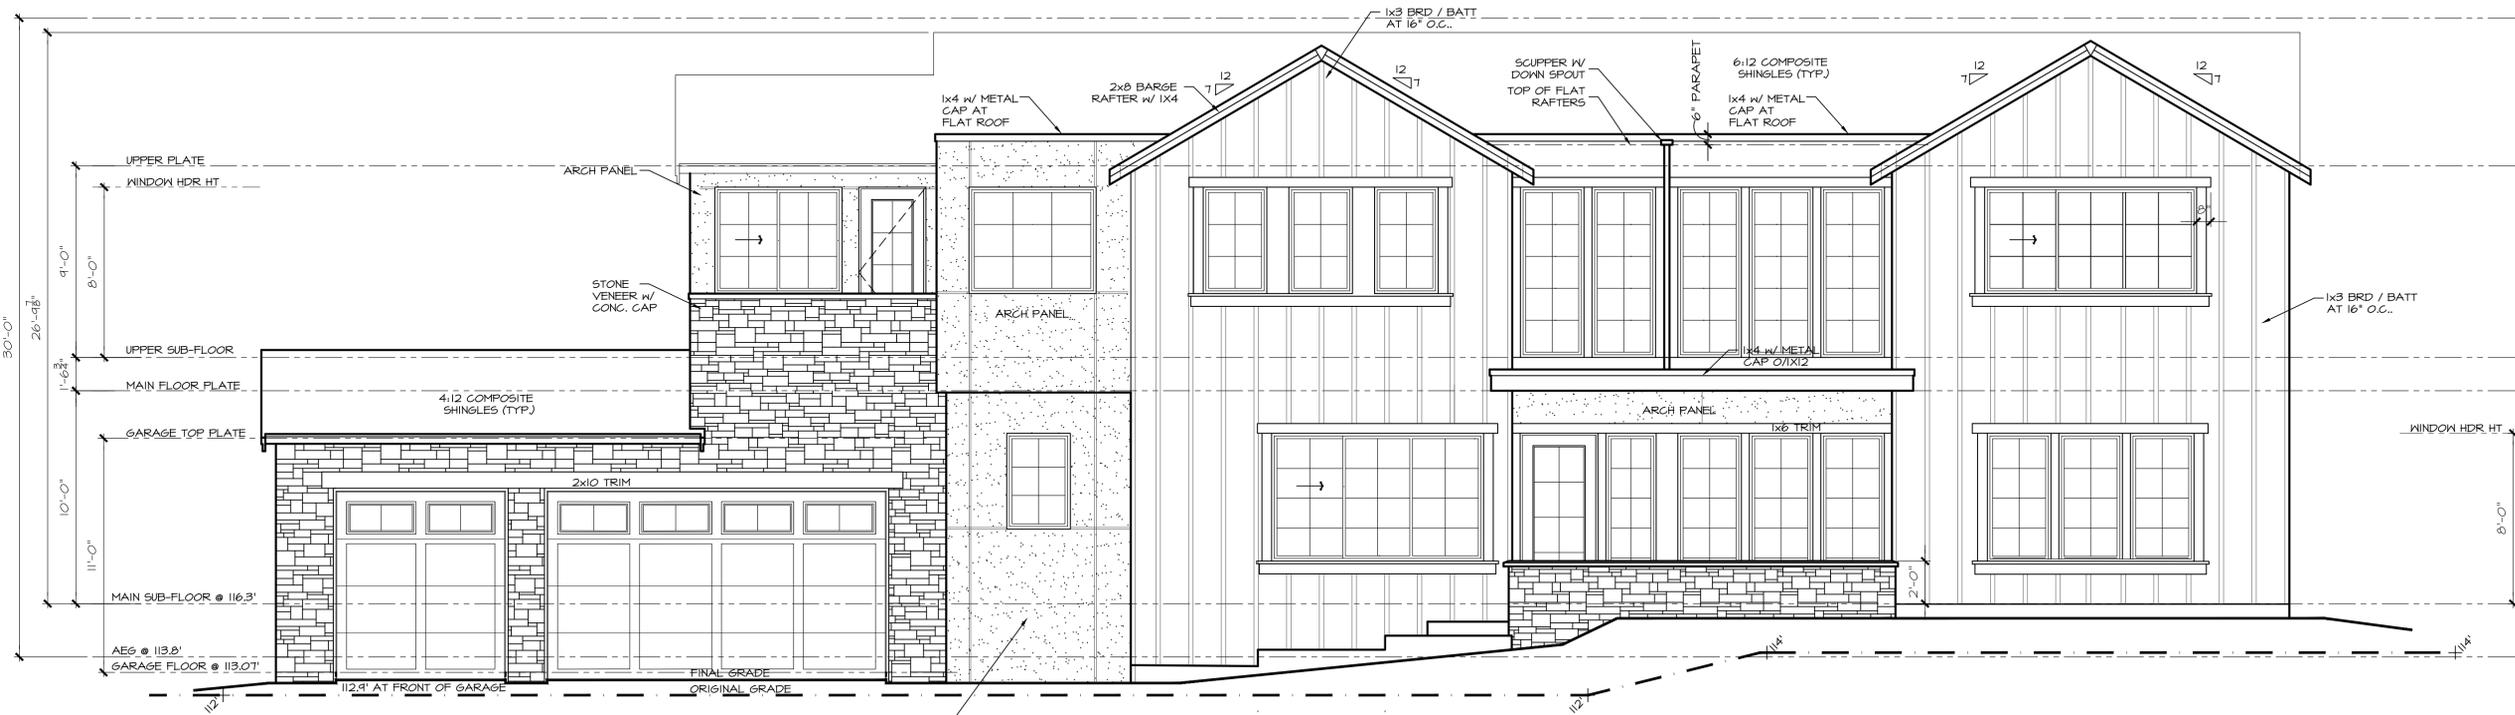

FRONT ELEVATION
 1/4" = 1'-0"

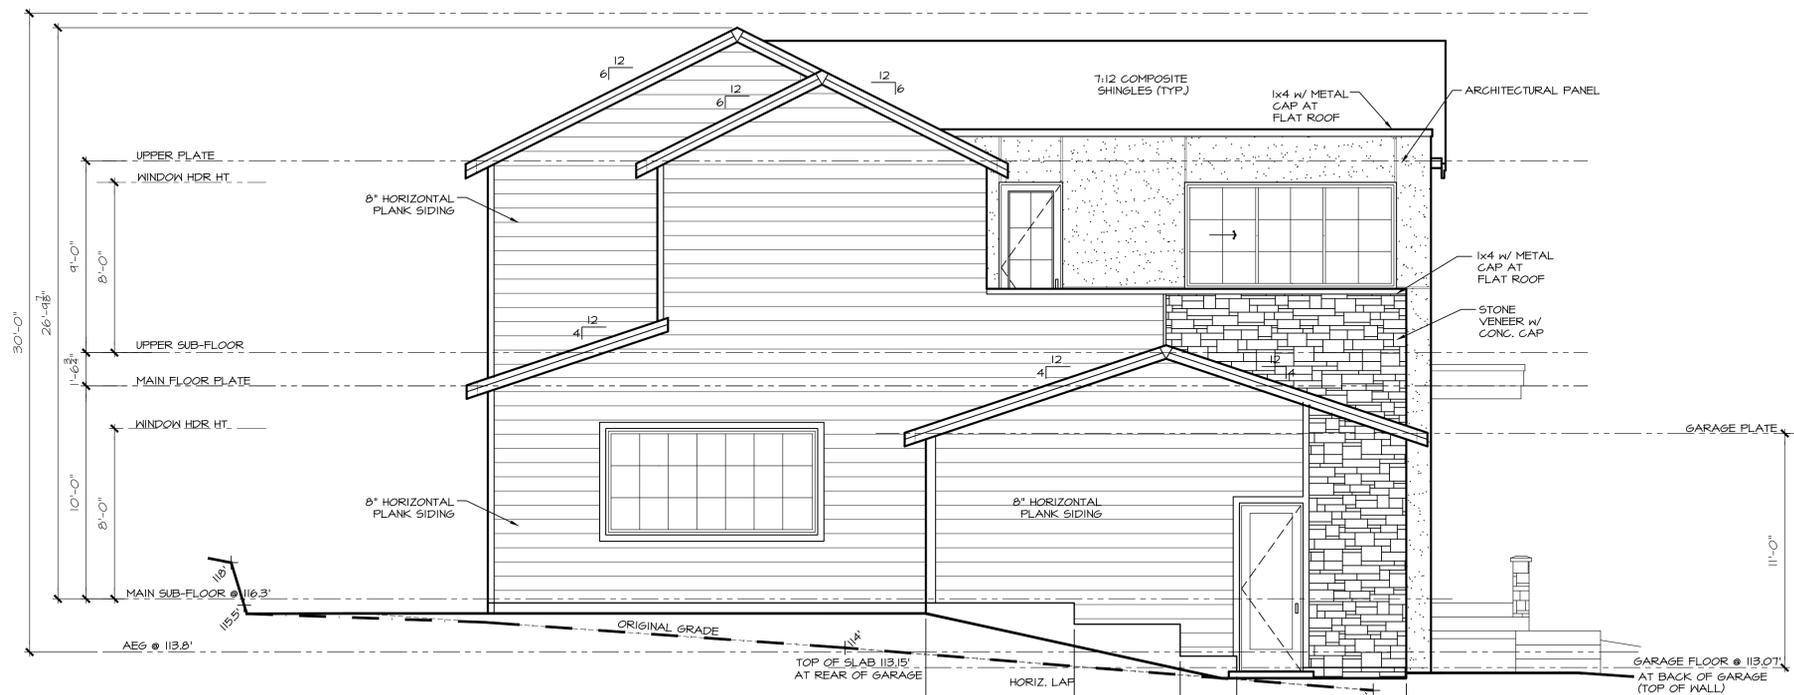

LEFT ELEVATION
 1/4" = 1'-0"

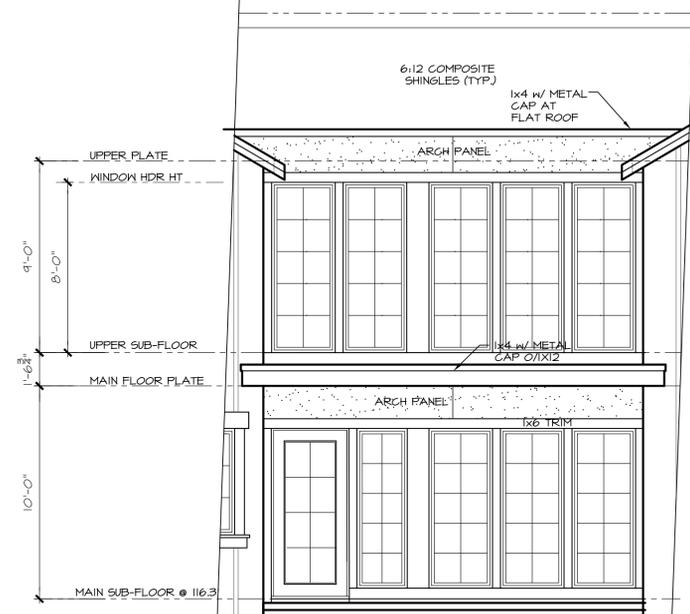


PARTIAL FRONT ELEVATION
 1/4" = 1'-0"

Sheet Title/Description



REAR ELEVATION



1/4" = 1'-0"

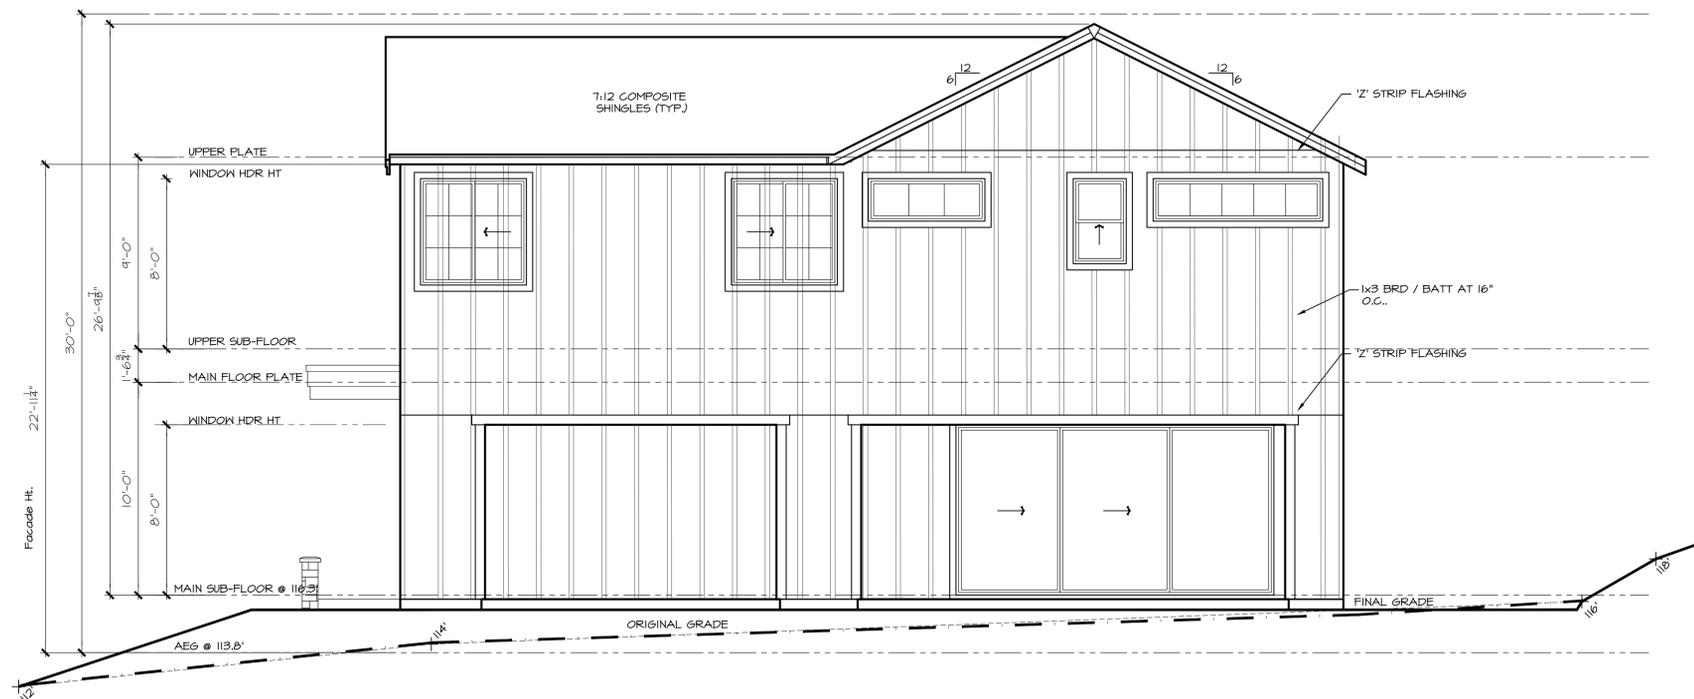

RIGHT ELEVATION

1/4" = 1'-0"

NOTES:

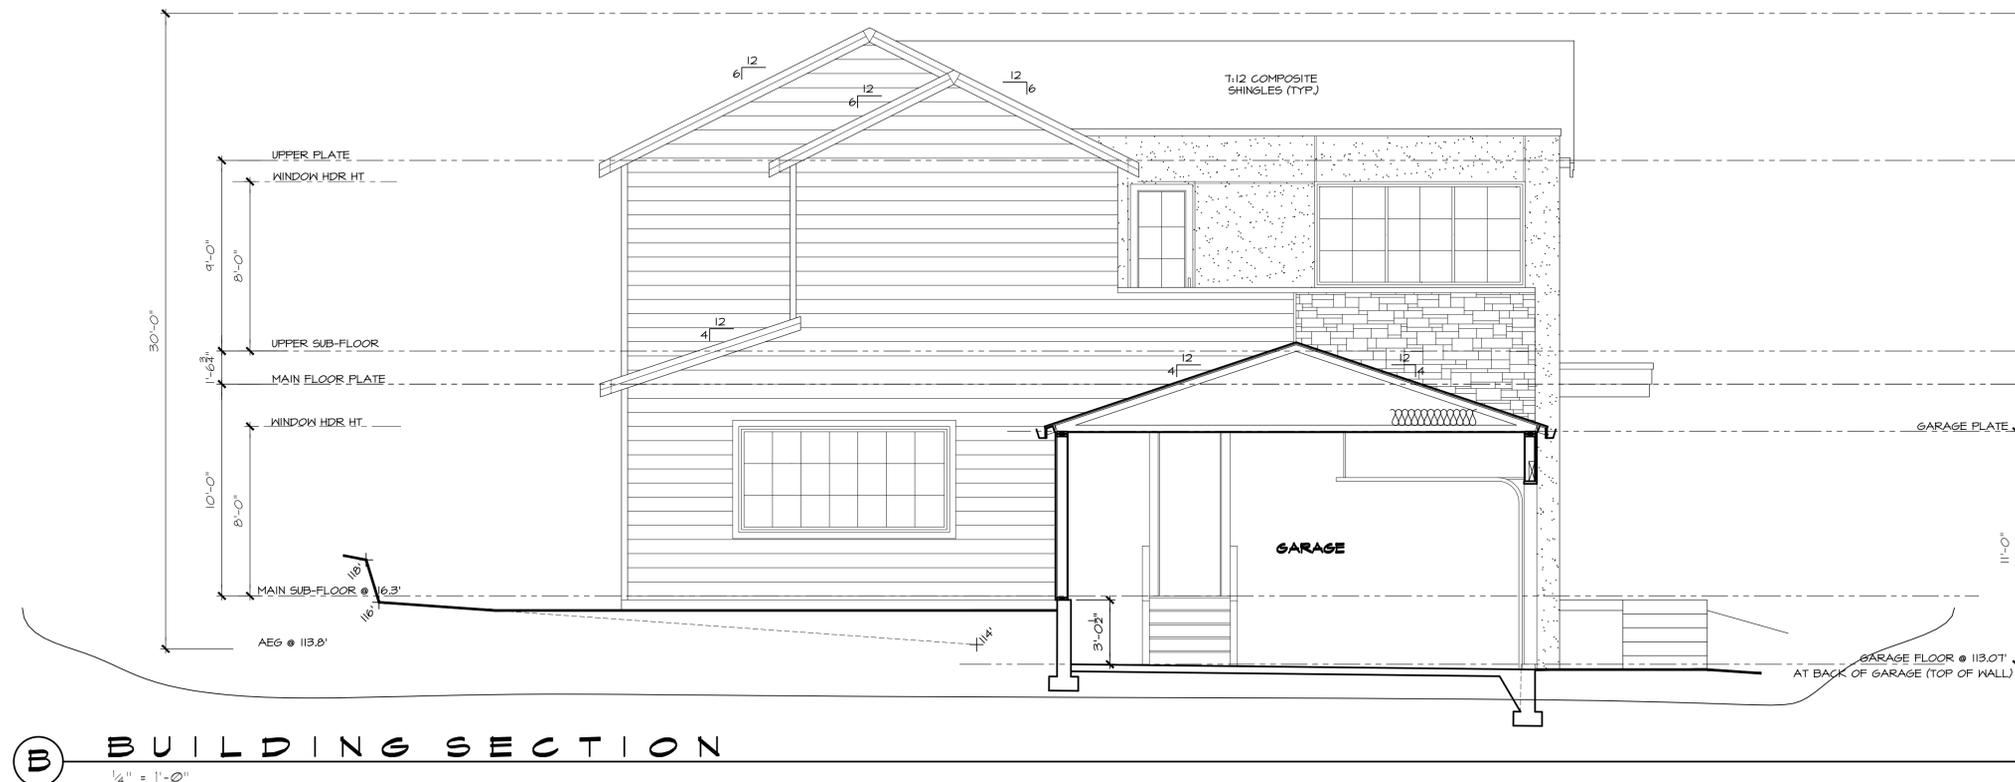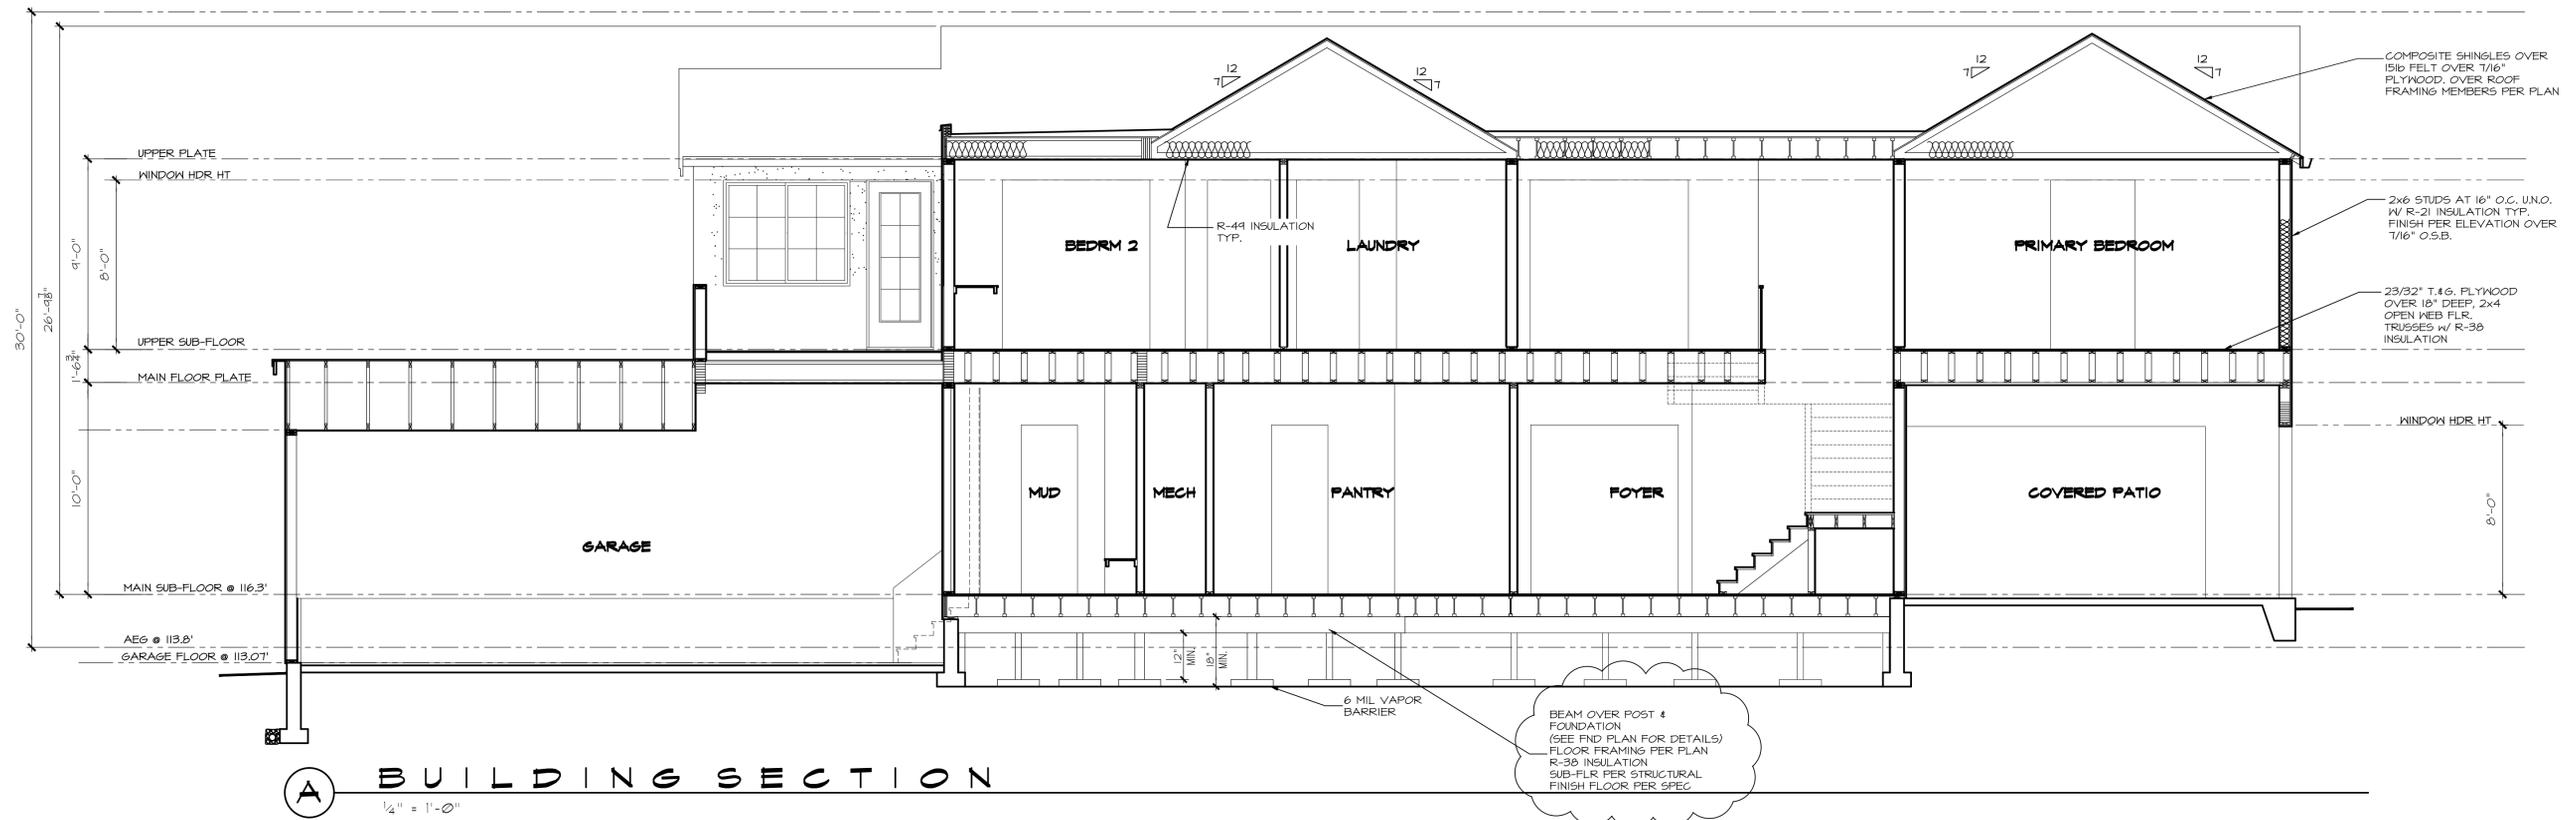

4.21.23 RKN
 M.I. BUILDING COMMENTS

Spring Residence
 4740 W. Mercer Way
 Mercer Island, WA.
 Job Number: Spring
 JMC011

plan name: -
 marketing name: -
 plan number: -
 mark sys. number: -

Conditions not specifically represented graphically or in writing or which conflict with the current international Residential Code (IRC.) or those of the local municipality then the current standards and requirements of each respectively shall govern.

The drawings in this set are instruments of service and shall remain the property of JayMarc Homes, LLC.

© 2017 JayMarc Homes, LLC; All rights reserved.

03.21.23
 Submittal Date

Sheet Title/Description
 JAYMARC HOMES
 Design Firm


R.K.N.
 Drawn by:

S.K.
 Checked by:


Primary Scale

A12
 of .


Sheet Title/Description

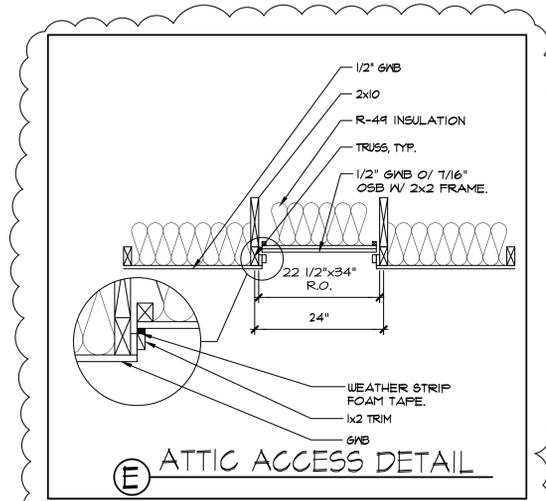

▲

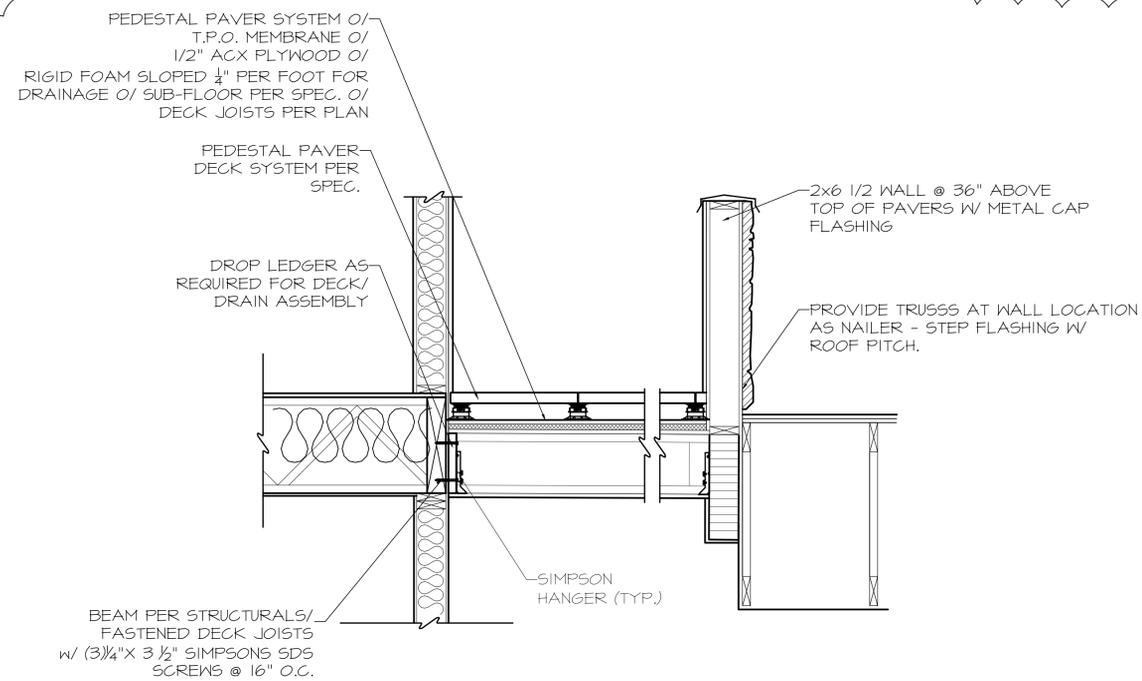

D PEDESTAL PAVER DECK
 1/2" = 1'-0"

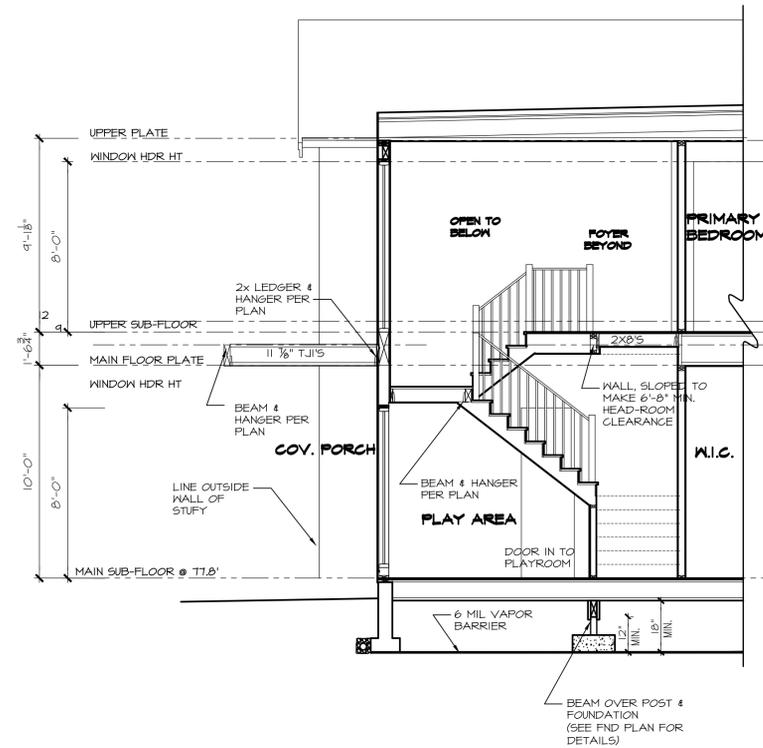

C STAIR SECTION
 1/4" = 1'-0"

BASEMENT SLAB
4" CONC. SLAB ON 6 MIL VAPOR BARRIER ON 4" MIN. GRANULAR FILL ON 95% COMPACTED FILL/VIRGIN SOIL
GARAGE SLAB
4" CONC. SLAB ON 6 MIL VAPOR BARRIER ON 4" MIN. GRANULAR FILL ON 95% COMPACTED FILL/VIRGIN SOIL
PORCH SLAB
4" CONC. SLAB ON GRADE ON 6 MIL VAPOR BARRIER ON 4" MIN. GRANULAR FILL ON 95% COMPACTED FILL/VIRGIN SOIL

GENERAL STRUCTURAL NOTES	
FOUNDATION	
<ul style="list-style-type: none"> DESIGN IS BASED ON 2018 INTERNATIONAL RESIDENTIAL CODE & 2018 INTERNATIONAL BUILDING CODE DESIGN LOADS: <ul style="list-style-type: none"> SOIL: 1500 PSF ALLOWABLE BEARING PRESSURE CONCRETE SHALL ATTAIN THE FOLLOWING MINIMUM COMPRESSIVE STRENGTHS IN 28 DAYS, UNO: <ul style="list-style-type: none"> F_c = 2500 psi: FOUNDATION WALLS* 2500 psi: FOOTINGS* 2500 psi: INTERIOR SLABS ON GRADE 3500 psi: GARAGE & EXT. SLABS ON GRADE f_y = 60,000 psi * UTILIZE 5# SACK 2500 PSI CONCRETE MIXES THAT ARE EQUIVALENT TO 3,000 PSI CONCRETE FOR WEATHERING POTENTIAL ALL CONCRETE EXPOSED TO THE WEATHER SHALL NOT HAVE LESS THAN 5% OR MORE THAN 7% AIR ENTRAINMENT. FOUNDATION WALL DESIGN IS BASED ON BACKFILL SOIL CLASSIFICATIONS OF SC, ML-CL, OR CL (60 pcf) SOIL. TYPICAL REINFORCEMENT DETAILS: LAP ALL REBAR 24" MIN; BEND BARS AND LAP AT CORNERS; PROVIDE 6" HOOK INTO SUPPORTING FOOTINGS WHEN FOOTINGS INTERSECT; PROVIDE 3" MINIMUM COVER AT THE BOTTOM BARS AND 1 1/2" COVER AT THE SIDES. FOUNDATION WALLS SHALL BE BRACED, PRIOR TO BACKFILLING, BY EITHER ADEQUATE TEMPORARY BRACING OR INSTALLATION OF FIRST FLOOR DECK. ALL FOOTINGS SHALL BEAR BELOW FROST LINE. CONSULT SOILS REPORT/ LOCAL MUNICIPALITY FOR MINIMUM DEPTH BELOW GRADE. FOOTINGS AND SLABS ON GRADE SHALL BEAR ON VIRGIN SOIL OR 95% COMPACTED FILL. PROVIDE CONTROL JOINTS AT ALL INSIDE CORNERS OF SLAB EDGES, AND OTHER LOCATIONS WHERE SLAB CRACKS ARE LIKELY TO DEVELOP. (5'-9" O.C.) FASTEN SILL FLATES TO FOUNDATION WALLS WITH 3/8" DIA. ANCHOR BOLTS W/ MIN. 3"x3"x 1/2" PLATE WASHERS (EDGE OF WASHER TO BE LOCATED WITHIN 1/2" OF EXTERIOR EDGE OF SILL PLATE) & NUTS @ 6'-0" O.C. @ 2-STORY & 4'-0" O.C. @ 3-STORY CONDITIONS W/ 7" MIN. EMBEDMENT INTO CONC. PROVIDE A MINIMUM OF 2 ANCHORS PER PLATE, 12" MAXIMUM FROM PLATE ENDS, UNO. SEE FND. DETAILS. ALL LUMBER EXPOSED TO WEATHER OR IN CONTACT W/ CONCRETE OR MASONRY FOUNDATION SHALL BE PRESERVATIVE TREATED HEM FIR #2. BUILDER TO VERIFY CORROSION-RESISTANCE COMPATIBILITY OF HARDWARE & FASTENERS IN CONTACT W/ PRESERVATIVE-TREATED WOOD. CONTACT LUMBER & HARDWARE SUPPLIERS TO COORDINATE. ARCHBUILDER TO VERIFY ALL DIMENSIONS. 	

LOADING AND DESIGN PARAMETERS	
GRAVITY DESIGN LOADS:	
DEAD LOAD (PSF):	
ROOF TRUSS TOP CHORD :	10
ROOF TRUSS BOTTOM CHORD :	7
FLOOR (TRUSSES) :	15
ROOF / FLOOR / DECK (JOISTS) :	10
FEDESTAL PAVERS :	15
TILE FLOORS :	10
STUCCO :	10
LIVE LOAD (PSF):	
ROOF :	20
RESIDENTIAL LIVING AREAS :	40
RESIDENTIAL SLEEPING AREAS :	30
RESIDENTIAL WOOD DECKS :	60
GARAGE :	50
SNOW LOAD:	
GROUND SNOW LOAD (P _g) (PSF) :	25
FLAT ROOF SNOW LOAD (P _f) (PSF) :	25
SNOW EXPOSURE FACTOR (C _e) :	0.9
SNOW LOAD IMPORTANCE FACTOR (I _s) :	1.0
THERMAL FACTOR (C _t) :	1.2
LATERAL DESIGN LOADS:	
WIND LOAD: (IBC 1604)	
SPEED (V ₅₀) (MPH) :	100
WIND RISK CATEGORY :	II
IMPORTANCE FACTOR (I _w) :	1.0
EXPOSURE CATEGORY :	1
INTERNAL PRESSURE COEFF. (GC _i) :	0.0
TOPOGRAPHIC FACTOR (K _z) :	1.6
SEISMIC LOAD: (IBC 1601)	
SEISMIC RISK CATEGORY :	II
SEISMIC IMPORTANCE FACTOR (I _s) :	1.0
MAPPED SPECTRAL RESPONSE :	
S _e 1.440	S _e 0.500
SITE CLASS :	(D) (DEFAULT)
SPECTRAL RESPONSE COEFF. :	S _s 1.52
S _s 0.600	D
SEISMIC DESIGN CATEGORY:	
BASIC SEISMIC-FORCE-RESISTING SYS :	
LIGHT FRAMED WALLS	
WOOD STRUCTURAL SYSTEMS	
ULTIMATE BASE SHEAR:	
TRANS: 23 K	LONG: 23 K
SEISMIC RESPONSE COEFF. (C _d) :	
TRANS: 0.111	LONG: 0.111
RESPONSE MODIFICATION FACTOR (R) :	
TRANS: 6.5	LONG: 6.5
ANALYSIS PROCEDURE USED:	EQUIVALENT LATERAL FORCE

LATERAL BRACING NOTES	
THIS HOME HAS BEEN ENGINEERED TO RESIST LATERAL FORCES RESULTING FROM: <ul style="list-style-type: none"> 100 MPH WIND SPEED, EXP. C (ASCE 7-16 WIND MAP, PER IRC R301.2.1.1) RISK CAT. 2 & SEISMIC CAT. D2. 	
110 MPH WIND IN 2018 IRC MAP	
ENGINEERED DESIGN WAS COMPLETED PER 2018 IBC (SECTION 1604 & 1613) & ASCE 7-16, AS PERMITTED BY R301.1.3 OF THE 2018 IRC. ACCORDINGLY, THIS HOME, AS DOCUMENTED AND DETAILED HEREWITHIN, IS ADEQUATE TO RESIST THE CODE REQUIRED LATERAL FORCES, AND DOES NOT NEED TO CONFORM TO THE PRESCRIPTIVE PROVISIONS OF R602.10.	
STANDARD EXTERIOR WALL SHEATHING SPECIFICATIONS	
(INTERIOR WALL SPECIFICATION WHERE NOTED ON PLANS)	
<ul style="list-style-type: none"> 1/8" OSB OR 1/2" PLYWOOD: <p>FASTEN SHEATHING W/ 2 1/2"x0.131" NAILS @ 6" O.C. AT ALL SUPPORTED PANEL EDGES AND 12" O.C. IN THE PANEL FIELD. ALL SHEATHING SHEET PANEL EDGES SHALL OCCUR OVER WALL FRAMING MEMBERS OR 2x HORIZONTAL BLOCKING SHALL BE PROVIDED TO SUPPORT PANEL EDGE. ALL EXTERIOR WALLS SHALL BE CONSTRUCTED PER THIS SPECIFICATION UNO. ON PLANS.</p>	
3" O.C. EDGE NAILING	
(WHERE NOTED ON PLANS)	
<ul style="list-style-type: none"> 1/8" OSB OR 1/2" PLYWOOD: <p>ONLY AT LOCATIONS INDICATED ON PLANS - SHEATH PANEL SHOWN WITH 1/8" OSB. FASTEN SHEATHING W/ 2 1/2"x0.131" NAILS @ 3" O.C. AT EDGES AND 12" O.C. AT CENTER. ALL SHEATHING SHEET PANEL EDGES SHALL OCCUR OVER WALL FRAMING MEMBERS OR 2x HORIZONTAL BLOCKING SHALL BE PROVIDED TO SUPPORT PANEL EDGE AND 3" O.C. FASTENING.</p>	
NOTES:	
<ol style="list-style-type: none"> LATERAL ANALYSIS ASSUMES STUD SPACING @ 16" O.C. ALL SHEAR WALLS SHALL HAVE DOUBLE TOP PLATES FASTENED TOGETHER W/ 3"x0.131" NAILS @ 8" O.C. USE (2) 2 1/2"x0.131" NAILS AT EACH LAP SPLICE. (6) EACH SIDE OF JOINT (TYP. UNO.) ALL EXTERIOR WALLS ARE CONTINUOUSLY SHEATHED. ALL INTERIOR SHEAR WALLS AND EXTERIOR WALLS ARE SHEATHED ABOVE AND BELOW OPENINGS. 	


GENERAL STRUCTURAL NOTES	
DESIGN PARAMETERS	
<ul style="list-style-type: none"> DESIGN IS BASED ON 2018 INTERNATIONAL RESIDENTIAL CODE & 2018 INTERNATIONAL BUILDING CODE WOOD FRAME ENGINEERING IS BASED ON NDS, NATIONAL DESIGN SPECIFICATION FOR WOOD CONSTRUCTION - LATEST EDITION. 	
GENERAL FRAMING	
<ul style="list-style-type: none"> EXTERIOR BEARING WALLS SHALL BE 2x4 OR 2x6 (AS SHOWN ON PLANS) @ 16" O.C. (W/ DOUBLE TOP PLATE) HEM FIR (HF) "STUD" GRADE LUMBER, OR BETTER, UNO. INTERIOR BEARING WALLS SHALL BE 2x4 OR 2x6 (AS SHOWN ON PLANS) @ 16" O.C. (W/ DOUBLE TOP PLATE) HEM FIR (HF) "STUD" GRADE LUMBER, OR BETTER, UNO. ALL NON-BEARING INTERIOR STUD WALLS SHALL BE CONSTRUCTED WITH 2x "STUD" GRADE MEMBERS SPACED @ 24" O.C. (MAX.) ALL WALLS TALLER THAN TYP. PLATE HEIGHT SHALL BE CONSIDERED BALLOON FRAMED & SHALL BE CONSTRUCTED FROM FLOOR TO UNDERSIDE OF FRAMING AT NEXT LEVEL. BF. WALLS SHALL BE 2x4 OR 2x6 (AS SHOWN ON PLANS) HEM FIR (HF) #2 GRADE LUMBER, OR BETTER. ALL HEADERS SHALL BE SUPPORTED BY (1) 2x JACK STUD & (1) 2x KING STUD, MINIMUM. THE NUMBER OF STUDS SPECIFIED AT A SUPPORT INDICATES THE NUMBER OF JACK STUDS REQUIRED, UNO. BUILT-UP POSTS SHALL BE 2x4 OR 2x6 HEM FIR (HF) "STUD" GRADE LUMBER, OR BETTER, UNO. & SOLID WOOD COLUMN SHALL BE SPRUCE PINE FIR (SPF) #2 GRADE LUMBER, OR BETTER, UNO. ALL 2x6 AND LARGER SOLID SAWN BEAMS/HEADERS SHALL BE HEM FIR #2 (HF #2) OR BETTER. ALL 4x6 AND LARGER SOLID SAWN LUMBER SHALL BE DOUG FIR #2 (DF #2) OR BETTER. ALL FRAMING LUMBER SHALL BE KILN DRIED TO 15% MC (KD-15). ALL TYP. NAIL FASTENER REQUIREMENTS ARE NOTED IN GENERAL NOTES, IN DETAILS, OR ON PLANS. ALL NAILS SPECIFIED ARE MIN DIAMETER AND LENGTH REQUIRED FOR CONNECTION. ALL HANGER NAILS SHALL BE INSTALLED PER MANUFACTURER'S REQUIREMENTS FOR MAX CHARTED CAPACITY. NOTE: HANGERS USE COMMON NAIL DIAMETERS NOT TYPICAL FRAMING SAWN NAILS. FASTEN ALL BEAMS TO COLUMN, OR FLUSH BEAMS TO SUPPORTING BEAMS, W/ (4) 3"x0.131" TOENAILS (MN), TYP. UNO. PROVIDE SOLID BLOCKING IN FLOOR SYSTEM UNDER ALL POSTS & HOLD-DOWNS CONTINUOUS TO FOUNDATION/BEARING. BLOCKING TO MATCH POST ABOVE. ENGINEERED LUMBER TO MEET OR EXCEED THE FOLLOWING: <ul style="list-style-type: none"> LVL MEMBERS - Fb=2525 PSI; Fv=910 PSI; E=1.55x10⁶ PSI LVL MEMBERS - Fb=2400 PSI; Fv=2885 PSI; E=1.2x10⁶ PSI GLB MEMBERS - Fb(1)=2400 PSI; Fv(1)=1850 PSI; Fv=265 PSI; E=1.8x10⁶ PSI; DF/DF; 24F-V4 (UNO) ENGINEERED LUMBER POSTS TO MEET OR EXCEED THE FOLLOWING: <ul style="list-style-type: none"> LVL MEMBERS - Fb=2400 PSI; Fc(1)=2500 PSI; E=1.8x10⁶ PSI FACE NAIL MULTI-PLY 2x BEAMS & HEADERS W/ 3-ROWS OF 3"x0.131" NAILS (MN) @ 12" O.C. STAGGERED. APPLY NAILING FROM BOTH FACES @ 3-PLY OR MORE CONDITIONS. UTILIZE 2 ROWS OF NAILS FOR 2x6 & 2x8 MEMBERS. ALL MEMBERS SPECIFIED AS MULTI-PLY (B) SHALL BE FASTENED TOGETHER PER MANUFACTURER. EQUIVALENT WIDTH SOLID MATERIAL MAY BE USED AS EQUAL. FASTEN 2x WOOD PLATES TO TOP FLANGE OF STEEL BEAMS W/ PAFs (HILT) X-U PING OR EQUAL (0.151" DIA. x 2" LONG MIN) @ 16" O.C. STAGGERED, OR 1/2" DIA. BOLTS @ 48" O.C. STAGGERED. REFER TO IRC FASTENING SCHEDULE TABLE R602.3(1) FOR ALL CONNECTIONS, TYP. UNO. 	
FLOOR FRAMING	
<ul style="list-style-type: none"> I-JOISTS/TRUSSES SHALL BE DESIGNED BY MANUF. TO MEET OR EXCEED L/480 LIVE LOAD DEFLECTION CRITERIA AND SHALL RUN CONTINUOUS OVER SUPPORTS WHEREVER POSSIBLE. ALL LOADS SHOWN ON PLAN FOR MANUF. DESIGNS ARE ASS LEVEL LOADS, UNO. (EXCLUDES STONE/MARBLE OR NET BED CONSTRUCTED FLOORS - CONTACT MKK FOR EXCLUDED DESIGNS). ALL METAL I-JOIST/TRUSS HANGERS SHALL BE SPECIFIED BY I-JOIST/TRUSS MANUFACTURER, UNLESS OTHERWISE NOTED. I-JOIST/TRUSS SHOP DRAWINGS SHALL BE SUBMITTED TO ARCHITECT AND ENGINEER FOR REVIEW AND APPROVAL PRIOR TO FABRICATION OR DELIVERY. 2x FLOOR JOISTS HAVE BEEN DESIGNED TO MEET OR EXCEED L/240 LIVE LOAD DEFLECTION CRITERIA. TYPICAL 2x JOIST HANGERS (UNO. ON PLANS): <ul style="list-style-type: none"> SINGLE PLY: SIMPSON LUS20 DOUBLES: SIMPSON LUS20-2 FLOOR SHEATHING SHALL BE 23/32" A.P.A. RATED "STURD-FLOOR" 24" O.C. EXPOSURE 1 (OR APPROVED EQUAL) WITH TONGUE AND GROOVE EDGES. FASTEN TO FRAMING MEMBERS W/ GLUE AND 2 1/2" x 0.131" NAILS @ 6" O.C. @ PANEL EDGES & @ 12" O.C. FIELD. ALL FLUSH CONNECTIONS SHALL BE CONNECTED WITH HANGER APPROPRIATE FOR MEMBER SIZE, UNO. FASTEN HANGERS TO SINGLE PLY FLUSH BEAMS W/ 1/2" LONG NAILS. 	
ROOF FRAMING	
<ul style="list-style-type: none"> FASTEN EACH ROOF TRUSS TO TOP PLATE W/ (4) 3"x0.131" TOENAILS (MN) & (1) SIMPSON 50NCL5600 SCREW @ ALL BEARING POINTS. PROVIDE (2) SIMPSON 50NCL5600 SCREWS AT 2-PLY GIRDER TRUSSES, (3) SIMPSON 50NCL5600 SCREWS AT 3-PLY GIRDER TRUSSES AT ALL BEARING POINTS. FASTEN EACH ROOF RAFTER TO TOP PLATE WITH (1) SIMPSON 50NCL5600 SCREW PROVIDE (2) SIMPSON 50NCL5600 SCREWS AT FLUSH BEAMS IN THE ROOF - AT ALL BEARING POINTS. ROOF SHEATHING SHALL BE 7/16" A.P.A. RATED SHEATHING 24/16 EXPOSURE 1 (OR APPROVED EQUAL). FASTEN TO FRAMING MEMBERS W/ 2 1/2" x 0.131" NAILS @ 6" O.C. AT PANEL EDGES & @ 12" O.C. AT INTERMEDIATE SUPPORTS. ROOF SHEATHING SHALL EXTEND BELOW ALL INSTANCES OF OVERFRAMING. BLOCKING SHALL BE INSTALLED AS REQUIRED TO LIMIT ROOF SHEATHING SPANS TO 24" MAX. WITHIN 48" OF ALL ROOF EDGES, RIDGES, & HIPs FASTEN ROOF SHEATHING FIELDS PER EDGE NAILING SPEC. ALL METAL HANGERS SHALL BE SPECIFIED BY THE TRUSS MANUFACTURER, UNLESS OTHERWISE NOTED. ROOF TRUSS SHOP DRAWINGS SHALL BE SUBMITTED TO ARCHITECT AND ENGINEER FOR REVIEW AND APPROVAL PRIOR TO FABRICATION OR DELIVERY. ROOF TRUSS SHOP DRAWINGS & CALCULATIONS SHALL BE PREPARED BY A WASHINGTON STATE LICENSED ENGINEER AND SHALL BE DESIGNED FOR UNBALANCED SNOW LOADING PER ASCE 7-16, SECTION 7.6. ERECT AND INSTALL ROOF TRUSSES PER WTCA & TP15 BC/S1 I-08 "GUIDE TO GOOD PRACTICE FOR HANDLING, INSTALLING & BRACING OF METAL PLATE CONNECTED WOOD TRUSSES." FASTEN OVER-FRAMED TRUSS SEITS TO TRUSSES BELOW W/ (2) 3"x0.131" TOENAILS AT EA TRUSS. SUPPORT PORCH & SHORT SPAN ROOF TRUSSES (UP TO 6' TRIB.) W/ 2x6 LEDGER FASTENED TO FRAMING W/ (3) 3"x0.131" NAILS @ 16" O.C. FASTEN ALL INTERIOR NON-BEARING PARTITION WALLS TO TRUSS BOTTOM CHORD ABOVE WITH SIMPSON 51C CLIPS AT 24" O.C. MAX. PROVIDE BLOCKING BETWEEN THE TRUSS BOTTOM CHORDS AS REQUIRED FOR THE PARALLEL CONDITIONS. 	

HOLD-DOWN SCHEDULE	
SYMBOL	SPECIFICATION
▶ HD-1	SIMPSON 5THD14 (R.J) HOLD-DOWN
▶ HD-5	SIMPSON CS16 STRAP TIE (14" END LENGTH)
▶ HD-6	SIMPSON MSTC40 STRAP TIE (CENTER STRAP ON FLOOR SYSTEM UNO.)
▶ HD-7	SIMPSON MSTC66 STRAP TIE (CENTER STRAP ON FLOOR SYSTEM UNO.)

MEANS & METHODS NOTES	
<p>THE STRUCTURE IS DESIGNED TO BE SELF SUPPORTING AND STABLE AFTER THE BUILDING IS FINISHED AND ALL PLAN, DETAIL, AND NOTE SPECIFICATIONS HAVE BEEN COMPLETED. IT IS THE CONTRACTOR'S SOLE RESPONSIBILITY TO DETERMINE THE ERECTION PROCEDURES AND SEQUENCE TO INSURE THE SAFETY OF THE BUILDING AND ITS COMPONENTS DURING CONSTRUCTION. THIS INCLUDES, BUT IS NOT LIMITED TO, THE ADDITION OF NECESSARY SHORINGS, SHEETING, TEMPORARY BRACING, GUYs, AND TIE-DOWNS. CONTRACTOR SHALL BE RESPONSIBLE FOR ALL SHORING AND BRACING REQUIRED TO STABILIZE AND PROTECT EXISTING AND ADJACENT STRUCTURES AND SYSTEMS DURING COURSE OF DEMOLITION AND CONSTRUCTION OF THE PROJECT.</p>	
<p>STRUCTURAL DESIGN AND SPECIFICATIONS ASSUME THAT ALL SUPPORTING AND NON-SUPPORTING ELEMENTS IN CONTACT WITH FLOOR FRAMING ARE LEVEL, INCLUDING, BUT NOT LIMITED TO: FOUNDATIONS, SLABS ON GRADE, BEAMS, WALLS, AND NON-BEARING ELEMENTS. IT IS THE CONTRACTOR'S RESPONSIBILITY TO VERIFY LEVELNESS AND MAKE ADJUSTMENTS AS NECESSARY, INCLUDING CONSIDERATION OF THOSE AREAS THAT MAY BE WITHIN CONTRACTUAL, INDUSTRY, OR WARRANTY TOLERANCES.</p>	

ADDITIONAL NOTES FOR TRUSS & I-JOIST MANUFACTURER	
<p>ROOF TRUSS, FLOOR TRUSS AND ENGINEERED JOISTS SHALL BE DESIGNED TO MEET THE DIFFERENTIAL DEFLECTION CRITERIA BELOW UNLESS NOTED OTHERWISE ON PLAN. MULHERN + KULP CANNOT BE HELD RESPONSIBLE FOR ANY STRUCTURAL ISSUES RELATED TO ANY BUILDING COMPONENT IF COMPONENT SHOP DRAWINGS ARE NOT SUBMITTED TO MKK FOR REVIEW PRIOR TO FABRICATION, DELIVERY, OR INSTALLATION.</p>	
<p>TRUSSES SHALL BE DESIGNED SO THAT DIFFERENTIAL DEFLECTION BETWEEN ADJACENT PARALLEL TRUSSES OR GIRDER TRUSSES DOES NOT EXCEED THE FOLLOWING:</p> <p>A. ROOF TRUSSES: 1/4" DEAD LOAD</p> <p>B. FLOOR TRUSSES, ATTIC TRUSSES, & I-JOISTS: 1/8" DEAD LOAD</p> <p>C. FLOOR TRUSSES & ATTIC TRUSSES ADJACENT TO FLOOR FRAMING BY OTHERS: LIMIT ABSOLUTE TRUSS DEFLECTION TO 3/16" DEAD LOAD. (NOT DIFFERENTIAL DEFLECTION)</p>	

LEGEND	
• ■■■■■■	INTERIOR BEARING WALL
• □ □ □ □ □	BEARING WALL ABOVE (B.W.A.) OR SHEARNAIL ABOVE (S.W.A.)
• - - - - -	BEAM / HEADER
• - - - - -	INTERIOR SHEAR WALL PANEL OR EXTERIOR SHEAR WALL W/ 3" O.C. EDGE NAILING
• ■■■■■■	AREA OF OVERFRAMING
JL	METAL HANGER
*	INDICATES POST ABOVE. PROVIDE SOLID BLOCKING UNDER POST OR JAMB ABOVE.
▶	INDICATES HOLD-DOWN.

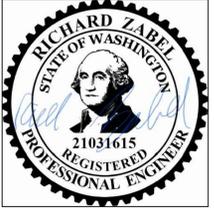

seal:
© copyright: MULHERN + KULP Structural Engineering, Inc.

MULHERN+KULP
RESIDENTIAL STRUCTURAL ENGINEERING
7220 Trade Street, Suite 350, San Diego, CA 92121
p 619-660-0010 ▶ mulhern+kulp.com

M&K project number:
154-22026

project mgr: **RJZ**
drawn by: **JCL**
issue date: **11-07-22**

REVISIONS:
date: _____ initial: _____

JAYMARC HOMES

STRUCTURAL NOTES

SPRING RESIDENCE
MERCER ISLAND, WASHINGTON

sheet:
S-O-O



© copyright: MULHERN + KULP Structural Engineering, Inc.

MULHERN+KULP
RESIDENTIAL STRUCTURAL ENGINEERING
7220 Trade Street, Suite 350, San Diego, CA 92121
p 619-560-0010 • mulhernkulp.com



M&K project number:
154-22026


project mgr: R.JZ
drawn by: JCL
issue date: 11-07-22

REVISIONS:
date: initial:




STRUCTURAL DETAILS
SPRING RESIDENCE
MERCER ISLAND, WASHINGTON


sheet:
LB-1

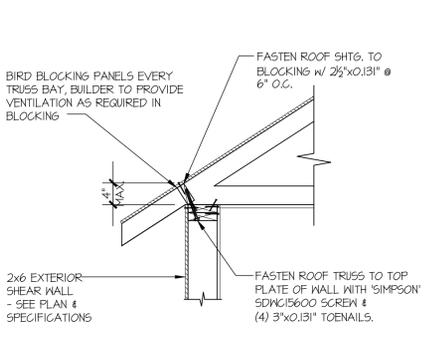


1 TYPICAL SHEAR TRANSFER DETAIL @ ROOF
SCALE: 3/4"=1'-0" HEEL HEIGHT LESS THAN 4"

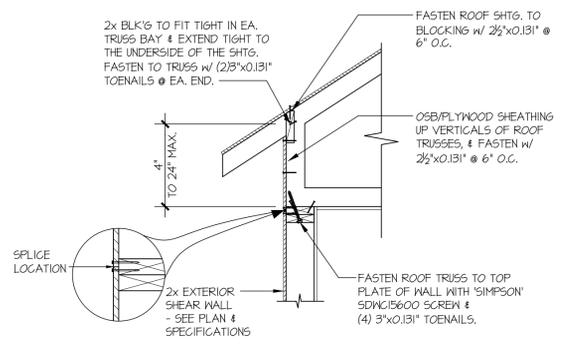


2 TYPICAL SHEAR TRANSFER DETAIL @ RAISED HEEL DETAIL
SCALE: 3/4"=1'-0" HEEL HEIGHT UP TO 24" MAX.

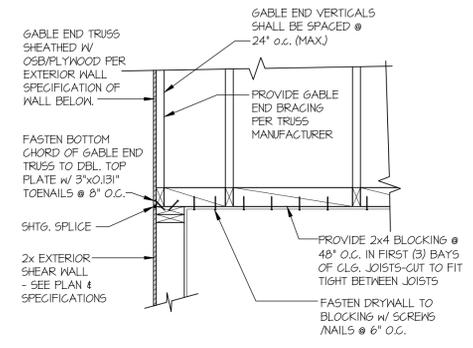


3 TYPICAL GABLE END DETAIL
SCALE: 3/4"=1'-0"

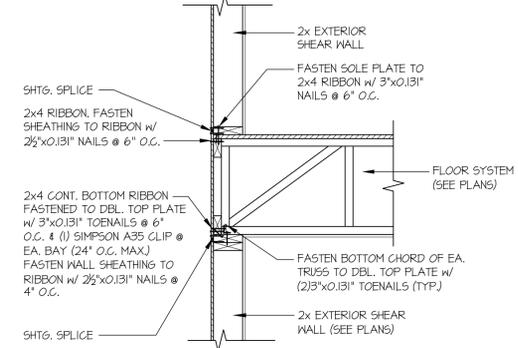


4 TYPICAL SHEAR TRANSFER DETAIL BETWEEN FLOORS @ EXTERIOR WALL
SCALE: 3/4"=1'-0" PERPENDICULAR FRAMING

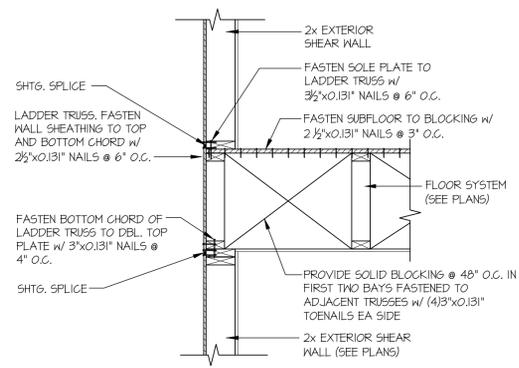


5 TYPICAL SHEAR TRANSFER DETAIL BETWEEN FLOORS @ EXTERIOR WALL
SCALE: 3/4"=1'-0" PARALLEL FRAMING

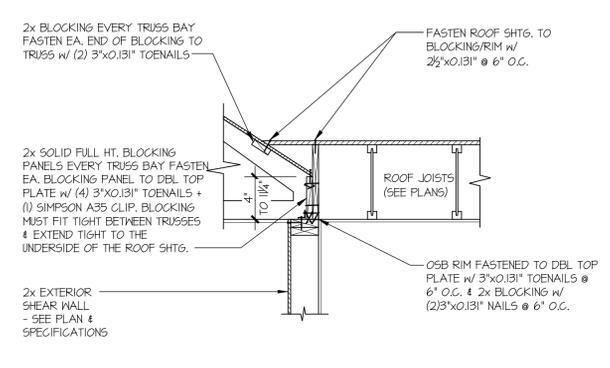


6 TYPICAL SHEAR TRANSFER DETAIL @ ROOF
SCALE: 3/4"=1'-0" HEEL HEIGHT BETWEEN 4" - 11 1/2"

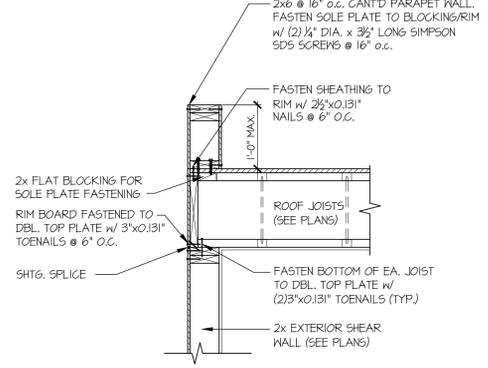


7 TYPICAL SHEAR TRANSFER DETAIL @ ROOF & EXTERIOR WALL
SCALE: 3/4"=1'-0"

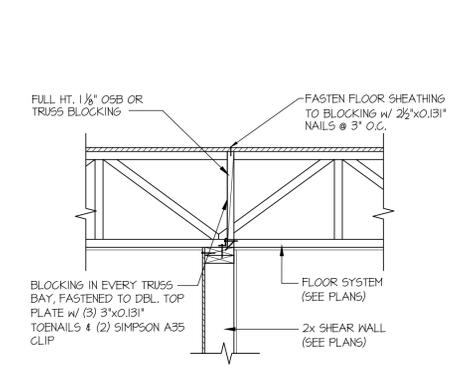


8 TYPICAL SHEAR TRANSFER DETAIL @ SHEAR WALL BELOW
SCALE: 3/4"=1'-0"

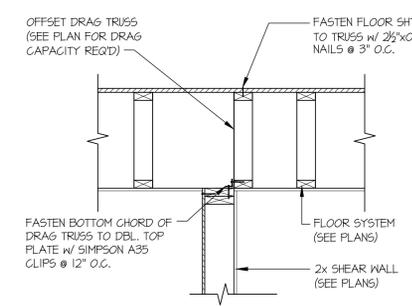


9 SHEAR TRANSFER DETAIL @ SHEAR WALL BELOW
SCALE: 3/4"=1'-0"

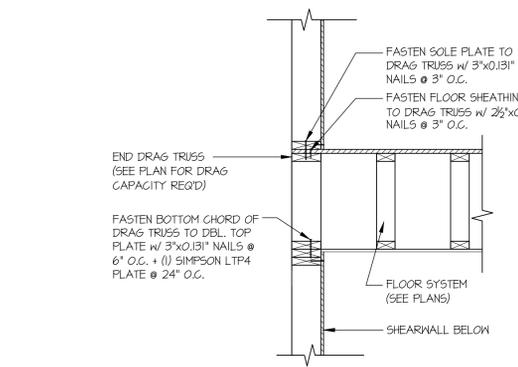


10 TYPICAL SHEAR TRANSFER DETAIL BETWEEN FLOORS @ EXTERIOR WALL
SCALE: 3/4"=1'-0"

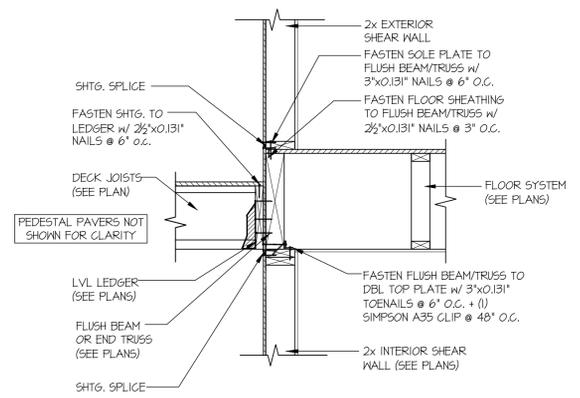


11 TYPICAL SHEAR TRANSFER DETAIL BETWEEN FLOORS @ EXTERIOR WALL
SCALE: 3/4"=1'-0"

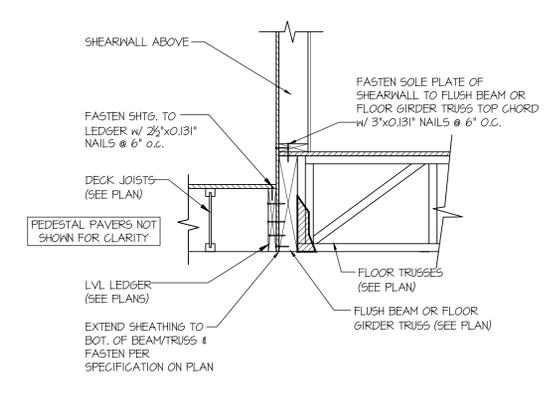


12 SHEAR TRANSFER DETAIL @ EXTERIOR SHEARWALL ABOVE
SCALE: 3/4"=1'-0"

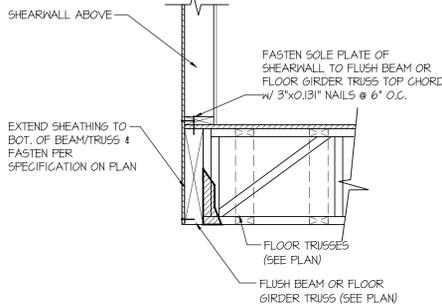


35 SHEAR TRANSFER DETAIL @
EXTERIOR SHEARWALL ABOVE
SCALE: 3/4"=1'-0"

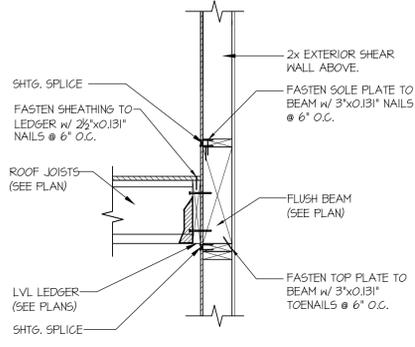


36 SECTION
SCALE: 3/4"=1'-0"

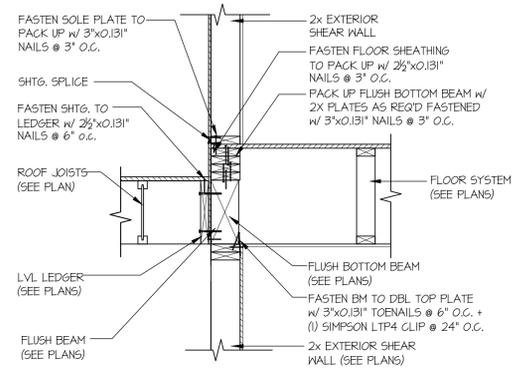


37 TYPICAL SHEAR TRANSFER DETAIL
BETWEEN FLOORS @ EXTERIOR WALL
SCALE: 3/4"=1'-0"

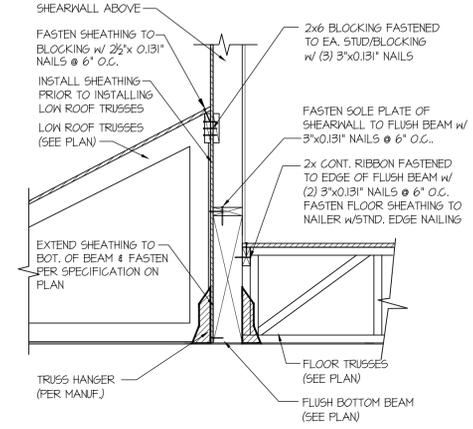


38 SHEAR TRANSFER DETAIL @
EXTERIOR SHEARWALL ABOVE
SCALE: 3/4"=1'-0"

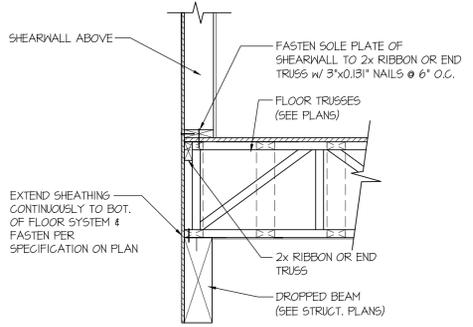


39 SHEAR TRANSFER DETAIL @
EXTERIOR SHEARWALL ABOVE
SCALE: 3/4"=1'-0"

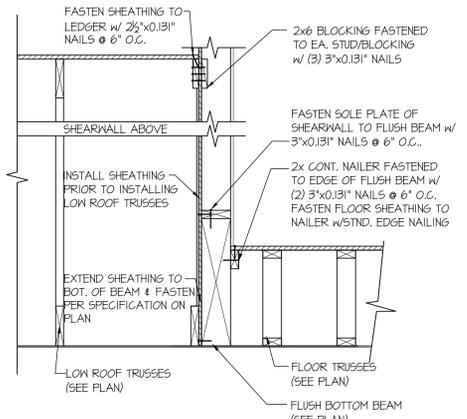


40 SHEAR TRANSFER DETAIL @
EXTERIOR SHEARWALL ABOVE
SCALE: 3/4"=1'-0"

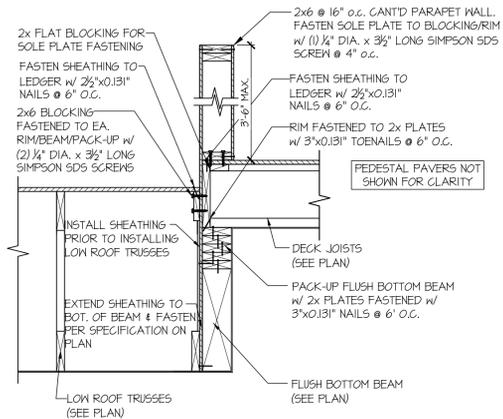


41 SHEAR TRANSFER DETAIL @
EXTERIOR SHEARWALL ABOVE
SCALE: 3/4"=1'-0"

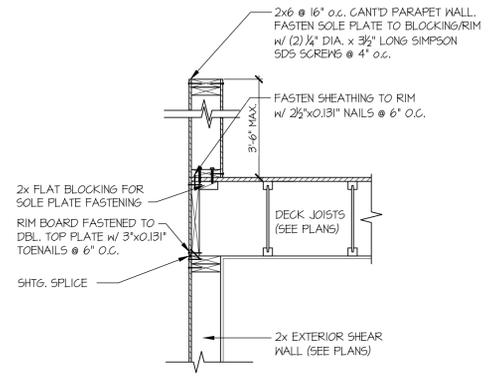


42 TYPICAL SHEAR TRANSFER DETAIL @
ROOF & EXTERIOR WALL
SCALE: 3/4"=1'-0"

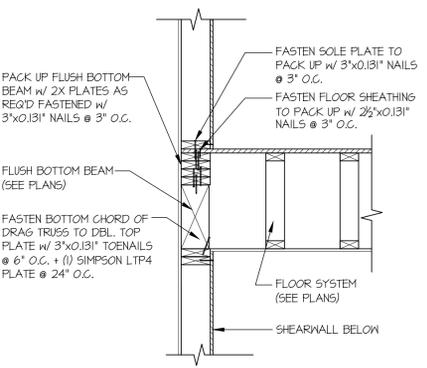


43 TYPICAL SHEAR TRANSFER DETAIL
BETWEEN FLOORS @ EXTERIOR WALL
SCALE: 3/4"=1'-0"

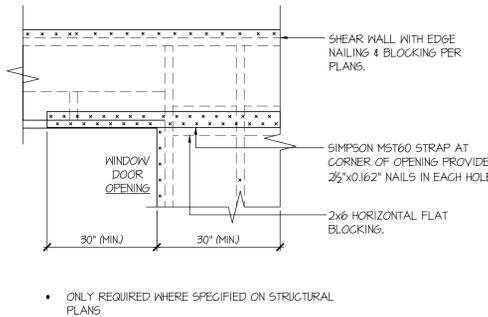

92 EXT. WALL & INT. SHEARWALL
OPENING ELEVATION
SCALE: NTS

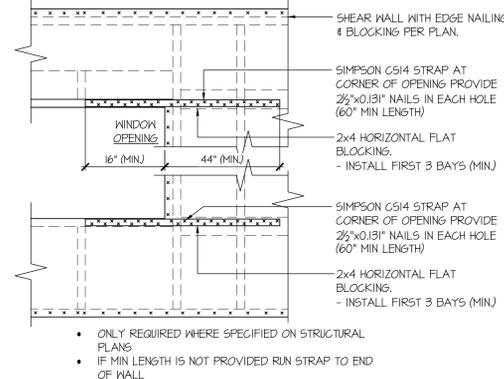

93 EXT. WALL & INT. SHEARWALL
OPENING ELEVATION
SCALE: NTS

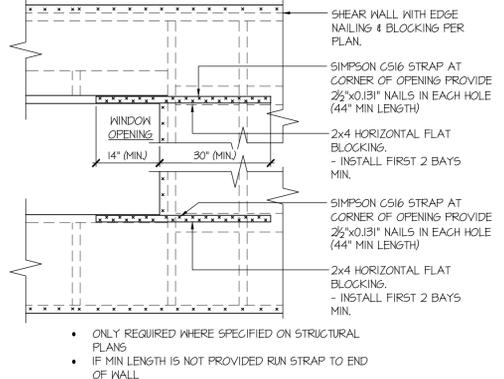

94 EXT. WALL & INT. SHEARWALL
OPENING ELEVATION
SCALE: NTS



MULHERN+KULP
RESIDENTIAL STRUCTURAL ENGINEERING
7720 Trade Street, Suite 350, San Diego, CA 92121
p 619-560-0010 • mulhernkulp.com


M&K project number:
154-22026

project mgr: **RJZ**
drawn by: **JCL**
issue date: **11-07-22**


REVISIONS:
date: initial:




STRUCTURAL DETAILS
SPRING RESIDENCE
MERCER ISLAND, WASHINGTON

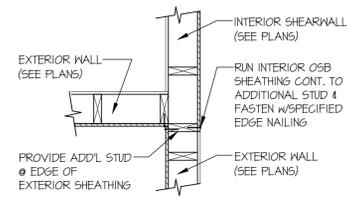


99 SHEAR TRANSFER DETAIL @ INTERSECTING INT. SHEARWALL
 SCALE: 3/4"=1'-0" SHTS. OPPOSITE PAGES

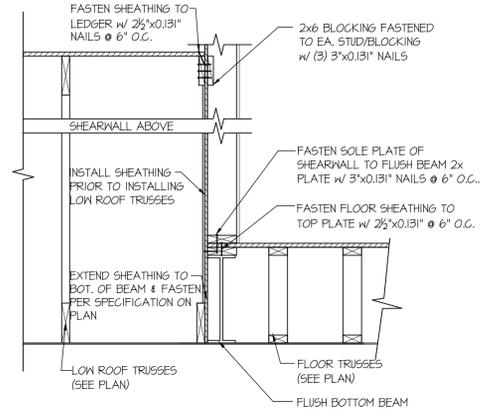


100 SHEAR TRANSFER DETAIL @ EXTERIOR SHEARWALL ABOVE
 SCALE: 3/4"=1'-0"

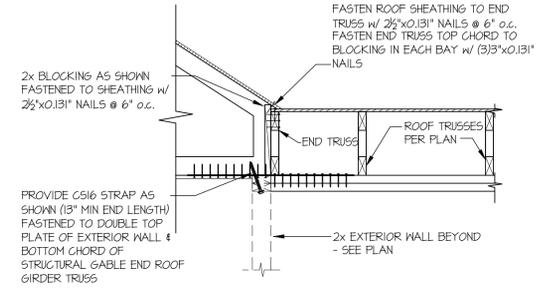


117 STRAP DETAIL
 SCALE: 3/4"=1'-0"

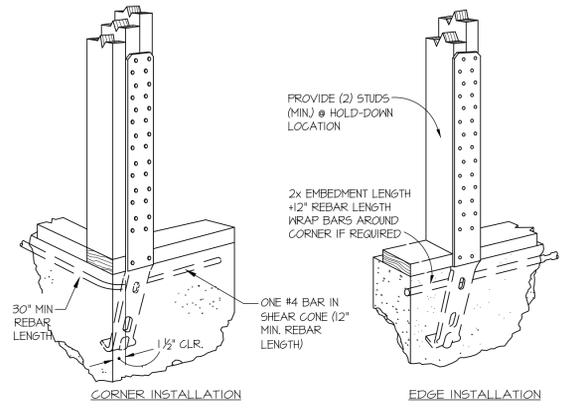


A TYPICAL HOLD-DOWN INSTALLATION
 NOT TO SCALE

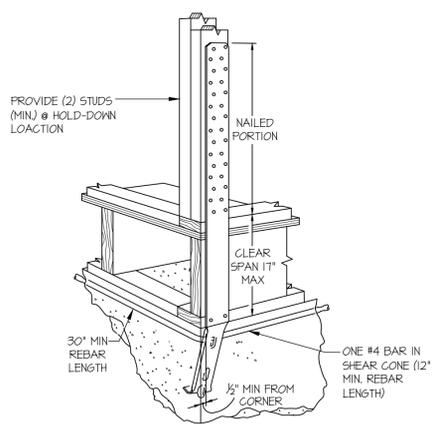


B TYPICAL HOLD-DOWN INSTALLATION
 NOT TO SCALE

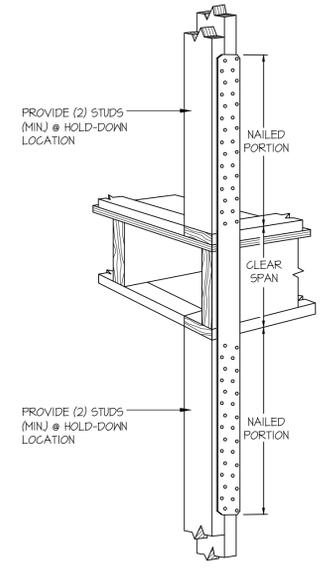

C TYPICAL HOLD-DOWN INSTALLATION
 NOT TO SCALE

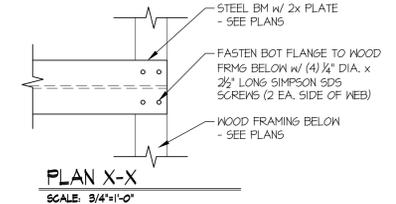

D STL BM TO WOOD FRMG CONNECTION
 SCALE: 3/4"=1'-0"

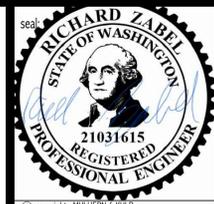


MULHERN+KULP
 RESIDENTIAL STRUCTURAL ENGINEERING
 7720 Trade Street, Suite 350, San Diego, CA 92121
 p 619-560-0010 > mulhernkulp.com

M&K project number:
 154-22026
 project mgr: R.JZ
 draw by: JCL
 issue date: 11-07-22

REVISIONS:	
date:	initial:



STRUCTURAL DETAILS
 SPRING RESIDENCE
 MERCER ISLAND, WASHINGTON

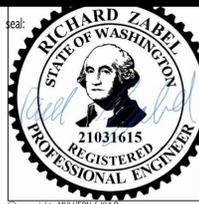

© copyright: MULHERN & KULP Structural Engineering, Inc.

MULHERN+KULP
RESIDENTIAL STRUCTURAL ENGINEERING
7220 Trade Street, Suite 350, San Diego, CA 92121
p 619-550-0010 • mulhernkulp.com

M&K project number:
154-22026












project mgr: R.JZ
drawn by: JCL
issue date: 11-07-22

REVISIONS:
date: initial:



STRUCTURAL DETAILS
SPRING RESIDENCE
MERCER ISLAND, WASHINGTON

sheet:
SD.01

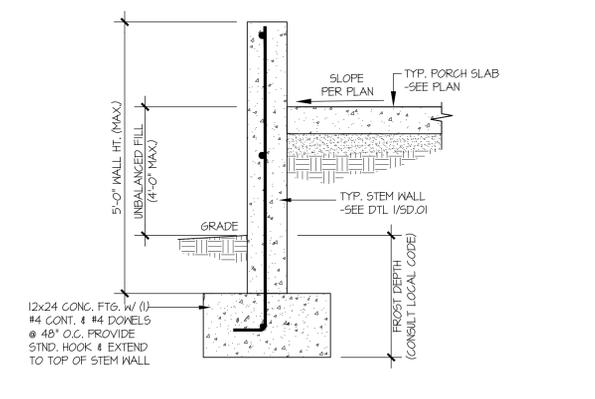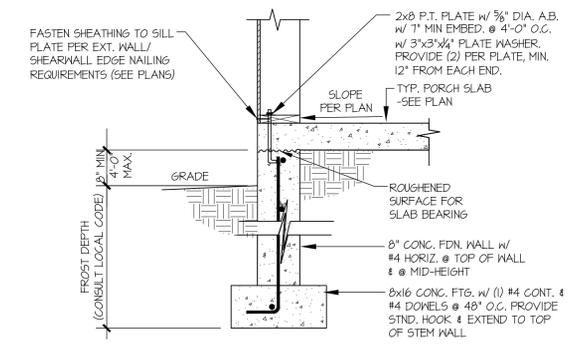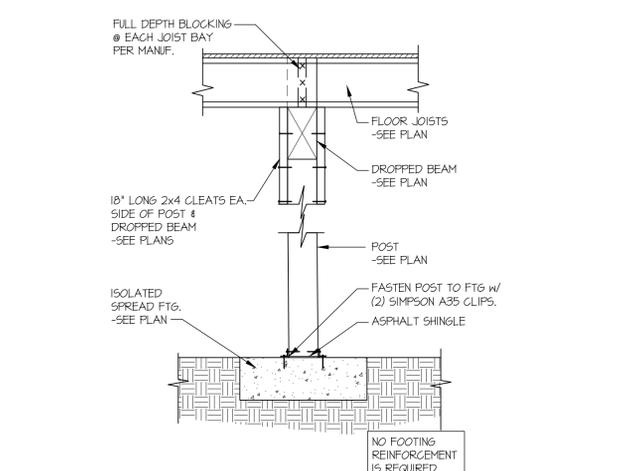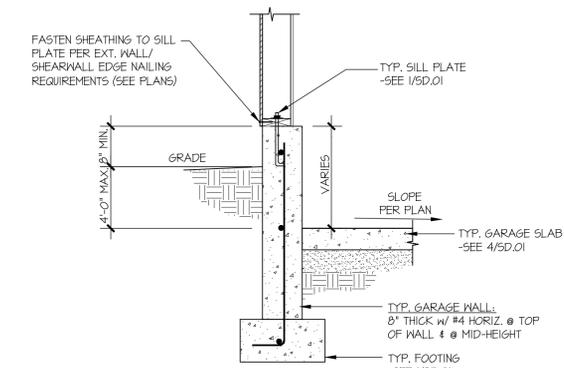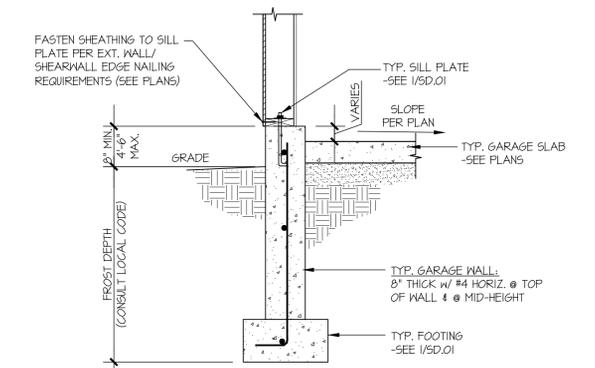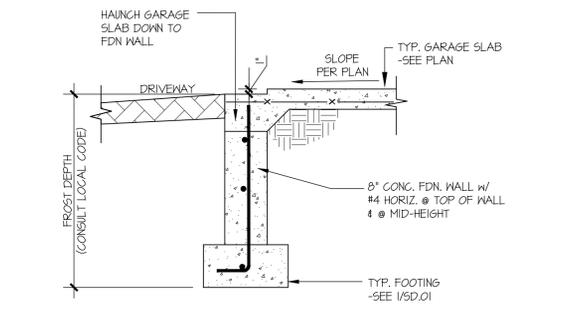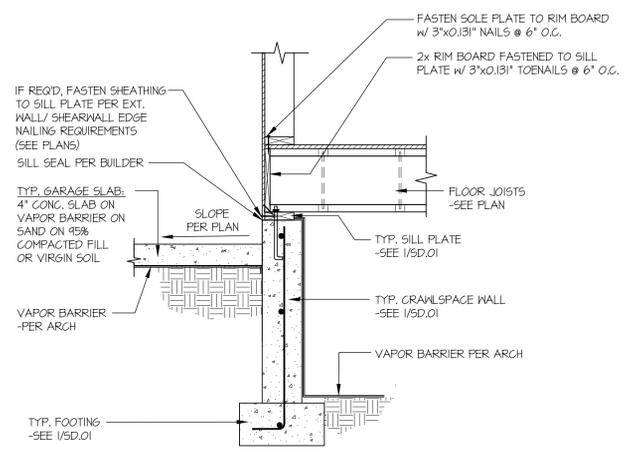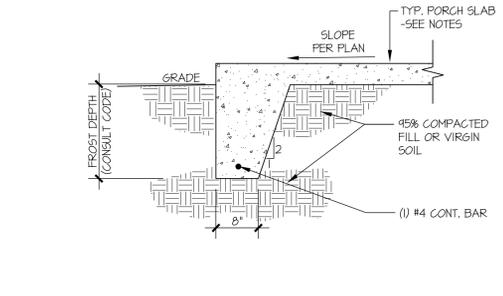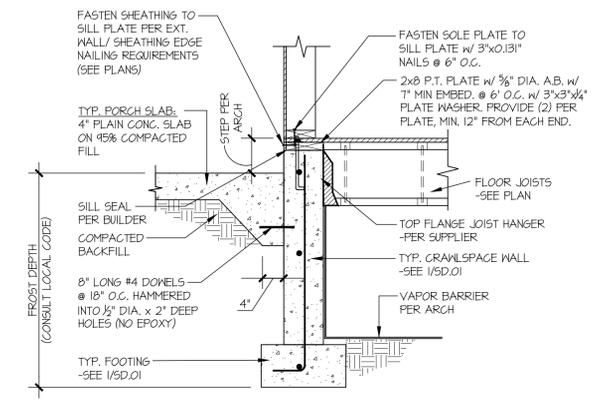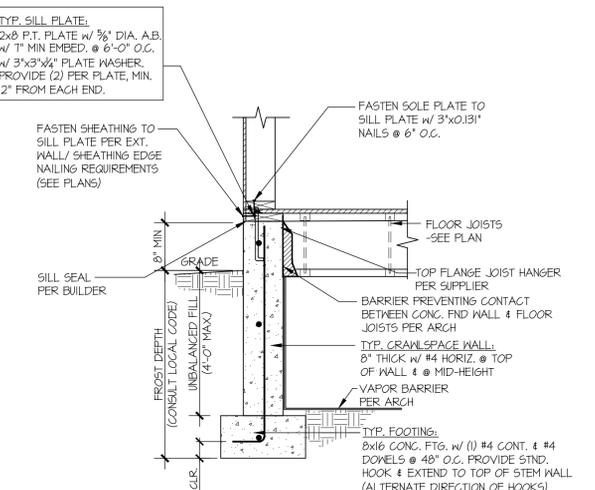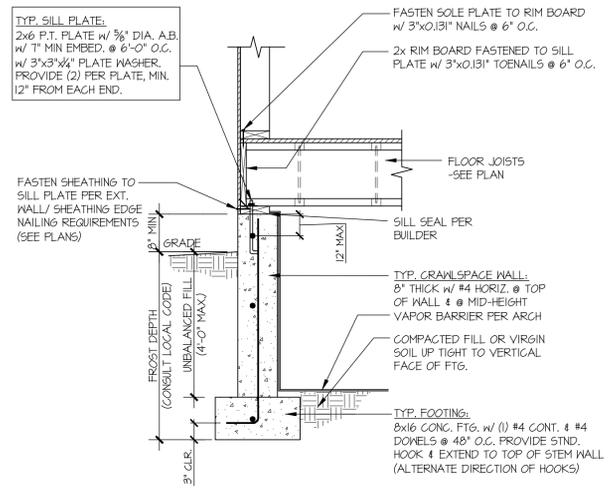

2018 WSEC COMPLIANCE NOTES:

CHAPTER 3 GENERAL REQUIREMENTS

SECTION R303 MATERIALS, SYSTEMS AND EQUIPMENT

R303.1 IDENTIFICATION

MATERIALS, SYSTEMS AND EQUIPMENT SHALL BE IDENTIFIED IN A MANNER THAT WILL ALLOW A DETERMINATION OF COMPLIANCE WITH THE APPLICABLE PROVISIONS OF THIS CODE.

R303.1.1 BUILDING THERMAL ENVELOPE INSULATION

AN R-VALUE IDENTIFICATION MARK SHALL BE APPLIED BY THE MANUFACTURER TO EACH PIECE OF BUILDING THERMAL ENVELOPE INSULATION 12 INCHES (305 MM) OR GREATER IN WIDTH. ALTERNATELY, THE INSULATION INSTALLERS SHALL PROVIDE A CERTIFICATION LISTING THE TYPE, MANUFACTURER AND R-VALUE OF INSULATION INSTALLED IN EACH ELEMENT OF THE BUILDING THERMAL ENVELOPE. FOR BLOWN OR SPRAYED INSULATION (FIBERGLASS AND CELLULOSE), THE INITIAL INSTALLED THICKNESS, SETTLED THICKNESS, SETTLED R-VALUE, INSTALLED DENSITY, COVERAGE AREA AND NUMBER OF BAGS INSTALLED SHALL BE LISTED ON THE CERTIFICATION. FOR SPRAYED POLYURETHANE FOAM (SPF) INSULATION, THE INSTALLED THICKNESS OF THE AREAS COVERED AND R-VALUE OF INSTALLED THICKNESS SHALL BE LISTED ON THE CERTIFICATION. FOR INSULATED SIDING, THE R-VALUE SHALL BE LABELED ON THE PRODUCTS PACKAGE AND SHALL BE LISTED ON THE CERTIFICATION. THE CERTIFICATION IN A CONSPICUOUS LOCATION ON THE JOB SITE.

R303.1.1.1 BLOWN OR SPRAYED ROOF/CEILING INSULATION

THE THICKNESS OF BLOWN-IN OR SPRAYED ROOF/CEILING INSULATION (FIBERGLASS OR CELLULOSE) SHALL BE WRITTEN IN INCHES (MM) ON MARKERS THAT ARE INSTALLED AT ONE FEET FOR EVERY 300 SQUARE FEET (28 M²) THROUGHOUT THE ATTIC SPACE. THE MARKERS SHALL BE AFFIXED TO THE TRUSSES OR JOISTS AND MARKED WITH THE MINIMUM INITIAL INSTALLED THICKNESS WITH NUMBERS A MINIMUM OF 1 INCH (25 MM) IN HEIGHT. EACH MARKER SHALL FACE THE ATTIC ACCESS OPENING. SPRAY POLYURETHANE FOAM THICKNESS AND INSTALLED R-VALUE SHALL BE LISTED ON CERTIFICATION PROVIDED BY THE INSULATION INSTALLER.

R303.1.2 INSULATION MARK INSTALLATION

INSULATING MATERIALS SHALL BE INSTALLED SUCH THAT THE MANUFACTURER'S R-VALUE MARK IS READILY OBSERVABLE UPON INSPECTION.

R303.1.3 PENETRATION PRODUCT RATINGS

U-FACTORS OF PENETRATION PRODUCTS (WINDOWS, DOORS AND SKYLIGHTS) SHALL BE DETERMINED IN ACCORDANCE WITH NFRC 100.

EXCEPTION: WHERE REQUIRED, GARAGE DOOR U-FACTORS SHALL BE DETERMINED IN ACCORDANCE WITH EITHER NFRC 100 OR ANSI/ASHRAE 105.

U-FACTORS SHALL BE DETERMINED BY AN ACCREDITED, INDEPENDENT LABORATORY, AND LABELED AND CERTIFIED BY THE MANUFACTURER. PRODUCTS LACKING SUCH A LABELED U-FACTOR SHALL BE ASSIGNED A DEFAULT U-FACTOR FROM TABLE R303.1.3(1), R303.1.3(2) OR R303.1.3(4). THE SOLAR HEAT GAIN COEFFICIENT (SHGC) AND VISIBLE TRANSMITTANCE (VT) OF GLAZED PENETRATION PRODUCTS (WINDOWS, GLAZED DOORS AND SKYLIGHTS) SHALL BE DETERMINED IN ACCORDANCE WITH NFRC 200 BY AN ACCREDITED, INDEPENDENT LABORATORY, AND LABELED AND CERTIFIED BY THE MANUFACTURER. PRODUCTS LACKING SUCH A LABELED SHGC OR VT SHALL BE ASSIGNED A DEFAULT SHGC OR VT FROM TABLE R303.1.3(5).

EXCEPTIONS: 1. UNITS WITHOUT NFRC RATINGS PRODUCED BY A SMALL BUSINESS MAY BE ASSIGNED DEFAULT U-FACTORS FROM TABLE R303.1.3(5) FOR VERTICAL PENETRATION.

2. OWNER-BUILT, NONPERMEABLE WOOD FRAME WINDOW CONSISTS OF A DOUBLE PANE UNIT WITH LOHIE (E=0.04 OR LESS), 1/2 INCH AIRSPACE WITH ARGON FILL.

R303.1.4 INSULATION PRODUCT RATINGS

THE THERMAL RESISTANCE (R-VALUE) OF INSULATION SHALL BE DETERMINED IN ACCORDANCE WITH THE U.S. FEDERAL TRADE COMMISSION R-VALUE RULE (16 C.F.R. TITLE 16, PART 460) IN UNITS OF H x FT² x °F/BTU AT A MEAN TEMPERATURE OF 75° (24°C).

R303.1.4.1 INSULATED SIDING. THE THERMAL RESISTANCE (R-VALUE) OF INSULATED SIDING SHALL BE DETERMINED IN ACCORDANCE WITH ASTM G163. INSTALLATION FOR TESTING SHALL BE IN ACCORDANCE WITH THE MANUFACTURER'S INSTALLATION INSTRUCTIONS.

R303.2 INSTALLATION

ALL MATERIALS, SYSTEMS AND EQUIPMENT SHALL BE INSTALLED IN ACCORDANCE WITH THE MANUFACTURER'S INSTALLATION INSTRUCTIONS AND THE INTERNATIONAL BUILDING CODE OR INTERNATIONAL RESIDENTIAL CODE, AS APPLICABLE.

R303.2.1 PROTECTION OF EXPOSED FOUNDATION INSULATION

INSULATION APPLIED TO THE EXTERIOR OF BASEMENT WALLS, CRAWLSPACE WALLS AND THE PERIMETER OF SLAB-ON-GRADE FLOORS SHALL HAVE A RIGID, OPAQUE AND WEATHER-RESISTANT PROTECTIVE COVERING TO PREVENT THE DEGRADATION OF THE INSULATION'S THERMAL PERFORMANCE. THE PROTECTIVE COVERING SHALL COVER THE EXPOSED EXTERIOR INSULATION AND EXTEND A MINIMUM OF 6 INCHES (153 MM) BELOW GRADE.

R303.3 MAINTENANCE INFORMATION

MAINTENANCE INSTRUCTIONS SHALL BE FURNISHED FOR EQUIPMENT AND SYSTEMS THAT REQUIRE PREVENTIVE MAINTENANCE. REQUIRED REGULAR MAINTENANCE ACTIONS SHALL BE CLEARLY STATED AND INCORPORATED ON A READILY ACCESSIBLE LABEL. THE LABEL SHALL INCLUDE THE TITLE OR PUBLICATION NUMBER FOR THE OPERATION AND MAINTENANCE MANUAL FOR THAT PARTICULAR MODEL AND TYPE OF PRODUCT.

CHAPTER 4 RESIDENTIAL ENERGY EFFICIENCY

SECTION R401 GENERAL

R401.1 SCOPE

THIS CHAPTER APPLIES TO RESIDENTIAL BUILDINGS.

R401.2 COMPLIANCE

PROJECTIONS SHALL COMPLY WITH ONE OF THE FOLLOWING:

- SECTIONS R401 THROUGH R404.
- SECTION R405 AND THE PROVISIONS OF SECTIONS R401 THROUGH R404 LABELED "MANDATORY."

IN ADDITION, DWELLING UNITS AND SLEEPING UNITS IN A RESIDENTIAL BUILDING SHALL COMPLY WITH SECTION R406.

R401.3 CERTIFICATE (MANDATORY)

A PERMANENT CERTIFICATE SHALL BE COMPLETED BY THE BUILDER OR REGISTERED DESIGN PROFESSIONAL AND POSTED ON A WALL IN THE SPACE WHERE THE FURNACE IS LOCATED, A UTILITY ROOM OR AN APPROVED LOCATION INSIDE THE BUILDING, WHEN LOCATED ON AN ELECTRICAL PANEL, THE CERTIFICATE SHALL COVER OR OBSTRUCT THE VISIBILITY OF THE CIRCUIT DIRECTORY LABEL. SERVICE DISCONNECT LABELS OR OTHER REQUIRED LABELS, THE CERTIFICATE SHALL LIST THE TYPICAL R-VALUES OF INSULATION INSTALLED IN OR ON CEILING/ROOF, WALLS, FOUNDATION (SLAB, BELOW-GRADE WALL, AND/OR FLOOR) AND DUCTS OUTSIDE CONDITIONED SPACES; U-FACTORS FOR PENETRATION AND THE SOLAR HEAT GAIN COEFFICIENT (SHGC) OF PENETRATION; AND THE RESULTS FROM ANY REQUIRED DUCT SYSTEM AND BUILDING ENVELOPE AIR LEAKAGE TESTING DONE ON THE BUILDING, WHERE THERE IS MORE THAN ONE VALUE FOR EACH COMPONENT; THE CERTIFICATE SHALL LIST THE VALUE COVERING THE LARGEST AREA; THE CERTIFICATE SHALL LIST THE TYPES AND EFFICIENCIES OF HEATING, COOLING AND SERVICE WATER HEATING EQUIPMENT; WHERE A GAS-FIRED UNVENTED ROOM HEATER, ELECTRIC FURNACE, OR BASEBOARD ELECTRIC HEATER IS INSTALLED IN THE RESIDENCE, THE CERTIFICATE SHALL LIST "GAS-FIRED UNVENTED ROOM HEATER," "ELECTRIC FURNACE," OR "BASEBOARD ELECTRIC HEATER," AS APPROPRIATE; AN EFFICIENCY SHALL NOT BE LISTED FOR GAS-FIRED UNVENTED ROOM HEATERS, ELECTRIC FURNACES OR ELECTRIC BASEBOARD HEATERS.

SECTION R402 BUILDING THERMAL ENVELOPE

R402.1 GENERAL (PRESCRIPTIVE)

THE BUILDING THERMAL ENVELOPE SHALL MEET THE REQUIREMENTS OF SECTIONS R402.1.1 THROUGH R402.1.5.

EXCEPTION: THE FOLLOWING BUILDINGS, OR PORTIONS THEREOF, SEPARATED FROM THE REMAINDER OF THE BUILDING BY BUILDING THERMAL ENVELOPE ASSEMBLIES COMPLYING WITH THIS CODE SHALL BE EXEMPT FROM THE BUILDING THERMAL ENVELOPE PROVISIONS OF THIS CODE.

- THOSE WITH A PEAK DESIGN RATE OF ENERGY USAGE LESS THAN 3.4 BTU/H FT² (101.01 MJ/M²) OR 1.0 WAT/FT² OF FLOOR AREA FOR SPACE CONDITIONING PURPOSES.
- THOSE THAT DO NOT CONTAIN CONDITIONED SPACE.
- GREENHOUSES ISOLATED FROM ANY CONDITIONED SPACE AND NOT INTENDED FOR OCCUPANCY.

R402.1.1 INSULATION AND PENETRATION CRITERIA

THE BUILDING THERMAL ENVELOPE SHALL MEET THE REQUIREMENTS OF TABLE R402.1.1 BASED ON THE CLIMATE ZONE SPECIFIED IN CHAPTER 3.

R402.1.2 R-VALUE COMPUTATION

INSULATION MATERIAL, USED IN LAYERS, SUCH AS FRAMING CAVITY INSULATION OR CONTINUOUS INSULATION, SHALL BE SUMMED TO COMPUTE THE CORRESPONDING COMPONENT R-VALUE. THE MANUFACTURER'S SETTLER R-VALUE SHALL BE USED FOR BLOWN INSULATION. COMPUTED R-VALUES SHALL NOT INCLUDE AN R-VALUE FOR OTHER BUILDING MATERIALS OR AIR FILMS, WHERE INSULATED SIDING IS USED FOR THE PURPOSE OF COMPLYING WITH THE CONTINUOUS INSULATION REQUIREMENTS OF TABLE R402.1.1. THE MANUFACTURER MUST SUPPLY AN ICC REPORT THAT THE R-FACTOR HAS BEEN CERTIFIED, OR USE R-5 PER INCH FOR EXTRUDED POLYSTYRENE, AND R-6 PER INCH FOR POLYISOCYANURATE RIGID INSULATION.

R402.1.3 U-FACTOR ALTERNATIVE

AN ASSEMBLY WITH A U-FACTOR EQUAL TO OR LESS THAN THAT SPECIFIED IN TABLE R402.1.3 SHALL BE PERMITTED AS AN ALTERNATIVE TO THE R-VALUE IN TABLE R402.1.1.

CLIMATE ZONE	5 and MARINE 4
CEILING R-VALUE ^a	44
WOOD FRAME WALL ^{b,m} R-VALUE	21/21
MASS WALL R-VALUE ¹	21/21
FLOOR R-VALUE	36
BELOW-GRADE ^{2,m} WALL R-VALUE	101/521 INT + TB
SLAB ³ R-VALUE 4' DEPTH	10, 2 FT

FOOTNOTES TO TABLE R402.1.1

- a. C = CONTINUOUS INSULATION, INT = INTERMEDIATE FRAMING.
- b. R-VALUES ARE MINIMUMS. U-FACTORS AND SHGC ARE MAXIMUMS. WHEN INSULATION IS INSTALLED IN A CAVITY WHICH IS LESS THAN THE LABEL OR DESIGN THICKNESS OF THE INSULATION, THE COMPRESSED R-VALUE OF THE INSULATION FROM APPENDIX GLAZED PENETRATION SHGC^{b,e}
- c. THE PENETRATION U-FACTOR COLUMN EXCLUDES SKYLIGHTS. THE SHGC COLUMN APPLIES TO ALL GLAZED PENETRATION.
- d. "101/521 INT" MEANS R-40 CONTINUOUS INSULATION ON THE EXTERIOR OF THE WALL, OR R-15 CONTINUOUS INSULATION ON THE INTERIOR OF THE WALL, OR R-21 CAVITY INSULATION PLUS A THERMAL BREAK BETWEEN THE SLAB AND THE BASEMENT WALL AT THE INTERIOR OF THE BASEMENT WALL. "101/521 TB" SHALL BE PERMITTED TO BE MET WITH R-13 CAVITY INSULATION ON THE INTERIOR OF THE BASEMENT WALL PLUS R-5 CONTINUOUS INSULATION ON THE INTERIOR OR EXTERIOR OF THE WALL. "15" MEANS THERMAL BREAK BETWEEN FLOOR, SLAB AND BASEMENT WALL.
- e. R-10 CONTINUOUS INSULATION IS REQUIRED UNDER HEATED SLAB ON GRADE FLOORS. SEE R402.2.1.1.
- f. THERE ARE NO SHGC REQUIREMENTS IN THE MARINE ZONE.
- g. THE SECOND R-VALUE APPLIES WHEN MORE THAN HALF THE INSULATION IS ON THE INTERIOR OF THE MASS WALL.
- h. FOR SINGLE RAFTER OR JOIST-VAULTED CEILING, THE INSULATION MAY BE REDUCED TO R-36.
- i. INT, INTERMEDIATE FRAMING) DENOTES STANDARD FRAMING 16 INCHES ON CENTER WITH HEADERS INSULATED WITH A MINIMUM R-10 INSULATION.

R402.1.4 TOTAL UA ALTERNATIVE

IF THE TOTAL BUILDING THERMAL ENVELOPE UA (SUM OF U-FACTOR TIMES ASSEMBLY AREA) IS LESS THAN OR EQUAL TO THE TOTAL UA REGD THIS CODE, THE U-FACTOR IN TABLE R402.1.1 MAY BE USED BY THE SAME ASSEMBLY AS SPEC'ED IN THE PROPOSED BLDG PLAN. THE NEW YORK BUILDING CODE (NYBC) SHALL HAVE TIGHT FITTING DOORS AND WINDOWS, AND OTHER COMPONENTS AND MEASURES.

INCLUDED IN APPENDIX A IN CHAPTER 51-11C NYC. THESE VALUES SHALL BE USED FOR ALL CALCULATIONS, WHERE PROPOSED CONSTRUCTION ASSEMBLIES ARE NOT REPRESENTED IN APPENDIX A, VALUES SHALL BE CALCULATED IN ACCORDANCE WITH THE ASHRAE HANDBOOK OF FUNDAMENTALS USING THE FRAMING FACTORS LISTED IN APPENDIX A WHERE APPLICABLE AND SHALL INCLUDE THE THERMAL BRIDGING EFFECTS OF FRAMING MATERIALS. THE SHGC REQUIREMENTS SHALL BE MET IN ADDITION TO UA COMPLIANCE, WHEN USING RESCHECK, THE U-FACTORS CALCULATED BY THE SOFTWARE BASED ON COMPONENT R-VALUE DESCRIPTIONS ARE ACCEPTABLE. FOR THE BASE BUILDING UA CALCULATION, THE MAXIMUM GLAZING AREA IS 15% OF THE FLOOR AREA.

R402.1.5 VAPOR RETARDER

WALL ASSEMBLIES IN THE BUILDING THERMAL ENVELOPE SHALL COMPLY WITH THE VAPOR RETARDER REQUIREMENTS OF SECTION R402.1.7 OF THE INTERNATIONAL RESIDENTIAL CODE OR SECTION 4405.3 OF THE INTERNATIONAL BUILDING CODE, AS APPLICABLE.

R402.2 SPECIFIC INSULATION REQUIREMENTS (PRESCRIPTIVE)

IN ADDITION TO THE REQUIREMENTS OF SECTION R402.1, INSULATION SHALL MEET THE SPECIFIC REQUIREMENTS OF SECTIONS R402.2.1 THROUGH R402.2.11.

R402.2.1 CEILING/6 WITH ATTIC SPACES

WHERE SECTION R402.2.1 WOULD REQUIRE R-44 IN THE CEILING, INSTALLING R-38 OVER 100 PERCENT OF THE CEILING AREA REQUIRING INSULATION SHALL BE DEEMED TO SATISFY THE REQUIREMENT FOR R-44 WHERE THE FULL HEIGHT OF UNCOMPLETED R-38 INSULATION EXTENDS OVER THE WALL, TOP PLATE AT THE EAVES. THIS REDUCTION SHALL NOT APPLY TO THE U-FACTOR ALTERNATIVE APPROACH IN SECTION R402.1.3 AND THE TOTAL UA ALTERNATIVE IN SECTION R402.1.4.

R402.2.1.1 LOOSE INSULATION IN ATTIC SPACES

OPEN-BLOWN OR POURED LOOSE FILL INSULATION MAY BE USED IN ATTIC SPACES WHERE THE SLOPE OF THE CEILING IS NOT MORE THAN 3 FEET IN 12 FEET AND THERE IS AT LEAST 30 INCHES OF CLEAR DISTANCE FROM THE TOP OF THE BOTTOM CHORD OF THE TRUSS OR CEILING JOIST TO THE UNDERSIDE OF THE SHEATHING AT THE ROOF RIDGE.

R402.2.2 RESERVED

R402.2.3 EAVE Baffle

FOR AIR PERMEABLE INSULATIONS IN VENTED ATTICS, A Baffle SHALL BE INSTALLED ADJACENT TO SOFFIT AND EAVE VENTS. Baffles SHALL MAINTAIN AN OPENING EQUAL OR GREATER THAN THE SIZE OF THE VENT. THE Baffle SHALL EXTEND OVER THE TOP OF THE ATTIC INSULATION. THE Baffle SHALL BE PERMITTED TO BE ANY SOLID MATERIAL.

R402.2.4 ACCESS HATCHES AND DOORS

ACCESS DOORS FROM CONDITIONED SPACES TO UNCONDITIONED SPACES (E.G., ATTICS AND CRAWL SPACES) SHALL BE WEATHERSTRIPPED AND INSULATED TO A LEVEL EQUIVALENT TO THE INSULATION ON THE SURROUNDING SURFACES. ACCESS SHALL BE PROVIDED TO ALL EQUIPMENT THAT PREVENTS DAMAGING OR COMPRESSING THE INSULATION. A WOOD FRAMED OR EQUIVALENT Baffle OR RESTRAINER IS REQUIRED TO BE PROVIDED WHEN LOOSE FILL INSULATION IS INSTALLED, THE PURPOSE OF WHICH IS TO PREVENT THE LOOSE FILL INSULATION FROM SPILLING INTO THE LIVING SPACE WHEN THE ATTIC ACCESS IS OPENED, AND TO PROVIDE A PERMANENT MEANS OF MAINTAINING THE INSTALLED INSULATION TO THE LOOSE FILL INSULATION.

EXCEPTION: VERTICAL DOORS THAT PROVIDE ACCESS FROM CONDITIONED TO UNCONDITIONED SPACES SHALL BE PERMITTED TO MEET THE PENETRATION REQUIREMENTS OF TABLE R402.1.1.

R402.2.5 MASS WALLS

MASS WALLS FOR THE PURPOSES OF THIS CHAPTER SHALL BE CONSIDERED ABOVE-GRADE WALLS OF CONCRETE BLOCK, CONCRETE, INSULATED CONCRETE FORM (ICF), MASONRY BRICK, BRICK (OTHER THAN BRICK VENEER), EARTH (ADOBE, COMPRESSED EARTH BLOCK, RAMMED EARTH) AND SOLID TIMBERLOGS, OR ANY OTHER WALLS HAVING A HEAT CAPACITY GREATER THAN OR EQUAL TO 8 BTU/FT² x "F (23 KJ/M² x °C).

R402.2.6 STEEL-FRAME CEILING, WALLS, AND FLOORS

STEEL-FRAME CEILING, WALLS, AND FLOORS SHALL MEET THE U-FACTOR REQUIREMENTS OF TABLE R402.

R402.2.7 FLOORS

FLOOR FRAMING CAVITY INSULATION SHALL BE INSTALLED TO MAINTAIN PERMANENT CONTACT WITH THE UNDERSIDE OF THE SUBFLOOR DECKING. INSULATION SHALL BE INSTALLED 50 SPACING IS NO MORE THAN 24 INCHES ON CENTER. FOUNDATION VENTS SHALL BE PLACED SO THAT THE TOP OF THE VENT IS BELOW THE LOWER SURFACE OF THE FLOOR INSULATION.

EXCEPTIONS:

- THE FLOOR FRAMING CAVITY INSULATION SHALL BE PERMITTED TO BE IN CONTACT WITH THE TOPSIDE OF SHEATHING OR CONTINUOUS INSULATION INSTALLED ON THE BOTTOM SIDE OF FLOOR FRAMING WHERE COHESIVE WITH INSULATION THAT MEETS OR EXCEEDS THE MINIMUM WOOD FRAME BELLOW-VALUE IN TABLE R402.1.1 AND EXTENDS FROM THE BOTTOM TO THE TOP OF ALL PERIMETER FLOOR FRAMING MEMBERS.
- WHEN FOUNDATION VENTS ARE NOT PLACED SO THAT THE TOP OF THE VENT IS BELOW THE LOWER SURFACE OF THE FLOOR INSULATION, A PERMANENT ATTACHED Baffle SHALL BE INSTALLED AT AN ANGLE OF 30° FROM HORIZONTAL, TO DIVERT AIR FLOW BELOW THE LOWER SURFACE OF THE FLOOR INSULATION.
- SUBSTANTIAL CONTACT WITH THE SURFACE BEING INSULATED IS NOT REQUIRED IN ENCLOSED FLOOR/CEILING ASSEMBLIES CONTAINING DUCTS WHERE FULL R-VALUE INSULATION IS INSTALLED BETWEEN THE DUCT AND THE EXTERIOR SURFACE.

R402.2.8 BELOW-GRADE WALLS

BELOW-GRADE EXTERIOR WALL INSULATION USED ON THE EXTERIOR (COLD) SIDE OF THE WALL SHALL EXTEND FROM THE TOP OF THE BELOW-GRADE WALL TO THE TOP OF THE FOOTING AND SHALL BE APPROVED FOR BELOW-GRADE USE. ABOVE-GRADE INSULATION SHALL BE PROTECTED. INSULATION USED ON THE INTERIOR (WARM) SIDE OF THE WALL SHALL EXTEND FROM THE TOP OF THE BELOW-GRADE WALL TO THE BELOW-GRADE FLOOR LEVEL AND SHALL INCLUDE R-5 RIGID BOARD PROVIDING A THERMAL BREAK BETWEEN THE CONCRETE WALL AND THE SLAB.

R402.2.9 SLAB-ON-GRADE FLOORS

THE MINIMUM THERMAL RESISTANCE (R-VALUE) OF THE INSULATION AROUND THE PERIMETER OF UNHEATED OR HEATED SLAB-ON-GRADE FLOORS SHALL BE AS SPECIFIED IN TABLE R402.1.1. THE INSULATION SHALL BE PLACED ON THE OUTSIDE OF THE FOUNDATION OR ON THE INSIDE OF THE FOUNDATION WALL. THE INSULATION SHALL EXTEND DOWNWARD FROM THE TOP OF THE SLAB FOR A MINIMUM DISTANCE AS SHOWN IN THE TABLE. THE TOP OF THE FOOTING, WHICH IS 15 LESS, OR DOWNWARD TO AT LEAST THE BOTTOM OF THE SLAB AND THEN HORIZONTALLY TO THE INTERIOR OR EXTERIOR FOR THE TOTAL DISTANCE SHOWN IN THE TABLE. A TWO-INCH (MAXIMUM) PRESSURE TREATED WALKER MAY BE PLACED AT THE FINISHED FLOOR ELEVATION FOR ATTACHMENT OF INTERIOR FINISH MATERIALS. INSULATION EXTENDING AWAY FROM THE BUILDING SHALL BE PROTECTED BY PAVEMENT OR BY A MINIMUM OF 10 INCHES (254 MM) OF SOIL.

R402.2.9.1 HEATED SLAB-ON-GRADE FLOORS (MANDATORY)

THE ENTIRE AREA OF A HEATED SLAB-ON-GRADE FLOOR SHALL BE THERMALLY ISOLATED FROM THE SOIL WITH A MINIMUM OF R-10 INSULATION. THE INSULATION SHALL BE AN APPROVED PRODUCT FOR ITS INTENDED USE. IF A SOIL GAS CONTROL SYSTEM IS PRESENT BELOW THE HEATED SLAB-ON-GRADE FLOOR, WHICH RESULTS IN INCREASED CONVECTIVE FLOW BELOW THE HEATED SLAB-ON-GRADE FLOOR, THE HEATED SLAB-ON-GRADE FLOOR SHALL BE THERMALLY ISOLATED FROM THE SUB-SLAB GRAVEL LAYER. R-10 HEATED SLAB-ON-GRADE FLOOR INSULATION IS REQUIRED FOR ALL COMPLIANCE PATHS.

R402.2.10 RESERVED

R402.2.11 MASONRY VENEER

INSULATION SHALL NOT BE REQUIRED ON THE HORIZONTAL PORTION OF THE FOUNDATION THAT SUPPORTS A MASONRY VENEER.

R402.3 PENETRATION (PRESCRIPTIVE)

IN ADDITION TO THE REQUIREMENTS OF SECTION R402, INSULATION SHALL COMPLY WITH SECTIONS R402.3.1 THROUGH R402.3.5.

R402.3.1 U-FACTOR

AN AREA-WEIGHTED AVERAGE OF PENETRATION PRODUCTS SHALL BE PERMITTED TO SATISFY THE U-FACTOR REQUIREMENTS.

R402.3.2 GLAZED PENETRATION SHGC

AN AREA-WEIGHTED AVERAGE OF PENETRATION PRODUCTS MORE THAN 50 PERCENT GLAZED SHALL BE PERMITTED TO SATISFY THE SHGC REQUIREMENTS.

R402.3.3 GLAZED PENETRATION EXEMPTION

UP TO 15 SQUARE FEET (1.4 M²) OF GLAZED PENETRATION PER DWELLING UNIT SHALL BE PERMITTED TO BE EXEMPT FROM U-FACTOR AND SHGC REQUIREMENTS IN SECTION R402.1.1. THIS EXEMPTION SHALL NOT APPLY TO THE U-FACTOR ALTERNATIVE APPROACH IN SECTION R402.1.3 AND THE TOTAL UA ALTERNATIVE IN SECTION R402.1.4.

R402.3.4 OPAQUE DOOR EXEMPTION

ONE SIDE-HINGED OPAQUE DOOR ASSEMBLY UP TO 24 SQUARE FEET (2.22 M²) AREA IS EXEMPTED FROM THE U-FACTOR REQUIREMENT IN SECTION R402.1.1. THIS EXEMPTION SHALL NOT APPLY TO THE U-FACTOR ALTERNATIVE APPROACH IN SECTION R402.1.3 AND THE TOTAL UA ALTERNATIVE IN SECTION R402.1.4.

R402.3.5 RESERVED

R402.4 AIR LEAKAGE (MANDATORY)

THE BUILDING THERMAL ENVELOPE SHALL BE CONSTRUCTED TO LIMIT AIR LEAKAGE IN ACCORDANCE WITH THE REQUIREMENTS OF SECTIONS R402.4.1 THROUGH R402.4.4.

R402.4.1 BUILDING THERMAL ENVELOPE

THE BUILDING THERMAL ENVELOPE SHALL COMPLY WITH SECTIONS R402.4.1.1 AND R402.4.1.2. THE SEALING METHODS BETWEEN DISSIMILAR MATERIALS SHALL ALLOW FOR DIFFERENTIAL EXPANSION AND CONTRACTION.

R402.4.1.1 INSTALLATION

THE COMPONENTS OF THE BUILDING THERMAL ENVELOPE AS LISTED IN TABLE R402.4.1.1 SHALL BE INSTALLED IN ACCORDANCE WITH THE MANUFACTURER'S INSTRUCTIONS AND THE CRITERIA LISTED IN TABLE R402.4.1.1, AS APPLICABLE TO THE METHOD OF CONSTRUCTION, WHERE REQUIRED BY THE CODE OFFICIAL, AN APPROVED THIRD PARTY SHALL INSPECT ALL COMPONENTS AND VERIFY COMPLIANCE.

R402.4.1.2 TESTING

THE BUILDING OR DWELLING UNIT SHALL BE TESTED AND VERIFIED AS HAVING AN AIR LEAKAGE RATE OF NOT EXCEEDING 5 AIR CHANGES PER HOUR. TESTING SHALL BE CONDUCTED WITH A BLOWER DOOR AT A PRESSURE OF 0.2 INCHES WATER (50 PASCALS), WHERE REQUIRED BY THE CODE OFFICIAL. TESTING SHALL BE CONDUCTED BY AN APPROVED THIRD PARTY, A WRITTEN REPORT OF THE RESULTS OF THE TEST SHALL BE SIGNED BY THE PARTY CONDUCTING THE TEST AND PROVIDED TO THE CODE OFFICIAL. TESTING SHALL BE PERFORMED AT ANY TIME AFTER CREATION OF ALL PENETRATIONS OF THE BUILDING THERMAL ENVELOPE. ONCE VISUAL INSPECTION HAS CONFIRMED SEALING (SEE TABLE R402.4.1.1), OPERABLE WINDOWS AND DOORS MANUFACTURED BY SMALL BUSINESS SHALL BE PERMITTED TO BE SEALED OFF AT THE FRAME PRIOR TO THE TEST.

DURING TESTING:

- EXTERIOR WINDOWS AND DOORS, FIREPLACE AND STOVE DOORS SHALL BE CLOSED, BUT NOT SEALED, HOWEVER THE INTENDED WEATHERSTRIPPING OR OTHER INFILTRATION CONTROL MEASURES.
- DAMPERS INCLUDING EXHAUST, INTAKE, MAKEUP AIR, BACKDRIFT AND FLUE DAMPERS SHALL BE CLOSED, BUT NOT SEALED BEYOND INTENDED INFILTRATION CONTROL MEASURES.
- INTERIOR DOORS, IF INSTALLED AT THE TIME OF THE TEST, SHALL BE OPEN. ACCESS HATCHES TO CONDITIONED CRAWL SPACES AND CONDITIONED ATTICS SHALL BE OPEN.
- EXTERIOR OPENINGS FOR CONTINUOUS VENTILATION SYSTEMS AND HEAT RECOVERY VENTILATORS SHALL BE CLOSED AND SEALED.
- HEATING AND COOLING SYSTEMS, IF INSTALLED AT THE TIME OF THE TEST, SHALL BE TURNED OFF, and
- SUPPLY AND RETURN REGISTERS, IF INSTALLED AT THE TIME OF THE TEST, SHALL BE FULLY OPEN.

EXCEPTIONS:

- ADDITIONS LESS THAN 500 SQUARE FEET OF CONDITIONED FLOOR AREA.
- ADDITIONS TESTED WITH THE EXISTING HOME HAVING A COMBINED MAXIMUM AIR LEAKAGE RATE OF 1 AIR CHANGES PER HOUR. TO QUALIFY FOR THIS EXCEPTION, THE DATE OF CONSTRUCTION OF THE EXISTING HOME MUST BE PRIOR TO THE 2004 WASHINGTON STATE ENERGY CODE.

R402.4.2 FIREPLACES

NEW YORK BUILDING CODE (NYBC) SHALL HAVE TIGHT FITTING DOORS AND WINDOWS, AND OTHER COMPONENTS AND MEASURES.

AND LISTED FOR THE FIREPLACE, WHERE USING TIGHT-FITTING DOORS ON MASONRY FIREPLACES, THE DOORS SHALL BE LISTED AND LABELED IN ACCORDANCE WITH UL 907.

R402.4.3 AIR LEAKAGE OF PENETRATION

WINDOWS, SKYLIGHTS AND SLIDING GLASS DOORS SHALL HAVE AN AIR INFILTRATION RATE OF NO MORE THAN 0.3 CFM PER SQUARE FOOT (1.5 L/S/M²), AND SWINGING DOORS NO MORE THAN 0.3 CFM PER SQUARE FOOT (2.6 L/S/M²), WHEN TESTED ACCORDING TO NFRC 400 OR ANSI/AIAA/CSA 101/15.2/1440 BY AN ACCREDITED, INDEPENDENT LABORATORY AND LISTED AND LABELED BY THE MANUFACTURER. EXCEPTIONS:

1. FIELD-FABRICATED PENETRATION PRODUCTS (WINDOWS, SKYLIGHTS AND DOORS)

2. CUSTOM EXTERIOR PENETRATION PRODUCTS MANUFACTURED BY A SMALL BUSINESS PROVIDED THEY MEET THE APPLICABLE PROVISIONS OF CHAPTER 24 OF THE INTERNATIONAL BUILDING CODE. ONCE VISUAL INSPECTION HAS CONFIRMED THE PRESENCE OF A GASKET, OPERABLE WINDOWS AND DOORS MANUFACTURED BY SMALL BUSINESS SHALL BE PERMITTED TO BE SEALED OFF AT THE FRAME PRIOR TO THE TEST.

R402.4.4 COMBUSTION AIR OPENINGS

WHERE OPEN COMBUSTION AIR DUCTS PROVIDE COMBUSTION AIR TO OPEN COMBUSTION SPACE CONDITIONING FUEL BURNING APPLIANCES, THE APPLIANCES AND COMBUSTION AIR OPENINGS SHALL BE LOCATED OUTSIDE OF THE BUILDING THERMAL ENVELOPE, OR ENCLOSED IN A ROOM ISOLATED FROM INSIDE THE THERMAL ENVELOPE. SUCH ROOMS SHALL BE SEALED AND INSULATED IN ACCORDANCE WITH THE ENVELOPE REQUIREMENTS OF TABLE R402.1.1, WHERE THE WALLS, FLOORS AND CEILING SHALL MEET THE MINIMUM OF THE BELOW-GRADE WALL R-VALUE REQUIREMENT, THE DOOR INTO THE ROOM SHALL BE FULLY GASKETED AND ANY WATER LINES AND DUCTS IN THE ROOM INSULATED IN ACCORDANCE WITH SECTION R403. THE COMBUSTION AIR DUCT SHALL BE INSULATED WHERE IT PASSES THROUGH CONDITIONED SPACE TO A MINIMUM OF R-6.

EXCEPTIONS:

- DIRECT VENT APPLIANCES WITH BOTH INTAKE AND EXHAUST PIPES INSTALLED CONTINUOUS TO THE OUTSIDE.
- FIREPLACES AND STOVES COMPLYING WITH SECTION R402.4.2 AND SECTION R1006 OF THE INTERNATIONAL RESIDENTIAL CODE.

R402.4.5 RECESSED LIGHTING

RECESSED LUMINAIRES INSTALLED IN THE BUILDING THERMAL ENVELOPE SHALL BE TYPE I-C RATED AND CERTIFIED UNDER ASTM E283 AS HAVING AN AIR LEAKAGE RATE NOT MORE THAN 2.0 CFM (0.444 L/S) WHEN TESTED AT A 1.51 PSF (75 PA) PRESSURE DIFFERENTIAL AND SHALL HAVE A LABEL ATTACHED SHOWING COMPLIANCE WITH THIS TEST METHOD. ALL RECESSED LUMINAIRES SHALL BE SEALED WITH A GASKET OR CAULK BETWEEN THE HOUSING AND THE INTERIOR WALL OR CEILING COVERING.

R402.5 MAXIMUM PENETRATION U-FACTOR (MANDATORY)

THE AREA-WEIGHTED AVERAGE MAXIMUM PENETRATION U-FACTOR PERMITTED USING TRADEOFFS FROM SECTION R402.1.4 OR R405 SHALL BE 0.49 FOR VERTICAL PENETRATION AND 0.15 FOR SKYLIGHTS.

TABLE R402.4.1.1 AIR BARRIER AND INSULATION INSTALLATION		
---	--	--

2018 WSEC COMPLIANCE NOTES - SHEET 3

2018 WASH. STATE ENERGY CODE (WSEC)

(CONTINUED FROM PREVIOUS SHEET)

R403.6 MECHANICAL VENTILATION (MANDATORY). BUILDING SHALL BE PROVIDED WITH VENTILATION THAT MEETS THE REQUIREMENTS OF THE INTERNATIONAL RESIDENTIAL CODE OR INTERNATIONAL MECHANICAL CODE, AS APPLICABLE, OR WITH OTHER APPROVED MEANS OF VENTILATION. OUTDOOR AIR INTAKES AND EXHAUSTS SHALL HAVE AUTOMATIC OR GRAVITY DAMPERS THAT CLOSE WHEN THE VENTILATION SYSTEM IS NOT OPERATING.

R403.6.1 WHOLE-HOUSE MECHANICAL VENTILATION SYSTEM FAN EFFICACY. MECHANICAL VENTILATION SYSTEM FANS SHALL MEET THE EFFICACY REQUIREMENTS OF TABLE R403.6.1. EXCEPTION: WHERE MECHANICAL VENTILATION FANS ARE INTEGRAL TO TESTED AND LISTED HVAC EQUIPMENT, THEY SHALL BE POWERED BY AN ELECTRONICALLY COMMUTATED MOTOR.

FAN LOCATION	AIR FLOW RATE (MINIMUM CFM)	MINIMUM EFFICACY (CFM/WATT)	AIR FLOW RATE MAXIMUM (CFM)
RANGE HOODS	ANY	2.0 CFM/WATT	ANY
IN-LINE FAN	ANY	2.0 CFM/WATT	ANY
BATHROOM, UTILITY ROOM	10	1.4 CFM/WATT	< 10
BATHROOM, UTILITY ROOM	40	2.0 CFM/WATT	ANY

R403.1 EQUIPMENT SIZING AND EFFICIENCY RATING (MANDATORY). HEATING AND COOLING EQUIPMENT SHALL BE SIZED IN ACCORDANCE WITH ACCA MANUAL 5 BASED ON BUILDING LOADS CALCULATED IN ACCORDANCE WITH ACCA MANUAL J OR OTHER APPROVED HEATING AND COOLING CALCULATION METHODOLOGIES. THE OUTPUT CAPACITY OF HEATING AND COOLING EQUIPMENT SHALL NOT BE GREATER THAN THAT OF THE SMALLEST AVAILABLE EQUIPMENT SIZE THAT EXCEEDS THE LOADS CALCULATED, INCLUDING ALLOWABLE OVERRIDES LIMITS. NEW OR REPLACEMENT HEATING AND COOLING EQUIPMENT SHALL HAVE AN EFFICIENCY RATING EQUAL TO OR GREATER THAN THE MINIMUM REQUIRED BY FEDERAL LAW FOR THE GEOGRAPHIC LOCATION WHERE THE EQUIPMENT IS INSTALLED.

R403.1.1 ELECTRIC RESISTANCE ZONE HEATED UNITS. ALL DETACHED ONE- AND TWO-FAMILY DWELLINGS AND MULTIPLE SINGLE-FAMILY DWELLINGS (TOWNHOUSES) UP TO THREE STORIES IN HEIGHT ABOVE GRADE PLAN USING ELECTRIC ZONAL HEATING AS THE PRIMARY HEAT SOURCE SHALL INSTALL AN INVERTER-DRIVEN DUCTLESS MINI-SPLIT HEAT PUMP IN THE LARGEST ZONE IN THE DWELLING. BUILDING PERMIT DRAWINGS SHALL SPECIFY THE HEATING EQUIPMENT TYPE AND LOCATION OF THE HEATING SYSTEM.

EXCEPTION: TOTAL INSTALLED HEATING CAPACITY OF 2KH PER DWELLING OR LESS.

R403.8 SYSTEMS SERVING MULTIPLE DWELLING UNITS (MANDATORY). SYSTEMS SERVING MULTIPLE DWELLING UNITS SHALL COMPLY WITH SECTIONS C403 AND C404 OF THE WSEC--COMMERICAL PROVISIONS IN LIEU OF SECTION R403.

R403.9 SNOW MELT SYSTEM CONTROLS (MANDATORY). SNOW AND ICE-MELTING SYSTEMS, SUPPLIED THROUGH ENERGY SERVICE TO THE BUILDING, SHALL INCLUDE AUTOMATIC CONTROLS CAPABLE OF SHUTTING OFF THE SYSTEM WHEN THE PAVEMENT TEMPERATURE IS ABOVE 50°F, AND NO PRECIPITATION IS FALLING AND AN AUTOMATIC OR MANUAL CONTROL THAT WILL ALLOW SHUTOFF WHEN THE OUTDOOR TEMPERATURE IS ABOVE 40°F.

R403.10 POOL AND PERMANENT SPA ENERGY CONSUMPTION (MANDATORY). POOLS AND PERMANENT SPAS SHALL COMPLY WITH SECTIONS R403.10.1 THROUGH R403.10.4.2.

R403.10.1 HEATERS. THE ELECTRIC POWER TO HEATERS SHALL BE CONTROLLED BY A READILY ACCESSIBLE ON-OFF SWITCH THAT IS AN INTEGRAL PART OF THE HEATER MOUNTED ON THE EXTERIOR OF THE HEATER OR EXTERNAL TO AND WITHIN 5 FEET (1.5 M) OF THE HEATER. OPERATION OF SUCH SWITCH SHALL NOT CHANGE THE SETTINGS OF THE HEATER THERMOSTAT. SUCH SWITCHES SHALL BE IN ADDITION TO A CIRCUIT BREAKER FOR THE POWER TO THE HEATER. GAS-FIRED HEATERS SHALL NOT BE EQUIPPED WITH CONSTANT BURNING PILOT LIGHTS.

R403.10.2 TIME SWITCHES. TIME SWITCHES OR OTHER CONTROL METHOD THAT CAN AUTOMATICALLY TURN OFF AND ON ACCORDING TO A PRESET SCHEDULE SHALL BE INSTALLED FOR HEATERS AND PUMP MOTORS. HEATERS AND PUMP MOTORS THAT HAVE BUILT IN TIME SWITCHES SHALL BE DEEMED IN COMPLIANCE WITH THIS REQUIREMENT.

EXCEPTIONS:

- WHERE PUBLIC HEALTH STANDARDS REQUIRE 24-HOUR PUMP OPERATION.
- PUMPS THAT OPERATE SOLAR- AND WASTE-HEAT-RECOVERY POOL HEATING SYSTEMS.

R403.10.3 COVERS. OUTDOOR HEATED POOLS AND OUTDOOR PERMANENT SPAS SHALL BE PROVIDED WITH A VAPOR-RETARDANT COVER, OR OTHER APPROVED VAPOR RETARDANT MEANS.

EXCEPTION: WHERE MORE THAN 10 PERCENT OF THE ENERGY FOR HEATING, COMPUTED OVER AN OPERATING SEASON, IS FROM SITE-RECOVERED ENERGY, SUCH AS FROM A HEAT PUMP OR SOLAR ENERGY SOURCE, COVERS OR OTHER VAPOR-RETARDANT MEANS SHALL NOT BE REQUIRED.

R403.10.4 RESIDENTIAL POOL PUMPS. POOL PUMP MOTORS MAY NOT BE SPLIT-PHASE OR CAPACITOR START-INDUCTION RUN TYPE.

R403.10.4.1 TWO-SPEED CAPABILITY.


- PUMP MOTORS: POOL PUMP MOTORS WITH A CAPACITY OF 1 HP OR MORE SHALL HAVE THE CAPABILITY OF OPERATING AT TWO OR MORE SPEEDS WITH LOW SPEED HAVING A ROTATION RATE THAT IS NO MORE THAN ONE-HALF OF THE MOTOR'S MAXIMUM ROTATION RATE.
- PUMP CONTROLS: POOL PUMP MOTOR CONTROLS SHALL HAVE THE CAPABILITY OF OPERATING THE POOL PUMP WITH AT LEAST TWO SPEEDS. THE DEFAULT CIRCULATION SPEED SHALL BE THE LOWEST SPEED, WITH A HIGH SPEED OVERRIDE CAPABILITY BEING FOR A TEMPORARY PERIOD NOT TO EXCEED ONE NORMAL CYCLE.

R403.10.4.2 PUMP OPERATION. CIRCULATING WATER SYSTEMS SHALL BE CONTROLLED SO THAT THE CIRCULATION PUMPS CAN BE CONVENIENTLY TURNED OFF, AUTOMATICALLY OR MANUALLY, WHEN THE WATER SYSTEM IS NOT IN OPERATION.

R403.11 PORTABLE SPAS (MANDATORY). THE ENERGY CONSUMPTION OF ELECTRIC-POWERED PORTABLE SPAS SHALL BE CONTROLLED BY THE REQUIREMENTS OF APSP-14.

R403.12 RESIDENTIAL POOLS AND PERMANENT RESIDENTIAL SPAS. RESIDENTIAL SWIMMING POOLS AND PERMANENT RESIDENTIAL SPAS THAT ARE ACCESSORY TO DETACHED ONE- AND TWO-FAMILY DWELLINGS AND TOWNHOUSES THREE STORIES OR LESS IN HEIGHT ABOVE GRADE PLANE AND THAT ARE AVAILABLE ONLY TO THE HOUSEHOLD AND ITS GUESTS SHALL BE IN ACCORDANCE WITH APSP-15.

CLIMATE ZONE 5 and MARINE 4							
FENESTRATION U-FACTOR	SKYLIGHT U-FACTOR	GLAZED FENESTRATION SHGC	CEILING R-VALUE	WOOD FRAMED WALL R-VALUE	FLOOR R-VALUE	BELOW GRADE WALL R-VALUE	SLAB R-VALUE & DEPTH
0.30	0.50	NR	R-49 R-30 VAULTED	R-21	R-30	10/15 R-21 + TB	R-10 2 FEET

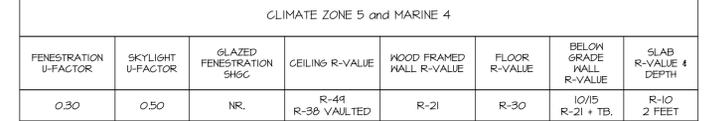

SECTION R404 ELECTRICAL POWER AND LIGHTING SYSTEMS

R404.1 LIGHTING EQUIPMENT (MANDATORY). A MINIMUM OF 75 PERCENT OF LAMPS IN PERMANENTLY INSTALLED LIGHTING FIXTURES SHALL BE HIGH-EFFICACY LAMPS. HIGH-EFFICACY LAMPS, COMPACT FLUORESCENT LAMPS, T-8 OR SMALLER DIAMETER LINEAR FLUORESCENT LAMPS, OR LAMPS WITH A MINIMUM EFFICACY OF:

- 60 LUMENS PER WATT FOR LAMPS OVER 40 WATTS;
- 50 LUMENS PER WATT FOR LAMPS OVER 15 WATTS TO 40 WATTS; AND
- 40 LUMENS PER WATT FOR LAMPS 15 WATTS OR LESS.

R404.1.1 LIGHTING EQUIPMENT (MANDATORY). FUEL GAS LIGHTING SYSTEMS SHALL NOT HAVE CONTINUOUSLY BURNING PILOT LIGHTS.

SECTION R406 ADDITIONAL ENERGY EFFICIENCY REQUIREMENTS

R406.1 SCOPE. THIS SECTION ESTABLISHES OPTIONS FOR ADDITIONAL CRITERIA TO BE MET FOR ONE- AND TWO-FAMILY DWELLINGS AND TOWNHOUSES, AS DEFINED IN SECTION 101.2 OF THE INTERNATIONAL RESIDENTIAL CODE TO DEMONSTRATE COMPLIANCE WITH THIS CODE.

R406.2 ADDITIONAL ENERGY EFFICIENCY REQUIREMENTS (MANDATORY). EACH DWELLING UNIT IN A RESIDENTIAL BUILDING SHALL COMPLY WITH SUFFICIENT OPTIONS FROM TABLE R406.2.50 AS TO ACHIEVE THE FOLLOWING MINIMUM NUMBER OF CREDITS:

- SMALL DWELLING UNIT: 15 CREDITS
DWELLING UNITS LESS THAN 1500 SQUARE FEET IN CONDITIONED FLOOR AREA WITH LESS THAN 300 SQUARE FEET OF FENESTRATION AREA. ADDITIONS TO EXISTING BUILDING GREATER THAN 500 SQUARE FEET OF HEATED FLOOR AREA BUT LESS THAN 1500 SQUARE FEET.
- MEDIUM DWELLING UNIT: 3.5 CREDITS
ALL DWELLING UNITS THAT ARE NOT INCLUDED IN #1 OR #3.
EXCEPTION: DWELLING UNITS SERVING R-2 OCCUPANCIES SHALL REQUIRE 2.5 CREDITS.
- LARGE DWELLING UNIT: 4.5 CREDITS
DWELLING UNITS GREATER THAN 1500 SQUARE FEET OF CONDITIONED FLOOR AREA.

OPTION	DESCRIPTION	CREDITS
1a	EFFICIENT BUILDING ENVELOPE 1a: PRESCRIPTIVE COMPLIANCE IS BASED ON TABLE R402.1.1 WITH THE FOLLOWING MODIFICATIONS: VERTICAL FENESTRATION U = 0.28 FLOOR R-30 SLAB ON GRADE R-10 PERIMETER AND UNDER ENTIRE SLAB BELOW GRADE SLAB R-10 PERIMETER AND UNDER ENTIRE SLAB OR COMPLIANCE BASED ON SECTION R402.1.4: REDUCE THE TOTAL UA BY 5%.	0.5
1b	EFFICIENT BUILDING ENVELOPE 1b: PRESCRIPTIVE COMPLIANCE IS BASED ON TABLE R402.1.1 WITH THE FOLLOWING MODIFICATIONS: VERTICAL FENESTRATION U = 0.25 WALL R-21 PLUS R-4 FLOOR R-30 BASEMENT WALL R-21 INT PLUS R-5 C1 SLAB ON GRADE R-10 PERIMETER AND UNDER ENTIRE SLAB BELOW GRADE SLAB R-10 PERIMETER AND UNDER ENTIRE SLAB OR COMPLIANCE BASED ON SECTION R402.1.4: REDUCE THE TOTAL UA BY 15%.	1.0
1c	EFFICIENT BUILDING ENVELOPE 1c: PRESCRIPTIVE COMPLIANCE IS BASED ON TABLE R402.1.1 WITH THE FOLLOWING MODIFICATIONS: VERTICAL FENESTRATION U = 0.22 CEILING AND SINGLE-RAFTER OR JOIST-VAULTED R-44 ADVANCED WOOD FRAME WALL R-21 INT PLUS R-12 C1 FLOOR R-30 BASEMENT WALL R-21 INT PLUS R-12 C1 SLAB ON GRADE R-10 PERIMETER AND UNDER ENTIRE SLAB BELOW GRADE SLAB R-10 PERIMETER AND UNDER ENTIRE SLAB OR COMPLIANCE BASED ON SECTION R402.1.4: REDUCE THE TOTAL UA BY 30%.	2.0
1d	EFFICIENT BUILDING ENVELOPE 1d: PRESCRIPTIVE COMPLIANCE IS BASED ON TABLE R402.1.1 WITH THE FOLLOWING MODIFICATIONS: VERTICAL FENESTRATION U = 0.24	0.5
2a	AIR LEAKAGE CONTROL AND EFFICIENT VENTILATION 2a: COMPLIANCE BASED ON R402.4.1.2: REDUCE THE TESTED AIR LEAKAGE TO 3.0 AIR CHANGES PER HOUR MAXIMUM AND ALL WHOLE HOUSE VENTILATION REQUIREMENTS AS DETERMINED BY SECTION M507.3 OF THE INTERNATIONAL RESIDENTIAL CODE SHALL BE MET WITH A HIGH EFFICIENCY FAN (MAXIMUM 0.35 WATTS/CFM), NOT INTERLOCKED WITH THE FURNACE FAN. VENTILATION SYSTEMS USING A FURNACE INCLUDING AN ECM MOTOR ARE ALLOWED, PROVIDED THAT THEY ARE CONTROLLED TO OPERATE AT LOW SPEED IN VENTILATION ONLY MODE. TO QUALIFY TO CLAIM THIS CREDIT, THE BUILDING PERMIT DRAWINGS SHALL SPECIFY THE OPTION BEING SELECTED AND SHALL SPECIFY THE MAXIMUM TESTED BUILDING AIR LEAKAGE AND SHALL SHOW THE QUALIFYING VENTILATION SYSTEM.	0.5
2b	AIR LEAKAGE CONTROL AND EFFICIENT VENTILATION 2b: COMPLIANCE BASED ON SECTION R402.4.1.2: REDUCE THE TESTED AIR LEAKAGE TO 2.0 AIR CHANGES PER HOUR MAXIMUM AND ALL WHOLE HOUSE VENTILATION REQUIREMENTS AS DETERMINED BY SECTION M507.3 OF THE INTERNATIONAL RESIDENTIAL CODE SHALL BE MET WITH A HEAT RECOVERY VENTILATION SYSTEM WITH MINIMUM SENSIBLE HEAT RECOVERY EFFICIENCY OF 0.10. TO QUALIFY TO CLAIM THIS CREDIT, THE BUILDING PERMIT DRAWINGS SHALL SPECIFY THE OPTION BEING SELECTED AND SHALL SPECIFY THE MAXIMUM TESTED BUILDING AIR LEAKAGE AND SHALL SHOW THE HEAT RECOVERY VENTILATION SYSTEM.	1.0
2c	AIR LEAKAGE CONTROL AND EFFICIENT VENTILATION 2c: COMPLIANCE BASED ON SECTION R402.4.1.2: REDUCE THE TESTED AIR LEAKAGE TO 1.5 AIR CHANGES PER HOUR MAXIMUM AND ALL WHOLE HOUSE VENTILATION REQUIREMENTS AS DETERMINED BY SECTION M507.3 OF THE INTERNATIONAL RESIDENTIAL CODE SHALL BE MET WITH A HEAT RECOVERY VENTILATION SYSTEM WITH MINIMUM SENSIBLE HEAT RECOVERY EFFICIENCY OF 0.25. TO QUALIFY TO CLAIM THIS CREDIT, THE BUILDING PERMIT DRAWINGS SHALL SPECIFY THE OPTION BEING SELECTED AND SHALL SPECIFY THE MAXIMUM TESTED BUILDING AIR LEAKAGE AND SHALL SHOW THE HEAT RECOVERY VENTILATION SYSTEM.	1.5
3a	HIGH EFFICIENCY HVAC EQUIPMENT 3a: GAS, PROPANE OR OIL-FIRED FURNACE WITH MINIMUM AFUE OF 94%, OR GAS, PROPANE OR OIL-FIRED BOILER WITH MINIMUM AFUE OF 92% TO QUALIFY TO CLAIM THIS CREDIT, THE BUILDING PERMIT DRAWINGS SHALL SPECIFY THE OPTION BEING SELECTED AND SHALL SPECIFY THE HEATING EQUIPMENT TYPE AND THE MINIMUM EQUIPMENT EFFICIENCY.	1.0
3b	HIGH EFFICIENCY HVAC EQUIPMENT 3b: AIR-SOURCE HEAT PUMP WITH MINIMUM SEER OF 14.0 TO QUALIFY TO CLAIM THIS CREDIT, THE BUILDING PERMIT DRAWINGS SHALL SPECIFY THE OPTION BEING SELECTED AND SHALL SPECIFY THE HEATING EQUIPMENT TYPE AND THE MINIMUM EQUIPMENT EFFICIENCY.	1.0
3c	HIGH EFFICIENCY HVAC EQUIPMENT 3c: CLOSED-LOOP GROUND SOURCE HEAT PUMP, WITH A MINIMUM COP OF 3.3 OR OPEN LOOP WATER SOURCE HEAT PUMP WITH A MAXIMUM PUMPING HYDRAULIC HEAD OF 150 FEET AND MINIMUM COP OF 3.6 TO QUALIFY TO CLAIM THIS CREDIT, THE BUILDING PERMIT DRAWINGS SHALL SPECIFY THE OPTION BEING SELECTED AND SHALL SPECIFY THE HEATING EQUIPMENT TYPE AND THE MINIMUM EQUIPMENT EFFICIENCY.	1.5
3d	HIGH EFFICIENCY HVAC EQUIPMENT 3d: DUCTLESS SPLIT SYSTEM HEAT PUMPS, ZONAL CONTROL. IN HOMES WHERE THE PRIMARY SPACE HEATING SYSTEM IS ZONAL ELECTRIC HEATING, A DUCTLESS HEAT PUMP SYSTEM SHALL BE INSTALLED AND PROVIDE HEATING TO THE LARGEST ZONE OF THE HOUSING UNIT. TO QUALIFY TO CLAIM THIS CREDIT, THE BUILDING PERMIT DRAWINGS SHALL SPECIFY THE OPTION BEING SELECTED AND SHALL SPECIFY THE HEATING EQUIPMENT TYPE AND THE MINIMUM EQUIPMENT EFFICIENCY.	1.0

OPTION	DESCRIPTION	CREDITS
4	HIGH EFFICIENCY HVAC DISTRIBUTION SYSTEM: ALL HEATING AND COOLING SYSTEM COMPONENTS INSTALLED INSIDE THE CONDITIONED SPACE. THIS INCLUDES ALL EQUIPMENT AND DISTRIBUTION SYSTEM COMPONENTS SUCH AS FORCED AIR DUCTS, HYDRONIC PIPING, HYDRONIC FLOOR HEATING LOOP, CONVECTORS AND RADIATORS. ALL COMBUSTION EQUIPMENT SHALL BE DIRECT VENT OR SEALED COMBUSTION. FOR FORCED AIR DUCTS: A MAXIMUM OF 10 LINEAR FEET OF RETURN DUCTS AND 5 LINEAR FEET OF SUPPLY DUCTS MAY BE LOCATED OUTSIDE THE CONDITIONED SPACE. ALL METALLIC DUCTS LOCATED OUTSIDE THE CONDITIONED SPACE MUST HAVE BOTH TRANSVERSE AND LONGITUDINAL JOINTS SEALED WITH MASTIC. IF FLEX DUCTS ARE USED, THEY CANNOT CONTAIN SPLICES. FLEX DUCT CONNECTIONS MUST BE MADE WITH NYLON STRAPS AND INSTALLED USING A PLASTIC STRAPPING-TENSIONING TOOL. DUCTS LOCATED OUTSIDE THE CONDITIONED SPACE MUST BE INSULATED TO A MINIMUM OF R-8. LOCATING SYSTEM COMPONENTS IN CONDITIONED GRABLL SPACES IS NOT PERMITTED UNDER THIS OPTION. ELECTRIC RESISTANCE HEAT AND DUCTLESS HEAT PUMPS ARE NOT PERMITTED UNDER THIS OPTION. DIRECT COMBUSTION HEATING EQUIPMENT WITH AFUE LESS THAN 90% IS NOT PERMITTED UNDER THIS OPTION. TO QUALIFY TO CLAIM THIS CREDIT, THE BUILDING PERMIT DRAWINGS SHALL SPECIFY THE OPTION BEING SELECTED AND SHALL SPECIFY THE HEATING EQUIPMENT TYPE AND SHALL SHOW THE LOCATION OF THE HEATING AND COOLING EQUIPMENT AND ALL THE DUCTWORK.	1.0
5a	EFFICIENT WATER HEATING 5a: ALL SHOWERHEAD AND KITCHEN SINK FAUCETS INSTALLED IN THE HOUSE SHALL BE RATED AT 1.75 GPM OR LESS. ALL OTHER LAVATORY FAUCETS SHALL BE RATED AT 1.0 GPM OR LESS. TO QUALIFY TO CLAIM THIS CREDIT, THE BUILDING PERMIT DRAWINGS SHALL SPECIFY THE OPTION BEING SELECTED AND SHALL SPECIFY THE MAXIMUM FLOW RATES FOR ALL SHOWERHEADS, KITCHEN SINK FAUCETS, AND OTHER LAVATORY FAUCETS.	0.5
5b	EFFICIENT WATER HEATING 5b: WATER HEATING SYSTEM SHALL INCLUDE ONE OF THE FOLLOWING: GAS, PROPANE OR OIL WATER HEATER WITH A MINIMUM EF OF 0.14 OR WATER HEATER HEATED BY GROUND SOURCE HEAT PUMP MEETING THE REQUIREMENTS OF OPTION 3c. OR FOR R-2 OCCUPANCY, A CENTRAL HEAT PUMP WATER HEATER WITH AN EF GREATER THAN 2.0 THAT WOULD SUPPLY DHW TO ALL THE UNITS THROUGH A CENTRAL WATER LOOP INSULATED WITH R-8 MINIMUM PIPE INSULATION. TO QUALIFY TO CLAIM THIS CREDIT, THE BUILDING PERMIT DRAWINGS SHALL SPECIFY THE OPTION BEING SELECTED AND SHALL SPECIFY THE WATER HEATER EQUIPMENT TYPE AND THE MINIMUM EQUIPMENT EFFICIENCY.	1.0
5c	EFFICIENT WATER HEATING 5c: WATER HEATING SYSTEM SHALL INCLUDE ONE OF THE FOLLOWING: GAS, PROPANE OR OIL WATER HEATER WITH A MINIMUM EF OF 0.91 OR SOLAR WATER HEATING SUPPLEMENTING A MINIMUM STANDARD WATER HEATER. SOLAR WATER HEATING WILL PROVIDE A RATED MINIMUM SAVINGS OF 85 THERMS OR 2000 KWH BASED ON THE SOLAR RATING AND CERTIFICATION CORPORATION (SRC/C) ANNUAL PERFORMANCE OF 06-300 CERTIFIED SOLAR WATER HEATING SYSTEMS. OR ELECTRIC HEAT PUMP WATER HEATER WITH A MINIMUM EF OF 2.0 AND MEETING THE STANDARDS OF NEEA'S NORTHERN CLIMATE SPECIFICATIONS FOR HEAT PUMP WATER HEATERS. TO QUALIFY TO CLAIM THIS CREDIT, THE BUILDING PERMIT DRAWINGS SHALL SPECIFY THE OPTION BEING SELECTED AND SHALL SPECIFY THE WATER HEATER EQUIPMENT TYPE AND THE MINIMUM EQUIPMENT EFFICIENCY AND, FOR SOLAR WATER HEATING SYSTEMS, THE CALCULATION OF THE MINIMUM ENERGY SAVINGS.	1.5
5d	EFFICIENT WATER HEATING 5d: A DRAIN WATER HEAT RECOVERY (UNIT) SHALL BE INSTALLED, WHICH CAPTURES WASTE WATER HEAT FROM ALL THE SHOWERS, AND HAS A MINIMUM EFFICIENCY OF 40%. IF INSTALLED FOR EQUAL FLOW OR A MINIMUM EFFICIENCY OF 52% IF INSTALLED FOR UNEQUAL FLOW. SUCH UNITS SHALL BE RATED IN ACCORDANCE WITH CSA B951 AND BE SO LABELED. TO QUALIFY TO CLAIM THIS CREDIT, THE BUILDING PERMIT DRAWINGS SHALL INCLUDE A PLUMBING DIAGRAM THAT SPECIFIES THE DRAIN WATER HEAT RECOVERY UNITS AND THE PLUMBING LAYOUT NEEDED TO INSTALL IT AND LABELS OR OTHER DOCUMENTATION SHALL BE PROVIDED THAT DEMONSTRATES THAT THE UNIT COMPLIES WITH THE STANDARD.	0.5
6	RENEWABLE ELECTRIC ENERGY: FOR EACH 1200 KWH OF ELECTRICAL GENERATION PER HOUSING UNIT PROVIDED ANNUALLY BY ON-SITE WIND OR SOLAR EQUIPMENT A 0.5 CREDIT SHALL BE ALLOWED, UP TO 3 CREDITS. GENERATION SHALL BE CALCULATED AS FOLLOWS: FOR SOLAR ELECTRIC SYSTEMS, THE DESIGN SHALL BE DEMONSTRATED TO MEET THIS REQUIREMENT USING THE NATIONAL RENEWABLE ENERGY LABORATORY CALCULATOR PVWATTS. DOCUMENTATION NOTING SOLAR ACCESS SHALL BE INCLUDED ON THE PLANS. FOR WIND GENERATION PROJECTS DESIGNS SHALL DOCUMENT ANNUAL POWER GENERATION BASED ON THE FOLLOWING FACTORS: THE WIND TURBINE POWER CURVE; AVERAGE ANNUAL WIND SPEED AT THE SITE; FREQUENCY DISTRIBUTION OF THE WIND SPEED AT THE SITE AND HEIGHT OF THE TOWER. TO QUALIFY TO CLAIM THIS CREDIT, THE BUILDING PERMIT DRAWINGS SHALL SPECIFY THE OPTION BEING SELECTED AND SHALL SHOW THE PHOTOVOLTAIC OR WIND TURBINE EQUIPMENT TYPE, PROVIDE DOCUMENTATION OF SOLAR AND WIND ACCESS, AND INCLUDE A CALCULATION OF THE MINIMUM ANNUAL ENERGY POWER PRODUCTION.	0.5

- A. PROJECTS USING THIS OPTION MAY NOT USE OPTION 1a, 1b or 1c.
- B. PROJECTS MAY ONLY INCLUDE CREDIT FROM ONE SPACE HEATING OPTION 3a, 3b, 3c or 3d. WHEN A HOUSING UNIT HAS TWO PIECES OF EQUIPMENT (I.E., TWO FURNACES) BOTH MUST MEET THE STANDARD TO RECEIVE THE CREDIT.
- C. PLUMBING FIXTURES FLOW RATINGS, LOW FLOW PLUMBING FIXTURES (WATER CLOSETS AND URINALS) AND FITTINGS (FAUCETS AND SHOWERHEADS) SHALL COMPLY WITH THE FOLLOWING REQUIREMENTS:
- RESIDENTIAL BATHROOM LAVATORY SINK FAUCETS: MAXIMUM FLOW RATE - 3.0 L/MIN (1.0 GAL/MIN) WHEN TESTED IN ACCORDANCE WITH ASME A112.18.1/CSA B125.1.
 - RESIDENTIAL KITCHEN FAUCETS: MAXIMUM FLOW RATE - 6.6 L/MIN (1.75 GAL/MIN) WHEN TESTED IN ACCORDANCE WITH ASME A112.18.1/CSA B125.1.
 - RESIDENTIAL SHOWERHEADS: MAXIMUM FLOW RATE - 6.6 L/MIN (1.75 GAL/MIN) WHEN TESTED IN ACCORDANCE WITH ASME A112.18.1/CSA B125.1.

Issue Issue Date By
Description

Spring Residence
4740 W. Mercer Way
Mercer Island, WA.
Job Number: Spring JMC011

plan name: -
marketing name: -
plan number: -
mark sys. number: -

Conditions not specifically represented graphically or in writing or which conflict with the current International Residential Code (IRC.) or those of the local municipality then the current standards and requirements of each respectively shall govern.

The drawings in this set are instruments of service and shall remain the property of JayMarc Homes, LLC.

© 2017 JayMarc Homes, LLC; All rights reserved.

12.09.22
Submittal Date

Sheet Title/Description
JAYMARC HOMES
Design Firm

R.K.N.
Drawn by:

S.K.
Checked by:

Primary Scale

EN2
of .

Sheet Title/Description

Issue	Issue Date By	Description

Spring Residence
 4740 W. Mercer Way
 Mercer Island, WA.
 Job Number: Spring JMC011

plan name: -
 marketing name: -
 plan number: -
 mark sys. number: -

Conditions not specifically represented graphically or in writing or which conflict with the current international Residential Code (IRC.) or those of the local municipality then the current standards and requirements of each respectively shall govern.

The drawings in this set are instruments of service and shall remain the property of JayMarc Homes, LLC.

© 2017 JayMarc Homes, LLC; All rights reserved.

12.09.22
 Submittal Date

Sheet Title/Description
 JAYMARC HOMES
 Design Firm

R.K.N.
 Drawn by:

S.K.
 Checked by:

Primary Scale

EN3
 of .

Sheet Title/Description

Project Information		Contact Information	
New SFR	4740 W. Mercer Way	JayMarc Homes	7525 SE 24th St. #487
	MERCER ISLAND, WA. 98040		Mercer Island, WA. 98040

Component	Ref.	U-Factor	Width	Height	Area	UA
Description			Qt. Feet	Inch Feet		
Exempt Swinging Door (24 sq. ft. max.)	WSEC	0.25	1	3 0 8 0	24.0	6.00
Exempt Glazed Fenestration (15 sq. ft. max.)					0.0	0.00

Vertical Fenestration (Windows and doors)		Contact Information				
Component	Ref.	U-Factor	Width	Height	Area	UA
Description			Qt. Feet	Inch Feet		
Great Room	WSEC	0.28	1	6 0 4 6	27.0	7.56
Great Room	WSEC	0.28	1	15 0 8 0	120.0	33.60
Great Room	WSEC	0.28	2	6 0 5 0	60.0	16.80
Kitchen	WSEC	0.28	3	4 0 4 6	54.0	15.12
Play Area	WSEC	0.28	3	3 0 8 0	72.0	20.16
Dining	WSEC	0.28	1	8 0 4 6	36.0	10.08
Dining	WSEC	0.28	1	10 0 5 0	50.0	14.00
Mud Room	WSEC	0.28	1	3 0 4 6	13.5	3.78
Study	WSEC	0.28	1	10 0 5 0	50.0	14.00
Entry	WSEC	0.28	1	3 0 8 0	24.0	6.72
Play Area	WSEC	0.28	3	3 0 8 0	72.0	20.16
Primary Bath	WSEC	0.28	1	6 0 5 0	30.0	8.40
Primary Bath	WSEC	0.28	1	8 0 2 0	16.0	4.48
Primary Bath	WSEC	0.28	1	2 0 4 0	10.0	2.80
W.I.C.	WSEC	0.28	1	5 0 2 0	11.0	3.08
Primary Bedroom	WSEC	0.28	2	5 0 5 0	50.0	14.00
Primary Bedroom	WSEC	0.28	1	10 0 5 0	50.0	14.00
Stairs/Entry	WSEC	0.28	5	3 0 8 0	120.0	33.60
Laundry	WSEC	0.28	2	3 0 5 0	30.0	8.40
Bedroom 2	WSEC	0.28	1	3 0 5 0	15.0	4.20
Bedroom 2	WSEC	0.28	1	6 0 5 0	30.0	8.40
Bedroom 2	WSEC	0.28	1	10 0 5 0	50.0	14.00
Bonus Room	WSEC	0.28	3	6 0 5 0	90.0	25.20
Bath 4	WSEC	0.28	1	2 0 3 0	6.0	0.00
Bedroom 4	WSEC	0.28	1	6 0 5 0	30.0	8.40
Bedroom 3	WSEC	0.28	1	6 0 5 0	30.0	8.40
Bath 3	WSEC	0.28	1	2 0 3 0	6.0	1.68
Bonus Room Doors	WSEC	0.25	2	3 0 8 0	48.0	12.00
					0.0	0.00
					0.0	0.00
Simple Heating System Size: Washington State
 This heating system sizing calculator is based on the Prescriptive Requirements of the 2015 Washington State Energy Code (WSEC) and ACCA Manuals J and S. This calculator will calculate heating loads only. ACCA procedures for sizing cooling systems should be used to determine cooling loads.
 Please fill out all of the green drop-downs and boxes that are applicable to your project. As you make selections in the drop-downs for each section, some values will be calculated for you. If you do not see the selection you need in the drop-down options, please call the WSU Energy Extension Program at (360) 956-2042 for assistance.

Project Information		Contact Information	
New SFR	4740 W. Mercer Way	JayMarc Homes	7525 SE 24th St. #500
	MERCER ISLAND, WA. 98040		MERCER ISLAND, WA. 98040

Heating System Type: All Other Systems Heat Pump

To see detailed instructions for each section, place your cursor on the word "Instructions".

Design Temperature
 Instructions: Mercer Island Design Temperature Difference (ΔT) 45
 ΔT = Indoor (°F) - Outdoor Design Temp

Area of Building
 Instructions: Conditioned Floor Area (sq ft) 4,840

Average Ceiling Height
 Instructions: Average Ceiling Height (ft) 9.5 Conditioned Volume 45,980

Glazing and Doors
 Instructions: U-Factor X Area = UA
 0.280 X 1,200 = 336.00

Skylights
 Instructions: U-Factor X Area = UA
 0.50 X 16 = 8.00

Insulation
 Instructions: R-49 U-Factor X Area = UA
 0.026 X 3,048 = 79.25

Single Rafter or Joist Vaulted Ceilings
 Instructions: No selection U-Factor X Area = UA

Above Grade Walls (see Figure 1)
 Instructions: R-21 Intermediate U-Factor X Area = UA
 0.055 X 5,182 = 176.51

Floors
 Instructions: R-38 U-Factor X Area = UA
 0.025 X 2,232 = 55.80

Below Grade Walls (see Figure 1)
 Instructions: No selection U-Factor X Area = UA

Slab Below Grade (see Figure 1)
 Instructions: No selection F-Factor X Length = UA

Slab on Grade (see Figure 1)
 Instructions: R-10 Fully Insulated F-Factor X Length = UA
 0.360 X 0 = 0

Location of Ducts
 Instructions: Conditioned Space Duct Leakage Coefficient 1.00

Sum of UA 655.56
Envelope Heat Load 28,500 Btu / Hour
Air Leakage Heat Load 22,346 Btu / Hour
Building Design Heat Load 51,846 Btu / Hour
Building and Duct Heat Load 51,846 Btu / Hour
Maximum Heat Equipment Output 72,585 Btu / Hour
 Ducts in unconditioned space: Sum of Building Heat Loss X 1.10
 Building and Duct Heat Loss X 1.40 for Forced Air Furnace
 Building and Duct Heat Loss X 1.25 for Heat Pump

Figure 1:

(07/01/23)

2018 Washington State Energy Code – Residential
 Prescriptive Energy Code Compliance for All Climate Zones in Washington
 Single Family – New & Additions (effective February 1, 2021) Version 1.0

These requirements apply to all IRC building types, including detached one- and two-family dwellings and multiple single-family dwellings (townhouses).

Project Information		Contact Information	
New SFR	7332 122nd Ave NE, Kirkland, WA.	Ryan Redman - JayMarc Homes	7525 SE 24th St. Mercer Island, WA. 98040

Instructions: This single-family project will use the requirements of the Prescriptive Path below and incorporate the minimum values listed. Based on the size of the structure, the appropriate number of additional credits are checked as chosen by the permit applicant.

Provide all information from the following tables as building permit drawings: Table R402.1 - Insulation and Fenestration Requirements by Component, Table R406.2 - Fuel Normalization Credits and 406.3 - Energy Credits.

Authorized Representative: **Ryan Redman** Digitally signed by Ryan Redman Date: 2021.03.24 15:42:38 -0700 Date: 03/24/2021

All Climate Zones (Table R402.1.1)		
	R-Value *	U-Factor *
Fenestration U-Factor ^a	n/a	0.30
Skylight U-Factor ^b	n/a	0.50
Glazed Fenestration SHGC ^{b,c}	n/a	n/a
Ceiling ^d	49	0.026
Wood Frame Wall ^{e,h}	21 Int	0.056
Floor	30	0.029
Below Grade Wall ^{e,h}	10/15/21 Int + TB	0.042
Slab ^f R-Value & Depth	10, 2 ft	n/a

^a R-values are minimums. U-factors and SHGC are maximums. When insulation is installed in a cavity that is less than the label or design thickness of the insulation, the compressed R-value of the insulation from Appendix Table A101.4 shall not be less than the R-value specified in the table.

^b The fenestration U-factor column excludes skylights.

^c "10/15/21 +5TB" means R-10 continuous insulation on the exterior of the wall, or R-15 continuous insulation on the interior of the wall, or R-21 cavity insulation plus a thermal break between the slab and the basement wall at the interior of the basement wall. "10/15/21 +5TB" shall be permitted to be met with R-13 cavity insulation on the interior of the basement wall plus R-5 continuous insulation on the interior or exterior of the wall. "5TB" means R-5 thermal break between floor slab and basement wall.

^d R-10 continuous insulation is required under heated slab on grade floors. See Section R402.2.9.1.

^e For single rafter- or joist-vaulted ceilings, the insulation may be reduced to R-38 if the full insulation depth extends over the top plate of the exterior wall.

^f R-7.5 continuous insulation installed over an existing slab is deemed to be equivalent to the required perimeter slab insulation when applied to existing slabs complying with Section R503.1.1. If foam plastic is used, it shall meet the requirements for thermal barriers protecting foam plastics.

^g For log structures developed in compliance with Standard ICC 400, log walls shall meet the requirements for climate zone 5 of ICC 400.

^h Int. (intermediate framing) denotes framing and insulation as described in Section A103.2.2 including standard framing 16 inches on center, 78% of the wall cavity insulated and headers insulated with a minimum of R-10 insulation.

2018 Washington State Energy Code – Residential
 Prescriptive Energy Code Compliance for All Climate Zones in Washington
 Single Family – New & Additions (effective February 1, 2021)

Each dwelling unit in a residential building shall comply with sufficient options from Table R406.2 (fuel normalization credits) and Table 406.3 (energy credits) to achieve the following minimum number of credits. To claim this credit, the building permit drawings shall specify the option selected and the maximum tested building air leakage, and show the qualifying ventilation system and its control sequence of operation.

- Small Dwelling Unit: 3 credits**
 Dwelling units less than 1,500 sf in conditioned floor area with less than 300 sf of fenestration area. Additions to existing building that are greater than 500 sf of heated floor area but less than 1,500 sf.
- Medium Dwelling Unit: 5 credits**
 All dwelling units that are not included in #1 or #3
- Large Dwelling Unit: 7 credits**
 Dwelling units exceeding 5,000 sf of conditioned floor area
- Additions less than 500 square feet: 1.5 credits**
 All other additions shall meet 1-3 above

Before selecting your credits on this Summary table, review the details in Table 406.3 (Single Family), on page 4.

Summary of Table R406.2			
Heating Options	Fuel Normalization Descriptions	Credits - select ONE heating option	User Notes
1	Combustion heating minimum NAECA ^b	0.0	<input type="radio"/>
2	Heat pump ^c	1.0	<input checked="" type="radio"/>
3	Electric resistance heat only - furnace or zonal	-1.0	<input type="radio"/>
4	DHP with zonal electric resistance per option 3.4	0.5	<input type="radio"/>
5	All other heating systems	-1.0	<input type="radio"/>
Energy Options	Energy Credit Option Descriptions	Credits - select ONE energy option from each category ^d	User Notes
1.1	Efficient Building Envelope	0.5	<input type="radio"/>
1.2	Efficient Building Envelope	1.0	<input type="radio"/>
1.3	Efficient Building Envelope	0.5	<input checked="" type="radio"/>
1.4	Efficient Building Envelope	1.0	<input type="radio"/>
1.5	Efficient Building Envelope	2.0	<input type="radio"/>
1.6	Efficient Building Envelope	3.0	<input type="radio"/>
1.7	Efficient Building Envelope	0.5	<input type="radio"/>
2.1	Air Leakage Control and Efficient Ventilation	0.5	<input type="radio"/>
2.2	Air Leakage Control and Efficient Ventilation	1.0	<input type="radio"/>
2.3	Air Leakage Control and Efficient Ventilation	1.5	<input type="radio"/>
2.4	Air Leakage Control and Efficient Ventilation	2.0	<input checked="" type="radio"/>
3.1 ^e	High Efficiency HVAC	1.0	<input type="radio"/>
3.2	High Efficiency HVAC	1.0	<input type="radio"/>
3.3 ^e	High Efficiency HVAC	1.5	<input type="radio"/>
3.4	High Efficiency HVAC	1.5	<input type="radio"/>
3.5	High Efficiency HVAC	1.5	<input checked="" type="radio"/>
3.6 ^e	High Efficiency HVAC	2.0	<input type="radio"/>
4.1	High Efficiency HVAC Distribution System	0.5	<input type="radio"/>
4.2	High Efficiency HVAC Distribution System	1.0	<input checked="" type="radio"/>

2018 Washington State Energy Code – Residential
 Prescriptive Energy Code Compliance for All Climate Zones in Washington
 Single Family – New & Additions (effective February 1, 2021)

Summary of Table R406.2 (cont.)			
Energy Options	Energy Credit Option Descriptions (cont.)	Credits - select ONE energy option from each category ^f	User Notes
5.1 ^g	Efficient Water Heating	0.5	<input type="radio"/>
5.2	Efficient Water Heating	0.5	<input type="radio"/>
5.3	Efficient Water Heating	3.0	<input type="radio"/>
5.4	Efficient Water Heating	1.5	<input type="radio"/>
5.5	Efficient Water Heating	2.0	<input checked="" type="radio"/>
5.6	Efficient Water Heating	2.5	<input type="radio"/>
6.1 ^h	Renewable Electric Energy (3 credits max)	1.0	<input type="radio"/>
7.1	Appliance Package	0.5	<input type="radio"/>
Total Credits		6.0	<input checked="" type="checkbox"/> Qualifies Table <input type="button" value="Clear Form"/>

a. An alternative heating source sized at a maximum of 0.5 W/sf (equivalent) of heated floor area or 500 W, whichever is bigger, may be installed in the dwelling unit.
 b. Equipment listed in Table C403.3.2(4) or C403.3.2(5)
 c. Equipment listed in Table C403.3.2(1) or C403.3.2(2)
 d. You cannot select more than one option from any category EXCEPT in category 5. Option 5.1 may be combined with options 5.2 through 5.6. See Table 406.3.
 e. 1.0 credit for each 1,200 kWh of electrical generation provided annually, up to 3 credits max.
 See the complete Table R406.2 for all requirements and option descriptions.
 f. Use the single radiobutton in the upper right of the second column to deselect radiobuttons in that group.

Please print only pages 1 through 3 of this worksheet for submission to your building official.

SE 1/4 OF THE SE 1/4 OF SECTION 13, TOWNSHIP 24 NORTH., RANGE 4 EAST, W.M., KING COUNTY, WA.




LEGEND

- ASPHALT SURFACE
- BRICK SURFACE
- BUILDING
- CENTERLINE ROW
- CLEANOUT
- CULVERT PIPE
- CONCRETE SURFACE
- RETAINING WALL
- DECK
- FENCE LINE (CHAIN LINK)
- FENCE LINE (WOOD)
- GAS METER
- GRAVEL SURFACE
- HEDGE FOLIAGE LINE
- INLET (TYPE 1)
- MAILBOX (RESIDENTIAL)
- EXISTING SPOT ELEVATIONS
- MONUMENT IN CASE (FOUND)
- POWER METER
- POWER (OVERHEAD)
- POWER POLE
- REBAR AS NOTED (FOUND)
- REBAR & CAP (SET)
- ROCKERY
- SEWER LINE
- SEWER MANHOLE
- STORM DRAIN LINE
- TELEPHONE (OVERHEAD)
- TELEPHONE SENTRY
- WATER METER
- POWER TRANSFORMER POLE
- TREE (AS NOTED)


4740 West Mercer Way TREE INVENTORY

Tree ID	Common Name	DSH	Multi	Health	Structural Condition	Drip Line				Exceptional Threshold	Exceptional Above 24"	Retain?	
						N	E	S	W				
377	Bigleaf Maple	34.7	24,25	Good	Good	26.4	26.4	33.4	31.4	30"	Size	Yes	Yes
378	Lodgepole Pine	11.5		Good	Fair	0.5	13.5	24.5	12.5	6	Size	No	No
379	Austrian Black Pine	26.7		Good	Fair	17.1	9.1	26.1	21.1	24	Size	Yes	Yes
380	Austrian Black Pine	28.3		Good	Fair	19.2	21.2	27.2	9.2	24	Size	Yes	Yes
381	Western Red Cedar	12.9		Good	Good	14.5	14.5	14.5	14.5	30	No	No	Yes
382	Western Red Cedar	32.5		Good	Good	21.4	21.4	21.4	21.4	30	Size	Yes	Yes
384	Western Red Cedar	45.4		Good	Good	31.9	21.9	26.9	21.9	30	Size	Yes	Yes
385	Doug-Fir	20.3		Good	Good	15.8	15.8	15.8	15.8	30	No	No	No
386	Doug-Fir	42		Good	Excellent	25.8	25.8	25.8	23.8	30	Size	Yes	Yes
10	TOTALS	9									7	6	7

OFFSITE	Common Name	DSH	Multi	Health	Structural Condition	N	E	S	W	Exceptional Threshold	Exceptional Above 24"	Retain?
A	Red Alder	12		Poor	Fair	15.5	17.5	10.5	16.5		No	Yes
383	Flowering Cherry	10.2	6,5,7,1,3,3	Good	Good	16.4	8.4	12.4	16.4	23	No	Yes

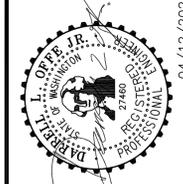

OFFE ENGINEERS
 13902 SOUTHEAST 159TH PLACE
 RENTON, WASHINGTON 98058
 PHONE: 425-260-3412
 CONTACT: DARRELL OFFE, P.E.

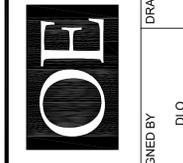

4740 West Mercer Way
JayMarc Custom Homes - Spring Residence
Temp. Erosion & Sedimentation Control Plan

DATE: 04/12/2023
 JOB NO.:
 DWG NO.:
 SHEET 1 OF 4

TABLE OF CONTENT

SHEET #	DESCRIPTION
1	TOPOGRAPHIC SURVEY
2	WETLAND UTILITY & TREE PLAN
3	UTILITY DETAILS
4	AMENDED SOILS PLAN




PERMIT #: 2212-080

SE 1/4 OF THE SE 1/4 OF SECTION 13, TOWNSHIP 24 NORTH., RANGE 4 EAST, W.M., KING COUNTY, WA.

NOTE: THE LAWN AND LANDSCAPE AREAS ARE REQUIRED TO PROVIDE POST-CONSTRUCTION SOIL QUALITY AND DEPTH IN ACCORDANCE WITH BMP T5.13. THE PROJECT CIVIL ENGINEER MUST PROVIDE A LETTER OF CERTIFICATION TO ENSURE THAT THE LAWN AND LANDSCAPE AREAS ARE MEETING THE POST-CONSTRUCTION SOIL QUALITY AND DEPTH REQUIREMENTS SPECIFIED ON THE APPROVED PLAN SET PRIOR TO FINAL INSPECTION OF THE PROJECT.

EXISTING UTILITY LOCATIONS SHOWN HEREON ARE APPROXIMATE ONLY. IT SHALL BE THE CONTRACTOR'S RESPONSIBILITY TO DETERMINE THE EXACT VERTICAL AND HORIZONTAL LOCATION OF ALL EXISTING UNDERGROUND UTILITIES PRIOR TO COMMENCING CONSTRUCTION. NO REPRESENTATION IS MADE THAT ALL EXISTING UTILITIES ARE SHOWN HEREON. THE ENGINEER ASSUMES NO RESPONSIBILITY FOR UTILITIES NOT SHOWN OR UTILITIES NOT SHOWN IN THEIR PROPER LOCATION.
CALL BEFORE YOU DIG: 811

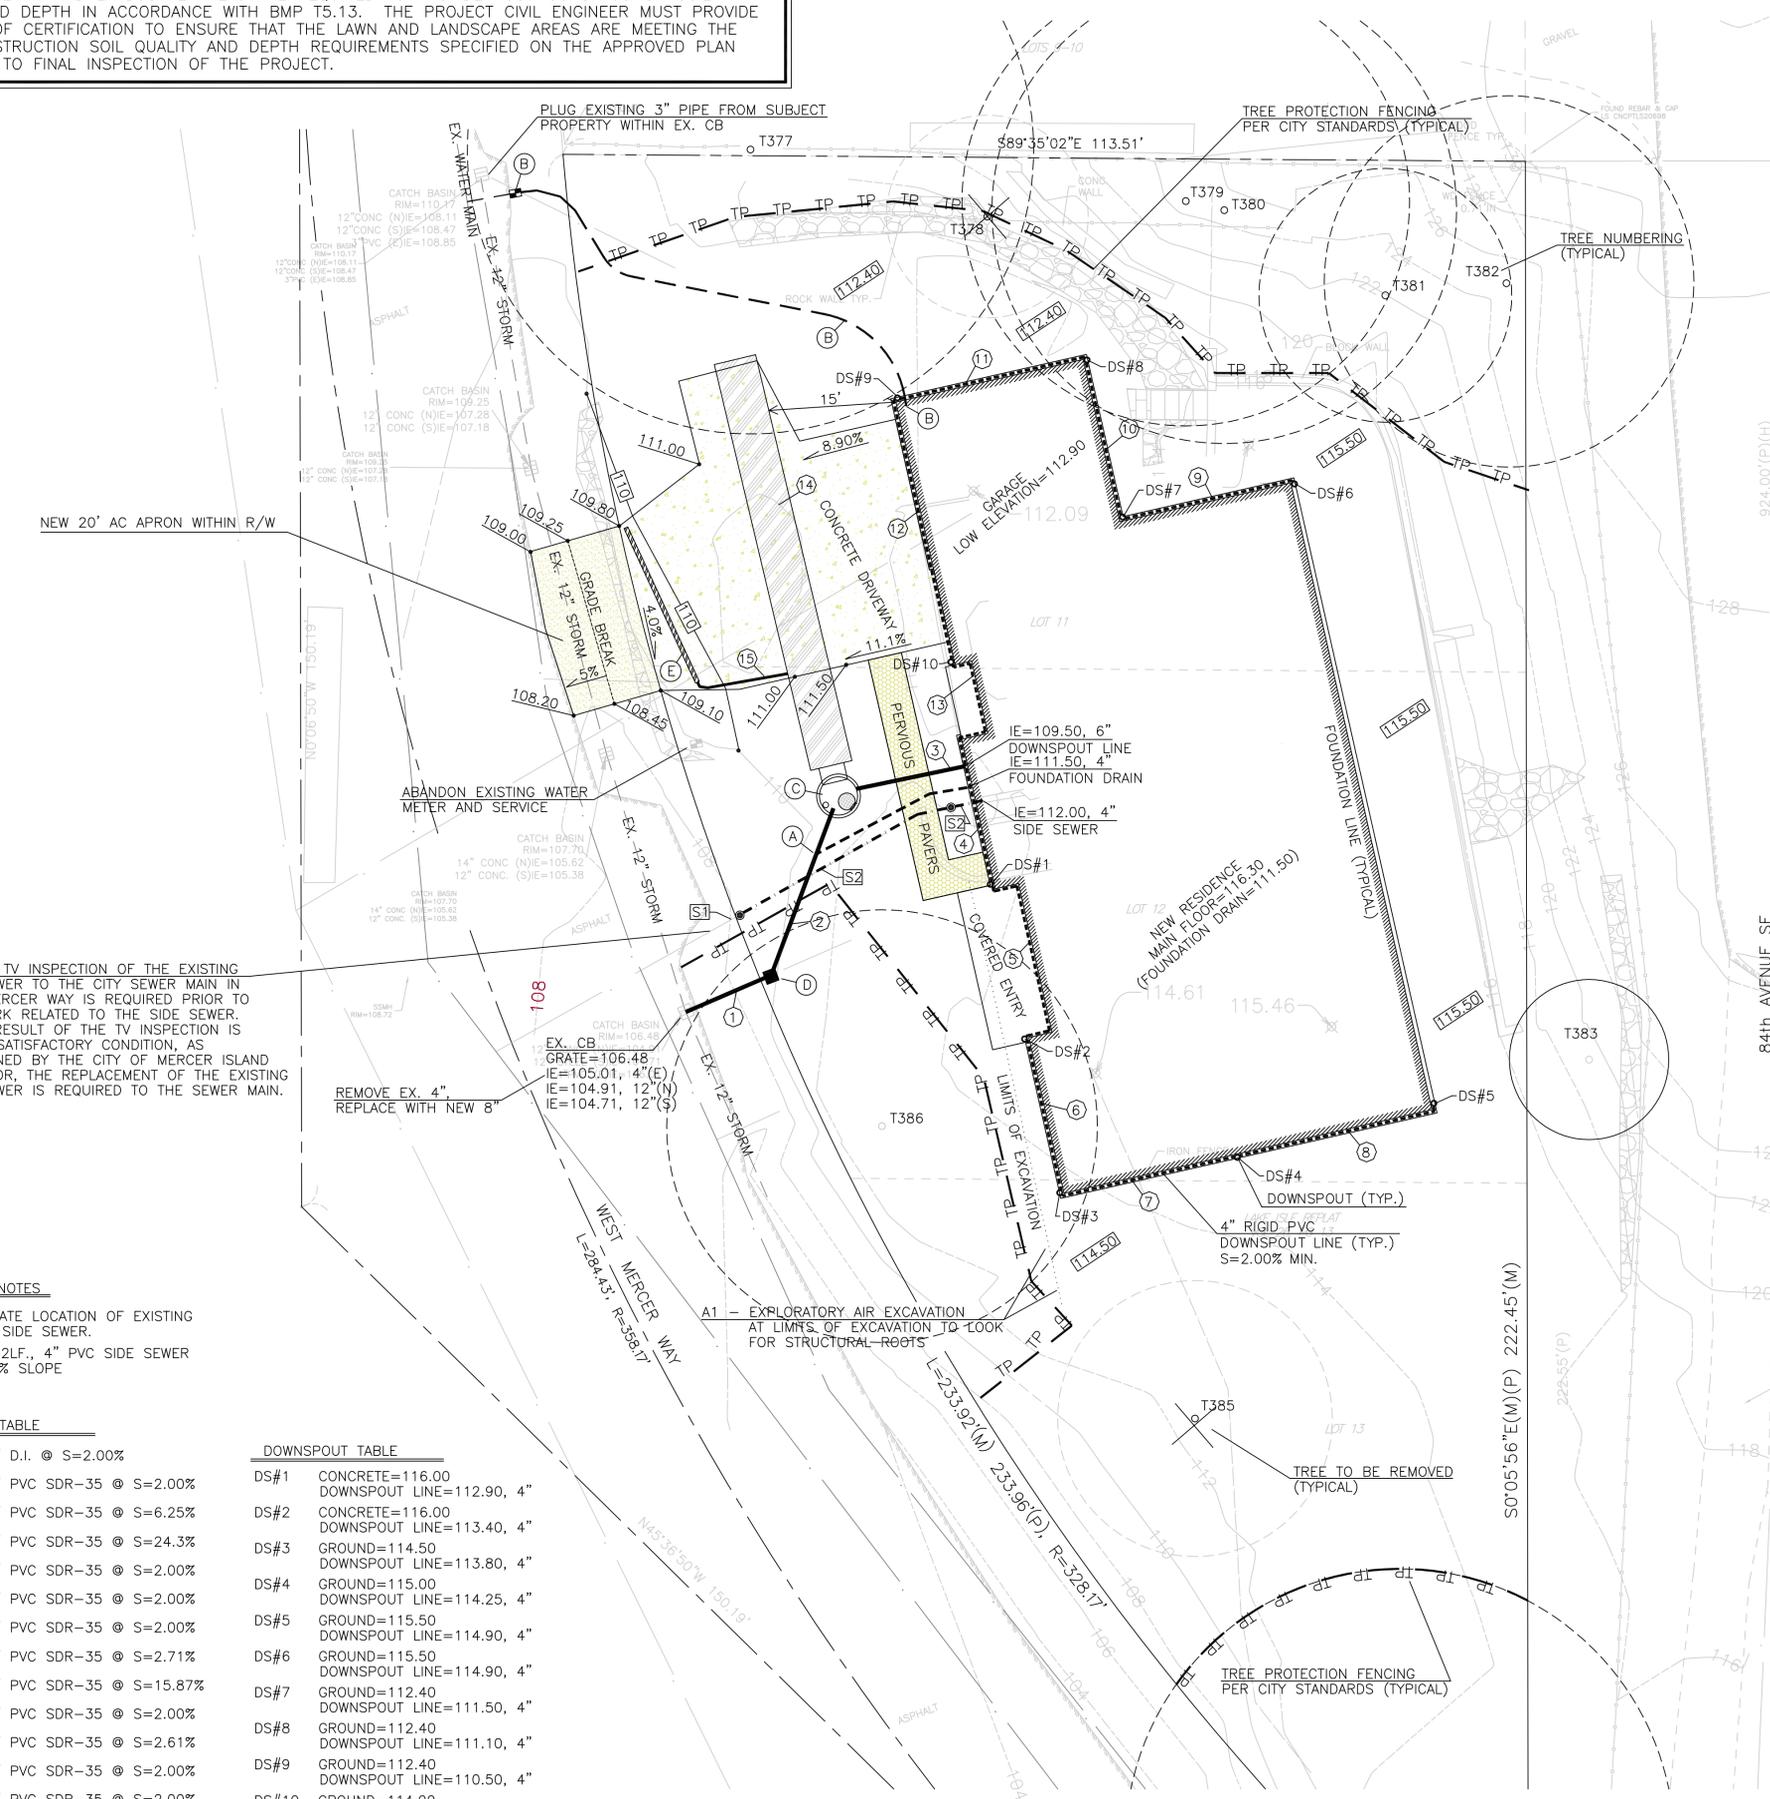

- LEGEND**
- ASPHALT SURFACE
 - BRICK SURFACE
 - BUILDING
 - CENTERLINE ROW
 - CLEANOUT
 - CULVERT PIPE
 - CONCRETE SURFACE
 - RETAINING WALL
 - DECK
 - FENCE LINE (CHAIN LINK)
 - FENCE LINE (WOOD)
 - GAS METER
 - GRAVEL SURFACE
 - HEDGE FOLIAGE LINE
 - INLET (TYPE 1)
 - MAILBOX (RESIDENTIAL)
 - EXISTING SPOT ELEVATIONS
 - MONUMENT IN CASE (FOUND)
 - POWER METER
 - POWER (OVERHEAD)
 - POWER POLE
 - REBAR AS NOTED (FOUND)
 - REBAR & CAP (SET)
 - ROCKERY
 - SEWER LINE
 - SEWER MANHOLE
 - STORM DRAIN LINE
 - TELEPHONE (OVERHEAD)
 - TELEPHONE SENTRY
 - WATER METER
 - POWER TRANSFORMER POLE
 - TREE (AS NOTED)

- NOTES:**
- (A) 4" FOUNDATION DRAIN
 - (B) INSTALL 1-1/2" METER AND 2" SERVICE LINE PER CITY OF MERCER ISLAND STANDARD PLAN W-14. NOTE: CONTRACTOR TO COORDINATE FINAL LOCATION OF NEW METER WITH CITY OF MERCER ISLAND INSPECTOR AT TIME OF CONSTRUCTION
 - (C) CB#2, CONTROL STRUCTURE, TYPE II-54"Ø ((SEE DETAIL ON SHEET 3 OF 4))
W/SOLID LOCKING LID
RIM=111.10
OVERFLOW=109.15, 8"(TOP OF TEE)
IE=108.50, 6"(E)
IE=105.65, 36"(N), 8"(SW)
ELEV.=103.65, 8"(BOTTOM OF TEE)
INSIDE BOTTOM=101.65
 - (D) CB#1, TYPE 1
W/SOLID LOCKING LID
RIM=109.50
IE=105.23 8"(W,NE)
 - (E) 20" SLOT DRAIN
GRATE=109.80
((DO NOT INSTALL LOWER THAN ELEV. 109.80))
IE=108.50, 4"(S)
 - (F) INSTALL PERMEABLE PAVERS OR STONE PER THE CITY OF MERCER ISLAND "PERMEABLE PAVER BLOCK DESIGN GUIDELINES" DATED 11/2019.
- A# - ARBORIST NOTES FROM 11/22/2022 EMAIL

NOTE: A TV INSPECTION OF THE EXISTING SIDE SEWER TO THE CITY SEWER MAIN IN WEST MERCER WAY IS REQUIRED PRIOR TO ANY WORK RELATED TO THE SIDE SEWER. IF THE RESULT OF THE TV INSPECTION IS NOT IN SATISFACTORY CONDITION, AS DETERMINED BY THE CITY OF MERCER ISLAND INSPECTOR, THE REPLACEMENT OF THE EXISTING SIDE SEWER IS REQUIRED TO THE SEWER MAIN.

- SIDE SEWER NOTES**
- S1 APPROXIMATE LOCATION OF EXISTING SANITARY SIDE SEWER.
 - S2 INSTALL 32LF., 4" PVC SIDE SEWER @ MIN. 2% SLOPE

STORM PIPE TABLE

1	11LF., 8" D.I. @ S=2.00%
2	21LF., 8" PVC SDR-35 @ S=2.00%
3	16LF., 6" PVC SDR-35 @ S=6.25%
4	14LF., 4" PVC SDR-35 @ S=24.3%
5	24LF., 4" PVC SDR-35 @ S=2.00%
6	18LF., 4" PVC SDR-35 @ S=2.00%
7	21LF., 4" PVC SDR-35 @ S=2.00%
8	24LF., 4" PVC SDR-35 @ S=2.71%
9	21LF., 4" PVC SDR-35 @ S=15.87%
10	19LF., 4" PVC SDR-35 @ S=2.00%
11	23LF., 4" PVC SDR-35 @ S=2.61%
12	32LF., 4" PVC SDR-35 @ S=2.00%
13	18LF., 4" PVC SDR-35 @ S=2.00%
14	49LF., 48" CMP @S=0.00% (LEVEL)
15	12LF., 4" CMP @S=11.25%

DOWNSPOUT TABLE

DS#1	CONCRETE=116.00 DOWNSPOUT LINE=112.90, 4"
DS#2	CONCRETE=116.00 DOWNSPOUT LINE=113.40, 4"
DS#3	GROUND=114.50 DOWNSPOUT LINE=113.80, 4"
DS#4	GROUND=115.00 DOWNSPOUT LINE=114.25, 4"
DS#5	GROUND=115.50 DOWNSPOUT LINE=114.90, 4"
DS#6	GROUND=115.50 DOWNSPOUT LINE=114.90, 4"
DS#7	GROUND=112.40 DOWNSPOUT LINE=111.50, 4"
DS#8	GROUND=112.40 DOWNSPOUT LINE=111.10, 4"
DS#9	GROUND=112.40 DOWNSPOUT LINE=110.50, 4"
DS#10	GROUND=114.00 DOWNSPOUT LINE=109.86, 4"

4740 West Mercer Way TREE INVENTORY

Tree ID	Common Name	DS#	Multi	Health Condition	Drip Line				Exceptional Threshold	Exceptional Above 24"	Retain?	
					N	E	S	W				
377	Bigleaf Maple	34.7	24,25	Good	26.4	26.4	33.4	31.4	30"	Size	Yes	Yes
378	Lodgepole Pine	11.5		Good	0.5	13.5	24.5	12.5	6	Size	No	No
379	Austrian Black Pine	26.7		Fair	17.1	9.1	26.1	21.1	24	Size	Yes	Yes
380	Austrian Black Pine	28.3		Good	19.2	21.2	27.2	9.2	24	Size	Yes	Yes
381	Western Red Cedar	12.9		Good	14.5	14.5	14.5	14.5	30	No	No	Yes
382	Western Red Cedar	32.5		Good	21.4	21.4	21.4	21.4	30	Size	Yes	Yes
384	Western Red Cedar	45.4		Good	31.9	21.9	26.9	21.9	30	Size	Yes	Yes
385	Doug-Fir	20.3		Good	15.8	15.8	15.8	15.8	30	No	No	No
386	Doug-Fir	42		Good	25.8	25.8	25.8	23.8	30	Size	Yes	Yes
10	TOTALS	9								7	6	7

OFFSITE

A	Red Alder	12	Poor	Fair	15.5	17.5	10.5	16.5		No	No	Yes
383	Flowering Cherry	10.2	6.5,7,1,3,3	Good	Good	16.4	8.4	12.4	16.4	23	No	Yes

STORM PIPE PVC SHALL BE SDR-35 PVC AT SLOPE=2.00% MINIMUM (TYPICAL) UNLESS OTHERWISE NOTED

IMPERVIOUS SURFACES:
ROOF AREA (UNDER EAVES) = 3,992 SQ. FEET
UNCOVERED DRIVEWAY AREA = 1,002 SQ. FEET
TOTAL IMPERVIOUS AREAS = 4,994 SQ. FEET

LANDSCAPE AREAS NOTE:
DISTURBED LANDSCAPE AREAS SHALL BE TREATED AS AMENDED SOILS PER DOE FIGURE V-5.3.3, TYPICAL



T384 NOTE: 4" PERFORATED FOUNDATION DRAIN REQUIRED BUT NOT SHOWN ON PLAN, CONNECT WHERE SHOWN ON PLAN, WYE INTO DETENTION TANK OUTFALL

PERMIT #: 2212-080

OFFE ENGINEERS
13902 SOUTHEAST 159TH PLACE
RENTON, WASHINGTON 98058
PHONE: 425-260-3412
CONTACT: DARRELL OFFE, P.E.

4740 West Mercer Way
JayMarc Custom Homes - Spring Residence
Utility & Tree Plan

PROJECT: 4740 West Mercer Way
CLIENT: JayMarc Custom Homes - Spring Residence
SHEET CONTENT: Utility & Tree Plan
DATE: 04/12/2023
JOB NO.:
DWG NO.: 2 OF 4




DESIGNED BY: DLO
DRAWN BY: SLM
CHECKED BY: DLO
DLO

REVISIONS:

REV. NO.	DATE	DESCRIPTION
1	04/12/2023	REVISED PER CITY COMMENTS 03/01/2023


PROFESSIONAL SEAL: DARRELL OFFE, P.E., LICENSE NO. 27460, STATE OF WASHINGTON

SE 1/4 OF THE SE 1/4 OF SECTION 13, TOWNSHIP 24 NORTH., RANGE 4 EAST, W.M., KING COUNTY, WA.

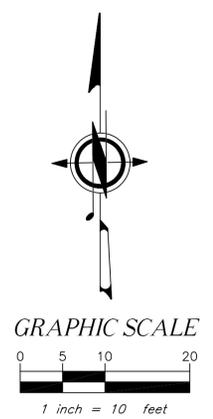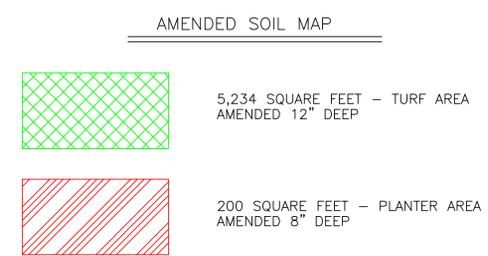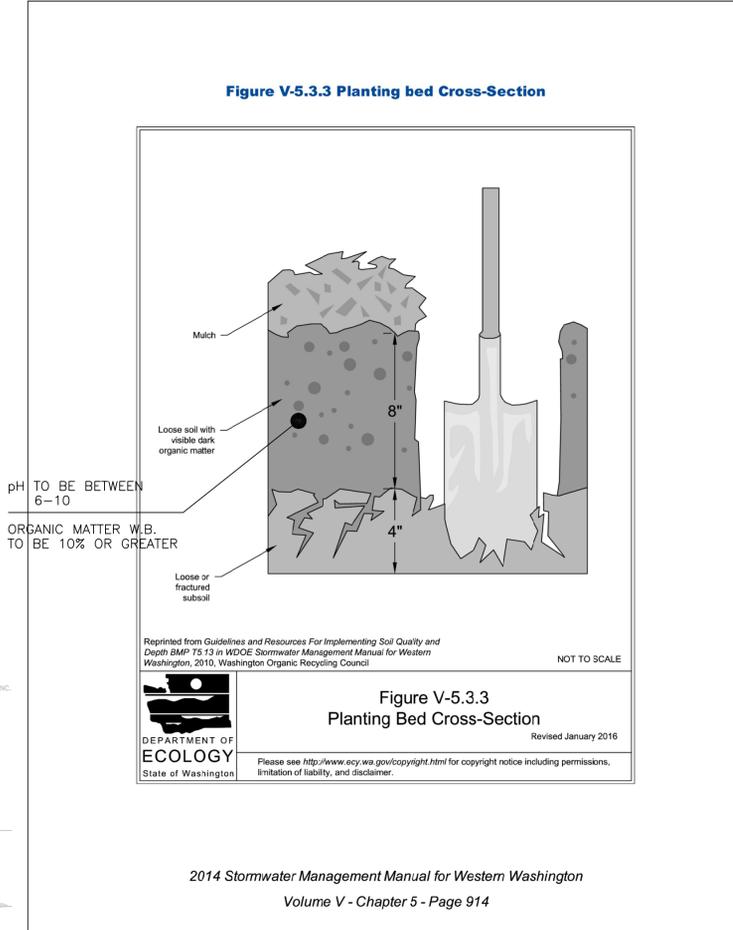

PERMIT #: 2212-080

		4740 West Mercer Way JayMarc Custom Homes - Spring Residence Amended Soil Map & Detail	DESIGNED BY: DLO DRAWN BY: SLM CHECKED BY: DLO	REVISED PER CITY COMMENTS 03/01/2023 DATE: 04/12/2023 REV. NO.: 1 DESCRIPTION:
PROJECT:	CLIENT:	SHEET CONTENT:	DATE:	DATE:
	JayMarc Custom Homes - Spring Residence		04/12/2023	04/12/2023
JOB NO.:				
DWG NO.:				
4	OF	4		

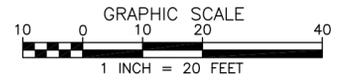


PROJECT INFORMATION	
SURVEYOR:	PLOG ENGINEERING, PLLC P.O. BOX 412 RAVENSDALE, WA 98051 PH: (206) 420-7130
PROPERTY OWNER:	ERIC & KATIE SPRING 4740 WEST MERCER WAY MERCER ISLAND, WA 98040
TAX PARCEL NUMBER:	404510-0055
PROJECT ADDRESS:	4740 WEST MERCER WAY MERCER ISLAND, WA 98040
PARCEL AREA:	16,710 S.F. (0.384 ACRES ±) AS SURVEYED

REFERENCE SURVEYS	
P1	REPLAT OF LAKE ISLE, VOL 26, PG 13
R1	AF# 2006102390004
SP1	AF# 9809099001 SP# M.I. 98-0179

- GENERAL NOTES**
1. INSTRUMENTATION FOR THIS SURVEY WAS A 3-SECOND LEICA VIVA TS15 SMART POLE TOTAL STATION/RTK GPS.
 2. PROCEDURES USED IN THIS SURVEY MEET OR EXCEED STANDARDS SET BY WAC 332-130-090. SURVEY WAS COMPLETED BY A FIELD TRAVERSE.
 3. ALL MONUMENTS WERE LOCATED DURING THIS SURVEY UNLESS OTHERWISE NOTED.
 4. ENCROACHMENTS NOTED AS "IN" OR "OUT" ARE RELATIVE TO THE SUBJECT PROPERTY.
 5. FENCE DIMENSIONS ARE GENERALLY TO THE CENTERLINE OF THE FENCE UNLESS OTHERWISE NOTED.
 6. STRUCTURE LOCATIONS ARE MEASURED TO THE FINISHED FASCIA UNLESS OTHERWISE NOTED.
 7. TREE LOCATIONS ARE MEASURED TO THE ESTIMATED CENTER OF THE TREE.
 8. ALL DIMENSIONS ARE IN DECIMAL FEET.

LEGAL DESCRIPTION
 LOTS 11, 12 AND 13, REPLAT OF A PORTION OF LAKE ISLE, ACCORDING TO THE PLAT THEREOF RECORDED IN VOLUME 26 OF PLATS, PAGE 13, RECORDS OF KING COUNTY, WASHINGTON.
 SITUATE IN THE COUNTY OF KING, STATE OF WASHINGTON.

BASIS OF BEARINGS
 PER THE REPLAT OF A PORTION OF LAKE ISLE, ACCORDING TO THE PLAT THEREOF RECORDED IN VOLUME 26 OF PLATS, PAGE 13, RECORDS OF KING COUNTY, WASHINGTON.
 ACCEPTED THE BEARING OF N 00°05'56" W FOR 84TH AVE SE BASED ON FOUND MONUMENTS IN CASE.

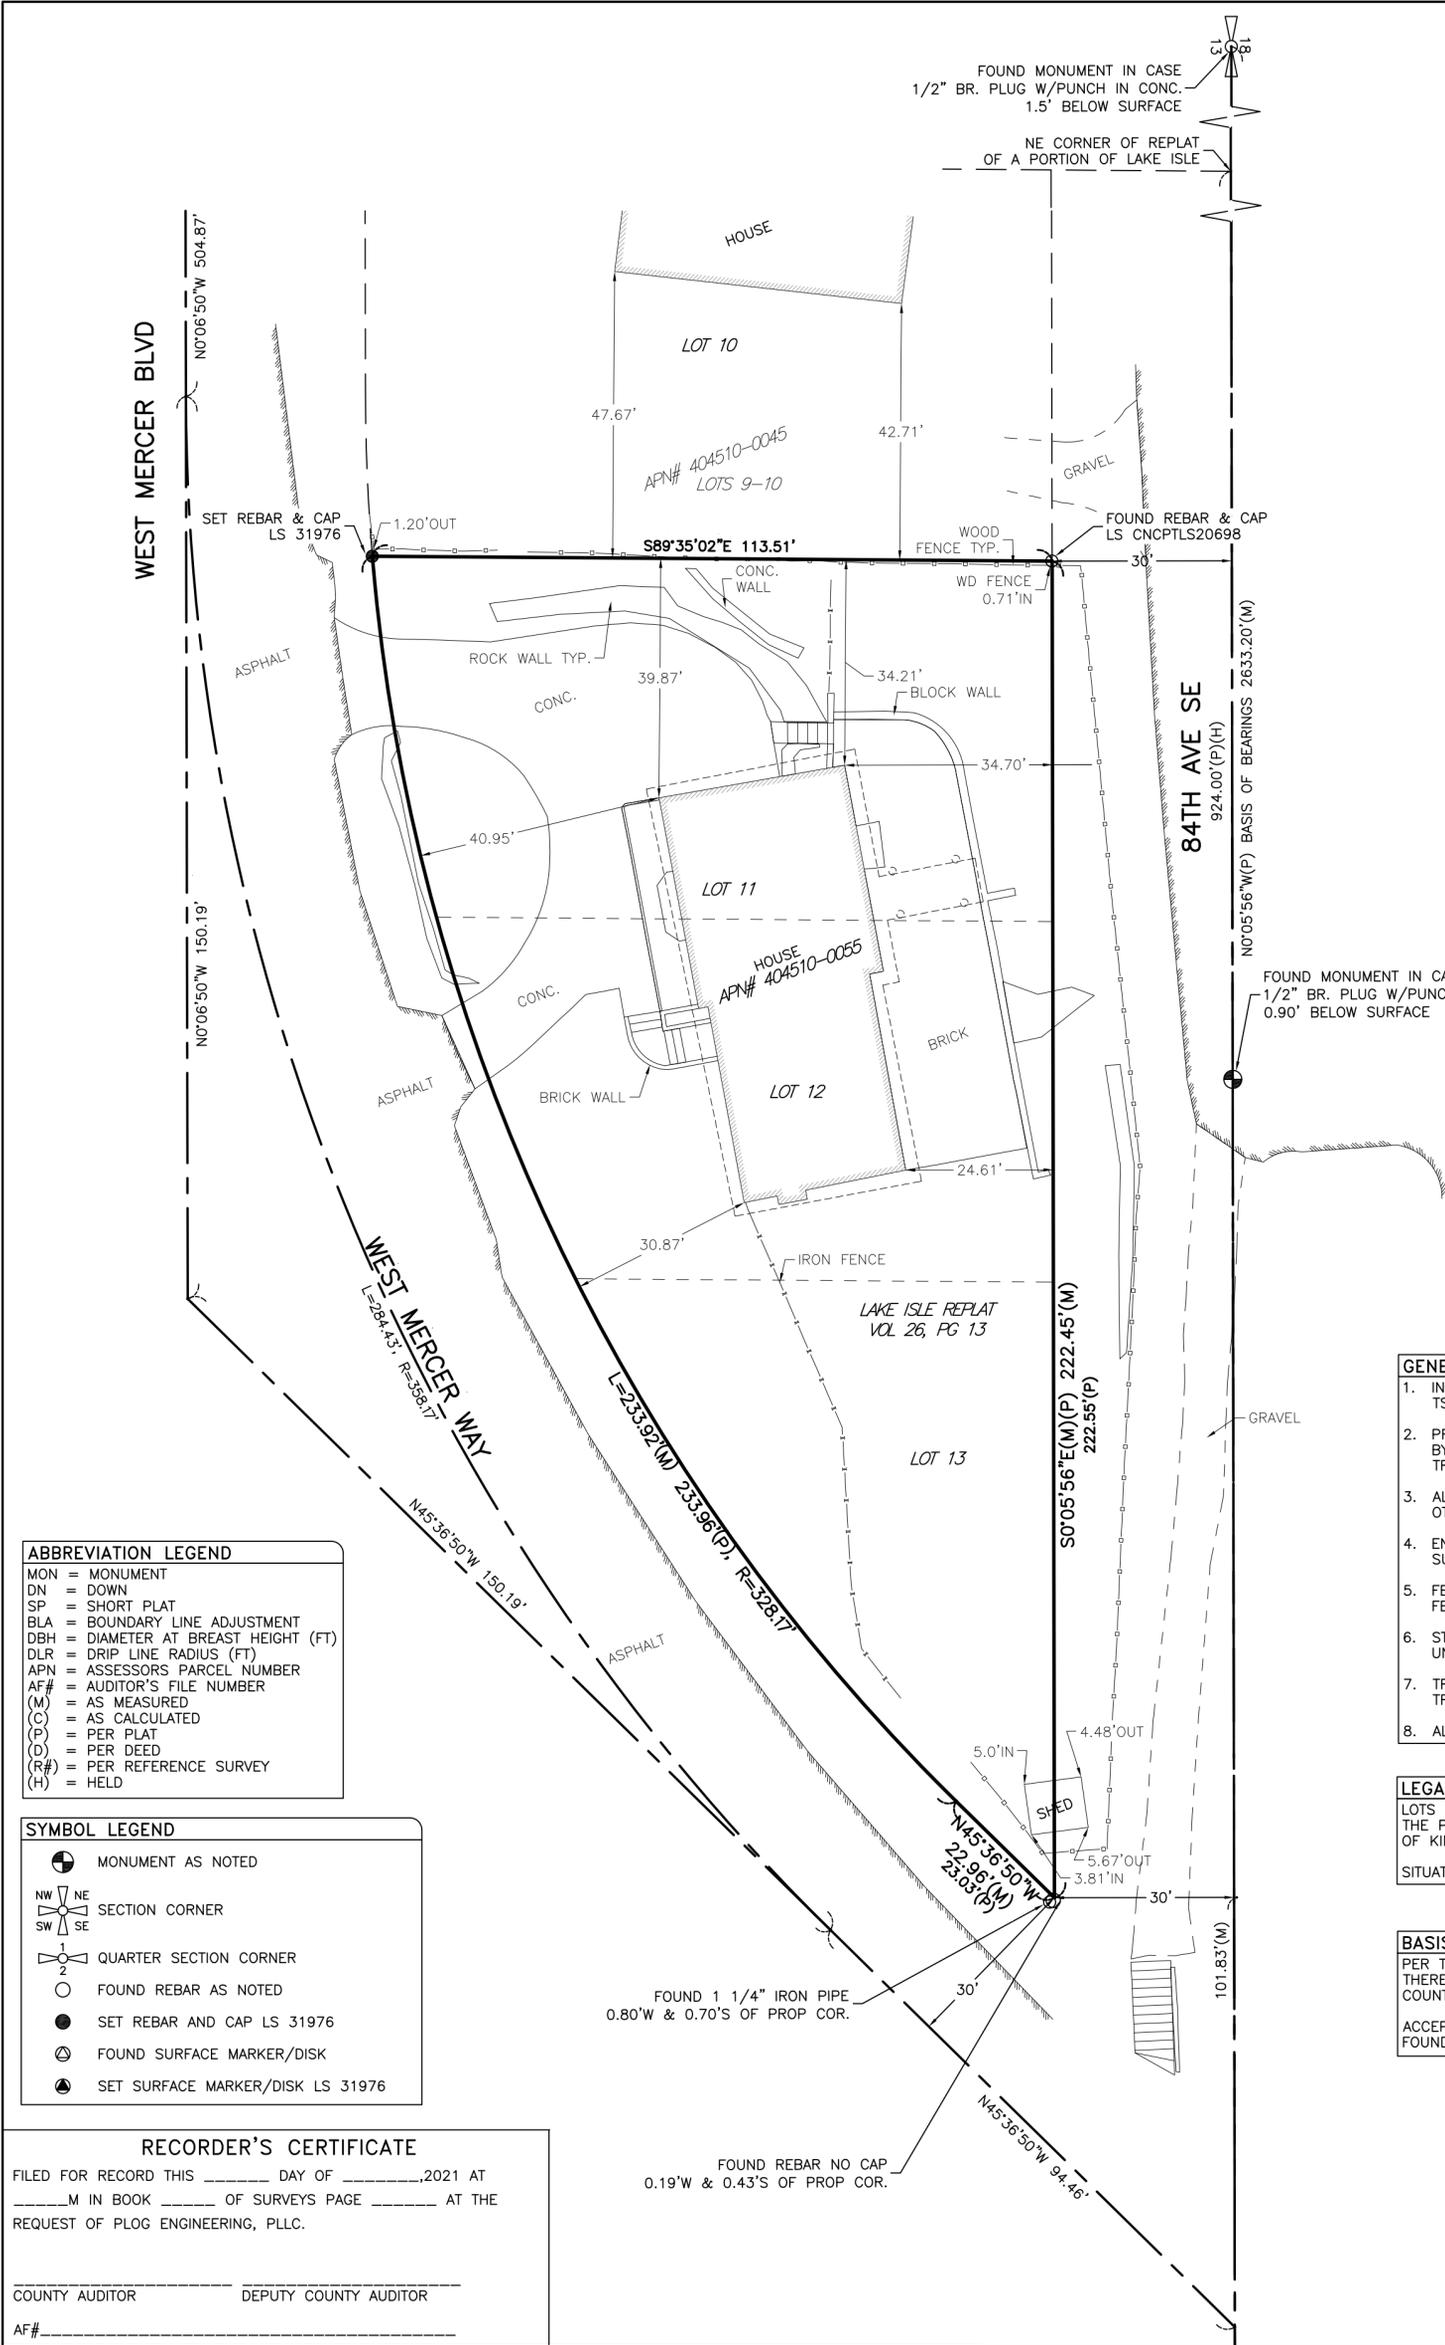

ABBREVIATION LEGEND

- MON = MONUMENT
- DN = DOWN
- SP = SHORT PLAT
- BLA = BOUNDARY LINE ADJUSTMENT
- DBH = DIAMETER AT BREST HEIGHT (FT)
- DLR = DRIP LINE RADIUS (FT)
- APN = ASSESSOR'S PARCEL NUMBER
- AF# = AUDITOR'S FILE NUMBER
- (M) = AS MEASURED
- (C) = AS CALCULATED
- (P) = PER PLAT
- (D) = PER DEED
- (R#) = PER REFERENCE SURVEY
- (H) = HELD

SYMBOL LEGEND

- MONUMENT AS NOTED
- SECTION CORNER
- QUARTER SECTION CORNER
- FOUND REBAR AS NOTED
- SET REBAR AND CAP LS 31976
- FOUND SURFACE MARKER/DISK
- SET SURFACE MARKER/DISK LS 31976

RECORDER'S CERTIFICATE
 FILED FOR RECORD THIS _____ DAY OF _____, 2021 AT _____ M IN BOOK _____ OF SURVEYS PAGE _____ AT THE REQUEST OF PLOG ENGINEERING, PLLC.
 COUNTY AUDITOR _____ DEPUTY COUNTY AUDITOR _____
 AF# _____

SURVEYOR'S CERTIFICATE
 THIS MAP CORRECTLY REPRESENTS A SURVEY MADE BY ME OR UNDER MY DIRECTION IN CONFORMANCE WITH THE REQUIREMENTS OF THE SURVEY RECORDING ACT AT THE REQUEST OF ERIC & KATIE SPRING IN AUGUST, 2021.
 MARK X. PEDERSEN LS 31976



PLOG ENGINEERING
 Surveyors & Civil Engineers
 P.O. Box 412
 Ravensdale, WA 98051
 (206) 420-7130
 www.PlogEngineering.com

INDEXING INFORMATION

SE 1/4, SE 1/4	SECTION 13
TOWNSHIP 24 NORTH	RANGE 4 EAST
WILLAMETTE MERIDIAN,	KING COUNTY

RECORD OF SURVEY
ERIC & KATIE SPRING
 4740 WEST MERCER WAY
 MERCER ISLAND, WA 98040

PROJECT NO.:	REVISION DATE	REVISION NO.:	SHEET
174-21	10/12/2021	0	1 OF 1