

2018 Residential Ventilation Compliance Summary

Applicant: RAQUEPAU Parcel: _____ Permit Number: _____

A whole-house ventilation system is required by the building code (2018 IRC Section M1505.4) to promote healthy indoor air quality in homes and provide increased comfort for occupants. **This is required for new dwelling units, and additions to existing dwelling units over 500 square feet.**

WHOLE HOUSE VENTILATION SYSTEM TYPE (see descriptions next page)
 Note: If the project has selected an Air Leakage Control and Efficient Ventilation Option from WSEC Table R409.3, the ventilation system type chosen must be consistent with that option's requirements.

- Exempt: addition less than 500 sq. ft. or remodel only
 - Exhaust fan(s) only (IRC M1505.4.1.2)
 - Supply fan(s) only (IRC M1505.4.1.3)
 - Balanced system (IRC M1505.4.1.4), including HRVs
 - Furnace Integrated Supply (IRC M1505.4.1.5)
- System will be distributed: Yes No (see definition next page)

Floor plans should indicate the location, type, and airflow rate of whole-house ventilation system.

WHOLE HOUSE VENTILATION SYSTEM AIRFLOW RATE

- Step 1: Find airflow rate minimum from Table 1, circle applicable airflow.
- Step 2: Multiple airflow rate by applicable multiplier from Table 2, type adjusted airflow in table.
- Step 3: Multiple airflow rate by applicable multiplier from Table 3, type adjusted airflow in table.

Table 1. WHOLE-HOUSE SYSTEM MINIMUM VENTILATION RATES (circle)

Conditioned Floor Area of the Home in square feet	Number of Bedrooms in the Home				
	Studio & 1 bedroom	2 bedrooms	3 bedrooms	4 bedrooms	5 or more bedrooms
< 500	30	35	45	55	60
501 - 1,000	30	35	40	50	55
1,001 - 1,500	30	40	45	55	60
1,501 - 2,000	35	45	50	60	65
2,001 - 2,500	40	50	55	65	70
2,501 - 3,000	45	55	60	70	75
3,001 - 3,500	50	60	65	75	80
3,501 - 4,000	55	65	70	80	85
4,001 - 4,500	60	70	75	85	90
4,501 - 5,000	65	75	80	90	95
> 5,001	(0.01 x Conditioned Floor Area of the Home in square feet) + (7.5 x (Number of Bedrooms in the Home + 1))				

Table 2. WHOLE-HOUSE VENTILATION QUALITY ADJUSTMENT (circle, type adjusted rate)

SYSTEM TYPE	DISTRIBUTED	NOT DISTRIBUTED	Min. adjusted fan size (CFM)
BALANCED	1.0	1.25	
NOT BALANCED	1.25	1.5	

Table 3. INTERMITTENT WHOLE-HOUSE VENTILATION RATE FACTORS (circle, type adjusted rate)

Run-time % in each 4-hour segment	Multiplier	Min. adjusted fan size (CFM)
50% (2 hrs every 4 hrs, 12 hrs /day)	2	
66% (2 hrs 40 min every 4 hrs, 16 hrs /day)	1.5	
75% (3 hrs every 4 hrs, 18 hrs /day)	1.3	
100% (continuously operating)	1.0	


WHOLE HOUSE VENTILATION SYSTEM SUMMARY

Specify: Location of ventilation equipment: ROOF Airflow rate (CFM) 200 Specify run-time: ALTERNATE @ 4 TIMES PER HOUR


WHOLE HOUSE VENTILATION SYSTEM TYPES

Balanced whole house ventilation is any combination of concurrently operating mechanical exhaust and mechanical supply whereby the total mechanical exhaust airflow rate is within 10% or 5 cfm of the total mechanical supply airflow rate, whichever is greater.


Distributed whole house ventilation is when outdoor air is supplied directly (not transfer air) to each habitable space and the exhausts air from all kitchen and bathrooms is vented directly to the outside.

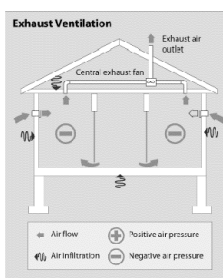


Exhaust fan(s) only (IRC M1505.4.1.2)
 This type of system has one or more exhaust fans, such as in bathrooms and laundry rooms, that have controls to provide intermittent or continuous exhaust from the dwelling unit to remove stale, moist air. In this type of system there is no dedicated supply air to replace the exhausted air, so fresh air is brought into the home passively through openings such as windows, window vents, through-wall vents, or leakage in the home's air barrier. With recent air barrier construction requirements and techniques improving, homes are becoming tighter and provide less opportunities for air leakage.

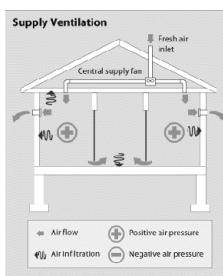

Supply fan(s) only (IRC M1505.4.1.3)
 This type of system has one or more supply fans that are provided with controls to provide intermittent or continuous fresh air into the dwelling unit. In this type of system there is no interconnected exhaust fans, so the system works to pressurize the home, pushing stale moist air out of the building through openings such as windows, window vents, through-wall vents, or leakage in the home's air barrier. With recent air barrier construction requirements and techniques improving, homes are becoming tighter and provide less opportunities for air leakage.

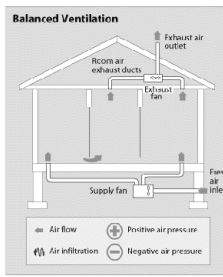

Balanced system (IRC M1505.4.1.4), including HRVs
 This type of system has both supply and exhaust fans that are provided with controls to provide intermittent or continuous fresh air into the dwelling unit and exhaust from the dwelling unit to remove stale, moist air. When two fans and two duct systems are used, these must provide a balanced airflow rate to operate as designed. A balanced system can also include an energy (or heat) recovery ventilator (ERV/HRV), an appliance that provides both supply and exhaust air in one unit and captures the energy or heat from the exhaust air and transfers it to the supply air via a heat exchanger to minimize energy loss in the system.

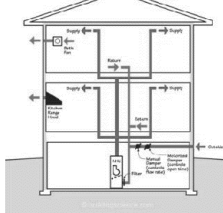

Furnace Integrated Supply (IRC M1505.4.1.5)
 Previous editions of the codes allowed fresh air to be introduced to the home from an outside air duct connected directly to a home's furnace. This is no longer permitted in the code outright, as the system uses excess energy when the fans in the heating/cooling equipment are required to operate to distribute the air. This type of system may only be used if the heating system air handler fan(s) have multi-speed or variable speed flow capability.

AIR BARRIER AND INSULATION INSTALLATION TABLE R402.4.1.1

COMPONENT	AIR BARRIER CRITERIA	INSULATION CRITERIA
Air barrier and thermal barrier	A continuous air barrier shall be installed in the building envelope. Exterior thermal envelope contains a continuous air barrier. Breaks or joints in the air barrier shall be sealed.	Air-permeable insulation shall not be used as a sealing material. Class 1 or if vapor retarders are required on the interior side of framed cavities.
Cavity insulation installation	All cavities in the thermal envelope shall be filled with insulation. The density of the insulation shall be at the manufacturer's product recommendation and said density shall be maintained for all volumes of each cavity. Batt type insulation will show no voids or gaps and maintain an even density for the entire cavity. Batt insulation shall be installed in the recommended cavity depth. Where an obstruction in the cavity due to services, blocking, trapping or other obstruction exists, the batt product will be cut to fit the remaining depth of the cavity. Where the batt is cut around obstructions, loose fill insulation shall be placed to fill any surface or concealed voids, and at the manufacturer's specified density. Where loose batt is used, the insulation tabs must be stapled to the face of the stud. There shall be no compression to the batt at the edges of the cavity due to inset stapling installation tabs. Insulation that upon installation readily conforms to available space shall be installed filling the entire cavity and within the manufacturer's density recommendation.	
Ceiling/attic	The air barrier in any dropped ceiling/joist shall be aligned with the insulation and any gaps in the air barrier sealed. Access openings, drop down star or knee wall doors to unconditioned attic spaces shall be sealed.	Batt insulation installed in attic roof assemblies may be compressed at exterior wall lines to allow for required attic ventilation. The insulation in any dropped ceiling or soffit shall be aligned with the air barrier.
Walls	The junction of the foundation and sill plate shall be filled the cavity with a material having a minimum thermal resistance of R-3 per inch. Exterior thermal envelope insulation for framed walls shall be sealed. Knee walls shall be sealed.	Cavities within corners and headers shall be insulated by completely filling the cavity with a material having a minimum thermal resistance of R-3 per inch. Exterior thermal envelope insulation for framed walls shall be installed in substantial contact and continuous alignment with the air barrier.
Windows, skylights and Rim joists	Spaces between window/door joints and framing and skylights and framing shall be sealed. Rim joists shall include the air barrier.	Rim joists shall be insulated.
Floors (including above-garage and cantilevers)	The air barrier shall be installed at any exposed edge of insulation.	Installed to maintain permanent contact with underside of subfloor decking or permitted to be in contact with the topside of sheathing or continuous insulation installed on the underside of floor framing and extend from the bottom to the top of all perimeter floor.
Crawl space walls	Soil in unvented crawl spaces shall be covered with Class 1, black vapor retarder with joints taped.	Where provided in lieu of floor insulation, insulation shall be permanently attached to the crawlspace walls.
Shafts, penetrations	Duct shafts, utility penetrations, and five shafts opening to exterior or unconditioned space shall be sealed.	Batts in narrow cavities shall be cut to fit and installed to the correct density without any voids or gaps or compression. Narrow cavities shall be filled by insulation that on installation readily conforms to the available cavity space.
Narrow cavities	Air sealing shall be provided between the garage and conditioned spaces.	
Garage separation	Recessed lighting shall be sealed to the drywall.	Batt insulation shall be cut neatly to fit around wiring and plumbing in exterior walls. There shall be no voids or gaps or compression where (a) to (c) Insulation that readily conforms to available space shall extend behind piping and wiring.
Plumbing and wiring	Shower and/or tubs installed at exterior walls adjacent to showers and tubs shall separate them from showers and tubs.	Exterior walls adjacent to showers or tubs shall be insulated.
Shower and/or tubs	Electrical/phone/HVAC register boots	Boots that generate building thermal envelope shall be sealed to the subfloor or drywall.
Electrical/phone/HVAC register boots	When required to be sealed, fire sprinklers shall only be sealed in a manner that is recommended by the manufacturer. Caulking or other adhesive sealants shall not be used to fill voids between fire sprinkler cover plates and walls or ceilings.	
Concealed Sprinklers		

AIR INFILTRATION AND TESTING

The building shall be tested and verified as having an air leakage rate not exceeding 5.0 air changes per hour (ACH). Note, if the project has selected an Air Leakage Control and Efficient Ventilation Option from WSEC Table R409.3, the maximum air leakage allowed may be reduced.

Testing shall be conducted with a blower door at a pressure of 0.2 in. w. g. For this test only, the volume of the home shall be the square feet of conditioned floor area multiplied by 8.5 feet. A written report of the results of the test shall be signed by the party conducting the test and provided to the code official.

- During testing:**
- Exterior windows and doors, fireplace and stove doors shall be closed, but not sealed, beyond the intended weatherstripping or other infiltration control measures.
 - Dampers including exhaust, intake, makeup air, backdraft and flue dampers shall be closed, but not sealed beyond intended infiltration control measures.
 - Interior doors, if installed at the time of the test, shall be open, access hatches to conditioned crawl spaces and conditioned attics shall be open.
 - Exterior or interior terminations for continuous ventilation systems and heat recovery ventilators shall be sealed.
 - Heating and cooling systems, if installed at the time of the test, shall be turned off.
 - Supply and return registers, if installed at the time of the test, shall be fully open.

- Exceptions:**
- Additions less than 500 square feet (46 m²) of conditioned floor area.
 - Additions tested with the existing home having a combined maximum air leakage rate of 7 air changes per hour. To qualify for this exception, the date of construction of the existing house must be prior to the 2009 Washington State Energy Code.

Blower door test calculated flow: BLDG Volume 27,675 ft.³ x 5 ACH / 60 min. = 2,306 cfm
OR Adjusted rate per Energy Credit Option 2 _____ cfm
Blower door test calculated flow: BLDG Volume _____ ft.³ x _____ ACH / 60 min. = _____ cfm


DUCT LEAKAGE AND TESTING

1. Ducts shall be leak tested in accordance with WSU RS-33, using the maximum 4 cfm per 100 square feet of conditioned floor area. If the air handler is not installed at the time of the test, total leakage shall be less than or equal to 3 cfm per 100 square feet of conditioned floor area.
Total sq.ft. 3,730 **sq.ft. / 100 sq.ft. X 4 cfm =** 149.2 **cfm**

- Exceptions:**
- The total leakage test or leakage to the outdoors is not required for ducts and air handlers located entirely within the building thermal envelope. For forced air ducts, a maximum of 10 linear feet of return ducts and 5 linear feet of supply ducts may be located outside the conditioned space. All metallic ducts located outside the conditioned space must have both transverse and longitudinal joints sealed with mastic. If flex ducts are used, they cannot contain splices. Flex duct connections must be made with nylon straps and installed using a plastic strapping tensioning tool. Ducts located in crawl spaces do not qualify for this exception.
 - A duct air leakage test shall not be required for ducts serving heat or energy recovery ventilators that are not integrated with ducts serving heating or cooling systems.

A written report of results must be signed by the party conducting the test and provided to the King County Building Inspector.

REF ARCHITECTURE
 PH: (253) 359-4039
 Richard@refarchitecture.com
 7421 21st Ave E Bonney Lake, WA 98391


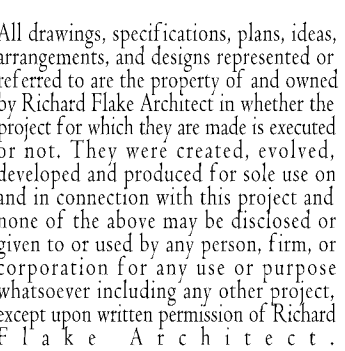


All drawings, specifications, plans, ideas, arrangements, and designs represented or referred to are the property of, and owned by Richard Flake Architect in whether the project for which they are made is executed or not. They were created, evolved, developed and produced for sole use on and in connection with this project and none of the above may be duplicated or given to or used by any person, firm, or corporation for any use or purpose whatsoever including any other project, except upon written permission of Richard Flake Architect.

Copyright 2023 Richard Flake Architect

RAQUEPAU RESIDENCE
 R E M O D E L & A D D I T I O N
 9 I I 6 S E 5 8 T H
 M E R C E R I S L A N D , W A 9 8 0 4 0

DESIGN: RWF
 DRAWN:
 CHECKED: RWF
 REVISIONS:
 CITY REVIEW
 1 3 . 1 8 . 2 0 2 3
 CITY REVIEW
 2 . 2 8 . 2 0 2 4

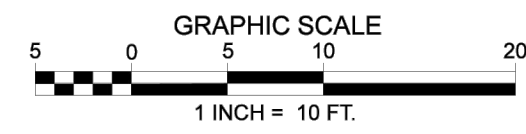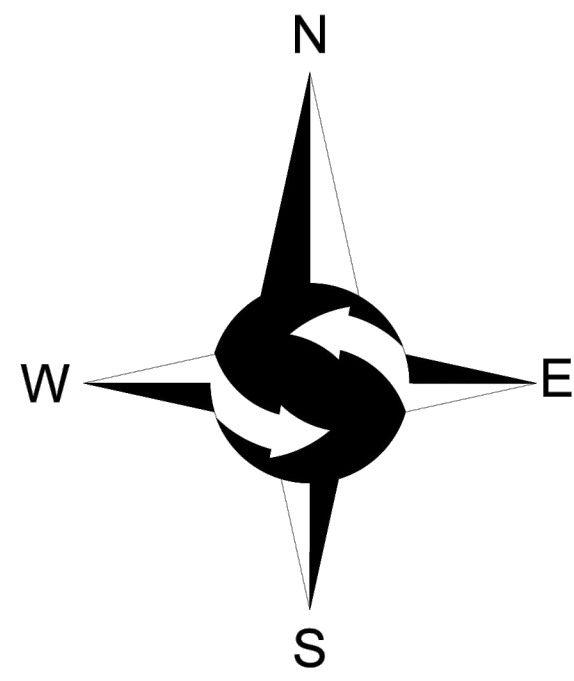

LEGEND

	FOUND MONUMENT IN CASE		OHP OVERHEAD POWER
	FOUND REBAR AS DESCRIBED		OHU OVERHEAD UTILITIES
	FOUND NAIL AS DESCRIBED		WOOD FENCE
	SET MAG NAIL AS DESCRIBED		CONCRETE WALL
	SET 5/8" X 24" IRON ROD W/1" YELLOW PLASTIC CAP		MAILBOX
	POWER METER		ASPHALT SURFACE
	GAS METER		CONCRETE SURFACE
	GUY WIRE		BRICK SURFACE
	UTILITY POLE		FLAGSTONE SURFACE
	YARD DRAIN		CE CEDAR
	SANITARY SEWER MANHOLE		DF DOUGLAS FIR
	WATER VALVE		DS DECIDUOUS
	FIRE HYDRANT		* INDICATES MULTI-TRUNK
	WATER METER		SS APPROXIMATE LOCATION SANITARY SEWER LINE
	W APPROXIMATE LOCATION UNDERGROUND WATER LINE		

LEGAL DESCRIPTION

LOT 12 OF EL DORADO ESTATES, AS PER PLAT RECORDED IN VOLUME 62 OF PLATS, PAGE 7, RECORDS OF KING COUNTY AUDITOR;
SITUATE IN THE CITY OF MERCER ISLAND, COUNTY OF KING, STATE OF WASHINGTON.

BASIS OF BEARINGS

RECORD OF SURVEY BY TERRANE, RECORDED IN VOLUME 390 OF SURVEYS, PAGE 163, UNDER RECORDING NO. 2018083090020, RECORDS OF KING COUNTY, WASHINGTON.

PROJECT INFORMATION

PROPERTY OWNER: JEREME RAQUEPAU & ANGELA GRIBBLE
9116 SE 58TH STREET
MERCER ISLAND, WA 98040

TAX PARCEL NUMBER: 228700-0120

PROJECT ADDRESS: 9116 SE 58TH STREET
MERCER ISLAND, WA 98040

ZONING: R-9.6

JURISDICTION: CITY OF MERCER ISLAND

PARCEL ACREAGE: 12,192 S.F. (0.280 ACRES) AS SURVEYED

GENERAL NOTES

- THIS SURVEY WAS COMPLETED WITHOUT BENEFIT OF A CURRENT TITLE REPORT. EASEMENTS AND OTHER ENCUMBRANCES MAY EXIST ON THIS PROPERTY THAT ARE NOT SHOWN HEREON.
- INSTRUMENTATION FOR THIS SURVEY WAS A 3-SECOND SPECTRAPRECISION FOCUS 35 TOTAL STATION AND AN EMLID REACH RS2 GPS RECEIVER. PROCEDURES USED IN THIS SURVEY MEET OR EXCEED STANDARDS SET BY WAC 332-130-090.
- THE INFORMATION ON THIS MAP REPRESENTS THE RESULTS OF A SURVEY MADE IN JANUARY 2023 AND CAN ONLY BE CONSIDERED AS INDICATING THE GENERAL CONDITIONS EXISTING AT THAT TIME.
- UTILITIES SHOWN ON THIS SURVEY ARE BASED UPON ABOVE GROUND OBSERVATIONS AND AS-BUILT PLANS WHERE AVAILABLE. ACTUAL LOCATIONS OF UNDERGROUND UTILITIES MAY VARY AND UTILITIES NOT SHOWN ON THIS SURVEY MAY EXIST ON THIS SITE.
- ALL MONUMENTS WERE LOCATED DURING THIS SURVEY UNLESS OTHERWISE NOTED.



VERTICAL DATUM & CONTOUR INTERVAL

ELEVATIONS SHOWN ON THIS DRAWING WERE DERIVED FROM GPS OBSERVATION USING THE WSRN.


DATUM - NAVD 88

2' CONTOUR INTERVAL - THE EXPECTED VERTICAL ACCURACY IS EQUAL TO 1/2 THE CONTOUR INTERVAL OR PLUS / MINUS 1.0' FOR THIS PROJECT.

SPOT ELEVATIONS SHOWN ON THE FACE OF THE SURVEY ARE ACCURATE TO 0.2'

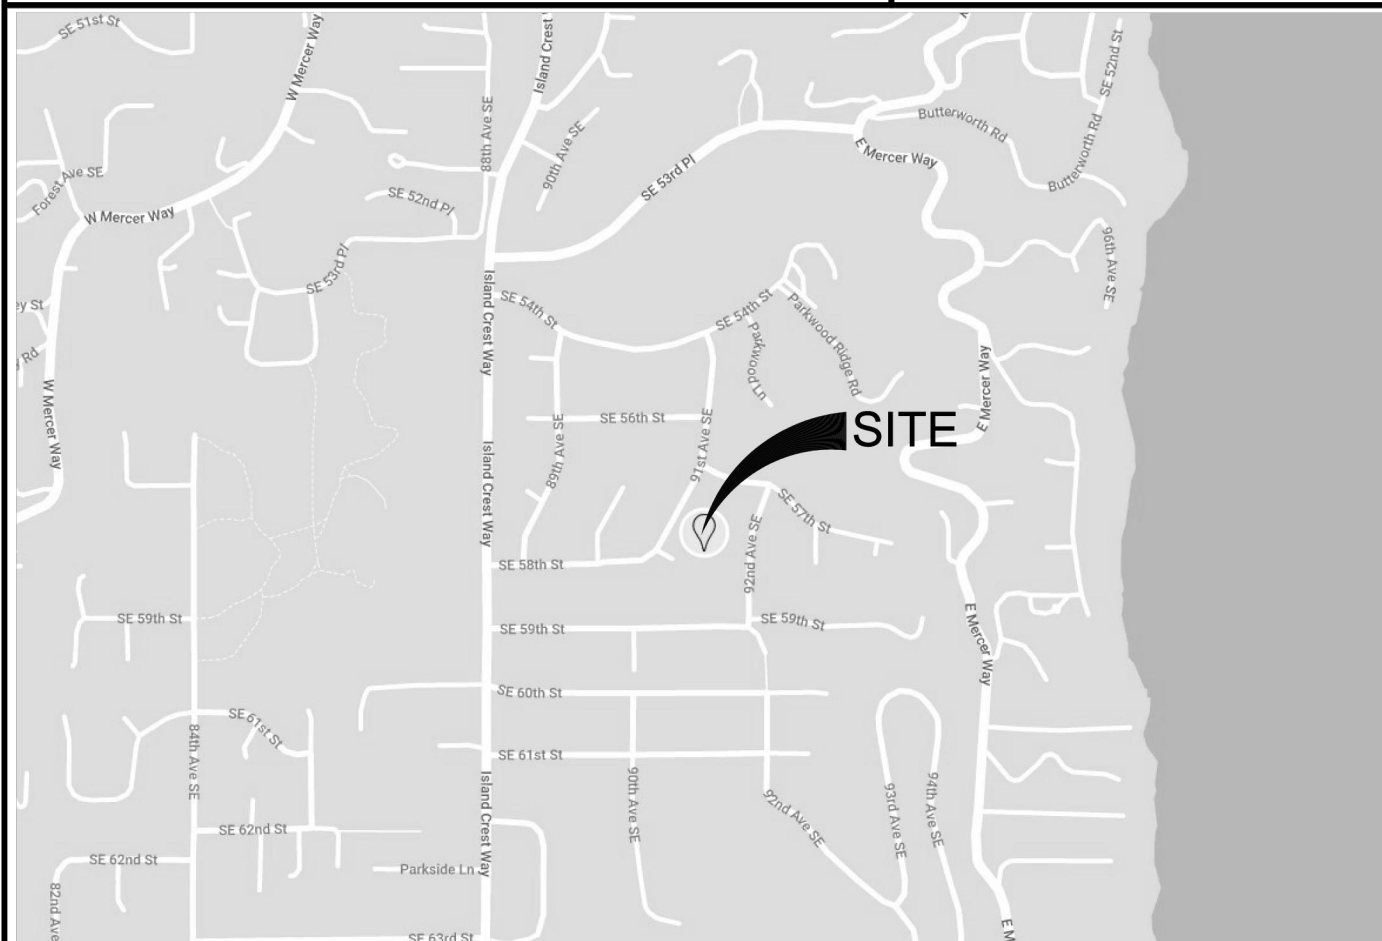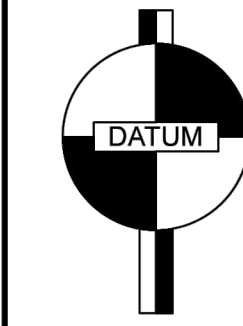

VICINITY MAP
NTS

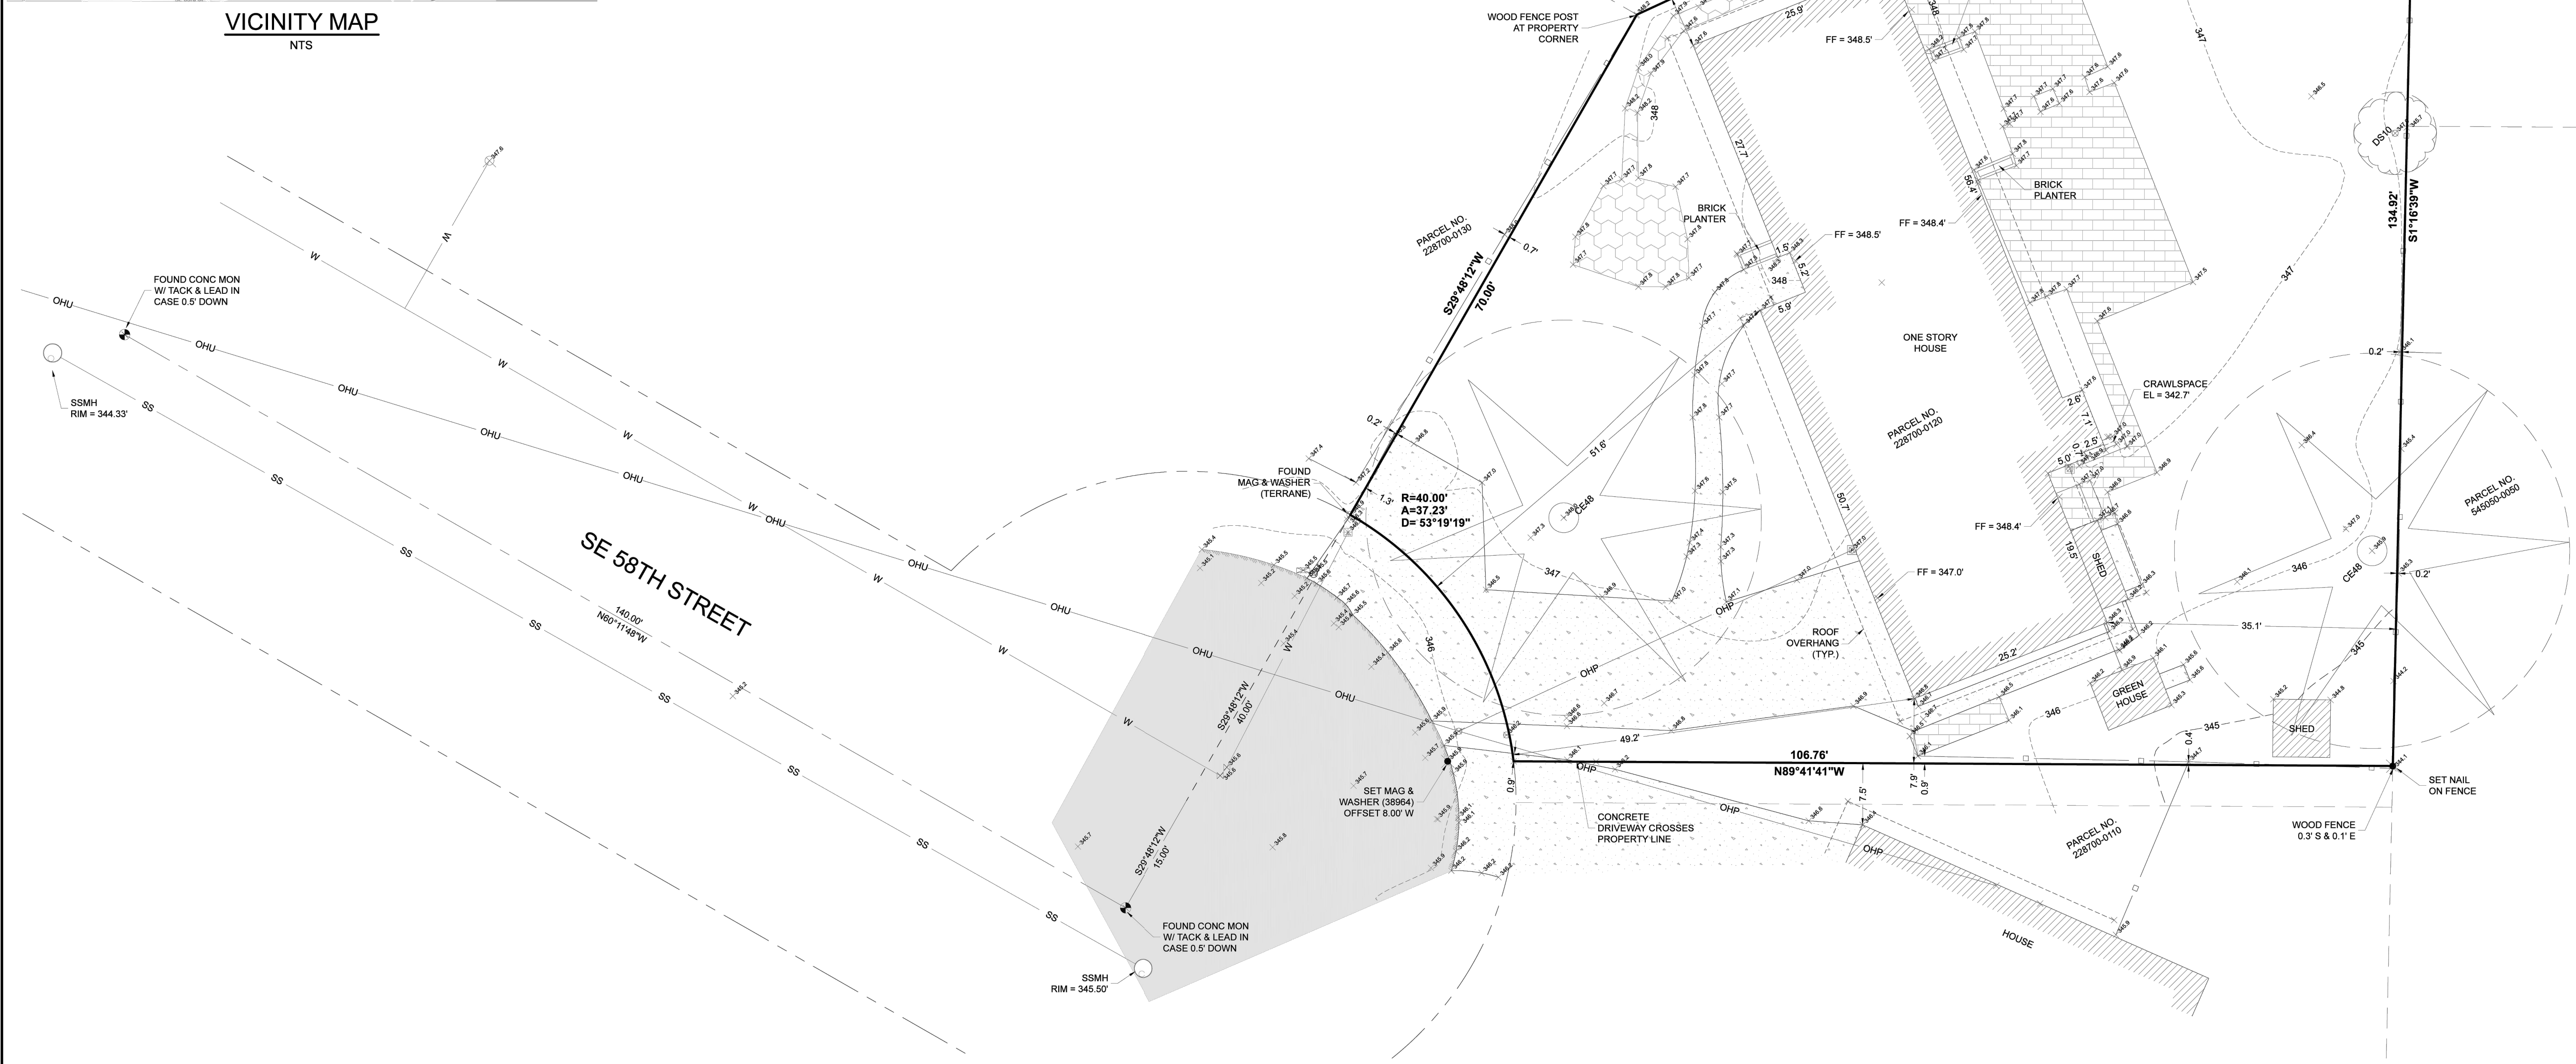

NE 1/4, SW 1/4, SEC 19, TWP 24N, RNG 5E, W.M.



www.siteurveying.com
21023 NE 11th Street Sammamish, WA 98074
Phone: 425.268.4412

DATE	REVISION	DRN

TOPOGRAPHIC SURVEY


JEREME RAQUEPAU
9116 SE 58TH STREET
MERCER ISLAND, WA 98040

PROJECT NO. 22-702

DRAWN BY: MTS
CHECKED BY: TNW
DATE: 1/13/2023

SHEET 1 OF 1

© 2023, SITE SURVEYING, INC. ALL RIGHTS RESERVED.

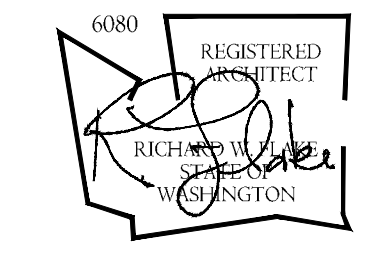

All drawings, specifications, plans, ideas, arrangements, and designs represented or referred to are the property of, and owned by Richard Flake Architect in whether the project for which they are made is executed or not. They were created, evolved, developed and produced for sole use on and in connection with this project and none of the above may be disclosed or given to or used by any person, firm, or corporation for any use or purpose whatsoever including any other project, except upon written permission of Richard F. Flake Architect.

Copyright 2023
 Richard Flake Architect

DESIGN: RWF
 DRAWN:
 CHECKED: RWF
 REVISIONS:

△	CITY REVIEW
1	3.19.2023
△	CITY REVIEW
2	2.28.2024



LOT COVERAGE (SEE SDEV)		ABE (MIDPOINT ELEV. AND LENGTH)	
GROSS LOT AREA:	12,192 SF	A:	347.8
NET LOT AREA:	12,192 SF	B:	347.9
ALLOWED LOT COVERAGE:	4,877 SF	C:	348.0
ALLOWED LOT COVERAGE:	40% OF LOT	D:	348.0
EXISTING LOT COVERAGE:		E:	348.1
1. MAIN STRUCTURE ROOF AREA:	2,873 SF	F:	348.1
2. ACCESSORY BLDG ROOF AREA:	141 SF	G:	348.0
3. VEHICULAR USE:	938 SF	H:	348.0
4. COVD PATIOS/DECKS:	0 SF	I:	347.9
5. TOTAL EXISTING LOT COVERAGE:	3,952 SF	J:	347.7
TOTAL EXISTING LOT AREA REMOVED:	302 SF	K:	347.6
PROPOSED ADJUSTMENTS FOR FLAG LOT:	0 SF	L:	347.5
TOTAL NEW LOT COVERAGE:		M:	347.3
1. MAIN STRUCTURE ROOF AREA:	2,878 SF	N:	347.2
2. ACCESSORY STRUCTURE ROOF AREA:	49 SF	O:	347.1
3. VEHICULAR USE:	878 SF	P:	347.0
4. COVD PATIOS/DECKS:	360 SF	Q:	347.0
5. TOTAL NEW LOT COVERAGE:	4,165 SF	R:	347.0
TOTAL PROJECT LOT COVERAGE AREA:	4,165 SF	S:	346.7
PROPOSED LOT COVERAGE AREA:	34.2%	T:	346.3
		U:	346.8
		V:	347.2
		W:	347.3
		X:	347.4
		Y:	347.6
		Z:	347.8
		AA:	347.8
		AB:	347.8
		TOTAL = 9,729.9	TOTAL = 264.16'
		TOTAL = 91,767.71/264.16	ABE = 347.39'

HARDSCAPE (SEE SDEV)	
GROSS LOT AREA:	12,192 SF
NET LOT AREA:	12,192 SF
AREA BORROWED FROM LOT COVERAGE:	0 SF
ALLOWED HARDSCAPE AREA:	9% OF LOT
ALLOWED HARDSCAPE AREA:	1,097 SF
TOTAL EXISTING HARDSCAPE AREA:	
1. UNCOVERED DECKS:	0 SF
2. UNCOVERED PATIOS:	770 SF
3. WALKWAYS:	724 SF
4. STAIRS:	0 SF
5. ROCKERIES/RETAINING WALLS:	6 SF
6. TOTAL EXISTING HARDSCAPE AREA:	1,500 SF
TOTAL HARDSCAPE AREA REMOVED:	1,500 SF
TOTAL NEW HARDSCAPE AREA:	
1. UNCOVERED DECKS:	255 SF
2. UNCOVERED PATIOS:	338 SF
3. WALKWAYS:	235 SF
4. STAIRS:	0 SF
5. ROCKERIES/RETAINING WALLS:	0 SF
6. TOTAL NEW HARDSCAPE AREA:	828 SF
TOTAL PROJECT HARDSCAPE AREA:	828 SF
TOTAL PROJECT HARDSCAPE AREA:	6.8%

LOT SLOPE		BENCHMARK	
HIGHEST ELEVATION POINT OF LOT:	347.0'	PER SURVEY WATER METER BOX EL.=346.2	
LOWEST ELEVATION POINT OF LOT:	344.5'		
ELEVATION DIFFERENCE:	2.5'		
HORIZONTAL DISTANCE BETWEEN HIGH AND LOW POINTS:	134.92'		
LOT SLOPE:	1.8%		

SIDE YARD CALC:

LOT WIDTH CIRCLE DIAMETER: 104.5'
 SIDE YARD TOTAL LOT PERCENT: 17%
 SIDE YARD REQUIRED: 104.5' * 0.17 = 17.77'
 SIDE YARD PROVIDED: 10.59' (N) + 7.21' (S) = 17.80'

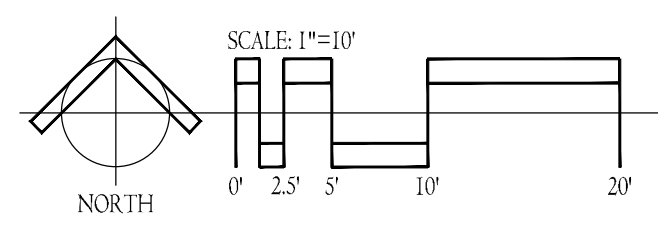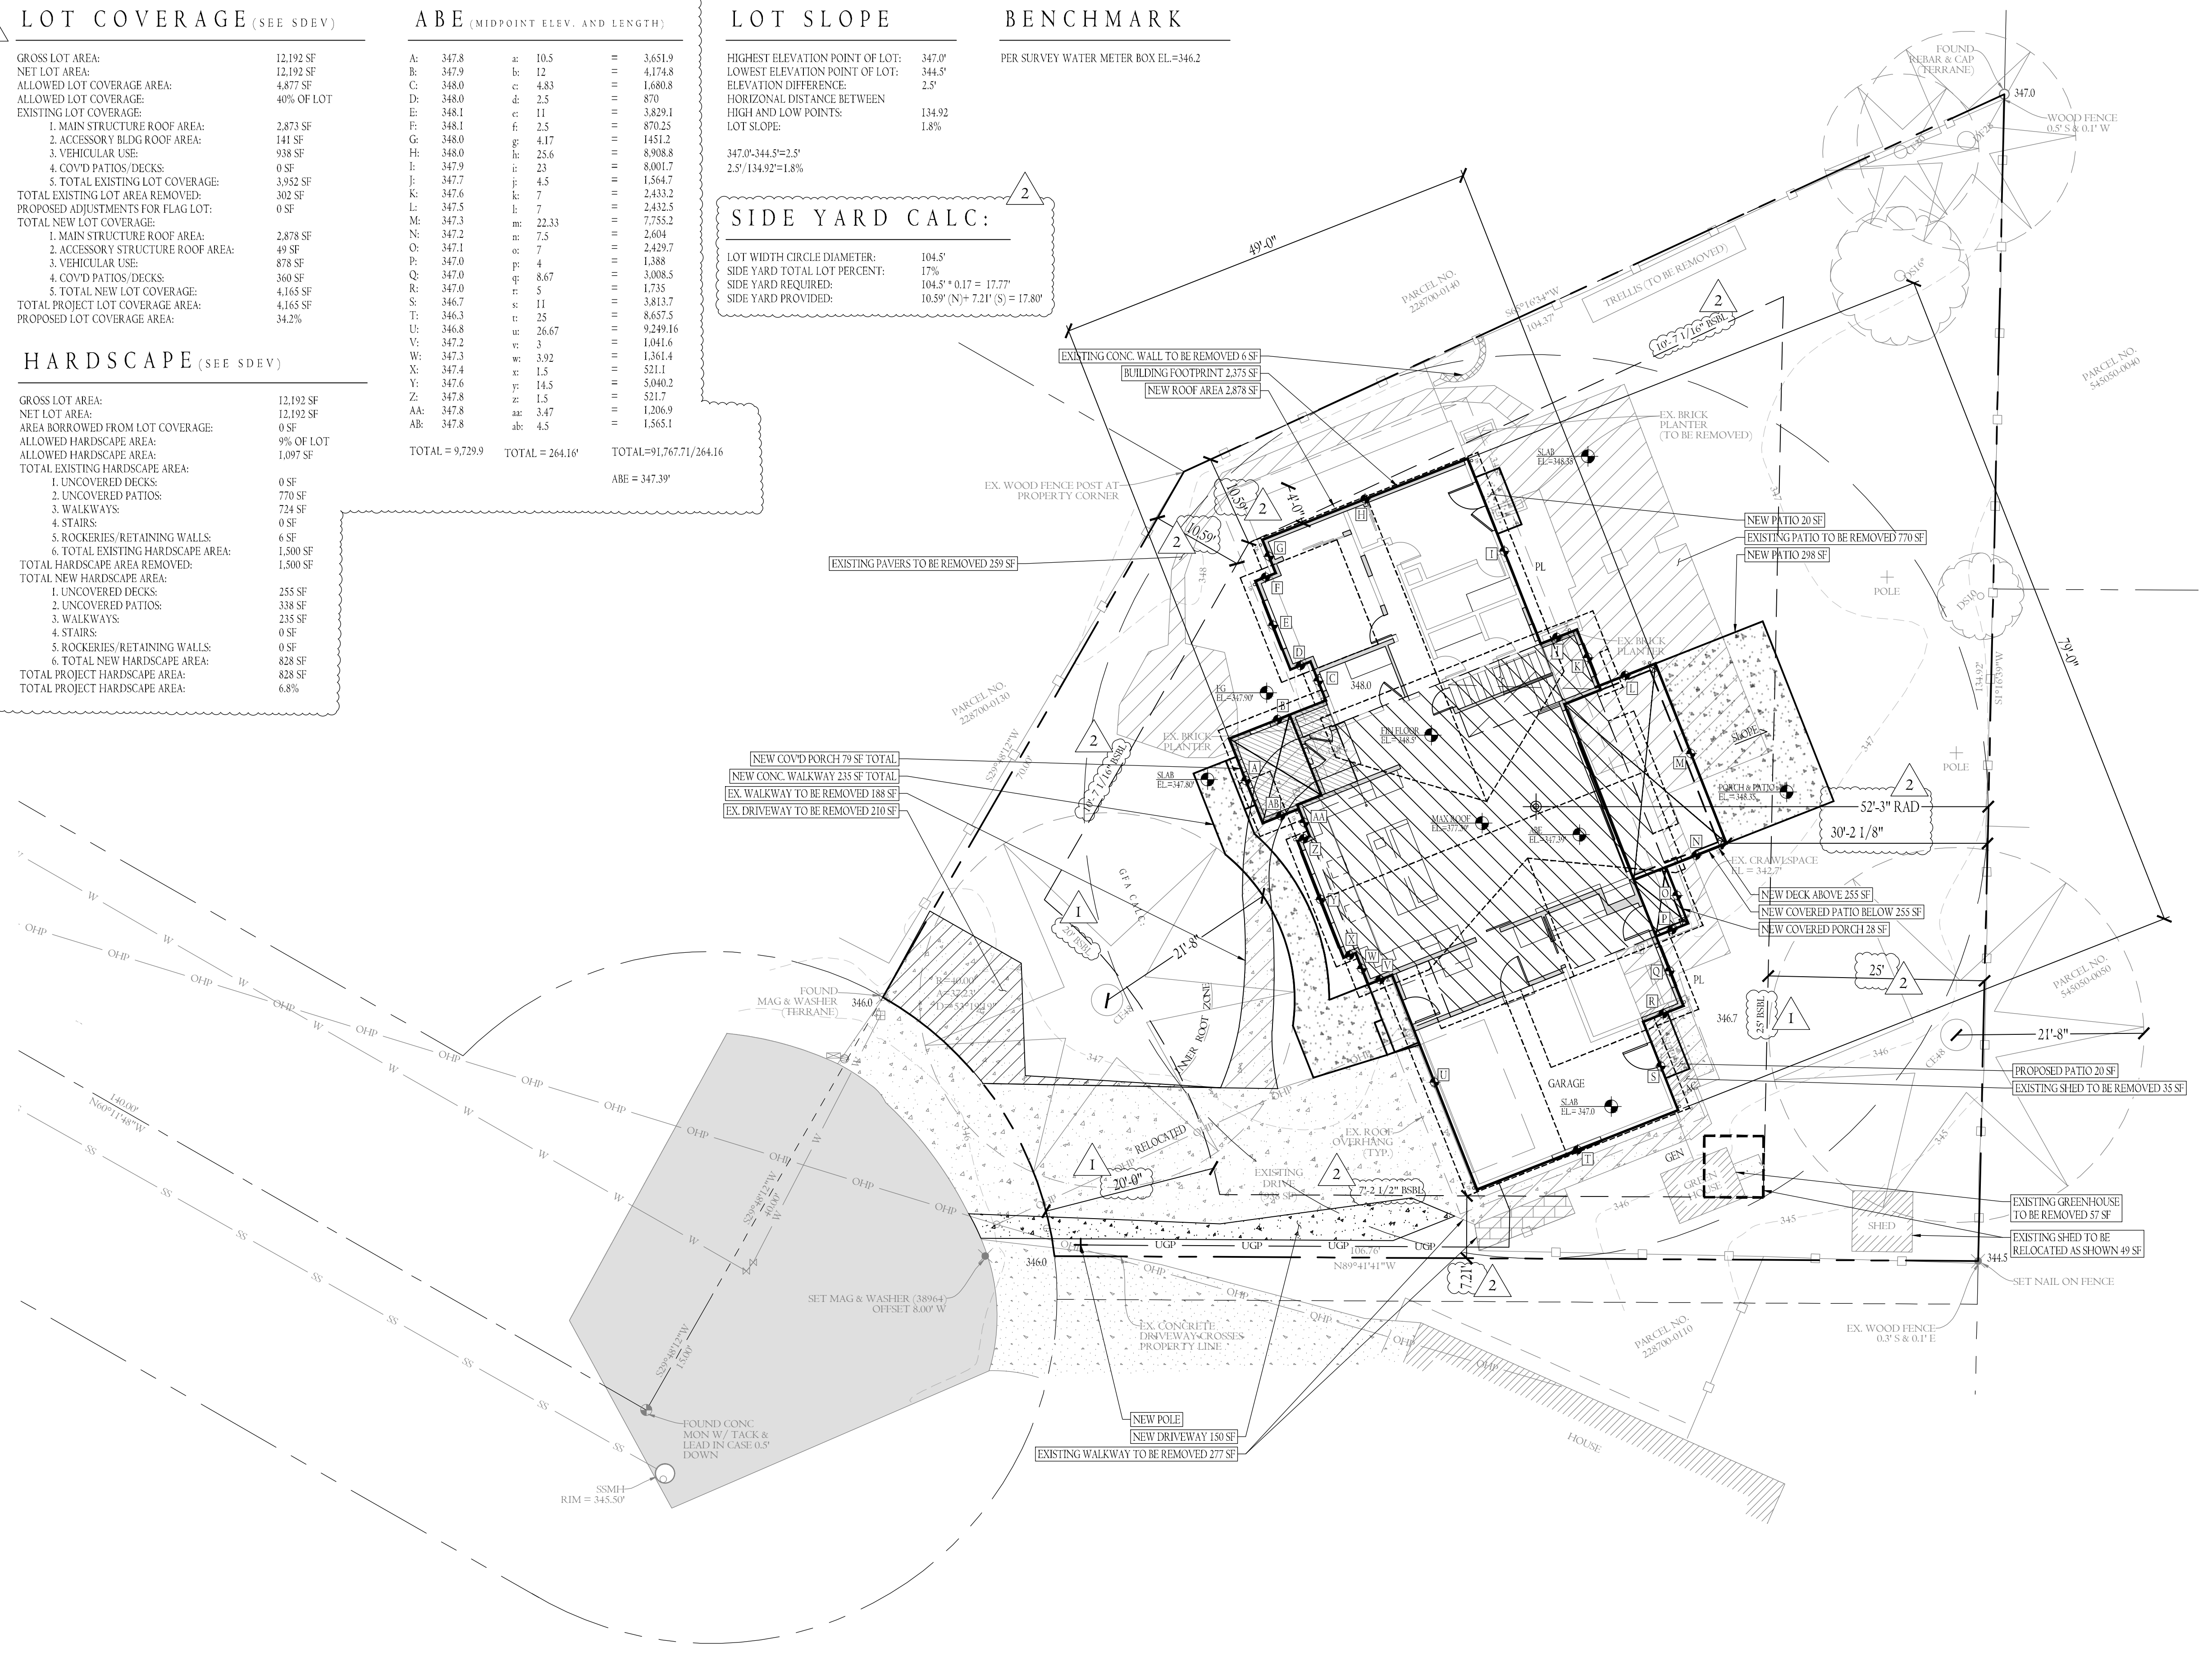

S I T E P L A N



MERCER ISLAND TREE INVENTORY & REPLACEMENT
SUBMITTAL INFORMATION

PROJECT INFORMATION

Property Owner Name: **Jeremy & Angela Raquepau**

Site Address or Parcel Number: **9116 SE 58th St**

Project Contact Name: **Richard Flake**

Contact Email Address: **richard@rfarchitecture.com**

Contact Phone Number: **(253) 359-4039**

EXCEPTIONAL TREES

Exceptional Trees- means a tree or group of trees that because of its unique historical, ecological or aesthetic value constitutes an important community resource. A tree that is rare or exceptional by virtue of its size, species, condition, cultural/historical importance, age, and/or contribution as part of a tree grove. Trees with a diameter of more than 36 inches, or with a diameter that is equal to or greater than the diameter listed in the Exceptional Tree Table shown in MICC 19.16 under Tree, Exceptional.

List the total number of trees for each category and the tree identification numbers from the arborist report.

Number of trees 36" or greater	2
List tree numbers: #1, #2	
Number of trees 24" or greater (including 36" or greater)	3
List tree numbers: #1, #2, #6	
Number of trees from Exceptional Tree Table (MICC 19.16)	3
List tree numbers: (2) Western Red Cedar: #1 and #2, (1) Douglas Fir #6	

LARGE REGULATED TREES

Large Regulated Trees- means any tree with a diameter of 10 inches or more, and any tree that meets the definition of an Exceptional Tree.

Number of Large Regulated Trees on site	6 (A)
List tree numbers: 1,2,3,4,5,6	
Number of Large Regulated Trees on site proposed for removal	0 (B)
List tree numbers: N/A	
Percentage of trees to be retained ((A-B)/Ax100) note: must be at least 30%	100 %

RIGHT OF WAY TREES

Right of Way Trees- means a tree that is located in the street right of way adjacent to the project property.

Number of Large Regulated Trees in right of way	0
List tree numbers: N/A	
Number of Large Regulated Trees in right of way proposed for removal	0
List tree numbers: N/A	
Reason for removal: N/A	

TREE REPLACEMENT

Tree replacement- removed trees must be replaced based on the ratio in the table below. Replacement trees shall be conifers at least six feet tall and or deciduous at least one and one-half inches in diameter at base.

Diameter of Removed Tree (measured 4.5' above ground)	Tree replacement Ratio	Number of Trees Proposed for Removal	Number of Tree Required for Replacement Based on Size/Type
Less than 10"	1	0	0
10" up to 24"	2	0	0
Greater than 24" up to 36"	3	0	0
Greater than 36" and any Exceptional Tree	6	0	0
TOTAL TREE REPLACEMENTS			0

*no replacement tree is needed if the tree fits all of the following:
 Less than 10 inches in diameter, not an exceptional tree, and not a replacement tree from another tree permit.*



NAME: RAQUEPAU
 PROJECT: 9116 SE 58TH ST

TREE #	TYPE	DBH"	DRPLN RAD'	STATUS	REMARKS
TREE #1	CE48	48"	21'-8"	RETAIN	EXCEPTIONAL
TREE #2	CE48	48"	21'-8"	RETAIN	EXCEPTIONAL
TREE #3	DS10	10"	5'	RETAIN	
TREE #4	DS16	16"	8'	RETAIN	
TREE #5	CE20	20"	9'	RETAIN	
TREE #6	DF28	28"	12'-6"	RETAIN	EXCEPTIONAL

TREE NOTES

- TREE PROTECTION FENCING SHALL CONSIST OF 6' TALL CHAIN-LINK FENCING, SECURELY STAKED INTO PLACE.
- TREE PROTECTION ZONE SIGNAGE, PER MERCER 2. ISLAND CODE SHALL BE POSTED EVERY TEN FEET (10') ALONG THE FENCE PERIMETER AND SHALL BE MADE TO BE WEATHER RESISTANT.
- TREE PROTECTION FENCING SHALL BE PLACED AS 3. SHOW ON THE PLAN.
- INVASIVE OR NON-NATIVE SPECIES SHALL BE 4. REMOVED, BY THE USE OF HAND TOOLS, WITHIN THE TREE PROTECTION ZONE.
- BARE SOILS INSIDE THE TREE PROTECTION ZONE 5. SHOULD BE COVERED WITH ARBORIST CHIPS OR A COMMERCIAL MULCH MATERIAL, TO A DEPTH OF 3".
- NO PRUNING OF LIMBS SHOULD BE NECESSARY FOR 6. BUILDING CLEARANCE OR CONSTRUCTION AREA ACCESS. IF LIMBS DO NEED TO BE TRIMMED, THIS WORK SHALL BE DONE UNDER THE SUPERVISION OF A PROFESSIONAL TREE PERSON.

TREE LEGEND

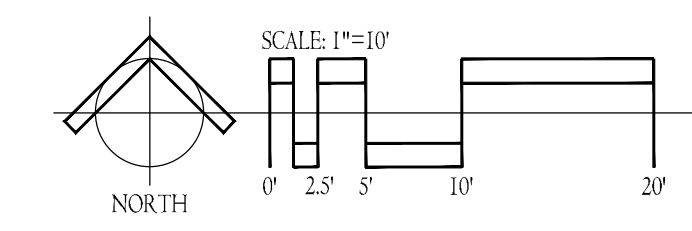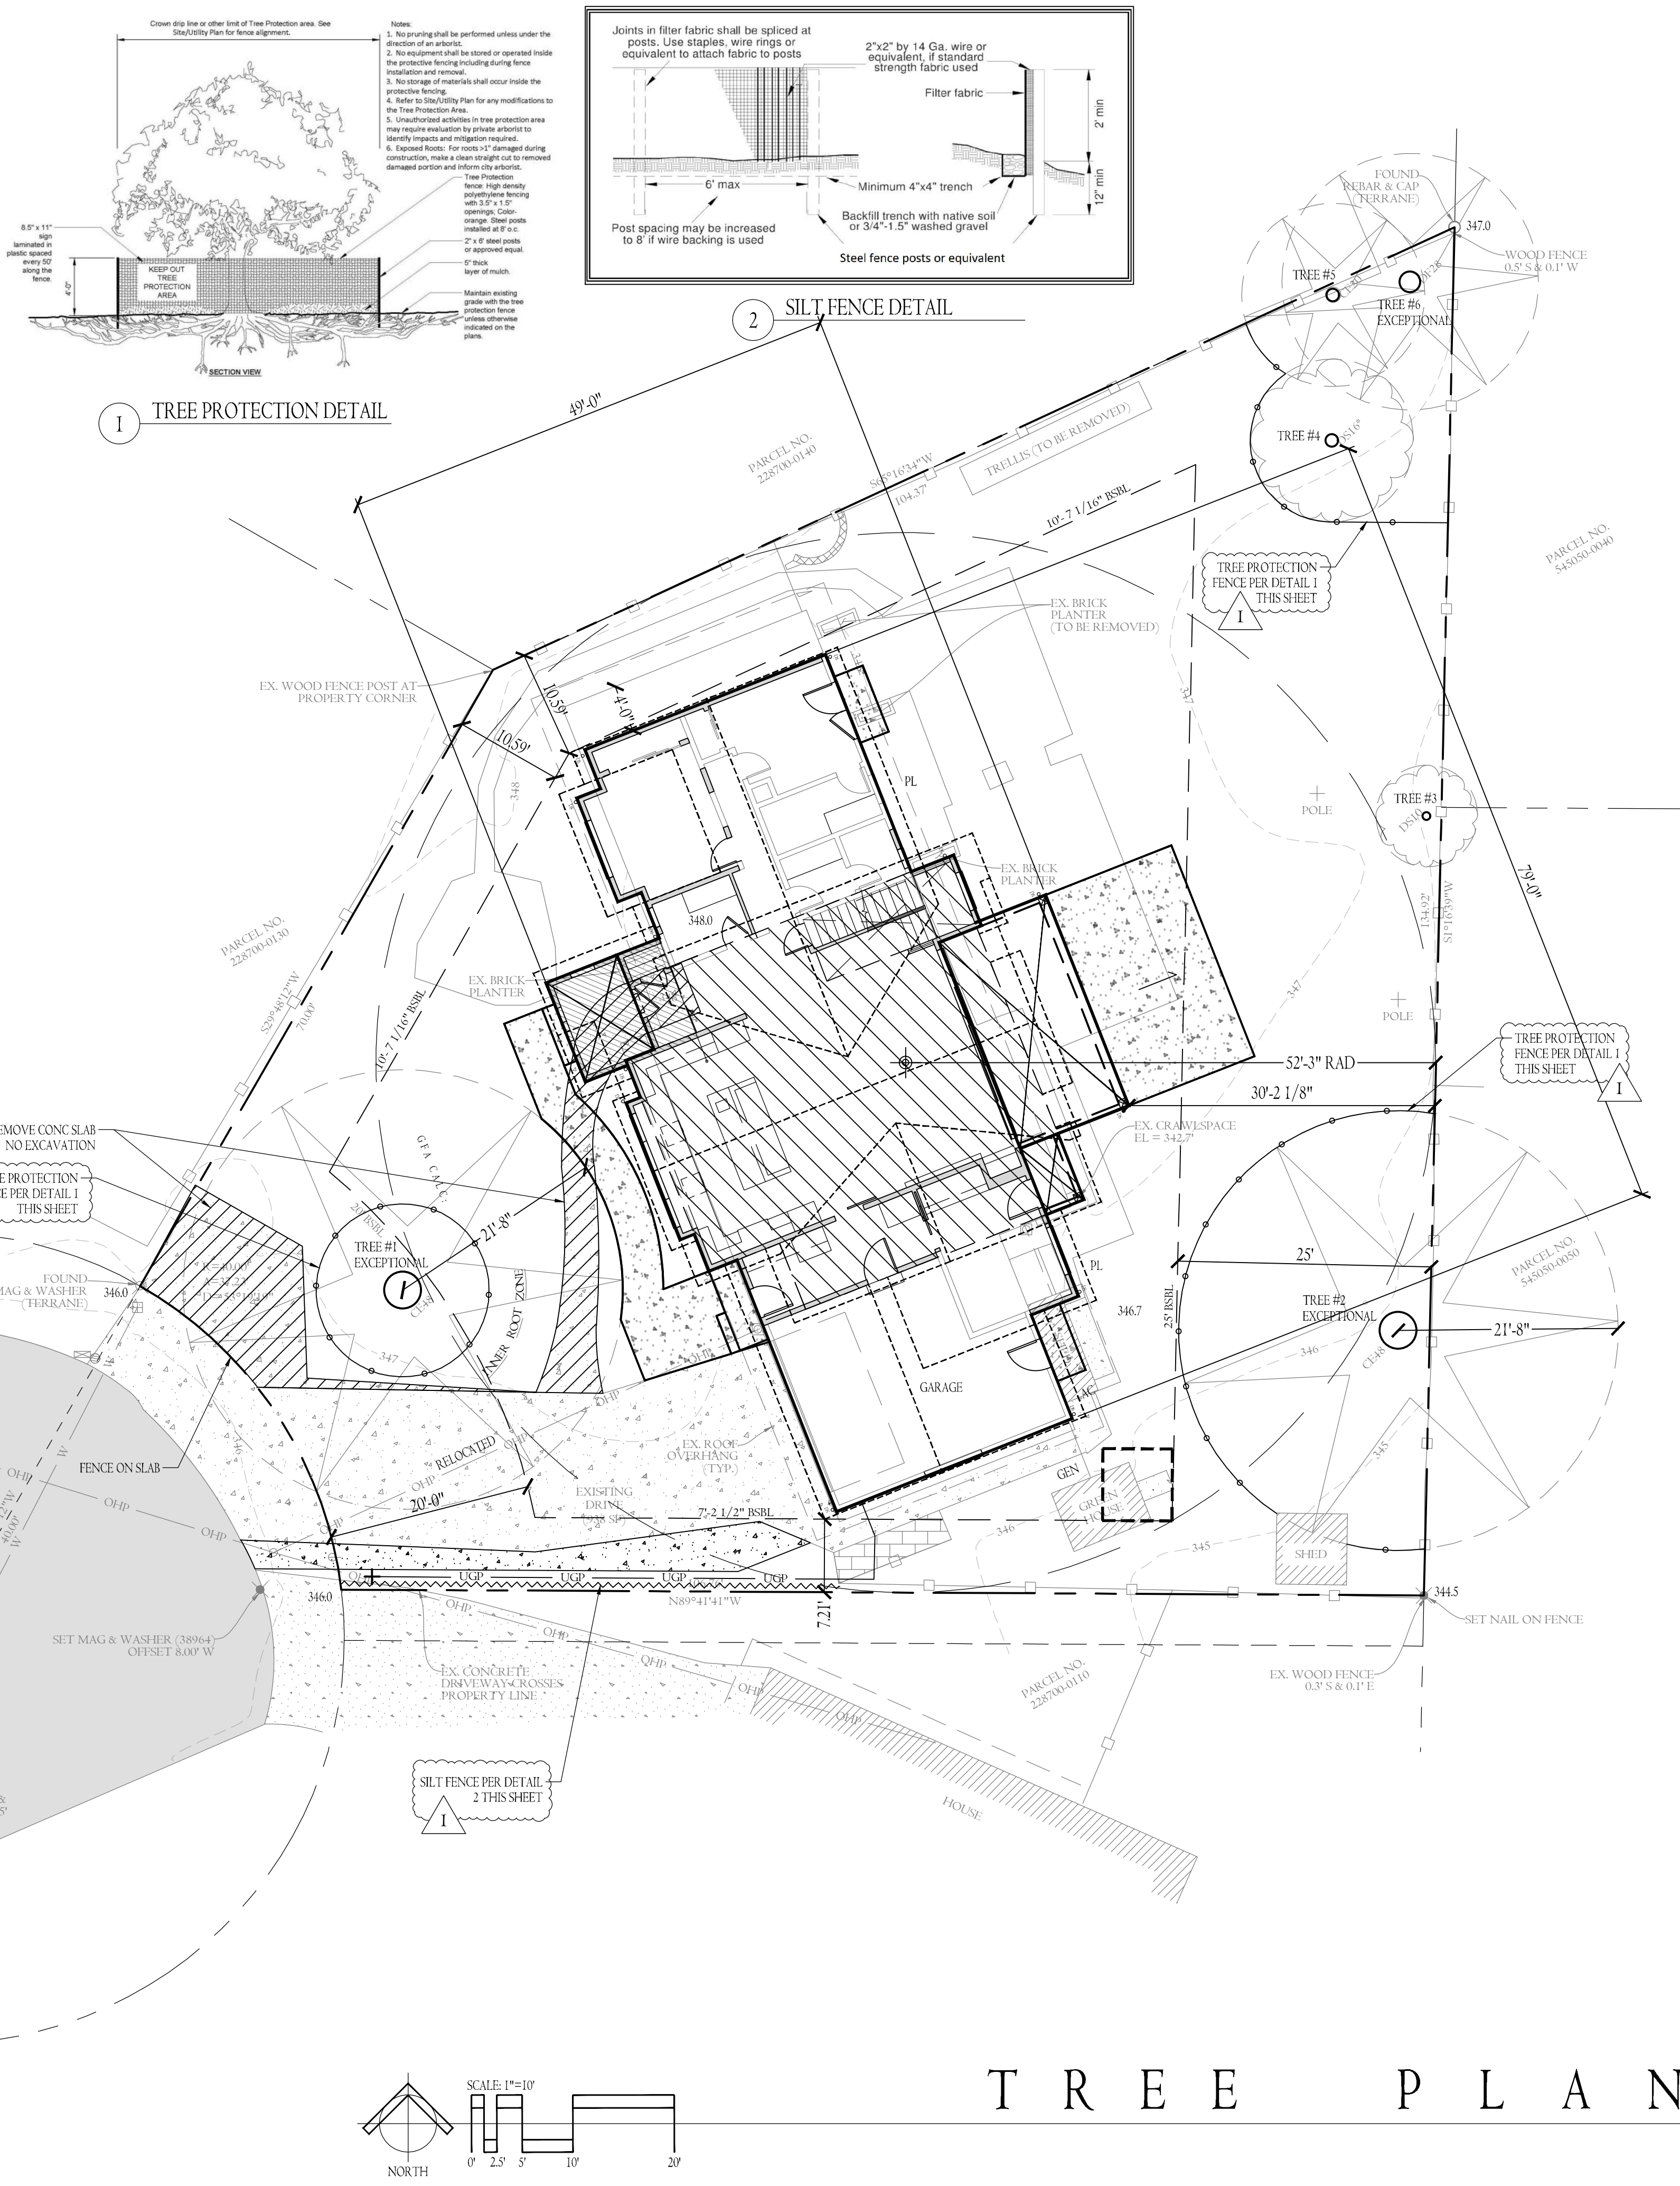

T R E E P L A N

CITY OF MERCER ISLAND

COMMUNITY PLANNING & DEVELOPMENT


9611 SE 36TH STREET | MERCER ISLAND, WA 98040
 PHONE: 206.275.7605 | www.mercer.gov
 Inspection Requests: Online: www.mybuildingpermit.com VM: 206.275.7730



SITE DEVELOPMENT INFORMATION

Worksheet for single family residential development

PROJECT INFORMATION

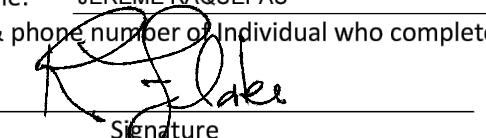Permit Number: _____ Parcel Number: 2287000120
 Site Address: 9116 SE 58TH STREET Phone Number: (206) 349-4272
 Owner Name: JEREME RAQUEPAU Date: DEC 28, 2023
 Signature & phone number of individual who completed this worksheet:
 (253) 359-4039

GENERAL INFORMATION

Will any large trees be removed as a result of this development activity? Yes No
 Large tree- trees with diameter of greater than or equal to 10 inches.
 Do you have an Accessory Dwelling Unit? New ADU Existing ADU No
 Will you be adding air conditioning to the proposed development? Yes No
 What is the total square footage of all proposed decks (covered and uncovered) on the property? N/A Square Feet

This is a worksheet and is not a substitute for the Mercer Island Development Regulations. Please consult the Mercer Island City Code. The City may require additional information to be supplied to document compliance with regulations.

LOT SLOPE

According to the Mercer Island City Code, slope is a measurement of the average incline of the lot or other piece of land calculated by subtracting the lowest elevation of the property from the highest elevation and dividing the resulting number by the shortest horizontal distance between these two points. The resulting product is multiplied by 100.

LOT SLOPE CALCULATIONS

Highest Elevation Point of Lot: 347.0 Feet
 Lowest Elevation Point of Lot: 344.5 Feet
 Elevation Difference: 2.5 Feet
 Horizontal Distance Between High and Low Points: 134.92 Feet
 Lot Slope* = 1.8 %

*Lot slope is the elevation difference divided by horizontal distance multiplied by 100.
 Lot slope calculations shown on Sheet # A-1.1

S:\CPD\FORMS\1\Current Forms\Land Use\SiteDevelopmentWorksheet.docx 12/2020

LOT COVERAGE

For single family residential development, "lot coverage" is the area of a lot that may be covered by a combination of the buildings and vehicular driving surfaces. Lot coverage is based on "net lot area". Net lot area is the size of the lot minus the area within any access easements on the property that do not provide access to the home on the subject lot. The maximum lot coverage for a specific lot is based upon the lots slope (see above). The area of the lot that cannot be used for lot coverage is "required landscaping area"; the landscaping area is typically improved with either hardscape (see below) or softscape.

Please note: Lot coverage is not the same as impervious surface calculations used for drainage review.

Lot Slope	Maximum Lot Coverage (House, driving surfaces, and accessory buildings)	Required Landscaping Area
Less than 15%	40%	60%
15% to less than 30%	35%	65%
30% to 50%	30%	70%
Greater than 50% slope	20%	80%

ADJUSTMENTS

A one-time reduction in the required landscaping area and an increase in the allowed maximum lot coverage is allowed if:

- The total reduction in required landscaping area shall not exceed 5%, and the total increase in maximum lot coverage shall not exceed 5%; and
- The reduction in required landscaping area is associated with:
 - A development proposal that will result in a single-story dwelling with wheelchair accessible entry, and may also include a single-story accessory building; or
 - A development proposal on a flag lot that, after optimizing driveway routing and minimizing driveway width, requires a driveway that is more than the 25% of the allowed lot coverage. The allowed reduction in the required landscaping area and increase in the maximum lot coverage shall not exceed 5% or the area of the driveway in excess of 25% of the lot coverage, whichever is less. For example, a development proposal with a driveway that occupies 27% of the allowed lot coverage, may increase the total lot coverage by 2%.
- A recorded notice on title, covenant, easement, or other documentation in a form approved by the city, shall be required. The notice on title or other documentation shall describe the basis for the reduced landscaping area an increase in lot coverage.

Does this project include a proposed adjustment? Yes No

LOT COVERAGE CALCULATIONS

A. Gross Lot Area 12,192 Square Feet
 B. Net Lot Area 12,192 Square Feet
 C. Allowed Lot Coverage Area 4,877 Square Feet
 D. Allowed Lot Coverage 40 % of Lot
 E. Existing Lot Coverage:
 1. Main Structure Roof Area 2,873 Square Feet
 2. Accessory Building Roof Area 141 Square Feet
 3. Vehicular Use (driveway, paved access easements [portion used by the lot for access], parking 938 Square Feet
 4. Covered Patios and Covered Decks 0 Square Feet

S:\CPD\FORMS\1\Current Forms\Land Use\SiteDevelopmentWorksheet.docx 12/2020

5. Total Existing Lot Coverage Area (E1+E2+E3+E4) 3,952 Square Feet
 F. (Total Lot Coverage Area Removed) 302 Square Feet
 G. Proposed Adjustment for Single Story (Area) _____ Square Feet
 H. Proposed Adjustment for Flag Lot _____ Square Feet
 I. Total New Lot Coverage Area:
 1. Main Structure Roof Area 2,878 Square Feet
 2. Accessory Structure Roof Area 49 Square Feet
 3. Vehicular Use (driveway, paved access easement [portion used by the lot for access], parking) 878 Square Feet
 4. Covered Patios and Covered Decks 380 Square Feet
 5. Total New Lot Coverage Area (I1 + I2 + I3 + I4) 4,165 Square Feet
 J. Total Project Lot Coverage Area = (E5 - F) + I5 4,165 Square Feet
 K. Proposed Lot Coverage Area = (I/B) x 100 34.2 % of Lot

Lot coverage calculations shown on Plan Sheet # A-1.1

HARDSCAPE

Up to 9% of the net lot area may consist of hardscape areas. For single family residential development, hardscape is the solid, hard, elements or structures that are incorporated into landscaping. The hardscape includes, but is not limited to, structures, paved areas, stairs, walkways, decks, patios, rockeries and retaining walls, and similar constructed elements that do not have a roof. The hardscape within the landscaping area consists of materials such as wood, stone, concrete, gravel, permeable pavements or pavers, and similar materials. Hardscape does not include solid, hard elements or structures that are covered by a minimum of two feet of soil intended for softscape (for example, a septic tank covered with at least two feet of soil and planted shrubs is not hardscape). The hardscape does not include driving surfaces or buildings. In addition, unused lot coverage may also be improved with hardscape.

HARDSCAPE CALCULATIONS

A. Gross Lot Area 12,192 Square Feet
 B. Net Lot Area 12,192 Square Feet
 C. Area Borrowed from Lot Coverage 0 Square Feet
 D. Allowed Hardscape Area = 9% of lot area + C 9 % of Lot
 E. Allowed Hardscape Area 1,097 Square Feet
 F. Total Existing Hardscape Area:
 1. Uncovered Decks 0 Square Feet
 2. Uncovered Patios 770 Square Feet
 3. Walkways 724 Square Feet
 4. Stairs 0 Square Feet
 5. Rockeries and Retaining Walls 6 Square Feet
 6. Other _____ Square Feet
 7. Total Existing Hardscape Area (F1+F2+F3+F4+F5+F6) 1,500 Square Feet
 G. (Total Hardscape Area Removed) 1,500 Square Feet
 H. Total New Hardscape Area:
 1. Uncovered Decks 255 Square Feet
 2. Uncovered Patios 338 Square Feet
 3. Walkways 235 Square Feet
 4. Stairs 0 Square Feet
 5. Rockeries and Retaining Walls 0 Square Feet

S:\CPD\FORMS\1\Current Forms\Land Use\SiteDevelopmentWorksheet.docx 12/2020

6. Other _____ Square Feet
 7. Total New Hardscape Area (H1+H2+H3+H4+H5+H6) 828 Square Feet
 I. Total Project Hardscape Area = (F7 - G) + H7 828 Square Feet
 J. Total Project Hardscape Area = (I/B)x100 6.8 % of Lot
 Hardscape calculations shown on Plan Sheet # A-1.1

GROSS FLOOR AREA (GFA)

For single family residential development, GFA is the total square footage of floor area, bounded by the exterior faces of the building(s). The GFA includes the floor area of the main building, accessory buildings, garages, attached roofed decks on the second or third story of a single family home, staircases, etc. The GFA does not include second- or third-story uncovered decks or uncovered rooftop decks. The GFA includes the floor area of the main building, accessory buildings, garages, attached roofed decks on the second or third story of a single family home, staircases, etc. The GFA does not include second- or third-story uncovered decks or uncovered rooftop decks. GFA does not include any portion of a building that is below ground (refer to page 6).

Allowed GFA

- R-8.4: 5,000 square feet or 40% of the lot area, whichever is less.
- R-9.6: 8,000 square feet or 40% of the lot area, whichever is less.
- R-12: 10,000 square feet or 40% of the lot area, whichever is less.
- R-15: 12,000 square feet or 40% of the lot area, whichever is less.
- All zones: Lots with a lot area of 7,500 square feet or less, the lesser of 3,000 square feet or 45% of the lot area.
- All zones: If an accessory dwelling unit is proposed, the 40% allowed GFA may be increased by the lesser of 5 percentile points, or the floor area of the accessory dwelling unit. Provided, this allowance shall not result in a GFA of more than 4,500 square feet or 45% of the lot area, whichever is less.

GFA Modifiers

The GFA calculation for a floor with a ceiling height of 12 to 16 feet, is 150% of the area of the floor. The GFA calculation for a floor with a ceiling height of more than 16 feet, is 200% of the area of the floor. The GFA calculation for a stair case shall be counted as a single floor for the first two stories accessed by the stair case. For each additional story above two stories, the stair case shall count as a single floor area. *Floor plans shall identify rooms with a ceiling height of more than 12 feet and rooms with a ceiling height of more than 16 feet.
 All building areas must be identified and labeled on the site plan. Please distinguish all new construction from existing areas on both your drawing and in the calculations you complete below.

Will you be excluding a portion of the basement floor area? Yes No
 If yes, you must provide basement floor area calculations, with your building permit application, that show how you determined what portion of the basement will be excluded. Refer to page 6.

GROSS FLOOR AREA CALCULATIONS

Building Area	Existing Area	Removed Area	New/Addition Area	Total
Upper Floor	0 Sq. Ft.	0 Sq. Ft.	1,243 Sq. Ft.	1,243 Sq. Ft.
Main Floor	1,765 Sq. Ft.	102 Sq. Ft.	277 Sq. Ft.	1,940 Sq. Ft.
Gross Basement Area	0 Sq. Ft.	0 Sq. Ft.	0 Sq. Ft.	0 Sq. Ft.
Garage/ Carport	435 Sq. Ft.	0 Sq. Ft.	435 Sq. Ft.	435 Sq. Ft.
Total Floor Area	_____ Sq. Ft.	_____ Sq. Ft.	_____ Sq. Ft.	3,618 Sq. Ft.
Accessory Buildings	49 Sq. Ft.	0 Sq. Ft.	49 Sq. Ft.	49 Sq. Ft.

S:\CPD\FORMS\1\Current Forms\Land Use\SiteDevelopmentWorksheet.docx 12/2020

Accessory Dwelling Unit _____ Sq. Ft. _____ Sq. Ft. _____ Sq. Ft. _____ Sq. Ft.
 2nd & 3rd Story Roofed Decks _____ Sq. Ft. _____ Sq. Ft. _____ Sq. Ft. _____ Sq. Ft.
 Basement Area _____ Sq. Ft. _____ Sq. Ft. _____ Sq. Ft. _____ Sq. Ft.
 Excluded 150% GFA Modifier* (main and upper floor x2) _____ Sq. Ft. _____ Sq. Ft. _____ Sq. Ft. _____ Sq. Ft.
 200% GFA Modifier* (main and upper floor x2) _____ Sq. Ft. _____ Sq. Ft. _____ Sq. Ft. _____ Sq. Ft.
 Staircase GFA Modifier* (x2 for a three story staircase, x3 for a four story staircase) _____ Sq. Ft. _____ Sq. Ft. _____ Sq. Ft. _____ Sq. Ft.

TOTAL Building Area 2,249 Sq. Ft. 102 Sq. Ft. 2,067 Sq. Ft. 4,214 Sq. Ft.
 *Enter the actual room area

A. Lot Area 12,192 Square Feet
 B. Zone R-8.4 R-9.6 R-12 R-15
 C. Allowed Gross Floor Area (refer to "allowed GFA") 4,877 Square Feet
 D. Allowed Gross Floor Area 40 % of Lot
 E. Proposed Gross Floor Area 4,214 Square Feet
 F. Proposed Gross Floor Area 34.6 % of Lot

Gross floor area calculations found on Plan Sheet # A-4.1

Basement exclusion calculations found on Plan Sheet # N/A

BUILDING HEIGHT

All building height measurements must be taken from existing grade or finished grade, whichever is lower. Existing grade refers to ground surface as it exists at the proposed building perimeter before grading or other alterations take place. Finished grade refers to the ground surface as it exists at the building perimeter after grading or other alterations take place.

Single family new construction and additions are limited to a maximum height of 30 ft. above the Average Building Elevation (ABE) – see section on next pages. The height is measured to the top of the structure. On the downhill side of a sloping lot, the wall façade height is also limited to a height of 30 feet measured from existing or finished grade (whichever is lower) to the top of the exterior wall facade supporting the roof framing, rafters, trusses, etc.

A topographic survey is required at permit application when the proposed building height is within 2 ft. of the allowable building height. The survey must include a statement that attests the average contour elevation within the vicinity of the building footprint to be accurate within 6 inches vertically and horizontally from actual elevations.

BUILDING HEIGHT CALCULATIONS

A. Average Building Elevation (ABE) calculations located on sheet #: A-1.1
 B. Allowable Building Height (ABE + 30 ft.) 377.38 Feet
 C. Proposed Building Height 30 Feet
 D. Benchmark Elevation* 346.2 Feet
 E. Describe Benchmark Location (must be undisturbed throughout project) WATER METER BOX PER SURVEY

S:\CPD\FORMS\1\Current Forms\Land Use\SiteDevelopmentWorksheet.docx 12/2020

F. Sloping lot (Downhill side)- maximum height of top of exterior wall façade above lowest existing grade (30-ft max) N/A Feet
 G. ABE and Allowable Building Height Shown on elevations plan sheet # A-6.1 - A-7.1
 H. Topo-survey Accuracy Attested on Plan Sheet # A-1.0

Note: survey must attest to accuracy when proposed building height is within 2 feet of the allowable building height. Please see page 8 for more information on calculating Average Building Elevation (ABE)
 **The benchmark elevation is a fixed elevation point on or off site that will not be disturbed during development activity and is used to verify the final building height.

BASEMENT FLOOR AREA CALCULATION


The Mercer Island Development Code allows for the portion of the basement floor area which is below grade to be excluded from the Gross Floor Area. That portion of the basement which will be excluded is calculated as shown:

Portion of Excluded Basement Floor Area = Total Basement Area x

$$\frac{\sum (\text{Wall Segment Coverage} \times \text{Wall Segment Length})}{\text{Total of all Wall Segment Lengths}}$$

Where the terms are defined as follows:

Total Basement Area: The total amount of all basement floor area.
Wall Segment: The portion of an exterior wall below existing or finished grade, whichever is lower. It is expressed as a percentage. Refer to example below.
Coverage: The horizontal length of each exterior wall in feet.
Wall Segment Length: The horizontal length of each exterior wall in feet.

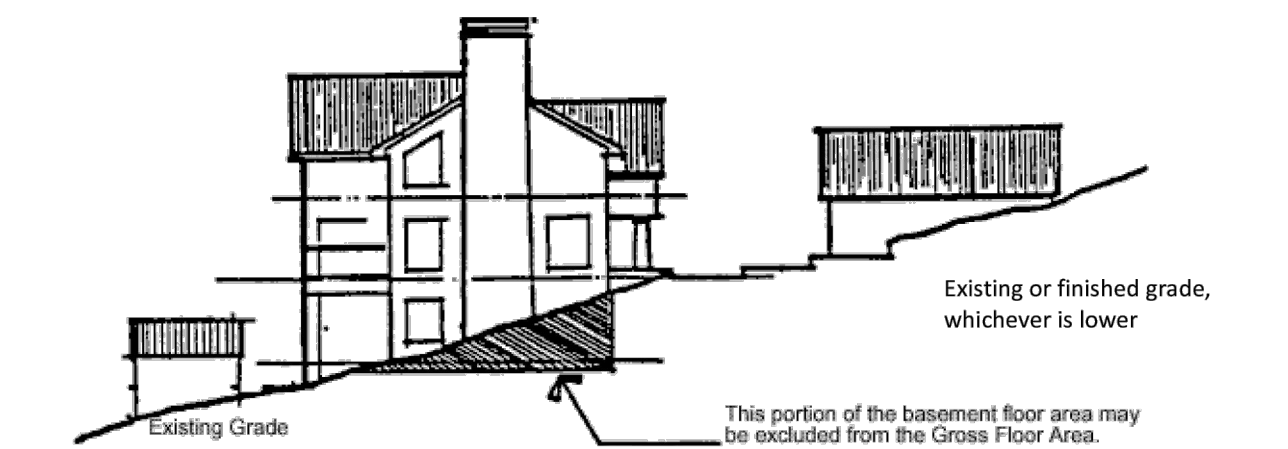

EXAMPLE OF BASEMENT FLOOR AREA CALCULATION

This example illustrates how a portion of the basement floor area may be excluded from the Gross Floor Area. In order to complete this example, the following information is needed:

- A topographic map of the existing (e) grades and showing proposed finished (f) grades.
- Building plans showing dimensions of all exterior wall segments and floor areas.
- Building elevations showing the location of existing and finished grades in relation to basement level.



Step One

Determine the number and lengths of the Wall Segments.
 174'

S:\CPD\FORMS\1\Current Forms\Land Use\SiteDevelopmentWorksheet.docx 12/2020

Step Two

Determine the Wall Segment Coverage (in %) for each Wall Segment. In most cases this will be readily apparent, for example a downhill elevation which is entirely above existing and finished grade. In other cases, where the existing contours are complex, an averaging system shall be used. Refer to illustration.

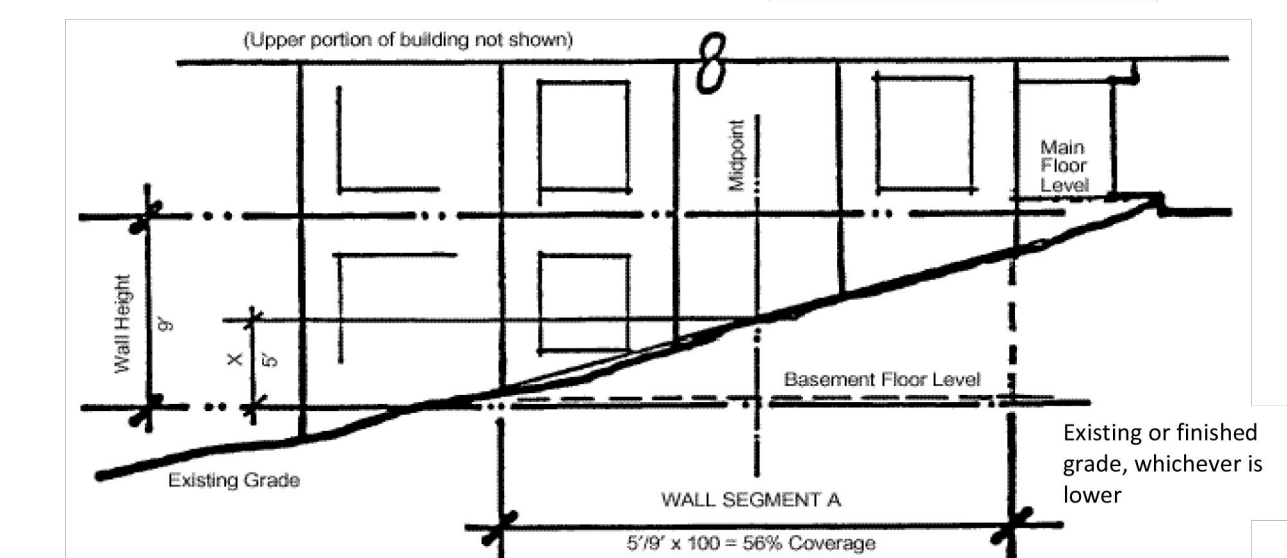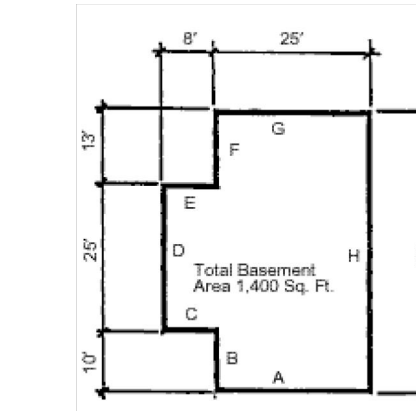

Step Three

Multiply each Wall Segment Length by the percentage of each Wall Segment Coverage and add these results together. Divide that number by the sum of all Wall Segment Lengths. This calculation will result in a percentage of basement wall which is below grade. (This calculation is most easily completed by compiling a table of the information as illustrated below.)

Wall Segment	Length x	Coverage	Result
A	25'	56%	14%
B	10'	0%	0%
B	8'	0%	0%
D	25'	0%	0%
E	8'	0%	0%
F	13'	0%	0%
G	25'	60%	15%
H	48'	100%	48%
Totals	162'	NA	77%

Step Four
 Multiply the Total Basement Floor Area by the above percentage to determine the Excluded Basement Floor Area. Portion of Excluded Basement Floor Area Calculation below

S:\CPD\FORMS\1\Current Forms\Land Use\SiteDevelopmentWorksheet.docx 12/2020

1,400 Sq. Ft. x $(25' \times 56\% + 10' \times 0\% + \dots + 25' \times 60\% + 48' \times 100\%)$

$$= 1,400 \text{ Sq. Ft.} \times 47.53\% = 665.42 \text{ Sq. Ft. Excluded from the Gross Floor Area}$$

CALCULATING AVERAGE BUILDING ELEVATION (ABE)

No part of a structure may exceed 30 feet in height above the "Average Building Elevation" to the top of the structure, except that on the downhill side of a sloping lot the structure shall not extend to a height greater than 30 feet measured from existing or finished grade to the top plate of the roof; provided the roof ridge does not exceed 30 feet in height above the "Average Building Elevation." ABE is defined as: The elevation established by averaging the elevation at existing or finished grade, whichever is lower, at the center of all exterior walls of the completed building.

NOTE:
 INCOMPLETE AVERAGE BUILDING ELEVATION INFORMATION COULD SUBSTANTIALLY DELAY THE PROCESSING OF YOUR APPLICATION

AVERAGE BUILDING ELEVATION FORMULA:
 (Mid-point Elevation of Individual Wall Segment) x (Length of Individual Wall Segment)
 (Total Length of Wall Segments)
 —OR—

$$\frac{(Axa)+(Bxb)+(Cxc)+(Dxd)+(Exe)+(Fxf)+(Ggx)+(Hxh)}{a+b+c+d+e+f+g+h}$$

 WHERE: A,B,C,D... = Lower of Finished or Existing Ground Elevation at Midpoint of Wall Segment
 AND: a,b,c,d... = Length of Wall Segment Measured on Outside Wall

MIDPOINT ELEVATION	WALL SEGMENT LENGTH
A = 105.9 feet	a = 30 feet
B = 104.7 feet	b = 9 feet
C = 103.7 feet	c = 17 feet
D = 102.7 feet	d = 25 feet
E = 101.6 feet	e = 13 feet
F = 101.7 feet	f = 6 feet
G = 102.2 feet	g = 34 feet
H = 104.5 feet	h = 40 feet

ABE CALCULATION:


$$\frac{(105.9)(30)+(104.7)(9)+(103.7)(17)+(102.2)(25)+(101.6)(13)+(101.7)(6)+(102.2)(34)+(104.5)(40)}{30+9+17+25+13+6+34+40}$$

$$\frac{18023'}{174'} = 103.6' \text{ Average Building Elevation (ABE)}$$

NOTE: This example is not to scale. Site plans submitted to the building department must be to scale.




S:\CPD\FORMS\1\Current Forms\Land Use\SiteDevelopmentWorksheet.docx 12/2020

REFERENCE RESIDENCE
 RAQUEPAU & ASSOCIATES ARCHITECTURE
 9116 SE 58TH STREET
 MERCEER ISLAND, WA 98040
 PH: (253) 359-4039
 richard@raquepau.com
 7421 21st Ave E Bonney Lake, WA 98391
 REGISTERED ARCHITECT
 RICHARD FLAKE ARCHITECT
 6080
 DESIGN: RWF
 DRAWN: HAVILAND CONSULTING
 CHECKED: RWF
 REVISIONS:
 CITY REVIEW
 CITY REVIEW
 Mar 12, 2024
 2 A-I.3

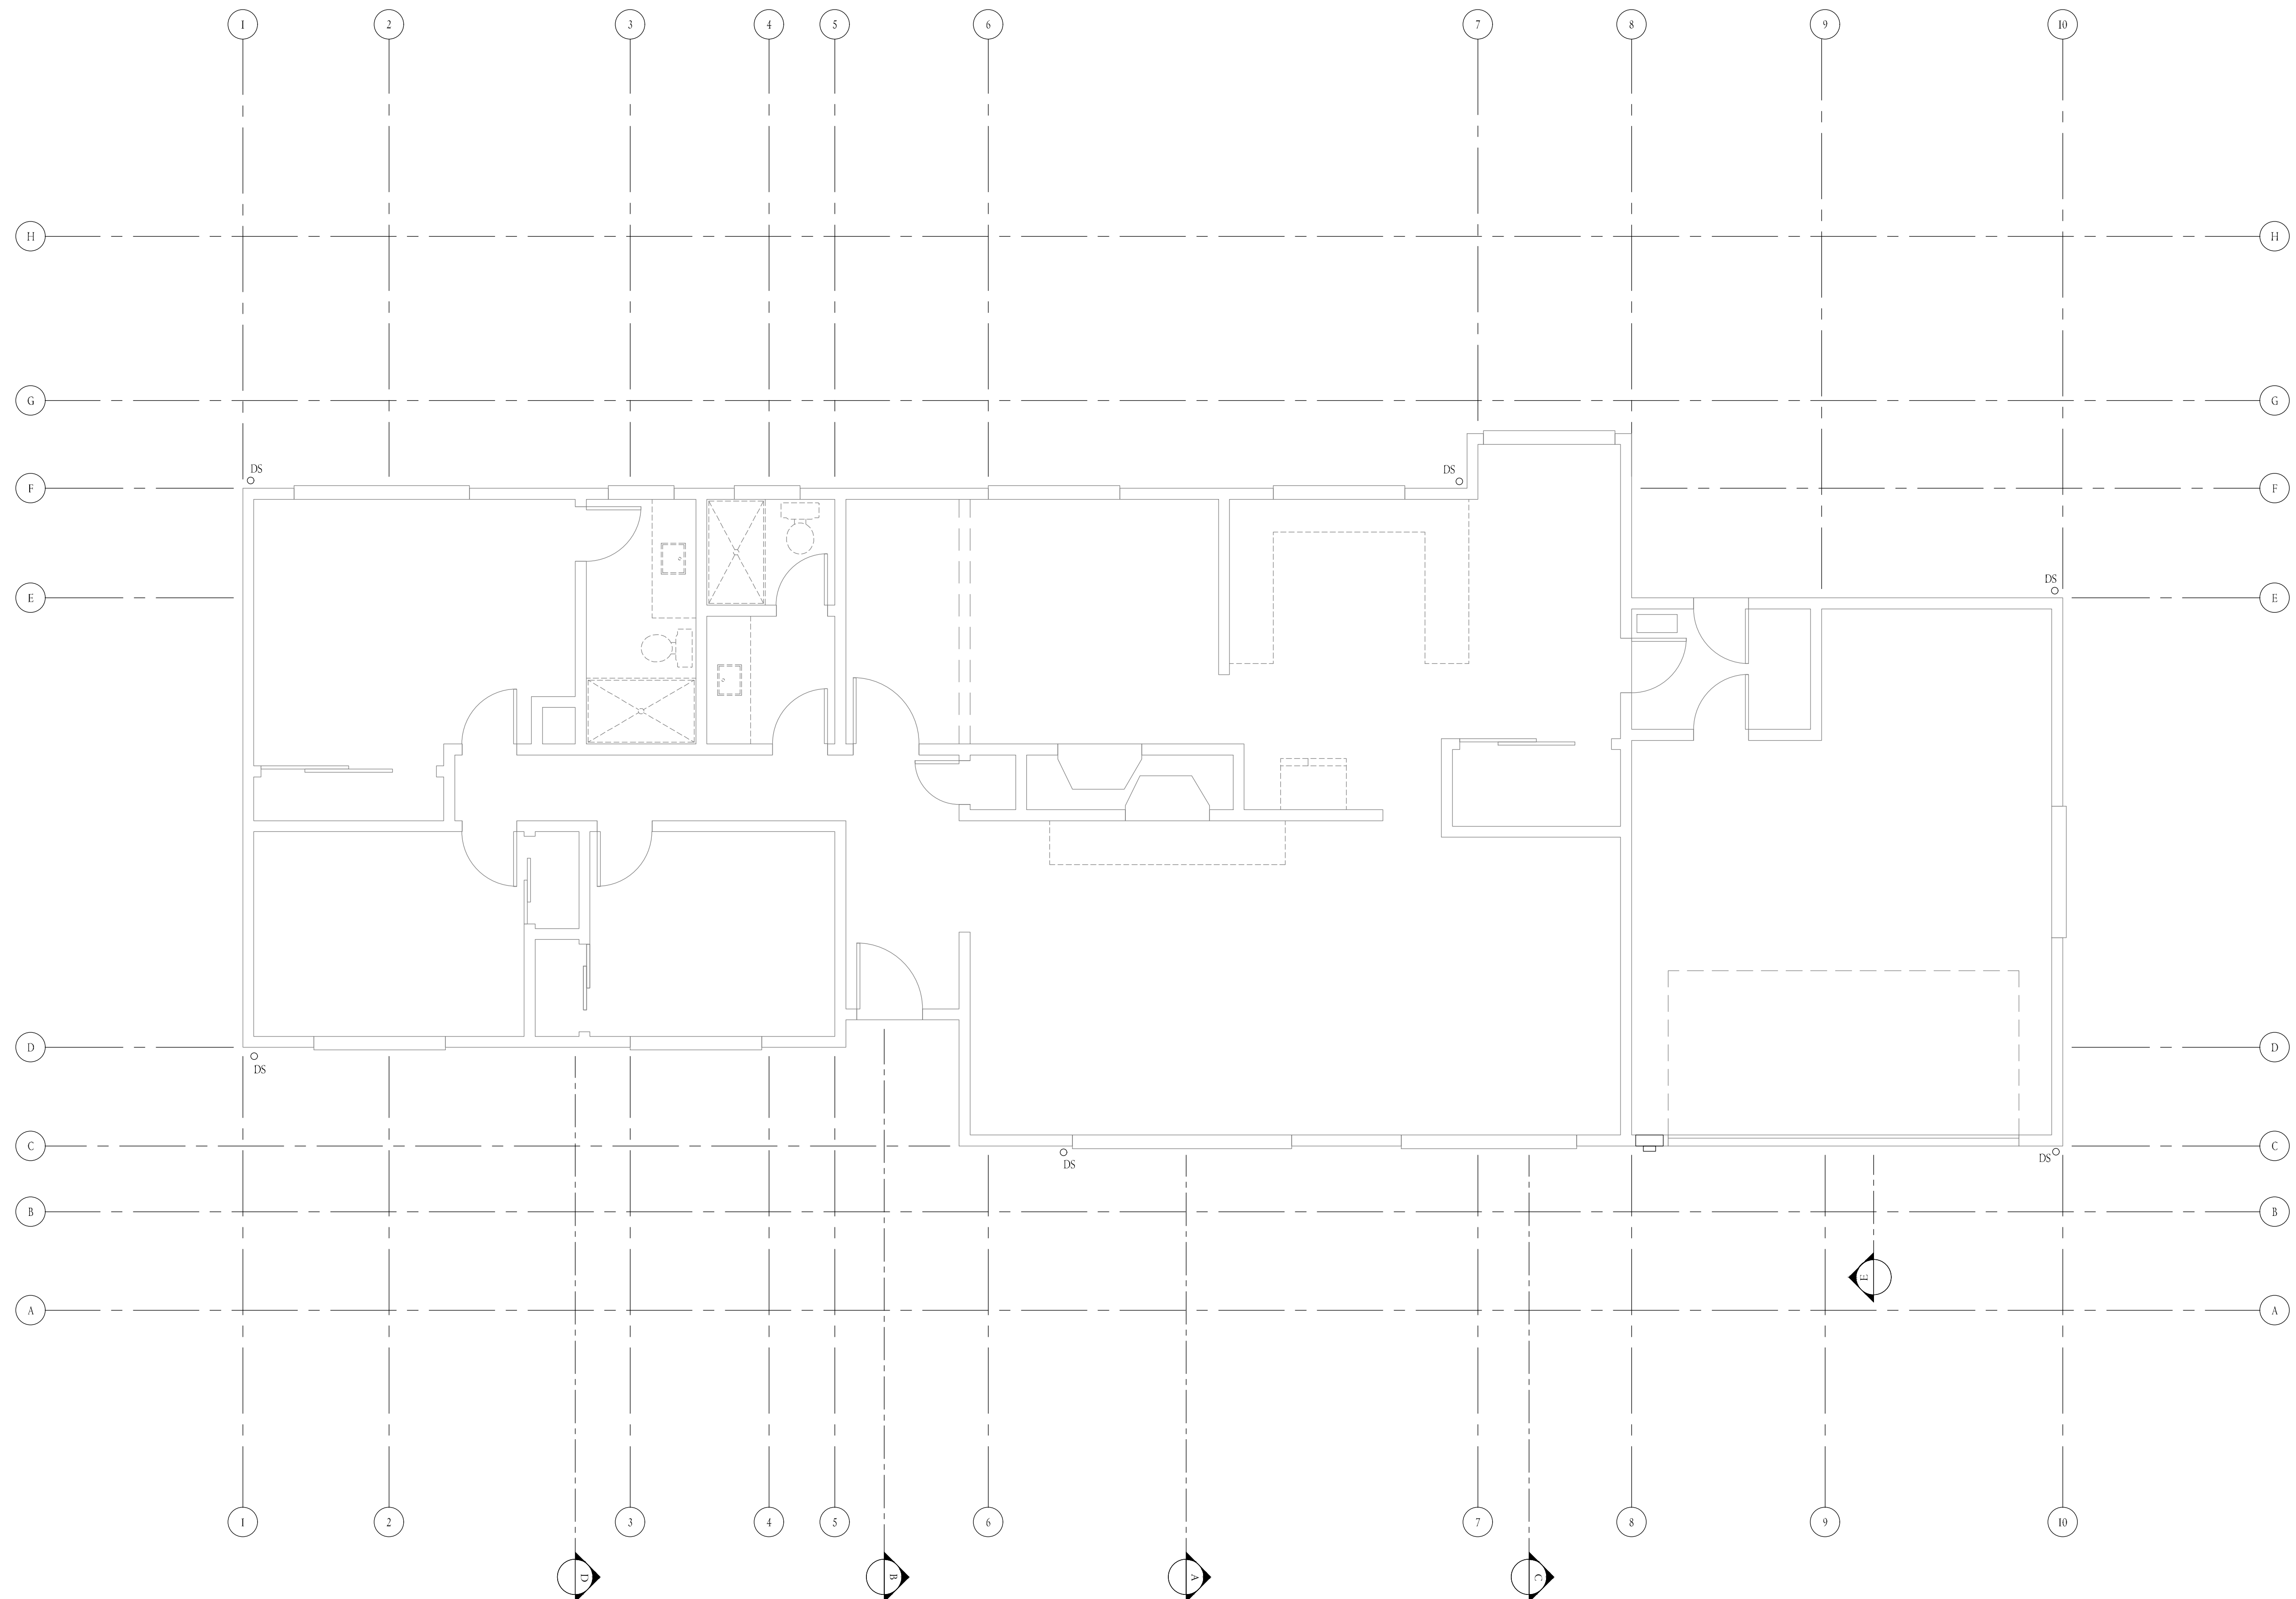


M A I N F L O O R A S B U I L T S L E G E N D

SCALE: 1/4"=1'-0"

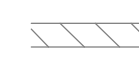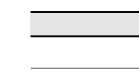-  EXISTING REMOVED
-  NEW WALLS
-  EXISTING TO REMAIN

R F A R C H I T E C T U R E
 P H : (2 5 3) 3 5 9 - 4 0 3 9
 R i c h a r d @ r f a r c h i t e c t u r e . c o m
 7 4 2 1 2 1 s t A v e E B o n n e y l a k e , W A 9 8 3 9 1

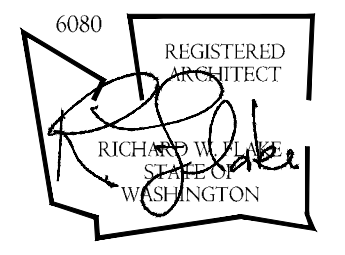

All drawings, specifications, plans, ideas, arrangements, and designs represented or referred to are the property of, and owned by Richard Flake Architect in whether the project for which they are made is executed or not. They were created, evolved, developed and produced for sole use on and in connection with this project and none of the above may be disclosed or given to or used by any person, firm, or corporation for any use or purpose whatsoever including any other project, except upon written permission of Richard Flake Architect.

Copyright 2023
 Richard Flake Architect

R A Q U E P A U R E S I D E N C E
 R E M O D E L & A D D I T I O N
 9 1 6 S E S T H M E R C E R I S L A N D , W A 9 8 0 4 0

DESIGN:
 RWF

DRAWN:
 HAVILAND CONSULTING



CHECKED:
 RWF


REVISIONS:

CITY REVIEW
 1 - 2 - 1 9 - 2 0 2 3

CITY REVIEW
 1 - 2 8 - 2 0 2 4

Mar 01, 2024

A-2.1

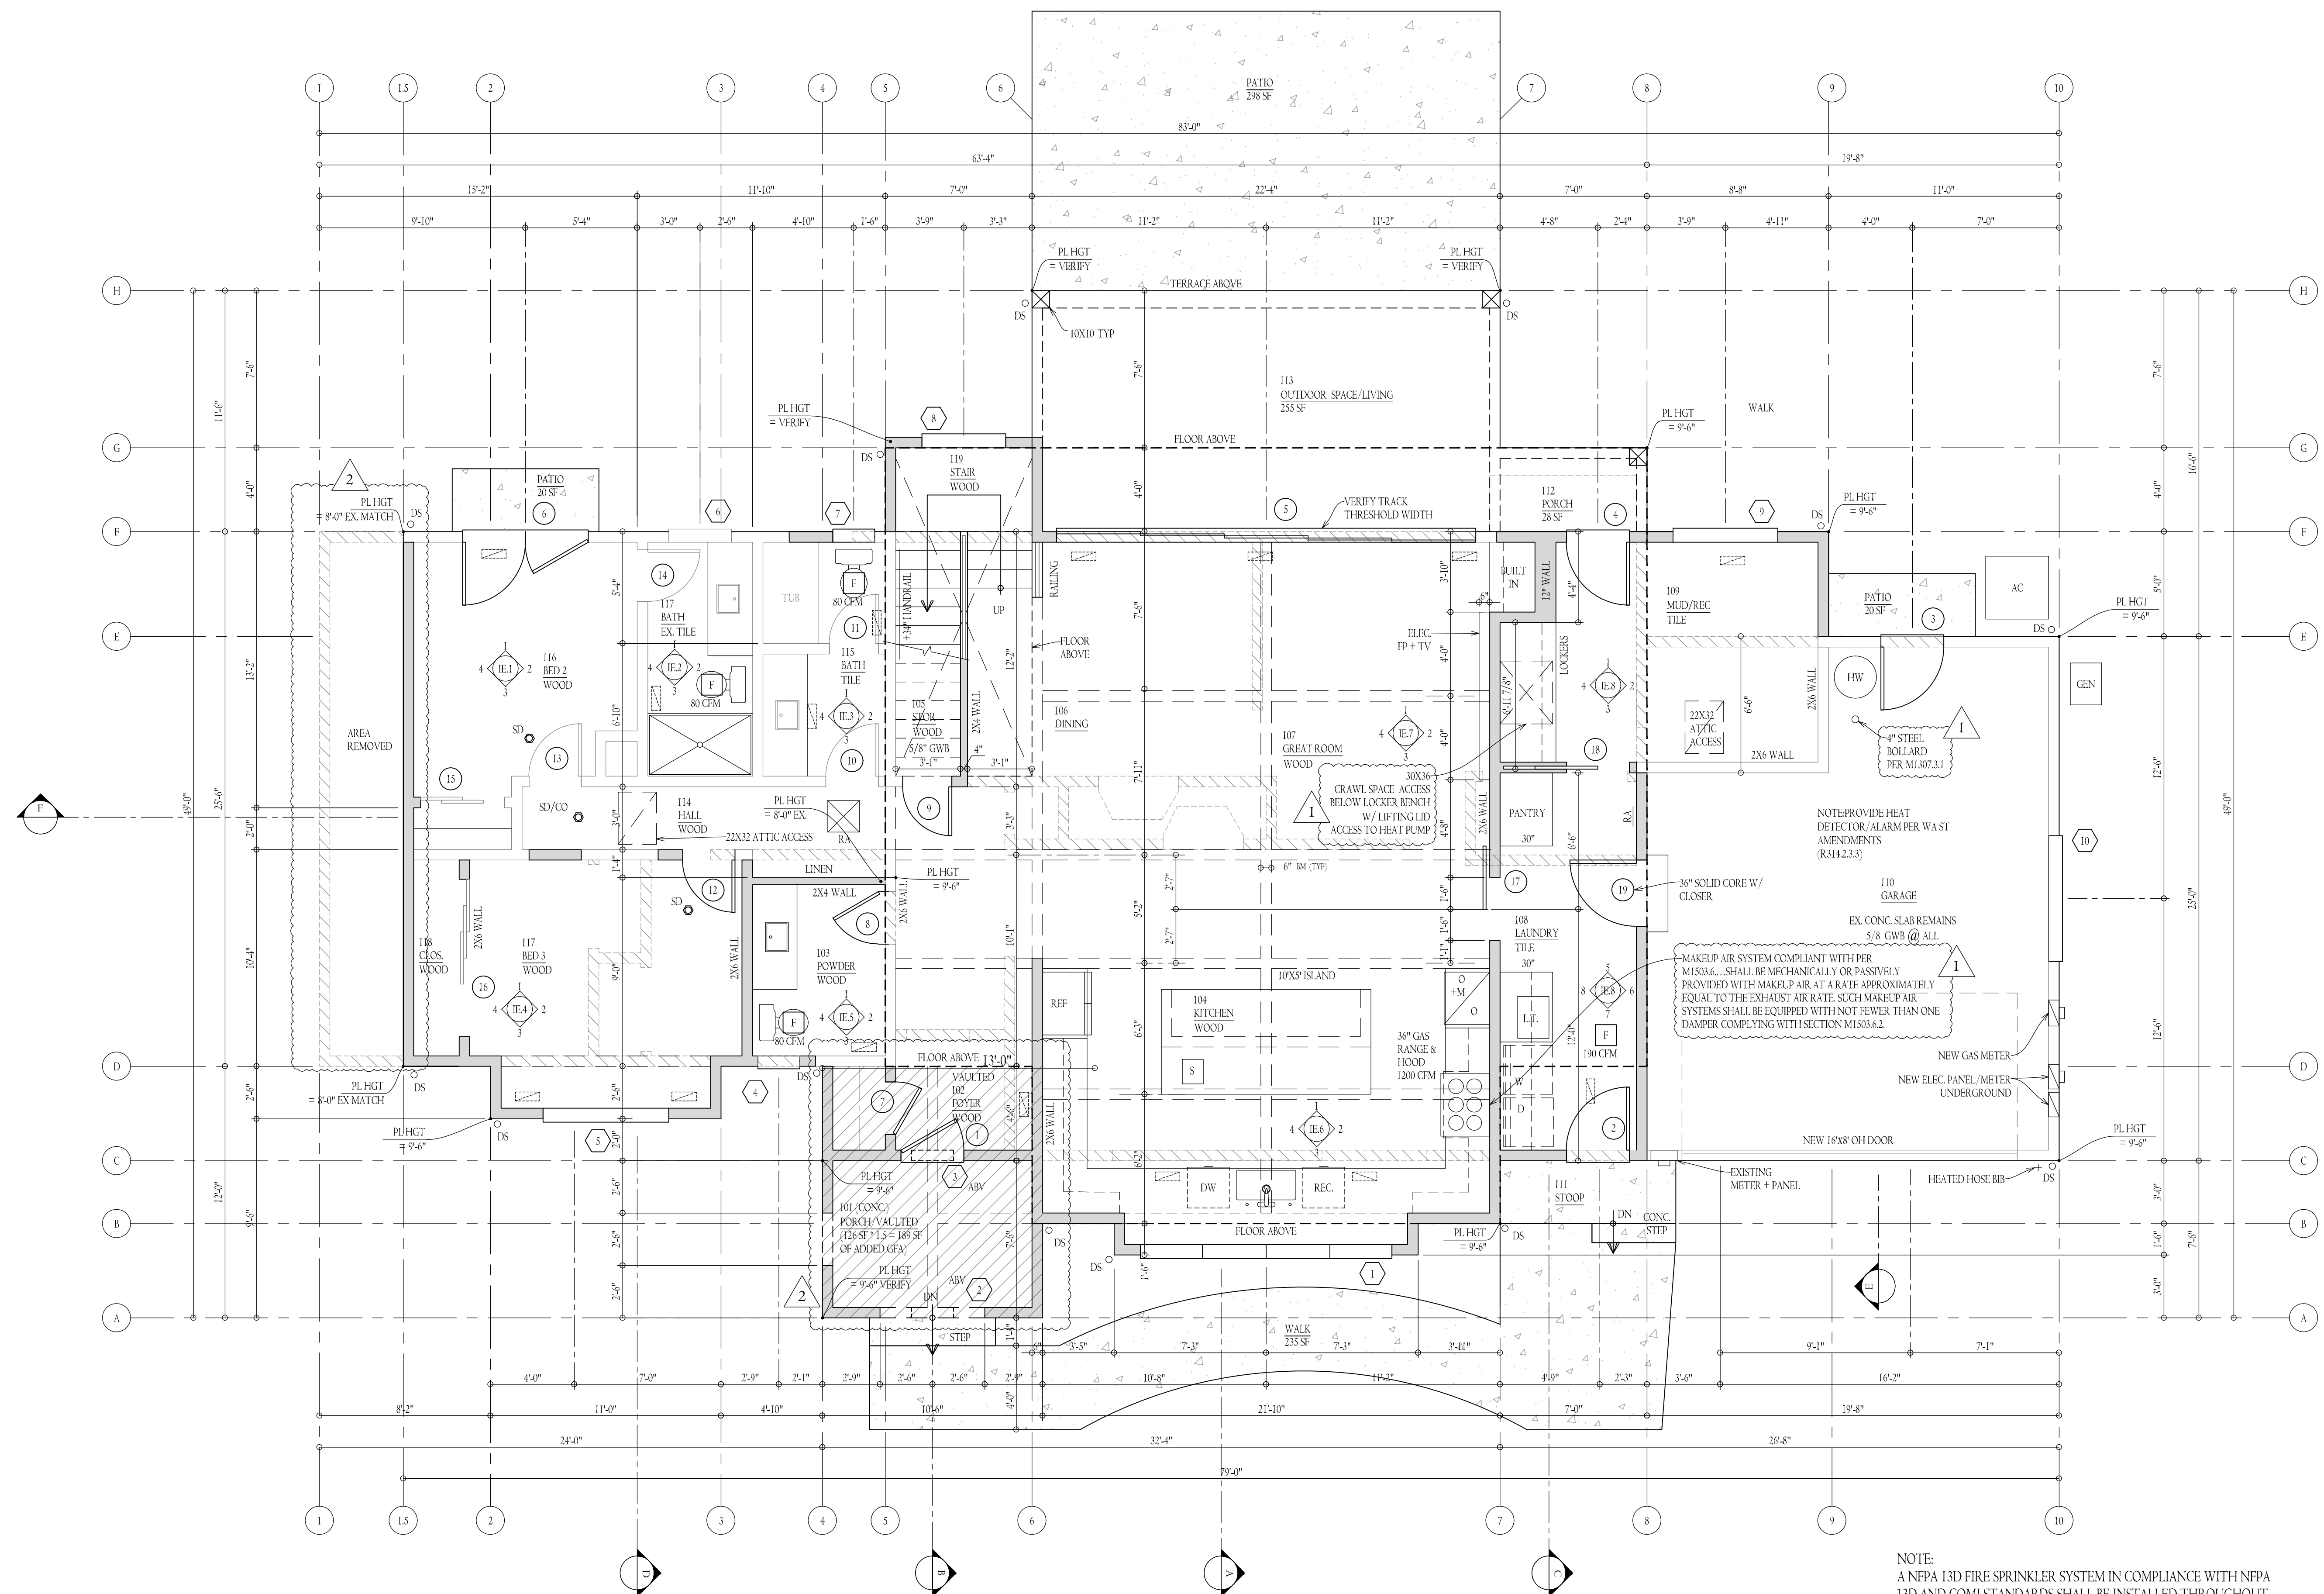


GFA CALC:		MAIN FLOOR PLAN		LEGEND	
GFA _A MAIN FLOOR	1,940 SF	1,940 SF HEATED MAIN FLOOR	435 SF GARAGE EXISTING	EXISTING REMOVED	SCALE: 1/4"=1'-0"
GFA _B UPPER FLOOR	1,243 SF	189 SF ADDED GFA MAIN FLOOR	235 SF WALKWAYS	NEW WALLS	
GARAGE	435 SF	1,243 SF HEATED FLOOR UPPER	338 SF UNCOVERED PATIOS	EXISTING TO REMAIN	
TOTAL FLOOR AREA	3,618 SF	358 SF ADDED GFA UPPER FLOOR	283 SF OUTDOOR SPACE/LIVING		
ACCESSORY BLDG	49 SF	3,730 SF TOTAL HEATED FLOOR AREA	49 SF ACCESSORY BLDG/SHED		
150% GFA MODIFIER	547				
TOTAL BUILDING AREA	4,214 SF				

NOTE:
 A NFPA 13D FIRE SPRINKLER SYSTEM IN COMPLIANCE WITH NFPA 13D AND COMI STANDARDS SHALL BE INSTALLED THROUGHOUT THE RESIDENCE. A SEPARATE FIRE PERMIT IS REQUIRED.
 MINIMUM OF 1" WATER METER WATER SUPPLY LINE.

6080 REGISTERED ARCHITECT
 RICHARD FLAKE ARCHITECTURE
 SEATTLE, WASHINGTON
 All drawings, specifications, plans, ideas, arrangements, and designs represented or referred to are the property of, and owned by, Richard Flake Architect in whether the project for which they are made is executed or not. They were created, evolved, developed and produced for sole use on and in connection with this project and none of the above may be disclosed or given to or used by any person, firm, or corporation for any use or purpose whatsoever including any other project, except upon written permission of Richard Flake Architect.
 Copyright 2023
 Richard Flake Architect

DESIGN: RWF
 DRAWN: [Signature]
 CHECKED: RWF
 REVISIONS:

1	CITY REVIEW	1-2-2023
2	CITY REVIEW	2-28-2024

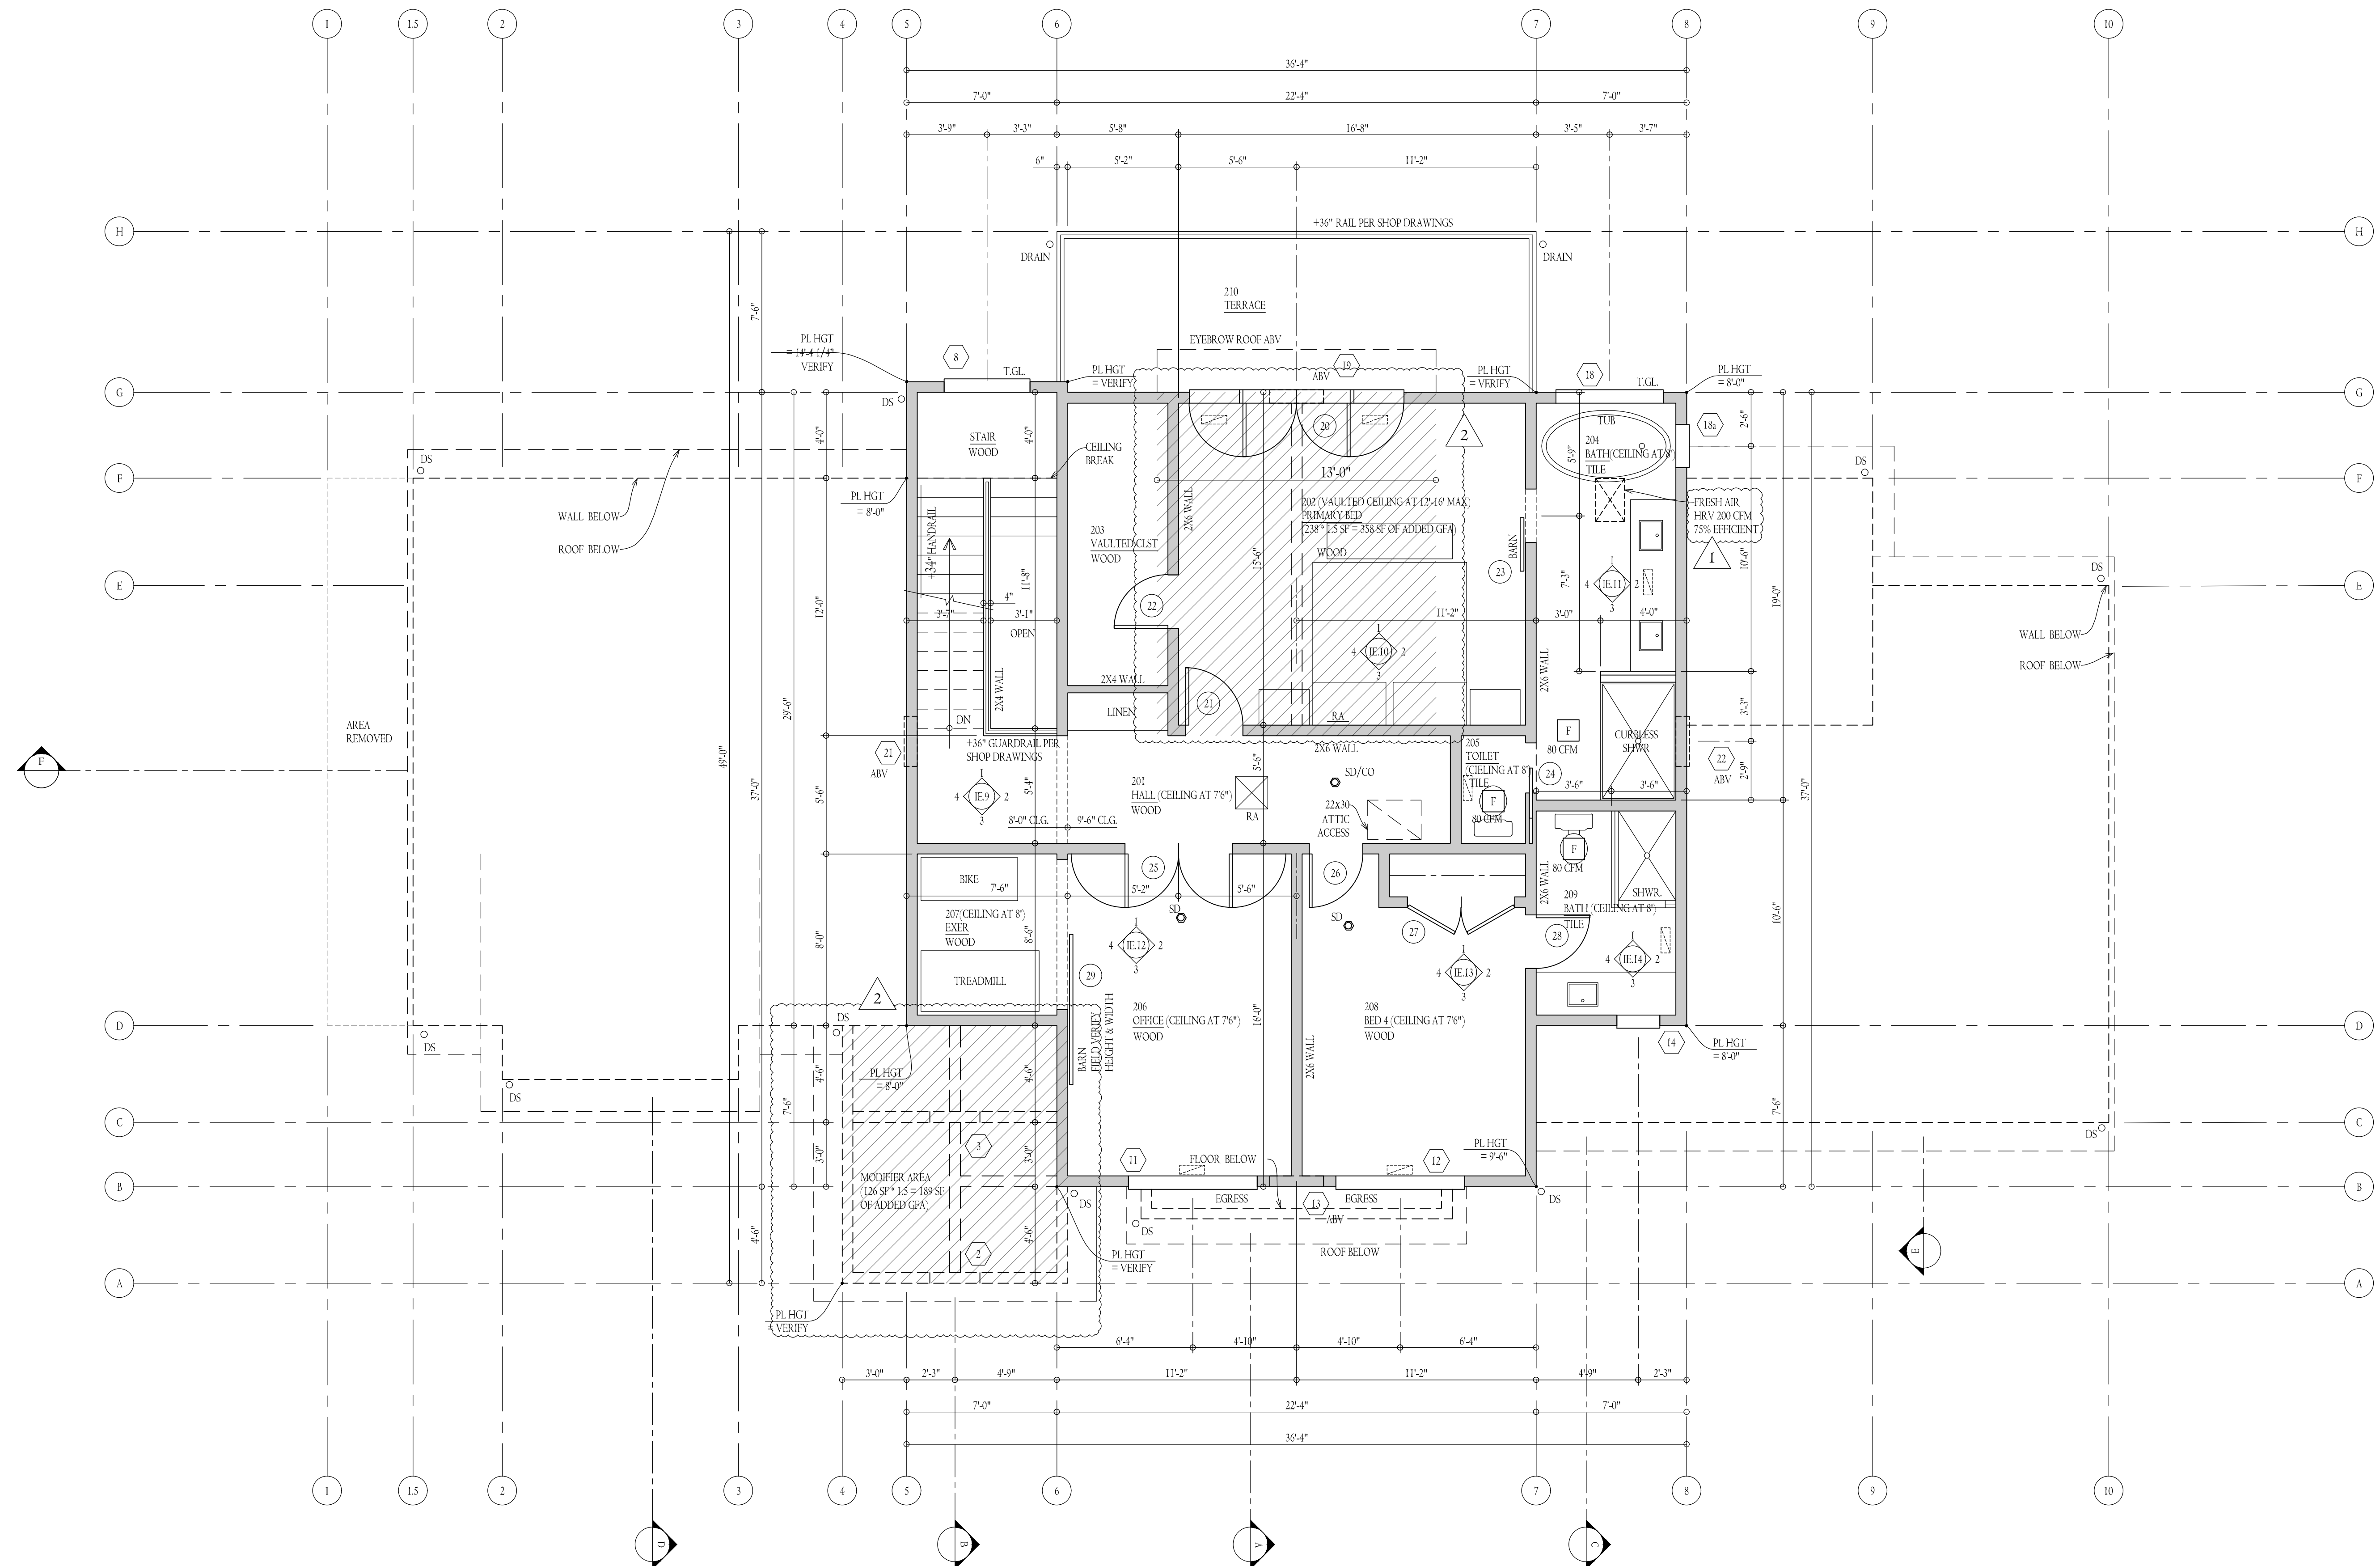

U P P E R F L O O R P L A N L E G E N D


<p>1,243 SF HEATED UPPER FLOOR ADDITION</p> <p>358 SF GFA ADDED</p> <p>1,601 SF HEATED UPPER FLOOR ADDITION TOTAL</p>	<p>SCALE: 1/4"=1'-0"</p>	<p> EXISTING REMOVED</p> <p> NEW WALLS</p> <p> EXISTING TO REMAIN</p>
---	--------------------------	---

6080 REGISTERED ARCHITECT
 RICHARD FLAKE ARCHITECT
 SEASIDE, WASHINGTON

All drawings, specifications, plans, ideas, arrangements, and designs represented or referred to are the property of and owned by Richard Flake Architect in whether the project for which they are made is executed or not. They were created, evolved, developed and produced for sole use on and in connection with this project and none of the above may be disclosed or given to or used by any person, firm, or corporation for any use or purpose whatsoever including any other project, except upon written permission of Richard Flake Architect.

Copyright 2023
 Richard Flake Architect


DESIGN:	RWF
DRAWN:	
CHECKED:	RWF
REVISIONS:	
CITY REVIEW	1 - 2 - 1 9 - 2 0 2 3
CITY REVIEW	2 - 2 8 - 2 0 2 4

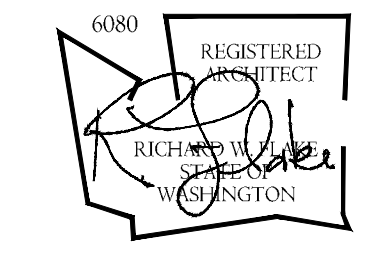

All drawings, specifications, plans, ideas, arrangements, and designs represented or referred to are the property of and owned by Richard Flake Architect in whether the project for which they are made is executed or not. They were created, evolved, developed and produced for sole use on and in connection with this project and none of the above may be disclosed or given to or used by any person, firm, or corporation for any use or purpose whatsoever including any other project, except upon written permission of Richard Flake Architect.
 Copyright 2023
 Richard Flake Architect

DESIGN: RWF
 DRAWN: [Signature]
 CHECKED: RWF
 REVISIONS:


△	CITY REVIEW	1.2.2023
△	CITY REVIEW	2.28.2024

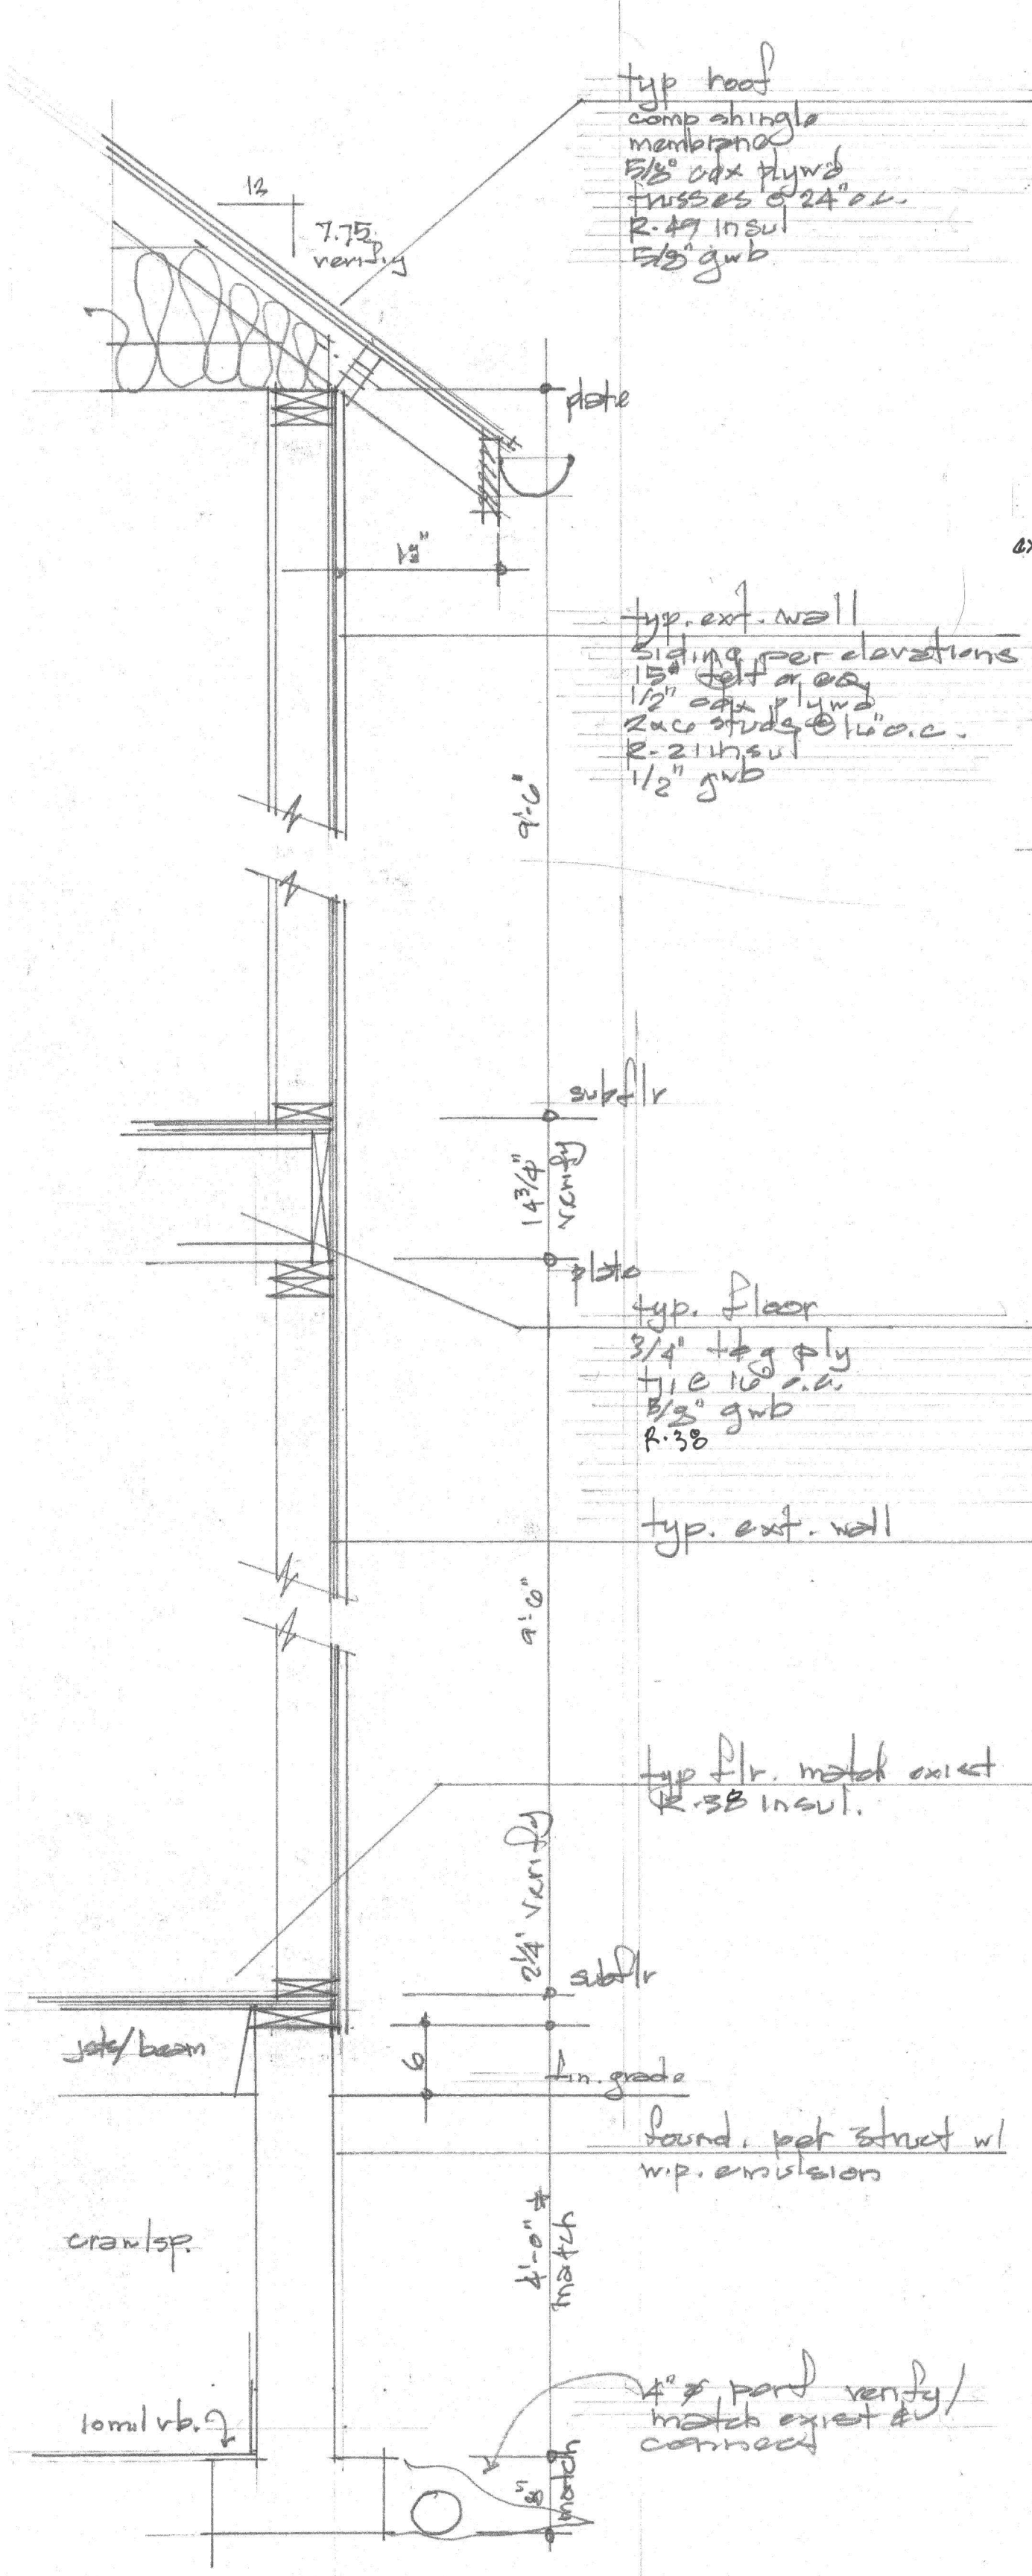


1 WALL SECTION
 scale: 1/4" = 1'-0"




FRONT ELEVATION
 scale: 1/4" = 1'-0"

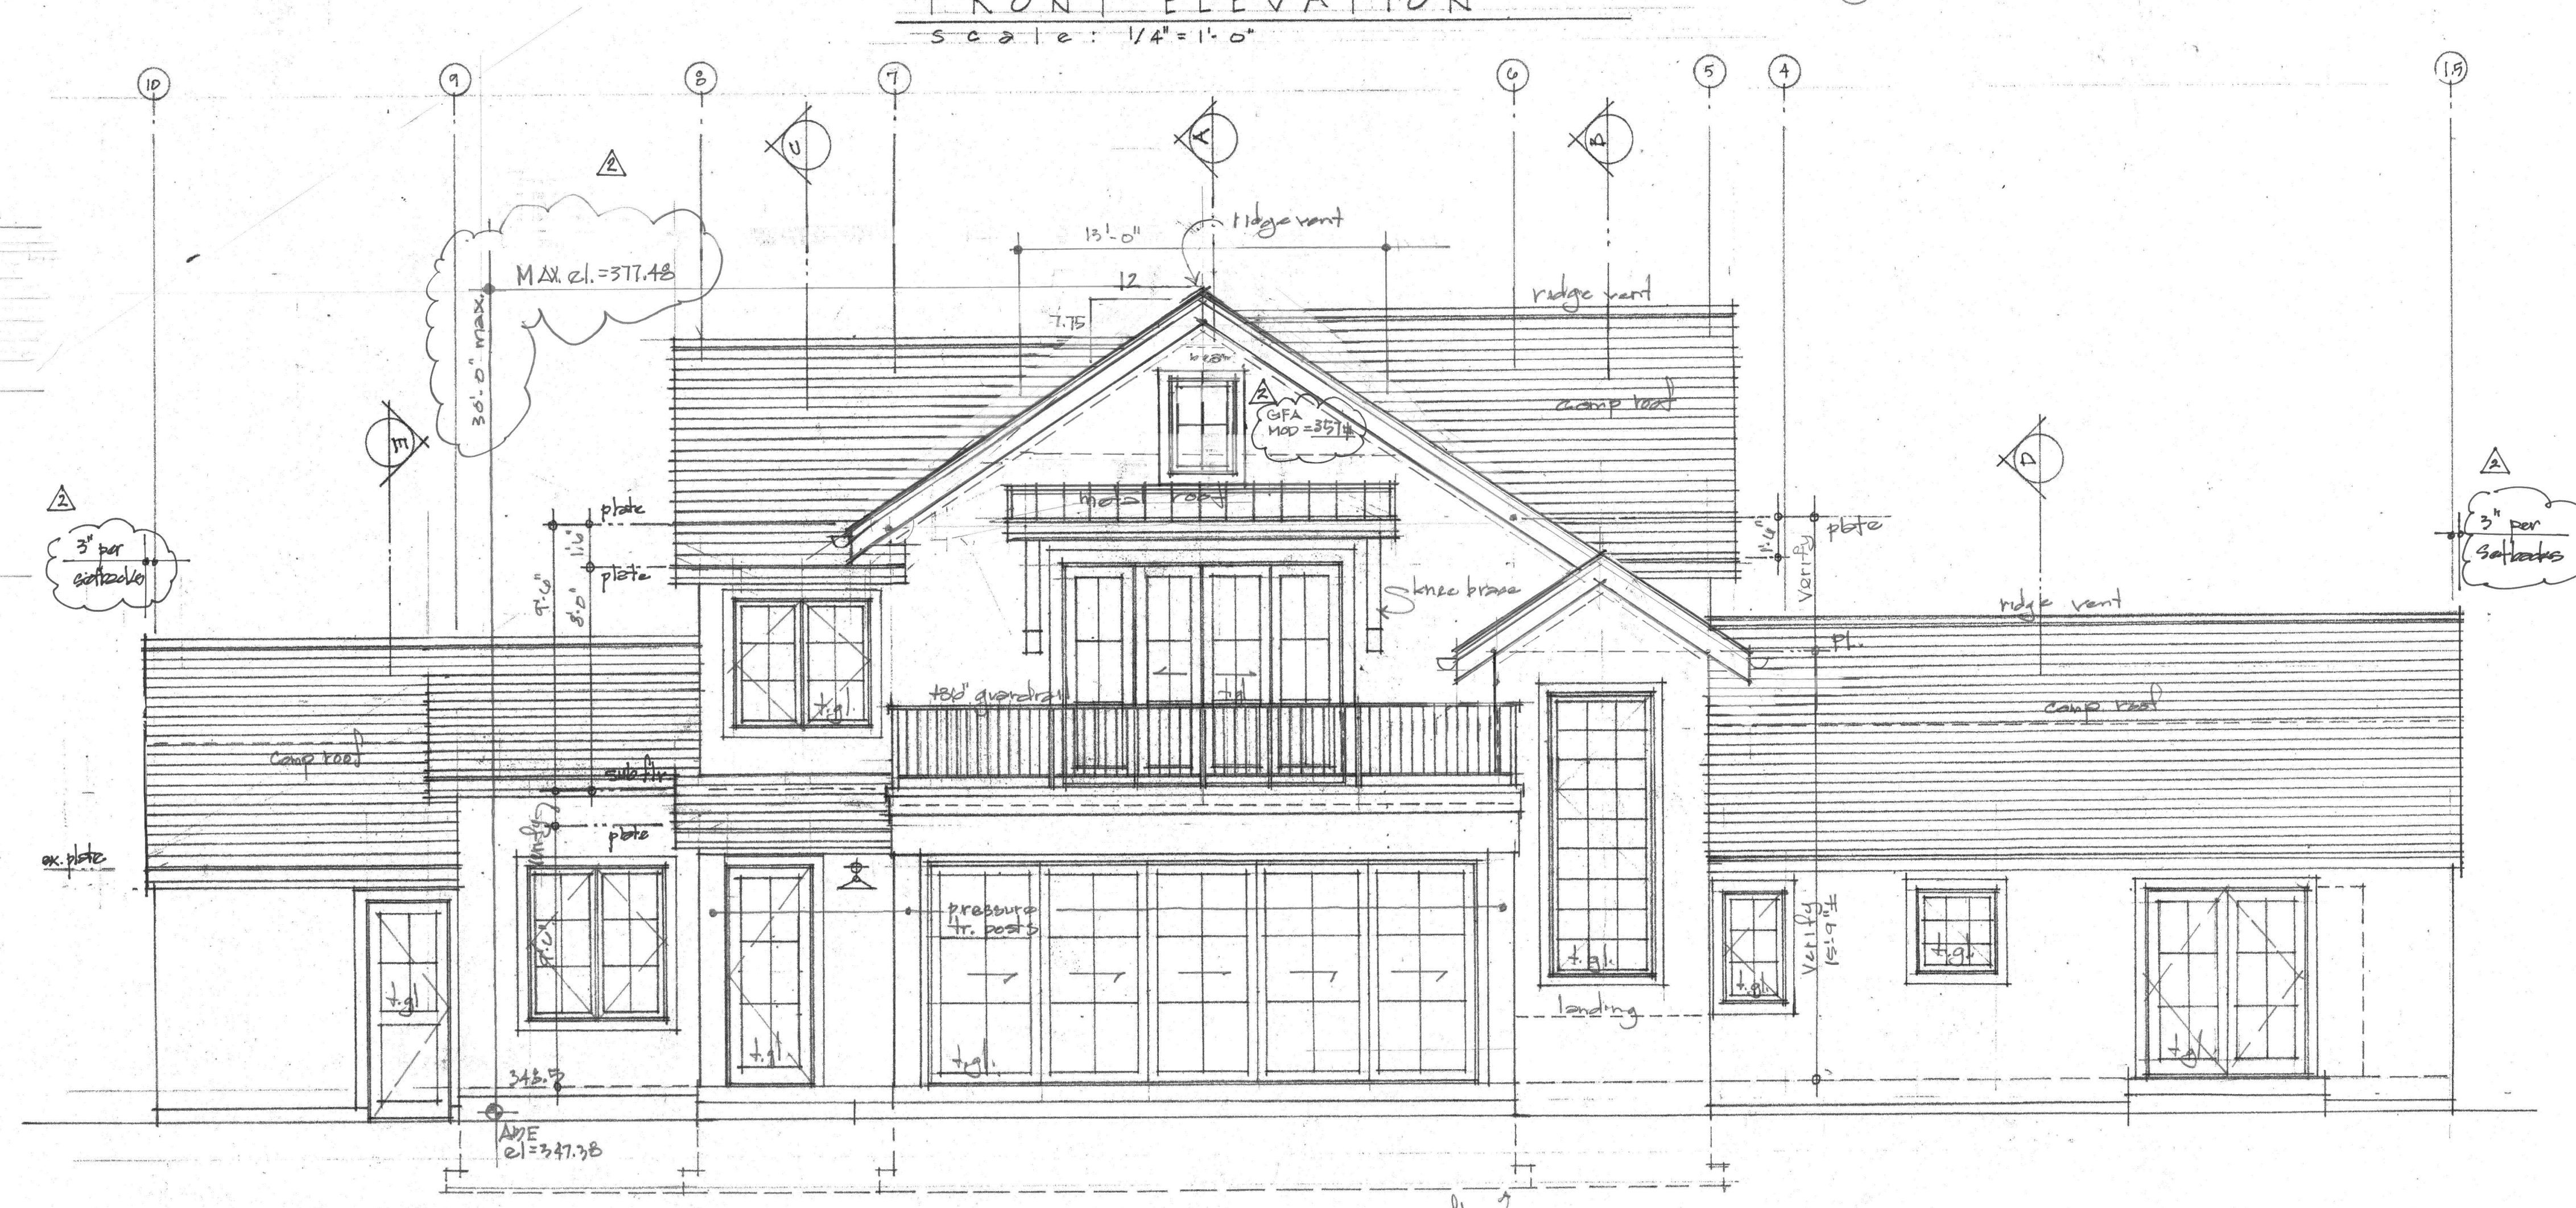


REAR ELEVATION
 scale: 1/4" = 1'-0"

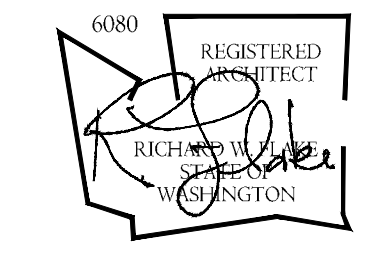


All drawings, specifications, plans, ideas, arrangements, and designs represented or referred to are the property of and owned by Richard Flake Architect in whether the project for which they are made is executed or not. They were created, evolved, developed and produced for sole use on and in connection with this project and none of the above may be disclosed or given to or used by any person, firm, or corporation for any use or purpose whatsoever including any other project, except upon written permission of Richard Flake Architect.
 Copyright 2023
 Richard Flake Architect

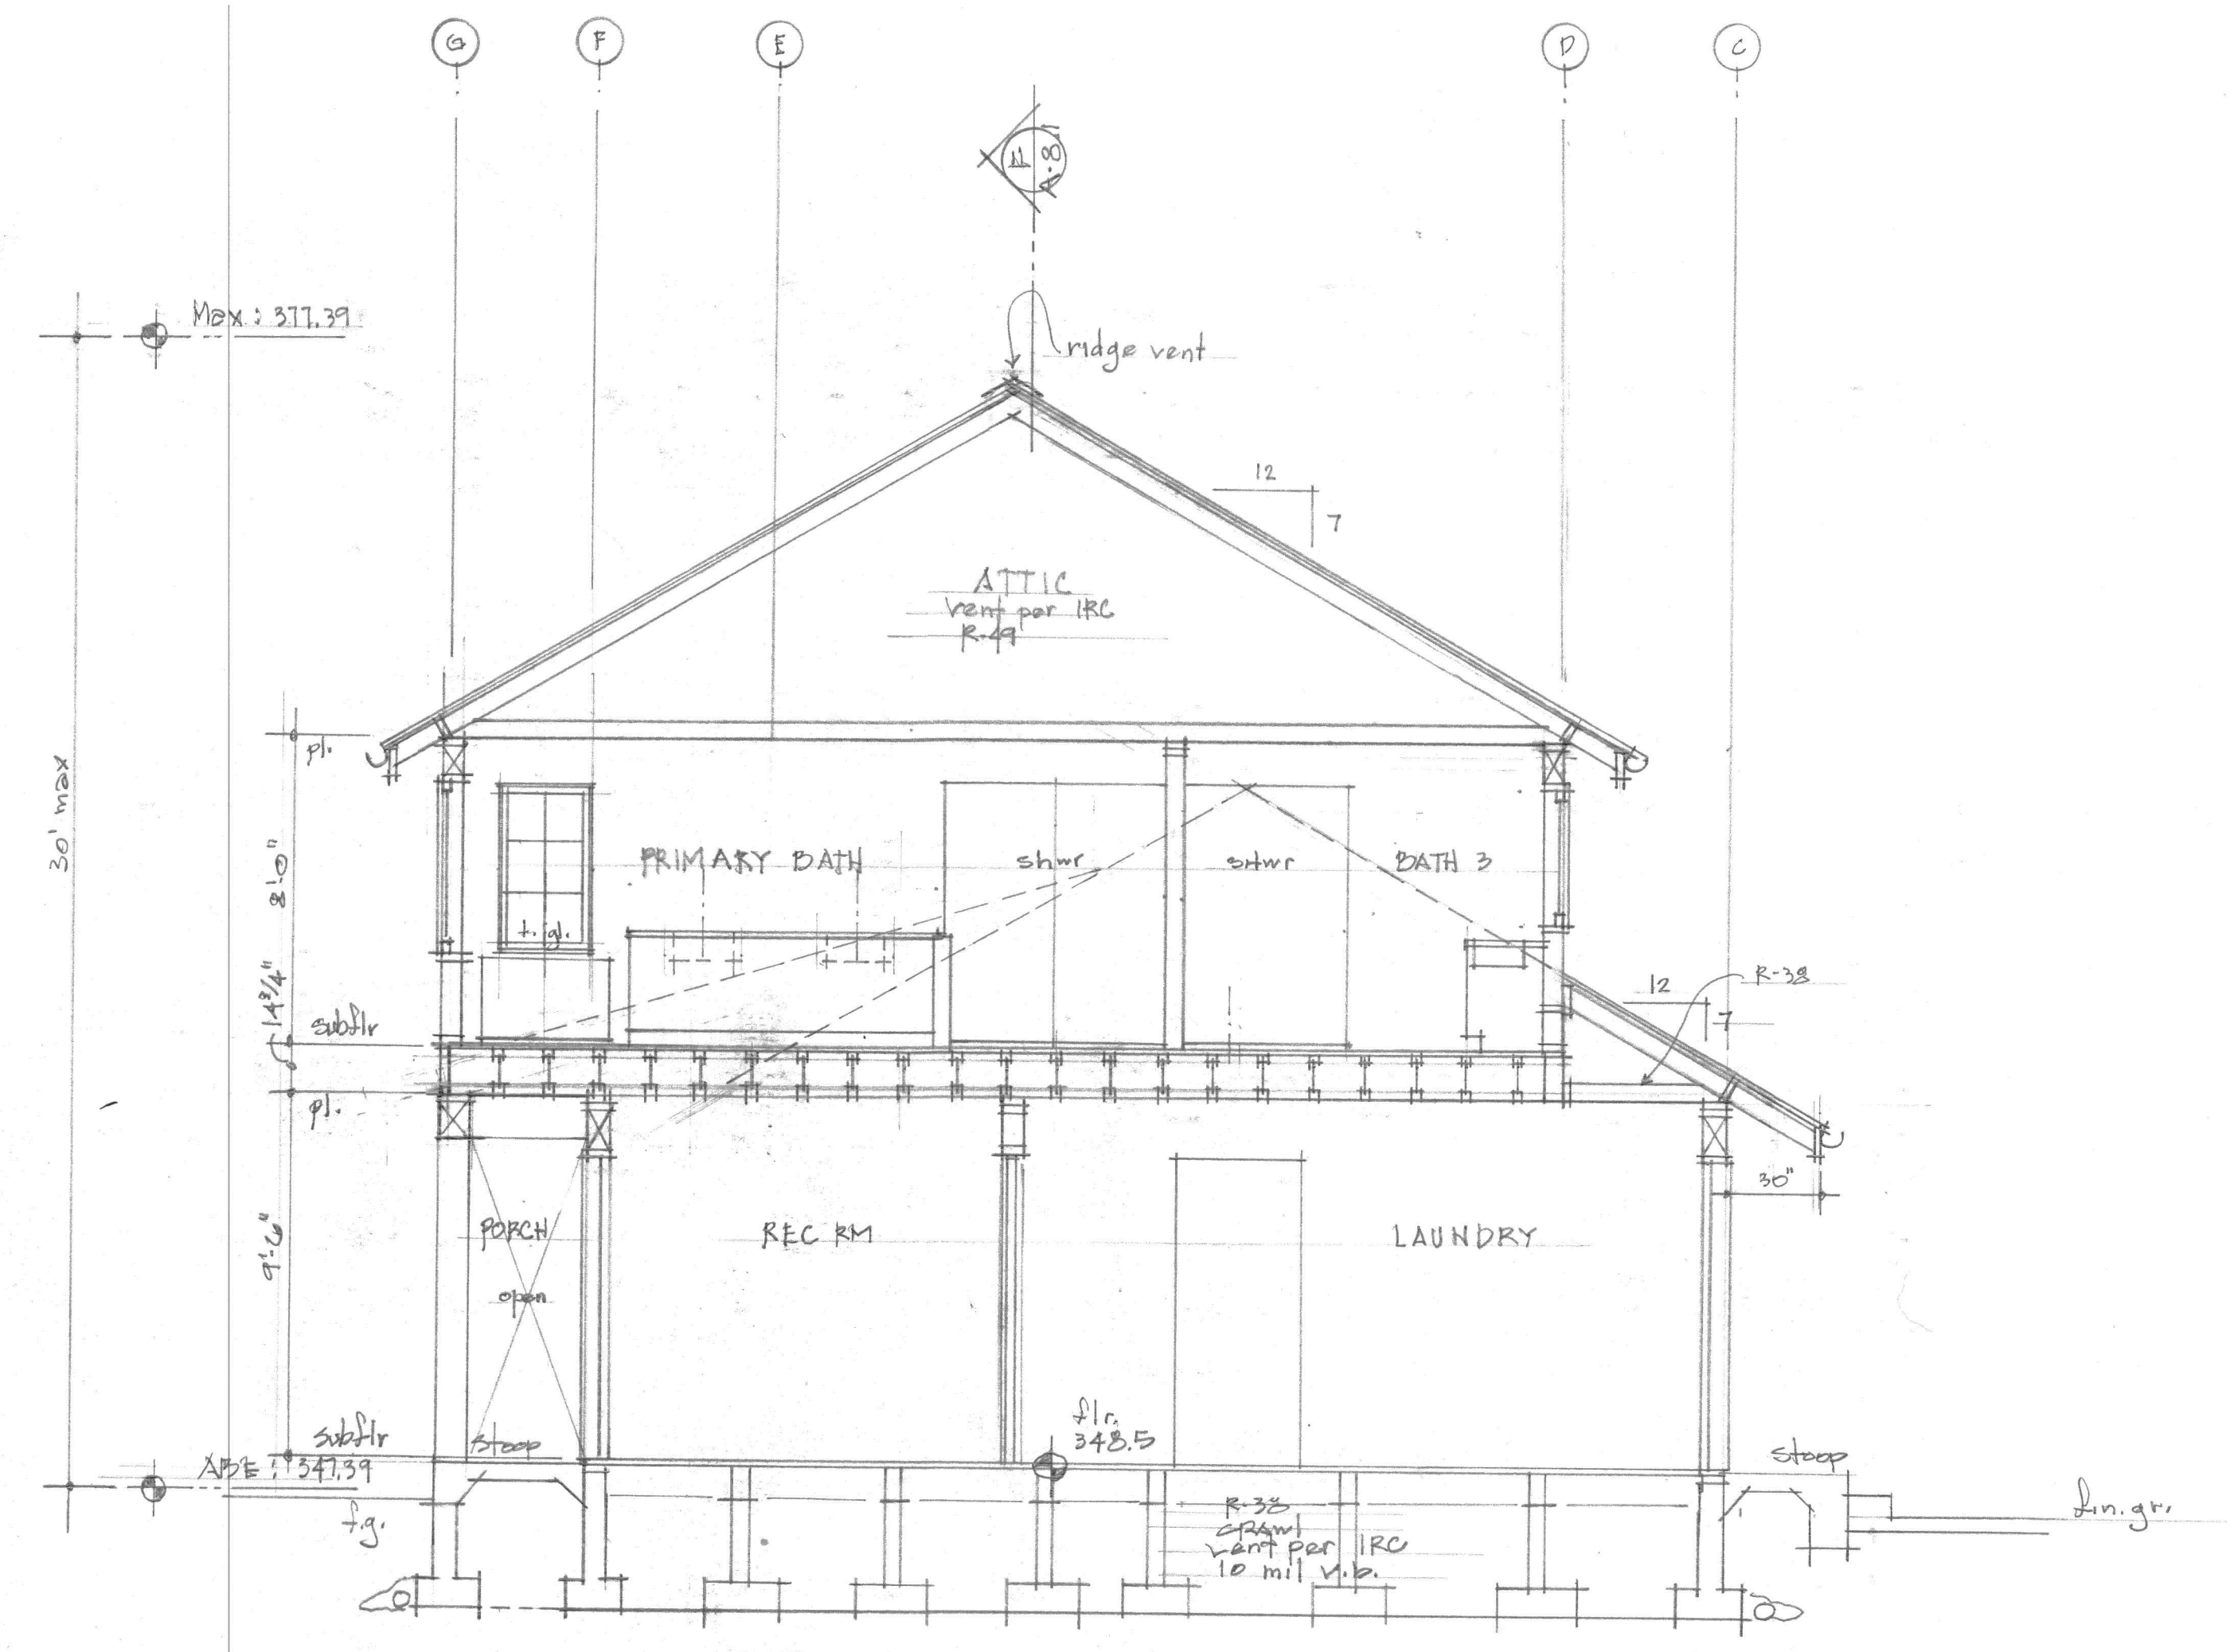

C BUILDING SECTION
 scale: 1/4" = 1'-0"

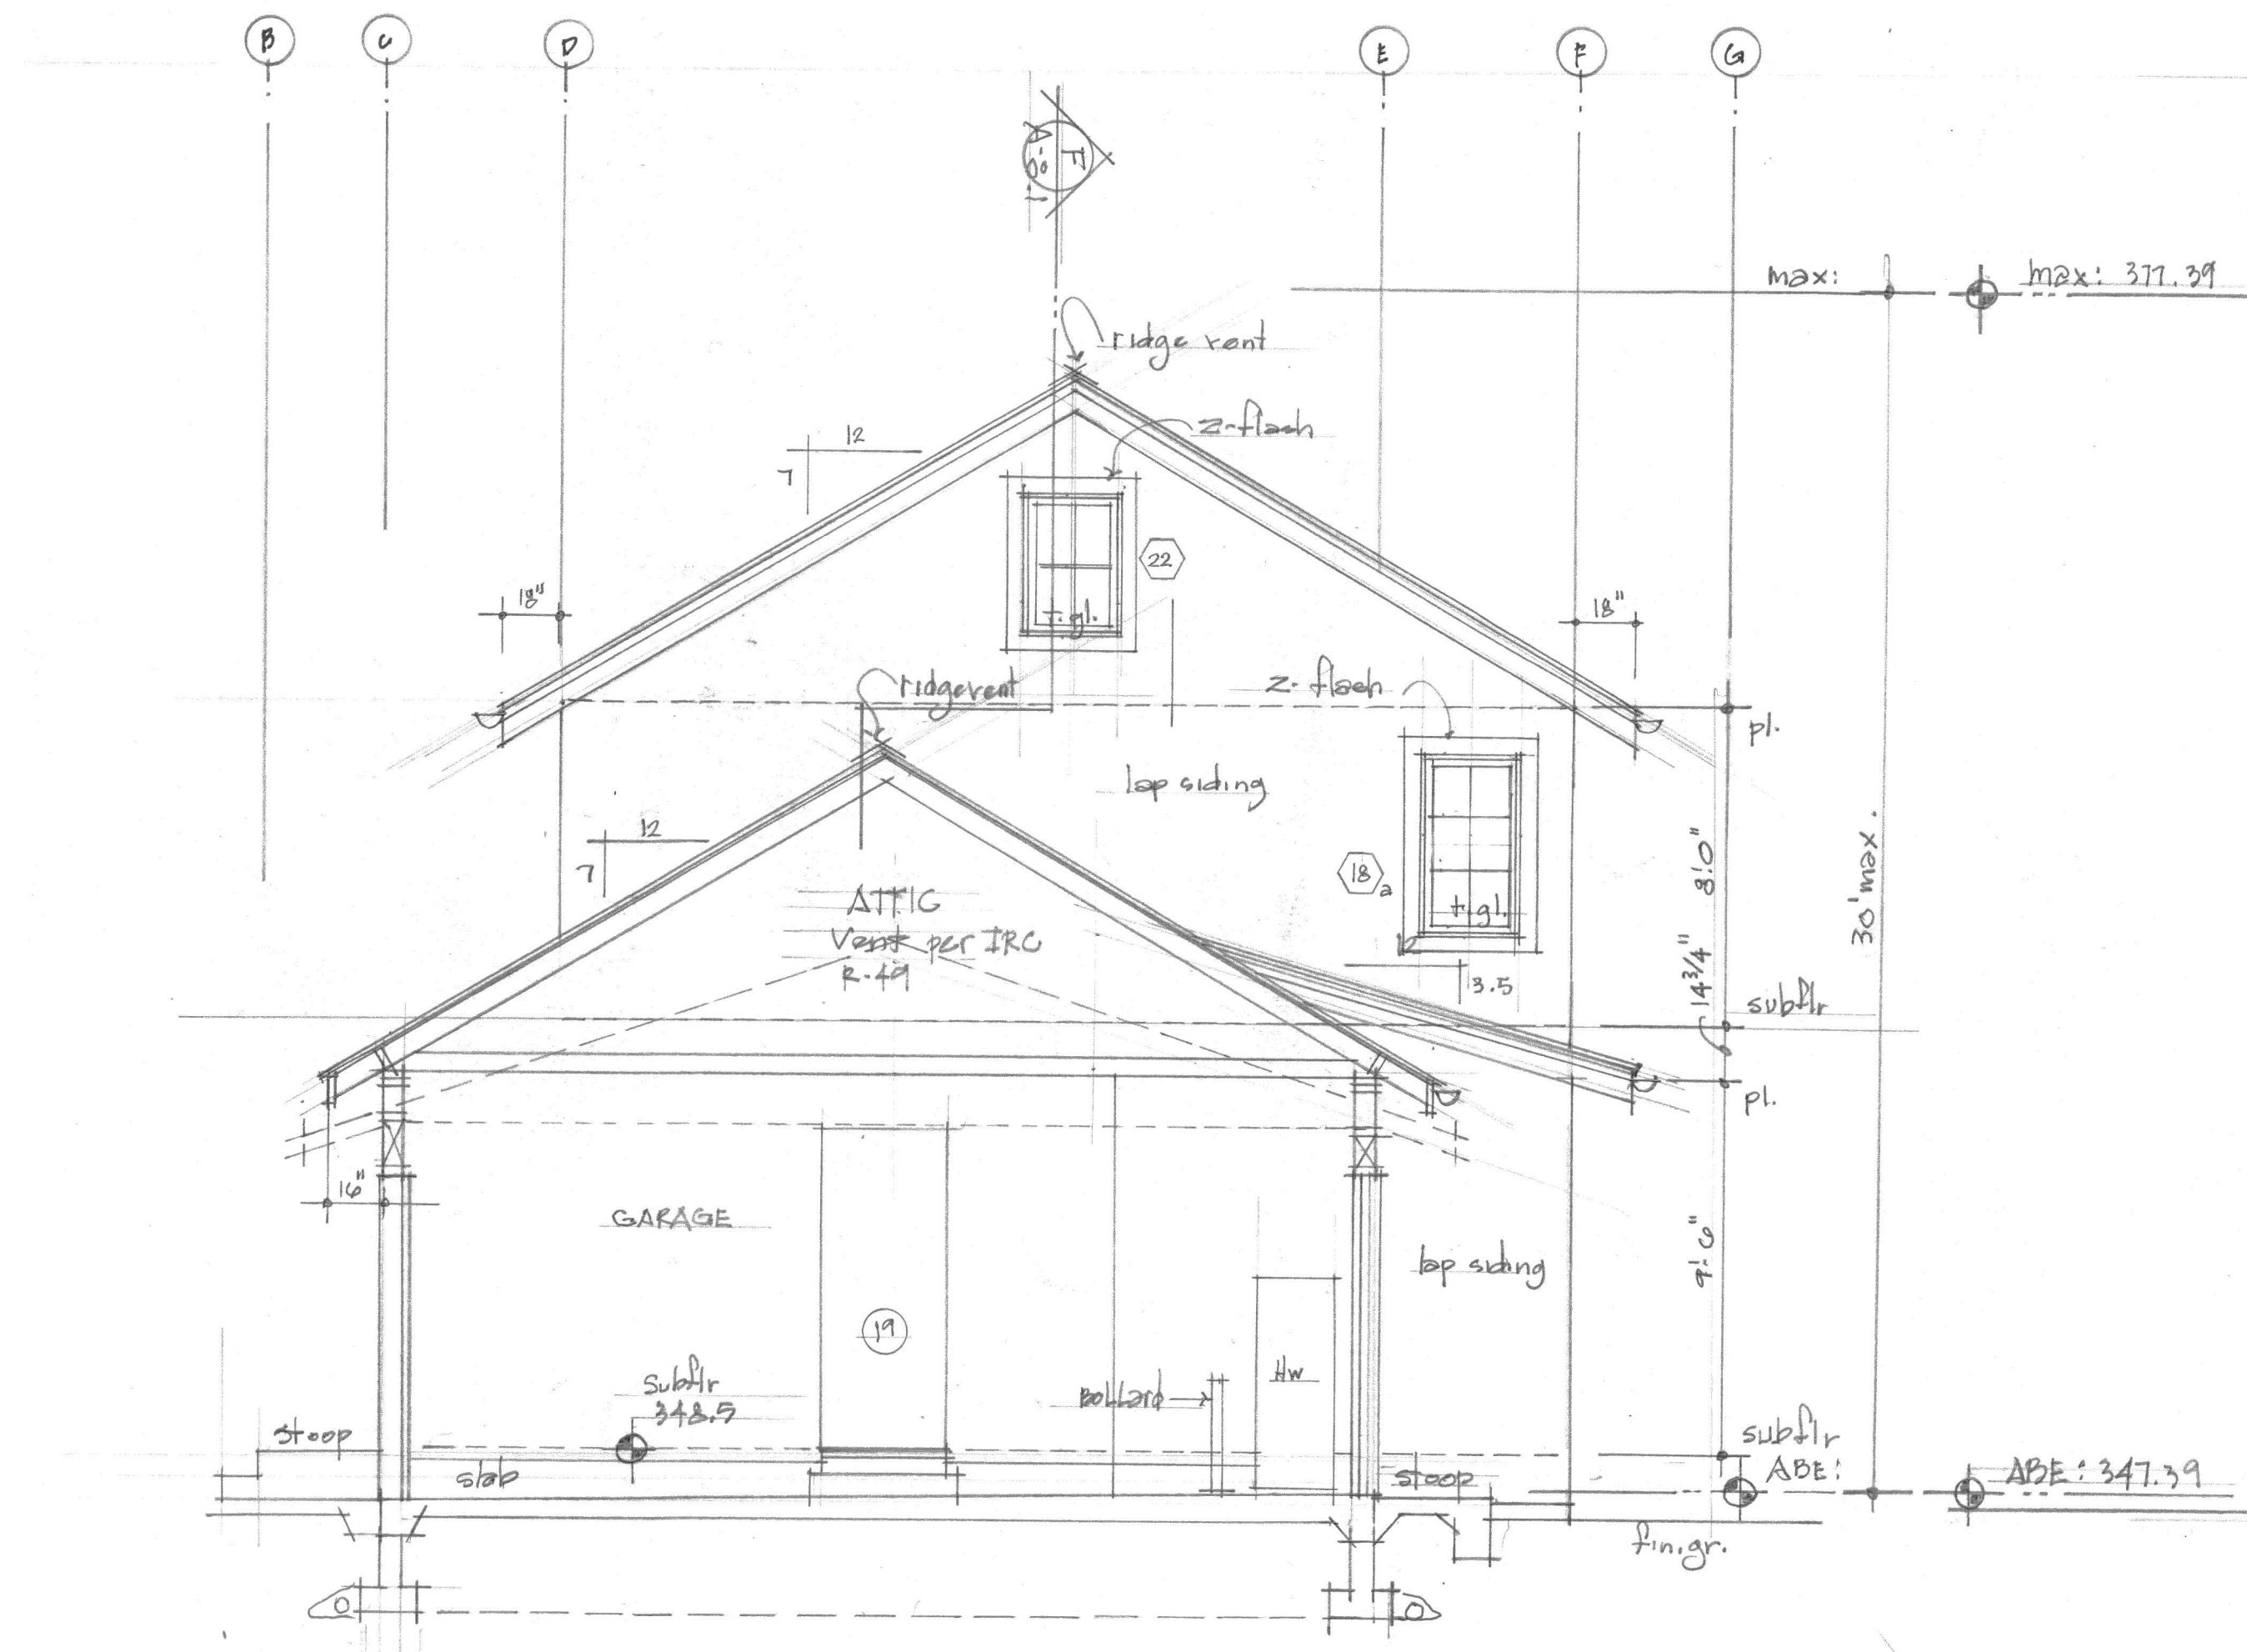

E BUILDING SECTION
 scale: 1/4" = 1'-0"

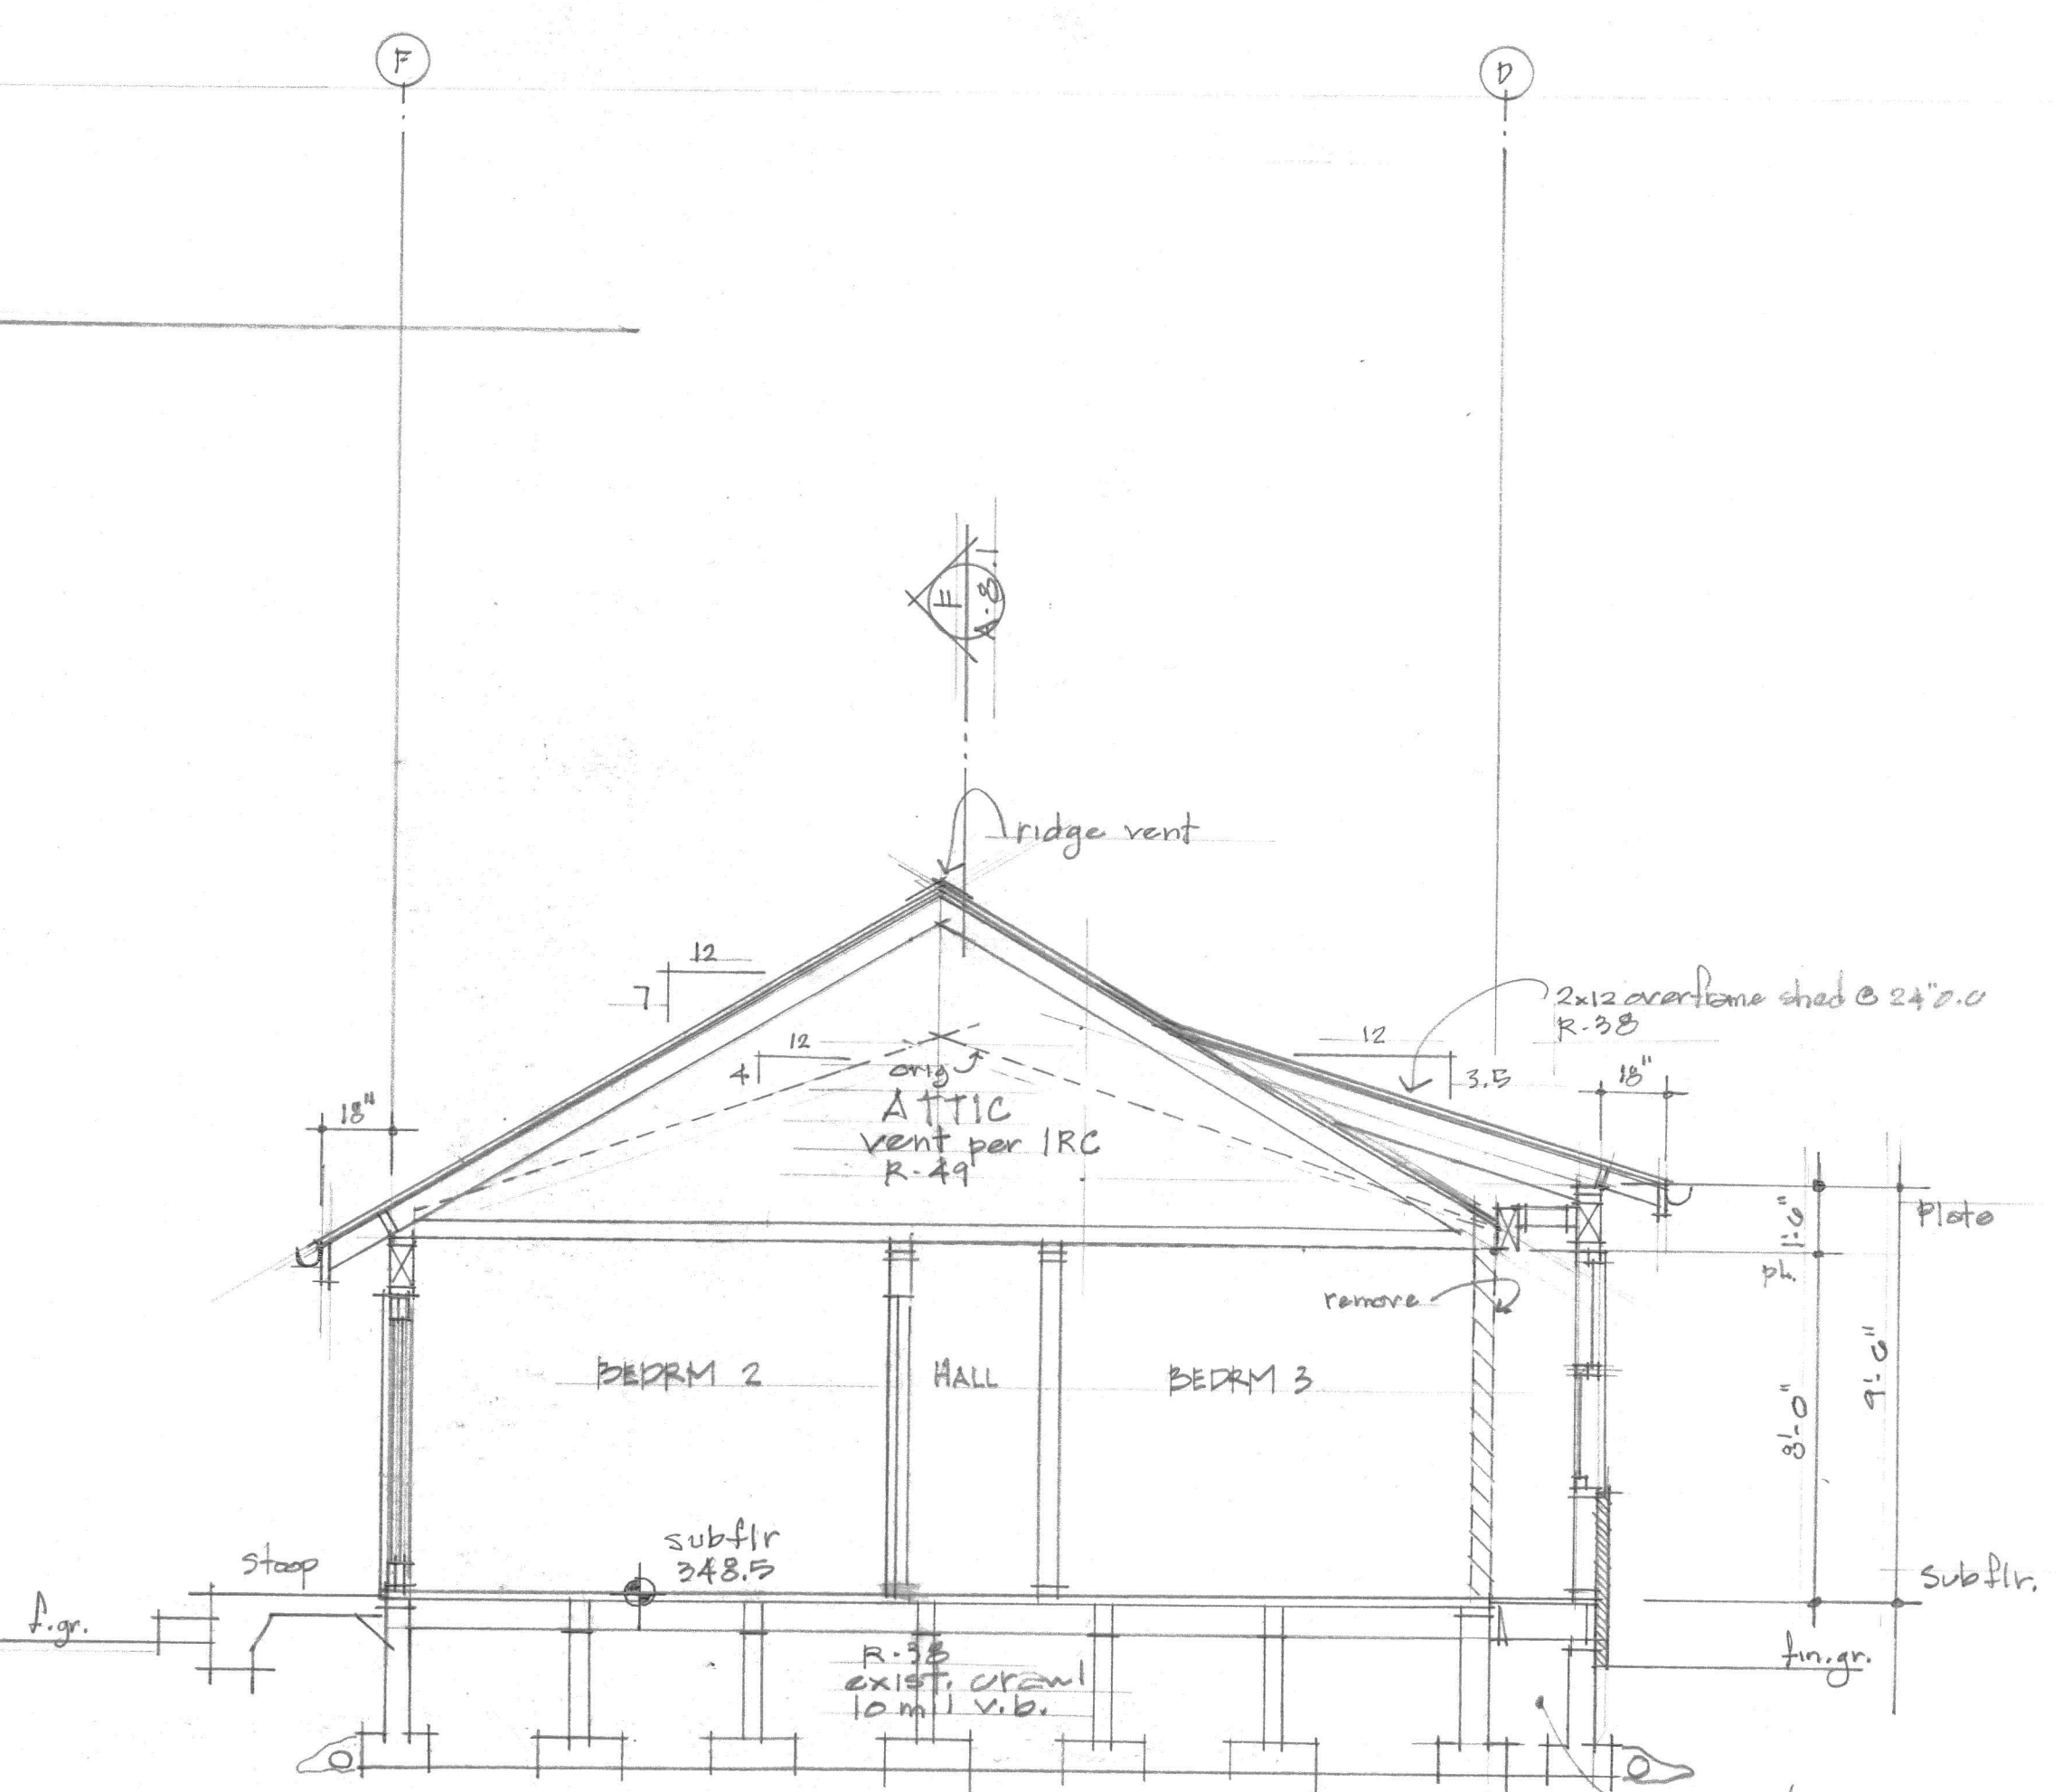

D BUILDING SECTION
 scale: 1/4" = 1'-0"


DESIGN: RWF

DRAWN:


CHECKED: RWF

REVISIONS:

CITY REVIEW	1.2.2023
CITY REVIEW	1.28.2024

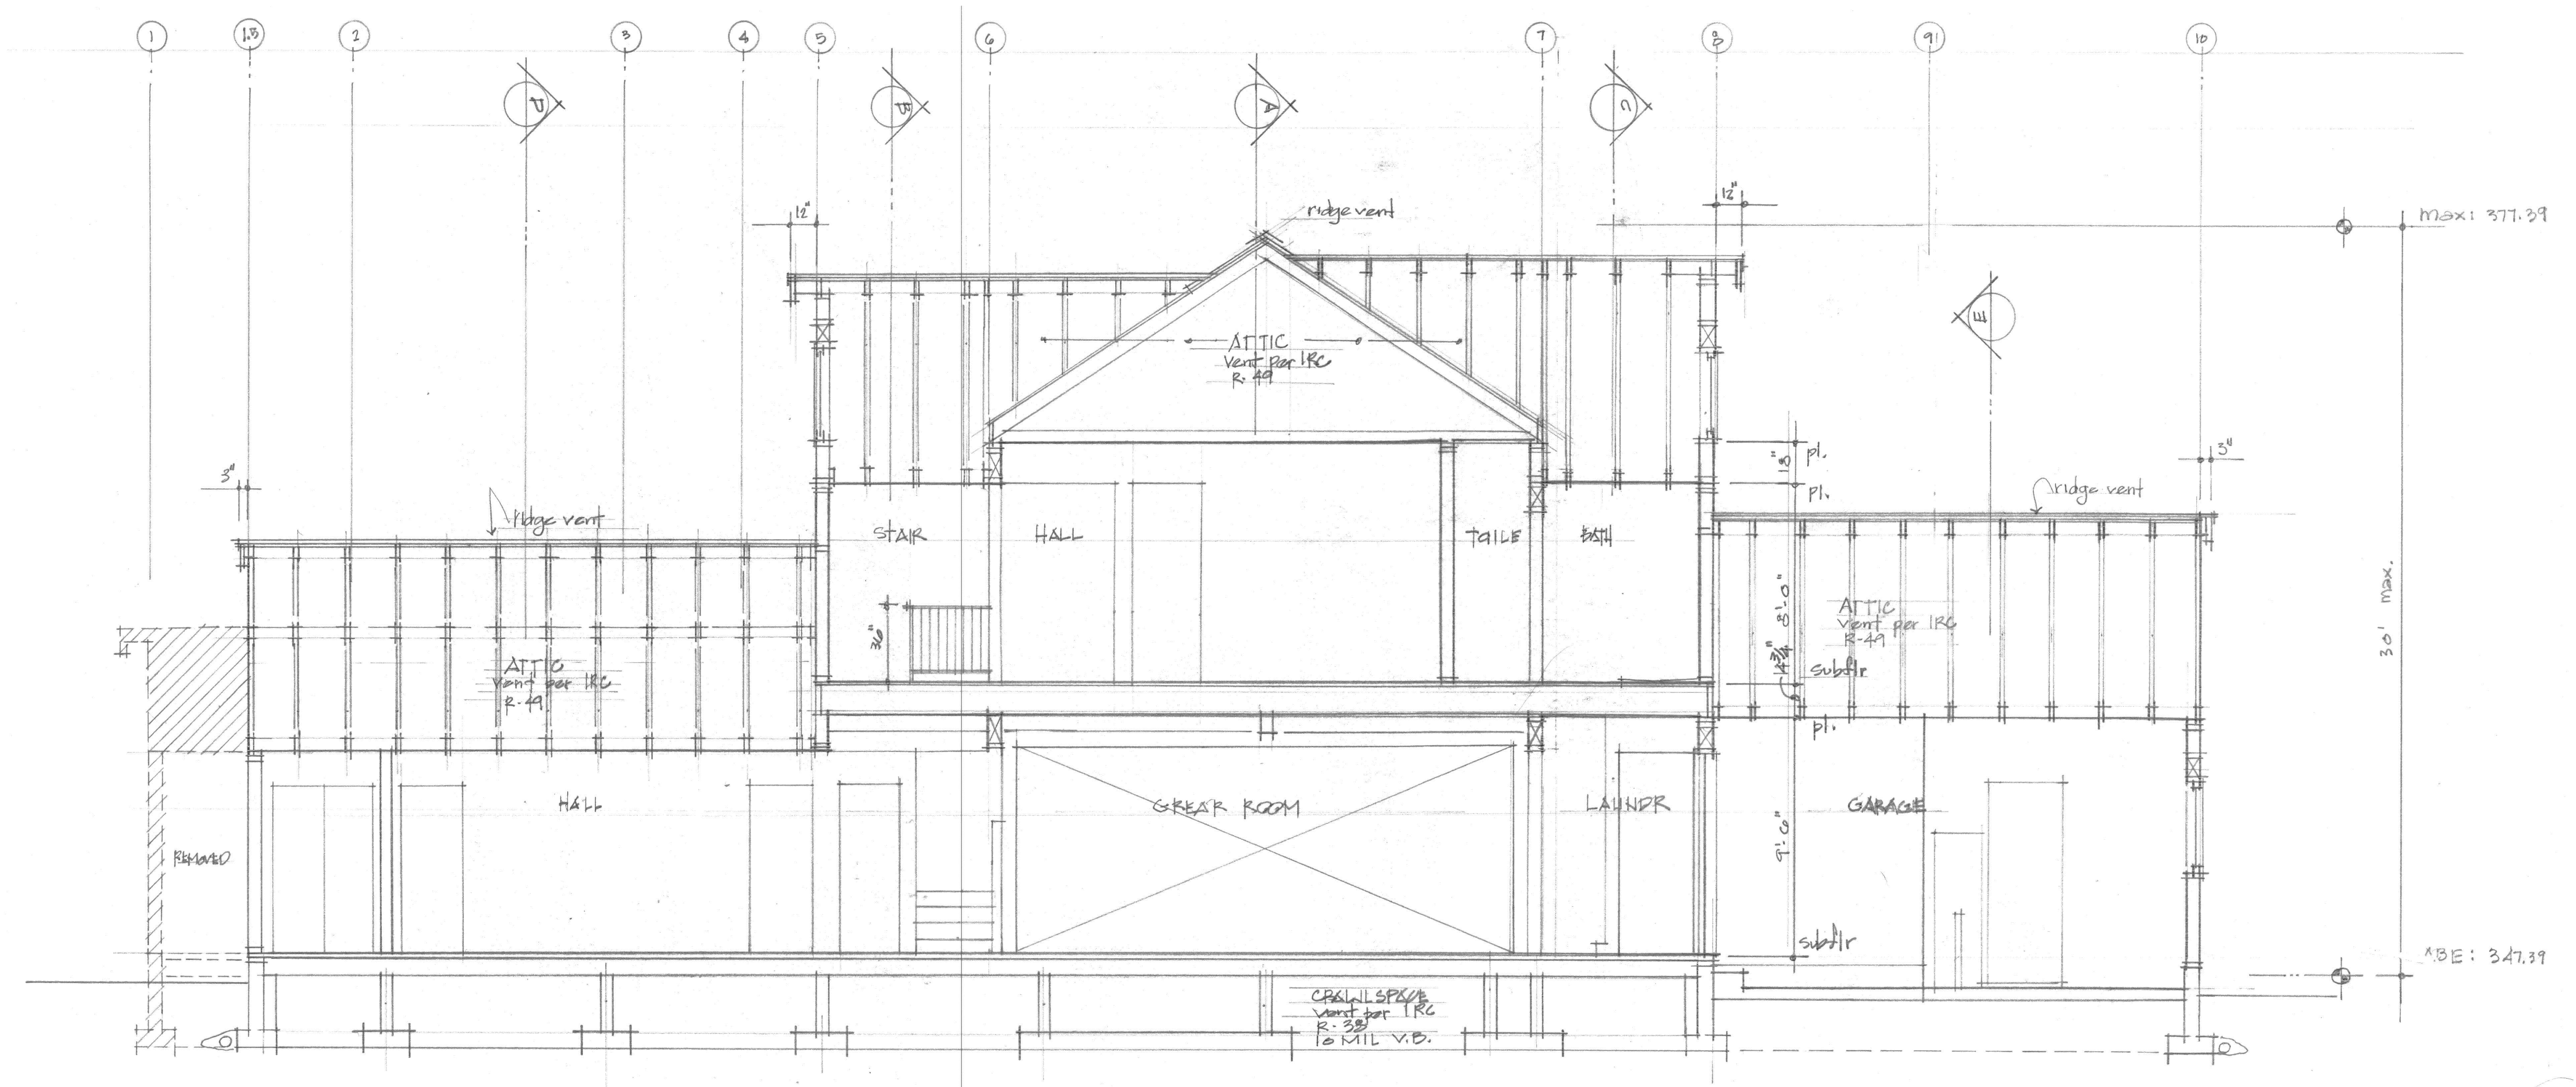

F BUILDING SECTION
 scale: 1/4" = 1'-0"

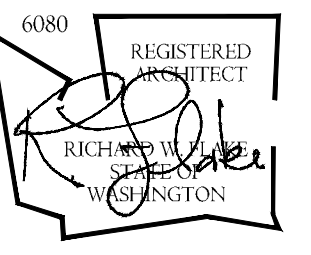

All drawings, specifications, plans, ideas, arrangements, and designs represented or referred to are the property of and owned by Richard Flake Architect in whether the project for which they are made is executed or not. They were created, evolved, developed and produced for sole use on and in connection with this project and none of the above may be disclosed or given to or used by any person, firm, or corporation for any use or purpose whatsoever including any other project, except upon written permission of Richard Flake Architect.
 Copyright 2023
 Richard Flake Architect

DESIGN:
 RWF




DRAWN:
 RWF

CHECKED:
 RWF

REVISIONS:

CITY REVIEW
 1-2-2023

CITY REVIEW
 1-28-2024

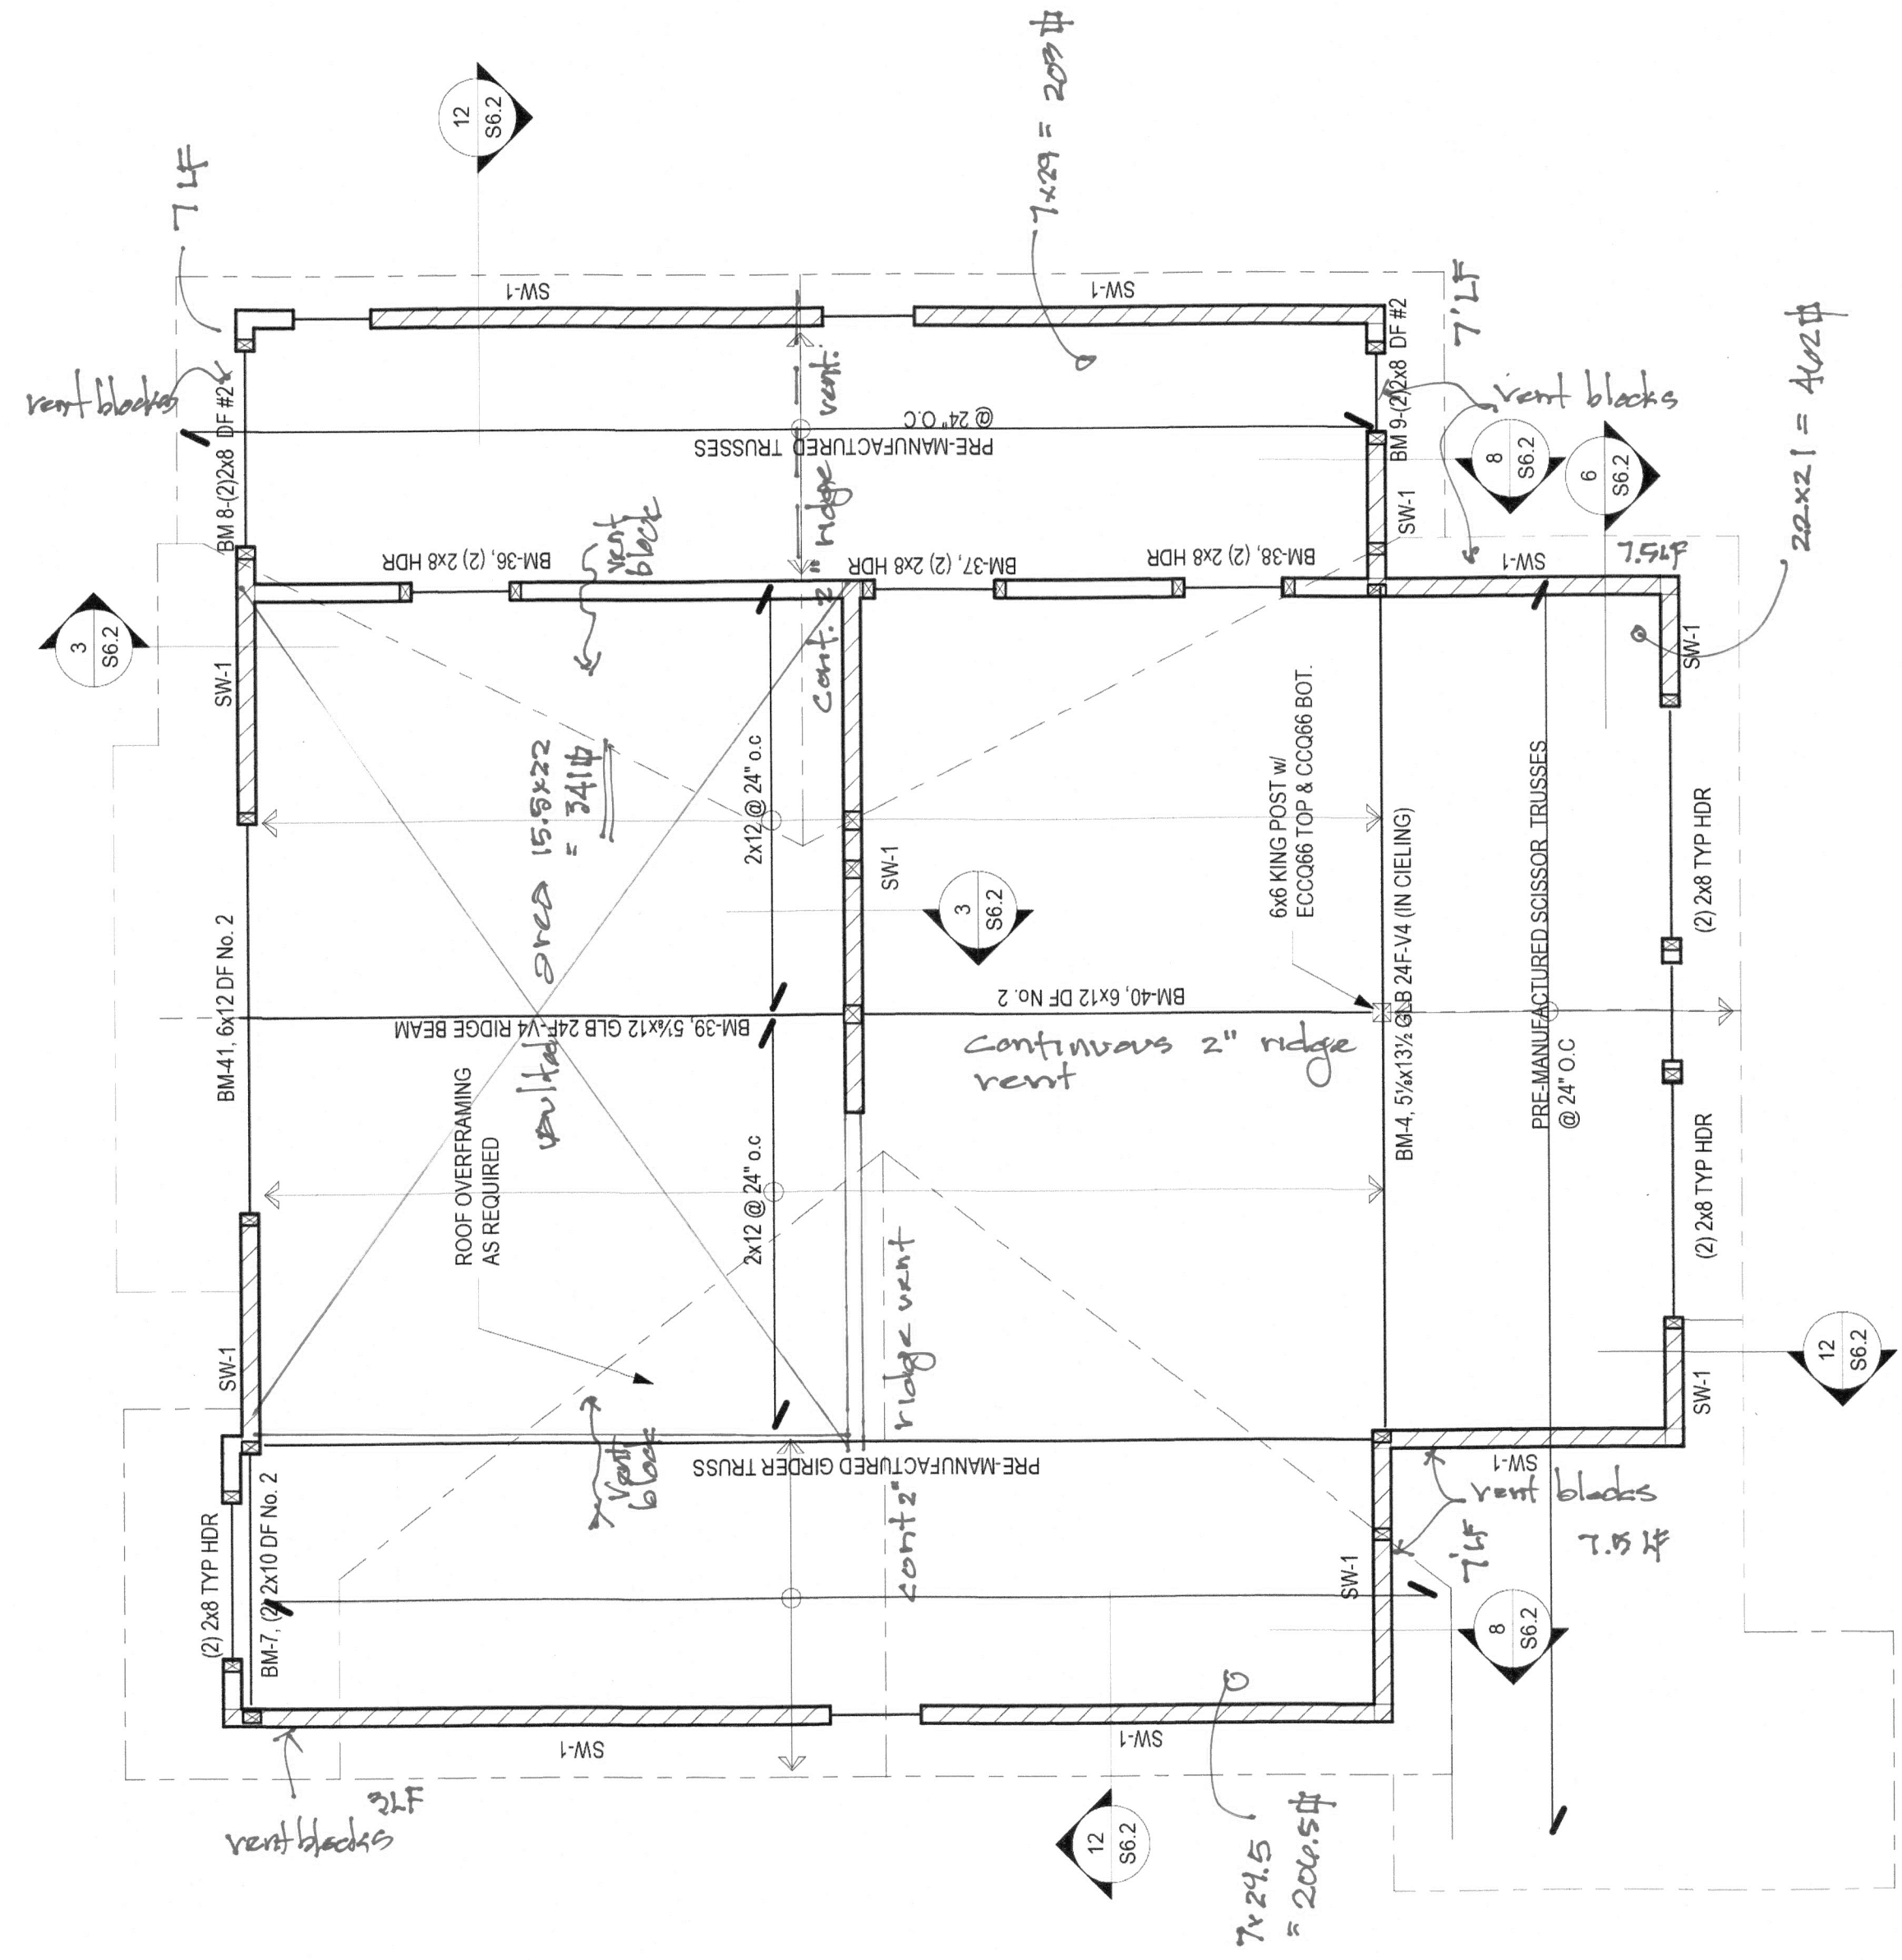


ROOF FRAMING PLAN
SCALE: 1/4"=1'-0"


ATTIC VENTILATION CALC @ UPPER ROOF

205
 + 462
 + 206.5
 + 341

 1213 # gross area
 $1213 \times 150 / \text{sf vent area} = 8.09 \# \text{ net}$
 4.05 # @ eaves
 4.05 # @ ridges
 Eaves: $4.05 \# \times 144 = 582 \text{ sq. in.}$
 Ridge: $50 \text{ LF} \times 12 = 600 \text{ in} \times 2"$
 $= 1200 \text{ sq. in.} \times .75 \text{ eff} = 900 \text{ sq. in.} > 582 \text{ sq. in. reqd}$

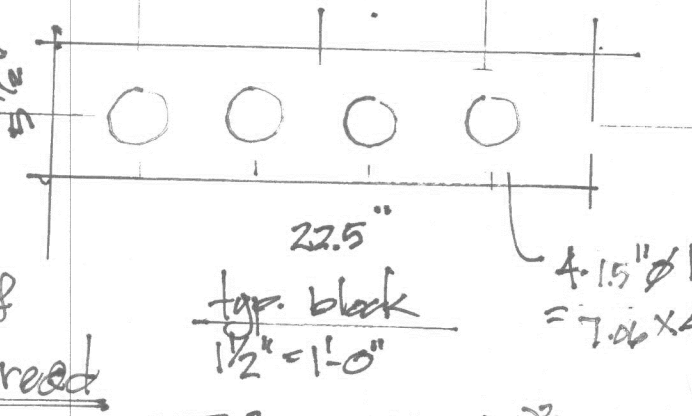


$39 \text{ blocks} \times 28.26 \text{ sq. in.} = 1102 \text{ sq. in.} > 582 \text{ sq. in. reqd}$
 area: $\pi r^2 = 3.14 \times (.5)^2 = 7.85 \text{ sq. in. hole}$

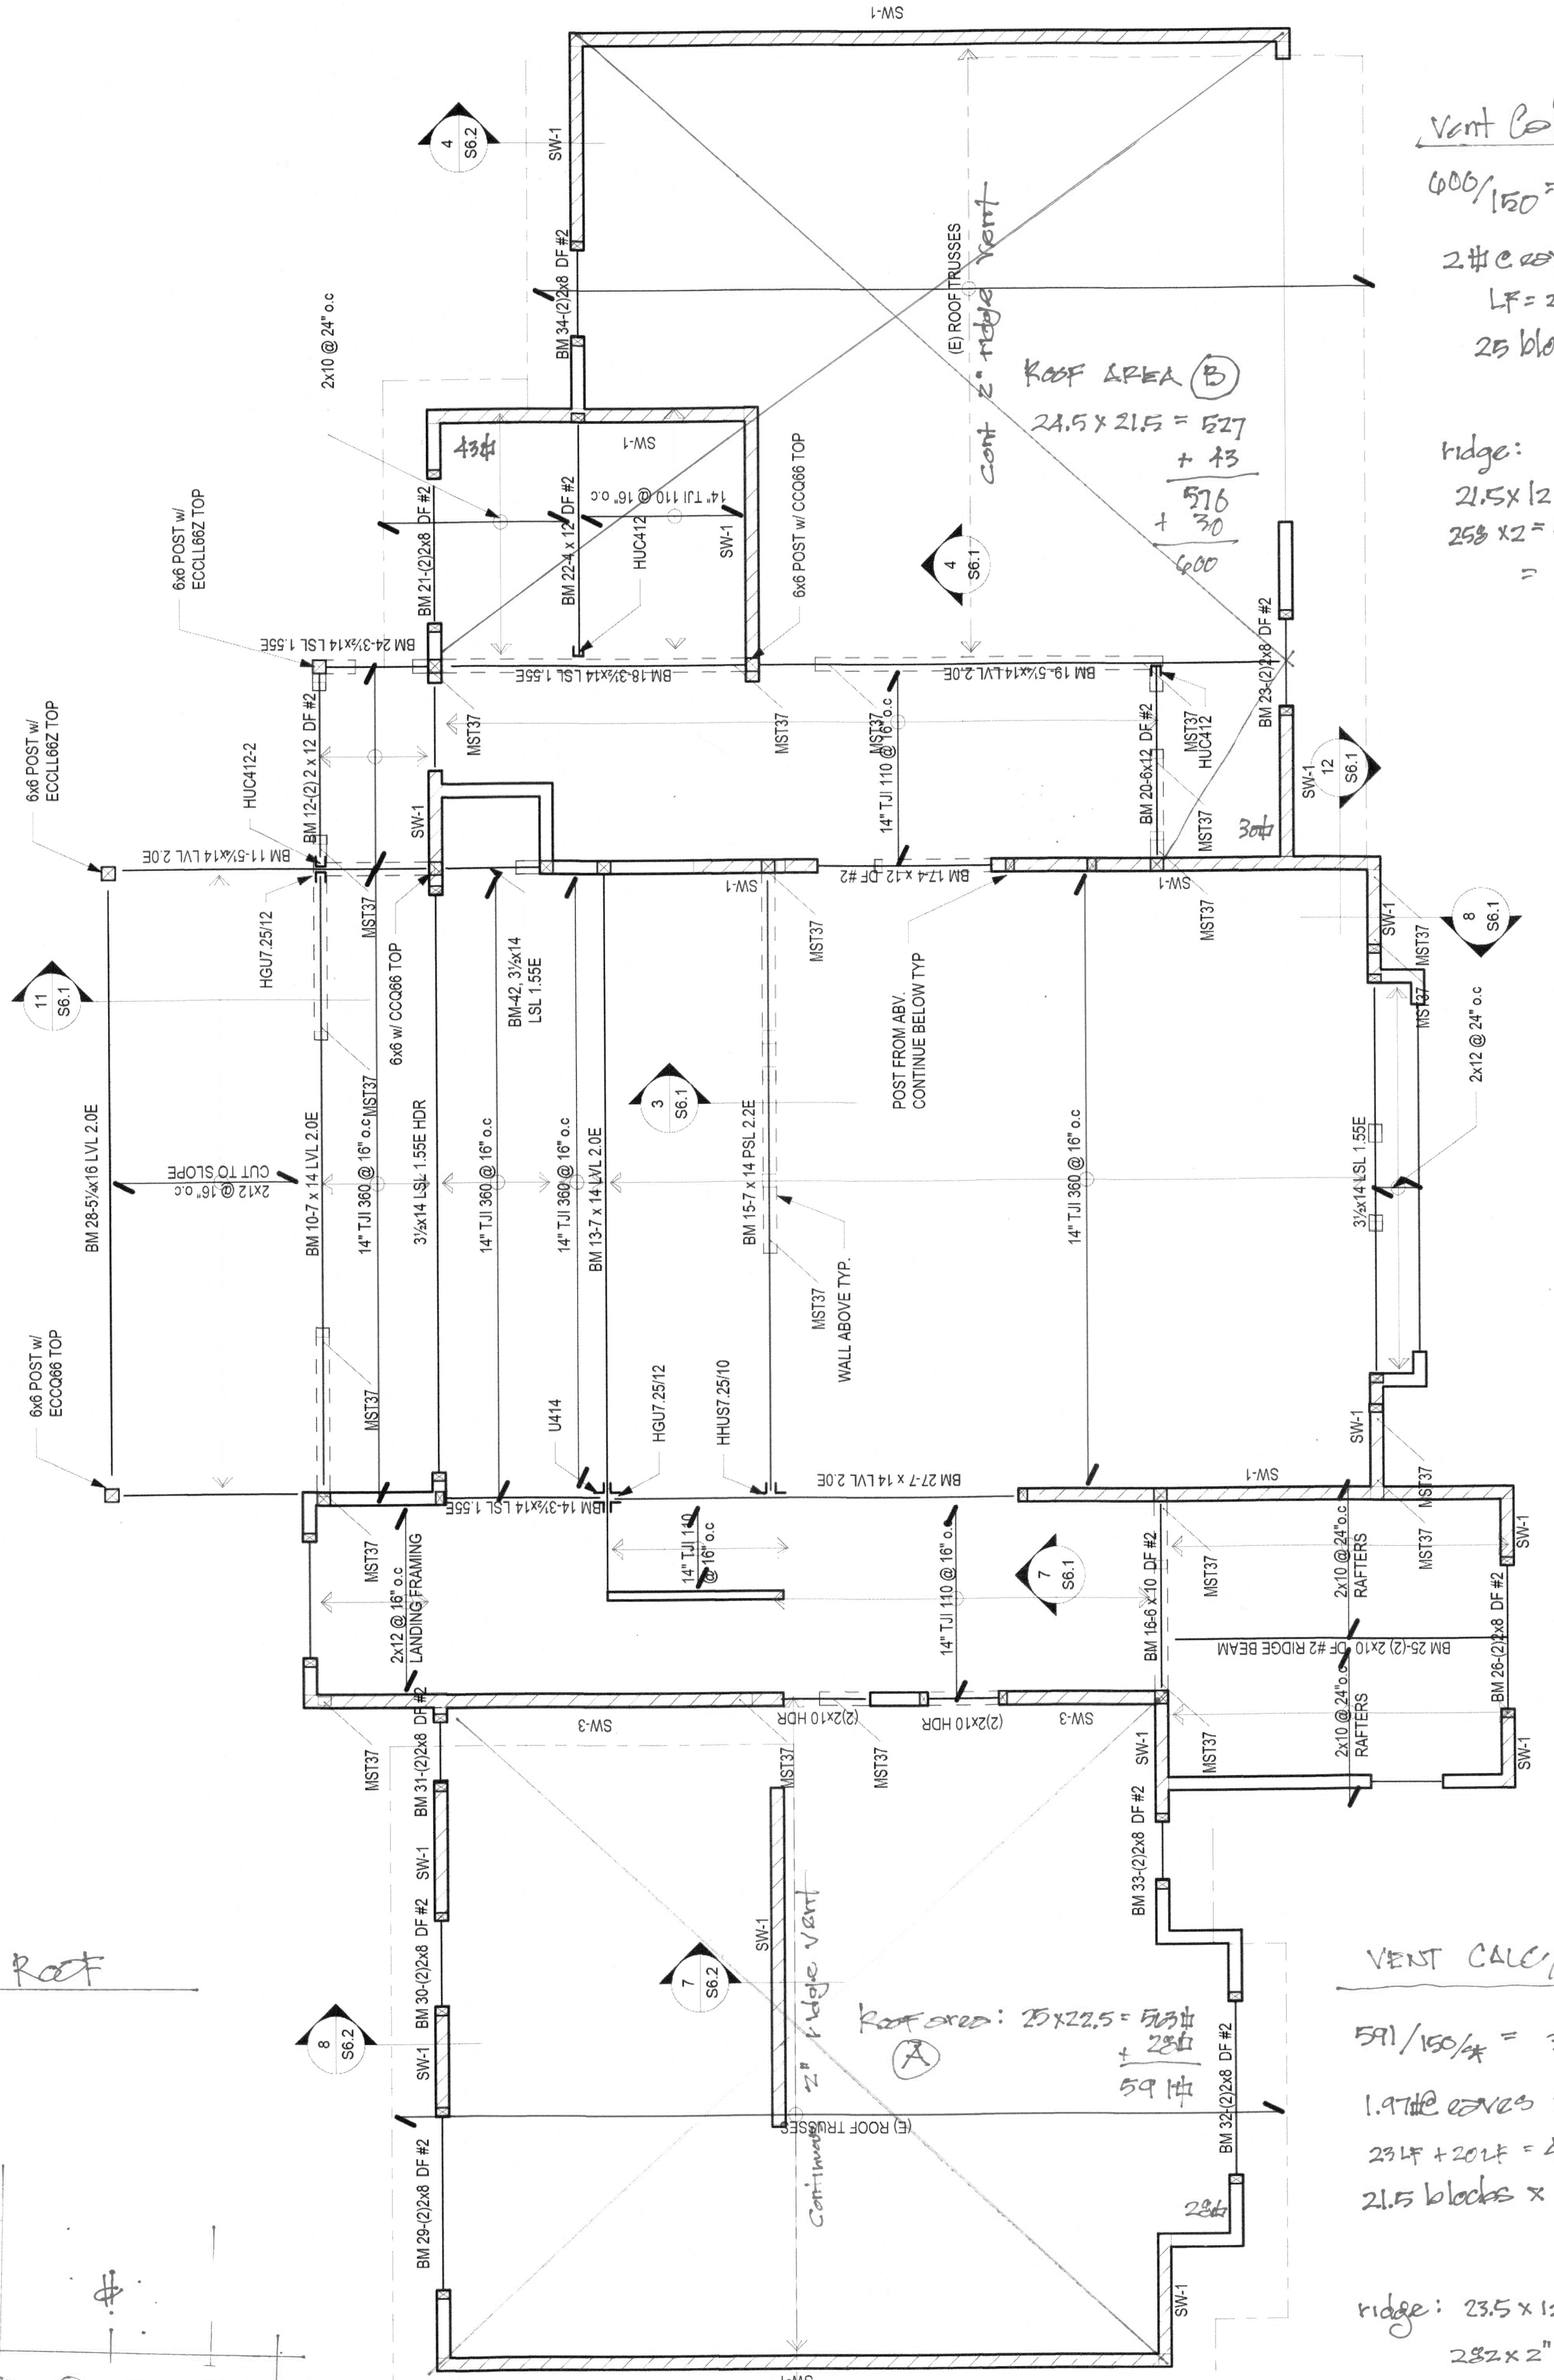

UPPER FLOOR FRAMING PLAN
SCALE: 1/4"=1'-0"


Vent Calc / AREA 'B'
 $600 / 150 = 4 \# \text{ reqd}$
 $2 \# \text{ eaves} \times 144 = 288 \text{ sq. in.}$
 $\text{LF} = 21.5 + 28.5 = 50 \text{ LF eave}$
 $25 \text{ blocks} \times 28.26 / \text{block} = 706 \text{ sq. in. reqd}$
 $= 529 > 288 \text{ ok}$
Ridge:
 $21.5 \times 12 = 258$
 $258 \times 2 = 516 \times .75$
 $= 387 > 288 \text{ ok}$

VENT CALC / AREA 'A'
 $591 / 150 \# = 3.94 \# \text{ reqd}$
 $1.9 \# \text{ eaves} \times 144 = 274 \text{ sq. in. reqd}$
 $23 \text{ LF} + 20 \text{ LF} = 43 \text{ LF eave}$
 $21.5 \text{ blocks} \times 28.26 / \text{block} = 601.6 \text{ sq. in. reqd}$
 $= 450 \text{ sq. in.} > 284 \text{ sq. in. ok}$
Ridge: $23.5 \times 12 = 282 \text{ in.}$
 $282 \times 2 = 564 \text{ sq. in.} \times .75 = 423 \text{ sq. in.}$
 $> 284 \text{ sq. in. ok}$

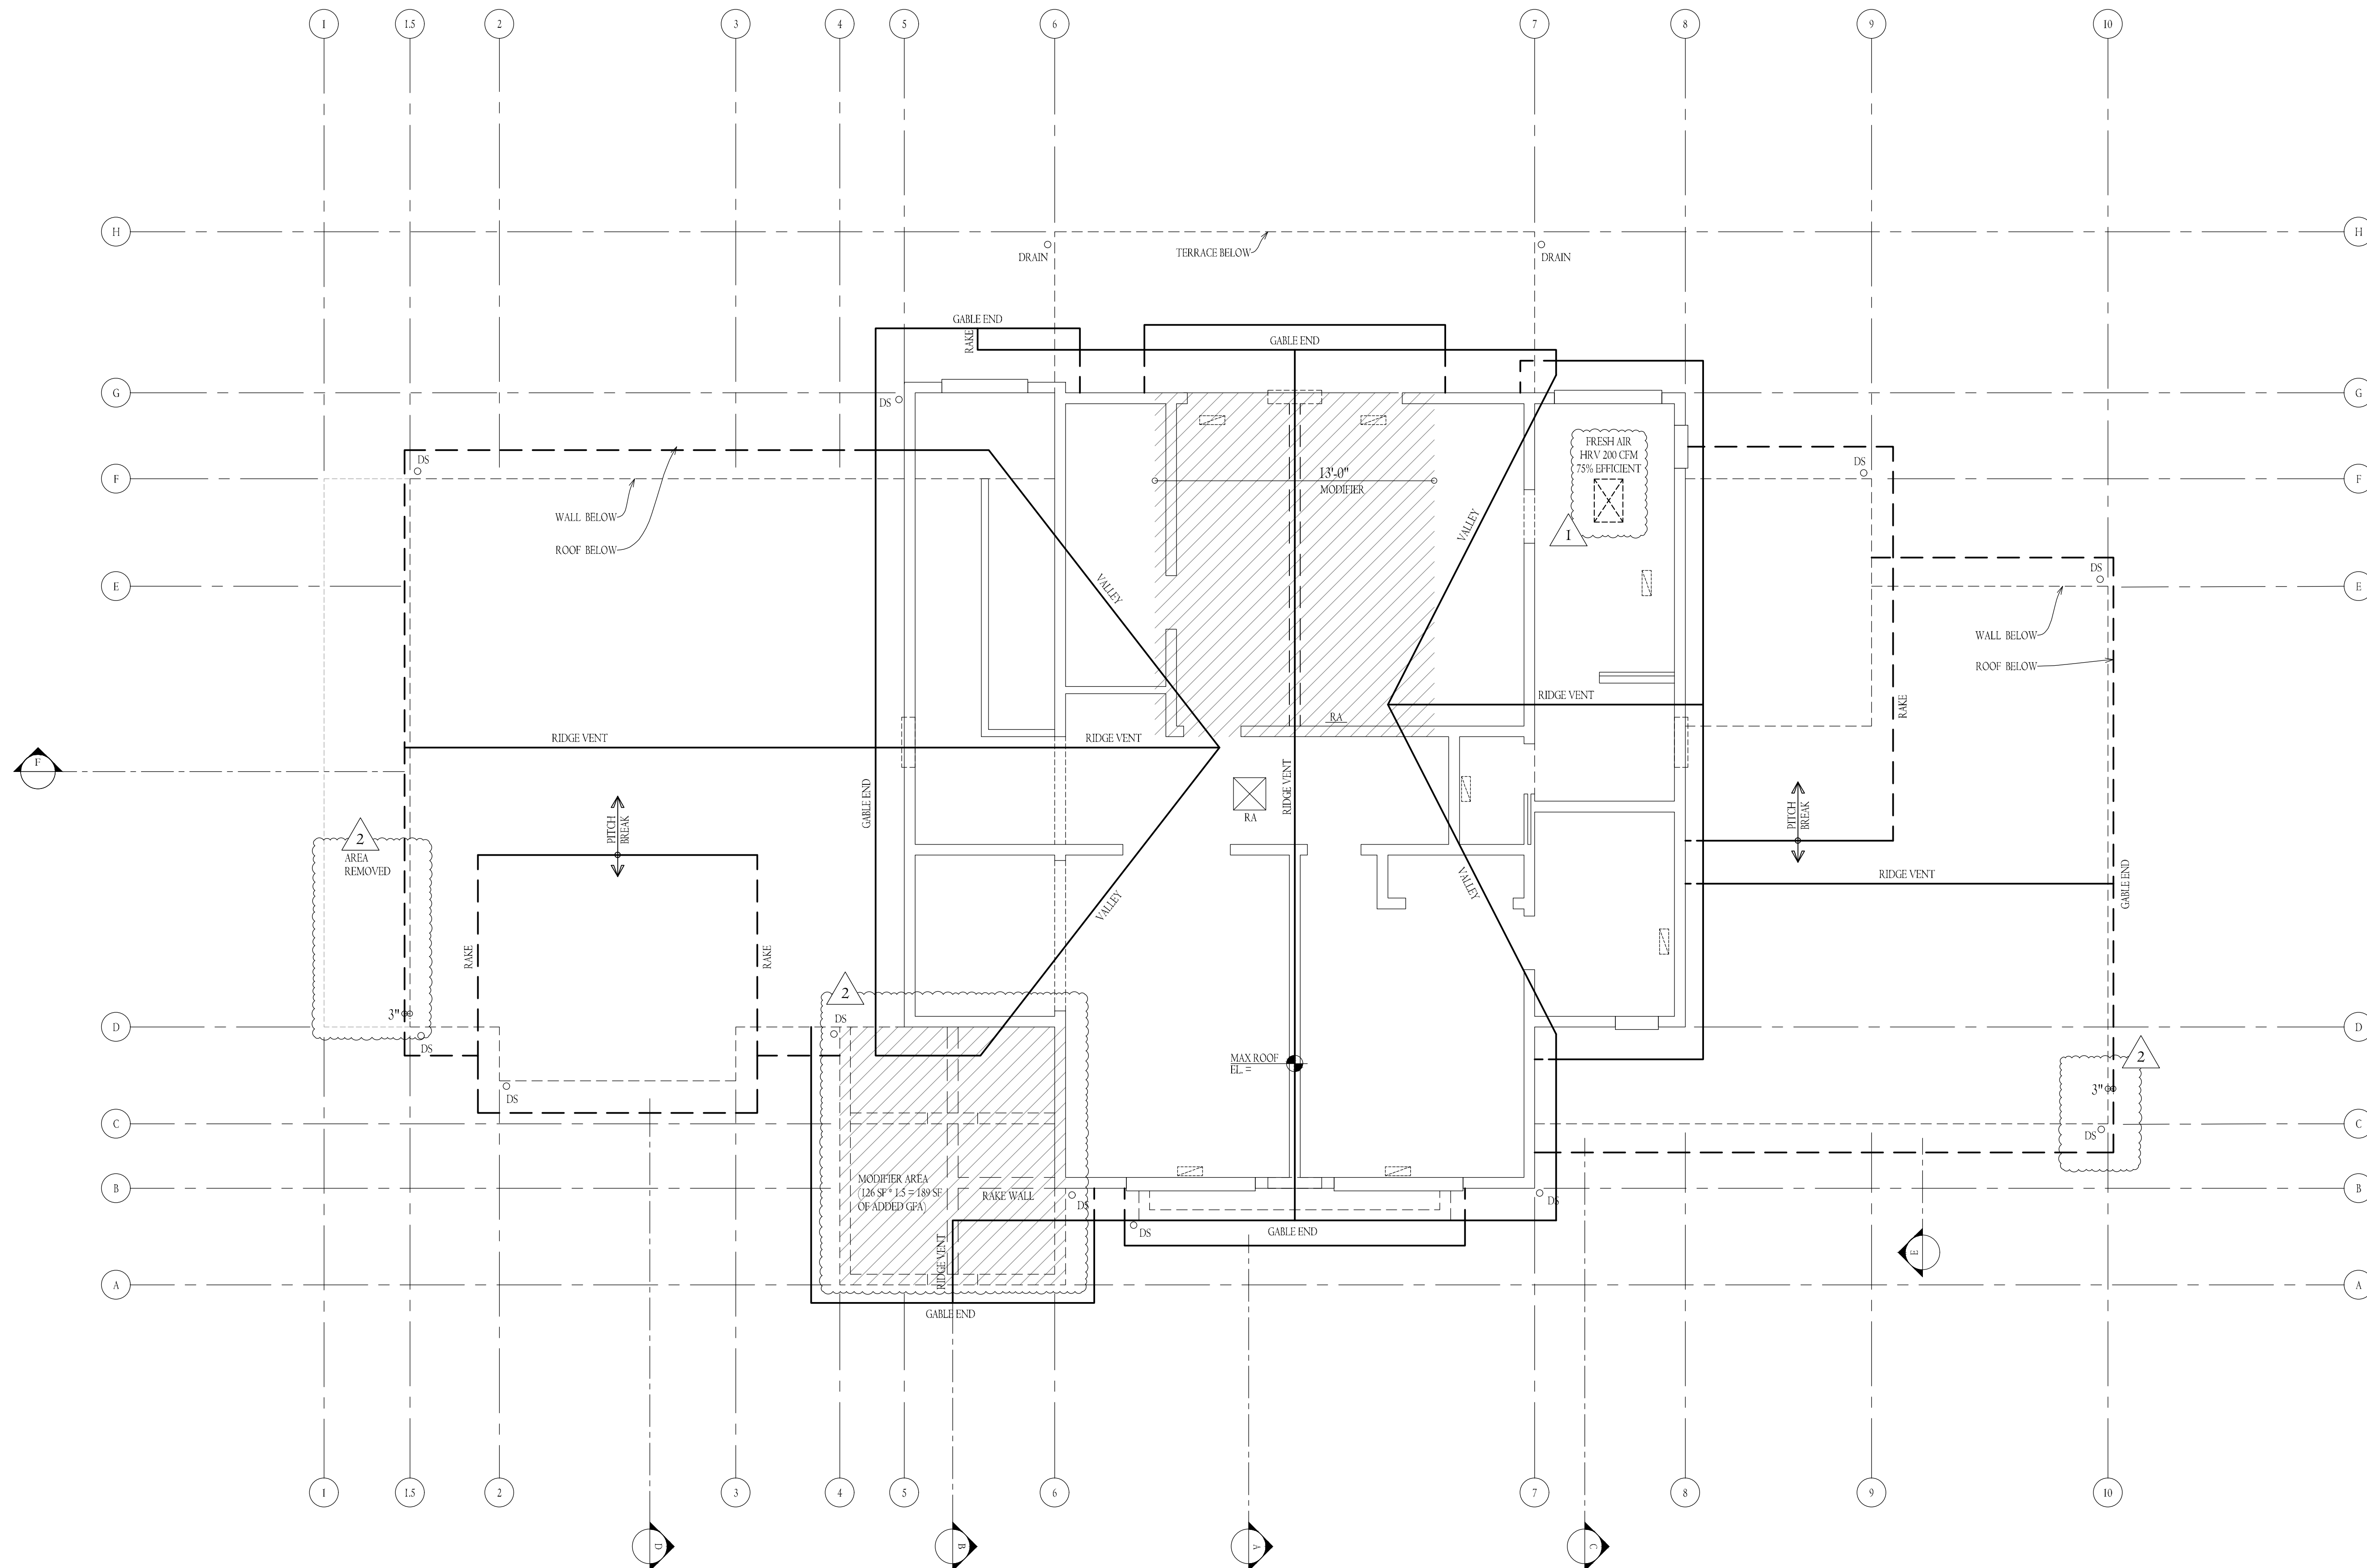

R O O F / A T T I C P L A N

SCALE: 1/4"=1'-0"

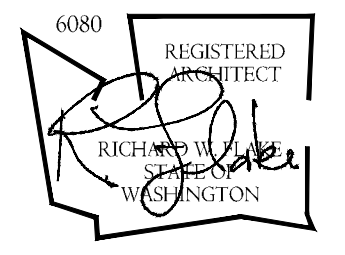

All drawings, specifications, plans, ideas, arrangements, and designs represented or referred to are the property of and owned by Richard Flake Architect in whether the project for which they are made is executed or not. They were created, evolved, developed and produced for sole use on and in connection with this project and none of the above may be disclosed or given to or used by any person, firm, or corporation for any use or purpose whatsoever including any other project, except upon written permission of Richard Flake Architect.

Copyright 2023
 Richard Flake Architect

DESIGN:
 RWF



DRAWN:
 RWF

CHECKED:
 RWF

REVISIONS:


△	CITY REVIEW	1-2-2023
△	CITY REVIEW	2-28-2024

ROOM FINISH SCHEDULE (TO BE DETERMINED)									
MARK	ROOM NAME	FLOOR FINISH		WALL FINISH				CEILING FINISH	REMARKS
		FLOOR	BASE	NORTH	EAST	SOUTH	WEST	CEILING	
101	PORCH/VAULTED								
102	FOYER								
103	POWDER								
104	KITCHEN								
105	STORAGE								
106	DINING								
107	GREAT ROOM								
108	LAUNDRY								
109	MUD/REC								
110	GARAGE								
111	STOOP								
112	PORCH								
113	OUTDOOR SPACE/LIVING								
114	HALL								
115	BATH								
116	BED 2								
117	BED 3								
118	CLOSET								
119	STAIR								
201	HALL								
202	PRIMARY BED								
203	VAULT								
204	BATH								
205	TOILET								
206	OFFICE								
207	EXER								
208	BED 4								
209	BATH								
210	TERRACE								

DOOR SCHEDULE											
MARK	SIZE	THICKNESS	TYPE	STYLE	DOOR FINISH	FRAME FINISH	MANUFACTURER	SERIES	U-VALUE	REMARKS	
EXTERIOR DOORS:											
1	3 ⁰ x 8 ⁰	1 3/4"	ENTRY	VERIFY	VERIFY	VERIFY	FRANK DR KOLBE	TBD	0.20	2X6 JAMBS TYP	
2	3 ⁰ x 8 ⁰	1 3/4"	1/2 LIGHT	VERIFY	VERIFY	VERIFY	FRANK DR KOLBE	TBD	0.28	2X6 JAMBS TYP	
3	3 ⁰ x 8 ⁰	1 3/4"	1/2 LIGHT	VERIFY	VERIFY	VERIFY	FRANK DR KOLBE	TBD	0.28	2X6 JAMBS TYP	
4	3 ⁰ x 8 ⁰	1 3/4"	STORE DOOR	VERIFY	VERIFY	VERIFY	FRANK DR KOLBE	TBD	0.28	2X6 JAMBS TYP	
5	20 ⁰ x 8 ⁰	1 3/4"	MULTI-SLIDE	VERIFY	VERIFY	VERIFY	FRANK DR KOLBE	TBD	0.28	2X6 JAMBS TYP	
6	6 ⁰ x 6 ⁸	1 3/4"	STORE DOOR	VERIFY	VERIFY	VERIFY	FRANK DR KOLBE	TBD	0.28	2X6 JAMBS TYP	
19	10 ⁰ x 8 ⁰	1 3/4"	STORE DOOR	VERIFY	VERIFY	VERIFY	FRANK DR KOLBE	TBD	0.28	FIXED PANELS	
INTERIOR DOORS:											
7	2 ⁶ x 8 ⁰	1 3/4"	SWING 2P/1P	2P/1P VERIFY	VERIFY	VERIFY					
8	2 ⁶ x 6 ⁸	1 3/4"	SWING 2P/1P	2P/1P VERIFY	VERIFY	VERIFY					
9	2 ⁶ x 6 ⁸	1 3/4"	SWING 2P/1P	2P/1P VERIFY	VERIFY	VERIFY					
10	2 ⁶ x 6 ⁸	1 3/4"	SWING 2P/1P	2P/1P VERIFY	VERIFY	VERIFY					
11	2 ⁶ x 6 ⁸	1 3/4"	SWING 2P/1P	2P/1P VERIFY	VERIFY	VERIFY					
12	2 ⁶ x 6 ⁸	1 3/4"	SWING 2P/1P	2P/1P VERIFY	VERIFY	VERIFY					
13	2 ⁶ x 6 ⁸	1 3/4"	SWING 2P/1P	2P/1P VERIFY	VERIFY	VERIFY					
14	2 ⁶ x 6 ⁸	1 3/4"	SWING 2P/1P	2P/1P VERIFY	VERIFY	VERIFY					
15	4 ⁰ x 6 ⁸	1 3/4"	BYPASS	2P/1P VERIFY	VERIFY	VERIFY					
16	7 ⁶ x 6 ⁸	1 3/4"	BYPASS	2P/1P VERIFY	VERIFY	VERIFY					
17	3 ⁰ x 8 ⁰	1 3/4"	BARN	2P/1P VERIFY	VERIFY	VERIFY					
18	3 ⁰ x 8 ⁰	1 3/4"	POCKET 2P/1P	2P/1P VERIFY	VERIFY	VERIFY					
19	3 ⁰ x 8 ⁰	1 3/4"	2P/1P	2P/1P VERIFY	VERIFY	VERIFY					SOLID CORE W/ BOMMER
21	2 ⁶ x 8 ⁰	1 3/4"	SWING 2P	2P/1P VERIFY	VERIFY	VERIFY					
22	2 ⁶ x 8 ⁰	1 3/4"	SWING 2P	2P/1P VERIFY	VERIFY	VERIFY					
23	3 ⁰ x 7 ⁰	1 3/4"	BARN (VERIFY)	2P/1P VERIFY	VERIFY	VERIFY					
24	2 ⁶ x 6 ⁸	1 3/4"	SWING 2P	2P/1P VERIFY	VERIFY	VERIFY					
25	PAIR 2 ⁶ x 8 ⁰	1 3/4"	SWING 2P	2P/1P VERIFY	VERIFY	VERIFY					
26	2 ⁶ x 8 ⁰	1 3/4"	SWING 2P	2P/1P VERIFY	VERIFY	VERIFY					
27	PAIR 2 ⁶ x 8 ⁰	1 3/4"	SWING 2P	2P/1P VERIFY	VERIFY	VERIFY					
28	2 ⁶ x 6 ⁸	1 3/4"	SWING 2P	2P/1P VERIFY	VERIFY	VERIFY					
29	7 ⁶ x 7 ⁰	1 3/4"	BARN (VERIFY)	2P/1P VERIFY	VERIFY	VERIFY					

WINDOW SCHEDULE						
MARK	SIZE (WXH)	TYPE	MANUFACTURER	SERIES	U-VALUE	REMARKS
1	12 ⁰ x 5 ⁰	VERT SLIDE	KOLBE	VERIFY	0.28	
2	2 ⁰ x 3 ⁰	PIC	KOLBE	VERIFY	0.28	
3	2 ⁰ x 3 ⁰	PIC	KOLBE	VERIFY	0.28	
4	2 ⁰ x 3 ⁶	CSMT	KOLBE	VERIFY	0.28	
5	6 ⁰ x 5 ⁶	V. SLIDE EGRESS	KOLBE	VERIFY	0.28	
6	3 ⁰ x 3 ⁰	CSMT	KOLBE	VERIFY	0.28	
7	2 ⁰ x 3 ⁶	CSMT	KOLBE	VERIFY	0.28	
8	4 ⁰ x 10 ⁰	PIC T.GL	KOLBE	VERIFY	0.28	
9	5 ⁰ x 5 ⁶	CSMT	KOLBE	VERIFY	0.28	
10	6 ⁰ x 3 ⁶	SLIDER	KOLBE	VERIFY	0.28	
11	6 ⁰ x 5 ⁶	V. SLIDER EGRESS	KOLBE	VERIFY	0.28	
12	6 ⁰ x 5 ⁶	V. SLIDER EGRESS	KOLBE	VERIFY	0.28	
13	2 ⁶ x 3 ⁶	PIC	KOLBE	VERIFY	0.28	
14	2 ⁰ x 3 ⁰	CSMT	KOLBE	VERIFY	0.28	
15	(NOT USED)		KOLBE	VERIFY	0.28	
16	(NOT USED)		KOLBE	VERIFY	0.28	
17	(NOT USED)		KOLBE	VERIFY	0.28	
18	5 ⁰ x 5 ⁶	CSMT T.GL	KOLBE	VERIFY	0.28	
18a	2 ⁶ x 5 ⁰	CSMT T.GL	KOLBE	VERIFY	0.28	
19	2 ⁶ x 3 ⁶	PIC	KOLBE	VERIFY	0.28	
20	(NOT USED)		KOLBE	VERIFY	0.28	
21	2 ⁶ x 3 ⁶	PIC	KOLBE	VERIFY	0.28	
22	2 ⁶ x 3 ⁶	PIC	KOLBE	VERIFY	0.28	

R F A R C H I T E C T U R E
 P H : (2 5 3) 3 5 9 - 4 0 3 9
 R i c h a r d @ r f a r c h i t e c t u r e . c o m
 7 4 2 1 2 1 s t A v e E B o n n e y l a k e , W A 9 8 3 9 1

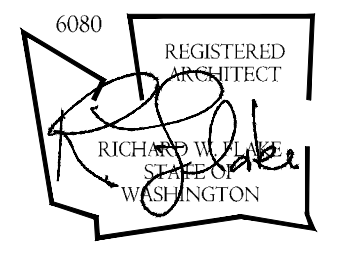

All drawings, specifications, plans, ideas, arrangements, and designs represented or referred to are the property of, and owned by Richard Flake Architect in whether the project for which they are made is executed or not. They were created, evolved, developed and produced for sole use on and in connection with this project and none of the above may be disclosed or given to or used by any person, firm, or corporation for any use or purpose whatsoever including any other project, except upon written permission of Richard Flake Architect.

Copyright 2023
 Richard Flake Architect

R A Q U E P A U R E S I D E N C E
 R E M O D E L & A D D I T I O N
 9 1 1 6 S E 5 8 T H
 M E R C E R I S L A N D , W A 9 8 0 4 0

DESIGN:
 RWF

DRAWN:

CHECKED:
 RWF

REVISIONS:
 CITY REVIEW
 1 - 2 8 - 2 0 2 3
 CITY REVIEW
 2 - 2 8 - 2 0 2 4

CITY REVIEW
 1 - 2 8 - 2 0 2 3
 CITY REVIEW
 2 - 2 8 - 2 0 2 4

Mar 12, 2024

RAQUEPAU RESIDENCE REMODEL

APPLICANT

JEREME RAQUEPAU
9116 SE 58TH STREET
MERCER ISLAND, WA 98040

ARCHITECT

RF ARCHITECTURE
7412 214TH AVENUE E
BONNEY LAKE, WA 98391
(253) 359-4039
CONTACT: RICHARD FLAKE

CIVIL ENGINEER

JMJ TEAM
905 MAIN STREET
SUITE 200
SUMNER, WA 98390
(206) 596-2020
CONTACT: JUSTIN JONES, PE

SURVEYOR

SITE SURVEYING INC.
21923 NE 11TH STREET
SAMMAMISH, WA 98074
(425) 298-4412
CONTACT: THOMAS WOLDENDROP, PLS

SITE INFORMATION:

SITE ADDRESS: 9116 SE 58TH STREET MERCER ISLAND, WA 98040
TAX PARCEL NUMBER(S): 228700-0120
ZONING: R-9.6
TOTAL PROJECT AREA: 0.280 ACRES

VERTICAL DATUM & CONTOUR INTERVAL

ELEVATIONS SHOWN ON THIS DRAWING WERE DERIVED FROM GPS OBSERVATION USING THE WSRN.
DATUM - NAVD 88
2.0' CONTOUR INTERVAL- THE EXPECTED VERTICAL ACCURACY IS EQUAL TO 1/2 THE CONTOUR INTERVAL OR PLUS / MINUS 1.0' FOR THIS PROJECT.

SURVEY DATE: JANUARY 13TH, 2023

BASIS OF BEARINGS

RECORD OF SURVEY BY TERRANE, RECORDED IN VOLUME 390 OF SURVEYS, PAGE 163, UNDER RECORDING NO. 20180830900020, RECORDS OF KING COUNTY, WASHINGTON.


LEGAL DESCRIPTION

LOT 12 OF EL DORADO ESTATES, AS PER PLAT RECORDED IN VOLUME 62 OF PLATS, PAGE 7, RECORDS OF KING COUNTY AUDITOR;
SITUATE IN THE CITY OF MERCER ISLAND, COUNTY OF KING, STATE OF WASHINGTON

SERVICE PROVIDERS:

WATER: CITY OF MERCER ISLAND
SEWER: CITY OF MERCER ISLAND
POWER: PUGET SOUND ENERGY
GAS: PUGET SOUND ENERGY

VICINITY MAP

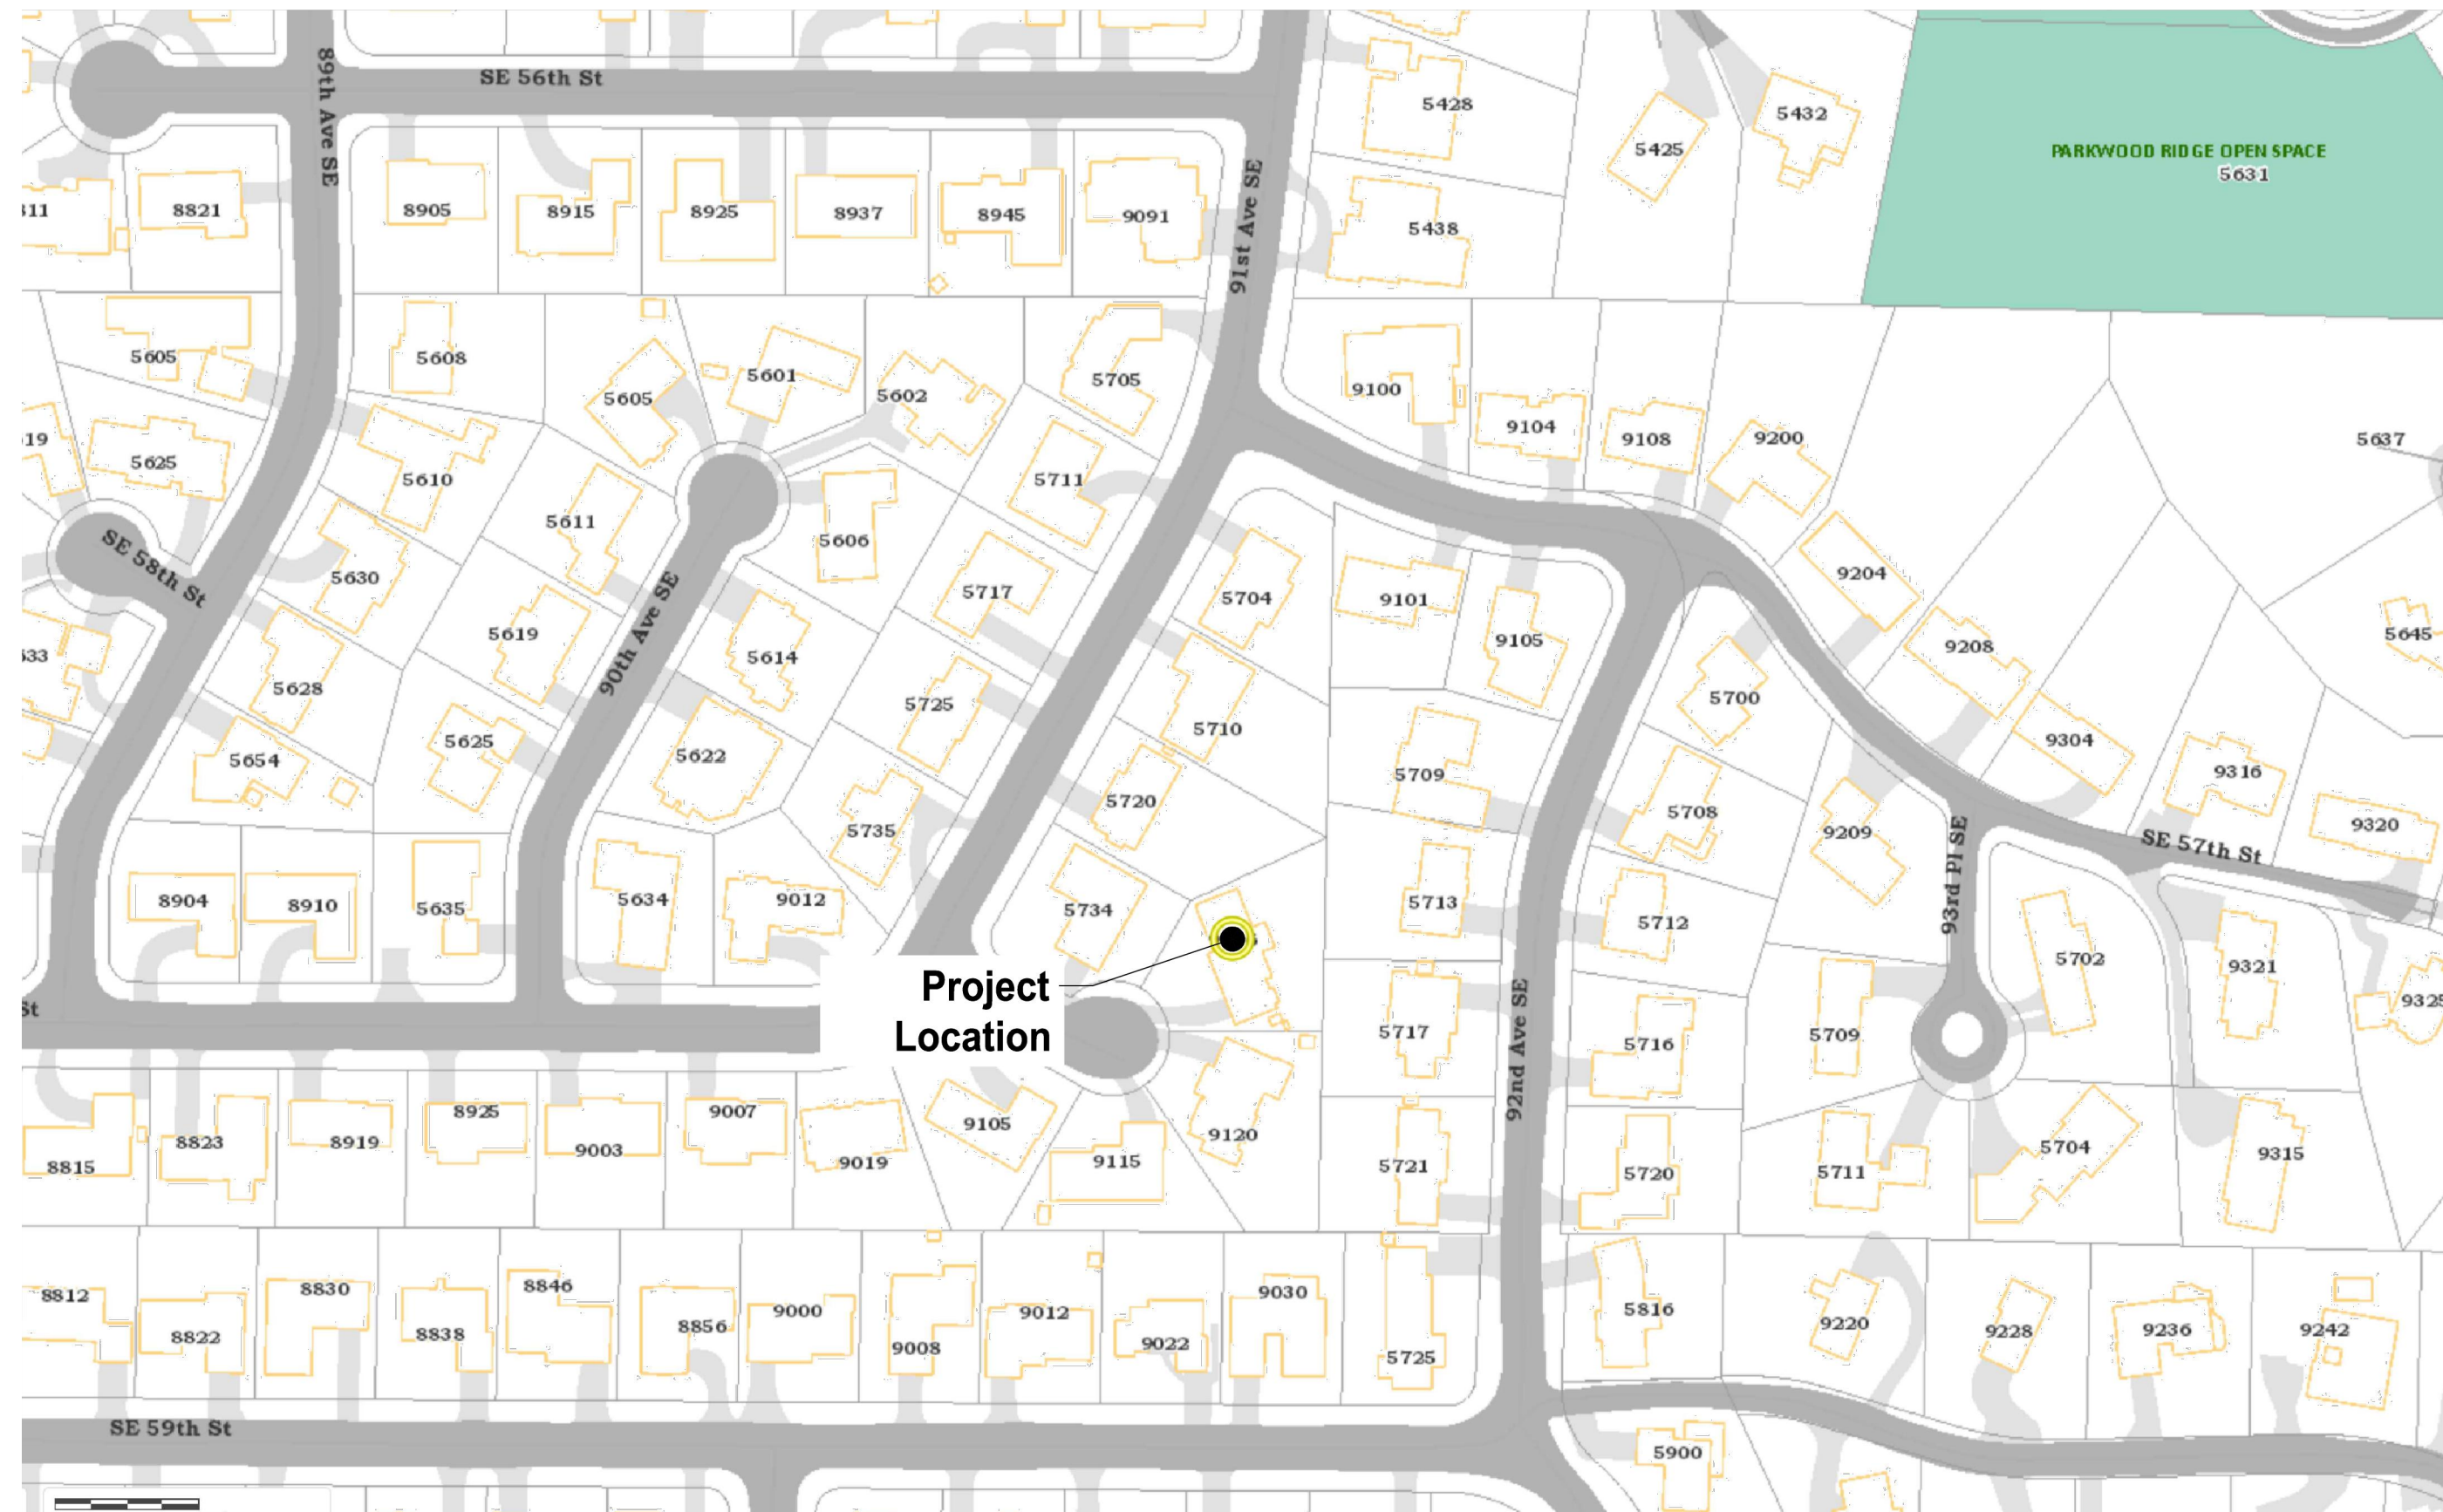

9116 SE 58th Street Mercer Island , WA 98040

SHEET INDEX

Page #	Sheet #	Sheet Name
1	C-01	Cover Sheet
2	C-02	Existing Site Plan
3	C-03	Demolition & TESC Plan
4	C-04	Site & Grading Plan
5	C-05	Storm Plan
6	C-06	Details
7	C-07	Details

Owner/Developer:

Jereme Raquepau
9116 SE 58th Street
Mercer Island, WA 98040

Architect:

RF Architecture
Richard Flake
7421 214th Avenue E
Bonneylake, WA 98391
(253) 359-4039

Engineer:



JMJ Team
905 Main Street, Suite #200
Sumner, WA 98390
(206) 596-2020


Project:

Raquepau Residence

9116 Se 58th Street
Mercer Island, WA 98040

ONE INCH AT FULL SCALE.
IF NOT, SCALE ACCORDINGLY

Civil Permit

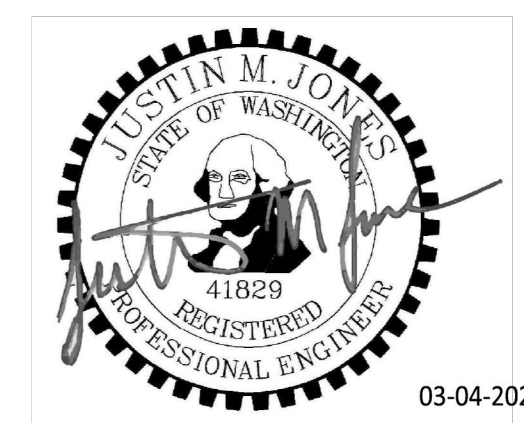

REV	DATE	DESCRIPTION
1	11-1-23	Revised per City Comments
2	3-4-24	Revised per City Comments

SHEET TITLE

Cover Sheet

PROJ. NO.:	1565-008
DATE:	March 4th, 2024
DRAWN BY:	MO
DESIGN BY:	JJ

SHEET NUMBER

C-01

DWG

1 OF 7



Path: J:\1565 - RF Architecture\008 - Raquepau Residence\CAD - Plotted by: MirissaOchoa Date: 04-Mar-24 2:57:19pm



LEGEND

- Existing Concrete
- Proposed Concrete
- Proposed Gravel
- New/Replaced Roof Area
- Proposed Bldg. Extents
- Proposed Eaves
- SE Spot Elevation
- ME Match Existing Grade

PROPOSED LOT COVERAGE

- Site Area: 12,192 SF (0.28 AC)
- Total Impervious Coverage: 4,854 SF (39.8%)
 - Existing Remain: 2,167 SF
 - Roof: 1,378 SF
 - Concrete Pavement: 789 SF
 - New/Replaced: 2,687 SF
 - Roof: 1,728 SF
 - Concrete Pavement: 704 SF
 - Gravel: 255 SF
- Total Pervious Coverage: 7,338 SF (60.2%)
- Net Impervious: -406 SF

Owner/Developer:

Jereme Raquepau
9116 SE 58th Street
Mercer Island, WA 98040

Architect:

RF Architecture
Richard Flake
7421 214th Avenue E
Bonneylake, WA 98391
(253) 359-4039

Engineer:



JMJ Team
905 Main Street, Suite #200
Sumner, WA 98390
(206) 596-2020


Project:

Raquepau Residence

9116 Se 58th Street
Mercer Island, WA 98040

ONE INCH AT FULL SCALE.
IF NOT, SCALE ACCORDINGLY

Civil Permit

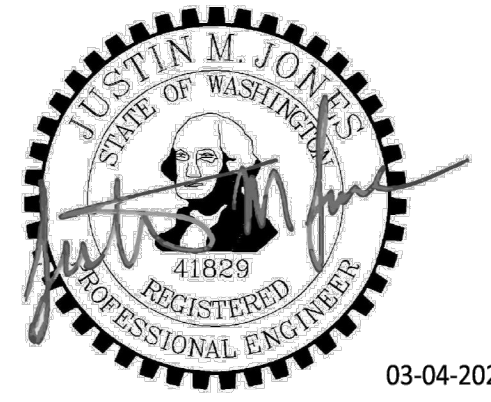

REV	DATE	DESCRIPTION
1	11-1-23	Revised per City Comments
2	3-4-24	Revised per City Comments

SHEET TITLE

Site & Grading Plan

PROJ. NO: 1565-008


DATE: March 4th, 2024

DRAWN BY: MO DESIGN BY: JJ

SHEET NUMBER


C-04

DWG: 4 OF 7

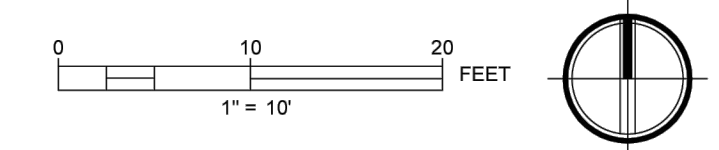

CALL TWO BUSINESS DAYS
BEFORE YOU DIG
1-800-424-5555
UTILITIES UNDERGROUND LOCATION CENTER

File: 1565008C-STRM.dwg Path: J:\1565 - RF Architecture\DOB - Raquepau Residence\CAD Plotted by: MissaOchoa Date: 04-Mar-24 2:58:19pm

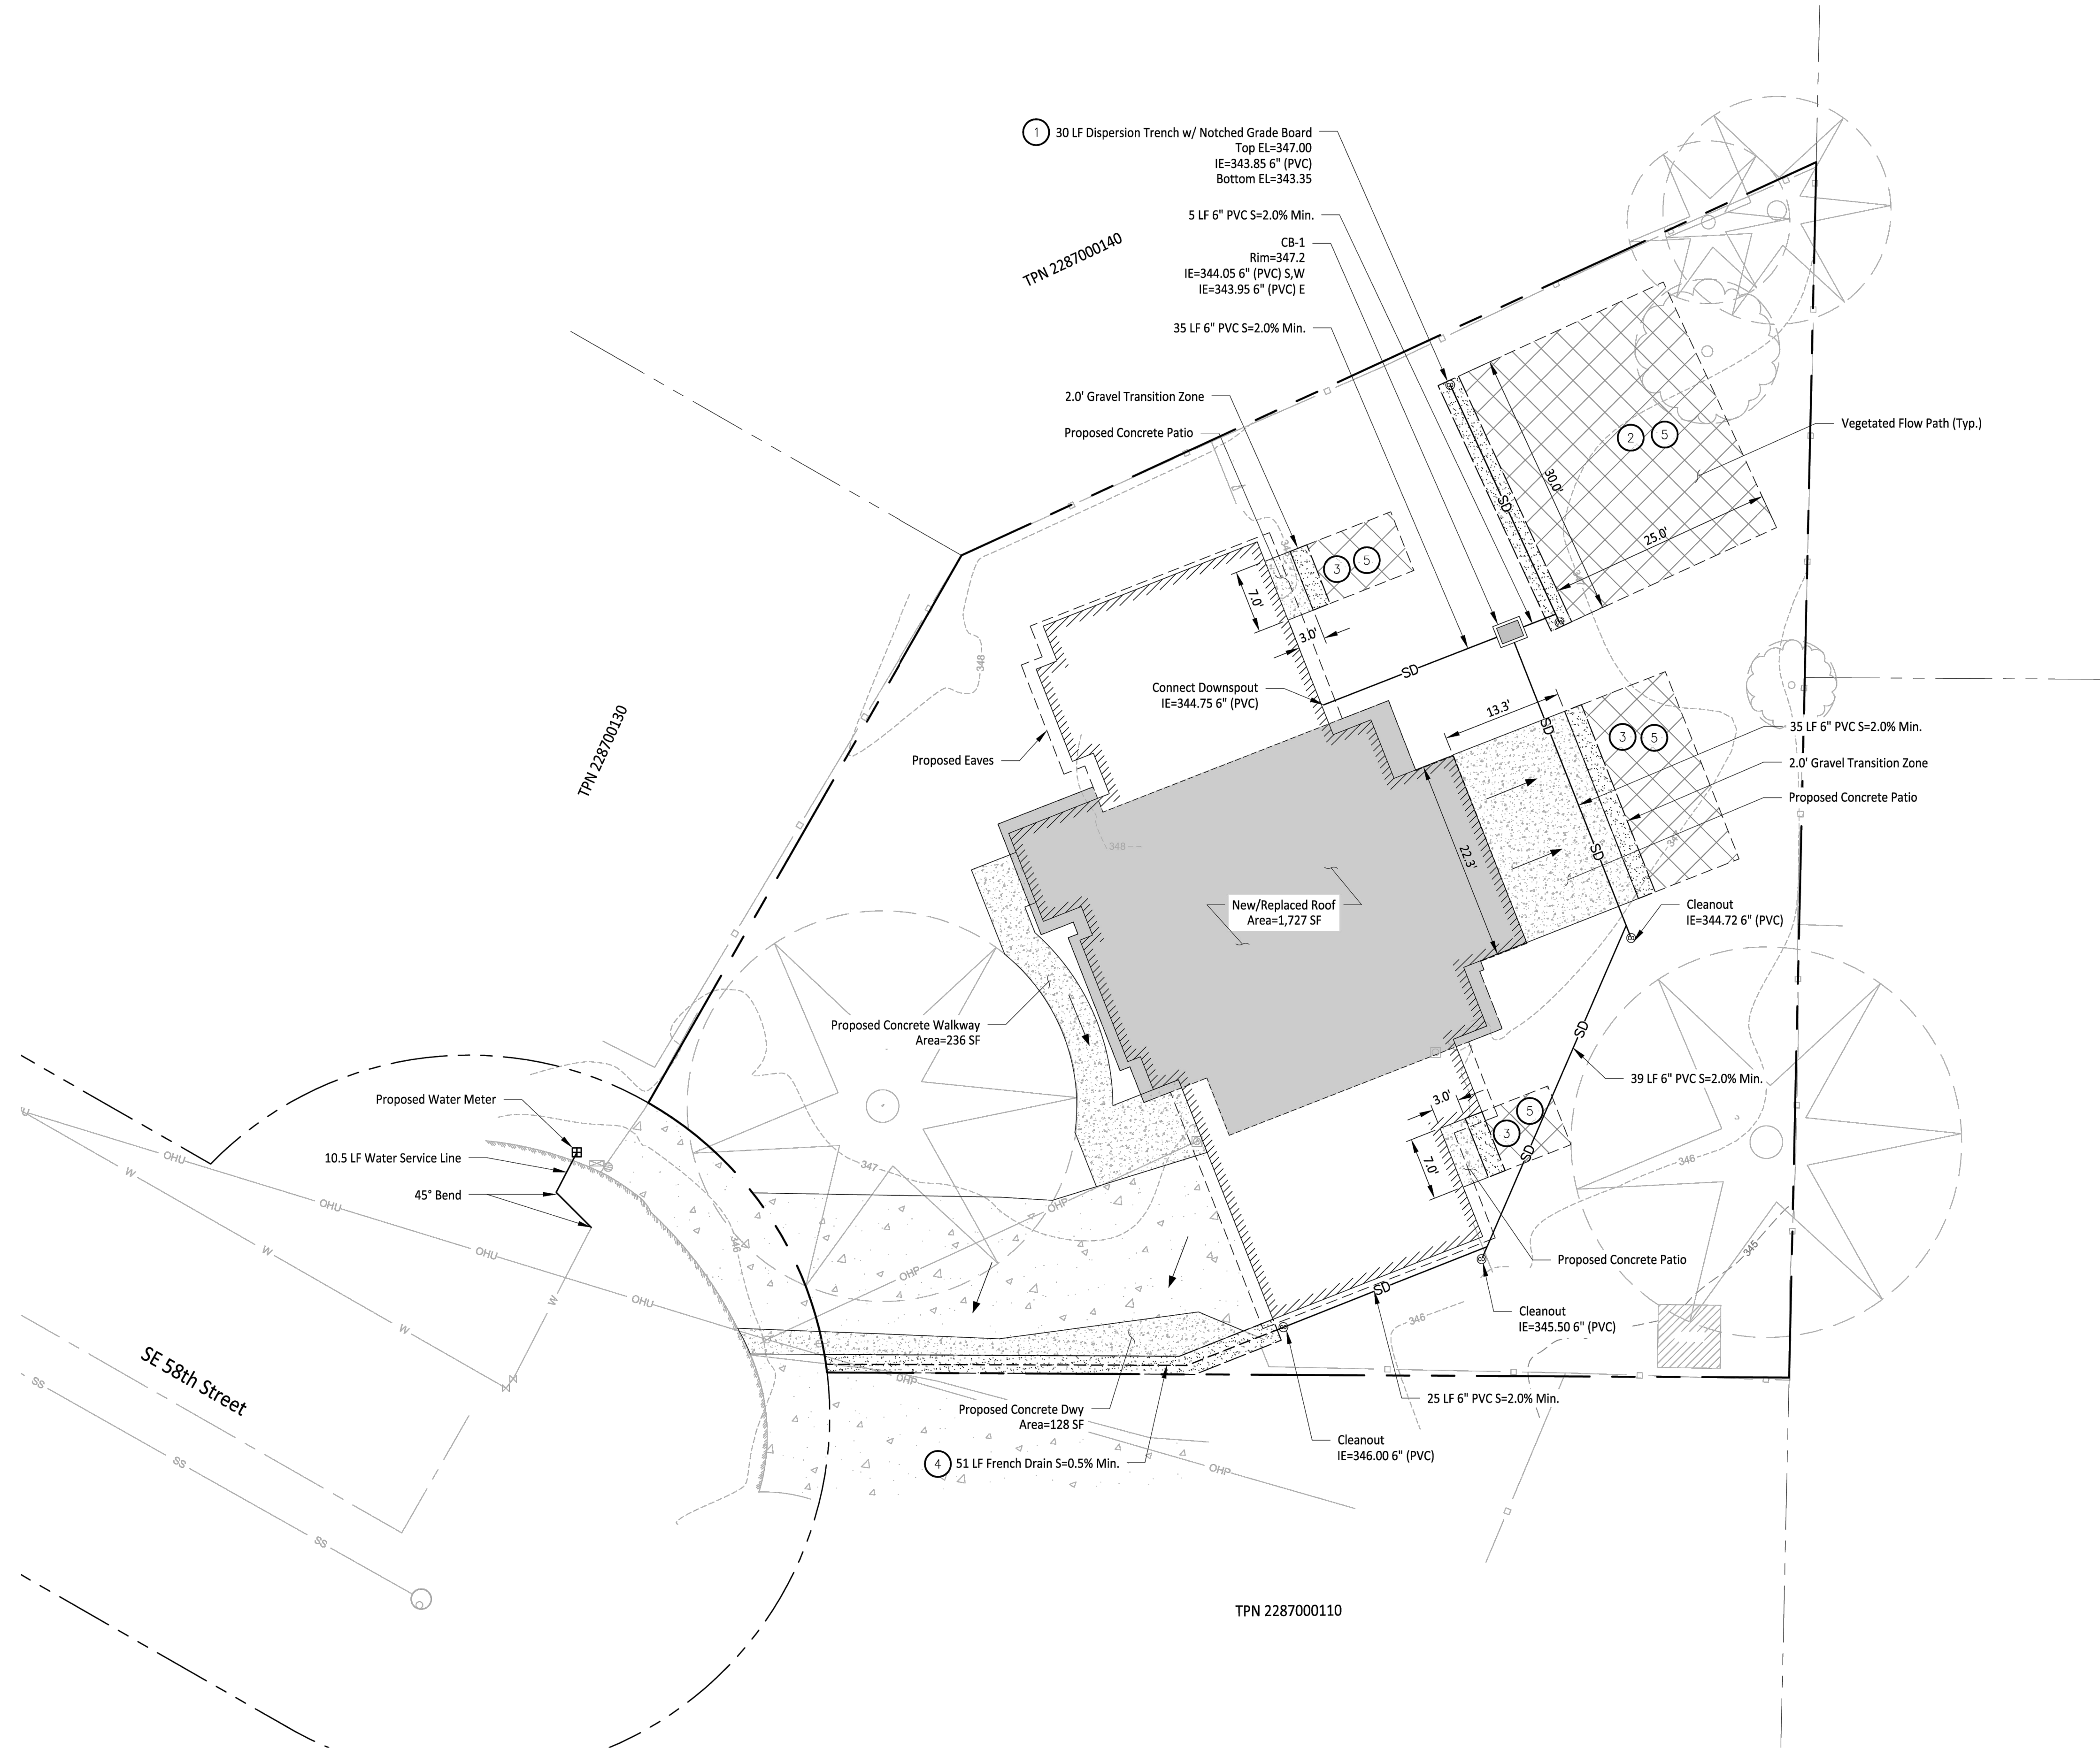

LEGEND

- Existing Concrete
- Proposed Concrete
- Proposed Gravel
- New/Replaced Roof Area
- Vegetated Flow Path
- Proposed Bldg. Extents
- Proposed Eaves
- 6" PVC Storm Line
- Water Line
- Water Meter
- Cleanout
- Type 1 Catch Basin, Solid Lid
- Flow Path

CONSTRUCTION NOTES

- 1 Dispersion Trench to be constructed per DOE Figure V-4.5. See Detail on Sheet C-06.
- 2 Dispersion Trench Vegetated Flow Path to be a minimum of 25 LF in length.
- 3 Sheet Flow Vegetated Flow Path to be a minimum of 10 LF in length.
- 4 Install French Drain per Section B on Sheet C-06.
- 5 All Vegetated flow path shall be amended to meet BMP T5.13. See Sheet C-07 for detail.
- 6 Storm Pipes to be SDR 35 PVC piping.
- 7 Storm Pipes to maintain a minimum cover of 1.5' from finished grade surface.

Owner/Developer:
Jereme Raquepau
9116 SE 58th Street
Mercer Island, WA 98040

Architect:
RF Architecture
Richard Flake
7421 214th Avenue E
Bonneylake, WA 98391
(253) 359-4039

Engineer:

JM Team
905 Main Street, Suite #200
Sumner, WA 98390
(206) 596-2020

Project:
Raquepau Residence

9116 Se 58th Street
Mercer Island, WA 98040

ONE INCH AT FULL SCALE.
IF NOT, SCALE ACCORDINGLY

Civil Permit



REV	DATE	DESCRIPTION
1	11-1-23	Revised per City Comments
2	3-4-24	Revised per City Comments



SHEET TITLE:
Storm Plan

PROJ. NO.: 1565-008
DATE: March 4th, 2024

DRAWN BY: MO DESIGN BY: JJ

SHEET NUMBER:
C-05


DWG: 5 OF 7

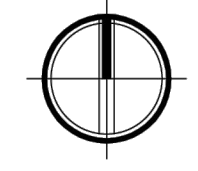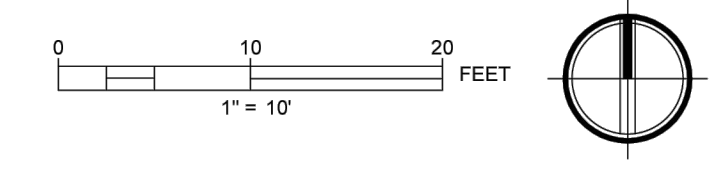

CALL TWO BUSINESS DAYS
BEFORE YOU DIG

1-800-424-5555
UTILITIES UNDERGROUND LOCATION CENTER

Figure V-11.1: Planting Bed Cross-Section

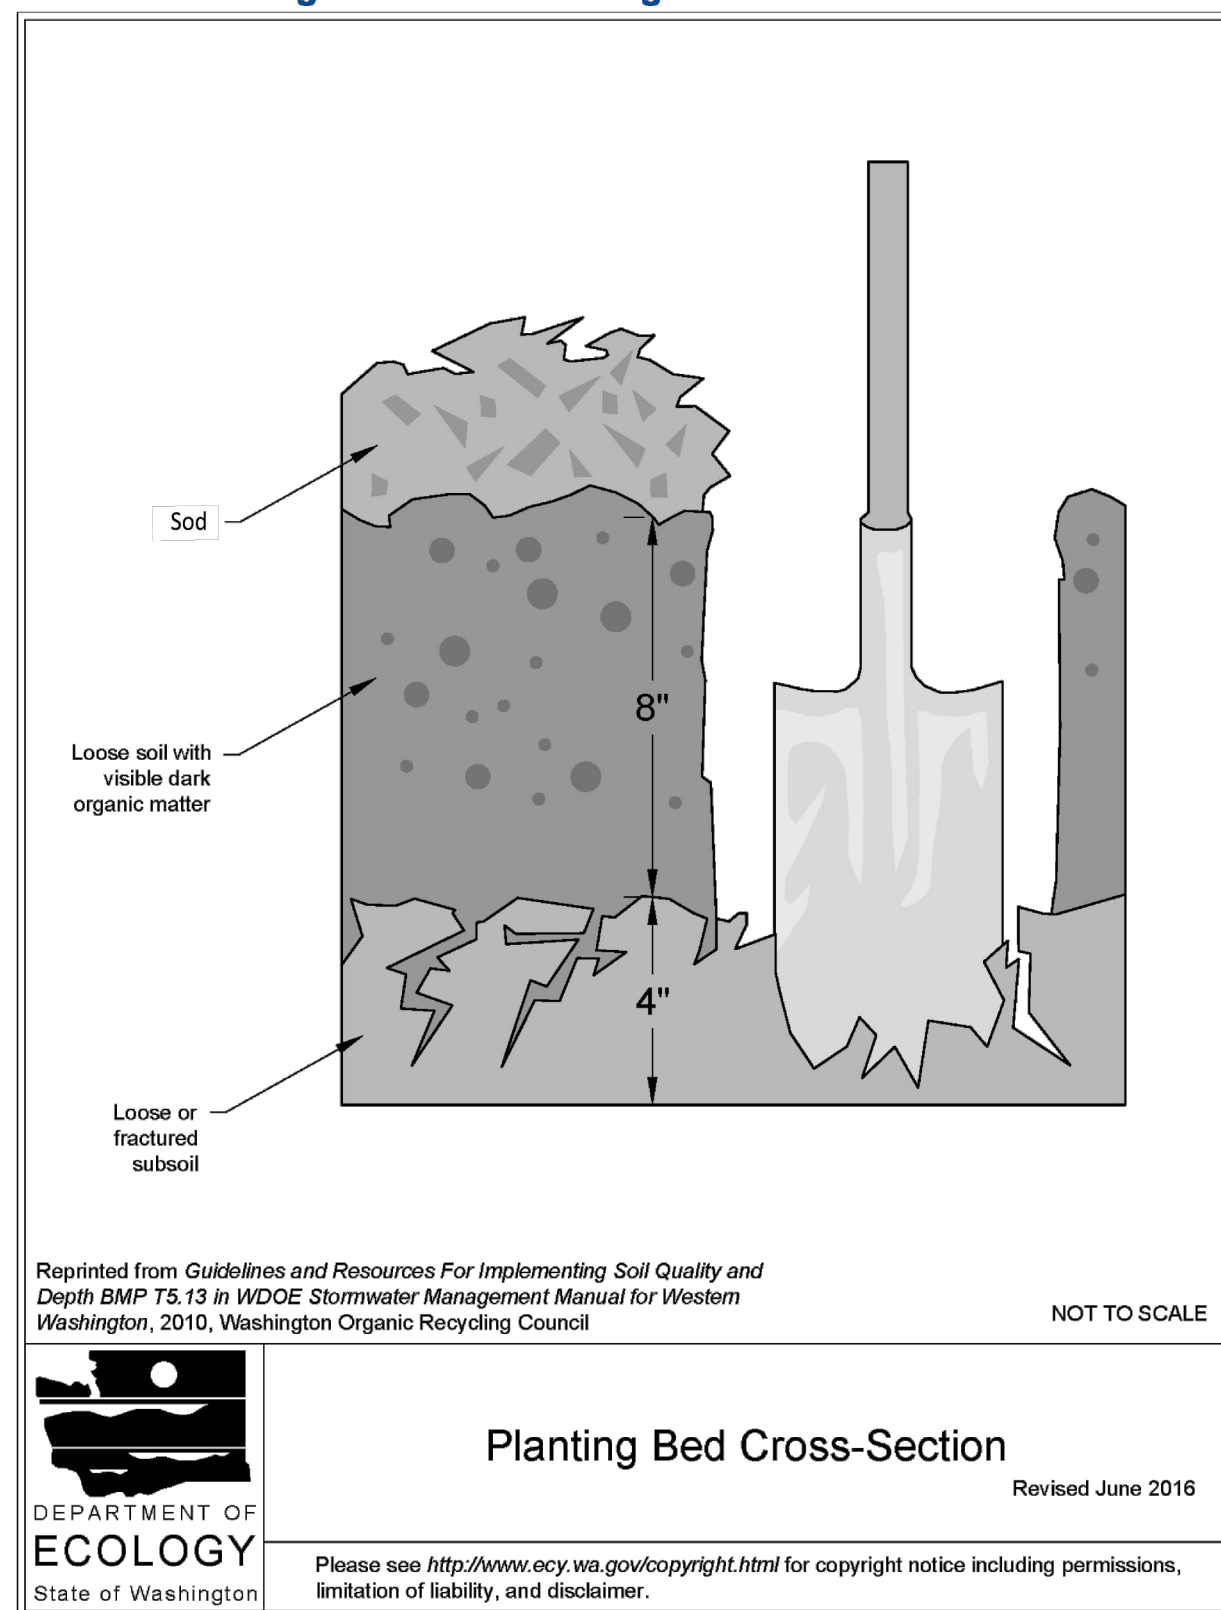

2019 Stormwater Management Manual for Western Washington
Volume V - Chapter 11 - Page 930

Owner/Developer:

Jereme Raquepau
9116 SE 58th Street
Mercer Island, WA 98040

Architect:

RF Architecture
Richard Flake
7421 214th Avenue E
Bonneylake, WA 98391
(253) 359-4039

Engineer:



JMJ Team
905 Main Street, Suite #200
Sumner, WA 98390
(206) 596-2020


Project:

Raquepau Residence

9116 Se 58th Street
Mercer Island, WA 98040

ONE INCH AT FULL SCALE.
IF NOT, SCALE ACCORDINGLY

Civil Permit

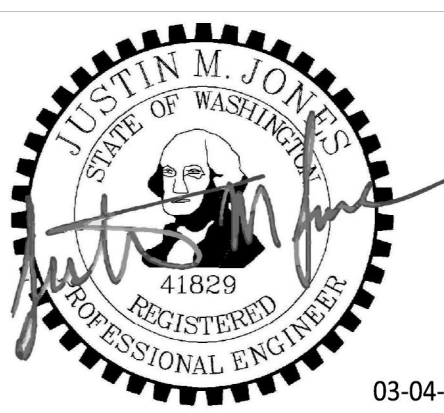

REV	DATE	DESCRIPTION
1	11-1-23	Revised per City Comments
2	3-4-24	Revised per City Comments

SHEET TITLE

Details

PROJ. NO: 1565-008

DATE: March 4th, 2024

DRAWN BY: MO

DESIGN BY: JJ

SHEET NUMBER

C-07

DWG

7 OF 7

CALL TWO BUSINESS DAYS
BEFORE YOU DIG
1-800-424-5555
UTILITIES UNDERGROUND LOCATION CENTER

GENERAL STRUCTURAL NOTES:

PROJECT SPECIFIC DESIGN CRITERIA

Wind Design Data	
Wind Design Speed, $V_u = 110$ MPH, $V_{asd} = 85$ MPH	
Wind Exposure = 9	
Wind Importance Factor, $I_w = 1.0$	
Internal Pressure Coefficient = +/- 0.18	
K _t = 1.00	
K _d = 0.85	
Seismic Design Data	
Importance factor = 1.0	
S _s = 1.47g, S ₁ = 0.57g	
Site Class = D	
SDS = 1.18g, SD1 = 0.65g	
SDC = D	
Seismic System = 15. Light-frame (wood) walls sheathed with wood structural panels rated for shear resistance	
Design Base Shear = 15.00 kips	
C _s = 0.161	
R = 6.5	
Analysis procedure: ASCE 11.4, 11.5 & 12.8	
Snow Loads	
Flat-roof snow load, $p_f = 25.0$ psf	
Snow exposure factor, $C_e = 1.00$	
Snow load important factor, $I_s = 1.00$	
Thermal factor, $C_t = 1.00$	

Gravity Loads*	
Roof Dead Load = 15 psf + 5 psf (SOLAR PANELS)	
Roof Live Load = 25 psf	
Floor Live Load (Office) = 50 psf	
Floor Live Load (Residential) = 40 psf, Balcony & Roof Decks = 60 psf	
Floor live Load (Corridor) = 100 psf	
Partition Loads = 10 psf (residential)	
Partition Loads = 20 psf (office)	
Floor Dead Loads = 12 psf (residential)	
At rest earth pressure = 60 pcf	
*As Applicable	

GENERAL

- ALL CONSTRUCTION SHALL CONFORM TO THE REQUIREMENTS OF THE 2018 EDITION OF THE INTERNATIONAL BUILDING CODE (IBC).
- THE ARCHITECT/ENGINEER (ARCH/ENGR) IS NOT RESPONSIBLE FOR THE LOCATION OF PROPERTY LINES AND/OR EASEMENT, SOIL CONDITIONS, MECHANICAL AND ELECTRICAL WORK, AND THE PRESENCE OF UTILITIES NOT REPORTED TO THE ARCH/ENGR IN WRITING BY THE OWNER.
- THE ENGINEER IS NOT RESPONSIBLE FOR FIELD REVIEW OF CONSTRUCTION UNLESS SPECIFICALLY RETAINED FOR THAT PURPOSE.
- STRUCTURAL DRAWINGS SHALL BE USED IN CONJUNCTION WITH ARCHITECTURAL DRAWINGS FOR BIDDING AND CONSTRUCTION. CONTRACTOR SHALL VERIFY DIMENSIONS AND CONDITIONS FOR COMPATIBILITY AND SHALL NOTIFY ARCHITECT OF ANY DISCREPANCIES PRIOR TO CONSTRUCTION. ALL DIMENSIONS SHOWN ON THE STRUCTURAL DRAWINGS ARE INTENDED FOR REFERENCE ONLY. REFER TO ARCHITECTURAL DRAWINGS FOR ALL DIMENSIONS.
- CONTRACTOR SHALL VERIFY ALL EXISTING DIMENSIONS, MEMBER SIZES, AND CONDITIONS PRIOR TO COMMENCING ANY WORK. ALL DIMENSIONS OF EXISTING CONSTRUCTION SHOWN ON THE STRUCTURAL DRAWINGS ARE INTENDED AS GUIDELINES ONLY AND MUST BE VERIFIED. CONTRACTOR SHALL COMPARE THE DRAWINGS AND NOTIFY THE ARCH/ENGR OF ANY DISCREPANCIES PRIOR TO COMMENCING WITH THE WORK.
- CONTRACTOR SHALL PROVIDE TEMPORARY BRACING FOR THE STRUCTURE AND STRUCTURAL COMPONENTS UNTIL ALL FINAL CONNECTIONS HAVE BEEN COMPLETED IN ACCORDANCE WITH THE PLANS.
- CONTRACTOR SHALL BE RESPONSIBLE FOR ALL SAFETY PRECAUTIONS AND THE METHODS, TECHNIQUES, SEQUENCES, OR PROCEDURES REQUIRED TO PERFORM HIS WORK. THE STRUCTURAL ENGINEER HAS NO OVERALL SUPERVISORY AUTHORITY OR ACTUAL AND/OR DIRECT RESPONSIBILITY FOR THE SPECIFIC WORKING CONDITIONS AT THE SITE AND/OR FOR ANY HAZARDS RESULTING FROM THE ACTIONS OF ANY TRADE CONTRACTOR. THE STRUCTURAL ENGINEER HAS NO DUTY TO INSPECT, SUPERVISE, NOTE, CORRECT, OR REPORT ANY HEALTH OR SAFETY DEFICIENCIES OF THE OWNER, CONTRACTORS, OR OTHER ENTITIES OR PERSONS AT THE PROJECT SITE.
- CONTRACTOR-INITIATED CHANGES SHALL BE SUBMITTED IN WRITING TO THE ARCHITECT AND STRUCTURAL ENGINEER FOR APPROVAL PRIOR TO FABRICATION OR CONSTRUCTION. CHANGES SHOWN ON SHOP DRAWINGS ONLY WILL NOT SATISFY THIS REQUIREMENT.
- DRAWINGS INDICATE GENERAL AND TYPICAL DETAILS OF CONSTRUCTION. WHERE CONDITIONS ARE NOT SPECIFICALLY INDICATED, BUT ARE OF SIMILAR CHARACTER TO DETAILS SHOWN, SIMILAR DETAILS OF CONSTRUCTION SHALL BE USED. SUBJECT TO REVIEW AND APPROVAL BY THE ARCHITECT AND THE STRUCTURAL ENGINEER.
- ALL STRUCTURAL SYSTEMS WHICH ARE TO BE COMPOSED OF COMPONENTS TO BE FIELD ERRECTED SHALL BE SUPERVISED BY THE SUPPLIER DURING MANUFACTURING, DELIVERY, HANDLING, STORAGE, AND ERECTION IN ACCORDANCE WITH INSTRUCTIONS PREPARED BY THE SUPPLIER.

GEOTECHNICAL

11. GEOTECHNICAL FOUNDATION NOTES: SUBGRADE PREPARATION INCLUDING DRAINAGE, EXCAVATION, COMPACTION, AND FILLING REQUIREMENTS, SHALL CONFORM STRICTLY WITH RECOMMENDATIONS GIVEN IN THE SOILS REPORT OR AS DIRECTED BY THE SOILS ENGINEER. FOOTINGS SHALL BEAR ON SOLID UNDISTURBED EARTH (CONTROLLED, COMPACTED STRUCTURAL FILL OR BOTH) AT LEAST 18" BELOW LOWEST ADJACENT FINISHED GRADE. FOOTING DEPTHS/ELEVATIONS SHOWN ON PLANS (OR IN DETAILS) ARE MINIMUM AND FOR GUIDANCE ONLY; THE ACTUAL ELEVATIONS OF FOOTINGS MUST BE ESTABLISHED BY THE CONTRACTOR IN THE FIELD WORKING WITH THE TESTING LAB AND SOILS ENGINEER. BACKFILL BEHIND ALL RETAINING WALLS WITH FREE DRAINING GRANULAR FILL AND PROVIDE FOR SUBSURFACE DRAINAGE AS NOTED IN THE SOILS REPORT.

IN THE ABSENCE OF A SOILS REPORT THE FOLLOWING VALUES ARE USED:

ALLOWABLE SOIL PRESSURE	2,000 PSF
LATERAL EARTH PRESSURE (RESTRAINED/UNRESTRAINED)	55 PCF/35 PCF
LATERAL EARTH PRESSURE (SEISMIC)	8H (ULTIMATE LOAD)
PASSIVE EARTH PRESSURE (INCLUDES FACTOR OF SAFETY = 1.5)	350 PCF
COEFFICIENT OF FRICTION (INCLUDES FACTOR OF SAFETY = 1.5)	0.35

SOILS REPORT REFERENCE: (N/A)

CONCRETE

12. CONCRETE SHALL BE MIXED, PROPORTIONED, CONVEYED, AND PLACED IN ACCORDANCE WITH ACI 318-14 AND ACI 301-10. CONCRETE SHALL ATTAIN A 28-DAY STRENGTH (f'_c) OF 3000 PSI, SHALL CONTAIN NO LESS THAN 5-1/2 SACKS OF CEMENT, HAVE A MAXIMUM WATER/CEMENT RATIO OF 0.45, AND A SLUMP OF 5 INCHES OR LESS. CONCRETE HAS BEEN DESIGNED BASED ON A CONCRETE STRENGTH (f'_c) OF 2500 PSI PER SEATTLE BUILDING CODE SECTION 1705.3 EXCEPTION 2.3 TO AVOID SPECIAL INSPECTIONS AND MATERIAL TESTING.

13. PERFORMANCE MIX DESIGNS SHALL BE SUBMITTED TO THE STRUCTURAL ENGINEER FOR APPROVAL TWO WEEKS PRIOR TO PLACING ANY CONCRETE. THE PERFORMANCE MIX DESIGN SHALL INCLUDE THE AMOUNTS OF CEMENT, FINE AND COARSE AGGREGATE (3/4" MAXIMUM), WATER AND ADMIXTURES AS WELL AS THE WATER CEMENT RATIO, SLUMP, TARGET CONCRETE STRENGTH. SUBSTANTIATING STRENGTH DATA CONFORMING TO CURRENT ACI AND ASTM STANDARDS SHALL BE SUBMITTED WITH THE PERFORMANCE MIX DESIGN. THE USE OF A PERFORMANCE MIX REQUIRES BATCH PLANT INSPECTION, THE COST OF WHICH SHALL BE PAID BY THE GENERAL CONTRACTOR. REVIEW OF MIX SUBMITTALS BY THE ENGINEER OF RECORD INDICATES ONLY THAT INFORMATION PRESENTED CONFORMS GENERALLY WITH CONTRACT DOCUMENTS. CONTRACTOR OR SUPPLIER MAINTAINS FULL RESPONSIBILITY FOR SPECIFIED PERFORMANCE.

14. ALL CONCRETE WITH SURFACES EXPOSED TO STANDING WATER SHALL BE AIR-ENTRAINED WITH AN AIR-ENTRAINING AGENT CONFORMING TO ASTM C260, C494M, AND C618. UNLESS OTHERWISE NOTED THE TOTAL AIR CONTENT SHALL BE 5%. AIR CONTENT SHALL BE SAMPLED IN ACCORDANCE WITH ASTM C172 ABD AIR CONTENT MEASURED IN ACCORDANCE WITH ASTM C231 OR C173.

15. REINFORCING STEEL SHALL CONFORM TO ASTM A615 (INCLUDING SUPPLEMENTS S1), GRADE 60, $F_y = 60,000$ PSI. WELDED WIRE FABRIC SHALL CONFORM TO ASTM A-185

16. DETAILING OF REINFORCING STEEL (INCLUDING HOOKS AND BENDS) SHALL BE IN ACCORDANCE WITH ACI SP-66-04 AND ACI 318-14 CHAPTER 25. UNLESS OTHERWISE NOTED LAP REINFORCEMENT A MINIMUM OF 48 X BAR DIAMETER AND EMBED STANDARD 90 DEGREE HOOKS A MINIMUM OF 6-INCHES. LAP SPLICES SHALL BE STAGGERED SUCH THAT A MAXIMUM OF 50% OF THE TOTAL REINFORCEMENT IS SPLACED AT ANY ONE LOCATION. PROVIDE CORNER BARS AT ALL WALL AND FOOTING INTERSECTIONS.

LAP ADJACENT MATS OF WELDED WIRE FABRIC A MINIMUM OF 8" AT SIDES AND ENDS.

NO BARS PARTIALLY EMBEDDED IN HARDENED CONCRETE SHALL BE FIELD BENT UNLESS SPECIFICALLY SO DETAILED OR APPROVED BY THE STRUCTURAL ENGINEER. FIELD BENDING OF GRADE 60 REINFORCEMENT SHALL NOT BE ALLOWED.

17. CONCRETE PROTECTION (COVER) FOR REINFORCING STEEL SHALL BE AS FOLLOWS:

FOOTINGS AND OTHER UNFORMED SURFACES CAST AGAINST AND PERMANENTLY EXPOSED TO EARTH	3"
ALL OTHER SURFACES	1 1/2"

18. SLABS-ON-GRADE: UNLESS NOTED OTHERWISE SHALL BE 4" CONCRETE, REINFORCED WITH 6X6 W1.4XW1.4 WELDED WIRE FABRIC CENTERED IN SLAB. UNLESS OTHERWISE DIRECTED BY SOILS REPORT PROVIDE MINIMUM 10 MIL VAPOR BARRIER OVER 4" OF COMPACTED SAND OR GRAVEL.

19. CAST-IN-PLACE CONCRETE: SEE ARCHITECTURAL DRAWINGS FOR EXACT LOCATIONS AND DIMENSIONS OF DOOR AND WINDOW OPENINGS IN ALL CONCRETE WALLS. SEE ARCHITECTURAL DRAWINGS FOR ALL GROOVES, NOTCHES, CHAMFERS, FEATURE STRIPS, COLOR, TEXTURE, AND OTHER FINISH DETAILS AT ALL EXPOSED CONCRETE SURFACES.

WOOD

20. FRAMING LUMBER SHALL BE KILN DRIED OR MC-19, AND GRADED AND MARKED IN CONFORMANCE WITH WCLIB STANDARD GRADING RULES FOR WEST COAST LUMBER NO. 17, LATEST EDITION. FURNISH TO THE FOLLOWING MINIMUM STANDARDS.

JOISTS: (2X, 3X, AND 4X MEMBERS)	HEM-FIR NO. 2 MINIMUM BASIC DESIGN STRESS, $F_b = 850$ PSI
BEAM AND STRINGERS: (6 X AND LARGER MEMBERS)	DOUGLAS FIR LARCH NO. 1 MINIMUM BASIC DESIGN STRESS, $F_b = 1,350$ PSI
STUDS PLATES & MISCELLANEOUS LIGHT FRAMING	DOUGLAS FIR LARCH OR HEM-FIR NO. 2, MINIMUM BASIC DESIGN STRESS $F_b = 850$ PSI, $F_c = 1,300$ PSI

21. GLUED LAMINATED MEMBERS SHALL BE FABRICATED AND IDENTIFIED AS REQUIRED BY ASTM D3737 AND A.I.T.C. A190.1. EACH MEMBER SHALL BEAR AN A.I.T.C. IDENTIFICATION MARK AND SHALL BE ACCOMPANIED BY AN A.I.T.C. CERTIFICATE OF CONFORMANCE. IN ADDITION ALL GLULAMS SHALL CONFORM TO APA PERFORMANCE STANDARD PRG-305. ALL SIMPLE SPAN BEAMS SHALL BE DOUGLAS FIR COMBINATION 24F-V4, $F_b = 2,400$ PSI, $F_v = 240$ PSI, E = 1,800,000 PSI. ALL CANTILEVERED BEAMS SHALL BE DOUGLAS FIR COMBINATION 24F-V8, $F_b = 2,400$ PSI, $F_v = 240$ PSI, E = 1,800,000 PSI. UNLESS OTHERWISE NOTED CAMBER ALL GLULAM BEAMS TO 2,000 FOOT RADIUS. WHERE REQUIRED BEAMS AND COLUMNS SHALL BE PRESSURE TREATED AFTER MANUFACTURE IN ACCORDANCE WITH AMERICAN WOOD-PRESERVATIVES ASSOCIATION STANDARD U1.

22. PARALLEL STRAND LUMBER (PSL): EACH PIECE SHALL BEAR A STAMP OR STAMPS NOTING THE NAME AND PLANT NUMBER OF THE MANUFACTURER, THE GRADE, PRODUCT DESIGNATION OR TYPE, THE PRODUCTION DATE, SPECIES OR SPECIES GROUP DESIGNATION, AND THE QUALITY CONTROL AGENCY. MEMBERS SHALL BE GLUED WITH A WATERPROOF ADHESIVE MEETING THE REQUIREMENTS OF ASTM D2559 WITH ALL GRAIN PARALLEL WITH THE LENGTH OF THE MEMBER. STRUCTURAL CAPACITIES SHALL BE ESTABLISHED IN ACCORDANCE WITH ASTM D5456 AND PRODUCT SHALL HAVE AN APPROVED I.C.C.-E.S. EVALUATION REPORT. MEMBERS SHALL BE TRANSPORTED AND STORED PER MANUFACTURERS RECOMMENDATIONS AND SHALL NOT BE EXPOSED TO PROLONGED MOISTURE. MINIMUM REQUIRED DESIGN PROPERTIES: $F_b = 2900$ PSI, E = 2200,000 PSI, $F_v = 290$ PSI.

DESIGN SHOWN ON PLANS IS BASED ON LUMBER MANUFACTURED BY THE WEYERHAEUSER. ALTERNATE MANUFACTURERS MAY BE USED SUBJECT TO REVIEW AND APPROVAL BY THE ARCHITECT AND STRUCTURAL ENGINEER. ALTERNATE JOIST HANGERS AND OTHER HARDWARE MAY BE SUBSTITUTED FOR ITEMS SHOWN PROVIDED THEY HAVE ICC-ES APPROVAL FOR EQUAL OR GREATER LOAD CAPACITIES. ALL JOIST HANGERS AND OTHER HARDWARE SHALL BE COMPATIBLE IN SIZE WITH MEMBERS PROVIDED.

WOOD CONTINUED

23. LAMINATED STRAND LUMBER (LSL): EACH PIECE SHALL BEAR A STAMP OR STAMPS NOTING THE NAME AND PLANT NUMBER OF THE MANUFACTURER, THE GRADE, PRODUCT DESIGNATION OR TYPE, THE PRODUCTION DATE, SPECIES OR SPECIES GROUP DESIGNATION, AND THE QUALITY CONTROL AGENCY. MEMBERS SHALL BE GLUED WITH A WATERPROOF ADHESIVE MEETING THE REQUIREMENTS OF ASTM D2559 WITH ALL GRAIN PARALLEL WITH THE LENGTH OF THE MEMBER. STRUCTURAL CAPACITIES SHALL BE ESTABLISHED IN ACCORDANCE WITH ASTM D5456 AND PRODUCT SHALL HAVE AN APPROVED I.C.C.-E.S. EVALUATION REPORT. MEMBERS SHALL BE TRANSPORTED AND STORED PER MANUFACTURERS RECOMMENDATIONS AND SHALL NOT BE EXPOSED TO PROLONGED MOISTURE. MINIMUM REQUIRED DESIGN PROPERTIES: $F_b = 2325$ PSI, $F_v = 310$ PSI, E = 1,550,000 PSI.

LSL RIM JOISTS SHALL CONFORM TO ANSI/APA PRR 410 AND SHALL BE MARKED IN ACCORDANCE WITH THE STANDARD.

DESIGN SHOWN ON PLANS IS BASED ON LUMBER MANUFACTURED BY WEYERHAEUSER. ALTERNATE MANUFACTURERS MAY BE USED SUBJECT TO REVIEW AND APPROVAL BY THE ARCHITECT AND STRUCTURAL ENGINEER. ALTERNATE JOIST HANGERS AND OTHER HARDWARE MAY BE SUBSTITUTED FOR ITEMS SHOWN PROVIDED THEY HAVE ICC-ES APPROVAL FOR EQUAL OR GREATER LOAD CAPACITIES. ALL JOIST HANGERS AND OTHER HARDWARE SHALL BE COMPATIBLE IN SIZE WITH MEMBERS PROVIDED.

24. PREFABRICATED PLYWOOD WEB JOIST DESIGN SHOWN ON PLANS IS BASED ON JOIST MANUFACTURED BY THE WEYERHAEUSER. ALTERNATE PLYWOOD WEB JOIST MANUFACTURERS MAY BE USED SUBJECT TO REVIEW AND APPROVAL BY THE ARCHITECT AND STRUCTURAL ENGINEER. ALTERNATE JOIST HANGERS AND OTHER HARDWARE MAY BE SUBSTITUTED FOR ITEMS SHOWN PROVIDED THEY HAVE ICC-ES APPROVAL FOR EQUAL OR GREATER LOAD CAPACITIES. ALL JOIST HANGERS AND OTHER HARDWARE SHALL BE COMPATIBLE IN SIZE WITH PLYWOOD WEB JOIST PROVIDED.

30. PLYWOOD SHEATHING SHALL BE GRADE C-D, EXTERIOR GLUE OR STRUCTURAL II, EXTERIOR GLUE IN CONFORMANCE WITH DOC PS 1-09 OR PS 2-10 AND AMERICAN PLYWOOD ASSOCIATION PERFORMANCE STANDARD PRP-108. ORIENTED STRAND BOARD OF EQUIVALENT THICKNESS, EXPOSURE RATING AND PANEL INDEX MAY BE USED IN LIEU OF PLYWOOD. SEE PLANS FOR THICKNESS, PANEL IDENTIFICATION INDEX AND NAILING REQUIREMENTS. EACH PANEL SHALL BE IDENTIFIED FOR GRADE AND GLUE TYPE BY THE TRADEMARKS OF AN APPROVED TESTING AND GRADING AGENCY.

31. ALL WOOD PLATES IN DIRECT CONTACT WITH CONCRETE OR MASONRY SHALL BE PRESSURE-TREATED WITH AN APPROVED PRESERVATIVE, PROVIDE 2 LAYERS OF ASPHALT IMPREGNATED BUILDING PAPER BETWEEN UNTREATED LEDGERS, BLOCKING, ETC. AND CONCRETE OR MASONRY.

PRESSURE TREATED LUMBER SHALL COMPLY WITH THE AMERICAN WOOD PROTECTION ASSOCIATION (AWPA) STANDARD U1, COMMODITY SPECIFICATION A. ALL TREATED LUMBER SHALL BEAR THE QUALITY MARK OF AN ACCREDITED INSPECTION AGENCY. THE QUALITY MARK SHALL INCLUDE:

- IDENTIFICATION OF TREATING MANUFACTURER
- TYPE OF PRESERVATIVE USED
- MINIMUM PRESERVATIVE RETENTION (PCF)
- END USE FOR WHICH THE PRODUCT IS TREATED
- IDENTITY OF THE ACCREDITED INSPECTION AGENCY
- STANDARD TO WHICH THE PRODUCT IS TREATED

32. TIMBER CONNECTORS CALLED OUT BY LETTERS AND NUMBERS SHALL BE "STRONG-TIE" BY SIMPSON COMPANY, AS SPECIFIED IN THEIR CATALOG NUMBER C-C-2019. EQUIVALENT DEVICES BY OTHER MANUFACTURERS MAY BE SUBSTITUTED, PROVIDED THEY HAVE ICC-ES APPROVAL FOR EQUAL OR GREATER LOAD CAPACITIES. PROVIDE NUMBER AND SIZE OF FASTENERS AS SPECIFIED BY MANUFACTURER. CONNECTORS SHALL BE INSTALLED IN ACCORDANCE WITH THE MANUFACTURER'S RECOMMENDATIONS. WHERE CONNECTOR STRAPS CONNECT TWO MEMBERS, PLACE ONE-HALF OF THE NAILS OR BOLTS IN EACH MEMBER. SHIMS, WHERE REQUIRED, SHALL BE SEASONED AND DRIED AND THE SAME GRADE (MINIMUM) AS MEMBERS CONNECTED.

ALL BOLTS IN WOOD MEMBERS SHALL CONFORM TO ASTM A307. PROVIDE WASHERS UNDER THE HEADS AND NUTS OF ALL BOLTS AND LAG SCREWS BEARING ON WOOD. ALL LAG SCREWS SHALL BE INSTALLED IN PRE-DRILLED HOLES.

UNLESS NOTED OTHERWISE, ALL NAILS SHALL BE COMMON AND MAXIMUM NUMBER OF NAILS AS SPECIFIED BY THE MANUFACTURER SHALL BE PROVIDED.

UNLESS NOTED OTHERWISE ALL SAWN LUMBER JOISTS SHALL BE CONNECTED TO FLUSH BEAMS WITH "LUS" SERIES JOIST HANGERS AND ALL PREFABRICATED PLYWOOD WEB JOISTS SHALL BE CONNECTED TO FLUSH BEAMS WITH "IUS" SERIES JOIST HANGERS UNLESS NOTED OTHERWISE.

ALL CONNECTIONS IN CONTACT WITH PRESERVATIVE-TREATED OR FIRE-RETARDANT-TREATED WOOD, SHALL BE OF HOT DIPPED ZINC-COATED GALVANIZED STEEL OR STAINLESS STEEL. HOT DIPPED GALVANIZED FASTENERS SHOULD CONFORM TO ASTM STANDARD 153, AND HOT DIPPED GALVANIZED CONNECTORS SHOULD CONFORM TO ASTM STANDARD A653 (CLASS G-185). STAINLESS STEEL FASTENERS AND CONNECTORS SHOULD BE TYPE 304 OR 316. NOTE: ELECTROPLATED GALVANIZED FASTENERS AND CONNECTORS ARE NOT TO BE USED WITH PRESSURE TREATED WOOD. SIMPSON PRODUCT FINISHES CORRESPONDING TO THE ABOVE REQUIREMENTS ARE ZMAX (HOT DIPPED GALVANIZED) AND S3T300 (STAINLESS STEEL). STAINLESS STEEL HARDWARE AND FASTENERS SHALL NOT BE COMBINED WITH UNTREATED OR GALVANIZED MATERIAL.

33. WOOD FASTENERS:

- NAIL SIZES** SPECIFIED ON DRAWINGS ARE BASED ON THE FOLLOWING SPECIFICATIONS:

SIZE	LENGTH	DIAMETER
6d	2"	0.113"
8d	2-1/2"	0.131"
10d	3"	0.148"
12d	3-1/4"	0.148"
16d	3-1/2"	0.162"

DESIGN IS BASED ON COMMON STEEL WIRE NAILS MEETING THE REQUIREMENTS OF ASTM F1667. USE OF ALTERNATE FASTENERS MUST BE SUBMITTED FOR REVIEW AND APPROVAL BY THE STRUCTURAL ENGINEER PRIOR TO THE START OF CONSTRUCTION.

- NAILS – PLYWOOD** (APA RATED SHEATHING) FASTENERS TO FRAMING SHALL BE DRIVEN FLUSH TO FACE OF SHEATHING WITH NO COUNTERSINKING PERMITTED.

WOOD CONTINUED

34. WOOD FRAMING NOTES – THE FOLLOWING APPLY UNLESS OTHERWISE SHOWN ON THE PLANS:

- ALL WOOD FRAMING DETAILS NOT SHOWN OTHERWISE SHALL BE CONSTRUCTED TO THE MINIMUM STANDARDS OF THE SEATTLE BUILDING CODE. MINIMUM NAILING, UNLESS OTHERWISE NOTED, SHALL CONFORM TO TABLE 2304.10.1 OF THE SEATTLE BUILDING CODE. UNLESS NOTED OTHERWISE, ALL NAILS SHALL BE AS SPECIFIED ABOVE. COORDINATE THE SIZE AND LOCATION OF ALL OPENINGS WITH MECHANICAL AND ARCHITECTURAL DRAWINGS. PROVIDE WASHERS UNDER THE HEADS AND NUTS OF ALL BOLTS AND LAG SCREWS BEARING ON WOOD. INSTALLATION OF BOLTS AND LAG SCREWS SHALL CONFORM TO SECTIONS 12.1.3 AND 12.1.4 OF THE 2015 NATIONAL DESIGN SPECIFICATION FOR WOOD CONSTRUCTION. NATURALLY DURABLE OR PRESSURE TREATED WOOD SHALL BE PROVIDED WHERE REQUIRED BY SECTION 2304.12 OF THE SEATTLE BUILDING CODE.

- WALL FRAMING: ALL STUD WALLS SHOWN AND NOT OTHERWISE NOTED SHALL BE 2X6 AT 16" O.C. TWO STUDS MINIMUM SHALL BE PROVIDED AT THE END OF ALL WALLS AND AT EACH SIDE OF ALL OPENINGS. TWO 2 x 8 HEADERS SHALL BE PROVIDED OVER ALL OPENINGS NOT OTHERWISE NOTED AND SHALL BEAR FULLY ON A MINIMUM OF TWO STUDS. SOLID BLOCKING FOR WOOD COLUMNS SHALL BE PROVIDED THROUGH FLOORS TO SUPPORTS BELOW. PROVIDE SOLID BLOCKING BETWEEN STUDS AT MID-HEIGHT OF ALL STUD WALLS OVER 10' IN HEIGHT.

STUDS MAY BE NOTCHED, CUT, OR PENETRATED WITH ROUND BORED HOLES AS FOLLOWS:

STUD SIZE	MAXIMUM NOTCH / CUT	MAXIMUM BORED HOLE
2X4	7/8"	1-3/8"
2X6	1-3/8"	2-1/8"

BORED HOLES SHALL NOT BE LOCATED WITH 5/8" FROM THE EDGE OF THE STUD OR AT THE SAME LOCATION AS A NOTCH OR CUT.

WALLS SHALL HAVE A SINGLE BOTTOM PLATE AND A DOUBLE TOP PLATE. END NAIL TOP PLATE TO EACH STUD WITH TWO 16d NAILS, AND TOENAIL OR END NAIL EACH STUD TO BOTTOM PLATE WITH TWO 16d NAILS. FACE NAIL DOUBLE TOP PLATE WITH 16d AT 12" O.C. AND LAP MINIMUM 4'-0" AT JOINTS AND PROVIDE EIGHT 16d NAILS AT 4" O.C. EACH SIDE OF JOINT.

ALL STUD WALLS SHALL HAVE THEIR LOWER WOOD PLATES ATTACHED TO WOOD FRAMING BELOW WITH 16d NAILS AT 12" O.C. STAGGERED OR BOLTED TO CONCRETE WITH 5/8" DIAMETER ANCHOR BOLTS (WITH 7" MINIMUM EMBEDMENT) @ 4'-0" O.C. UNLESS INDICATED OTHERWISE. PROVIDE 3"x3"x1/4" HOT-DIPPED GALVANIZED PLATE WASHERS AT ALL ANCHOR BOLTS. INDIVIDUAL MEMBERS OF BUILT-UP POSTS SHALL BE NAILED TO EACH OTHER WITH 16d NAILS @ 12" O.C. STAGGERED. REFER TO THE PLANS AND SHEAR WALL SCHEDULE FOR REQUIRED SHEATHING AND NAILING. WHEN NOT OTHERWISE NOTED, PROVIDE GYPSUM WALLBOARD ON INTERIOR SURFACES NAILED TO ALL STUDS, TOP AND BOTTOM PLATES AND BLOCKING WITH NAILS AT 7" O.C. USE 5d COOLER NAILS FOR 1/2" GWB AND 6d COOLER NAILS FOR 5/8" GWB. PROVIDE 15/32" APA RATED SHEATHING (SPAN RATING 24(0) ON EXTERIOR SURFACES NAILED AT ALL PANEL EDGES (BLOCK UNSUPPORTED EDGES), TOP AND BOTTOM PLATES WITH 8d NAILS @ 6" O.C. AND TO ALL INTERMEDIATE STUDS AND BLOCKING WITH NAILS @ 12" O.C. ALLOW 1/8" SPACING AT ALL PANEL EDGES AND ENDS.

- FLOOR AND ROOF FRAMING: PROVIDE DOUBLE JOISTS UNDER ALL PARALLEL PARTITIONS THAT EXTEND OVER MORE THAN HALF THE JOIST LENGTH AND AROUND ALL OPENINGS IN FLOORS OR ROOFS UNLESS OTHERWISE NOTED. PROVIDE SOLID BLOCKING AT ALL BEARING POINTS.

NOTCHES AT THE END OF JOISTS AND RAFTERS SHALL NOT EXCEED 1/4 THE DEPTH OF THE MEMBER. NOTCHES IN THE TOP OR BOTTOM SHALL NOT EXCEED 1/6 THE DEPTH OF THE MEMBER AND SHALL NOT BE LOCATED WITHIN THE MIDDLE 1/3 OF THE SPAN. THE DIAMETER OF ROUND HOLES BORED IN JOISTS AND RAFTERS SHALL NOT EXCEED 1/3 OF THE DEPTH OF THE MEMBER AND SHALL NOT BE LOCATED WITHIN 2" FROM THE TOP OR BOTTOM EDGE.


TOENAIL JOISTS TO SUPPORTS WITH TWO 16d NAILS. ATTACH TIMBER JOISTS TO FLUSH HEADERS OR BEAMS WITH SIMPSON METAL JOIST HANGERS IN ACCORDANCE WITH NOTES ABOVE. NAIL ALL MULTI-JOIST BEAMS TOGETHER WITH TWO ROWS OF 16d @ 12" O.C. ATTACH RAFTERS AND ROOF TRUSSES AT BEARING LINES WITH H2.5 @ 24" O.C. UNLESS OTHER METAL CONNECTIONS ARE PROVIDED.

UNLESS OTHERWISE NOTED ON THE PLANS, APA RATED ROOF AND FLOOR SHEATHING SHALL BE LAID UP WITH STRENGTH AXIS PERPENDICULAR TO SUPPORTS AND NAILED WITH NAILS @ 6" O.C. TO FRAMED PANEL EDGES AND OVER STUD WALLS AS SHOWN ON PLANS AND @ 12" O.C. TO INTERMEDIATE SUPPORTS. PROVIDE APPROVED PLYWOOD EDGE CLIPS CENTERED BETWEEN JOISTS/TRUSSES AT UNBLOCKED ROOF SHEATHING EDGES. ALL FLOOR SHEATHING EDGES SHALL HAVE APPROVED TONGUE-AND-GROOVE JOINTS OR SHALL BE SUPPORTED WITH SOLID BLOCKING. ALLOW 1/8" SPACING AT ALL PANEL EDGES AND ENDS OF ALL ROOF AND FLOOR SHEATHING. TOENAIL BLOCKING TO SUPPORTS WITH 16d @ 12" O.C. UNLESS OTHERWISE NOTED. AT BLOCKED FLOOR AND ROOF DIAPHRAGMS PROVIDE FLAT 2X BLOCKING AT ALL UNFRAMED PLYWOOD PANEL EDGES AND NAIL WITH EDGE NAILING SPECIFIED.

POST INSALLED ANCHORS

35. POST-INSTALLED ANCHORS SHALL ONLY BE USED WHERE SPECIFIED ON THE CONSTRUCTION DOCUMENTS. THE CONTRACTOR SHALL OBTAIN APPROVAL FROM THE ENGINEER-OF-RECORD PRIOR TO INSTALLING POST-INSTALLED ANCHORS IN PLACE OF MISSING OR MISPLACED CAST-IN-PLACE ANCHORS. CARE SHALL BE TAKEN IN PLACING POST-INSTALLED ANCHORS TO AVOID CONFLICTS WITH EXISTING REINFORCEMENT. HOLES SHALL BE DRILLED AND CLEANED IN ACCORDANCE WITH THE MANUFACTURER'S WRITTEN INSTRUCTIONS AND ICC-ES REPORT. SUBSTITUTION REQUESTS, FOR PRODUCTS OTHER THAN THOSE SPECIFIED BELOW SHALL BE SUBMITTED BY THE CONTRACTOR TO THE ENGINEER-OF-RECORD. SUBSTITUTIONS SHALL HAVE CURRENT ICC-ES APPROVAL.

- CONCRETE ANCHORS
 - MECHANICAL ANCHORS FOR USE IN CRACKED AND UNCRACKED CONCRETE SHALL HAVE BEEN TESTED AND QUALIFIED FOR USE IN ACCORDANCE WITH ACI 355.2 AND ICC-ES AC193. PRE-APPROVED MECHANICAL ANCHORS INCLUDE:
 - SIMPSON STRONG-TIE "STRONG-BOLT" (ICC-ES ESR-1771)
 - SIMPSON STRONG-TIE "TITEN-HD" (ICC-ES ESR-2713)
 - ADHESIVE ANCHORS FOR USE IN CRACKED AND UNCRACKED CONCRETE SHALL HAVE BEEN TESTED AND QUALIFIED FOR USE IN ACCORDANCE WITH ICC-ES AC308. PRE-APPROVED ADHESIVE ANCHORS INCLUDE:
 - SIMPSON STRONG-TIE "SET-XP" (ICC-ES ESR-2508)
 - SIMPSON STRONG-TIE "AT-XP" (APMO UES ER-263)

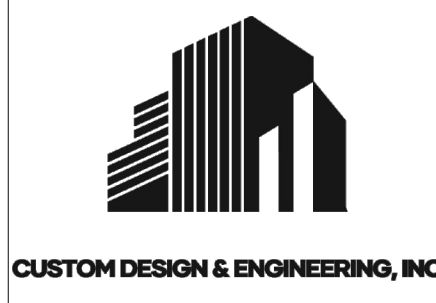

Custom Design and Engineering, Inc
6021 Roosevelt Way Ne
Seattle, WA 98115
www.cdengr.com
email: kam@cdengr.com

PROJECT NAME: RAQUEPAU RESIDENCE	PROJECT ADDRESS: 9116 SE 58th ST MERCER ISLAND, WA 98040

DWG TITLE GENERAL NOTES	Revision
	Number
	Date



7/31/2023

PROJECT #
Z4-3205

SHEET NO

S1.0

FOUNDATION PLAN NOTES: (TYPICAL UNLESS NOTED OTHERWISE)

1. SLAB ON GRADE ELEVATION VARIES PER ARCHITECTURAL PLAN. SLAB SHALL BE 4" THICK WITH 6x6 W1.4xW1.4 WWM CENTERED, U.O.N. PREPARE SOILS AND PROVIDE MINIMUM 6-MIL VISQUEEN VAPOR BARRIER UNDER ALL SLABS. SLABS SHALL BE SUPPORTED ON MINIMUM 4 INCHES OF FREE DRAINING MATERIAL.
2. REFER ARCHITECTURAL SHEETS FOR DIMENSIONS AND ADDITIONAL TOP OF SLAB/CURB ELEVATIONS.


FRAMING PLAN NOTES: (TYPICAL UNLESS NOTED OTHERWISE)

1. FLOOR SHEATHING SHALL BE 23/32" TONGUE AND GROOVE APA RATED SHEATHING (SPAN RATING 40/20). NAIL @ ALL FRAMED PANEL EDGES AND OVER SHEARWALLS w/10d @ 6"oc AND 12"oc TO ALL INTERMEDIATE FRAMING.
2. ROOF SHEATHING SHALL BE 15/32" APA RATED SHEATHING (SPAN RATING 24/0). NAIL @ ALL FRAMED PANEL EDGES AND OVER SHEARWALLS w/ 8d @ 6"oc AND 12"oc TO ALL INTERMEDIATE FRAMING. ENTIRE ROOF HAS BEEN DESIGNED FOR ADDITIONAL 5 PSF SOLAR PANELS.
3. SW- INDICATES STRUCTURAL WALL TYPE PER SCHEDULE 12/S6.0b. SEE ARCHITECTURAL DRAWINGS FOR ADDITIONAL WALL INFORMATION.
4. ALL HEADERS AND BEAMS ARE MARKED ON PLAN. REFER NOTE 5 FOR SUPPORT REQUIREMENTS.
5. COLUMNS SHALL CONSIST OF STUDS TO MATCH WIDTH OF BEAM TYPICAL OR MATCH POST SIZE SPECIFIED ON PLAN IF APPLICABLE. NOTE THE MINIMUM SUPPORT STUDS SHALL BE (2) 2x BEAM OR HEADER SHALL BEAR FULLY ON COLUMN.


LEGEND

- HANGER
- COLUMNS BELOW
- COLUMNS ABOVE
- ABRUPT CHANGE IN SLAB/FRAMING ELEVATION
- FB INDICATES FLUSH BEAM
- SPAN AND EXTENTS
- SPOT FOOTING - SIZE AND REQUIRED REINFORCING PER FOOTING SCHEDULE
- INDICATES SHEARWALL PER SCHEDULE 12/S6.0b
- INDICATES SIMPSON HOLDOWN. REFER DETAIL 8/S6.0b FOR REQUIRED NUMBER OF STUDS, THREADED ROD CALLOUT & EMBEDMENT INTO CONCRETE.
- INDICATES SIMPSON STRAP HOLDOWN. REFER DETAIL 8/S6.0b
- HANGER ID PER SCHEDULE

FOOTING SCHEDULE			
FOOTING ID	SIZE (WIDTH X LENGTH X DEPTH)	REINFORCING	NOTES (IF APPLICABLE)
FTG1	2'-0" x 2'-0" x 1'-0" FTG	(3) #4 E.W	

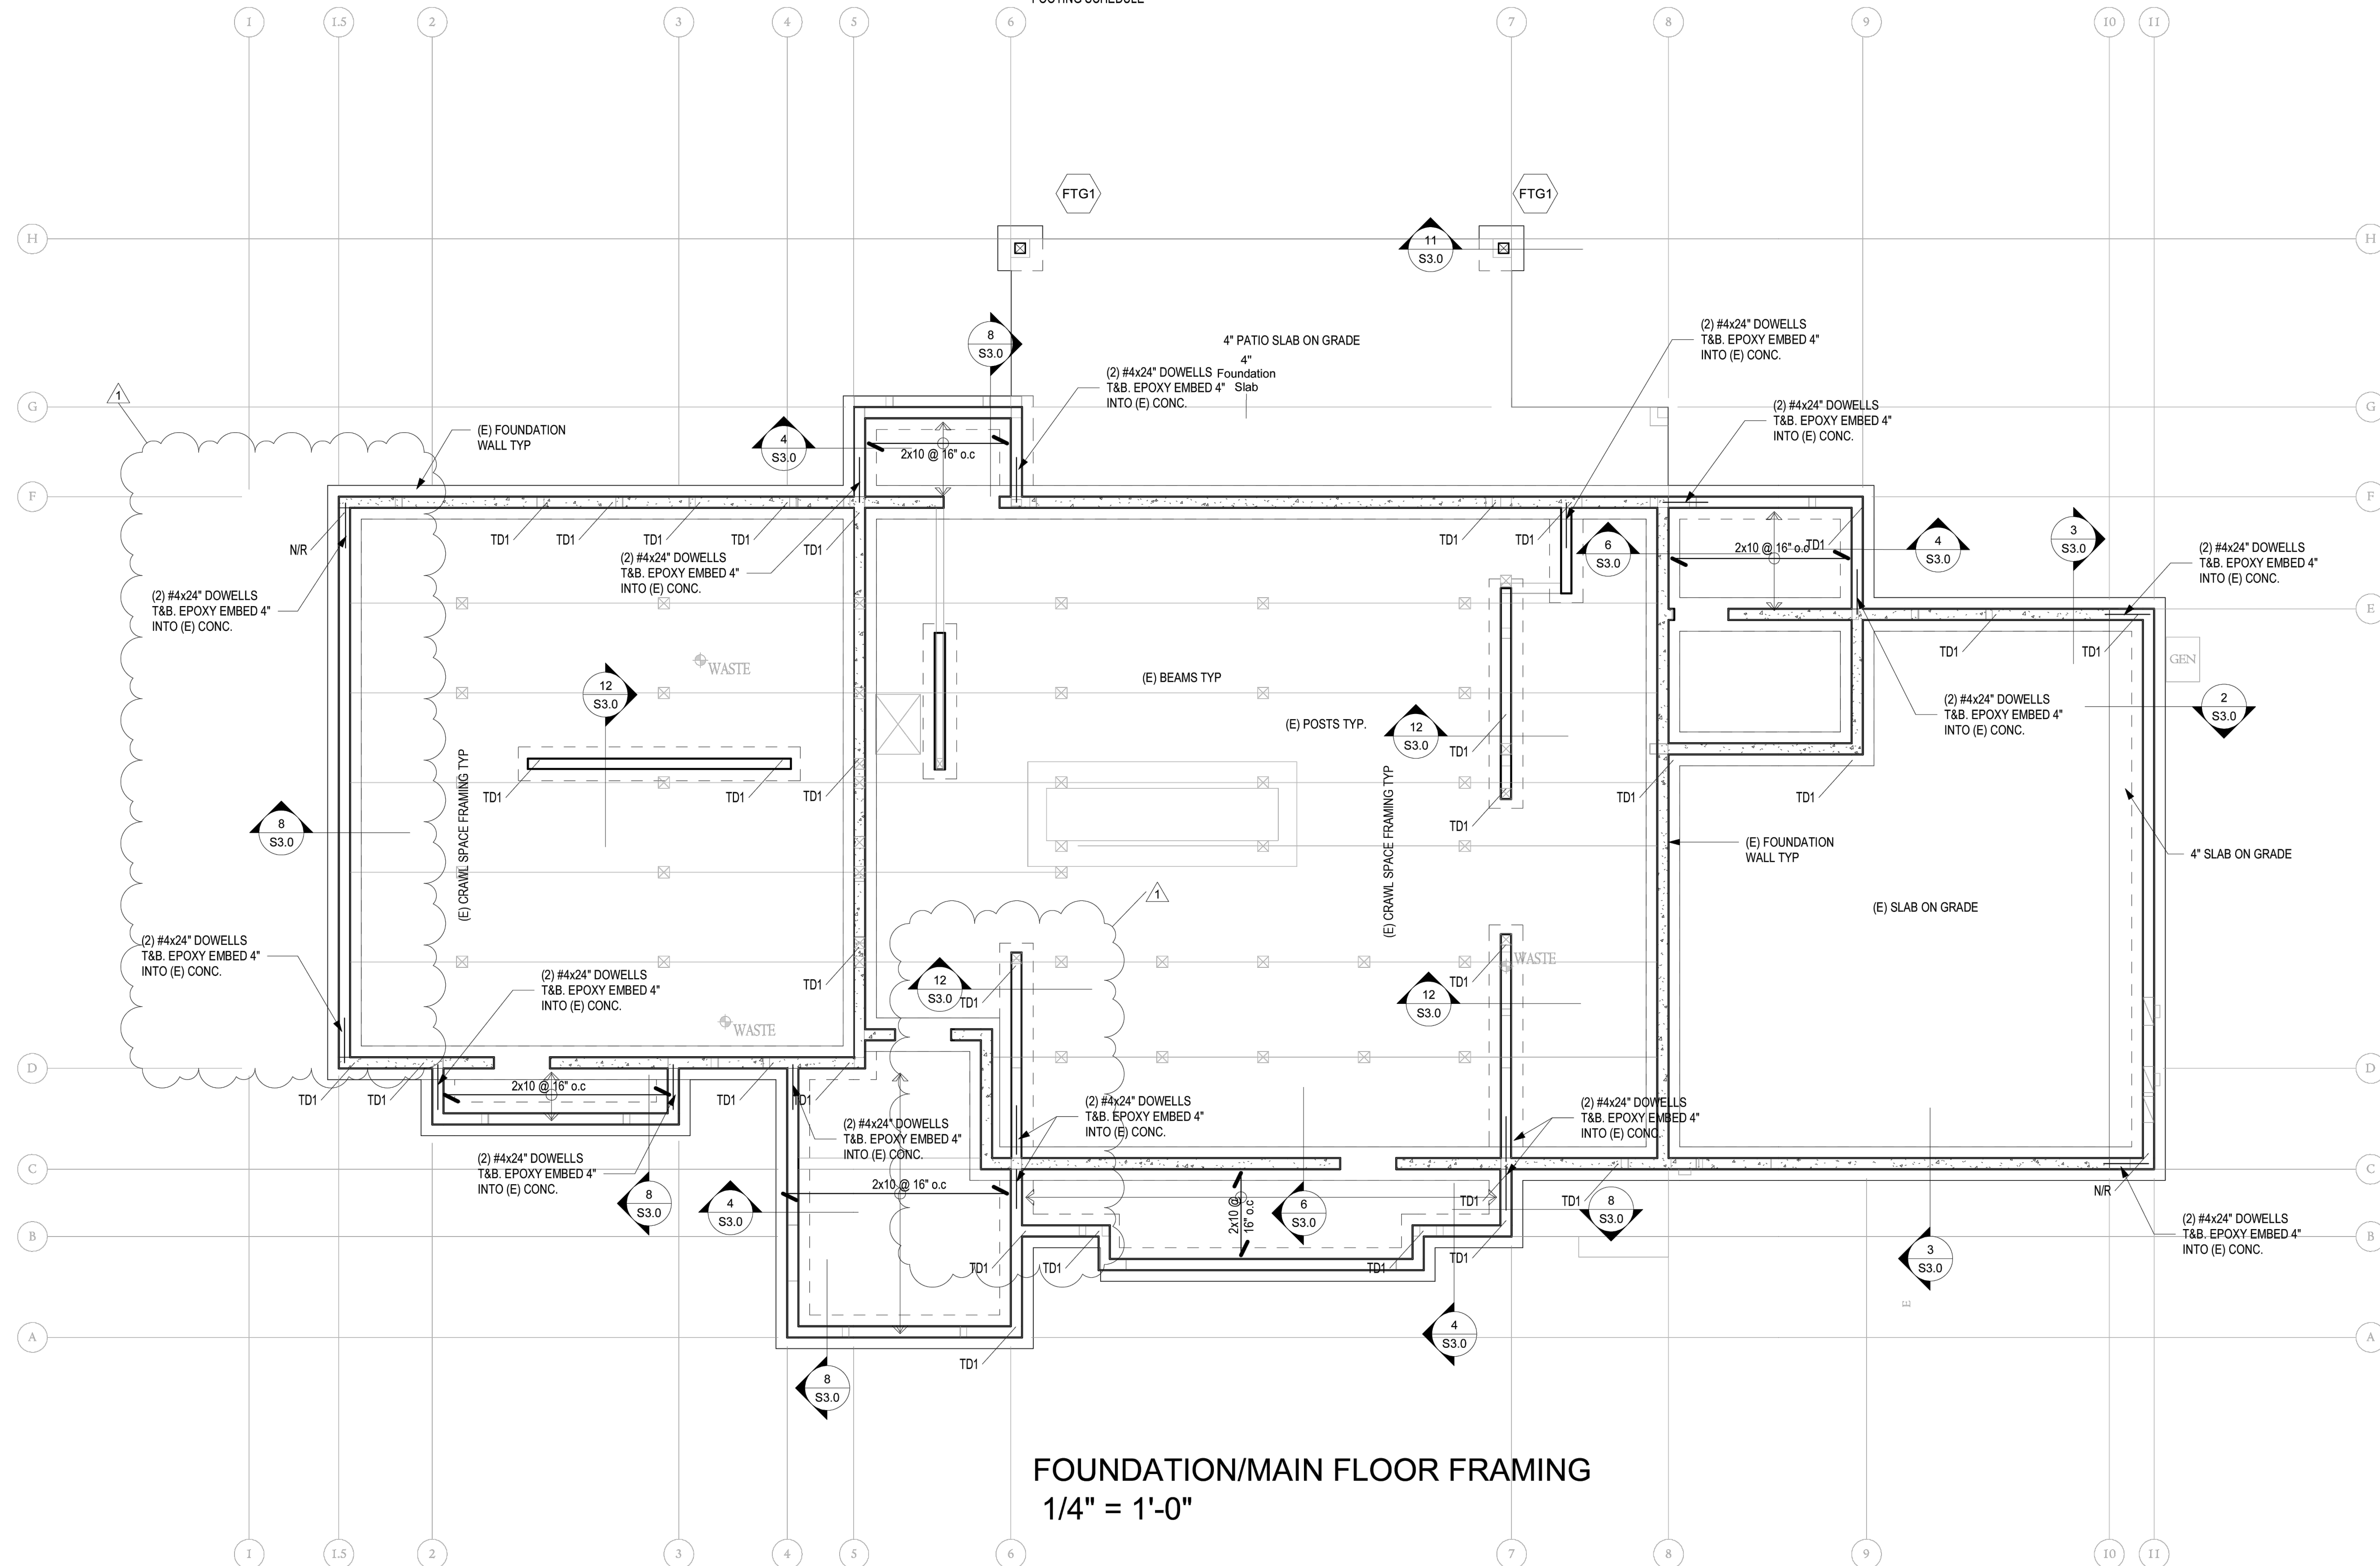


FOUNDATION/MAIN FLOOR FRAMING
1/4" = 1'-0"

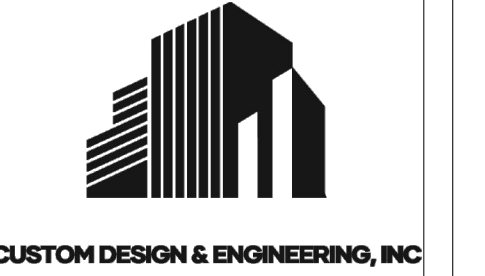

Custom Design and Engineering, Inc
6021 Roosevelt Way Ne
Seattle, WA 98115
www.cdengr.com
email: kam@cdengr.com

PROJECT NAME: **RAQUEPAU RESIDENCE**
PROJECT ADDRESS: **9116 SE 58th ST
MERCER ISLAND, WA 98040**

DWG TITLE: **FOUNDATION & MAIN FLOOR FRAMING PLAN**
Revision: DMB
Number: 1
Date: 2/29/2024
PERMIT CORRECTION SET

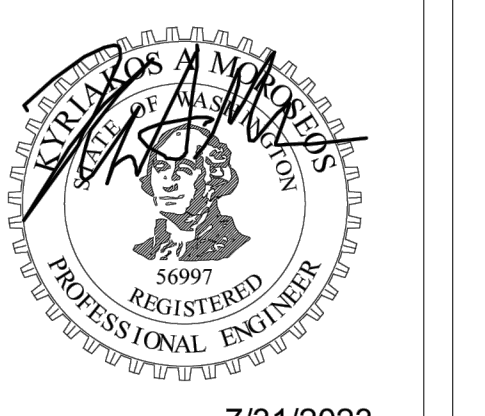


7/31/2023
PROJECT # **Z4-3205**

SHEET NO
S2.0

FRAMING PLAN NOTES: (TYPICAL UNLESS NOTED OTHERWISE)

- FLOOR SHEATHING SHALL BE 23/32" TONGUE AND GROOVE APA RATED SHEATHING (SPAN RATING 40/20). NAIL @ ALL FRAMED PANEL EDGES AND OVER SHEARWALLS w/10d @ 6"oc AND 12"oc TO ALL INTERMEDIATE FRAMING.
- ROOF SHEATHING SHALL BE 15/32" APA RATED SHEATHING (SPAN RATING 24/0). NAIL @ ALL FRAMED PANEL EDGES AND OVER SHEARWALLS w/ 8d @ 6"oc AND 12"oc TO ALL INTERMEDIATE FRAMING. ENTIRE ROOF HAS BEEN DESIGNED FOR ADDITIONAL 5 PSF SOLAR PANELS.
- SW- INDICATES STRUCTURAL WALL TYPE PER SCHEDULE 12/S6.0b. SEE ARCHITECTURAL DRAWINGS FOR ADDITIONAL WALL INFORMATION.
- ALL HEADERS AND BEAMS ARE MARKED ON PLAN. REFER NOTE 5 FOR SUPPORT REQUIREMENTS.
- COLUMNS SHALL CONSIST OF STUDS TO MATCH WIDTH OF BEAM TYPICAL OR MATCH POST SIZE SPECIFIED ON PLAN IF APPLICABLE. NOTE THE MINIMUM SUPPORT STUDS SHALL BE (2) 2x. BEAM OR HEADER SHALL BEAR FULLY ON COLUMN.

LEGEND

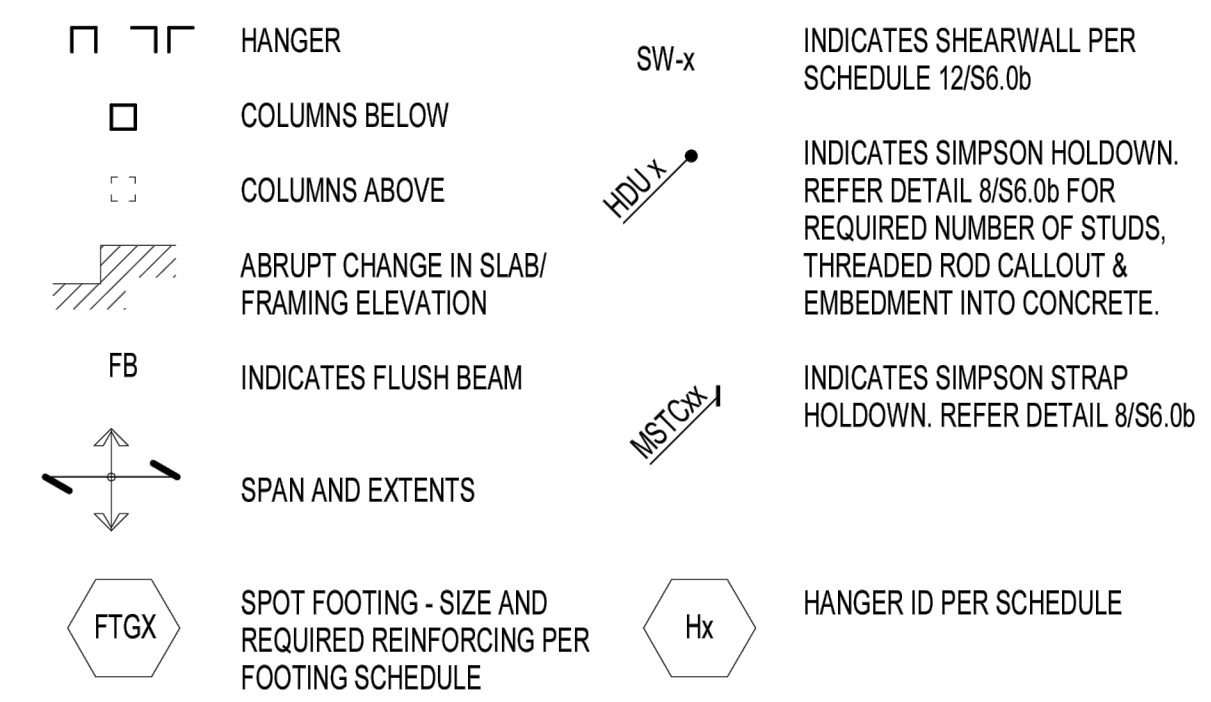

FRAMING PLAN NOTES: (TYPICAL UNLESS NOTED OTHERWISE)


TRUSS DESIGN LOADS:
 SNOW: 25 PSF
 ROOF DEAD = 15 PSF
 UPLIFT = 10 PSF
 MINIMUM LWR CHORD DESIGN LOAD = 20 PSF

PRE-MANUFACTURED TRUSSES PER SECTION IBC 2303.4.1
 TRUSS DESIGN DRAWINGS, TRUSS CONSTRUCTION DOCUMENTS SHALL BE PREPARED BY A WASHINGTON STATE LICENSED ENGINEER AND SHALL BE PROVIDED TO THE BUILDING OFFICIAL AND APPROVED PRIOR TO INSTALLATION. THESE CONSTRUCTION DOCUMENTS SHALL INCLUDE, AT A MINIMUM, THE INFORMATION SPECIFIED BELOW. TRUSS SHOP DRAWINGS SHALL BE PROVIDED WITH THE SHIPMENT OF TRUSSES DELIVERED TO THE JOB SITE.


- SLOPE OR DEPTH, SPAN AND SPACING;
- LOCATION OF JOINTS;
- REQUIRED BEARING WIDTHS;
- DESIGN LOADS AS APPLICABLE;
- TOP CHORD LIVE LOAD (INCLUDING SNOW LOADS);
- TOP CHORD DEAD LOAD;
- BOTTOM CHORD LIVE LOAD;
- BOTTOM CHORD DEAD LOAD;
- CONCENTRATED LOADS AND THEIR POINTS OF APPLICATION;
- CONTROLLING WIND AND EARTHQUAKE LOADS;
- ADJUSTMENTS TO LUMBER AND METAL CONNECTOR PLATE DESIGN VALUE FOR CONDITIONS OF USE;
- EACH REACTION FORCE AND DIRECTION;
- METAL CONNECTOR PLATE TYPE, SIZE, THICKNESS OR GAGE, AND THE DIMENSIONED LOCATION OF EACH METAL CONNECTOR PLATE EXCEPT WHERE SYMMETRICALLY LOCATED RELATIVE TO THE JOINT INTERFACE;
- LUMBER SIZE, SPECIES AND GRADE FOR EACH MEMBER;
- CONNECTION REQUIREMENTS FOR:
 - TRUSS TO TRUSS GIRDER;
 - TRUSS PLY TO PLY; AND
 - FIELD SPECIES;
- DRAG TRUSS CONNECTION TO SHEAR WALLS FOR THE LOADS SPECIFIED (WHERE APPLICABLE);
- CALCULATED DEFLECTION RATIO OR MAXIMUM DEFLECTION FOR LIVE AND TOTAL LOAD;
- MAXIMUM AXIAL COMPRESSION FORCES IN THE TRUSS MEMBERS TO DESIGN THE SIZE, CONNECTIONS AND ANCHORAGE OF THE PERMANENT CONTINUOUS LATERAL BRACING. FORCES SHALL BE SHOWN ON THE TRUSS CONSTRUCTION DOCUMENTS OR ON SUPPLEMENTAL DOCUMENTS; AND
- REQUIRED PERMANENT TRUSS MEMBER BRACING LOCATION.

PROVIDE 4 X 6 DF 1 POST UNDER ALL GIRDER TRUSS SUPPORT LOCATIONS. THESE SUPPORTS MUST FOLLOW TO FOUNDATION TO DISTRIBUTE BEARING LOADS
 UNLESS NOTED OTHERWISE THE ROOF STRUCTURE SHALL CONSIST OF THE FOLLOWING:

- LIGHT WEIGHT ROOF NOT EXCEEDING 6 PSF. THIS MAY CONSIST OF: LIGHT WEIGHT TILE, CEDAR SHAKES, COMPOSITION ROOF, LIGHT GAUGE METAL.
 - 15# FELT (OR AS SPECIFIED BY ARCHITECT).
 - 15 / 32 CDX OR 1/2" OSB. NAILED TO 2X NOMINAL FRAMING MEMBERS WITH 10D @ 6" O.C. EDGES & 12" O.C. FIELD. NO BLOCKING IS REQUIRED, UNLESS SPECIFIED ON PLAN.
 - INSULATION PER ARCHITECTURAL DRAWINGS.
- NO MODIFICATION IS ALLOWED ON PRE-ENGINEERED TRUSSES.
 FRAMING/BRACING IS ERECTORS RESPONSIBILITY.
 OVER FRAMING SHALL CONSIST OF THE FOLLOWING:
- 2 X 4 HF #2 FOR SPANS UP TO 6'
 - 2 X 6 HF #2 FOR SPANS UP TO 8'
 - 2 X 8 HF #2 FOR SPANS UP TO 12'
 - 2 X 10 HF #2 FOR SPANS UP TO 16'
- REFER TO THE TYPICAL HEADER DETAIL ON THIS SHEET FOR HEADERS NOT SPECIFICALLY CALLED OUT ON THE PLAN. THIS DETAIL IS TYPICAL FOR NON-BEARING EXTERIOR WALLS.

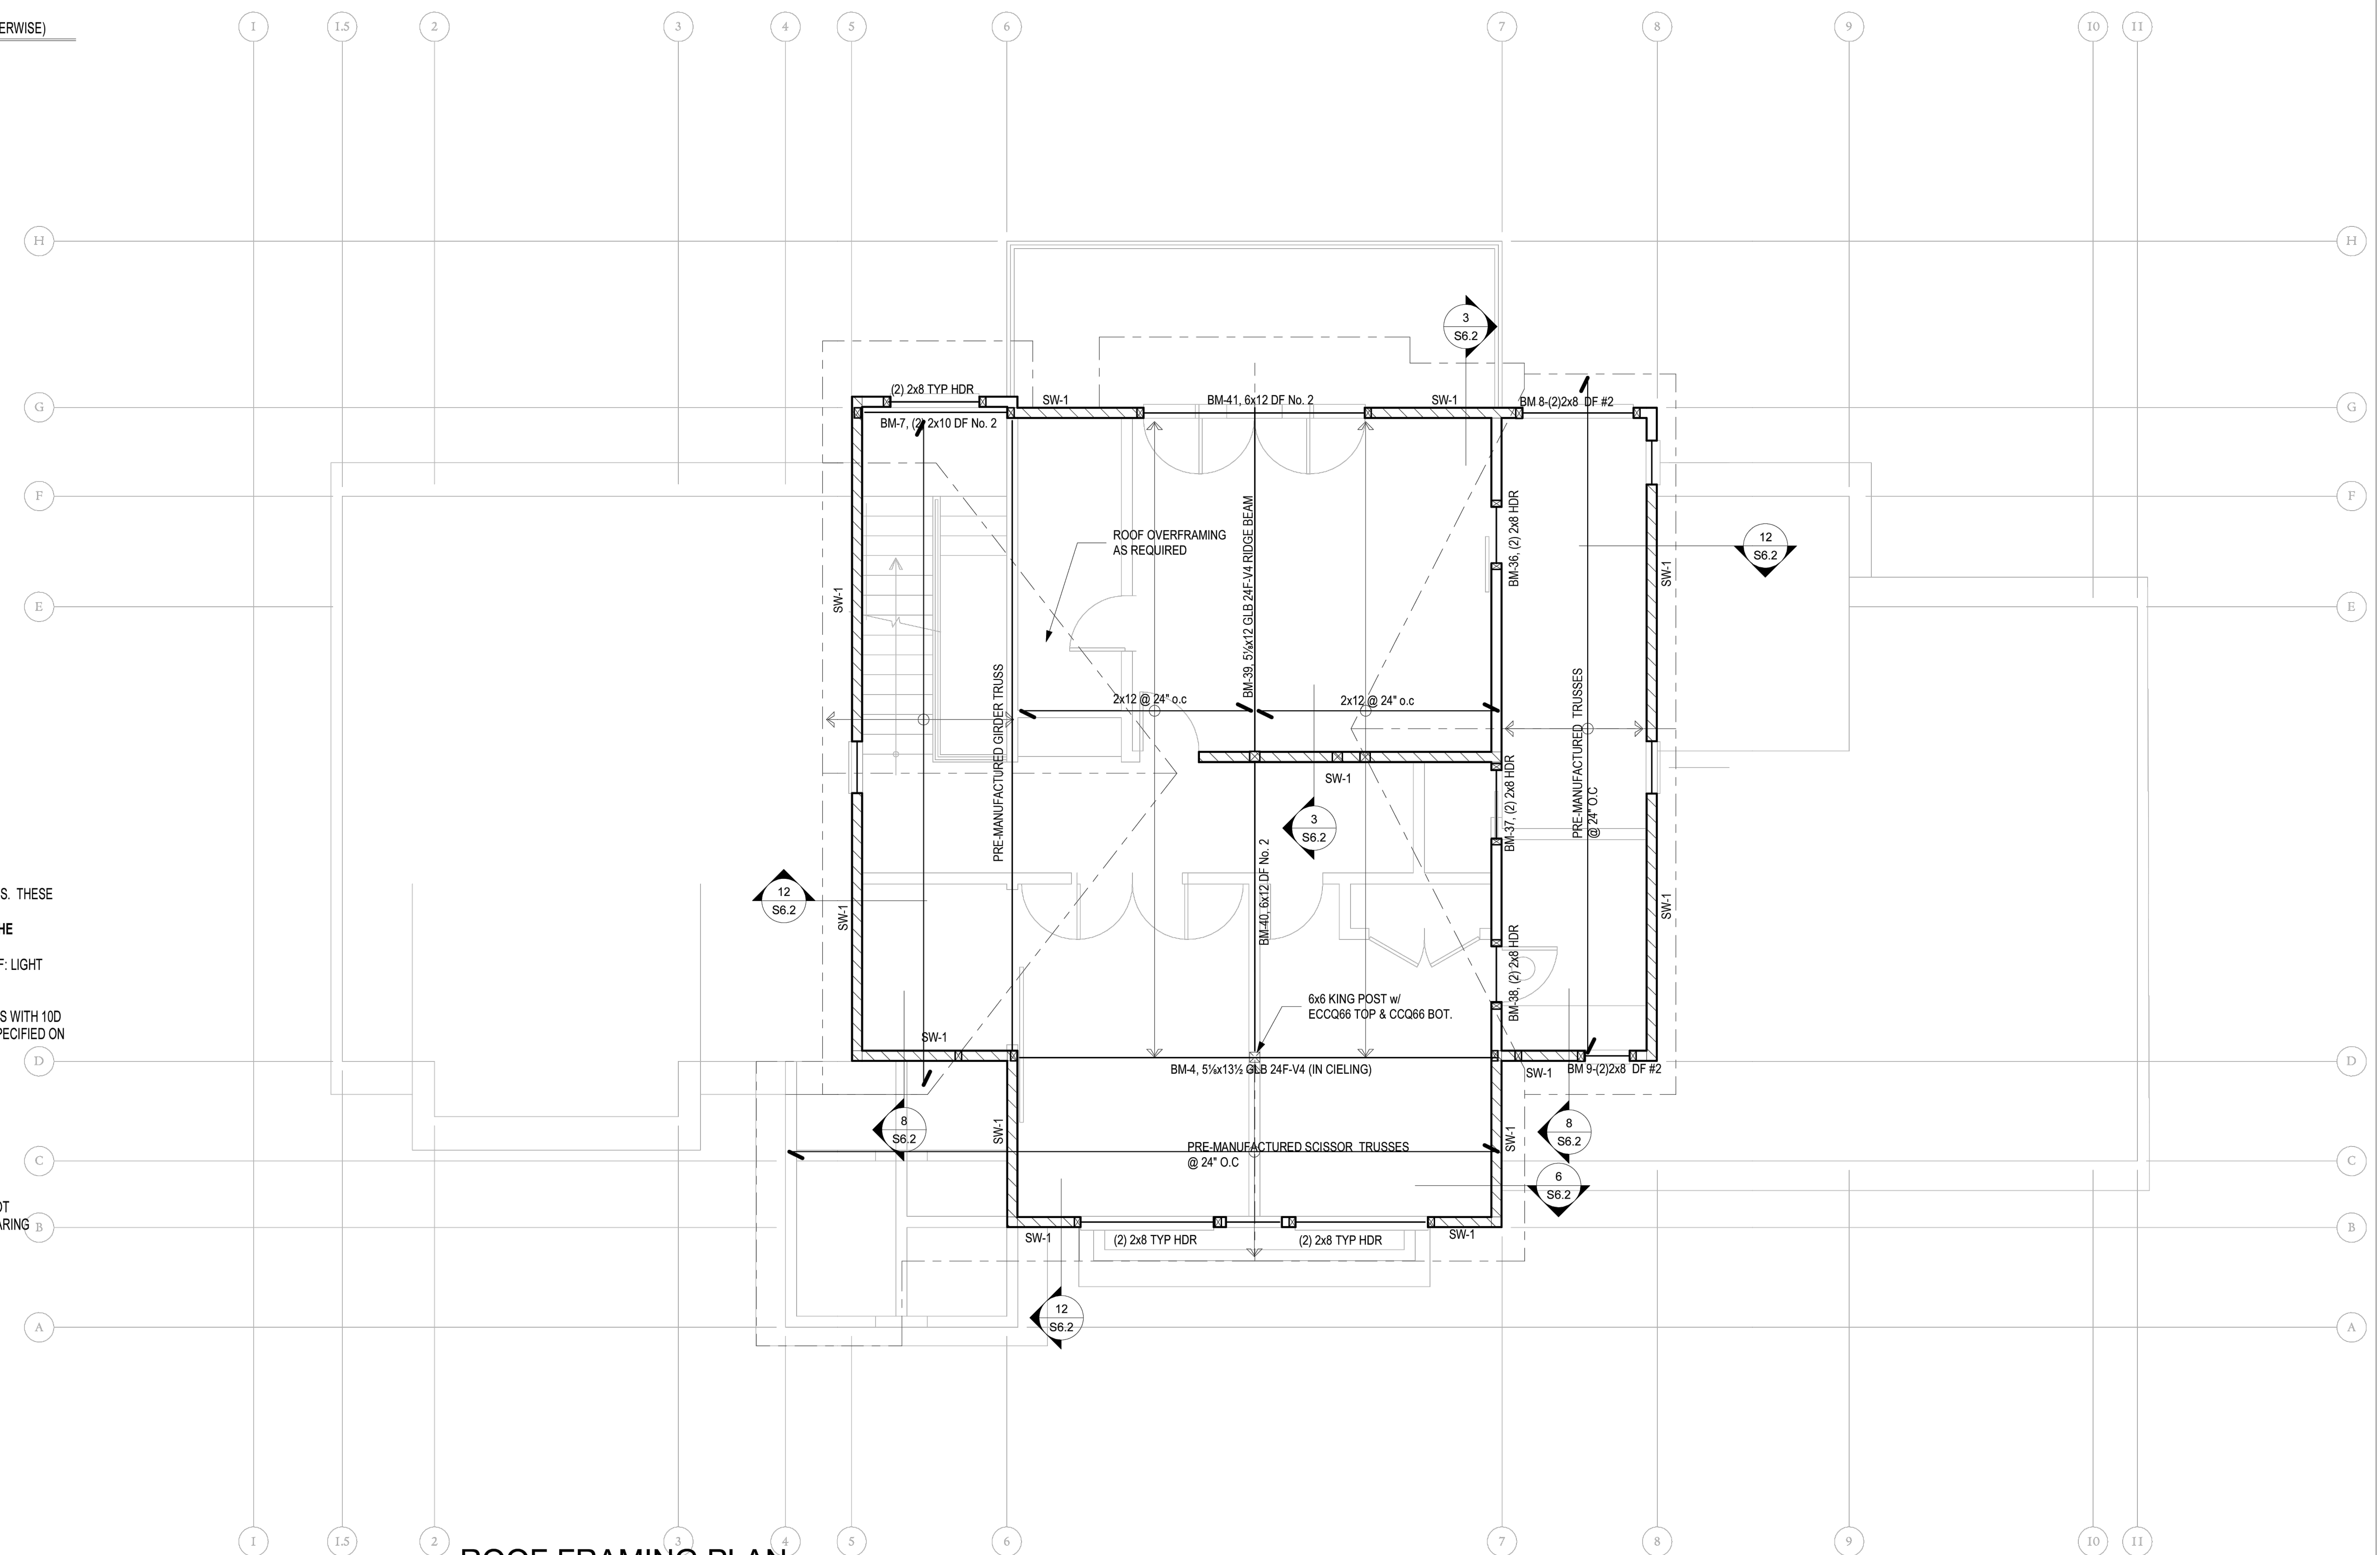


ROOF FRAMING PLAN
 1/4" = 1'-0"

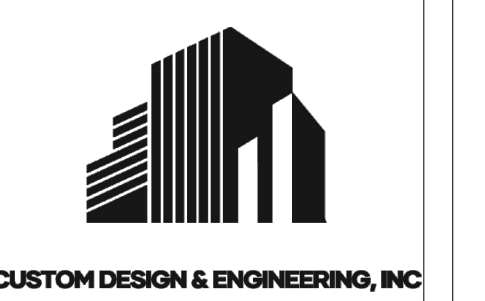

Custom Design and Engineering, Inc
 6021 Roosevelt Way Ne
 Seattle, WA 98115
 www.cdengr.com
 email: kam@cdengr.com


PROJECT NAME: **RAQUEPAU RESIDENCE**
 PROJECT ADDRESS: **9116 SE 58th ST
 MERCER ISLAND, WA 98040**

DWG TITLE
ROOF FRAMING PLAN

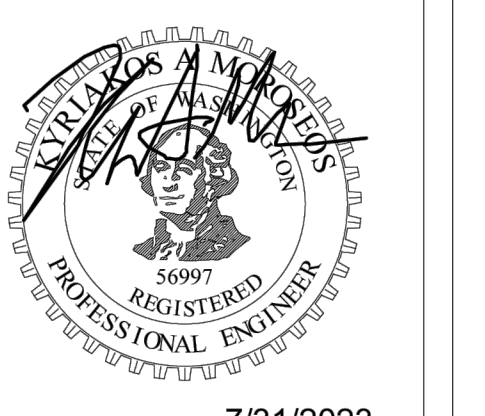


7/31/2023
 PROJECT #
Z4-3205


SHEET NO
S2.2

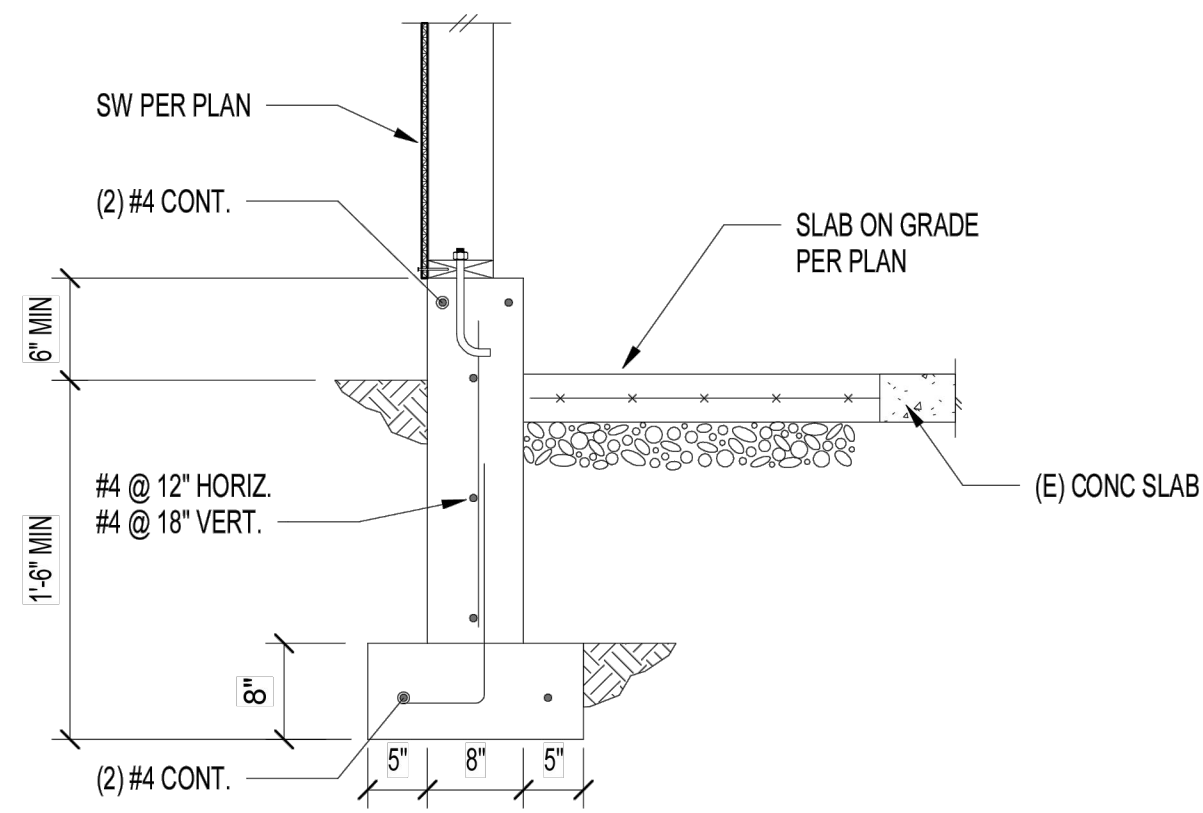


1

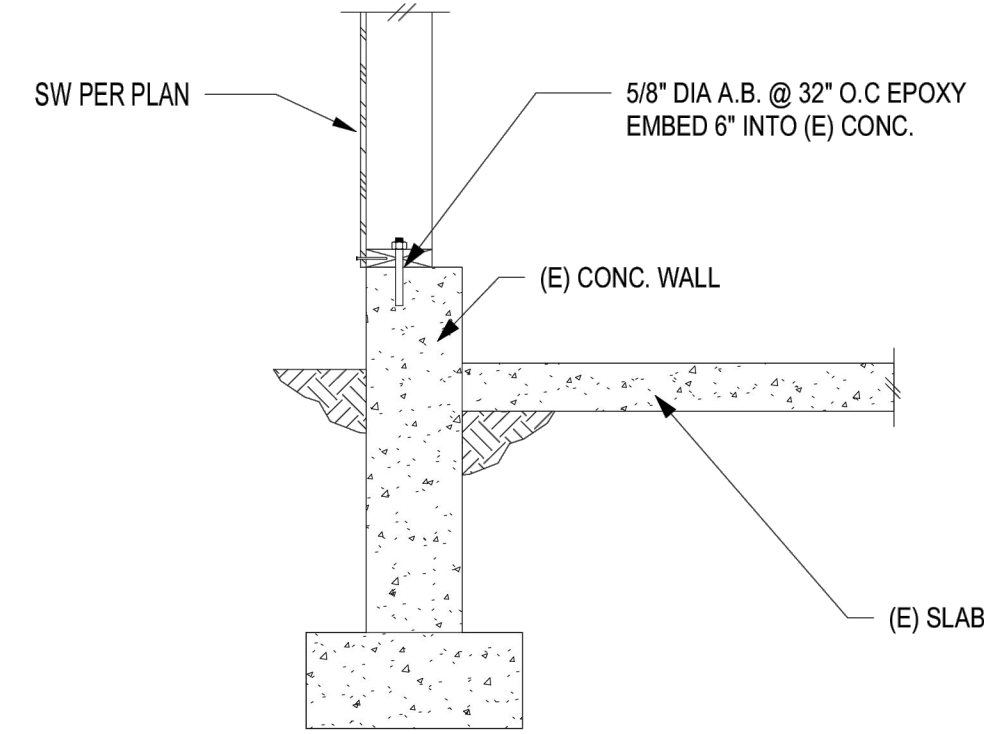


2

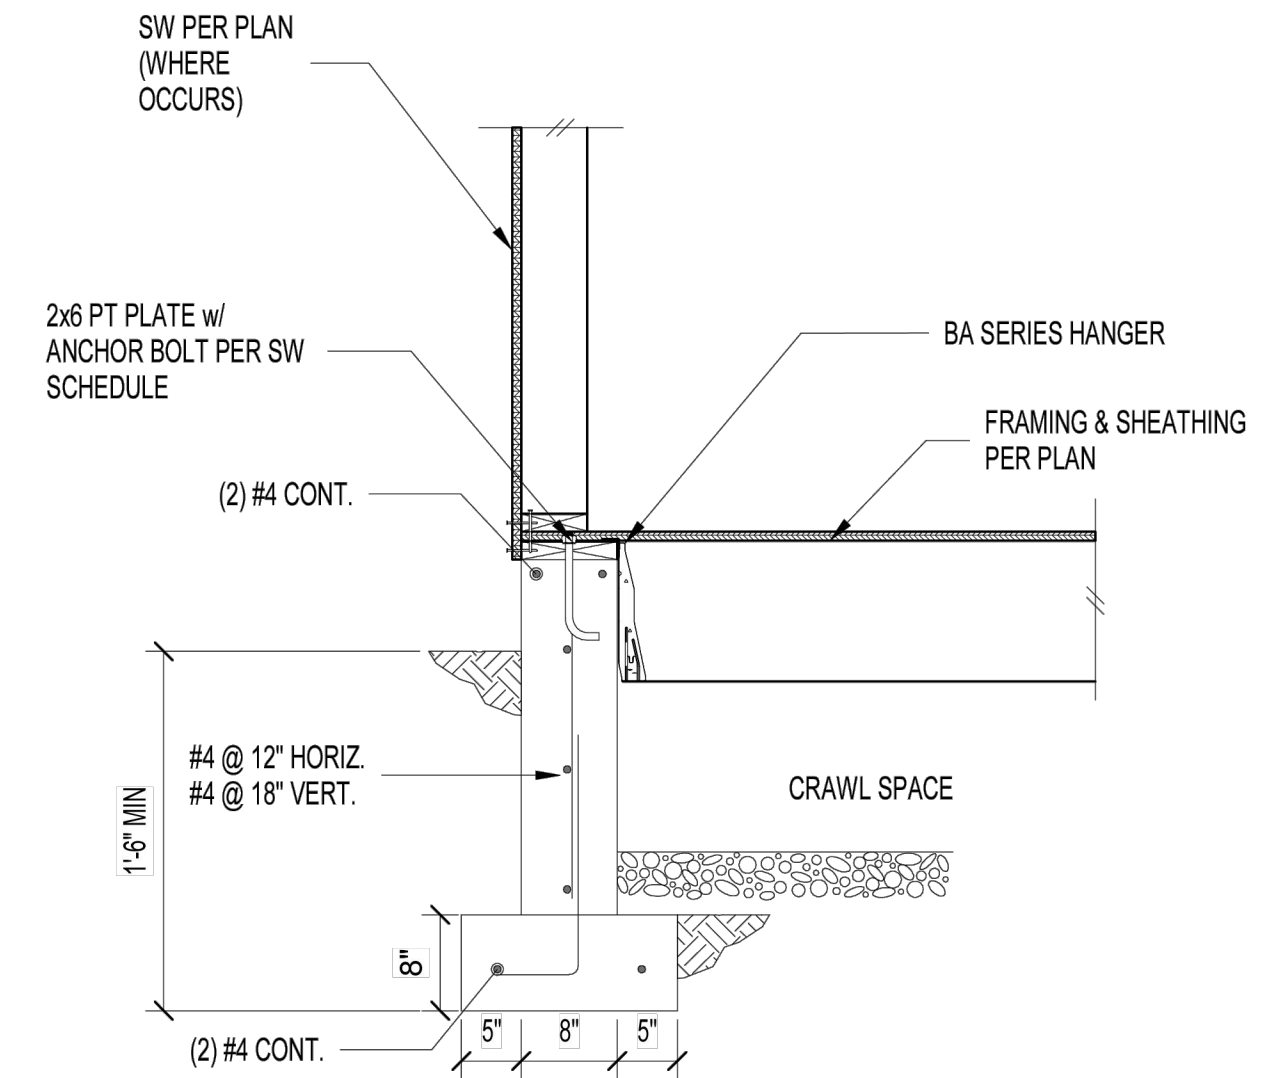


3

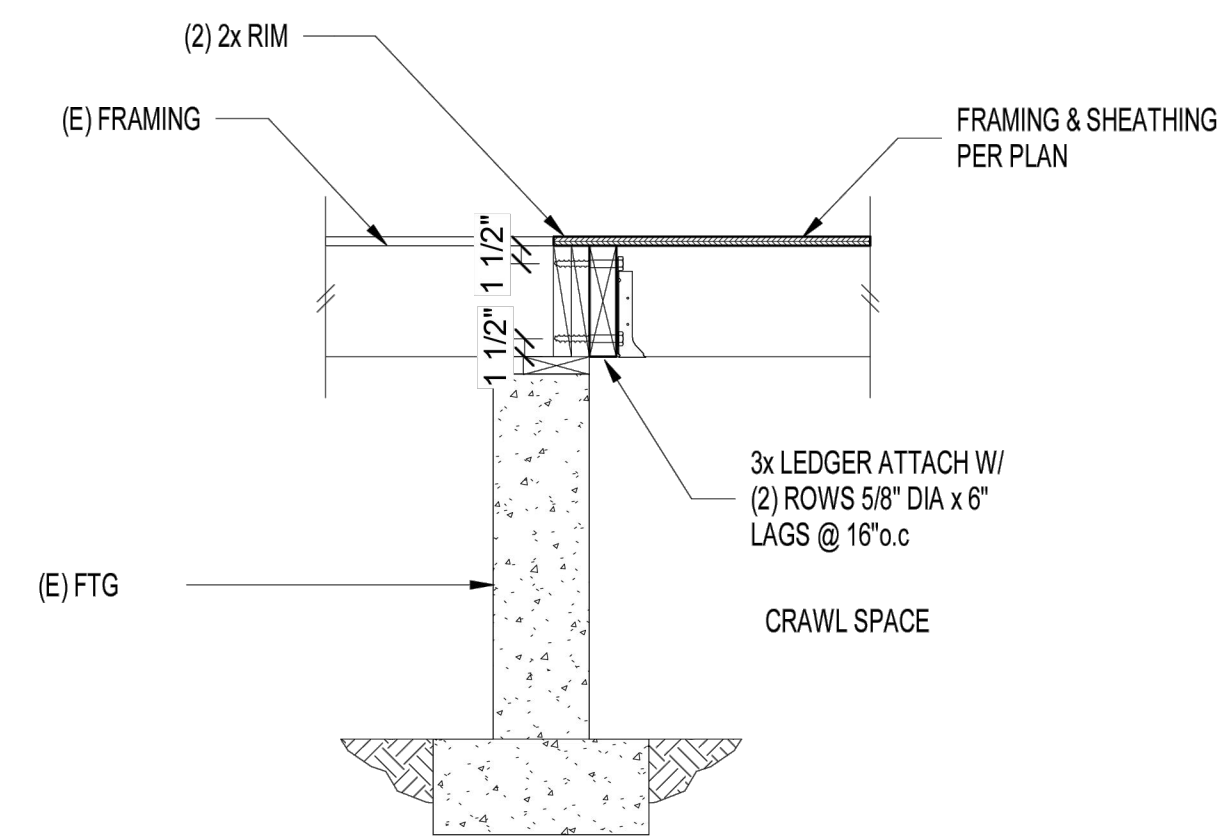

5

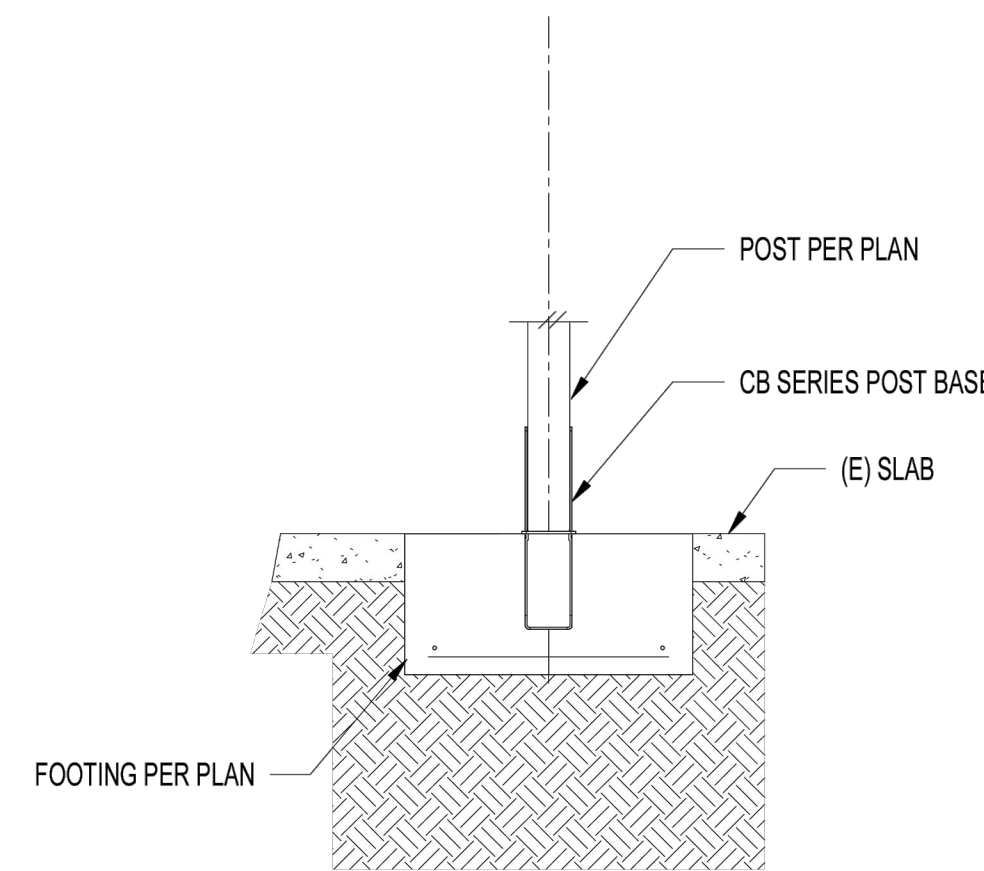


6

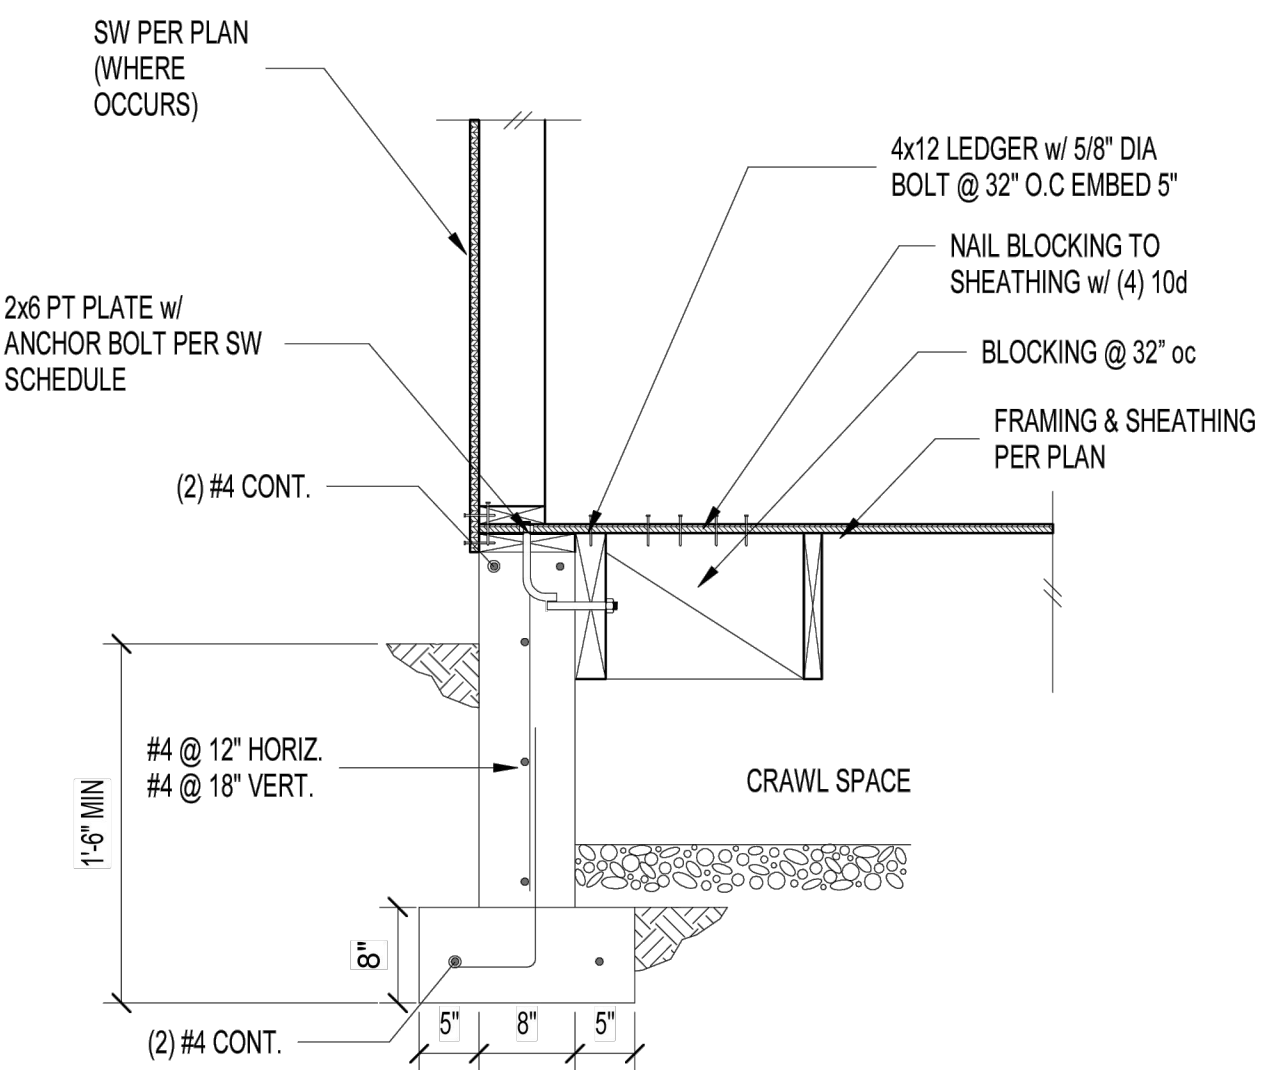


7




9

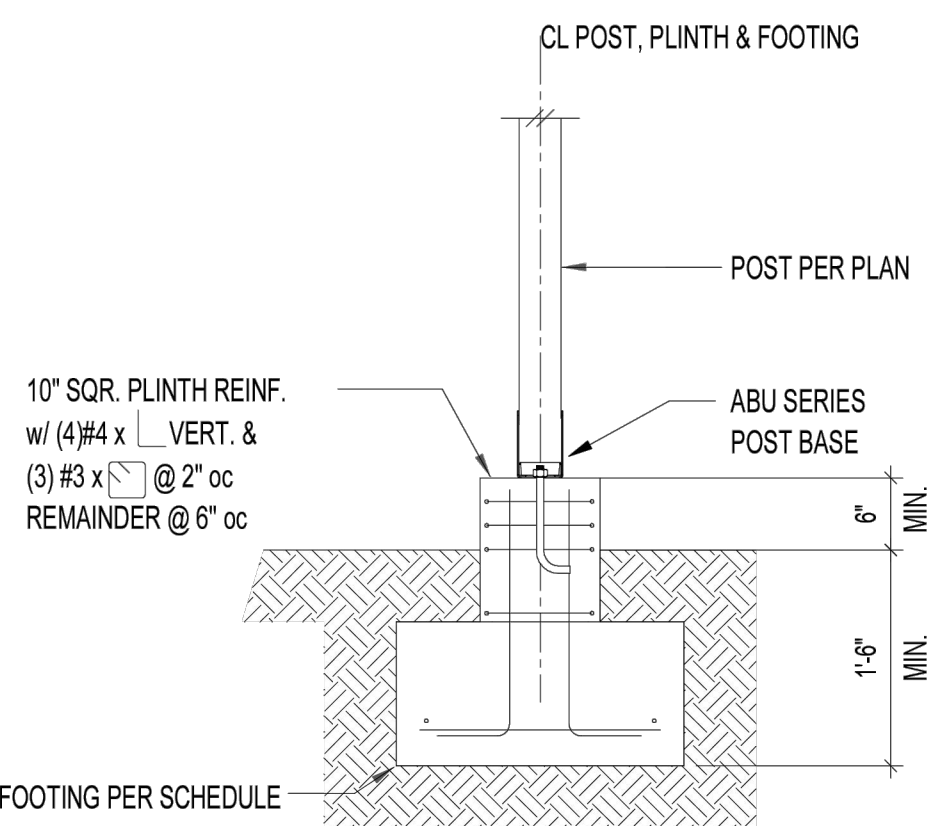

10

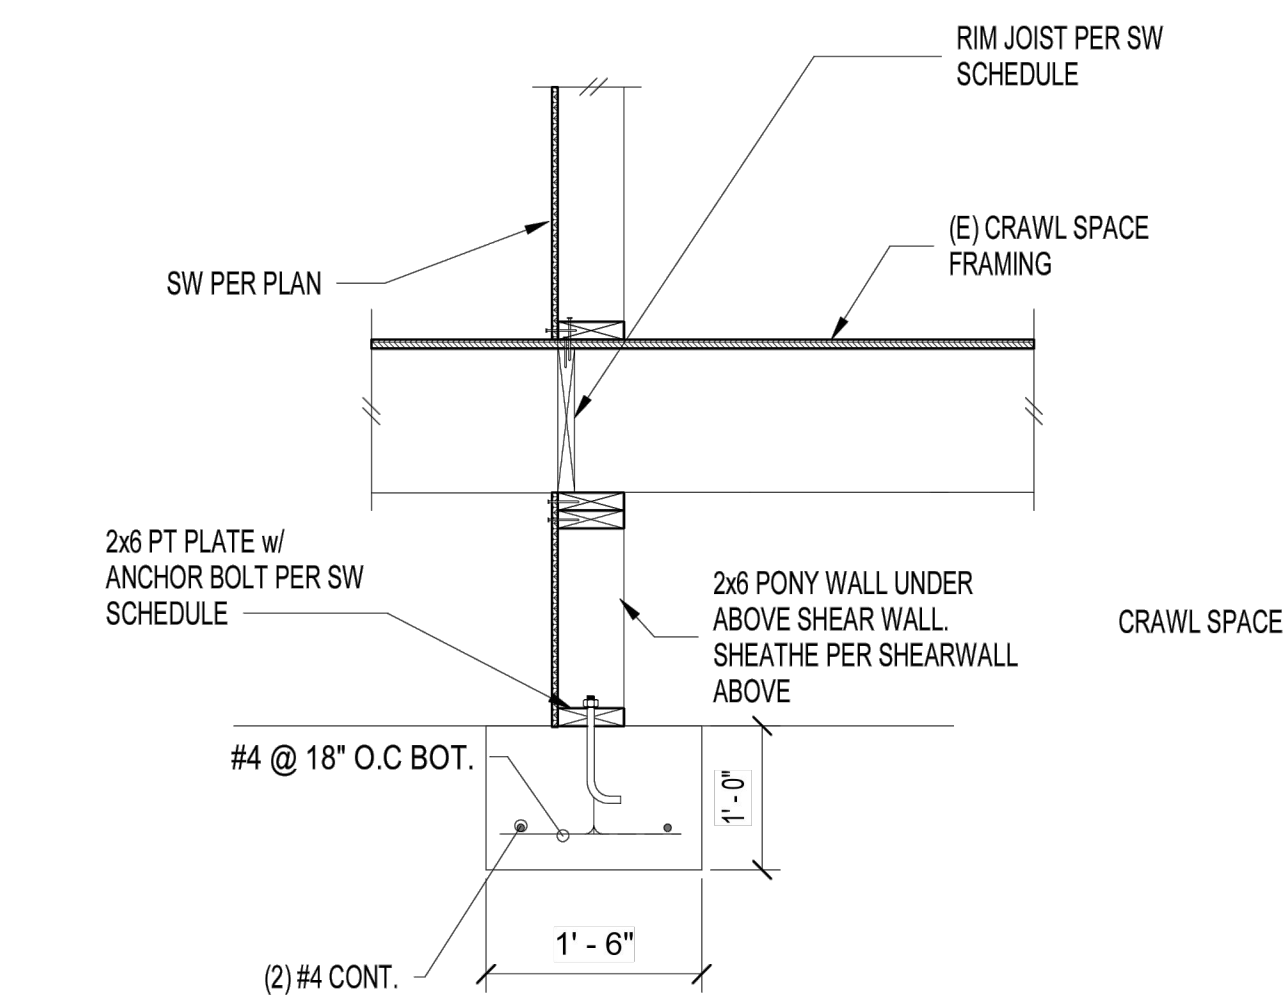

11

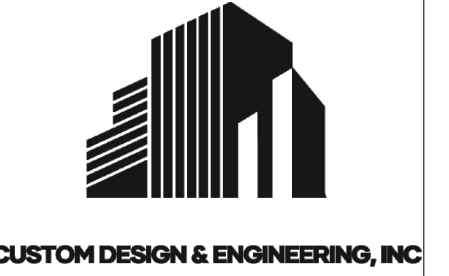

Custom Design and Engineering, Inc
6021 Roosevelt Way Ne
Seattle, WA 98115
www.cdengr.com
email: kam@cdengr.com

PROJECT NAME: **RAQUEPAU RESIDENCE**
PROJECT ADDRESS: **9116 SE 58th ST
MERCER ISLAND, WA 98040**

DWG TITLE
DETAILS

Number	Revision	Date




7/31/2023
PROJECT #
Z4-3205

SHEET NO
S3.0

12


NOTE: NOTCHES SHALL NOT OCCUR IN MORE THAN (2) SUCCESSIVE STUDS

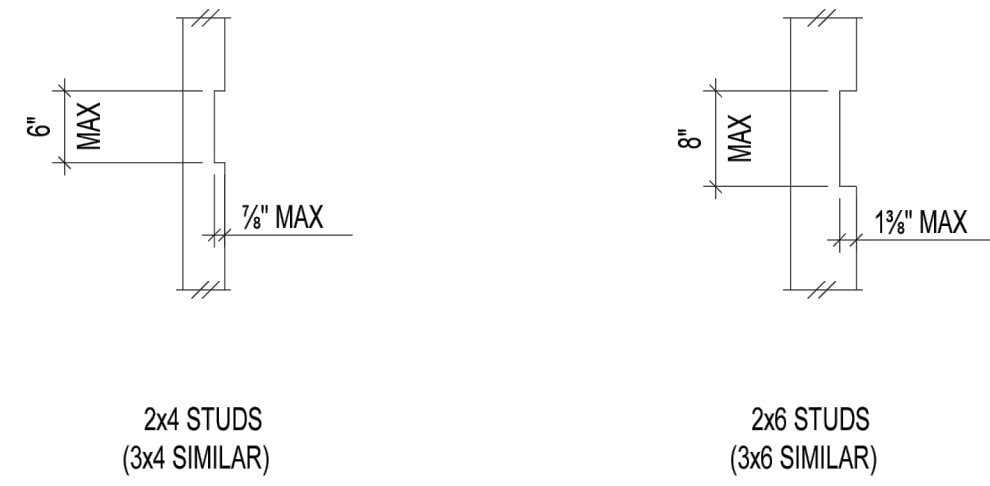

ANY NOTCH OR HOLE THRU STUDS EXCEEDING ABOVE DETAIL SHALL GET E.O.R. APPROVAL FOR POSSIBLE REINFORCING REQUIREMENTS PRIOR TO DRILLING/NOTCHING


ALLOWABLE NOTCHES IN STUDS - N.T.S 1

NOTE: BORED HOLES SHALL NOT BE LOCATED @ THE SAME SECTION OF STUD AS A NOTCH.

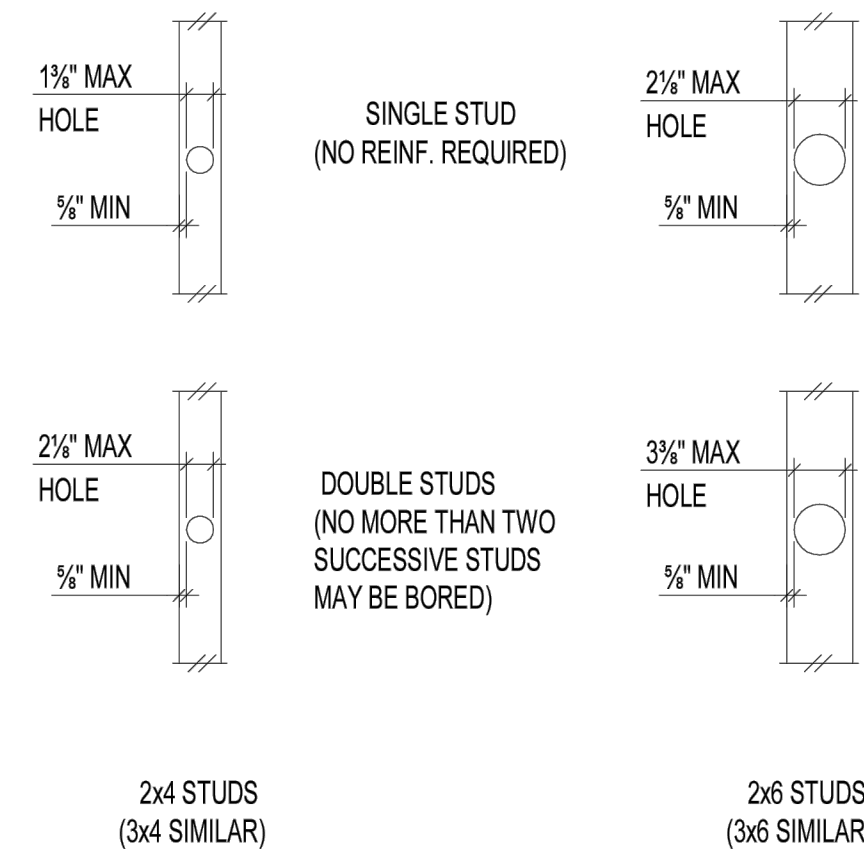


NOTE: BORED HOLES SHALL NOT BE LOCATED @ THE SAME SECTION OF STUD AS A NOTCH.


HOLES ALLOWED THROUGH STUDS - N.T.S 2

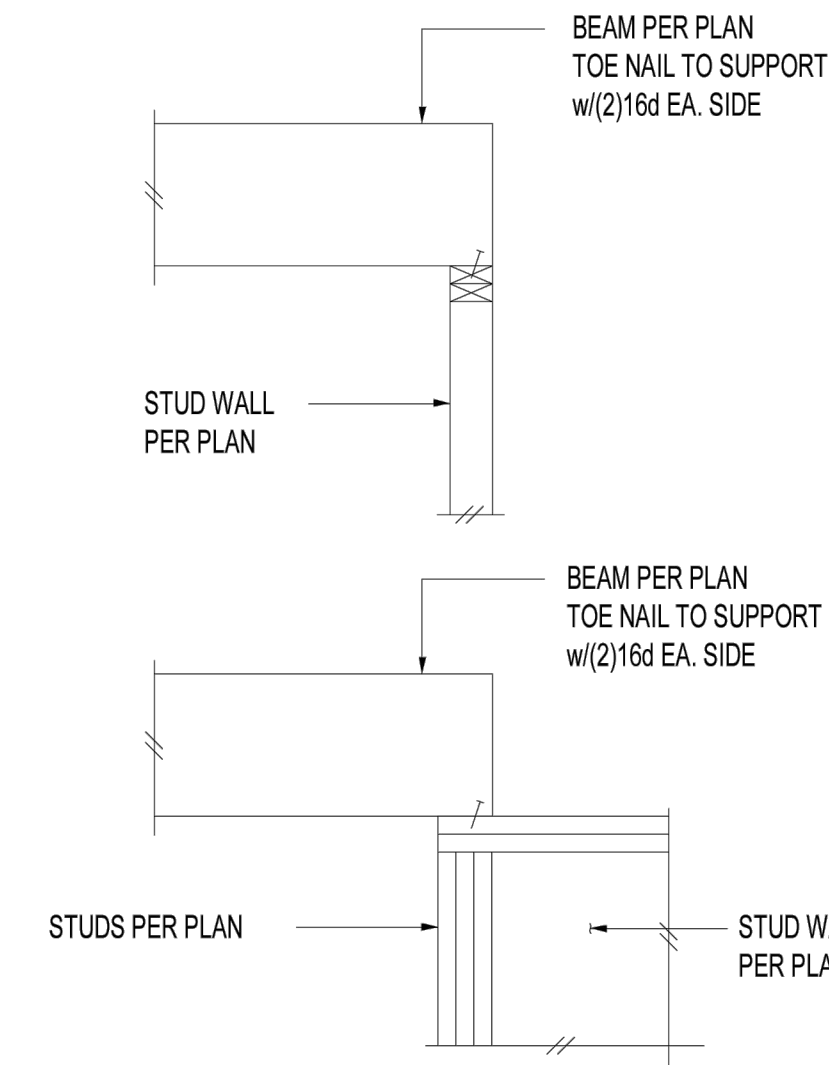

TYPICAL BEAM TO STUD DETAIL - N.T.S 3

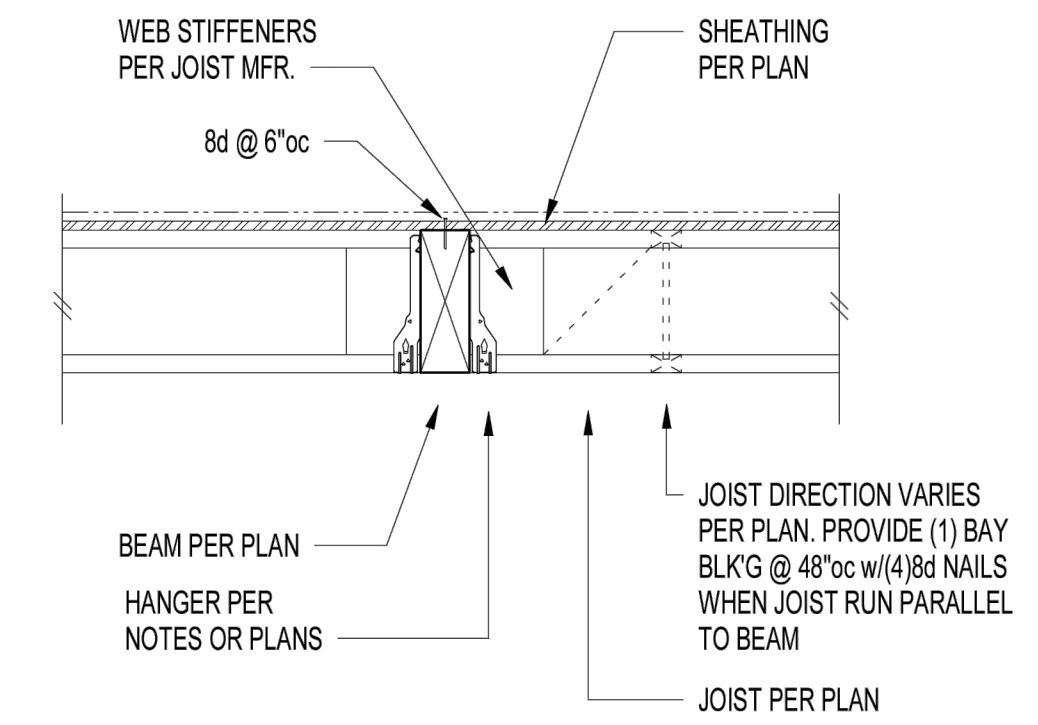


TYPICAL FLUSH BEAM CONNECTION - N.T.S 4

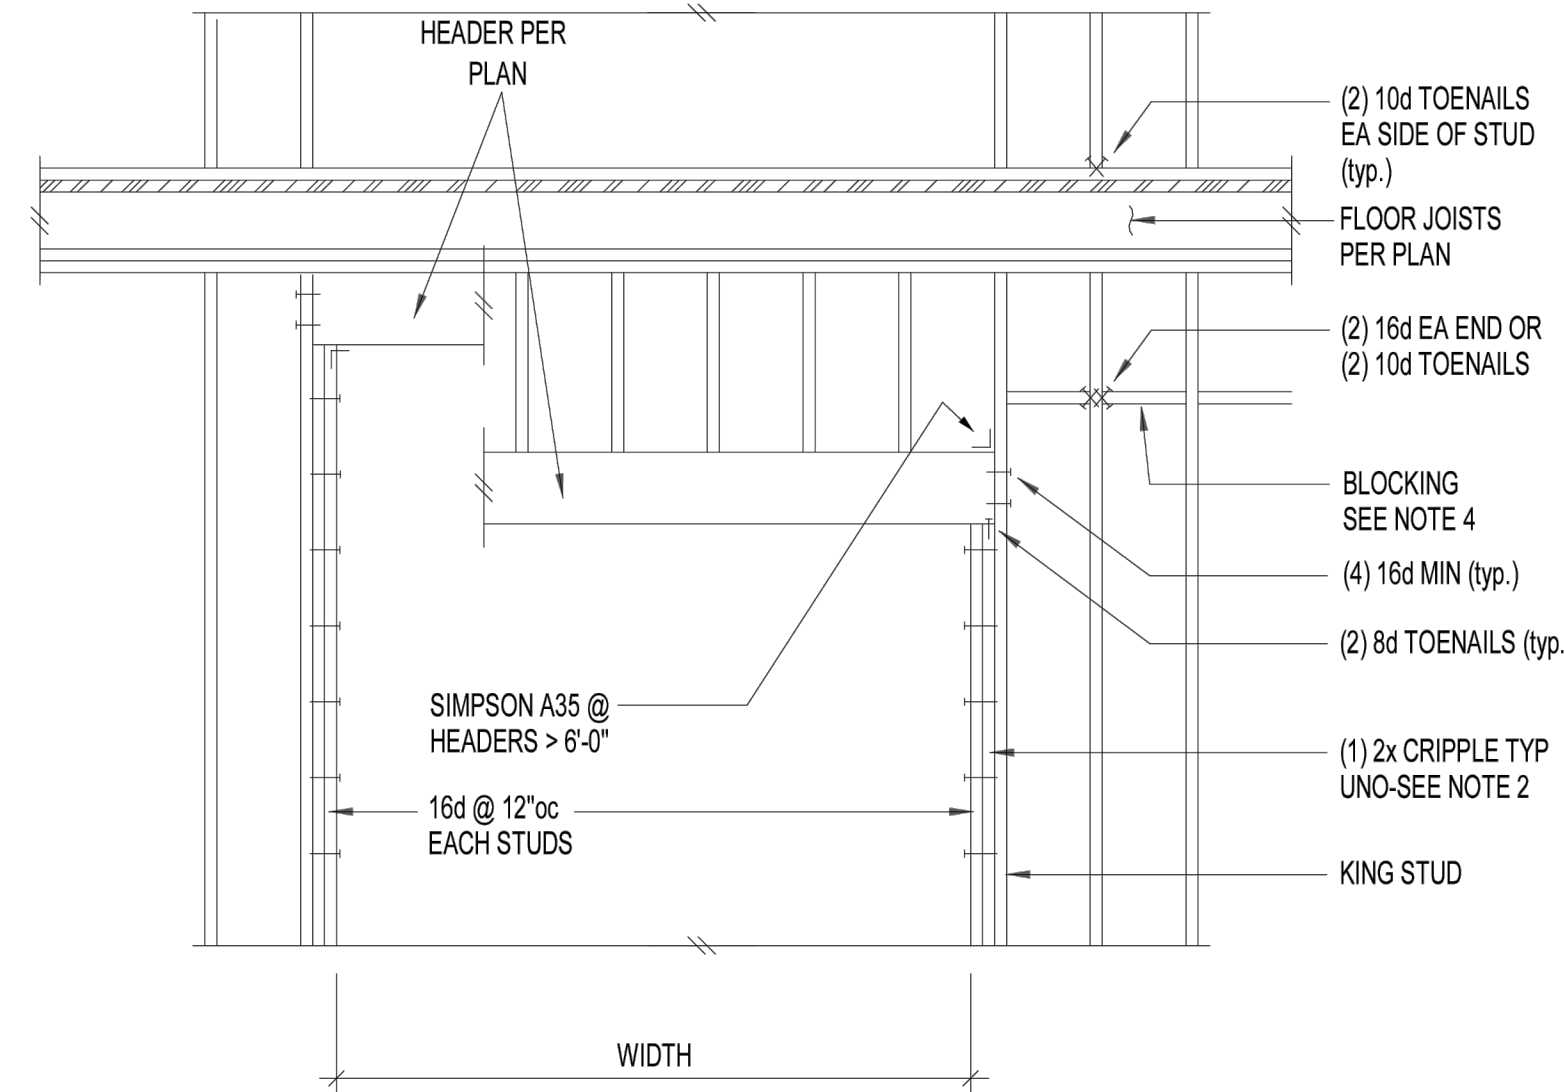

NOTES:


1. HEADERS PER PLAN
2. PROVIDE (1) 2x CRIPPLE STUDS MINIMUM TYPICAL, U.O.N.
3. SEE ARCHITECTURAL DRAWINGS FOR OPENING SIZES AND LOCATIONS
4. 2x SOLID BLOCKING REQUIRED AT CEILING LINE, ALL PANEL EDGES, AND @ 8'-0" ON CENTER MAX.

TYPICAL WALL OPENING FRAMING ELEVATION - N.T.S 6

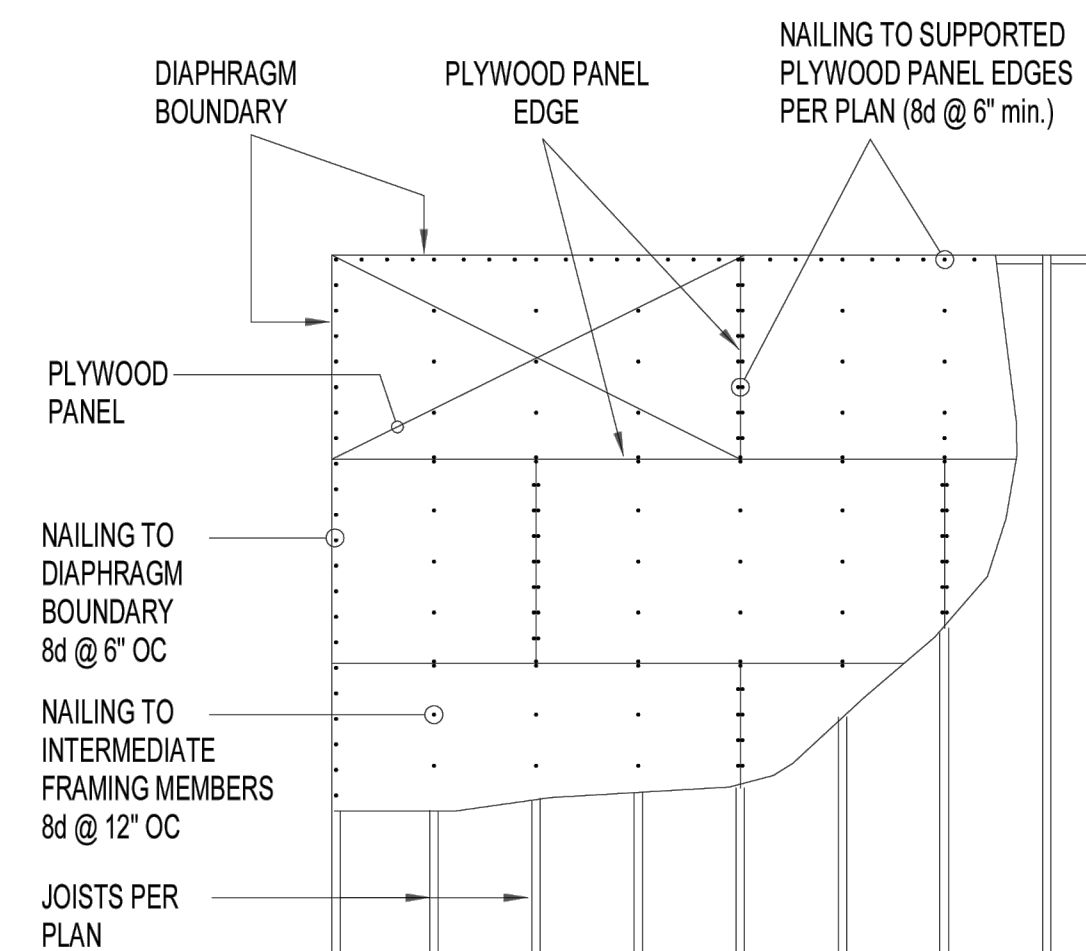


NOTE: BEARING AND SHEAR WALL INTERSECTIONS SHALL BE CONSIDERED DIAPHRAGM BOUNDARIES, TYP


TYPICAL UNBLOCKED SHEATHING - N.T.S 7

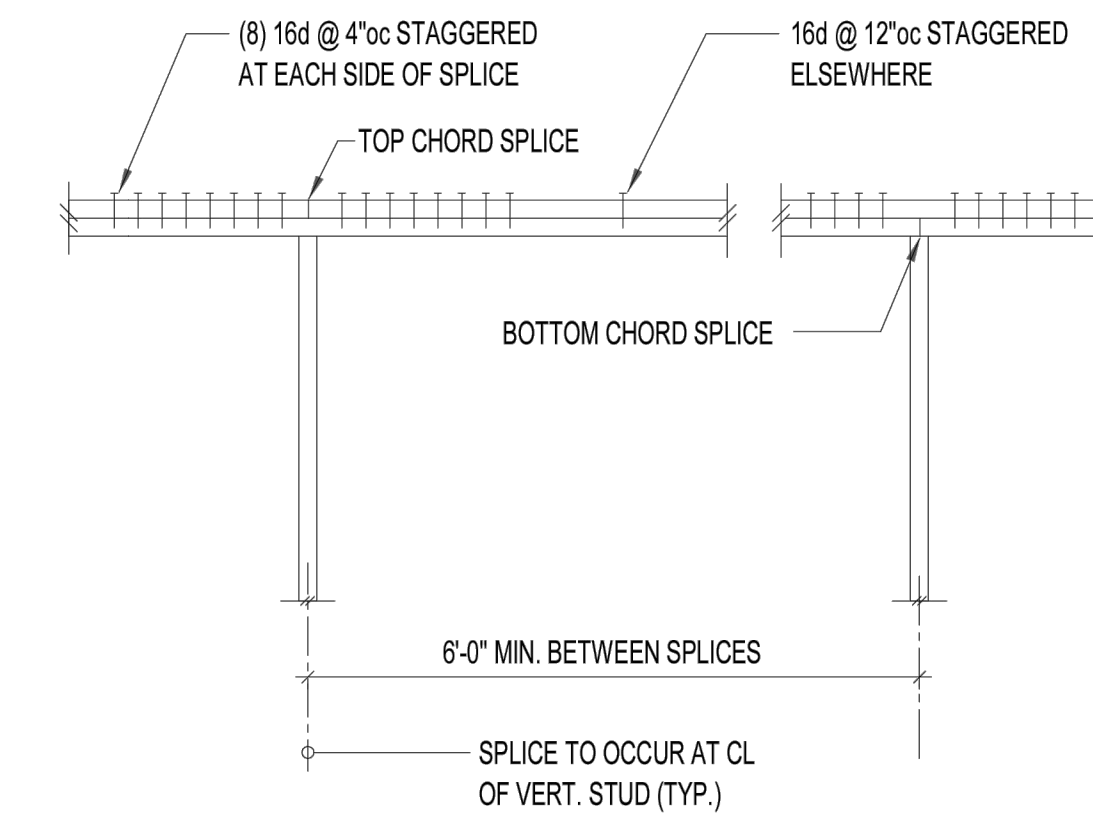

TOP PLATE SPLICE - N.T.S 8

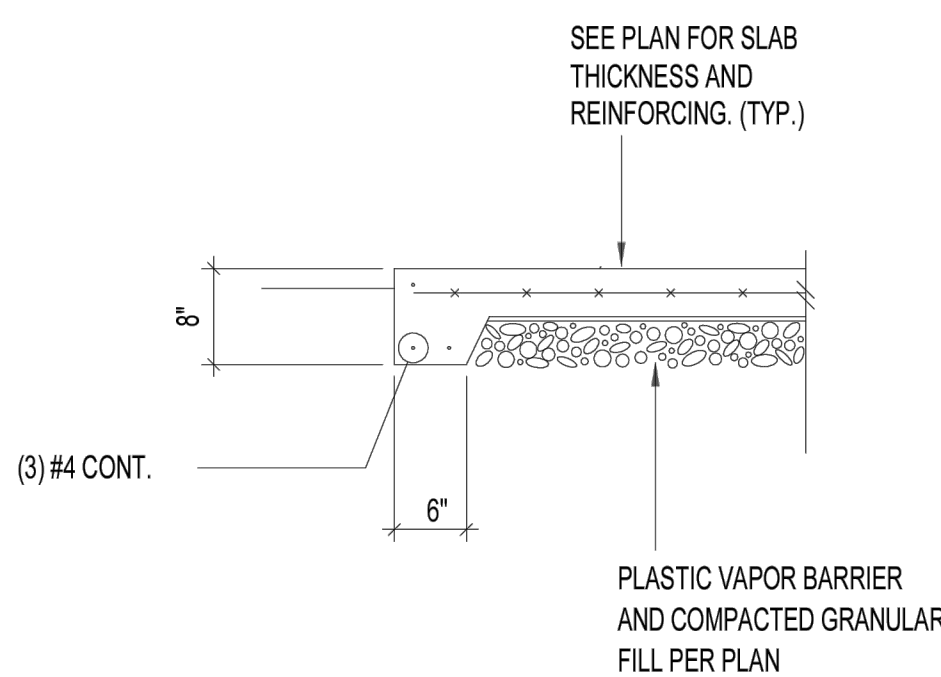

TYPICAL SLAB EDGE - N.T.S 9

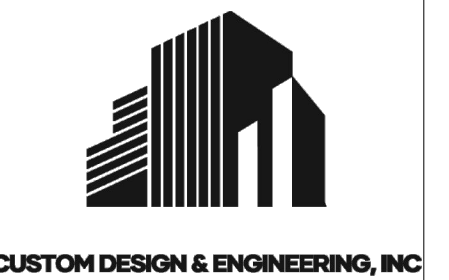

Custom Design and Engineering, Inc
6021 Roosevelt Way Ne
Seattle, WA 98115
www.cdengr.com
email: kam@cdengr.com

PROJECT NAME: **RAQUEPAU RESIDENCE**
PROJECT ADDRESS: **9116 SE 58th ST
MERCER ISLAND, WA 98040**

DWG TITLE: **TYPICAL WOOD DETAILS**




7/31/2023


PROJECT #
Z4-3205

SHEET NO


S6.0a

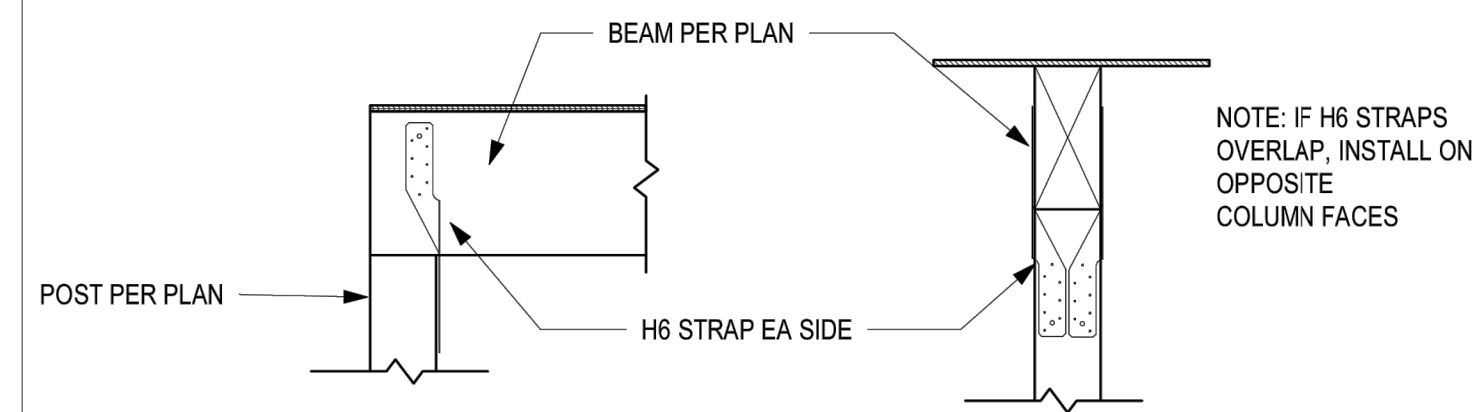


1

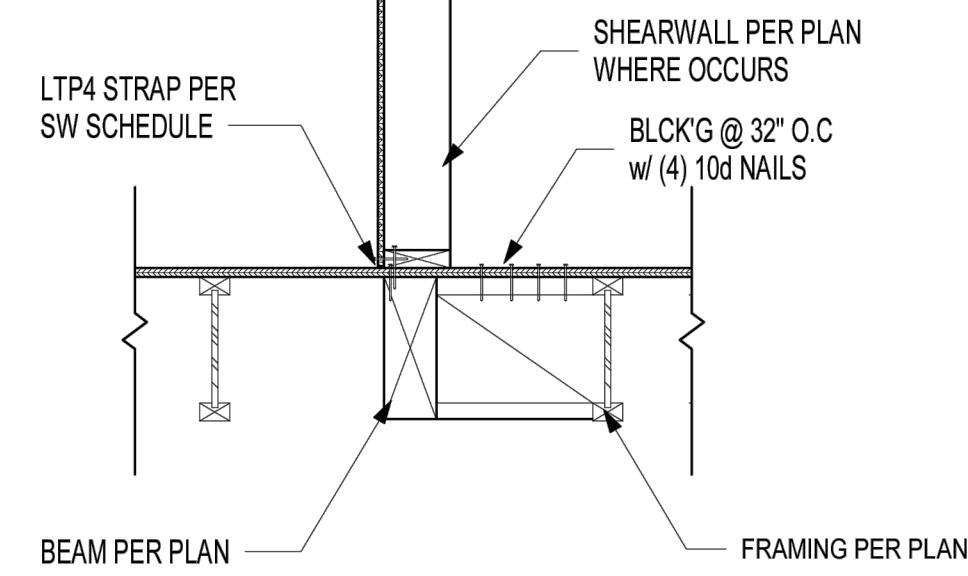

3

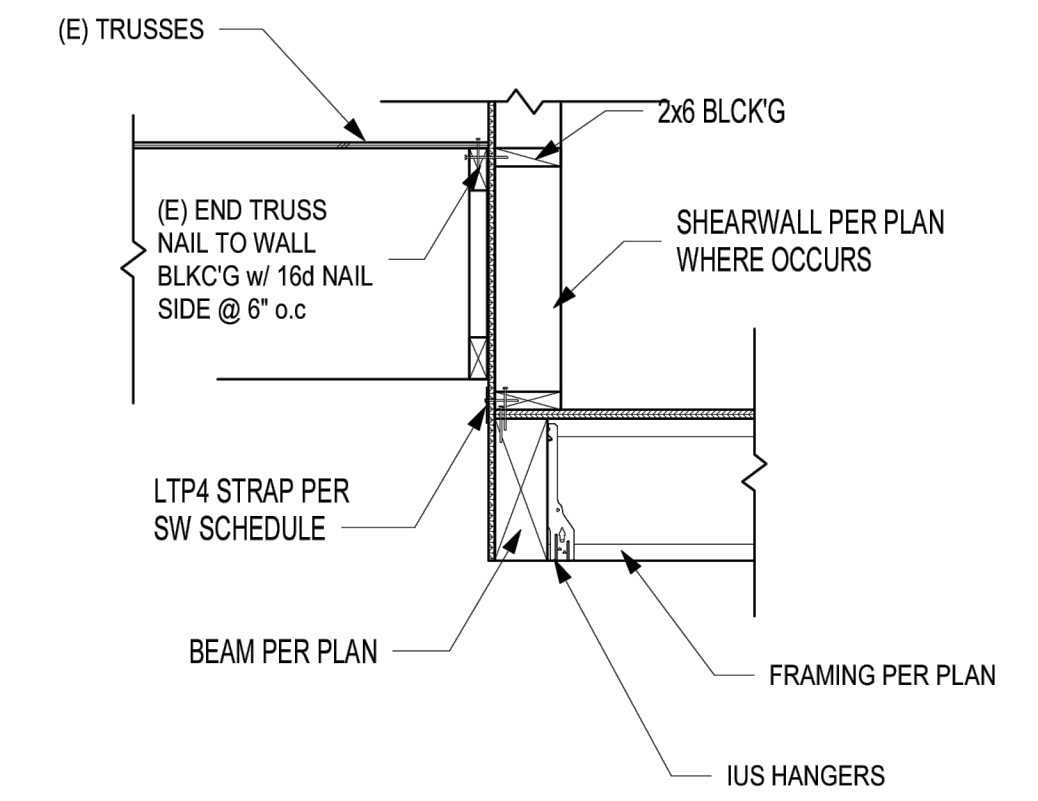


4

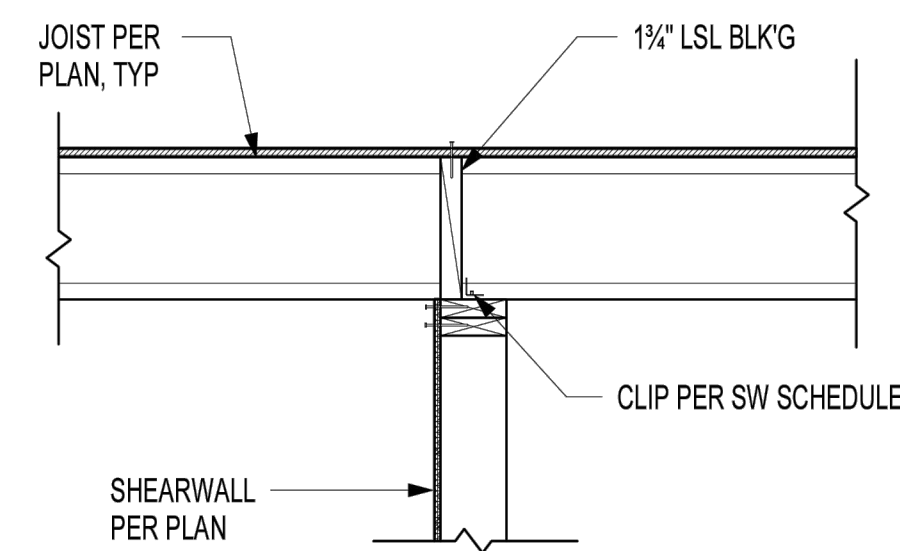


5

6


7

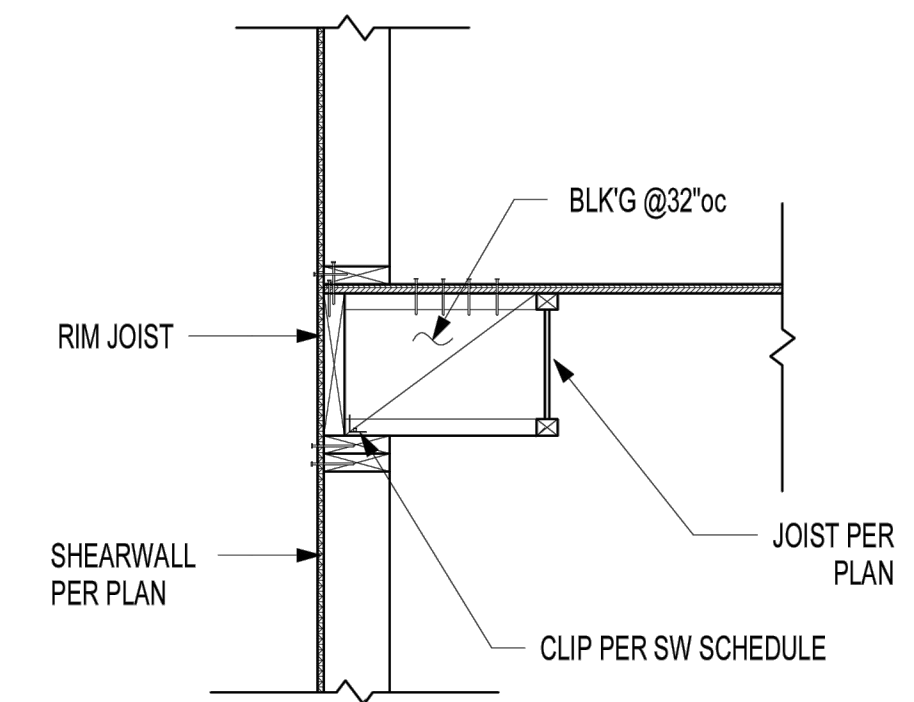

8

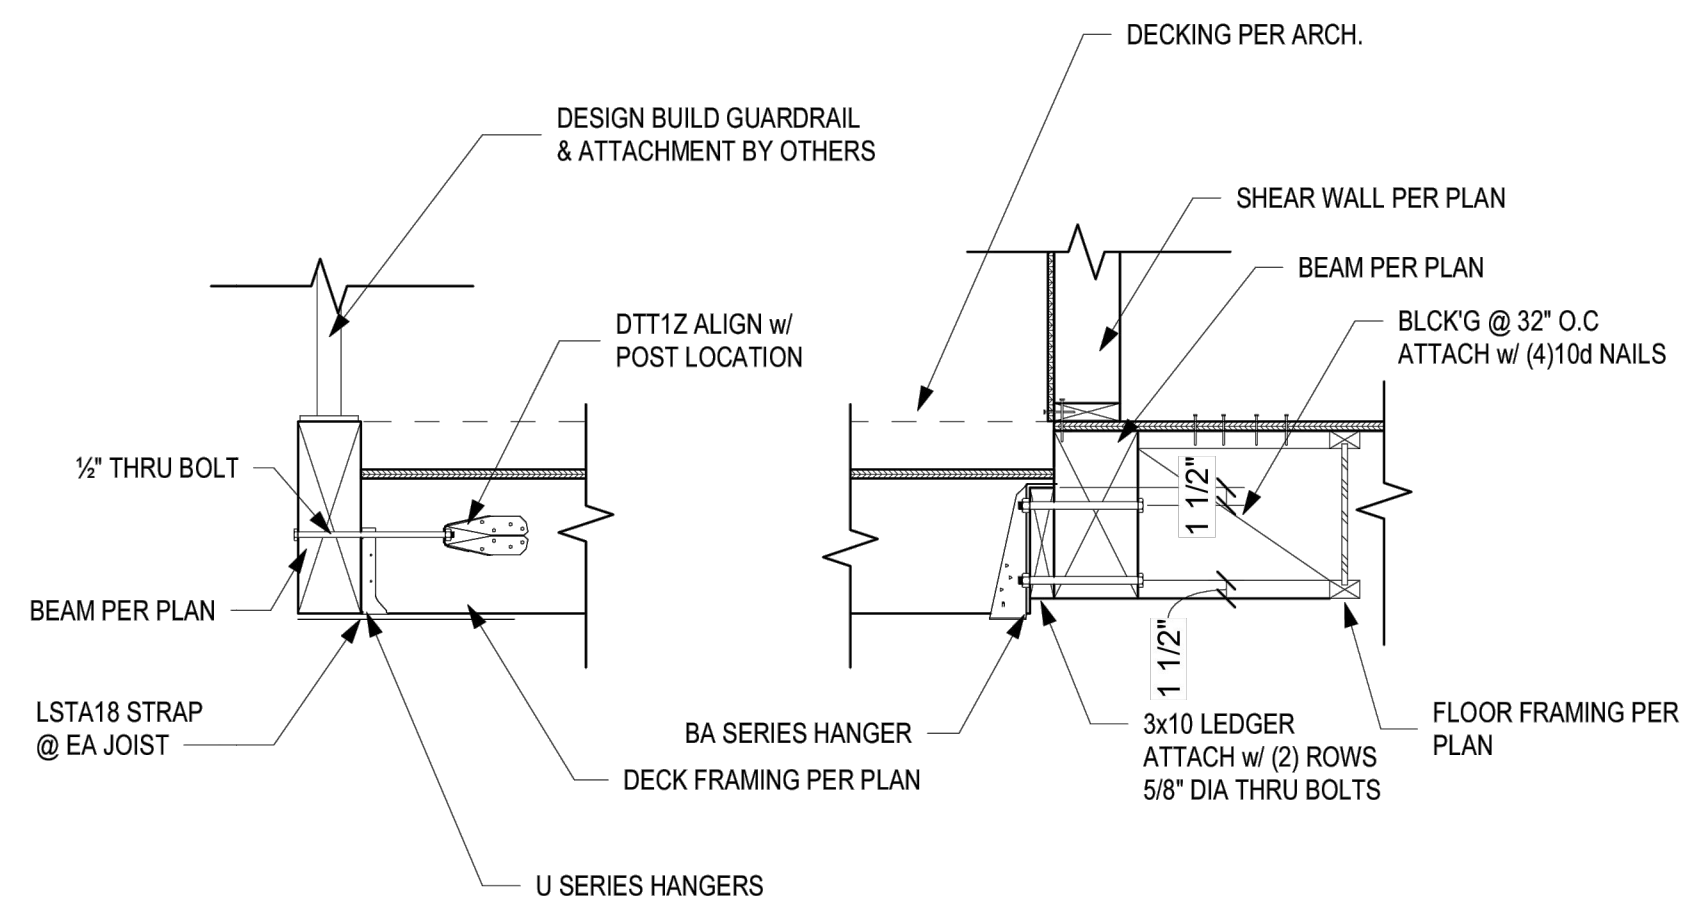


11

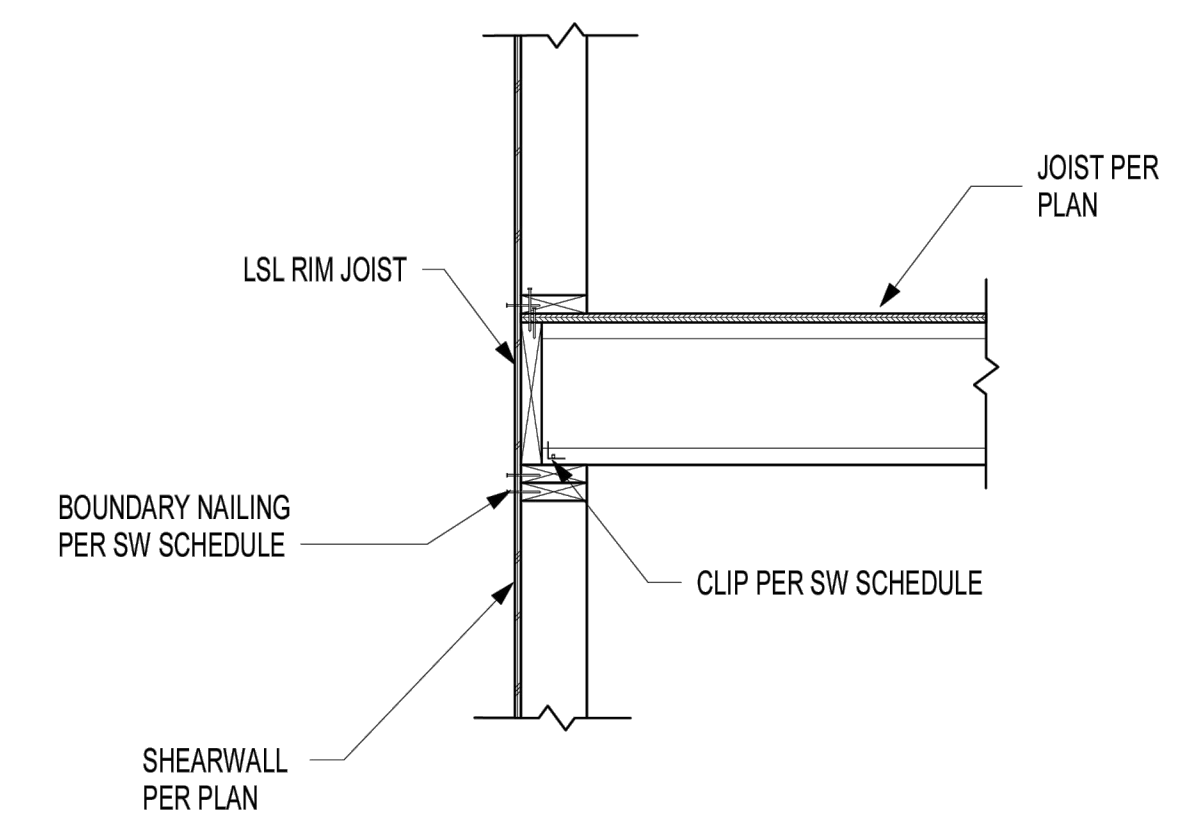

12

9

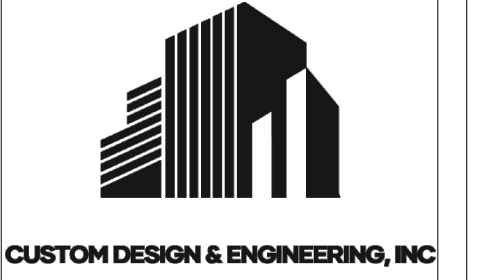

Custom Design and Engineering, Inc
6021 Roosevelt Way Ne
Seattle, WA 98115
www.cdengr.com
email: kam@cdengr.com

PROJECT NAME: **RAQUEPAU RESIDENCE**
PROJECT ADDRESS: **9116 SE 58th ST
MERCER ISLAND, WA 98040**

DWG TITLE
DETAILS

Number	Revision	Date



7/31/2023

PROJECT #
Z4-3205

SHEET NO

S6.1

1

2

3

4

5

6

7







8

9


10

11

12

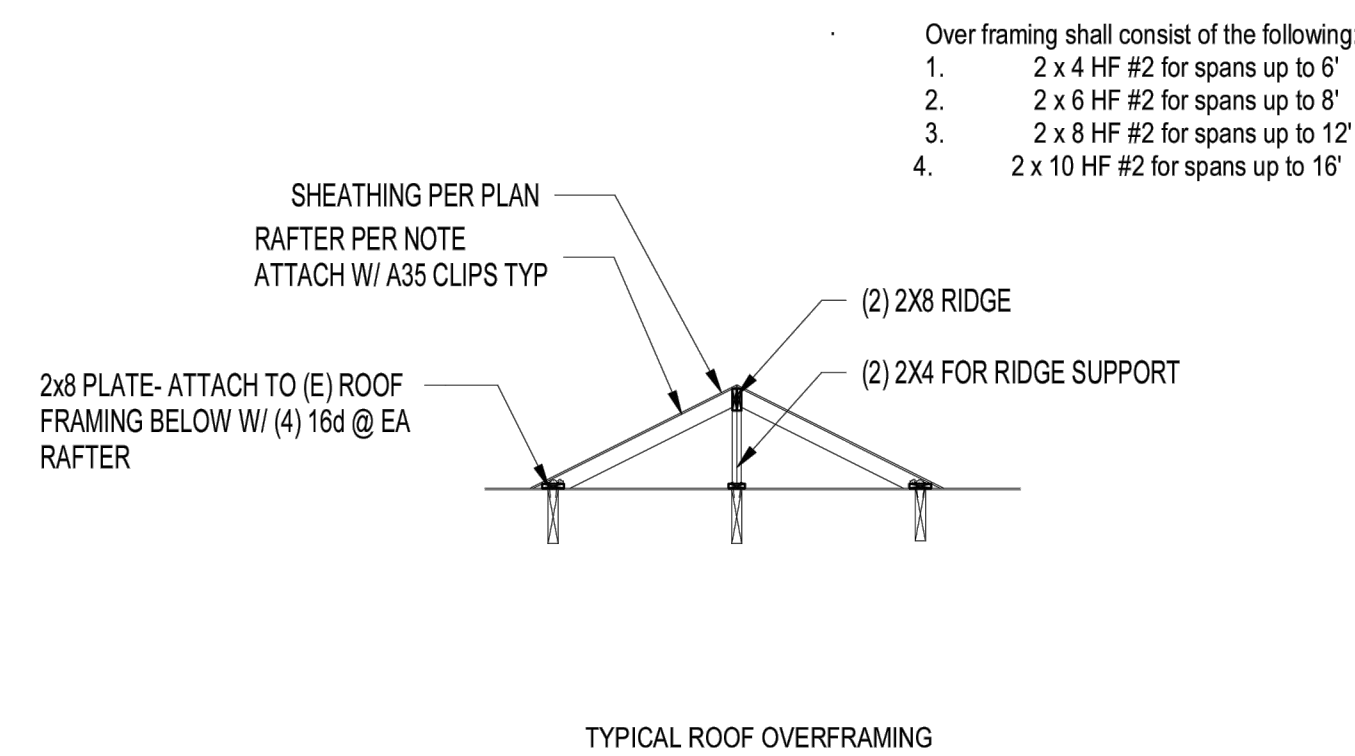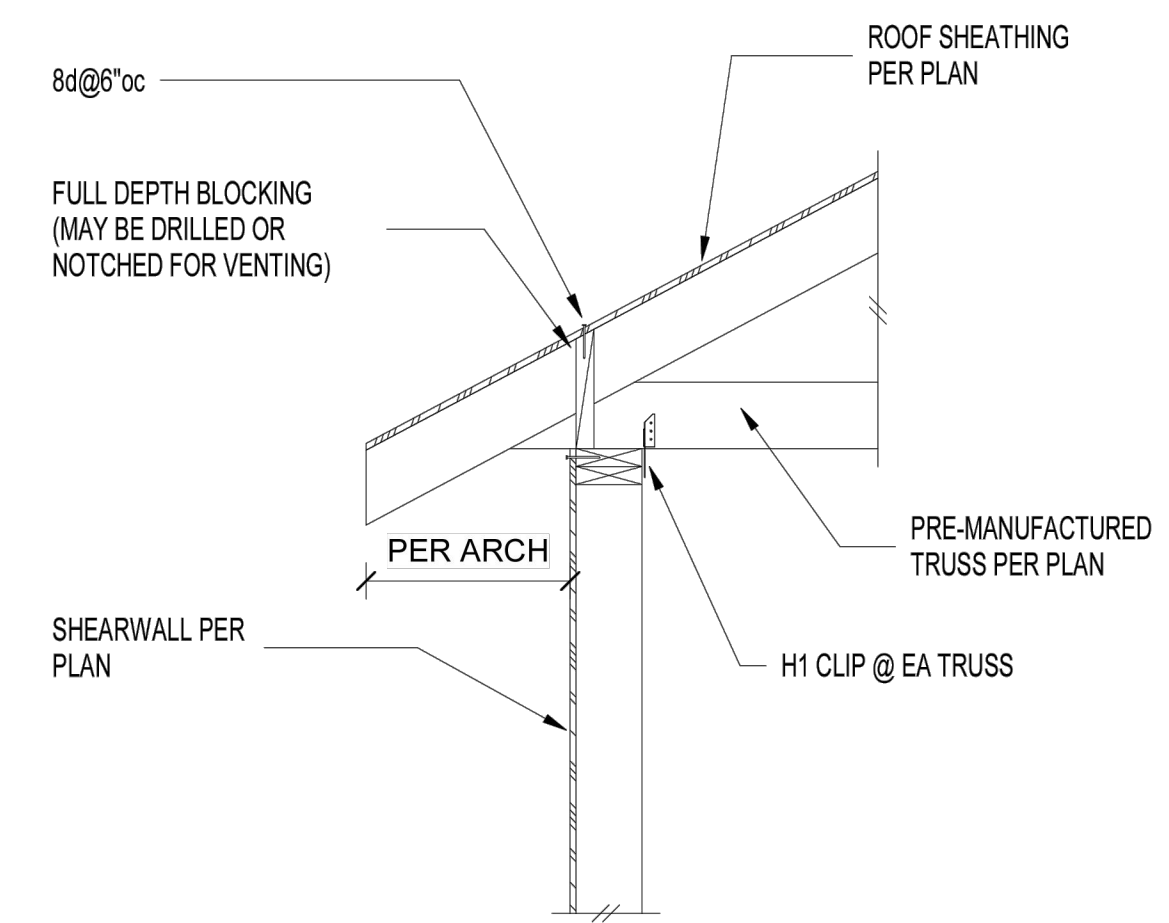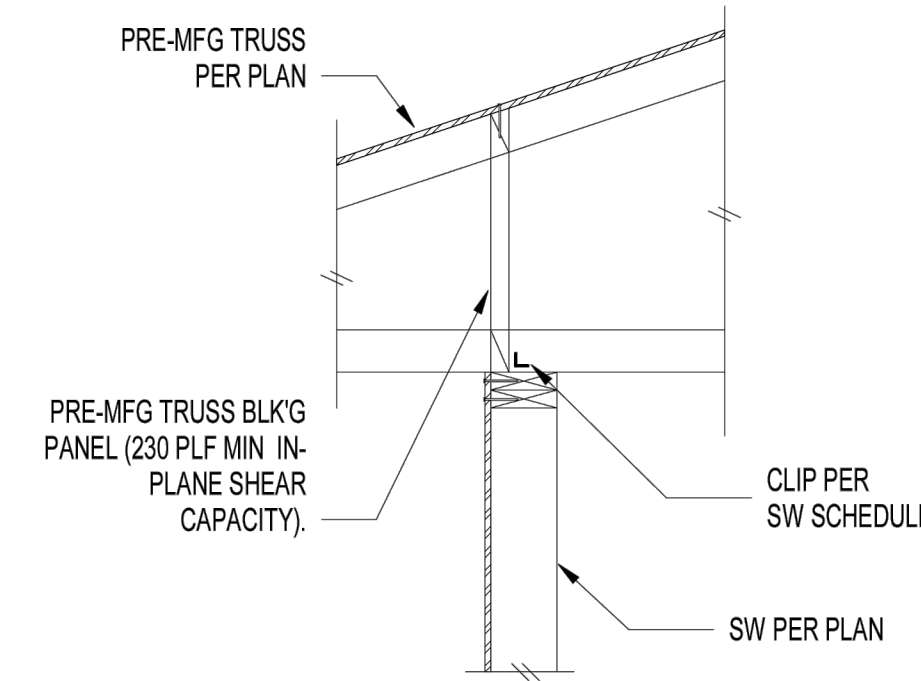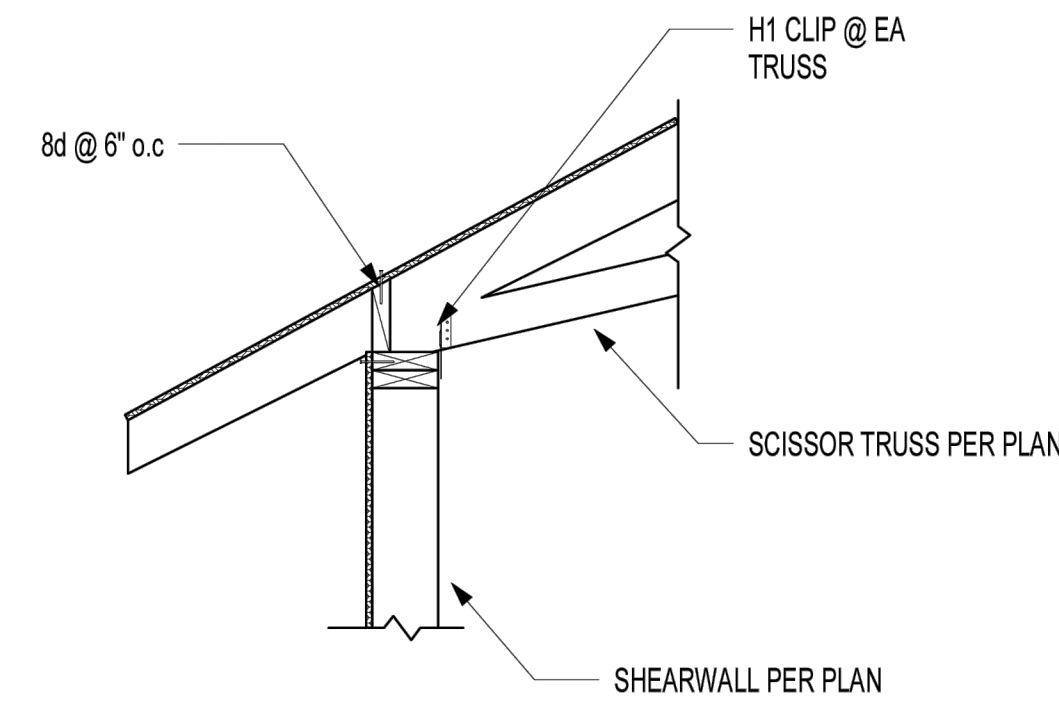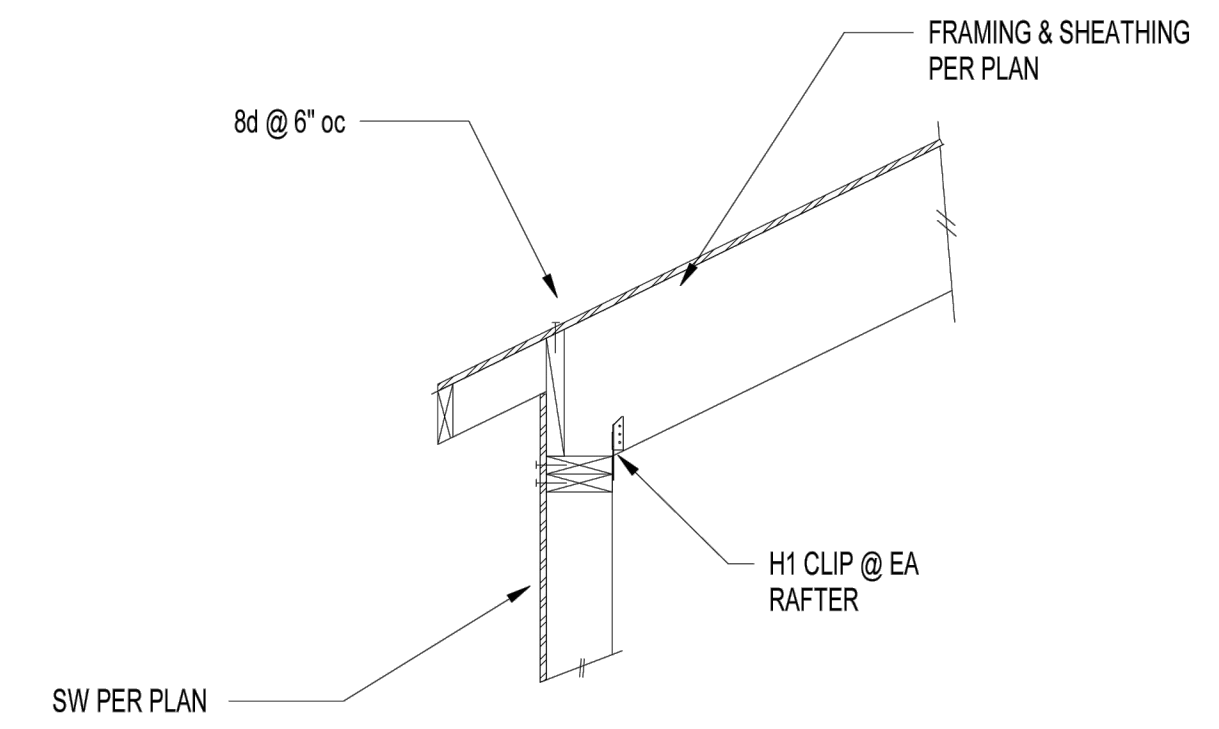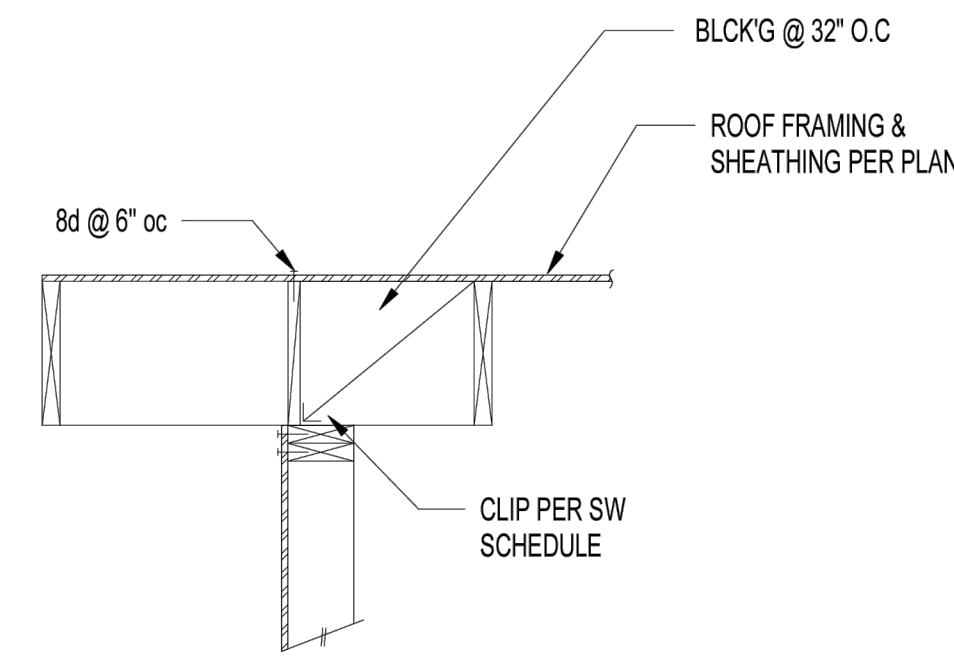


- Over framing shall consist of the following:
1. 2 x 4 HF #2 for spans up to 6'
 2. 2 x 6 HF #2 for spans up to 8'
 3. 2 x 8 HF #2 for spans up to 12'
 4. 2 x 10 HF #2 for spans up to 16'

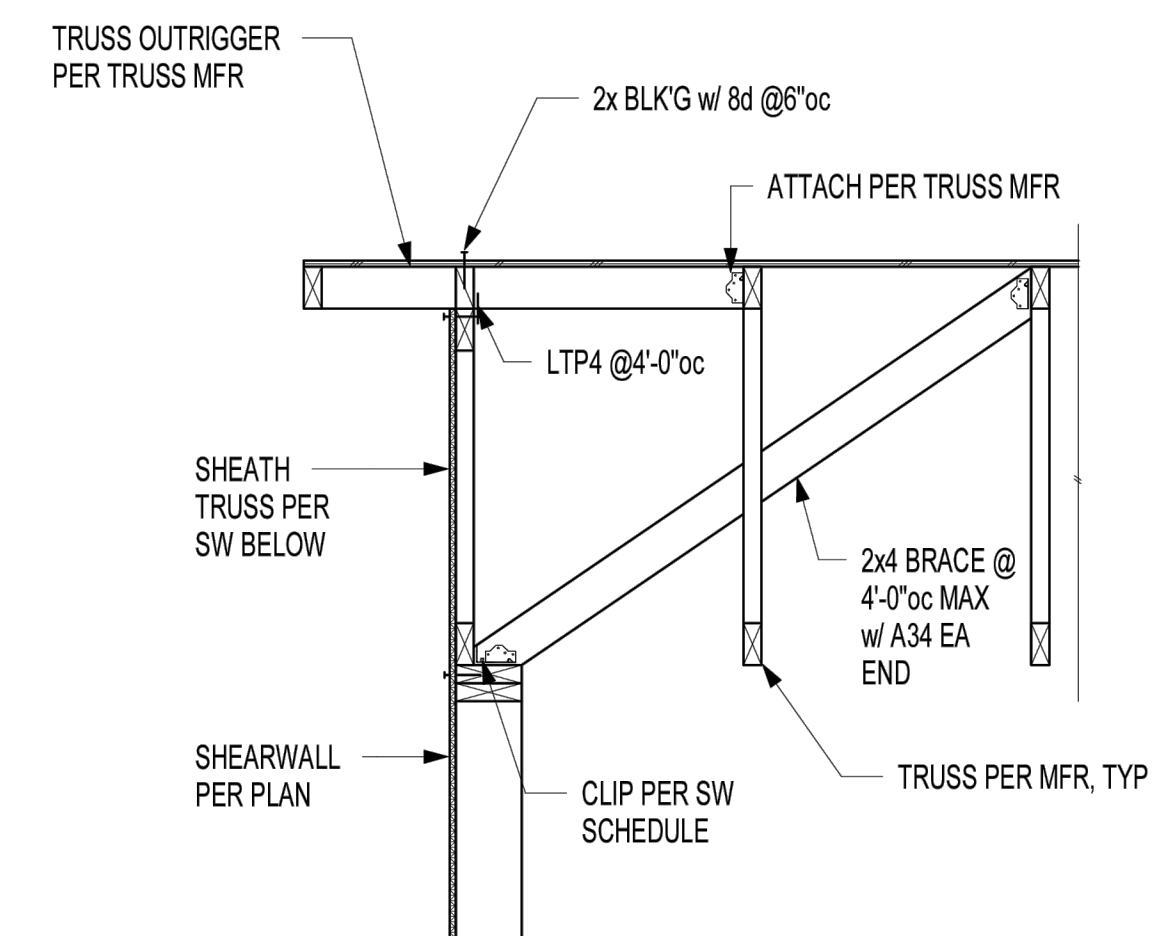

Custom Design and Engineering, Inc
6021 Roosevelt Way Ne
Seattle, WA 98115
www.cdengr.com
email: kam@cdengr.com

PROJECT NAME: **RAQUEPAU RESIDENCE**
PROJECT ADDRESS: **9116 SE 58th ST
MERCER ISLAND, WA 98040**

DWG TITLE	Number	Revision	Date
DETAILS			

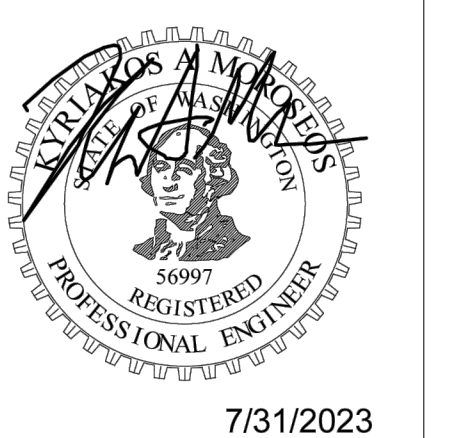

PROJECT #
Z4-3205

SHEET NO
S6.2