

# CORRECTIONS

---

## Mercer Residence

6950 SE Maker Street  
Mercer Island, WA 98040

---

PROJECT NO.: 2207-19

DATE: January 25, 2023


**D. S. Engineering**  
Consulting Structural Engineers

3121 147th Place SE  
Mill Creek, WA 98012  
T: 425-338-4776

01/25/2023




00466

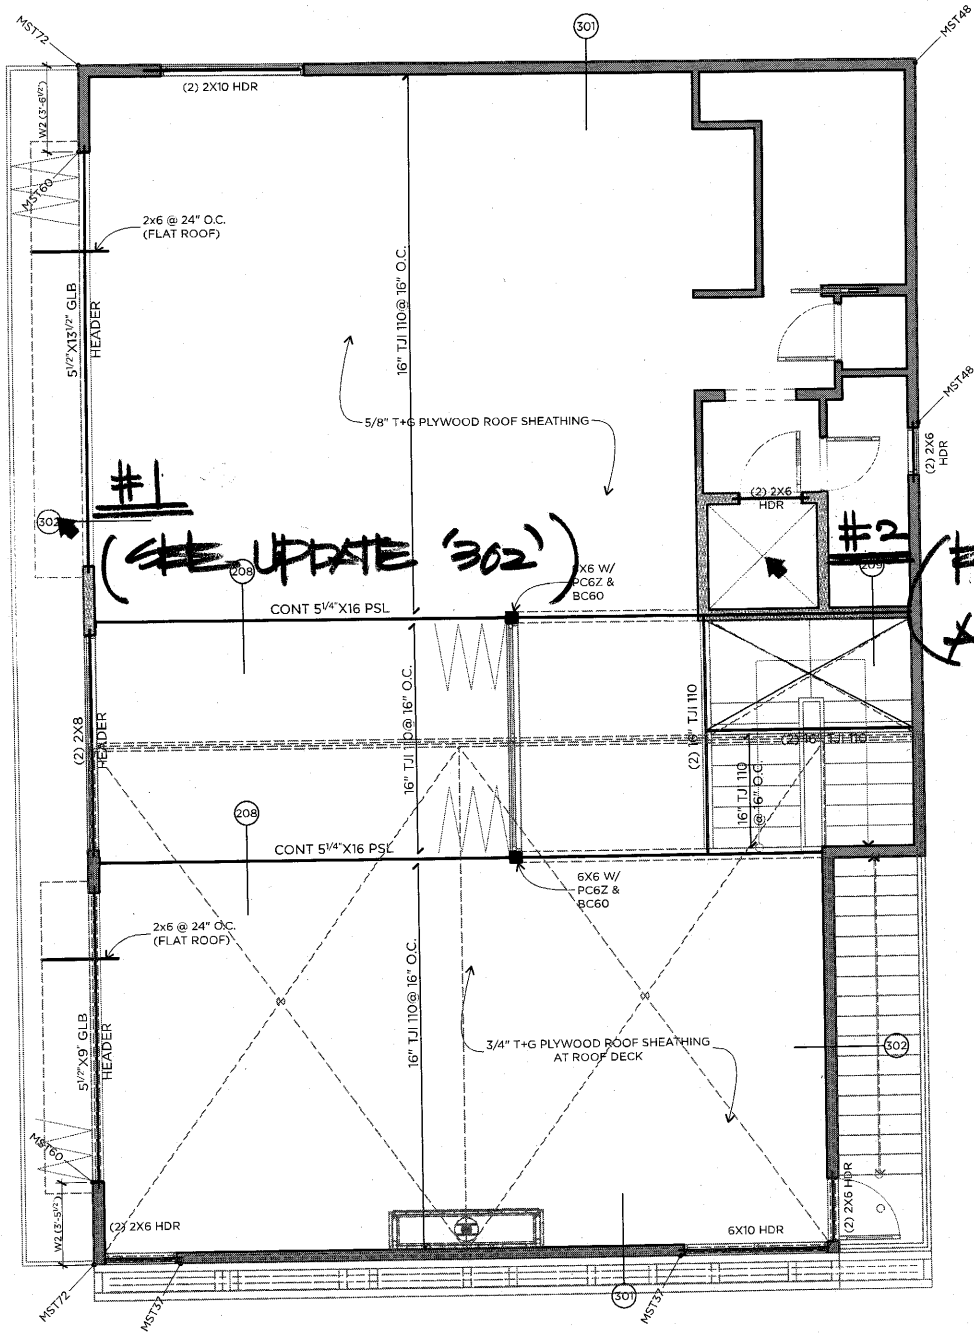

# ROOF FRAMING

SCALE: 1/4" = 1'-0"

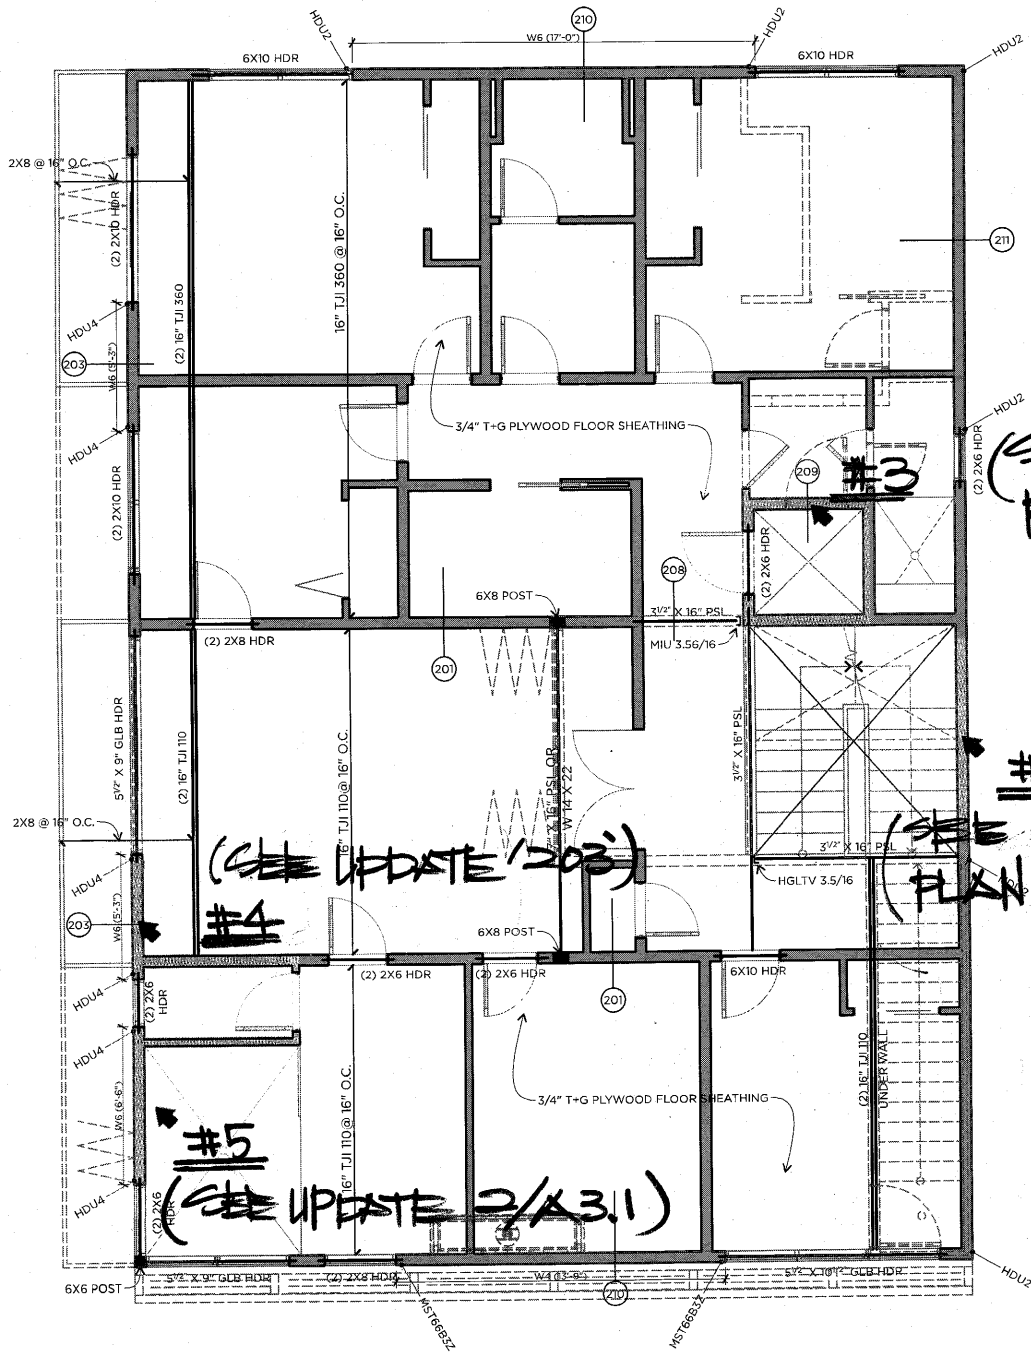

~~SEE~~ UPDATE  
 PLAN &  
 DETAIL  
 @ S1.2


~~SEE~~ UPDATE  
 PLAN &  
 S1.2

~~SEE~~ UPDATE / 203  
 #4

~~SEE~~ UPDATE 2/A3.1  
 #5

SECOND FLOOR FRAMING

SCALE: 1/4" = 1'-0"

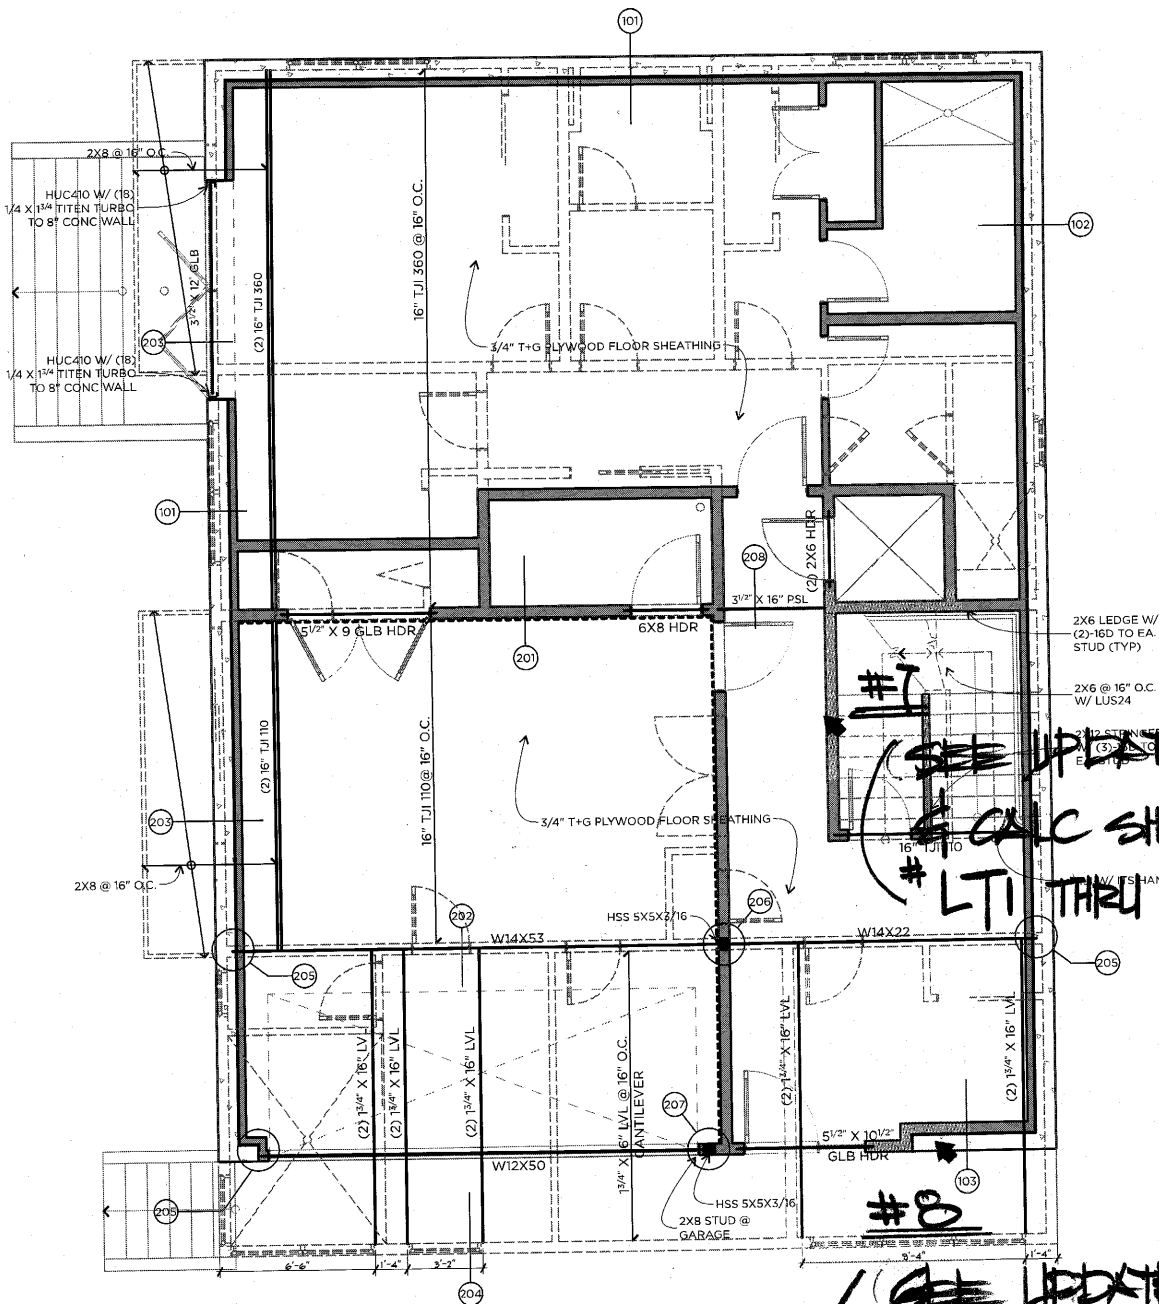


FIRST FLOOR FRAMING

SCALE: 1/4" = 1'-0"

#7  
 SEE UPDATE PLAN  
 & CALC SHEET  
 #LT1 THRU #LT9

#8  
 SEE UPDATE PLAN  
 & DETAIL '20'  
 & CALC SHEET  
 #LT11 & #LT12



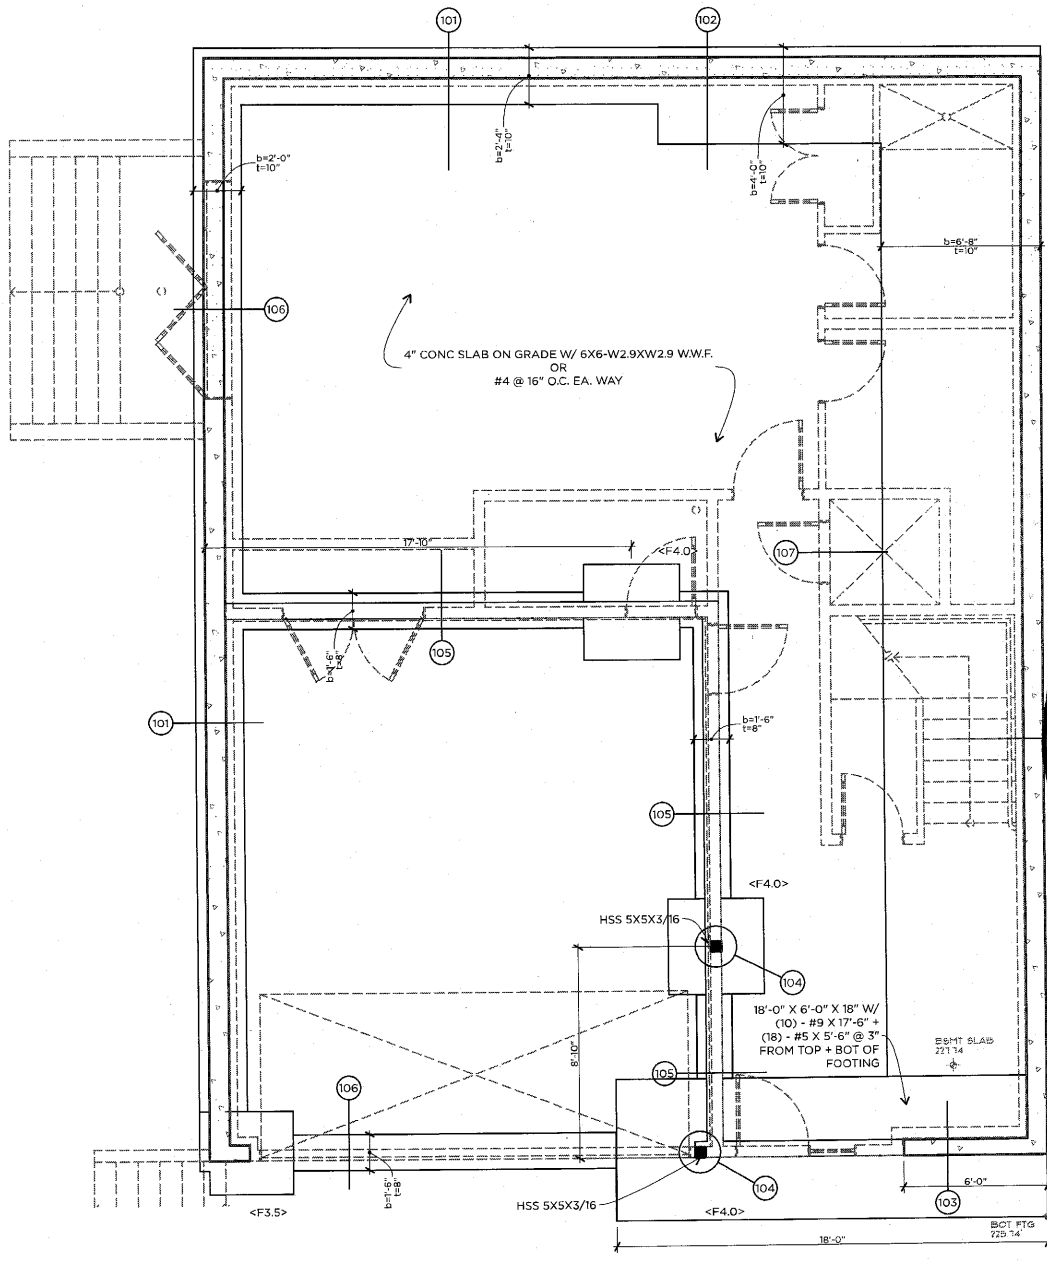


#9  
SEE UPDATE  
EAST WALL  
@ S.I. /

FOUNDATION PLAN

SCALE: 1/4" = 1'-0"

# **Design Analysis**

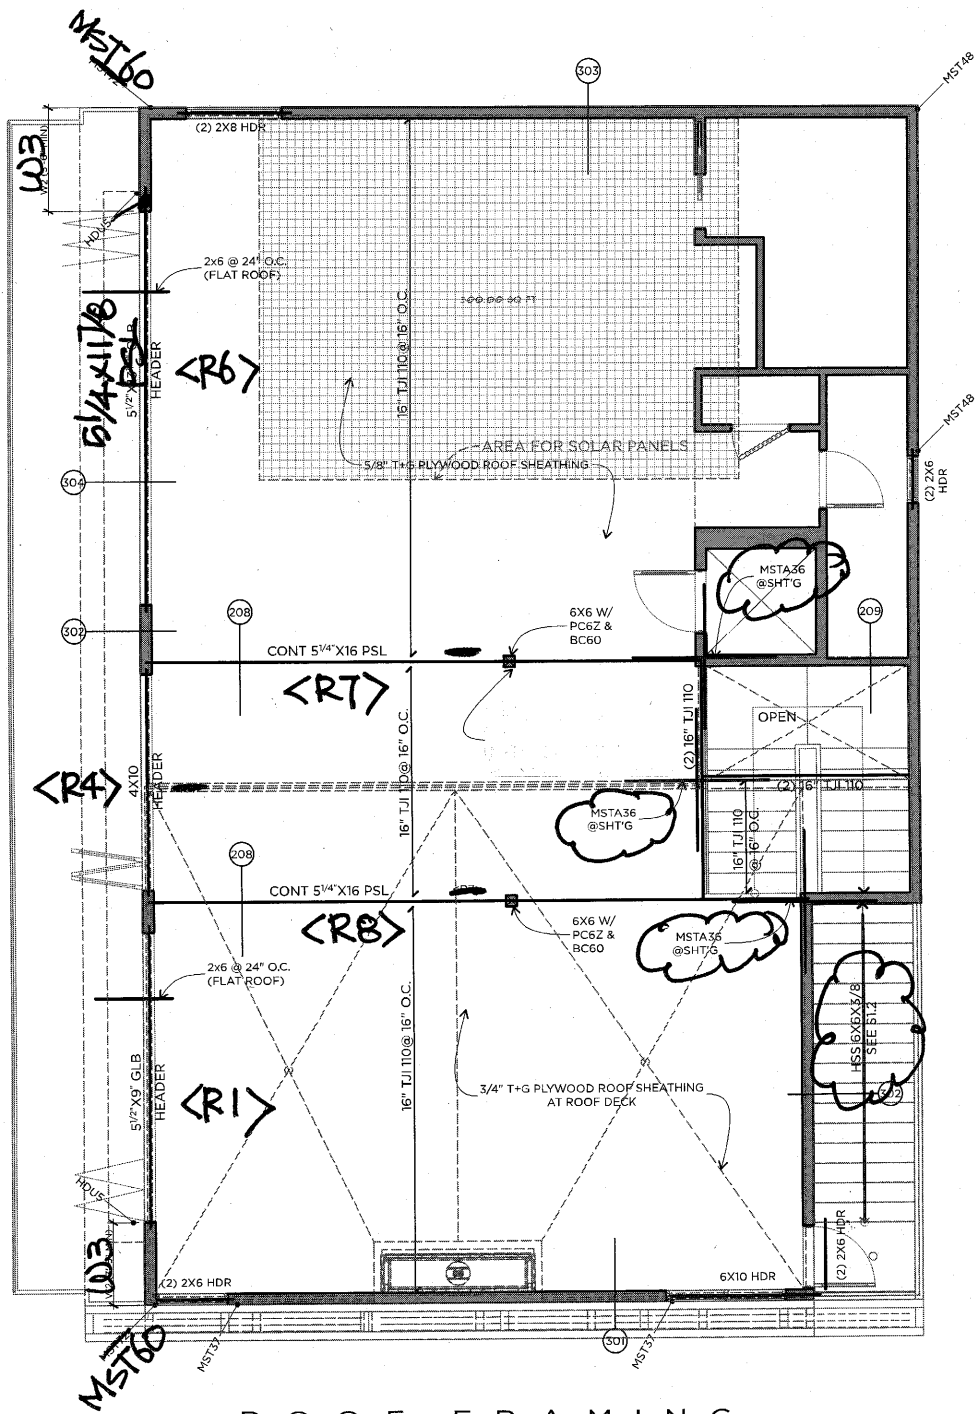

ROOF FRAMING

SCALE: 1/4" = 1'-0"

**Wood Beam**

Project File: ENERCALC\_20

LIC#: KW-06015335, Build:20.22.12.28

D.S. ENGINEERING PC

(c) ENERCALC INC 1983-2022

**DESCRIPTION:** header

**CODE REFERENCES**


*(@ NORTH OAH)*

Calculations per NDS 2018, IBC 2018, CBC 2019, ASCE 7-16

Load Combination Set : IBC 2018

**Material Properties**

Analysis Method : Allowable Stress Design	Fb +	850 psi	<i>E : Modulus of Elasticity</i>	
Load Combination : IBC 2018	Fb -	850 psi	Ebend- xx	1300ksi
	Fc - Prll	1300 psi	Eminbend - xx	470ksi
Wood Species : Hem-Fir	Fc - Perp	405 psi		
Wood Grade : No.2	Fv	150 psi		
	Ft	525 psi	Density	26.84 pcf
Beam Bracing : Completely Unbraced				

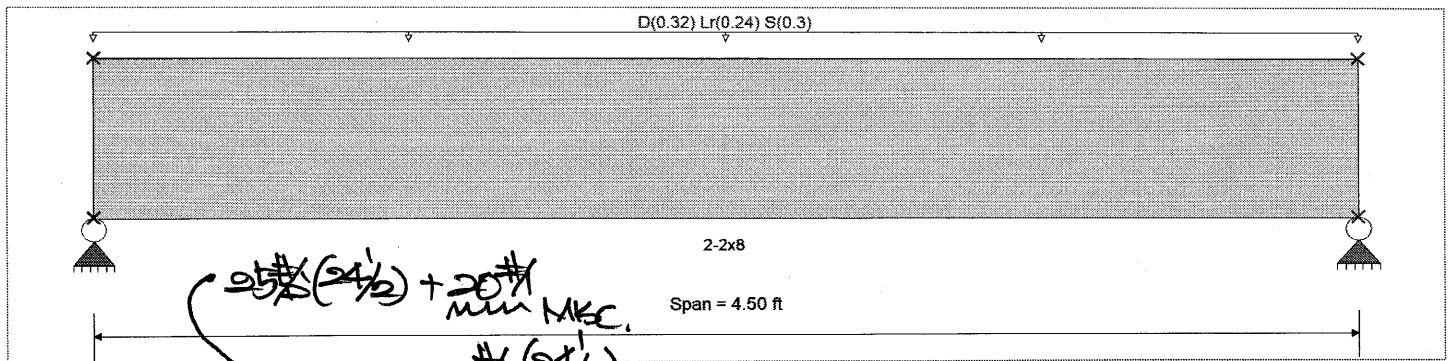

**Applied Loads**

Service loads entered. Load Factors will be applied for calculations.

Beam self weight calculated and added to loading

Uniform Load : D = 0.320, Lr = 0.240, S = 0.30, Tributary Width = 1.0 ft

**DESIGN SUMMARY**

**Design OK**

Maximum Bending Stress Ratio = 0.622 1	Maximum Shear Stress Ratio = 0.414 : 1
Section used for this span = 2-2x8	Section used for this span = 2-2x8
fb: Actual = 721.26psi	fv: Actual = 71.39 psi
F'b = 1,160.10psi	F'v = 172.50 psi
Load Combination = +D+S	Load Combination = +D+S
Location of maximum on span = 2.250ft	Location of maximum on span = 3.909 ft
Span # where maximum occurs = Span # 1	Span # where maximum occurs = Span # 1
Maximum Deflection	
Max Downward Transient Deflection 0.022 in Ratio = 2402 >= 360	Span: 1 : S Only
Max Upward Transient Deflection 0 in Ratio = 0 < 360	n/a
Max Downward Total Deflection 0.047 in Ratio = 1154 >= 240	Span: 1 : +D+S
Max Upward Total Deflection 0 in Ratio = 0 < 240	n/a

**Overall Maximum Deflections**

Load Combination	Span	Max. "-" Defl	Location in Span	Load Combination	Max. "+" Defl	Location in Span
+D+S	1	0.0468	2.266		0.0000	0.000

**Vertical Reactions**

Support notation : Far left is #1

Values in KIPS

Load Combination	Support 1	Support 2
Max Upward from all Load Conditions	1.404	1.404
Max Upward from Load Combinations	1.404	1.404
Max Upward from Load Cases	0.729	0.729
D Only	0.729	0.729
+D+Lr	1.269	1.269
+D+S	1.404	1.404
+D+0.750Lr	1.134	1.134
+D+0.750S	1.235	1.235
+0.60D	0.437	0.437
Lr Only	0.540	0.540

**Wood Beam**

Project File: ENERCALC\_20

LIC#: KW-06015335, Build:20.22.12.28

D.S. ENGINEERING PC

(c) ENERCALC INC 1983-2022

**DESCRIPTION:** header

**Vertical Reactions**

(@ NORTH WALL)

Support notation : Far left is #1

Values in KIPS

Load Combination

Support 1 Support 2

S Only

0.675

0.675

# Wood Beam

Project File: ENERCALC\_20

LIC#: KW-06015335, Build:20.22.12.28

D.S. ENGINEERING PC

(c) ENERCALC INC 1983-2022

**DESCRIPTION:** header <R1 >


## CODE REFERENCES

Calculations per NDS 2018, IBC 2018, CBC 2019, ASCE 7-16

Load Combination Set : IBC 2018

## Material Properties

Analysis Method : Allowable Stress Design	Fb +	2400 psi	E : Modulus of Elasticity	
Load Combination : IBC 2018	Fb -	1850 psi	Ebend- xx	1800 ksi
	Fc - Prll	1650 psi	Eminbend - xx	950 ksi
Wood Species : DF/DF	Fc - Perp	650 psi	Ebend- yy	1600 ksi
Wood Grade : 24F-V4	Fv	265 psi	Eminbend - yy	850 ksi
	Ft	1100 psi	Density	31.21 pcf
Beam Bracing : Completely Unbraced				

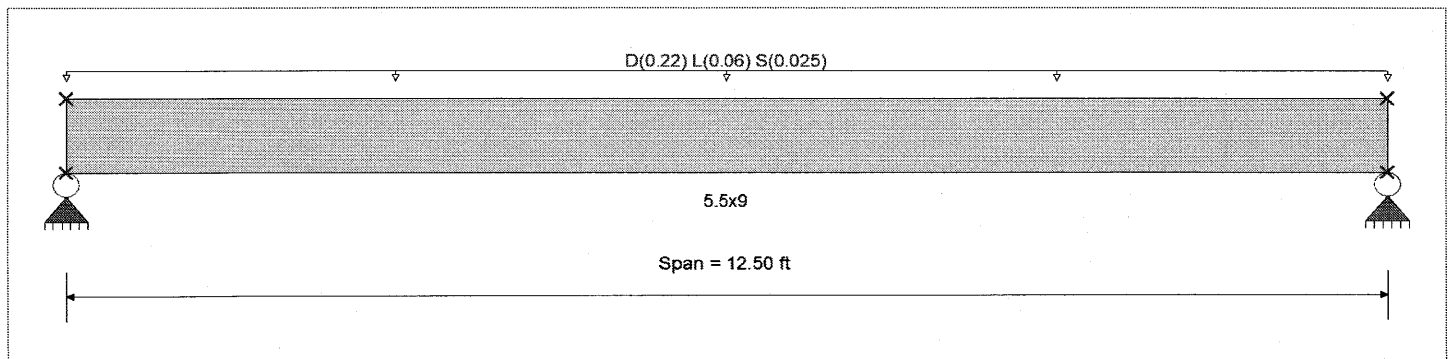

## Applied Loads

Service loads entered. Load Factors will be applied for calculations.

Beam self weight calculated and added to loading

Uniform Load : D = 0.220, L = 0.060, S = 0.0250, Tributary Width = 1.0 ft

## DESIGN SUMMARY

**Design OK**

Maximum Bending Stress Ratio	=	0.386	1	Maximum Shear Stress Ratio	=	0.184	: 1
Section used for this span		<b>5.5x9</b>		Section used for this span		<b>5.5x9</b>	
fb: Actual	=	917.70psi		fv: Actual	=	48.63 psi	
F'b	=	2,375.48psi		F'v	=	265.00 psi	
Load Combination		+D+L		Load Combination		+D+L	
Location of maximum on span	=	6.250ft		Location of maximum on span	=	11.770 ft	
Span # where maximum occurs	=	Span # 1		Span # where maximum occurs	=	Span # 1	
<b>Maximum Deflection</b>							
Max Downward Transient Deflection		0.055 in	Ratio = 2721	>=360	Span: 1 : L Only		
Max Upward Transient Deflection		0 in	Ratio = 0	<360	n/a		
Max Downward Total Deflection		0.271 in	Ratio = 554	>=180	Span: 1 : +D+0.750L+0.750S		
Max Upward Total Deflection		0 in	Ratio = 0	<180	n/a		

## Overall Maximum Deflections

Load Combination	Span	Max. "-" Defl	Location in Span	Load Combination	Max. "+" Defl	Location in Span
+D+0.750L+0.750S	1	0.2705	6.296		0.0000	0.000

## Vertical Reactions

Support notation : Far left is #1

Values in KIPS

Load Combination	Support 1	Support 2
Max Upward from all Load Conditions	1.840	1.840
Max Upward from Load Combinations	1.840	1.840
Max Upward from Load Cases	1.442	1.442
D Only	1.442	1.442
+D+L	1.817	1.817
+D+Lr	1.442	1.442
+D+S	1.598	1.598
+D+0.750Lr+0.750L	1.723	1.723
+D+0.750L+0.750S	1.840	1.840
+0.60D	0.865	0.865

**Wood Beam**

Project File: ENERCALC\_20

LIC#: KW-06015335, Build:20.22.12.28

D.S. ENGINEERING PC

(c) ENERCALC INC 1983-2022

**DESCRIPTION:** header <R>**Vertical Reactions**

Support notation : Far left is #1

Values in KIPS

Load Combination	Support 1	Support 2
L Only	0.375	0.375
S Only	0.156	0.156

# Wood Beam

Lic. #: KW-06010224

File: examples.ec6  
 Software copyright ENERCALC, INC. 1983-2020, Build: 12.20.8.24  
 D.S. ENGINEERING PC

DESCRIPTION: header <R4>

## CODE REFERENCES

Calculations per NDS 2015, IBC 2015, CBC 2016, ASCE 7-10

Load Combination Set : IBC 2018


## Material Properties

Analysis Method : Allowable Stress Design  
 Load Combination IBC 2018

Fb +	850 psi	E : Modulus of Elasticity	
Fb -	850 psi	Ebend- xx	1300 ksi
Fc - Prll	1300 psi	Eminbend - xx	470 ksi
Fc - Perp	405 psi		
Fv	150 psi		
Ft	525 psi	Density	26.84 pcf

Wood Species : Hem-Fir  
 Wood Grade : No.2

Beam Bracing : Completely Unbraced

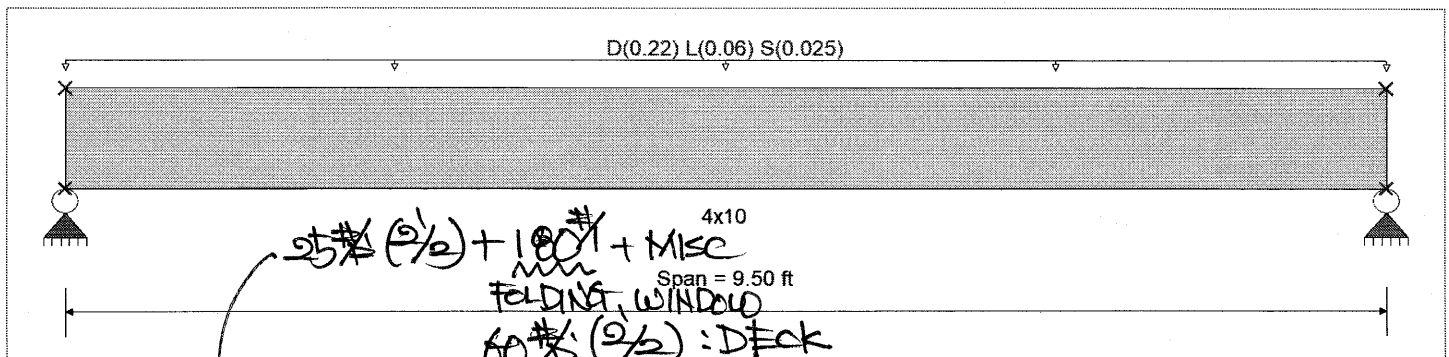

## Applied Loads

Beam self weight calculated and added to loads

Uniform Load : D = 0.220, L = 0.060, S = 0.0250, Tributary Width = 1.0 ft

Service loads entered. Load Factors will be applied for calculations.

## DESIGN SUMMARY

Design OK

Maximum Bending Stress Ratio	=	0.776	1	Maximum Shear Stress Ratio	=	0.352	1
Section used for this span		4x10		Section used for this span		4x10	
fb: Actual	=	775.81	psi	fv: Actual	=	52.84	psi
Fb: Allowable	=	999.98	psi	Fv: Allowable	=	150.00	psi
Load Combination		+D+L		Load Combination		+D+L	
Location of maximum on span	=	4.750	ft	Location of maximum on span	=	8.737	ft
Span # where maximum occurs	=	Span # 1		Span # where maximum occurs	=	Span # 1	
Maximum Deflection							
Max Downward Transient Deflection		0.037	in	Ratio =		3093	>=360
Max Upward Transient Deflection		0.000	in	Ratio =		0	<360
Max Downward Total Deflection		0.178	in	Ratio =		640	>=240
Max Upward Total Deflection		0.000	in	Ratio =		0	<240

## Overall Maximum Deflections

Load Combination	Span	Max. "-" Defl	Location in Span	Load Combination	Max. "+" Defl	Location in Span
+D+0.750L+0.750S	1	0.1780	4.785		0.0000	0.000

## Vertical Reactions

Support notation : Far left is #1

Values in KIPS

Load Combination	Support 1	Support 2
Overall MAXimum	1.503	1.503
Overall MINimum	0.119	0.119
+1.40D	1.503	1.503
+D+L	1.359	1.359
+D+Lr	1.074	1.074
+D+S	1.192	1.192
+D+0.750Lr+0.750L	1.287	1.287
+D+0.750L+0.750S	1.376	1.376
D Only	1.074	1.074
+0.60D	0.644	0.644



**Wood Beam**

File: examples.ec6

Lic. #: KW-06010224

Software copyright ENERCALC, INC. 1983-2020, Build: 12.20.8.24

D.S. ENGINEERING PC

DESCRIPTION: header <R4>

**Vertical Reactions**

Support notation : Far left is #1

Values in KIPS

Load Combination	Support 1	Support 2
L Only	0.285	0.285
S Only	0.119	0.119

# Wood Beam

Project File: ENERCALC\_20

LIC#: KVV-06015335, Build:20.22.12.28

D.S. ENGINEERING PC

(c) ENERCALC INC 1983-2022

**DESCRIPTION:** header <R6>

## CODE REFERENCES

Calculations per NDS 2018, IBC 2018, CBC 2019, ASCE 7-16

Load Combination Set : IBC 2018


## Material Properties

Analysis Method : Allowable Stress Design  
Load Combination : IBC 2018

Fb +	2900 psi	E : Modulus of Elasticity	
Fb -	2900 psi	Ebend- xx	2200ksi
Fc - Prll	2900 psi	Eminbend - xx	1118.19ksi
Fc - Perp	750 psi		
Fv	290 psi		
Ft	2025 psi	Density	45.07pcf

Wood Species : iLevel Truss Joist  
Wood Grade : Parallam PSL 2.2E

Beam Bracing : Completely Unbraced

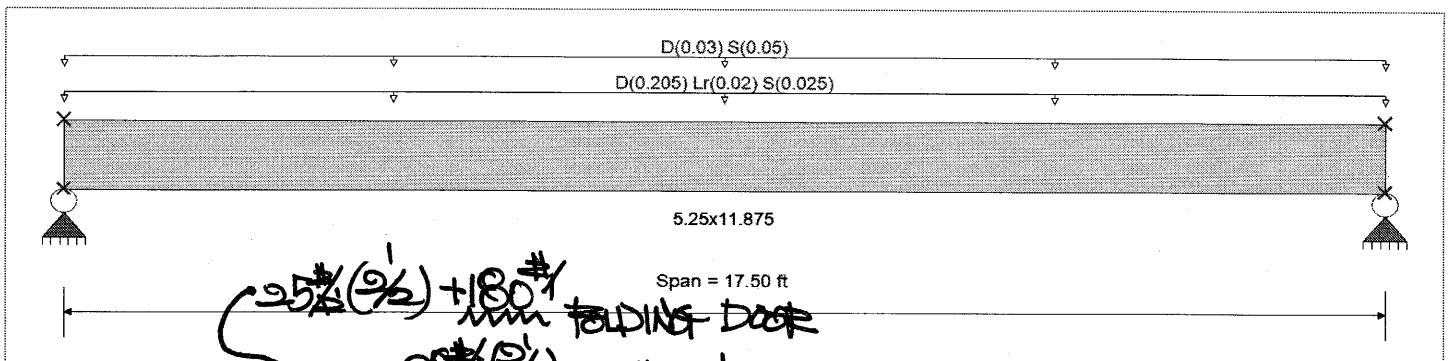

## Applied Loads

Beam self weight calculated and added to loading

Uniform Load : D = 0.2050, Lr = 0.020, S = 0.0250, Tributary Width = 1.0 ft

Uniform Load : D = 0.030, S = 0.050, Tributary Width = 1.0 ft, (from flat roof)

## DESIGN SUMMARY

Maximum Bending Stress Ratio	=	0.380	1	Maximum Shear Stress Ratio	=	0.185	: 1
Section used for this span	=	5.25x11.875		Section used for this span	=	5.25x11.875	
fb: Actual	=	1,226.77	psi	fv: Actual	=	61.78	psi
F'b	=	3,230.81	psi	F'v	=	333.50	psi
Load Combination	=	+D+S		Load Combination	=	+D+S	
Location of maximum on span	=	8.750	ft	Location of maximum on span	=	0.000	ft
Span # where maximum occurs	=	Span # 1		Span # where maximum occurs	=	Span # 1	
<b>Maximum Deflection</b>							
Max Downward Transient Deflection	0.099	in	Ratio =	2126	>=	360	Span: 1 : S Only
Max Upward Transient Deflection	0	in	Ratio =	0	<	360	n/a
Max Downward Total Deflection	0.434	in	Ratio =	483	>=	180	Span: 1 : +D+S
Max Upward Total Deflection	0	in	Ratio =	0	<	180	n/a

## Overall Maximum Deflections

Load Combination	Span	Max. "-" Defl	Location in Span	Load Combination	Max. "+" Defl	Location in Span
+D+S	1	0.4339	8.814		0.0000	0.000

## Vertical Reactions

Support notation : Far left is #1

Values in KIPS

Load Combination	Support 1	Support 2
Max Upward from all Load Conditions	2.883	2.883
Max Upward from Load Combinations	2.883	2.883
Max Upward from Load Cases	2.227	2.227
D Only	2.227	2.227
+D+Lr	2.402	2.402
+D+S	2.883	2.883
+D+0.750Lr	2.358	2.358
+D+0.750S	2.719	2.719
+0.60D	1.336	1.336

**Wood Beam**

Project File: ENERCALC\_20

LIC# : KW-06015335, Build:20.22.12.28

D.S. ENGINEERING PC

(c) ENERCALC INC 1983-2022

**DESCRIPTION:** header <R6>**Vertical Reactions**

Support notation : Far left is #1

Values in KIPS

Load Combination	Support 1	Support 2
Lr Only	0.175	0.175
S Only	0.656	0.656

# Wood Beam

Project File: ENERCALC\_20

LIC#: KW-06015335, Build:20.22.12.28

D.S. ENGINEERING PC

(c) ENERCALC INC 1983-2022

DESCRIPTION: <R7>


## CODE REFERENCES

Calculations per NDS 2018, IBC 2018, CBC 2019, ASCE 7-16

Load Combination Set : IBC 2018

## Material Properties

Analysis Method : Allowable Stress Design	Fb +	2900 psi	E : Modulus of Elasticity
Load Combination : IBC 2018	Fb -	2900 psi	Ebend- xx 2200ksi
	Fc - Prll	2900 psi	Eminbend - xx 1118.19ksi
Wood Species : iLevel Truss Joist	Fc - Perp	750 psi	
Wood Grade : Parallam PSL 2.2E	Fv	290 psi	
Beam Bracing : Beam is Fully Braced against lateral-torsional buckling	Ft	2025 psi	Density 45.07pcf

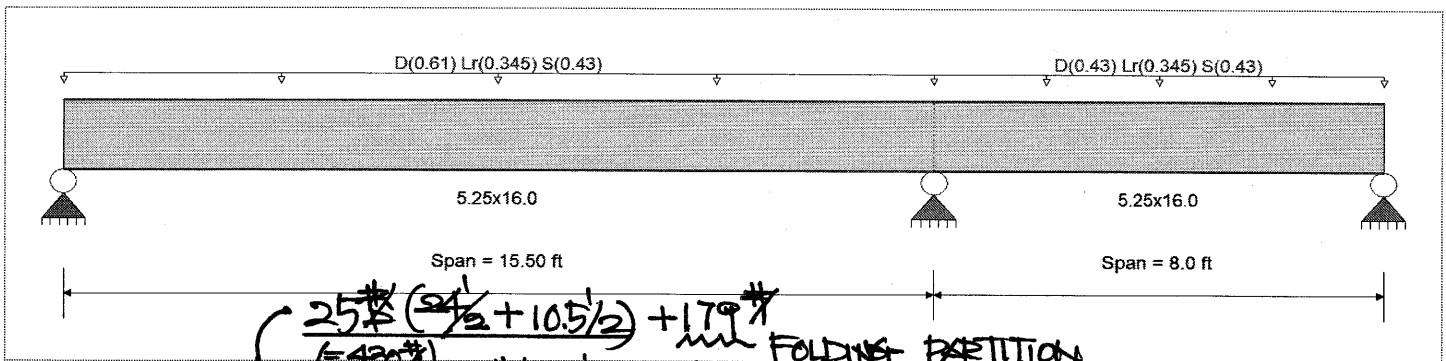

## Applied Loads

Beam self weight calculated and added to loading  
 Load for Span Number 1  
 Uniform Load : D = 0.610, Lr = 0.3450, S = 0.430, Tributary Width = 1.0 ft  
 Load for Span Number 2  
 Uniform Load : D = 0.430, Lr = 0.3450, S = 0.430, Tributary Width = 1.0 ft

## DESIGN SUMMARY

				<b>Design OK</b>			
Maximum Bending Stress Ratio	=	0.390	1	Maximum Shear Stress Ratio	=	0.450	: 1
Section used for this span	=	5.25x16.0		Section used for this span	=	5.25x16.0	
fb: Actual	=	1,260.78psi		fv: Actual	=	149.95 psi	
F'b	=	3,230.19psi		F'v	=	333.50 psi	
Load Combination	=	+D+S		Load Combination	=	+D+S	
Location of maximum on span	=	15.500ft		Location of maximum on span	=	14.201 ft	
Span # where maximum occurs	=	Span # 1		Span # where maximum occurs	=	Span # 1	
<b>Maximum Deflection</b>							
Max Downward Transient Deflection	0.080 in	Ratio =	2333 >= 360	Span: 1 : S Only			
Max Upward Transient Deflection	-0.008 in	Ratio =	11701 >= 360	Span: 2 : S Only			
Max Downward Total Deflection	0.201 in	Ratio =	926 >= 180	Span: 1 : +D+S			
Max Upward Total Deflection	-0.023 in	Ratio =	4134 >= 180	Span: 2 : +D+S			

## Overall Maximum Deflections

Load Combination	Span	Max. "-" Defl	Location in Span	Load Combination	Max. "+" Defl	Location in Span
+D+S	1	0.2008	7.101	+D+S	0.0000	0.000
	2	0.0000	7.101		-0.0232	2.860

## Vertical Reactions

Support notation : Far left is #1

Values in KIPS

Load Combination	Support 1	Support 2	Support 3
Max Upward from all Load Conditions	6.745	16.269	0.603
Max Upward from Load Combinations	6.745	16.269	0.603
Max Upward from Load Cases	4.038	9.380	0.509
D Only	4.038	9.380	0.094
+D+Lr	6.210	14.907	0.503
+D+S	6.745	16.269	0.603

**Wood Beam**

Project File: ENERCALC\_20

LIC#: KW-06015335, Build:20.22.12.28

D.S. ENGINEERING PC

(c) ENERCALC INC 1983-2022

**DESCRIPTION:** <R7>**Vertical Reactions**

Support notation : Far left is #1

Values in KIPS

Load Combination	Support 1	Support 2	Support 3
+D+0.750Lr	5.667	13.526	0.401
+D+0.750S	6.069	14.547	0.476
+0.60D	2.423	5.628	0.057
Lr Only	2.172	5.527	0.408
S Only	2.707	6.889	0.509

**Wood Beam**

Lic. #: KW-06010224

File: examples.ec6  
Software copyright ENERCALC, INC. 1983-2020, Build: 12.20.8.24

D.S. ENGINEERING PC

DESCRIPTION: beam <R8>

**CODE REFERENCES**

Calculations per NDS 2015, IBC 2015, CBC 2016, ASCE 7-10

Load Combination Set : IBC 2018


**Material Properties**

Analysis Method : Allowable Stress Design  
Load Combination : IBC 2018

Fb +	2900 psi	E : Modulus of Elasticity	
Fb -	2900 psi	Ebend-xx	2200 ksi
Fc - Prll	2900 psi	Eminbend-xx	1118.19 ksi
Fc - Perp	750 psi		
Fv	290 psi		
Ft	2025 psi	Density	45.07 pcf

Wood Species : iLevel Truss Joist  
Wood Grade : Parallam PSL 2.2E

Beam Bracing : Beam is Fully Braced against lateral-torsional buckling

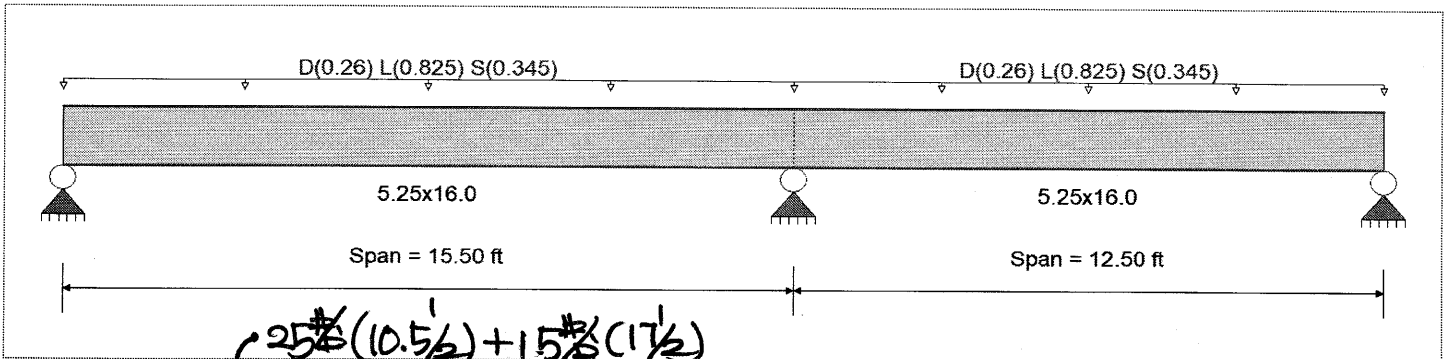

**Applied Loads**

Service loads entered. Load Factors will be applied for calculations.

Beam self weight calculated and added to loads.

Load for Span Number 1  
Uniform Load : D = 0.260, L = 0.8250, S = 0.3450, Tributary Width = 1.0 ft

Load for Span Number 2  
Uniform Load : D = 0.260, L = 0.8250, S = 0.3450, Tributary Width = 1.0 ft

**DESIGN SUMMARY**

**Design OK**

Maximum Bending Stress Ratio	=	0.537 : 1	Maximum Shear Stress Ratio	=	0.553 : 1
Section used for this span	=	5.25x16.0	Section used for this span	=	5.25x16.0
fb: Actual	=	1,508.80 psi	fv: Actual	=	160.47 psi
Fb: Allowable	=	2,808.86 psi	Fv: Allowable	=	290.00 psi
Load Combination	=	+D+L	Load Combination	=	+D+L
Location of maximum on span	=	15.500ft	Location of maximum on span	=	14.201 ft
Span # where maximum occurs	=	Span # 1	Span # where maximum occurs	=	Span # 1
Maximum Deflection					
Max Downward Transient Deflection		0.138 in Ratio = 1345 >=360			
Max Upward Transient Deflection		-0.005 in Ratio = 29676 >=360			
Max Downward Total Deflection		0.195 in Ratio = 953 >=240			
Max Upward Total Deflection		-0.007 in Ratio = 21037 >=240			

**Overall Maximum Deflections**

Load Combination	Span	Max. "-" Defl	Location in Span	Load Combination	Max. "+" Defl	Location in Span
+D+0.750L+0.750S	1	0.1951	6.841	+D+0.750L+0.750S	0.0000	0.000
+D+0.750L+0.750S	2	0.0412	7.891	+D+0.750L+0.750S	-0.0071	1.187

**Vertical Reactions**

Support notation : Far left is #1

Values in KIPS

Load Combination	Support 1	Support 2	Support 3
Overall MAXimum	7.116	20.556	4.914
Overall MINimum	2.110	6.094	1.457
+1.40D	2.451	7.079	1.692
+D+L	6.795	19.628	4.692
+D+Lr	1.751	5.057	1.209
+D+S	3.860	11.150	2.666

# Wood Beam

File: examples.ec6

Lic. #: KW-06010224

Software copyright ENERCALC, INC. 1983-2020, Build: 12.20.8.24

D.S. ENGINEERING PC

DESCRIPTION: beam <R8>

## Vertical Reactions

Support notation : Far left is #1

Values in KIPS

Load Combination	Support 1	Support 2	Support 3
+D+0.750Lr+0.750L	5.534	15.985	3.822
+D+0.750L+0.750S	7.116	20.556	4.914
D Only	1.751	5.057	1.209
+0.60D	1.050	3.034	0.725
L Only	5.045	14.572	3.484
S Only	2.110	6.094	1.457

# Wood Column

Project File: ENERCALC\_20

LIC#: KW-06015335, Build:20.22.12.28

D.S. ENGINEERING PC

(c) ENERCALC INC 1983-2022

**DESCRIPTION:** under <R8>

## Code References

Calculations per NDS 2018, IBC 2018, CBC 2019, ASCE 7-16

Load Combinations Used : IBC 2018

## General Information

Analysis Method	Allowable Stress Design			Wood Section Name	<b>6x6</b>
End Fixities	Top & Bottom Pinned			Wood Grading/Manuf.	Graded Lumber
Overall Column Height	10 ft			Wood Member Type	Sawn
<i>(Used for non-slender calculations)</i>					
Wood Species	Douglas Fir-Larch			Exact Width	<b>5.50 in</b>
Wood Grade	No.2			Exact Depth	<b>5.50 in</b>
Fb +	750 psi	Fv	170 psi	Area	30.250 in <sup>2</sup>
Fb -	750 psi	Ft	475 psi	Ix	76.255 in <sup>4</sup>
Fc - Prll	700 psi	Density	31.21 pcf	Iy	76.255 in <sup>4</sup>
Fc - Perp	625 psi				
E : Modulus of Elasticity . . .	x-x Bending	y-y Bending	Axial		
	Basic	1300	1300	1300 ksi	
	Minimum	470	470		
				Brace condition for deflection (buckling) along columns :	
				X-X (width) axis :	Fully braced against buckling ABOUT Y-Y Axis
				Y-Y (depth) axis :	Fully braced against buckling ABOUT X-X Axis
					Allow Stress Modification Factors
					Cf or Cv for Bending 1.0
					Cf or Cv for Compression 1.0
					Cf or Cv for Tension 1.0
					Cm : Wet Use Factor 1.0
					Ct : Temperature Fact 1.0
					Cfu : Flat Use Factor 1.0
					Kf : Built-up columns 1.0 <i>NDS 15.3.2</i>
					Use Cr : Repetitive ? No

## Applied Loads

Service loads entered. Load Factors will be applied for calculations.

Column self weight included : 65.563 lbs \* Dead Load Factor

AXIAL LOADS . . .

Axial Load at 10.0 ft, D = 5.057, L = 14.572, S = 6.094 k

## DESIGN SUMMARY

### Bending & Shear Check Results

PASS Max. Axial+Bending Stress Ratio =	<b>0.9301 : 1</b>	<b>Maximum SERVICE Lateral Load Reactions . .</b>	
Load Combination	+D+L	Top along Y-Y	0.0 k
Governing NDS Formula	Comp Only, fc/Fc'	Bottom along Y-Y	0.0 k
Location of max.above base	0.0 ft	Top along X-X	0.0 k
At maximum location values are .		Bottom along X-X	0.0 k
Applied Axial	19.695 k	<b>Maximum SERVICE Load Lateral Deflections . . .</b>	
Applied Mx	0.0 k-ft	Along Y-Y	0.0 in at 0.0 ft above base
Applied My	0.0 k-ft	for load combination : n/a	
Fc : Allowable	700.0 psi	Along X-X	0.0 in at 0.0 ft above base
		for load combination : n/a	
PASS Maximum Shear Stress Ratio =	<b>0.0 : 1</b>	<b>Other Factors used to calculate allowable stresses . . .</b>	
Load Combination	+0.60D	<u>Bending</u>	<u>Compression</u>
Location of max.above base	10.0 ft		<u>Tension</u>
Applied Design Shear	0.0 psi		
Allowable Shear	272.0 psi		

## Load Combination Results

Load Combination	C <sub>D</sub>	C <sub>P</sub>	Maximum Axial + Bending Stress Ratios			Maximum Shear Ratios		
			Stress Ratio	Status	Location	Stress Ratio	Status	Location
D Only	0.900	1.000	0.2688	PASS	0.0 ft	0.0	PASS	10.0 ft
+D+L	1.000	1.000	0.9301	PASS	0.0 ft	0.0	PASS	10.0 ft
+D+S	1.150	1.000	0.4606	PASS	0.0 ft	0.0	PASS	10.0 ft
+D+0.750L	1.250	1.000	0.6064	PASS	0.0 ft	0.0	PASS	10.0 ft
+D+0.750L+0.750S	1.150	1.000	0.8469	PASS	0.0 ft	0.0	PASS	10.0 ft
+0.60D	1.600	1.000	0.09072	PASS	0.0 ft	0.0	PASS	10.0 ft

## Maximum Reactions

Note: Only non-zero reactions are listed.

Load Combination	X-X Axis Reaction		k	Y-Y Axis Reaction		Axial Reaction	My - End Moments		k-ft		Mx - End Moments	
	@ Base	@ Top		@ Base	@ Top		@ Base	@ Top	@ Base	@ Top		
D Only						5.123						



# Wood Column

Project File: ENERCALC\_20

LIC#: KW-06015335, Build:20.22.12.28

D.S. ENGINEERING PC

(c) ENERCALC INC 1983-2022

**DESCRIPTION:** under <R8>

## Maximum Reactions


Note: Only non-zero reactions are listed.

Load Combination	X-X Axis Reaction		k	Y-Y Axis Reaction		Axial Reaction	My - End Moments		Mx - End Moments	
	@ Base	@ Top		@ Base	@ Top		@ Base	@ Top	@ Base	@ Top
+D+L						19.695				
+D+S						11.217				
+D+0.750L						16.052				
+D+0.750L+0.750S						20.622				
+0.60D						3.074				
L Only						14.572				
S Only						6.094				

## Maximum Deflections for Load Combinations

Load Combination	Max. X-X Deflection	Distance	Max. Y-Y Deflection	Distance
D Only	0.0000 in	0.000ft	0.000 in	0.000ft
+D+L	0.0000 in	0.000ft	0.000 in	0.000ft
+D+S	0.0000 in	0.000ft	0.000 in	0.000ft
+D+0.750L	0.0000 in	0.000ft	0.000 in	0.000ft
+D+0.750L+0.750S	0.0000 in	0.000ft	0.000 in	0.000ft
+0.60D	0.0000 in	0.000ft	0.000 in	0.000ft
L Only	0.0000 in	0.000ft	0.000 in	0.000ft
S Only	0.0000 in	0.000ft	0.000 in	0.000ft

## Sketches

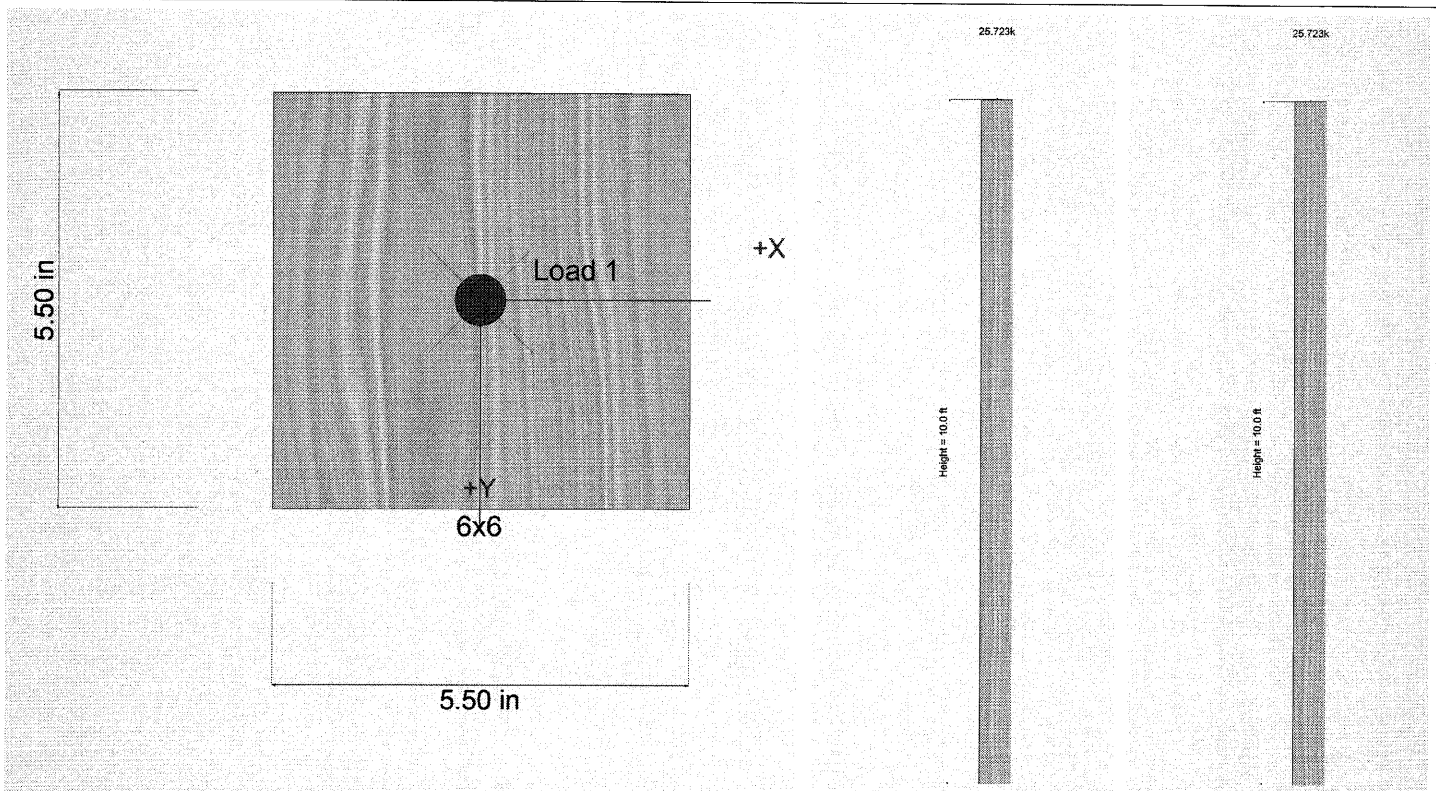

# Steel Beam

Project File: ENERCALC\_20

LIC#: KW-06015335, Build:20.22.12.28

D.S. ENGINEERING PC

(c) ENERCALC INC 1983-2022

**DESCRIPTION:** stair (outside)

## CODE REFERENCES

Calculations per AISC 360-16, IBC 2018, CBC 2019, ASCE 7-16

Load Combination Set : IBC 2018

## Material Properties


Analysis Method : Allowable Strength Design

Beam Bracing : Completely Unbraced

Bending Axis : Major Axis Bending

Fy : Steel Yield : 46.0 ksi

E: Modulus : 29,000.0 ksi

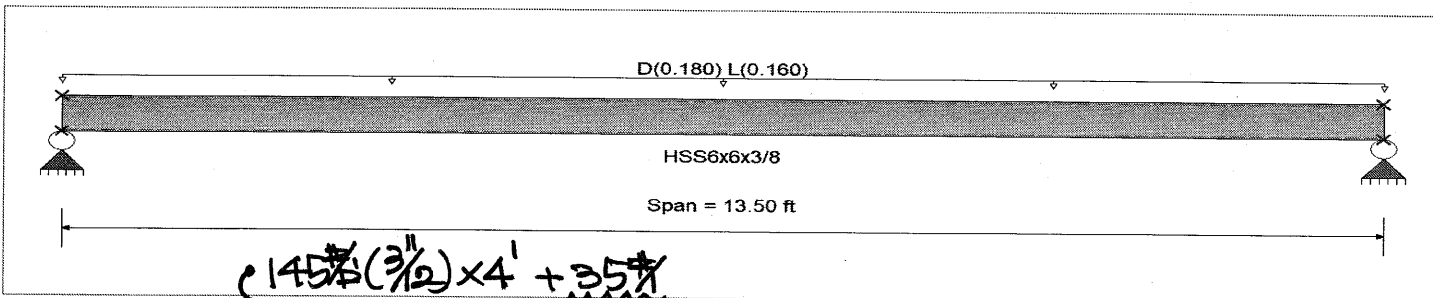

## Applied Loads

Beam self weight calculated and added to loading

Uniform Load : D = 0.180, L = 0.160 k/ft, Tributary Width = 1.0 ft, (3" max. concrete tread)

Some loads entered. Load Factors will be applied for calculations.

## DESIGN SUMMARY

				Design OK	
Maximum Bending Stress Ratio =	0.231 : 1	Maximum Shear Stress Ratio =		0.043 : 1	
Section used for this span	HSS6x6x3/8	Section used for this span		HSS6x6x3/8	
Ma : Applied	8.372 k-ft	Va : Applied		2.480 k	
Mn / Omega : Allowable	36.267 k-ft	Vn/Omega : Allowable		57.137 k	
Load Combination	+D+L	Load Combination		+D+L	
Span # where maximum occurs	Span # 1	Location of maximum on span		0.000 ft	
		Span # where maximum occurs		Span # 1	
Maximum Deflection					
Max Downward Transient Deflection	0.105 in Ratio = 1,544	>=360			
Max Upward Transient Deflection	0.000 in Ratio = 0	<360	Span: 1 : L Only		
Max Downward Total Deflection	0.241 in Ratio = 673	>=180	Span: 1 : +D+L		
Max Upward Total Deflection	0.000 in Ratio = 0	<180			

## Overall Maximum Deflections

Load Combination	Span	Max. "-" Defl	Location in Span	Load Combination	Max. "+" Defl	Location in Span
+D+L	1	0.2408	6.789		0.0000	0.000

## Vertical Reactions

Support notation : Far left is #

Values in KIPS

Load Combination	Support 1	Support 2
Max Upward from all Load Conditions	2.480	2.480
Max Upward from Load Combinations	2.480	2.480
Max Upward from Load Cases	1.400	1.400
D Only	1.400	1.400
+D+L	2.480	2.480
+D+0.750L	2.210	2.210
+0.60D	0.840	0.840
L Only	1.080	1.080

**Steel Beam**

Project File: ENERCALC\_20


LIC# : KW-06015335, Build:20.22.12.28

D.S. ENGINEERING PC

(c) ENERCALC INC 1983-2022

**DESCRIPTION:** stair (outside)**Steel Section Properties : HSS6x6x3/8**

Depth	=	6.000 in	I xx	=	39.50 in <sup>4</sup>	J	=	64.600 in <sup>4</sup>
			S xx	=	13.20 in <sup>3</sup>			
Width	=	6.000 in	R xx	=	2.280 in			
Wall Thick	=	0.349 in	Zx	=	15.800 in <sup>3</sup>			
Area	=	7.580 in <sup>2</sup>	I yy	=	39.500 in <sup>4</sup>	C	=	0.000 in <sup>3</sup>
Weight	=	27.480 plf	S yy	=	13.200 in <sup>3</sup>			
			R yy	=	2.280 in			
Ycg	=	3.000 in						

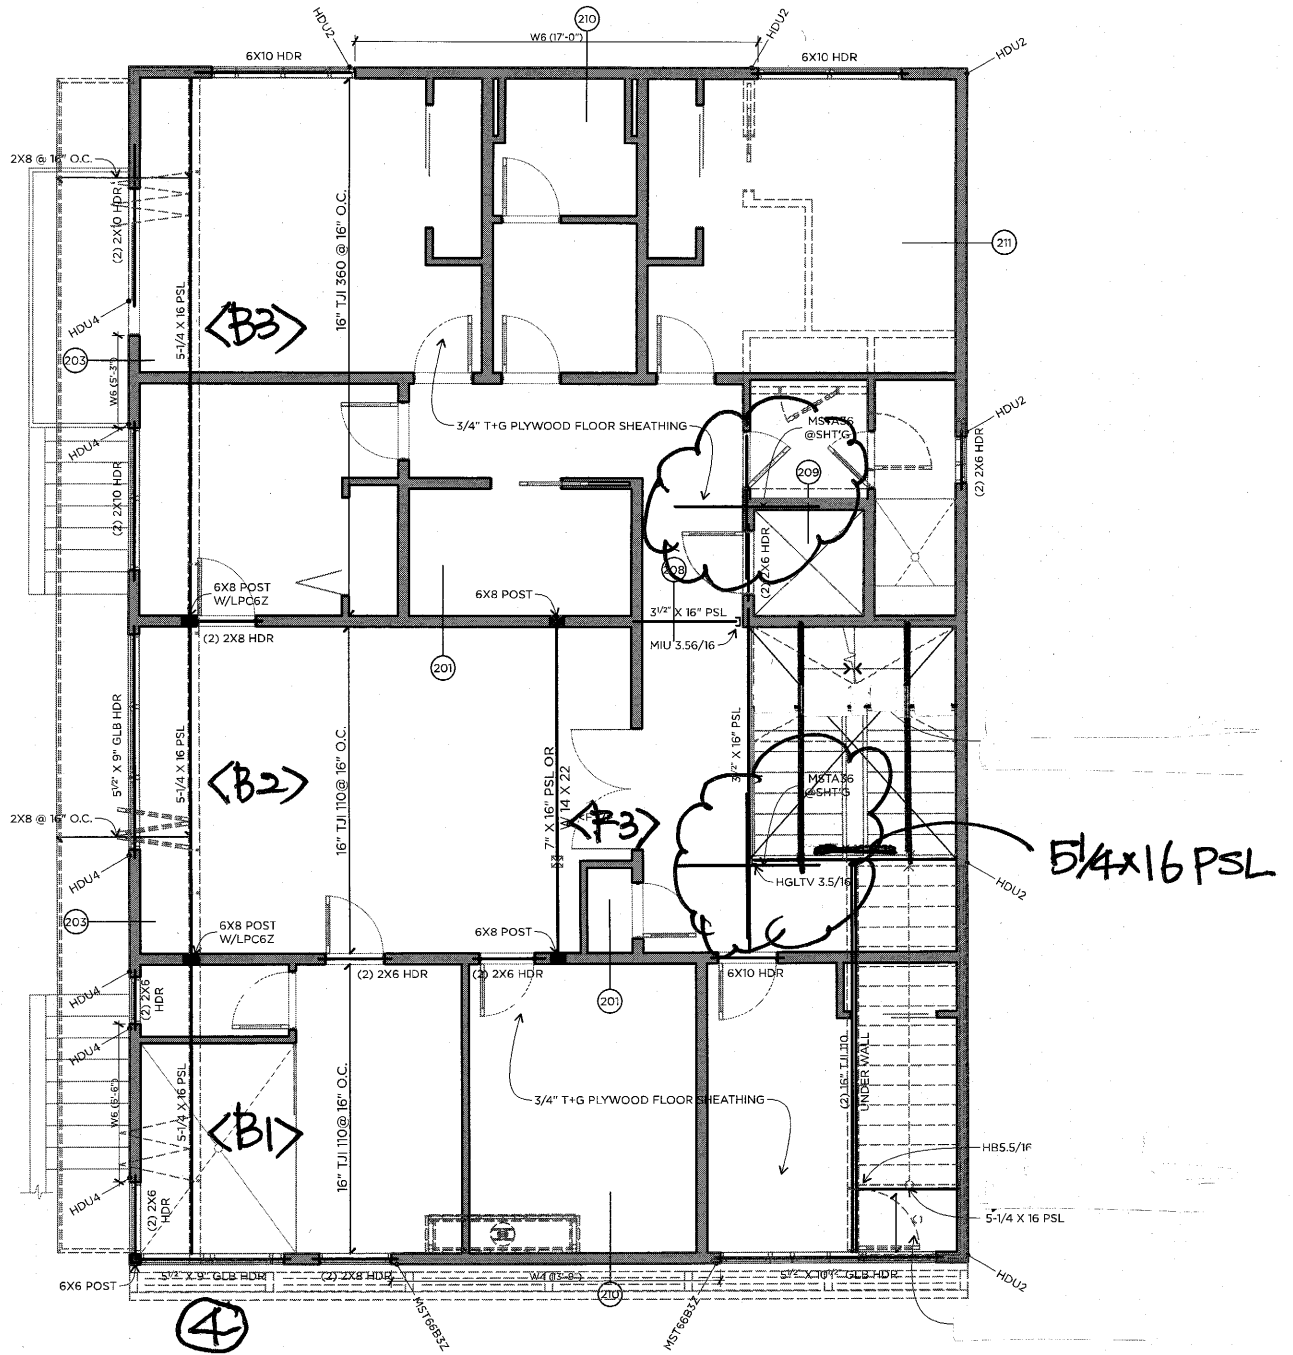

SECOND FLOOR FRAMING

SCALE: 1/4" = 1'-0"

# Wood Beam

Project File: ENERCALC\_20

LIC#: KVV-06015335, Build:20.22.12.28

D.S. ENGINEERING PC

(c) ENERCALC INC 1983-2022

DESCRIPTION: 2nd floor <B1>


## CODE REFERENCES

Calculations per NDS 2018, IBC 2018, CBC 2019, ASCE 7-16

Load Combination Set : IBC 2018

## Material Properties

Analysis Method : Allowable Stress Design	Fb +	2900 psi	E : Modulus of Elasticity
Load Combination : IBC 2018	Fb -	2900 psi	Ebend- xx 2000ksi
	Fc - Prll	2900 psi	Eminbend - xx 1016.535ksi
Wood Species : iLevel Truss Joist	Fc - Perp	750 psi	
Wood Grade : Parallam PSL 2.0E	Fv	290 psi	
	Ft	2025 psi	Density 45.07pcf
Beam Bracing : Beam is Fully Braced against lateral-torsional buckling			

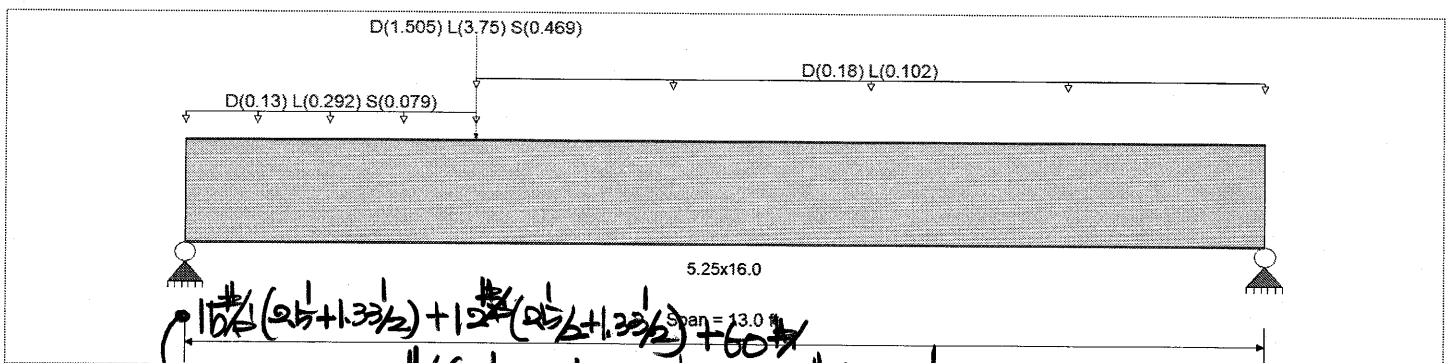

## Applied Loads

Beam self weight NOT internally calculated and added

Load for Span Number 1

Uniform Load : D = 0.130, L = 0.2920, S = 0.0790 k/ft, Extent = 0.0 -->> 3.50 ft, Tributary Width = 1.0 ft

Point Load : D = 1.505, L = 3.750, S = 0.4690 k @ 3.50 ft, (from <R5>)

Uniform Load : D = 0.180, L = 0.1020 k/ft, Extent = 3.50 -->> 13.0 ft, Tributary Width = 1.0 ft

## DESIGN SUMMARY

Maximum Bending Stress Ratio =	0.358	1	Maximum Shear Stress Ratio =	0.341	: 1
Section used for this span	5.25x16.0		Section used for this span	5.25x16.0	
fb: Actual =	1,004.39psi		fv: Actual =	98.87 psi	
F'b =	2,808.86psi		F'v =	290.00 psi	
Load Combination =	+D+L		Load Combination =	+D+L	
Location of maximum on span =	3.511ft		Location of maximum on span =	0.000ft	
Span # where maximum occurs =	Span # 1		Span # where maximum occurs =	Span # 1	
Maximum Deflection					
Max Downward Transient Deflection	0.086 in	Ratio = 1821 >= 360	Span: 1 : L Only		
Max Upward Transient Deflection	0 in	Ratio = 0 < 360	n/a		
Max Downward Total Deflection	0.141 in	Ratio = 1105 >= 240	Span: 1 : +D+L		
Max Upward Total Deflection	0 in	Ratio = 0 < 240	n/a		

## Overall Maximum Deflections

Load Combination	Span	Max. "-" Defl	Location in Span	Load Combination	Max. "+" Defl	Location in Span
+D+L	1	0.1411	6.073		0.0000	0.000

## Vertical Reactions

Load Combination	Support notation : Far left is #1		Values in KIPS
	Support 1	Support 2	
Max Upward from all Load Conditions	6.097	3.314	
Max Upward from Load Combinations	6.097	3.314	
Max Upward from Load Cases	3.979	1.762	
D Only	2.118	1.552	
+D+L	6.097	3.314	
+D+Lr	2.118	1.552	
+D+S	2.700	1.715	

**Wood Beam**

Project File: ENERCALC\_20

LIC# : KW-06015335, Build:20.22.12.28

D.S. ENGINEERING PC

(c) ENERCALC INC 1983-2022

**DESCRIPTION:** 2nd floor <B1>**Vertical Reactions**

Support notation : Far left is #1

Values in KIPS

Load Combination	Support 1	Support 2
+D+0.750Lr+0.750L	5.103	2.873
+D+0.750L+0.750S	5.539	2.996
+0.60D	1.271	0.931
L Only	3.979	1.762
S Only	0.582	0.163

**Wood Beam**

Project File: ENERCALC\_20

LIC#: KVV-06015335, Build:20.22.12.28

D.S. ENGINEERING PC

(c) ENERCALC INC 1983-2022


**DESCRIPTION:** 2nd floor <B2>

**CODE REFERENCES**

Calculations per NDS 2018, IBC 2018, CBC 2019, ASCE 7-16  
Load Combination Set : IBC 2018

**Material Properties**

Analysis Method : Allowable Stress Design	Fb +	2900 psi	E : Modulus of Elasticity
Load Combination : IBC 2018	Fb -	2900 psi	Ebend- xx 2000ksi
	Fc - Prll	2900 psi	Eminbend - xx 1016.535ksi
Wood Species : iLevel Truss Joist	Fc - Perp	750 psi	
Wood Grade : Parallam PSL 2.0E	Fv	290 psi	
	Ft	2025 psi	Density 45.07pcf
Beam Bracing : Beam is Fully Braced against lateral-torsional buckling			

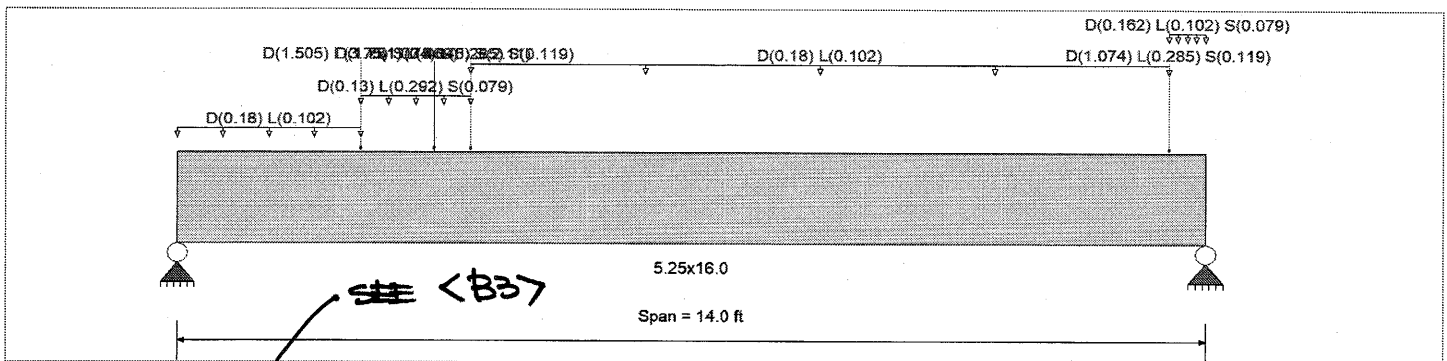

**Applied Loads**

Service loads entered. Load Factors will be applied for calculations.

Beam self weight calculated and added to loading

Load for Span Number 1

- Uniform Load : D = 0.180, L = 0.1020 k/ft, Extent = 0.0 --> 2.50 ft, Tributary Width = 1.0 ft, (folding window)
- Uniform Load : D = 0.130, L = 0.2920, S = 0.0790 k/ft, Extent = 2.50 --> 4.0 ft, Tributary Width = 1.0 ft
- Uniform Load : D = 0.180, L = 0.1020 k/ft, Extent = 4.0 --> 13.50 ft, Tributary Width = 1.0 ft, (folding window)
- Uniform Load : D = 0.1620, L = 0.1020, S = 0.0790 k/ft, Extent = 13.50 --> 14.0 ft, Tributary Width = 1.0 ft
- Point Load : D = 1.505, L = 3.750, S = 0.4690 k @ 2.50 ft, (from <R5>)
- Point Load : D = 1.751, L = 5.045, S = 2.110 k @ 3.50 ft, (from <R8>)
- Point Load : D = 1.074, L = 0.2850, S = 0.1190 k @ 4.0 ft, (from <R4>)
- Point Load : D = 1.074, L = 0.2850, S = 0.1190 k @ 13.50 ft, (from <R4>)

**DESIGN SUMMARY**

**Design OK**

Maximum Bending Stress Ratio	=	0.713	1	Maximum Shear Stress Ratio	=	0.760	: 1
Section used for this span		5.25x16.0		Section used for this span		5.25x16.0	
fb: Actual	=	2,003.85	psi	fv: Actual	=	220.40	psi
F'b	=	2,808.86	psi	F'v	=	290.00	psi
Load Combination		+D+L		Load Combination		+D+L	
Location of maximum on span	=	3.526	ft	Location of maximum on span	=	0.000	ft
Span # where maximum occurs	=	Span # 1		Span # where maximum occurs	=	Span # 1	
Maximum Deflection							
Max Downward Transient Deflection		0.189	in	Ratio =	889	>=360	Span: 1 : L Only
Max Upward Transient Deflection		0	in	Ratio =	0	<360	n/a
Max Downward Total Deflection		0.319	in	Ratio =	526	>=240	Span: 1 : +D+L
Max Upward Total Deflection		0	in	Ratio =	0	<240	n/a

**Overall Maximum Deflections**

Load Combination	Span	Max. "-" Defl	Location in Span	Load Combination	Max. "+" Defl	Location in Span
+D+L	1	0.3188	6.387		0.0000	0.000

**Vertical Reactions**

Support notation : Far left is #1

Values in KIPS

Load Combination	Support 1	Support 2
Max Upward from all Load Conditions	12.752	6.534
Max Upward from Load Combinations	12.752	6.534

**Wood Beam**

Project File: ENERCALC\_20

LIC#: KW-06015335, Build:20.22.12.28

D.S. ENGINEERING PC

(c) ENERCALC INC 1983-2022

**DESCRIPTION:** 2nd floor <B2>**Vertical Reactions**

Support notation : Far left is #1

Values in KIPS

Load Combination	Support 1	Support 2
Max Upward from Load Cases	8.011	3.467
D Only	4.741	3.467
+D+L	12.752	6.534
+D+Lr	4.741	3.467
+D+S	6.890	4.293
+D+0.750Lr+0.750L	10.749	5.767
+D+0.750L+0.750S	12.361	6.387
+0.60D	2.845	2.080
L Only	8.011	3.067
S Only	2.149	0.826



# Wood Beam

Project File: ENERCALC\_20

LIC#: KW-06015335, Build:20.22.12.28

D.S. ENGINEERING PC

(c) ENERCALC INC 1983-2022

DESCRIPTION: 2nd floor <B3>


## CODE REFERENCES

Calculations per NDS 2018, IBC 2018, CBC 2019, ASCE 7-16

Load Combination Set : IBC 2018

## Material Properties

Analysis Method : Allowable Stress Design	Fb +	2900 psi	E : Modulus of Elasticity
Load Combination : IBC 2018	Fb -	2900 psi	Ebend- xx
	Fc - Prll	2900 psi	2000ksi
	Fc - Perp	750 psi	Eminbend - xx
Wood Species : iLevel Truss Joist	Fv	290 psi	1016.535ksi
Wood Grade : Parallam PSL 2.0E	Ft	2025 psi	Density
Beam Bracing : Beam is Fully Braced against lateral-torsional buckling			45.07 pcf

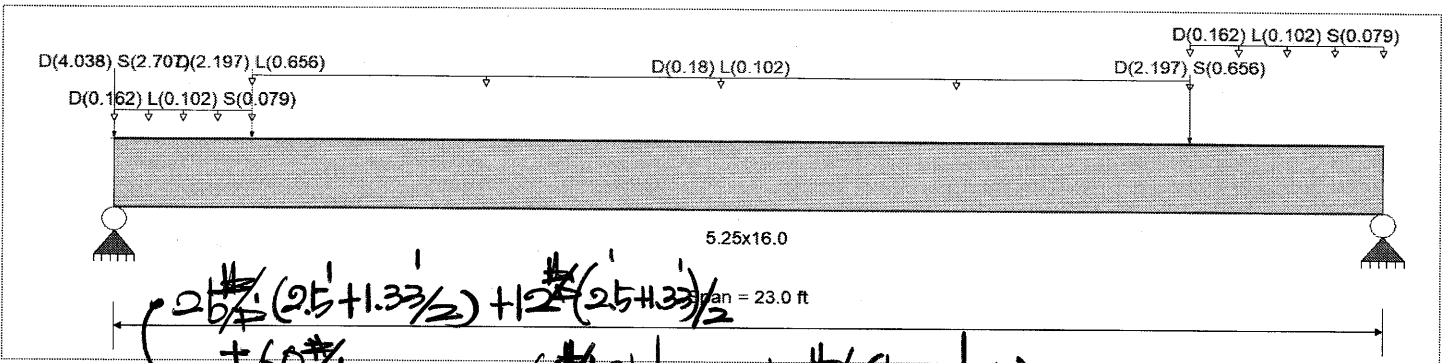

## Applied Loads

Beam self weight NOT internally calculated and added. All loads entered and factors will be applied for calculations.

- Point Load : D = 4.038, S = 2.707 k @ 0.0 ft, (from <B7>)
- Uniform Load : D = 0.1620, L = 0.1020, S = 0.0790 k/ft, Extent = 0.0 --> 2.50 ft, Tributary Width = 1.0 ft
- Point Load : D = 2.197, L = 0.6560 k @ 2.50 ft, (from <R6>)
- Uniform Load : D = 0.180, L = 0.1020 k/ft, Extent = 2.50 --> 19.50 ft, Tributary Width = 1.0 ft, (folding window)
- Point Load : D = 2.197, S = 0.6560 k @ 19.50 ft, (from <R6>)
- Uniform Load : D = 0.1620, L = 0.1020, S = 0.0790 k/ft, Extent = 19.50 --> 23.0 ft, Tributary Width = 1.0 ft

## DESIGN SUMMARY

				<b>Design OK</b>			
Maximum Bending Stress Ratio	=	0.495	1	Maximum Shear Stress Ratio	=	0.353	1
Section used for this span	=	<b>5.25x16.0</b>		Section used for this span	=	<b>5.25x16.0</b>	
fb: Actual	=	1,391.56psi		fv: Actual	=	102.51 psi	
F'b	=	2,808.86psi		F'v	=	290.00 psi	
Load Combination	=	+D+L		Load Combination	=	+D+L	
Location of maximum on span	=	11.584ft		Location of maximum on span	=	0.000ft	
Span # where maximum occurs	=	Span # 1		Span # where maximum occurs	=	Span # 1	
<b>Maximum Deflection</b>							
Max Downward Transient Deflection	0.206 in	Ratio =	1338 >= 360	Span: 1 : L Only			
Max Upward Transient Deflection	0 in	Ratio =	0 < 360	n/a			
Max Downward Total Deflection	0.728 in	Ratio =	379 >= 240	Span: 1 : +D+L			
Max Upward Total Deflection	0 in	Ratio =	0 < 240	n/a			

## Overall Maximum Deflections

Load Combination	Span	Max. "-" Defl	Location in Span	Load Combination	Max. "+" Defl	Location in Span
+D+L	1	0.7279	11.584		0.0000	0.000

## Vertical Reactions

Load Combination	Support notation : Far left is #1		Values in KIPS	
	Support 1	Support 2		
Max Upward from all Load Conditions	11.932	5.661		
Max Upward from Load Combinations	11.932	5.661		
Max Upward from Load Cases	8.353	4.111		
D Only	8.353	4.111		
+D+L	10.111	5.355		

**Wood Beam**

Project File: ENERCALC\_20

LIC#: KW-06015335, Build:20.22.12.28

D.S. ENGINEERING PC

(c) ENERCALC INC 1983-2022

**DESCRIPTION:** 2nd floor <B3>**Vertical Reactions**

Support notation : Far left is #1

Values in KIPS

Load Combination	Support 1	Support 2
+D+Lr	8.353	4.111
+D+S	11.368	4.933
+D+0.750Lr+0.750L	9.671	5.044
+D+0.750Lr+0.750S	11.932	5.661
+0.60D	5.012	2.466
L Only	1.758	1.244
S Only	3.015	0.822

# Wood Beam

Project File: ENERCALC\_20

LIC#: KW-06015335, Build:20.22.12.28

D.S. ENGINEERING PC

(c) ENERCALC INC 1983-2022

**DESCRIPTION:** header (south wall @ 2nd floor)



## CODE REFERENCES

Calculations per NDS 2018, IBC 2018, CBC 2019, ASCE 7-16

Load Combination Set : IBC 2018


## Material Properties

Analysis Method : Allowable Stress Design  
Load Combination : IBC 2018

Wood Species : DF/DF  
Wood Grade : 24F-V4

Beam Bracing : Completely Unbraced

Fb +	2400 psi	E : Modulus of Elasticity	
Fb -	1850 psi	Ebend- xx	1800 ksi
Fc - Prll	1650 psi	Eminbend - xx	950 ksi
Fc - Perp	650 psi	Ebend- yy	1600 ksi
Fv	265 psi	Eminbend - yy	850 ksi
Ft	1100 psi	Density	31.21 pcf

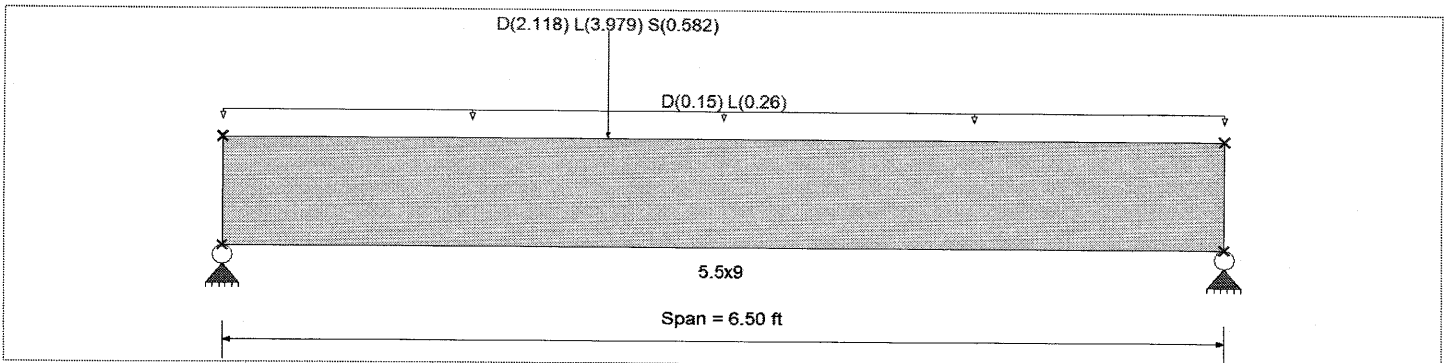

## Applied Loads

Service loads entered. Load Factors will be applied for calculations.

Beam self weight calculated and added to loading

Uniform Load : D = 0.150, L = 0.260, Tributary Width = 1.0 ft

Point Load : D = 2.118, L = 3.979, S = 0.5820 k @ 2.50 ft, (from <B1>)

## DESIGN SUMMARY

**Design OK**

Maximum Bending Stress Ratio	=	0.775	1	Maximum Shear Stress Ratio	=	0.550	: 1
Section used for this span		<b>5.5x9</b>		Section used for this span		<b>5.5x9</b>	
fb: Actual	=	1,851.15 psi		fv: Actual	=	145.76 psi	
F'b	=	2,387.32 psi		F'v	=	265.00 psi	
Load Combination		+D+L		Load Combination		+D+L	
Location of maximum on span	=	2.515 ft		Location of maximum on span	=	0.000 ft	
Span # where maximum occurs	=	Span # 1		Span # where maximum occurs	=	Span # 1	
<b>Maximum Deflection</b>							
Max Downward Transient Deflection		0.079 in	Ratio = 991	>=360	Span: 1 : L Only		
Max Upward Transient Deflection		0 in	Ratio = 0	<360	n/a		
Max Downward Total Deflection		0.122 in	Ratio = 639	>=240	Span: 1 : +D+L		
Max Upward Total Deflection		0 in	Ratio = 0	<240	n/a		

## Overall Maximum Deflections

Load Combination	Span	Max. "-" Defl	Location in Span	Load Combination	Max. "+" Defl	Location in Span
+D+L	1	0.1221	3.084		0.0000	0.000

## Vertical Reactions

Support notation : Far left is #1

Values in KIPS

Load Combination	Support 1	Support 2
Max Upward from all Load Conditions	5.119	3.712
Max Upward from Load Combinations	5.119	3.712
Max Upward from Load Cases	3.294	2.375
D Only	1.826	1.337
+D+L	5.119	3.712
+D+Lr	1.826	1.337
+D+S	2.184	1.561
+D+0.750Lr+0.750L	4.296	3.119
+D+0.750L+0.750S	4.565	3.286

# Wood Beam

Project File: ENERCALC\_20

LIC#: KW-06015335, Build:20.22.12.28

D.S. ENGINEERING PC

(c) ENERCALC INC 1983-2022

**DESCRIPTION:** header (south wall @ 2nd floor)



Support notation : Far left is #1

Values in KIPS

## Vertical Reactions

Load Combination	Support 1	Support 2
+0.60D	1.095	0.802
L Only	3.294	2.375
S Only	0.358	0.224

# Wood Column

Project File: ENERCALC\_20

LIC#: KW-06015335, Build:20.22.12.28

D.S. ENGINEERING PC

(c) ENERCALC INC 1983-2022

**DESCRIPTION:** under <R7>, <B2>, <B3>

## Code References

Calculations per NDS 2018, IBC 2018, CBC 2019, ASCE 7-16

Load Combinations Used : IBC 2018

## General Information

Analysis Method	Allowable Stress Design			Wood Section Name	4-2x6	<div style="border: 1px solid black; border-radius: 50%; padding: 5px; display: inline-block;">(ALT. 6x8)</div>		
End Fixities	Top & Bottom Pinned			Wood Grading/Manuf.	Graded Lumber			
Overall Column Height	10 ft			Wood Member Type	Sawn			
<i>( Used for non-slender calculations )</i>				Exact Width	6.0 in		Allow Stress Modification Factors	
Wood Species	Douglas Fir-Larch			Exact Depth	5.50 in		Cf or Cv for Bending	1.30
Wood Grade	No.2			Area	33.0 in <sup>2</sup>		Cf or Cv for Compression	1.10
Fb +	750 psi	Fv	170 psi	Ix	83.188 in <sup>4</sup>		Cf or Cv for Tension	1.30
Fb -	750 psi	Ft	475 psi	Iy	99.0 in <sup>4</sup>		Cm : Wet Use Factor	1.0
Fc - Prll	700 psi	Density	31.21 pcf				Ct : Temperature Fact	1.0
Fc - Perp	625 psi						Cfu : Flat Use Factor	1.0
E : Modulus of Elasticity		x-x Bending	y-y Bending	Axial		Kf : Built-up columns	1.0 <small>NDS 15.3.2</small>	
	Basic	1300	1300	1300 ksi		Use Cr : Repetitive ?	No	
	Minimum	470	470					

Brace condition for deflection (buckling) along columns :

X-X (width) axis : Fully braced against buckling ABOUT Y-Y Axis

Y-Y (depth) axis : Fully braced against buckling ABOUT X-X Axis

## Applied Loads

Service loads entered. Load Factors will be applied for calculations.

Column self weight included : 71.523 lbs \* Dead Load Factor

AXIAL LOADS ...

Axial Load at 10.0 ft, D = 15.858, L = 4.825, S = 6.548 k

	DL	LL	SL
<B2>	3467	3067	826
<B3>	8353	1758	3015
<R7>	4038	Ø	2707
	15858	4825	6548

## DESIGN SUMMARY

### Bending & Shear Check Results

PASS Max. Axial+Bending Stress Ratio = **0.8370 : 1**

Load Combination +D+0.750L+0.750S

Governing NDS Formula Comp Only, fc/Fc'

Location of max.above base 0.0 ft

At maximum location values are .

Applied Axial 24.459 k

Applied Mx 0.0 k-ft

Applied My 0.0 k-ft

Fc : Allowable 885.50 psi

Maximum SERVICE Lateral Load Reactions . .

Top along Y-Y	0.0 k	Bottom along Y-Y	0.0 k
Top along X-X	0.0 k	Bottom along X-X	0.0 k

Maximum SERVICE Load Lateral Deflections . . .

Along Y-Y	0.0 in	at	0.0 ft	above base
for load combination : n/a				
Along X-X	0.0 in	at	0.0 ft	above base
for load combination : n/a				

Other Factors used to calculate allowable stresses . . .

<u>Bending</u>	<u>Compression</u>	<u>Tension</u>
----------------	--------------------	----------------

PASS Maximum Shear Stress Ratio = **0.0 : 1**

Load Combination +0.60D

Location of max.above base 10.0 ft

Applied Design Shear 0.0 psi

Allowable Shear 272.0 psi

## Load Combination Results

Load Combination	C <sub>D</sub>	C <sub>p</sub>	Maximum Axial + Bending Stress Ratios			Maximum Shear Ratios		
			Stress Ratio	Status	Location	Stress Ratio	Status	Location
D Only	0.900	1.000	0.6966	PASS	0.0 ft	0.0	PASS	10.0 ft
+D+L	1.000	1.000	0.8168	PASS	0.0 ft	0.0	PASS	10.0 ft
+D+S	1.150	1.000	0.7692	PASS	0.0 ft	0.0	PASS	10.0 ft
+D+0.750L	1.250	1.000	0.6155	PASS	0.0 ft	0.0	PASS	10.0 ft
+D+0.750L+0.750S	1.150	1.000	0.8370	PASS	0.0 ft	0.0	PASS	10.0 ft
+0.60D	1.600	1.000	0.2351	PASS	0.0 ft	0.0	PASS	10.0 ft

## Maximum Reactions

Note: Only non-zero reactions are listed.

Load Combination	X-X Axis Reaction		k	Y-Y Axis Reaction		Axial Reaction	My - End Moments		k-ft		Mx - End Moments	
	@ Base	@ Top		@ Base	@ Top		@ Base	@ Top	@ Base	@ Top		
D Only												
						15.930						

# Wood Column

Project File: ENERCALC\_20

LIC#: KW-06015335, Build:20.22.12.28

D.S. ENGINEERING PC

(c) ENERCALC INC 1983-2022

**DESCRIPTION:** under <R7>, <B2>, <B3>

## Maximum Reactions

Note: Only non-zero reactions are listed.

Load Combination	X-X Axis Reaction k		Y-Y Axis Reaction		Axial Reaction @ Base	My - End Moments k-ft		Mx - End Moments	
	@ Base	@ Top	@ Base	@ Top		@ Base	@ Top	@ Base	@ Top
+D+L					20.755				
+D+S					22.478				
+D+0.750L					19.548				
+D+0.750L+0.750S					24.459				
+0.60D					9.558				
L Only					4.825				
S Only					6.548				

$$A_{req} = (24.459k + 6.031k) / 3$$


$$= 10.2 \text{ D'}$$

<F3.5>

## Maximum Deflections for Load Combinations

Load Combination	Max. X-X Deflection		Max. Y-Y Deflection	
	Distance	Distance	Distance	Distance
D Only	0.0000 in	0.000ft	0.000 in	0.000ft
+D+L	0.0000 in	0.000ft	0.000 in	0.000ft
+D+S	0.0000 in	0.000ft	0.000 in	0.000ft
+D+0.750L	0.0000 in	0.000ft	0.000 in	0.000ft
+D+0.750L+0.750S	0.0000 in	0.000ft	0.000 in	0.000ft
+0.60D	0.0000 in	0.000ft	0.000 in	0.000ft
L Only	0.0000 in	0.000ft	0.000 in	0.000ft
S Only	0.0000 in	0.000ft	0.000 in	0.000ft

## Sketches

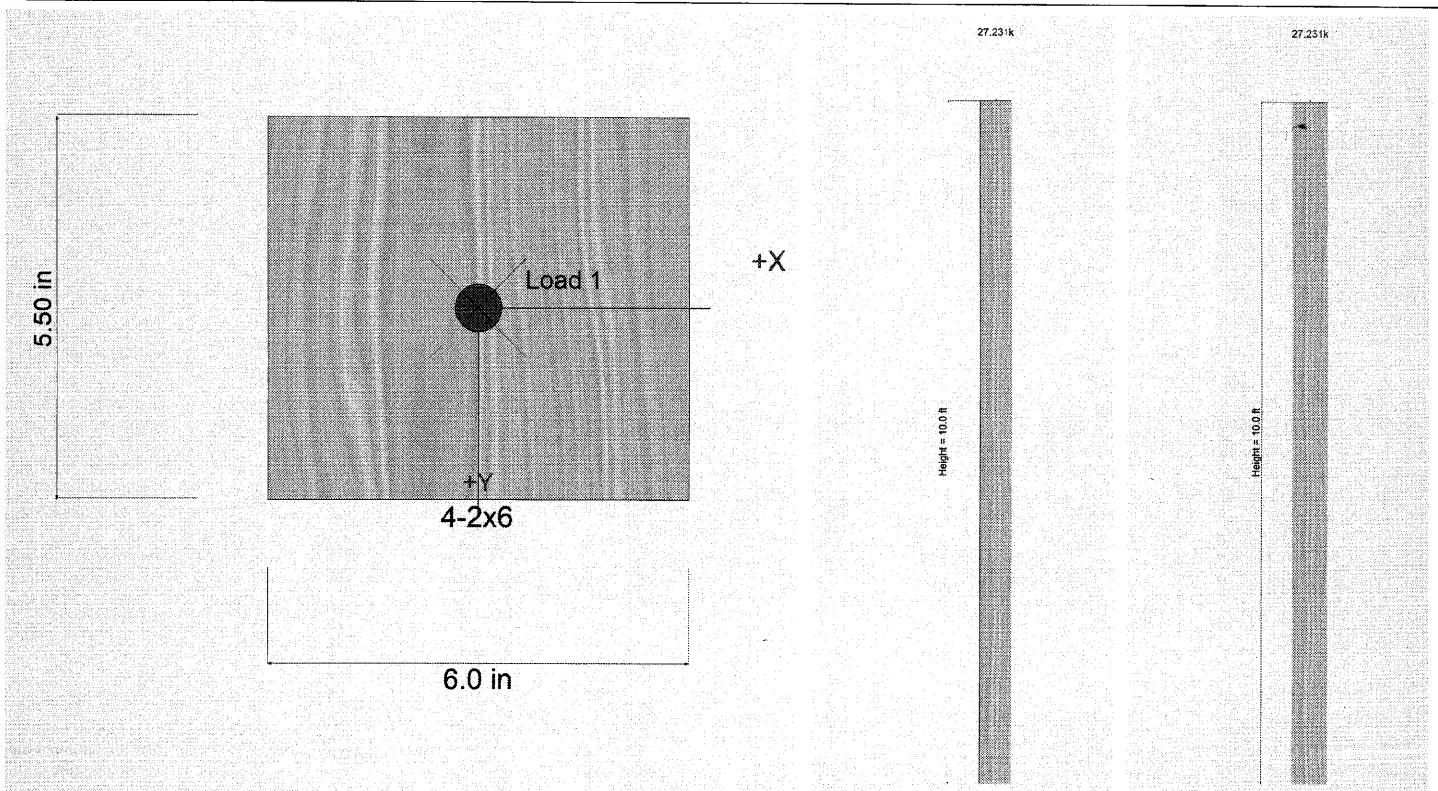

# Wood Beam

Lic. # : KW-06010224

File: examples.ec6  
Software copyright ENERCALC, INC. 1983-2020, Build: 12.20.8.24  
D.S. ENGINEERING PC

DESCRIPTION: beam <F3> update

## CODE REFERENCES

Calculations per NDS 2015, IBC 2015, CBC 2016, ASCE 7-10

Load Combination Set : IBC 2018


## Material Properties

Analysis Method : Allowable Stress Design  
Load Combination IBC 2018

Fb +	2,900.0 psi	E : Modulus of Elasticity	
Fb -	2,900.0 psi	Ebend- xx	2,200.0 ksi
Fc - Prll	2,900.0 psi	Eminbend - xx	1,118.19 ksi
Fc - Perp	750.0 psi		
Fv	290.0 psi		
Ft	2,025.0 psi	Density	45.070 pcf

Wood Species : iLevel Truss Joist  
Wood Grade : Parallam PSL 2.2E

Beam Bracing : Beam is Fully Braced against lateral-torsional buckling

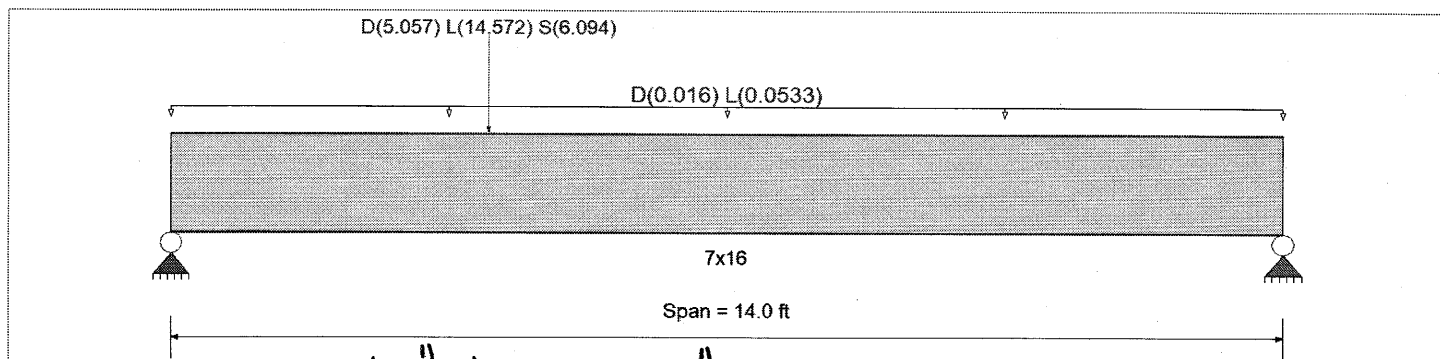

## Applied Loads

Beam self weight calculated and added to loads

Uniform Load : D = 0.0160, L = 0.05330, Tributary Width = 1.0 ft  
Point Load : D = 5.057, L = 14.572, S = 6.094 k @ 4.0 ft, (from <R8>)

Service loads entered. Load Factors will be applied for calculations.

## DESIGN SUMMARY

Design OK

Maximum Bending Stress Ratio	=	0.829	1	Maximum Shear Stress Ratio	=	0.675	1
Section used for this span		7x16		Section used for this span		7x16	
fb: Actual	=	2,329.42 psi		fv: Actual	=	195.70 psi	
Fb: Allowable	=	2,808.86 psi		Fv: Allowable	=	290.00 psi	
Load Combination		+D+L		Load Combination		+D+L	
Location of maximum on span	=	4.036 ft		Location of maximum on span	=	0.000 ft	
Span # where maximum occurs	=	Span # 1		Span # where maximum occurs	=	Span # 1	
Maximum Deflection							
Max Downward Transient Deflection		0.222 in	Ratio = 756	>=360			
Max Upward Transient Deflection		0.000 in	Ratio = 0	<360			
Max Downward Total Deflection		0.316 in	Ratio = 531	>=240			
Max Upward Total Deflection		0.000 in	Ratio = 0	<240			

## Overall Maximum Deflections

Load Combination	Span	Max. "-" Defl	Location in Span	Load Combination	Max. "+" Defl	Location in Span
+D+0.750L+0.750S	1	0.3159	6.336		0.0000	0.000

## Vertical Reactions

Support notation : Far left is #1

Values in KIPS

Load Combination	Support 1	Support 2
Overall MAXimum	15.320	6.510
Overall MINimum	4.353	1.741
+1.40D	5.557	2.523
+D+L	14.751	6.339
+D+Lr	3.970	1.802
+D+S	8.322	3.543
+D+0.750Lr+0.750L	12.056	5.205
+D+0.750L+0.750S	15.320	6.510
D Only	3.970	1.802

# Wood Beam

File: examples.ec6

Software copyright ENERCALC, INC. 1983-2020, Build:12.20.8.24

Lic. # : KW-06010224

D.S. ENGINEERING PC

DESCRIPTION: beam <F3> update


## Vertical Reactions

Support notation : Far left is #1

Values in KIPS

Load Combination	Support 1	Support 2
+0.60D	2.382	1.081
L Only	10.782	4.537
S Only	4.353	1.741



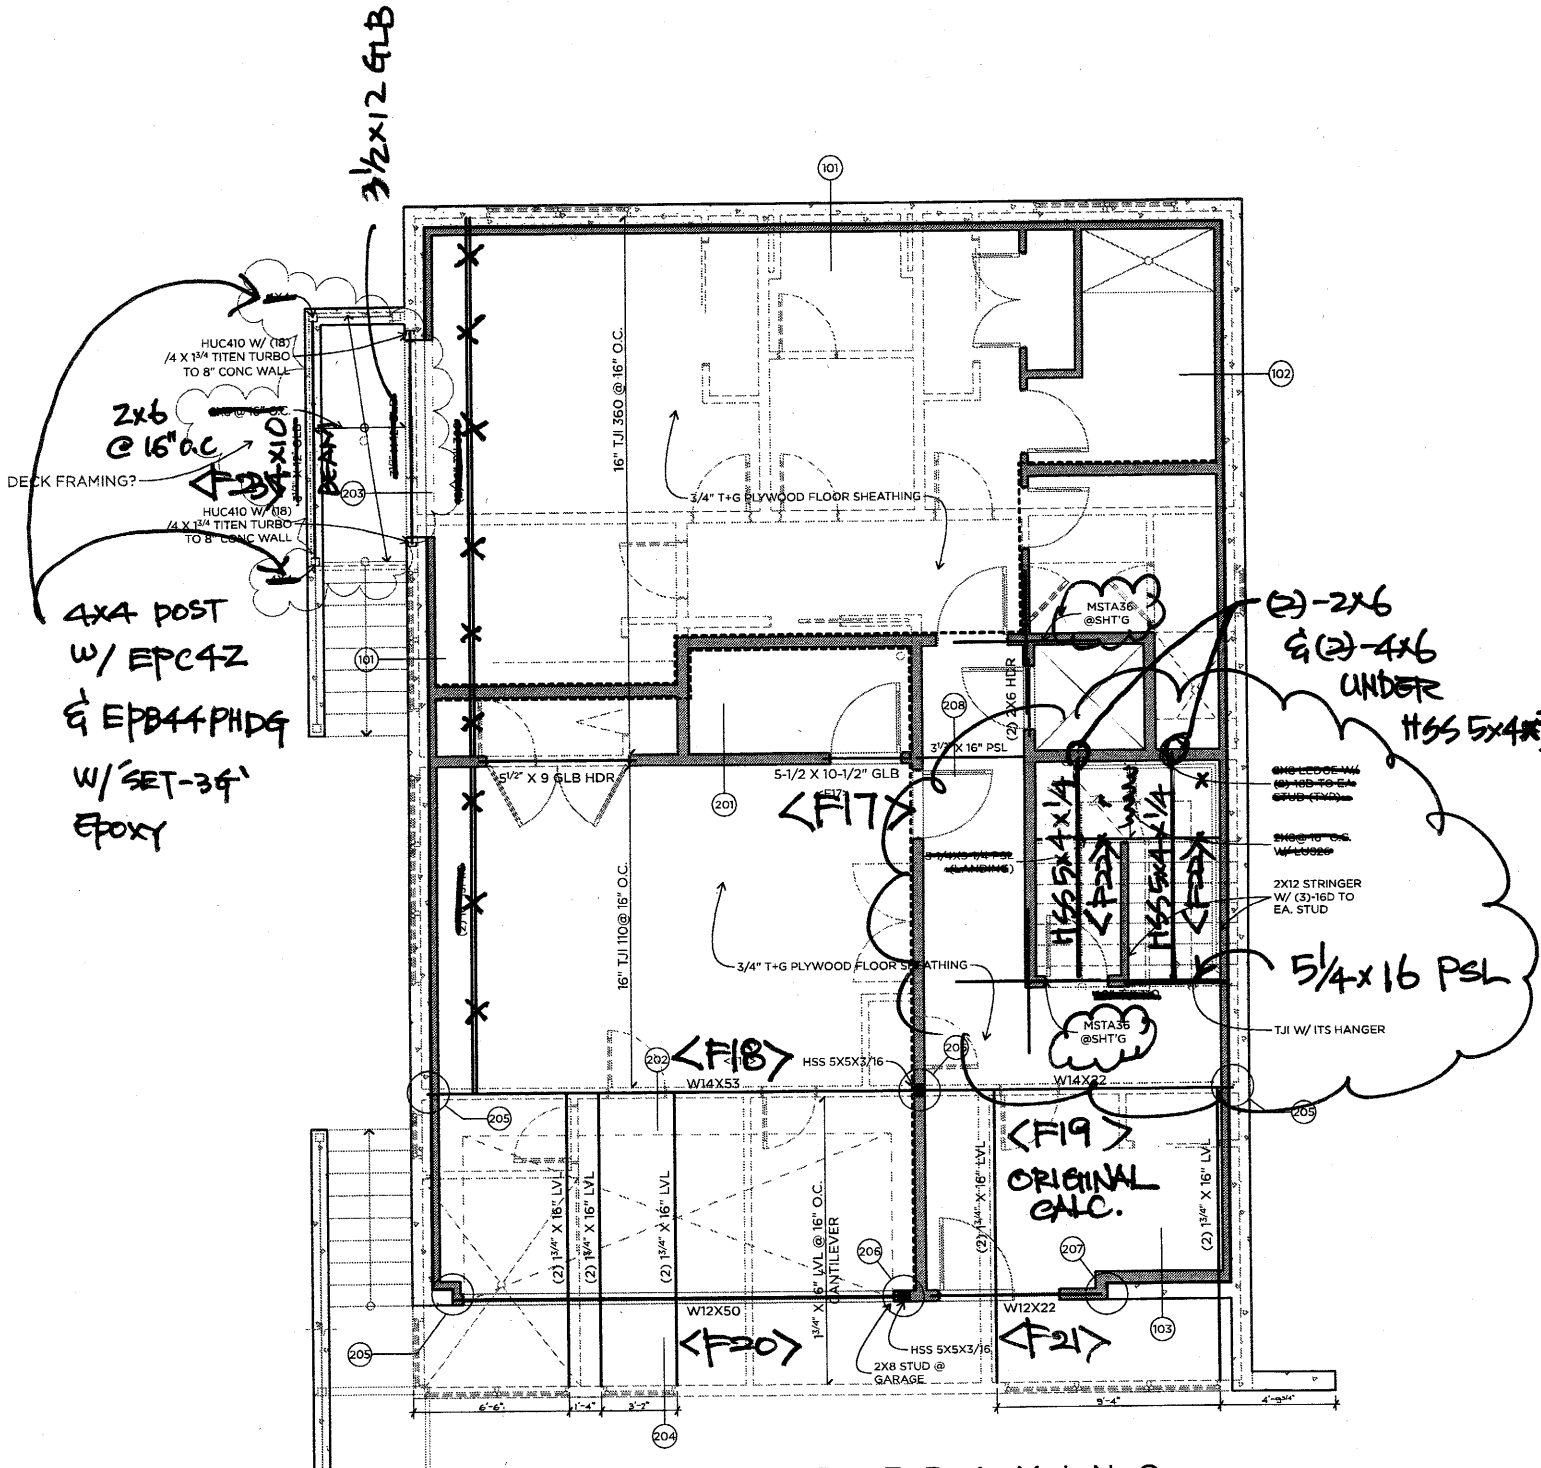

FIRST FLOOR FRAMING


SCALE: 1/4" = 1'-0"

b=2'-8"  
t=9"

108

b=2'-8"  
t=9"

108

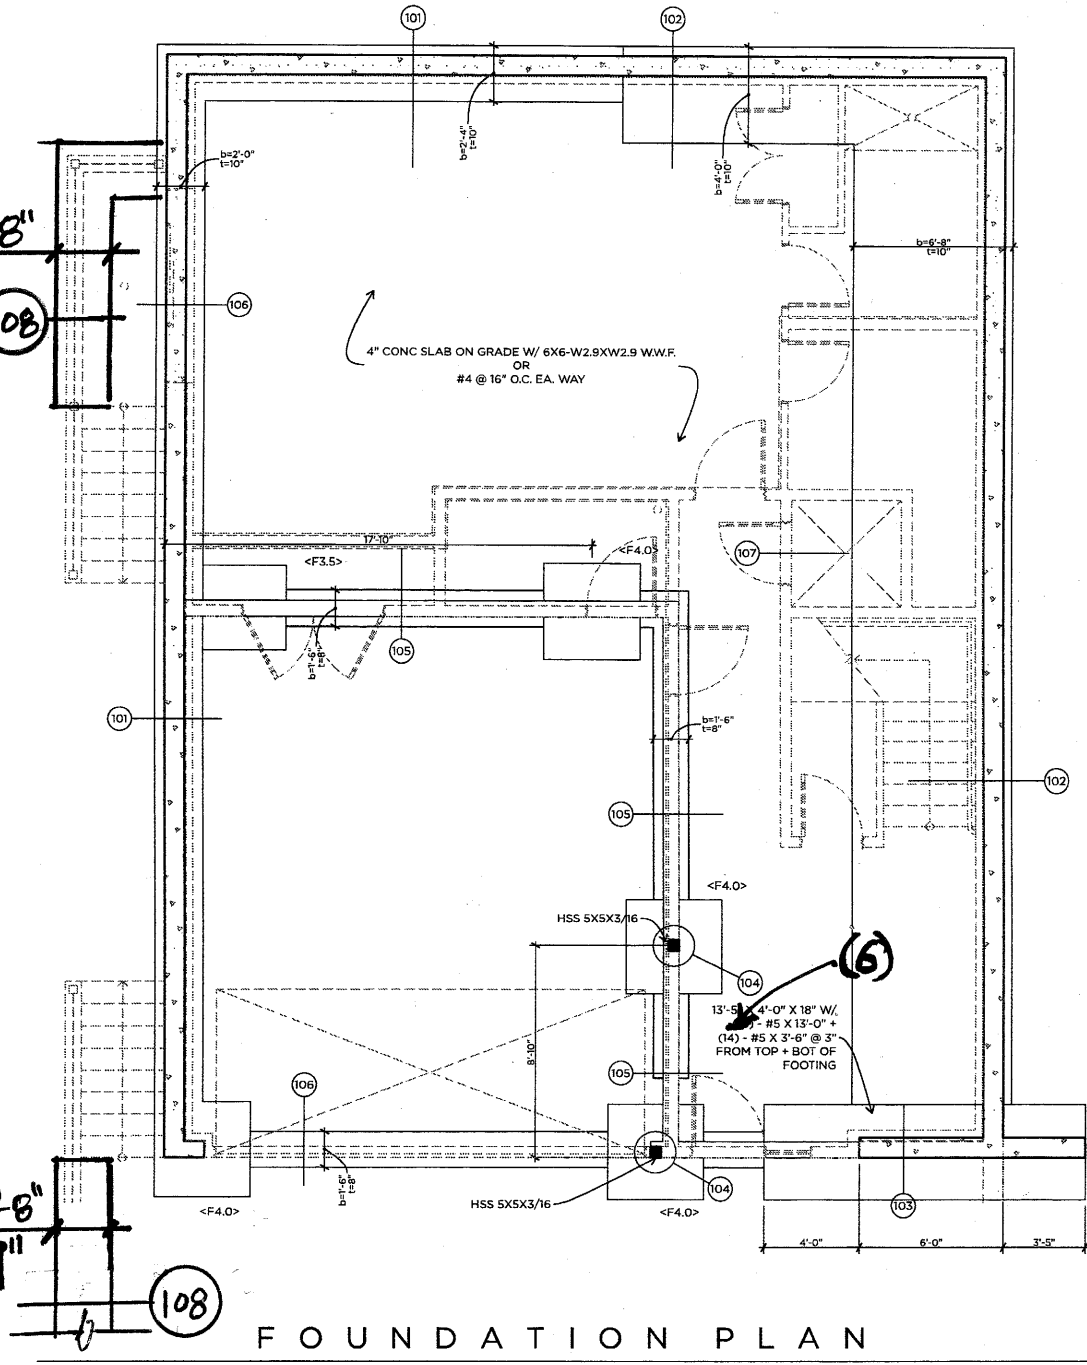

# Wood Beam

Project File: ENERCALC\_20

LIC#: KW-06015335, Build:20.22.12.28

D.S. ENGINEERING PC

(c) ENERCALC INC 1983-2022

**DESCRIPTION:** header <F17> update

## CODE REFERENCES

Calculations per NDS 2018, IBC 2018, CBC 2019, ASCE 7-16

Load Combination Set : IBC 2018


## Material Properties

Analysis Method : Allowable Stress Design  
Load Combination : IBC 2018

Wood Species : DF/DF  
Wood Grade : 24F-V4

Beam Bracing : Completely Unbraced

Fb +	2400 psi	E : Modulus of Elasticity	
Fb -	1850 psi	Ebend- xx	1800ksi
Fc - Prll	1650 psi	Eminbend - xx	950ksi
Fc - Perp	650 psi	Ebend- yy	1600ksi
Fv	265 psi	Eminbend - yy	850ksi
Ft	1100 psi	Density	31.21 pcf

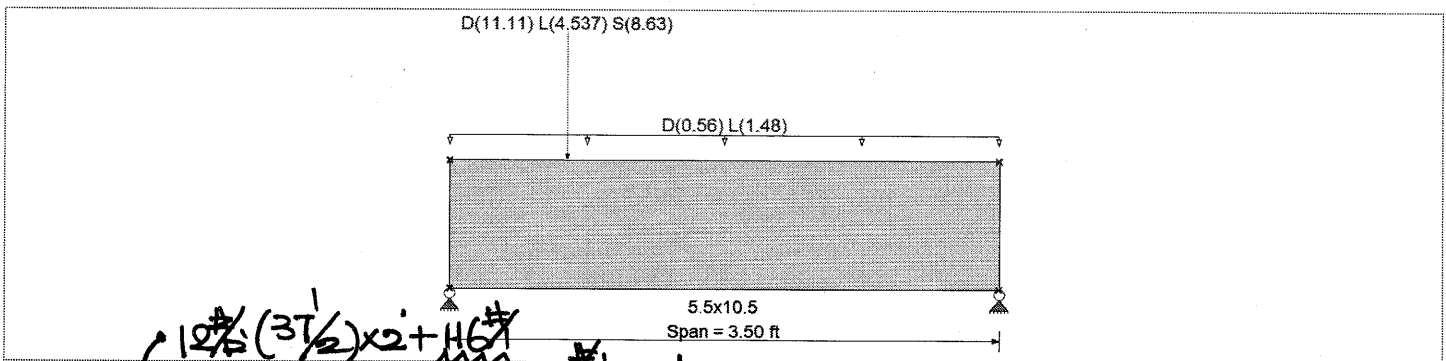

## Applied Loads

Beam self weight calculated and added to loading  
Uniform Load : D = 0.560, L = 1.480, Tributary Width = 1.0 ft  
Point Load : D = 11.110, L = 4.537, S = 8.630 k @ 0.750 ft, (from <F3> & <R7>)

## DESIGN SUMMARY

				Design OK			
Maximum Bending Stress Ratio	=	0.609	1	Maximum Shear Stress Ratio	=	0.510	1
Section used for this span		5.5x10.5		Section used for this span		5.5x10.5	
fb: Actual	=	1,673.16 psi		fv: Actual	=	155.32 psi	
F'b	=	2,749.27 psi		Fv	=	304.75 psi	
Load Combination		+D+0.750L+0.750S		Load Combination		+D+0.750L+0.750S	
Location of maximum on span	=	0.754 ft		Location of maximum on span	=	2.631 ft	
Span # where maximum occurs	=	Span # 1		Span # where maximum occurs	=	Span # 1	
Maximum Deflection							
Max Downward Transient Deflection		0.010 in	Ratio = 4304 >= 360	Span: 1 : L Only			
Max Upward Transient Deflection		0 in	Ratio = 0 < 360	n/a			
Max Downward Total Deflection		0.027 in	Ratio = 1561 >= 180	Span: 1 : +D+0.750L+0.750S			
Max Upward Total Deflection		0 in	Ratio = 0 < 180	n/a			

## Overall Maximum Deflections

Load Combination	Span	Max. "-" Defl	Location in Span	Load Combination	Max. "+" Defl	Location in Span
+D+0.750L+0.750S	1	0.0269	1.584		0.0000	0.000

## Vertical Reactions

Load Combination	Support notation : Far left is #1		Values in KIPS		
	Support 1	Support 2	DL	LL	SL
Max Upward from all Load Conditions	19.433	7.441			
Max Upward from Load Combinations	19.433	7.441			
Max Upward from Load Cases	9.731	3.562			
D Only	9.731	3.383			
+D+L	15.886	6.945	<F3>	1802#	4537#
+D+Lr	9.731	3.383	<R7>	9308#	0
+D+S	16.512	5.232			1741#
+D+0.750Lr+0.750L	14.347	6.054			6889#
+D+0.750L+0.750S	19.433	7.441			

00504 FL 16

**Wood Beam**

Project File: ENERCALC\_20

LIC#: KW-06015335, Build:20.22.12.28

D.S. ENGINEERING PC

(c) ENERCALC INC 1983-2022

**DESCRIPTION:** header <F17> update**Vertical Reactions**

Support notation : Far left is #1

Values in KIPS

Load Combination	Support 1	Support 2
+0.60D	5.839	2.030
L Only	6.155	3.562
S Only	6.781	1.849

**Steel Beam**

Project File: ENERCALC\_20

LIC#: KW-06015335, Build: 20.22.12.28

D.S. ENGINEERING PC

(c) ENERCALC INC 1983-2022

**DESCRIPTION:** update beam (F18)


**CODE REFERENCES**

Calculations per AISC 360-16, IBC 2018, CBC 2019, ASCE 7-16  
Load Combination Set : IBC 2018

**Material Properties**

Analysis Method : Allowable Strength Design  
Beam Bracing : Beam is Fully Braced against lateral-torsional buckling  
Bending Axis : Major Axis Bending

Fy : Steel Yield : 50.0 ksi  
E : Modulus : 29,000.0 ksi

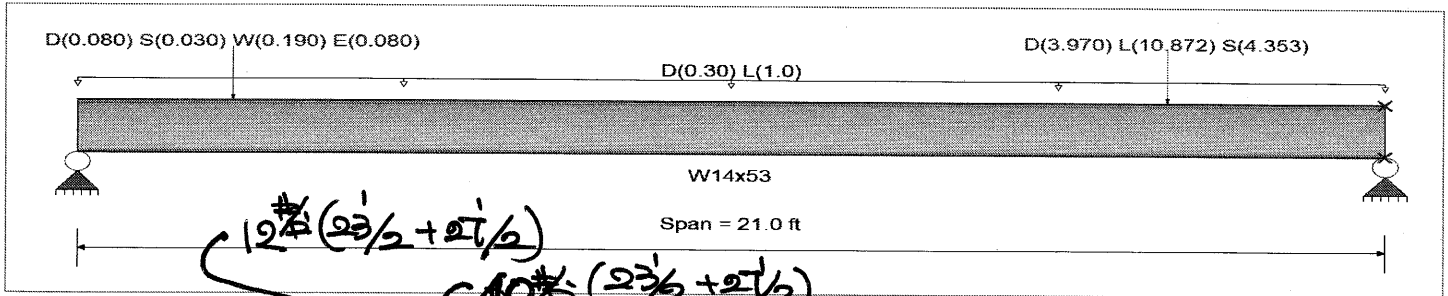

**Applied Loads**

Service loads entered. Load Factors will be applied for calculations.

Beam self weight calculated and added to loading  
Uniform Load : D = 0.30, L = 1.0 k/ft, Tributary Width = 1.0 ft

Point Load : D = 0.080, S = 0.030, W = 0.190, E = 0.080 k @ 2.50 ft, (from <B1> & <B2>)

Point Load : D = 3.970, L = 10.872, S = 4.353 k @ 17.50 ft, (from <F3>)

**DESIGN SUMMARY**

**Design OK**

Maximum Bending Stress Ratio =	0.474 : 1	Maximum Shear Stress Ratio =	0.258 : 1
Section used for this span	<b>W14x53</b>	Section used for this span	<b>W14x53</b>
Ma : Applied	102.901 k-ft	Va : Applied	26.584 k
Mn / Omega : Allowable	217.315 k-ft	Vn/Omega : Allowable	102.860 k
Load Combination	+D+L	Load Combination	+D+L
Span # where maximum occurs	Span # 1	Location of maximum on span	21.000 ft
Span # where maximum occurs	Span # 1	Span # where maximum occurs	Span # 1
Maximum Deflection			
Max Downward Transient Deflection	0.392 in Ratio = 642	>=360	
Max Upward Transient Deflection	0.000 in Ratio = 0	<360	Span: 1 : L Only
Max Downward Total Deflection	0.533 in Ratio = 473	>=180	Span: 1 : +D+L
Max Upward Total Deflection	0.000 in Ratio = 0	<180	

**Overall Maximum Deflections**

Load Combination	Span	Max. "-" Defl	Location in Span	Load Combination	Max. "+" Defl	Location in Span
+D+L	1	0.5330	10.920		0.0000	0.000

**Vertical Reactions**

Support notation : Far left is #

Values in KIPS

Load Combination	Support 1	Support 2
Max Upward from all Load Conditions	16.751	26.584
Max Upward from Load Combinations	16.751	26.584
Max Upward from Load Cases	12.312	19.560
D Only	4.439	7.024
+D+L	16.751	26.584
+D+S	5.191	10.655
+D+0.750L	13.673	21.694
+D+0.750L+0.750S	14.237	24.418
+D+0.60W	4.539	7.038
+D+0.70E	4.488	7.031
+D+0.750L+0.450W	13.748	21.705
+D+0.750L+0.750S+0.450W	14.312	24.428
+D+0.750L+0.750S+0.5250E	14.274	24.423
+0.60D+0.60W	2.764	4.228

**W14x22**  
 $P = 26.584k + 9.254k$   
 $= 35.84k$   
 $35.84k / 3 = 11.95k < F4.0 >$   
**FL18**

**Steel Beam**

Project File: ENERCALC\_20

LIC#: KW-06015335, Build:20.22.12.28

D.S. ENGINEERING PC

(c) ENERCALC INC 1983-2022

**DESCRIPTION:** update beam (F18)**Vertical Reactions**

Support notation : Far left is #

Values in KIPS

Load Combination	Support 1	Support 2
+0.60D+0.70E	2.713	4.221
L Only	12.312	19.560
S Only	0.752	3.631
W Only	0.167	0.023
E Only	0.070	0.010

**Steel Section Properties : W14x53**

Depth	=	13.900 in	I xx	=	541.00 in <sup>4</sup>	J	=	1.940 in <sup>4</sup>
Web Thick	=	0.370 in	S xx	=	77.80 in <sup>3</sup>	Cw	=	2,540.00 in <sup>6</sup>
Flange Width	=	8.060 in	R xx	=	5.890 in			
Flange Thick	=	0.660 in	Zx	=	87.100 in <sup>3</sup>			
Area	=	15.600 in <sup>2</sup>	I yy	=	57.700 in <sup>4</sup>			
Weight	=	53.000 plf	S yy	=	14.300 in <sup>3</sup>	Wno	=	26.700 in <sup>2</sup>
Kdesign	=	1.250 in	R yy	=	1.920 in	Sw	=	35.500 in <sup>4</sup>
K1	=	1.000 in	Zy	=	22.000 in <sup>3</sup>	Qf	=	16.800 in <sup>3</sup>
rts	=	2.220 in				Qw	=	42.500 in <sup>3</sup>
Ycg	=	6.950 in						

**Steel Beam**

Project File: ENERCALC\_20

LIC#: KW-06015335, Build:20.22.12.28

D.S. ENGINEERING PC

(c) ENERCALC INC 1983-2022

DESCRIPTION: beam

<F21>


**CODE REFERENCES**

Calculations per AISC 360-16, IBC 2018, CBC 2019, ASCE 7-16  
Load Combination Set : IBC 2018

**Material Properties**

Analysis Method Allowable Strength Design  
Beam Bracing : Beam is Fully Braced against lateral-torsional buckling  
Bending Axis : Major Axis Bending

Fy : Steel Yield : 50.0 ksi  
E : Modulus : 29,000.0 ksi

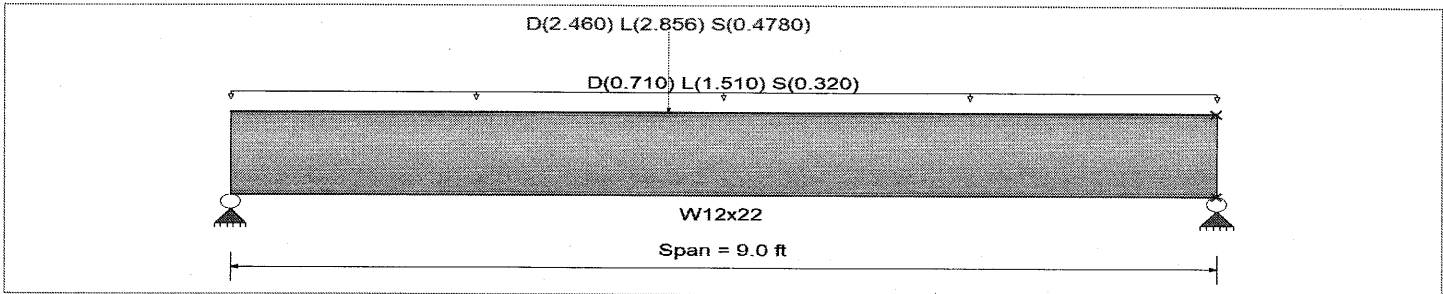

**Applied Loads**

Service loads entered. Load Factors will be applied for calculations.

Beam self weight calculated and added to loading

Uniform Load : D = 0.710, L = 1.510, S = 0.320 k/ft, Tributary Width = 1.0 ft, (from 1.75x16 LVL joist (see <F20>))

Point Load : D = 2.460, L = 2.856, S = 0.4780 k @ 4.0 ft, (from <F11>)

**DESIGN SUMMARY**

(SEE ORIGINAL CALC ENT # 1-16)

Design OK

Maximum Bending Stress Ratio =	0.468 : 1	Maximum Shear Stress Ratio =	0.204 : 1
Section used for this span	W12x22	Section used for this span	W12x22
Ma : Applied	34.219 k-ft	Va : Applied	13.042 k
Mn / Omega : Allowable	73.104 k-ft	Vn/Omega : Allowable	63.960 k
Load Combination	+D+L	Load Combination	+D+L
Span # where maximum occurs	Span # 1	Location of maximum on span	0.000 ft
Span # where maximum occurs	Span # 1	Span # where maximum occurs	Span # 1
Maximum Deflection			
Max Downward Transient Deflection	0.066 in Ratio = 1,640	>=360	
Max Upward Transient Deflection	0.000 in Ratio = 0	<360	Span: 1 : L Only
Max Downward Total Deflection	0.104 in Ratio = 1039	>=180	Span: 1 : +D+L
Max Upward Total Deflection	0.000 in Ratio = 0	<180	

**Overall Maximum Deflections**

Load Combination	Span	Max. "-" Defl	Location in Span	Load Combination	Max. "+" Defl	Location in Span
+D+L	1	0.1039	4.474		0.0000	0.000

**Vertical Reactions**

Support notation : Far left is #

Values in KIPS

Load Combination	Support 1	Support 2
Max Upward from all Load Conditions	13.042	12.452
Max Upward from Load Combinations	13.042	12.452
Max Upward from Load Cases	8.382	8.064
D Only	4.661	4.387
+D+L	13.042	12.452
+D+S	6.366	6.040
+D+0.750L	10.947	10.436
+D+0.750L+0.750S	12.226	11.675
+0.60D	2.796	2.632
L Only	8.382	8.064
S Only	1.706	1.652

TO CONC WALL

<F4.0>

$P = 13.042^k + 20.998^k = 34.04^k$   
<F20>

**Steel Beam**

Project File: ENERCALC\_20

LIC#: KW-06015335, Build:20.22.12.28

D.S. ENGINEERING PC

(c) ENERCALC INC 1983-2022

DESCRIPTION: beam

**Steel Section Properties : W12x22**

Depth	=	12.300 in	I xx	=	156.00 in <sup>4</sup>	J	=	0.293 in <sup>4</sup>
Web Thick	=	0.260 in	S xx	=	25.40 in <sup>3</sup>	Cw	=	164.00 in <sup>6</sup>
Flange Width	=	4.030 in	R xx	=	4.910 in			
Flange Thick	=	0.425 in	Zx	=	29.300 in <sup>3</sup>			
Area	=	6.480 in <sup>2</sup>	I yy	=	4.660 in <sup>4</sup>			
Weight	=	22.000 plf	S yy	=	2.310 in <sup>3</sup>	Wno	=	12.000 in <sup>2</sup>
Kdesign	=	0.725 in	R yy	=	0.848 in	Sw	=	5.120 in <sup>4</sup>
K1	=	0.625 in	Zy	=	3.660 in <sup>3</sup>	Qf	=	4.760 in <sup>3</sup>
rts	=	1.040 in				Qw	=	14.400 in <sup>3</sup>
Ycg	=	6.150 in						

6.92k (DEAD) ~~11.5~~ ~~11.5~~ 'L10'


OR

10.76k (WIND)

$$\# \text{ of } 3/4" \text{ Bolt } = \frac{10.76k}{7.51k}$$

$$= 1.43 < 4 \text{ PROVIDED}$$

(206/51.1)

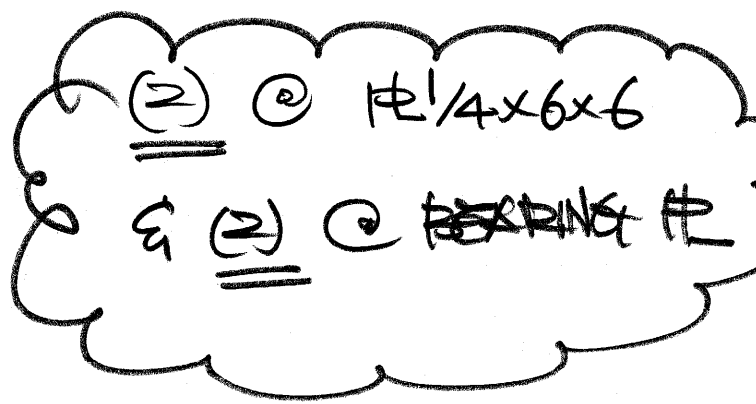




**DESCRIPTION:** beam (stair)

**CODE REFERENCES** ← F22 →

Calculations per AISC 360-16, IBC 2018, CBC 2019, ASCE 7-16  
 Load Combination Set : IBC 2018

**Material Properties**

Analysis Method : Allowable Strength Design Fy : Steel Yield : 46.0 ksi  
 Beam Bracing : Completely Unbraced E : Modulus : 29,000.0 ksi  
 Bending Axis : Major Axis Bending

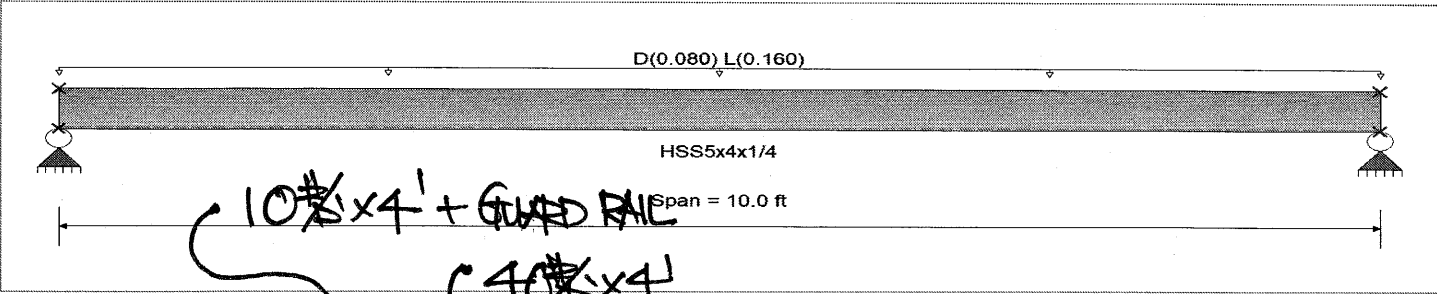

**Applied Loads**

Service loads entered. Load Factors will be applied for calculations.

Beam self weight calculated and added to loading  
 Uniform Load : D = 0.080, L = 0.160 k/ft, Tributary Width = 1.0 ft

**DESIGN SUMMARY**

Design OK

<p>Maximum Bending Stress Ratio = <b>0.213 : 1</b></p> <p>Section used for this span <b>HSS5x4x1/4</b></p> <p>Ma : Applied <b>3.174 k-ft</b></p> <p>Mn / Omega : Allowable <b>14.897 k-ft</b></p> <p>Load Combination <b>+D+L</b></p> <p>Span # where maximum occurs <b>Span # 1</b></p> <p>Maximum Deflection</p> <p>Max Downward Transient Deflection <b>0.093 in Ratio = 1,289 &gt;=360</b></p> <p>Max Upward Transient Deflection <b>0.000 in Ratio = 0 &lt;360</b></p> <p>Max Downward Total Deflection <b>0.148 in Ratio = 813 &gt;=180</b></p> <p>Max Upward Total Deflection <b>0.000 in Ratio = 0 &lt;180</b></p>	<p>Maximum Shear Stress Ratio = <b>0.038 : 1</b></p> <p>Section used for this span <b>HSS5x4x1/4</b></p> <p>Va : Applied <b>1.270 k</b></p> <p>Vn/Omega : Allowable <b>33.124 k</b></p> <p>Load Combination <b>+D+L</b></p> <p>Location of maximum on span <b>0.000 ft</b></p> <p>Span # where maximum occurs <b>Span # 1</b></p>
----------------------------------------------------------------------------------------------------------------------------------------------------------------------------------------------------------------------------------------------------------------------------------------------------------------------------------------------------------------------------------------------------------------------------------------------------------------------------------------------------------------------------------------------------------------------------------------------------------------------------	-----------------------------------------------------------------------------------------------------------------------------------------------------------------------------------------------------------------------------------------------------------------------------------------------------------------------------------

**Overall Maximum Deflections**

Load Combination	Span	Max. "-" Defl	Location in Span	Load Combination	Max. "+" Defl	Location in Span
+D+L	1	0.1477	5.029		0.0000	0.000

**Vertical Reactions**

Support notation : Far left is # Values in KIPS

Load Combination	Support 1	Support 2
Max Upward from all Load Conditions	1.270	1.270
Max Upward from Load Combinations	1.270	1.270
Max Upward from Load Cases	0.800	0.800
D Only	0.470	0.470
+D+L	1.270	1.270
+D+0.750L	1.070	1.070
+0.60D	0.282	0.282
L Only	0.800	0.800

(2) - 2x6 & (2) - 4x6



$$P_{allow} = (10'' + 4'' \times 2)(5.5'' + 4'' \times 2) / 144 \times 3000 \text{ PSF} = 5060^{\#} \gg 1270^{\#}$$

4" CONE SLAB ON GRADE  
 UNDER (2) - 2x6 & (2) - 4x6  
 O.K. FOR P = 1240<sup>#</sup>

**Steel Beam**


Project File: ENERCALC\_20

LIC#: KW-06015335, Build:20.22.12.28

D.S. ENGINEERING PC

(c) ENERCALC INC 1983-2022

DESCRIPTION: beam (stair)

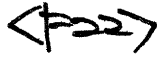**Steel Section Properties : HSS5x4x1/4**

Depth	=	5.000 in	I xx	=	13.40 in <sup>4</sup>	J	=	18.000 in <sup>4</sup>
			S xx	=	5.35 in <sup>3</sup>	Cw	=	8.32 in <sup>6</sup>
Width	=	4.000 in	R xx	=	1.870 in			
Wall Thick	=	0.233 in	Zx	=	6.490 in <sup>3</sup>			
Area	=	3.840 in <sup>2</sup>	I yy	=	9.460 in <sup>4</sup>	C	=	0.000 in <sup>3</sup>
Weight	=	13.910 plf	S yy	=	4.730 in <sup>3</sup>			
			R yy	=	1.570 in			
			Zy	=	5.570 in <sup>3</sup>			
Ycg	=	2.500 in						

# Wood Beam

Project File: ENERCALC\_20

LIC#: KW-06015335, Build:20.22.12.28

D.S. ENGINEERING PC

(c) ENERCALC INC 1983-2022

**DESCRIPTION:** deck


## CODE REFERENCES

Calculations per NDS 2018, IBC 2018, CBC 2019, ASCE 7-16

Load Combination Set : IBC 2018

## Material Properties

Analysis Method : Allowable Stress Design	Fb +	850 psi	E : Modulus of Elasticity	
Load Combination : IBC 2018	Fb -	850 psi	Ebend- xx	1300ksi
	Fc - Prll	1300 psi	Eminbend - xx	470ksi
Wood Species : Hem-Fir	Fc - Perp	405 psi		
Wood Grade : No.2	Fv	150 psi		
	Ft	525 psi	Density	26.84pcf
Beam Bracing : Beam is Fully Braced against lateral-torsional buckling			Repetitive Member Stress Increase	

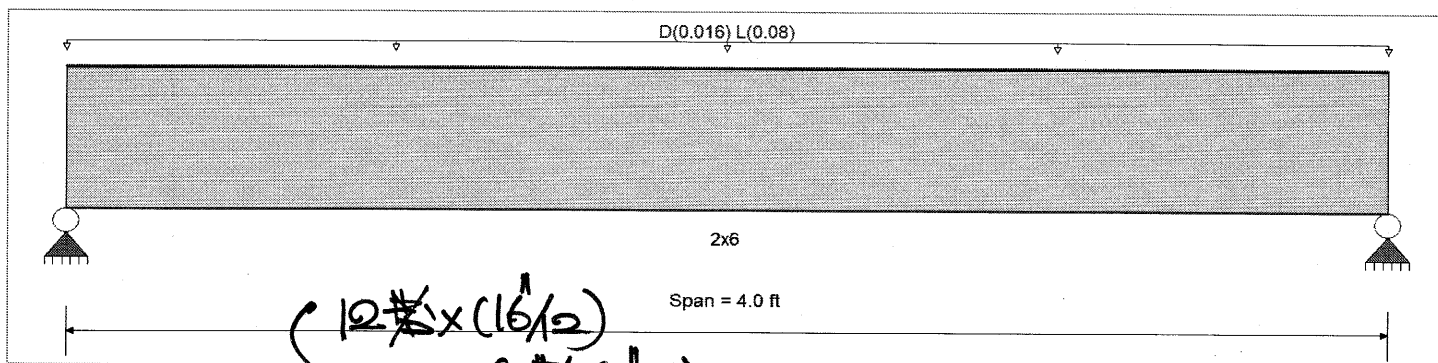

## Applied Loads

Beam self weight NOT internally calculated and added

Service loads entered. Load Factors will be applied for calculations.

Uniform Load : D = 0.0160, L = 0.080, Tributary Width = 1.0 ft

## DESIGN SUMMARY

				Design OK			
Maximum Bending Stress Ratio	=	0.240	1	Maximum Shear Stress Ratio	=	0.180	1
Section used for this span		2x6		Section used for this span		2x6	
fb: Actual	=	304.66psi		fv: Actual	=	27.01	psi
F'b	=	1,270.75psi		F'v	=	150.00	psi
Load Combination		+D+L		Load Combination		+D+L	
Location of maximum on span	=	2.000ft		Location of maximum on span	=	3.547ft	
Span # where maximum occurs	=	Span # 1		Span # where maximum occurs	=	Span # 1	
Maximum Deflection							
Max Downward Transient Deflection		0.017 in	Ratio = 2799 >= 360	Span: 1 : L Only			
Max Upward Transient Deflection		0 in	Ratio = 0 < 360	n/a			
Max Downward Total Deflection		0.021 in	Ratio = 2333 >= 180	Span: 1 : +D+L			
Max Upward Total Deflection		0 in	Ratio = 0 < 180	n/a			

## Overall Maximum Deflections

Load Combination	Span	Max. "-" Defl	Location in Span	Load Combination	Max. "+" Defl	Location in Span
+D+L	1	0.0206	2.015		0.0000	0.000

## Vertical Reactions

Load Combination	Support 1	Support 2
Max Upward from all Load Conditions	0.192	0.192
Max Upward from Load Combinations	0.192	0.192
Max Upward from Load Cases	0.160	0.160
D Only	0.032	0.032
+D+L	0.192	0.192
+D+Lr	0.032	0.032
+D+S	0.032	0.032
+D+0.750Lr+0.750L	0.152	0.152
+D+0.750L+0.750S	0.152	0.152
+0.60D	0.019	0.019

**Wood Beam**

Project File: ENERCALC\_20

LIC#: KW-06015335, Build:20.22.12.28

D.S. ENGINEERING PC

(c) ENERCALC INC 1983-2022

**DESCRIPTION:** deck

**Vertical Reactions**

Support notation : Far left is #1

Values in KIPS

Load Combination	Support 1	Support 2
L Only	0.160	0.160
S Only		

00513 FL25

# Wood Beam


Project File: ENERCALC\_20

LIC#: KW-06015335, Build:20.22.12.28

D.S. ENGINEERING PC

(C) ENERCALC INC 1983-2022

DESCRIPTION: deck

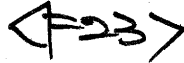


## CODE REFERENCES

Calculations per NDS 2018, IBC 2018, CBC 2019, ASCE 7-16

Load Combination Set : IBC 2018

## Material Properties

Analysis Method : Allowable Stress Design	Fb +	850 psi	E : Modulus of Elasticity	
Load Combination : IBC 2018	Fb -	850 psi	Ebend- xx	1300 ksi
	Fc - Prll	1300 psi	Eminbend - xx	470 ksi
Wood Species : Hem-Fir	Fc - Perp	405 psi		
Wood Grade : No.2	Fv	150 psi		
	Ft	525 psi	Density	26.84 pcf
Beam Bracing : Beam is Fully Braced against lateral-torsional buckling				

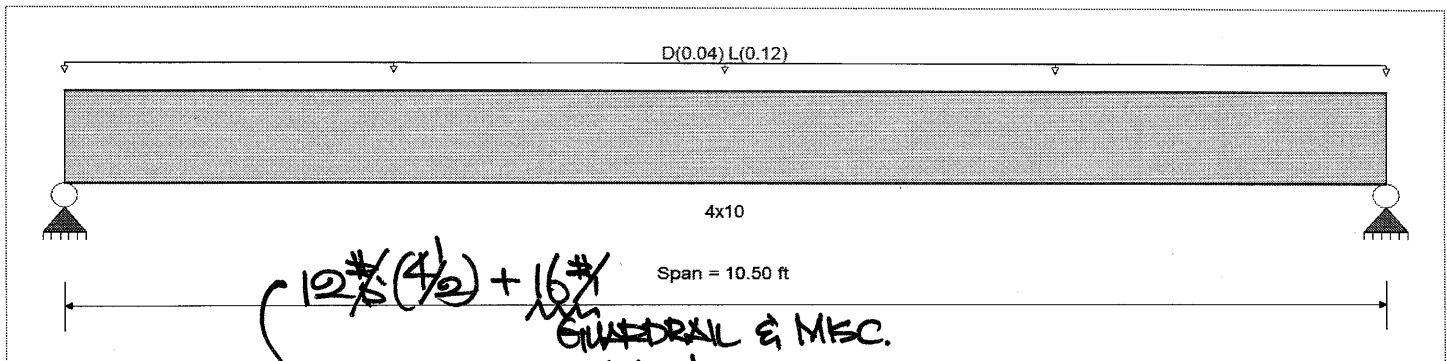

## Applied Loads

Beam self weight calculated and added to loading

Uniform Load : D = 0.040, L = 0.120, Tributary Width = 1.0 ft

Service loads entered. Load Factors will be applied for calculations.

## DESIGN SUMMARY

Design OK

Maximum Bending Stress Ratio =	0.539	1	Maximum Shear Stress Ratio =	0.230	1
Section used for this span	4x10		Section used for this span	4x10	
fb: Actual =	550.13psi		fv: Actual =	34.49 psi	
F'b =	1,020.00psi		F'v =	150.00 psi	
Load Combination	+D+L		Load Combination	+D+L	
Location of maximum on span =	5.250ft		Location of maximum on span =	0.000 ft	
Span # where maximum occurs =	Span # 1		Span # where maximum occurs =	Span # 1	
Maximum Deflection					
Max Downward Transient Deflection	0.110 in	Ratio = 1145 >= 360	Span: 1 : L Only		
Max Upward Transient Deflection	0 in	Ratio = 0 < 360	n/a		
Max Downward Total Deflection	0.152 in	Ratio = 827 >= 240	Span: 1 : +D+L		
Max Upward Total Deflection	0 in	Ratio = 0 < 240	n/a		

## Overall Maximum Deflections

Load Combination	Span	Max. "-" Defl	Location in Span	Load Combination	Max. "+" Defl	Location in Span
+D+L	1	0.1522	5.288		0.0000	0.000

## Vertical Reactions

Load Combination	Support 1	Support 2
Max Upward from all Load Conditions	0.872	0.872
Max Upward from Load Combinations	0.872	0.872
Max Upward from Load Cases	0.630	0.630
D Only	0.242	0.242
+D+L	0.872	0.872
+D+Lr	0.242	0.242
+D+S	0.242	0.242
+D+0.750Lr+0.750L	0.714	0.714
+D+0.750L+0.750S	0.714	0.714
+0.60D	0.145	0.145

Support notation : Far left is #1

Values in KIPS

Handwritten notes: 4x4 POST W/ EPCAZ & EPB 44 PHDG W/ 1/2" SET-3G EPOXY " 3/8" x 12/5" (UPU#T) " FL 26

00514

**Wood Beam**

Project File: ENERCALC\_20

LIC#: KW-06015335, Build:20.22.12.28

D.S. ENGINEERING PC

(c) ENERCALC INC 1983-2022

**DESCRIPTION:** deck

*<F23>*

**Vertical Reactions**

Support notation : Far left is #1

Values in KIPS

Load Combination	Support 1	Support 2
L Only	0.630	0.630
S Only		

RetainPro (c) 1987-2019, Build 11.20.03.31  
 License : KW-06061521  
 License To : D.S. Engineering

### Cantilevered Retaining Wall


Code: IBC 2018,ACI 318-14,TMS 402-16

#### Criteria

Retained Height = 5.17 ft  
 Wall height above soil = 0.50 ft  
 Slope Behind Wall = 0.00  
 Height of Soil over Toe = 4.00 in  
 Water height over heel = 0.0 ft

#### Soil Data

Allow Soil Bearing = 3,000.0 psf  
 Equivalent Fluid Pressure Method  
 Active Heel Pressure = 35.0 psf/ft  
 =  
 Passive Pressure = 300.0 psf/ft  
 Soil Density, Heel = 110.00 pcf  
 Soil Density, Toe = 110.00 pcf  
 Footing||Soil Friction = 0.250  
 Soil height to ignore for passive pressure = 12.00 in

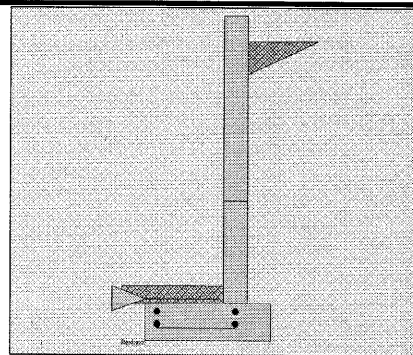

#### Surcharge Loads

Surcharge Over Heel = 0.0 psf  
 Used To Resist Sliding & Overturning  
 Surcharge Over Toe = 0.0 psf  
 NOT Used for Sliding & Overturning

#### Lateral Load Applied to Stem

Lateral Load = 0.0 #/ft  
 ...Height to Top = 0.00 ft  
 ...Height to Bottom = 0.00 ft  
 Load Type = Wind (W)  
 (Service Level)  
 Wind on Exposed Stem = 15.0 psf  
 (Service Level)  
 Wind acts left-to-right toward retention side.

#### Adjacent Footing Load

Adjacent Footing Load = 0.0 lbs  
 Footing Width = 0.00 ft  
 Eccentricity = 0.00 in  
 Wall to Ftg CL Dist = 0.00 ft  
 Footing Type = Square Footing  
 Base Above/Below Soil at Back of Wall = 0.0 ft  
 Poisson's Ratio = 0.300

#### Axial Load Applied to Stem

Axial Dead Load = 0.0 lbs  
 Axial Live Load = 0.0 lbs  
 Axial Load Eccentricity = 0.0 in

#### Earth Pressure Seismic Load

Method : Uniform  
 Multiplier Used = 1.750  
 (Multiplier used on soil density)

Uniform Seismic Force = 10.360  
 Total Seismic Force = 61.331

#### Design Summary

**Wall Stability Ratios**  
 Overturning = 1.52 OK  
 Slab Resists All Sliding !

Total Bearing Load = 1,071 lbs  
 ...resultant ecc. = 8.56 in

Soil Pressure @ Toe = 1,149 psf OK  
 Soil Pressure @ Heel = 0 psf OK  
 Allowable = 3,000 psf  
 Soil Pressure Less Than Allowable  
 ACI Factored @ Toe = 1,609 psf  
 ACI Factored @ Heel = 0 psf  
 Footing Shear @ Toe = 15.9 psi OK  
 Footing Shear @ Heel = 5.7 psi OK  
 Allowable = 75.0 psi

**Sliding Calcs**  
 Lateral Sliding Force = 648.7 lbs

#### Stem Construction

	2nd	Bottom
Design Height Above Ftg	ft = Stem OK 2.00	Stem OK 0.00
Wall Material Above "Ht"	= Concrete	Concrete
Design Method	= LRFD	LRFD
Thickness	= 6.00	6.00
Rebar Size	= # 4	# 4
Rebar Spacing	= 18.00	12.00
Rebar Placed at	= Center	Center

**Design Data**  
 fb/FB + fa/Fa = 0.196 0.585


**Total Force @ Section**  
 Service Level lbs =  
 Strength Level lbs = 322.0 839.0

**Moment....Actual**  
 Service Level ft-# =  
 Strength Level ft-# = 334.6 1,456.0  
 Moment.....Allowable ft-# = 1,705.6 2,487.6

**Shear.....Actual**  
 Service Level psi =  
 Strength Level psi = 8.9 23.3  
 Shear.....Allowable psi = 75.0 75.0  
 Anet (Masonry) in2 =  
 Rebar Depth 'd' in = 3.00 3.00

**Masonry Data**  
 fm psi =  
 Fs psi =  
 Solid Grouting =  
 Modular Ratio 'n' =  
 Wall Weight psf = 75.0 75.0  
 Short Term Factor =  
 Equiv. Solid Thick. =  
 Masonry Block Type = Medium Weight  
 Masonry Design Method = ASD

**Concrete Data**  
 fc psi = 2,500.0 2,500.0  
 Fy psi = 60,000.0 60,000.0

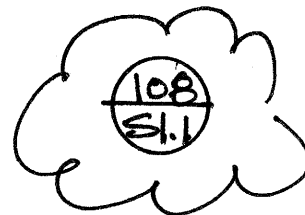

Vertical component of active lateral soil pressure IS NOT considered in the calculation of soil bearing

**Load Factors**  
 Building Code IBC 2018,ACI  
 Dead Load 1.400  
 Live Load 1.700  
 Earth, H 1.700  
 Wind, W 1.300  
 Seismic, E 1.000

**Concrete Stem Rebar Area Details**

2nd Stem	Vertical Reinforcing	Horizontal Reinforcing	
As (based on applied moment) :	0.0277 in2/ft		
(4/3) * As :	0.037 in2/ft	Min Stem T&S Reinf Area 0.528 in2	
200bd/fy : 200(12)(3)/60000 :	0.12 in2/ft	Min Stem T&S Reinf Area per ft of stem Height : 0.144 in2/ft	
0.0018bh : 0.0018(12)(6) :	0.1296 in2/ft	Horizontal Reinforcing Options :	
	=====	One layer of :	Two layers of :
Required Area :	0.1296 in2/ft	#4@ 16.67 in	#4@ 33.33 in
Provided Area :	0.1333 in2/ft	#5@ 25.83 in	#5@ 51.67 in
Maximum Area :	0.4064 in2/ft	#6@ 36.67 in	#6@ 73.33 in

Bottom Stem	Vertical Reinforcing	Horizontal Reinforcing	
As (based on applied moment) :	0.1207 in2/ft		
(4/3) * As :	0.1609 in2/ft	Min Stem T&S Reinf Area 0.288 in2	
200bd/fy : 200(12)(3)/60000 :	0.12 in2/ft	Min Stem T&S Reinf Area per ft of stem Height : 0.144 in2/ft	
0.0018bh : 0.0018(12)(6) :	0.1296 in2/ft	Horizontal Reinforcing Options :	
	=====	One layer of :	Two layers of :
Required Area :	0.1207 in2/ft	#4@ 16.67 in	#4@ 33.33 in
Provided Area :	0.2 in2/ft	#5@ 25.83 in	#5@ 51.67 in
Maximum Area :	0.4064 in2/ft	#6@ 36.67 in	#6@ 73.33 in

**Footing Data**

Toe Width	=	1.67 ft
Heel Width	=	1.00
Total Footing Width	=	2.67
Footing Thickness	=	9.00 in
Key Width	=	0.00 in
Key Depth	=	0.00 in
Key Distance from Toe	=	0.00 ft
$f_c$ =	2,500 psi	$F_y$ = 60,000 psi
Footing Concrete Density	=	150.00 pcf
Min. As %	=	0.0018
Cover @ Top	2.00	@ Btm = 3.00 in

**Footing Design Results**

		<u>Toe</u>	<u>Heel</u>
Factored Pressure	=	1,609	0 psf
$M_u'$ : Upward	=	18,883	0 ft-#
$M_u'$ : Downward	=	3,494	119 ft-#
$M_u$ : Design	=	1,282	119 ft-#
Actual 1-Way Shear	=	15.90	5.68 psi
Allow 1-Way Shear	=	75.00	40.00 psi
Toe Reinforcing	=	# 4 @ 12.00 in	
Heel Reinforcing	=	None Spec'd	
Key Reinforcing	=	# 4 @ 18.00 in	
Footing Torsion, $T_u$	=		0.00 ft-lbs
Footing Allow. Torsion, $\phi T_u$	=		0.00 ft-lbs

**If torsion exceeds allowable, provide supplemental design for footing torsion.**

**Other Acceptable Sizes & Spacings**

Toe: #4@ 12.34 in, #5@ 19.13 in, #6@ 27.16 in, #7@ 37.03 in, #8@ 48.76 in, #9@ 6  
 Heel:  $\phi M_n = \phi'5'\lambda\sqrt{f_c}'S_m$   
 Key: No key defined

Min footing T&S reinf Area	0.52 in2
Min footing T&S reinf Area per foot	0.19 in2 /ft
If one layer of horizontal bars:	If two layers of horizontal bars:
#4@ 12.35 in	#4@ 24.69 in
#5@ 19.14 in	#5@ 38.27 in
#6@ 27.16 in	#6@ 54.32 in



**Cantilevered Retaining Wall**

**Summary of Overturning & Resisting Forces & Moments**

Item	.....OVERTURNING.....			.....RESISTING.....			
	Force lbs	Distance ft	Moment ft-#	Force lbs	Distance ft	Moment ft-#	
HL Act Pres (ab water tbl)	613.3	1.97	1,210.3	Soil Over HL (ab. water tbl)	284.4	2.42	688.1
HL Act Pres (be water tbl)				Soil Over HL (bel. water tbl)		2.42	688.1
Hydrostatic Force				Water Table			
Buoyant Force =				Sloped Soil Over Heel =			
Surcharge over Heel =				Surcharge Over Heel =			
Surcharge Over Toe =				Adjacent Footing Load =			
Adjacent Footing Load =				Axial Dead Load on Stem =			
Added Lateral Load =				* Axial Live Load on Stem =			
Load @ Stem Above Soil =	-7.5	6.17	-46.3	Soil Over Toe =	61.2	0.84	51.1
Seismic Earth Load =	42.9	2.96	127.1	Surcharge Over Toe =			
				Stem Weight(s) =	425.3	1.92	816.5
				Earth @ Stem Transitions =			
<b>Total</b>	<b>= 648.7</b>	<b>O.T.M. =</b>	<b>1,291.1</b>	Footing Weight =	300.4	1.34	401.0
				Key Weight =			
				Vert. Component =			
<b>Resisting/Overturning Ratio</b>		<b>= 1.52</b>		<b>Total =</b>	<b>1,071.2 lbs</b>	<b>R.M. =</b>	<b>1,956.7</b>
Vertical Loads used for Soil Pressure =		1,071.2 lbs					

\* Axial live load NOT included in total displayed, or used for overturning resistance, but is included for soil pressure calculation.

If seismic is included, the OTM and sliding ratios may be 1.1 per section 1807.2.3 of IBC.

Vertical component of active lateral soil pressure IS NOT considered in the calculation of Sliding Resistance.

Vertical component of active lateral soil pressure IS NOT considered in the calculation of Overturning Resistance.

**Tilt**

**Horizontal Deflection at Top of Wall due to settlement of soil**

(Deflection due to wall bending not considered)

Soil Spring Reaction Modulus 250.0 pci

Horizontal Defl @ Top of Wall (approximate only) 0.068 in

The above calculation is not valid if the heel soil bearing pressure exceeds that of the toe, because the wall would then tend to rotate into the retained soil.

**Design Lateral Seismic Load per "IBC 2018" & "ASCE/SEI 7-16":**

The total design lateral seismic force is determined from:

$V = C_s \times W = 0.1015 \times W = 8670 \text{ lb.} \quad : \text{ ASD}$

- From:
- $S_s = 1.414 \text{ g}$  (=0.2 sec response)      Seismic Design Category : **D**
  - $S_1 = 0.492 \text{ g}$  (=1.0 sec response)      Occupancy Category : **II**
  - $F_a = 1.000$  (=site Coefficients: site classification 'D')      Seismic Use Group : **I**
  - $F_v = 1.808$  (=site Coefficients: site classification 'D')
  - $S_{MS} = 1.414$  (=  $F_a \times S_s$ )
  - $S_{M1} = 0.890$  (=  $F_v \times S_1$ )
  - $S_{DS} = 0.943$  [=  $S_{MS} \times (2/3)$ ]
  - $S_{D1} = 0.593$  [=  $S_{M1} \times (2/3)$ ]
  - $C_t = 0.020$        $T_L = 6.00 \text{ sec.}$
  - $h_n = 21.00 \text{ ft.}$  (=Mean Height of Roof)       $T = 0.20 \text{ sec.}$
  - $I_e = 1.00$
  - $R = 6.50$
  - $C_s = 0.1015$  (=  $S_{DS} / (R / I_e) \times 0.7$ )      : **ASD**
  - $W = 85400 \text{ lb.}$  (=Included Exterior & Interior Partition Wall)

ASCE/SEI 7-16' Section 12.8.1 has a requirement that V be not less than 0.01 W  
BUT not more than  $\{(S_{D1} \times I) / (R \times T)\} \times W$

Check:  $(0.01) \times W < V < \{(S_{D1} \times I_e) / (R \times T)\} \times W$   
598 lb. < V < 27798 lb. : **O. K.**

**Distribution of Base Shear (ASD):**

Level	$W_i$ (lb)	$h_i$ (ft)	$(W_i)(h_i)$	$(W_i h_i) / \text{Sum}(W_i h_i)$	$F_x$	Sum ( $F_x$ )
Roof	46900	21.00	984900	0.709	6147	6147 lb.
2nd Floor	38500	10.50	404250	0.291	2523	8670 lb.
	85400		1389150	1.000		

From Roof :  $(25+4) \text{ ft} \times 35 \text{ ft} \times 28 \text{ ft} + (20+4) \text{ ft} \times 35 \text{ ft} \times 22 \text{ ft} = 46900 \text{ lb.}$

2nd Floor :  $(12+10) \text{ ft} \times 35 \text{ ft} \times 60 \text{ ft} = 38500 \text{ lb.}$

**Diaphragm Load (ASD):**

Level	$F_i$ (lb)	sum: $F_i$	$W_i$	sum: $F_i$ /sum: $W_i$	Adjust	$F_{ox}$
Roof	6147	6147	46900	0.131	0.132	6191 lb.
2nd Floor	2523	8670	38500	0.102	0.132	5082 lb.
			85400			

$F_x(\text{max}) = 0.4 S_{DS} I_e W_{px} (0.7) = 0.264$   
 $F_x(\text{min}) = 0.2 S_{DS} I_e W_{px} (0.7) = 0.132$

1st Floor :  $(12+10) \text{ ft} \times 35 \text{ ft} \times 60 \text{ ft} \times 0.1015 = 3020 \text{ lb.}$   
(SUPPORT BY CONC. WALL)

LTI  
12

GRIDS


$F_{\text{roof}} = 2230\# + 1790\# = 4020\#$

Table 27.5-1: 30'

$F_{\text{2ND}} = 4060\# (\Sigma 8080\#)$

$F_{\text{1ST}} = 2680\# (\Sigma 10760\#)$

$(\frac{19.6+16.9}{2})\# \times 2.25 \times 2.5 \times 21' = 2160\# \times 1.38$   
 $\times 0.6 = 1790\#$   
 #4 27.5-2

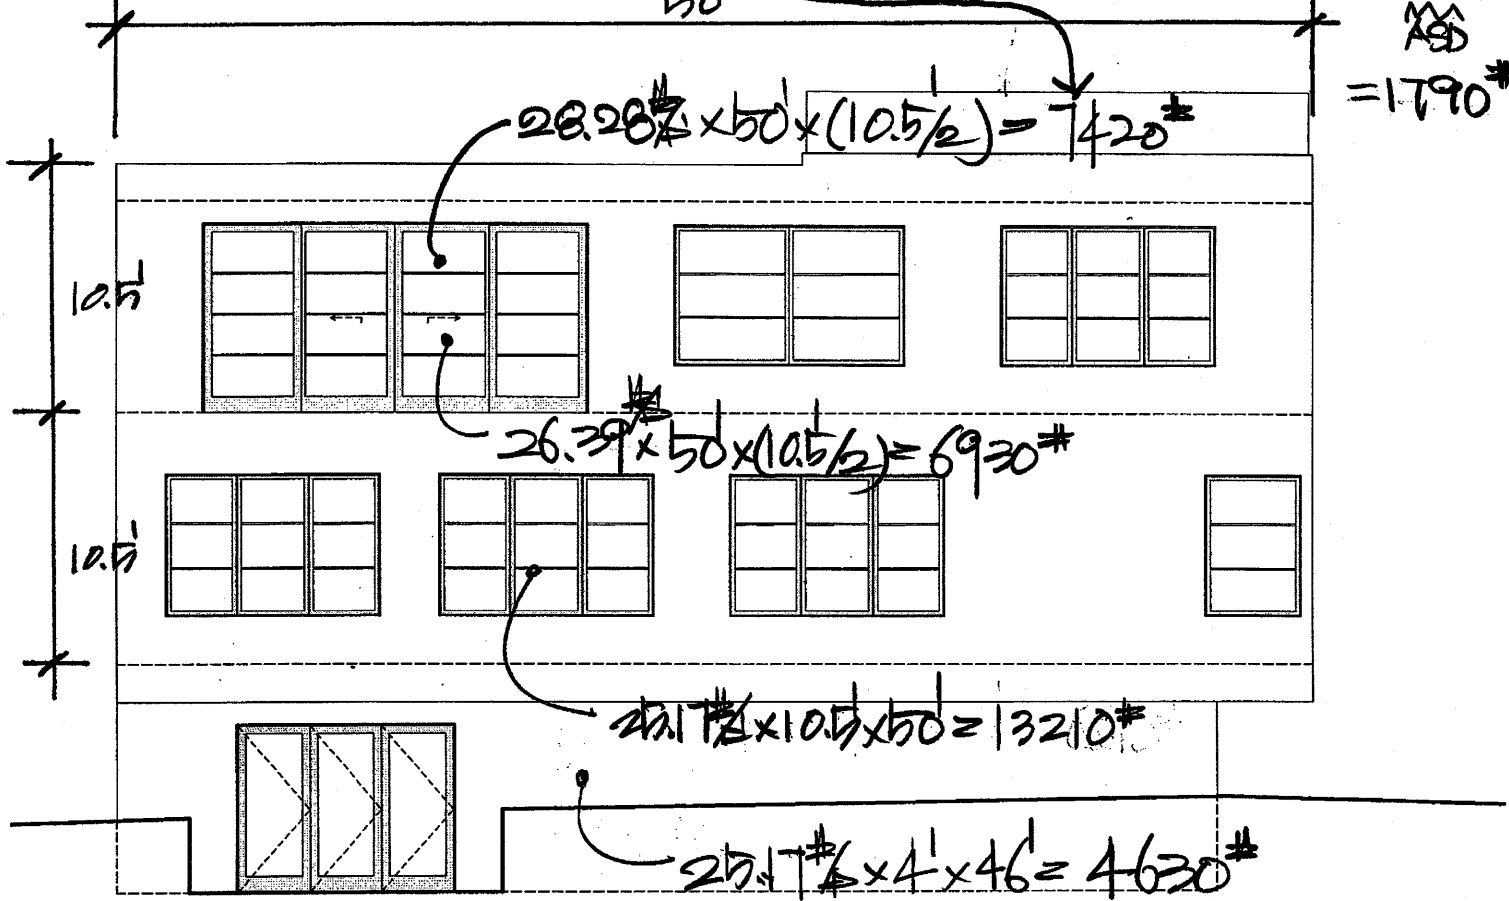

WEST ELEVATION

SCALE: 1/4" = 1'-0"

GRID (N)

$F_{\text{roof}} = 7420\# / 2 = 3710\# \times 0.6 = 2230\#$


$F_{\text{2ND}} = 6930\# / 2 + 13210\# / 4 = 6710\# \times 0.6 = 4060\#$

$F_{\text{1ST}} = 13210\# / 4 + 4630\# / 4 = 4460\# \times 0.6 = 2680\#$   
 $(\Sigma 6290\#)$   
 $(\Sigma 8970\#)$   
 LT 2  
 1-6

Table 27.5-1

$$\left(\frac{19.6 + 16.9}{2}\right) \times 2.25 \times 2.5 \times 35 = 359 \times 1.38 \times 0.6$$

FH 27.5-2

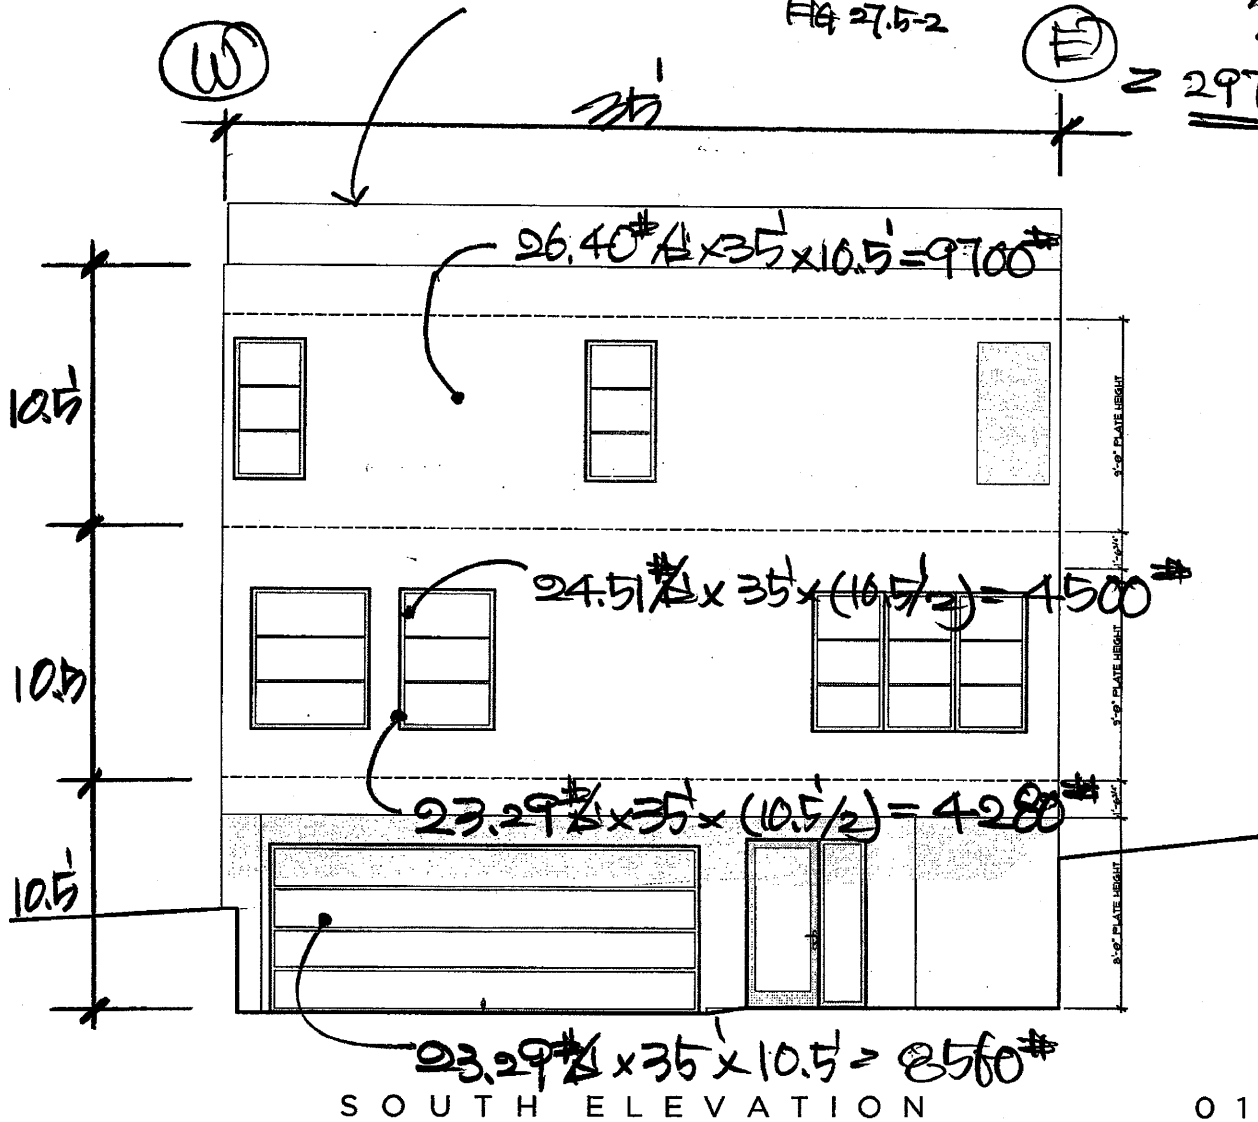

01

SCALE: 1/4" = 1'-0"

FRID (E) & (W):




$$F_{FRID} = 9700/4 = 2425 \times 0.6 = 1455 + 2910/2 = 2940$$

$$F_{SND} = 9700/4 + 4500/2 = 4675 \times 0.6 = 2805 \quad (\Sigma 5745)$$

$$F_{ST} = 4280/4 + 8560/4 = 3220 \times 0.6 = 1932 \quad (\Sigma 7670)$$

00521 L3-L7

DIXIE EXEM:

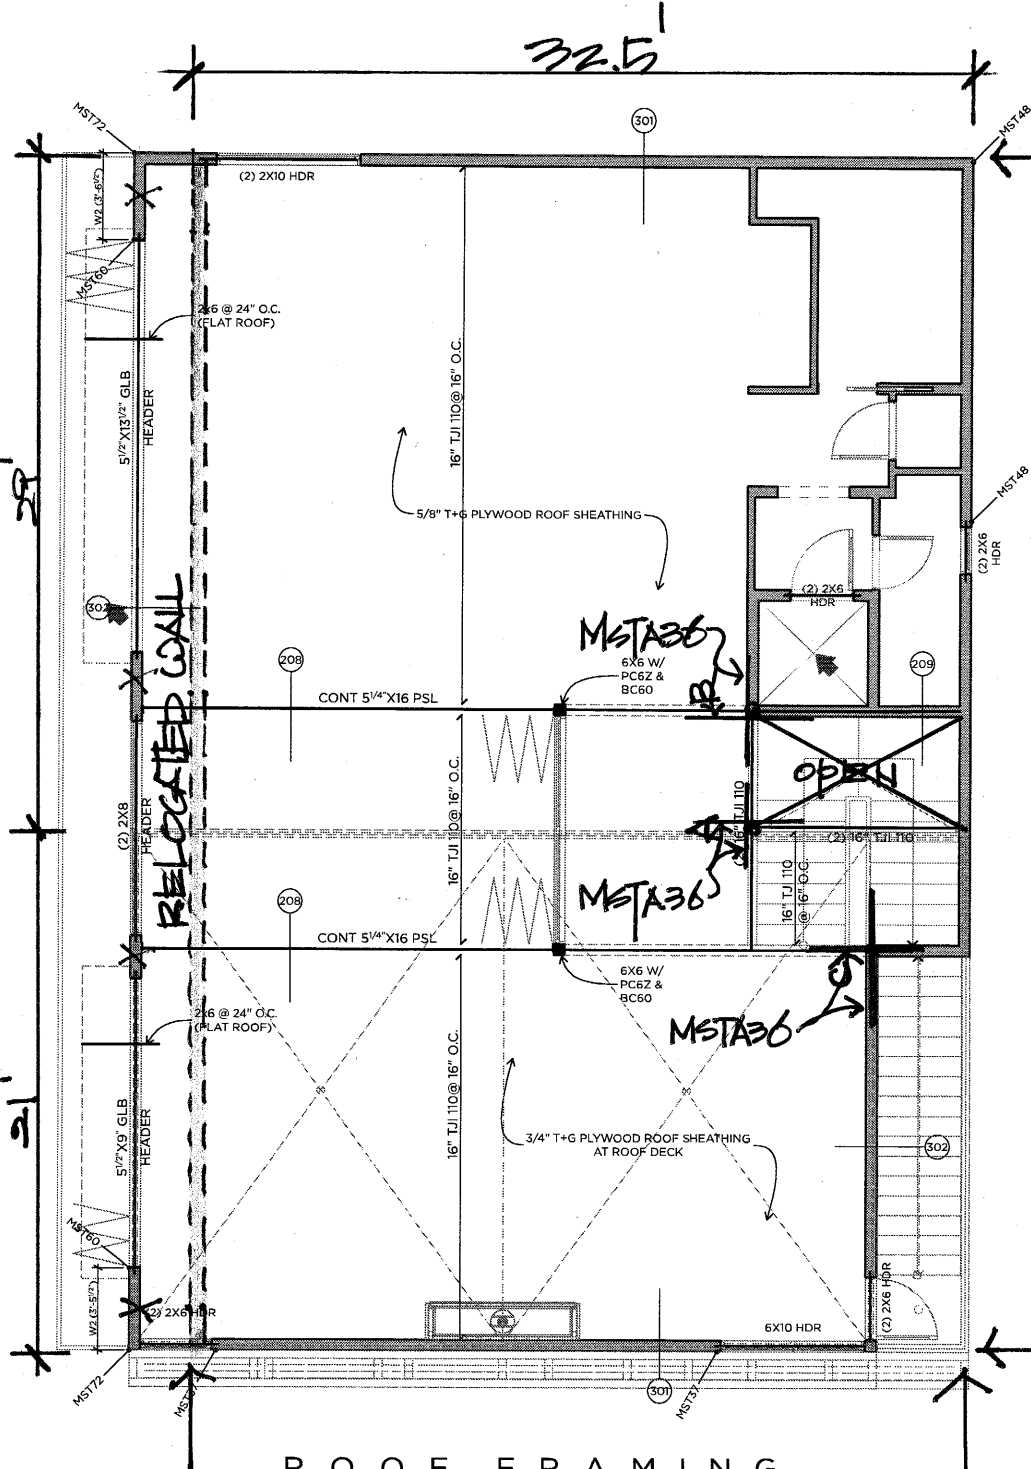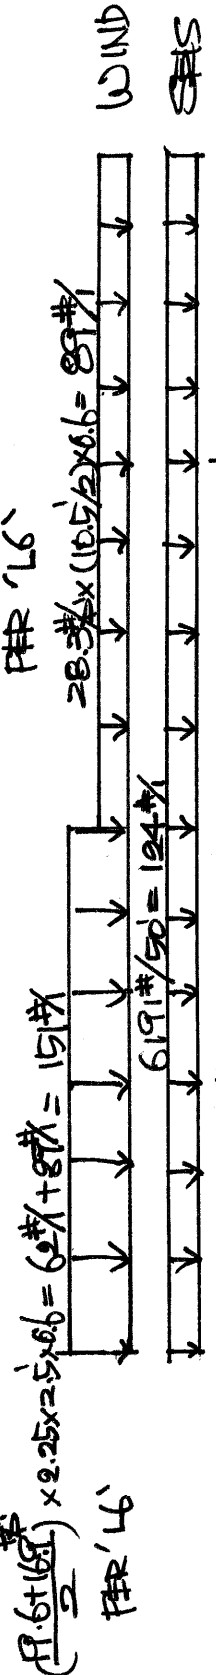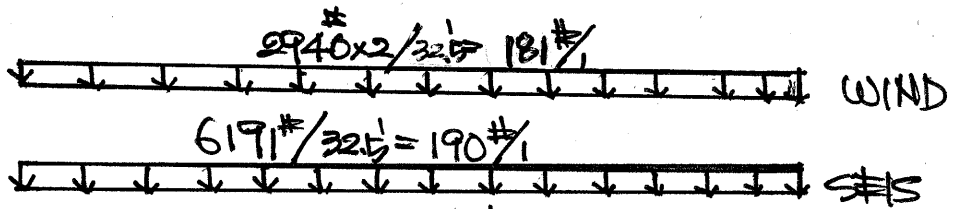

$F = 2500$   
 $V = 3100$

$F = 3250$   
 $V = 3100$

$F = 2940$   
 $V = 3090$

$F = 2940$   
 $V = 3090$


ROOF FRAMING

SCALE: 1/4" = 1'-0"

DIAPHRAGM:

- V: SWS
- F: WIND

$W_{SWS} = 5082 / 35 = 145 \#$   
 $W_{WIND} = 2805 \times 2 / 35 = 160.3 \#$

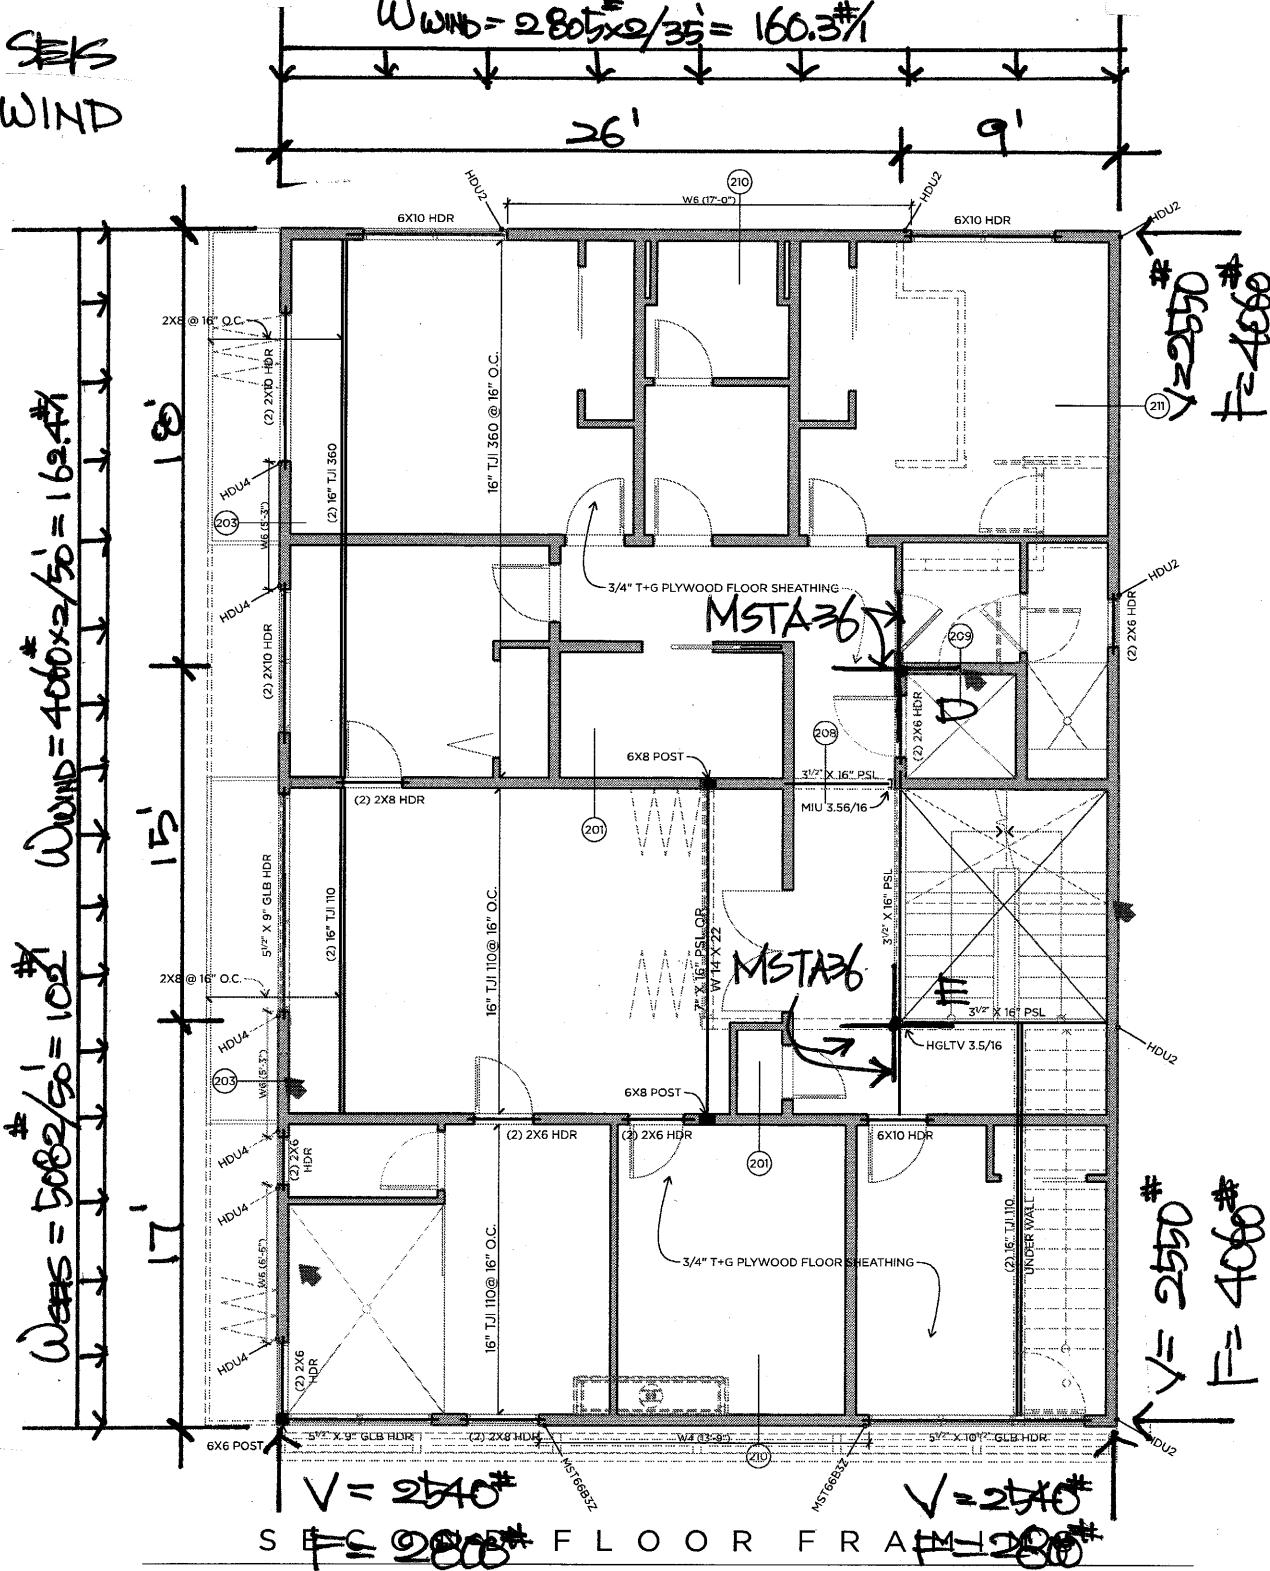

$W_{SWS} = 5082 / 50 = 102 \#$   
 $W_{WIND} = 4060 \times 2 / 50 = 162.4 \#$

$V = 2550 \#$   
 $F = 4060 \#$

$V = 2550 \#$   
 $F = 4060 \#$

$V = 2540 \#$   
 $F = 2800 \#$


**S E C 200 FLOOR FRAM 200**

SCALE: 1/4" = 1'-0"

DIAPHRAGM


$$W_{WIND} = 3020 \# / 35' = 86.3 \# / 1 \text{ (6.5/5)} = 112 \# / 1$$

$$W_{WIND} = 1925 \# / 35' = 55 \# / 1 \times 2 = 110 \# / 1$$

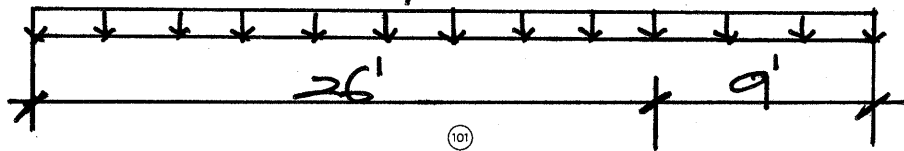

$$W_{WIND} = 3020 \# / 50' \text{ (6.5/5)} = 78.5 \# / 1$$

$$W_{WIND} = 2680 \# / 50' \times 2 = 107.2 \# / 1$$

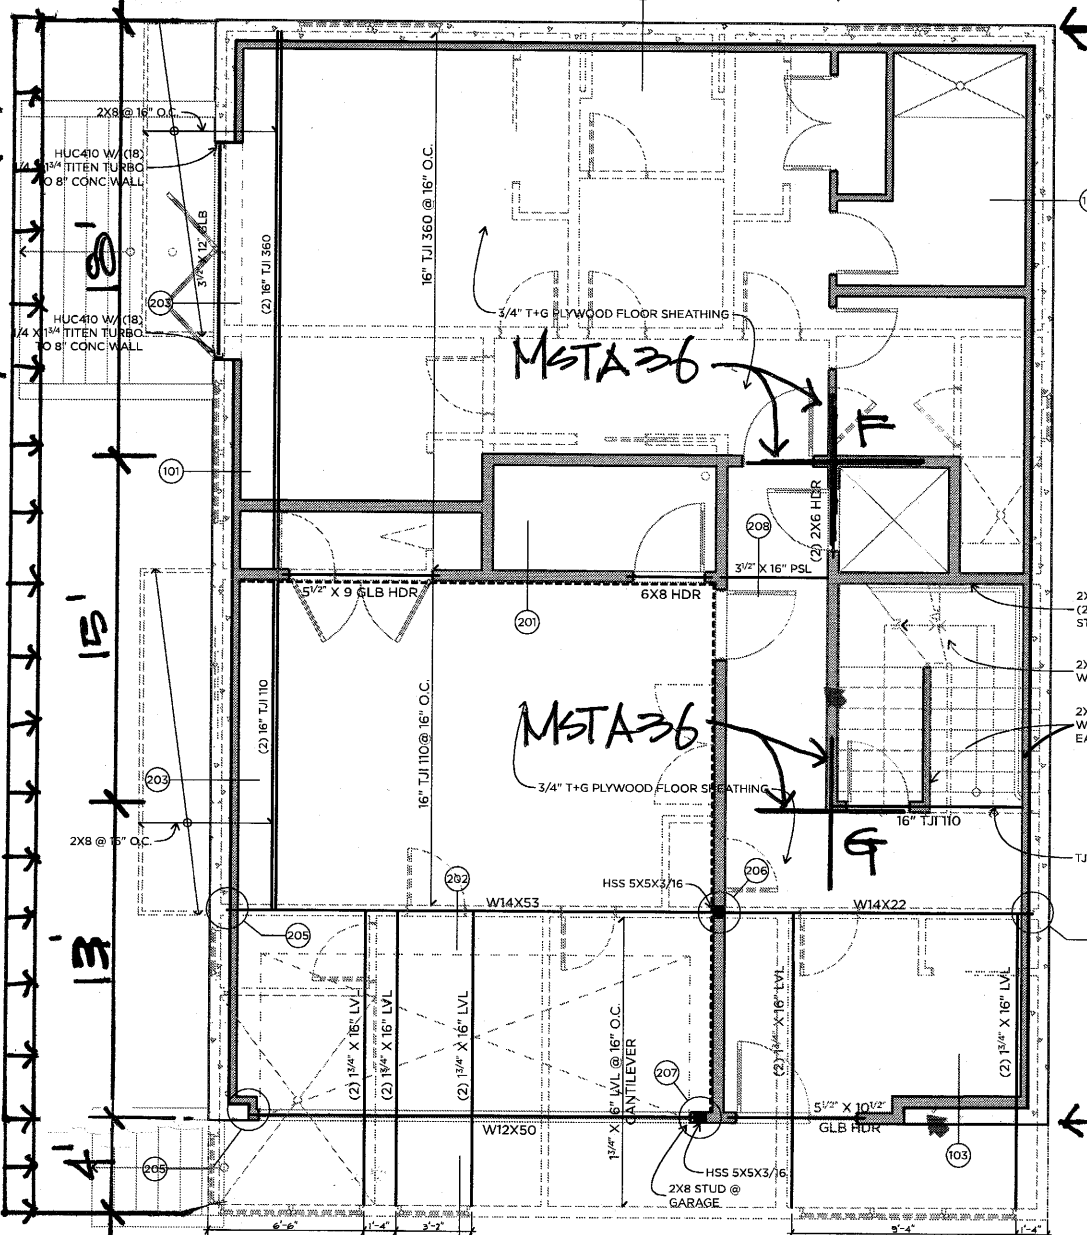

$$V = 1805 \#$$

$$F = 2470 \#$$

$$V = 2120 \#$$

$$F = 2895 \#$$

$$V = 1960 \#$$

$$F = 1925 \#$$

$$V = 1960 \#$$

$$F = 1925 \#$$

FIRST FLOOR FRAMING

SCALE: 1/4" = 1'-0"

## E-W DIRECTION:

- @ A:  $F = (3250 \times 22' - 151 \times \frac{22^2}{2}) / 235' = 1490 \#$   
 $V = (3100 \times 22' - 124 \times \frac{22^2}{2}) / 235' = 1630 \#$
- @ B:  $F = (2500 \times 23' - 89 \times \frac{23^2}{2}) / 226' = 1450 \#$   
 $V = (3100 \times 23' - 124 \times \frac{23^2}{2}) / 225' = 1640 \#$
- @ C:  $F = (2250 \times 17' - 151 \times \frac{17^2}{2}) / 28.5' = 1170 \#$   
 $V = (3100 \times 17' - 124 \times \frac{17^2}{2}) / 28.5' = 1220 \#$

## N-S DIRECTION:

- @ A:  $F = (2940 \times 9' - 181 \times \frac{9^2}{2}) / 22' = 870 \#$   
 $V = (3090 \times 9' - 190 \times \frac{9^2}{2}) / 22' = 910 \#$
- @ B:  $F = \quad (1) / 23' = 830 \#$   
 $V = \quad (1) / 23' = 880 \#$
- @ C:  $F = (2940 \times 4' - 181 \times \frac{4^2}{2}) / 17' = 610 \#$   
 $V = (3090 \times 4' - 190 \times \frac{4^2}{2}) / 17' = 640 \#$

## 'MSTAS6' (2050#) STRAP:

(~~BETWEEN~~ ~~FOR~~ STRUCTURAL MEMBERS)  
OF 1 1/2" RIM BOARD



## E-W DIRECTION:

$$\textcircled{a} \text{ D: } F = (4060 \times 18' - 162.4 \times \frac{18^2}{2}) / 26' = 1800 \#$$

$$V = (2550 \times 18' - 102 \times \frac{18^2}{2}) / 26' = 1130 \#$$

$$\textcircled{a} \text{ E: } F = (4060 \times 17' - 162.4 \times \frac{17^2}{2}) / 26' = 1750 \#$$

$$V = (2550 \times 17' - 102 \times \frac{17^2}{2}) / 26' = 1100 \#$$

$$T = C_{\text{CRITICAL}} = 162.4 \times 50' / (8 \times 26) = 1952 \#$$

$$\textcircled{a} - 2 \times 6 : 625 \times 1.5 \times 5.5 \times 2 \times \frac{1.6}{100} = 16500 \# \text{ O.K.}$$

## N-S DIRECTION:

$$\textcircled{a} \text{ D: } F = (2800 \times 9' - 160.3 \times \frac{9^2}{2}) / 18' = 1040 \#$$

$$V = (2540 \times 9' - 145 \times \frac{9^2}{2}) / 18' = 940 \#$$

$$\textcircled{a} \text{ E: } F = (2800 \times 9' - 160.3 \times \frac{9^2}{2}) / 17' = 1100 \#$$

$$V = (2540 \times 9' - 145 \times \frac{9^2}{2}) / 17' = 1000 \#$$

'MST X 36' (2060#) STAIR:

(BETWEEN 2ND FLOOR STRUCTURAL MEMBERS & 1 1/2" RIM BOARD)

## E-W DIRECTION:

$$\textcircled{C} F : F = (2470^{\#} \times 18' - 107.2^{\#} \times \frac{18^2}{2}) / 26' = 1040^{\#}$$
$$V = (1805^{\#} \times 18' - 78.5^{\#} \times \frac{18^2}{2}) / 26' = 760^{\#}$$

$$\textcircled{C} G : F = (2470^{\#} \times 33' - 107.2^{\#} \times \frac{33^2}{2}) / 26' = 890^{\#}$$
$$V = (1805^{\#} \times 33' - 78.5^{\#} \times \frac{33^2}{2}) / 26' = 650^{\#}$$

$$\cdot FC = 107.2^{\#} \times 50' / (8' \times 26') = 1290^{\#}$$

CRITICAL

$$\textcircled{2} \rightarrow \times 6 : 625 \times 1.5'' \times 5.5'' \times 2 \times 1.6' = 16500^{\#}$$

## N-S DIRECTION:

$$\textcircled{C} F : F = (1925^{\#} \times 9' - 110^{\#} \times \frac{9^2}{2}) / 18' = 720^{\#}$$
$$V = (1960^{\#} \times 9' - 112^{\#} \times \frac{9^2}{2}) / 18' = 730^{\#}$$

$$\textcircled{C} G : F = (1925^{\#} \times 9' - 110^{\#} \times \frac{9^2}{2}) / 17' = 760^{\#}$$
$$V = (1960^{\#} \times 9' - 112^{\#} \times \frac{9^2}{2}) / 17' = 770^{\#}$$

'MSTA 36' (2050<sup>#</sup>) STRAP:

(~~BETWEEN~~ 1ST FLOOR STRUCTURAL MEMBERS & 1/2" RIM BOARD)

Reliability/Redundancy Factor: SEISMIC

Use R.F. = 1.00  $S_{DS} = 0.943$

$0.6D + 0.6W$  (Eq. 16-15)  
 $0.6D + 0.7E$  (Eq. 16-16) &  $E = Q_E - 0.2 S_{DS} D$   
 $\rightarrow 0.47 D + 0.7 Q_E$

SEISMIC:

@ Grid 'N': Roof : V = 3070 #

L = 26.5'

$V_{wall} = 3070$  lb.

$V_{wall}' = 3070$  lb ( $V_{wall} \times R.F.$ )

L = 26.50 ft.

H = 10.50 ft.

$V_{shear} = 116$  plf < TYP

T=C= 1240 lb.

@ Grid 'N': Roof : F = 2230 #

L = 26.5'

$F_{wall} = 2230$  lb.

L = 26.50 ft.

H = 10.50 ft.

$V_{shear} = 84$  plf < TYP

T=C= 901 lb.

$RES: [25\#(23\frac{1}{2}) + 60\#] (26\frac{1}{2}) = 4600 \times 0.47 = 2162\# > 1240\#$   
 $\times 0.60 = 2760\# > 910\#$

NO UPLIFT

SEISMIC:

@ Grid 'N': 2nd Fir : V = 4330 #

L = 17'

$V_{wall} = 4330$  lb.

$V_{wall}' = 4330$  lb ( $V_{wall} \times R.F.$ )

L = 17.00 ft.

H = 10.50 ft.

$V_{shear} = 255$  plf

T=C= 2755 lb.

WIND:

@ Grid 'N': 2nd Fir : F = 6290 #

L = 17'

$F_{wall} = 6290$  lb.

L = 17.00 ft.

H = 10.50 ft.

$V_{shear} = 370$  plf

T=C= 4003 lb.

SEISMIC:

@ Grid 'N': 1st Fir : V = 5840 #

L = 35' (8" Concrete Shearwall)

WIND:

@ Grid 'N': 1st Fir : F = 8970 #

L = 35' (8" Concrete Shearwall)

SEISMIC:

@ Grid 'S': Roof: V = 3070 #  
L = 18'

V<sub>wall</sub> = 3070 lb.  
V<sub>wall</sub>' = 3070 lb (V<sub>wall</sub> x R.F.)  
L = 18.00 ft.  
H = 10.50 ft.

V<sub>shear</sub> = 171 plf < TYP  
T=C= 1842 lb.

RES:  $[207 \times (1/2) + 60 \times 1] (10/2) = 1960 \times 0.47 = 930 \#$   
 $\times 0.60 = 1180$   
T<sub>NET</sub> = 912 #  
T<sub>NET</sub> = 1224 #

JAN 25, 2023

'MST37'  
(1720 #)

WIND:

@ Grid 'S': Roof: F = 4020 #  
L = 18'

F<sub>wall</sub> = 4020 lb.  
L = 18.00 ft.  
H = 10.50 ft.  
V<sub>shear</sub> = 223 plf < TYP  
T=C= 2412 lb.

SEISMIC:

@ Grid 'S': 2nd Fir: V = 4330 #  
L = 13.75'

V<sub>wall</sub> = 4330 lb.  
V<sub>wall</sub>' = 4330 lb (V<sub>wall</sub> x R.F.)  
L = 13.75 ft.  
H = 10.50 ft.

V<sub>shear</sub> = 315 plf  
T=C= 3431 lb.

WIND:

@ Grid 'S': 2nd Fir: F = 8080 #  
L = 13.75'

F<sub>wall</sub> = 8080 lb.  
L = 13.75 ft.  
H = 10.50 ft.  
V<sub>shear</sub> = 588 plf  
T=C= 6403 lb.

JAN 25, 2023

SEISMIC:

@ Grid 'S': 1st Fir: V = 6920 #  
L = 6' (8" Concrete Shearwall)

MIN. CHANGE TO \* 10(60 # / 35) = 307 # / 9'-5"

930 x 1.6 / 307 # = 4.84 o.c (MAX) > 1.33  
TABLE 12E CP

MIN. CHANGE TO 9'-5"

16" o.c.

60000 →  $\frac{3fy A_{ps}}{50 \lambda \sqrt{A_c}} \leq 1.0$  ← 3000


\*  $d_b \leq 4" \text{ MIN.}$

•  $F_{WIND_u} = 10.76 \text{ k} / 0.6 = 17.93 \text{ k} \times 2 = 35.9 \text{ k} \rightarrow \Omega$

•  $V_u = 9 \text{ k} / 0.7 = 12.9 \text{ k} \times 2 = 25.8 \text{ k} \rightarrow \Omega$

•  $A_{ps} = 35.9 \text{ k} / (0.9 \times 60) = 0.66 \text{ in}^2$

(6) - #5 x 4'-0" (1.86 in<sup>2</sup>)

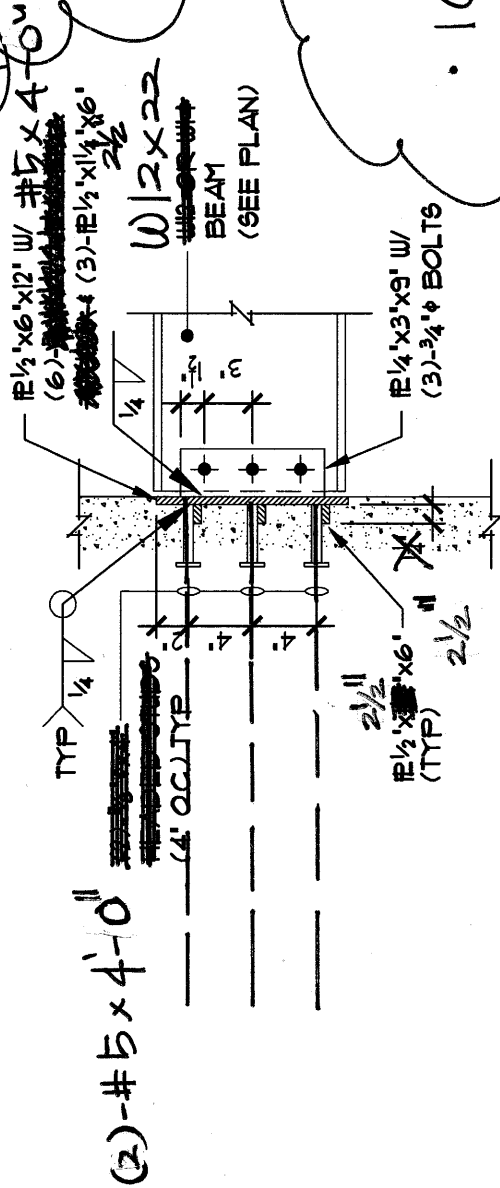

•  $10.76 \text{ k} \times 2 / 7.51 = 2.9 < 3$  (3/4" BOLTS PROVIDED)

**DETAIL**  
SCALE: 1" = 1'-0"

205

20

# Concrete Shear Wall

Project File: ENERCALC\_20

LIC# : KW-06015335, Build:20.22.12.28

D.S. ENGINEERING PC

(c) ENERCALC INC 1983-2022

**DESCRIPTION:** Concrete Shear Wall (South)

## Code References

Calculations per ACI 318-14, IBC 2018, CBC 2019, ASCE 7-16


Load Combinations Used : IBC 2018

## General Information

Wall Material CONCRETE		Material Properties			
Sds	0.9430	fc	3.0 ksi	Ec	3,120.0 ksi
		fy	60.0 ksi	Ev	1,248.0 ksi
		Density	150.0 pcf	Phi - Shear	0.650

## Wall Data

	Bottom
Analysis Height	0.00 ft
Wall Offset (datum)	ft
Wall Length	9.333 ft
Wall Thickness	8.0 in
Structural Depth	8.833 ft

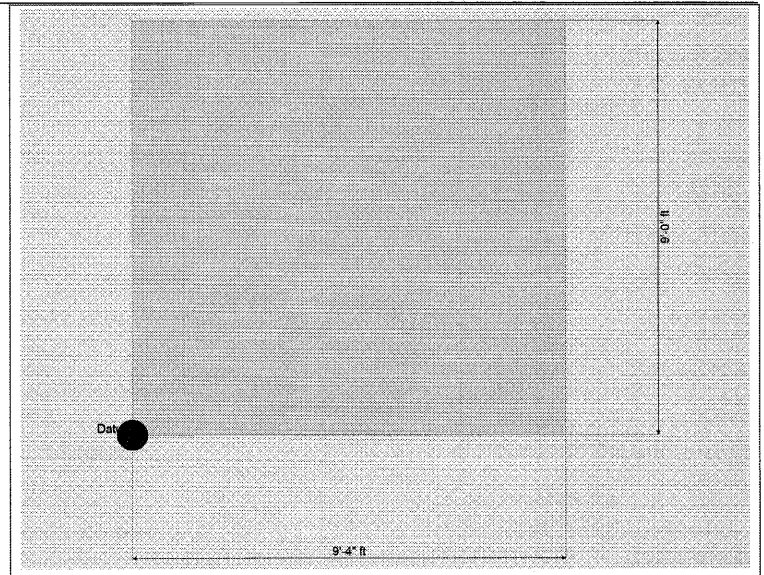

## Applied Concentrated Vertical Loads

Load Location (ft)		Load Magnitude (kips)				
X Location	Y Location	Dead Load	Roof Live Load	Live Load	Snow Load	Earth Load
0.0	9.0	4.387	0.0	8.064	1.652	0.0

## Applied Distributed Vertical Loads

Load Location (ft)			Load Magnitude (kips)				
Start Location	End Location	Height of Application	Dead Load	Roof Live Load	Live Load	Snow Load	Earth Load
0.0	6.0	9.0	0.710	0.0	1.510	0.320	0.0

## Applied Concentrated Lateral Loads

Load "Y" Location (ft)	Load Magnitude (kips)					
	Dead Load	Roof Live Load	Floor Live Load	Wind Load	Seismic Load	Earth Load
9.0	0.0	0.0	0.0	10.760	9.0	0.0

# Concrete Shear Wall

Project File: ENERCALC\_20

LIC#: KW-06015335, Build:20.22.12.28

D.S. ENGINEERING PC

(c) ENERCALC INC 1983-2022

**DESCRIPTION:** Concrete Shear Wall (South)

## DESIGN SUMMARY

### Bottom Level

Vu : Story Shear 10.760 +1.20D+0.50L+  
 Mu : Story Moment 122.906 +1.20D+1.60L+  
 Nu : Axial 49.640 +1.20D+1.60L+  
 Uplift @ Left End 5.667 +0.90D+W  
 Uplift @ Right End 5.667 +0.90D+W

Phi \* 10 \* sqrt(fc)\*h\*d301.893 k  
 Phi \* Vc 60.379 k  
 Phi \* Vs Req'd 0.0 k  
 Horizontal As Req'd 0.1920 in^2  
 Vertical As Req'd 0.240 in^2  
 Bending As Req'd 1.526 in^2

## Force Summary

Load Combination Wall Level	Values for Wall section			Resultant Ecc (ft)	Overturning Ratio	Uplift (k)	
	Vu (k)	Mu (k)	Pu (k)			Left	Right
+1.40D							
Wall Level : 1		38.600	23.865	1.617			
+1.20D+1.60L							
Wall Level : 1		117.452	47.854	2.454			
+1.20D+1.60L+0.50S							
Wall Level : 1		122.906	49.640	2.476			
+1.20D+0.50L							
Wall Level : 1		59.450	29.018	2.049			
+1.20D+0.50W							
Wall Level : 1	5.380	15.335	20.456	0.750	2.655		
+1.20D+0.50L+1.60S							
Wall Level : 1		76.904	34.733	2.214			
+1.20D+1.60S+0.50W							
Wall Level : 1	5.380	2.119	26.171	0.081	3.566		
+1.20D+0.50L+W							
Wall Level : 1	10.760	37.390	29.018	1.289	2.012	2.364	2.364
+1.20D+0.50L+0.50S+W							
Wall Level : 1	10.760	31.936	30.804	1.037	2.155	2.038	2.038
+1.20D+0.50L+0.70S+E							
Wall Level : 1	9.000	13.914	31.518	0.441	2.644	0.114	0.114
+0.90D+W							
Wall Level : 1	10.760	72.026	15.342	4.695	0.996	5.667	5.667
+0.90D+E							
Wall Level : 1	9.000	56.186	15.342	3.662	1.190	3.874	3.874

# Concrete Shear Wall

Project File: ENERCALC\_20

LIC# : KW-06015335, Build:20.22.12.28

D.S. ENGINEERING PC

(c) ENERCALC INC 1983-2022

**DESCRIPTION:** Concrete Shear Wall (South)

## Footing Information

### Footing Dimensions

Dist. Left	4.0 ft	fc	3.0 ksi	Rebar Cover	3.0 in
Wall Length	9.333 ft	Fy	60.0 ksi	Footing Thickness	18.0 in
Dist. Right	0.0 ft			Width	4.0 ft
Total Ftg Length	13.333 ft				

### Max Factored Soil Pressures

@ Left Side of Footing	1,514.16 psf
.... governing load comb	+1.20D+1.60L+0.50S
@ Right Side of Footing	2,385.84 psf
.... governing load comb	+0.90D+W

### Max UNfactored Soil Pressures

@ Left Side of Footing	1,007.84 psf
.... governing load comb	D+L
@ Right Side of Footing	1,253.03 psf
.... governing load comb	D+0.750L+0.750S+0.450W

### Footing One-Way Shear Check...

vu @ Left End of Footing	26.674 psi
vu @ Right End of Footing	0.0 psi
vn * phi : Allowable	93.113 psi

### Overturning Stability...

	@ Left End of Ftg	@ Right End of Ftg
Overturning Moment	66.528 k-ft	66.528 k-ft
Resisting Moment	163.774 k-ft	135.788 k-ft
Stability Ratio	2.462 : 1	2.041 : 1
.... governing load comb	+0.60D+0.70E	+0.60D+0.70E

### Footing Bending Design...

	@ Left End	@ Right End
Mu	47.519 k-ft	0.0 k-ft
Ru	58.666 psi	0.0 psi
As % Req'd	0.00180 in^2	0.00180 in^2
As Req'd in Footing Width	1.555 in^2	1.555 in^2

$$1.555 / 0.31 = 5$$

Mu  
#5  
BAR




1'-6" MIN

4'-0" MIN

9'-0"

WEST ELEV.

FEB 6, 2023

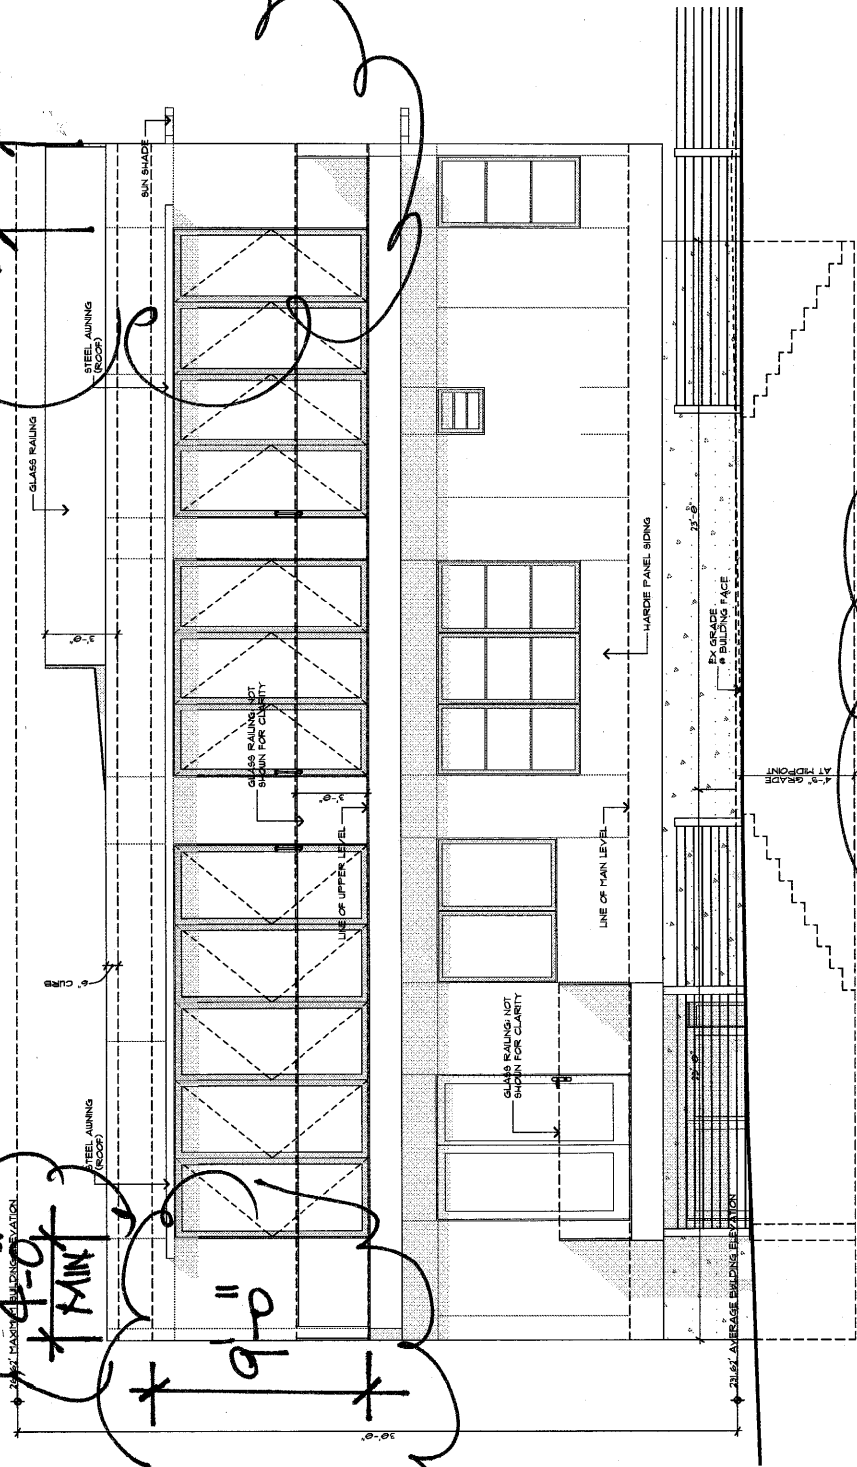

FEB-6, 2023

**SEISMIC:**

@ Grid 'W': Roof: V = 3070 #  
L = 3.5' + 4'

V<sub>wall</sub> = 1433 lb.

V<sub>wall</sub>' = 1433 lb (V<sub>wall</sub> x R.F.)

L = 3.50 ft.

H = 9.00 ft.

V<sub>shear</sub> = 409 plf < W3

T=C= 4299 lb.

**WIND:**

@ Grid 'W': Roof: F = 2940 #  
L = 3.5' + 4'

F<sub>wall</sub> = 1372 lb.

L = 3.50 ft.

H = 9.00 ft.

V<sub>shear</sub> = 392 plf < W3

T=C= 4116 lb.

'MST 60' (5240)  
OR 'HDU5' (5645)

V<sub>wall</sub> = 1637 lb.

V<sub>wall</sub>' = 1637 lb (V<sub>wall</sub> x

L = 4.00 ft.

H = 9.00 ft.

V<sub>shear</sub> = 409 plf < W3

T=C= 4209 lb.

**SEISMIC:**

@ Grid 'W': 2nd Flr: V = 4330 #  
L = 5.25' + 5.25' + 6.5'

V<sub>wall</sub> = 1337 lb.

V<sub>wall</sub>' = 1337 lb (V<sub>wall</sub> x R.F.)

L = 5.25 ft.

H = 10.50 ft.

V<sub>shear</sub> = 255 plf

T=C= 2955 lb.

V<sub>wall</sub> = 1656 lb.

V<sub>wall</sub>' = 1656 lb (V<sub>wall</sub> x R.F.)

L = 6.50 ft.

H = 10.50 ft.

V<sub>shear</sub> = 255 plf

T=C= 2898 lb.

W3: 600 x 2 x 3.5' / 9' = 467 # > 409 # O.K.

**WIND:**

@ Grid 'W': 2nd Flr: F = 5745 #  
L = 5.25' + 5.25' + 6.5'

F<sub>wall</sub> = 1774 lb.

L = 5.25 ft.

H = 10.50 ft.

V<sub>shear</sub> = 338 plf

T=C= 3921 lb.

F<sub>wall</sub> = 2197 lb.

L = 6.50 ft.

H = 10.50 ft.

V<sub>shear</sub> = 338 plf

T=C= 3845 lb.

5/8" x 12" LAG SCREW

447 # x 5.59" x 1.6 = 3990 #  
TABLE M  
TABLE CP

**SEISMIC:**

@ Grid 'W': 1st Flr: V = 5840 #  
L = 32' (8" Concrete Shearwall)

678 #

CALC SHEET #R4

**WIND:**

@ Grid 'W': 1st Flr: F = 7670 #  
L = 32' (8" Concrete Shearwall)

O.K.

07 / 51.0