

AVERAGE BUILDING ELEVATION			
PROPOSED RESIDENCE			
WALL	WALL SEGMENT	MIDPT. ELEV.	WALL SEGMENT X ELEV.
A	20'	84.5'	1690
B	21.5'	81'	1763
C	116.7'	81'	9452.7
D	12'	81'	972
E	116.7'	81'	9452.7
F	11'	80.5'	1368.5
G	25'	80.5'	2025
H	9.15'	81'	1946.2
I	20'	81.5'	1630
J	34.67'	84.5'	2929.6
K	12.5'	85.5'	1068.75
L	4'	85.5'	342
M	12.5'	85'	1062.5
TOTAL	212.26'		17536.53

AVERAGE BUILDING ELEVATION = $17536.53/212.26' = 82.61'$
 MAXIMUM BUILDING HEIGHT = $82.61' + 30.0' = 112.61'$
 PROPOSED BUILDING HEIGHT = 111.1'

BASEMENT FLOOR AREA CALCULATION			
WALL	LENGTH	COVERAGE	RESULT
A	16.7'	36.4%	2.8%
B	2'	33%	1%
C	18'	16.6%	3.5%
D	20'	8%	1.6%
TOTAL	47.67'		8.6%



PORTION OF EXCLUDED BASEMENT FLOOR AREA:
 $530 \text{ (ACTUAL SQ. FT. W/ GARAGE)} \times (86/47.67) = 95.61 \text{ SQ. FT.}$
 AREA OF BASEMENT EXCLUDED = $530 - 95.61 = 434.4 \text{ SQ. FT.}$

GROSS FLOOR AREA		
LOWER FLOOR W/ GARAGE	530	SQ. FT.
MAIN FLOOR W/ STAIR	1571	SQ. FT.
UPPER FLOOR W/ STAIR	1254	SQ. FT.
TOTAL	3355	SQ. FT.
BASEMENT EXCLUDED	95.61	SQ. FT.
TOTAL	3259	SQ. FT.
LOT AREA	1291	SQ. FT.
SQUARE FOOTAGE ALLOWED (45%)	3284	SQ. FT.

IMPERVIOUS SURFACE		
PROPOSED HOME W/ O.H.	1940	SQ. FT.
WATERPROOF DECK	631	SQ. FT.
FRONT PORCH	20	SQ. FT.
WALKS, DRIVE AND PATIO	629	SQ. FT.
TOTAL	3226	SQ. FT. (44.2%)
LOT AREA	1291	SQ. FT.
ALLOWABLE	3284	SQ. FT. (45%)

LOT COVERAGE		
MAIN STRUCTURE ROOF AREA	1960	SQ. FT.
DRIVEWAYS, WALK, PATIO	629	SQ. FT.
WATERPROOF DECKS	631	SQ. FT.
TOTAL	3226	SQ. FT.
LOT AREA	1291	SQ. FT.
PROPOSED LOT COVERAGE	44.2%	
SQUARE FOOTAGE ALLOWED (45%)	3284	SQ. FT.

HARDSCAPE CALC		
LOT AREA	1291	SQ. FT.
WATERPROOF DECK	284	SQ. FT.
FRONT & SIDE WALK	253	SQ. FT.
PATIO	88	SQ. FT.
ROCKERY	86	SQ. FT.
TOTAL	711	SQ. FT.
HARDSCAPE ALLOWED	12% (815 SQ. FT.)	
PROPOSED HARDSCAPE	9.1% (711 SQ. FT.)	

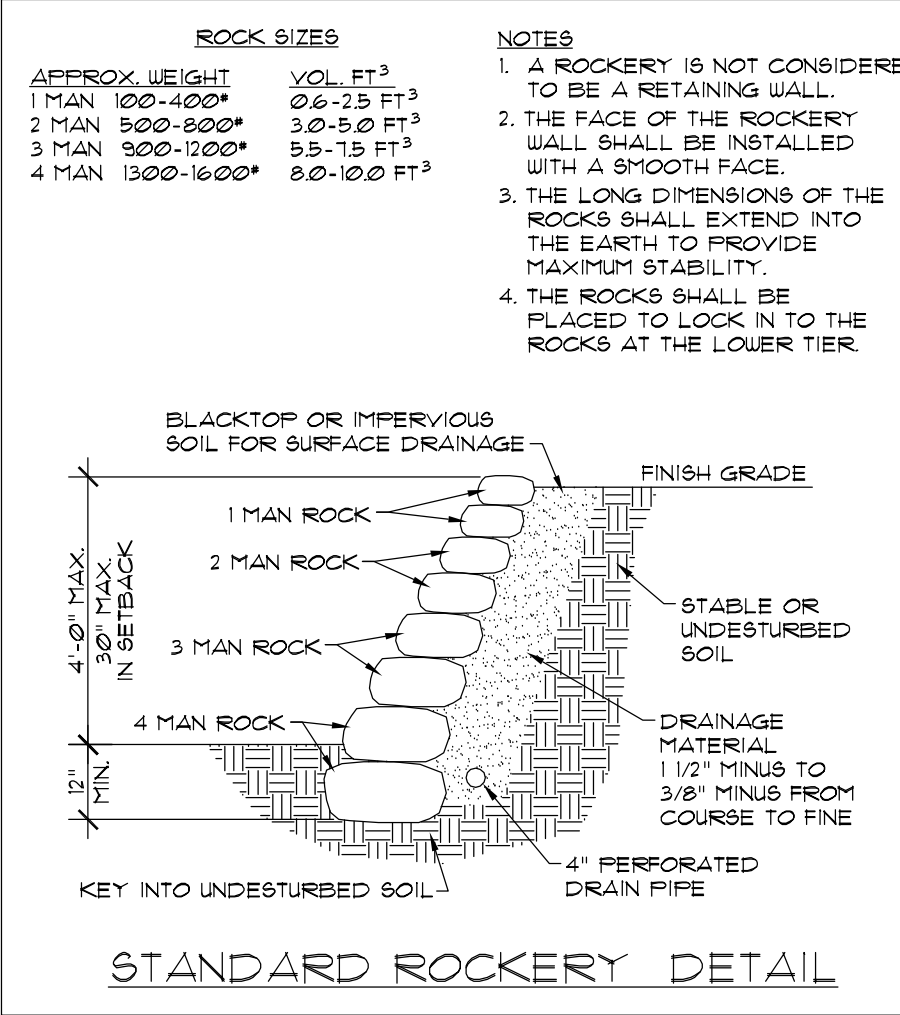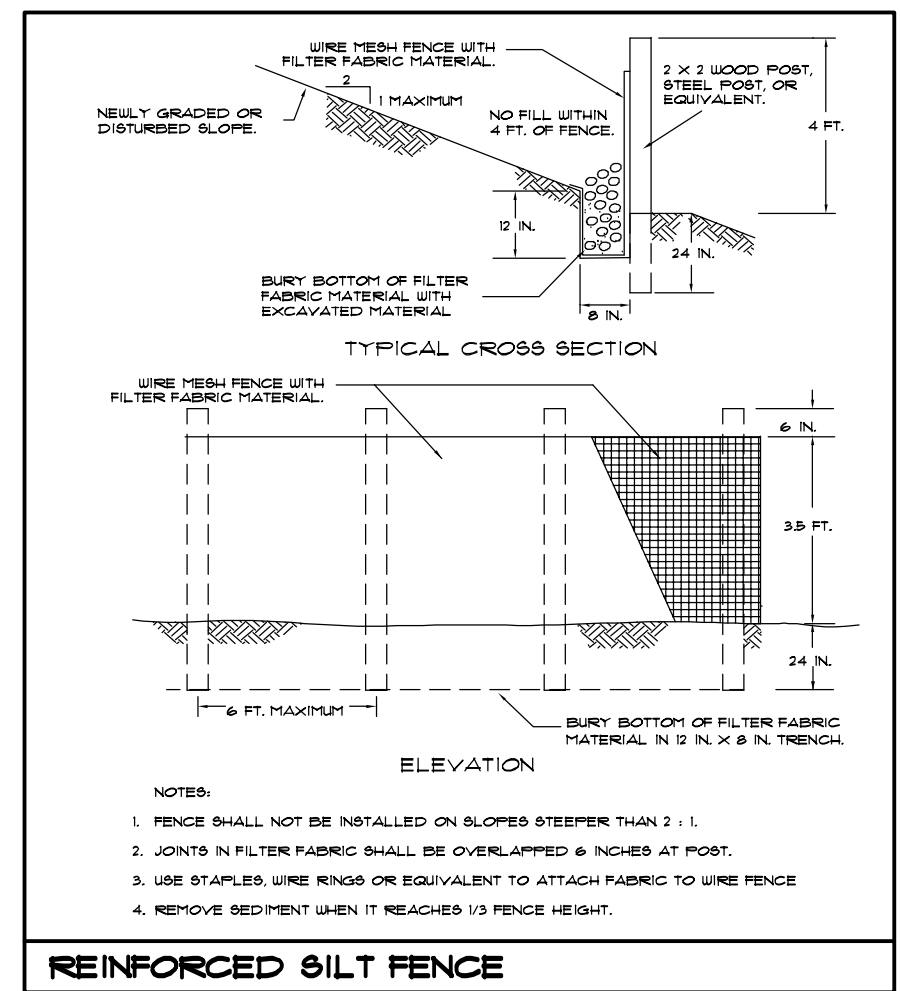

MICC 19.02.020(F)(3)(d) requires noxious weeds to be removed during new development proposals. Please add a note to the plan set that states:

"Development proposals for a new single-family home shall remove Japanese knotweed (*Polygonum cuspidatum*) and Regulated Class A, Regulated Class B, and Regulated Class C weeds identified on the King County Noxious Weed list, as amended, from required landscaping areas established pursuant to subsection 19.02.020(F)(3)(a). New landscaping associated with new single-family home shall not incorporate any weeds identified on the King County Noxious Weed list, as amended. Provided, that removal shall not be required if the removal will result in increased slope instability or risk of landslide or erosion."

Pursuant to MICC 19.02.050(D) any "...rockeries, retaining walls, fences, or any combination thereof, are limited to a maximum height of 42 inches within that portion of any required yard which lies within 20 feet of any improved street." Please indicate the height of the rock wall that falls within 20 feet of the public-right-of-way.


If the height exceeds the 42-inch height limitation you can apply for a fence height deviation pursuant to MICC 19.02.050(F).

Fence height deviation required for 4' retaining walls.

A NFPA 13D Fire Sprinkler System in compliance with NFPA 13D and CoMI standards shall be installed throughout the residence. A separate FIRE permit is required.

Note that this system requires a minimum of 1" water meter and 1" water supply line.

A NFPA 72 - Chapter 29 Monitored Fire Alarm System in compliance with NFPA 72 and CoMI standards shall be installed throughout the residence. A separate FIRE permit is required."

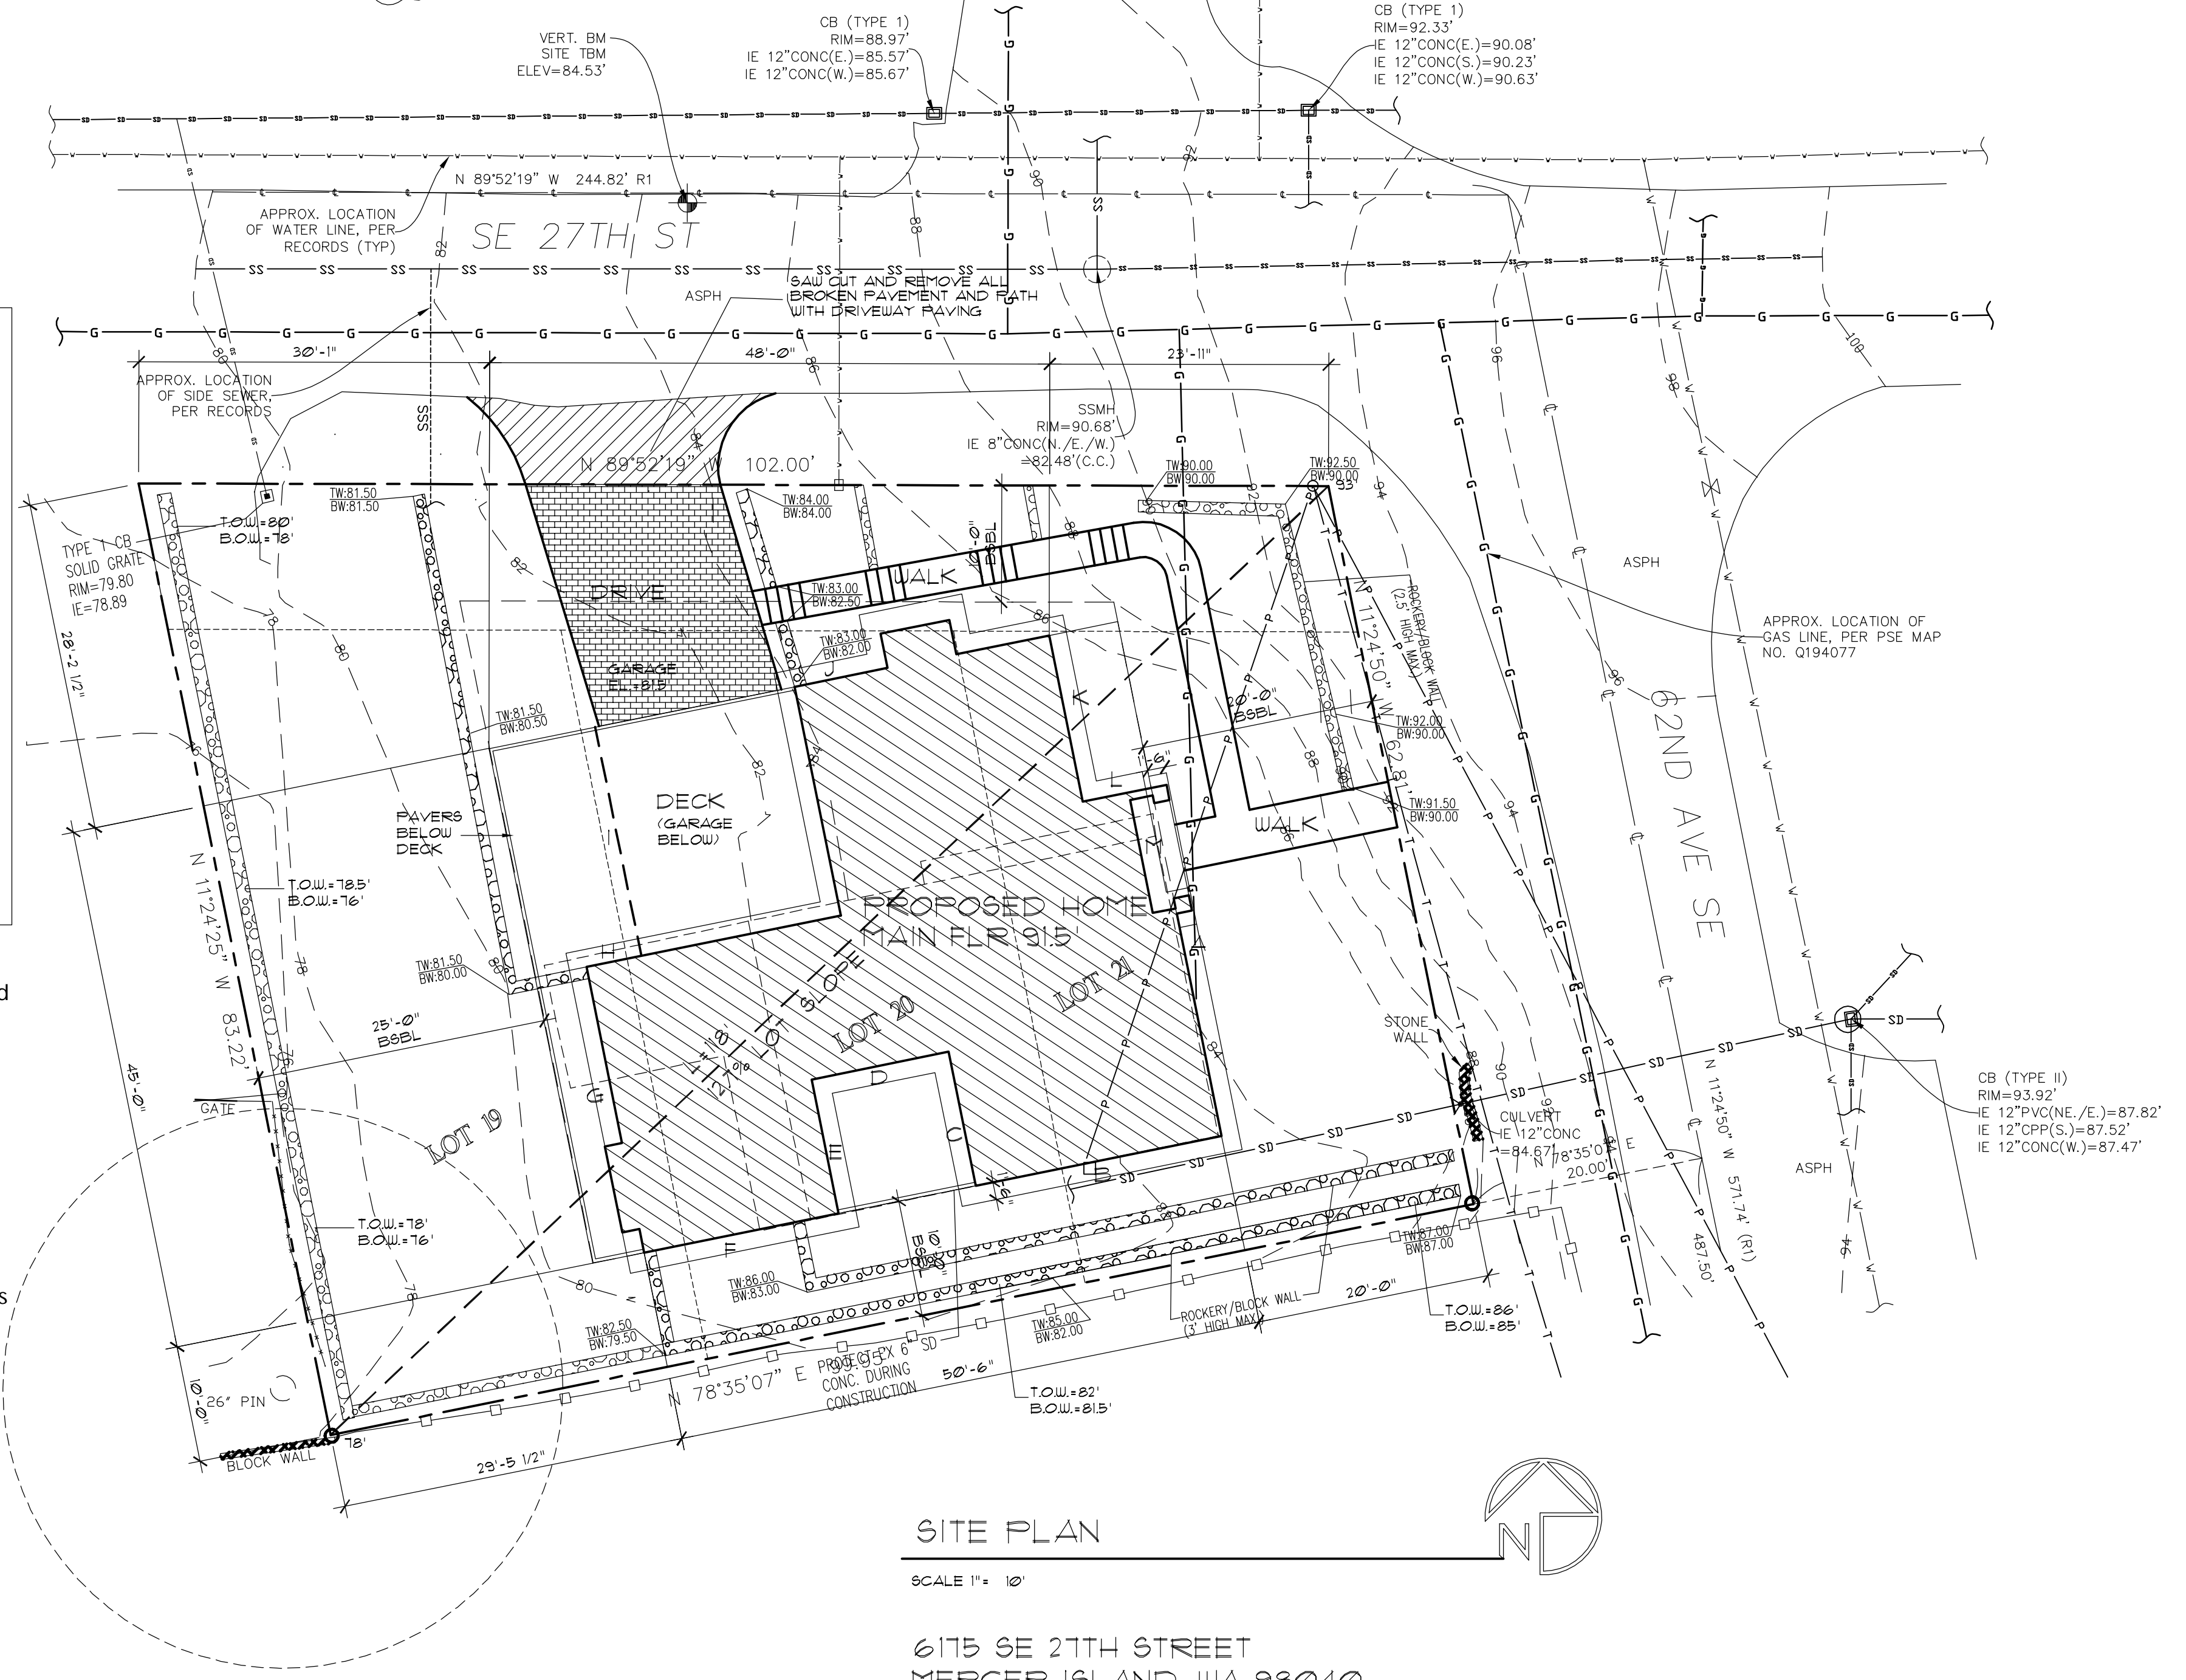

SITE PLAN

SCALE 1" = 10'

6175 SE 21TH STREET
 MERCER ISLAND, WA 98040
 PARCEL #2114503305
 ZONING: R-8.4

LEGAL:
 (PER STATUTORY WARRANTY DEED RECORDING# 2007052902539)


LOTS 19, 20 AND 21, BLOCK 19, EAST SEATTLE ADDITION TO THE CITY OF SEATTLE, ACCORDING TO THE PLAT THEREOF, RECORDED IN VOLUME 3 OF PLATS, PAGE 22 AND 23, IN KING COUNTY, WASHINGTON, TOGETHER WITH PORTION OF VACATED CABLE AVENUE 'SOUTHEAST 21TH STREET' ADJOINING ON THE NORTH.

CONTACT:
 TONY CHEN
 PH: 206-412-3998

A NEW HOME AT:
 6175 SE 21TH STREET
 MERCER ISLAND, WA 98040

JOB NO: 23006
 DATE: 12/11/23
 DRWN. BY: TH
 REVISED:

SHEET NO.
 10

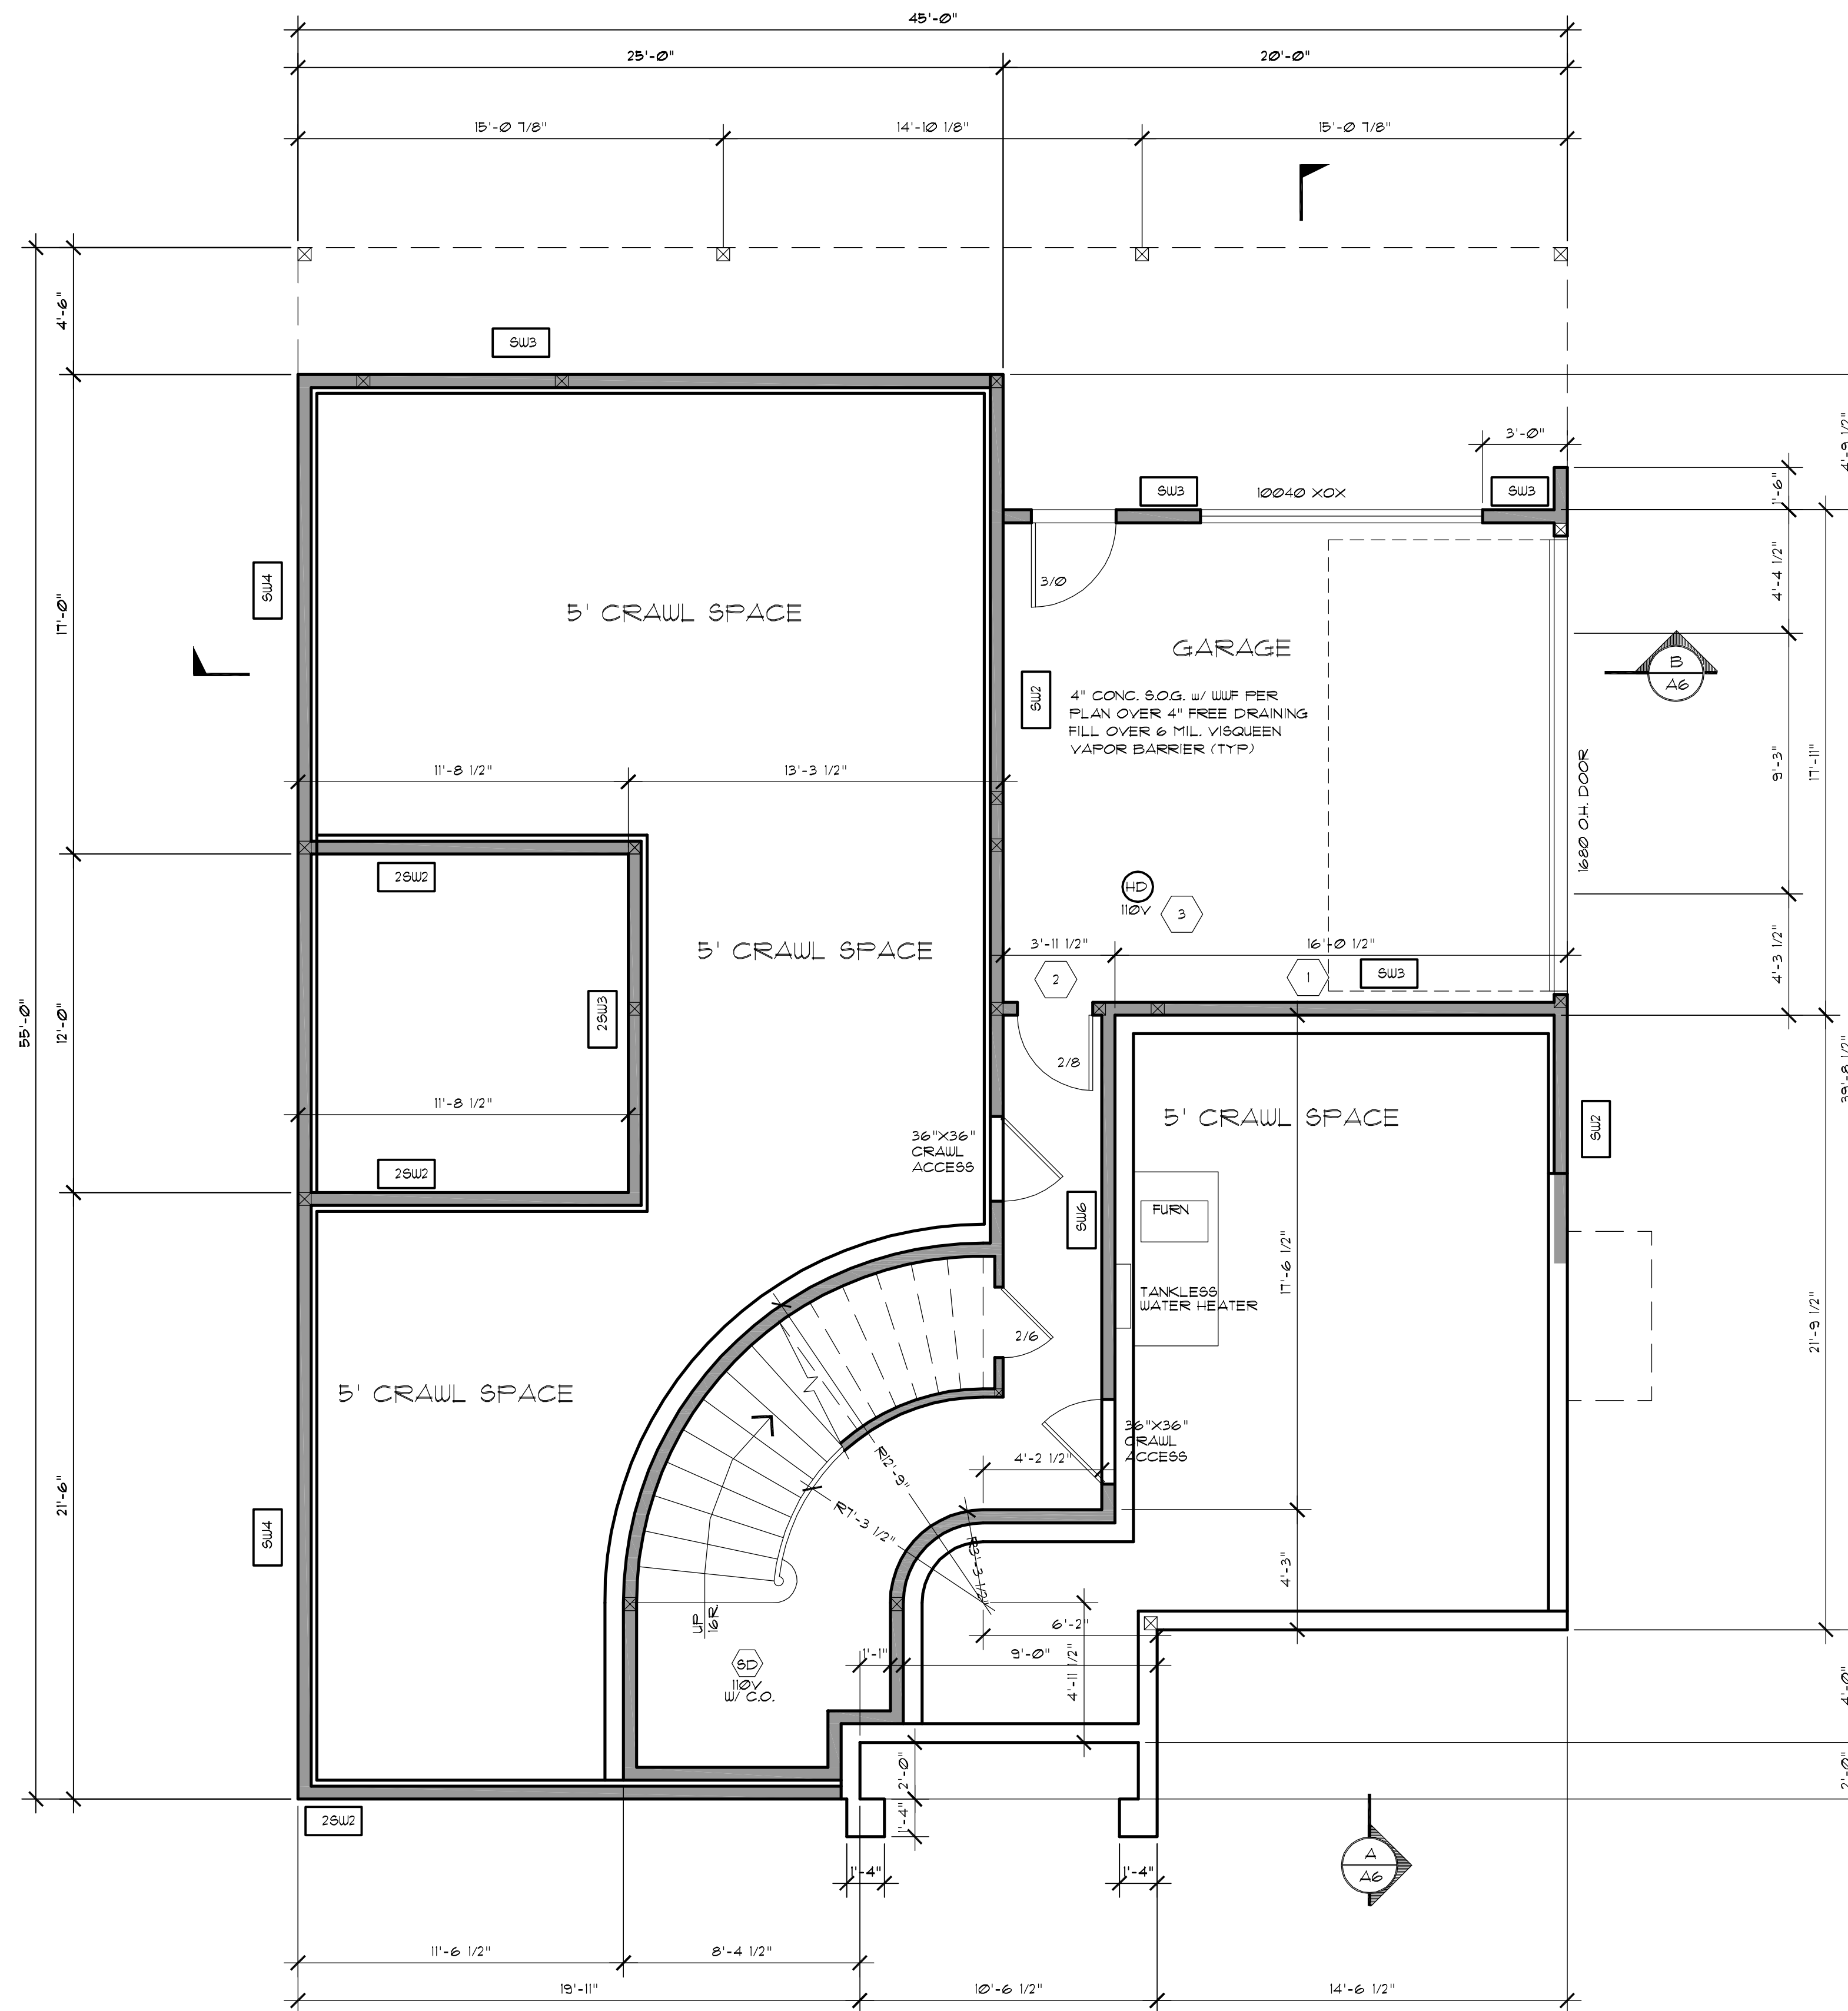

LOWER FLOOR PLAN
SCALE: 1/4" = 1' - 0"

A NFPA 72- Chapter 29 Monitored Fire Alarm System in compliance with NFPA 72 and CoMi standards shall be installed throughout the residence.

A separate FIRE permit is required.

A NFPA 13D Fire Sprinkler System in compliance with NFPA 13D and CoMi standards shall be installed throughout the residence.

A separate FIRE permit is required.

LOCAL EXHAUST FANS SHALL BE PROVIDED IN EACH KITCHEN, BATHROOM, WATER CLOSET, LAUNDRY ROOM, INDOOR SWIMMING POOL, SPA, AND OTHER ROOMS WHERE WATER VAPOR OR COOKING ODOR IS PRODUCED. IRC R507.4

NOTE: CONTRACTOR SHALL VERIFY TO INSPECTOR ALL GUARDS AND RAILINGS SHALL BE CAPABLE OF RESISTING 200 LB LOAD ON TOP RAIL IN ANY DIRECTION AS REQUIRED BY IRC TABLE 302.5

STAIR LIGHTING ALL STAIRWAYS SHALL BE PROVIDED WITH LIGHT SOURCES, LIGHT ACTIVATION CONTROLS SHALL BE ACCESSIBLE AT THE TOP AND BOTTOM OF INTERIOR STAIRWAYS AND WITHIN DWELLING UNIT FOR EXTERIOR STAIRS
IRC SECTIONS R303.1.4 R311.7.9

- 1 2018 IRC R302.6, Dwelling/garage separation required. The garage shall be separated as required by Table R302.6. Openings in garage walls shall comply with Section R302.5. This provision does not apply to garage walls that are perpendicular to the adjacent dwelling unit wall. Ceilings and beams will be covered by 5/8" Type X gypsum run perpendicular to the floor joists (see 2018 IRC Table R102.3.5 Footnote e)
- 2 Openings between the garage and residence shall be equipped with solid wood doors not less than 1-3/8-inches (35mm) in thickness, solid or honeycomb core steel doors not less than 1-3/8 inches (35mm) thick, or 20-minute fire-rated doors, equipped with a self-closing device.
- 3 R314.4 Heat detection interconnection. Heat detectors and heat alarms shall be connected to an alarm or a smoke alarm that is installed in the dwelling. Alarms and smoke alarms that are installed for this purpose shall be located in a hallway, room, or other location that will provide occupant notification.


Winder treads shall have a tread depth of not less than 10 inches measured between the vertical planes of the foremost projection of adjacent treads at the intersections with the walkline. Winder treads shall have a tread depth of not less than 6 inches at any point within the clear width of the stair. Within any flight of stairs, the largest winder tread depth at the walkline shall not exceed the smallest winder tread by more than 3/8 inch. Consistently shaped winders at the walkline shall be allowed within the same flight of stairs as rectangular treads and do not have to be within 3/8 inch of the rectangular tread depth (R311.5.2.1)

A NEW HOME AT:
6115 SE 27TH STREET
MERCER ISLAND, WA 98040

JOB NO: 23006
DATE: 12/11/23
DRAWN BY: TH
REVISED: 5/18/24

SHEET NO.

A1

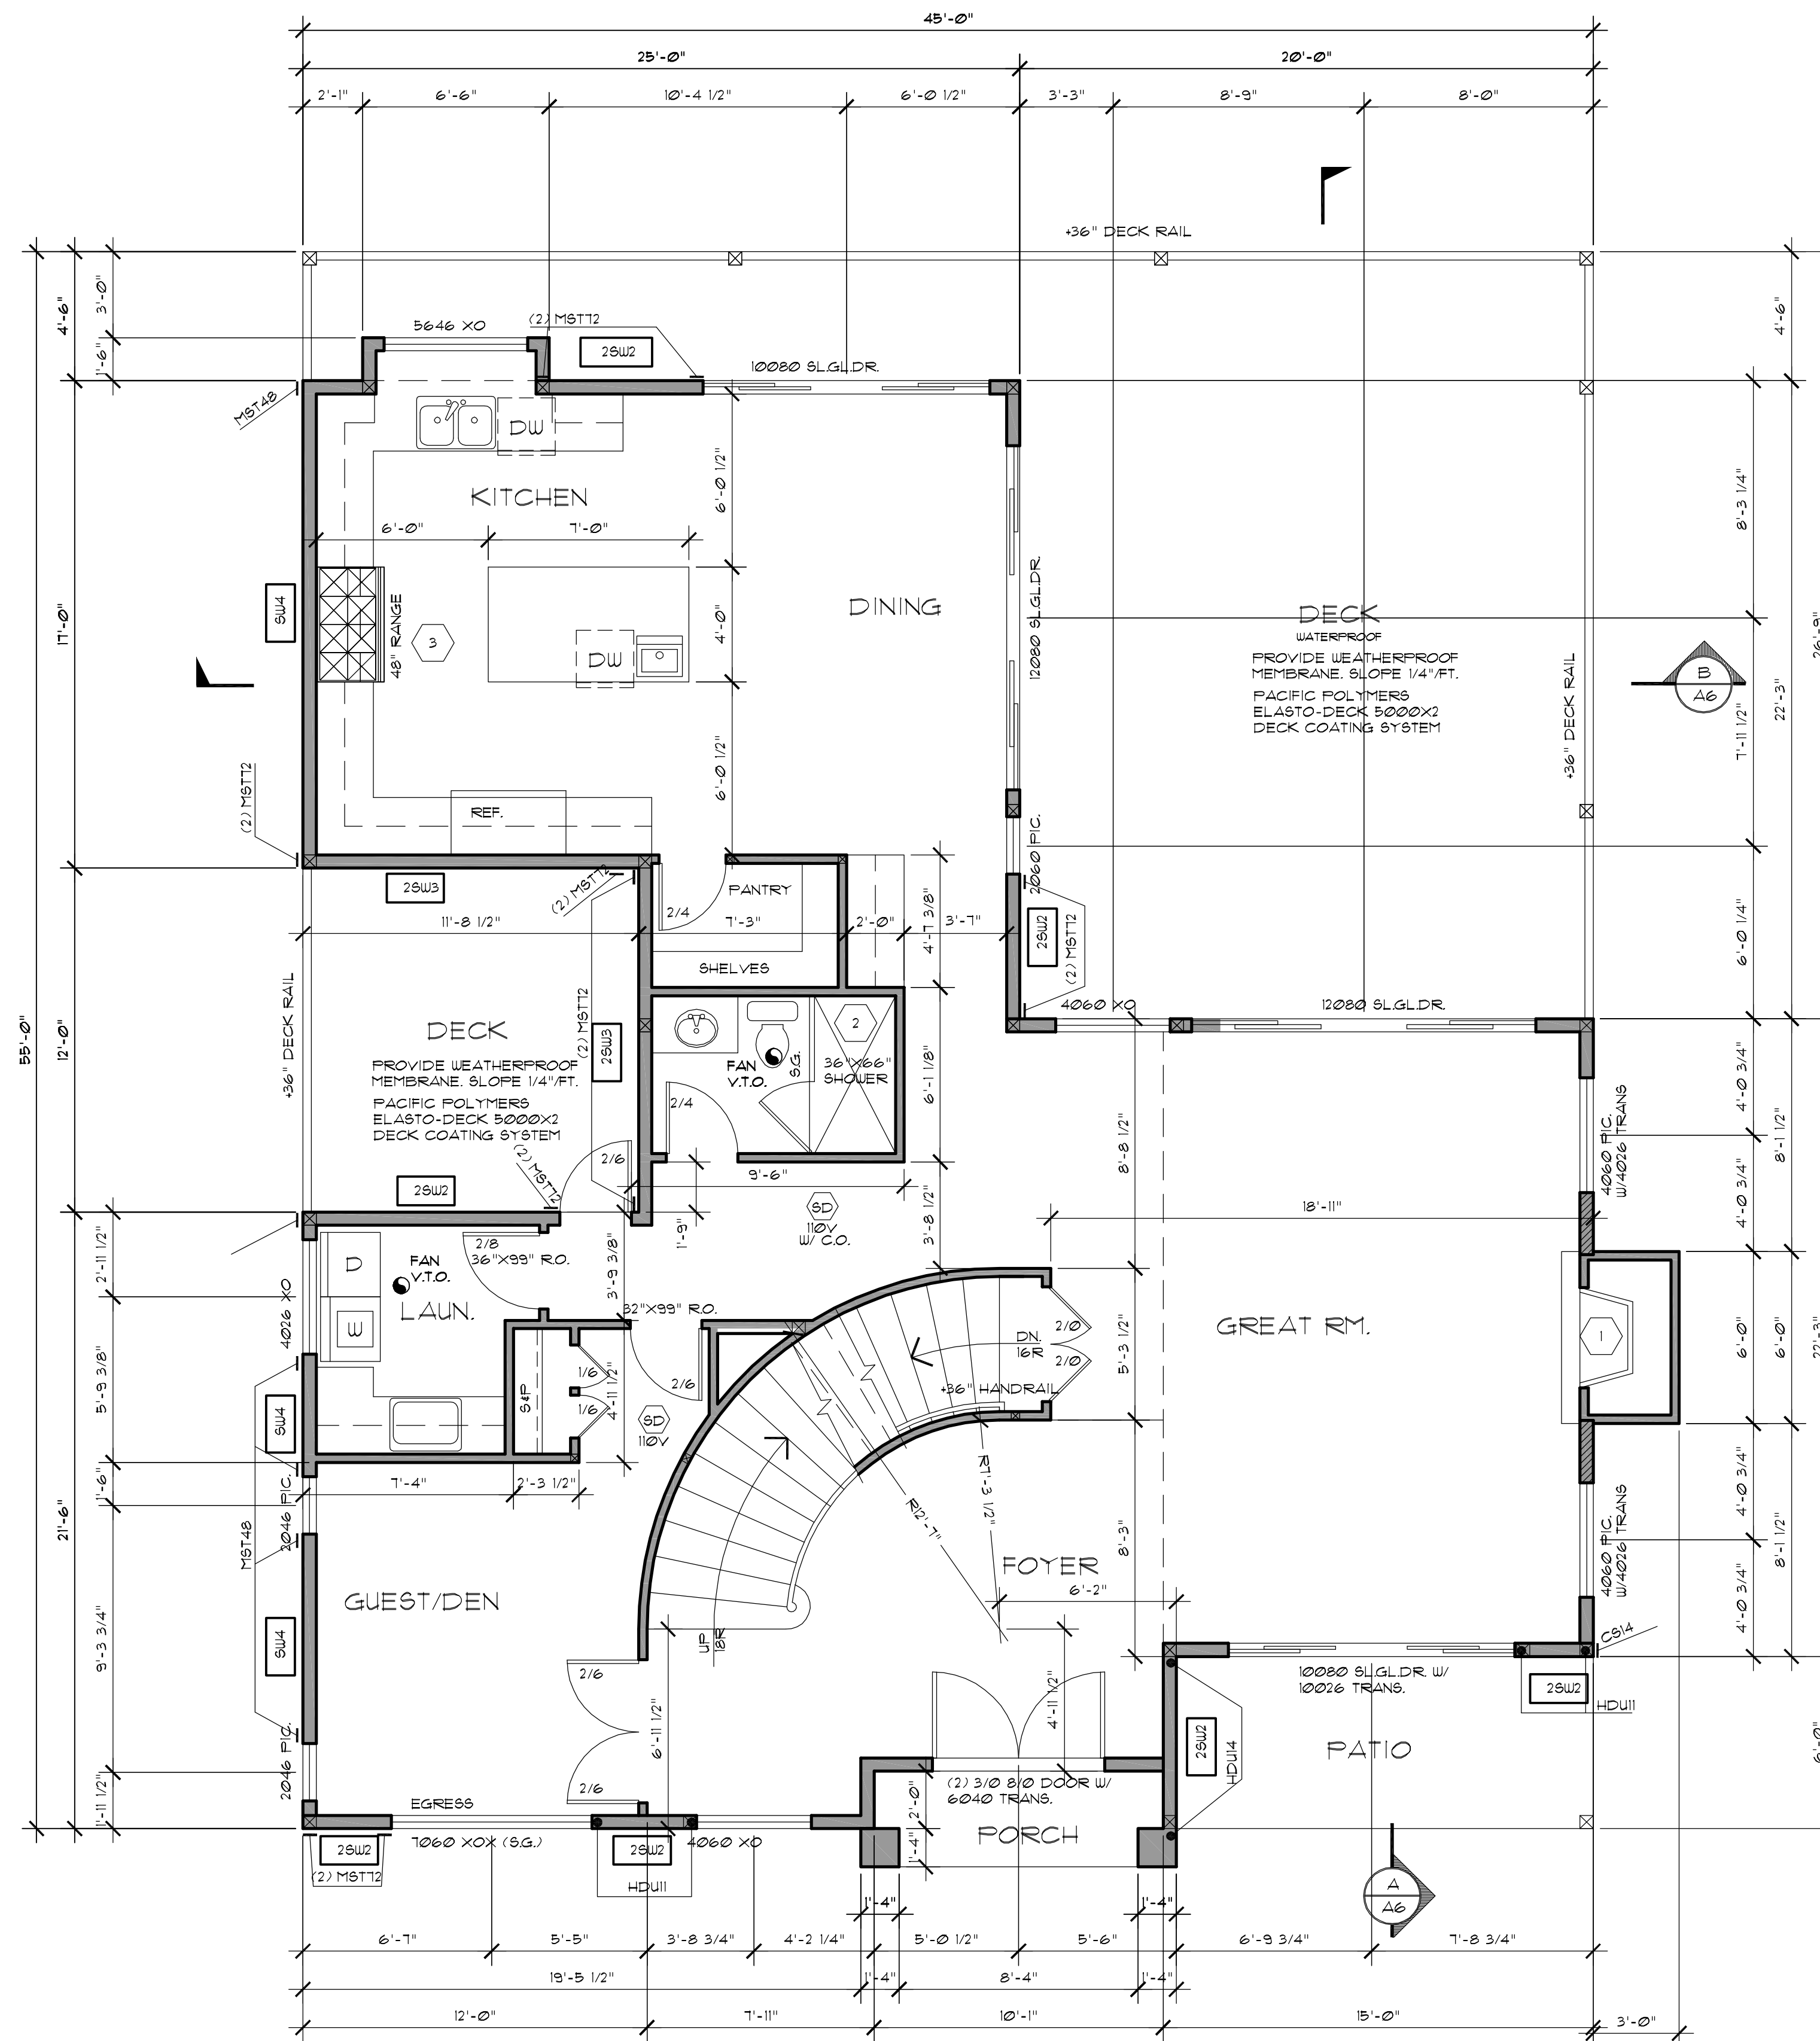

MAIN FLOOR PLAN
SCALE: 1/4" = 1' - 0"

A NFPA 72- Chapter 29 Monitored Fire Alarm System in compliance with NFPA 72 and CoMI standards shall be installed throughout the residence.
A separate FIRE permit is required.
A NFPA 13D Fire Sprinkler System in compliance with NFPA 13D and CoMI standards shall be installed throughout the residence.
A separate FIRE permit is required.

NOTE: CONTRACTOR SHALL VERIFY TO INSPECTOR ALL GUARDS AND RAILINGS SHALL BE CAPABLE OF RESISTING 200 LB. LOAD ON TOP RAIL IN ANY DIRECTION AS REQUIRED BY IRC TABLE 301.5
STAIR LIGHTING ALL STAIRWAYS SHALL BE PROVIDED WITH LIGHT SOURCES LIGHT ACTIVATION CONTROLS SHALL BE ACCESSIBLE AT THE TOP AND BOTTOM OF INTERIOR STAIRWAYS AND WITHIN DWELLING UNIT FOR EXTERIOR STAIRS
IRC SECTIONS R303.1 & R311.1.9

WHOLE HOUSE VENTILATION PER SECTION M1505.4
INTERMITTENTLY OPERATION VENTILATION SYSTEM PER IRC SECTION M1501.2
REF TO TABLE M1505.4 (1) FOR MINIMUM OUTDOOR AIRFLOW RATES - CFM
RUN TIME: ON ONCE EVERY THREE HOURS, FOR ONE HOUR PER TABLE M1501.3.2
OPERATION: THE CLOCK TO OPEN DAMPER LOCATED IN FRESH AIR INTAKE DUCT BETWEEN THE OUTSIDE CAP AND THE RETURN AIR DUCT AT FURNACE AND THE CLOCK ALSO STARTS THE FURNACE FAN TO DISTRIBUTE FRESH AIR THROUGH THE HEAT DUCT SYSTEM THAT WAS BROUGHT IN THROUGH THE AIR INTAKE DUCT. THE AIR VOLUME BROUGHT IN WILL BE FLOW TESTED AND ADJUSTED TO MATCH THE AMOUNT REQUIRED BY CALCULATIONS.
(PRIOR TO THE FINAL INSPECTION)

FLOOR AREA	BEDROOMS				
	0-1	2	3	4	5 OR MORE
LESS THAN 500	30 CFM	30 CFM	35 CFM	45 CFM	50 CFM
501-1000	30 CFM	35 CFM	40 CFM	50 CFM	55 CFM
1001-1500	30 CFM	40 CFM	45 CFM	55 CFM	60 CFM
1501-2000	35 CFM	45 CFM	50 CFM	60 CFM	65 CFM
2001-2500	40 CFM	50 CFM	55 CFM	65 CFM	70 CFM
2501-3000	45 CFM	55 CFM	60 CFM	70 CFM	75 CFM
3001-3500	50 CFM	60 CFM	65 CFM	75 CFM	80 CFM
3501-4000	55 CFM	65 CFM	70 CFM	80 CFM	85 CFM
4001-4500	60 CFM	70 CFM	75 CFM	85 CFM	90 CFM
4501-5000	65 CFM	75 CFM	80 CFM	90 CFM	95 CFM

TABLE 406.3
2018 ENERGY CREDITS (DEBITS)
SEE RESIDENTIAL ENERGY EFFICIENCY SHEET ATTACHED

HEAT OPTION 2	- 10 PTS
OPTION 2.2	- 15 PTS
OPTION 3.5	- 15 PTS
OPTION 4.1	- 5 PTS
OPTION 5.3	- 10 PTS
OPTION 1.0	- 5 PTS
TOTAL POINTS	- 60 PTS

PRESCRIPTIVE REQUIREMENTS 2018 W.S.E.C. (UNLIMITED)
CLIMATE ZONES 5 AND MARINE 4
GLAZING U-FACTOR: VERTICAL U+30, OVERHEAD U+50
DOOR U-FACTOR: U+20
INSULATION: CEILING: R-49, R-38 (ADV) VAULTED CEILING: R-38
ABOVE GRADE WALLS: R-21, BELOW GRADE WALLS: R-21
FLOOR OVER VENTED CRAWL SPACE: R-30
SLAB ON GRADE: R-10
VENTILATION DUCTS IN UNCONDITIONED SPACE TO BE R-8

ENERGY CODE COMPLIANCE

MECHANICAL VENTILATION
REQUIRED VENTILATION PER TABLE M1501.3.3 (1) 90 CFM
INTERMITTENT RUN TIME FACTOR 2 = 180 CFM
PROVIDE WHOLE HOUSE VENTILATION INTEGRATED WITH A FORCED AIR SYSTEM M1501.3.5

A MINIMUM OF 75% OF ALL LIGHT FIXTURES WILL BE HIGH EFFICACY. (USEC R404.1)

- 1 DIRECT VENT FIREPLACE
INSTALL PER MANUFACTURERS SPECIFICATIONS
- 2 CONC. FIBERBOARD @ TUB & SHOWER
SURROUND TO 6' ABOVE DRAIN
- 3 NOTE: PER M1503.6, EXHAUST HOOD SYSTEMS CAPABLE OF EXHAUSTING IN EXCESS OF 400 CFM SHALL BE PROVIDED WITH MAKEUP AIR AT A RATE EQUAL TO THE EXHAUST RATE. SUCH MAKEUP AIR SYSTEMS SHALL BE EQUIPPED WITH A MEANS OF CLOSURE AND SHALL BE AUTOMATICALLY CONTROLLED TO START AND OPERATE SIMULTANEOUSLY WITH THE EXHAUST SYSTEM

NOTE: CONTRACTOR SHALL VERIFY TO INSPECTOR ALL GUARDS AND RAILINGS SHALL BE CAPABLE OF RESISTING 200 LB. LOAD ON TOP RAIL IN ANY DIRECTION AS REQUIRED BY IRC TABLE 301.5

SQUARE FOOTAGE SUMMARY


LOWER FLOOR	259	SQ. FT.
MAIN FLOOR	1498	SQ. FT.
UPPER FLOOR	1025	SQ. FT.
TOTAL	2782	SQ. FT.
GARAGE	357	SQ. FT.
MAIN FLOOR DECKS	787	SQ. FT.
UPPER FLOOR DECKS	647	SQ. FT.

A NEW HOME AT:
6175 SE 27TH STREET
MERCER ISLAND, WA 98040

JOB NO: 23006
DATE: 12/11/23
DRWN. BY: TH
REVISED: 5/18/24

SHEET NO.

A2

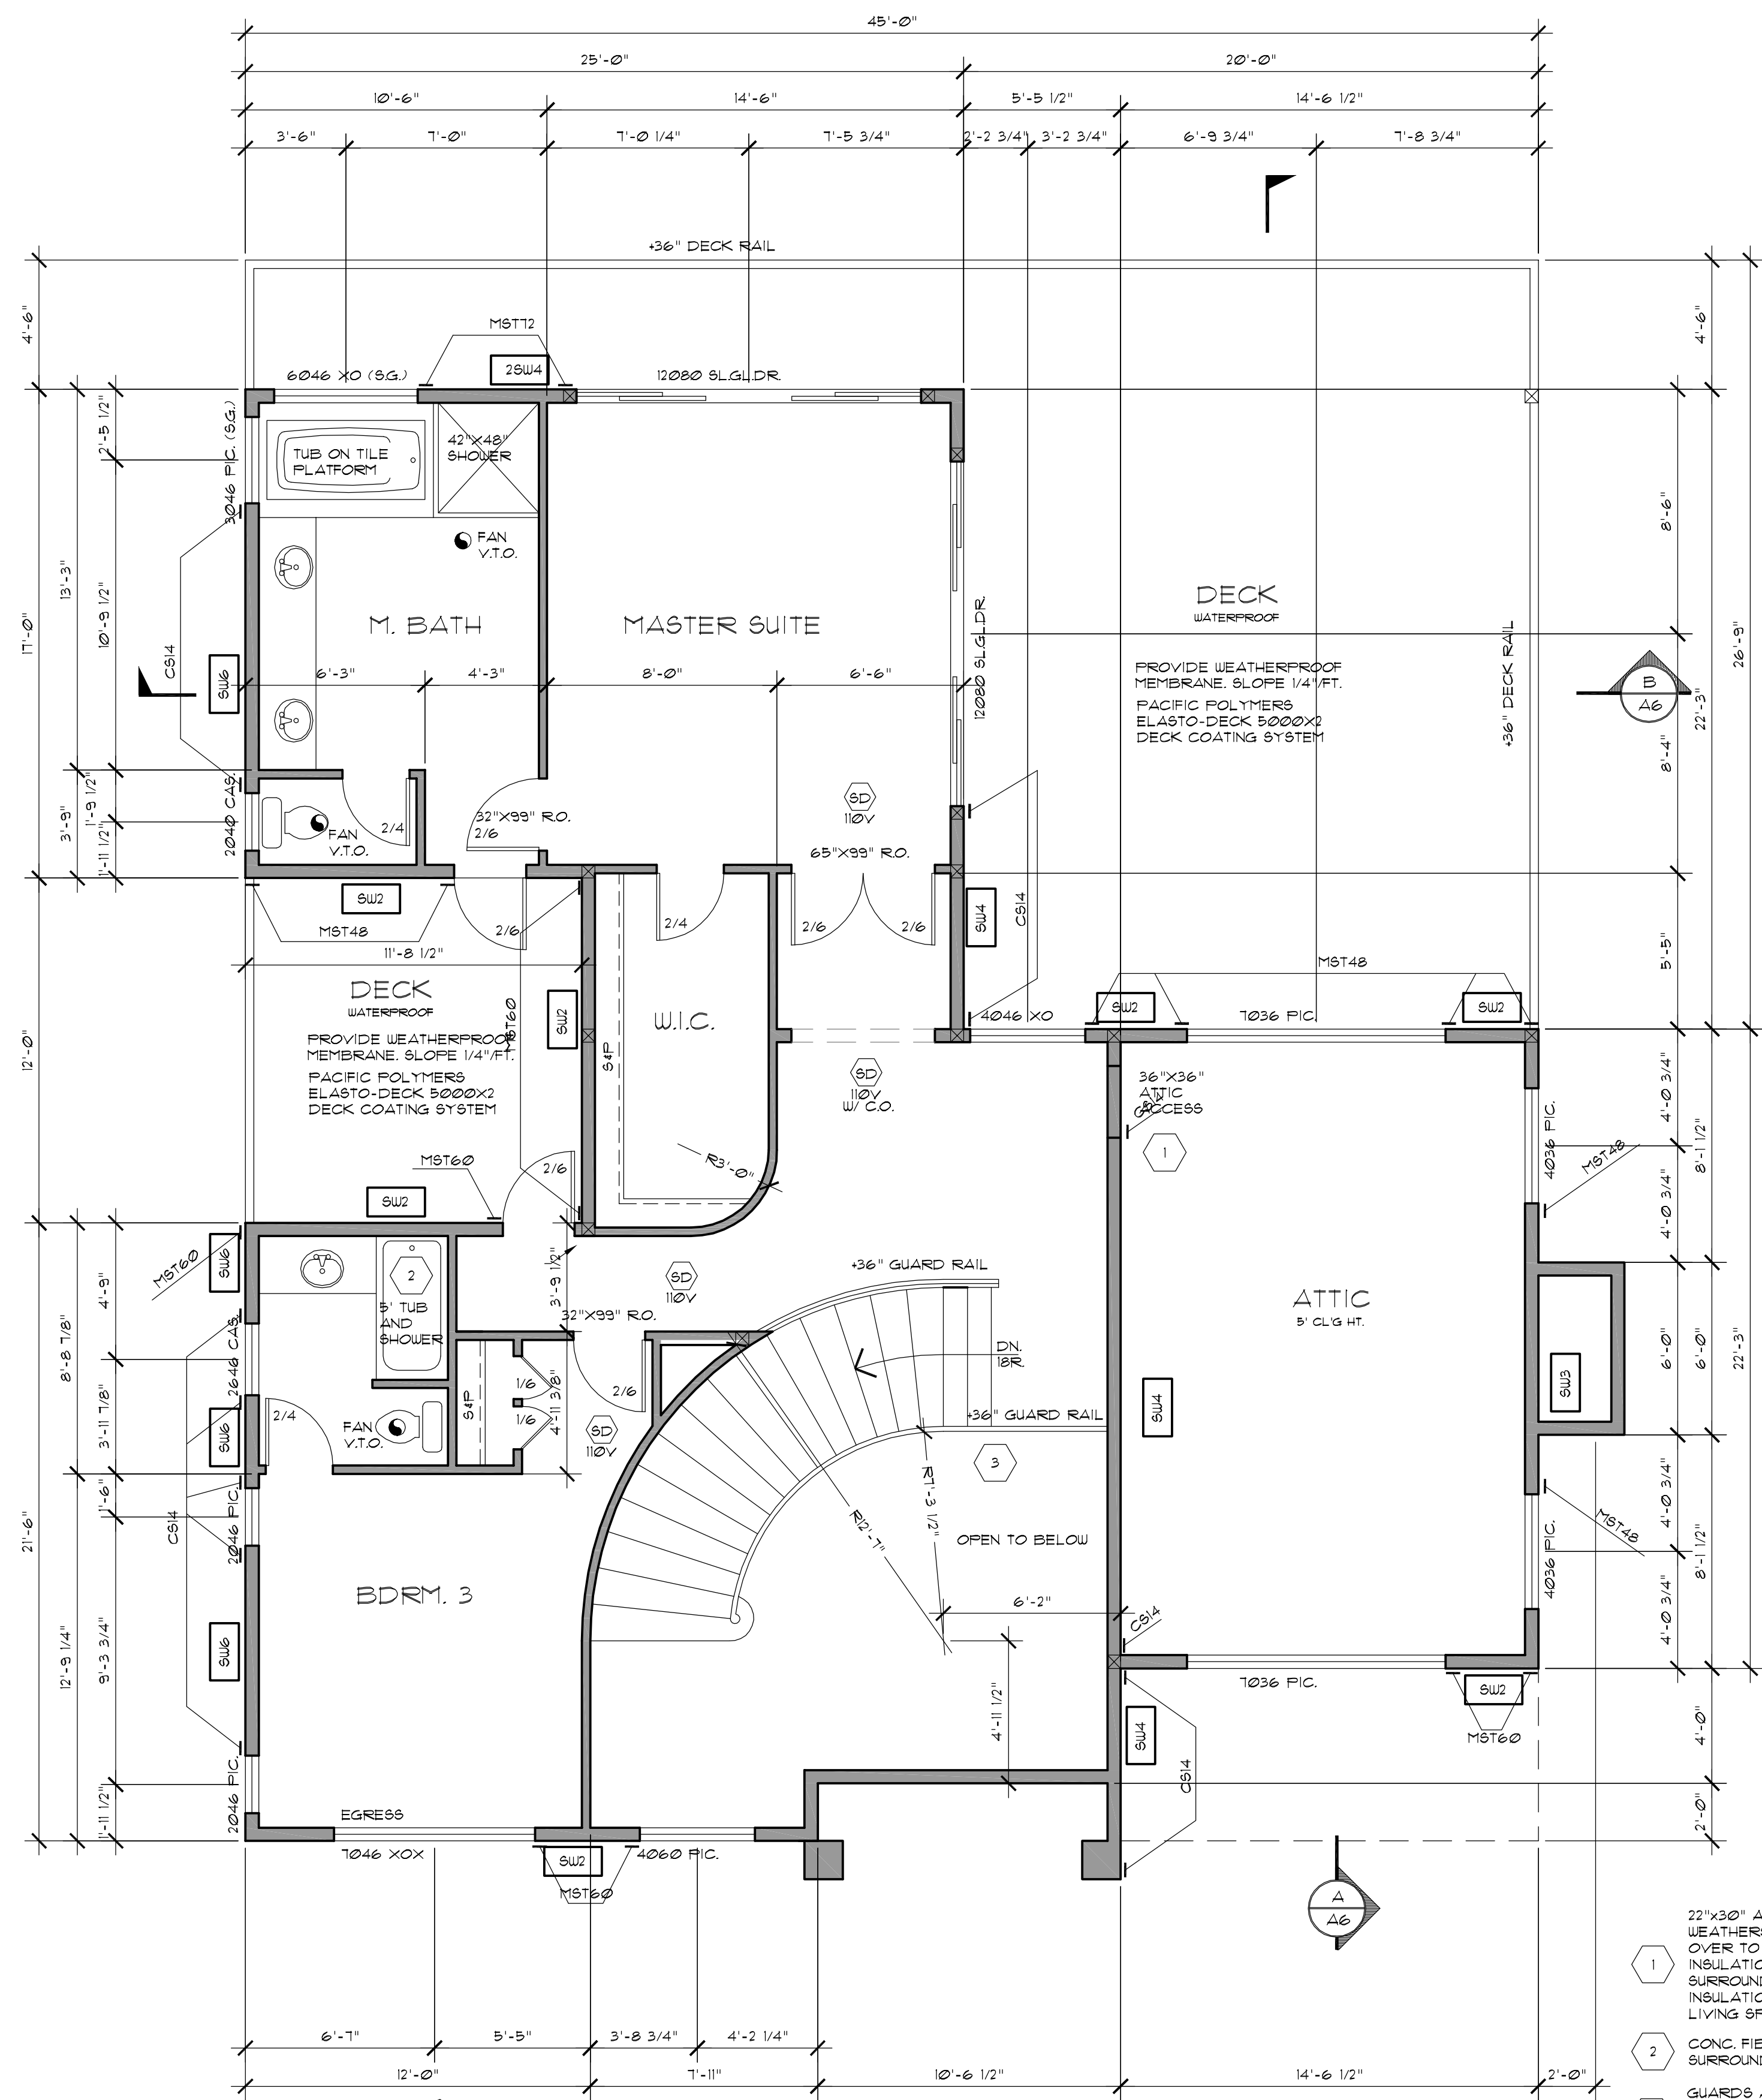

UPPER FLOOR PLAN
SCALE: 1/4" = 1' - 0"

A NFPA 72- Chapter 29 Monitored Fire Alarm System in compliance with NFPA 72 and CoMI standards shall be installed throughout the residence.
A separate FIRE permit is required.

A NFPA 13D Fire Sprinkler System in compliance with NFPA 13D and CoMI standards shall be installed throughout the residence.
A separate FIRE permit is required.

- 1 22"X30" ATTIC ACCESS. WEATHERSTRIP & INSULATE OVER TO EQUAL CEILING INSULATION. PROVIDE WOOD SURROUND TO PREVENT LOOSE INSULATION SPILLAGE TO LIVING SPACE. (IBC SEC. R807.1)
- 2 CONC. FIBERBOARD @ TUB & SHOWER SURROUND TO 6' ABOVE DRAIN
- 3 GUARDS ARE NOT OF GLASS BALUSTER CONSTRUCTION. IF GUARDS TO BE OF GLASS BALUSTER CONSTRUCTION, PROVIDE DETAILS OF CONSTRUCTION. GLASS INFILL IS PERMITTED.



NOTE: CONTRACTOR SHALL VERIFY TO INSPECTOR ALL GUARDS AND RAILINGS SHALL BE CAPABLE OF RESISTING 200 LB LOAD ON TOP RAIL IN ANY DIRECTION AS REQUIRED BY IRC TABLE 302.5

STAIR LIGHTING ALL STAIRWAYS SHALL BE PROVIDED WITH LIGHT SOURCES. LIGHT ACTIVATION CONTROLS SHALL BE ACCESSIBLE AT THE TOP AND BOTTOM OF INTERIOR STAIRWAYS AND WITHIN DWELLING UNIT FOR EXTERIOR STAIRS. IRC SECTIONS R303.7 & R311.7.3

A NEW HOME AT:
6115 SE 27TH STREET
MERCER ISLAND, WA 98040

JOB NO: 23006
DATE: 12/11/23
DRWN. BY: TH
REVISED: 5/18/24



SHEET NO.
A3

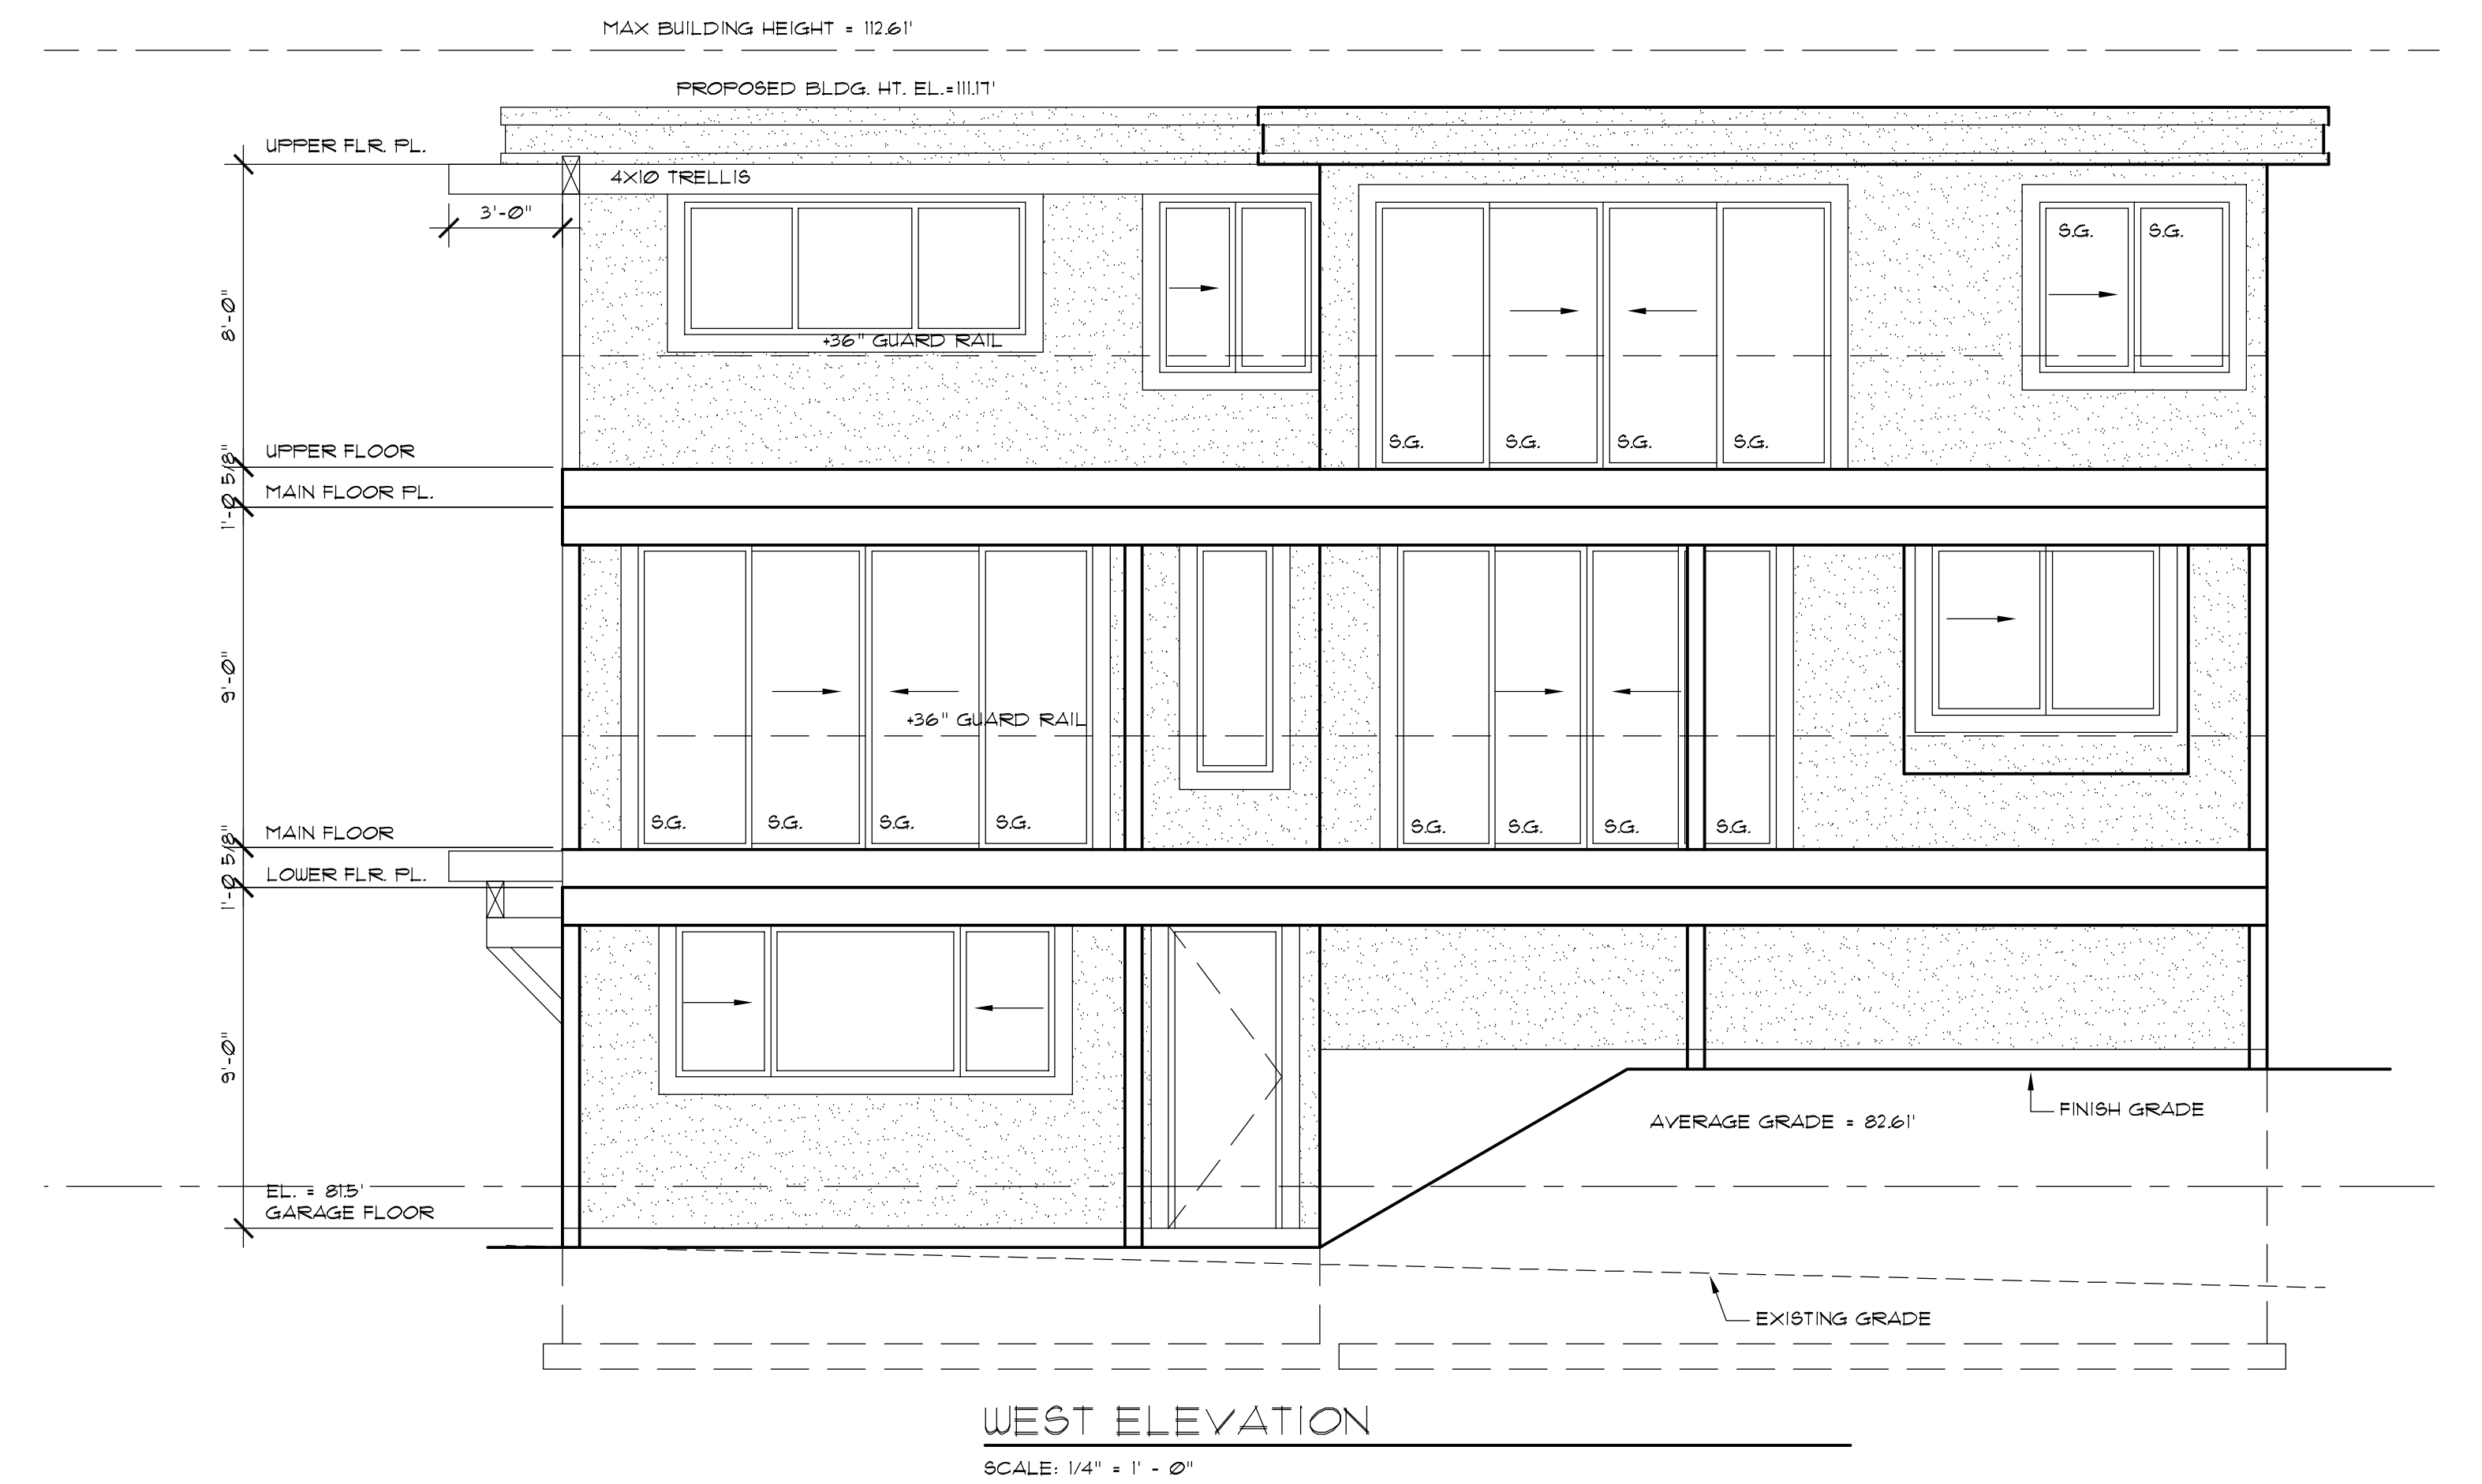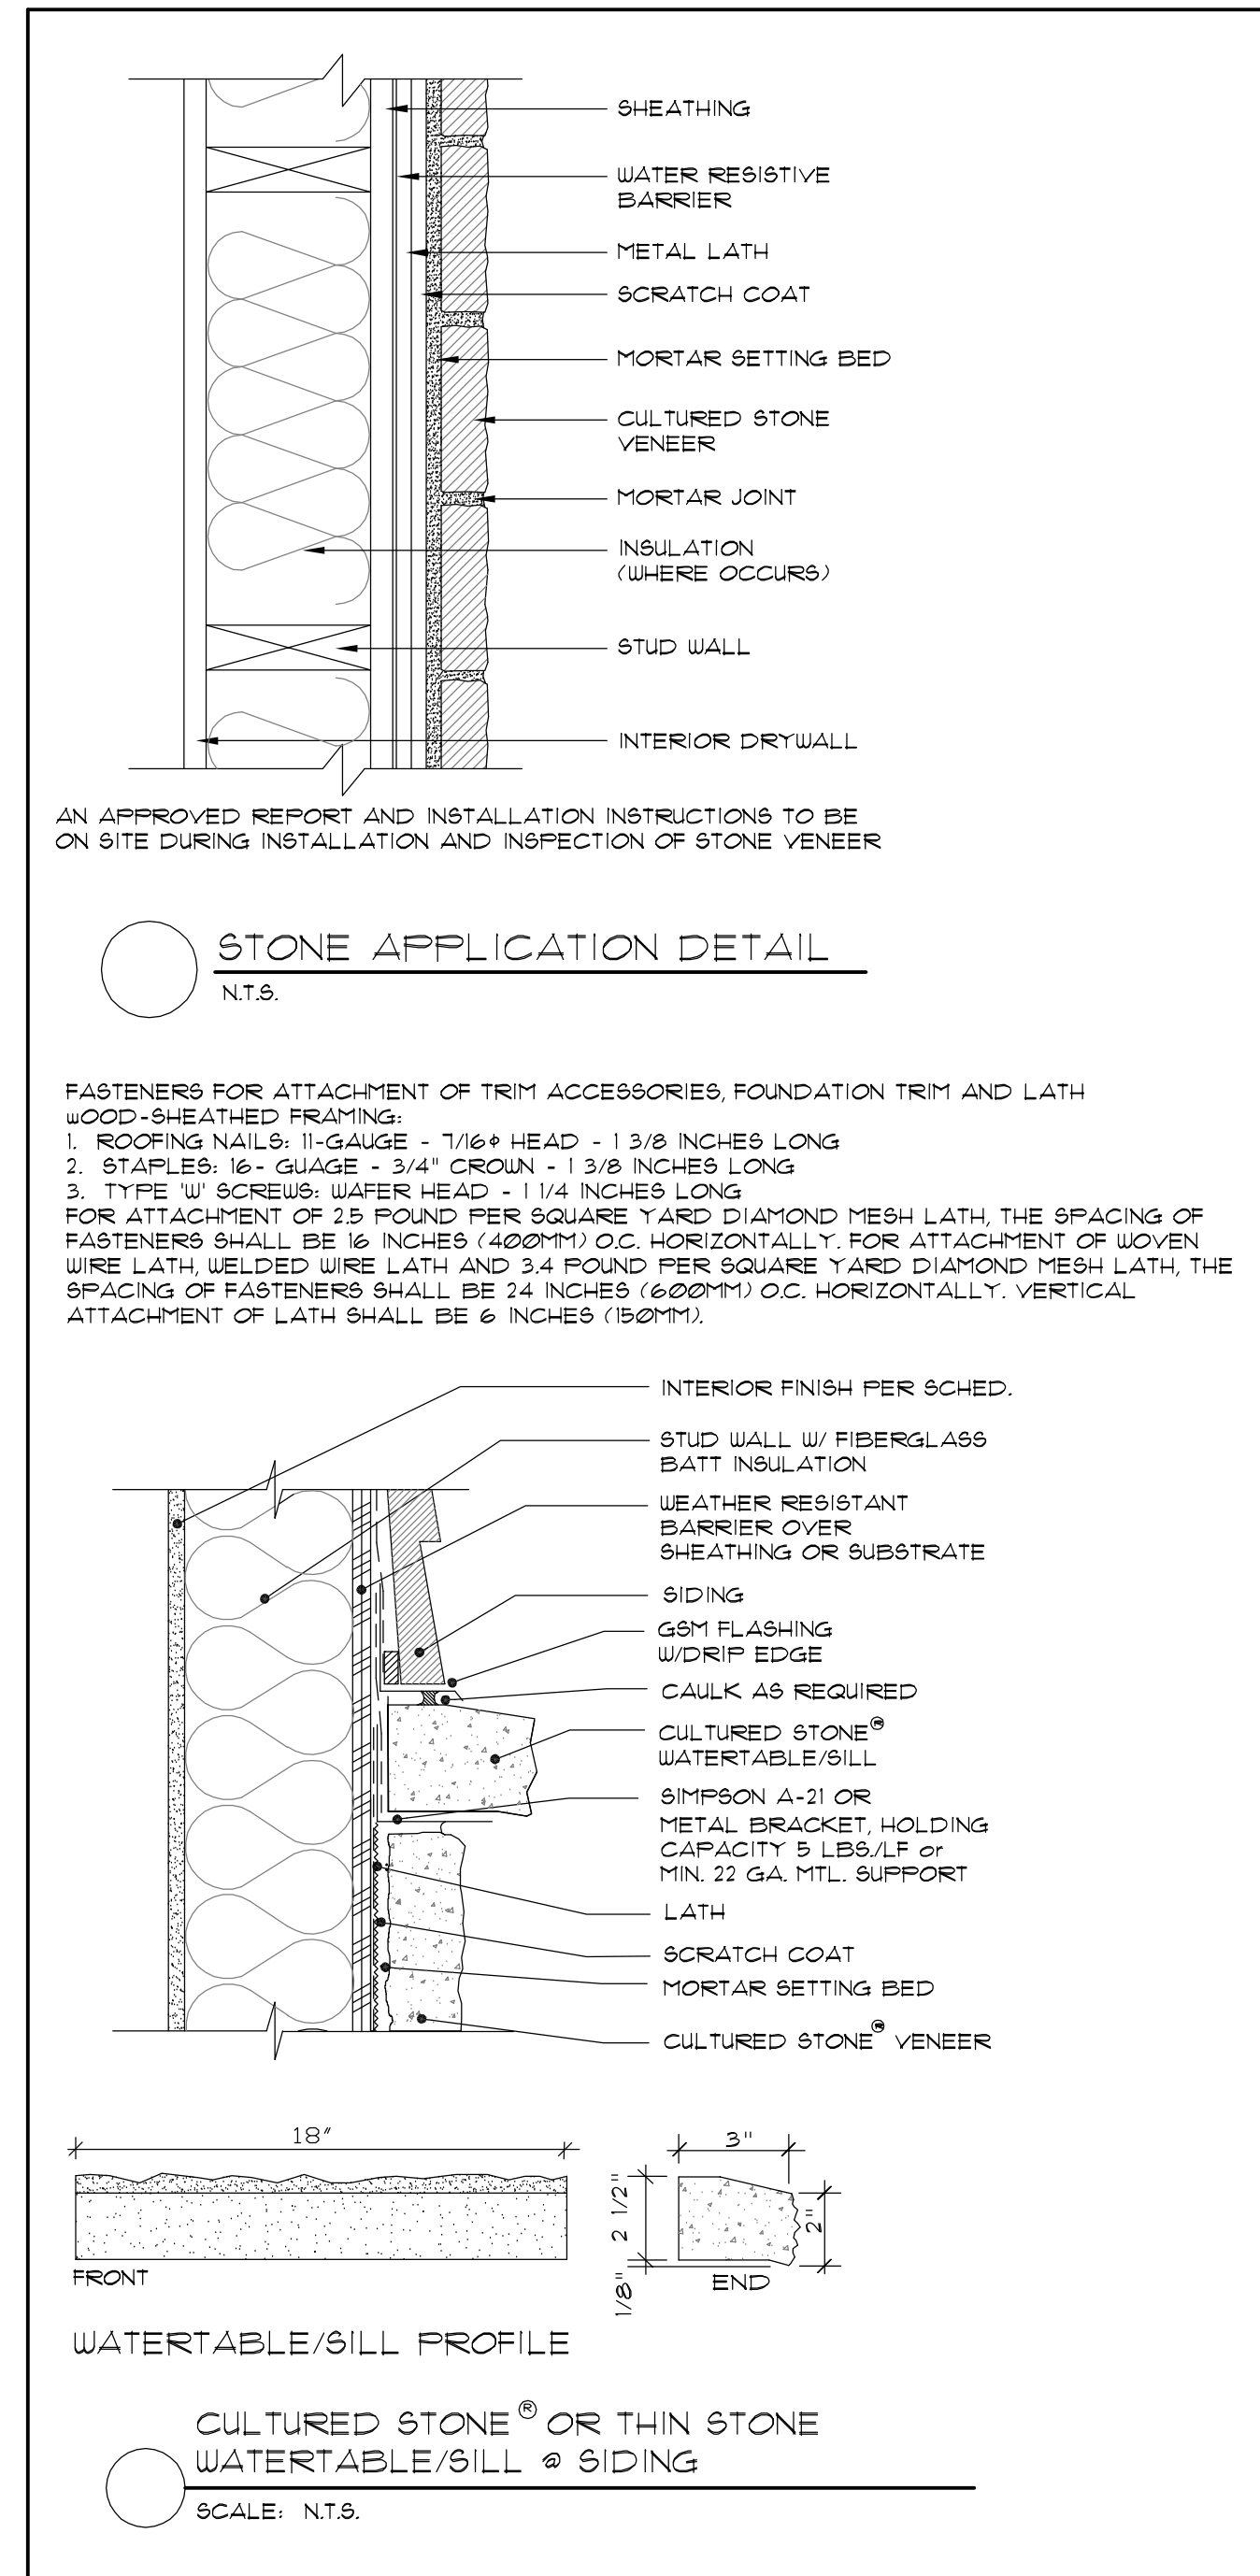

A NEW HOME AT:
 6115 SE 27TH STREET
 MERCER ISLAND, WA 98040

JOB NO: 23006
 DATE: 12/11/23
 DRWN. BY: TH
 REVISED:

SHEET NO.
 A4

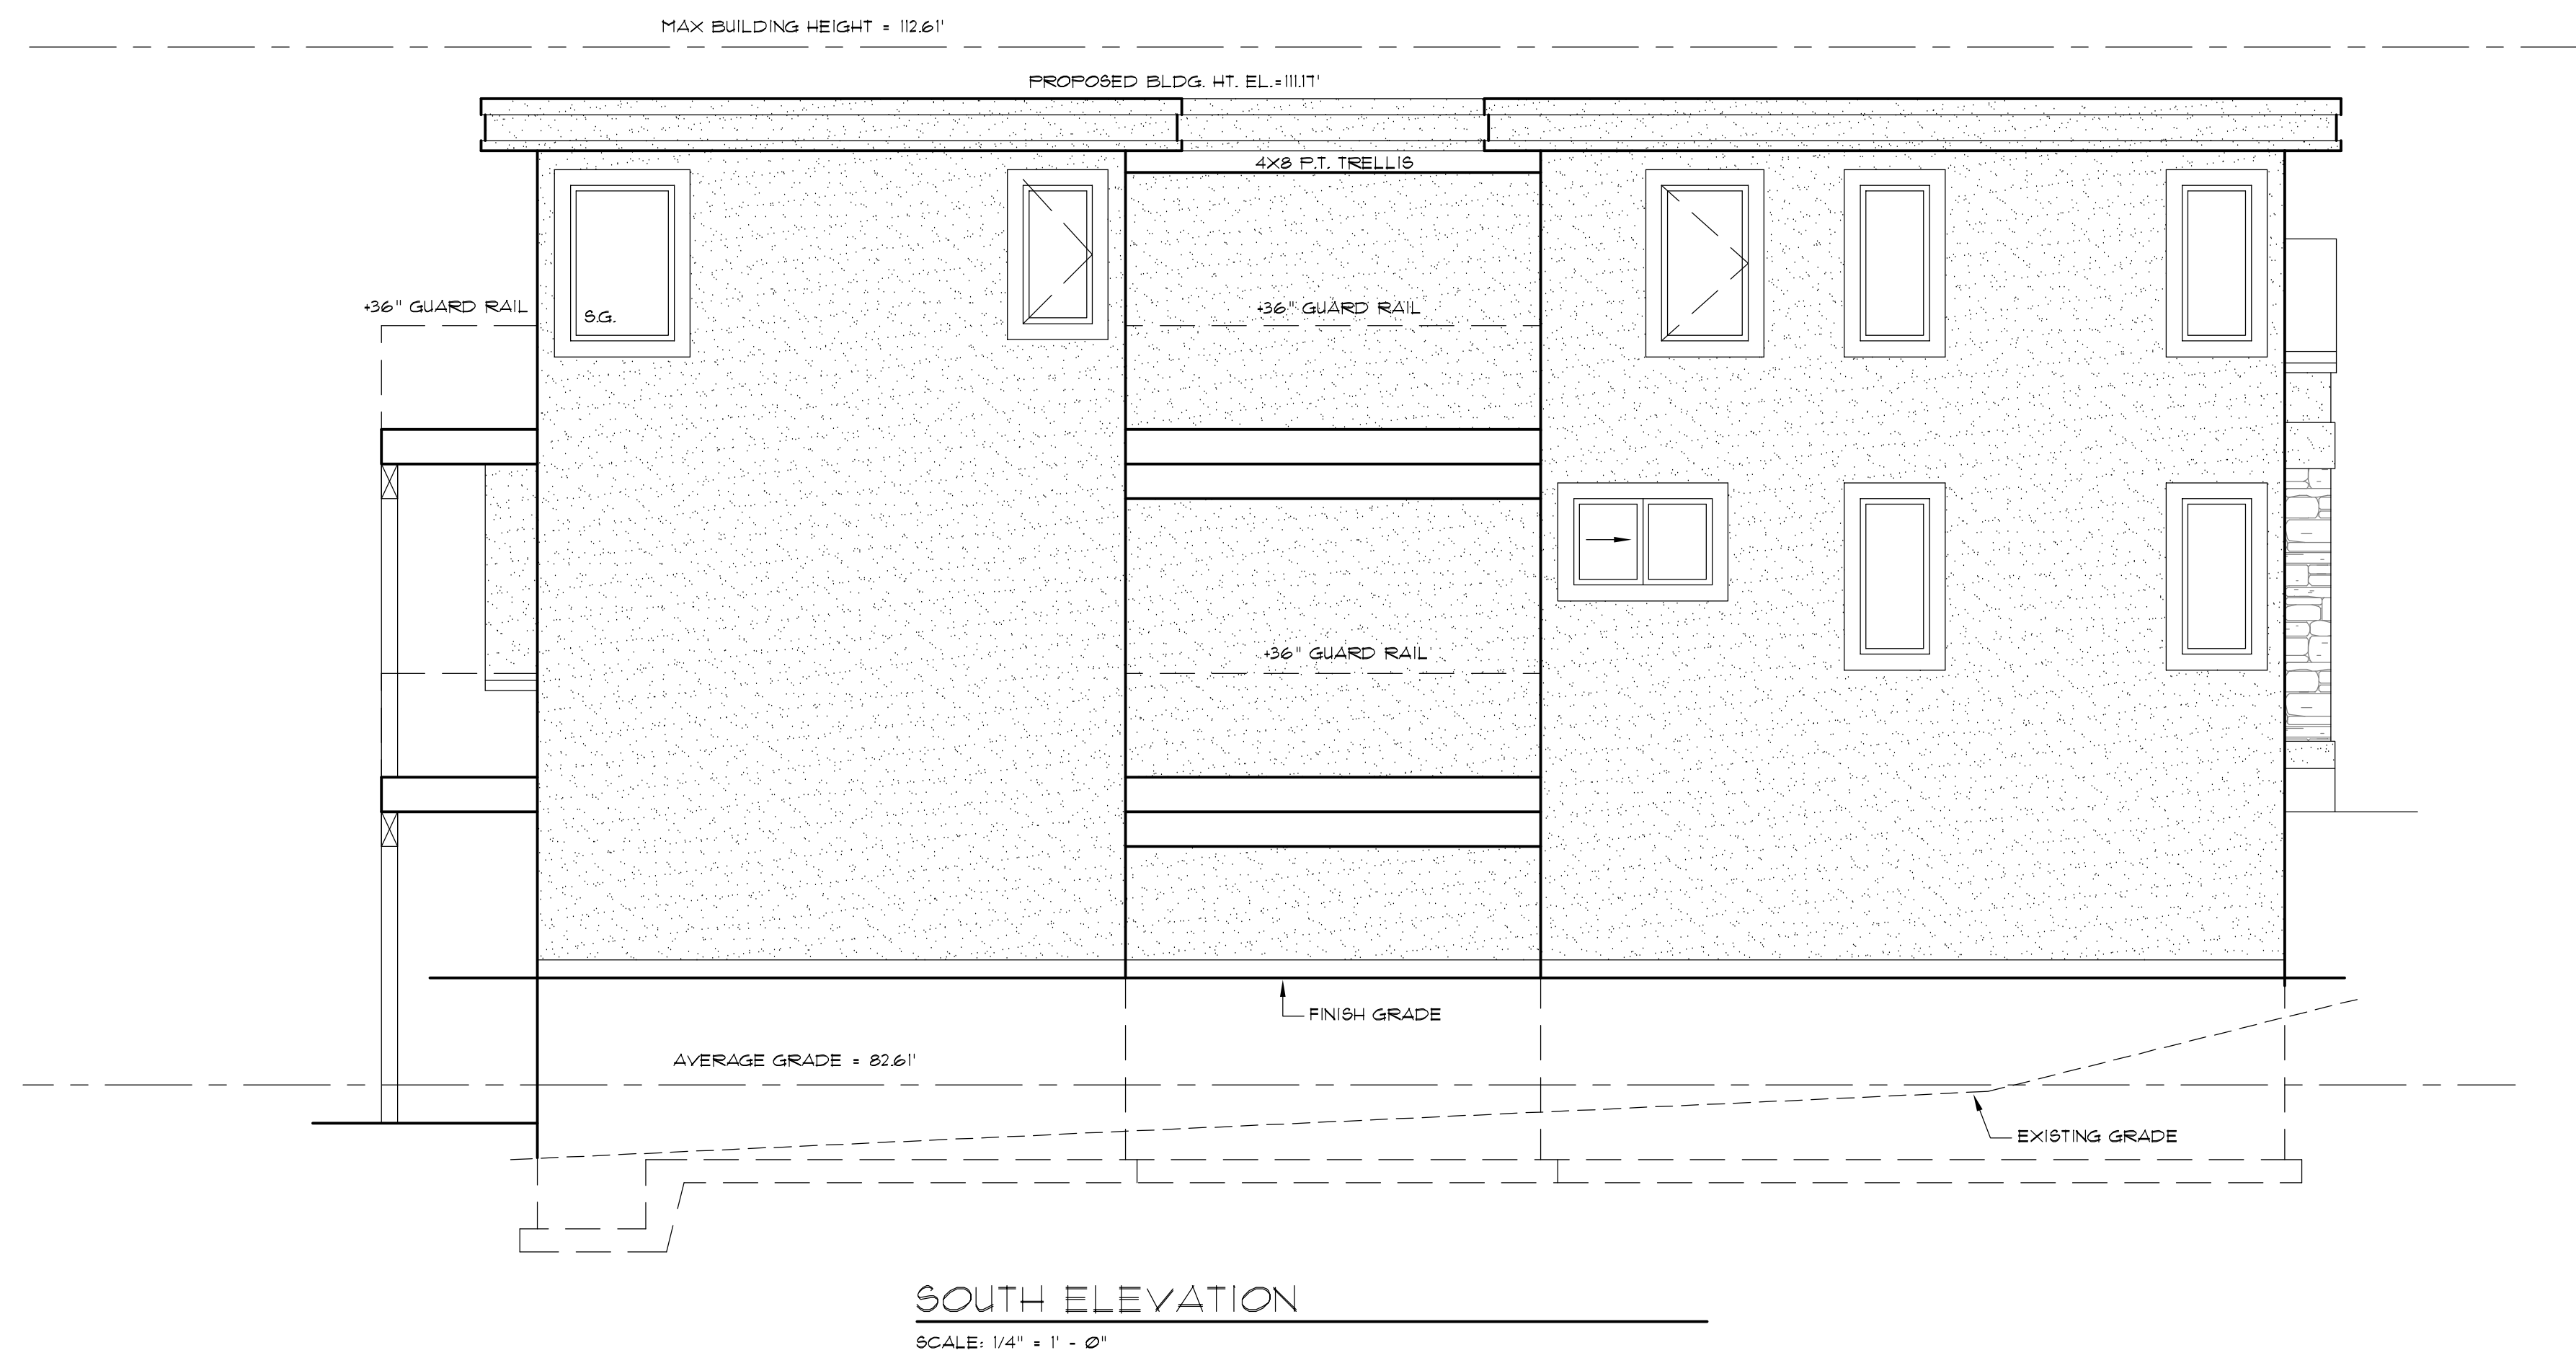
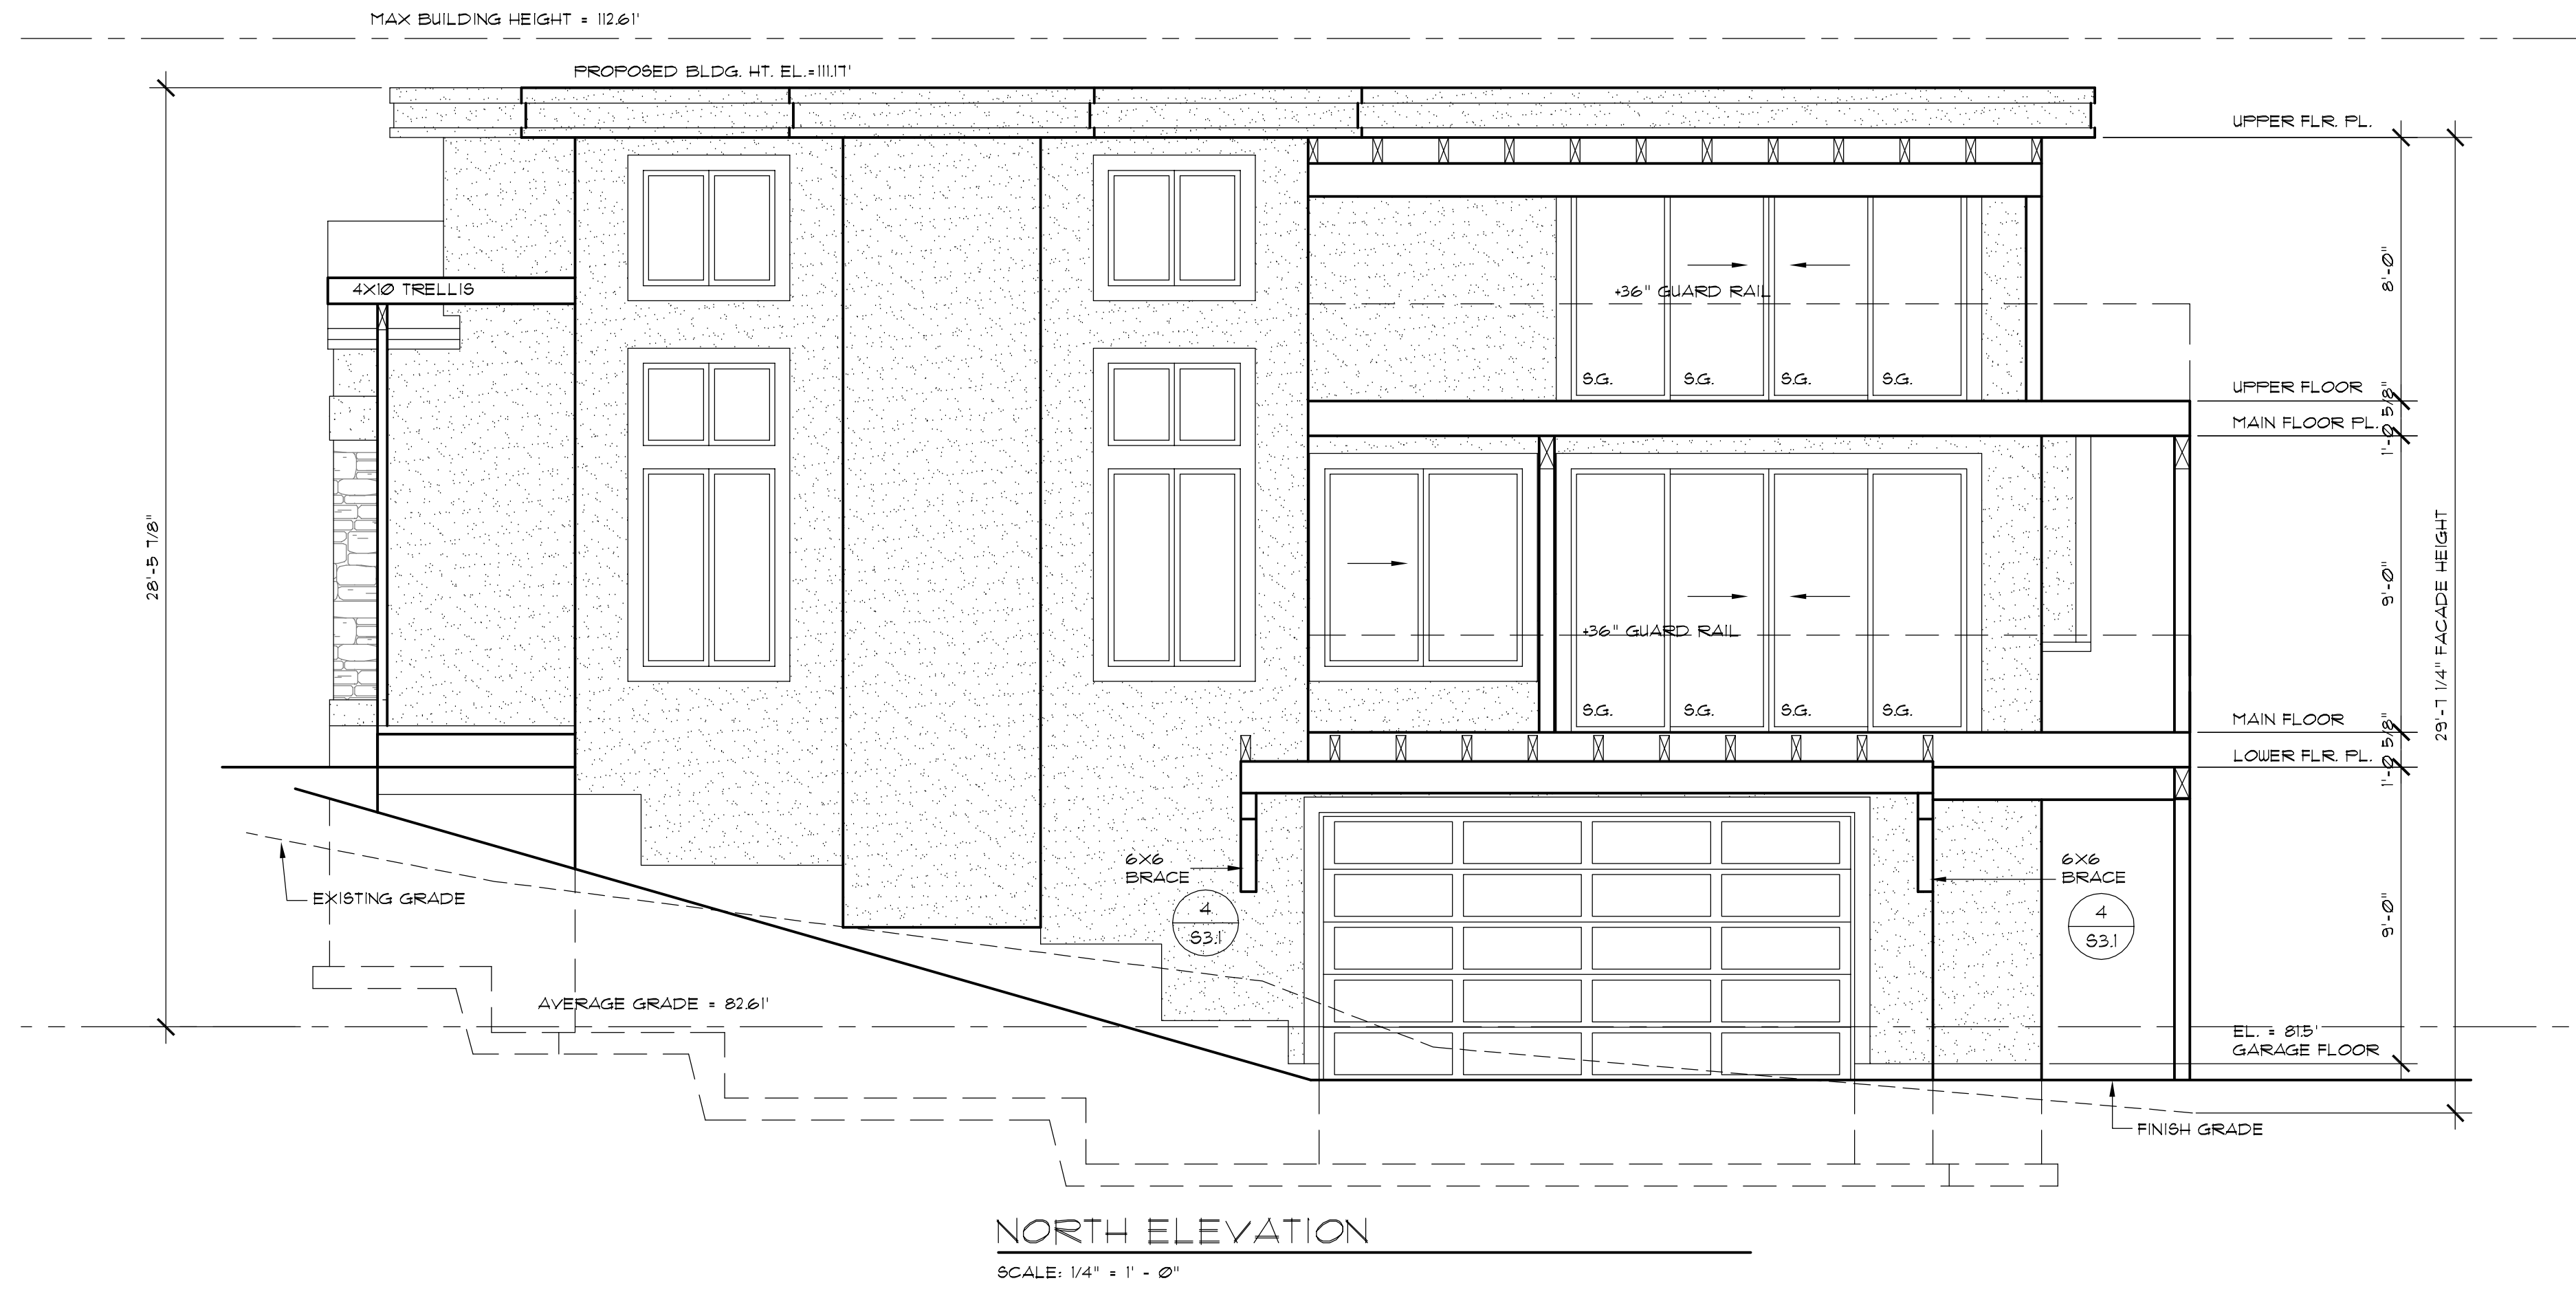


A NEW HOME AT:
 6115 SE 27TH STREET
 MERCER ISLAND, WA 98040

JOB NO: 23006
 DATE: 12/11/23
 DRAWN BY: TH
 REVISED:

SHEET NO.

A5

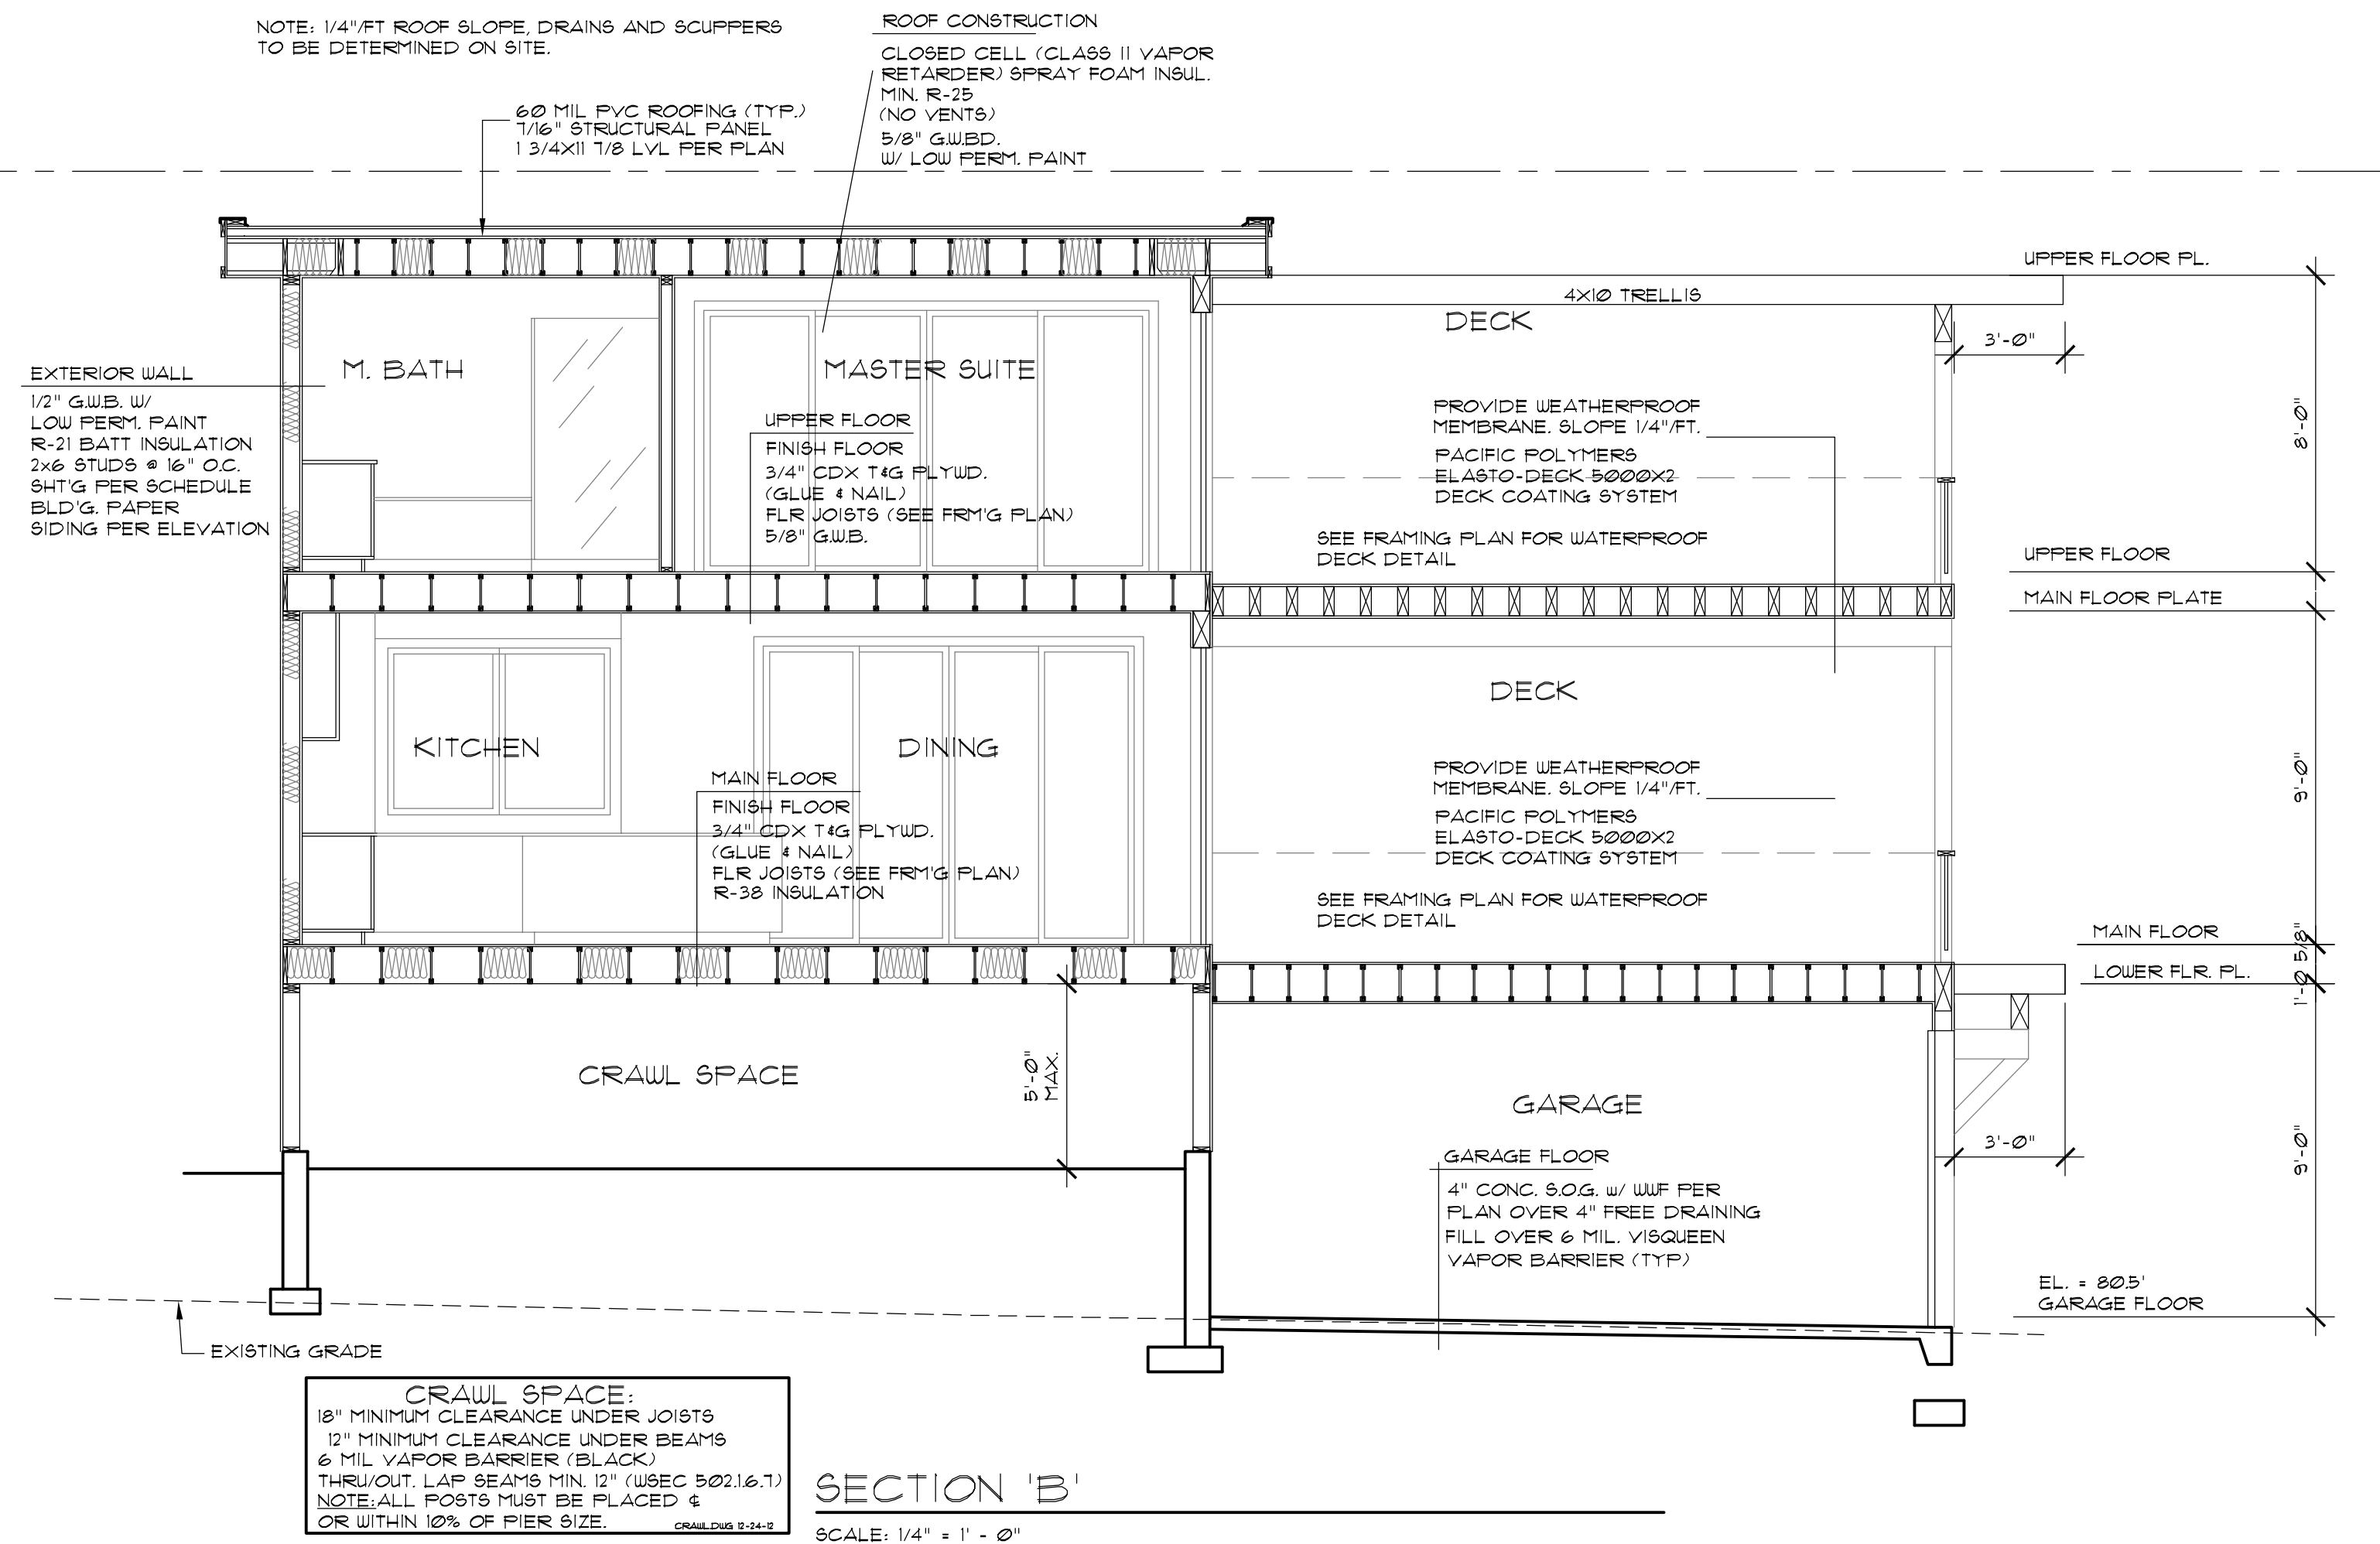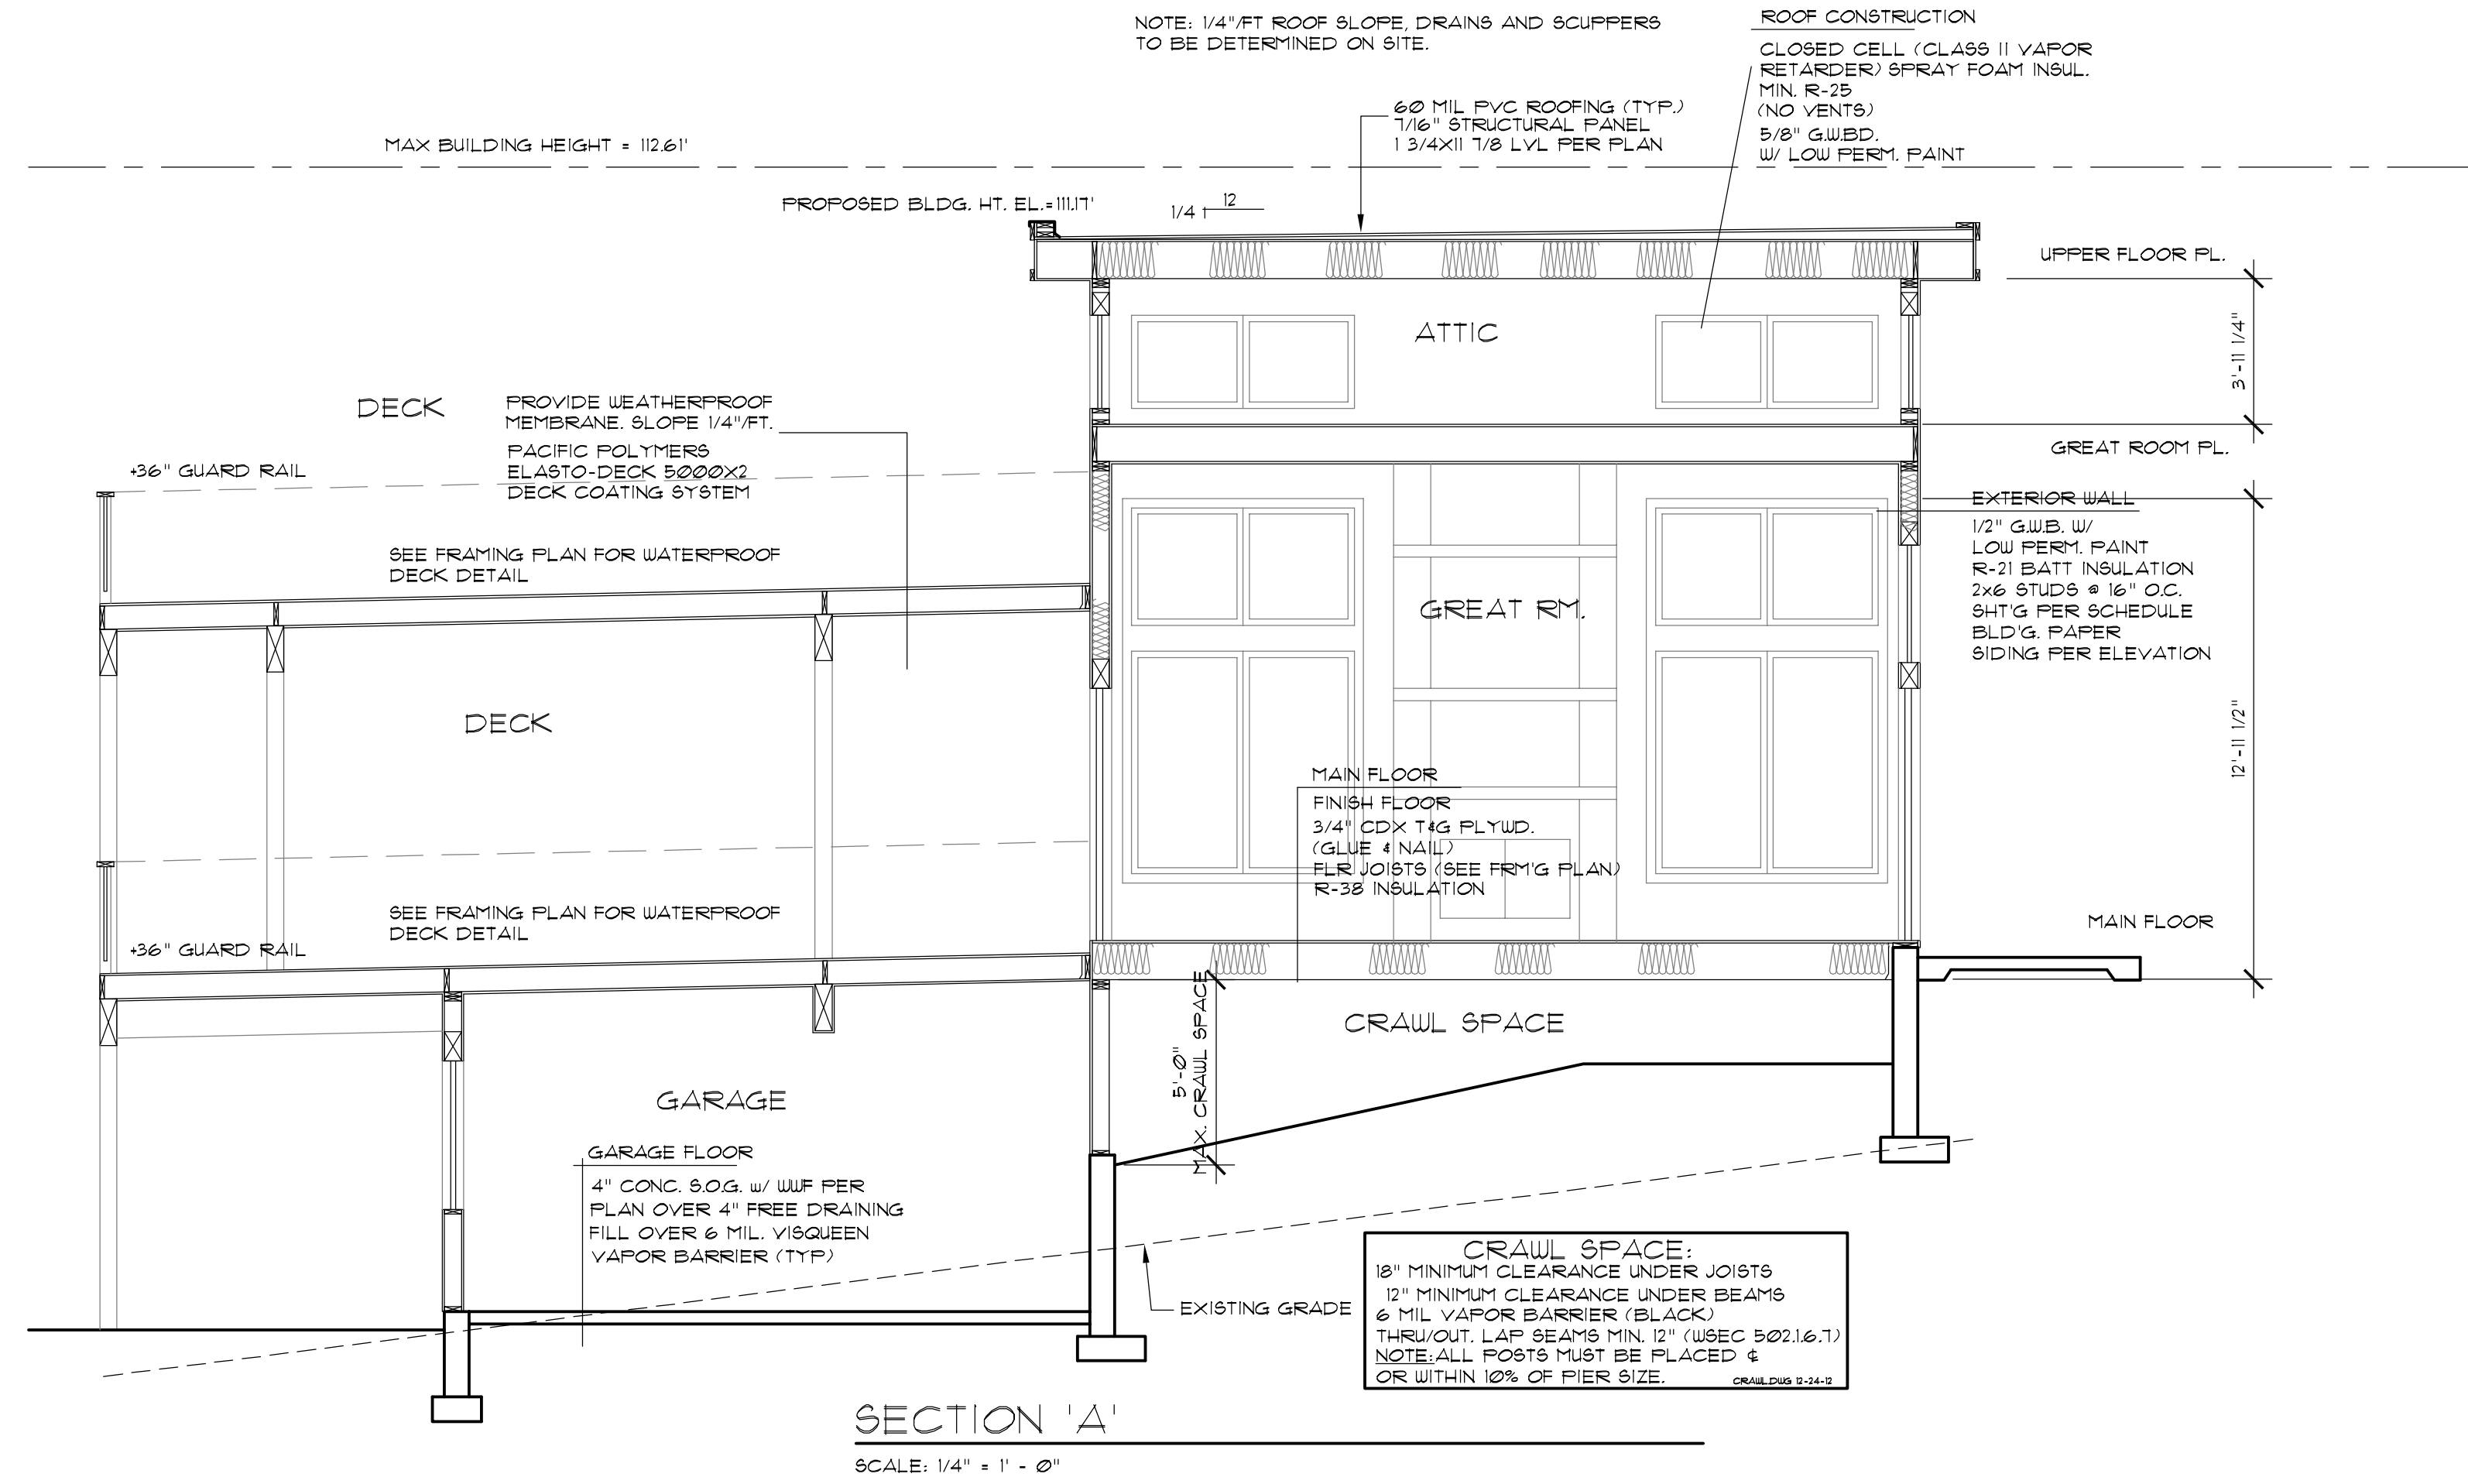

A NEW HOME AT:
6115 SE 27TH STREET
MERCER ISLAND, WA 98040

JOB NO: 23006
DATE: 12/11/23
DRWN. BY: TH
REVISED:

SHEET NO.
A6

2018 Washington State Energy Code – Residential
**Prescriptive Energy Code Compliance for All Climate Zones in Washington
 Single Family – New & Additions (effective February 1, 2021)**

Each dwelling unit in a residential building shall comply with sufficient options from Table R406.2 (fuel normalization credits) and Table 406.3 (energy credits) to achieve the following minimum number of credits. To claim this credit, the building permit drawings shall specify the option selected and the maximum tested building air leakage, and show the qualifying ventilation system and its control sequence of operation.

1. **Small Dwelling Unit: 3 credits**
 Dwelling units less than 1,500 sf in conditioned floor area with less than 300 sf of fenestration area. Additions to existing building that are greater than 500 sf of heated floor area but less than 1,500 sf.

2. **Medium Dwelling Unit: 6 credits**
 All dwelling units that are not included in #1 or #3

3. **Large Dwelling Unit: 7 credits**
 Dwelling units exceeding 5,000 sf of conditioned floor area

4. **Additions less than 500 square feet: 1.5 credits**
 All other additions shall meet 1-3 above

Summary of Table R406.2			
Heating Options	Fuel Normalization Descriptions	Credits - select ONE heating option	User Notes
1	Combustion heating minimum NAECab	0.0	
2	Heat pumpc	1.0	●
3	Electric resistance heat only - furnace or zonal	-1.0	
4	DHP with zonal electric resistance per option 3.4	0.5	
5	All other heating systems	-1.0	
Energy Options	Energy Credit Option Descriptions	Credits - select ONE energy option from each categoryd	
1.1	Efficient Building Envelope	0.5	
1.2	Efficient Building Envelope	1.0	
1.3	Efficient Building Envelope	0.5	
1.4	Efficient Building Envelope	1.0	
1.5	Efficient Building Envelope	2.0	
1.6	Efficient Building Envelope	3.0	
1.7	Efficient Building Envelope	0.5	
2.1	Air Leakage Control and Efficient Ventilation	0.5	
2.2	Air Leakage Control and Efficient Ventilation	1.0	●
2.3	Air Leakage Control and Efficient Ventilation	1.5	
2.4	Air Leakage Control and Efficient Ventilation	2.0	
3.1a	High Efficiency HVAC	1.0	
3.2	High Efficiency HVAC	1.0	
3.3a	High Efficiency HVAC	1.5	
3.4	High Efficiency HVAC	1.5	
3.5	High Efficiency HVAC	1.5	●
3.6a	High Efficiency HVAC	2.0	
4.1	High Efficiency HVAC Distribution System	0.5	●
4.2	High Efficiency HVAC Distribution System	1.0	
5.1d	Efficient Water Heating	0.5	
5.2	Efficient Water Heating	0.5	
5.3	Efficient Water Heating	1.0	●
5.4	Efficient Water Heating	1.5	
5.5	Efficient Water Heating	2.0	
5.6	Efficient Water Heating	2.5	
6.1e	Renewable Electric Energy (3 credits max)	1.0	
7.1	Appliance Package	0.5	●
Total Credits		6.0	

- a. An alternative heating source sized at a maximum of 0.5 W/sf (equivalent) of heated floor area or 500 W, whichever is bigger, may be installed in the dwelling unit.
- b. Equipment listed in Table C403.3.2(4) or C403.3.2(5)
- c. Equipment listed in Table C403.3.2(1) or C403.3.2(2)
- d. You cannot select more than one option from any category EXCEPT in category 5. Option 5.1 may be combined with options 5.2 through 5.6. See Table 406.3.
- e. 1.0 credit for each 1,200 kWh of electrical generation provided annually, up to 3 credits max. See the complete Table R406.2 for all requirements and option descriptions.

Energy Credits (2018 Code)

TABLE 406.3 2018 ENERGY CREDITS			
OPTION	DESCRIPTION	CREDIT(S)	
		All Other	Group R-2
1. EFFICIENT BUILDING ENVELOPE OPTIONS			
Only one option from Items 1.1 through 1.7 may be selected in this category. Compliance with the conductive UA targets is demonstrated using Section R402.1.4, Total UA alternative, where [1-(Proposed UA/Target UA)] > the required %UA reduction			
2. AIR LEAKAGE CONTROL AND EFFICIENT VENTILATION OPTIONS			
Only one option from Items 2.1 through 2.4 may be selected in this category.			
2.1	Compliance based on R402.4.1.2: Reduce the tested air leakage to 3.0 air changes per hour maximum at 50 Pascals For R-2 Occupancies, optional compliance based on Section R402.4.1.2: Reduce the tested air leakage to 0.3 cfm/ft2 maximum at 50 Pascals All whole house ventilation requirements as determined by Section M1507.3 of the International Residential Code or Section 403.8 of the International Mechanical Code shall be met with a high efficiency fan(s) (maximum 0.35 watts/cfm), not interlocked with the furnace fan (if present). Ventilation systems using a furnace including an ECM motor are allowed, provided that they are controlled to operate at low speed in ventilation only To qualify to claim this credit, the building permit drawings shall specify the option being selected, the maximum tested building air leakage, and shall show the qualifying ventilation system and its control sequence of operation.	0.5	1.0
3. HIGH EFFICIENCY HVAC EQUIPMENT OPTIONS			
3.5a	Air-source, centrally ducted heat pump with minimum HSPF of 11.0. To qualify to claim this credit, the building permit drawings shall specify the option being selected and shall specify the heating equipment type and the minimum equipment efficiency.	1.5	N/A

TABLE 406.3 2018 ENERGY CREDITS			
OPTION	DESCRIPTION	CREDIT(S)	
		All Other	Group R-2
4. HIGH EFFICIENCY HVAC DISTRIBUTION SYSTEM OPTIONS			
4.1	All supply and return ducts located in an unconditioned attic shall be deeply buried in ceiling insulation in accordance with Section R403.3.7. For mechanical equipment located outside the conditioned space, a maximum of 10 linear feet of return duct and 5 linear feet of supply duct connections to the equipment may be outside the deeply buried insulation. All metallic ducts located outside the conditioned space must have both the ends and all joints sealed with mastic. If flex ducts are used, the maximum length shall be limited to 3 cfm per 100 square feet of conditioned space. Air handler(s) shall be located within the conditioned space.	0.5	0.5
5. EFFICIENT WATER HEATING OPTIONS			
5.3	Water heating system shall include one of the following: Energy Star rated gas or propane water heater with a minimum UEF of 0.91 or Solar water heating supplementing a minimum standard water heater. Solar water heating will provide a rated minimum savings of 85 therms or 2000 kWh based on the Solar Rating and Certification Corporation (SRCC) Annual Performance of OG-300 Certified Solar Water Heating Systems or Water heater heated by ground source heat pump meeting the requirements of Option 3.3. To qualify to claim this credit, the building permit drawings shall specify the option being selected and shall specify the water heater equipment type and the minimum equipment efficiency and, for solar water heating systems, the calculation of the minimum energy savings.	1.0	1.0
7. APPLIANCE PACKAGE OPTION			
7.1	All of the following appliances shall be new and installed in the dwelling unit and shall meet the following standards: Dishwasher – Energy Star rated Refrigerator (if provided) – Energy Star rated Washing machine – Energy Star rated Dryer – Energy Star rated, ventless dryer with a minimum CEF rating of 5.2. To qualify to claim this credit, the building permit drawings shall specify the option being selected and shall show the appliance type and provide documentation of Energy Star compliance. At the time of inspection, all appliances shall be installed and connected to utilities. Dryer ducts and exterior dryer vent caps are not permitted to be installed in the dwelling unit.	0.5	1.5

2018 Washington State Energy Code – Residential
**Prescriptive Energy Code Compliance for All Climate Zones in Washington
 Single Family – New & Additions (effective February 1, 2021)**

These requirements apply to all IRC building types, including detached one- and two-family dwellings and multiple single-family dwellings (townhouses).

Project Information	Contact Information

Instructions: This single-family project will use the requirements of the Prescriptive Path below and incorporate the minimum values listed. Based on the size of the structure, the appropriate number of additional credits are checked as chosen by the permit applicant.

Provide all information from the following tables as building permit drawings: Table R402.1 - Insulation and Fenestration Requirements by Component, Table R406.2 - Fuel Normalization Credits and 406.3 - Energy Credits.

Authorized Representative	Date

All Climate Zones (Table R402.1.1)		
	R-Value a	U-Factor a
Fenestration U-Factor b	n/a	0.28
Skylight U-Factor b	n/a	0.50
Glazed Fenestration SHGC b,e	n/a	n/a
Ceiling	49j	0.026
Wood Frame Wall g,h	21 int	0.056
Floor	38	0.026
Below Grade Wall c,h	10/15/21 int + TB	0.042
Slab d,f R-Value & Depth	10, 2 ft	n/a

R-values are minimums. U-factors and SHGC are maximums. When insulation is installed in a cavity that is less than the label or design thickness of the insulation, the compressed R-value of the insulation from Appendix Table A101.4 shall not be less than the R-value specified in the table.

b. The fenestration U-factor column excludes skylights.

c. "10/15/21 +5TB" means R-10 continuous insulation on the exterior of the wall, or R-15 continuous insulation on the interior of the wall, or R-21 cavity insulation plus a thermal break between the slab and the basement wall at the interior of the basement wall. "10/15/21 +5TB" shall be permitted to be met with R-13 cavity insulation on the interior of the basement wall plus R-5 continuous insulation on the interior or exterior of the wall. "5TB" means R-5 thermal break between floor slab and basement wall.

d. R-10 continuous insulation is required under heated slab on grade floors. See Section R402.2.9.1.

e. For single rafter- or joist-vaulted ceilings, the insulation may be reduced to R-38 if the full insulation depth extends over the top plate of the exterior wall.

f. R-7.5 continuous insulation installed over an existing slab is deemed to be equivalent to the required perimeter slab insulation when applied to existing slabs complying with Section R503.1.1. If foam plastic is used, it shall meet the requirements for thermal barriers protecting foam plastics.

g. For log structures developed in compliance with Standard ICC 400, log walls shall meet the requirements for climate zone 5 of ICC 400.

h. Int. (intermediate framing) denotes framing and insulation as described in Section A103.2.2 including standard framing 16 inches on center, 78% of the wall cavity insulated and headers insulated with a minimum of R-10 insulation.

Vertical Fenestration (Windows and doors)							
Component Description	Ref.	U-factor	Width		Height	Area	UA
			Qt	Feet Inch			
ENTRY		0.28	1	6	4	24.0	6.72
GREAT RM		0.28	1	10	11	110.0	30.80
GREAT RM		0.28	2	4	8	68.0	19.04
GREAT RM		0.28	1	12	8	96.0	26.88
GREAT RM		0.28	1	4	6	24.0	6.72
DINING		0.28	1	2	6	12.0	3.36
DINING		0.28	1	12	8	96.0	26.88
DINING		0.28	1	10	8	80.0	22.40
KITCHEN		0.28	1	6	4	24.0	6.72
HALL DECK DOOR		0.28	1	2	6	20.0	5.60
LAUNDRY		0.28	1	4	2	10.0	2.80
GUEST		0.28	2	2	4	18.0	5.04
GUEST		0.28	1	7	6	42.0	11.76
FOYER		0.28	1	4	6	24.0	6.72
STAIR / FOYER		0.28	1	4	6	24.0	6.72
ATTIC		0.28	2	7	3	49.0	13.72
ATTIC		0.28	1	4	3	14.0	3.92
UPPER HALL		0.28	1	4	6	24.0	6.72
MASTER SUITE		0.28	2	12	8	192.0	53.76
MASTER BATH		0.28	1	6	4	27.0	7.56
MASTER BATH		0.28	1	3	4	13.5	3.78
MASTER BATH		0.28	1	2	4	8.0	2.24
BATH		0.28	1	2	6	11.3	3.15
BDRM 3		0.28	2	1	4	9.0	2.52
BDRM 3		0.28	1	7	4	31.5	8.82
		0.28				0.0	0.00
		0.28				0.0	0.00

Sum of Vertical Fenestration Area and UA **1019.8 285.53**
 Vertical Fenestration Area Weighted U = UA/Area **0.28**

Overhead Glazing (Skylights)							
Component Description	Ref.	U-factor	Width		Height	Area	UA
			Qt	Feet Inch			
						0.0	0.00
						0.0	0.00
						0.0	0.00

Sum of Overhead Glazing Area and UA **0.0 0.00**
 Overhead Glazing Area Weighted U = UA/Area **0.00**

Total Sum of Fenestration Area and UA (for heating system sizing calculations) 1019.8 285.53

Simple Heating System Size: Washington State
 This heating system sizing calculator is based on the Prescriptive Requirements of the 2015 Washington State Energy Code (WSEC) and ACCA Manuals J and S. This calculator will calculate heating loads only. ACCA procedures for sizing cooling systems should be used to determine cooling loads.

Please fill out all of the green drop-downs and boxes that are applicable to your project. As you make selections in the drop-downs for each section, some values will be calculated for you. If you do not see the selection you need in the drop-down options, please call the WSU Energy Extension Program at (360) 956-2042 for assistance.

Project Information	Contact Information

Heating System Type: All Other Systems Heat Pump

Design Temperature: Design Temperature Difference (ΔT) **45**
 ΔT = Indoor (70 degrees) - Outdoor Design Temp

Area of Building
 Conditioned Floor Area Conditioned Volume **25,038**
 Average Ceiling Height Average Ceiling Height (ft)

Glazing and Doors
 Instruction: U-Factor X Area = UA
 0.280 X 1,020 = 285.60

Skylights
 Instruction: U-Factor X Area = UA
 0.50 X --- = ---

Insulation
 Attic
 Instruction: U-Factor X Area = UA
 No selection X --- = ---

Single Rafter or Joist Vaulted Ceilings
 Instruction: U-Factor X Area = UA
 0.020 X 1,579 = 31.58

Above Grade Walls (see Figure 1)
 Instruction: U-Factor X Area = UA
 0.056 X 3,852 = 215.71

Floors
 Instruction: U-Factor X Area = UA
 0.025 X 1,315 = 32.88

Below Grade Walls (see Figure 1)
 Instruction: U-Factor X Area = UA
 0.042 X 747 = 31.37

Slab Below Grade (see Figure 1)
 Instruction: F-Factor X Length = UA
 0.303 X 83 = 25.15

Slab on Grade (see Figure 1)
 Instruction: F-Factor X Length = UA
 No selection X --- = ---

Location of Ducts
 Instruction: Duct Leakage Coefficient **1.10**

Sum of UA **622.29**


Envelope Heat Load **28,003 Btu / Hour**
 Sum of UA X ΔT

Air Leakage Heat Load **12,168 Btu / Hour**
 Volume X 0.6 X ΔT X 0.18

Building Design Heat Load **40,172 Btu / Hour**
 Air Leakage + Envelope Heat Load

Building and Duct Heat Load **44,189 Btu / Hour**
 Ducts in unconditioned space. Sum of Building Heat Loss X 1.10
 Ducts in conditioned spaces. Sum of Building Heat Loss X 1


Maximum Heat Equipment Output **61,864 Btu / Hour**
 Building and Duct Heat Loss X 1.40 for Forced Air Furnace
 Building and Duct Heat Loss X 1.25 for Heat Pump

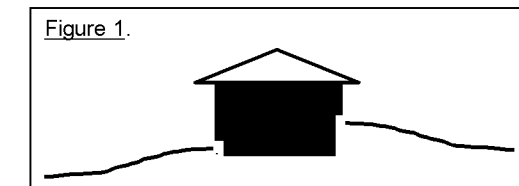

A NEW HOME AT:
 6175 SE 27TH STREET
 MERCER ISLAND, WA 98040

JOB NO: 23006
 DATE: 12/11/23
 DRWN. BY: TH
 REVISED:

SHEET NO.
 A7

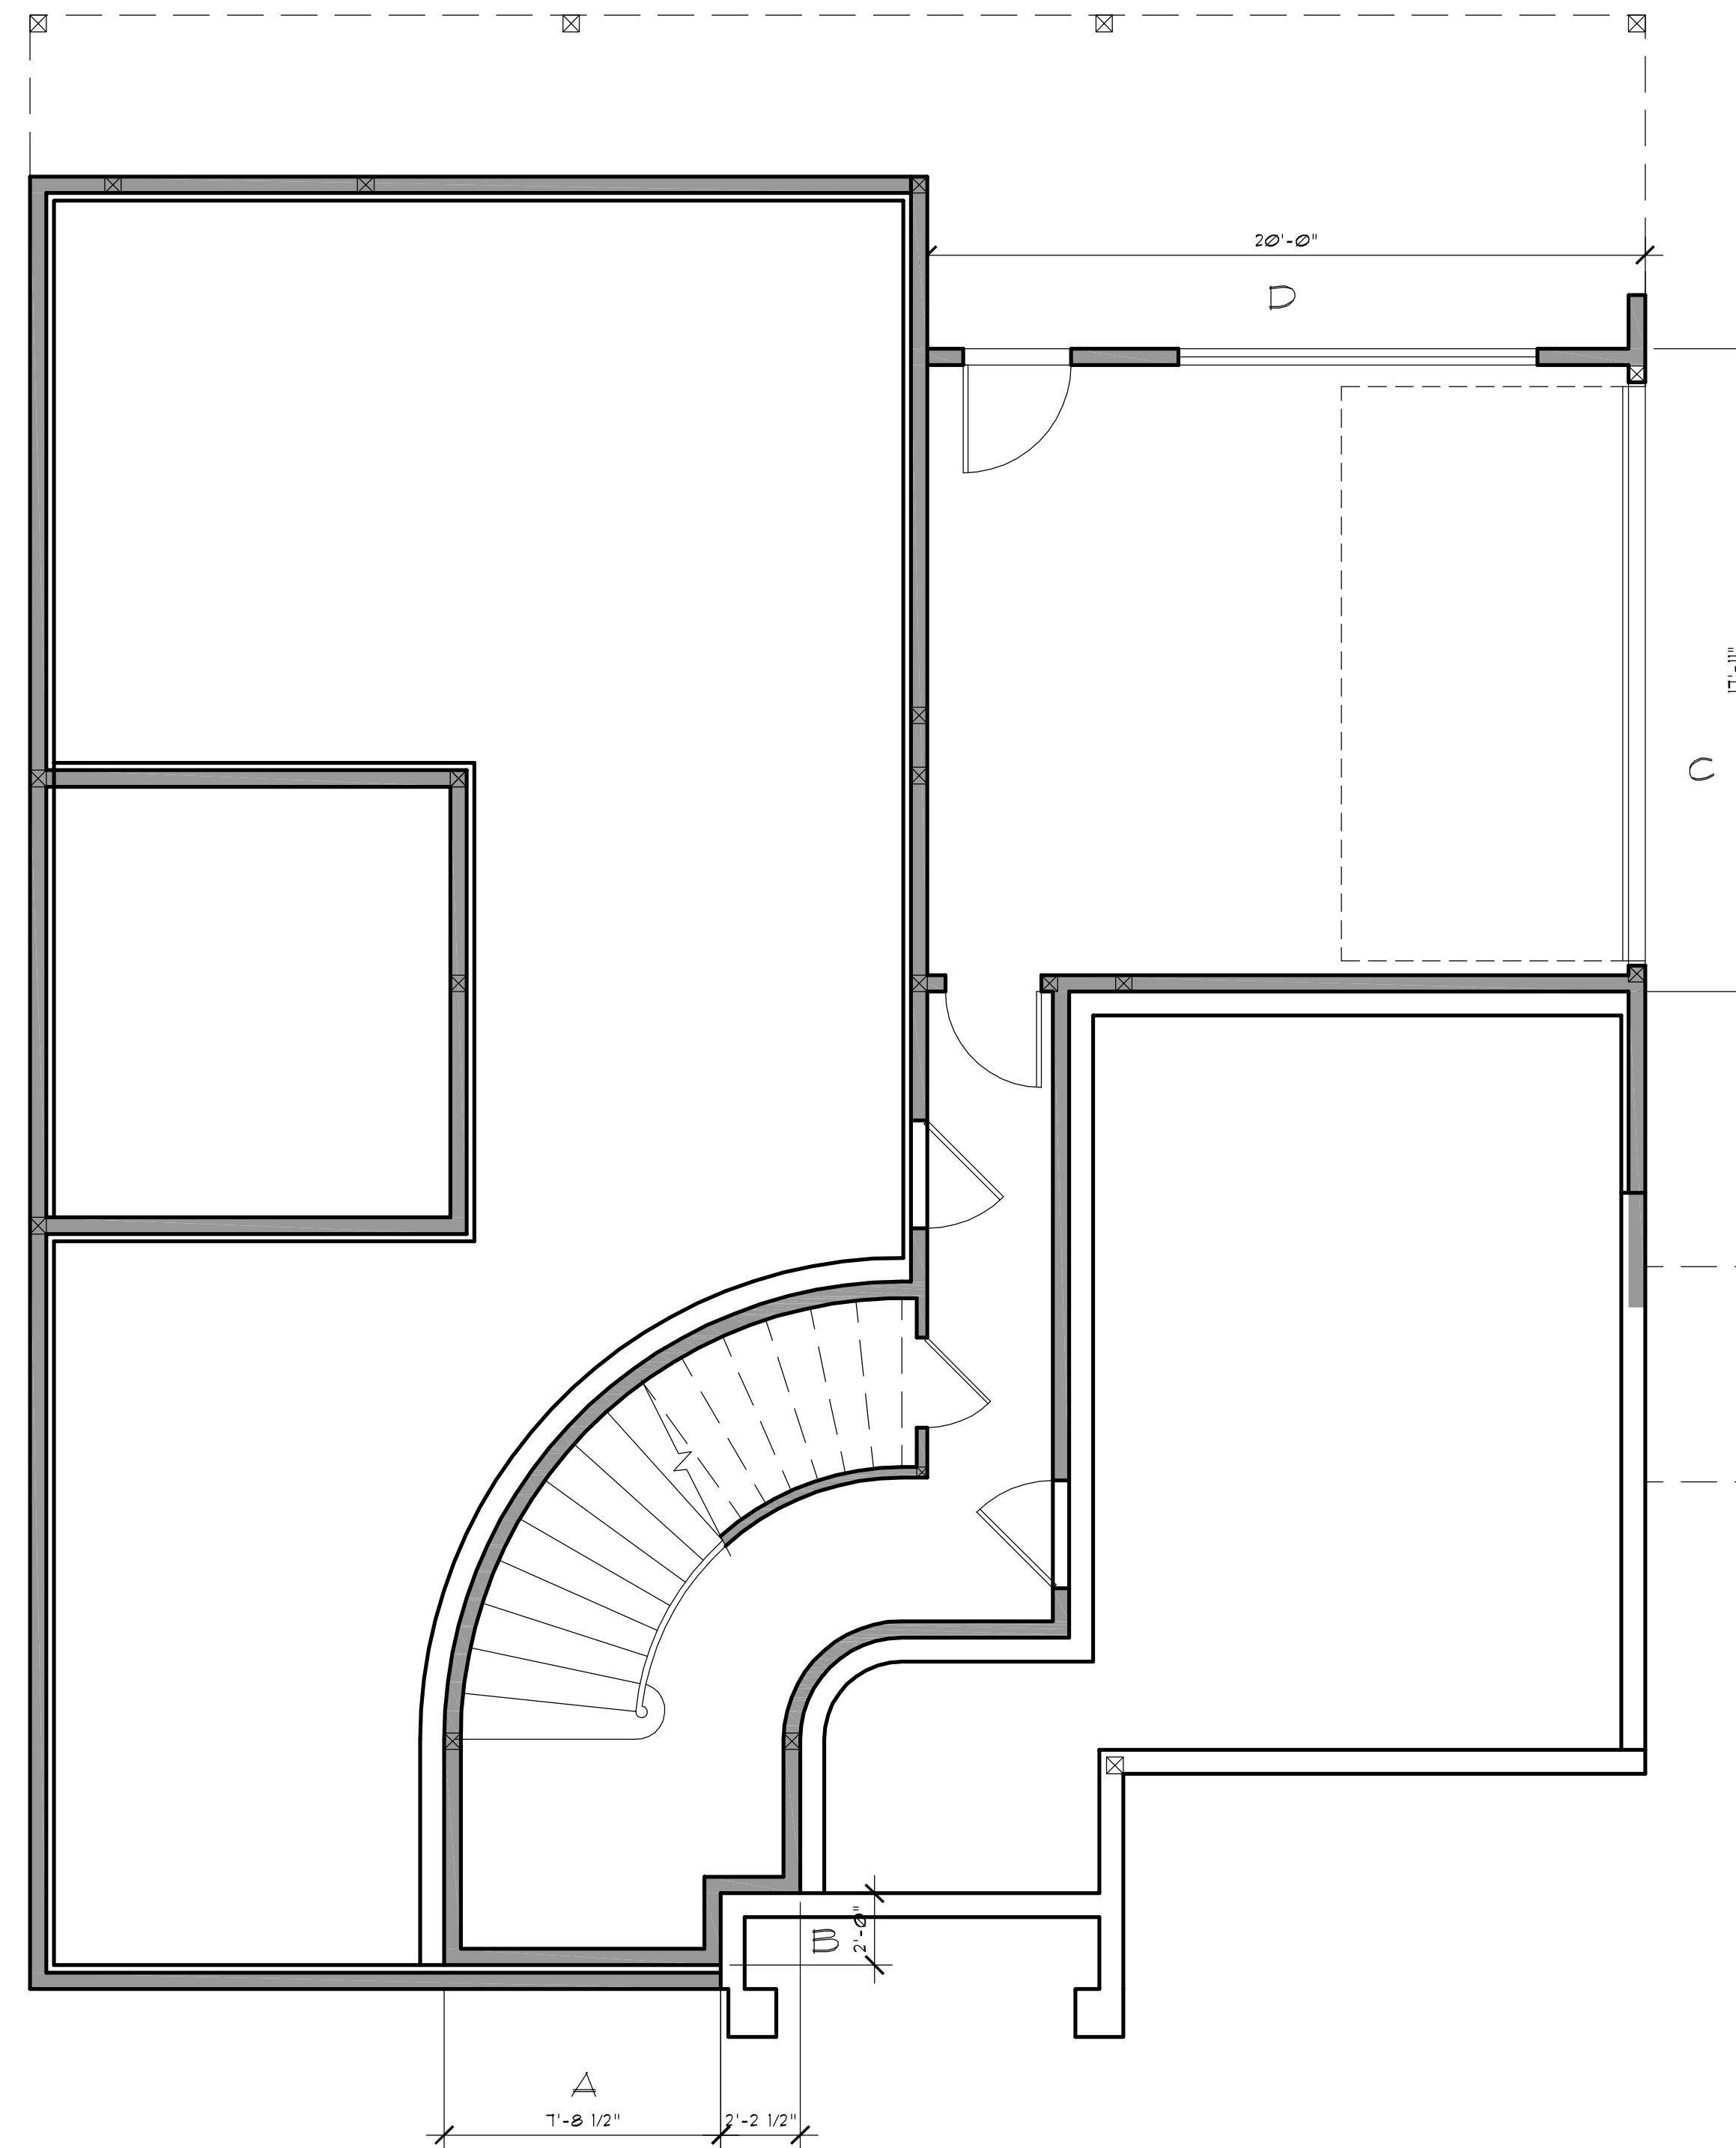

BASEMENT FLOOR AREA CALCULATION			
WALL	LENGTH	COVERAGE	RESULT
A	7.6'	36.4%	2.8%
B	2'	33%	.1%
C	18'	18.6%	3.5%
D	20'	8%	1.6%
TOTAL	47.6'		8.6%

PORTION OF EXCLUDED BASEMENT FLOOR AREA:
 $530 \text{ (ACTUAL SQ. FT. W/ GARAGE)} \times (8.6/47.6) = 95.61 \text{ SQ. FT.}$
 AREA OF BASEMENT EXCLUDED = $530 - 95.61 = 434.4 \text{ SQ. FT.}$

GROSS FLOOR AREA		
LOWER FLOOR W/ GARAGE	530	SQ. FT.
MAIN FLOOR W/ STAIR	1511	SQ. FT.
UPPER FLOOR W/ STAIR	1254	SQ. FT.
TOTAL	3361	SQ. FT.
BASEMENT EXCLUDED	95.61	SQ. FT.
TOTAL	3265	SQ. FT.
LOT AREA	7291	SQ. FT.
SQUARE FOOTAGE ALLOWED (45%)	3283.6	SQ. FT.











BASEMENT REDUCTION CALC
 SCALE: 1/4" = 1' - 0"

A NEW HOME AT:
 6115 SE 27TH STREET
 MERCER ISLAND, WA 98040

JOB NO: 23006
 DATE: 12/11/23
 DRAWN BY: TH
 REVISED:

SHEET NO.

A8

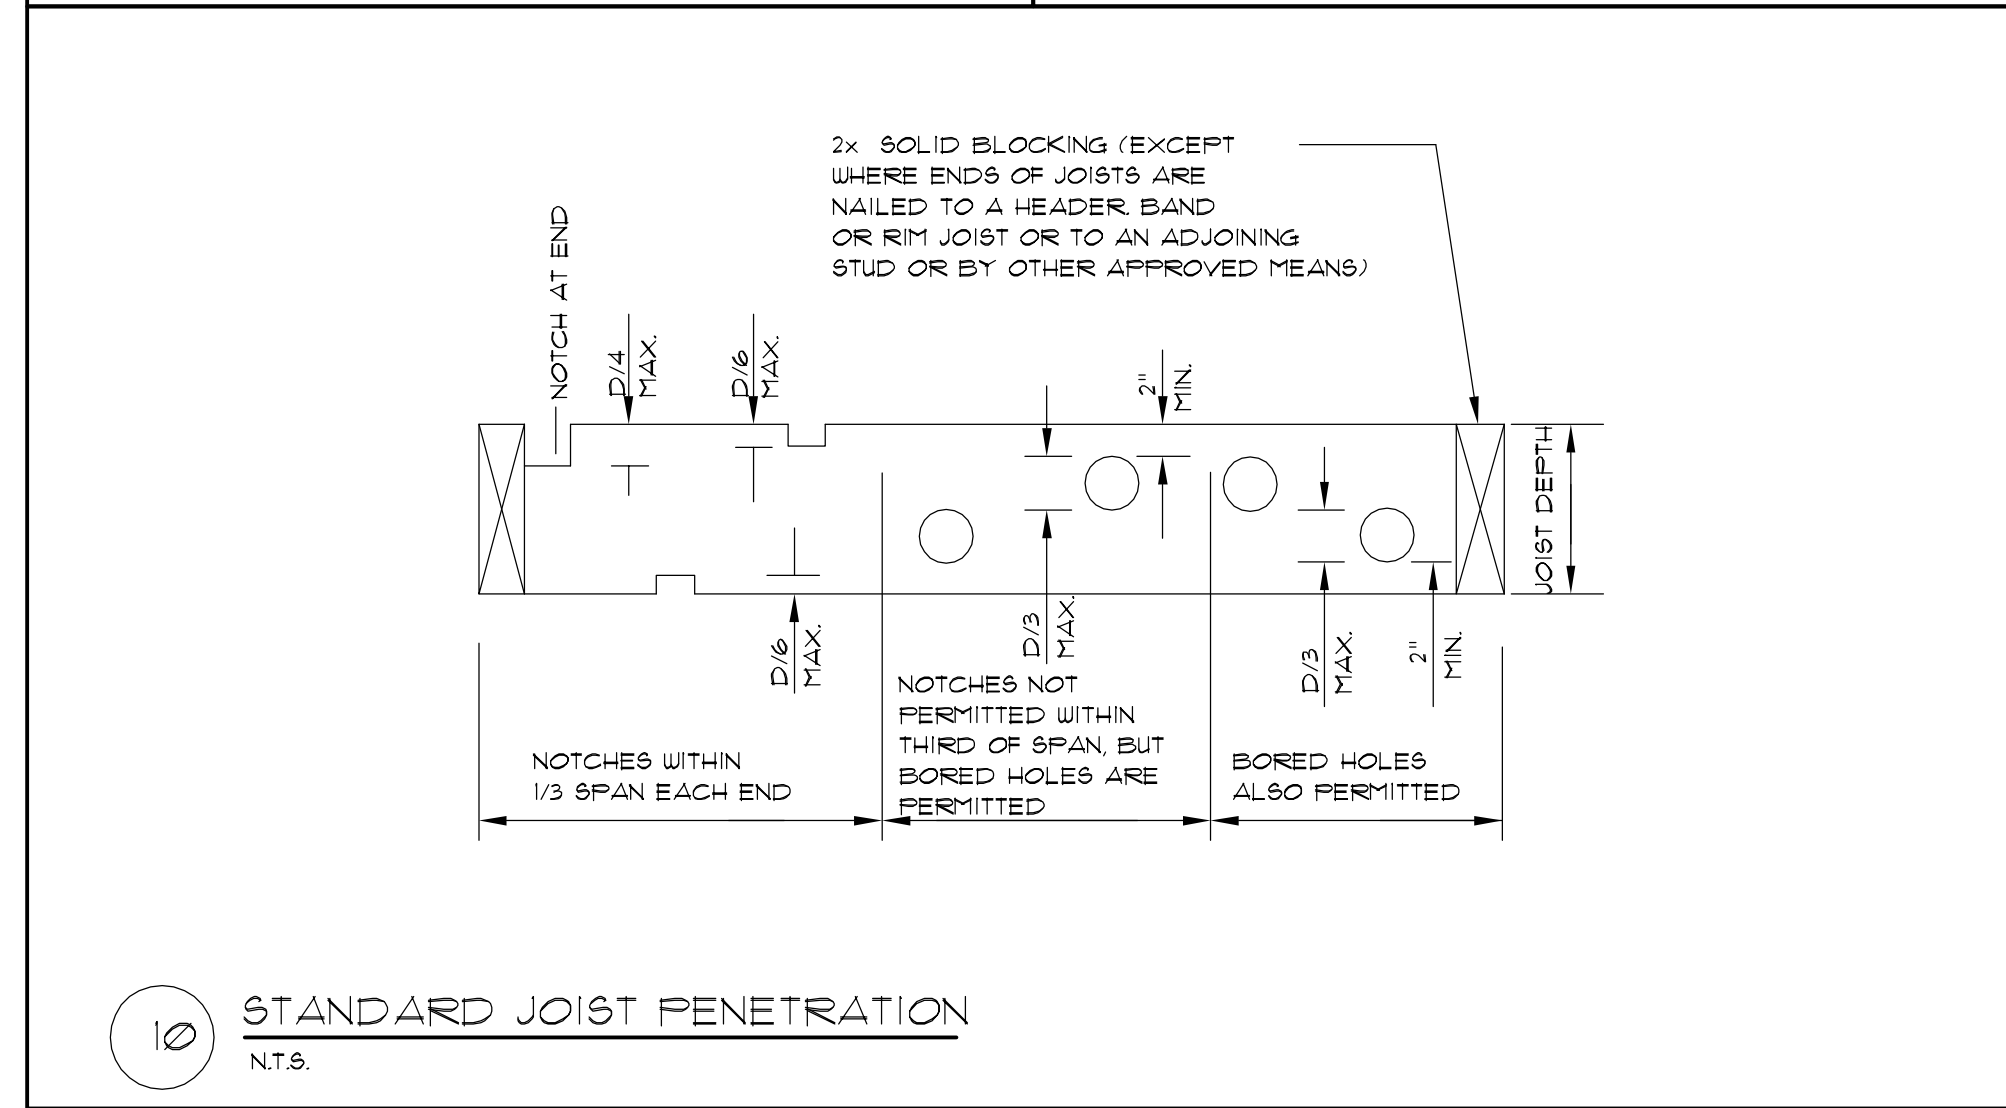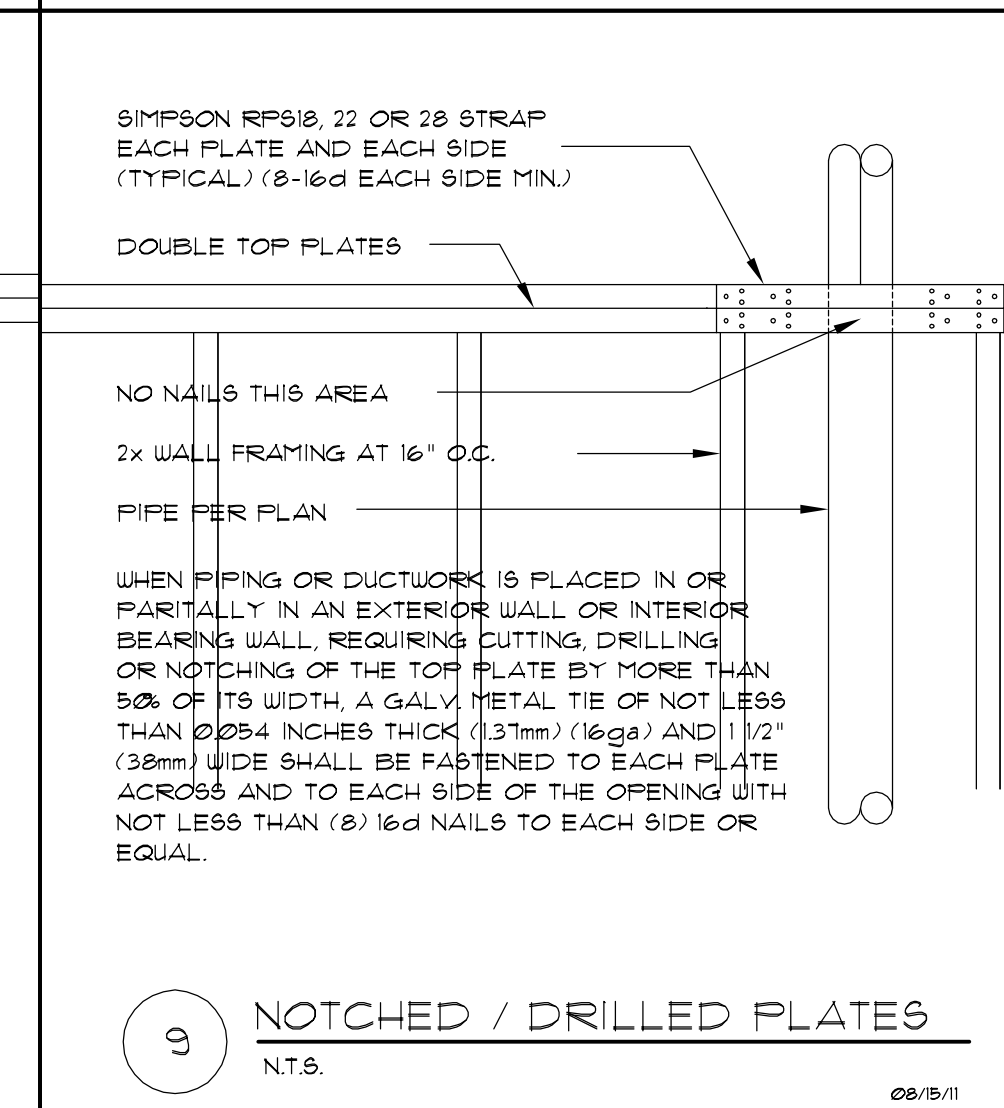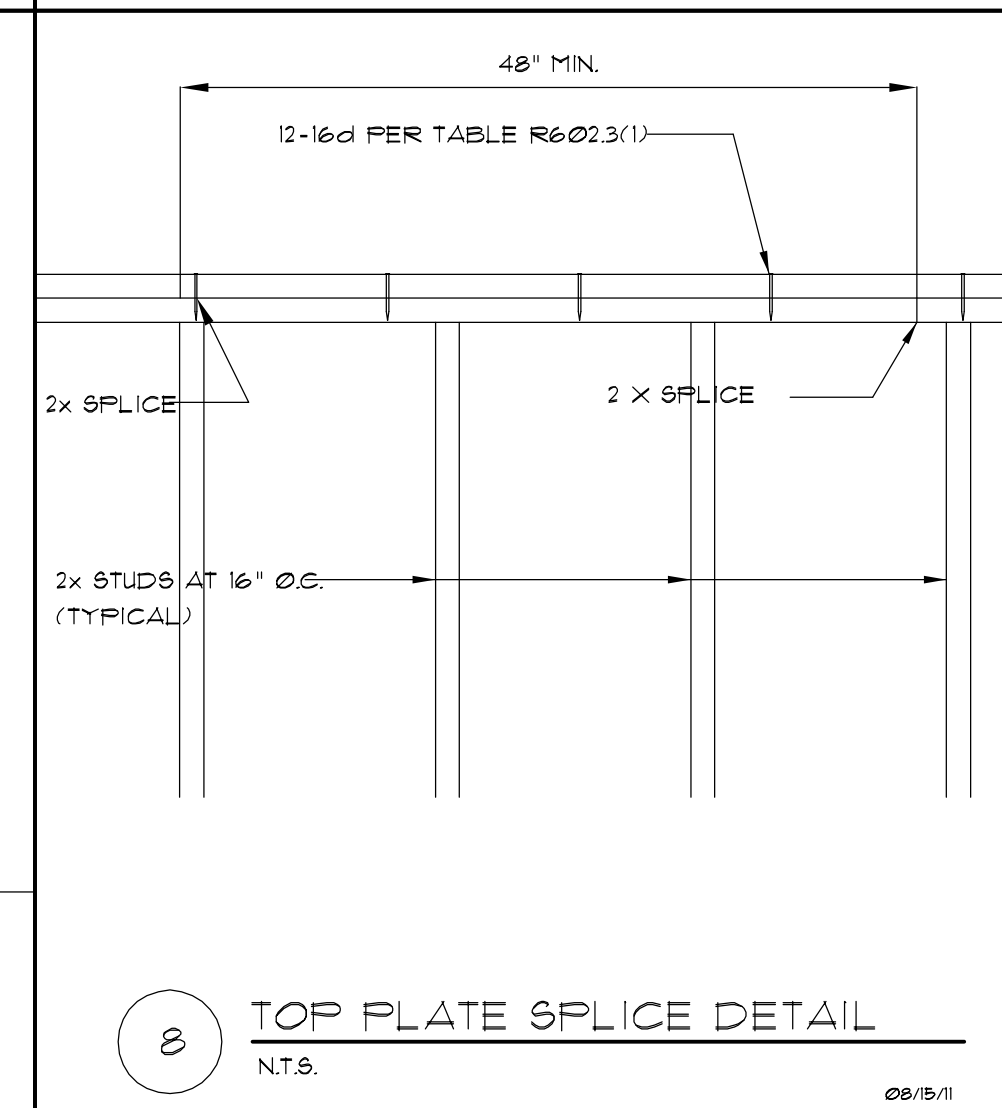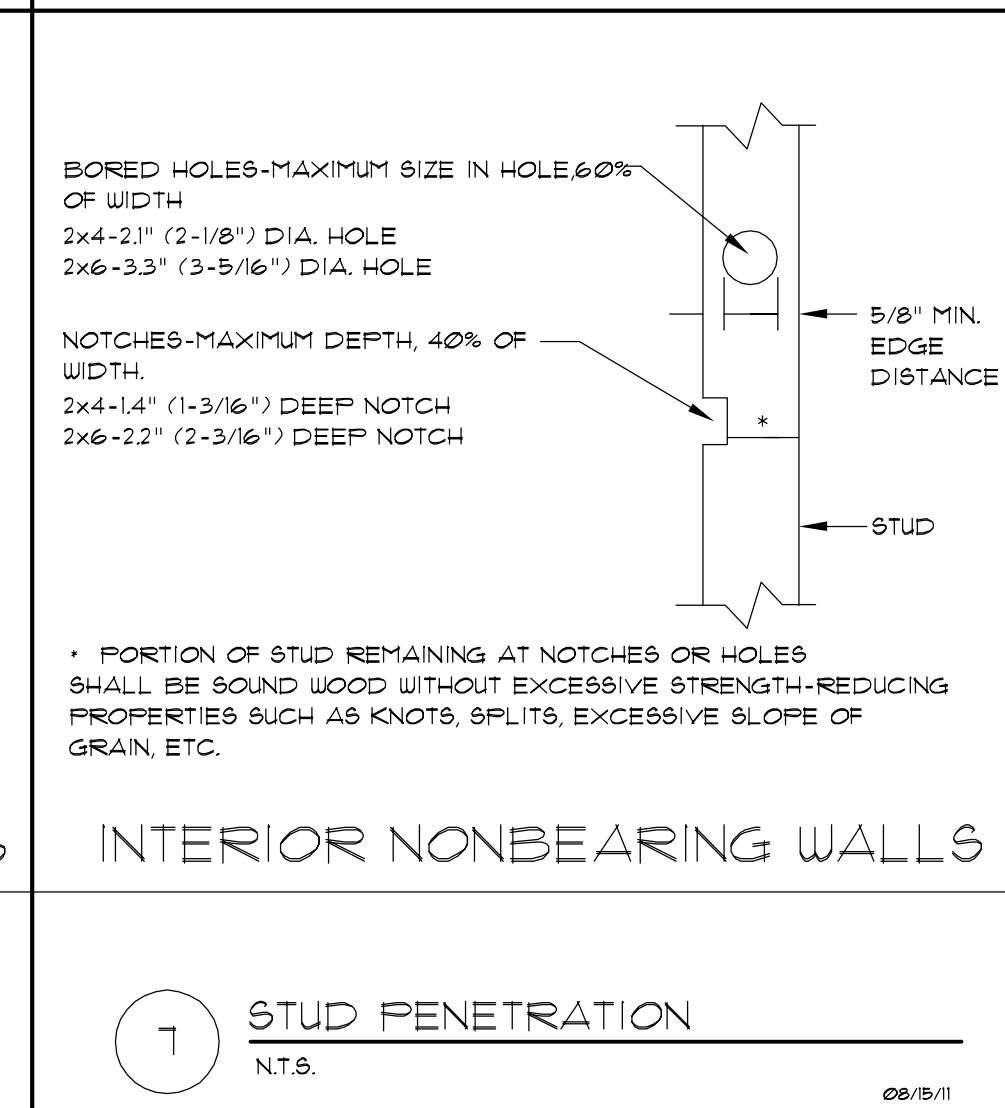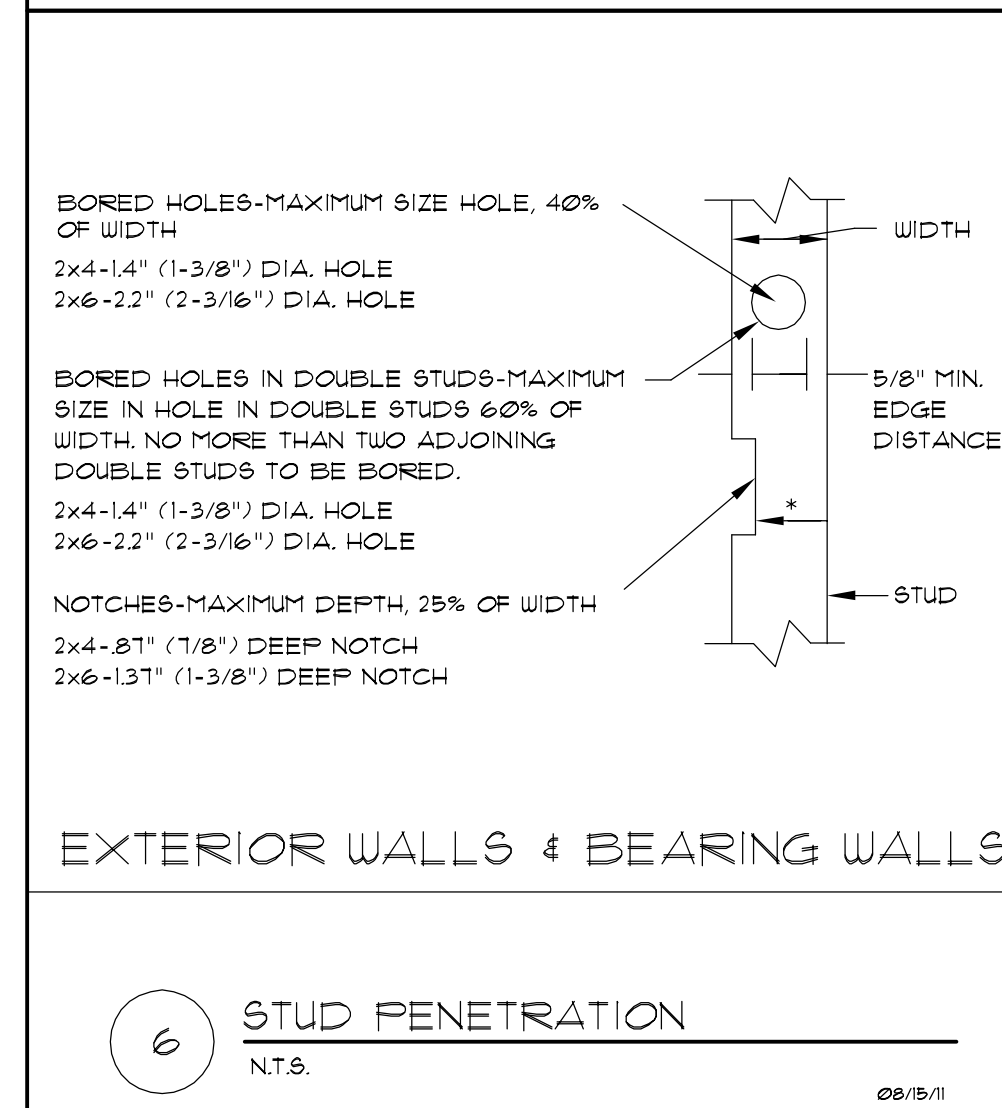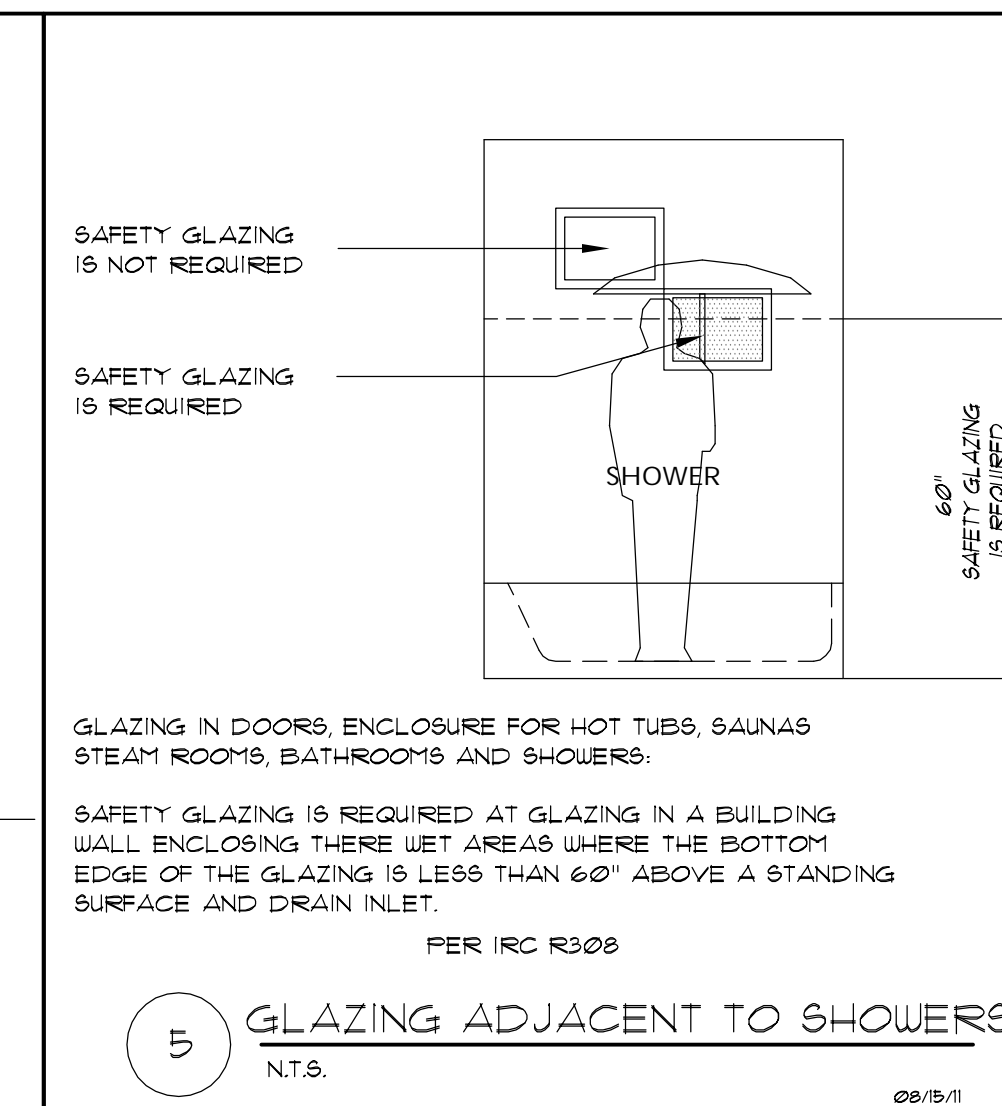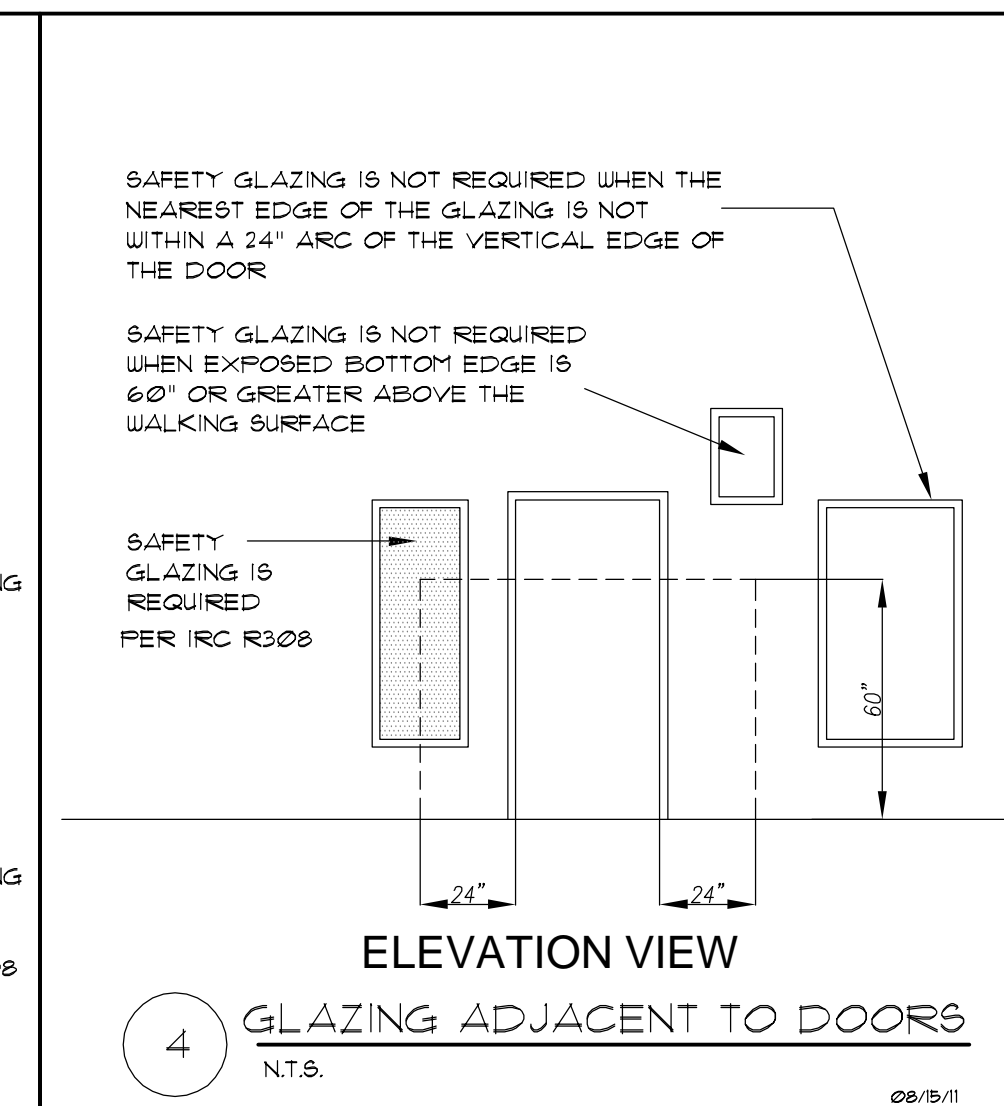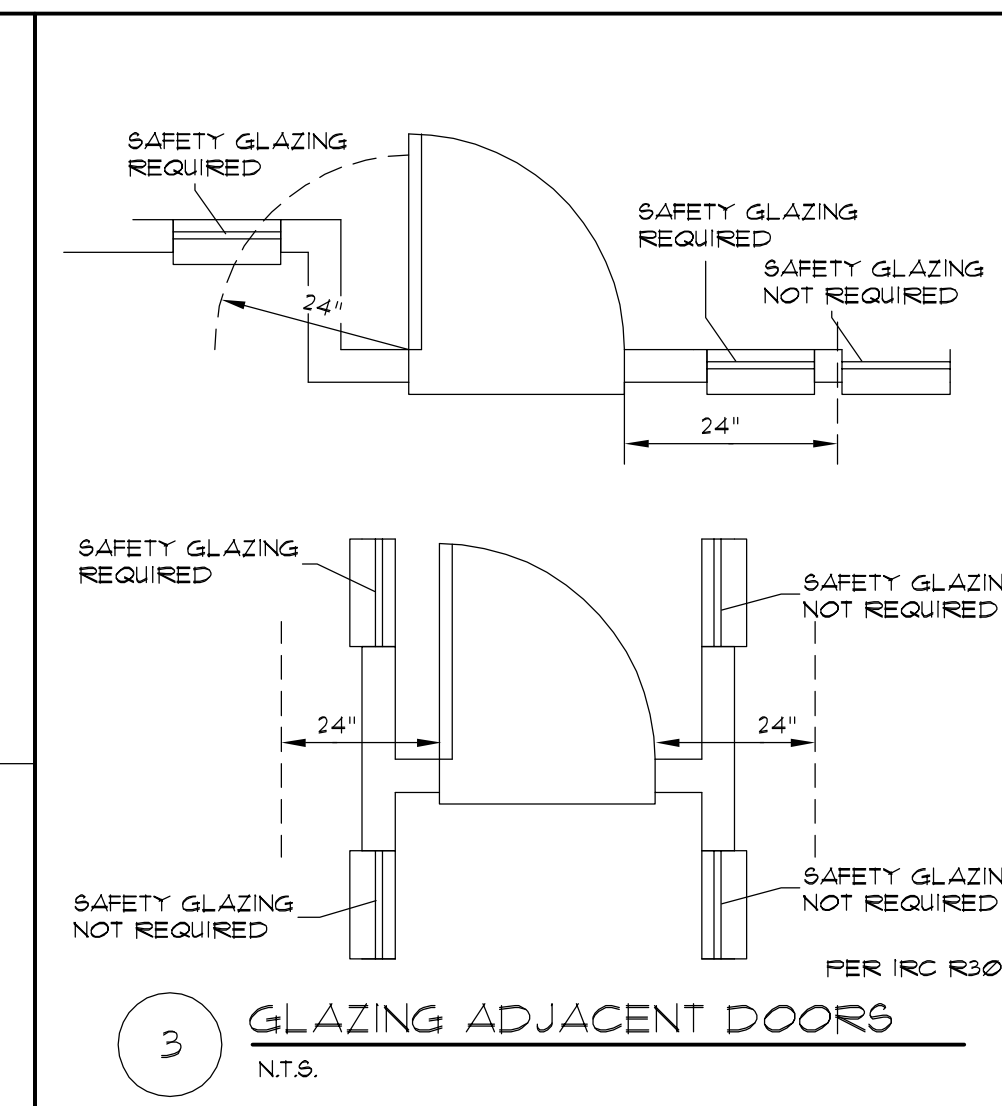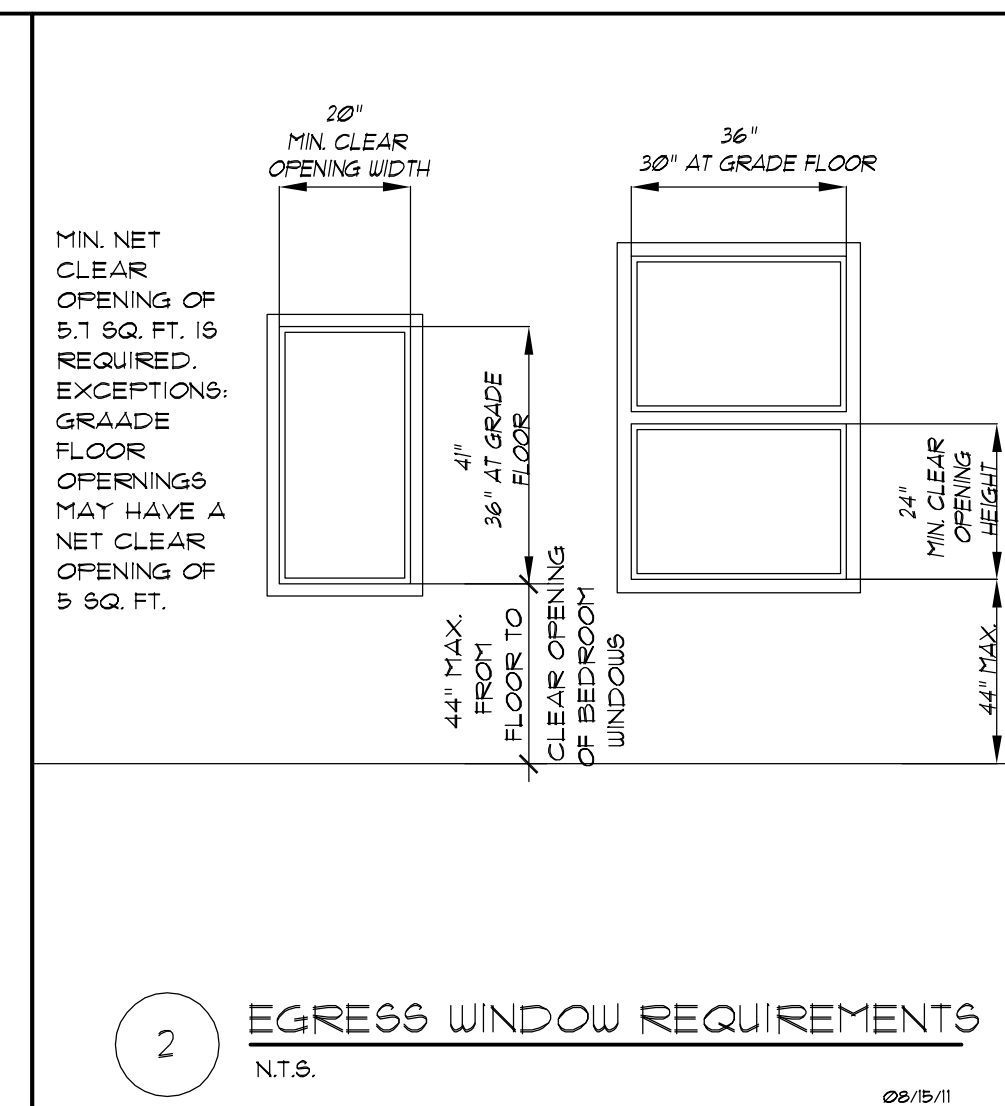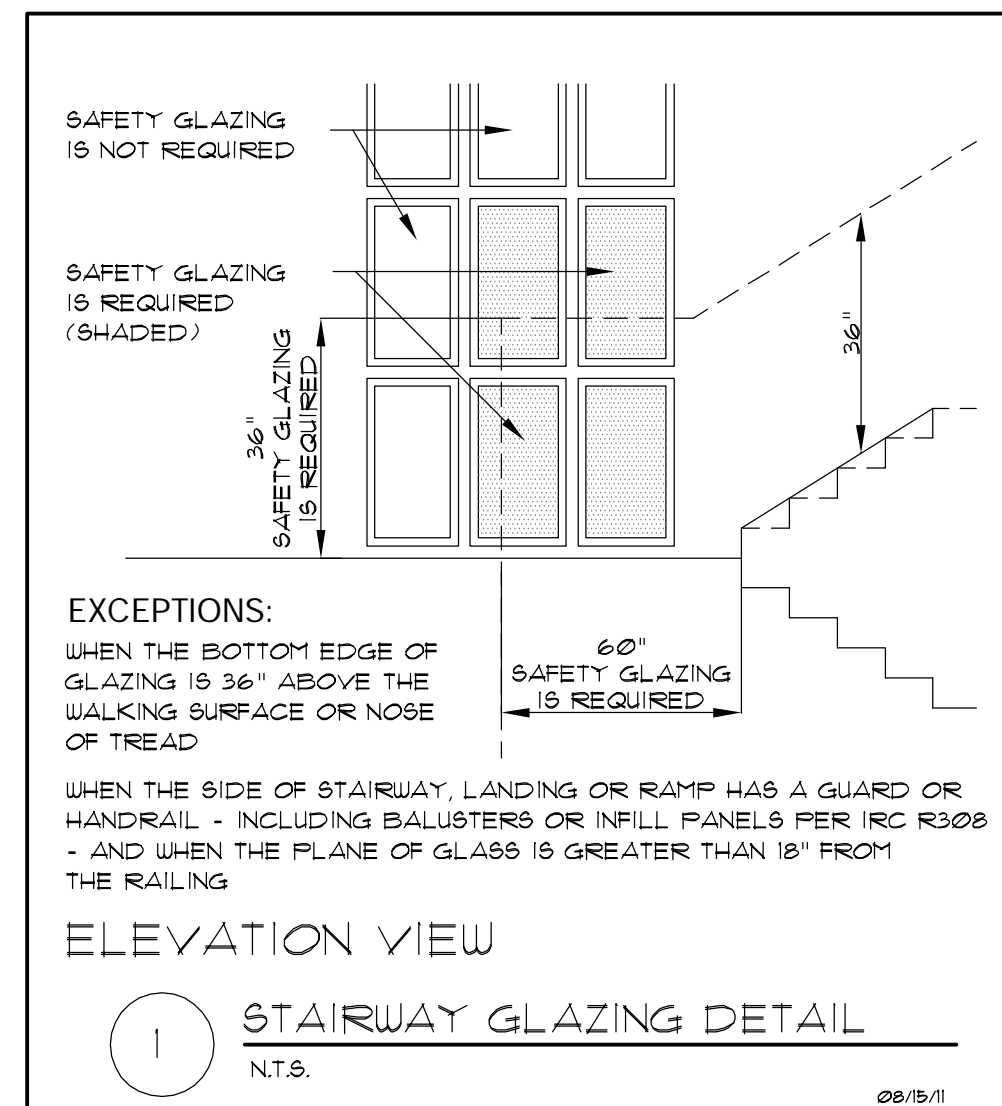


A NEW HOME AT:

6115 SE 27TH STREET
MERCER ISLAND, WA 98040


JOB NO: 23006
DATE: 12/11/23
DRWN. BY: TH
REVISED:

SHEET NO.


D1

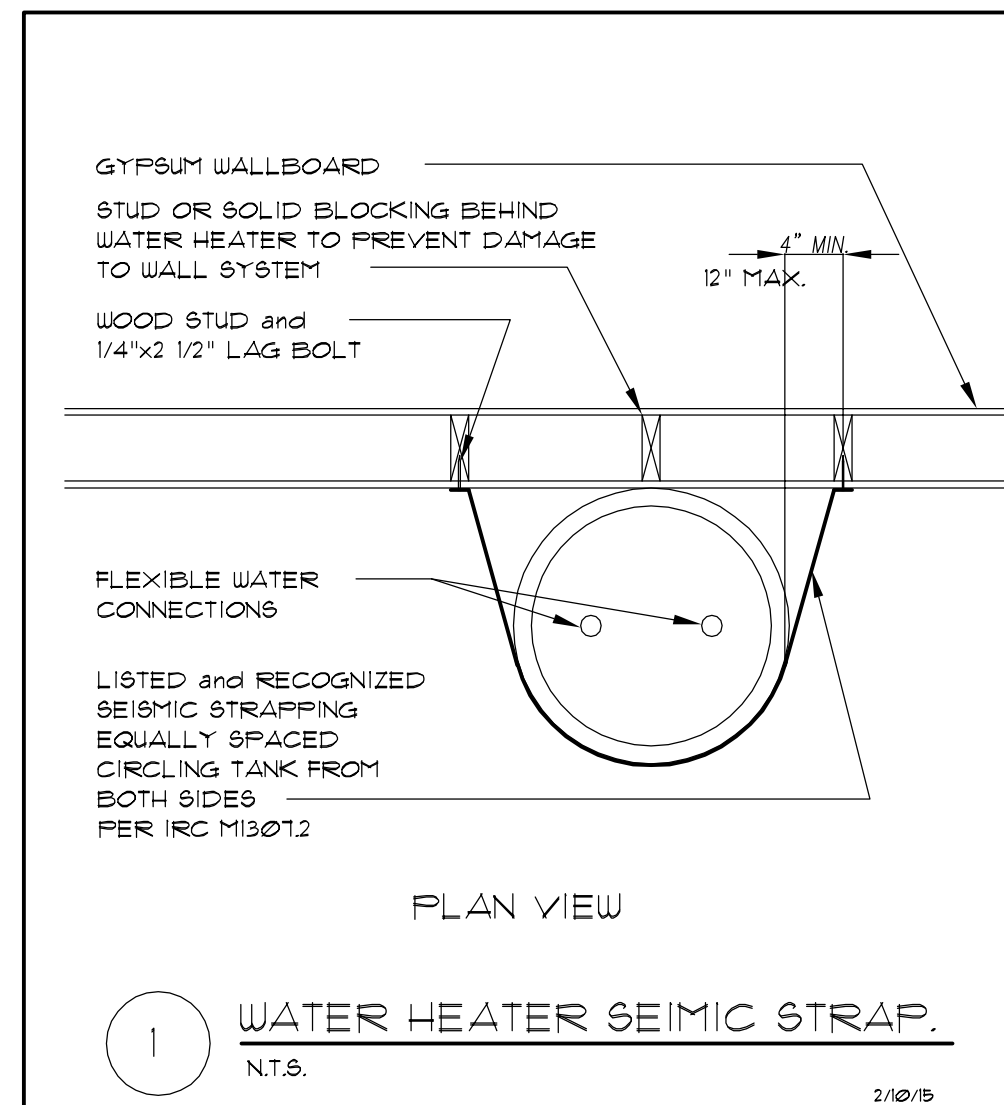


1 WATER HEATER SEISMIC STRAP.
N.T.S. 2/10/15

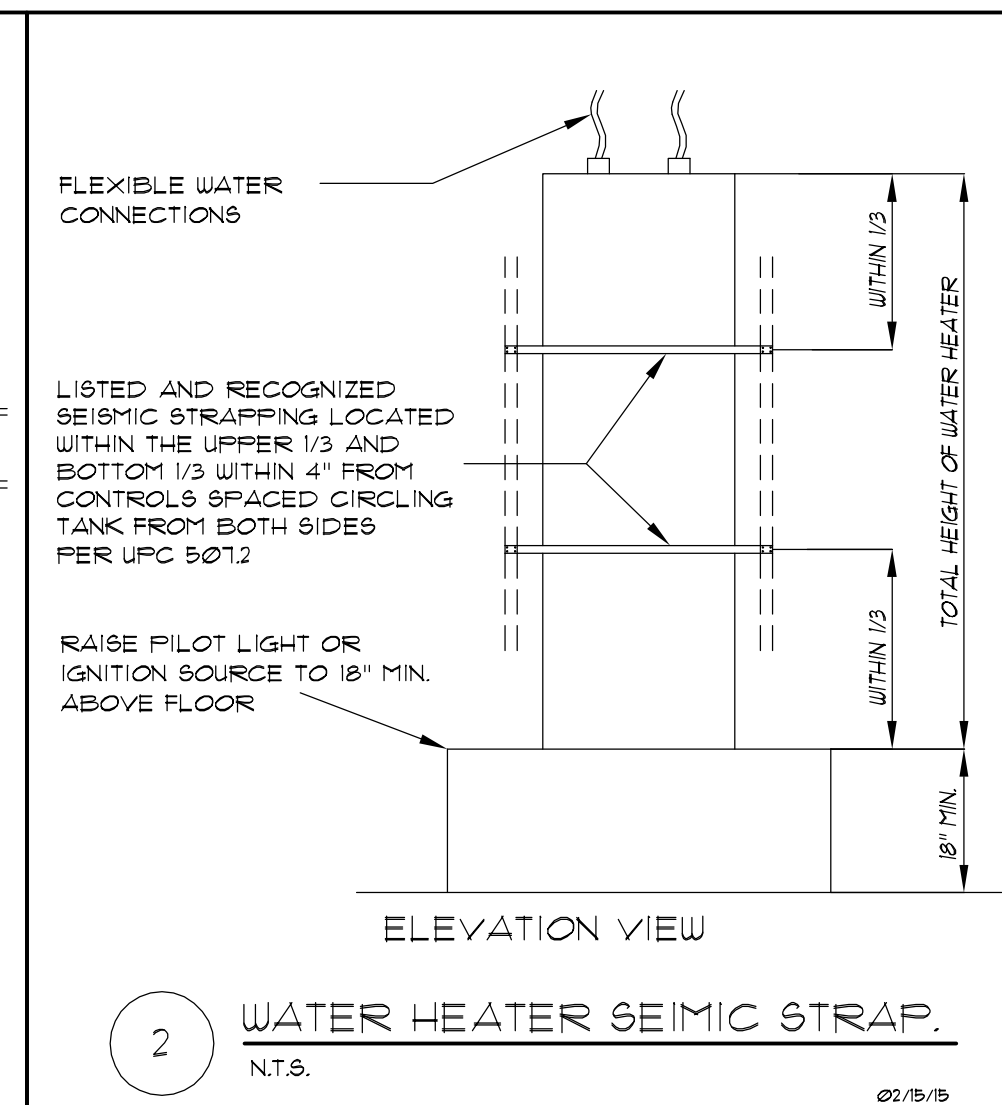


2 WATER HEATER SEISMIC STRAP.
N.T.S. 02/15/15

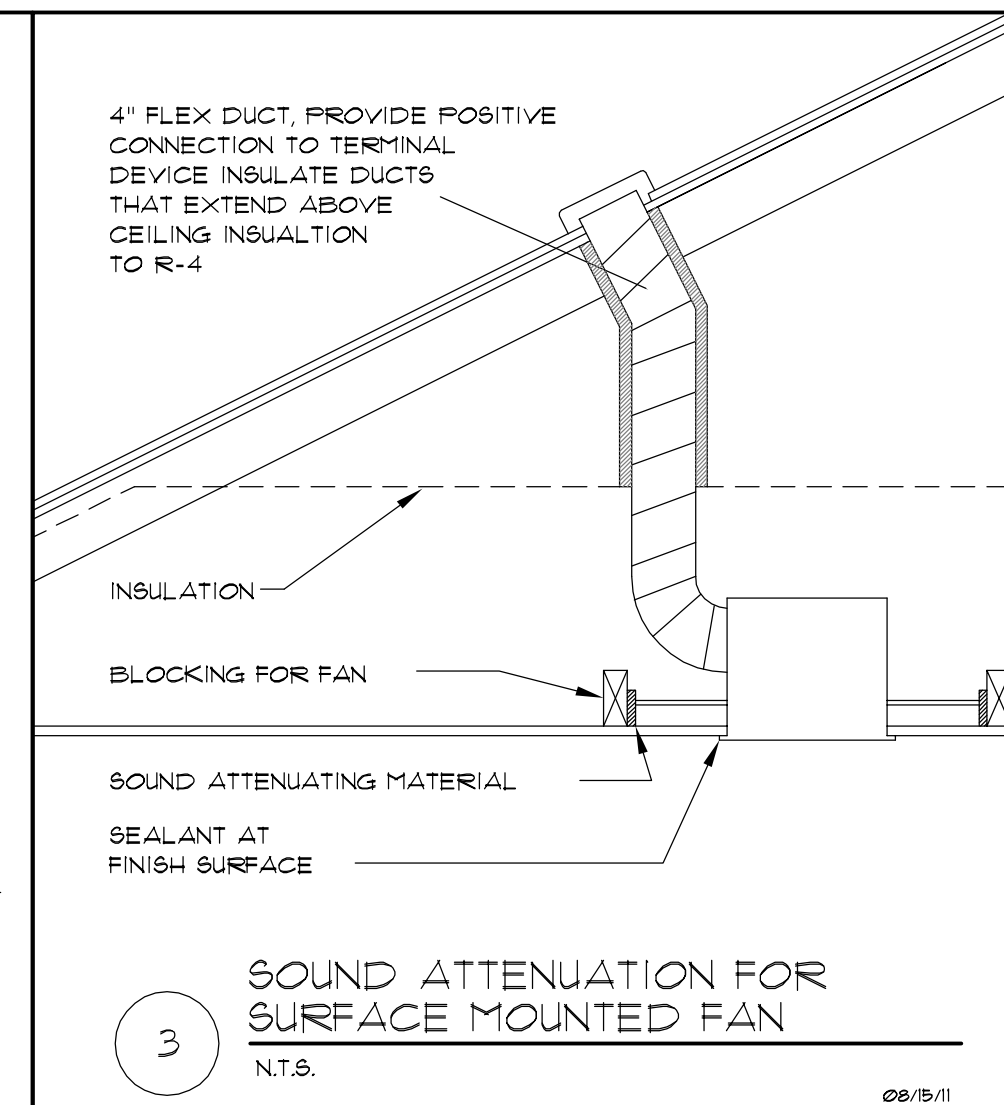


3 SOUND ATTENUATION FOR SURFACE MOUNTED FAN
N.T.S. 06/15/11

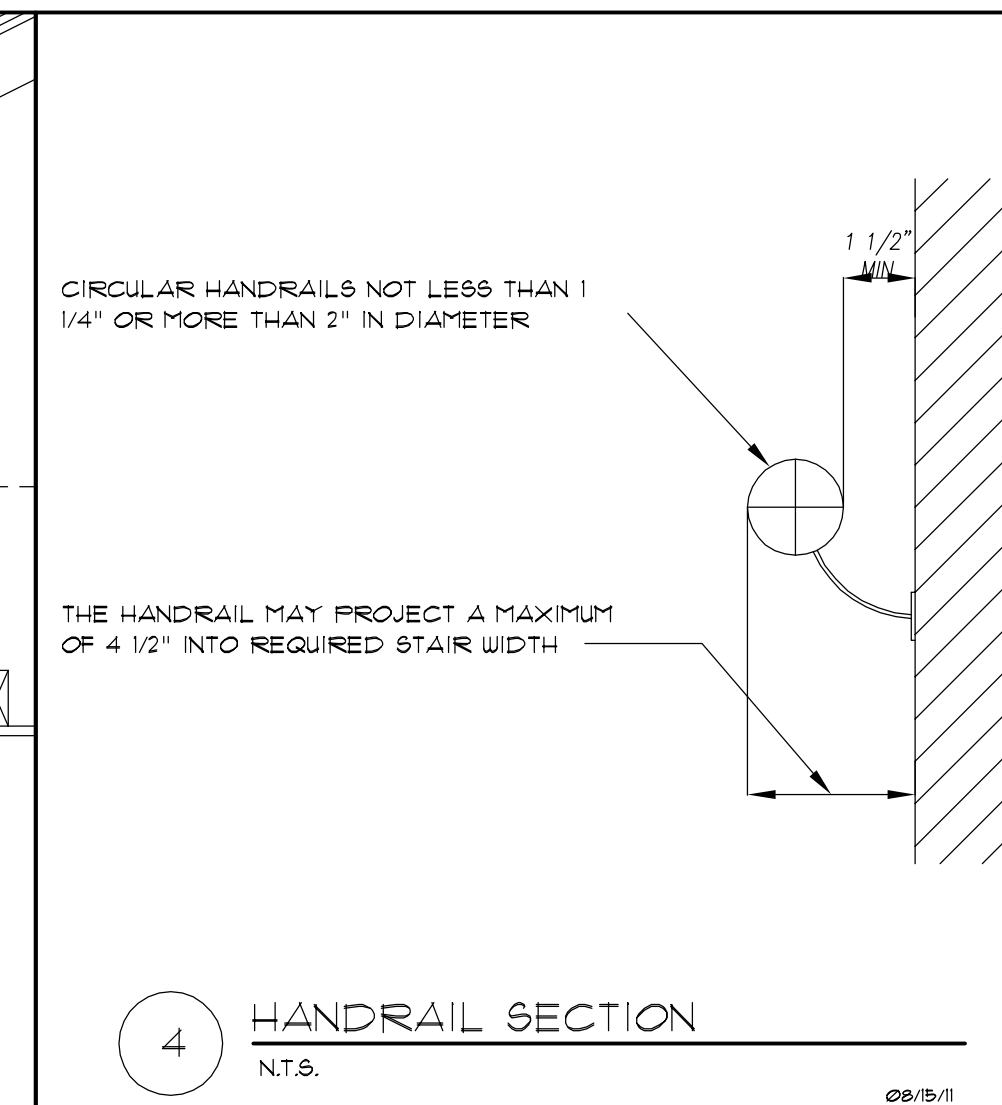


4 HANDRAIL SECTION
N.T.S. 06/15/11

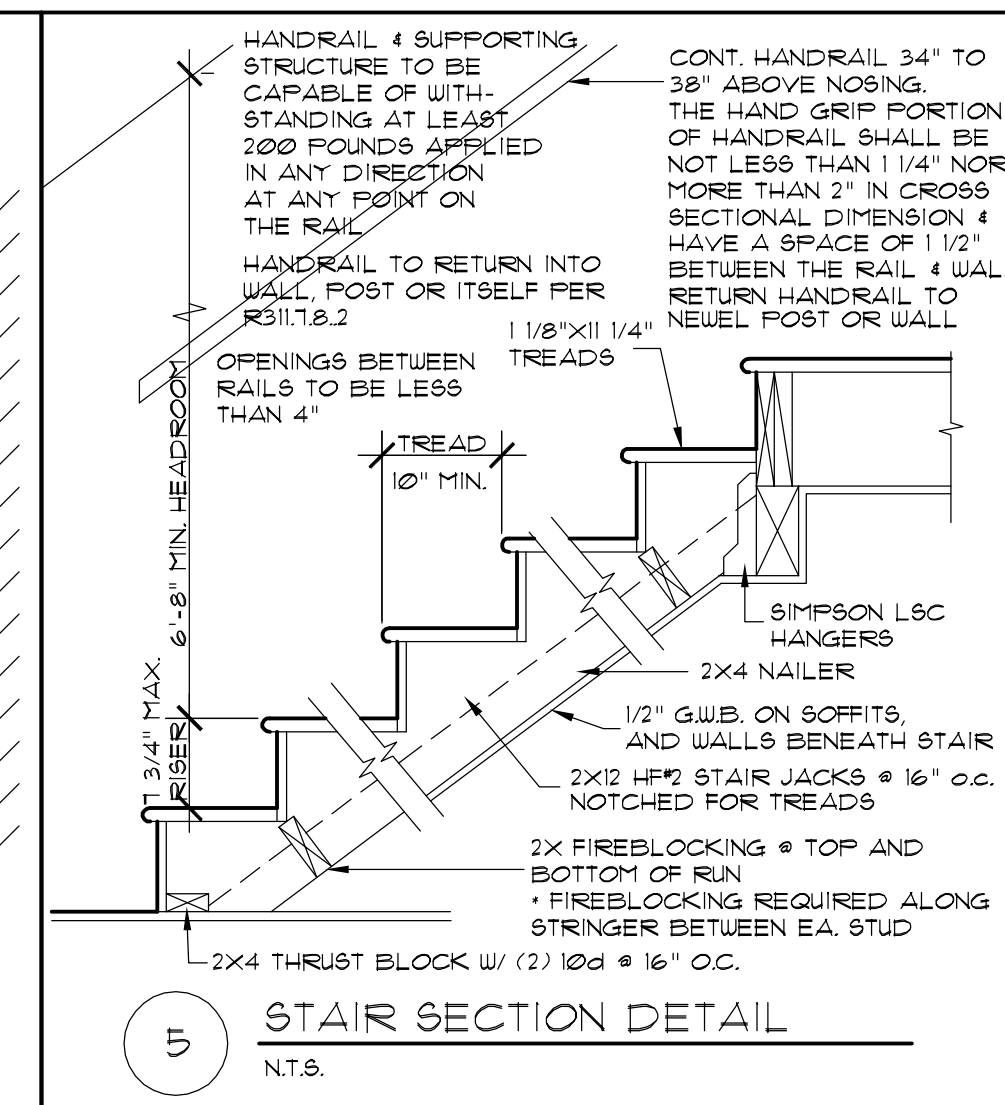


5 STAIR SECTION DETAIL
N.T.S.

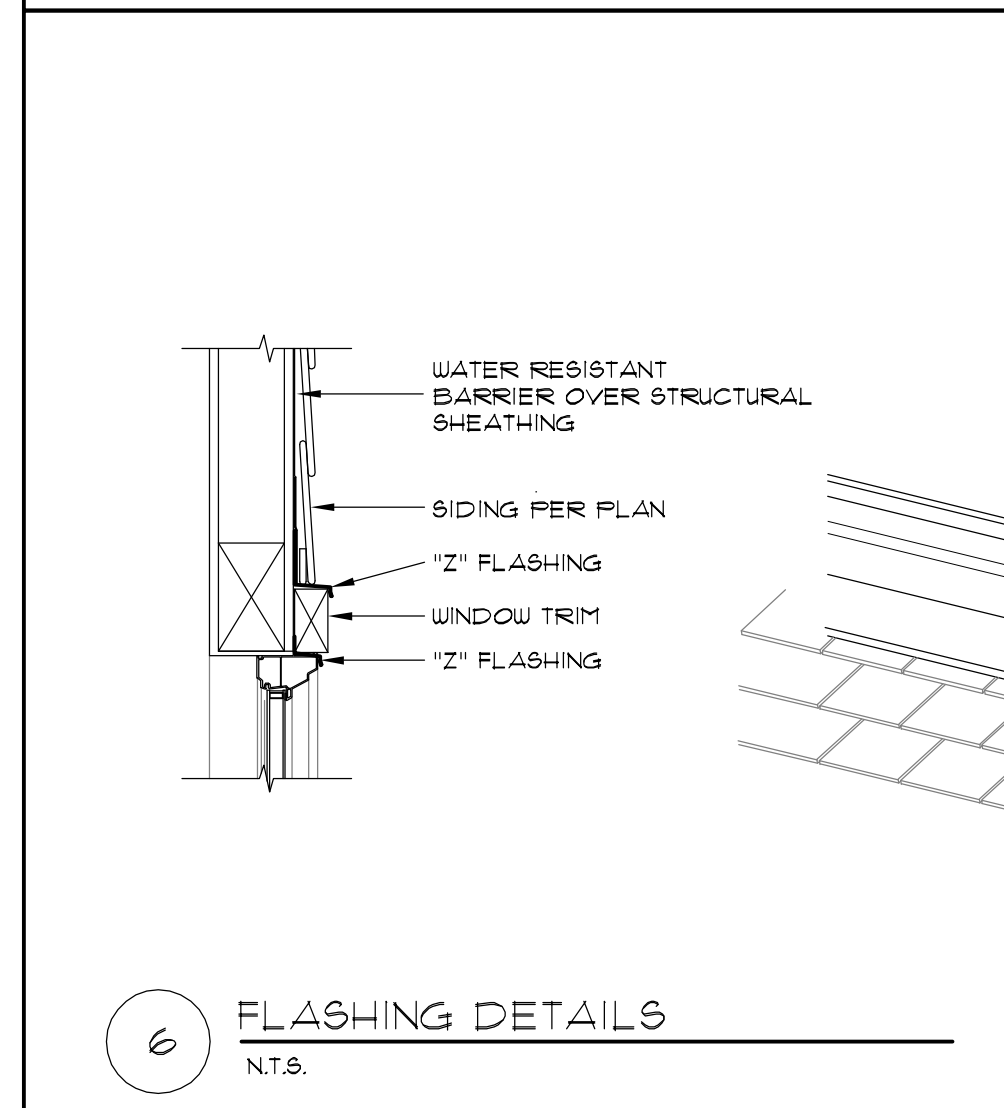


6 FLASHING DETAILS
N.T.S.

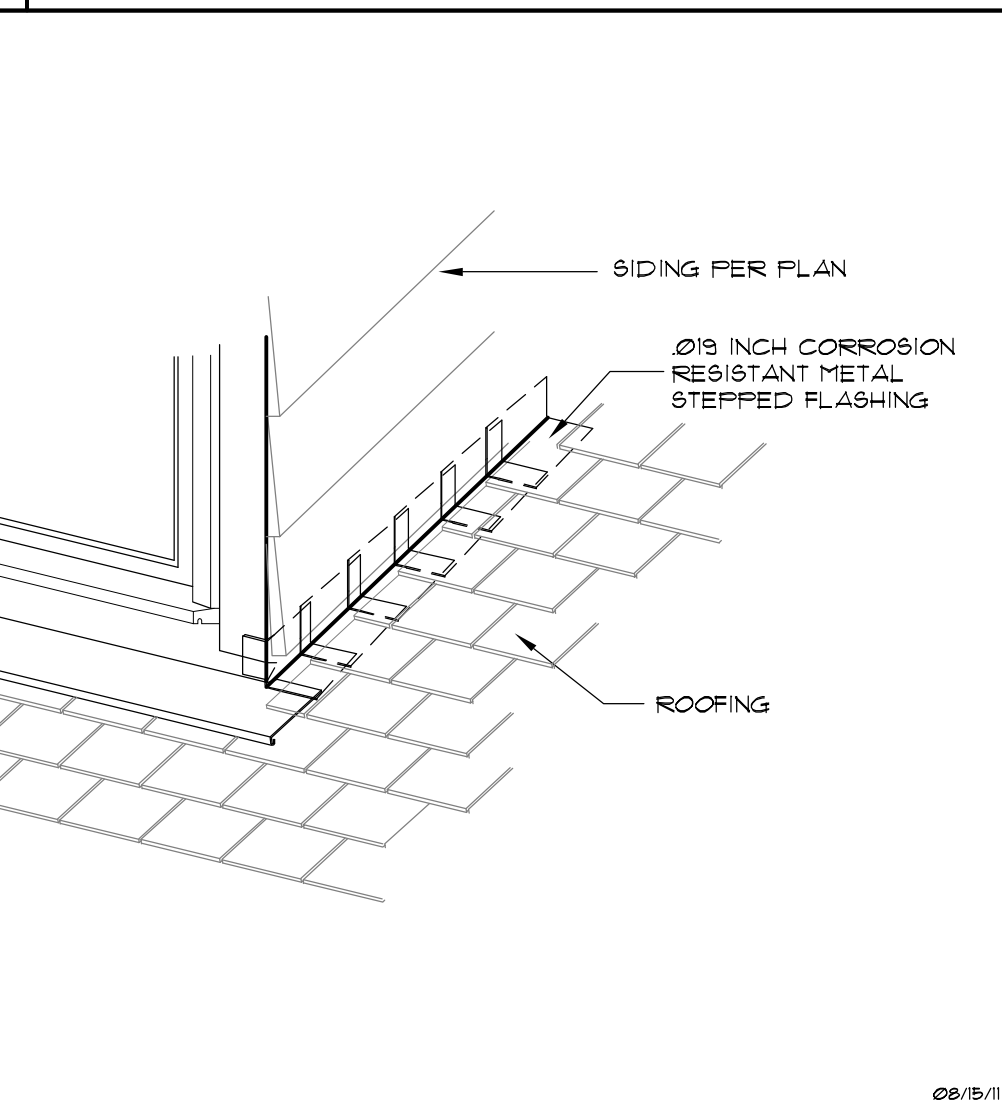


7 PLUMBING VENT FLASHING
N.T.S. 06/15/11

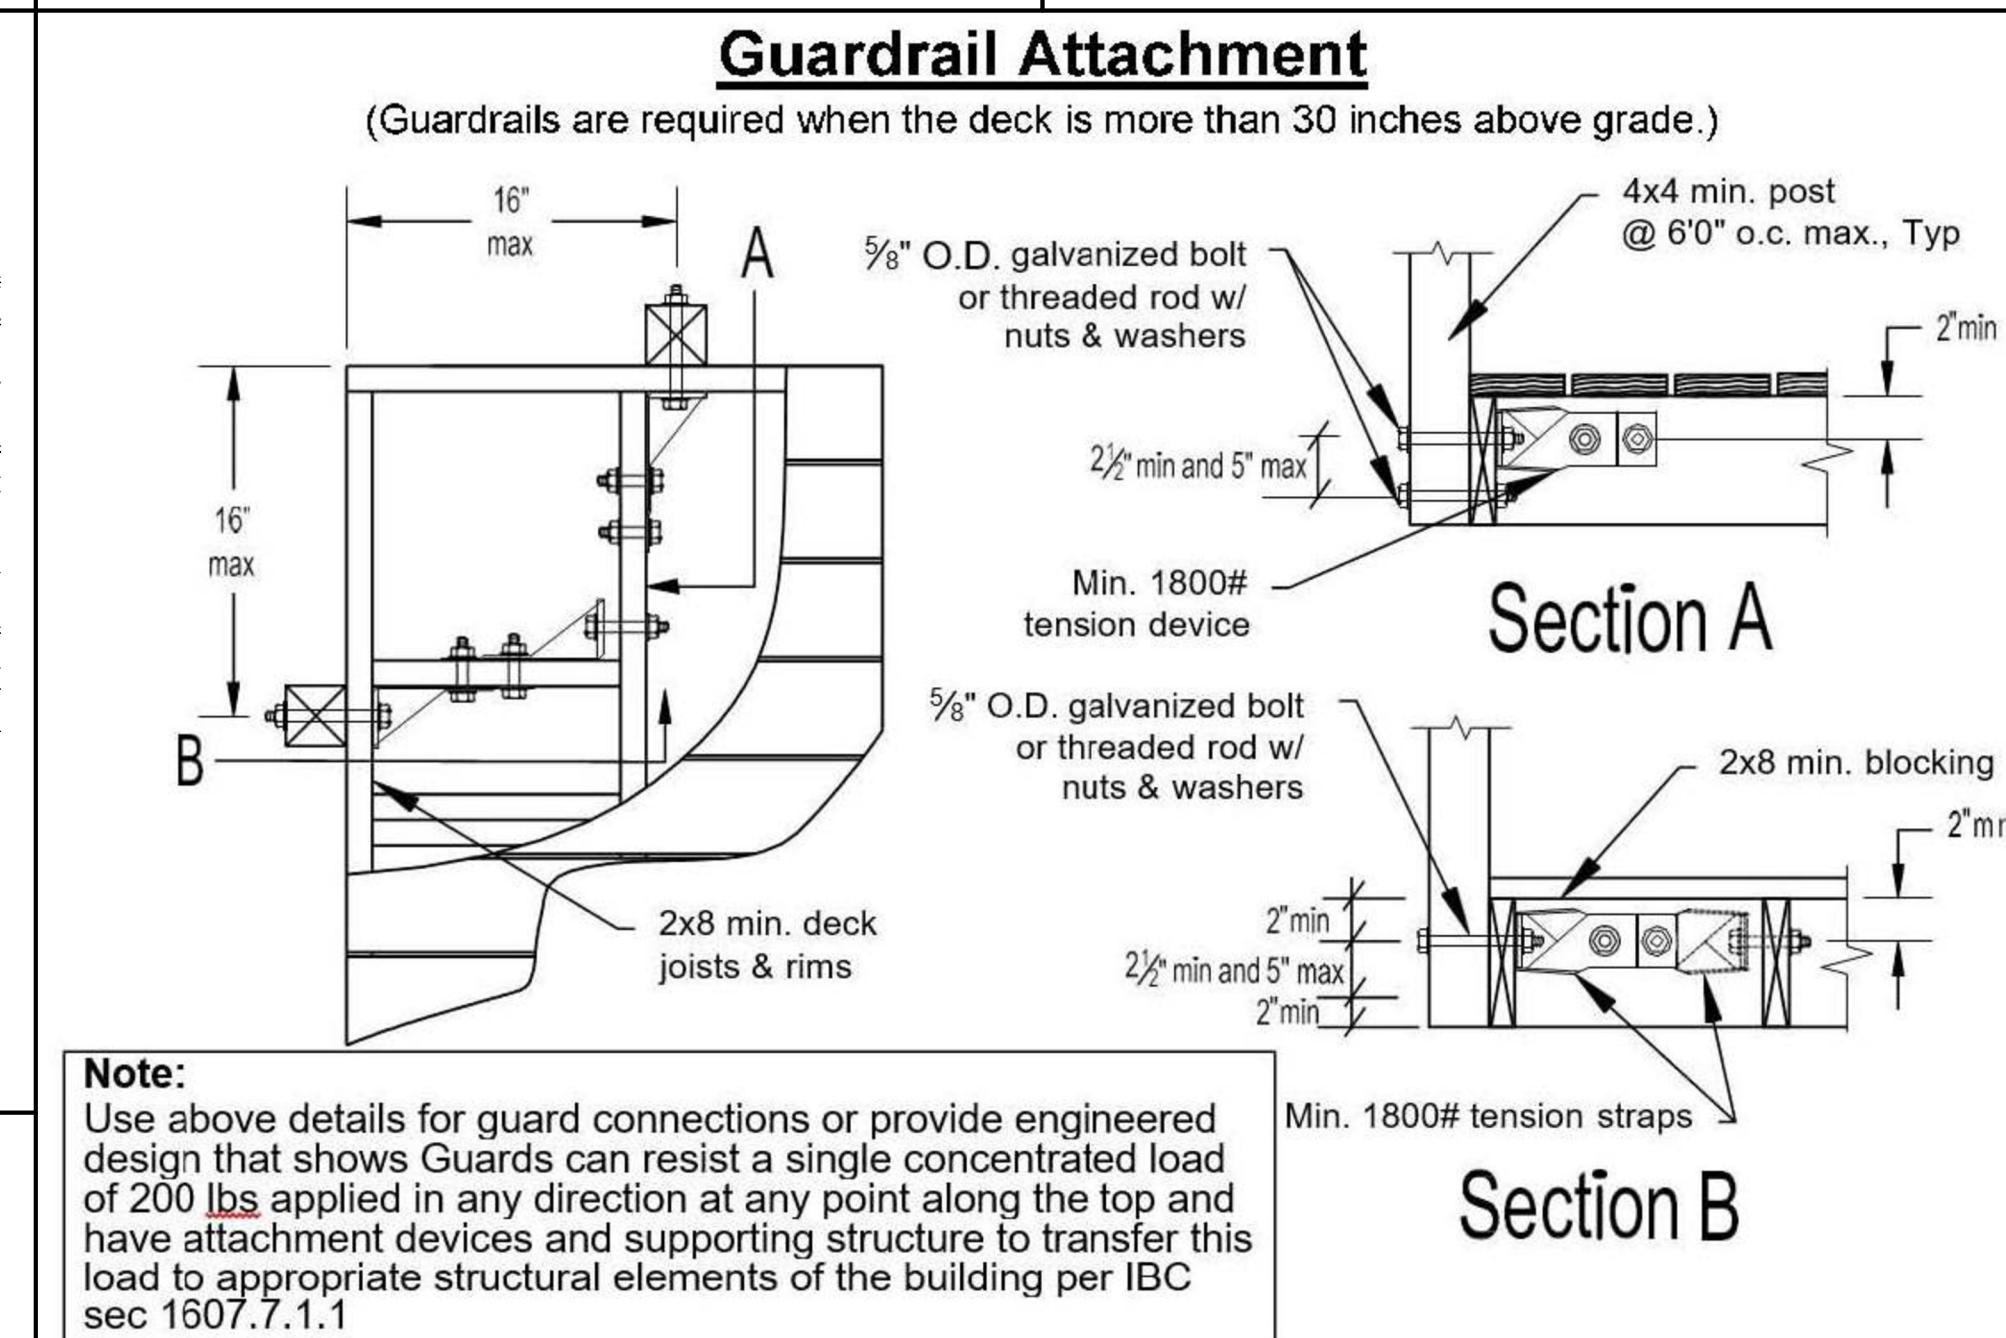


8 GUARD RAIL ATTACHMENT
N.T.S.

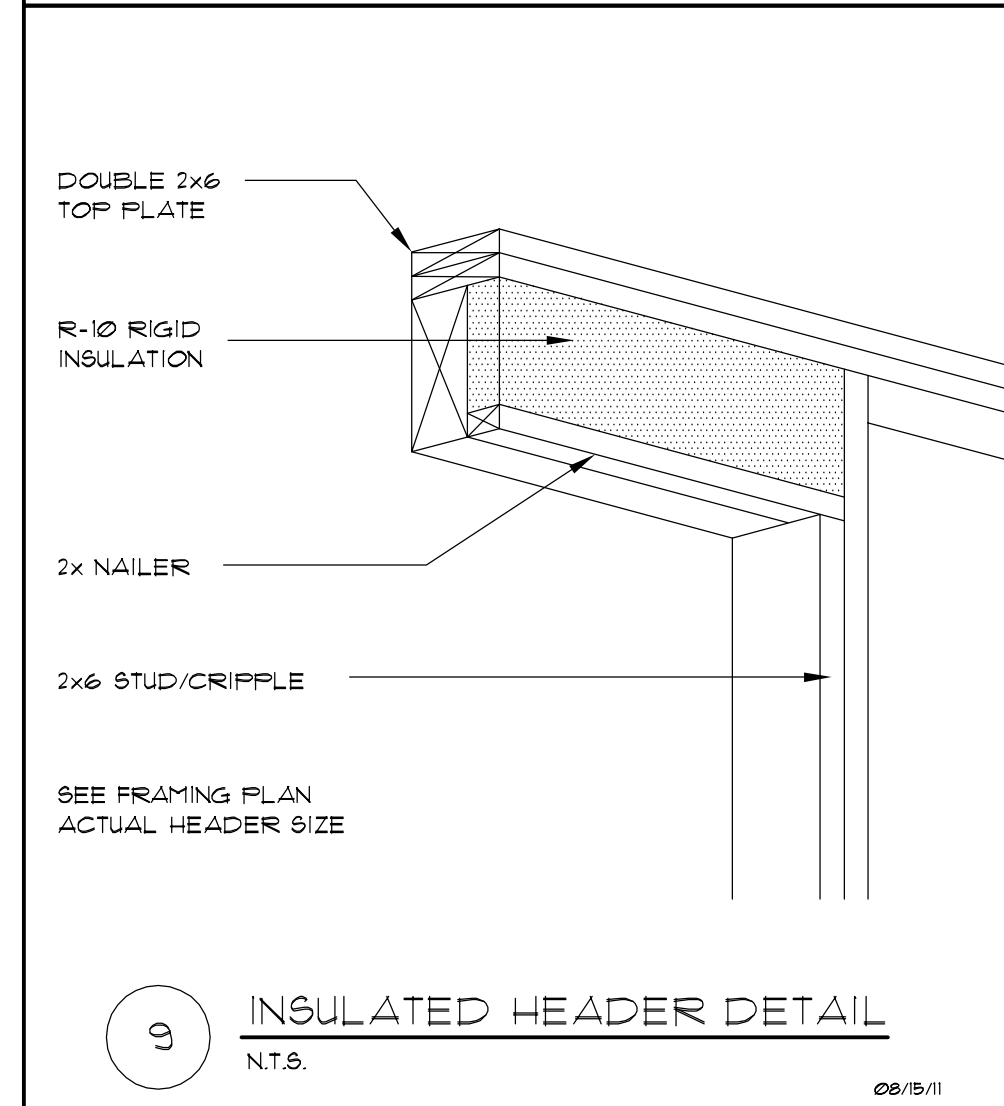


9 INSULATED HEADER DETAIL
N.T.S. 06/15/11

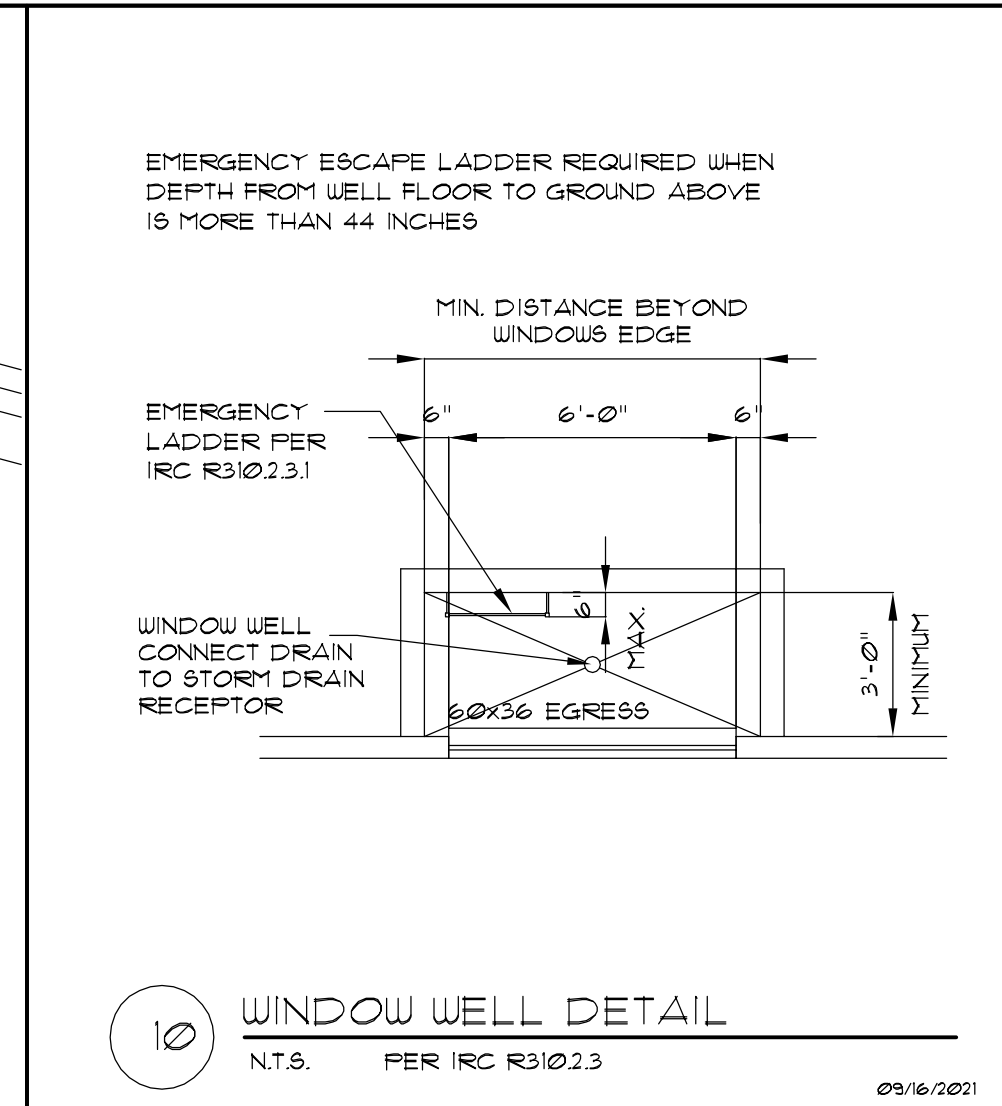


10 WINDOW WELL DETAIL
N.T.S. 09/16/2012

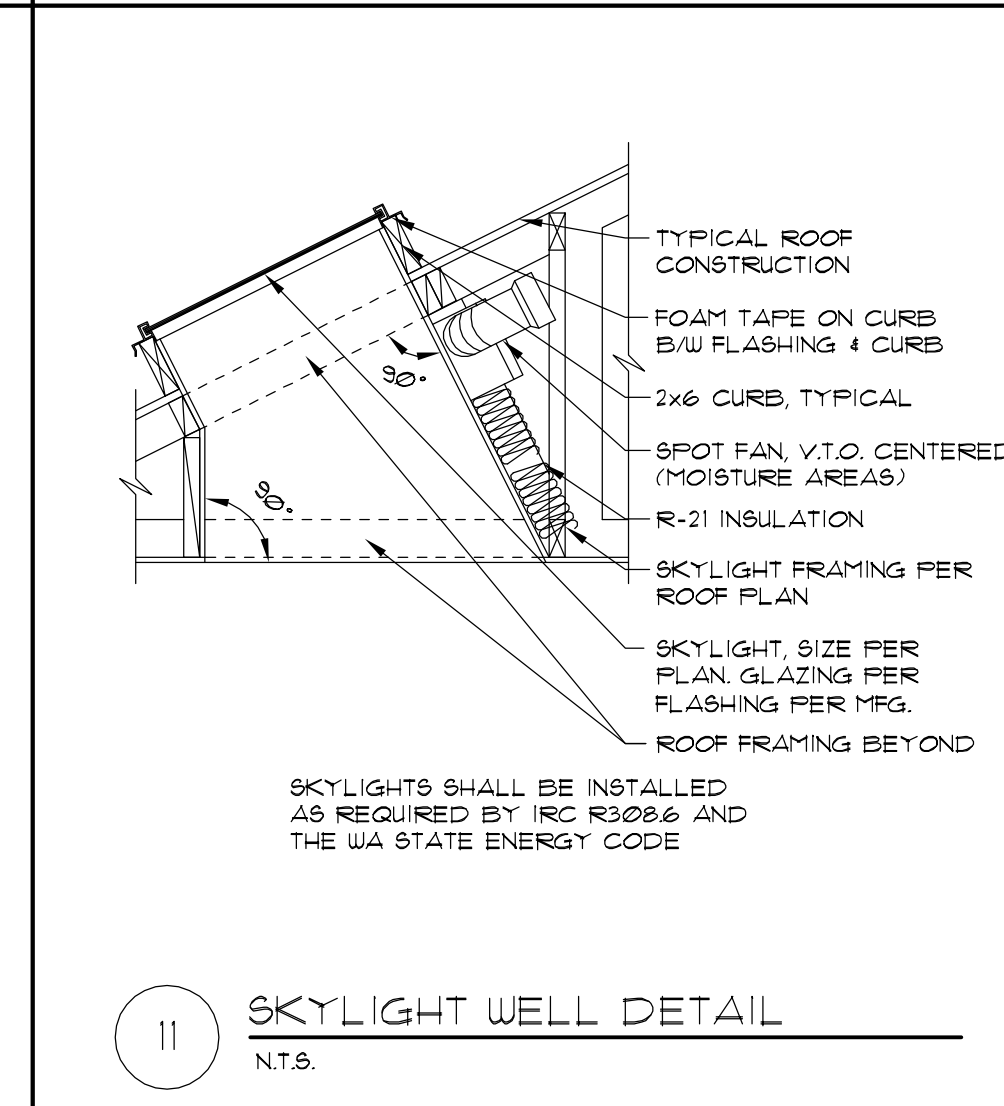


11 SKYLIGHT WELL DETAIL
N.T.S.

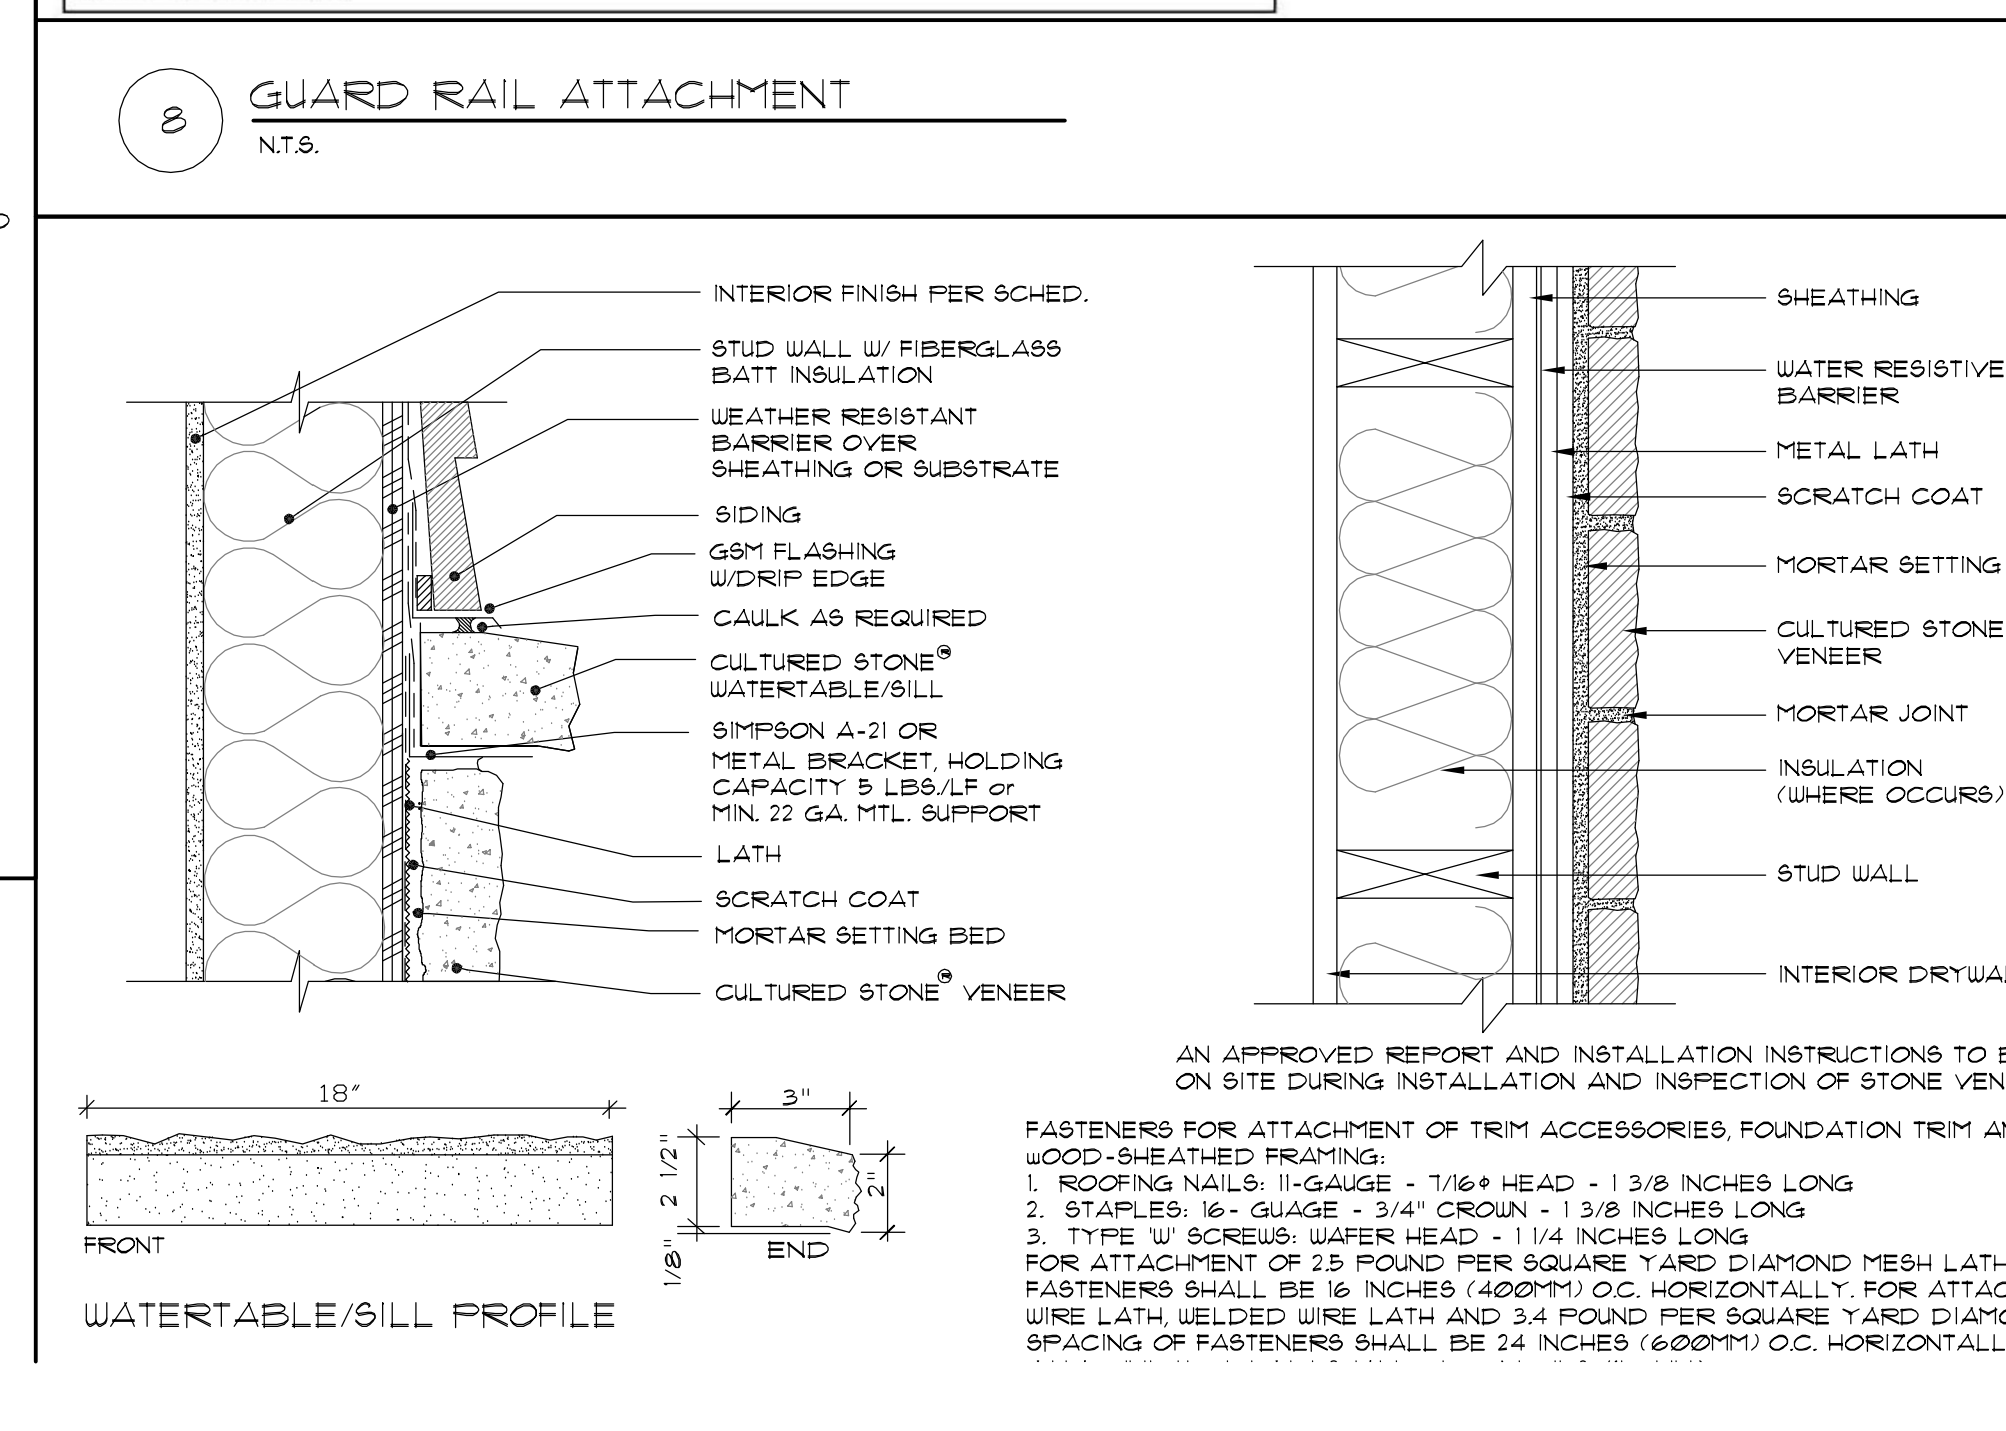


9 INSULATED HEADER DETAIL
N.T.S. 06/15/11

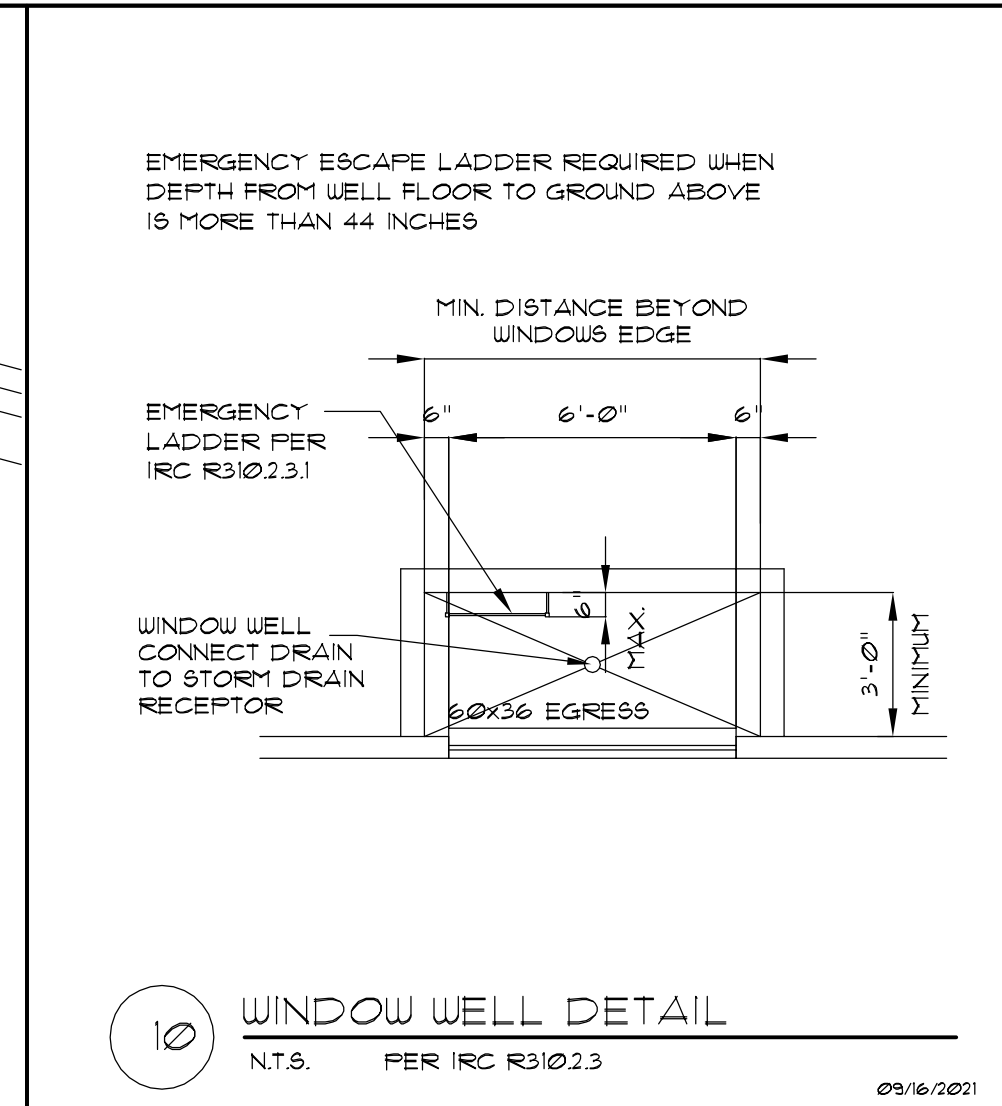


10 WINDOW WELL DETAIL
N.T.S. 09/16/2012

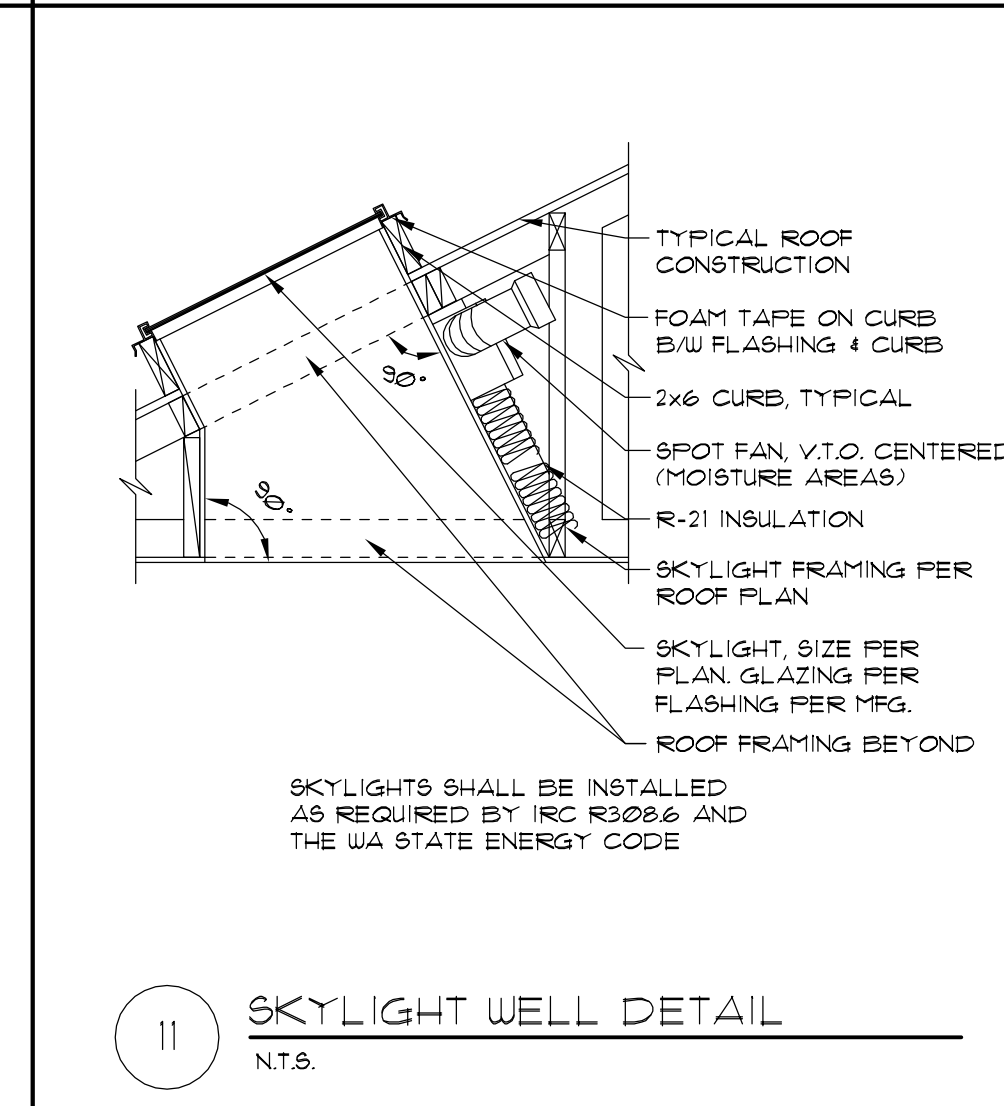


11 SKYLIGHT WELL DETAIL
N.T.S.

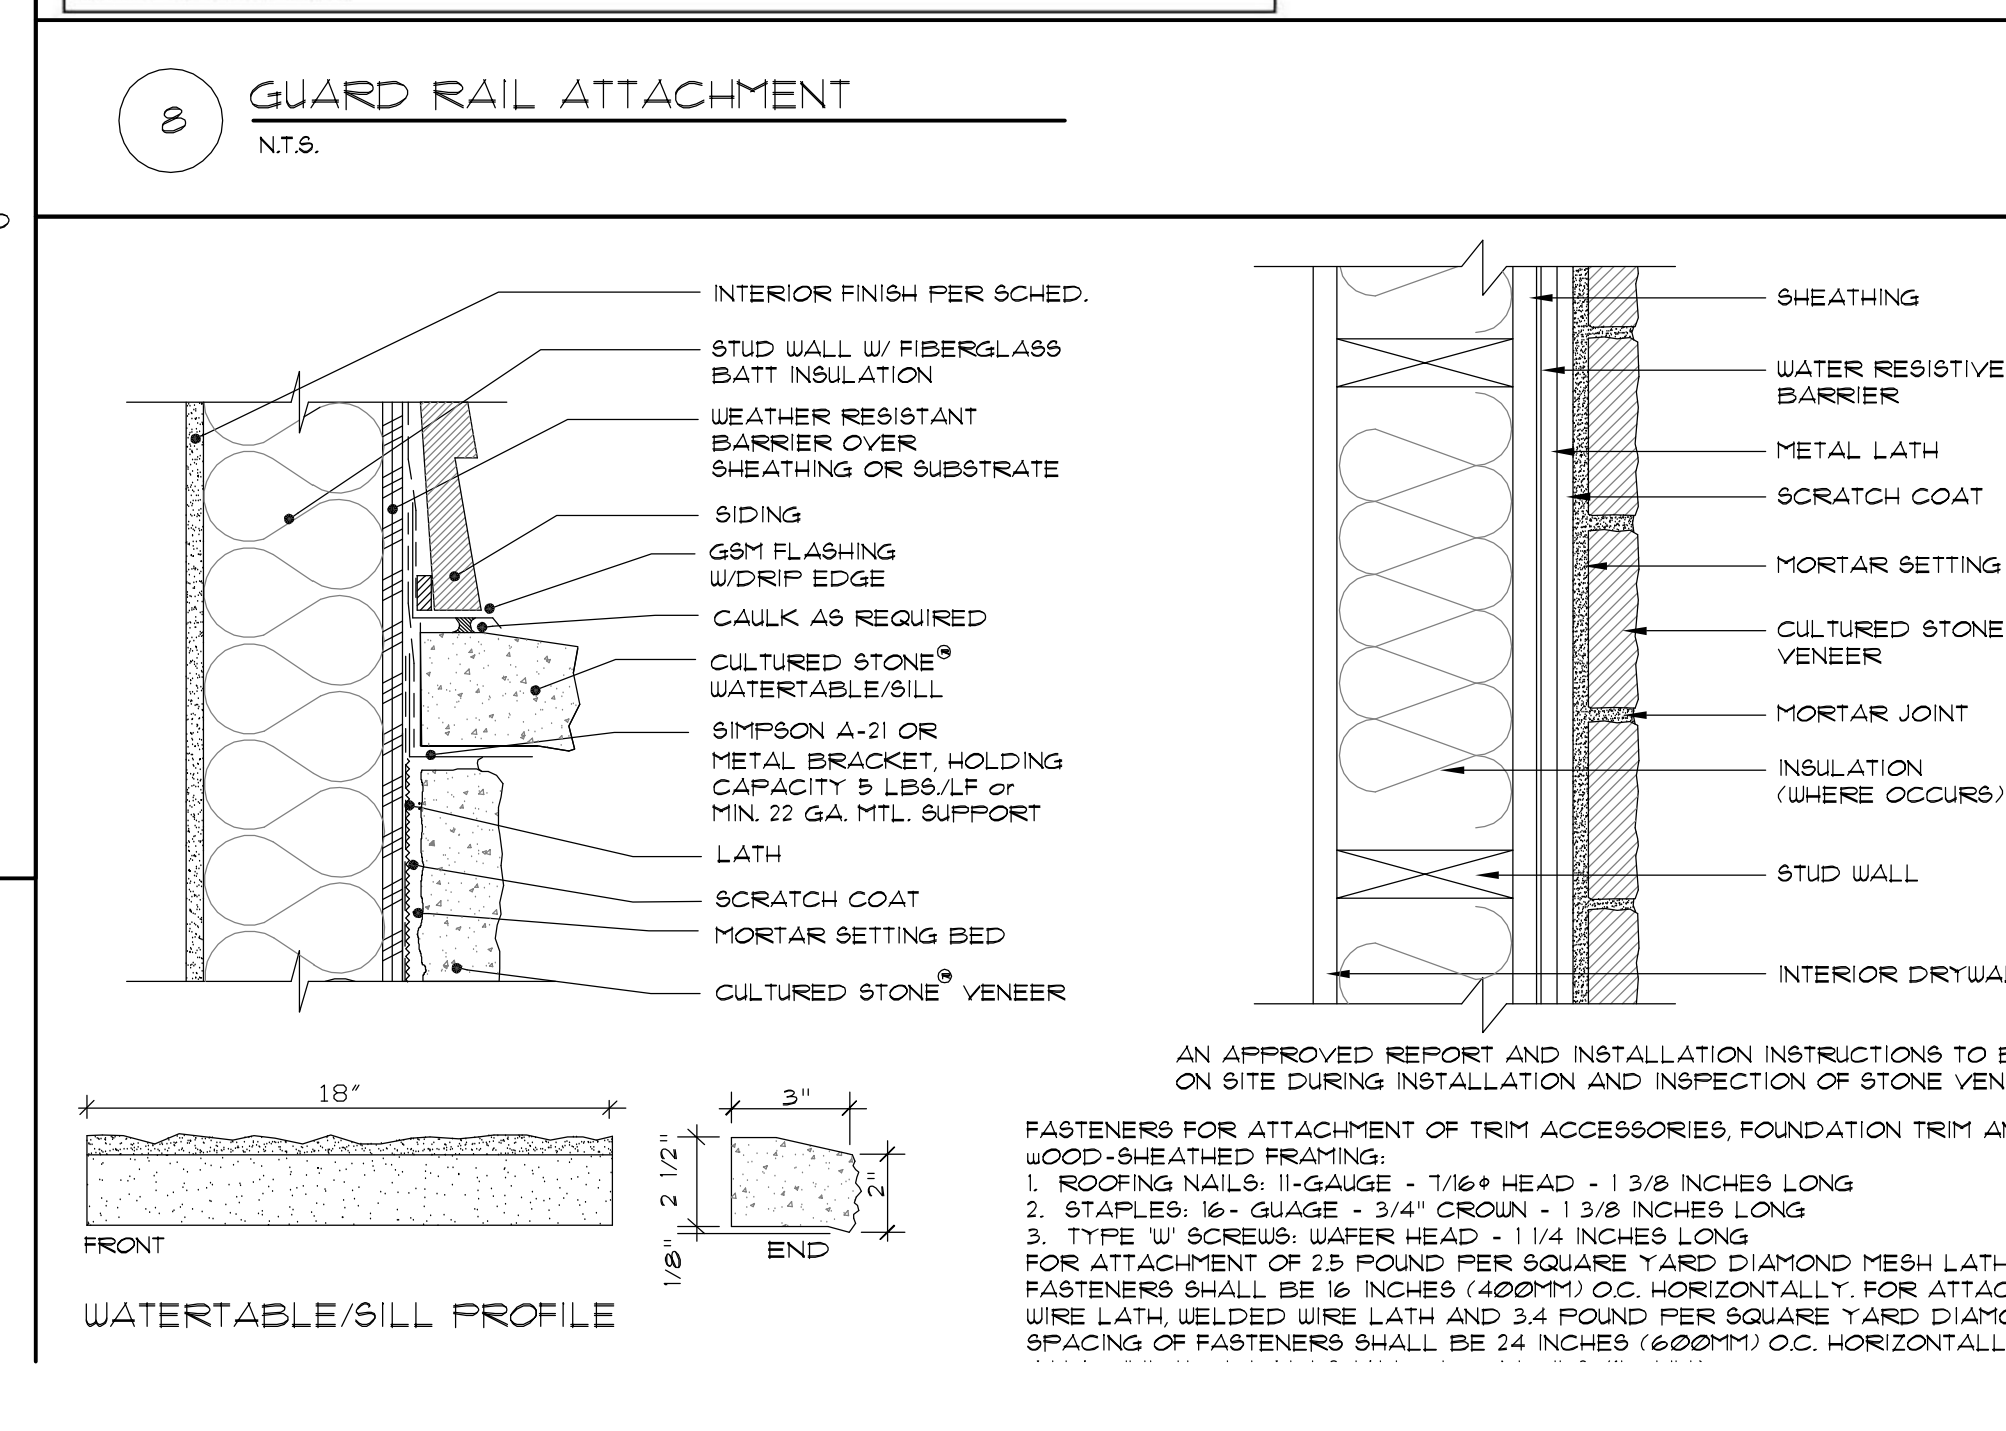


9 INSULATED HEADER DETAIL
N.T.S. 06/15/11

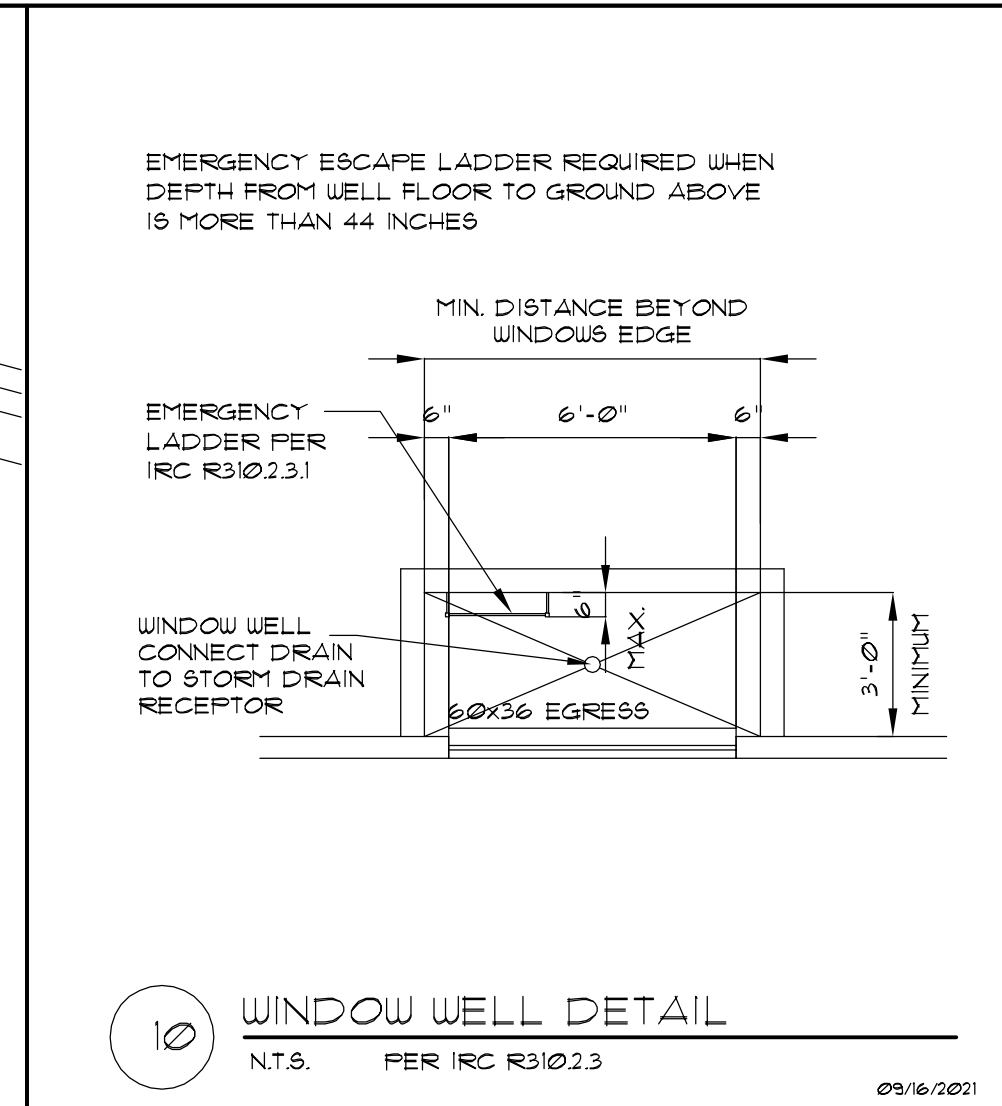


10 WINDOW WELL DETAIL
N.T.S. 09/16/2012

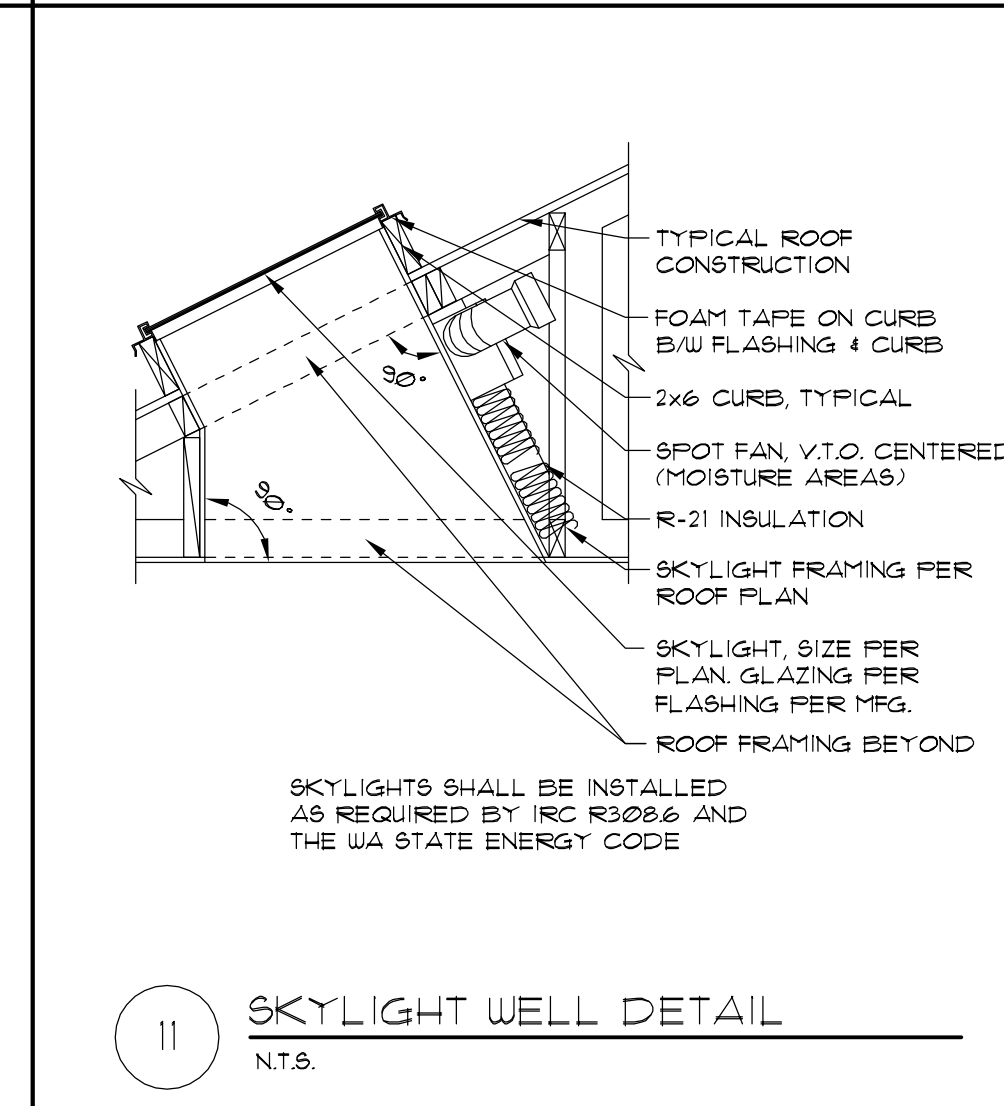


11 SKYLIGHT WELL DETAIL
N.T.S.

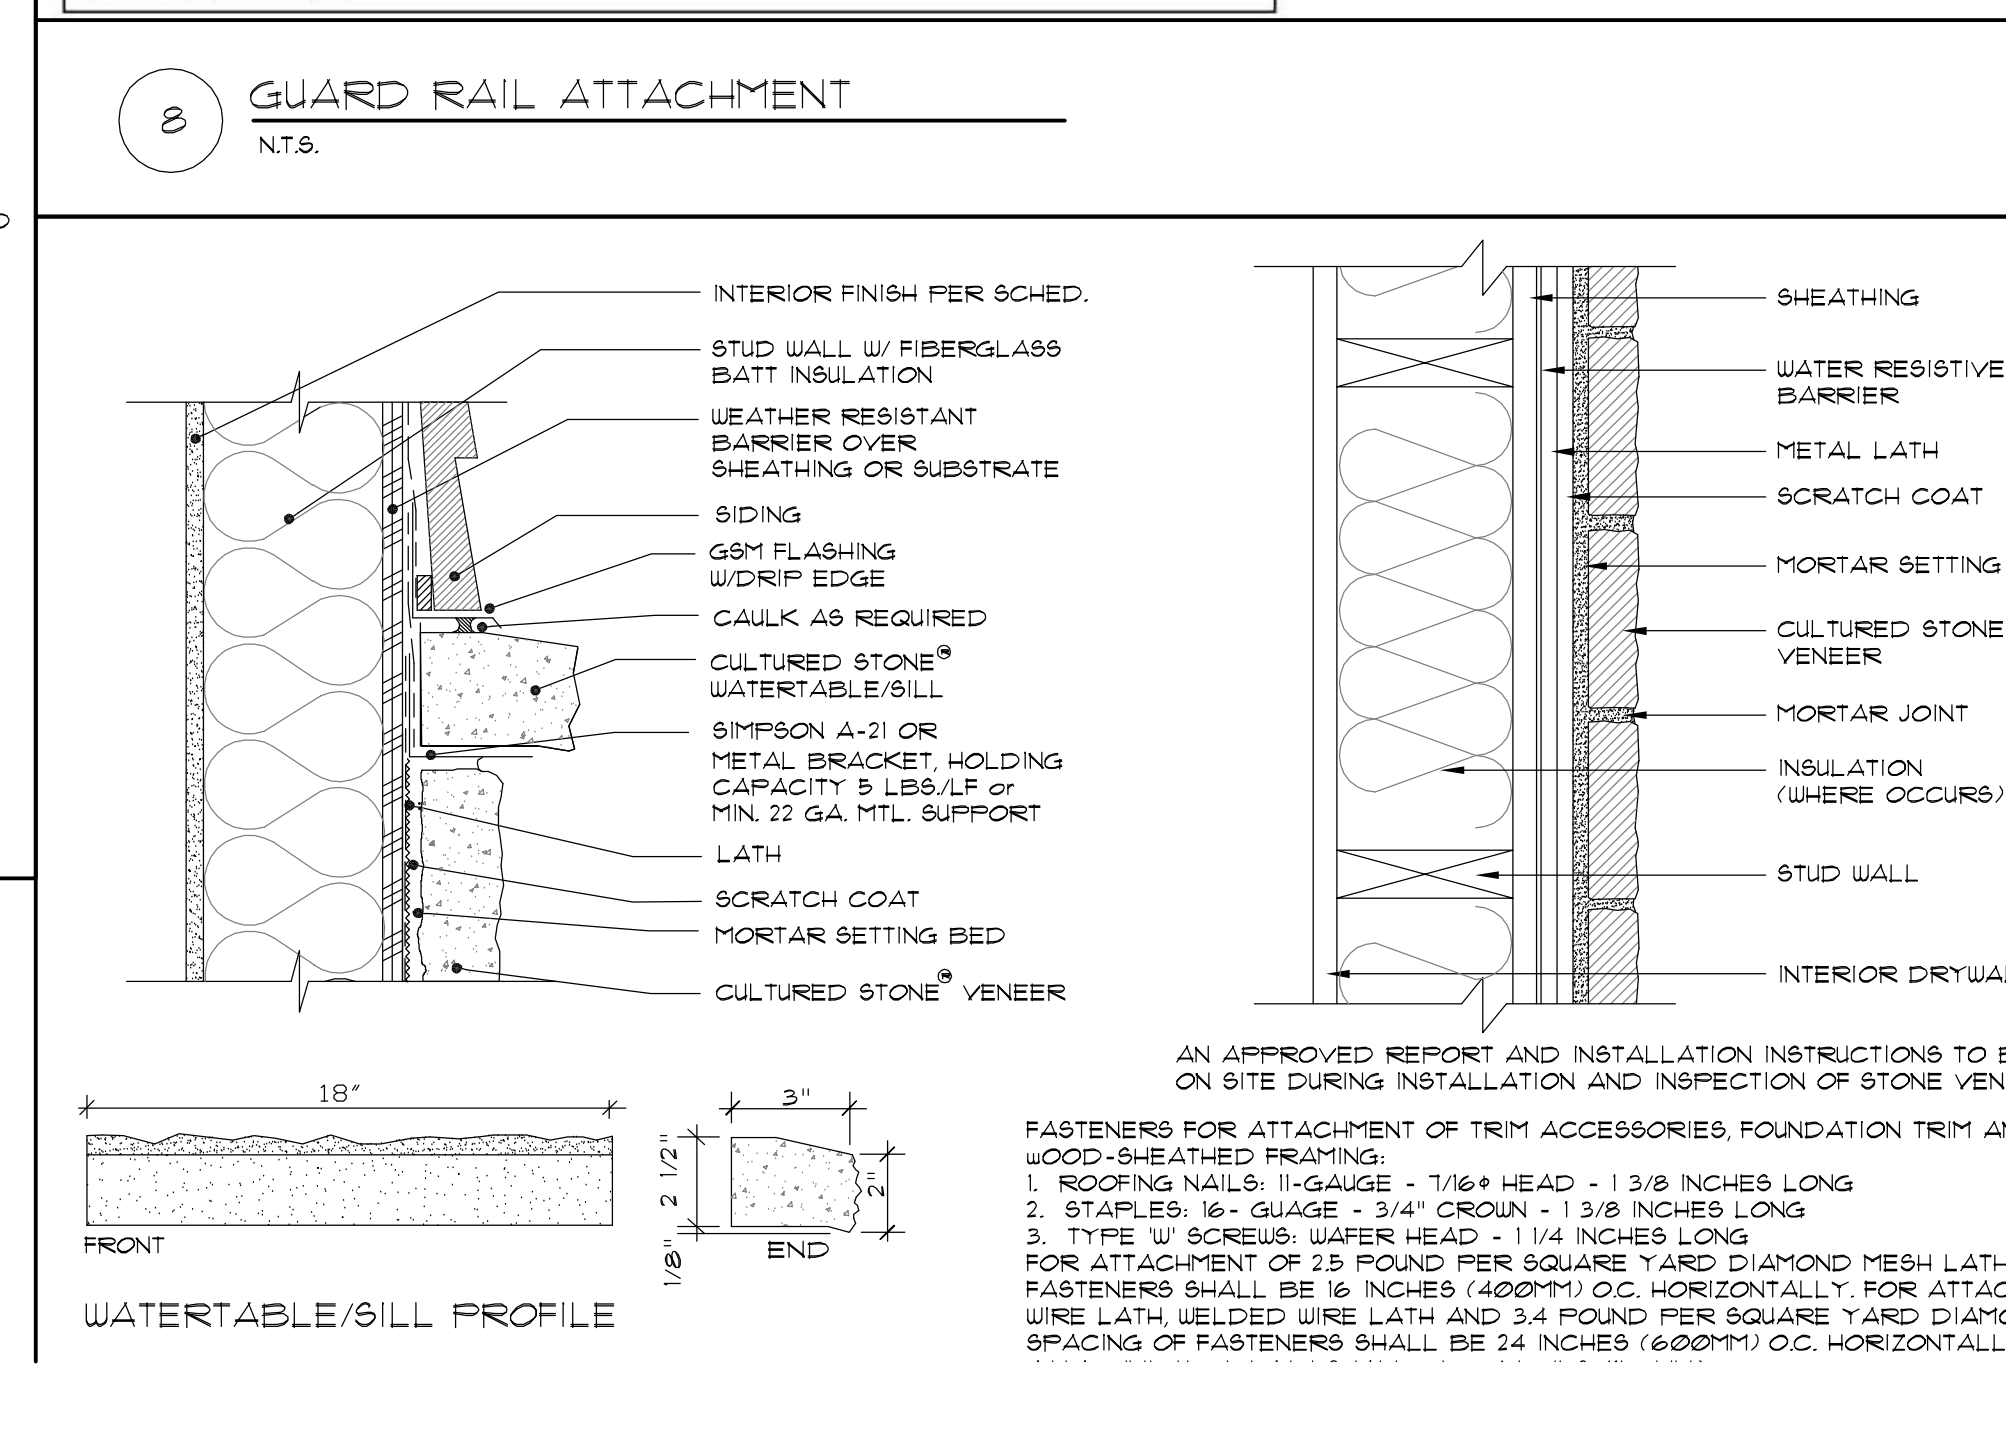


9 INSULATED HEADER DETAIL
N.T.S. 06/15/11

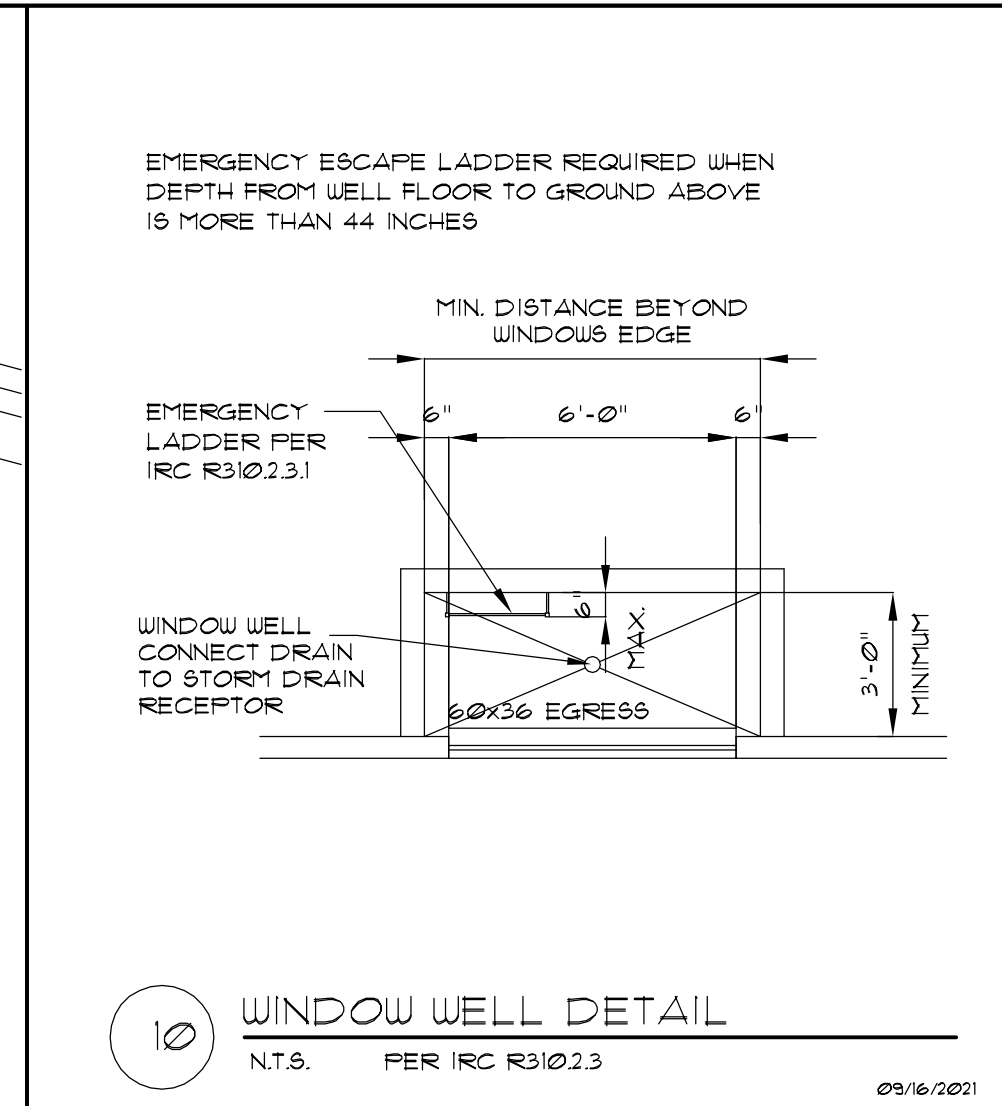


10 WINDOW WELL DETAIL
N.T.S. 09/16/2012

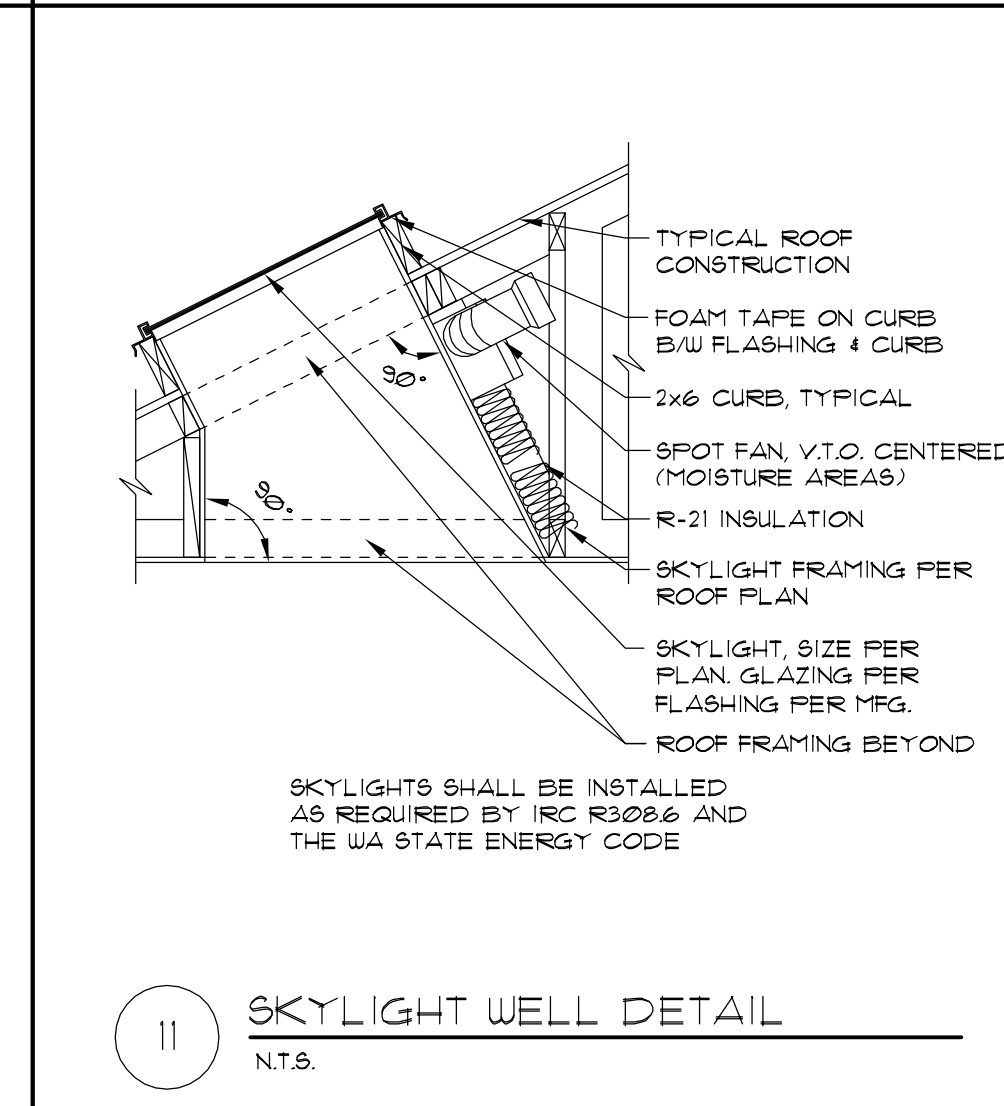


11 SKYLIGHT WELL DETAIL
N.T.S.

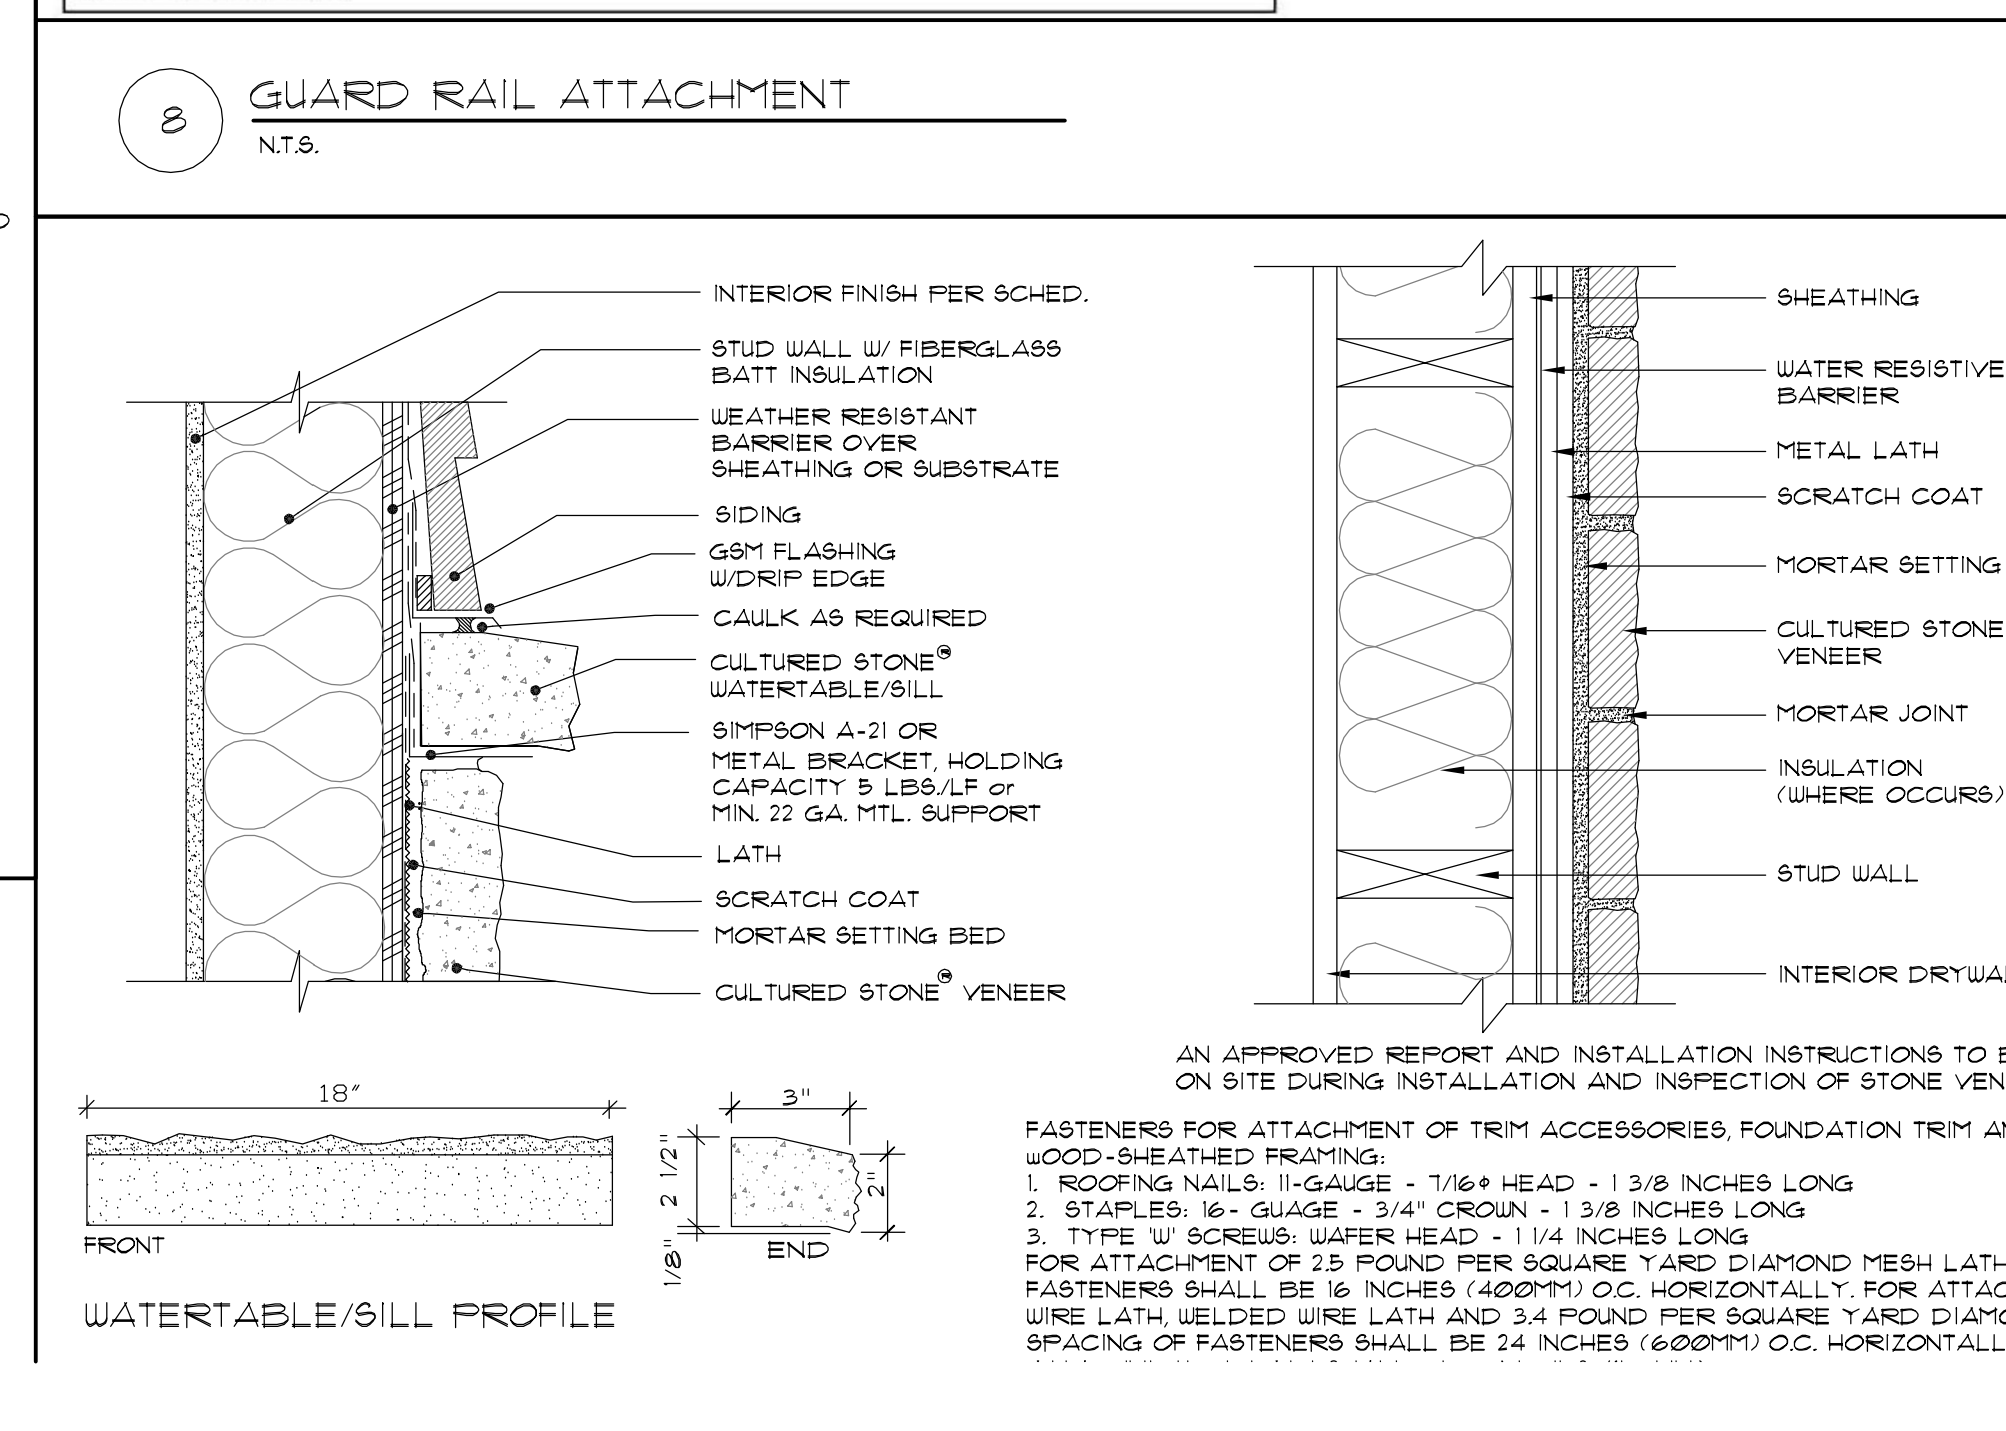


9 INSULATED HEADER DETAIL
N.T.S. 06/15/11

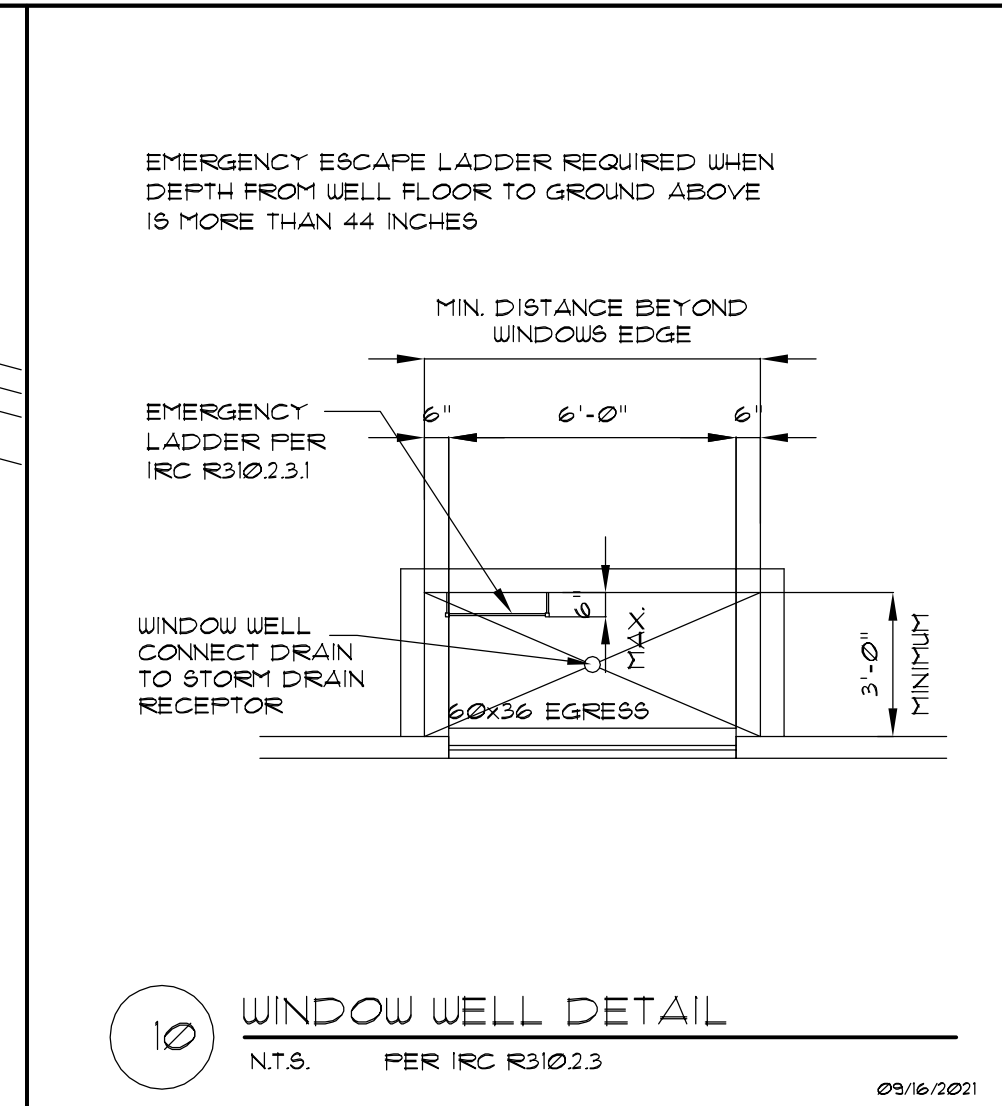


10 WINDOW WELL DETAIL
N.T.S. 09/16/2012

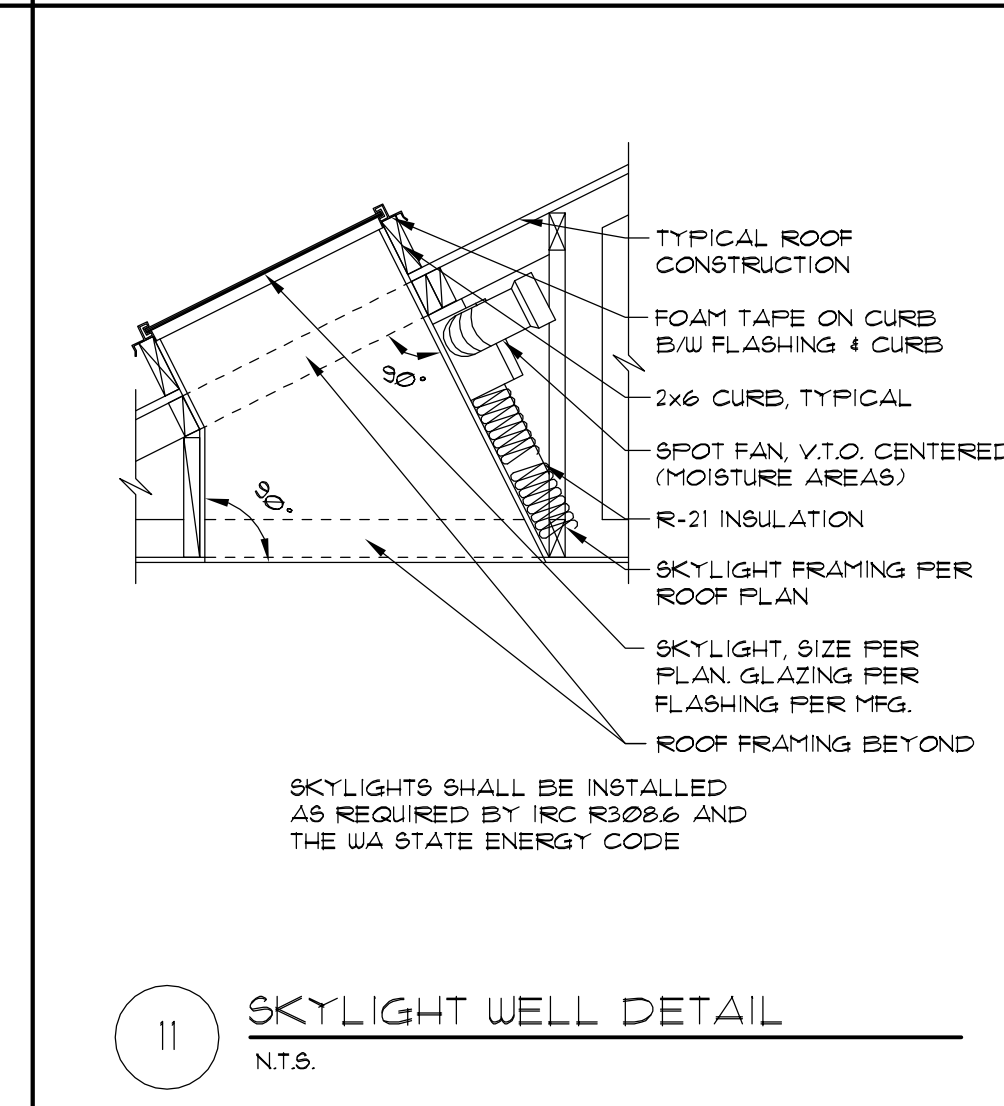


11 SKYLIGHT WELL DETAIL
N.T.S.

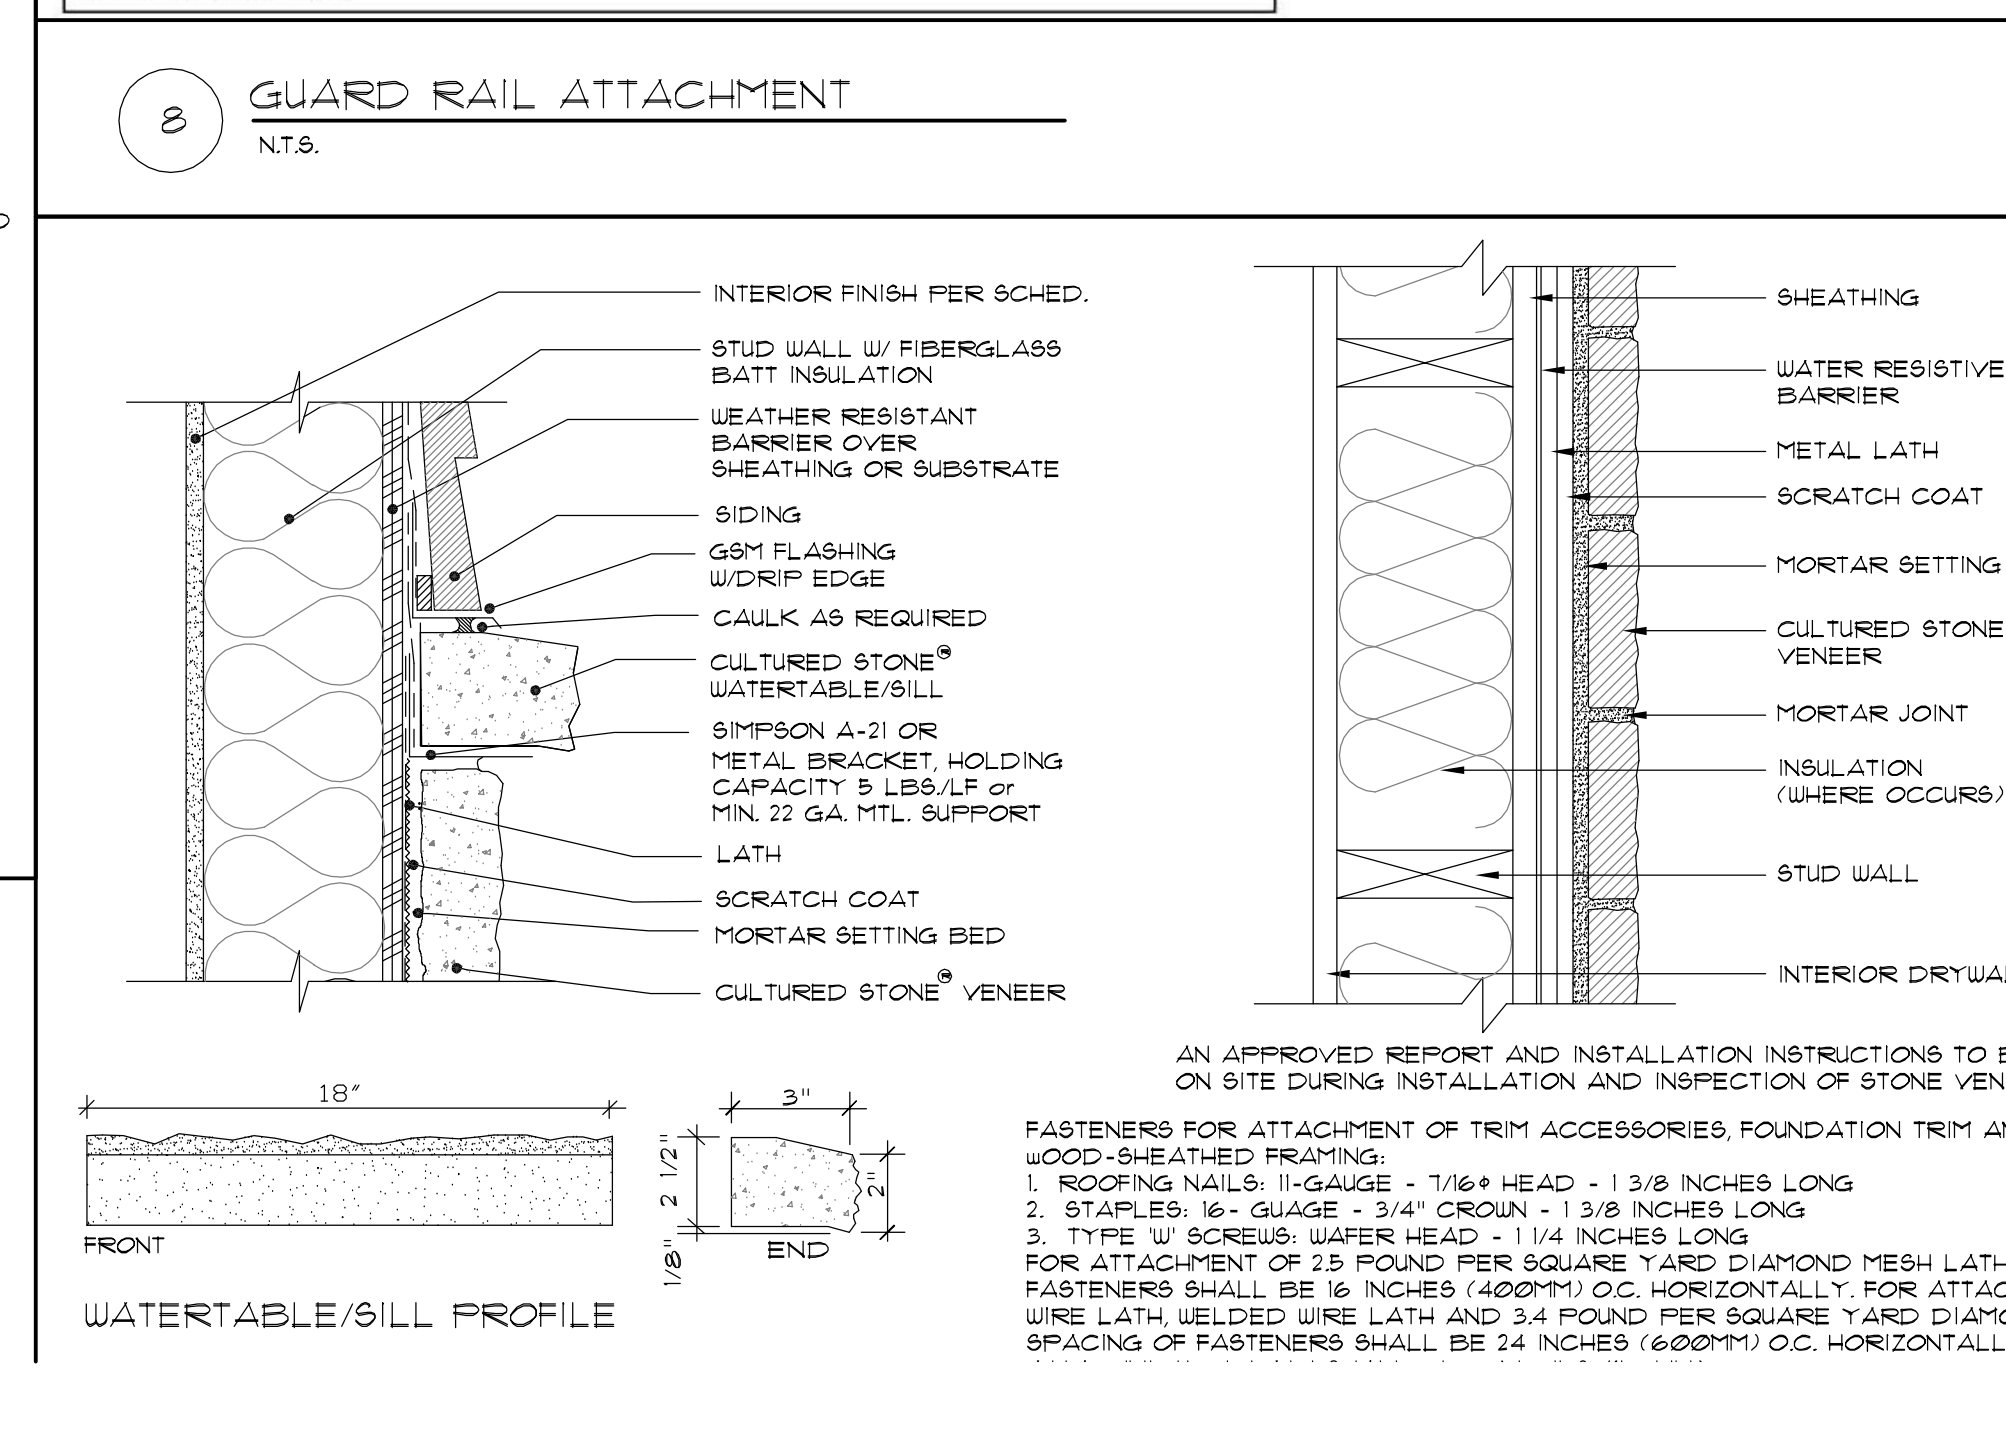


9 INSULATED HEADER DETAIL
N.T.S. 06/15/11

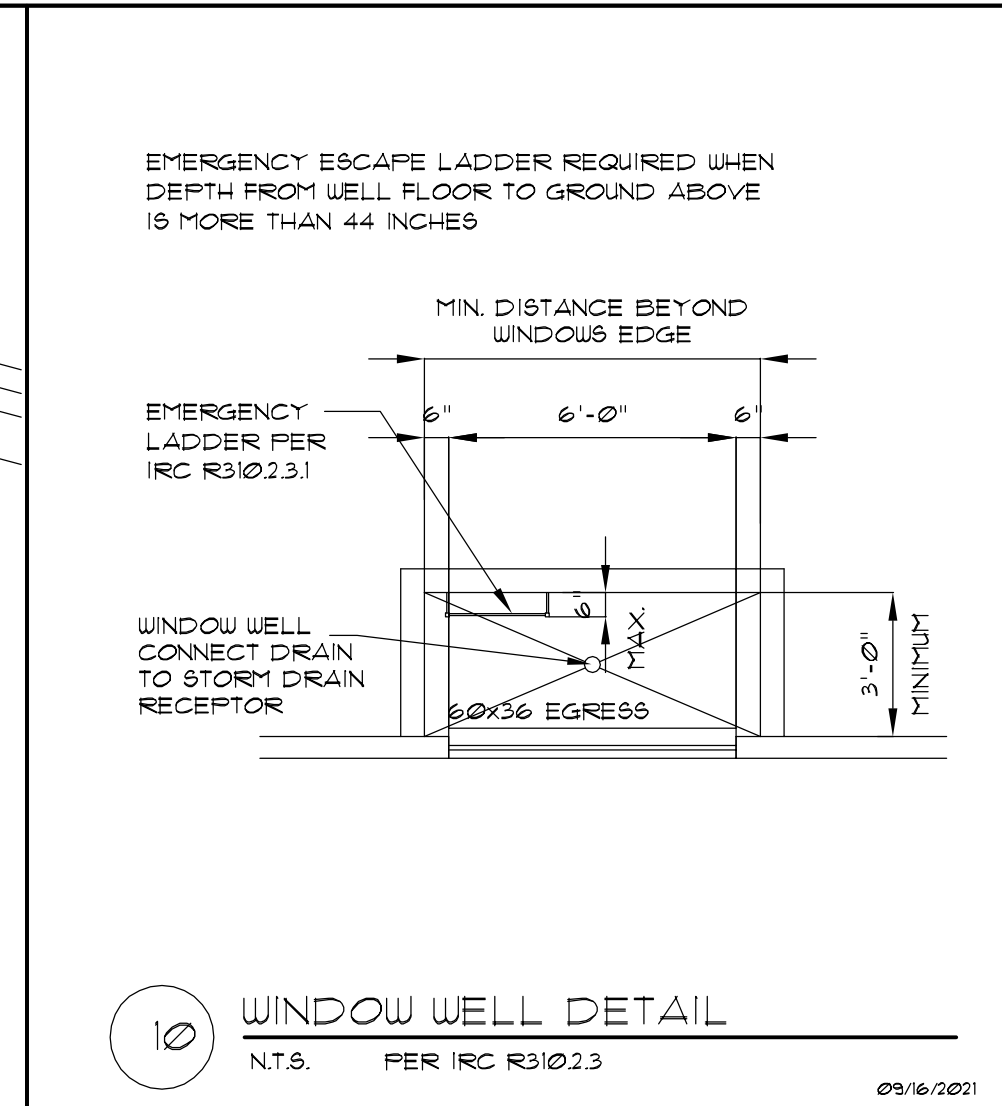


10 WINDOW WELL DETAIL
N.T.S. 09/16/2012

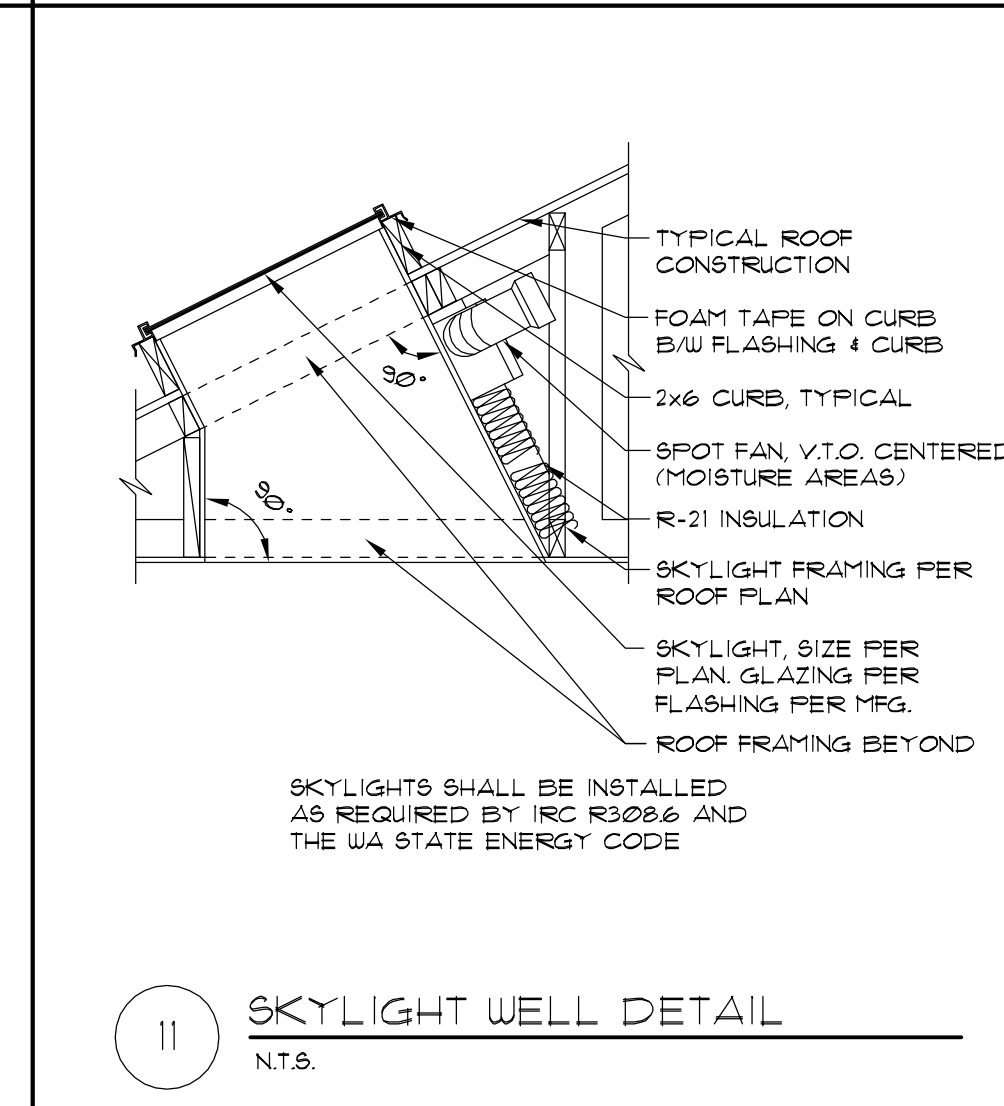


11 SKYLIGHT WELL DETAIL
N.T.S.

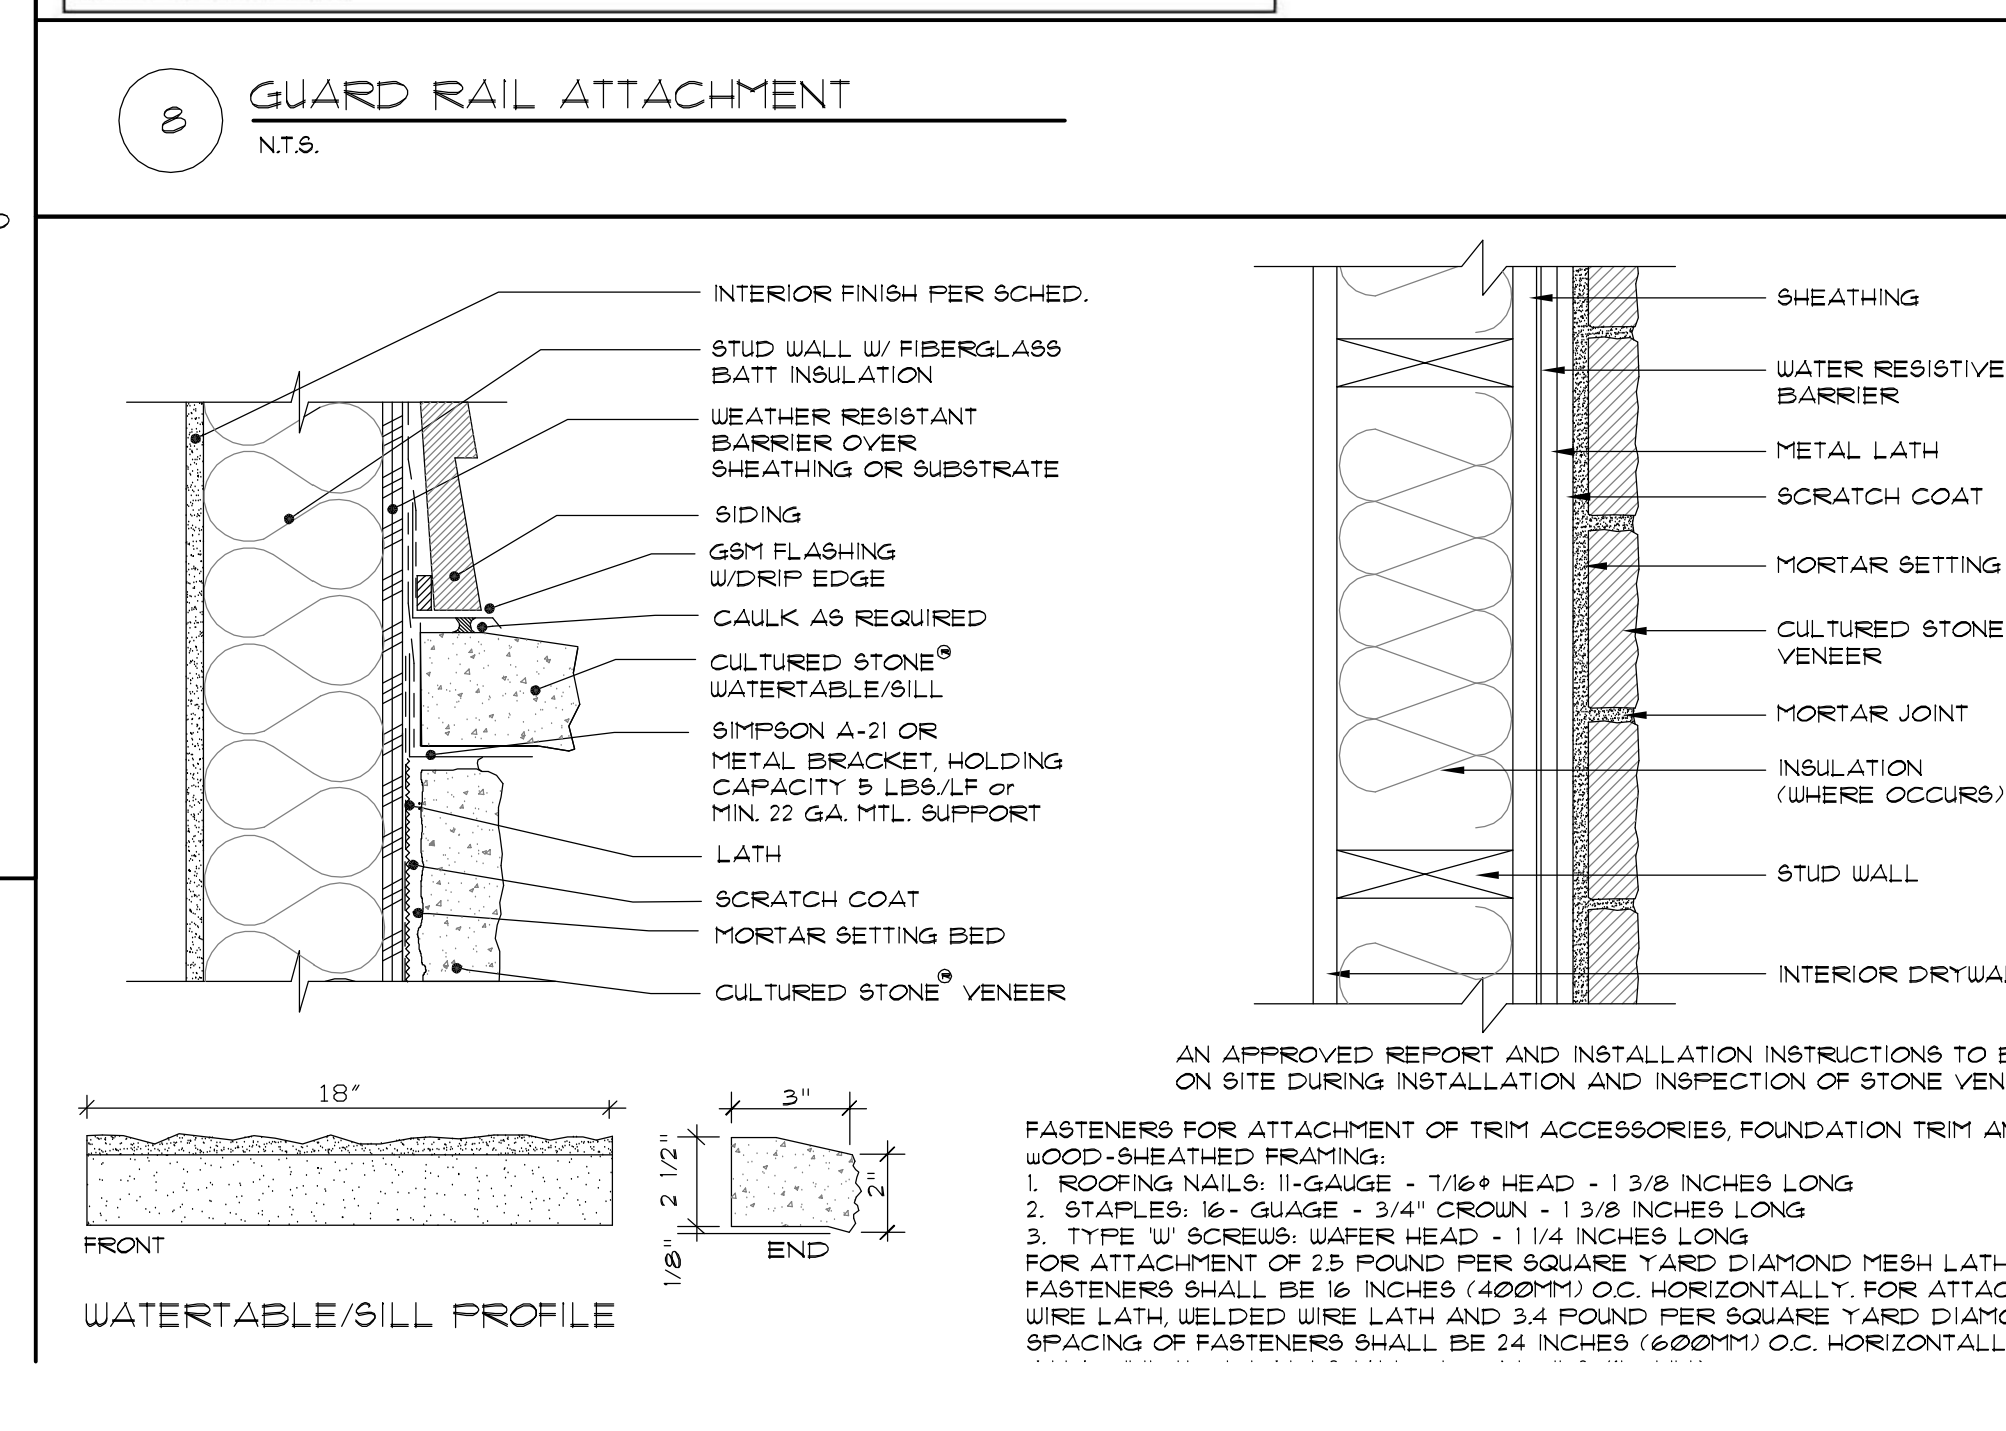


9 INSULATED HEADER DETAIL
N.T.S. 06/15/11

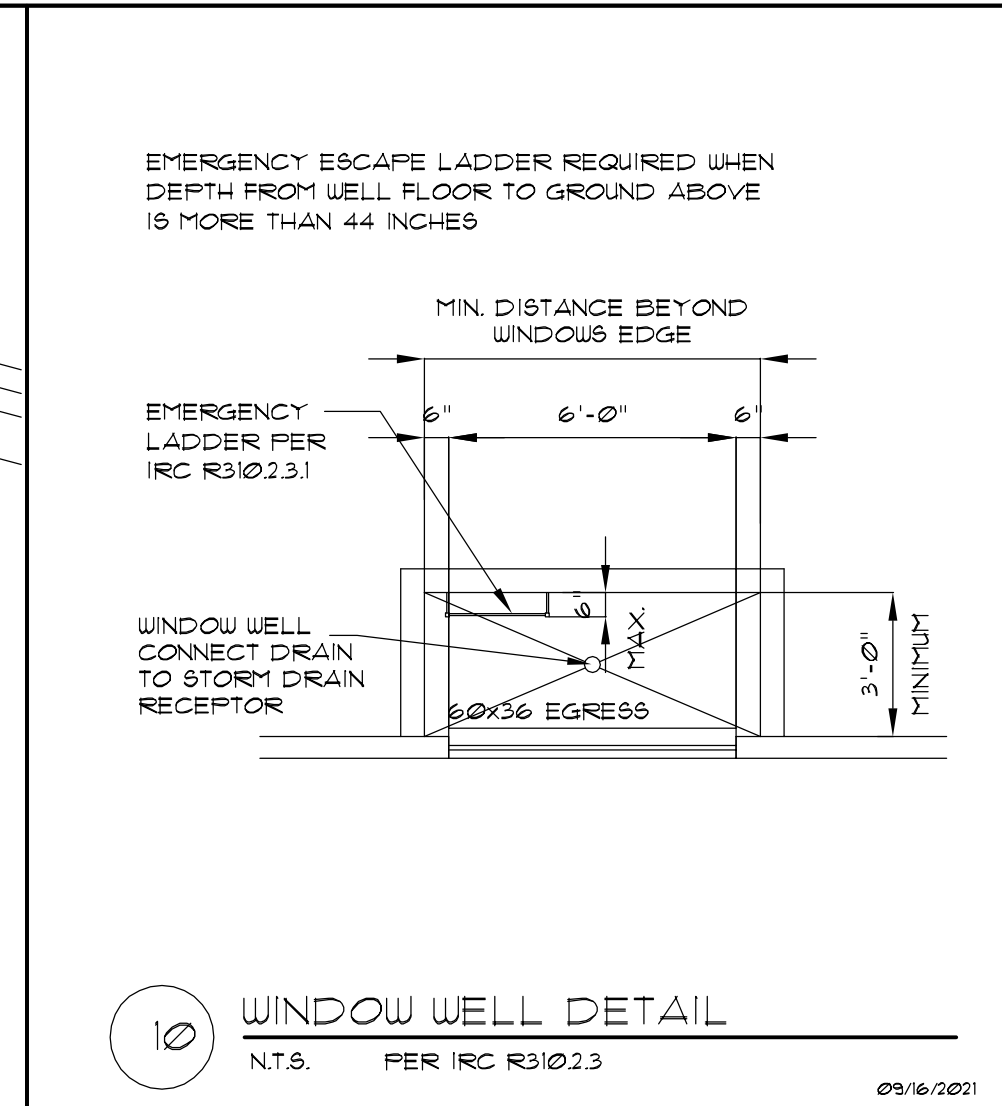


10 WINDOW WELL DETAIL
N.T.S. 09/16/2012

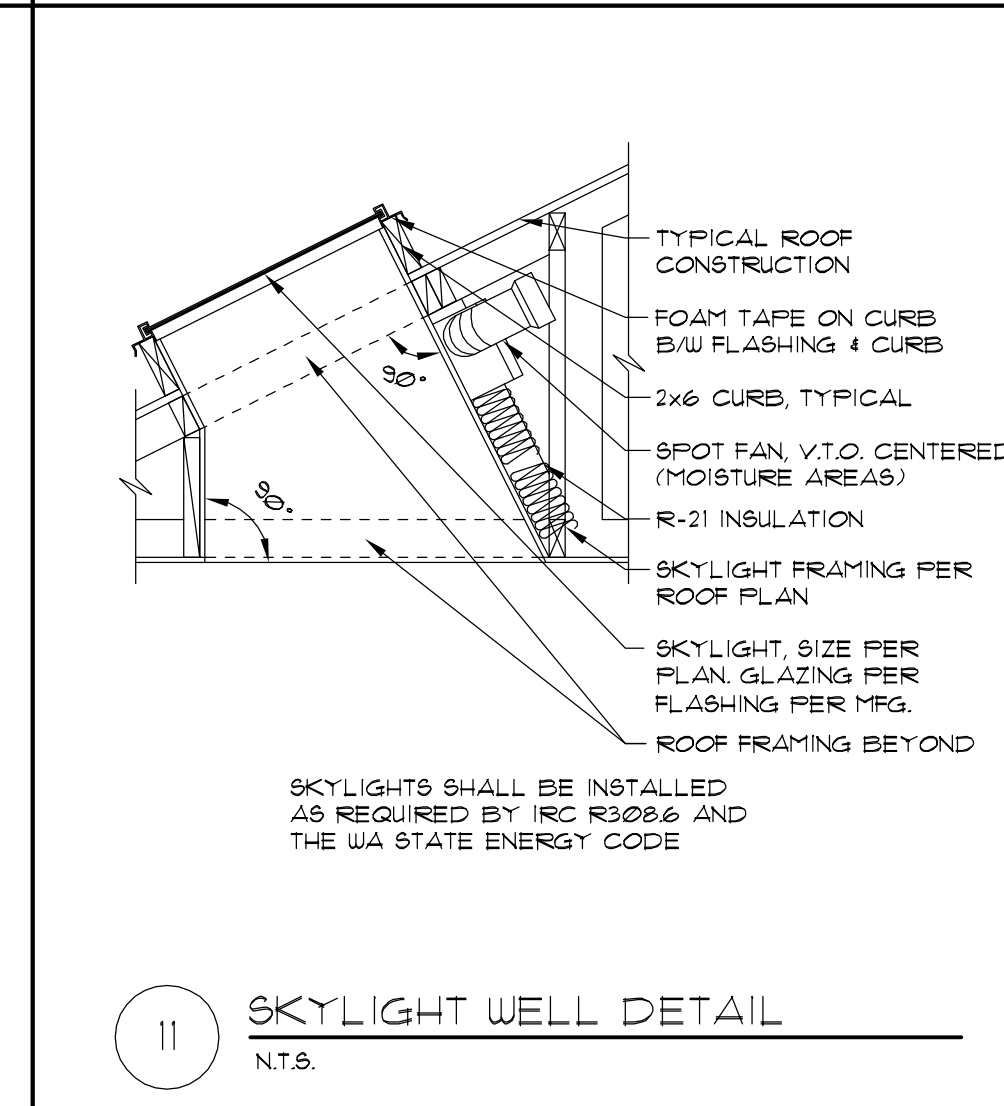


11 SKYLIGHT WELL DETAIL
N.T.S.

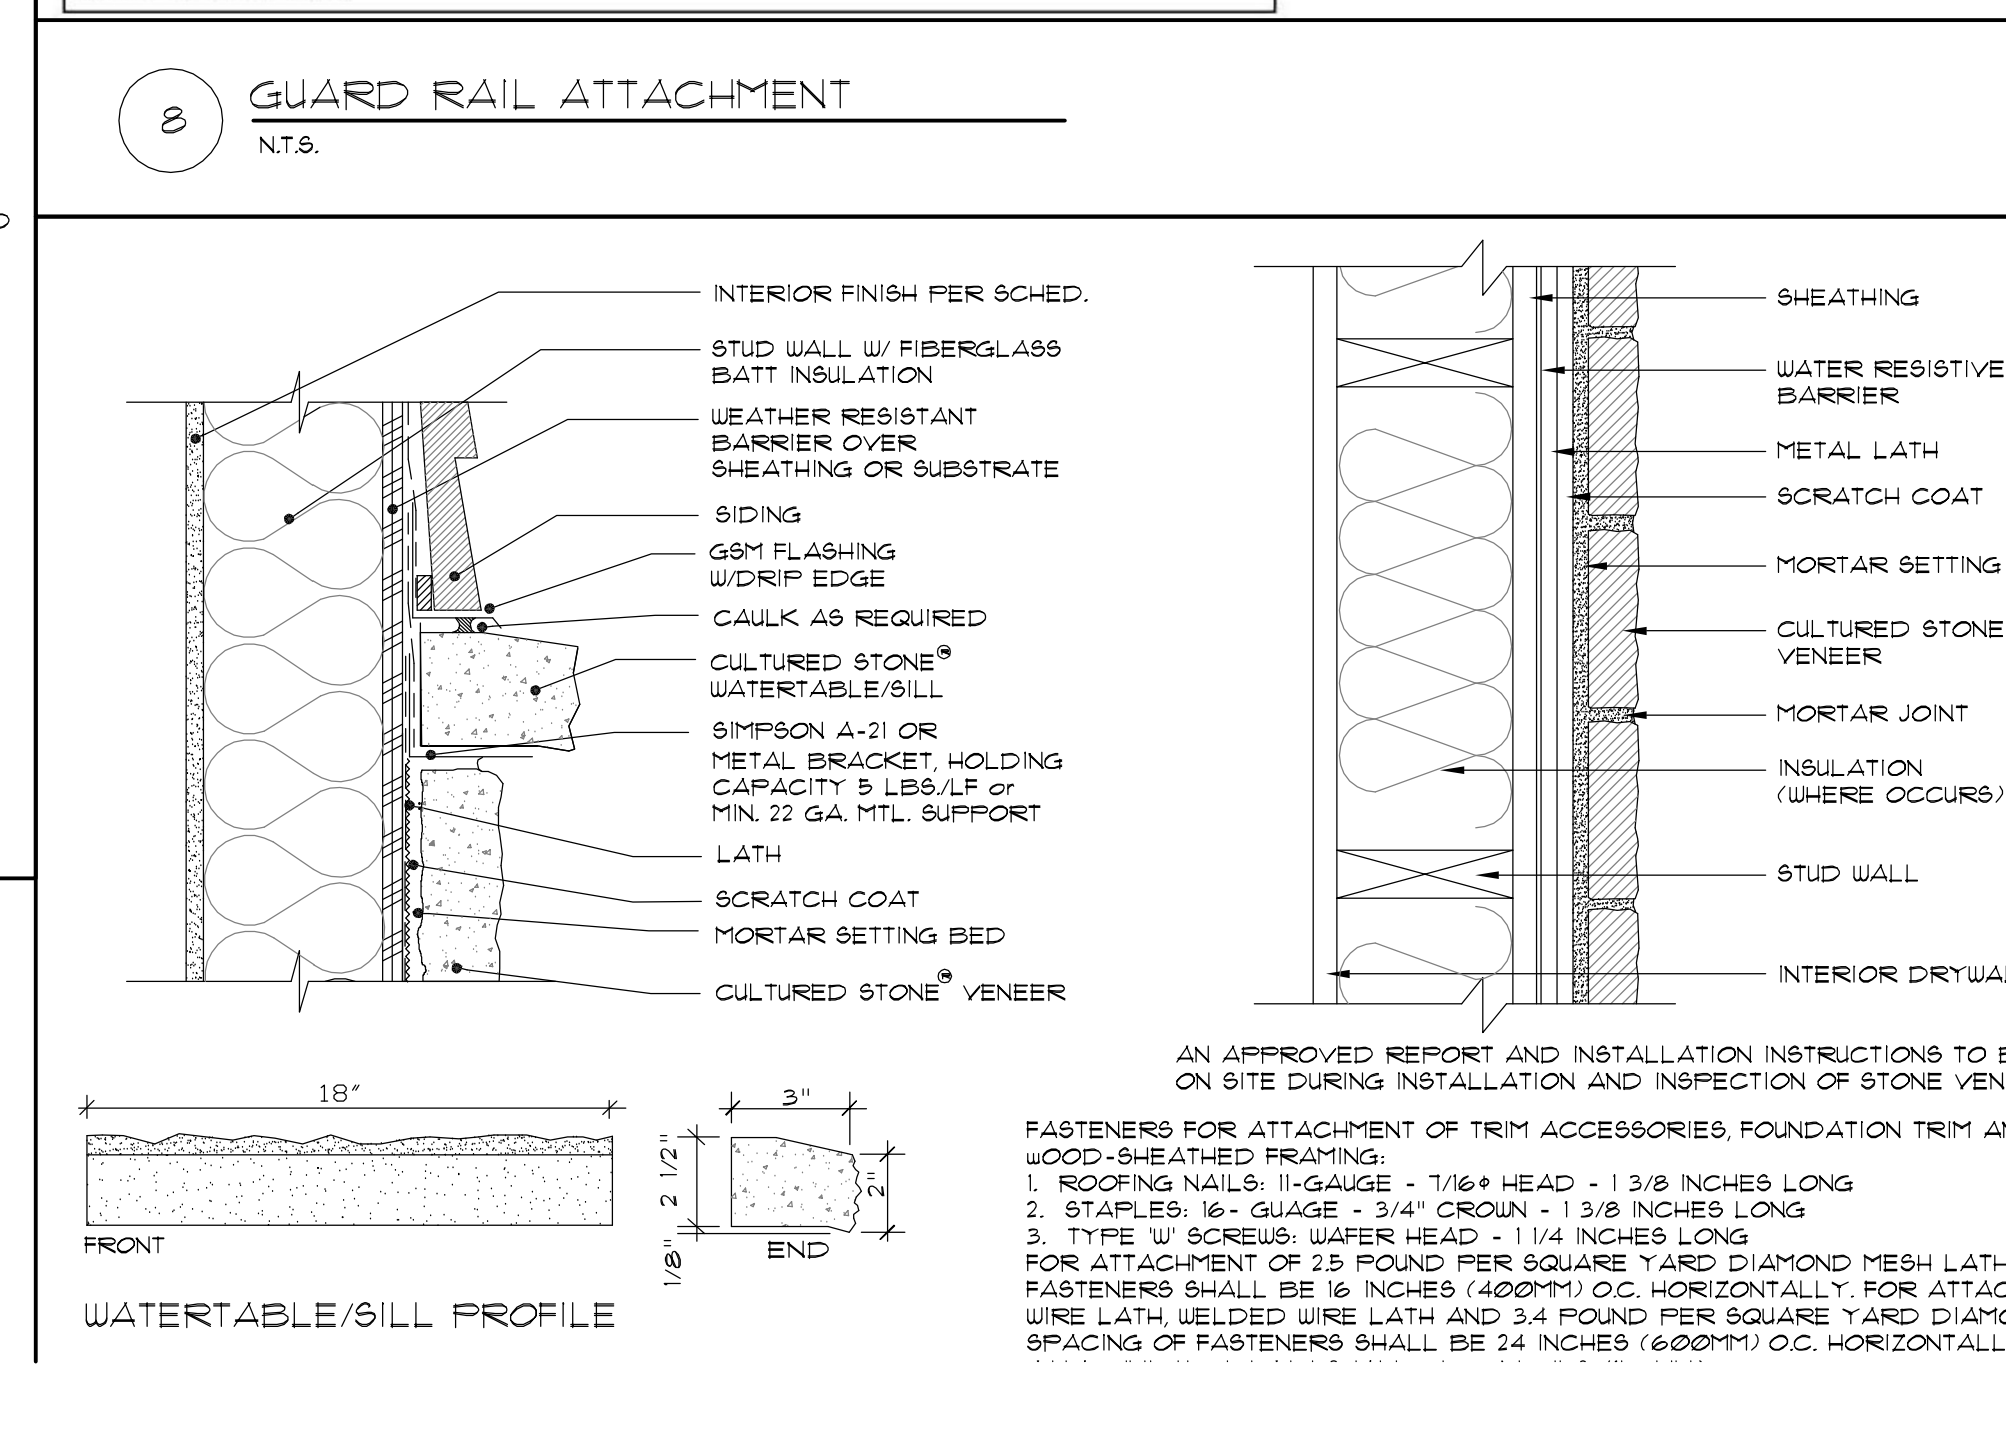


9 INSULATED HEADER DETAIL
N.T.S. 06/15/11

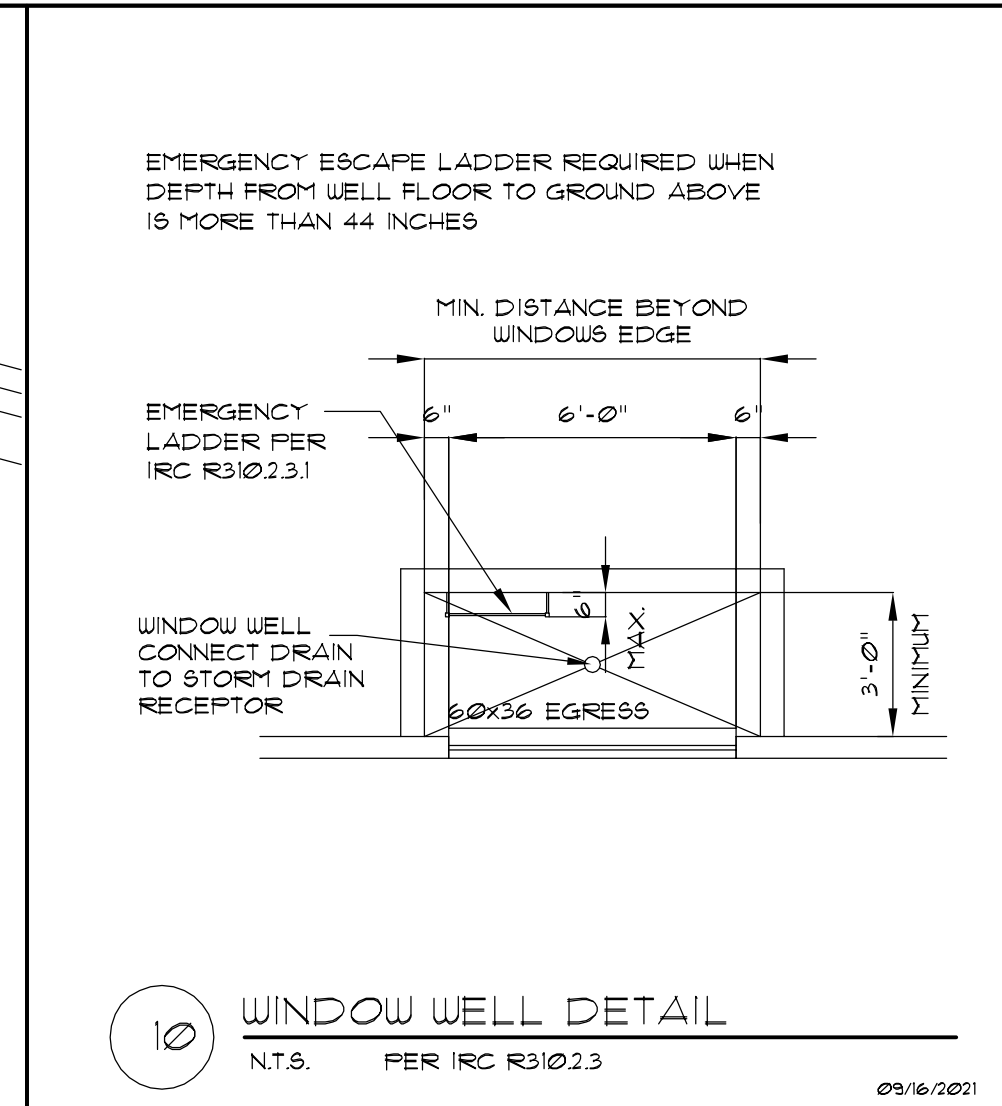


10 WINDOW WELL DETAIL
N.T.S. 09/16/2012

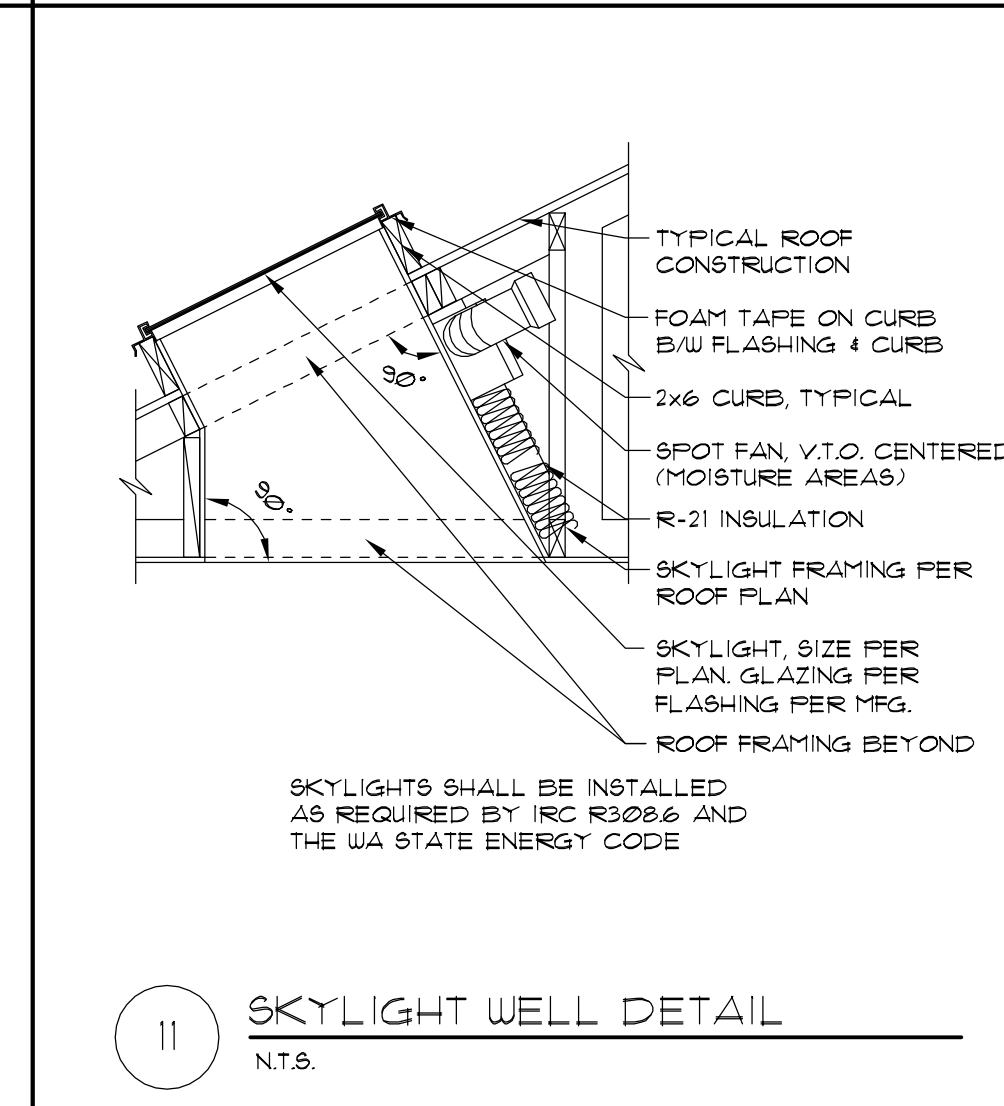


11 SKYLIGHT WELL DETAIL
N.T.S.

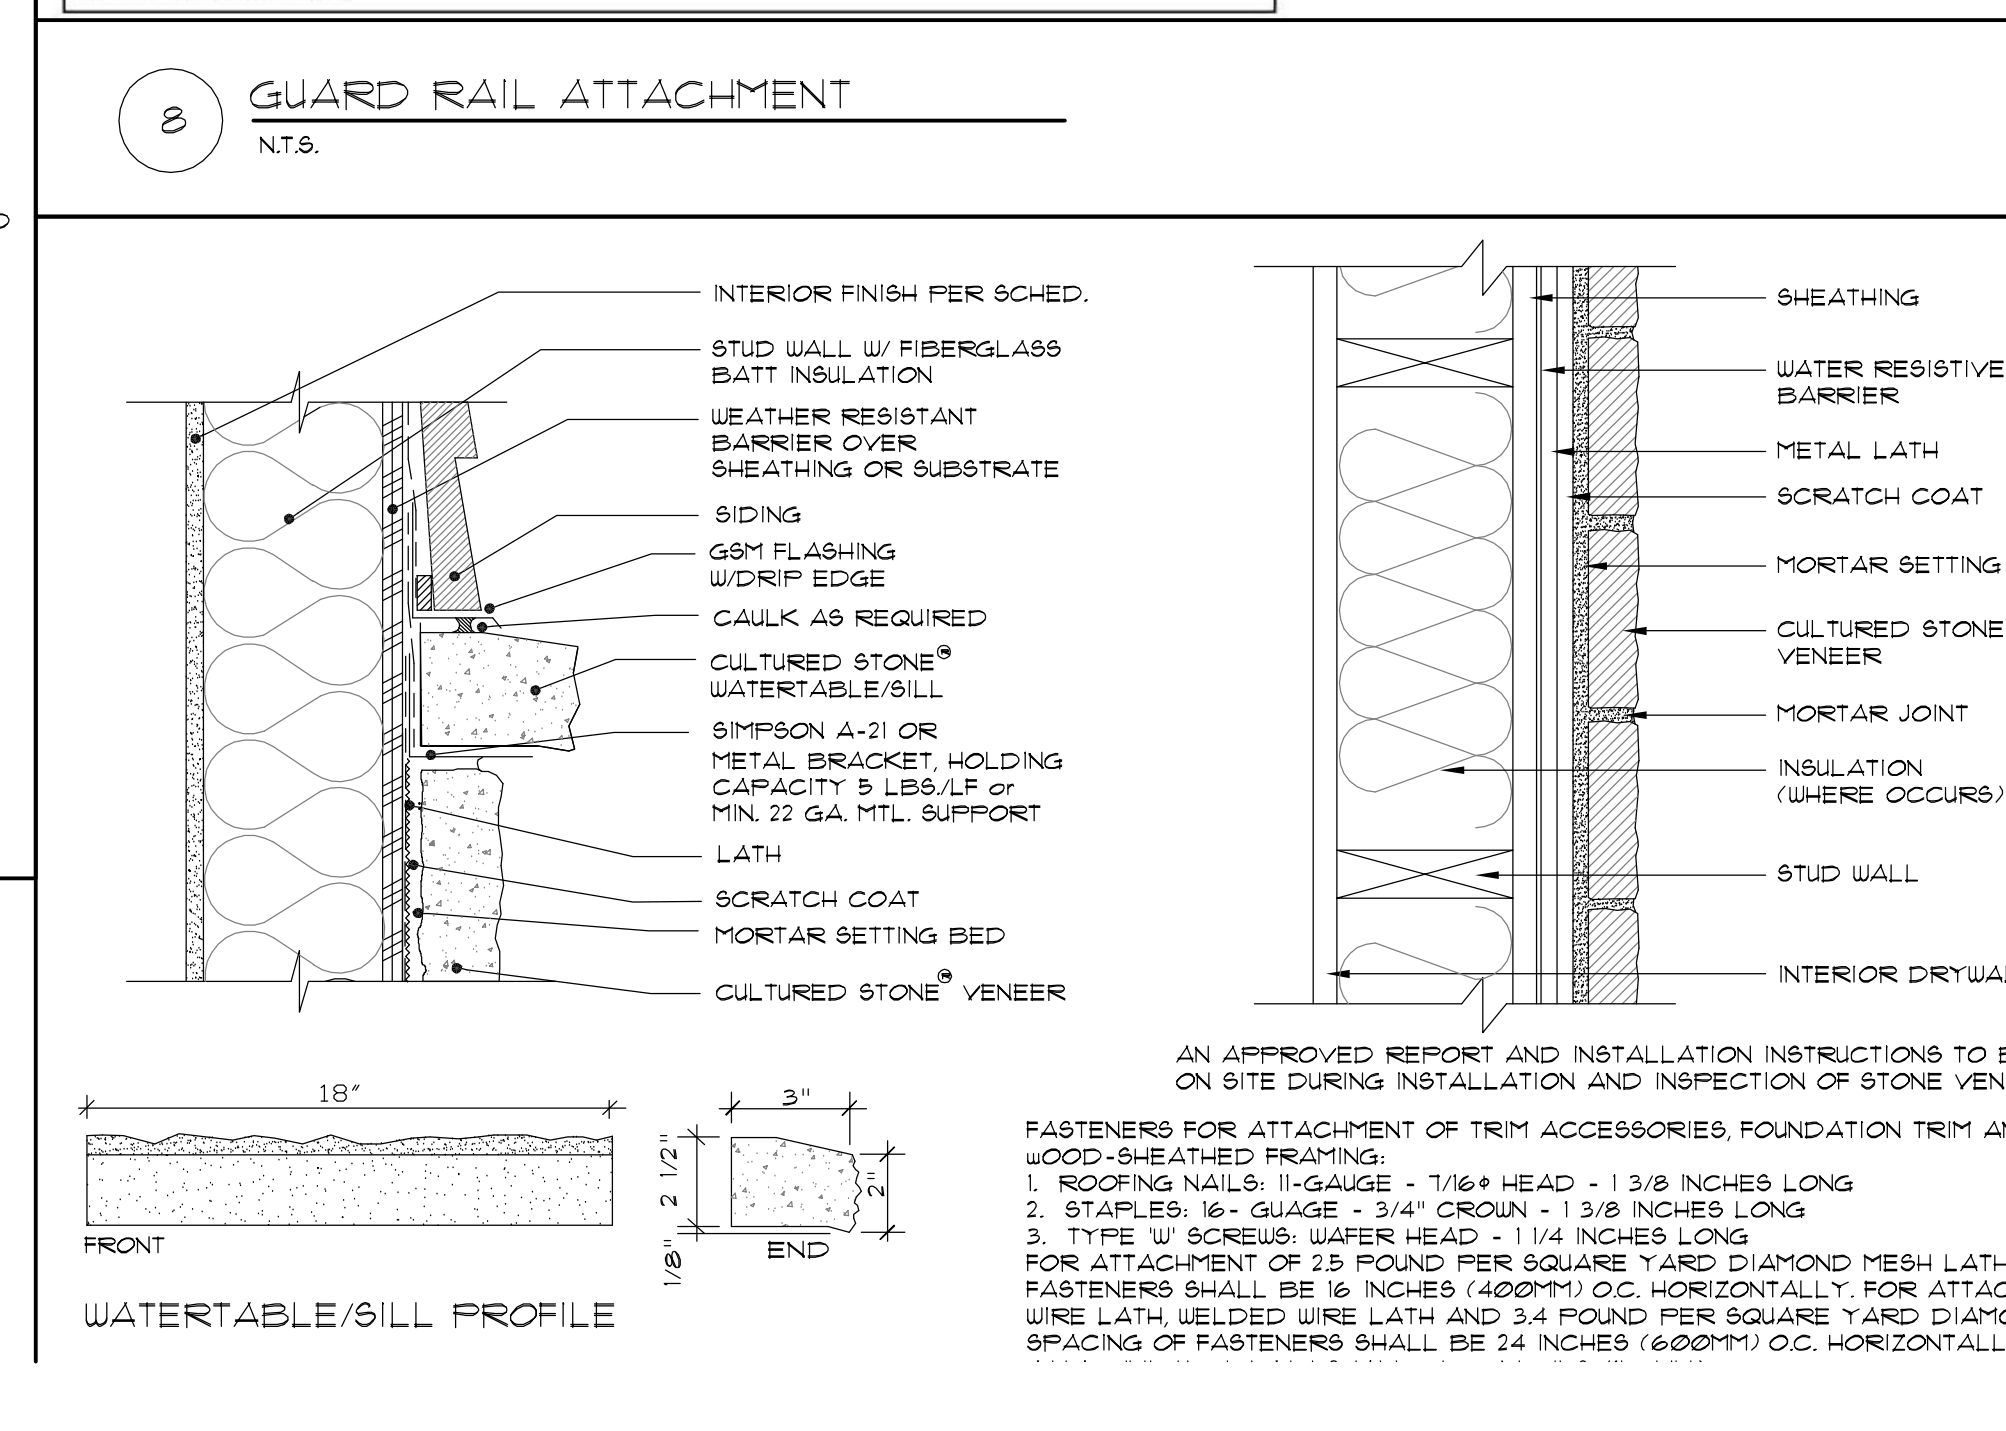


9 INSULATED HEADER DETAIL
N.T.S. 06/15/11

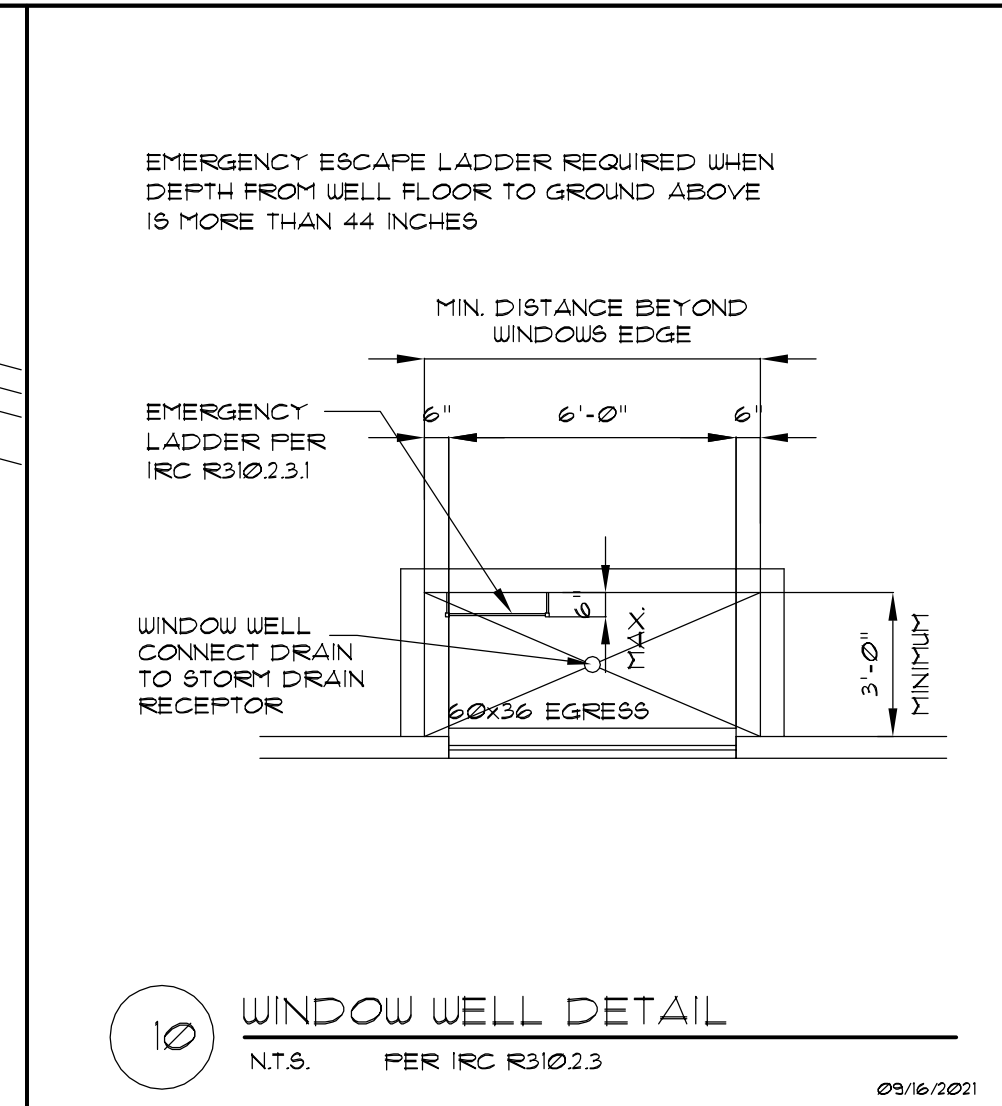


10 WINDOW WELL DETAIL
N.T.S. 09/16/2012

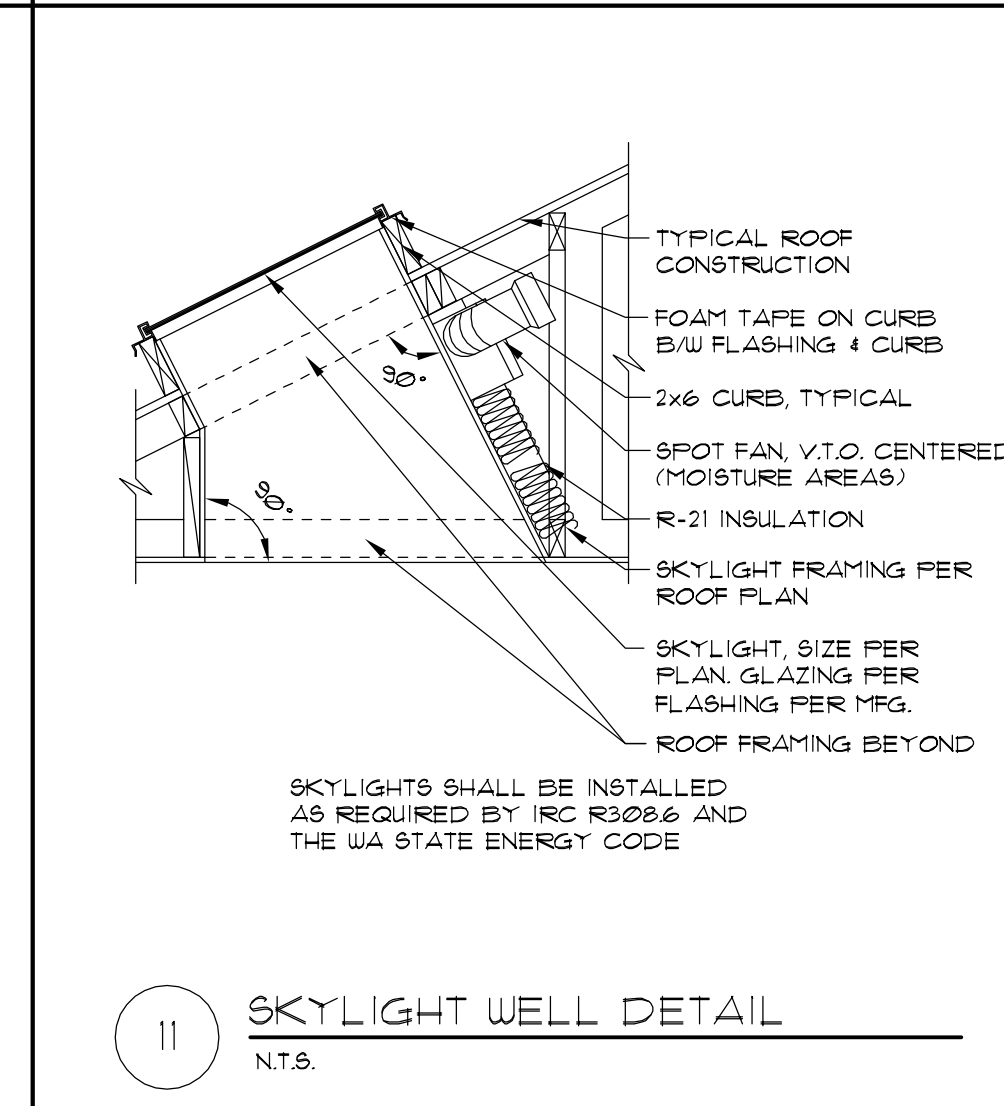


11 SKYLIGHT WELL DETAIL
N.T.S.

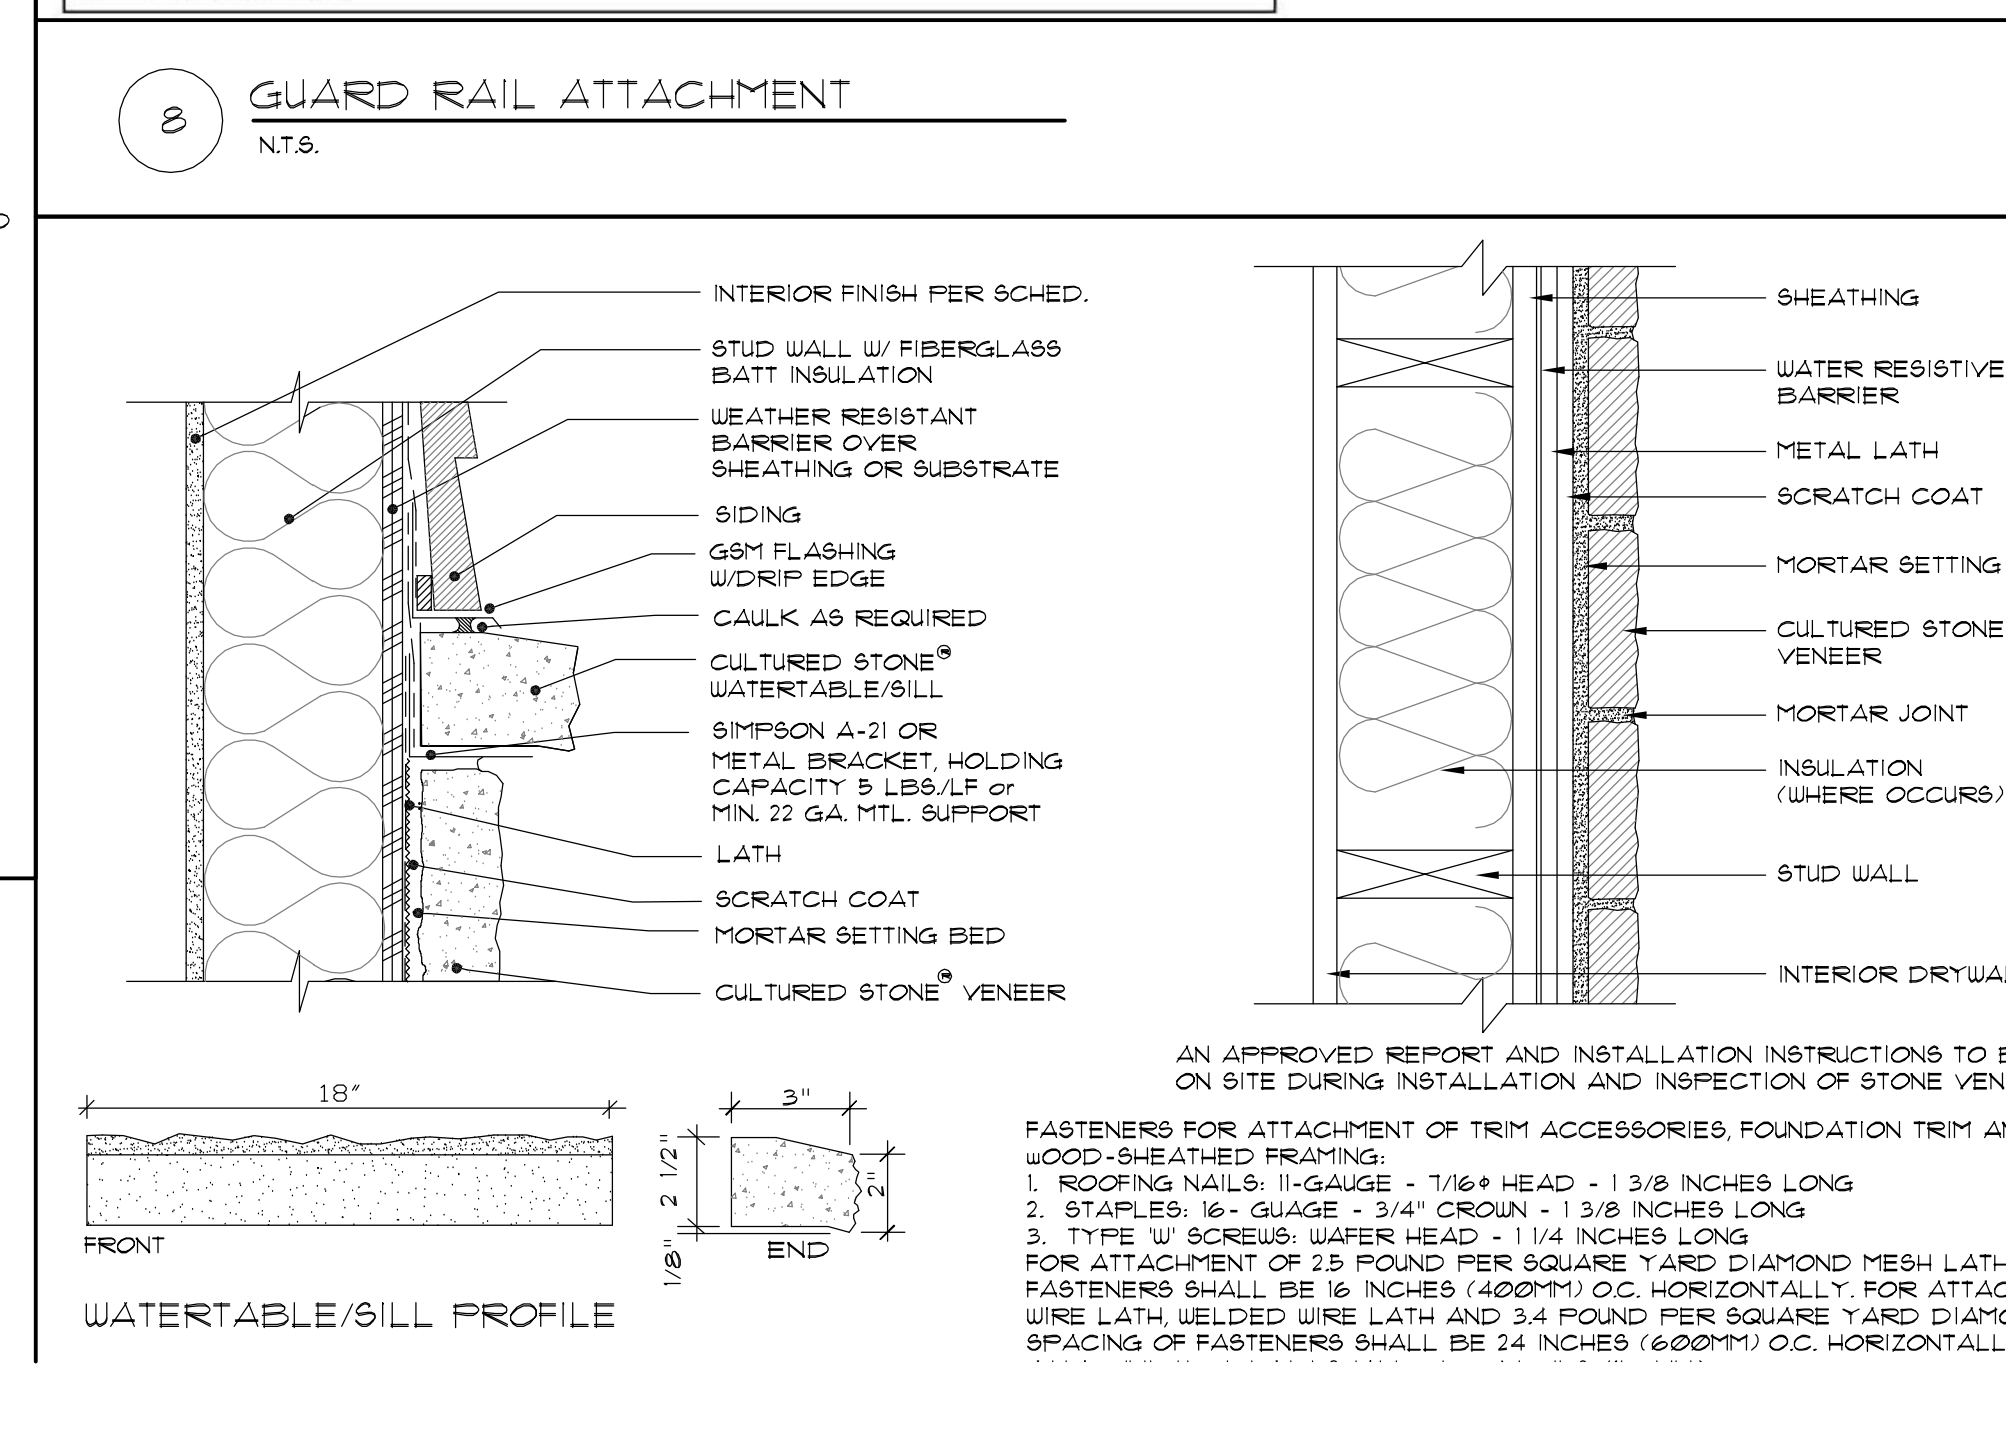


9 INSULATED HEADER DETAIL
N.T.S. 06/15/11

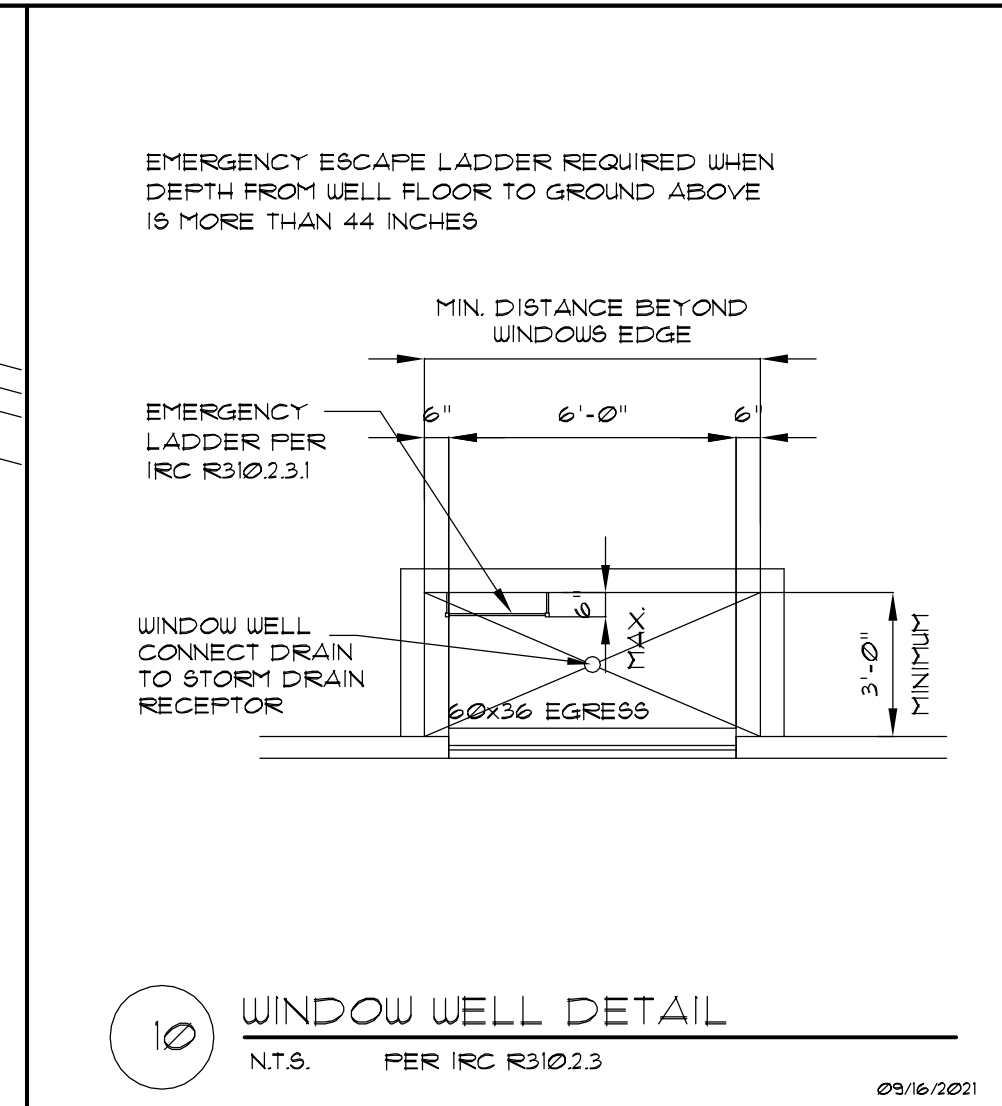


10 WINDOW WELL DETAIL
N.T.S. 09/16/2012

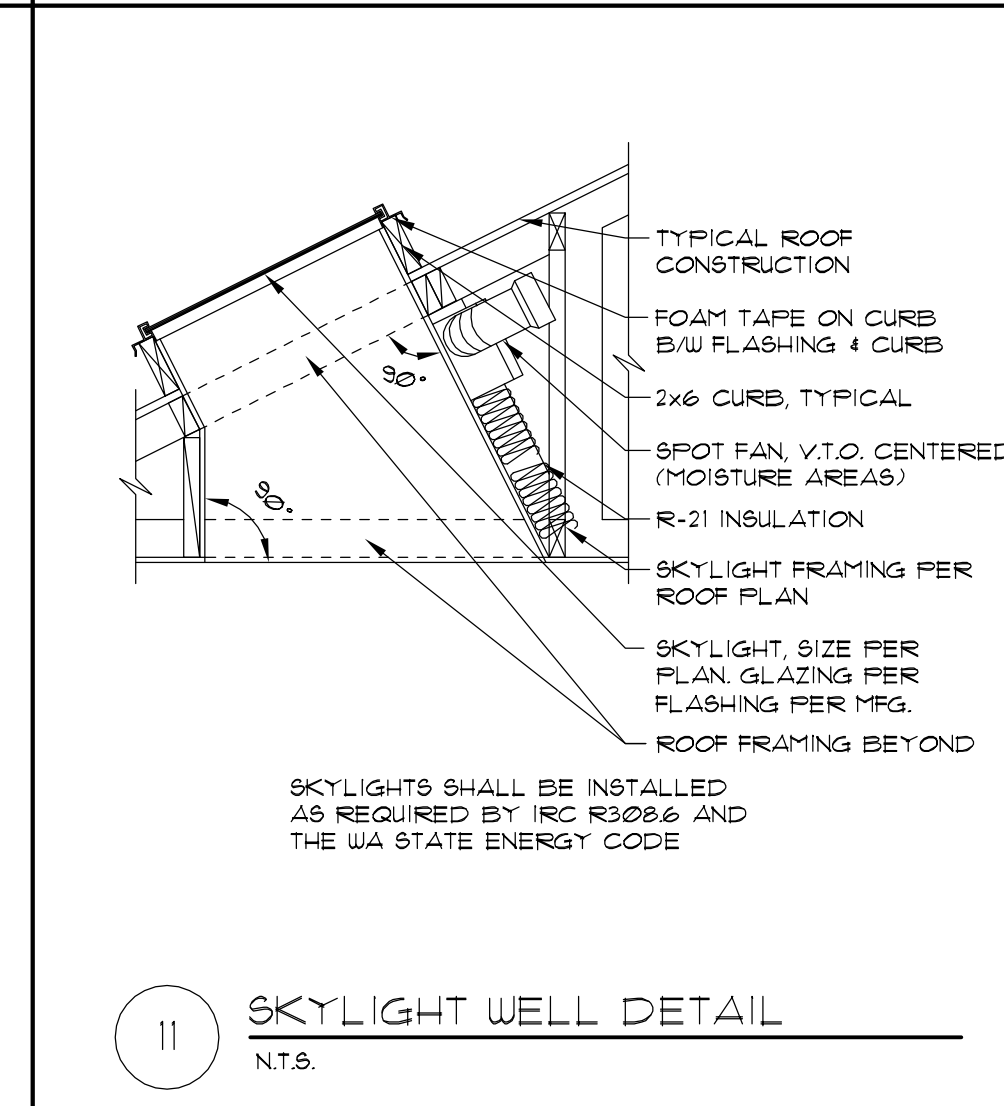


11 SKYLIGHT WELL DETAIL
N.T.S.

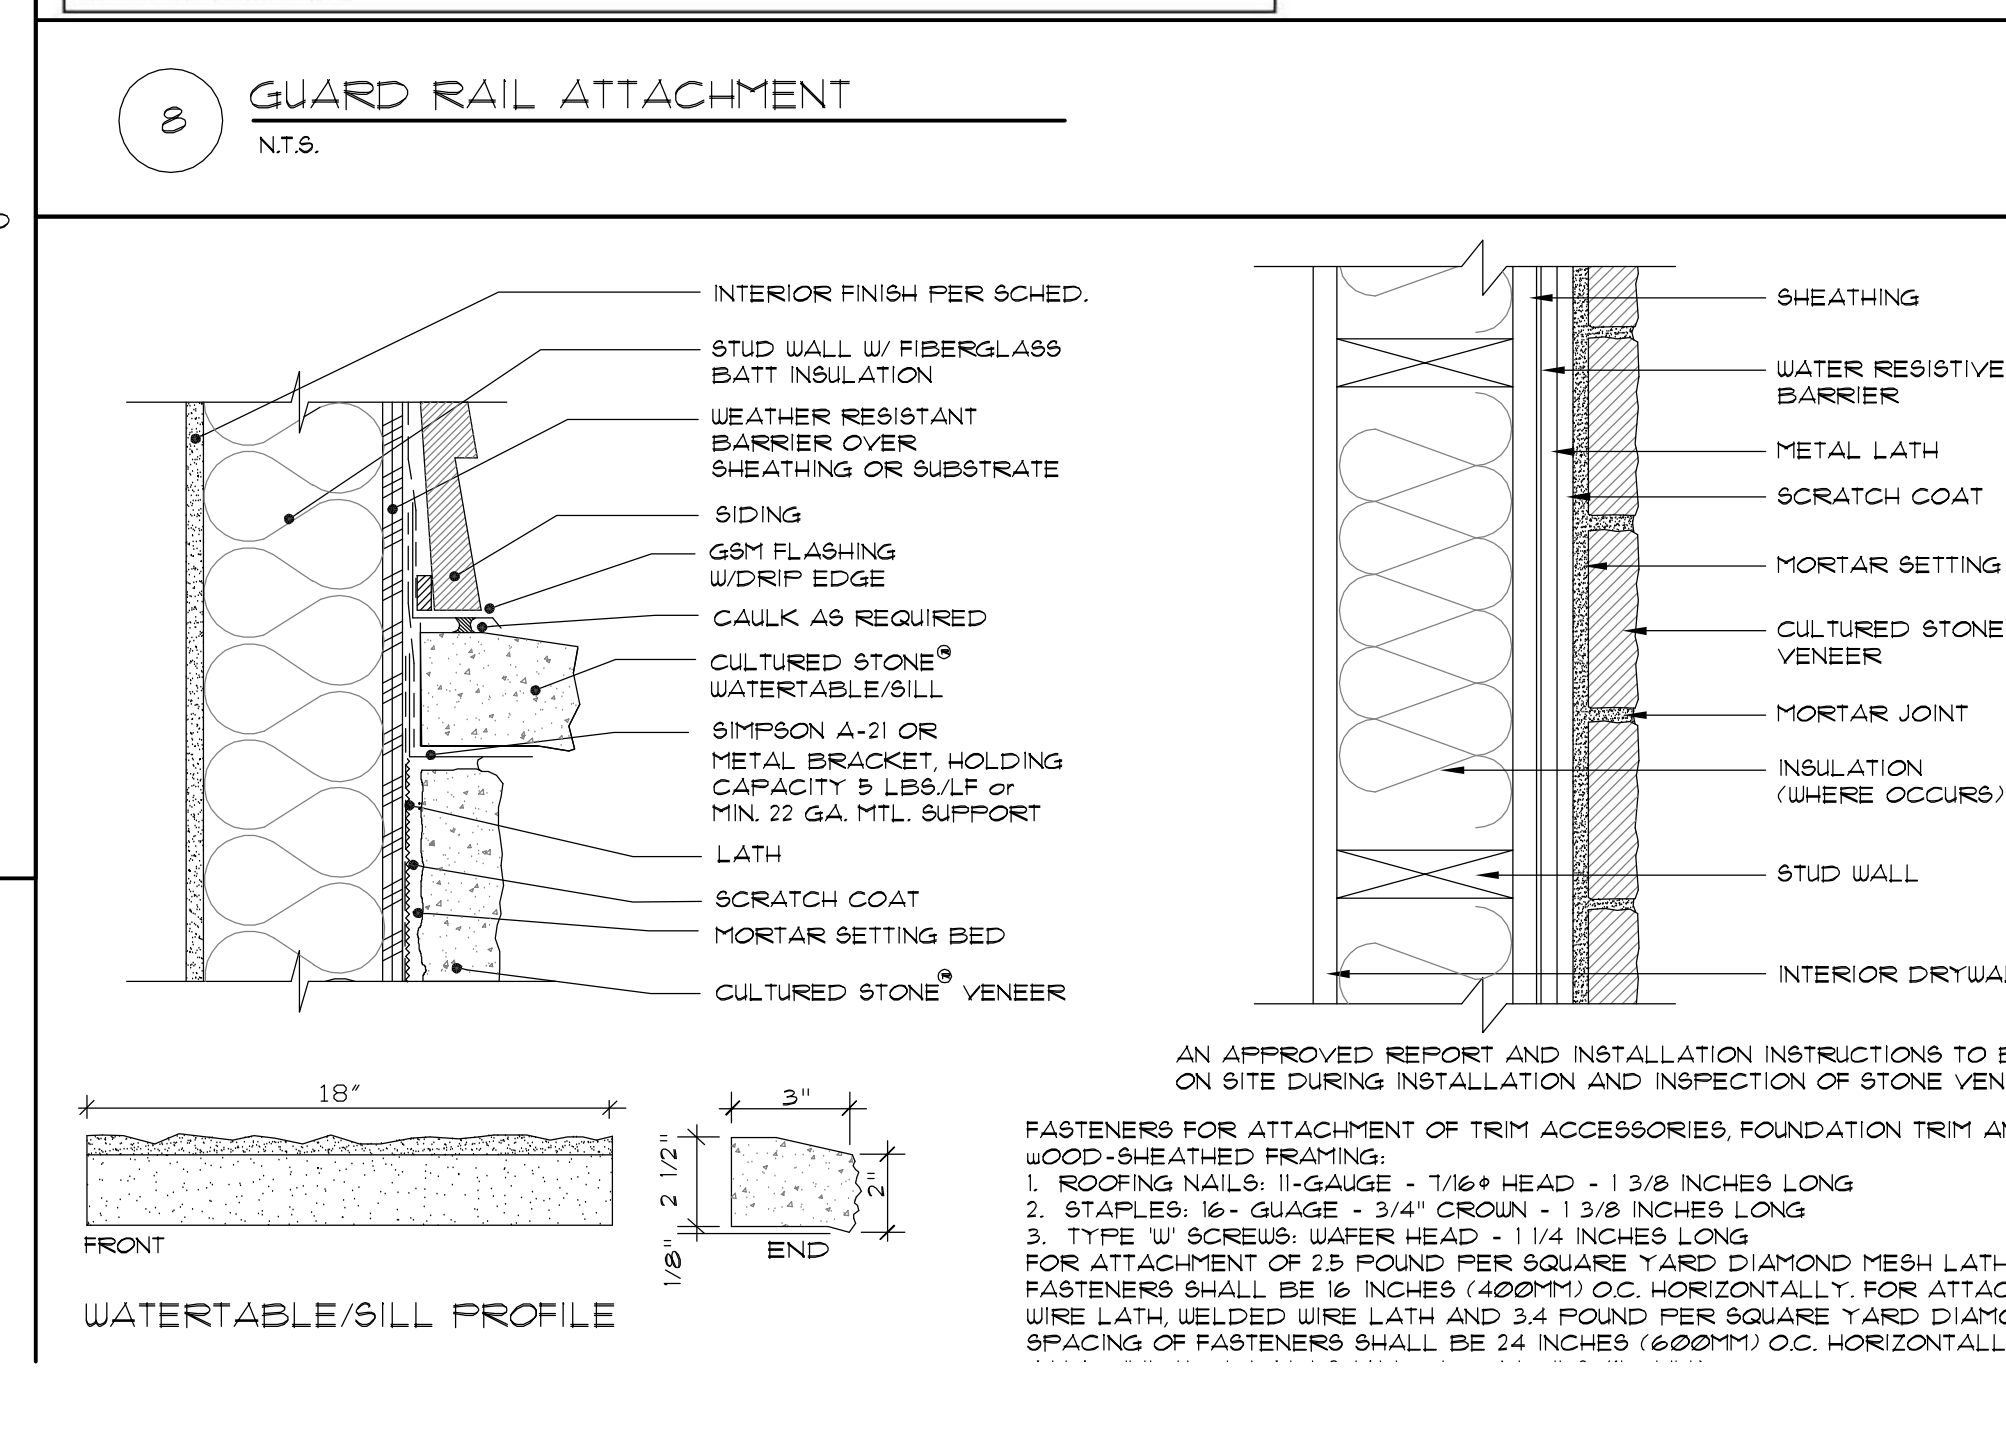


9 INSULATED HEADER DETAIL
N.T.S. 06/15/11

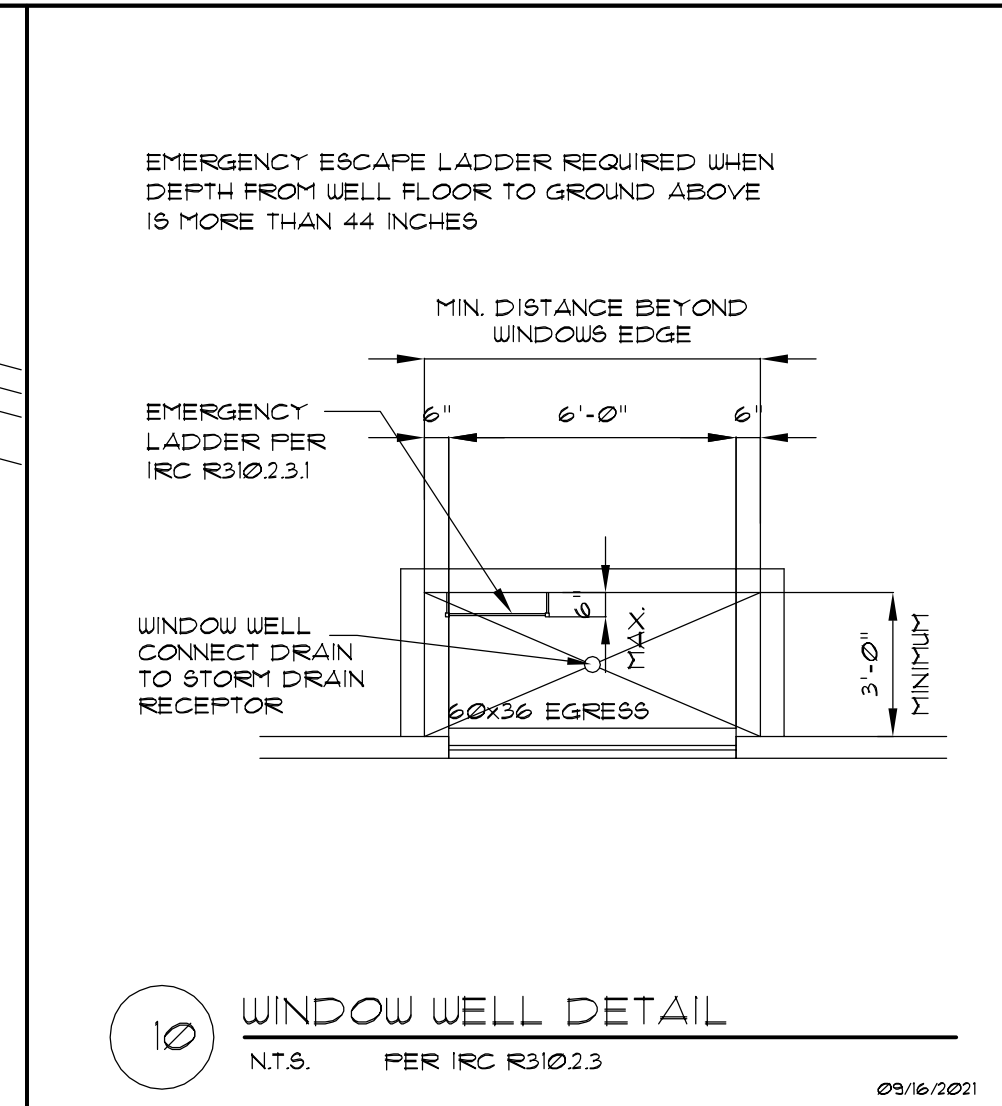


10 WINDOW WELL DETAIL
N.T.S. 09/16/2012

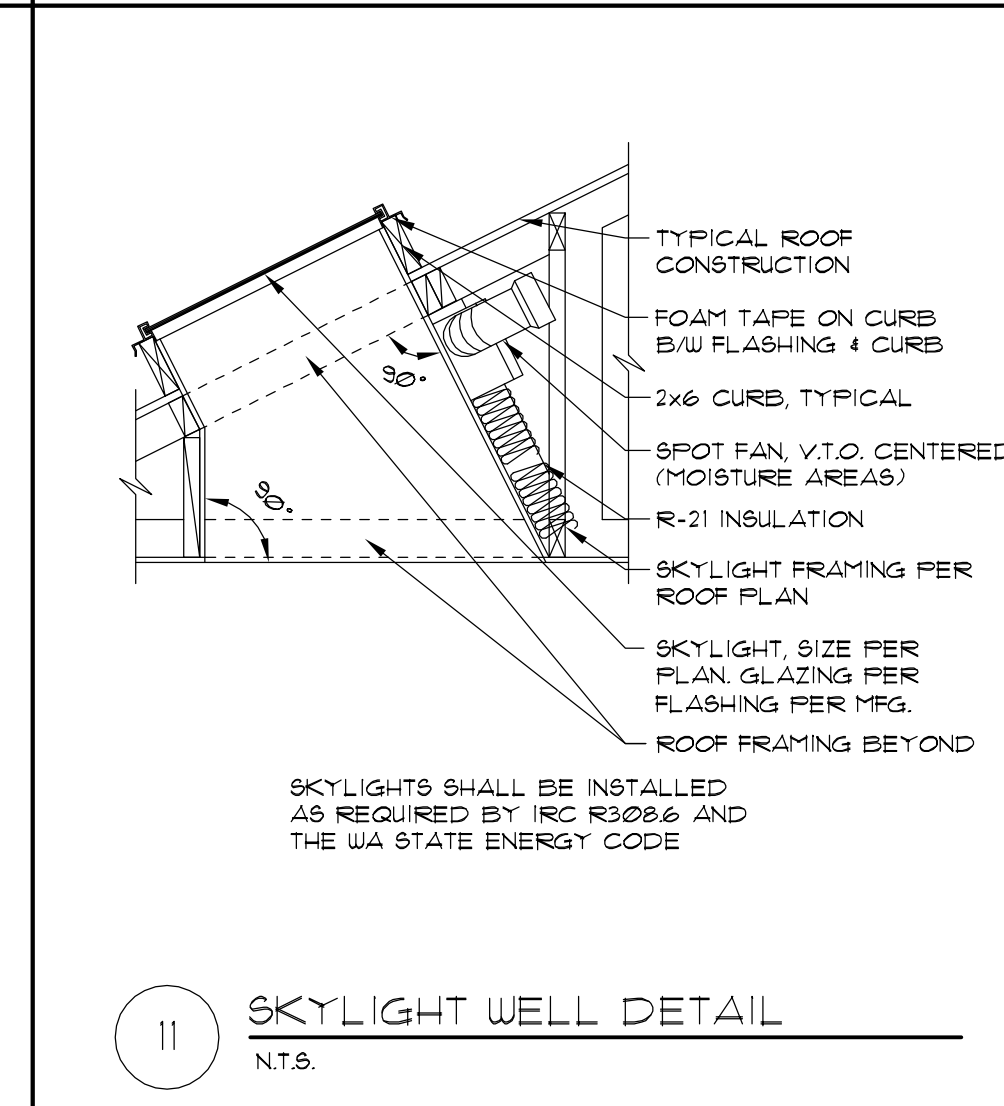


11 SKYLIGHT WELL DETAIL
N.T.S.

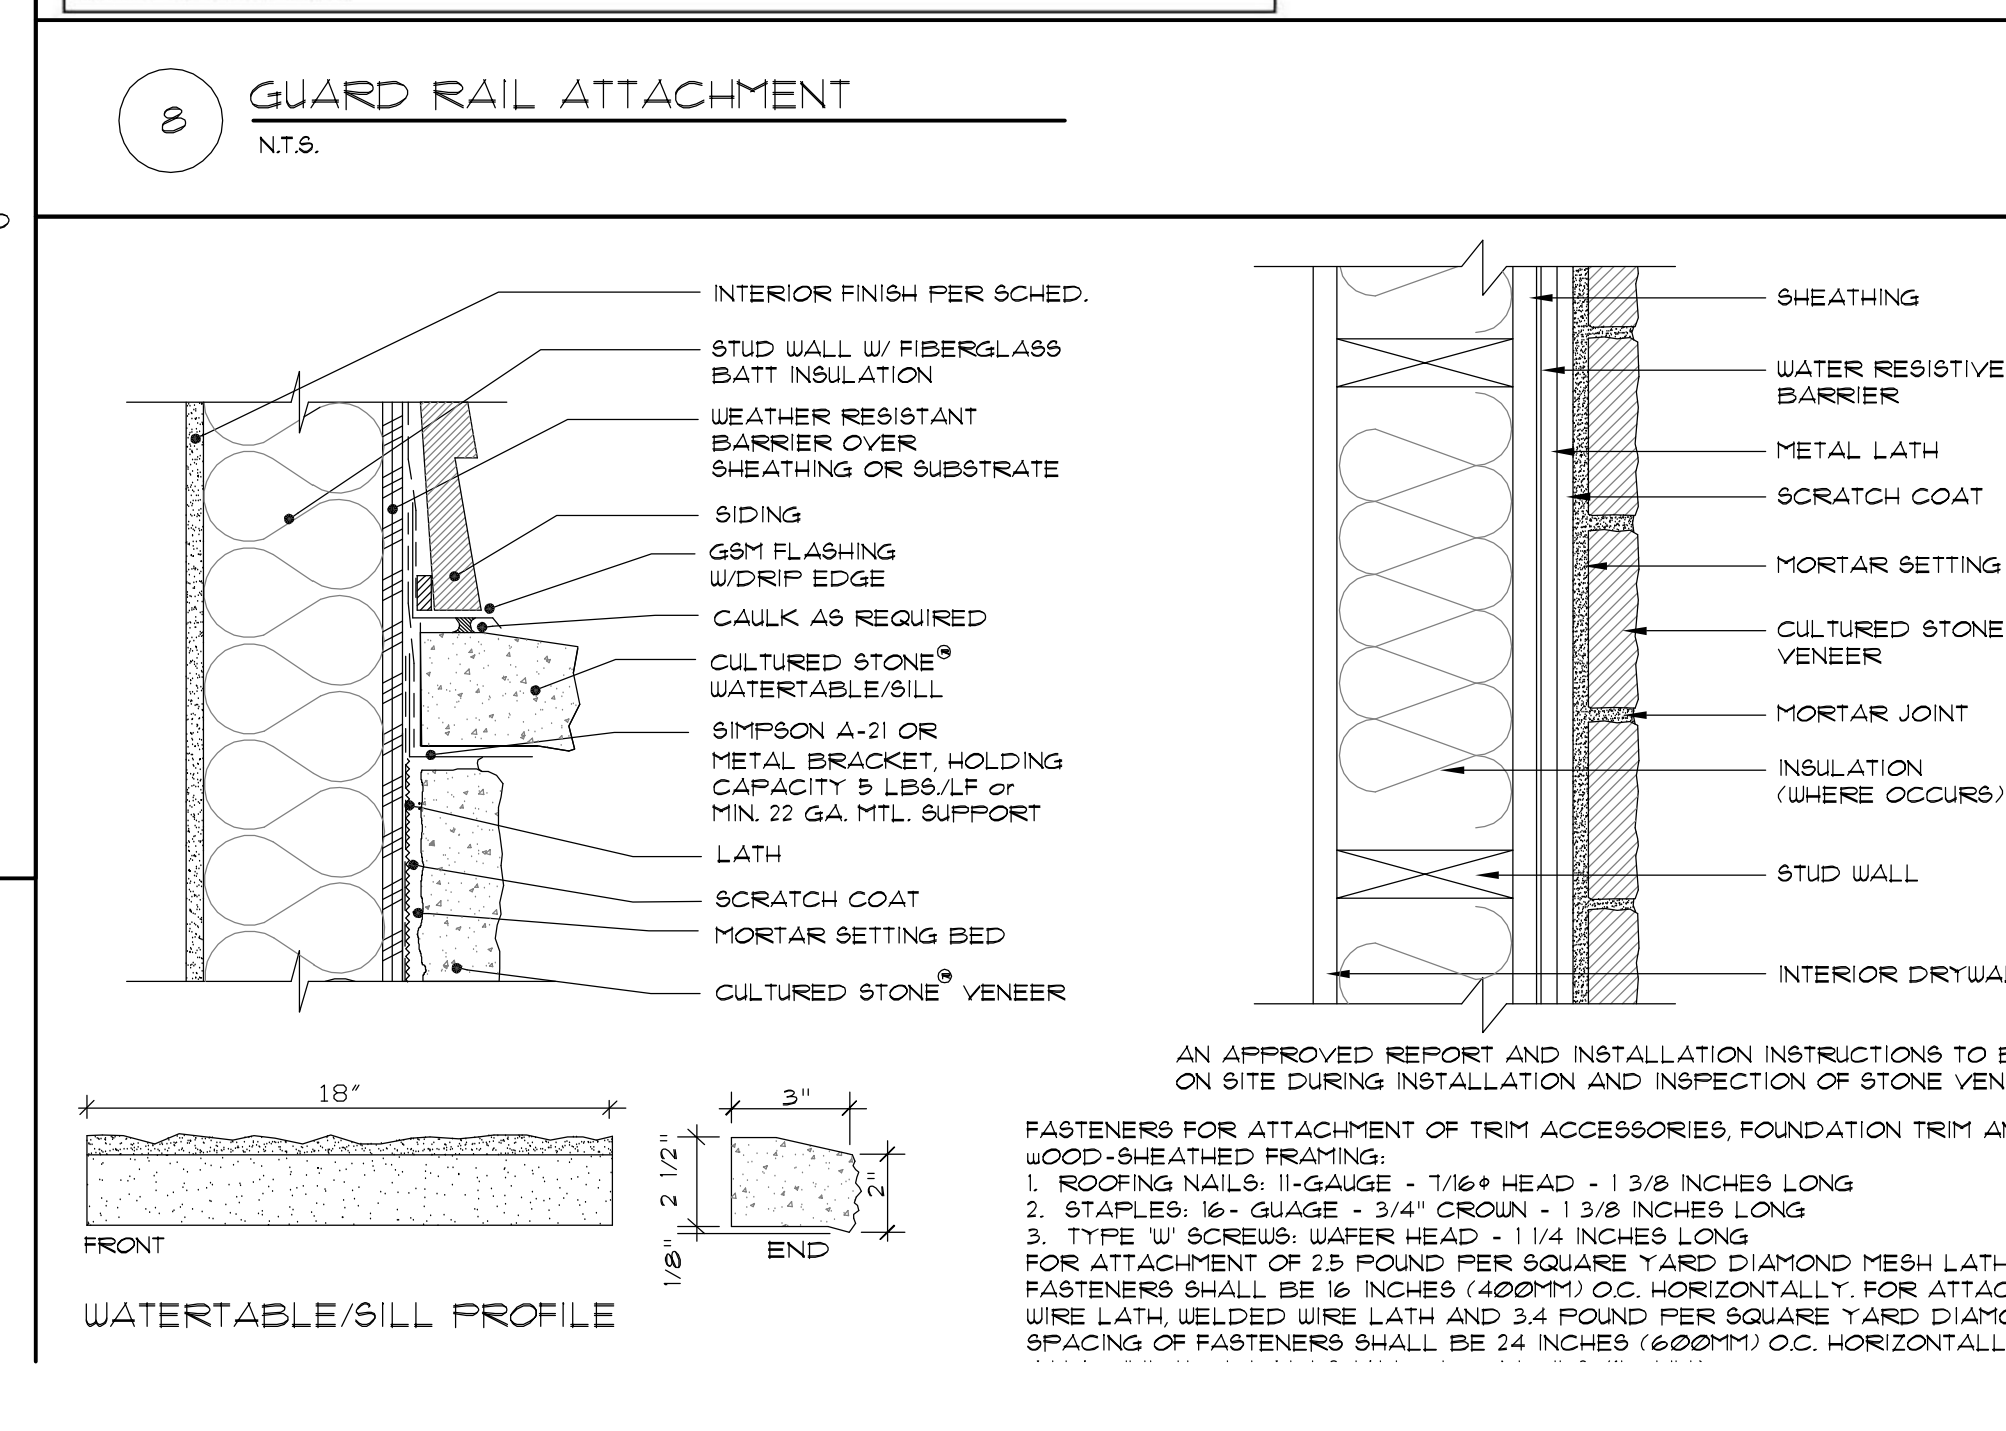


9 INSULATED HEADER DETAIL
N.T.S. 06/15/11

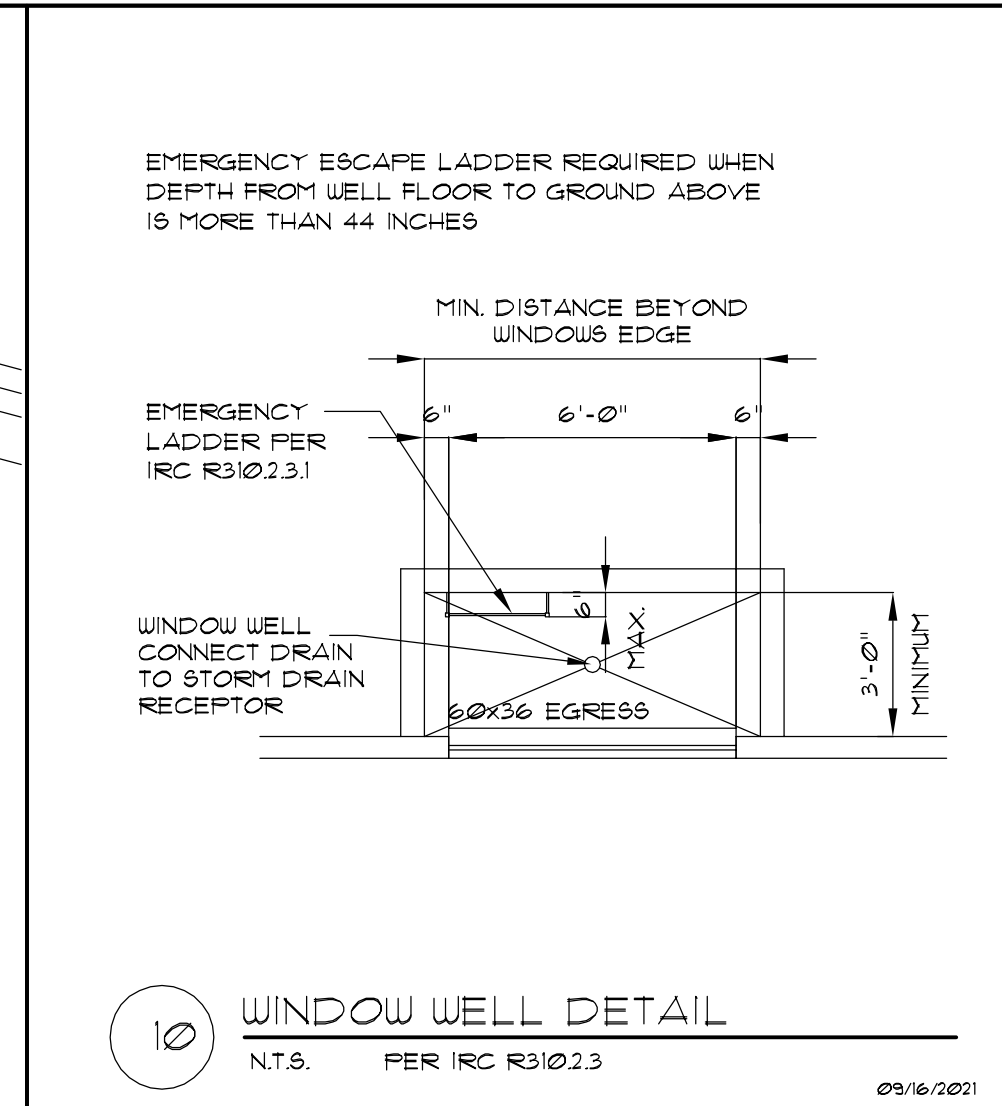


10 WINDOW WELL DETAIL
N.T.S. 09/16/2012

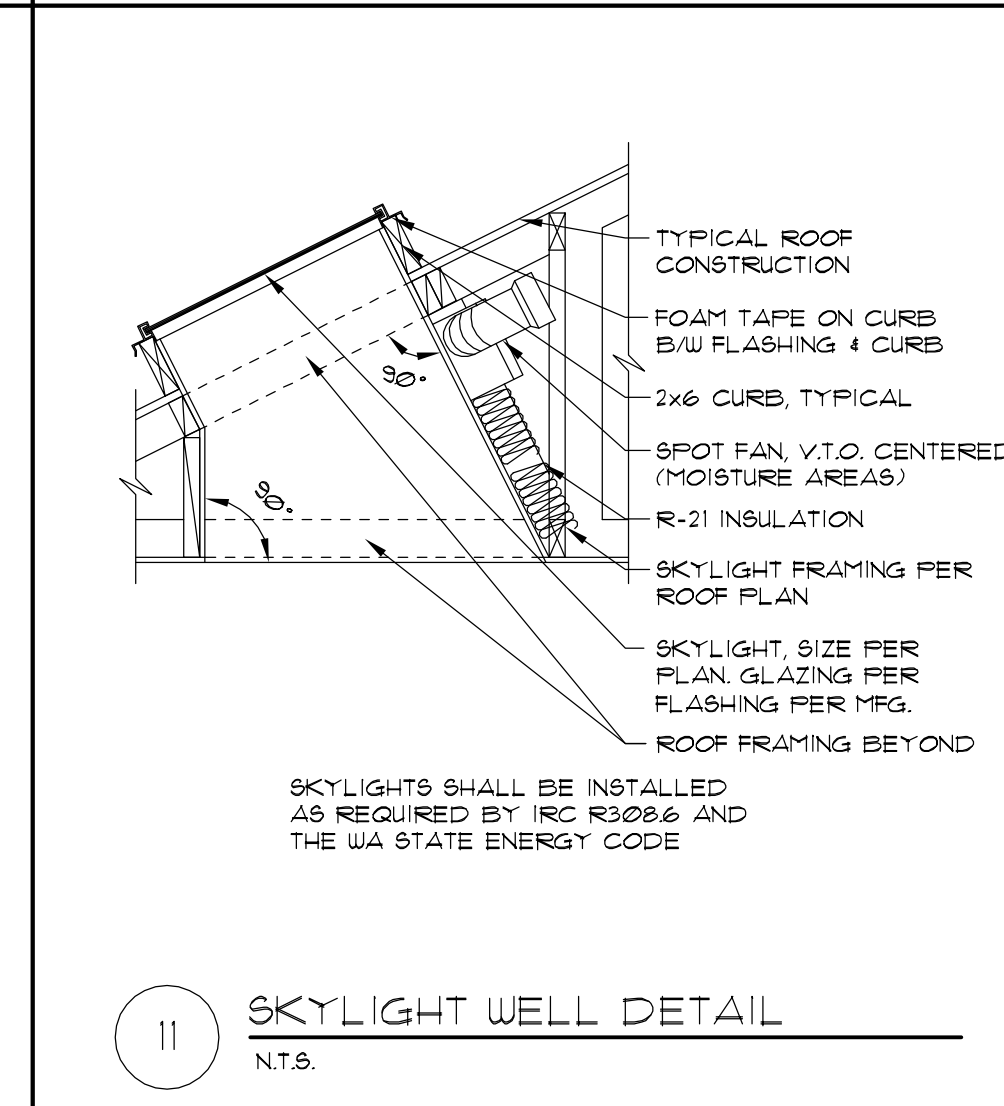


11 SKYLIGHT WELL DETAIL
N.T.S.

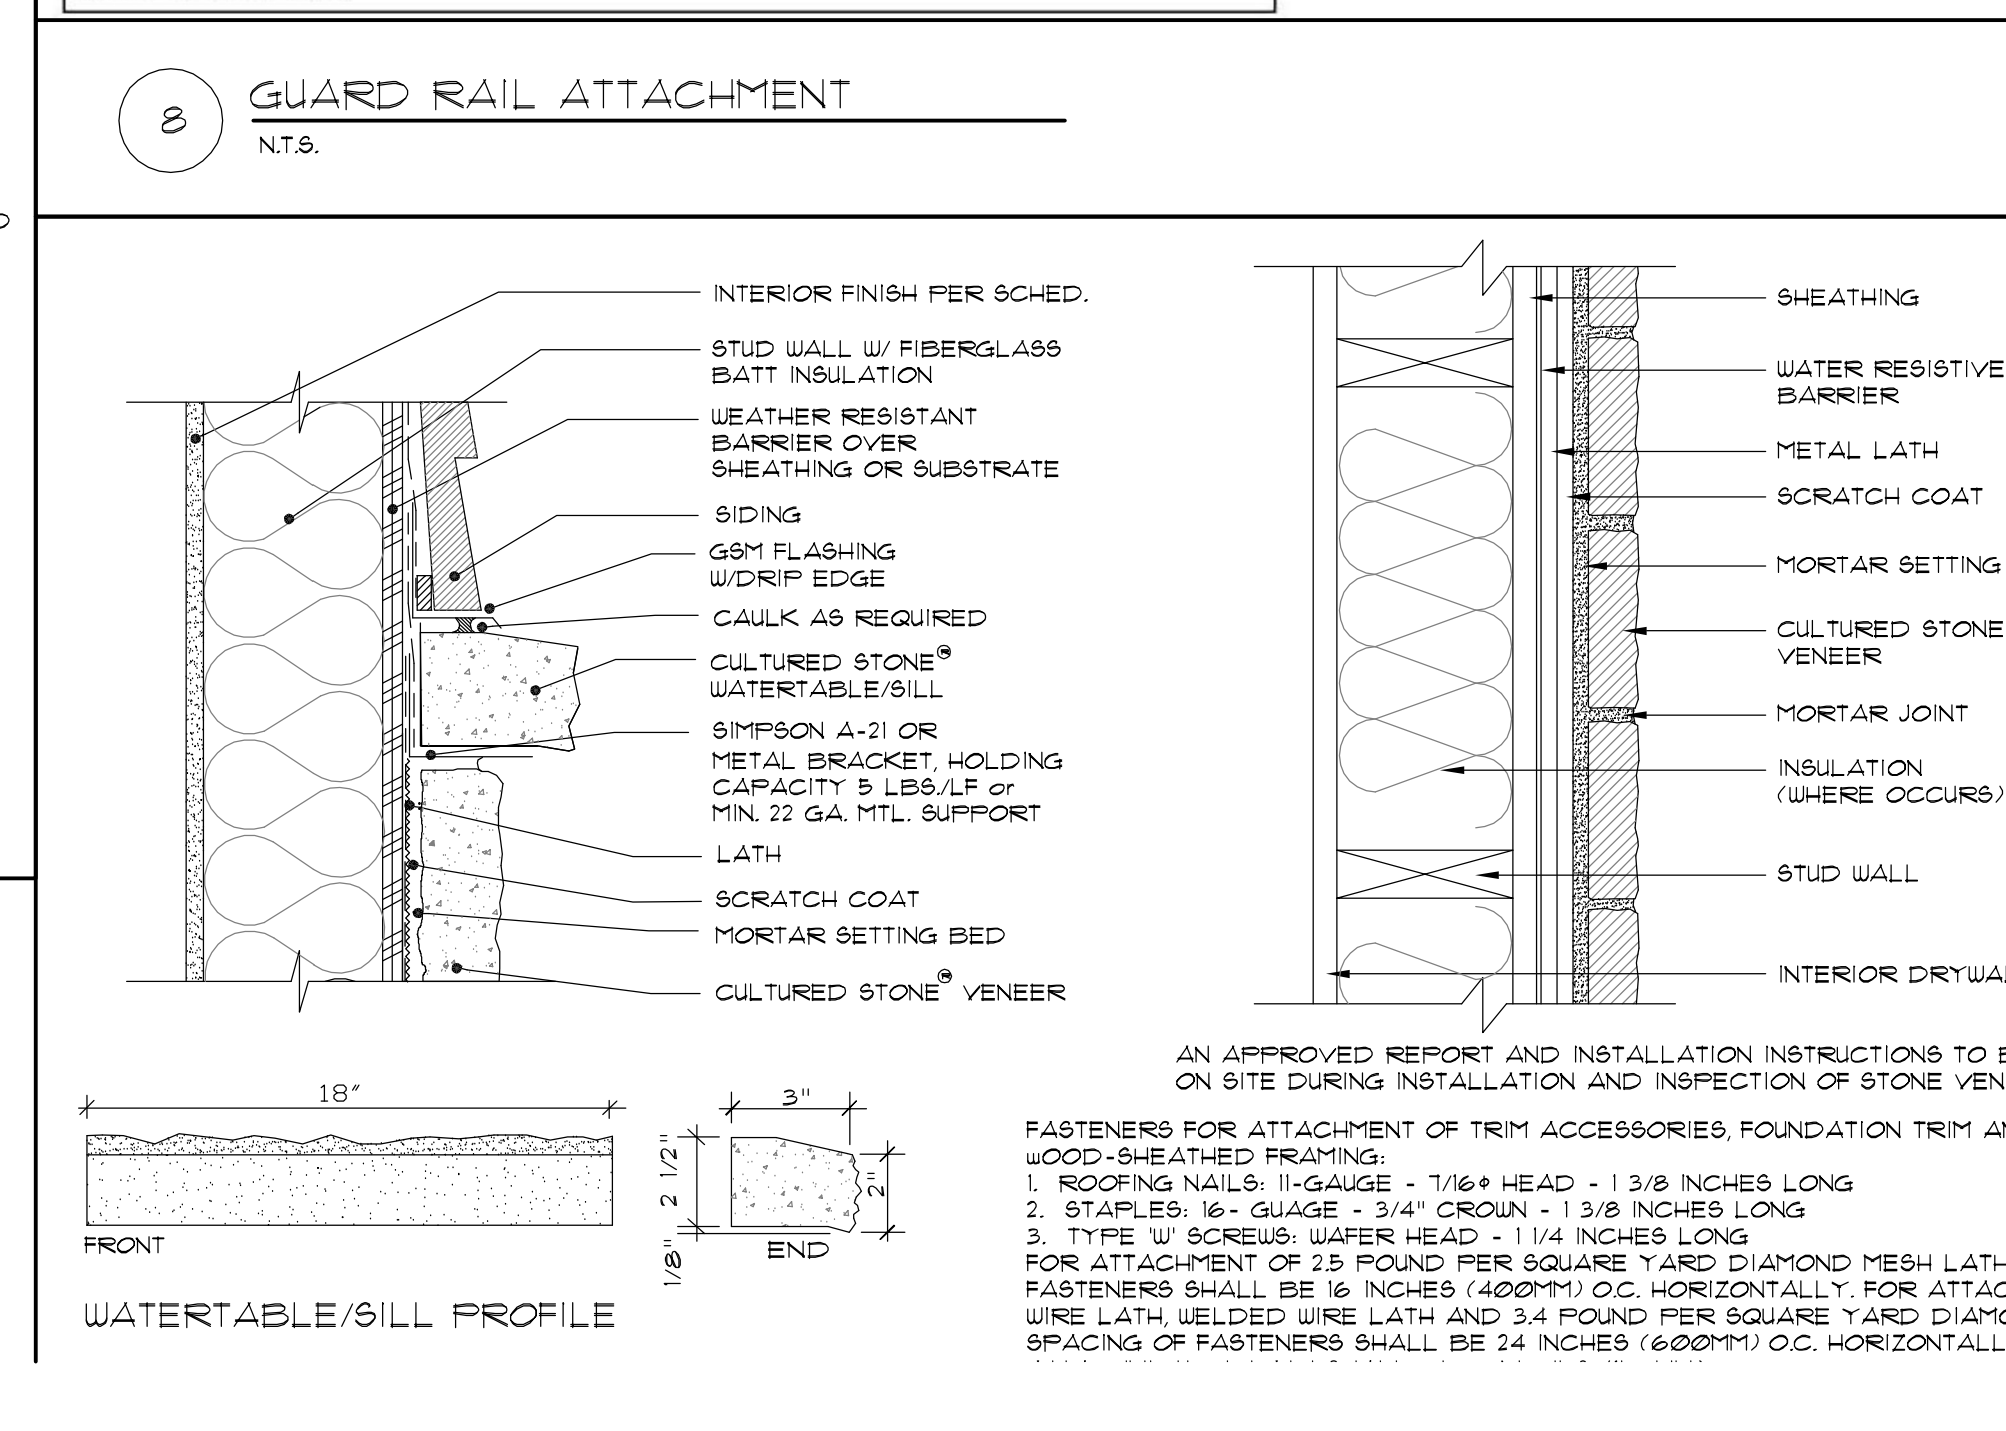


9 INSULATED HEADER DETAIL
N.T.S. 06/15/11

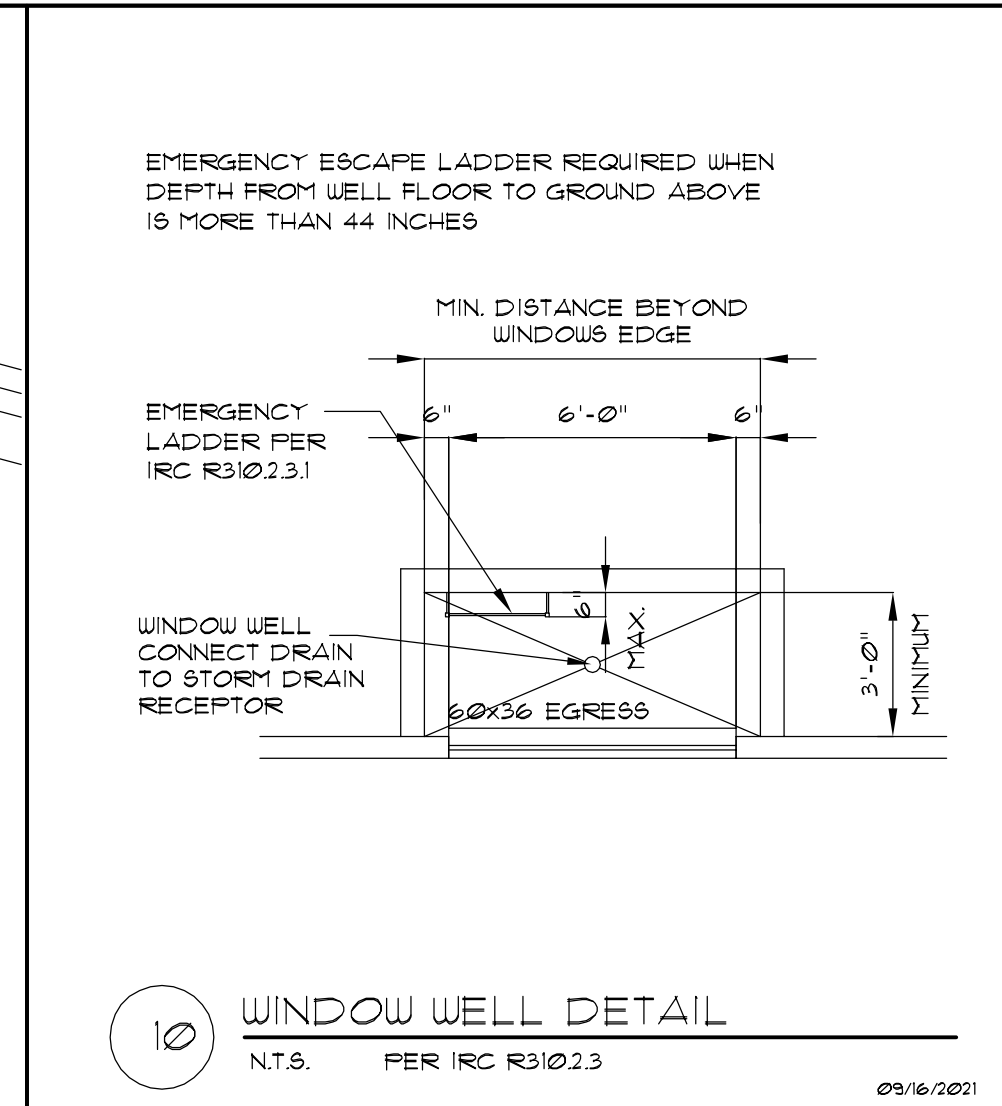


10 WINDOW WELL DETAIL
N.T.S. 09/16/2012

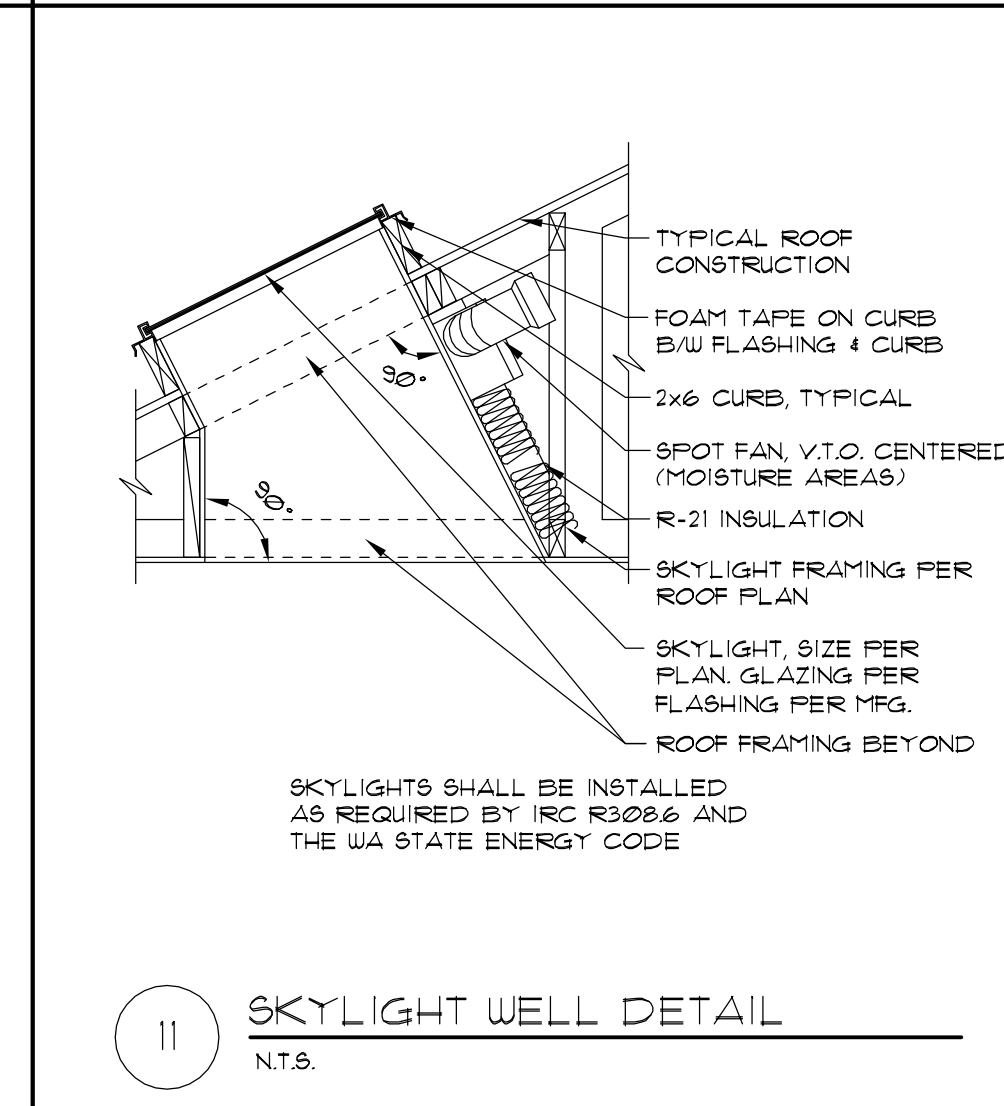


11 SKYLIGHT WELL DETAIL
N.T.S.

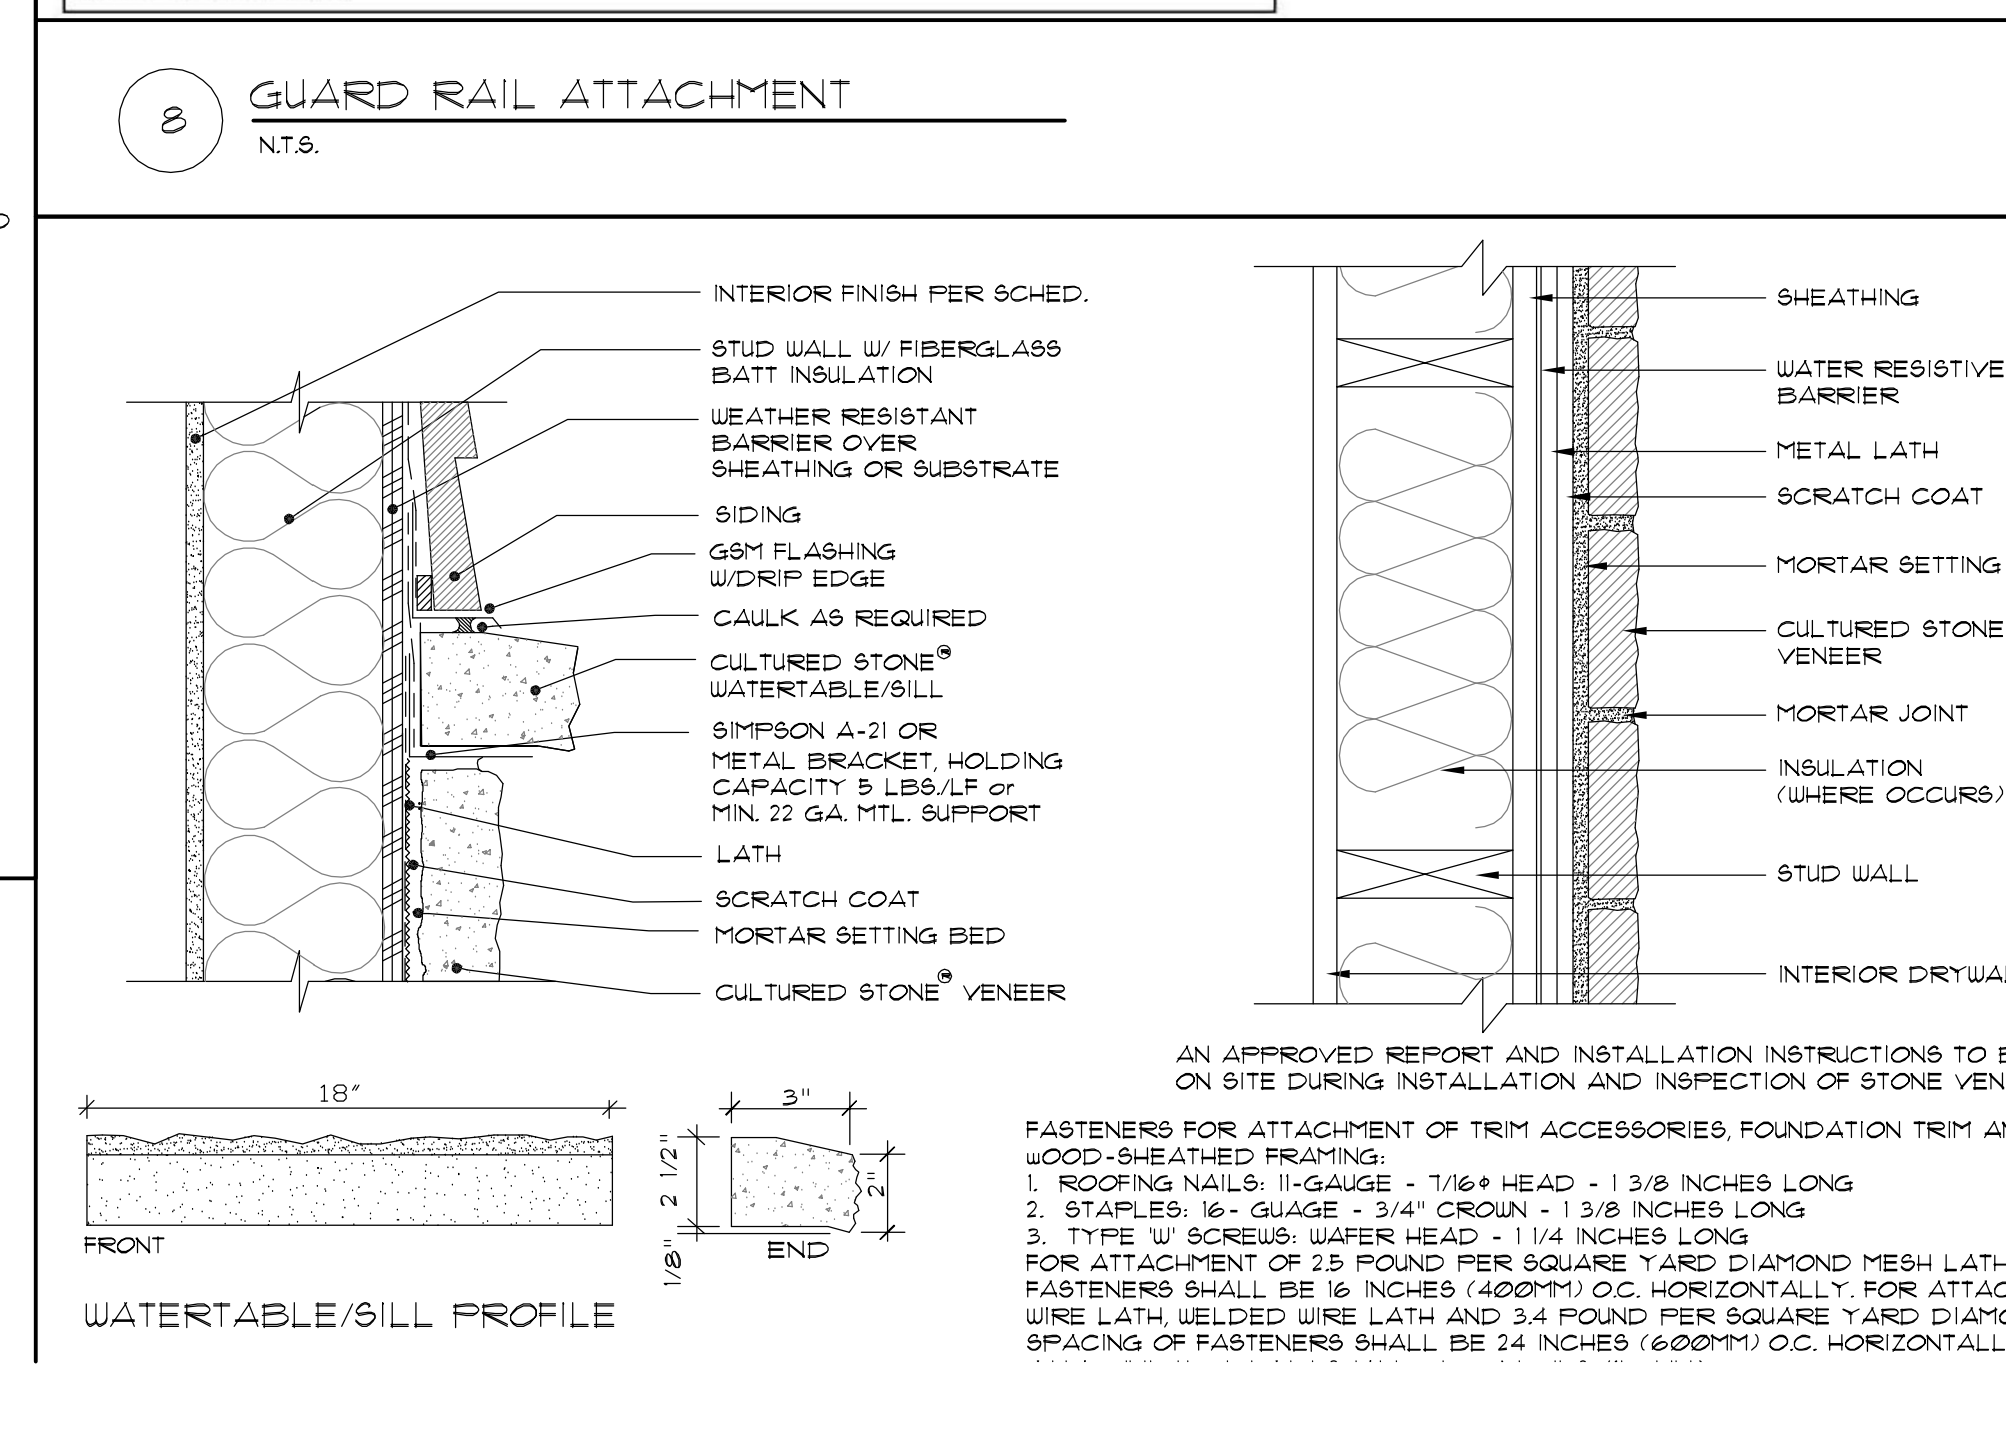


9 INSULATED HEADER DETAIL
N.T.S. 06/15/11

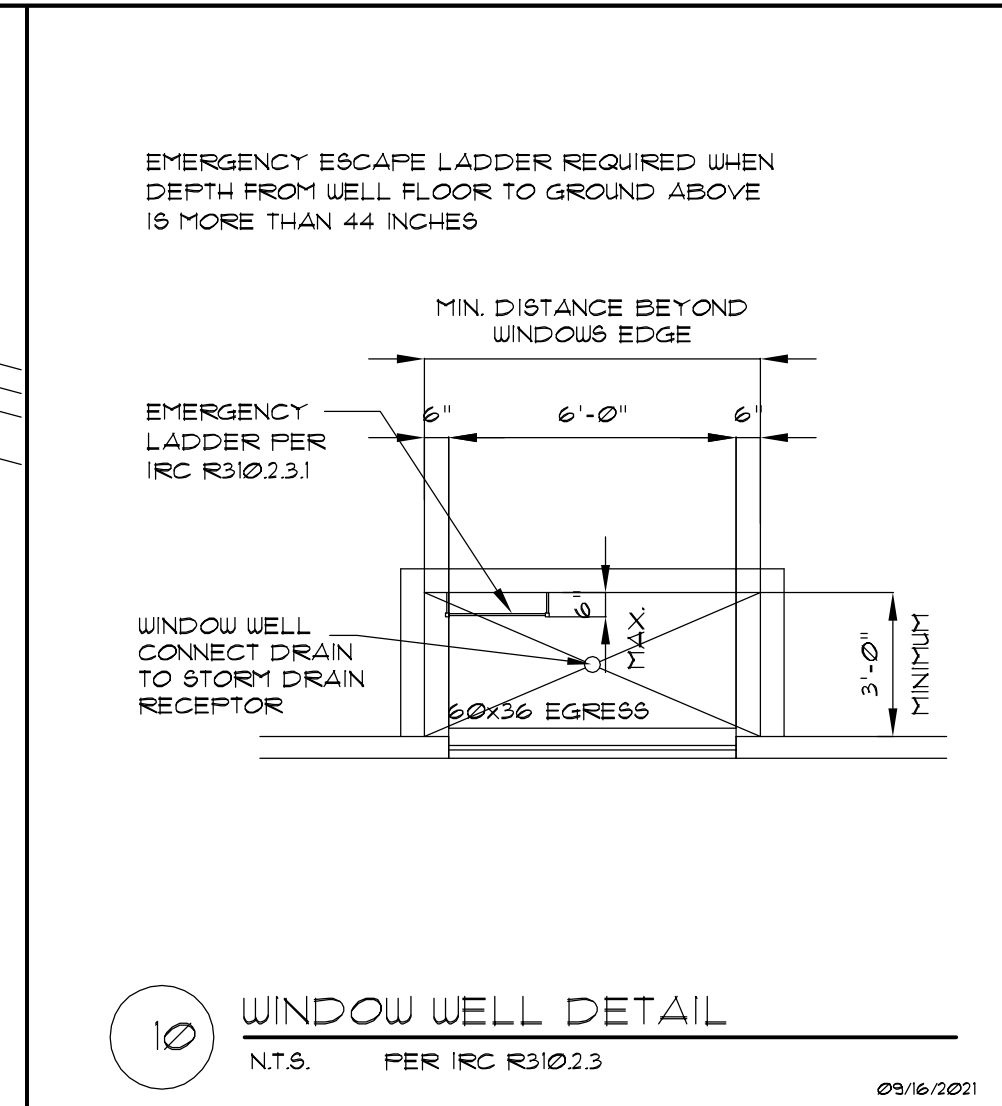


10 WINDOW WELL DETAIL
N.T.S. 09/16/2012

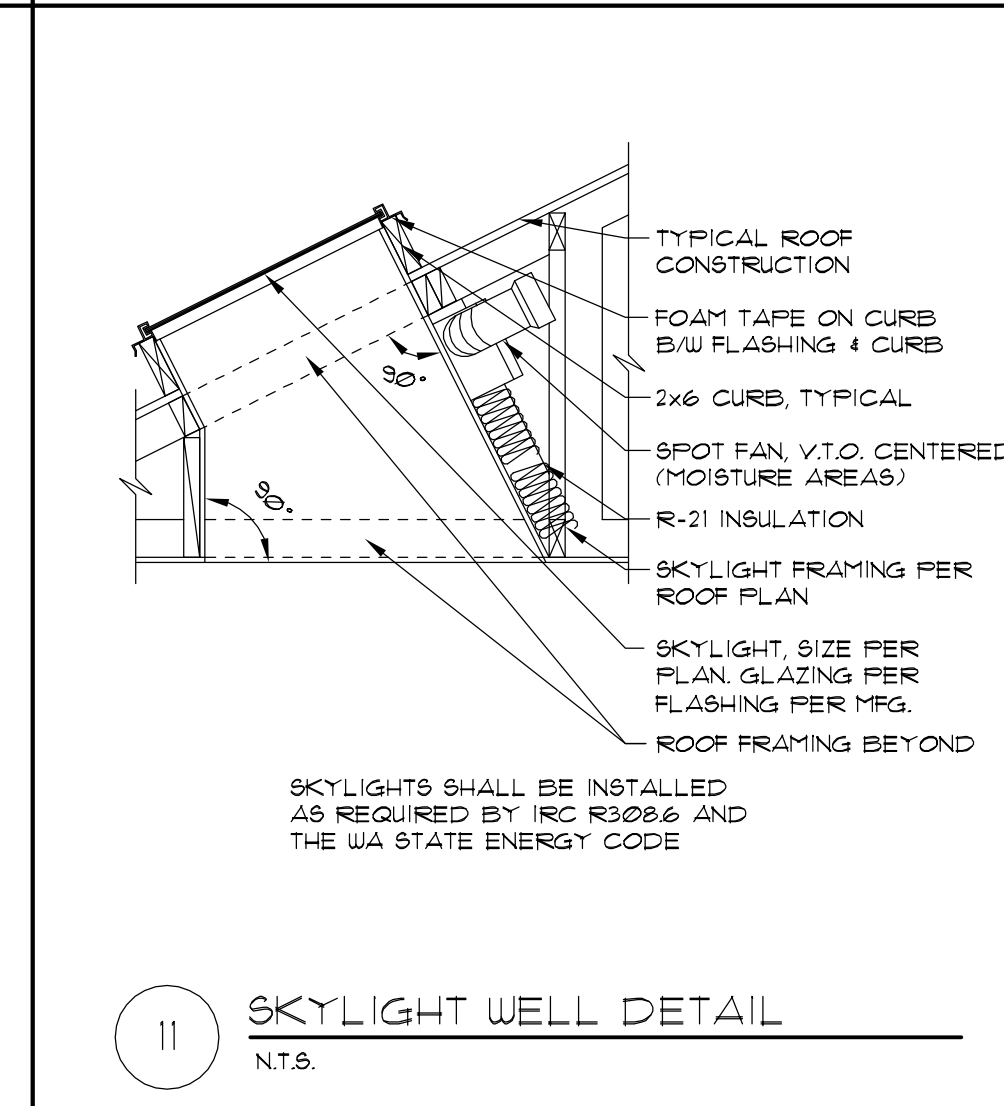


11 SKYLIGHT WELL DETAIL
N.T.S.

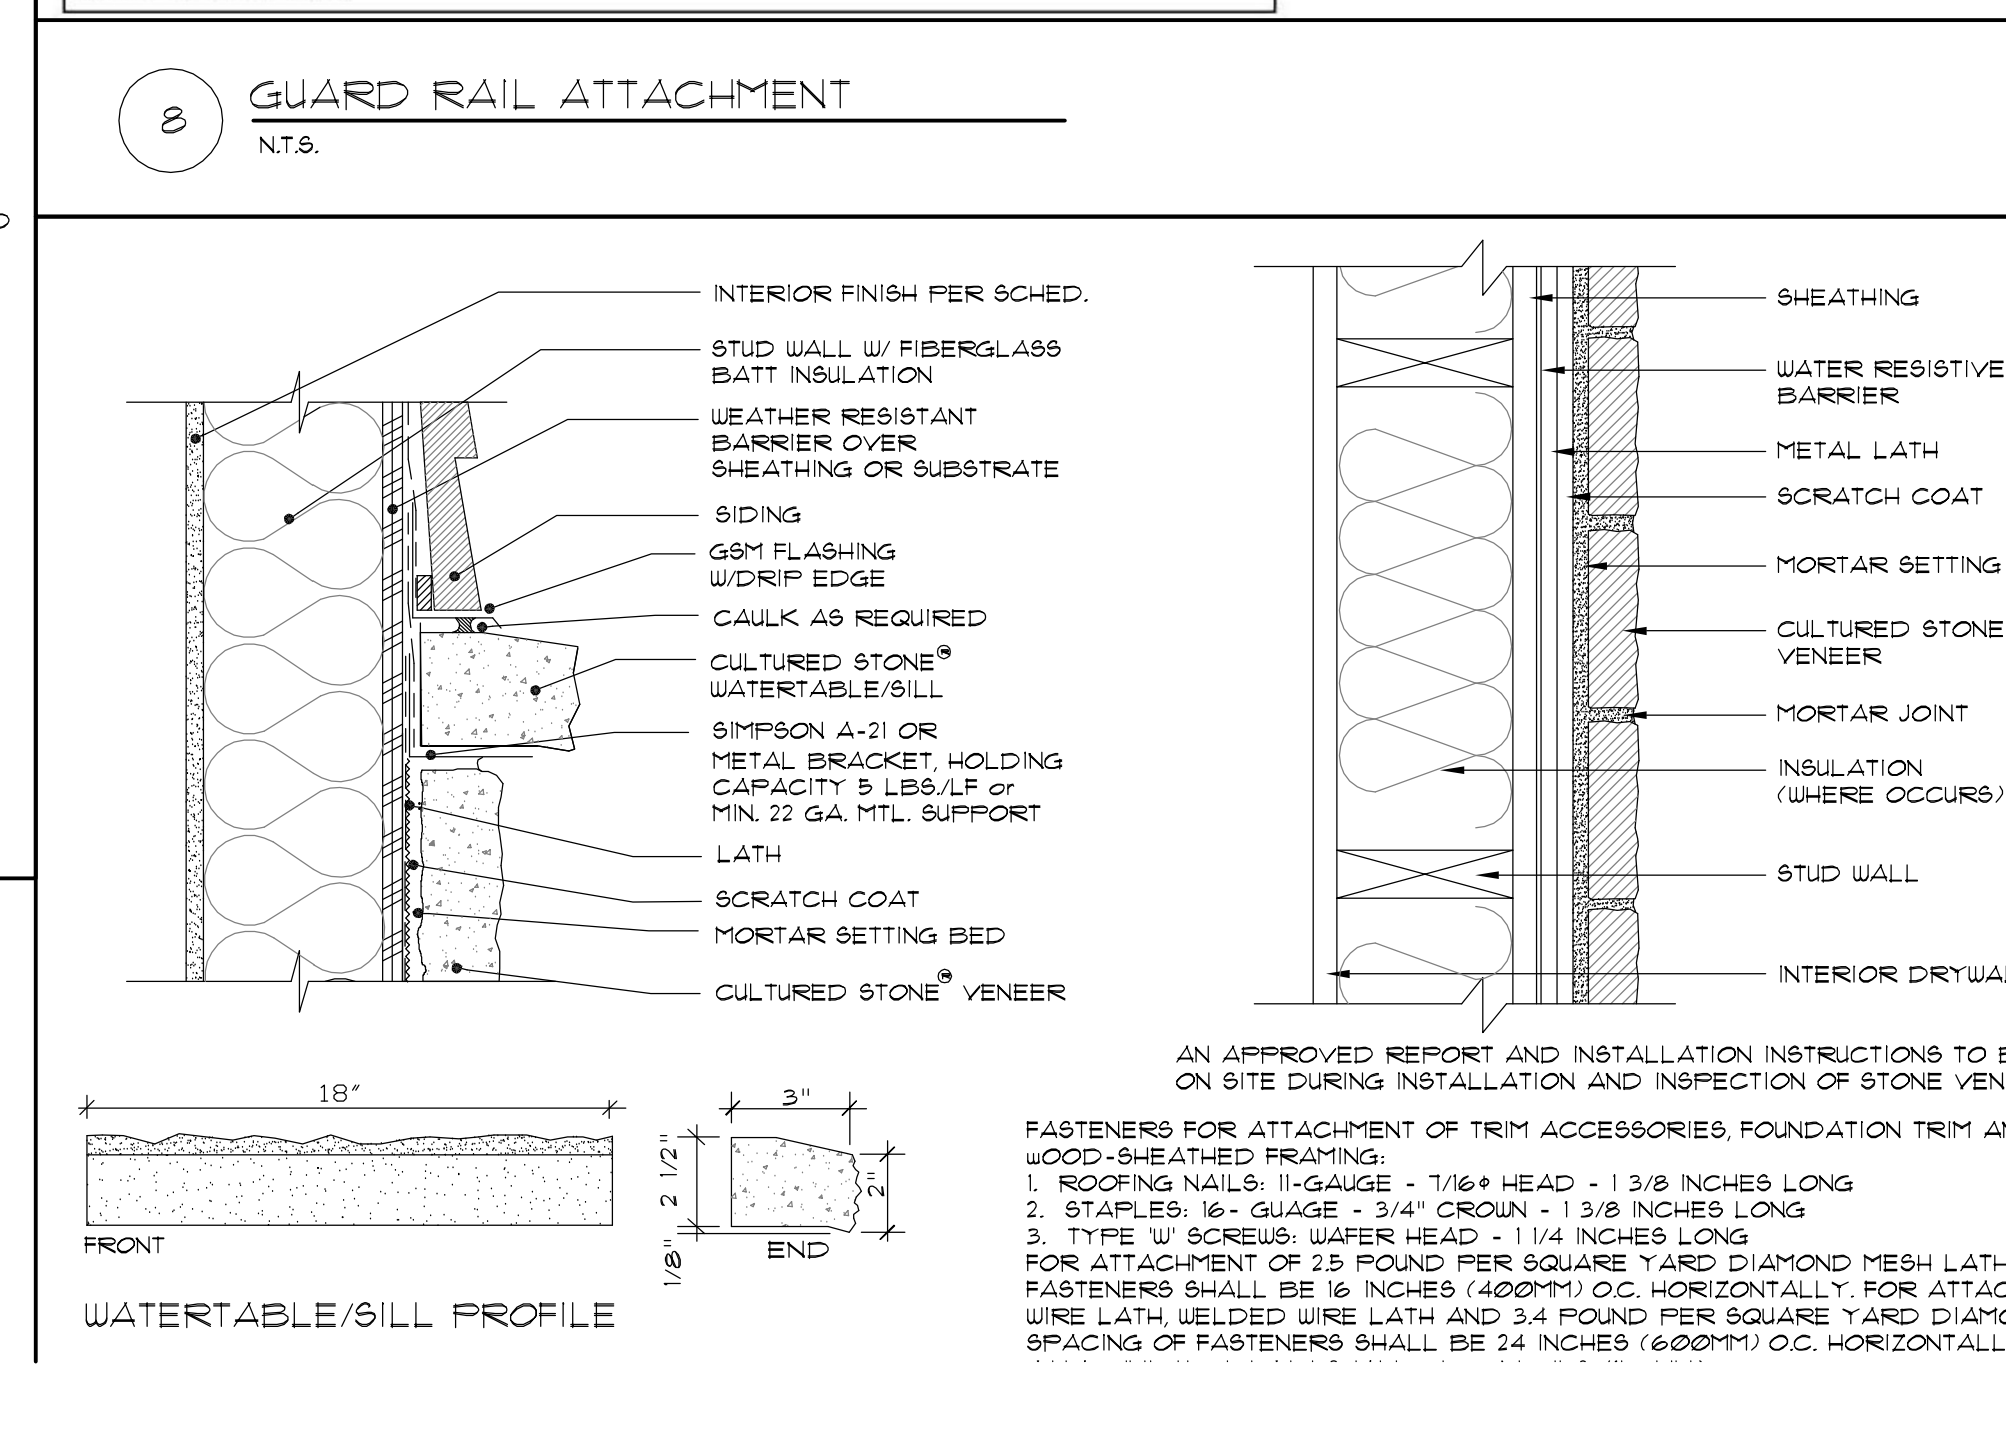


9 INSULATED HEADER DETAIL
N.T.S. 06/15/11

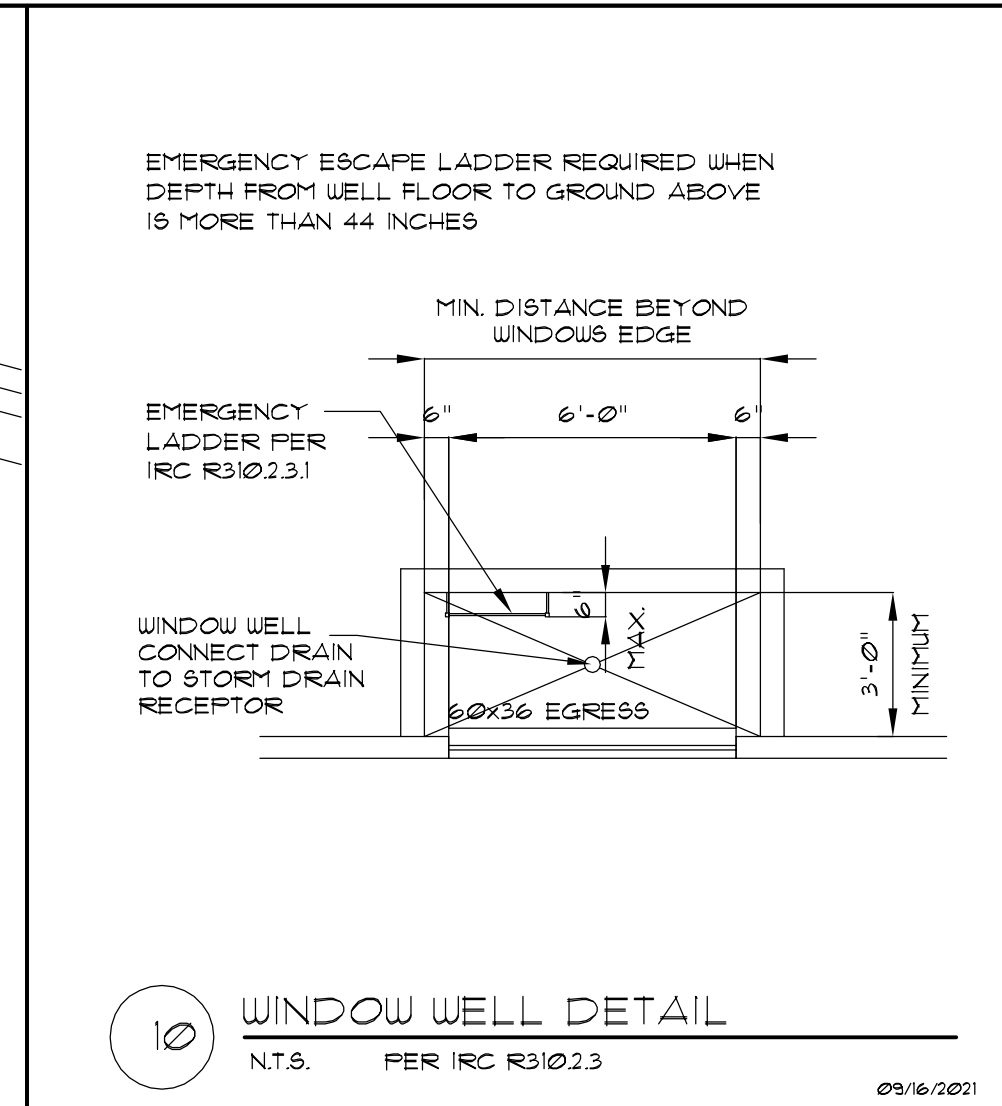


10 WINDOW WELL DETAIL
N.T.S. 09/16/2012

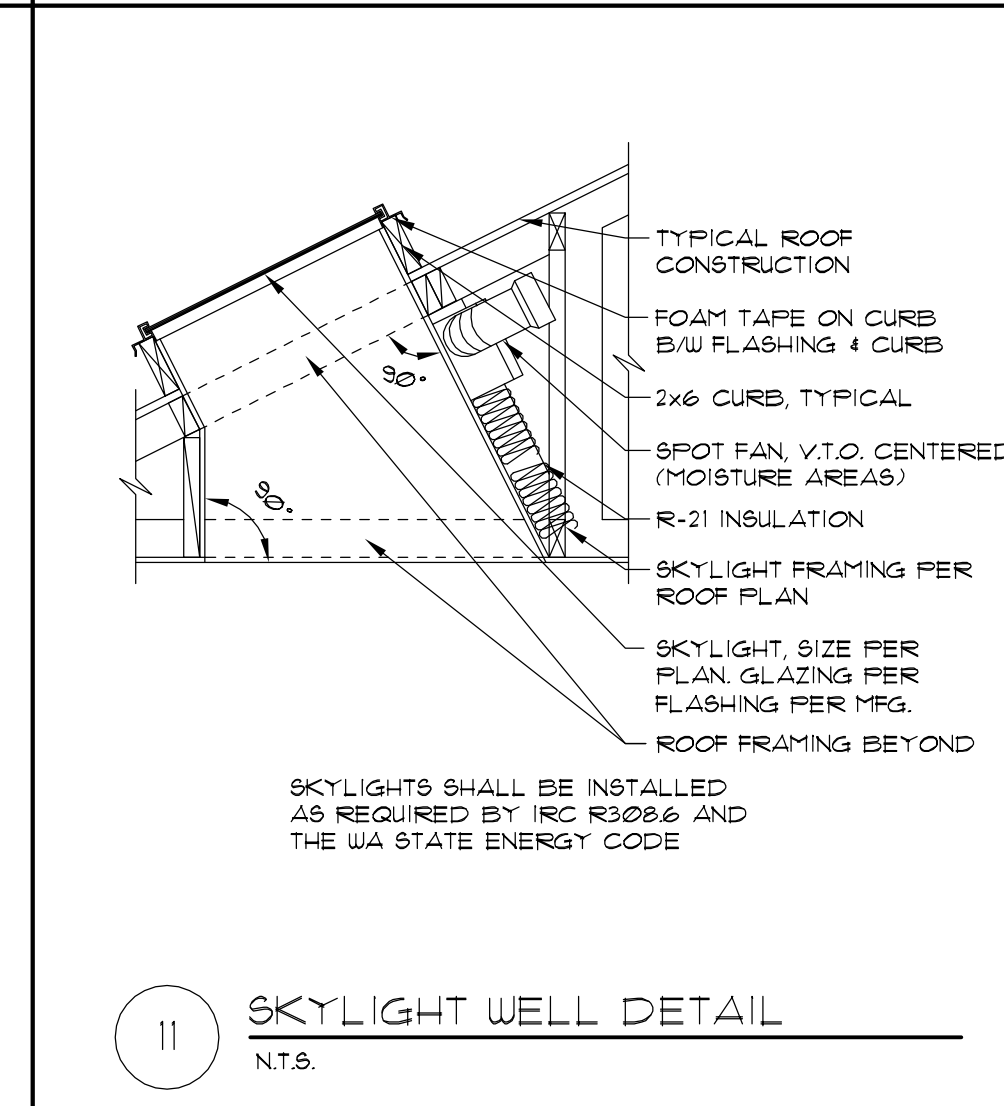

11 SKYLIGHT WELL DETAIL
N.T.S.

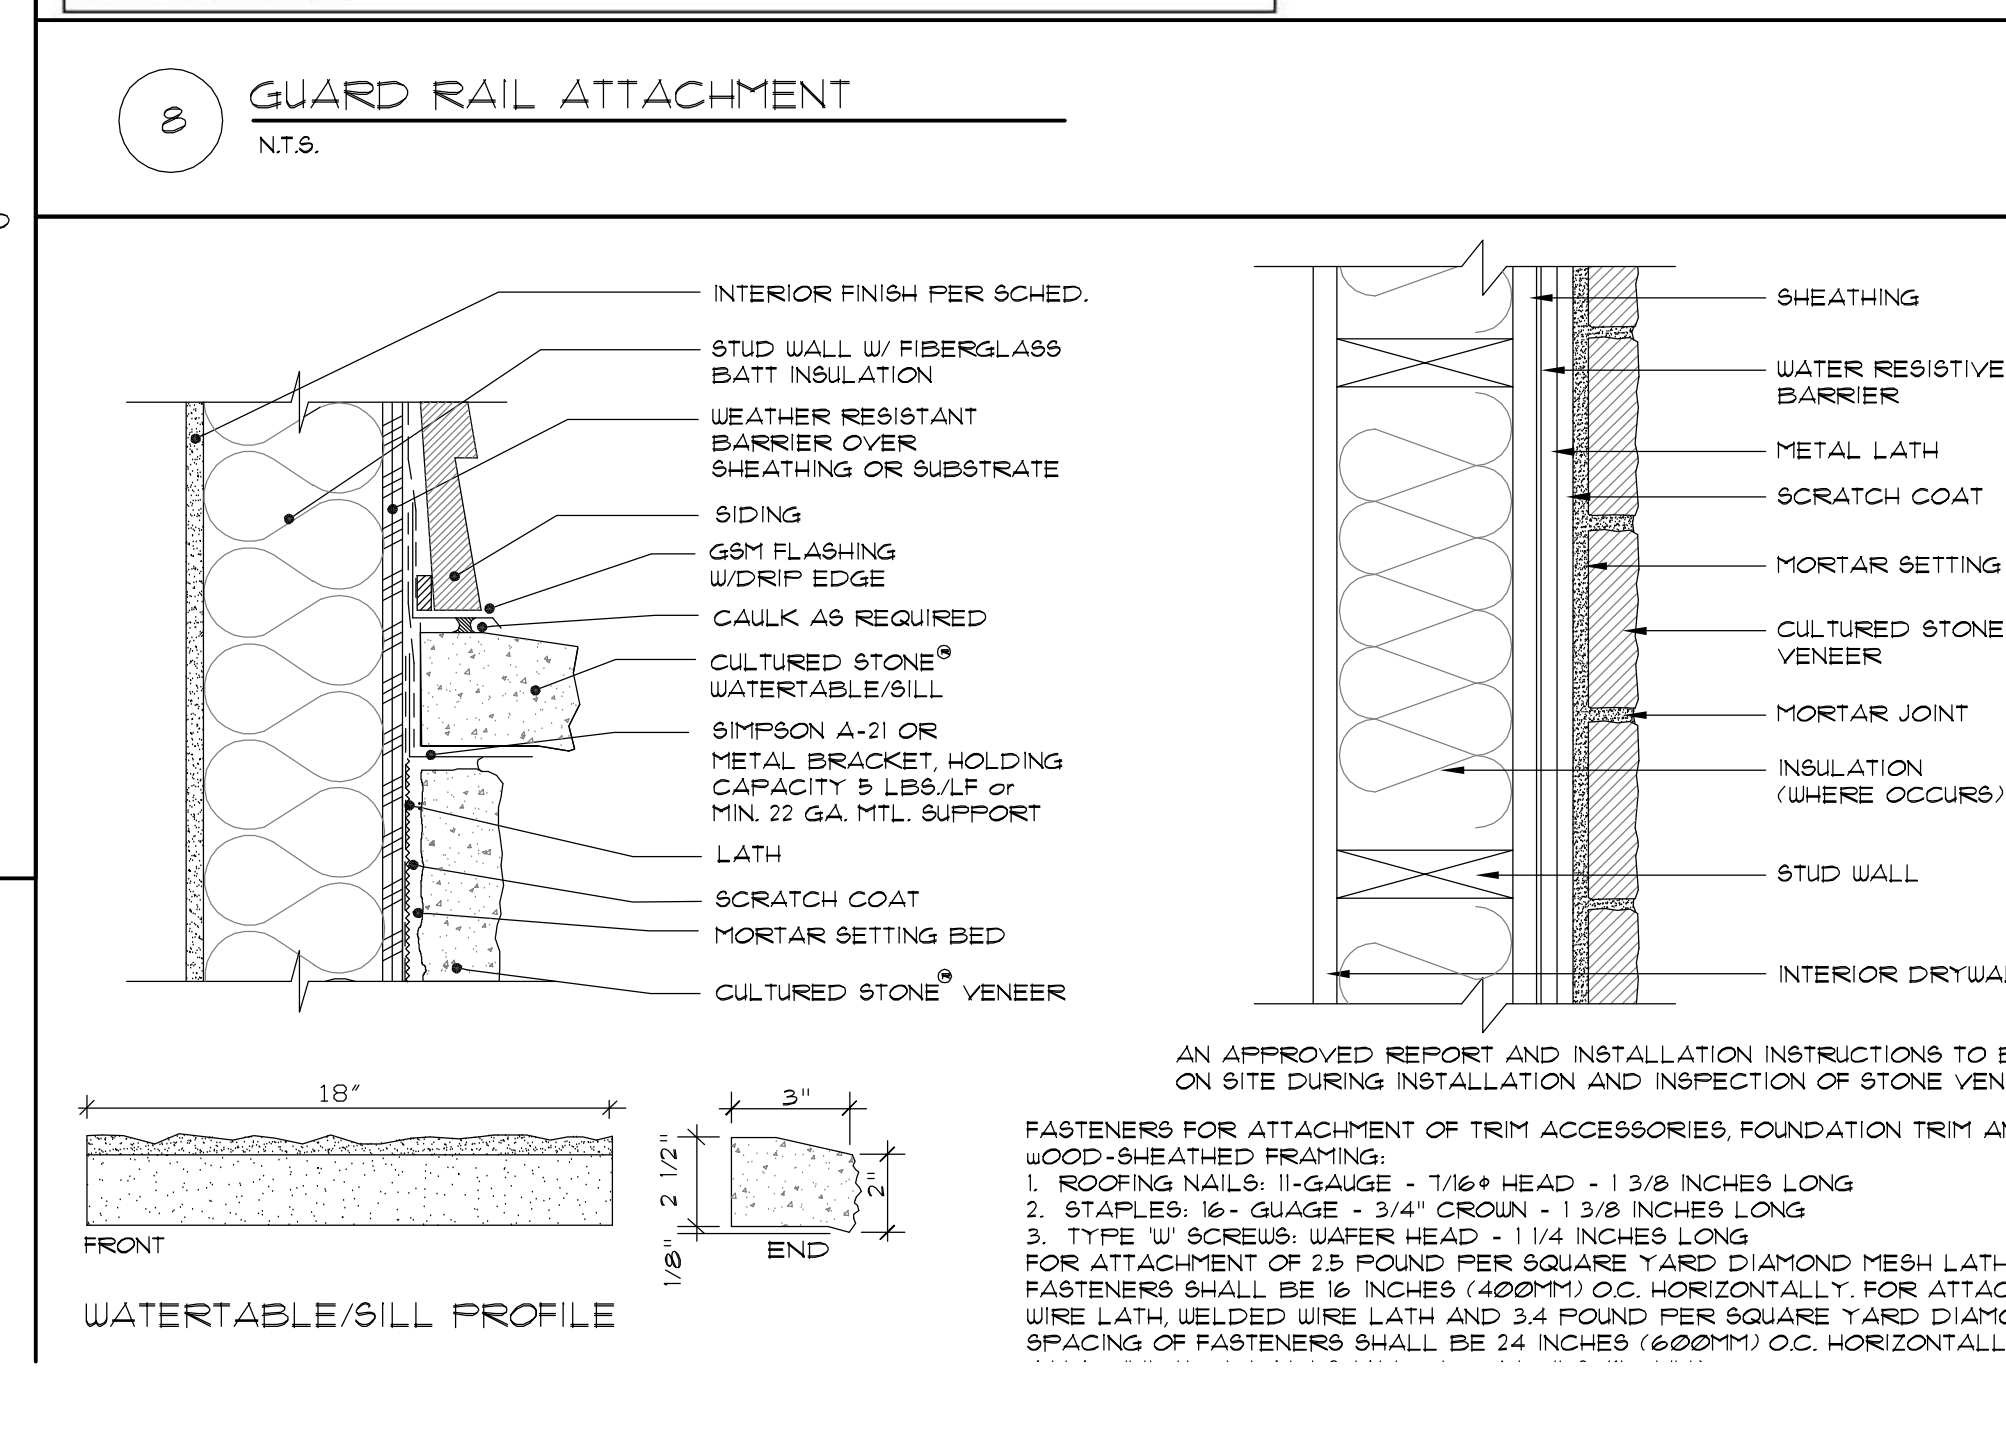

9 INSULATED HEADER DETAIL
N.T.S. 06/15/11

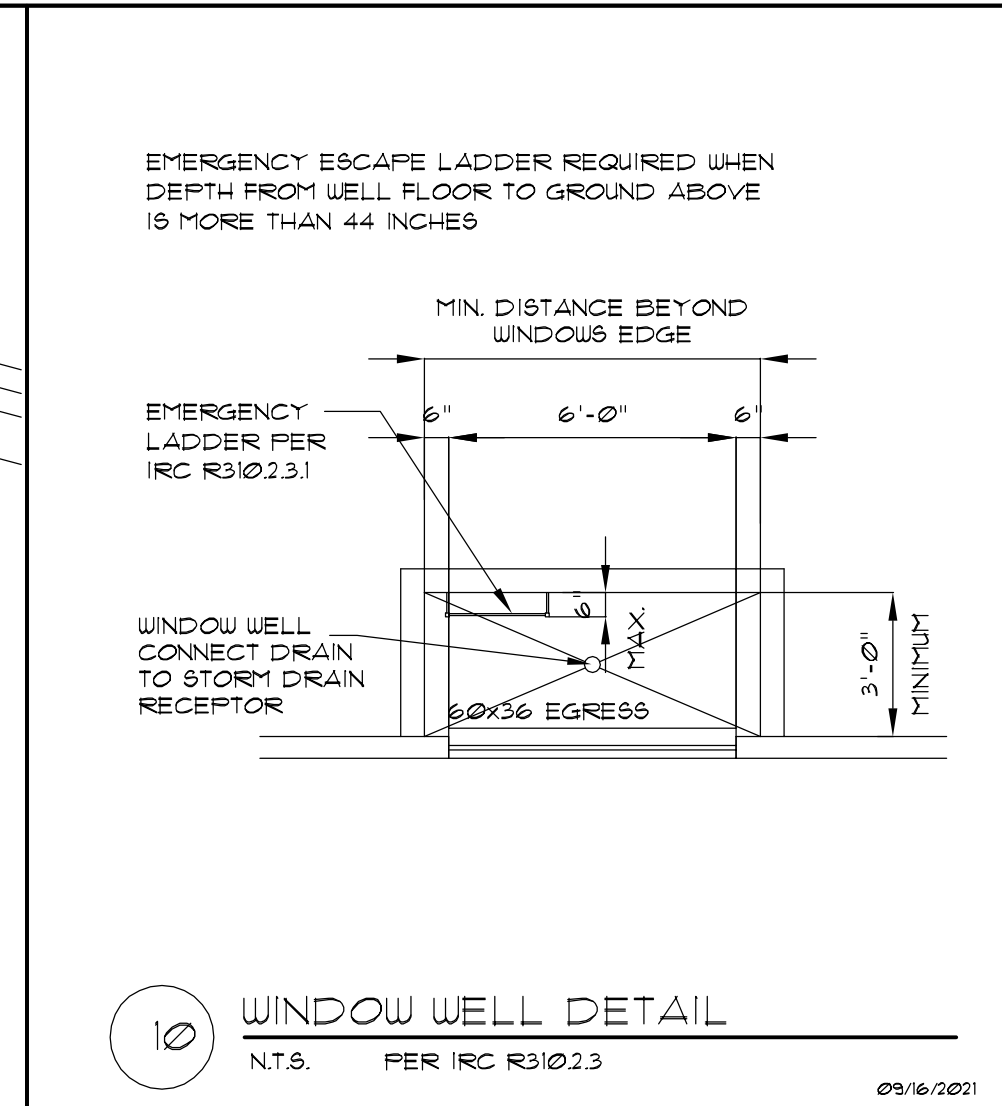

STRUCTURAL NOTES

GENERAL REQUIREMENTS & DESIGN CRITERIA

BUILDING CODE & REFERENCE STANDARDS: THE "INTERNATIONAL BUILDING CODE", 2018 EDITION, GOVERNS THE DESIGN AND CONSTRUCTION OF THIS PROJECT.

ARCHITECTURAL DRAWINGS: REFER TO THE ARCHITECTURAL DRAWINGS FOR INFORMATION INCLUDING, BUT NOT LIMITED TO: DIMENSIONS, ELEVATIONS, SLOPES, DOOR AND WINDOW OPENINGS, NON-BEARING WALLS, STAIRS, CURBS, DRAINS, DEPRESSIONS, RAILINGS, WATERPROOFING, FINISHES AND OTHER NONSTRUCTURAL ITEMS.

STRUCTURAL RESPONSIBILITIES: THE PE IS RESPONSIBLE FOR THE STRENGTH AND STABILITY OF THE PRIMARY STRUCTURE IN ITS COMPLETED STATE.

CONTRACTOR RESPONSIBILITIES: THE CONTRACTOR IS RESPONSIBLE FOR THE MEANS AND METHODS OF CONSTRUCTION AND ALL JOB RELATED SAFETY STANDARDS SUCH AS OSHA AND WSHA.

DISCREPANCIES: IN CASE OF DISCREPANCIES BETWEEN THESE GENERAL NOTES, THE CONTRACT DRAWINGS AND SPECIFICATIONS, AND/OR REFERENCE STANDARDS, THE ENGINEER SHALL DETERMINE WHICH SHALL GOVERN.

SITE VERIFICATION: THE CONTRACTOR SHALL VERIFY ALL DIMENSIONS AND CONDITIONS AT THE SITE PRIOR TO FABRICATION AND/OR CONSTRUCTION.

WIND DESIGN: BASIC WIND SPEED (3-SECOND GUST), V = 85 MPH(ASD); WIND IMPORTANCE FACTOR, IW = 1.0; OCCUPANCY CATEGORY = II; EXPOSURE CATEGORY = C;

SEISMIC DESIGN: SEISMIC IMPORTANCE FACTOR IE = 1.0; OCCUPANCY CATEGORY = II; SS = 1.40G; S1 = 0.488G; SITE CLASS = D; SDS = 1.12G; SD1 = 0.488G; SEISMIC DESIGN CATEGORY = D;

SNOW LOAD: GROUND SNOW LOAD, PG = 20 PSF; FLAT ROOF SNOW LOAD, PF = 25 PSF (DRIFT LOADS CONSIDERED PER ASCE 7 WHERE APPLICABLE); SNOW EXPOSURE FACTOR, CE = 1.0; SNOW IMPORTANCE FACTOR, IS = 1.0; THERMAL FACTOR, CT = 1.0.

LIVE LOADS: ROOF (LIVE) 20 PSF, ROOF (SNOW) 25 PSF, RESIDENTIAL FLOOR 40 PSF, RESIDENTIAL DECK 60 PSF

DESIGN-BY-OTHERS (DEFERRED SUBMITTALS) LOADS: ALL PRE-ENGINEERED/FABRICATED/MANUFACTURED OR OTHER PRODUCTS DESIGNED BY OTHERS SHALL BE DESIGNED FOR THE TRIBUTARY DEAD AND LIVE LOADS PLUS WIND, EARTHQUAKE, AND COMPONENT AND CLADDING LOADS WHEN APPLICABLE.

DEFERRED SUBMITTALS: ITEMS DESIGNED BY OTHERS SHALL INCLUDE CALCULATIONS, SHOP DRAWINGS AND PRODUCT DATA. DESIGN SHALL BE PREPARED BY THE SSE AND SUBMITTED TO THE ARCHITECT AND SER FOR REVIEW PRIOR TO SUBMISSION TO THE JURISDICTION FOR APPROVAL.

INSPECTIONS: ALL CONSTRUCTION IS SUBJECT TO INSPECTION BY THE BUILDING OFFICIAL IN ACCORDANCE WITH IBC SEC 109. THE CONTRACTOR SHALL COORDINATE ALL REQUIRED INSPECTIONS WITH THE BUILDING OFFICIAL.

PREFABRICATED CONSTRUCTION: ALL PREFABRICATED CONSTRUCTION SHALL CONFORM TO IBC SEC 1703.6.

GEOTECHNICAL INSPECTION: THE GEOTECHNICAL ENGINEER OR BUILDING OFFICIAL SHALL INSPECT ALL PREPARED SOIL BEARING SURFACES PRIOR TO PLACEMENT OF CONCRETE AND REINFORCING STEEL AND PROVIDE A LETTER TO THE OWNER STATING THAT SOILS ARE ADEQUATE TO SUPPORT THE "ALLOWABLE FOUNDATION PRESSURE".

GEOTECHNICAL REPORT: RECOMMENDATIONS CONTAINED IN "GEOTECHNICAL ENGINEERING INVESTIGATION" G-6035 BY GROUP NORTHWEST, INC., DATED MAR 8, 2024 WERE USED FOR FOOTING DESIGN.

DESIGN SOIL VALUES: ALLOWABLE BEARING PRESSURE (ASSUMED) 2000 PSF, PASSIVE LATERAL PRESSURE 350 PSF/FT, ACTIVE LATERAL PRESSURE (UNRESTRAINED) 35 PSF/FT, ACTIVE LATERAL PRESSURE (RESTRAINED) 45 PSF/FT, COEFFICIENT OF SLIDING FRICTION 0.35

SLABS-ON-GRADE & FOUNDATIONS: ALL FOUNDATIONS SHALL BEAR ON STRUCTURAL COMPACTED FILL OR COMPETENT NATIVE SOIL PER THE GEOTECHNICAL REPORT.

COMPACTION: UNLESS OTHERWISE SPECIFIED BY A GEOTECHNICAL ENGINEER, FOOTINGS SHALL BE PLACED ON COMPACTED MATERIAL AND SHALL BE WELL-GRADED GRANULAR MATERIAL WITH NO MORE THAN 5% PASSING A #2 SIEVE.

CAST-IN-PLACE CONCRETE & REINFORCEMENT

- REFERENCE STANDARDS: CONFORM TO: (1) ACI 318 "BUILDING CODE REQUIREMENTS FOR STRUCTURAL CONCRETE AND COMMENTARY", (2) IBC CHAPTER 19, (3) ACI 301 "STANDARD SPECIFICATIONS FOR STRUCTURAL CONCRETE", SEC 3 "REINFORCEMENT AND REINFORCEMENT SUPPORTS."

FIELD REFERENCE: THE CONTRACTOR SHALL KEEP A COPY OF ACI FIELD REFERENCE MANUAL, SP-15, "STANDARD SPECIFICATIONS FOR STRUCTURAL CONCRETE (ACI 301) WITH SELECTED ACI AND ASTM REFERENCES."

CONCRETE MIXTURES: CONFORM TO ACI 318 CHAPTER 5 "CONCRETE QUALITY, MIXING, AND PLACING."

MATERIALS: CONFORM TO ACI 318 CHAPTER 3 "MATERIALS" FOR REQUIREMENTS FOR CEMENTITIOUS MATERIALS, AGGREGATES, MIXING WATER AND ADMIXTURES. REINFORCING BARS ASTM A615, GRADE 60, DEFORMED BARS. DEFORMED WELDED WIRE FABRIC ASTM A497. BAR SUPPORTS CRSI MSP-2, CHAPTER 3 "BAR SUPPORTS." TIE WIRE 16.5 GAGE OR HEAVIER, BLACK ANNEALED.

MIX DESIGNS: PROVIDE A 5-SACK MINIMUM, 28-DAY COMPRESSIVE STRENGTH F'c = 2,500 PSI CONCRETE MIX WITH MAXIMUM 3/4" AGGREGATE AND 0.50 W/C RATIO FOR ALL ISOLATED POST AND CONTINUOUS WALL FOOTINGS, SLABS-ON-GRADE, AND BASEMENT WALLS EXTENDING NO MORE THAN 8" ABOVE FINISH GRADE.

MIX DESIGN NOTES: (1) W/C RATIO: WATER-CEMENTITIOUS MATERIAL RATIOS SHALL BE BASED ON THE TOTAL WEIGHT OF CEMENTITIOUS MATERIALS. (2) CEMENTITIOUS CONTENT: THE USE OF FLY ASH, OTHER POZZOLANS, SILICA FUME, OR SLAG SHALL CONFORM TO ACI 301 SEC 4.2.2.8.B. MAXIMUM AMOUNT OF FLY ASH SHALL BE 20% OF TOTAL CEMENTITIOUS CONTENT UNLESS REVIEWED AND APPROVED OTHERWISE BY SER.

- (3) AIR CONTENT: CONFORM TO ACI 301 SEC 4.2.2.4. HORIZONTAL EXTERIOR SURFACES IN CONTACT WITH THE SOIL REQUIRE ENTRAINED AIR. USE "MODERATE EXPOSURE". VERTICAL EXTERIOR SURFACES REQUIRE "MODERATE EXPOSURE". TOLERANCE IS +/- 1-1/2%. AIR CONTENT SHALL BE MEASURED AT POINT OF PLACEMENT. (4) SLUMP: CONFORM TO ACI 301 SEC 4.2.2.2. SLUMP SHALL BE DETERMINED AT POINT OF PLACEMENT. (5) NON-CHLORIDE ACCELERATOR: NON-CHLORIDE ACCELERATING ADMIXTURE MAY BE USED IN CONCRETE SLABS PLACED AT AMBIENT TEMPERATURES BELOW 50 F AT THE CONTRACTOR'S OPTION.

FORMWORK: CONFORM TO ACI 301 SEC 2 "FORMWORK AND FORM ACCESSORIES." REMOVAL OF FORMS SHALL CONFORM TO SEC 2.3.2 EXCEPT STRENGTH INDICATED IN SEC 2.3.2.5 SHALL BE 0.75 F'c.

MEASURING, MIXING, AND DELIVERY: CONFORM TO ACI 301 SEC 4.3.

HANDLING, PLACING, CONSTRUCTING AND CURING: CONFORM TO ACI 301 SEC 5.

REBAR FABRICATION & PLACING: CONFORM TO ACI 301, SEC 3.2.2 "FABRICATION", AND ACI SP-66 "ACI DETAILING MANUAL." CONFORM TO ACI 301, SEC 3.3.2 "PLACEMENT." PLACING TOLERANCES SHALL CONFORM TO SEC 3.3.2.1 "TOLERANCES."

SPLICING: CONFORM TO ACI 301, SEC 3.3.2.7. REFER TO PLANS FOR TYPICAL SPLICES.

FIELD BENDING: CONFORM TO ACI 301 SEC 3.3.2.8. "FIELD BENDING OR STRAIGHTENING." BAR SIZES #3 THROUGH #5 MAY BE FIELD BENT COLD THE FIRST TIME. OTHER BARS REQUIRE PREHEATING. DO NOT TWIST BARS.

CORNER BARS: PROVIDE MATCHING-SIZED "L" CORNER BARS FOR ALL HORIZONTAL WALL AND FOOTING BARS WITH THE APPROPRIATE SPLICE LENGTH, UNO.

CONCRETE COVER: CONFORM TO THE FOLLOWING COVER REQUIREMENTS FROM ACI 301, TABLE 3.3.2.3: CONCRETE CAST AGAINST EARTH 3", CONCRETE EXPOSED TO EARTH OR WEATHER (#5 & SMALLER) 1-1/2", BARS IN SLABS AND WALLS 3/4"

CONSTRUCTION JOINTS: CONFORM TO ACI 301 SEC 2.2.2.5, 5.1.2.3A, 5.2.2.1, AND 5.3.2.6. CONSTRUCTION JOINTS SHALL BE LOCATED AND DETAILED AS ON THE CONSTRUCTION DRAWINGS. USE OF AN ACCEPTABLE ADHESIVE, SURFACE RETARDER, PORTLAND CEMENT GROUT, OR ROUGHENING THE SURFACE IS NOT REQUIRED UNLESS SPECIFICALLY NOTED ON THE DRAWINGS. WHERE SHEAR BOND IS REQUIRED, ROUGHEN SURFACES TO 1/4" AMPLITUDE.

WOOD FRAMING

- REFERENCE STANDARDS: CONFORM TO: (1) IBC CHAPTER 23 "WOOD", (2) NDS AND NDS SUPPLEMENT - "NATIONAL DESIGN SPECIFICATION FOR WOOD CONSTRUCTION", (3) ANSI/TPI 1 "NATIONAL DESIGN STANDARD FOR METAL-PLATE-CONNECTED WOOD TRUSS CONSTRUCTION".

DEFERRED SUBMITTALS: SUBMIT PRODUCT DATA AND PROOF OF ICC APPROVAL FOR FRAMING MEMBERS AND FASTENERS THAT HAVE BEEN DESIGNED BY OTHERS. SUBMIT CALCULATIONS PREPARED BY THE SSE IN THE STATE OF WASHINGTON FOR ALL MEMBERS AND CONNECTIONS DESIGNED BY OTHERS ALONG WITH SHOP DRAWINGS.

IDENTIFICATION: ALL SAWN LUMBER AND PRE-MANUFACTURED WOOD PRODUCTS SHALL BE IDENTIFIED BY THE GRADE MARK OR A CERTIFICATE OF INSPECTION ISSUED BY THE CERTIFYING AGENCY.

MATERIALS: - SAWN LUMBER: CONFORM TO GRADING RULES OF WMPA, WCLIB OR NLGA. FINGER JOINTED STUDS ACCEPTABLE AT INTERIOR WALLS ONLY.

MEMBER USE SIZES SPECIES STRESS CLASS USES: BEAMS ALL ALL DF/DF 24F-1.8E SIMPLE SPANS, ALL ALL DF/DF 24F-1.8E [(-FB)=(+FB)] CANTILEVER SPANS

- METAL PLATE CONNECTED WOOD ROOF TRUSSES: CONFORM TO IBC SEC 2303.4 "TRUSSES." - WOOD STRUCTURAL SHEATHING (PLYWOOD): WOOD APA-RATED STRUCTURAL SHEATHING INCLUDES: ALL VENEER PLYWOOD, ORIENTED STRAND BOARD, WATERBOARD, PARTICLEBOARD, 11-11 SIDING, AND COMPOSITES OF VENEER AND WOOD BASED MATERIAL.

MEMBER USE SIZES SPECIES STRESS CLASS USES: BEAMS ALL ALL DF/DF 24F-1.8E SIMPLE SPANS, ALL ALL DF/DF 24F-1.8E [(-FB)=(+FB)] CANTILEVER SPANS

LOCATION THICKNESS SPAN RATING PLYWOOD GRADE EXPOSURE: ROOF 15/32" 32/16 C-D 1, FLOOR 23/32" T&G 24 OC STURD-I-FLOOR 1, WALLS 15/32" 32/16 C-D 1, WALLS(ALT) 7/16" OSB 24/16 C-D 1

- JOIST HANGERS AND CONNECTORS: SHALL BE "STRONG TIE" BY SIMPSON COMPANY OR USP EQUIVALENT AS SPECIFIED IN THEIR LATEST CATALOGS. ALTERNATE CONNECTORS BY OTHER MANUFACTURERS MAY BE SUBSTITUTED PROVIDED THEY HAVE CURRENT ICC APPROVAL FOR EQUIVALENT OR GREATER LOAD CAPACITIES AND ARE REVIEWED AND APPROVED BY THE SER PRIOR TO ORDERING.

- NAILS AND STAPLES: CONFORM TO IBC SEC 2303.6 "NAILS AND STAPLES," UNLESS NOTED ON PLANS, NAIL PER IBC TABLE 2304.9.1. UNLESS NOTED OTHERWISE ALL NAILS SHALL BE COMMON. NAIL SIZES SPECIFIED ON THE DRAWINGS ARE BASED ON THE FOLLOWING SPECIFICATIONS:

SIZE LENGTH DIAMETER: 8d 2-1/2" 0.131", 10d 3" 0.148", (8d & 10d ALTERNATIVE) PASLODE TETRAGRIP NAILS 2-3/8" 0.113", 12d (16d SINKER) 3-1/4" 0.148", 16d 3-1/2" 0.162"

NAILING REQUIREMENTS: PROVIDE MINIMUM NAILING IN ACCORDANCE WITH IBC TABLE 2304.9.1 "FASTENING SCHEDULE" EXCEPT AS NOTED ON THE DRAWINGS. NAILING FOR ROOF/FLOOR DIAPHRAGMS/SHEAR WALLS SHALL BE PER DRAWINGS.

STANDARD LIGHT-FRAME CONSTRUCTION: UNLESS NOTED ON THE PLANS, CONSTRUCTION SHALL CONFORM TO IBC SEC 2308 "CONVENTIONAL LIGHT-FRAME CONSTRUCTION" AND IBC SEC 2304 "GENERAL CONSTRUCTION REQUIREMENTS."


(1) WALL FRAMING: UNLESS OTHERWISE NOTED, ALL INTERIOR WALLS SHALL BE 2x4 @ 16"OC AND ALL EXTERIOR WALLS SHALL BE 2x6 @ 16"OC. PROVIDE (2)BUNDLED STUDS MIN AT WALL ENDS AND EACH SIDE OF ALL OPENINGS.

- (2) ROOF/FLOOR FRAMING: UNLESS OTHERWISE NOTED, PROVIDE DOUBLE JOISTS/RAFTERS UNDER ALL PARALLEL BEARING PARTITIONS AND SOLID BLOCKING AT ALL BEARING POINTS. PROVIDE DOUBLE JOISTS AROUND ALL ROOF/FLOOR OPENINGS.

MOISTURE CONTENT: WOOD MATERIAL USED FOR THIS PROJECT SHALL HAVE MAXIMUM MOISTURE CONTENT OF 19% EXCEPT FOR THE PRESSURE-TREATED WOOD SILL PLATE.

PRESERVATIVE TREATMENT: WOOD MATERIALS ARE REQUIRED TO BE "TREATED WOOD" UNDER CERTAIN CONDITIONS IN ACCORDANCE WITH IBC SEC 2304.11 "PROTECTION AGAINST DECAY AND TERMITES". CONFORM TO THE APPROPRIATE STANDARDS OF THE AMERICAN WOOD-PRESERVERS ASSOCIATION (AWPA) FOR SAWN LUMBER, GLUED LAMINATED TIMBER, ROUND POLES, WOOD PILES AND MARINE PILES.

METAL CONNECTORS/PT WOOD: CK ENGINEERING LLC RECOMMENDS THAT ALL METAL HARDWARE AND FASTENERS IN CONTACT WITH TREATED LUMBER BE STAINLESS STEEL TYPE 316L.

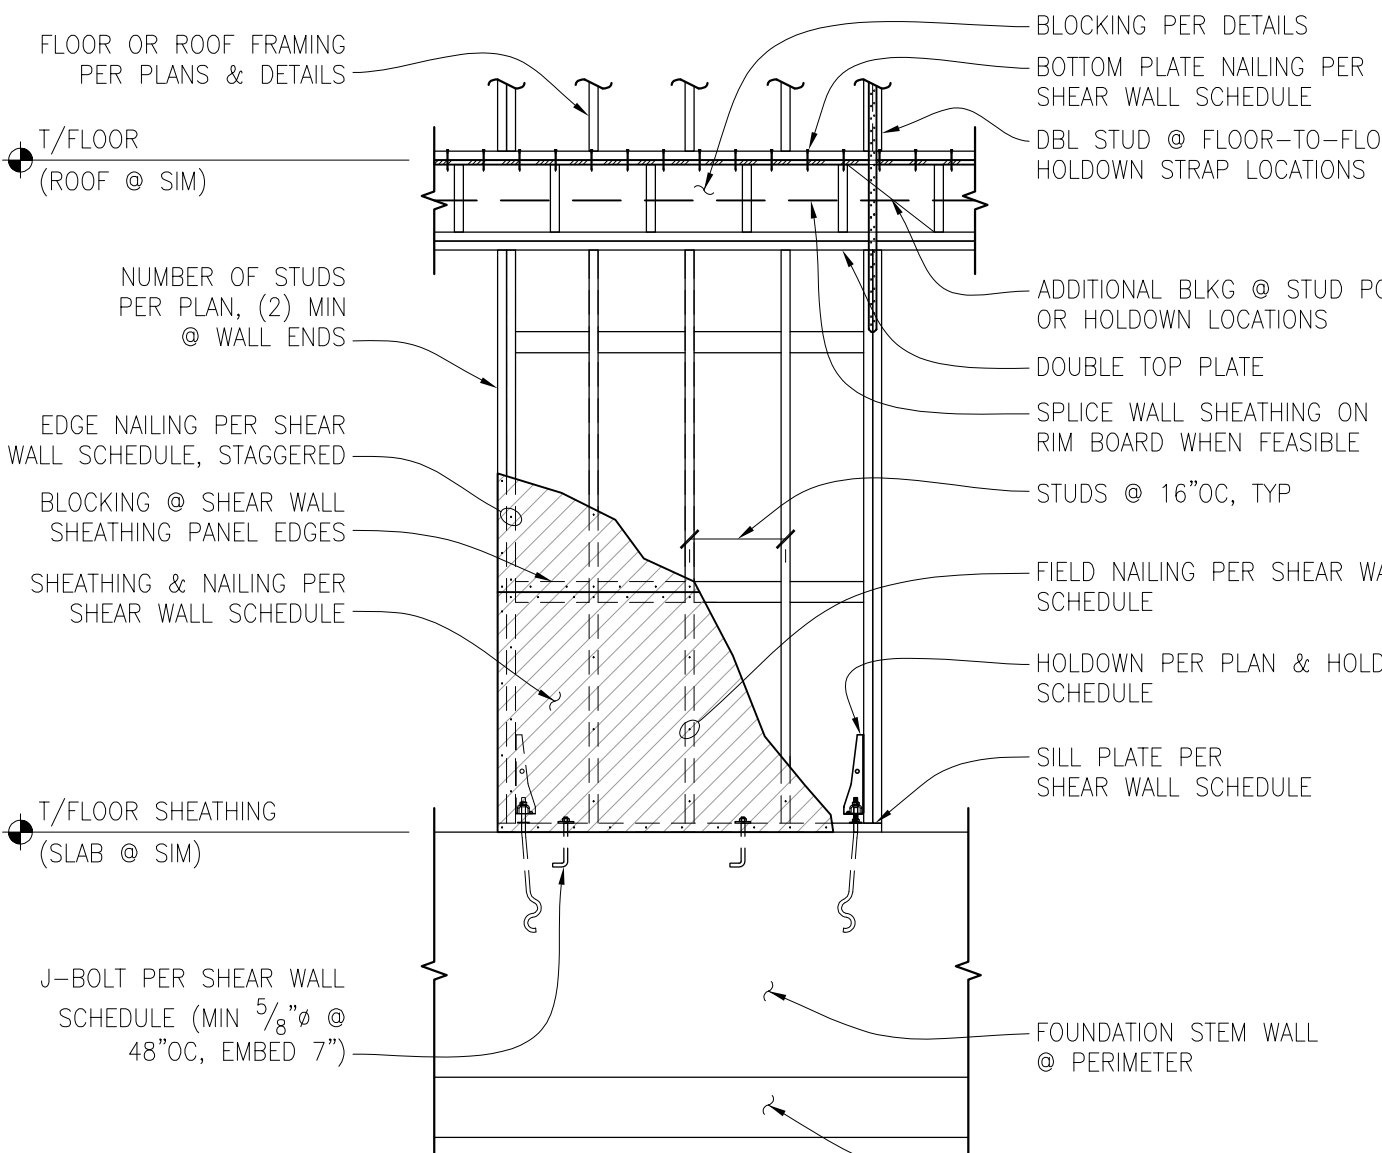

TYPICAL SHEAR WALL ELEVATION

SCALE: N.T.S.

7

WOOD-FRAMED SHEAR WALL SCHEDULE table with columns: MODEL #, ANCHORAGE TYPE, FASTENERS, END STUD REQUIRED, CAPACITY (LBS).

NOTES:

- 1. HOLD-DOWNS SPECIFIED ARE AS MANUFACTURED BY SIMPSON ANCHOR TIE DOWN CO., INC.; ACCEPTABLE EQUIVALENT PRODUCT SUBSTITUTIONS ARE AVAILABLE FROM OTHER MANUFACTURERS WITH SER APPROVAL.

HOLD-DOWN SCHEDULE

SCALE: N.T.S.

8

WOOD-FRAMED SHEAR WALL SCHEDULE FOR HEM-FIR/DOUG-FIR STUD FRAMING

Detailed WOOD-FRAMED SHEAR WALL SCHEDULE table for HEM-FIR/DOUG-FIR STUD FRAMING with columns for SW TYPE, SW SHEATHING, NAIL SIZE & SPACING, RIM JOIST OR BLOCKING ATTACHMENT, BOTTOM PLATE & EDGE MEMBER REQUIREMENTS, SILL PLATE REQUIREMENTS, and SHEAR LOAD CAPACITY (PLF).

NOTES:

- 1. INSTALL PANELS EITHER HORIZONTALLY OR VERTICALLY. WHERE SHEATHING IS APPLIED ON BOTH SIDES OF WALL, PANEL EDGE JOINTS ON 2x FRAMING SHALL BE STAGGERED SO THAT JOINTS ON OPPOSITE SIDES ARE NOT LOCATED ON THE SAME STUDS.

- 10. ANCHOR BOLTS SHALL BE PROVIDED WITH HOT-DIPPED GALVANIZED STEEL PLATE WASHERS 3"x3"x0.229"(MIN). THE HOLE IN THE PLATE WASHER MAY BE DIAGONALLY SLOTTED 1 3/16"x1 3/4" PROVIDED A STANDARD CUT WASHER IS PLACED BETWEEN THE PLATE WASHER AND NUT.

WOOD-FRAMED SHEAR WALL SCHEDULE

SCALE: N.T.S.

12



CK ENGINEERING LLC PROFESSIONAL STRUCTURAL ENGINEERING SERVICES 19105 34th Ave W, Suite 205 Lynnwood, WA 98036 Phone: (206) 417-0670



3/15/2024

NEW HOME AT: 6175 SE 27TH ST. MERCER ISLAND, WA 98040


REVISION table with columns: REVISION #, DATE, DESCRIPTION

Drawn By: PK Checked By: SC Date: 3-15-2024

CK JOB NO. 23-043

STRUCTURAL NOTES/SCHED.

S-1.0

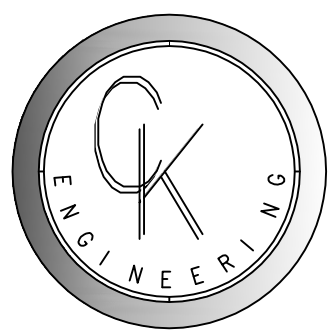

CK ENGINEERING LLC
 PROFESSIONAL STRUCTURAL
 ENGINEERING SERVICES
 19105 34th Ave. W. Suite 205
 Lynnwood, WA 98036
 Phone: (206) 417-0670



12/8/2023

NEW HOME AT:
 6175 SE 27TH ST.
 MERCER ISLAND, WA 98040


REVISION #	DATE	DESCRIPTION

Drawn By: PK
 Checked By: SC
 Date: 12-8-2023


CK JOB NO.
23-043

STRUCTURAL
 DETAILS

S-2.0

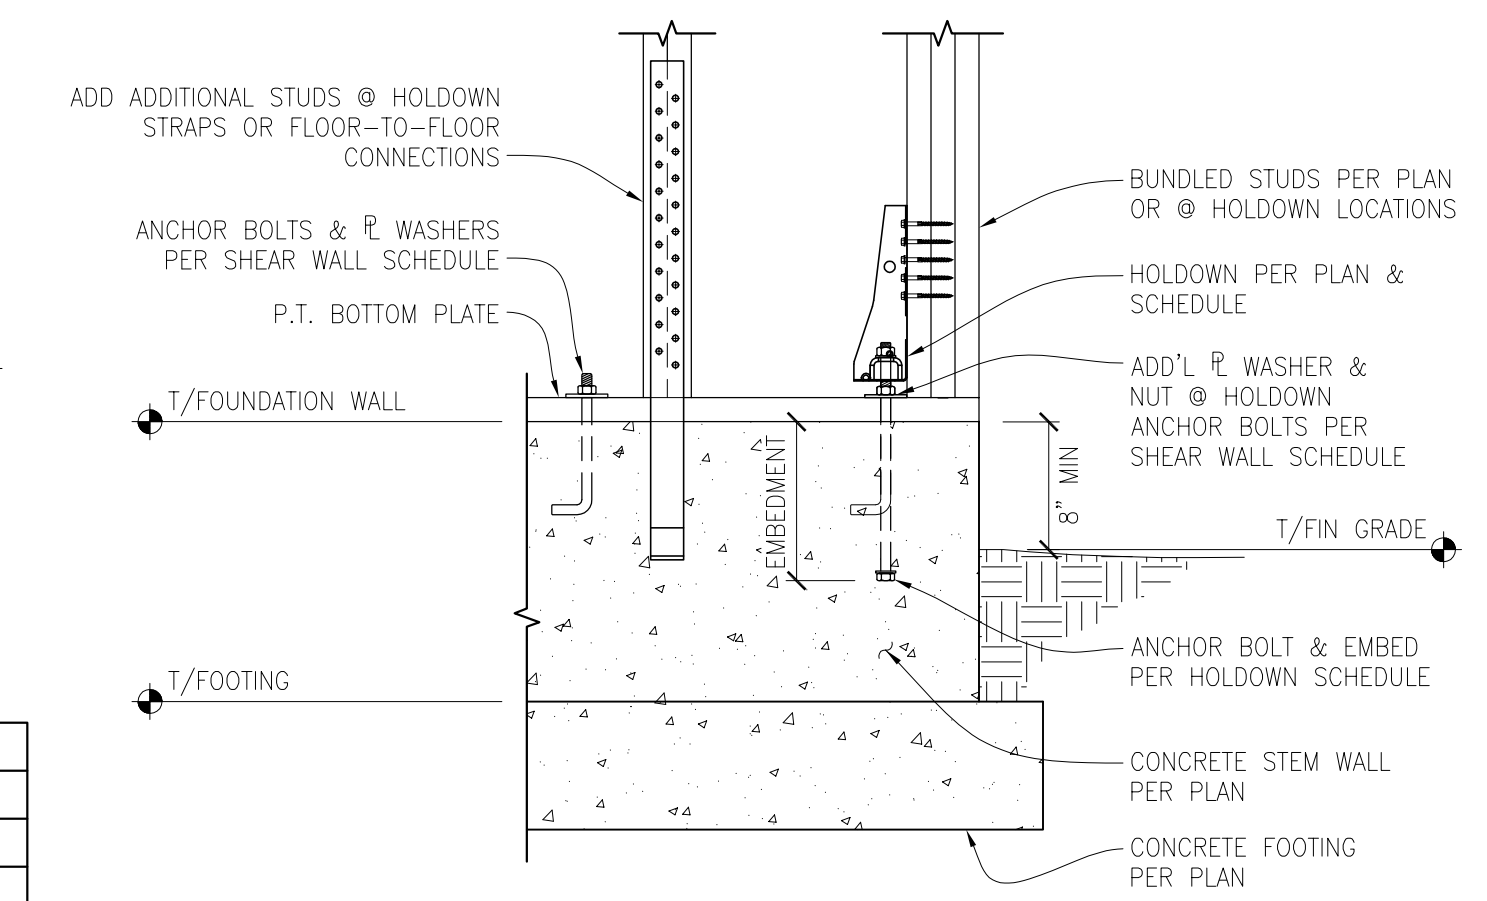


4 TYPICAL SHEAR WALL HOLDDOWN CONNECTIONS AT FOUNDATION CONCRETE WALL
 SCALE: 3/4" = 1'-0"

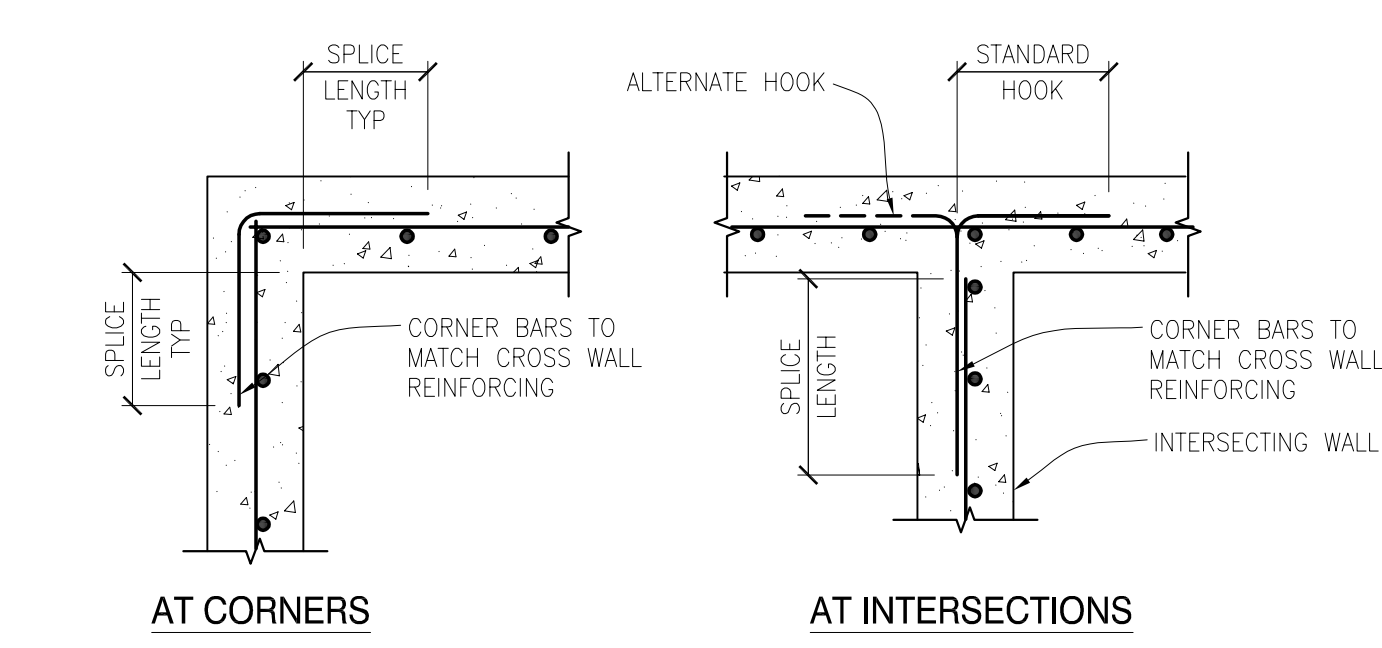


3 TYPICAL CORNER BARS AT CONCRETE WALLS - SINGLE MAT
 SCALE: N.T.S.


SPlice LENGTH	
BAR	LENGTH
#4	28"
#5	36"

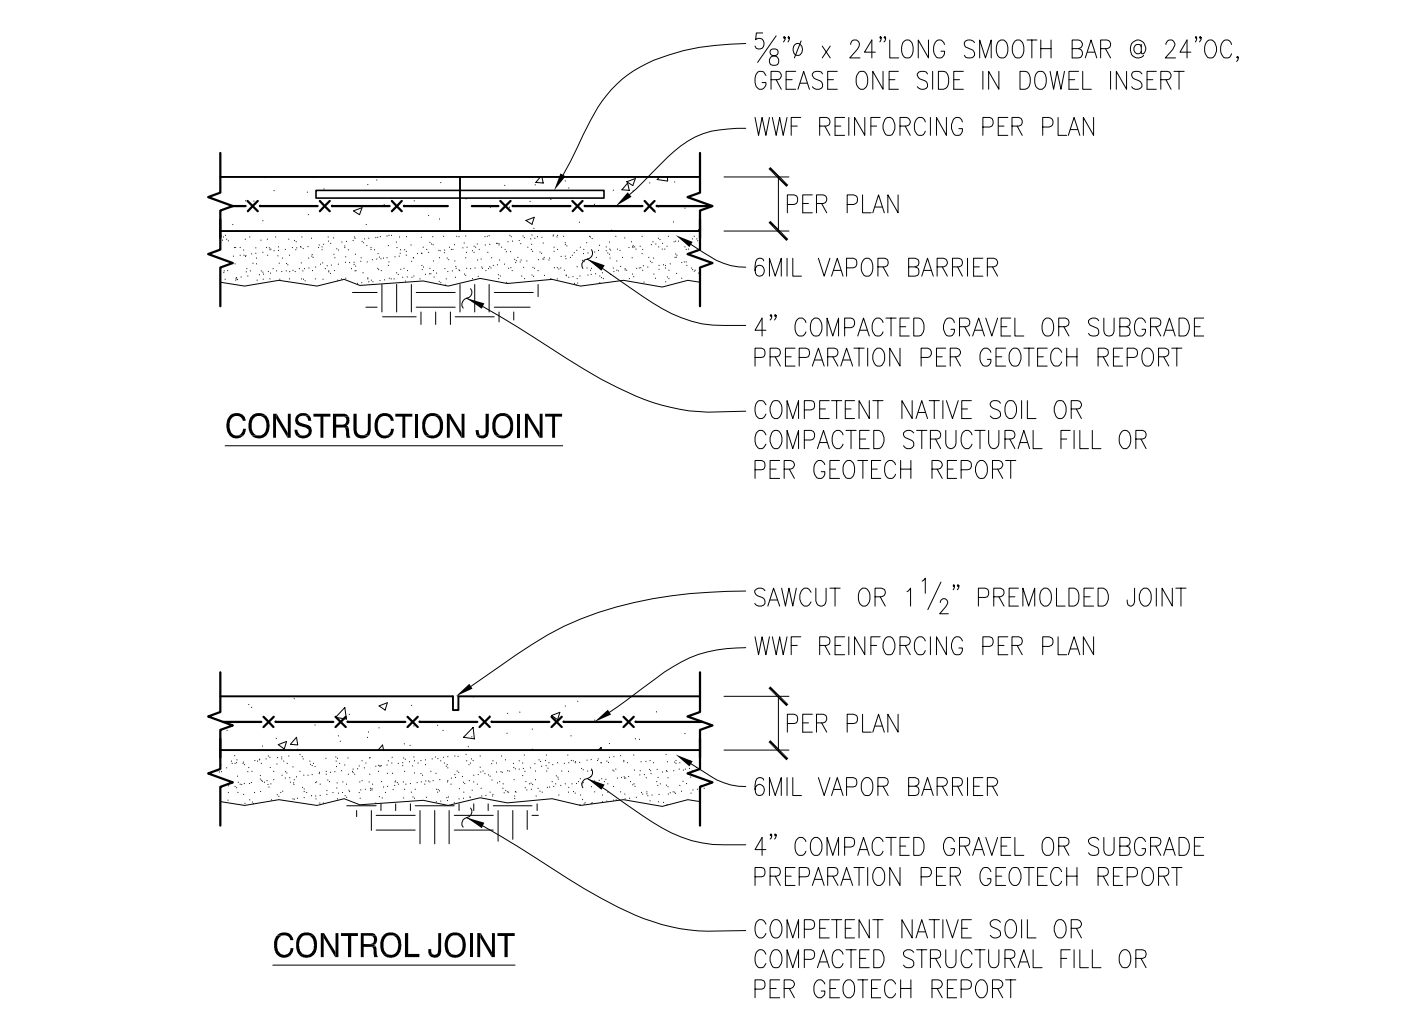


2 TYPICAL SLAB ON GRADE JOINT DETAILS
 SCALE: N.T.S.

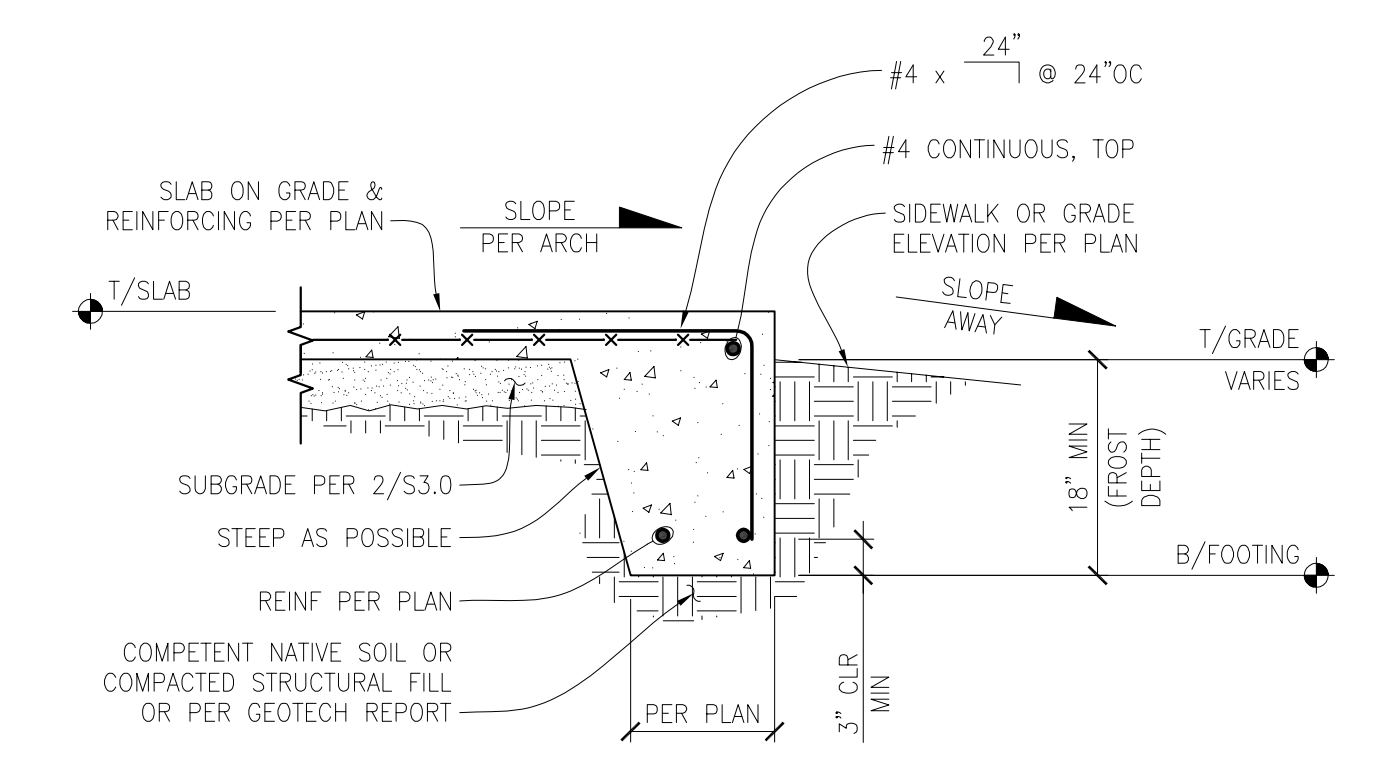


1 TYPICAL THICKENED SLAB EDGE FOOTING
 SCALE: 3/4" = 1'-0"

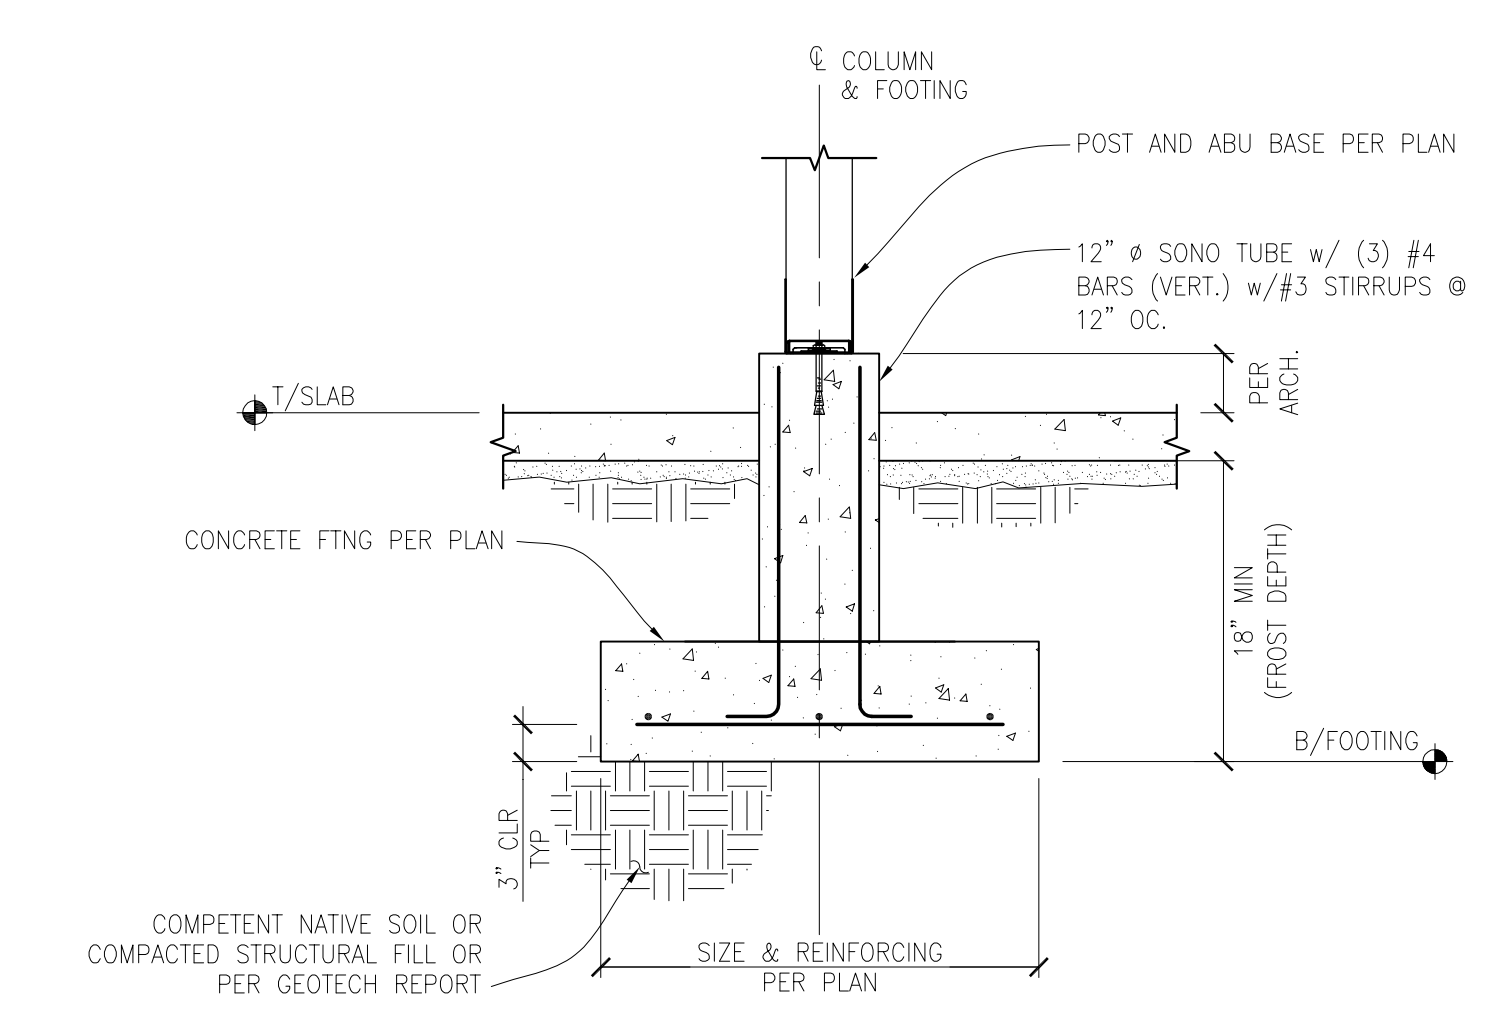

8 NEW FOOTING/POST CONNECTION
 SCALE: 3/4" = 1'-0"

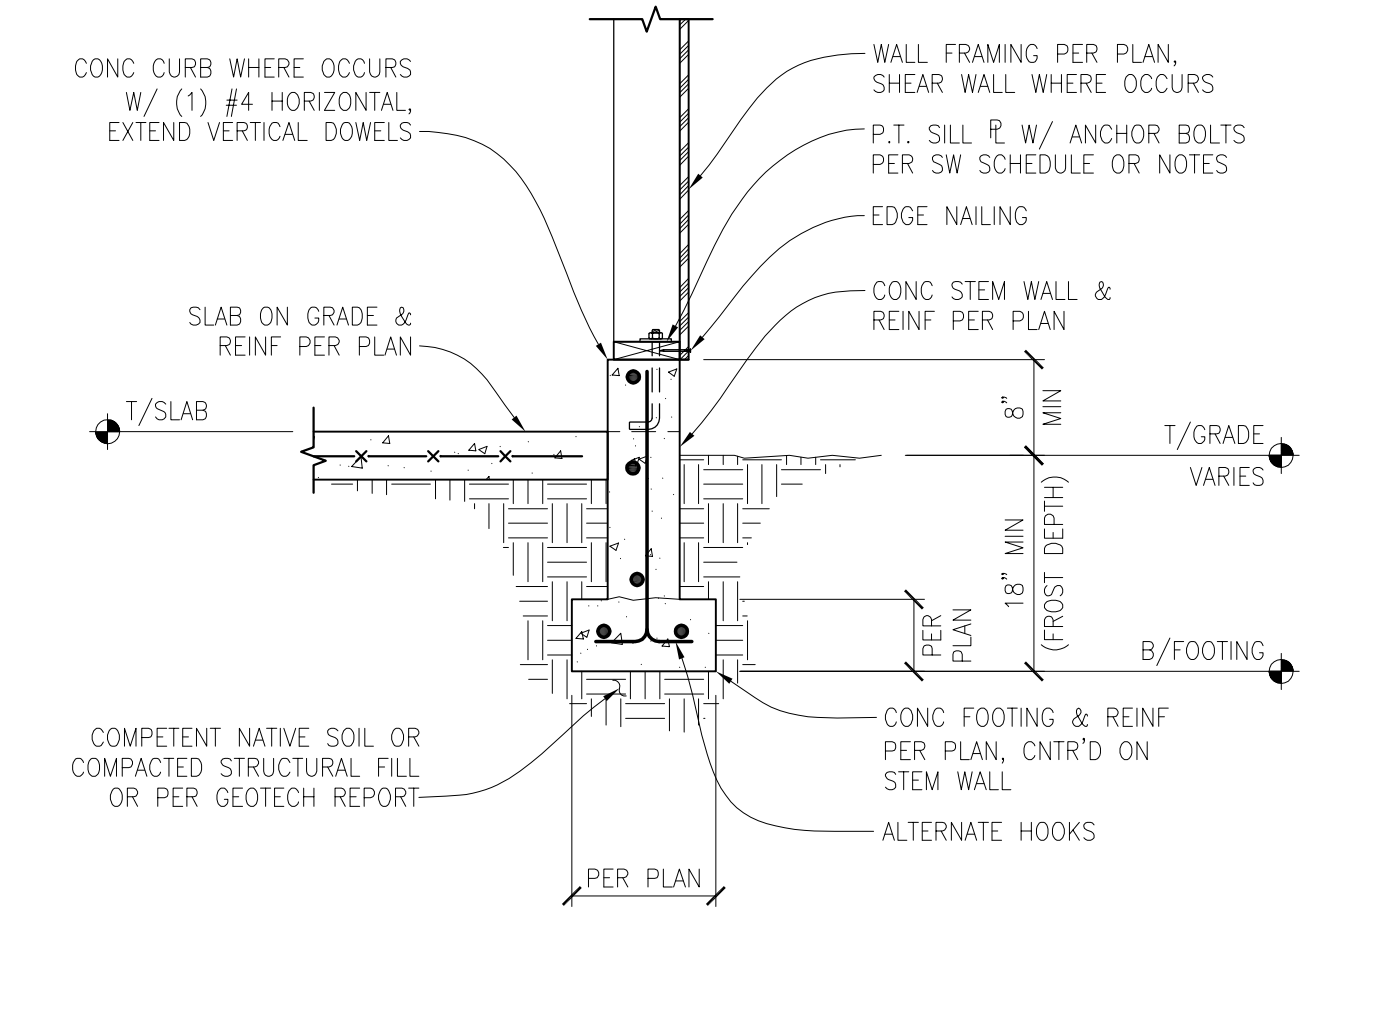


7 TYPICAL FOUNDATION FOOTING AND STEM WALL WITH SLAB ON GRADE
 SCALE: 3/4" = 1'-0"

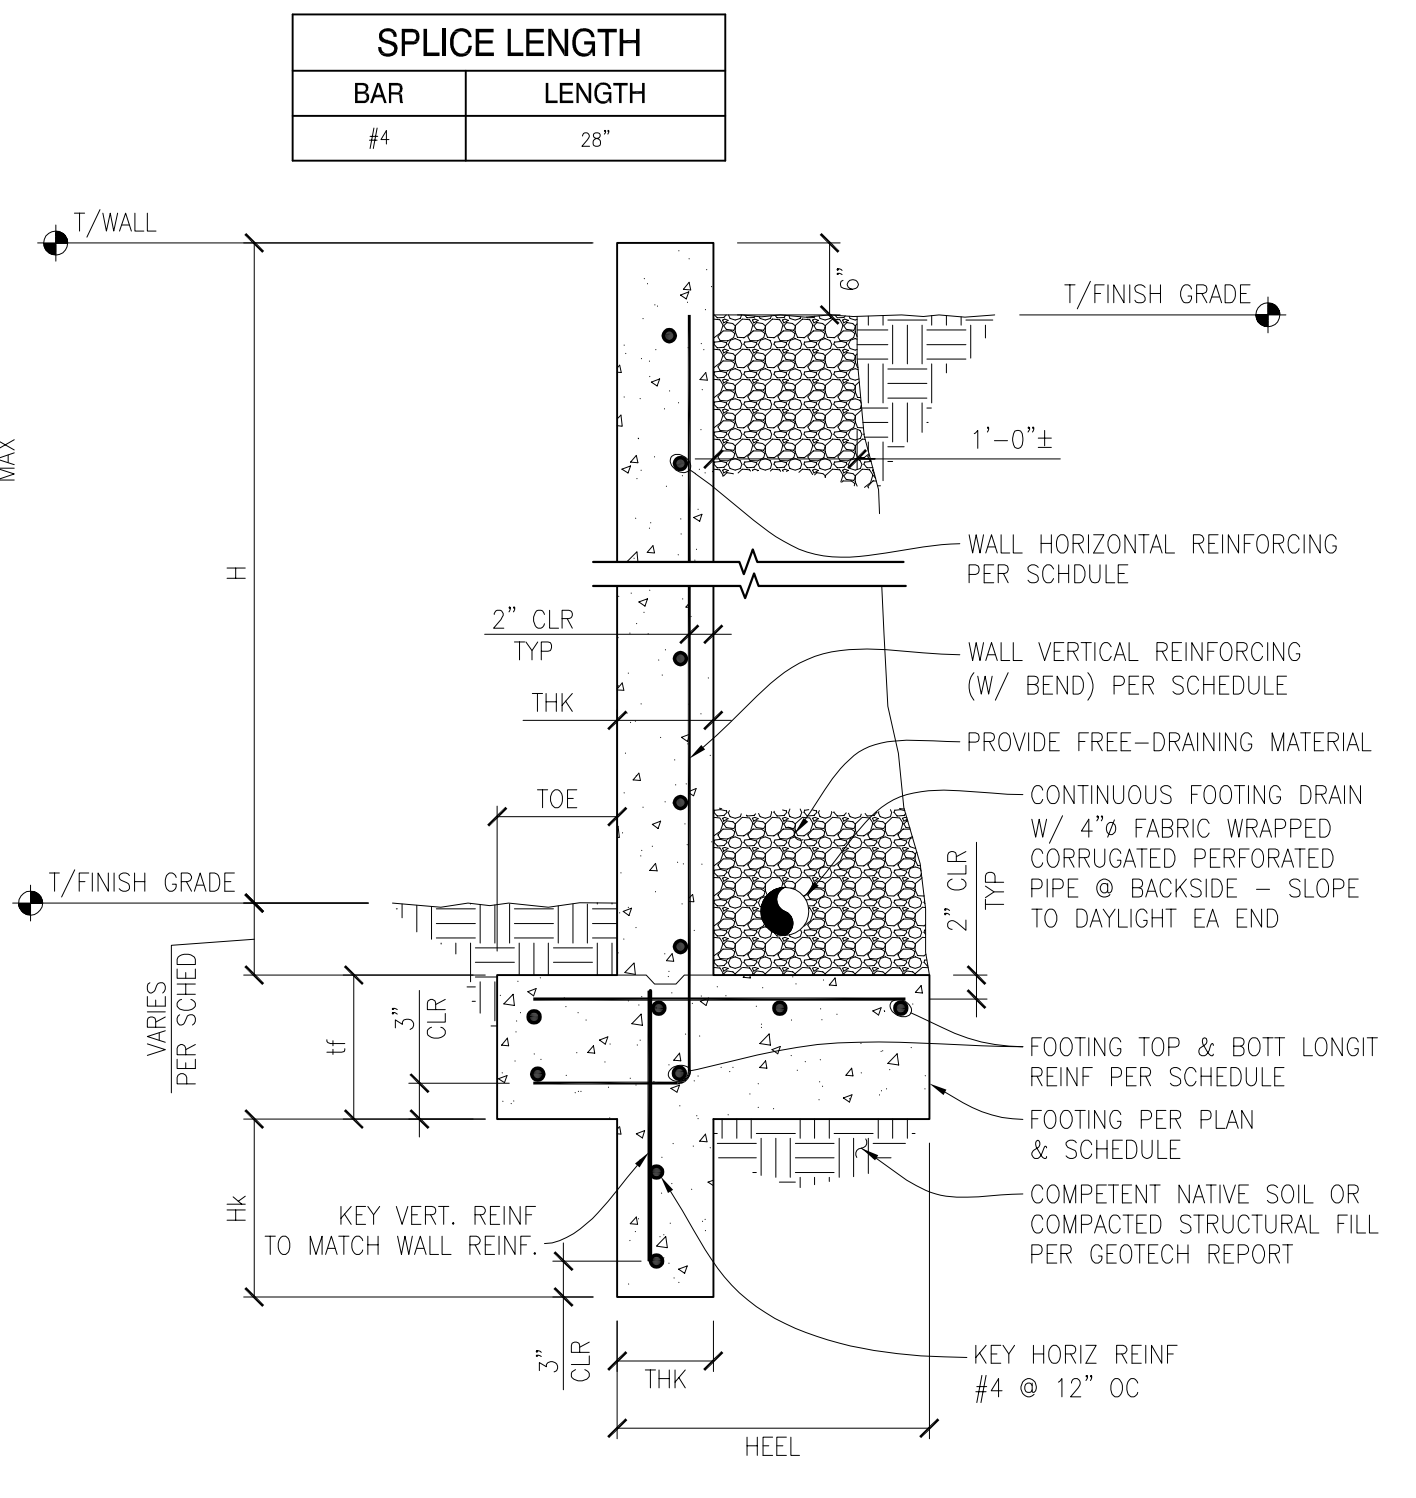


10 TALL CRAWL SPACE RETAINING WALL SCHEDULE
 SCALE: N.T.S.

RETAINING WALL/FOOTING SCHEDULE											
WALL						FOOTING					
HT (MAX)	THK	VERTICAL	HORIZONTAL	TOE	HEEL	DEPTH	TOP/TRANSV	TOP/LONGIT	BOTTOM/LONGIT	Hk	
4'-0"	8"	#4 @ 12"OC	#4 @ 12"OC	1'-0"	1'-6"	10"	#4 @ 10"OC	(3) #4	(2) #4	18"	
6'-0"	8"	#4 @ 8"OC	#4 @ 12"OC	2'-6"	1'-6"	10"	#4 @ 10"OC	(4) #4	(3) #4	18"	
8'-0"	8"	#5 @ 10"OC	#4 @ 12"OC	3'-6"	2'-0"	14"	#5 @ 10"OC	(5) #5	(3) #5	30"	
9'-0"	8"	#5 @ 8"OC	#4 @ 12"OC	3'-6"	3'-0"	14"	#5 @ 10"OC	(6) #5	(4) #5	30"	

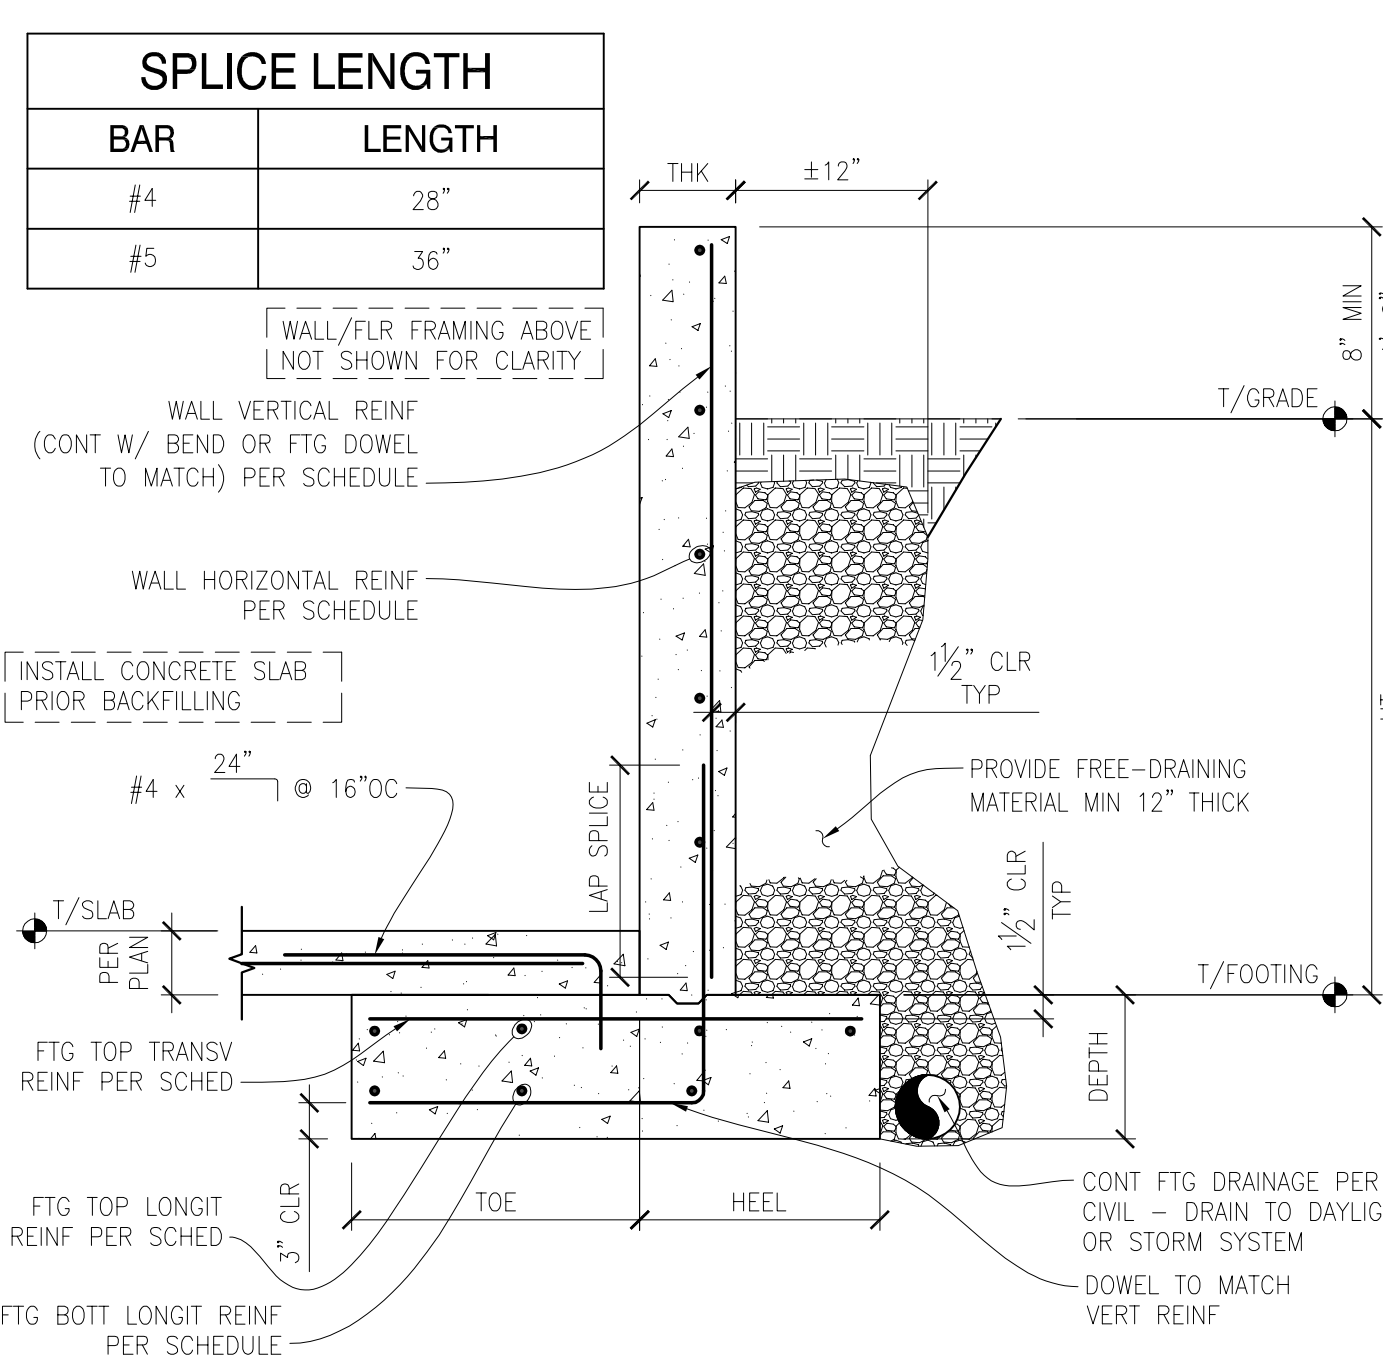


9 RETAINING WALL SCHEDULE
 SCALE: N.T.S.


RETAINING WALL/FOOTING SCHEDULE											
WALL						FOOTING					
HT (MAX)	THK	VERTICAL	HORIZONTAL	TOE	HEEL	DEPTH	TOP/TRANSV	TOP/LONGIT	BOTTOM/LONGIT	Hk	
4'-0"	8"	#4 @ 12"OC	#4 @ 12"OC	1'-0"	1'-6"	10"	#4 @ 10"OC	(3) #4	(2) #4	18"	
6'-0"	8"	#4 @ 8"OC	#4 @ 12"OC	2'-6"	1'-6"	10"	#4 @ 10"OC	(4) #4	(3) #4	18"	
8'-0"	8"	#5 @ 10"OC	#4 @ 12"OC	3'-6"	2'-0"	14"	#5 @ 10"OC	(5) #5	(3) #5	30"	
9'-0"	8"	#5 @ 8"OC	#4 @ 12"OC	3'-6"	3'-0"	14"	#5 @ 10"OC	(6) #5	(4) #5	30"	

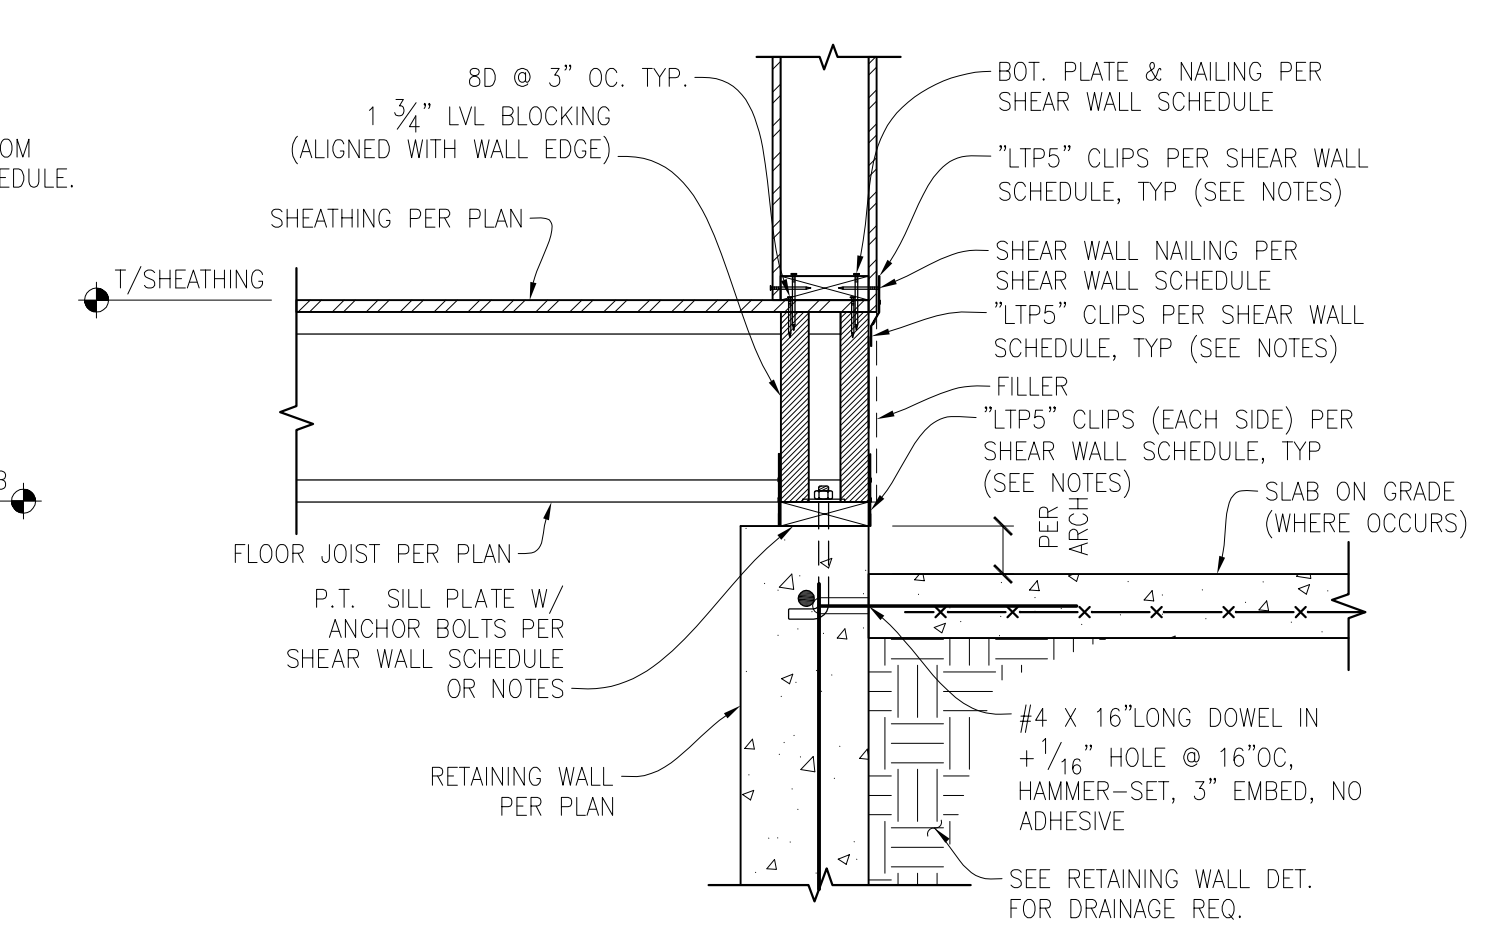

12 DBL SIDED SHEAR WALL TO RETAINING WALL CONNECTION
 SCALE: 1" = 1'-0"

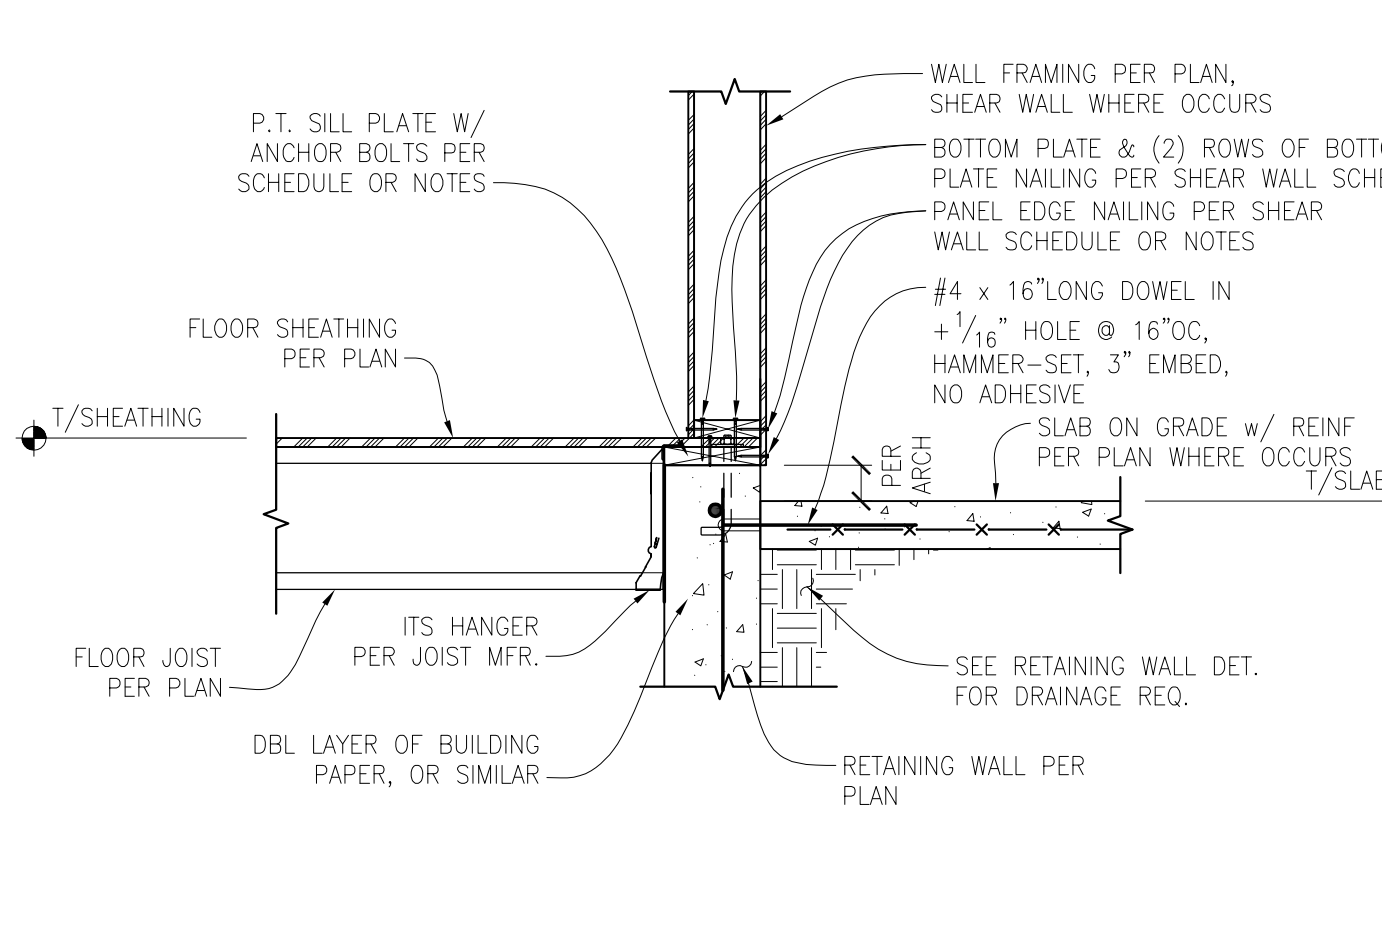

11 EXTERIOR SHEAR WALL WITH JOISTS PERPENDICULAR TO RETAINING WALL
 SCALE: 3/4" = 1'-0"

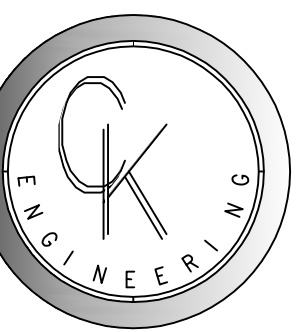

CK ENGINEERING LLC
PROFESSIONAL STRUCTURAL
ENGINEERING SERVICES


19105 34th Ave W, Suite 205
Lynnwood, WA 98036
Phone: (206) 417-0670




12/8/2023

NEW HOME AT:
6175 SE 27TH ST.
MERCER ISLAND, WA 98040


NOTES:
FOR SW-6 TO SW-4, TO ELIMINATE SHEAR WALL
CLIPS @ R'S, LOCATE SHEATHING SPLICES AT
MID-HT OF RIM BOARD & NAIL W/ (2) ROWS OF
PANEL EDGE NAILING PER SHEAR WALL SCHEDULE.

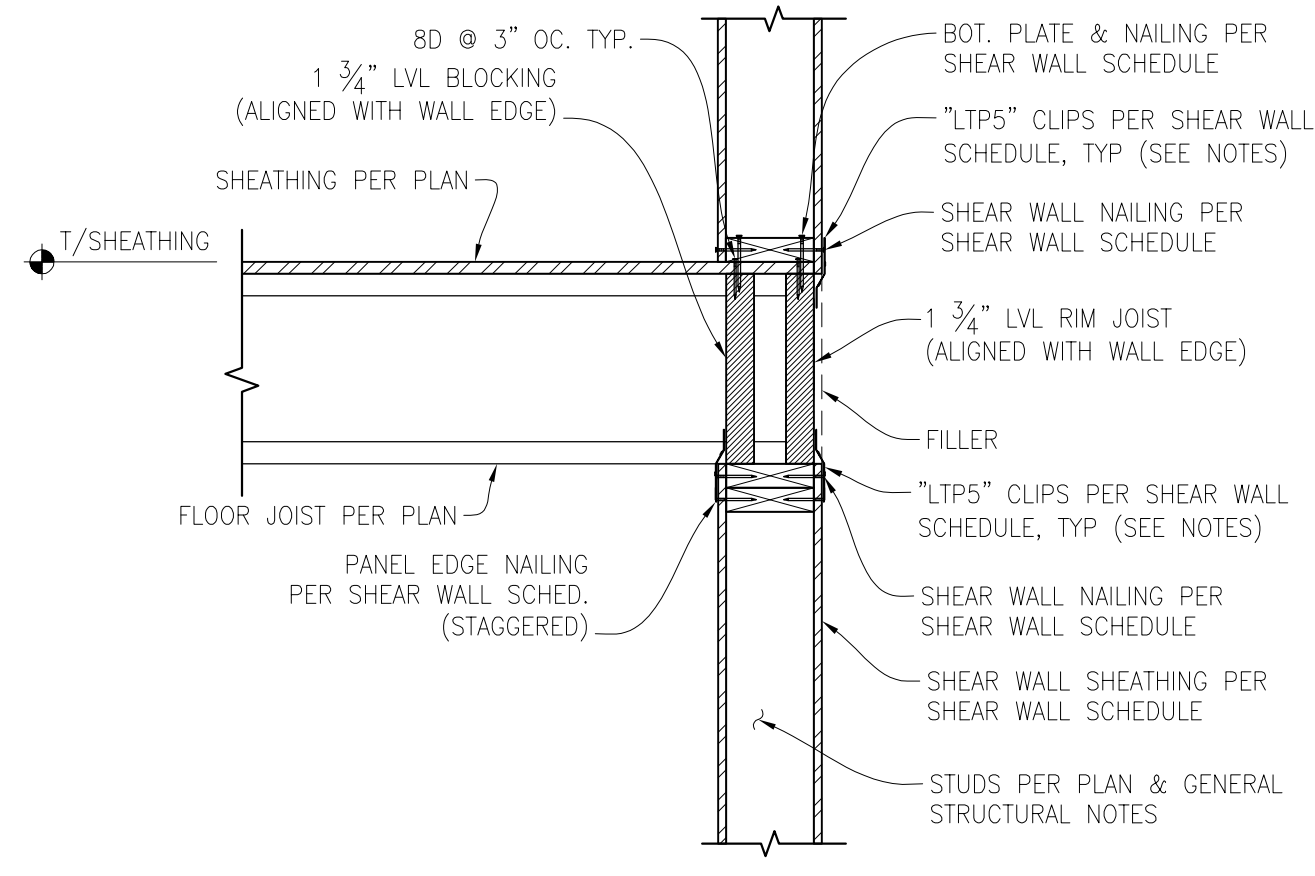


FL. JOIST PERP. TO DBL SIDED SHEAR WALL CON. 1
SCALE: 1" = 1'-0"

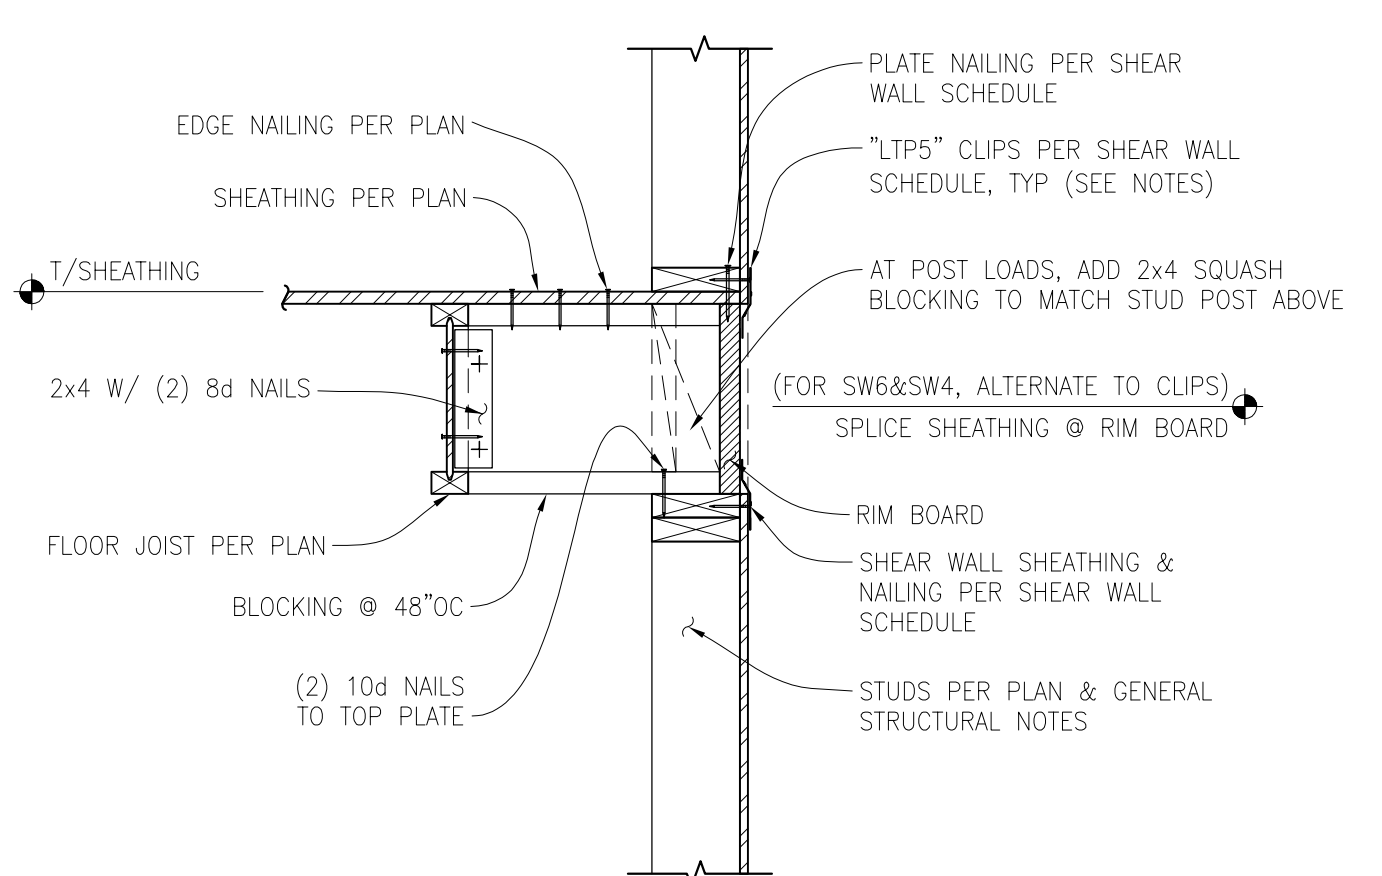


FLOOR JOIST PARALLEL TO EXTERIOR WALL CON. 2
SCALE: 1" = 1'-0"

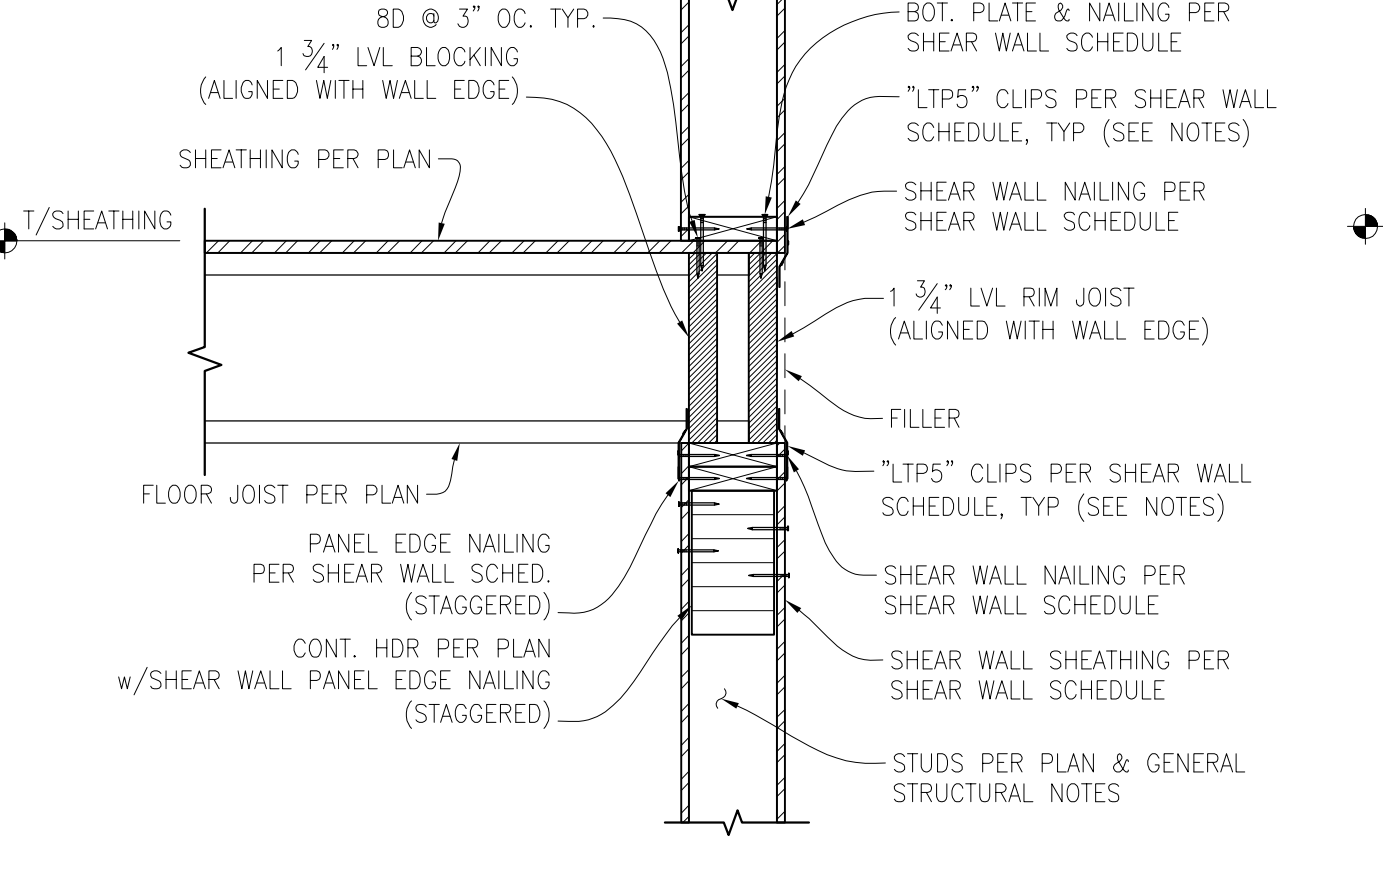


CONT. HEADER & FL. JOIST PERP. TO DBL SIDED SHEAR WALL CON. 3
SCALE: 1" = 1'-0"

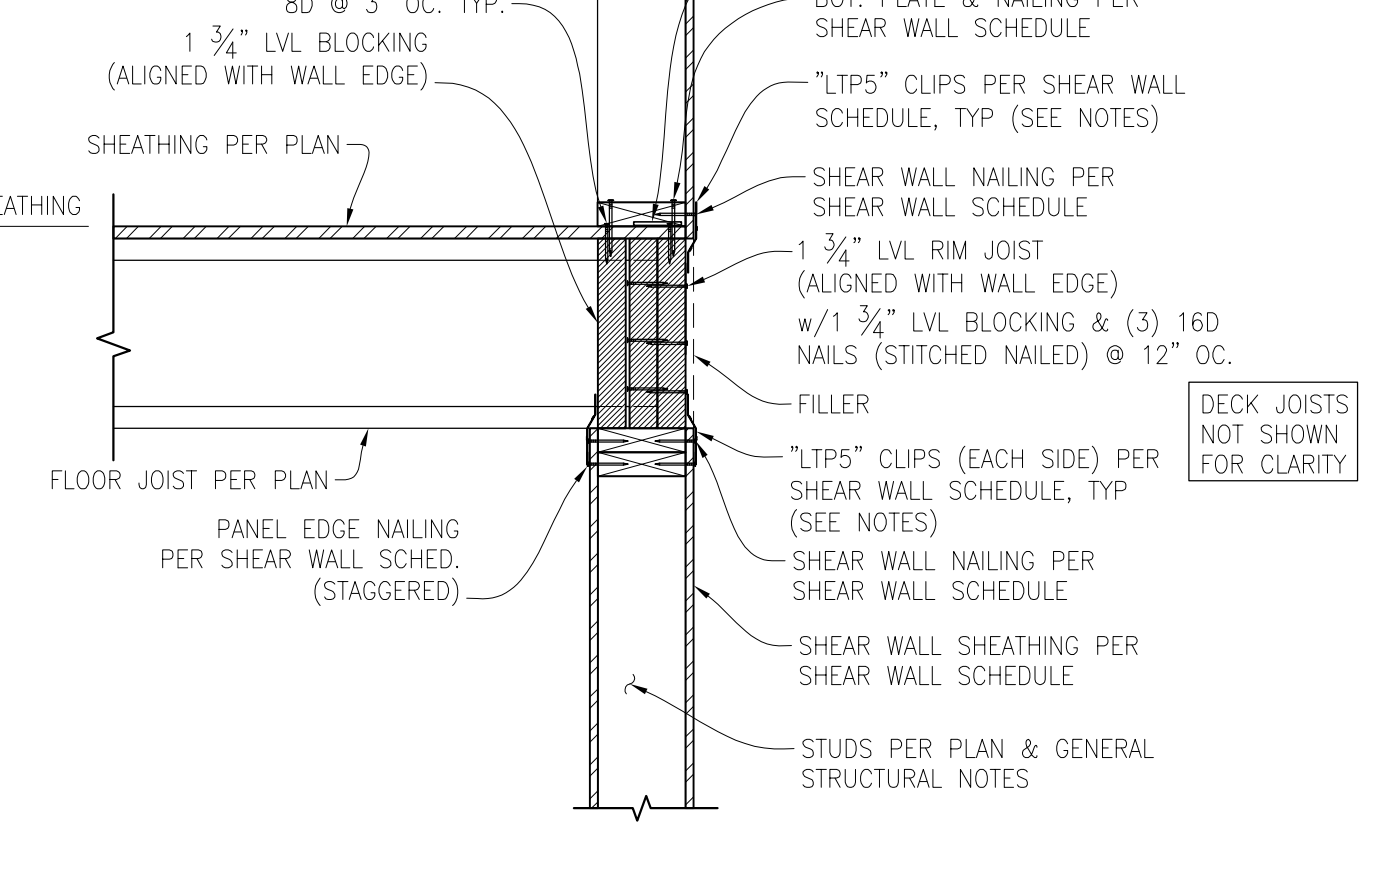


CMST STRAP TO BLOCKING & FL. JOIST PERP. TO DBL SIDED SHEAR WALL CON. 4
SCALE: 1" = 1'-0"

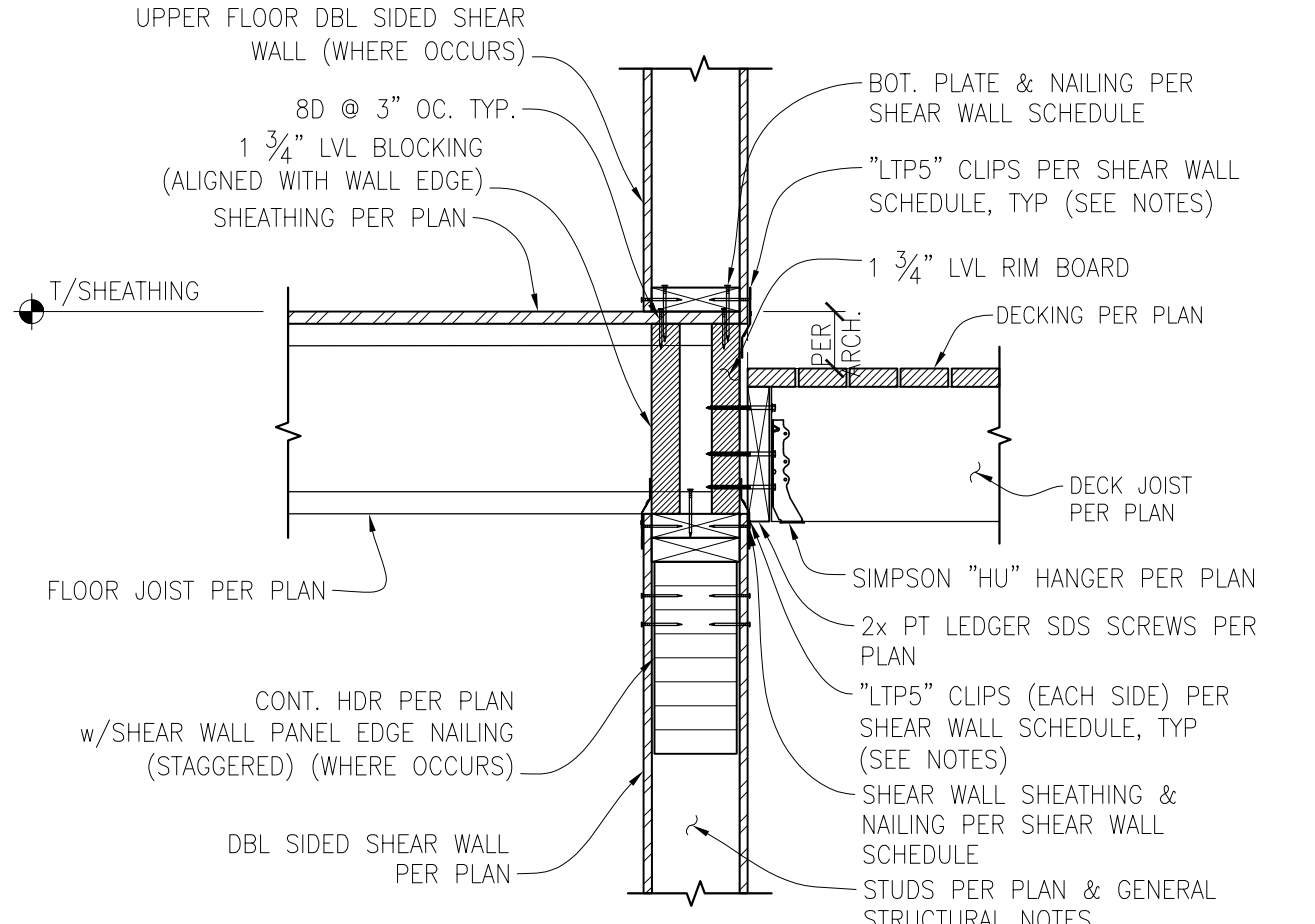


DBL SIDED SHEAR WALL/ RIM JOIST TO LEDGER CONNECTION 5
SCALE: 1" = 1'-0"

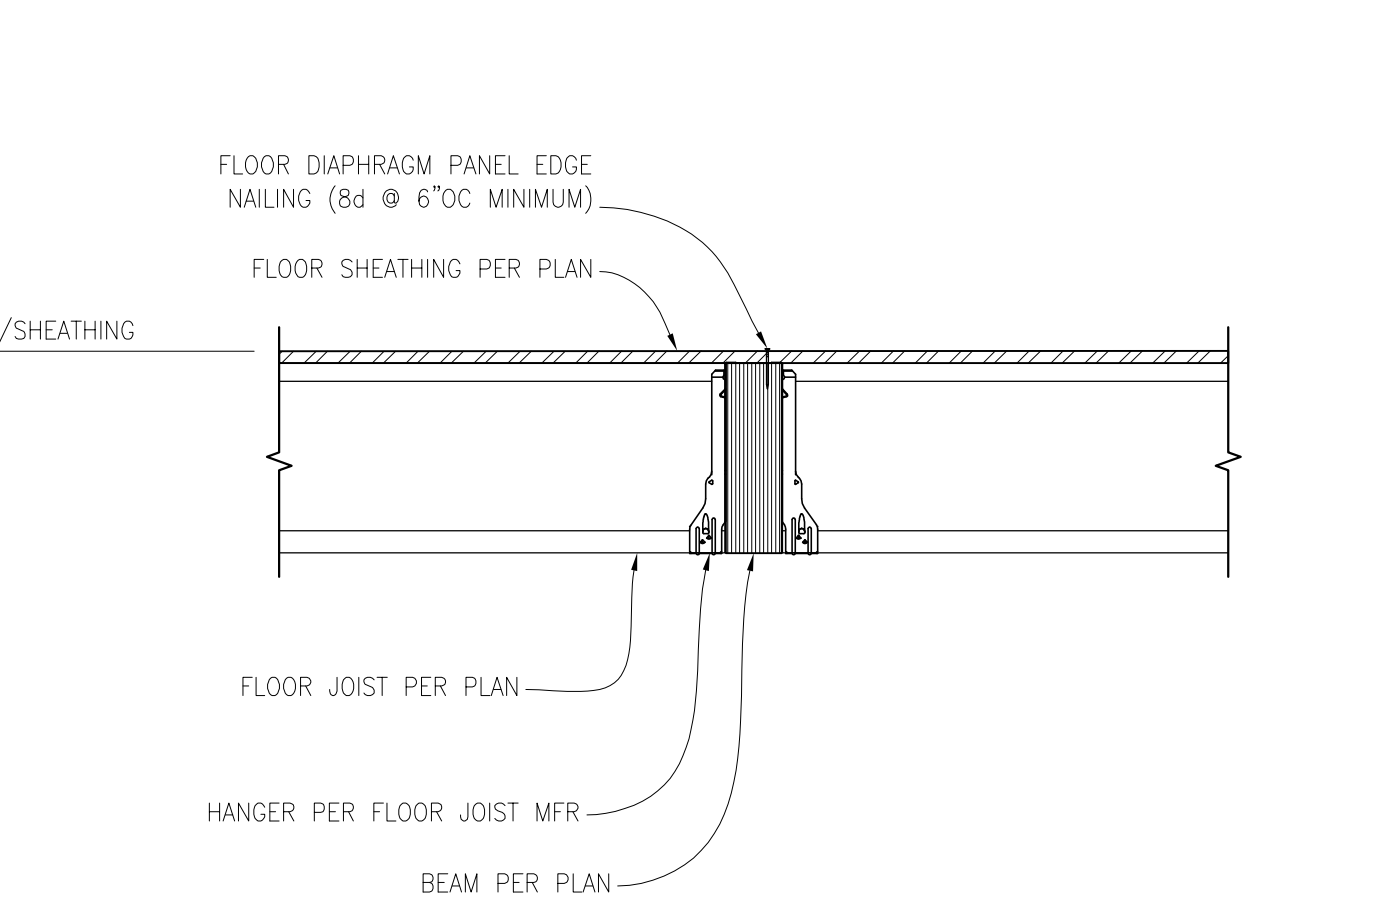


FLOOR JOIST/FLUSH BEAM CONNECTION 6
SCALE: 1" = 1'-0"

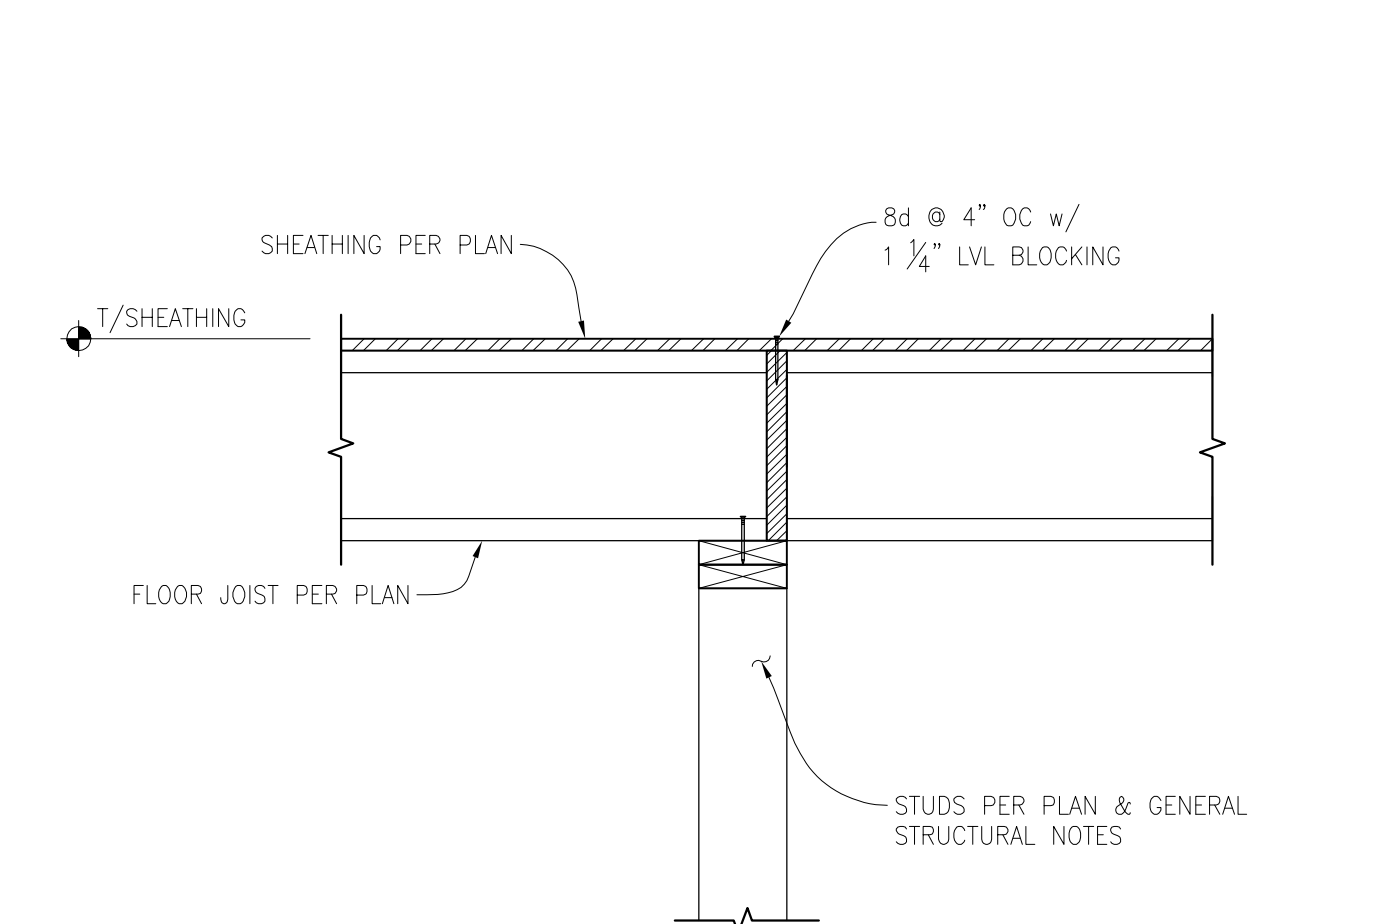


FLOOR JOIST PERP. AT INTERIOR BEARING WALL 7
SCALE: 1" = 1'-0"

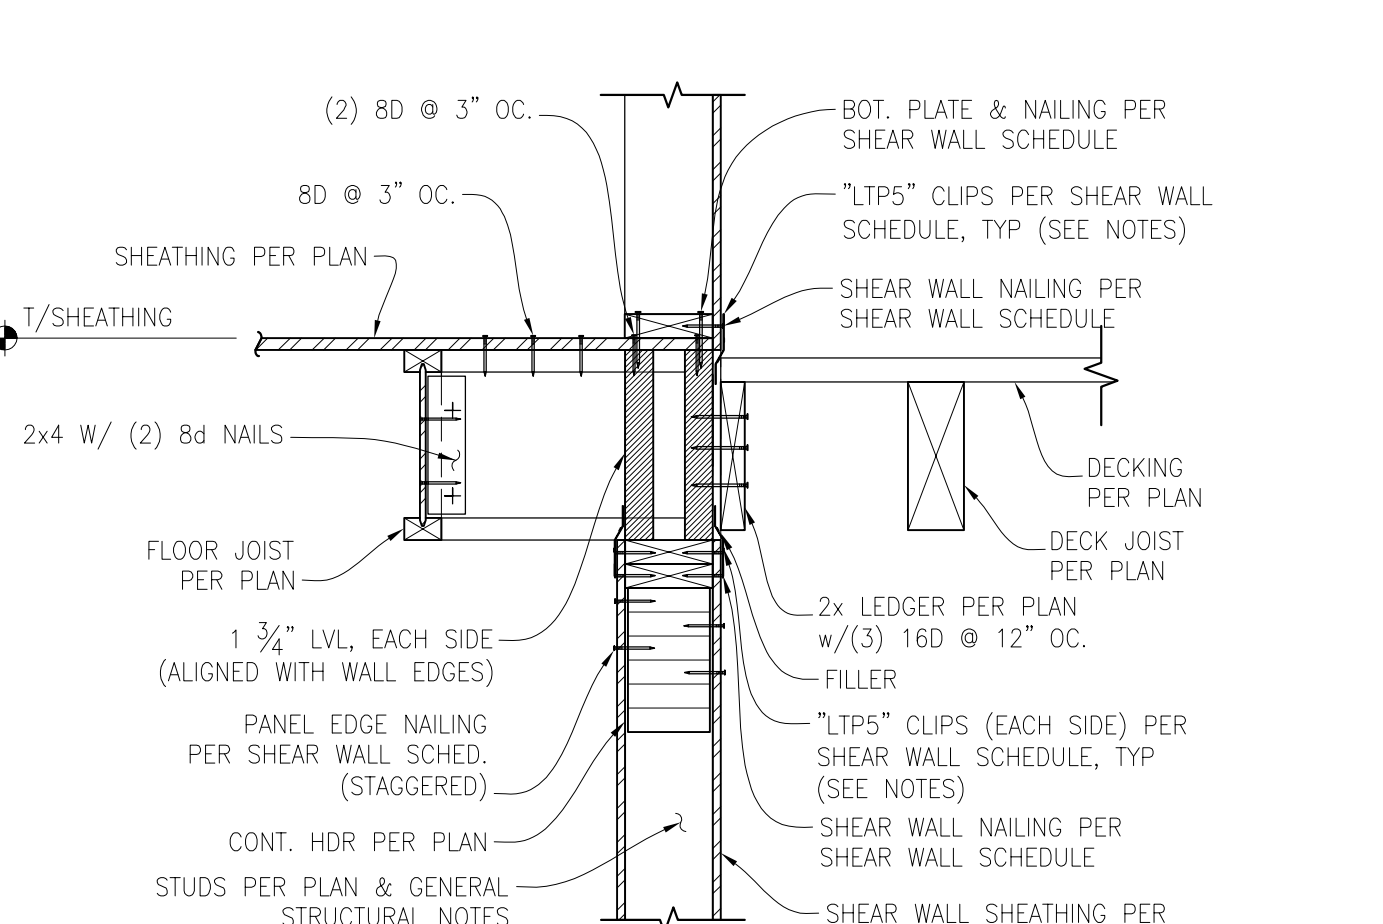


CONT. HEADER/SHEAR WALL CONNECTION (FLOOR/DECK JOIST PARALLEL) 8
SCALE: 1" = 1'-0"

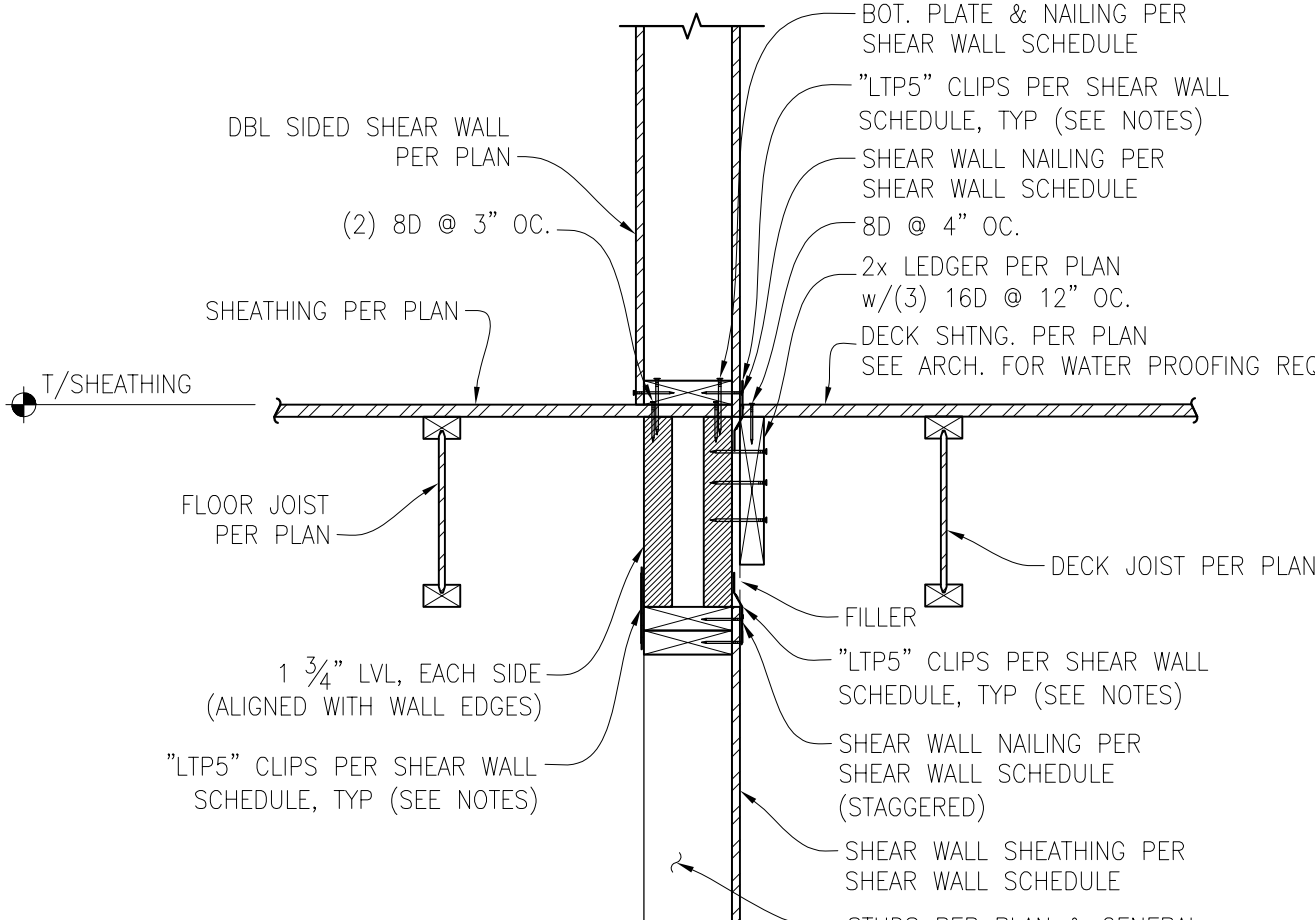


DBL SIDED SHEAR WALL CONNECTION (DECK/FLOOR JOIST PARALLEL) 9
SCALE: 1" = 1'-0"

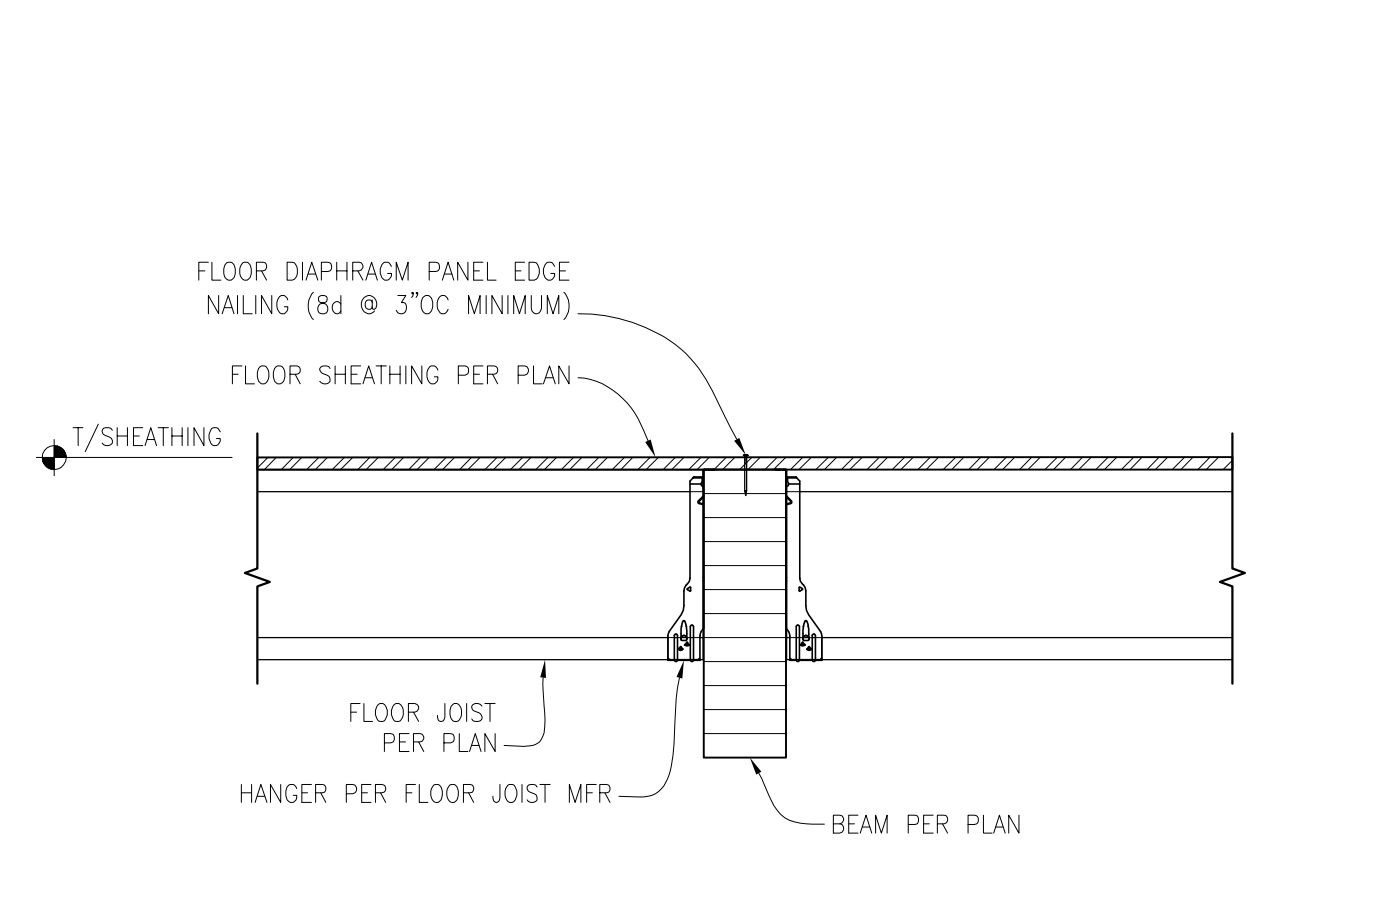

FLOOR JOIST/TOP FLUSH BEAM CONNECTION 10
SCALE: 1" = 1'-0"

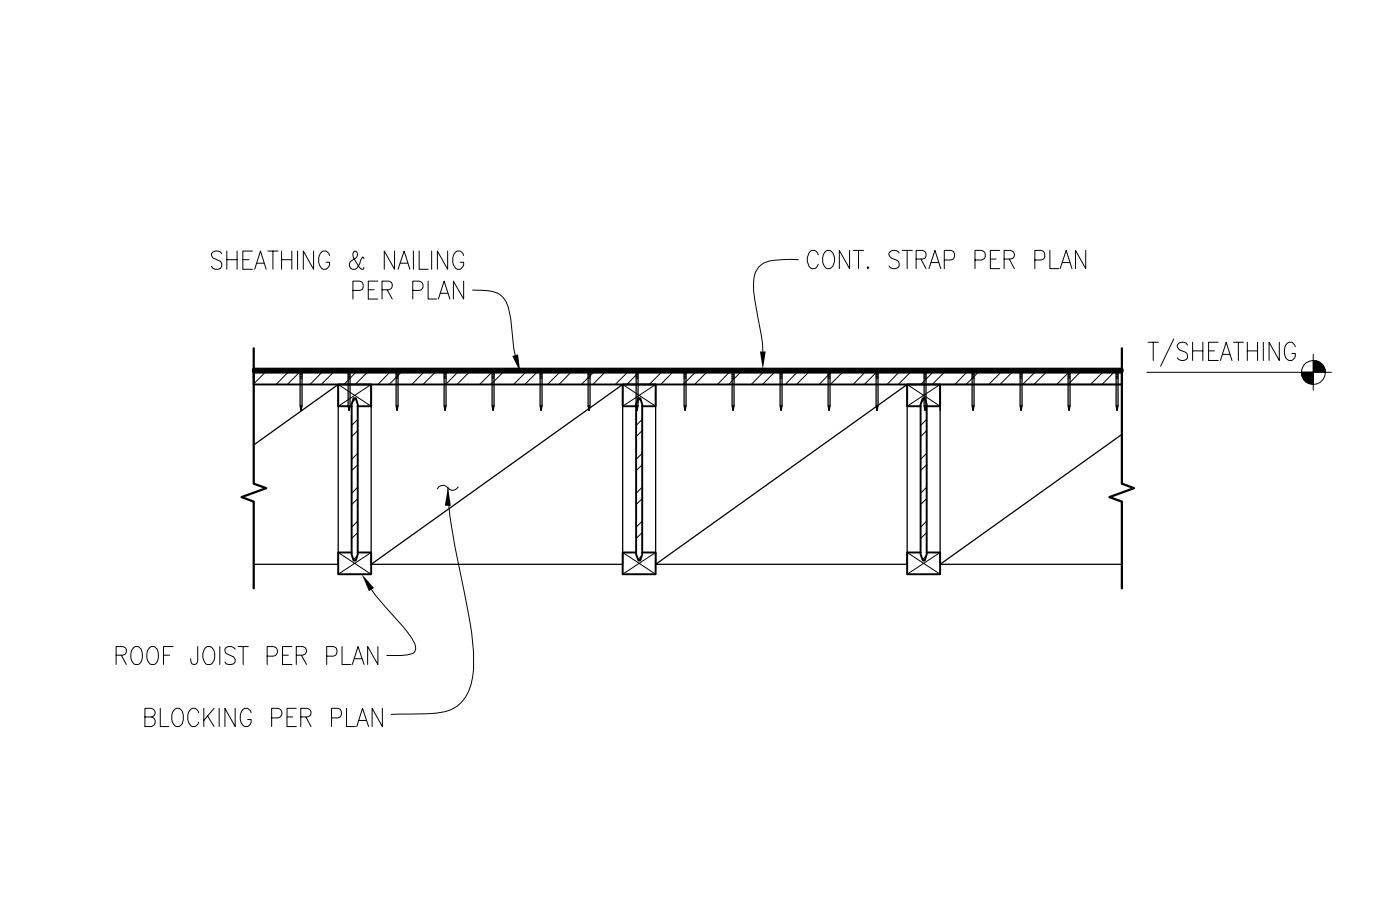

FLOOR JOIST BLOCKING 11
SCALE: 1" = 1'-0"

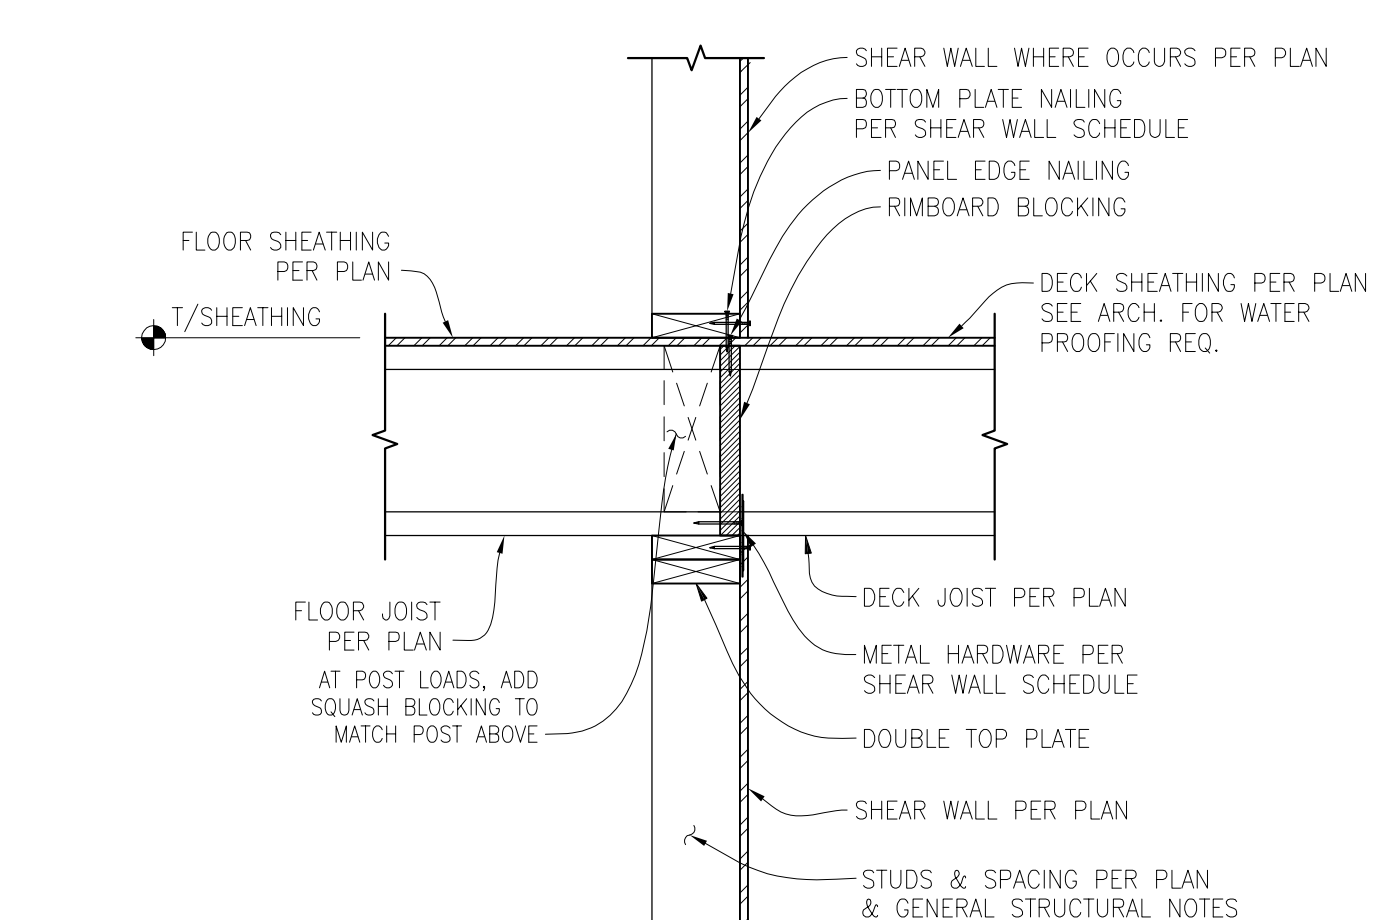

INTERIOR BEARING/SHEAR WALL CON. 12
SCALE: 1" = 1'-0"


REVISION #	DATE	DESCRIPTION

Drawn By: PK
Checked By: SC
Date: 12-8-2023

CK JOB NO.
23-043

STRUCTURAL
DETAILS

S-3.0

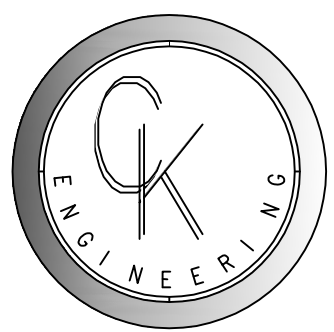

CK ENGINEERING LLC
 PROFESSIONAL STRUCTURAL
 ENGINEERING SERVICES
 19105 36th Ave. W. Suite 205
 Lynnwood, WA 98036
 Phone: (206) 417-0670



12/8/2023

NEW HOME AT:
 6175 SE 27TH ST.
 MERCER ISLAND, WA 98040


REVISION #	DATE	DESCRIPTION:

Drawn By: PK
 Checked By: SC
 Date: 12-8-2023


CK JOB NO.
23-043

STRUCTURAL
 DETAILS


S-3.1

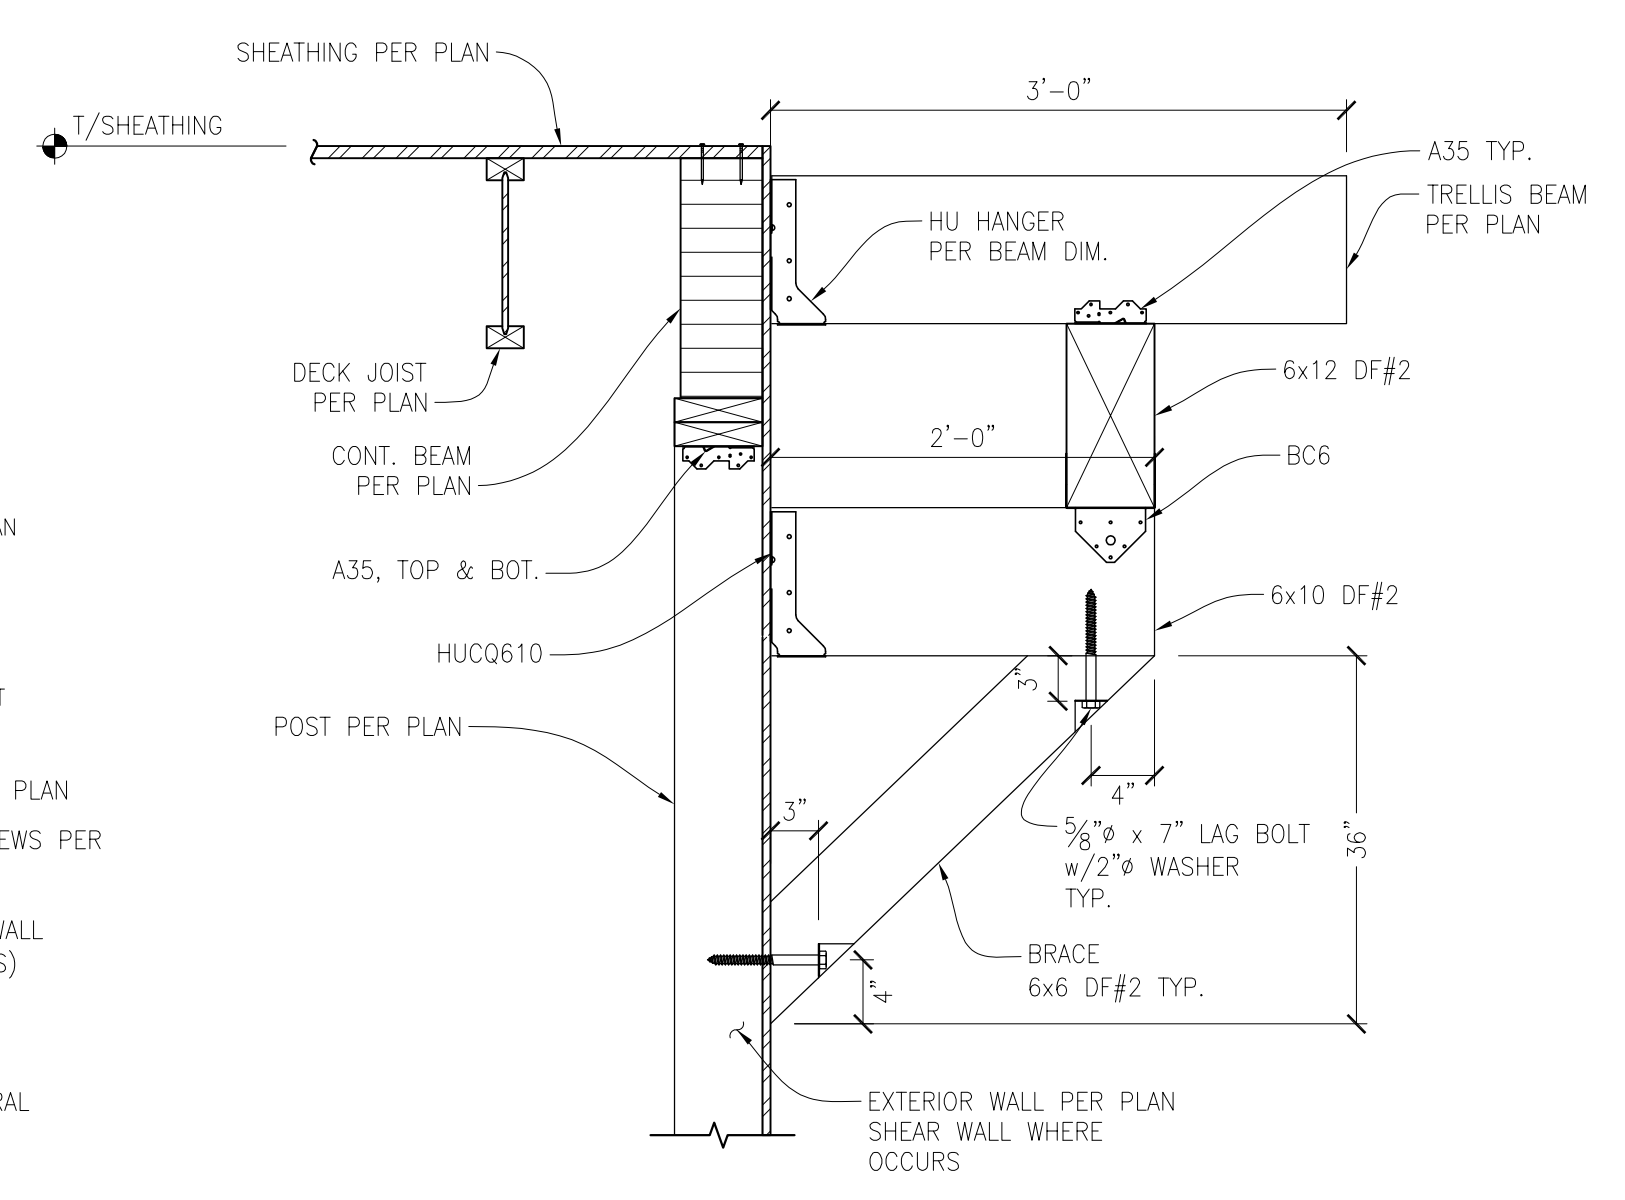


4 TYPICAL KNEE BRACE AT TRELLIS CONNECTION
 SCALE: NTS

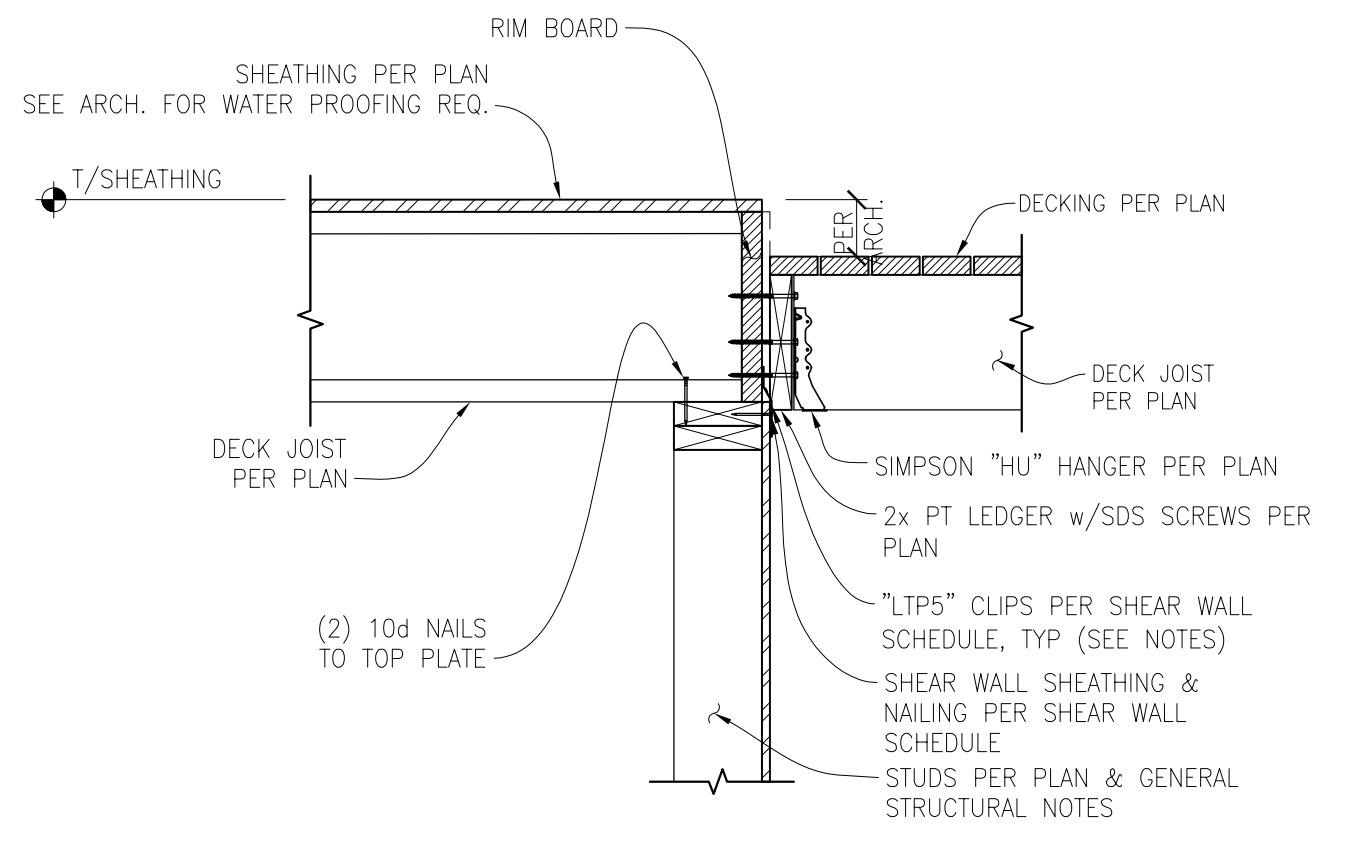


3 DECK JOIST/SHEAR WALL CONNECTION
 SCALE: 1" = 1'-0"

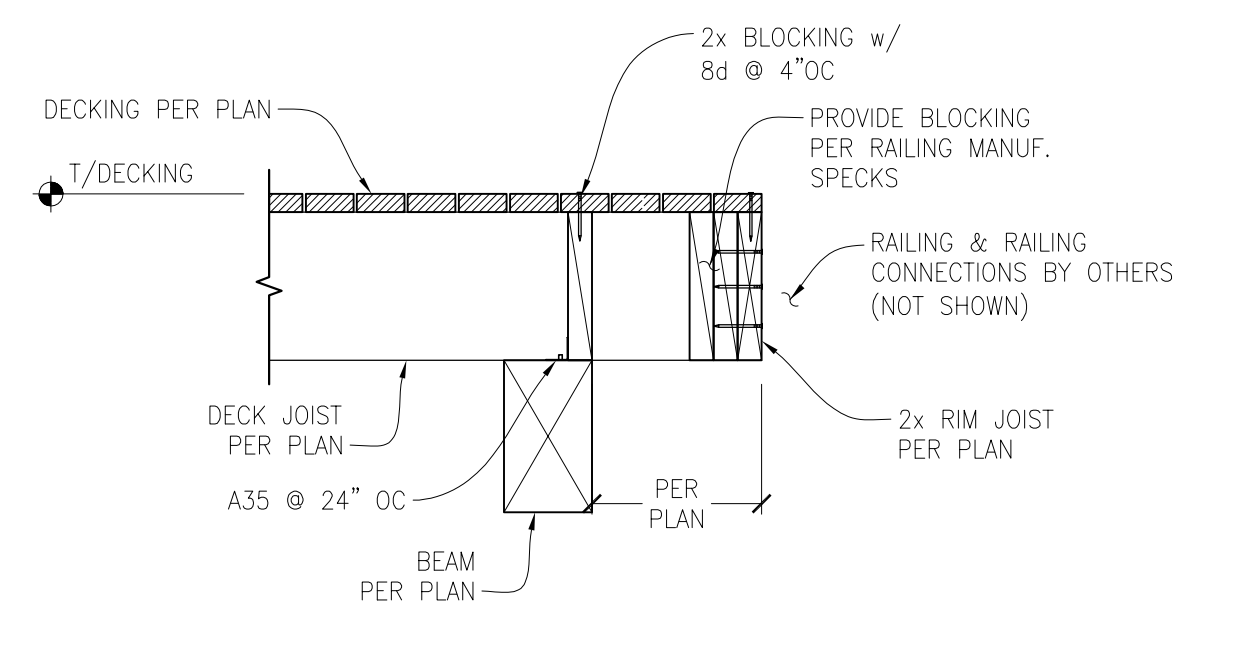

2 DECK JOIST TO DECK BEAM CONNECTION
 SCALE: 1" = 1'-0"

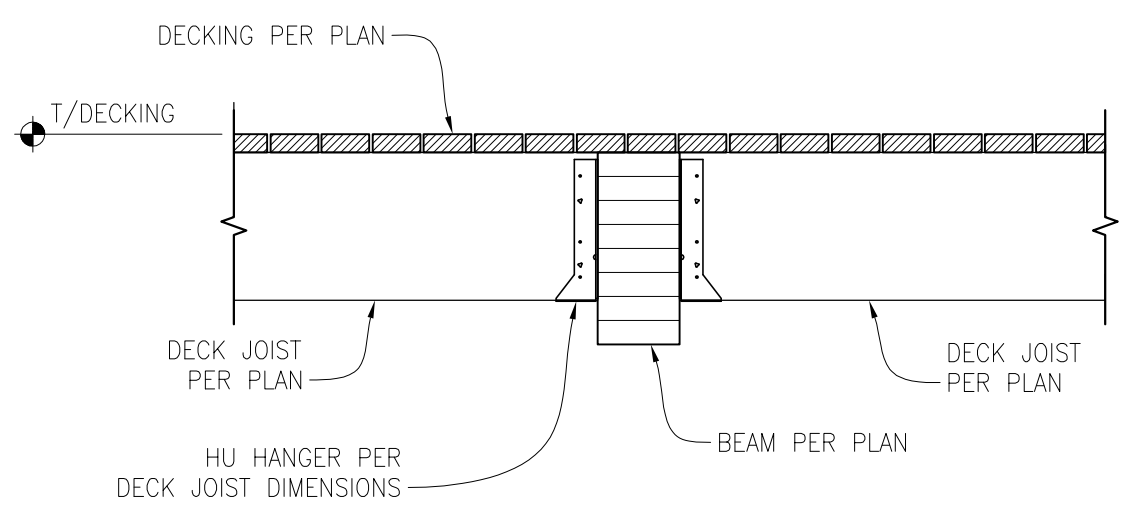


1 DECK JOIST MID BEAM CONNECTION
 SCALE: 1" = 1'-0"

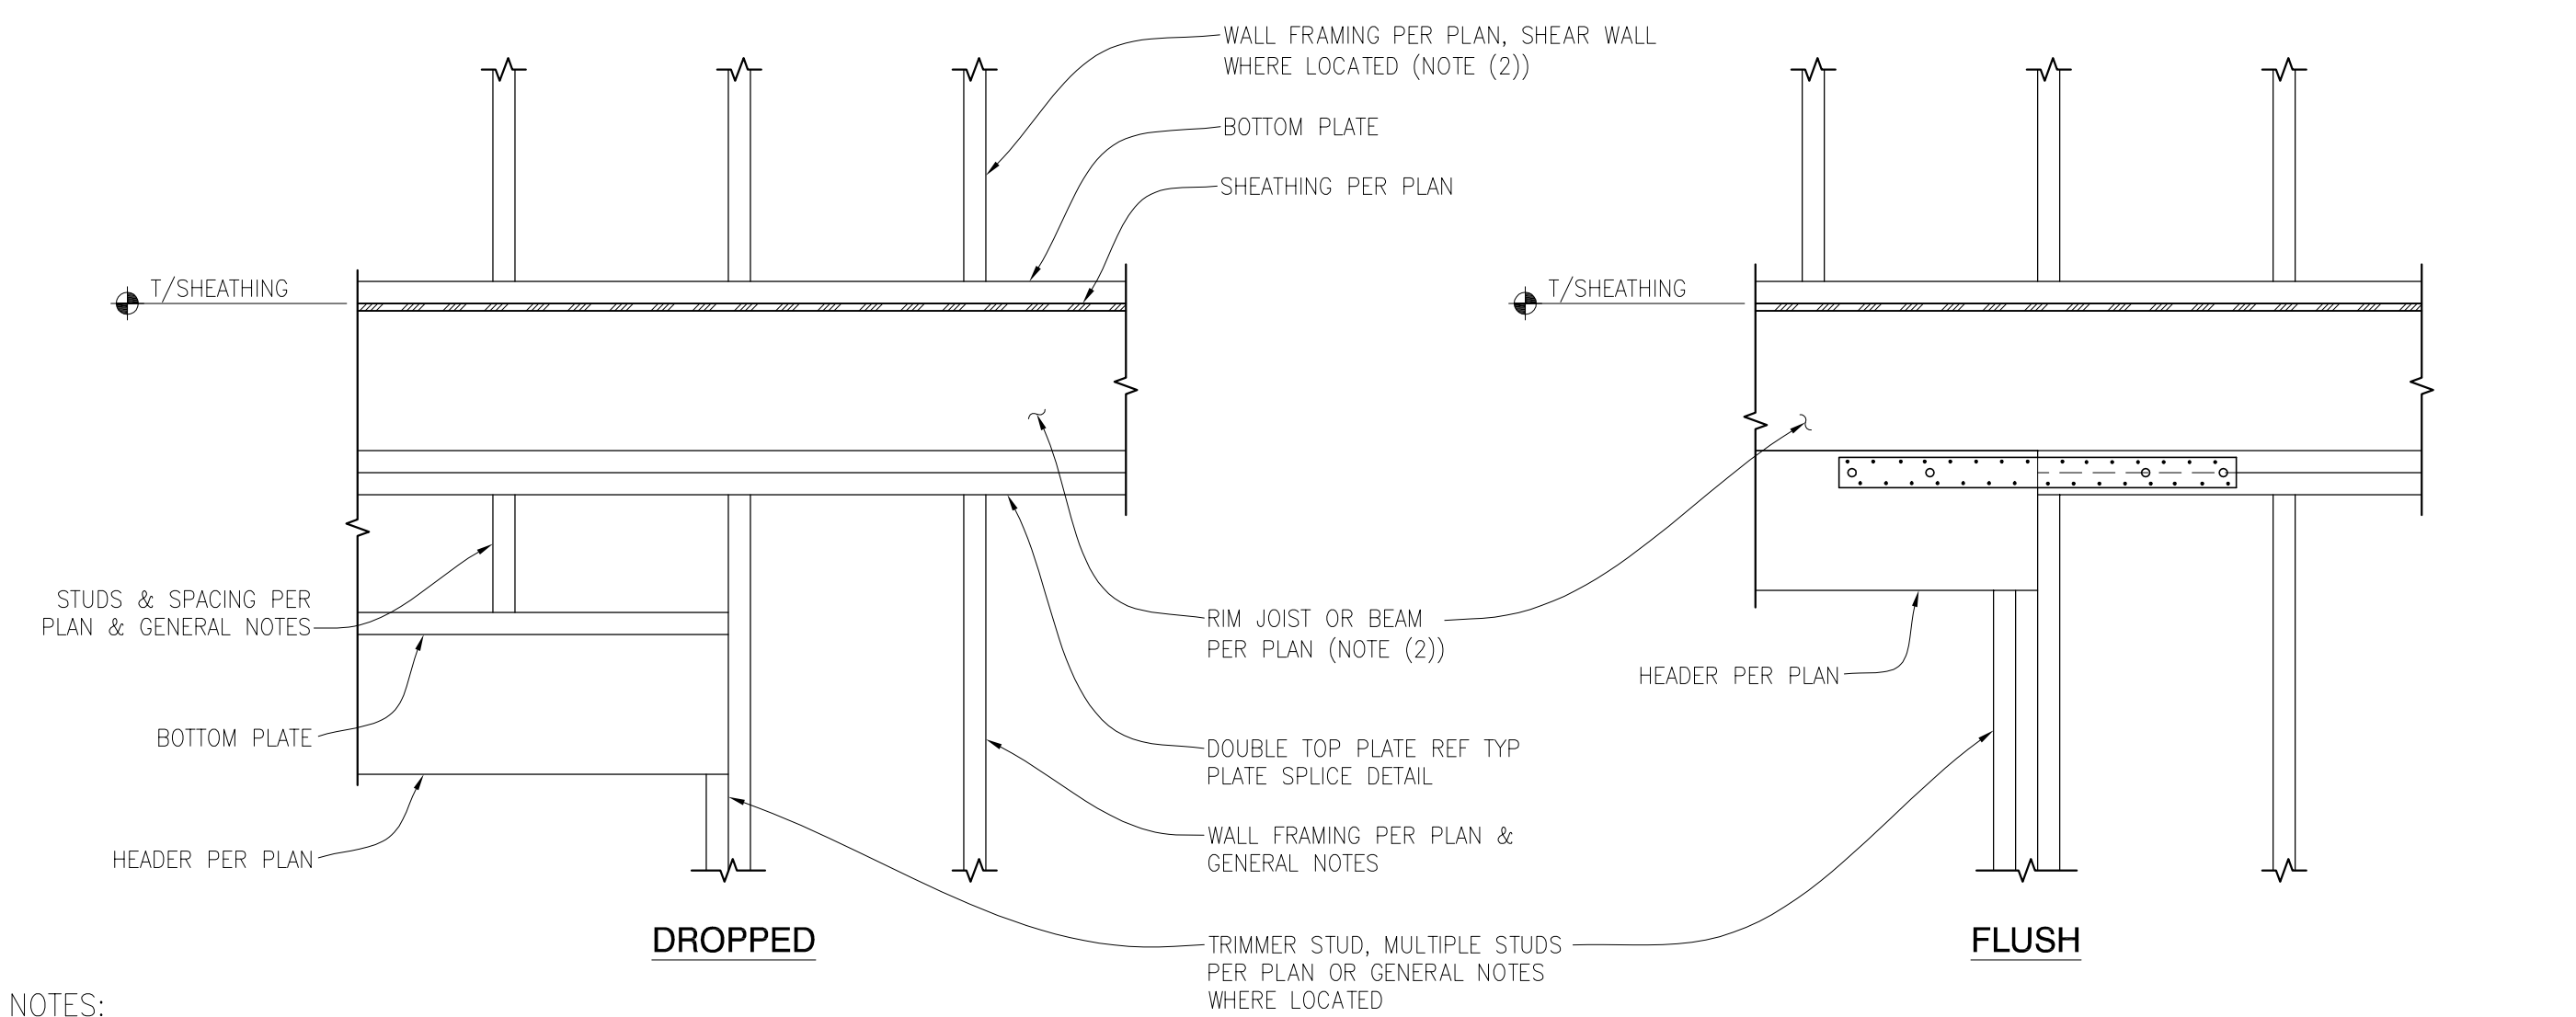


8 TYPICAL HEADER FRAMING
 SCALE: 1" = 1'-0"

NOTES:
 1. WALL SHEATHING NOT SHOWN FOR CLARITY
 2. WHERE ROOF ABOVE, RAFTERS OR PRE-MANUFACTURED TRUSSES PER PLAN REPLACES RIM JOIST

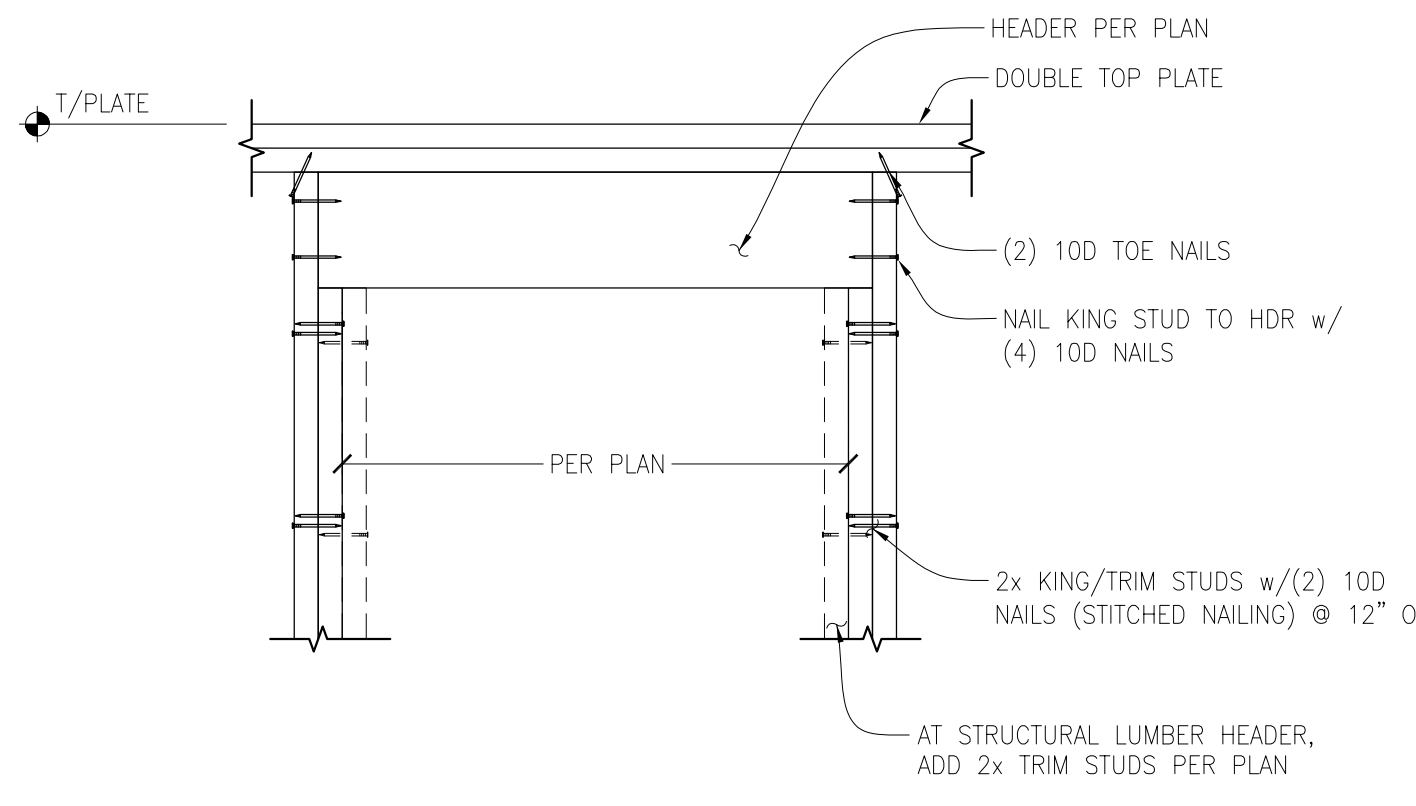


6 TYPICAL HEADER CONNECTION
 SCALE: N.T.S.

NOTE:
 FLOOR/ROOF FRAMING NOT SHOWN FOR CLARITY.

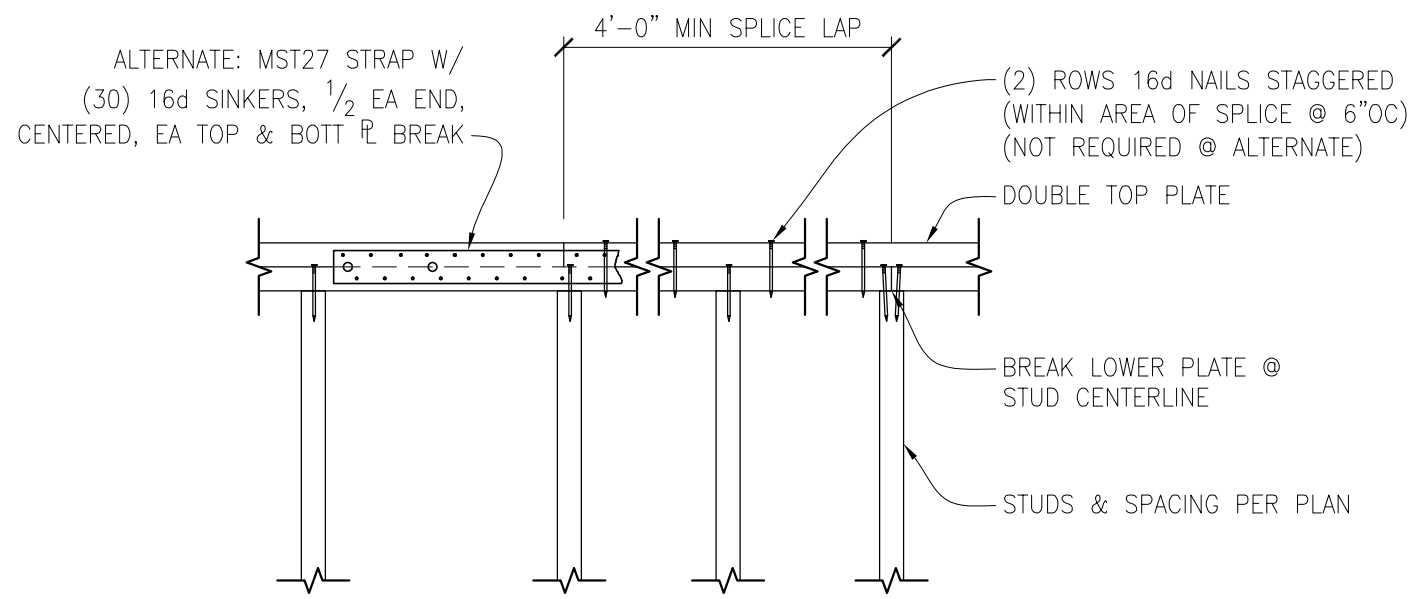


5 TYPICAL PLATE SPLICE DETAIL
 SCALE: N.T.S.


NOTE:
 FLOOR JOISTS NOT SHOWN FOR CLARITY.

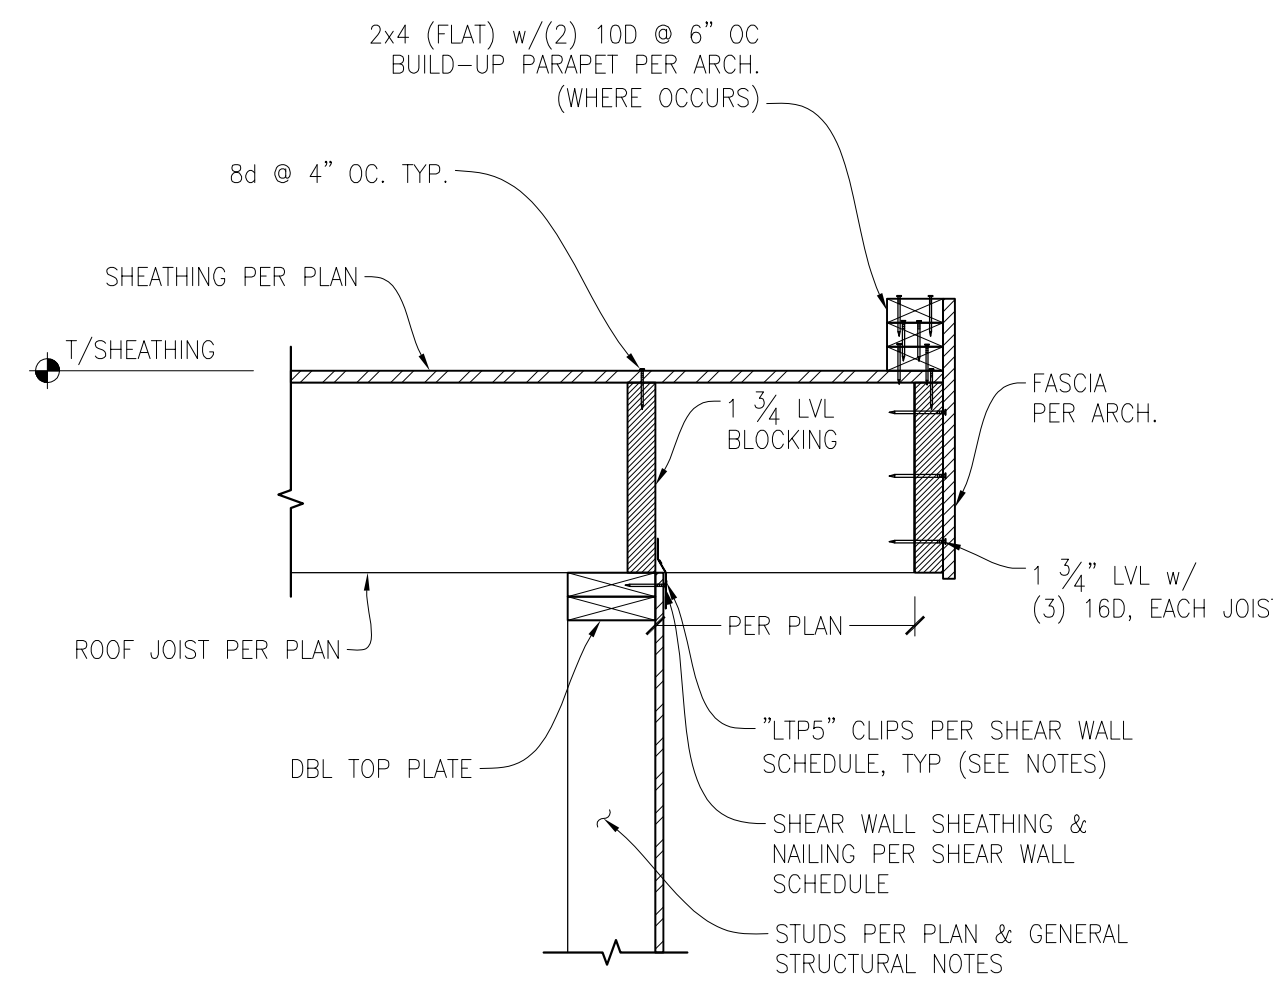


ROOF JOIST PERPENDIC. TO BEARING/SHEAR WALL 1
SCALE: 1" = 1'-0"

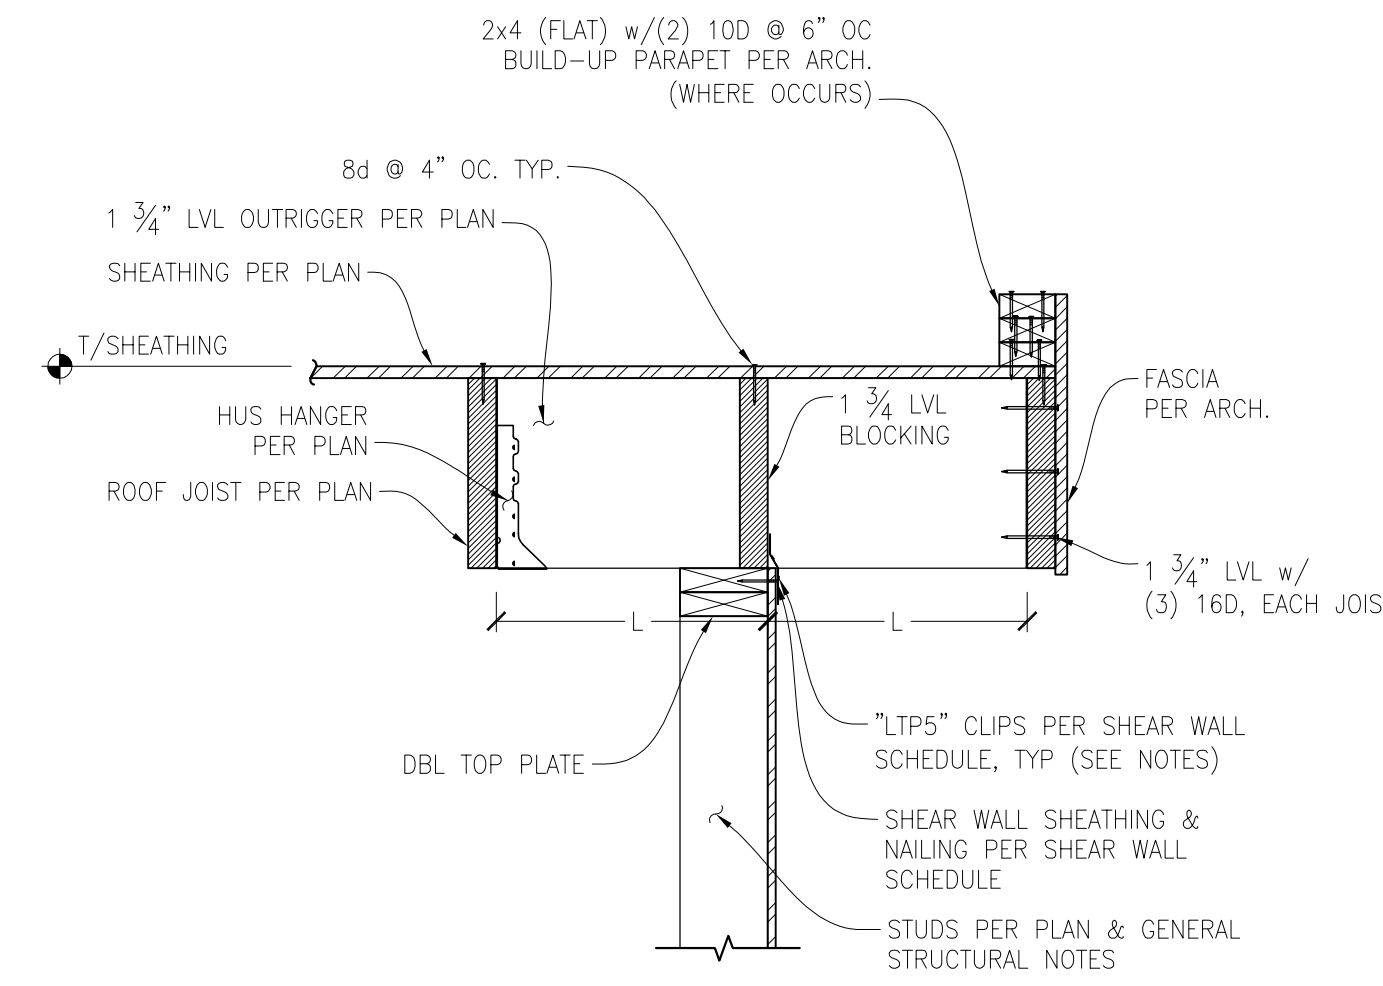


ROOF JOIST PARALLEL TO BEARING/SHEAR WALL 2
SCALE: 1" = 1'-0"

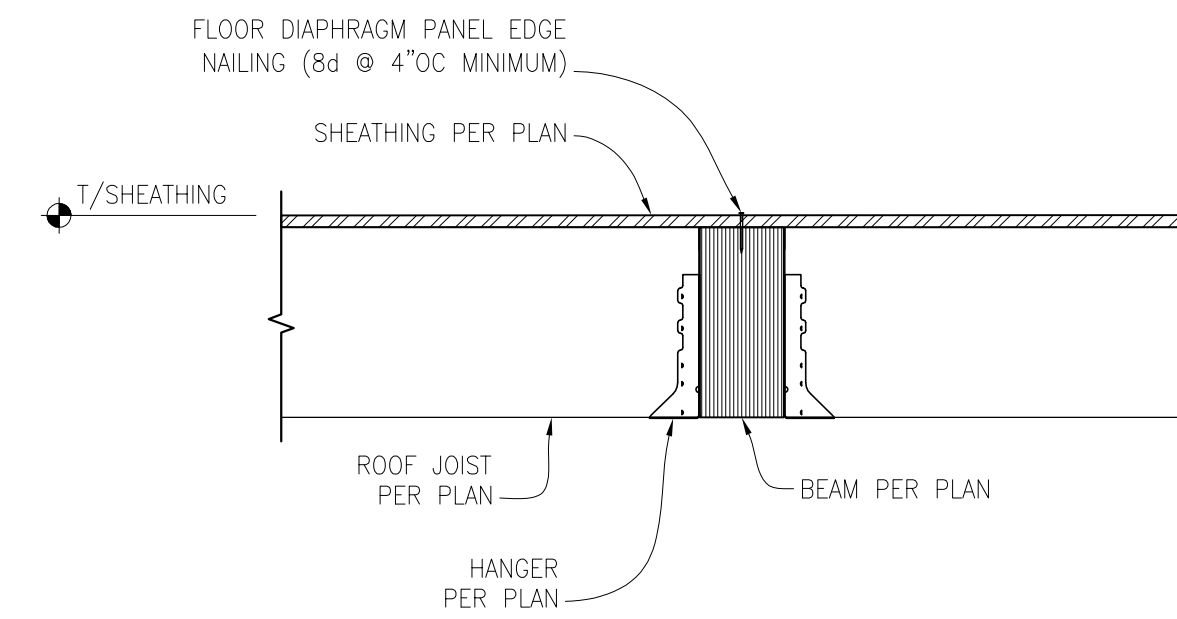


ROOF JOIST/TOP FLUSH BEAM CONNECTION 3
SCALE: 1" = 1'-0"

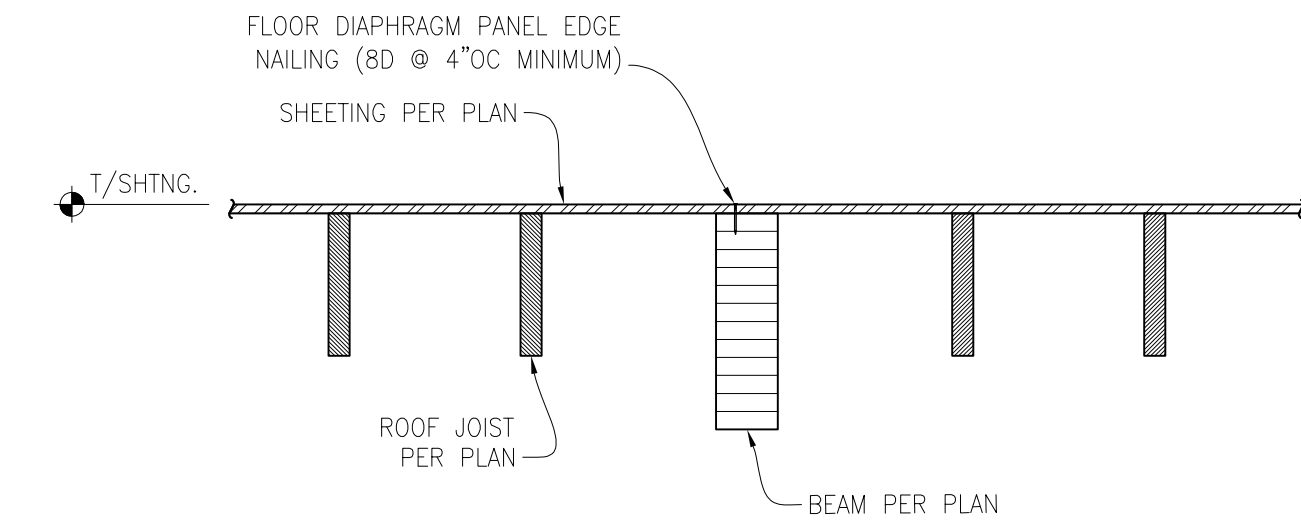


ROOF BEAM (TOP FLUSH) CONNECTION 4
SCALE: 3/4" = 1'-0"

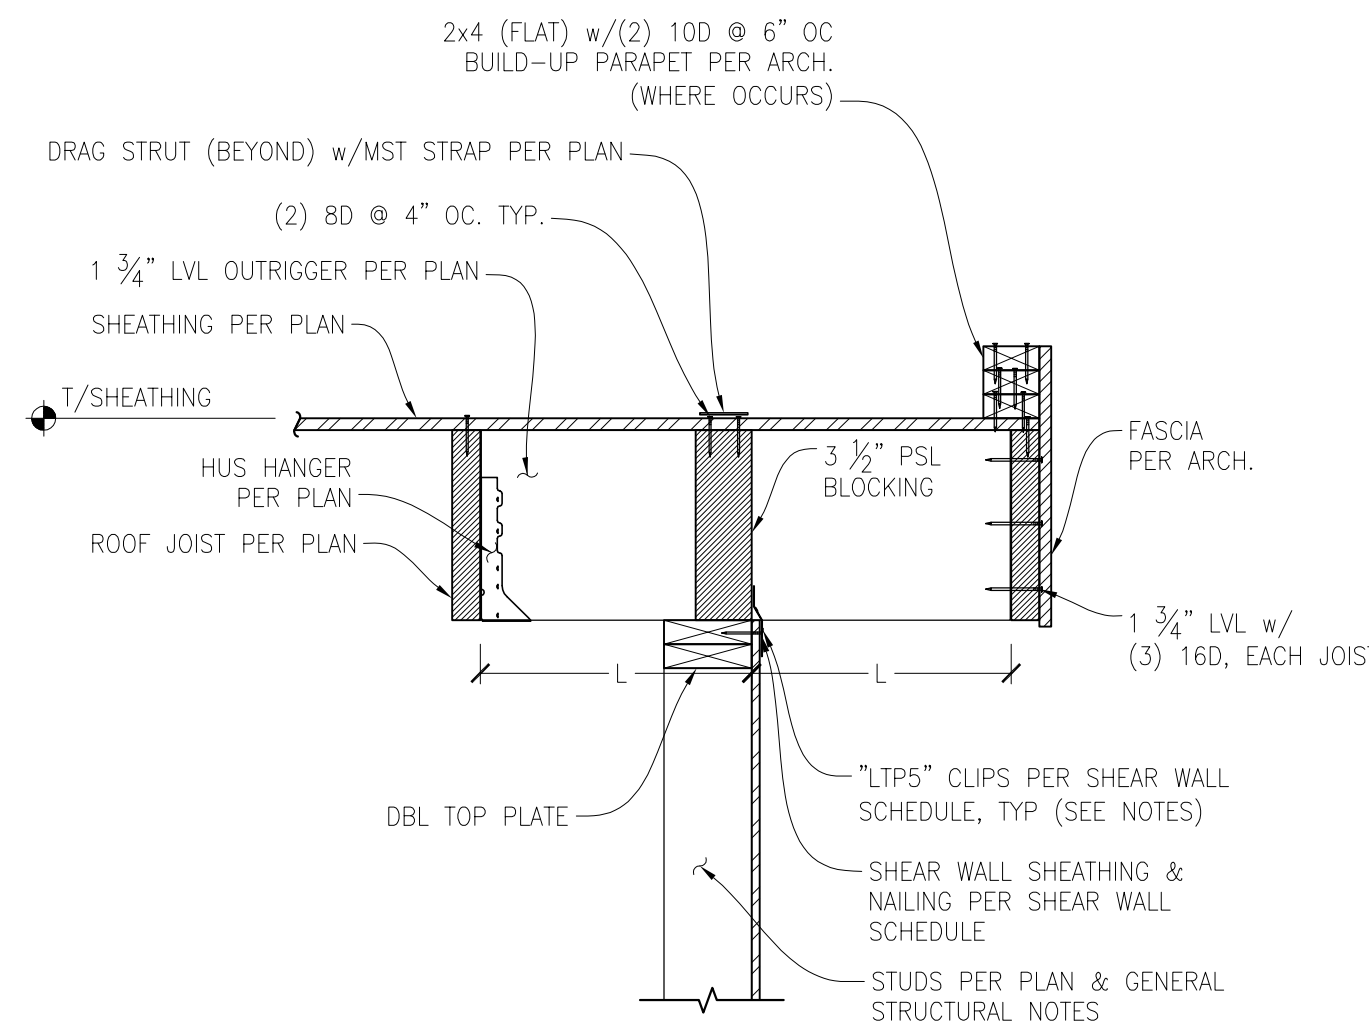


DRAG STRUT TO ROOF JOIST BLOCKING SHEAR WALL CONNECTION 5
SCALE: 1" = 1'-0"

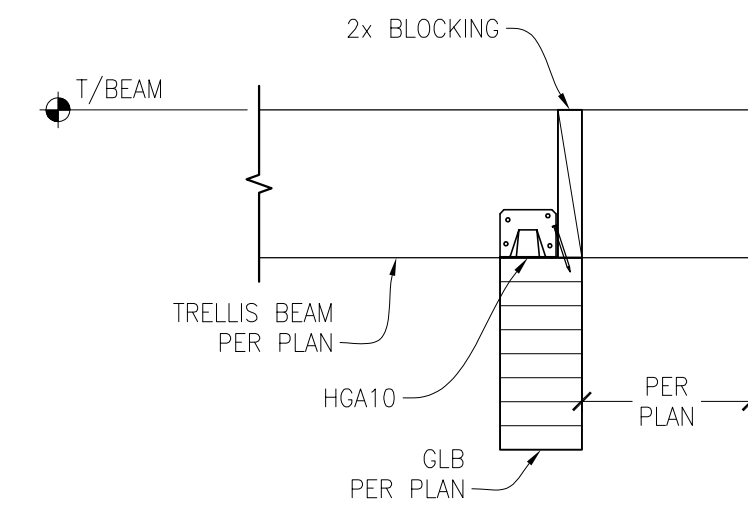

TRELLIS BEAM TO BEAM CONNECTION 6
SCALE: 1" = 1'-0"

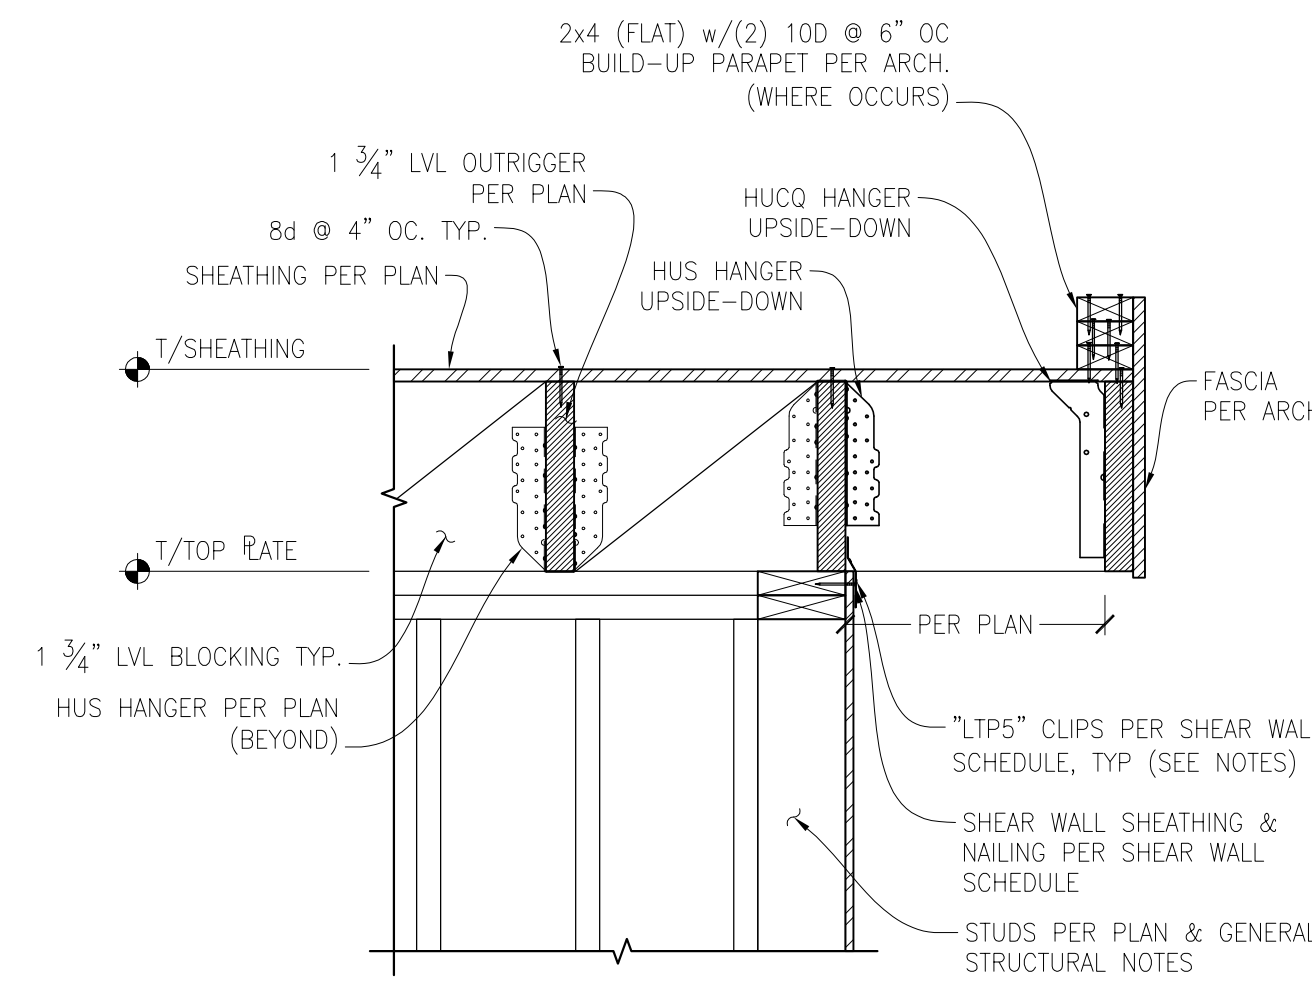

ROOF JOIST CORNER CONNECTION 7
SCALE: 1" = 1'-0"

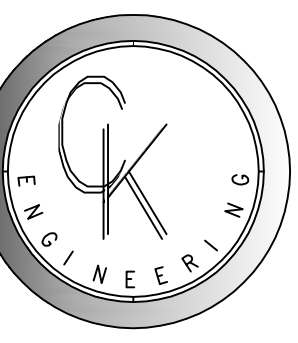

CK ENGINEERING LLC
PROFESSIONAL STRUCTURAL
ENGINEERING SERVICES
19105 36th Ave. W. Suite 205
Lynnwood, WA 98036
Phone: (206) 417-0670



12/8/2023

NEW HOME AT:
6175 SE 27TH ST.
MERCER ISLAND, WA 98040


REVISION #	DATE	DESCRIPTION:

Drawn By: PK
Checked By: SC
Date: 12-8-2023

CK JOB NO.
23-043

STRUCTURAL
DETAILS

S-4.0

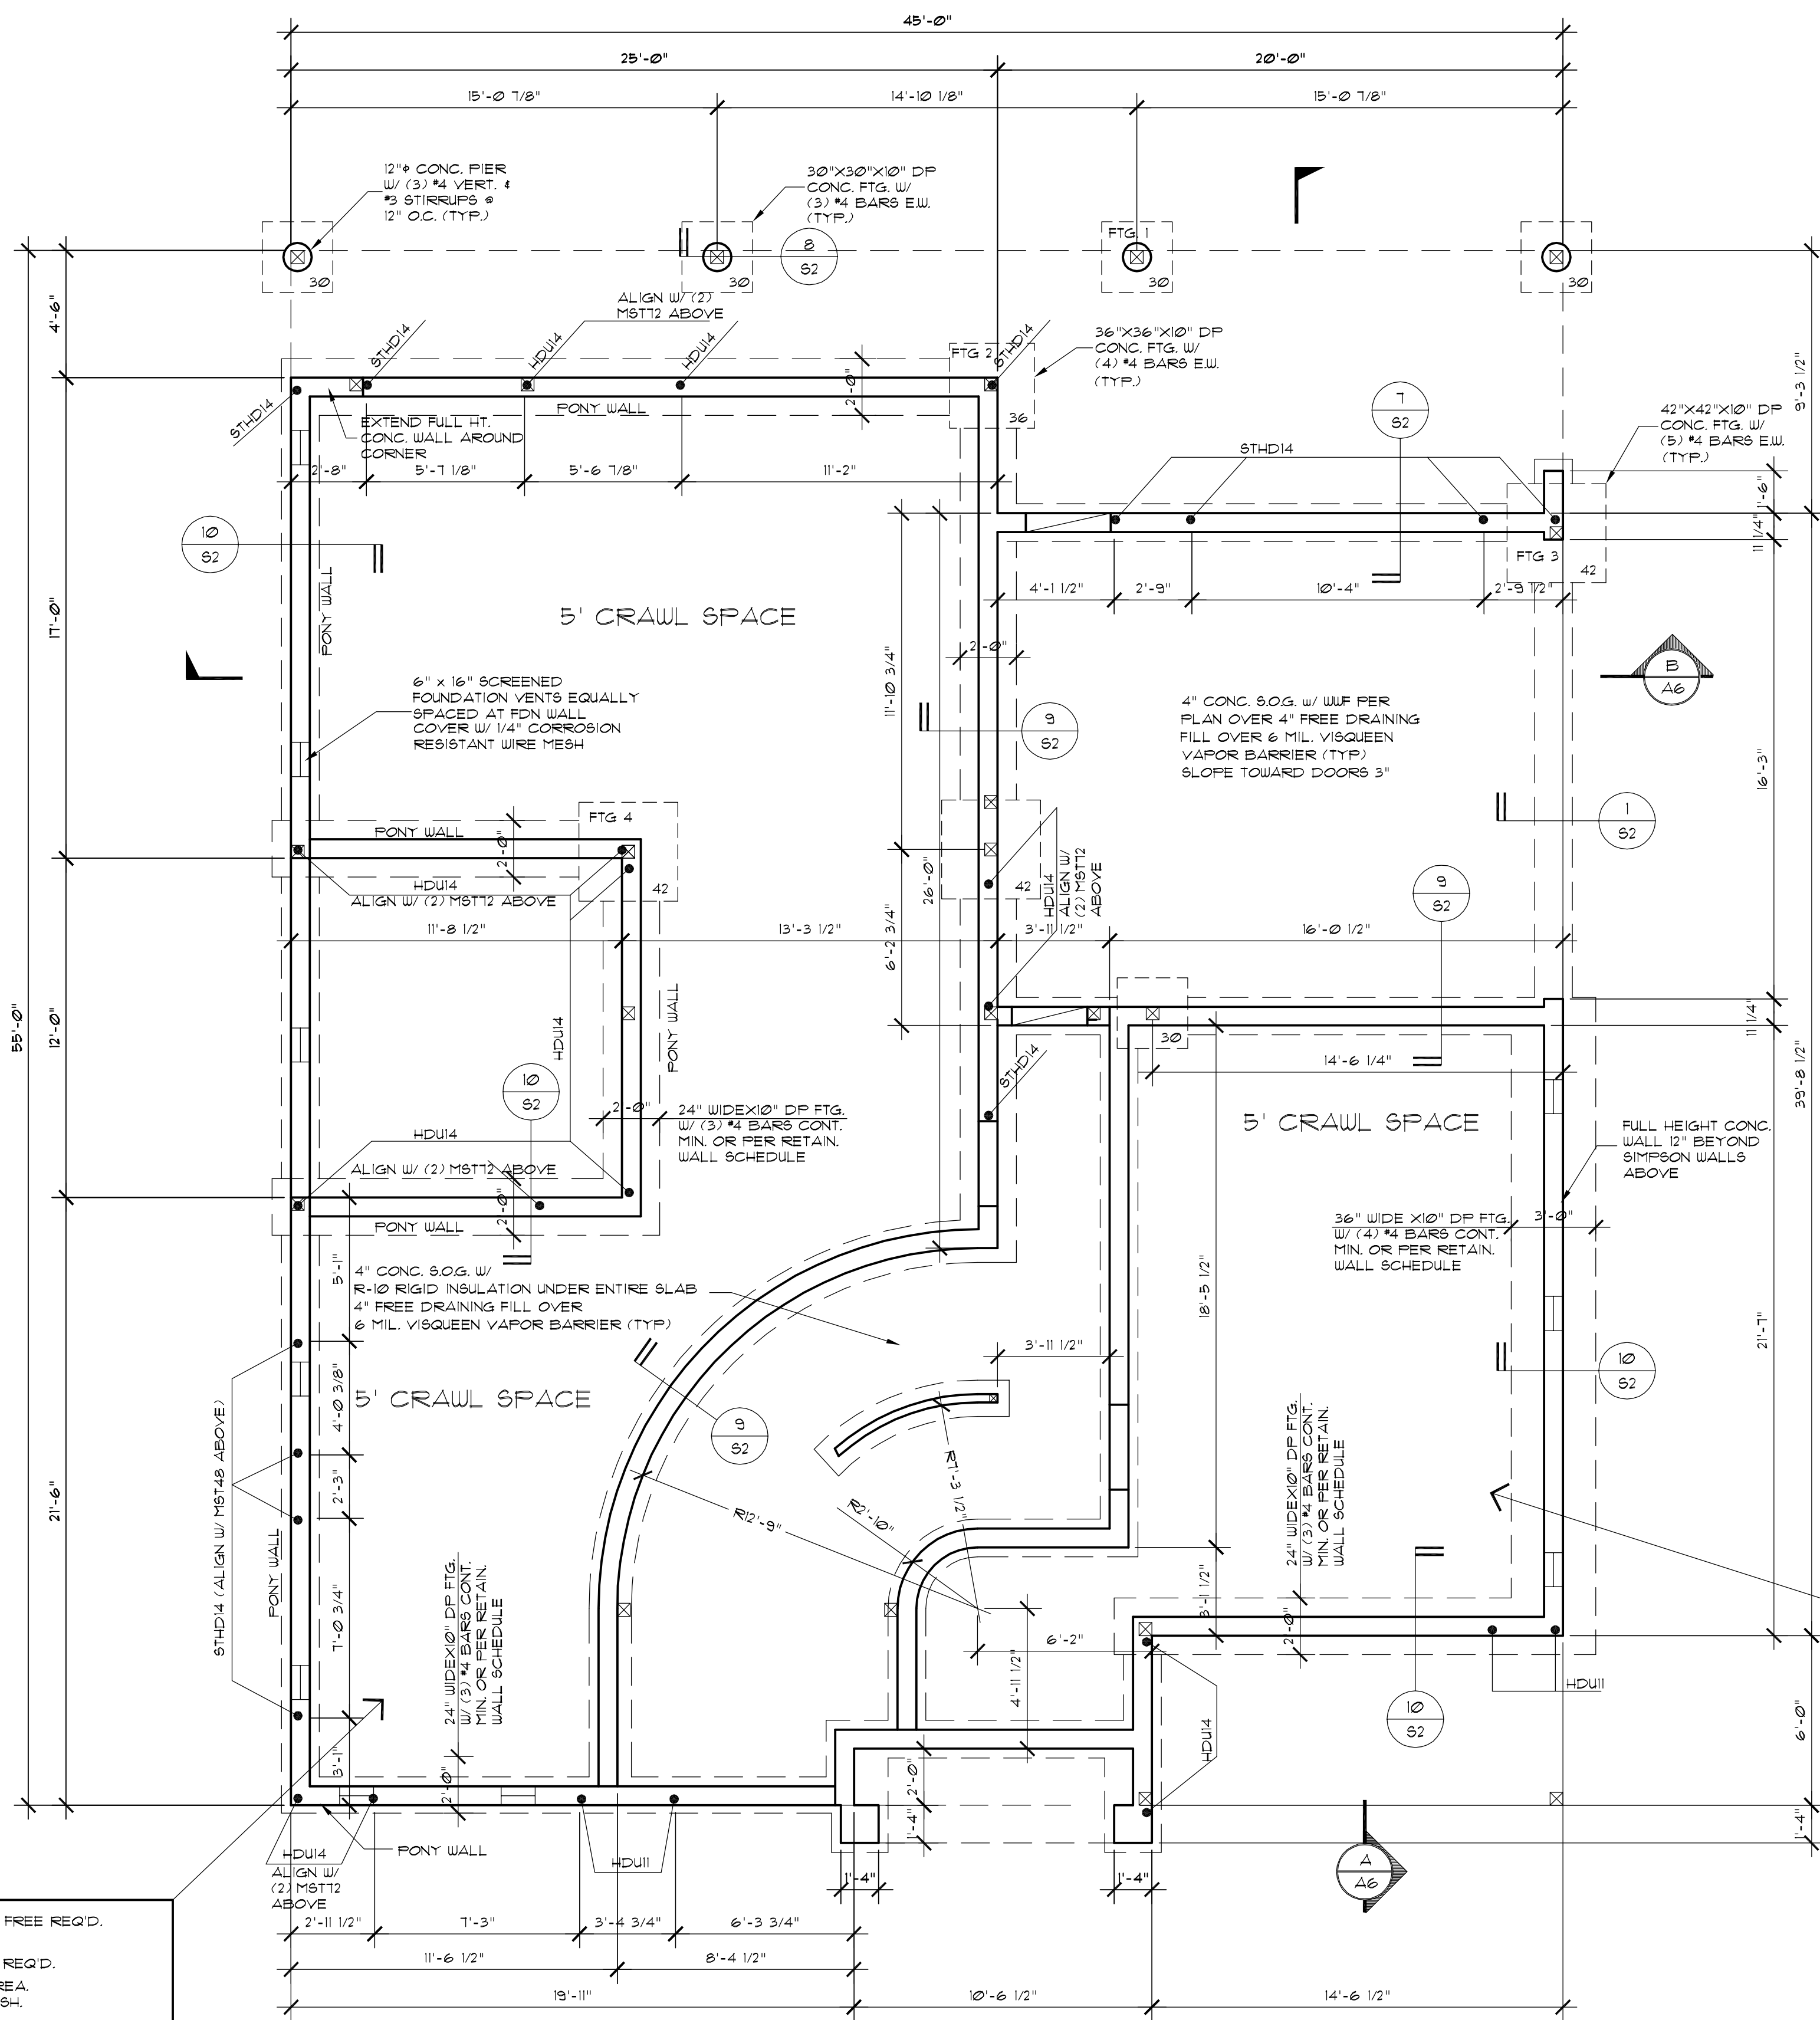

946	UNDER-FLOOR AREA	= 32	SQ. FT. NET FREE REQ'D.
300			
32	NET FREE x 144	= 461	SQ. IN./SQ. FT. NET FREE REQ'D.
PROVIDE 1 SQ. FT. PER 300 SQ. FT. OF UNDER FLOOR AREA. COVER VENTS WITH 1/4" CORROSION RESISTANT WIRE MESH. LOCATE VENTS AS CLOSE TO CORNERS AS PRACTICAL. EFFICIENT VENT AREA = 72.5 SQ. IN.			
SQ. IN. NET FREE	461	= 1	* VENTS REQ'D.
VENT AREA	72.5		

CRAWL VENTILATION CALCULATION

FOUNDATION PLAN
SCALE: 1/4" = 1' - 0"

- GENERAL NOTES:**
- 1) ALL FLR JSTs TO BE TJI FLOOR SYSTEM, REFER TO MFG. LAYOUT FOR ALL FRAMING DETAILS AND BLOCKING. REVIEW MFG. LAYOUT PRIOR TO FRAMING. OR ALL FLR JSTs AND RFTS TO BE 2" HEM-FIR DOUBLE UNDER BEARING PARTITIONS. PROVIDE SOLID BLOCKING OVER BEARING MEMBERS.
 - 2) ALL EXT. DR. & LINEN. DRs TO BE 4x10 DP2 (1x10)
 - 3) ALL PRE-MANUFACTURED TRUSSES TO BE IDENTIFIED BY MFG'S STAMP.
 - 4) FACTORY BILT FRPLC 4 CHIMNEY TO BE UL LABELED. INSTALL PER MFR'S SPECS. 6" SIDE CHESTN AIR REQ'D (MIN 6 SQ IN) DUCTED TO FIBOX W/ OPERABLE 6" SIDE DAMPER. TIGHTLY FITTG FLUE DAMPER AND TIGHT FITTING GLASS OR METAL DOORS OR FLUE DRAFT INDUCTION FAN.
 - 5) LIMIT SHOWER FLOW TO 2.0 GALLON/MIN.
 - 6) HWT. TO BE LABELED PER ASHRAE STD. NO. 90A-20. AND MEET THE REQNTS. PER NATIONAL AFFLIANCE ENERGY CONSERVATION ACT.
 - 7) TURN AND HUI TANKS. FILLERS. BURNERS. HEATING ELEMENTS, AND SWITCHES TO BE A MIN. OF 18" ABOVE FINISHED FLOOR.
 - 8) ALL SKYLITES TO COMPLY W/ IRC. SECTION R308.6
 - 9) ALL SIDELITES. SLIDING GLASS DOORS AND TUB/SHOWER ENCLOSURES TO COMPLY WITH IRC. SECTION R308
 - 10) HEAT REGISTERS TO BE PER LEGEND. LOCATE APPROXIMATELY AS SHOWN. 6" IN FROM EXTERIOR WALLS. 3" IN FROM INTERIOR WALLS.
 - 11) VENT DRYER. OVERHANG. & EXHAUST FANS TO 6" SIDE. DRYER EXH. DUCTS SHALL NOT EXCEED A TOTAL COMB. HORIZ. AND VERT. LENGTH OF 14'-0". INCL. 2 90d. ELBOWS. DEDUCT 2'-0" FOR EA. 90d. ELBOW EXCEEDING 2'.
 - 12) ALL EXHAUST DUCTS INSLTD (MIN. OF R-4)
 - 13) ALL NAILING TO COMPLY WITH 2021 I.B.C. COLUMN. POST & BEAM CONNECTIONS TO COMPLY WITH 2021 I.B.C.
 - 14) TUB/SHOWER SURROUND WALLS TO HAVE WATER RESNT GYP BRD AND A SMOOTH HARD SURFACE TO A MINIMUM HEIGHT OF 10' ABOVE DRAIN INLET
 - 15) PROVIDE 8PK DETCTR AND CO ALARMS IN COMPLIANCE WITH IRC. R314
 - 16) ALL 8PK DETCTRS. SHALL BE PROVIDED TO CUT OFF ALL CONCLD. DRAFT OPNGS THROUGH WALLS, FLRS, AND ROOFS. ALL OTHER OPNGS IN BLDG ENVELOPE.
 - 17) ALL EXTERIOR DOORS OR ACCESS HATCHES TO ENCLOSED UNHEATED AREAS MUST BE WEATHERSTRIPPED.
 - 18) MINIMUM SOIL BEARING PRESSURE = 1500 PSF.
 - 19) FOOTINGS TO BE PLACED ON FIRM, UNDISTURBED NATIVE SOIL.
 - 20) DWELLING TO COMPLY WITH IRC. 2021 EDITION
 - 21) FIRE STOPS SHALL BE PROVIDED TO CUT OFF ALL CONCLD. DRAFT OPNGS FROM VERT. TO HRZNTL. SPACES. INCLG THE STAIR. TUB. SHWR. FRPLCE. ETC.
 - 22) OSB ROOF SHEATHING W/ COMP. ROOFING AND PLYWD. AT ALL OVERHANGS. SEE DETAIL SHT FOR ALL ADDITIONAL NOTES.

Concrete batch ticket or delivery receipt for 2500 PSI concrete on site for Building Inspector verification at under-floor inspection. Concrete shall be air entrained. Total air content (Percent by volume of concrete) shall not be less than 5 percent or more than 7 percent per IRC Table 402.2.)

-UNDERFLOOR INSPECTION REQUIRED PRIOR TO LAYING SUBFLOOR

-CONTRACTOR SHOULD VERIFY THE TRANSFER OF ALL POINT LOADS FROM THE ROOF DOWN THROUGH FRAMING MEMBERS AND INTO THE FOUNDATION

GROUNDING ELECTRODE SYSTEM: ALL GROUNDING ELECTRODES AS DESCRIBED IN 25052(A)(1) THROUGH (A)(6) THAT ARE PRESENT AT EACH BUILDING OR STRUCTURE SERVED SHALL BE BONDED TOGETHER TO FORM THE GROUNDING ELECTRODE SYSTEM WHERE NONE OF THESE GROUNDING ELECTRODES EXIST, ONE OR MORE OF THE GROUNDING ELECTRODES SPECIFIED IN 25052(A)(1) THROUGH (A)(7) SHALL BE INSTALLED AND USED

-NOTE: SHOP DRAWINGS FOR PRE-ENGINEERED FLOORS OR TRUSSES MUST BE ON SITE AT TIME OF FRAMING INSPECTION, AND HAVE AN ORIGINAL WASHINGTON SEAL AND SIGNATURE OF THE DESIGNER. PROCEEDING WITH FRAMING WITHOUT APPROVED DETAILS AND PLAN IS DONE SO AT THE CONTRACTORS/APPLICANTS RISK


3" x 3" x 1/4" PLATE WASHERS REQUIRED AT EACH ANCHOR BOLT, IRC R602.11

CRAWL SPACE:
18" MINIMUM CLEARANCE UNDER JOISTS
12" MINIMUM CLEARANCE UNDER BEAMS
6 MIL VAPOR BARRIER (BLACK)
THRU/OUT LAP SEAMS MIN. 12" (WSEC 502.1.6.7)
NOTE: ALL POSTS MUST BE PLACED 4" OR WITHIN 10% OF PIER SIZE.

355	UNDER-FLOOR AREA	= 12	SQ. FT. NET FREE REQ'D.
300			
12	NET FREE x 144	= 173	SQ. IN./SQ. FT. NET FREE REQ'D.
PROVIDE 1 SQ. FT. PER 300 SQ. FT. OF UNDER FLOOR AREA. COVER VENTS WITH 1/4" CORROSION RESISTANT WIRE MESH. LOCATE VENTS AS CLOSE TO CORNERS AS PRACTICAL. EFFICIENT VENT AREA = 72.5 SQ. IN.			
SQ. IN. NET FREE	173	= 3	* VENTS REQ'D.
VENT AREA	72.5		

CRAWL VENTILATION CALCULATION

FOOTING SCHEDULE

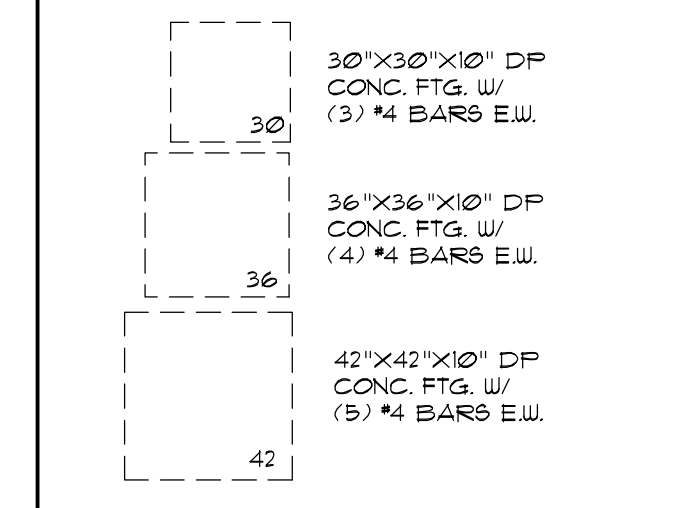

A NEW HOME AT:
6175 SE 27TH STREET
MERCER ISLAND, WA 98040



JOB NO: 23006
DATE: 12/11/23
DRWN. BY: TH
REVISED:

SHEET NO.

55

WOOD-FRAMED SHEAR WALL SCHEDULE								
FOR HEM-FIR/DOUG-FIR STUD FRAMING								
SW TYPE	SW SHEATHING APA-RATED (D, S, TR)	NAIL SIZE & SPACING @ PANEL EDGES (D, S, TR)	RIM JOIST OR BLOCKING ATTACHMENT TO TOP PLATE BELOW (D, S, TR)	BOTTOM PLATE & EDGE MEMBER REQUIREMENTS (D, S, TR)		SILL PLATE REQUIREMENTS (D, S, TR)		
				SHEAR NAILING TO WOOD FRAMING BELOW	BOTTOM R. AT FRAMING	ANCHOR BOLT TO CONCRETE FOUNDATION (10)	SILL R. AT FOUNDATION (11)	
SW-6	15/32" CD-EXT	0.131" x 2 1/2" @ 6"OC	CLIP @ 18"OC	0.148" x 3 1/4" @ 6"OC	2x	5/8" @ 48"OC	P.T. 2x	242
SW-4	15/32" CD-EXT	0.131" x 2 1/2" @ 4"OC	CLIP @ 14"OC	0.148" x 3 1/4" @ 4"OC	3x	5/8" @ 32"OC	P.T. 2x	353
SW-3	15/32" CD-EXT	0.131" x 2 1/2" @ 3"OC, STAGGERED	CLIP @ 12"OC	0.148" x 3 1/4" @ 4"OC & CLIP @ 18"OC	3x	5/8" @ 24"OC	P.T. 2x	456
SW-2	15/32" CD-EXT	0.131" x 2 1/2" @ 2"OC, STAGGERED	CLIP @ 8"OC	0.148" x 3 1/4" @ 4"OC & CLIP @ 16"OC	3x	5/8" @ 16"OC	P.T. 2x	595
2SW-4	15/32" CD-EXT BOTH SIDE	0.131" x 2 1/2" @ 4"OC, STAGGERED	CLIP @ 6"OC	0.148" x 3 1/4" @ 4"OC & CLIP @ 12"OC	3x	5/8" @ 24"OC	P.T. 3x	707
2SW-3	15/32" CD-EXT BOTH SIDE	0.131" x 2 1/2" @ 3"OC, STAGGERED	CLIP @ 8"OC	0.148" x 3 1/4" @ 4"OC & CLIP @ 8"OC	3x	5/8" @ 16"OC	P.T. 3x	911
2SW-2	15/32" CD-EXT BOTH SIDE	0.131" x 2 1/2" @ 2"OC, STAGGERED	CLIP @ 6"OC	0.148" x 3 1/4" @ 4"OC & CLIP @ 8"OC	3x	5/8" @ 12"OC	P.T. 3x	1190

- NOTES:
- INSTALL PANELS EITHER HORIZONTALLY OR VERTICALLY.
 - WHERE SHEATHING IS APPLIED ON BOTH SIDES OF WALL, PANEL JOINTS ON 2x FRAMING SHALL BE STAGGERED SO THAT JOINTS ON OPPOSITE SIDES ARE NOT LOCATED ON THE SAME STUDS.
 - BLOCKING IS REQUIRED AT ALL PANEL EDGES.
 - PROVIDE SHEAR WALL SHEATHING AND NAILING FOR ENTIRE LENGTH OF THE WALLS INDICATED ON THE PLANS. ENDS OF FULL HEIGHT WALLS ARE DESIGNATED BY WINDOWS, OR DOORWAYS OR AS DESIGNATED ON PLANS. HOLDOWN REQUIREMENTS PER PLANS.
 - SHEAR WALLS DESIGNATED AS PERFORATED SHEAR WALLS REQUIRE SHEATHING, SHEAR WALL NAILING, ETC. ABOVE AND BELOW ALL OPENINGS.
 - SHEATHING EDGE NAILING IS REQUIRED AT ALL HOLDOWN POSTS. EDGE NAILING MAY ALSO BE REQUIRED TO EACH STUD USED IN BUILT-UP HOLDOWN POSTS. ADDITIONAL INFORMATION PER SCHEDULE & DETAILS.
 - INTERMEDIATE FRAMING TO BE 2x MINIMUM MEMBERS. ATTACH SHEATHING TO INTERMEDIATE FRAMING WITH 0.148" x 2 1/2" NAILS AT 12"OC WHERE STUDS ARE SPACED AT 16"OC AND 0.148" x 2 1/2" NAILS AT 6"OC WHERE STUDS ARE SPACED AT 24"OC.
 - BASED ON 0.131" x 1 1/2" NAILS USED TO ATTACH FRAMING CLIPS DIRECTLY TO FRAMING, USE 0.131" x 2 1/2" NAILS WHERE INSTALLED OVER SHEATHING.
 - FRAMING CLIPS: SIMPSON "A35" OR "11P5" OR APPROVED EQUIVALENT.
 - ANCHOR BOLTS SHALL BE PROVIDED WITH HOT-DIPPED GALVANIZED STEEL PLATE WASHERS 3"x3"x0.229"(MIN). THE HOLE IN THE PLATE WASHER MAY BE DIAGONALLY SLOTTED 1/4"x1 1/2" PROVIDED A STANDARD CUT WASHER IS PLACED BETWEEN THE PLATE WASHER AND NUT. PLATE WASHER TO EXTEND TO WITHIN 1/2" OF THE EDGE OF THE SILL PLATE ON THE SIDE(S) WITH SHEATHING. WHERE SHEAR WALLS ARE SHEATHED ON BOTH SIDES OF 2x4 WALL FRAMING, USE 4.5"x4.5"x0.229"(MIN) PLATE WASHERS. EMBED ANCHOR BOLTS 1" MINIMUM INTO THE CONCRETE.
 - PRESSURE TREATED MATERIAL CAN CAUSE EXCESSIVE CORROSION IN THE FASTENERS. PROVIDE HOT-DIPPED GALVANIZED (ELECTRO-PLATING IS NOT ACCEPTABLE) NAILS AND CONNECTOR PLATES (FRAMING ANGLES, ETC.) FOR ALL CONNECTORS IN CONTACT WITH PRESSURE TREATED FRAMING MEMBERS. ADDITIONAL INFORMATION PER STRUCTURAL NOTES.
 - WHERE WOOD SHEATHING IS APPLIED OVER GYPSUM SHEATHING, CONTACT THE ENGINEER OF RECORD FOR ALTERNATE NAILING REQUIREMENTS.
 - AT ADJOINING PANEL EDGES, (2) 2x STUDS NAILED TOGETHER MAY BE USED IN PLACE OF SINGLE 3x STUD. DOUBLE 2x STUDS SHALL BE CONNECTED TOGETHER BY NAILING THE STUDS TOGETHER WITH 3" LONG NAILS OF THE SAME SPACING AND DIAMETER AS THE PLATE NAILING.
 - CONTACT THE STRUCTURAL ENGINEER OF RECORD FOR ADHESIVE OR EXPANSION CLIP ALTERNATIVES TO CAST-IN-PLACE ANCHOR BOLTS. SPECIAL INSPECTION MAY BE REQUIRED.
 - NAIL STUDS TO 3x BOTTOM/SILL PLATES WITH EITHER (2) 0.148"x4" (4) 0.131"x2 1/2" TONNALS.
 - END NAILS OR

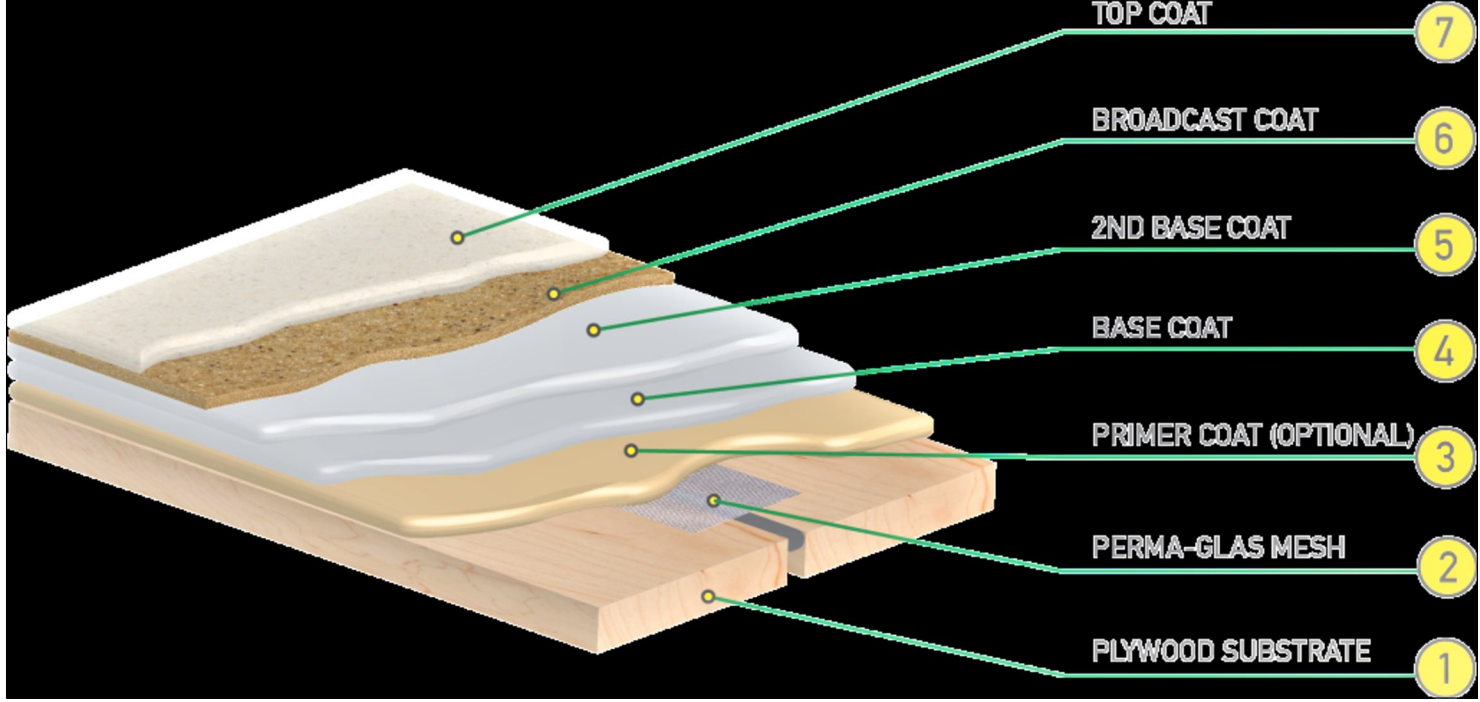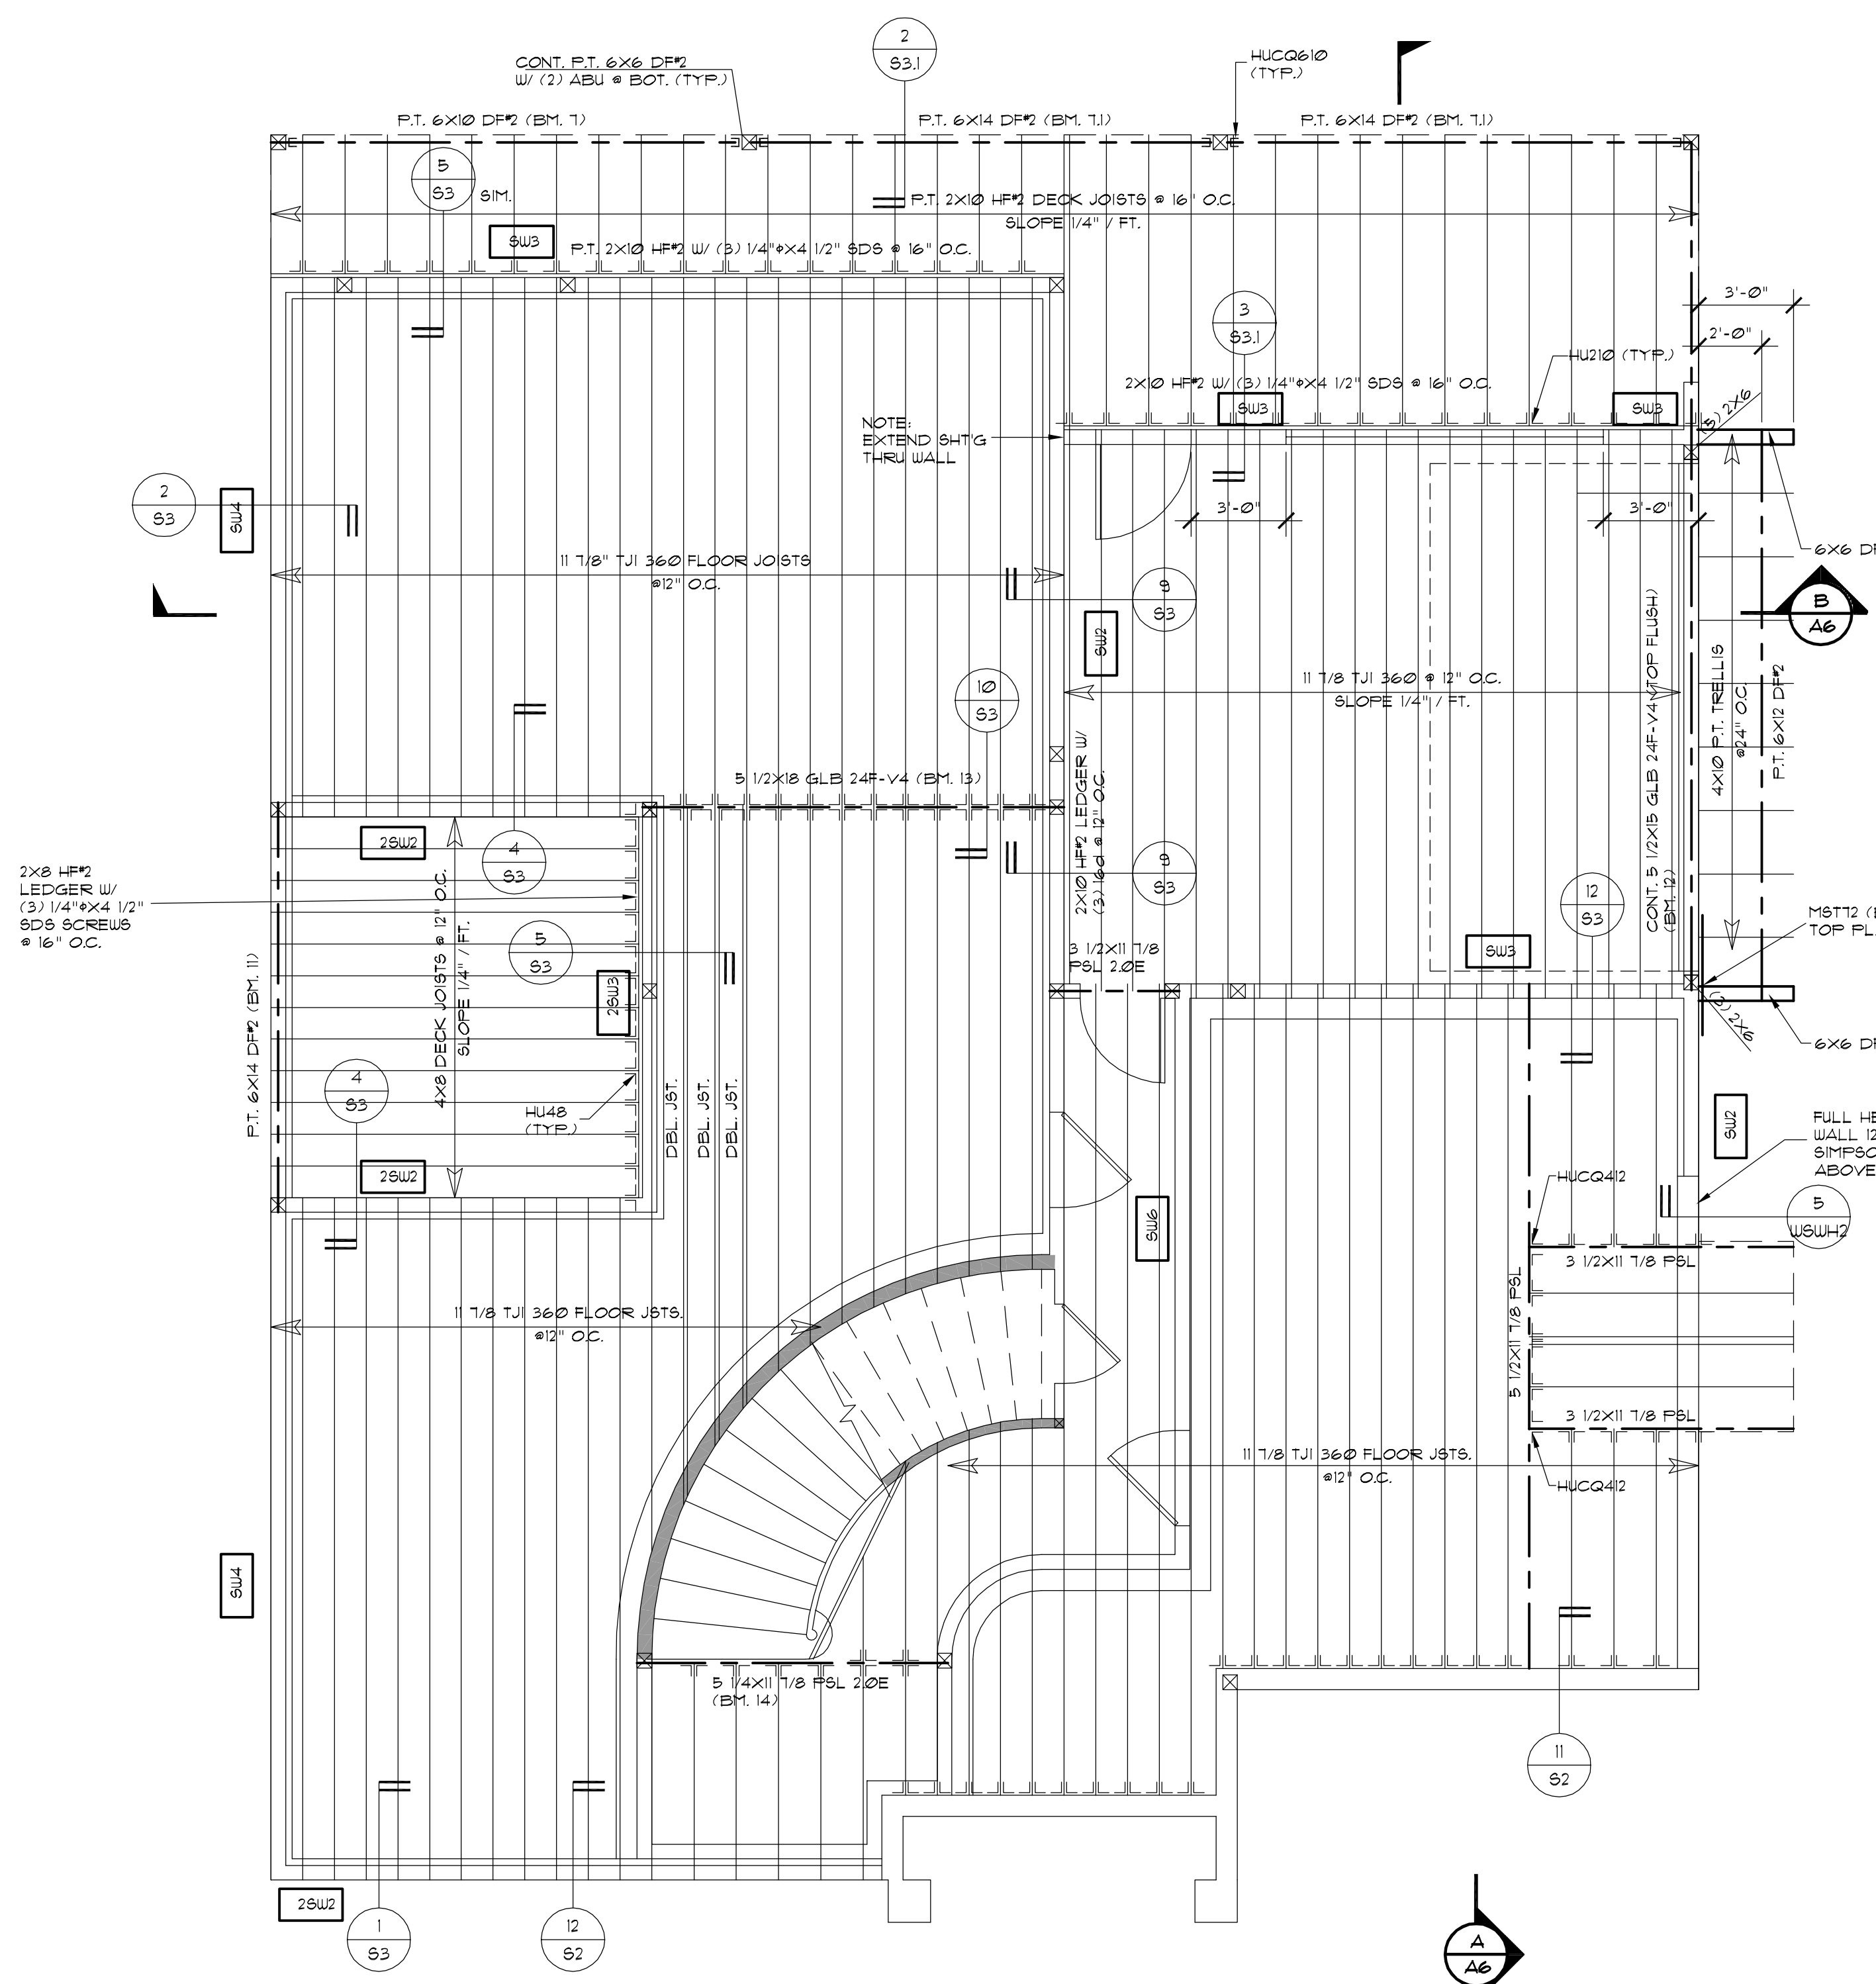

WATERPROOF DECK DETAIL

- FLOOR FRAMING NOTES:
- ALL BEAMS AND HEADERS TO BE 4x8 DF2 UNLESS NOTED OTHERWISE.
 - PROVIDE SOLID PRESSURE BLOCKING AT ALL POINT LOADS FROM ABOVE.
 - PROVIDE SOLID BLOCKING OR BRIDGING AT MID-SPAN OF ALL FLOOR JOISTS WITH SPANS OVER 10'-0" OR PER JOIST SPECIFICATIONS PER JOIST MANUFACTURER.
 - PROVIDE BLOCKING OR OTHER APPROVED MEANS OF LATERAL SUPPORT AT ALL JOIST BEARING LOCATIONS.
 - [xxx] DENOTES SHEARWALL CALLOUT PER SHEARWALL TABLE.
 - ALL HEADERS TO HAVE (1) 2x BEARING STUD AND (1) 2x KING STUD AT EACH END UNLESS NOTED OTHERWISE.

Joists shall be laterally supported at the ends by full-depth solid blocking not less than 2 inches nominal in thickness or by attachment to a full-depth header, band or rim joist, or to an adjoining stud to provide lateral support to prevent rotation. Additionally, in Seismic Design Categories D0, D1, and D2, lateral restraint shall be provided at each intermediate support. See IRC Sections 106.11 and 502.7.

MAIN FLOOR FRAMING PLAN
SCALE: 1/4" = 1' - 0"



A NEW HOME AT:
6175 SE 27TH STREET
MERCER ISLAND, WA 98040

JOB NO: 23006
 DATE: 12/11/23
 DRWN. BY: TH
 REVISED:

SHEET NO.
56

WOOD-FRAMED SHEAR WALL SCHEDULE								
FOR HEM-FIR/DOUG-FIR STUD FRAMING								
SW TYPE	SW SHEATHING APA-RATED (D, S, I)	NAIL SIZE & SPACING @ PANEL EDGES (D, S, I)	RIM JOIST OR BLOCKING ATTACHMENT TO TOP PLATE BELOW (D, S, I)	BOTTOM PLATE & EDGE MEMBER REQUIREMENTS (D, S, I)		SILL PLATE REQUIREMENTS		
				SHEAR NAILING TO WOOD FRAMING BELOW (D, S, I)	BOTTOM R. AT FRAMING (D, S, I)	ANCHOR BOLT TO CONCRETE FOUNDATION (10)	SILL R. AT FOUNDATION (11)	
SW-6	15/32" CD-EXT	0.131" x 2 1/2" @ 6" OC	CLIP @ 18" OC	0.148" x 3 1/4" @ 6" OC	2x	5/8" @ 48" OC	P.T. 2x	242
SW-4	15/32" CD-EXT	0.131" x 2 1/2" @ 4" OC	CLIP @ 14" OC	0.148" x 3 1/4" @ 4" OC	3x	5/8" @ 32" OC	P.T. 2x	353
SW-3	15/32" CD-EXT	0.131" x 2 1/2" @ 3" OC, STAGGERED	CLIP @ 12" OC	0.148" x 3 1/4" @ 4" OC & CLIP @ 18" OC	3x	5/8" @ 24" OC	P.T. 2x	456
SW-2	15/32" CD-EXT	0.131" x 2 1/2" @ 2" OC, STAGGERED	CLIP @ 8" OC	0.148" x 3 1/4" @ 4" OC & CLIP @ 16" OC	3x	5/8" @ 16" OC	P.T. 2x	595
2SW-4	15/32" CD-EXT BOTH SIDE	0.131" x 2 1/2" @ 4" OC, STAGGERED	CLIP @ 6" OC	0.148" x 3 1/4" @ 4" OC & CLIP @ 12" OC	3x	5/8" @ 24" OC	P.T. 3x	707
2SW-3	15/32" CD-EXT BOTH SIDE	0.131" x 2 1/2" @ 3" OC, STAGGERED	CLIP @ 8" OC	0.148" x 3 1/4" @ 4" OC & CLIP @ 8" OC	3x	5/8" @ 16" OC	P.T. 3x	911
2SW-2	15/32" CD-EXT BOTH SIDE	0.131" x 2 1/2" @ 2" OC, STAGGERED	CLIP @ 6" OC	0.148" x 3 1/4" @ 4" OC & CLIP @ 8" OC	3x	5/8" @ 12" OC	P.T. 3x	1190

- NOTES:
- INSTALL PANELS EITHER HORIZONTALLY OR VERTICALLY.
 - WHERE SHEATHING IS APPLIED ON BOTH SIDES OF WALL, PANEL EDGE JOINTS ON 2x FRAMING SHALL BE STAGGERED SO THAT JOINTS ON OPPOSITE SIDES ARE NOT LOCATED ON THE SAME STUDS.
 - BLOCKING IS REQUIRED AT ALL PANEL EDGES.
 - PROVIDE SHEAR WALL SHEATHING AND NAILING FOR ENTIRE LENGTH OF THE WALLS INDICATED ON THE PLANS. ENDS OF FULL HEIGHT WALLS ARE DESIGNATED BY WINDOWS, OR DOORWAYS OR AS DESIGNATED ON PLANS. HOLDOWN REQUIREMENTS PER PLANS.
 - SHEAR WALLS DESIGNATED AS PERFORATED SHEAR WALLS REQUIRE SHEATHING, SHEAR WALL NAILING, ETC. ABOVE AND BELOW ALL OPENINGS.
 - SHEATHING EDGE NAILING IS REQUIRED AT ALL HOLDOWN POSTS. EDGE NAILING MAY ALSO BE REQUIRED TO EACH STUD USED IN BUILT-UP HOLDOWN POSTS. ADDITIONAL INFORMATION PER HOLDOWN SCHEDULE & DETAILS.
 - INTERMEDIATE FRAMING TO BE 2x MINIMUM MEMBERS. ATTACH SHEATHING TO INTERMEDIATE FRAMING WITH 0.148" x 2 1/2" NAILS AT 12" OC WHERE STUDS ARE SPACED AT 16" OC AND 0.148" x 2 1/2" NAILS AT 6" OC WHERE STUDS ARE SPACED AT 24" OC.
 - BASED ON 0.131" x 1 1/2" NAILS USED TO ATTACH FRAMING CLIPS DIRECTLY TO FRAMING, USE 0.131" x 2 1/2" NAILS WHERE INSTALLED OVER SHEATHING.
 - FRAMING CLIPS: SIMPSON "J35" OR "11P5" OR APPROVED EQUIVALENT.
 - ANCHOR BOLTS SHALL BE PROVIDED WITH HOT-DIPPED GALVANIZED STEEL PLATE WASHERS 3"x3"x0.225"(MIN). THE HOLE IN THE PLATE WASHER MAY BE DIAGONALLY SLOTTED 1/4"x1 1/2" PROVIDED A STANDARD CUT WASHER IS PLACED BETWEEN THE PLATE WASHER AND NUT. PLATE WASHER TO EXTEND TO WITHIN 1/2" OF THE EDGE OF THE SILL PLATE ON THE SIDE(S) WITH SHEATHING. WHERE SHEAR WALLS ARE SHEATHED ON BOTH SIDES OF 2x4 WALL FRAMING, USE 4.5"x4.5"x0.225"(MIN) PLATE WASHERS. EMBED ANCHOR BOLTS 1" MINIMUM INTO THE CONCRETE.
 - PRESSURE TREATED MATERIAL CAN CAUSE EXCESSIVE CORROSION IN THE FASTENERS. PROVIDE HOT-DIPPED GALVANIZED (ELECTRO-PLATING IS NOT ACCEPTABLE) NAILS AND CONNECTOR PLATES (FRAMING ANGLES, ETC.) FOR ALL CONNECTORS IN CONTACT WITH PRESSURE TREATED FRAMING MEMBERS. ADDITIONAL INFORMATION PER STRUCTURAL NOTES.
 - WHERE WOOD SHEATHING IS APPLIED OVER OYPYUM SHEATHING, CONTACT THE ENGINEER OF RECORD FOR ALTERNATE NAILING REQUIREMENTS.
 - AT ADJOINING PANEL EDGES, (2) 2x STUDS NAILED TOGETHER MAY BE USED IN PLACE OF SINGLE 3x STUD. DOUBLE 2x STUDS SHALL BE CONNECTED TOGETHER BY NAILING THE STUDS TOGETHER WITH 3" LONG NAILS OF THE SAME SPACING AND DIAMETER AS THE PLATE NAILING.
 - CONTACT THE STRUCTURAL ENGINEER OF RECORD FOR ADHESIVE OR EXPANSION CLIP ALTERNATIVES TO CAST-IN-PLACE ANCHOR BOLTS. SPECIAL INSPECTION MAY BE REQUIRED.
 - NAIL STUDS TO 3x BOTTOM/SILL PLATES WITH EITHER (2) 0.148" x 4" (4) 0.131" x 2 1/2" TOWELS.
 - END NAILS OR

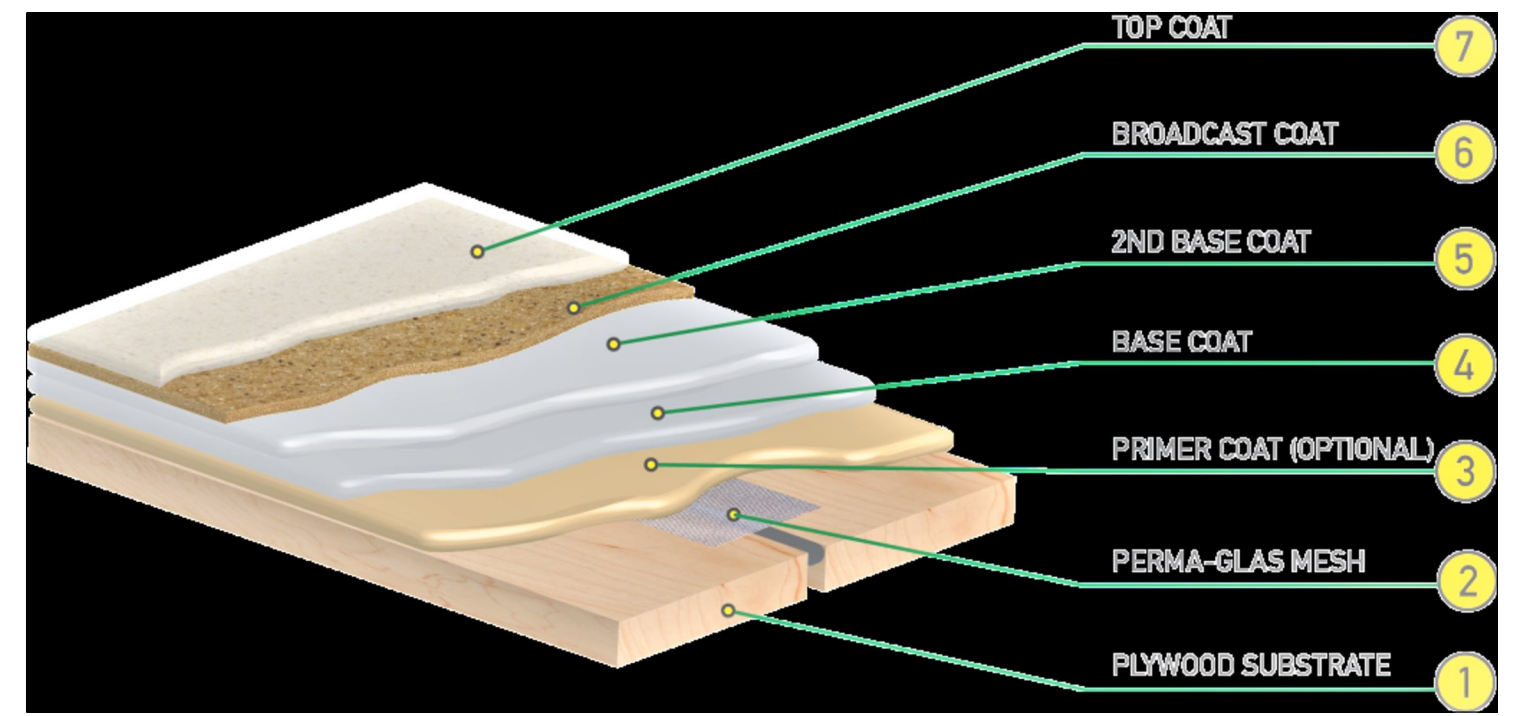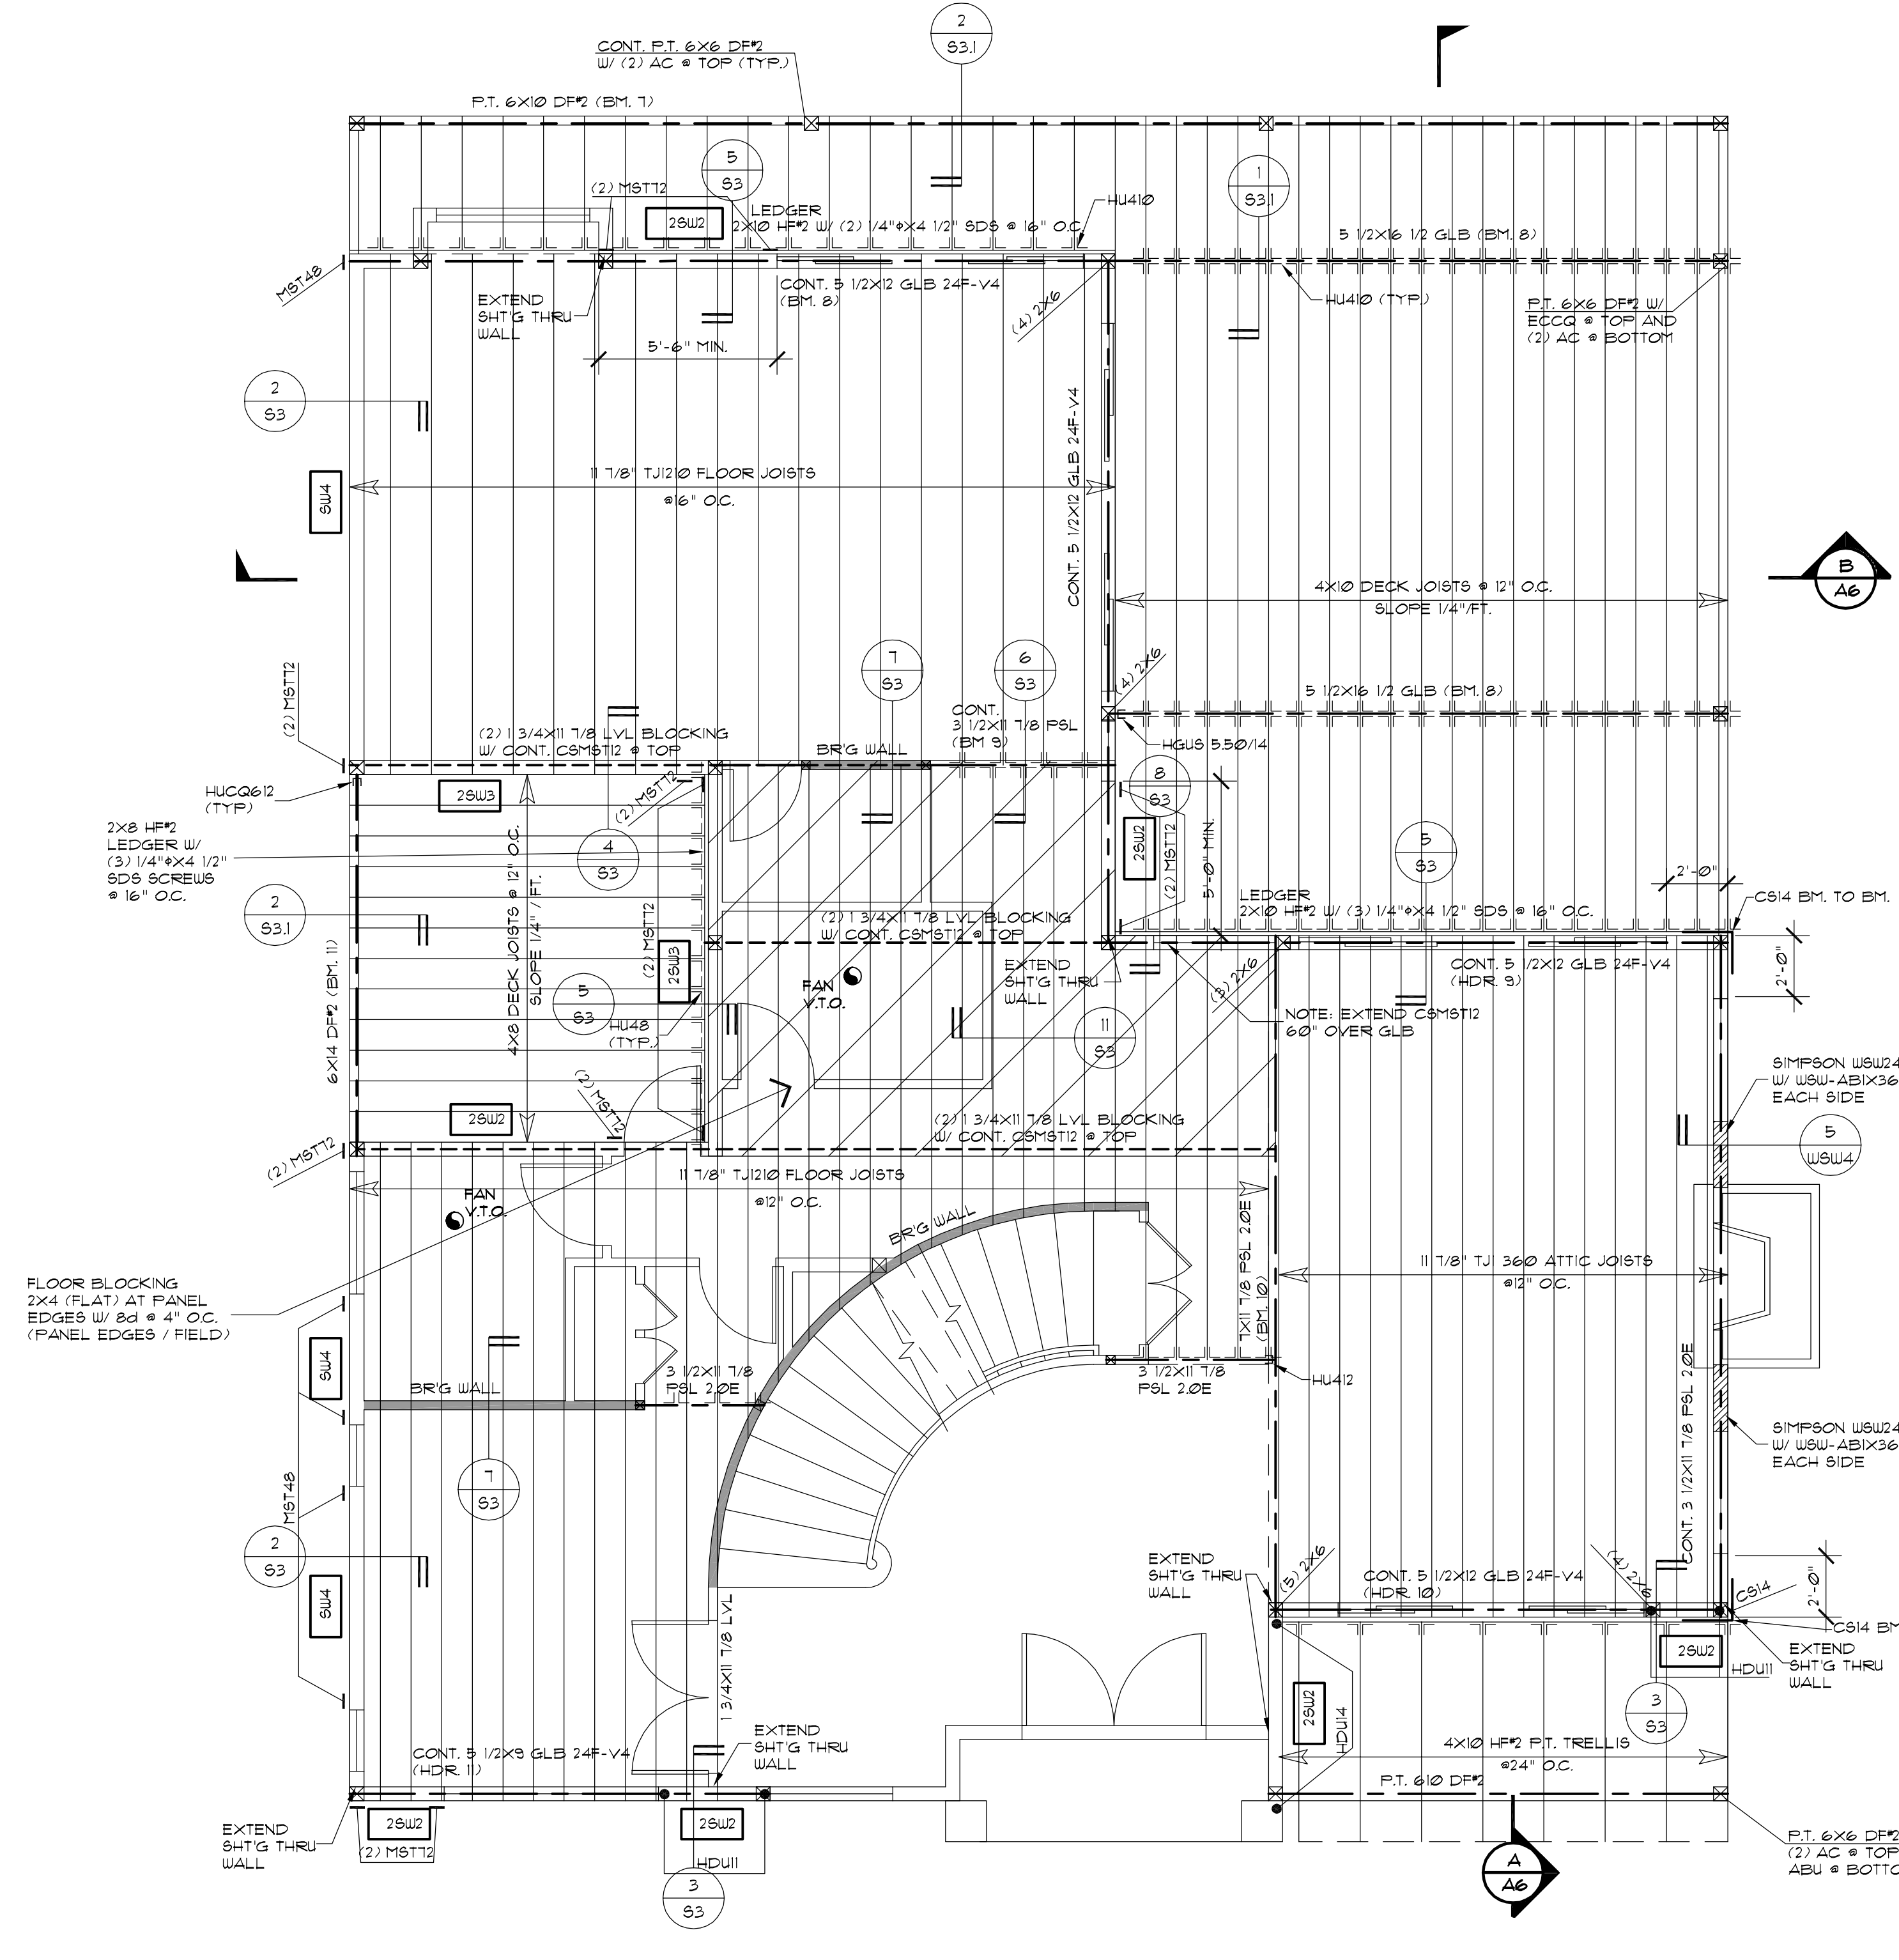

WATERPROOF DECK DETAIL

- FLOOR FRAMING NOTES:
- ALL BEAMS AND HEADERS TO BE 4x8 DP2 UNLESS NOTED OTHERWISE.
 - PROVIDE SOLID PRESSURE BLOCKING AT ALL POINT LOADS FROM ABOVE.
 - PROVIDE SOLID BLOCKING OR BRIDGING AT MID-SPAN OF ALL FLOOR JOISTS WITH SPANS OVER 10'-0" OR PER JOIST SPECIFICATIONS PER JOIST MANUFACTURER.
 - PROVIDE BLOCKING OR OTHER APPROVED MEANS OF LATERAL SUPPORT AT ALL JOIST BEARING LOCATIONS.
 - [xxx] DENOTES SHEARWALL CALLOUT PER SHEARWALL TABLE.
 - ALL HEADERS TO HAVE (1) 2x BEARING STUD AND (1) 2x KING STUD AT EACH END UNLESS NOTED OTHERWISE.
 - EXPOSED WOOD TO BE PROTECTED AGAINST DECAY. PRESERVATIVE TREATED WOOD TO BE USED PER IRC R301.

Joists shall be laterally supported at the ends by full-depth solid blocking not less than 2 inches nominal thickness or by attachment to a full-depth header, band or rim joist, or to an adjoining stud to provide lateral support to prevent rotation. Additionally, in Seismic Design Categories D0, D1, and D2, lateral restraint shall be provided at each intermediate support. See IRC Sections 106.11 and 802.1.

UPPER FLOOR FRAMING PLAN
SCALE: 1/4" = 1' - 0"

A NEW HOME AT:

6175 SE 27TH STREET
MERCER ISLAND, WA 98040



JOB NO: 23006
DATE: 12/11/23
DRWN. BY: TH
REVISED:

SHEET NO.

57

SW TYPE	SW SHEATHING APA-RATED	NAIL SIZE & SPACING @ PANEL EDGES	RIM JOIST OR BLOCKING ATTACHMENT TO TOP PLATE BELOW	BOTTOM PLATE & EDGE MEMBER REQUIREMENTS		SILL PLATE REQUIREMENTS		SHEAR LOAD CAPACITY (PLF)
				SHEAR NAILING TO WOOD FRAMING BELOW	BOTTOM R AT FRAMING	ANCHOR BOLT TO CONCRETE FOUNDATION	SILL R AT FOUNDATION	
SW-6	15/32" CD-EXT	0.131" x 2 1/2" @ 6"OC	CLIP @ 18"OC	0.148" x 3 1/4" @ 4"OC	2x	5/8" @ 48"OC	P.T. 2x	242
SW-4	15/32" CD-EXT	0.131" x 2 1/2" @ 4"OC	CLIP @ 14"OC	0.148" x 3 1/4" @ 4"OC	3x	5/8" @ 32"OC 5/8" @ 48"OC	P.T. 2x P.T. 3x	353
SW-3	15/32" CD-EXT	0.131" x 2 1/2" @ 3"OC, STAGGERED	CLIP @ 12"OC	0.148" x 3 1/4" @ 4"OC & CLIP @ 18"OC	3x	5/8" @ 24"OC 5/8" @ 32"OC	P.T. 2x P.T. 3x	456
SW-2	15/32" CD-EXT	0.131" x 2 1/2" @ 2"OC, STAGGERED	CLIP @ 8"OC	0.148" x 3 1/4" @ 4"OC & CLIP @ 16"OC	3x	5/8" @ 16"OC 5/8" @ 24"OC	P.T. 2x P.T. 3x	595
ZSW-4	15/32" CD-EXT BOTH SIDE	0.131" x 2 1/2" @ 4"OC, STAGGERED	CLIP @ 6"OC	0.148" x 3 1/4" @ 4"OC & CLIP @ 12"OC	3x	5/8" @ 24"OC	P.T. 3x	707
ZSW-3	15/32" CD-EXT BOTH SIDE	0.131" x 2 1/2" @ 3"OC, STAGGERED	CLIP @ 8"OC BOTH SIDES, STAGGERED	0.148" x 3 1/4" @ 4"OC & CLIP @ 8"OC	3x	5/8" @ 16"OC	P.T. 3x	911
ZSW-2	15/32" CD-EXT BOTH SIDE	0.131" x 2 1/2" @ 2"OC, STAGGERED	CLIP @ 6"OC BOTH SIDES, STAGGERED	0.148" x 3 1/4" @ 4"OC & CLIP @ 5"OC	3x	5/8" @ 12"OC	P.T. 3x	1190

- NOTES:
- INSTALL PANELS EITHER HORIZONTALLY OR VERTICALLY.
 - WHERE SHEATHING IS APPLIED ON BOTH SIDES OF WALL, PANEL EDGE JOINTS ON 2x FRAMING SHALL BE STAGGERED SO THAT JOINTS ON OPPOSITE SIDES ARE NOT LOCATED ON THE SAME STUDS.
 - BLOCKING IS REQUIRED AT ALL PANEL EDGES.
 - PROVIDE SHEAR WALL SHEATHING AND NAILING FOR ENTIRE LENGTH OF THE WALLS INDICATED ON THE PLANS. ENDS OF FULL HEIGHT WALLS ARE DESIGNATED BY WINDOWS, OR DOORWAYS OR AS DESIGNATED ON PLANS. HOLDOWN REQUIREMENTS PER PLANS.
 - SHEAR WALLS DESIGNATED AS PERFORATED SHEAR WALLS REQUIRE SHEATHING, SHEAR WALL NAILING, ETC. ABOVE AND BELOW ALL OPENINGS.
 - SHEATHING EDGE NAILING IS REQUIRED AT ALL HOLDOWN POSTS. EDGE NAILING MAY ALSO BE REQUIRED TO EACH STUD USED IN BUILT-UP HOLDOWN POSTS. ADDITIONAL INFORMATION PER HOLDOWN SCHEDULE & DETAILS.
 - INTERMEDIATE FRAMING TO BE 2x MINIMUM MEMBERS. ATTACH SHEATHING TO INTERMEDIATE FRAMING WITH 0.148" x 2 1/2" NAILS AT 12"OC WHERE STUDS ARE SPACED AT 16"OC AND 0.148" x 2 1/2" NAILS AT 6"OC WHERE STUDS ARE SPACED AT 24"OC.
 - BADED ON 0.131" x 1 1/2" NAILS USED TO ATTACH FRAMING CLIPS DIRECTLY TO FRAMING. USE 0.131" x 2 1/2" NAILS WHERE INSTALLED OVER SHEATHING.
 - FRAMING CLIPS: SIMPSON "A35" OR "L1PS" OR APPROVED EQUIVALENT.
 - ANCHOR BOLTS SHALL BE PROVIDED WITH HOT-DIPPED GALVANIZED STEEL PLATE WASHERS 3"x3"x0.229"(MIN). THE HOLE IN THE PLATE WASHER MAY BE DIAGONALLY SLOTTED 1/16"x1 1/2" PROVIDED A STANDARD CUT WASHER IS PLACED BETWEEN THE PLATE WASHER AND NAIL. PLATE WASHER TO EXTEND TO WITHIN 1/2" OF THE EDGE OF THE SILL PLATE ON THE SIDES WITH SHEATHING. WHERE SHEAR WALLS ARE SHEATHED ON BOTH SIDES OF 2x6 WALL FRAMING, USE 4.5"x4.5"x0.229"(MIN) PLATE WASHERS. EMBED ANCHOR BOLTS 7" MINIMUM INTO THE CONCRETE.
 - PRESSURE TREATED MATERIAL CAN CAUSE EXCESSIVE CORROSION IN THE FASTENERS. PROVIDE HOT-DIPPED GALVANIZED (ELECTRO-PLATING IS NOT ACCEPTABLE) NAILS AND CONNECTOR PLATES (FRAMING ANGLES, ETC.) FOR ALL CONNECTORS IN CONTACT WITH PRESSURE TREATED FRAMING MEMBERS. ADDITIONAL INFORMATION PER STRUCTURAL NOTES.
 - WHERE WOOD SHEATHING IS APPLIED OVER GYPSUM SHEATHING, CONTACT THE ENGINEER OF RECORD FOR ALTERNATE NAILING REQUIREMENTS.
 - AT ADDITIONAL PANEL EDGES, (2) 2x STUDS NAILED TOGETHER MAY BE USED IN PLACE OF SINGLE 3x STUD. DOUBLE 2x STUDS SHALL BE CONNECTED TOGETHER BY NAILING THE STUDS TOGETHER WITH 3" LONG NAILS OF THE SAME SPACING AND DIAMETER AS THE PLATE NAILING.
 - CONTACT THE STRUCTURAL ENGINEER OF RECORD FOR ADHESIVE OR EXPANSION BOLT ALTERNATIVES TO CAST-IN-PLACE ANCHOR BOLTS. SPECIAL INSPECTION MAY BE REQUIRED.
 - NAIL STUDS TO 3x BOTTOM/SILL PLATES WITH EITHER (2) 0.148"x4" END NAILS OR (4) 0.131"x2 1/2" TOENAILS.

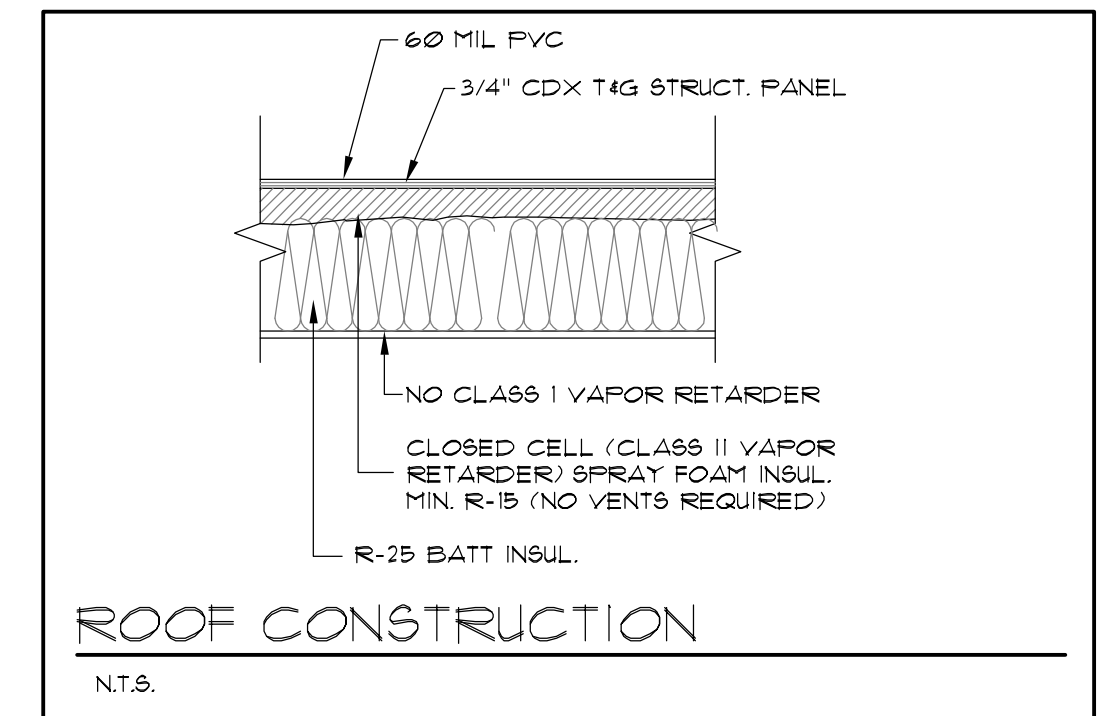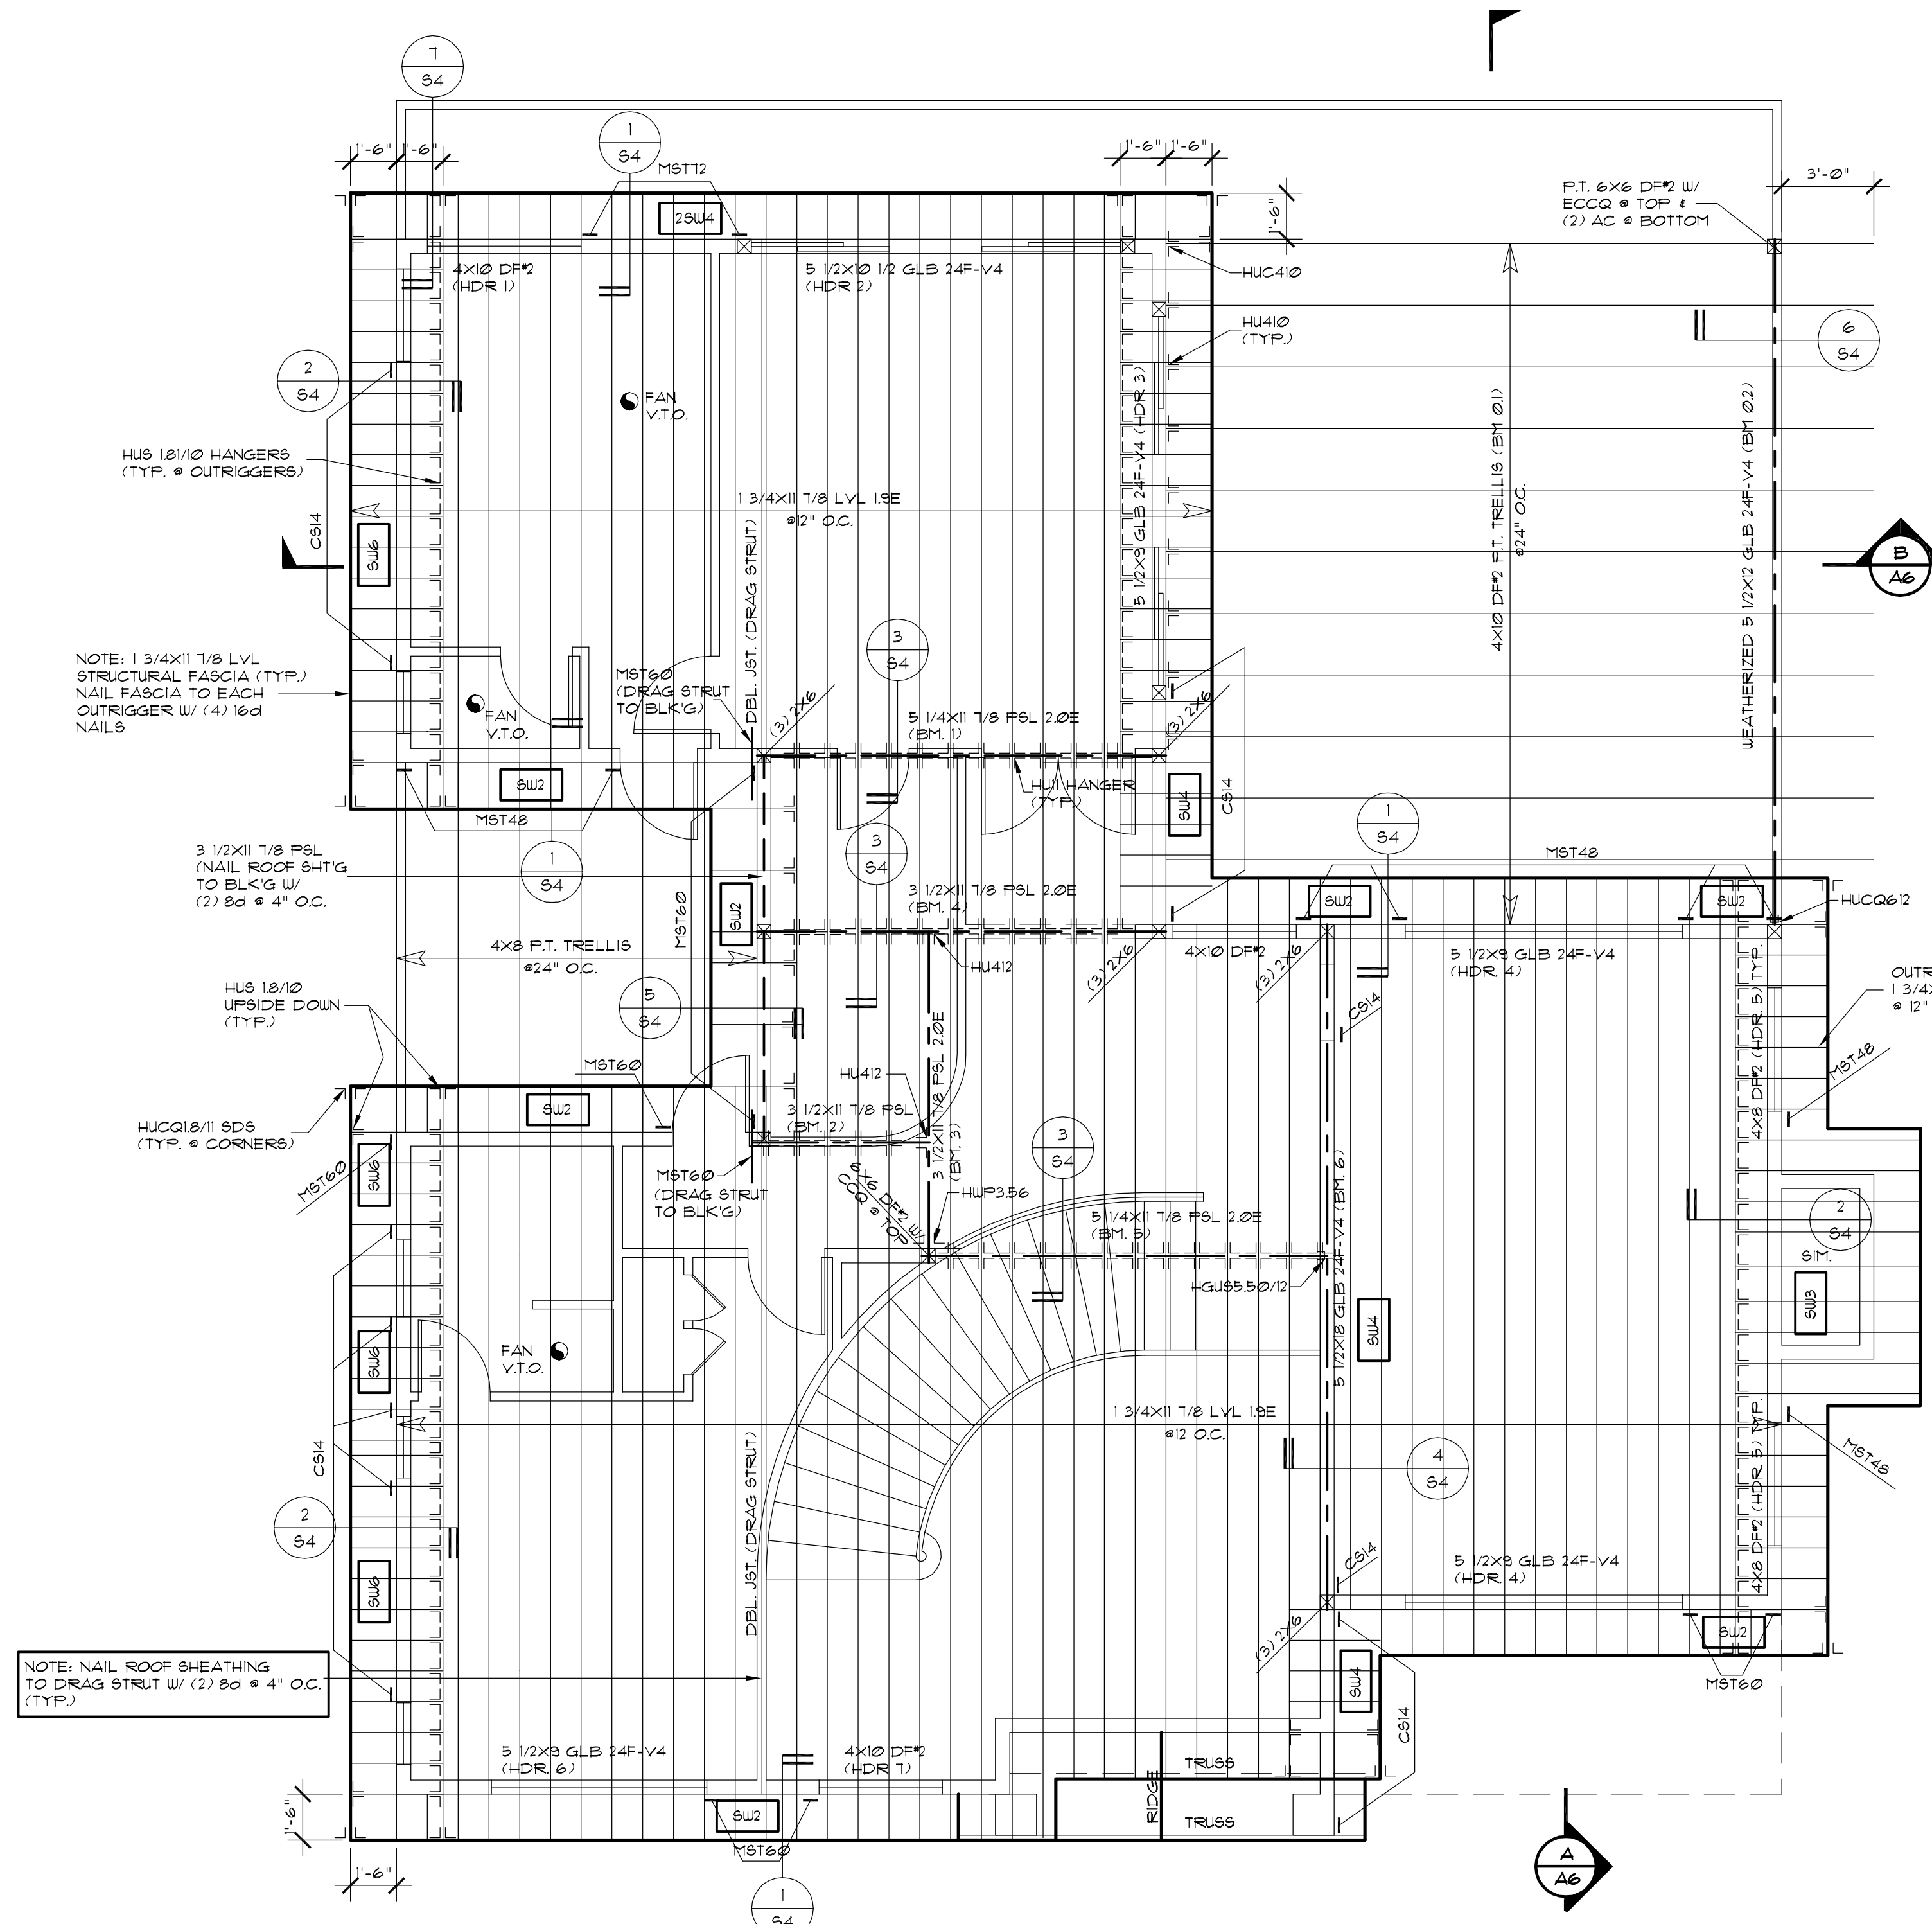

- ROOF FRAMING NOTES:
- ALL BEAMS AND HEADERS TO BE 4x8 DF#2 UNLESS NOTED OTHERWISE.
 - NO TRUSS SHALL BE FIELD MODIFIED WITHOUT PRIOR CONSENT OF THE TRUSS ENGINEER AND THE BUILDING DEPARTMENT.
 - ROOF SHEATHING TO BE 1/2" APA RATED SHEATHING WITH 10d NAILS AT PERIMETER AND ALL SUPPORTED PANEL EDGES AT 6" ON CENTER AND AT 12" ON CENTER AT FIELD.
 - XXX DENOTES SHEARWALL CALLOUT PER SHEARWALL TABLE.
 - ☒ DENOTES SOLID 2x STUD BEARING BELOW END OF HEADER OR GIRDER.
 - ALL HEADERS TO HAVE (1) 2x BEARING STUD AND (1) 2x KING STUD AT EACH END UNLESS NOTED OTHERWISE.
 - PROVIDE SOLID BEARING STUDS AT ALL BEARING LOCATIONS INCLUDING GIRDER TRUSSES AND BEAMS.

ROOF FRAMING PLAN
SCALE: 1/4" = 1' - 0"



HDR: 4x8 DF#2 TYP. (U.N.O.)
POST: (2) 2x6 HF#2 TYP. (U.N.O.)

A NEW HOME AT:
6175 SE 27TH STREET
MERCER ISLAND, WA 98040

JOB NO: 23006
DATE: 12/11/23
DRWN. BY: TH
REVISED:

SHEET NO.

58

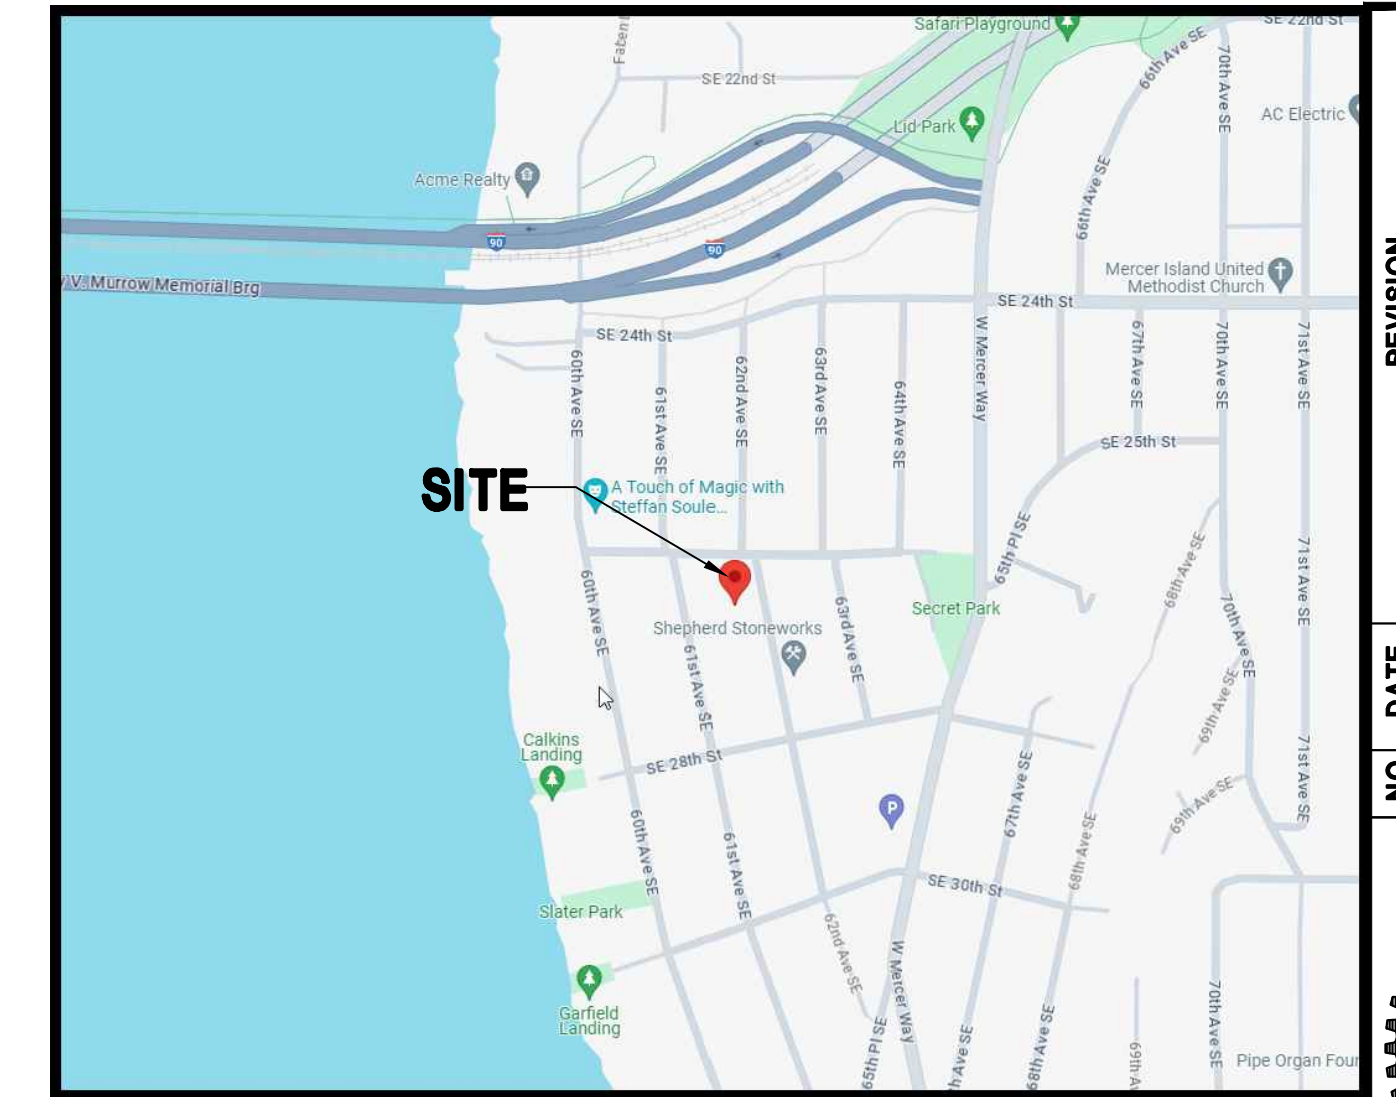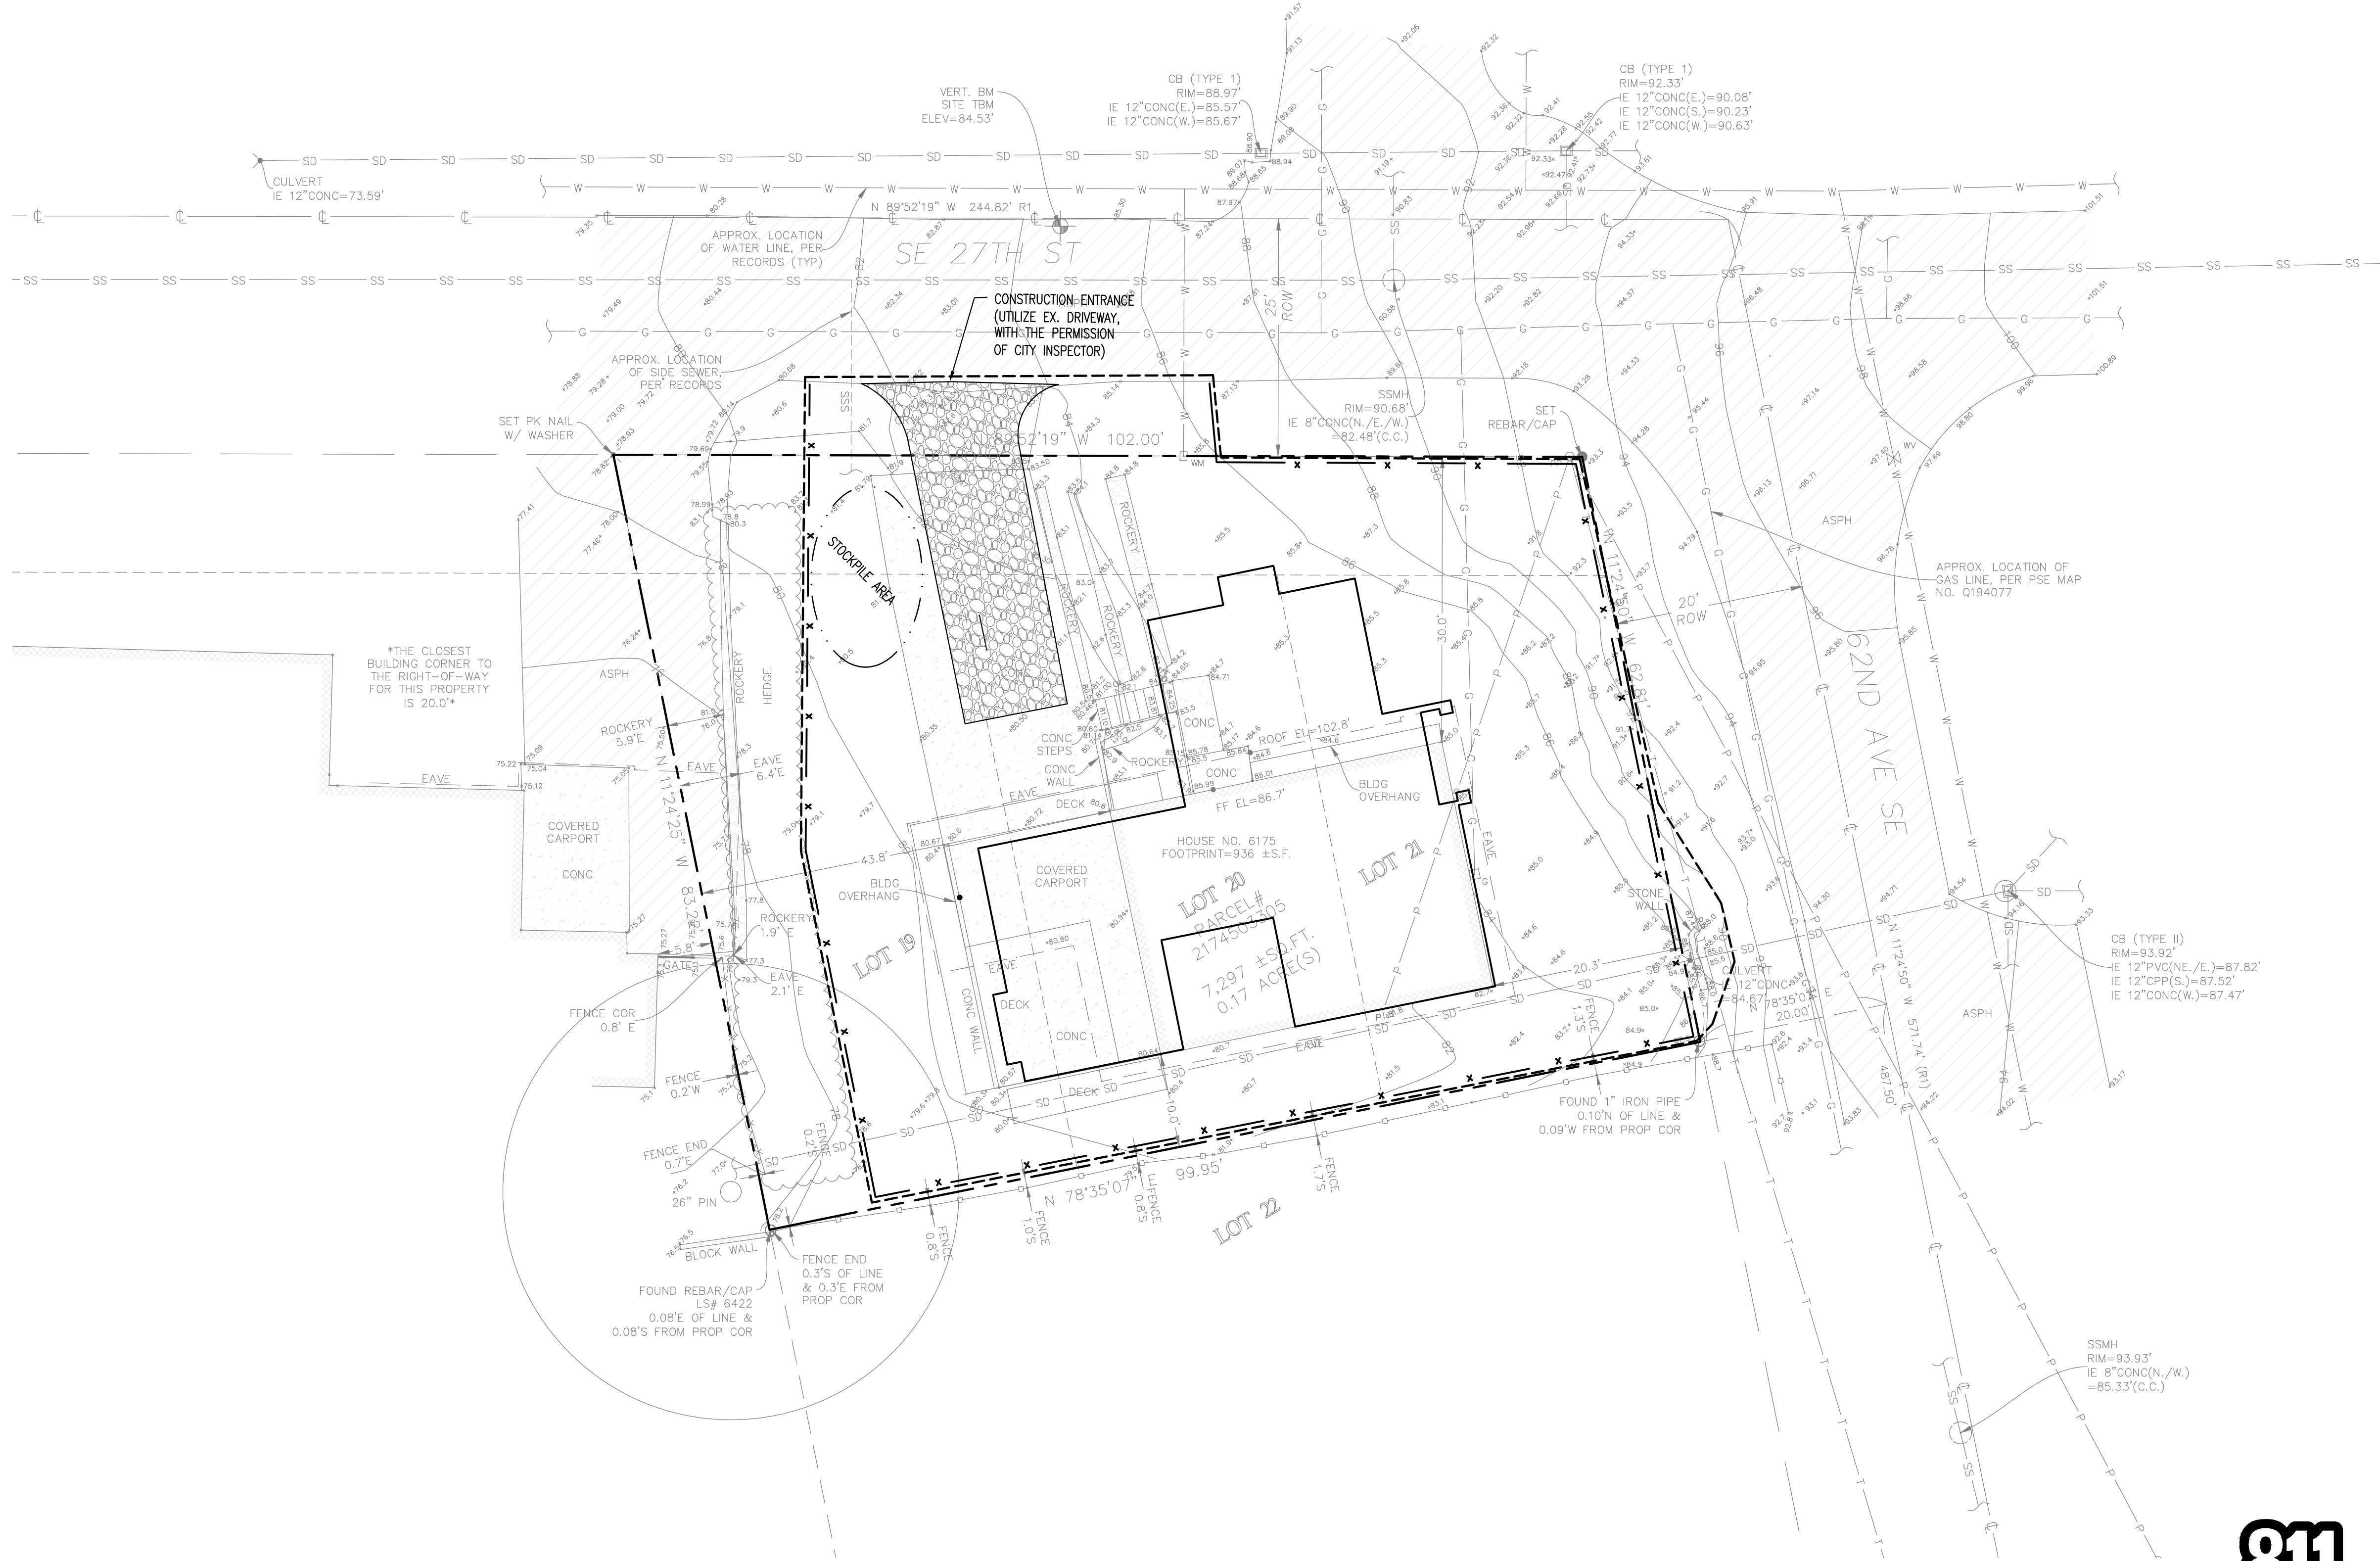

LEGEND:

- TEMPORARY CONSTRUCTION ENTRANCE (USING EX. ASP. DRWY.)
- SILT FENCE/CLEARING LIMITS
- DISTURBANCE LIMITS
- PROPOSED BUILDING

SURVEY LEGEND:

- ASPHALT SURFACE
- BENCHMARK
- BUILDING
- CENTERLINE ROW
- CONCRETE SURFACE
- CONCRETE PIPE
- DECK
- FENCE LINE (CHAIN LINK)
- FENCE LINE (WOOD)
- GAS LINE
- GAS METER
- GRAVEL SURFACE
- HEDGE FOLIAGE LINE
- INLET (TYPE 1)
- INLET (TYPE 2)
- MONUMENT (IN CASE, FOUND)
- NAIL AS NOTED
- POWER METER
- POWER (OVERHEAD)
- POWER POLE
- REBAR & IRON PIPE (SET)
- RETAINING WALL
- ROCKERY
- SEWER LINE
- SEWER MANHOLE
- STORM DRAIN LINE
- TELEPHONE (OVERHEAD)
- TREE (AS NOTED)
- WATER LINE
- WATER METER
- WATER VALVE

LEGAL DESCRIPTION

(PER STATUTORY WARRANTY DEED RECORDING# 20070529002539)

LOTS 19, 20 AND 21, BLOCK 19, EAST SEATTLE ADDITION TO THE CITY OF SEATTLE, ACCORDING TO THE PLAT THEREOF, RECORDED IN VOLUME 3 OF PLATS, PAGE 22 AND 23, IN KING COUNTY, WASHINGTON; TOGETHER WITH PORTION OF VACATED CABLE AVENUE "SOUTHEAST 27TH STREET" ADJOINING ON THE NORTH.

BENCHMARK AND DATUM PER SURVEY


ACCEPTED A BEARING OF N 78°35'37" E BETWEEN MONUMENTS FOUND ALONG THE CENTERLINE OF SE 26TH ST, PER R1

NAVD 88 PER GPS OBSERVATIONS

SITE TEMP. BENCHMARK
DESCRIPTION: PK NAIL W/ RED WASHER
LOCATION: NORTH SIDE SE 27TH ST MIDDLE OF SUBJECT PROPERTY
ELEVATION: 84.53'

EARTHWORK QUANTITIES:

CUT = 120 C.Y.
FILL = 20 C.Y.

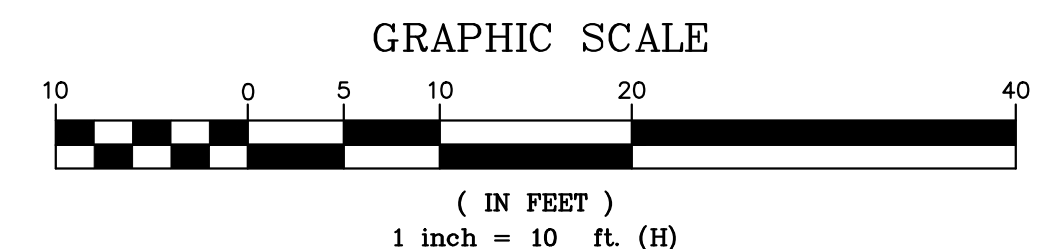

NO.	DATE	REVISION



C2MY
C2MY ENGINEERS, LLC
PO BOX 52883
BELLEVUE, WA 98015
(206) 922-9376
cmchen.c2my@gmail.com

PROJECT: CHEN RESIDENCE
6175 SE 27TH STREET
MERCER ISLAND, WA 98040


DATE: 12-21-23

TESC PLAN

FILE NO:
2342
DWG

SHEET
C1.0

NE 1/4, NE 1/4, SEC 11, TWP. 24N., RGE 4E., W.M.

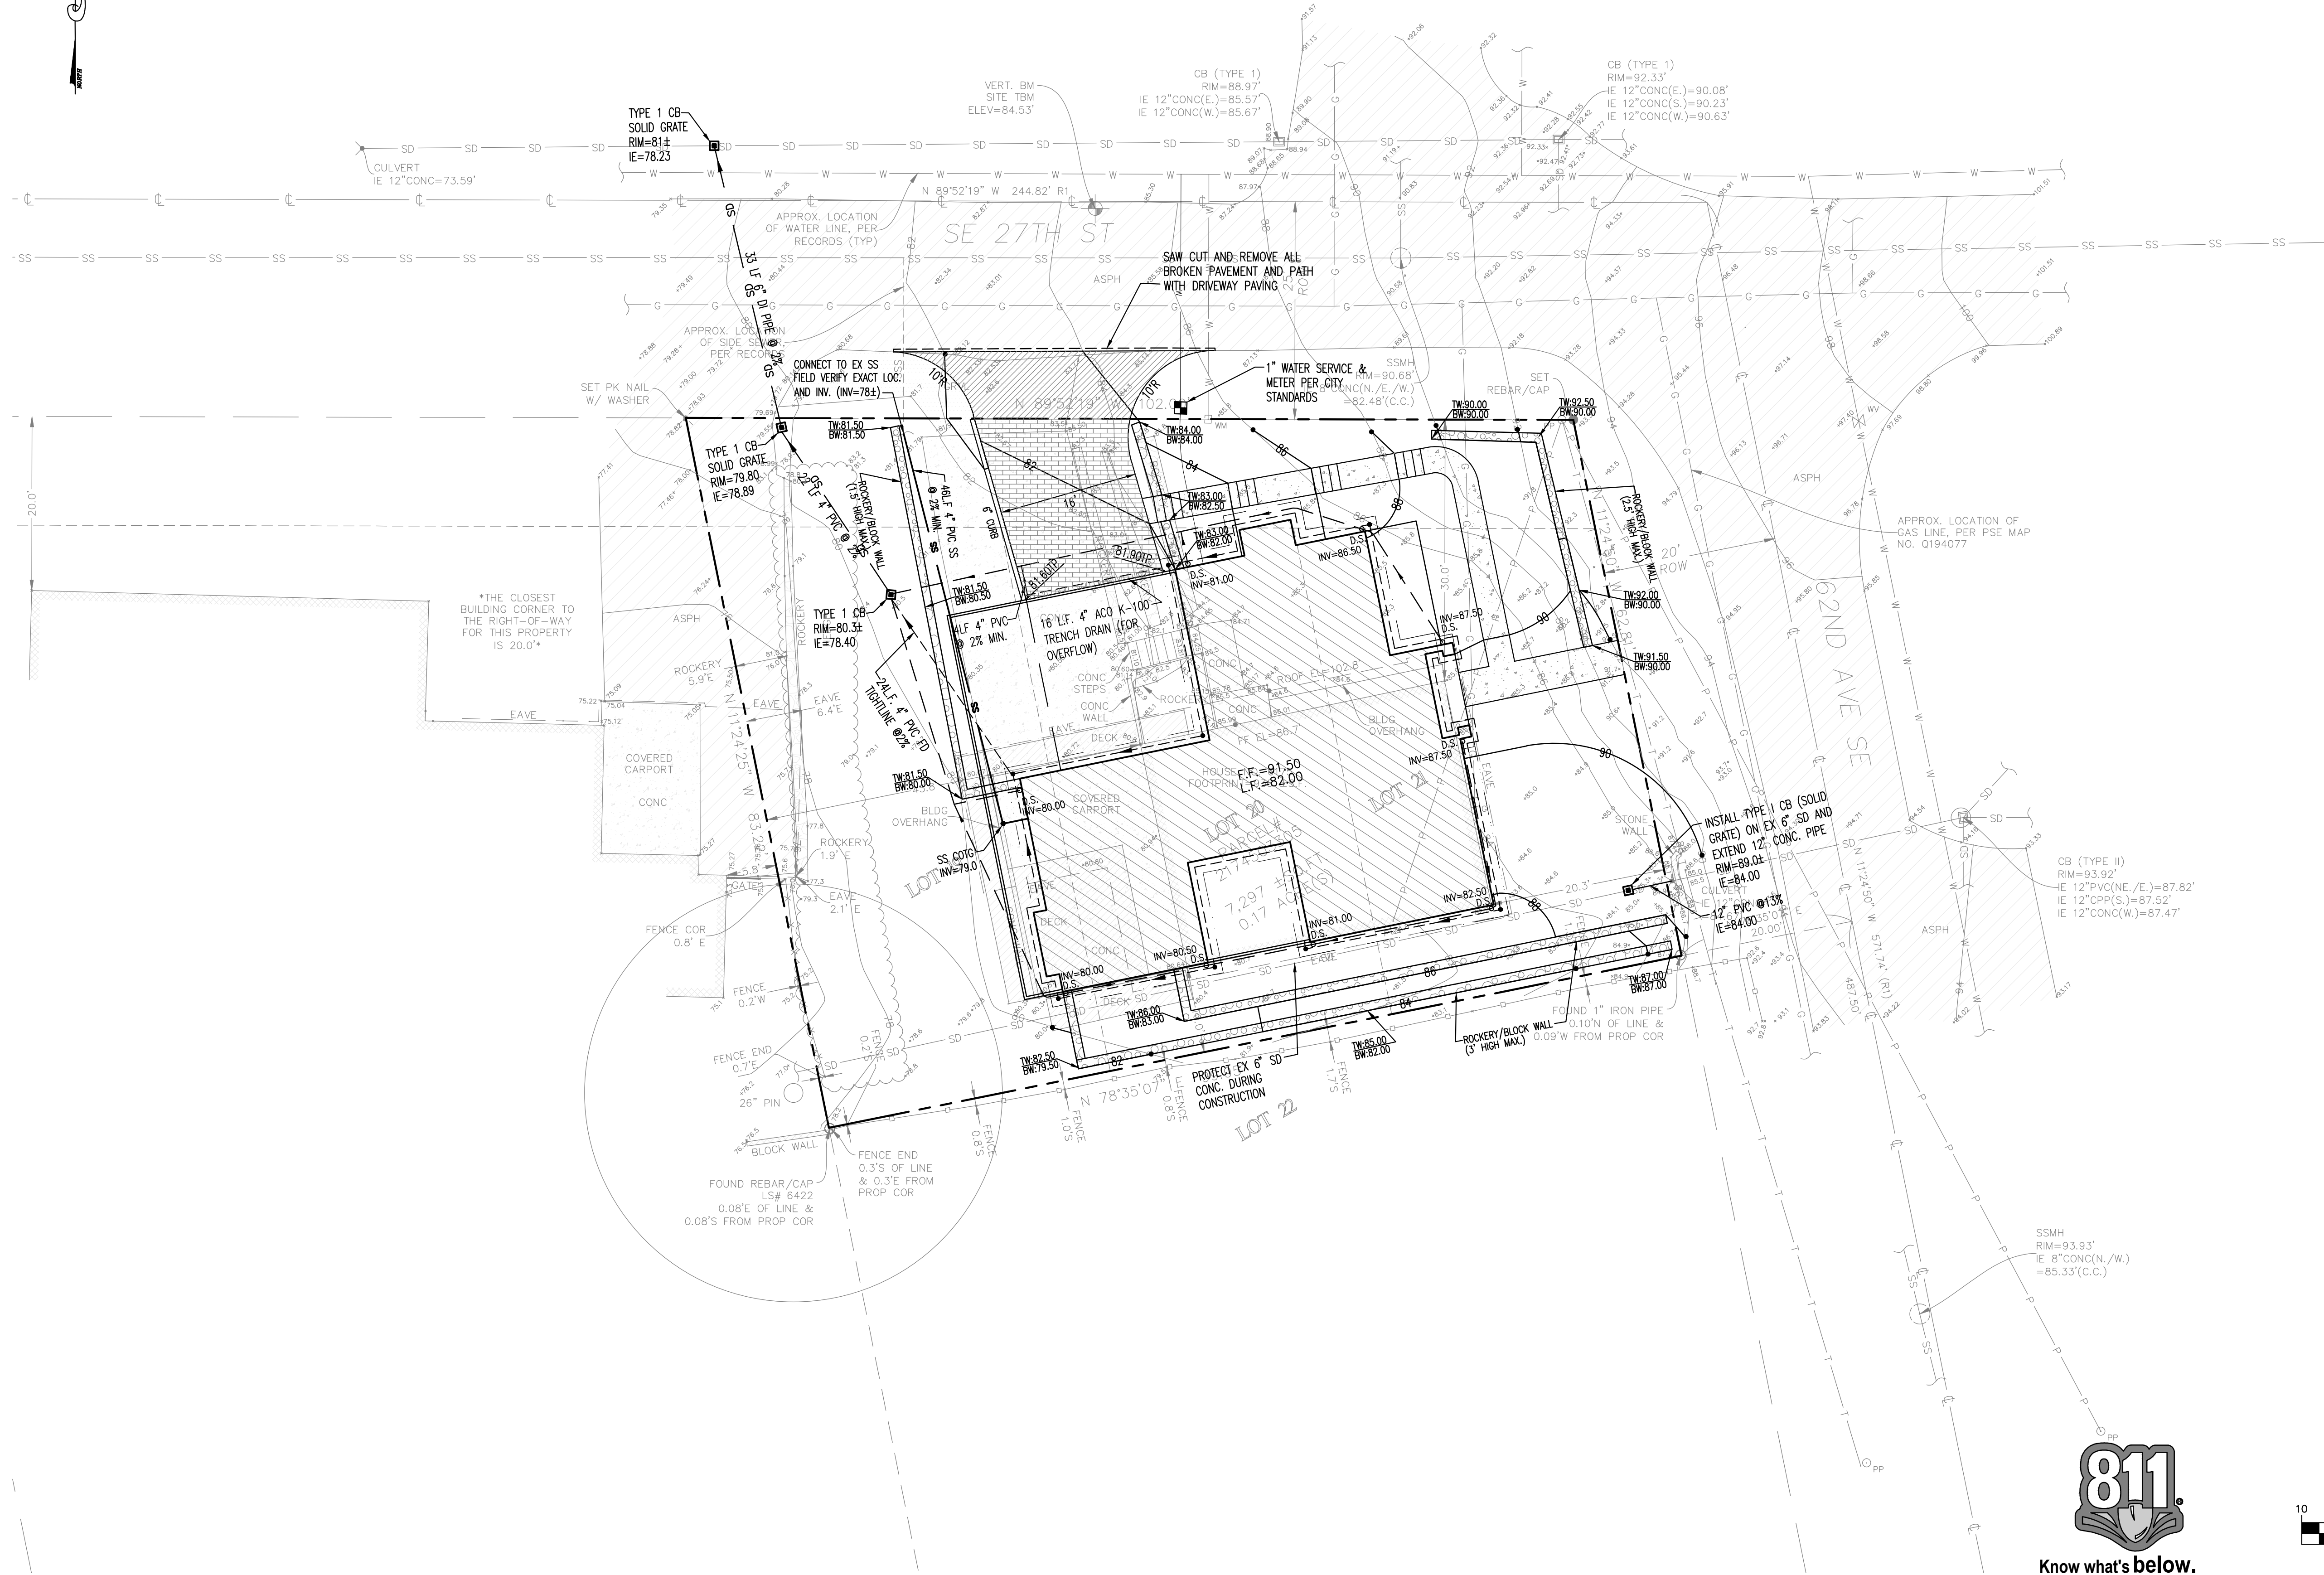

SITE IMPERVIOUS AREA SUMMARY:

EXISTING LOT AREA = 7297 S.F.
EXISTING BUILDING ROOF: 1600 S.F.
EXISTING DRIVEWAY: 646 S.F.
EXISTING DECK: 186+58 = 244 S.F.
EXISTING WALKWAY: 63 S.F.
TOTAL EXISTING IMPERVIOUS AREA = 2553 S.F.
EXISTING IMPERVIOUS IS 35% < 35% (NEW DEVELOPMENT FLOW CHART)

PROPOSED DRIVEWAY WITHIN ROW: 177 S.F.
PROPOSED DRIVEWAY WITHIN PROPERTY: 322 S.F.
PROPOSED WALKWAY: 254 S.F.
PROPOSED BUILDING ROOF: 1961 S.F.
PROPOSED PATIO/DECK: 92+547=639 S.F.
TOTAL NEW IMPERVIOUS AREA: 3,176 S.F. < 5000 S.F.

PER FIGURE I-3.1 FLOW CHART FOR DETERMINING FOR NEW DEVELOPMENT:
MINIMUM #1 TO #5 APPLIED TO NEW AND REPLACED HARD SURFACES AND THE LAND DISTURBED

NET INCREASE IN IMPERVIOUS AREA ON-SITE= 623 S.F.

LEGEND

- EX. SANITARY SEWER
- EX. WATER LINE
- EX. STORM DRAIN
- CONCRETE DRIVEWAY
- GRASS LAWN
- SAW CUT LINE
- ROOF DRAIN TIGHTLINE WITH C.O.T.G.(4" PVC)
- FOOTING DRAIN
- W/ CLEANOUT TO GRADE (C.O.T.G.)

NOTES:

- 1. SEE ARCHITECTURE SITE PLAN FOR OTHER PROPOSED INFORMATION NOT SHOWN ON THIS SHEET.

DRAINAGE GENERAL NOTES:

- 1. DOWNSPOUTS SHALL BE TIED INTO A NON-PERFORATED, RIGID, SMOOTH-BORE PIPE WHICH DRAINS TO AN APPROVED STORM SYSTEM
- 2. PROVIDE CLEANOUTS AT THE UPPER END OF THE SYSTEM AND AT EACH CUMULATIVE CHANGE OF DIRECTION IN EXCESS OF 135 DEGREES.
- 3. ALL PIPE FITTINGS SHALL BE MADE OF THE SAME MATERIAL AS THE STRAIGHT PIPE. GLEED JOINTS SHALL USE A BONDING AGENT RECOMMENDED BY THE PIPE MANUFACTURER.
- 4. FOOTING DRAINS SHALL BE INSTALLED AROUND ALL NEW FOUNDATIONS AND SHALL BE TIGHTLINED TO DISCHARGE TO THE SPLASH BLOCK. FOOTING DRAINS SHALL BE CONSTRUCTED OF PERFORATED PIPE AT THE BASE OF THE FOOTING, AND SHALL MEET MATERIAL STANDARDS OF D2729 FOR PVC PIPE, WITH THE PERFORATIONS DIRECTED DOWNWARD. PLACE GRANULAR BACKFILL AROUND AND ABOVE THE FOOTING DRAIN TO A DEPTH OF 2/3 OF THE WALL HEIGHT. PROVIDE FILTER FABRIC WRAP AROUND BETWEEN THE GRANULAR BACKFILL AND THE NATIVE SOIL.


BENCHMARK AND DATUM PER SURVEY

ACCEPTED A BEARING OF N 78°35'37" E BETWEEN MONUMENTS FOUND ALONG THE CENTERLINE OF SE 28TH ST, PER R1

NAVD 88 PER GPS OBSERVATIONS
SITE TEMP. BENCHMARK
DESCRIPTION: PK NAIL W/ RED WASHER
LOCATION: NORTH SIDE SE 27TH ST MIDDLE OF SUBJECT PROPERTY
ELEVATION: 84.53'



Know what's below.
Call before you dig.

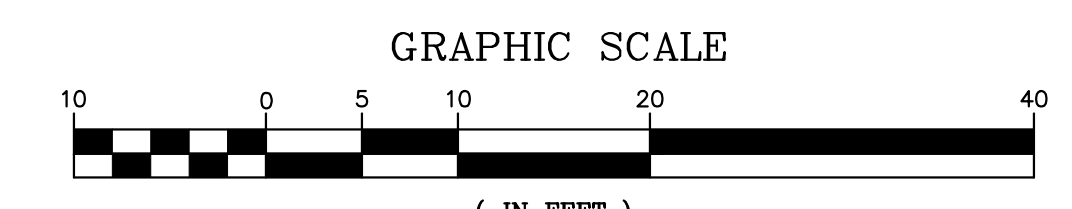

GRAPHIC SCALE
(IN FEET)
1 inch = 10 ft. (H)
FILE NAME: 2342-C2.0 PLOT DATE: 12/21/23 PLOT BY: CMC PLOT SCALE: 1=1

Jan 02, 2024 - 4:55pm CMC G:\Projects\2023\2342 - 6175 SE 27th St Mercer Island SFR - Johnson-Tony Chen\Island SFR - 6175 SE 27th St Mercer Island SFR - 2342-C2.0.dwg Layout Name: C2

NO.	DATE	REVISION



C2MY ENGINEERS, LLC
PO BOX 52883
BELLEVUE, WA 98015
(206) 922-9376
cmchen.c2my@gmail.com

DATE: 12-21-23
PROJECT: CHEN RESIDENCE
6175 SE 27TH STREET
MERCER ISLAND, WA 98040
Paving, Grading, Drainage Plan

FILE NO:
2342
DWS

SHEET
C2.0