

CITY OF MERCER ISLAND

DEVELOPMENT SERVICES GROUP

9611 SE 36TH STREET | MERCER ISLAND, WA 98040
PHONE: 206.275.7605 | www.mercergov.org



INSPECTION REQUESTS:

online:



voicemail: (206) 275-7730

NOTE: ALL RECORDS AND DRAWINGS ARE SUBJECT TO PUBLIC DISCLOSURE AS REQUIRED BY RCW 42.56

CONTACT INFORMATION:

Applicant is to complete the following information.

Applicant Contact information prior to permit issuance: Name, Address, Phone, Email
Applicant Contact information post permit issuance: Name, Address, Phone, Email

REQUIRED SPECIAL INSPECTIONS / STRUCTURAL OBSERVATIONS:

It is the Engineer of Record's responsibility to specify all required Special Inspections or Structural Observation (check items below). The owner is responsible for hiring an approved private Special Inspector for the checked inspections noted below.

STRUCTURAL OBSERVATION BY ENGINEER OF RECORD (EOR): Engineer of Record, Company, Phone, General Conformance to Construction Documents, Other

SOILS / GEOTECHNICAL: Special Inspector, Company, Phone, Erosion control measures, Shoring installation and monitoring, Observe and monitor excavation, Verification of soil bearing, Other

REINFORCED CONCRETE: Special Inspector, Company, Phone, Concrete strength, Reinforcing steel and concrete placement, Shotcrete placement, Other

STRUCTURAL STEEL: Special Inspector, Company, Phone, Fabrication and shop welds, Structural steel erection, field welds and bolting, Other

STRUCTURAL MASONRY: Special Inspector, Company, Phone, Mortar strength, Masonry unit strength, Other

WOOD: Special Inspector / Engineer of Record, Company, Phone, Lateral resisting system construction, High strength diaphragm construction, Other

OTHER SPECIAL INSPECTIONS: Special Inspector, Company, Phone, Epoxy grout installations, Expansion anchor installations, Other post installed anchors, Alternative construction methods, Alternative construction materials, Other

DEFERRED SUBMITTALS:

The Applicant is required to select all deferred submittals / shop drawings for submittal to the City for review and approval prior to item fabrication / construction.

Connector plate wood trusses, Metal joist / metal trusses, Premanufactured structures (stairs, etc.), Precast concrete elements, Other, Post tension layout, Exterior cladding, Window wall / curtain wall construction, Other

ENERGY CODE COMPLIANCE INFORMATION:

Indicate where the following information is located in the drawing set. Alternatively, incorporate or include the Residential Energy Code Prescriptive Compliance (RECPC) Form into the drawing set.

Building envelope, Whole house ventilation, Energy Credit Information, RECPC Form Information, Air Leakage Testing, Duct Leakage Testing, Postconstruction Test, Rough-in Test

TO BE COMPLETED BY DSG

PROJECT ALERTS: Construction of the project shall be from approved plans only. No deviation from the approved project plans is allowed without prior approval from the City of Mercer Island. Approved plans must be kept on site and maintained in good condition.

TREE PROTECTION REQUIREMENTS: Tree protection as shown on approved drawings shall be installed at tree dripline prior to start of any site work and must remain in place throughout the project.

FIRE PROTECTION REQUIREMENTS: Separate Permits are required for ALL fire protection systems. Fire Sprinkler, Monitored Household Fire Alarm per NFPA 72, Monitored Sprinkler, Water Flow Alarm, Other

WATER SUPPLY REQUIREMENTS: Fire sprinkler design calculations must be provided prior to determining water supply system requirements. Water Supply system upgrade required, City Installation, Applicant Installation, Required Service Line Size, Required Supply Line Size, Required Meter Size

DRAINAGE REQUIREMENTS: On site detention system required, On site infiltration system required, As-built Utility drawings required, Full Size drawings required, Direct discharge into the lake, No Storm Water permit required, Connection to public storm drainage conveyance system req'd, Other

SIDE SEWER REQUIREMENTS: Side sewer requires a backflow preventer when connecting to the lake line or when the elevation of the lowest plumbing fixture is lower than the elevation of the upstream manhole rim or when side sewer is shared with one or more properties. Video tape of existing sewer required (see standard details), New connection, Connect to existing, Disconnect permit required, Reconnect permit required, Other

APPROVED CODE ALTERNATIVES: Code alternatives must be inspected. Refer to the Inspection Checklist. CA1, CA2

SURVEY REQUIREMENTS (The following survey information must be submitted when checked): Surveyor shall verify points chosen for height calculations and point verification shall be submitted at the time of City foundation inspection. A property survey may be required to verify setbacks and in some cases buildings must be surveyed onto the lot. The City reserves the right to request an impervious area survey at any time prior to issuance of Certificate of Occupancy.

MAXIMUM 40 PERCENT ALTERATION INSPECTION: A Building Inspection prior to demolition is required for all legally nonconforming single family dwelling to ensure no more than 40 percent of the dwelling's exterior walls are structurally altered. Contact the Building Inspector at (206) 275-7730. Civil / Drainage, LUP / Setback requirements

GEOTECHNICAL INFORMATION: Land clearing, grading, filling and foundation work within geologic hazard areas is NOT PERMITTED between October 1 and April 1 without an approved Seasonal Development Limitation Waiver.

Geotechnical Report provided. All construction must comply with the recommendations of the Geotechnical Report. A copy of report and other geotechnical information must be kept on site at all times.

SEASONAL DEVELOPMENT LIMITATION RESTRICTION: Applies (Geologic Hazard area). Grading not permitted between October 1 through April 1. Waiver approved. Grading and excavation permitted subject to all conditions noted in Seasonal Development Limitation Waiver Permit.

Permit number, Approved by, Date

TO BE COMPLETED BY DSG

TO BE COMPLETED BY DSG

REQUIRED CONSTRUCTION INSPECTIONS: It is the applicant's responsibility to contact DSG to schedule ALL inspections appropriate for the project. Request inspections online at www.MyBuildingPermit.com or by calling the Inspection Hotline at (206) 275-7730. Allow at least 24 hours (48 hours for Reinforcing steel) in advance of desired inspection. Be specific as to type of inspection.

TO BE COMPLETED BY DSG

Final Inspection: Tree Restoration, Final Inspection: Fire protection, including (but not limited to): Sprinkler, Access Road, Fire Code Alternatives (see below), FCA1, FCA2, FCA3, FCA4, Final Inspection: Water supply protection, including (but not limited to): backflow devices for: Waterfront property, Well water on property, Fire / lawn sprinkler, Boiler, Final Inspection: Site and utility: includes landscape, utilities and ROW. Site restoration complete and as-built drawings ready for submittal. Final Inspection: Building, including electrical / mechanical / plumbing. If applicable, provide closeout (summary) letters from Engineer, Special Inspectors, Geotechnical Engineer, and exterior wall cladding inspectors (EIFS).

90 DAY TEMPORARY CERTIFICATE OF OCCUPANCY (TCO): Applicant option. Additional fees will be required and must be approved prior to occupancy. TCO requires tree plantings be completed.

Approved, Start Date, End Date

ADDITIONAL REQUIRED CITY INSPECTIONS: Call the appropriate contact to arrange the inspection. Required Inspection(s), Contact, Phone, Scheduling

IMPACT FEES: If applicable. Impact fees apply and are due prior to Final Inspection or on Date, whichever occurs first. PLAN REVIEW APPROVALS: Not all review disciplines may be required to review the documents.

Building, Planning, Engineering, Tree, Fire

TO BE COMPLETED BY DSG

TO BE COMPLETED BY APPLICANT

TO BE COMPLETED BY APPLICANT



CERTIFICATE OF OCCUPANCY Issued after all required inspections have been performed and approved.

PROJECT NAME: PROJECT ADDRESS:


APPROVED DRAWINGS MUST BE KEPT ON THE BUILDING SITE AT ALL TIMES REVIEWED FOR CODE COMPLIANCE

PERMIT NUMBER

Approved, Date

Approved, Date



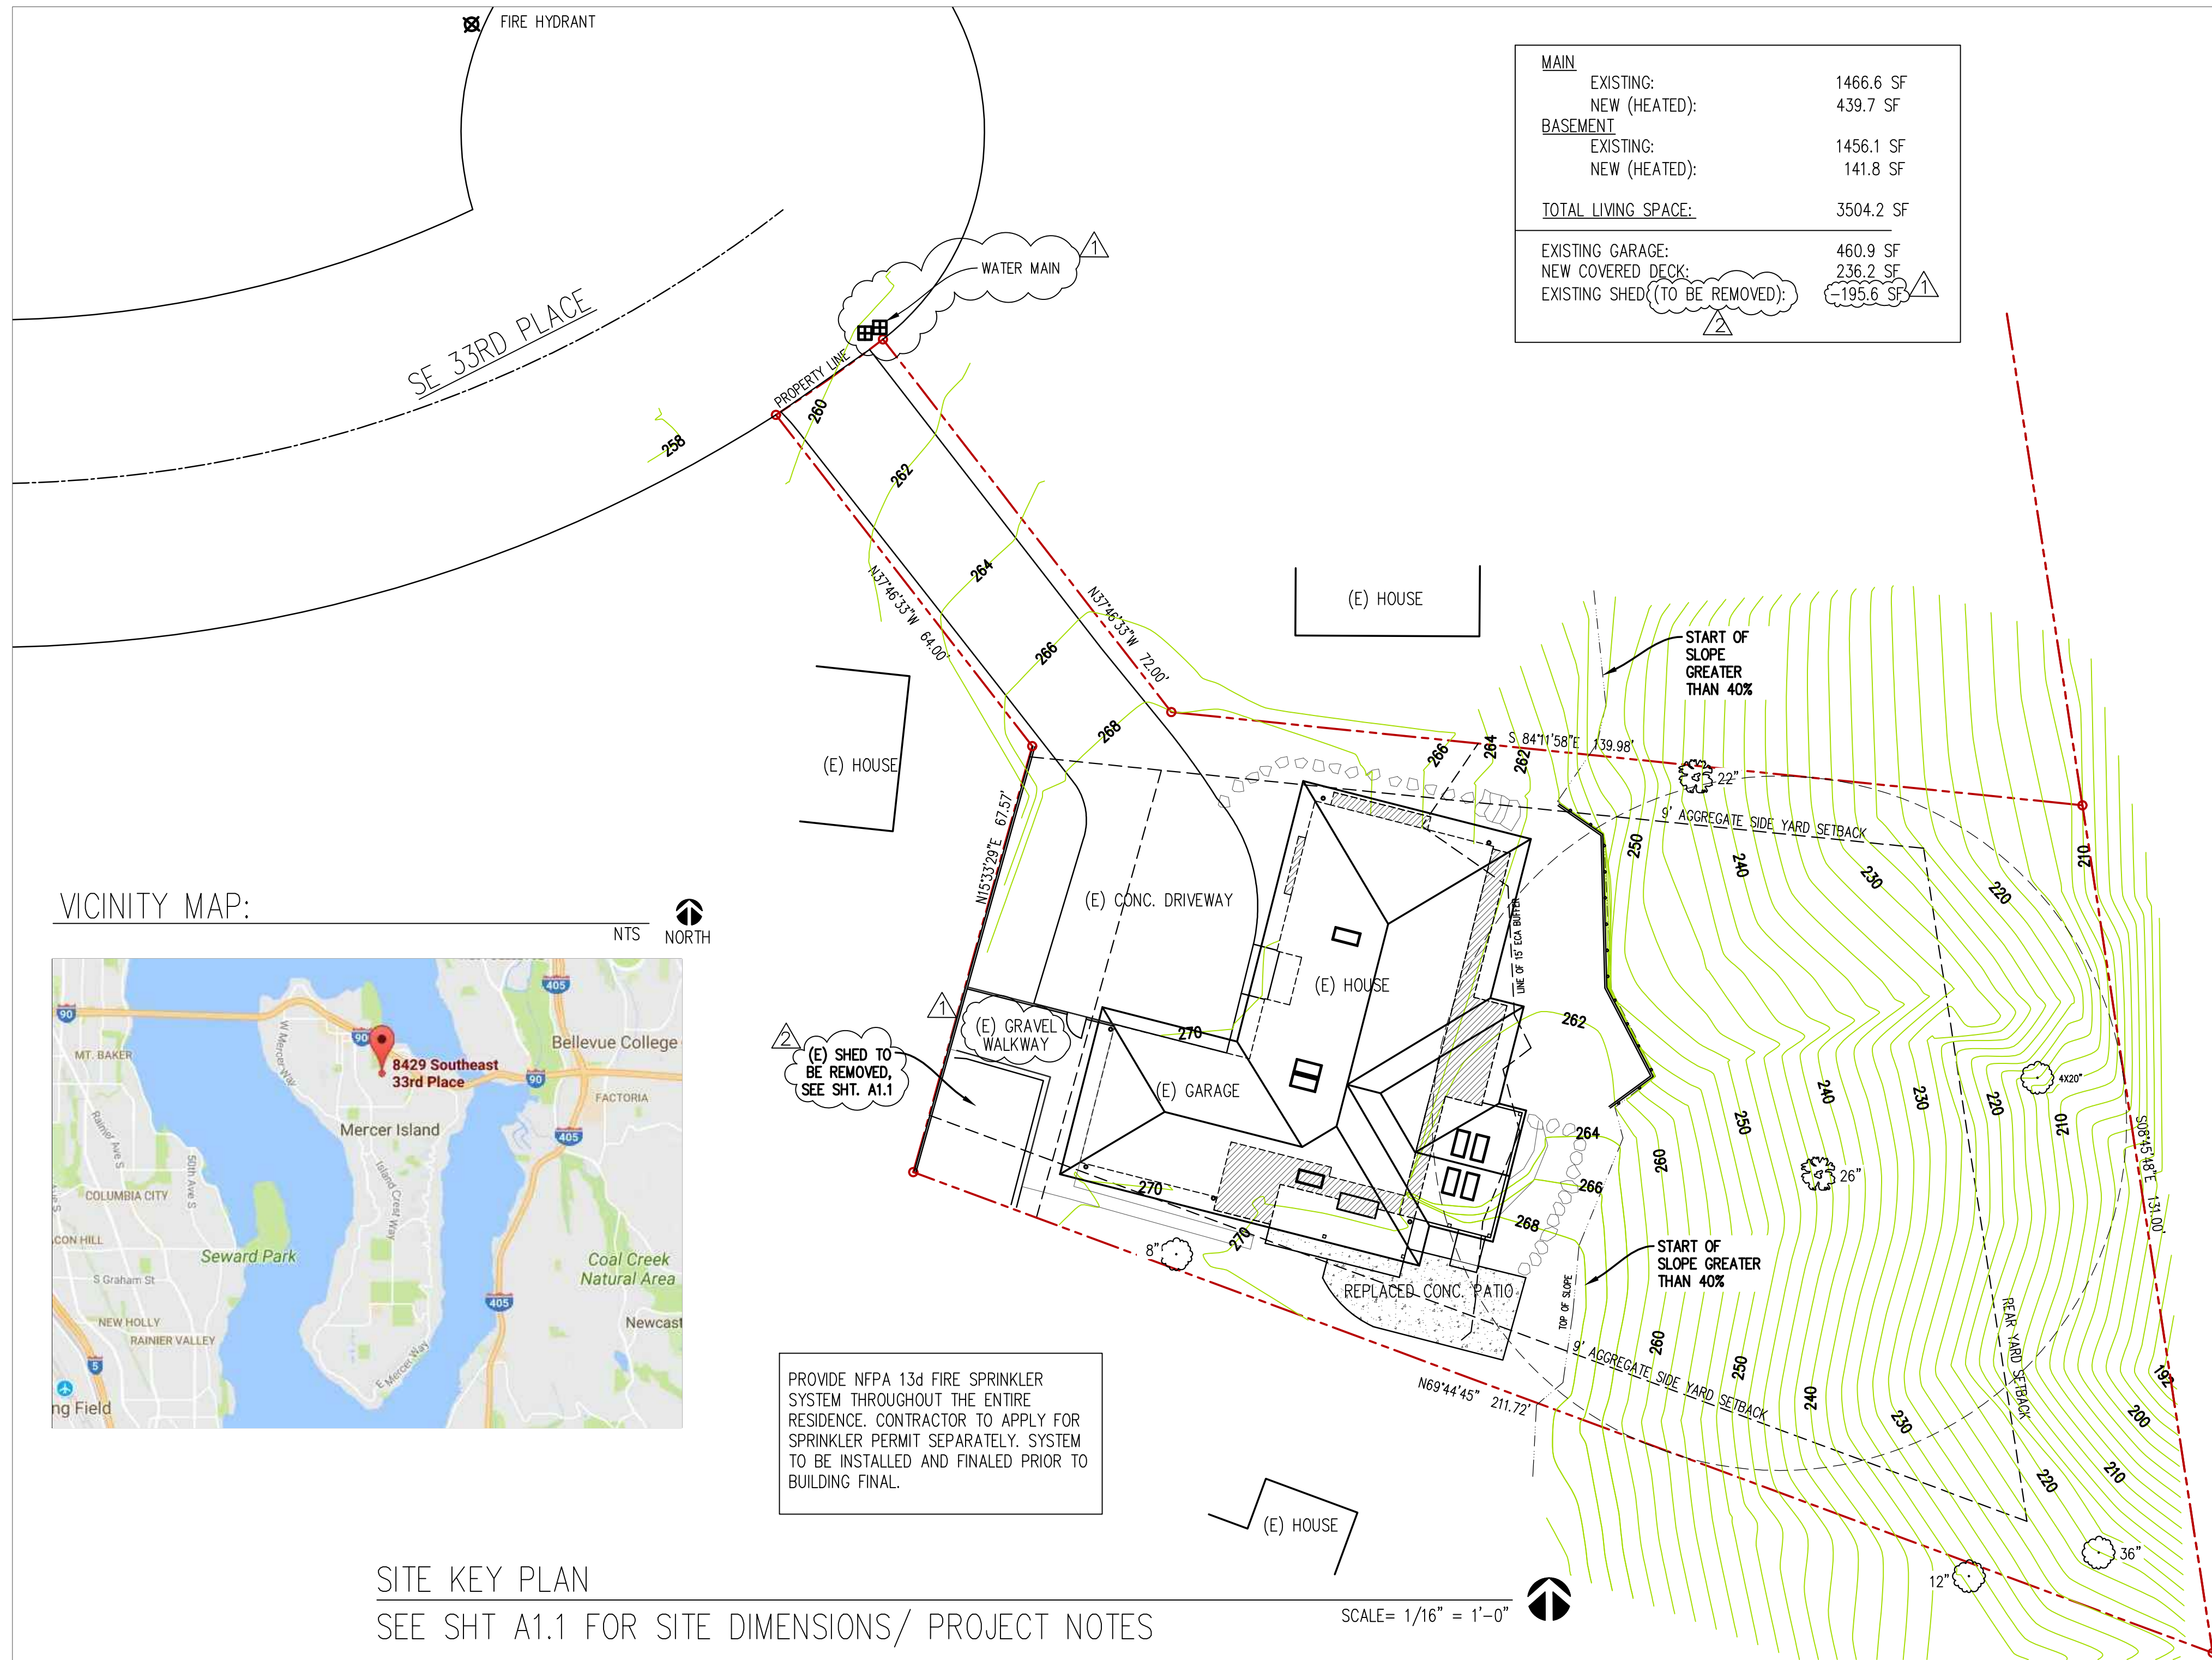

<b>MAIN</b>	EXISTING:	1466.6 SF
	NEW (HEATED):	439.7 SF
<b>BASEMENT</b>	EXISTING:	1456.1 SF
	NEW (HEATED):	141.8 SF
<b>TOTAL LIVING SPACE:</b>		3504.2 SF
EXISTING GARAGE:		460.9 SF
NEW COVERED DECK:		236.2 SF
EXISTING SHED (TO BE REMOVED):		-195.6 SF


PROVIDE NFPA 13d FIRE SPRINKLER SYSTEM THROUGHOUT THE ENTIRE RESIDENCE. CONTRACTOR TO APPLY FOR SPRINKLER PERMIT SEPARATELY. SYSTEM TO BE INSTALLED AND FINALED PRIOR TO BUILDING FINAL.

**SITE KEY PLAN**  
SEE SHT A1.1 FOR SITE DIMENSIONS/ PROJECT NOTES


SCALE = 1/16" = 1'-0"

- CODE NOTES:**
- OPENINGS SHALL BE CAULKED, OR WEATHER STRIPPED.
  - SEAL TEARS AND JOINTS IN INSULATION WITH TAPE.
  - MOISTURE CONTROL TO BE PROVIDED PER WA STATE ENERGY CODE.
  - HOT WATER HEATERS SHALL COMPLY WITH THE NATIONAL APPLIANCE ENERGY CONSERVATION ACT. (EXISTING WH TO REMAIN)
  - PROVIDE SEISMIC STRAP FOR WATER HEATER. (VERIFY EXISTING OR PROVIDE NEW)
  - SERVICE WATER PIPES IN UNHEATED SPACES SHALL BE INSULATED PER WA STATE ENERGY CODE.
  - ALL NAILING PER IRC
  - PROVIDE SMOKE DETECTORS PER IRC - IN EACH SLEEPING ROOM, OUTSIDE EACH SEPARATE SLEEPING AREA AND ON EACH STORY OF THE HOUSE. CONTRACTOR TO VERIFY SD'S ARE PROPERLY INSTALLED IN THE EXISTING HOUSE.
  - SMOKE DETECTORS SHALL BE POWERED BY THE BUILDING WIRING WITH A BATTERY BACKUP.
  - CARBON MONOXIDE ALARMS TO BE INSTALLED PER IRC- OUTSIDE OF EACH SEPARATE SLEEPING AREA IN THE IMMEDIATE VICINITY OF BEDROOMS. CONTRACTOR TO VERIFY HEAT DETECTOR TO BE INSTALLED PER IRC- IN CENTRAL LOCATION OF THE (E) ATTACHED GARAGE.
  - PROVIDE FIRE BLOCKING, DRAFTSTOPS AND FIRESTOPS PER THE IRC.
  - PROVIDE APPROVED SECURITY AND LOCKING DEVICES AT NEW DOORS AND WINDOWS PER IRC.

- GENERAL NOTES:**
- ALL WORK UNDER THIS CONTRACT SHALL COMPLY WITH THE CURRENT EDITIONS OF THE INTERNATIONAL RESIDENTIAL CODE (2018), WASHINGTON STATE ENERGY CODE (2018), WASHINGTON STATE VENTILATION AND INDOOR AIR QUALITY CODE, UNIFORM PLUMBING CODE, NATIONAL ELECTRIC CODE, AND WASHINGTON STATE DEPARTMENT OF LABOR AND INDUSTRIES REGULATIONS.
  - GENERAL CONTRACTOR SHALL VERIFY AND COORDINATE ALL EXISTING AND NEW UTILITIES AND SITE CONDITIONS BEFORE AND DURING CONSTRUCTION. INFORM ARCHITECT OF VARIATIONS BETWEEN CONTRACT DOCUMENTS AND EXISTING CONDITIONS.
  - DO NOT SCALE DRAWINGS; VERIFY ALL DIMENSIONS ON THE JOB.
  - DIMENSIONS ARE TO FACE OF FOUNDATION WALLS AND FACE OF ROUGH FRAMING, UNLESS NOTED OTHERWISE. FOR DIMENSIONS TO EXIST. STRUCTURE - ASSUME FACE OF (E) FINISHED SURFACE.
  - FLOOR-TO-FLOOR DIMENSIONS FROM TOP OF SUBFLOOR TO TOP PLATES, UNLESS NOTED OTHERWISE.
  - PROVIDE SOLID BLOCKING BEHIND ALL WALL HUNG FIXTURES AND ACCESSORIES.

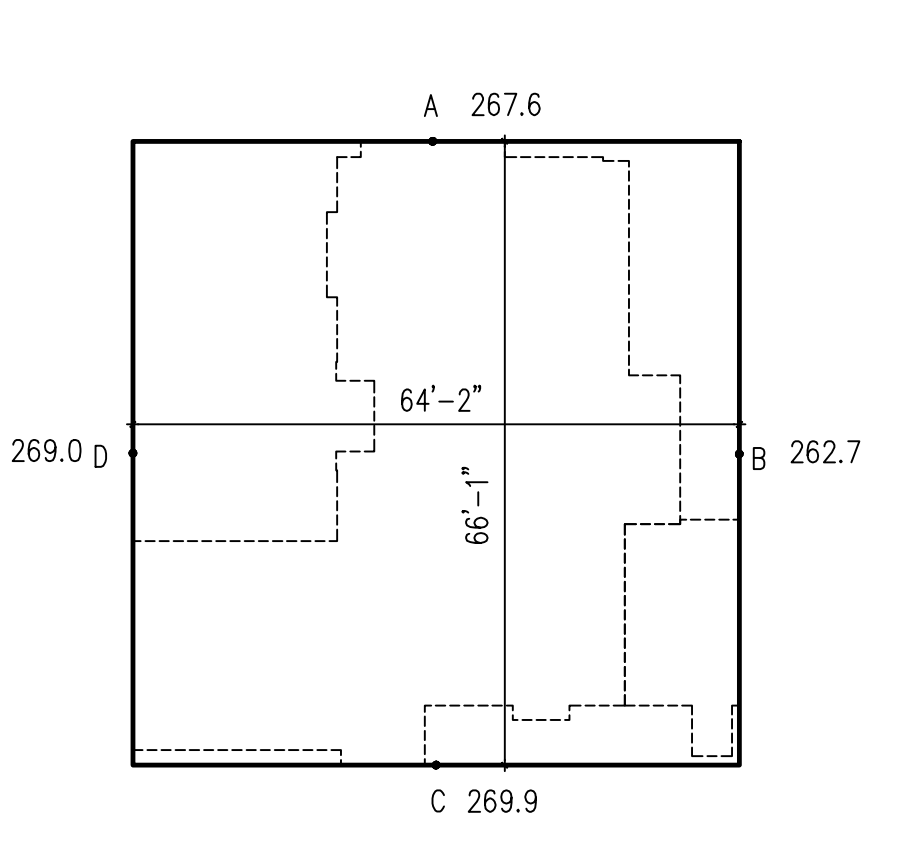

ENCLOSING RECTANGLE DIAGRAM

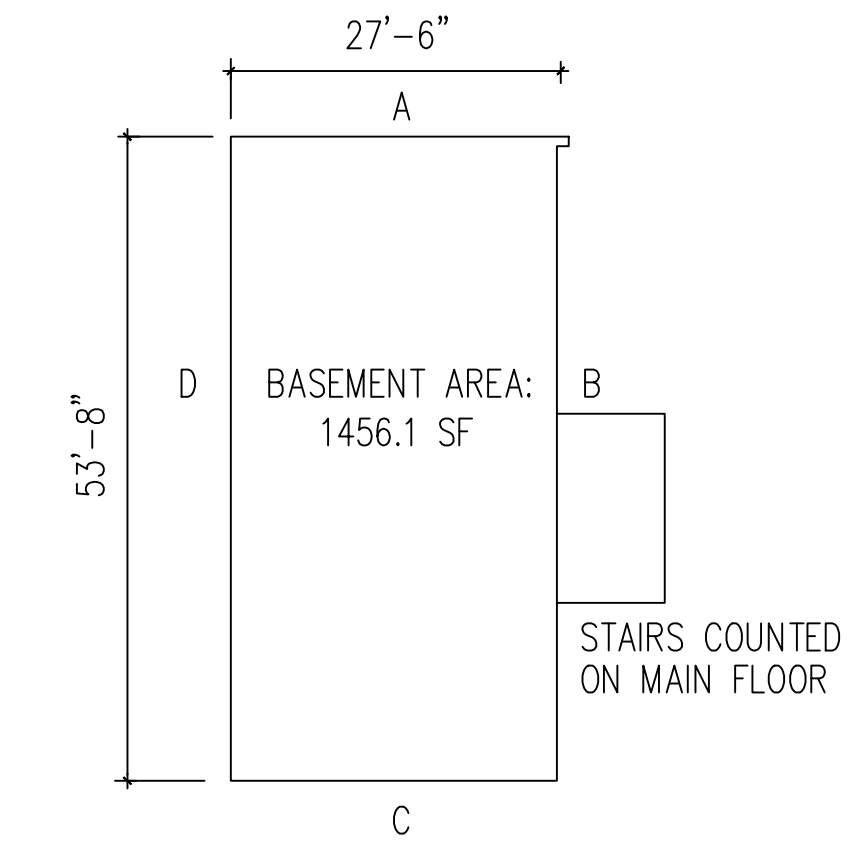

BASEMENT FLOOR AREA EXEMPTION

**PROJECT DIRECTORY: TABLE OF CONTENTS:**

<b>OWNER:</b> KEVIN & SUZETTE PIPER 8429 SE 33RD PLACE MERCER ISLAND, WA 98040	<b>ARCHITECTURAL</b> A 1.0 SITE PLAN & PROJECT NOTES A 1.1 DETAILED SITE PLAN, TEMPORARY EROSION & SEDIMENT CONTROL PLAN A 2.0 EXISTING BASEMENT DEMO PLAN A 2.1 MAIN FLOOR & ROOF DEMO PLAN A 2.2 BASEMENT PLAN A 2.3 MAIN FLOOR PLAN A 3.0 WEST EXTERIOR ELEV., WINDOW SCHED., ROOF PLAN A 3.1 EXTERIOR ELEVATIONS A 3.2 SECTIONS, DOOR SCHEDULE A 3.3 SECTION B-B, STAIR SECTION & DETAILS
<b>ARCHITECT:</b> FORM + FUNCTION ARCHITECTURE 1800 WESTLAKE AVE N., SUITE 205 SEATTLE, WA 98109 (206) 372-9796 CONTACT: JUDY TUCKER, AIA	<b>STRUCTURAL</b> S 1.0 STRUCTURAL NOTES S 1.1 SHEARWALL SCHEDULE & DETAILS S 1.2 HOLDDOWN SCHEDULE & DETAILS S 2.0 BASEMENT LEVEL WALLS OVER FOUNDATION S 2.1 MAIN LEVEL FRAMING PLAN OVER BASEMENT LEVEL SHEARWALLS S 2.2 ROOF FRAMING PLAN OVER MAIN LEVEL SHEARWALLS S 6.0 TYPICAL CONCRETE DETAILS S 8.0 MOMENT FRAME DETAILS S 8.1 MOMENT FRAME DETAILS S 8.2 MOMENT FRAME DETAILS S 8.3 MOMENT FRAME DETAILS S 9.0 TYPICAL WOOD FRAMING DETAILS S 9.1 TYPICAL WOOD FRAMING DETAILS S 9.2 TYPICAL WOOD FRAMING DETAILS S 10.0 TYPICAL COMPONENTS
<b>STRUCTURAL ENGINEERING:</b> CT ENGINEERING INC. 180 NICKERSON ST SUITE 302 SEATTLE, WA 98109 (206) 285-4512 CONTACT: BEN McCANN	<b>STRUCTURAL SURV</b> TOPOGRAPHIC SURVEY
<b>GEOTECHNICAL ENGINEERING:</b> ZIPPER GEO ASSOC. 19019 36TH AVE W, STE E LYNNWOOD, WA 98036 (425) 582-9928 CONTACT: DAVE MATTHEWS	
<b>SURVEYOR:</b> APEX ENGINEERING 2601 S 35TH ST, STW 200 TACOMA, WA 98409 (253) 473-4494 CONTACT: KURT PARCHER	

**PROJECT NOTES:**

**PROJECT DESCRIPTION:** REMODEL MAIN FLOOR KITCHEN, MOVE STAIRS TO NEW REAR YARD ADDITION, NEW REAR YARD COVERED DECK, NEW SIDE YARD MUDROOM ADDITION TO CONNECT HOUSE TO GARAGE, NEW GUEST BATH, NEW MAIN FLOOR MASTER SUITE, NEW ROOF.

**KING COUNTY ASSESSOR PARCEL NUMBER:** 6666800250

**PROJECT ADDRESS:** 8429 SE 33RD PL MERCER ISLAND, WA 98040

**LEGAL DESCRIPTION:** PARKRIDGE ADD, LOT 25

**ZONING:** SF 9.6

**CONSTRUCTION TYPE:** TYPE V B

**ENVIRONMENTAL CRITICAL AREAS:** LANDSLIDE HAZARD, EROSION CONTROL

**LOT AREA:** 19,302 SF (0.44 ACRES)

**SETBACKS:** FRONT YARD: 20' MIN  
REAR YARD: 25' MIN  
SIDE YARD: 5' MIN, 18' COMBINED (17% OF LOT WIDTH: 106'-3")

**LOT SLOPE:** BASED ON LOT SLOPE. LOW ELEVATION = 192.0' HIGHEST ELEVATION = 270.0' (270.0-192.0) / 163.7' LOT SLOPE LINE = 47.6% SLOPE  
30% - 50% LOT SLOPE ALLOWS FOR 30% LOT COVERAGE  
30% OF 19,302 SF = 5,790.6 SF

**LOT COVERAGE:**

EXIST ROOF =	2659.6 SF
NEW ROOF =	196.6 SF
EXIST. DRIVEWAY =	2310.3 SF
NEW COVERED PATIO/ DECK =	413.4 SF
EXIST. SHED ROOF =	289.5 SF
EXIST. SHED ROOF TO BE REMOVED =	-289.5 SF
<b>TOTAL LOT COVERAGE =</b>	<b>5579.9 SF (28.9%)</b>
ALLOWABLE LOT COVERAGE:	5790.6 SF (30%)

**IMPERVIOUS SURFACE:** SEE SHEET A2.2 FOR IMPERVIOUS SURFACE CALCULATIONS & SITE PLAN DIAGRAM

**HARDSCAPE SURFACE:**

EXIST UNCOVERED PATIOS =	533.3 SF
EXIST WALKWAYS =	100.0 SF
EXIST. ROCKERIES/RETAINING WALLS =	75.0 SF
EXIST. GRVEL WALKWAY =	370.9 SF
NEW UNCOVERED PATIOS =	490.9 SF
EXIST. CONC. PATIO (TO BE REMOVED) =	-533.3 SF
<b>TOTAL HARDSCAPE AREA =</b>	<b>1036.8 SF (5.3%)</b>
ALLOWABLE HARDSCAPE:	1737.2 SF (9%)

**GROSS FLOOR AREA:**

BASEMENT =	899.24 SF
EXISTING MAIN FLOOR =	1466.6 SF
NEW MAIN FLR =	439.7 SF
EXISTING GARAGE =	460.9 SF
MAIN FLOOR COVERED DECK =	236.2 SF
<b>TOTAL GROSS FLOOR AREA =</b>	<b>3502.6 SF (18%)</b>
40% OF 19,302 =	7,720.8 SF ALLOWED

**BASEMENT FLOOR AREA EXEMPTION CALCULATION:** 1456.1 (BSMT SF) X 61.7% (BELOW GRADE %) = 899.24 SF


WALL SEGMENT	LENGTH X	COVERAGE =	RESULT
A	27.1	50.6	15.2
B	53.7	7	3.8
C	27.1	100	27.1
D	53.7	100	53.7
<b>TOTALS</b>	<b>161.6</b>		<b>99.8</b>

**BUILDING HEIGHT:** MAX 30' ABE (AVERAGE BUILDING ELEVATION):  
(MID POINT ELEVATION X LENGTH OF WALL) / TOTAL LENGTH OF WALL SEGMENTS  
(60,044.25) / 229 = 262.2' ABE

**BUILDING HEIGHT:** AVERAGE GRADE = (Aa)+(Bb)+(Cc)+(Dd)/a+b+c+d =  
A=267.6 a=64.2  
B=262.7 b=66.1  
C=269.9 c=64.2  
D=269.0 d=66.1  
(267.6x64.2)+(262.7x66.1)+(269.9x64.2)+(269.0x66.1)/64.2+66.1+64.2+66.1 = 267.3'  
AVERAGE EXISTING GRADE = 267.3', ALLOWABLE HT = 297.3'

NO.	REVISION DATE
▲ 1	CITY CORRECTIONS DATED 6/9/2022
▲ 2	CITY CORRECTIONS DATED 7/26/2022

**FORM + FUNCTION ARCHITECTURE**  
1800 WESTLAKE AVE. N. #205 SEATTLE, WA 98109  
206.372.9796

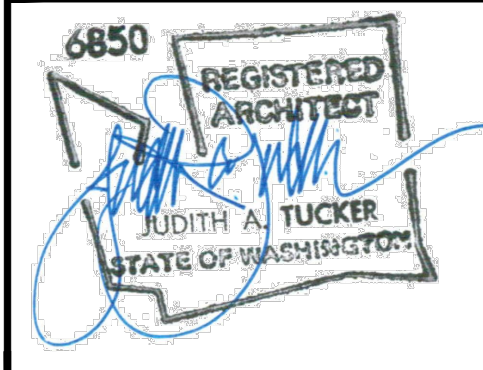

PIPER REMODEL  
8429 SE 33RD PL  
MERCER ISLAND, WA  
98040

PROJECT NO. 1212

DATE 3/29/22  
DRAWN BY JT SD  
CHECKED BY JT

SHEET TITLE  
SITE PLAN  
PROJ INFO

SHEET NO.  
A1.0




**LEGEND**

	CONSTRUCTION ACCESS
	FILTER FENCE
	TREE & VEGETATION PROTECTION

**NOTES:**

1. PROTECT EXIST. TREES DURING CONSTRUCTION. STAY OUT OF DRIP LINES/ OFF ROOTS IF POSSIBLE. COORDINATE W/ OWNER ON ALL PLANTINGS TO BE SALVAGED/ RELOCATED IN CONSTRUCTION AREAS.
2. NO CONSTRUCTION ACTIVITIES TO OCCUR NEAR TOP OF SLOPE- CONTRACTOR TO UTILIZE BMP TO PROTECT EXIST. SITE, VEGETATION, & ROCKERIES TO MINIMIZE SITE DISTURBANCE.

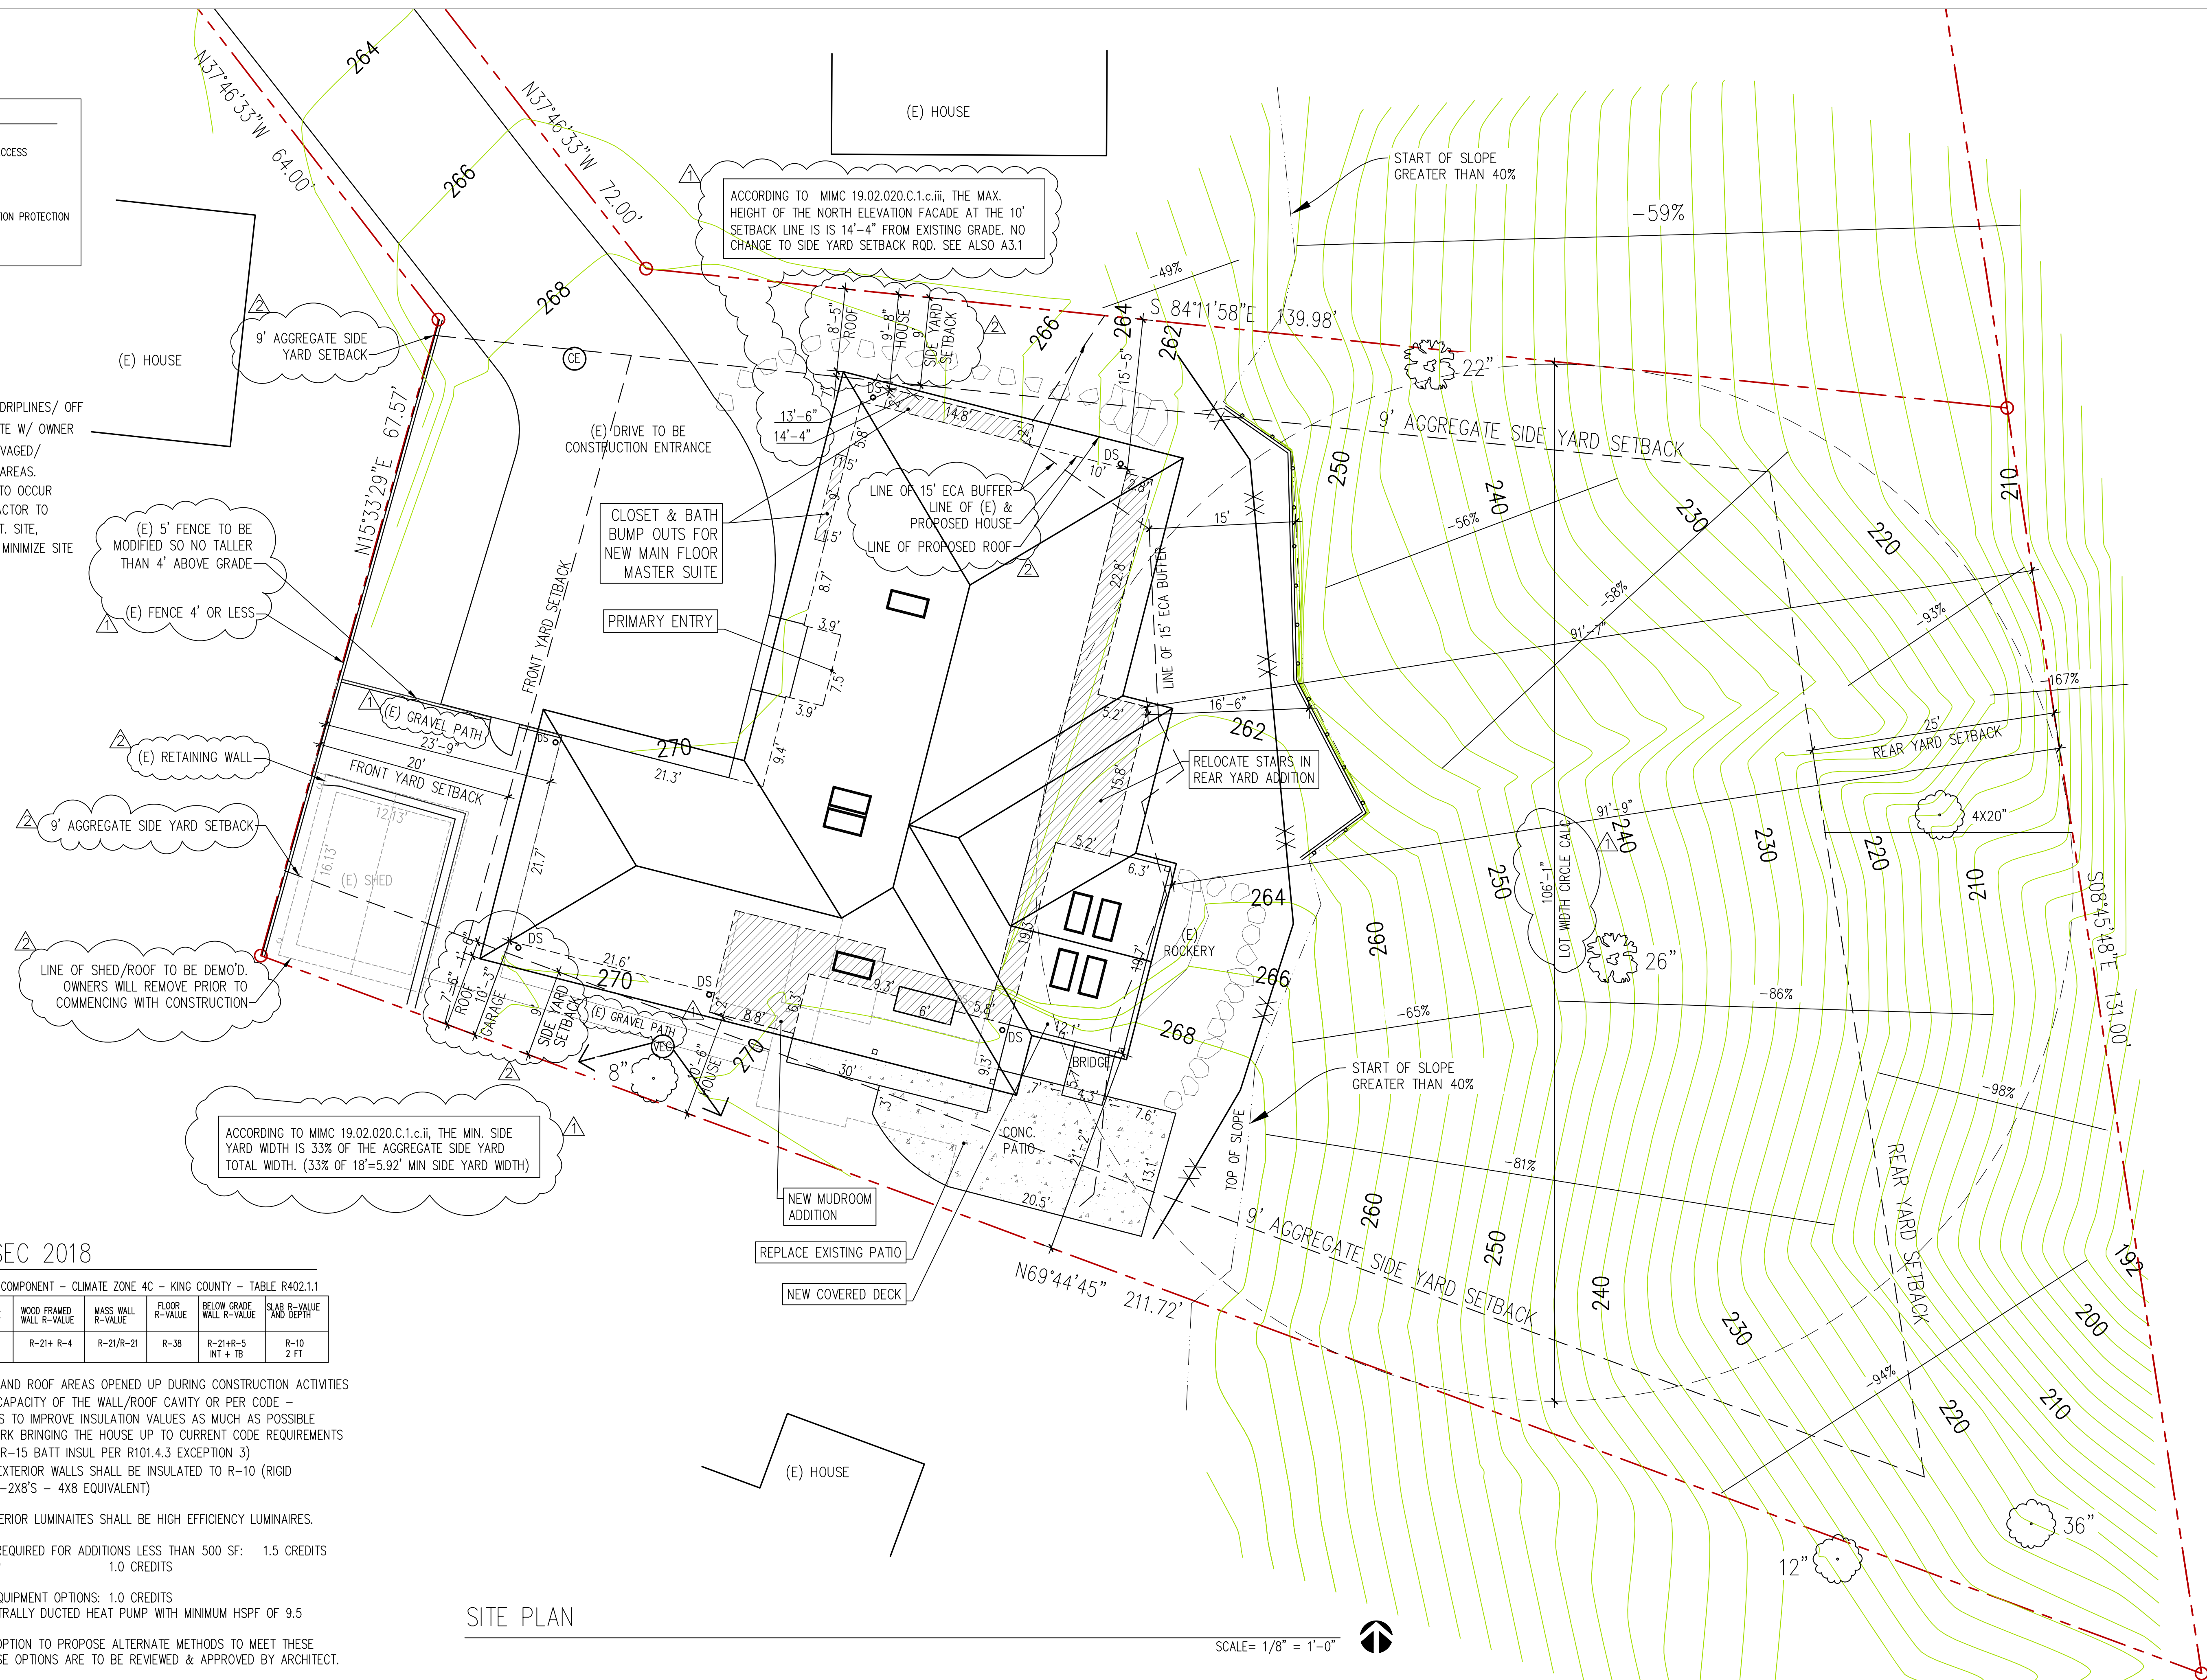

**ENERGY NOTES: WSEC 2018**

INSULATION & FENESTRATION RQMTS BY COMPONENT - CLIMATE ZONE 4C - KING COUNTY - TABLE R402.1.1

FENESTRATION U-FACTOR	SKYLIGHT U-FACTOR	CEILING R-VALUE	WOOD FRAMED WALL R-VALUE	MASS WALL R-VALUE	FLOOR R-VALUE	BELOW GRADE WALL R-VALUE	SLAB R-VALUE AND DEPTH
.24	.50	R-38 VAULTED R-49 FLAT	R-21+ R-4	R-21/R-21	R-38	R-21+R-5 INT + TB	R-10 2 FT

1. ALL EXISTING WALL, FLR, CLG AND ROOF AREAS OPENED UP DURING CONSTRUCTION ACTIVITIES WILL BE INSULATED PER THE CAPACITY OF THE WALL/ROOF CAVITY OR PER CODE - WHICHEVER IS LESS- INTENT IS TO IMPROVE INSULATION VALUES AS MUCH AS POSSIBLE WITHIN THE EXISTING FRAMEWORK BRINGING THE HOUSE UP TO CURRENT CODE REQUIREMENTS (2X6=R-21 BATT INSUL, 2X4=R-15 BATT INSUL PER R101.4.3 EXCEPTION 3)  
ALL NEW HEADERS IN EXTERIOR WALLS SHALL BE INSULATED TO R-10 (RIGID INSULATION BETWEEN 2-2X8'S - 4X8 EQUIVALENT)
2. MINIMUM 75% OF ALL NEW INTERIOR LUMINAITES SHALL BE HIGH EFFICIENCY LUMINAIRES.
3. ADDITIONAL ENERGY CREDITS REQUIRED FOR ADDITIONS LESS THAN 500 SF: 1.5 CREDITS HEATING OPTIONS: HEAT PUMP 1.0 CREDITS  
3 - HIGH EFFICIENCY HVAC EQUIPMENT OPTIONS: 1.0 CREDITS  
3.2 AIR-SOURCED CENTRALLY DUCTED HEAT PUMP WITH MINIMUM HSPF OF 9.5  
CONTRACTOR ALSO HAS THE OPTION TO PROPOSE ALTERNATE METHODS TO MEET THESE ADDITIONAL ENERGY CREDITS - THESE OPTIONS ARE TO BE REVIEWED & APPROVED BY ARCHITECT.


SITE PLAN

SCALE= 1/8" = 1'-0"

NO.	REVISION DATE
	CITY CORRECTIONS DATED 6/9/2022
	CITY CORRECTIONS DATED 7/26/2022

FORM + FUNCTION  
ARCHITECTURE

1800 WESTLAKE AVE. N. #205 SEATTLE, WA 98109  
206.372.9796

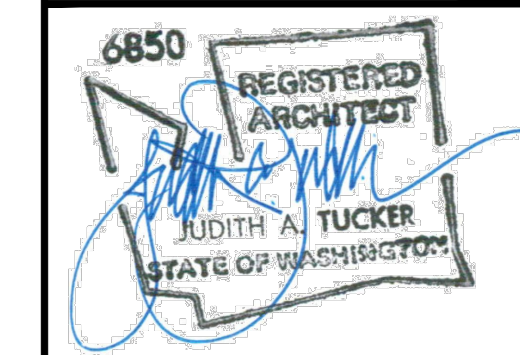




PIPER REMODEL  
8429 SE 33RD PL  
MERCER ISLAND, WA  
98040


PROJECT NO. 1212

DATE	3/4/22
DRAWN BY	JT SD
CHECKED BY	JT
SHEET TITLE	SITE PLAN
SHEET NO.	TEMP. EROSION & SEDIMENT CONTROL

A1.1




LEGEND	
	EXISTING TO REMAIN
	EXISTING TO BE DEMOLISHED
	NEW WALLS

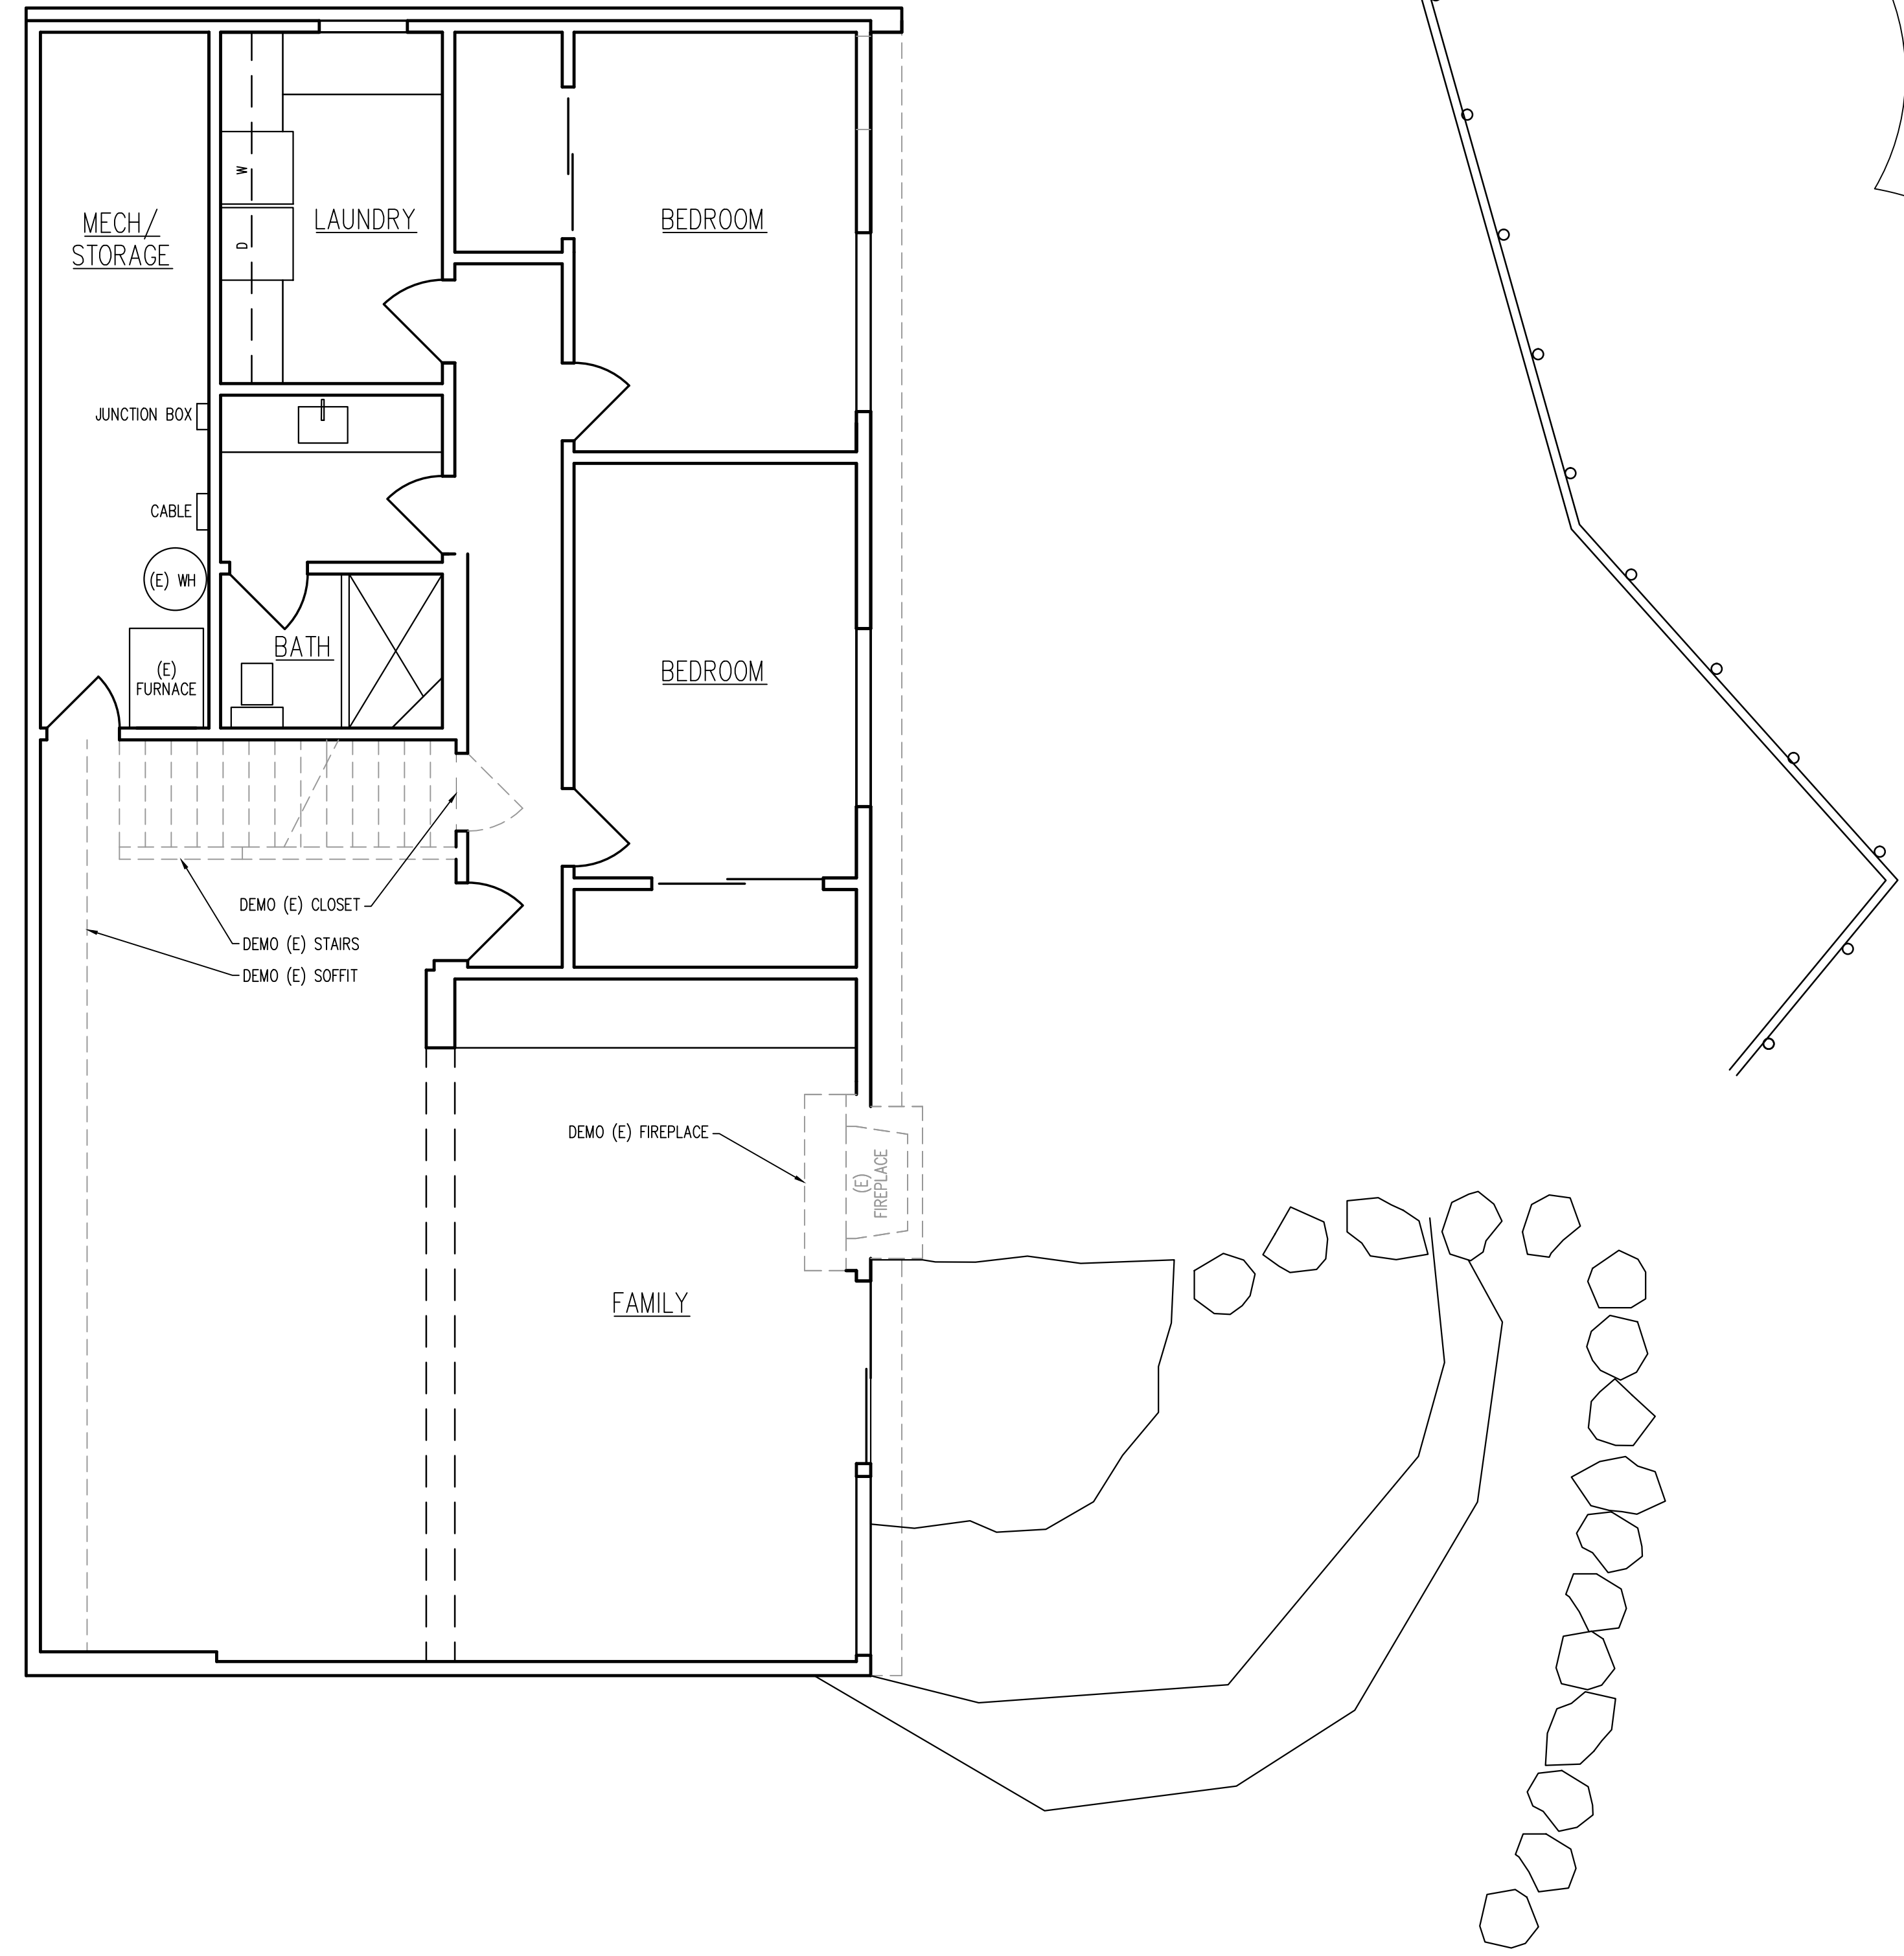


EXISTING BASEMENT DEMO PLAN  
 VERIFY ALL DIMENSIONS TO EXISTING ELEMENTS

1/4"=1'-0"

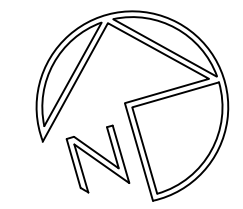

NO.	REVISION DATE
△	CITY CORRECTIONS DATED 6/9/2022

FORM + FUNCTION  
 ARCHITECTURE  
 1800 WESTLAKE AVE. N. #205 SEATTLE, WA 98109  
 206.372.9796

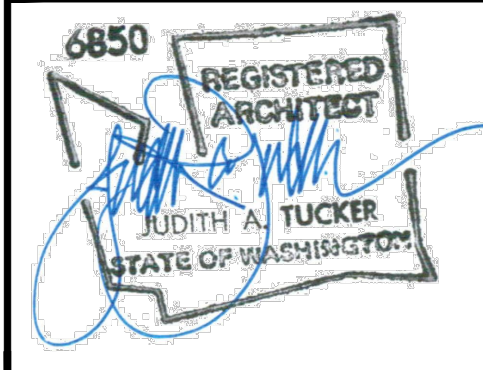

PIPER REMODEL  
 8429 SE 33RD PL  
 MERCER ISLAND, WA  
 98040  
 PROJECT NO. 1212

DATE 6/1/22

DRAWN BY JT SM

CHECKED BY JT


SHEET TITLE  
 EXISTING BSMT  
 PLAN W/ DEMO

SHEET NO.

A2.0



FORM + FUNCTION  
ARCHITECTURE  
1800 WESTLAKE AVE. N. #205 SEATTLE, WA 98109  
206.372.9796

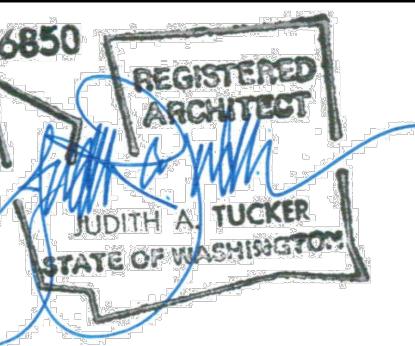


PIPER REMODEL  
8429 SE 33RD PL  
MERCER ISLAND, WA  
98040

PROJECT NO. 1212

DATE 6/1/22  
DRAWN BY JT SM  
CHECKED BY JT

SHEET TITLE  
EXIST. MAIN FLR  
& ROOF PLAN  
W/ DEMO

SHEET NO.  
A2.1

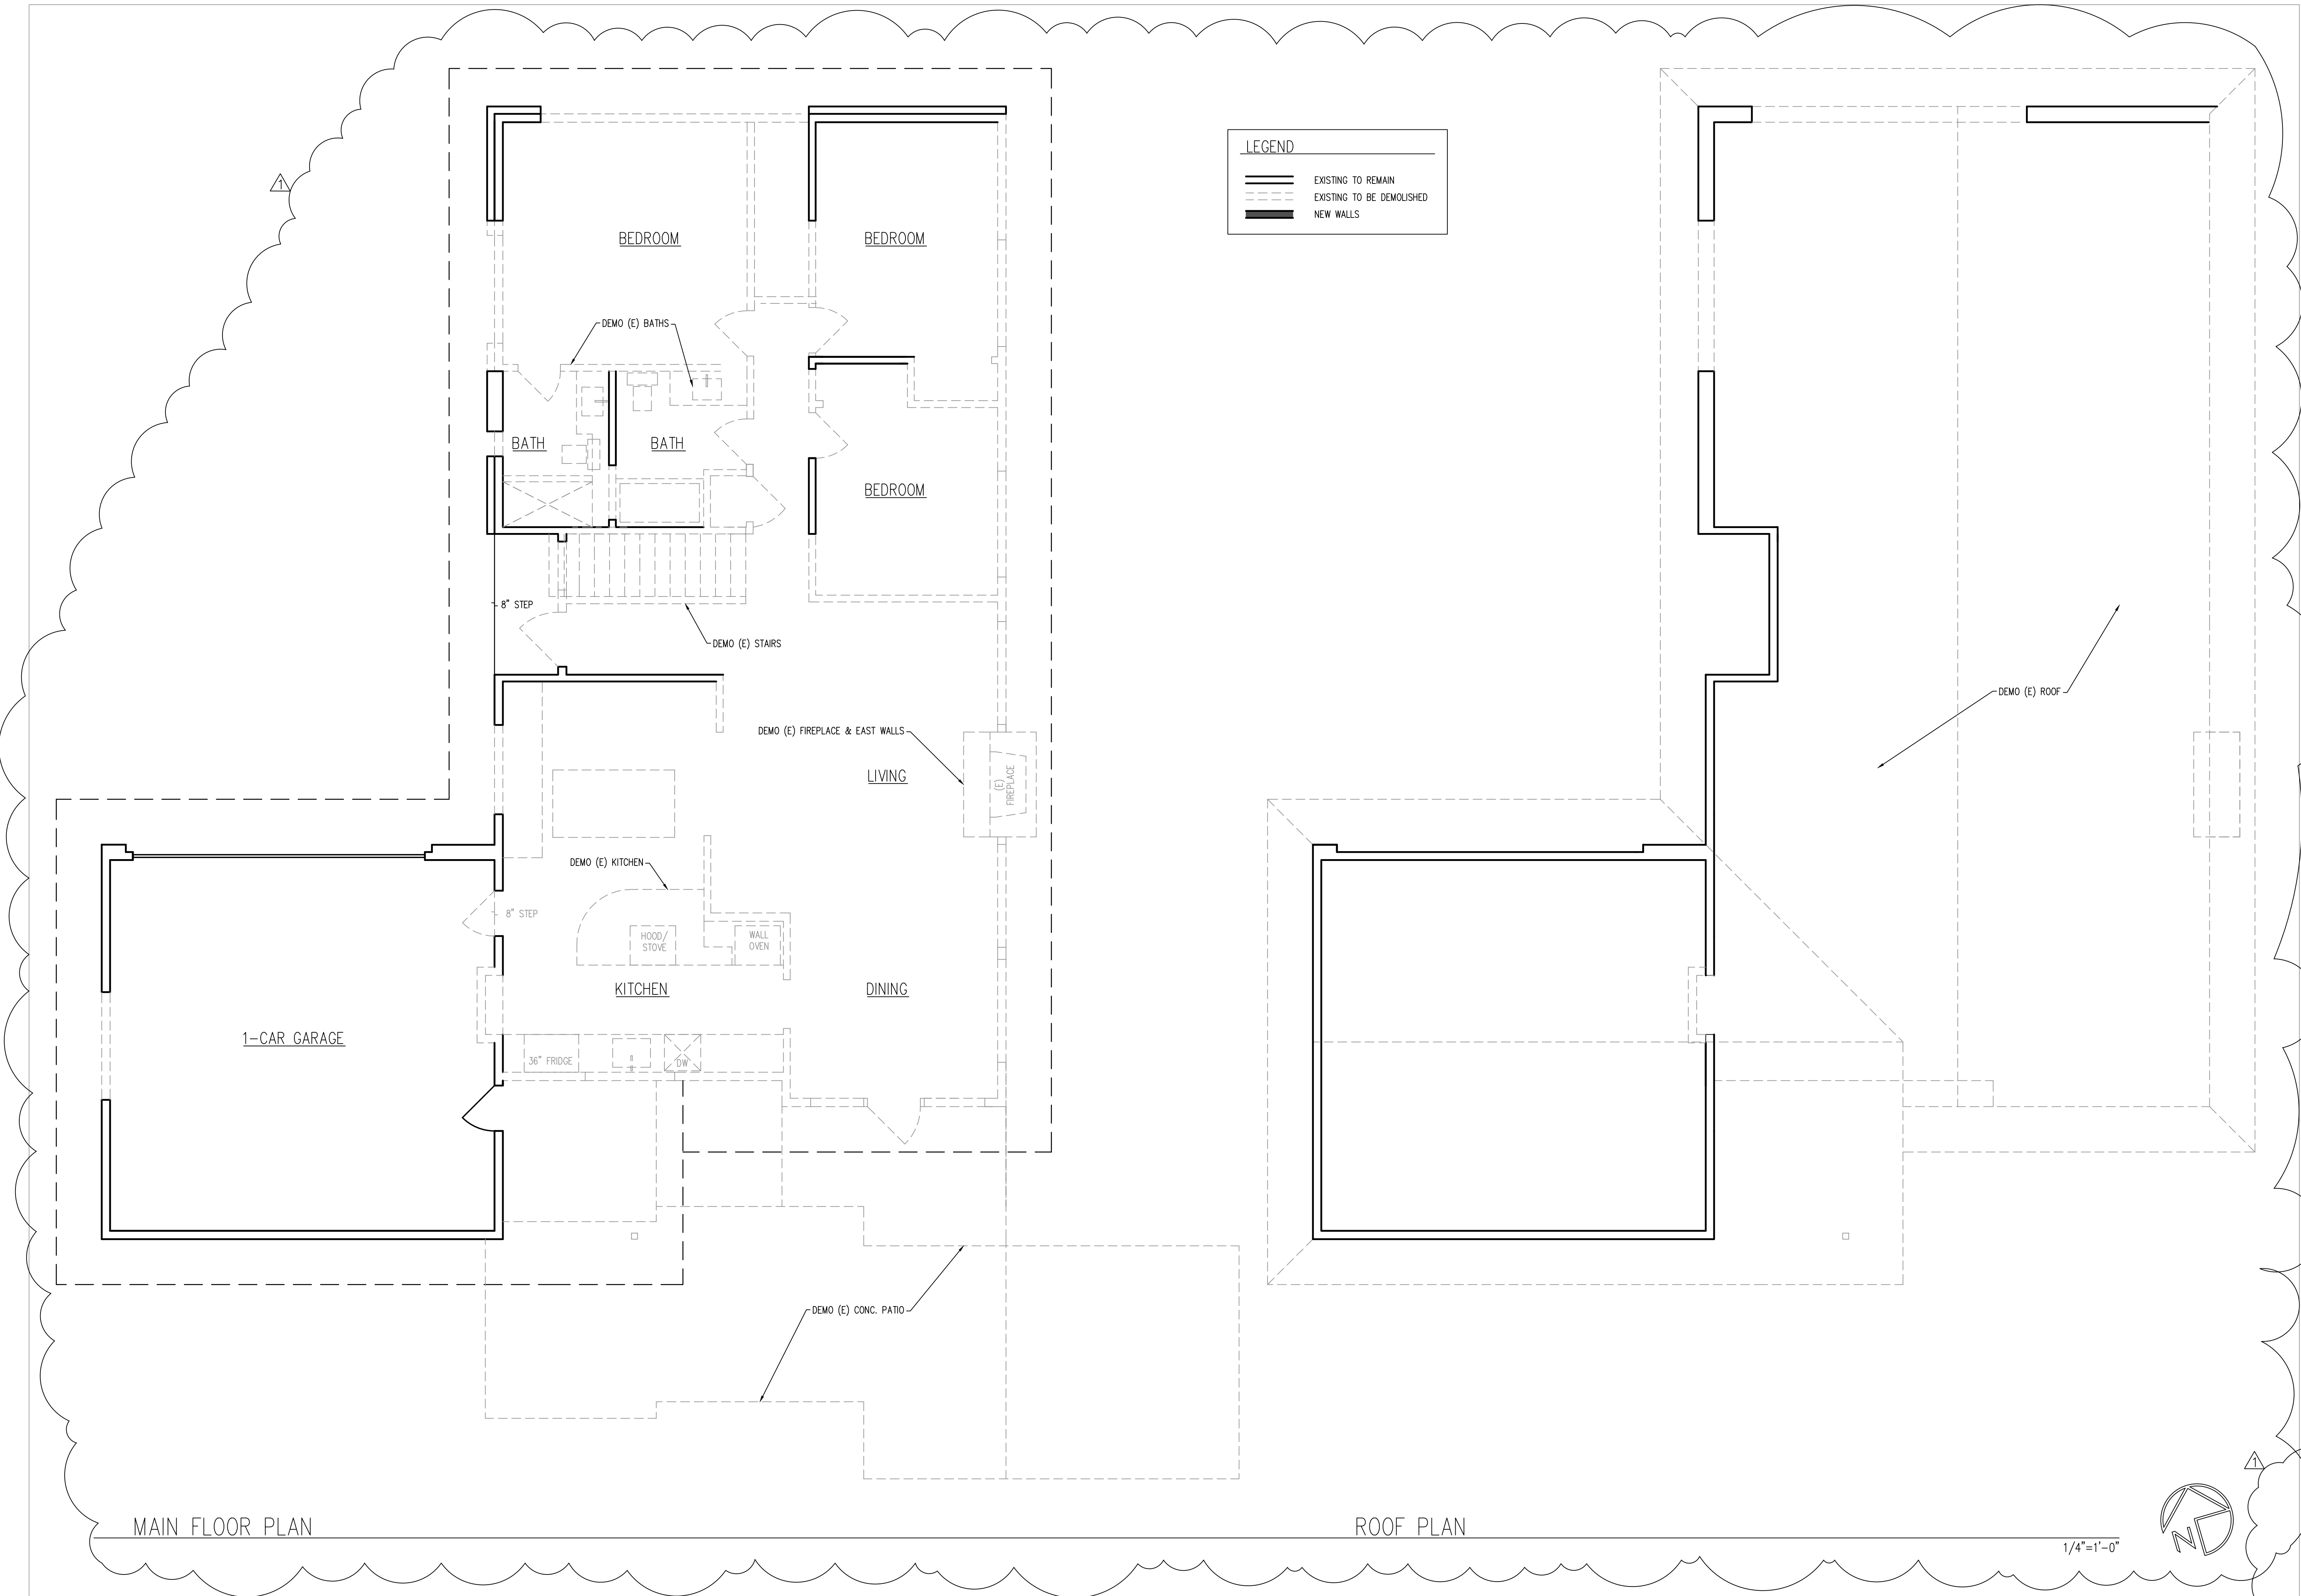


**LEGEND**

- EXISTING TO REMAIN
- EXISTING TO BE DEMOLISHED
- NEW WALLS

MAIN FLOOR PLAN

ROOF PLAN

1/4"=1'-0"

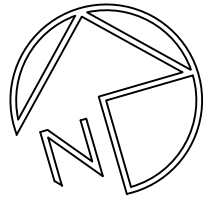








LEGEND	
	EXISTING TO REMAIN
	EXISTING TO BE DEMOLISHED
	NEW WALLS

NO.	REVISION DATE
1	CITY CORRECTIONS DATED 6/9/2022

**FORM + FUNCTION ARCHITECTURE**  
 1800 WESTLAKE AVE. N. #205 SEATTLE, WA 98109  
 206.372.9796

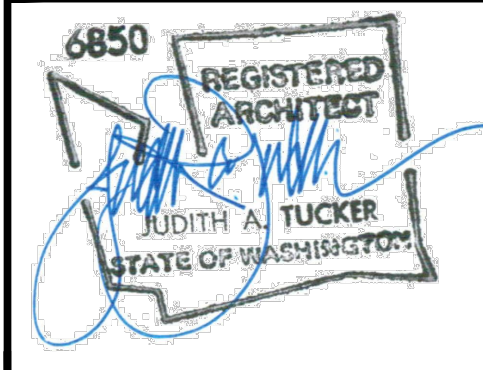


PIPER REMODEL  
 8429 SE 33RD PL  
 MERCER ISLAND, WA 98040  
 PROJECT NO. 1212

DATE	3/29/22
DRAWN BY	JT SM
CHECKED BY	JT

SHEET TITLE  
**MAIN FLR PLAN**

SHEET NO.  
**A2.3**

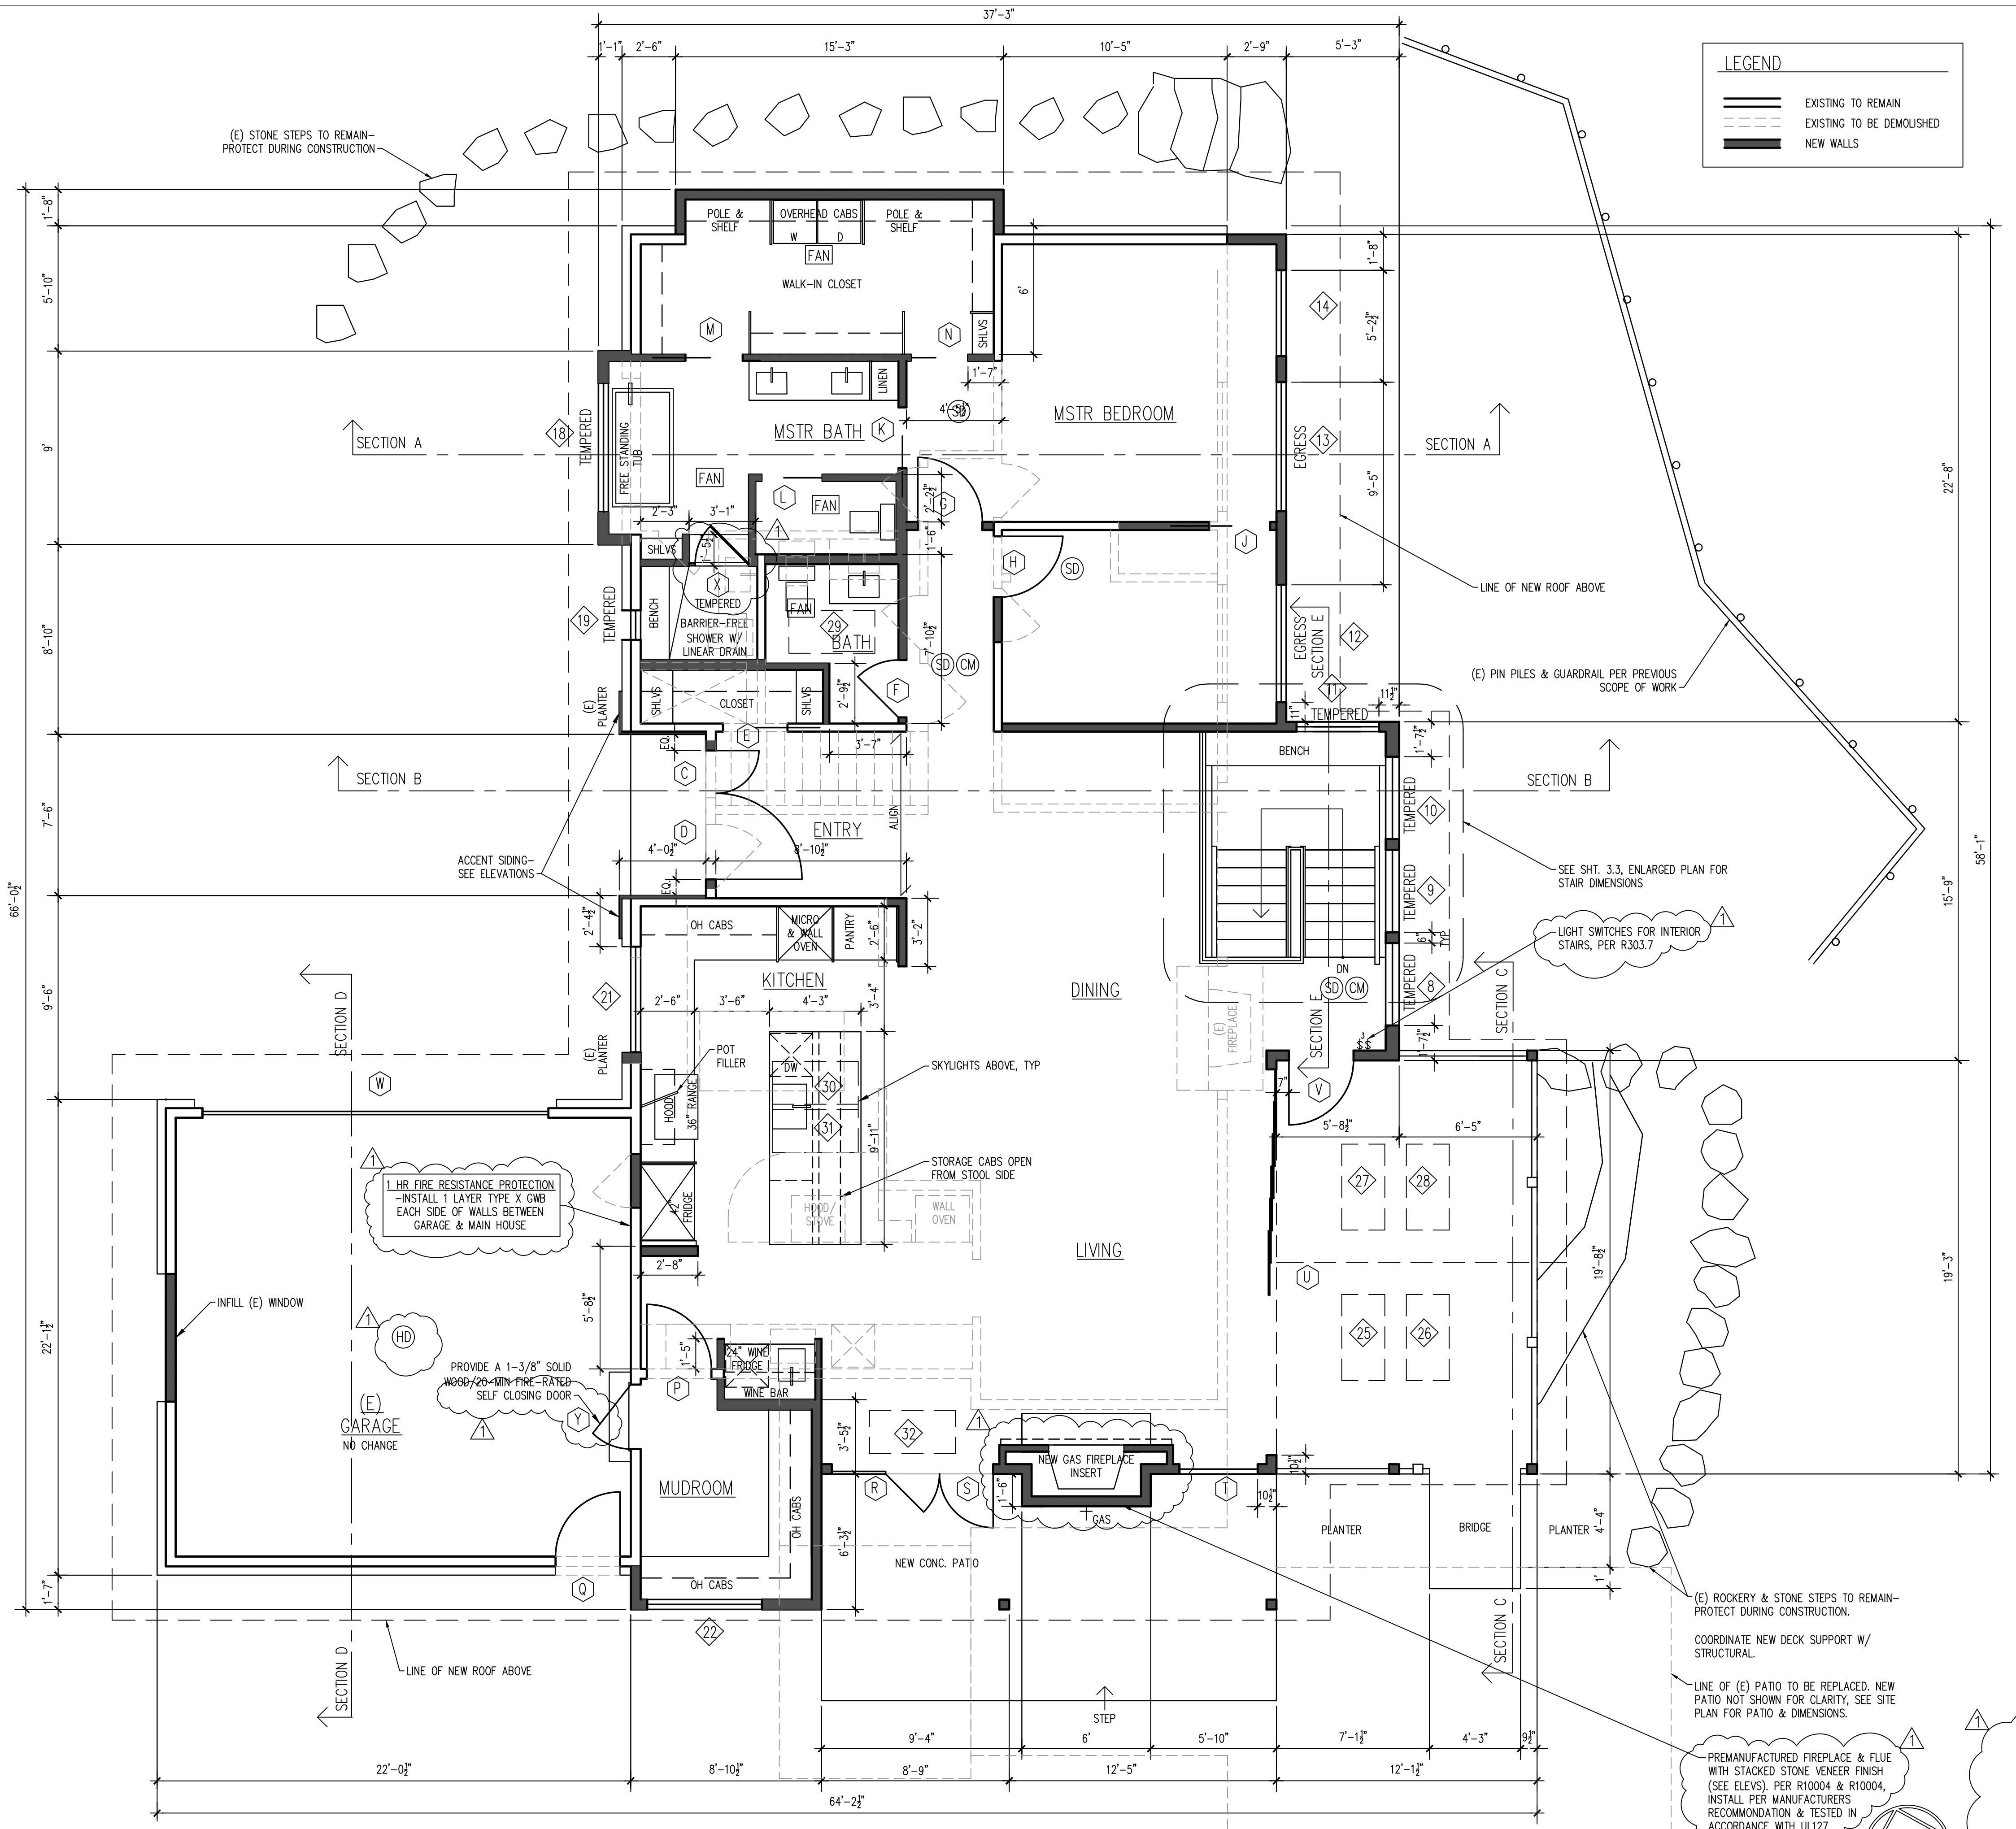

**MAIN FLOOR PLAN**  
 VERIFY ALL DIMENSIONS TO EXISTING ELEMENTS

1/4"=1'-0"

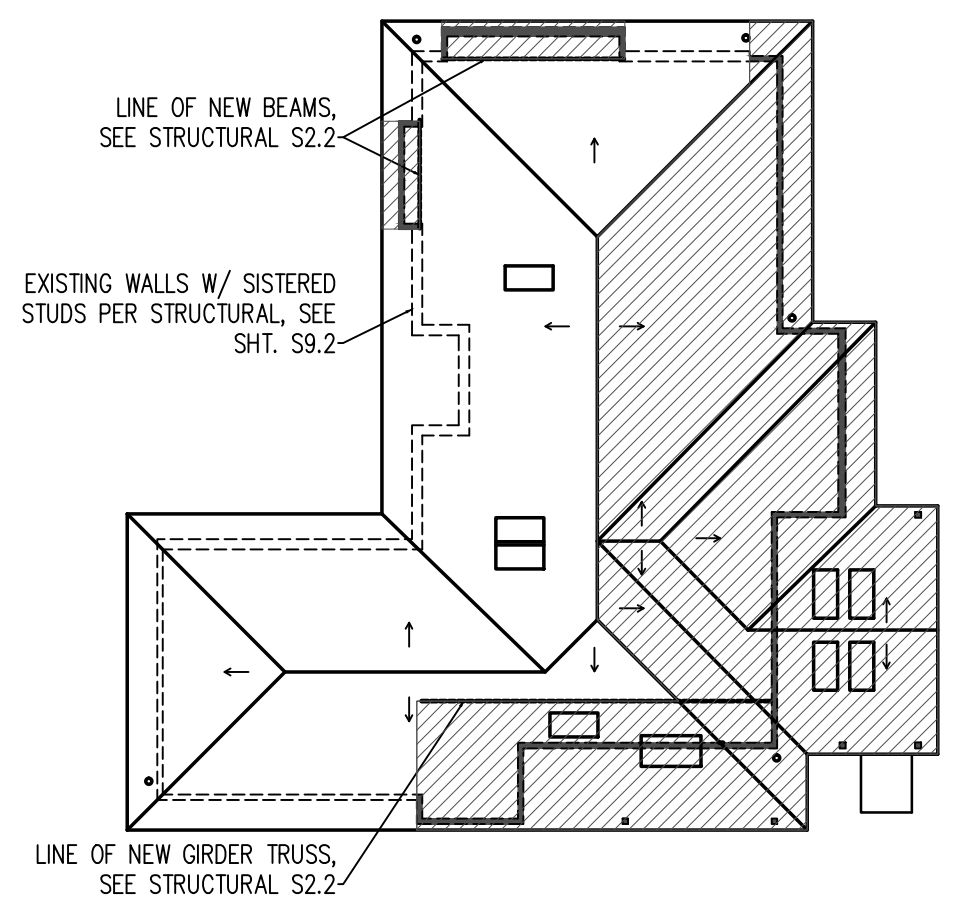
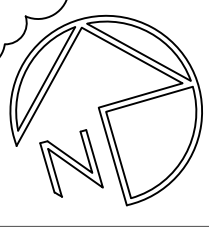


DIAGRAM OF NEW/REPLACED HARD SURFACE FOR STRUCTURES BASED ON SUPPORTED ROOF AREA BY NEW WALLS

NEW/REPLACED HARD SURFACE:	NORTH BAY =	47.82 SF
	WEST BAY =	28.38 SF
	SOUTH/EAST ADDITION =	1493.38 SF
	NEW CONCRETE PATIO =	369.90 SF
	TOTAL =	1939.48 SF

TOTAL NEW/REPLACED HARD SURFACE IS UNDER THE 2000 SF THRESHOLD, THEREFORE, FULL DRAINAGE PLAN & REPORT BY A CIVIL ENGINEER IS NOT REQUIRED.

**STAIR NOTES:**

- WIDTH MIN. 36" CLEAR
- TREAD DEPTH 10" CLEAR (ALLOW FOR 1" OVERHANG - 11" TOTAL)
- RISER HEIGHT 7 1/2" +/- VERIFY W/ EXISTING GRADE/ FLOOR HEIGHTS (MAX. HT. 7.75")
- HANDRAIL MIN. 34", MAX 38" ABOVE TREAD NOSINGS
- HANDRAIL GRASP MIN. 1-1/4", MAX. 2"
- HANDRAIL PROJECTION MAX. 4-1/2" FROM EACH SIDE OF STAIRWAY INTO REQUIRED WIDTH. MIN. 1-1/2" BETWEEN THE WALL
- GUARDRAIL MAX OPENING 4" PER SRC R312.1.3  
 MIN. UNIFORMLY DISTRIBUTED LIVE LOADS (LBS PER SF)  
 200LB CONCENTRATED LOAD ON THE TOP RAIL & 50 PSF ON GUARDRAIL INFILL COMPONENTS PER SRC R301.5-  
 SEE STRUCTURAL FOR DETAILS

**NOTES:**

1. CONTRACTOR WILL APPLY FOR PLUMBING, MECHANICAL, ELECTRICAL PERMITS SEPARATELY. CONTRACTOR TO REVIEW EXISTING CONDITIONS PRIOR TO STARTING CONSTRUCTION.
2. ALL WALLS THAT HAVE FINISHES REMOVED WILL BE SUBJECT TO CURRENT CODE REQMTS - INCLUDES PLUMBING/MECHANICAL/ELECTRICAL/INSULATION.
3. WHOLE HOUSE FAN SHALL BE LOCATED/ASSOCIATED WITH THE MAIN FLOOR GUEST BATH, THIS FAN TO BE EQUIPPED WITH CONTROLS CAPABLE OF MANUAL AND AUTOMATIC OPERATION, SUCH AS A CLOCK TIMER AND SHALL BE DESIGNED TO RUN CONTINUOUSLY PER SRC M1507.3.3.
- 3.1. IN NEW MASTER BATH & CLOSET- INSTALL PANASONIC WHISPERQUET FAN SIZED PER SPACE. (75 C.F.M., 1.0 SONES OR BETTER). FAN SHALL TERMINATE VERTICALLY TO THE EXTERIOR OF THE HOUSE.
- 3.2. NEW KITCHEN HOOD ON MAIN FLOOR TO BE SELECTED- MIN 100 C.F.M., 1.5 SONES OR BETTER. FANS SHALL TERMINATE HORIZONTALLY TO THE EXTERIOR OF THE HOUSE.
4. DOOR JAMBS SHALL BE 3 1/2" TYPICAL, UNLESS NOTED OTHERWISE.
5. SEE SHTS A3.0 & A3.2 FOR WINDOW & DOOR SCHEDULES AND ELEVATIONS (A3.0 & A3.1) FOR ADDITIONAL INFORMATION.
6. PROVIDE BLOCKING FOR FUTURE GRAB BARS IN BOTH MAIN FLOOR BATHROOMS.

1 HR FIRE RESISTANCE PROTECTION  
 -INSTALL 1 LAYER TYPE X GWB  
 EACH SIDE OF WALLS BETWEEN  
 GARAGE & MAIN HOUSE

PROVIDE A 1-3/8" SOLID  
 W860/26-MIN-FIRE-RATED  
 SELF CLOSING DOOR


(E) ROCKERY & STONE STEPS TO REMAIN-  
 PROTECT DURING CONSTRUCTION.  
 COORDINATE NEW DECK SUPPORT W/  
 STRUCTURAL.

PREMANUFACTURED FIREPLACE & FLUE  
 WITH STACKED STONE VENER FINISH  
 (SEE ELEV). PER R10004 & R10004.  
 INSTALL PER MANUFACTURERS  
 RECOMMENDATION & TESTED IN  
 ACCORDANCE WITH UL127.



NO.	REVISION DATE
△	CITY CORRECTIONS DATED 6/9/2022
△	CLIENT REVISIONS DATED 6/9/2022

**FORM + FUNCTION ARCHITECTURE**  
 1800 WESTLAKE AVE. N. #205 SEATTLE, WA 98109  
 206.372.9796

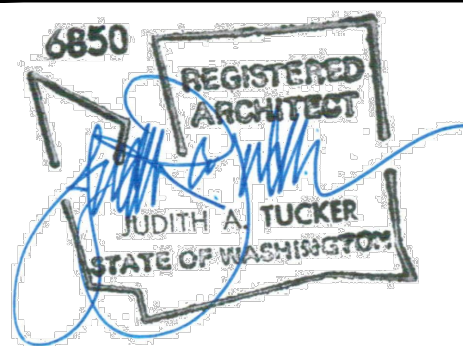


PIPER REMODEL  
 8429 SE 33RD PL  
 MERCER ISLAND, WA  
 98040  
 PROJECT NO. 1212

DATE: 3/4/22  
 DRAWN BY: JT SM  
 CHECKED BY: JT

SHEET TITLE:  
 EXTERIOR ELEV  
 ROOF PLAN  
 WINDOW SCHEDULE

SHEET NO.  
A3.0

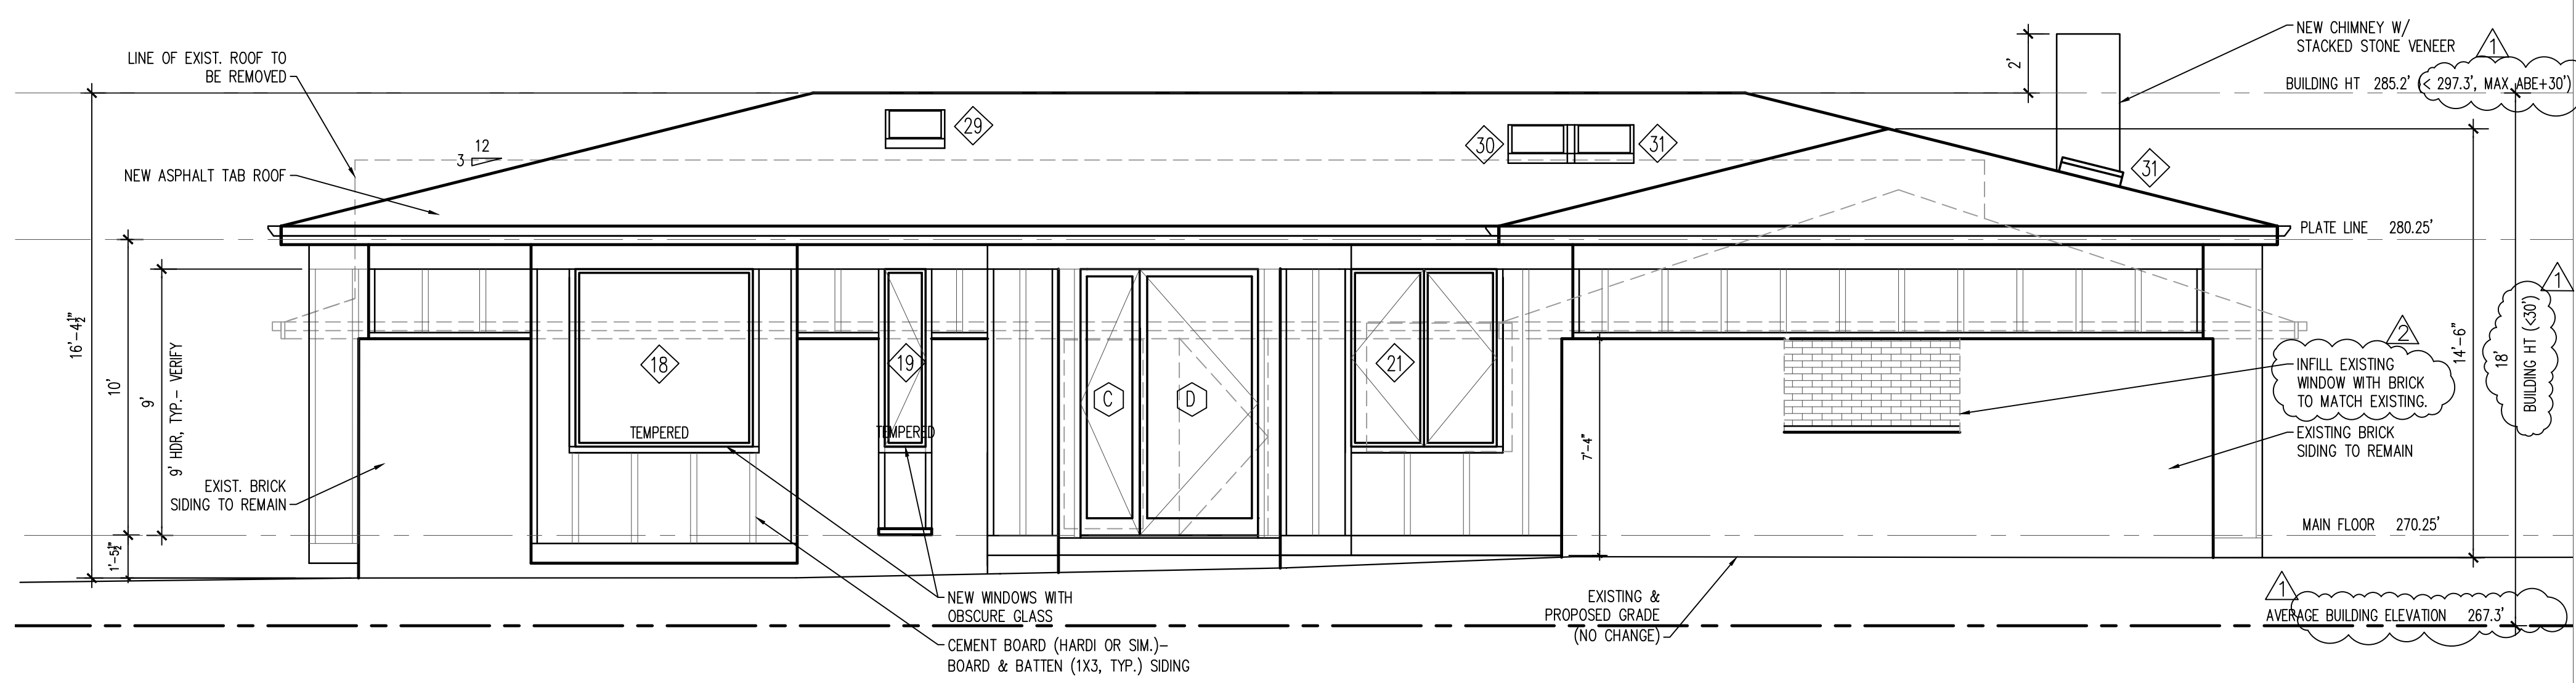

WEST ELEVATION  
SEE SHT. A3.2 FOR DOOR SCHEDULE

1/4"=1'-0"

WINDOW SCHEDULE- BASEMENT & MAIN FLOOR

MARK	WINDOW SIZE	OPERATION	MATERIAL	MFGR	GLAZING	U-VALUE	NOTES
1	5'-9" x 4'-2"	FIXED	THERMAL BREAK WOOD CLAD	MARVIN SIGNATURE MODERN	LOW-E, CLR	0.27 MIN	ARGON
2	5'-10" x 4'-2"	FIXED	THERMAL BREAK WOOD CLAD	MARVIN SIGNATURE MODERN	LOW-E, CLR	0.27 MIN	ARGON
3	3'-10" x 4'-2"	FIXED	THERMAL BREAK WOOD CLAD	MARVIN SIGNATURE MODERN	LOW-E, CLR	0.27 MIN	ARGON, TEMPERED MULLED WITH #8
4	3'-10" x 4'-2"	FIXED	THERMAL BREAK WOOD CLAD	MARVIN SIGNATURE MODERN	LOW-E, CLR	0.27 MIN	ARGON, TEMPERED MULLED WITH #9
5	5'-6" x 4'-2"	CSMT	THERMAL BREAK WOOD CLAD	MARVIN SIGNATURE MODERN	LOW-E, CLR	0.28 MIN	ARGON, EGRESS
6	5'-6" x 4'-2"	CSMT	THERMAL BREAK WOOD CLAD	MARVIN SIGNATURE MODERN	LOW-E, CLR	0.28 MIN	ARGON, EGRESS
7	3'-0" x 2'-4"	AWNING	THERMAL BREAK WOOD CLAD	MARVIN SIGNATURE MODERN	LOW-E, CLR	0.28 MIN	ARGON, (E) OPENING
8	3'-10" x 10'-8"	FIXED	THERMAL BREAK WOOD CLAD	MARVIN SIGNATURE MODERN	LOW-E, CLR	0.27 MIN	ARGON, TEMPERED MULLED WITH #3
9	3'-10" x 10'-8"	FIXED	THERMAL BREAK WOOD CLAD	MARVIN SIGNATURE MODERN	LOW-E, CLR	0.27 MIN	ARGON, TEMPERED MULLED WITH #4
10	3'-10" x 10'-8"	FIXED	THERMAL BREAK WOOD CLAD	MARVIN SIGNATURE MODERN	LOW-E, CLR	0.27 MIN	ARGON, TEMPERED
11	3'-10" x 10'-8"	FIXED	THERMAL BREAK WOOD CLAD	MARVIN SIGNATURE MODERN	LOW-E, CLR	0.27 MIN	ARGON, TEMPERED
12	5'-6" x 6'-2"	CSMT	THERMAL BREAK WOOD CLAD	MARVIN SIGNATURE MODERN	LOW-E, CLR	0.28 MIN	ARGON, EGRESS
13	6'-0" x 6'-2"	CSMT	THERMAL BREAK WOOD CLAD	MARVIN SIGNATURE MODERN	LOW-E, CLR	0.28 MIN	ARGON, EGRESS
14	4'-0" x 6'-2"	FIXED	THERMAL BREAK WOOD CLAD	MARVIN SIGNATURE MODERN	LOW-E, CLR	0.27 MIN	ARGON
15	3'-0" x 2'-2"	FIXED	THERMAL BREAK WOOD CLAD	MARVIN SIGNATURE MODERN	LOW-E, CLR	0.27 MIN	ARGON, TRANSOM
16	3'-0" x 2'-2"	FIXED	THERMAL BREAK WOOD CLAD	MARVIN SIGNATURE MODERN	LOW-E, CLR	0.27 MIN	ARGON, TRANSOM
17	3'-0" x 2'-2"	FIXED	THERMAL BREAK WOOD CLAD	MARVIN SIGNATURE MODERN	LOW-E, CLR	0.27 MIN	ARGON, TRANSOM
18	6'-0" x 6'-0"	FIXED	THERMAL BREAK WOOD CLAD	MARVIN SIGNATURE MODERN	LOW-E, OBSCURE	0.27 MIN	ARGON, TEMPERED SANDBLASTED
19	1'-4" x 6'-0"	CSMT	THERMAL BREAK WOOD CLAD	MARVIN SIGNATURE MODERN	LOW-E, OBSCURE	0.28 MIN	ARGON, TEMPERED SANDBLASTED
20	6'-0" x 1'-9"	FIXED	THERMAL BREAK WOOD CLAD	MARVIN SIGNATURE MODERN	LOW-E, CLR	0.27 MIN	ARGON, TRANSOM
21	4'-11" x 6'-0"	CSMT	THERMAL BREAK WOOD CLAD	MARVIN SIGNATURE MODERN	LOW-E, CLR	0.28 MIN	ARGON
22	5'-4" x 1'-6"	FIXED	THERMAL BREAK WOOD CLAD	MARVIN SIGNATURE MODERN	LOW-E, CLR	0.27 MIN	ARGON
23	7'-6" x 1'-9"	FIXED	THERMAL BREAK WOOD CLAD	MARVIN SIGNATURE MODERN	LOW-E, CLR	0.27 MIN	ARGON, TRANSOM
24	3'-0" x 1'-9"	FIXED	THERMAL BREAK WOOD CLAD	MARVIN SIGNATURE MODERN	LOW-E, CLR	0.27 MIN	ARGON, TRANSOM

LEGEND


	EXISTING TO REMAIN
	EXISTING TO BE DEMOLISHED
	NEW WALLS

WINDOW SCHEDULE- ROOF

MARK	WINDOW SIZE	OPERATION	MATERIAL	MFGR	GLAZING	U-VALUE	NOTES
25	2'-0" x 4'-0"	SKYLIGHT	ALUMINUM	VELUX	LOW-E, CLR	0.50	ARGON
26	2'-0" x 4'-0"	SKYLIGHT	ALUMINUM	VELUX	LOW-E, CLR	0.50	ARGON
27	2'-0" x 4'-0"	SKYLIGHT	ALUMINUM	VELUX	LOW-E, CLR	0.50	ARGON
28	2'-0" x 4'-0"	SKYLIGHT	ALUMINUM	VELUX	LOW-E, CLR	0.50	ARGON
29	2'-0" x 4'-0"	SKYLIGHT	ALUMINUM	VELUX	LOW-E, CLR	0.50	ARGON
30	2'-0" x 4'-0"	SKYLIGHT	ALUMINUM	VELUX	LOW-E, CLR	0.50	ARGON
31	2'-0" x 4'-0"	SKYLIGHT	ALUMINUM	VELUX	LOW-E, CLR	0.50	ARGON
32	2'-0" x 4'-0"	SKYLIGHT	ALUMINUM	VELUX	LOW-E, CLR	0.50	ARGON

WINDOW GENERAL NOTES:

- ALL WINDOWS TO BE NFRC CERTIFIED.
- CONTRACTOR TO CONFIRM ROUGH OPENING REQUIREMENT W/ MNFR
- WINDOW MFGR TO BE MARVIN SIGNATURE MODERN (VELUX FOR SKYLIGHTS). SCHEDULE ASSUMES ALUMINUM (EBONY FINISH) W/ LOW E 272 GLASS-ARGON. SUBSTITUTIONS ARE ACCEPTABLE AS LONG AS WINDOWS MEET THE ENERGY CODE REQMTS LISTED ON SHEET A1.0
- ALL EXTERIOR WINDOW OPENINGS TO BE WRAPPED W/ VIDAFLX FOR APPROVED EQUAL PEEL & STICK MEMBRANE AND METAL FLASHINGS PER NORTHWEST WALL AND CEILING BUREAU STANDARD DETAILS.
- INSTALL TEMPERED/SAFETY GLAZING AS REQUIRED PER IRC R308 AND NOTED ABOVE.

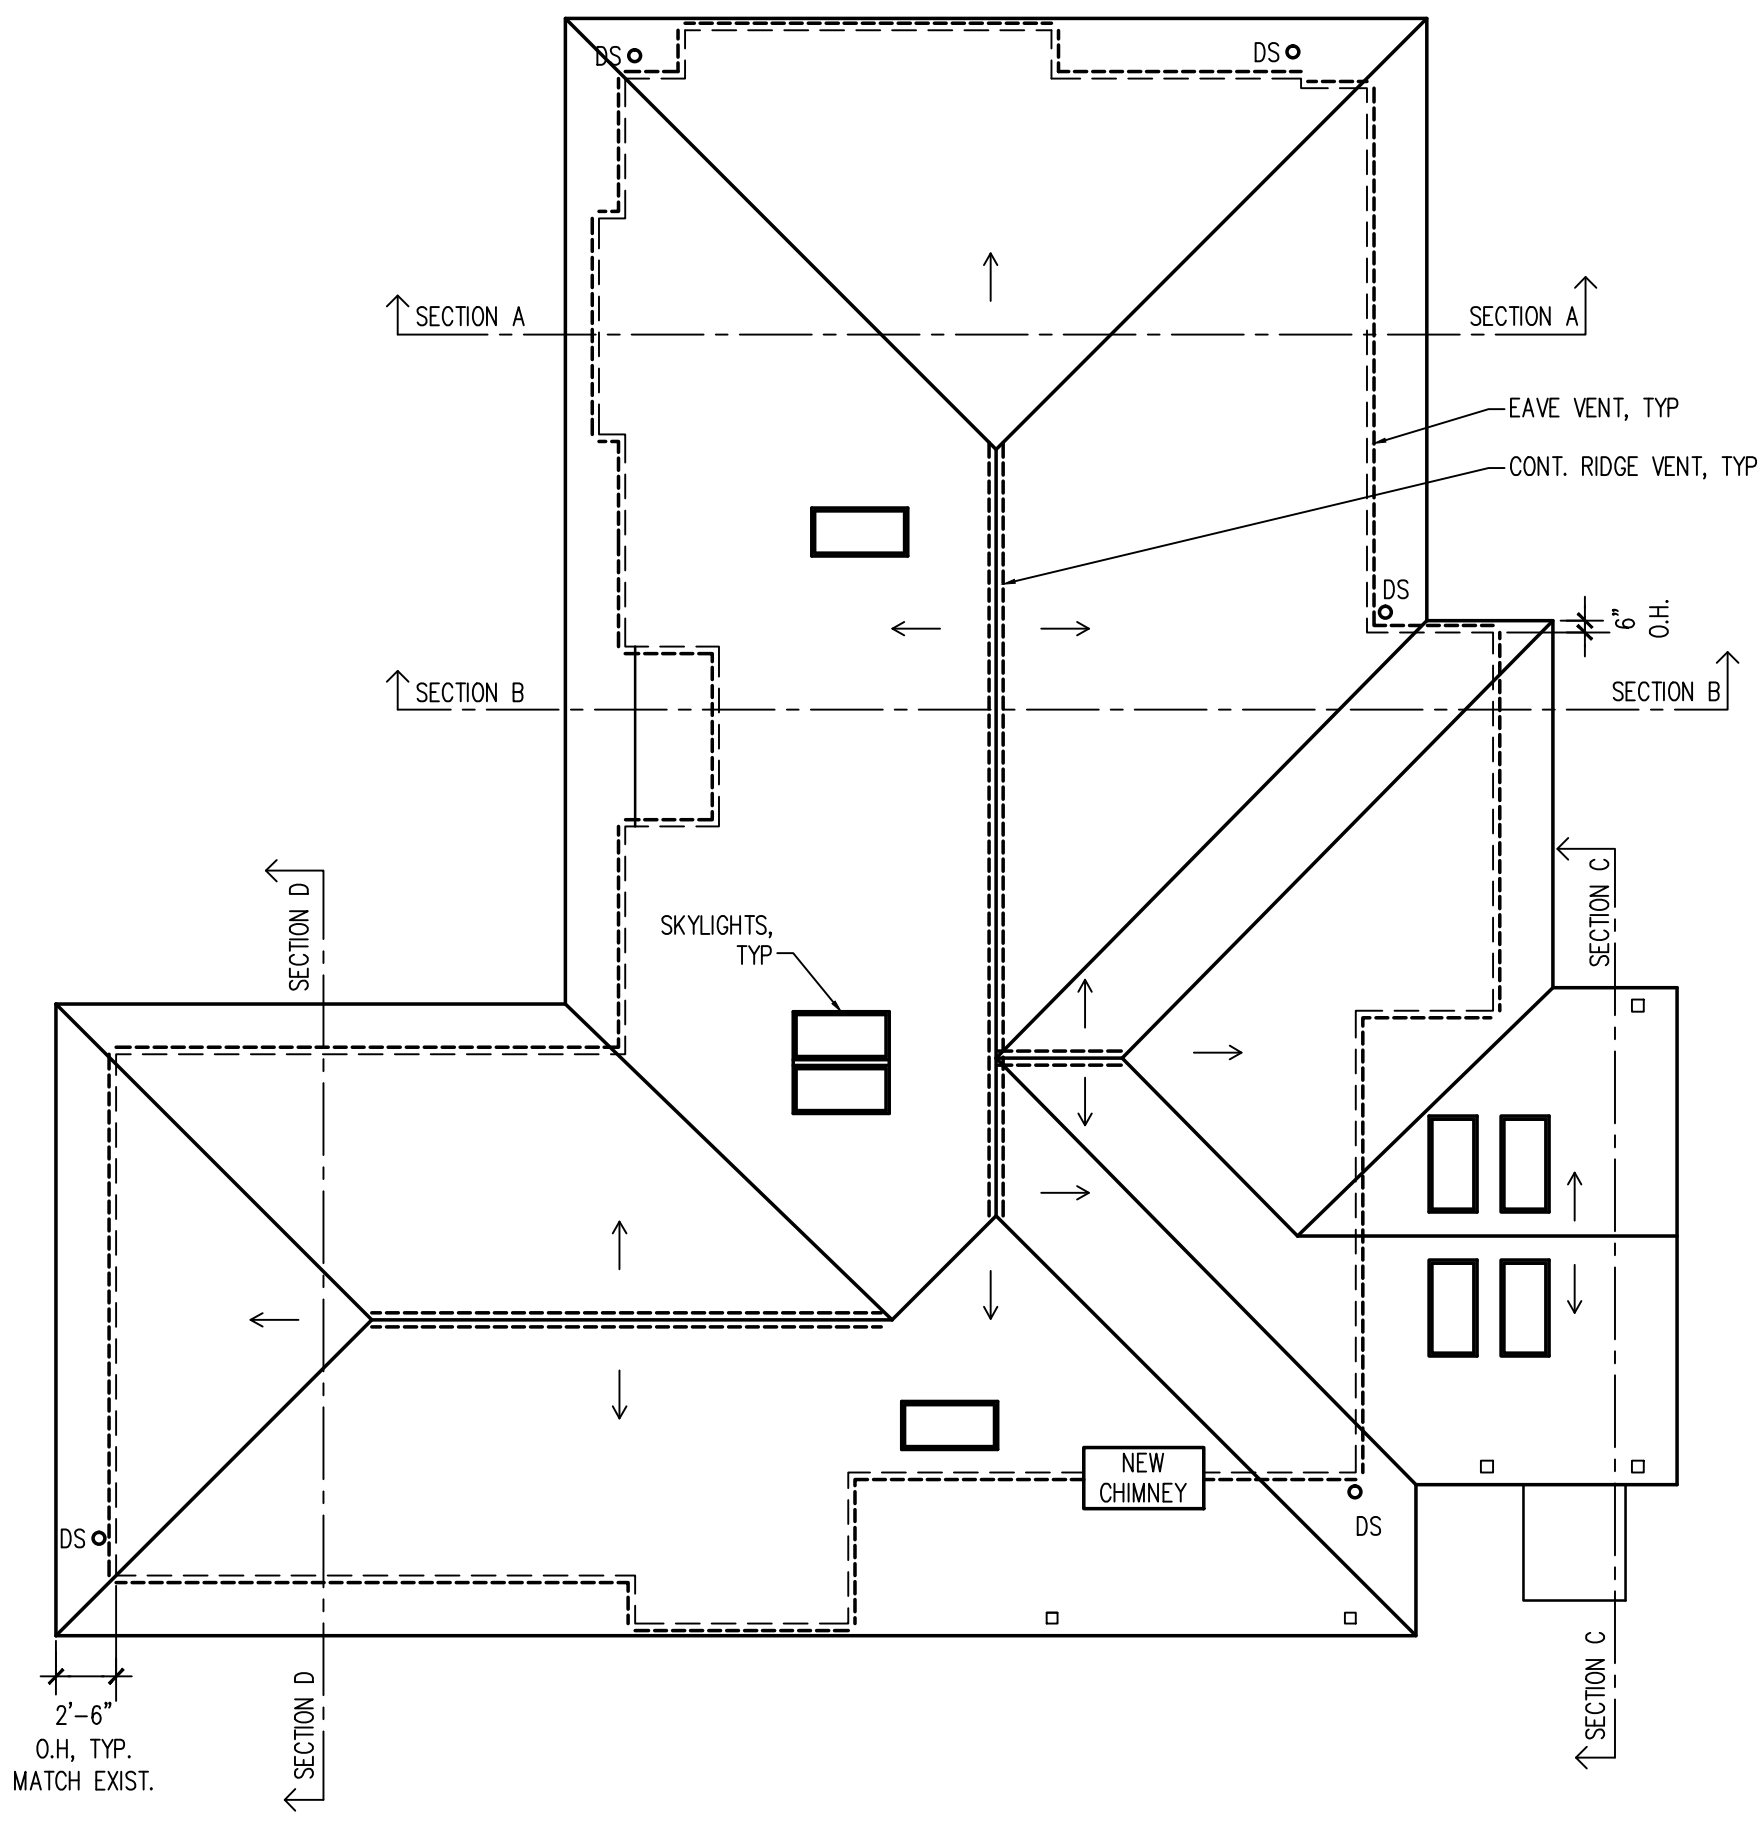

ROOF PLAN  
CONNECT ALL NEW GUTTERS/ DOWNSPOUTS TO EXISTING SITE DRAINAGE SYSTEM  
1/8"=1'-0"

ROOF VENTILATION NOTES:

CONTRACTOR TO PROVIDE NEW VENTING TO MEET CODE REQUIREMENTS PER IRC R806.2 (SEE NOTES ON ROOF PLAN FOR PROPOSED VENTILATION SOLUTIONS):

1 SQ.FT. OF VENTING PER 300 SQ.FT. OF AREA TO BE VENTED (1/150 REDUCED TO 1/300 PROVIDED THAT AT LEAST 40% AND NOT MORE THAN 50% OF THE RQD VENTING PROVIDED IN THE UPPER PORTION OF THE SPACE - MIN 3' ABOVE EAVE LINE.


1" AIR SPACE REQUIRED ABOVE ROOF INSULATION  
EAVE/SOFFIT VENTS - (3) 2" DIAMETER VENTS PER RAFTER BAY 9 SQ IN +/- PER BAY MIN.

HOUSE/GARAGE: 2396.5 SF/300= 8.0 SF (1152.0 SQ IN) RQD  
RIDGE: REQUIRED: 576.0 SQ IN RQD (32.0 LF)  
PROPOSED: 1056.5 SQ IN (58.7 LF)

SOFFIT: REQUIRED: 576.0 SQ IN RQD (64 RAFTER BAYS)  
PROPOSED: 1053.0 SQ IN (117.0 RAFTER BAYS)

PROPOSED VENTILATION MEETS/EXCEEDS CODE RQMT FOR 1/300 FOR UNIQUE SITUATIONS THAT ARISE DURING CONSTRUCTION COORDINATE VENTILATION (& INSULATION) RQMTS WITH ARCHITECT




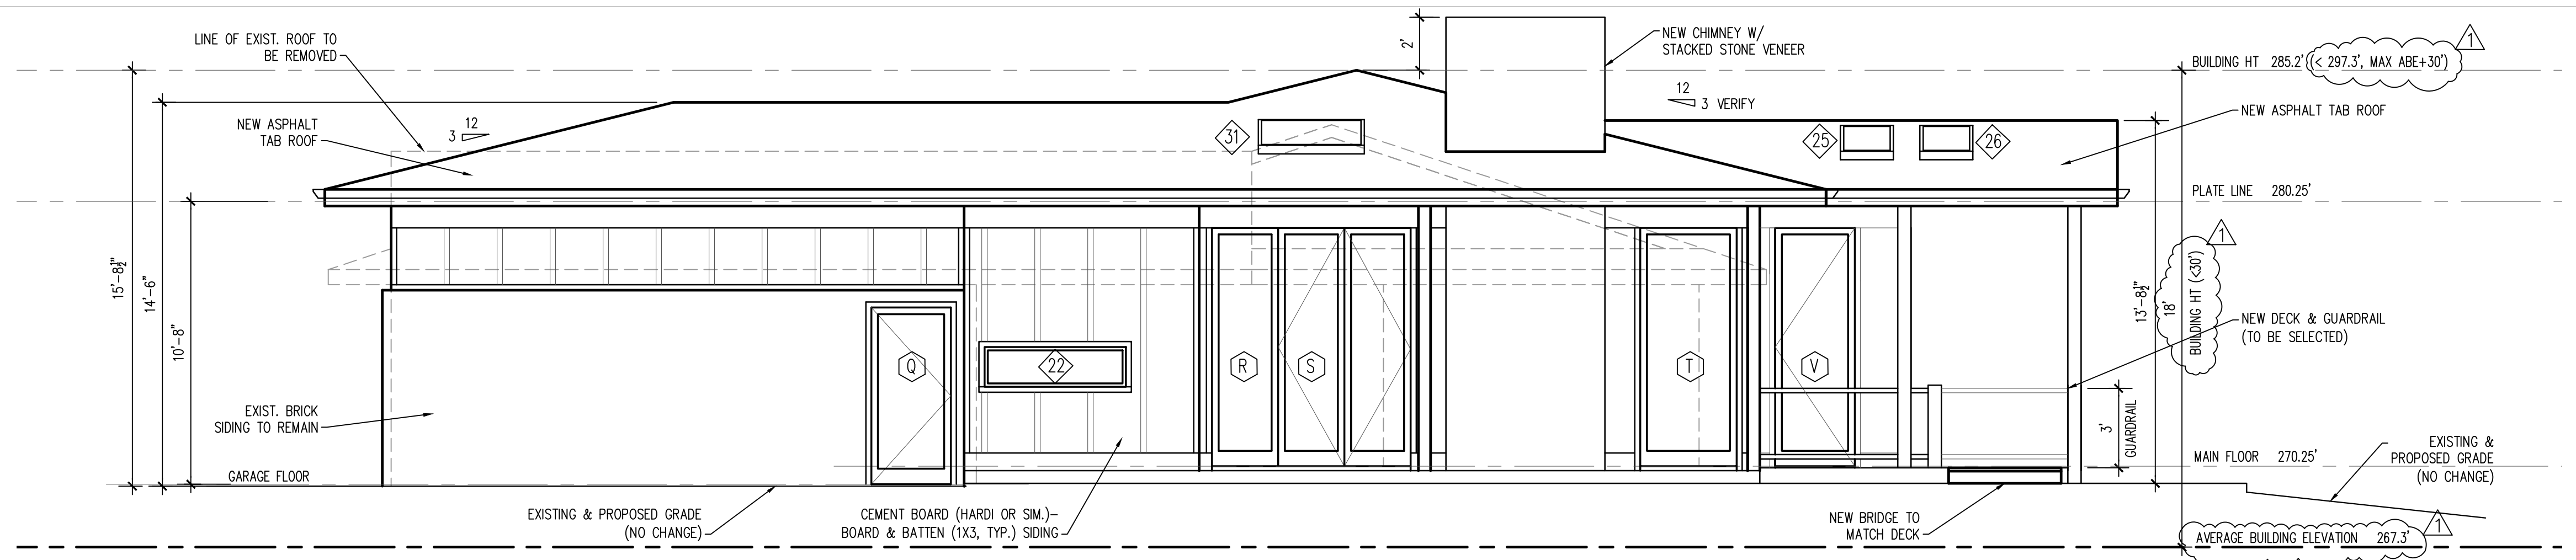

**SOUTH ELEVATION**

SEE SHT. A3.0 FOR WINDOW SCHEDULE, A3.2 FOR DOOR SCHEDULE


1/4"=1'-0"

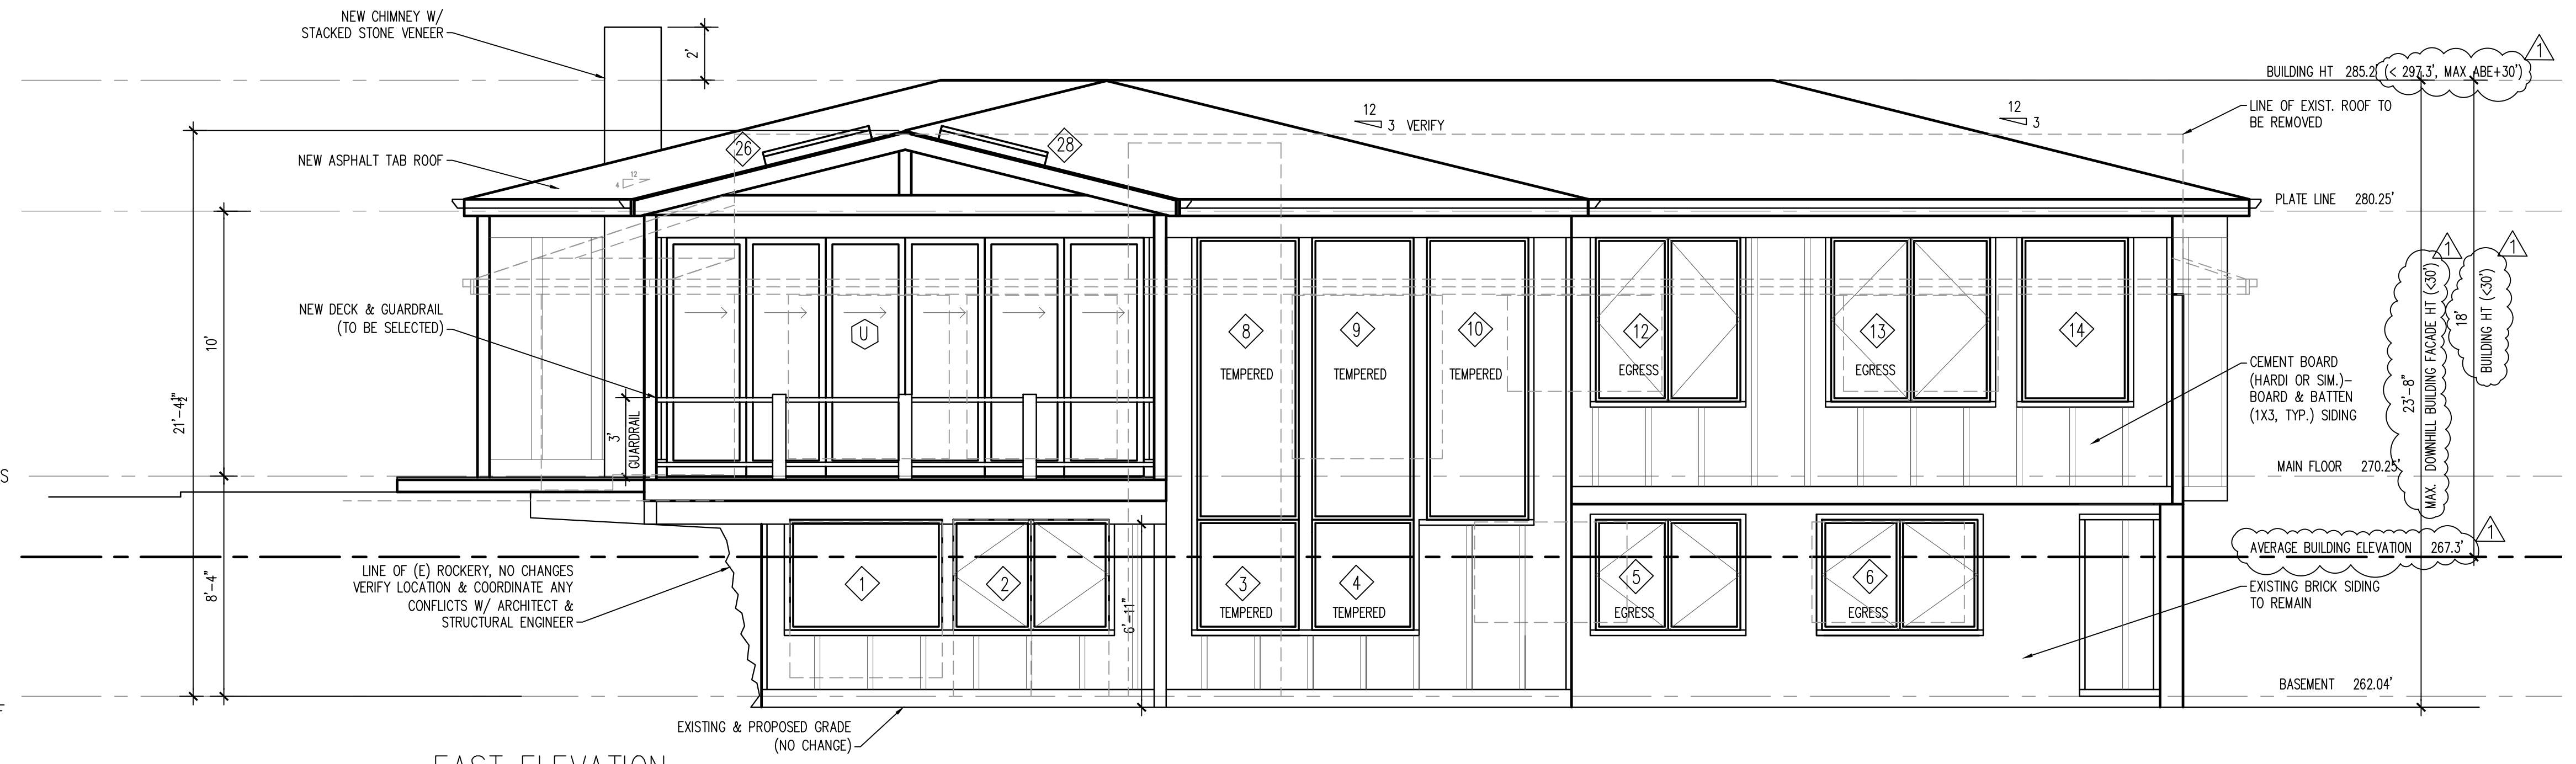

**EAST ELEVATION**

SEE SHT. A3.0 FOR WINDOW SCHEDULE, A3.2 FOR DOOR SCHEDULE

1/4"=1'-0"

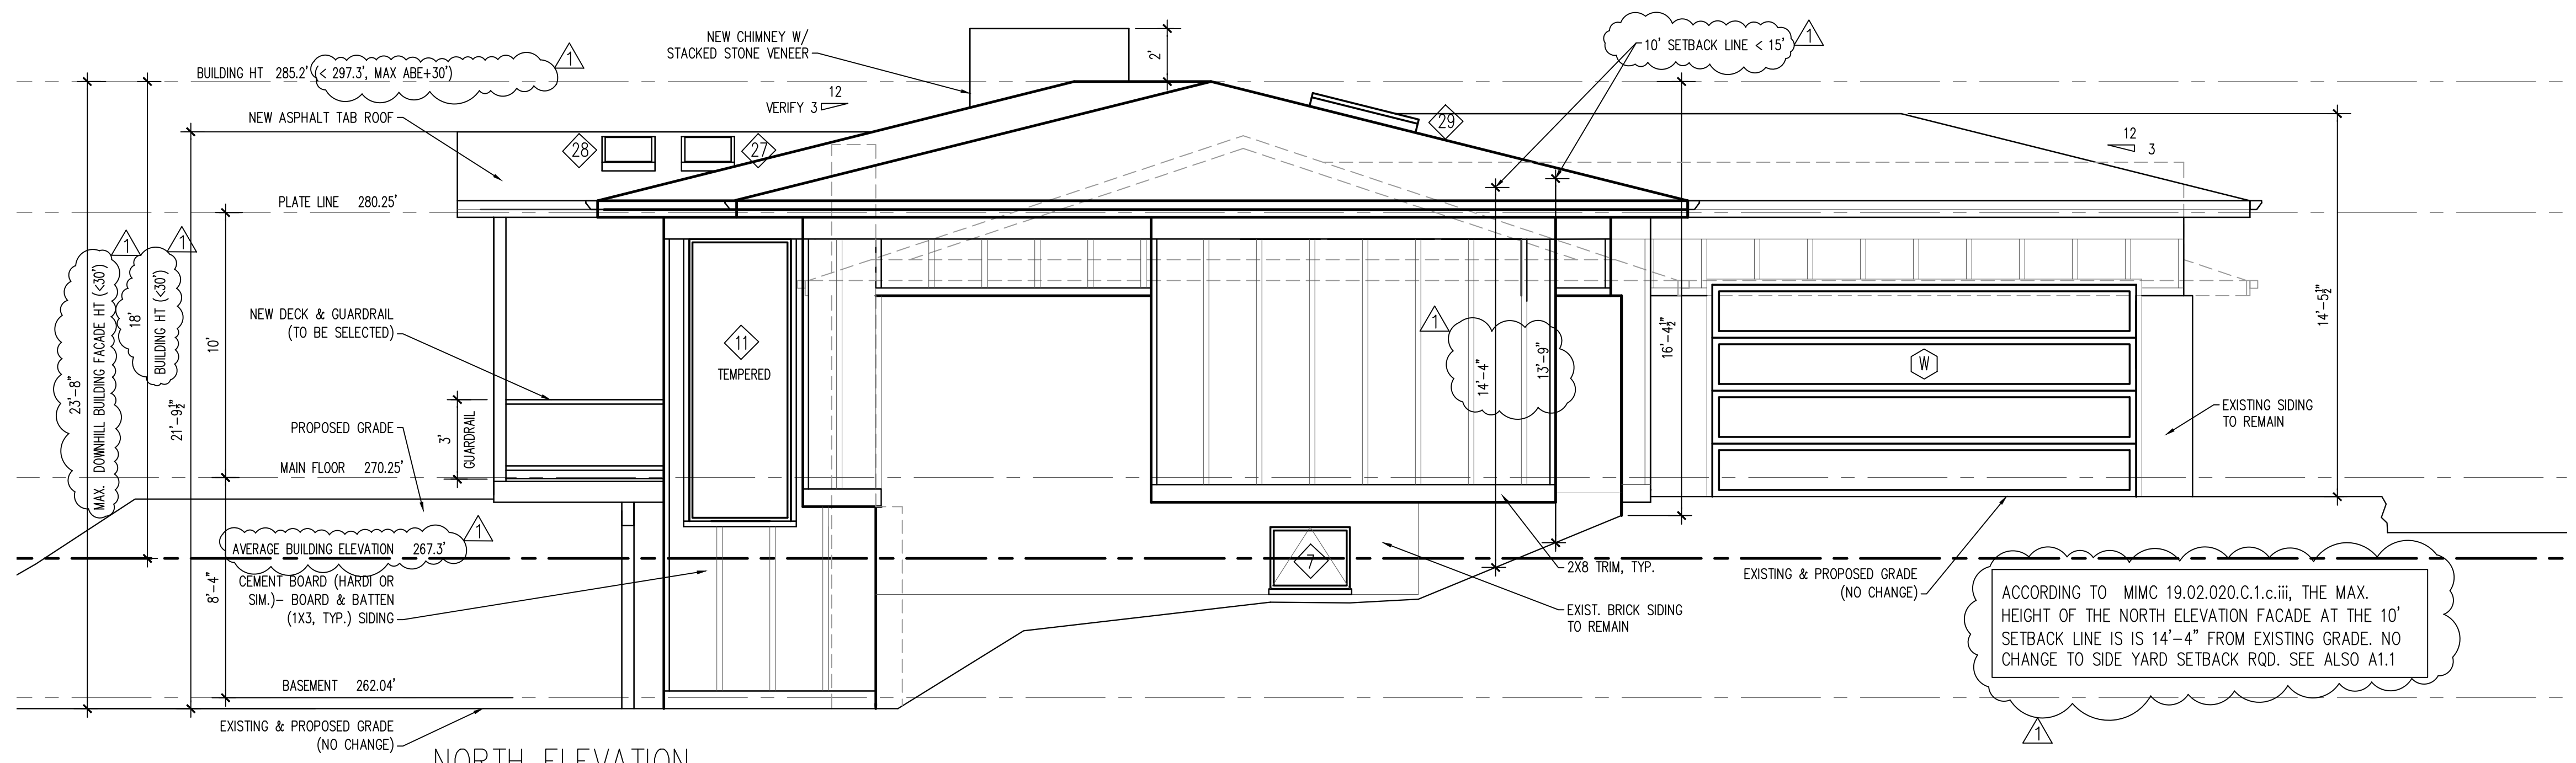

**NORTH ELEVATION**

SEE SHT. A3.0 FOR WINDOW SCHEDULE, A3.2 FOR DOOR SCHEDULE

1/4"=1'-0"

**LEGEND**

	EXISTING TO REMAIN
	EXISTING TO BE DEMOLISHED
	NEW WALLS

**STAIR NOTES:**

- WIDTH: MIN. 36" CLEAR
- TREAD DEPTH: 10" CLEAR (ALLOW FOR 1" OVERHANG - 11" TOTAL)
- RISER HEIGHT: 7 1/2" +/- VERIFY W/ EXISTING GRADE/ FLOOR HEIGHTS (MAX. HT. 7.75")
- HANDRAIL: MIN. 34", MAX 38" ABOVE TREAD NOSINGS
- HANDRAIL GRASP: MIN. 1-1/4", MAX. 2"
- HANDRAIL PROJECTION: MAX. 4-1/2" FROM EACH SIDE OF STAIRWAY INTO REQUIRED WIDTH. MIN. 1-1/2" BETWEEN THE WALL
- GUARDRAIL: MAX OPENING 4" PER SRC R312.1.3  
MIN. UNIFORMLY DISTRIBUTED LIVE LOADS (LBS PER SF)  
200LB CONCENTRATED LOAD ON THE TOP RAIL & 50 PSF ON GUARDRAIL INFILL COMPONENTS PER SRC R301.5-  
SEE STRUCTURAL FOR DETAILS

NO.	REVISION DATE
▲	CITY CORRECTIONS DATED 6/9/2022
<b>FORM + FUNCTION ARCHITECTURE</b>	
1800 WESTLAKE AVE. N. #205 SEATTLE, WA 98109 206.372.9796	
PIPER REMODEL 8429 SE 33RD PL MERCER ISLAND, WA 98040	PROJECT NO. 1212
DATE	3/4/22
DRAWN BY	JT SM
CHECKED BY	JT
SHEET TITLE	ELEVATIONS
SHEET NO.	A3.1



DOOR SCHEDULE- BASEMENT & MAIN FLOOR

MARK	DOOR SIZE W X H	OPERATION	MATERIAL	GLAZING	U-VALUE	NOTES
A	3'-0" x 6'-8"	SWING	GLASS/ SC WOOD	LOW E/ARGON TEMPERED	0.30 MIN	THRESHOLD BY MFGR W/ WEATHERSTRIPPING FOR TIGHT SEAL KEYED LOCK & DEADBOLT (MATCH HOUSE KEY)
B	3'-0" x 6'-8"	SWING	SC WOOD	NA	NA	PRIVACY LATCH
C	2'-0" x 9'-0"	SWING/ FRENCH DR	SC WOOD OR GLASS/ SC WOOD	LOW E/ARGON TEMPERED	0.20 MIN	THRESHOLD BY MFGR W/ WEATHERSTRIPPING FOR TIGHT SEAL-COORD. ASTRIGAL OPTIONS W/ ARCHITECT
D	4'-0" x 9'-0"	SWING/ FRENCH DR	SC WOOD OR GLASS/ SC WOOD	LOW E/ARGON TEMPERED	0.20 MIN	THRESHOLD BY MFGR W/ WEATHERSTRIPPING FOR TIGHT SEAL KEYED LOCK & DEADBOLT (MATCH HOUSE KEY)
E	3'-0" x 6'-8"	POCKET	SC WOOD	NA	NA	
F	2'-8" x 6'-8"	SWING	SC WOOD	NA	NA	PRIVACY LATCH
G	3'-0" x 6'-8"	SWING	SC WOOD	NA	NA	PRIVACY LATCH
H	2'-10" x 6'-8"	SWING	SC WOOD	NA	NA	PRIVACY LATCH
I	NOT USED FOR CLARITY					
J	2'-10" x 6'-8"	POCKET	SC WOOD	NA	NA	PRIVACY LATCH
K	2'-10" x 6'-8"	POCKET	SC WOOD	NA	NA	PRIVACY LATCH
L	2'-10" x 6'-8"	POCKET	SC WOOD	NA	NA	PRIVACY LATCH
M	2'-8" x 6'-8"	POCKET	SC WOOD	NA	NA	PRIVACY LATCH
N	2'-8" x 6'-8"	POCKET	SC WOOD	NA	NA	
O	NOT USED FOR CLARITY					
P	3'-0" x 6'-8"	SWING	SC WOOD	NA	NA	
Q	3'-0" x 6'-8"	SWING	GLASS/ SC WOOD	LOW E/ARGON TEMPERED	0.30 MIN	THRESHOLD BY MFGR W/ WEATHERSTRIPPING FOR TIGHT SEAL
R	2'-6" x 9'-0"	FIXED/ FRENCH DR	GLASS/ SC WOOD	LOW E/ARGON TEMPERED	0.30 MIN	THRESHOLD BY MFGR W/ WEATHERSTRIPPING FOR TIGHT SEAL
S	(2) 2'-6" x 9'-0"	SWING/ FRENCH DR	GLASS/ SC WOOD	LOW E/ARGON TEMPERED	0.30 MIN	THRESHOLD BY MFGR W/ WEATHERSTRIPPING FOR TIGHT SEAL
T	3'-8" x 9'-0"	FIXED/ FRENCH DR	GLASS/ SC WOOD	LOW E/ARGON TEMPERED	0.30 MIN	THRESHOLD BY MFGR W/ WEATHERSTRIPPING FOR TIGHT SEAL
U	(6) 3'-0" x 9'-0"	SLIDER/ FRENCH DR	GLASS/ SC WOOD	LOW E/ARGON TEMPERED	0.30 MIN	THRESHOLD BY MFGR W/ WEATHERSTRIPPING FOR TIGHT SEAL
V	3'-0" x 9'-0"	SWING/ FRENCH DR	GLASS/ SC WOOD	LOW E/ARGON TEMPERED	0.30 MIN	THRESHOLD BY MFGR W/ WEATHERSTRIPPING FOR TIGHT SEAL KEYED LOCK & DEADBOLT (MATCH HOUSE KEY)
W	16'-0" x 8'-0"	GARAGE	OBSOLETE GLASS/ SC WOOD	LOW E/ARGON TEMPERED	0.30 MIN	THRESHOLD BY MFGR W/ WEATHERSTRIPPING FOR TIGHT SEAL
X	2'-6" x 6'-0"	SHOWER	GLASS	NA	NA	TEMPERED GLASS
Y	3'-0" x 6'-8"	SWING	SC WOOD	NA	NA	20 MIN RATED DR ON CLOSER ALUMINUM THRESHOLD BY PEMCO OR EQUAL SMOKE GASKETING FOR A TIGHT SEAL KEYED LOCK & DEADBOLT (MATCH HOUSE KEY)


DOOR GENERAL NOTES:

- ALL DOORS TO BE NFRC CERTIFIED.
- CONTRACTOR TO CONFIRM ROUGH OPENING REQUIREMENT W/ MNFR
- ALL INTERIOR & EXTERIOR DOORS BY LOEWEN OR SIMPSON OR EQUIVALENT.
- SET EXTERIOR DOORS IN DOOR PAN PER NORTHWEST WALL & CLG BUREAU STANDARD DETAILS
- ALL EXT. DOOR OPENINGS TO BE WRAPPED W/ VIDAFLEX F OR APPROVED EQUAL PEEL & STICK OR METAL FLASHINGS PER THE NORTHWEST WALL & CLG BUREAU STANDARD DETAILS
- ALL U-VALUES PROVIDED FOR DOORS ARE PRESCRIPTIVE VALUES (MINIMUMS TO BE USED) UNTIL SPECIFIC MANUFACTURERS/DOOR MODELS ARE SELECTED.
- ALL HARDWARE TO BE LEVER TYPE- FINISH TO BE SELECTED.

SEE SHT A3.3 FOR TYPICAL WALL SECTION W/ ADDITIONAL DETAIL

**LEGEND**


- EXISTING TO REMAIN
- EXISTING TO BE DEMOLISHED
- NEW WALLS

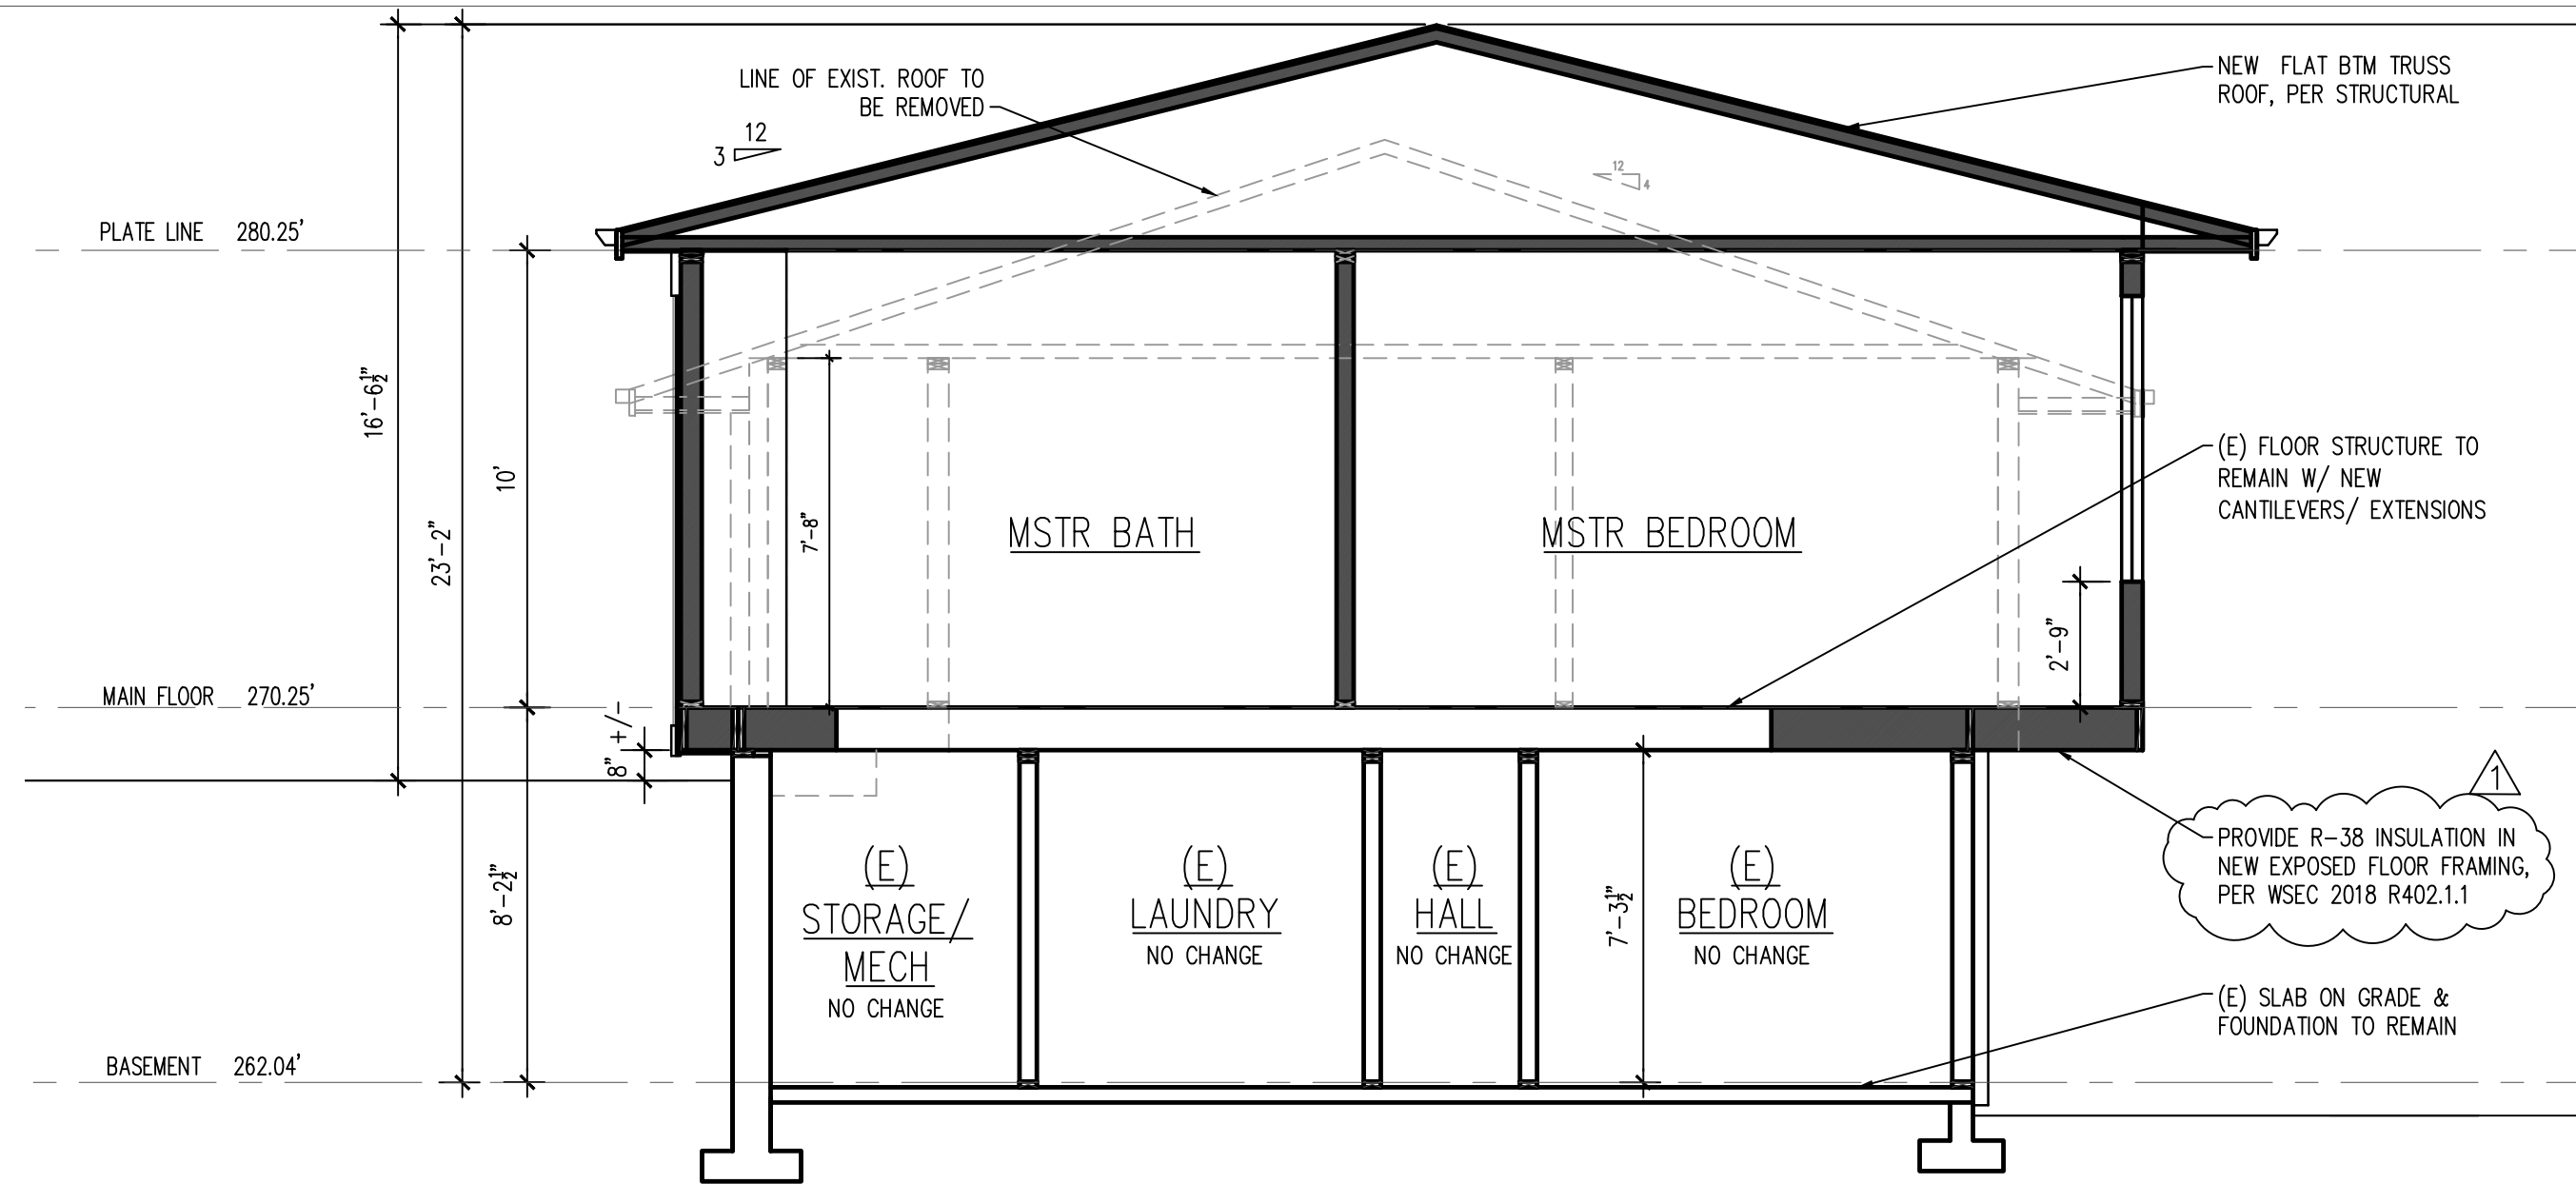


SECTION A-A

VERIFY ALL DIMENSIONS TO EXISTING ELEMENTS

1/4"=1'-0"

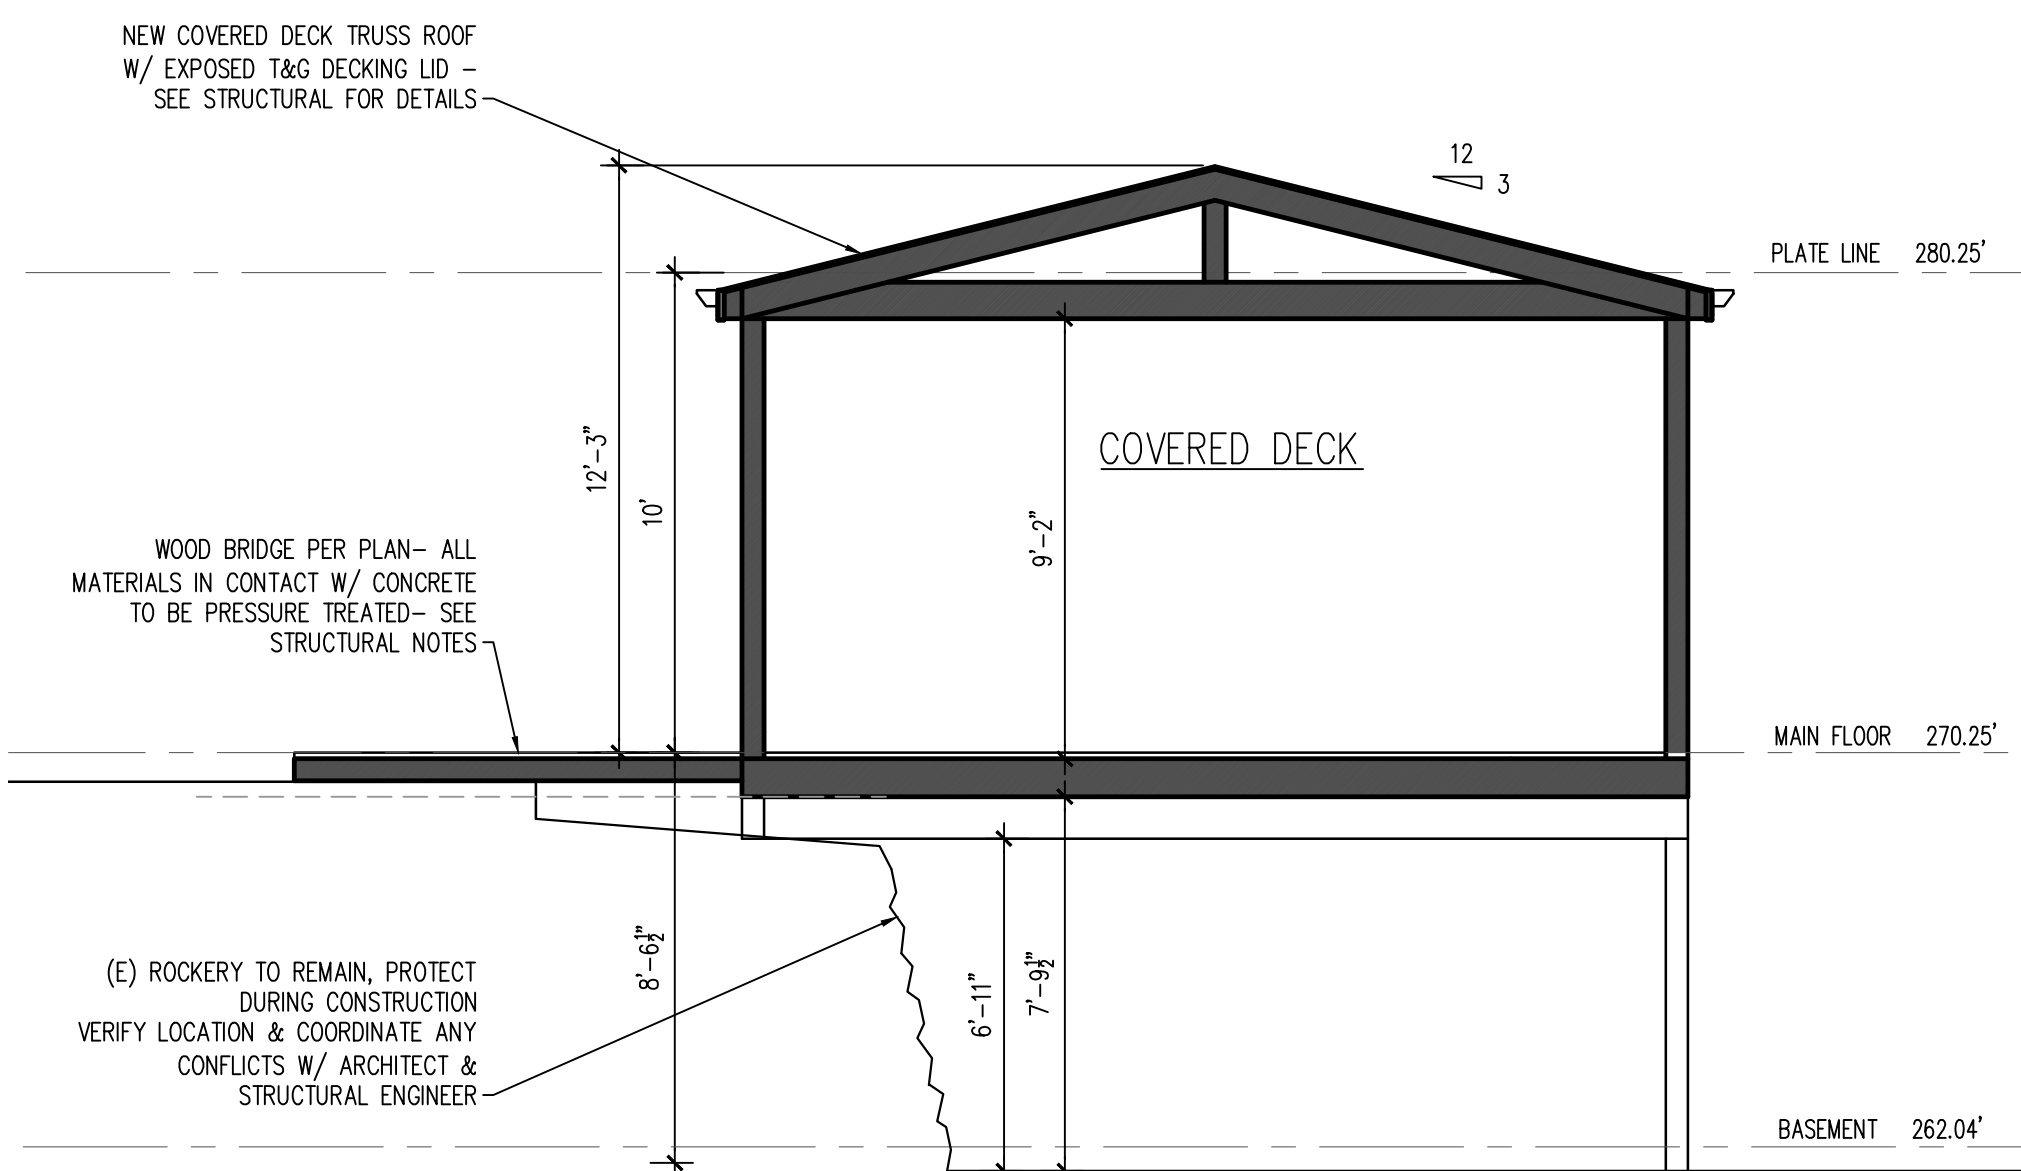


SECTION C-C

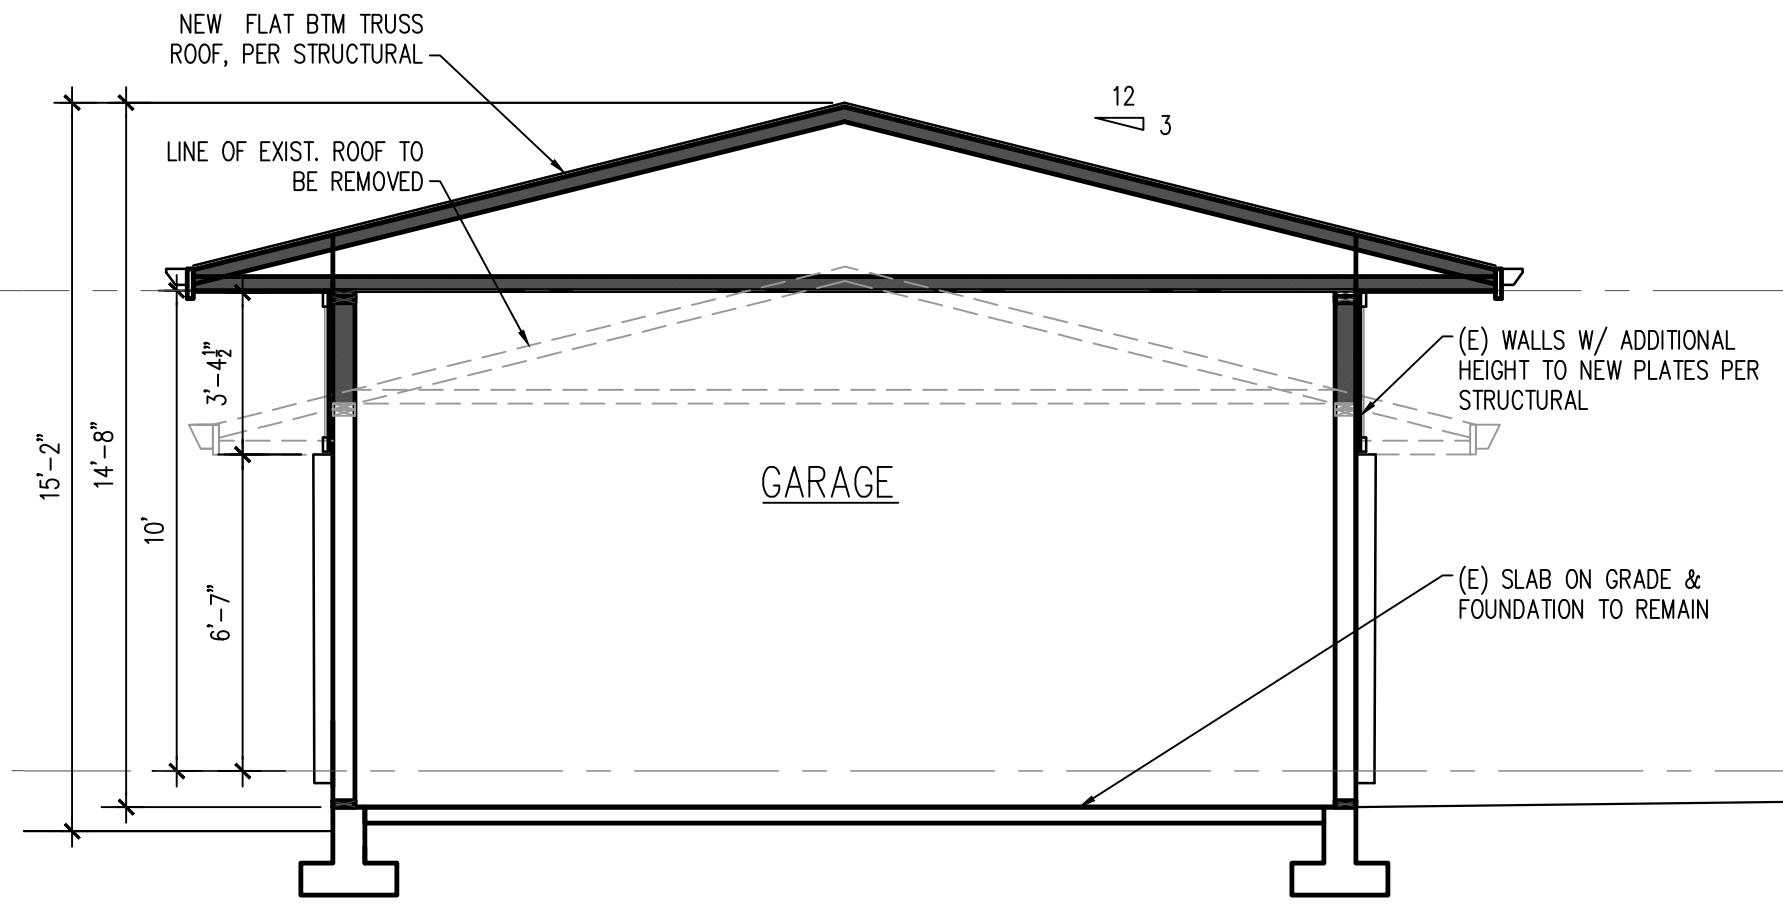

SECTION D-D

1/4"=1'-0"

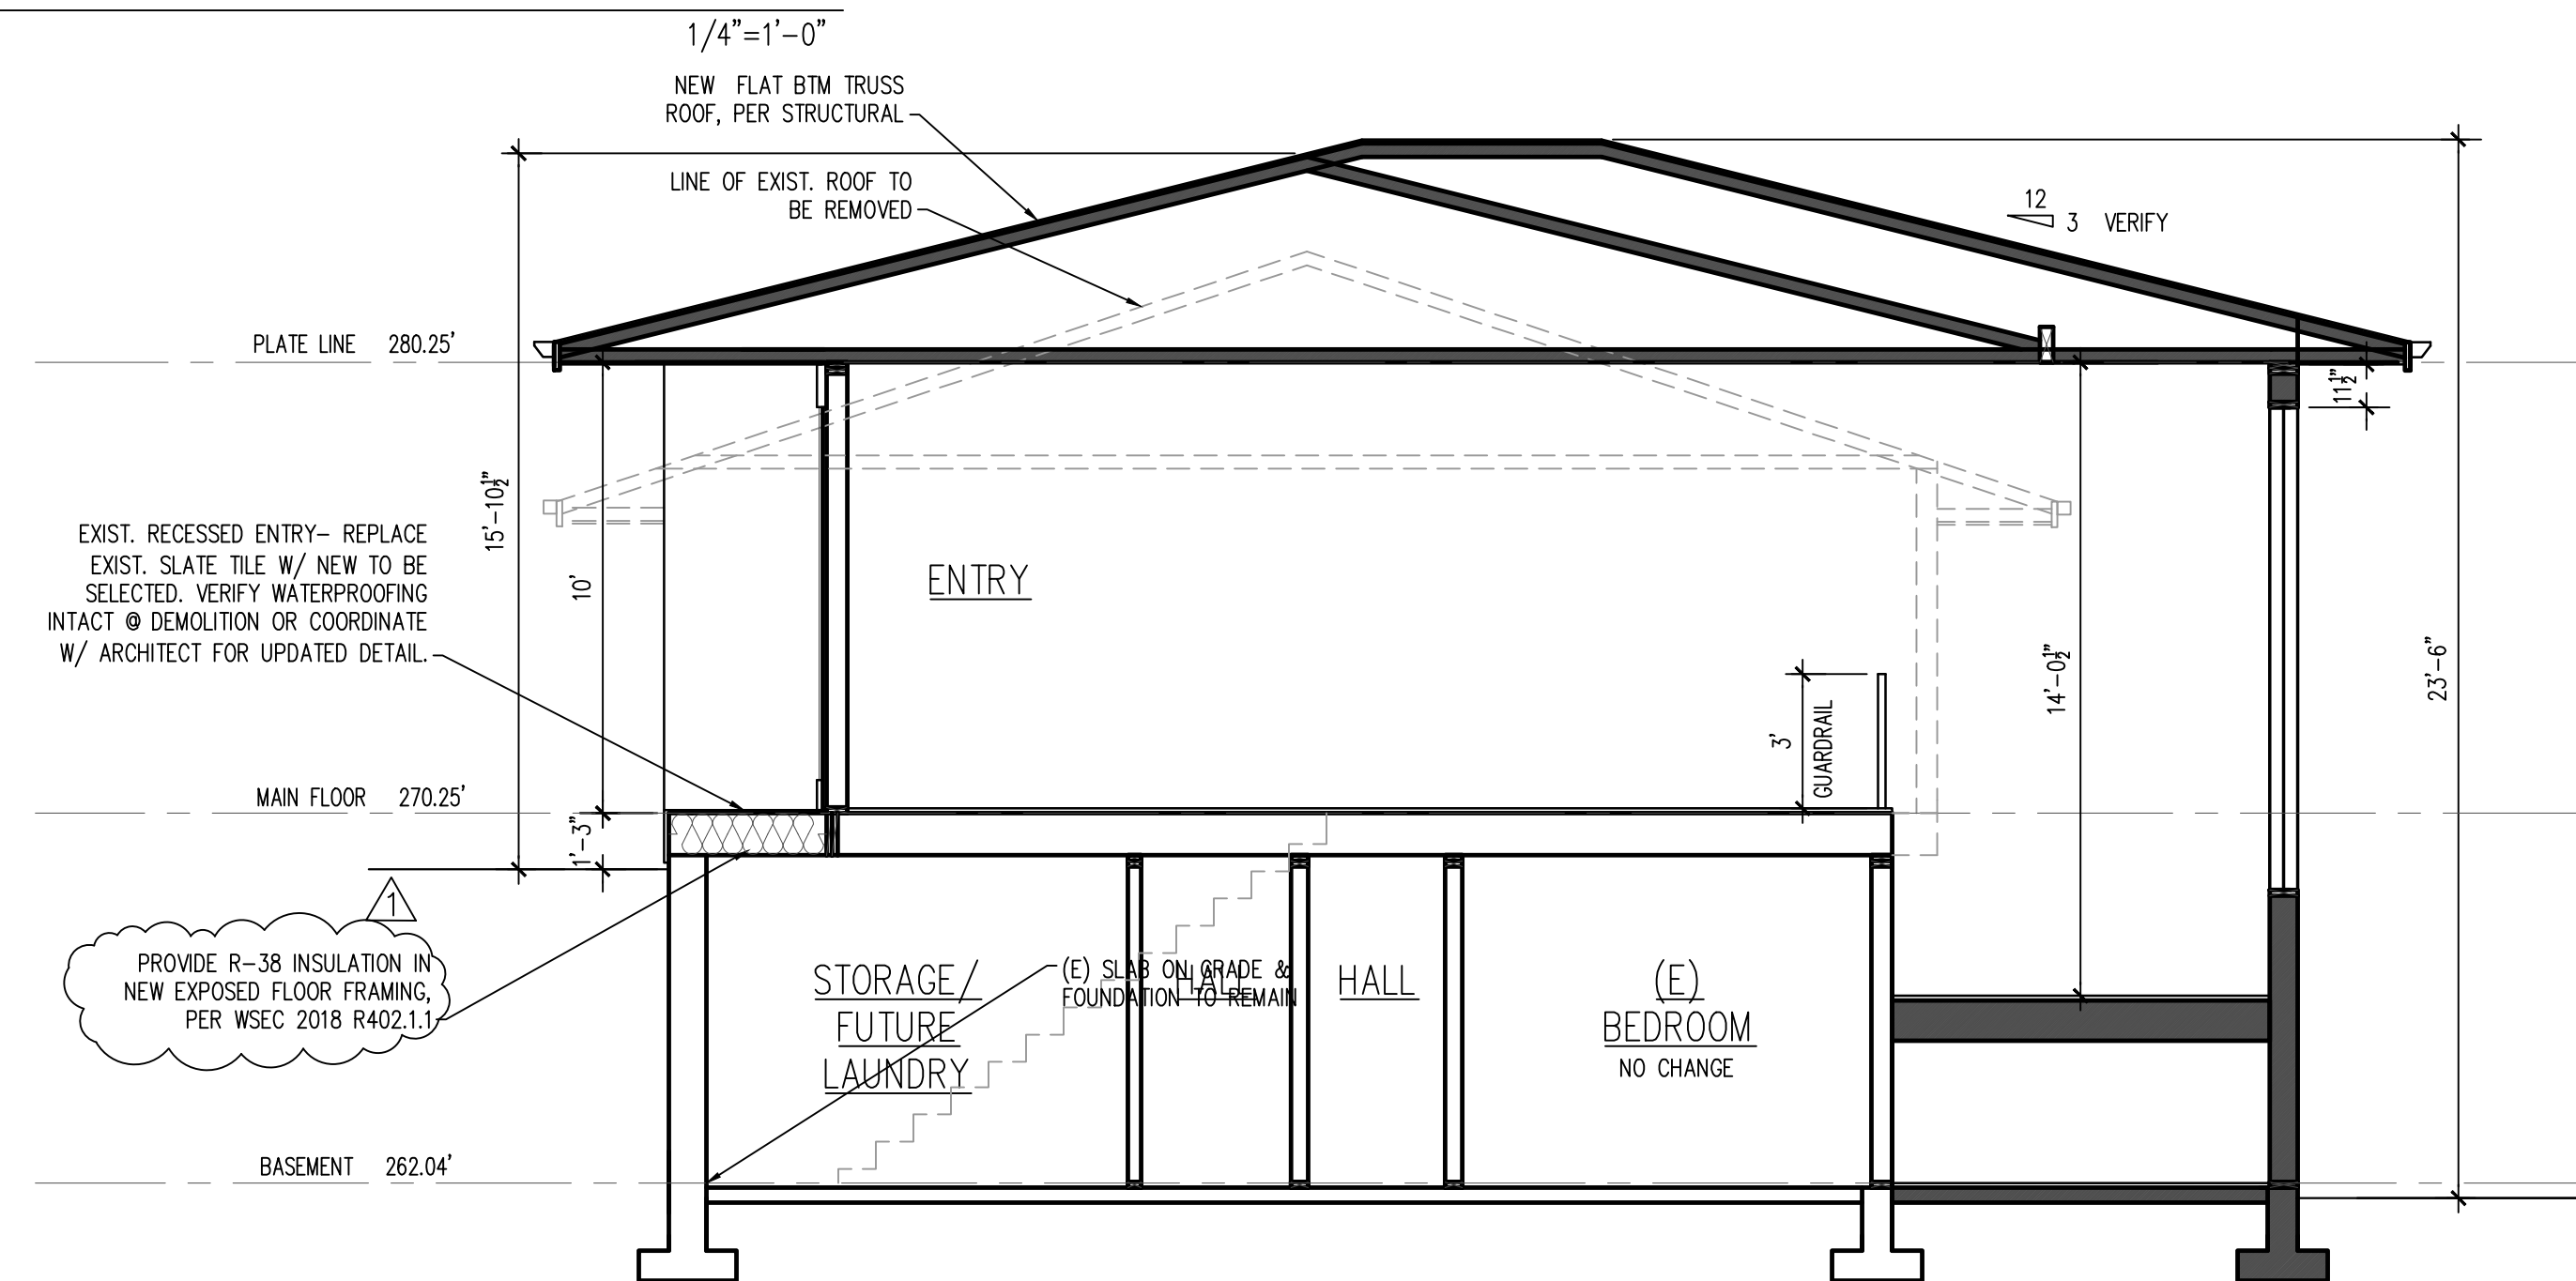

SECTION B-B

VERIFY ALL DIMENSIONS TO EXISTING ELEMENTS


1/4"=1'-0"

NO. REVISION DATE

CITY CORRECTIONS DATED 6/9/2022

FORM + FUNCTION  
ARCHITECTURE

1800 WESTLAKE AVE. N. #205 SEATTLE, WA 98109  
206.372.9796

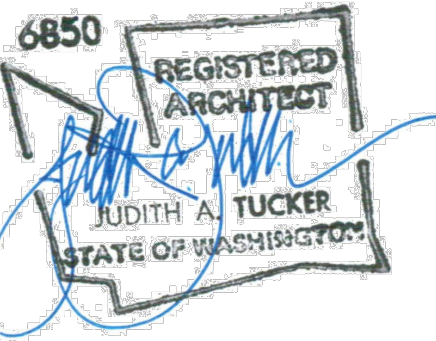

PIPER REMODEL  
8429 SE 33RD PL  
MERCER ISLAND, WA  
98040

PROJECT NO. 1212

DATE 3/4/22

DRAWN BY JT SM

CHECKED BY JT


SHEET TITLE  
SECTIONS  
DOOR SCHEDULE

SHEET NO.

A3.2




LEGEND	
	EXISTING TO REMAIN
	EXISTING TO BE DEMOLISHED
	NEW WALLS

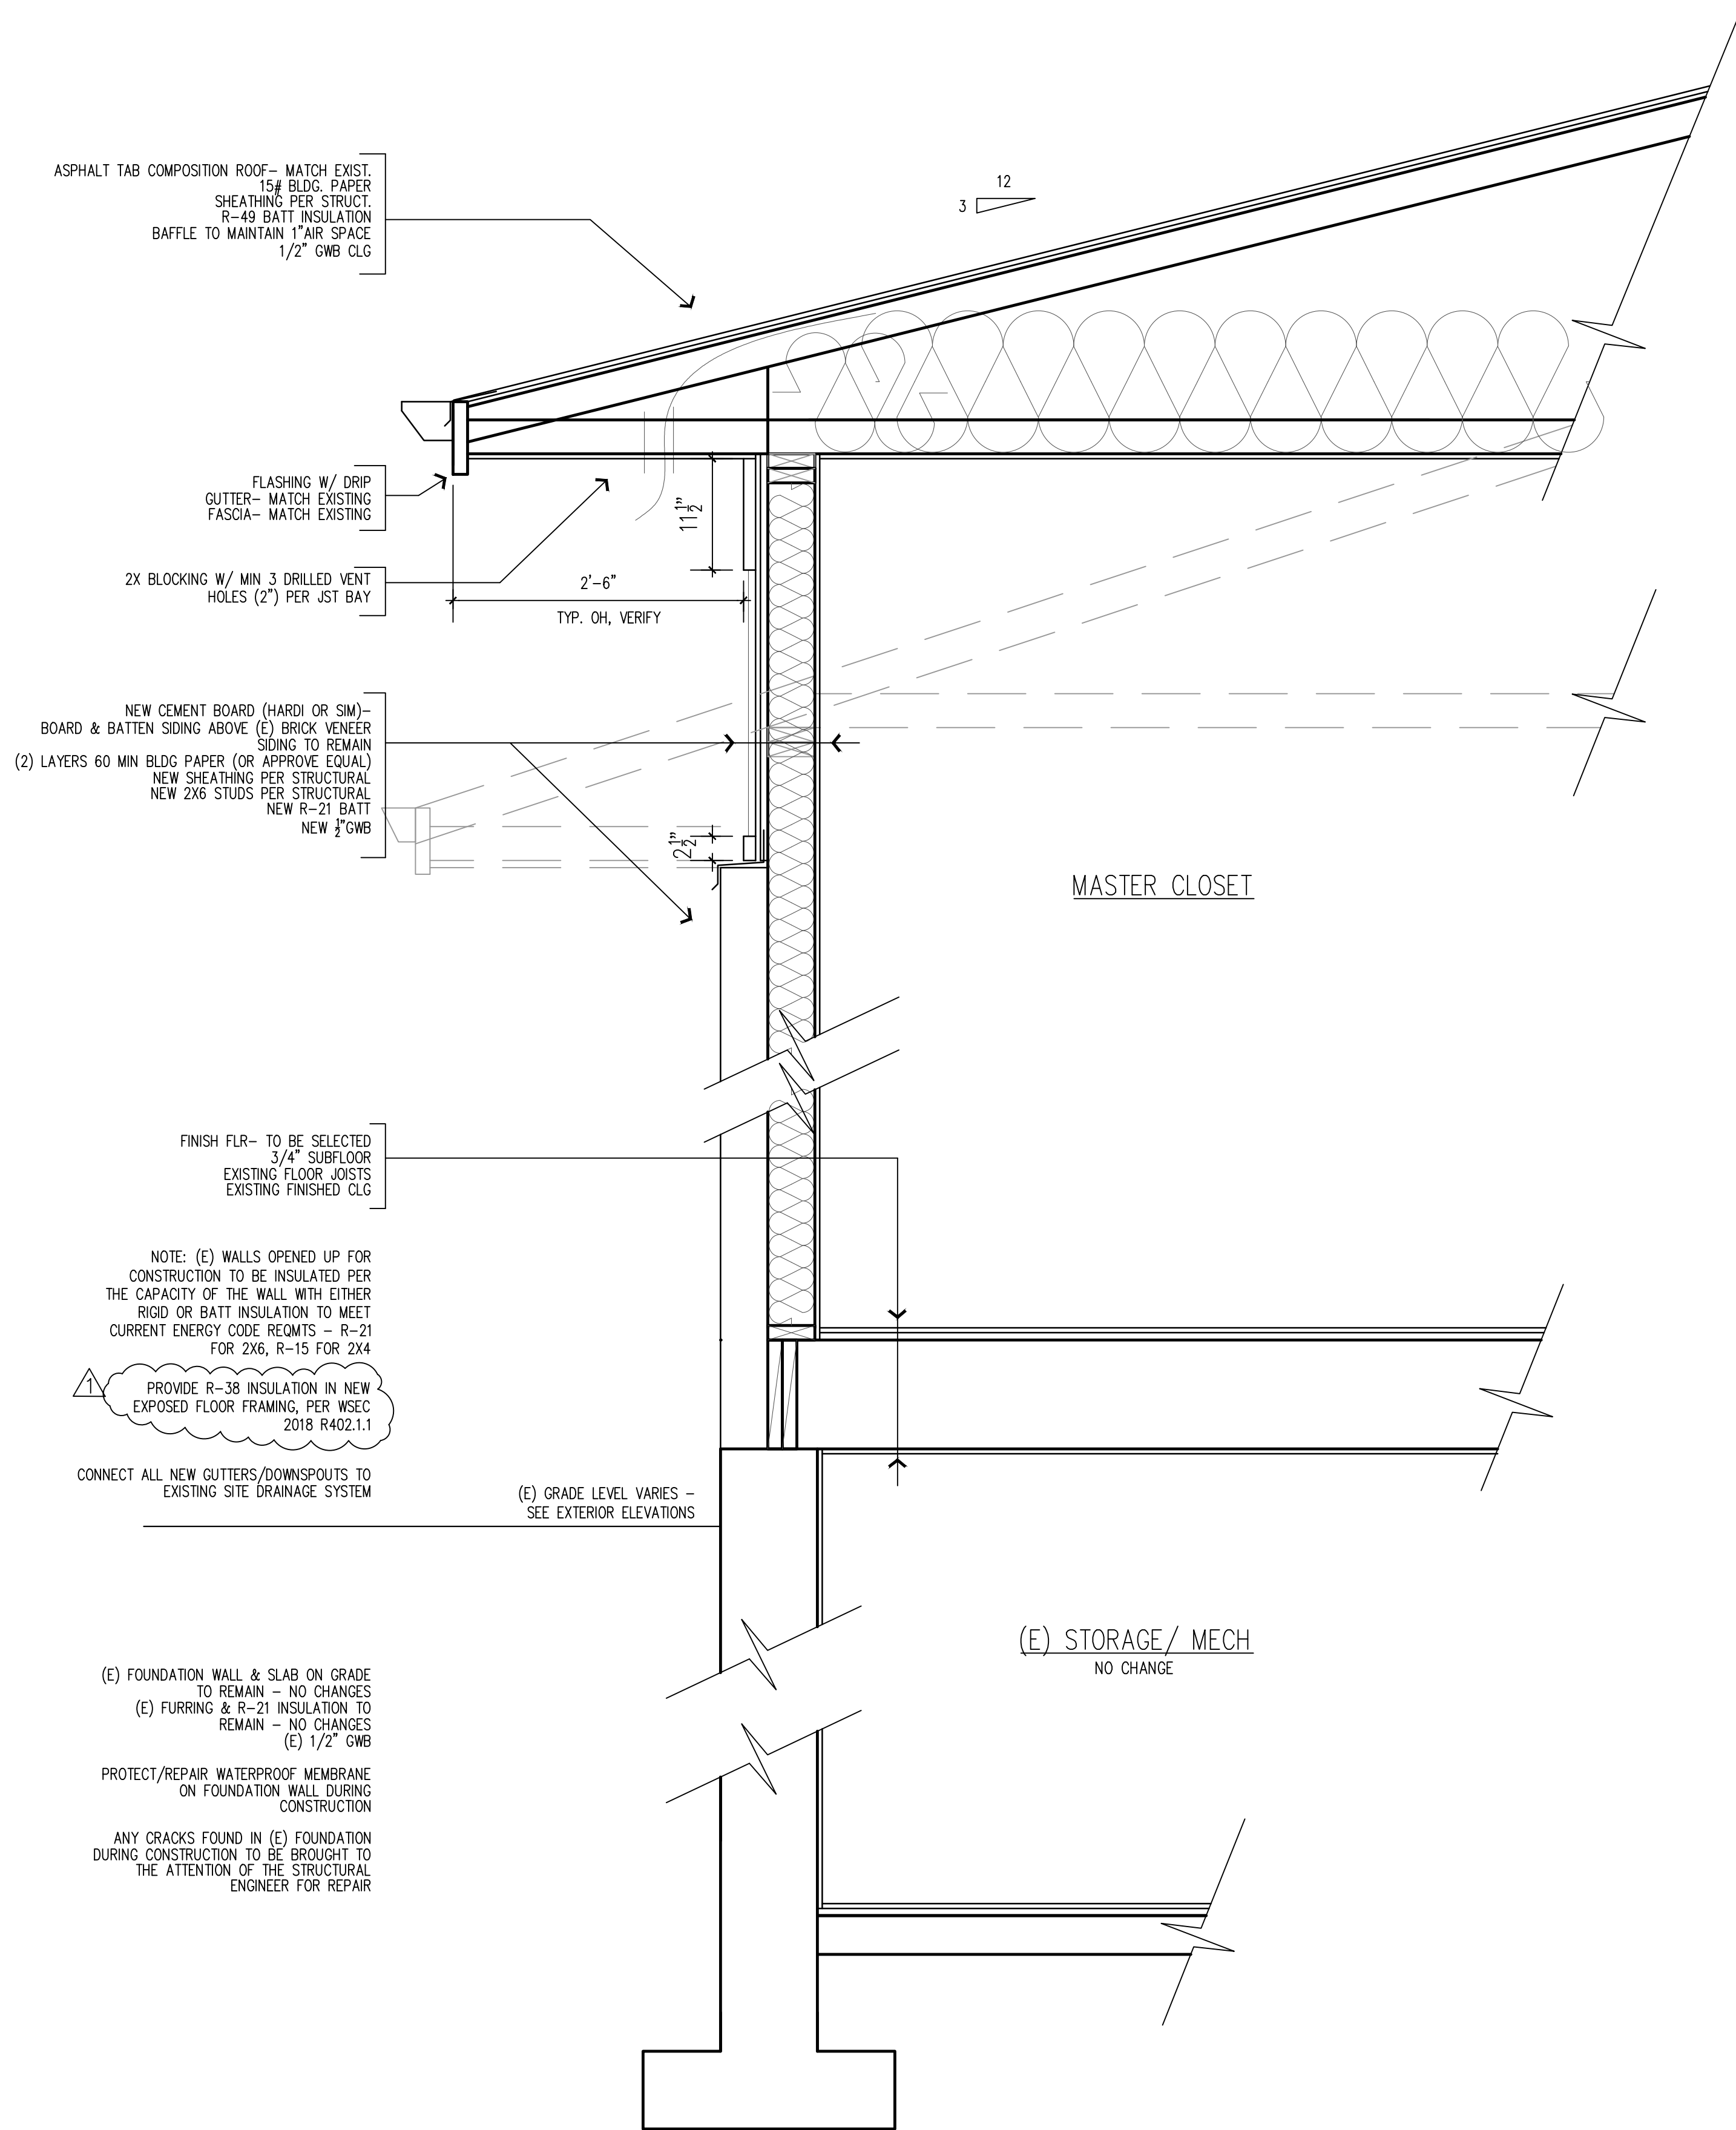


TYP WALL DETAIL

1"=1'-0"

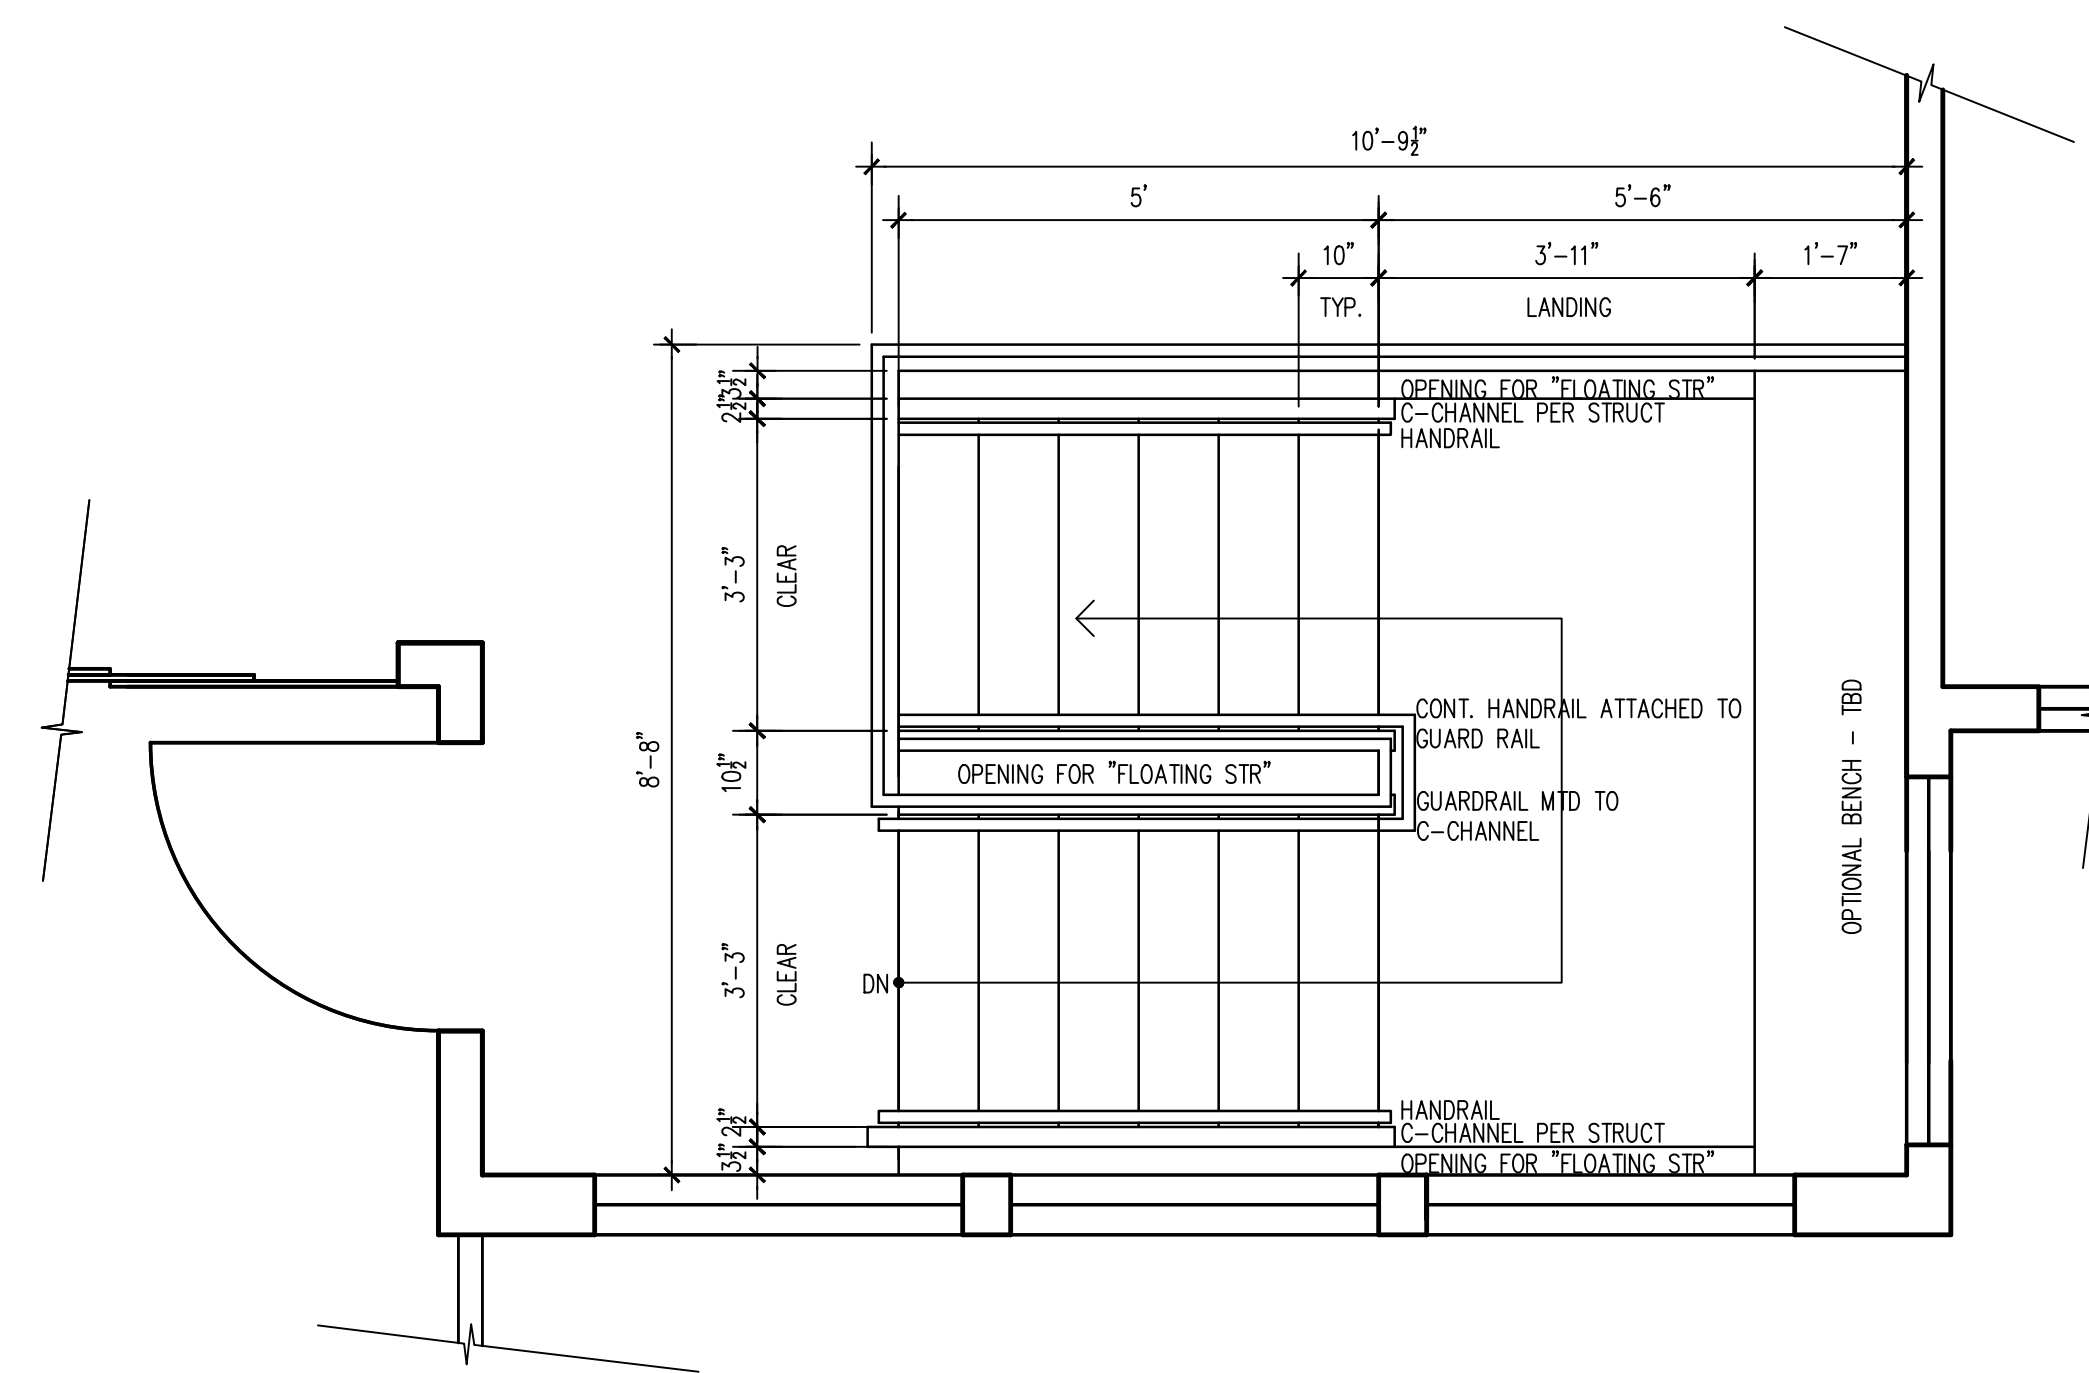

STAIR PLAN

1/2"=1'-0"

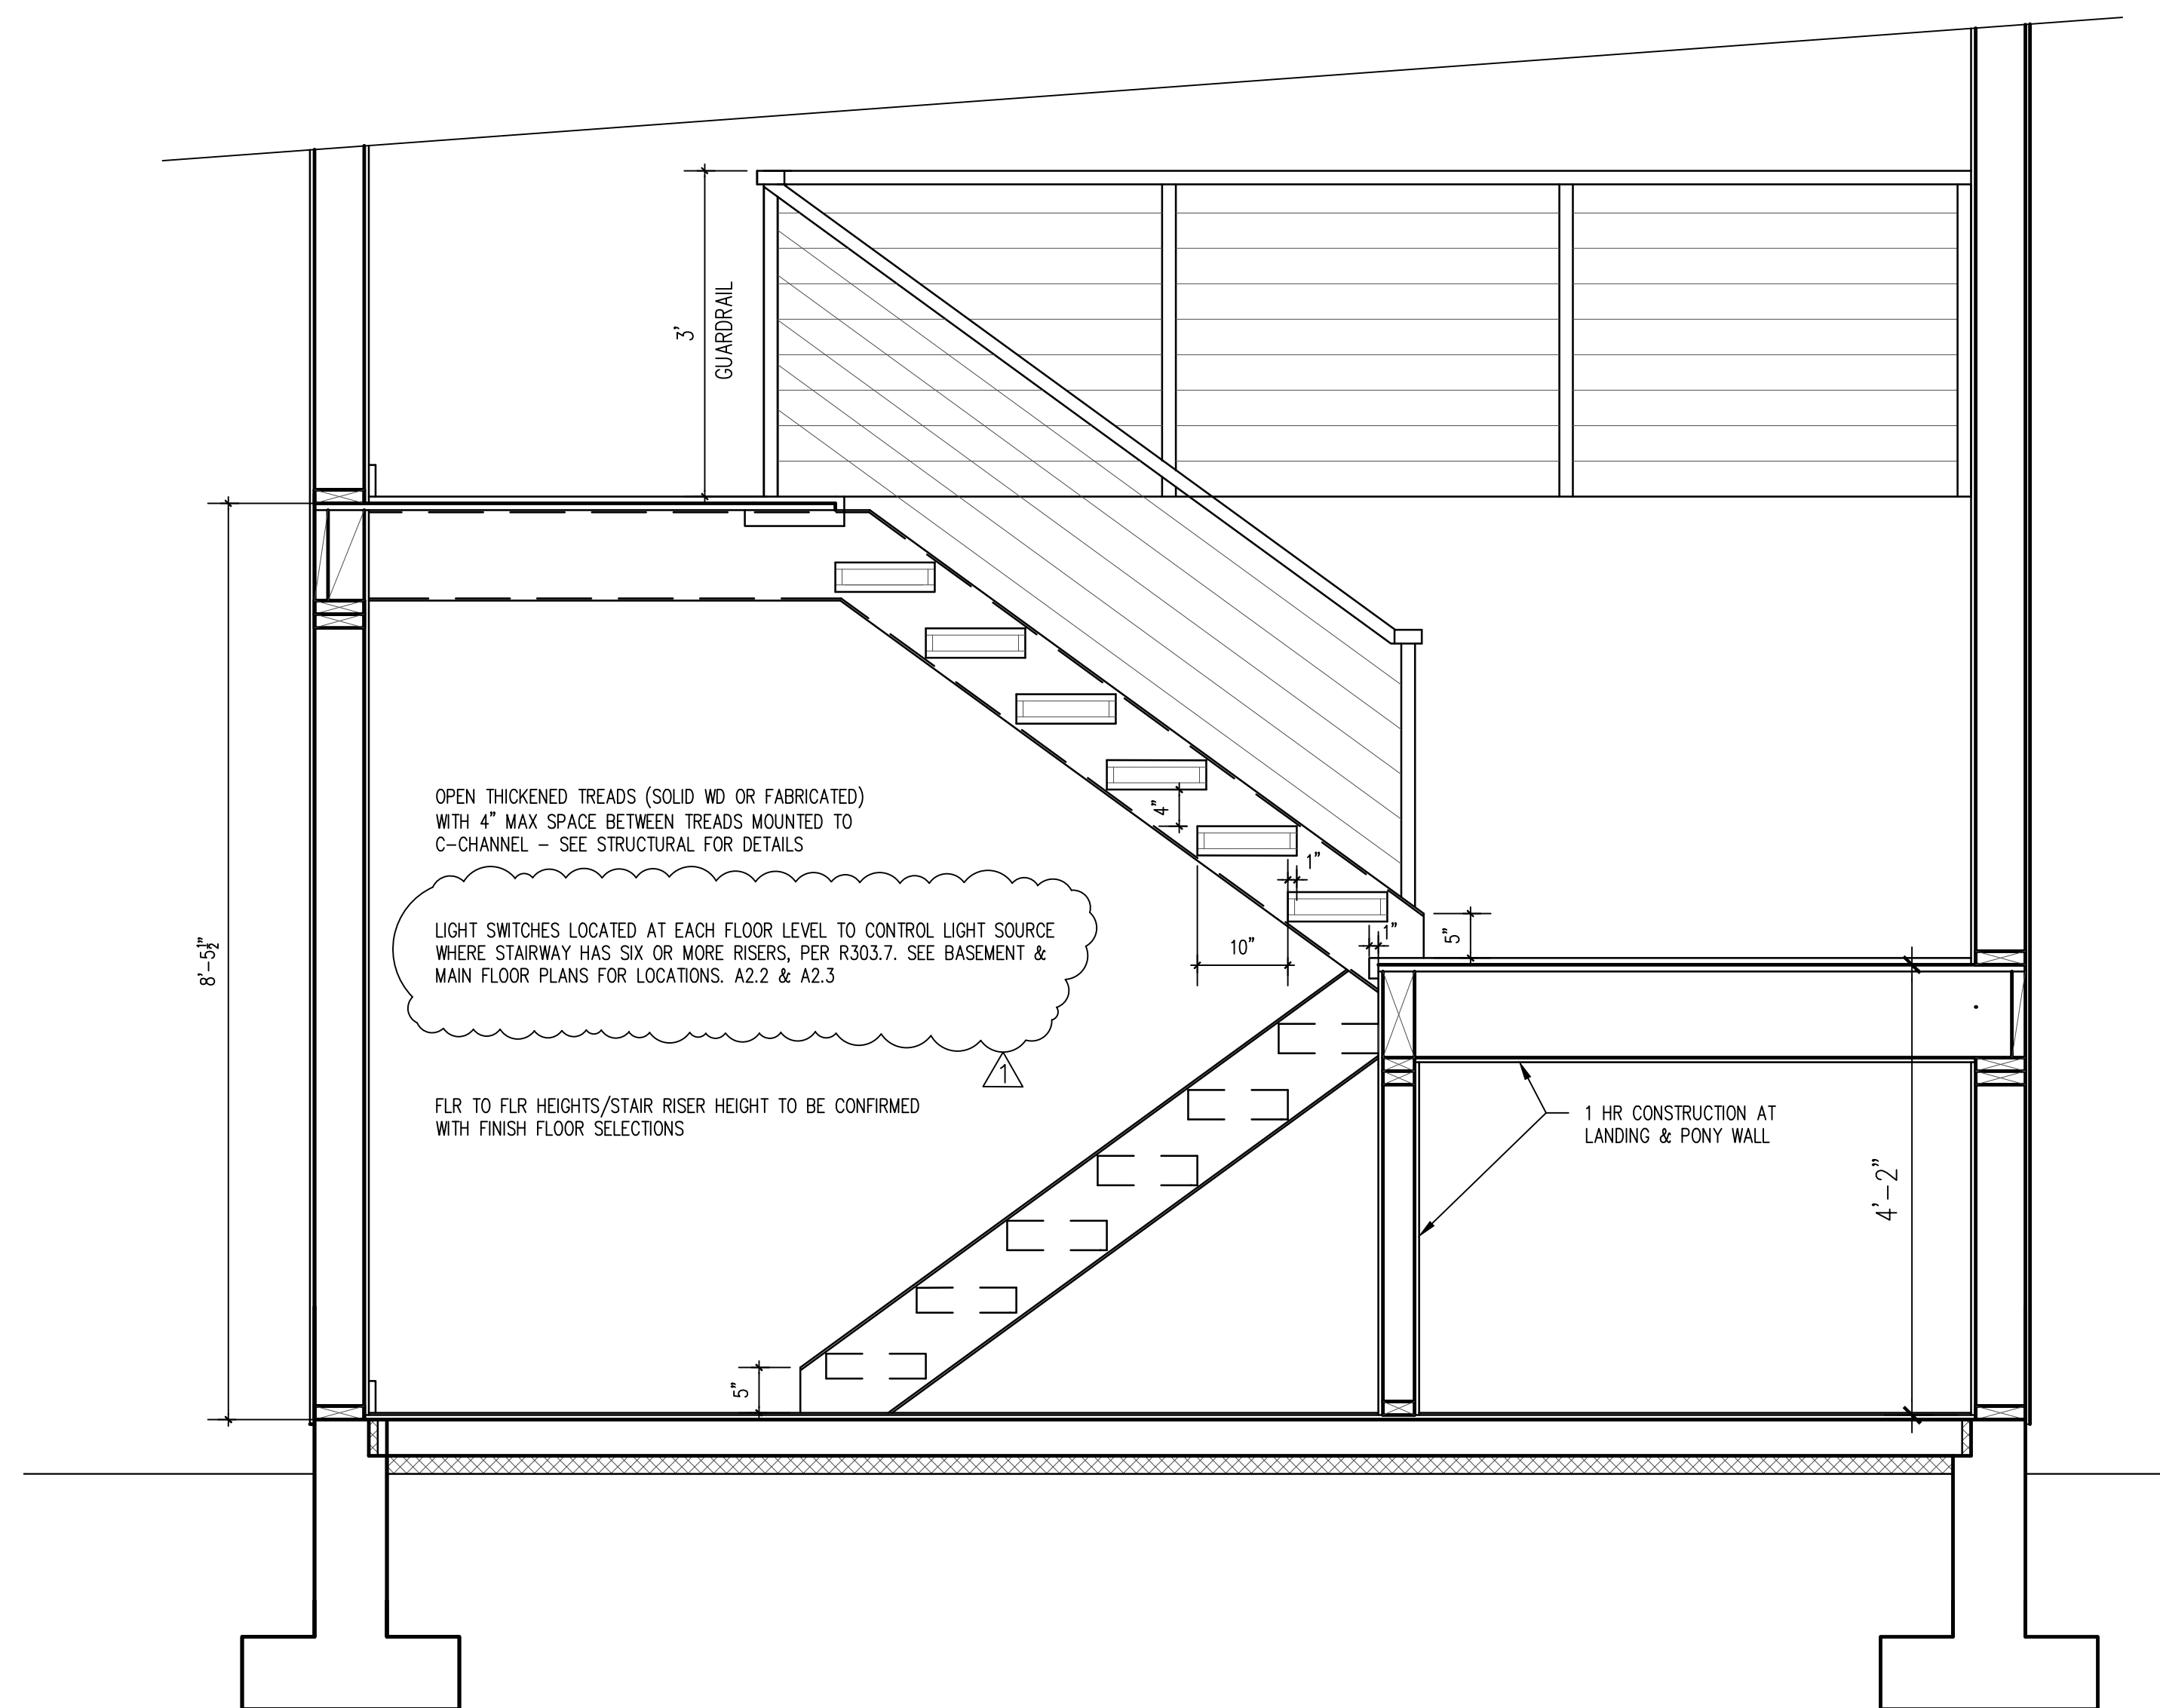


SECTION E-E: NEW STAIR ADDITION

3/4"=1'-0"

NO.	REVISION DATE
△	CITY CORRECTIONS DATED 6/9/2022

FORM + FUNCTION  
ARCHITECTURE  
1800 WESTLAKE AVE. N. #205 SEATTLE, WA 98109  
206.372.9796

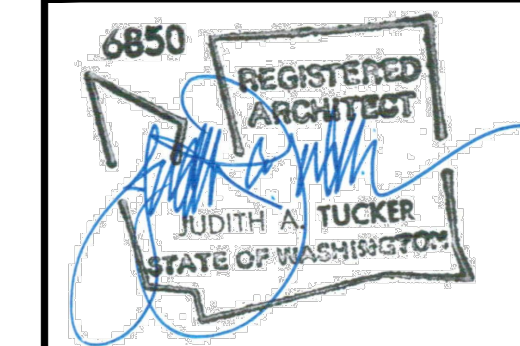

PIPER REMODEL  
8429 SE 33RD PL  
MERCER ISLAND, WA  
98040  
PROJECT NO. 1212

DATE	3/4/22
DRAWN BY	JT SM
CHECKED BY	JT

SHEET TITLE  
SECTION E-E  
STAIR PLAN  
TYP. WALL DETAIL

SHEET NO.  
A3.3



01000 - GENERAL REQUIREMENTS
THE STRUCTURAL NOTES SUPPLEMENT THE PLANS AND SPECIFICATIONS. ANY DISCREPANCY FOUND BETWEEN THE DRAWINGS, NOTES, SPECIFICATIONS, SITE CONDITIONS, AND ARCHITECTURAL PLANS SHALL BE REPORTED TO THE ARCHITECT WHO SHALL CORRECT THE DISCREPANCY IN WRITING. ANY WORK COMPLETED AFTER DISCOVERY OF THE DISCREPANCY SHALL BE DONE AT THE CONTRACTOR'S RISK.

2

01700 - EXECUTION REQUIREMENTS
INSTALLATION OF ALL STRUCTURAL COMPONENTS SHALL BE AS REQUIRED PER ALL LOCAL CODES.
02000 - SITE CONSTRUCTION
ALL SITE CONSTRUCTION SHALL BE CONSISTENT WITH THE GEOTECHNICAL ENGINEERING RECOMMENDATIONS AS NOTED IN THE GEOTECHNICAL ENGINEERING REPORT (SEE SECTION 01200) AND IN SUBSEQUENT DIRECTIVES.

06000 - WOOD FRAMING NOTES
FRAMING CONNECTORS, ACCESSORIES, AND FASTENERS AS NOTED IN THE PLANS AND DETAILS SHALL BE AS MANUFACTURED BY SIMPSON STRONG-TIE. EQUIVALENT HARDWARE MAY BE USED WITH PRIOR APPROVED BY ENGINEER OF RECORD.
06510 - SHOP FABRICATED METAL PLATE CONNECTED WOOD TRUSSES
PREMANUFACTURED METAL-PLATE-CONNECTED WOOD TRUSSES SHALL BE DESIGNED AND MANUFACTURED IN ACCORDANCE WITH IBC SECTION 2303.4 TRUSSES, AND THE TRUSS PLATE INSTITUTE ANS/TPI 1-2007 NATIONAL DESIGN STANDARD FOR METAL-PLATE-CONNECTED WOOD TRUSS CONSTRUCTION.













STRUCTURAL NOTES
06610 - SHOP FABRICATED METAL PLATE CONNECTED WOOD TRUSSES
PREMANUFACTURED METAL-PLATE-CONNECTED WOOD TRUSSES SHALL BE DESIGNED AND MANUFACTURED IN ACCORDANCE WITH IBC SECTION 2303.4 TRUSSES, AND THE TRUSS PLATE INSTITUTE ANS/TPI 1-2007 NATIONAL DESIGN STANDARD FOR METAL-PLATE-CONNECTED WOOD TRUSS CONSTRUCTION.

Table with 4 columns: SHEET, DESCRIPTION, Rev, Rev Date. Lists drawing sheets S1.0 through S10.0 and their corresponding descriptions like Structural Notes, Shearwall Schedule and Details, etc.

Vertical sidebar on the right containing CT ENGINEERING INC. logo, project information (No., DATE, REVISION), and a 'REVIEWED FOR CODE COMPLIANCE' stamp dated July 29, 2022.

6/16/2022 4:16:14 PM
6/16/2022 4:16:14 PM
Summary: A QUALITY ASSURANCE PLAN IS NOT REQUIRED BY CODE FOR THIS STRUCTURE.



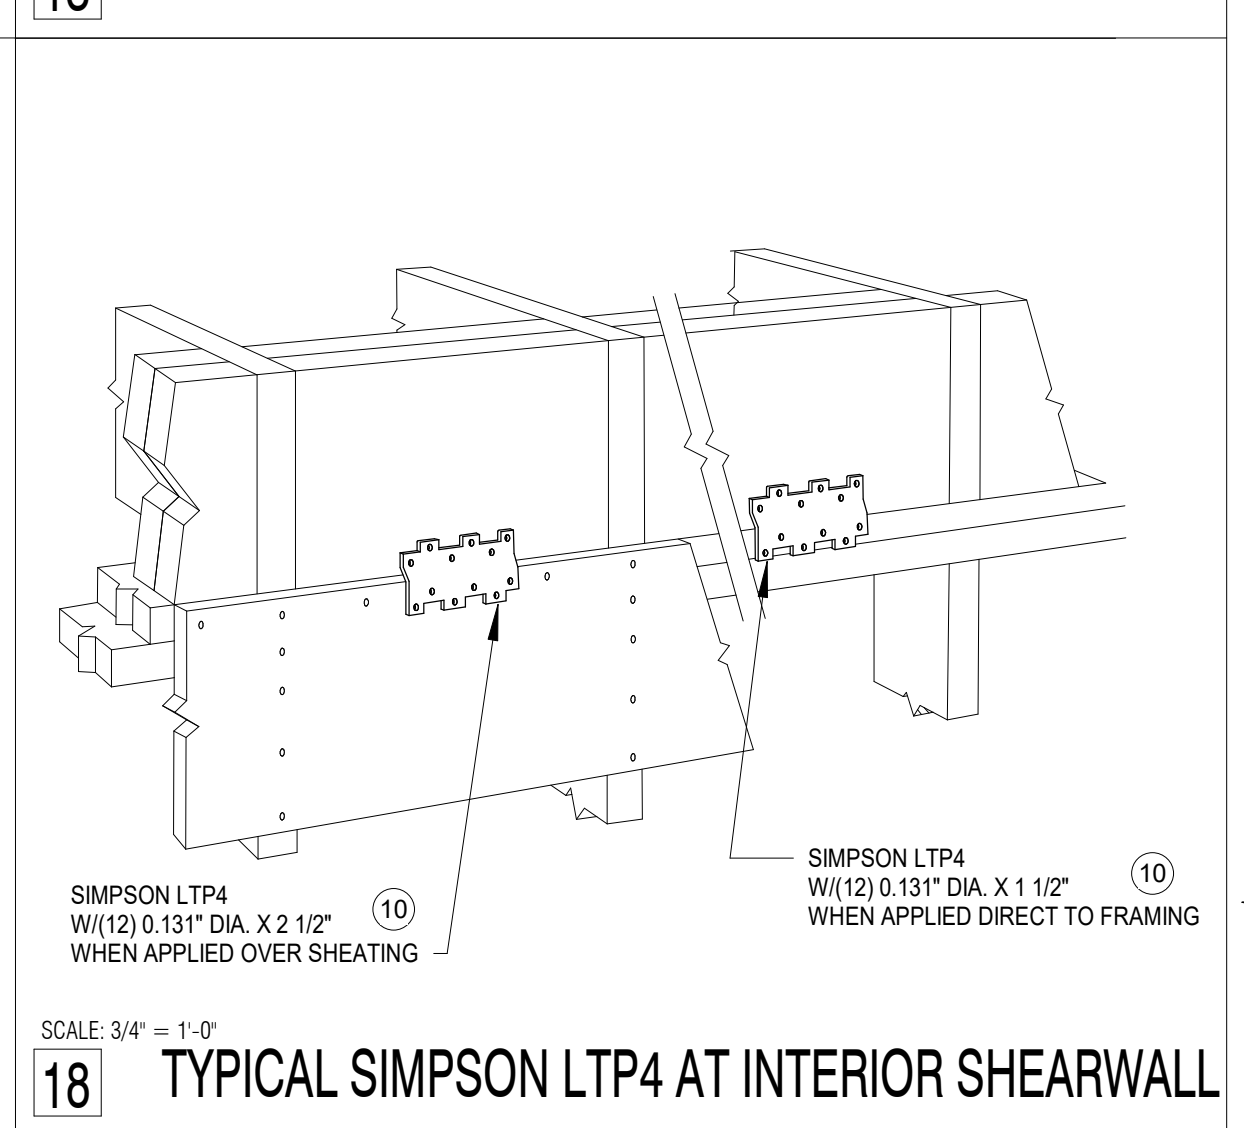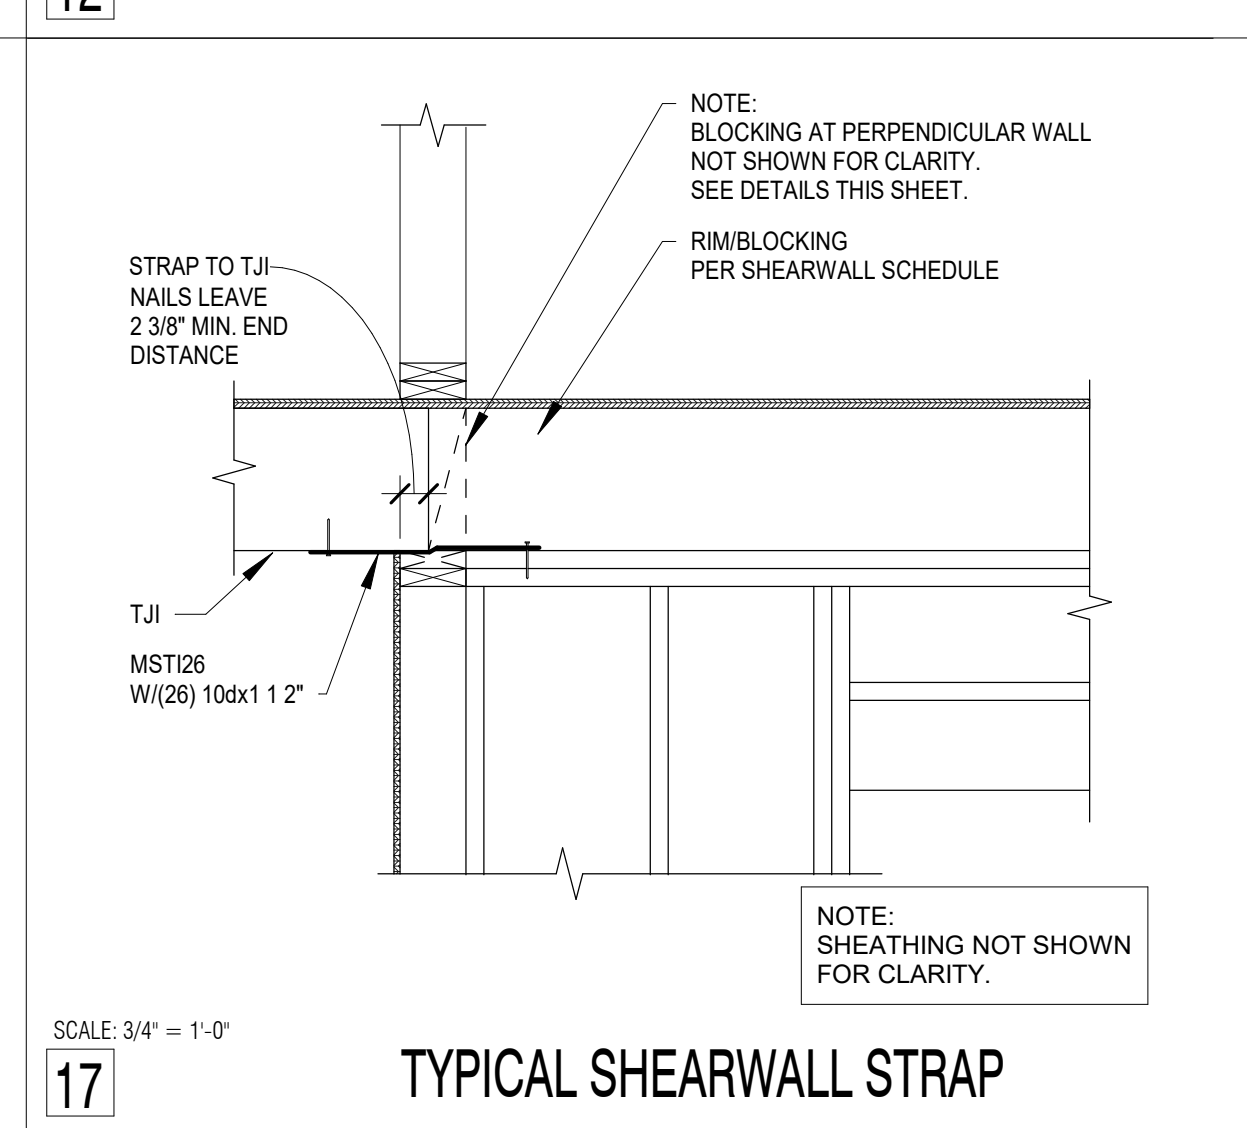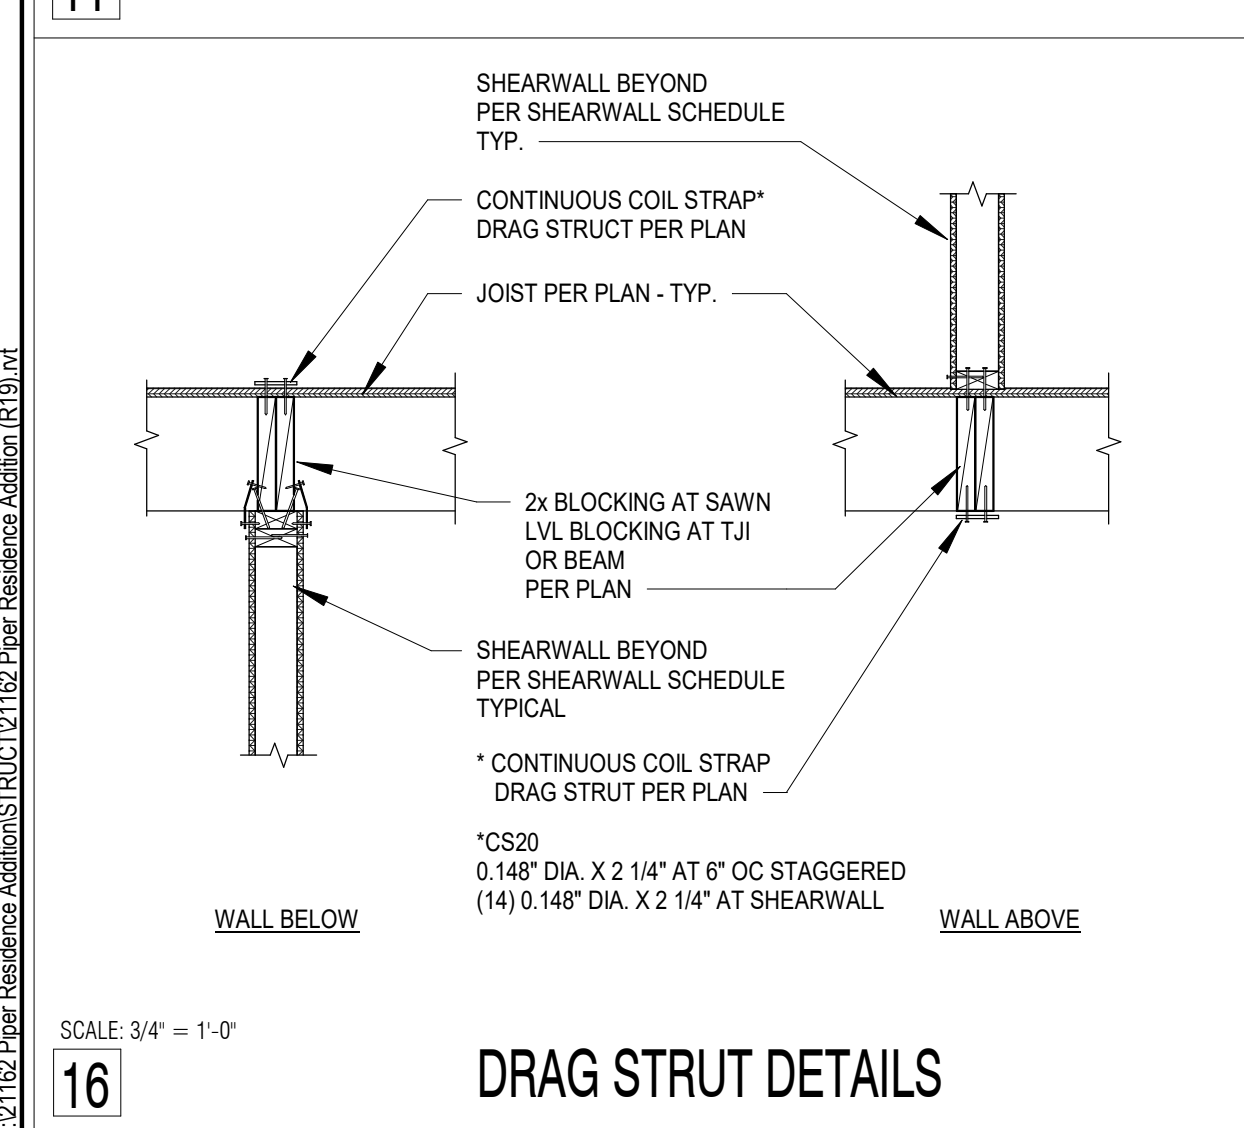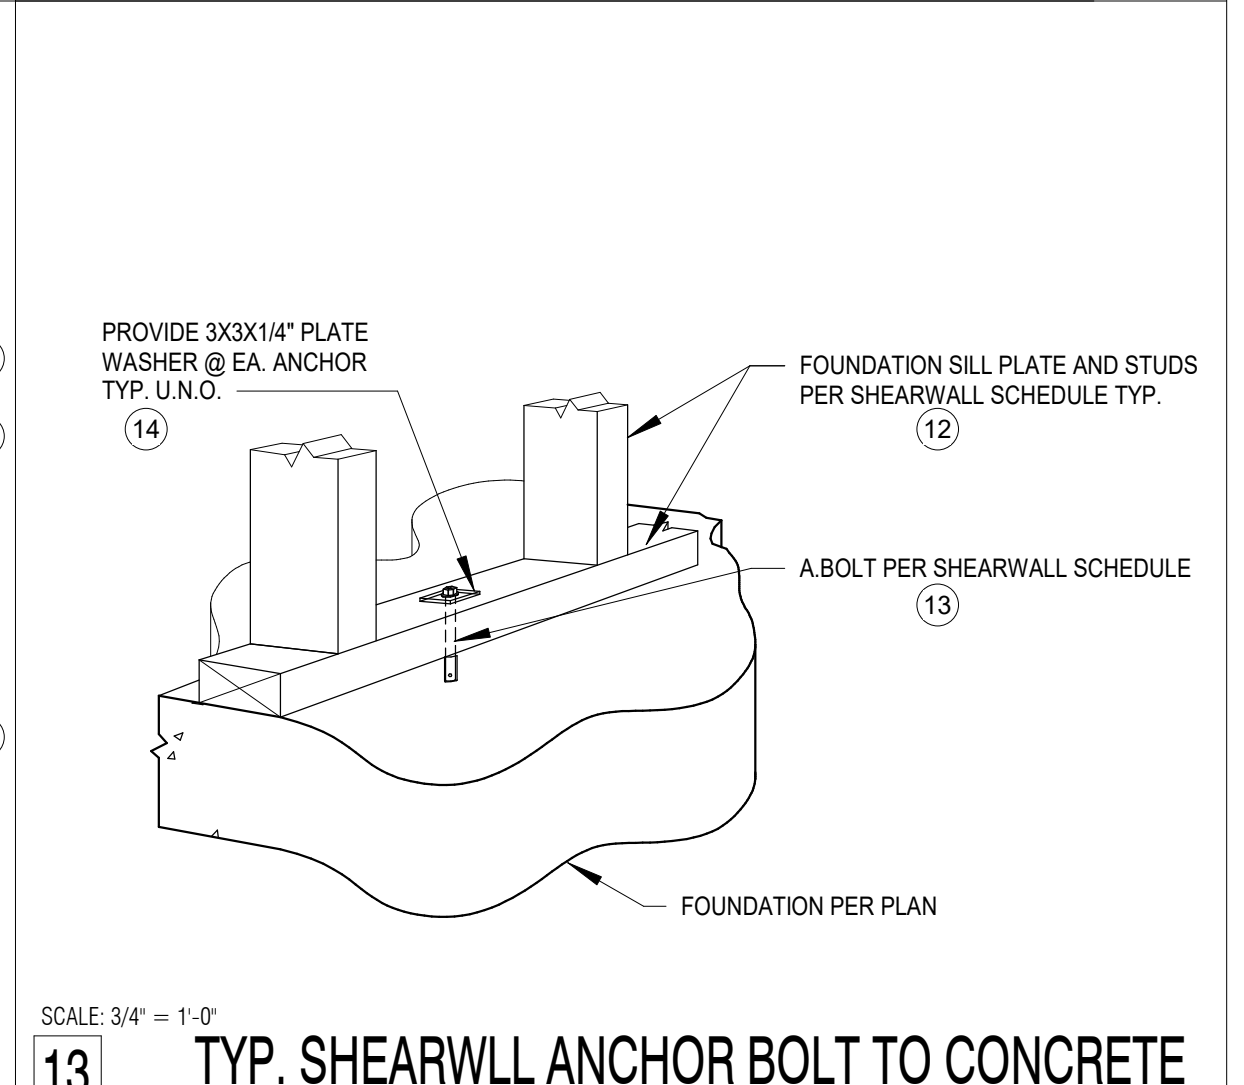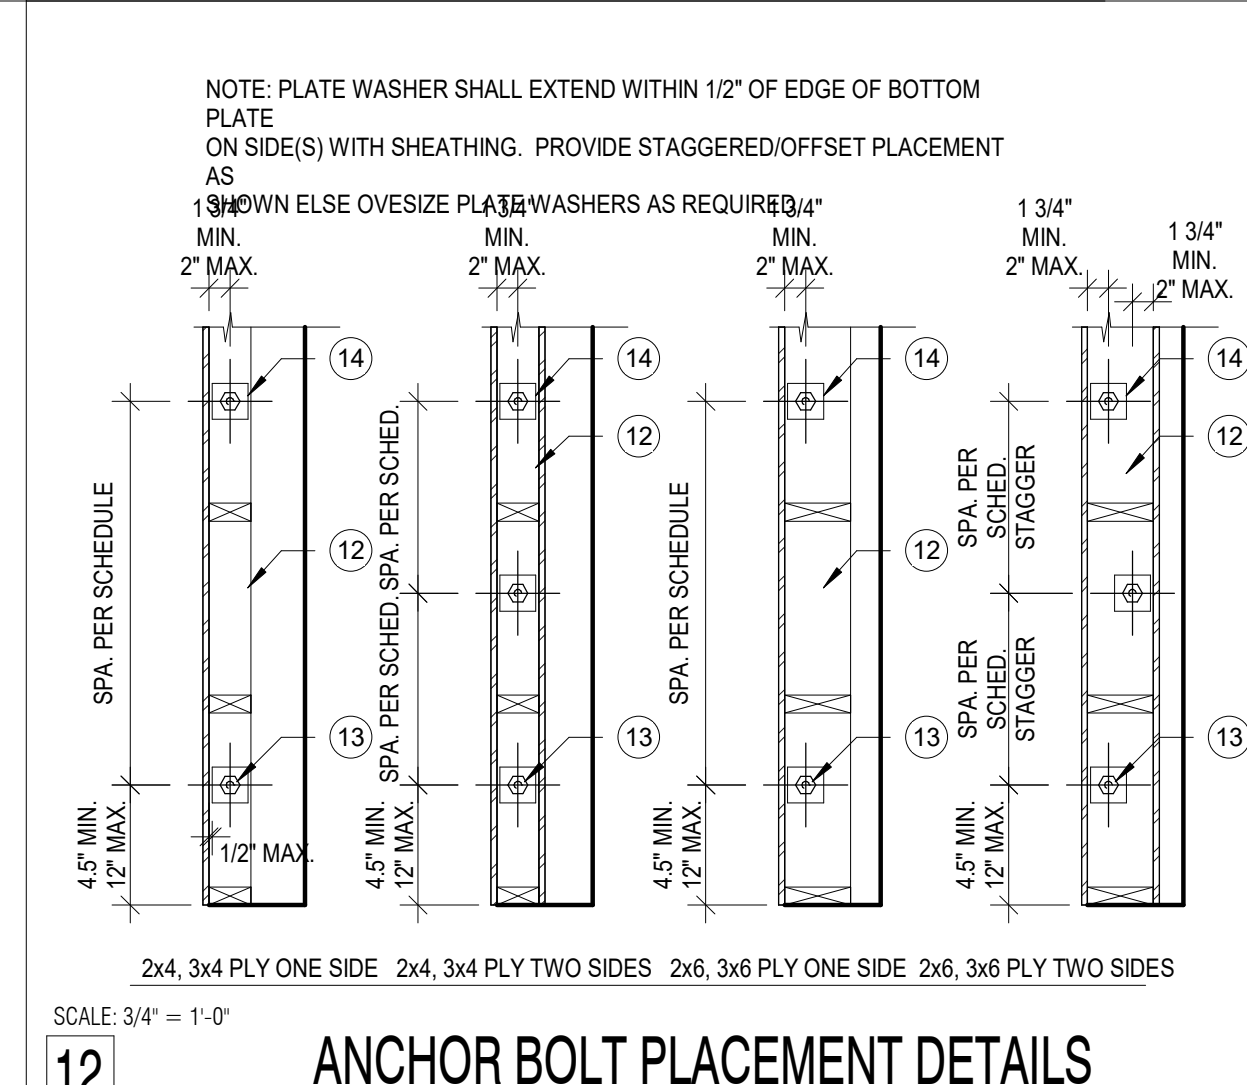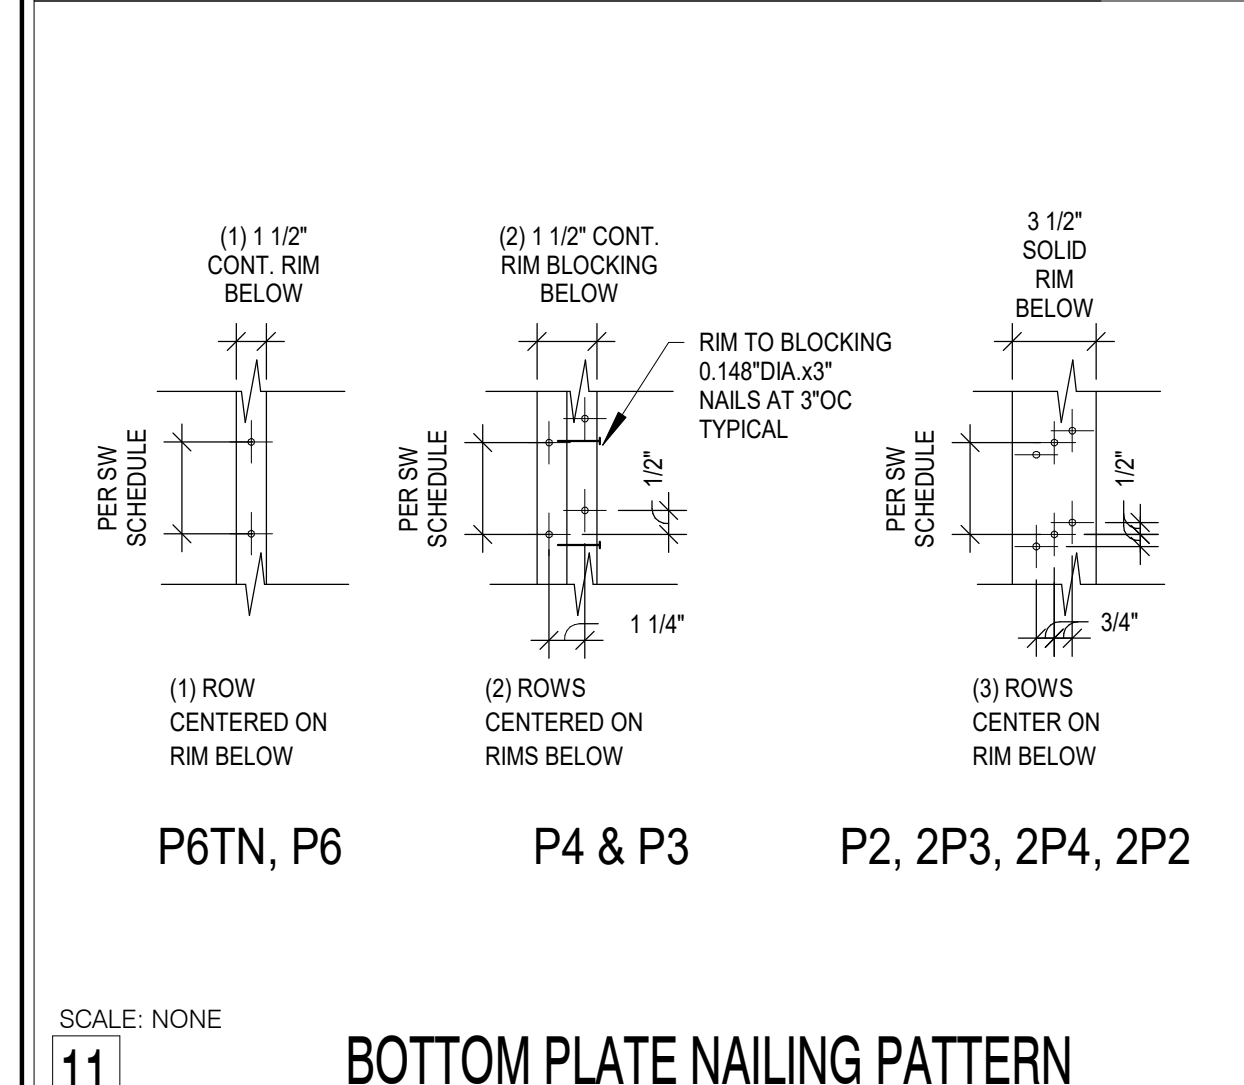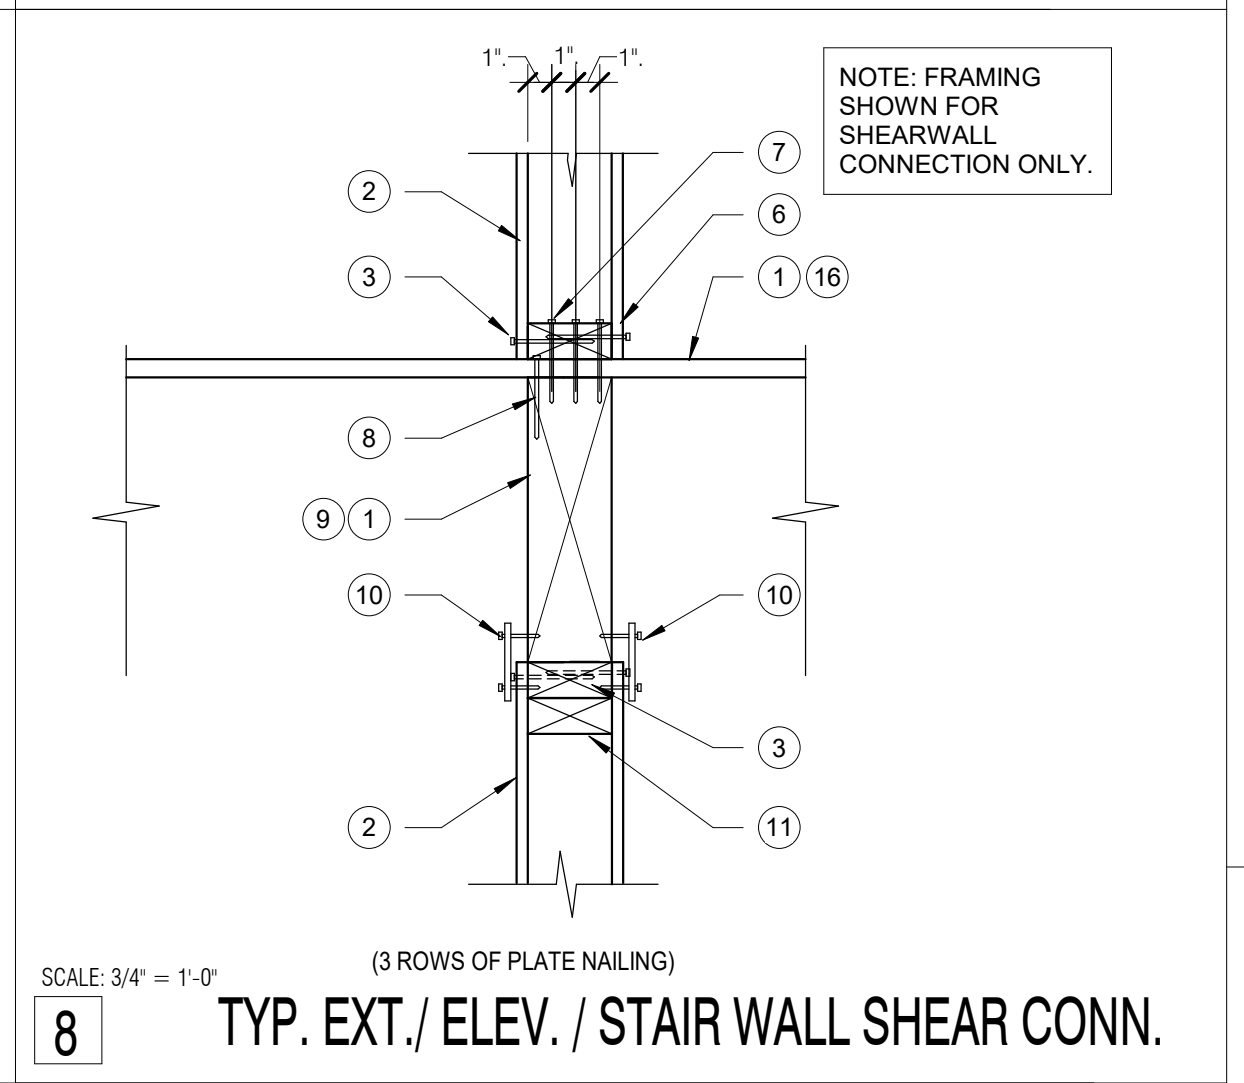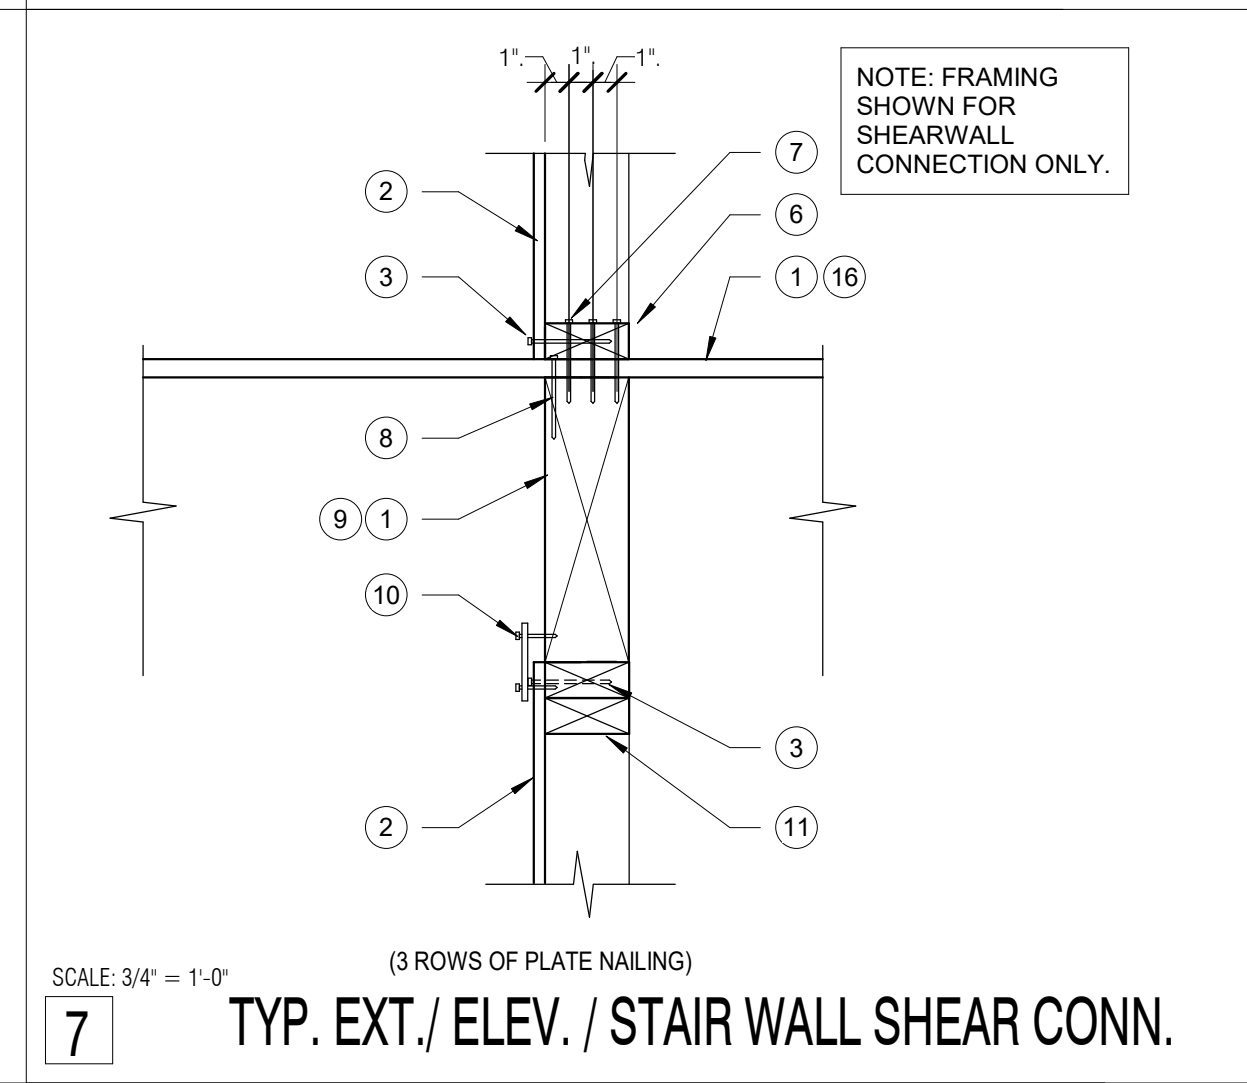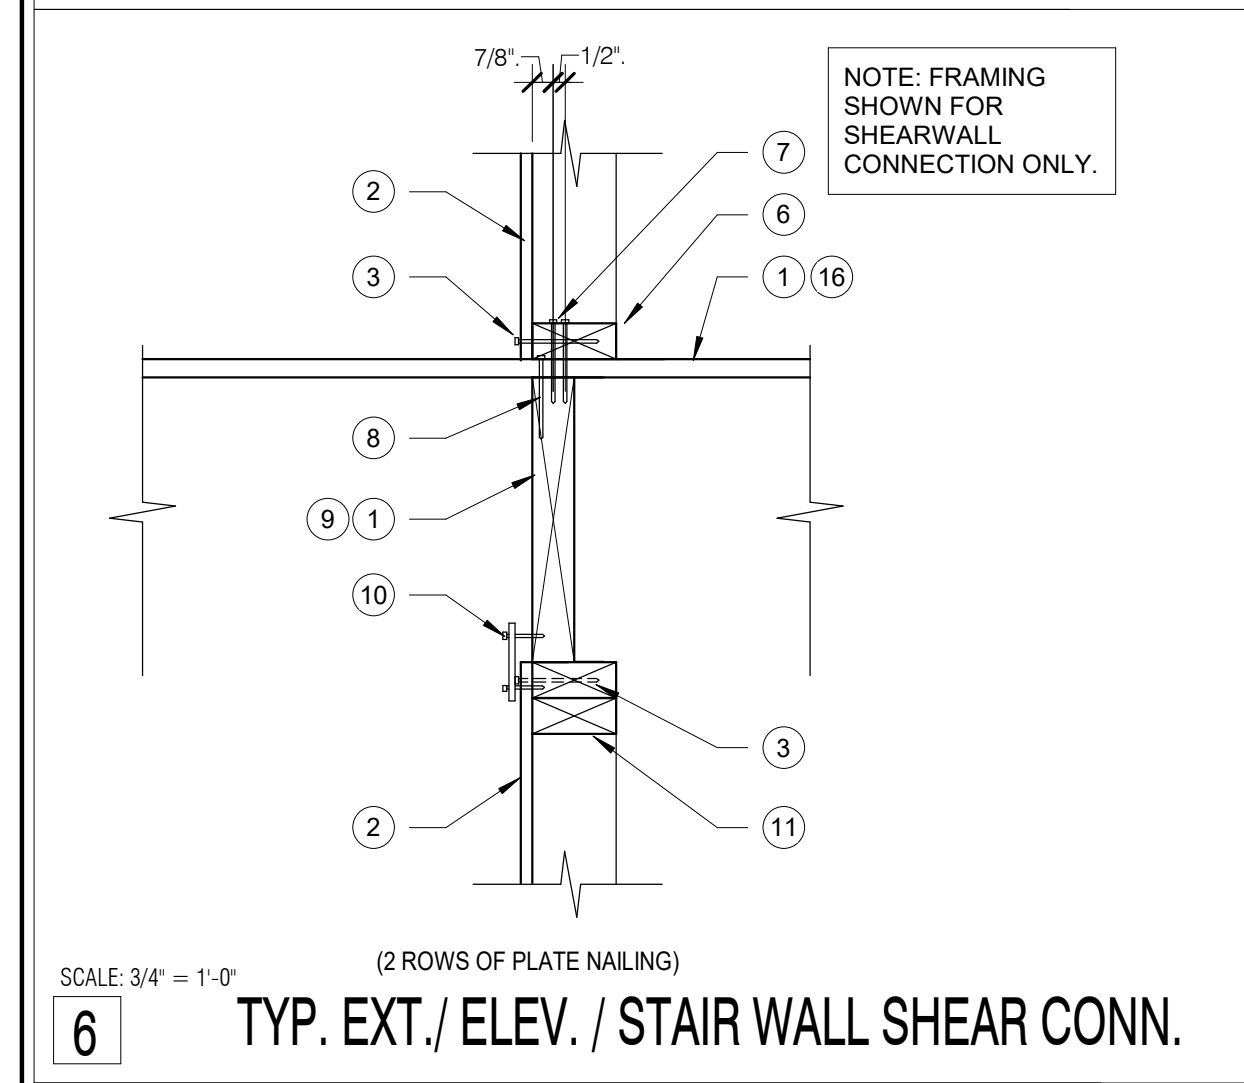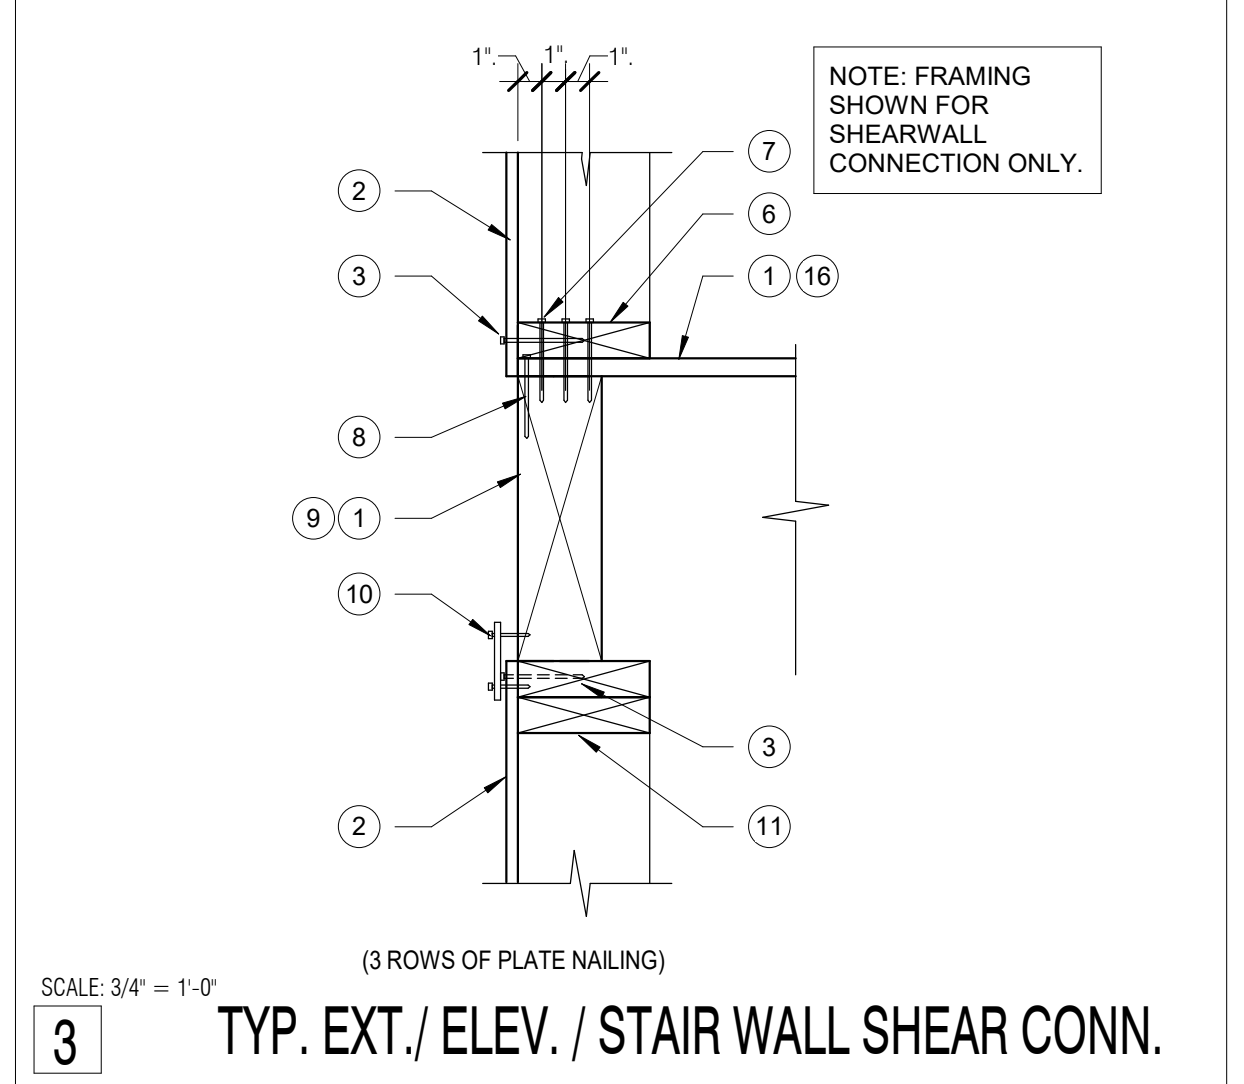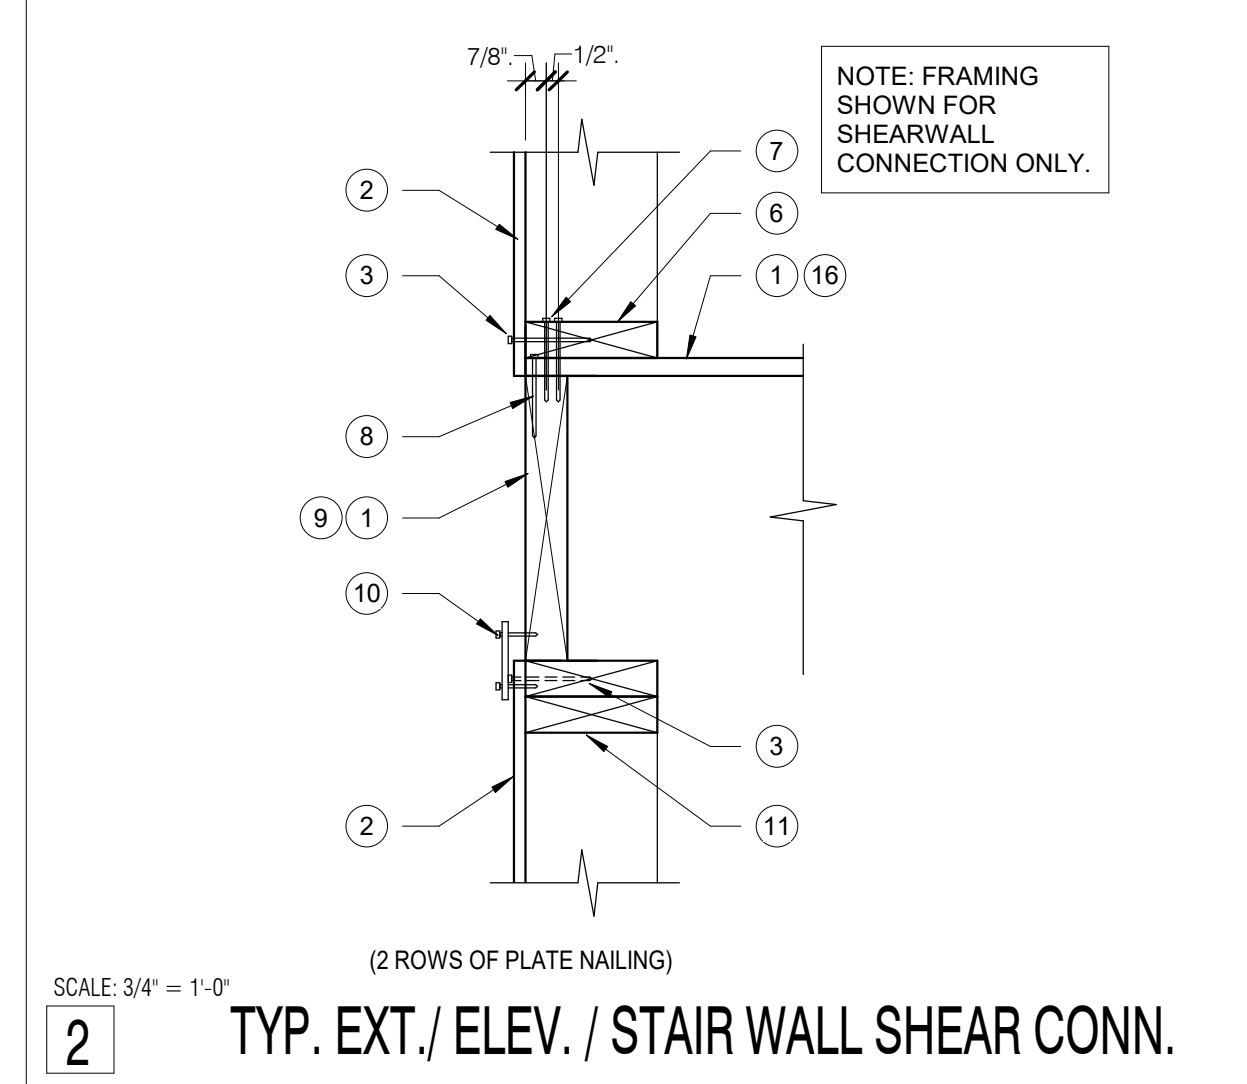
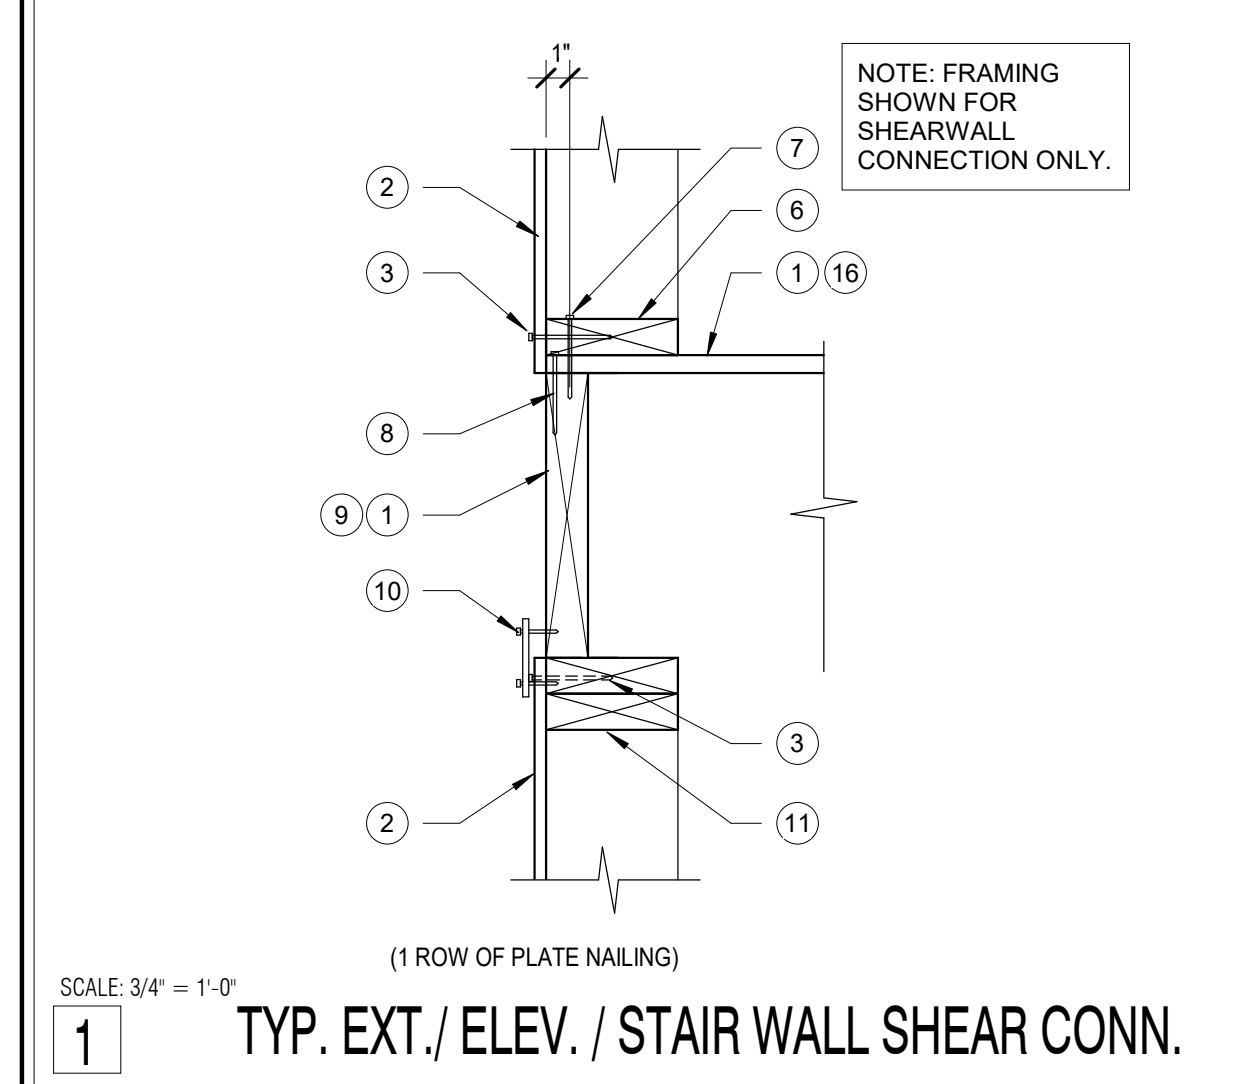


SHEARWALL SCHEDULE - 7/16" APA RATED SHEATHING W/ HEM-FIR STUDS AND HEM-FIR PLATES

WALL TYPE	SHEATHING (2)	PANEL EDGE NAILING (3)	FIELD NAILING (4)	BOTTOM PLATE NAILING (7)		RIM OR BLOCKING TO TOP PLATE CONN. (10)			FRAMING AT ADJOINING PANEL EDGES (5)	FOUNDATION SILL PLATE (12)	ANCHOR BOLT SPACING 5/8" DIA. 7" EMBED (13)
				ROWS	SPACING	0.148"x3.25" TOENAIL	LTP4 DIRECT TO FRAMING	A35 ONLY			
P6TN	7/16" SHT. ONE SIDE	6" O.C.	12" O.C.	(1)	4" O.C.	4" O.C.	N/A	N/A	2x	2x	48" O.C.
P6	7/16" SHT. ONE SIDE	6" O.C.	12" O.C.	(1)	4" O.C.	N/A	24" O.C.	16" O.C.	2x	2x	48" O.C.
P4	7/16" SHT. ONE SIDE	4" O.C.	12" O.C.	(2)	6" O.C.	N/A	16" O.C.	12" O.C.	(2)x OR 3x	2x	32" O.C.
P3	7/16" SHT. ONE SIDE	3" O.C.	12" O.C.	(2)	4" O.C.	N/A	12" O.C.	10" O.C.	(2)x OR 3x	2x	24" O.C.
P2	7/16" SHT. ONE SIDE	2" O.C.	12" O.C.	(3)	6" O.C.	N/A	10" O.C.	10" O.C.	(2)x OR 3x	2x	18" O.C.
2P4	7/16" SHT. BOTH SIDES	4" O.C.	12" O.C.	(3)	5" O.C.	N/A	10" O.C.	10" O.C.	(2)x OR 3x	2x	16" O.C.
2P3	7/16" SHT. BOTH SIDES	3" O.C.	12" O.C.	(3)	4" O.C.	N/A	8" O.C.	8" O.C.	(2)x OR 3x	2x	12" O.C.
2P2	7/16" SHT. BOTH SIDES	2" O.C.	12" O.C.	(3)	3" O.C.	N/A	6" O.C.	6" O.C.	(2)x OR 3x	2x	8" O.C.

# REFERS TO KEYNOTES IN DETAIL 19 THIS SHEET

- SHEARWALL SCHEDULE NOTES:
- STUDS SHALL NOT BE SPACED MORE THAN 16" O.C.
  - RE: S1.0 SECTION 06100 "ROUGH FRAMING" FOR REQUIRED WALL STUD AND PLATE SPECIES AND GRADE.
  - RE: S1.0 SECTION 06160 "WOOD SHEATHING" FOR REQUIRED SHEAR WALL SHEATHING, THICKNESS AND GRADE. ALL SHEAR WALL PANELS SHALL BE APPLIED DIRECTLY TO FRAMING.
  - SHEATHING PANELS MAY BE INSTALLED EITHER HORIZONTALLY OR VERTICALLY WITH ALL PANEL EDGES BACKED/BLOCKED WITH 2" NOMINAL OR WIDER FRAMING. SEE NOTE 5.
  - FRAMING MEMBERS RECEIVING EDGE NAILING FROM ADJOINING PANELS SHALL NOT BE LESS THAN 3" NOMINAL AND NAILS SHALL BE STAGGERED FOR ALL SHEARWALL MARKS EXCEPT "P6".
  - WHERE PANELS ARE APPLIED ON BOTH FACES OF A WALL AND NAIL SPACING IS LESS THAN 6" O.C. ON EITHER SIDE, PANEL JOINTS SHALL BE OFFSET TO FALL ON DIFFERENT FRAMING MEMBERS OR FRAMING SHALL BE 3" NOMINAL OR THICKER AND NAILS SHALL BE STAGGERED.
  - NAILS FOR PLYWOOD AND OSB PANEL EDGE AND FIELD NAILING SHALL BE 8D COMMON (0.131" X 2 1/2").
  - NAILS FOR BOTTOM PLATE FRAMING SHALL BE 12D COMMON (0.148" X 3.25").
  - FLOOR DIAPHRAGM NAILING SHALL BE PLACED BETWEEN THE SPACING CALLED OUT FOR BOTTOM PLATE NAILING. DO NOT OVER NAIL THE BLOCKING.
  - ANCHOR BOLTS SHALL BE GALVANIZED 5/8" DIAMETER A-307 AND SHALL BE SECURED IN PLACE PRIOR TO CONCRETE POUR. WET STICKING OF ANCHOR BOLTS IS NOT ALLOWED.
  - GALVANIZED 3" X 3" X 0.225" (MIN.) PLATE WASHERS ARE REQUIRED AT EACH ANCHOR BOLT - SEE 8 THIS SHEET FOR PLACEMENT REQUIREMENTS. RECESSING PLATE WASHERS IN PLATES IS NOT ALLOWED.
  - LTP4 FRAMING PLATES SHALL BE INSTALLED WITH 12-8D X 1 1/2" (0.131" X 2 1/2") NAILS. RE: DETAILS 1, 2, 3 & 8/S.1.
  - A35 FRAMING ANGLES SHALL BE INSTALLED WITH 12-8D X 1 1/2" (0.131" X 1 1/2") NAILS. RE: DETAILS 1, 2 & 8/S.1.
  - ALL NAILS INTO PRESSURE TREATED WOOD SHALL BE HOT-DIPPED GALVANIZED CONFORMING TO ASTM 153 OR STAINLESS STEEL.
  - ALL WOOD IN CONTACT WITH CONCRETE OR MASONRY SHALL BE PRESERVATIVE TREATED.
  - WHERE BOTTOM PLATE NAILING SPECIFIES A SPACING OF 4 INCHES OR LESS NAILS SHALL BE INSTALLED IN TWO ROWS OFFSET 1/2 INCH AND STAGGERED.
  - GALVANIZED EXPANSION ANCHORS OF SIMILAR DIAMETER AND EMBEDMENT ALLOWED AT INTERIOR BEARING AND PARTY WALLS.
  - 2-2X'S IN LIEU OF 3X'S AT PANEL EDGES ACCEPTABLE PROVIDED STUDS ARE ATTACHED PER 10/S1.2 SIM. AND BOTTOM PLATE NAILING.
  - WHERE BUILDING OFFICIALS ALLOW, OSB SHEATHING MAY BE APPLIED OVER 1/2" OR 3/8" GYPSUM WALL BOARD PROVIDED SHEATHING IS NAILED WITH 10D NAILS (0.148" DIA X 3" LONG)
- SCALE: NONE

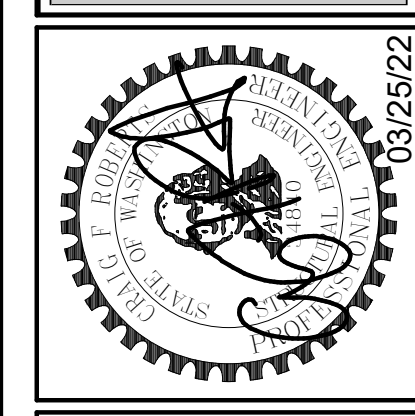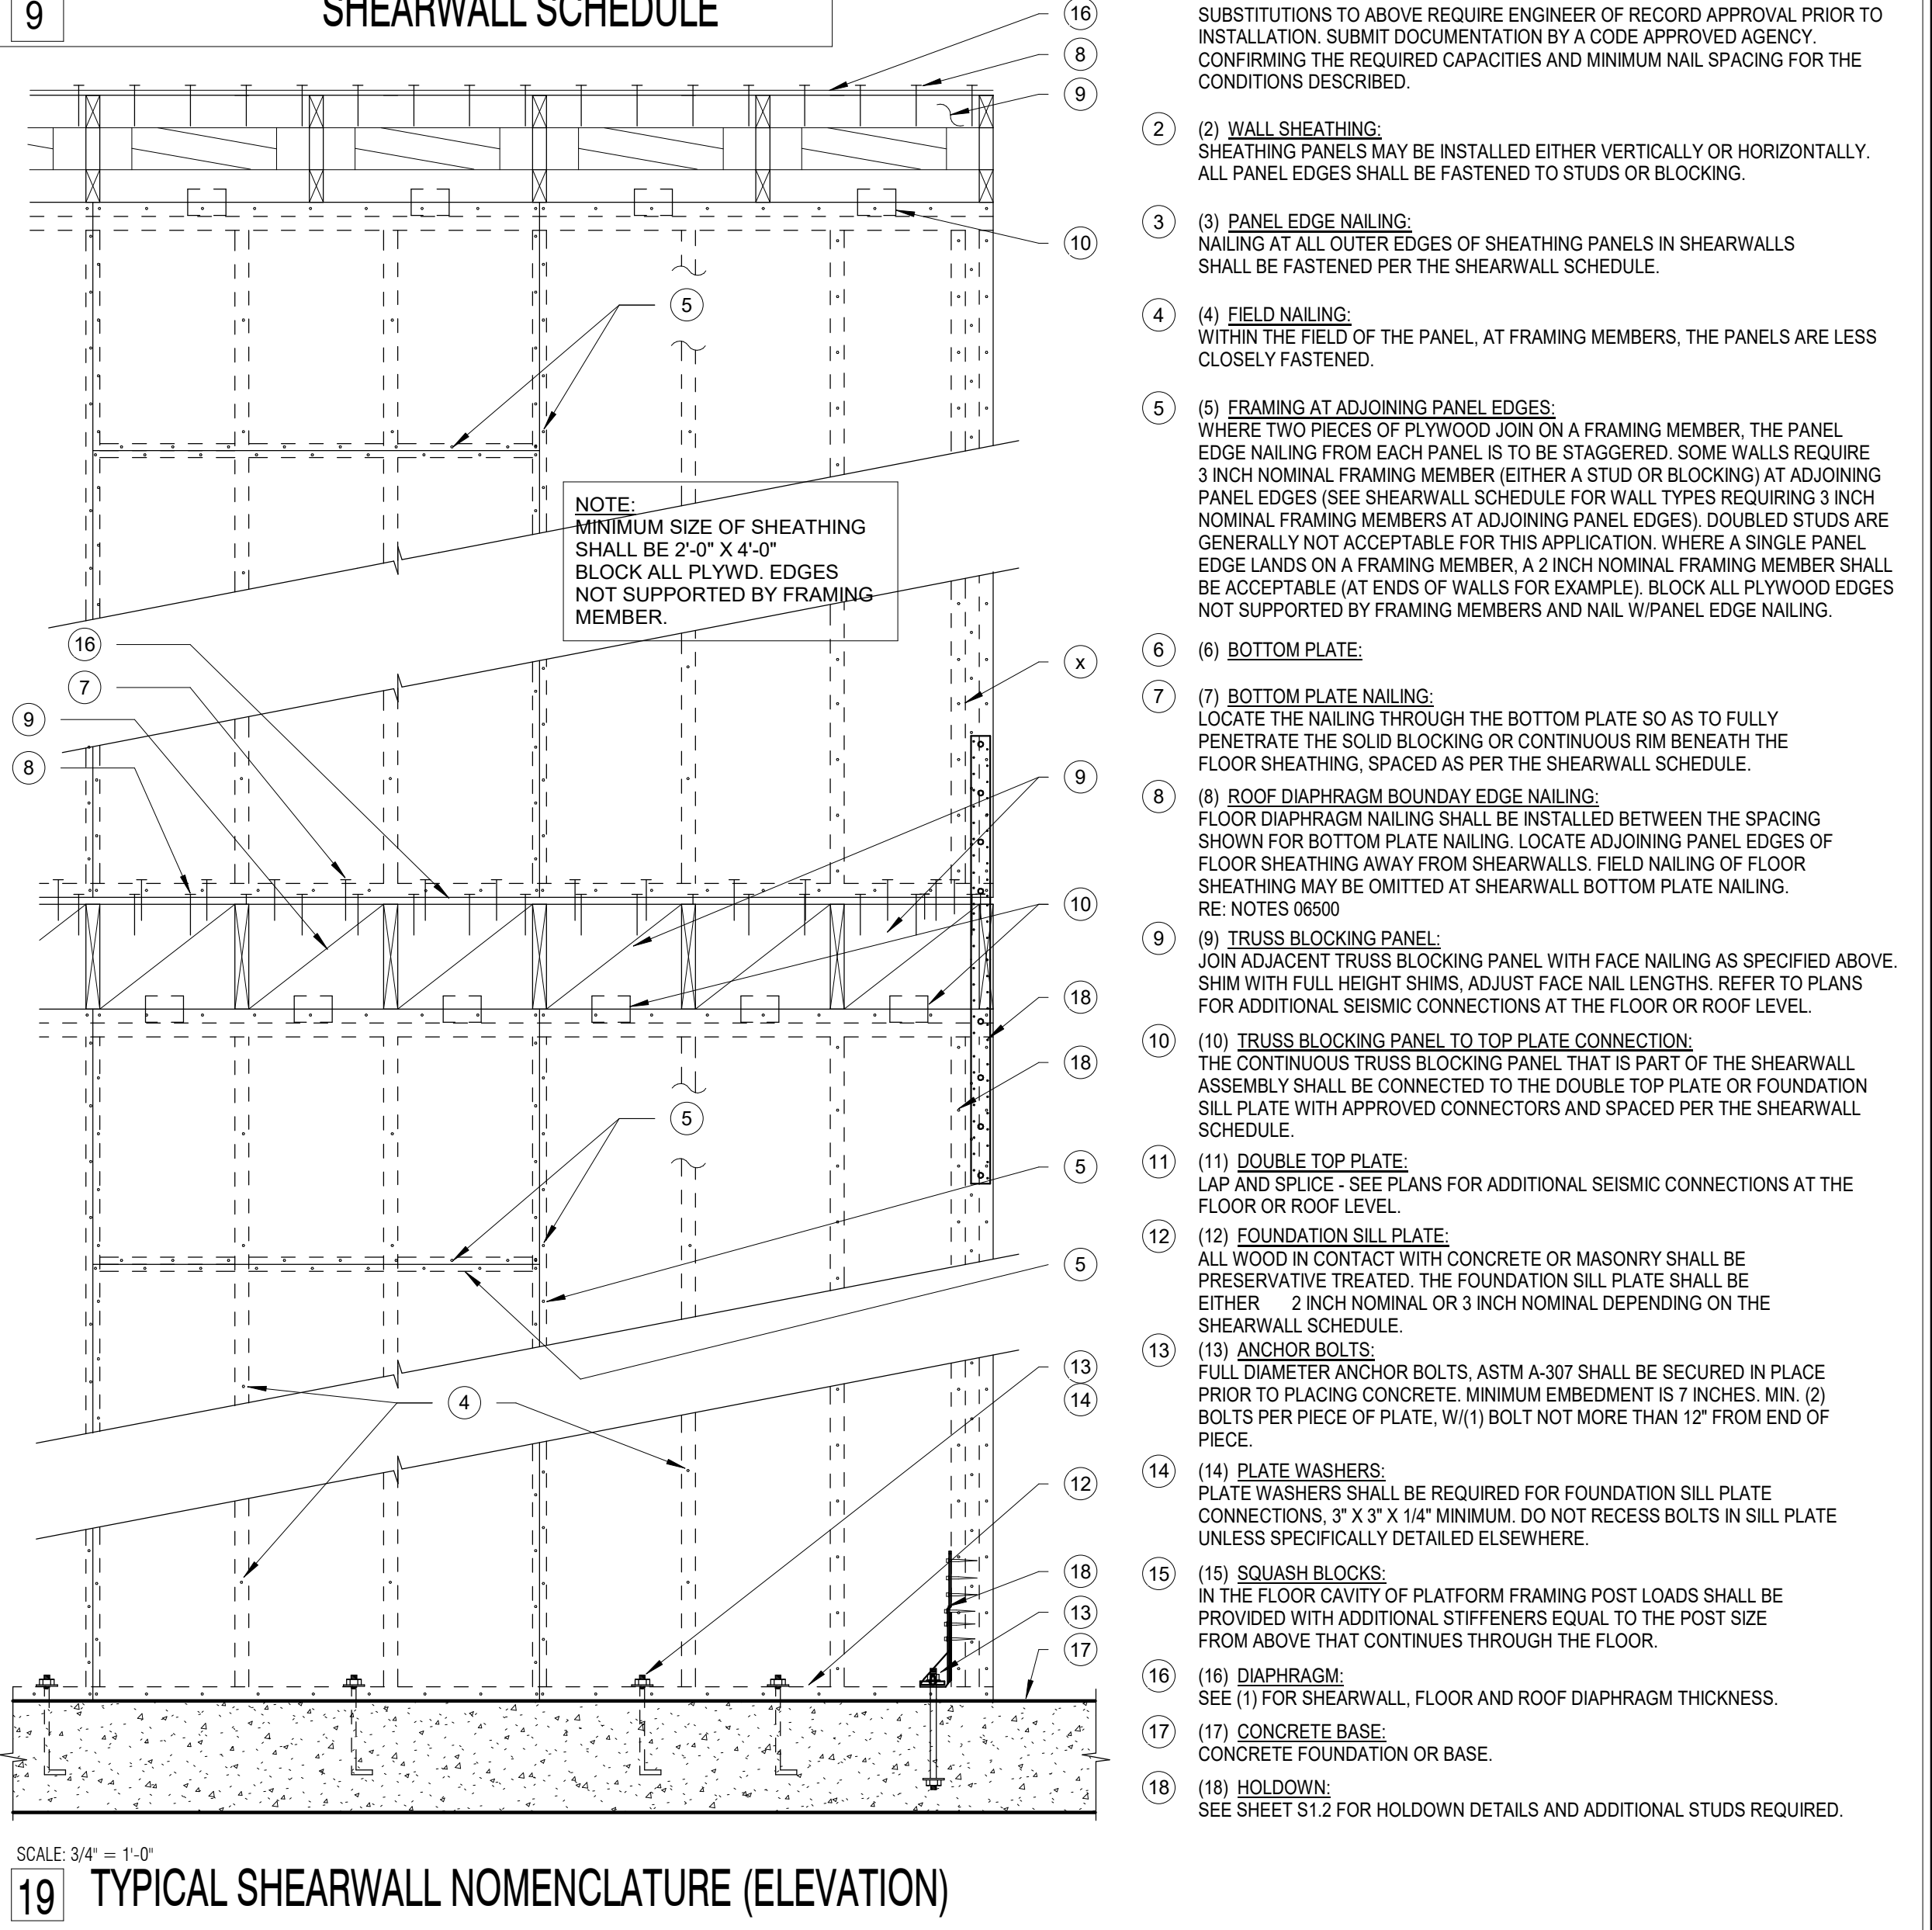


DATE	REVISION

JOB #:	ENG:	BJM	JMA
21162			





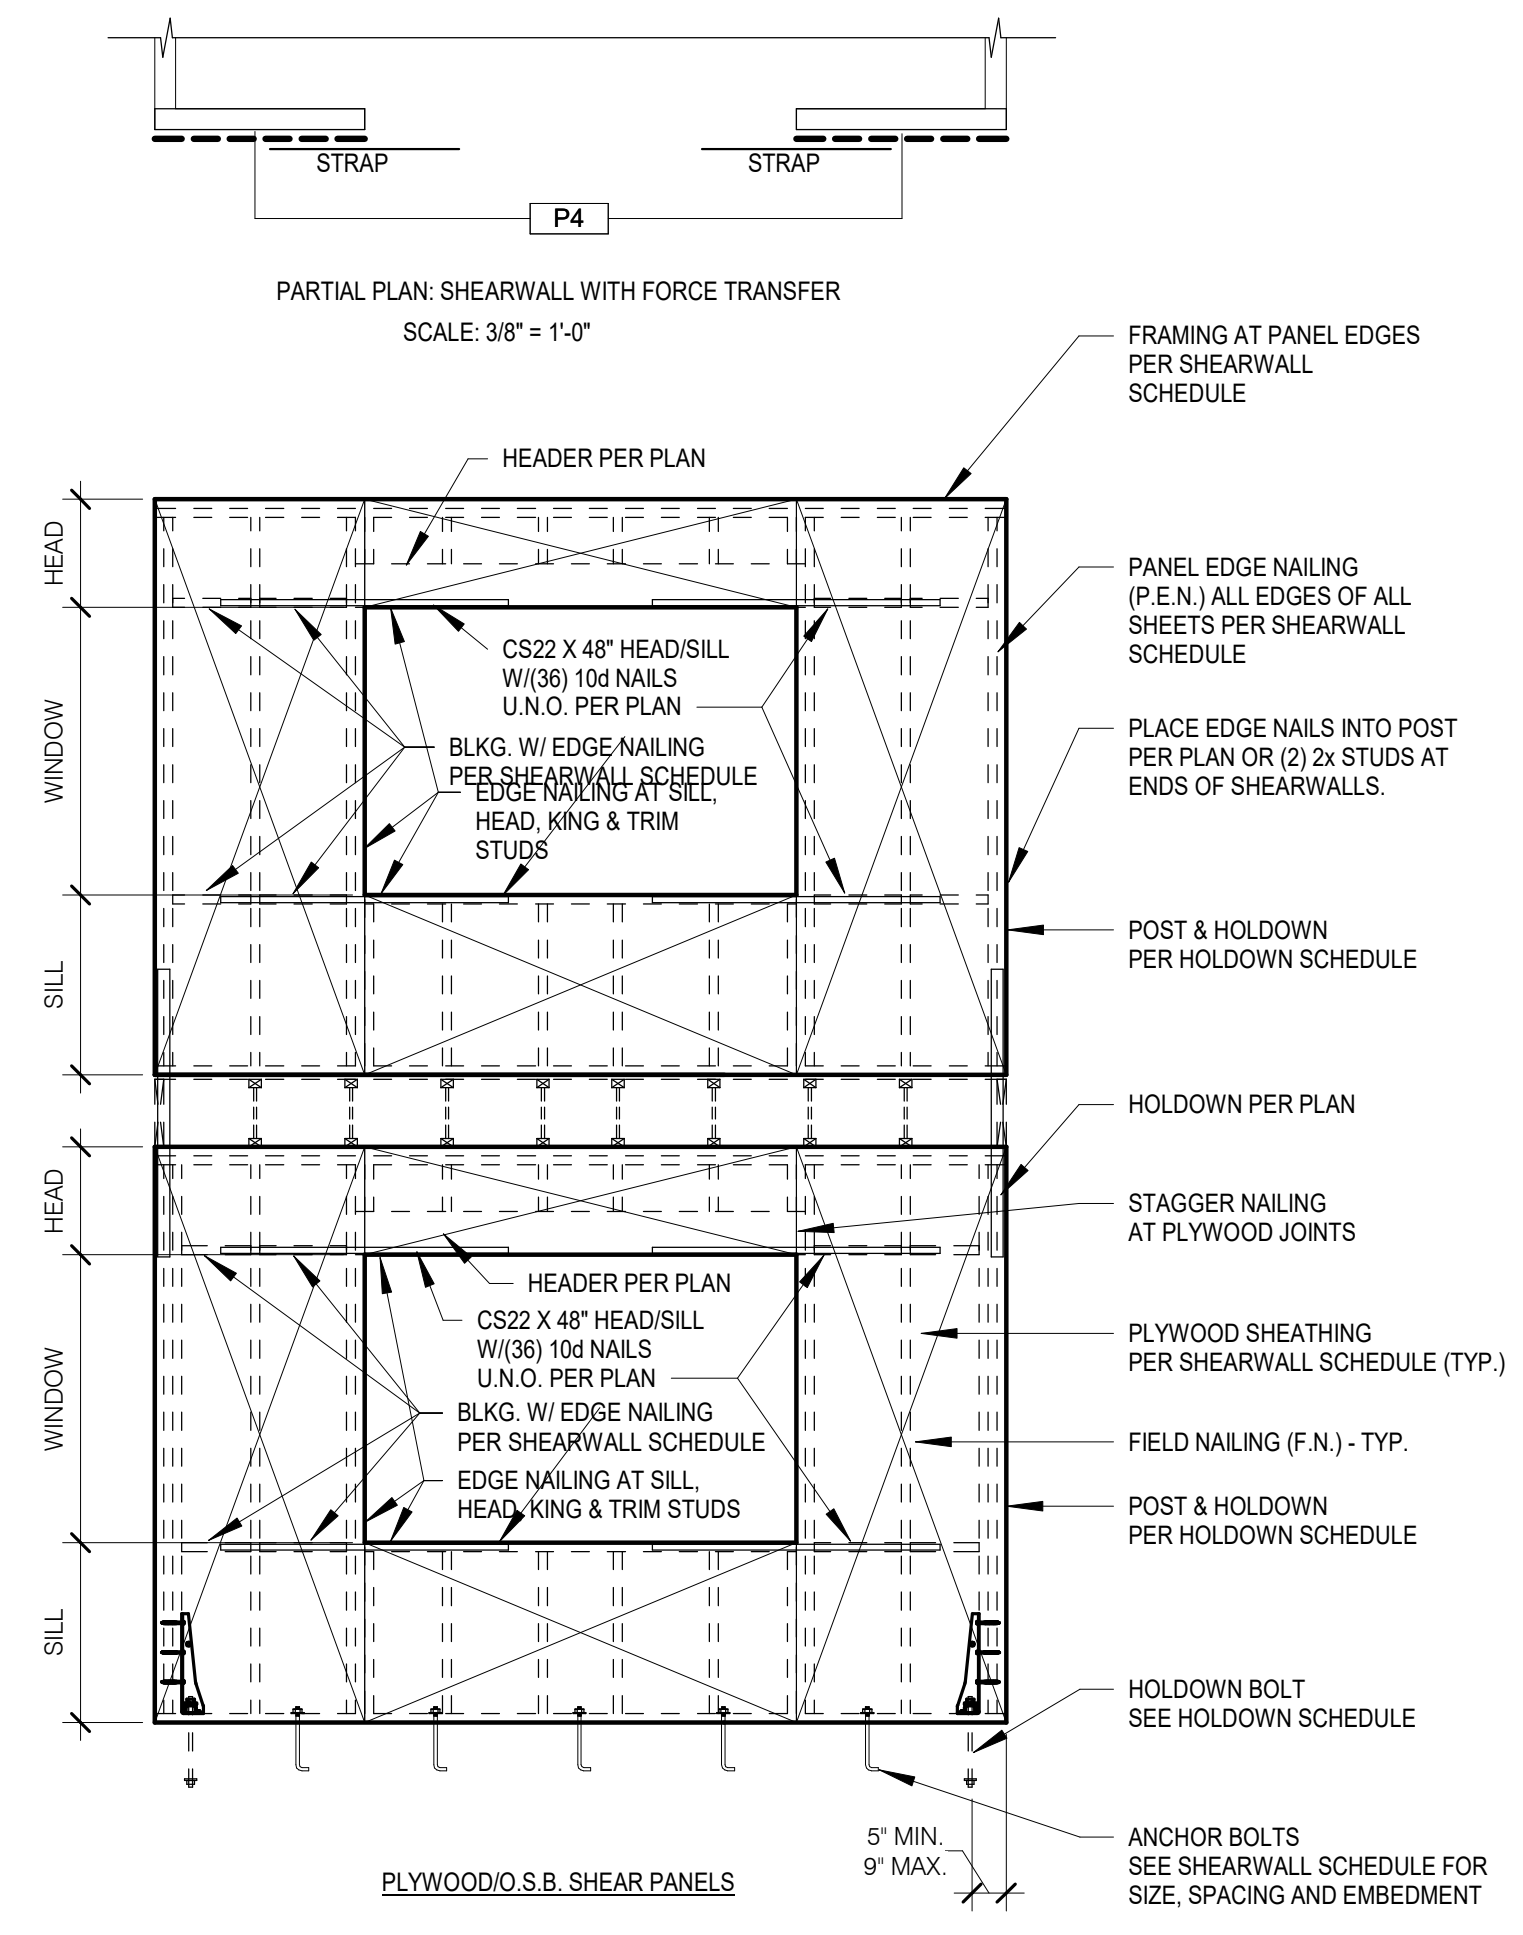


8 TYPICAL DETAIL FOR SHEARWALL W/ FORCE TRANSFER AROUND WINDOW OPENINGS


LOAD	MARK	HARDWARE TYPE	WOOD MEMBER/POST		FASTENER	ROD DIAMETER	ANCHOR			STEM (MINIMUM)	DETAIL		
			2X4 WALL	2X6 WALL			STEM	THICKENED FOOTING	GRADE BEAM			THICKENED SLAB	
			1705	HD1			CS16	2X4	2X6			(28) 8d	N.A.
2345	HD2	MST37	(2) 2X4	(2) 2X6	(22) 16d	N.A.	N.A.	-	N.A.	N.A.			
3640	HD3	MST48	(2) 2X4	(2) 2X6	(34) 16d	N.A.	N.A.	-	N.A.	N.A.			
4830	HD4	MST60	(2) 2X4	(2) 2X6	(48) 16d	N.A.	N.A.	-	N.A.	N.A.			
2.9W/2.2EQ	HD5	LSDTHD8 LSDTHD8RJ	(2) 2X4	(2) 2X6	(16) 12d	STRAP	N.A.	-	8"	-	8"	RE: 13/S1.2	
5.3W/3.8EQ	HD6	STHD14 STHD14RJ	(2) 2X4	(2) 2X6	(24) 12d	STRAP	N.A.	-	14"	-	8"		
3580	HD7	HTT22	(2) 2X4	(2) 2X6	(32) 12d	5/8"	N.A.	-	9"	-	8"		
2215	HD8	HDU2-SDS2.5	(2) 2X4	(2) 2X6	(6) SDS 1/4X2 1/2"	5/8"	ROD & NUT/WASHER NUT PER 13/S1.2	-	11"	-	6"		
3285	HD9	HDU4-SDS2.5	(2) 2X4	(2) 2X6	(10) SDS 1/4X2 1/2"	5/8"		-	11"	-	6"		
4065	HD10	HDU5-SDS2.5	(2) 2X4	(2) 2X6	(14) SDS 1/4X2 1/2"	5/8"		-	11"	RE: 13/S1.2	6"		
4305/6970	HD11	HDU8-SDS2.5	(2) 2X4	(2) 2X6	(20) SDS 1/4X2 1/2"	7/8"		-	11"	-	8"		
9535	HD12	HDU11-SDS2.5	4X6	6X6	(30) SDS 1/4X2 1/2"	1"		-	16"	-	8"		
1492	HD13	HD19	-	6X6	(5) 1"DIA. M.B.	1 1/4"		-	16"	-	8"		
	HD14	HDU14-SDS2.5	4X6	6X6	(36) SDS 1/4X2 1/2"	1"		-	16"	-	8"		
	HD15	MSTC48B3	(2) 2X4	(2) 2X6	(12) 10d FACE, (4) 10d BOTTOM, (38) 10d STUDS/POST			-	-	-	-		

- HOLDOWN AND FASTENER SCHEDULE NOTES:
- HOLDOWNS SHALL BE AS MANUFACTURED BY THE SIMPSON STRONG-TIE COMPANY.
  - 16D = 0.162" DIA. X 3 1/2" LONG.
  - USE HALF THE REQUIRED NAILS IN EACH MEMBER BEING CONNECTED.
  - SCREWS SHALL BE SDS 1/4" DIA. X 2 1/2" AS MANUFACTURED BY SIMPSON STRONG-TIE COMPANY.
  - HOLDDOWN ANCHORS SHALL BE SECURED IN PLACE PRIOR TO PLACING CONCRETE.
  - ANCHOR BOLT NUT SHALL BE FINGER-TIGHT PLUS 1/3 - 1/2" TURN WITH HAND WRENCH. CARE SHALL BE TAKEN TO NOT OVER-TORQUE THE NUT. IMPACT WRENCHES SHALL NOT BE USED.
  - HDU HOLDOWNS SHALL BE INSTALLED CENTERED ALONG THE WIDTH OF THE ATTACHED POST.
  - RE: NOTES SECTION 06100 "ROUGH FRAMING" FOR THE REQUIRED POST SPECIES AND GRADE.
  - BUNDLED STUDS PER DETAIL 10/S1.2
  - STRAP TIE HOLDOWNS. NAIL STRAPS FROM BOTTOM UP. INSTALL WITH STRAP MATE "NO WET STICKING".
  - ANCHOR BOLT HOLDOWNS SHALL BE ASTM A307 OR A36 STEEL. ANCHOR HEAD REQUIRES NUT/WASHER NUT PER 2/S1.2.


10 SHEARWALL SCHEDULE

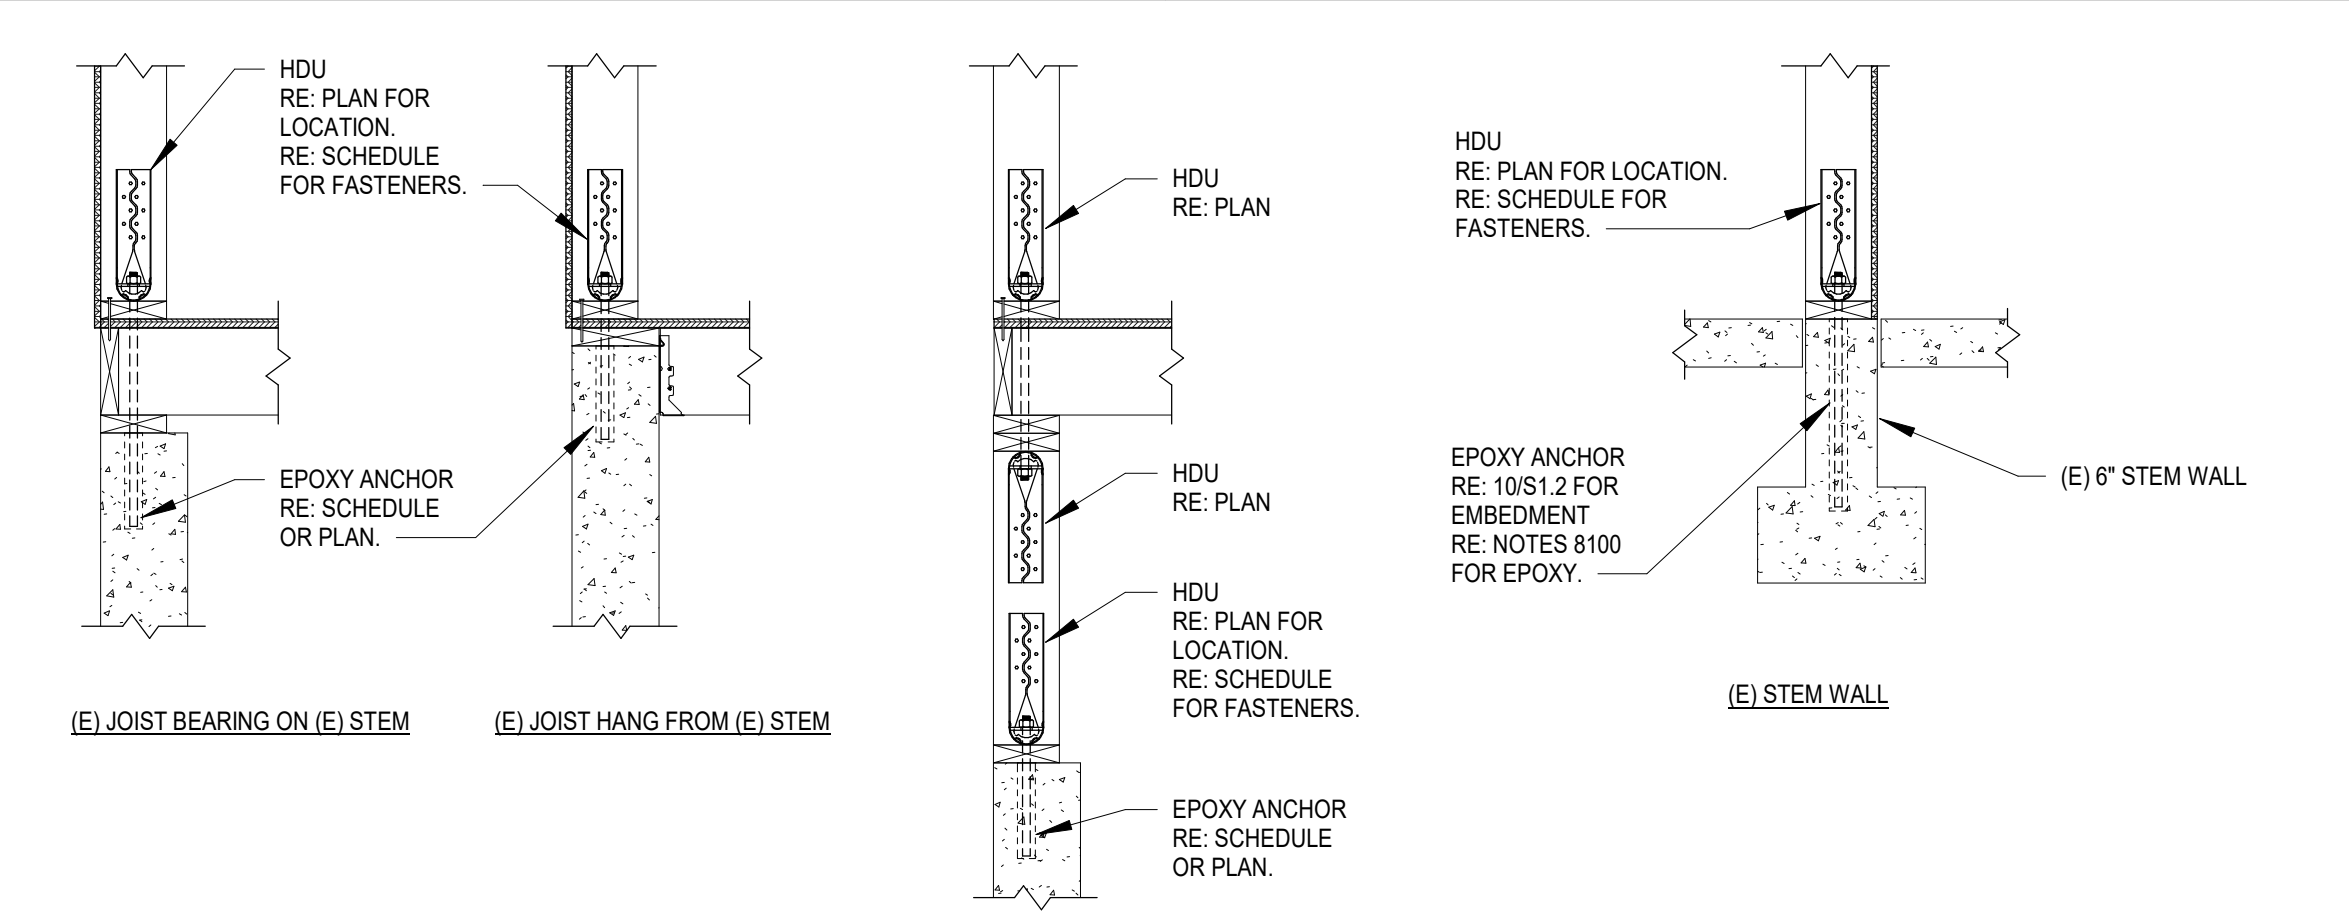


11 EPOXY ANCHORAGE OF HDU TYPE HARDWARE

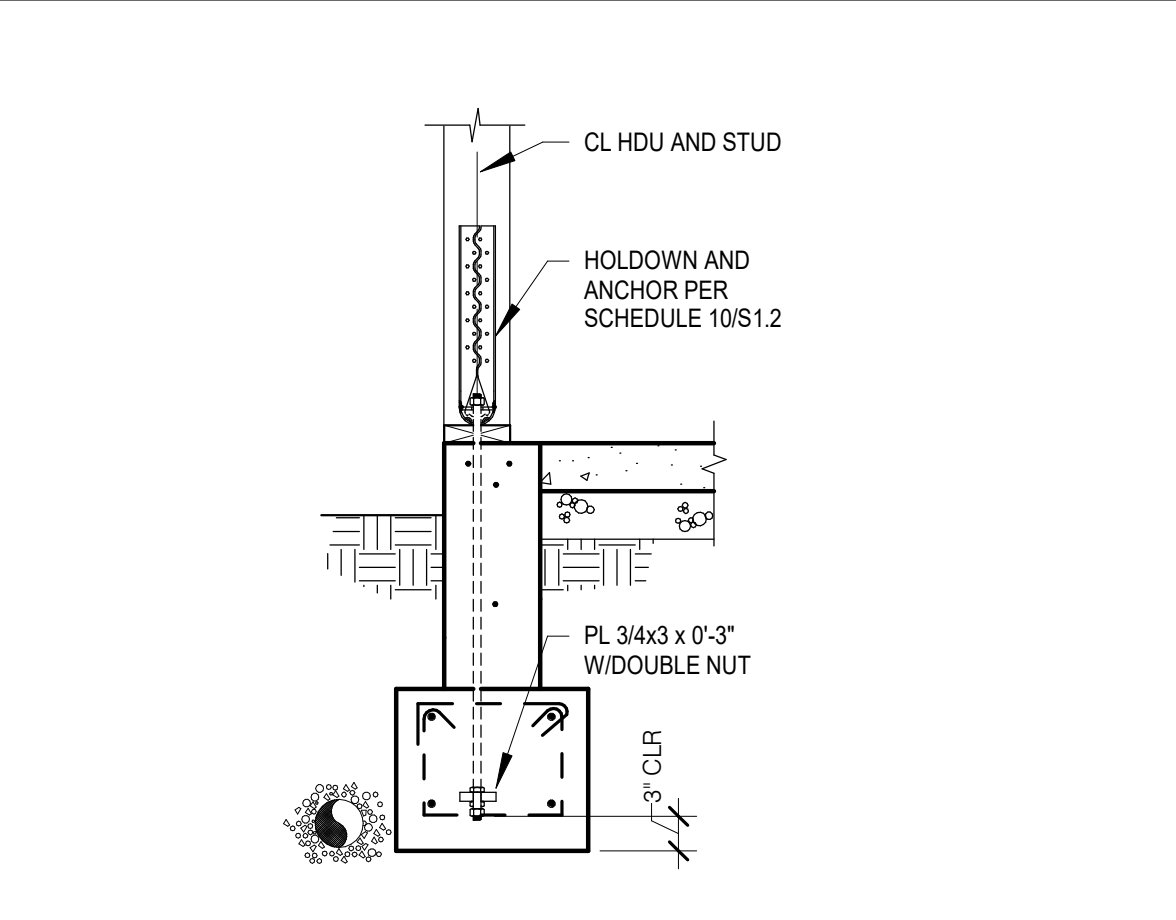

13 EXTERIOR HOLDOWN - SECTION

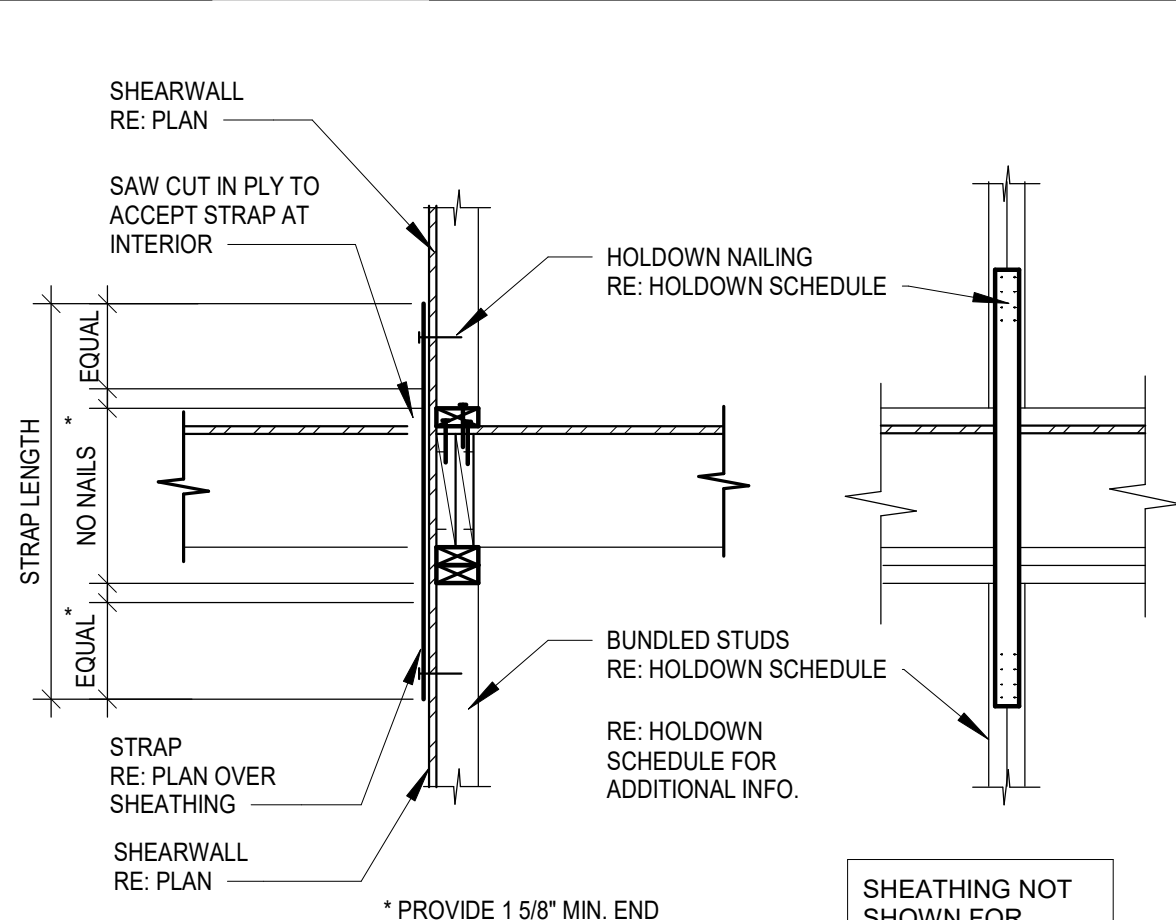


14 INTERIOR HOLDOWN

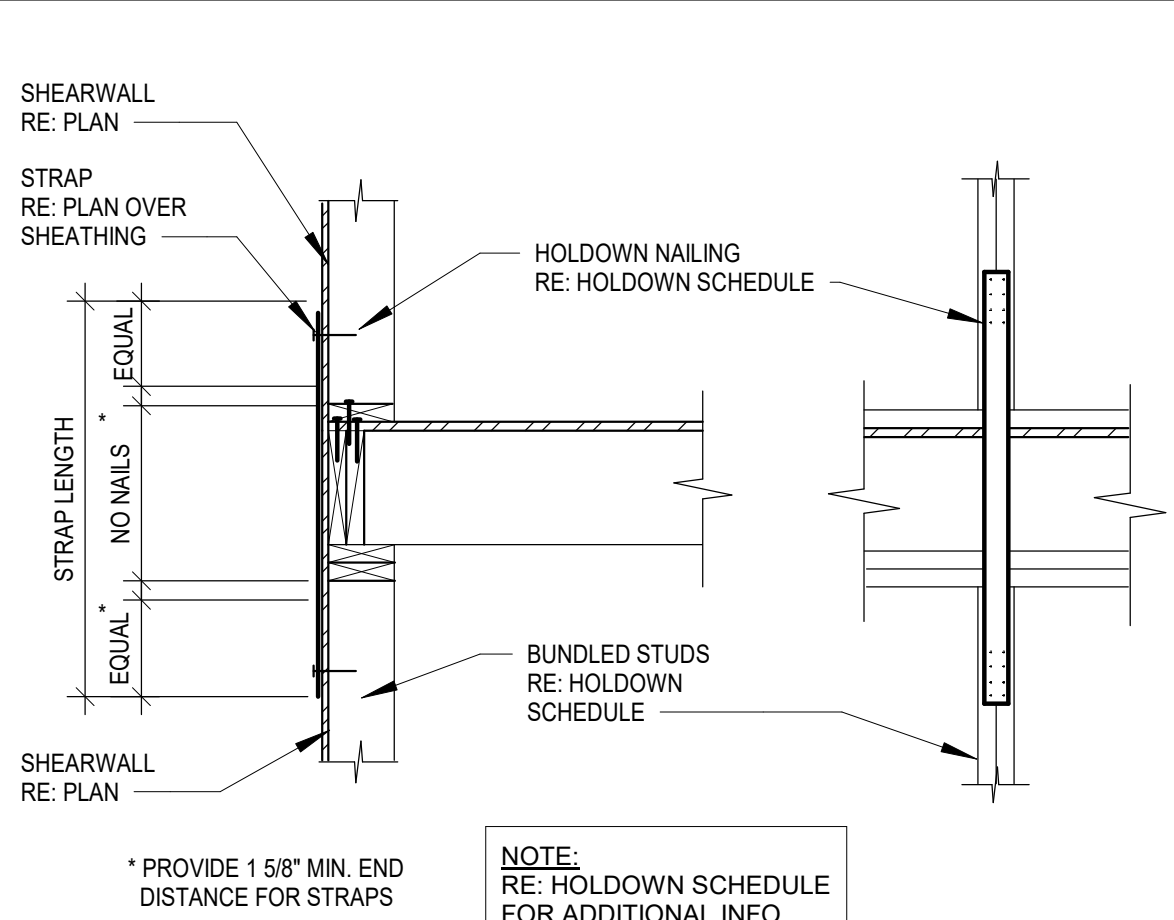

15 EXTERIOR HOLDOWN

**CT ENGINEERING INC.**  
Structural Engineers  
180 Nickerson Street, Suite 302, Seattle, WA 98109  
206.285.4512 (V) 206.285.0616 (F)  
www.ctengineering.com

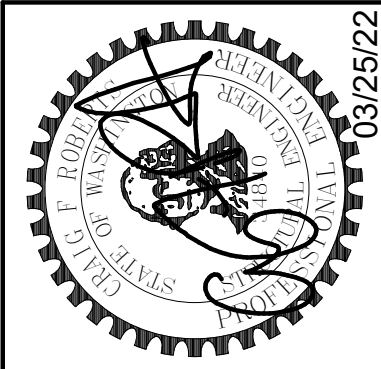

NO.	REVISION	DATE

JOB #: 21162  
ENG: BJM  
CAD: JMA  
SCALE: 3/4" = 1'-0"  
KEY ISSUE DATES:  
SD:      
SD:      
CD:      
CD:      
PERMIT: 03.25.2022  
OTHER: BD



Holddown Schedule and Details  
PIPER REMODEL  
8429 SE 33RD PLACE  
MERCER ISLAND, WA 98040

S1.2



### FOUNDATION LEGEND

	SEE FOOTING TYPE THIS SHEET	<b>Note:</b> ALL SECTION CUTS ARE TYPICAL	
	TOP OF FOOTING ELEVATION		
	TOP OF CONCRETE ELEVATION		
S.J.	SHRINKAGE CONTROL JOINT PER DETAIL 2/S6.0		DARK SOLID LINES ARE NEW WALLS ABOVE THE BASEMENT LEVEL.
C.J.	CONSTRUCTION JOINT PER DETAIL 3/S6.0		LIGHT SOLID LINES ARE EXISTING WALLS ABOVE THE BASEMENT LEVEL.
	STEPPED FOOTING PER DETAIL 48/S6.0		
	SLOPE SLAB 1/4" PER FOOT U.N.O. PER PLAN		
	HOLD-DOWNS INDICATED ON THE FOUNDATION PLAN ARE SHOWN HALFTONE FOR REFERENCE ONLY. REFER TO THE S2.1 SHEET FOR SPECIFICS OF EMBEDDED ITEMS RELATED TO HOLD-DOWNS.		

### FOUNDATION SCHEDULE

MARK	DEPTH	WIDTH	LENGTH	REINFORCING	DETAILS
F1	8"	1'-4"	CONT.	(2) #4 CONT.	FTG. W/ STEM WALL: 6&7/S6.0
FS	12"	1'-6"	CONT.	(2) #4 CONT.	TYP. THICKENED SLAB FOOTING
F24	12"	24"	24"	(2) #4 EA. WAY	POST FTG.: 9/S6.0 16&17/S6.0
F30	12"	30"	30"	(3) #4 EA. WAY	POST FTG.: 9/S6.0 16&17/S6.0
F36	12"	36"	36"	(3) #4 EA. WAY	POST FTG.: 9/S6.0 16&17/S6.0
F1	8"	1'-4"	CONT.	(2) #4 CONT.	TURNED DOWN SLAB EDGE 6,7,8/S6.0


### FOUNDATION NOTES

- ALL SOIL BEARING SURFACES ARE SUBJECT TO INSPECTION AND APPROVAL BY THE GEOTECHNICAL ENGINEER PRIOR TO REINFORCING AND CONCRETE PLACEMENT.
- CENTER INTERIOR FOOTINGS ON WALLS OR COLUMNS TYPICAL U.N.O.
- VERIFY ALL DIMENSIONS PRIOR TO CONSTRUCTION.
- SEE ARCHITECTURAL PLANS FOR WALL LOCATIONS.
- CONCRETE WALLS ARE 8" THICK TYPICAL U.N.O.
- SEE SHEET S2.1 FOR WOOD FRAMING LEGEND, NOTES, AND SCHEDULES.
- PROVIDE 4" DIAMETER PERFORATED FOOTING DRAINS AT PERIMETER OF FOUNDATIONS TYPICAL. PROVIDE 4" DIAMETER TIGHTLINES FOR DOWNSPOUTS, EXTEND TO DAYLIGHT.

### FOUNDATION KEY NOTES

- ASSUMED EXISTING STRIP FOOTING. CONTRACTOR TO VERIFY AND INFORM ENGINEER OF EXISTING CONDITIONS DURING CONSTRUCTION.
- ASSUMED EXISTING PAD FOOTING. CONTRACTOR TO VERIFY AND INFORM ENGINEER OF EXISTING CONDITIONS DURING CONSTRUCTION.


**NOTE:**  
PLANS PREPARED USING ARCHITECTURAL BACKGROUNDS RECEIVED 02/28/2022.

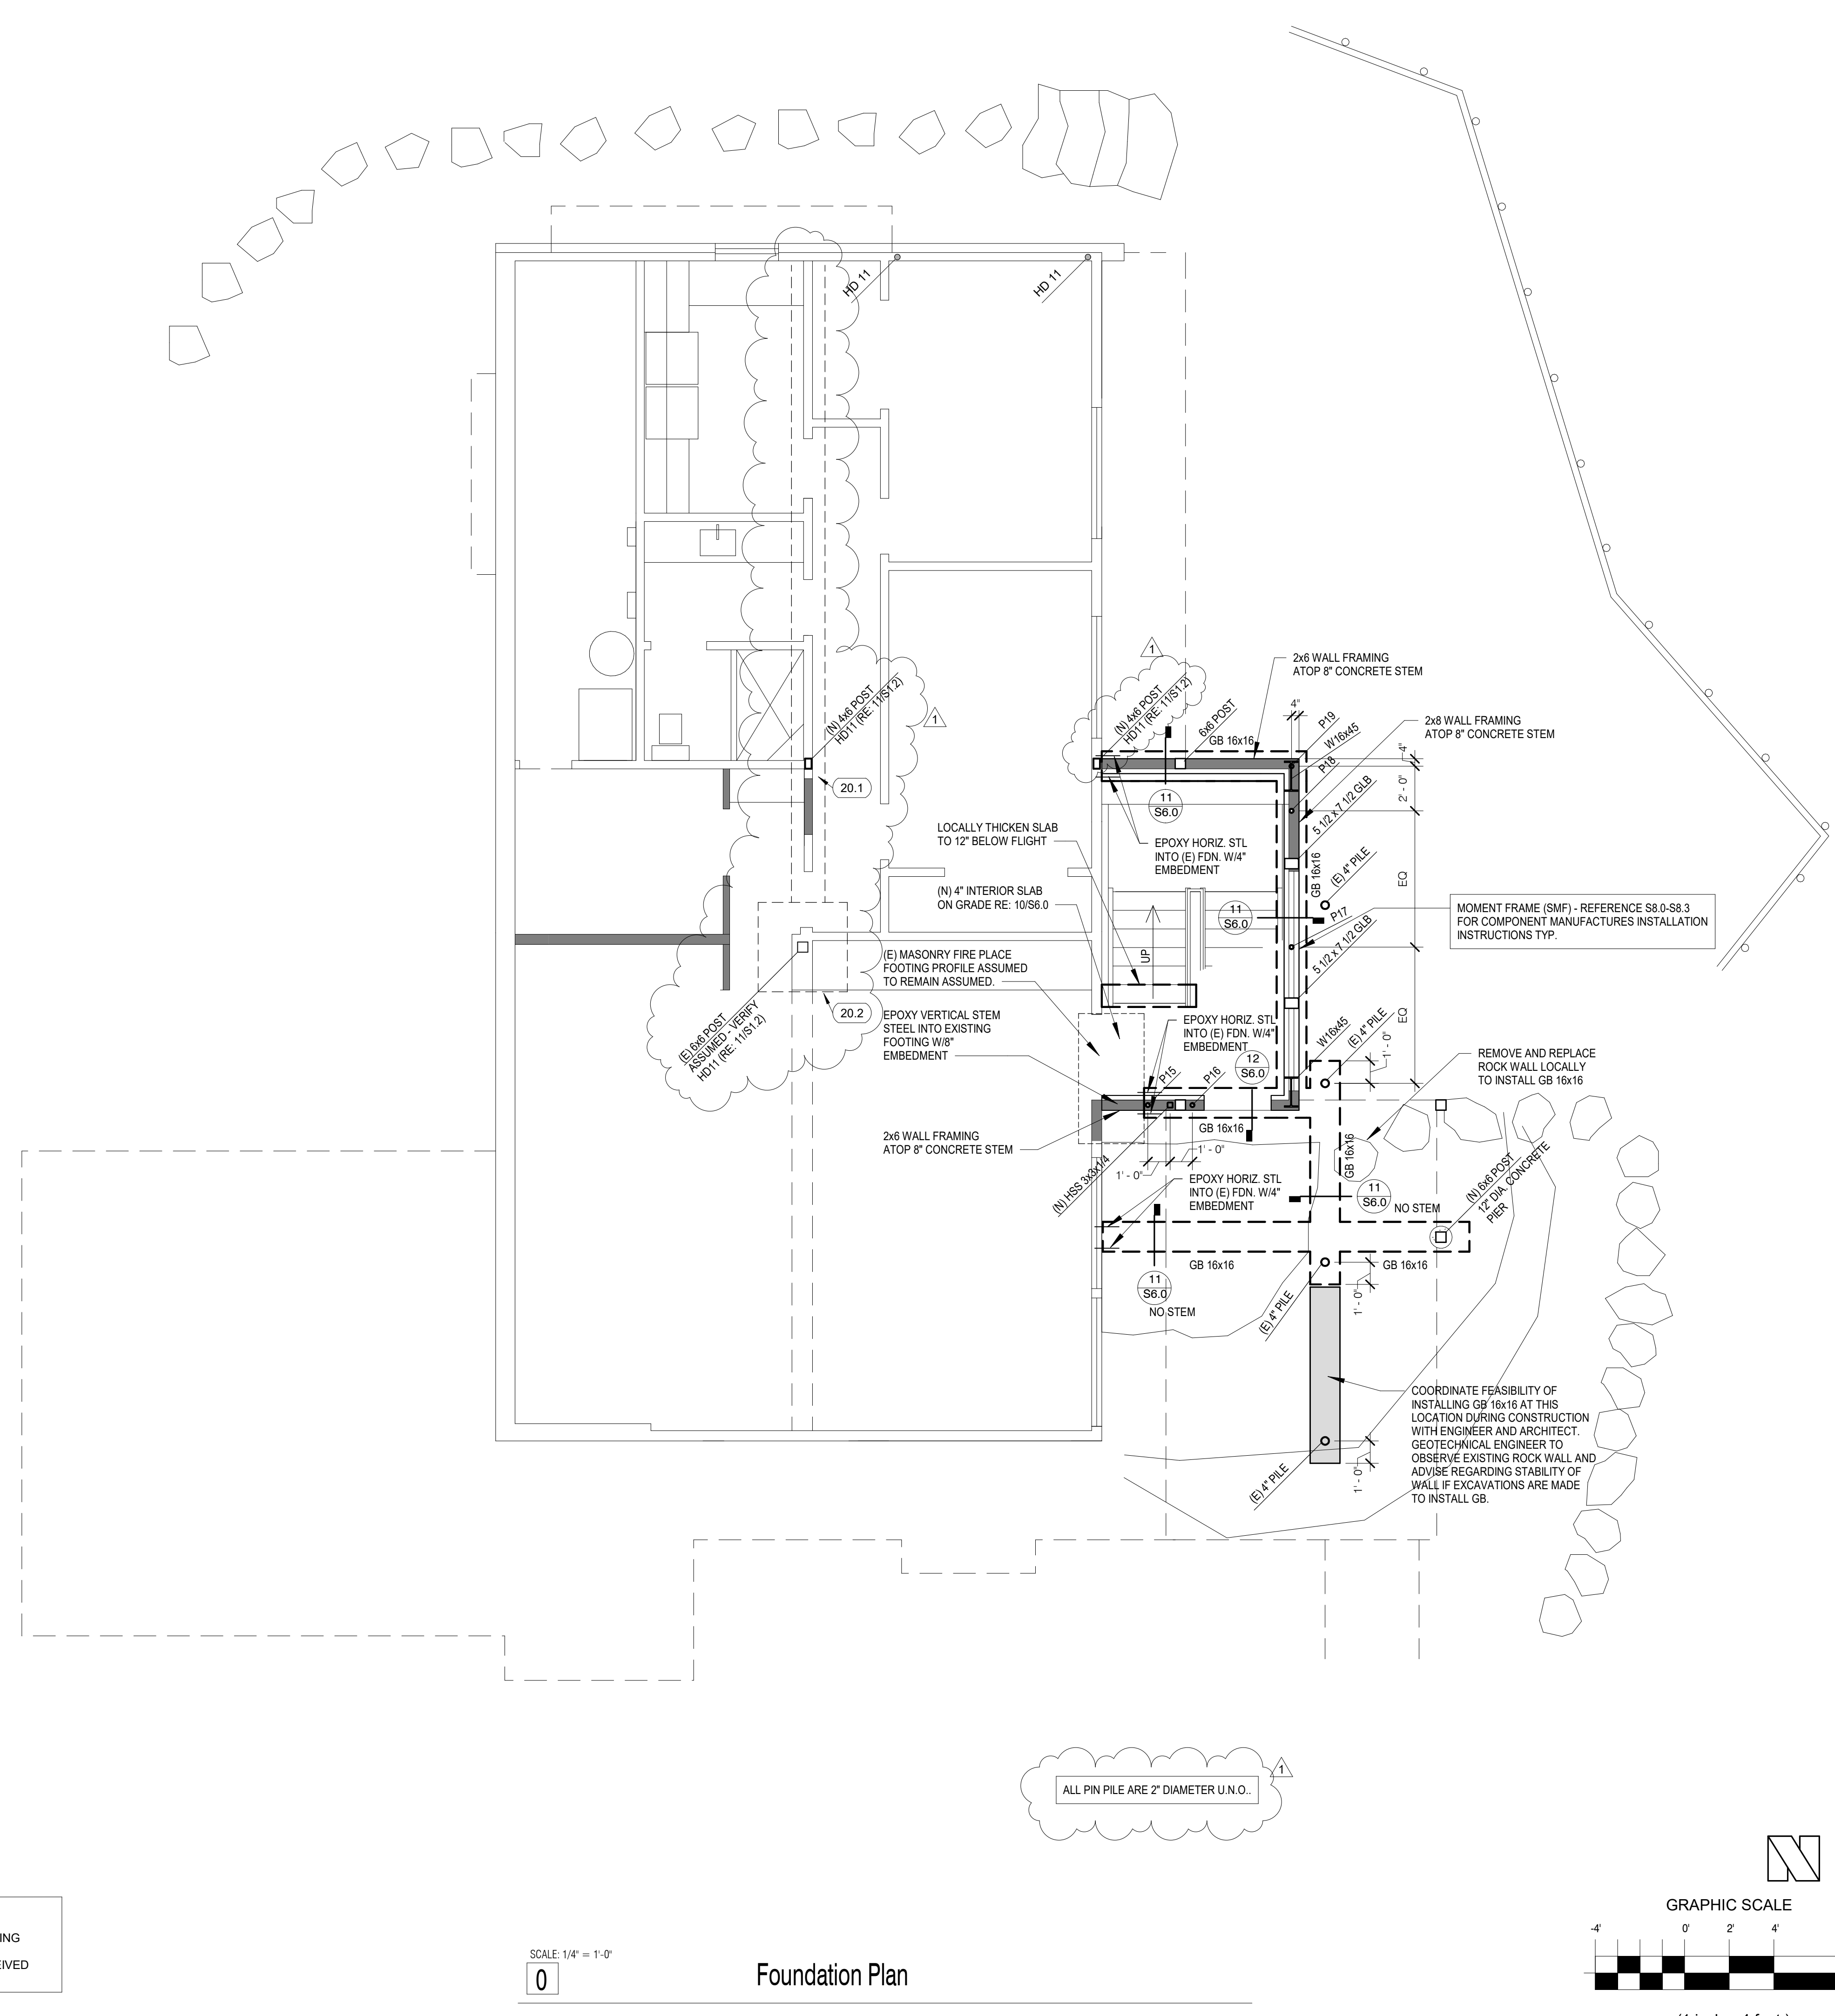


ALL PIN PILE ARE 2" DIAMETER U.N.O.

SCALE: 1/4" = 1'-0"  
0

Foundation Plan

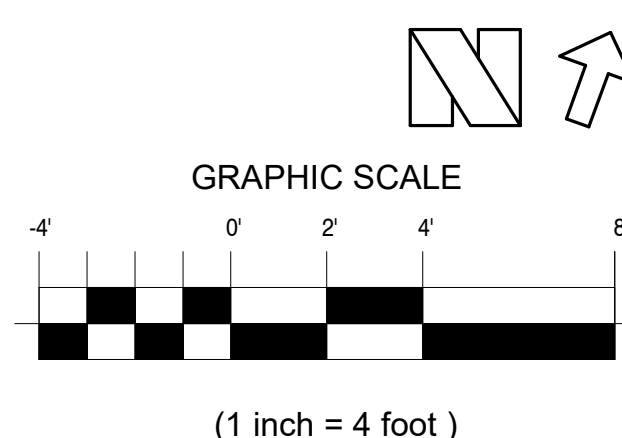

**CT ENGINEERING INC.**  
Structural Engineers  
180 N. Jackson Street, Suite 302, Seattle, WA 98109  
206.265.4512 (V) 206.265.0616 (F)  
www.ctengineering.com

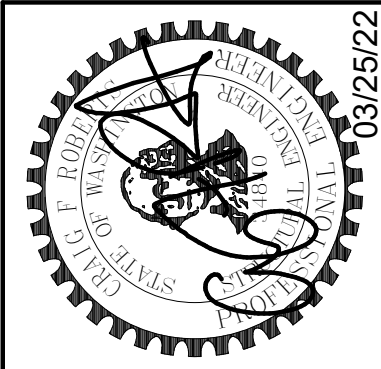

No.	REVISION	DATE
1	Response to Comments	06-10-2022

JOB #:	21162
ENG.:	BJM
CAD.:	JMA
SCALE:	As indicated
KEY ISSUE DATES:	
SD:	SD
CD:	CD
PERMIT:	03/25/2022
OTHER:	BD


**PERFECT FOR CODE COMPLIANCE**  
July 29, 2022  
SITE COPY

**Basement Level Walls Over Foundation**  
PIPER REMODEL  
8429 SE 33RD PLACE  
MERCER ISLAND, WA 98040

**S2.0**



**FRAMING LEGEND**

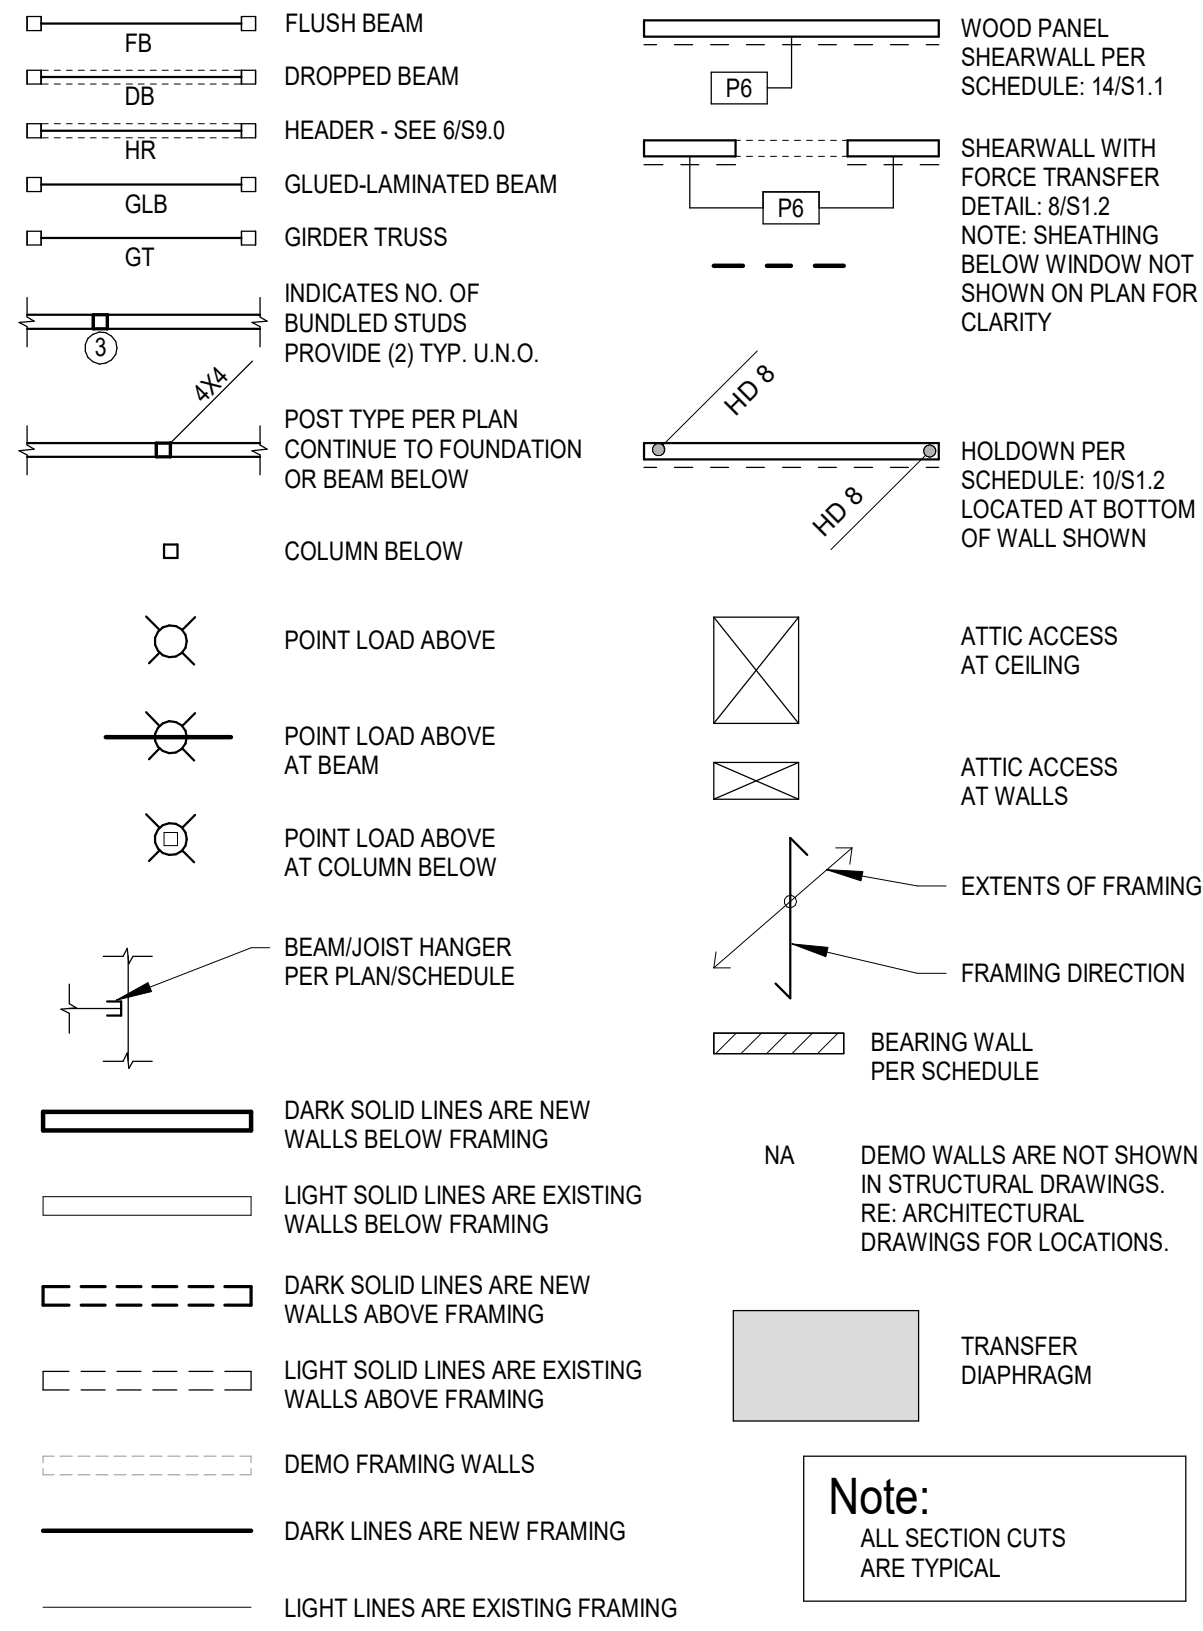


**FRAMING NOTES**

1. PROVIDE 4X8 FOR ALL EXTERIOR HEADERS U.N.O. PER PLAN.
2. RE: 1/S9.0 FOR INTERIOR HEADERS U.N.O. PER PLAN.
3. RE: NOTES S1.0 FOR FRAMING SPECIES AND GRADE, HANGERS, SHEATHING, NAILS, GLB'S AND ENGINEERED LUMBER SPECIFICATIONS ETC.
4. ALL BEAMS AND HEADERS SHALL HAVE A MINIMUM OF (1) FULL HEIGHT STUD EACH END (KING STUD) FOR BRACING.
5. ALL EXTERIOR WALLS ARE P6 SHEARWALLS U.N.O. PER PLAN.
6. SEE SHEET S6.0, S9.0 FOR TYPICAL FRAMING DETAILS.
7. ALL EXTERIOR WALLS ARE 2x6 AT 16" O.C. (MAX. HEIGHT = 10'-0")  
ALL INTERIOR WALLS ARE 2x4 AT 16" O.C. MINIMUM - PROVIDE 2x6 AT 16" O.C. WHERE ARCHITECT SPECIFIES 2x6 CONSTRUCTION.


**FRAMING KEY NOTES**

- 21.1 .
- 21.2 .
- 21.3 .
- 21.4 .
- 21.5 .

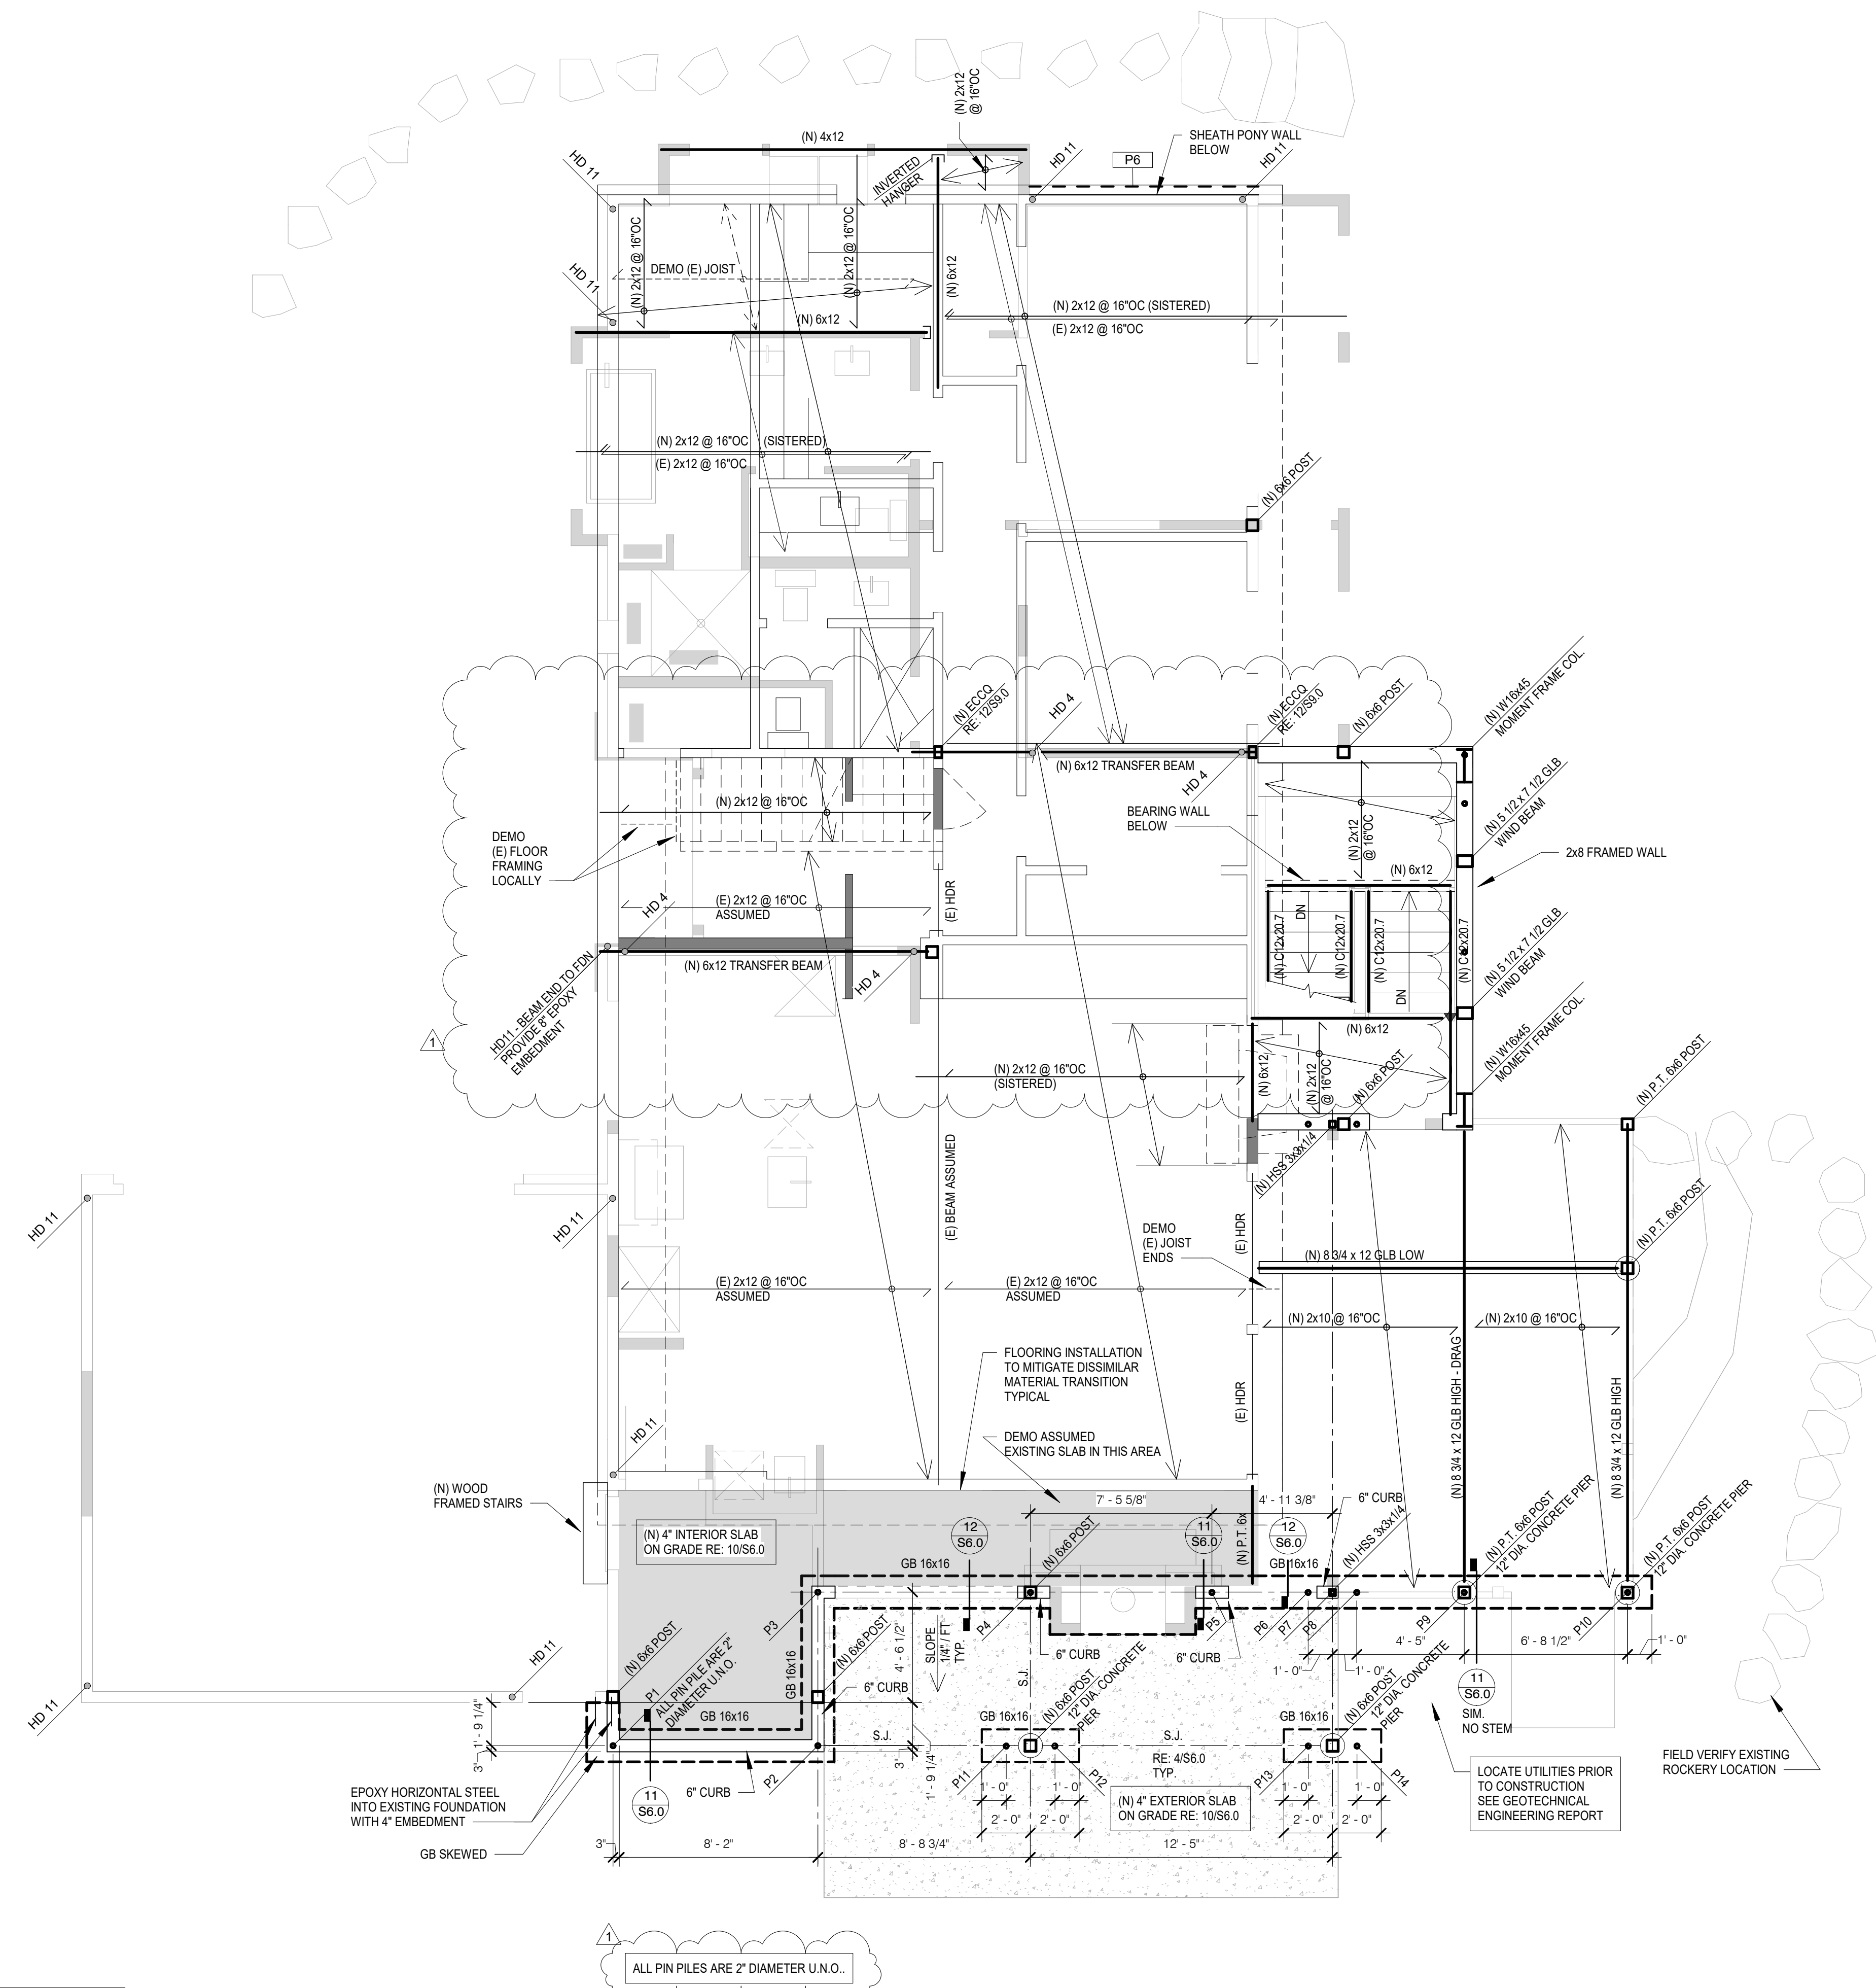


**NOTE:**  
PLANS PREPARED USING ARCHITECTURAL BACKGROUNDS RECEIVED 02/28/2022.

SCALE: 1/4" = 1'-0"  
**1 Main Floor Framing Over Basement Level Shear Walls**

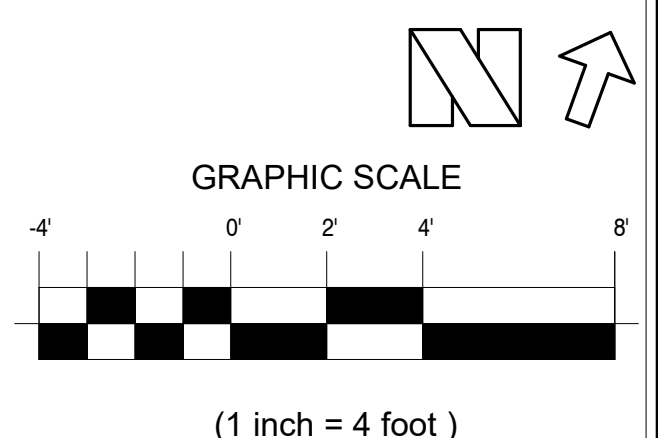

6/14/2022 4:16:50 PM C:\Users\james\AppData\Local\Temp\AutoCAD\2022\1162\1162.dwg

**CT ENGINEERING INC.**  
Structural Engineers  
180 N. Jackson Street, Suite 302, Seattle, WA 98109  
206.285.4572 (V) 206.285.0618 (F)  
www.ctengineering.com

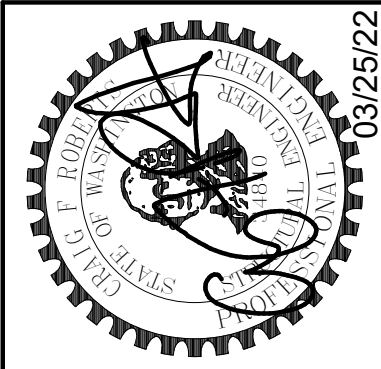

No.	REVISION	DATE
1	Response to Comments	06-10-2022

JOB #:	2162
ENG:	JMA
CAD:	JMA
SCALE:	As indicated
KEY ISSUE DATES:	
SY:	SD
SD:	SD
CD:	CD
PERMIT:	03/25/2022
OTHER:	BD

**REVIEWED FOR CODE COMPLIANCE**  
July 29, 2022  
SITE COPY

**Main Frmg Over Basement Lvl Shear**  
**PIPER REMODEL**  
8429 SE 33RD PLACE  
MERCER ISLAND, WA 98040

**S2.1**








BAR SIZE	f <sub>c</sub> =3000 PSI		
	L <sub>d</sub>	OTHER BARS LAP SPLICE	TOP BARS LAP SPLICE
#3	16"	21"	28"
#4	22"	28"	37"
#5	27"	36"	46"
#6	33"	43"	56"

- LAP SPLICE SCHEDULE NOTES:
- TENSION LAP SPLICE SHOWN ABOVE FOR CONCRETE COVER GREATER THAN OR EQUAL TO BAR DIAMETER AND CENTER TO CENTER SPACING GREATER THAN OR EQUAL TO TWO BAR DIAMETERS (SPACING AND COVER CASE 1). TENSION LAP SPLICE SHOWN ABOVE ARE CLASS B SPLICES.
  - "OTHER BARS" ARE ALL VERTICAL BARS AND HORIZONTAL BARS WITH LESS THAN 12" OF CONCRETE CAST BELOW THE BAR.
  - "TOP BARS" ARE HORIZONTAL BARS WITH MORE THAN 12" OF CONCRETE CAST BELOW THE BARS.
  - COMPRESSION LAP SPLICES SHALL BE 30 BAR DIAMETERS MIN. U.N.O. ON THE DRAWINGS
  - DEVELOPMENT LENGTH (L<sub>d</sub>) IS "OTHER BARS", CLASS A.


SCALE: NONE  
1 TYPICAL LAP SPLICE SCHEDULE

BAR SIZE	D	STANDARD 180 DEGREE HOOK			STANDARD 90 DEGREE HOOK		
		D	A OR G	J	BAR SIZE	D	A OR G
#3	6db	2 1/4"	5"	3"	#3	2 1/4"	6"
#4	6db	3"	6"	4"	#4	3"	8"
#5	6db	3 3/4"	7"	5"	#5	3 3/4"	10"
#6	6db	4 1/2"	8"	6"	#6	4 1/2"	11-0"

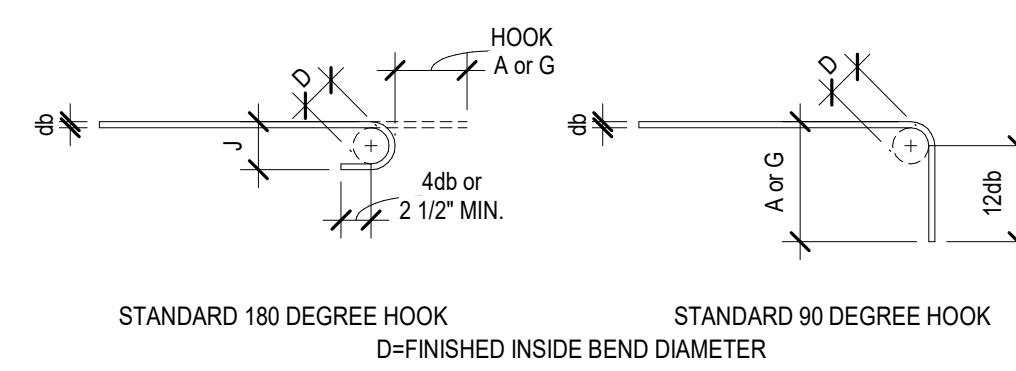


SCALE: NONE  
2 STANDARD HOOK DETAILS


BAR SIZE	D	D	STIRRUP HOOKS/TIES			SEISMIC STIRRUP/TIE	
			90 DEGREE	135 DEGREE	135 DEGREE SEISMIC HOOK	A or G	APPROX. H
#3	4db	1 1/2"	4"	4"	2 1/2"	4 1/4"	3"
#4	4db	2"	4 1/2"	4 1/2"	3"	4 1/2"	3"
#5	4db	2 1/2"	6"	5 1/2"	3 3/4"	5 1/2"	3 3/4"
#6	6db	4 1/2"	11-0"	7 3/4"	4 1/2"	7 3/4"	4 1/2"

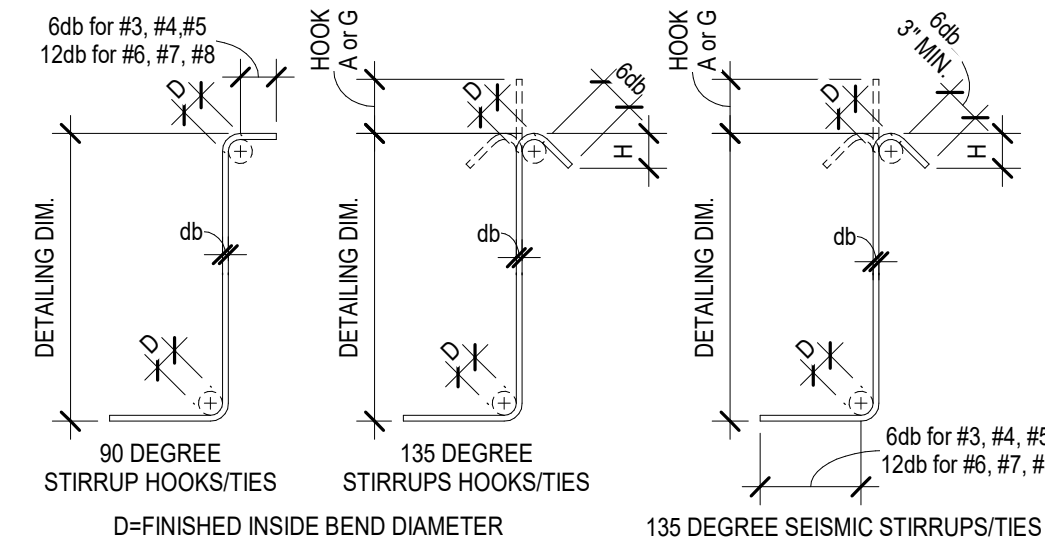


SCALE: NONE  
3 STIRRUP and TIE HOOK DETAILS

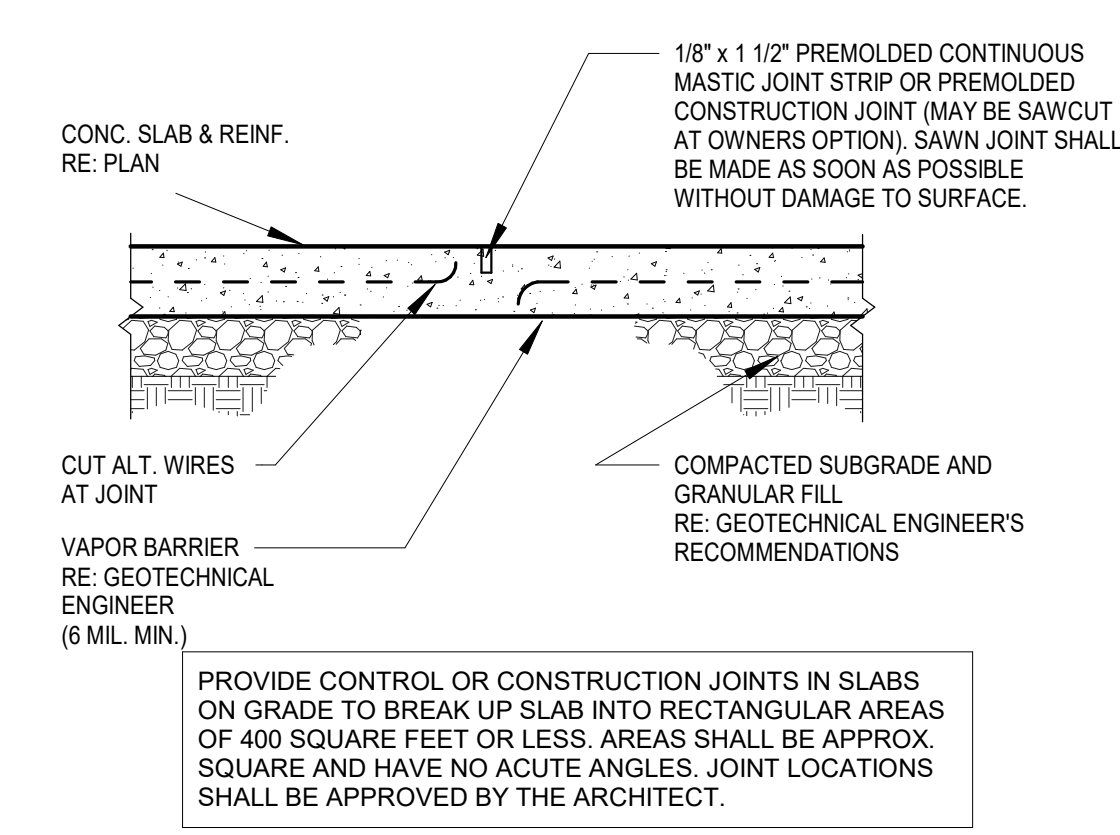


SCALE: NONE  
4 TYPICAL SHRINKAGE CONTROL JOINT (S.J.)

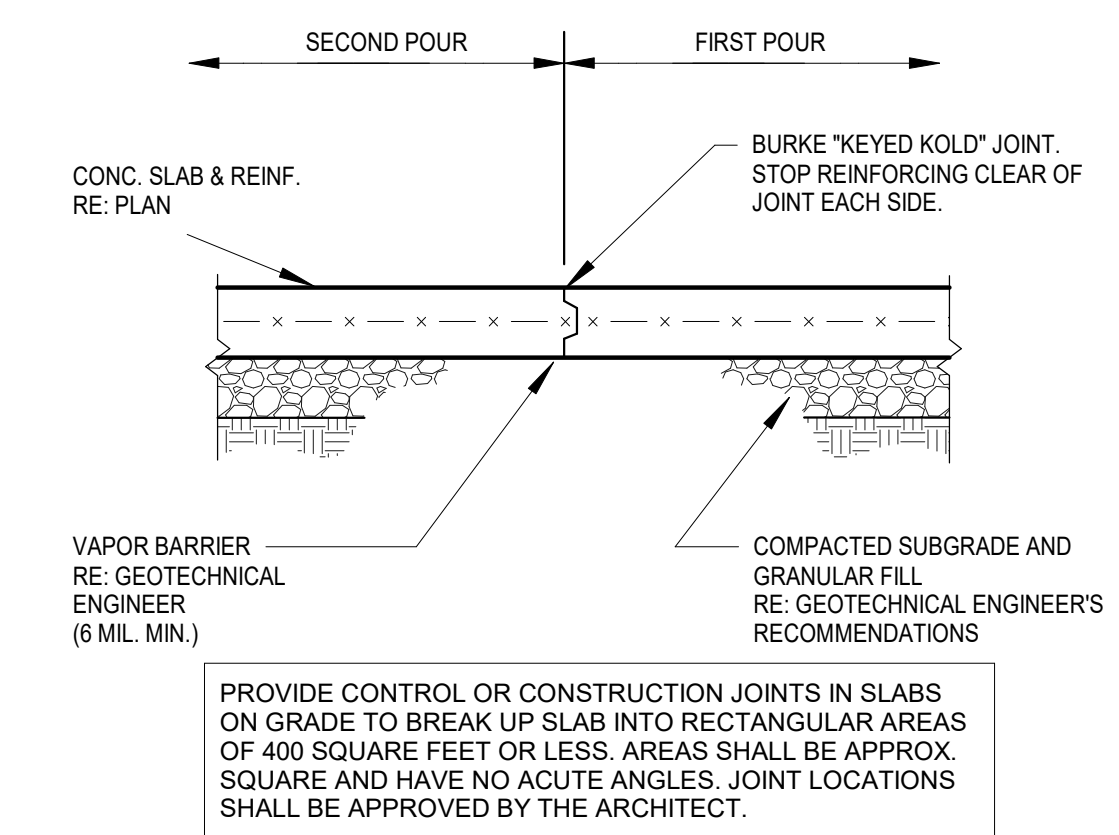


SCALE: NONE  
5 TYPICAL CONSTRUCTION JOINT (C.J.)

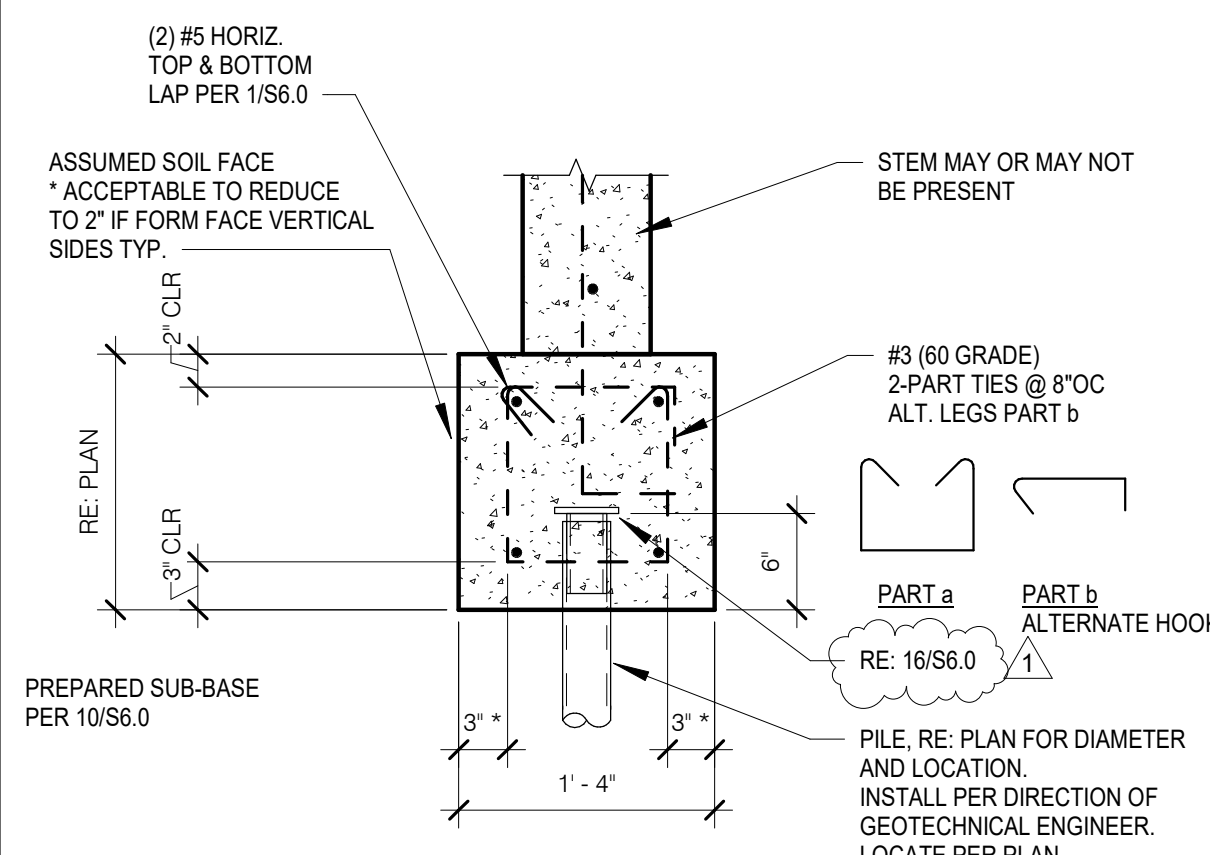


SCALE: 1" = 1'-0"  
6 TYPICAL GRADEBEAM 16x16

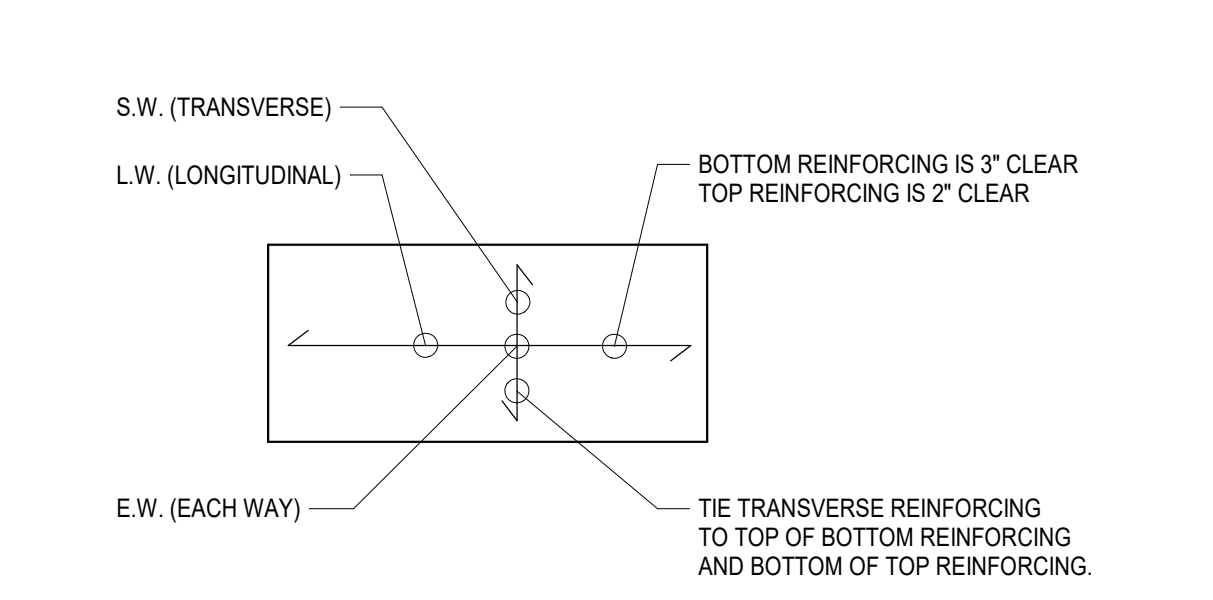


SCALE: 3/4" = 1'-0"  
7 TYPICAL FOOTING REINFORCEMENT PLACEMENT

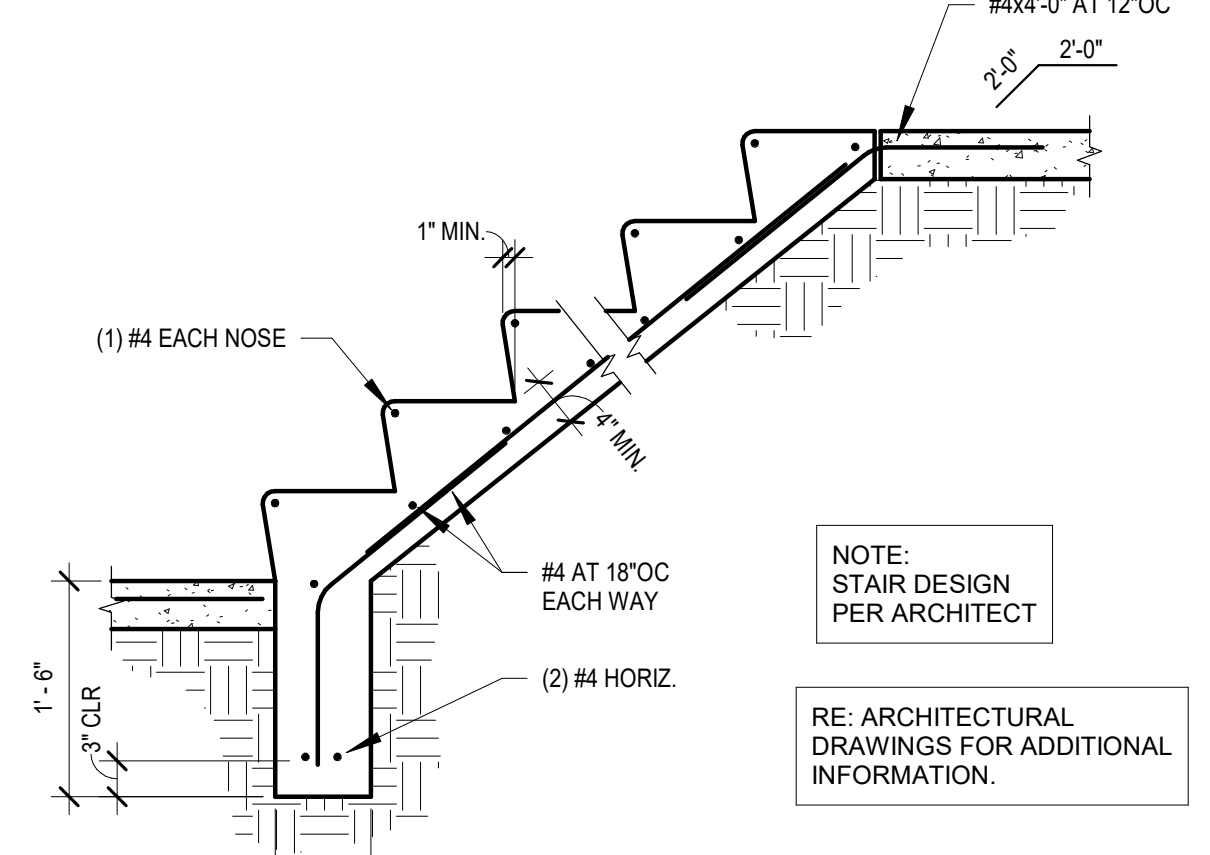


SCALE: 3/4" = 1'-0"  
8 TYPICAL STAIR ON GRADE

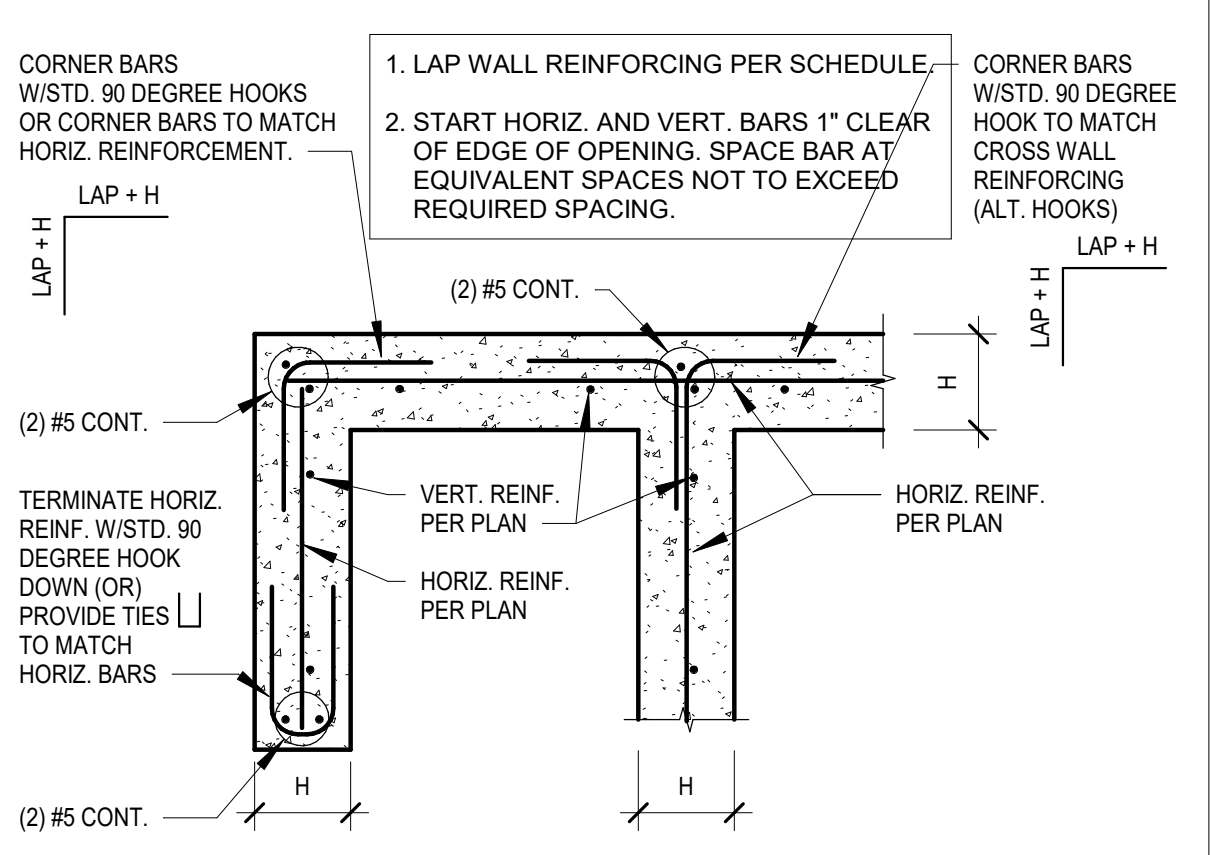


SCALE: 3/4" = 1'-0"  
9 SINGLE CURTAIN WALL REINFORCEMENT PLACEMENT

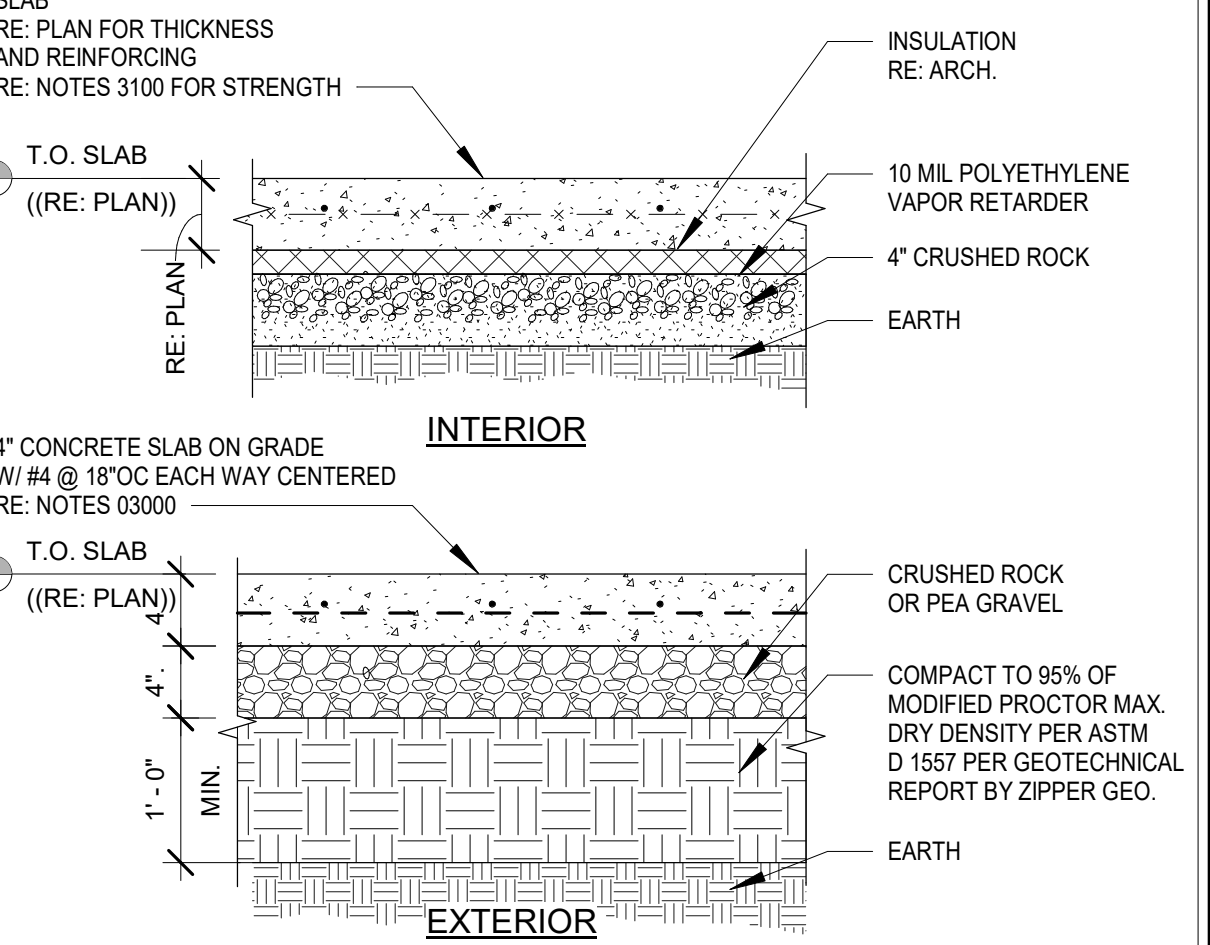


SCALE: 3/4" = 1'-0"  
10 TYPICAL SLAB ON GRADE

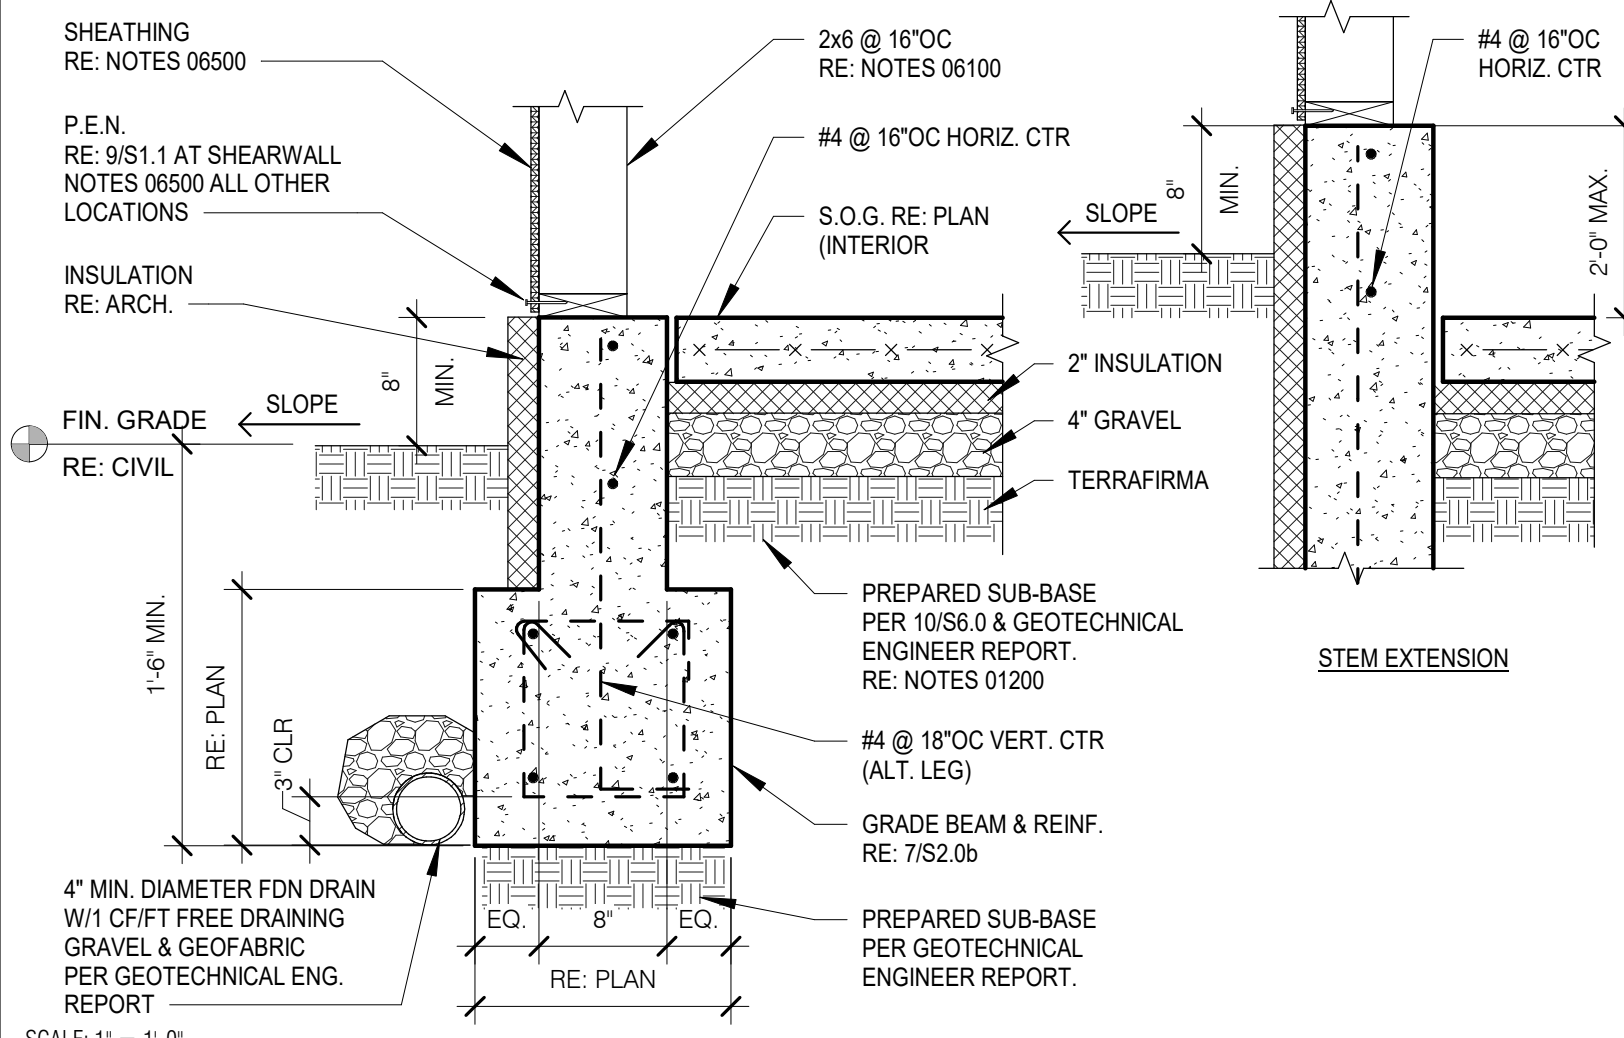


SCALE: 1" = 1'-0"  
11 TYPICAL PERIMETER GRADEBEAM

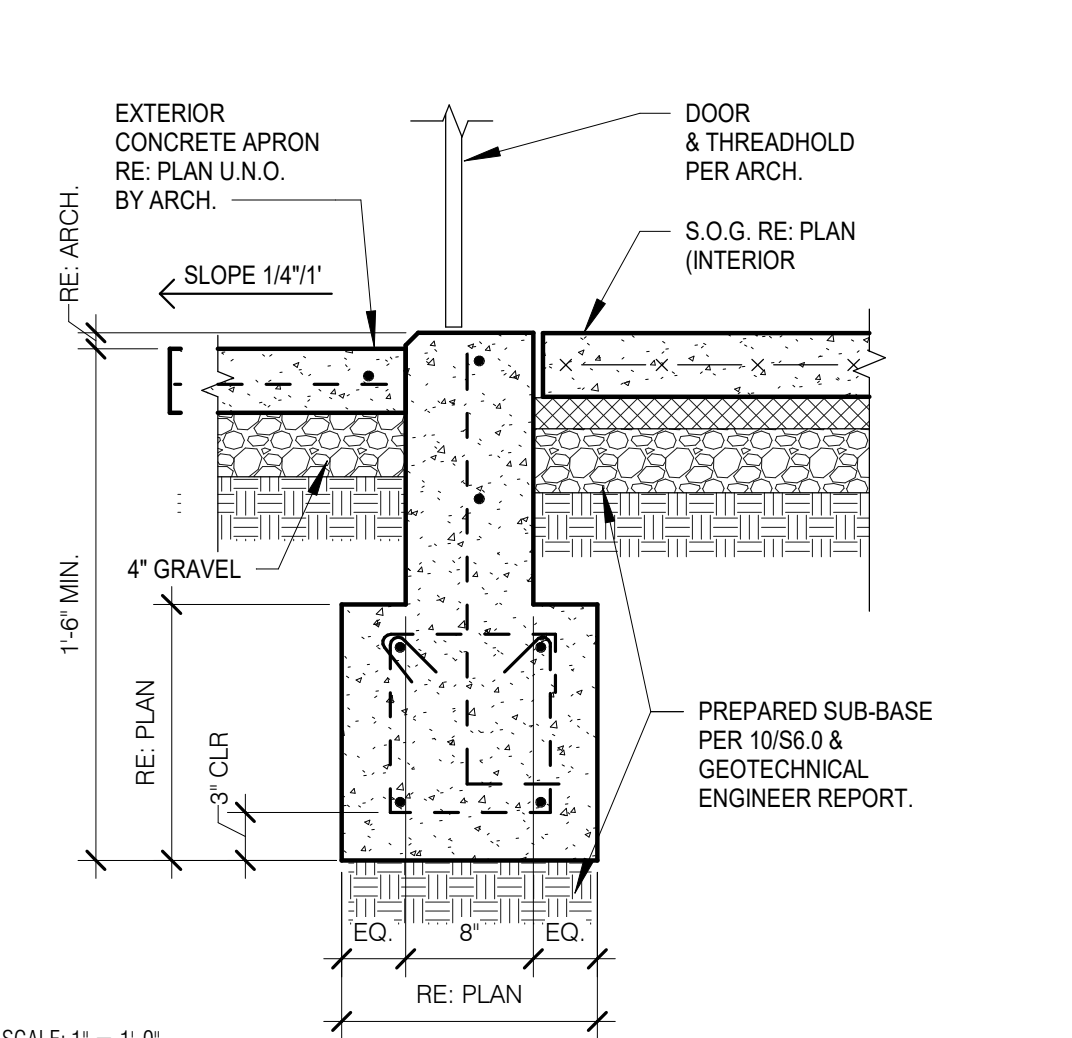


SCALE: 1" = 1'-0"  
12 TYP. PERIMETER FTG AT OPENING

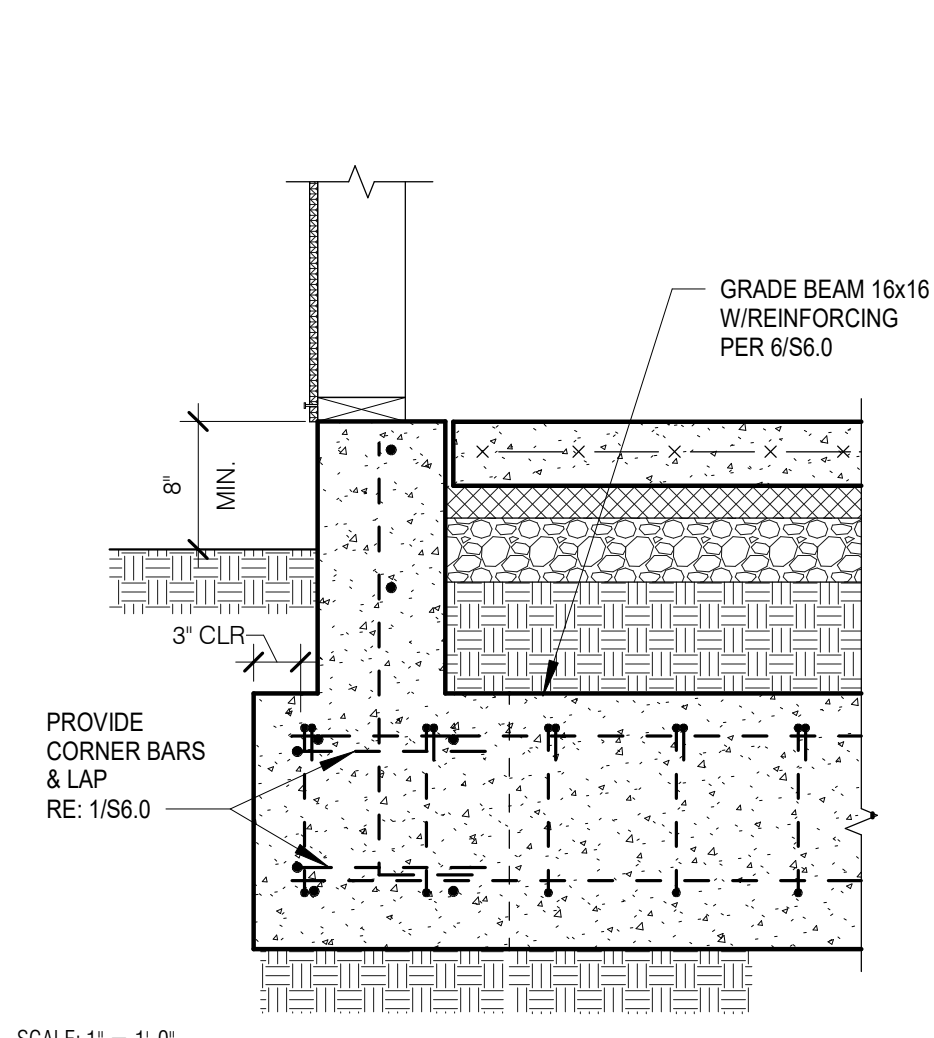

SCALE: 1" = 1'-0"  
13 TYP. GRADE BEAM AT CORNER

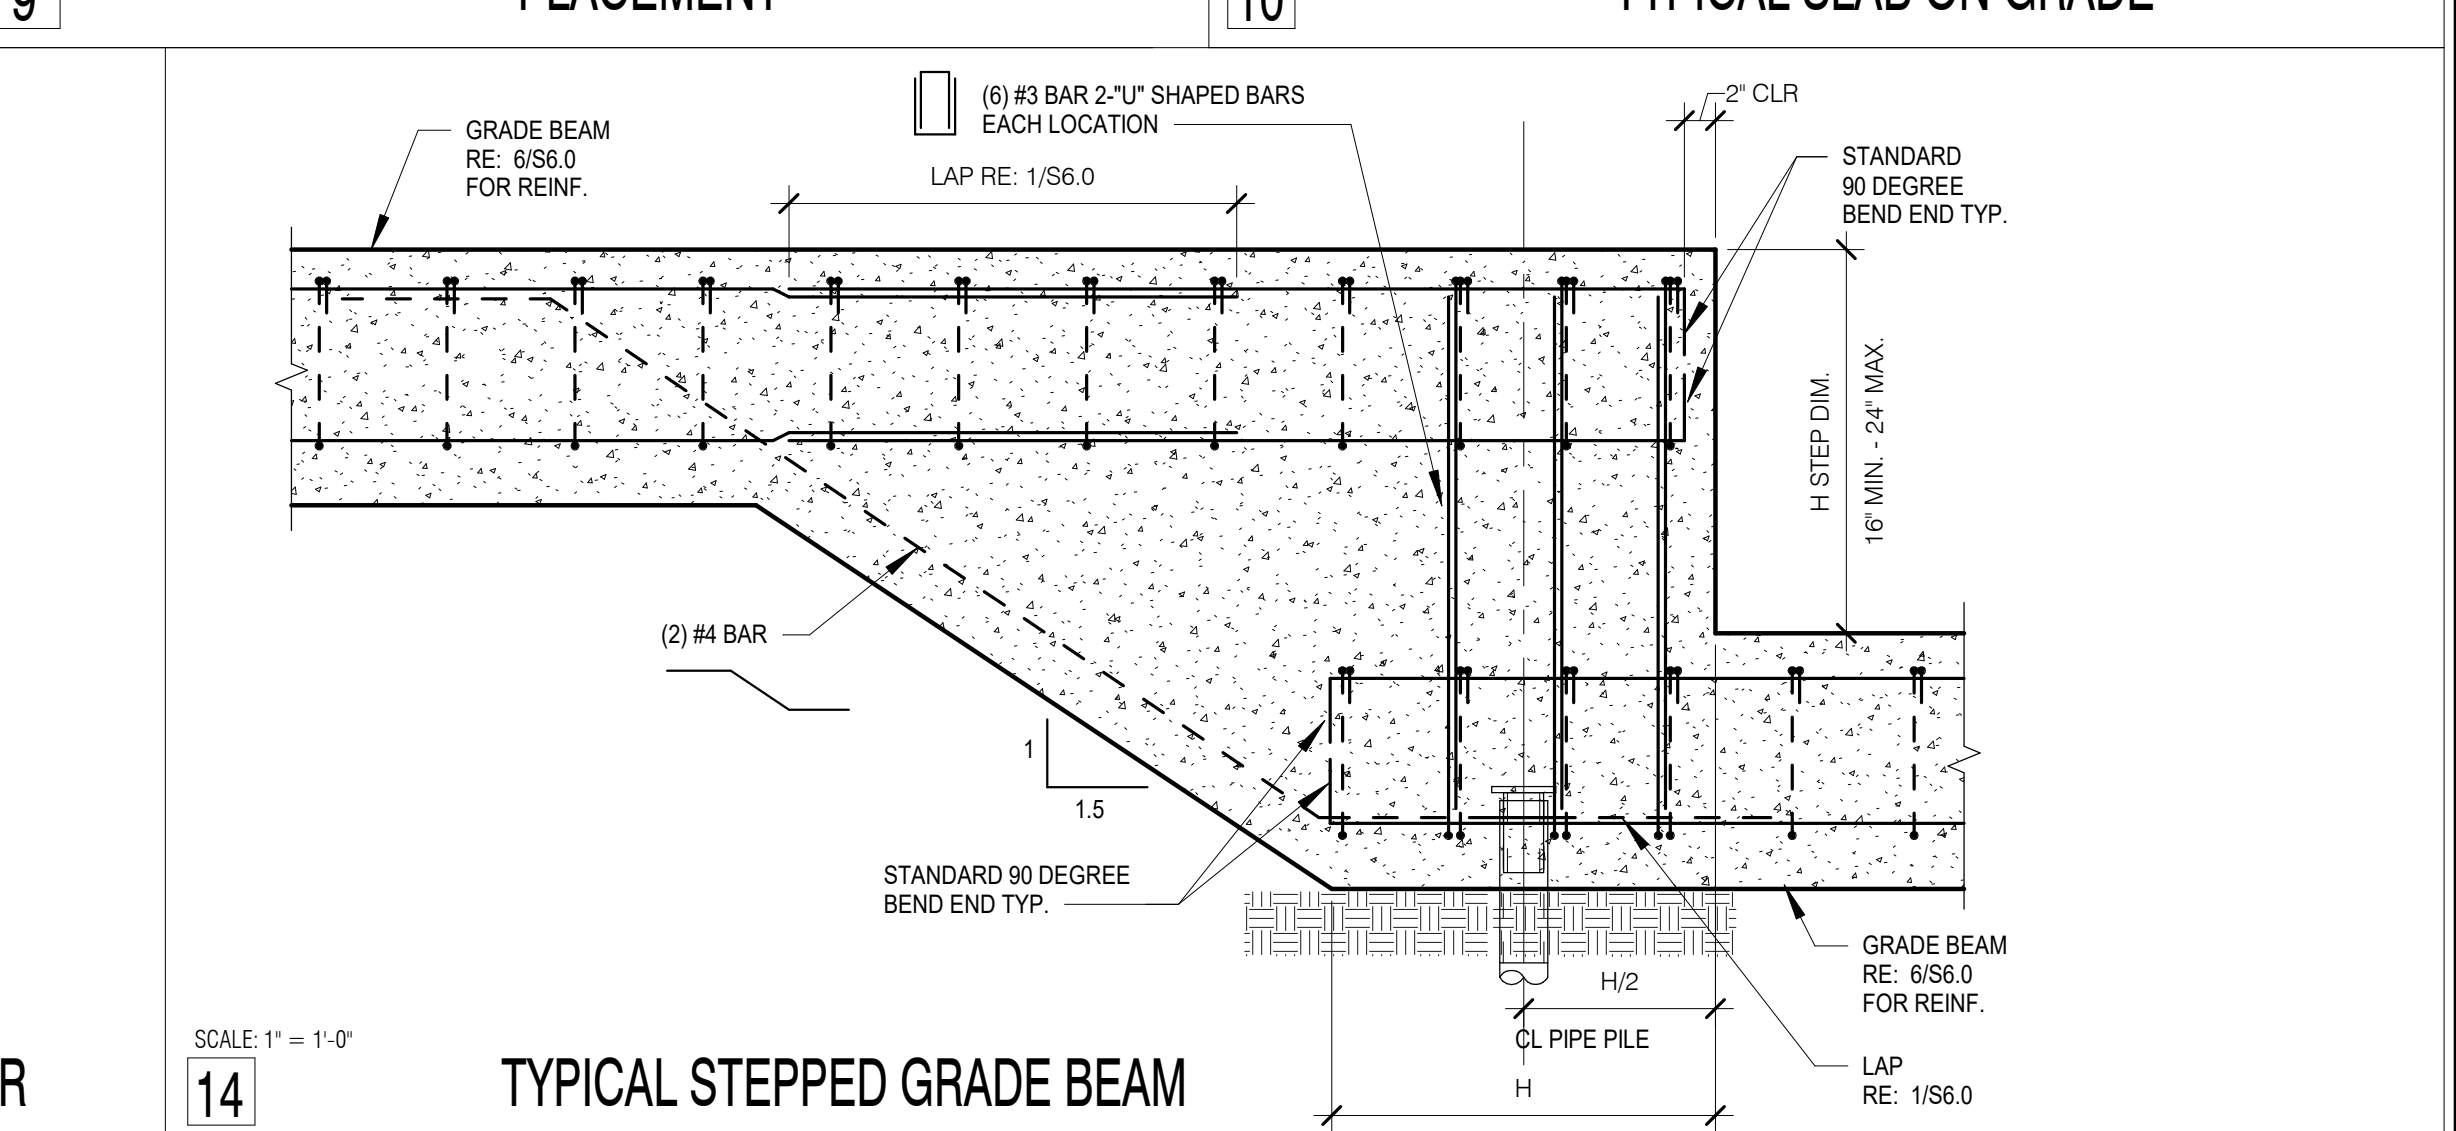


SCALE: 1" = 1'-0"  
14 TYPICAL STEPPED GRADE BEAM

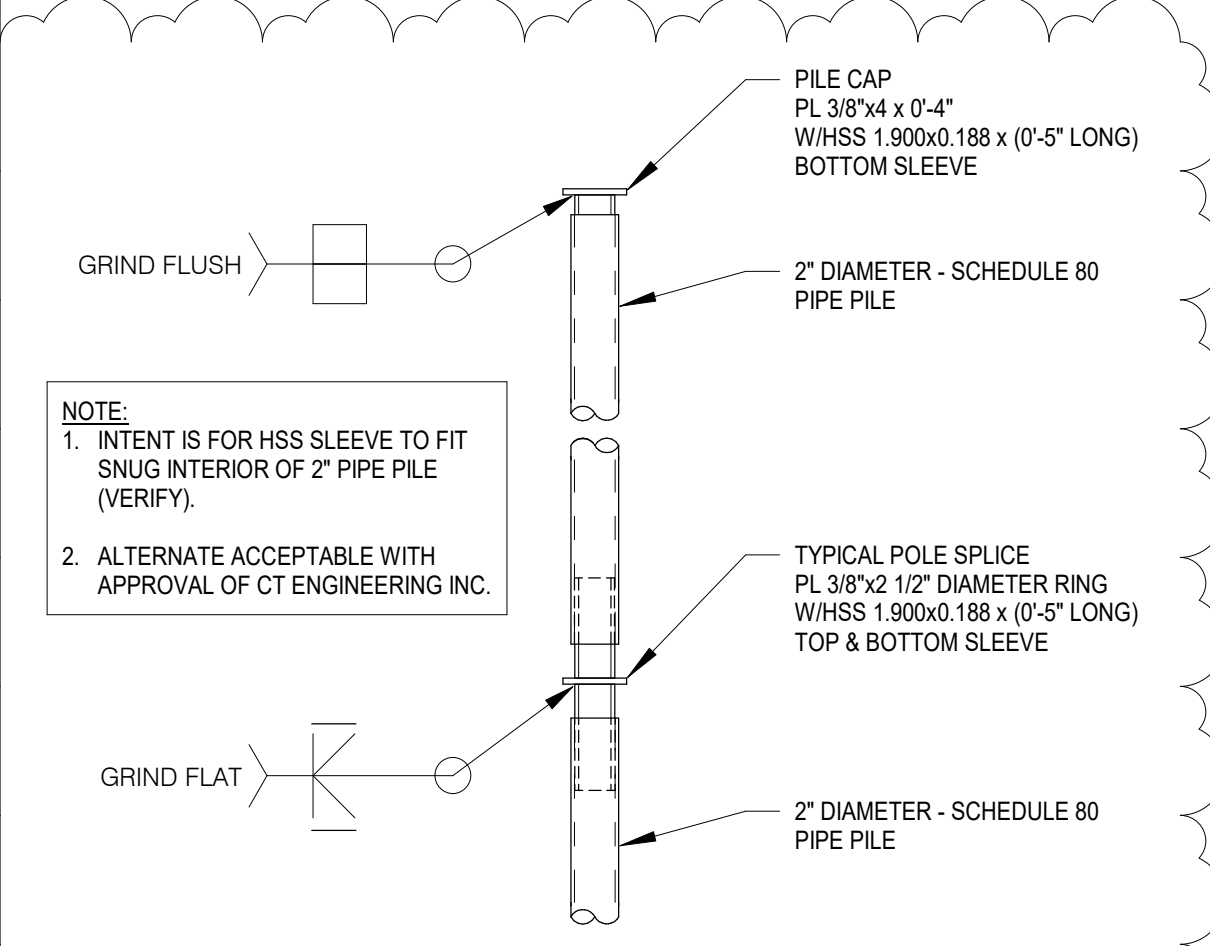

SCALE: 1" = 1'-0"  
16 TYPICAL 2" SCHEDULE 80 PILE ASSEMBLY

**CT ENGINEERING INC.**  
Structural Engineers  
180 N. Jackson Street, Suite 302, Seattle, WA 98109  
206.285.4512 (V) 206.285.0616 (F)  
www.ctengineering.com

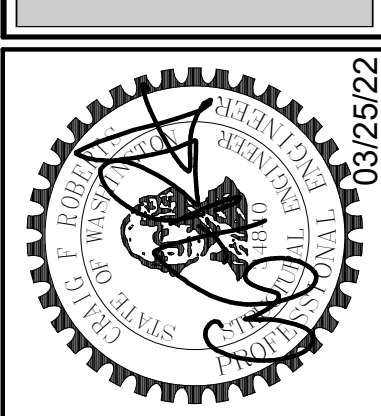

DATE	REVISION
06-10-2022	Response to Comments


JOB #:	ENG.:	CAD.:	SCALE:	KEY ISSUE DATES:
21162	BJM	JMA	As Indicated	SD: SD CD: CD PD: CD PERMIT: 03/25/2022 OTHER: BD



Typical Concrete Details  
PIPER REMODEL  
8429 SE 33RD PLACE  
MERCER ISLAND, WA 98040

**S6.0**



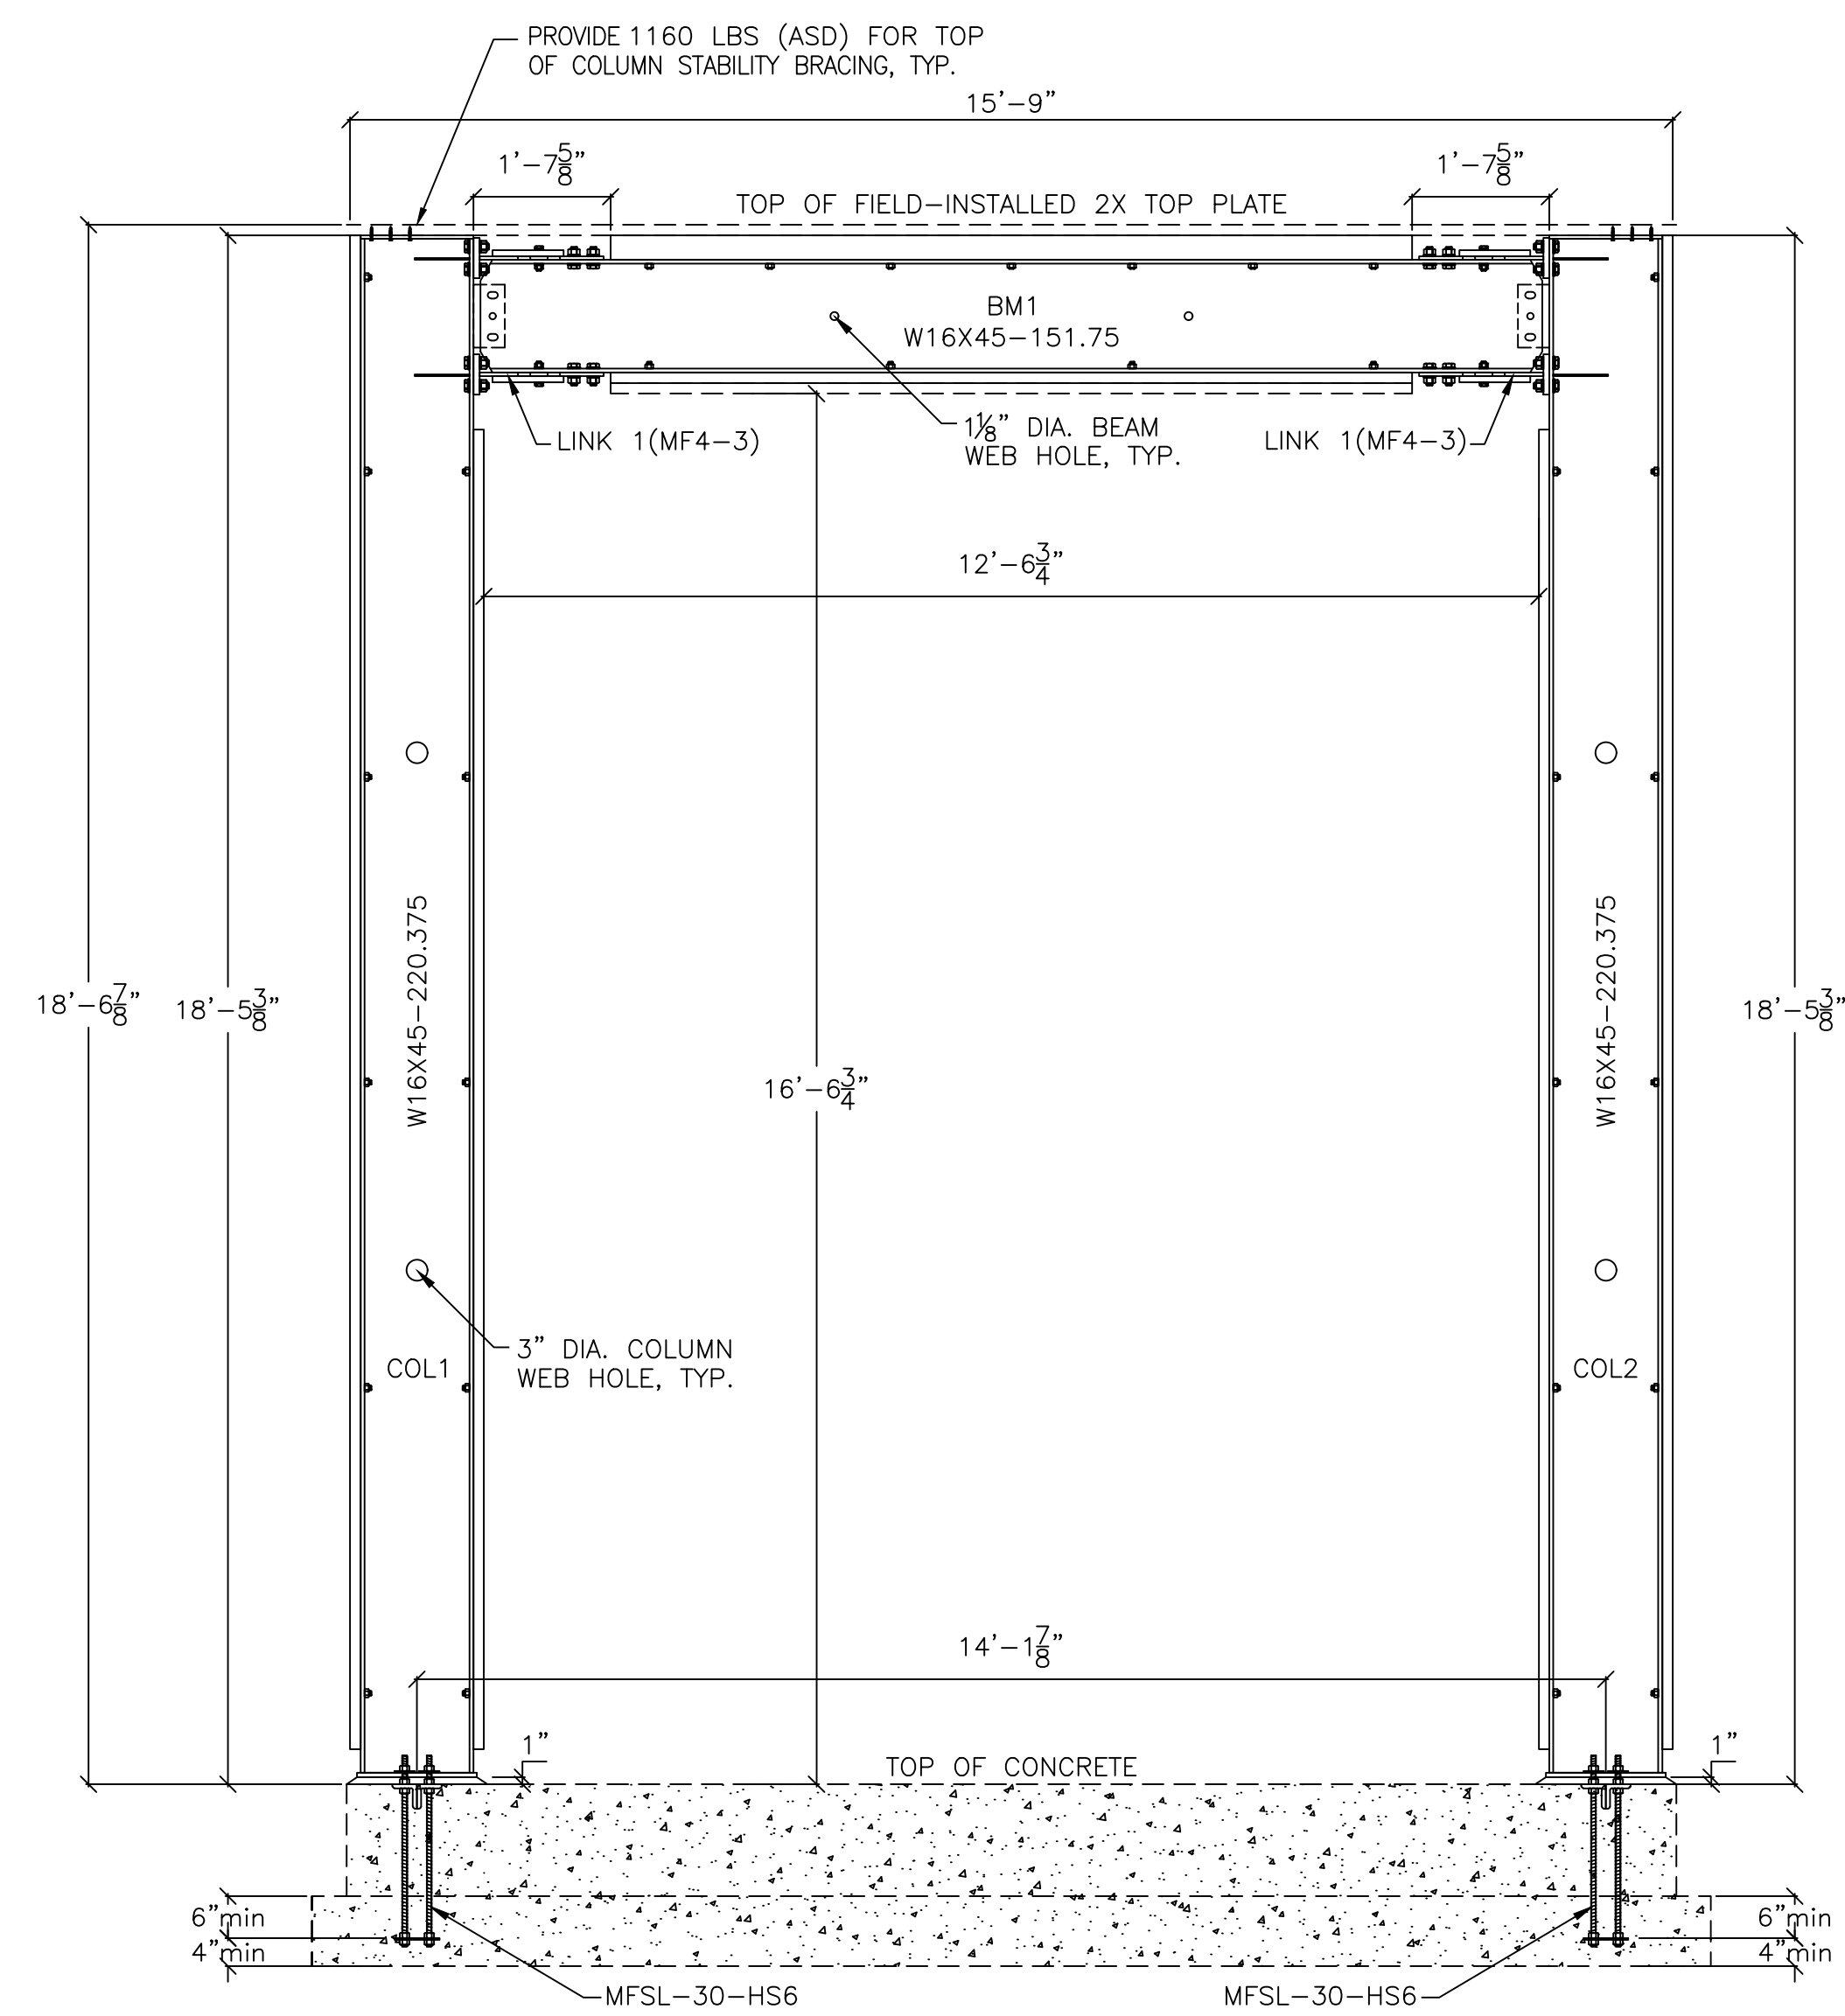

**NOTE:**  
REFER TO GENERAL NOTES 9, 10, 11, AND 12 REGARDING MINIMUM ANCHORAGE LENGTHS, ANCHORAGE EMBEDMENT, AND FOOTING DIMENSIONS, REINFORCING, AND DESIGN.




GRADE BEAM PER DESIGNER  
FRAME MODEL: SMF16z16-151.75x220.375-(MF4-3)

**FRAME ELEVATION**  
SCALE: 1/2" = 1'-0"



SECTION AT COLUMN 1      SECTION AT COLUMN 2  
**COLUMN SECTION**  
SCALE: 1" = 1'-0"

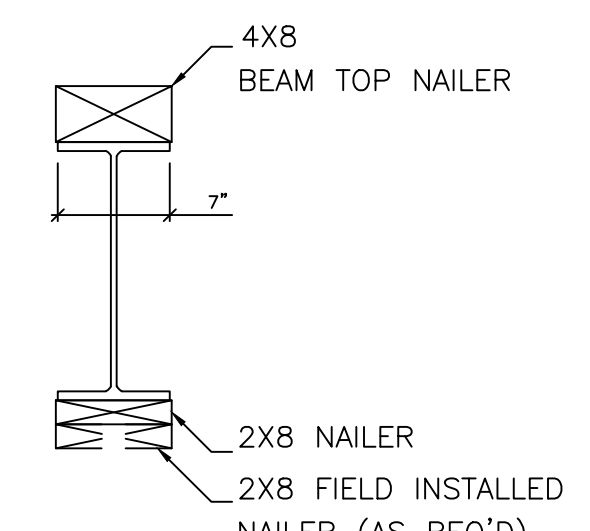

SECTION AT BEAM 1  
**BEAM SECTION**  
SCALE: 1" = 1'-0"

**GENERAL NOTES:**

- SIMPSON STRONG-TIE® STRONG FRAME® AND THE YIELD-LINK™ STRUCTURAL FUSE ARE PROTECTED UNDER ONE OR MORE OF THE FOLLOWING US PATENTS AND APPLICATIONS: US PATENT NO. 8,001,734 B2, US PATENT NO. 8,375,652 B2, AND US PATENT PUBLICATION NO. 2015/0159362, AND MUST BE SUPPLIED OR LICENSED THROUGH SIMPSON STRONG-TIE.
- STRONG FRAME® SPECIAL MOMENT FRAME IS MANUFACTURED AND TRADEMARKED BY "SIMPSON STRONG-TIE COMPANY INC." HOME OFFICE: 5956 W. LAS POSITAS BLVD., PLEASANTON, CA 94588 TEL: (800) 999-5099, FAX: (925) 847-1597. "SIMPSON STRONG-TIE COMPANY INC." IS AN ISO 9001 REGISTERED COMPANY.
- DESIGN FOR STRONG FRAME® MOMENT FRAMES ARE IN ACCORDANCE WITH THE FOLLOWING:
  - 2018, 2015 AND 2012 INTERNATIONAL BUILDING CODE
  - AISC SPECIFICATION FOR STRUCTURAL STEEL BUILDINGS (ANSI/AISC 360-05, 360-10, 360-16)
  - AISC SEISMIC PROVISIONS (ANSI/AISC 341-05, 341-10, 341-16)
  - RCSC SPECIFICATION FOR STRUCTURAL JOINTS USING ASTM A325 OR A490 BOLTS
  - BUILDING CODE REQUIREMENTS FOR STRUCTURAL CONCRETE (ACI318-11, ACI318-14)
- USE OF THIS PRODUCT IS SUBJECT TO THE APPROVAL OF THE LOCAL BUILDING DEPARTMENT.
- THIS PRODUCT IS PART OF THE OVERALL LATERAL FORCE RESISTING SYSTEM OF THE STRUCTURE. DESIGN OF THE BUILDING'S LATERAL FORCE RESISTING SYSTEM, INCLUDING THE LOAD PATH TO TRANSFER LATERAL FORCES FROM THE STRUCTURE TO THE GROUND, IS THE RESPONSIBILITY OF THE DESIGNER.
- THE DESIGNER MUST SPECIFY THE REQUIRED COMPONENTS OF THE COMPLETE LOAD TRANSFER PATH INCLUDING DIAPHRAGMS, SHEAR TRANSFER, CHORDS AND COLLECTORS AND FOUNDATIONS.
- ALL CONNECTED MEMBERS AND RELATED ELEMENTS SHALL BE DESIGNED BY THE DESIGNER.
- DESIGNER IS PERMITTED TO MODIFY DETAILS FOR SPECIFIC CONDITIONS. SEE LIMITATIONS NOTED ON SHEET SMF3.
- ANCHORAGE LENGTHS PROVIDED ARE SHOWN FOR MINIMUM EMBEDMENT INTO FOOTING BASED ON TENSION ANCHORAGE DESIGN ONLY. ACTUAL LENGTH OF ANCHORAGE SHALL BE PER DESIGNER'S SPECIFICATIONS AND PROJECT SPECIFIC INSTALLATION REQUIREMENTS.
- PRE-ASSEMBLED ANCHORAGE KITS PROVIDED BY SIMPSON (MFSL OR MFAB) SHALL BE SPECIFIED BY DESIGNER AND SHOULD INCLUDE ANCHORAGE TYPE, ROD GRADE, AND LENGTH OF ASSEMBLY. REFER TO DETAIL 2 FOR AVAILABLE LENGTHS OF FULLY ASSEMBLED ANCHORAGE ASSEMBLIES. EXTENSION KITS IN 36" LENGTHS ARE AVAILABLE FOR USE IN STEMWALLS OR APPLICATIONS WHERE DEEPER EMBEDMENT IS REQUIRED.
- FOOTING DIMENSIONS SHOWN ARE THE MINIMUMS REQUIRED FOR CONCRETE ANCHORAGE REQUIREMENTS ONLY. THE DESIGNER MUST DETERMINE REQUIRED FOOTING SIZE AND REINFORCING FOR OTHER DESIGN LIMITS, SUCH AS FOUNDATION SHEAR AND BENDING, SOIL BEARING SHEAR TRANSFER, AND FRAME STABILITY / OVERTURNING.
- DESIGNER MUST DETAIL ACTUAL FOOTING / GRADE BEAM SIZE AND REINFORCING.
- HOLES IN BASE PLATES ARE OVER-SIZED FOR ERECTION TOLERANCE. DESIGNER MUST EVALUATE EFFECTS OF OVER-SIZED HOLES AND PROVIDE PLATE WASHER WITH STANDARD-SIZE HOLES WELDED TO BASE PLATE OR REQUEST BASE PLATES WITH STANDARD SIZE HOLES WHERE REQUIRED.
- THE CONTRACTOR SHALL VERIFY ALL DIMENSIONS, CONDITIONS, ELEVATIONS, ETC. PRIOR TO INSTALLATION OF ANY COMPONENTS FOR THE STEEL STRONG FRAME SYSTEM. IF ANY DISCREPANCIES ARE FOUND, THEY SHALL BE BROUGHT TO THE ATTENTION OF THE DESIGNER FOR CLARIFICATION PRIOR TO CONSTRUCTION.
- INSTALLATION OF PRODUCT SHALL BE DONE IN CONFORMANCE WITH THESE DRAWINGS AND ICC ESR-2802. THE PERFORMANCE OF MODIFIED PRODUCTS OR ALTERED INSTALLATION PROCEDURES ARE THE SOLE RESPONSIBILITY OF THE DESIGNER.
- SIMPSON STRONG-TIE® COMPANY, INC. RESERVES THE RIGHT TO CHANGE SPECIFICATIONS, DESIGNS, AND MODELS WITHOUT NOTICE OR LIABILITY FOR SUCH CHANGES.
- ALL HARDWARE CALLED OUT IS SIMPSON STRONG-TIE®.
- USE OF A SIMPSON STRONG-TIE PRODUCT DOES NOT IMPLY THAT SIMPSON STRONG-TIE ENDORSES ANY PROJECT, STRUCTURE OR USE. NO LICENSE IS GRANTED WITH RESPECT TO ANY SIMPSON STRONG-TIE TRADEMARK OR OTHER INTELLECTUAL PROPERTY RIGHTS. WRITTEN PERMISSION MUST BE OBTAINED PRIOR TO USING ANY SIMPSON STRONG-TIE TRADEMARKS OR PROPRIETARY DOCUMENTS AND MATERIALS.
- SIMPSON STRONG-TIE IS NOT AFFILIATED WITH, AND DOES NOT SPONSOR OR ENDORSE, THE DESIGNER, INSTALLER OR USERS OF THIS DRAWING, NOR DOES SIMPSON STRONG-TIE HAVE ANY JOINT VENTURE, PARTNERSHIP, AGENCY, EMPLOYMENT OR FIDUCIARY RELATIONSHIP WITH SUCH PERSONS.

**MATERIAL:**

- BARS/PLATES: ASTM 572 GR. 50, ASTM A529 GR. 50, OR ASTM A1011 HSLAS GR. 50
- W-SECTIONS (HOT ROLLED SECTIONS): ASTM A992
- LINK TO COLUMN FLANGE HIGH STRENGTH BOLTS: 7/8" DIA. ASTM A325, TYPE 1 (SNUG-TIGHT)
- BRP TO BEAM FLANGE AND SHEAR PLATE TO BEAM WEB HIGH STRENGTH BOLTS: ASTM A325, TYPE 1 (SNUG-TIGHT)
- LINK TO BEAM FLANGE HIGH STRENGTH BOLTS: ASTM F2280 TWIST OFF TYPE (A490 EQUIVALENT) (PRETENSIONED)
- BEAM TOP FLANGE WOOD NAILER BOLT: ASTM A307 GR. A
- CARRIAGE BOLTS: ASTM A307 GR. A
- ANCHOR RODS: ASTM F1554 GR 36 OR A36 (MFAB, MFSL, AND MF-ATR6EXT-LS); ASTM A449 (MFAB-HS, MFSL-HS, AND MF-ATR6EXT-HS)
- GROUT: ASTM C1107, MINIMUM 5,000 PSI COMPRESSIVE STRENGTH

**INSTALLATION AND FIELD MODIFICATIONS:**

THESE GENERAL INSTRUCTIONS FOR THE INSTALLER ARE PROVIDED TO ENSURE PROPER SELECTION AND INSTALLATION OF SIMPSON STRONG-TIE COMPANY INC. PRODUCTS AND MUST BE FOLLOWED CAREFULLY. THESE GENERAL INSTRUCTIONS ARE IN ADDITION TO THE SPECIFIC INSTALLATION INSTRUCTIONS AND NOTES PROVIDED FOR EACH PARTICULAR PRODUCT, ALL OF WHICH SHOULD BE CONSULTED PRIOR TO AND DURING INSTALLATION OF SIMPSON STRONG-TIE COMPANY INC. PRODUCTS.

- PROPER PRODUCT INSTALLATION REQUIRES CAREFUL ATTENTION TO ALL NOTES AND INSTRUCTIONS. IN ADDITION TO THE NOTES, WARNINGS, AND INSTRUCTIONS PROVIDED IN THE CATALOG, INSTALLERS, DESIGNERS, ENGINEERS AND CONSUMERS SHOULD CONSULT THE SIMPSON STRONG-TIE COMPANY INC. WEBSITE AT WWW.STRONGTIE.COM TO OBTAIN ADDITIONAL INFORMATION FOR INSTALLATION, SPECIFICATIONS, CODE REPORTS, TECHNICAL FLIERS AND BULLETINS, FAQs, AND OTHER PERTINENT INFORMATION.
- PROVIDE TEMPORARY DIAGONAL BRACING OF STRONG FRAME® AS REQUIRED UNTIL FRAME IS TIED INTO THE FLOOR OR ROOF FRAMING ABOVE.
- USE PROPER SAFETY AND INSTALLATION EQUIPMENT DURING INSTALLATION OF STRONG FRAME®.
- ALL SPECIFIED FASTENERS MUST BE INSTALLED ACCORDING TO THE INSTRUCTIONS PROVIDED IN THE CATALOG, CODE REPORT, AND INSTALLATION DETAILS. INCORRECT FASTENER QUANTITY, SIZE, PLACEMENT, TYPE, MATERIAL, OR FINISH MAY CAUSE THE CONNECTION TO FAIL.
- FILL ALL FASTENER HOLES AS SPECIFIED IN THE INSTALLATION INSTRUCTIONS FOR THE SPECIFIED PRODUCT. INSTALL ALL FASTENERS BEFORE LOADING THE FRAME. SOME PRE-INSTALLED ITEMS MAY NOT USE ALL HOLES.
- NUTS SHALL BE INSTALLED SUCH THAT THE END OF THE THREADED ROD OR BOLT IS AT LEAST FLUSH WITH THE TOP OF THE NUT.
- REFER TO DETAIL 12/SMF3 FOR ALLOWABLE HOLE OPENINGS IN BEAM AND COLUMNS.
- REFER TO DETAIL 11/SMF3 FOR CONNECTION PROTECTED ZONE.
- WELDING SHALL BE IN ACCORDANCE WITH AWS D1.1 AND AWS D1.8 (AS APPLICABLE FOR SEISMIC). WELDS SHALL BE SPECIFIED BY THE DESIGNER. PROVIDE WELDING SPECIAL INSPECTION AS REQUIRED BY THE LOCAL BUILDING DEPARTMENT.

**INSPECTIONS:**

- WELDING OF FRAME MEMBERS AND APPLICABLE WELDING SPECIAL INSPECTIONS REQUIRED BY IBC SECTION 1707 ARE PERFORMED ON THE PREMISES OF A FABRICATOR REGISTERED AND APPROVED IN ACCORDANCE WITH THE REQUIREMENTS OF IBC SECTION 1704.2.5 FOR FABRICATOR APPROVAL.
- PRE-INSTALLATION VERIFICATION TESTING IS PERFORMED ON HIGH-STRENGTH FASTENER ASSEMBLIES.
- INSPECTION REQUIREMENTS OUTSIDE THE SHOP MANUFACTURING AND ASSEMBLY PROCESS SHALL BE IN ACCORDANCE WITH THE LOCAL CODE, BASED ON BUILDING OCCUPANCY, CONCRETE STRENGTH, REQUIREMENTS OF THE LOCAL BUILDING OFFICIAL, AND OTHER CONSIDERATIONS AND SHALL BE SPECIFIED BY THE DESIGNER.
- GROUTING UNDER COLUMN BASE PLATE MAY REQUIRE SPECIAL INSPECTION, CONTACT THE LOCAL BUILDING DEPARTMENT FOR COMPLIANCE REQUIREMENTS.
- CONTACT SIMPSON STRONG-TIE® AT 800-999-5099 TO REQUEST PRE-INSTALLATION TESTING, WELDING REPORTS, MILL CERTS, ETC. WHEN REQUIRED.

**GENERAL NOTES**


1

MODEL NO.	ROD SIZE & NUMBER	LENGTH (in)	l <sub>e</sub> (in)	BEARING PLATE (in)
MFSL-14-6	4 - 3/4"	14	8 1/2"	3/8" x 7" x 7"
MFSL-14-HS6	4 - 3/4"	14	8 1/2"	
MFSL-18-6	4 - 3/4"	18	12 1/2"	
MFSL-18-HS6	4 - 3/4"	18	12 1/2"	
MFSL-24-6	4 - 3/4"	24	18 1/2"	
MFSL-24-HS6	4 - 3/4"	24	18 1/2"	
MFSL-30-6	4 - 3/4"	30	24 1/2"	
MFSL-30-HS6	4 - 3/4"	30	24 1/2"	
MFSL-36-6	4 - 3/4"	36	30 1/2"	
MFSL-36-HS6	4 - 3/4"	36	30 1/2"	

THE MFSL ANCHOR ASSEMBLIES HAVE BEEN ENGINEERED TO PROVIDE A COMPLETE ANCHORAGE SOLUTION MEETING THE 2012 AND 2015, 2018 INTERNATIONAL BUILDING CODE REQUIREMENTS FOR BOTH TENSION AND SHEAR.

ANCHOR RODS AND THE MFTPL TEMPLATE ARE INCLUDED PRE-ATTACHED WITH THE ASSEMBLY.

INSPECTION IS EASY; THE HEAD IS STAMPED WITH A "NO EQUAL" SYMBOL FOR IDENTIFICATION, BOLT LENGTH, BOLT DIAMETER, AND OPTIONAL "HS" FOR HIGH STRENGTH IF SPECIFIED.

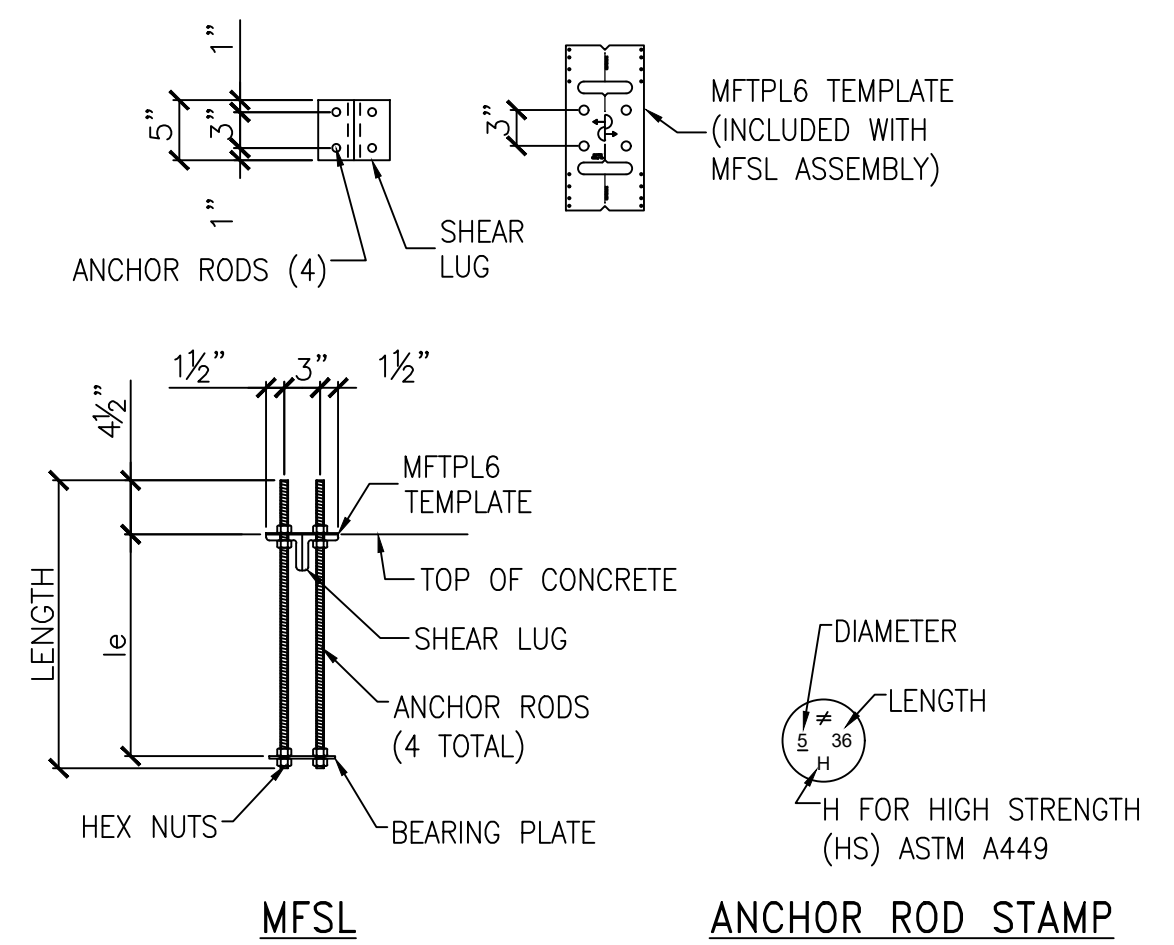


**MFSL ANCHORAGE ASSEMBLIES**

2

11/20/22 10:02 AM  
 8429 SE 33RD PLACE  
 MERCER ISLAND, WA 98040

Simpson Strong-Tie® Strong Frame® and the Yield-Link™ structural fuse are protected under one or more of the following US patents and applications: US patent No. 8,001,734 B2, US patent No. 8,375,652 B2, and US patent publication No. 2015/0159362, and must be supplied or licensed through Simpson Strong-Tie.

**CT ENGINEERING INC.**  
 Structural Engineers  
 180 N. 30th Street, Suite 302, Seattle, WA 98109  
 206.265.4572 (V) 206.265.0616 (F)  
 www.ctengineering.com

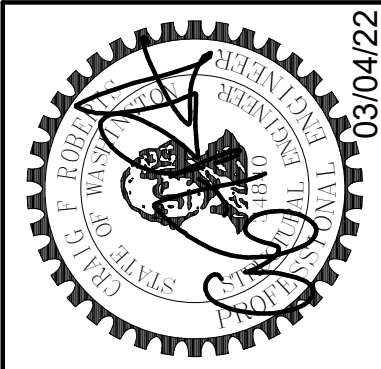

DATE	REVISION	No.


JOB #:	21162	Designer:	
ENG:		Author:	
CAD:			
SCALE:			
KEY ISSUE DATES:			



**Moment Frame Details**  
 PIPER REMODEL  
 8429 SE 33RD PLACE  
 MERCER ISLAND, WA 98040

**S8.0**




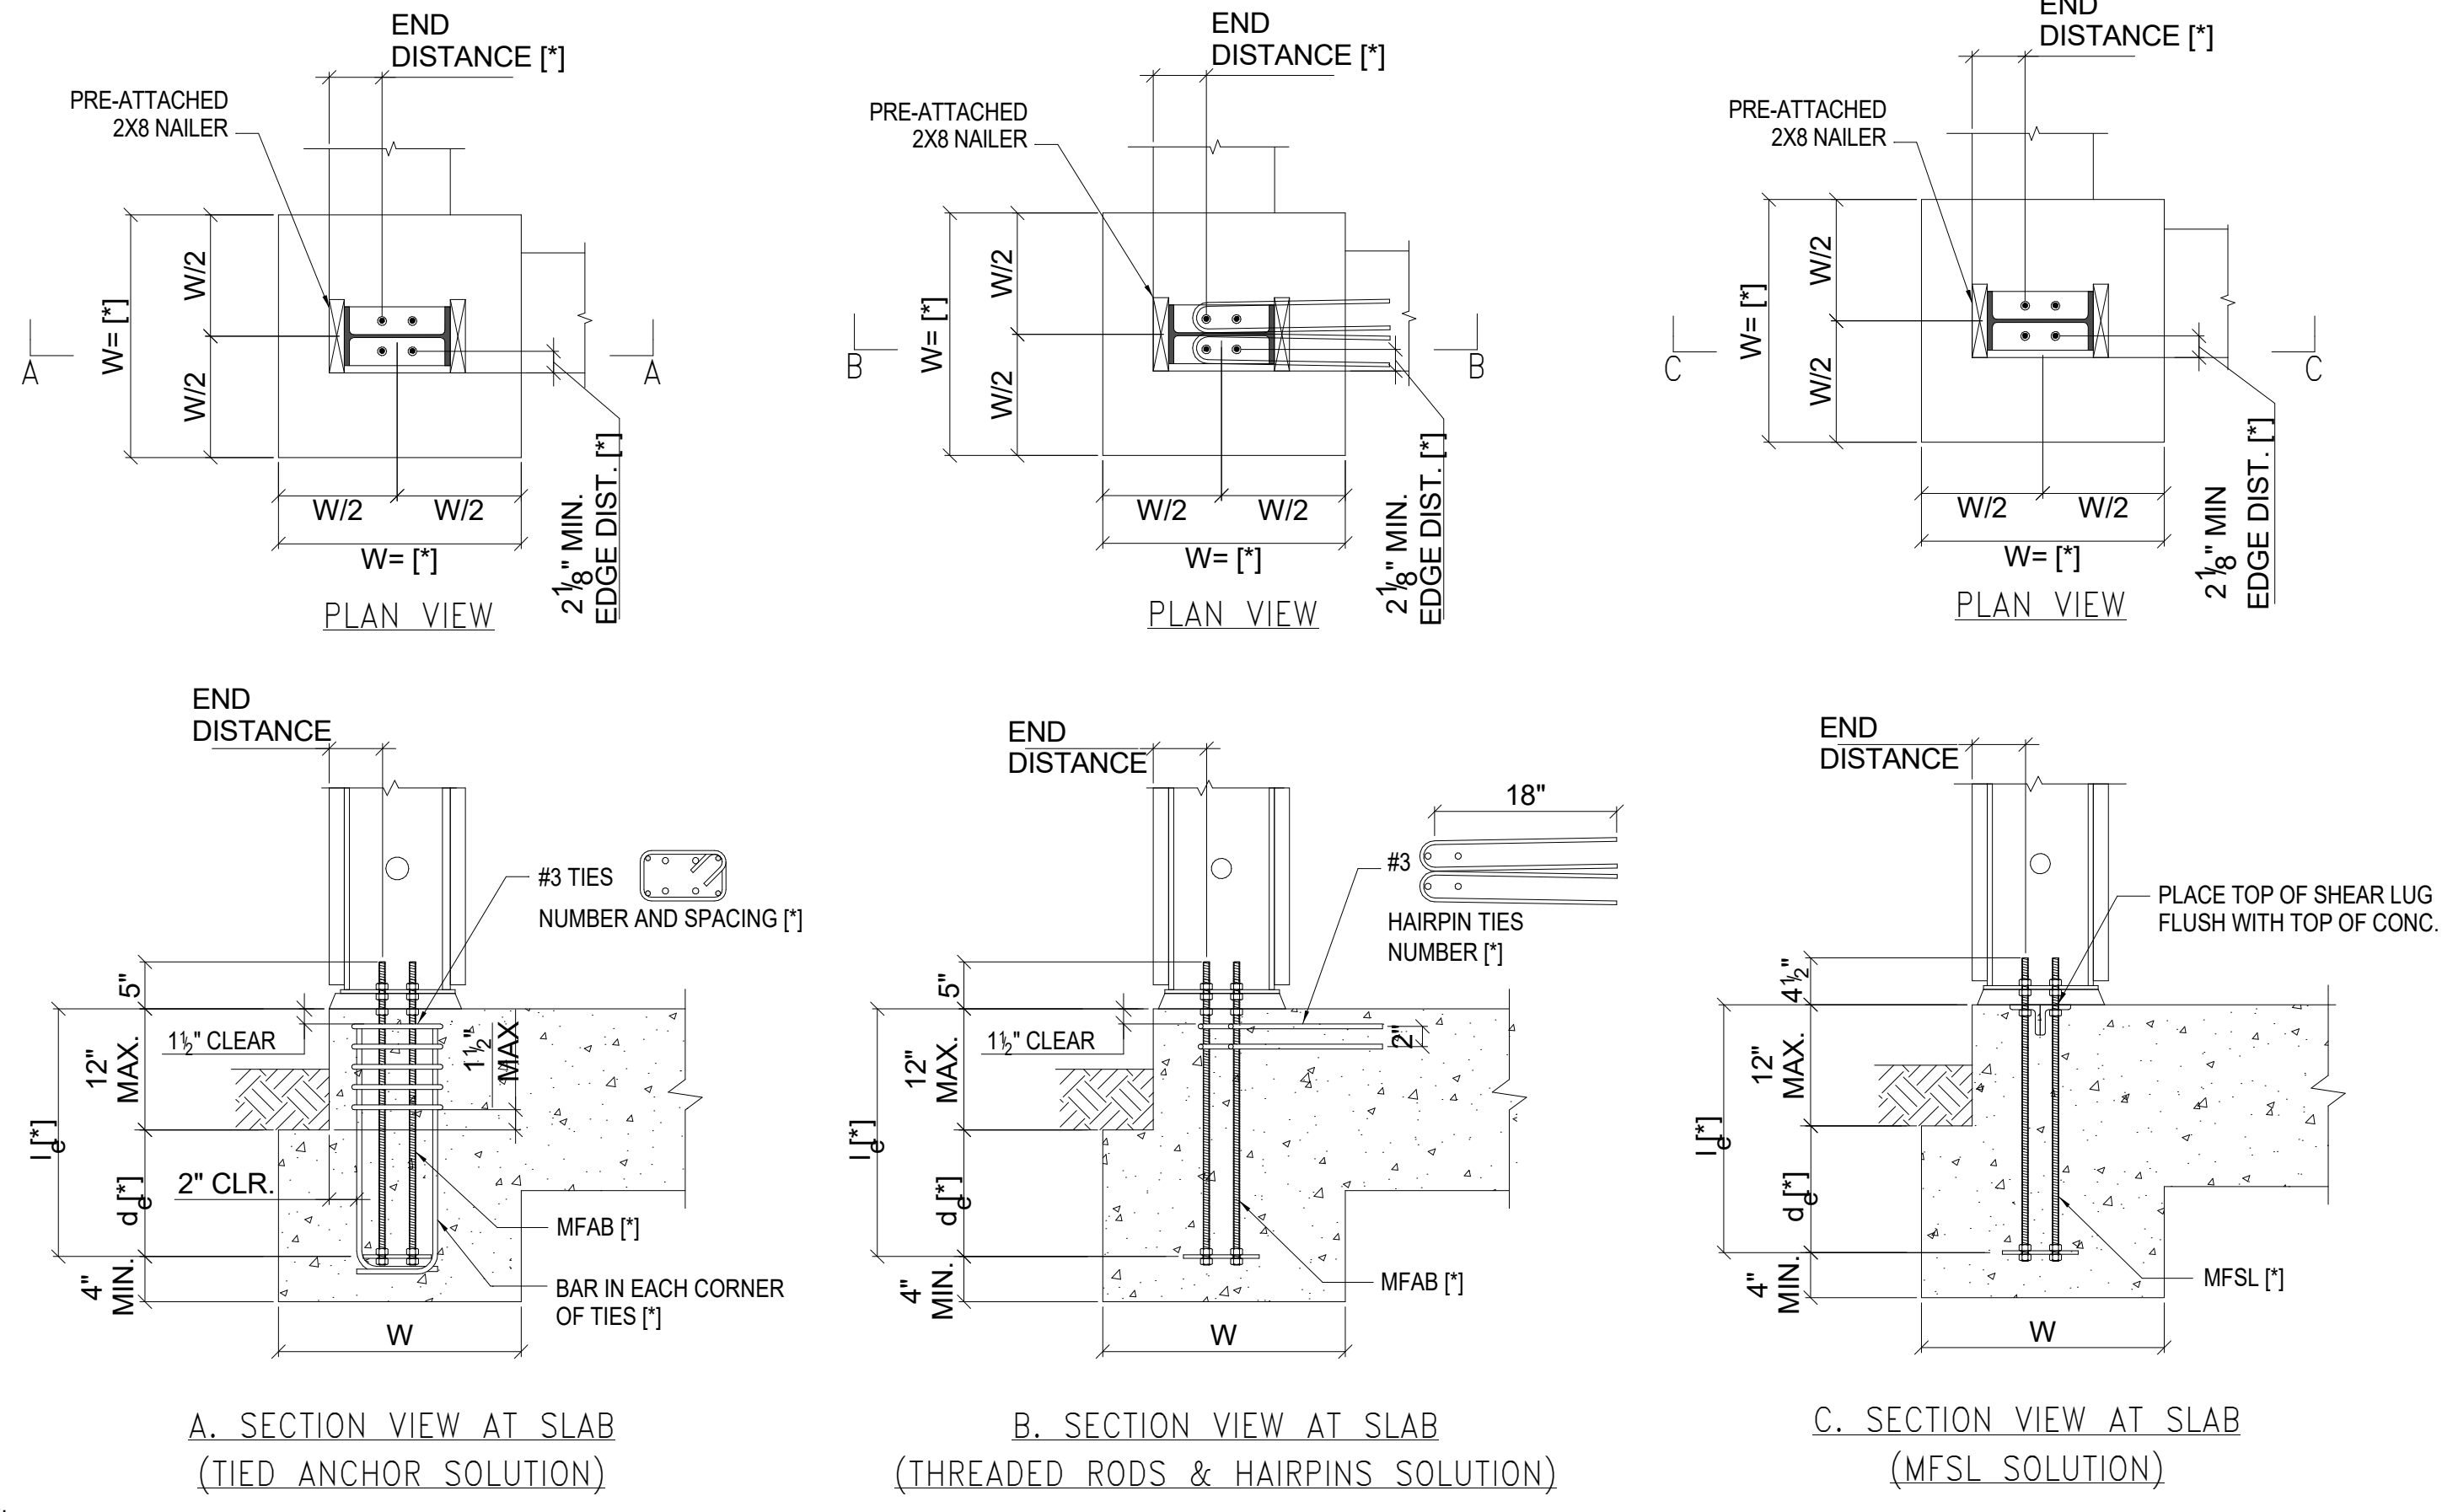

**NOTES:**  
 1. [ ] DENOTES INFORMATION TO BE PROVIDED BY DESIGNER  
 2. FOOTING/GRADE BEAM SIZE AND REINFORCING SHALL BE SPECIFIED BY THE DESIGNER AS REQUIRED TO RESIST IMPOSED LOADS, SUCH AS FOUNDATION SHEAR AND BENDING, SOIL BEARING PRESSURE, SHEAR TRANSFER, AND FRAME STABILITY/OVERTURNING

**SLAB-ON-GRADE FOUNDATION ANCHORAGE DETAILS**


**1**

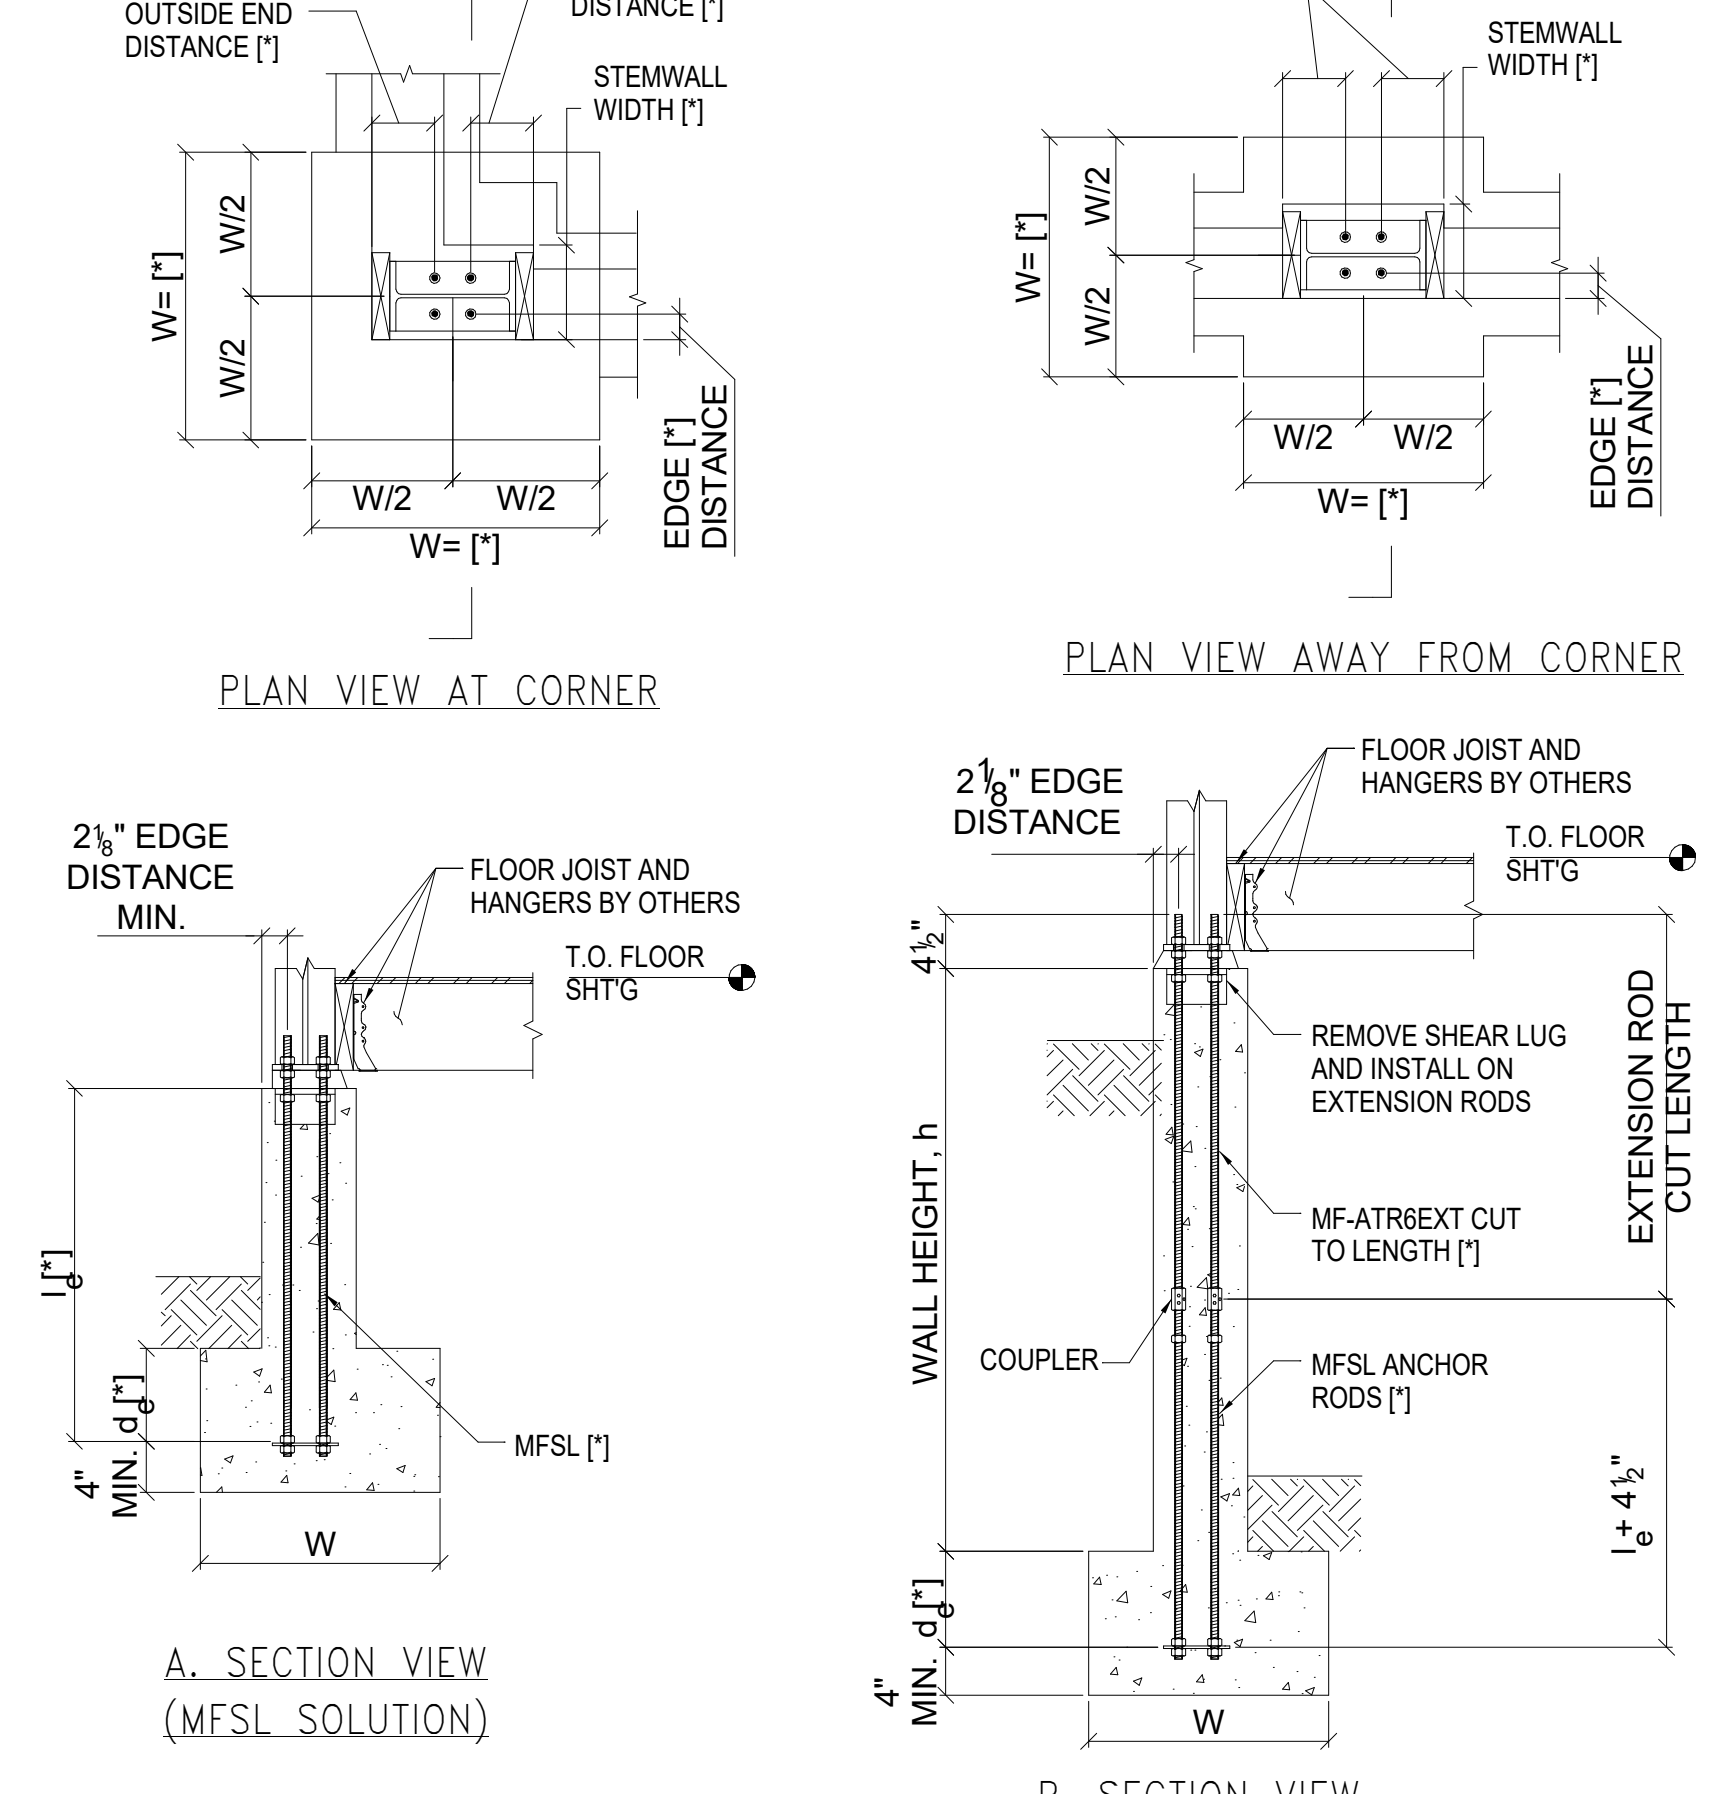

**NOTES:**  
 SEE NOTES ON 1/SMF2

**STEMWALL FOUNDATION ANCHORAGE DETAILS**


**3**

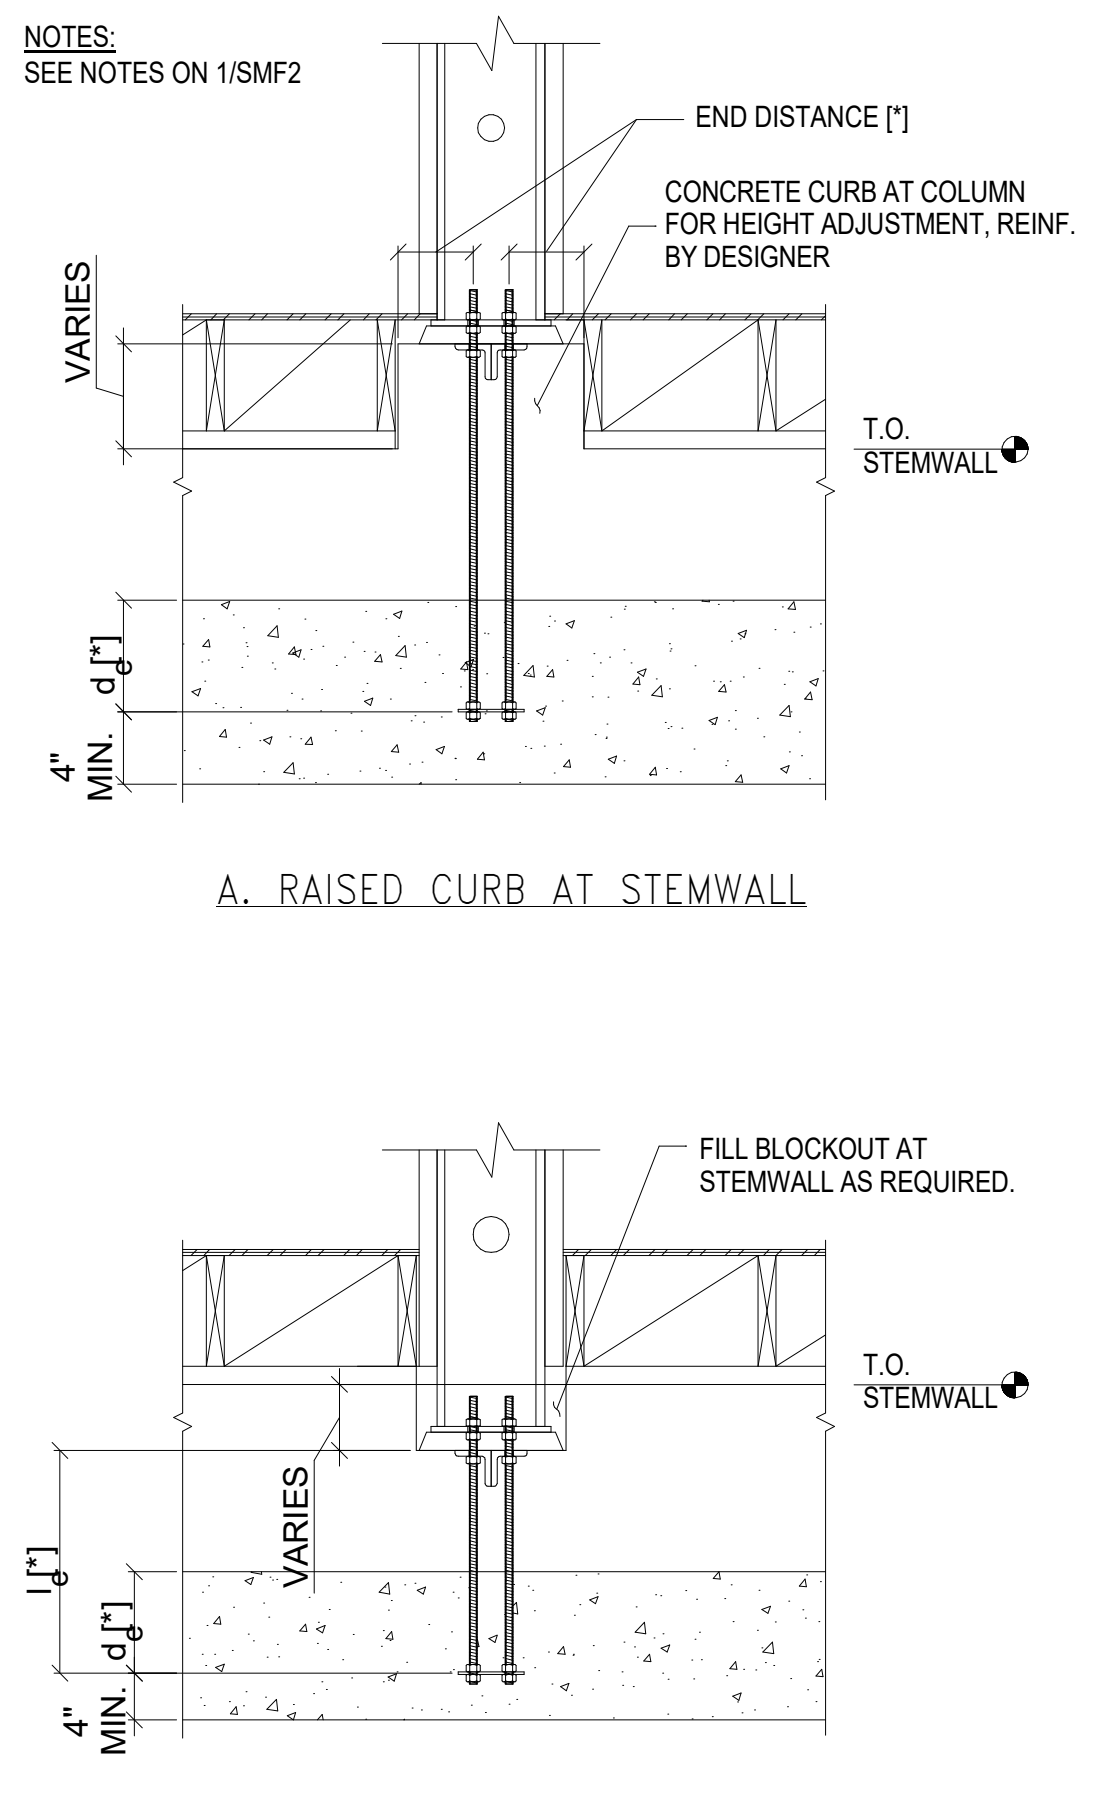

**NOTES:**  
 SEE NOTES ON 1/SMF2

**COL. HEIGHT ADJ. AT STEMWALL**


**6**

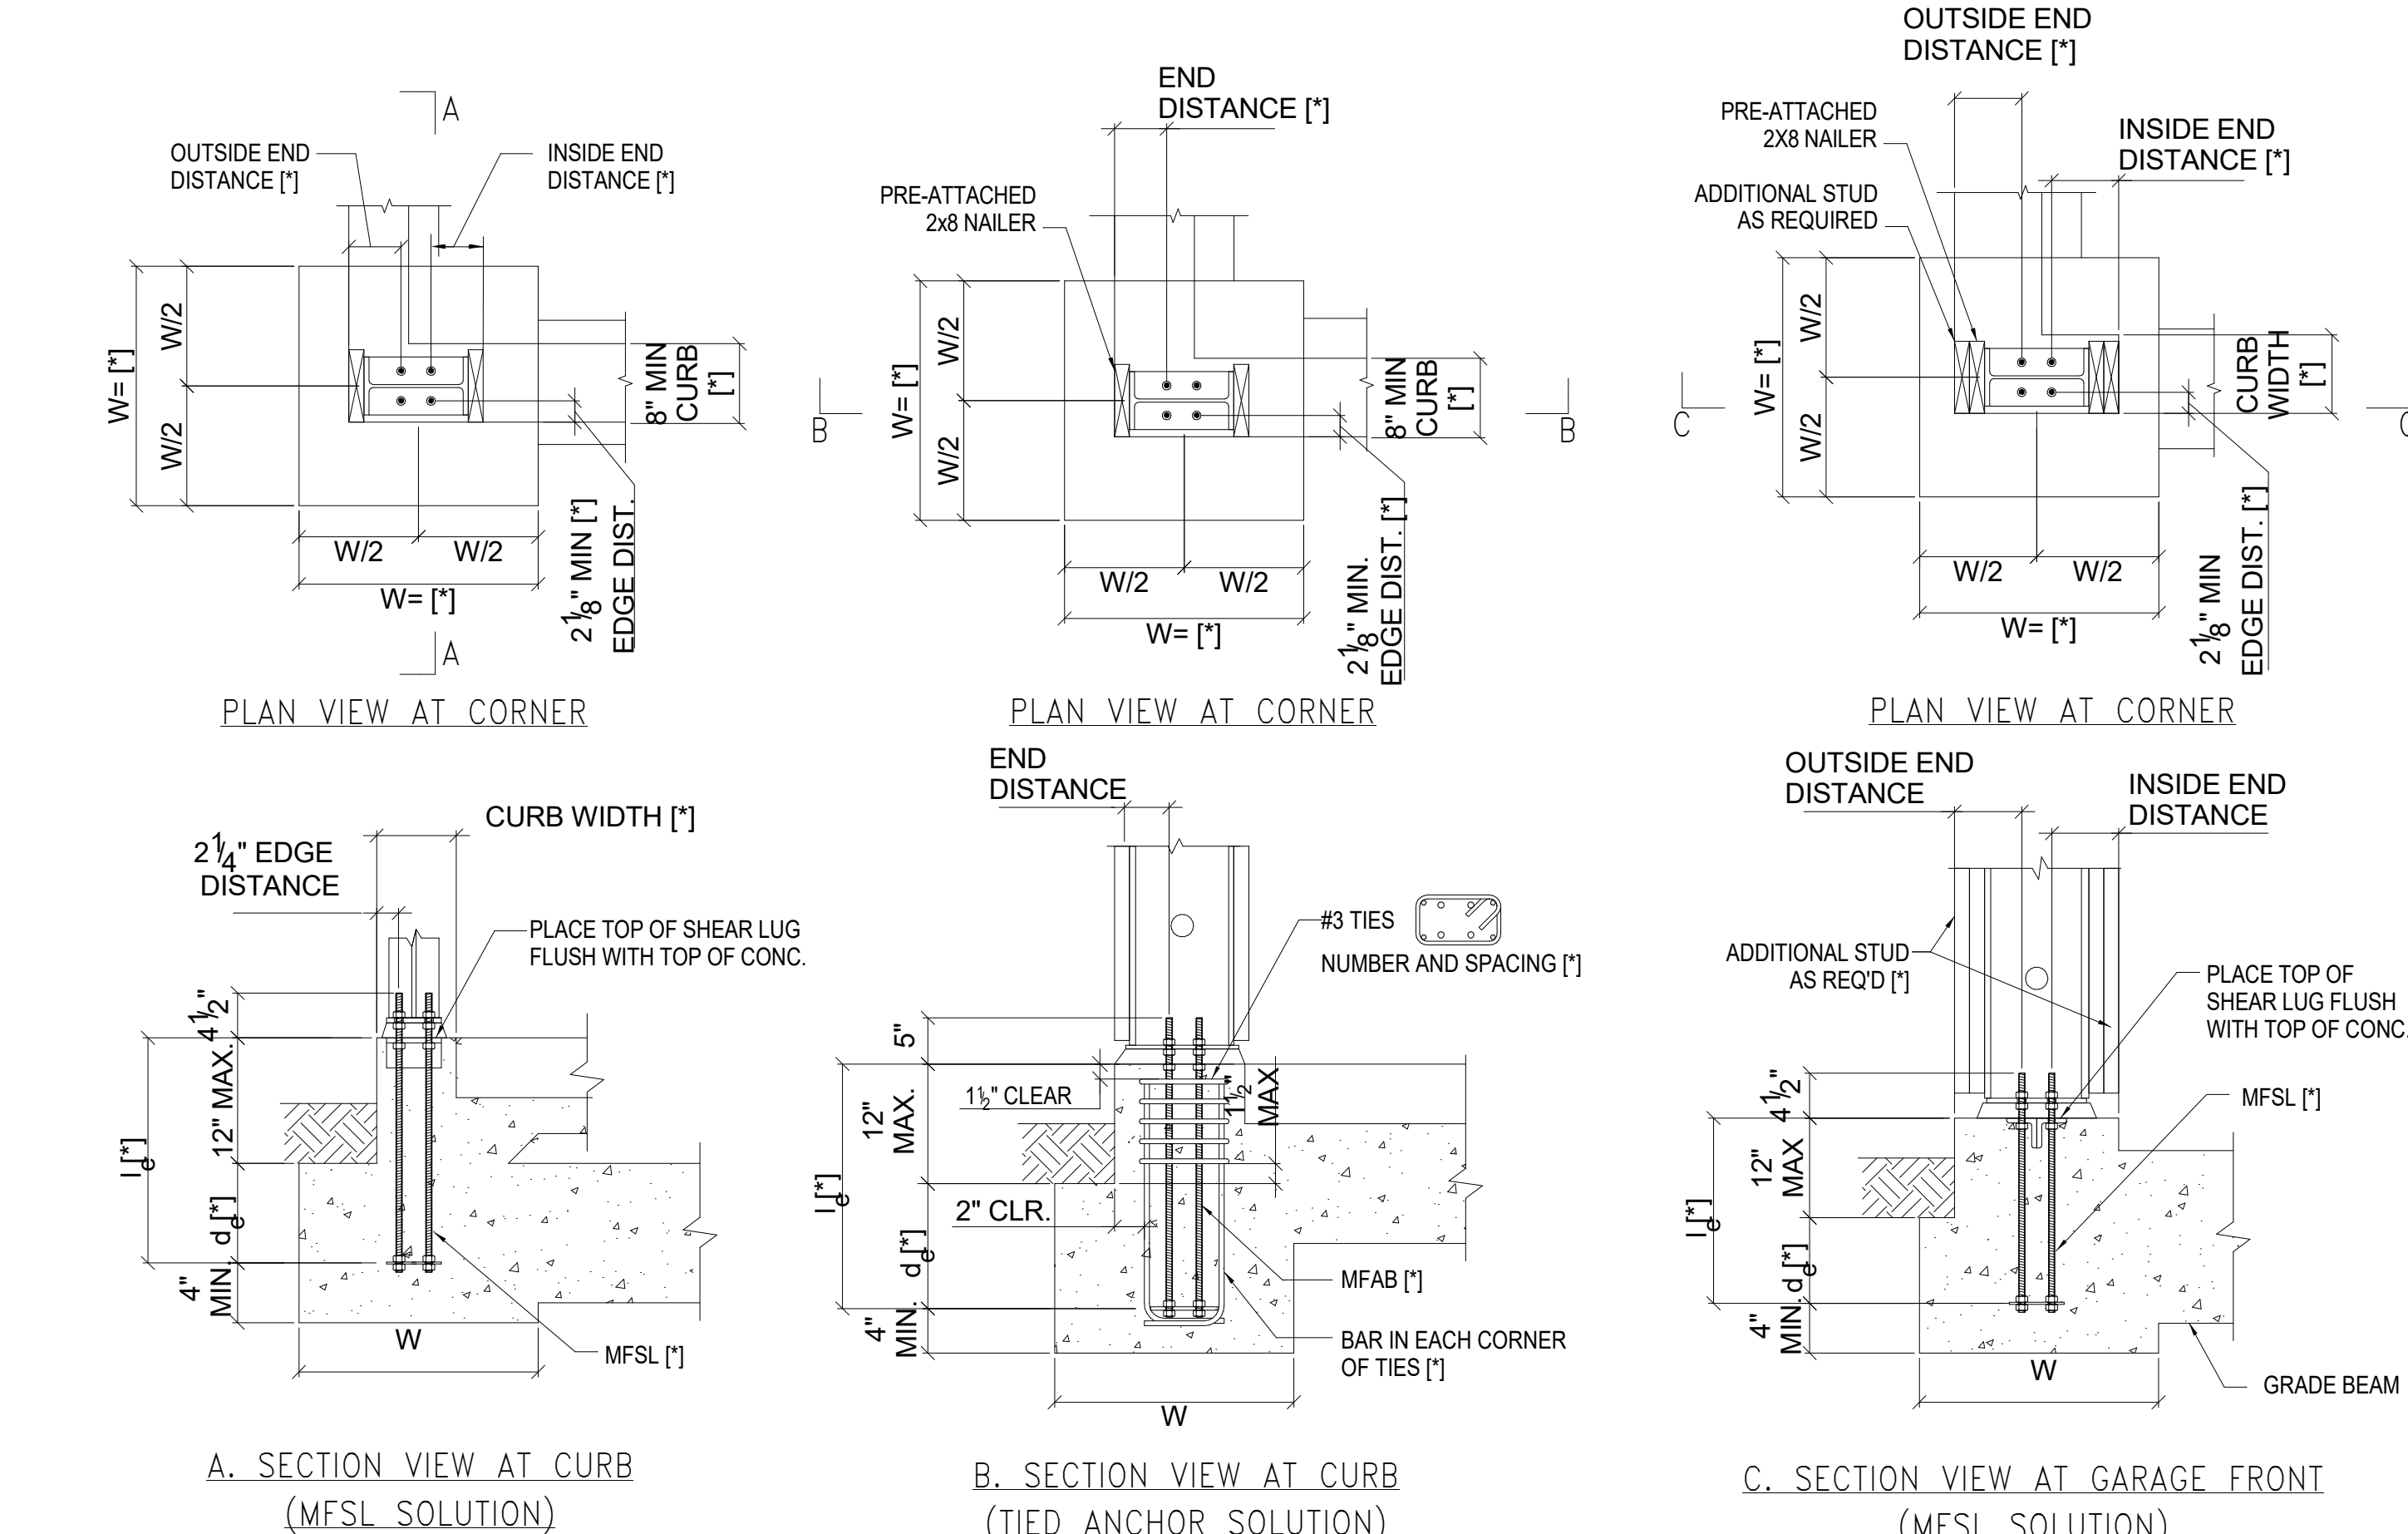

**NOTES:**  
 SEE NOTES ON 1/SMF2

**CONCRETE CURB FOUNDATION ANCHORAGE DETAILS**


**2**

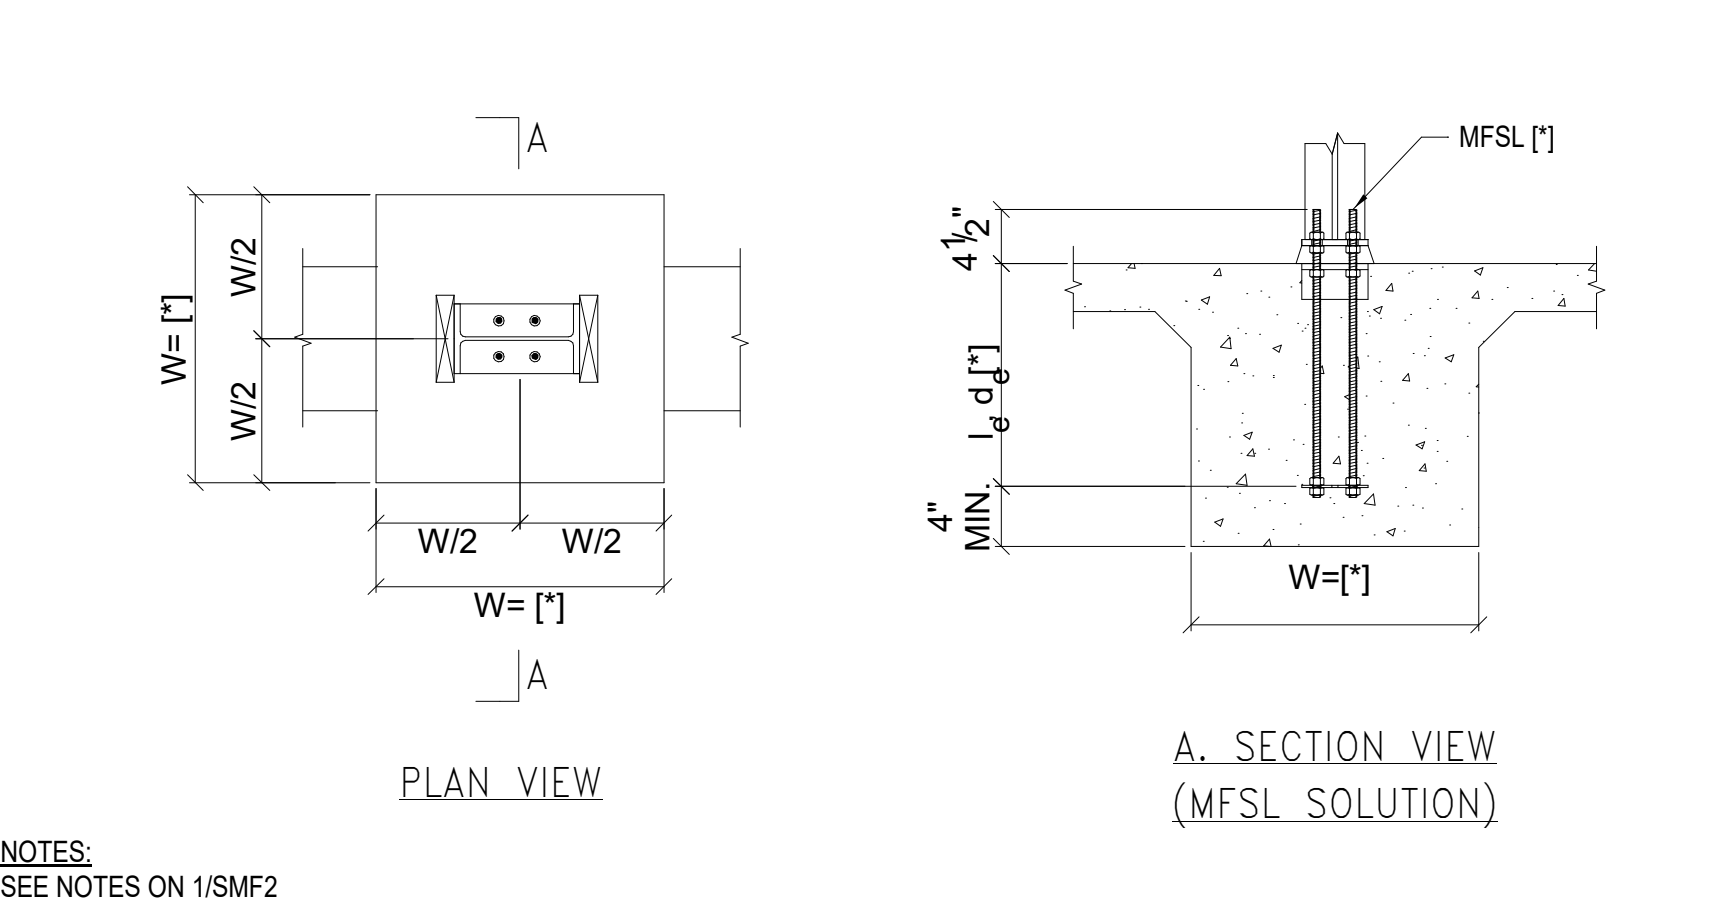

**NOTES:**  
 SEE NOTES ON 1/SMF2

**INTERIOR FOUNDATION ANCHORAGE DETAILS**


**4**

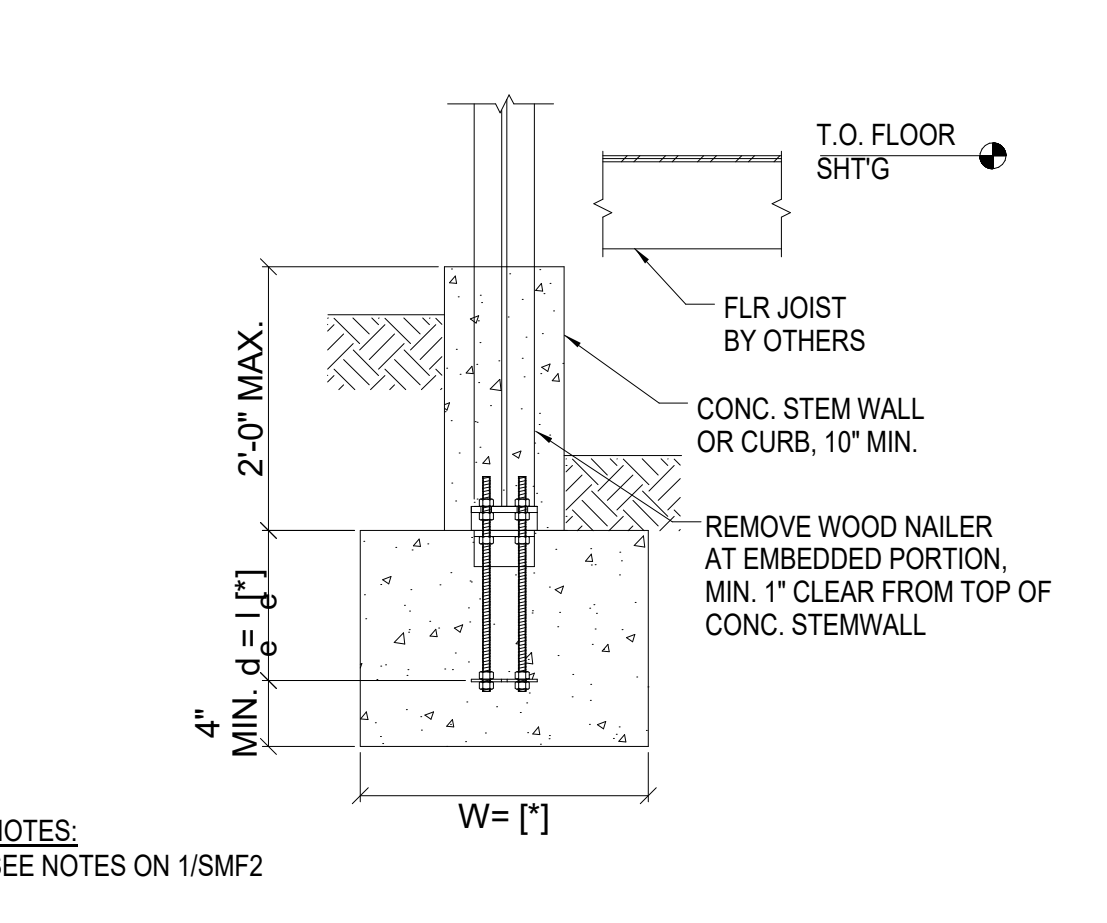

**NOTES:**  
 SEE NOTES ON 1/SMF2

**DEPRESSED COL. AT STEMWALL**


**7**

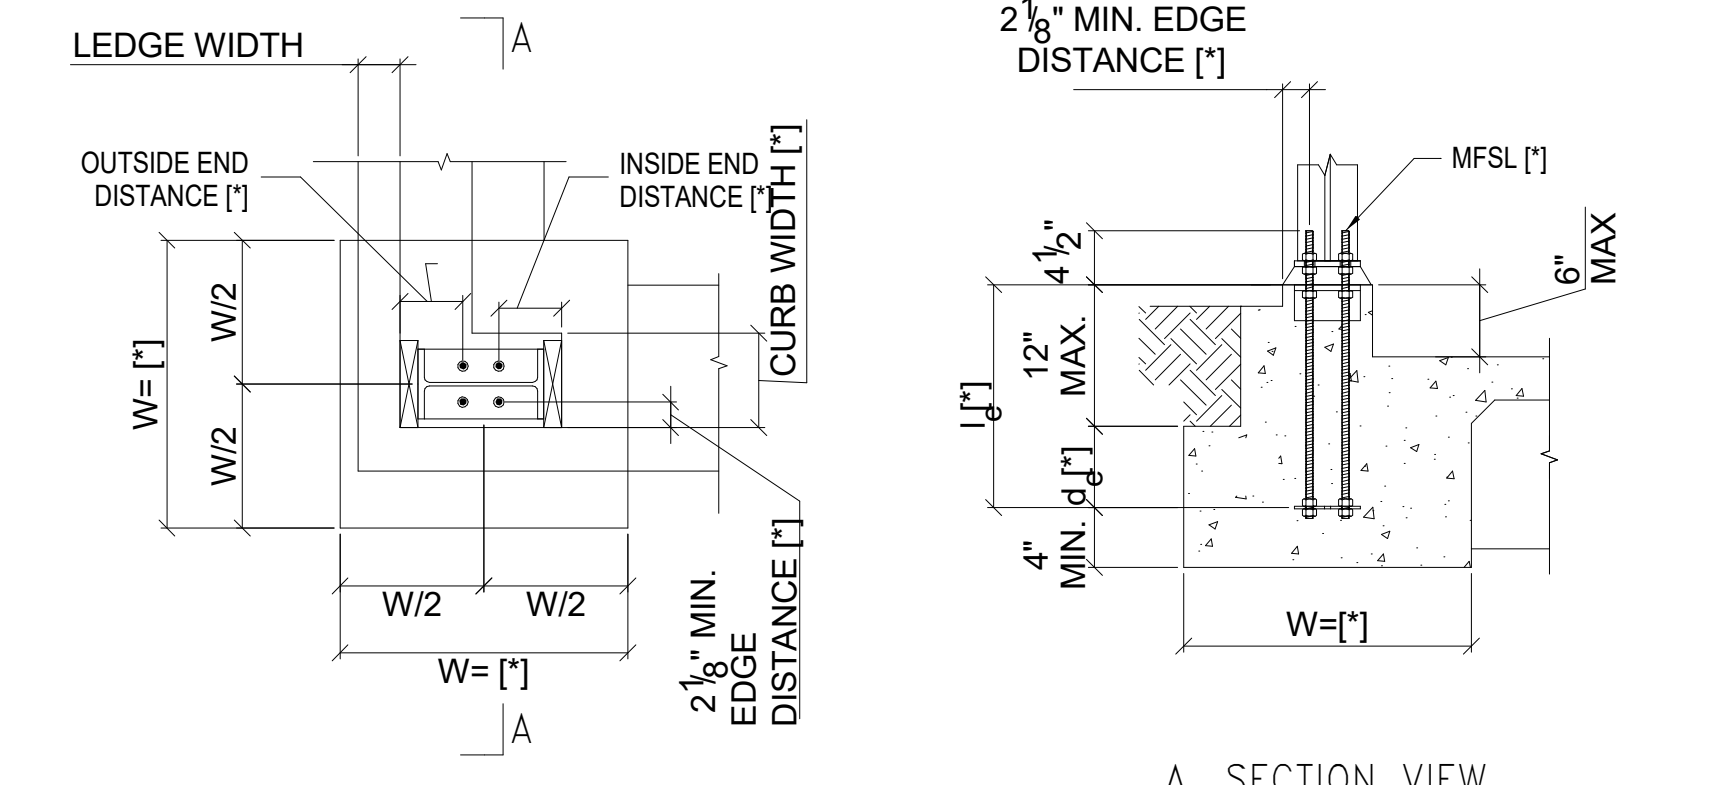

**NOTES:**  
 SEE NOTES ON 1/SMF2

**BRICK LEDGE FOUNDATION ANCHORAGE DETAILS**


**5**

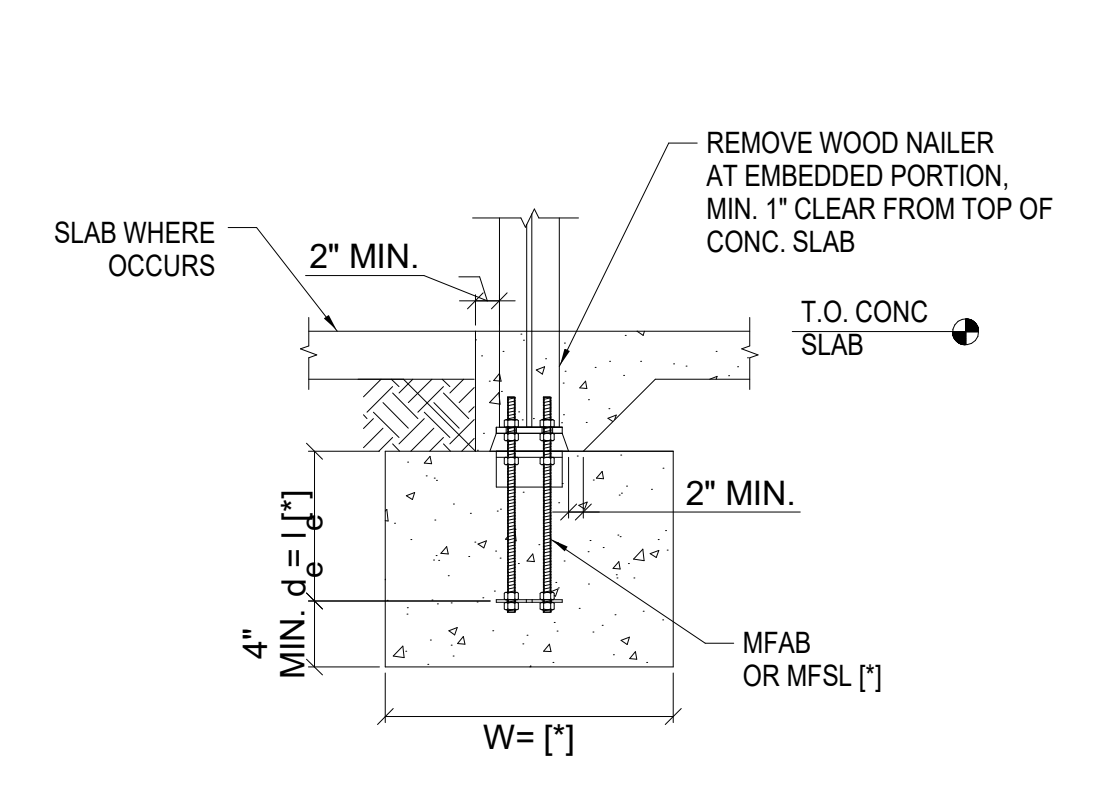

**NOTES:**  
 SEE NOTES ON 1/SMF2

**DEPRESSED COL. AT S.O.G.**

**8**

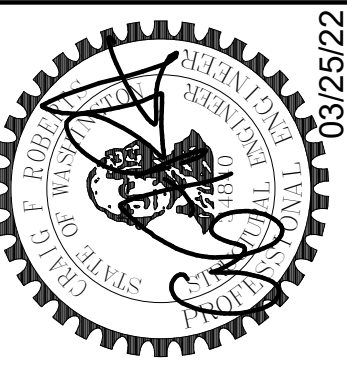


DATE	
REVISION	
No.	

JOB #:	21162
ENG.:	BJM
CAD.:	JMA
SCALE:	3/4" = 1'-0"
KEY ISSUE DATES:	
SD:	SD
CD:	CD
PERMIT:	03/25/2022
OTHER:	BD




6/14/2022 4:16:52 PM  
 C:\Users\BJM\Desktop\Address\STRUCT1162.Piper\_Remodel\Address (R) (1).rvt




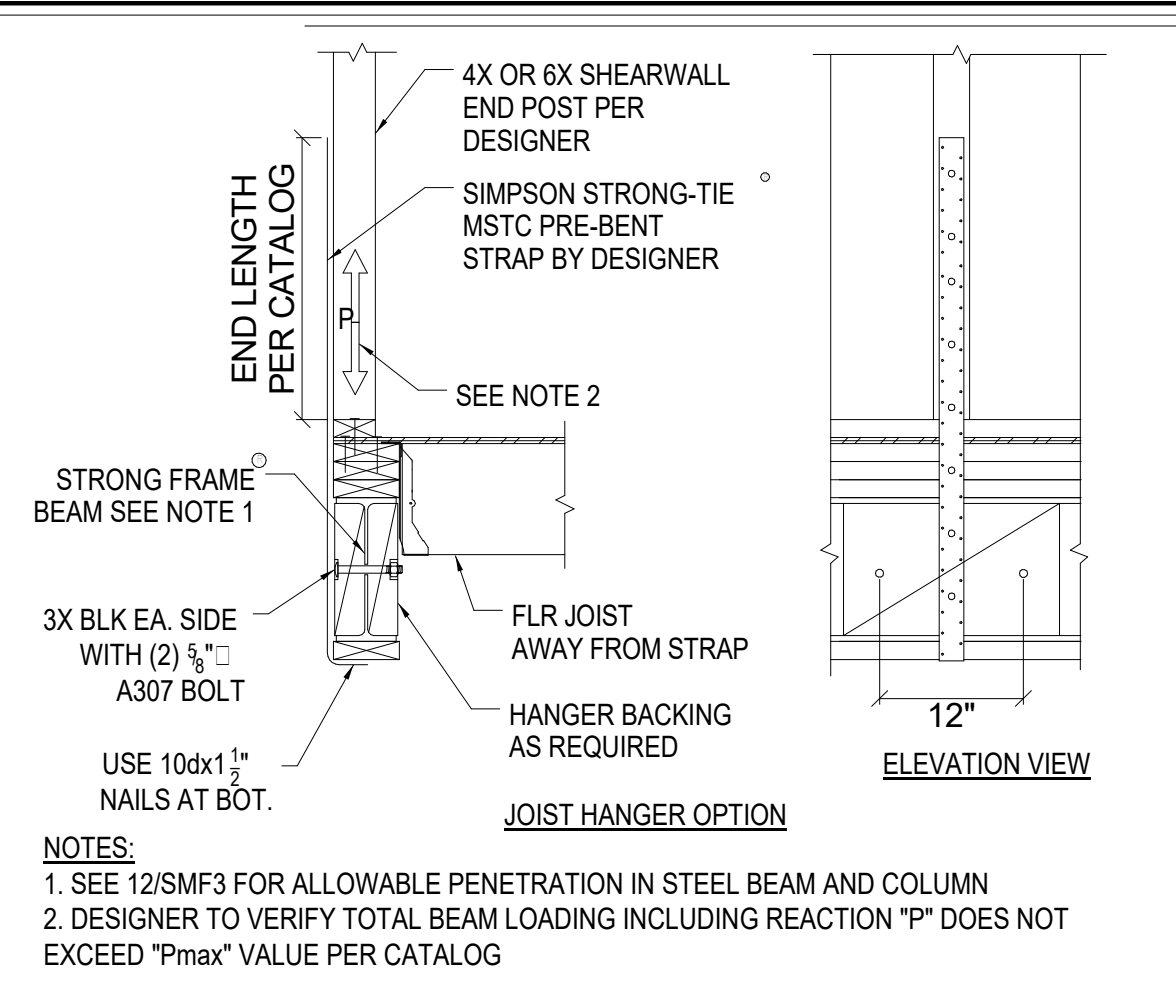


**HOLDOWN POST TO SMF BEAM** 1

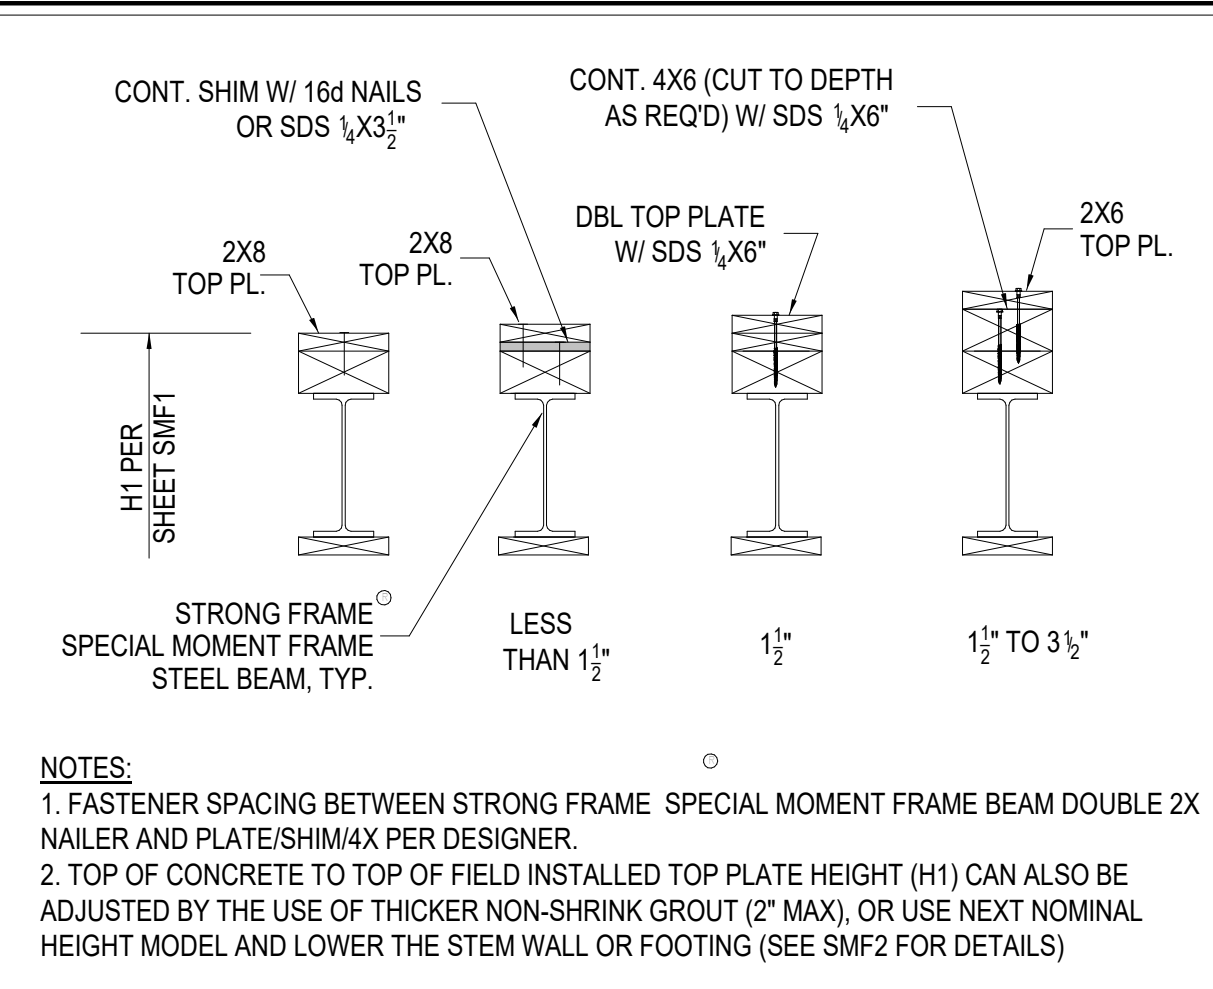


**TOP OF FRAME ADJUSTMENT** 5

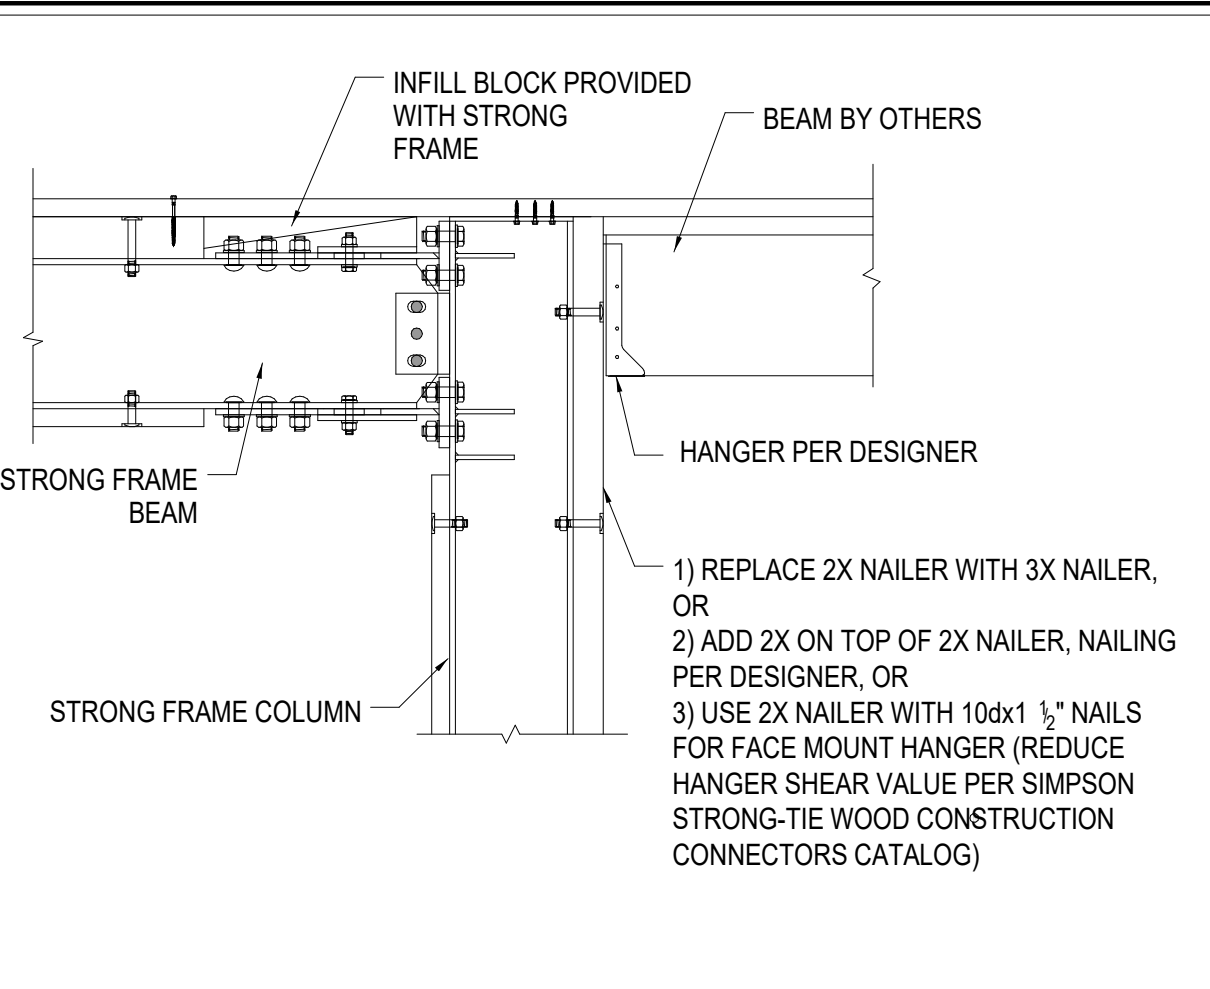


**WOOD BM TO SMF COL. CONN.** 8

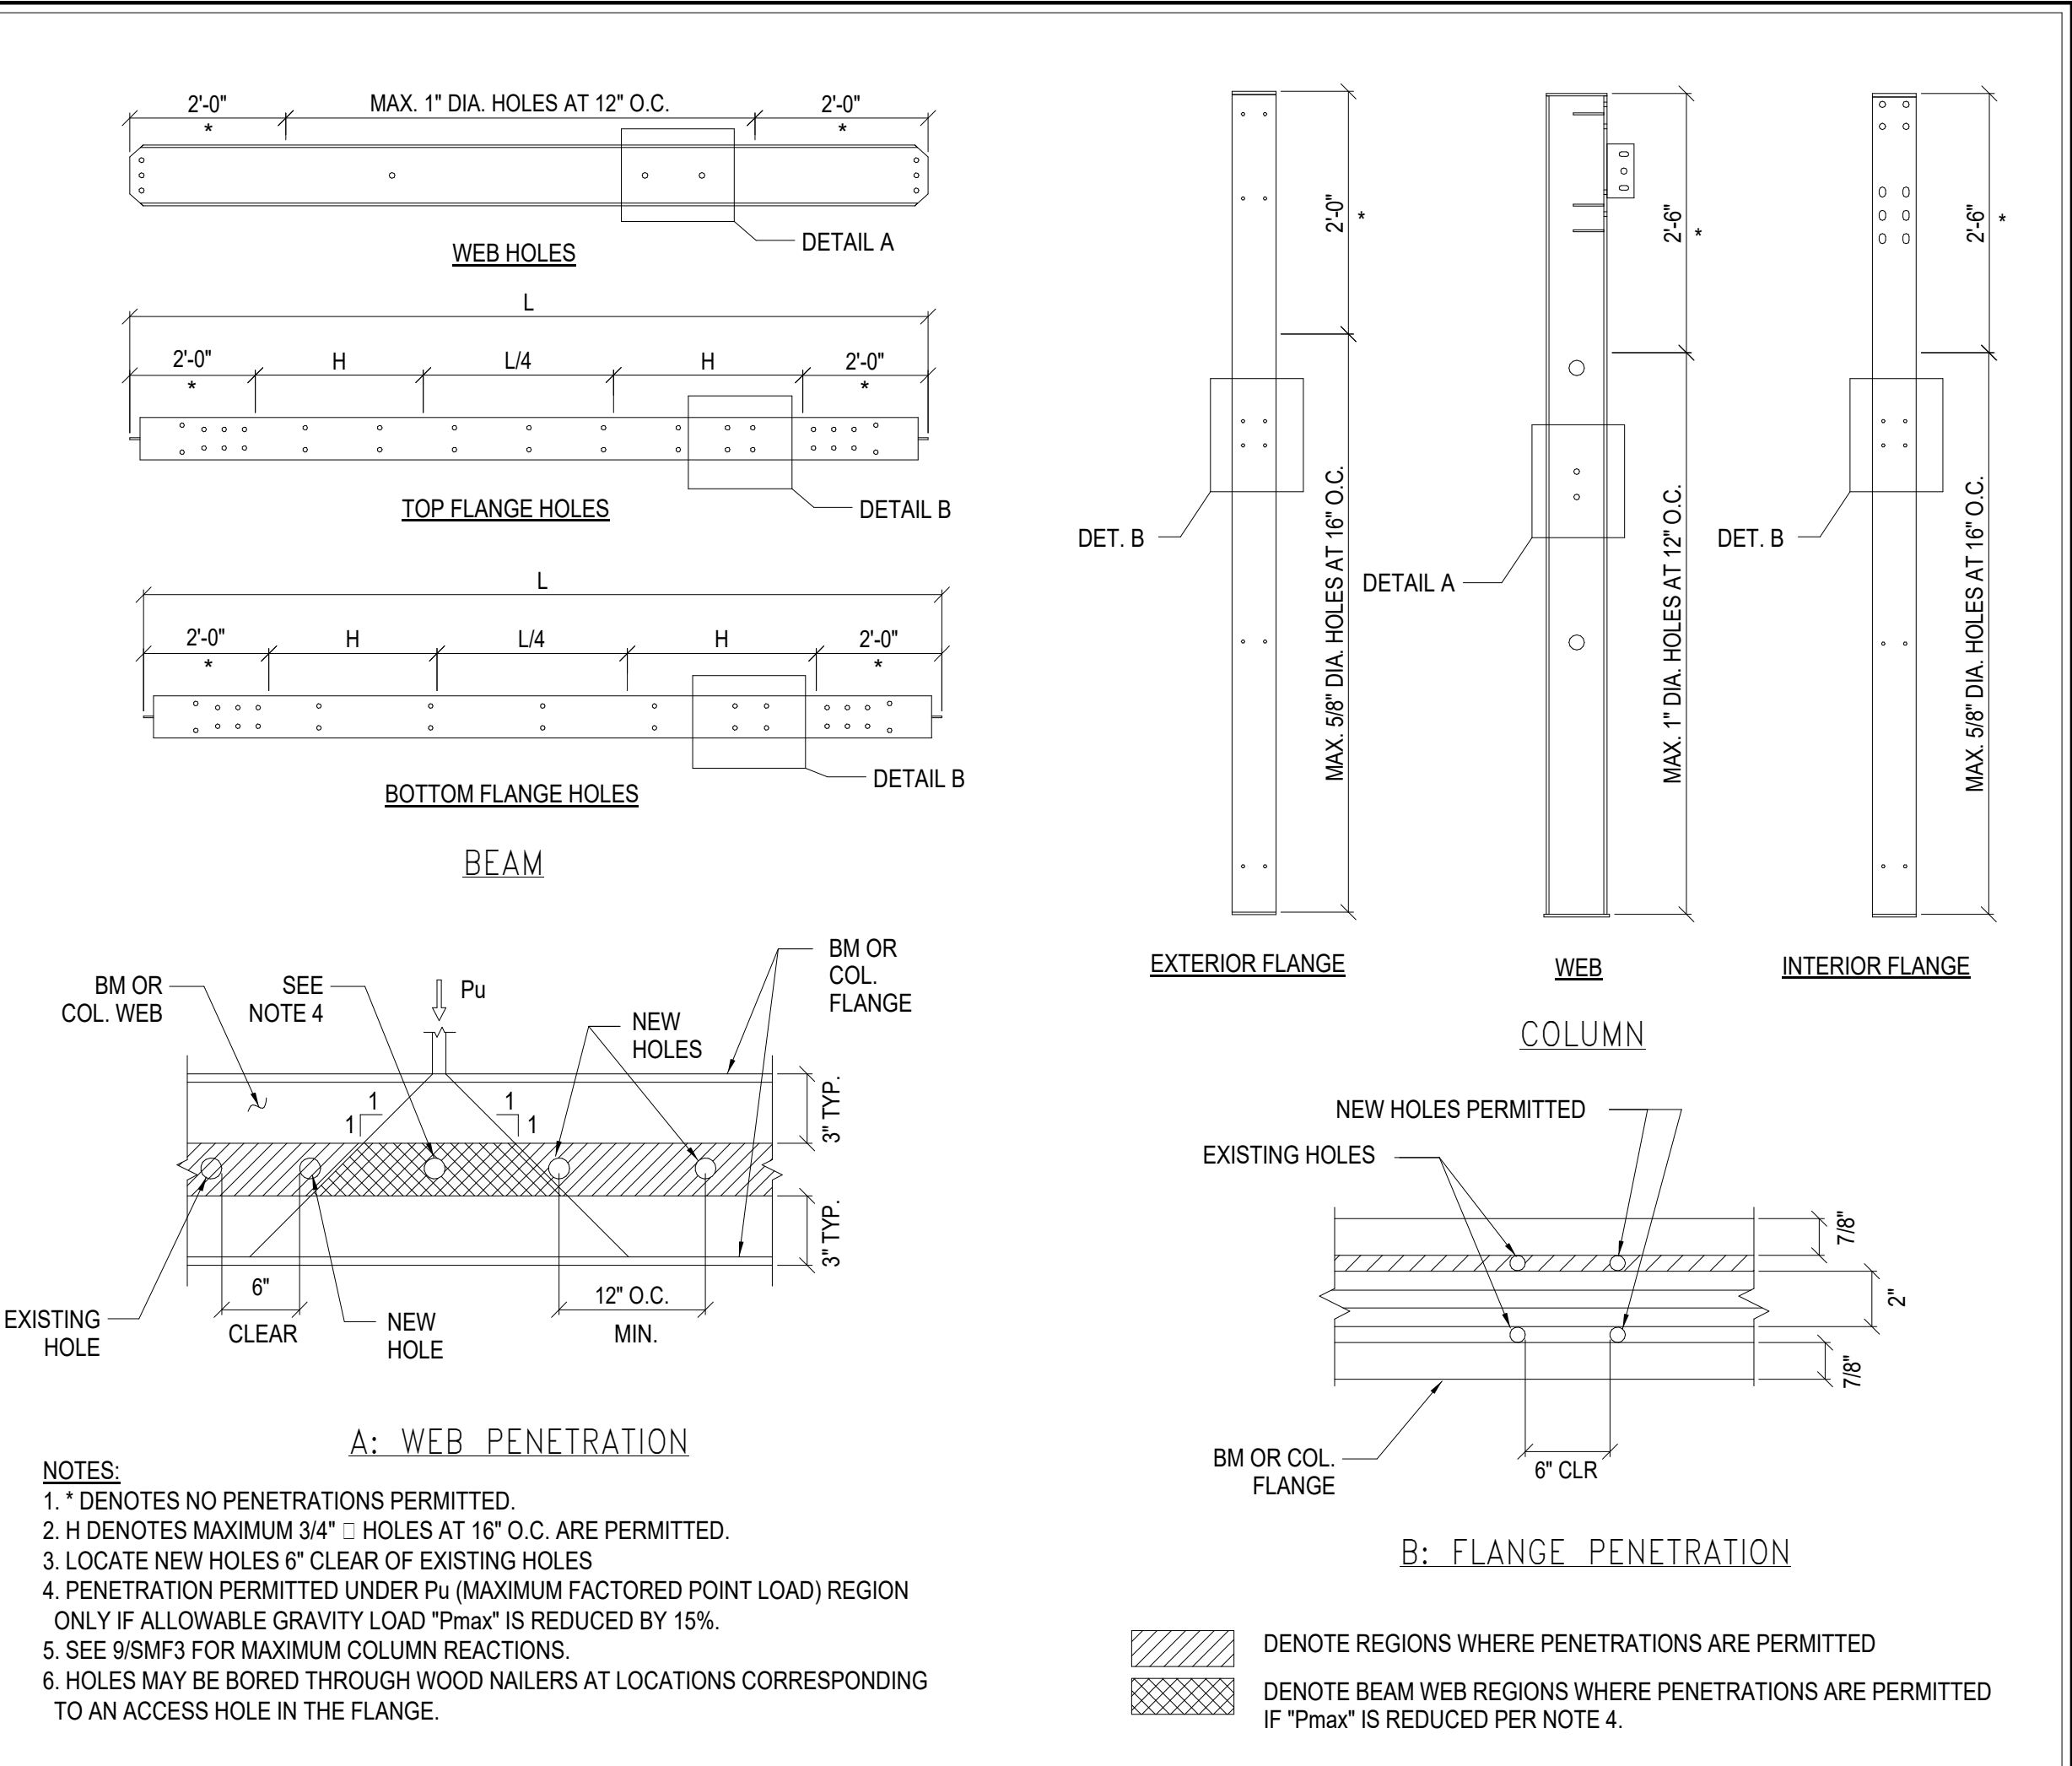


**ALLOWABLE BEAM AND COLUMN PENETRATIONS** 12

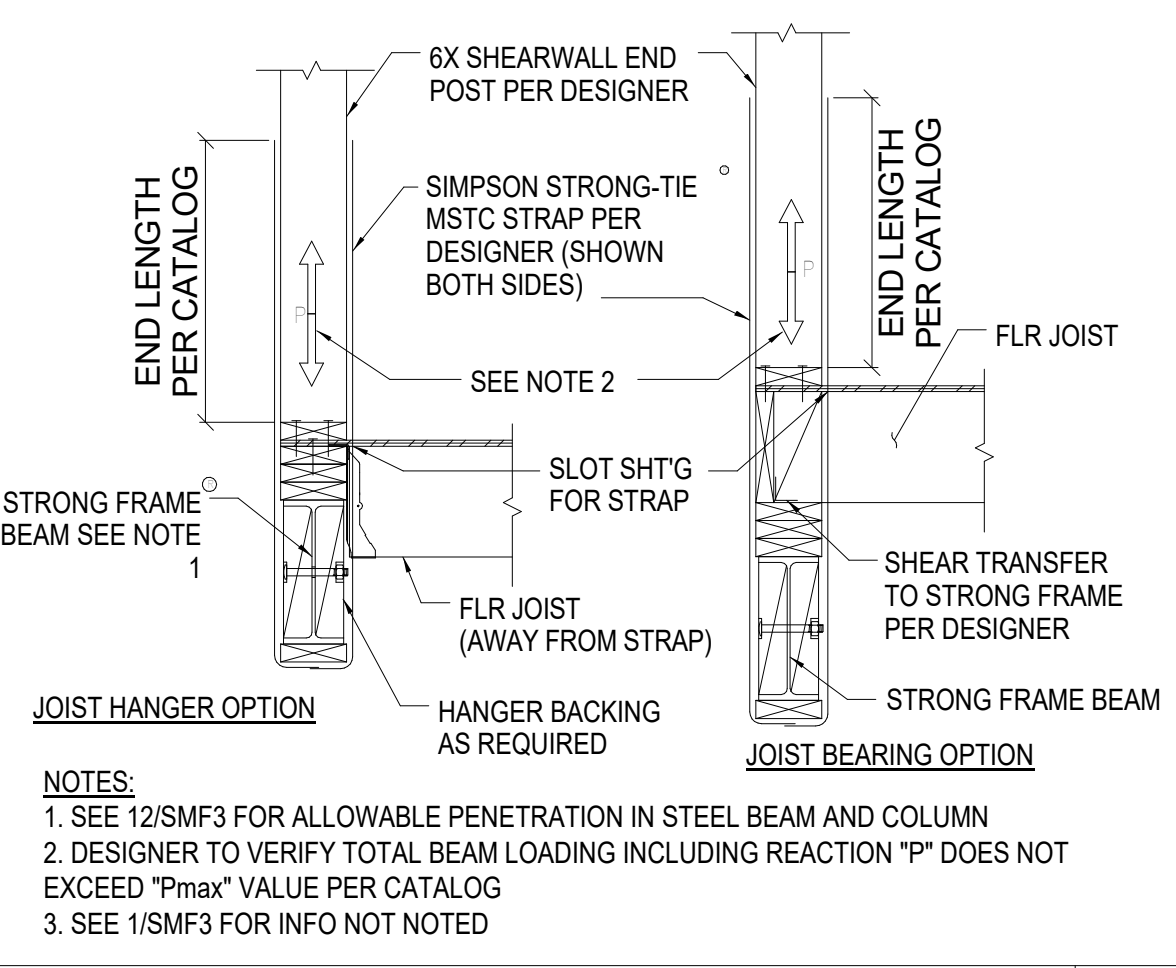


**6x HOLDOWN POST TO SMF BEAM** 2

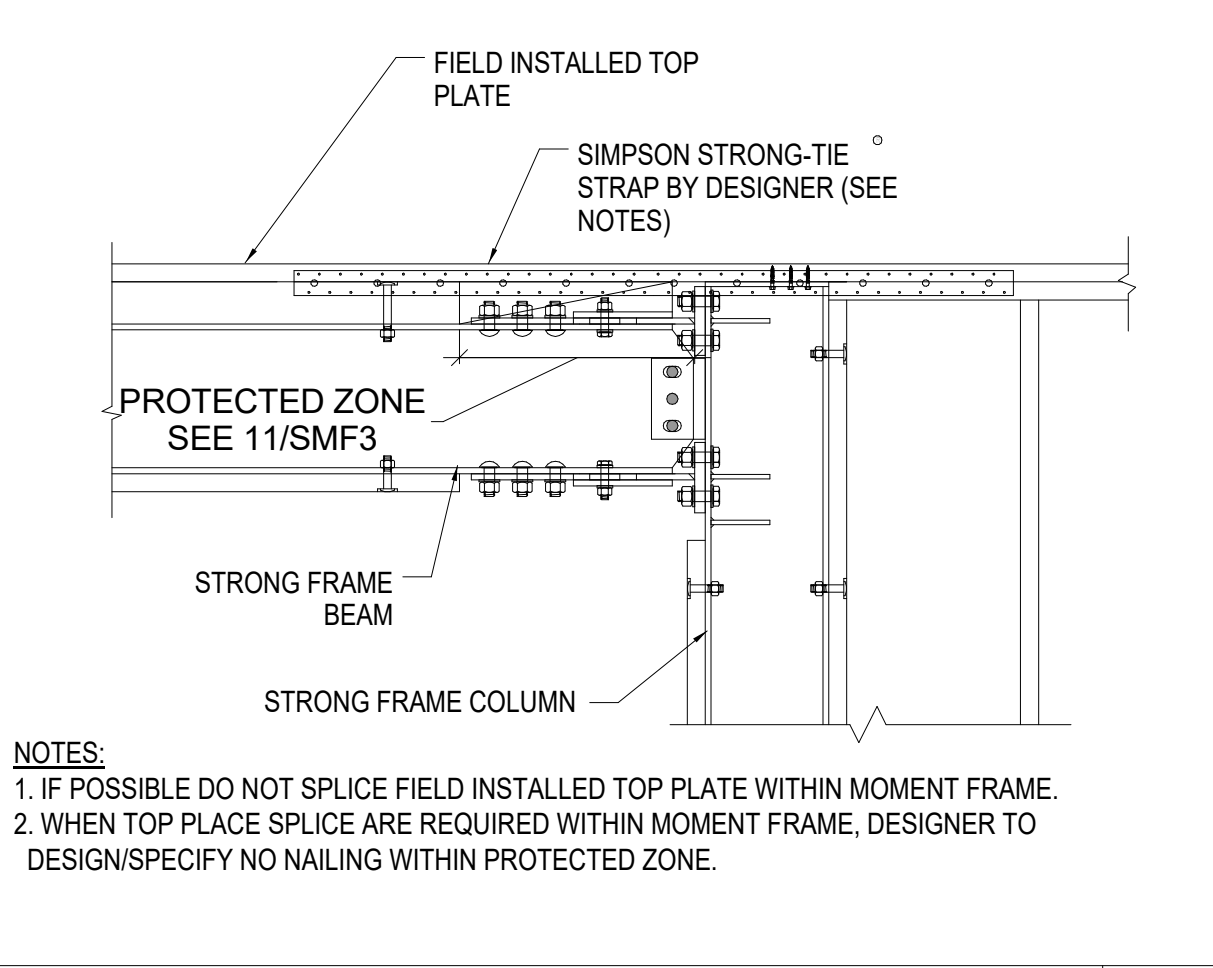


**TOP PLATE SPLICE DETAIL** 6

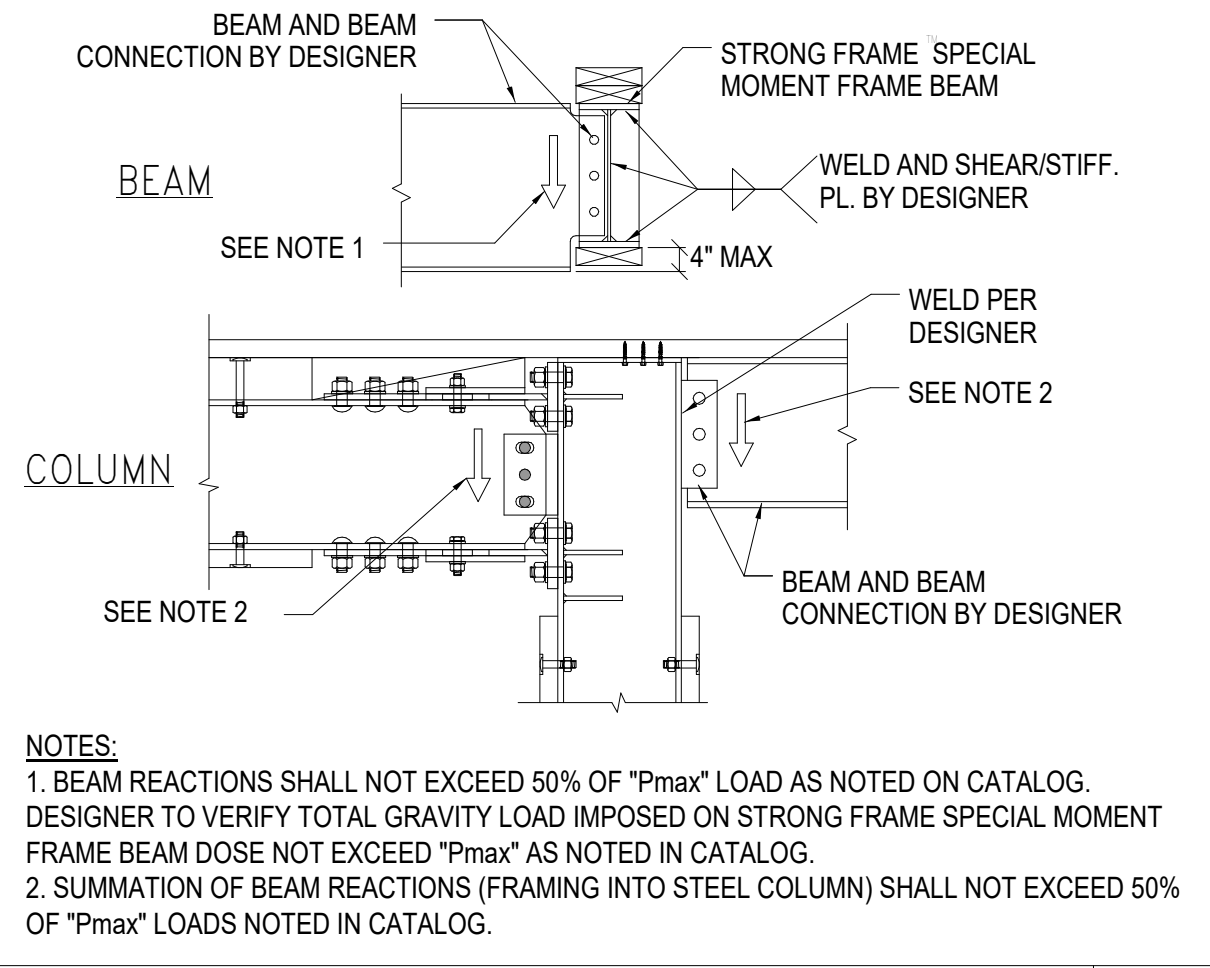


**STEEL BEAM TO SMF BEAM/COL.** 9

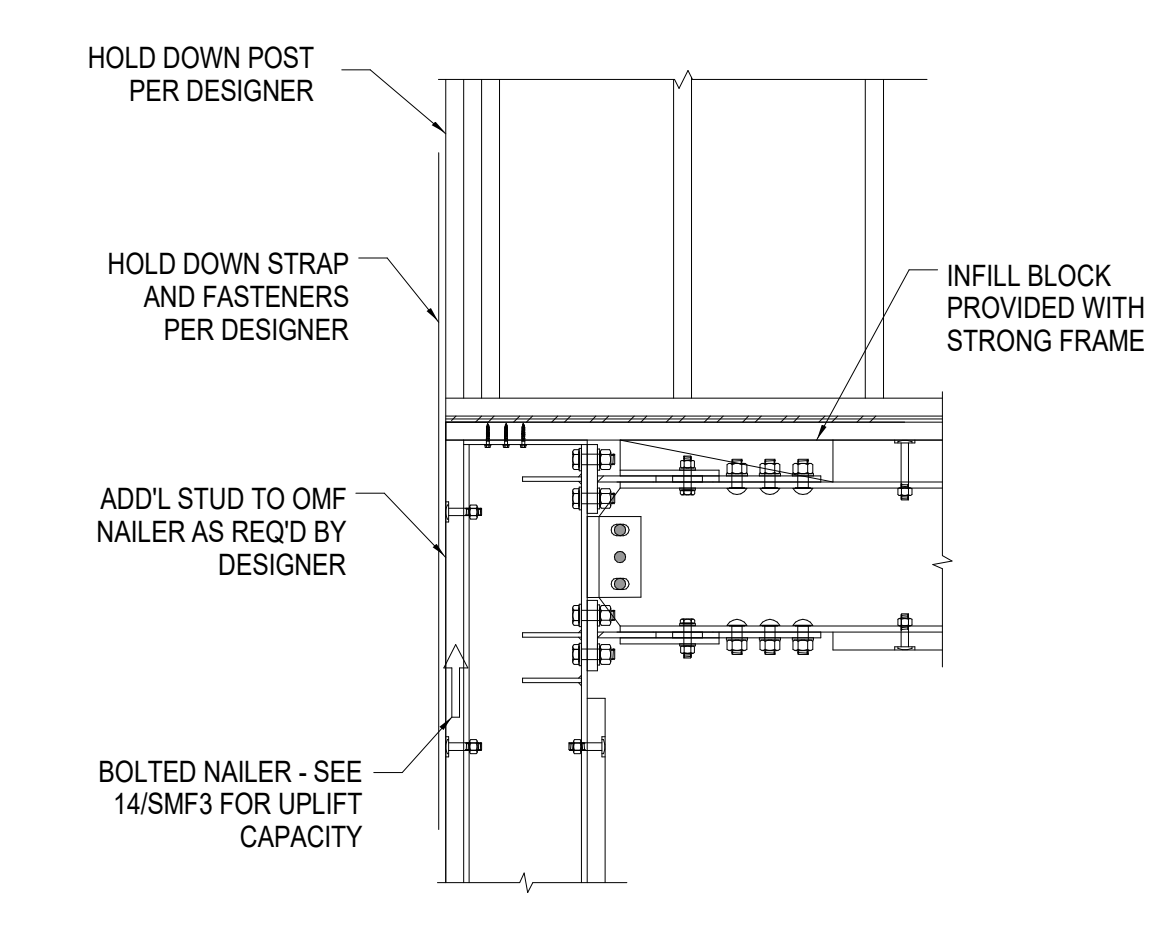


**HOLDOWN POST TO SMF COL.** 3

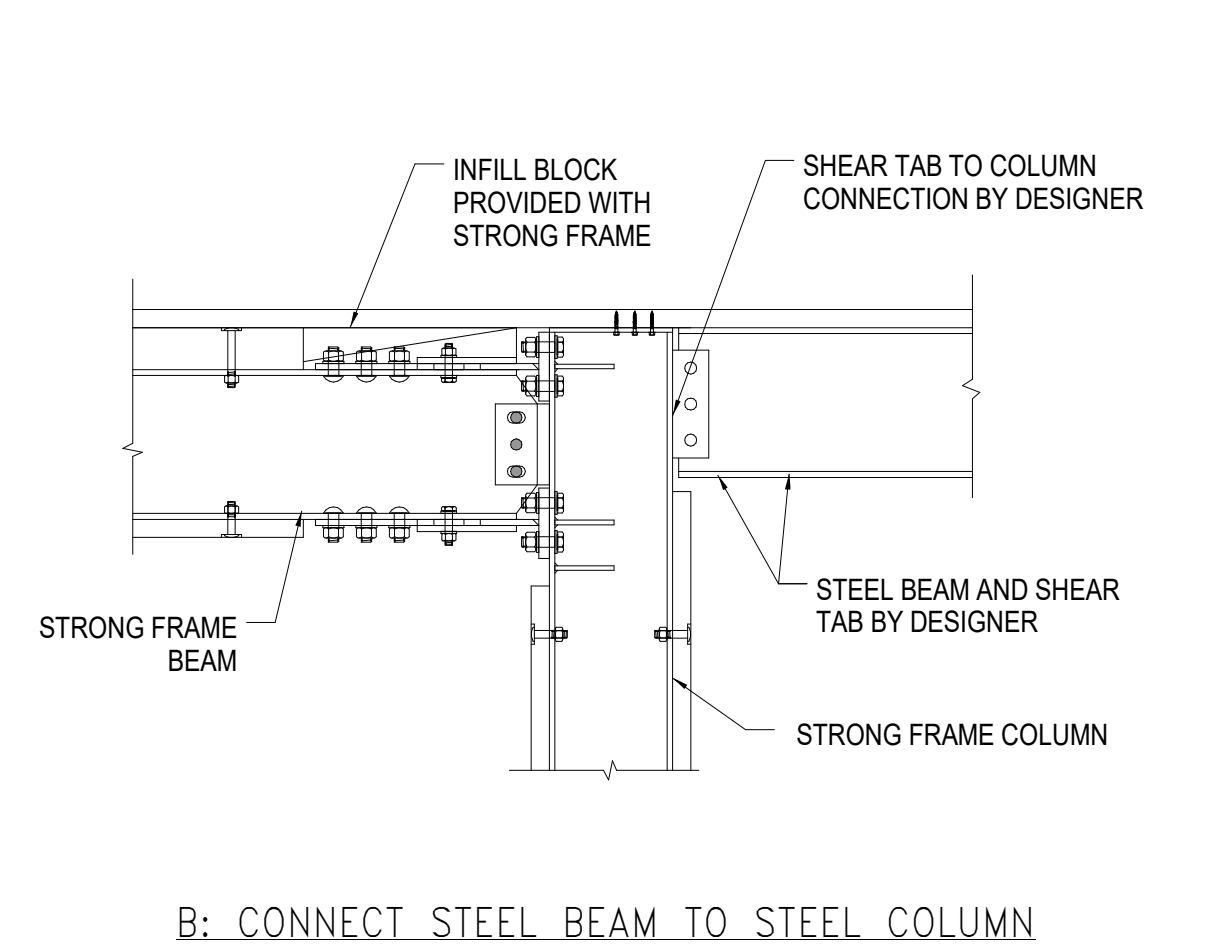


**B: CONNECT STEEL BEAM TO STEEL COLUMN**

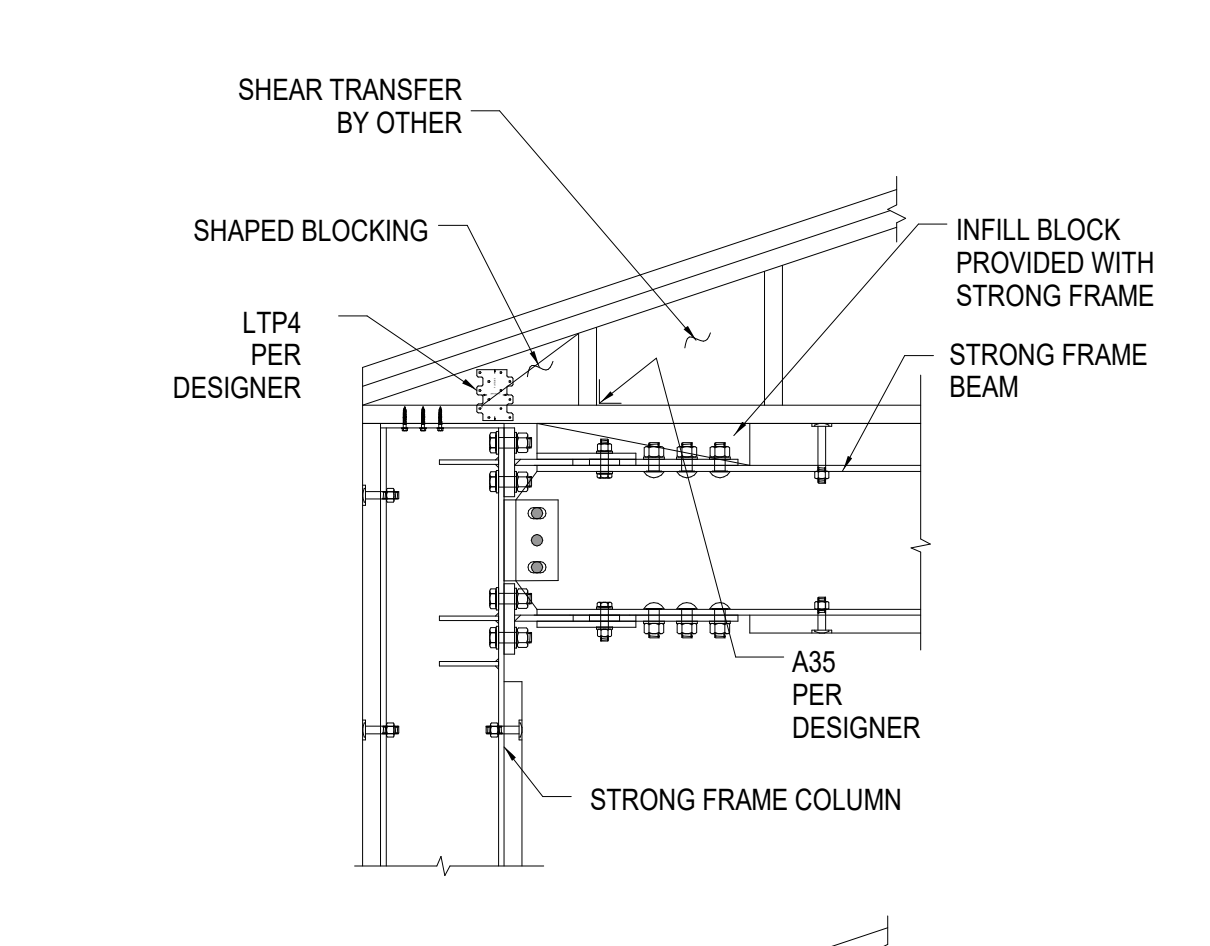


**B: CONNECT WOOD BEAM TO STEEL COLUMN**

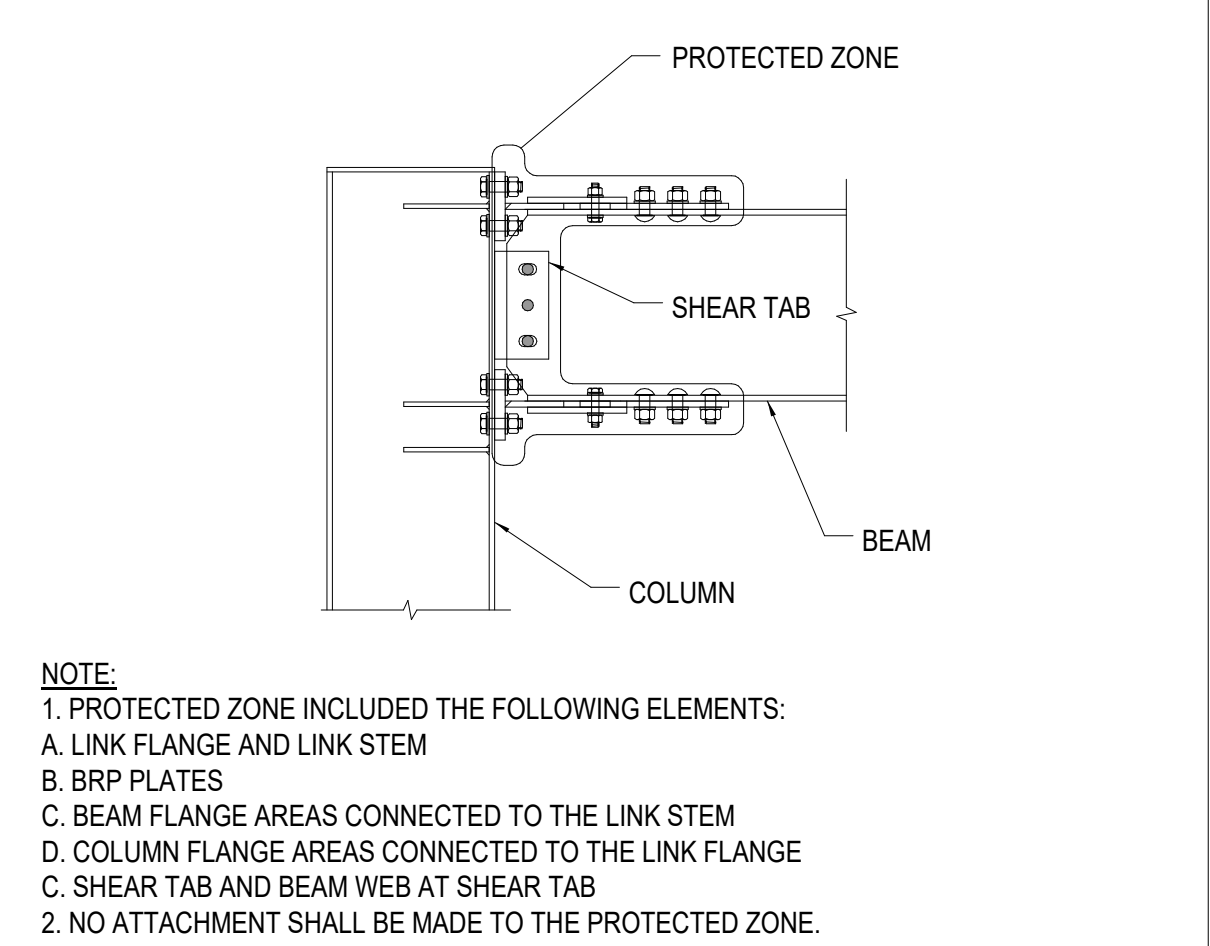


**PROTECTED ZONE** 11

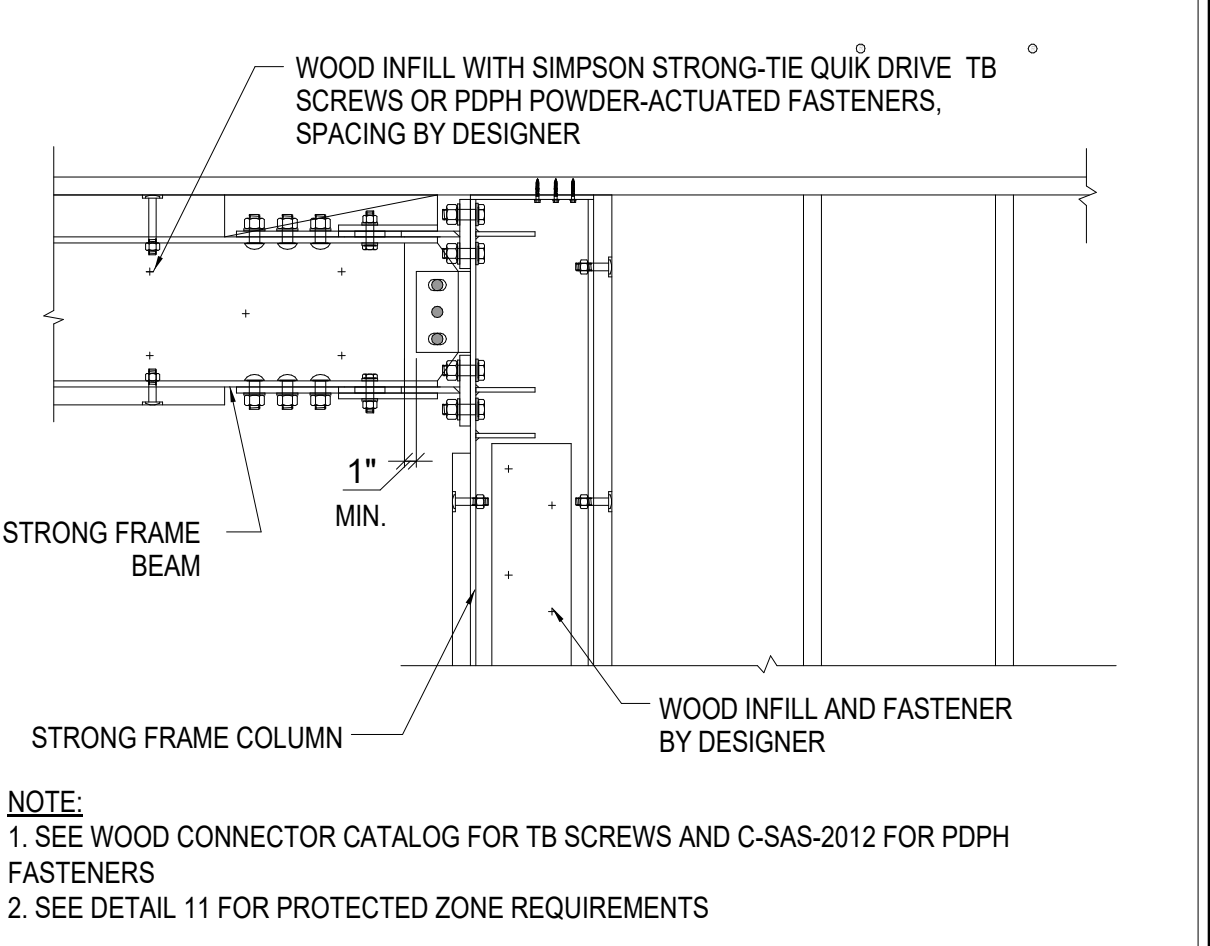


**WOOD INFILLS** 13

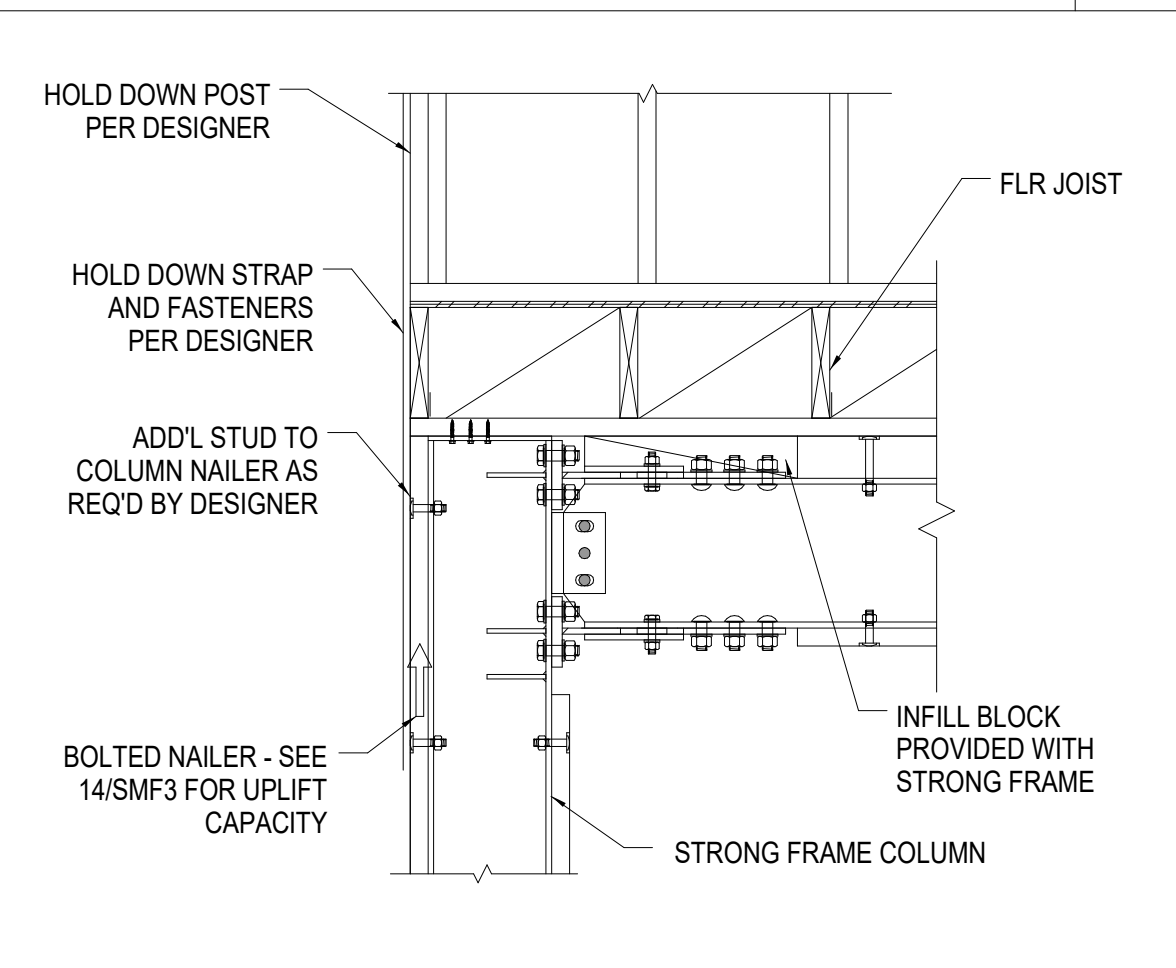


**HOLDOWN POST TO SMF COL.** 4

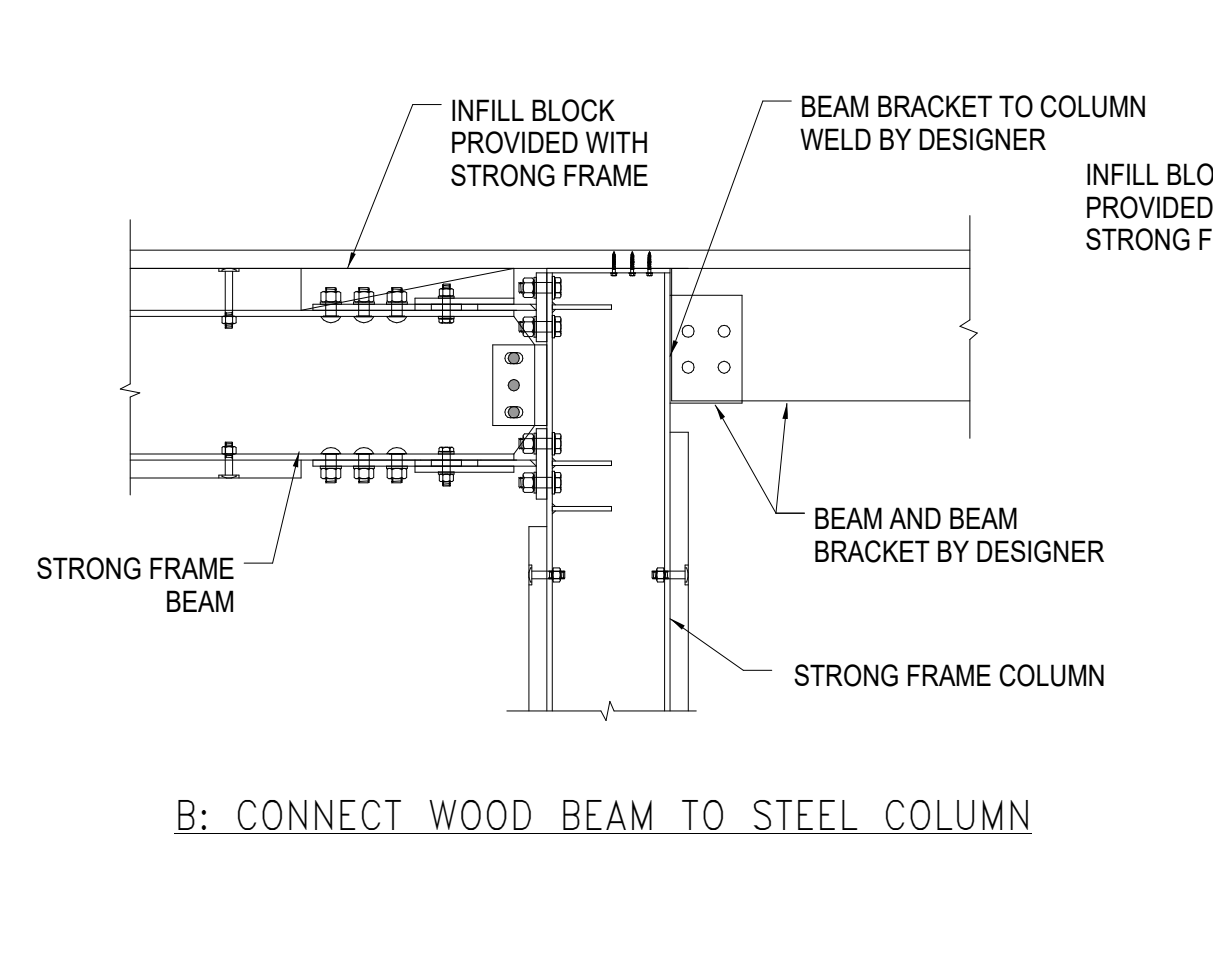


**COLLECTOR DETAILS** 7

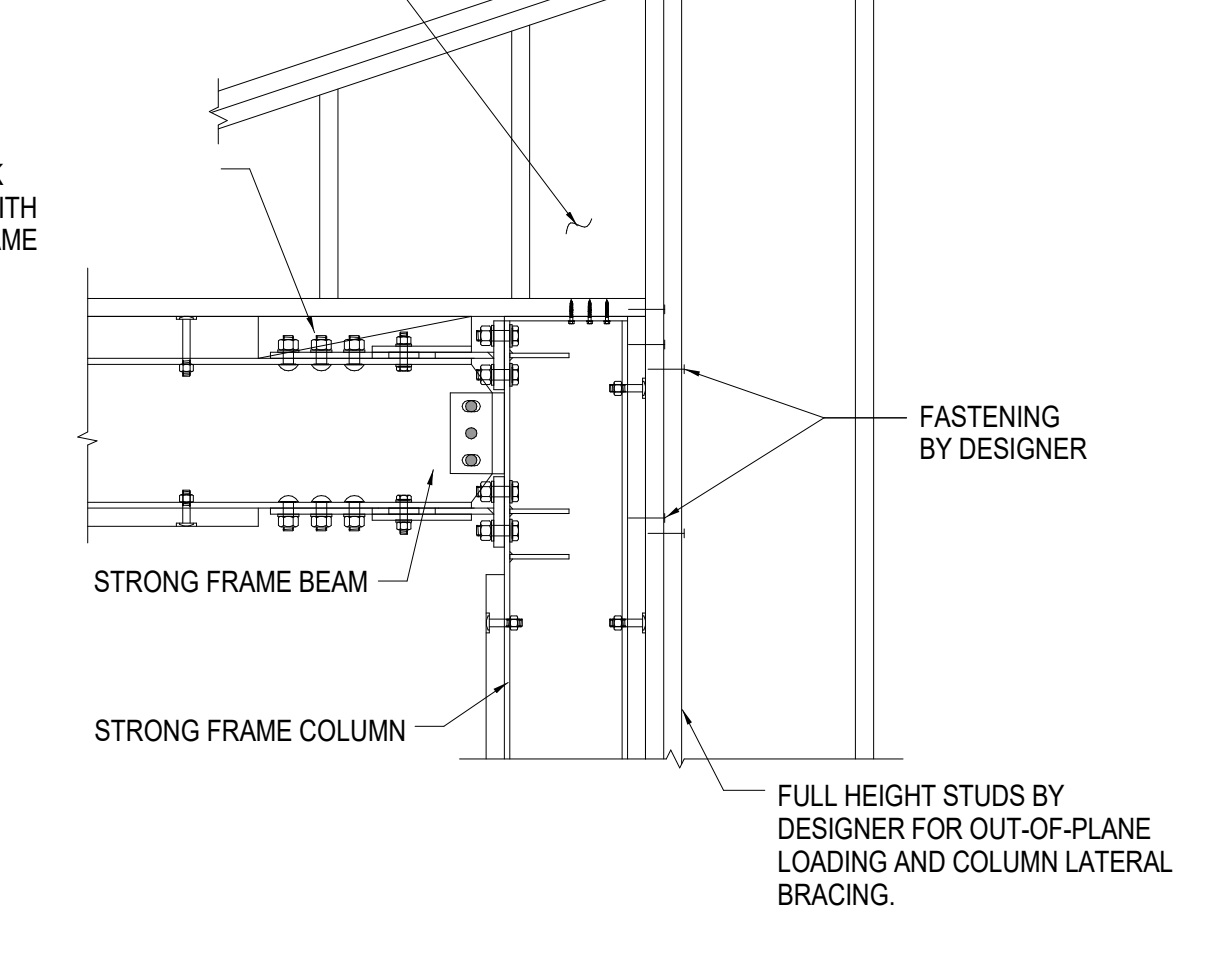

**RAKE WALL DETAILS** 10

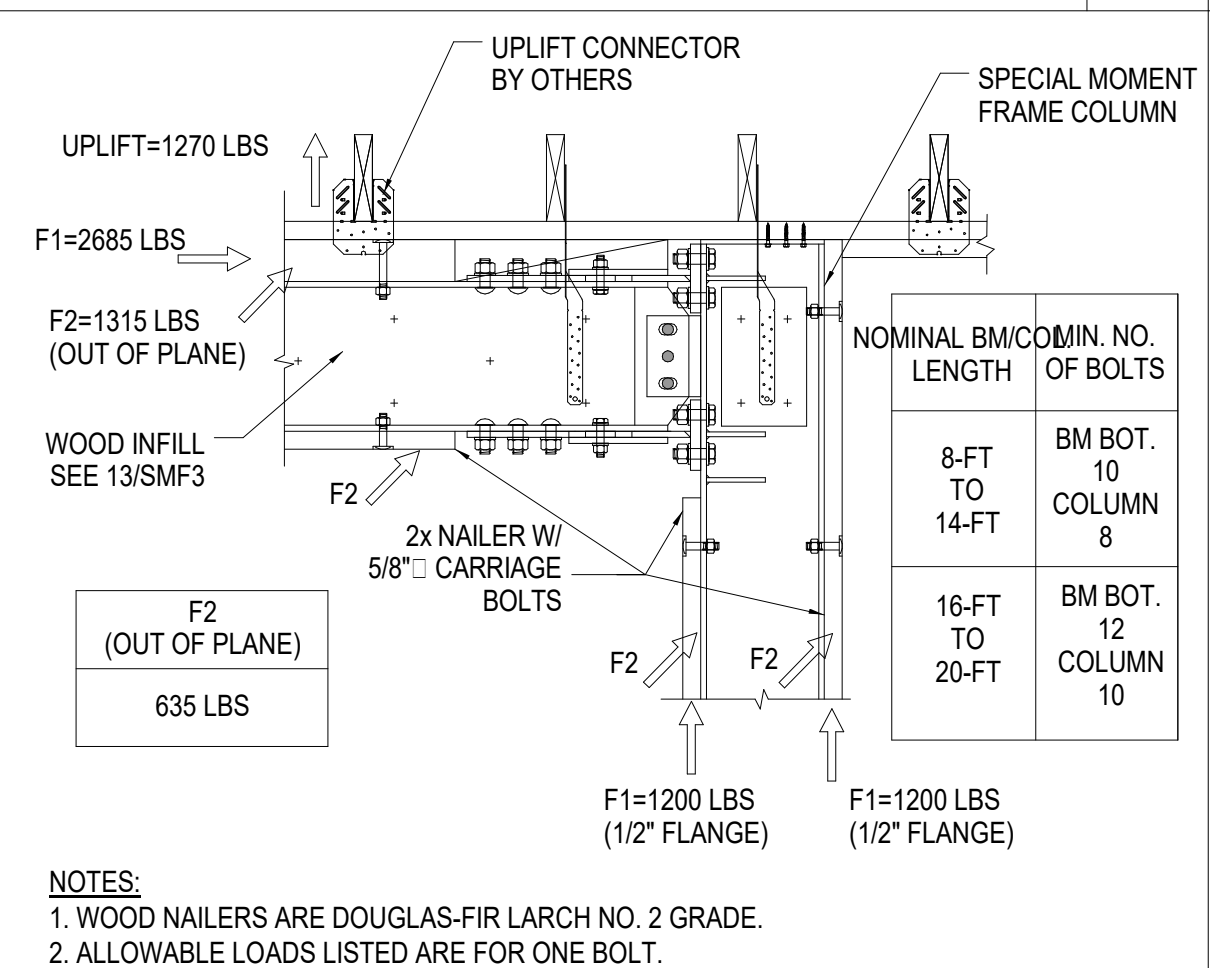


**NAILER BOLT ALLOWABLE LOADS** 14

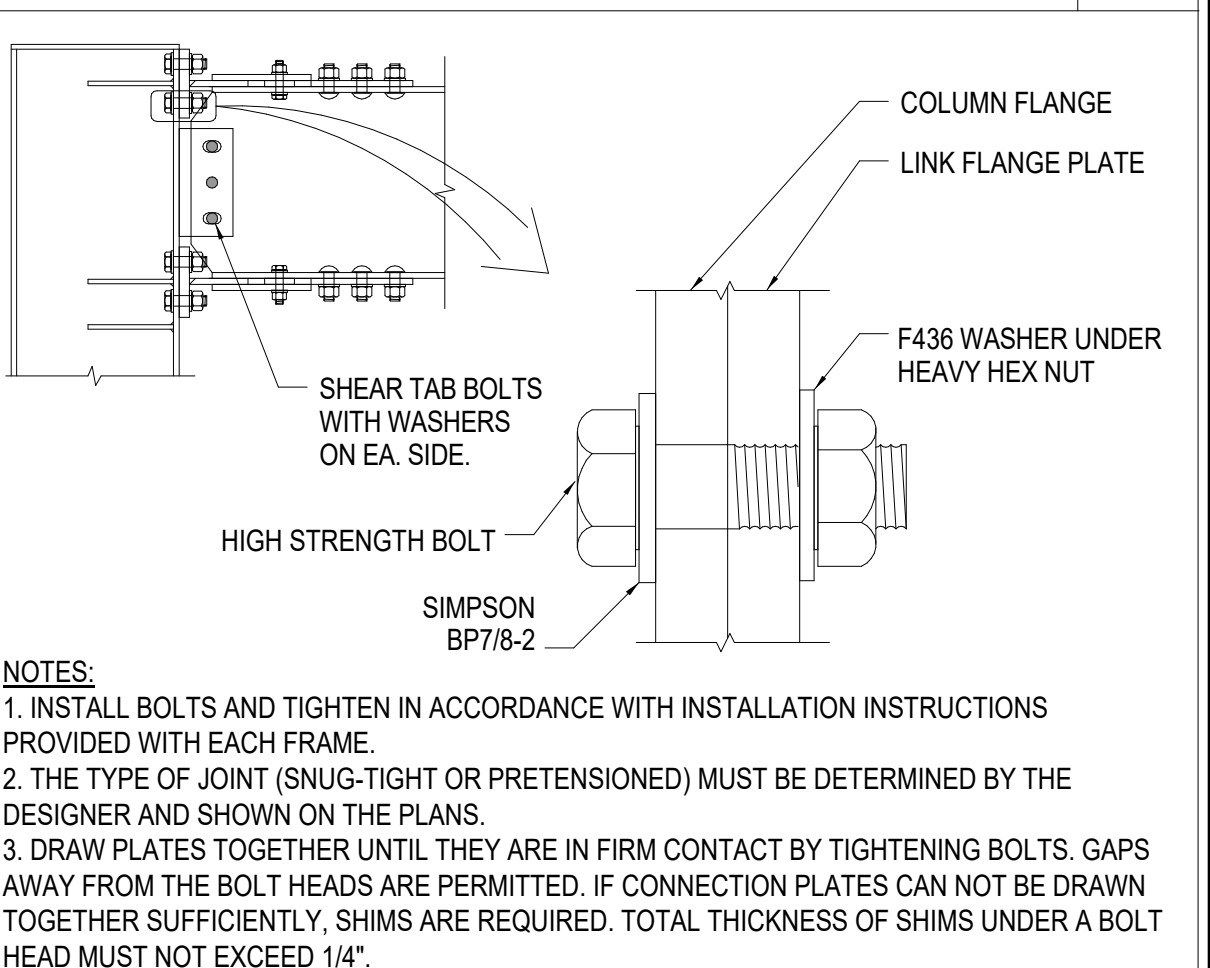

**BEAM-TO-COLUMN CONNECTION** 15

6/14/2022 4:16:52 PM C:\Users\jacob\OneDrive\Documents\STRUCT121162\Paper\_References\_Address\RS191.dwg

**CT ENGINEERING INC.**  
 Structural Engineers  
 180 Nickerson Street, Suite 302, Seattle, WA 98109  
 206.285.4572 (V) 206.285.0618 (F)  
 www.ctengineering.com

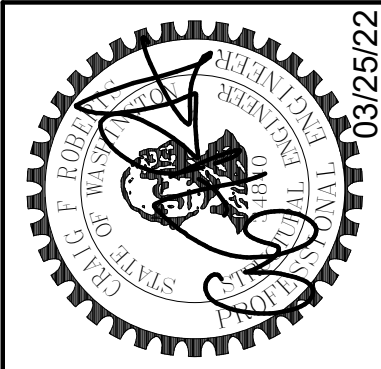

DATE	
REVISION	
No.	





JOB #:	21162	DESIGNER	
ENG:		AUTHOR	
CAD:		SCALE:	As indicated
KEY ISSUE DATES:		SD	
		CD	
		PD	
		PERMIT:	03/25/2022
		OTHER:	BD




**Moment Frame Details**  
 PIPER REMODEL  
 8429 SE 33RD PLACE  
 MERCER ISLAND, WA 98040

**S8.2**



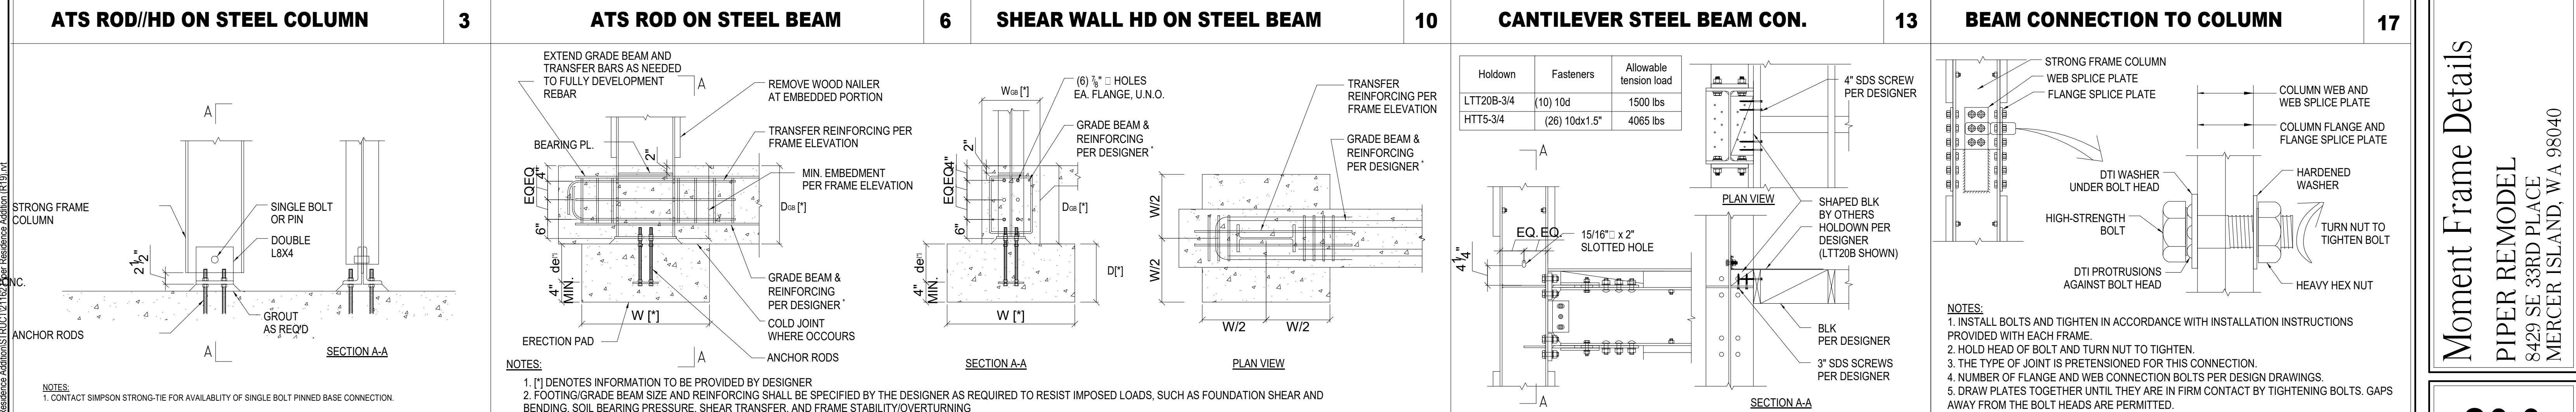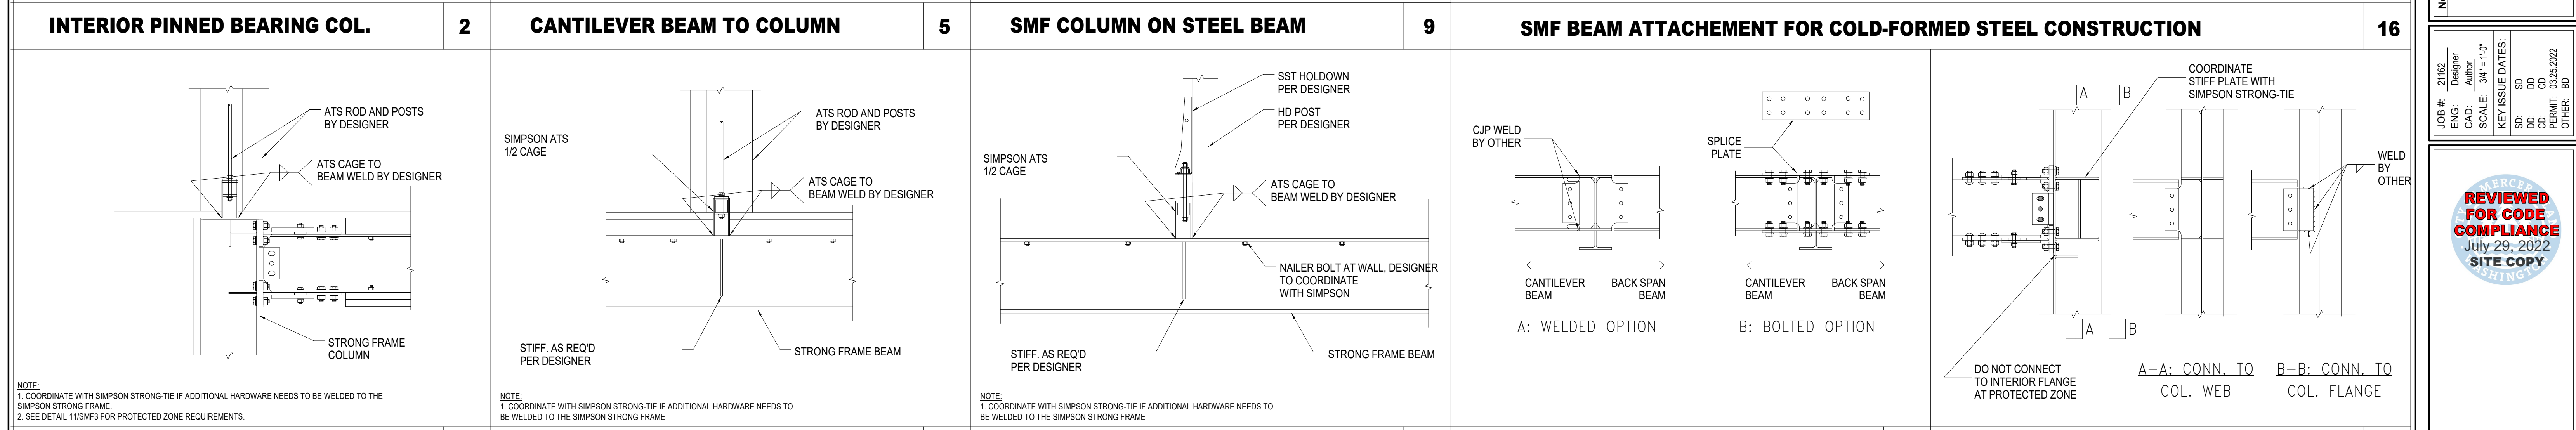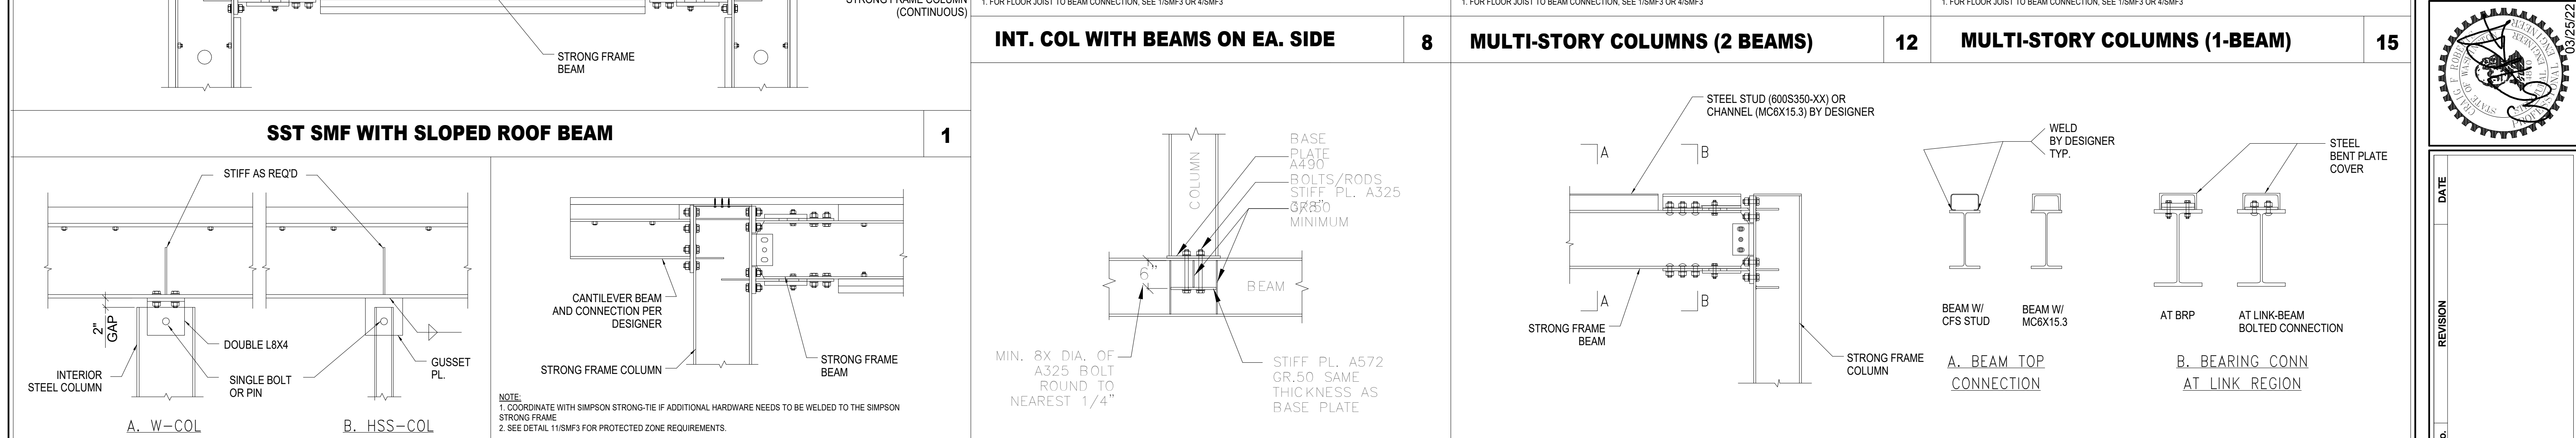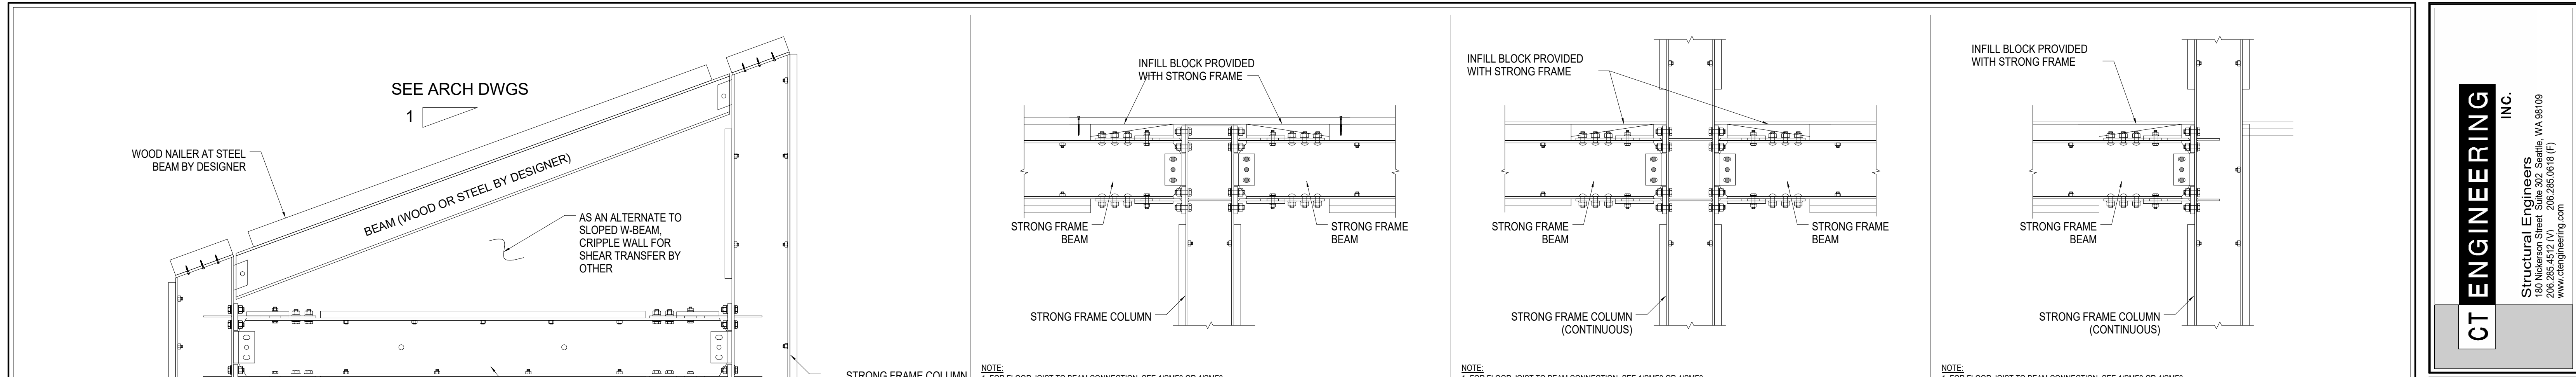

<b>SST SMF WITH SLOPED ROOF BEAM</b>	<b>1</b>	<b>INT. COL WITH BEAMS ON EA. SIDE</b>	<b>8</b>	<b>MULTI-STORY COLUMNS (2 BEAMS)</b>	<b>12</b>	<b>MULTI-STORY COLUMNS (1-BEAM)</b>	<b>15</b>
<b>INTERIOR PINNED BEARING COL.</b>	<b>2</b>	<b>CANTILEVER BEAM TO COLUMN</b>	<b>5</b>	<b>SMF COLUMN ON STEEL BEAM</b>	<b>9</b>	<b>SMF BEAM ATTACHMENT FOR COLD-FORMED STEEL CONSTRUCTION</b>	<b>16</b>
<b>ATS ROD//HD ON STEEL COLUMN</b>	<b>3</b>	<b>ATS ROD ON STEEL BEAM</b>	<b>6</b>	<b>SHEAR WALL HD ON STEEL BEAM</b>	<b>10</b>	<b>CANTILEVER STEEL BEAM CON.</b>	<b>13</b>
<b>SINGLE BOLT PINNED BASE DETAIL</b>	<b>4</b>	<b>FIXED BASE CONNECTION</b>	<b>11</b>	<b>COL. BRACING AT FLOOR LEVEL</b>	<b>14</b>	<b>BOLTED COLUMN SPLICE</b>	<b>18</b>

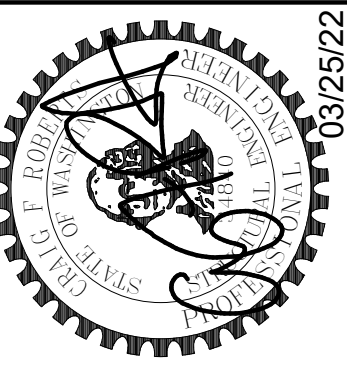


NO.	REVISION	DATE

JOB #: 21162  
ENG: Designer  
CAD: Author  
SCALE: 3/4" = 1'-0"  
KEY ISSUE DATES:  
DATE: 03/25/2022  
BY: CD  
CHECKED BY: CD  
PERMIT: 03/25/2022  
OTHER: BD




6/14/2022 4:16:53 PM  
 C:\Users\jctaylor\AppData\Local\Temp\Residence Address\RES191.dwg




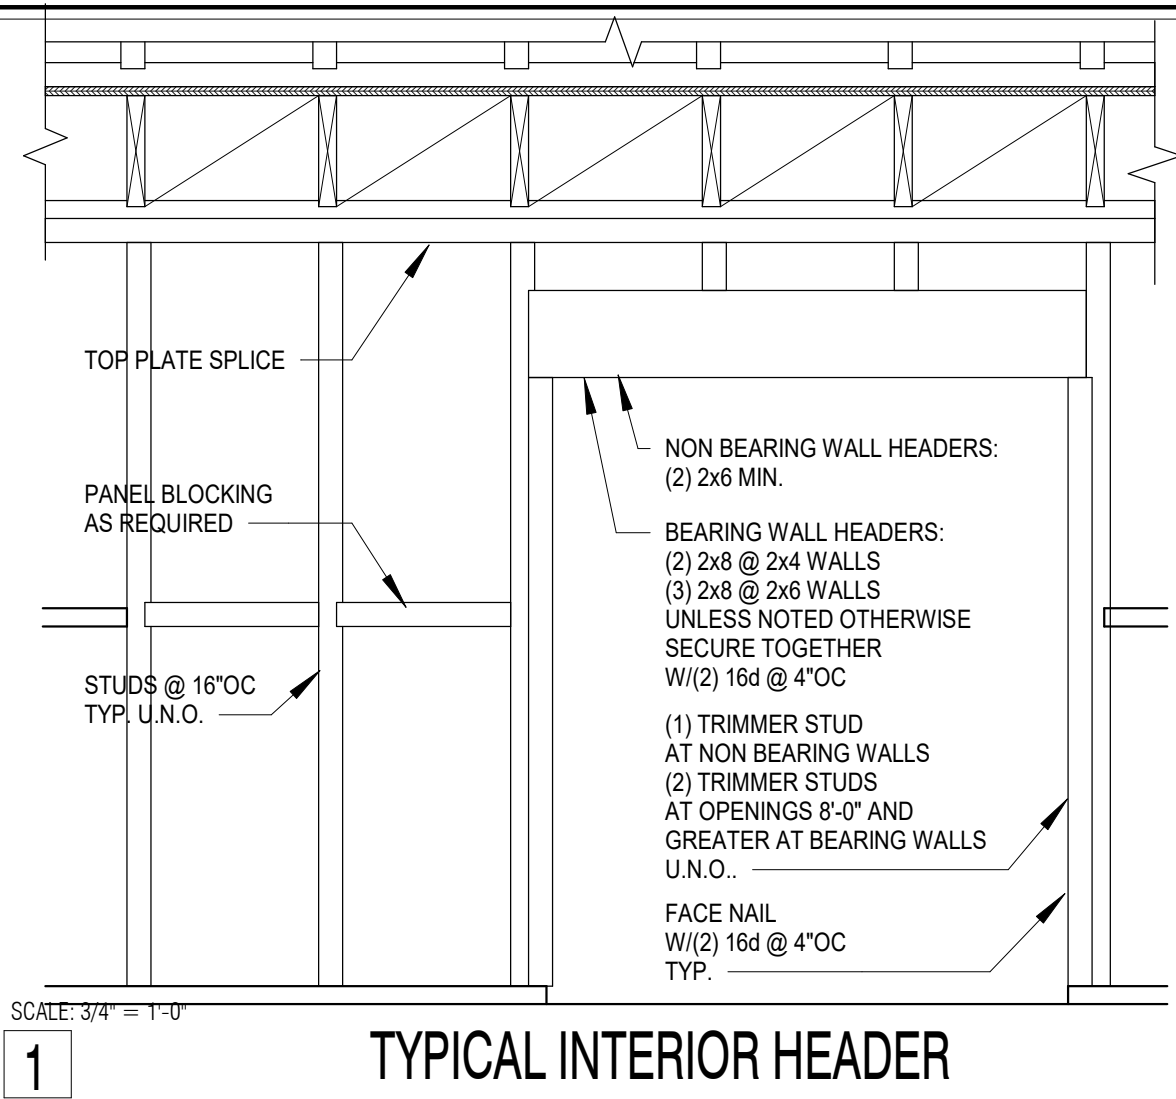


1 TYPICAL INTERIOR HEADER

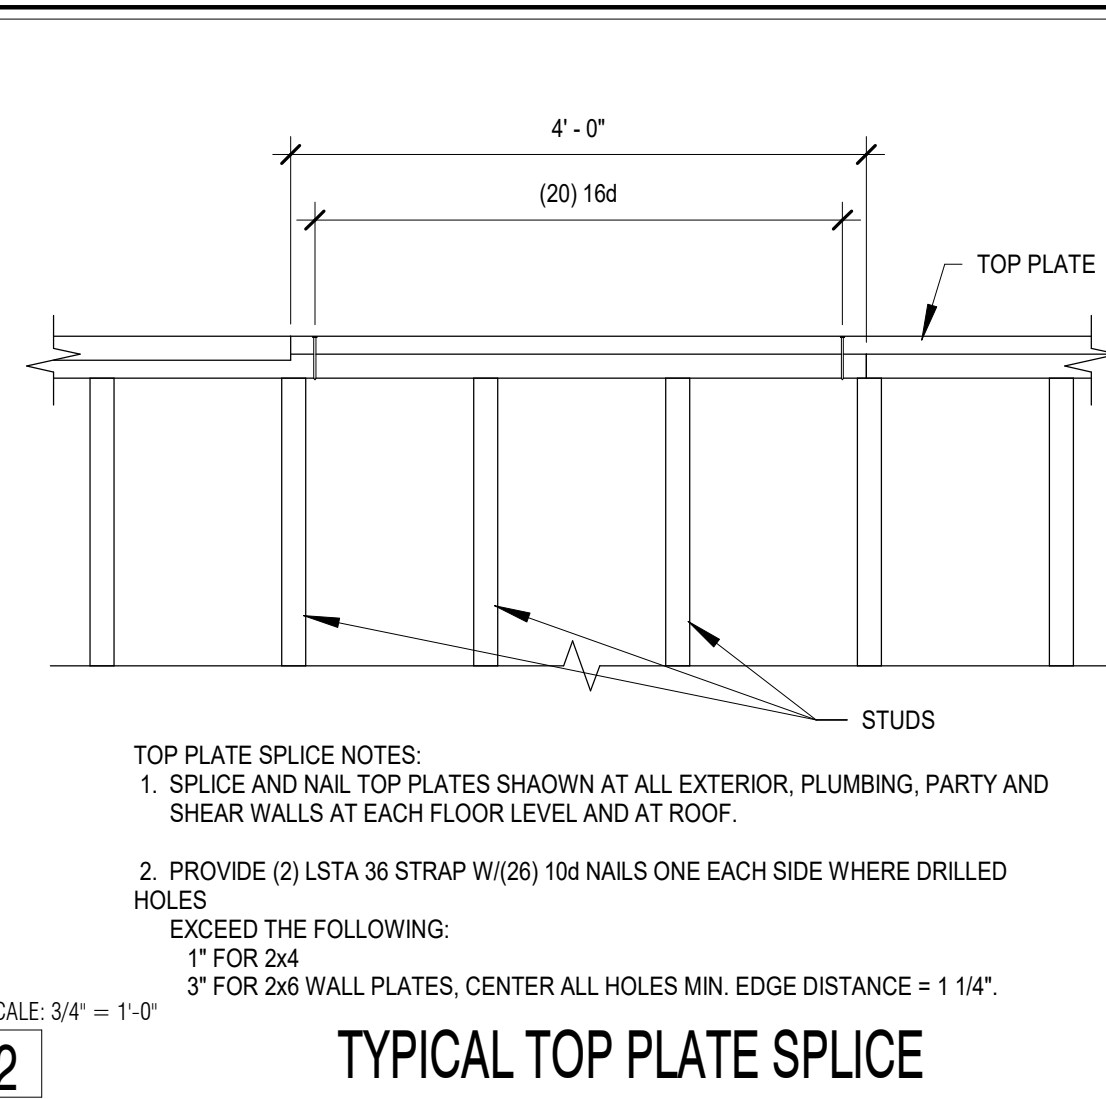

2 TYPICAL TOP PLATE SPLICE

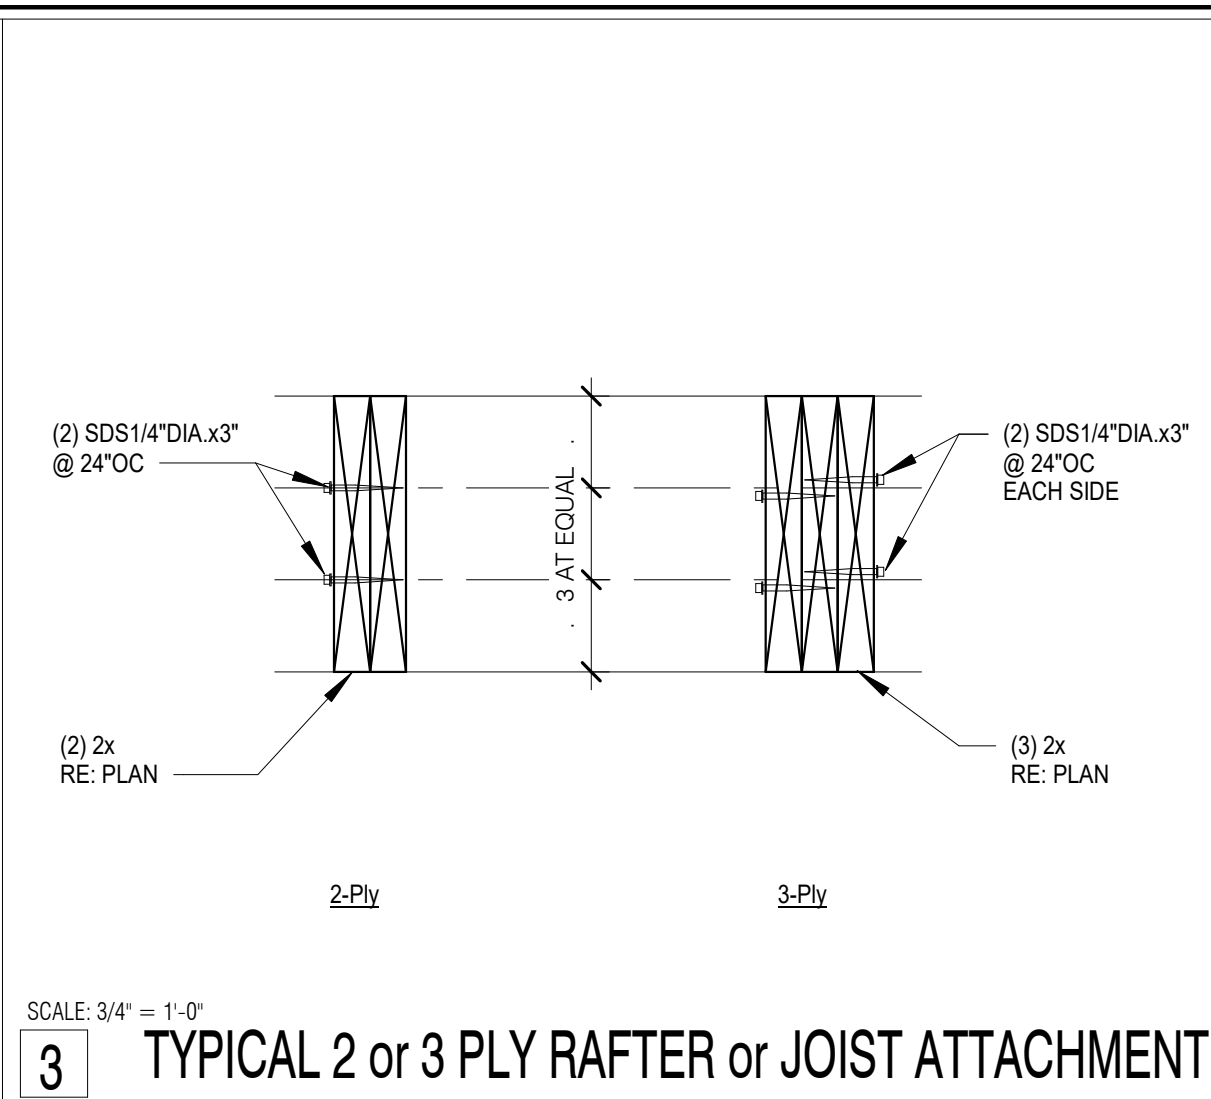


3 TYPICAL 2 or 3 PLY RAFTER or JOIST ATTACHMENT

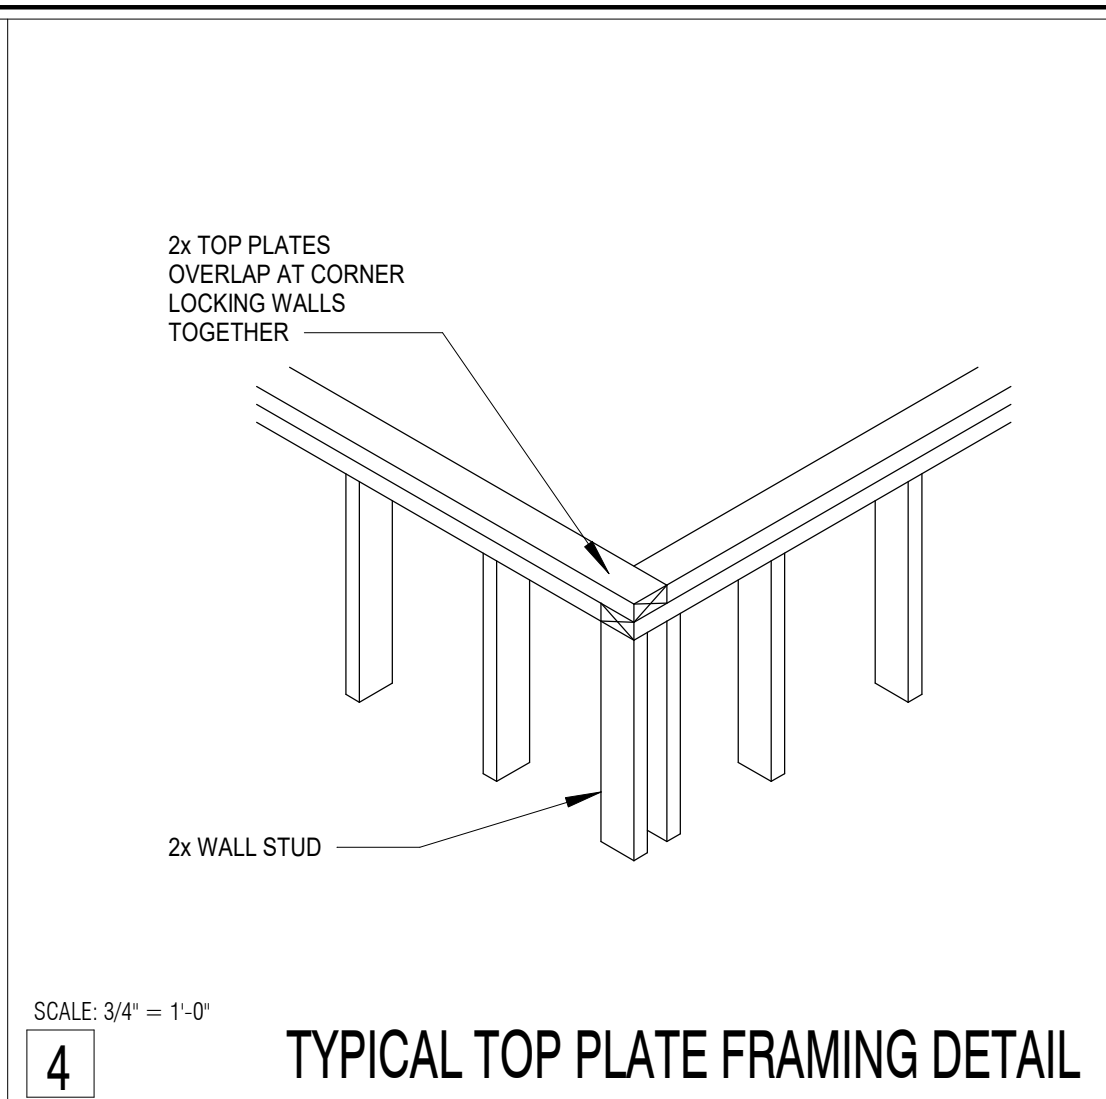


4 TYPICAL TOP PLATE FRAMING DETAIL


IBC 2015 TABLE 2304.10.1 FASTENING SCHEDULE			
CONNECTION	FASTENING (a)	LOCATION	
<b>ROOF</b>			
1. BLOCKING BETWEEN CEILING JOISTS/RAFTERS OR TRUSSES TO TOP PLATE OR OTHER FRAMING BELOW	(3) 8d COMMON (2 1/2" X 0.131"); OR (3) 3" X 0.131" NAILS	EACH END, TOENAIL	
BLOCKING BETWEEN RAFTERS OR TRUSSES NOT AT THE WALL TOP PLATE, TO RAFTER OR TRUSS	(2) 8d COMMON (2 1/2" X 0.131")	EACH END, TOENAIL	
BLOCKING BETWEEN RAFTERS OR TRUSSES NOT AT THE WALL TOP PLATE, TO RAFTER OR TRUSS	(2) 16d COMMON (3 1/2" X 0.162") (3) 3" X 0.131" NAILS	EACH END	
FLAT BLOCKING TO TRUSS AND WEB FILLER	16d COMMON (3 1/2" X 0.161") AT 6"OC...	FACE NAIL	
2. CEILING JOISTS TO TOP PLATE	(3) 8d COMMON (3 1/2" X 0.131"); OR (4) 3" X 0.131" NAILS	EACH JOIST, TOENAIL	
3. CEILING JOIST NOT ATTACHED TO PARALLEL RAFTER, LAPS OVER PARTITIONS (NO THRUST) (SEE SECTION 2308.7.3.1, TABLE 2308.7.3.1)	(3) 16d COMMON (3 1/2" X 0.162"); OR FACE NAIL (4) 3" X 0.131" NAILS	FACE NAIL	
4. CEILING JOIST ATTACHED TO PARALLEL RAFTER (HEEL JOINT) (SEE SECTION 2308.7.3.1, TABLE 2308.7.3.1)	PER TABLE 2308.7.3.1	FACE NAIL	
5. COLLAR TIE TO RAFTER	(3) 10d COMMON (3" X 0.148"); OR (4) 3" X 0.131" NAILS	FACE NAIL	
6. RAFTER OR ROOF TRUSS TO TOP PLATE (SEE SECTION 2308.7.5, TABLE 2308.7.5)	(3) 10d COMMON (3" X 0.148"); OR (4) 3" X 0.131" NAILS	TOENAIL	
7. ROOF RAFTERS TO RIDGE VALLEY OR HIP RAFTERS; OR ROOF RAFTER TO 2-INCH RIDGE BEAM	(2) 16d COMMON (3 1/2" X 0.162"); OR (3) 3" X 0.131" NAILS	END NAIL	
<b>WALL</b>			
8. STUD TO STUD (NOT AT BRACED WALL PANELS)	16d COMMON (3 1/2" X 0.162"); 3" X 0.131" NAILS	24"OC FACE NAIL 16"OC FACE NAIL	
9. STUD TO STUD AND ABUTTING STUDS AT INTERSECTING WALL CORNERS (AT BRACED WALL PANELS)	16d COMMON (3 1/2" X 0.162"); OR 3" X 0.131" NAILS	16"OC FACE NAIL 12"OC FACE NAIL	
10. BUILT-UP HEADER (2" TO 2" HEADER)	16d COMMON (3 1/2" X 0.162")	16"OC EACH EDGE, FACE NAIL	
11. CONTINUOUS HEADER TO STUD	(4) 8d COMMON (2 1/2" X 0.131")	TOENAIL	
12. TOP PLATE TO TOP PLATE	16d COMMON (3 1/2" X 0.162") OR 3" X 0.131" NAILS	16"OC FACE NAIL 12"OC FACE NAIL	
13. TOP PLATE TO TOP PLATE, AT END JOINTS	(8) 16d COMMON (3 1/2" X 0.162") OR (12) 3" X 0.131" NAILS	EACH SIDE OF END JOINT, FACE NAIL (MINIMUM 24" LAP SPLICE LENGTH EACH SIDE OF END JOINT)	
14. BOTTOM PLATE TO JOIST, RIM JOIST, BAND JOIST OR BLOCKING (NOT AT BRACED WALL PANELS)	16d COMMON (3 1/2" X 0.162"); OR 3" X 0.131" NAILS	16"OC FACE NAIL 12"OC FACE NAIL	
15. BOTTOM PLATE TO JOIST, RIM JOIST, BAND JOIST OR BLOCKING AT BRACED WALL PANELS	(2) 16d COMMON (3 1/2" X 0.162"); OR (4) 3" X 0.131" NAILS	16"OC FACE NAIL	
16. STUD TO TOP OR BOTTOM PLATE	(4) 8d COMMON (2 1/2" X 0.131"); OR (3) 3" X 0.131" NAILS	TOENAIL	
STUD TO TOP OR BOTTOM PLATE	(2) 16d COMMON (3 1/2" X 0.162"); OR (3) 3" X 0.131" NAILS	END NAIL OR...	
17. TOP OR BOTTOM PLATE TO STUD	(2) 16d COMMON (3 1/2" X 0.162"); OR END NAIL (3) 3" X 0.131" NAILS	OR END NAIL	
18. TOP PLATES, LAPS AT CORNERS AND INTERSECTIONS	(2) 16d COMMON (3 1/2" X 0.162"); OR FACE NAIL (3) 3" X 0.131" NAILS	OR FACE NAIL	
19. 1" BRACE TO EACH STUD AND PLATE	(2) 8d COMMON (2 1/2" X 0.131"); OR (2) 3" X 0.131" NAILS	FACE NAIL	
20. 1" X 6" SHEATHING TO EACH BEARING	(2) 8d COMMON (2 1/2" X 0.131")	FACE NAIL	
21. 1" X 8" AND WIDER SHEATHING TO EACH BEARING	(3) 8d COMMON (2 1/2" X 0.131")	FACE NAIL	
<b>FLOOR</b>			
22. JOIST TO SILL, TOP PLATE, OR GIRDER	(3) 8d COMMON (2 1/2" X 0.131"); OR 3" X 0.131" NAILS	TOENAIL	
23. RIM JOIST, BAND JOIST, OR BLOCKING TO TOP PLATE, SILL OR OTHER...	8d COMMON (2 1/2" X 0.131"); OR 3" X 0.131" NAILS	6"OC, TOENAIL	
24. 1" X 6" SUBFLOOR OR LESS TO EACH...	(2) 8d COMMON (2 1/2" X 0.131")	FACE NAIL	
25. 2" SUBFLOOR TO JOIST OR GIRDER	(2) 16d COMMON (3 1/2" X 0.162")	FACE NAIL	
26. 2" PLANKS (PLANK NAD BEAM-FLOOR AND ROOF)	(2) 16d COMMON (3 1/2" X 0.162")	EACH BEARING, FACE NAIL	
27. BUILT-UP GIRDERS AND BEAMS, 2" LUMBER LAYERS	20d COMMON (4" X 0.192")	32"OC, FACE NAIL AT TOP AND BOTTOM STAGGERED ON OPPOSITE SIDES	
	3" X 0.131" NAILS	24"OC, FACE NAIL AT TOP AND BOTTOM STAGGERED ON...	
28. LEDGER STRIP SUPPORTING JOISTS OR RAFTERS	(2) 20d COMMON (4" X 0.192"); OR (3) 3" X 0.131" NAILS	END JOIST OR RAFTER, FACE NAIL	
	(3) 16d COMMON (3 1/2" X 0.162"); OR FACE NAIL (4) 3" X 0.131" NAILS	OR FACE NAIL	
	(2) 16d COMMON (3 1/2" X 0.162")	FACE NAIL	
29. JOIST TO BAND JOIST OR RIM JOIST	(3) 16d COMMON (3 1/2" X 0.162"); OR END NAIL (4) 3" X 0.131" NAILS	OR END NAIL	
30. BRIDGING OR BLOCKING TO JOIST, RAFTER OR TRUSS	(2) 8d COMMON (2 1/2" X 0.131"); OR (2) 3" X 0.131" NAILS	EACH END, TOENAIL	
31. WOOD STRUCTURAL PANELS TO FRAMING SUBFLOOR TO FRAMING	SEE SHEARWALL SCHEDULE SEE SECTION 06160 STRUCTURAL NOTES		
a. COMMON OR BOX NAILS ARE PERMITTED TO BE USED EXCEPT WHERE NOTED OTHERWISE.			
b. FASTENING SCHEDULE BASED ON IBC TABLE 2304.10.1 AND PROVIDES THE MINIMUM NAILING REQUIRED. WHEN SPECIFIED ELSEWHERE IN THESE PLANS PROVIDE NAILING AS SPECIFIED. SEE IBC FOR COMPLETE NAILING SCHEDULE.			

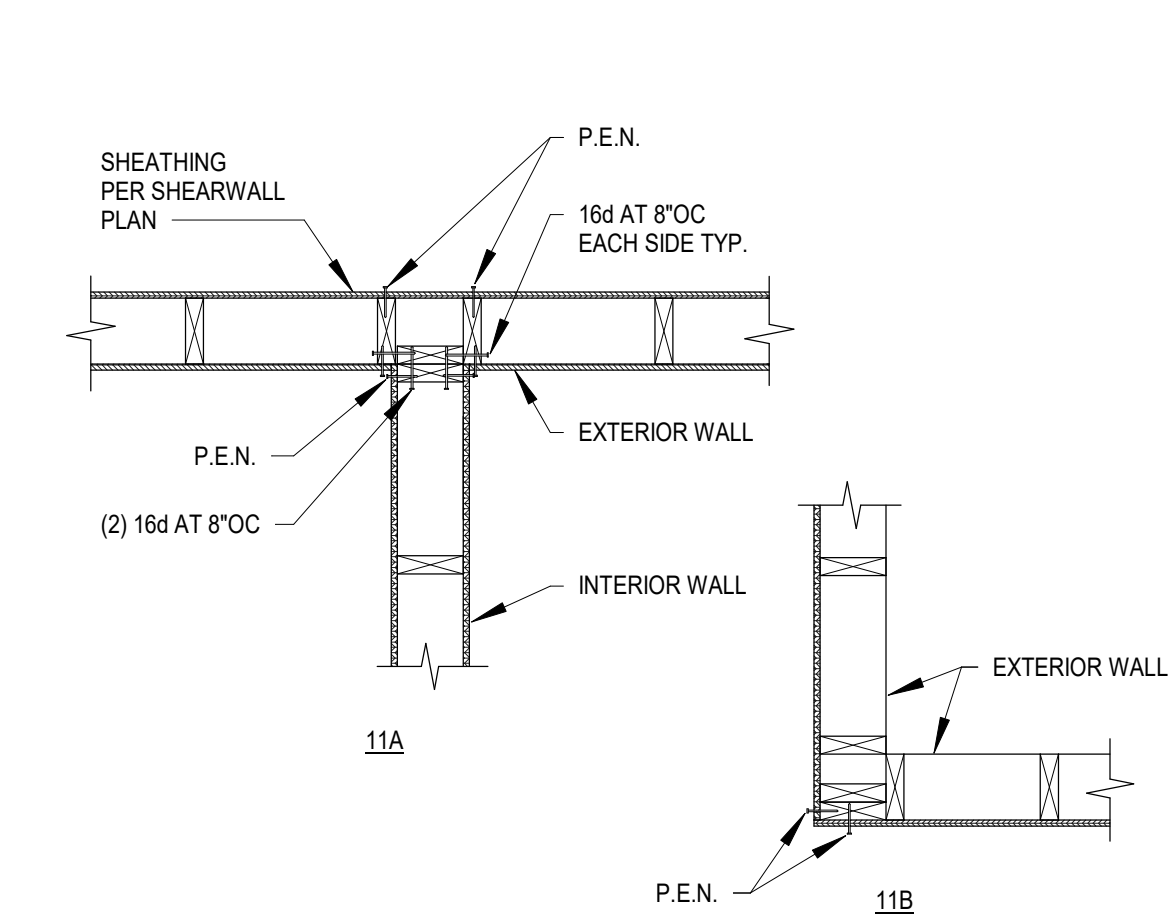


6 PLAN VIEW

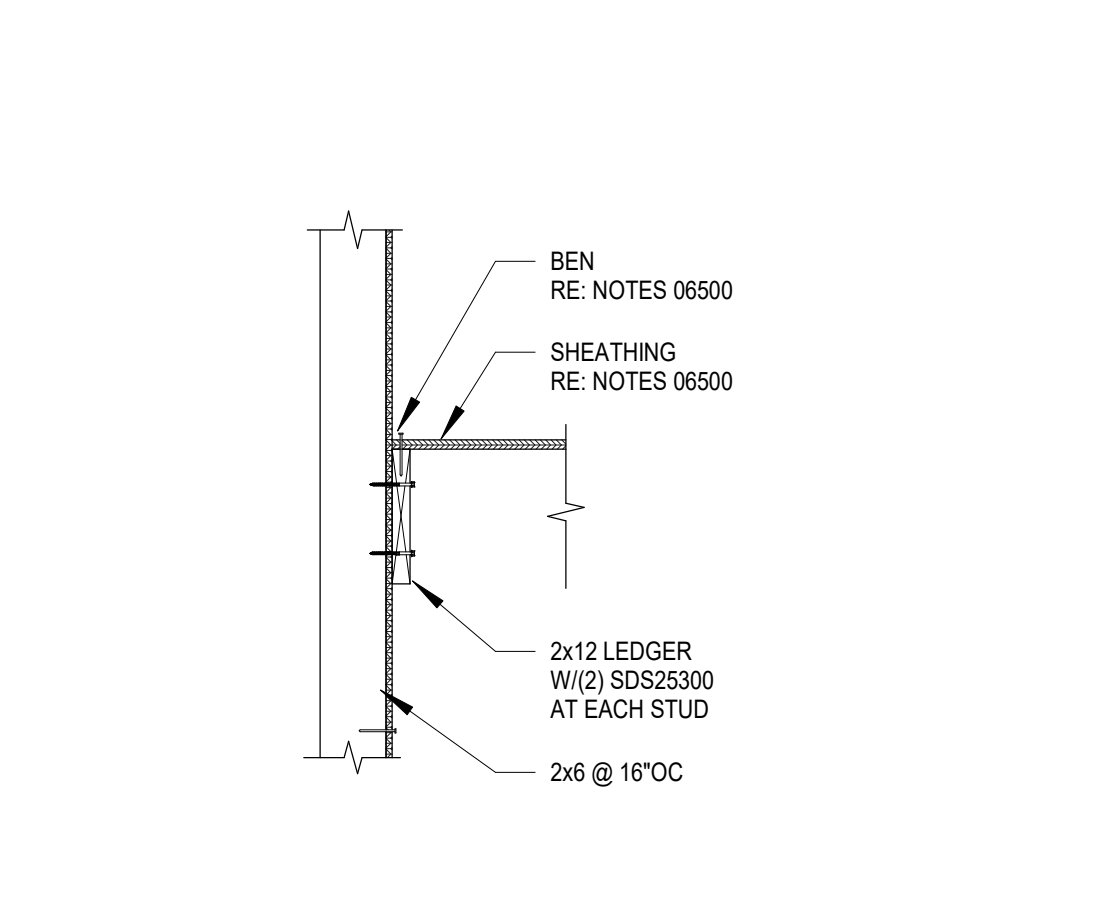


7 TYPICAL LEDGER AT EXTERIOR WALL

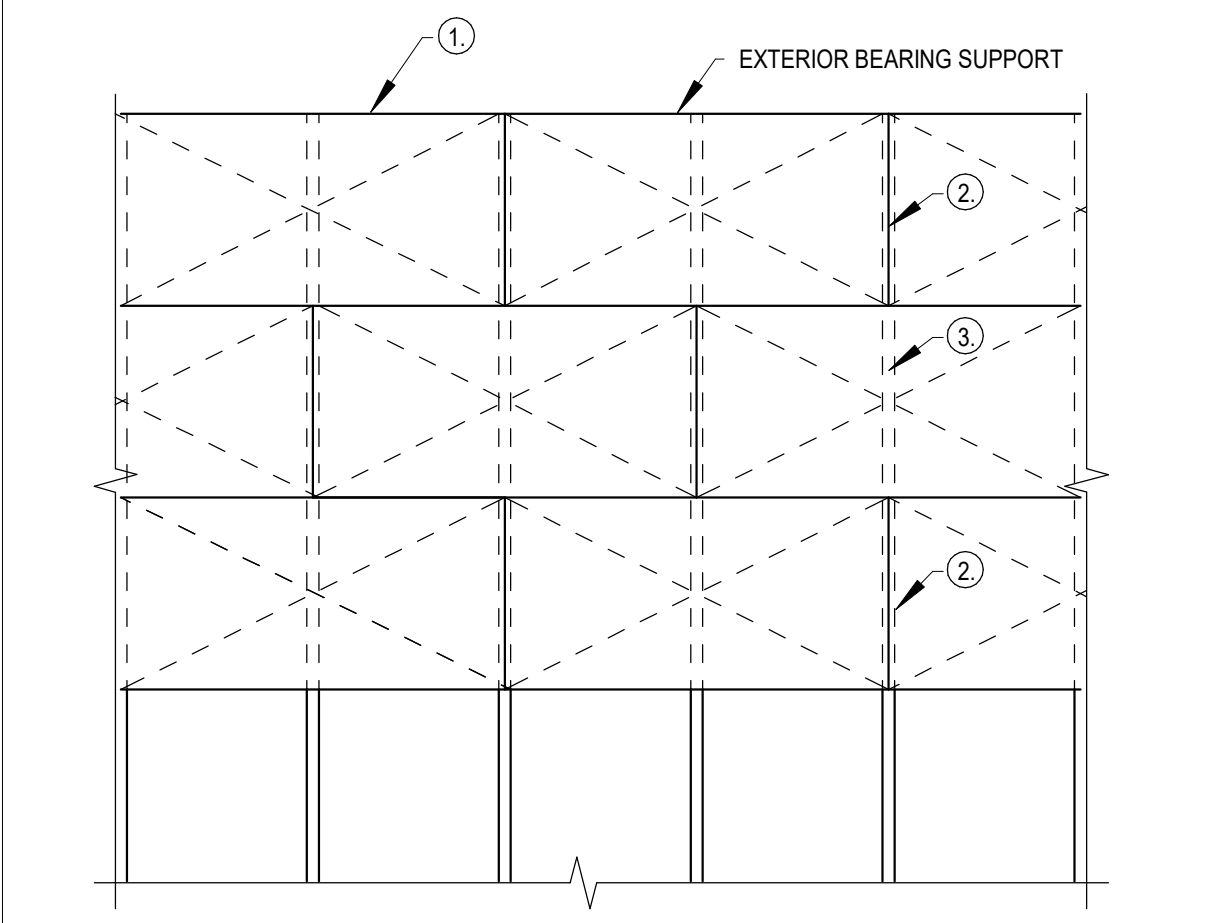


8 ROOF/FLOOR SHEATHING LAYOUT

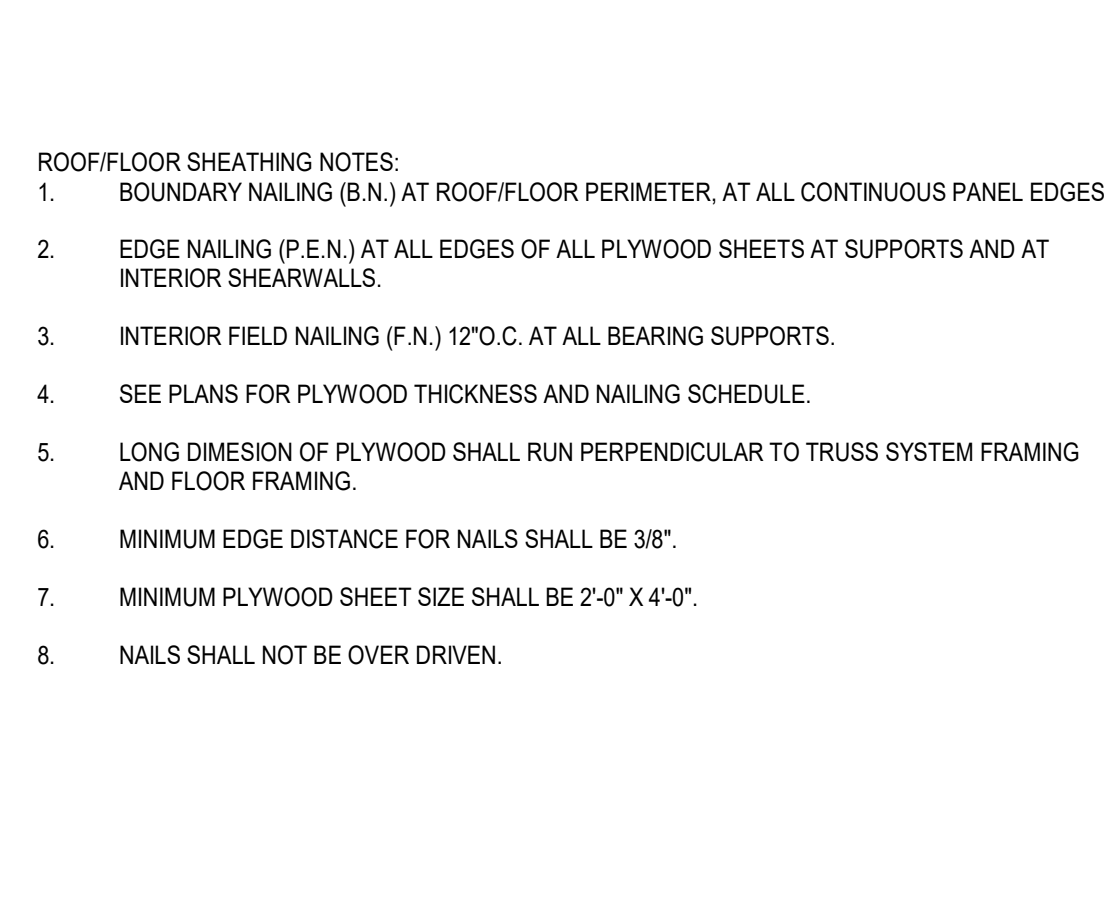


14 TYPICAL CONNECTION TO WOOD BEAM

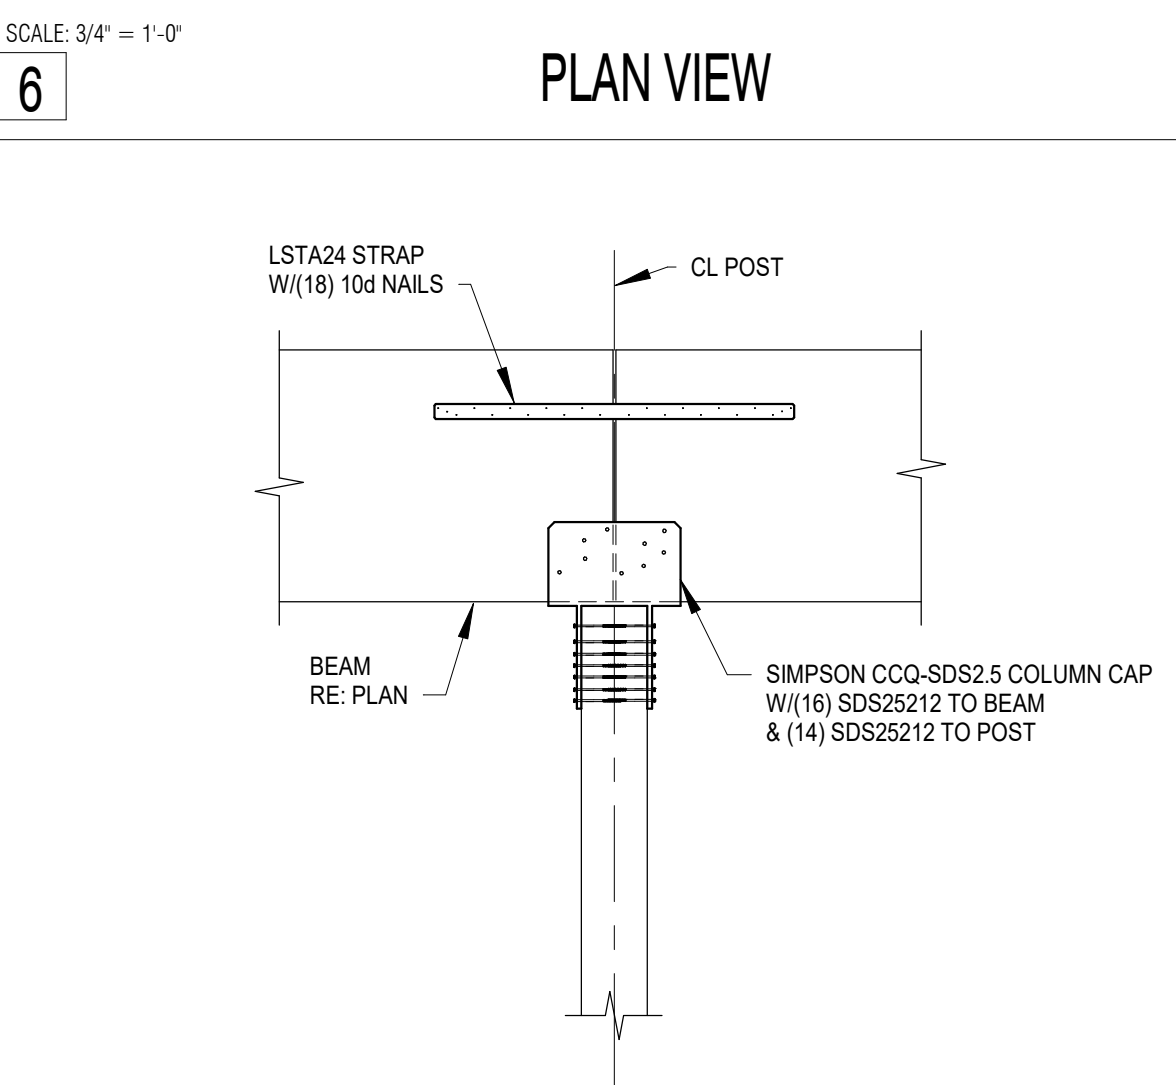


11 TYPICAL BEAM TO POST CONNECTION

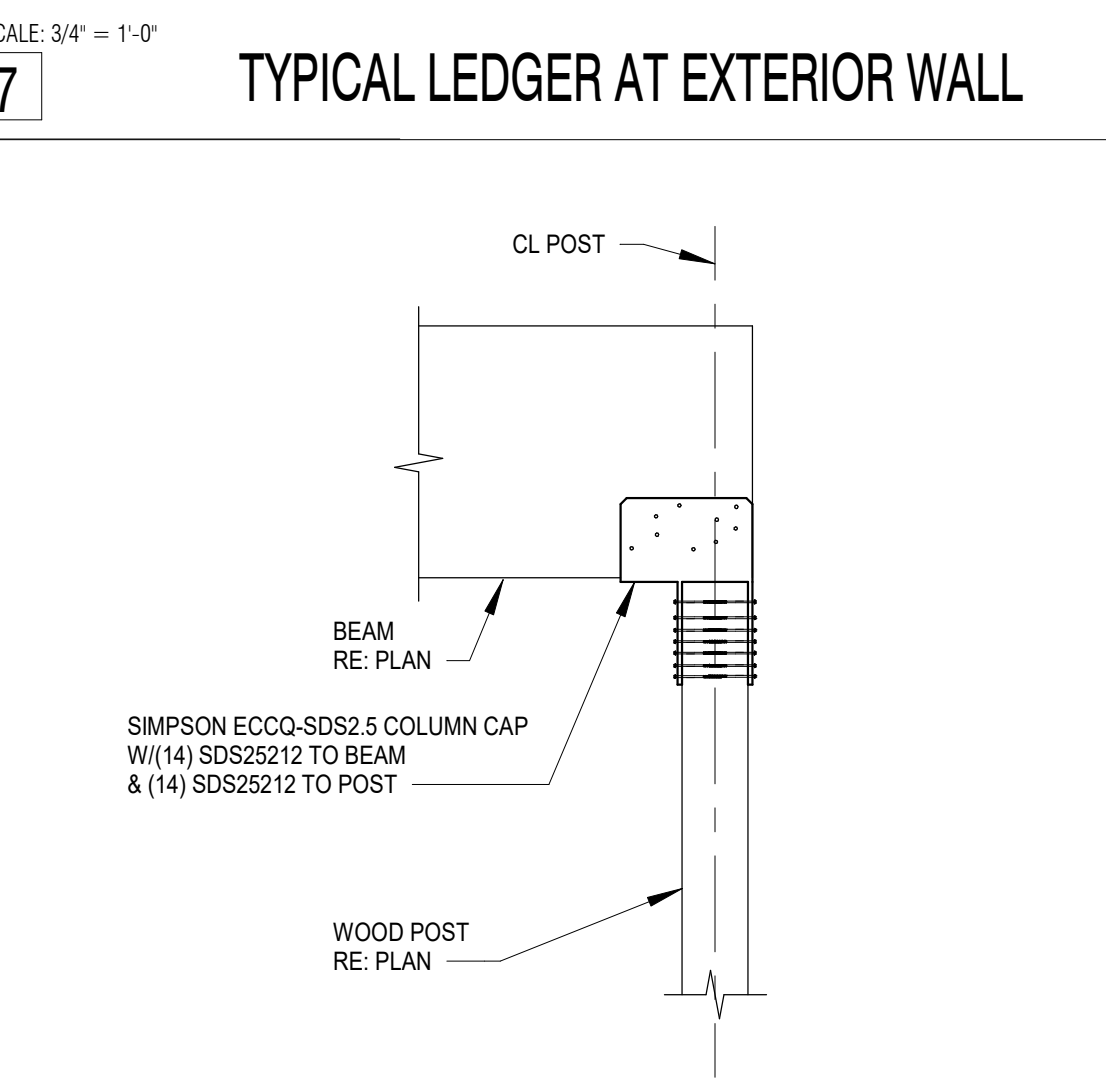


12 TYPICAL BEAM TO POST CONNECTION

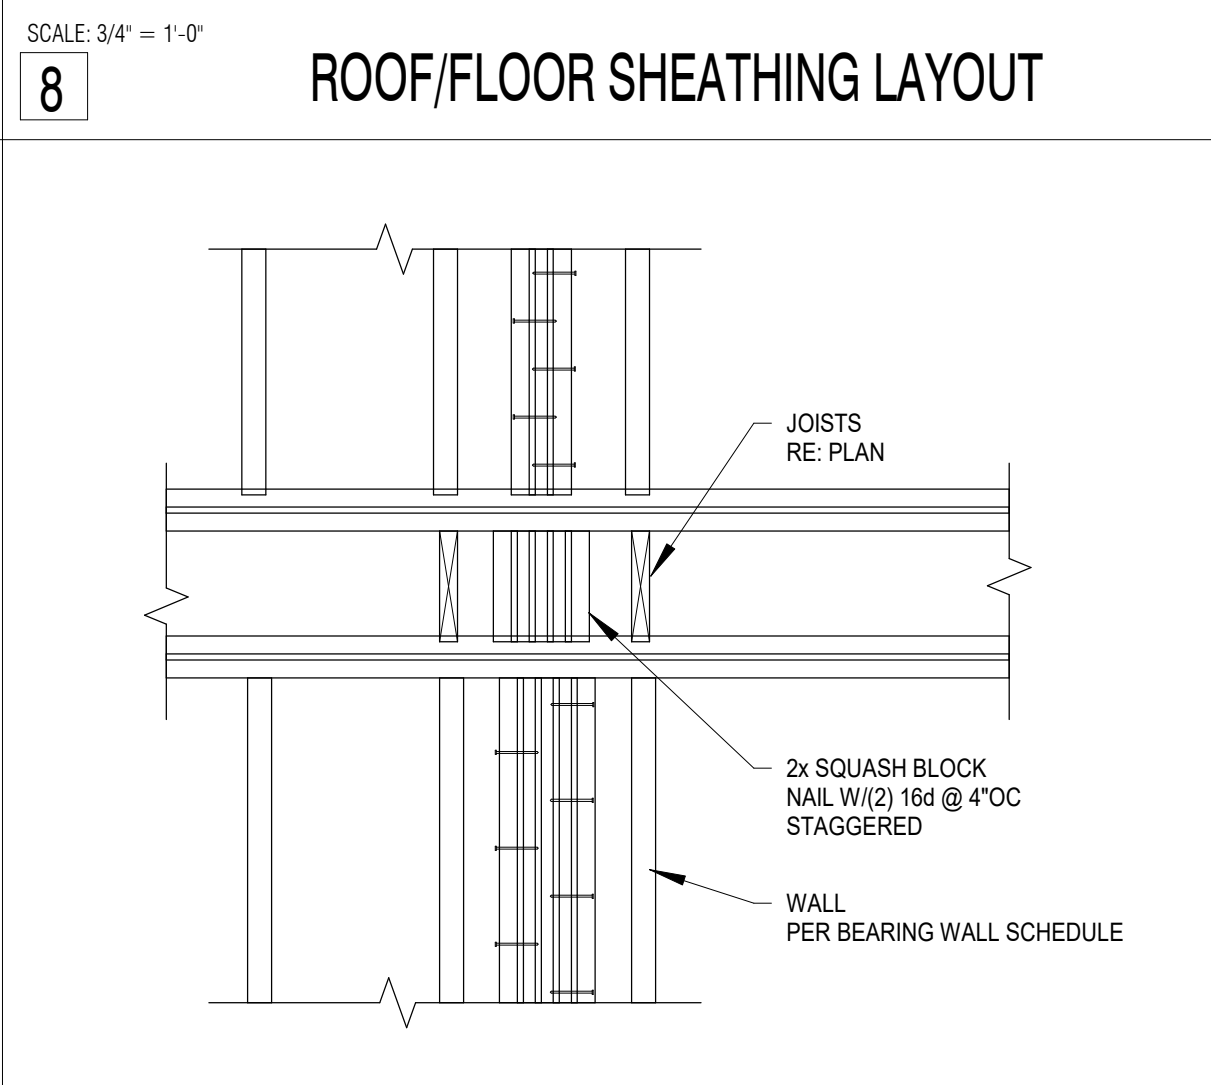


13 TYPICAL BLOCKING AT BUNDLED STUD

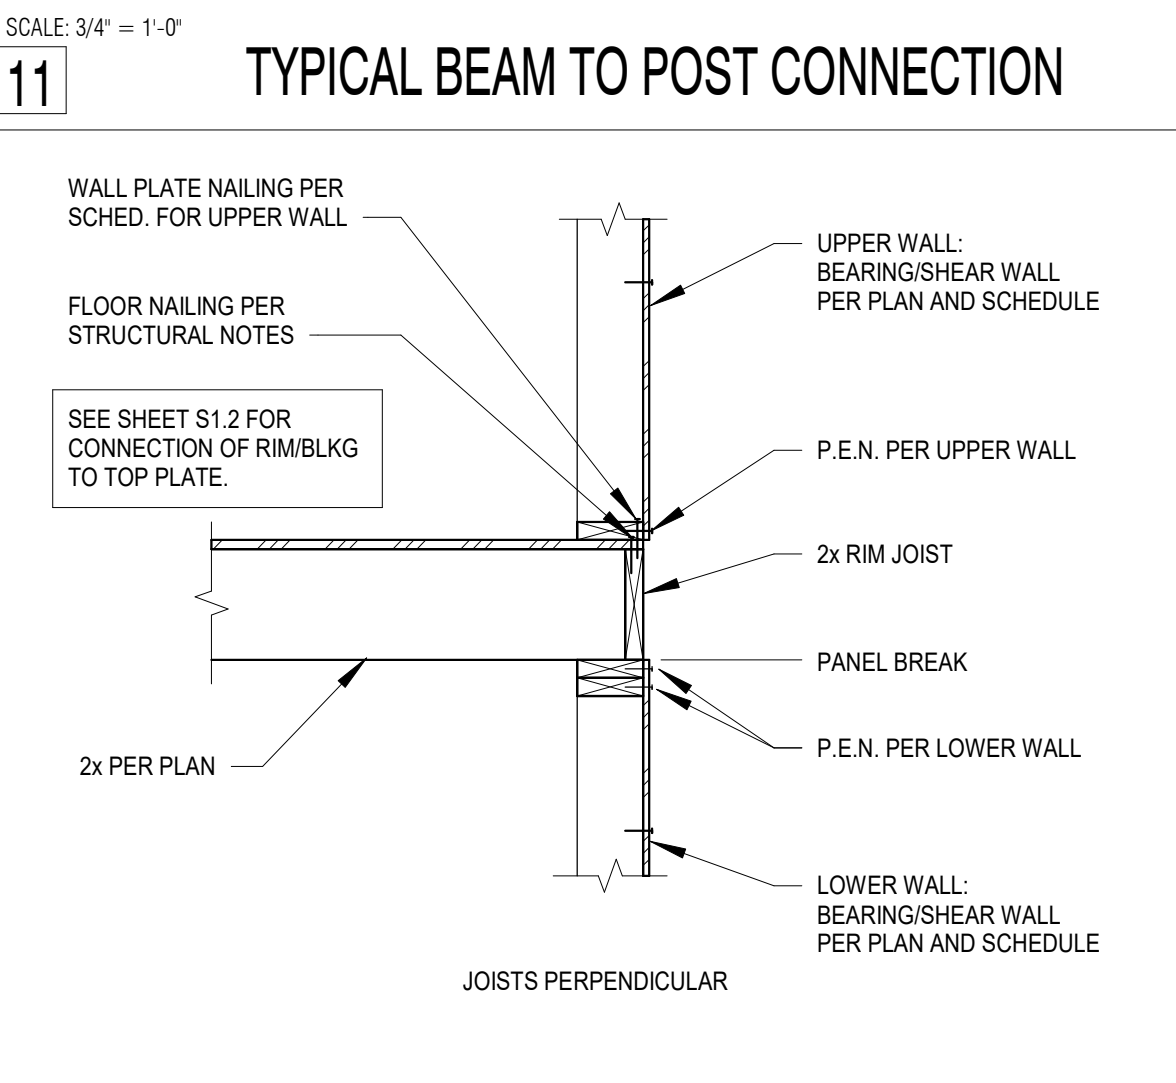


16 TYPICAL EXTERIOR WALL AT FRAMING

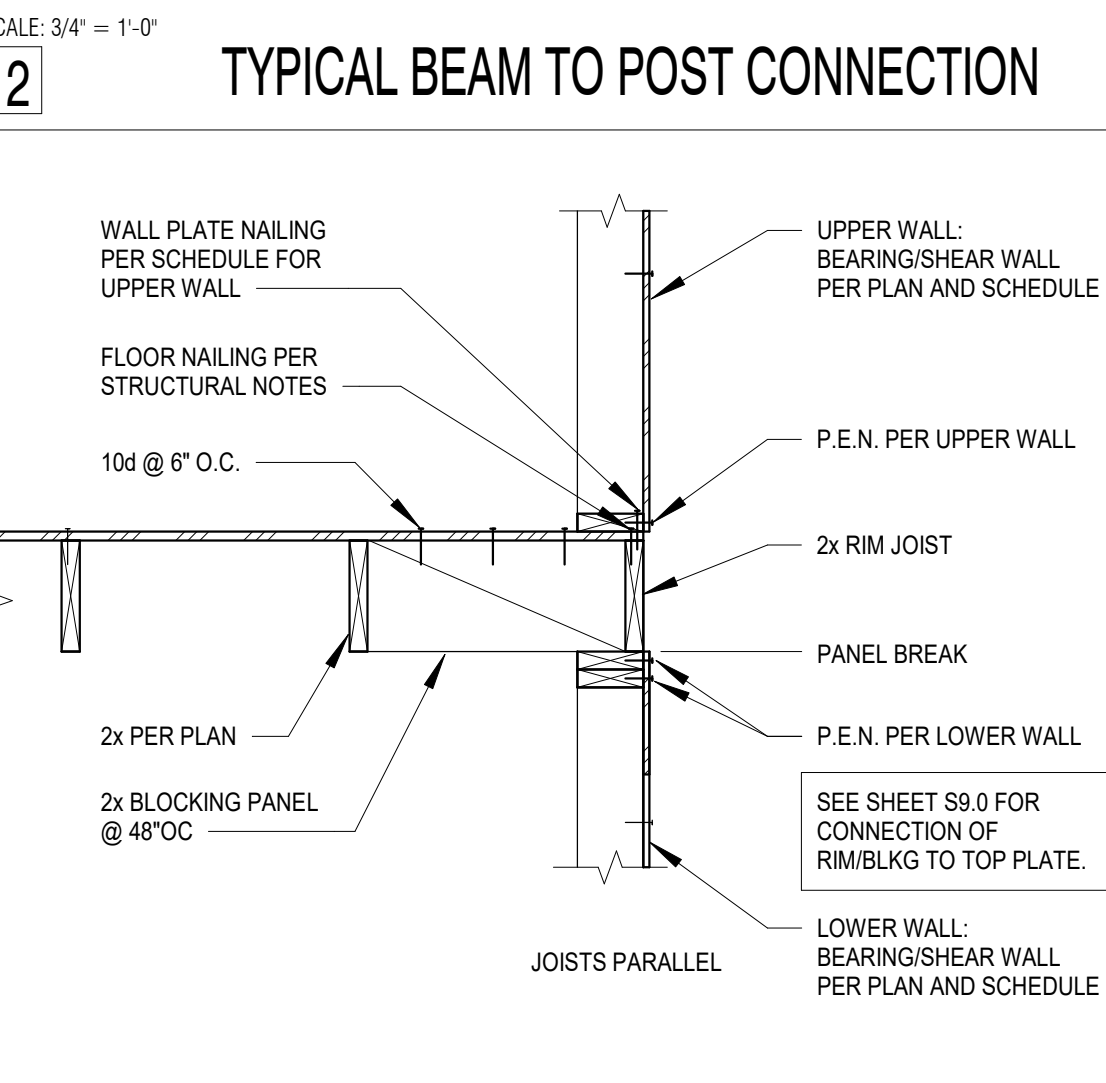

17 TYPICAL EXTERIOR WALL TO FRAMING

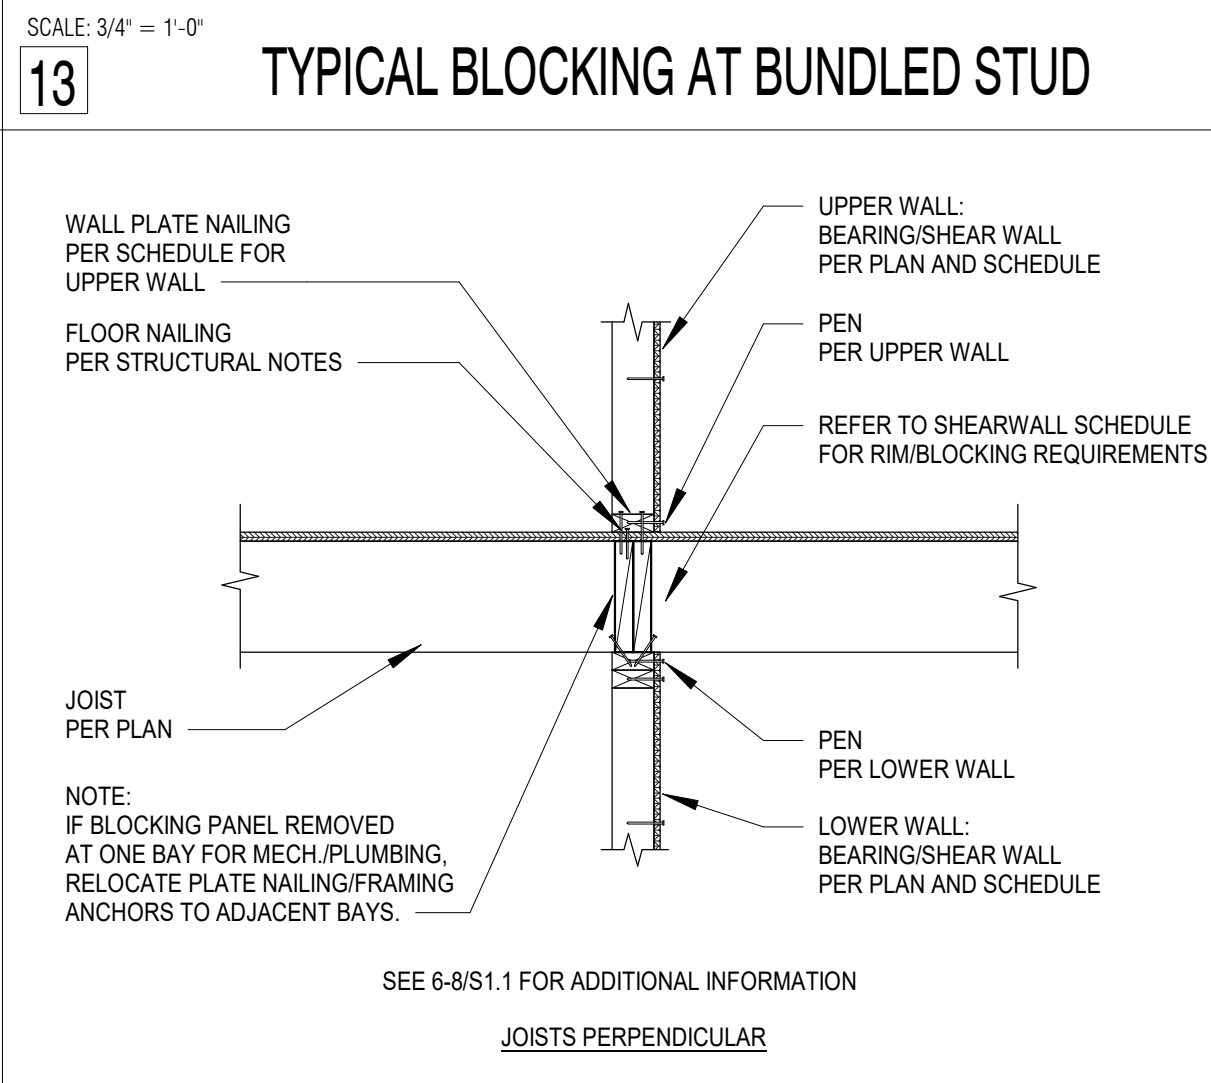

18 TYPICAL INTERIOR WALL TO FRAMING

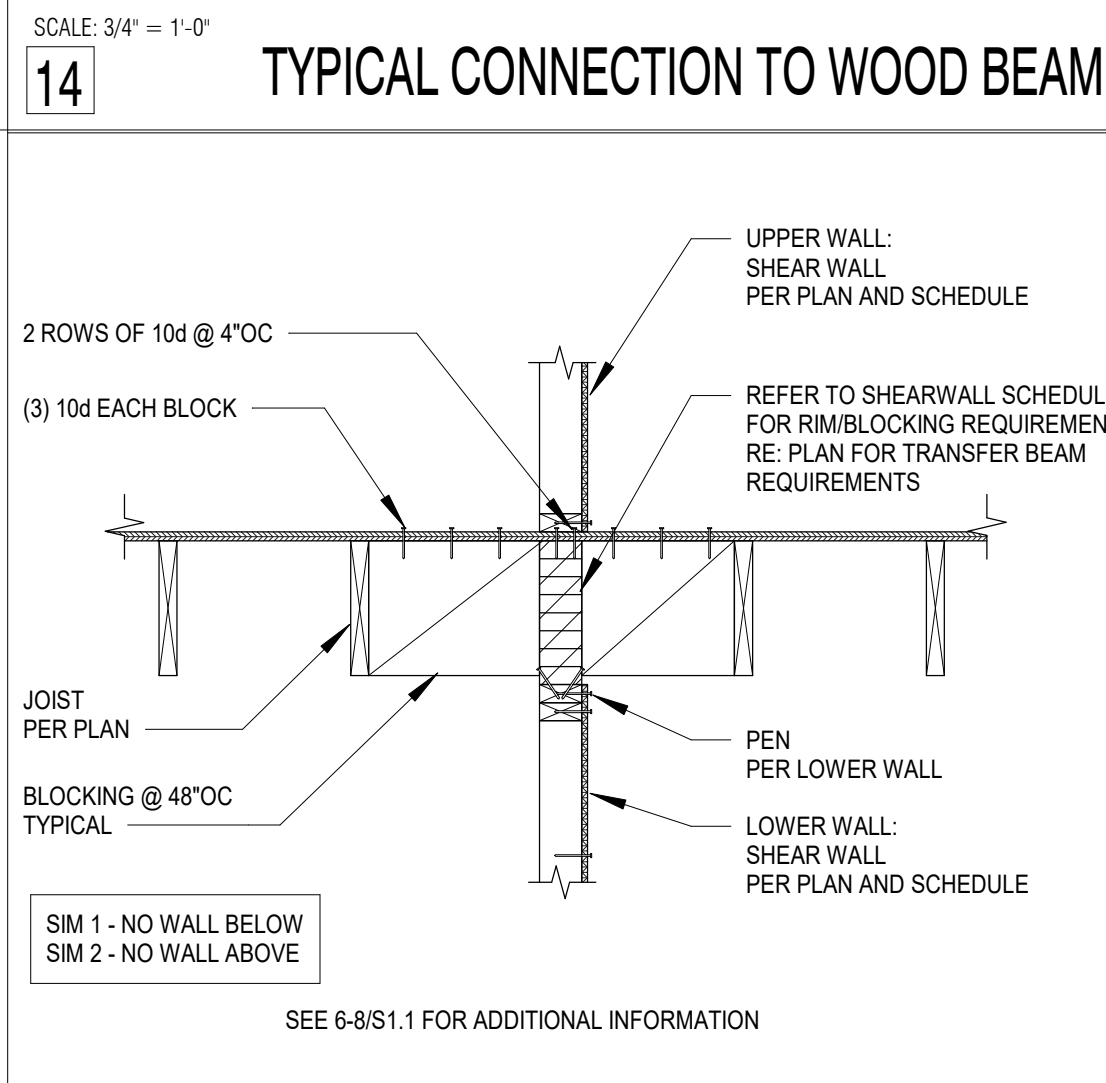

19 TYPICAL INTERIOR WALL TO FRAMING

**CT ENGINEERING INC.**

Structural Engineers  
180 N. Jackson Street, Suite 302, Seattle, WA 98109  
206.265.4512 (V) 206.265.0616 (F)  
www.ctengineering.com

03/25/22


REVIEWED FOR CODE COMPLIANCE  
July 29, 2022  
SITE COPY  
SHINGLER

Typical Wood Framing Details  
PIPER REMODEL  
8429 SE 33RD PLACE  
MERCER ISLAND, WA 98040


**S9.0**

6/14/2022 4:16:55 PM  
C:\Users\jlm\OneDrive\Documents\Structural\1162 Piper Residence Address (S) (S) 1.dwg




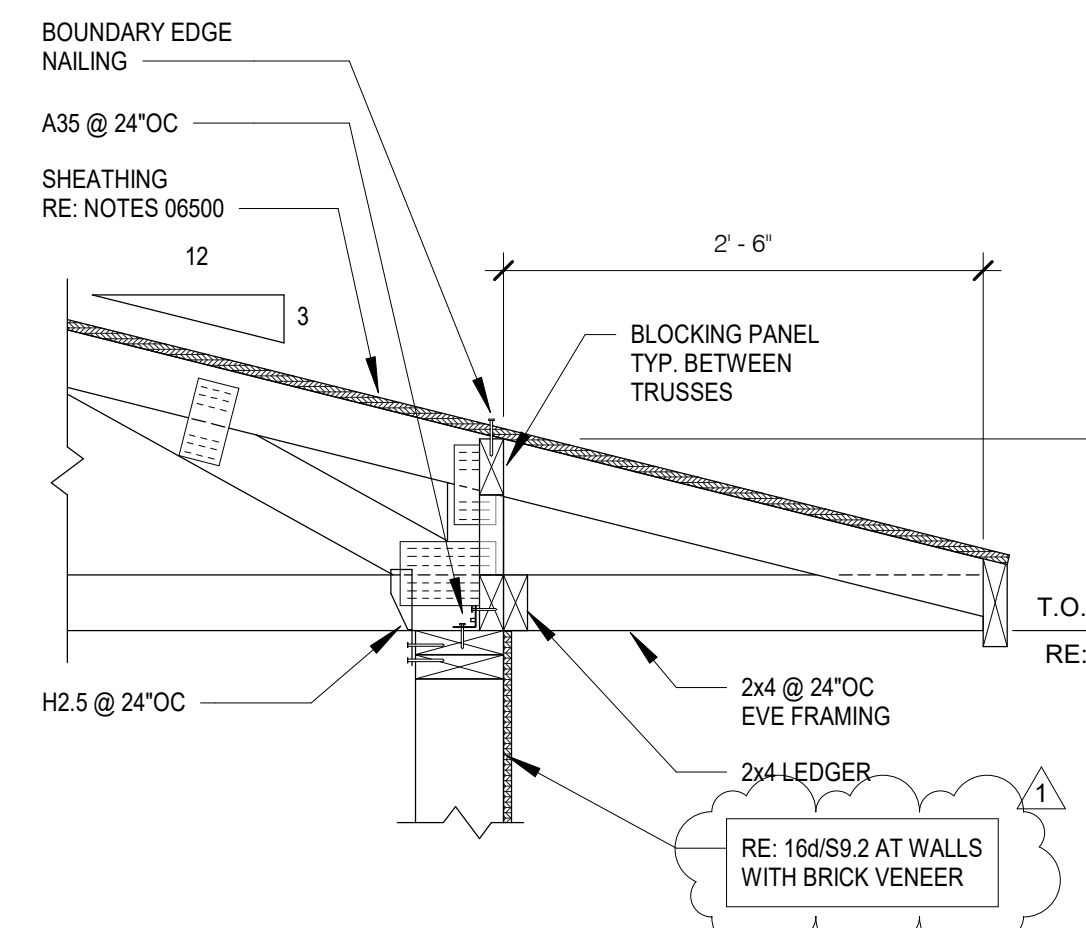


1 TYPICAL TRUSS AT EXTERIOR WALL  
SCALE: 1" = 1'-0"

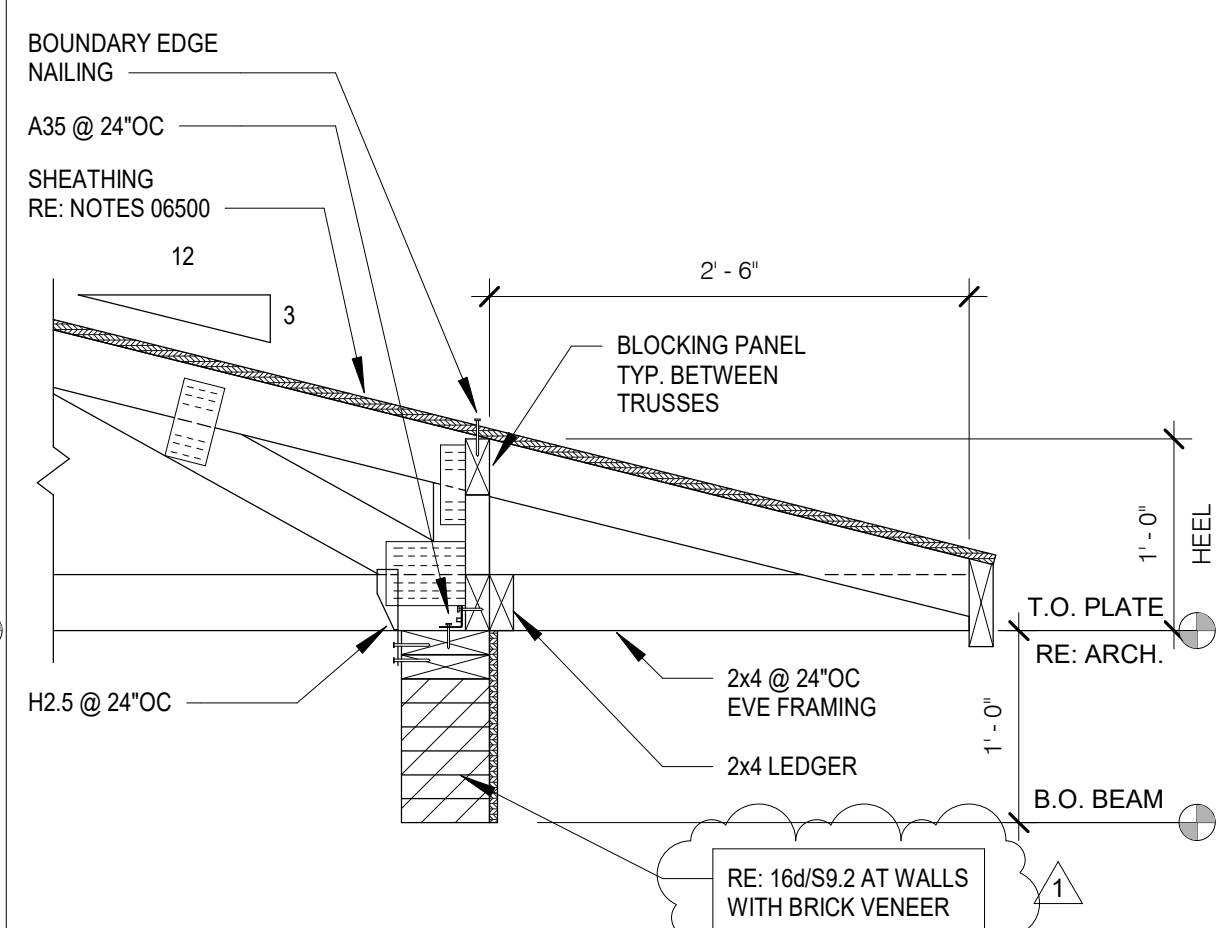


2 TYPICAL TRUSS AT DROPPED HEADER  
SCALE: 1" = 1'-0"

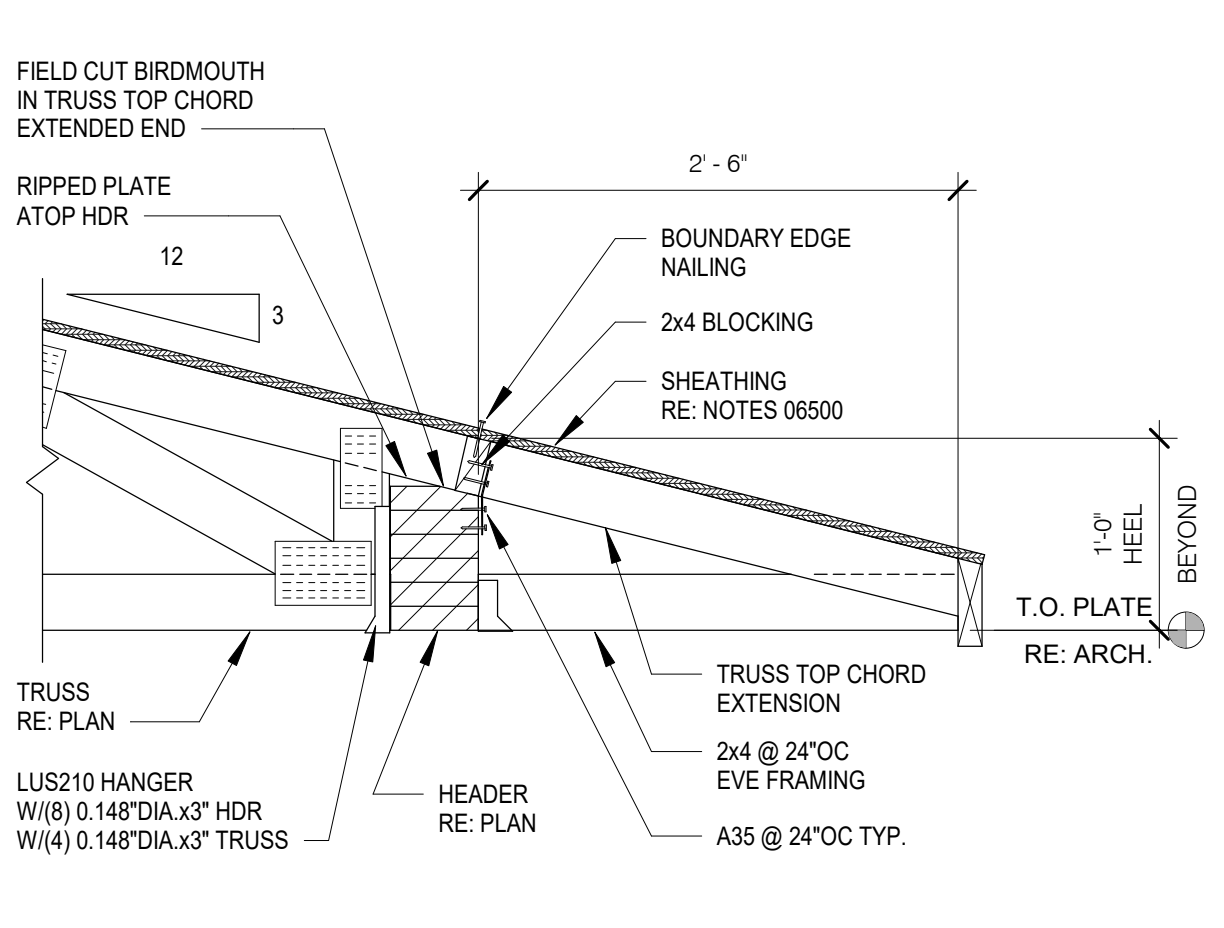


3 TYPICAL TRUSS AT UPSET HEADER  
SCALE: 1" = 1'-0"

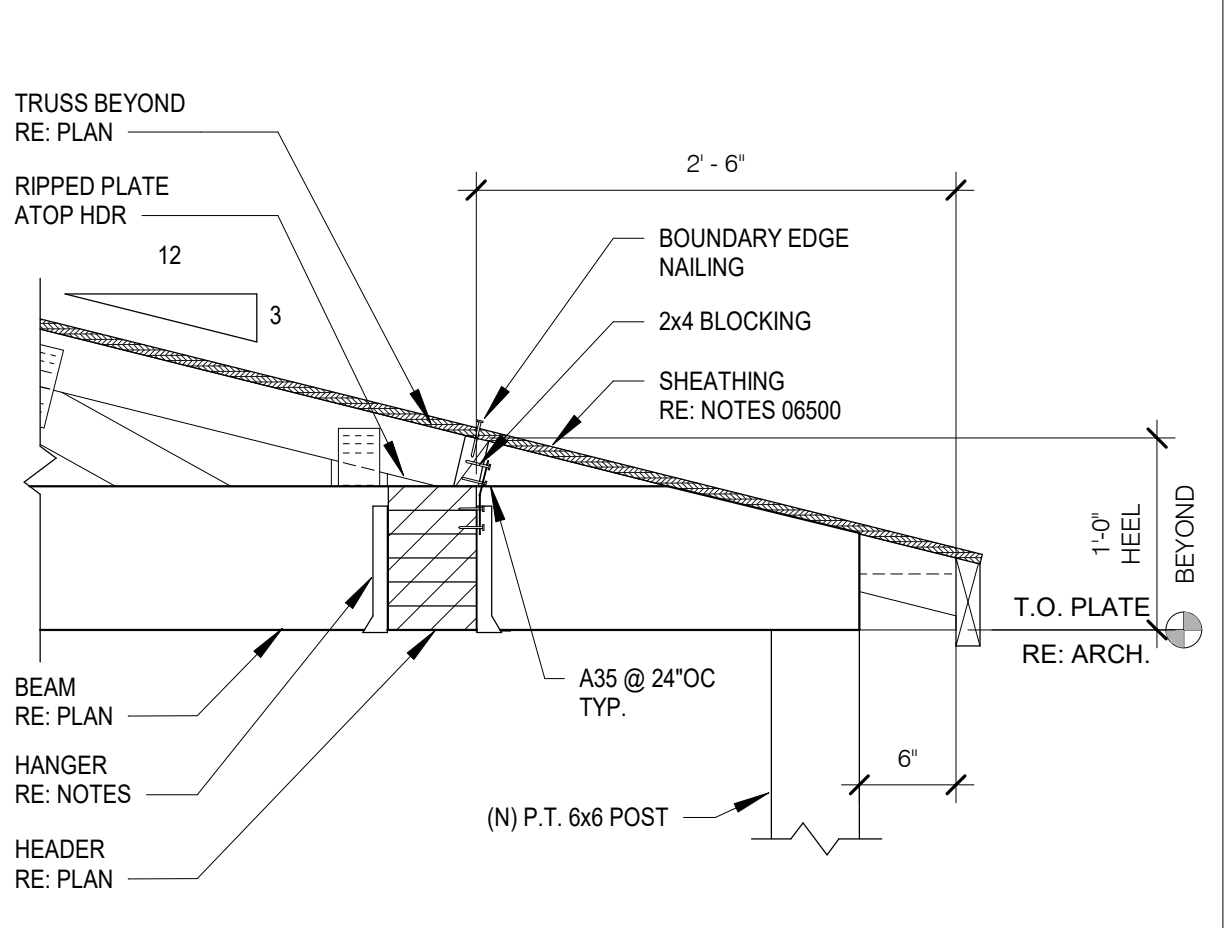


4 TYPICAL BEAM AT UPSET HEADER  
SCALE: 1" = 1'-0"

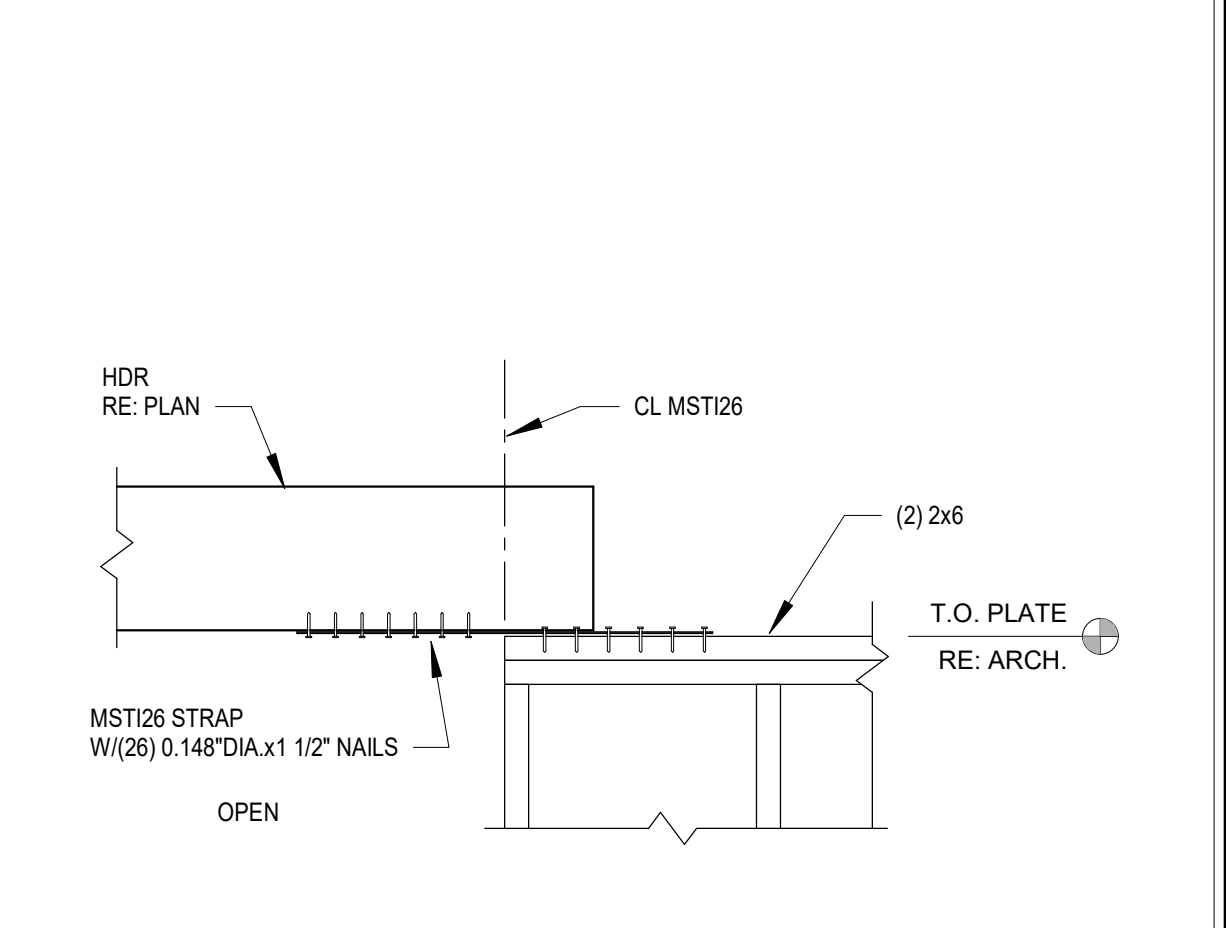


5 UPSET DRAG AT DOUBLE TOP PLATE  
SCALE: 1" = 1'-0"

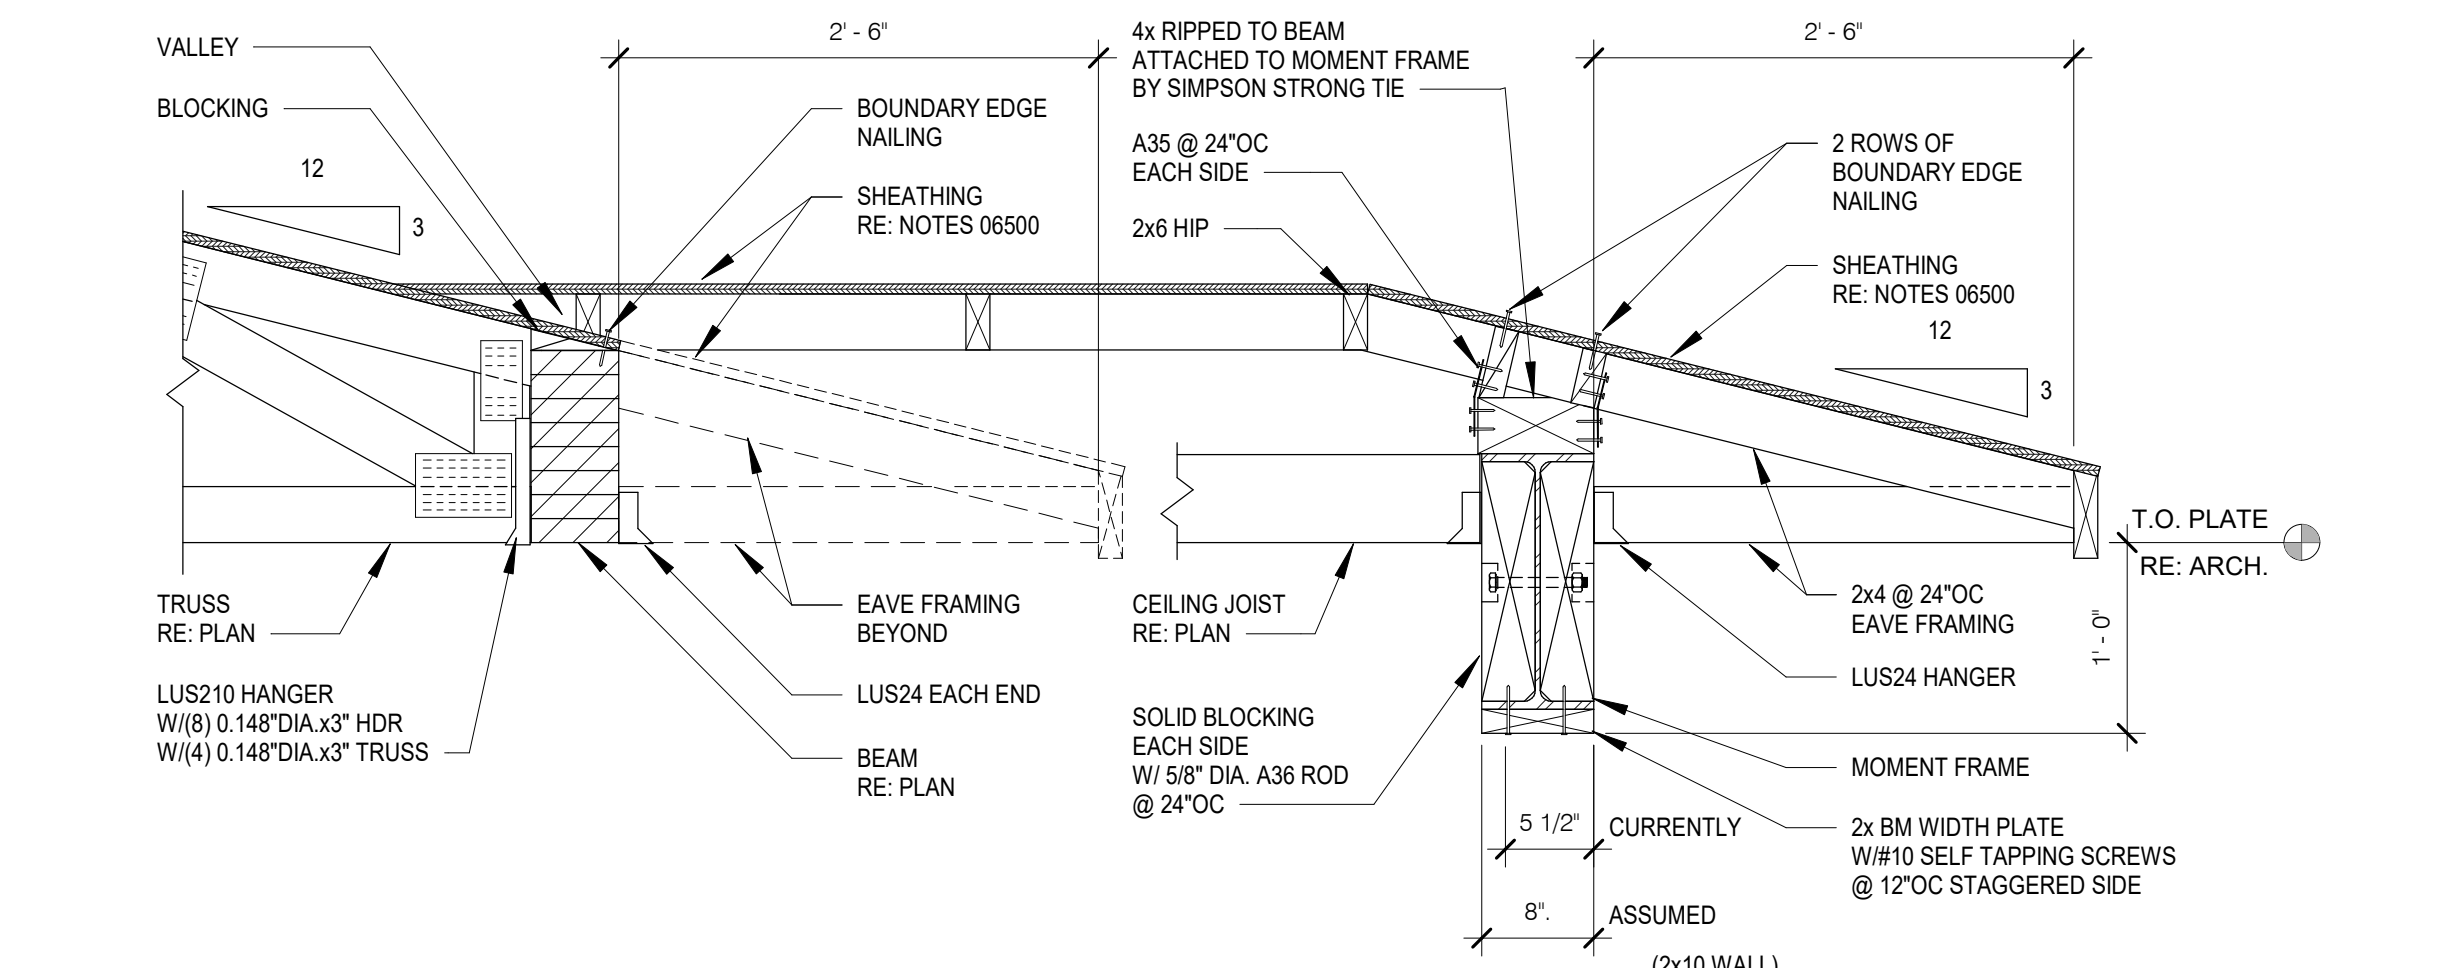


6 ROOF SECTION AT UPSET GLB AND MOMENT FRAME  
SCALE: 1" = 1'-0"

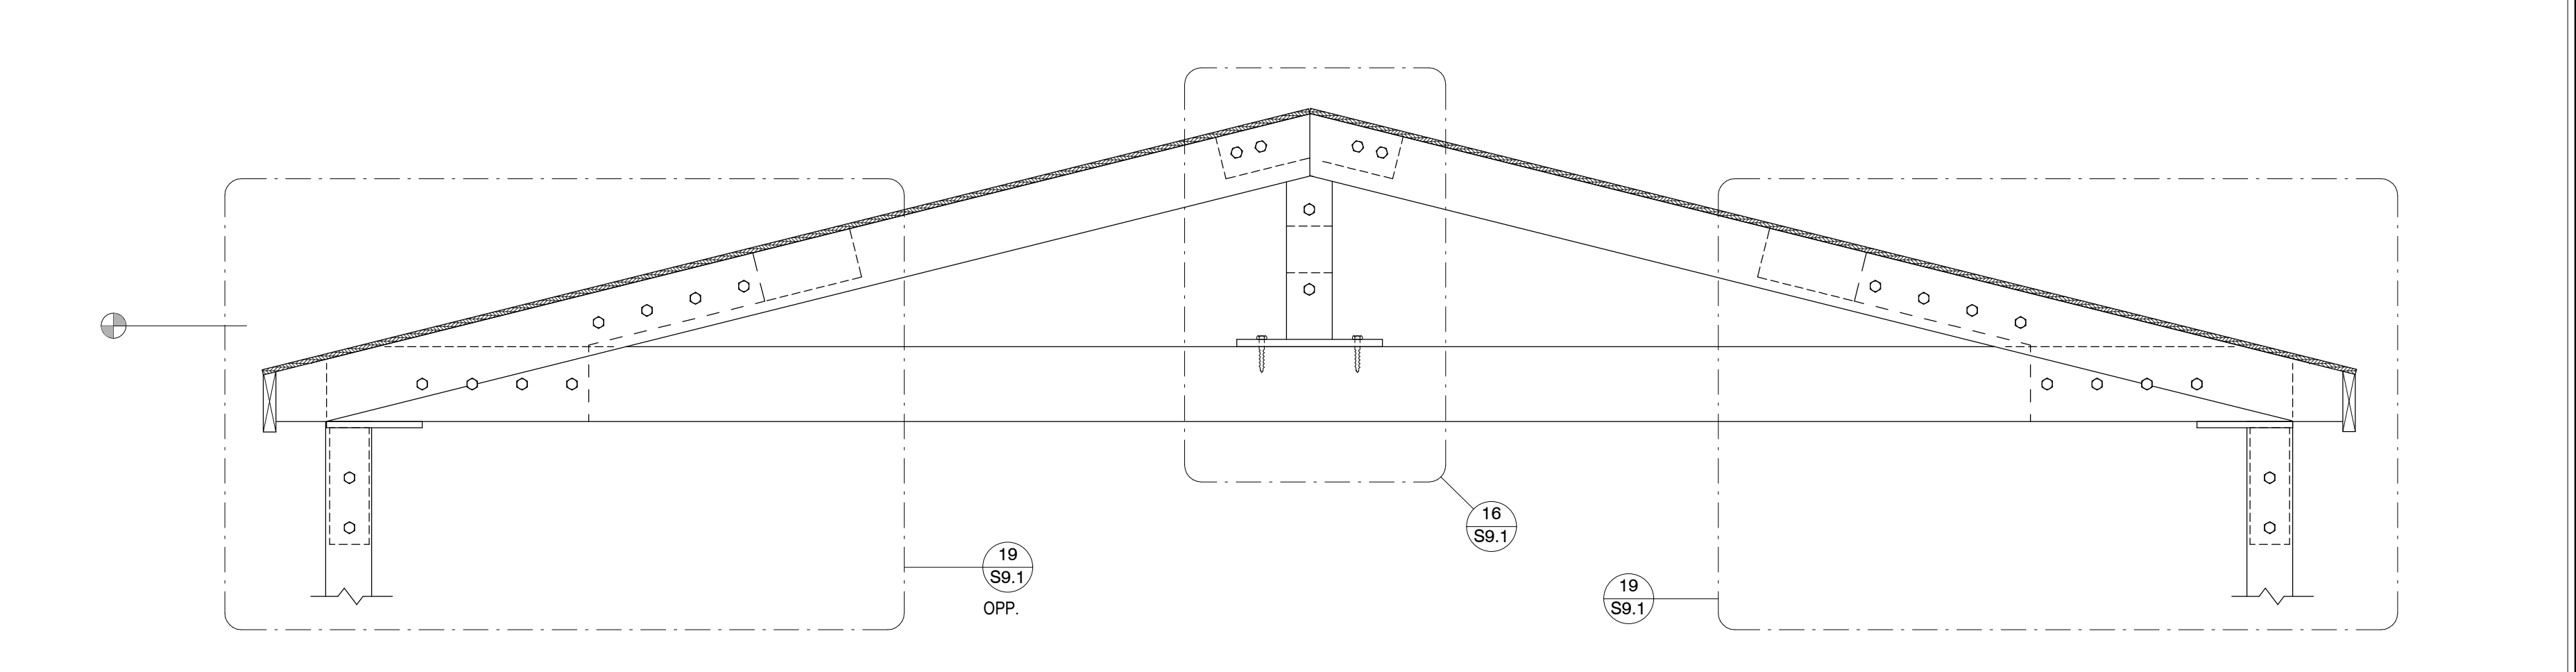


7 TRUSS PROFILE A  
SCALE: 3/4" = 1'-0"

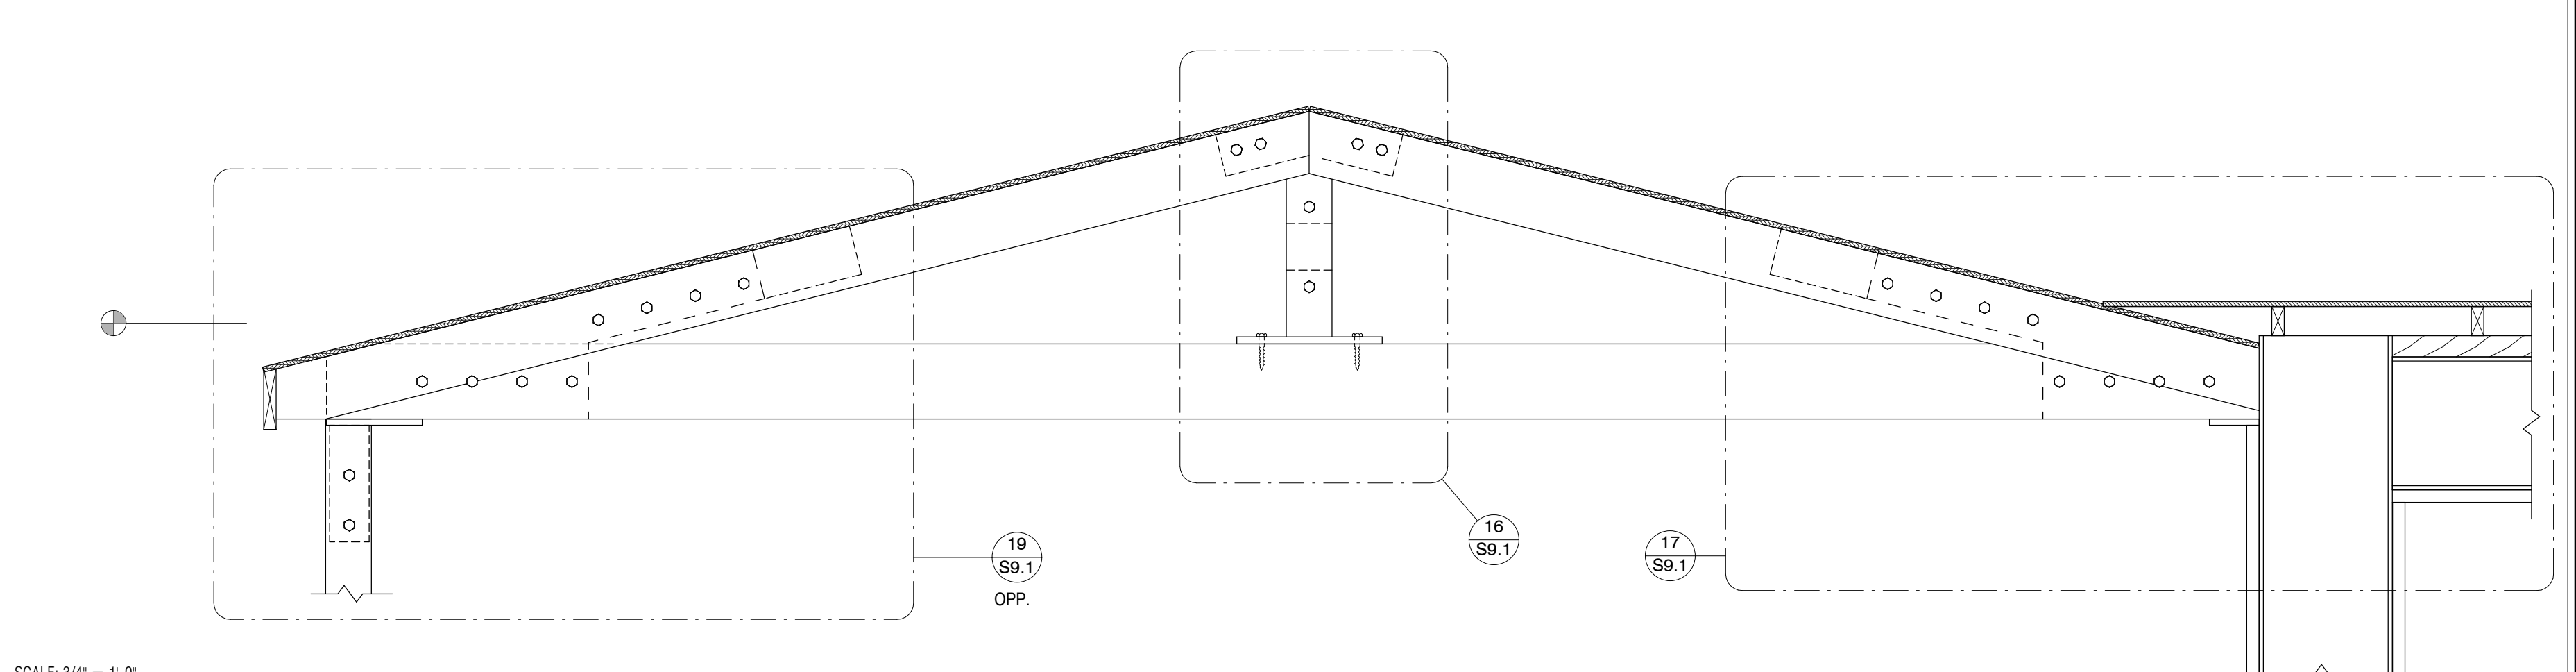


13 TRUSS PROFILE B  
SCALE: 3/4" = 1'-0"

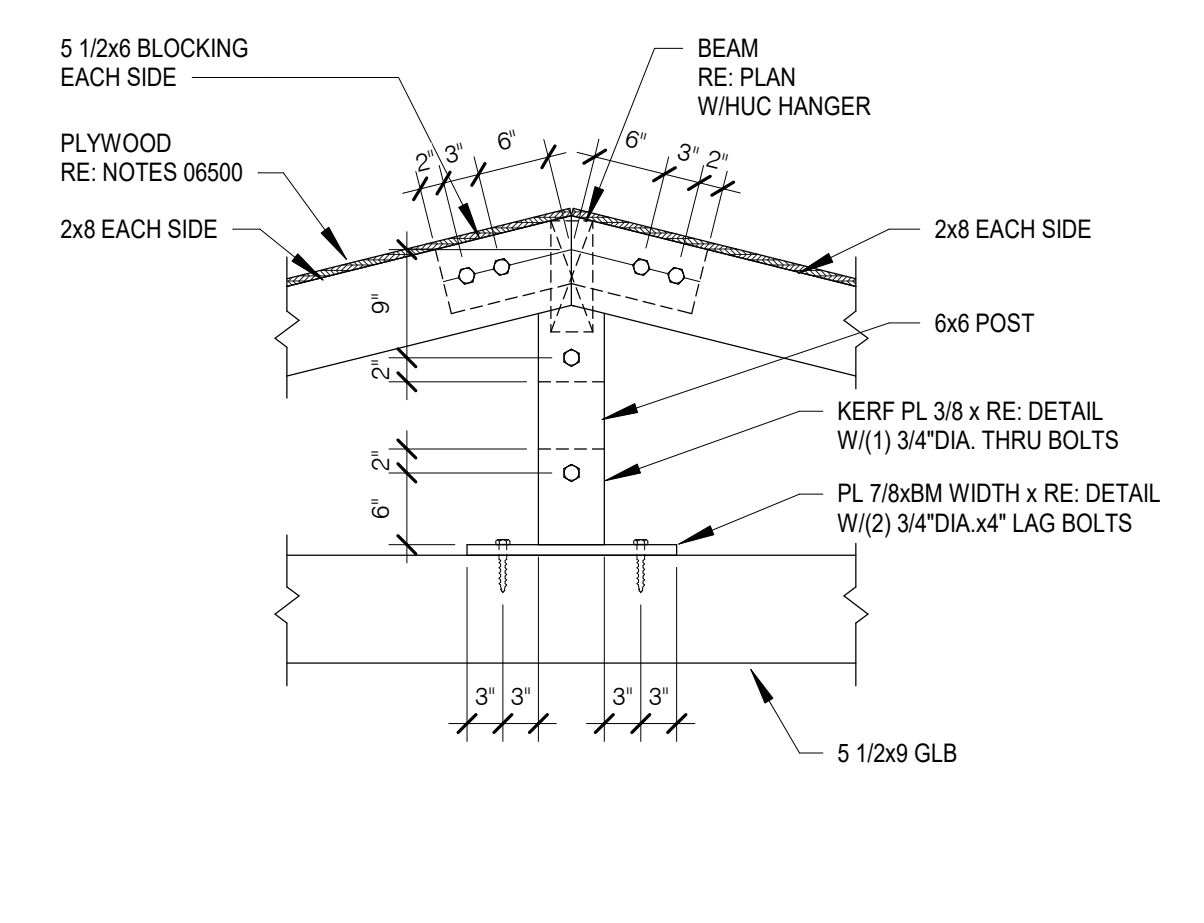

16 TRUSS A AND B AT KING POST  
SCALE: 3/4" = 1'-0"

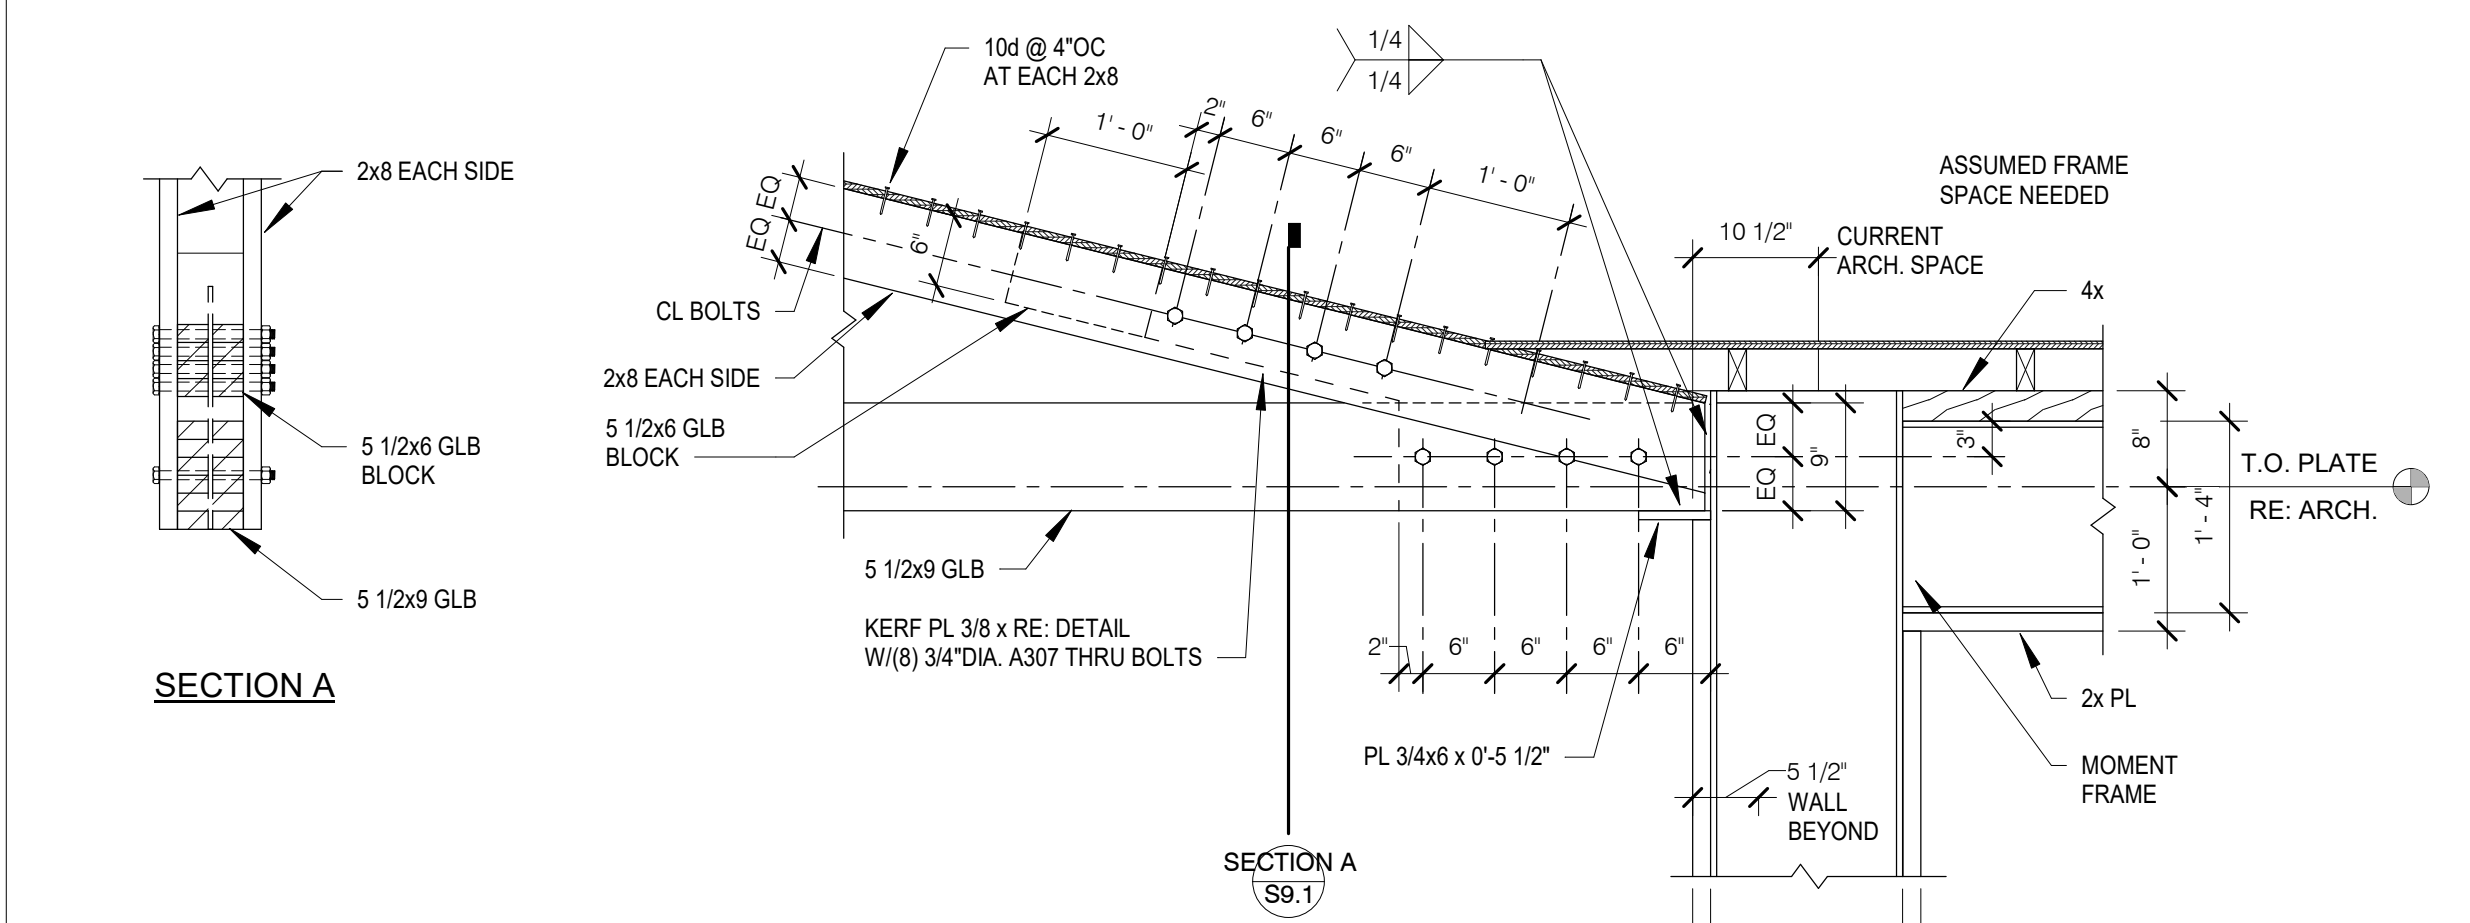


17 TRUSS A AT MOMENT FRAME  
SCALE: 3/4" = 1'-0"

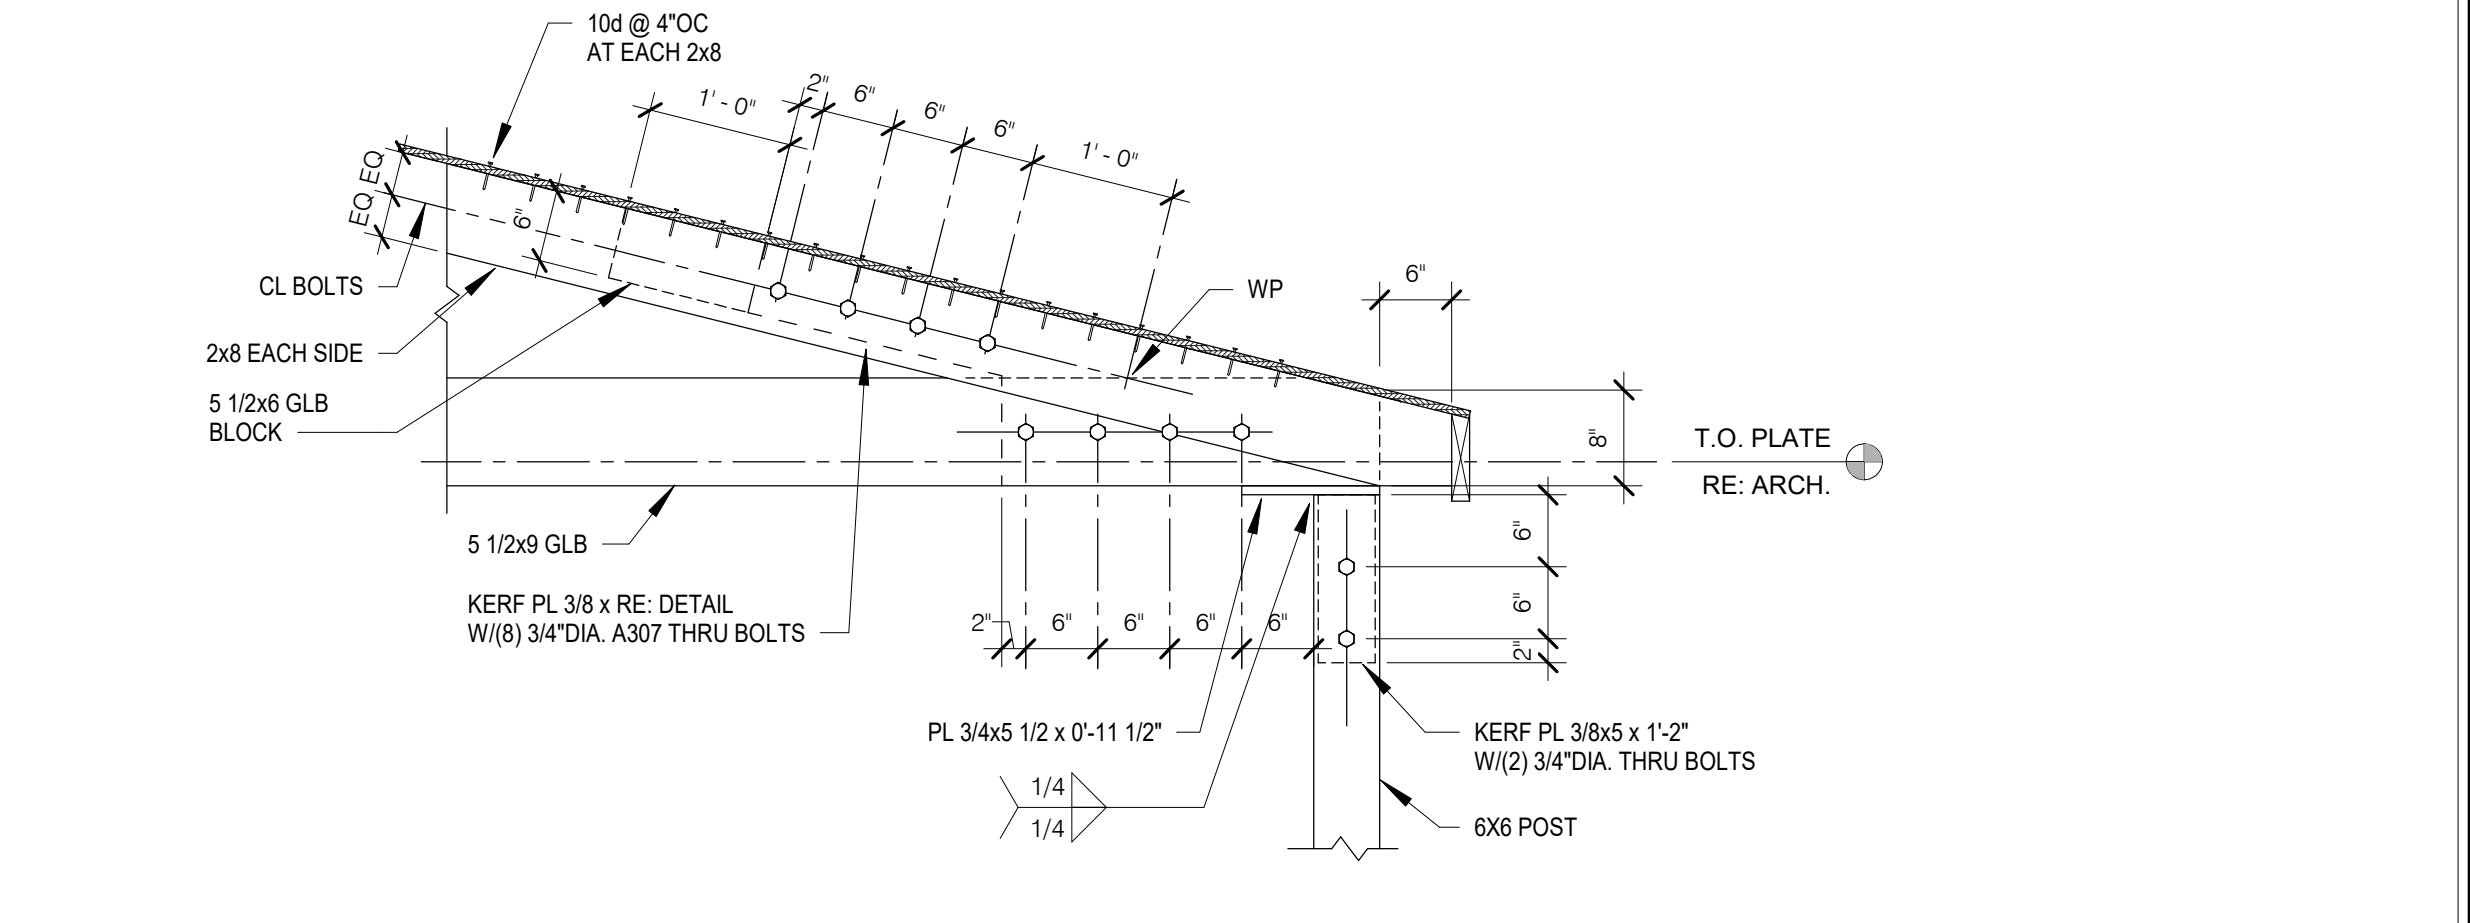

19 TRUSS A AND B AT 6x6 POST  
SCALE: 3/4" = 1'-0"

**CT ENGINEERING INC.**  
Structural Engineers  
180 Nickerson Street, Suite 302, Seattle, WA 98109  
206.285.4512 (V) 206.285.0616 (F)  
www.ctengineering.com

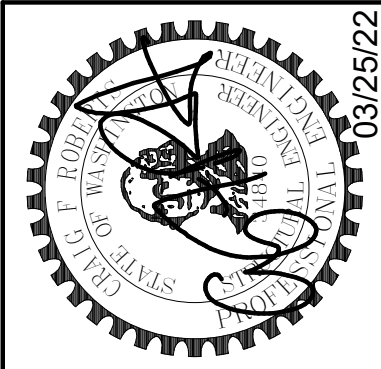

No.	REVISION	DATE
1	Response to Comments	06-10-2022

JOB #:	21162
ENG:	BJM
CAD:	JMA
SCALE:	As indicated
KEY ISSUE DATES:	
SD:	SD
CD:	CD
PERMIT:	03.25.2022
OTHER:	BD




Typical Wood Framing Details  
PIPER REMODEL  
8429 SE 33RD PLACE  
MERCER ISLAND, WA 98040


**S9.1**

6/14/2022 4:16:56 PM C:\Users\jma\OneDrive\Documents\PROJECTS\1162 PIPER Remodel\Address Address (R) (S) (1)




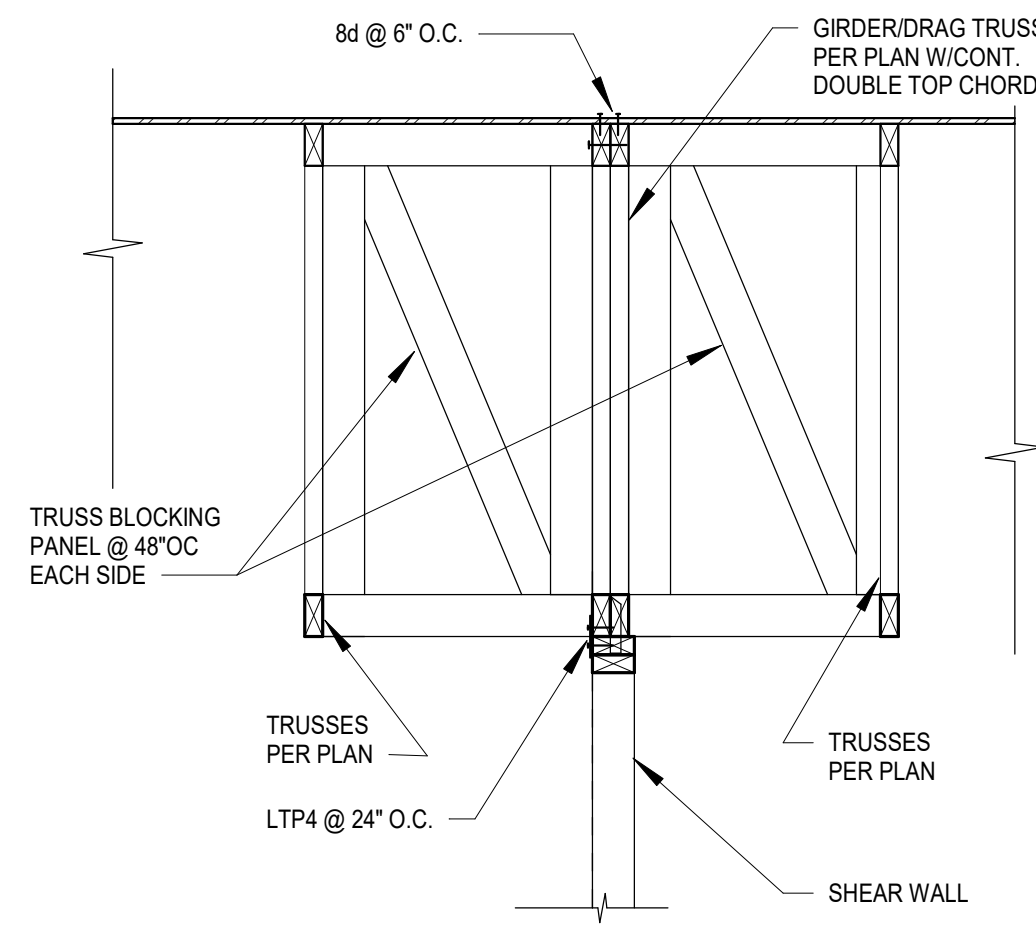


SCALE: 3/4" = 1'-0"  
**2** DRAG TRUSS TO WALL

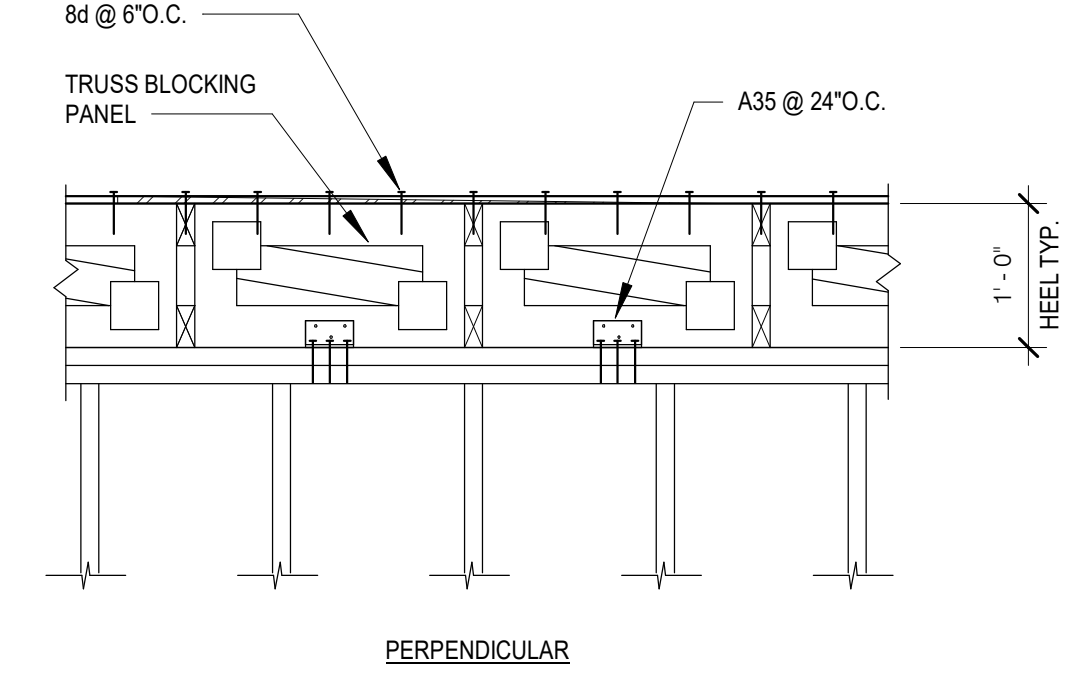




SCALE: 3/4" = 1'-0"  
**3** TYPICAL EXTERIOR WALL TO TRUSS

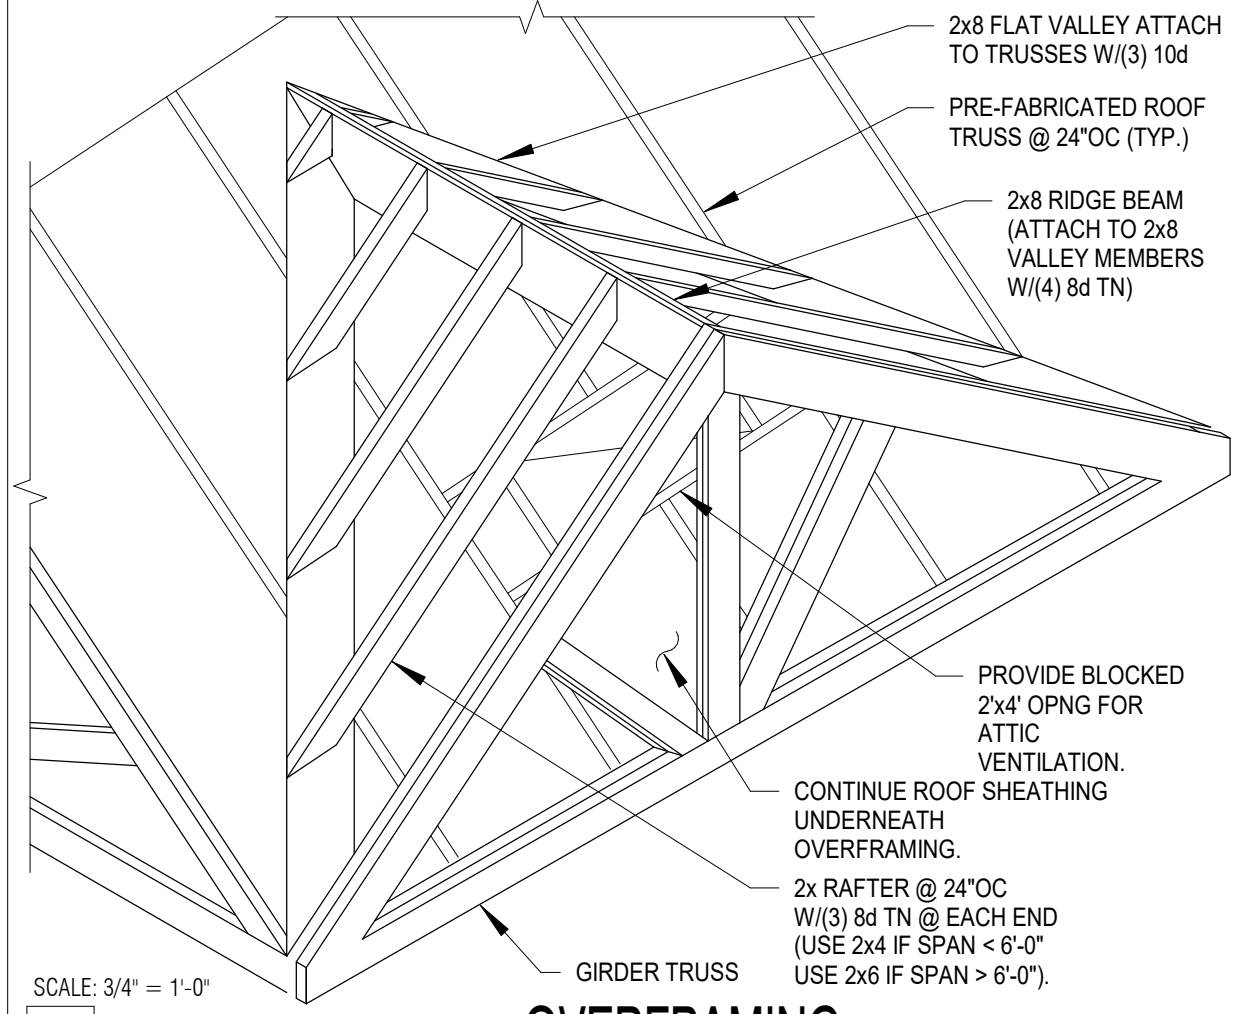

SCALE: 3/4" = 1'-0"  
**4** OVERFRAMING

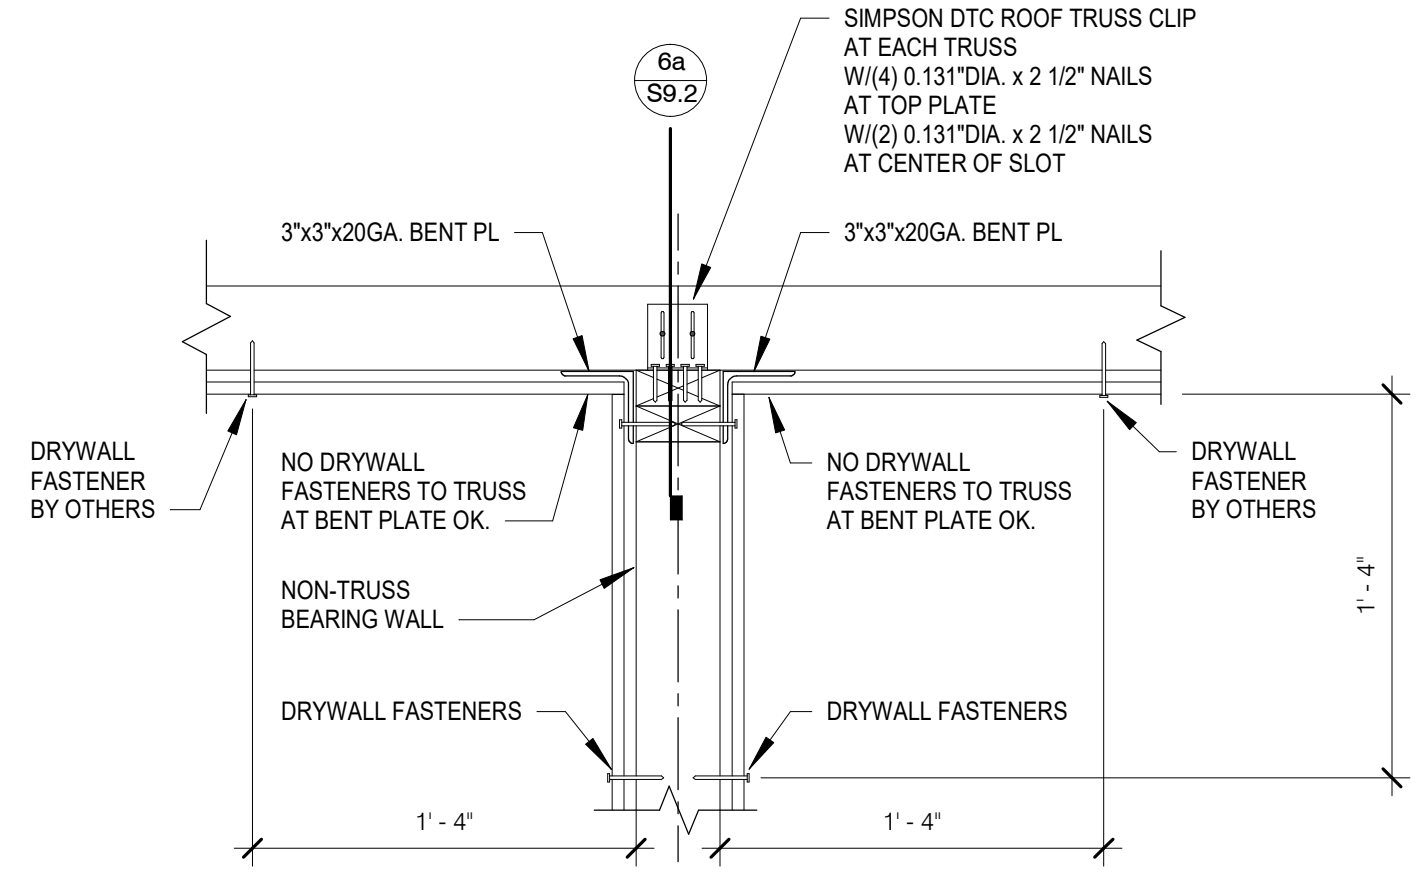


SCALE: 1 1/2" = 1'-0"  
**6** TYPICAL NON-BEARING WALL TO TRUSS

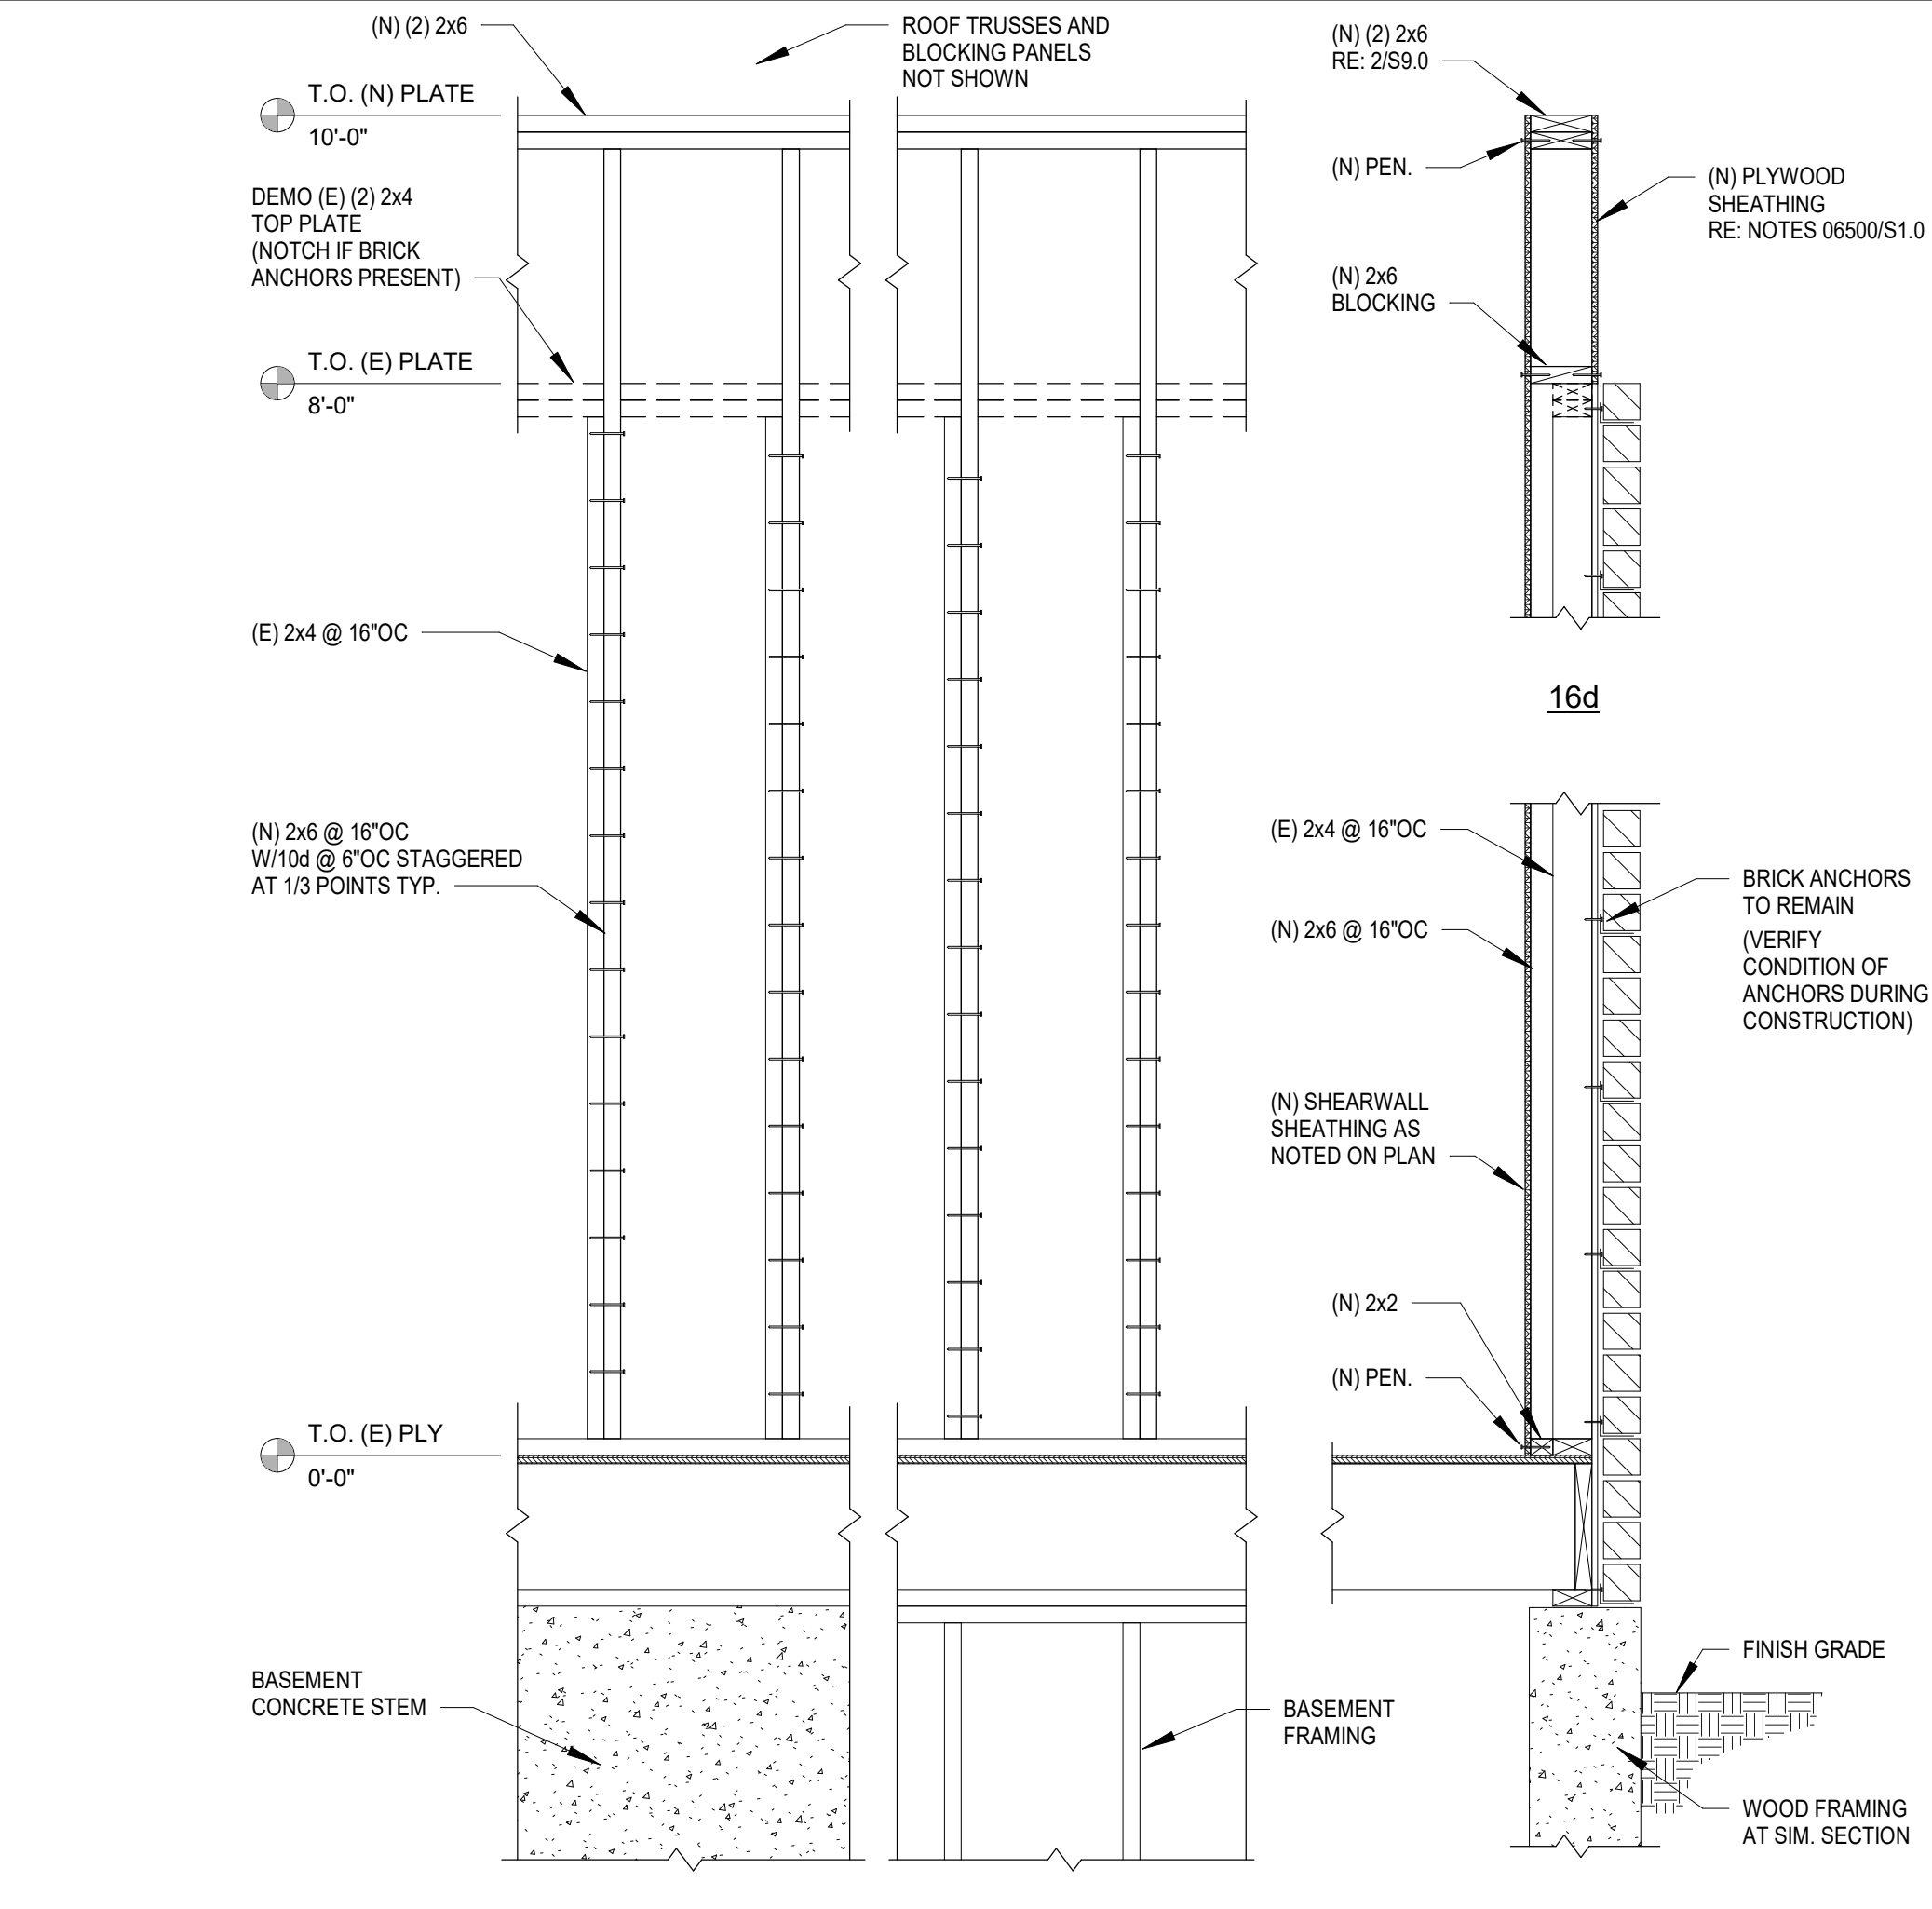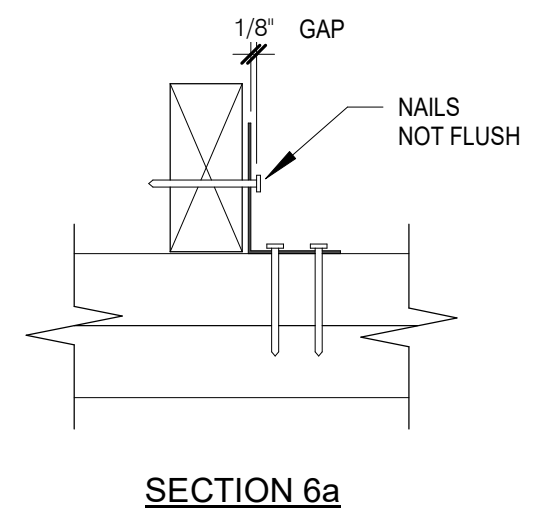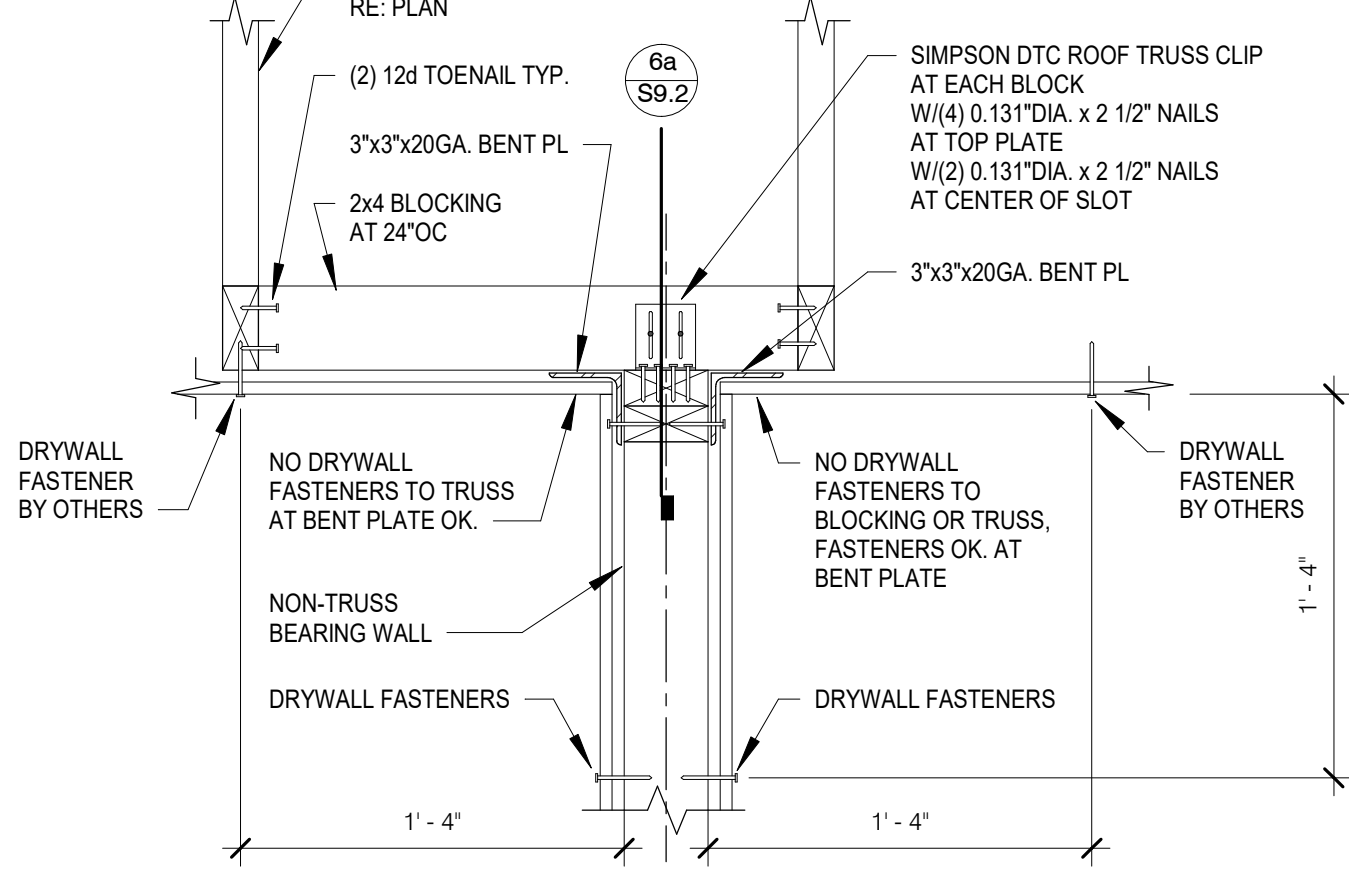

SCALE: 3/4" = 1'-0"  
**16** TYPICAL SISTERING OF (E) 2x4 EXTERIOR WALLS

**CT ENGINEERING INC.**  
 Structural Engineers  
 180 N. Jackson Street, Suite 302, Seattle, WA 98109  
 206.265.4512 (V) 206.265.0616 (F)  
 www.ctengineering.com

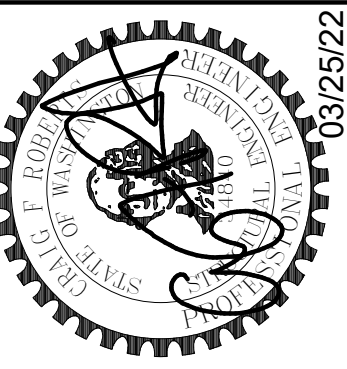

No.	REVISION	DATE

JOB #:	21162
ENG.:	Designer
CAD:	Author
SCALE:	As indicated
KEY ISSUE DATES:	
SD:	SD
BD:	CD
PERMIT:	03/25/2022
OTHER:	BD




Typical Wood Framing Details  
 PIPER REMODEL  
 8429 SE 33RD PLACE  
 MERCER ISLAND, WA 98040


**S9.2**

6/14/2022 4:16:57 PM  
 C:\Users\jrb\OneDrive\Documents\Address\STRUCT121162 Piper Residence Address (S) 01.dwg




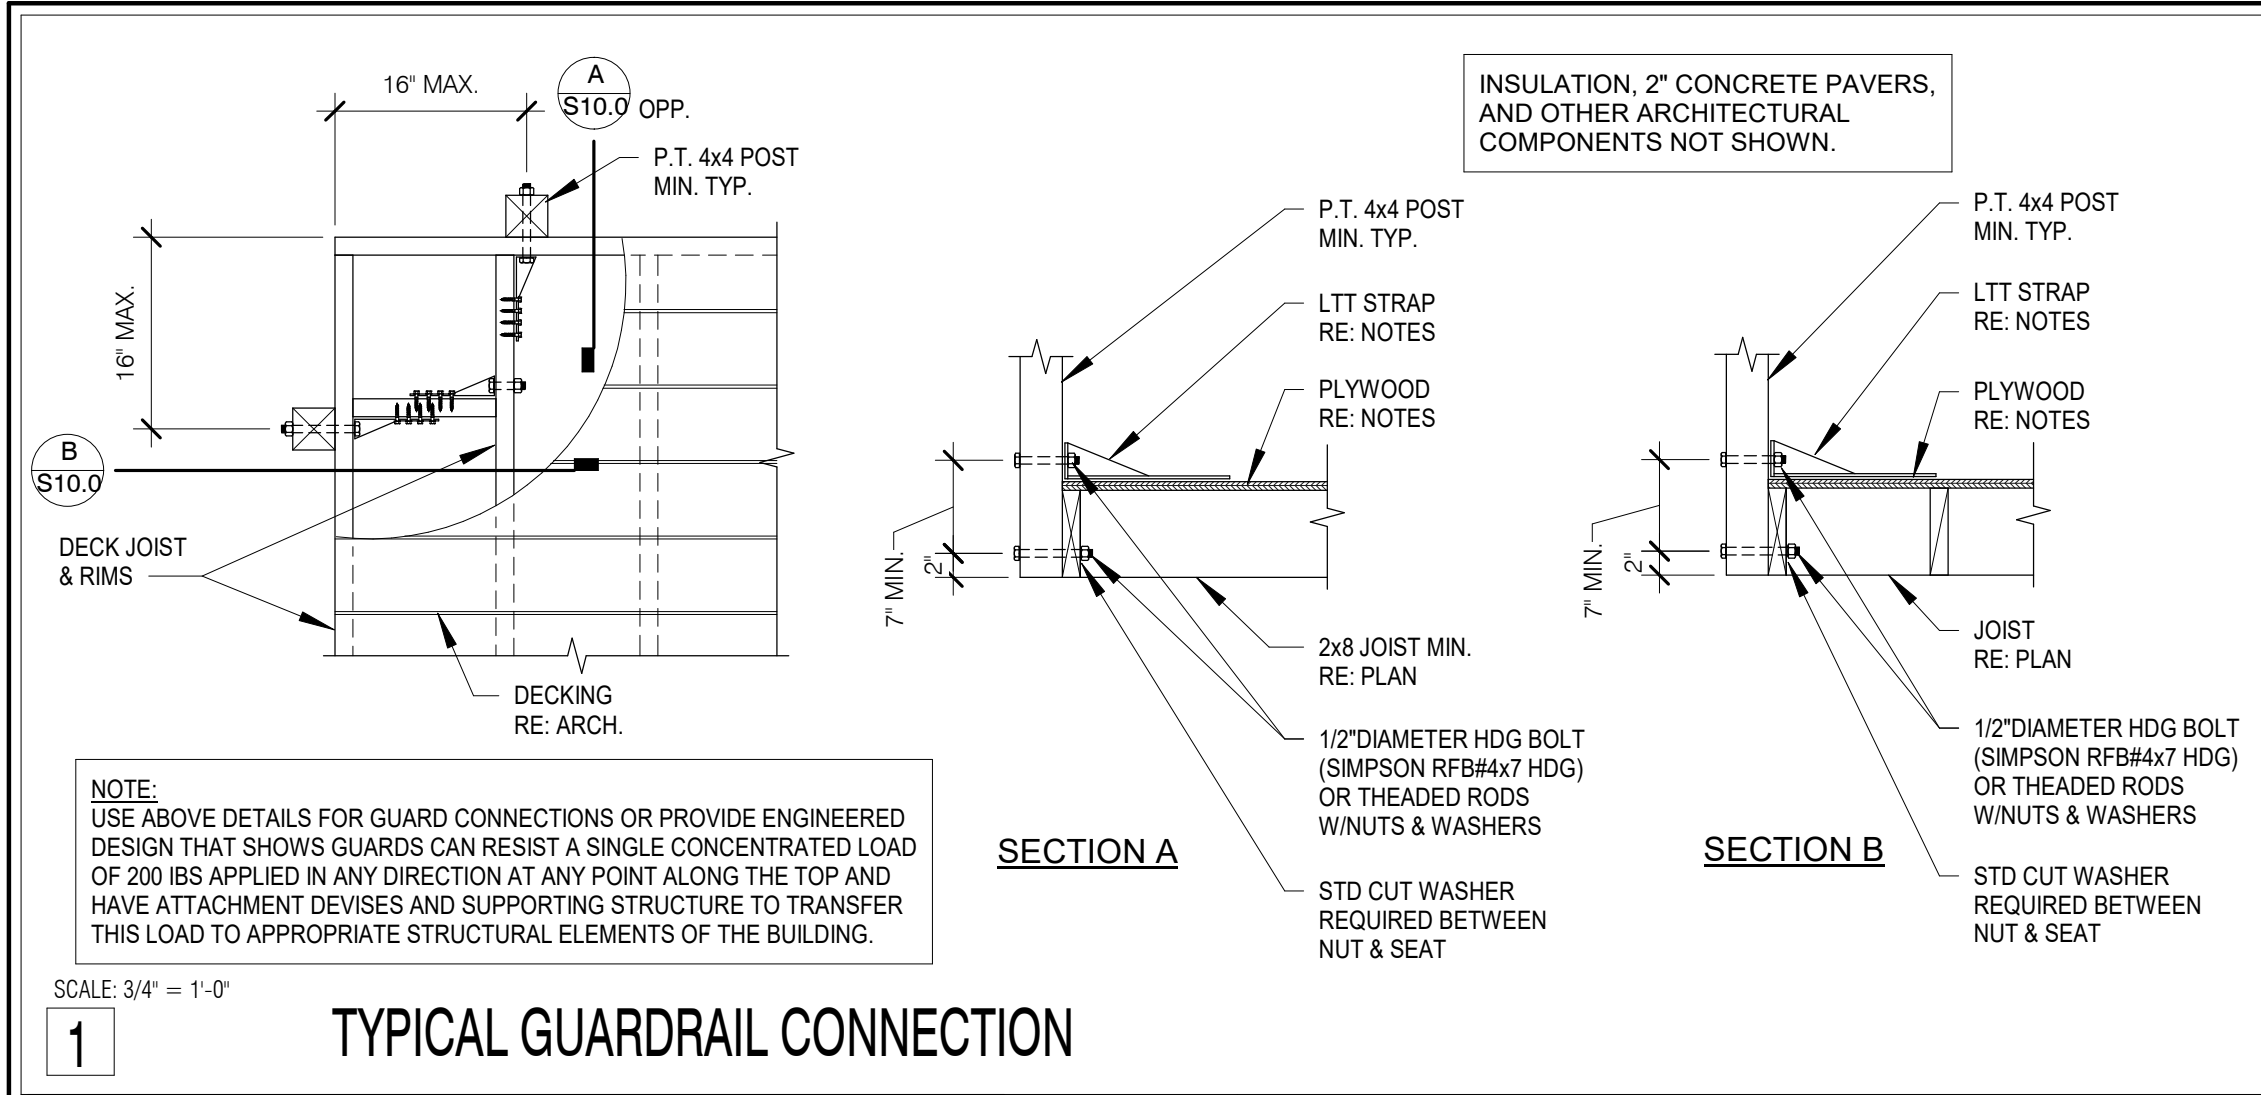


**1** TYPICAL GUARDRAIL CONNECTION  
SCALE: 3/4" = 1'-0"

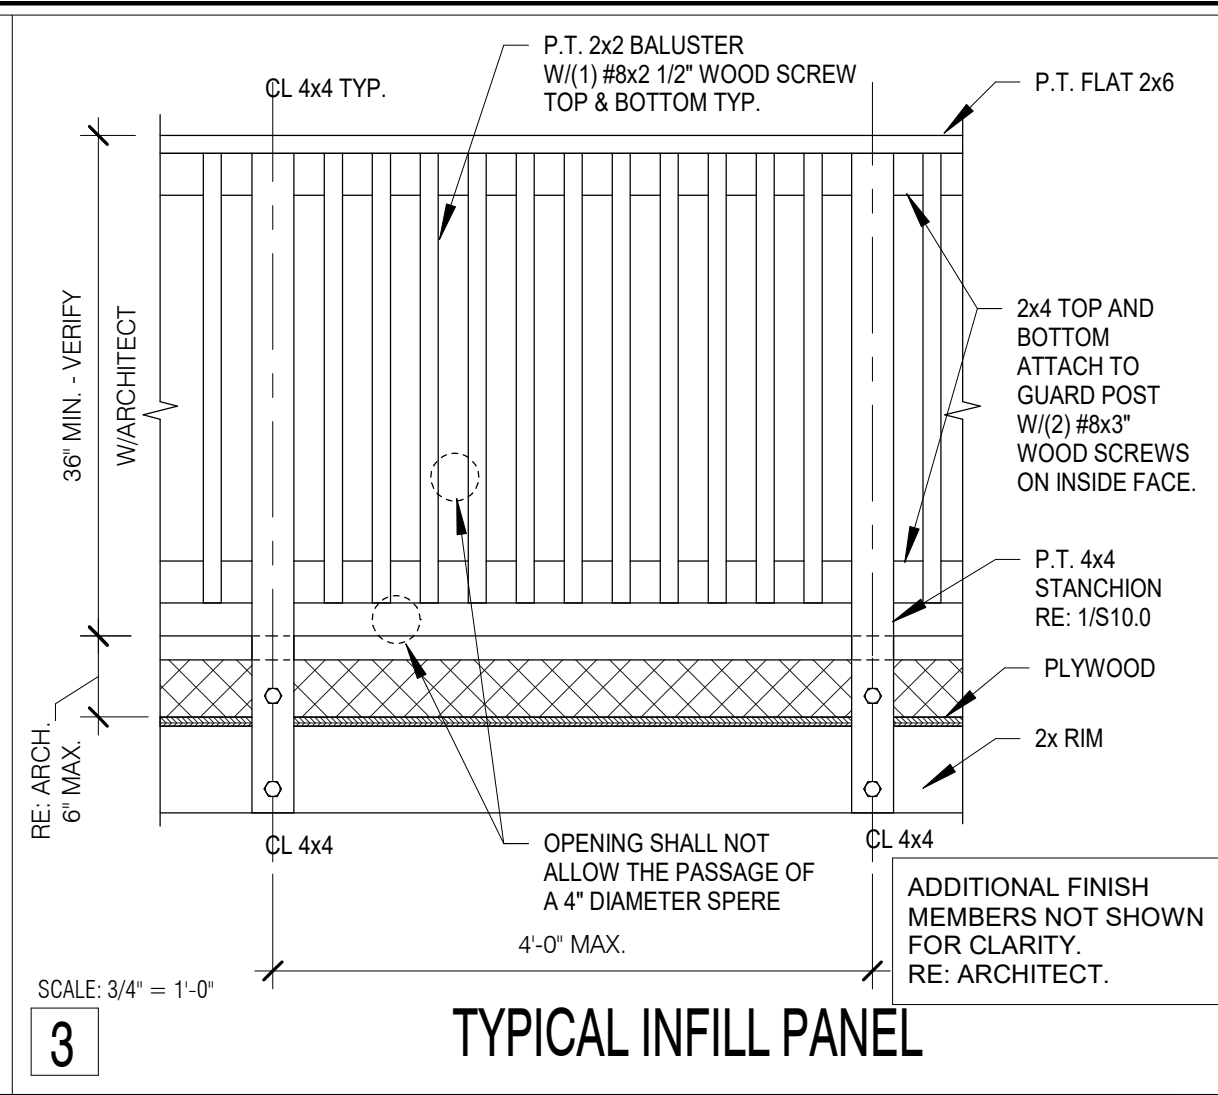


**3** TYPICAL INFILL PANEL  
SCALE: 3/4" = 1'-0"

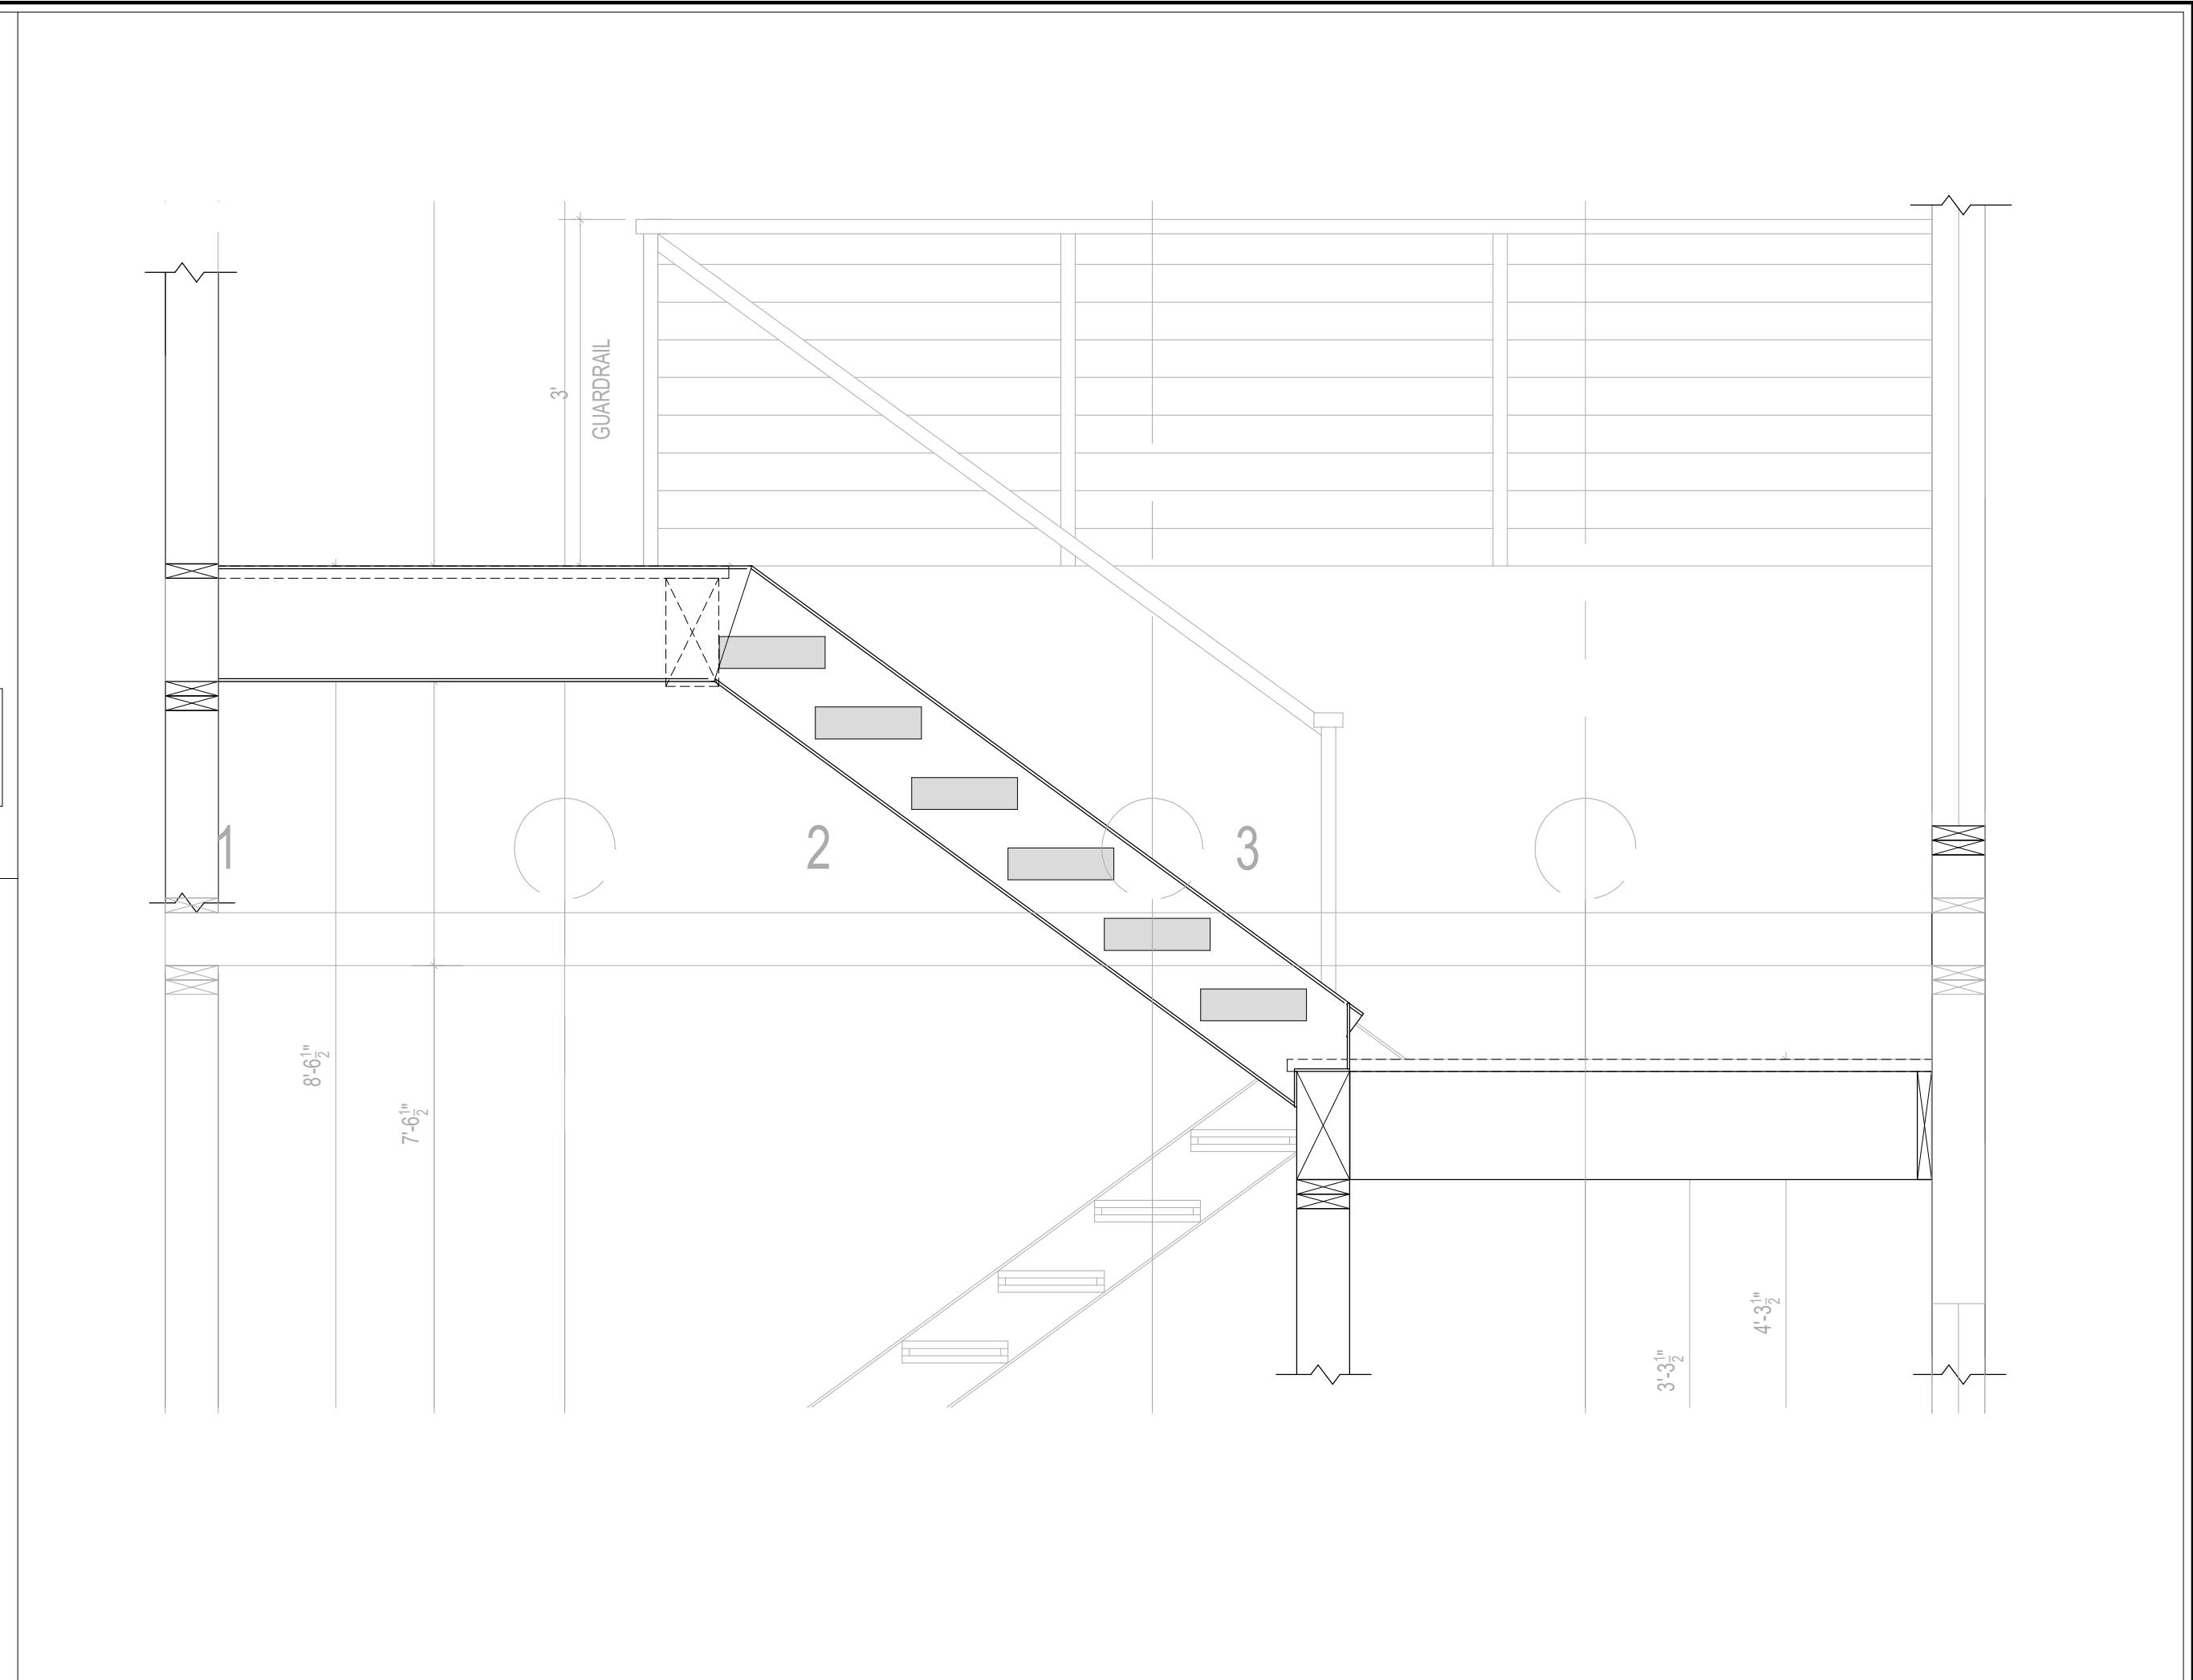

**9** TYPICAL STAIR FRAMING  
SCALE: 3/4" = 1'-0"

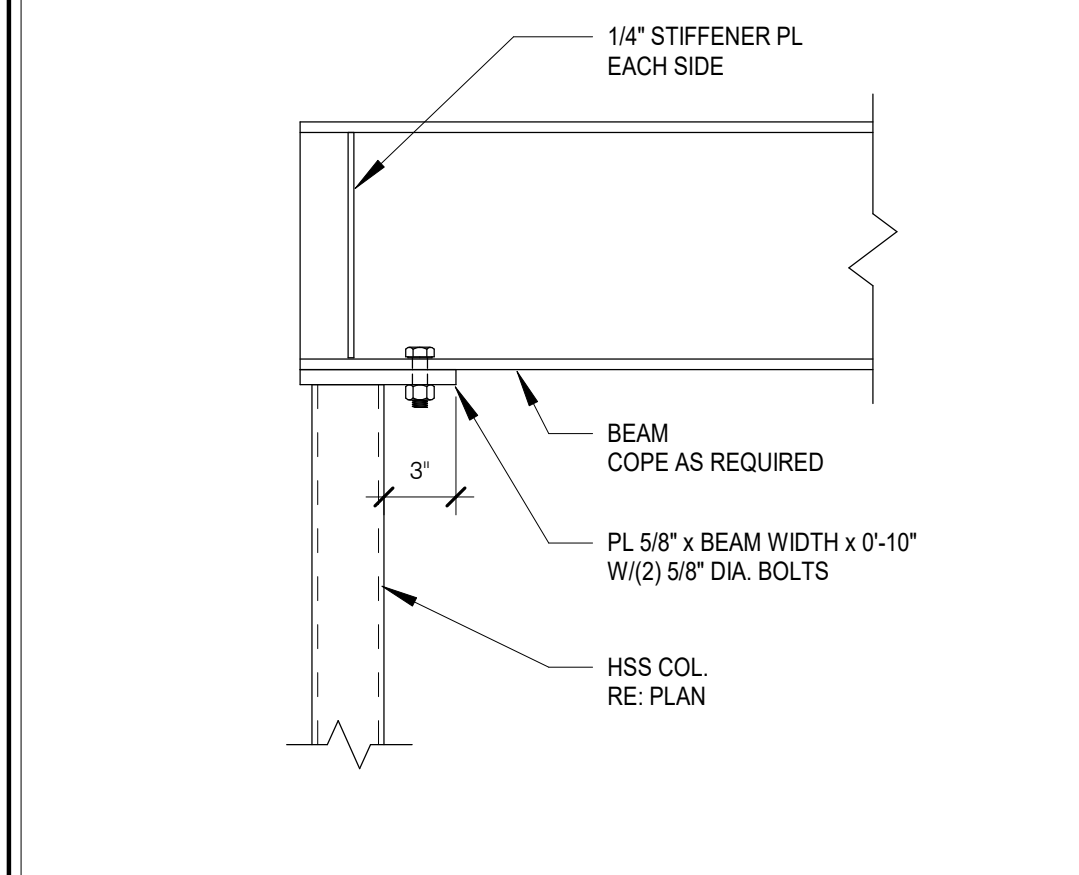


**4** TYPICAL COLUMN TO END BEAM  
SCALE: 1 1/2" = 1'-0"

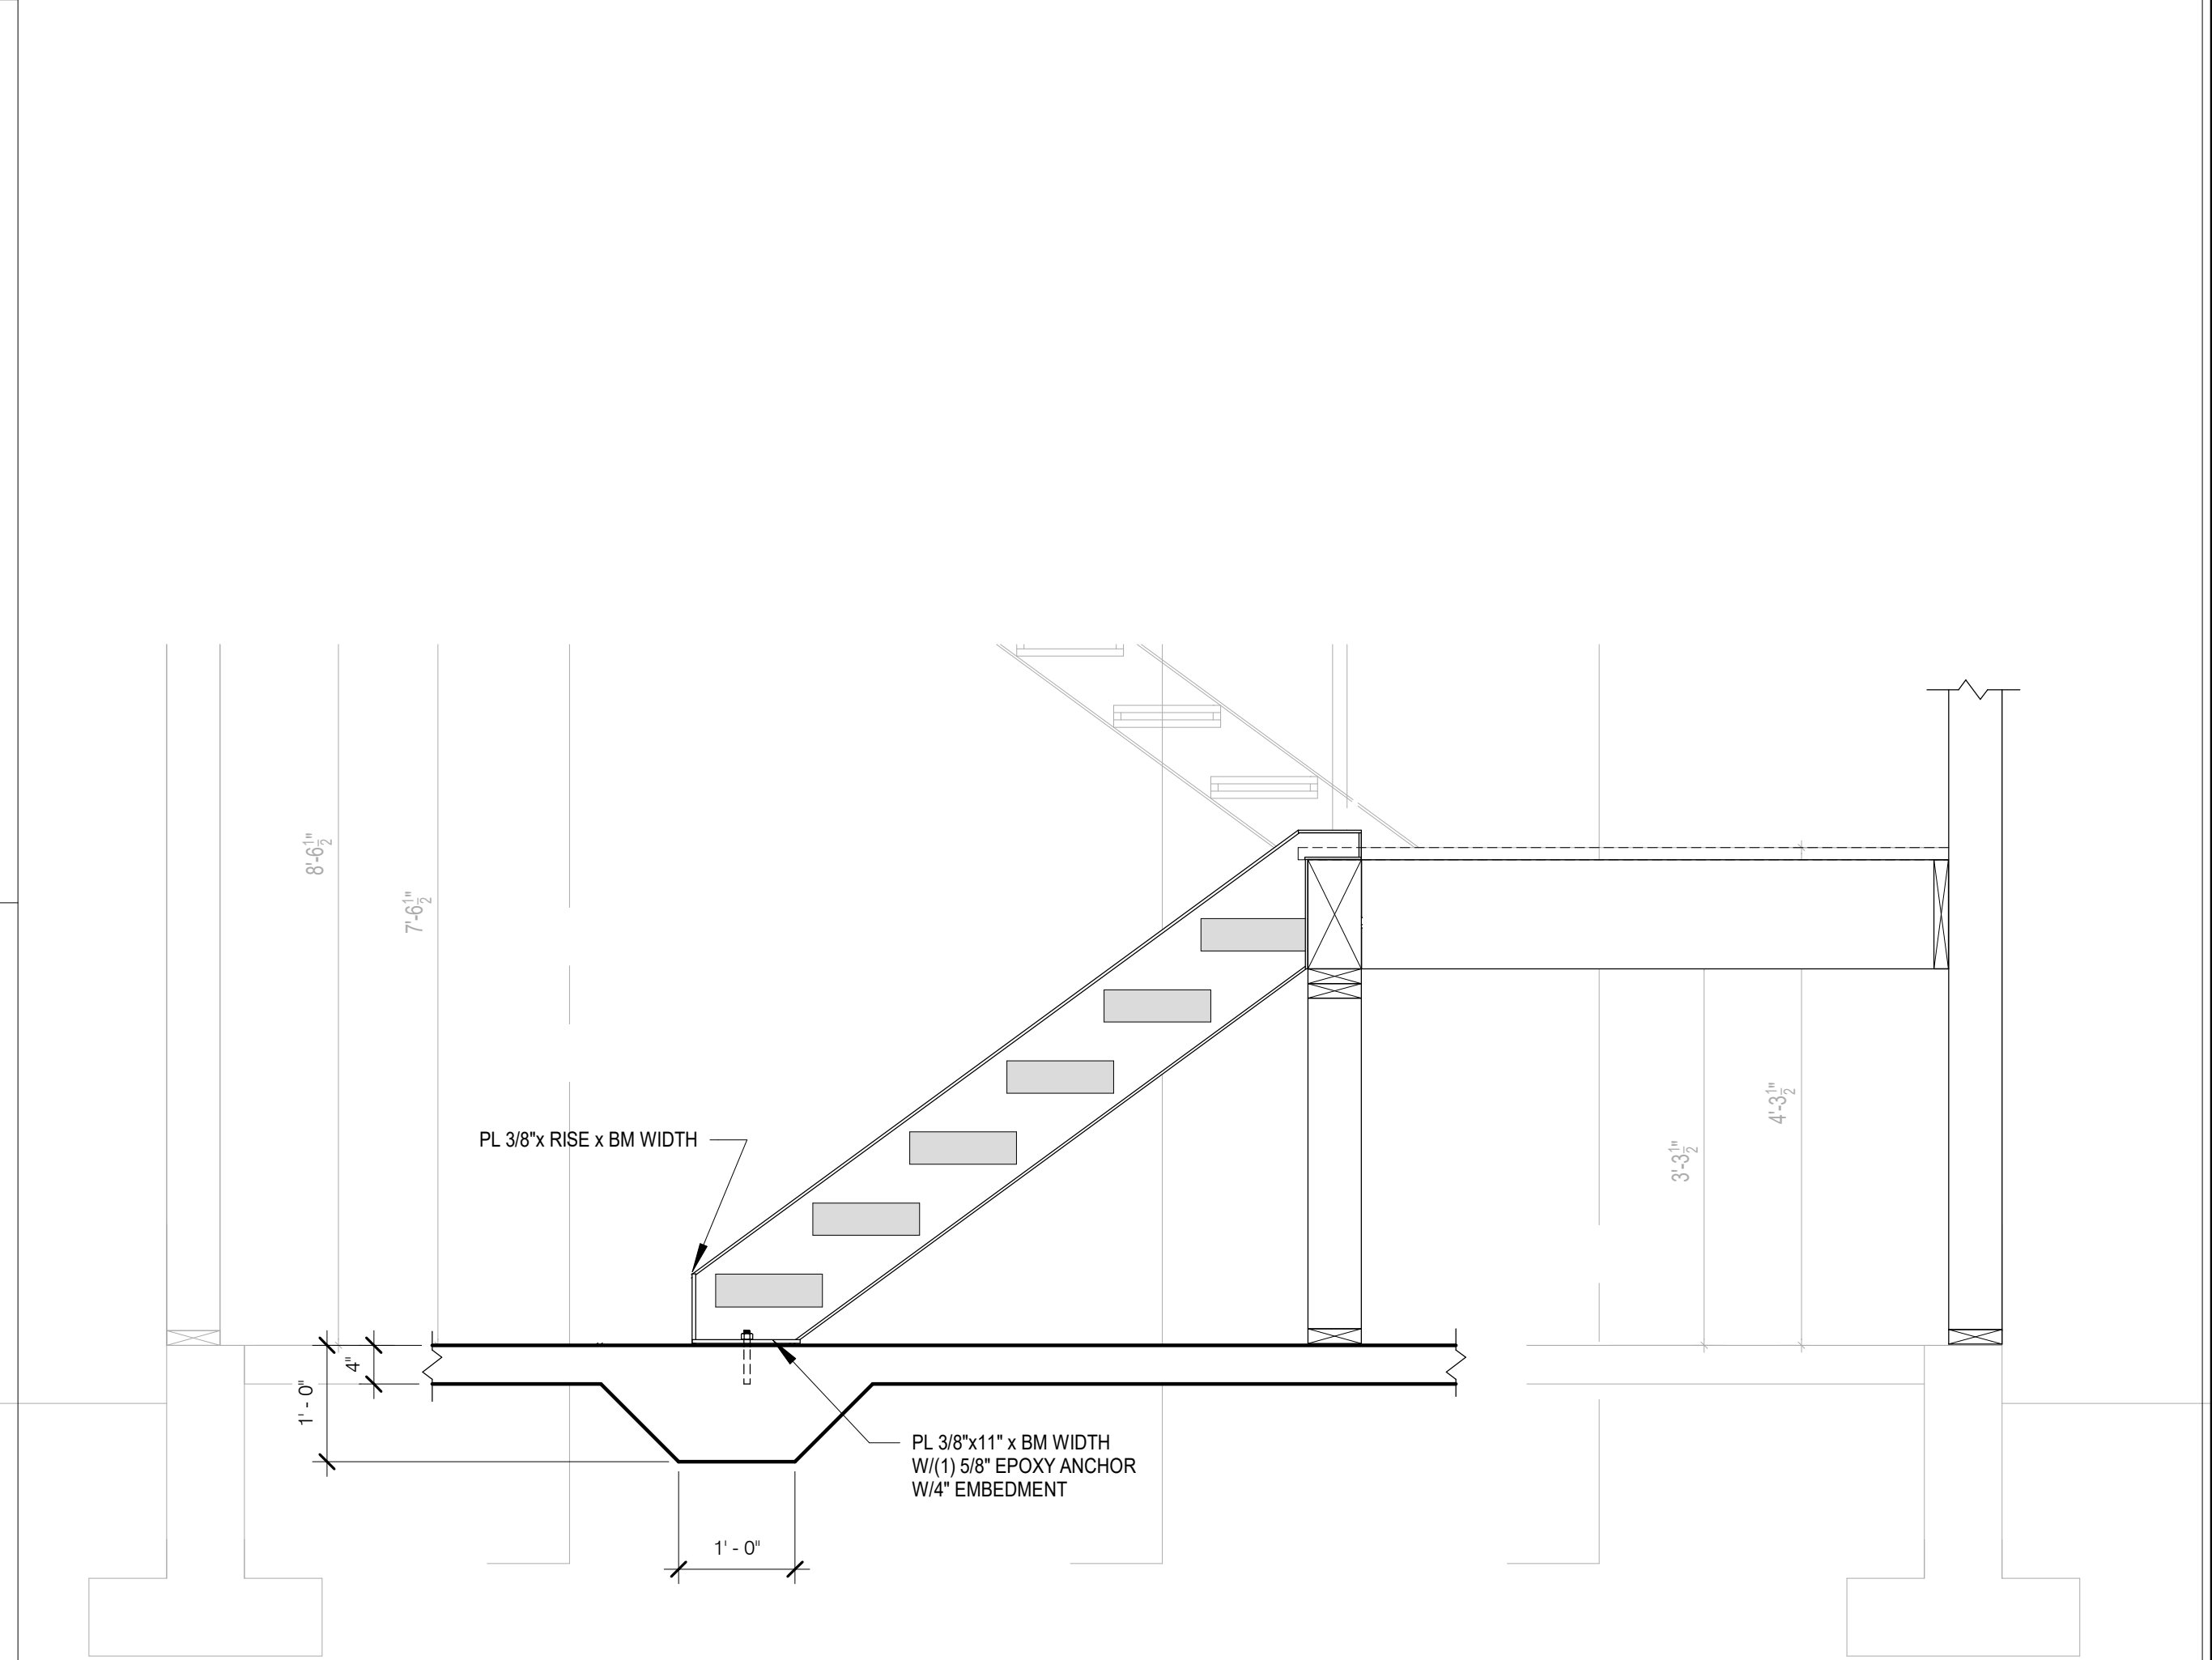

**19** TYPICAL STAIR FRAMING  
SCALE: 3/4" = 1'-0"

**CT ENGINEERING INC.**  
Structural Engineers  
180 Nockeson Street, Suite 302, Seattle, WA 98109  
206.265.4512 (V) 206.265.0616 (F)  
www.ctengineering.com

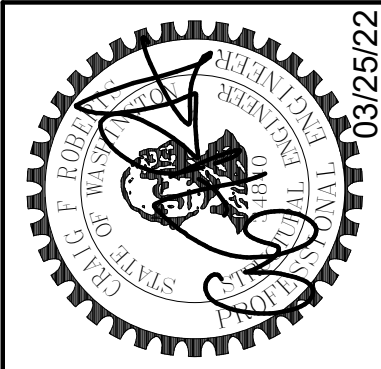

No.	REVISION	DATE

JOB #:	21162
ENG:	BJM
CAD:	JMA
SCALE:	As indicated
KEY ISSUE DATES:	
	SD
	BD
	CD
PERMIT:	03/25/2022
OTHER:	BD




Typical Components  
PIPER REMODEL  
8429 SE 33RD PLACE  
MERCER ISLAND, WA 98040

**S10.0**



# TOPOGRAPHIC MAP

THE NW 1/4 OF THE SW 1/4 OF SECTION 7, TOWNSHIP 24 NORTH, RANGE 5 EAST, W.M.  
KING COUNTY, WASHINGTON

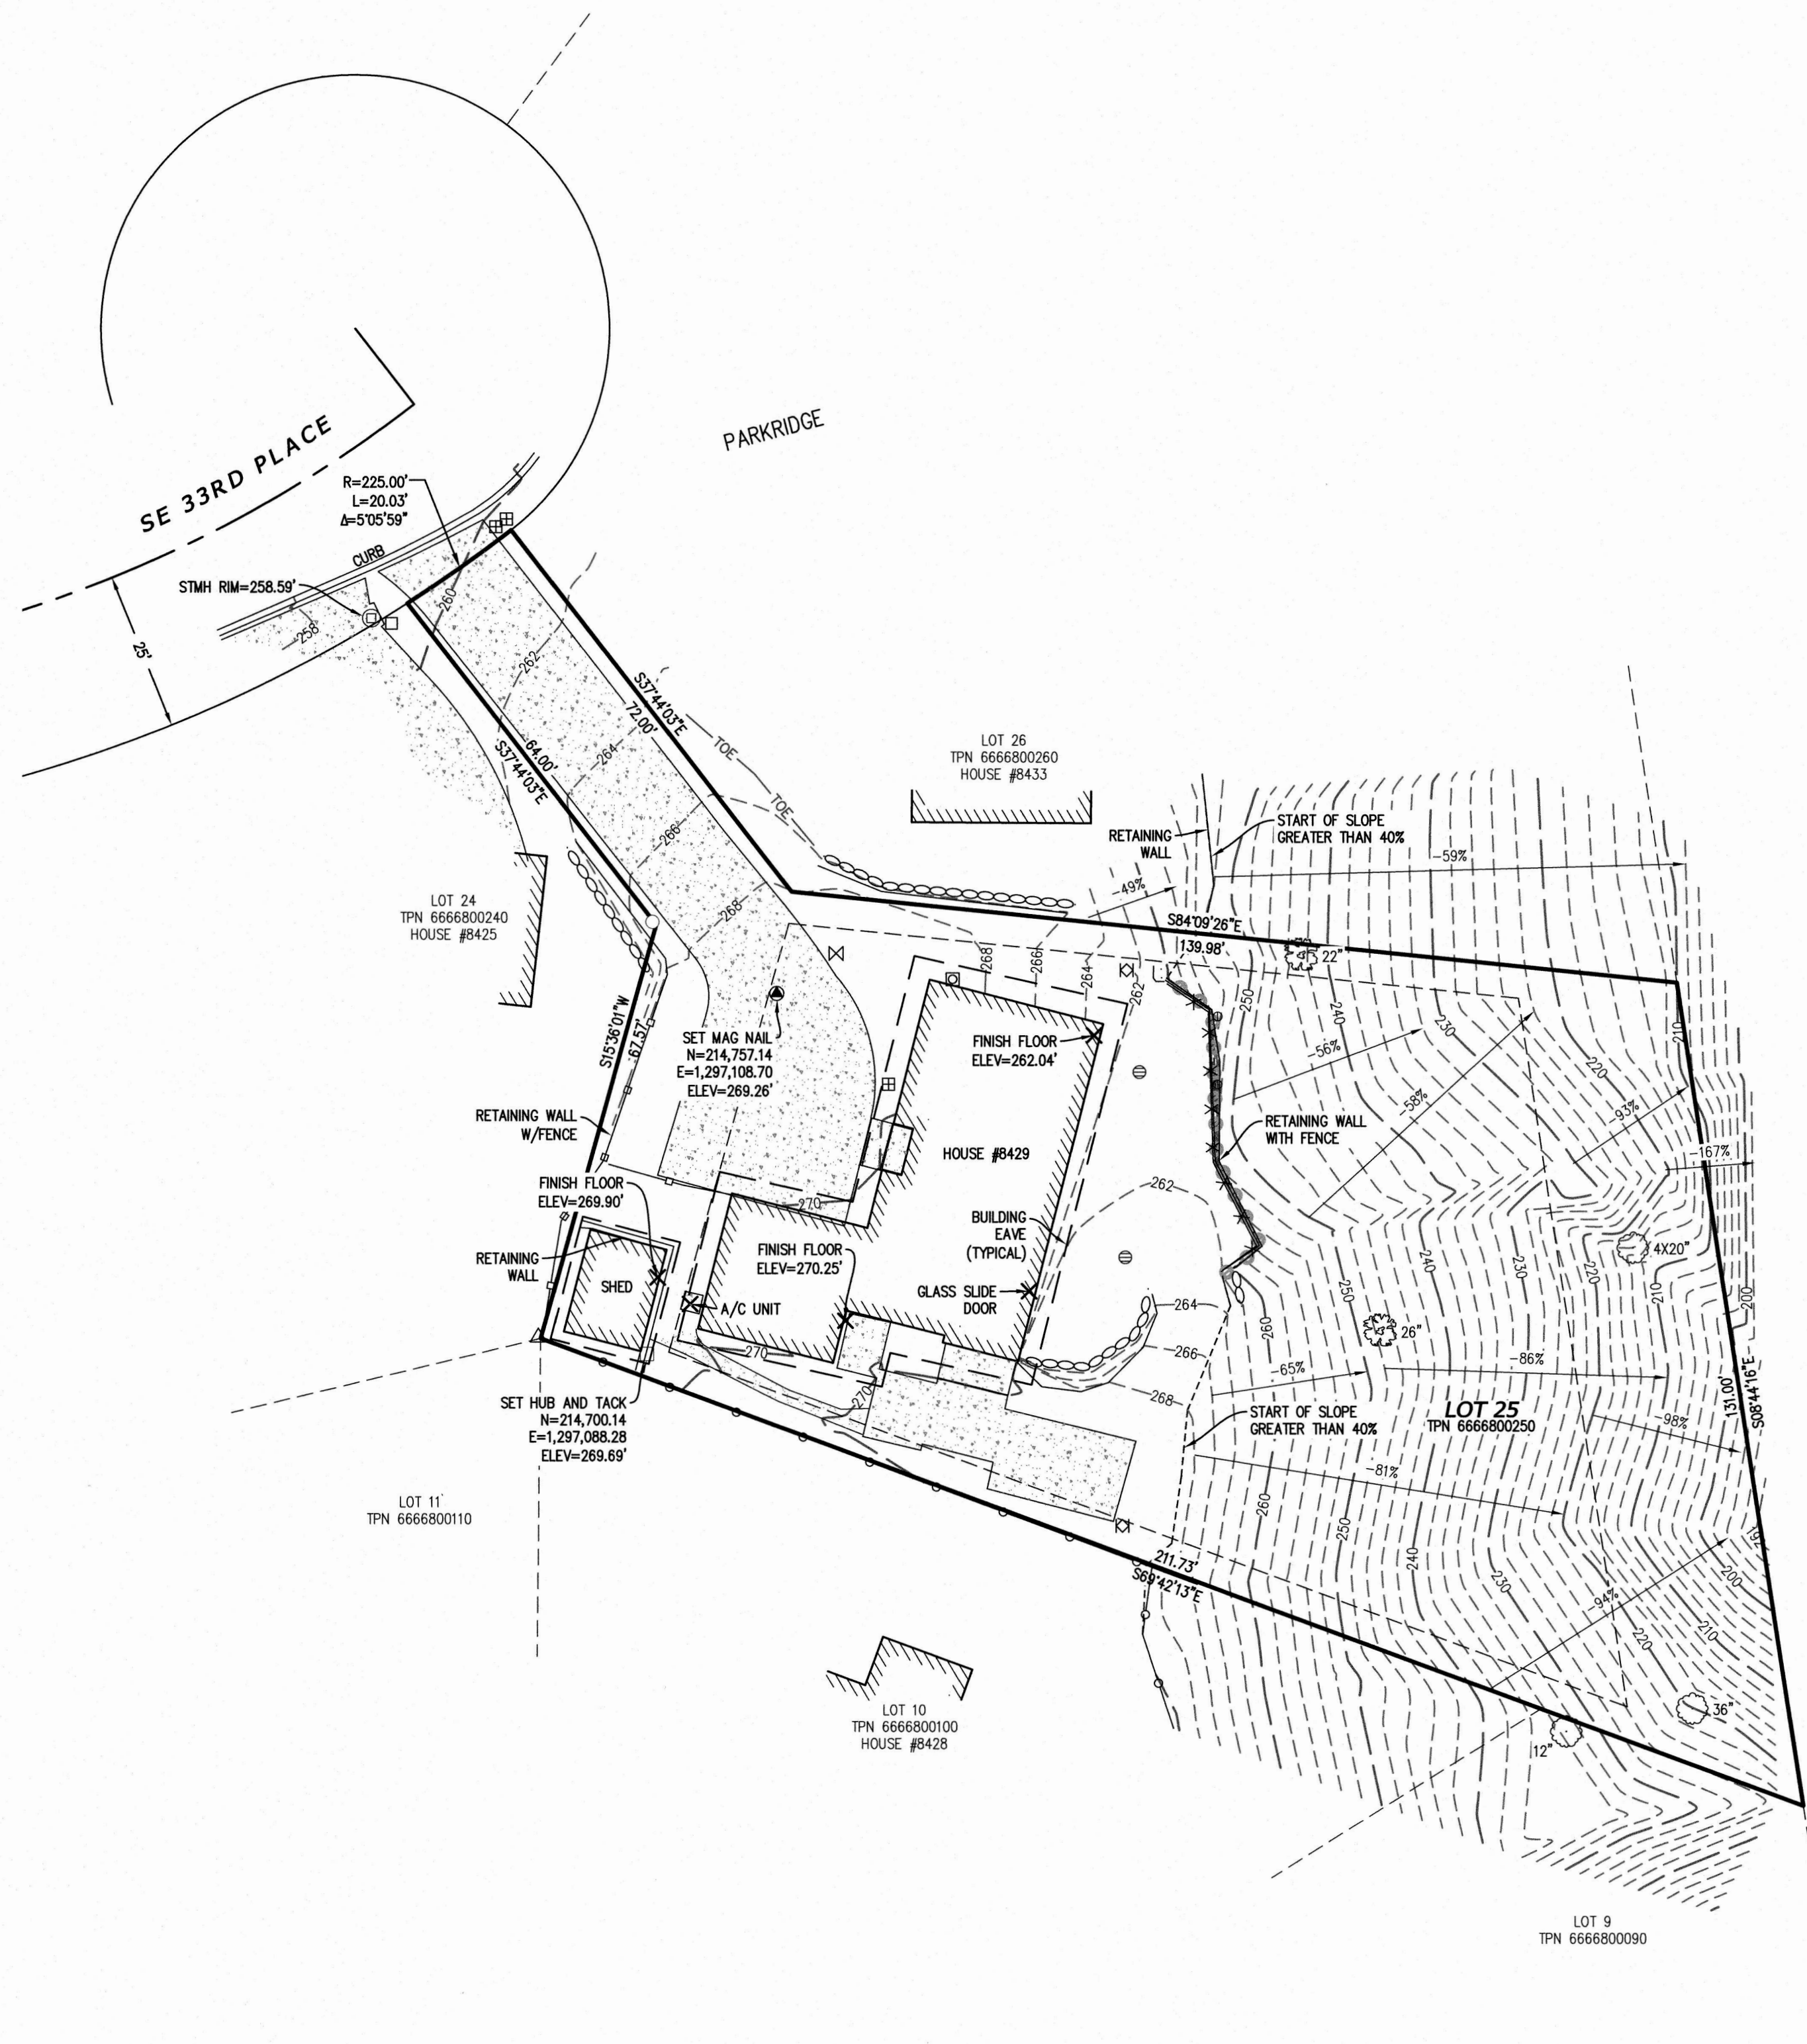

### LEGAL DESCRIPTION

PER WARRANTY DEED, KING COUNTY RECORDING NO. 20200410000015  
LOT 25 OF PARKRIDGE, AS PER PLAT RECORDED IN VOLUME 78 OF PLATS, PAGES 29 AND 30, RECORDS OF KING COUNTY.  
SITUATE IN THE CITY OF MERCER ISLAND, COUNTY OF KING, STATE OF WASHINGTON.

### HORIZONTAL DATUM

WASHINGTON STATE PLANE COORDINATE SYSTEM, NORTH ZONE (NAD 83/2011) BASED ON RTK GPS MEASUREMENTS CONSTRAINED TO THE WASHINGTON STATE REFERENCE NETWORK.

### VERTICAL DATUM


NAVD 88 BASED ON RTK GPS MEASUREMENTS CONSTRAINED TO THE WASHINGTON STATE REFERENCE NETWORK.

### SURVEY NOTES


- DATA FOR THIS SURVEY WAS GATHERED BY FIELD TRAVERSE UTILIZING ELECTRONIC DATA COLLECTION, AND MEETS OR EXCEEDS ACCURACY REQUIREMENTS CONTAINED IN W.A.C. 332.130.090. ALL MEASURING INSTRUMENTS EMPLOYED IN THIS SURVEY HAVE BEEN MAINTAINED IN ACCORDANCE WITH MANUFACTURER'S SPECIFICATIONS.
- THIS MAP GRAPHICALLY REPRESENTS CONDITIONS AND FEATURES EXISTING AT THE TIME OF THIS SURVEY ONLY, WHICH WAS PERFORMED DURING DECEMBER OF 2021.
- THE CERTIFICATION OF THIS SURVEY AND MAP IS EXCLUSIVE TO THE NAMED CLIENT WHO REQUESTED THIS SURVEY. IT WAS SPECIFICALLY DESIGNED TO MEET THEIR STATED NEED(S). THAT CERTIFICATION DOES NOT EXTEND TO ANY OTHER PARTIES OR FOR ANY ALTERNATIVE USE OF THIS MAP WITHOUT THE EXPRESS RECERTIFICATION BY THE SURVEYOR NAMING THOSE PARTIES.
- THE PURPOSE OF THIS SURVEY IS TO PROVIDE A TOPOGRAPHIC MAP OF THE EXISTING CONDITIONS WITHIN KING COUNTY PARCEL #6666800250 FOR PLANNING, DESIGN AND CONSTRUCTION.
- UTILITIES OTHER THAN SHOWN MAY EXIST ON THE SITE. THE SURVEYOR DOES NOT WARRANT THAT THE UNDERGROUND UTILITIES SHOWN ARE IN THE EXACT LOCATION INDICATED. LACKING EXCAVATION, THE EXACT LOCATION OF UNDERGROUND FEATURES CANNOT BE ACCURATELY, COMPLETELY, AND RELIABLY DEPICTED. WHERE ADDITIONAL OR MORE DETAILED INFORMATION IS REQUIRED, THE CLIENT IS ADVISED THAT EXCAVATION MAY BE NECESSARY. THE SURVEYOR DOES CERTIFY THAT THEY ARE SHOWN AS ACCURATELY AS POSSIBLE FROM FIELD SURVEY INFORMATION.
- PARCEL AREA: 19,304 ± SQ.FT. (0.44 ACRES)
- ALL DISTANCES AND DIMENSIONS SHOWN ARE U.S. SURVEY FEET GROUND MEASUREMENTS.
- CONTOUR INTERVALS ARE 2-FOOT AND ARE COMPUTER GENERATED FROM GROUND FIELD TOPOGRAPHY GATHERED FOR THIS SURVEY UTILIZING ELECTRONIC DATA COLLECTION.
- THE PROPERTY AND RIGHT-OF-WAY LINES SHOWN HEREON ARE BASED ON FIELD TIES TO SEVERAL OF THE ORIGINAL PLAT MONUMENTS, FROM WHICH WE CONDUCTED A MATHEMATICAL CALCULATION OF THE PARCEL BASED ON THE GEOMETRY OF THE RECORDED PLAT MAP. NO PROPERTY CORNERS WERE ESTABLISHED DURING THIS SURVEY.
- WE HAVE USED GRAPHIC SYMBOLS TO REPRESENT SOME FEATURES ON THIS MAP, SUCH AS UTILITIES, TREES AND FENCES. THE DEFAULT SIZE OF THOSE SYMBOLS MAY NOT REFLECT THE TRUE SIZE OF THE FEATURE THAT WAS MAPPED.

### LEGEND

- TPN TAX PARCEL NUMBER
- FOUND REBAR & CAP, LS #38992
- △ FOUND SURVEY NAIL, LS #3135
- SET MAG NAIL - AS NOTED
- SET HUB AND TACK - AS NOTED
- BOUNDARY LINE
- - - ADJONER PROPERTY BOUNDARY
- RIGHT OF WAY LINE
- ROAD CENTERLINE
- - - BUILDING SET BACK LINE
- DECIDUOUS TREE (DIAMETER AS NOTED)
- MAPLE TREE (DIAMETER AS NOTED)
- PILING
- WOOD FENCE
- CHAIN LINK FENCE
- SPLIT RAIL FENCE
- STORM MANHOLE
- STORM YARD DRAIN
- 4" PVC STORM ROOF DRAIN
- TELEPHONE RISER
- GAS METER
- WATER VALVE
- WATER METER
- IRRIGATION CONTROL VALVE
- ROCKERY
- CONCRETE SURFACE
- GRAVEL SURFACE

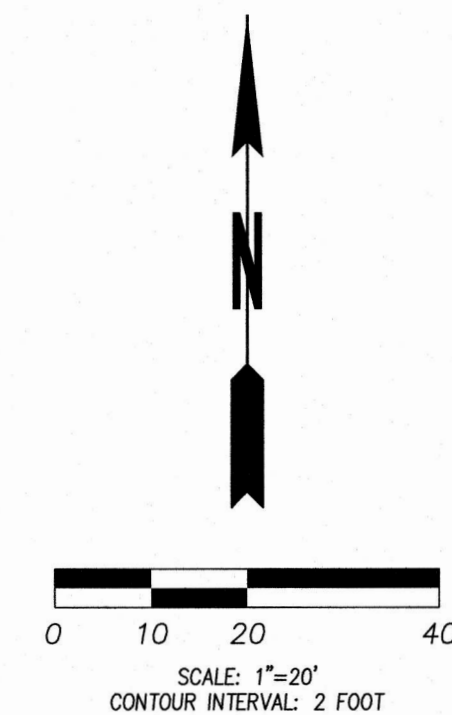

REV NO	REVISION DESCRIPTION	DATE BY
1	ADDED STEEP SLOPE INFORMATION	12/17/21 BFM

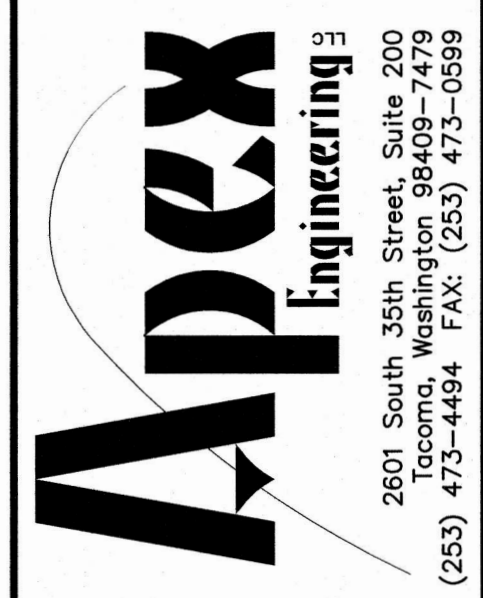

**TOPOGRAPHIC SURVEY**

**KEVIN AND SUZETTE PIPER**  
8429 SE 33RD PLACE  
MERCER ISLAND, WASHINGTON 98040

**TITLE**

**CLIENT**

**DATE SEALED** 12/20/2021



**PROJECT MANAGER**  
KAP

**DESIGN**

**DRAWN** BFM

**CHECKED** KAP

**SEC** 7 **T** 24 **N** R 5 **E**

**FILE NO** 35970

**DATE** 12/20/2021

**SCALE** 1" = 20'

**SHEET 1 OF 1**

**FILE NO** 35970

© APEX ENGINEERING LLC 2021

**SURVEYOR'S CERTIFICATE**  
I HEREBY CERTIFY THAT THIS MAP CORRECTLY REPRESENTS A TOPOGRAPHIC SURVEY MADE BY ME OR UNDER MY DIRECTION AND TO THE BEST OF MY KNOWLEDGE REPRESENTS THE TOPOGRAPHIC FEATURES AS THEY EXIST ON THE GROUND AS OF 12/3/2021.

KAP 12/20/2021  
KURT A PARGHER P.L.S. NO. 49286 DATE