


Owner Leo Diamond Address 7210 N. Mercer Way Contractor _____

Date Permit Issued _____ Date Job Completed and Accepted _____ By _____

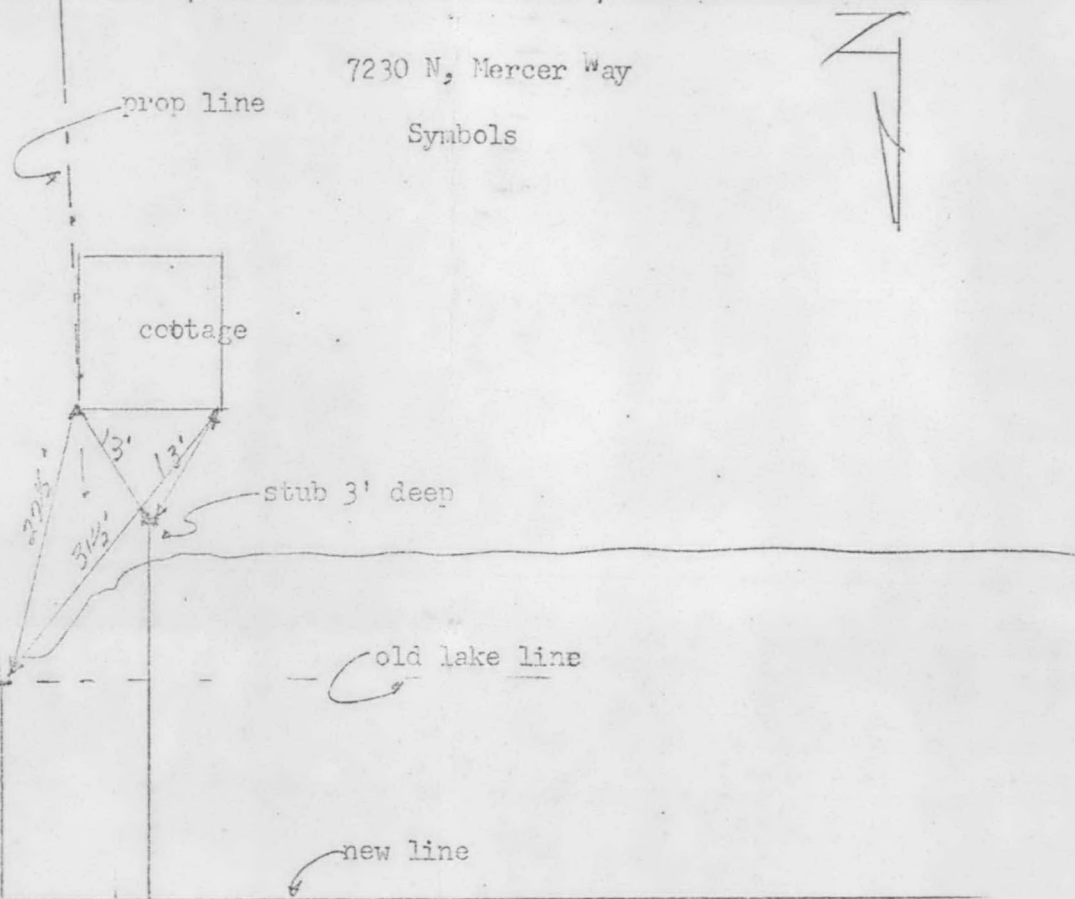

1. Commercial or Domestic _____ Joint _____ 14'
2. Dist. from property line to sewer main _____
3. Dist. from house bldg. line to property line _____ STA 1048.89
4. Min. grade from main to property line _____ From property line _____
5. Dist. of M. H. No. _____ to Wye _____
6. Depth of sewer main to wye _____
7. Basement _____ Basement connection _____
8. Depth of pipe at house connection _____
9. Type of pipe _____ Size of pipe _____
10. Remarks _____

STA 11402.9

COMMERCIAL ONLY

1. Name _____
2. Type _____
3. Frontage _____
4. No. of Floors _____
5. Remarks _____

MERCER ISLAND SEWER DISTRICT

SIDE SEWER PLAT

PERMIT No. 102

AD2-8493

Owner Geo Diamond


Address 7240 N. Alvarado Way

Contractor Geo. Palfley

Date Permit Issued

Date Job Completed & Accepted

Sept 6, '56 By J. Bedlow

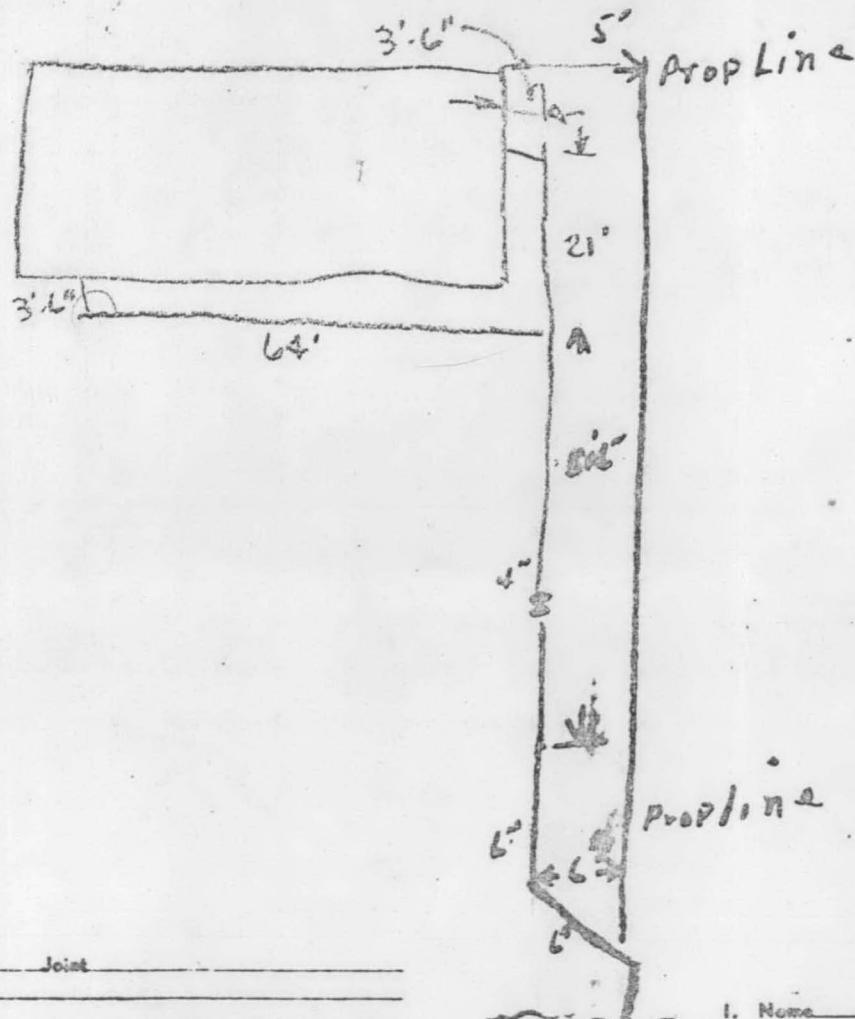

1. Commercial or Domestic _____ Joint _____
2. Dist. from property line to sewer main _____
3. Dist. from house bldg. line to property line _____
4. Min. grade from main to property line $5\frac{1}{2}\%$ From property line $over 2\%$
5. Dist. of M. H. No. _____ to Wye _____
6. Depth of sewer main to wye _____
7. Basement _____ Basement connection _____
8. Depth of pipe at house connection $3'$
9. Type of pipe _____ Size of pipe _____
10. Remarks _____

COMMERCIAL ONLY


1. Name _____
2. Type _____
3. Frontage _____
4. No. of Floors _____
5. Remarks _____

PERMIT No.

AD 2-8493

Owner Lois Diamond Address 7240 1/2 Mercer way Contractor Geo. Piffik

Date Permit Issued Aug 31 Date Job Completed & Accepted Sept 6-56 By Beddow

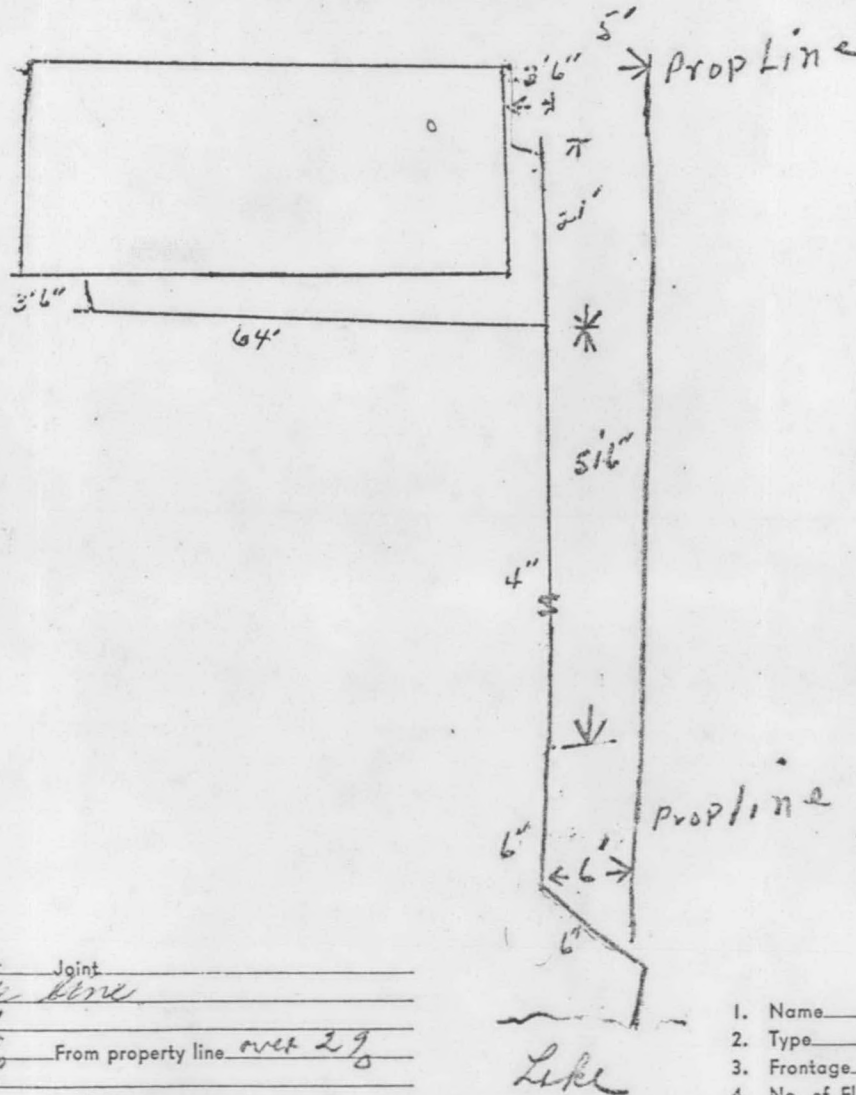

1. Commercial or Domestic _____ Joint _____
2. Dist. from property line to sewer main Like above
3. Dist. from house bldg. line to property line 5'
4. Min. grade from main to property line over 2 1/2 From property line over 2 1/2
5. Dist. of M. H. No. _____ to Wye _____
6. Depth of sewer main to wye _____
7. Basement _____ Basement connection _____
8. Depth of pipe at house connection 5'
9. Type of pipe _____ Size of pipe _____
10. Remarks _____

COMMERCIAL ONLY

1. Name _____
2. Type _____
3. Frontage _____
4. No. of Floors _____
5. Remarks _____