



**DRAINAGE NOTES:**

- 1. PROOF OF LIABILITY INSURANCE SHALL BE SUBMITTED TO CITY PRIOR TO THE PRECONSTRUCTION MEETING.
2. ALL PIPE AND APPURTENANCES SHALL BE LAID ON A PROPERLY PREPARED FOUNDATION IN ACCORDANCE WITH WSDOT 7-02.3(1). THIS SHALL INCLUDE LEVELING AND COMPACTING THE TRENCH BOTTOM, THE TOP OF THE FOUNDATION MATERIAL, AND ANY REQUIRED PIPE BEDDING, TO A UNIFORM GRADE SO THAT THE ENTIRE PIPE IS SUPPORTED BY A UNIFORMLY DENSE UNYIELDING BASE.
3. STEEL PIPE SHALL BE GALVANIZED AND HAVE ASPHALT TREATMENT #1 OR BETTER INSIDE AND OUTSIDE
4. ALL DRAINAGE STRUCTURES, SUCH AS CATCH BASINS AND MANHOLES, NOT LOCATED WITHIN A TRAVELED ROADWAY OR SIDEWALK, SHALL HAVE SOLID LOCKING LIDS. ALL DRAINAGE STRUCTURES ASSOCIATED WITH A PERMANENT RETENTION/DETENTION FACILITY SHALL HAVE SOLID LOCKING LIDS.
5. ALL CATCH BASIN GRATES SHALL CONFORM TO WSDOT DRAWING NUMBERS B-35.20-00 AND B-35.40-00, WHICH INCLUDES THE STAMPING "OUTFALL TO STREAM, DUMP NO POLLUTANTS".
6. ROCK FOR EROSION PROTECTION OF ROADWAY DITCHES, WHERE REQUIRED, MUST BE OF SOUND QUARRY ROCK, PLACED TO A DEPTH OF 1 FOOT, AND MUST MEET THE FOLLOWING SPECIFICATIONS: 4"- 8" ROCK/40%-70% PASSING; 2"-4" ROCK/30%-40% PASSING; AND -2" ROCK/10%-20% PASSING. INSTALLATION SHALL BE IN ACCORDANCE WITH WSDOT STANDARDS

**PERMANENT SEEDING NOTES**

- 1. SEEDING SHOULD BE DONE IMMEDIATELY AFTER FINAL SHAPING IF COMPLETED DURING THE PERIODS OF APRIL 1 THROUGH JUNE 30 AND SEPTEMBER 1 THROUGH OCTOBER 1 (IF PLANTED BETWEEN JULY 1 AND AUGUST 31 IRRIGATION MAY BE REQUIRED). SITES WHICH CANNOT BE SEEDD DURING THIS TIME PERIOD SHOULD BE PROTECTED UNTIL THE NEXT SEEDING PERIOD WITH MULCH.
2. PERMANENT VEGETATION MAY BE IN THE FORM OF GRASS SEED MIXTURES, SOD, OR WETLANDS SEED/TUBER MIXTURES. SEED ESTABLISHMENT SHALL INCLUDE THE USE OF SUPPLEMENTAL MATERIALS, SUCH AS MULCH.
3. SITE PREPARATION - INSTALL ALL REQUIRED SURFACE WATER CONTROL MEASURES.
4. SEEDBED PREPARATION MAY INCLUDE THE FOLLOWING:
A. IF INFERTILE OR COARSE TEXTURED SUBSOIL WILL BE EXPOSED DURING GRADING, STOCKPILE TOPSOIL AND RE-SPREAD IT OVER THE FINISHED SLOPE AND ROLL IT TO PROVIDE A FIRM SEEDBED.
B. IF CONSTRUCTION FILLS HAVE LEFT SOIL EXPOSED WITH A LOOSE, ROUGH, OR IRREGULAR SURFACE, TRACK WALK UP SLOPE.
C. IF CUTS OR CONSTRUCTION EQUIPMENT HAVE LEFT A TIGHTLY COMPACTED SURFACE, BREAK WITH CHISEL PLOW OR OTHER SUITABLE IMPLEMENT. PERFORM ALL CULTURAL OPERATIONS ACROSS OR AT RIGHT ANGLES TO THE SLOPES (CONTOURED). THE SEEDBED SHOULD BE FIRM WITH A FAIRLY FINE SURFACE AFTER ROUGHENING.
5. FERTILIZATION - IN GENERAL, 10-20-20 N-P-K FERTILIZER AT A RATE OF 90 LBS./ACRE. DEVELOPMENTS ADJACENT TO WATER BODIES AND WETLANDS MUST USE SLOW RELEASE LOW-PHOSPHORUS FERTILIZER (TYPICAL 3-1-2 N-P-K).
6. "HYDROSEEDING" APPLICATIONS WITH APPROVED SEED-MULCH-FERTILIZER MIXTURES MAY ALSO BE USED, AS LONG AS TACKIFIER IS INCLUDED.
7. SEEDING - APPLY APPROPRIATE MIXTURE TO THE PREPARED SEEDBED AT A RATE OF 120 LBS./ACRE. COVER THE SEED WITH TOPSOIL OR MULCH NO DEEPER THAN 1/2 INCH.
8. INSPECT SEEDD AREAS FOR FAILURE AND MAKE NECESSARY REPAIRS AND RE-SEEDINGS IMMEDIATELY.
A. IF VEGETATIVE COVER IS INADEQUATE TO PREVENT RILL EROSION, OVERSEED AND FERTILIZE IN ACCORDANCE WITH SOIL TEST.
B. IF A STAND HAS LESS THAN 40% COVER, REEVALUATE CHOICE OF PLANT MATERIALS AND QUANTITIES OF LIME AND FERTILIZER. RE-ESTABLISH THE STAND FOLLOWING SEEDBED PREPARATION AND SEEDING RECOMMENDATIONS, OMITTING LIME AND FERTILIZER IN THE ABSENCE OF SOIL TEST RESULTS.

**GENERAL NOTES**

- 1. ALL CONSTRUCTION SHALL BE IN ACCORDANCE WITH THE MERCER ISLAND STANDARDS, AND THE CITY CONDITIONS OF APPROVAL. IT SHALL BE THE SOLE RESPONSIBILITY OF THE APPLICANT AND THE PROFESSIONAL CIVIL ENGINEER TO CORRECT ANY ERROR, OMISSION, OR VARIATION FROM THE ABOVE REQUIREMENTS FOUND IN THESE PLANS. ALL CORRECTIONS SHALL BE AT NO ADDITIONAL COST OR LIABILITY TO KING COUNTY.
2. BEFORE ANY CONSTRUCTION OR DEVELOPMENT ACTIVITY, A PRE-CONSTRUCTION MEETING MUST BE HELD BETWEEN THE CITY INSPECTION UNIT, THE APPLICANT, AND THE APPLICANT'S CONSTRUCTION REPRESENTATIVE.
3. A COPY OF THESE APPROVED PLANS MUST BE ON THE JOB SITE WHENEVER CONSTRUCTION IS IN PROGRESS. CONSTRUCTION NOISE SHALL BE LIMITED AS PER CODE; NORMALLY, THIS IS 7 A.M. TO 10 P.M. WEEKDAYS AND 9 A.M. TO 10 P.M. ON WEEKENDS.
4. IT SHALL BE THE APPLICANT'S/CONTRACTOR'S RESPONSIBILITY TO OBTAIN ALL CONSTRUCTION EASEMENTS NECESSARY BEFORE INITIATING OFF-SITE WORK WITHIN THE ROAD RIGHTS-OF-WAY. DATUM SHALL BE KCAS UNLESS OTHERWISE APPROVED BY THE CITY. GROUNDWATER SYSTEM CONSTRUCTION SHALL BE WITHIN A RIGHT-OF-WAY OR APPROPRIATE DRAINAGE EASEMENT, BUT NOT UNDERNEATH THE ROADWAY SECTION. ALL GROUNDWATER SYSTEMS MUST BE CONSTRUCTED IN ACCORDANCE WITH SECTION B1 3.02 OF THE APWA STANDARD SPECIFICATIONS.
5. ALL UTILITY TRENCHES SHALL BE BACK FILLED AND COMPACTED TO 95 PERCENT DENSITY.
6. OPEN CUTTING OF EXISTING ROADWAYS IS NOT ALLOWED UNLESS SPECIFICALLY APPROVED BY THE CITY AND NOTED ON THESE APPROVED PLANS.
7. THE CONTRACTOR SHALL BE RESPONSIBLE FOR PROVIDING ADEQUATE SAFEGUARDS, SAFETY DEVICES, PROTECTIVE EQUIPMENT, FLAGGERS, AND ANY OTHER NEEDED ACTIONS TO PROTECT THE LIFE, HEALTH, AND SAFETY OF THE PUBLIC, AND TO PROTECT PROPERTY IN CONNECTION WITH THE PERFORMANCE OF WORK COVERED BY THE CONTRACTOR. ANY WORK WITHIN THE TRAVELED RIGHT-OF-WAY THAT MAY INTERRUPT NORMAL TRAFFIC FLOW SHALL REQUIRE AT LEAST ONE FLAGGER FOR EACH LANE OF TRAFFIC AFFECTED. ALL SECTIONS OF THE WSDOT STANDARD SPECIFICATIONS 1-07.23 - TRAFFIC CONTROL, SHALL APPLY.

**EMBANKMENT NOTES**

- 1. EMBANKMENTS SHALL BE CONSTRUCTED IN ALL ASPECTS TO THE PROVISIONS OF SECTION 2.03 OF THE WSDOT / APWA STANDARD SPECIFICATIONS.
2. COMPACTION OF THE TOP TWO FEET OF FILL SUBGRADE AND TOP SIX INCHES OF CUT SUBGRADE SHALL MEET A MINIMUM 95% MAXIMUM DENSITY IN ACCORDANCE WITH WSDOT / APWA STANDARD SPECIFICATION SECTION 2-03.3(14)C - METHOD B. SUBGRADE FILL BELOW THE TOP TWO FEET SHALL BE COMPACTED TO 90% OF MAXIMUM DENSITY.
3. IN CASES WHERE TESTS DO NOT MEET THE MINIMUM STANDARD, CORRECTIVE ACTION SHALL BE TAKEN SUCH AS ADDING WATER, AERATING, REPLACING MATERIAL, OR APPLYING MORE COMPACTIVE EFFORT AS DIRECTED BY THE DEVELOPERS GEOTECHNICAL ENGINEER. RETESTS SHALL SHOW PASSING DENSITIES PRIOR TO PLACING THE NEXT LIFT OF SUBGRADE FILL.
4. IMMEDIATELY UPON COMPLETING EMBANKMENT CONSTRUCTION, THE SIDESLOPES SHALL BE SEEDD WITH A KING COUNTY APPROVED EROSION CONTROL SEED MIX AND JUTE MATTING PLACED AND ANCHORED PER MANUFACTURER. NO FERTILIZER SHALL BE USED. 5. SIDESLOPES SHALL NOT EXCEED 2:1 WITHOUT RECEIVING PRIOR APPROVAL FROM THE DEVELOPER'S GEOTECHNICAL ENGINEER.

**GRADING NOTES:**

- 1. ALL CUT MATERIAL GENERATED DURING THE PROJECT THAT IS NOT ACCEPTABLE FOR USE AS COMPACTED FILL MATERIAL AT ANOTHER LOCATION ON-SITE MUST BE HAULED TO AN APPROVED LOCATION OFF-SITE.
2. ALL TEMPORARY OR PERMANENT SLOPES SHALL NOT EXCEED 2H:1V UNLESS APPROVED BY A GEOTECHNICAL ENGINEER.
3. FILL MATERIAL PLACED UNDER BUILDING FOUNDATIONS OR PAVEMENT SHALL BE CRUSHED BASE ROCK OR COMPACTED STRUCTURAL FILL IN ACCORDANCE TO WSDOT STANDARD SPECIFICATIONS.
4. ROCKERY AND/OR RETAINING WALLS GREATER THAN FOUR (4) FEET IN HEIGHT REQUIRES A BUILDING PERMIT FROM THE CITY OF MERCER ISLAND.
5.
6. IT WILL BE THE PERMITEE'S RESPONSIBILITY TO SUCCESSFULLY CAP AND ABANDON ALL EXISTING UTILITIES WITHIN THE DEVELOPMENT IN ACCORDANCE TO THE GOVERNING UTILITY AGENCY.
7. ALL STRUCTURAL FILL AND BACKFILL AREAS MUST BE INSPECTED AND APPROVED AFTER STRIPPING AND PRIOR TO PLACING FILL, BY THE PROJECT GEOTECHNICAL ENGINEER OR DESIGNATED REPRESENTATIVE. PROPER FILL PLACEMENT AND COMPACTION SHALL BE VERIFIED WITH FIELD AND LABORATORY DENSITY TESTING BY THE GEOTECHNICAL ENGINEER OR A QUALIFIED TESTING LABORATORY. WRITTEN CERTIFICATION OF ALL APPROVALS SHALL BE GIVEN TO THE KING COUNTY SITE INSPECTOR.

**ADDITIONAL NOTES**

- 1. THIS PLAN MAY NOT SHOW THE LOCATION OF ALL EXISTING UTILITIES, IT IS THE RESPONSIBILITY OF THE CONTRACTOR TO LOCATE ALL EXISTING UTILITIES PRIOR TO EXCAVATION.
2. THE CONTRACTOR SHALL EXPOSE ALL EXISTING PIPING THAT WILL BE CONNECTED TO WITH NEW PIPING. DEPTH, LOCATION, AND CONDITION SHALL BE RELAYED TO THE ENGINEER IF CONDITIONS VARY SIGNIFICANTLY FROM WHAT IS DETAILED OR ANTICIPATED.

**STRUCTURAL NOTES**

- 1. ROCKERIES ARE CONSIDERED TO BE A METHOD OF BANK STABILIZATION AND EROSION CONTROL. ROCKERIES SHALL NOT BE CONSTRUCTED TO SERVE AS RETAINING WALLS. ALL ROCKERIES SHALL BE DESIGNED. SEE DETAIL INCLUDED IN PLAN SET.

**EROSION AND SEDIMENT CONTROL NOTES:**

- 1. APPROVAL OF THIS EROSION AND SEDIMENT CONTROL (ESC) PLAN DOES NOT CONSTITUTE AN APPROVAL OF PERMANENT ROAD OR DRAINAGE DESIGN (E.G. SIZE AND LOCATION OF ROADS, PIPES, RESTRICTORS, CHANNELS, RETENTION FACILITIES, UTILITIES, ETC.).
2. THE IMPLEMENTATION OF THESE ESC PLANS AND THE CONSTRUCTION, MAINTENANCE, REPLACEMENT, AND UPGRADING OF THESE ESC FACILITIES IS THE RESPONSIBILITY OF THE APPLICANT/ESC SUPERVISOR UNTIL ALL CONSTRUCTION IS APPROVED.
3. THE BOUNDARIES OF THE CLEARING LIMITS SHOWN ON THIS PLAN SHALL BE CLEARLY FLAGGED BY A CONTINUOUS LENGTH OF SURVEY TAPE (OR FENCING, IF REQUIRED) PRIOR TO CONSTRUCTION. DURING THE CONSTRUCTION PERIOD, NO DISTURBANCE BEYOND THE CLEARING LIMITS SHALL BE PERMITTED. THE CLEARING LIMITS SHALL BE MAINTAINED BY THE APPLICANT/ESC SUPERVISOR FOR THE DURATION OF CONSTRUCTION.
4. THE ESC FACILITIES SHOWN ON THIS PLAN MUST BE CONSTRUCTED PRIOR TO OR IN CONJUNCTION WITH ALL CLEARING AND GRADING SO AS TO ENSURE THAT THE TRANSPORT OF SEDIMENT TO SURFACE WATERS, DRAINAGE SYSTEMS, AND ADJACENT PROPERTIES IS MINIMIZED.
5. THE ESC FACILITIES SHOWN ON THIS PLAN ARE THE MINIMUM REQUIREMENTS FOR ANTICIPATED SITE CONDITIONS. DURING THE CONSTRUCTION PERIOD, THESE ESC FACILITIES SHALL BE UPGRADED AS NEEDED FOR UNEXPECTED STORM EVENTS AND MODIFIED TO ACCOUNT FOR CHANGING SITE CONDITIONS (E.G. ADDITIONAL SUMP PUMPS, RELOCATION OF DITCHES AND SILT FENCES, ETC.).
6. THE ESC FACILITIES SHALL BE INSPECTED DAILY BY THE APPLICANT/ESC SUPERVISOR AND MAINTAINED TO ENSURE CONTINUED PROPER FUNCTIONING. WRITTEN RECORDS SHALL BE KEPT OF WEEKLY REVIEWS OF THE TESC FACILITIES DURING THE WET SEASON (OCT. 1 TO APRIL 30) AND OF MONTHLY REVIEWS DURING THE DRY SEASON (MAY 1 TO SEPT. 30).
7. ANY AREAS OF EXPOSED SOILS, INCLUDING ROADWAY EMBANKMENTS, THAT WILL NOT BE DISTURBED FOR TWO DAYS DURING THE WET SEASON OR SEVEN DAYS DURING THE DRY SEASON SHALL BE IMMEDIATELY STABILIZED WITH THE APPROVED ESC METHODS (E.G., SEEDING, MULCHING, PLASTIC COVERING, ETC.).
8. ANY AREA NEEDING ESC MEASURES, NOT REQUIRING IMMEDIATE ATTENTION, SHALL BE ADDRESSED WITHIN FIFTEEN (15) DAYS.
9. THE ESC FACILITIES ON INACTIVE SITES SHALL BE INSPECTED AND MAINTAINED A MINIMUM OF ONCE A MONTH OR WITHIN 48 HOURS FOLLOWING A STORM EVENT.
10. AT NO TIME SHALL MORE THAN ONE (1) FOOT OF SEDIMENT BE ALLOWED TO ACCUMULATE WITHIN A CATCH BASIN. ALL CATCH BASINS AND CONVEYANCE LINES SHALL BE CLEANED PRIOR TO PAVING. THE CLEANING OPERATION SHALL NOT FLUSH SEDIMENT-LADEN WATER INTO THE DOWNSTREAM SYSTEM.
11. STABILIZED CONSTRUCTION ENTRANCES AND ROADS SHALL BE INSTALLED AT THE BEGINNING OF CONSTRUCTION AND MAINTAINED FOR THE DURATION OF THE PROJECT. ADDITIONAL MEASURES, SUCH AS WASH PADS, MAY BE REQUIRED TO ENSURE THAT ALL PAVED AREAS ARE KEPT CLEAN FOR THE DURATION OF THE PROJECT.
12. ANY PERMANENT FLOW CONTROL FACILITY USED AS A TEMPORARY SETTLING BASIN SHALL BE MODIFIED WITH THE NECESSARY EROSION CONTROL MEASURES AND SHALL PROVIDE ADEQUATE STORAGE CAPACITY. IF THE FACILITY IS TO FUNCTION ULTIMATELY AS AN INFILTRATION SYSTEM, THE TEMPORARY FACILITY MUST BE GRADED SO THAT THE BOTTOM AND SIDES ARE AT LEAST THREE FEET ABOVE THE FINAL GRADE OF THE PERMANENT FACILITY.
13. WHERE STRAW MULCH FOR TEMPORARY EROSION CONTROL IS REQUIRED, IT SHALL BE APPLIED AT A MINIMUM THICKNESS OF TWO TO THREE INCHES.
14. PRIOR TO THE BEGINNING OF THE WET SEASON (OCT. 1), ALL DISTURBED AREAS SHALL BE REVIEWED TO IDENTIFY WHICH ONES CAN BE SEEDD IN PREPARATION FOR THE WINTER RAINS. DISTURBED AREAS SHALL BE SEEDD WITHIN ONE WEEK OF THE BEGINNING OF THE WET SEASON. A SKETCH MAP OF THOSE AREAS TO BE SEEDD AND THOSE AREAS TO REMAIN UNCOVERED SHALL BE SUBMITTED TO THE DDES INSPECTOR. THE DDES INSPECTOR CAN REQUIRE SEEDING OF ADDITIONAL AREAS IN ORDER TO PROTECT SURFACE WATERS, ADJACENT PROPERTIES, OR DRAINAGE FACILITIES.

**SEEDING NOTES**

Table with 4 columns: TEMPORARY SEED MIX, WEIGHT, PURITY, GERMINATION. Rows include CHEWINGS OR RED FESCUE, FESTUCA RUBRA VAR. COMMUTATA OR FESTUCA RUBRA, ANNUAL OR PERENNIAL RYE, LOLIUM MULTIFLORUM OR LOLIUM PERENN, RED TOP OR COLONIAL BENTGRASS, AGROSTIS ALBA OR AGROSTIS TENUIS, WHITE DUTCH CLOVER, TRIFOLIUM REPENS.

Table with 4 columns: LANDSCAPE SEED MIX, WEIGHT, PURITY, GERMINATION. Rows include CHEWINGS OR RED FESCUE, FESTUCA RUBRA VAR. COMMUTATA OR FESTUCA RUBRA, PERENNIAL RYE BLEND, LOLIUM PERENNE.

Revision table with columns: SYM, REVISION, COMMENTS, DATED, DATE. Row 1: SYM, RESPONSE TO COMMENTS, DATED 7/21/22, 8/19/22.



DHEERAJ KONERU
7002 93RD AVENUE SE
MERCER ISLAND, WA 98040

KONERU
BUILDING PERMIT
6610 EAST MERCER WAY
MERCER ISLAND, WA 98040
GENERAL NOTES

VERIFY SCALE
BAR IS ONE INCH ON ORIGINAL DRAWING.
SCALE: AS SHOWN
DATE: 05/11/22
DESIGNED BY: MA
CHECKED BY: JA
PACE PROJECT NO. 21436.00

SHEET C0.1

CALL BEFORE YOU DIG 811 UNDERGROUND SERVICE (USA)


FILE NAME: P:\21436\21436\_KONERU\_BUILDING\_PERMIT\21436\_C0P-SFR.DWG
USER: JVA
DATE: 5/9/2022 3:49 PM
PLOT FILE: 21436\_PLOT.DWG
PLOT DATE: 5/9/2022 3:49 PM
PLOT USER: JVA









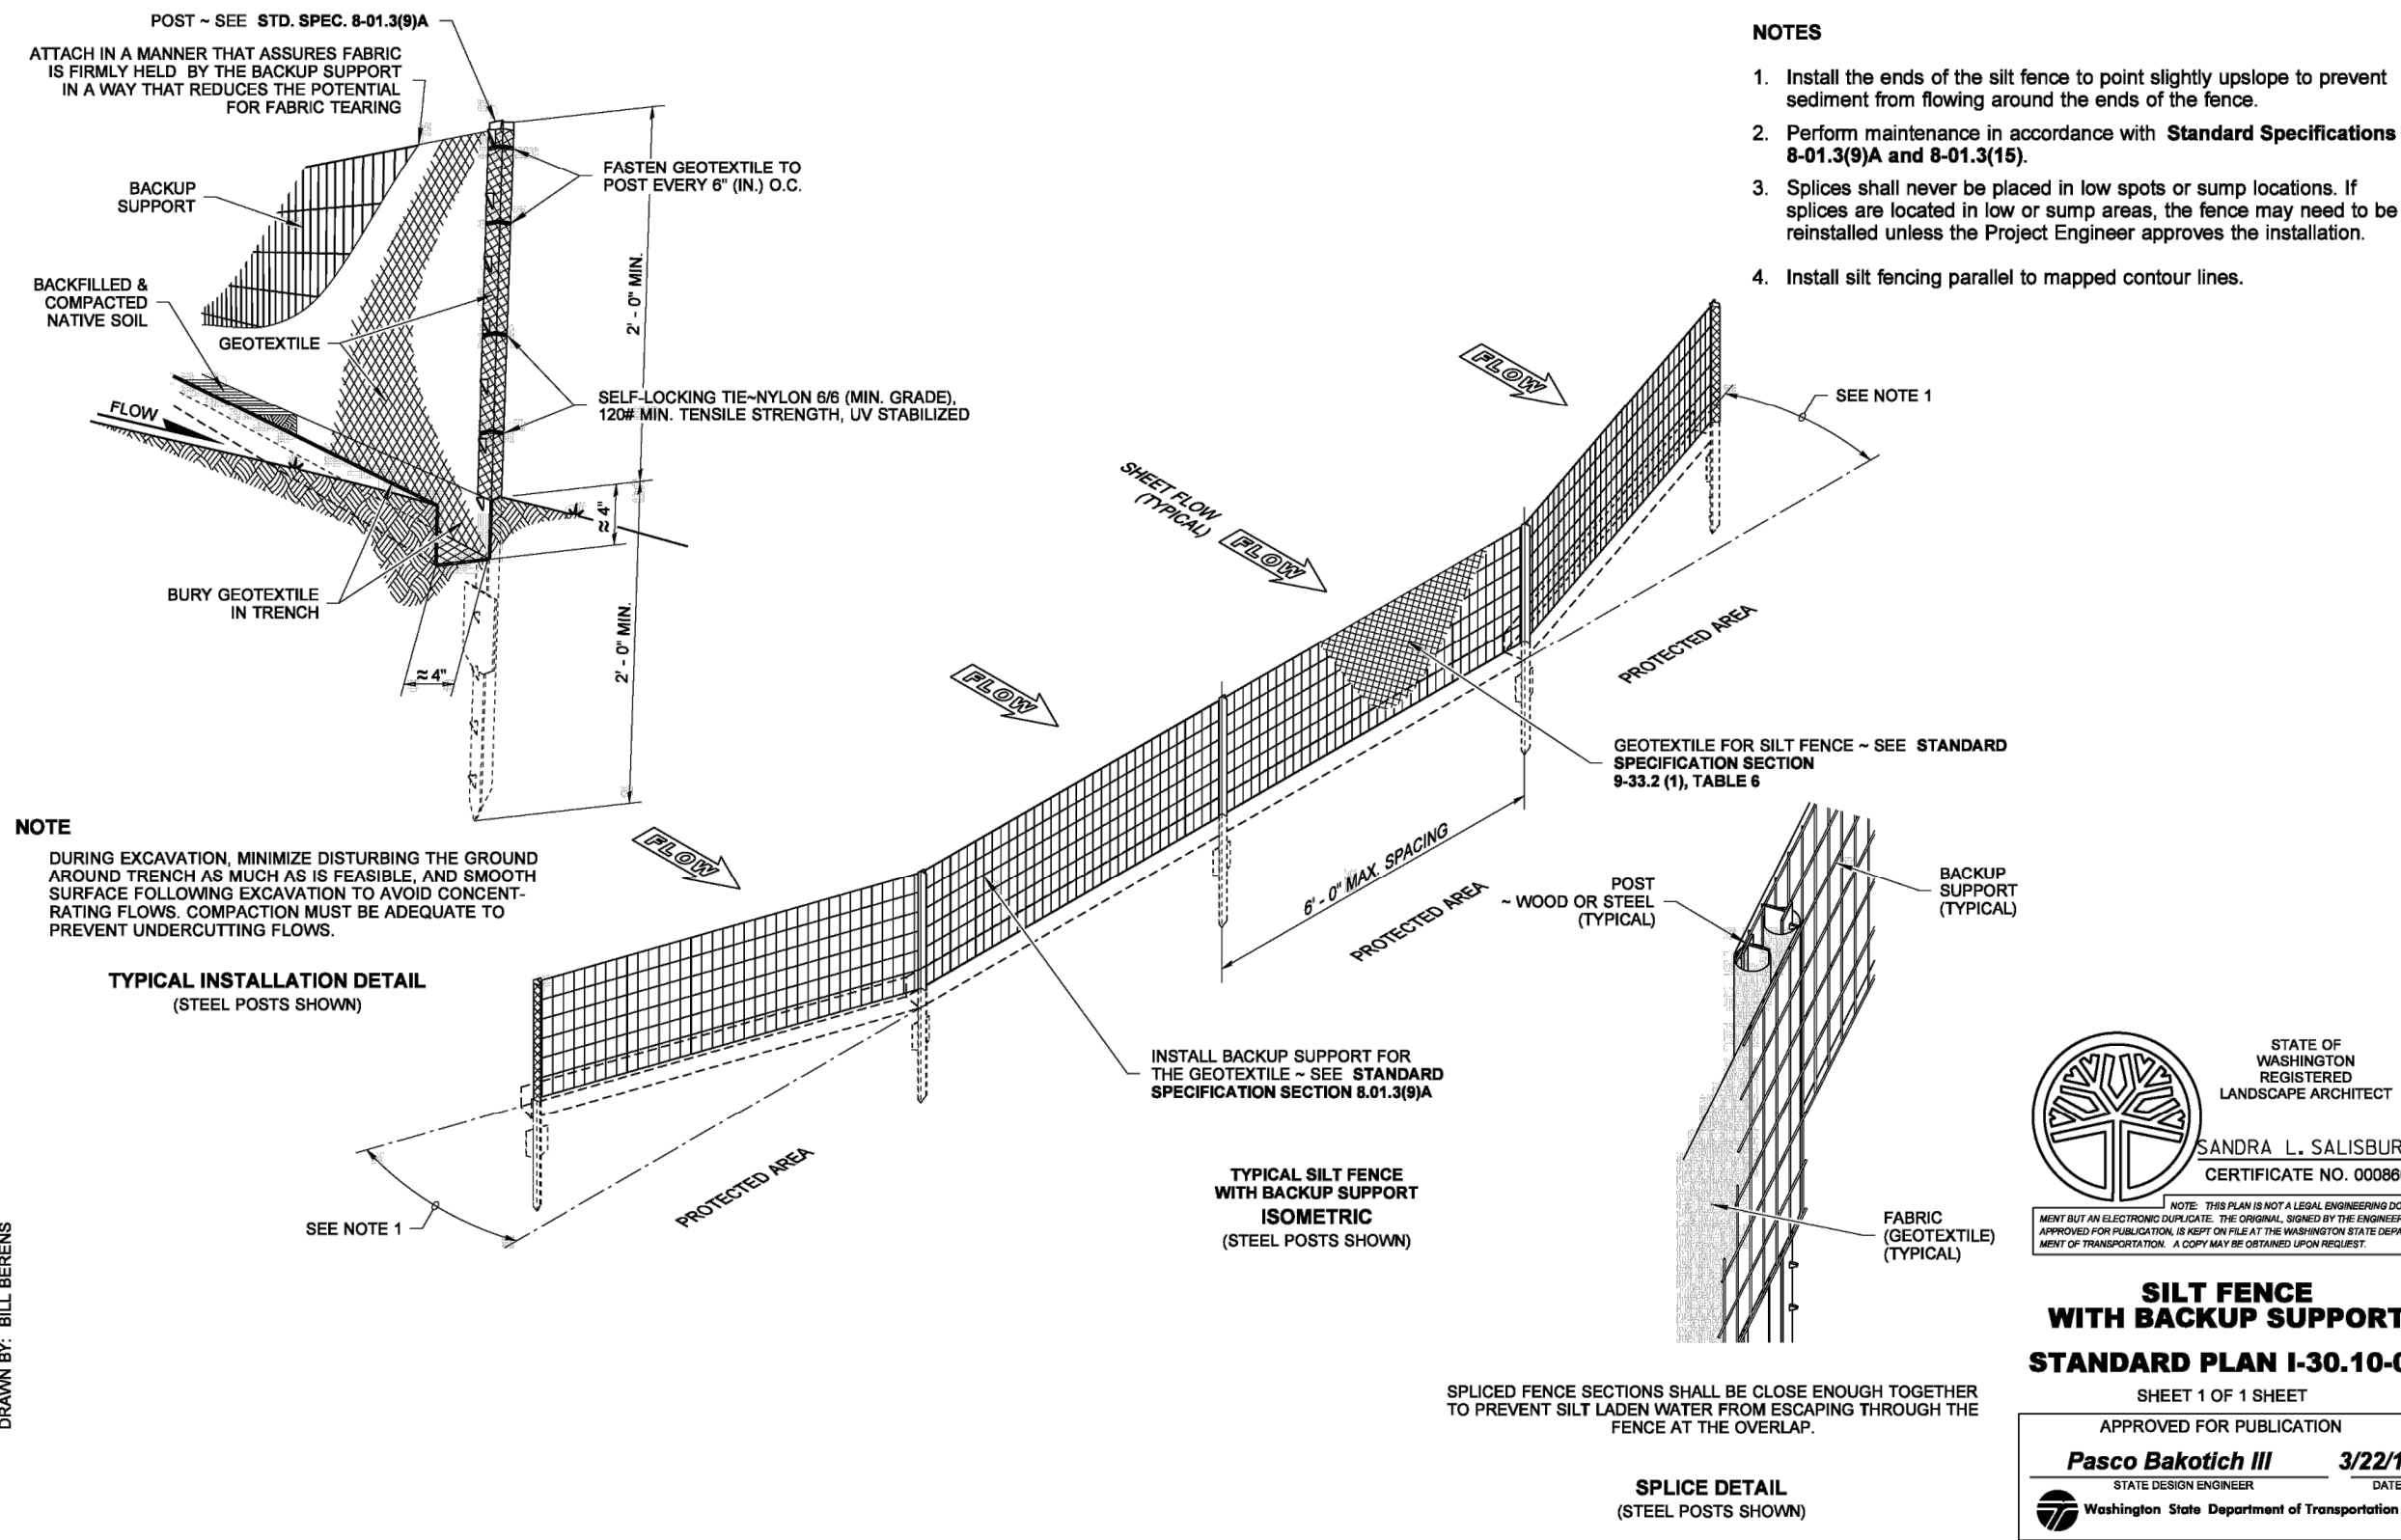


STATE OF WASHINGTON REGISTERED LANDSCAPE ARCHITECT  
SANDRA L. SALISBURY  



**SILT FENCE WITH BACKUP SUPPORT**  
STANDARD PLAN I-30.10-02  
SHEET 1 OF 1 SHEET

APPROVED FOR PUBLICATION  
**Pasco Bakotich III**  
STATE DESIGN ENGINEER  
DATE: 3/22/13  
Washington State Department of Transportation


FRAME AND VANED GRATE

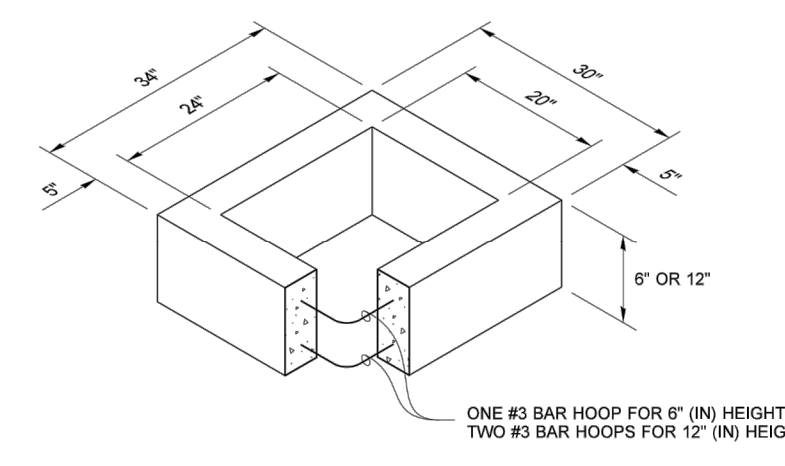

RECTANGULAR ADJUSTMENT SECTION

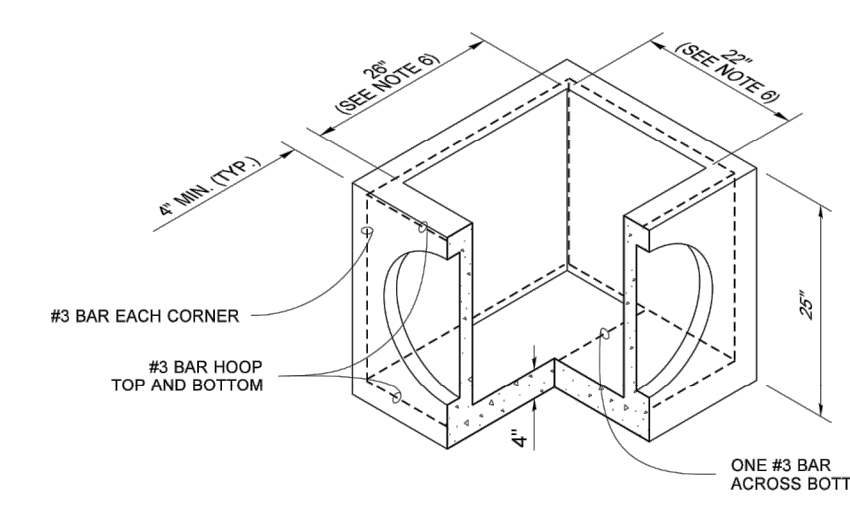

PRECAST BASE SECTION

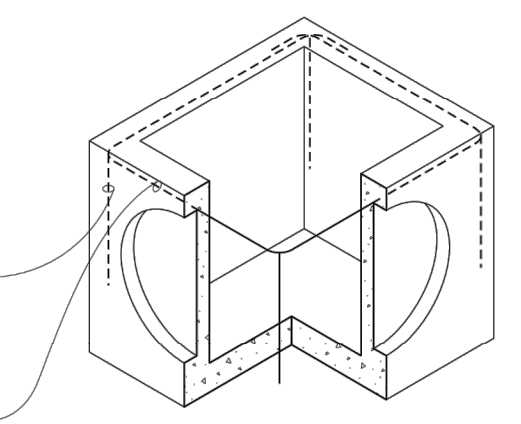

ALTERNATIVE PRECAST BASE SECTION


STATE OF WASHINGTON REGISTERED PROFESSIONAL ENGINEER  
Jodie Hillman  
CERTIFICATE NO. 002060

NOTE: THIS PLAN IS NOT A LEGAL ENGINEERING DOCUMENT. IT IS NOT TO BE USED FOR THE DESIGN OR CONSTRUCTION OF STRUCTURES OR FOR ANY OTHER PURPOSES WITHOUT THE WRITTEN CONSENT OF THE ENGINEER.


**CONCRETE INLET**  
STANDARD PLAN B-25.60-02  
SHEET 1 OF 1 SHEET

APPROVED FOR PUBLICATION  
**Pasco Bakotich III**  
STATE DESIGN ENGINEER  
DATE: 3/22/13  
Washington State Department of Transportation


View Looking Upstream

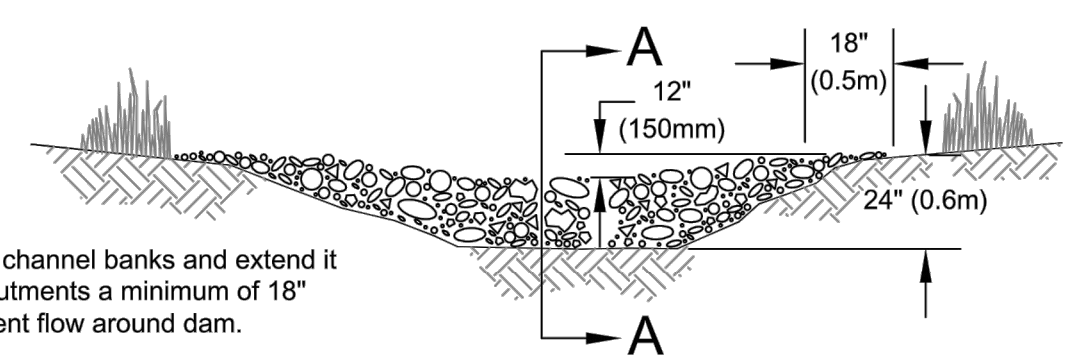

Section A-A

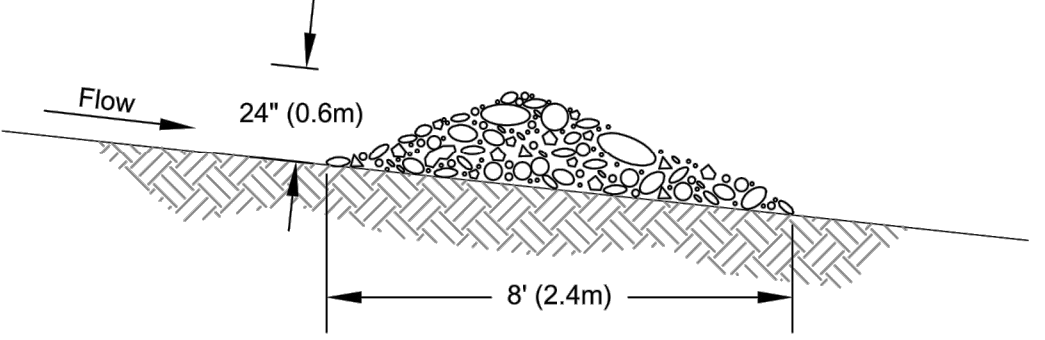


Spacing Between Check Dams

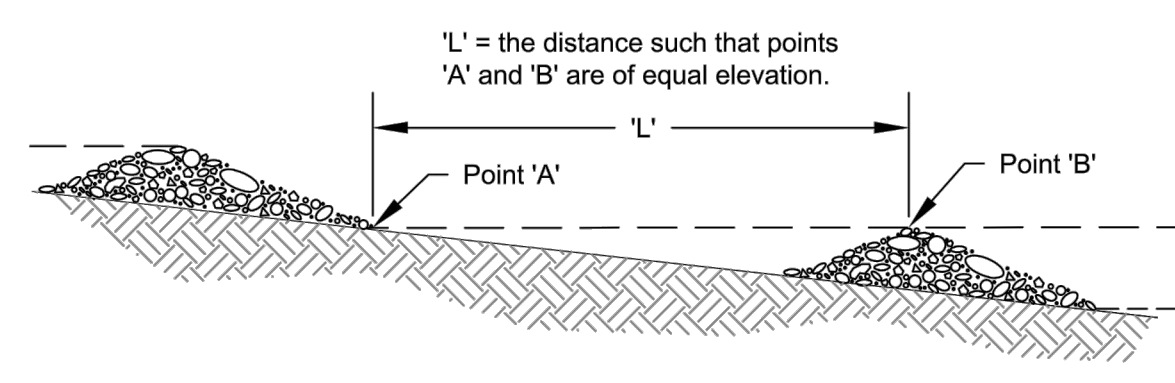


Rock Check Dam

Revised June 2016

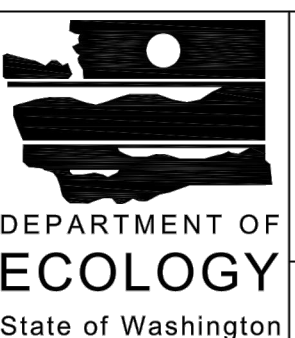

Please see <http://www.ecy.wa.gov/copyright.html> for copyright notice including permissions, limitation of liability, and disclaimer.

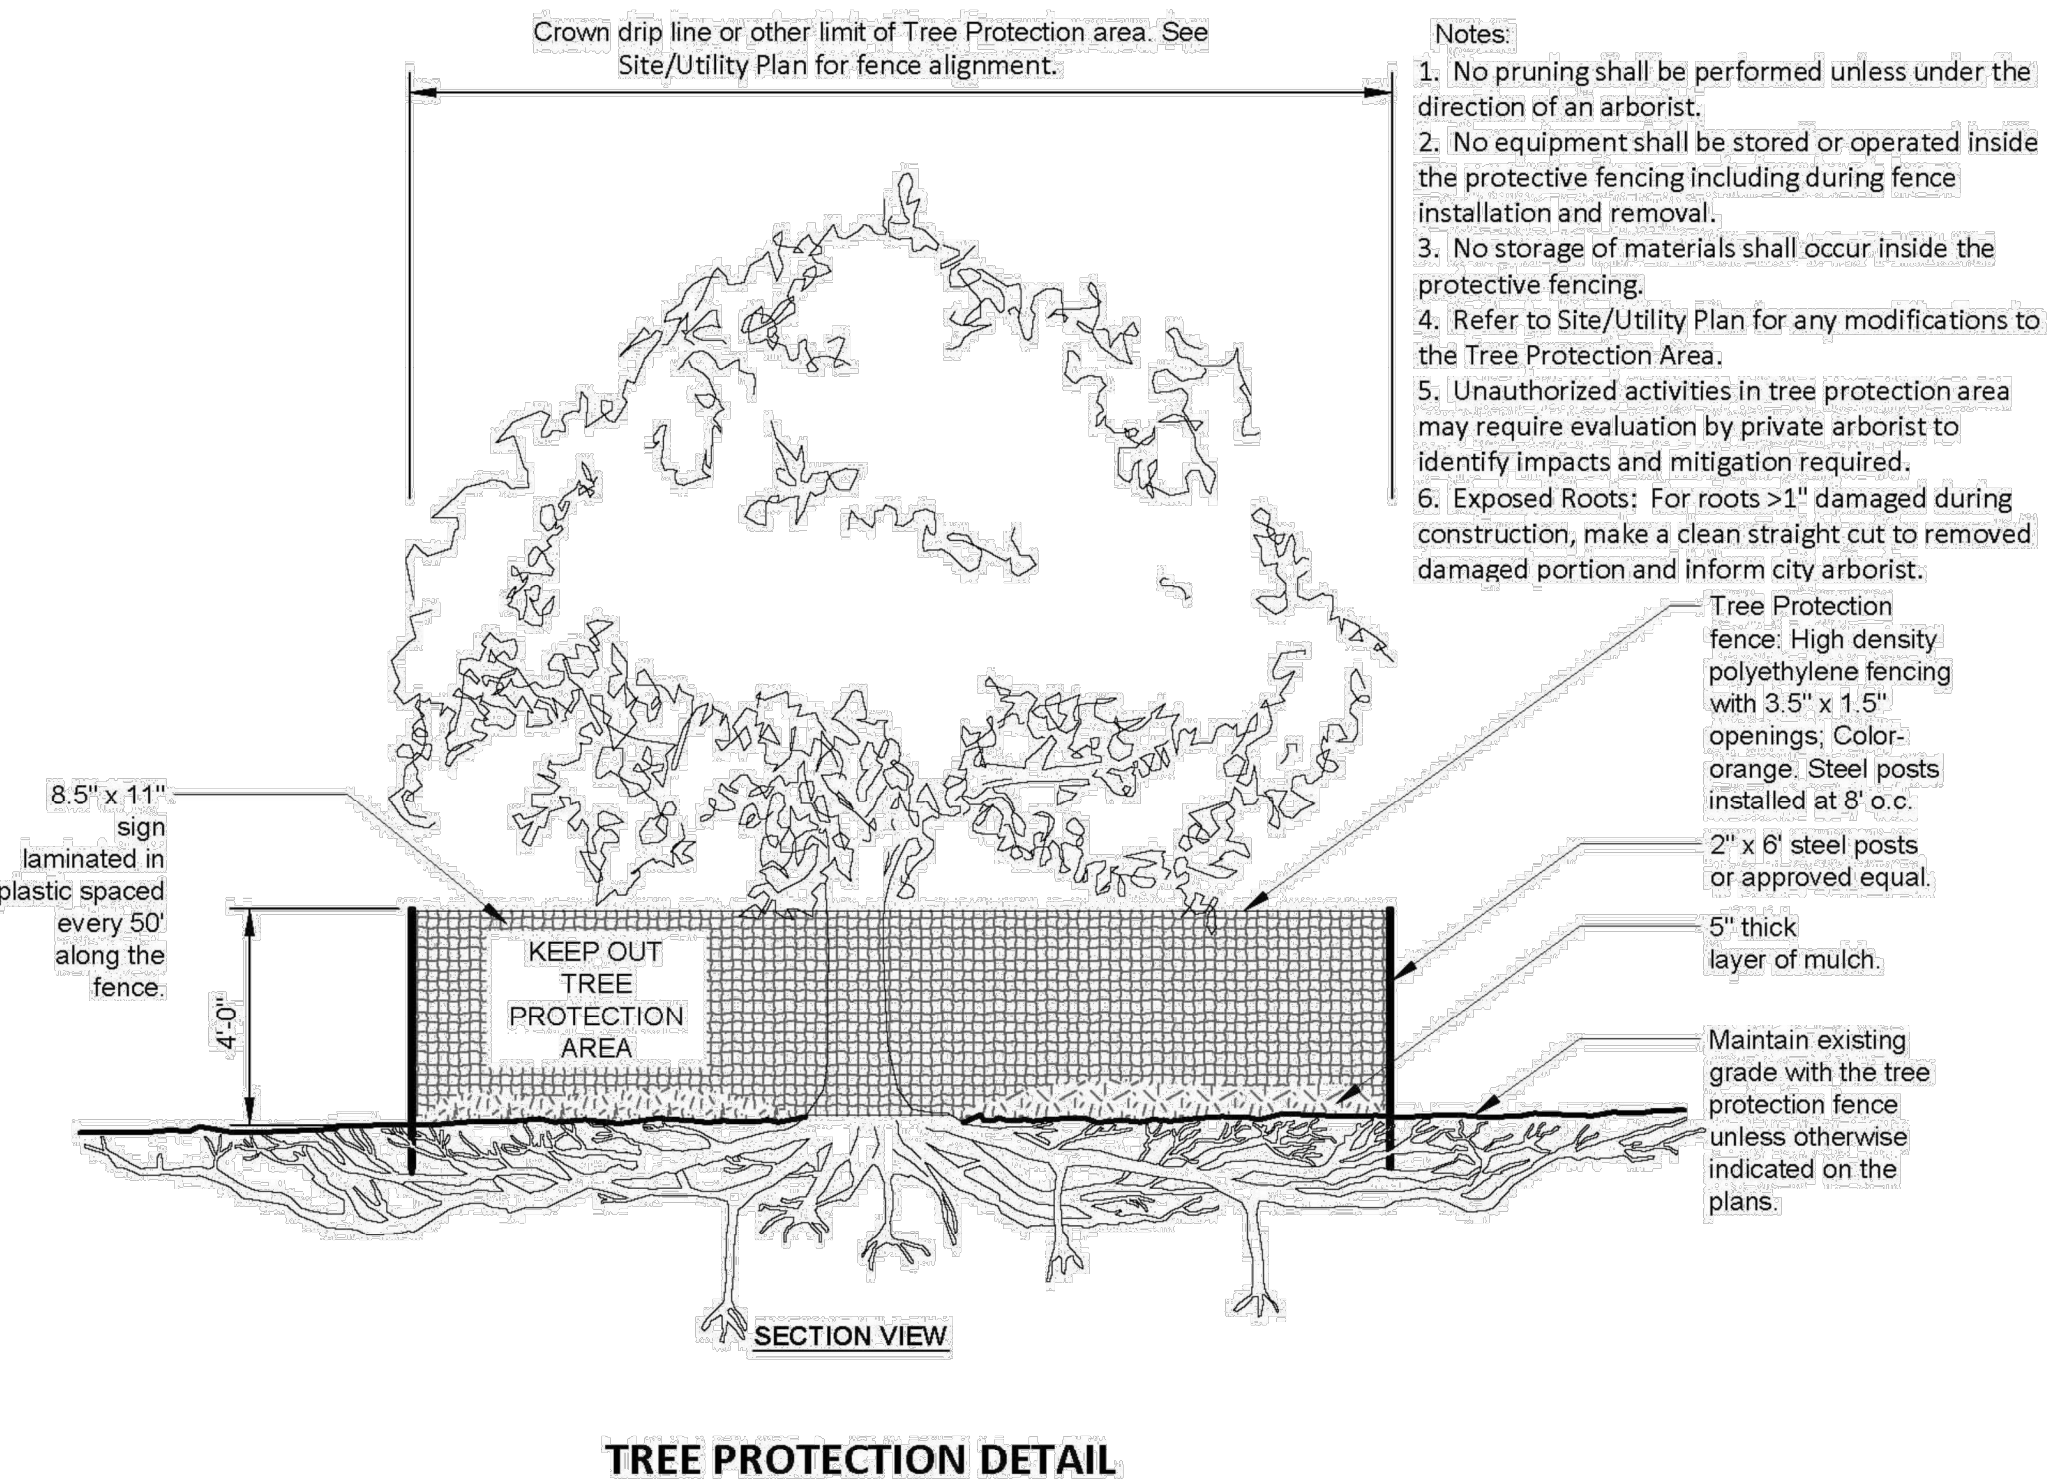

**PACE**  
An Engineering Services Company  
11255 Kirkland Way, Suite 300  
Kirkland, WA 98033  
p. 425.827.2014 f. 425.827.5043  
www.paceengr.com

STATE OF WASHINGTON REGISTERED PROFESSIONAL ENGINEER  
DHEERAJ KONERU  
CERTIFICATE NO. 002060

**DHEERAJ KONERU**  
7002 93RD AVENUE SE  
MERCER ISLAND, WA 98040

**KONERU BUILDING PERMIT**  
6610 EAST MERCER WAY  
MERCER ISLAND, WA 98040

**TESC DETAILS**

**VERIFY SCALE**  
BAR IS ONE INCH ON ORIGINAL DRAWING.  
IF NOT ONE INCH ON THIS SHEET, ADJUST SCALES ACCORDINGLY.

SCALE: AS SHOWN  
DATE: 05/11/22

DESIGNED BY: MA  
CHECKED BY: JA

PACE PROJECT NO. 21436.00

SHEET **C2.1**

CALL BEFORE YOU DIG 811  
UNDERGROUND SERVICE (USA)

FILE NAME: P:\21436\_KONERU\RESIDENCE\CAD\ENGINEERING\SHETS\SPR\_BLDG\PERMIT\21436\_TESC-SFR.DWG  
PLOT TIME: 9/19/2022 3:49 PM  
USER NAME: JVA  
PLOTTER: HP  
REF FILES: X21436\_SFR.dwg; X21436\_TREE.dwg; X21436\_TESC.dwg; 9433-11-SRW.dwg



DATE	8/19/22
REVISION	
SYN	
RESPONSE TO COMMENTS DATED	7/21/22

**PACE**  
An Engineering Services Company  
11255 Kirkland Way, Suite 300  
Kirkland, WA 98033  
p. 425.827.2014 | f. 425.827.5043  
www.paceeng.com



**DHEERAJ KONERU**  
7002 93RD AVENUE SE  
MERCER ISLAND, WA 98040


**KONERU BUILDING PERMIT**  
6610 EAST MERCER WAY  
MERCER ISLAND, WA 98040

**STORM & GRADING PLAN**

**VERIFY SCALE**  
BAR IS ONE INCH ON ORIGINAL DRAWING.  
IF NOT ONE INCH ON THIS SHEET, ADJUST SCALES ACCORDINGLY.

SCALE: AS SHOWN DATE: 05/11/22  
DESIGNED BY: MA CHECKED BY: JA  
PACE PROJECT NO. 21436.00

**SHEET C3.0**

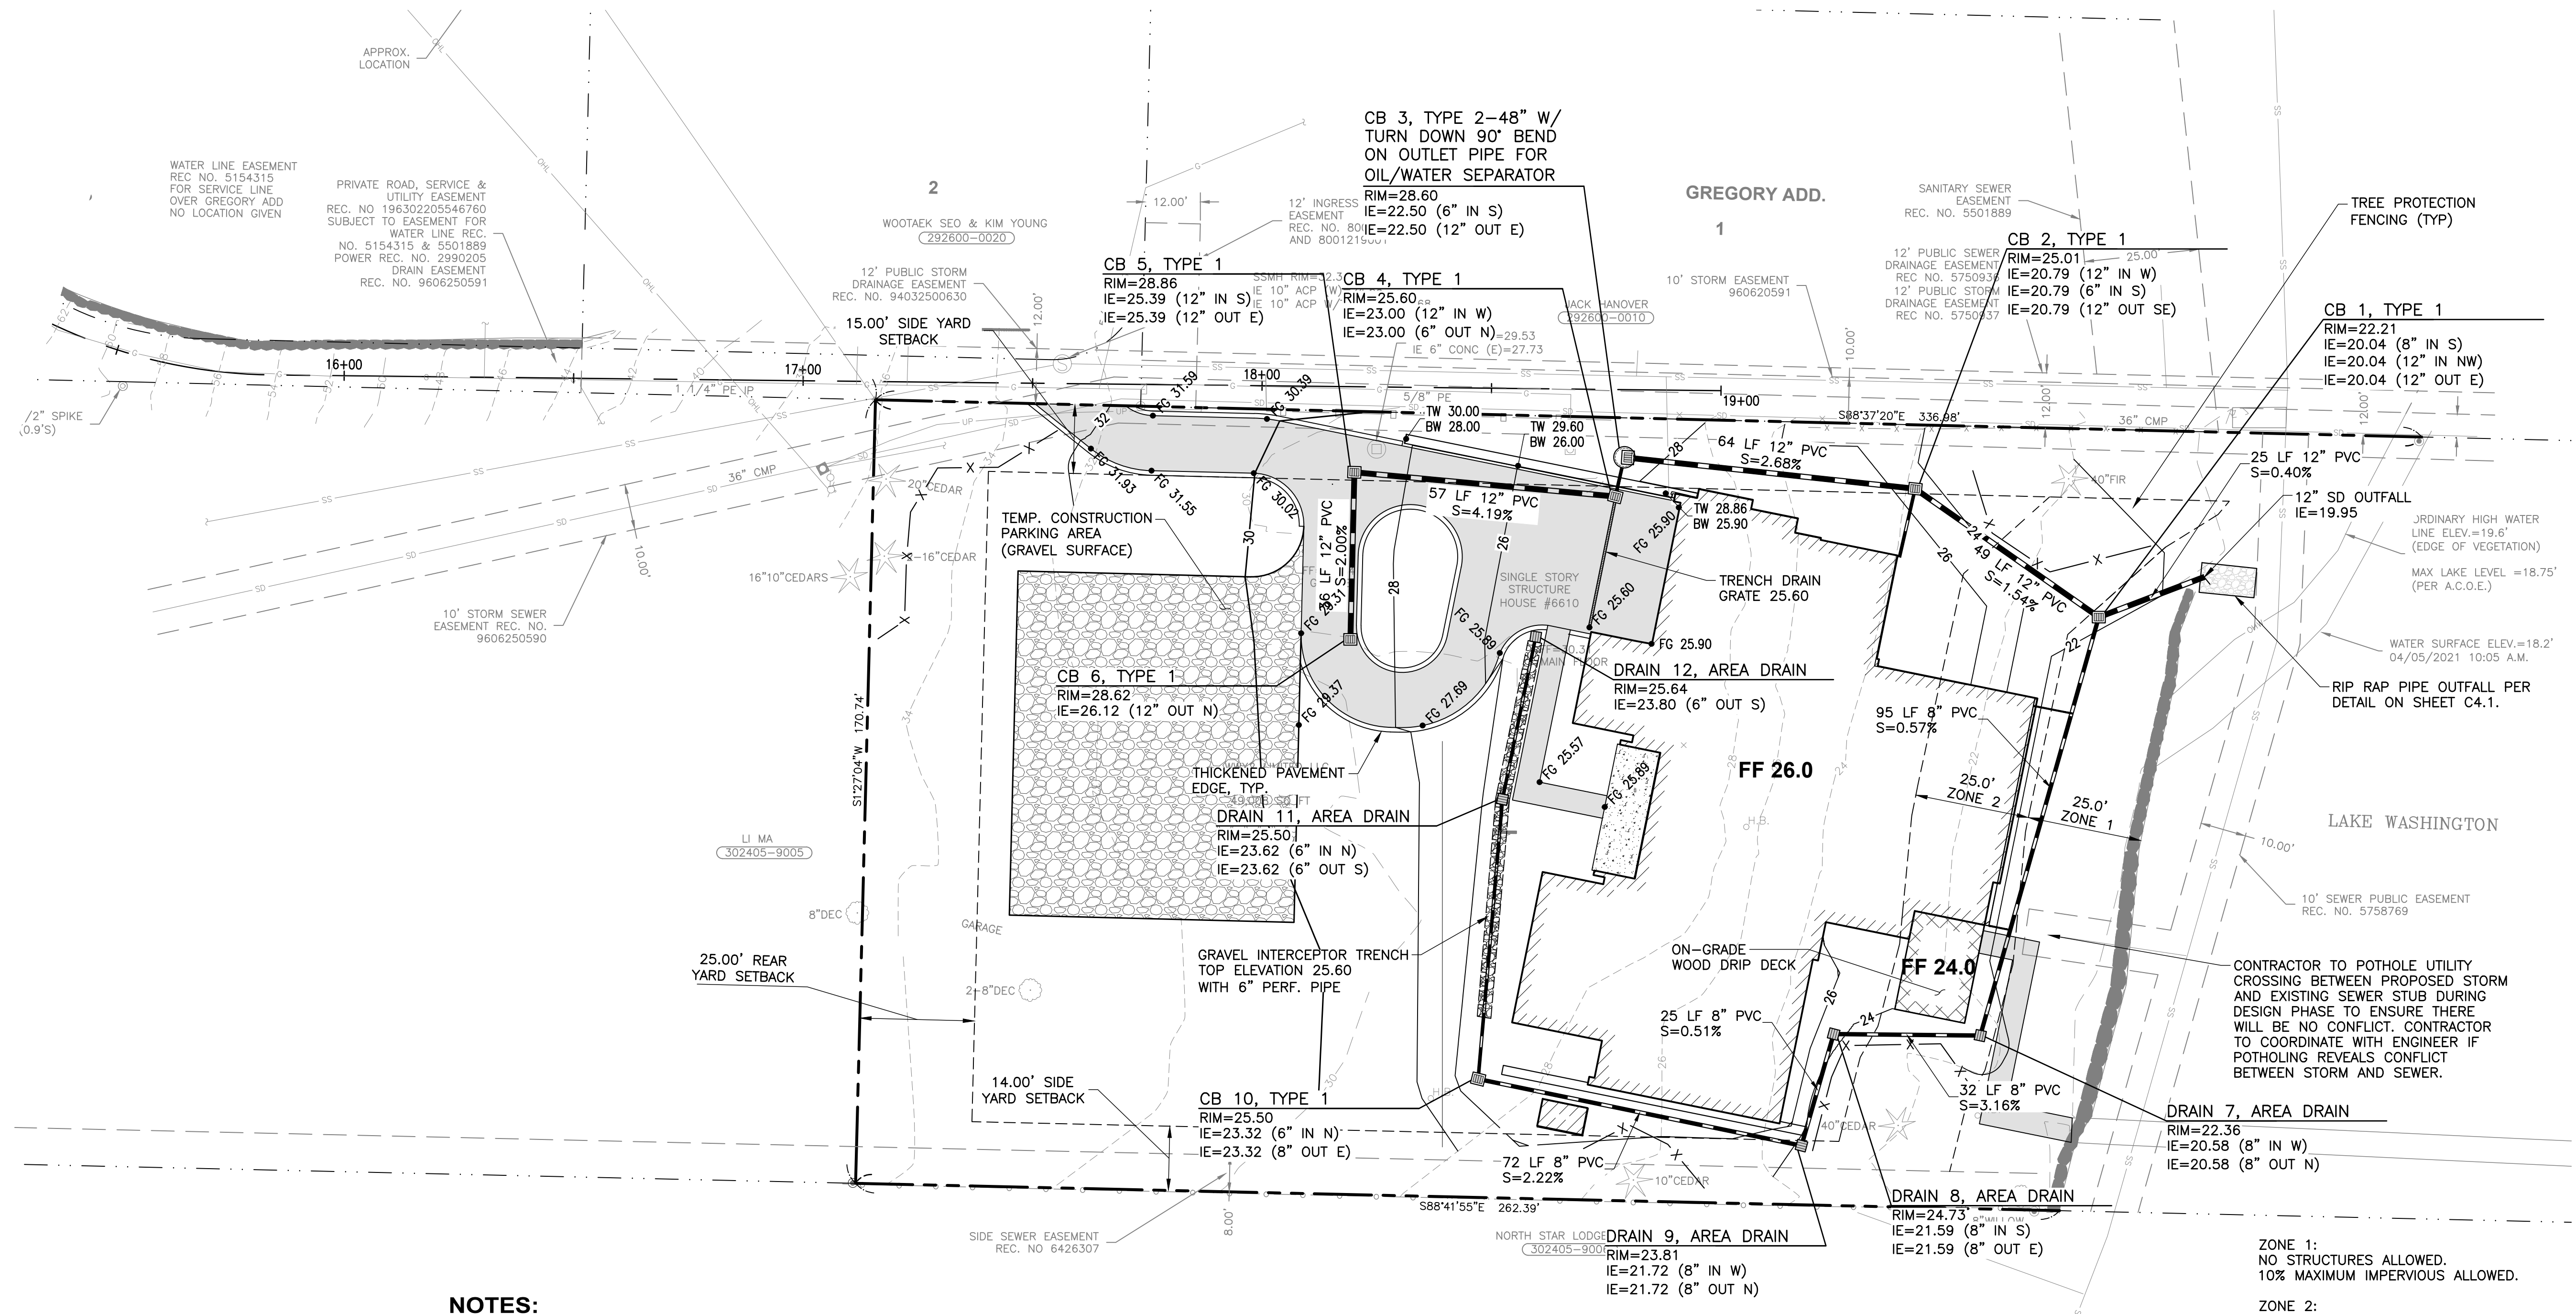

**NOTES:**

THE LAWN AND LANDSCAPE AREAS ARE REQUIRED TO PROVIDE POST-CONSTRUCTION SOIL QUALITY AND DEPTH IN ACCORDANCE WITH BMP T5.13. THE PROJECT CIVIL ENGINEER MUST PROVIDE A LETTER OF CERTIFICATION TO ENSURE THAT THE LAWN AND LANDSCAPE AREAS ARE MEETING THE POST-CONSTRUCTION SOIL QUALITY AND DEPTH REQUIREMENTS SPECIFIED ON THE APPROVED PLAN SET PRIOR TO FINAL INSPECTION OF THE PROJECT.

**DESIGN GUIDELINES**  
L SOIL RETENTION. RETAIN IN AN UNDISTURBED STATE, THE DUFF LAYER AND NATIVE TOPSOIL TO THE MAXIMUM EXTENT PRACTICABLE. IN ANY AREAS REQUIRING GRADING REMOVE AND STOCKPILE THE DUFF LAYER AND TOPSOIL ON SITE IN A DESIGNATED, CONTROLLED AREA, NOT ADJACENT TO PUBLIC RESOURCES AND CRITICAL AREAS, TO BE REAPPLIED TO OTHER PORTIONS OF THE SITE WHERE FEASIBLE.  
L SOIL QUALITY. ALL AREAS SUBJECT TO CLEARING AND GRADING THAT HAVE NOT BEEN COVERED BY IMPERVIOUS SURFACE, INCORPORATED INTO A DRAINAGE FACILITY OR ENGINEERED AS STRUCTURAL FILL OR SLOPE SHALL, AT PROJECT COMPLETION, DEMONSTRATE THE FOLLOWING:  
1. A TOPSOIL LAYER WITH A MINIMUM ORGANIC MATTER CONTENT OF 10% DRY WEIGHT IN PLANTING BEDS, AND 5% ORGANIC MATTER CONTENT IN TURF AREAS, AND A PH FROM 6.0 2014 STORMWATER MANAGEMENT MANUAL FOR WESTERN WASHINGTON VOLUME V - CHAPTER 5 - PAGE 911 TO 8.0 OR MATCHING THE PH OF THE UNDISTURBED SOIL. THE TOPSOIL LAYER SHALL HAVE A MINIMUM DEPTH OF EIGHT INCHES EXCEPT WHERE TREE ROOTS LIMIT THE DEPTH OF INCORPORATION OF AMENDMENTS NEEDED TO MEET THE CRITERIA. SUBSOILS BELOW THE TOPSOIL

LAYER SHOULD BE SCARIFIED AT LEAST 4 INCHES WITH SOME INCORPORATION OF THE UPPER MATERIAL TO AVOID STRATIFIED LAYERS, WHERE FEASIBLE.  
2. MULCH PLANTING BEDS WITH 2 INCHES OF ORGANIC MATERIAL  
3. USE COMPOST AND OTHER MATERIALS THAT MEET THESE ORGANIC CONTENT REQUIREMENTS:  
a. THE ORGANIC CONTENT FOR "PRE-APPROVED" AMENDMENT RATES CAN BE MET ONLY USING COMPOST MEETING THE COMPOST SPECIFICATION FOR BMP T7.30: BIORETENTION CELLS, SWALES, AND PLANTER BOXES (P.959), WITH THE EXCEPTION THAT THE COMPOST MAY HAVE UP TO 35% BIOSOLIDS OR MANURE. THE COMPOST MUST ALSO HAVE AN ORGANIC MATTER CONTENT OF 40% TO 65%, AND A CARBON TO NITROGEN RATIO BELOW 25:1. THE CARBON TO NITROGEN RATIO MAY BE AS HIGH AS 35:1 FOR PLANTINGS COMPOSED ENTIRELY OF PLANTS NATIVE TO THE PUGET SOUND LOWLANDS REGION.  
c. CALCULATED AMENDMENT RATES MAY BE MET THROUGH USE OF COMPOSTED MATERIAL MEETING (A.) ABOVE; OR OTHER ORGANIC MATERIALS AMENDED TO MEET THE CARBON TO NITROGEN RATIO REQUIREMENTS, AND NOT EXCEEDING THE CONTAMINANT LIMITS IDENTIFIED IN TABLE 220-B, TESTING PARAMETERS, IN WAC 173-350-220. THE RESULTING SOIL SHOULD BE CONDUCIVE TO THE TYPE OF VEGETATION TO BE ESTABLISHED.  
L IMPLEMENTATION OPTIONS: THE SOIL QUALITY DESIGN GUIDELINES LISTED ABOVE CAN BE MET BY USING ONE OF THE METHODS LISTED BELOW:  
1. LEAVE UNDISTURBED NATIVE VEGETATION AND SOIL, AND PROTECT FROM COMPACTION DURING CONSTRUCTION.  
2. AMEND EXISTING SITE TOPSOIL OR SUBSOIL EITHER AT DEFAULT "PRE-APPROVED" RATES, OR AT CUSTOM CALCULATED RATES BASED ON TESTS OF THE SOIL AND AMENDMENT.  
3. STOCKPILE EXISTING TOPSOIL DURING GRADING, AND REPLACE IT



PRIOR TO PLANTING. STOCKPILED TOPSOIL MUST ALSO BE AMENDED IF NEEDED TO MEET THE ORGANIC MATTER OR DEPTH REQUIREMENTS, EITHER AT A DEFAULT "PRE-APPROVED" RATE OR AT A CUSTOM CALCULATED RATE.  
4. IMPORT TOPSOIL MIX OF SUFFICIENT ORGANIC CONTENT AND DEPTH TO MEET THE REQUIREMENTS. 2014 STORMWATER MANAGEMENT MANUAL FOR WESTERN WASHINGTON VOLUME V - CHAPTER 5 - PAGE 912. MORE THAN ONE METHOD MAY BE USED ON DIFFERENT PORTIONS OF THE SAME SITE. SOIL THAT ALREADY MEETS THE DEPTH AND ORGANIC MATTER QUALITY STANDARDS, AND IS NOT COMPACTED,  
5. DOES NOT NEED TO BE AMENDED.

ZONE 1:  
NO STRUCTURES ALLOWED.  
10% MAXIMUM IMPERVIOUS ALLOWED.

ZONE 2:  
STRUCTURES ALLOWED.  
30% MAXIMUM IMPERVIOUS ALLOWED

**LEGEND**

SD	STORM DRAIN (<6")
RD	ROOF DRAIN
UD	UNDER DRAIN
SD	EX. STORM DRAIN
SS	SANITARY SEWER
SS	EX. SANITARY SEWER
W	WATER LINE
W	EXISTING WATER LINE
EXISTING	PROPOSED
○	AREA DRAINS PER CONCRETE INLET DETAIL ON SHEET C2.1
□	CB TYPE 1
○	SS CLEANOUT
○	SSMH 48"
○	WATER METER
○	2 NOZZLE FIRE HYDRANT/FDC
○	3 NOZZLE FIRE HYDRANT
○	HOSE BIB

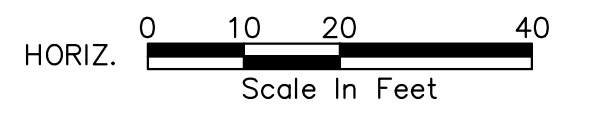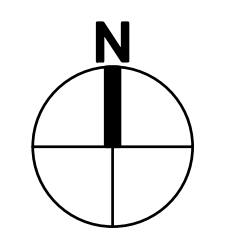

**CALL BEFORE YOU DIG 811**  
UNDERGROUND SERVICE (USA)

FILE NAME: P:\21436\_KONERU\RESUBMIT\21436\_SFR\_BLDG\_PERMIT\21436\_GRTU-SFR.DWG  
USER: JAY  
DATE: 5/19/2022 3:49 PM  
PLOT FILE: 21436\_SFR-BLDG.DWG  
XREF FILES: 21436\_SFR-BLDG.DWG



- 1- 6 X 6 TEE (MJxFL) CUT IN
- 1- GATE VALVE (FL)
- 1- 90° BEND (FL)
- 1- 6" ADAPTER (FLxMJ)
- 2- CONC. BLOCKS

CONNECT NEW DOMESTIC WATER METER TO EXISTING 6" MAIN USING 2" SERVICE TAP PER W-14.

CITY OF MERCER ISLAND HAS OWNERSHIP FROM THE CITY WATER MAIN TO THIS GATE VALVE. THE PROPERTY OWNER HAS OWNERSHIP FROM THE DOWNSTREAM OF THE GATE VALVE TO THE END OF THE PRIVATE FIRE HYDRANT. THE DOUBLE CHECK VAULT IS OWNED BY THE PRIVATE PROPERTY OWNER OF 6610 E MERCER WAY.

FIRE HYDRANT SUPPLY LINE 1-6" BACKFLOW DEVICE PER DETAIL W-19A LOCATED WITHIN EXISTING EASEMENT. VAULT TO HAVE A NON-SLIP TRAFFIC BEARING ACCESS HATCH NOTE: CONTRACTOR TO PROVIDE SHOP DRAWINGS TO CITY FOR PLAN APPROVAL. FIRE SYSTEM DESIGN SHALL BE REVIEWED UNDER A SEPARATE PERMIT.

ONE 1" WATER SERVICE PER DETAIL W-13 ON SHEET C4.1. ONE WATER METER WILL BE INSTALLED UNDER THIS PERMIT. HOMES REQUIRE FIRE SUPPRESSION SYSTEMS, VERIFY SIZE OF WATER METER AND SERVICE LINE WITH FIRE SYSTEM DESIGNER PRIOR TO CONSTRUCTION.

INSTALL ONE 2" HDPE WATER SERVICE LINE AND 6" PRIVATE WATER LINE IN COMMON UTILITY TRENCH. FIELD LOCATE TRENCH IN PAVEMENT PRISM TO MINIMIZE ADJACENT TREE IMPACTS ALONG DRIVE LANE. RESTORE EXISTING PAVEMENT TO EQUAL OR BETTER CONDITION.

DEFLECT WATER LINE AT JOINT TO ACHIEVE LINE AND GRADE (MAX DEFLECTION 4 DEGREES). TYP.


**NOTES:**

- UTILITY MAINTENANCE: EACH PROPERTY OWNER SHALL BE RESPONSIBLE FOR MAINTENANCE OF THE SANITARY SEWER, STORM WATER STUB, RAIN GARDEN, PERMEABLE PAVEMENT, OR ANY INFILTRATION FACILITIES (KNOWN AS LOW IMPACT DEVELOPMENT) FROM THE POINT OF USE ON THEIR OWN PROPERTY TO THE POINT OF CONNECTION IN THE CITY SANITARY SEWER MAIN OR STORM WATER MAIN. ANY PORTION OF A SANITARY SEWER, SURFACE WATER STUB, RAIN GARDEN, PERMEABLE PAVEMENT, OR ANY INFILTRATION FACILITIES, WHICH JOINTLY SERVES MORE THAN ONE PROPERTY, SHALL BE JOINTLY MAINTAINED AND REPAIRED BY THE PROPERTY OWNERS SHARING SUCH STUB. THE JOINT USE AND MAINTENANCE SHALL "RUN WITH THE LAND" AND WILL BE BINDING ON ALL PROPERTY OWNERS WITHIN THIS SUBDIVISION, INCLUDING THEIR HEIRS, SUCCESSORS AND ASSIGNS.
- ALL BUILDINGS ARE SUBJECT TO MEETING THE CURRENT FIRE CODE REQUIREMENTS AT THE TIME OF PERMIT SUBMITTAL. ACCESS SHALL BE PROVIDED AS OUTLINED IN THE INTERNATIONAL FIRE CODE APPENDIX D AS ADOPTED AND/OR AMENDED AND MICC 19.09.40. FIRE PLAN REVIEWS WILL BE CONDUCTED AT THE TIME OF BUILDING PERMIT SUBMITTAL AND MAY REQUIRE ADDITIONAL FIRE PROTECTION SYSTEMS AND/OR FIRE PREVENTION MEASURES FOR PERMIT APPROVAL.
- ALL NEW CONSTRUCTION AND ALTERATIONS OVER 50% VALUATION ARE REQUIRED TO INSTALL A MINIMUM OF NFPA 13D FIRE SPRINKLER SYSTEM.
- DECREASED FIRE FLOW, ACCESS, GRADE, OR BUILDING SIZE MAY REQUIRE THE INSTALLATION OF A NFPA 13R OR 13 SPRINKLER SYSTEM.
- REMOVE EXISTING WATER METER LOCATED AT 6466 E. MERCER WAY PER CITY OF MERCER ISLAND REQUIREMENTS.
- ALL WATER INFRASTRUCTURE TO BE INSTALLED PER CITY OF MERCER ISLAND STANDARD WATER DETAILS. APPLICABLE DETAILS INCLUDED ON SHEET C4.1.
- TV INSPECTION OF EXISTING SIDE SEWER TO THE CITY SEWER MAIN IS REQUIRED PRIOR TO ANY WORK RELATED TO THE SIDE SEWER. IF THE RESULT OF THE TV INSPECTION IS NOT IN SATISFACTORY CONDITION, AS DETERMINED BY THE CITY OF MERCER ISLAND INSPECTOR, THE REPLACEMENT OF THE EXISTING SIDE SEWER IS REQUIRED.

DATE	8/19/22
REVISION	RESPONSE TO COMMENTS DATED 7/21/22
SYM	

**PACE**  
An Engineering Services Company  
11755 Kirkland Way, Suite 300  
Kirkland, WA 98033  
p. 425.827.2014 f. 425.827.5043  
www.paceengr.com

Civil | Structural | Planning | Survey

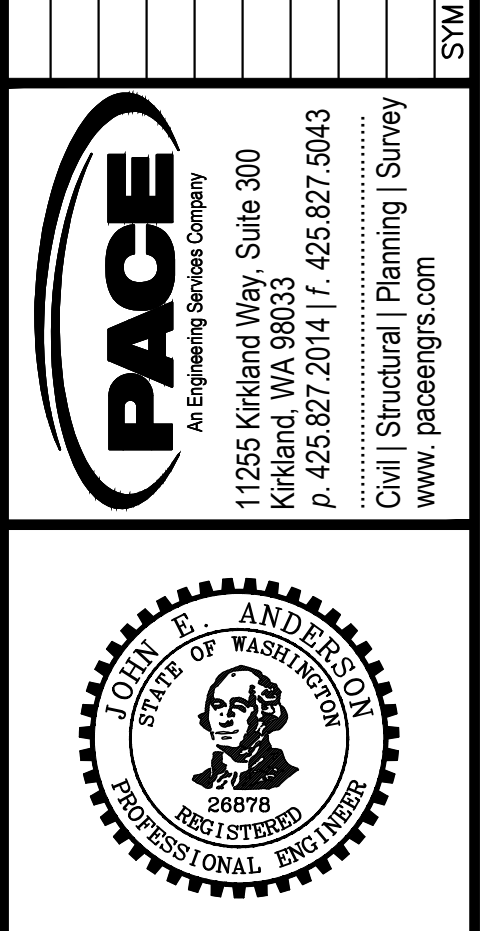


**DHEERAJ KONERU**  
7002 93RD AVENUE SE  
MERCER ISLAND, WA 98040

**KONERU BUILDING PERMIT**  
6610 EAST MERCER WAY  
MERCER ISLAND, WA 98040

**UTILITY PLAN**

<b>VERIFY SCALE</b>	
BAR IS ONE INCH ON ORIGINAL DRAWING.	
IF NOT ONE INCH ON THIS SHEET, ADJUST SCALES ACCORDINGLY.	
SCALE:	DATE:
AS SHOWN	05/11/22
DESIGNED BY:	CHECKED BY:
MA	JA
PACE PROJECT NO. 21436.00	
<b>SHEET C4.0</b>	

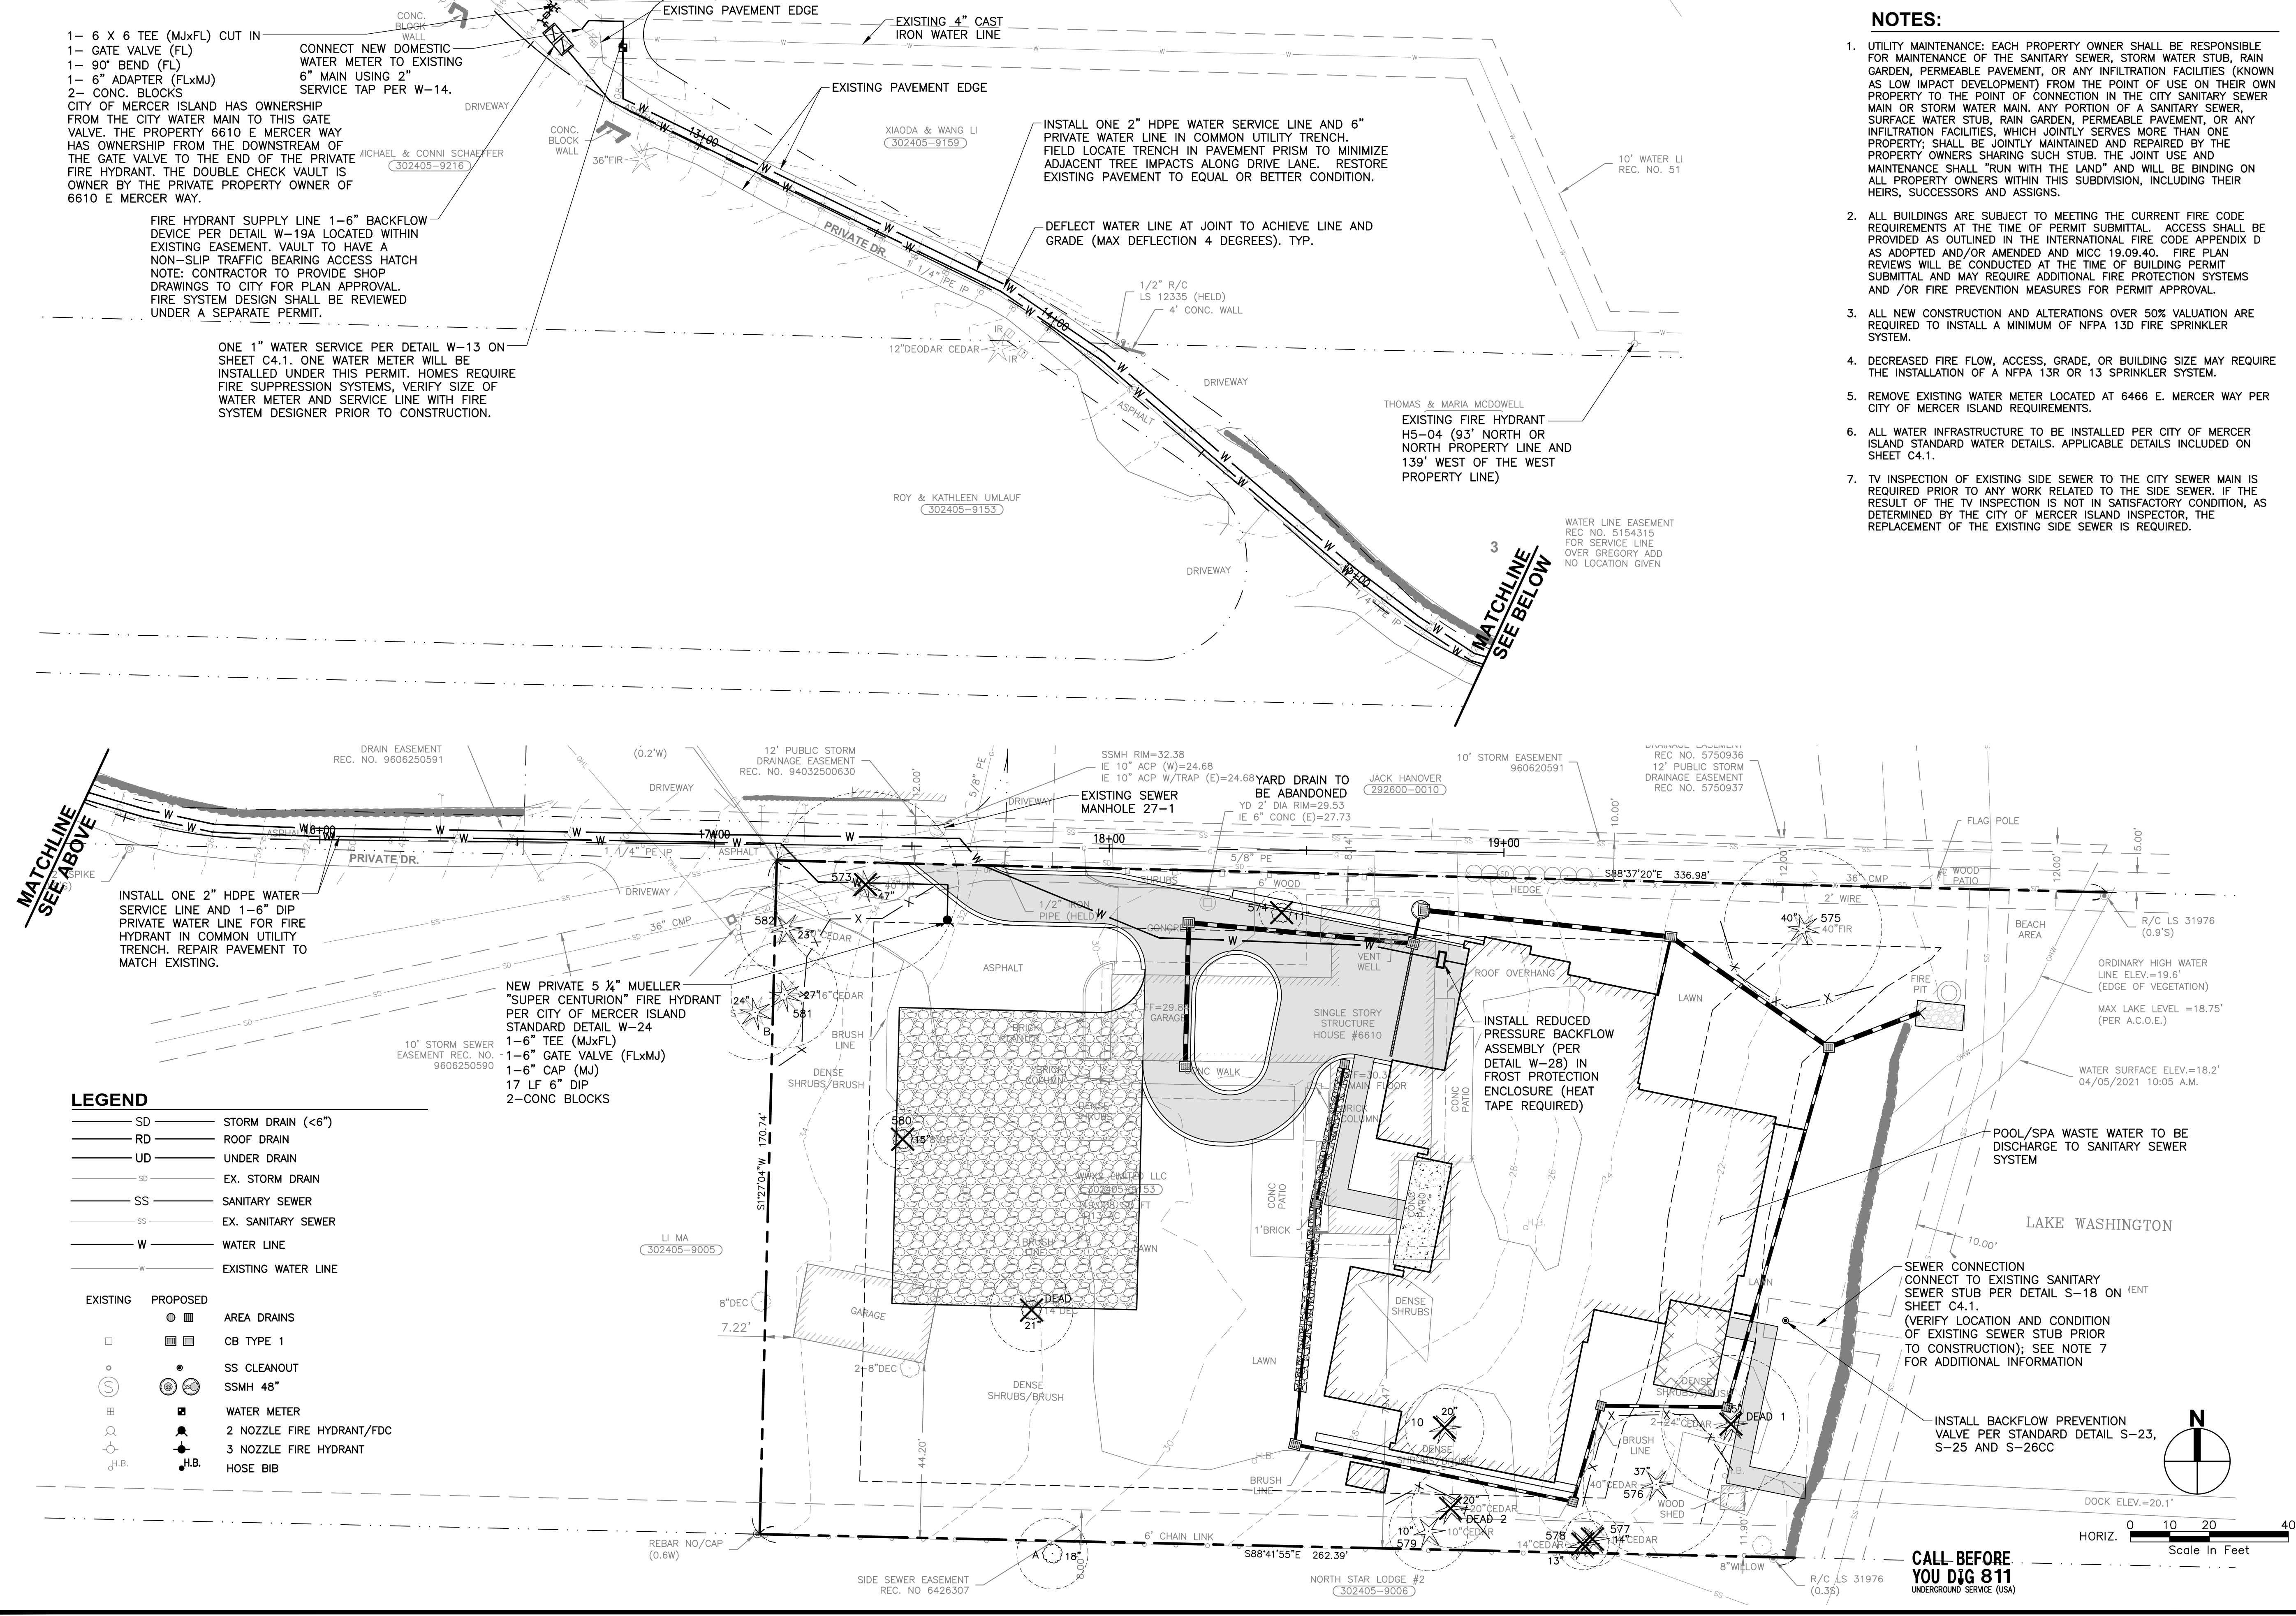


**LEGEND**

SD	STORM DRAIN (<6")
RD	ROOF DRAIN
UD	UNDER DRAIN
SD	EX. STORM DRAIN
SS	SANITARY SEWER
SS	EX. SANITARY SEWER
W	WATER LINE
w	EXISTING WATER LINE


EXISTING	PROPOSED	
○	■	AREA DRAINS
□	■	CB TYPE 1
○	○	SS CLEANOUT
○	○	SSMH 48"
○	○	WATER METER
○	○	2 NOZZLE FIRE HYDRANT/FDC
○	○	3 NOZZLE FIRE HYDRANT
○	○	HOSE BIB

**CALL BEFORE YOU DIG 811**  
UNDERGROUND SERVICE (USA)

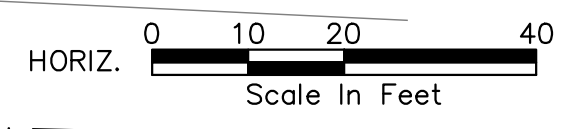

FILE NAME: P:\21436\_KONERU\_BUILDING\_PERMIT\21436\_UT-SFD.DWG  
USER: JAVIER  
DATE: 5/9/2022 3:49 PM  
PLOT FILE: P:\21436\_KONERU\_BUILDING\_PERMIT\21436\_UT-SFD.DWG  
PLOT FILE: P:\21436\_KONERU\_BUILDING\_PERMIT\21436\_UT-SFD.DWG  
XREF FILES: P:\21436\_KONERU\_BUILDING\_PERMIT\21436\_UT-SFD.DWG




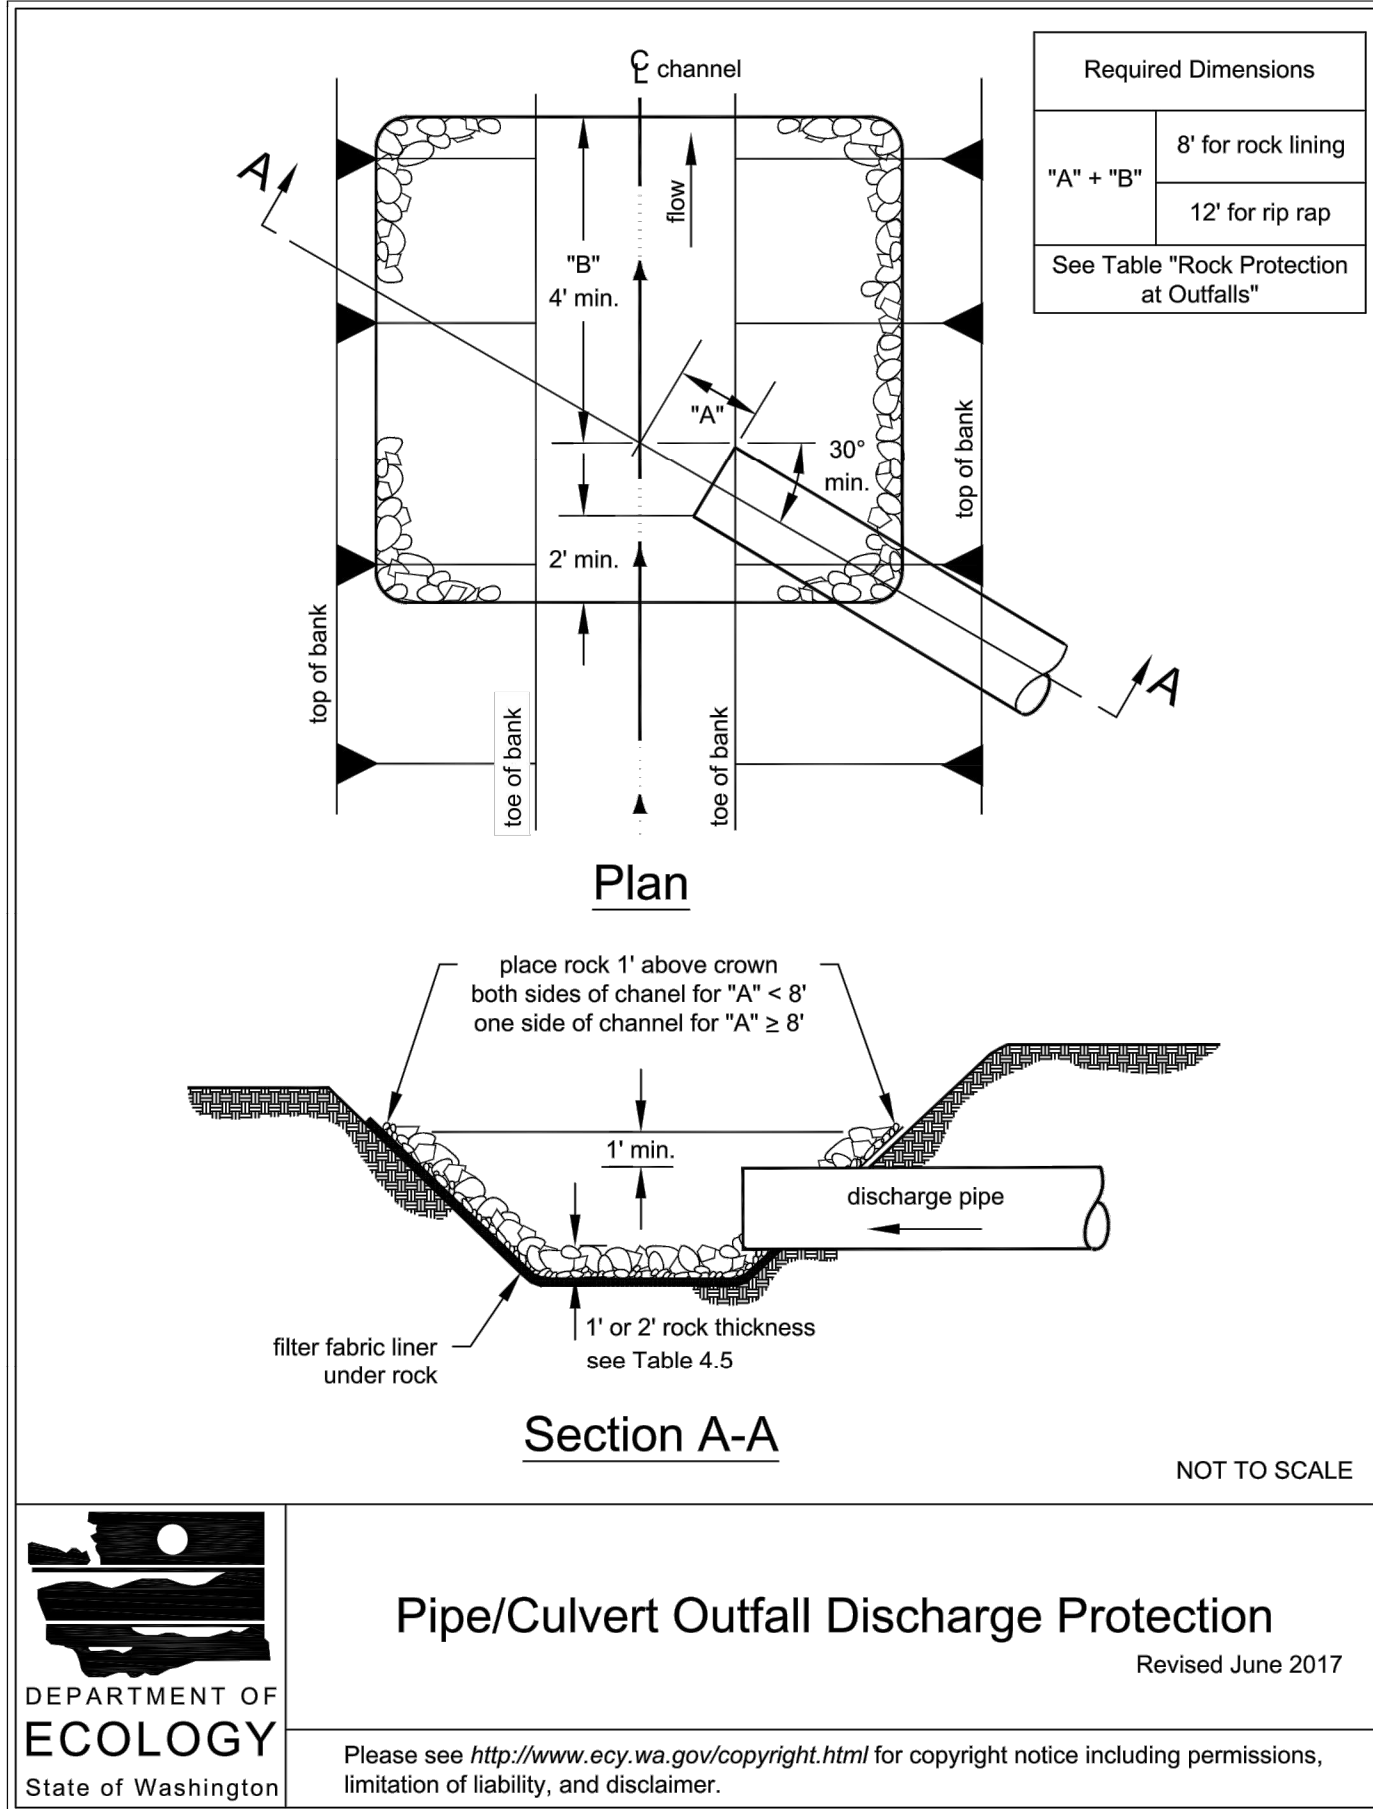

**DEPARTMENT OF ECOLOGY**  
State of Washington

**Pipe/Culvert Outfall Discharge Protection**  
Revised June 2017

Please see <http://www.ecy.wa.gov/copyright.html> for copyright notice including permissions, limitation of liability, and disclaimer.

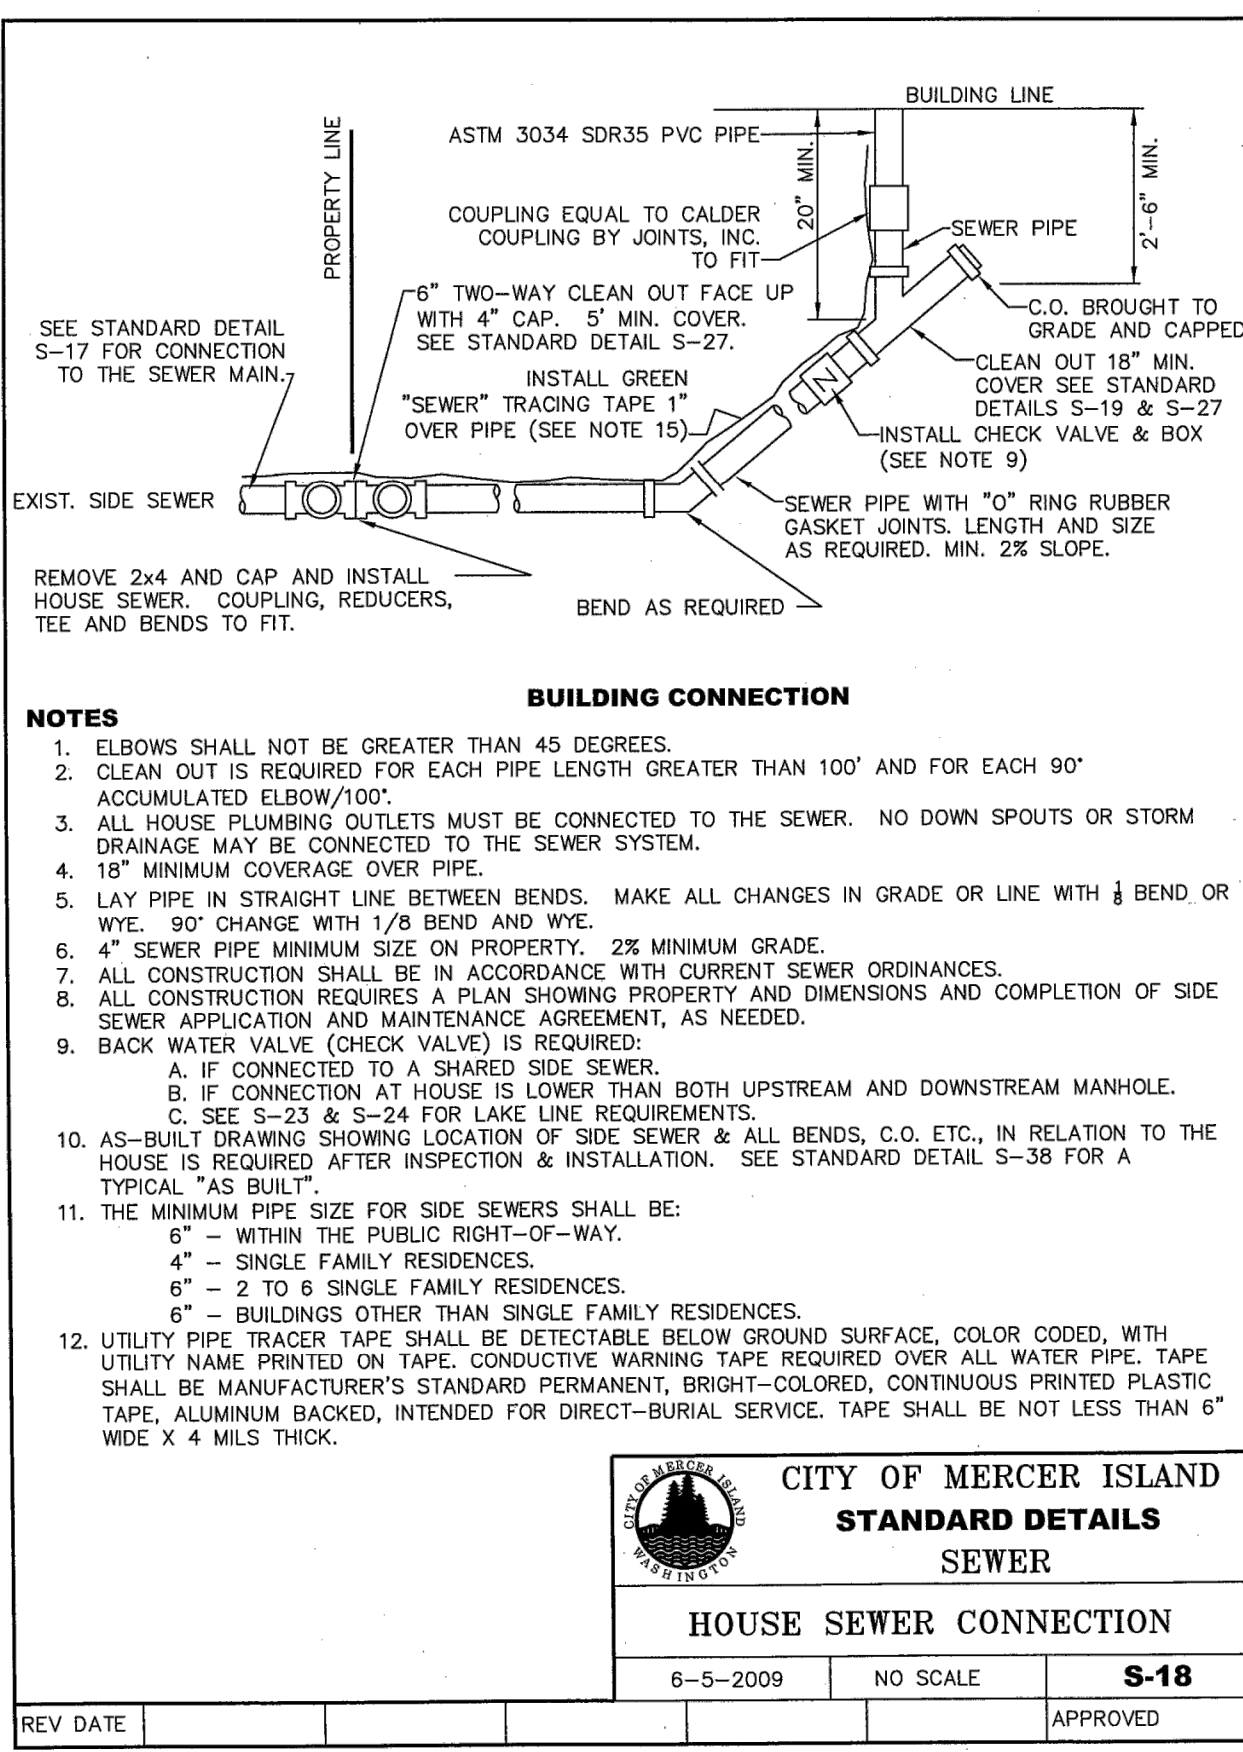


**CITY OF MERCER ISLAND STANDARD DETAILS SEWER**

**HOUSE SEWER CONNECTION**

6-5-2009 NO SCALE **S-18**

REV DATE APPROVED

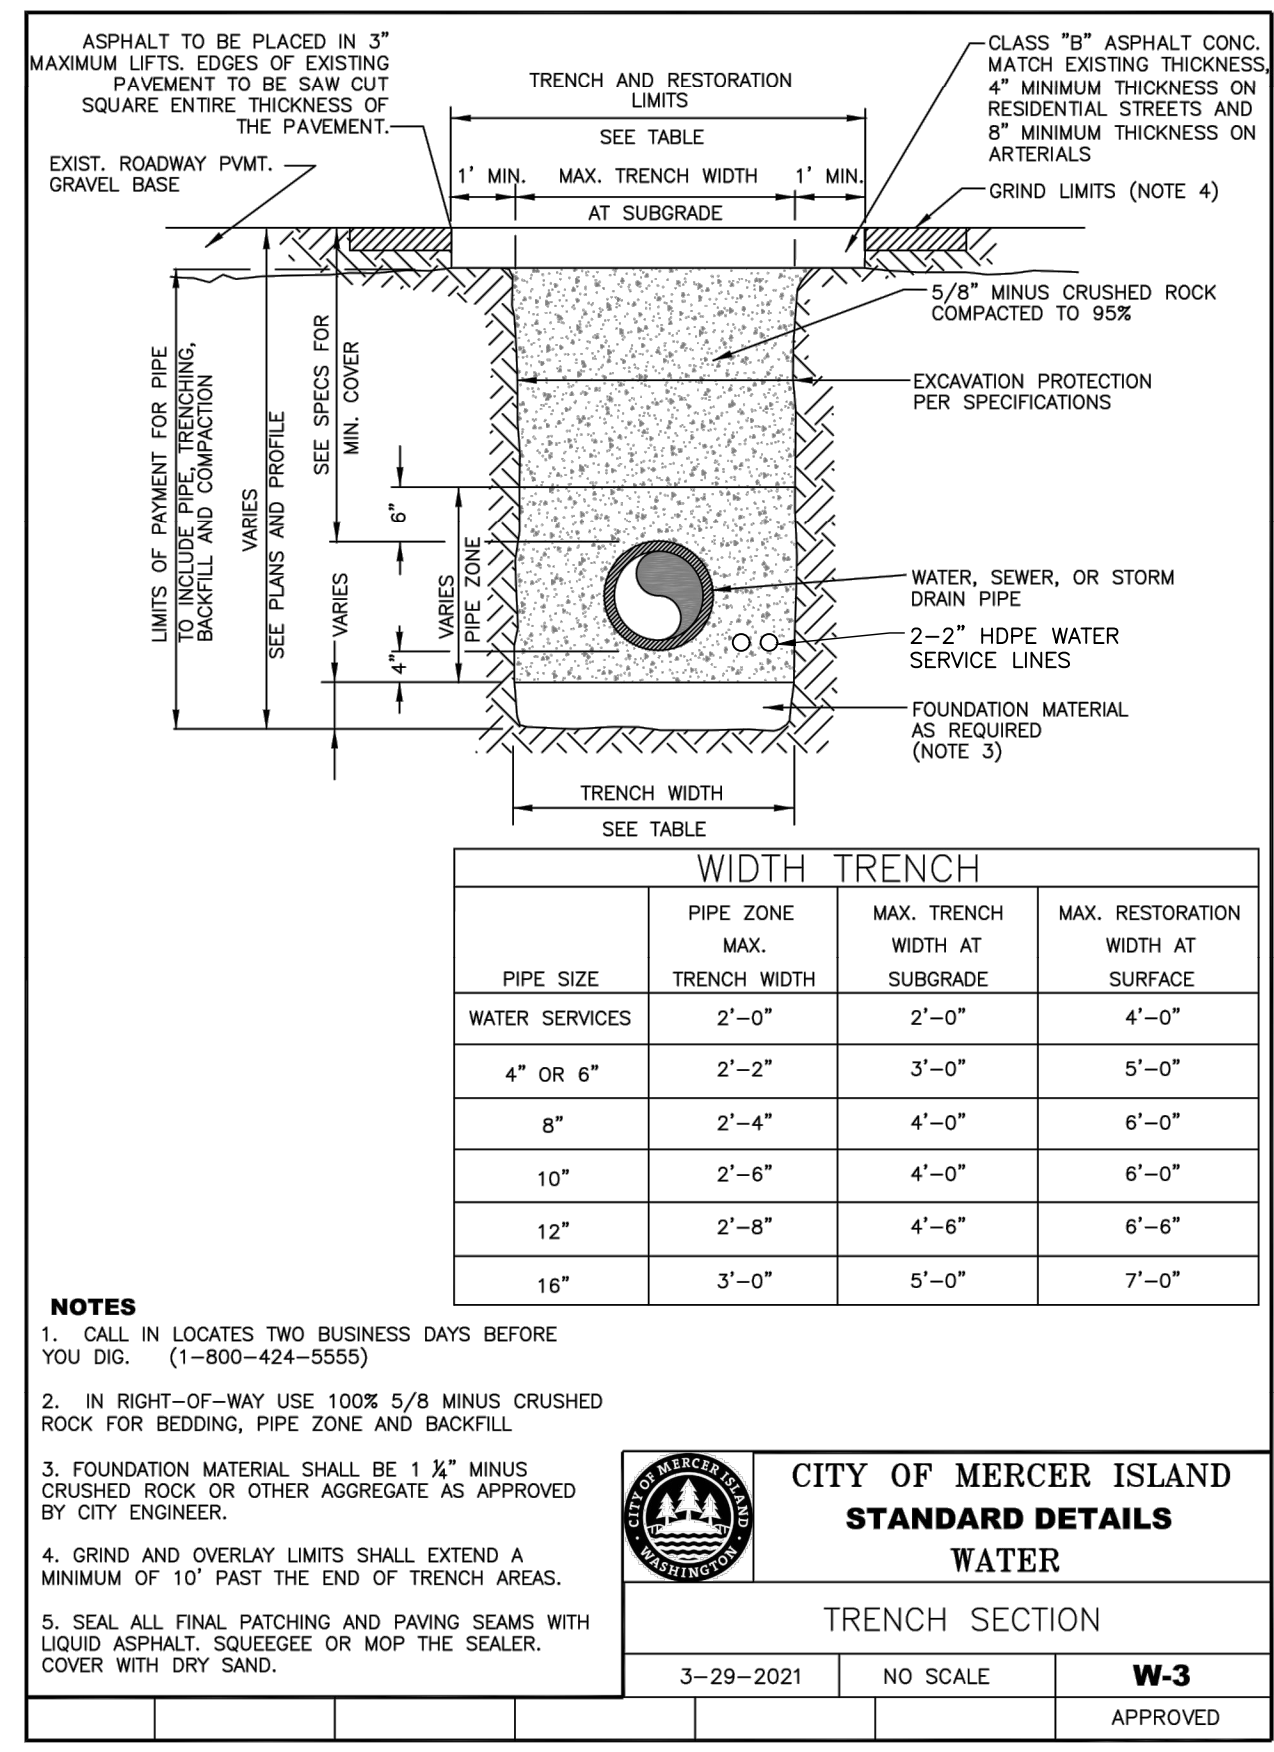


**CITY OF MERCER ISLAND STANDARD DETAILS WATER**

**TRENCH SECTION**

3-29-2021 NO SCALE **W-3**

REV DATE APPROVED

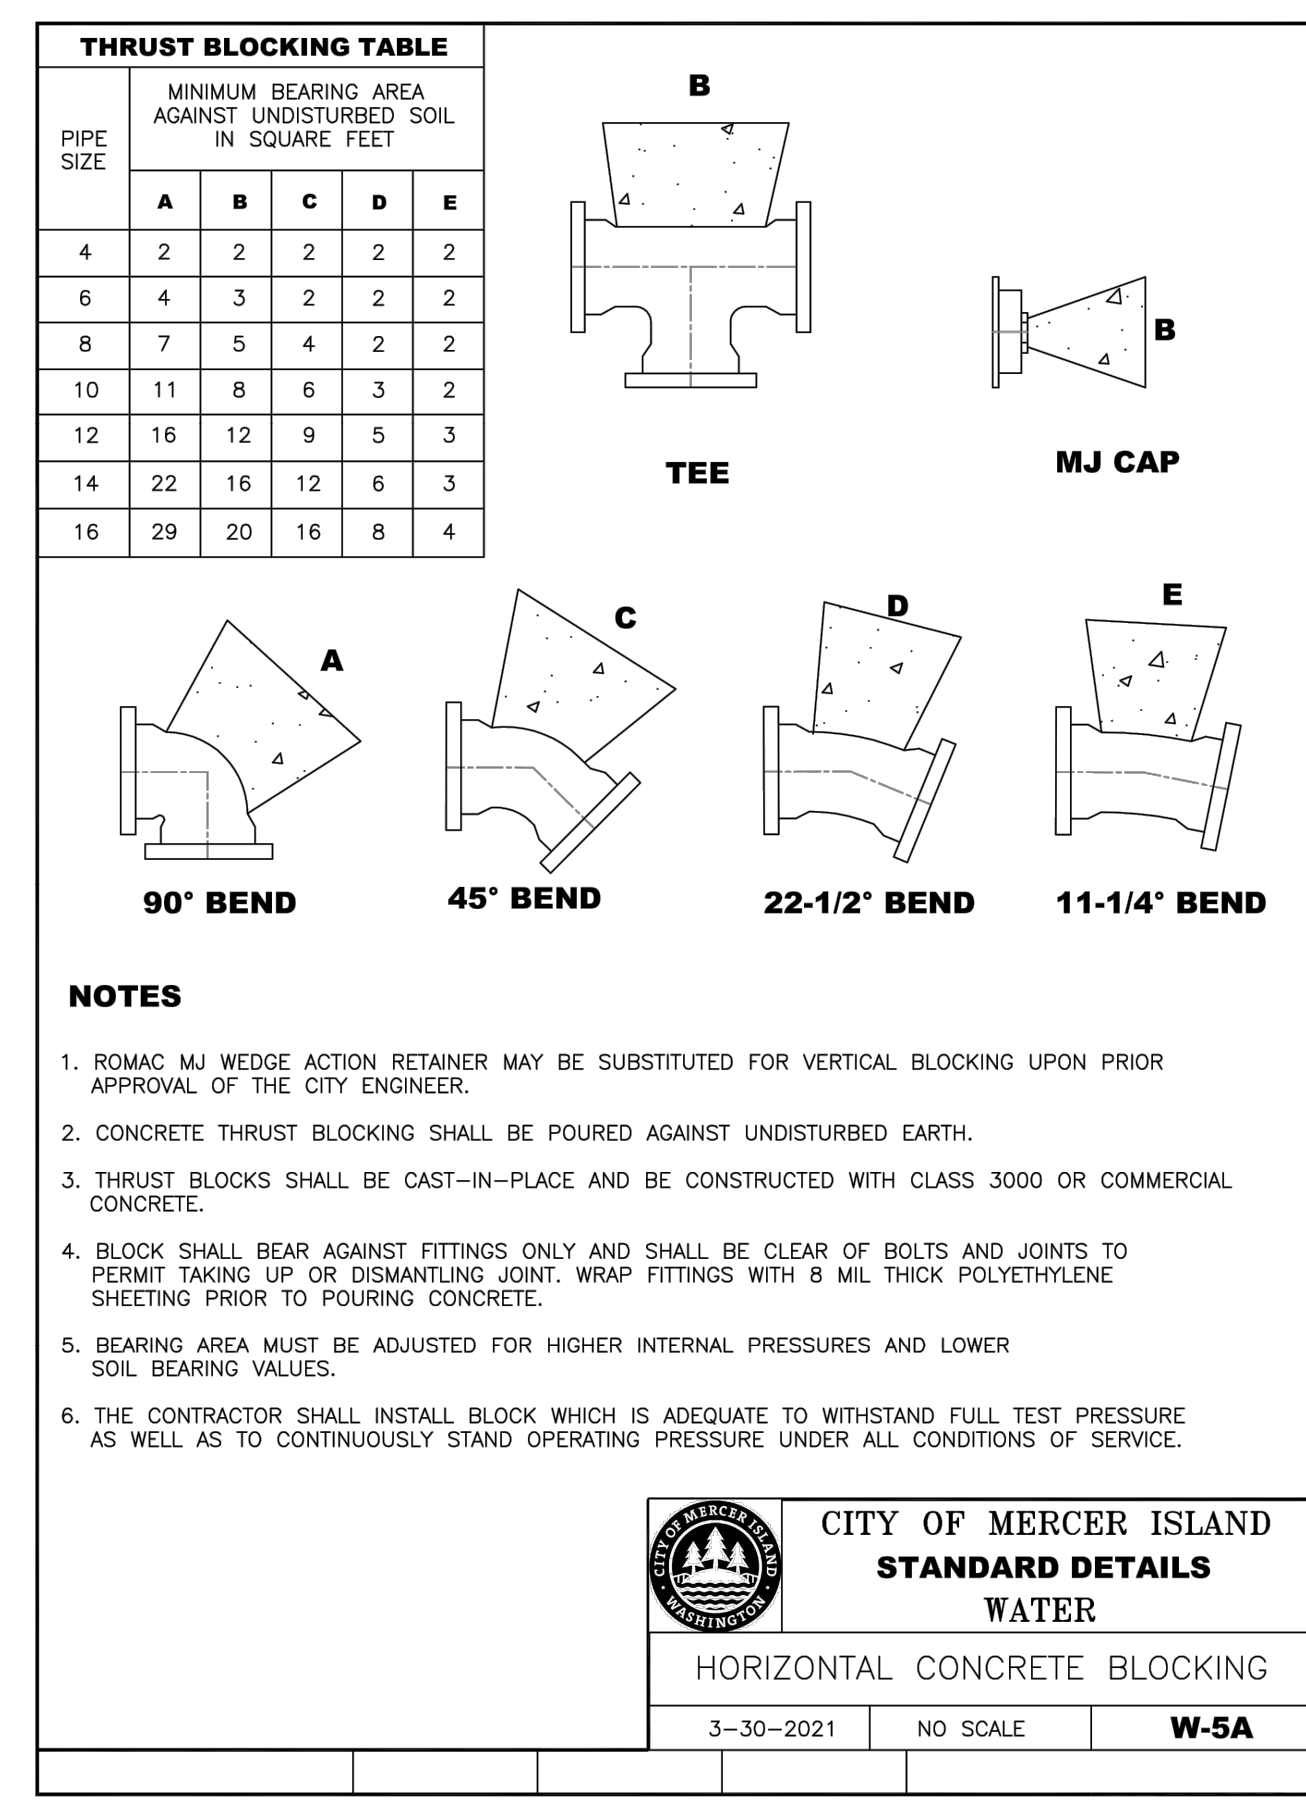


**CITY OF MERCER ISLAND STANDARD DETAILS WATER**

**HORIZONTAL CONCRETE BLOCKING**

3-30-2021 NO SCALE **W-5A**

REV DATE APPROVED

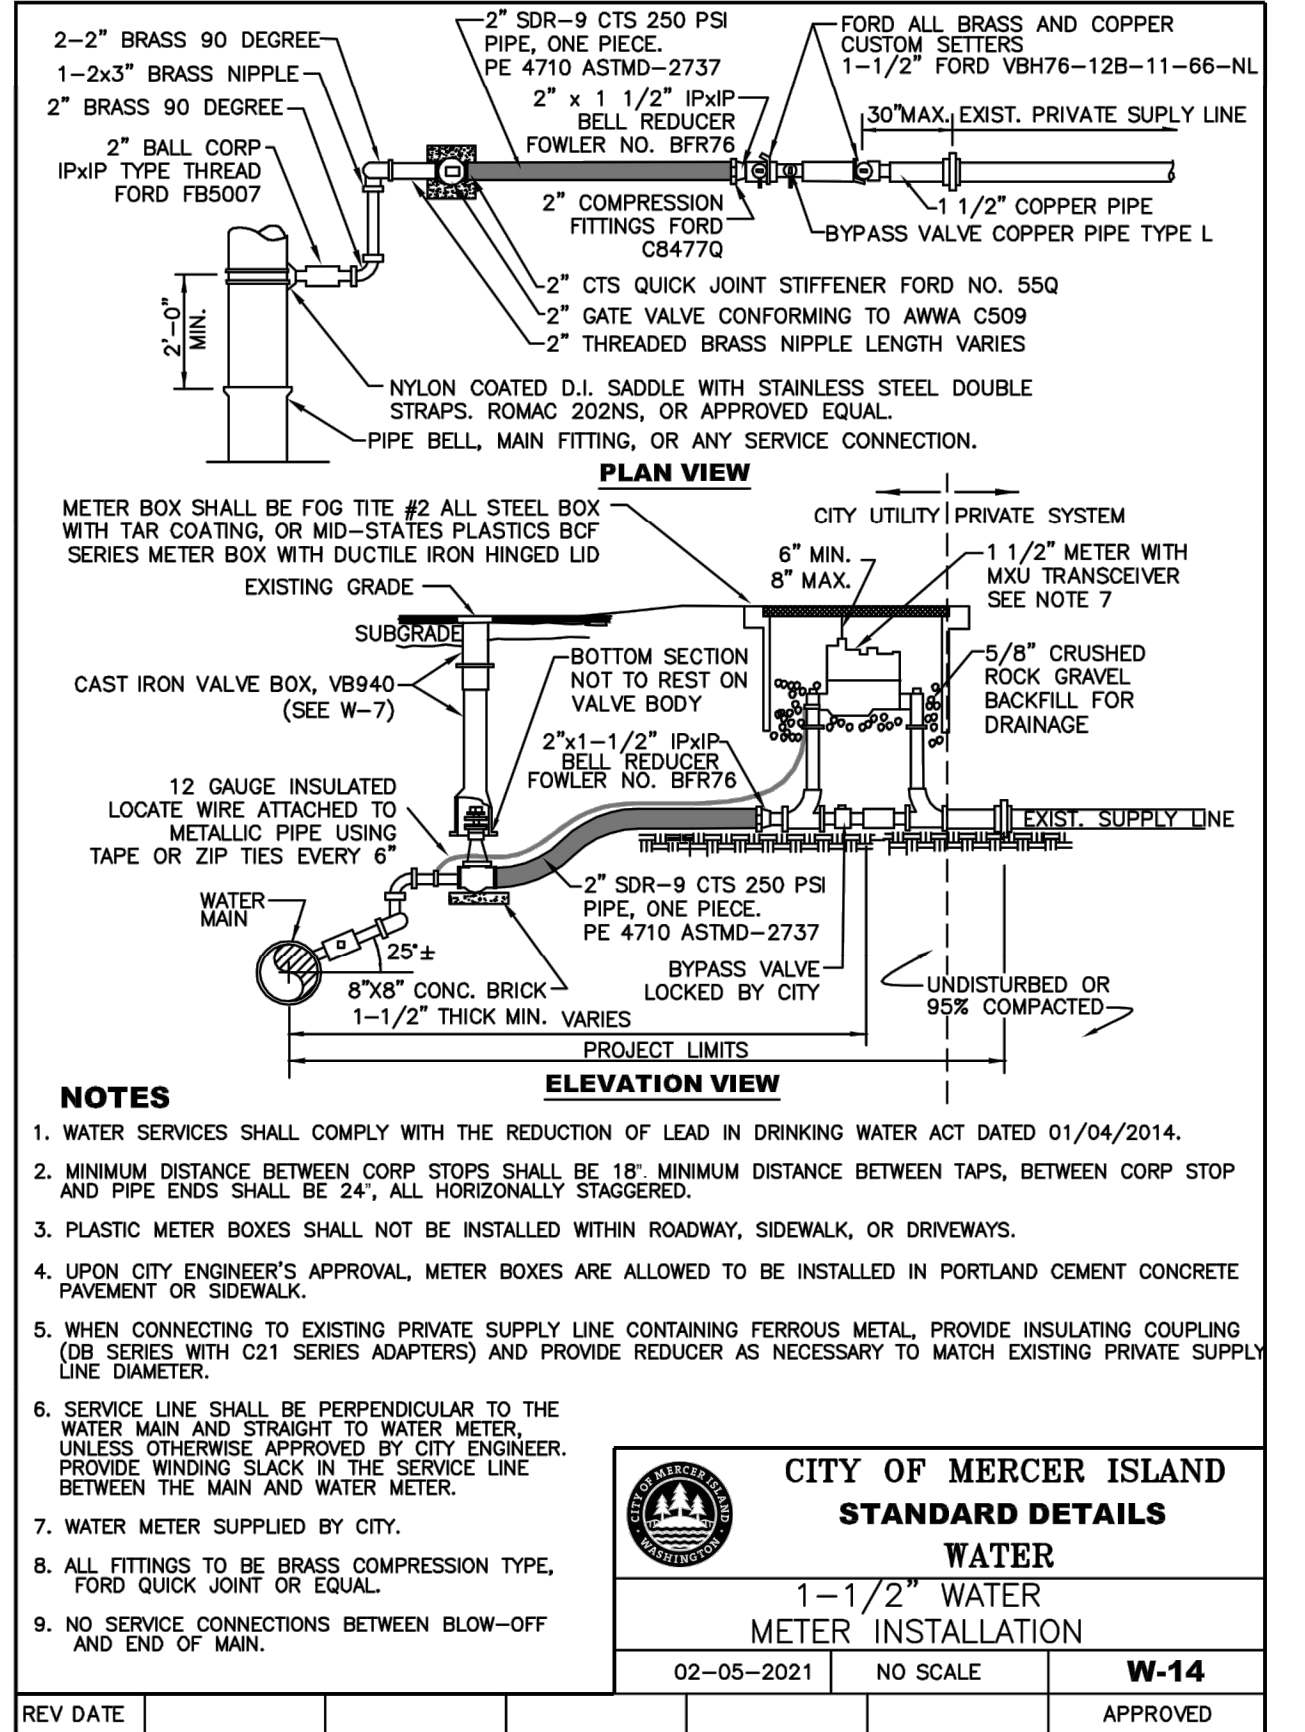


**CITY OF MERCER ISLAND STANDARD DETAILS WATER**

**1-1/2" WATER METER INSTALLATION**

02-05-2021 NO SCALE **W-14**

REV DATE APPROVED

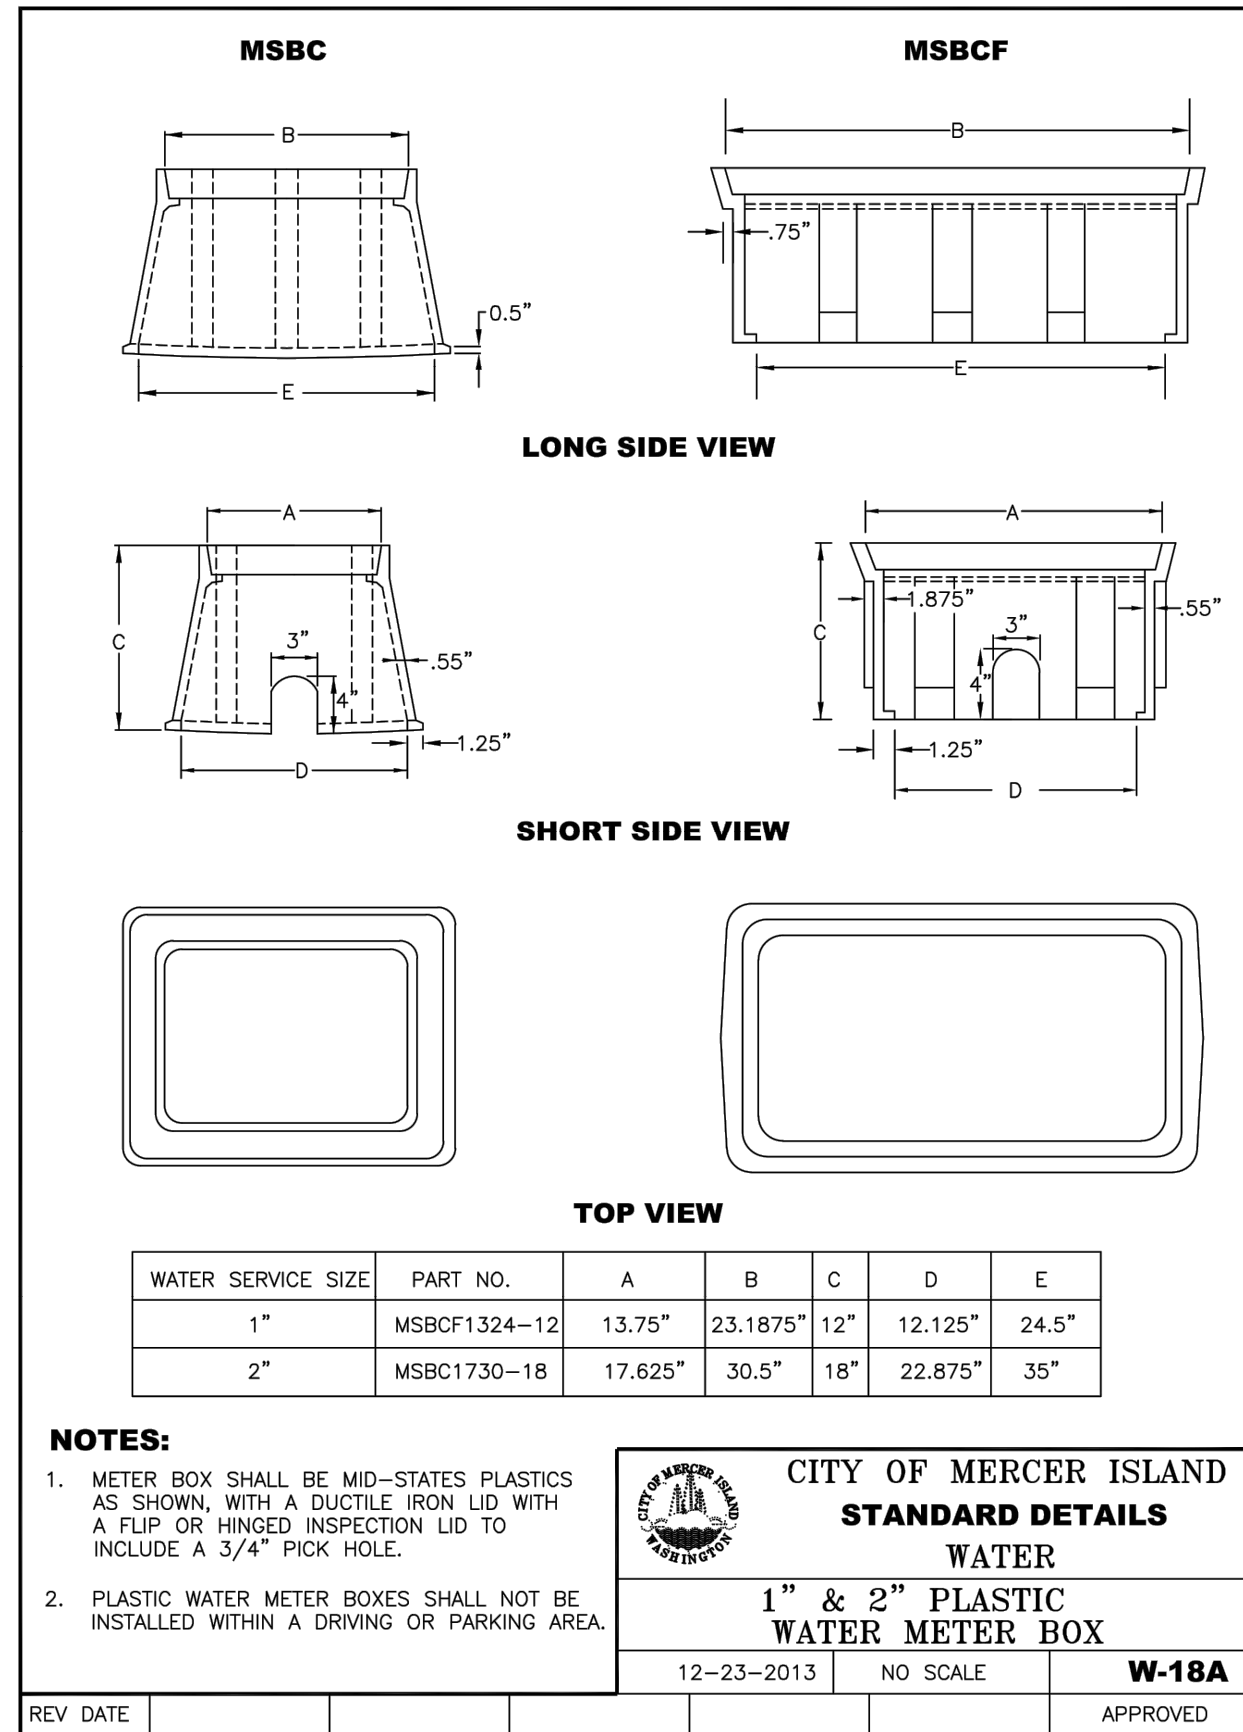


**CITY OF MERCER ISLAND STANDARD DETAILS WATER**

**1" & 2" PLASTIC WATER METER BOX**

12-23-2013 NO SCALE **W-18A**

REV DATE APPROVED

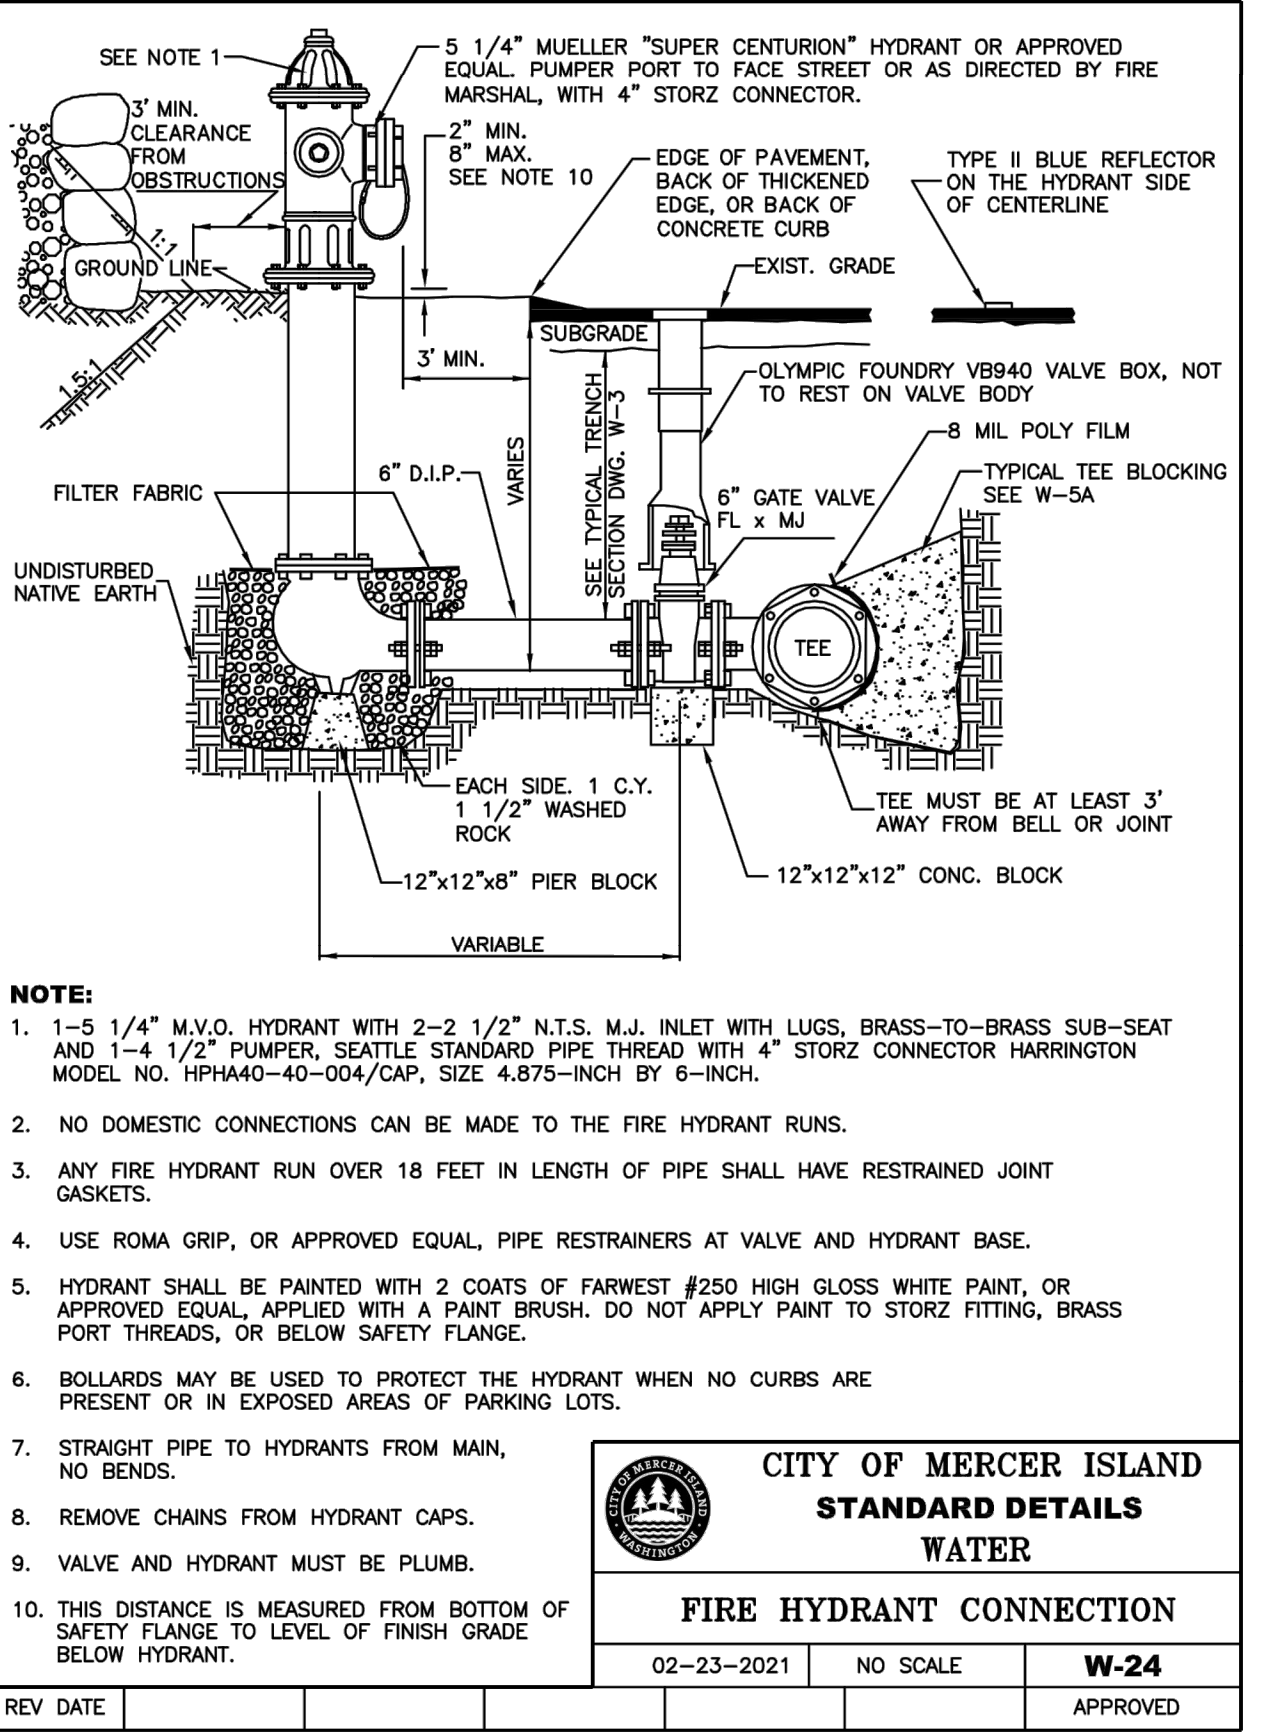


**CITY OF MERCER ISLAND STANDARD DETAILS WATER**

**FIRE HYDRANT CONNECTION**

02-23-2021 NO SCALE **W-24**

REV DATE APPROVED

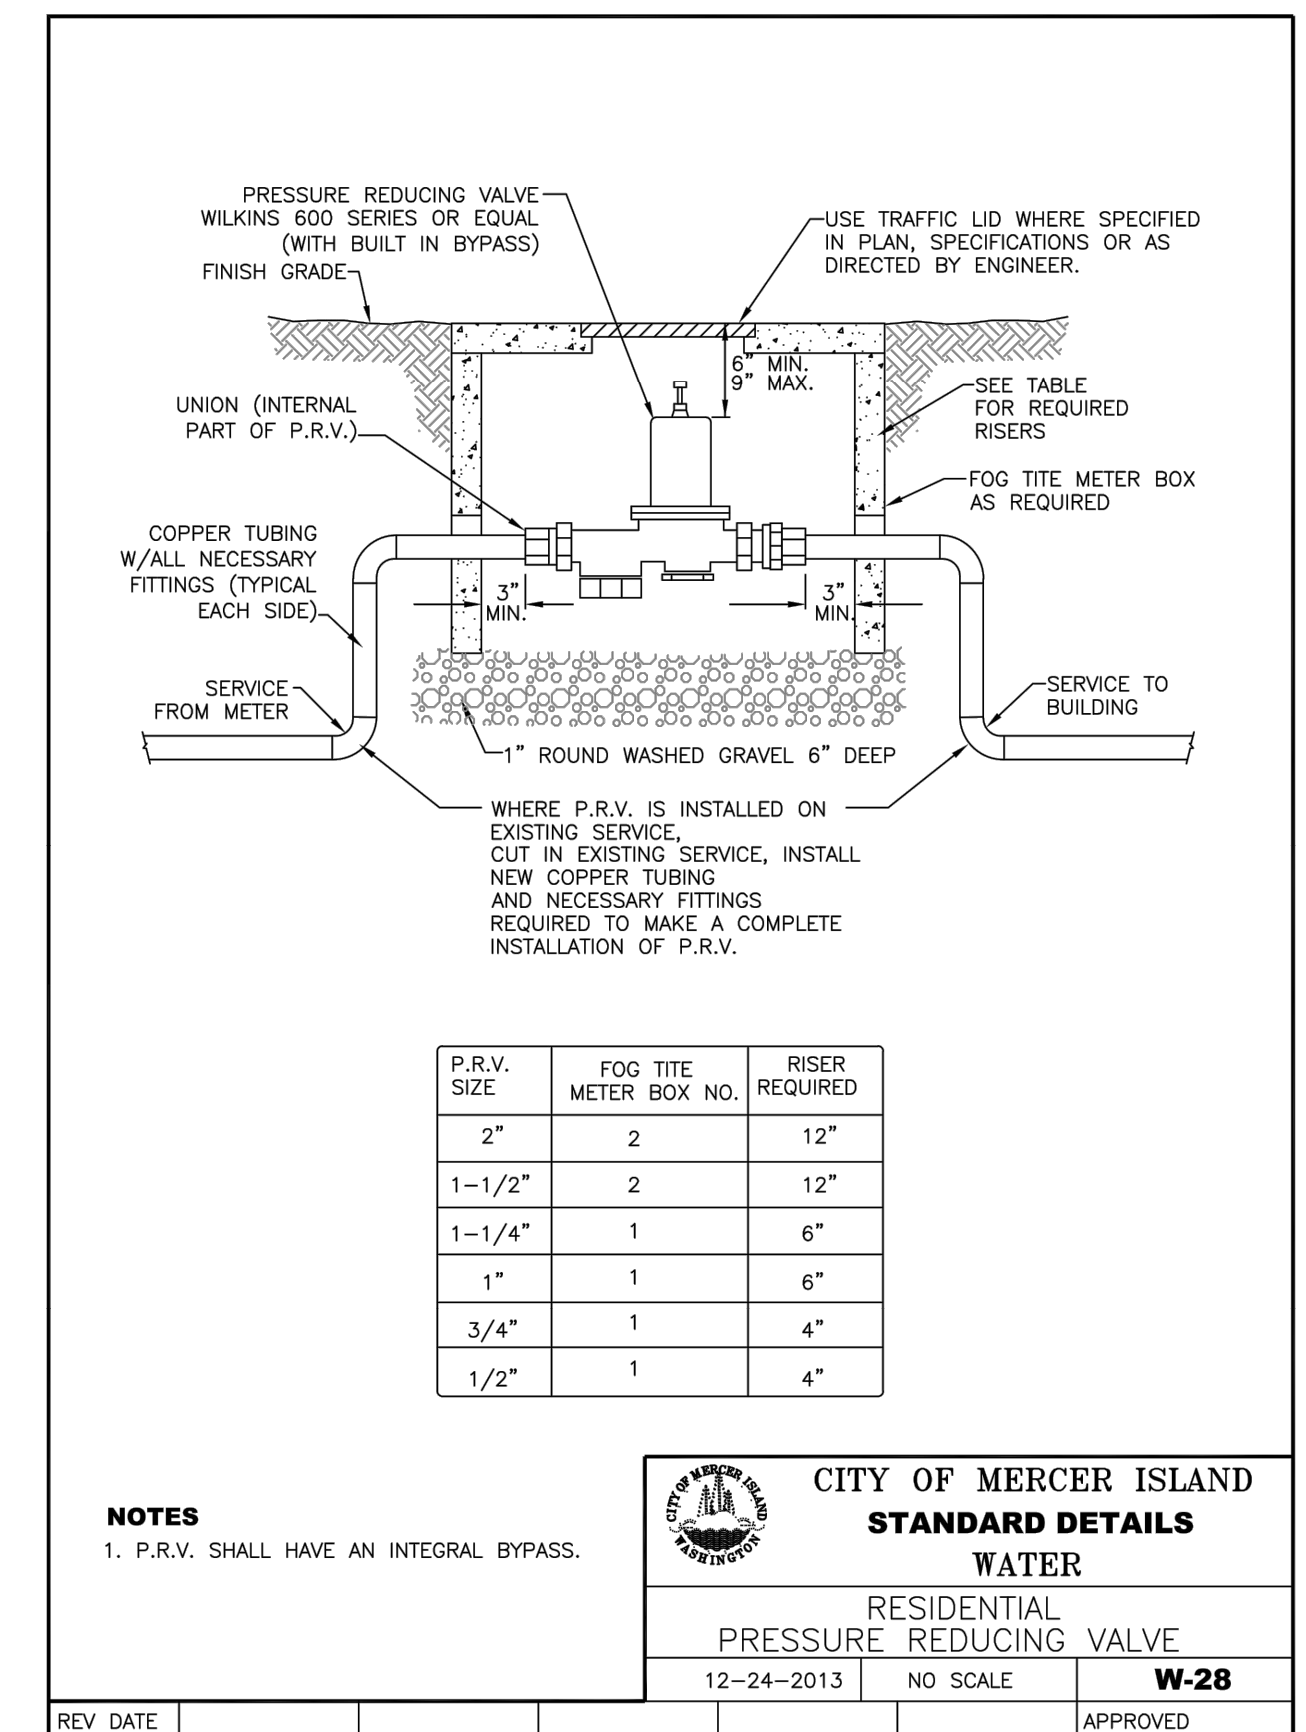

**CITY OF MERCER ISLAND STANDARD DETAILS WATER**

**RESIDENTIAL PRESSURE REDUCING VALVE**

12-24-2013 NO SCALE **W-28**

REV DATE APPROVED

FILE NAME: P:\21436\_KONERU\RESIDENCE\CAD\ENGINEERING\DWG\PERMIT\21436\_UF-SFD.DWG  
 USER: JACOB  
 PLOT TIME: 9/19/2022 3:50 PM  
 XREF FILES: 21436\_SDR.dwg, 21436\_SDI.dwg, 21436\_SIT.dwg, 21436\_HA.dwg, 21436\_WF.dwg, 21436\_TRE.dwg, 21436\_9433-11-SRW.dwg

**PACE**  
An Engineering Services Company  
11255 Kirkland Way, Suite 300  
Kirkland, WA 98033  
p. 425.827.2014 f. 425.827.5043  
Civil | Structural | Planning | Survey  
www.paceengr.com

**OHIO B. ANDERSON**  
STATE OF WASHINGTON  
REGISTERED PROFESSIONAL ENGINEER

**DHEERAJ KONERU**  
7002 93RD AVENUE SE  
MERCER ISLAND, WA 98040

**KONERU BUILDING PERMIT**  
6610 EAST MERCER WAY  
MERCER ISLAND, WA 98040

**UTILITY DETAILS**

**VERIFY SCALE**  
BAR IS ONE INCH ON ORIGINAL DRAWING.  
IF NOT ONE INCH ON THIS SHEET, ADJUST SCALES ACCORDINGLY.  
SCALE: AS SHOWN DATE: 05/11/22  
DESIGNED BY: MA CHECKED BY: JA  
PACE PROJECT NO. 21436.00

**CALL BEFORE YOU DIG 811**  
UNDERGROUND SERVICE (USA)


**SHEET C4.1**

RESPONSE TO COMMENTS DATED 7/21/22  
REVISION  
DATE  
8/19/22





FILE NAME: P:\211436\_KONERU RESIDENCE CAD\ENGINEERING SHEETS\SPR BUILDING PERMIT\211436\_TREE-SFR-DWG  
 USER: JAVIER  
 PLOT TIME: 9/19/2022 3:50 PM  
 XREF FILES: 211436\_BDR.dwg 211436\_SFR.dwg 211436\_TREE.dwg 211436\_SITE.dwg 211436\_TREE-HATCH.dwg 211436\_SD.dwg 211436\_WA-SFR.dwg 9433-11-SRV.dwg

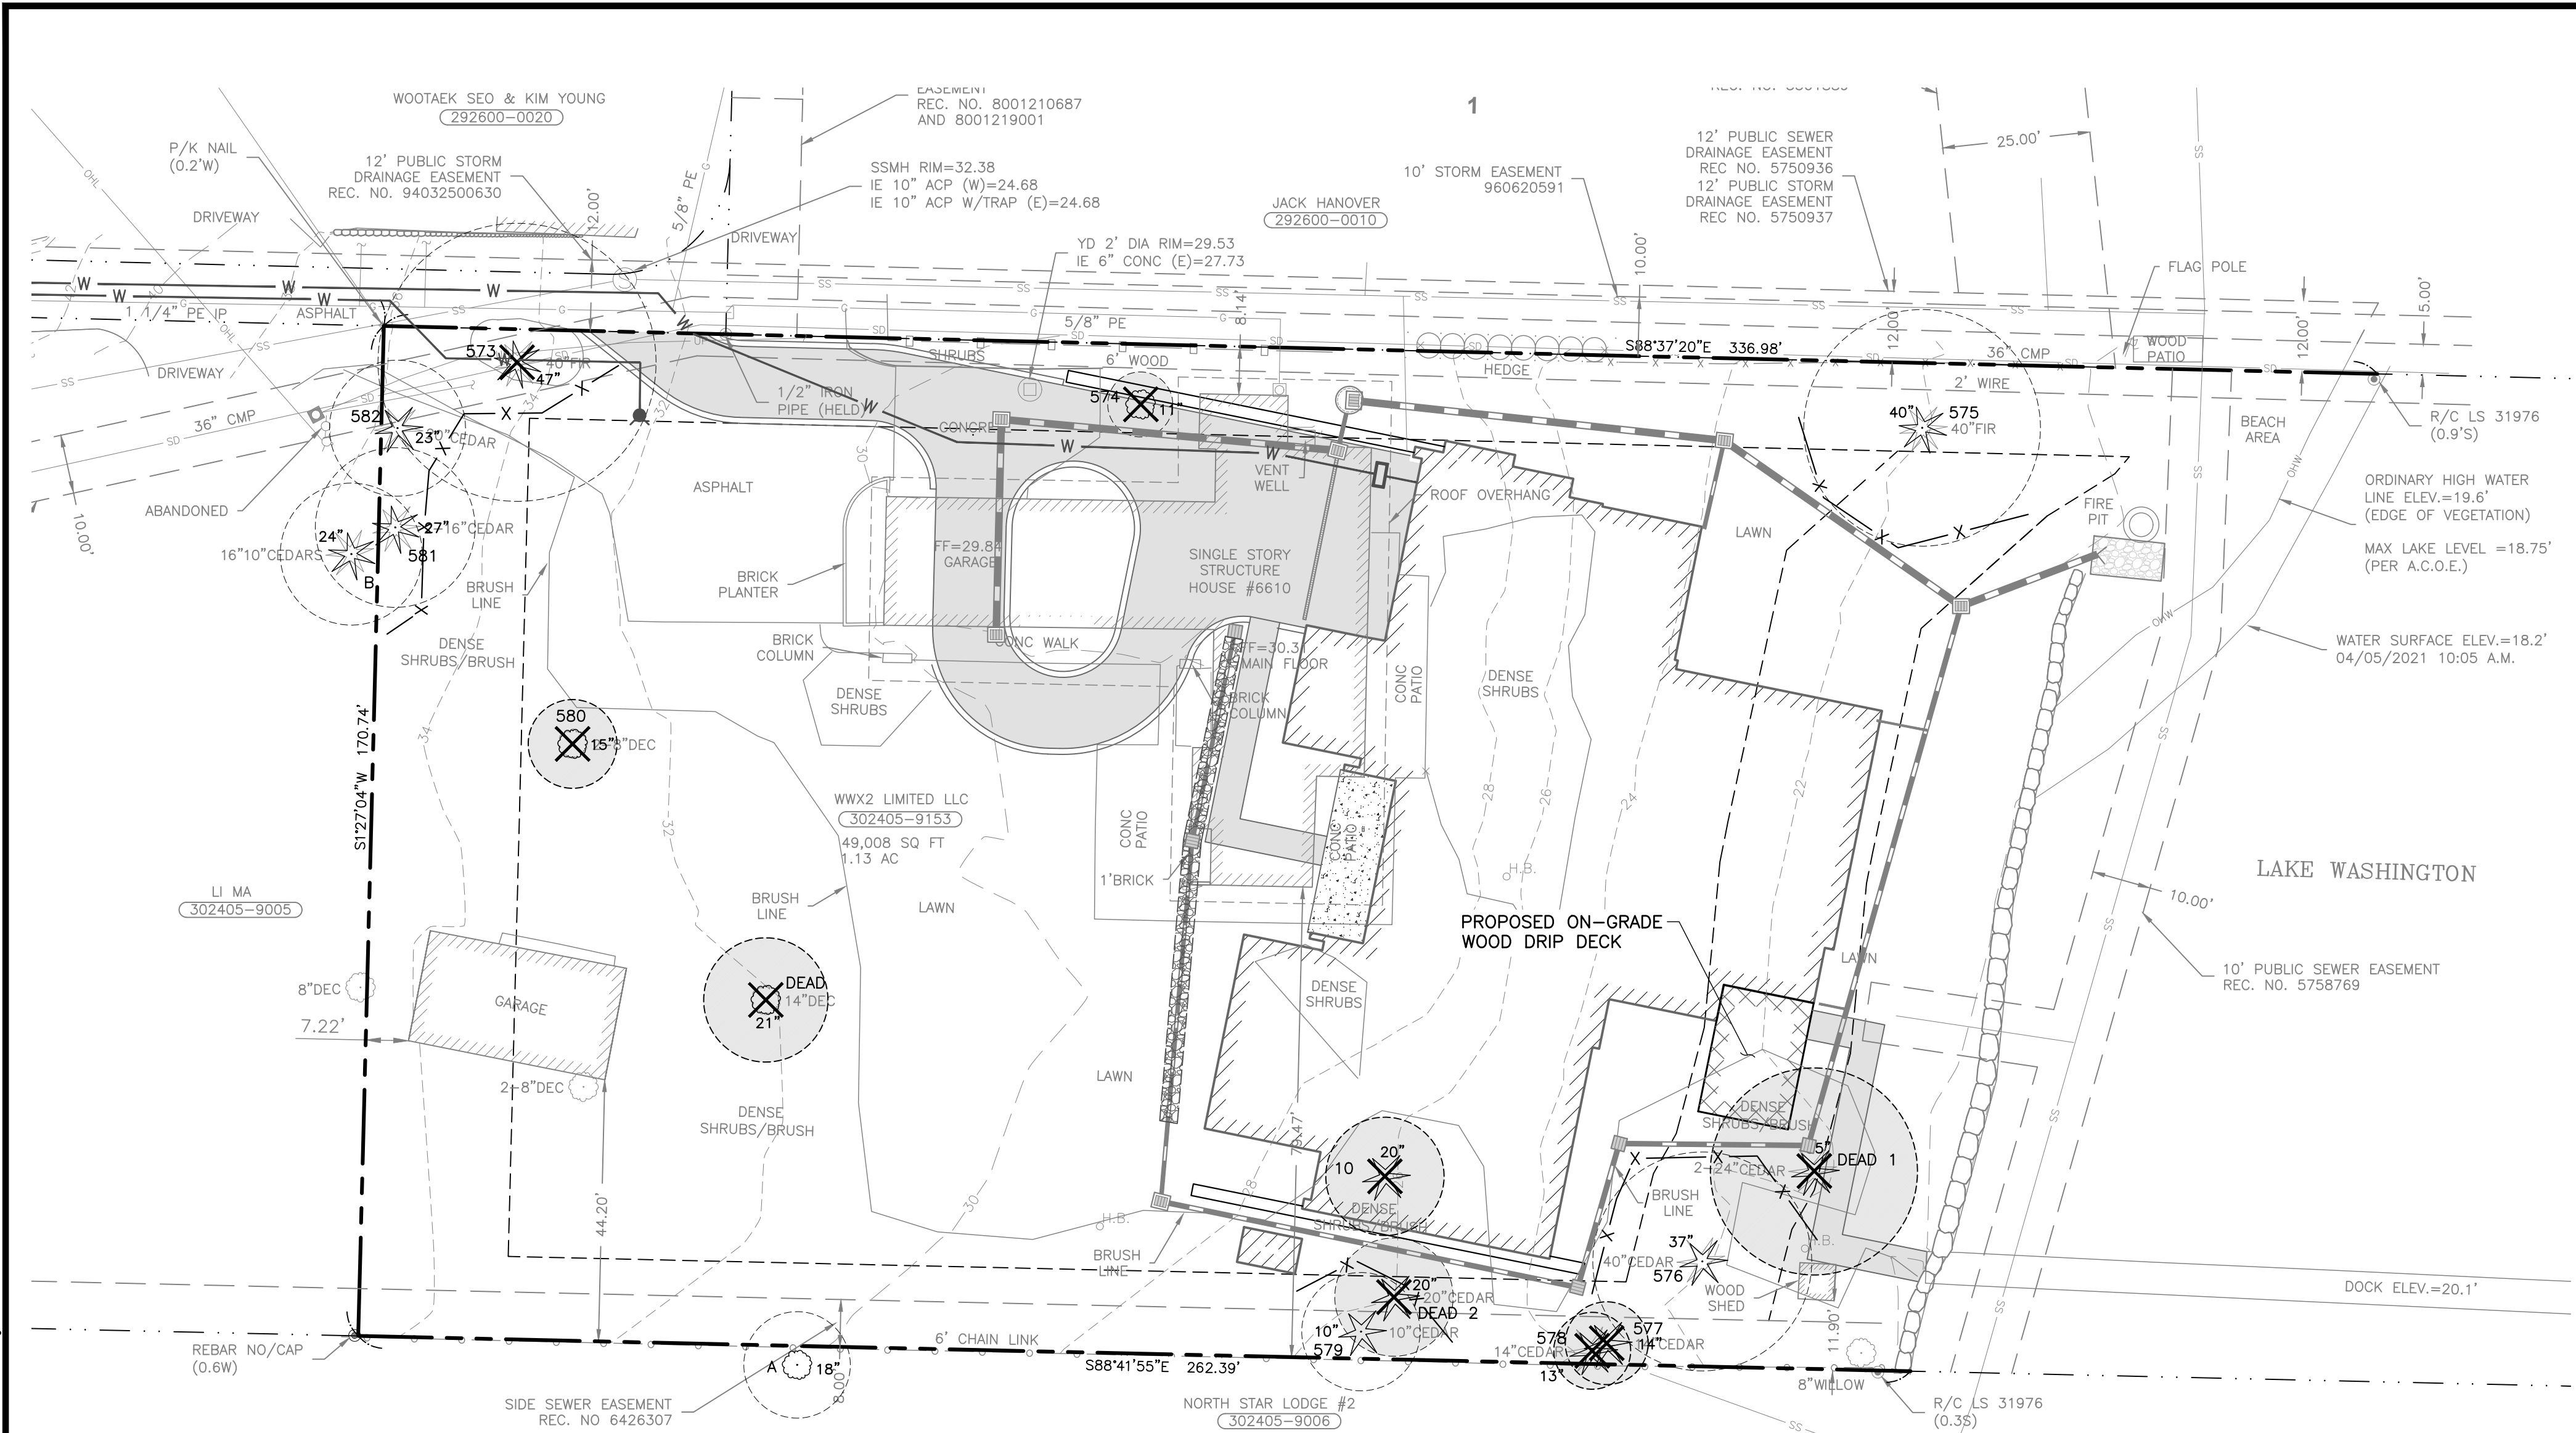


**LEGEND**

- 888 VIABLE TREE TO REMAIN
- 889 VIABLE TREE TO BE REMOVED DUE TO PROJECT OR NOT-SUITABLE TO MAINTAIN
- CONIFEROUS
- DECIDUOUS TREE
- DRIP LINE PER TABLE
- TREE PROTECTION
- A-C TREES LOCATED OFF SITE

**TREE INVENTORY**


Tree ID	Scientific Name	Common Name	DSH (inches)	DSH Multistem	Health Condition	Structural Condition	Dripline Radius (feet)				Exceptional Threshold	Exceptional	24-inch DSH or Greater	MLOD (feet)	RLOD (feet)	Proposed Action	Notes
							N	E	S	W							
573	<i>Pseudotsuga menziesii</i>	Douglas-fir	47.0		Good	Good	24.0	24.5	22.5	28.5	30.0	Exceptional - Size	Yes	20	47	Remove	Pavement on all sides, center of drive, crown raised, end weight reduction pruning on north side, water main bored beneath tree
574	<i>Comus florida</i>	Eastern Dogwood	10.7	8,8,6,1	Good	Good	6.4	8.9	11.9	12.9	12.0		-	6	10	Remove	Hollow tree, very old specimen
575	<i>Pseudotsuga menziesii</i>	Douglas-fir	39.5		Good	Good	21.6	19.6	23.6	25.6	30.0	Exceptional - Size	Yes	16	40	Retain	Top blown out repeatedly, storm damaged limbs, excellent health, soil saturated, gnarled trunk
576	<i>Thuja plicata</i>	Western Redcedar	37.0		Fair	Good	18.5	20.5	18.5	19.5	30.0	Exceptional - Size	Yes	15	37	Retain	Thin canopy, drought stress
577	<i>Thuja plicata</i>	Western Redcedar	14.0		Fair	Good	11.6	10.6	10.6	4.6	30.0		-	6	14	Remove	
578	<i>Thuja plicata</i>	Western Redcedar	13.0		Fair	Good	4.5	11.5	10.5	11.5	30.0		-	6	13	Remove	
579	<i>Thuja plicata</i>	Western Redcedar	10.0		Fair	Good	8.4	8.4	8.4	8.4	30.0		-	6	10	Retain	
580	<i>Magnolia x soulangiana</i>	Saucer magnolia	15.0	9,12	Good	Fair	23.6	20.6	15.1	9.6	-		-	6	15	Remove	Phototropic sprouting, failed tree on too
581	<i>Thuja plicata</i>	Western Redcedar	27.0		Good	Good	21.1	23.1	19.1	5.1	30.0		Yes	11	27	Retain	Codominant at 6' with narrow union
582	<i>Thuja plicata</i>	Western Redcedar	23.0		Good	Good	22.0	21.0	11.0	19.0	30.0		-	10	23	Retain	
Dead 1	<i>Thuja plicata</i>	Western Redcedar	34.8	27,14,17	N/A	N/A	16.5	23.0	21.5	22.5	30.0	Exceptional - Size	Yes	15	N/A	Reduce to wildlife snag	Dead tree, clear signs of purposeful girdling, codominant at base, good candidate for wildlife snag
Dead 2	<i>Thuja plicata</i>	Western Redcedar	20.0		N/A	N/A	16.8	19.8	18.8	18.8	30.0		-	8	N/A	Remove	Dead tree, clear signs of purposeful girdling, funnel sticking out of tree, likely for herbicide application
A	<i>Fraxinus pennsylvanica</i>	Green Ash	18.0		Good	Good	30.8	30.8	30.8	30.8	30.0		-	8	18	Retain	
B	<i>Thuja plicata</i>	Western Redcedar	23.7	11,21	Good	Good	15.0	13.0	19.0	21.0	30.0		-	10	24	Retain	Codominant with narrow union, part of grove with tree 582 and 581

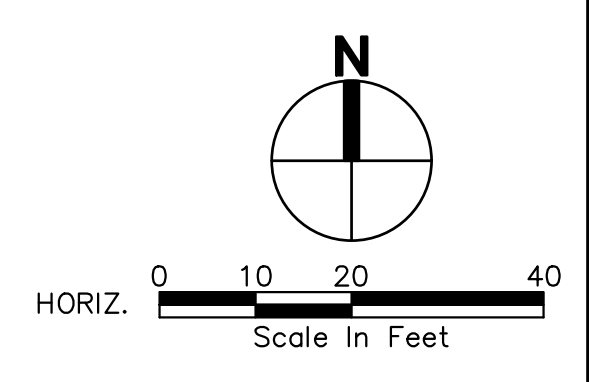

CALL BEFORE YOU DIG 811  
 UNDERGROUND SERVICE (USA)

 11255 Kirkland Way, Suite 300 Kirkland, WA 98033 p. 425.827.2014   f. 425.827.5043 www.paceengr.com	 <b>DHEERAJ KONERU</b> 7002 93RD AVENUE SE MERCER ISLAND, WA 98040
<b>KONERU</b> <b>BUILDING PERMIT</b> 6610 EAST MERCER WAY MERCER ISLAND, WA 98040	<b>TREE RETENTION PLAN</b>
<b>VERIFY SCALE</b> BAR IS ONE INCH ON ORIGINAL DRAWING. IF NOT ONE INCH ON THIS SHEET, ADJUST SCALES ACCORDINGLY.	
DESIGNED BY: MA PACE PROJECT NO. 211436.00	DATE: 05/11/22 CHECKED BY: JA
<b>L1.0</b> SHEET	
RESPONSE TO COMMENTS DATED 7/21/22	REVISION DATE 8/19/22



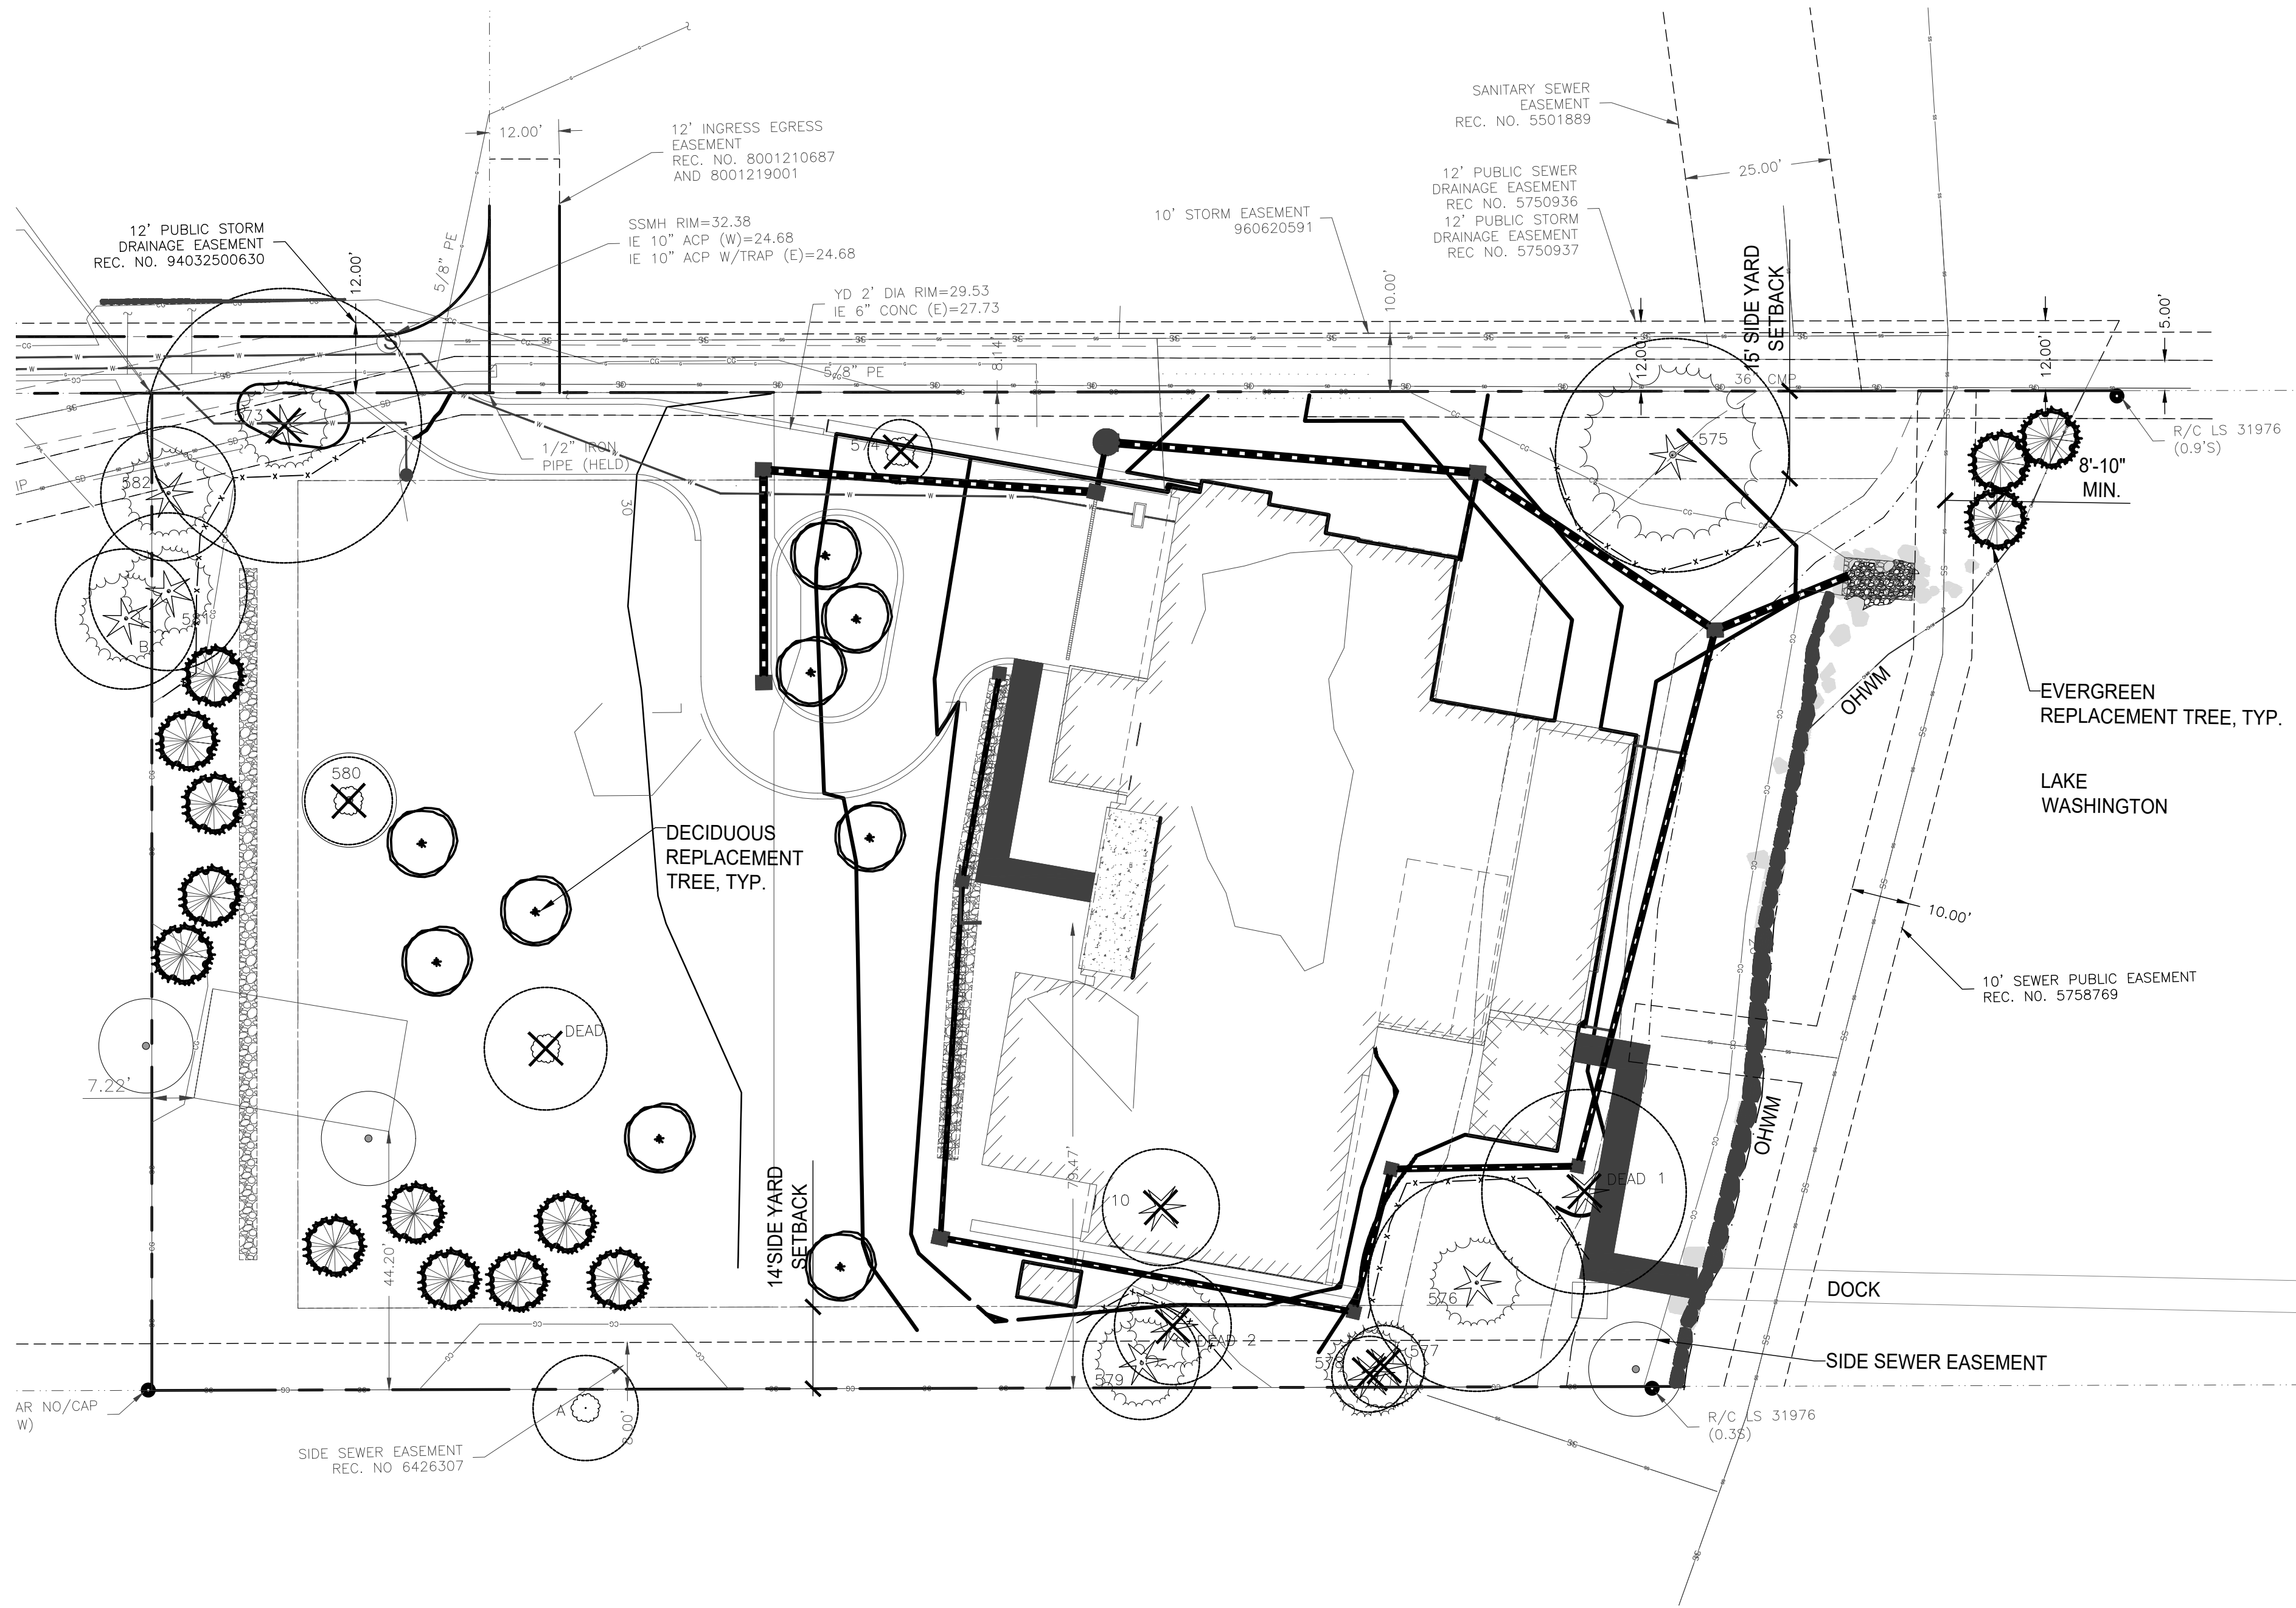

**REPLACEMENT TREE SCHEDULE**

SYMBOL	BOTANICAL NAME/ COMMON NAME	SIZE	QTY.	REMARKS
<b>DECIDUOUS TREES</b>				
⊙	ACER CIRCINATUM	1-1/2" CAL.	9	MULTI-STEMMED
⊙	VINE MAPLE	1-1/2" CAL.		
⊙	ACER GLABRUM VAR DOUGLASII	1-1/2" CAL.		
⊙	ROCKY MOUNTAIN MAPLE	1-1/2" CAL.		
⊙	ACER RUBRUM 'SCARLET SENTINEL'	1-1/2" CAL.		
⊙	SCARLET SENTINEL RED MAPLE	1-1/2" CAL.		
⊙	CERCIDIPHYLLUM JAPONICUM	1-1/2" CAL.		
⊙	KATSURA TREE	1-1/2" CAL.		
⊙	CORNUS NUTTALLII	1-1/2" CAL.		
⊙	PACIFIC DOGWOOD	1-1/2" CAL.		
<b>EVERGREEN TREES</b>				
⊙	PINUS CONTORTA VAR CONTORTA	6-7' HT.	13	EVERGREEN REPLACEMENT TREE, TYP.
⊙	SHORE PINE	6-7' HT.		
⊙	PSEUDOTSUGA MENZIESII	6-7' HT.		
⊙	DOUGLAS FIR	6-7' HT.		
⊙	THUJA PLICATA	6-7' HT.		
⊙	WESTERN RED CEDAR	6-7' HT.		


**GENERAL NOTES**

- SEE CIVIL PLANS FOR EXISTING TREE TABLE AND TREE PROTECTION NOTES AND DETAILS.

**Koneru**  
21.14

**Darwin Webb**  
LANDSCAPE ARCHITECTS P.S.  
485 Rainier Blvd. N. #103B  
Issaquah, WA 98027  
P. 425.391.6946  
F. 425.391.1292  
www.darwinwebb.com

**KONERU RESIDENCE**  
6610 E Mercer Way  
Mercer Island, WA 98040

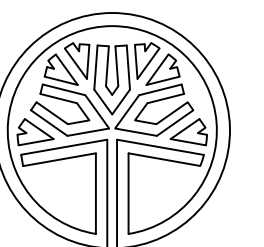

STATE OF WASHINGTON  
REGISTERED  
LANDSCAPE ARCHITECT

DARWIN D. WEBB  
CERTIFICATE NO. 564

**ISSUES:**



NO.	DATE	DESCRIPTION
1	09.23.22	PERMIT REVISIONS


PROJECT #: 21.14

DRAWN: NP  
CHECKED: DW

TITLE: TREE REPLACEMENT PLAN

SHEET: L1.1

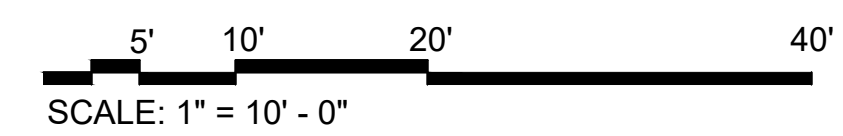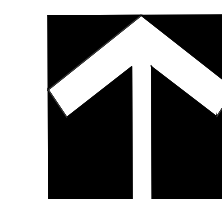

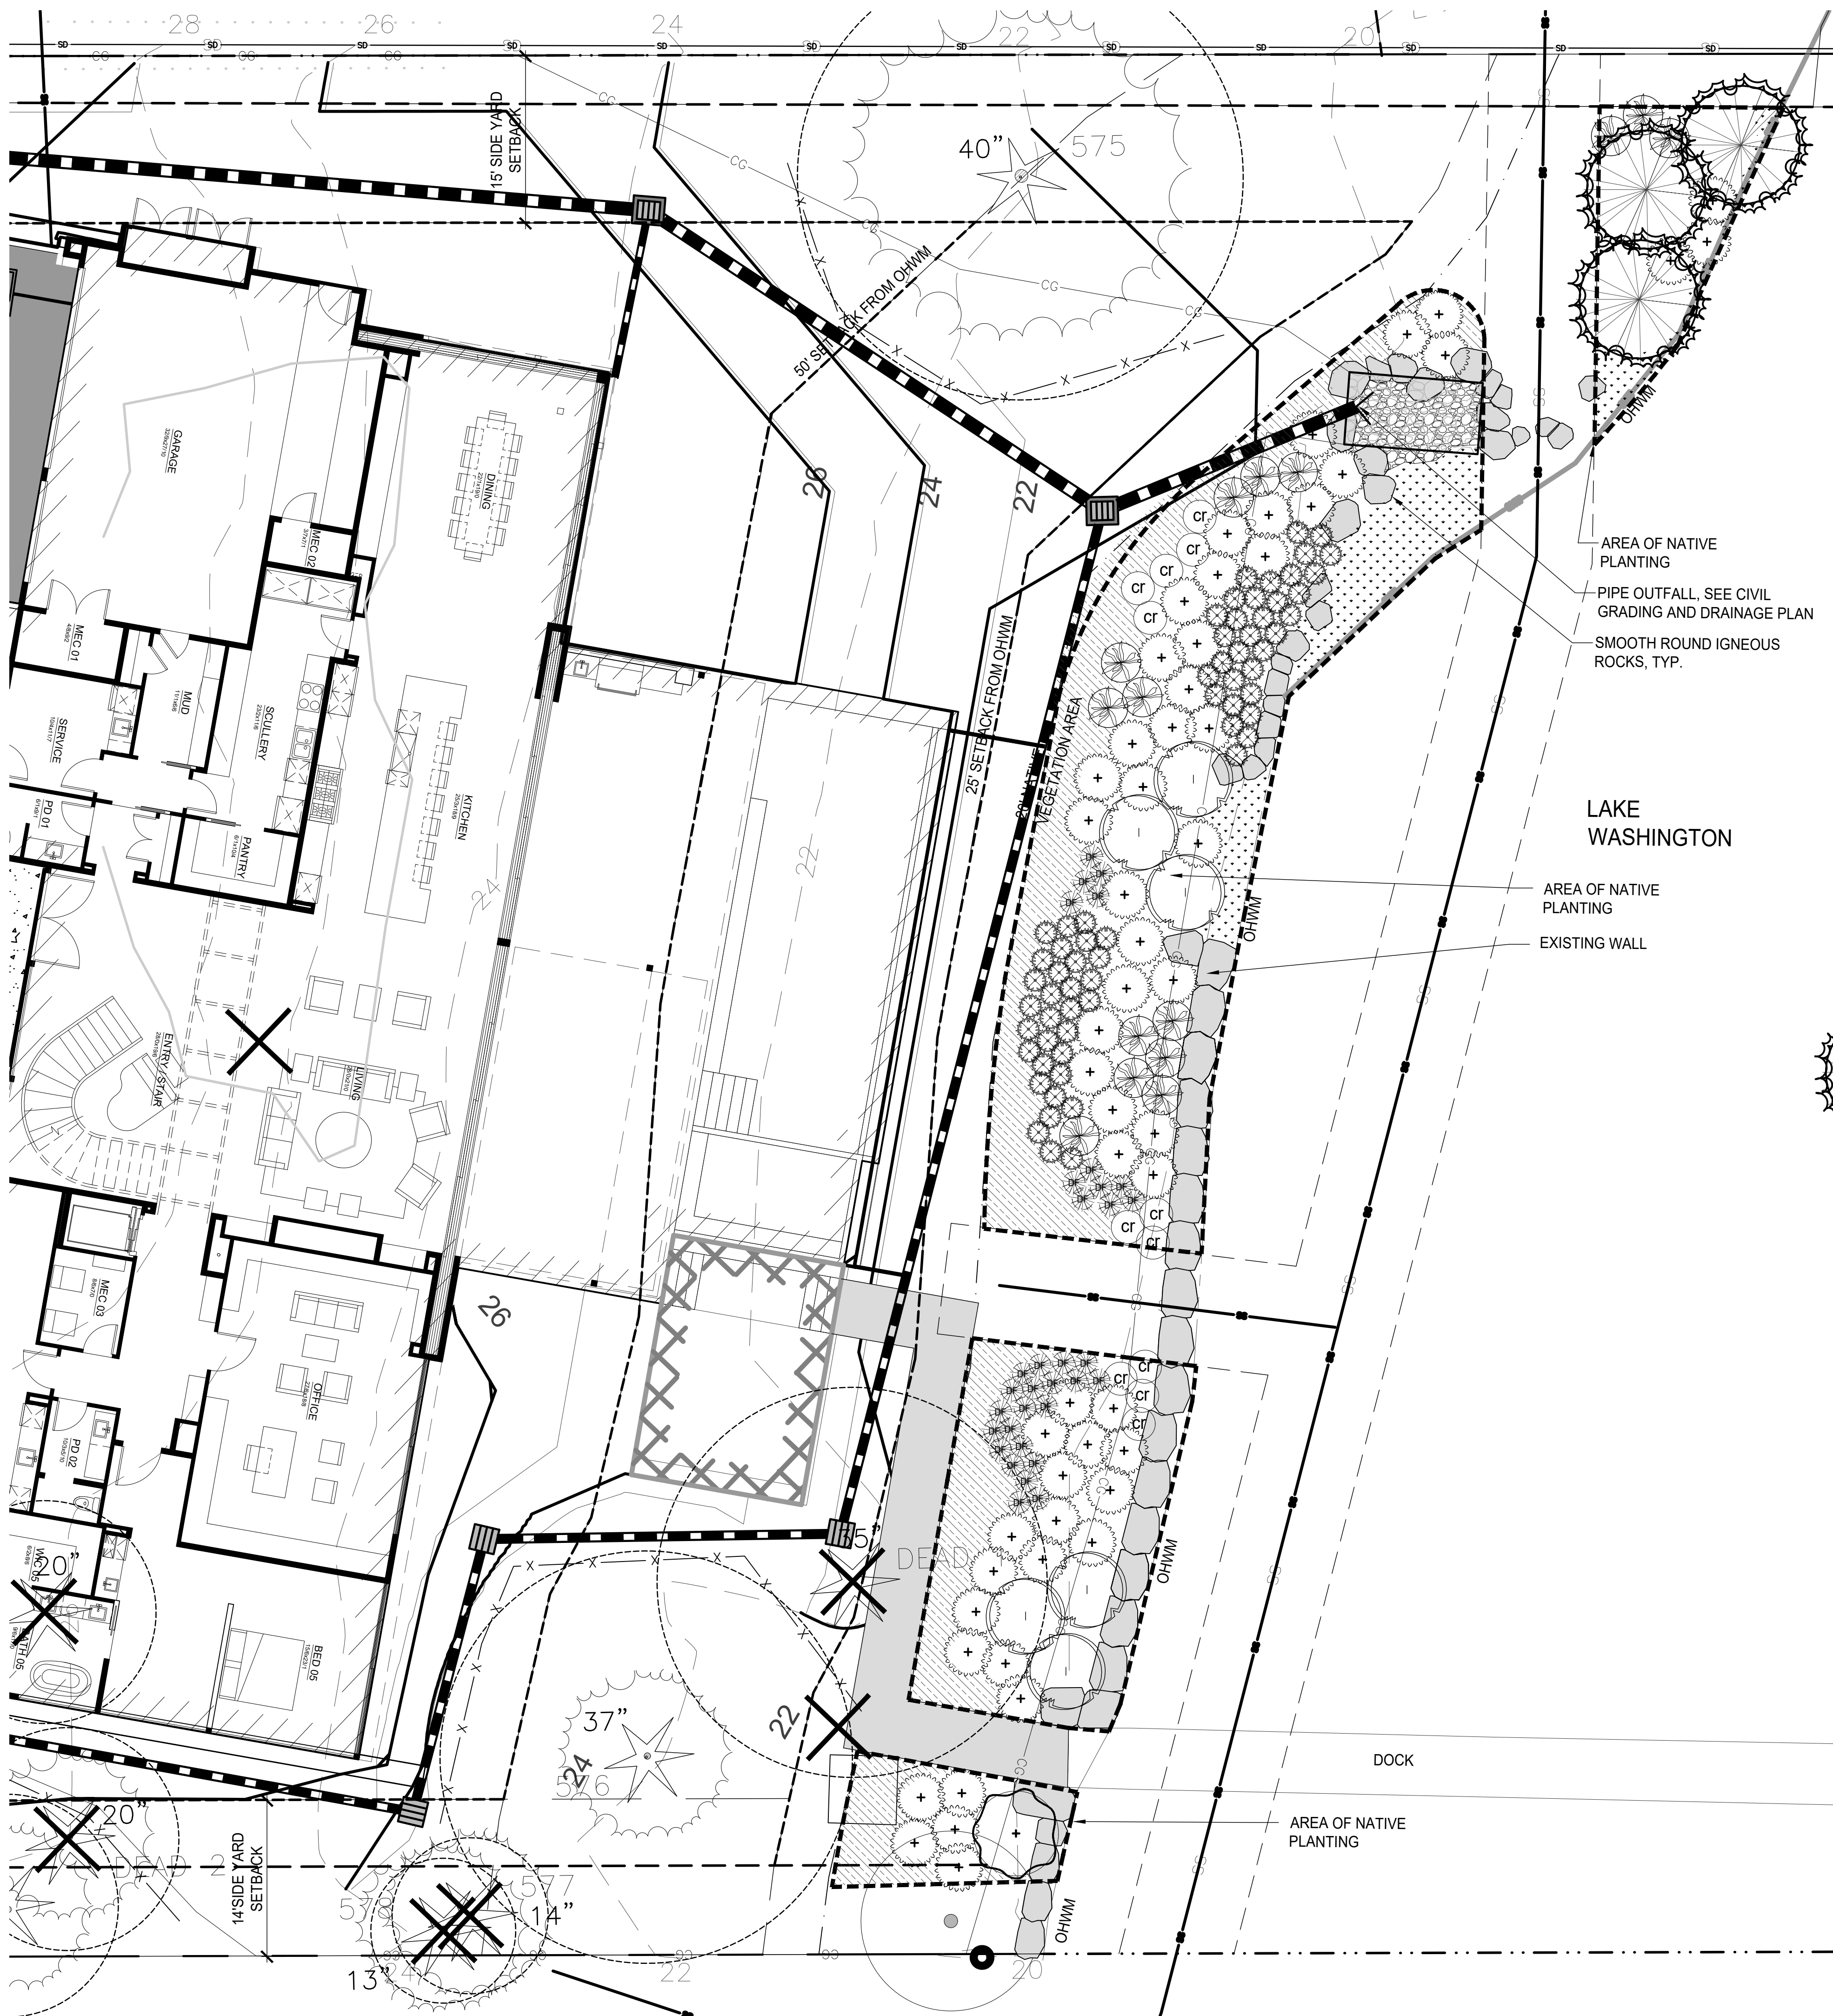

AREA OF NATIVE PLANTING  
 PIPE OUTFALL, SEE CIVIL GRADING AND DRAINAGE PLAN  
 SMOOTH ROUND IGNEOUS ROCKS, TYP.

LAKE WASHINGTON

AREA OF NATIVE PLANTING  
 EXISTING WALL

**PLANT SCHEDULE**

SYMBOL	BOTANICAL NAME/ COMMON NAME	SIZE	QTY.	REMARKS
<b>TREES</b>				
	PINUS CONTORTA SHORE PINE	4'-5' SP.		
<b>SHRUBS</b>				
	CORNUS SERICEA REDTWIG DOGWOOD	1 GAL.		
	GAULTHERIA SHALLON SALAL	1 GAL.		
	SALIX SCOULERIANA SCOULER'S WILLOW	1 GAL.		
<b>PERENNIALS AND GROUNDCOVERS</b>				
	ARCTOSTAPHYLOS UVA-URSI KINNIKINICK	4" POT		SPACING @ 18" OC
	BLECHNUM SPICANT DEER FERN	1 GAL.		
	CAREX OBNUPTA SLOUGH SEDGE	4" POT		
	CAREX ROSTRATA BEAKED SEDGE	4" POT		
	POLYSTICHUM MUNITUM SWORD FERN	1 GAL.		
	SCIRPUS ACUTUS HARDSTEM BULLRUSH	4" POT		SPACING @ 18" OC

NOTE:  
 ALL PROPOSED PLANTS ARE PACIFIC NORTHWEST NATIVES


**AREA CALCULATIONS**

TOTAL AREA BETWEEN OHWM AND 20' SETBACK = 3,833 S.F.  
 3,833 X .751 = 2,878.58 S.F. REQUIRED NATIVE VEGETATION  
 TOTAL PROPOSED NATIVE VEGETATION (75.6%) 2,899 S.F.

Koneru  
 21.14

Darwin Webb  
 LANDSCAPE ARCHITECTS P.S.  
 485 Rainier Blvd. N. #103B  
 Issaquah, WA 98027  
 P. 425.391.6946  
 F. 425.391.1292  
 www.darwinwebb.com

**KONERU RESIDENCE**  
 6610 E Mercer Way  
 Mercer Island, WA 98040

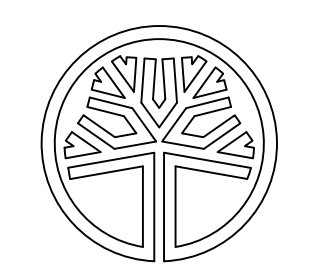


ISSUES:

NO.	DATE	DESCRIPTION
1	12.17.21	REVIEW
2	05.25.22	REVISIONS
3	06.09.22	REVISIONS
4	09.23.22	PERMIT REVISIONS

PROJECT #: 21.14

DRAWN: RB  
 CHECKED: DW

TITLE: SHORELINE PLANTING PLAN  
 SHEET: L3.0

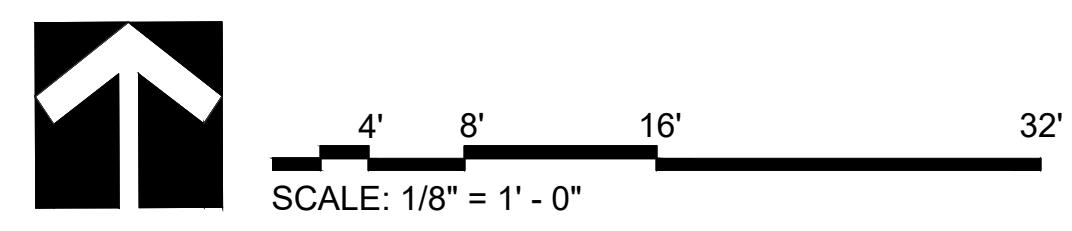













5601 6th Ave S, Suite 371  
Seattle, WA 98108  
206.443.1181  
mccullougharchitects.com


**MCCULLOUGH**  
ARCHITECTS

UNPUBLISHED WORK 2016 © McCullough Architects

**Revisions**

Date	Revised By	Comment
2021.11.17		Updated Plans to Structural
2021.12.13		Structural Backcheck 01
2021.12.22		Structural Backcheck 03
2021.12.22		Permit Corrections
2022.05.02		Structural Backcheck
2022.05.04		Commentary Response
2022.05.12		Cycle 2 Structural Backcheck
2022.07.13		Cycle 3 Structural Backcheck
2022.08.18		


Date: 2021.10.13  
Job No: 21-041  
Project No:  
Drawn: DJR  
Approved: APM

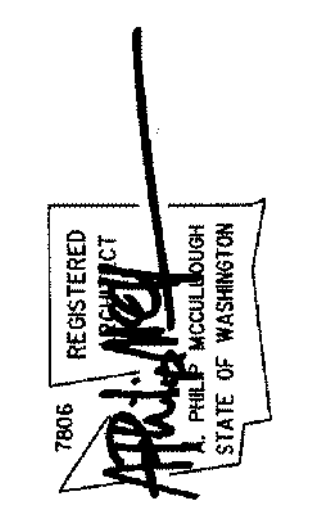

**KONERU RESIDENCE**  
6610 E Mercer Way  
Mercer Island, WA 98040

PERMIT SET

Pin Pile Plan

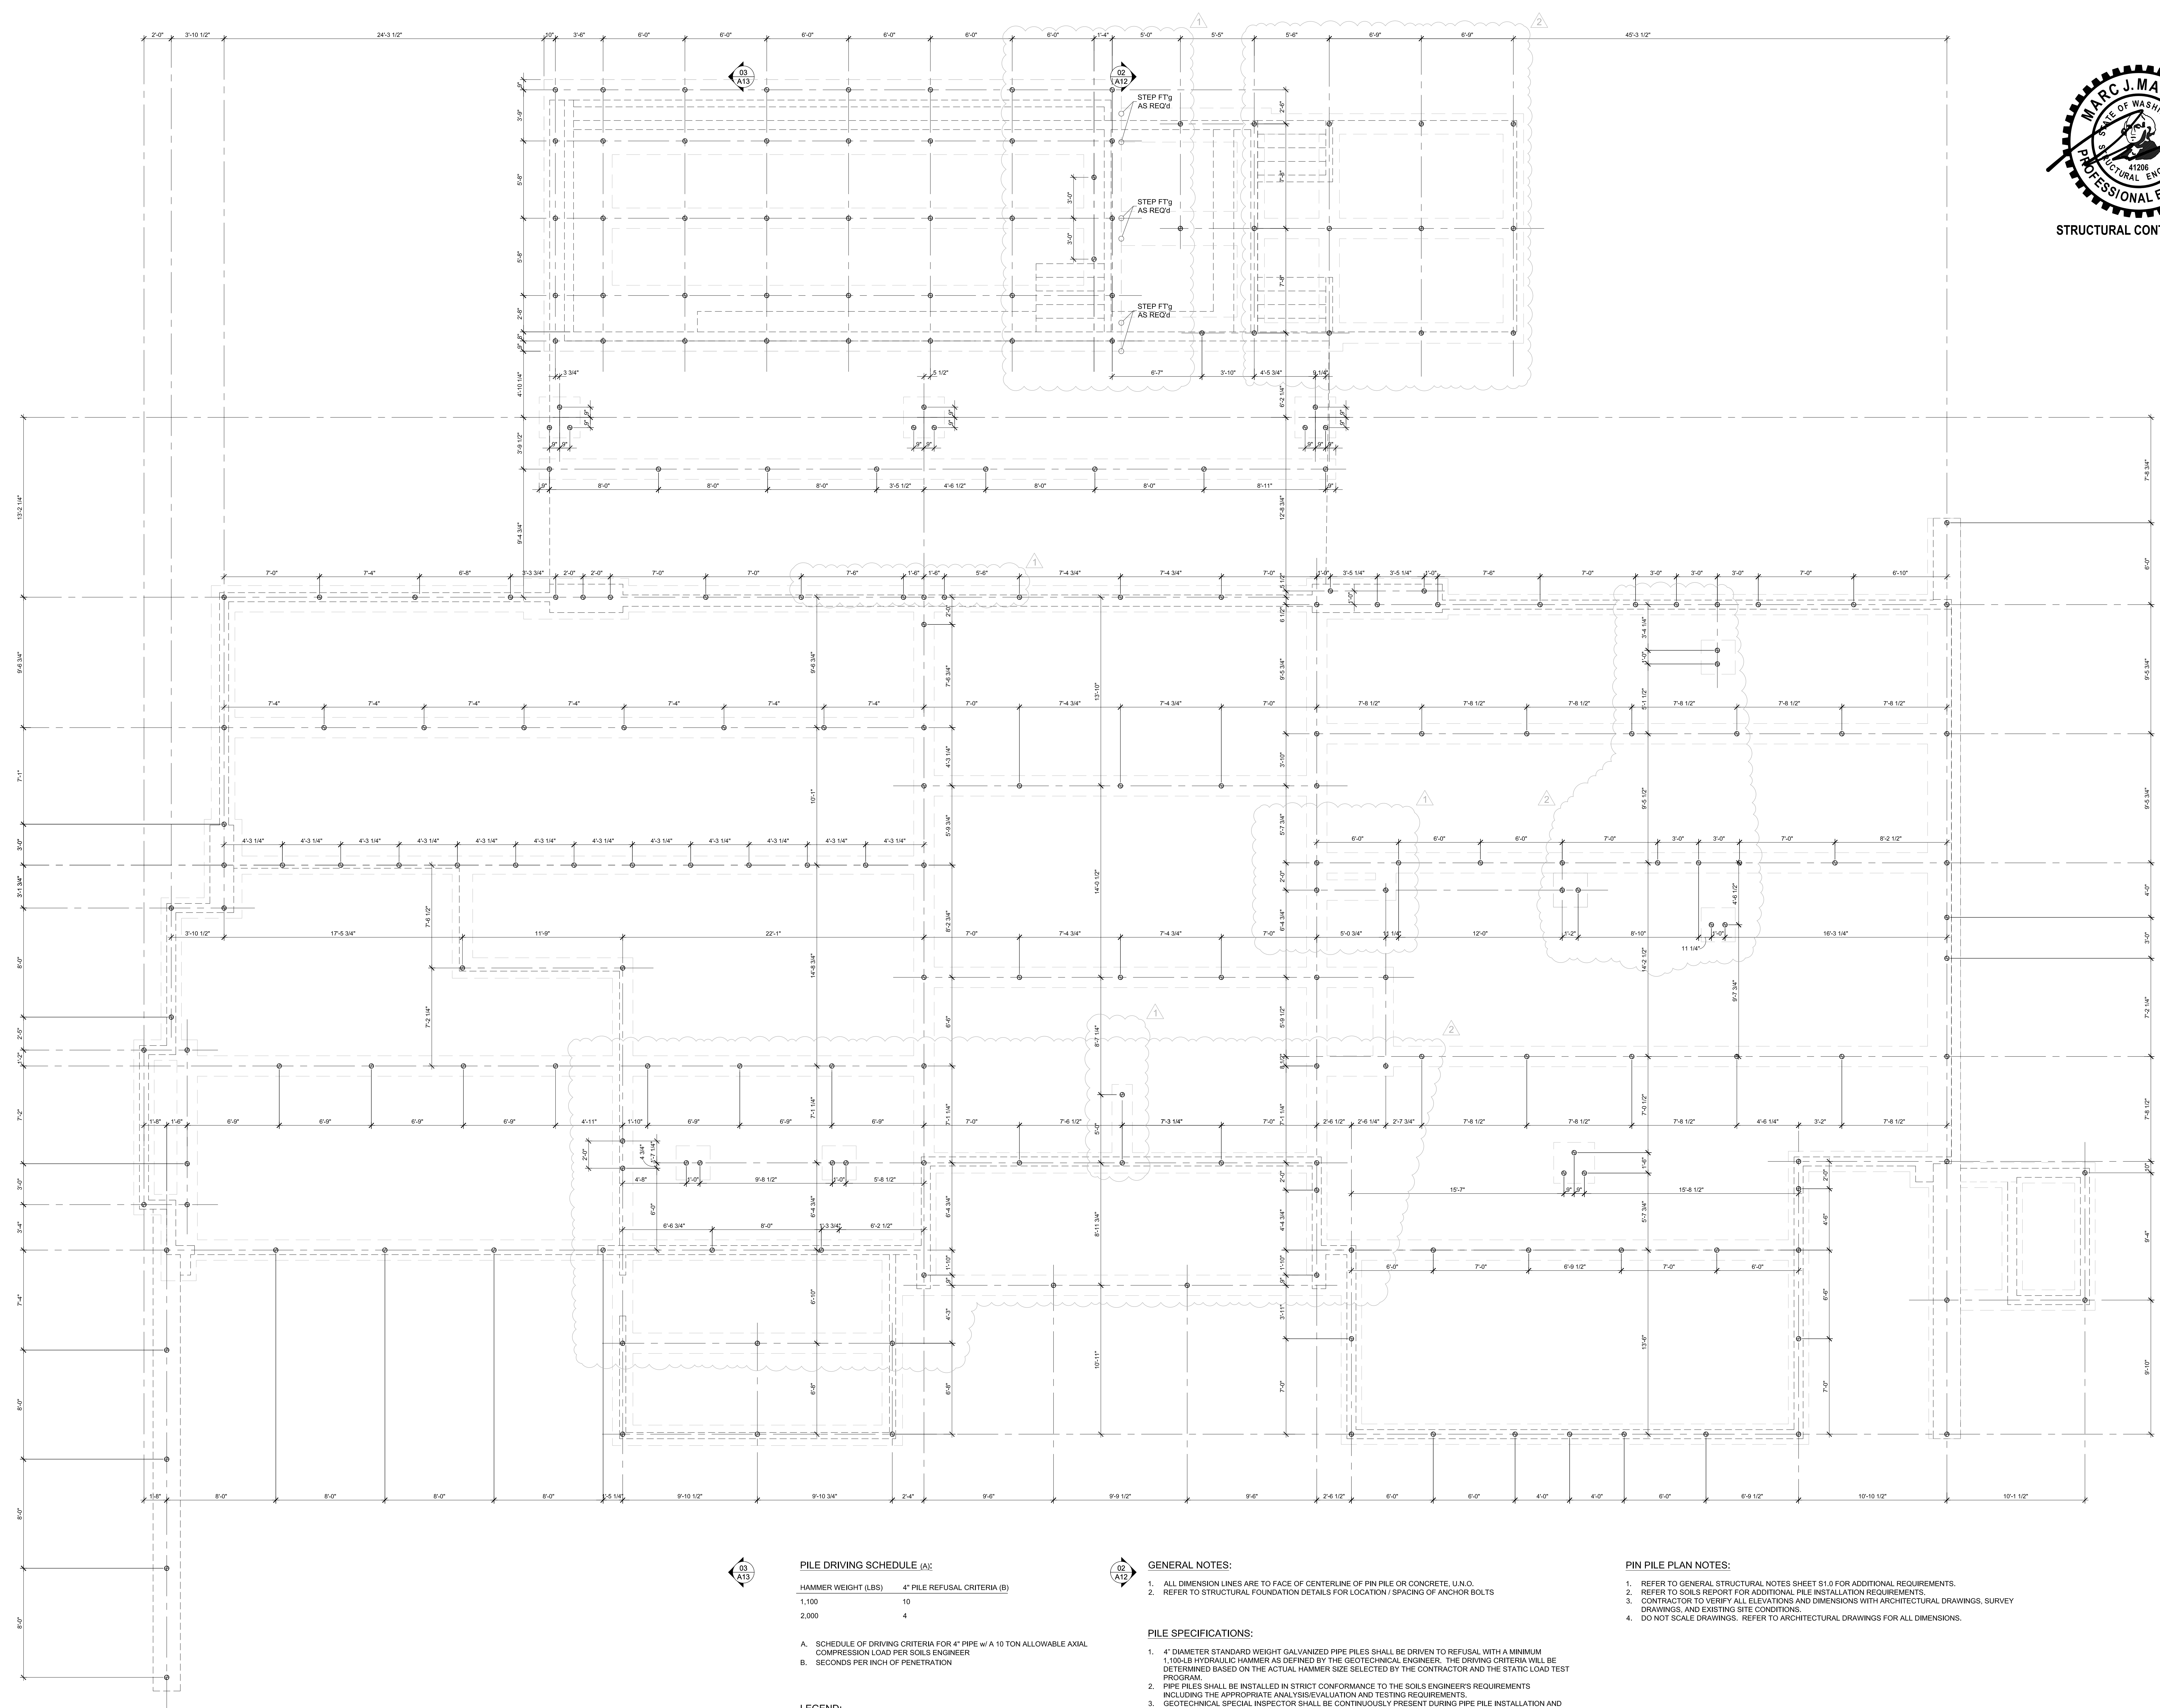

**PILE DRIVING SCHEDULE (A):**

HAMMER WEIGHT (LBS)	4" PILE REFUSAL CRITERIA (B)
1,100	10
2,000	4

A. SCHEDULE OF DRIVING CRITERIA FOR 4" PIPE w/ A 10 TON ALLOWABLE AXIAL COMPRESSION LOAD PER SOILS ENGINEER  
B. SECONDS PER INCH OF PENETRATION


**LEGEND:**  
⊙ 4" STANDARD WEIGHT GALVANIZED PIPE PILE (10-TON CAPACITY) REFER TO 2/3.1 FOR EMBEDMENT INTO FOOTING

- GENERAL NOTES:**
- ALL DIMENSION LINES ARE TO FACE OF CENTERLINE OF PIN PILE OR CONCRETE, U.N.O.
  - REFER TO STRUCTURAL FOUNDATION DETAILS FOR LOCATION / SPACING OF ANCHOR BOLTS

- PILE SPECIFICATIONS:**
- 4" DIAMETER STANDARD WEIGHT GALVANIZED PIPE PILES SHALL BE DRIVEN TO REFUSAL WITH A MINIMUM 1,100-LB HYDRAULIC HAMMER AS DEFINED BY THE GEOTECHNICAL ENGINEER. THE DRIVING CRITERIA WILL BE DETERMINED BASED ON THE ACTUAL HAMMER SIZE SELECTED BY THE CONTRACTOR AND THE STATIC LOAD TEST PROGRAM.
  - PIPE PILES SHALL BE INSTALLED IN STRICT CONFORMANCE TO THE SOILS ENGINEER'S REQUIREMENTS INCLUDING THE APPROPRIATE ANALYSIS/EVALUATION AND TESTING REQUIREMENTS.
  - GEOTECHNICAL SPECIAL INSPECTOR SHALL BE CONTINUOUSLY PRESENT DURING PIPE PILE INSTALLATION AND TESTING.
  - THE GEOTECHNICAL ENGINEER OF RECORD OR THEIR REPRESENTATIVE SHALL PROVIDE FULL TIME OBSERVATION OF PILE INSTALLATION.
  - STEEL PIPE SHALL CONFORM TO ASTM A53, GRADE A OR B, Fy = 35 KSI. PILES SHALL BE DRIVEN IN NOMINAL SECTIONS AND CONNECTED WITH COMPRESSION FITTED SLEEVE COUPLERS.
  - PIPE PILES NEED TO BE PLACED WITHIN 3" OF SPECIFIED LOCATION. THE CONTRACTOR SHALL DETERMINE THE LOCATION OF ALL ADJACENT UNDERGROUND UTILITIES PRIOR TO DRIVING PILES.

- PIN PILE PLAN NOTES:**
- REFER TO GENERAL STRUCTURAL NOTES SHEET S1.0 FOR ADDITIONAL REQUIREMENTS.
  - REFER TO SOILS REPORT FOR ADDITIONAL PILE INSTALLATION REQUIREMENTS.
  - CONTRACTOR TO VERIFY ALL ELEVATIONS AND DIMENSIONS WITH ARCHITECTURAL DRAWINGS, SURVEY DRAWINGS, AND EXISTING SITE CONDITIONS.
  - DO NOT SCALE DRAWINGS. REFER TO ARCHITECTURAL DRAWINGS FOR ALL DIMENSIONS.

**PIN PILE PLAN**  
SCALE: 1/4" = 1'-0"

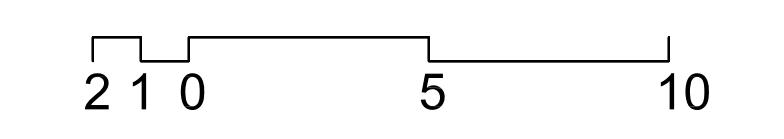





STRUCTURAL CONTENTS ONLY

5601 6th Ave S, Suite 371  
Seattle, WA 98108  
206.443.1181  
mccullougharchitects.com


**MCCULLOUGH**  
ARCHITECTS

UNPUBLISHED WORK 2016 © McCullough Architects

Comment  
Updated Plans to Structural  
Structural Backcheck 01  
Structural Backcheck 02  
Structural Backcheck 03  
Permit Corrections  
Structural Backcheck  
Commentary Response  
Cycle 2 Structural Backcheck  
Cycle 3 Structural Backcheck

Revisions  
2021.11.17  
2021.12.13  
2021.12.13  
2022.05.02  
2022.05.04  
2022.05.12  
2022.07.13  
2022.06.18

Date: 2021.10.13  
Job No: 21-041  
Project No:  
Drawn: DUR  
Approved: APM

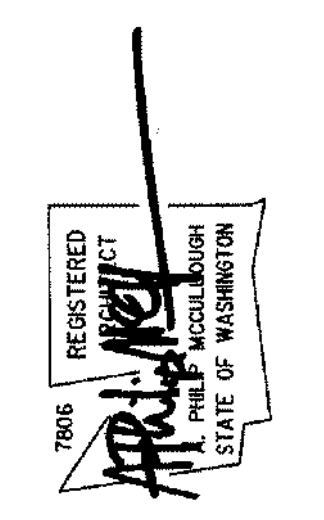


**KONERU RESIDENCE**  
6610 E Mercer Way  
Mercer Island, WA 98040

PERMIT SET

Structural SOG  
Reinforcing Plan

**A4**

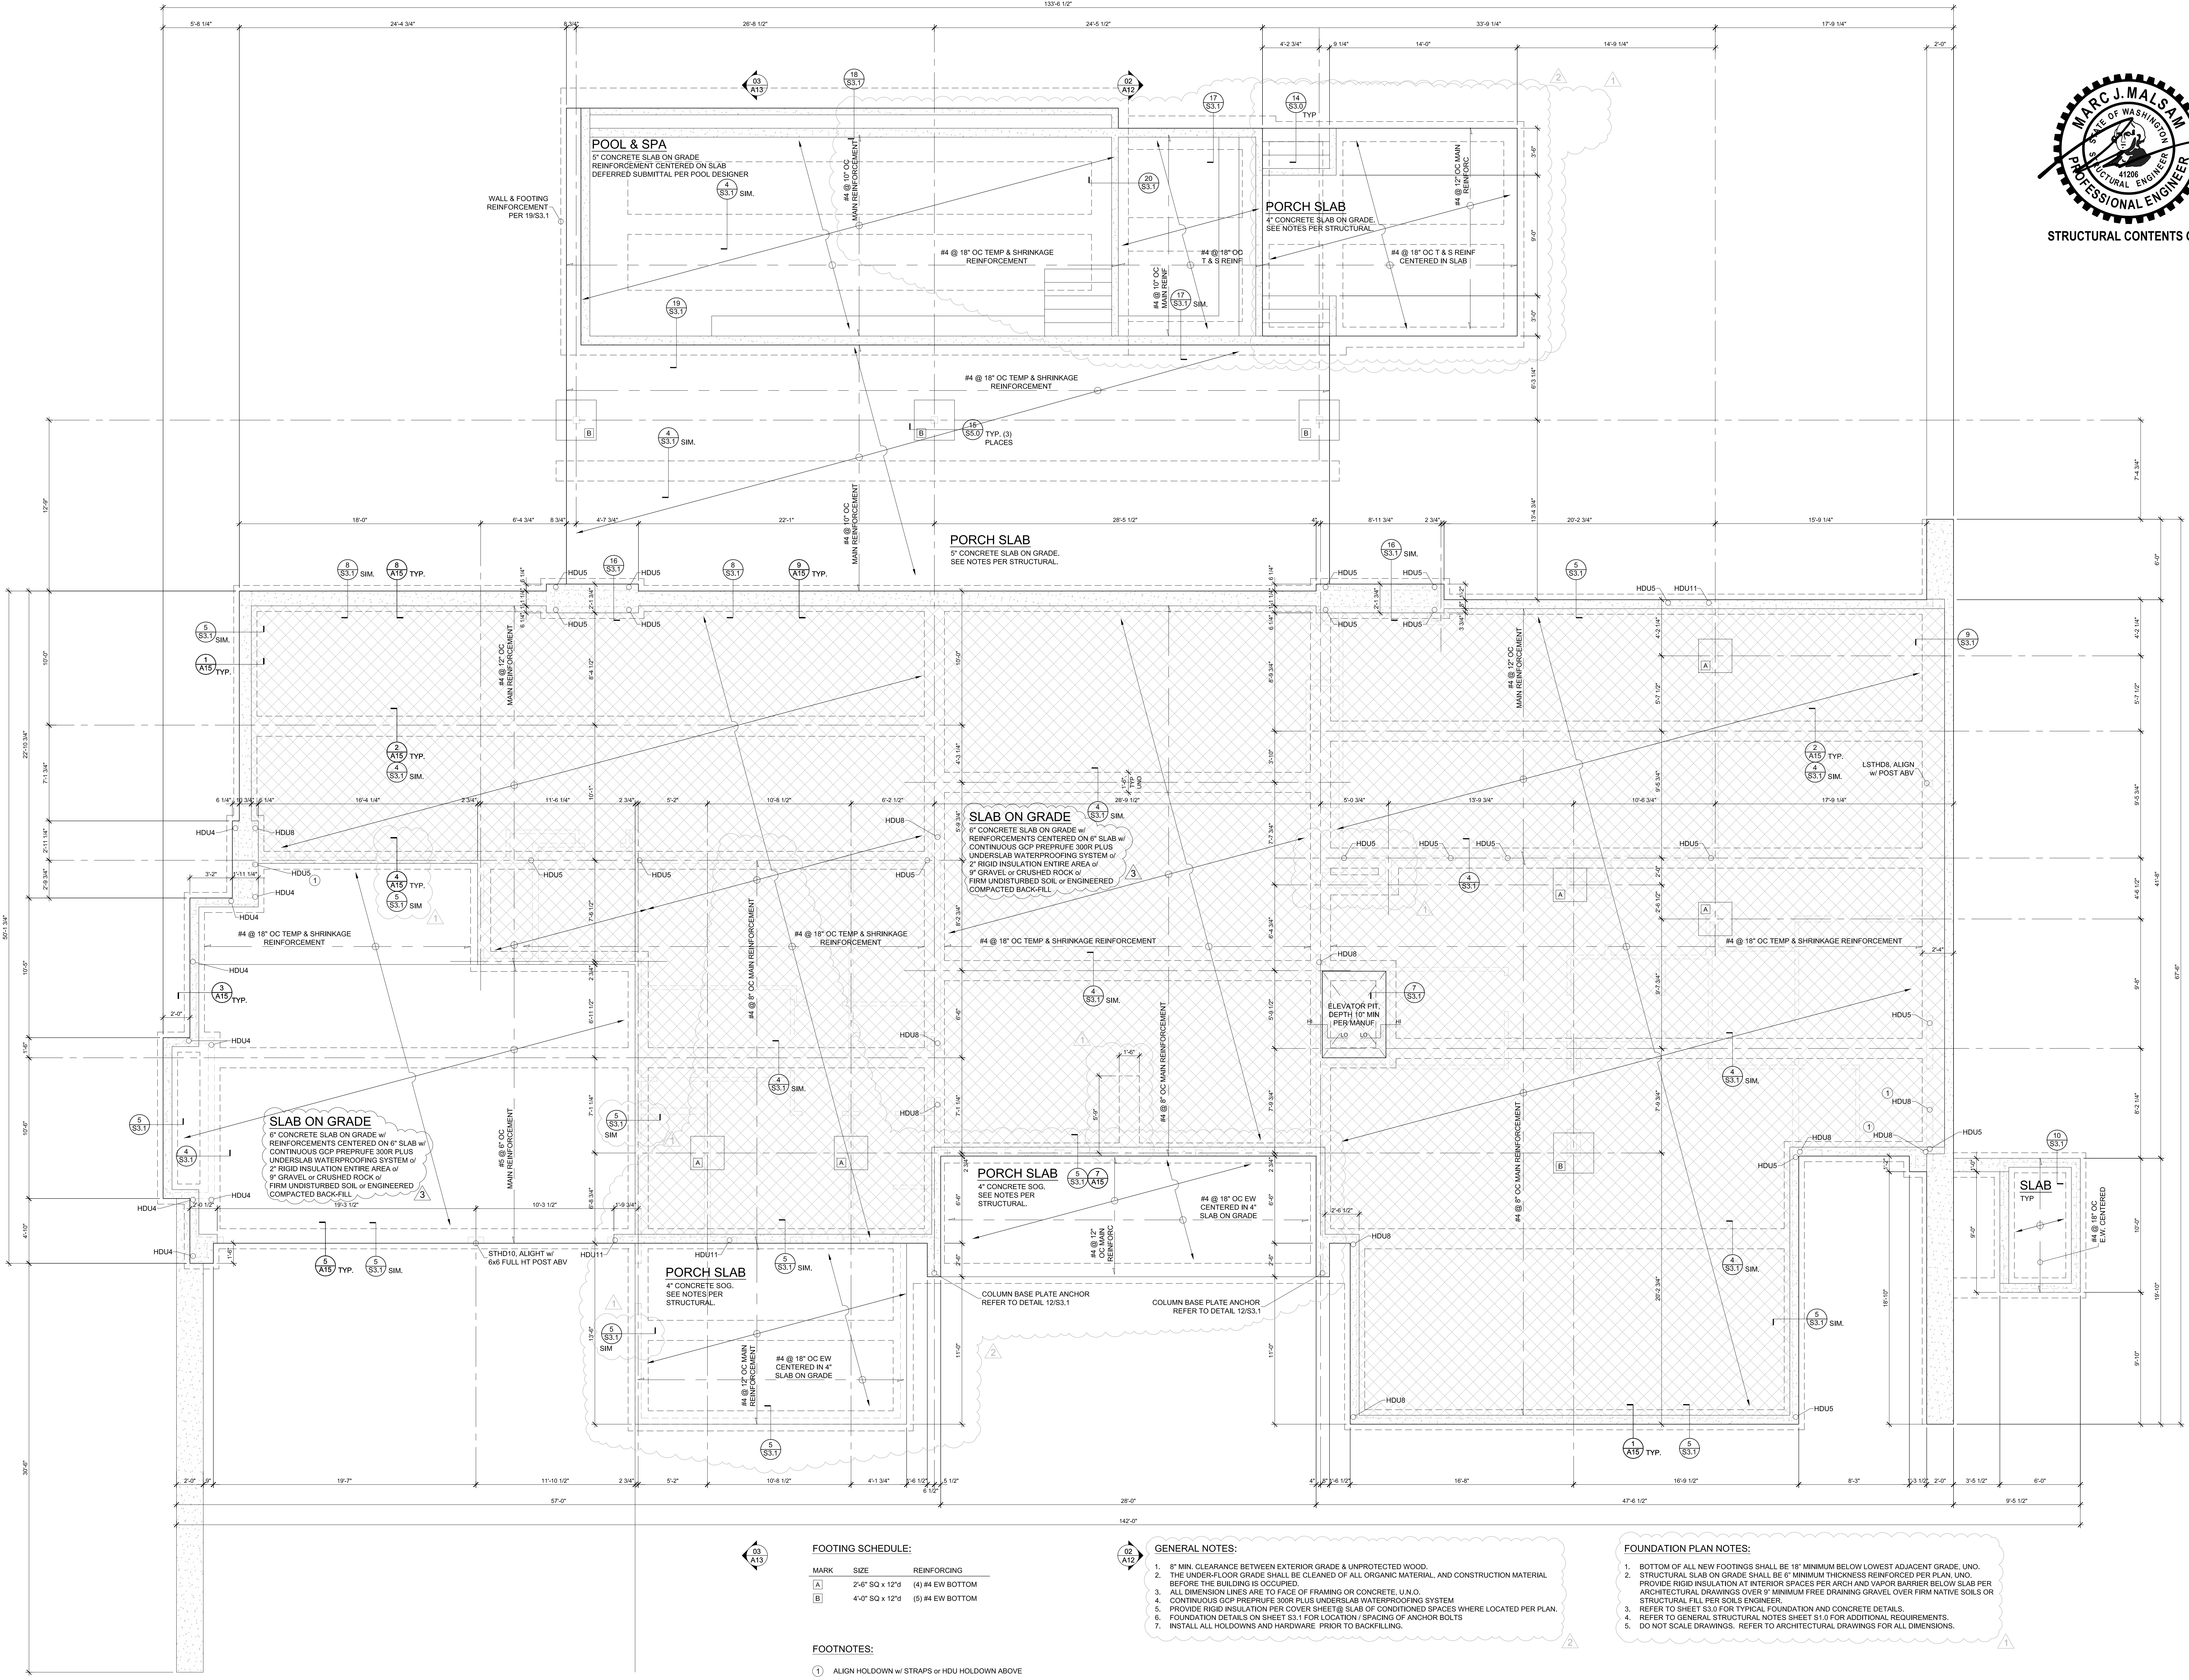

**FOOTING SCHEDULE:**

MARK	SIZE	REINFORCING
[B]	4'-0" SQ x 12"	(5) #4 EW BOTTOM

**FOOTNOTES:**  
① ALIGN HOLDOWN w/ STRAPS or HDU HOLDOWN ABOVE


- GENERAL NOTES:**
- 8" MIN. CLEARANCE BETWEEN EXTERIOR GRADE & UNPROTECTED WOOD.
  - THE UNDER-FLOOR GRADE SHALL BE CLEARED OF ALL ORGANIC MATERIAL AND CONSTRUCTION MATERIAL BEFORE THE BUILDING IS OCCUPIED.
  - ALL DIMENSION LINES ARE TO FACE OF FRAMING OR CONCRETE UNLESS NOTED OTHERWISE.
  - CONTINUOUS CGP PREPREFUR 300R PLUS UNDERSLAB WATERPROOFING SYSTEM.
  - PROVIDE RIGID INSULATION PER COVER SHEET @ SLAB OF CONDITIONED SPACES WHERE LOCATED PER PLAN.
  - FOUNDATION DETAILS ON SHEET S3.1 FOR LOCATION SPACING OF ANCHOR BOLTS.
  - INSTALL ALL HOLDDOWNS AND HARDWARE PRIOR TO BACKFILLING.

- FOUNDATION PLAN NOTES:**
- BOTTOM OF ALL NEW FOOTINGS SHALL BE 18" MINIMUM BELOW LOWEST ADJACENT GRADE UNO.
  - REFER TO SHEET S3.0 FOR TYPICAL FOUNDATION AND CONCRETE DETAILS.
  - REFER TO GENERAL STRUCTURAL NOTES SHEET S1.0 FOR ADDITIONAL REQUIREMENTS.
  - DO NOT SCALE DRAWINGS. REFER TO ARCHITECTURAL DRAWINGS FOR ALL DIMENSIONS.

**STRUCTURAL SOG REINFORCING PLAN**  
SCALE: 1/4" = 1'-0"

2 10 5 10



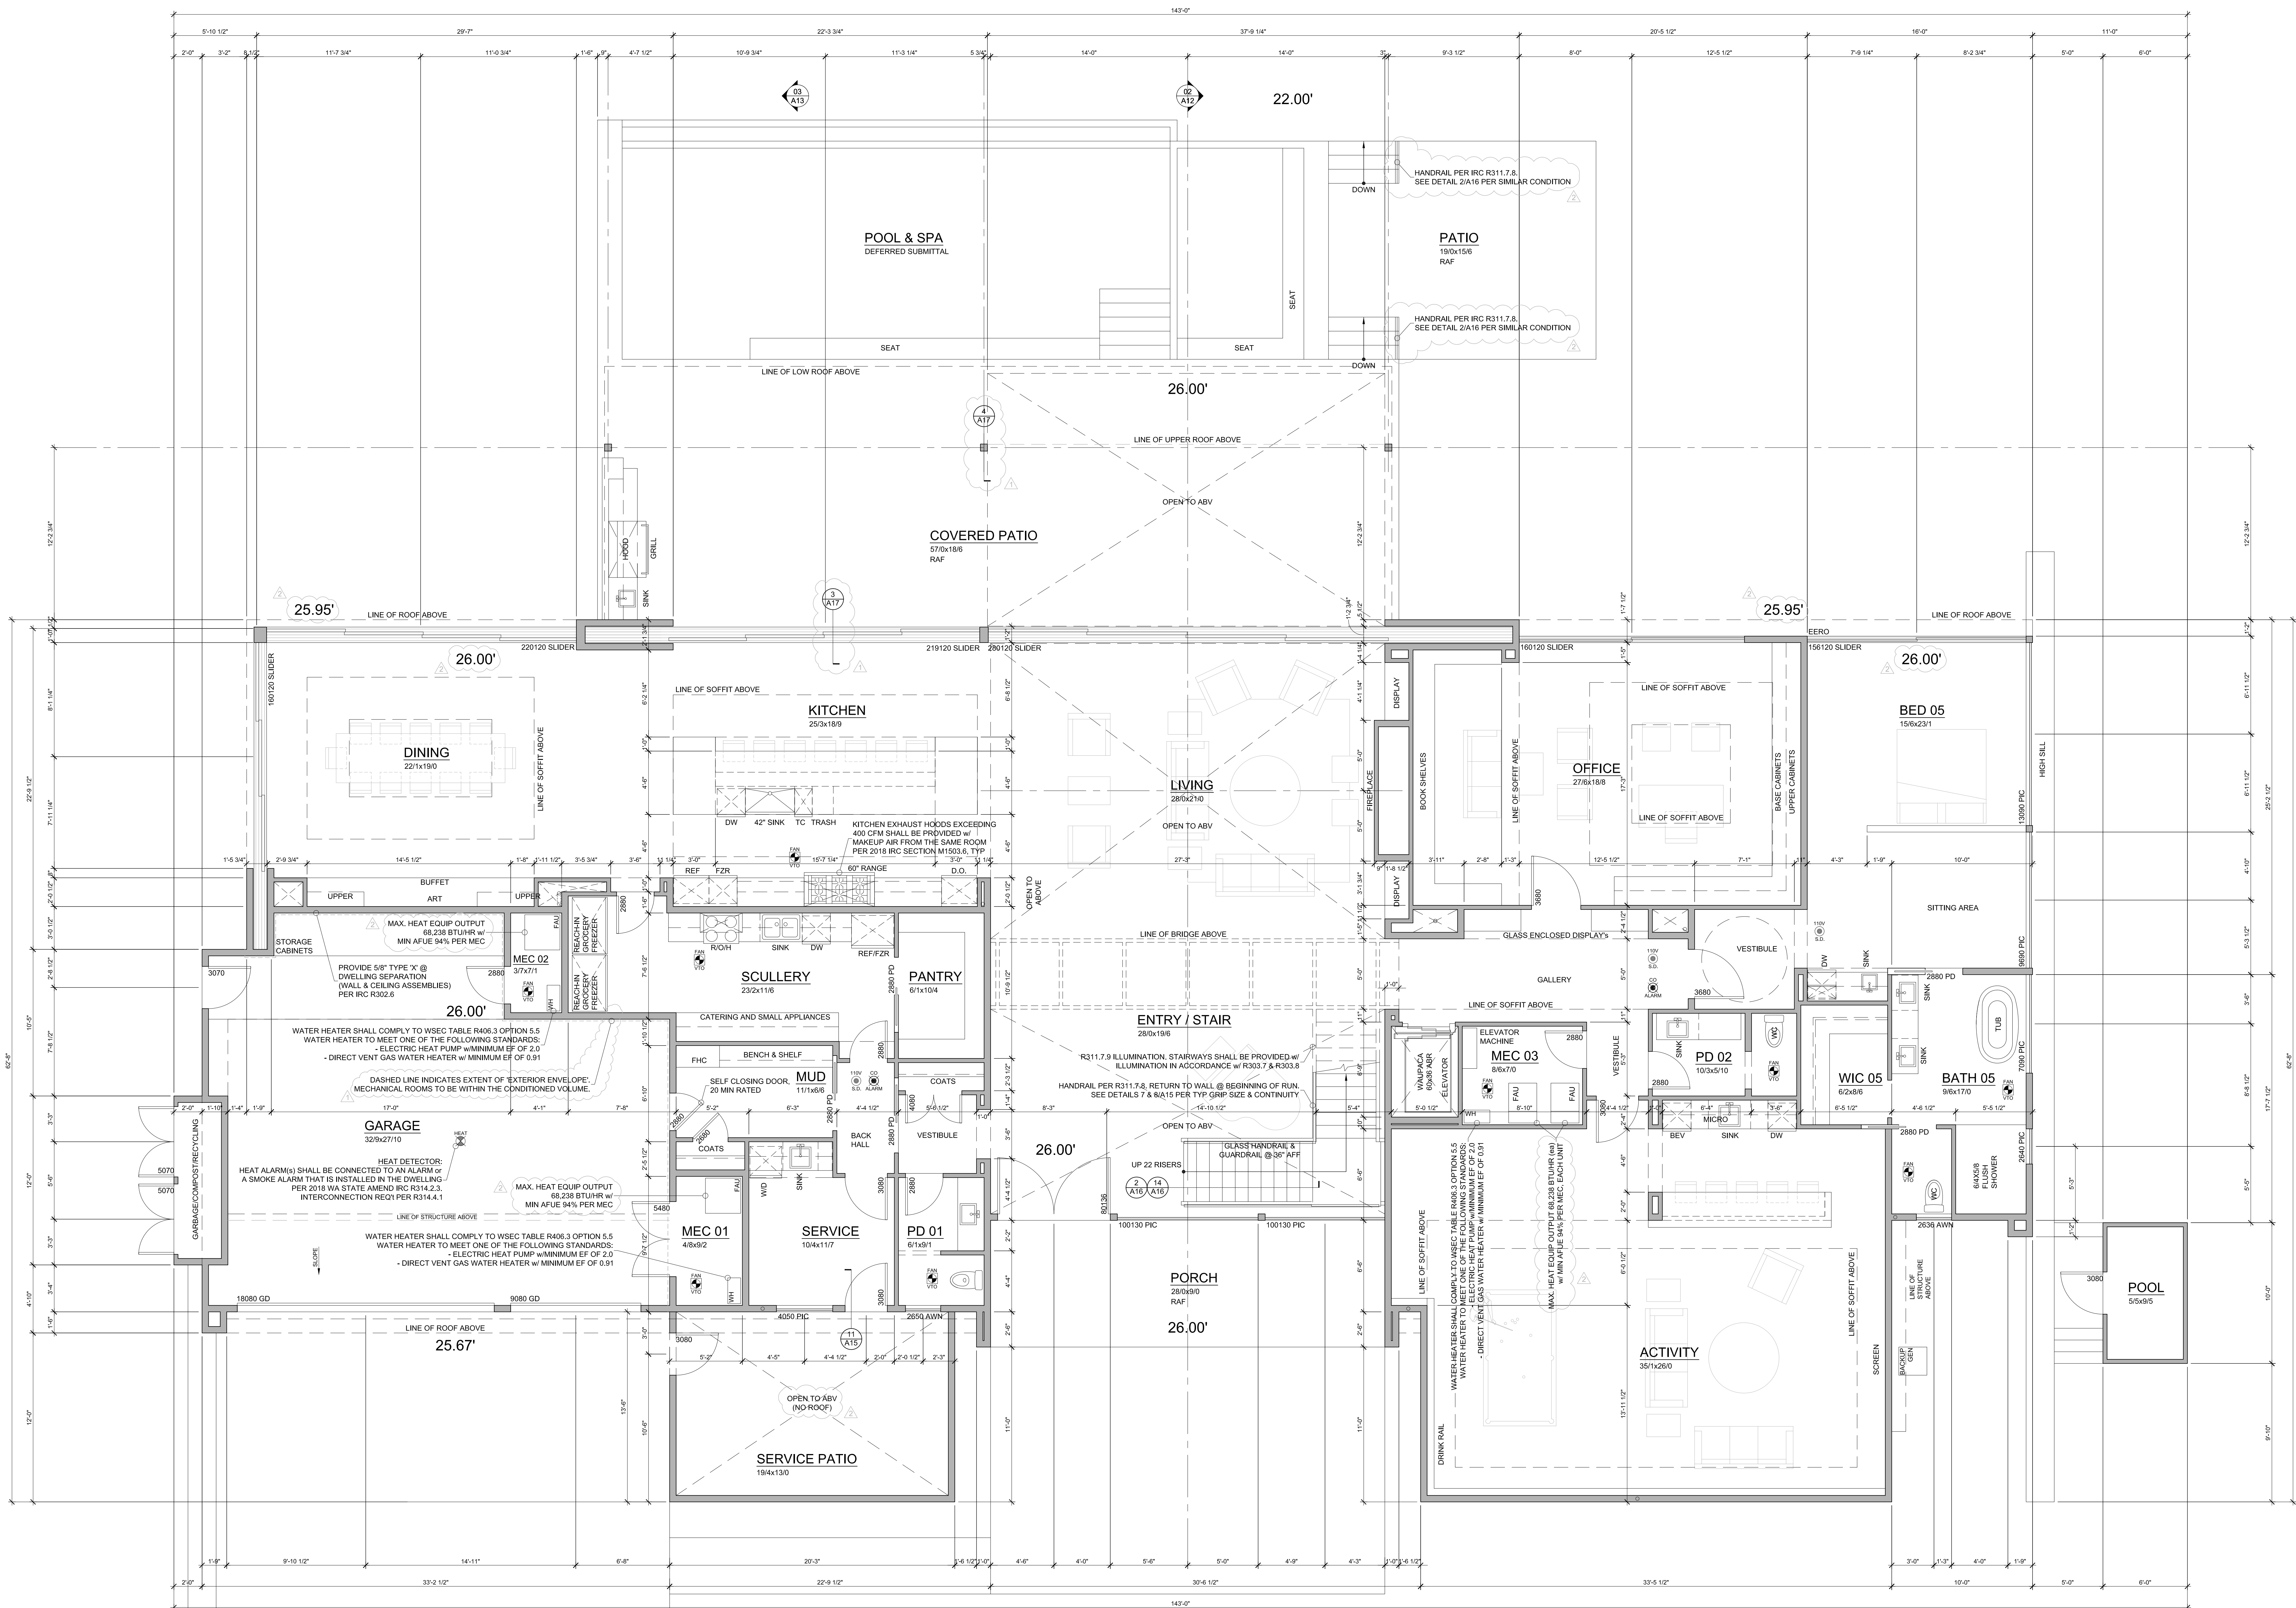

# MAIN FLOOR PLAN

SCALE: 1/4" = 1'-0"  
 5,469 SF // 9,966 SF TOTAL CONDITIONED // 945 GARAGE

### GENERAL NOTES:

- SEE ELEVATIONS, SECTIONS AND ROOF PLAN FOR PLATE HEIGHTS.
- DIMENSION LINES ARE TO FACE OF STUD U.N.O.
- WINDOW SIZES & ROUGH OPENINGS TO BE VERIFIED BY CONTRACTOR.
- IF NOMINAL DOOR AND WINDOW HEIGHTS ARE SIMILAR, COORDINATE WITH DOOR AND WINDOW SPECS TO LOCATE FINAL ELEVATION OF THE HEAD HEIGHTS SO THAT ALL DOOR AND WINDOW TRIM ALIGN.
- WINDOW AND DOOR SIZES ARE DIMENSIONED IN FEET AND INCHES (E.G. 2828R 2'-8" W x 7'-8" H).
- EXTERIOR WALLS TO BE 2x8 STUDS AT 16" O.C., INTERIOR WALLS TO BE 2x4 STUDS AT 16" O.C., U.N.O.
- FIREBLOCK ALL PLUMBING PENETRATIONS AND STAIR RUNS PER IRC SEC. R302.11.
- SAFETY GLAZING PER IRC SEC. R308.4.
- ALL WOOD IN CONTACT WITH CONCRETE TO BE PRESSURE TREATED PER IRC SEC. R317.1.
- PROVIDE UNDER-STAR PROTECTION (1/2" GWB) PER IRC SEC. R302.7.
- PROVIDE (1) LAYER OR 1/2" GWB AT THE GARAGE SIDE OF ALL WALLS SEPARATING THE GARAGE FROM THE RESIDENCE. ALL WALLS SUPPORTING A FLOOR CEILING ASSEMBLY BETWEEN THE GARAGE AND RESIDENCE, AND BETWEEN THE GARAGE AND ITS ATTIC, PROVIDE (1) LAYER 5/8" TYPE X GWS TO GARAGE CEILING IF BELOW HABITABLE ROOMS.
- PER IRC SEC. R311.7.5, MAX. RISER HEIGHT SHALL BE 7/32" MIN. TREAD DEPTH SHALL BE 10". STAIR NOSINGS: 3/4" MIN., 1-1/4" MAX. RADIUS @ LEADING EDGE OF TREAD: 3/8" MAX.
- PROVIDE HANDRAILS PER IRC SEC. R311.7.8. TOP OF HANDRAIL SHALL BE NOT LESS THAN 34" OR MORE THAN 38" ABOVE THE TREAD NOSINGS. HANDRAILS SHALL BE CONTINUOUS THE FULL LENGTH OF THE FLIGHT PER R311.7.8.2. THE HANDRAIL GRIP-SIZE SHALL BE PROVIDED PER R311.7.8.3.
- PROVIDE GUARDS (MIN. 36" HEIGHT) IN LOCATIONS PER IRC SEC. R312.
- FACTORY BUILT FIREPLACES & CHIMNEYS SHALL BE LISTED & LABELED AND SHALL BE INSTALLED & TERMINATED IN ACCORDANCE TO THE CONDITIONS OF THE LISTINGS. FACTORY BUILT FIREPLACES SHALL MEET EMISSION STANDARDS PER CH. 51-01 WAC-R308.1.1.
- ALL SHOWERHEAD AND KITCHEN SINK FAUCETS INSTALLED IN THE HOUSE SHALL BE RATED AT 1.75 GPM OR LESS. ALL OTHER LAVATORY FAUCETS SHALL BE RATED AT 1.0 GPM OR LESS.

### PLAN KEY:

- INDICATES 110V SMOKE DET. PER I.R.C. 313.4 INTERCONNECTED W/ EMERGENCY BATTERY BACKUP
- INDICATES CARBON MONOXIDE ALARM PER I.R.C. R315.1
- INDICATES EXHAUST VENTILATION FAN PER COVER SHEET.
- INDICATES HEAT ALARM

306.1 ACCESS, APPLIANCES, CONTROLS DEVICES, HEAT EXCHANGERS AND HVAC SYSTEM COMPONENTS THAT UTILIZE ENERGY SHALL BE ACCESSIBLE FOR INSPECTION, SERVICE, REPAIR AND REPLACEMENT W/O DISABLING THE FUNCTION OF A FIRE-RESISTANCE RATED ASSEMBLY OR REMOVING PERMANENT CONSTRUCTION. OTHER APPLIANCES, VENTING SYSTEMS OR ANY OTHER PIPING OR DUCTS NOT CONNECTED TO THE APPLIANCE BEING INSPECTED, SERVICED, REPAIRED OR REPLACED, A LEVEL WORKING SPACE NOT LESS THAN 30 INCHES DEEP AND 30 INCHES WIDE (762 MM BY 762 MM) SHALL BE PROVIDED IN FRONT OF THE CONTROL SIDE TO SERVICE AN APPLIANCE.

# KONERU RESIDENCE

6610 E Mercer Way  
 Mercer Island, WA 98040

PERMIT SET

Main Floor Plan

# A5


5601 8th Ave S, Suite 371  
 Seattle, WA 98108  
 206.443.1181  
 mccullougharchitects.com

# MCCULLOUGH ARCHITECTS

UNPUBLISHED WORK 2016 © McCullough Architects

Revisions	Comment
2021.11.17	Updated Plans to Structural
2021.12.13	Structural Backcheck 01
2022.01.13	Structural Backcheck 02
2022.01.22	Structural Backcheck 03
2022.05.02	Permit Corrections
2022.05.04	Structural Backcheck
2022.05.12	Commentary Response
2022.07.13	Cycle 2 Structural Backcheck
2022.08.18	Cycle 3 Structural Backcheck

Date: 2021.10.13  
 Job No: 21-041  
 Project No:  
 Drawn: DUR  
 Approved: APM

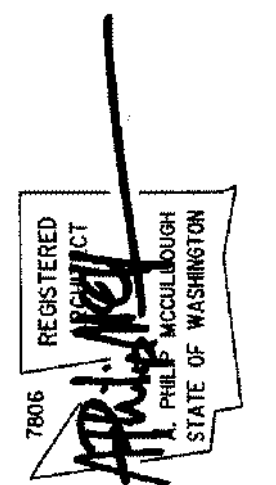

2 10 5 10





STRUCTURAL CONTENTS ONLY


5601 6th Ave S, Suite 371  
Seattle, WA 98108  
206.443.1181  
mccullougharchitects.com

**MCCULLOUGH**  
ARCHITECTS

UNPUBLISHED WORK 2016 © McCullough Architects

Comment  
Updated Plans to Structural  
Structural Backcheck 01  
2021.12.13  
Structural Backcheck 02  
2021.12.22  
Permit Corrections  
2022.05.02  
Structural Backcheck  
2022.05.04  
Commentary Response  
2022.05.12  
Cycle 2 Structural Backcheck  
2022.07.13  
Cycle 3 Structural Backcheck  
2022.06.18

2021.10.13  
Date: 21-041  
Job No: 21-041  
Project No:  
Drawn: DUR  
Approved: APM

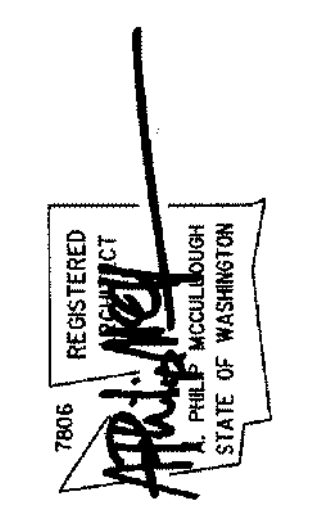


**KONERU RESIDENCE**  
6610 E Mercer Way  
Mercer Island, WA 98040

PERMIT SET

Upper Floor & Lower  
Roof Framing Plan

**A6**

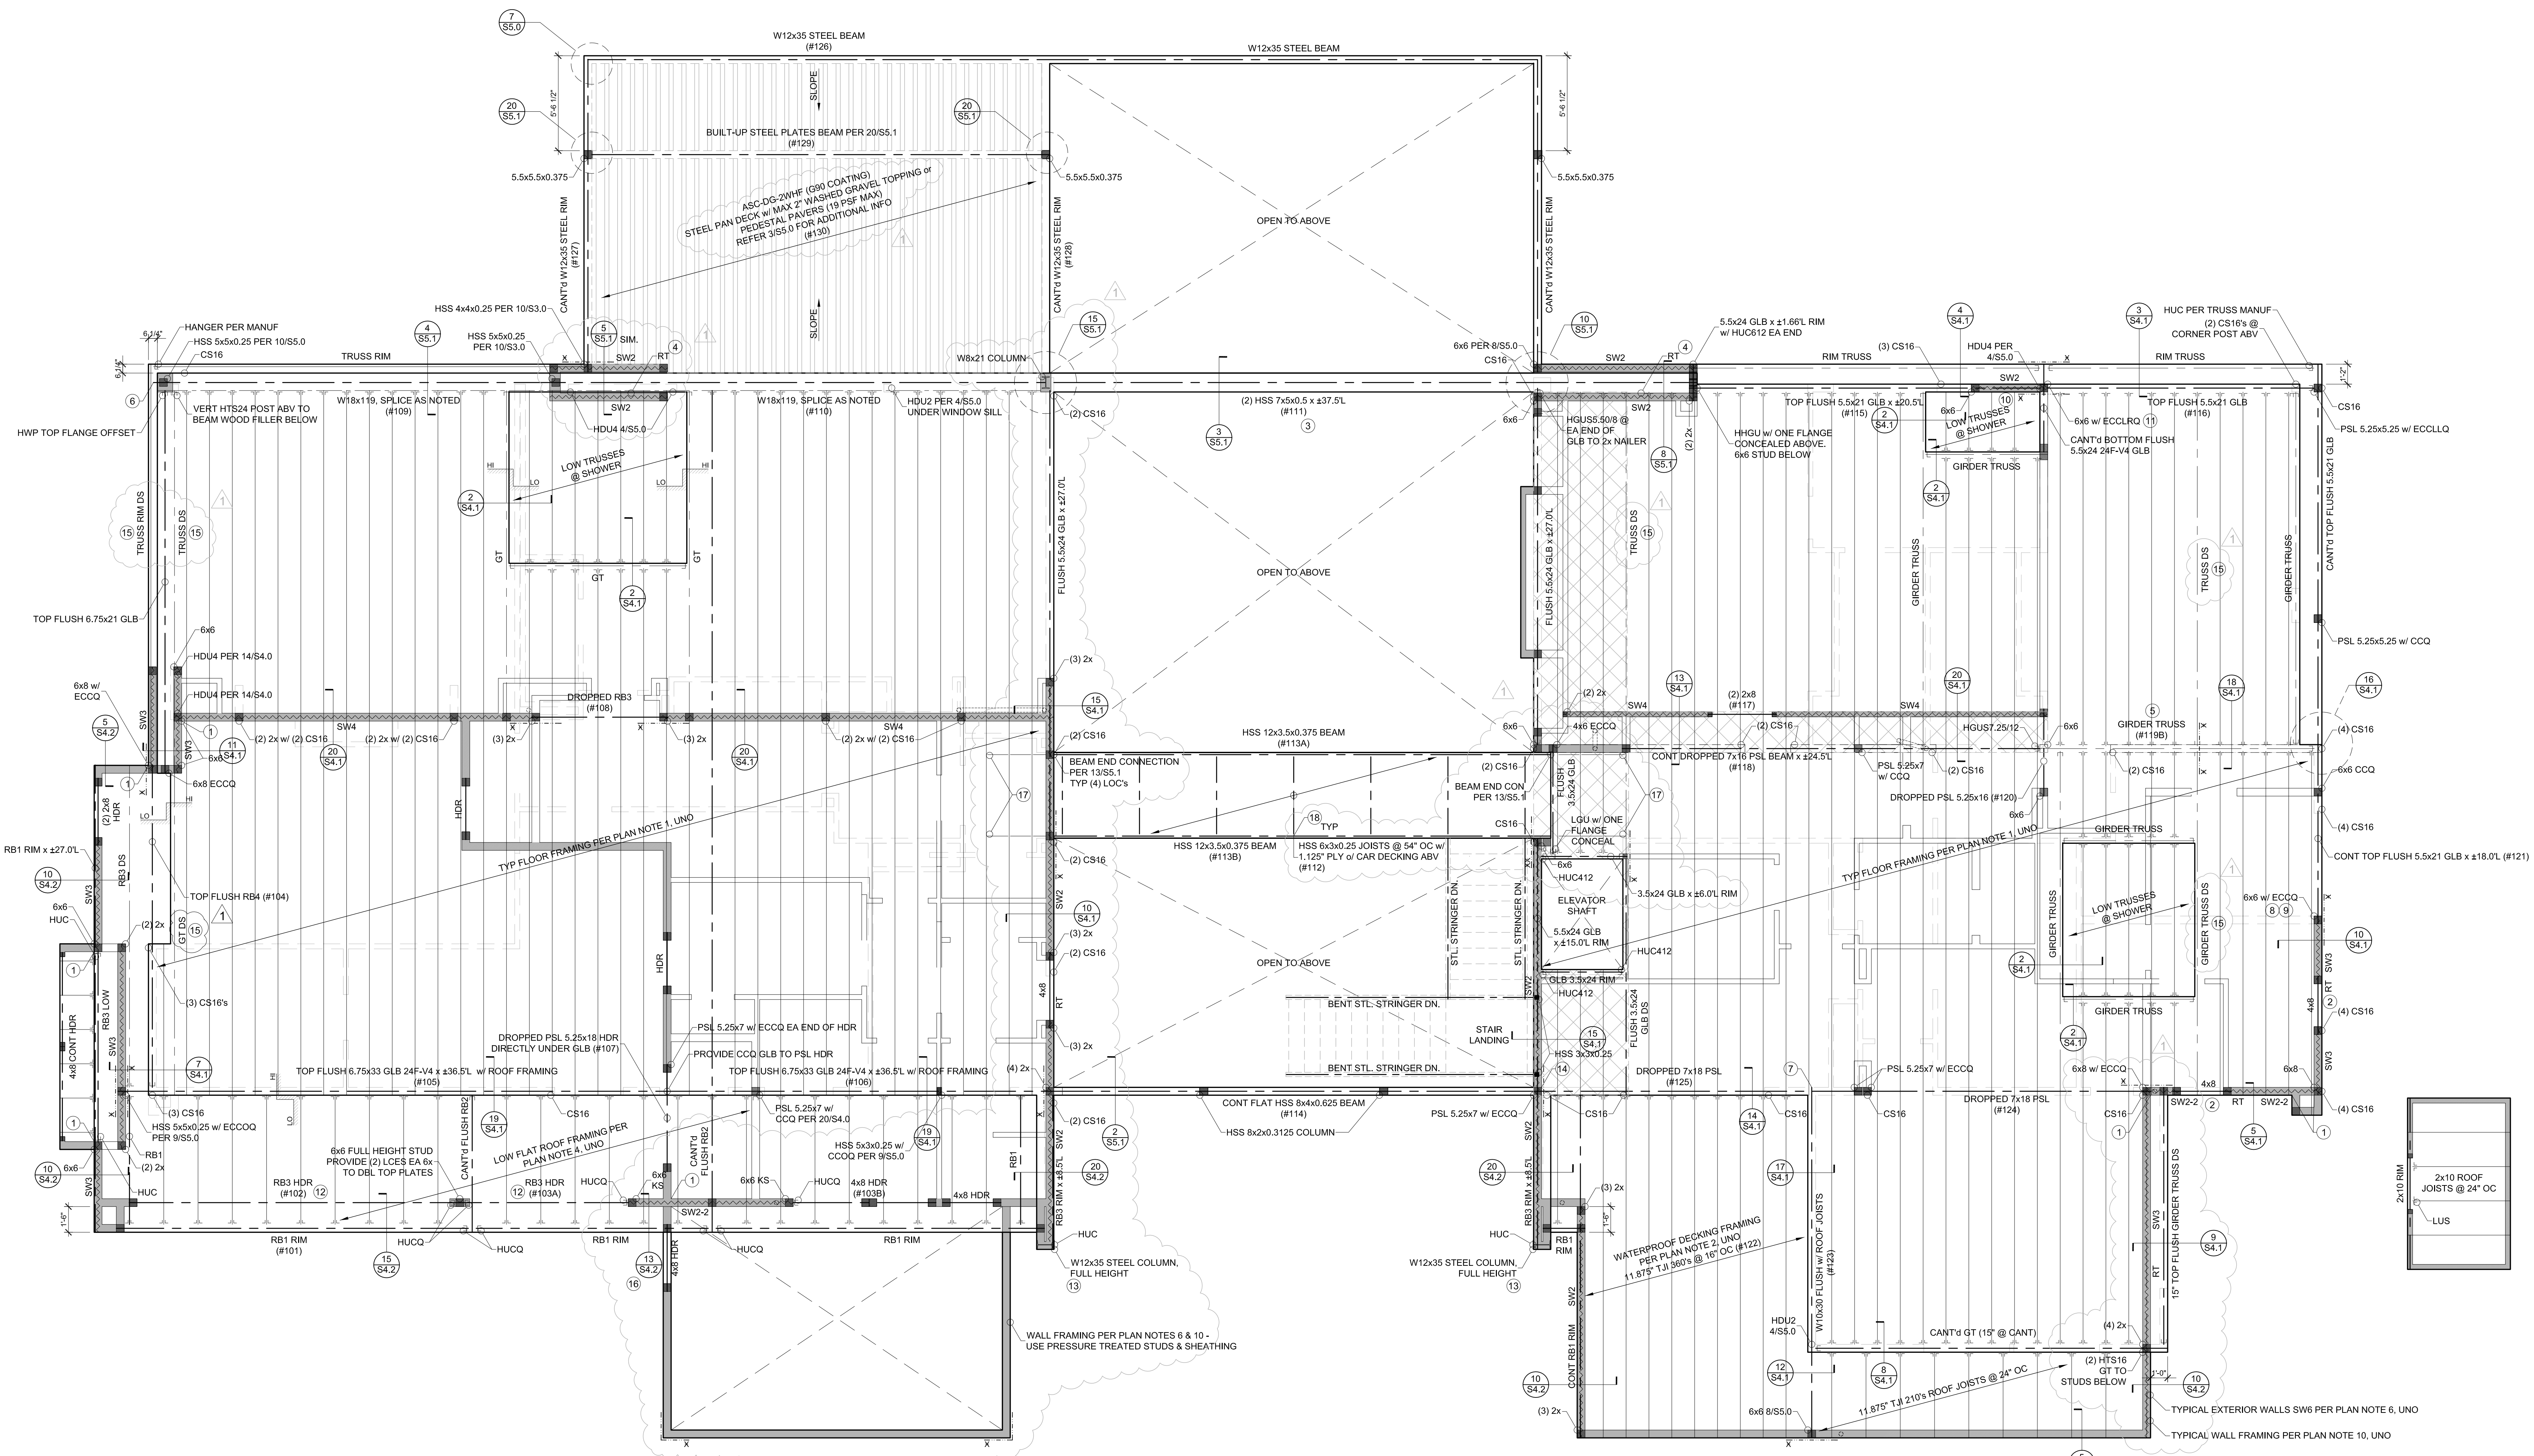

**FLUSH BEAM SCHEDULE:**

MARK	SIZE	BRG STUDS	HANGER, UNO
RB1	1.75x11.875 LSL	2	HUS1.81/10
RB2	3.5x11.875 GLB or 3.5x11.875 LSL	2	HRUS410
RB3	5.5x11.875 GLB or 5.25x11.875 PSL	3	HGUS5.50/10
RB4	7x11.875 PSL	4	HGUS7.25/10

① ALL GLB ARE 24F-1/4, UNO


- LEGEND:**
- X - HORIZ CS16 x 3'-0" LONG - TOP PLATE TO TOP PLATE ( @ BREAK ) or TOP FLUSHED BEAM TO TOP PLATE or RIM TO RIM or BEAM TO BEAM or BEAM TO RT or TOP PLATES TO TOP PLATES (XX INDICATES 2-CS16 STRAPS)
  - DS - DRAG STRUT - NAIL THRU SHEATHING w/ 8d NAILS @ 4" OC INTO ENTIRE LENGTH OF MEMBER
  - KS - KING STUD
  - (X) - NUMBER OF BUILT-UP STUDS
  - GT - GIRDER TRUSS
  - RT - RIM TRUSS
  - - BLOCK DIAPHRAGM - PROVIDE FLAT 2x4 BLKs w/ 8d @ 4" OC @ ALL PANEL EDGES @ 84 @ 12" OC IN THE FIELD
  - ▨ - INDICATES EXTENT OF SHEARWALL SEGMENT
  - ▭ - BEARING WALL

- FOOTNOTES:**
- 1 SHEARWALL SHEATHING CONTINUOUS THRU WALL INTERSECTION
  - 2 SHEATH AND NAIL ABOVE AND BELOW WINDOW AND PANEL EDGE NAIL AROUND OPENING PER SHEARWALL SCHEDULE
  - 3 (2) HSS 7x5x1/2 BUILT-UP BEAM SHALL BE GROOVE WELD TOGETHER TOP AND BOTTOM AND PROVIDE 1/2" DIAM. WTS AT 36" OC FOR 2x NAILER CONNECTION EACH SIDE OF BUILT-UP BEAM AND USE 5/4" WOOD NAILER TOP AND BOTTOM OF BUILT-UP BEAM WITH 18 SCREWS AT 36" OC STAGGERED INTO HSS BEAMS, PRE-DRILL AS REQUIRED
  - 4 TRUSS MANUFACTURER TO DESIGN RIM TRUSS TO TRANSFER 600 PLF LATERALLY FROM TOP TO BOTTOM CHORD
  - 5 TRUSS MANUFACTURER TO DESIGN GIRDER TRUSS FOR A 4,500 LBS (WINDSEISMIC) POINT LOAD AT HOLD-DOWN AND PROVIDE VERTICAL MEMBER TO RECEIVE HOLD-DOWN NAILS
  - 6 PROVIDE (1)180 WITH #9 x 1-1/2" SS CONNECTORS SCREWS EACH SIDE OF STEEL BEAM SNUG FIT WOOD FILLER TO TRUSS, (2)1/80 TOTAL AND TRUSS MANUFACTURER TO PROVIDE VERTICAL MEMBERS TO RECEIVE L90 FASTENERS
  - 7 PROVIDE 3-1/2" BEARING LENGTH OF STEEL BEAM TO TOP OF PSL WITH (2)1/2" DIAM. x 6" LAG BOLTS AT BEAM GAGE WITH 2-1/2" EDGE DISTANCE FROM FACE OF PSL BEAM
  - 8 RAISE TOP OF POST TO BOTTOM OF GLB 2" DEPTH TOP FLUSH BEAM AND PROVIDE POST CAP PER PLAN, REFER DETAIL 1684-D
  - 9 PROVIDE HORIZ CS16 x 4" STRAP AT TOP PLATE AND WRAP AROUND CENTERED ON POST PER PLAN, REFER DETAIL 1684-D
  - 10 PROVIDE SOLID WOOD SHIM BETWEEN BOTTOM OF GLB 2" DEPTH BEAM AND DBL 2x6 TOP PLATES AS REQUIRED TO BE FLUSHED WITH FLOOR FRAMING AND PROVIDE 0.22" DIAM. x 8" SOWS TIMBER SCREWS AT 16" MAX. THRU UNDERSIDE OF DBL TOP PLATES TO BOTTOM OF BEAM
  - 11 PROVIDE SOLID WOOD SHIM BETWEEN BOTTOM OF GLB 2" DEPTH BEAM AND POST CAP AS REQUIRED TOP FLUSHED WITH FLOOR TRUSSES
  - 12 PLACE GARAGE HEADER DIRECTLY ABOVE DOOR ROUGH OPENING
  - 13 PROVIDE FULL HEIGHT SOLID WOOD W/NAILER AS REQUIRED FOR NAILER AND BOLT WITH 5/8" WTS AT 32" OC, REFER DETAIL 1253-1
  - 14 POCKET BEAM INTO WALL WITH BUILT-UP 2x BEARING STUDS TO MATCH BEAM WIDTH AND (12x) FULL HEIGHT STUD EACH SIDE WITH A36 EACH TOP AND BOTTOM

- FOOTNOTES cont:**
- 15 TRUSS MANUFACTURER TO DESIGN DRAG TRUSS FOR 300 lb/ft OF LATERAL LOAD
  - 16 PROVIDE LSL 3.5x11.875 BLOCKING BETWEEN TJ RAFTERS OVER SHEARWALL SW-2, CONNECTION PER DETAIL 1354-2
  - 17 PROVIDE DT2Z @ THIRD FLOOR TRUSS BAY PER DETAIL 1355-1
  - 18 3/16 FILLET WELD AROUND ONTO HSS 12x3.5x0.375 BRIDGE BEAM

- UPPER FLOOR & LOWER FLOOR FRAMING NOTES:**
- 1 TYPICAL FLOOR FRAMING CONSISTS OF 1/4" T&G OR 1-1/8" GYPCRETE PER ARCH OF 1-1/8" T&G APA RATED SHEATHING (SPAN RATING 48-0) OVER PREFABRICATED TRUSSES AT 16" OC, UNO. TRUSSES TO BE A MIN DEPTH OF 24".
  - 2 TYPICAL WATER PROOF DECK FRAMING CONSISTS OF CONCRETE PAVERS (18 PSF MAX.) OR TAPERED RIGID INSULATION PER ARCH OF 3/4" T&G APA RATED SHEATHING (SPAN RATING 48-24) OVER 1-1/8" T&G 300's AT 16" OC, UNO.
  - 3 GUE AND NAIL FLOOR AND WATERPROOF DECK SHEATHING w/ 8d AT 6" OC AT FRAMED PANEL EDGES AND AT 12" OC IN THE FIELD, UNO.
  - 4 TYPICAL LOWER ROOF FRAMING CONSISTS OF 2" THICK MAX. WASHED GRAVEL TOPPING (25 PSF MAX.) OVER TAPERED RIGID INSULATION PER ARCH OVER 3/4" T&G APA RATED SHEATHING (SPAN RATING 48-24) OVER 1-1/8" T&G 210's AT 24" OC, UNO. PROVIDE HB EACH END OF ALL RAFTERS, HB EACH SIDE OF ALL MULTIPLE RAFTERS, UNO.
  - 5 NAIL ROOF SHEATHING w/ 8d AT 6" OC AT FRAMED PANEL EDGES AND OVER SHEARWALLS, AND AT 12" OC IN THE FIELD, UNO.
  - 6 "SW\_" INDICATES SHEARWALL BELOW FRAMING SHOWN. REFER TO SHEARWALL SCHEDULE ON 5/4-0 FOR ADDITIONAL INFORMATION. ALL EXTERIOR WALLS ARE SW6, UNO.
  - 7 ALL HEADERS REQUIRED ARE SHOWN ON PLAN AND SHALL BE 2X26x UNO. REFER TO DETAIL 1054-0 FOR ADDITIONAL REQUIREMENTS.
  - 8 PROVIDE (2) BEARING (TRIMMER) STUDS AT EACH END OF ALL HEADERS, BEAMS, AND GIRDER TRUSSES 6'-0" IN LENGTH AND OVER UNO.
  - 9 WHERE POSTS OCCUR PROVIDE SOLID VERTICAL GRAIN BLOCKING SOLID THRU FLOOR TO MATCHING SUPPORTS BELOW, UNO.
  - 10 TYPICAL WALL FRAMING CONSISTS OF 2x4s OR 2x6s AT 16" OC AT EXTERIOR WALLS AND 2x4s OR 2x6s AT 16" OC AT INTERIOR WALLS PER ARCH DRAWINGS, UNO.
  - 11 REFER TO SHEET S4.0 FOR TYPICAL WOOD FRAMING DETAILS.
  - 12 REFER TO GENERAL STRUCTURAL NOTES SHEET S1.0 FOR ADDITIONAL REQUIREMENTS.
  - 13 DO NOT SCALE DRAWINGS. REFER TO ARCHITECTURAL DRAWINGS FOR ALL DIMENSIONS.



**UPPER FLOOR & LOWER ROOF FRAMING PLAN**  
SCALE: 1/4" = 1'-0"

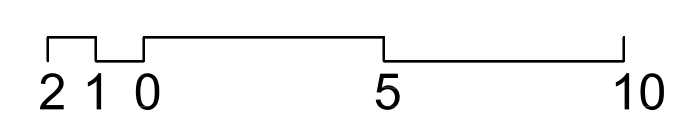







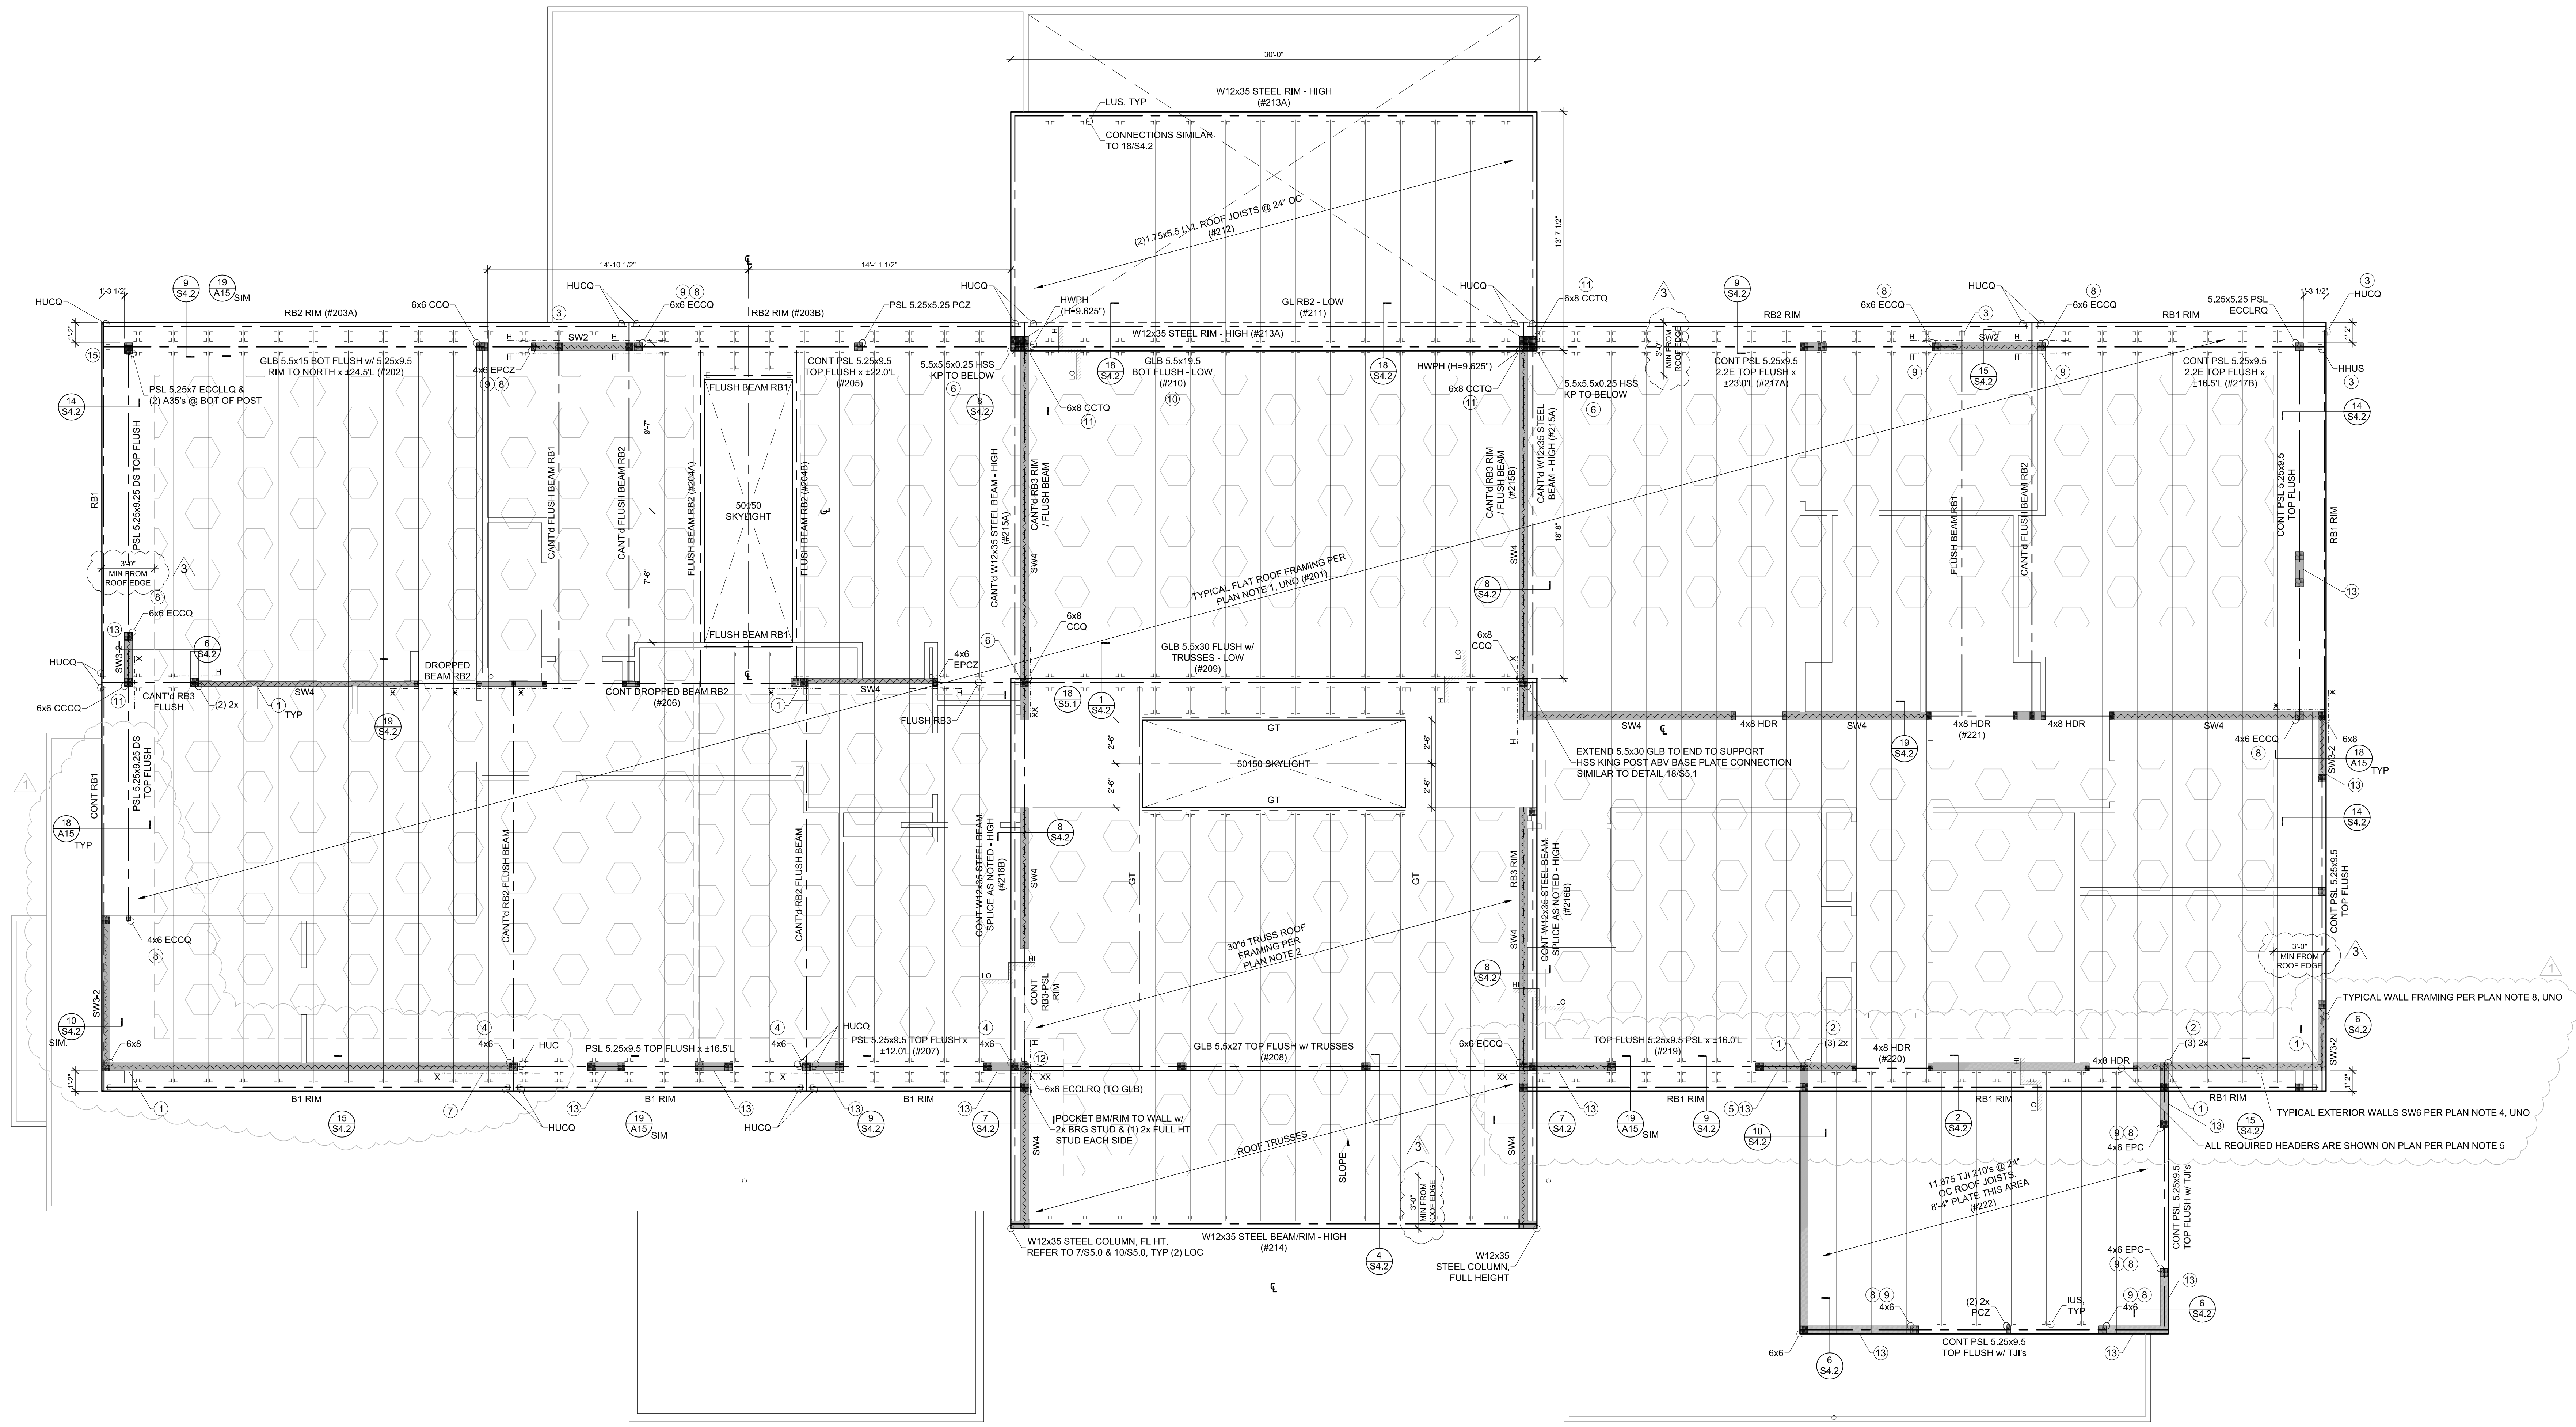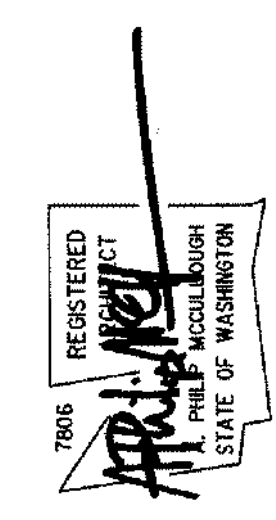

GENERAL NOTES:

- EAVE OVERHANG PER PLAN. APPLY ROOFING IN ACCORDANCE WITH I.R.C. SEC. 905. PROVIDE DRIP EDGE PER R902.2.8.5.
- HEADERS (HOR) TO BE PER STRUCTURAL. FILL CAVITIES WITH RIGID INSULATION WHERE POSSIBLE.
- COLUMNS @ HEADERS, BEAMS, & GIRDERS TO BE (2) 2x STUDS (U.N.O.)


FLUSH BEAM SCHEDULE:

MARK	SIZE (1)	BRG STUDS	HANGER, UNO
RB1	1.75x11.875 LSL	2	HUS1.8110
RB2	3.5x11.875 GLB or 3.5x11.875 LSL	2	HRUS410
RB3	5.5x11.875 GLB or 5.25x11.875 PSL	3	HGUS5.5010
RB4	7x11.875 PSL	4	HGUS7.2510

(1) ALL GLB ARE 24F-1/4 UNO

LEGEND:

- X - HORIZ CS16 x 2'-0" LONG - TOP PLATE TO TOP PLATE (Ø BREAK) or TOP FLUSHED BEAM TO TOP PLATE or RIM TO RIM or BEAM TO BEAM (XX INDICATES 2-CS16 STRAPS)
- DS DRAG STRUT - NAIL THRU SHEATHING w/ 8d NAILS @ 4" OC INTO ENTIRE LENGTH OF MEMBER
- (X) NUMBER OF BUILT-UP STUDS
- GT GIRDER TRUSS
- RT RIM TRUSS
- KP KING POST

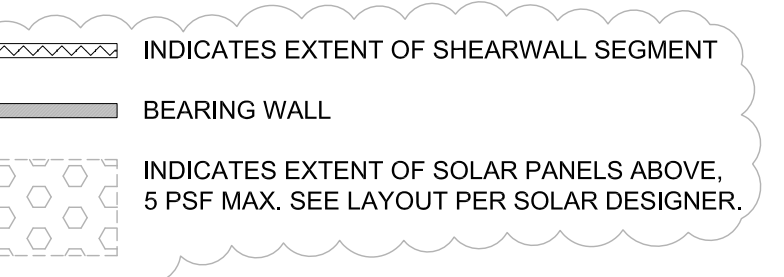

FOOTNOTES:


- SHEARWALL SHEATHING CONTINUOUS THRU WALL INTERSECTION
- PROVIDE (2)A35 TOP AND BOTTOM OF POST/BUILT-UP STUDS
- HANGER PER PLAN INSTALL UPSIDE DOWN
- PROVIDE VERT. HTS20 STRAP EACH BEAM END TO POST BELOW (AT EACH END OF EACH BEAM WERE HANGER NOT OCCURS)
- PROVIDE (5)LTP'S ORIENT UPRIGHT AND CENTERED ON 2x SHIM BETWEEN BEAM AND DOUBLE TOP PLATES FOR DRAG CONNECTION
- PROVIDE HSS 3-1/2x3-1/2x1/4 MIN. KING POST (KP) AT HIGH STEEL BEAM AND SET COLUMN BASE PLATE AND CONNECTION TO TOP OF ROOF BEAM BELOW, REFER 18S5.1
- PROVIDE SNUG FIT LSL 1-3/4" BLOCKING BETWEEN (3) RAFTER BAYS WITH A35 TO TOP PLATE AND PROVIDE HORIZ CS16 x 6-0" OVER ROOF SHEATHING - LAP RIM BEAM 1'-0" AND NAIL REMAINING LENGTH TO LSL 1-3/4" BLOCKS
- RAISE TOP OF POST TO BOTTOM OF 9-1/2" DEPTH TOP FLUSH BEAM AND PROVIDE POST CAP PER PLAN, REFER DETAIL 18S4.0
- PROVIDE HORIZ CS16 x 4'-0" STRAP AT TOP PLATE AND WRAP AROUND CENTERED ON POST PER PLAN
- RAISED BOTTOM OF BEAM (+1/4) 2'-1/4" FROM BOTTOM OF T.J RAFTERS
- PROVIDE SOLID WOOD SHIM BETWEEN BOTTOM OF 9-1/2" DEPTH BEAM AND POST CAP AS REQUIRED TOP FLUSHED WITH TOP OF T.J RAFTERS
- NOTCH BOTTOM OF RB3-PSL BEAM TO FIT INTO RAISED POST CAP - NO OVERCUTS
- PROVIDE SOLID WOOD SHIM BETWEEN BOTTOM OF 9-1/2" DEPTH BEAM AND DBL 2x6 TOP PLATES TO BE FLUSHED WITH TOP OF ROOF FRAMING AND PROVIDE 0.22" DIAM. x 8" SDWS TIMBER SCREWS AT 16"oc MAX. THRU UNDERSIDE OF DBL TOP PLATES CENTERED INTO BOTTOM OF BEAM.
- PROVIDE SOLID WOOD SHIM BETWEEN BOTTOM OF 9-1/2" DEPTH BEAM AND DBL 2x6 TOP PLATES TO BE FLUSHED WITH TOP OF ROOF FRAMING AND PROVIDE 0.22" DIAM. x 8" SDWS TIMBER SCREWS AT 16"oc MAX. THRU UNDERSIDE OF DBL TOP PLATES CENTERED INTO BOTTOM OF BEAM
- PROVIDE L570 EACH FACE. (2) TOTAL WITH #9 x 1'-1/2" SD CONNECTOR SCREWS IN LIEU OF NAILS

ROOF FRAMING NOTES:










- TYPICAL ROOF FRAMING CONSISTS OF SOLAR PANELS (5 PSF MAX.) OVER TAPERED RIGID INSULATION PER ARCH OVER 3/4" TAG APA RATED SHEATHING (SPAN RATING 4820) OVER 11/16" T.J 3809 AT 24"oc. UNO. PROVIDE H8 EACH END OF ALL RAFTERS. H8 EACH SIDE OF ALL MULTIPLE RAFTERS. UNO.
- TRUSS ROOF FRAMING PER PLAN CONSISTS OF SOLAR PANELS (5 PSF MAX.) OVER TAPERED RIGID INSULATION PER ARCH OVER 3/4" TAG APA RATED SHEATHING (SPAN RATING 4820) OVER PREFABRICATED TRUSSES AT 24"oc. UNO. TRUSSES TO BE A MIN DEPTH OF 24". PROVIDE H2.5A EACH END OF ALL TRUSSES. H2.5A EACH SIDE OF ALL MULTIPLE TRUSSES. UNO. REFER TO ARCHITECTURAL DRAWINGS FOR TRUSS PROFILE.
- NAIL ROOF SHEATHING W/ 8d AT 6"oc AT FRAMED PANEL EDGES AND OVER SHEARWALLS, AND AT 12"oc IN THE FIELD. UNO.
- "SW" INDICATES SHEARWALL BELOW FRAMING SHOWN. REFER TO SHEARWALL SCHEDULE ON S18.0 FOR ADDITIONAL INFORMATION. ALL EXTERIOR WALLS ARE SW. UNO.
- ALL HEADERS REQUIRED ARE SHOWN ON PLAN AND SHALL BE (2)2x8, UNO. REFER TO DETAIL 10S4.0 FOR ADDITIONAL REQUIREMENTS.
- PROVIDE (2) BEARING (TRIMMER) STUDS AT EACH END OF ALL HEADERS AND BEAMS 6'-0" IN LENGTH AND OVER UNO.
- WHERE POSTS OCCUR PROVIDE SOLID VERTICAL GRAN BLOCKING SNUG THRU FLOOR TO MATCHING SUPPORTS BELOW.
- TYPICAL WALL FRAMING CONSISTS OF 2x6s AT 16"oc AT EXTERIOR WALLS AND 2x4s OR 2x6s AT 16"oc AT INTERIOR WALLS PER ARCH DRAWINGS. UNO.
- REFER TO SHEET S4.0 FOR TYPICAL WOOD FRAMING DETAILS.
- REFER TO GENERAL STRUCTURAL NOTES SHEET S1.0 FOR ADDITIONAL REQUIREMENTS.
- DO NOT SCALE DRAWINGS. REFER TO ARCHITECTURAL DRAWINGS FOR ALL DIMENSIONS.

UPPER ROOF FRAMING PLAN


SCALE: 1/4" = 1'-0"

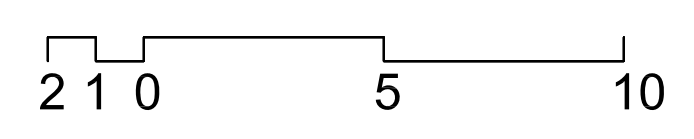



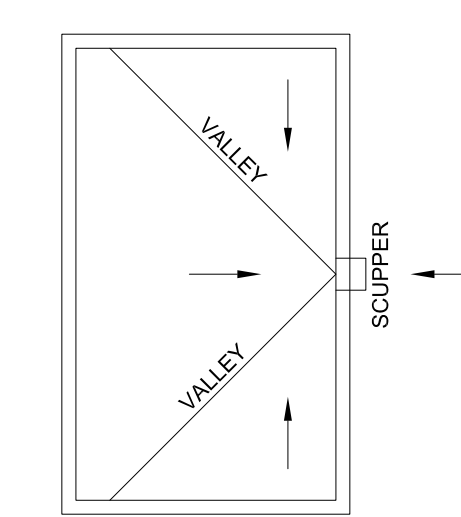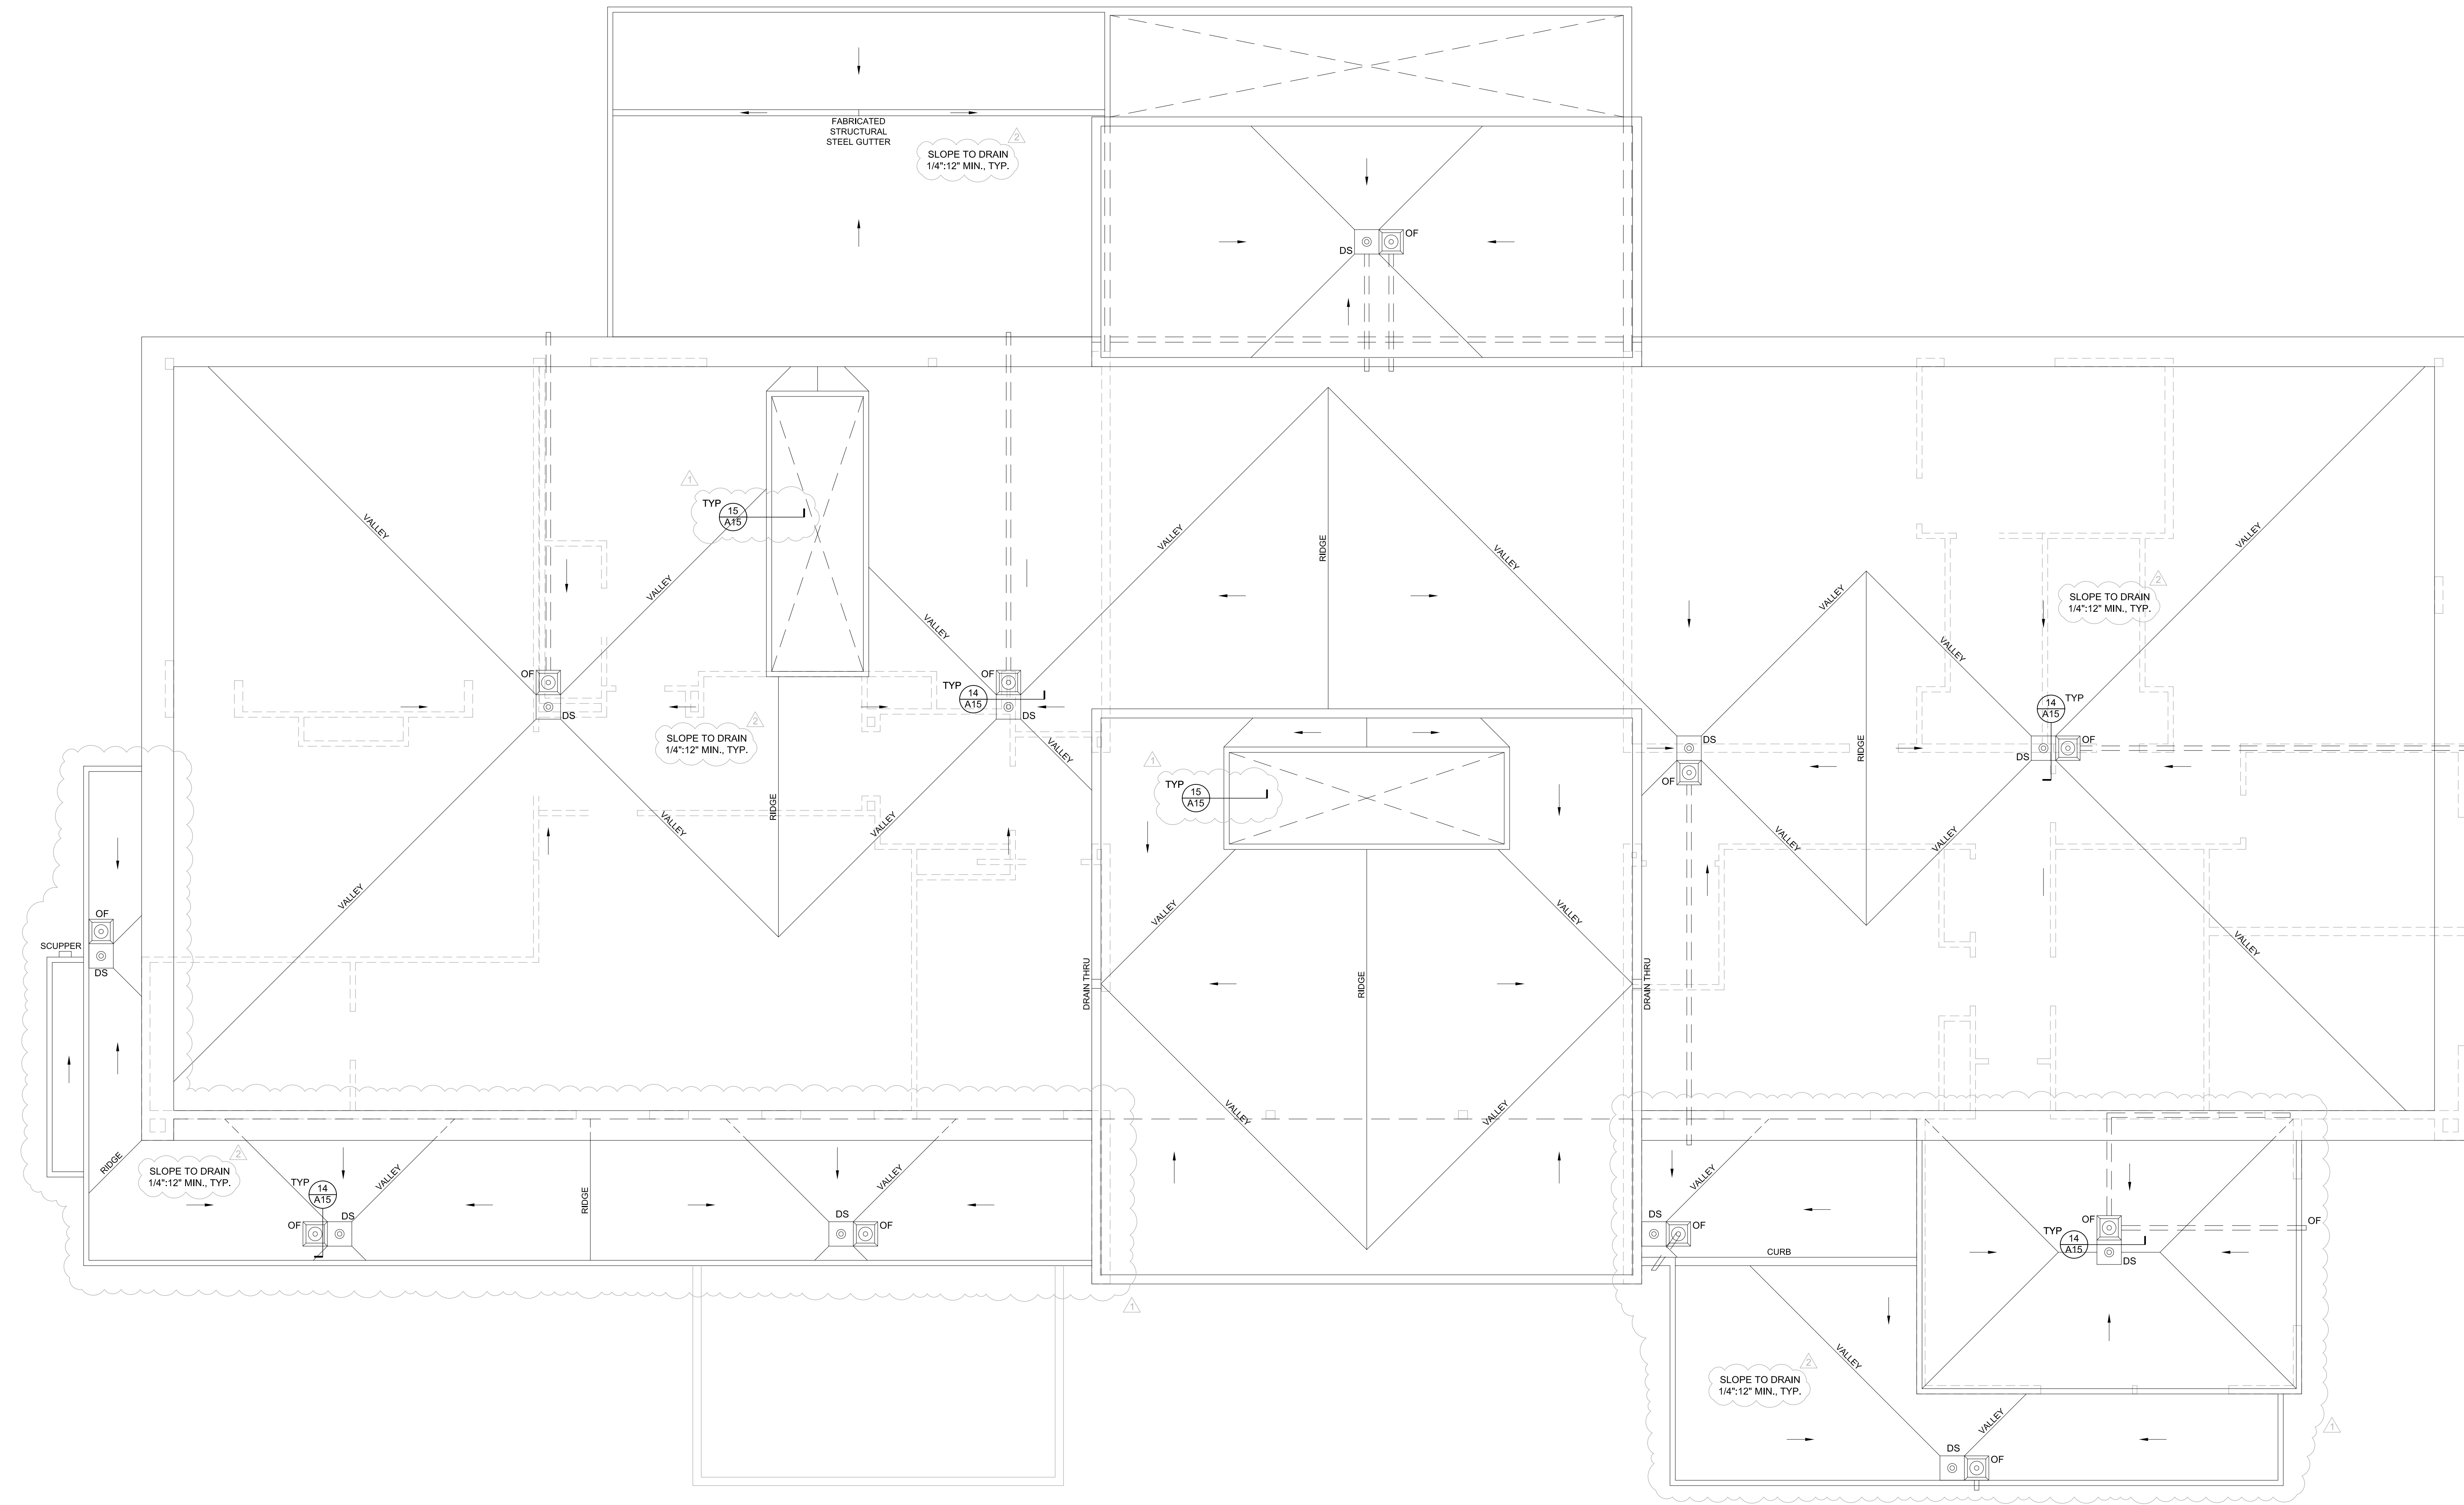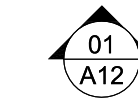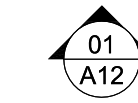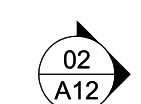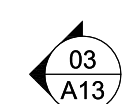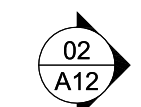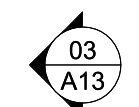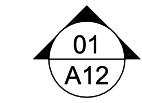


**ROOF DRAINAGE PLAN**  
SCALE: 1/4" = 1'-0"

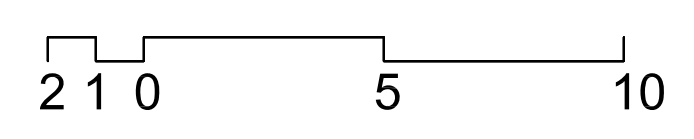

Revisions	Comment
2021.11.17	Updated Plans to Structural
2021.12.13	Structural Backcheck 01
2021.12.13	Structural Backcheck 02
2021.12.22	Structural Backcheck 03
2022.05.02	Permit Corrections
2022.05.04	Structural Backcheck
2022.05.12	Commentary Response
<b>2022.07.13</b>	<b>Cycle 2 Structural Backcheck</b>
<b>2022.08.18</b>	<b>Cycle 3 Structural Backcheck</b>

Date:	2021.10.13
Job No:	21-041
Project No:	DJR
Drawn:	APM
Approved:	

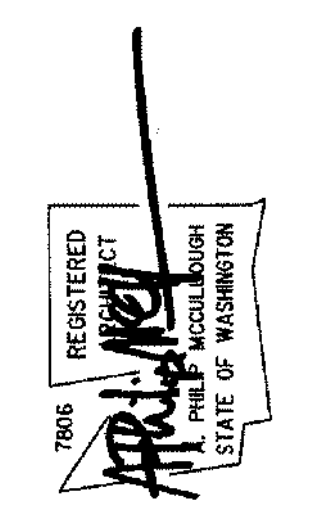


**KONERU RESIDENCE**  
6610 E Mercer Way  
Mercer Island, WA 98040

PERMIT SET  
Roof Drainage Plan







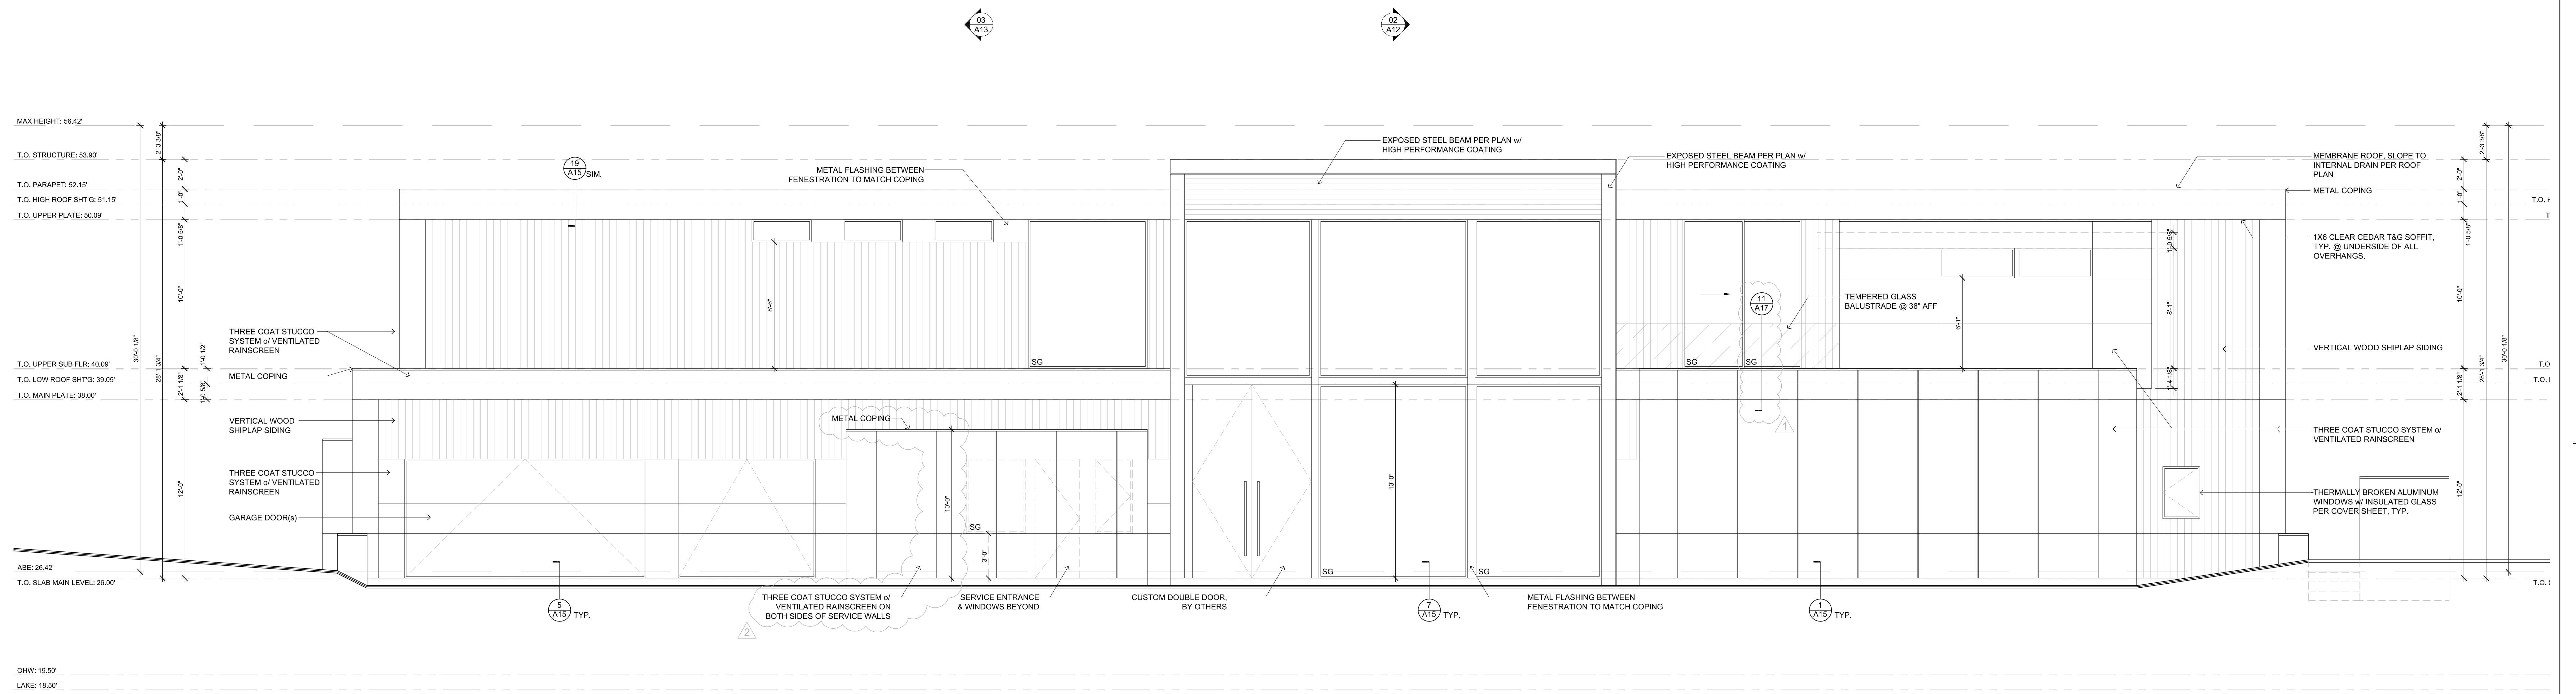


**WEST ELEVATION**

SCALE: 1/4" = 1'-0"

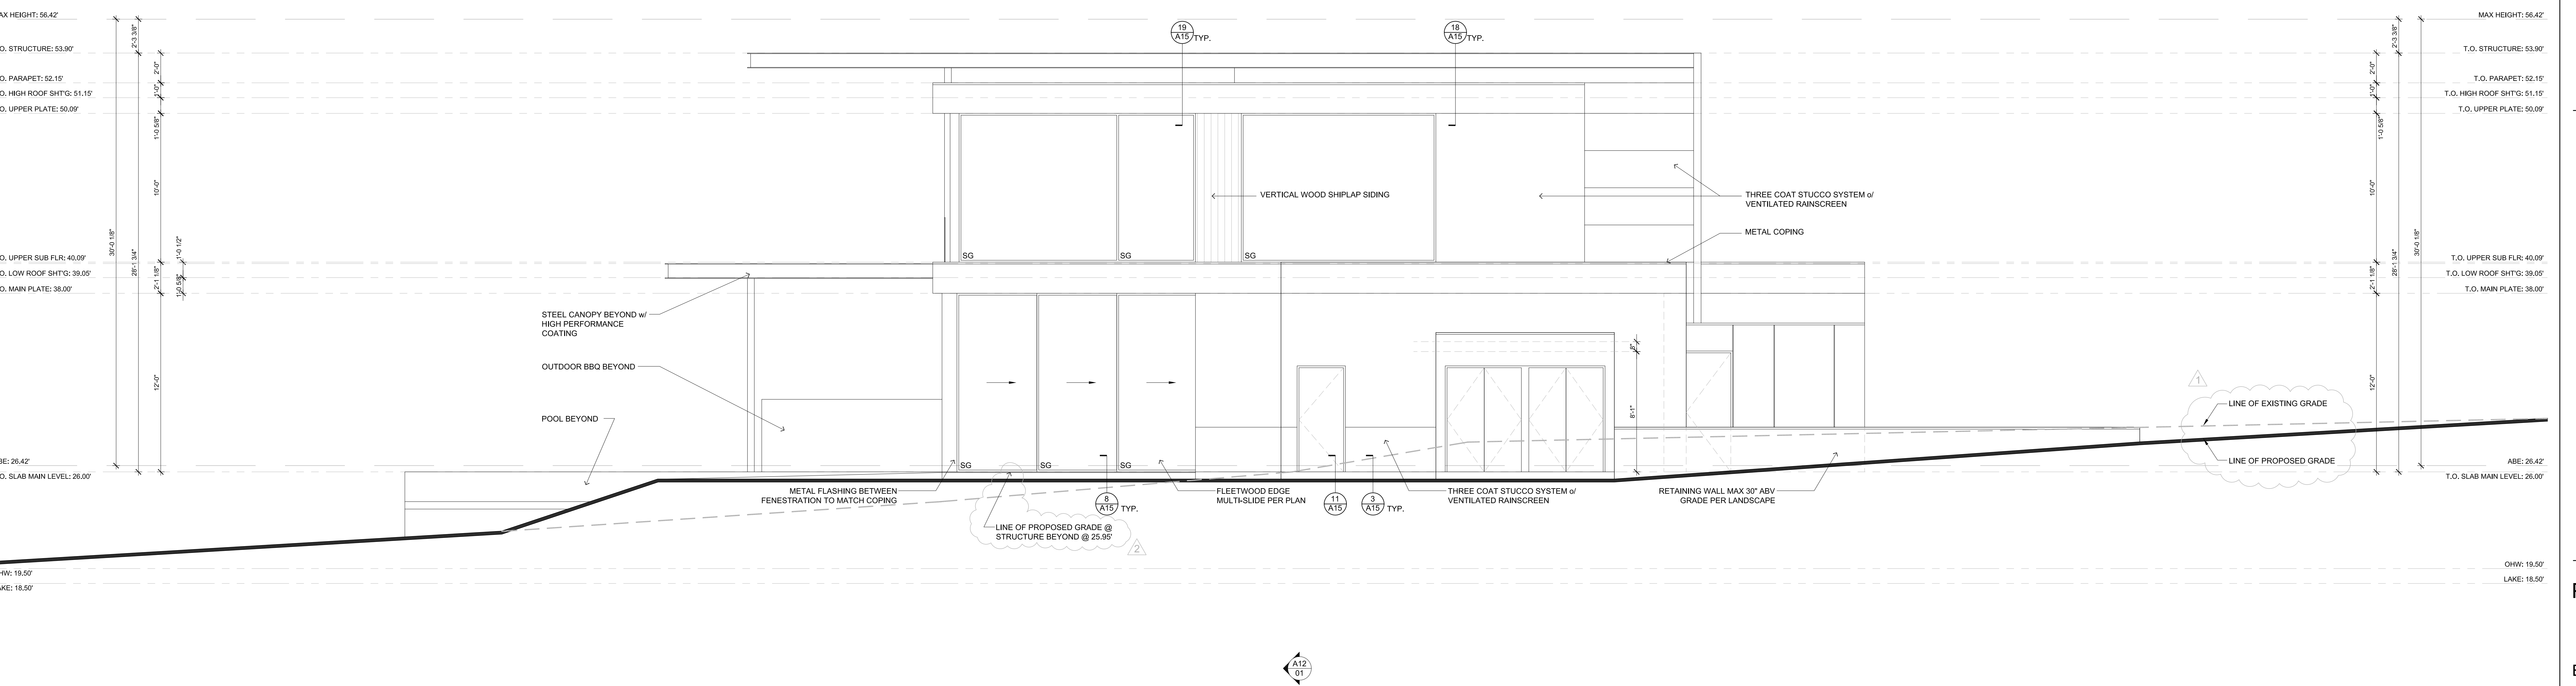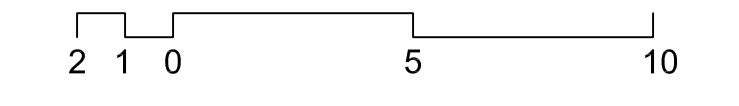

**NORTH ELEVATION**

SCALE: 1/4" = 1'-0"

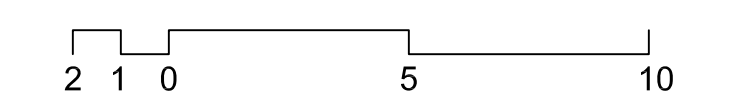

5601 6th Ave S, Suite 371  
Seattle, WA 98108  
206.443.1181  
mccullougharchitects.com


**MCCULLOUGH**  
ARCHITECTS

UNPUBLISHED WORK 2016 © McCullough Architects

**Comment**  
Updated Plans to Structural Backcheck 01  
Structural Backcheck 02  
Structural Backcheck 03  
Permit Corrections  
Structural Backcheck  
Commentary Response  
**Cycle 2 Structural Backcheck**  
**Cycle 3 Structural Backcheck**

**Revisions**  
2021.11.17  
2021.12.13  
2021.12.13  
2021.12.22  
2022.05.02  
2022.05.04  
2022.05.12  
2022.07.13  
2022.08.18

**Date:** 2021.10.13  
**Job No:** 21-041  
**Project No:** DJR  
**Drawn:** APM  
**Approved:**

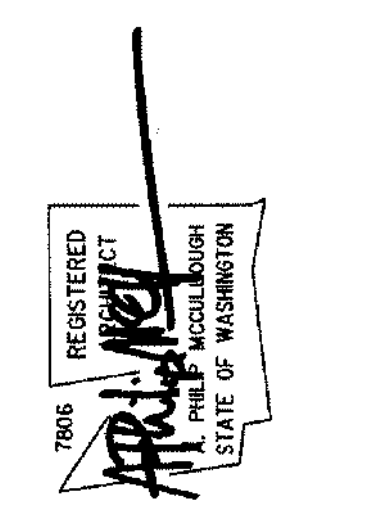


**KONERU RESIDENCE**  
6610 E Mercer Way  
Mercer Island, WA 98040

PERMIT SET

Exterior Elevations



**A10**



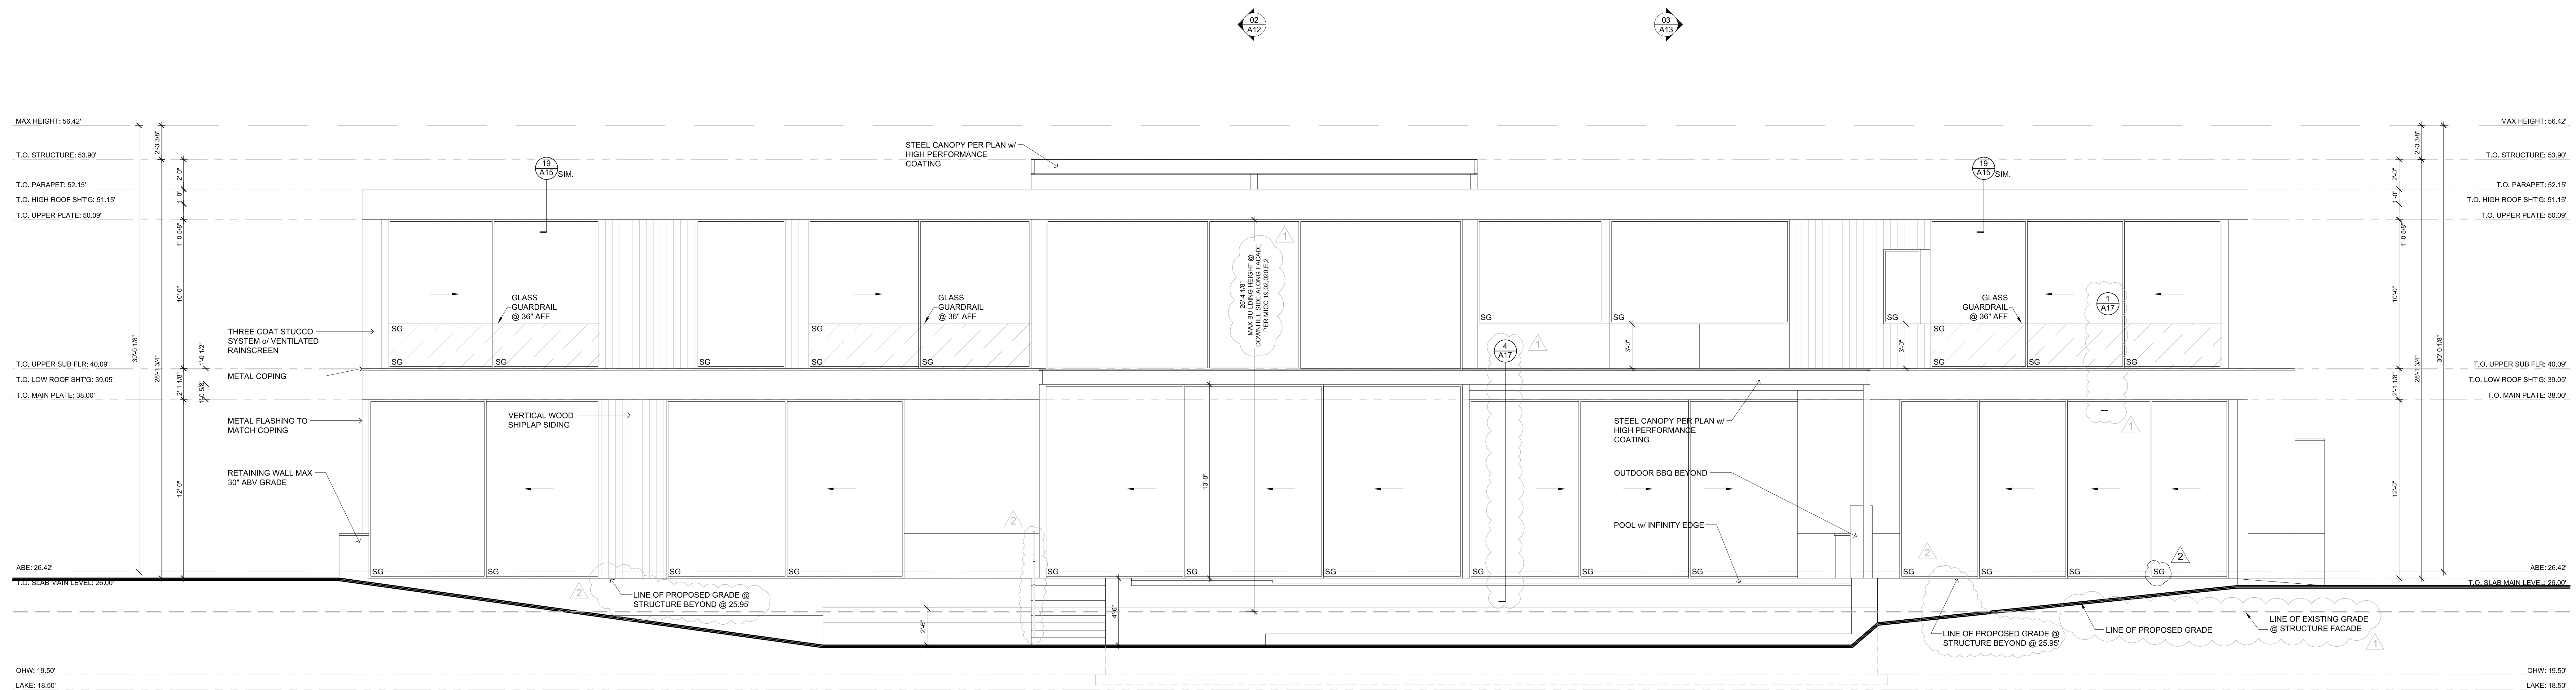


**EAST ELEVATION**

SCALE: 1/4" = 1'-0"

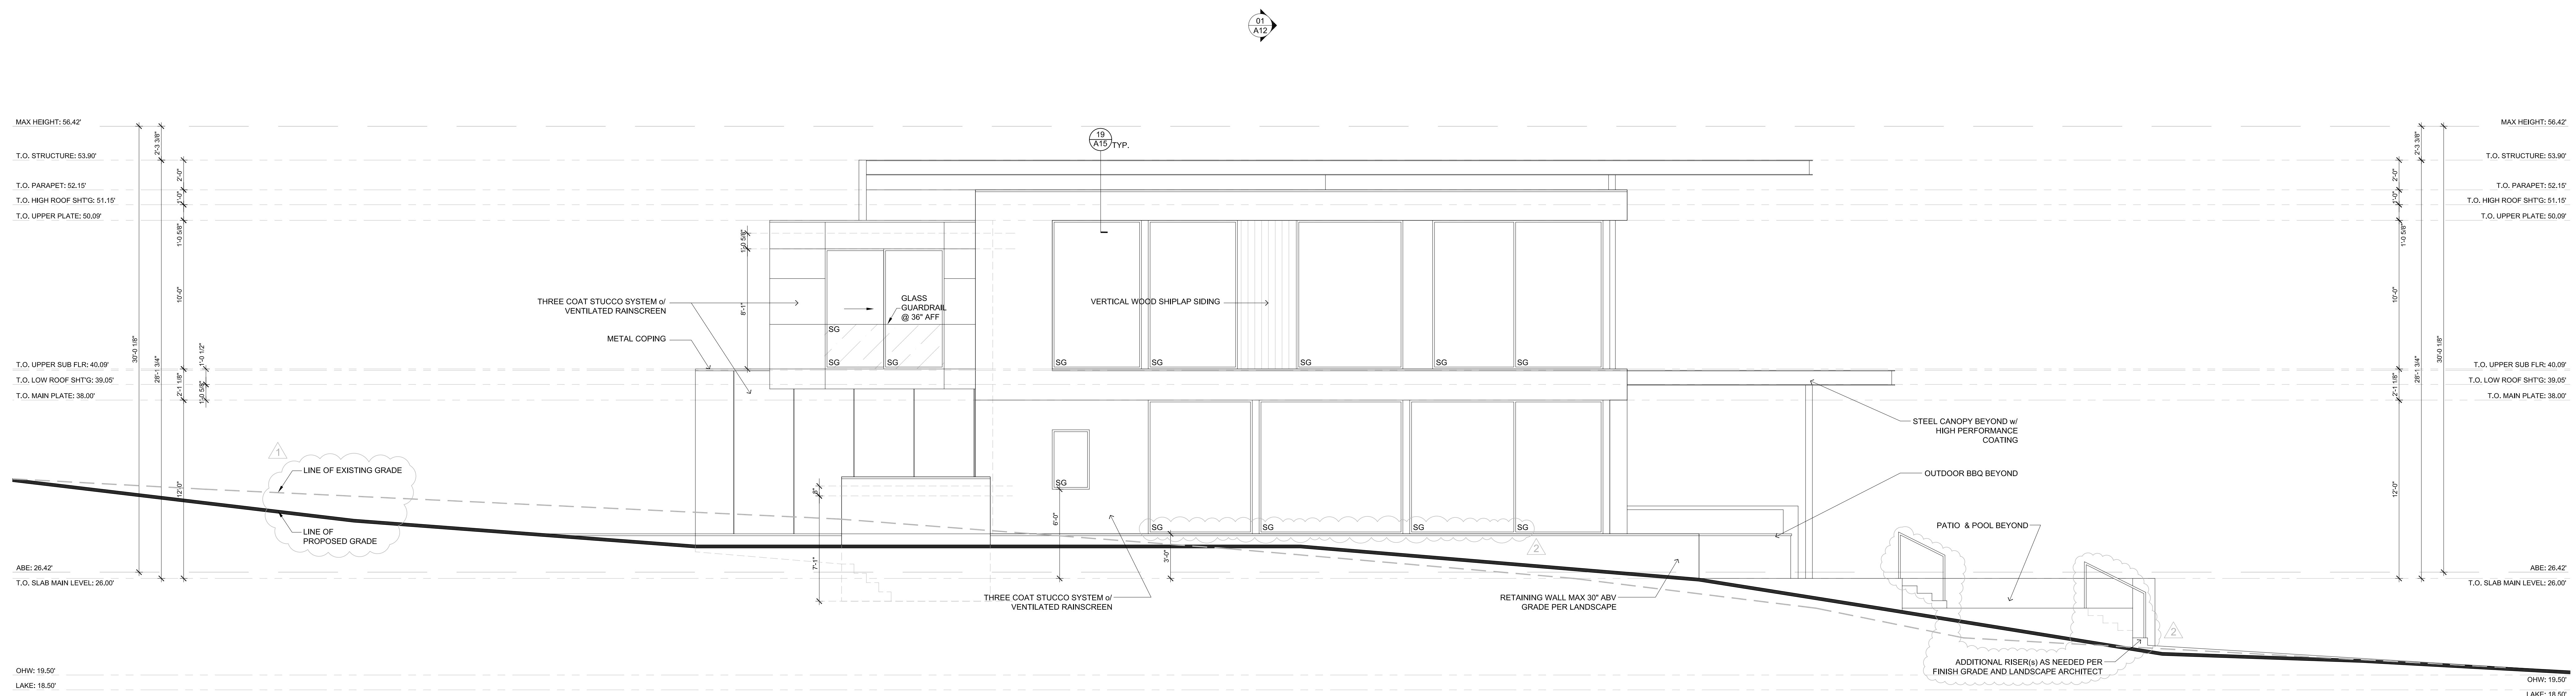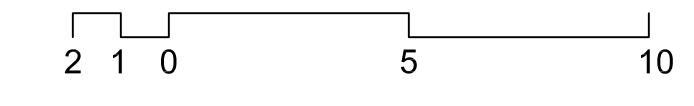

**SOUTH ELEVATION**

SCALE: 1/4" = 1'-0"

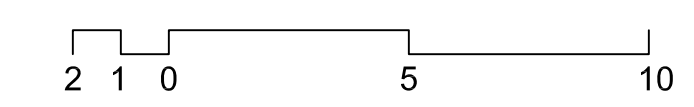

Revisions	Comment
2021.11.17	Updated Plans to Structural
2021.12.13	Structural Backcheck 01
2021.12.13	Structural Backcheck 02
2021.12.22	Structural Backcheck 03
2022.05.02	Permit Corrections
2022.05.04	Structural Backcheck
2022.05.12	Commentary Response
2022.07.13	Cycle 2 Structural Backcheck
2022.08.18	Cycle 3 Structural Backcheck


Date: 2021.10.13  
Job No: 21-041  
Project No:  
Drawn: DJR  
Approved: APM

**KONERU RESIDENCE**  
6610 E Mercer Way  
Mercer Island, WA 98040


PERMIT SET  
Exterior Elevations

**A11**




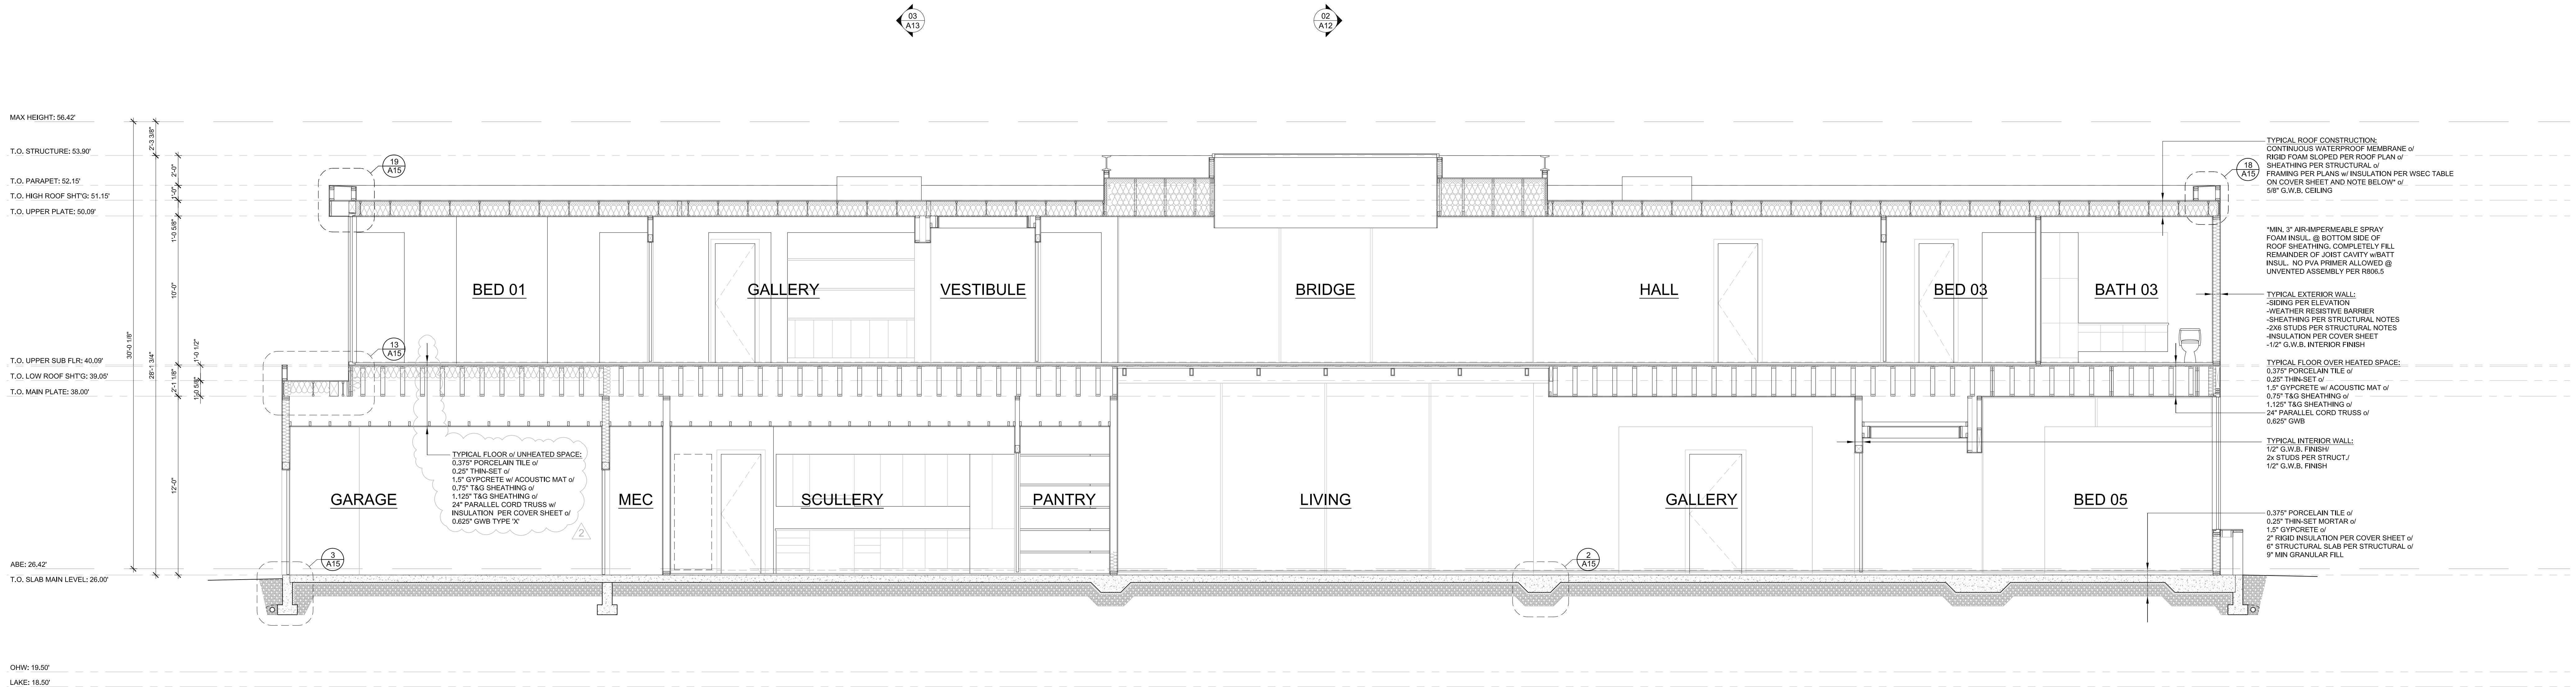

**SECTION 01**  
 SCALE: 1/4" = 1'-0"

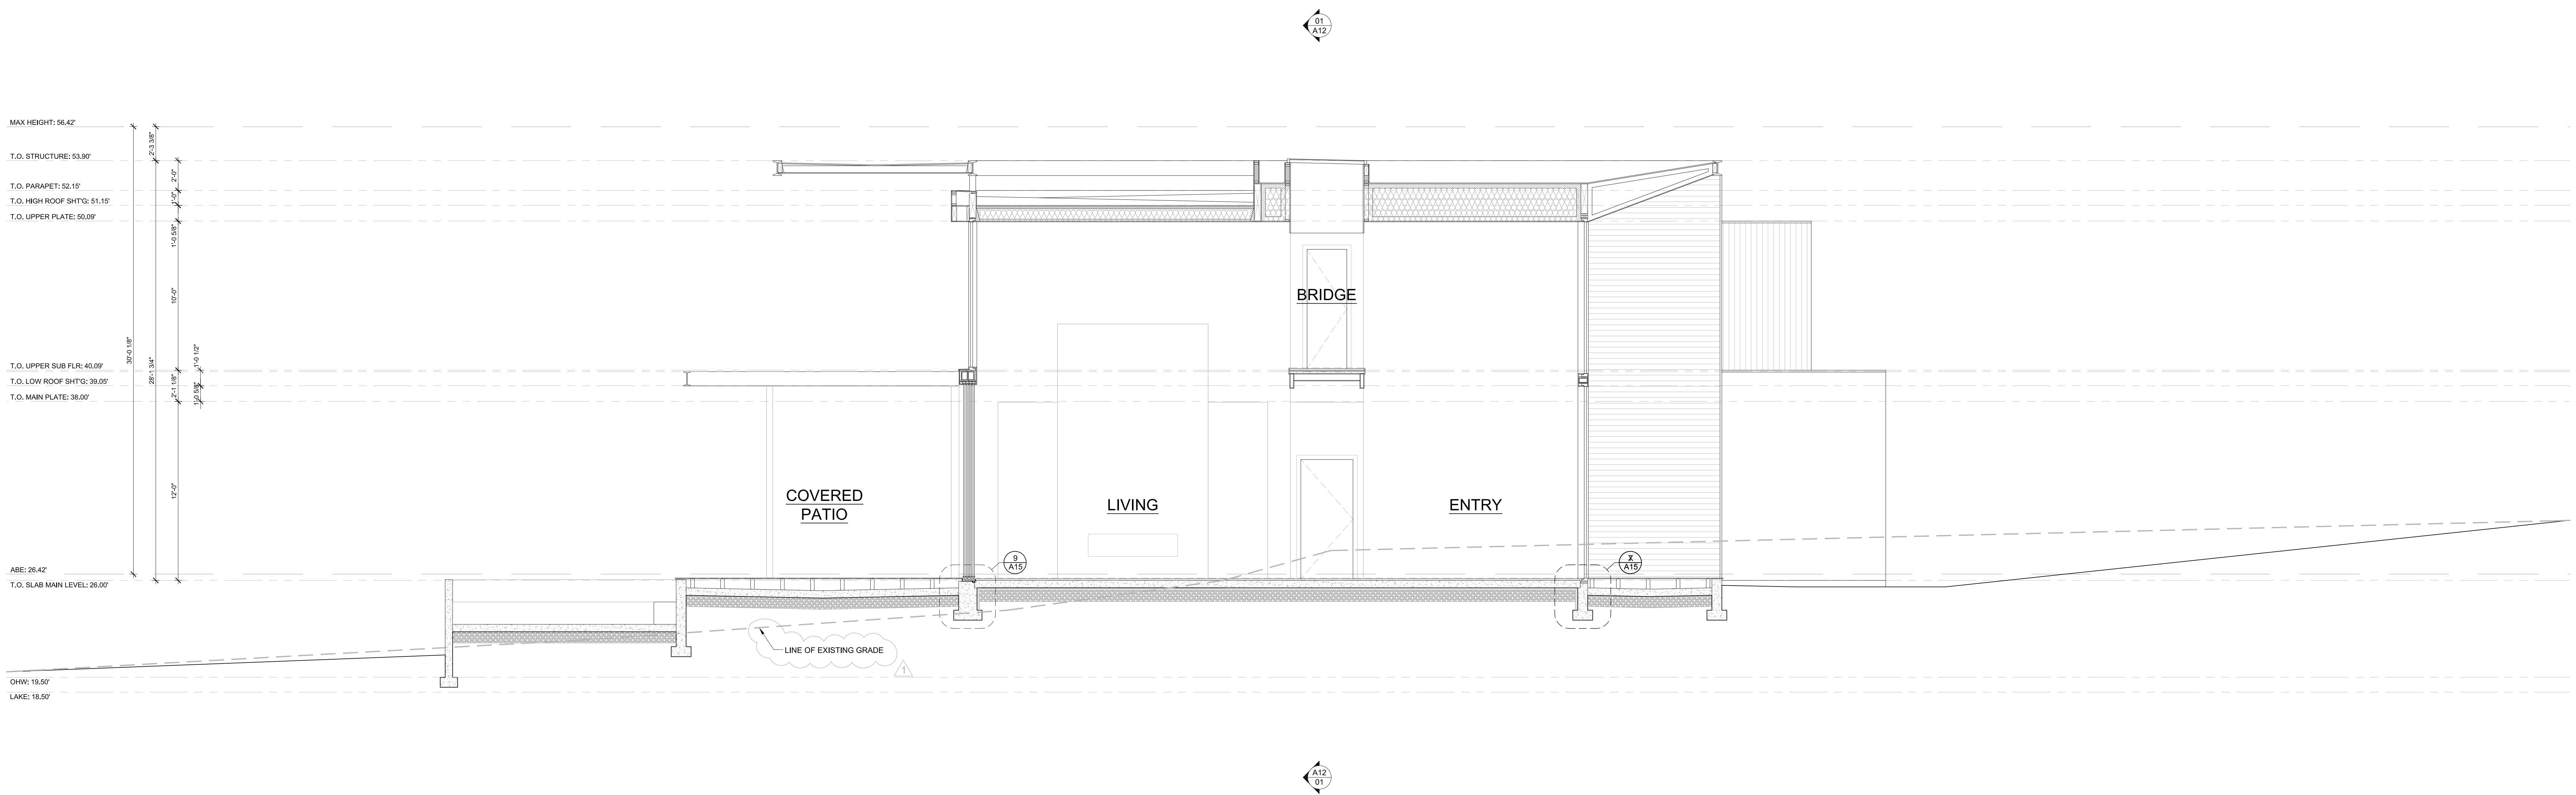

**SECTION 02**  
 SCALE: 1/4" = 1'-0"

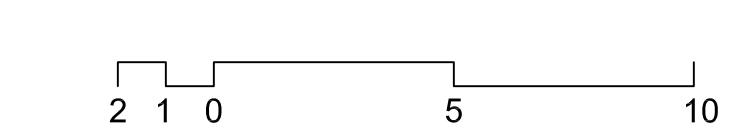

5601 6th Ave S, Suite 371  
 Seattle, WA 98108  
 206.443.1181  
 mccullougharchitects.com


**MCCULLOUGH**  
 ARCHITECTS

UNPUBLISHED WORK 2016 © McCullough Architects

Comment  
 Updated Plans to Structural  
 Structural Backcheck 01  
 Structural Backcheck 02  
 Structural Backcheck 03  
 Permit Corrections  
 Structural Backcheck  
 Commentary Response  
 Cycle 2 Structural Backcheck  
 Cycle 3 Structural Backcheck

Revisions  
 2021.11.17  
 2021.12.13  
 2021.12.13  
 2021.12.22  
 2022.05.02  
 2022.05.04  
 2022.05.12  
 2022.07.13  
 2022.08.18

2021.10.13  
 21-041  
 JUR  
 APM

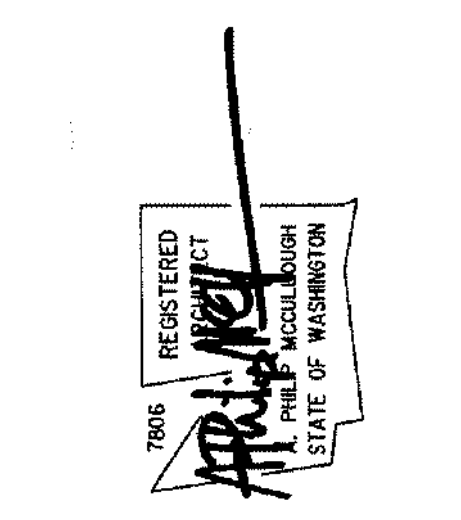

**KONERU RESIDENCE**  
 6610 E Mercer Way  
 Mercer Island, WA 98040

PERMIT SET  
 Building Sections

**A12**



MAX HEIGHT: 56.42

T.O. STRUCTURE: 53.90

T.O. PARAPET: 52.19

T.O. HIGH ROOF SHTG: 51.19

T.O. UPPER PLATE: 50.09

T.O. UPPER SUB FLR: 40.09

T.O. LOW ROOF SHTG: 38.05

T.O. MAIN PLATE: 38.00

ABE: 26.42

T.O. SLAB MAIN LEVEL: 26.00

CHW: 19.50

LAKE: 18.50


**TYPICAL ROOF CONSTRUCTION:**  
CONTINUOUS WATERPROOF MEMBRANE  
RIGID FOAM SLOPED PER ROOF PLAN  
SHEATHING PER STRUCTURAL  
FRAMING PER PLANS W/ INSULATION  
PER PISC. TABLE ON COVER SHEET  
AND NOTE BELOW?  
5/8" G.W.B. CEILING

**TYPICAL EXTERIOR WALL:**  
SERVIC PER ELEVATION  
WEATHER RESISTIVE BARRIER  
SHEATHING PER STRUCTURAL NOTES  
2X8 STUDS PER STRUCTURAL NOTES  
INSULATION PER COVER SHEET  
1/2" G.W.B. INTERIOR FINISH


**TYPICAL FLOOR OVER HEATED SPACE:**  
0.75" PORCELAIN TILE w/  
0.25" THIN-SET w/  
1.5" GYPCRETE w/ ACCESS MAT w/  
0.75" TAG SHEATHING w/  
1.50" TAG SHEATHING w/  
24" PARALLEL CORD TRUSS w/  
0.025" CWB

**TYPICAL INTERIOR WALL:**  
1/2" G.W.B. FINISH  
2x STUDS PER STRUCT.  
1/2" G.W.B. FINISH

0.75" PORCELAIN TILE w/  
0.25" THIN-SET MORTAR w/  
1.5" GYPCRETE w/  
2" RIGID INSULATION PER COVER SHEET w/  
6" STRUCTURAL SLAB PER STRUCTURAL w/  
8" MIN GRANULAR FILL

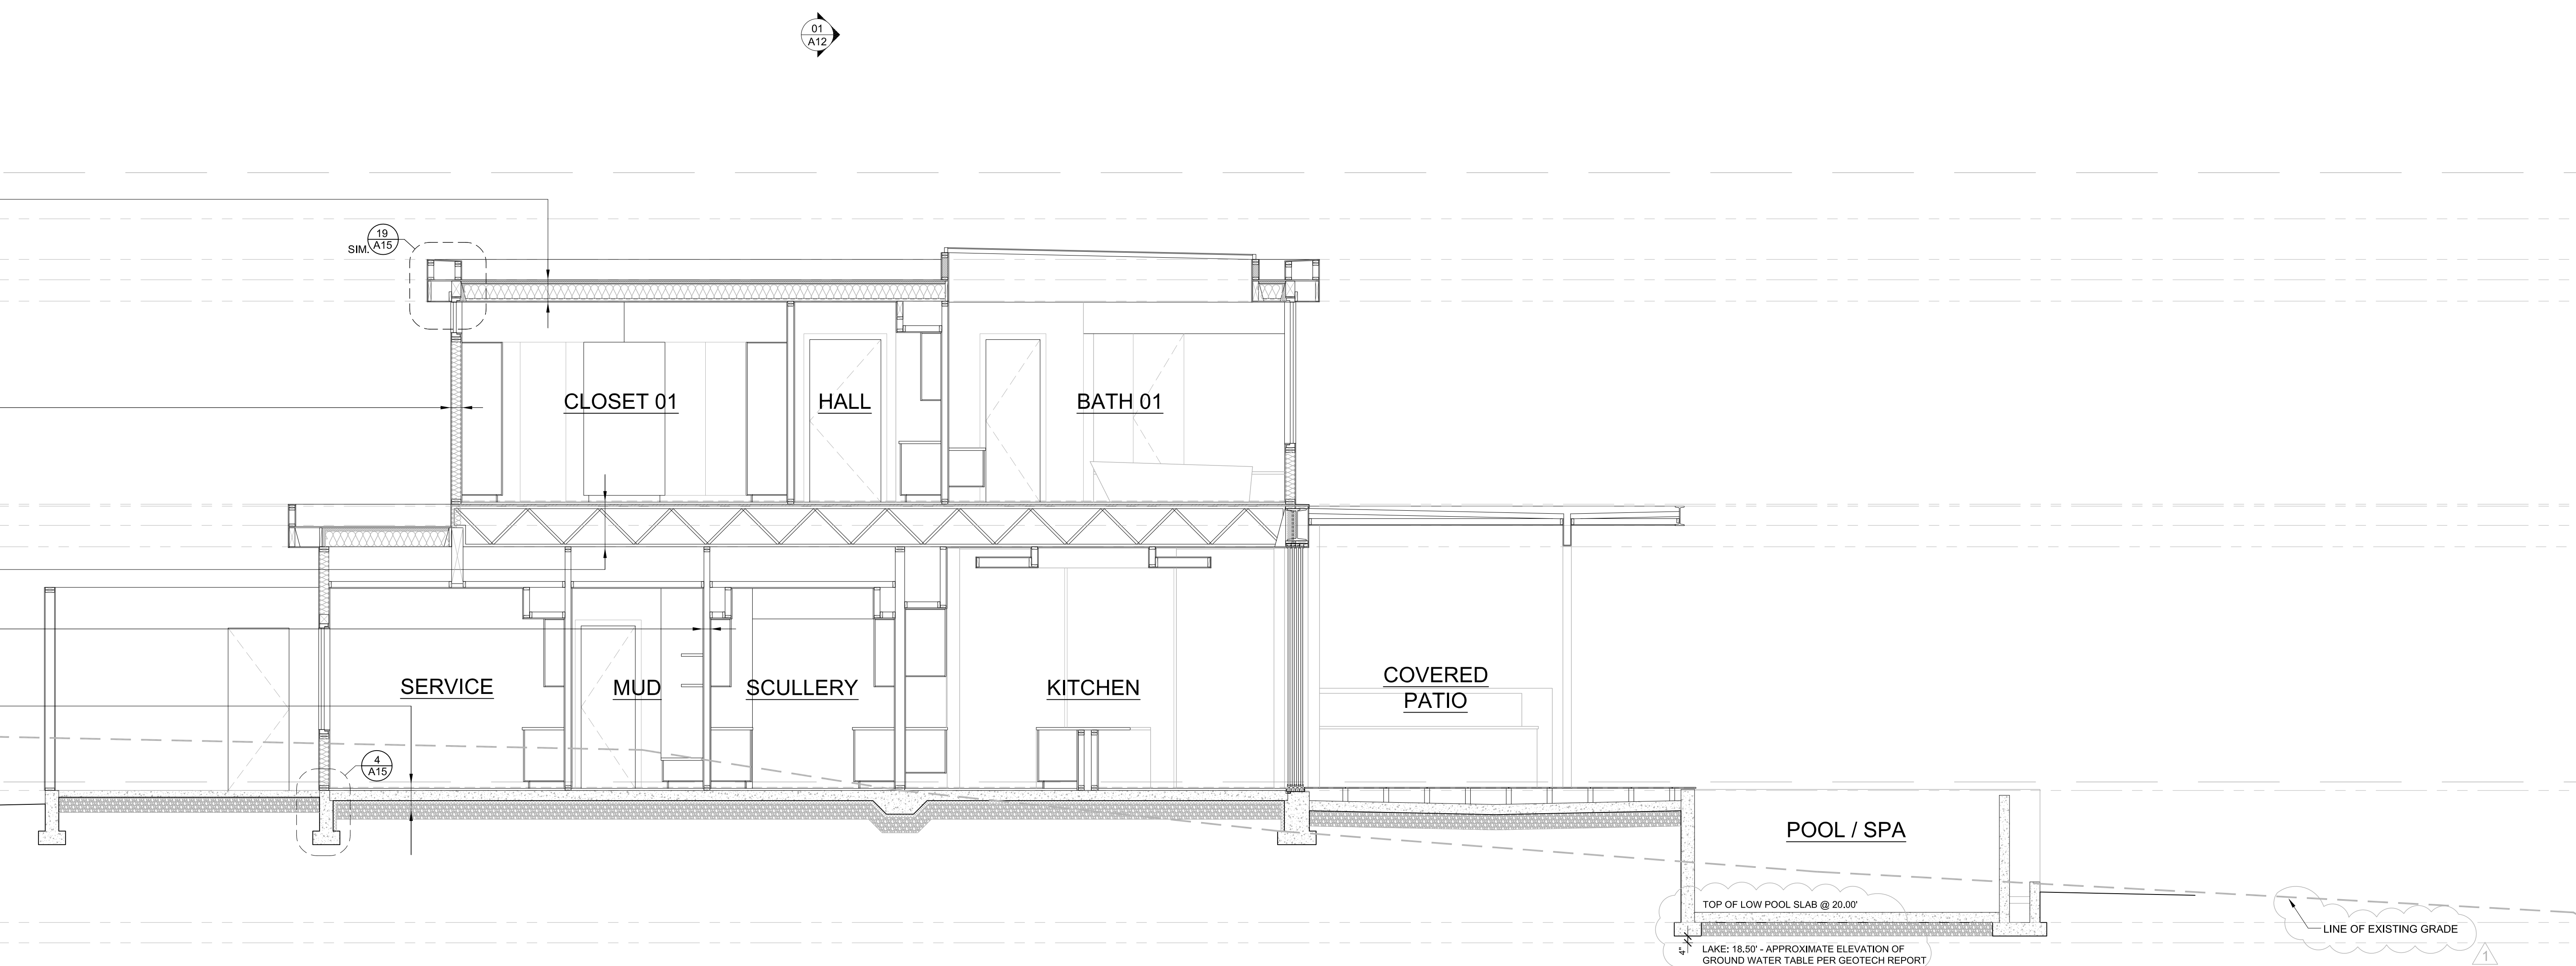


**SECTION 03**  
SCALE: 1/4" = 1'-0"

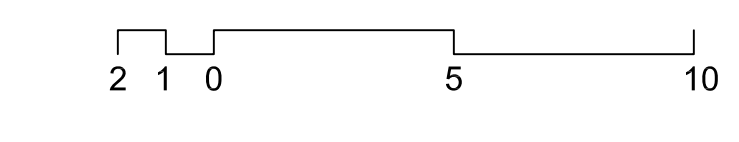

Revisions	Comment
2021.11.17	Updated Plans to Structural
2021.12.13	Structural Backcheck 01
2021.12.13	Structural Backcheck 02
2021.12.22	Structural Backcheck 03
2022.05.02	Permit Corrections
2022.05.04	Structural Backcheck
2022.05.12	Commentary Response
<b>2022.07.13</b>	<b>Cycle 2 Structural Backcheck</b>
<b>2022.08.18</b>	<b>Cycle 3 Structural Backcheck</b>

Date: 2021.10.13  
Job No: 21-041  
Project No:  
Drawn: DJR  
Approved: APM

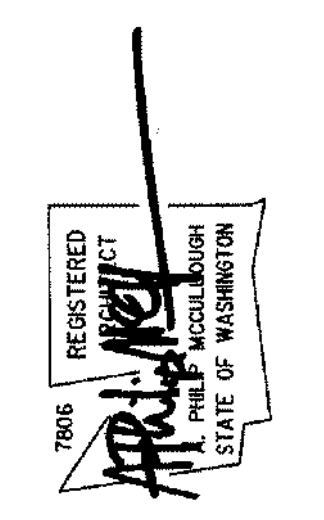


**KONERU RESIDENCE**  
6610 E Mercer Way  
Mercer Island, WA 98040

PERMIT SET


Building Sections

**A13**




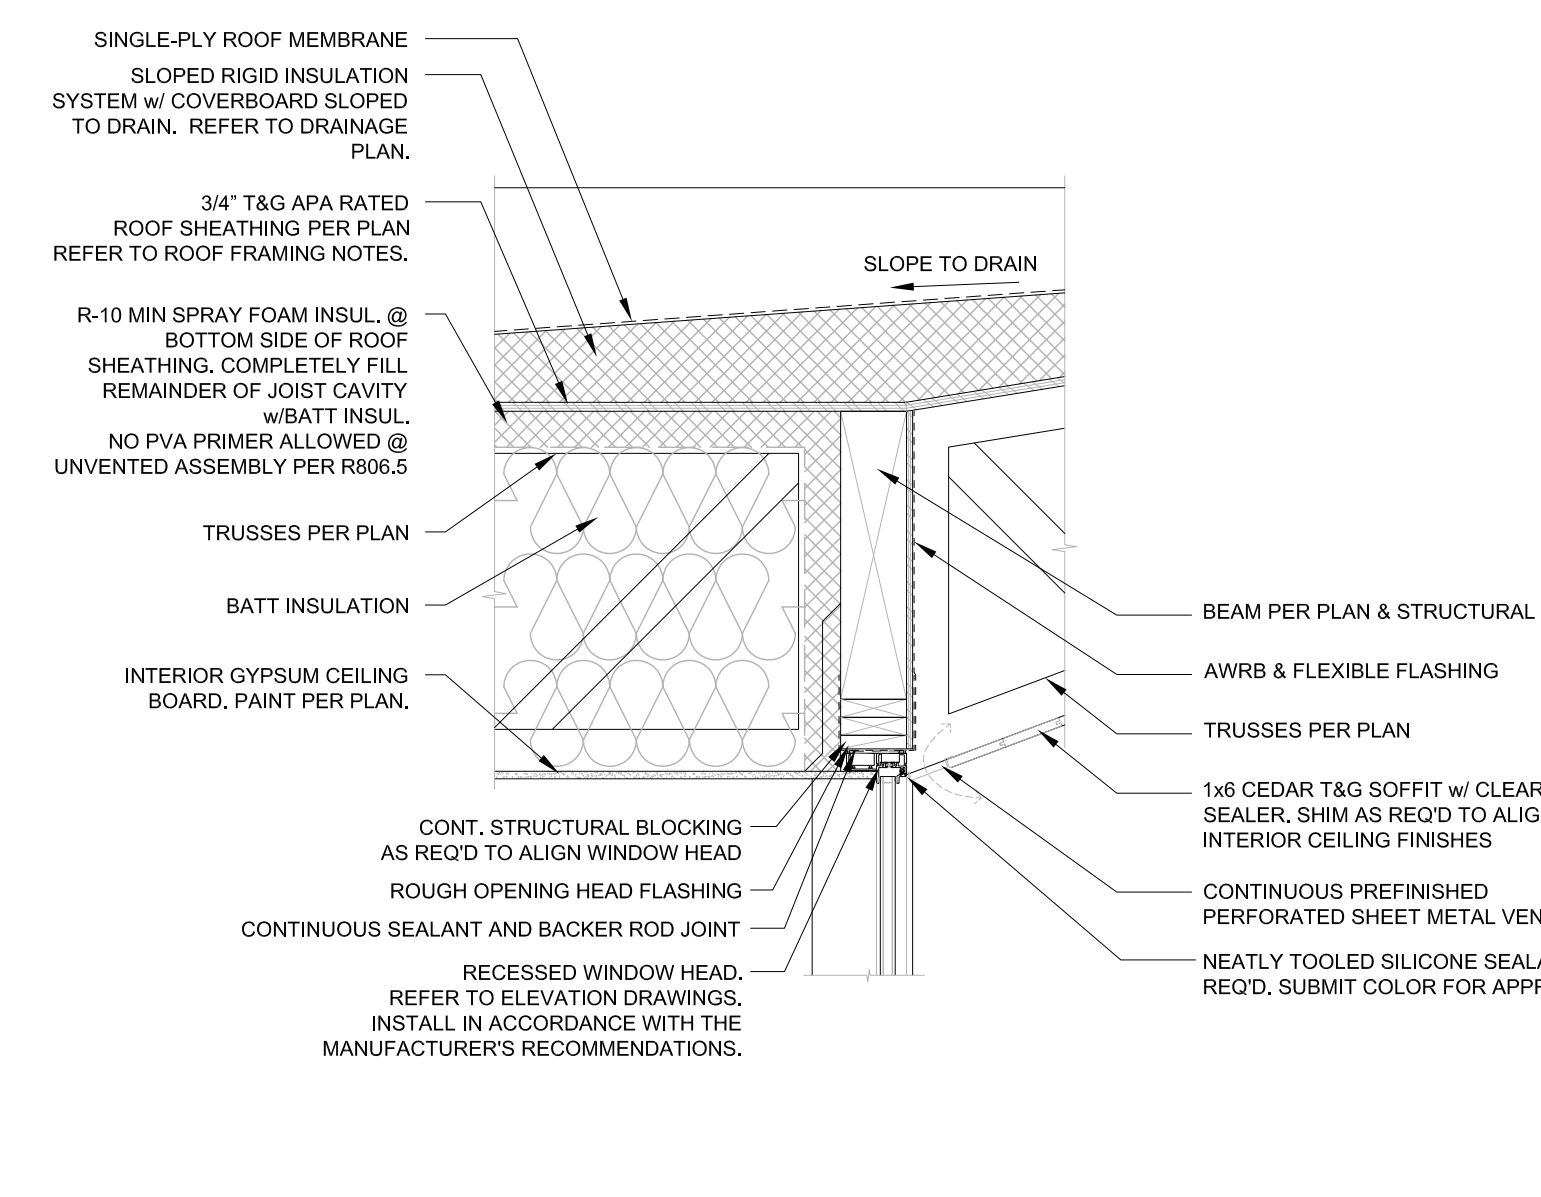


RECESSED WINDOW HEAD AT ENTRY PORTAL  
SCALE: 3/4" = 1'-0"

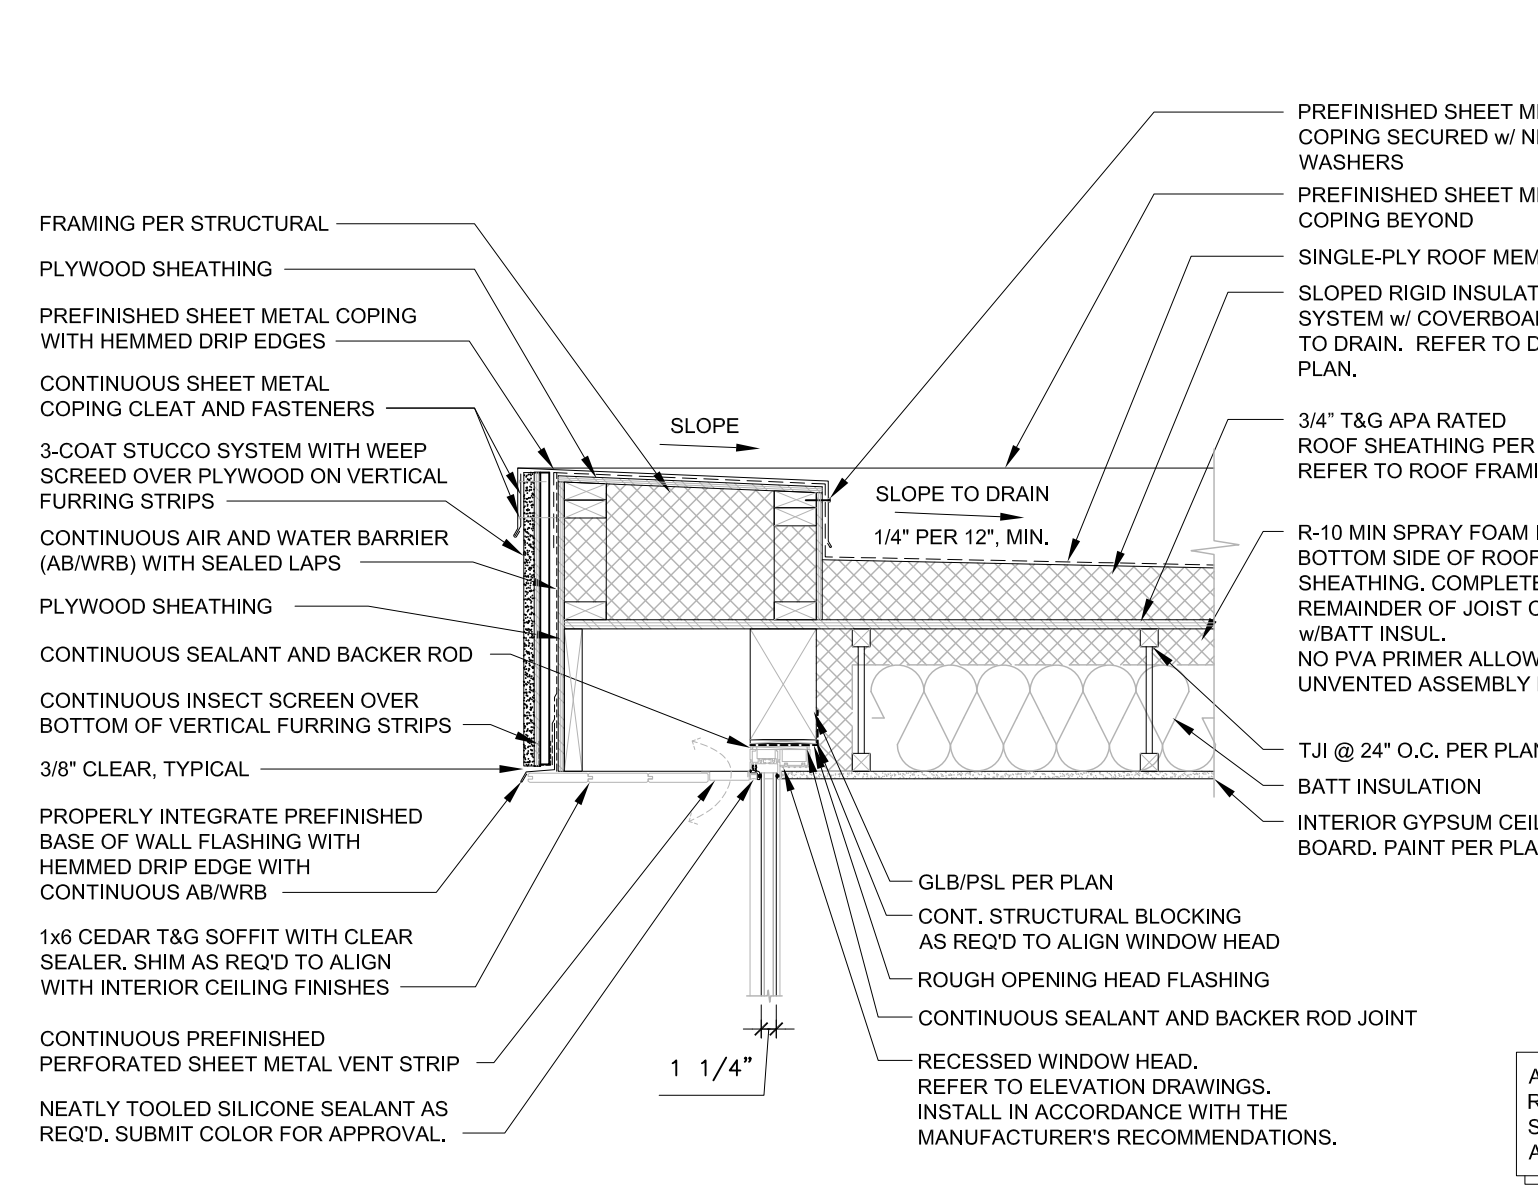


TYPICAL - ROOF EAVE @ UNVENTED PARAPET  
SCALE: 3/4" = 1'-0"

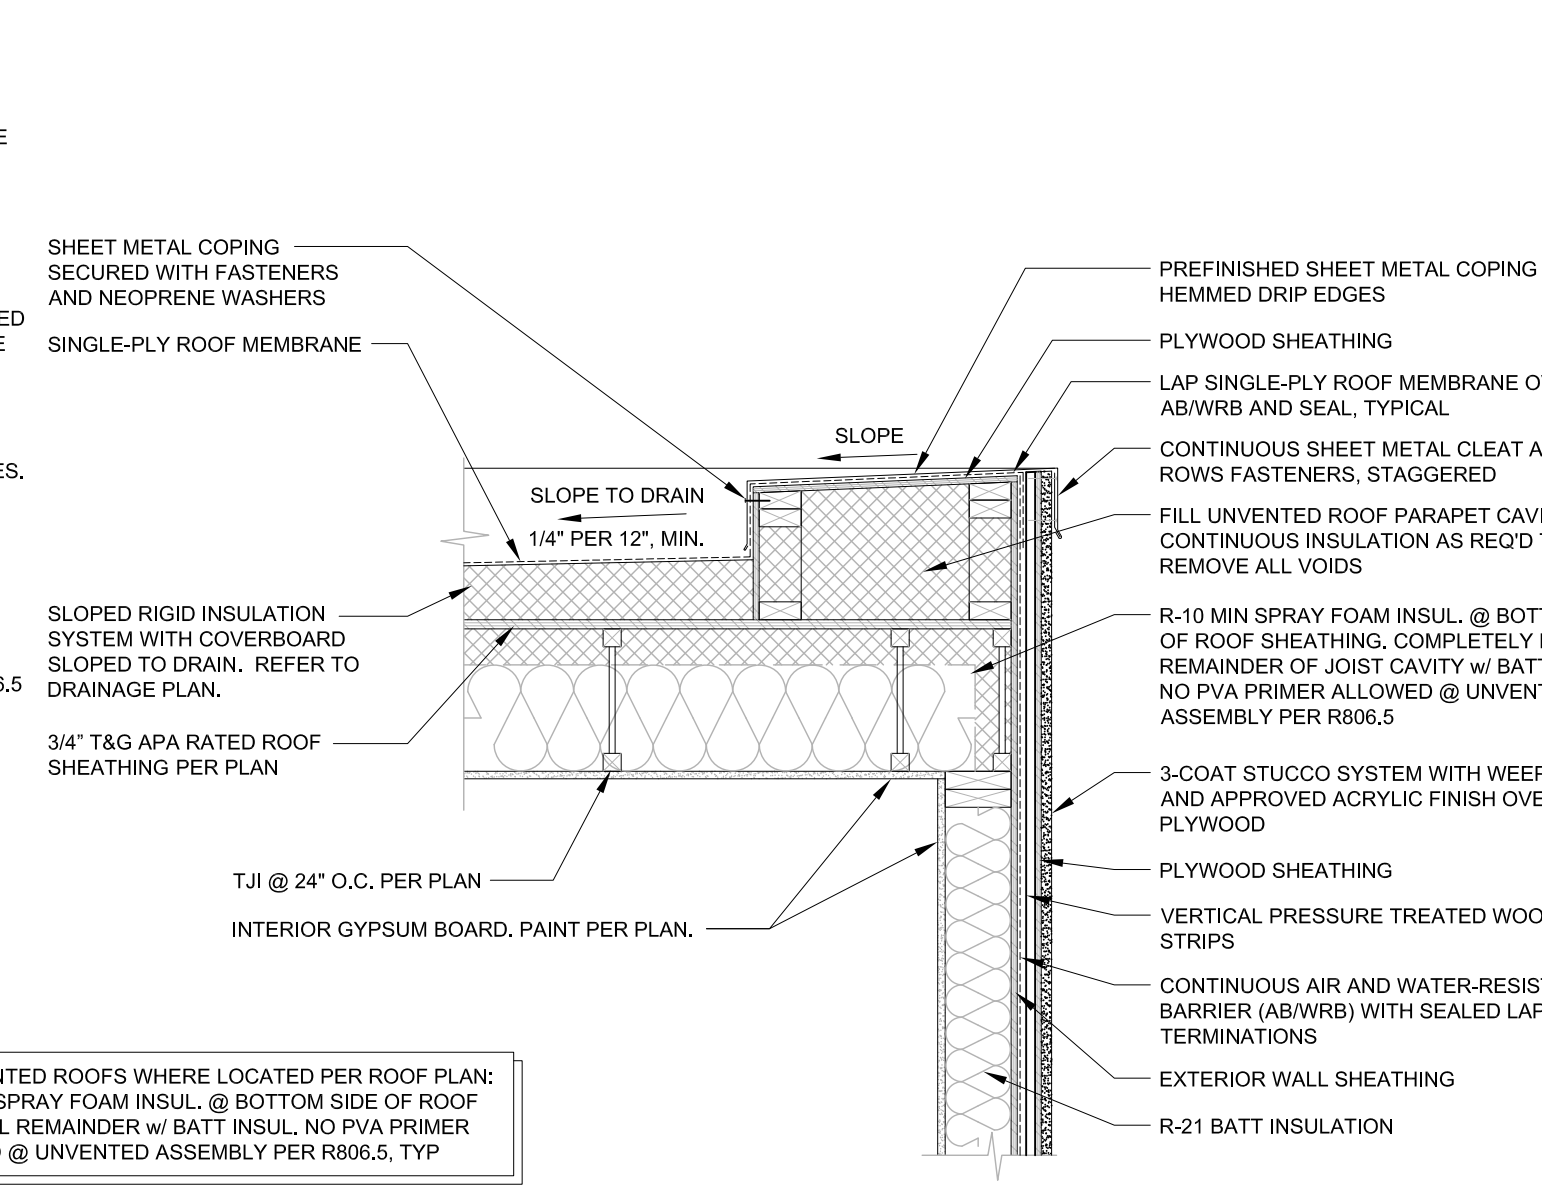


TYPICAL - ROOF @ UNVENTED PARAPET  
SCALE: 3/4" = 1'-0"

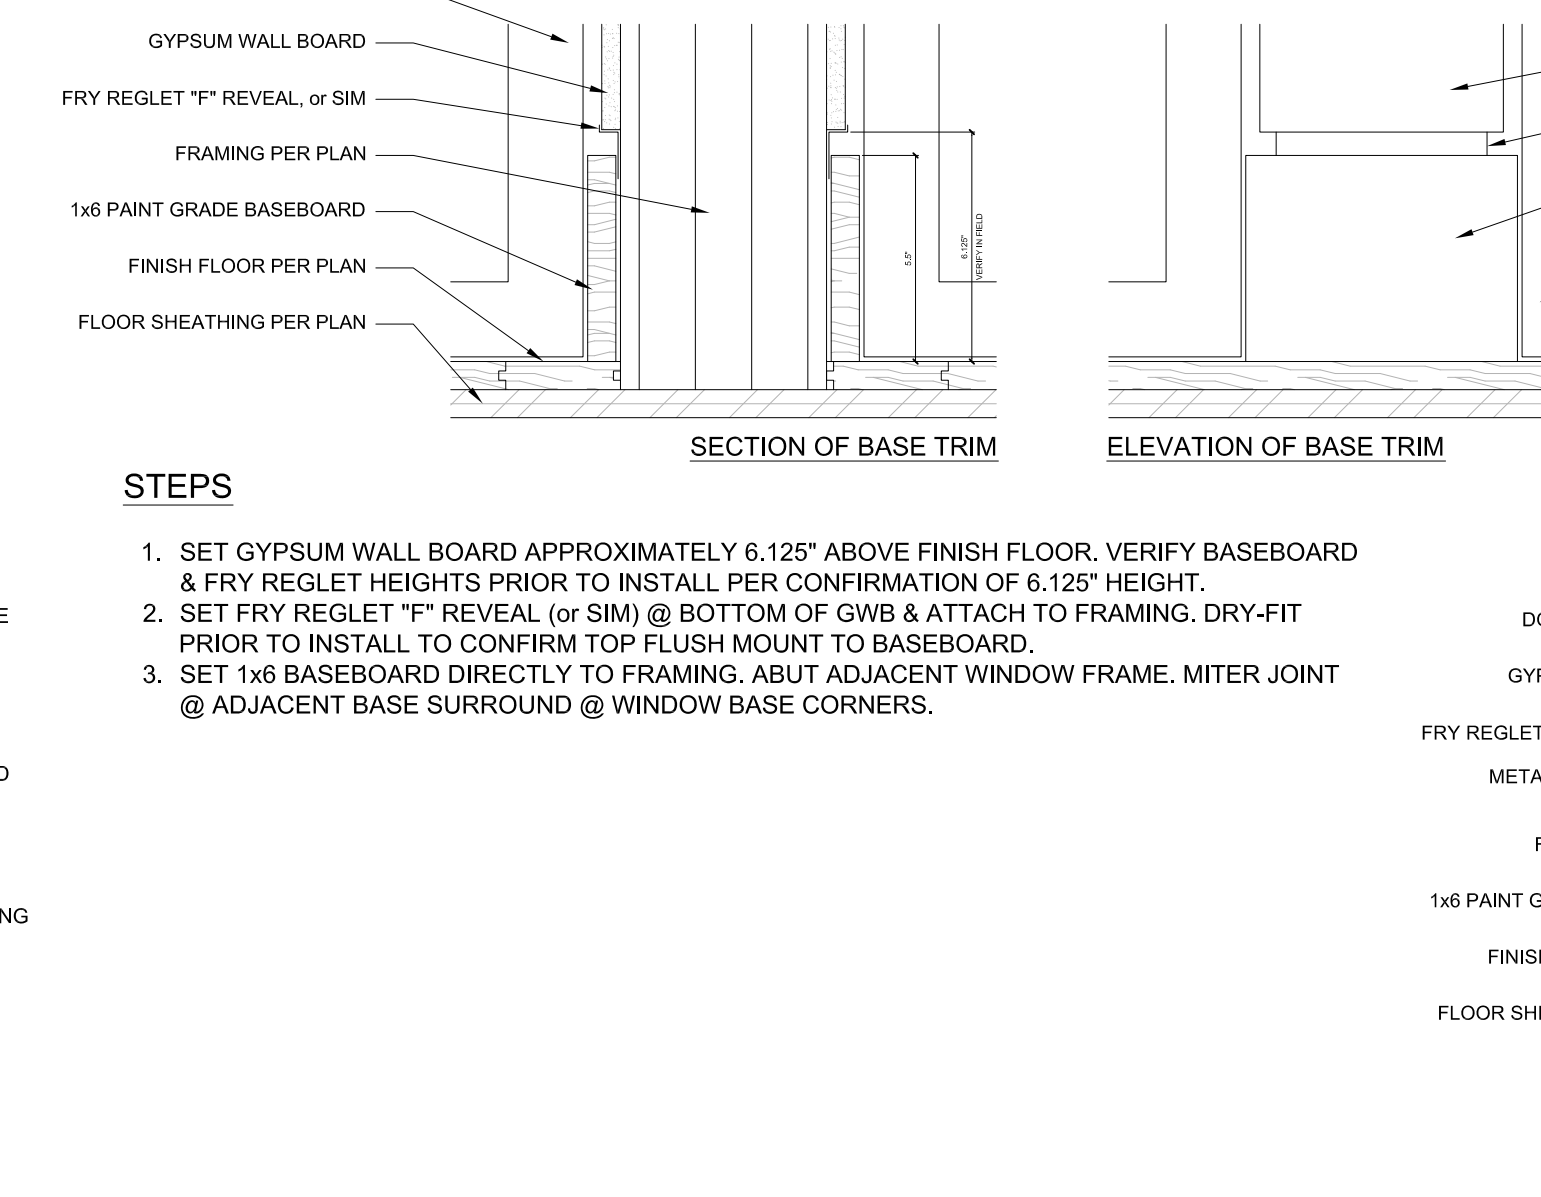


SCALE: 3/4" = 1'-0"

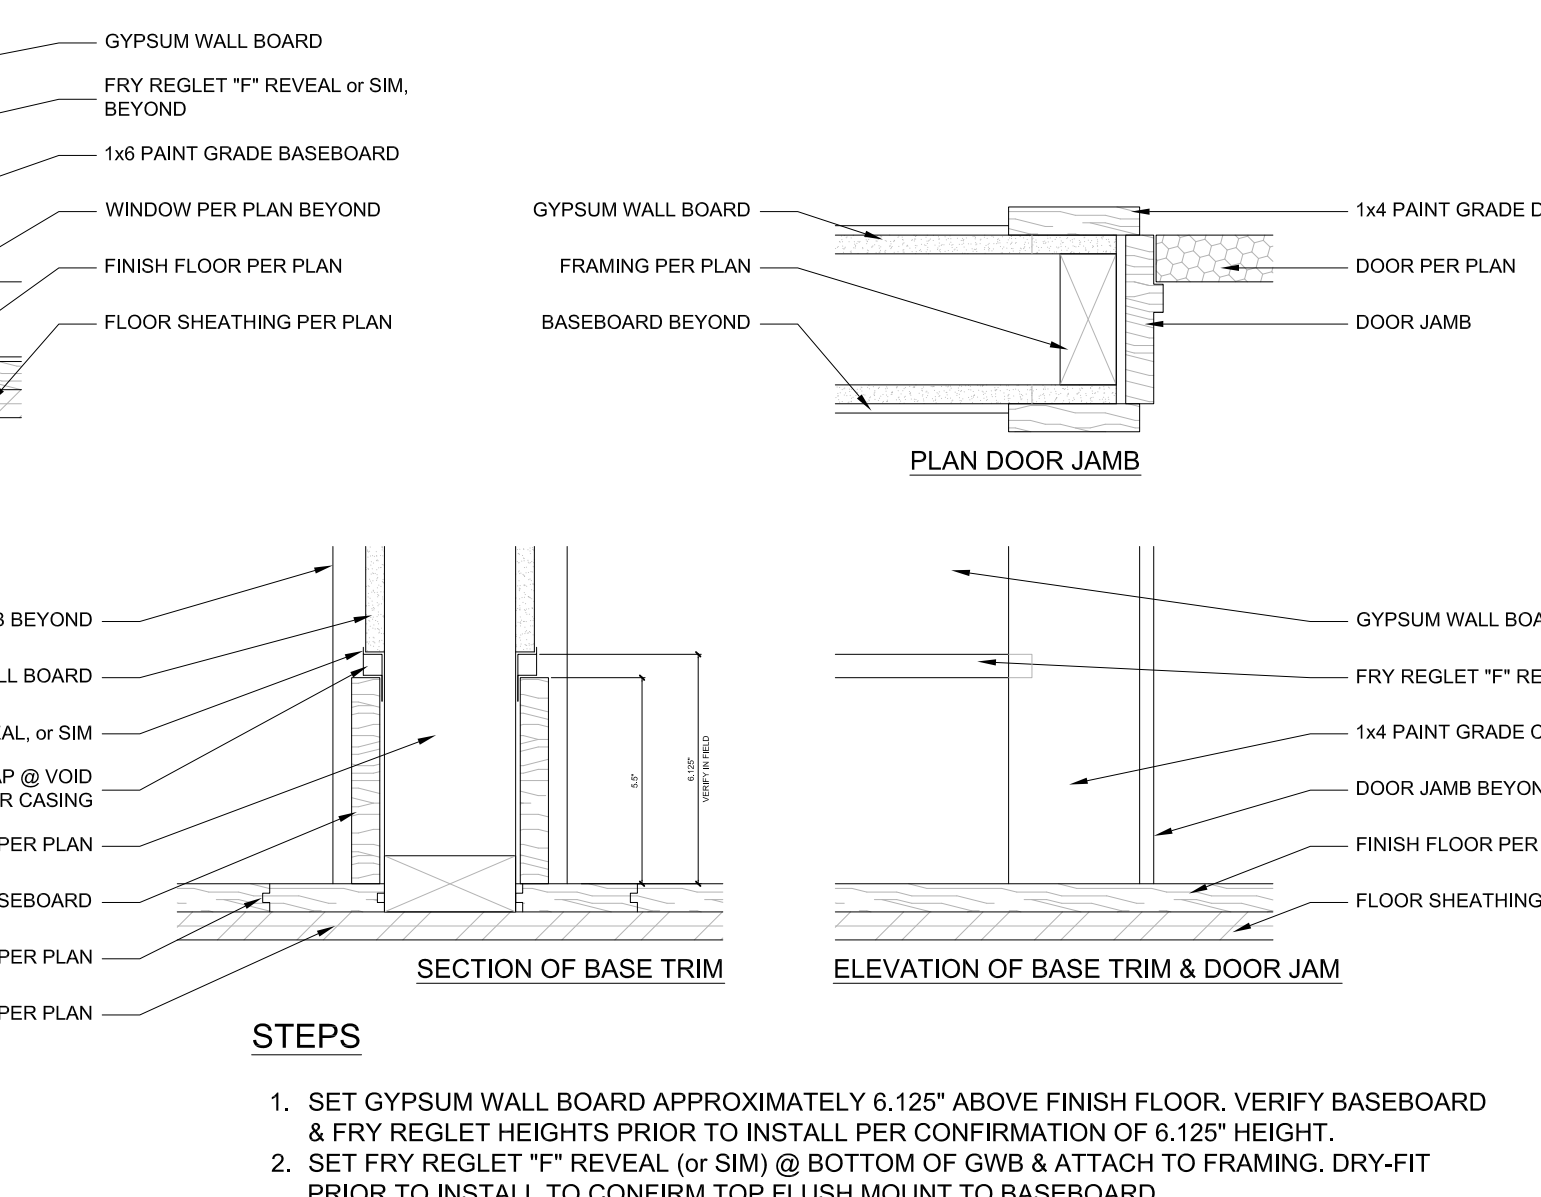


BASEBOARD & DOOR JAMB INTERSECTION DETAIL  
SCALE: 3/4" = 1'-0"

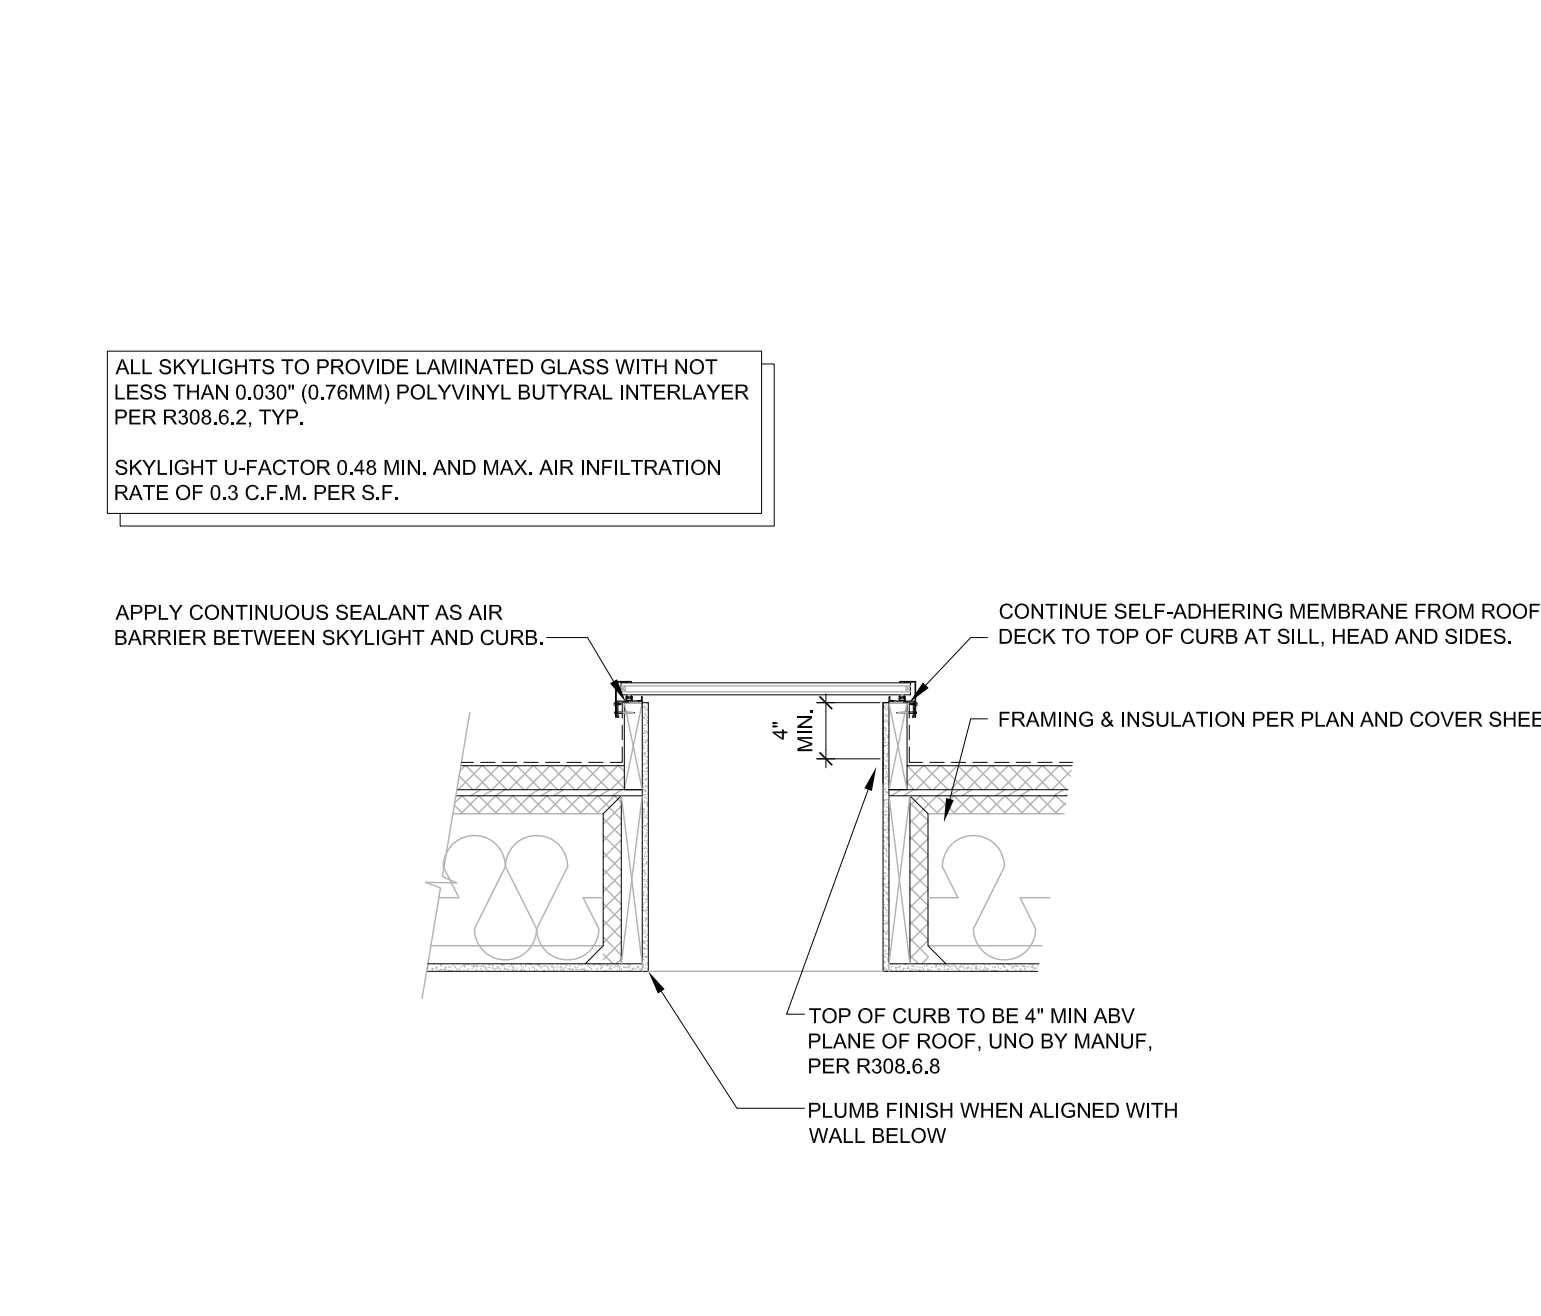


TYPICAL SKYLIGHT INSTALLATION  
SCALE: 3/4" = 1'-0"

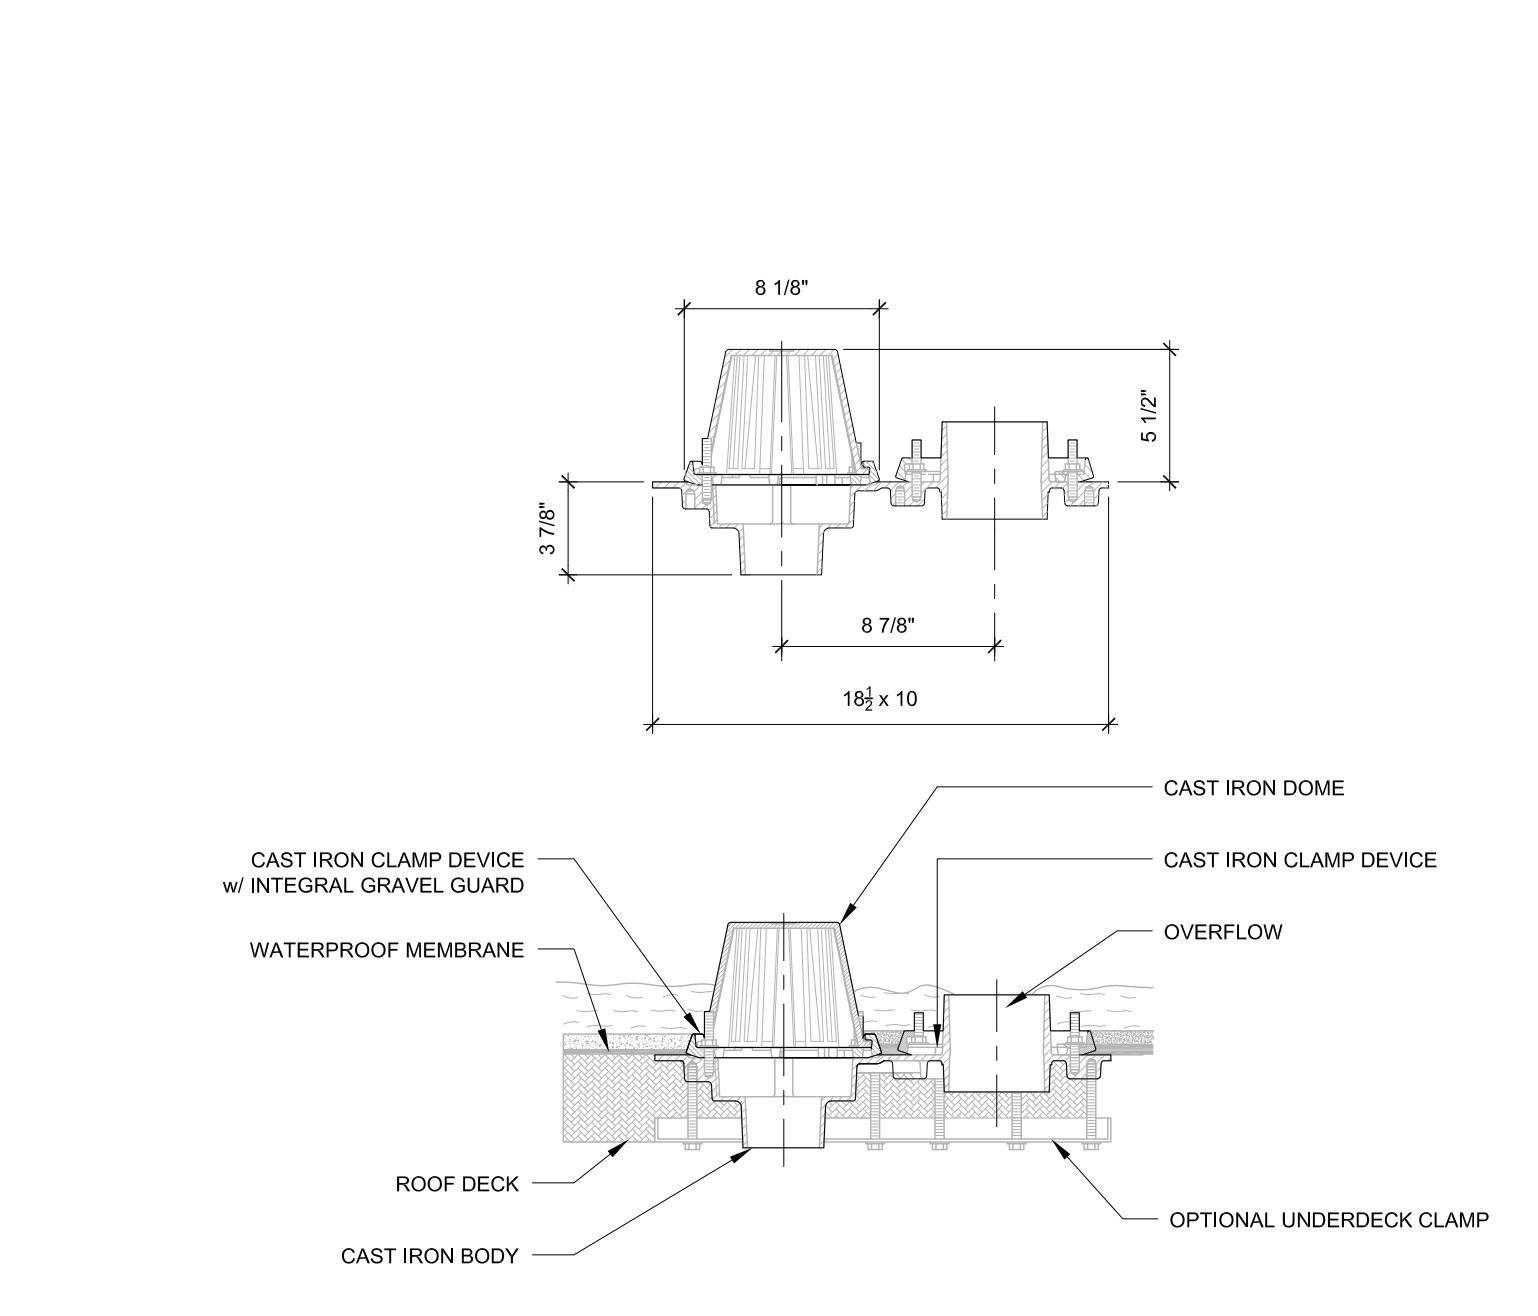


ROOF DRAIN & OVERFLOW @ DECK  
SCALE: 3/4" = 1'-0"

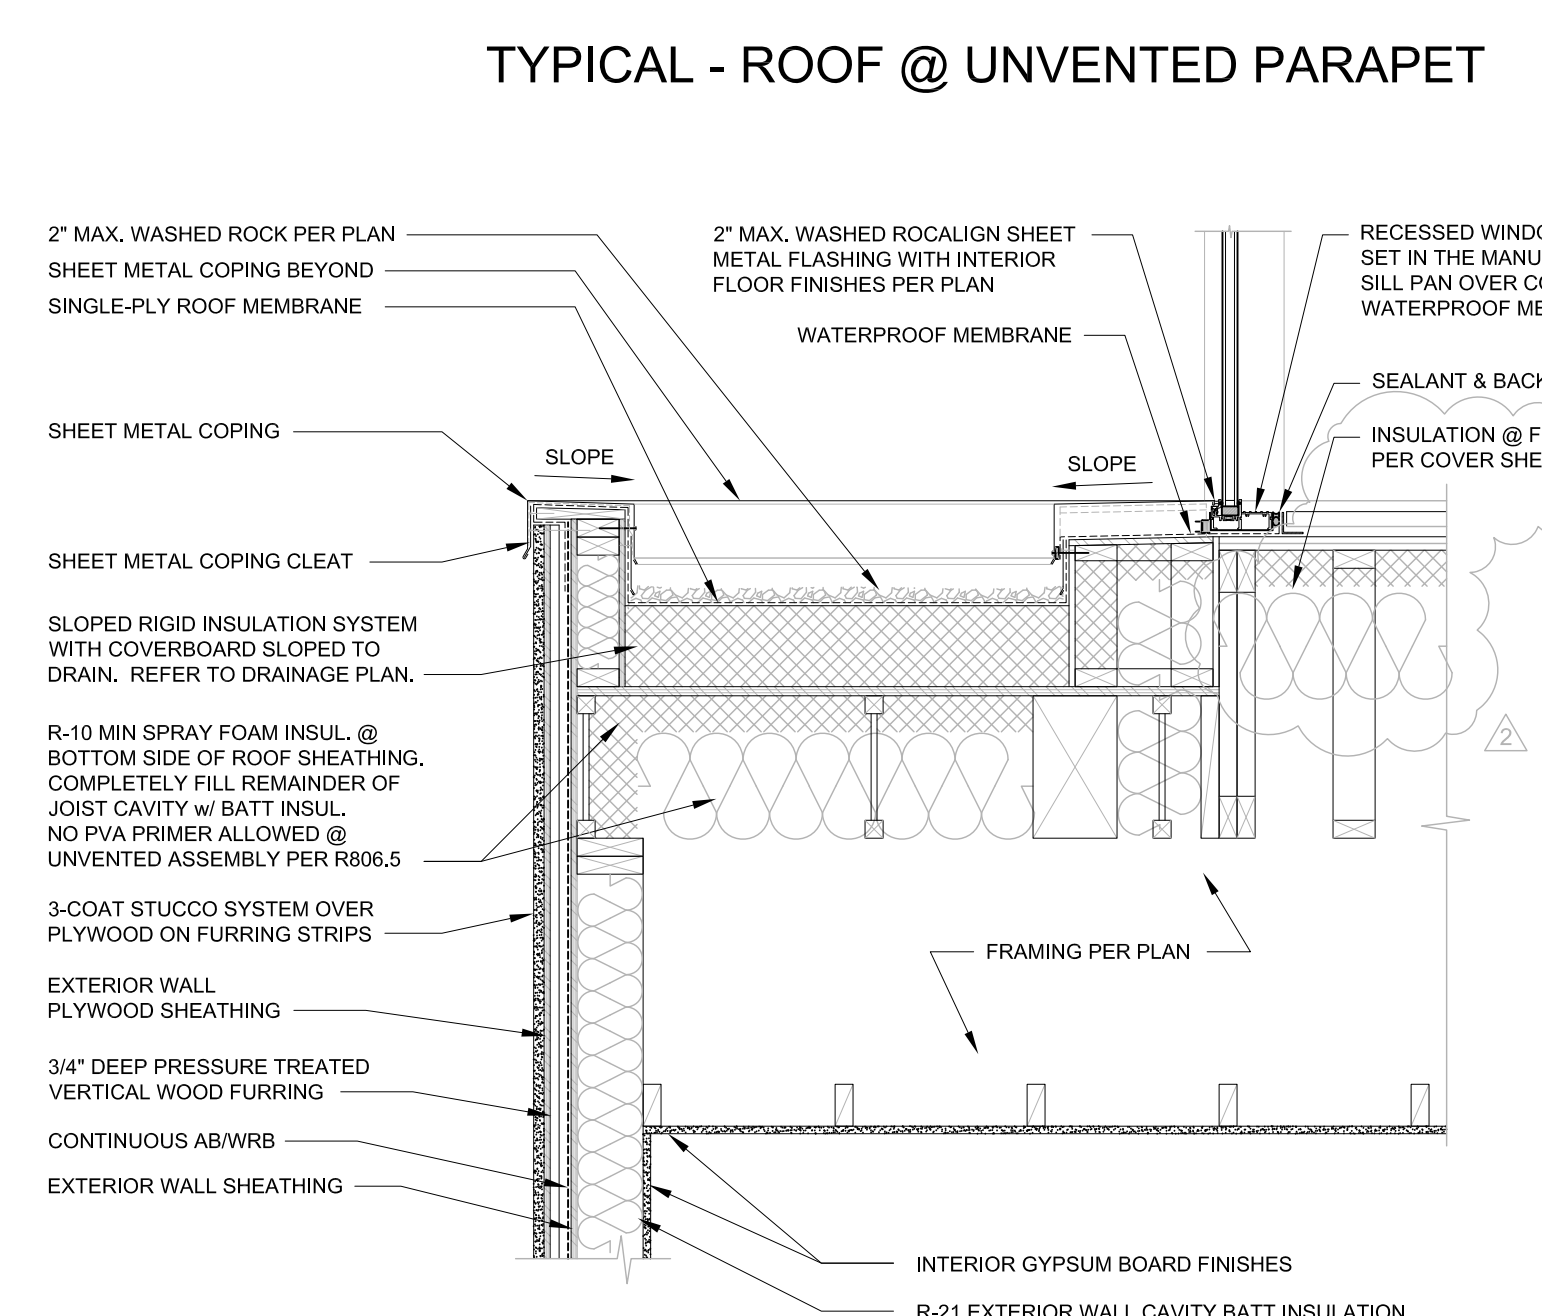


LOW ROOF AT RECESSED WINDOW SILL  
SCALE: 3/4" = 1'-0"

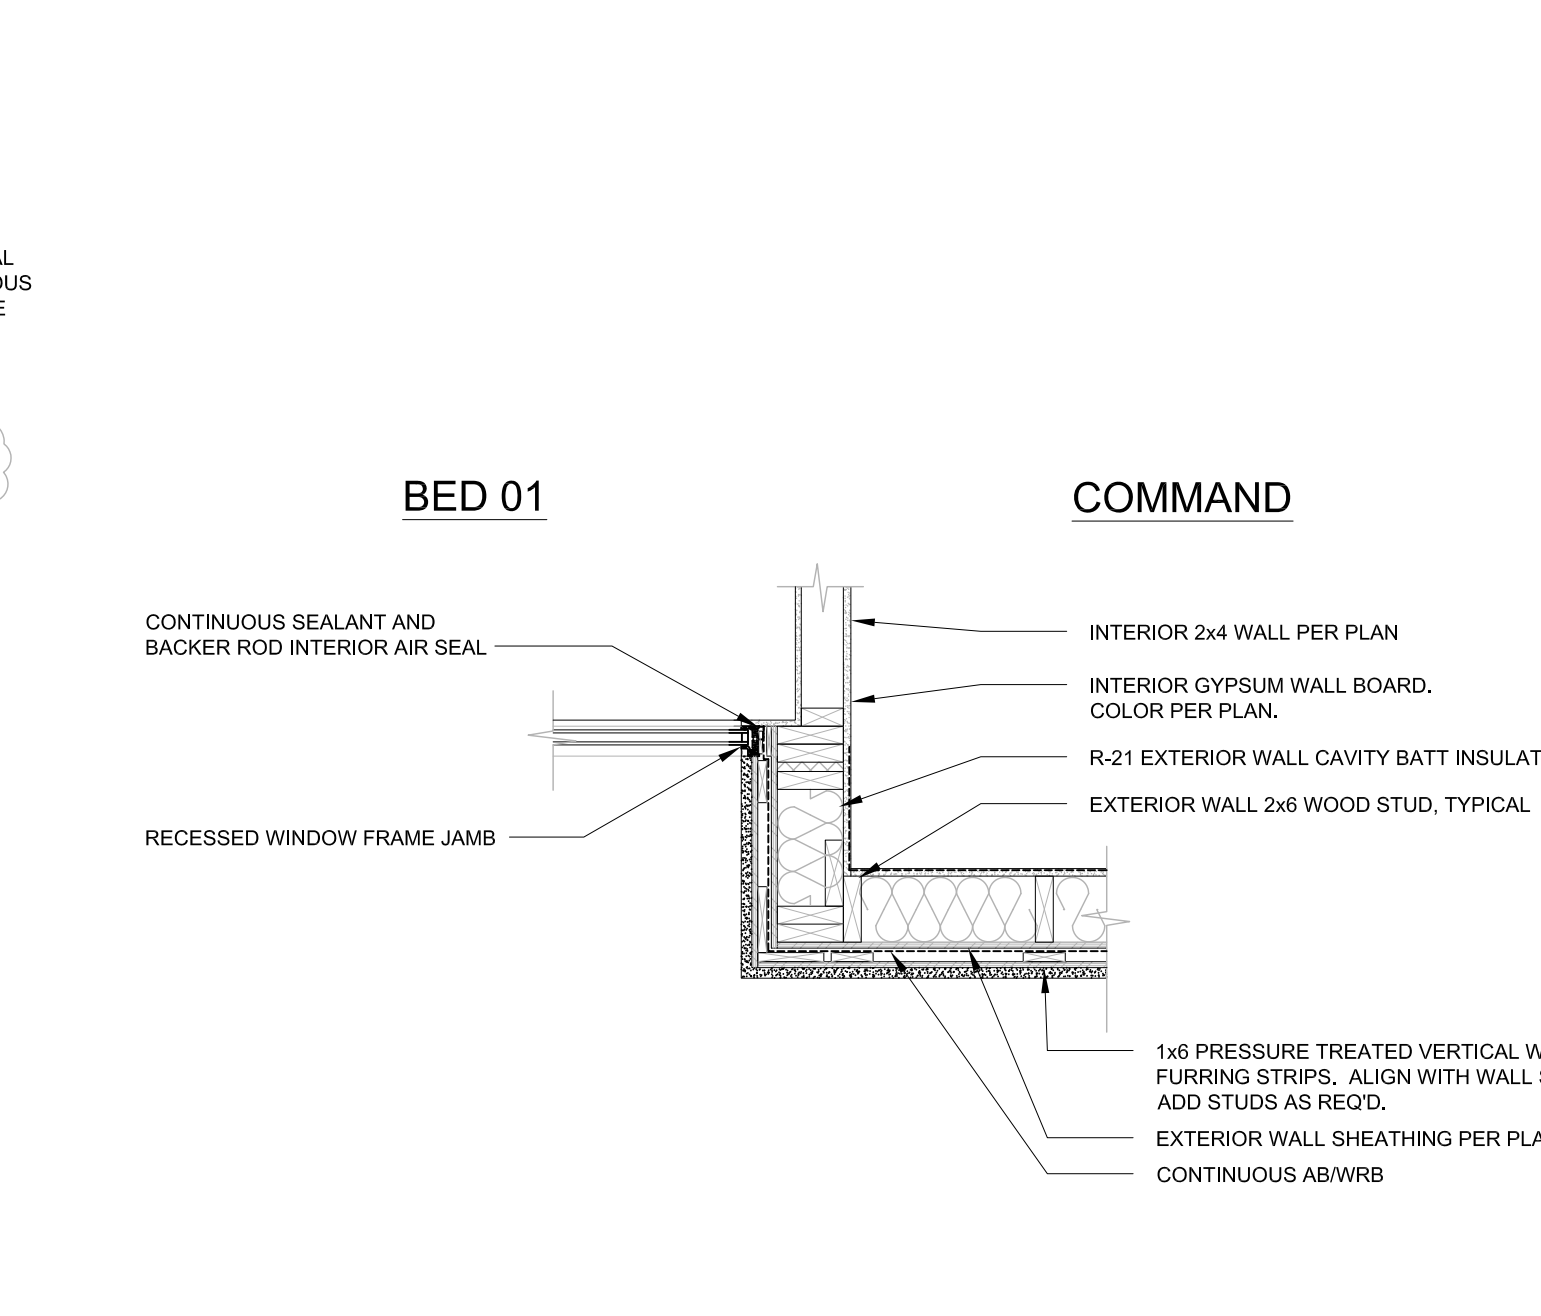


TYPICAL - RECESSED WINDOW JAMB  
SCALE: 3/4" = 1'-0"

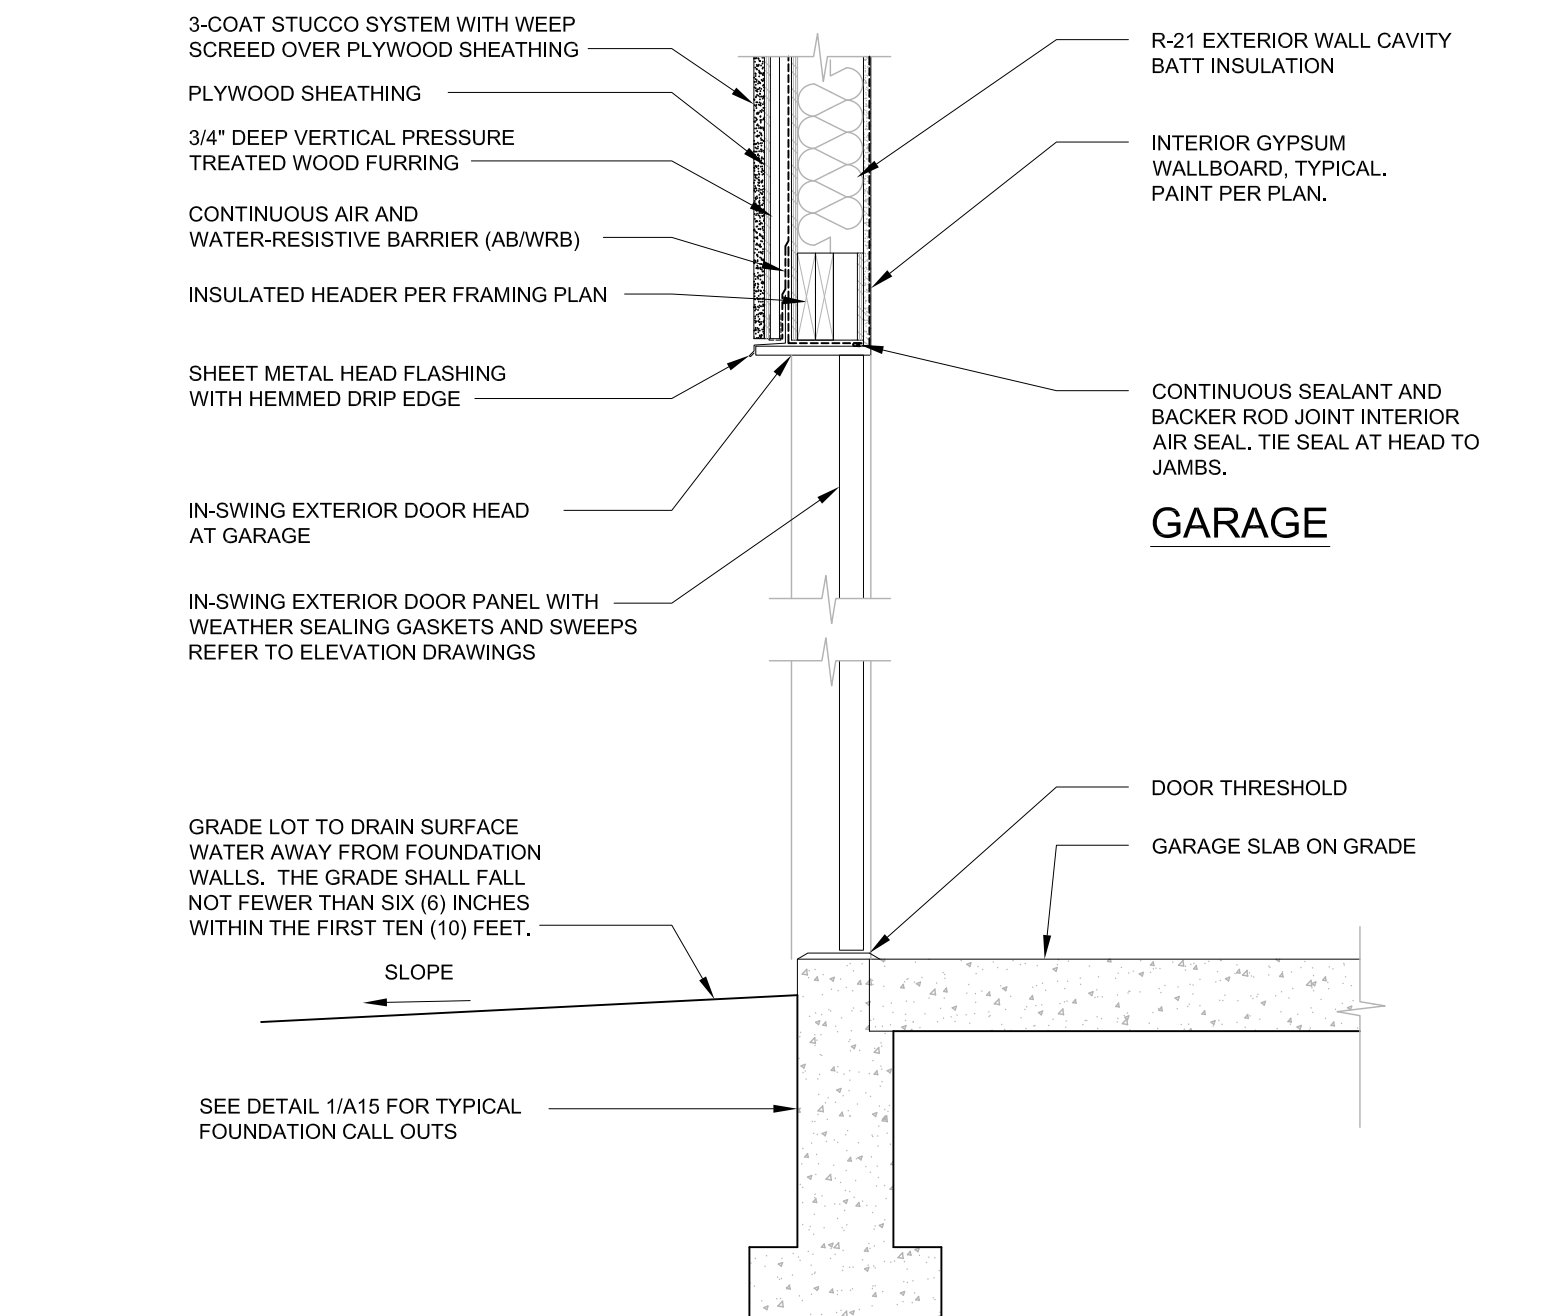


TYPICAL - EXTERIOR SWING DOOR  
SCALE: 3/4" = 1'-0"

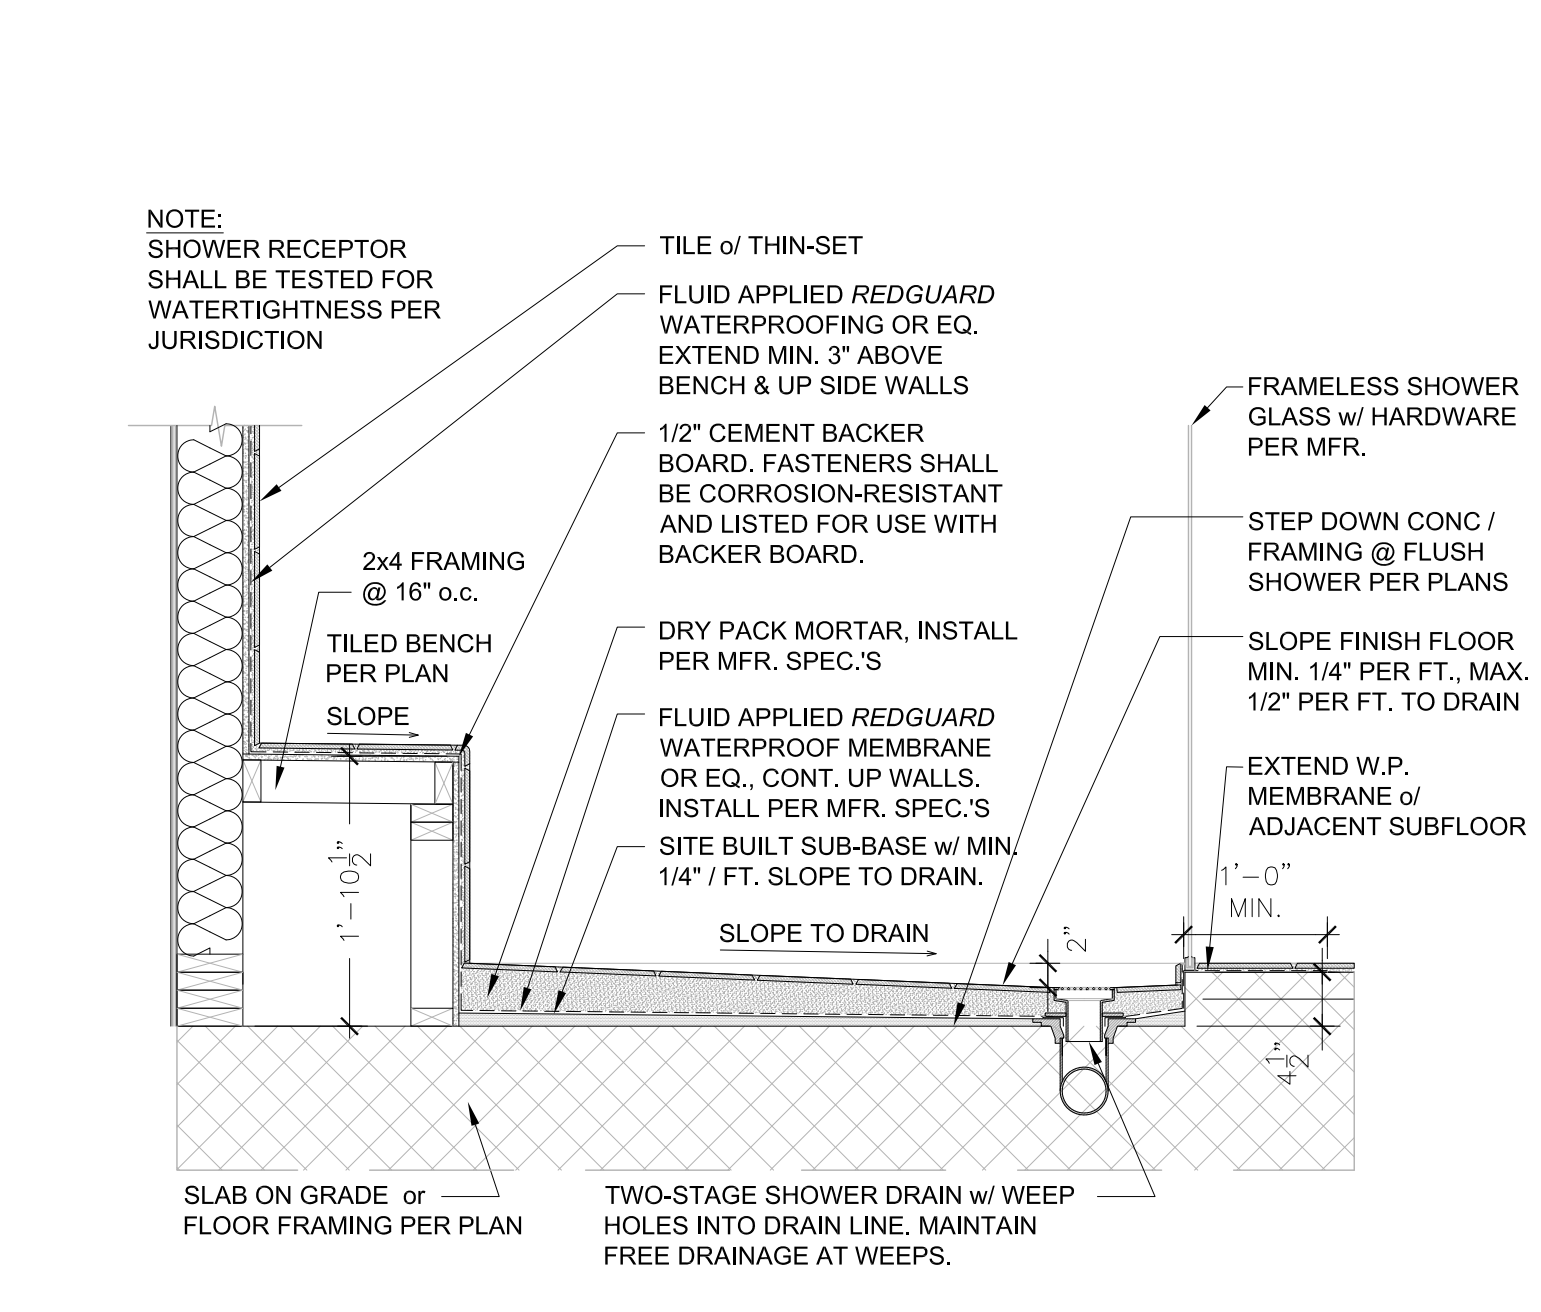


RECESSED MUD SET SHOWER  
SCALE: 3/4" = 1'-0"

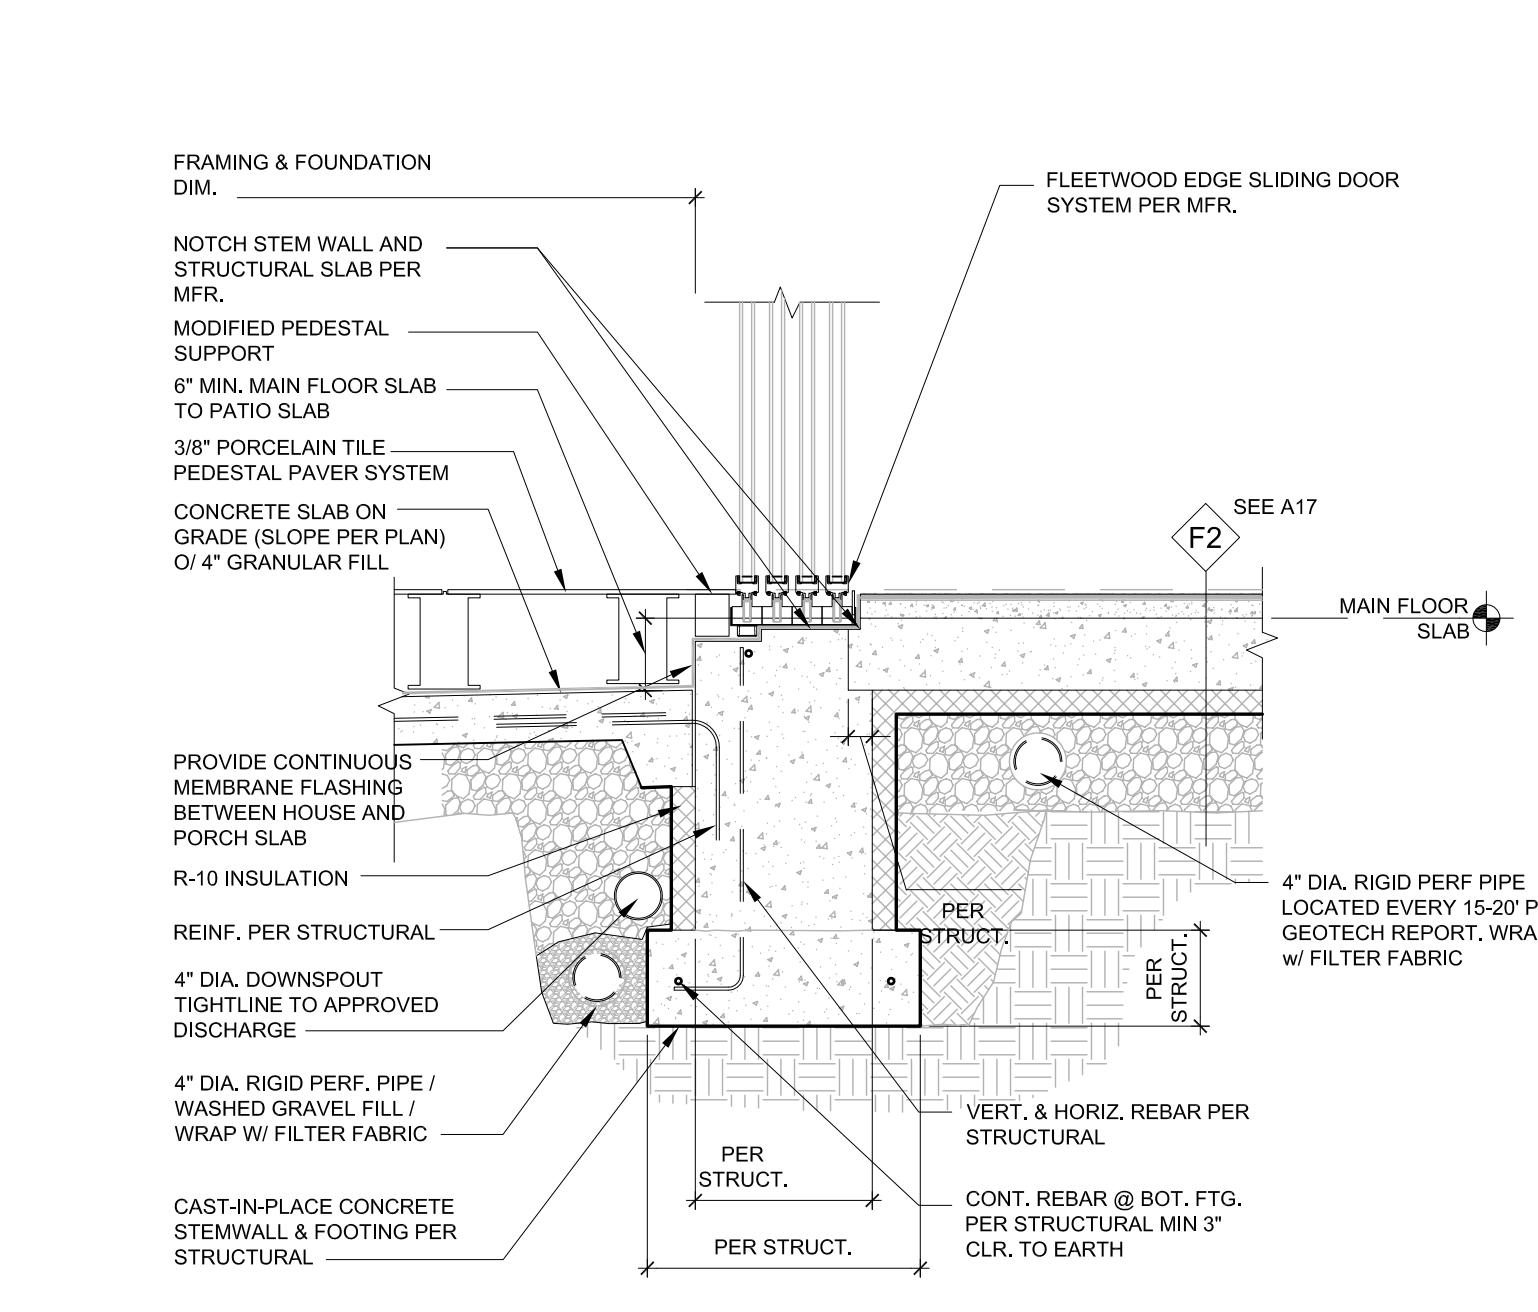


PORCH SLAB @ SLIDING DOOR SILL  
SCALE: 3/4" = 1'-0"

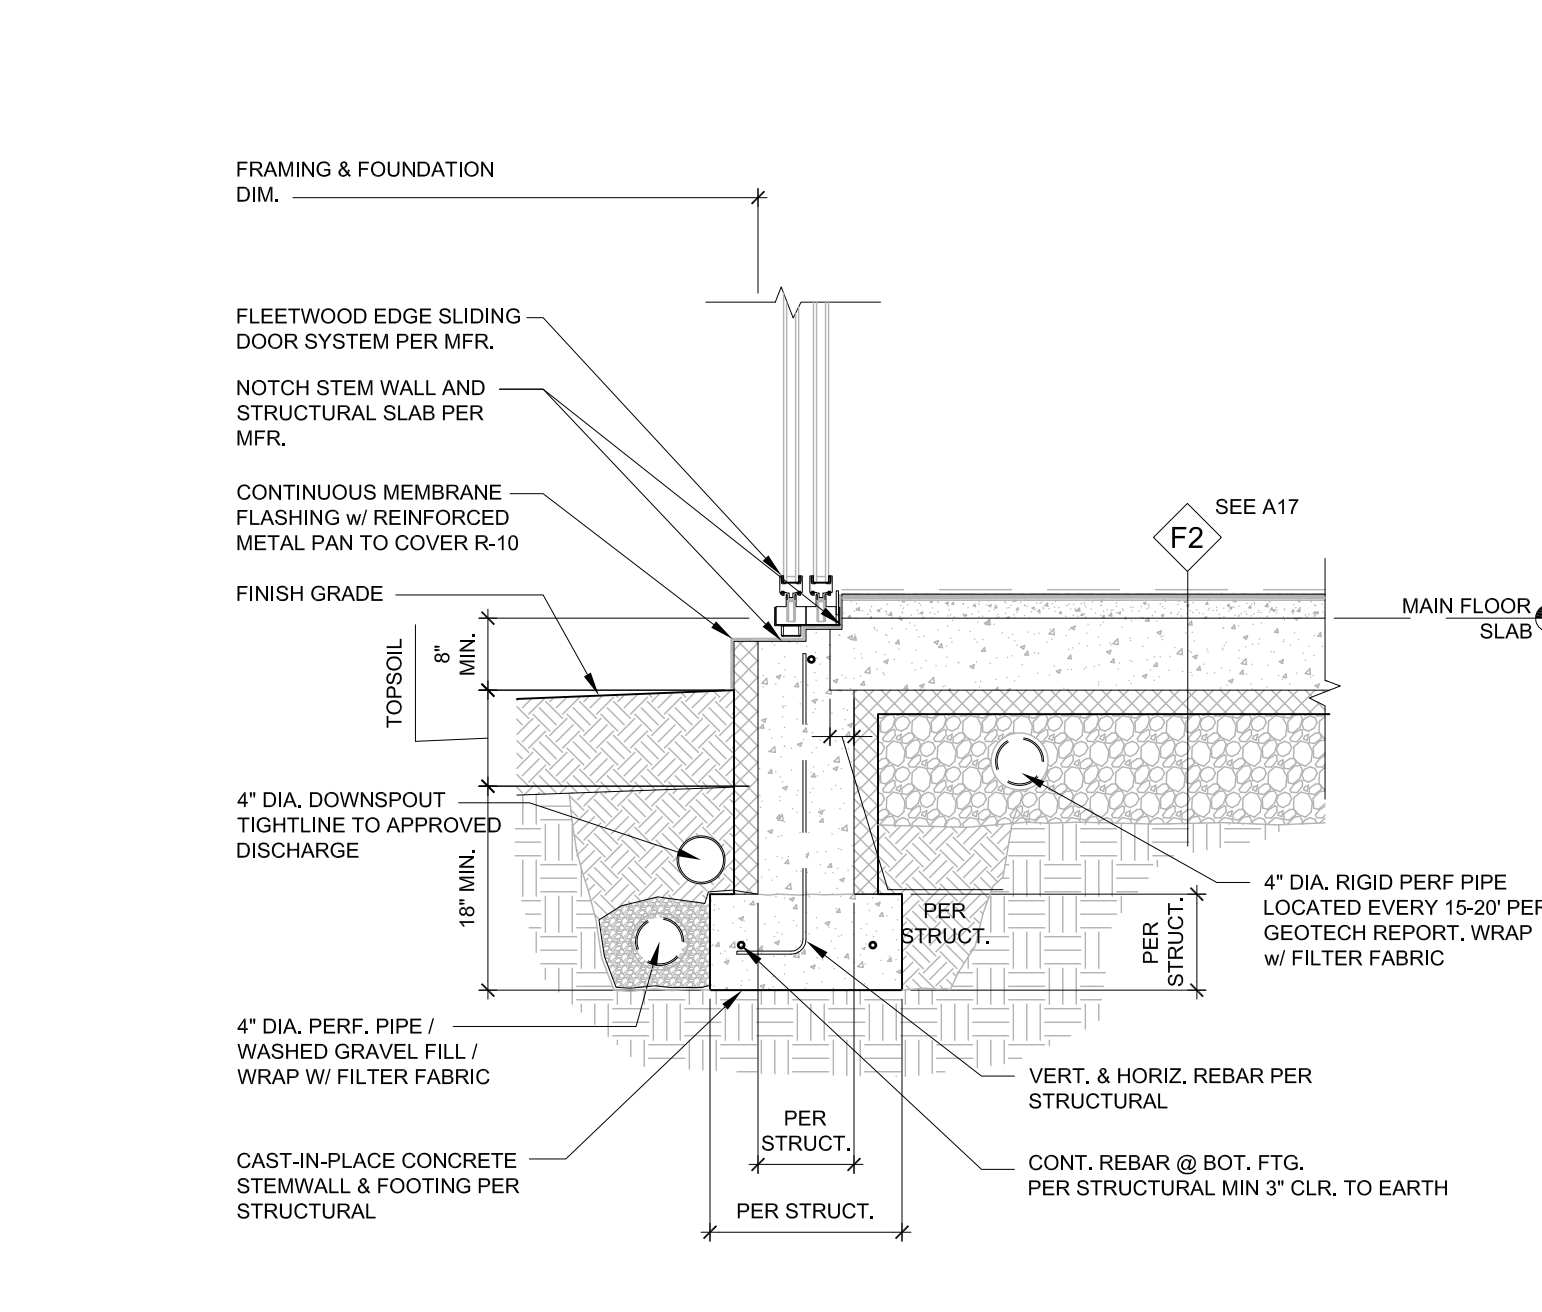


SLIDING DOOR SILL @ HOUSE PERIMETER  
SCALE: 3/4" = 1'-0"

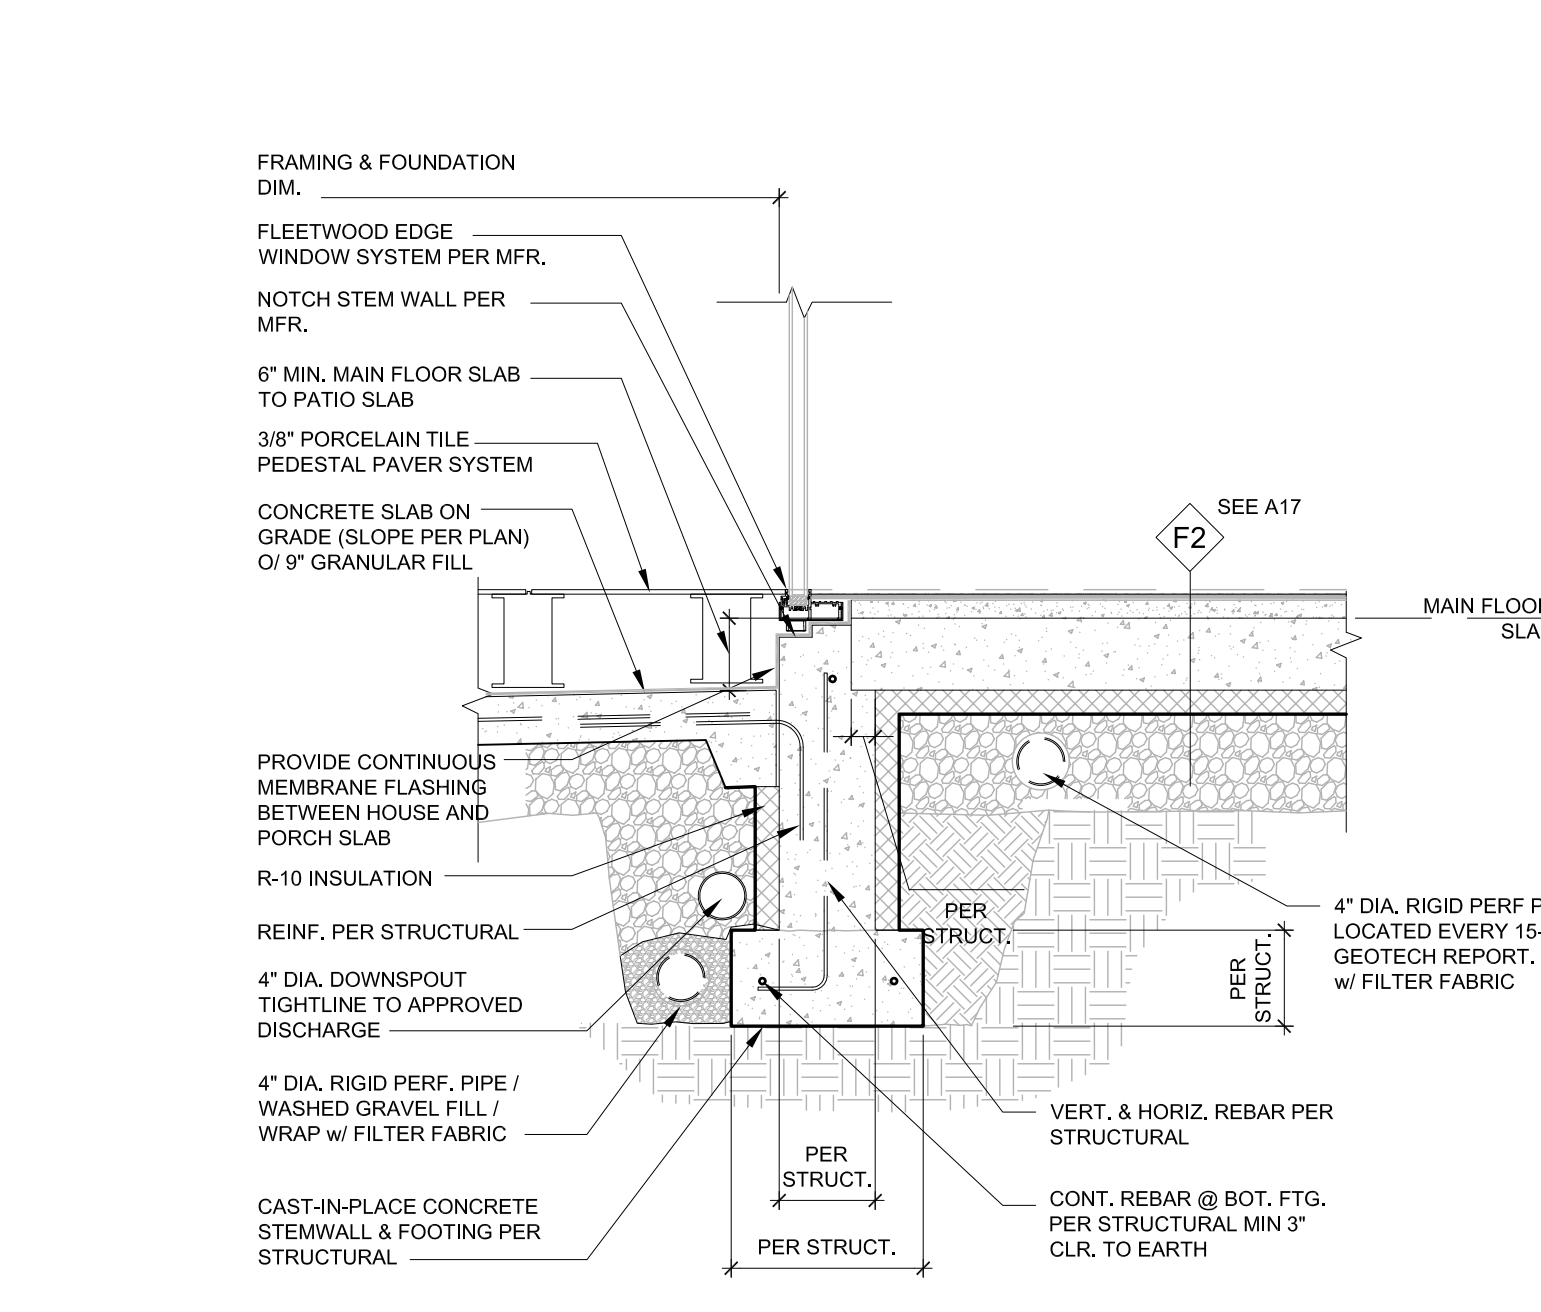


PORCH SLAB @ WINDOW  
SCALE: 3/4" = 1'-0"

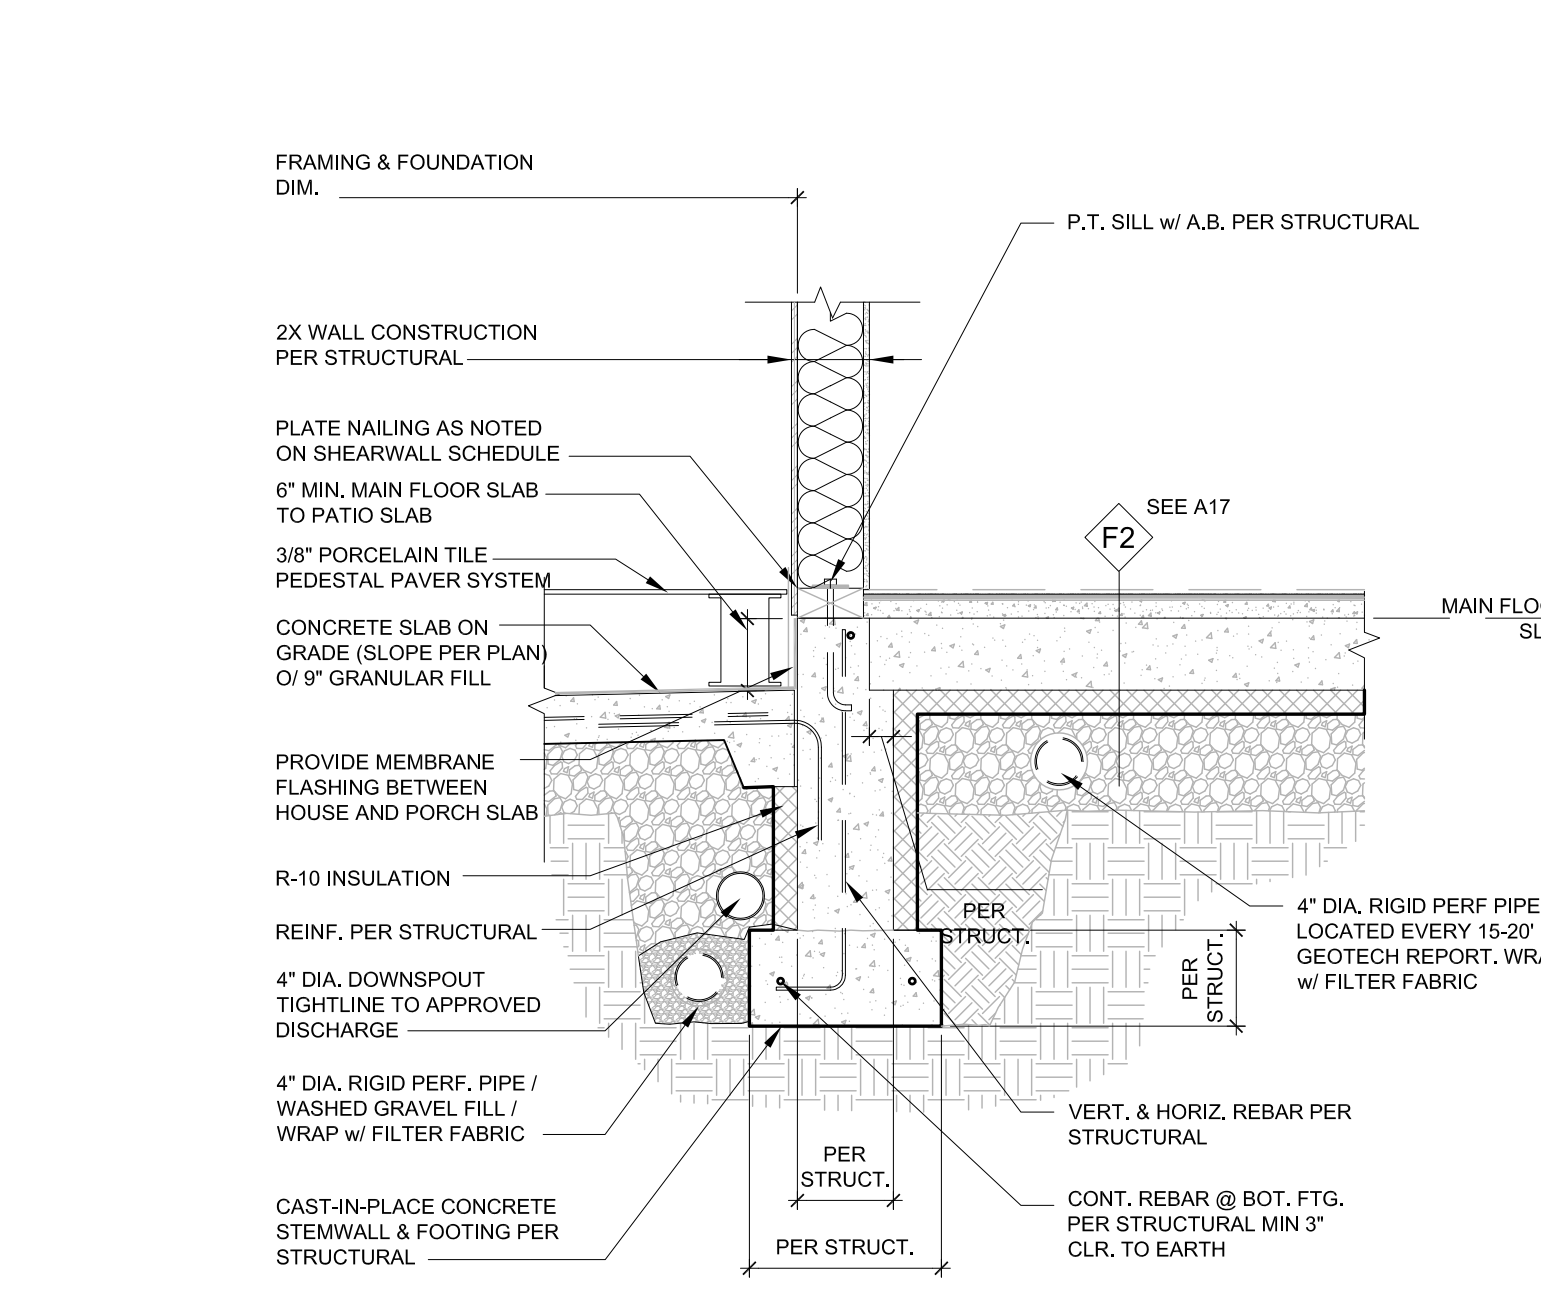


PORCH SLAB @ HOUSE PERIMETER  
SCALE: 3/4" = 1'-0"

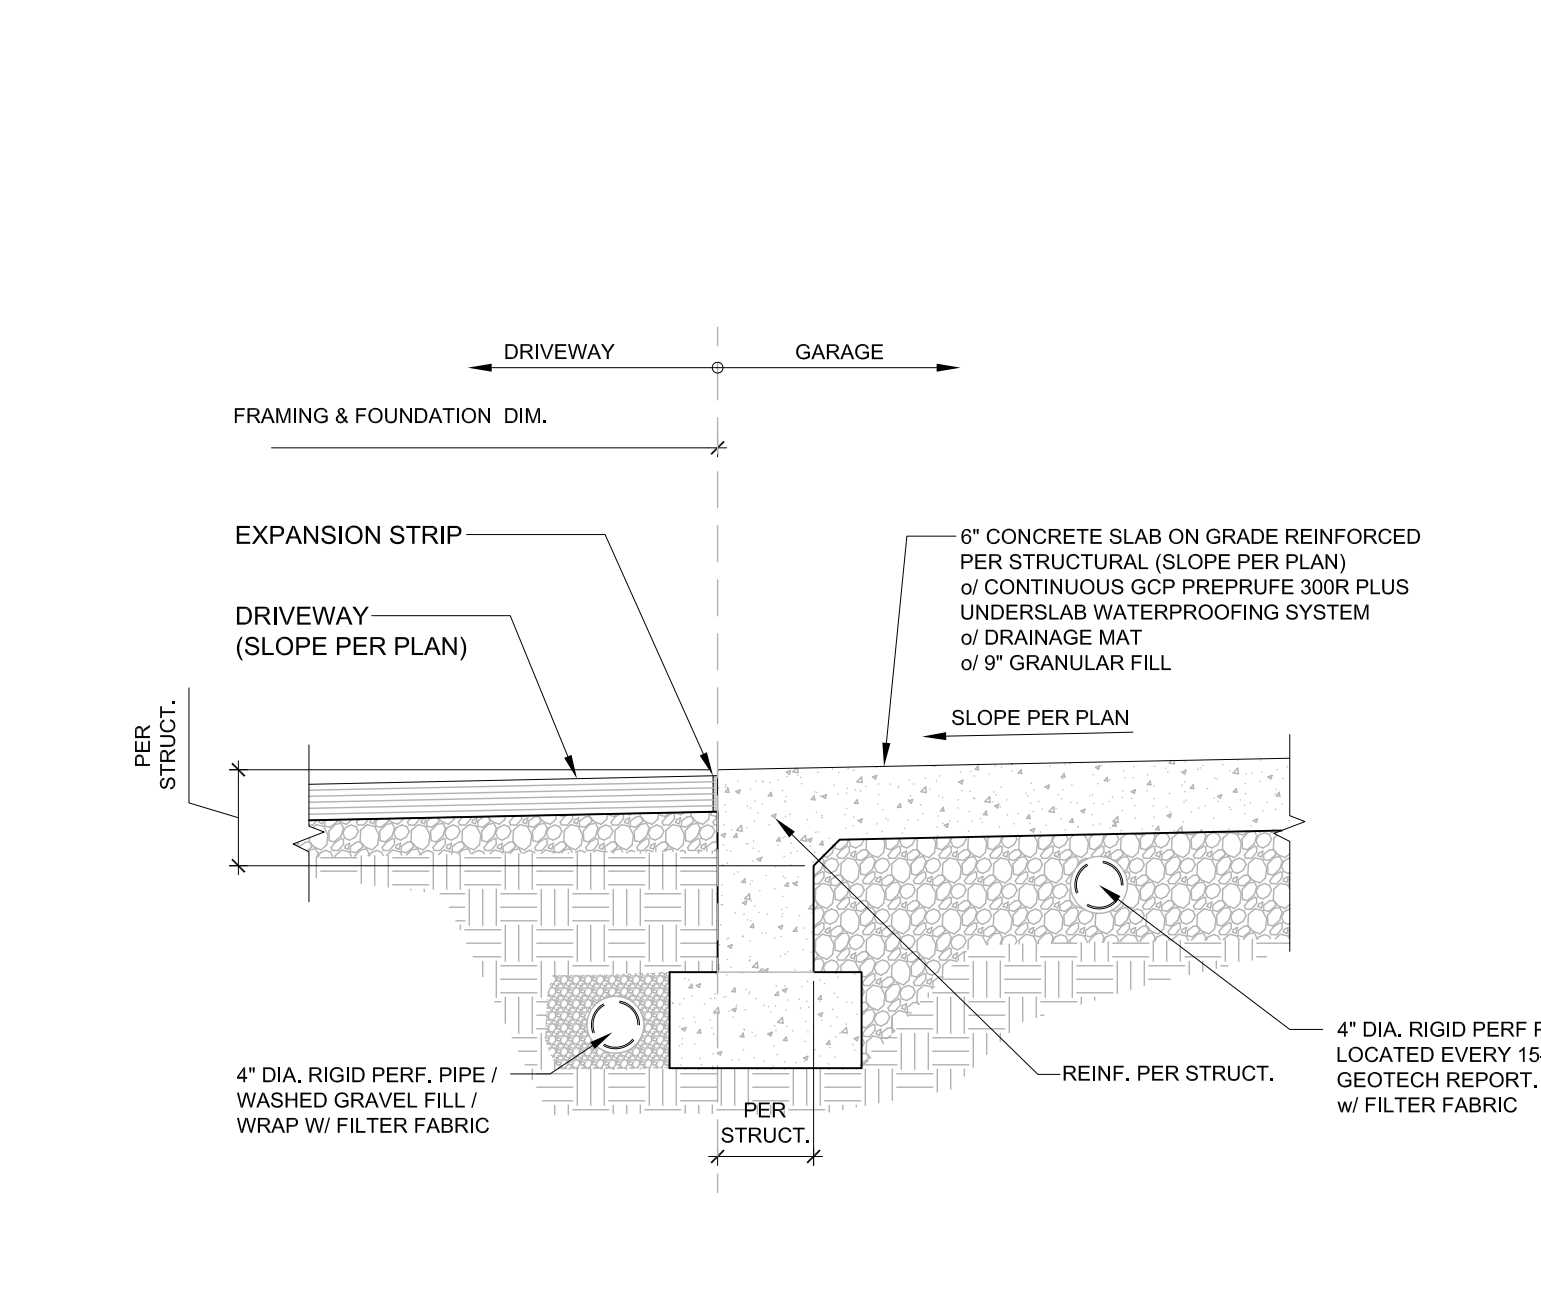


FOUNDATION @ GARAGE DOOR  
SCALE: 3/4" = 1'-0"

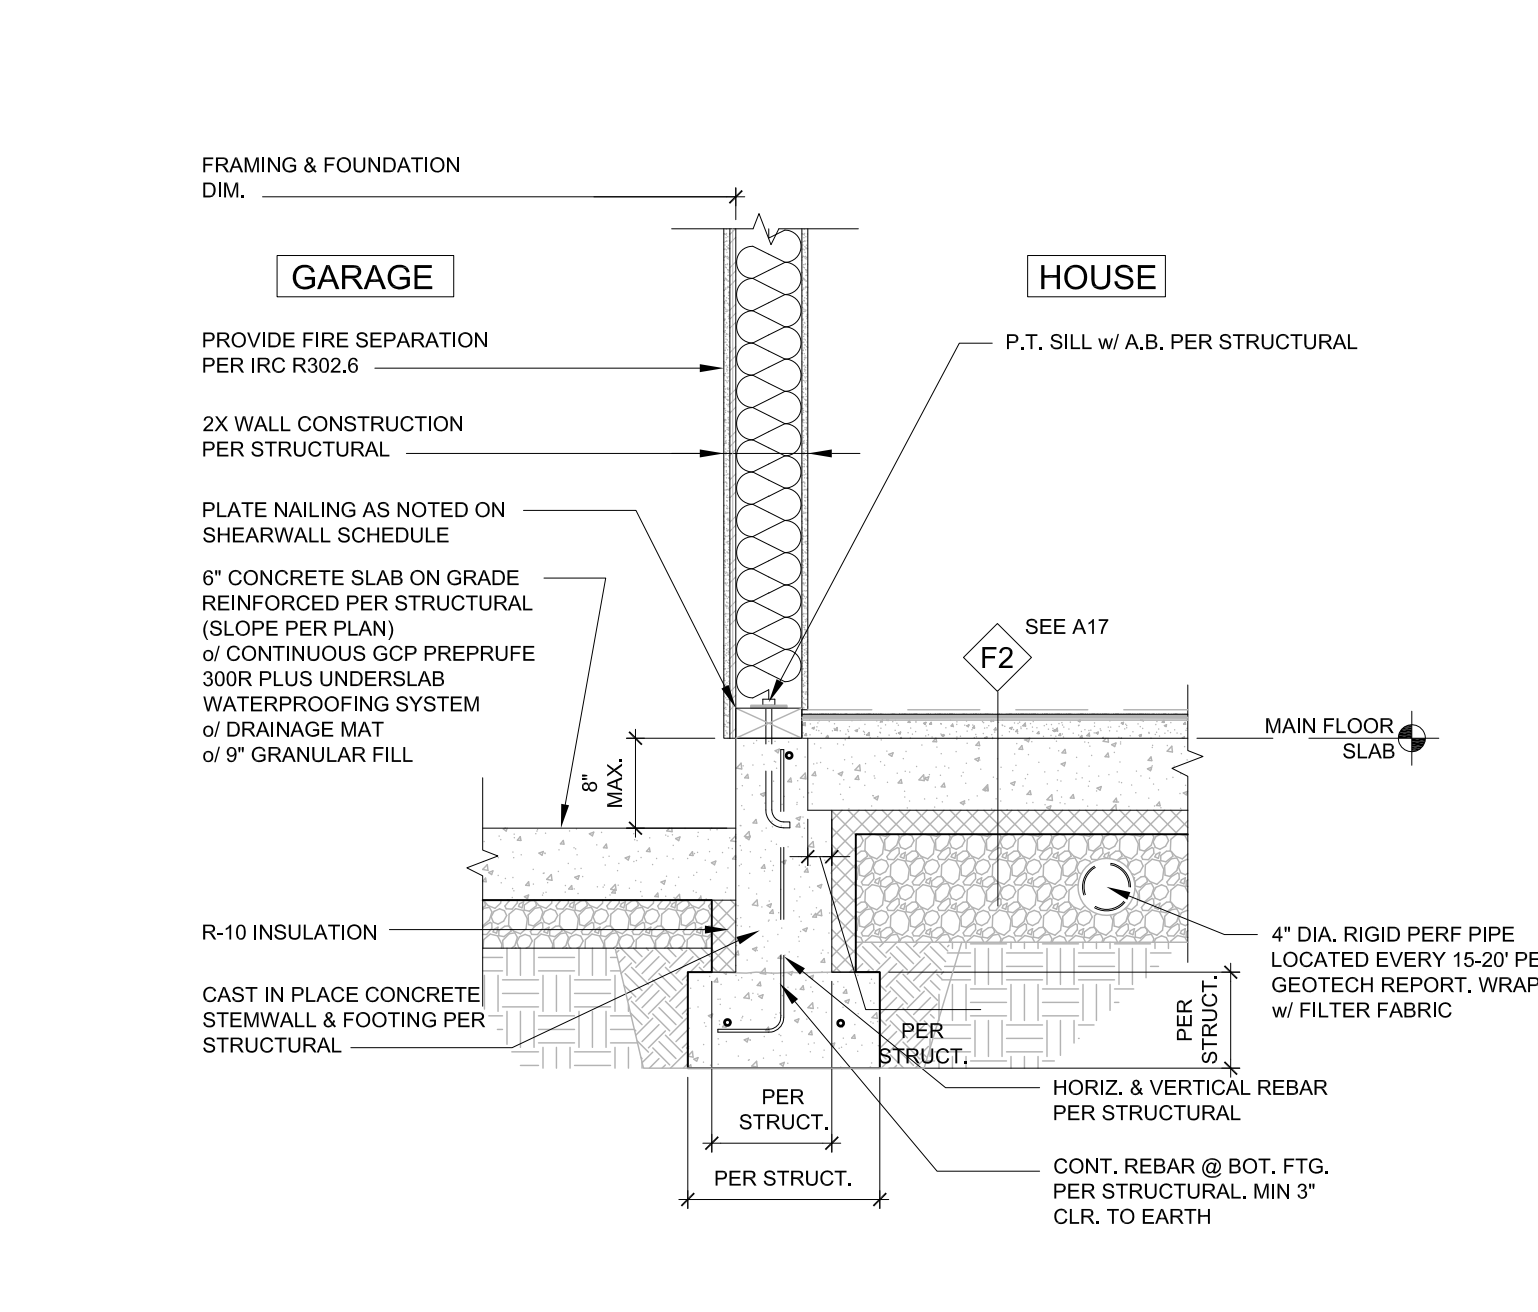


FOUNDATION @ GARAGE-HOUSE  
SCALE: 3/4" = 1'-0"

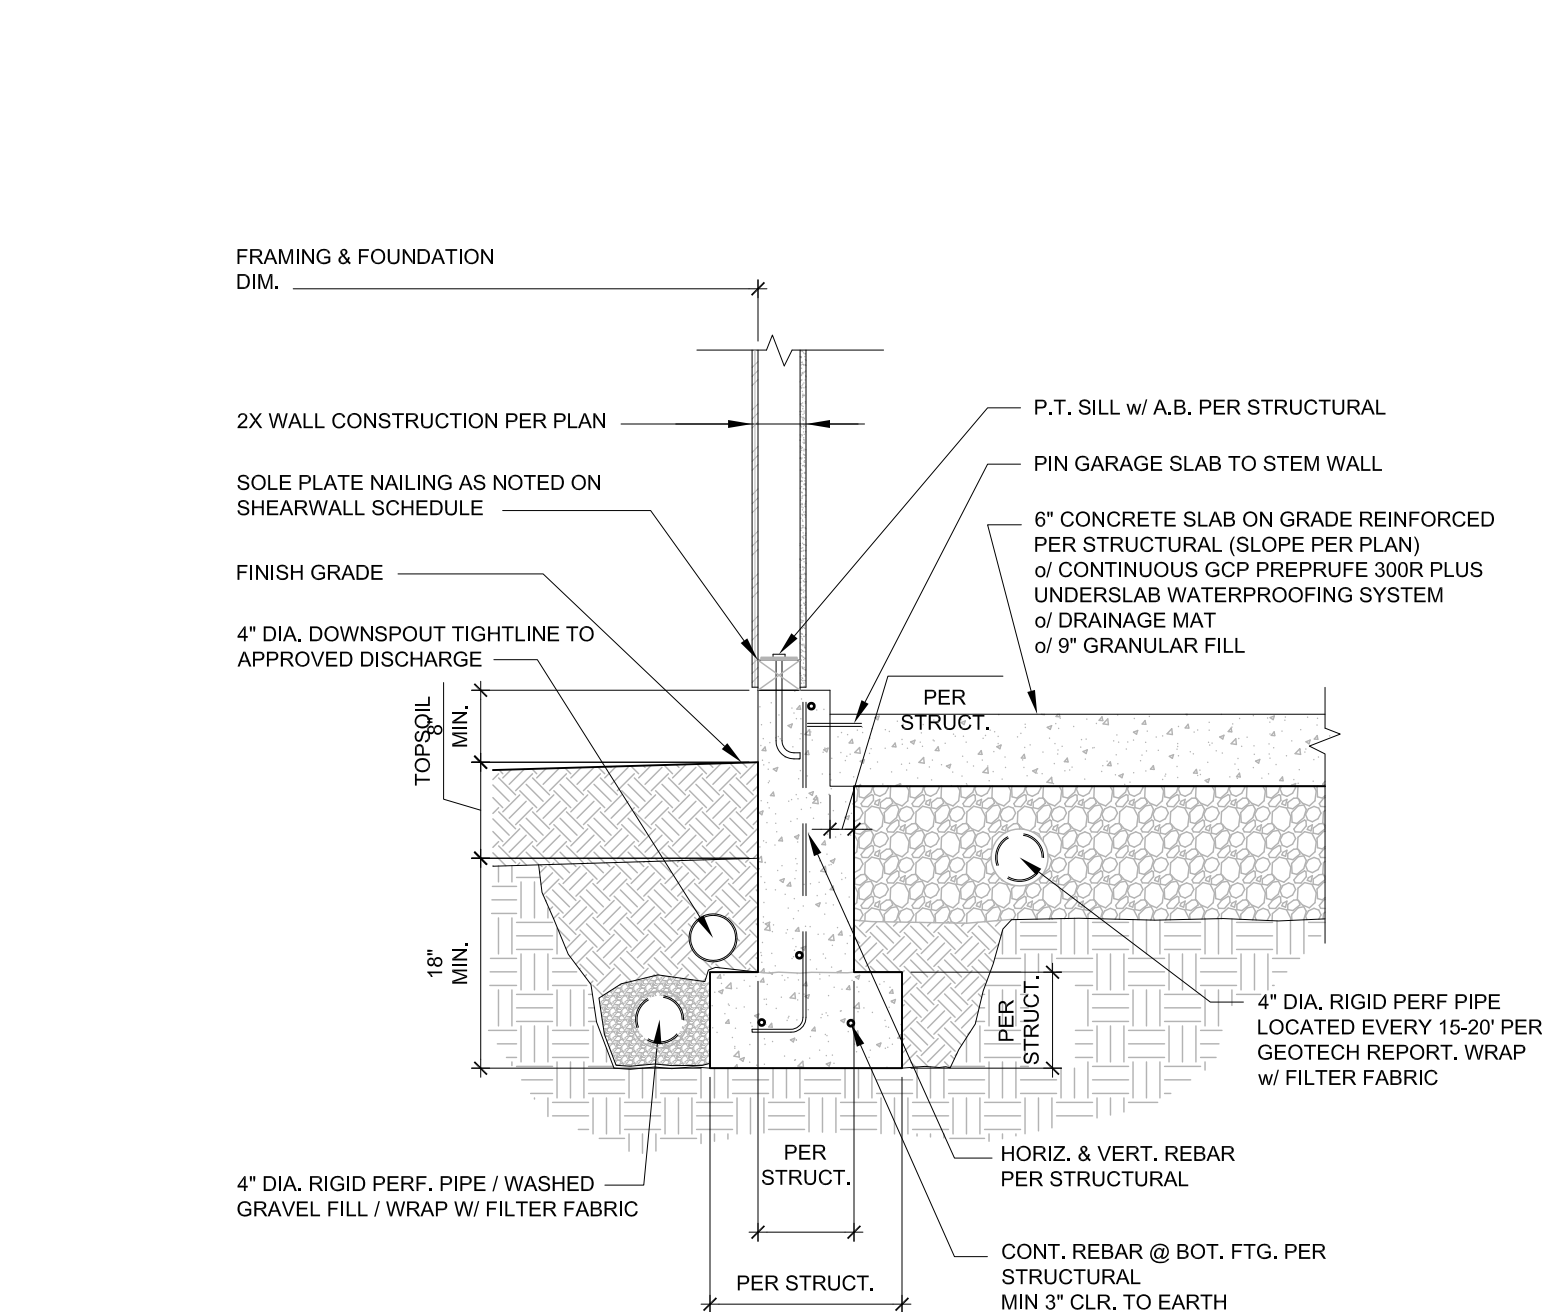

FOUNDATION @ GARAGE PERIMETER  
SCALE: 3/4" = 1'-0"

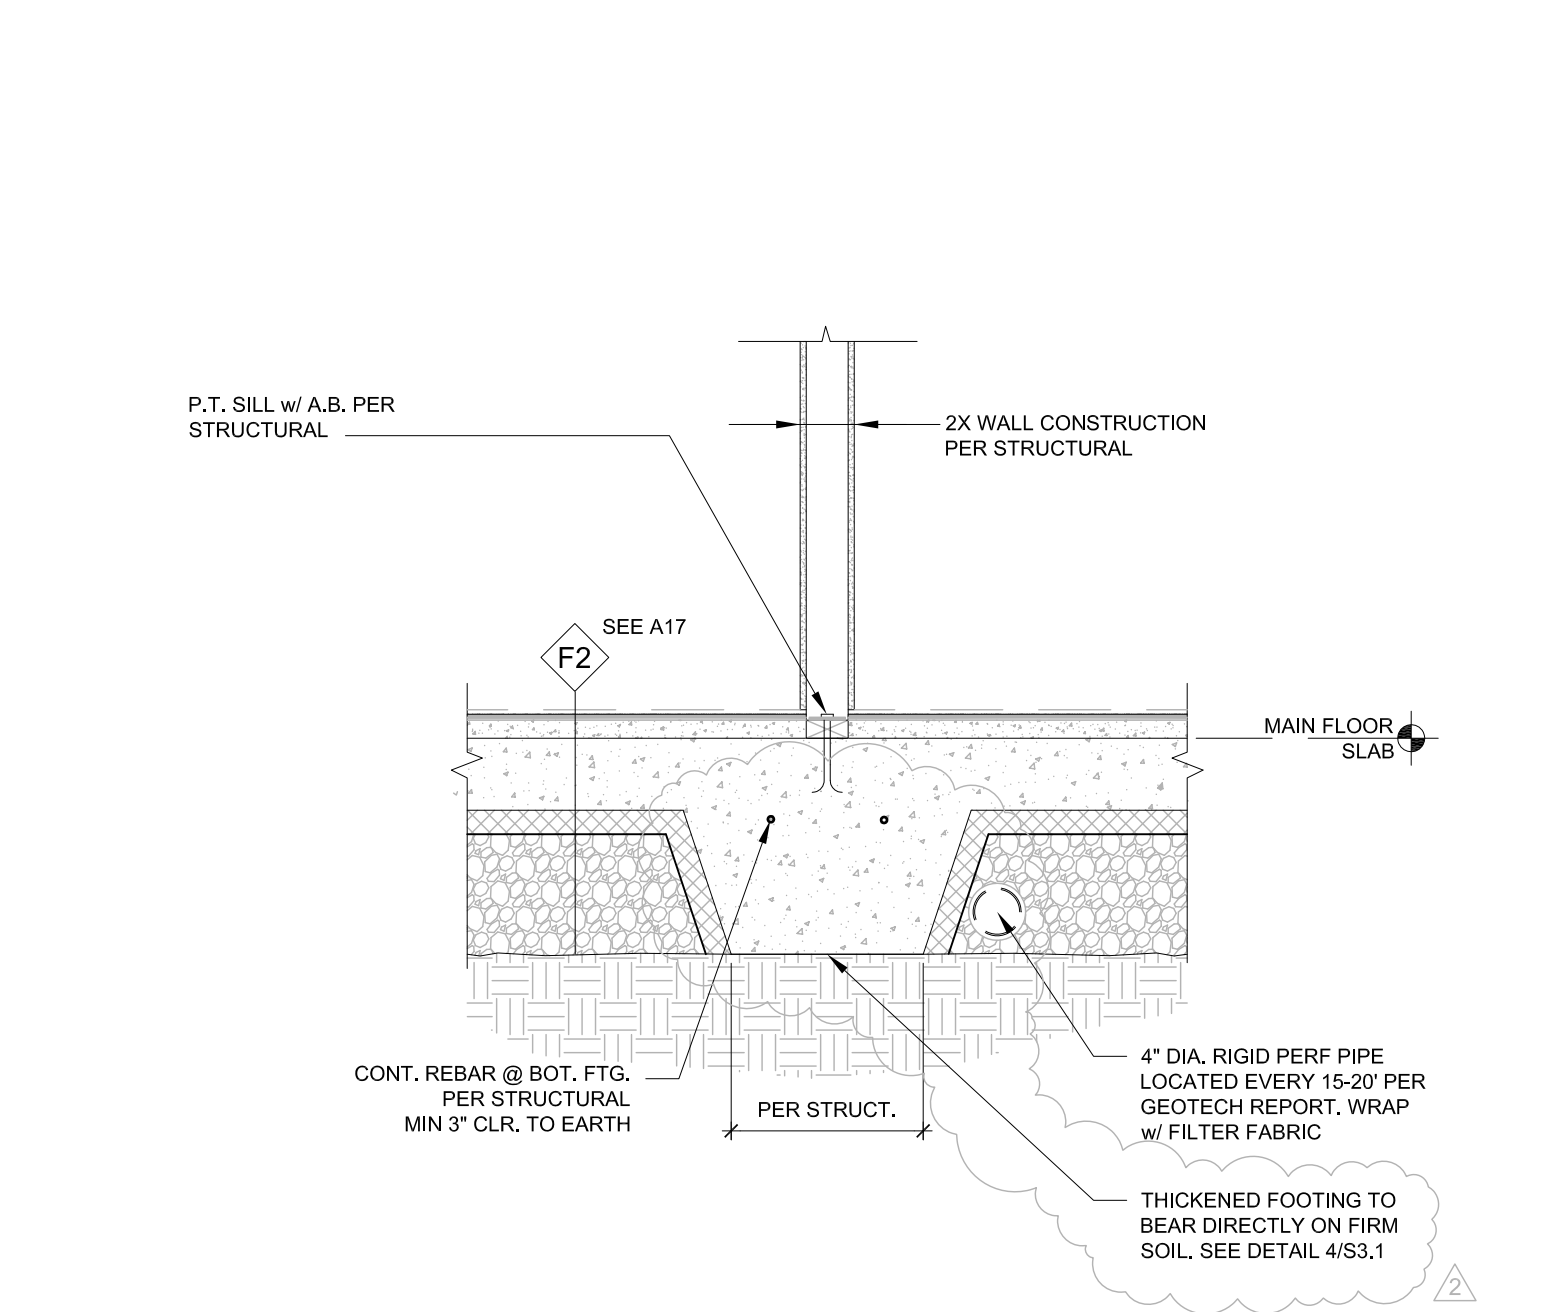

INTERIOR THICKENED SLAB  
SCALE: 3/4" = 1'-0"

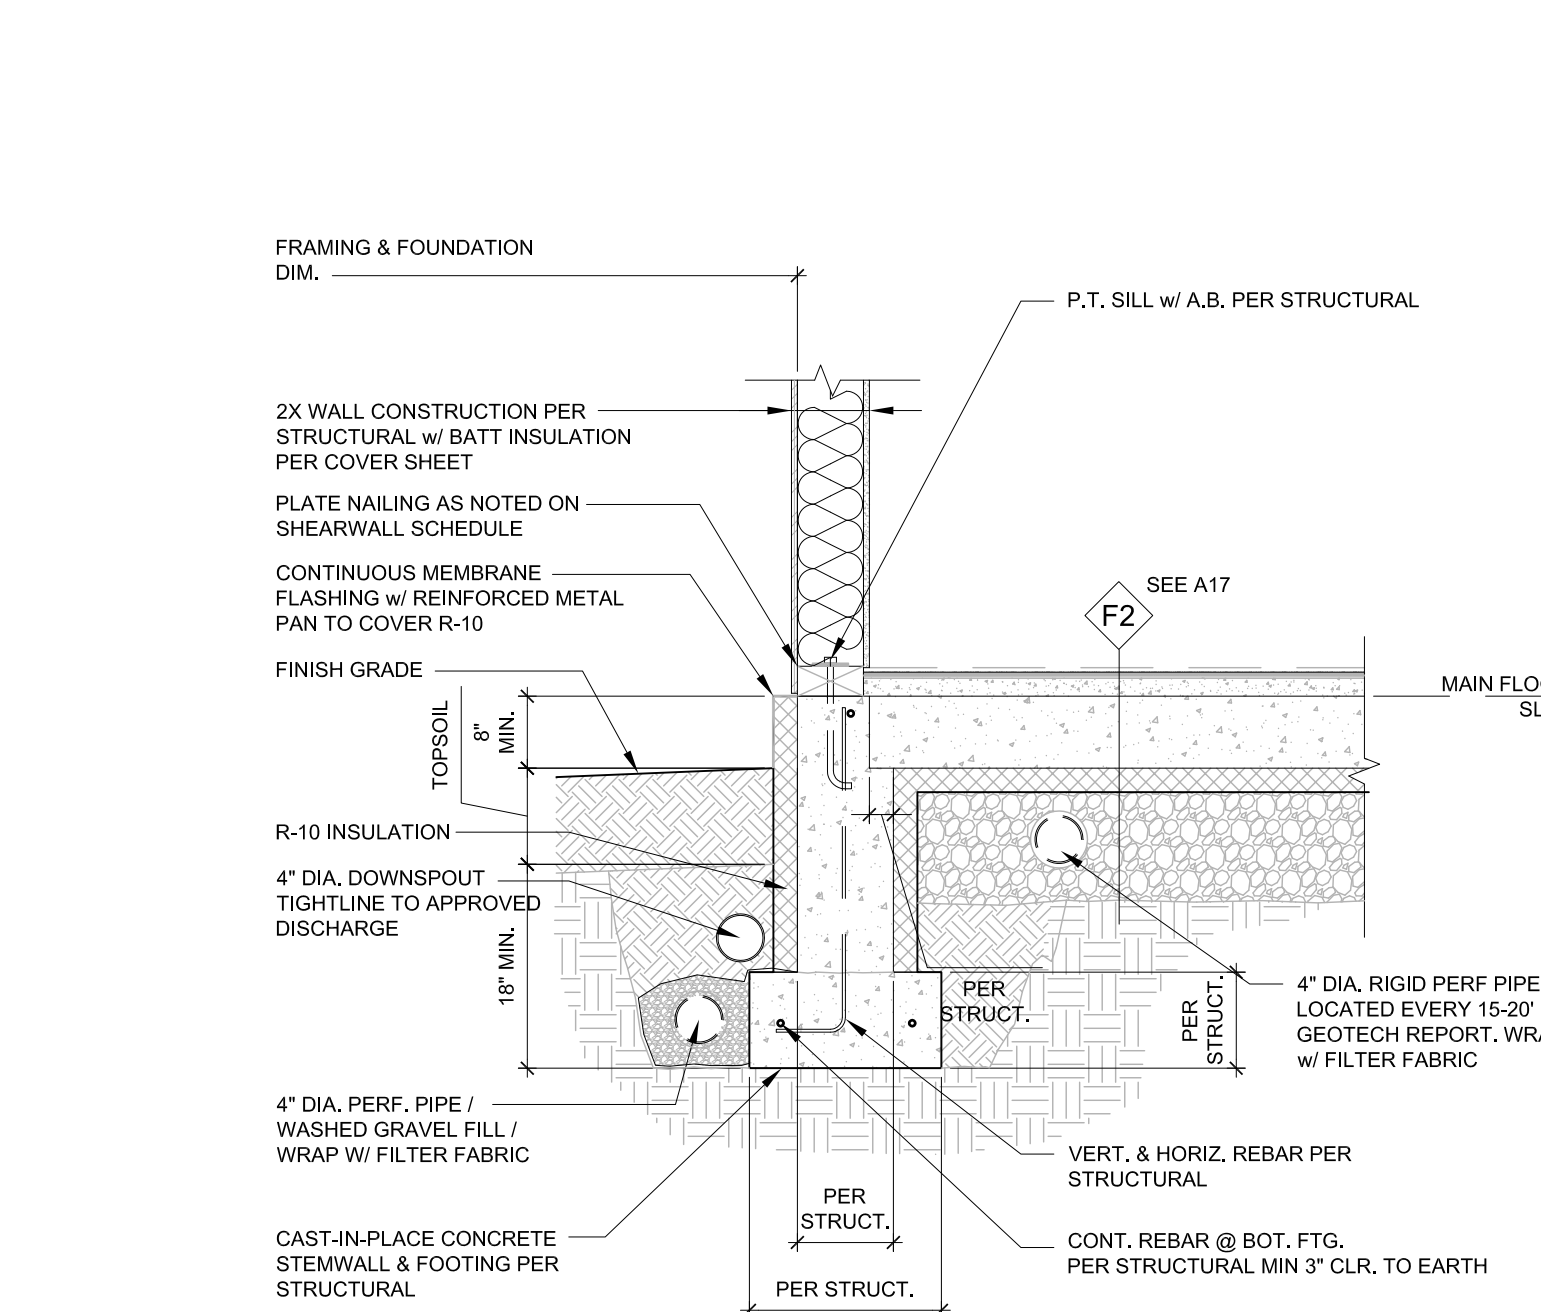

FOUNDATION @ HOUSE PERIMETER  
SCALE: 3/4" = 1'-0"

5601 6th Ave S, Suite 371  
Seattle, WA 98108  
206.443.1181  
mccullougharchitects.com

**MCCULLOUGH**  
ARCHITECTS

UNPUBLISHED WORK 2016 © McCullough Architects

Comment: Updated Plans to Structural Backcheck 01  
2021.11.17 Structural Backcheck 01  
2021.12.13 Structural Backcheck 02  
2021.12.22 Structural Backcheck 03  
2022.05.02 Permit Corrections  
2022.05.04 Structural Backcheck  
2022.05.12 Commentary Update  
2022.07.13 Cycle 2 Structural Backcheck  
2022.06.18 Cycle 3 Structural Backcheck

Date: 2021.10.13  
Job No: 21-041  
Project No:  
Drawn: DJR  
Approved: APM

**KONERU RESIDENCE**  
6610 E Mercer Way  
Mercer Island, WA 98040


PERMIT SET  
Architectural Details

**A15**









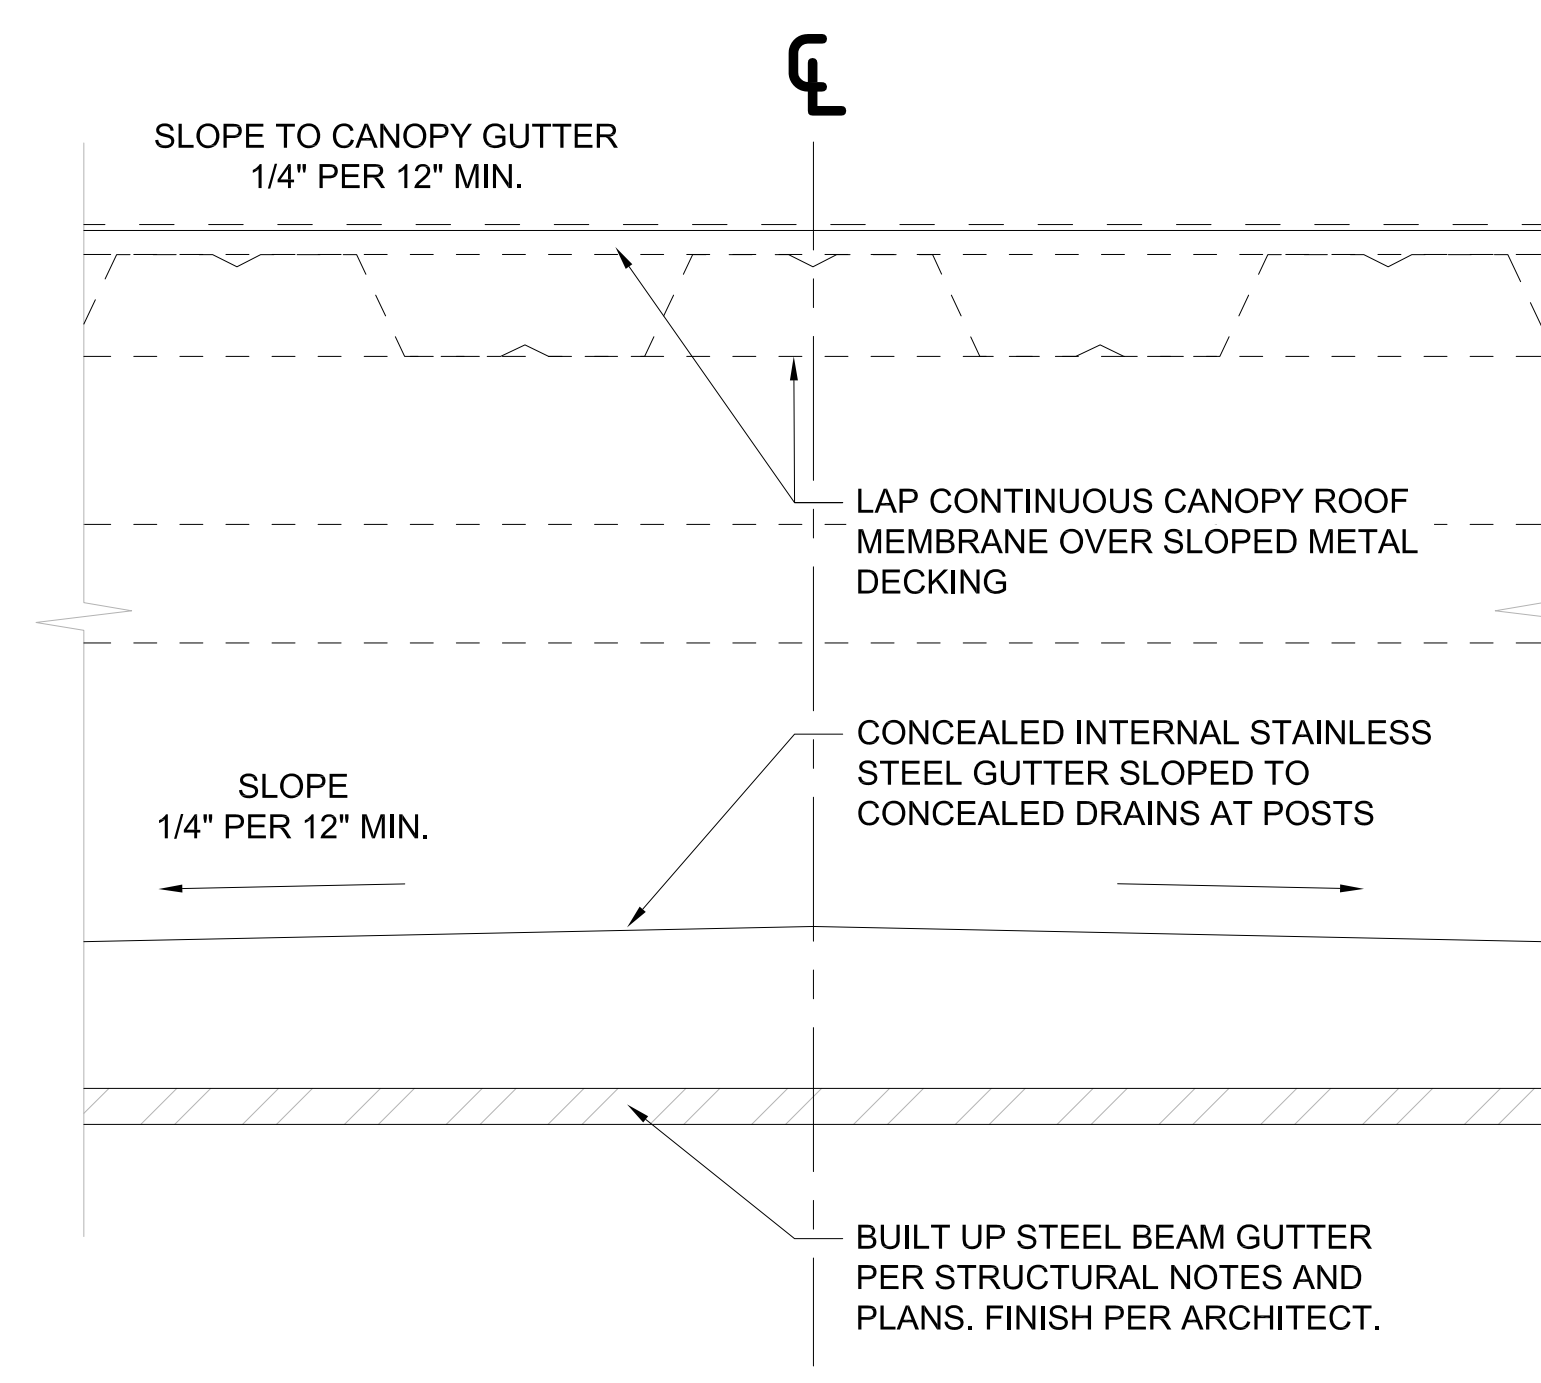


**CANOPY GUTTER SECTION**  
SCALE: 3/4\"/>

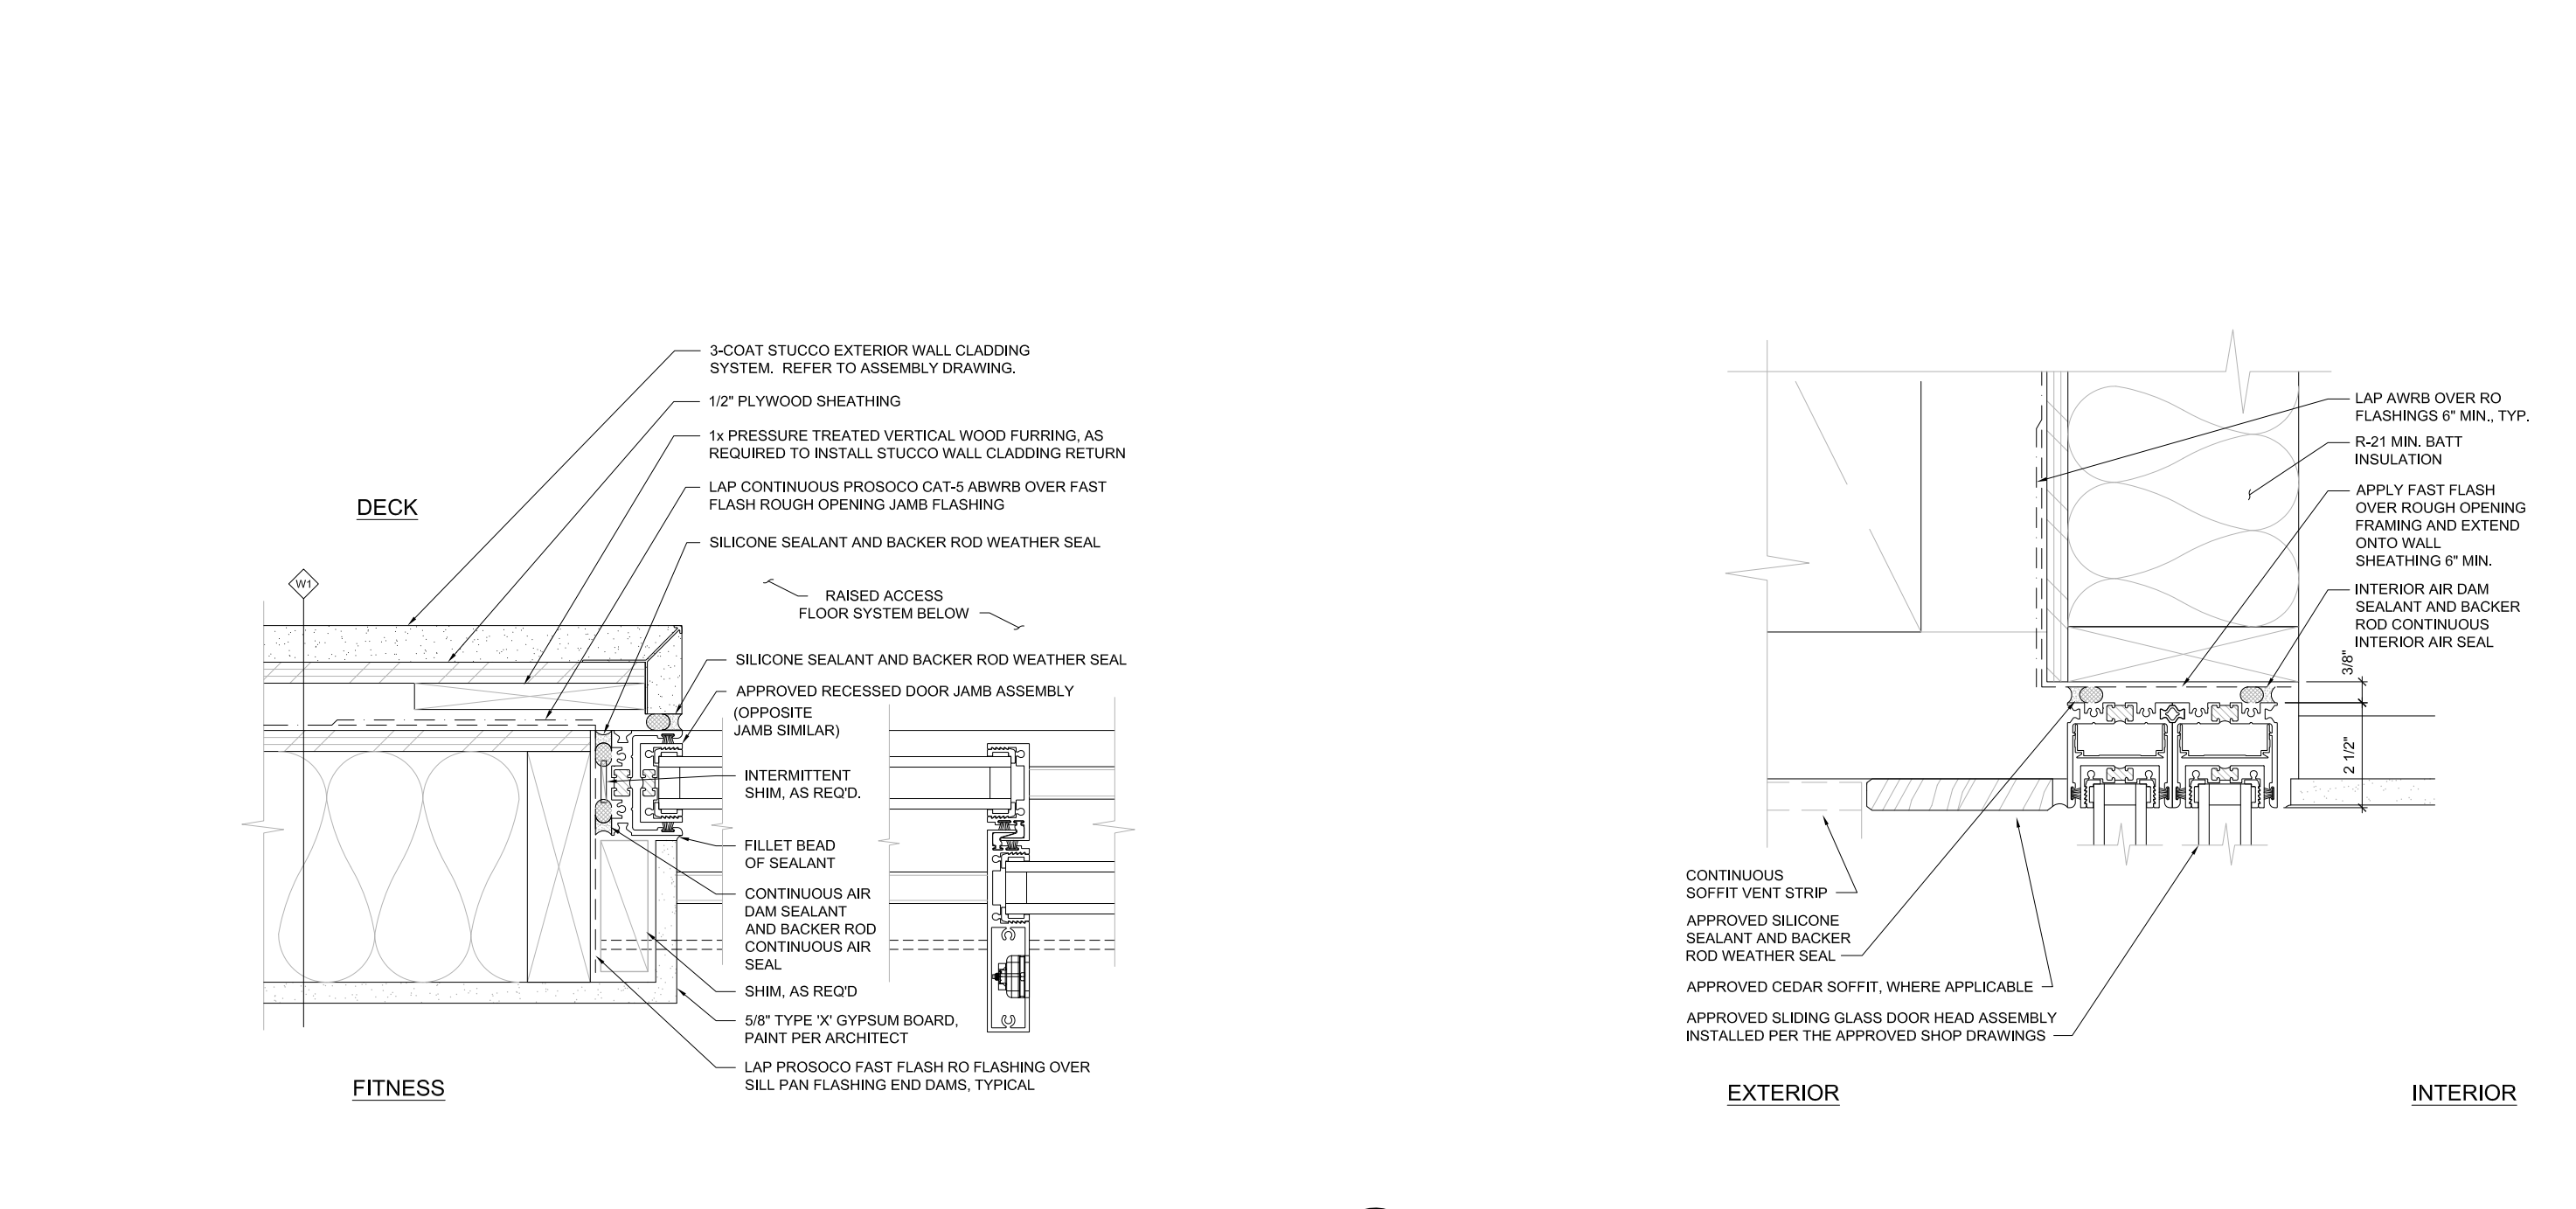


**RECESSED SLIDING DOOR JAMB - TYP**  
SCALE: 3/4\"/>

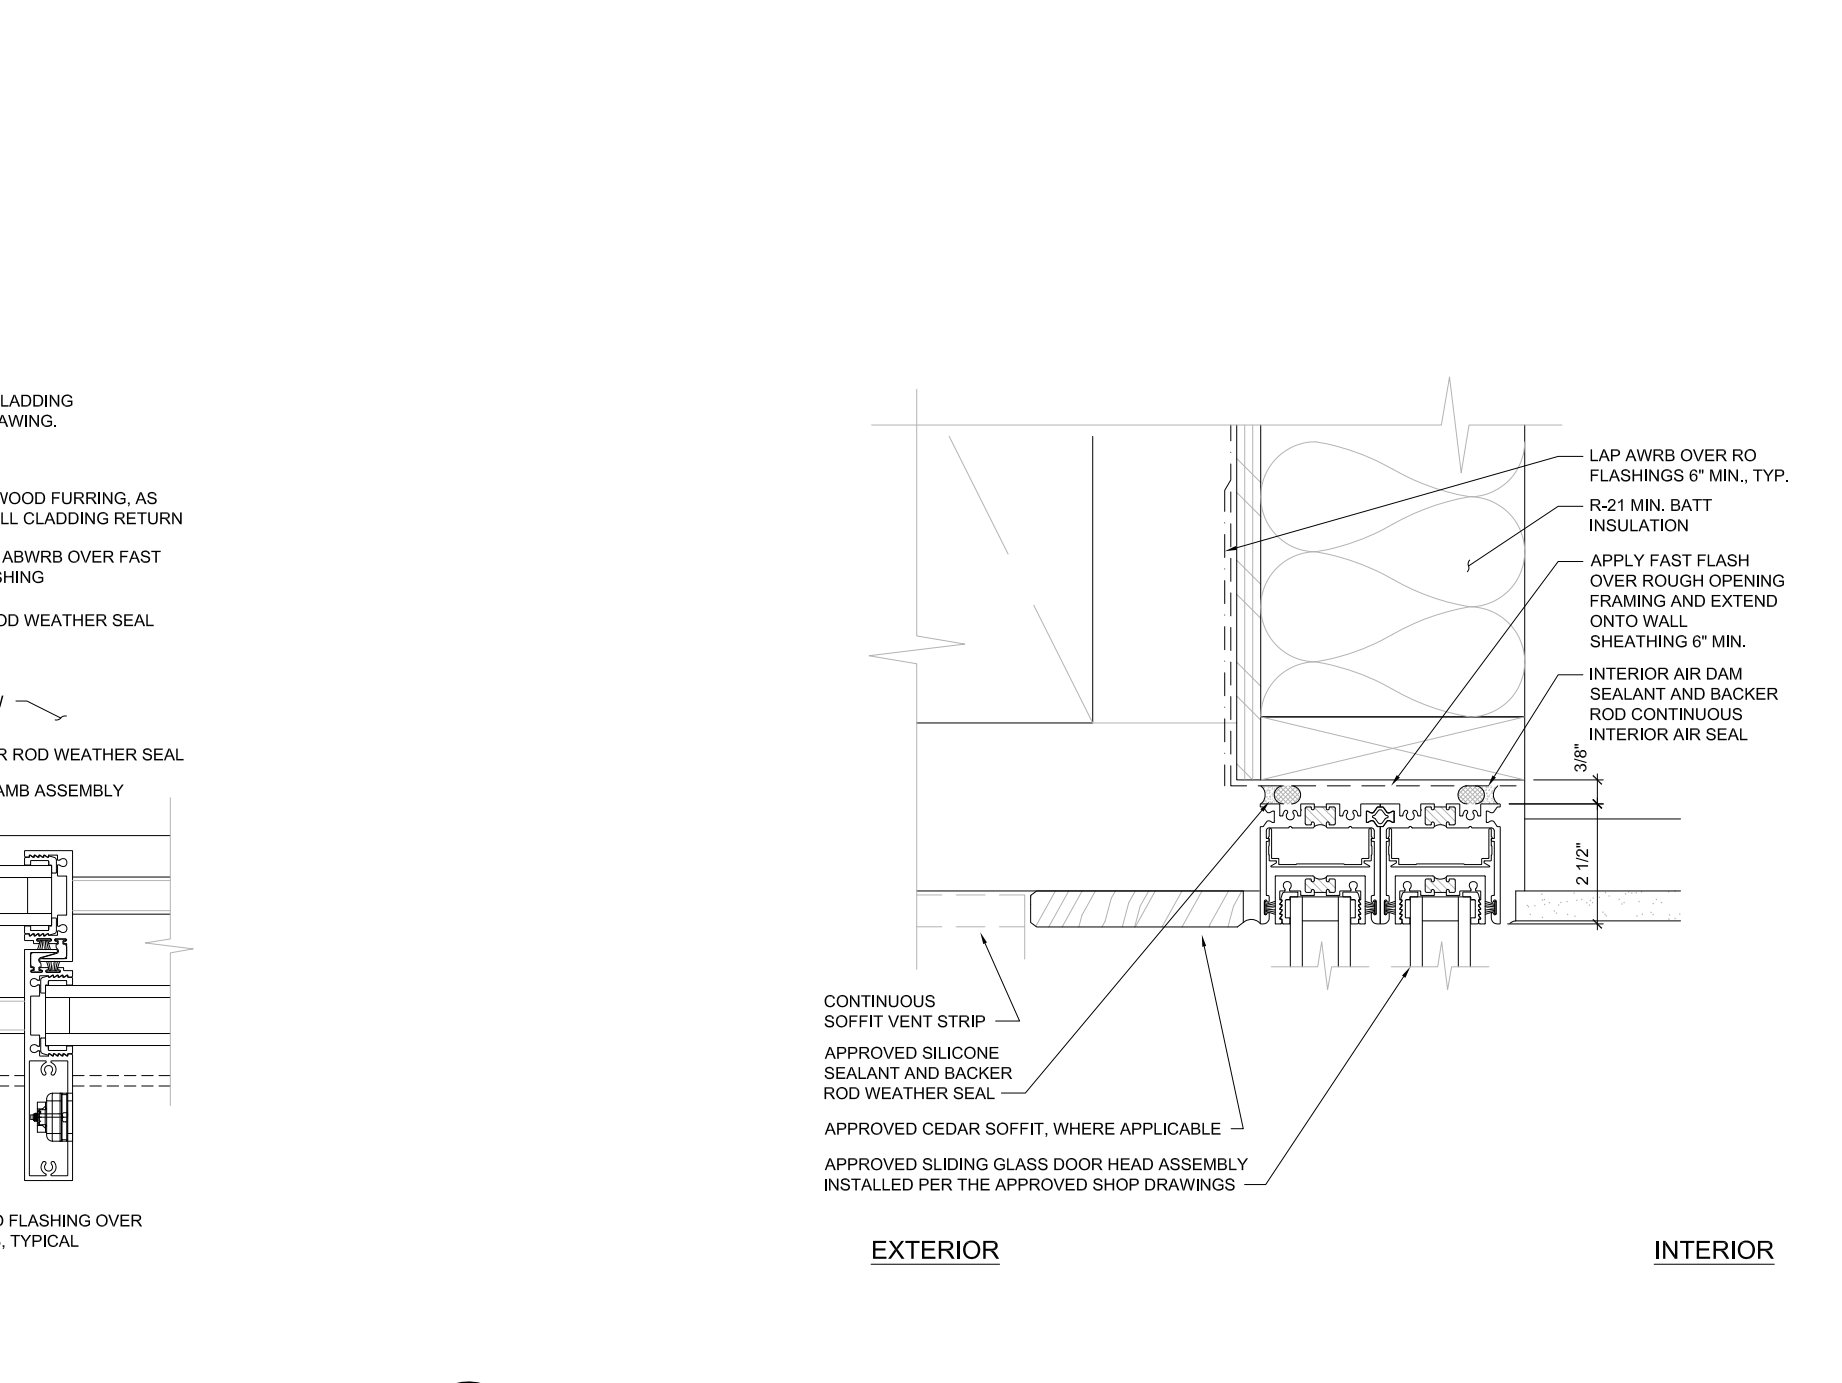


**RECESSED SLIDING DOOR HEAD - TYP**  
SCALE: 3/4\"/>

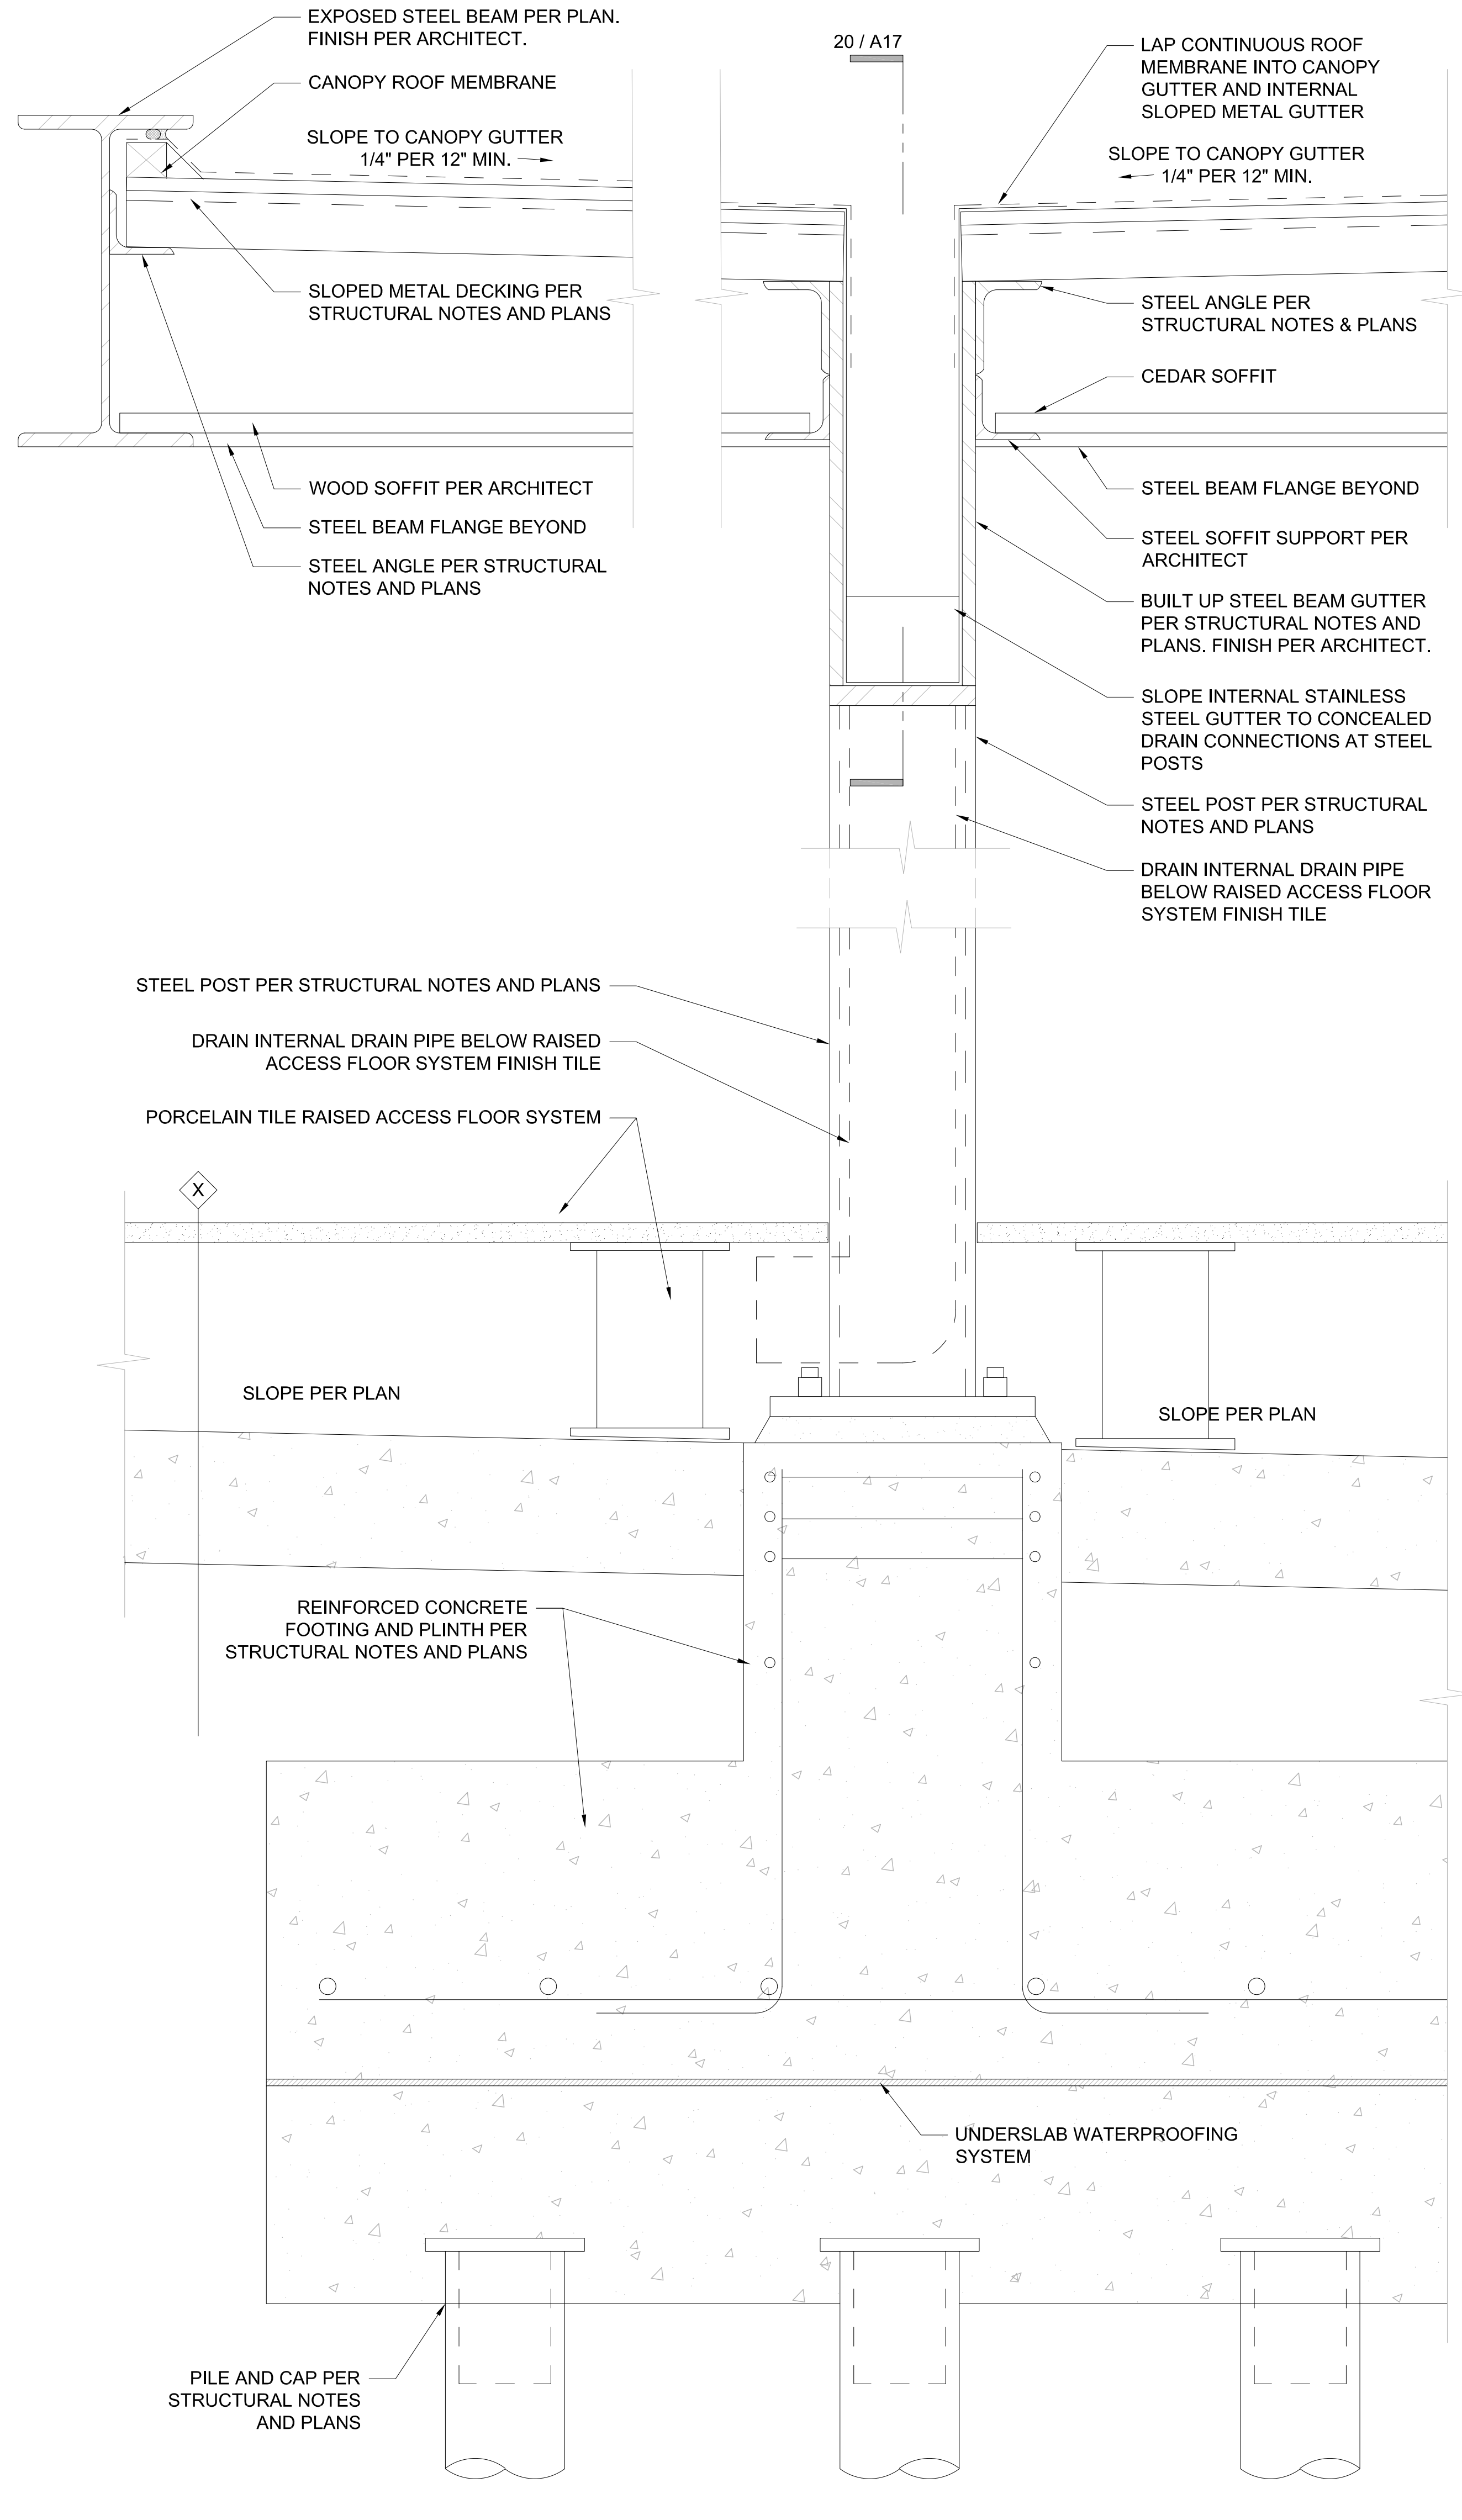


**CANOPY COLUMN, EDGE, & GUTTER CROSS SECTION**  
SCALE: 3/4\"/>

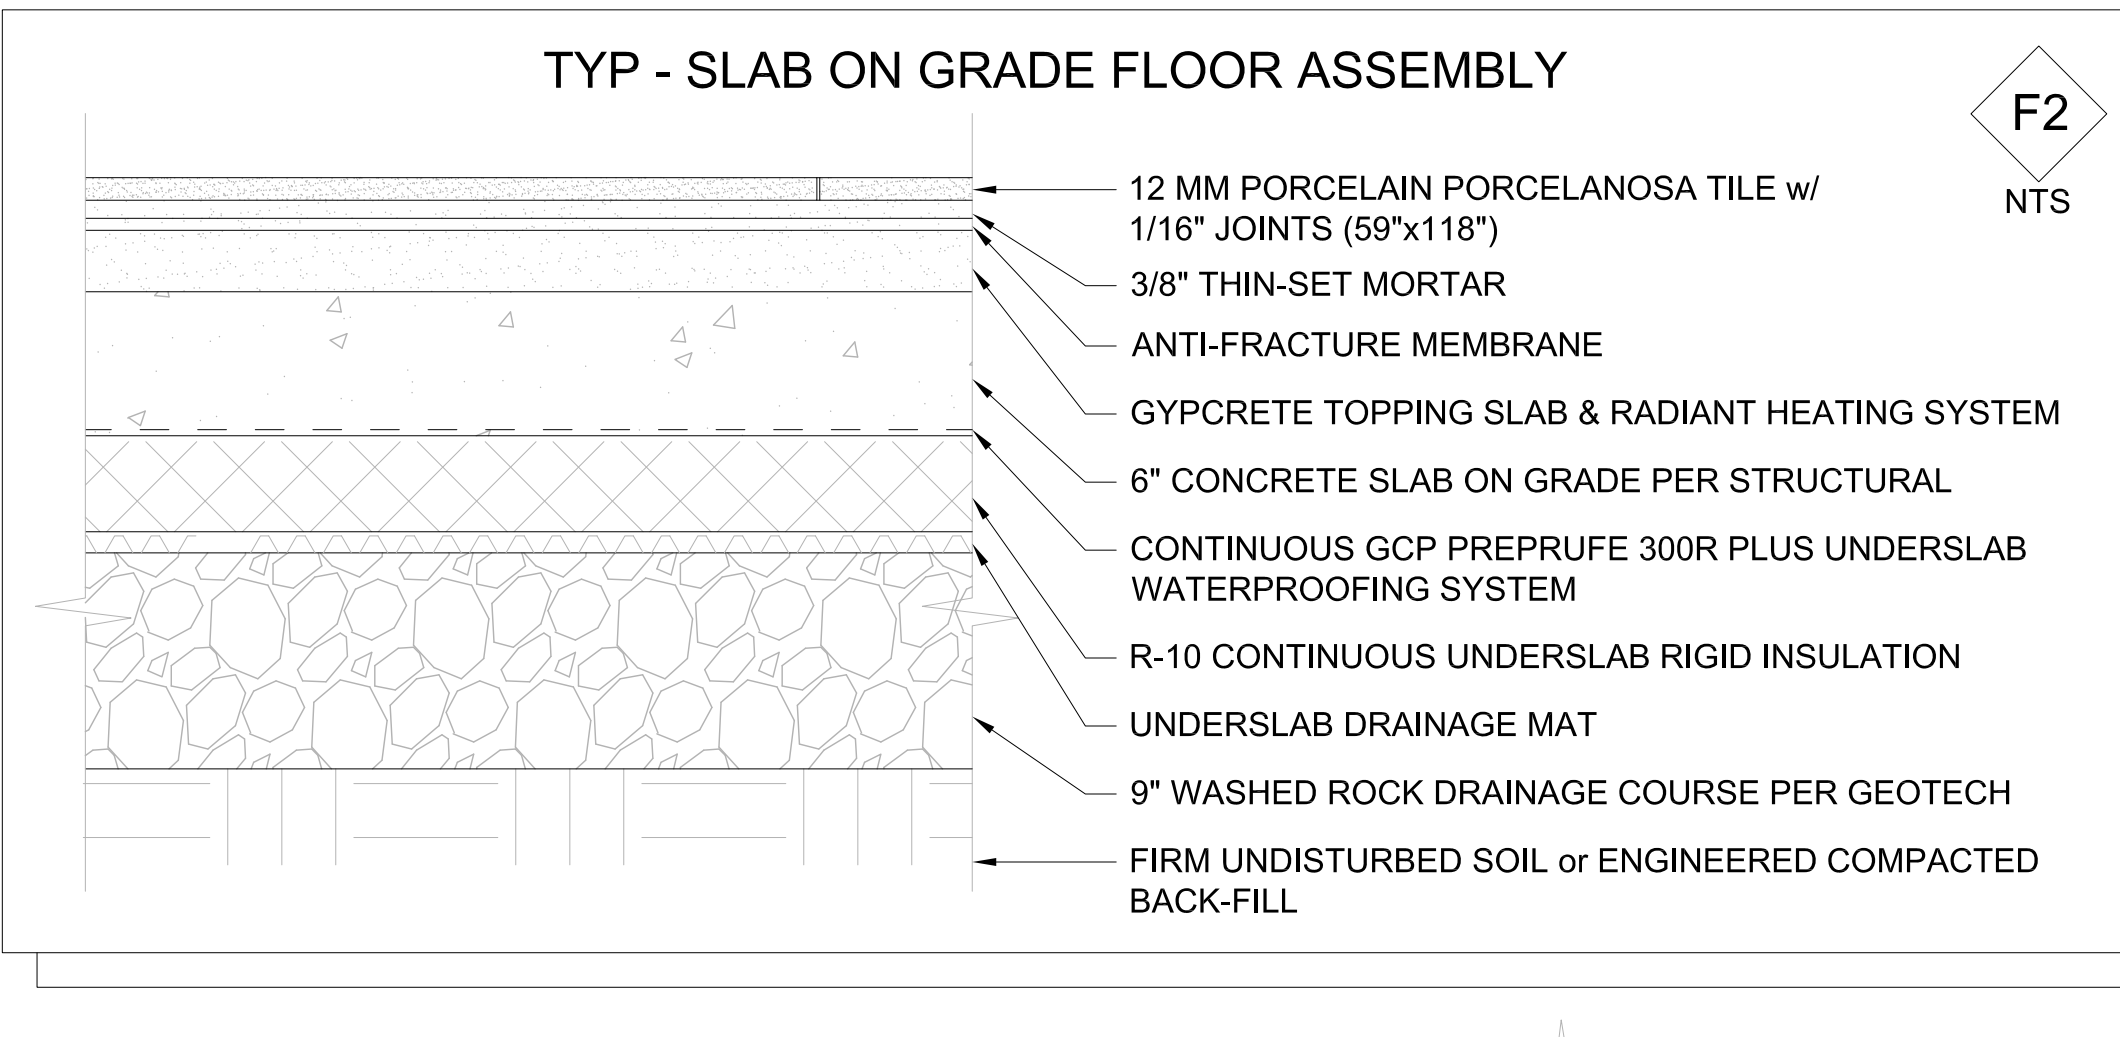


**TYP - SLAB ON GRADE FLOOR ASSEMBLY**  
SCALE: 3/4\"/>

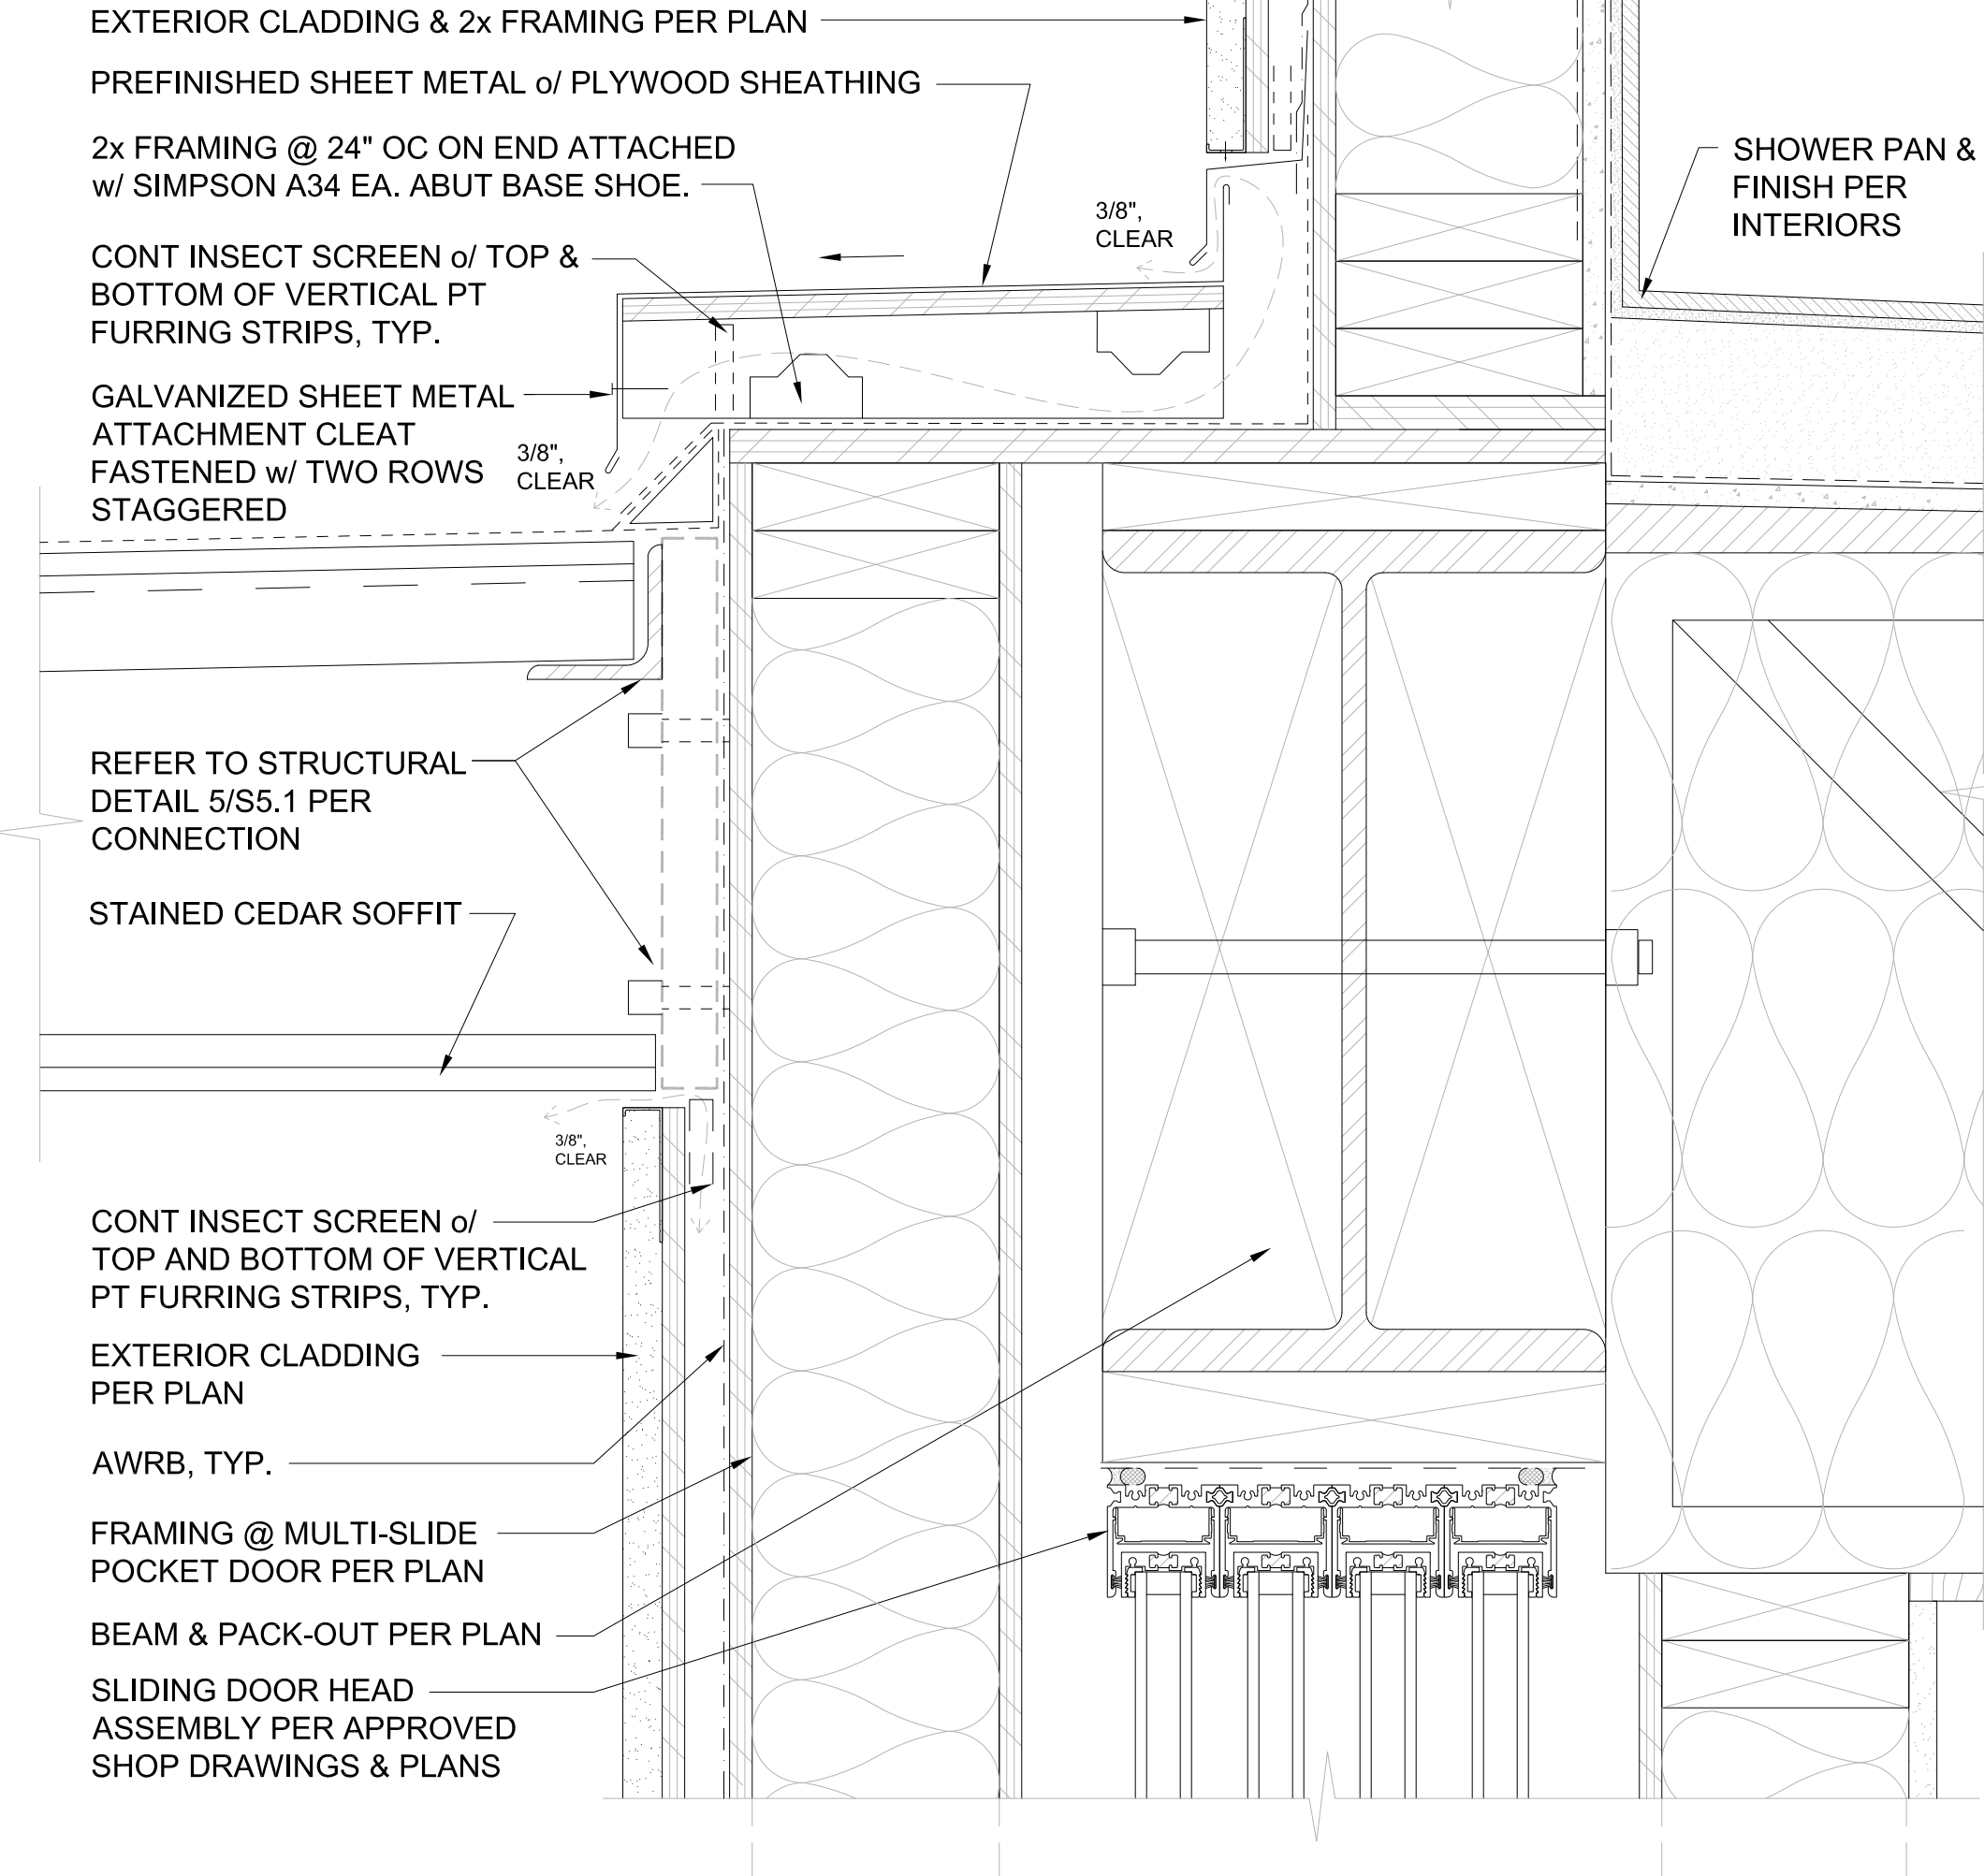


**CANOPY CONNECTION TO STRUCTURE**  
SCALE: 3/4\"/>

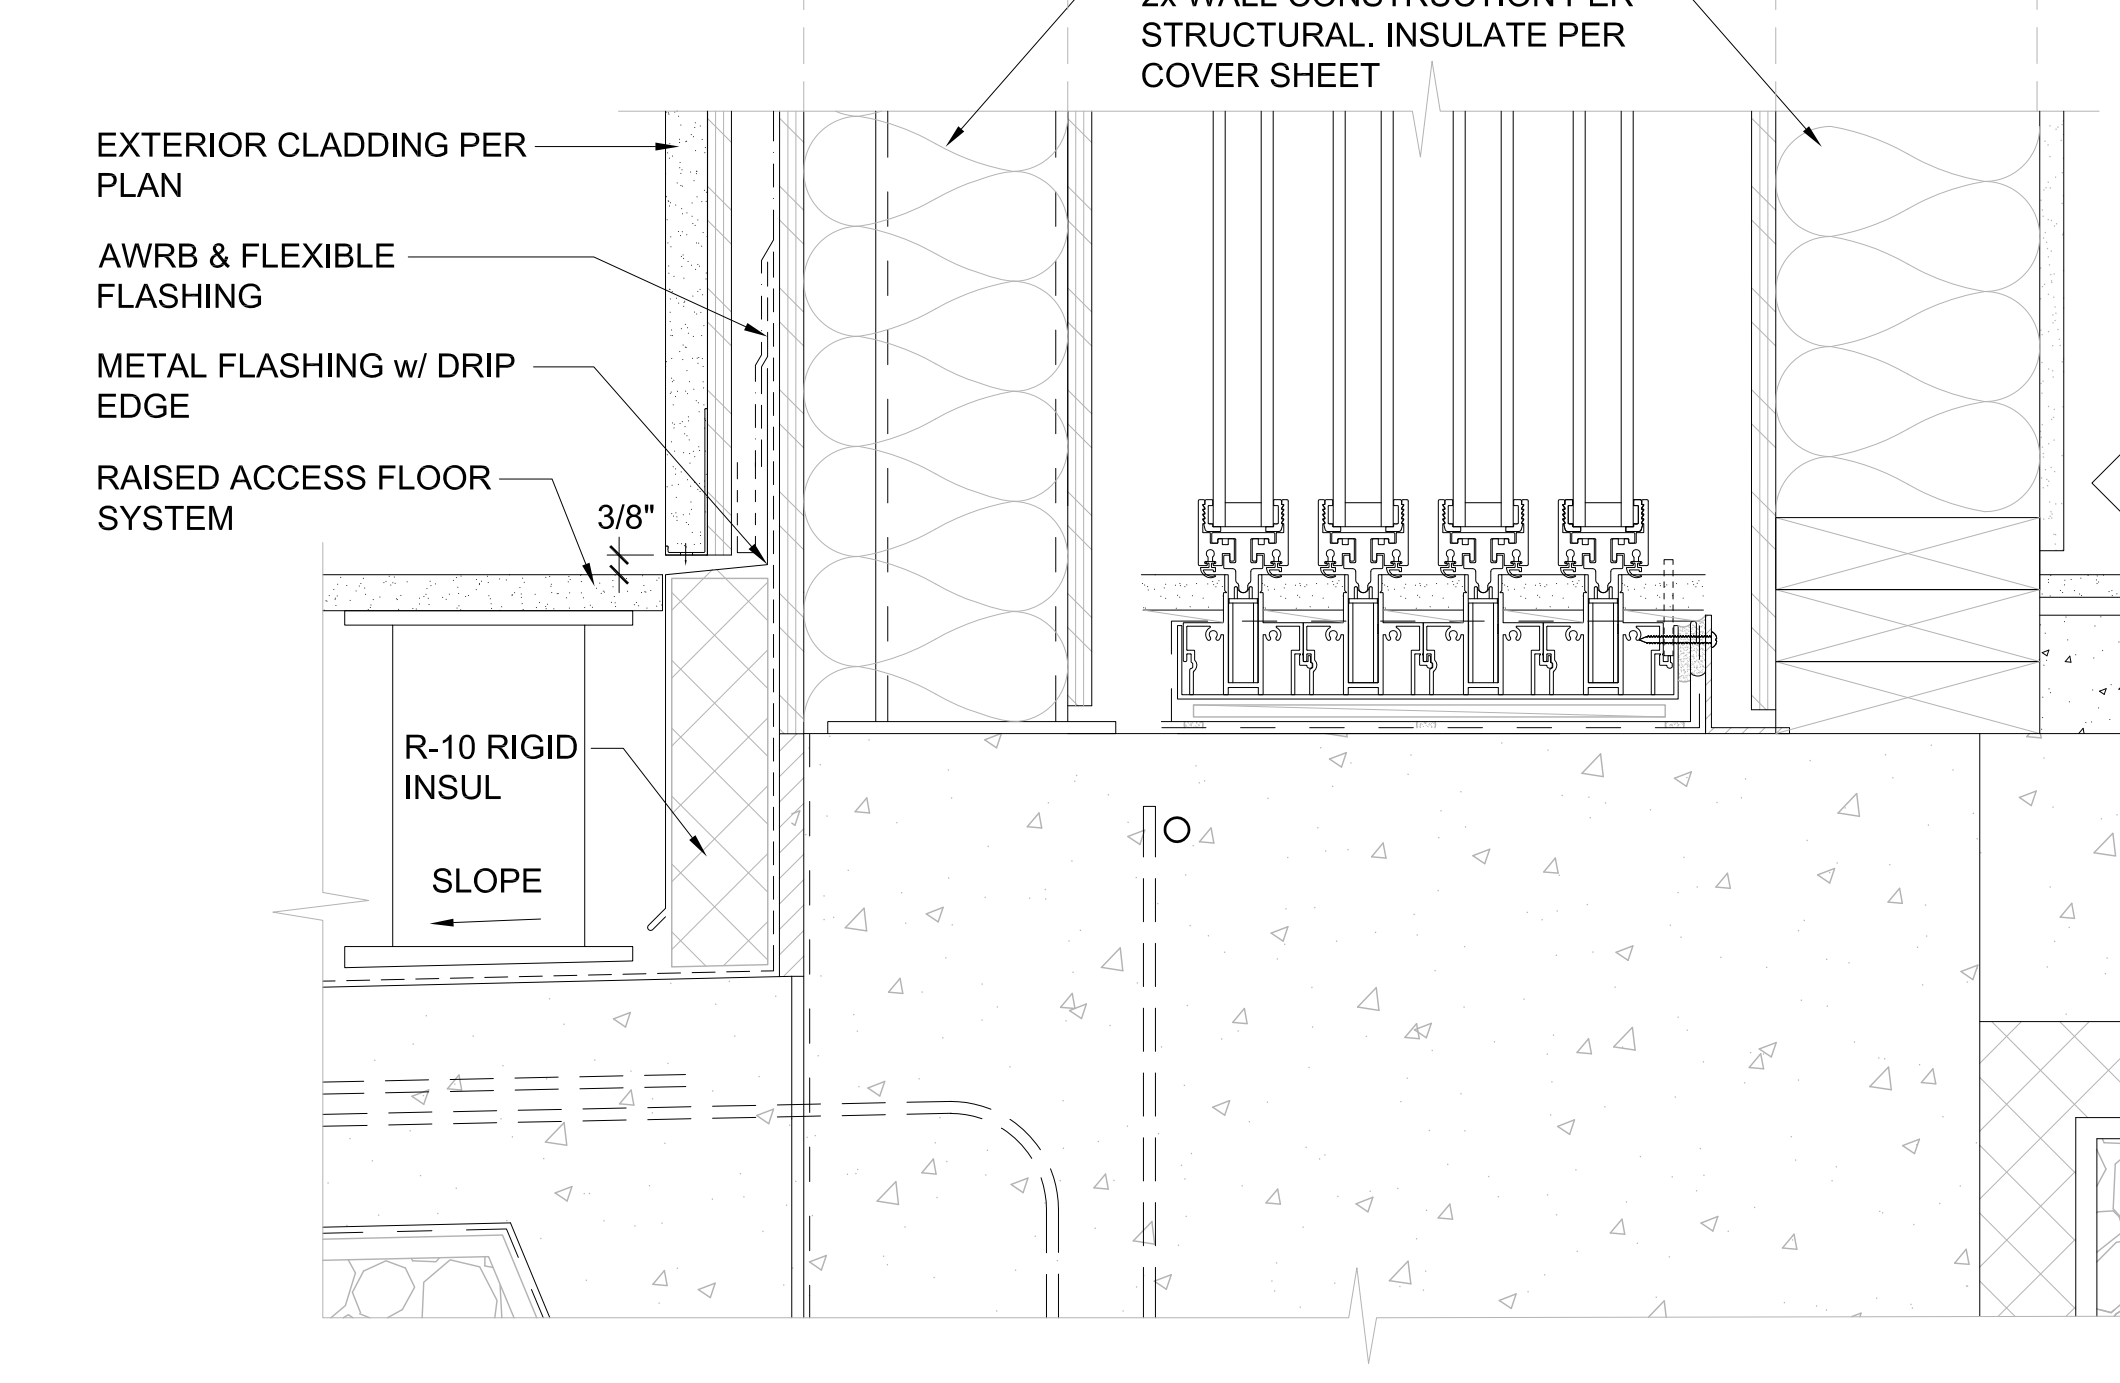


**FLEETWOOD EDGE MULTI-SLIDE POCKET**  
SCALE: 3/4\"/>

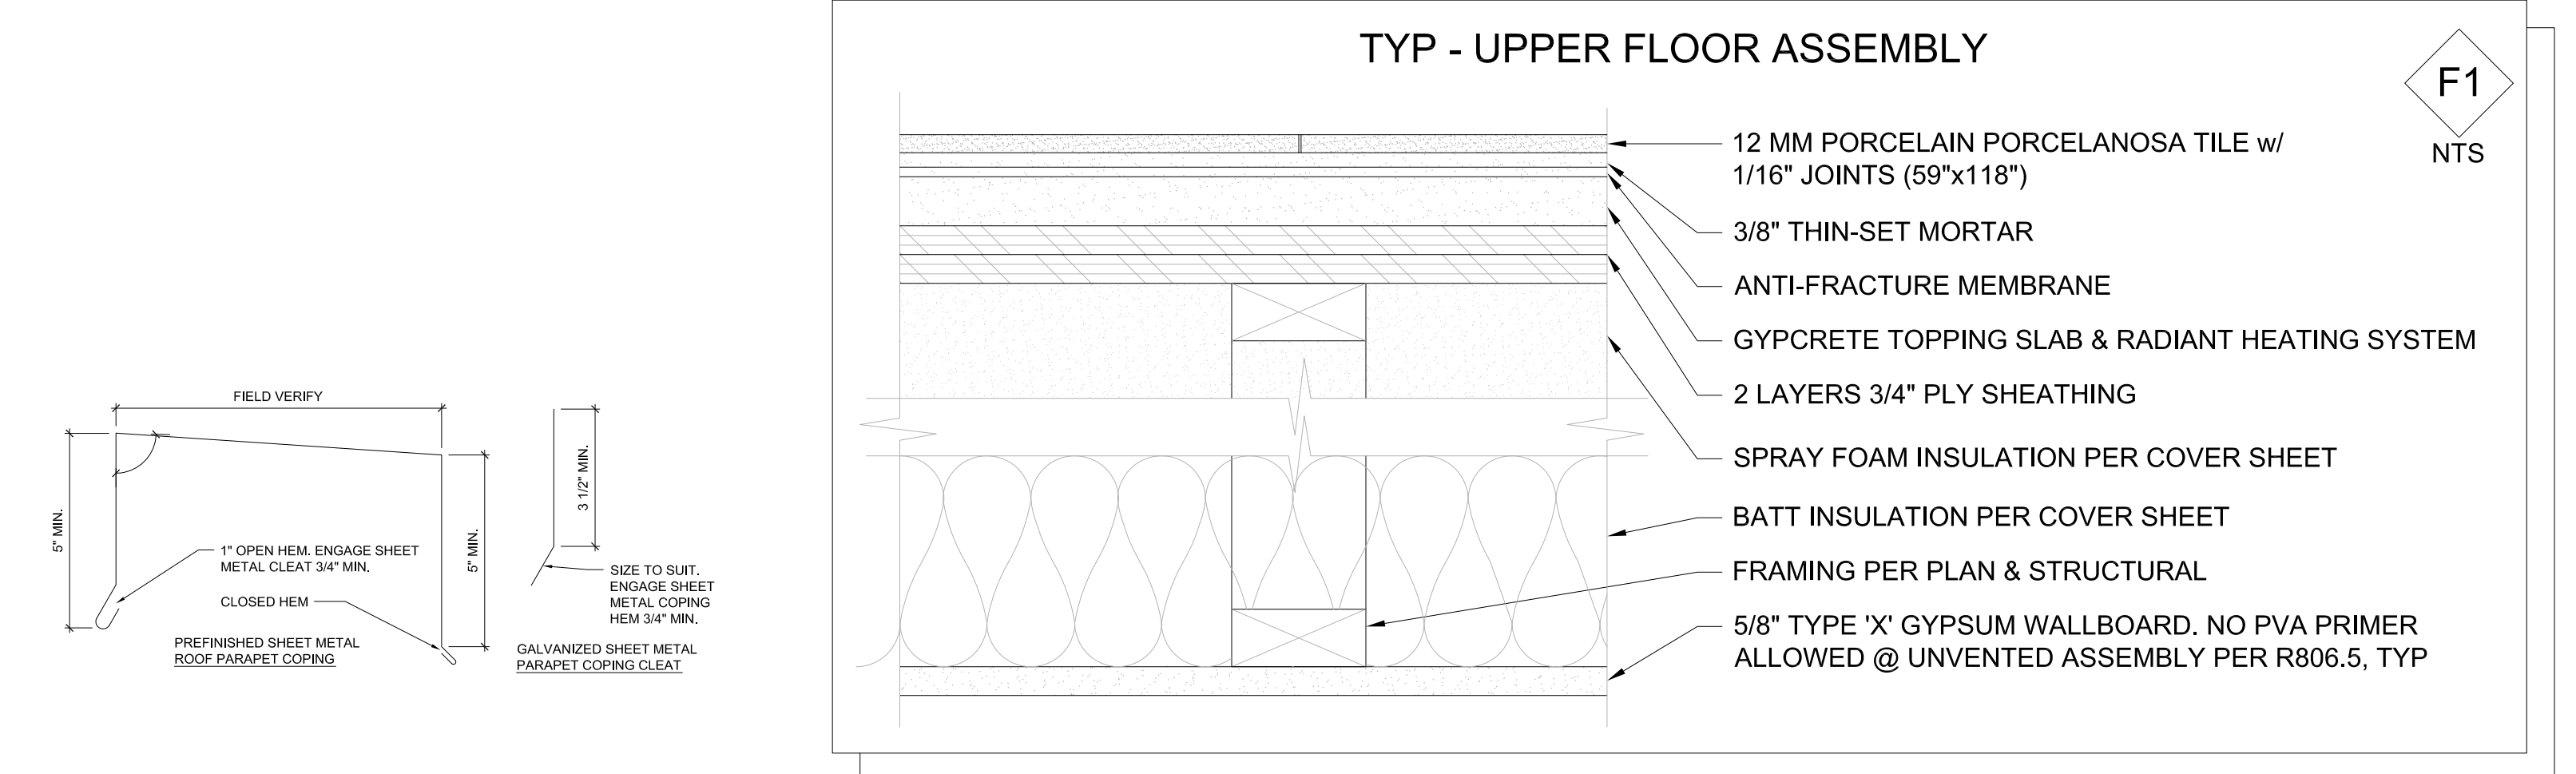

**TYP - UPPER FLOOR ASSEMBLY**  
SCALE: 3/4\"/>

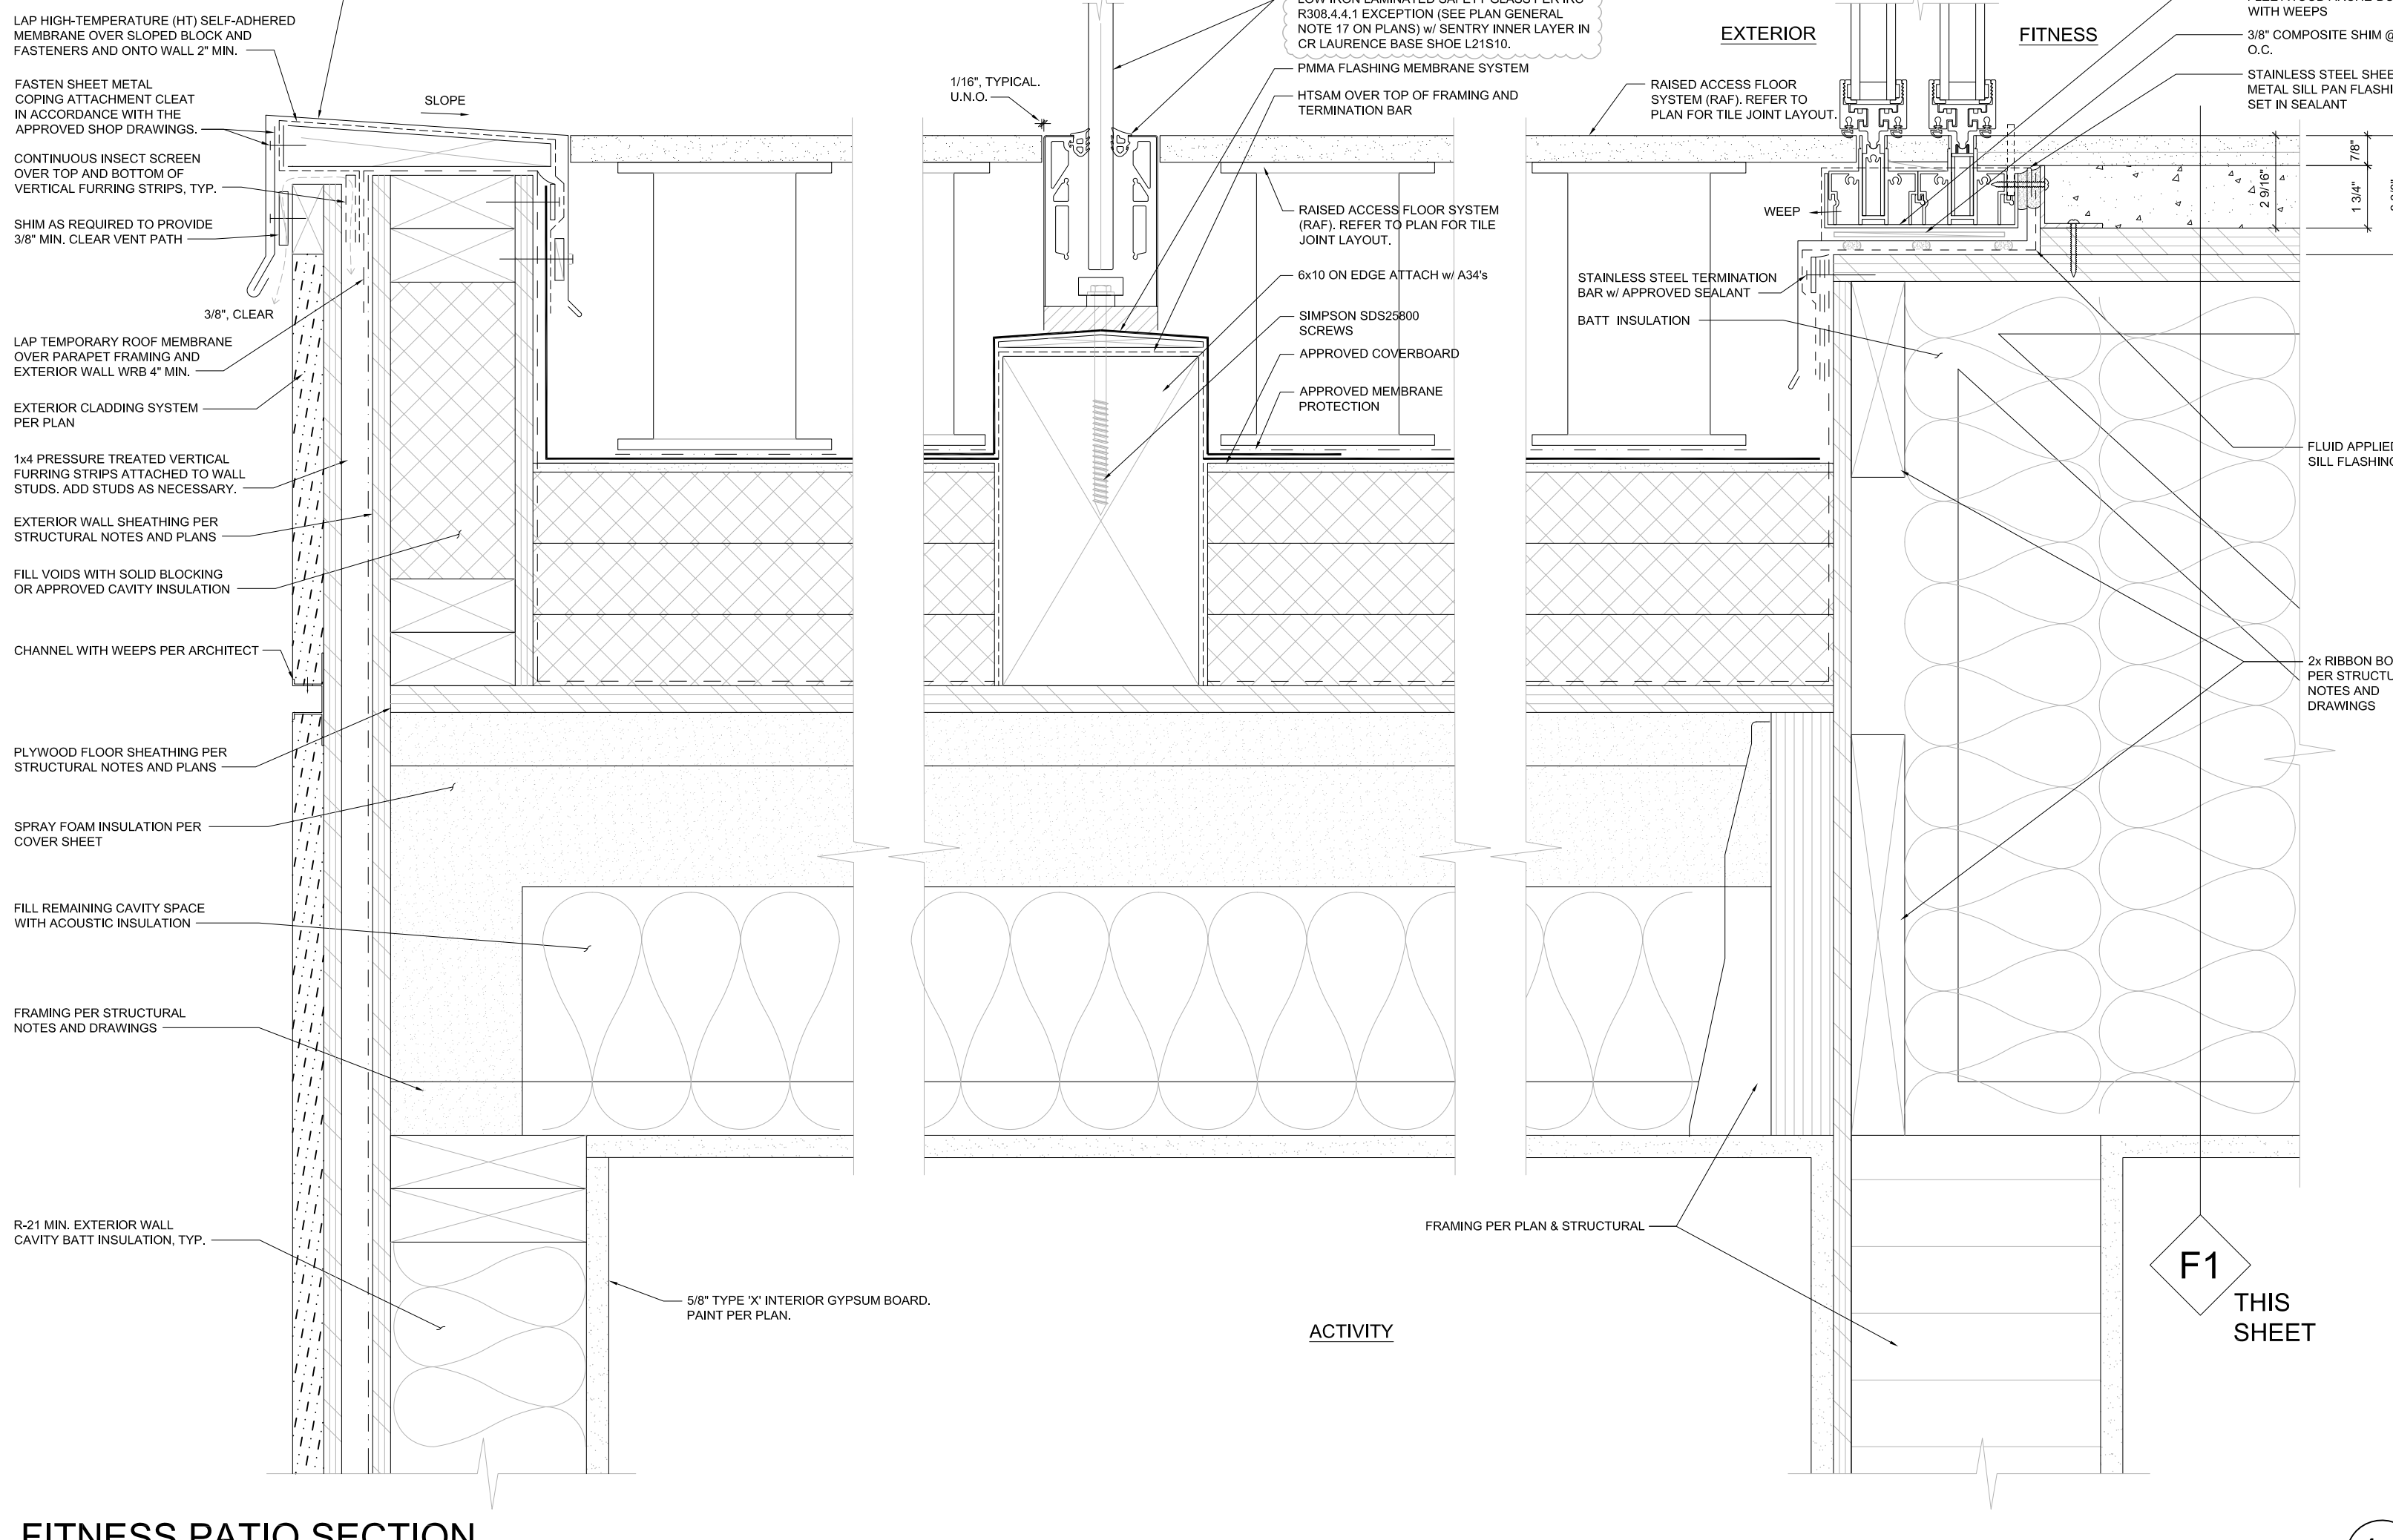

**FITNESS PATIO SECTION**  
SCALE: 3/4\"/>

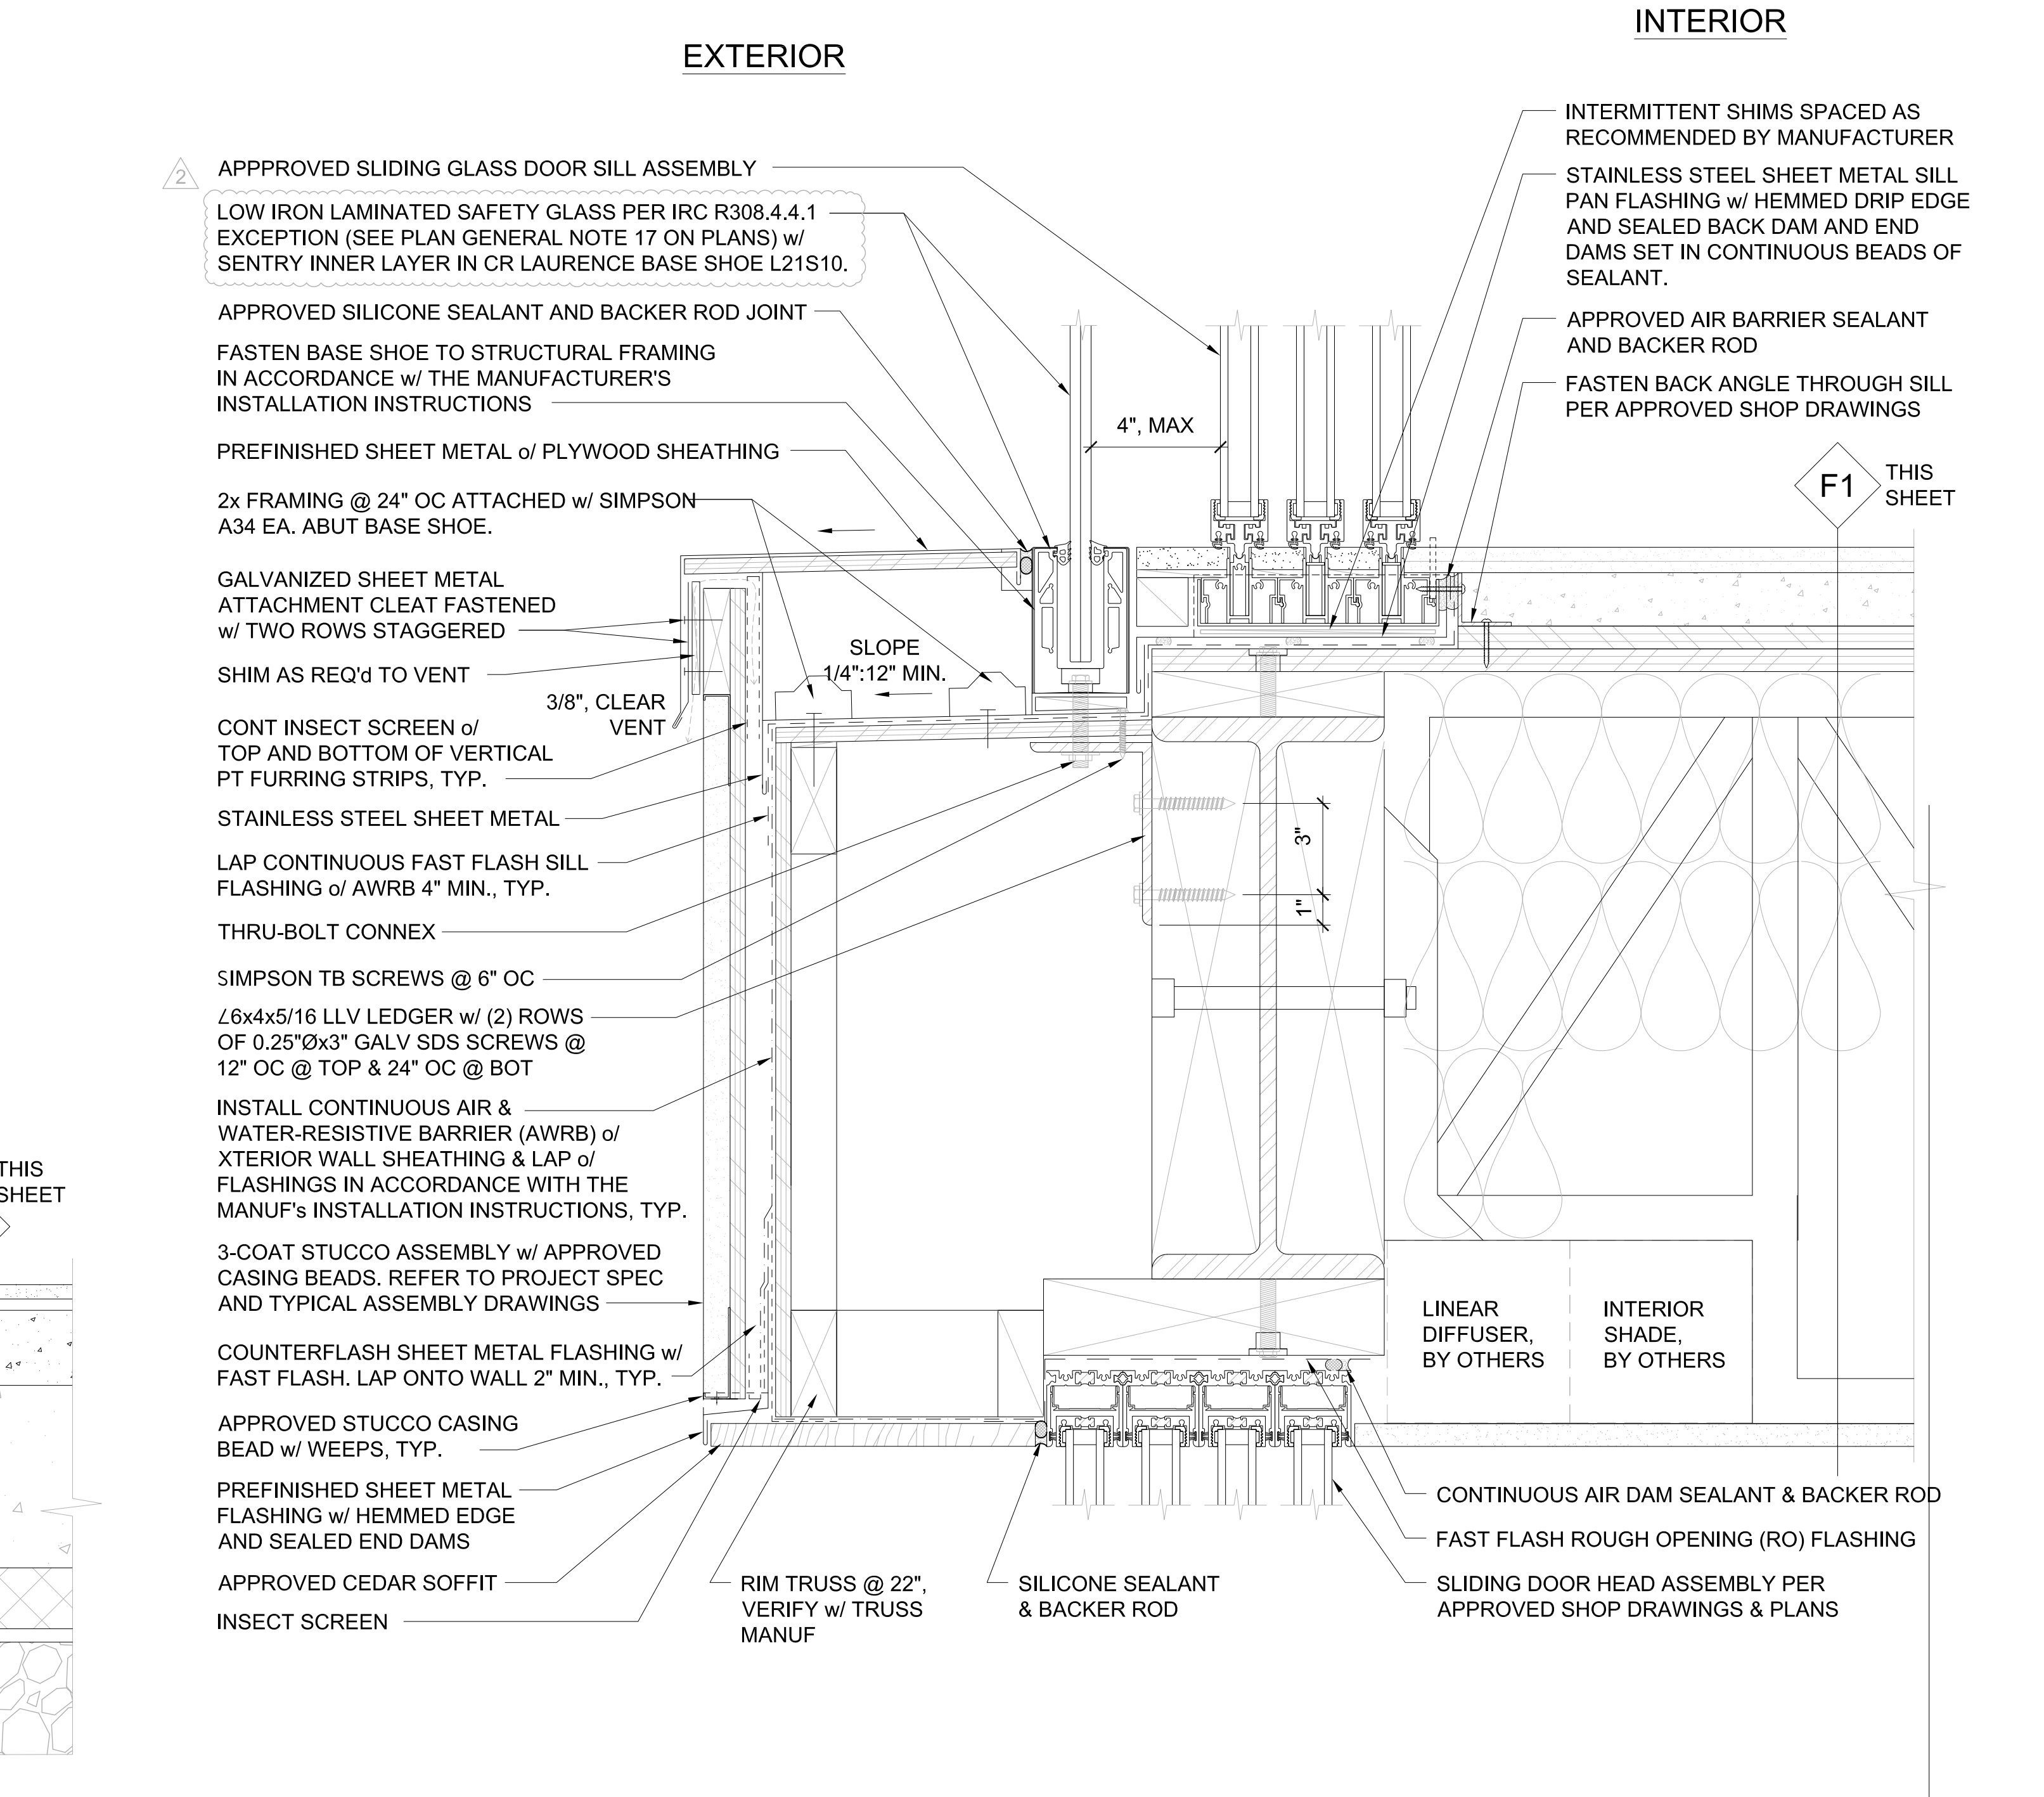

**GLASS GUARDRAIL @ EERO SLIDING GLASS DOOR, TYP**  
SCALE: 3/4\"/>

**McCULLOUGH ARCHITECTS**  
 5601 6th Ave S, Suite 371  
 Seattle, WA 98108  
 206.443.1181  
 mccullougharchitects.com

**KONERU RESIDENCE**  
 6610 E Mercer Way  
 Mercer Island, WA 98040

2021.10.13  
 21-041  
 Date: Project No:  
 Drawn: DJR  
 Approved: APM

2021.11.17  
 2021.12.13  
 2021.12.22  
 2022.05.02  
 2022.05.04  
 2022.05.12  
 2022.06.18

Comment:  
 Updated Plans to Structural  
 Structural Backcheck 01  
 Structural Backcheck 02  
 Structural Backcheck 03  
 Permit Corrections  
 Structural Backcheck  
 Commentary Response  
 Cycle 2 Structural Backcheck  
 Cycle 3 Structural Backcheck

UNPUBLISHED WORK 2016 © McCullough Architects

**A17**



# GENERAL STRUCTURAL NOTES

THE FOLLOWING APPLY UNLESS SHOWN OTHERWISE ON THE DRAWINGS

## CRITERIA

- ALL MATERIALS, WORKMANSHIP, DESIGN, AND CONSTRUCTION SHALL CONFORM TO THE DRAWINGS, SPECIFICATIONS, AND THE INTERNATIONAL BUILDING CODE (IBC) 2018 EDITION.

DESIGN (LOADING CRITERIA)	40 PSF
FLOOR LIVE LOAD (RESIDENTIAL)	40 PSF
FLOOR LIVE LOAD (RESIDENTIAL DECKS AND BALCONIES)	25 PSF
SNOW	5 PSF
RAIN ON SNOW	5 PSF
SOLAR PANEL	5 PSF
WIND	METHOD - DIRECTIONAL PROCEEDURE
Kz=1.0, GcPd=0.18, 110 MPH (RISK CATEGORY II), EXPOSURE "C"	
EARTHQUAKE	ANALYSIS PROCEDURE: EQUIVALENT LATERAL FORCE PROCEDURE
LATERAL SYSTEM: LIGHT FRAMED SHEAR WALLS	
SDC D, SITE CLASS E, I <sub>m</sub> =1.0, S <sub>s1</sub> =1.45, S <sub>s2</sub> =1.50	
S <sub>d1</sub> =1.059, S <sub>d1</sub> =0.567, C <sub>s</sub> =0.163, R <sub>w</sub> =6.5	
SEISMIC DESIGN BASE SHEAR V <sub>u</sub> =68.0 KIPS (ULTIMATE)	

- STRUCTURAL DRAWINGS SHALL BE USED IN CONJUNCTION WITH ARCHITECTURAL DRAWINGS FOR BIDDING AND CONSTRUCTION. CONTRACTOR SHALL VERIFY DIMENSIONS AND CONDITIONS FOR COMPATIBILITY AND SHALL NOTIFY ARCHITECT OF ANY DISCREPANCIES PRIOR TO CONSTRUCTION.
- PRIMARY STRUCTURAL ELEMENTS NOT DIMENSIONED ON THE STRUCTURAL PLANS AND DETAILS SHALL BE LOCATED BY THE ARCHITECT DURING CONSTRUCTION. VERTICAL DIMENSION CONTROL IS DEFINED BY THE ARCHITECTURAL WALL SECTIONS, BUILDING SECTIONS, AND PLANS. DETAILING AND SHOP DRAWING PRODUCTION FOR STRUCTURAL ELEMENTS WILL REQUIRE DIMENSIONAL INFORMATION CONTAINED IN BOTH ARCHITECTURAL AND STRUCTURAL DRAWINGS.
- CONTRACTOR SHALL PROVIDE TEMPORARY BRACING FOR THE STRUCTURE AND STRUCTURAL COMPONENTS UNTIL ALL FINAL CONNECTIONS HAVE BEEN COMPLETED IN ACCORDANCE WITH THE PLANS. CONFORM TO ASCE 31-14 DESIGN LOADS ON STRUCTURES DURING CONSTRUCTION.

- CONTRACTOR SHALL BE RESPONSIBLE FOR ALL SAFETY PRECAUTIONS AND THE METHODS, TECHNIQUES, SEQUENCES REQUIRED TO PERFORM THE CONTRACTOR'S WORK. THE STRUCTURAL ENGINEER HAS NO OVERALL SUPERVISORY AUTHORITY OR ACTUAL AND/OR DIRECT RESPONSIBILITY FOR THE SPECIFIC WORKING CONDITIONS AT THE SITE AND/OR FOR ANY HAZARDS RESULTING FROM THE ACTIONS OF ANY TRADE CONTRACTOR. THE STRUCTURAL ENGINEER HAS NO DUTY TO INSPECT, SUPERVISE, NOTE, CORRECT, OR REPORT ANY HEALTH OR SAFETY DEFICIENCIES TO THE OWNER, CONTRACTORS, OR OTHER ENTITIES OR PERSONS AT THE PROJECT SITE.

- CONTRACTOR-INITIATED CHANGES SHALL BE SUBMITTED IN WRITING TO THE ARCHITECT AND STRUCTURAL ENGINEER FOR APPROVAL PRIOR TO FABRICATION OR CONSTRUCTION. CHANGES SHOWN ON SHOP DRAWINGS ONLY WILL NOT SATISFY THIS REQUIREMENT.

- DRAWINGS INDICATE GENERAL AND TYPICAL DETAILS OF CONSTRUCTION, WHERE CONDITIONS ARE NOT SPECIFICALLY INDICATED BUT ARE OF SIMILAR CHARACTER TO DETAILS SHOWN. SIMILAR DETAILS OF CONSTRUCTION SHALL BE USED, SUBJECT TO REVIEW AND APPROVAL BY THE ARCHITECT AND THE STRUCTURAL ENGINEER.

- ALL STRUCTURAL SYSTEMS WHICH ARE TO BE COMPOSED OF COMPONENTS TO BE FIELD ERRECTED SHALL BE SUPERVISED BY THE SUBTRACTOR'S DESIGNER. THE CONTRACTOR SHALL PROVIDE STORAGE AND ERECTION IN ACCORDANCE WITH INSTRUCTIONS PREPARED BY THE SUPPLIER. MANUFACTURERS INSTALLATION INSTRUCTIONS SHALL BE AVAILABLE ON THE JOB SITE AT THE TIME OF INSPECTION FOR THE INSPECTORS USE AND REFERENCE.

- SHOP DRAWINGS FOR THE FOLLOWING ITEMS SHALL BE SUBMITTED TO THE ARCHITECT AND STRUCTURAL ENGINEER FOR REVIEW PRIOR TO FABRICATION OF THESE ITEMS.

- REINFORCING STEEL
- STRUCTURAL STEEL
- METAL DECKING
- GLUED LAMINATED MEMBERS
- MANUFACTURED LUMBER (PSL'S, LSL'S, LVL'S)
- PLYWOOD WEB JOISTS
- CONNECTOR PLATE WOOD FLOOR TRUSSES
- CONNECTOR PLATE WOOD ROOF TRUSSES
- PREFABRICATED STAIR SYSTEM

APPROVED SETS OF SHOP DRAWINGS SHALL ALSO BE SUBMITTED TO THE BUILDING DEPARTMENT AS REQUIRED BY THE JURISDICTION. IF THERE IS A DOUBT WHETHER OR NOT A POST-PERMIT SUBMITTAL IS NECESSARY OR WILL BE ACCEPTED, CONSULT THE BUILDING CODE REVIEWER FOR THE ORIGINAL PERMIT. NO DRAWING SHOULD BE SUBMITTED TO THE BUILDING OFFICIAL THAT STILL BEARS THE DISPOSITION OF "REVISE AND RESUBMIT" OR SIMILAR LANGUAGE.

- SHOP DRAWING REVIEW OF DIMENSIONS AND QUANTITIES ARE NOT REVIEWED BY THE ENGINEER OF RECORD. THEREFORE MUST BE VERIFIED BY THE CONTRACTOR. CONTRACTOR SHALL REVIEW AND APPROVE SHOP DRAWINGS PRIOR TO REVIEW BY ARCHITECT AND STRUCTURAL ENGINEER. CONTRACTOR SHALL PROVIDE DRAWINGS FOR CONFORMANCE WITH THE MEANS, METHODS, TECHNIQUES, SEQUENCES AND OPERATIONS OF CONSTRUCTION, AND ALL SAFETY PRECAUTIONS AND PROGRAMS INCIDENTAL THERETO. SUBMITTALS SHALL INCLUDE A REPRODUCIBLE AND (1) COPY; REPRODUCIBLE WILL BE MARKED AND RETURNED WITHIN (2) WEEKS OF RECEIPT WITH A NOTATION INDICATING THAT THE SUBMITTED HAS BEEN FOUND TO BE IN GENERAL CONFORMANCE WITH THE DESIGN OF THE BUILDING. THE SUBMITTED ITEMS SHALL NOT BE INSTALLED UNTIL THEY HAVE BEEN APPROVED BY THE BUILDING OFFICIAL AS REQUIRED BY THE JURISDICTION.

SHOP DRAWING SUBMITTALS PROCESSED BY THE ENGINEER ARE NOT CHANGE ORDERS. THE PURPOSE OF SHOP DRAWINGS SUBMITTED TO THE CONTRACTOR IS TO DEMONSTRATE TO THE ENGINEER THAT THE CONTRACTOR UNDERSTANDS THE DESIGN CONCEPT, BY INDICATING WHICH MATERIAL IS INTENDED TO BE FURNISHED AND INSTALLED AND BY DETAILING THE INTENDED FABRICATION AND INSTALLATION METHODS. IF DEVIATIONS, DISCREPANCIES, OR CONFLICTS BETWEEN SHOP DRAWING SUBMITTALS AND THE CONTRACT DOCUMENTS ARE DISCOVERED EITHER PRIOR TO OR AFTER SHOP DRAWING SUBMITTALS ARE PROCESSED BY THE ENGINEER, THE DESIGN DRAWINGS AND SPECIFICATIONS SHALL CONTROL AND SHALL BE FOLLOWED.

- SHOP DRAWINGS OF DESIGN BUILD COMPONENTS INCLUDING AWNINGS, BALCONIES, BASE ISOLATORS, CANOPES, CURTAIN WALL SYSTEMS, ELEVATORS, EXTERIOR CLADDING, FALL PROTECTION ANCHORS, HOLD-DOWN SYSTEMS (MULTI-STORY), SKYLIGHT FRAMES, STAIR SYSTEMS, STEEL STUD FRAMING, STORAGE RACKS (GREATER THAN 6 FEET IN HEIGHT), AND SUNROOMS SHALL BE STAMPED AND SIGNED BY A STRUCTURAL ENGINEER REGISTERED IN THE STATE OF WASHINGTON AND SHALL BE APPROVED BY THE COMPONENT DESIGNER PRIOR TO REVIEW BY THE ARCHITECT OR ENGINEER OF RECORD FOR GENERAL CONFORMANCE WITH THE DESIGN OF THE BUILDING. THE COMPONENT DESIGNER IS RESPONSIBLE FOR CODE CONFORMANCE AND ALL NECESSARY CONNECTIONS NOT SPECIFICALLY CALLED OUT ON ARCHITECTURAL OR STRUCTURAL DRAWINGS. SHOP DRAWINGS SHALL INDICATE MAGNITUDE AND DIRECTION OF ALL LOADS IMPOSED ON BASIC STRUCTURE. DESIGN CALCULATIONS SHALL BE MADE AVAILABLE UPON WRITTEN REQUEST.

## QUALITY ASSURANCE

- SPECIAL INSPECTION SHALL BE PROVIDED IN ACCORDANCE WITH THE PROJECT SPECIFICATIONS AND SECTIONS 110, 1704 AND 1705 OF THE IBC BY A QUALIFIED TESTING AGENCY DESIGNATED BY THE ARCHITECT, AND RETAINED BY THE BUILDING OWNER, THE ARCHITECT, STRUCTURAL ENGINEER, AND BUILDING DEPARTMENT SHALL BE FURNISHED WITH COPIES OF ALL INSPECTION AND TEST RESULTS. SPECIAL INSPECTION OF THE FOLLOWING TYPES OF CONSTRUCTION SHALL BE PERFORMED.

SOIL CONDITIONS, FILL PLACEMENT, AND DENSITY	PER SOILS REPORT
PILE OR PIER FOUNDATIONS <td>PER SOILS REPORT</td>	PER SOILS REPORT
EPOXY GROUTED INSTALLATIONS <td>PER MANUFACTURER</td>	PER MANUFACTURER
STRUCTURAL STEEL FABRICATION AND ERECTION <td>PER ASCE 360</td>	PER ASCE 360
METAL DECK INSTALLATION (INCLUDING FIELD WELDING) <td>PER SDI GA/QC</td>	PER SDI GA/QC

- STRUCTURAL OBSERVATION SHALL BE PERFORMED IN ACCORDANCE WITH SECTION 1704.6 OF THE IBC FOR THE FOLLOWING BUILDING ELEMENTS:

CONCRETE CONSTRUCTION	STRUCTURAL STEEL CONSTRUCTION	SHEARWALLS	HOLD-DOWNS

THE CONTRACTOR SHALL PROVIDE THE ENGINEER OF RECORD ADEQUATE NOTICE TO SCHEDULE APPROPRIATE SITE VISITS FOR STRUCTURAL OBSERVATION.

STRUCTURAL OBSERVATION MEANS THE VISUAL OBSERVATION OF THE STRUCTURAL SYSTEM, FOR GENERAL CONFORMANCE TO THE APPROVED PLANS AND SPECIFICATIONS, AT SIGNIFICANT CONSTRUCTION STAGES AND AT COMPLETION OF THE STRUCTURAL SYSTEM. STRUCTURAL OBSERVATION DOES NOT INCLUDE OR WAIVE THE RESPONSIBILITY FOR THE INSPECTIONS REQUIRED IN SECTION 110 OR SPECIAL INSPECTIONS IN SECTION 1705 OR OTHER SECTIONS OF THE IBC.

THE OWNER SHALL EMPLOY THE STRUCTURAL ENGINEER OR ARCHITECT RESPONSIBLE FOR THE STRUCTURAL DESIGN, TO PERFORM STRUCTURAL OBSERVATION. OBSERVED DEFICIENCIES SHALL BE REPORTED IN WRITING TO THE OWNER'S REPRESENTATIVE, SPECIAL INSPECTOR, CONTRACTOR, AND THE BUILDING OFFICIAL. THE CONTRACTOR SHALL BE RESPONSIBLE FOR THE INSPECTION AND TEST RESULTS. A WRITTEN STATEMENT THAT THE SITE VISITS HAVE BEEN MADE AND IDENTIFY ANY REPORTED DEFICIENCIES WHICH, TO THE BEST OF THE STRUCTURAL OBSERVER'S KNOWLEDGE, HAVE NOT BEEN

## GEOTECHNICAL

- SUBGRADE PREPARATION INCLUDING DRAINAGE, EXCAVATION, COMPACTION, AND FILLING REQUIREMENTS SHALL CONFORM STRICTLY WITH THE RECOMMENDATIONS GIVEN IN THE SOILS REPORT OR AS DIRECTED BY THE SOILS ENGINEER. FOOTINGS SHALL BEAR ON SOUND UNDISTURBED EARTH AT LEAST 18" BELOW LOWEST ADJACENT FINISHED GRADE. FOOTING DEPTHS/ELEVATIONS SHOWN ON PLANS (OR IN DETAILS) ARE MINIMUM AND FOR GUIDANCE ONLY; THE ACTUAL ELEVATIONS OF FOOTINGS MUST BE ESTABLISHED BY THE CONTRACTOR IN THE FIELD WORKING WITH THE TESTING LAB AND SOILS ENGINEER. BACKFILL BEHIND ALL RETAINING WALLS WITH FREE DRAINING GRANULAR FILL AND PROVIDE FOR SUBSURFACE DRAINAGE AS NOTED IN THE SOILS REPORT.

LATERAL EARTH PRESSURE (RESTRAINED/UNRESTRAINED)	SEE SOILS REPORT / 45 PCF
TRAFFIC SURCHARGE <td>90 PSF</td>	90 PSF
SEISMIC SURCHARGE <td>300 PCF</td>	300 PCF
PASSIVE PRESSURE <td>10 TONS</td>	10 TONS

SOILS REPORT REFERENCE: GEOTECHNICAL ENGINEERING STUDY AND CRITICAL AREA STUDY OF PROPOSED PROPERTY REDEVELOPMENT LOCATED AT 6610 EAST MERCER WAY, MERCER ISLAND, WASHINGTON, 98040. PREPARED BY GEOTECH CONSULTANTS, INC., REPORT NUMBER JN21151, DATED JUNE 8, 2021.

- DIAMETER STANDARD WEIGHT PIPE PILES SHALL BE DRIVEN TO REFUSAL AS DEFINED BY THE SOILS ENGINEER. PIPE PILES SHALL BE INSTALLED IN STRICT CONFORMANCE TO SOILS ENGINEER'S REQUIREMENTS. TESTING OF PILES SHALL BE ACCORDANCE WITH SOILS ENGINEER'S REQUIREMENTS. TESTING OF PILES SHALL BE IN ACCORDANCE TO ASTM STANDARD D1143-83 FOR A MINIMUM OF (1)PILE OR 3% OF 3", 4" AND 6" DIAMETER PILES UP TO (5)PILES OF EACH SIZE MAXIMUM; USE OF THE QUICK LOAD TEST METHOD IN THE STANDARD IS THE MINIMUM REQUIRED. STEEL PIPE SHALL CONFORM TO ASTM A53, GRADE A OR B, F<sub>y</sub> = 35 KSI. PILES SHALL BE DRIVEN IN NOMINAL SECTIONS AND CONNECTED WITH COMPRESSION FITTED SLEEVE COUPLERS. PIPE JOINTS SHOULD NOT BE WELDED TOGETHER. PILES SHALL BE PLACED WITHIN 3" OF SPECIFIED LOCATION. THE CONTRACTOR SHALL DETERMINE THE LOCATION OF ALL ADJACENT UNDERGROUND UTILITIES PRIOR TO DRIVING PILES.

- SPECIAL INSPECTION OF PILES SHALL BE REQUIRED FOR INSTALLATION AND TESTING.

## CONCRETE

- CONCRETE SHALL BE MIXED, PROPORTIONED, CONVEYED AND PLACED IN ACCORDANCE WITH ACI 318 AND ACI 301, INCLUDING THEIR TESTING PROCEDURES. CONCRETE SHALL ATTAIN A 28-DAY STRENGTH OF F<sub>c</sub> = 3000 PSI. SLUMP OF CONCRETE SHALL NOT EXCEED 6". STRUCTURAL DESIGN IS BASED ON A GREATER LOAD CAPACITY. PROVIDE NUMBER AND SIZE OF FASTENERS AS SPECIFIED BY CONTRACTOR. CONCRETE EXPOSURE CATEGORIES ARE F1, S0, W0, AND C1.

ALL CONCRETE WITH SURFACES EXPOSED TO STANDING WATER SHALL BE AIR ENTRAINED WITH AN AIR-ENTRAINING AGENT CONFORMING TO ASTM C266. TOTAL AIR CONTENT FOR FROST-RESISTANT CONCRETE SHALL BE IN ACCORDANCE WITH ACI 318-14, TABLE 19.3.3.1.

- REINFORCING STEEL SHALL CONFORM TO ASTM A615, GRADE 60, F<sub>y</sub> = 40 KSI. EXCEPTIONS: ANY BARS SPECIFICALLY SO NOTED ON THE DRAWINGS SHALL BE GRADE 40, F<sub>y</sub> = 40 KSI. WELDED WIRE FABRIC SHALL CONFORM TO ASTM A1064. SPIRAL REINFORCEMENT SHALL BE DEFORMED WIRE CONFORMING TO ASTM A615, GRADE 60, F<sub>y</sub> = 40 KSI.

- DETAILING OF REINFORCING STEEL (INCLUDING HOOKS AND BENDS) SHALL BE IN ACCORDANCE WITH ACI 318-14 AND 318-14. LAP ALL CONTINUOUS REINFORCEMENT BARS AT 48 BAR DIAMETERS OR 2'-0" MINIMUM. PROVIDE CORNER BARS AT ALL WALL AND FOOTING INTERSECTIONS. LAP CORNER BARS #5 AND SMALLER 48 BAR DIAMETERS OR 2'-0" MINIMUM. LAPS OF LARGER BARS SHALL BE MADE IN ACCORDANCE WITH ACI 318-14, CLASS B. LAP ADJACENT MATS OF WELDED WIRE FABRIC A MINIMUM OF 6" AT SIDES AND ENDS.

NO BARS PARTIALLY EMBEDDED IN HARDENED CONCRETE SHALL BE FIELD BENT UNLESS SPECIFICALLY SO DETAIL OR APPROVED BY THE STRUCTURAL ENGINEER.

- CONCRETE PROTECTION (COVER) FOR REINFORCING STEEL SHALL BE AS FOLLOWS:

FOOTINGS AND OTHER UNFORMED SURFACES CAST AGAINST AND PERMANENTLY EXPOSED TO EARTH	3"
FORMED SURFACES EXPOSED TO EARTH OR WEATHER (#6 BARS OR LARGER)	2"
FORMED SURFACES EXPOSED TO EARTH OR WEATHER (#5 BARS OR SMALLER)	1-1/2"
COLUMN TIES OR SPIRALS AND BEAM STRIPUPS	1-1/2"
SLABS AND WALLS (NOT FACE)	GREATER OF BAR DIAMETER PLUS 1/8" OR 3/4"

## ANCHORAGE

- EPOXY-GROUTED ITEMS (THREADED RODS OR REINFORCING BARS) SPECIFIED ON THE DRAWINGS SHALL BE INSTALLED USING "SET-UP" EPOXY ADHESIVE AS MANUFACTURED BY THE SIMPSON STRONG TIE COMPANY. INSTALL IN STRICT ACCORDANCE WITH ICC-ES REPORT ESR-2508 AND IAPMO UES REPORT ESR-265. SUBSTITUTIONS PROPOSED BY THE CONTRACTOR SHALL BE SUBMITTED FOR REVIEW WITH CURRENT ICC REPORTS INDICATING EQUIVALENT OR GREATER LOAD CAPACITIES. SPECIAL INSPECTION OF INSTALLATION IS REQUIRED. RODS SHALL BE ASTM A36, UNO.

- HEAVY DUTY THREADED CONCRETE ANCHORS SPECIFIED ON THE DRAWINGS SHALL BE "TREN HD SCREW ANCHOR" AS MANUFACTURED BY THE SIMPSON STRONG TIE COMPANY. INSTALL IN STRICT ACCORDANCE WITH ICC-ES REPORT ESR-2713 AND ESR-1056, INCLUDING MINIMUM EMBEDMENT AND EDGE DISTANCE REQUIREMENTS. SUBSTITUTIONS PROPOSED BY THE CONTRACTOR SHALL BE SUBMITTED FOR REVIEW WITH CURRENT ICC REPORTS INDICATING EQUIVALENT OR GREATER LOAD CAPACITIES. SPECIAL INSPECTION OF INSTALLATION IS REQUIRED.

- EXPANSION BOLTS INTO CONCRETE AND CONCRETE MASONRY UNITS SHALL BE "STRONG-BOLT Z" ANCHORS AS MANUFACTURED BY THE SIMPSON STRONG TIE COMPANY. INSTALL IN STRICT CONFORMANCE TO ICC-ES REPORT ESR-3037 AND IAPMO UES REPORT ESR-240, INCLUDING MINIMUM EMBEDMENT AND EDGE DISTANCE REQUIREMENTS. SUBSTITUTIONS PROPOSED BY THE CONTRACTOR SHALL BE SUBMITTED FOR REVIEW WITH CURRENT ICC REPORTS INDICATING EQUIVALENT OR GREATER LOAD CAPACITIES. BOLTS INTO CONCRETE MASONRY OR BRICK MASONRY UNITS SHALL BE FULLY GROUTED CELLS. SPECIAL INSPECTION OF INSTALLATION IS REQUIRED.

- DRIVE PINS AND OTHER POWDER-ACTUATED FASTENERS SHALL BE LOW VELOCITY TYPE (POPW-300MG, 0.145" DIAMETER, UNO) AS MANUFACTURED BY THE SIMPSON STRONG TIE COMPANY OR AN APPROVED EQUIVALENT IN STRENGTH AND EMBEDMENT. INSTALL IN STRICT ACCORDANCE WITH ICC-ES REPORT ESR-2138. MINIMUM EMBEDMENT IN CONCRETE SHALL BE 1", UNO. MAINTAIN AT LEAST 3" TO NEAREST CONCRETE EDGE.

## WOOD

- 2x LUMBER SHALL BE KILN DRIED OR MC-19; AND ALL LUMBER SHALL BE GRADED AND MARKED IN ACCORDANCE WITH NDS STANDARD GRADING RULES FOR WEST COAST LUMBER NO 17. FURNISH TO THE FOLLOWING MINIMUM STANDARDS:

JOISTS AND BEAMS	(2x, 3x, 4x MEMBERS)	DOUGLAS FIR-LARCH NO 2 MINIMUM BASE VALUE, F <sub>b</sub> = 900 PSI
BEAMS	(6x AND LARGER)	DOUGLAS FIR-LARCH NO 2 MINIMUM BASE VALUE, F <sub>b</sub> = 875 PSI
POSTS	(4x MEMBERS)	DOUGLAS FIR-LARCH NO 2 MINIMUM BASE VALUE, F <sub>c</sub> = 1350 PSI
	(6x AND LARGER)	DOUGLAS FIR-LARCH NO 2 MINIMUM BASE VALUE, F <sub>c</sub> = 600 PSI
STUDS, PLATES AND MISG FRAMING		DOUGLAS FIR-LARCH NO 2

- GLUED LAMINATED MEMBERS SHALL BE FABRICATED IN CONFORMANCE WITH ASTM AND ANSI/AITC STANDARDS. EACH MEMBER SHALL BEAR AN AITC OR APA-EWS IDENTIFICATION MARK AND SHALL BE ACCOMPANIED BY AN AITC OR APA-EWS CERTIFICATE OF CONFORMANCE. ALL SIMPLE SPAN GLULAM BEAMS SHALL BE DOUGLAS FIR COMBINATION 24F-V8, F<sub>b</sub> = 2400 PSI, F<sub>v</sub> = 265 PSI, E = 1800 KSI, UNO. ALL CANTILEVER GLULAM BEAMS SHALL BE DOUGLAS FIR COMBINATION 24F-V8, F<sub>b</sub> = 2400 PSI, F<sub>v</sub> = 265 PSI, E = 1800 KSI, UNO. GLUED LAMINATED COLUMNS SHALL BE DOUGLAS FIR COMBINATION 3, 12D GRADE, F<sub>c</sub> = 2300 PSI, F<sub>b</sub> = 2000 PSI, E = 1900 KSI.

- MANUFACTURED LUMBER: PSL, LVL AND LSL SHALL BE MANUFACTURED UNDER A PROCESS APPROVED BY THE NATIONAL RESEARCH BOARD. EACH PIECE SHALL BEAR A STAMP OR STAMPS NOTING THE NAME AND PLANT NUMBER OF THE MANUFACTURER, THE GRADE, THE NATIONAL RESEARCH BOARD NUMBER, AND THE QUALITY CONTROL AGENCY. ALL PSL, LVL, AND LSL LUMBER SHALL BE MANUFACTURED IN ACCORDANCE WITH ICC-ES REPORT ESR-1387 USING DOUGLAS FIR VENEER GLUED WITH A WATERPROOF ADHESIVE MEETING THE REQUIREMENTS OF ASTM D2659 WITH ALL GRAN PARALLEL WITH THE LENGTH OF THE MEMBER. THE MEMBER SHALL HAVE THE FOLLOWING MINIMUM PROPERTIES:

PSL (2.0E)	F <sub>b</sub> = 2900 PSI	E = 2000 KSI	F <sub>v</sub> = 290 PSI
LVL (2.0E) <th>F<sub>b</sub> = 2600 PSI</th> <th>E = 2000 KSI</th> <th>F<sub>v</sub> = 285 PSI</th>	F <sub>b</sub> = 2600 PSI	E = 2000 KSI	F <sub>v</sub> = 285 PSI
LSL (1.55E) <th>F<sub>b</sub> = 2325 PSI</th> <th>E = 1500 KSI</th> <th>F<sub>v</sub> = 310 PSI</th>	F <sub>b</sub> = 2325 PSI	E = 1500 KSI	F <sub>v</sub> = 310 PSI
PSL COMB (1.8E) <th>F<sub>b</sub> = 2900 PSI</th> <th>E = 1800 KSI</th> <th>F<sub>v</sub> = 190 PSI</th>	F <sub>b</sub> = 2900 PSI	E = 1800 KSI	F <sub>v</sub> = 190 PSI


MANUFACTURED LUMBER PRODUCTS SHALL BE INSTALLED WITH A MOISTURE CONTENT OF 12% OR LESS. THE CONTRACTOR SHALL MAKE PROVISIONS DURING CONSTRUCTION TO PREVENT THE MOISTURE CONTENT OF INSTALLED BEAMS FROM EXCEEDING 12%. EXCESSIVE DEFLECTIONS MAY OCCUR IF MOISTURE CONTENT EXCEEDS THIS VALUE.

- PREFABRICATED PLYWOOD WEB JOIST DESIGN SHOWN ON PLANS IS BASED ON JOISTS MANUFACTURED BY THE TRUS-JOIST CORPORATION. ALTERNATE PLYWOOD WEB JOIST MANUFACTURERS MAY BE USED SUBJECT TO REVIEW AND APPROVAL BY THE ARCHITECT AND STRUCTURAL ENGINEER. ALTERNATE JOIST HANGERS AND OTHER HARDWARE MAY BE SUBSTITUTED FOR ITEMS SHOWN PROVIDED THEY HAVE CURRENT ICC APPROVAL FOR EQUAL OR GREATER LOAD CAPACITY. ALL JOIST HANGERS AND OTHER HARDWARE SHALL BE COMPATIBLE IN SIZE WITH MEMBERS PROVIDED.




- PREFABRICATED CONNECTOR PLATE WOOD FLOOR TRUSSES SHALL BE DESIGNED BY THE MANUFACTURER IN ACCORDANCE WITH THE NATIONAL DESIGN STANDARD FOR METAL PLATE CONNECTED WOOD TRUSS CONSTRUCTION, ANSI/TPI 1 BY THE TRUSS PLATE INSTITUTE FOR THE SPANS AND CONDITIONS SHOWN ON THE PLANS. LOADING SHALL BE AS FOLLOWS:

TOP CHORD LIVE LOAD	40 PSF
TOP CHORD DEAD LOAD	25 PSF
BOTTOM CHORD DEAD LOAD	5 PSF
TOTAL LOAD	70 PSF

REFER TO PLAN FOR ADDITIONAL LOADING. ALL FLOOR TRUSSES SHALL BE DESIGNED FOR A MAXIMUM LIVE LOAD DEFLECTION OF THE PLAN DIVIDED BY 480.

WOOD TRUSSES SHALL UTILIZE APPROVED CONNECTOR PLATES (GANGNAIL OR EQUAL). SUBMIT SHOP DRAWINGS AND DESIGN CALCULATIONS TO THE ARCHITECT AND STRUCTURAL ENGINEER FOR REVIEW PRIOR TO FABRICATION. SUBMITTED DOCUMENTS SHALL BE STAMPED AND SIGNED BY A STRUCTURAL ENGINEER REGISTERED IN THE STATE OF WASHINGTON. PROVIDE FOR SHAPE BEARING POINTS, INTERSECTIONS, HPS, VALLEYS, ETC. SHOWN ON THE DRAWINGS. PROVIDE ALL TRUSS TO TRUSS AND TRUSS TO GIRDER TRUSS CONNECTION DETAILS AND REQUIRED CONNECTION MATERIALS. PROVIDE FOR ALL TEMPORARY AND PERMANENT TRUSS BRACING AND BRIDGING.

- WOOD IN DIRECT CONTACT WITH CONCRETE OR MASONRY SHALL BE PRESURE-TREATED WITH AN APPROVED PRESERVATIVE OR (2) LAYERS OF ASPHALT IMPREGNATED BUILDING PAPER SHALL BE PROVIDED BETWEEN UNTREATED WOOD AND CONCRETE OR MASONRY.

- PRESURE TREATED WOOD (INCLUDES PRESERVATIVE AND FIRE TREATED) SHALL BE TREATED PER AWPA STANDARDS. PRESURE TREATED WOOD FOR ABOVE GROUND USE SHALL BE TREATED TO RETENTION OF 0.25 PCF. WOOD IN CONTINUOUS CONTACT WITH FRESH WATER OR SOIL SHALL BE TREATED TO A RETENTION OF 0.40 PCF. SODIUM BORATE (58X) TREATED WOOD SHALL NOT BE USED WHERE EXPOSED TO WEATHER. FASTENERS AND TIMBER CONNECTORS WITHOUT AMMONIA IN DIRECT CONTACT WITH ACQ-A TO A RETENTION LEVEL OF 0.40 PCF). CBA-A (UP TO A RETENTION LEVEL OF 0.41 PCF) (UP TO A RETENTION LEVEL OF 0.21 PCF). SHALL BE G185 OR A185 HOT DIPPED OR CONTINUOUSLY GALVANIZED PER ASTM A653. FASTENERS AND TIMBER CONNECTORS WITH AMMONIA IN DIRECT CONTACT WITH ACQ-A COVER A RETENTION LEVEL OF 0.40 PCF). CBA-A COVER A RETENTION LEVEL OF 0.41 PCF). CBA-B COVER A RETENTION LEVEL OF 0.21 PCF). OR WITH ACQ-A TREATED WOOD SHALL BE TYPE 304 OR 316 STAINLESS STEEL.

- CONNECTORS CALLED OUT BY LETTERS AND NUMBERS SHALL BE "STRONG-TIE" BY SIMPSON COMPANY, AS SPECIFIED IN THEIR CATALOG NUMBER C-C-2019. EQUIVALENT FASTENERS BY OTHER MANUFACTURERS MAY BE SUBSTITUTED, PROVIDED THEY HAVE CURRENT ICC APPROVAL FOR EQUAL OR GREATER LOAD CAPACITIES. PROVIDE NUMBER AND SIZE OF FASTENERS AS SPECIFIED BY MANUFACTURER. CONNECTORS SHALL BE INSTALLED IN ACCORDANCE WITH THE MANUFACTURER'S RECOMMENDATIONS.

- 2x JOISTS SHALL BE CONNECTED TO FLUSH BEAMS WITH "LUS" SERIES JOIST HANGERS. ALL TJ JOISTS SHALL BE CONNECTED TO FLUSH BEAMS WITH "HUS" SERIES JOIST HANGERS. ALL DOUBLE-JOIST BEAMS SHALL BE CONNECTED TO FLUSH BEAMS WITH "MIU" SERIES JOIST HANGERS.

WHERE CONNECTOR STRAPS CONNECT (2) MEMBERS, PLACE ONE-HALF OF THE NAILS OR BOLTS IN EACH MEMBER.

ALL SHIMS SHALL BE SEASONED AND DRIED AND THE SAME GRADE (MINIMUM) AS MEMBERS CONNECTED.

## WOOD FASTENERS

- NAIL SIZES SPECIFIED ON DRAWINGS ARE BASED ON THE FOLLOWING SPECIFICATIONS:

SIZE	TYPE	LENGTH	DIAMETER
8d	COMMON	2-1/2"	0.131"
10d	GUN	3"	0.131"
12d	GUN	3-1/4"	0.131"
16d	GUN	3-1/2"	0.131"

IF CONTRACTOR PROPOSES THE USE OF ALTERNATE NAILS, THEY SHALL SUBMIT NAIL SPECIFICATIONS TO THE STRUCTURAL ENGINEER (PRIOR TO CONSTRUCTION) FOR REVIEW AND APPROVAL.

NAILS - LUSTROU (APA RATED SHEATHING) FASTENERS TO FRAMING SHALL BE DRIVEN FLUSH TO FACE OF SHEATHING WITH NO COUNTERSINKING PERMITTED.

- BOLTS IN WOOD MEMBERS SHALL CONFORM TO ASTM A307. PROVIDE WASHERS UNDER THE HEADS AND NUTS OF ALL BOLTS AND LAG BOLTS BEARING ON WOOD. INSTALLATION OF LAG SCREWS SHALL CONFORM TO THE NATIONAL DESIGN SPECIFICATION FOR WOOD CONSTRUCTION (2018 EDITION) WITH A LEAD BORE HOLE OF 40% OF THE SHANK DIAMETER. LEAD HOLES ARE NOT REQUIRED FOR 3/8" AND SMALLER LAG SCREWS. BOLT HOLES SHALL BE A MINIMUM OF 1/32" TO A MAXIMUM OF 1/16" LARGER THAN THE BOLT DIAMETER. HOLES SHALL BE ACCURATELY ALIGNED IN MAIN MEMBERS AND END PLATES/MEMBERS. BOLTS SHALL NOT BE FORCIBLY DRIVEN.

- SDS AND SDSWS SCREWS CALLED OUT ON PLAN ARE TIMBER SCREWS MANUFACTURED BY SIMPSON STRONG-TIE COMPANY. SCREWS SHALL BE INSTALLED IN ACCORDANCE WITH THE MANUFACTURER'S RECOMMENDATIONS. EQUIVALENT SCREWS BY OTHER MANUFACTURERS MAY BE SUBSTITUTED PROVIDED THEY HAVE CURRENT ICC APPROVAL FOR EQUAL OR GREATER LOAD CAPACITIES. LAG SCREWS ARE NOT AN EQUIVALENT SUBSTITUTION.

- WOOD FRAMING NOTES - THE FOLLOWING APPLY UNLESS NOTED OTHERWISE ON THE PLANS:

- WOOD FRAMING DETAILS NOT SHOWN OTHERWISE SHALL BE CONSTRUCTED TO THE MINIMUM STANDARDS OF THE IBC, THE AITC "TIMBER CONSTRUCTION MANUAL", AND THE AF&PA "NATIONAL DESIGN SPECIFICATION FOR WOOD CONSTRUCTION". MINIMUM NAILING, SHALL CONFORM TO TABLE 2304.101.1 OF THE IBC, UNO. COORDINATE THE SIZE AND LOCATION OF ALL OPENINGS WITH ARCHITECTURAL AND MECHANICAL DRAWINGS.

- WALL FRAMING: REFER TO ARCHITECTURAL DRAWINGS FOR THE SIZE OF ALL WALLS. ALL STUDS SHALL BE DRIVEN INTO CONCRETE MASONRY OR CONCRETE MASONRY UNITS SHALL BE FULLY GROUTED CELLS. SPECIAL INSPECTION OF INSTALLATION IS REQUIRED.

ALL WALLS SHALL HAVE A SINGLE BOTTOM PLATE AND A DOUBLE TOP PLATE. END NAIL TOP PLATE AND BOTTOM PLATE TO EACH STUD WITH (3) 10d NAILS. FACE NAIL DOUBLE TOP PLATES WITH 10d AT 12"oc AND LAP MINIMUM 4'-0" AT JOINTS AND PROVIDE (12) 10d NAILS AT 6"oc EACH SIDE OF JOINT. AT TOP PLATE INTERSECTIONS PROVIDE (3) 10d FACE NAILS.

JOIST STUDS SHALL HAVE THEIR LOWER WOOD PLATES ATTACHED TO WOOD FRAMING BELOW JOIST STUDS WITH (2) 10d NAILS AT 12"oc OR ATTACHED TO CONCRETE BELOW WITH 5/8" DIAMETER ANCHOR BOLTS AT 4'-0"oc EMBEDDED 7" MINIMUM UNO. THERE SHALL BE A MINIMUM OF (2) BOLTS PER PLATE SECTION WITH (1) BOLT LOCATED NOT MORE THAN 1/2" OR LESS THAN 4'-1/2" FROM EACH END OF THE PLATE SECTION. INDIVIDUAL MEMBERS OF BUILT-UP POSITS SHALL BE NAILED TO EACH OTHER WITH (2) ROWS OF 10d AT 12"oc. UNLESS NOTED OTHERWISE, GYPSUM WALLBOARD SHALL BE FASTENED TO THE INTERIOR SURFACE OF ALL STUDS AND PLATES WITH #6 x 1-1/4" TYPE S OR W SCREWS AT 12"oc. UNLESS NOTED OTHERWISE, 7/16" OR 1/2" (NOMINAL) APA RATED SHEATHING (SPAN RATINGS 24W) SHALL BE NAILED TO ALL EXTERIOR SURFACES WITH 8d NAILS AT 6"oc AT PANEL EDGES AND TOP AND BOTTOM PLATES (BLOCK UN-SUPPORTED EDGES) AND TO ALL INTERMEDIATE STUDS AND BOTTOM PLATING WITH 8d NAILS AT 12"oc. ALLOW 1/8" SPACING AT ALL PANEL EDGES AND PANEL ENDS.

- FLOOR AND ROOF FRAMING: PROVIDE DOUBLE JOISTS UNDER ALL PARALLEL PARTITIONS THAT EXTEND OVER MORE THAN HALF THE JOIST LENGTH AND AROUND ALL OPENINGS IN FLOORS OR ROOFS, UNO. PROVIDE SOLID BLOCKING AT ALL BEARING POINTS. TOENAIL TIMBER JOISTS TO SUPPORTS WITH (3) 10d NAILS AND NAIL TJ JOISTS TO SUPPORTS WITH (2) 10d NAILS. ATTACH JOISTS TO BEAMS WITH SIMPSON JOIST HANGERS IN ACCORDANCE WITH NOTES ABOVE. NAIL ALL MULTI-JOIST BEAMS TOGETHER WITH (2) ROWS OF 10d AT 12"oc. TOENAIL RM JOIST TO TOP PLATE WITH 10d AT 6"oc. TOENAIL BLOCKING BETWEEN JOISTS TO TOP PLATE WITH (3) 10d NAILS.

UNLESS NOTED OTHERWISE ON THE PLANS, PLYWOOD FLOOR AND FLOOR SHEATHING SHALL BE LAID UP WITH GRAN PERPENDICULAR TO SUPPORTS WITH END JOINTS STAGGERED, AND NAILED AT 6"oc WITH 8d NAILS TO FRAMED PANEL EDGES, STRIPS AND OVER STUD WALLS AS SHOWN ON PLANS AND AT 12"oc TO INTERMEDIATE SUPPORTS. PROVIDE APPROVED PLYWOOD EDGE CLIPS CENTERED BETWEEN JOISTS/RUSSES AT UNBLOCKED ROOF SHEATHING EDGES. ALL FLOOR SHEATHING EDGES SHALL HAVE APPROVED 1/8" JOINTS OR ENDS BE SUPPORTED WITH SOLID BLOCKING. ALLOW 1/8" SPACING AT ALL PANEL EDGES AND SHALL BE FLOOR AND ROOF SHEATHING. TOENAIL BLOCKING TO SUPPORTS WITH 10d AT 12"oc, UNO.

- NOTCHES AND HOLES IN WOOD FRAMING:

A. SAWN LUMBER JOISTS AND RAFTERS: NOTCHES AT THE ENDS OF JOISTS SHALL NOT EXCEED 1/4 THE JOIST DEPTH. NOTCHES IN THE TOP OR BOTTOM OF JOISTS SHALL NOT EXCEED 1/6 THE JOIST DEPTH. BE LONGER THAN 1/3 THE JOIST DEPTH, OR BE LOCATED IN THE MIDDLE 1/3 OF THE SPAN. HOLES SHALL NOT BE WITHIN 2" OF THE TOP OR BOTTOM OF THE JOIST AND THE DIAMETER SHALL NOT EXCEED 1/3 THE JOIST DEPTH. SPACING BETWEEN HOLES SHALL BE A MINIMUM OF (2)TIMES THE DIAMETER OF THE LARGEST HOLE OR 2" AND SHALL BE LOCATED A MINIMUM OF 2" FROM ANY NOTCH.

- EXTERIOR AND BEARING WALLS: WOOD STUDS ARE PERMITTED TO BE NOTCHED TO A DEPTH NOT EXCEEDING 1/4 OF ITS WIDTH. A HOLE NOT GREATER IN DIAMETER THAN 40% OF THE STUD WIDTH IS PERMITTED IN WOOD STUDS. HOLES SHALL NOT BE WITHIN 5/8" TO THE EDGE OF THE STUD. SPACING BETWEEN HOLES SHALL BE A MINIMUM OF (2)TIMES THE DIAMETER OF THE LARGEST HOLE OR 2" AND SHALL NOT BE LOCATED AT THE SAME SECTION AS A NOTCH.

- CUTS, NOTCHES, AND HOLES IN MANUFACTURED LUMBER, PREFABRICATED PLYWOOD WEB JOISTS, AND PREFABRICATED TRUSSES ARE PROHIBITED EXCEPT WHERE NOTED ON STRUCTURAL PLANS OR PERMITTED BY MANUFACTURER'S RECOMMENDATIONS.

- ELECTRICAL, MECHANICAL, PLUMBING, AND DRAINAGE SYSTEMS SHALL BE DESIGNED TO ACCOMMODATE THE DIFFERENTIAL SHRINKAGE OR MOVEMENT OF THE WOOD STRUCTURE (3/8" PER FOOT).


- DEFLECTION OF CANTILEVERS SHALL BE CLOSELY MONITORED BY THE CONTRACTOR DURING CONSTRUCTION. CONTRACTOR TO VERIFY AND ENSURE ALL POST CAPS AND POST BRACING CONDITIONS ARE INSTALLED IN STRICT CONFORMANCE TO THE STRUCTURAL PLANS. CANTILEVERS IN WOOD FRAMING CAN DEFLECT UP TO 1/8" PER FOOT (IE. A CANTILEVER MAY DEFLECT 1/2"). IF DEFLECTION EXCEEDS 1/8" PER FOOT NOTIFY STRUCTURAL ENGINEER IMMEDIATELY. BEFORE FINISHES ARE INSTALLED, FLOORS AT OR ABOVE CANTILEVERS MAY REQUIRE LEVELING



1

2

3

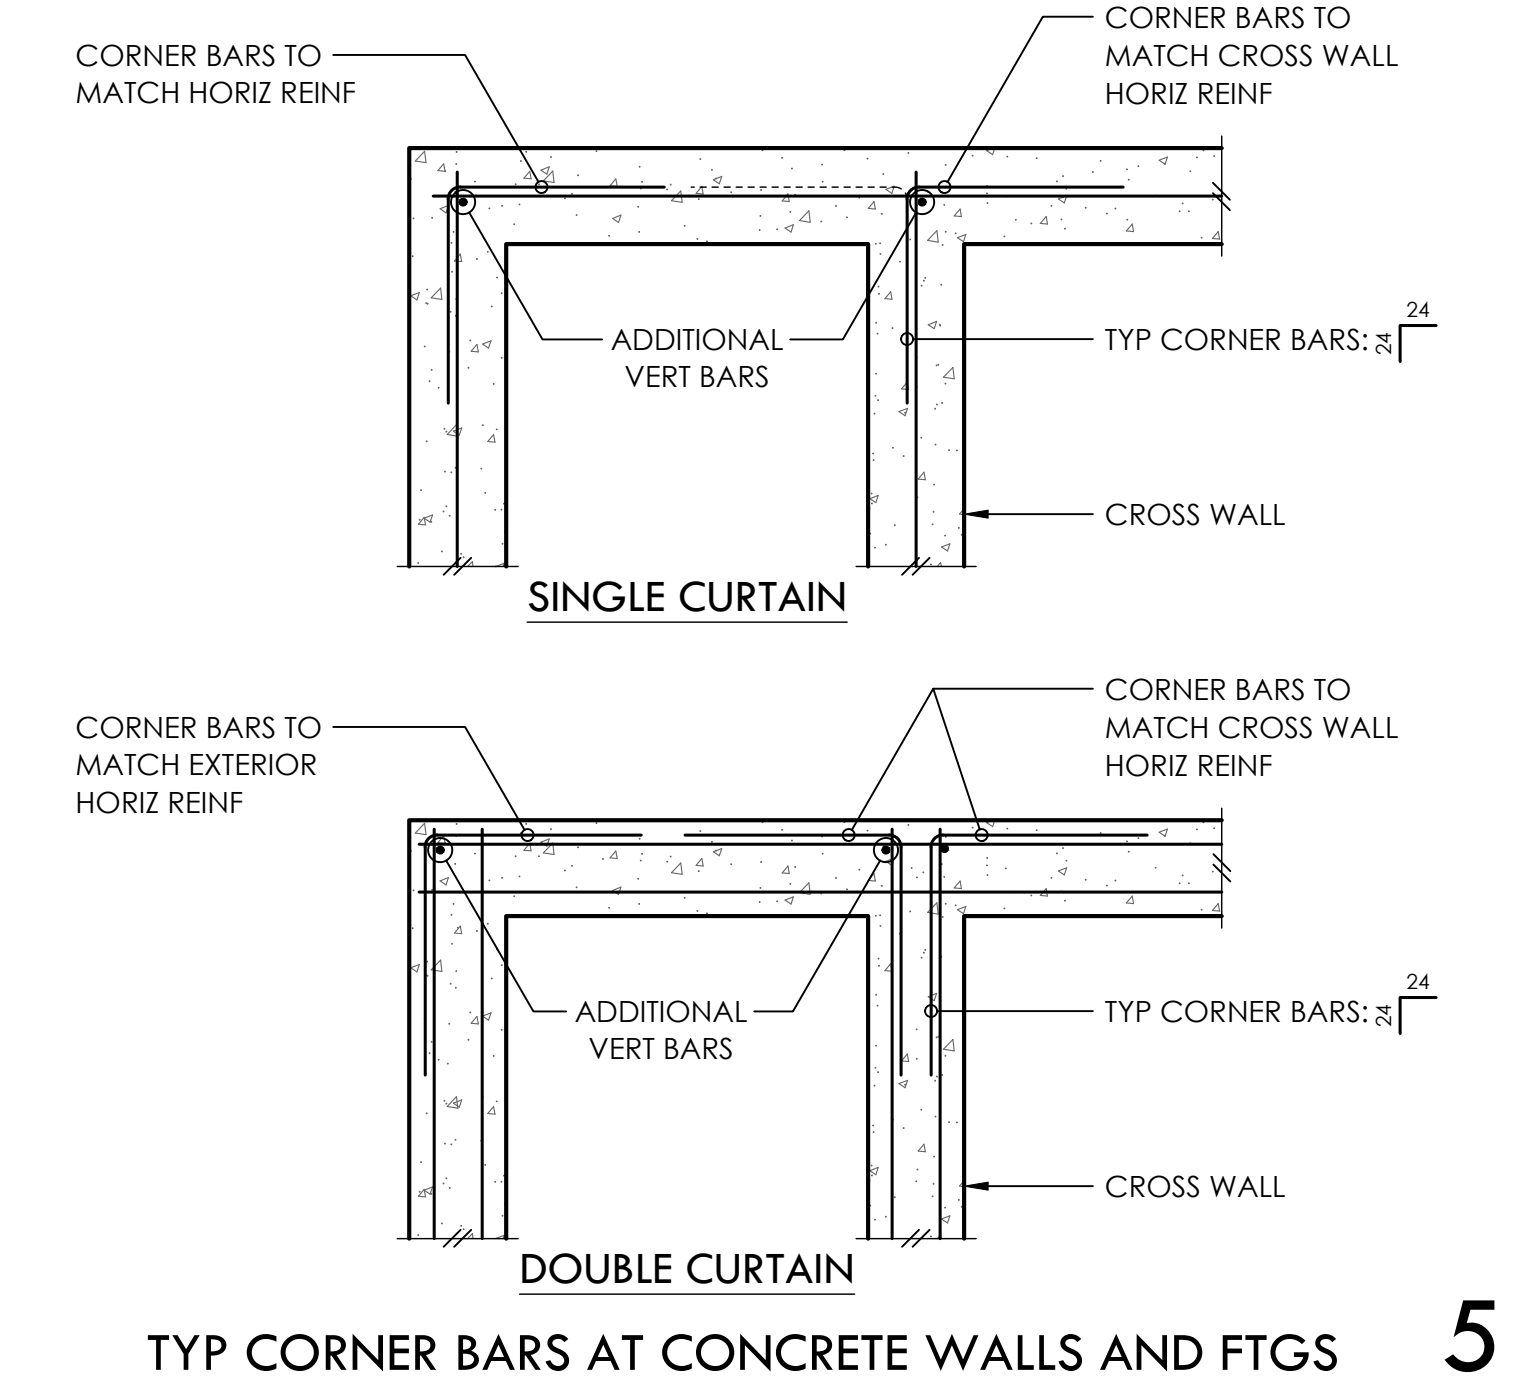


TYP CORNER BARS AT CONCRETE WALLS AND FTGS 5

6

7

8

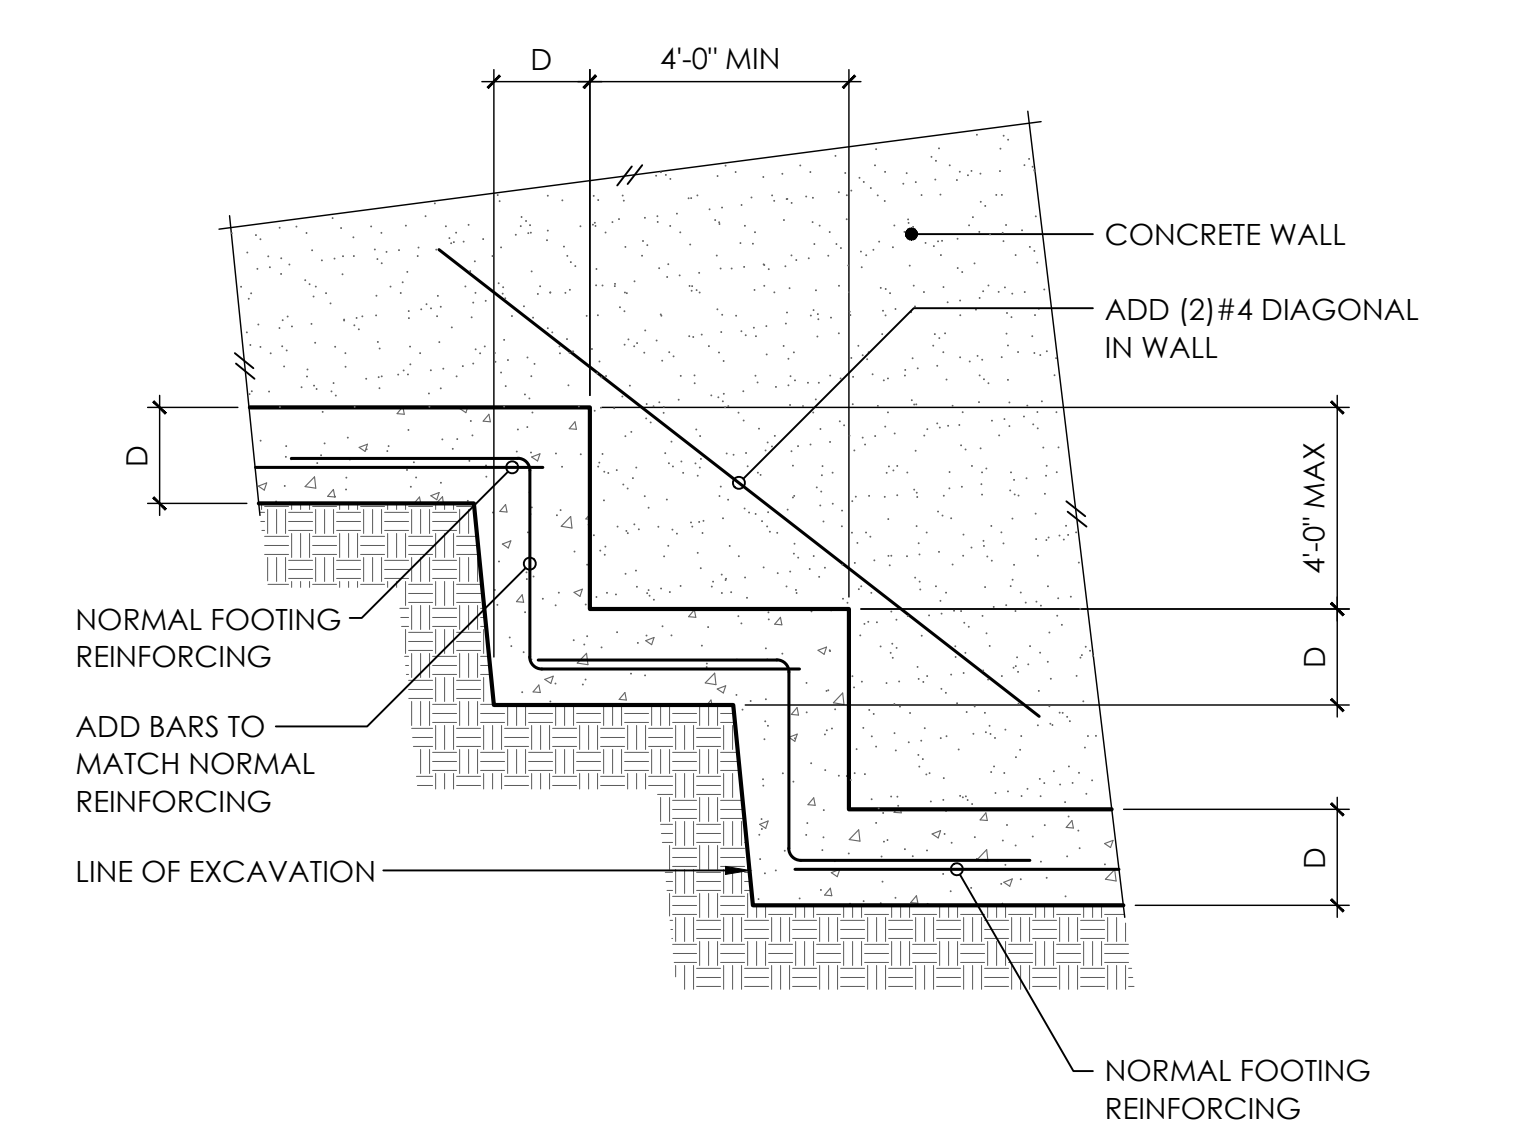


TYPICAL STEPPED FOOTING 10


11

12

13

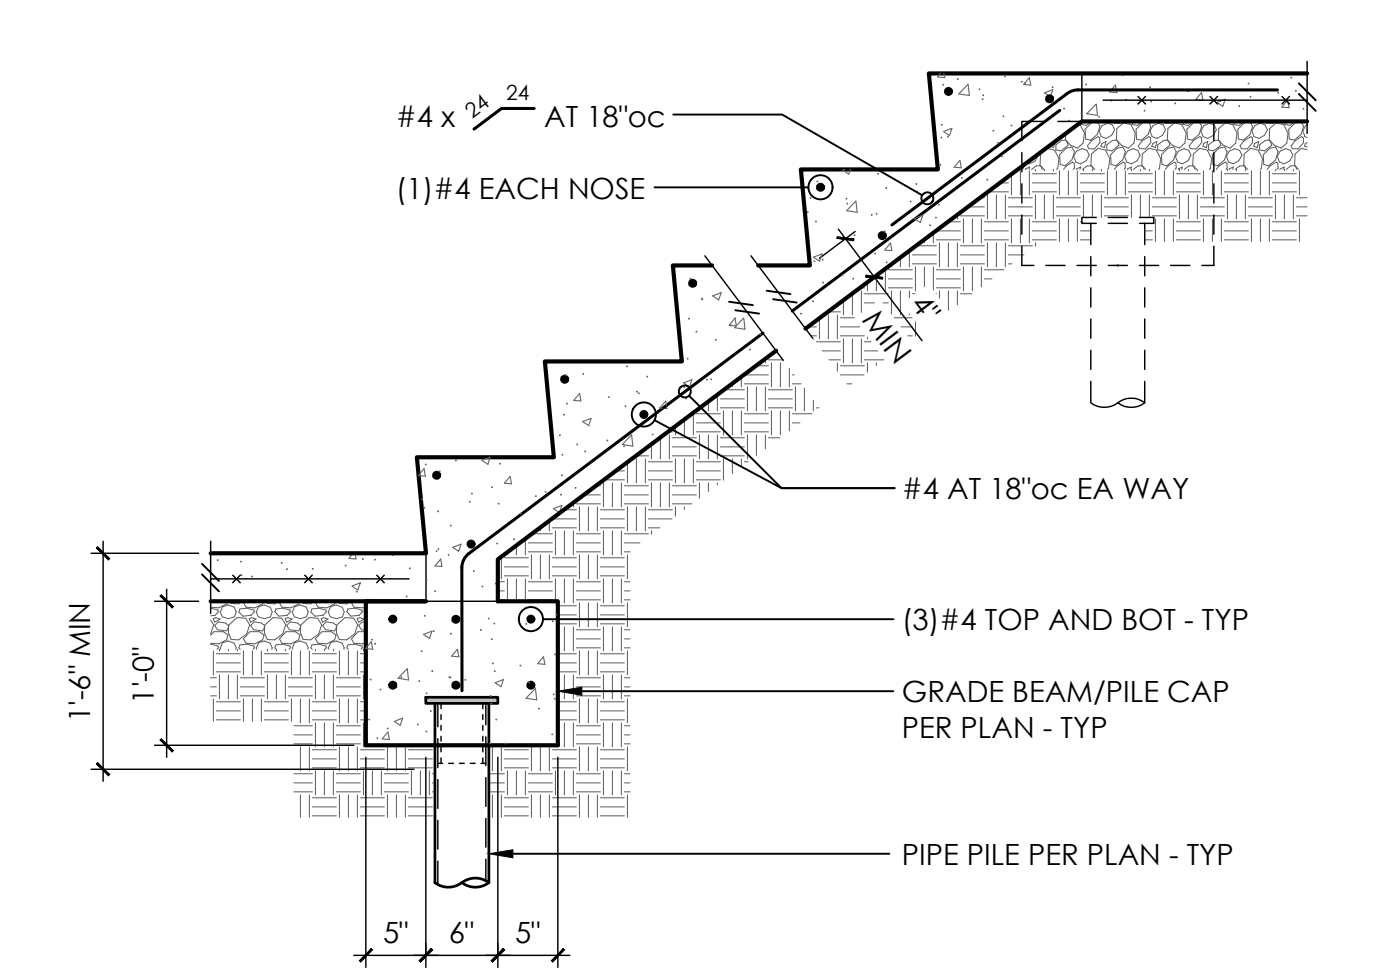

TYPICAL STAIR ON GRADE 14

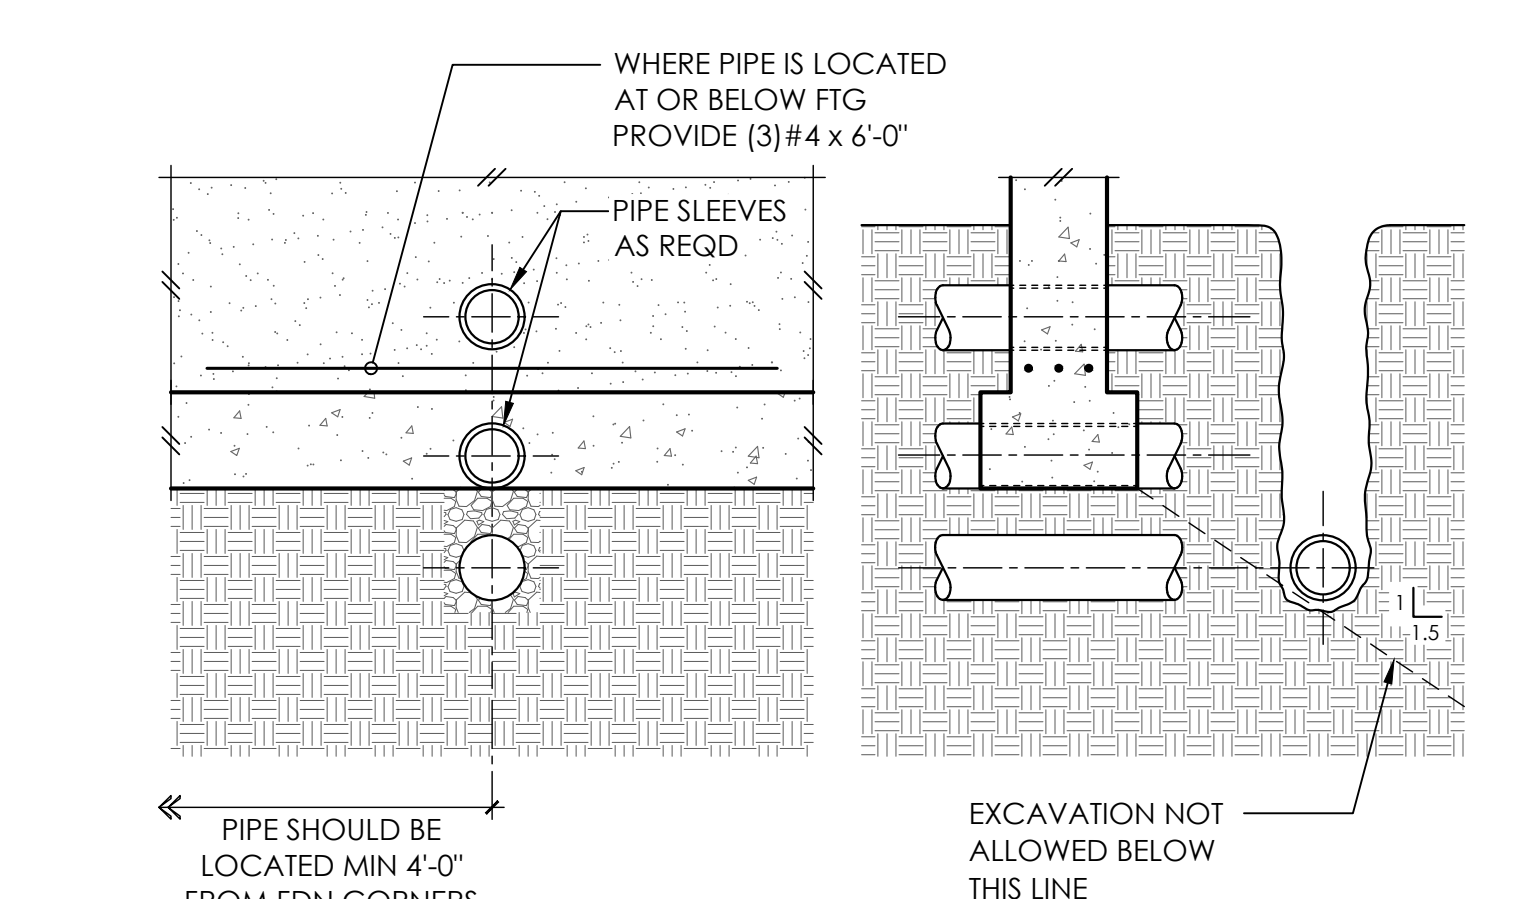


PIPE AND TRENCH LOCATIONS 15

16

17


18

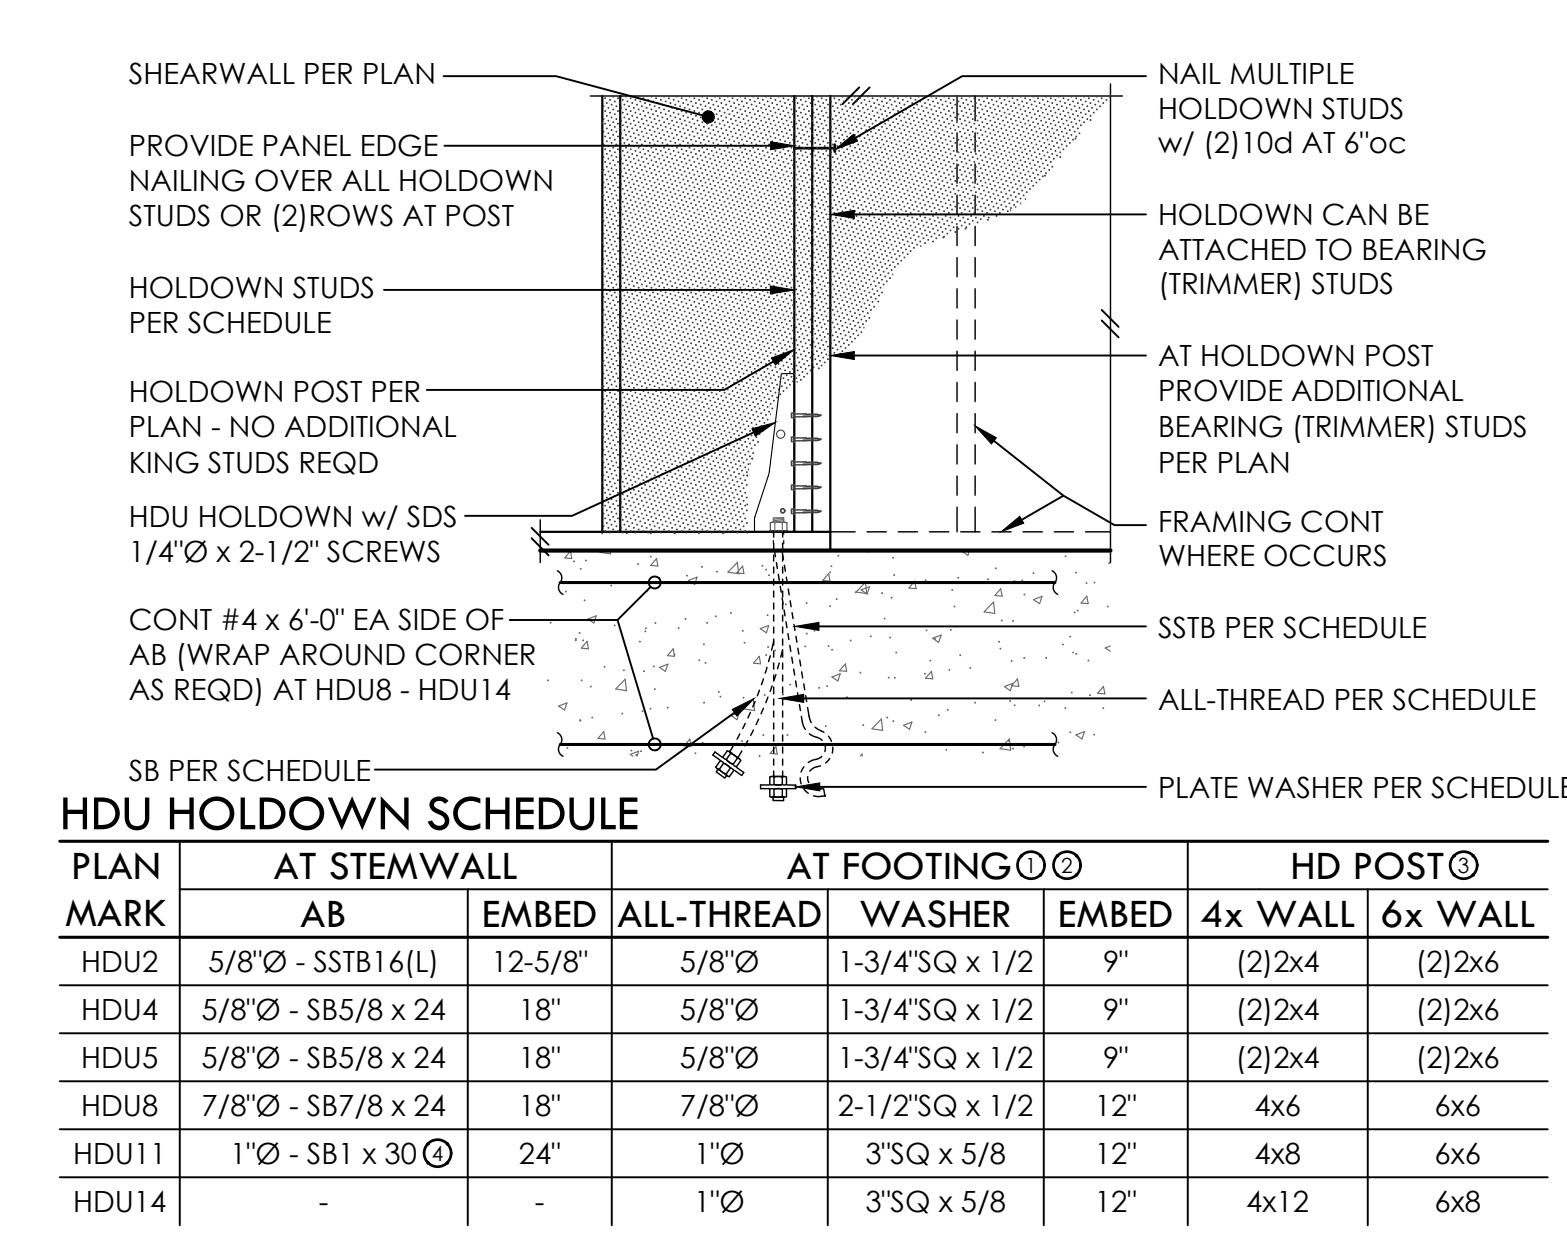

**HDU HOLDOWN SCHEDULE**

PLAN MARK	AT STEMWALL	AT FOOTING	HD POST
	AB	EMBED ALL-THREAD WASHER EMBED	4x WALL 6x WALL
HDU4	5/8" - S85/8 x 24	18" 5/8" 1-3/4" SQ x 1/2"	9" (2)2x4 (2)2x6
HDU5	5/8" - S85/8 x 24	18" 5/8" 1-3/4" SQ x 1/2"	9" (2)2x4 (2)2x6
HDU8	7/8" - S87/8 x 24	18" 7/8" 2-1/2" SQ x 1/2"	12" 4x6 6x6
HDU11	1" - S81 x 30	24" 1" 3" SQ x 5/8"	12" 4x8 6x6
HDU14	-	1" 3" SQ x 5/8"	12" 4x12 6x8


⊙ ALL HOLDOWN ANCHOR BOLTS THAT NEED TO BE EMBEDDED INTO FOOTING ARE SPECIFICALLY SHOWN ON PLAN  
 ⊙ A307 ALL-THRD w/ PLATE WASHER PER SCHEDULE AND DOUBLE NUT BOT OR EQUIVALENT SIMPSON PAB  
 ⊙ MINIMUM SIZE OF POST UNO ON FRAMING PLANS  
 ⊙ REQUIRES MINIMUM 8" THICK CONCRETE WALL

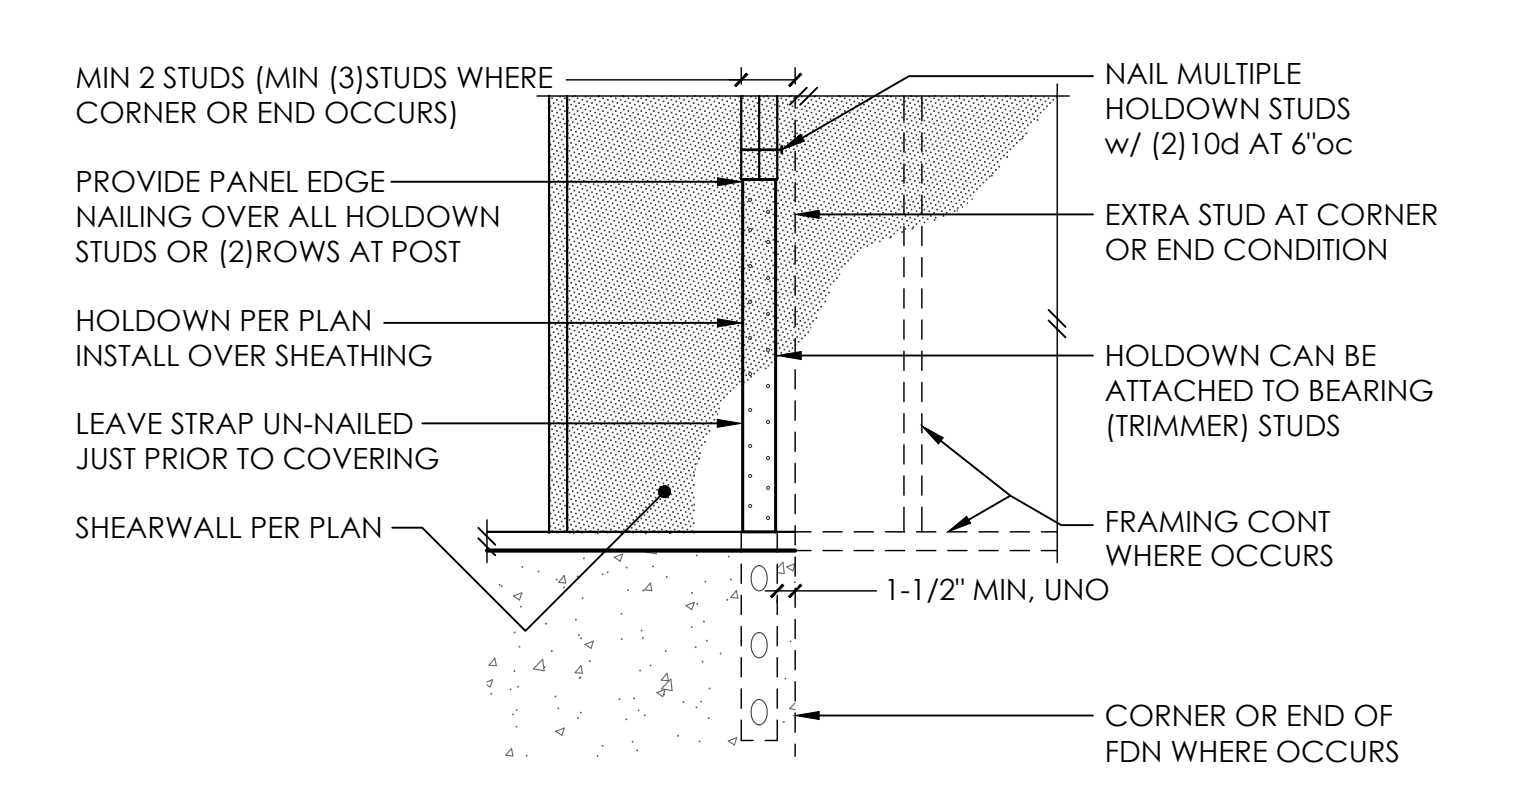

**LSTHD/STHD HOLDOWN SCHEDULE**

PLAN MARK	NAILS	HD POST
LSTHD1(R,J)	(20) 6d SINKERS	DBL STUD
STHD10(R,J)	(28) 6d SINKERS	DBL STUD
STHD14(R,J)	(30) 6d SINKERS	DBL STUD

⊙ 16d SINKERS = 0.148" x 3-1/4"  
 ⊙ MINIMUM SIZE OF POST UNO ON FRAMING PLANS

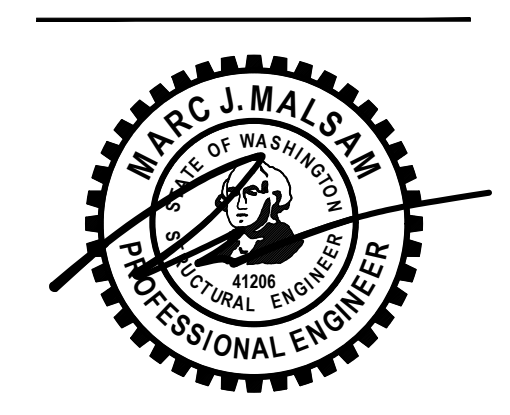

PROJECT NO: 0426-2021-03101  
 PROJECT MANAGER: JAS VAC  
 DRAWN: JOSEPH MARQUEZ  
 ENGINEER: JOSEPH MARQUEZ  
 JOSEPH@MALSAM-TSANG.COM

REV DESCRIPTION DATE


PERMIT SET	12.23.21
PERMIT CORRECTIONS	5.5.22
PERMIT CORRECTIONS	7.13.22
PERMIT CORRECTIONS	8.19.22

ARCH: MACULLOUGH ARCHITECTS  
 206-443-1181


TYPICAL CONCRETE DETAILS

**S3.0**  
 SCALE: 3/4" = 1'-0"




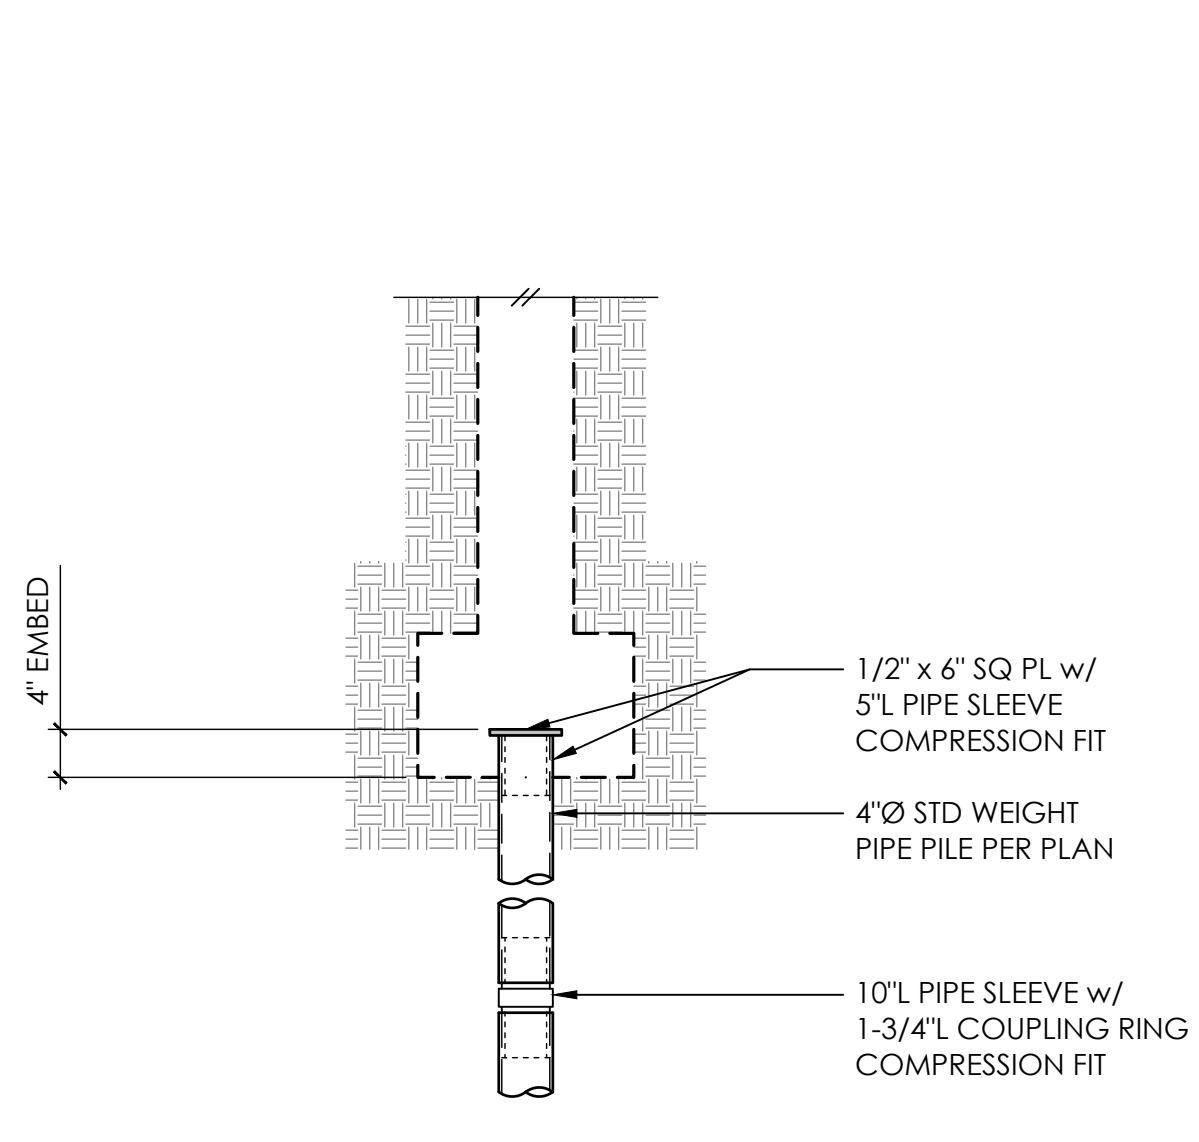


**1** TYPICAL PIPE PILE **2**

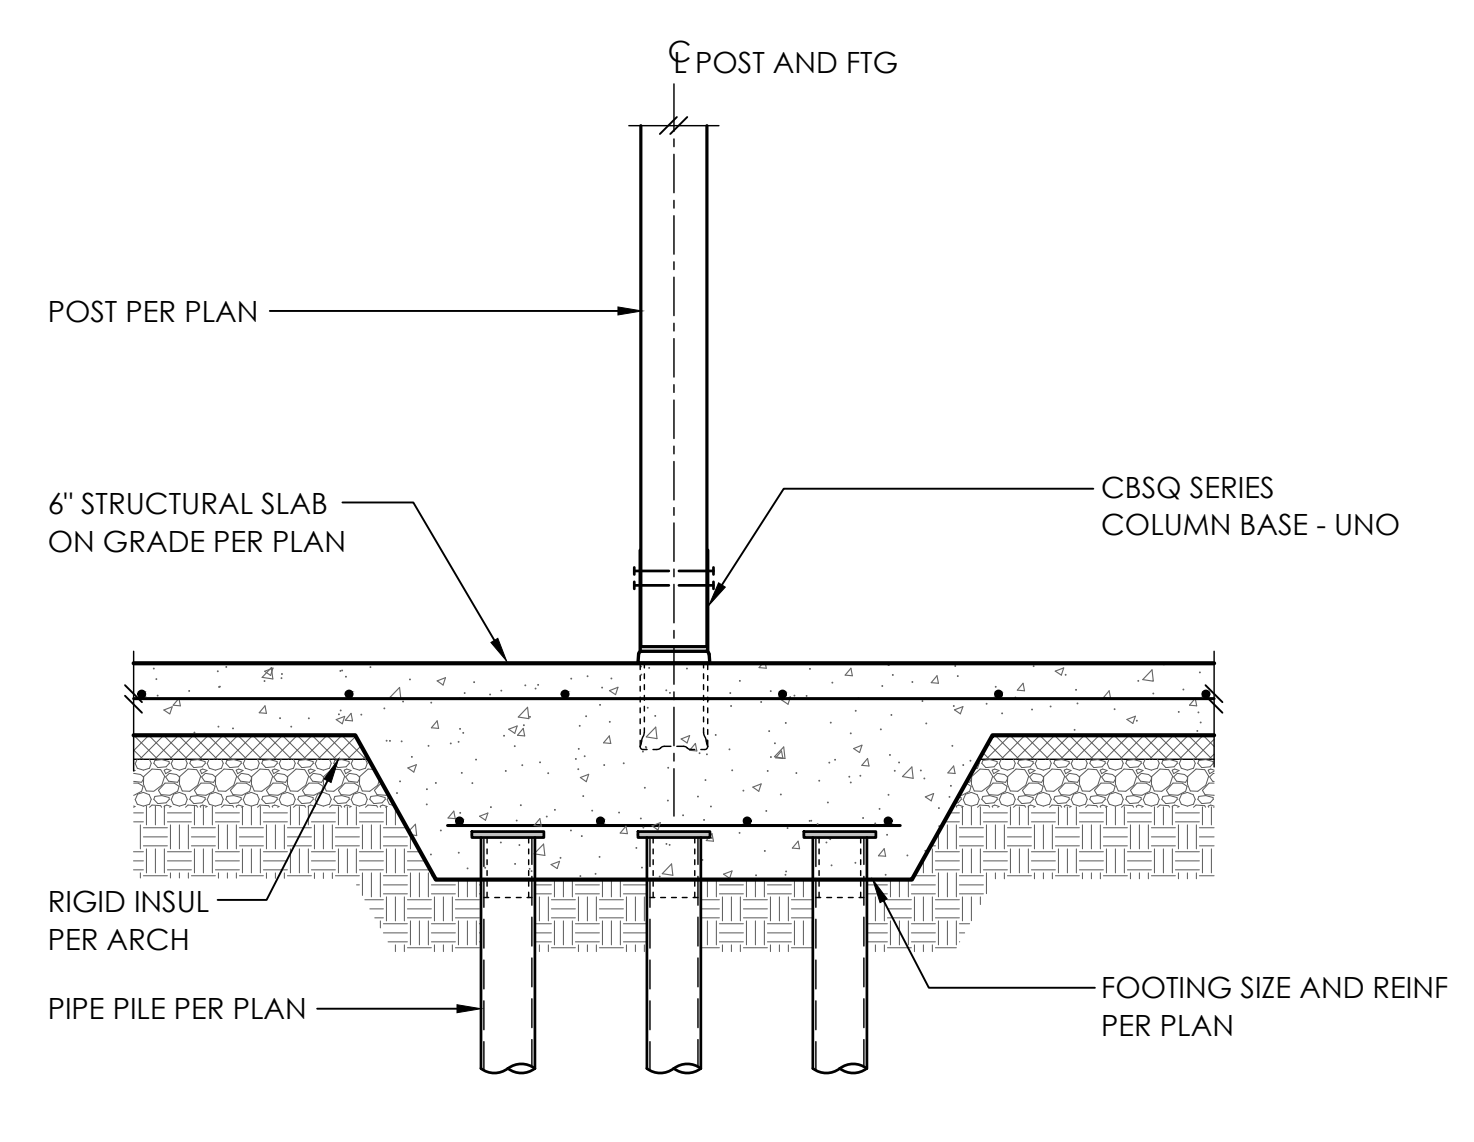


**3**

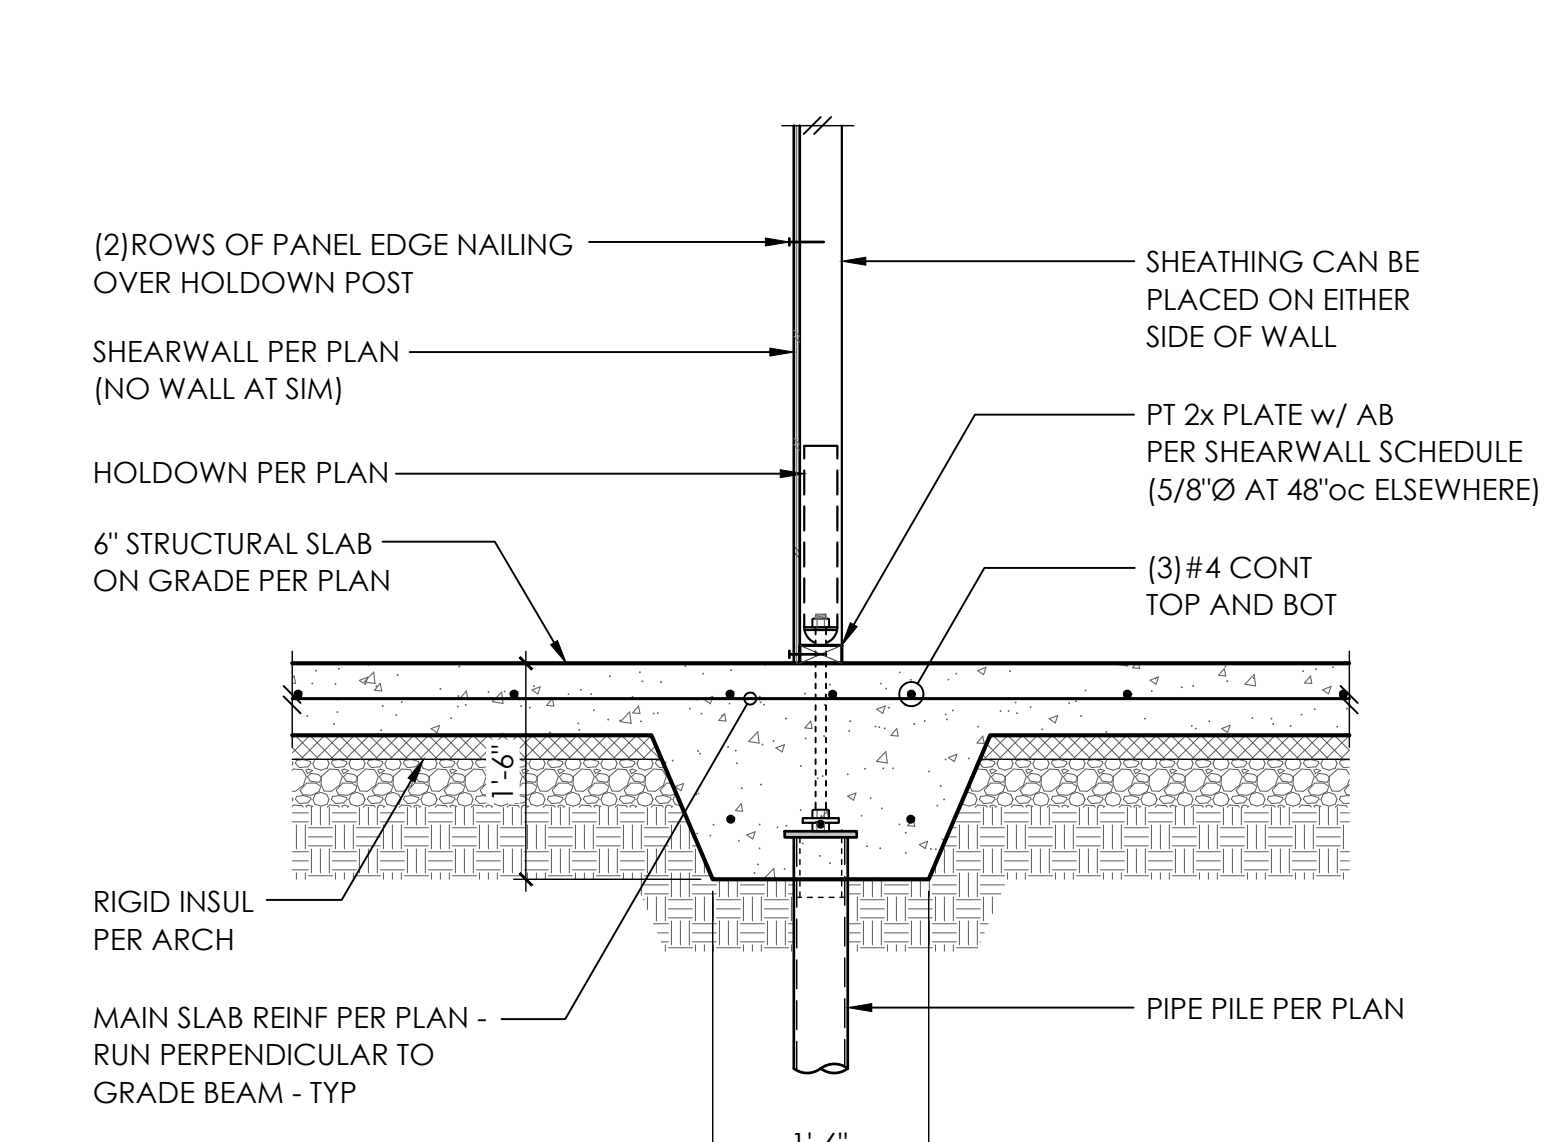


**4**

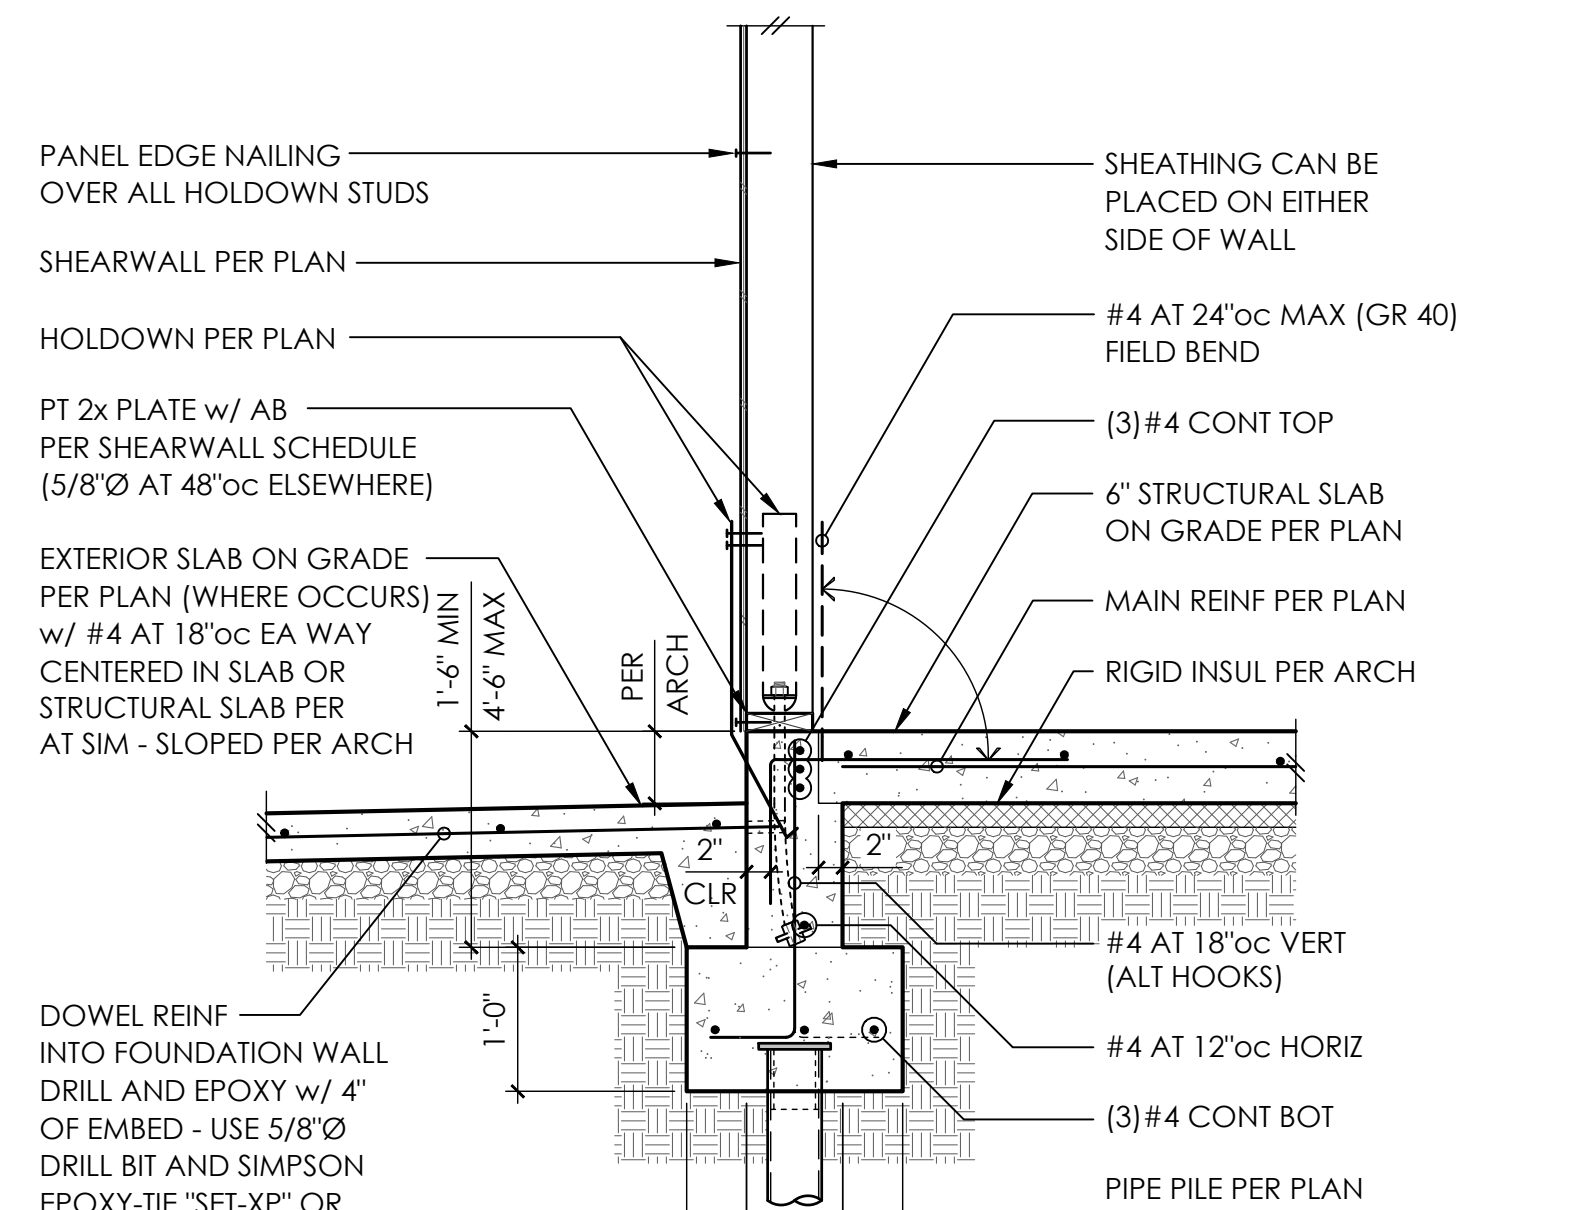


**5** TYPICAL FOUNDATION WALL / STRUCTURAL SLAB ON GRADE

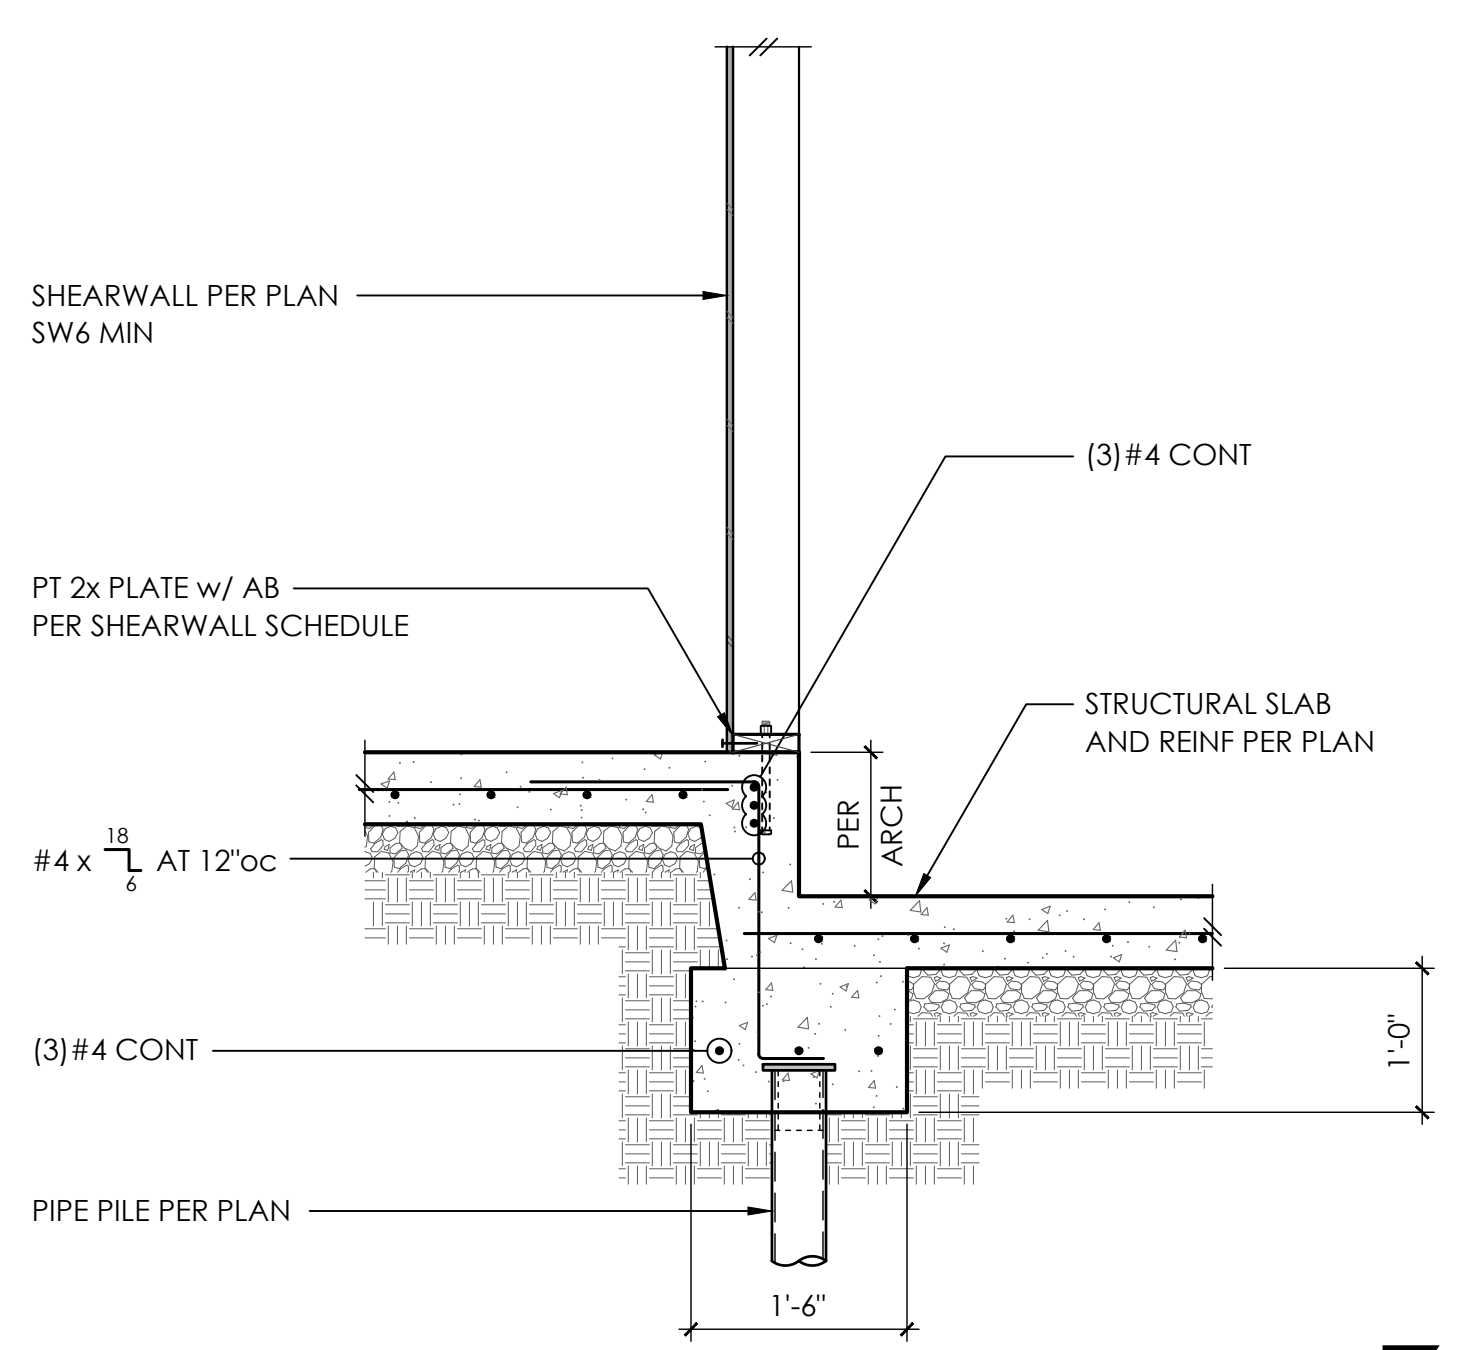


**6** ELEVATOR PIT SLAB ELEVATION CHANGE **7**

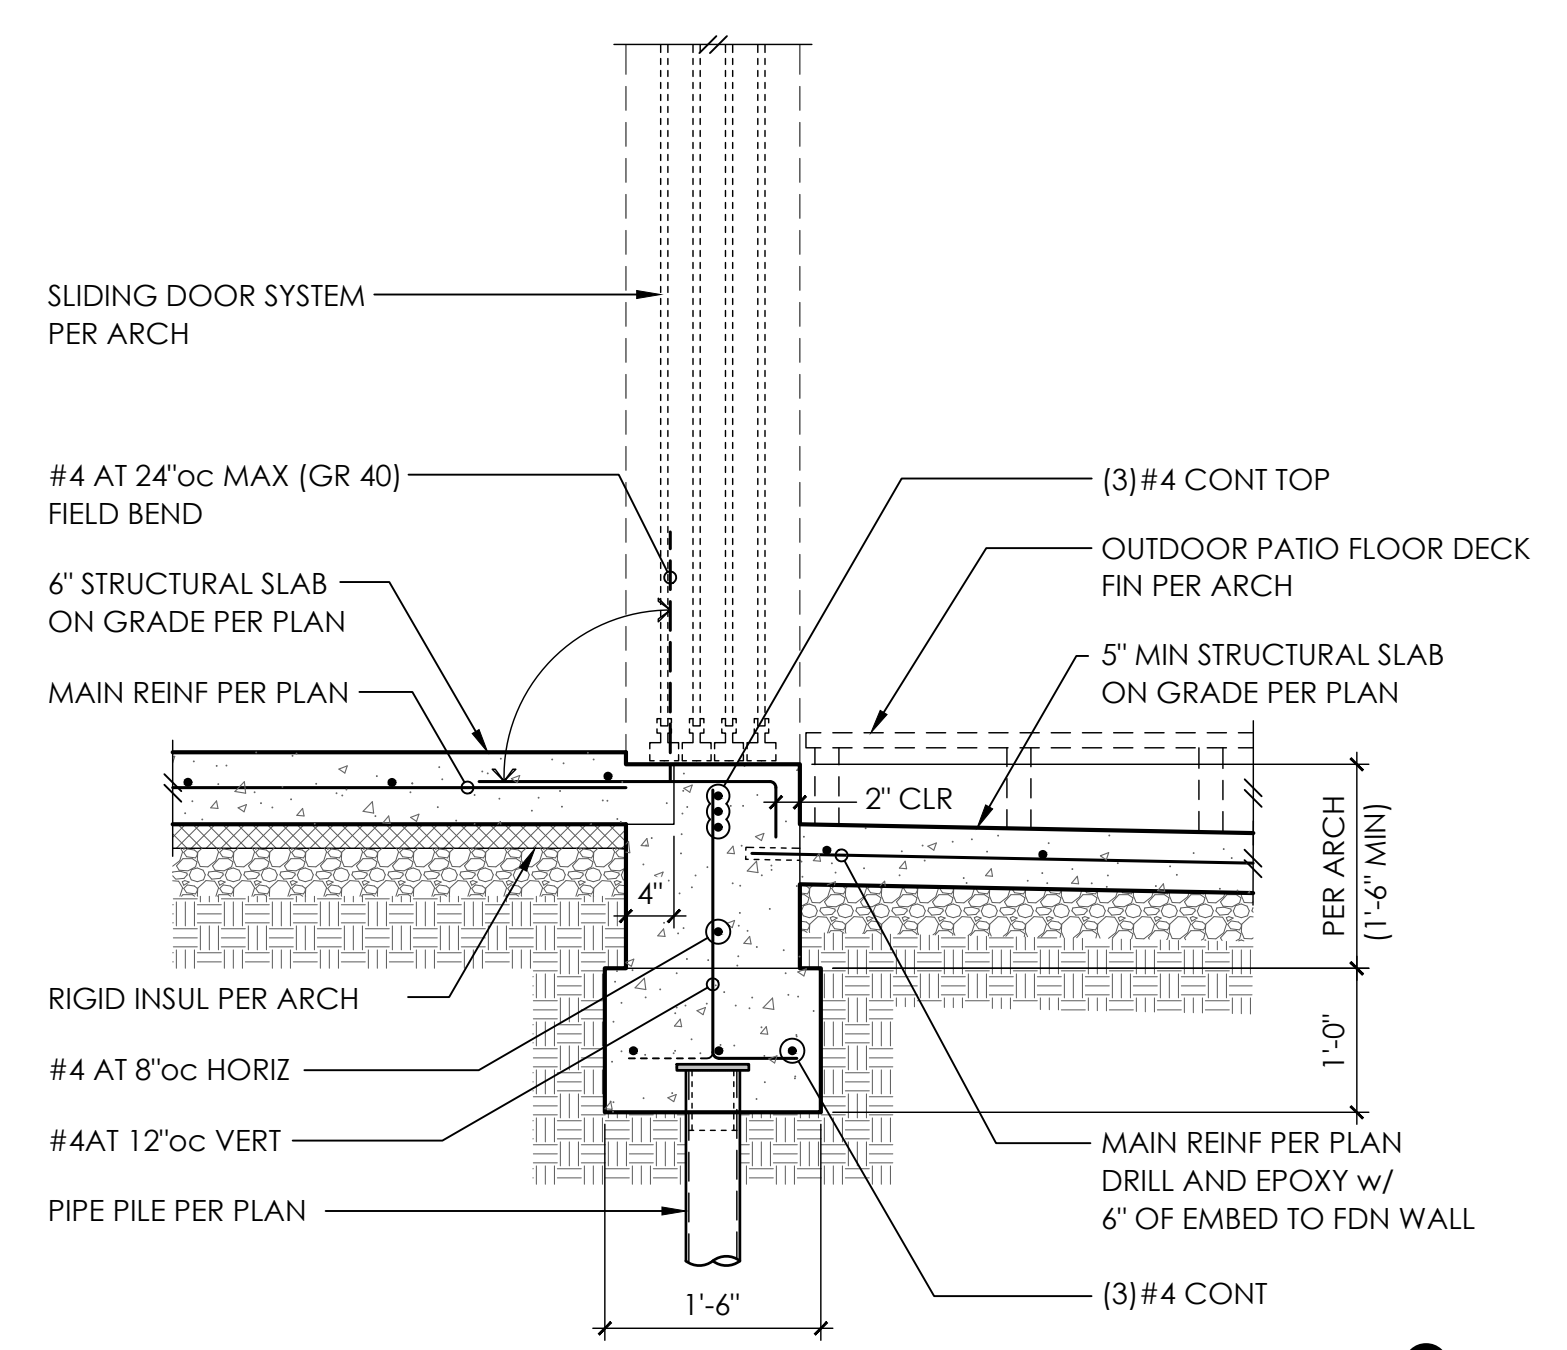


**8**

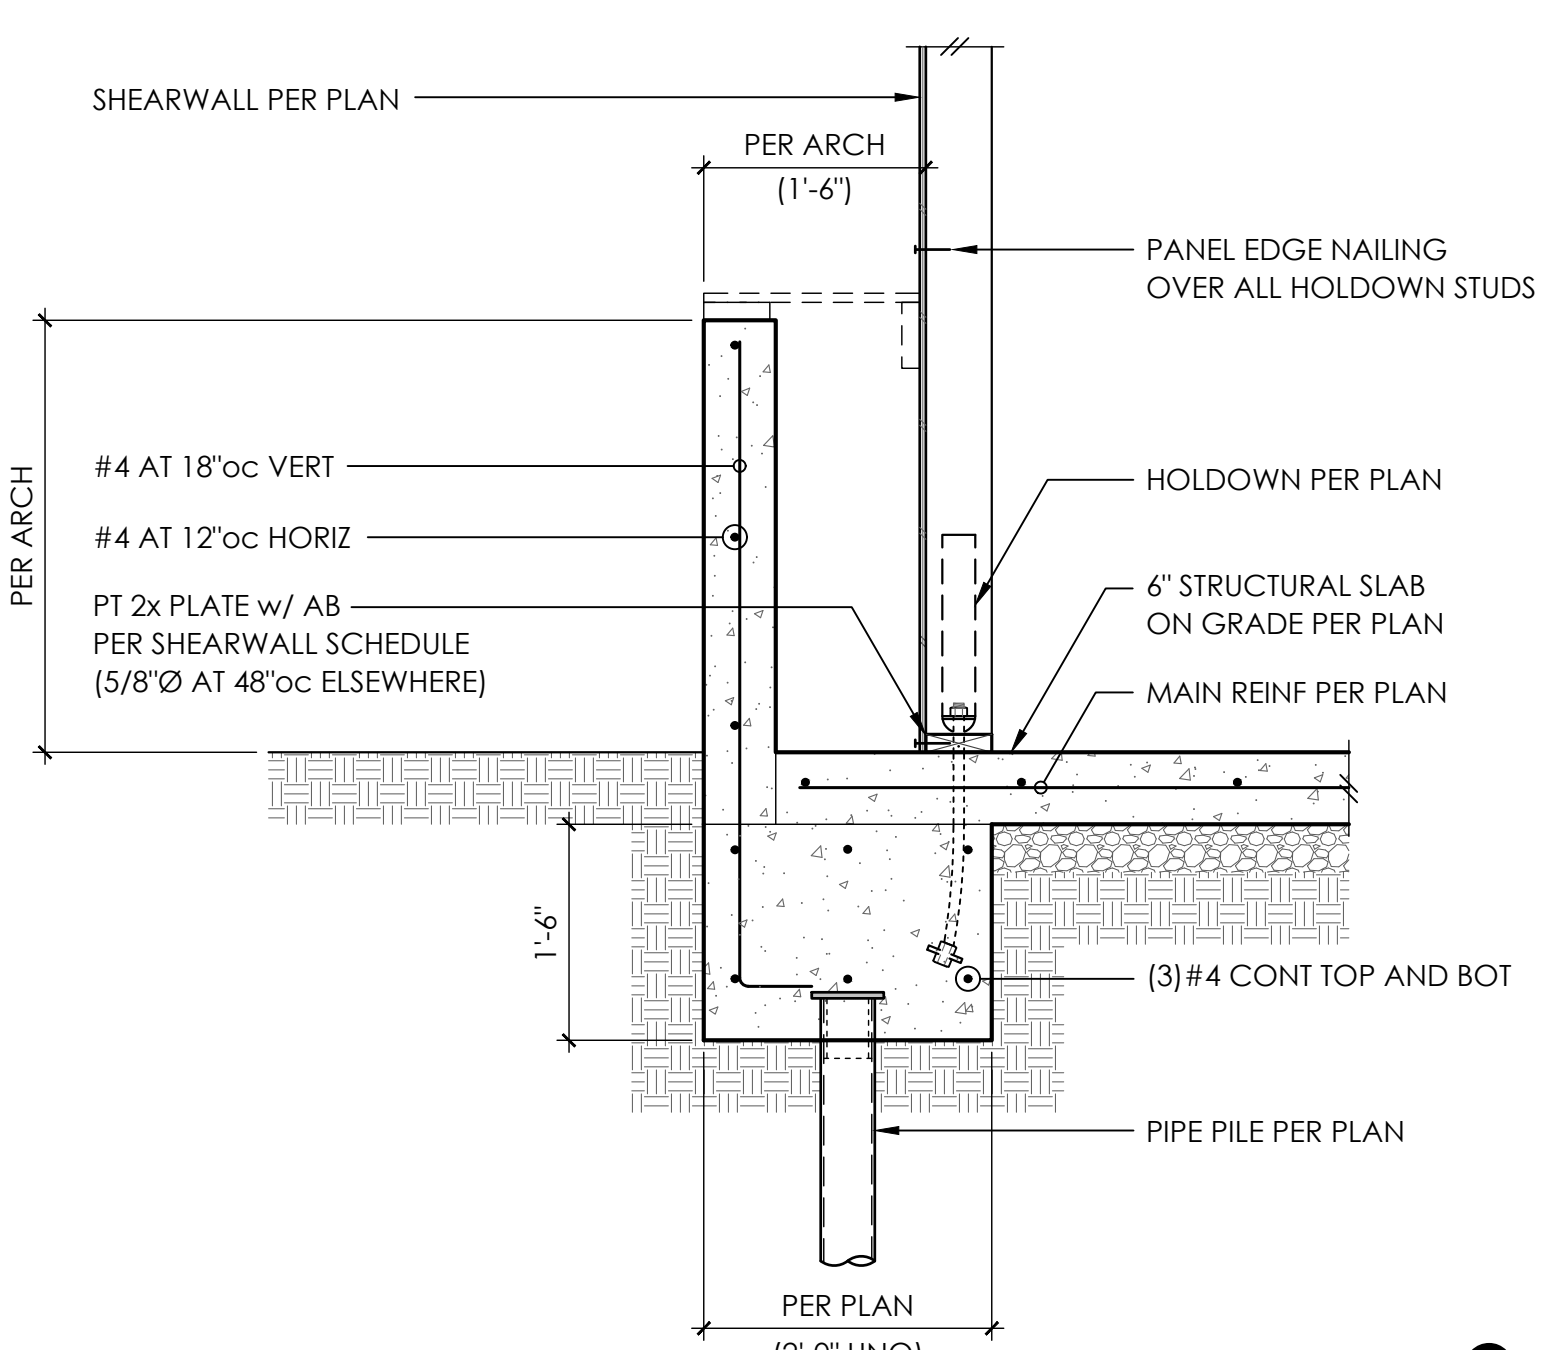


**9**

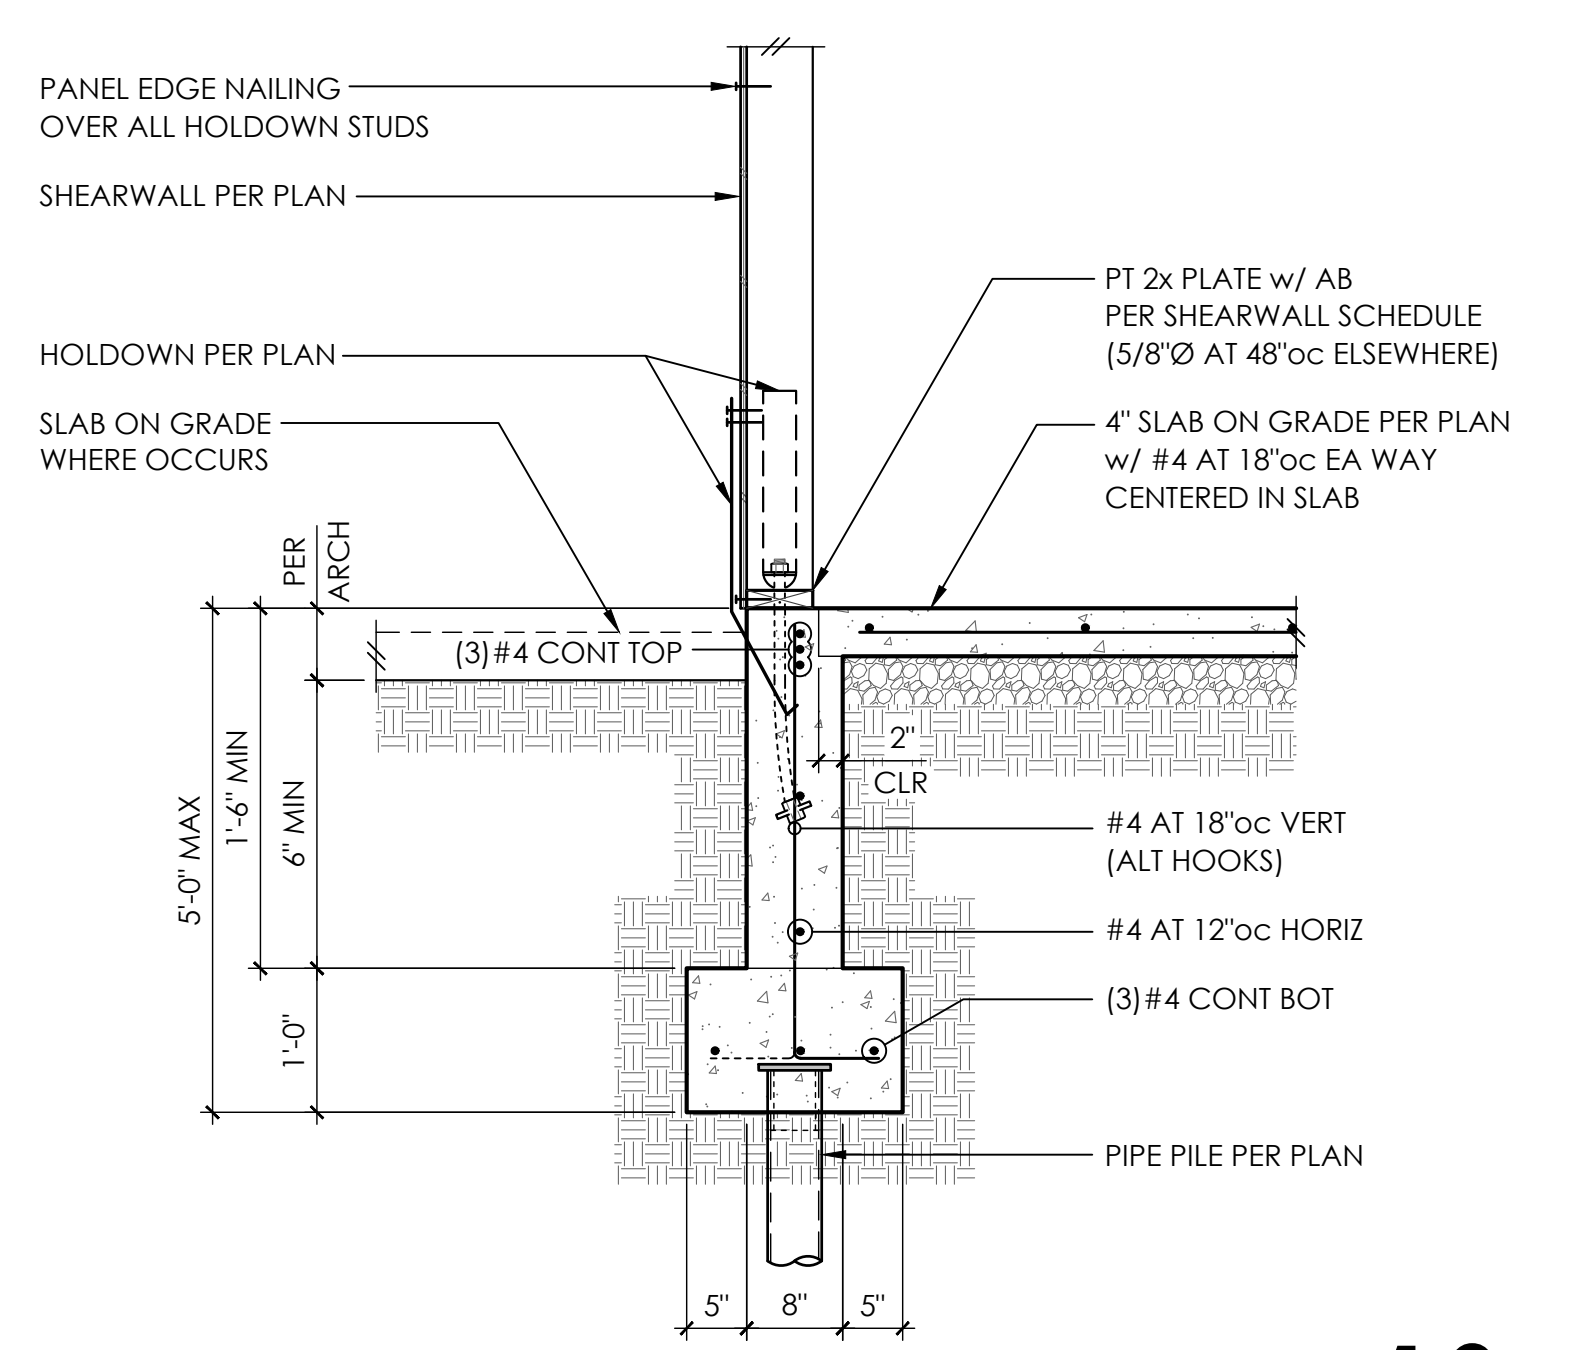


**10**

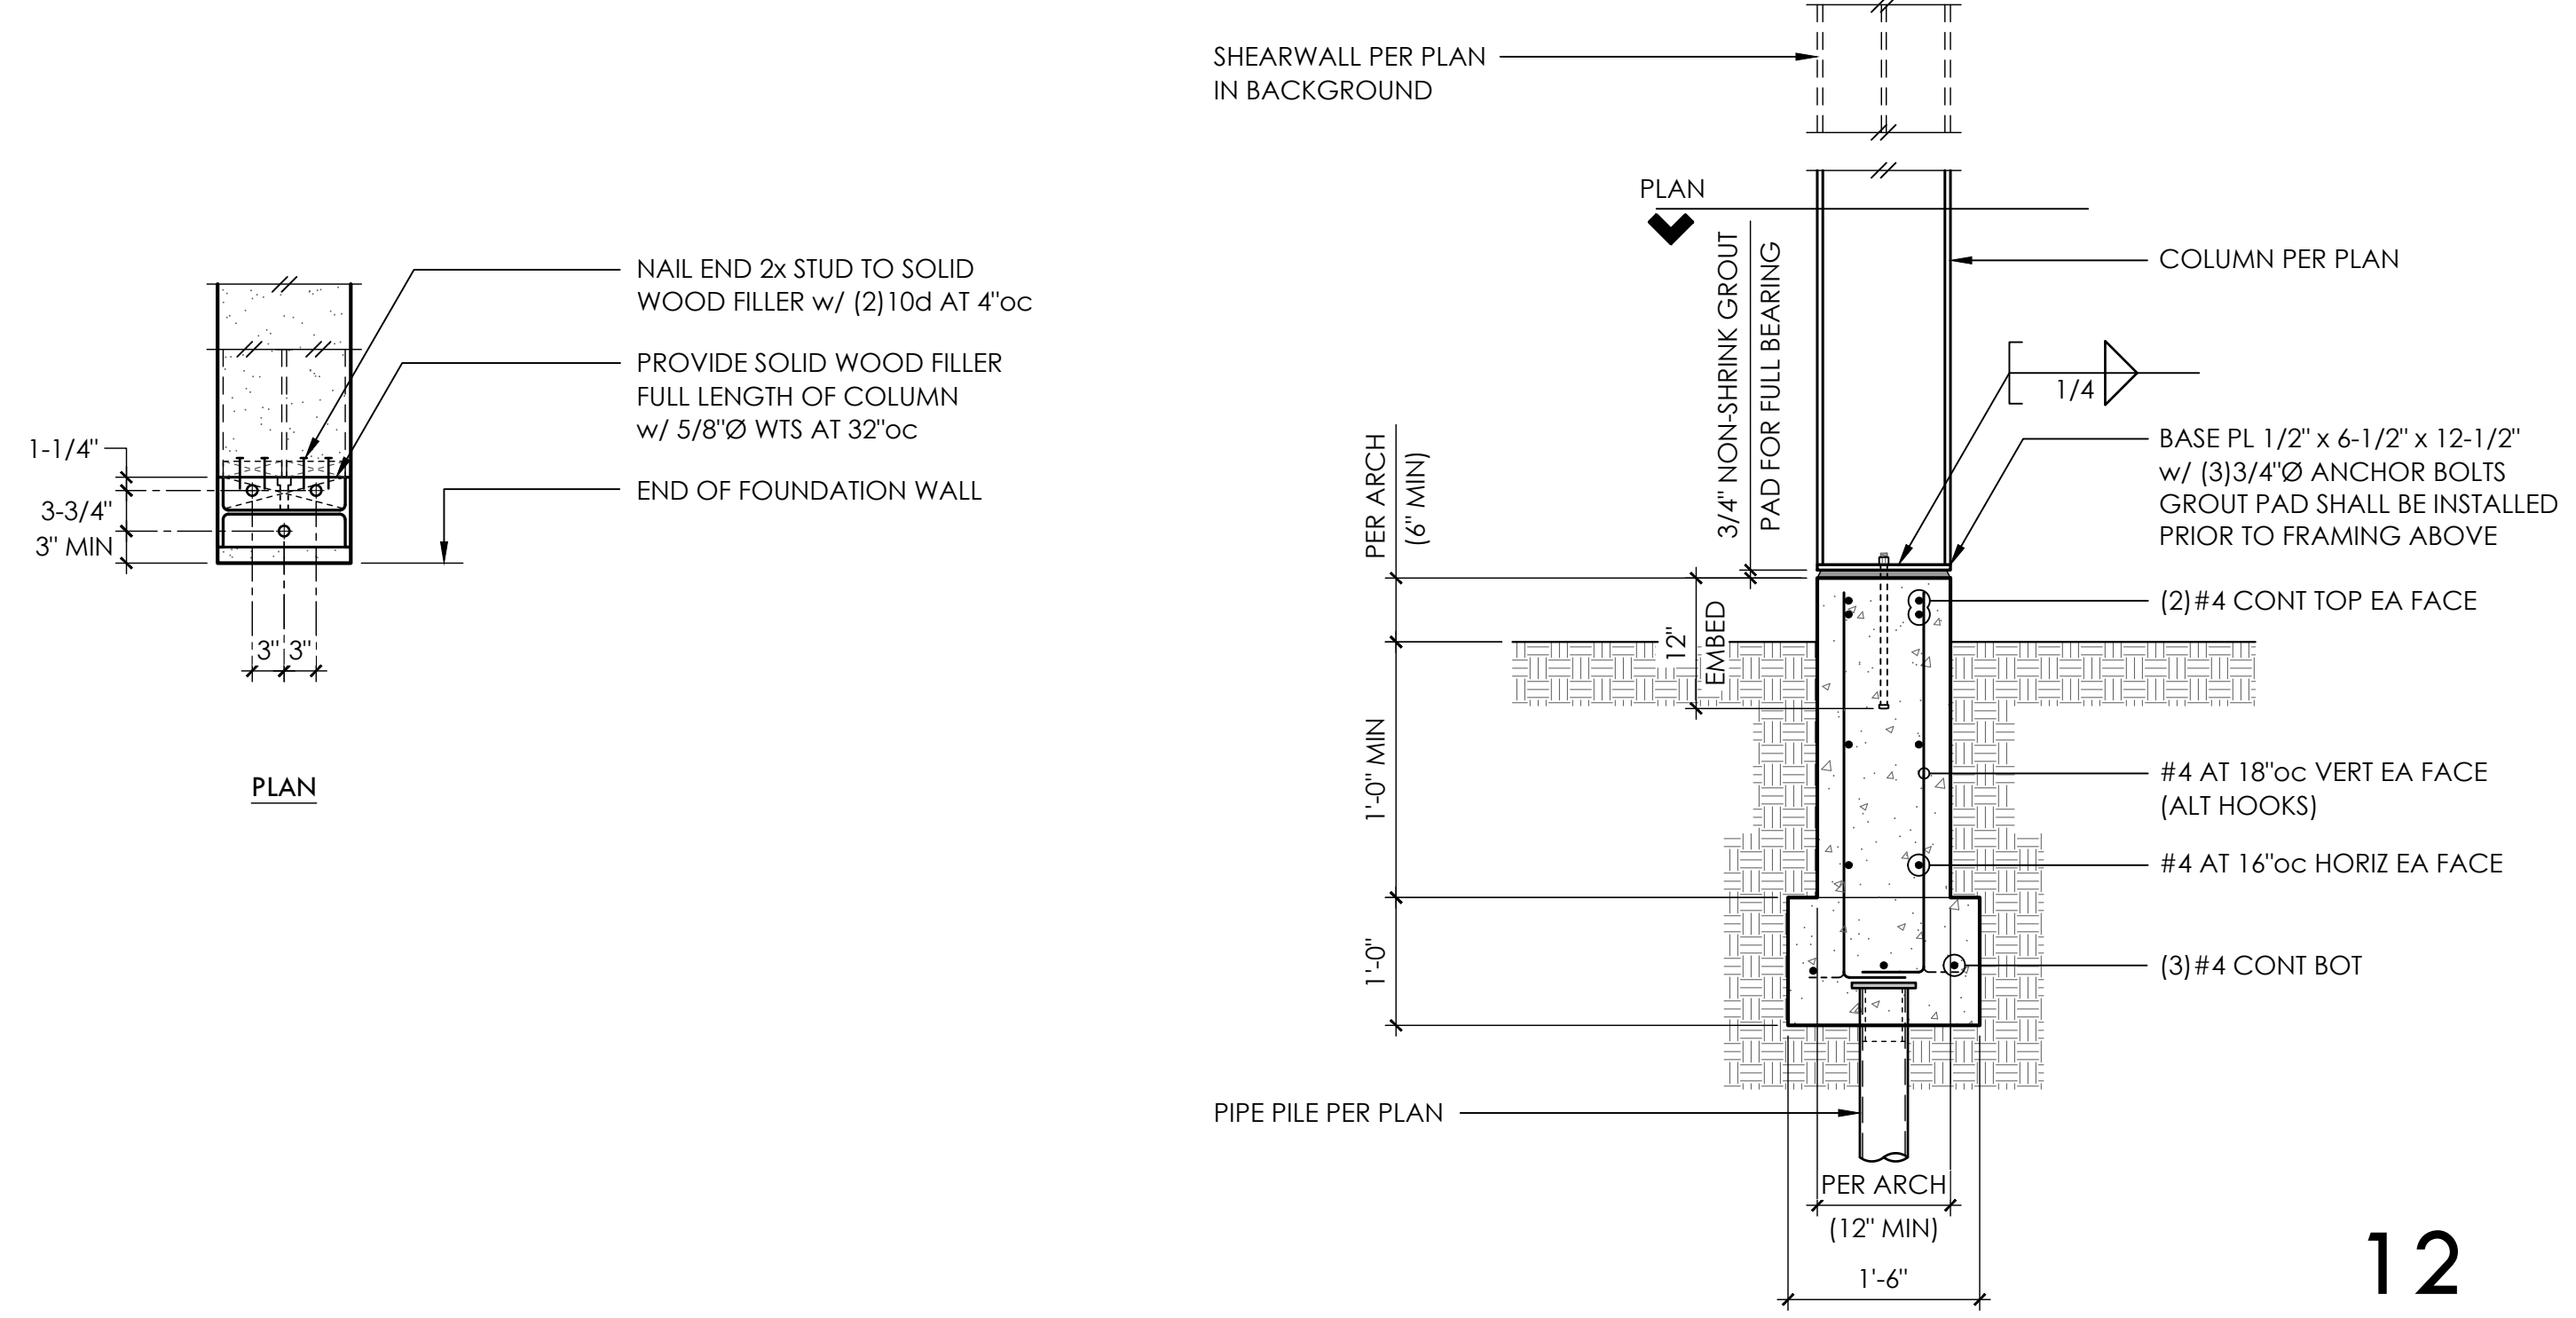


**12**

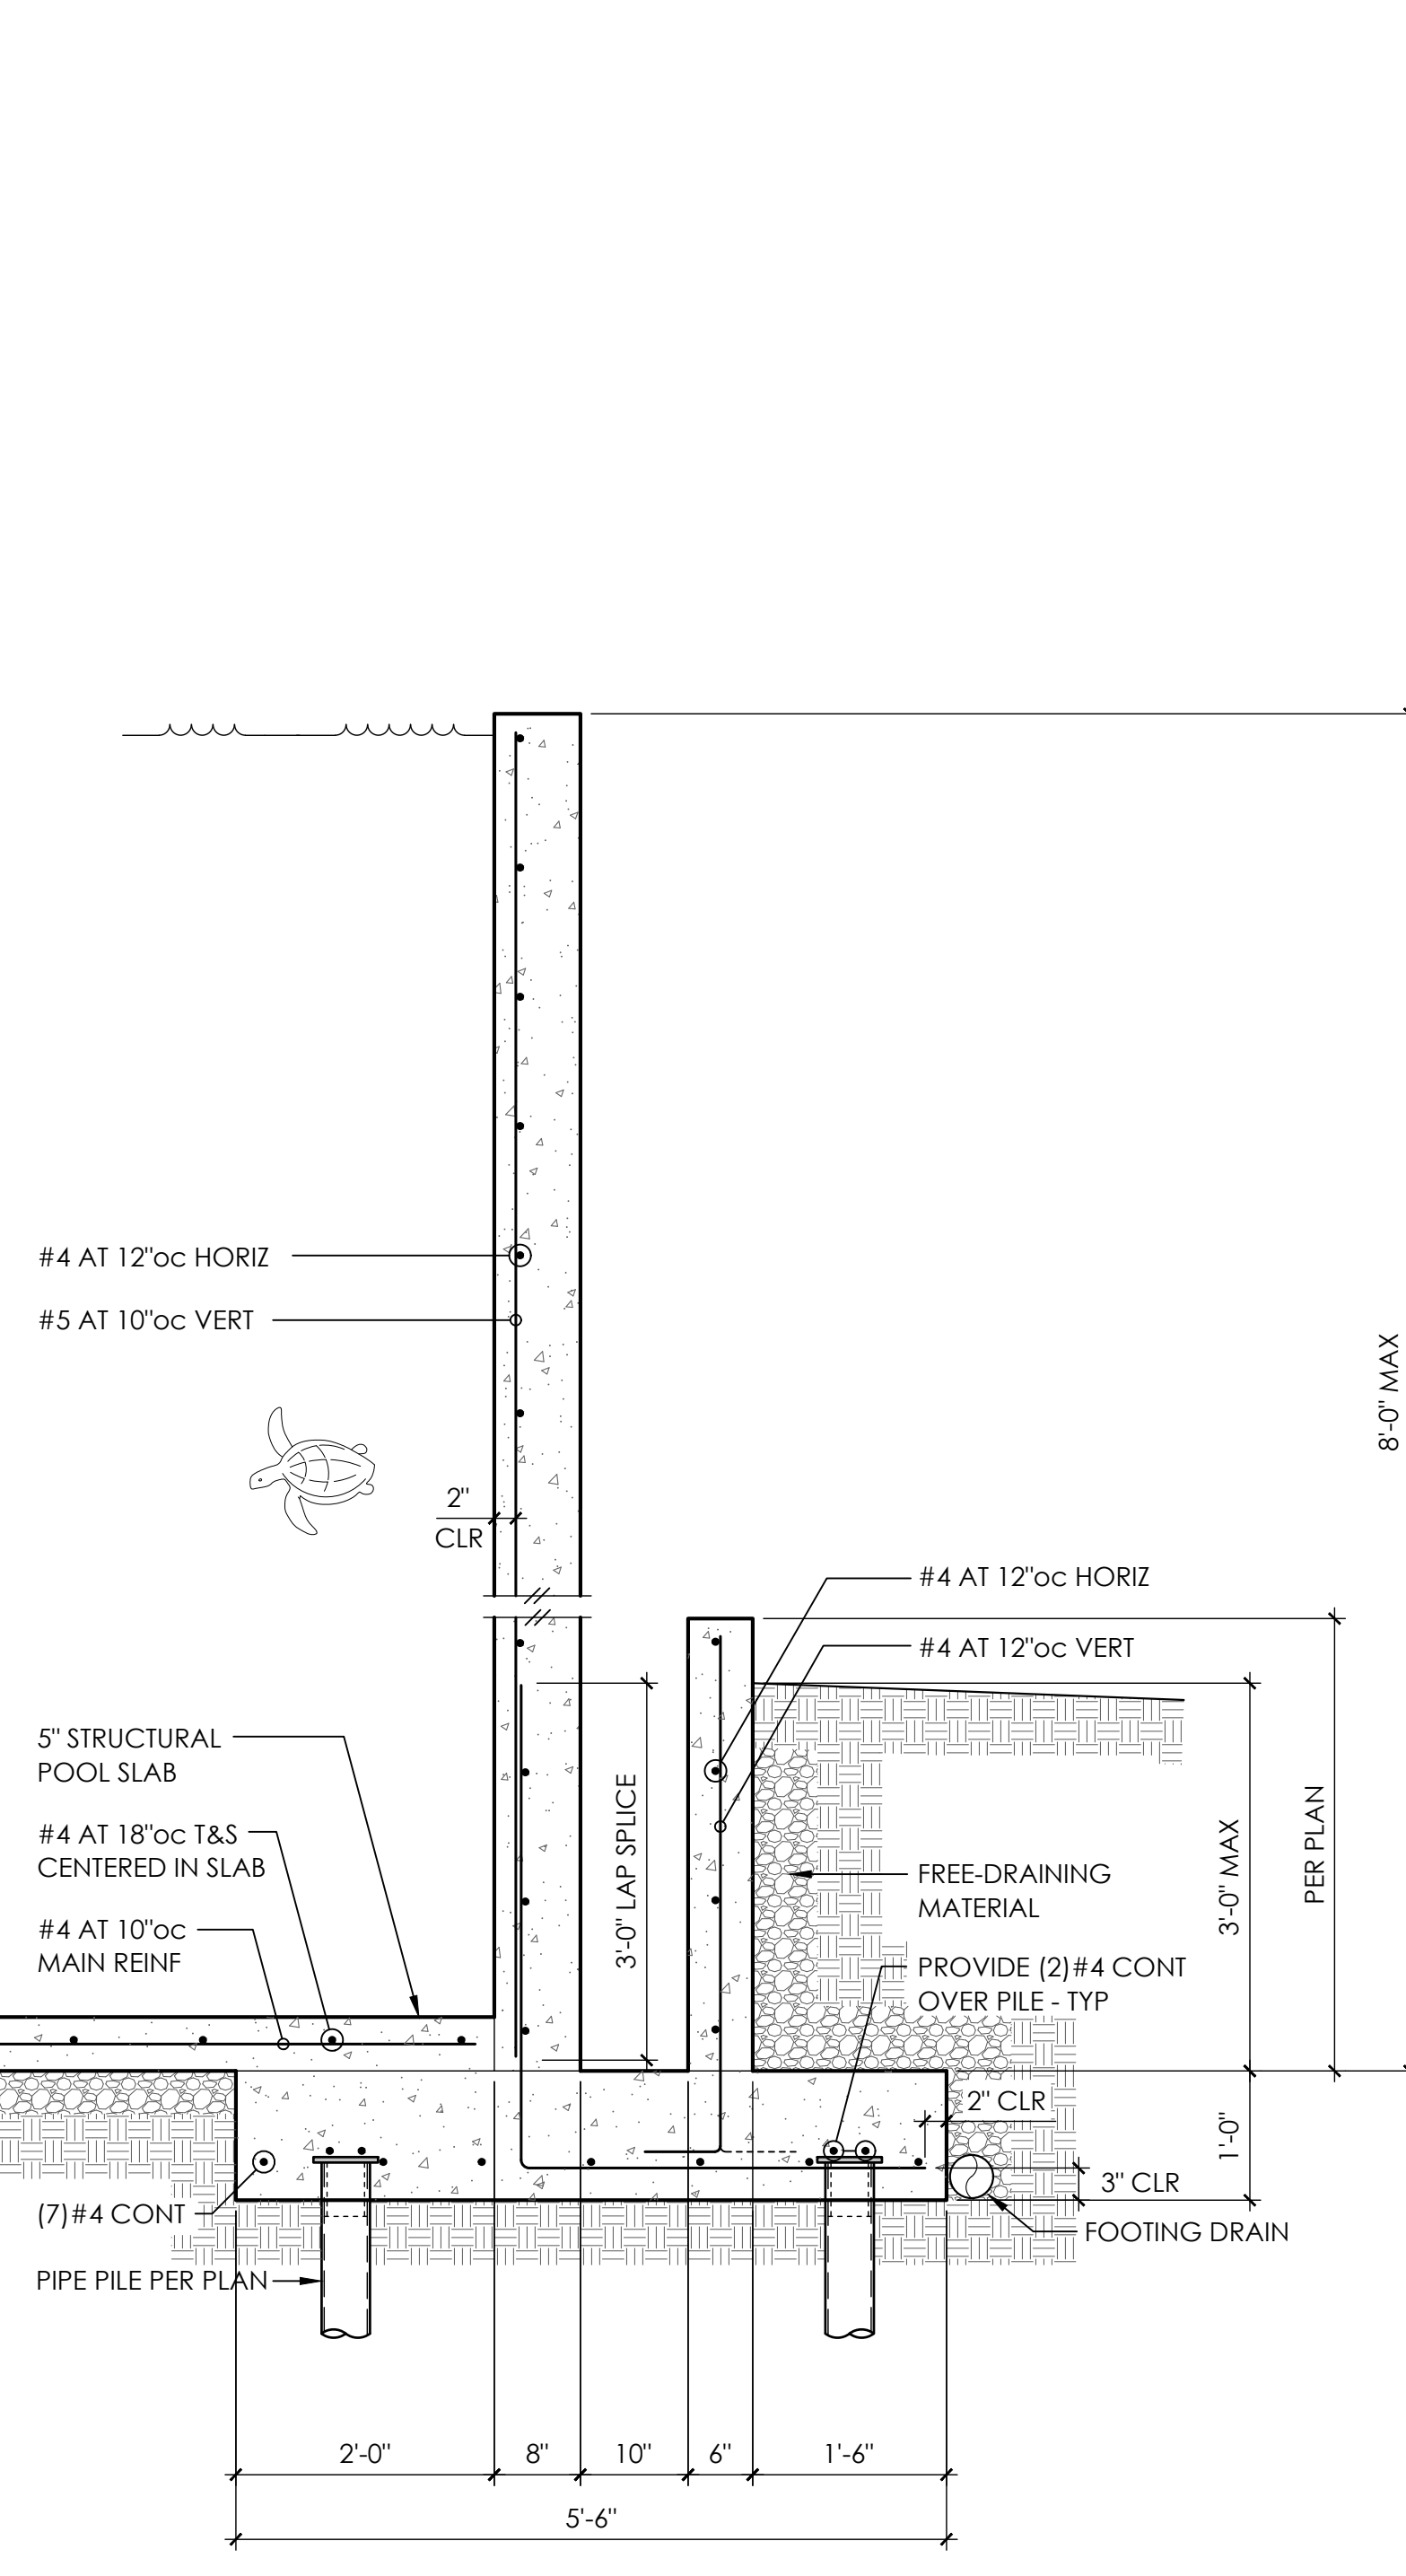


**17**

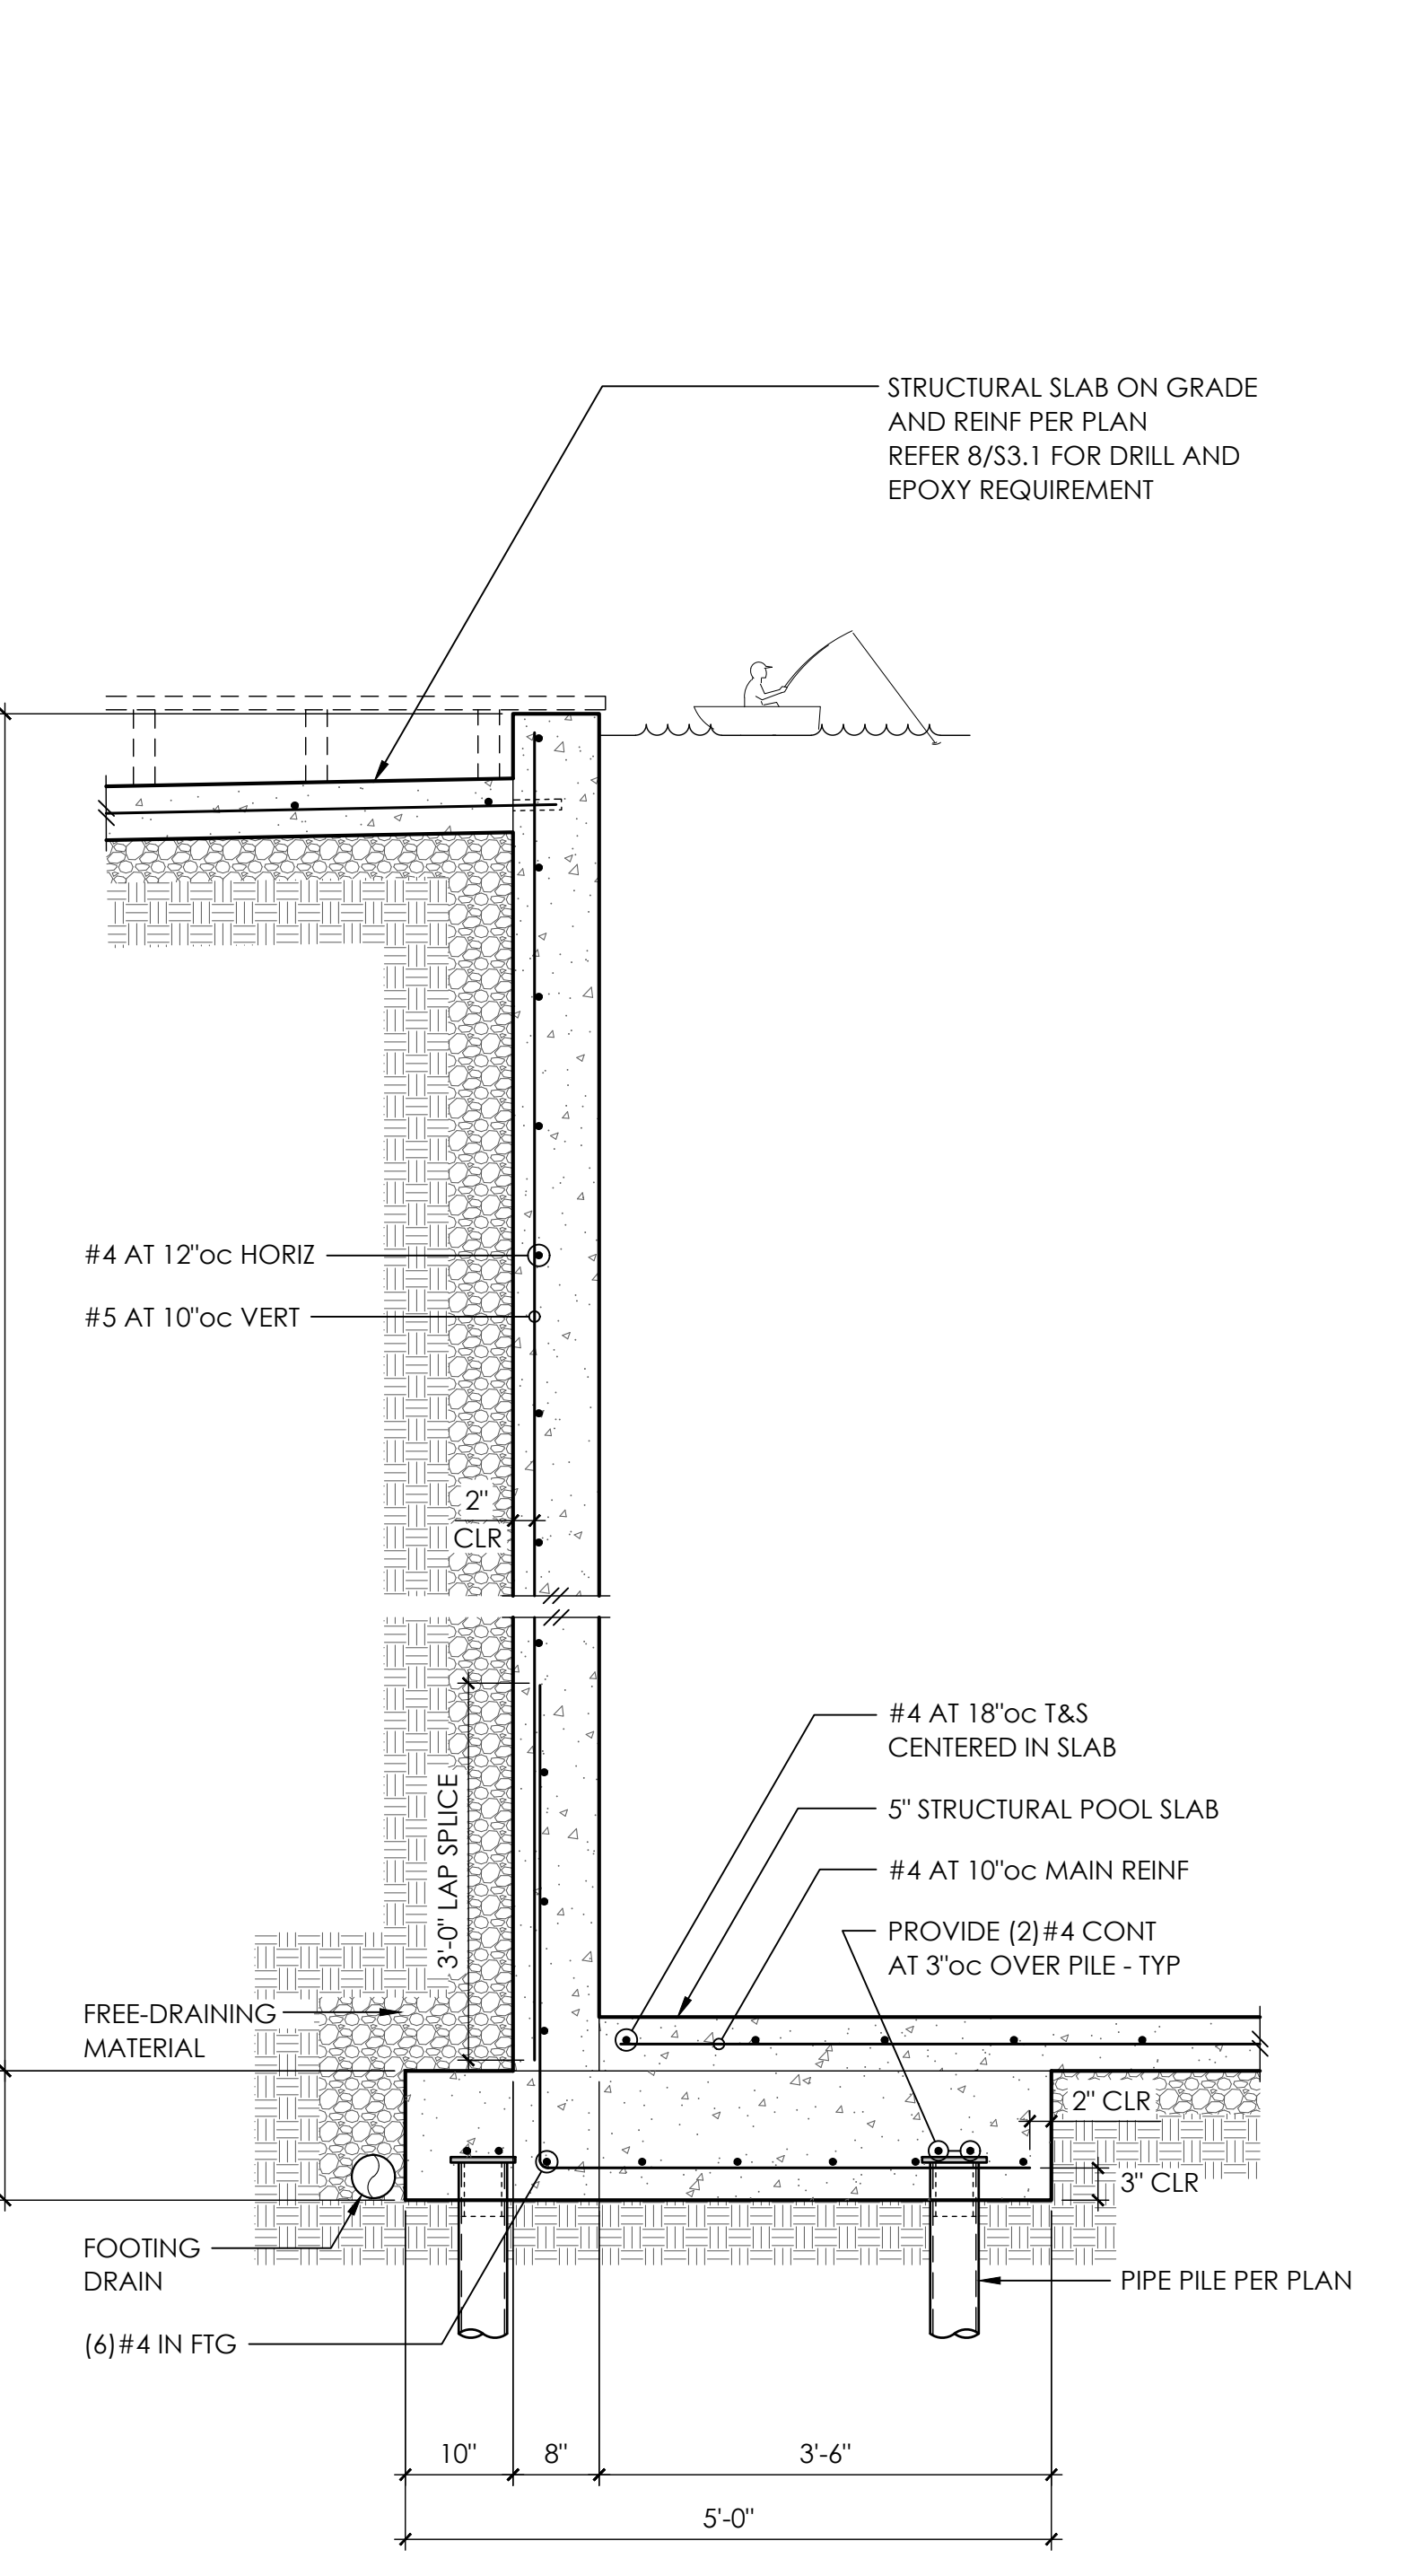


**18**

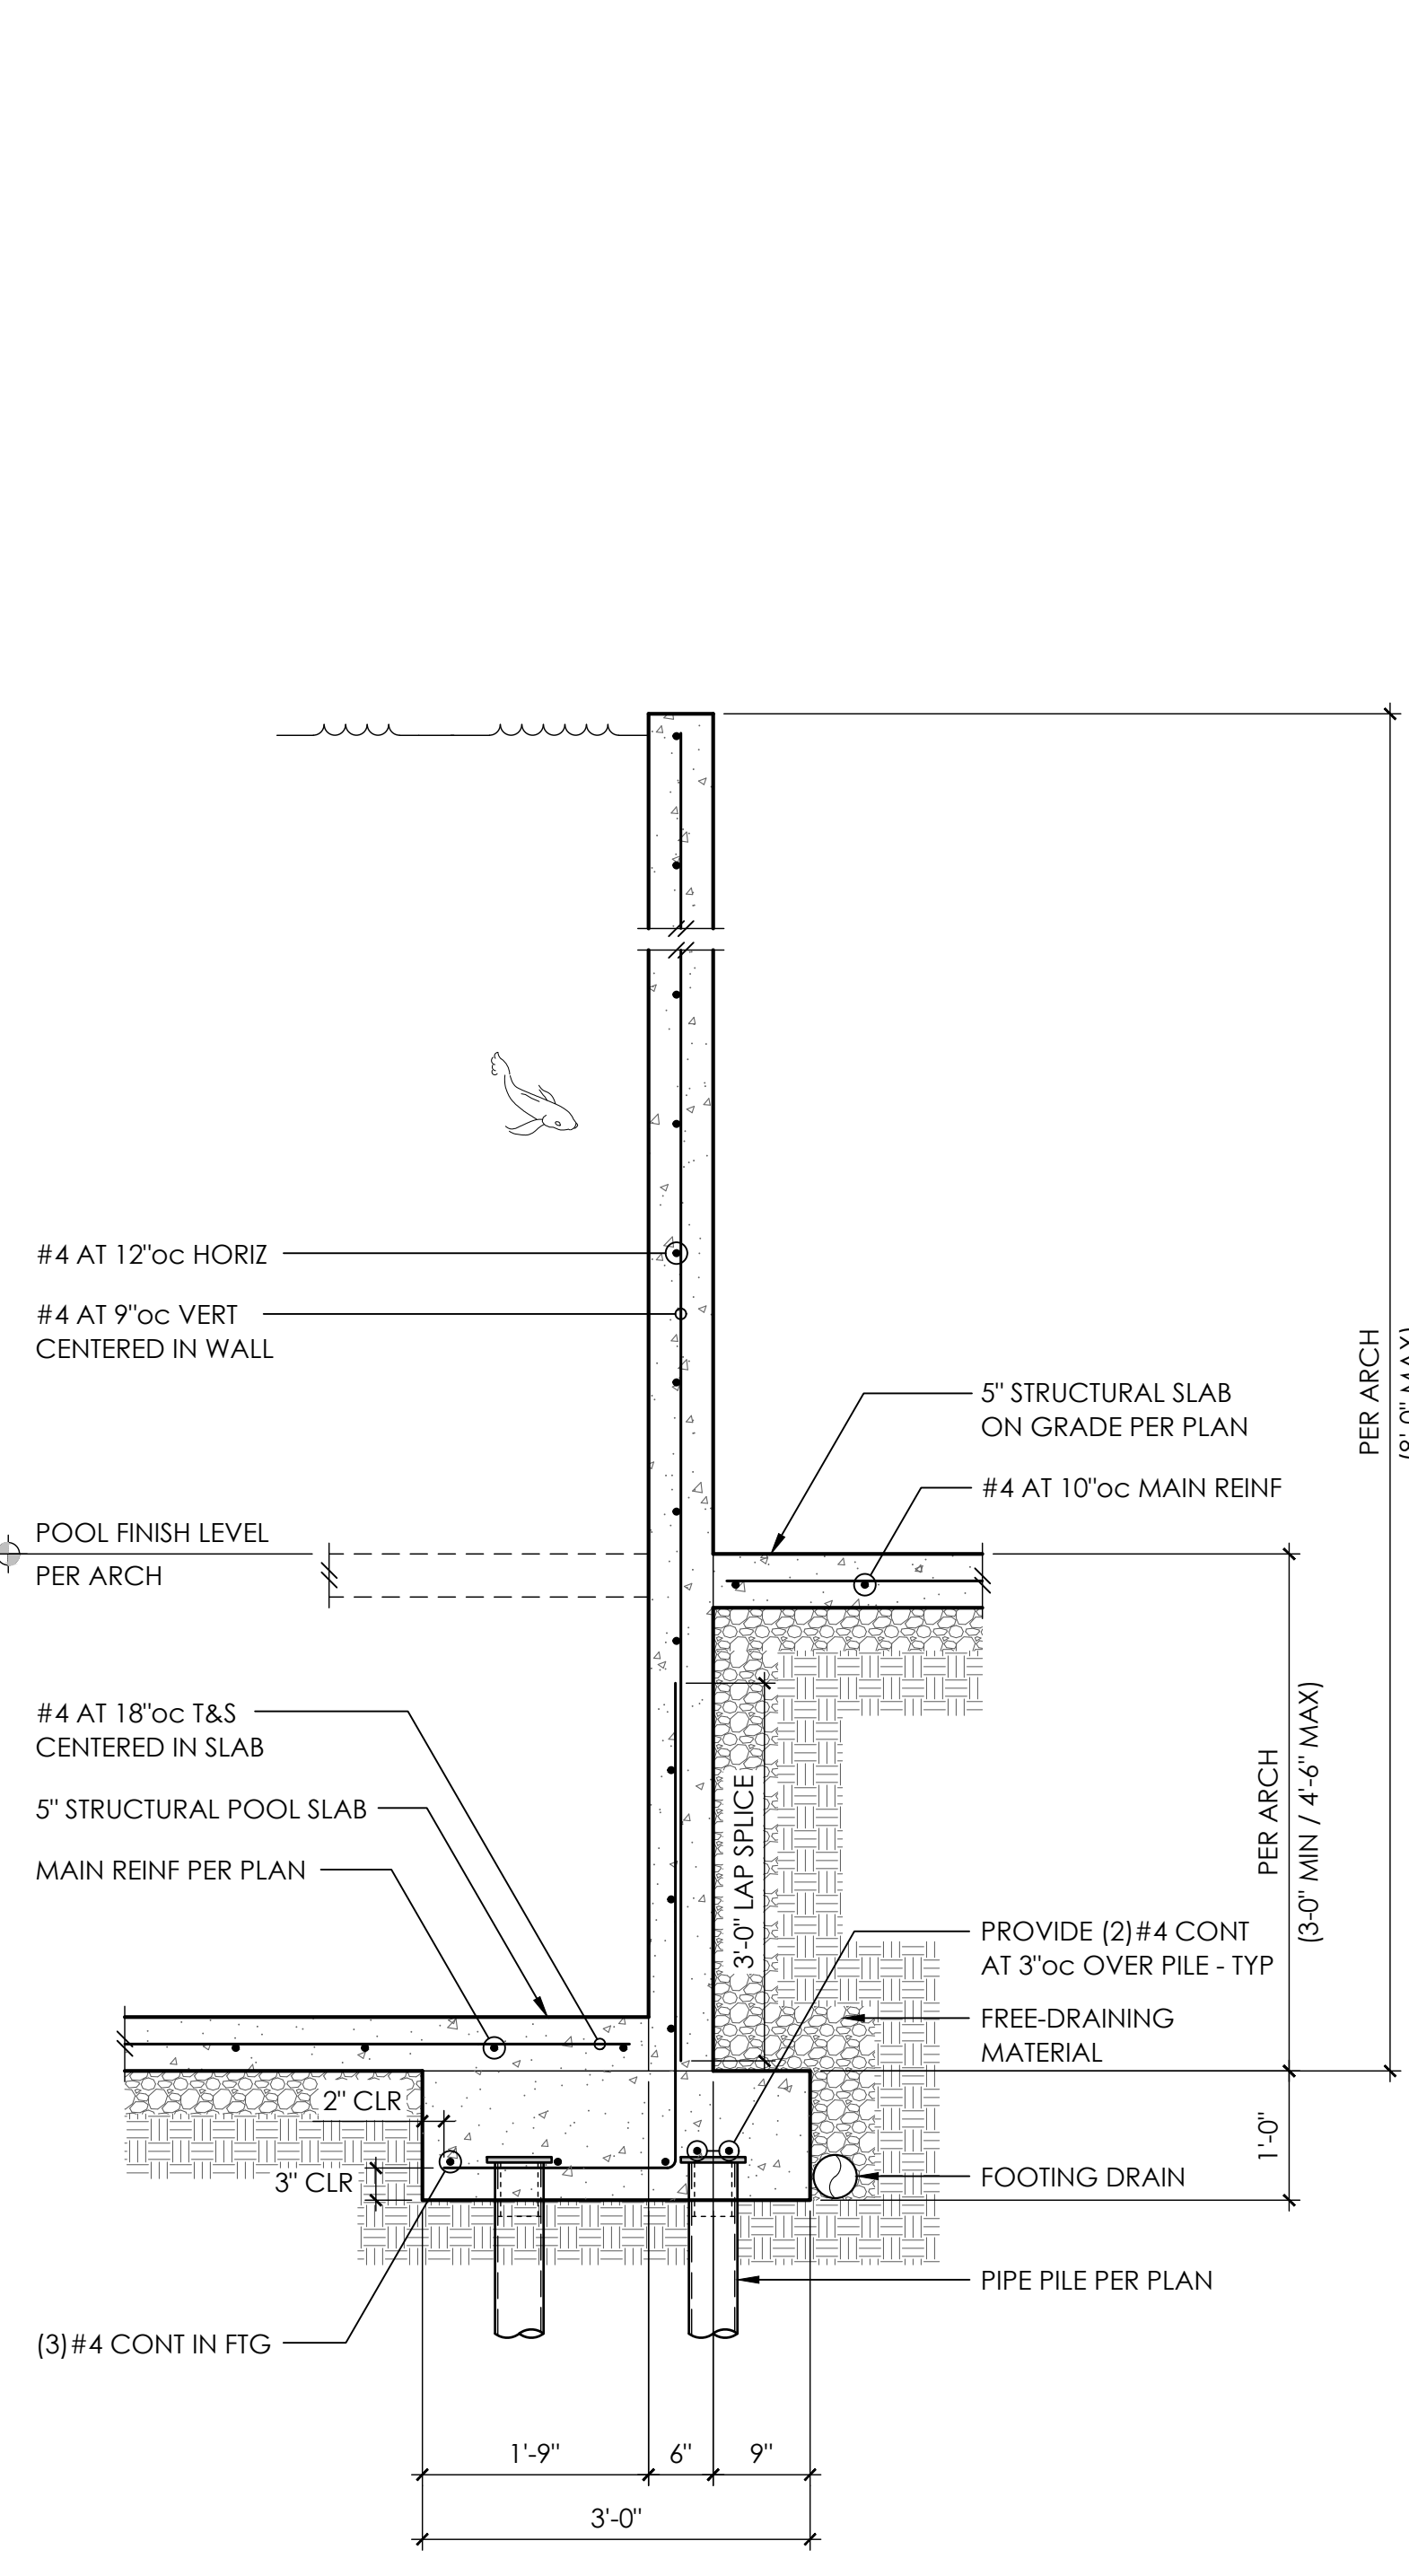


**19**

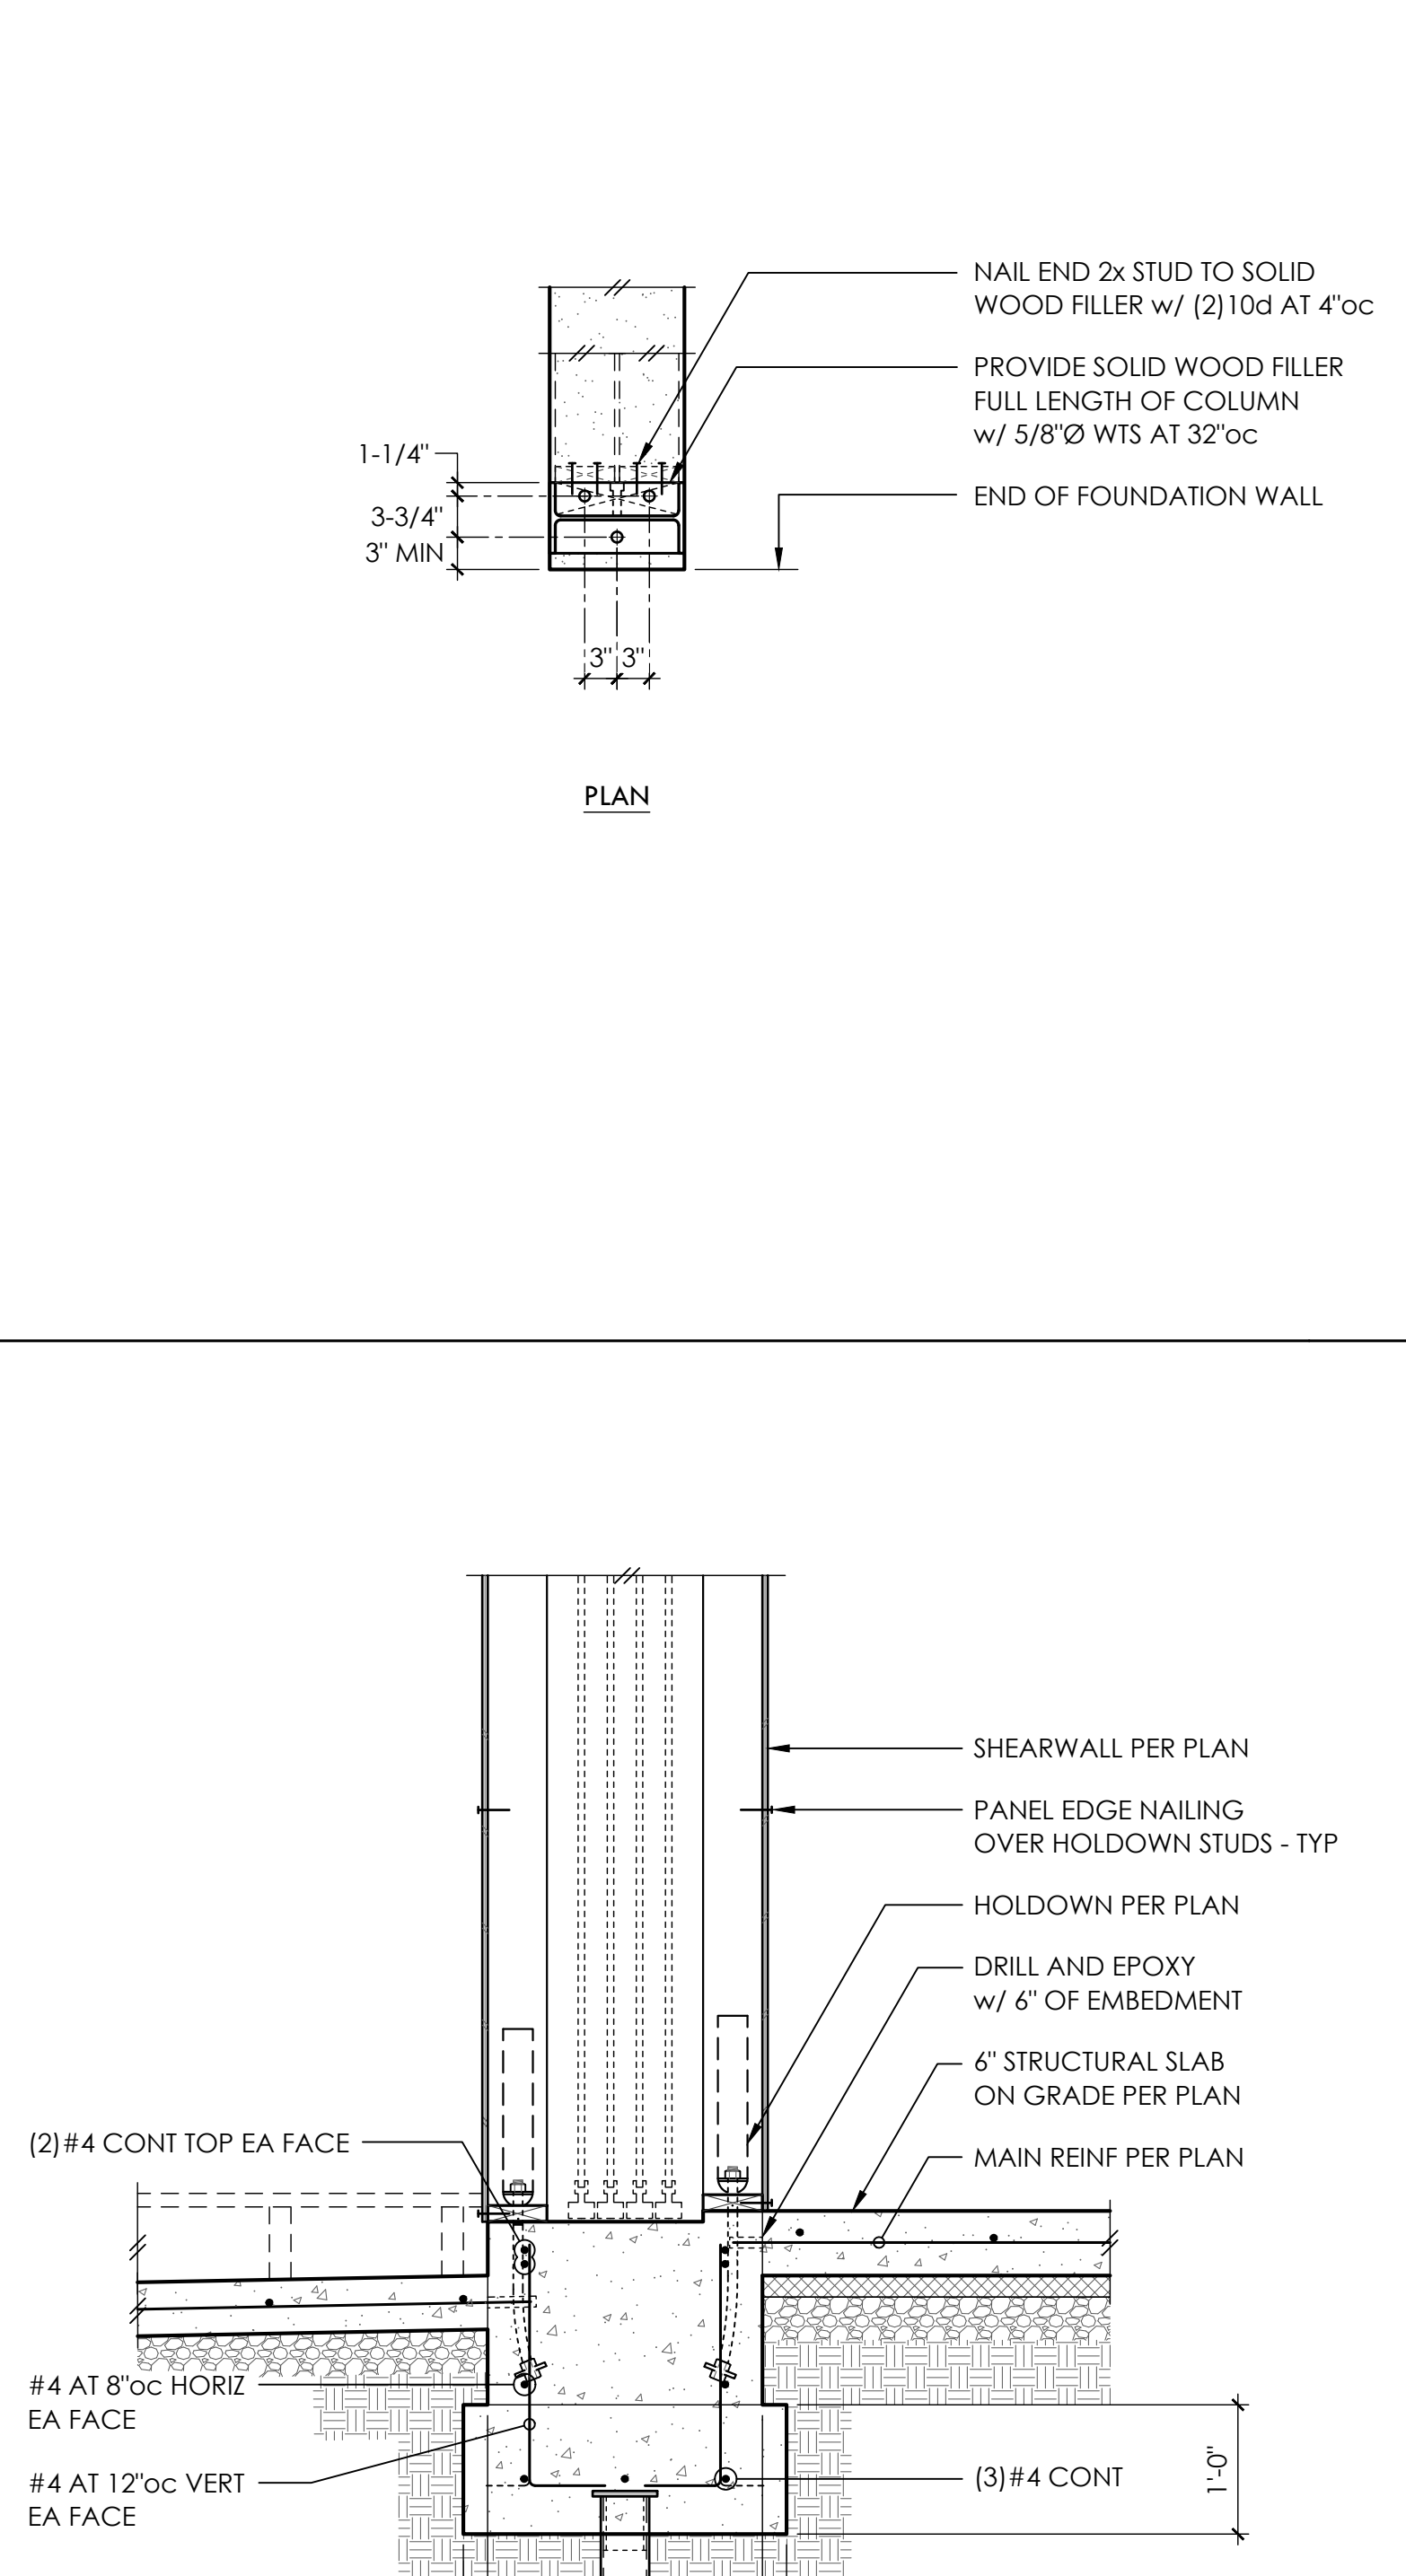


**16**

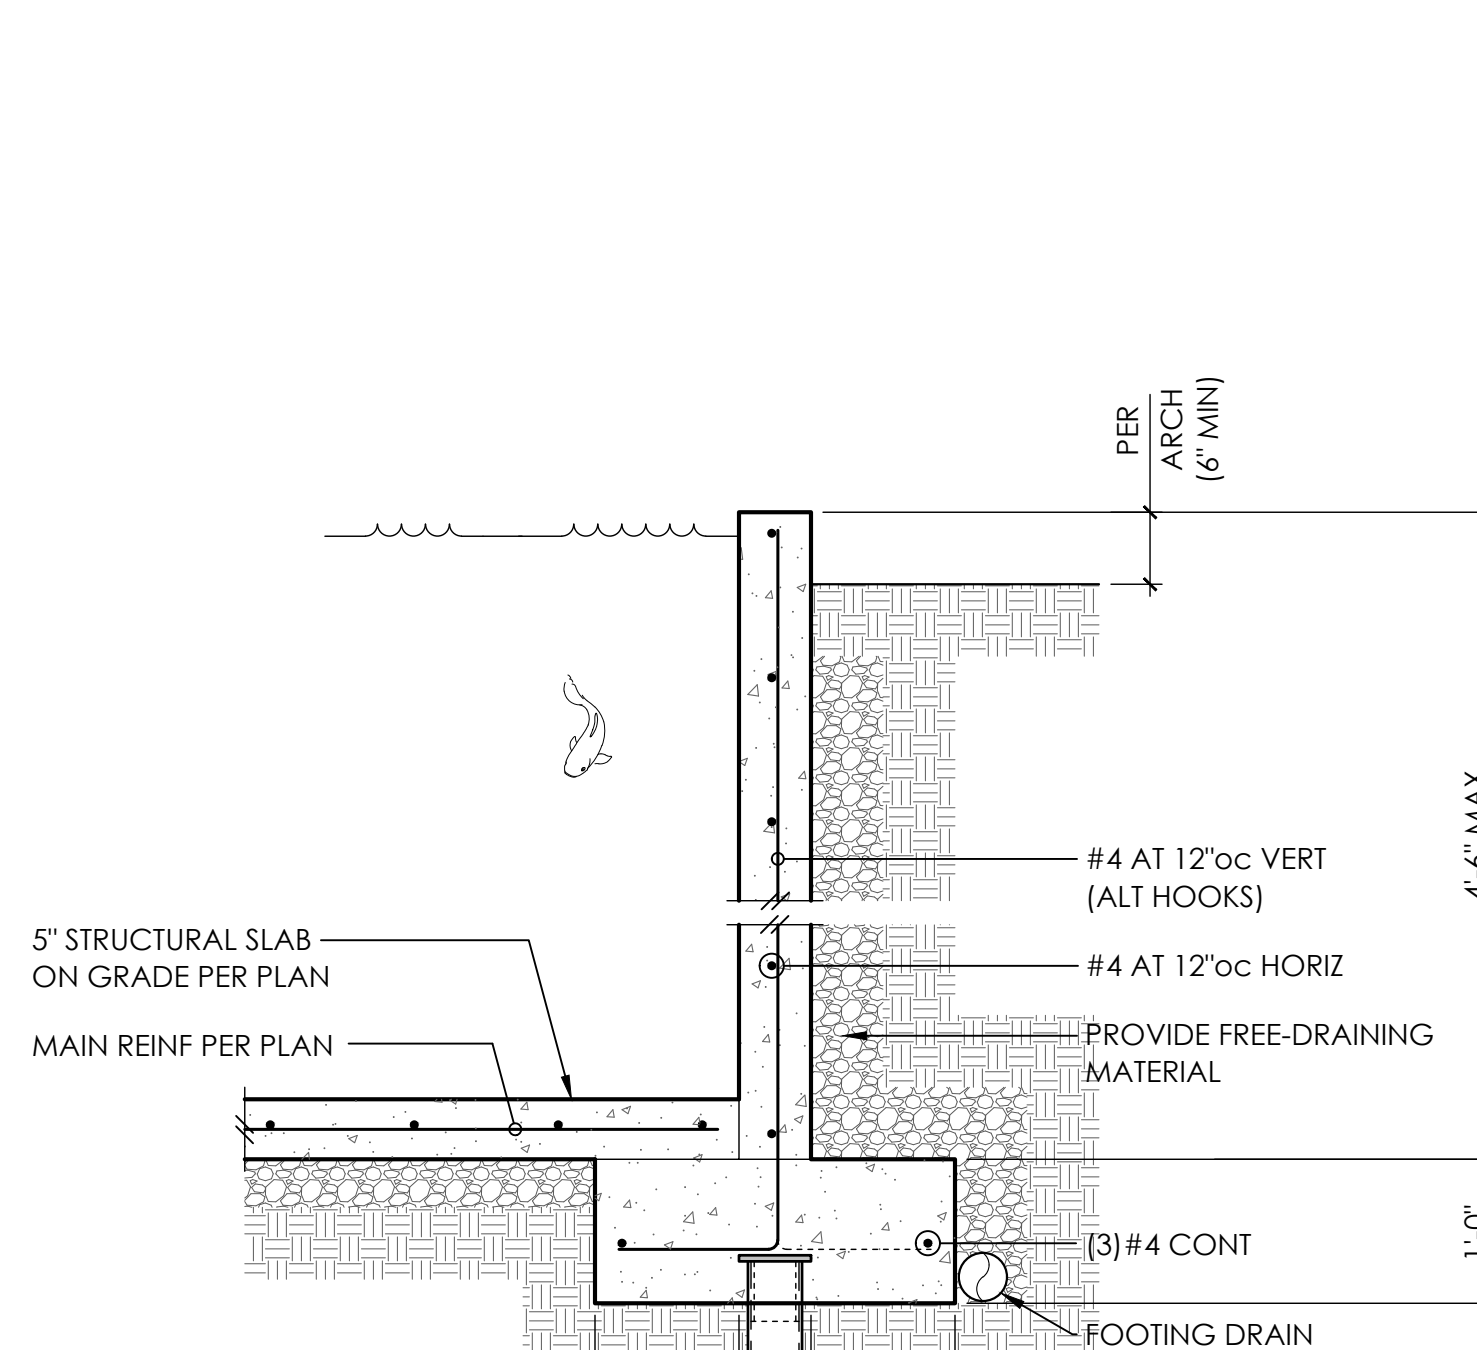


**17**

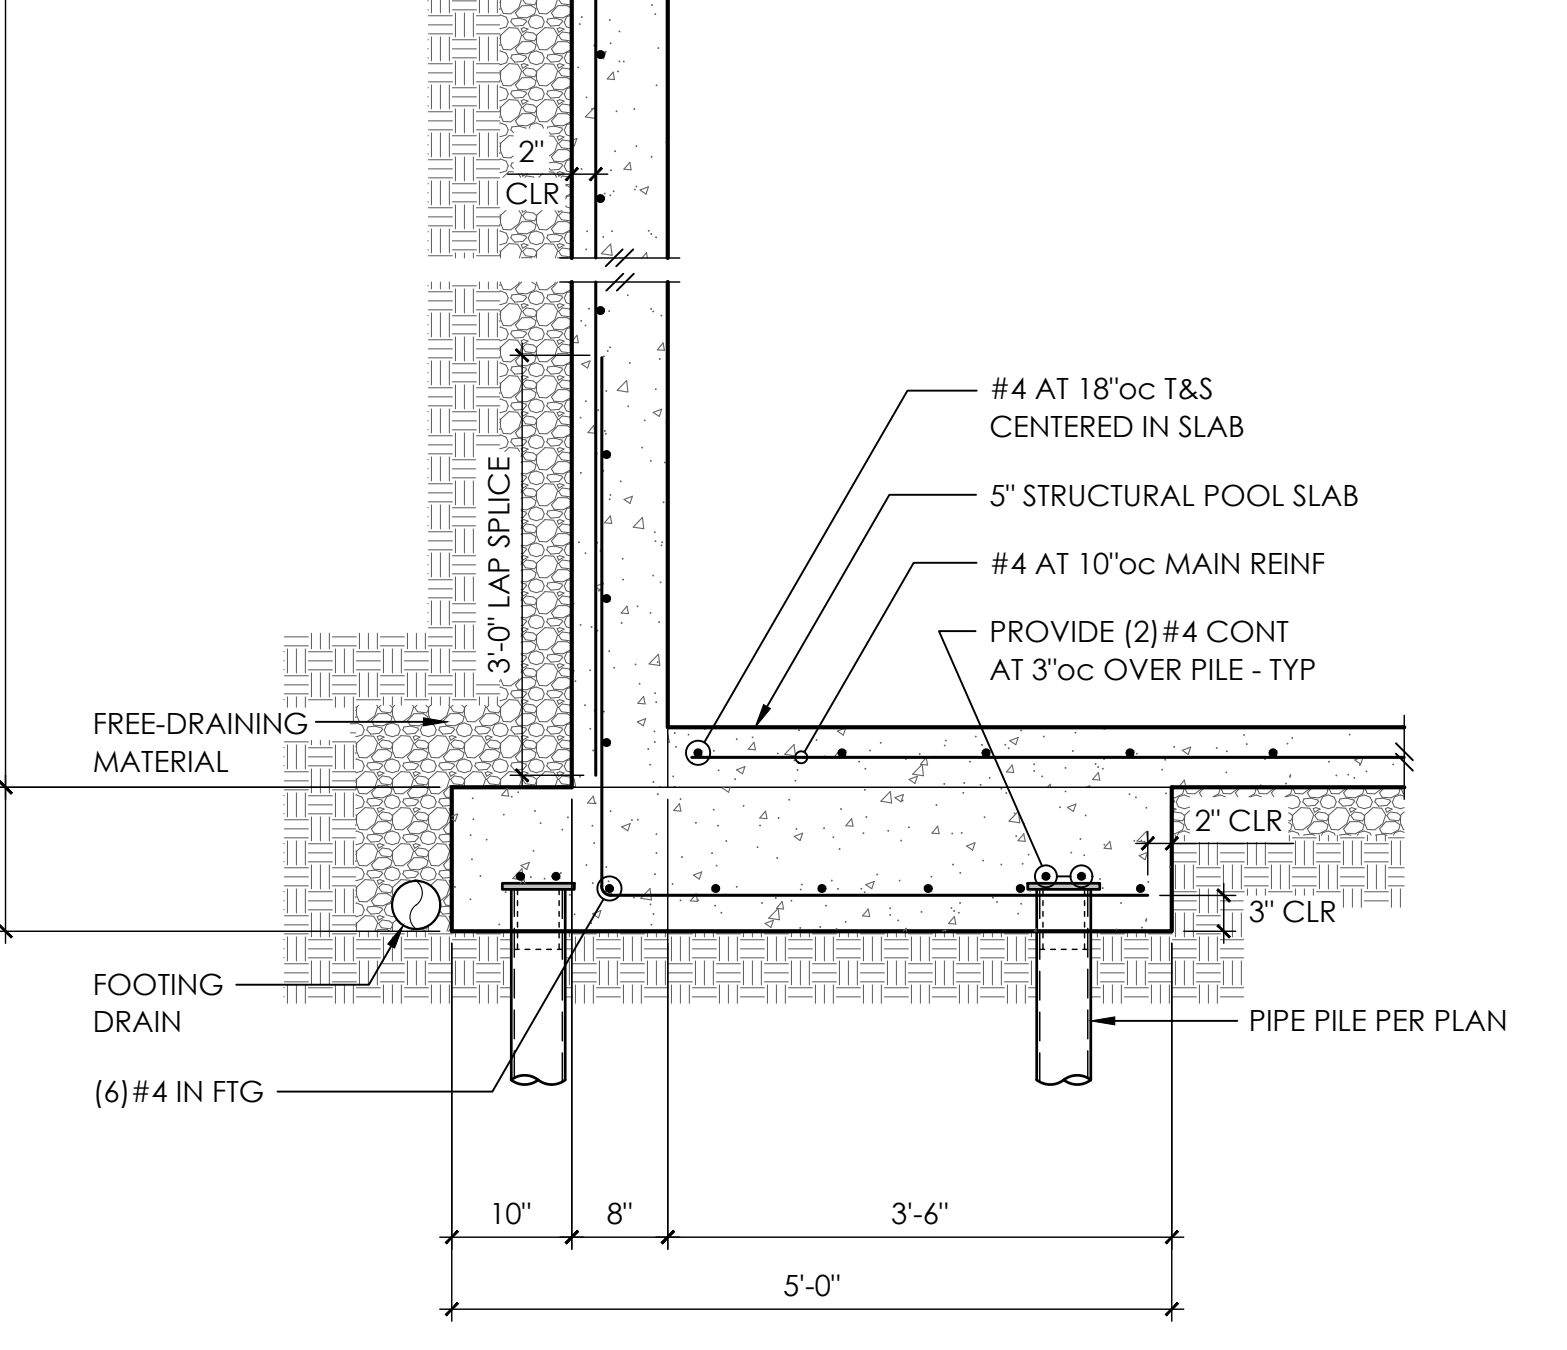

**18**

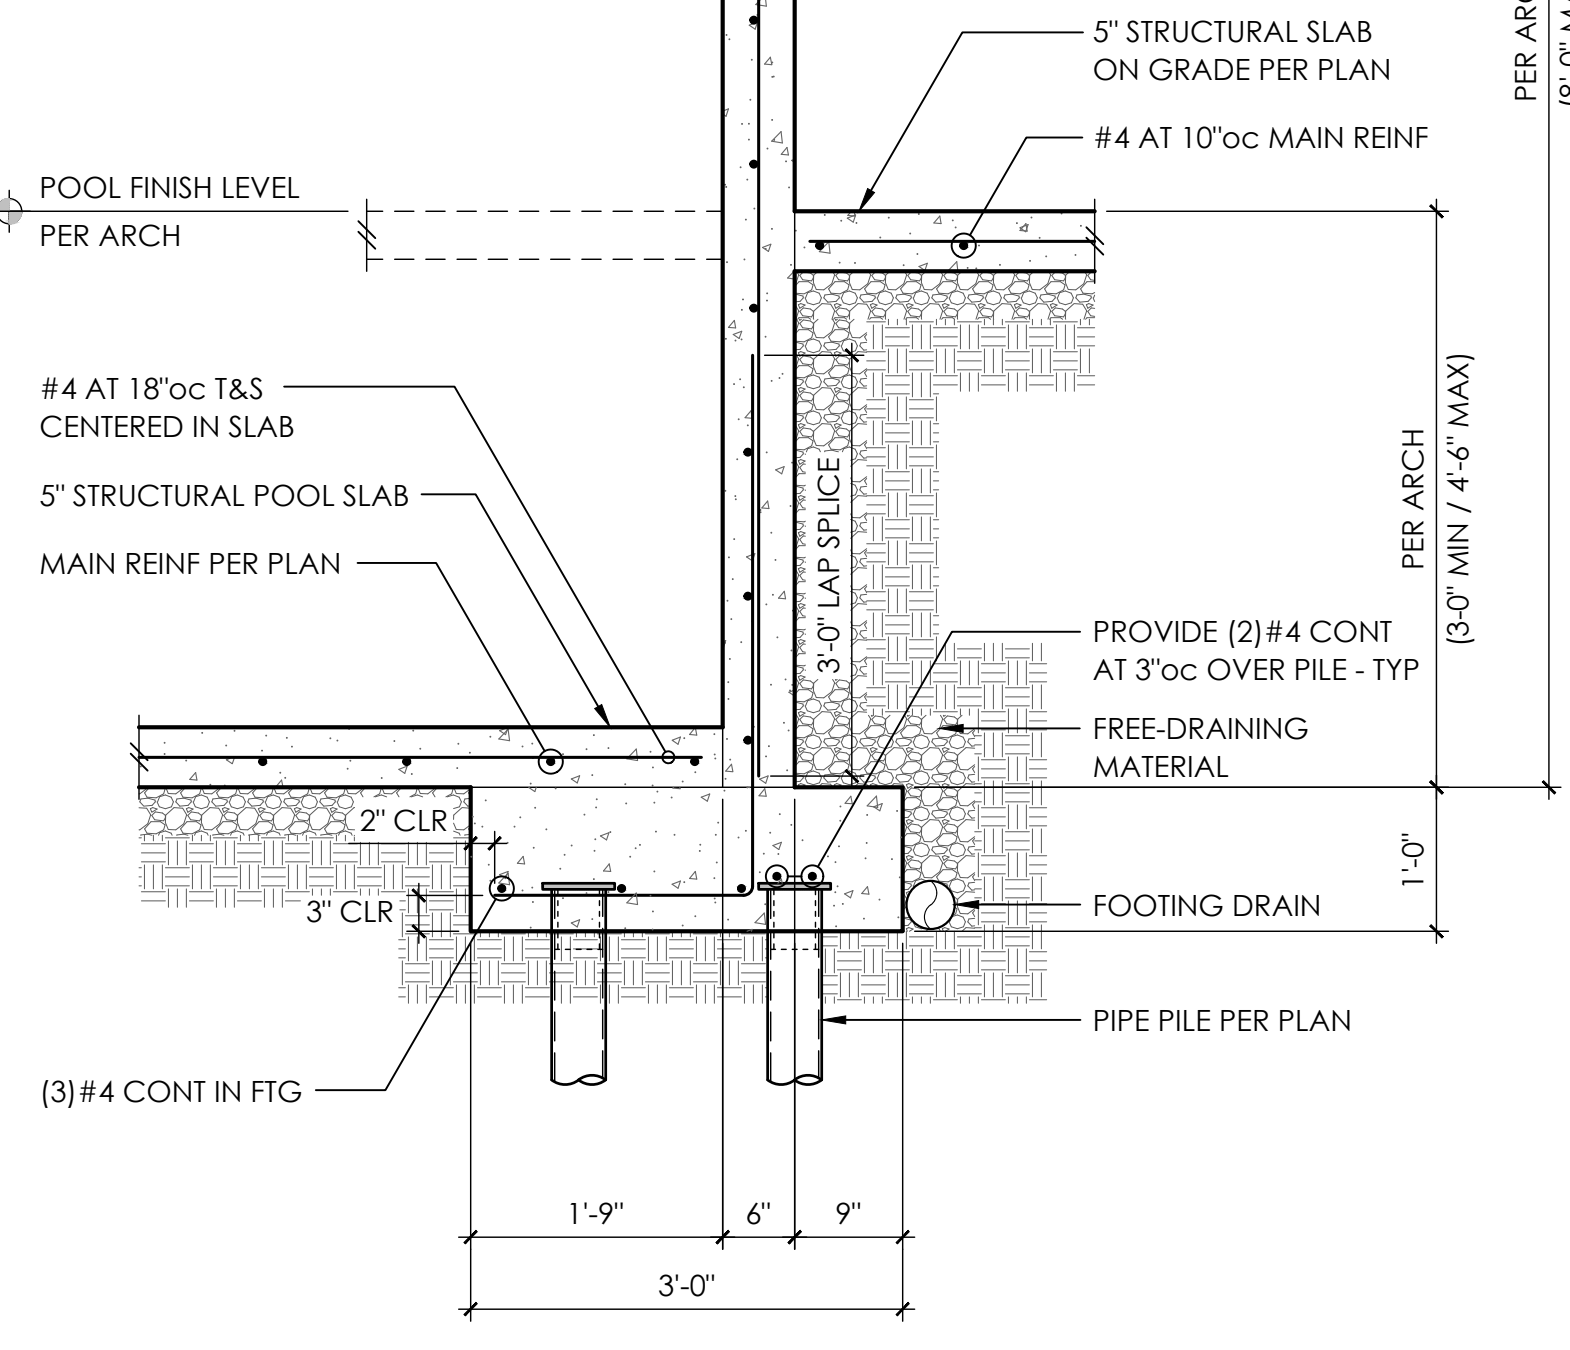

**19**

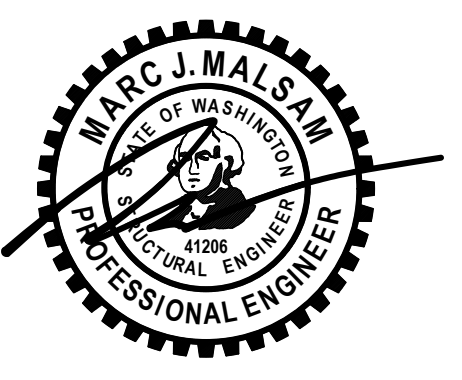


PROJECT NO	0426-2021-0301	
PROJECT MANAGER	WAC	
DRAWN	JAS	
ENGINEER	JOSEPH MARQUEZ	
	206.692.5122	
	JOSEPHM@MALSAMTSANG.COM	
REV	DESCRIPTION	DATE
1	PERMIT SET	12.23.21
2	PERMIT CORRECTIONS	5.5.22
3	PERMIT CORRECTIONS	7.13.22
4	PERMIT CORRECTIONS	8.19.22

ARCH MACULOUGH ARCHITECTS 206.443.1181


CONCRETE DETAILS

**S3.1**  
SCALE: 3/4" = 1'-0"




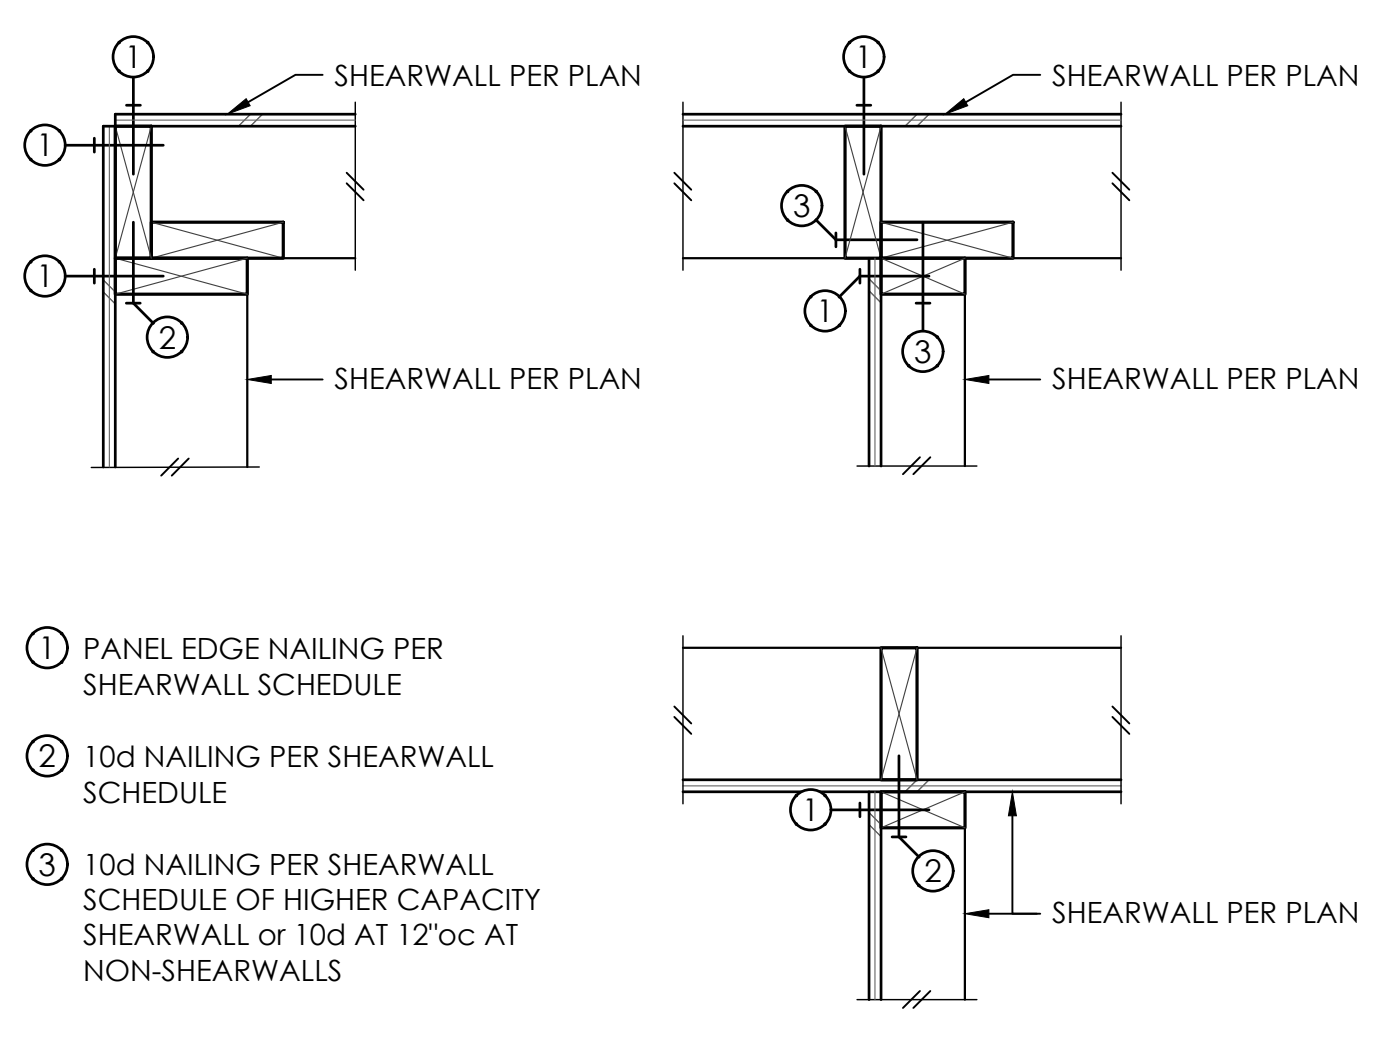


SCALE: 1'-1/2" = 1'-0"  
**TYPICAL SHEARWALL INTERSECTIONS 1**

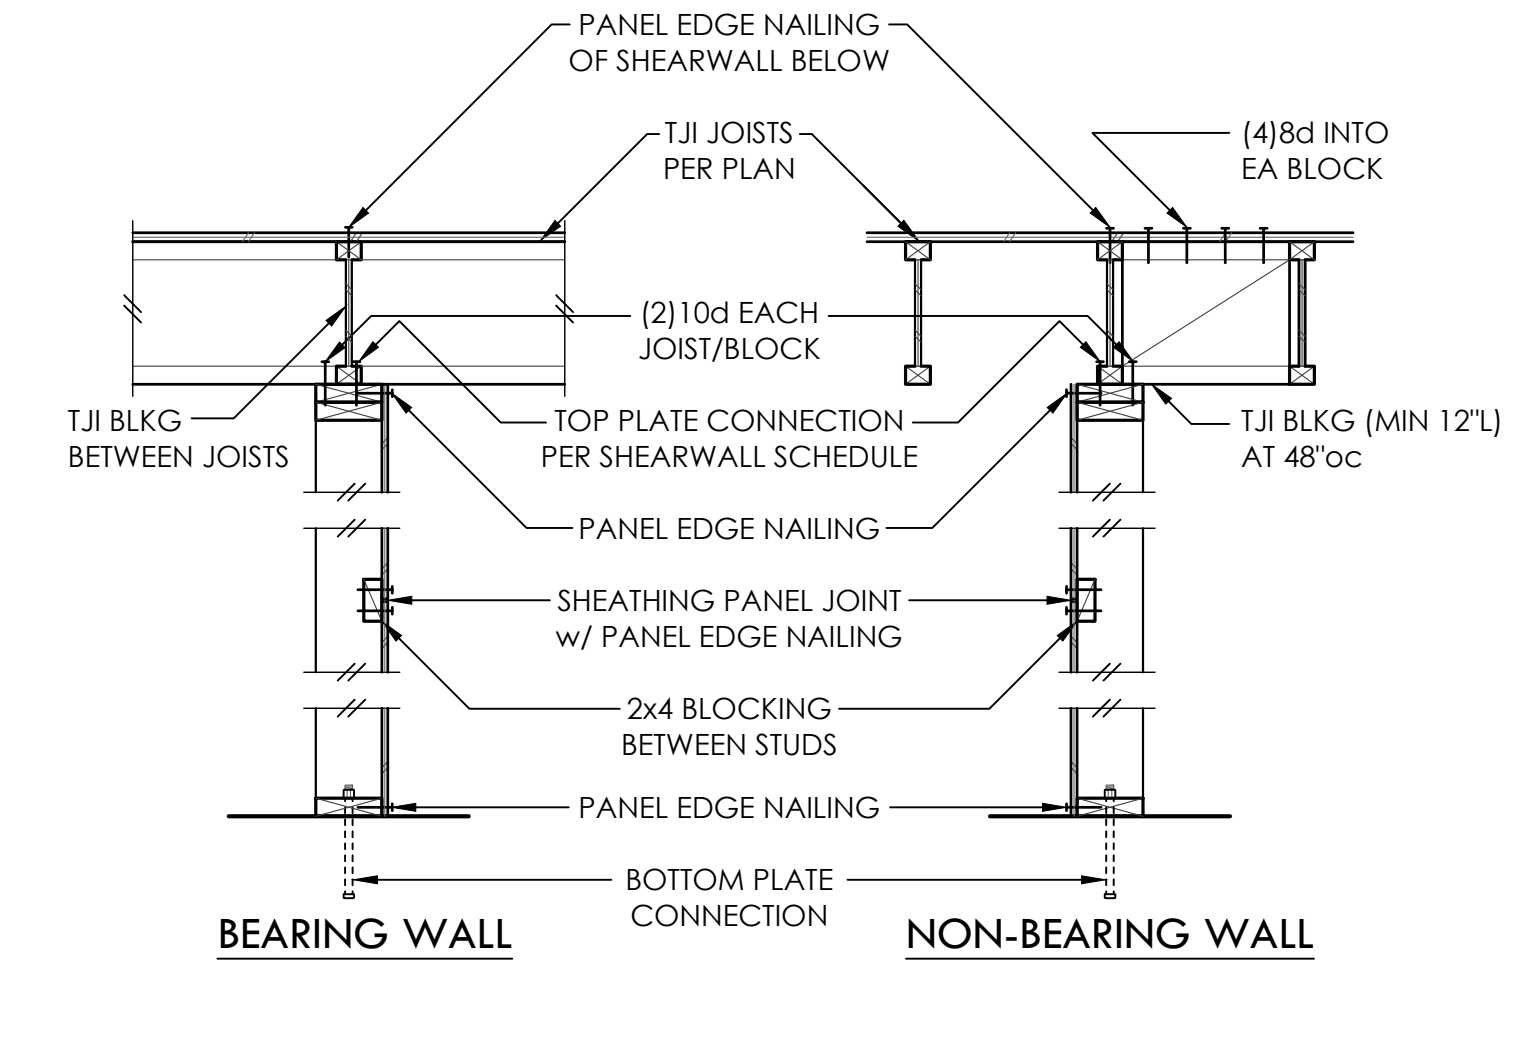

**TYPICAL SHEARWALL CONSTRUCTION 2**

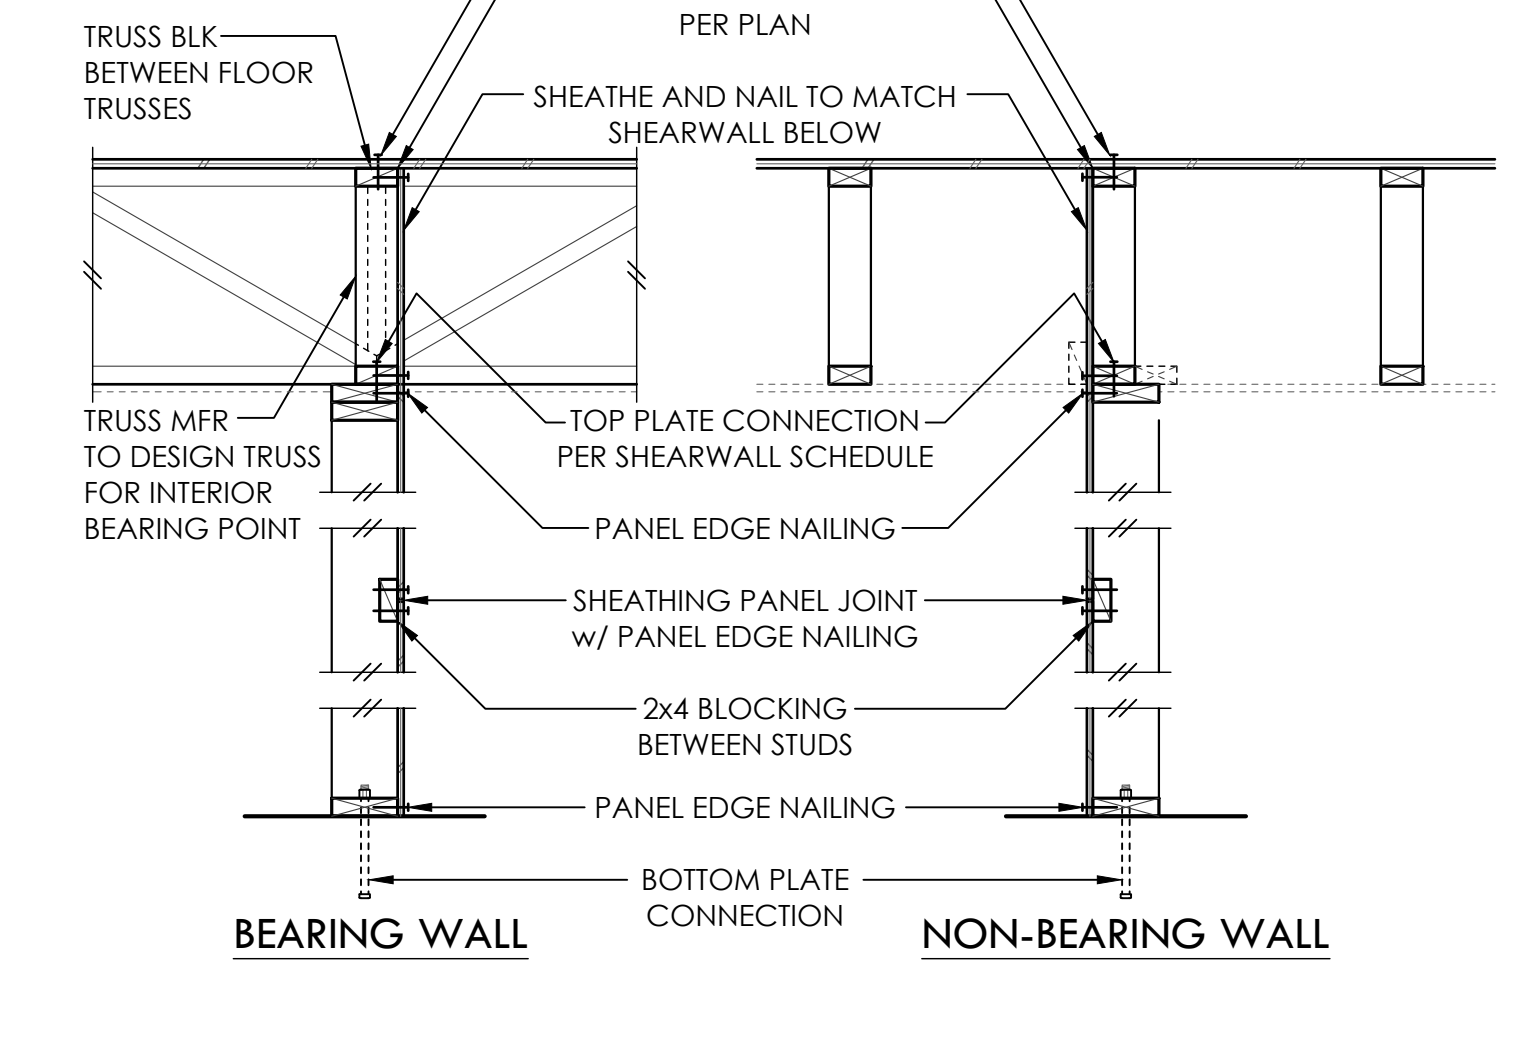

**TYPICAL SHEARWALL CONSTRUCTION 3**

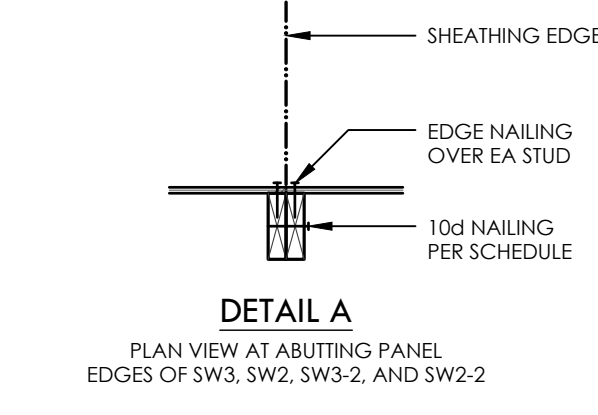


**SHEARWALL SCHEDULE**


MARK	SHEATHING	PANEL EDGE NAILING	TOP PLATE CONNECTION		BASE PLATE CONNECTION	
			TRUSS	RIM/BEAM	AT WOOD	AT CONCRETE
SW6	1/2" PLY or 7/16" OSB	8d AT 6"oc	10d AT 6"oc	A35 AT 30"oc	12d AT 6"oc	5/8" AB AT 48"oc
SW4	1/2" PLY or 7/16" OSB	8d AT 4"oc	10d AT 4"oc	A35 AT 18"oc	12d AT 4"oc	5/8" AB AT 42"oc
SW3	1/2" PLY or 7/16" OSB	8d AT 3"oc	(2) ROWS 10d AT 6"oc	A35 AT 12"oc	(2) ROWS 12d AT 4"oc	5/8" AB AT 36"oc
SW2	1/2" PLY or 7/16" OSB	8d AT 2"oc	(2) ROWS 10d AT 4"oc	A35 AT 8"oc	(2) ROWS 12d AT 3"oc	5/8" AB AT 24"oc
SW3-2	1/2" PLY or 7/16" OSB EA SIDE	8d AT 3"oc EA SIDE	N/A	A35 AT 8"oc	(2) ROWS 12d AT 3"oc	5/8" AB AT 18"oc
SW2-2	1/2" PLY or 7/16" OSB EA SIDE	8d AT 2"oc EA SIDE	N/A	A35 AT 6"oc	(3) ROWS 12d AT 3"oc	5/8" AB AT 12"oc

- BLOCK PANEL EDGES WITH 2x4 LAID FLAT AND NAIL PANELS TO INTERMEDIATE SUPPORTS WITH 8d AT 12"oc.
- 8d NAILS SHALL BE 0.131"Ø x 2-1/2". 10d NAILS SHALL BE 0.131"Ø x 3". AND 12d NAILS SHALL BE 0.131"Ø x 3-1/4".
- EMBED ANCHOR BOLTS AT LEAST 7". ALL BOLTS SHALL HAVE 3" x 3" x 0.229" PLATE WASHERS. THE PLATE WASHER SHALL EXTEND TO WITHIN 1/2" OF THE EDGE OF THE BOTTOM PLATE ON THE SIDES w/ SHEATHING. AT 2x6 SW3-2 AND SW2-2 WALLS. PROVIDE 4-1/2" x 3" x 0.229" PLATE WASHERS CENTERED ON PLATE.
- 3x STUDS OR DBL STUDS NAILED TOGETHER w/ 10d NAILING IS REQD AT ABUTTING PANEL EDGES OF SW3, SW2, SW3-2, AND SW2-2. REFER TO DETAIL A. WHERE 3x STUDS ARE USED, STAGGER STUDS AT ADJOINING PANEL EDGES. ABUTTING PANEL EDGES SHALL BE OFFSET EACH SIDE OF WALL AT SW3-2 AND SW2-2.
- TWO STUDS MINIMUM OR POST PER PLAN ARE REQUIRED AT EACH END OF ALL SHEARWALLS AND ALL END STUDS SHALL RECEIVE PANEL EDGE NAILING.
- ALL EXTERIOR WALLS SHALL BE SW6, UNLESS NOTED OTHERWISE.
- NAILS SHALL NOT BE SPACED LESS THAN 3/8" FROM EDGES OF SHEATHING. SHEATHING NAILS SHALL BE DRIVEN SO THEIR HEADS ARE FLUSH WITH SHEATHING (NOT COUNTERSUNK).
- LTPs INSTALLED OVER SHEATHING WITH 8d (0.131"Ø x 2-1/2") NAILS MAY BE SUBSTITUTED FOR A35s AT CONTRACTOR'S OPTION.


**5**

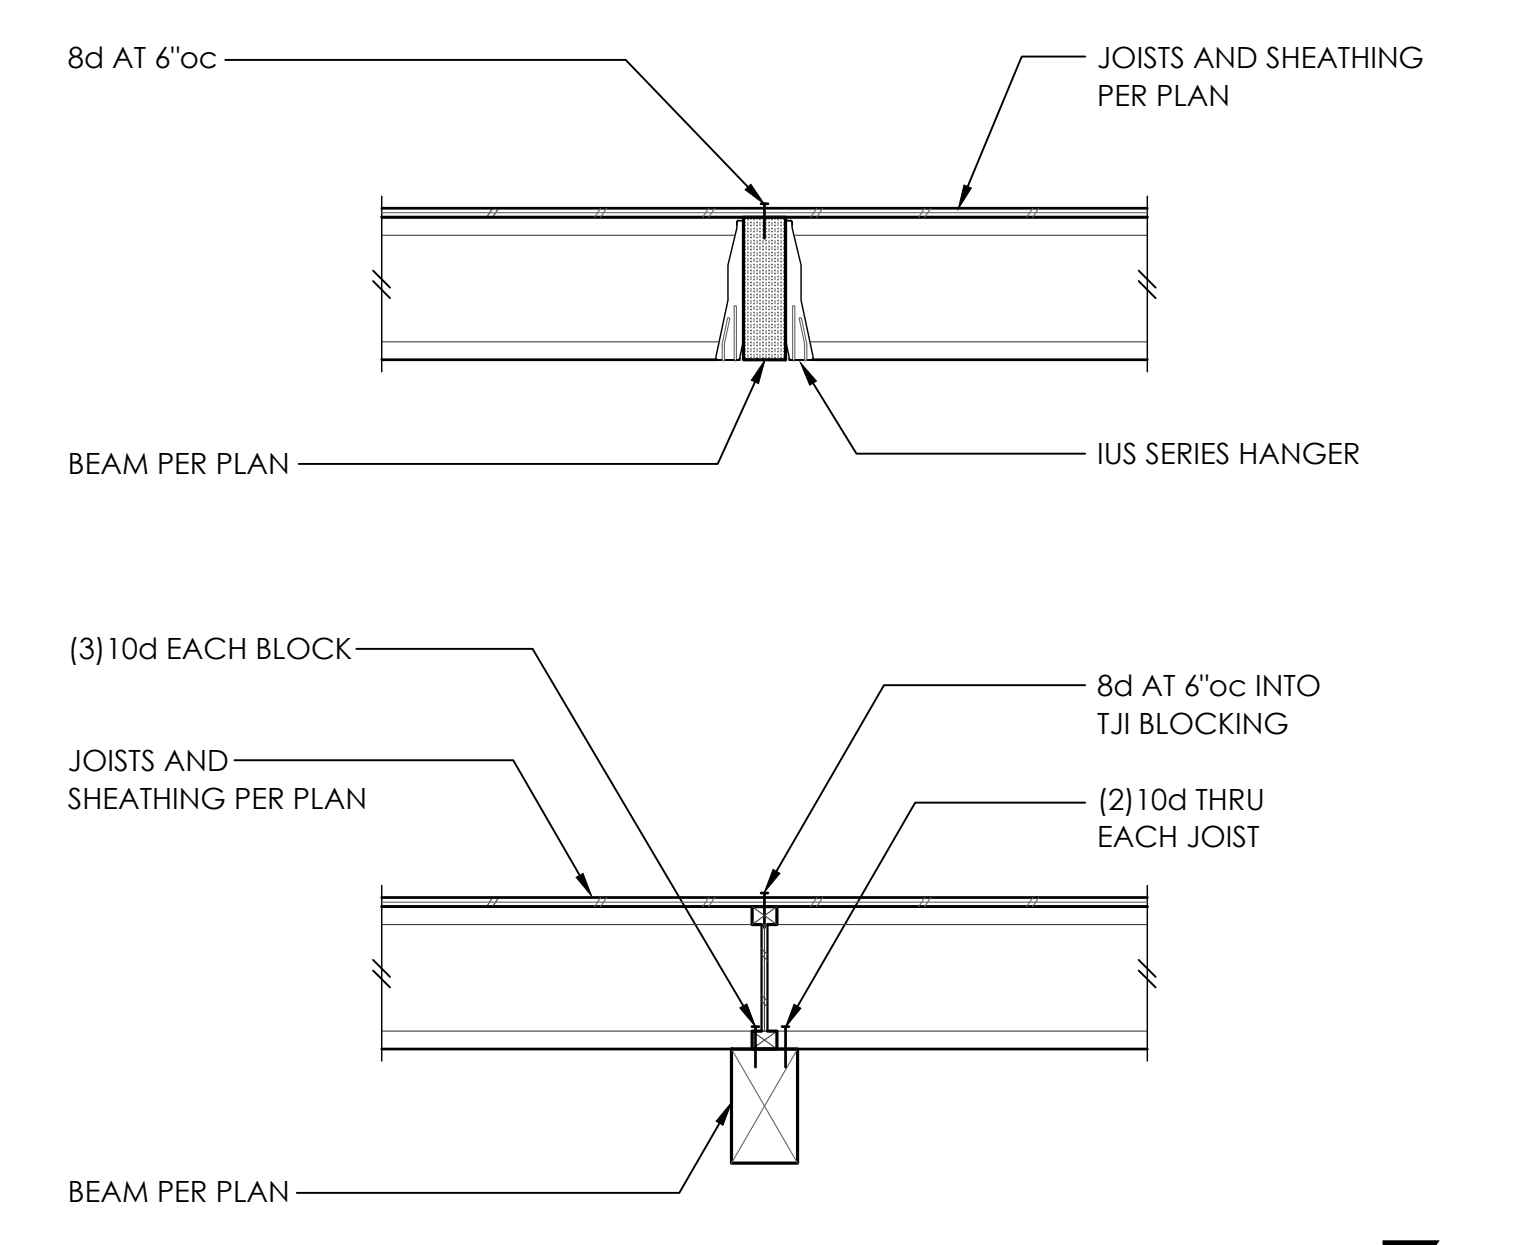

**TYPICAL FLUSH AND DROPPED BEAM 6**

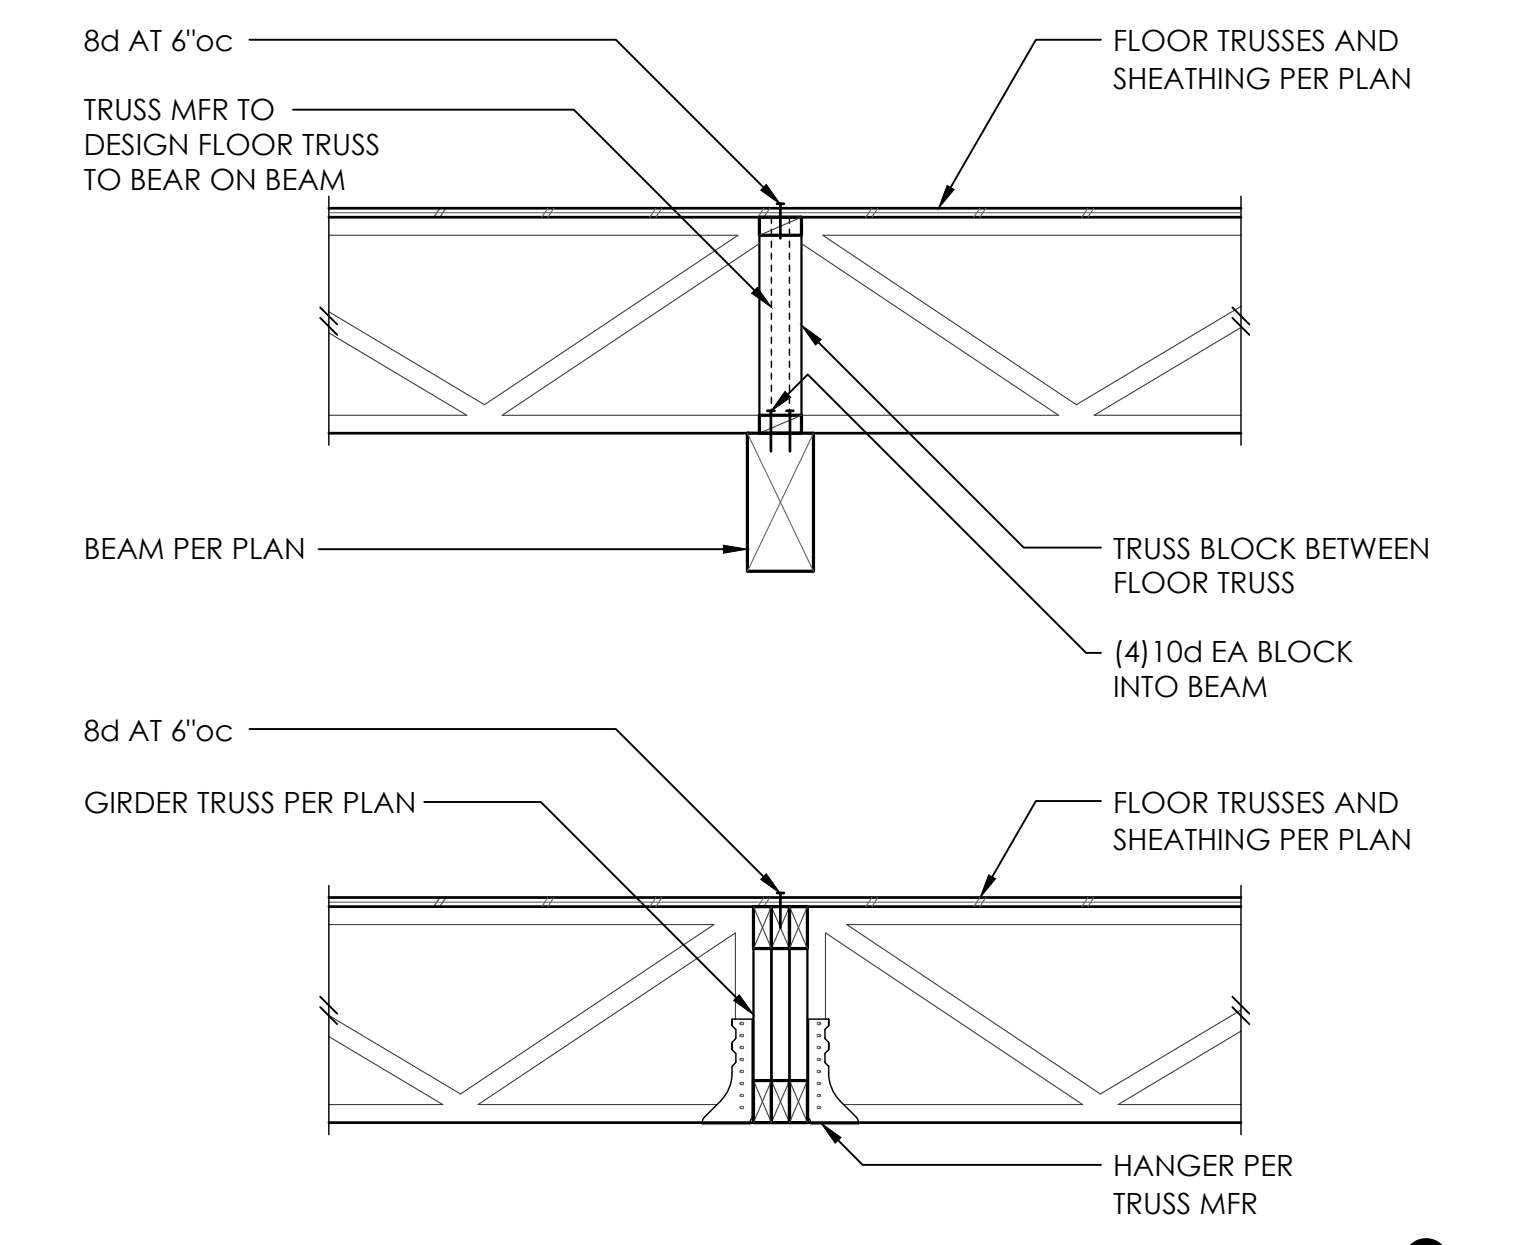


**TYPICAL DROPPED BEAM AND GIRDER TRUSS 7**

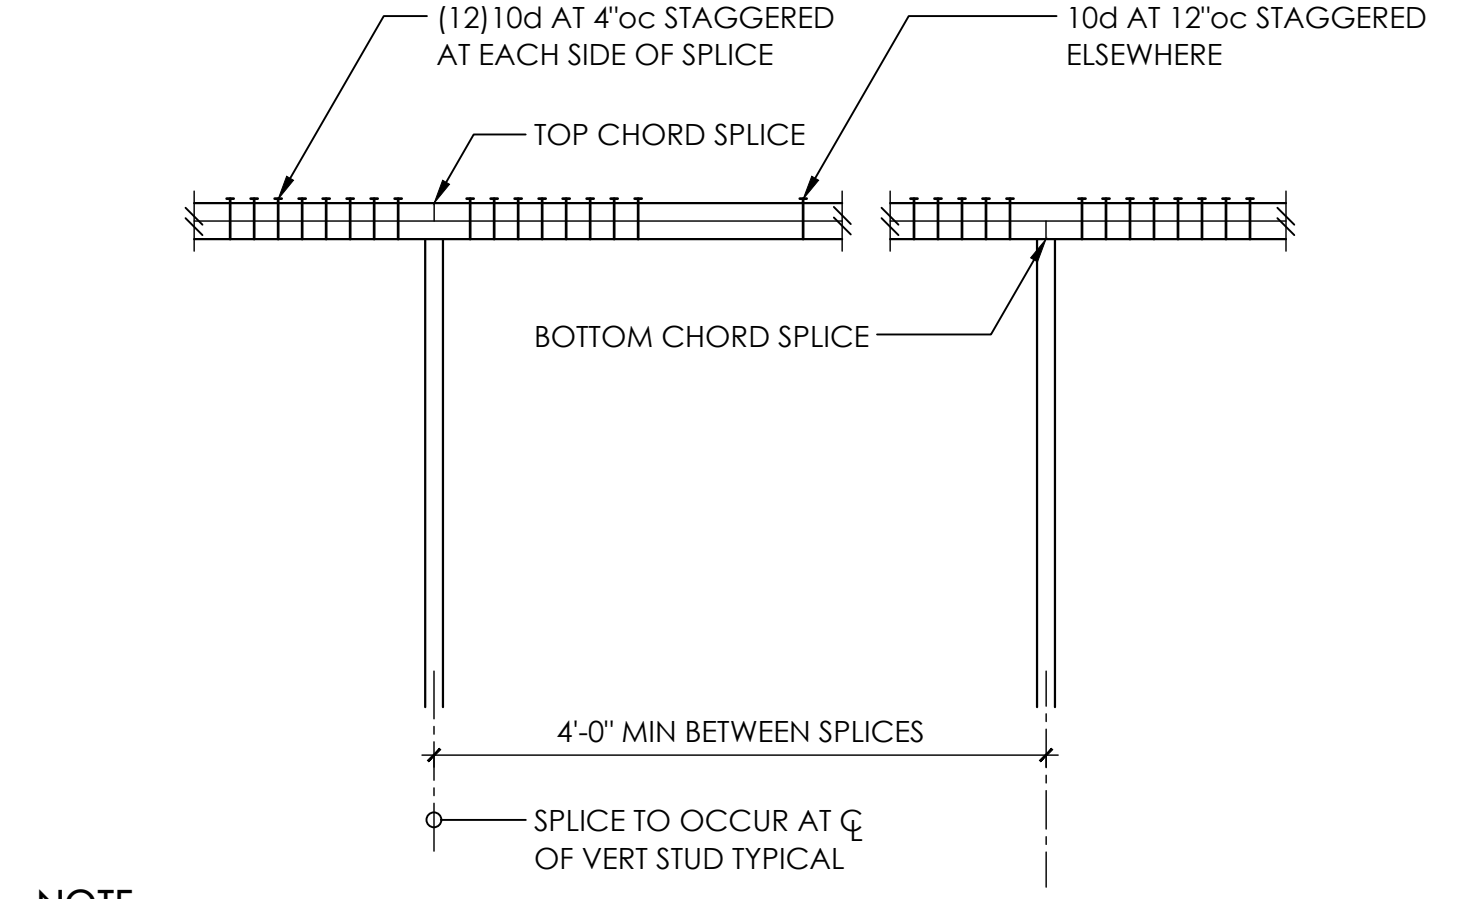

- NOTE:**
- NAILING AT TOP PLATE SPLICES MAY BE ELIMINATED w/ CS16 x 30'
  - WHERE VERTICAL PENETRATIONS THRU PLATE EXCEED 1" FOR A 4x WALL OR 3" FOR A 6x WALL - PROVIDE CS16 x 30' AT TOP PLATE
  - MINIMUM EDGE DISTANCE FOR VERTICAL PENETRATIONS THRU TOP PLATE IS 1-1/4"


**TYPICAL TOP PLATE SPLICE 8**

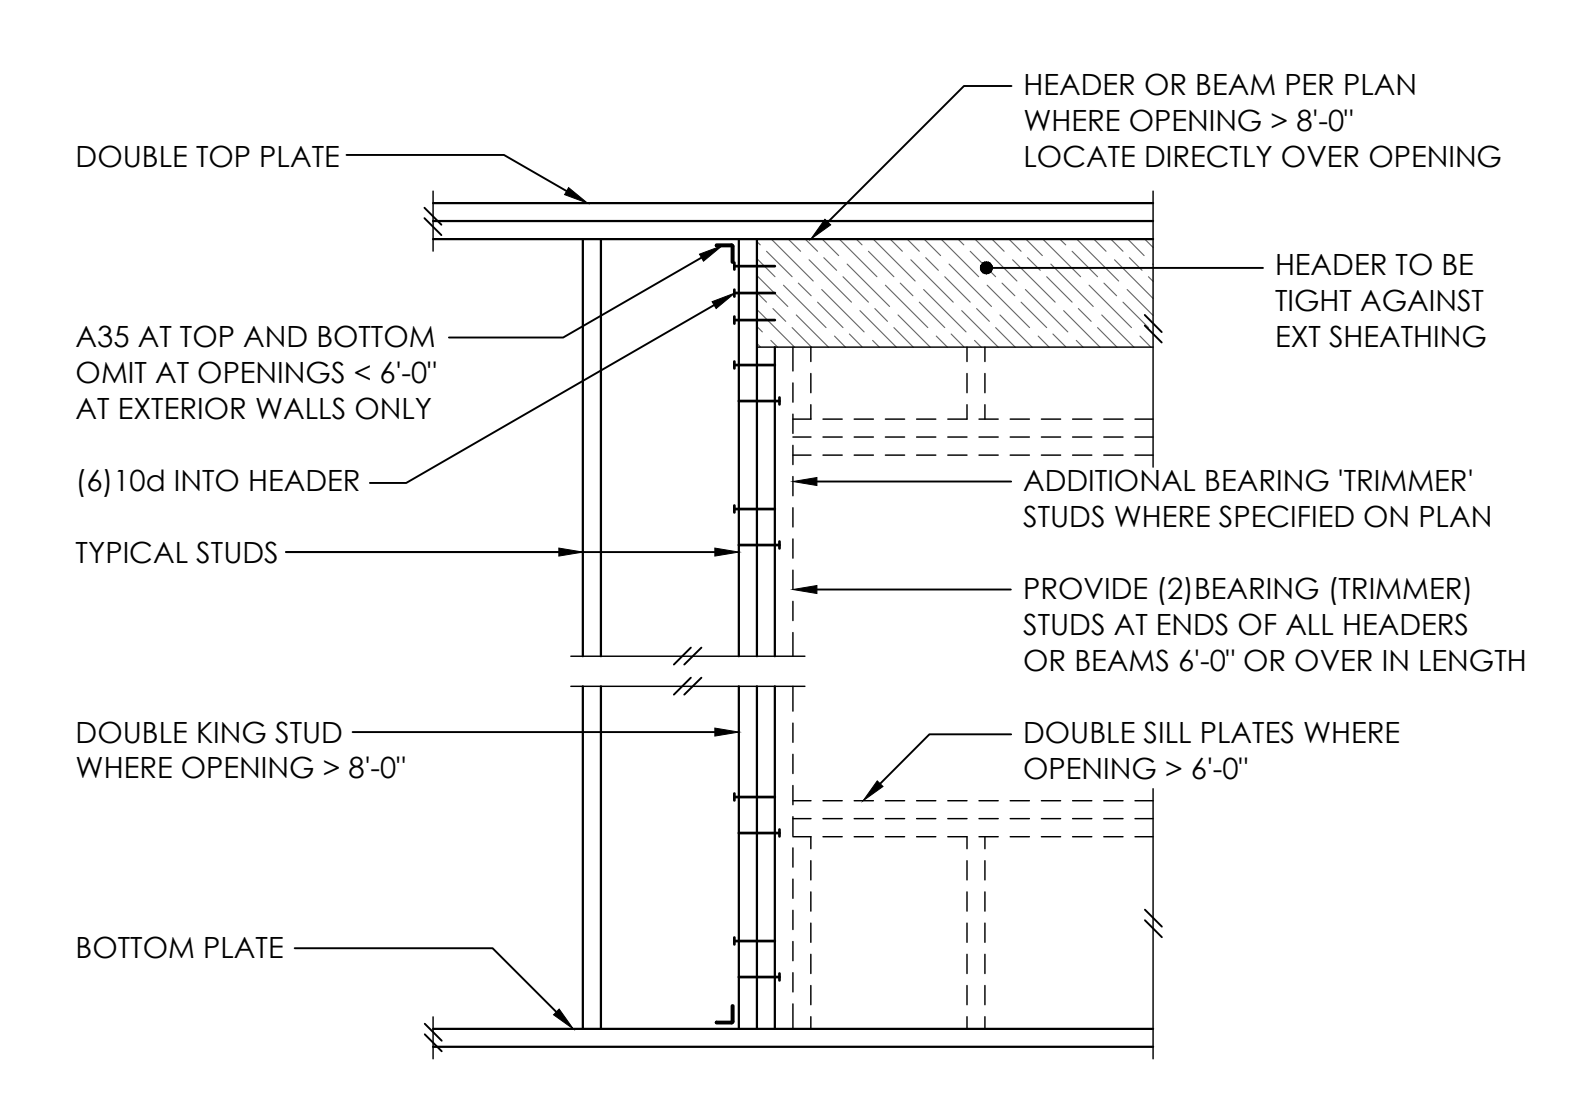


**TYPICAL HEADER SUPPORT 9**

BEARING AND EXTERIOR WALLS				NON-BEARING WALLS			
STUD SIZE	MAX DEPTH OF NOTCH	MAX DIA. OF HOLE	MAX DIA. OF NOTCH	STUD SIZE	MAX DEPTH OF NOTCH	MAX DIA. OF HOLE	MAX DIA. OF NOTCH
2x4	3/4"	1-3/8"	2x4	1-3/8"	2"	2"	2"
2x6	1-1/4"	2-1/8"	2x6	2-1/4"	3-1/4"	3-1/4"	3-1/4"


HOLE AND NOTCH SIZE FOR NON-BEARING WALLS MAY BE USED FOR BEARING WALLS IF REQUIRED NUMBER OF STUDS ARE DOUBLED. DOUBLE STUDS SHALL BE LIMITED TO TWO SUCCESSIVE STUDS.

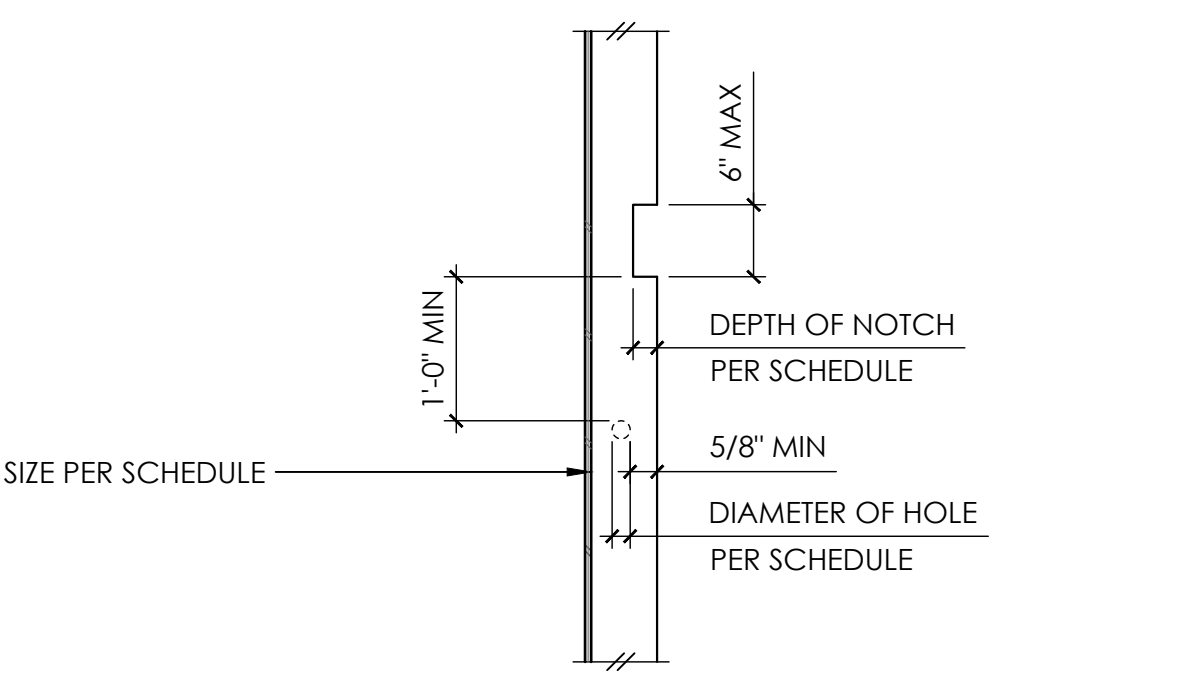


**TYPICAL ALLOWABLE HOLES AND NOTCHES IN WALL STUDS 11**

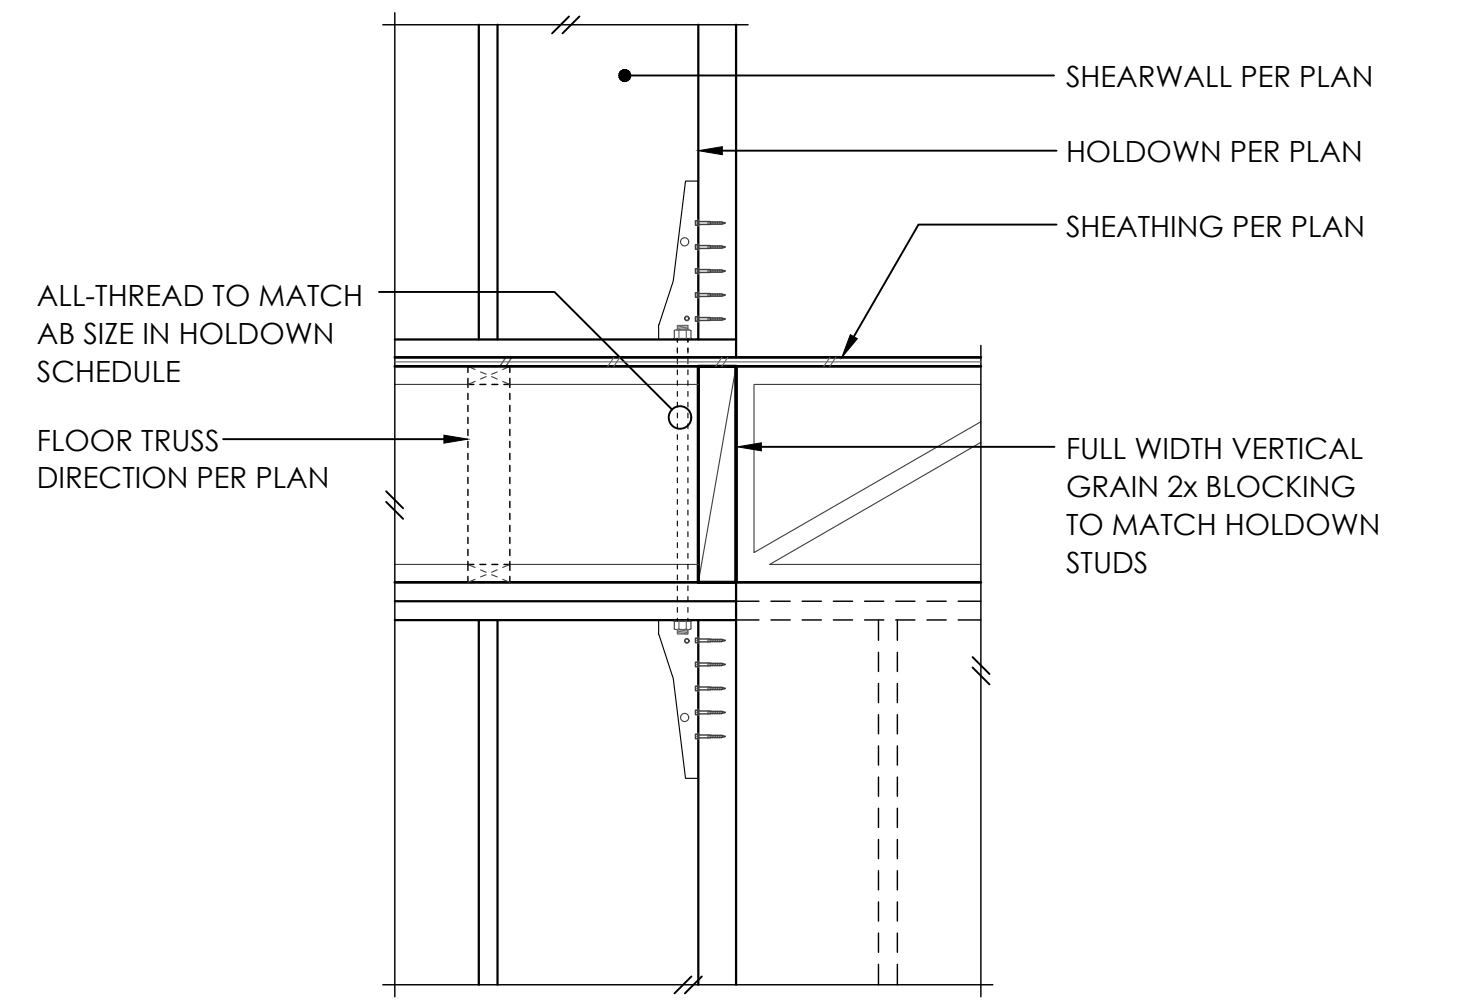


**TYPICAL HDU HOLDOWN 12**

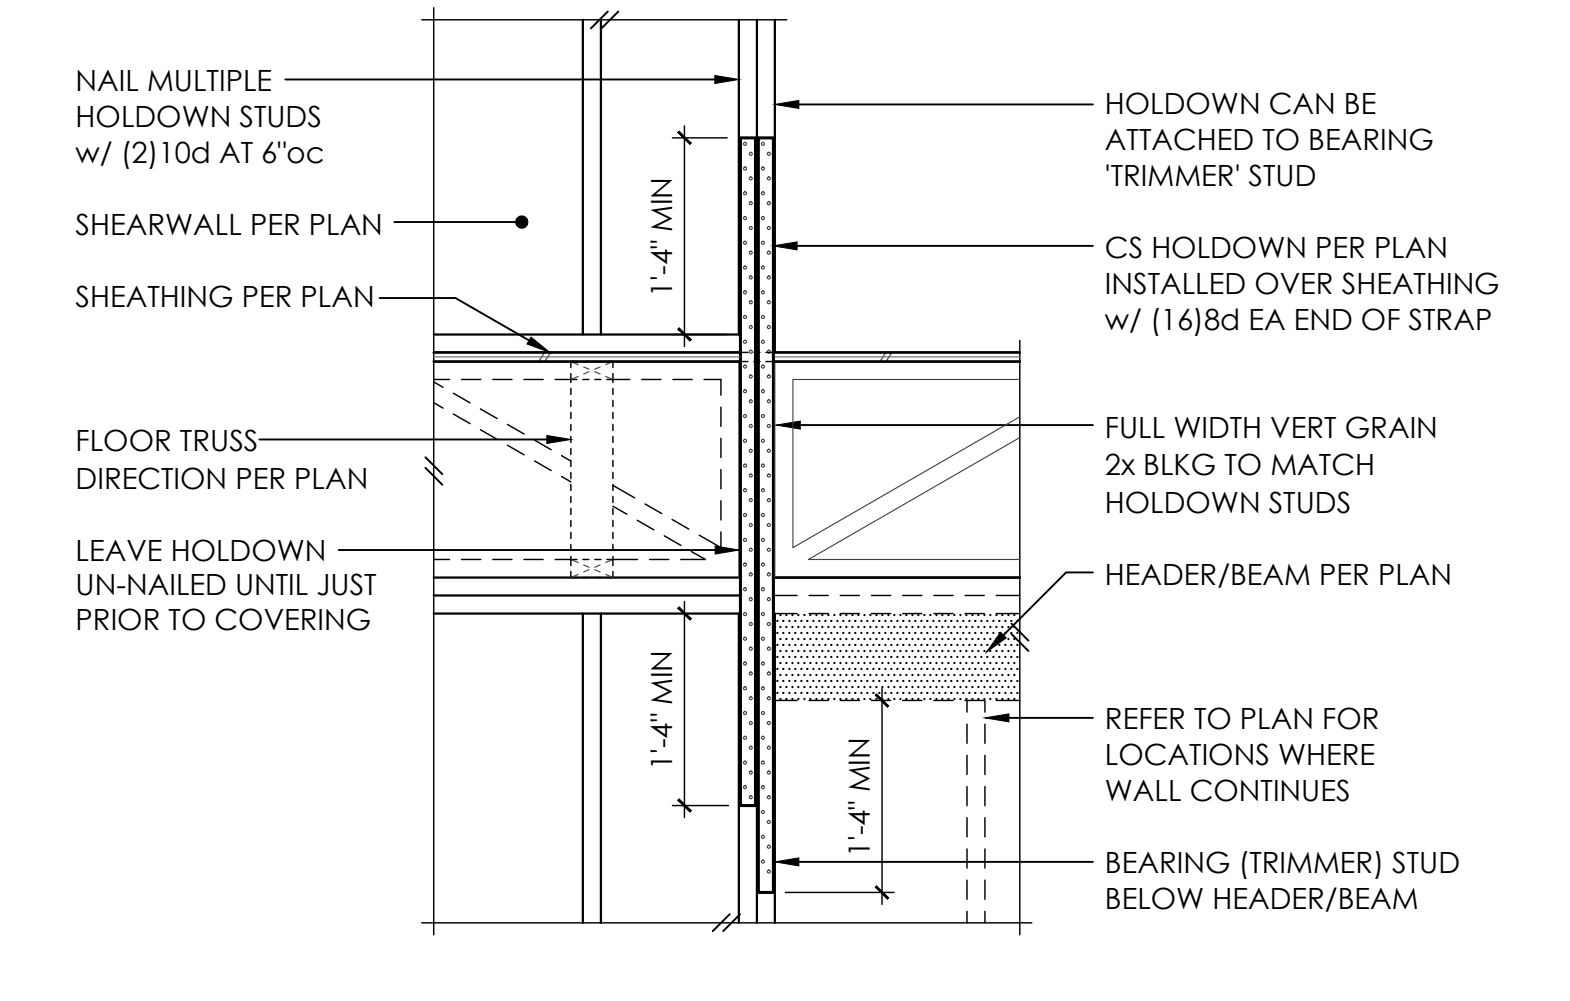


**TYPICAL CS16 HOLDOWN 13**

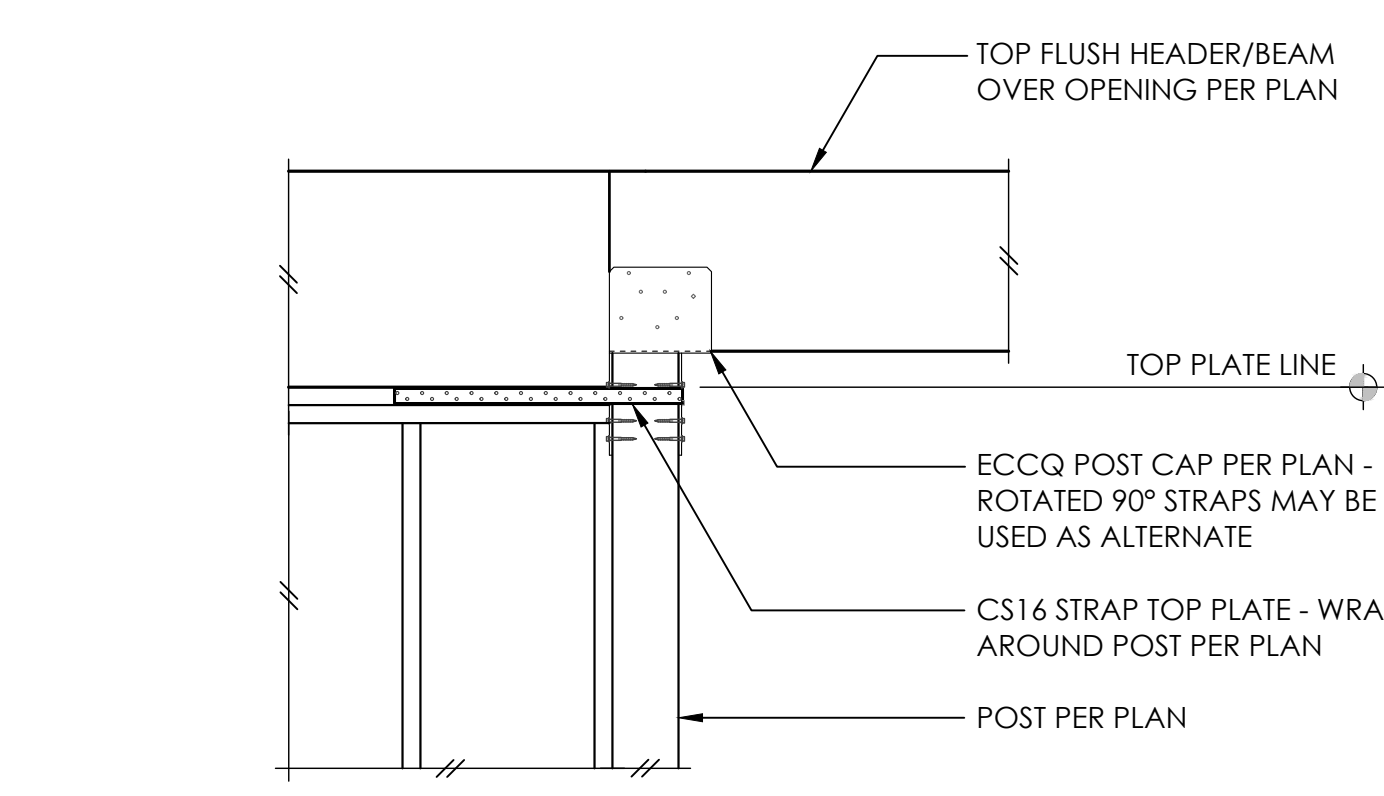

**TYPICAL HEADER/BEAM END CONNECTION OVER WDO/SGD 14**

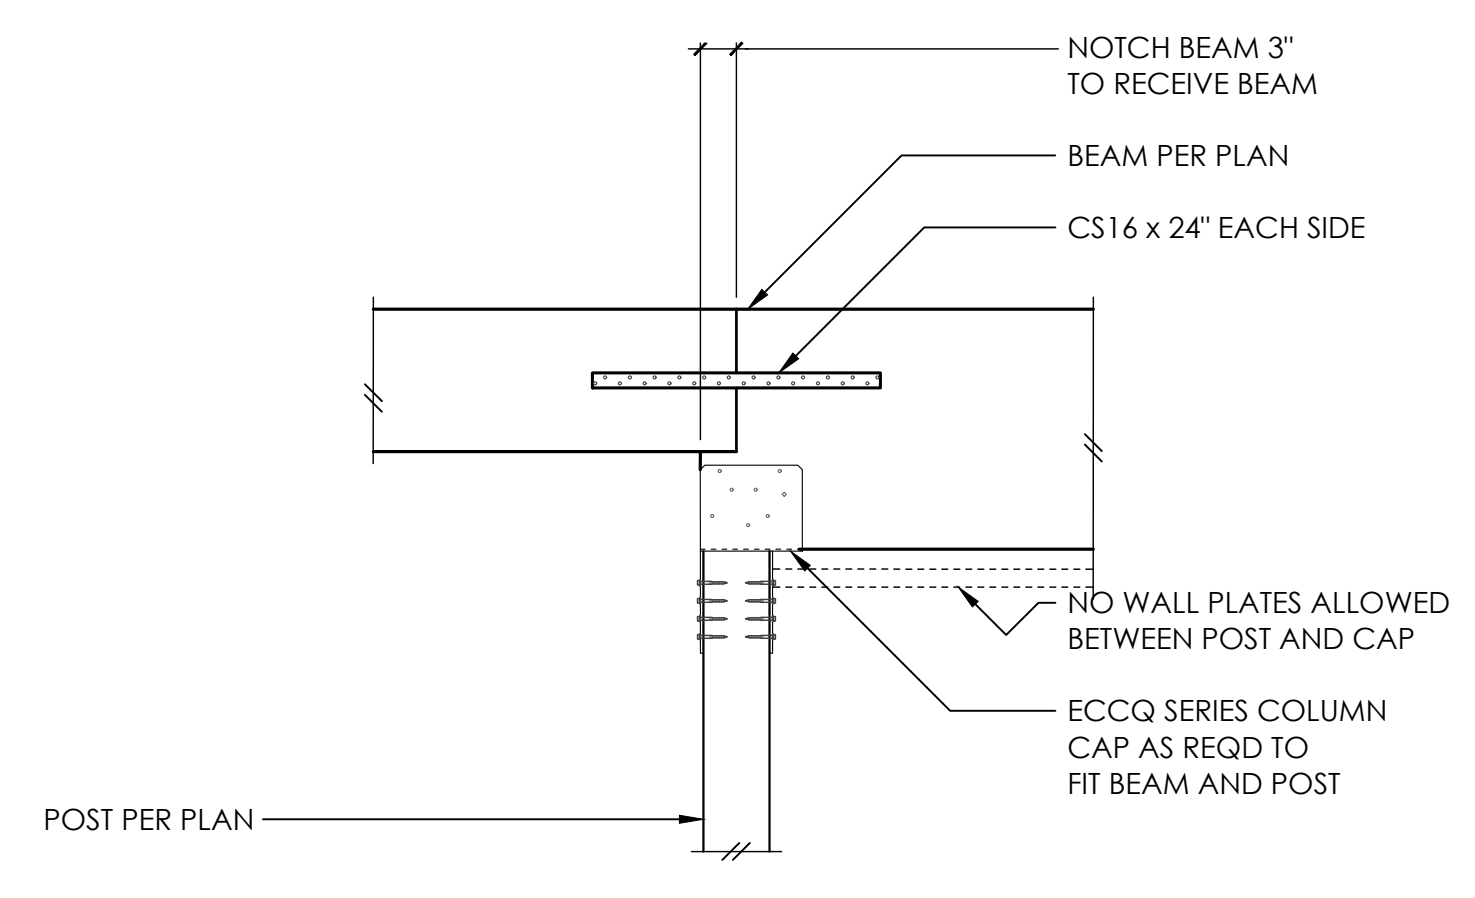


**15**

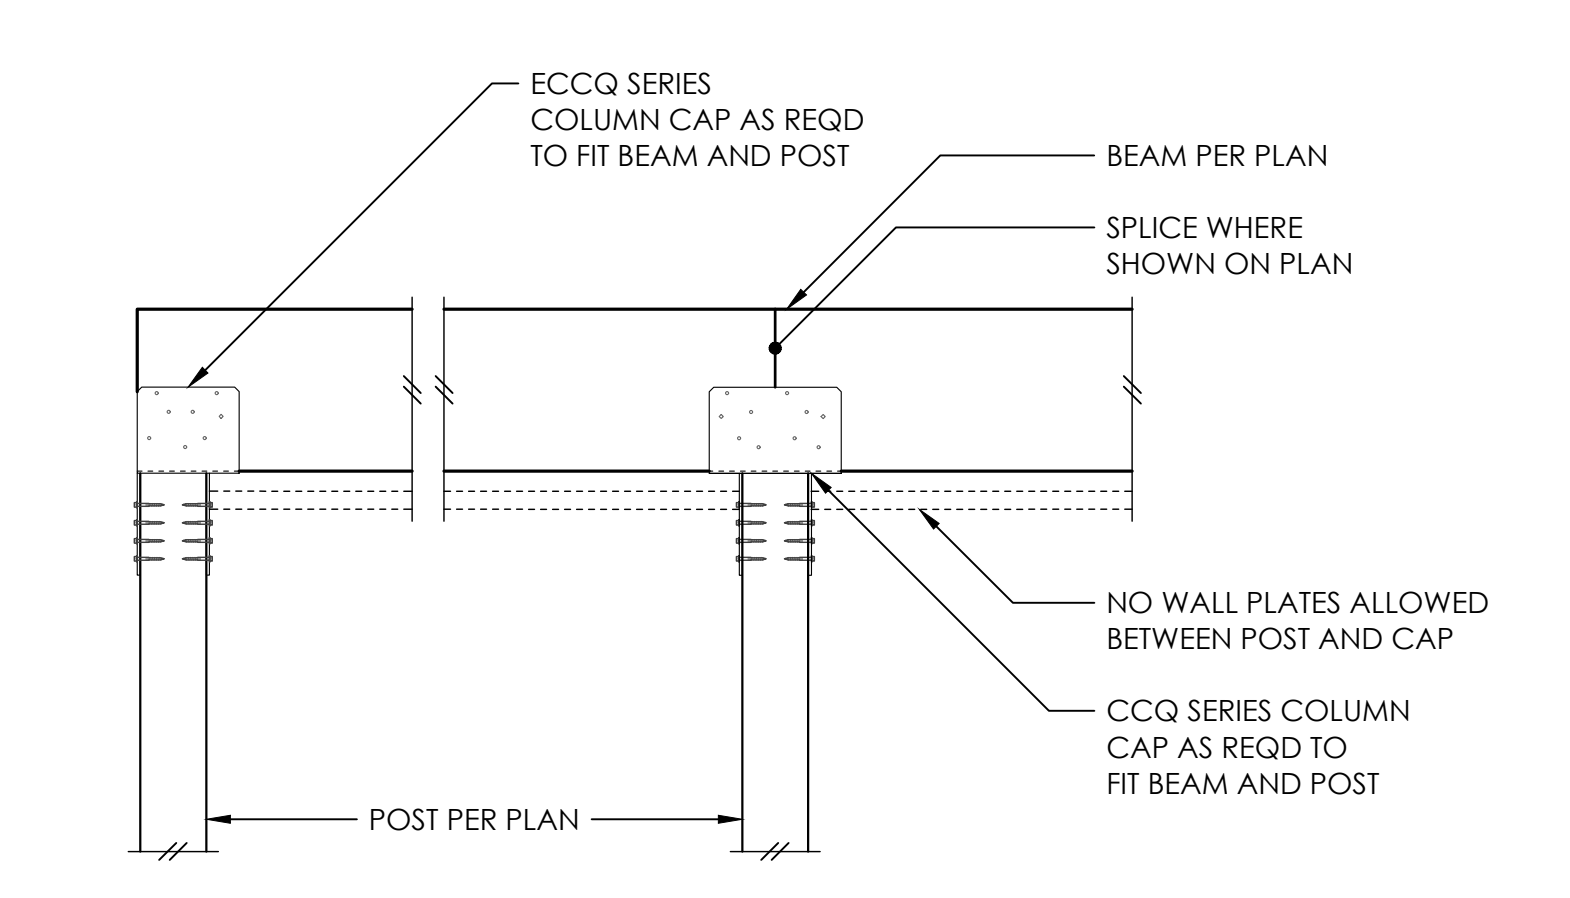

**16**

COPYRIGHT © 2021 MALSAM TSANG ENGINEERING CORPORATION - ALL RIGHTS RESERVED

Printed On: 10/20/21  
 Printed Date: 10/20/21 1:46pm

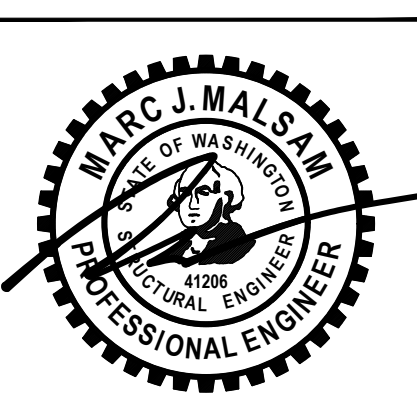


PROJECT NO: 0426-2021-0301  
 PROJECT MANAGER: JAS  
 DRAWN: JOSEPH MARQUEZ  
 ENGINEER: JOSEPH MARQUEZ  
 JOSEPHM@MALSAM-TSANG.COM

REV	DESCRIPTION	DATE
1	PERMIT SET	12.23.21
2	PERMIT CORRECTIONS	5.5.22
3	PERMIT CORRECTIONS	7.13.22
4	PERMIT CORRECTIONS	8.19.22

ARCH: MACULLOUGH ARCHITECTS  
 206-443-1181


TYPICAL WOOD FRAMING DETAILS



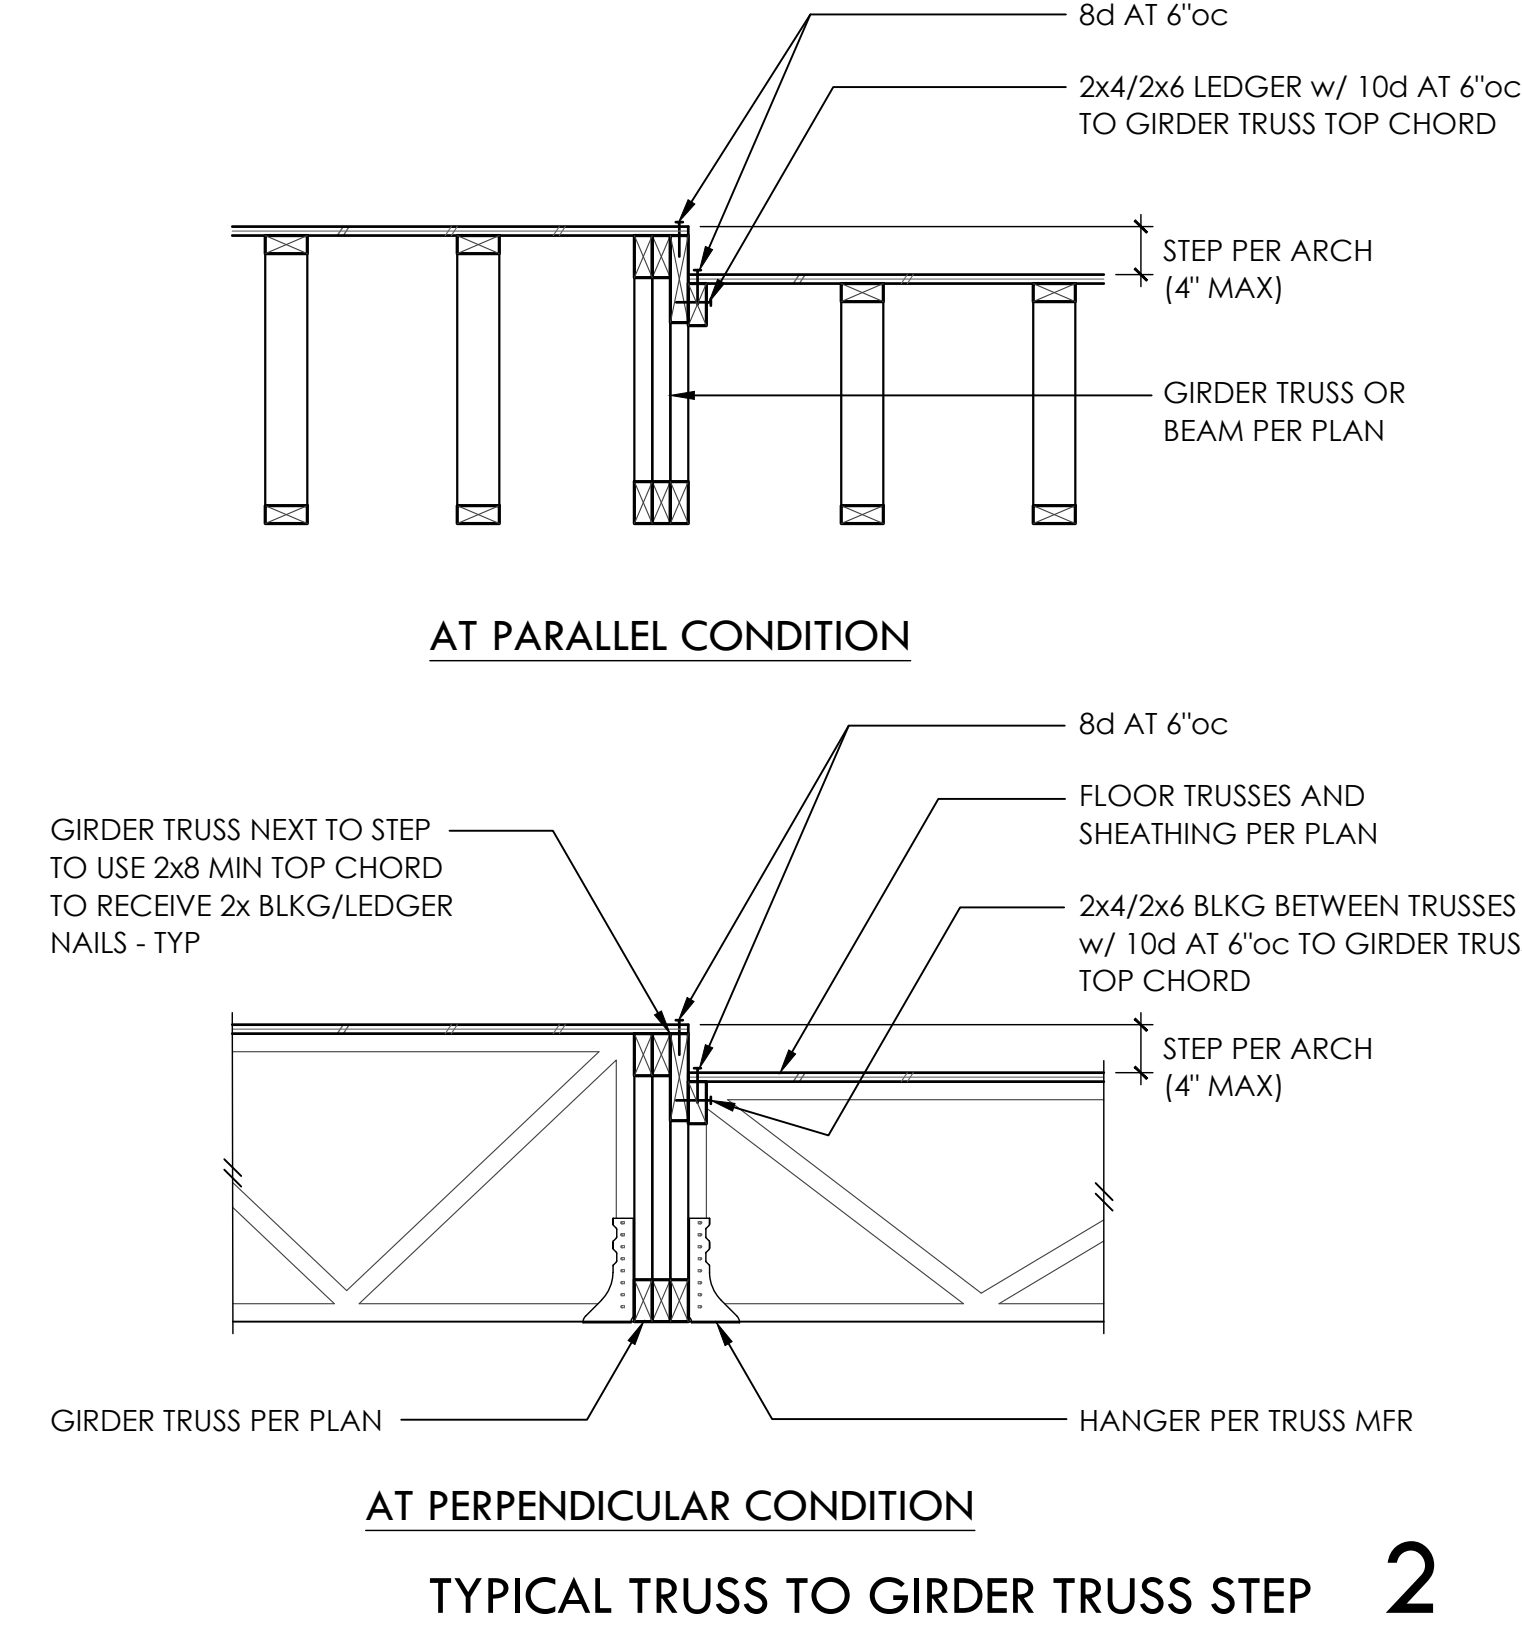


1


2

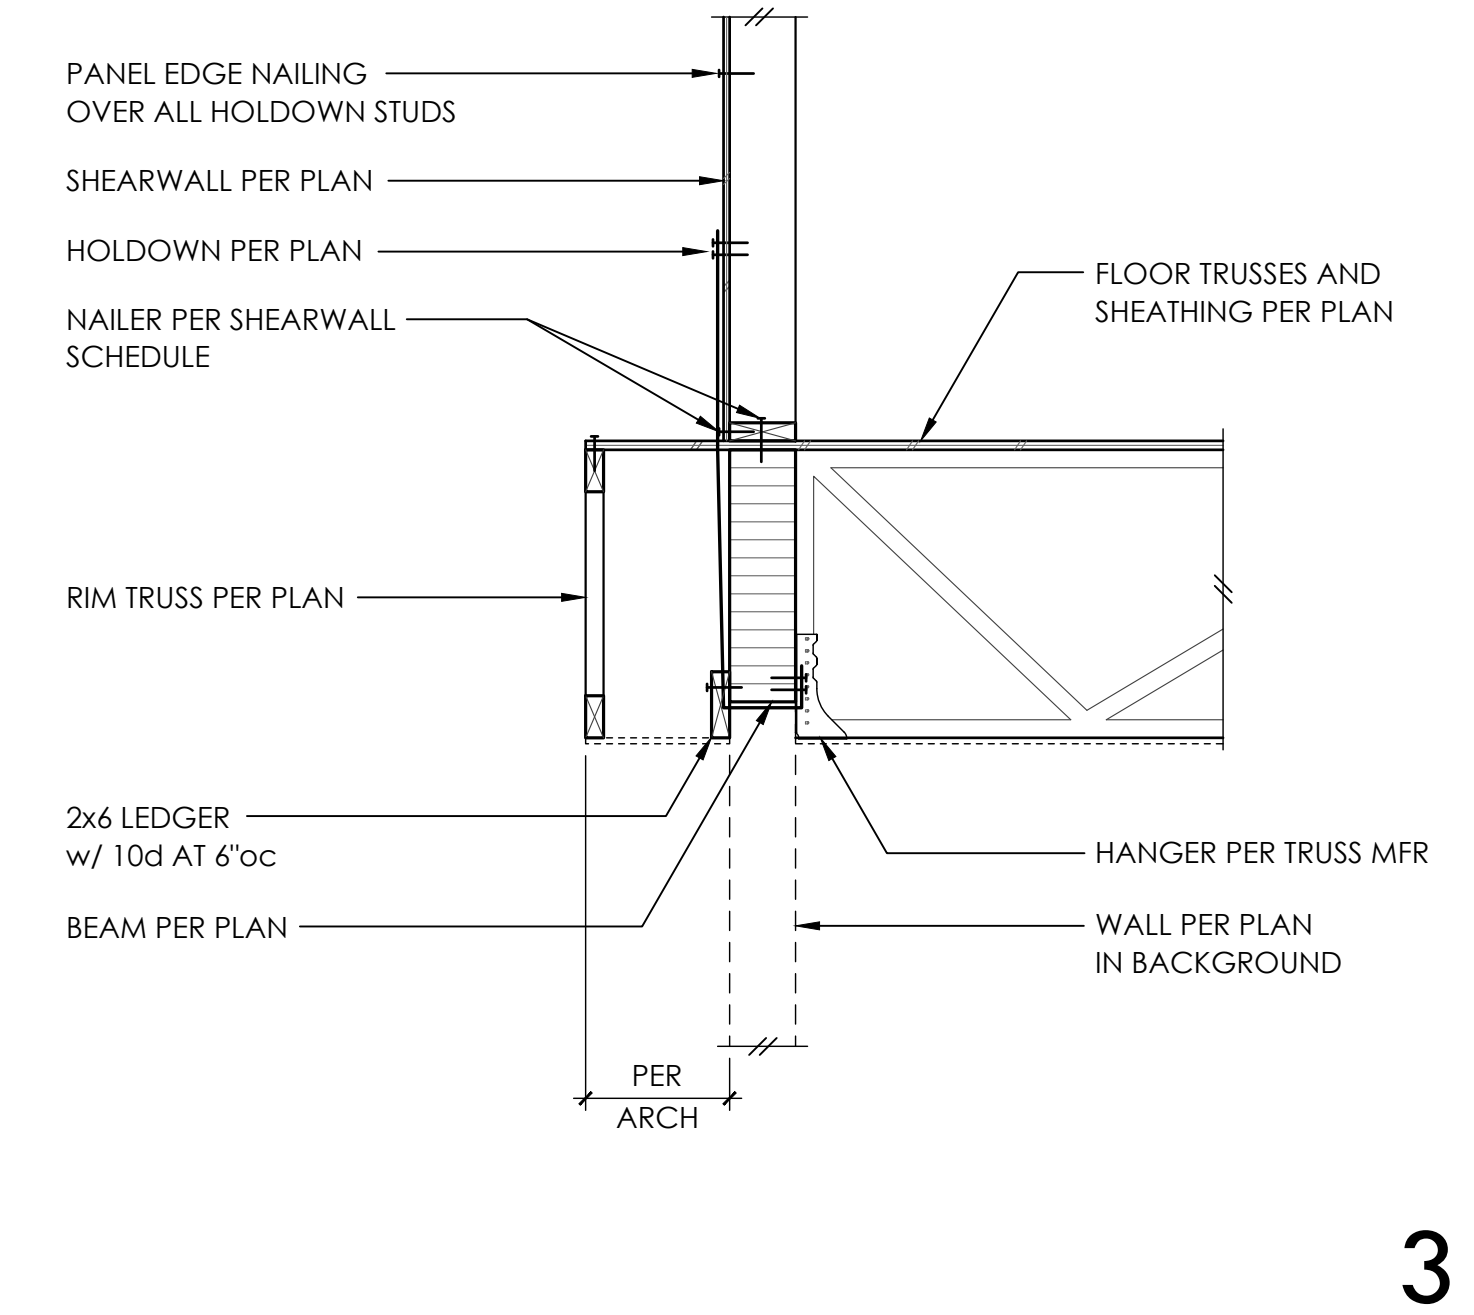


3

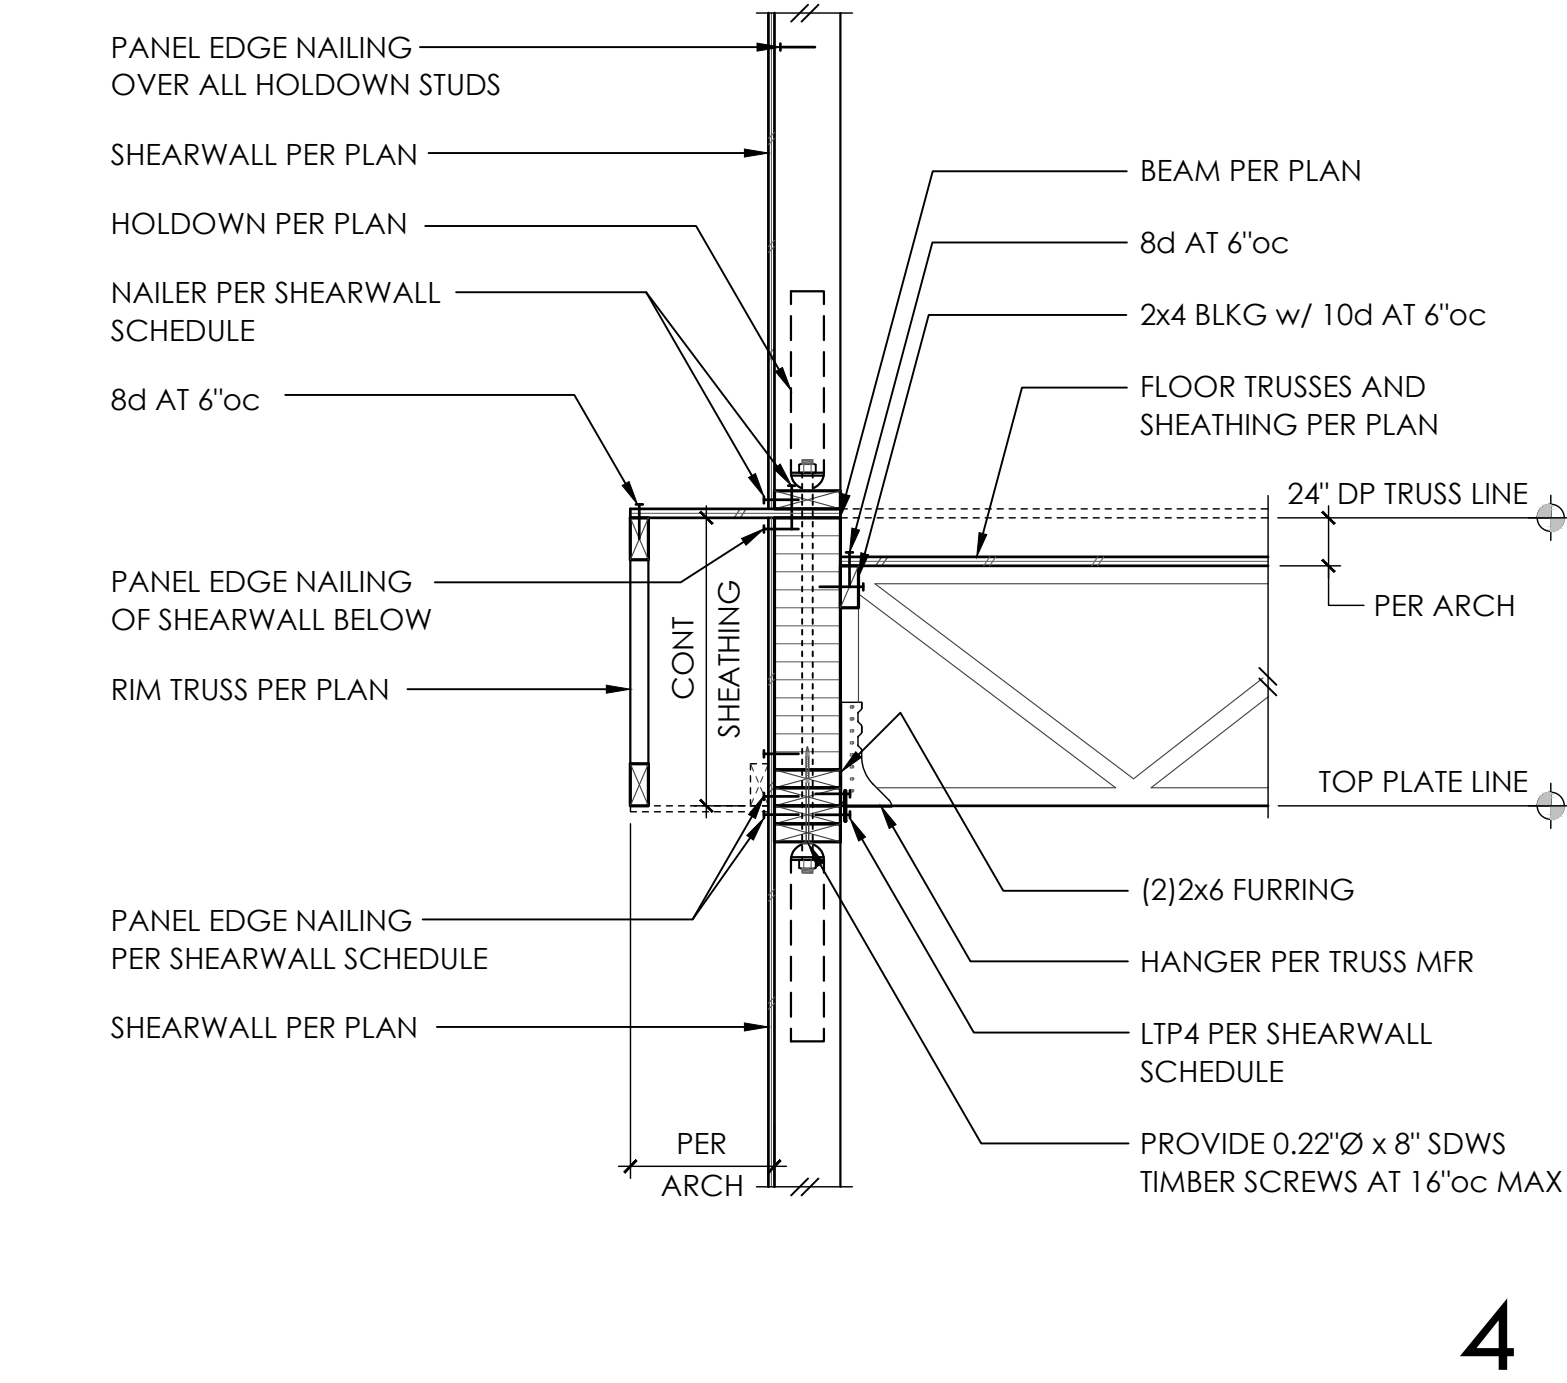

4

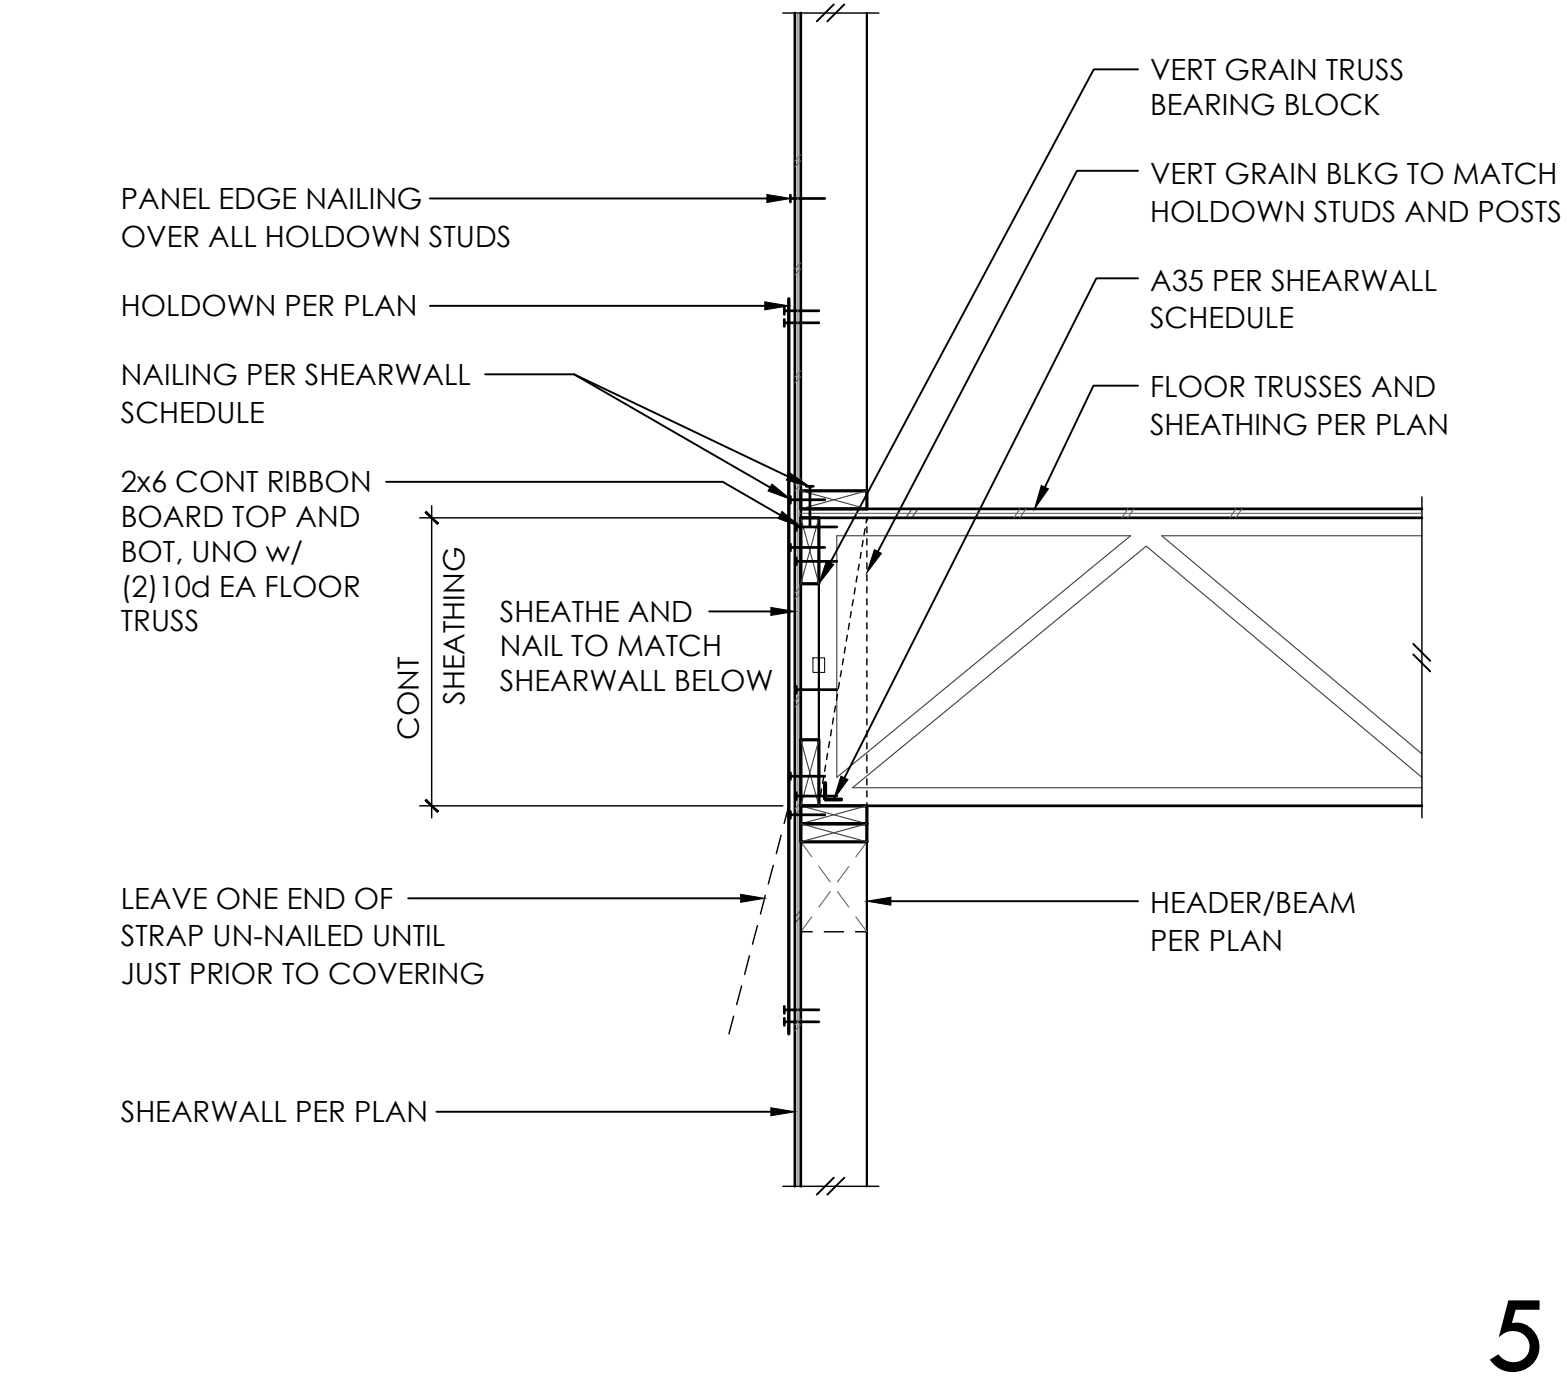


5

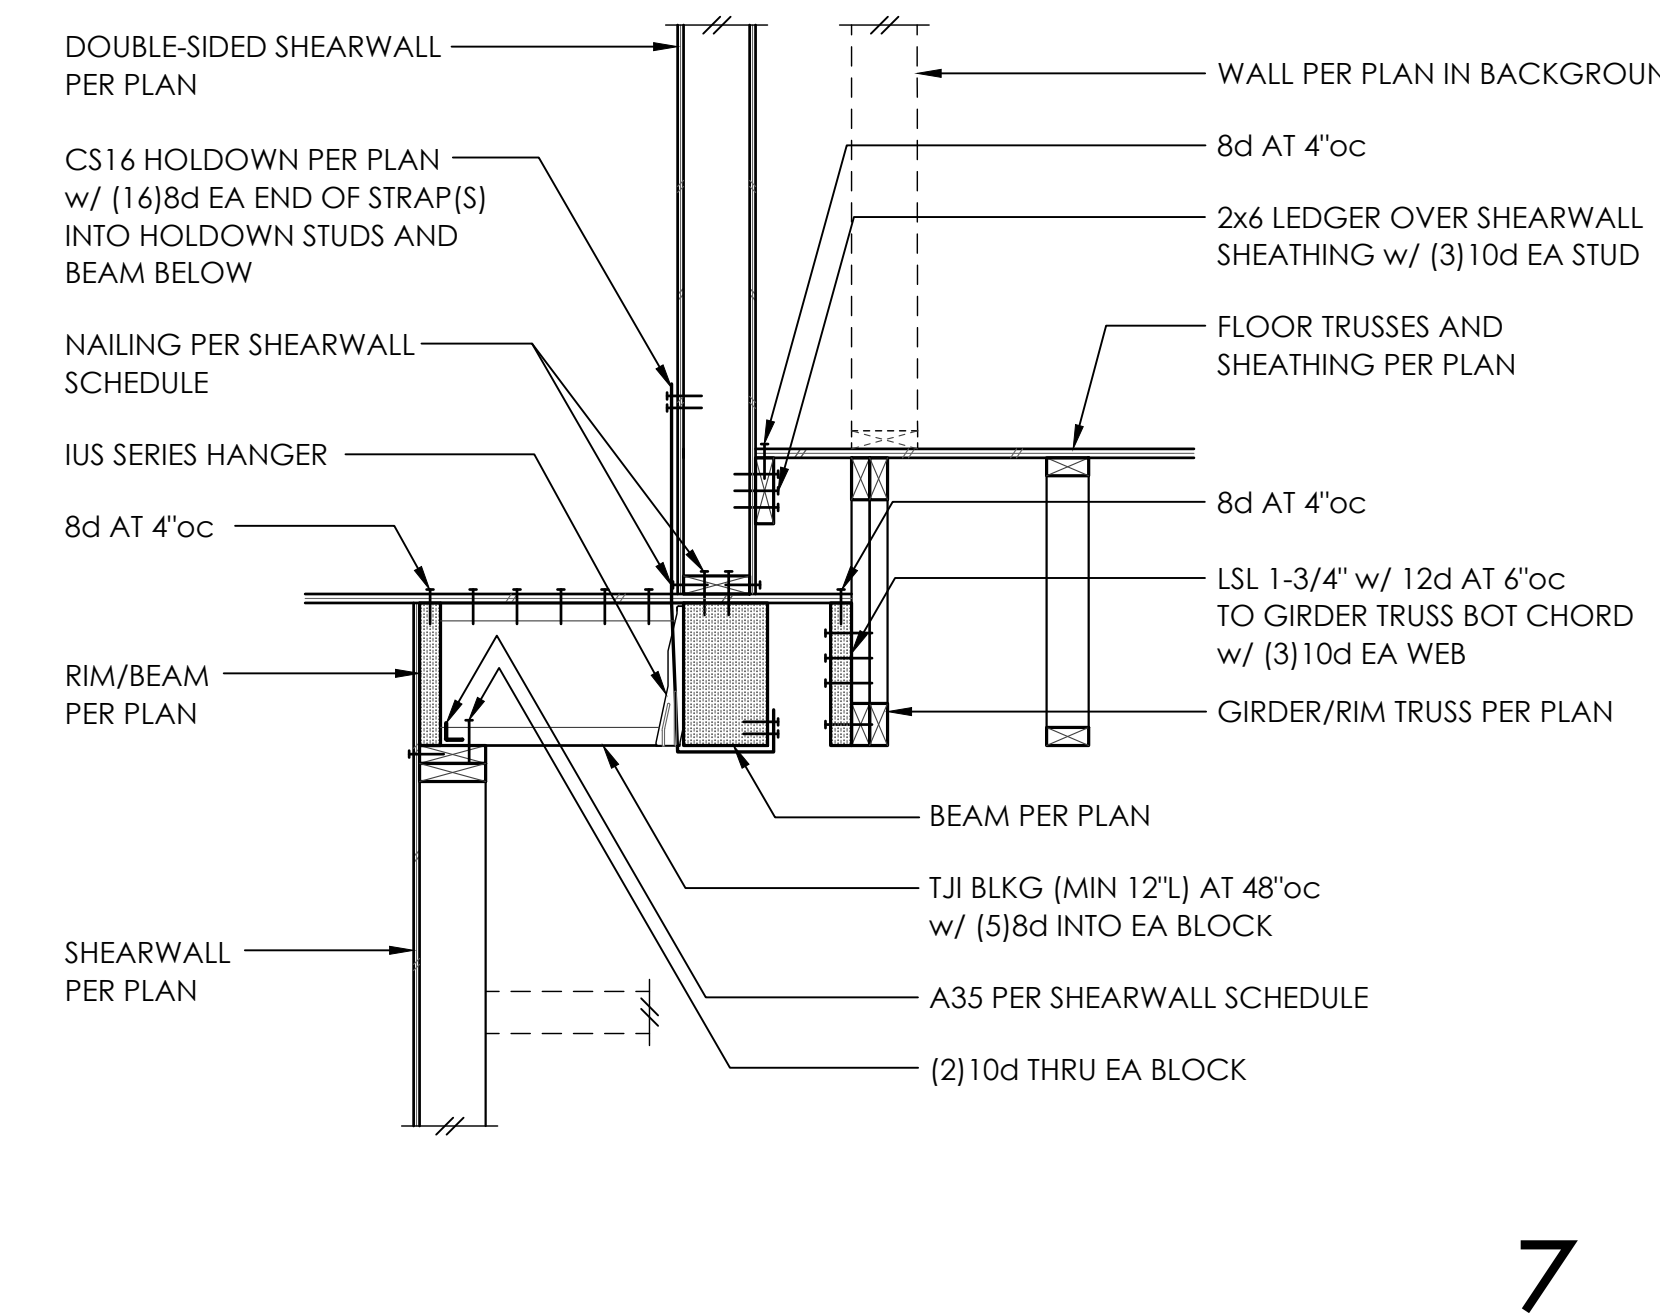


6


7

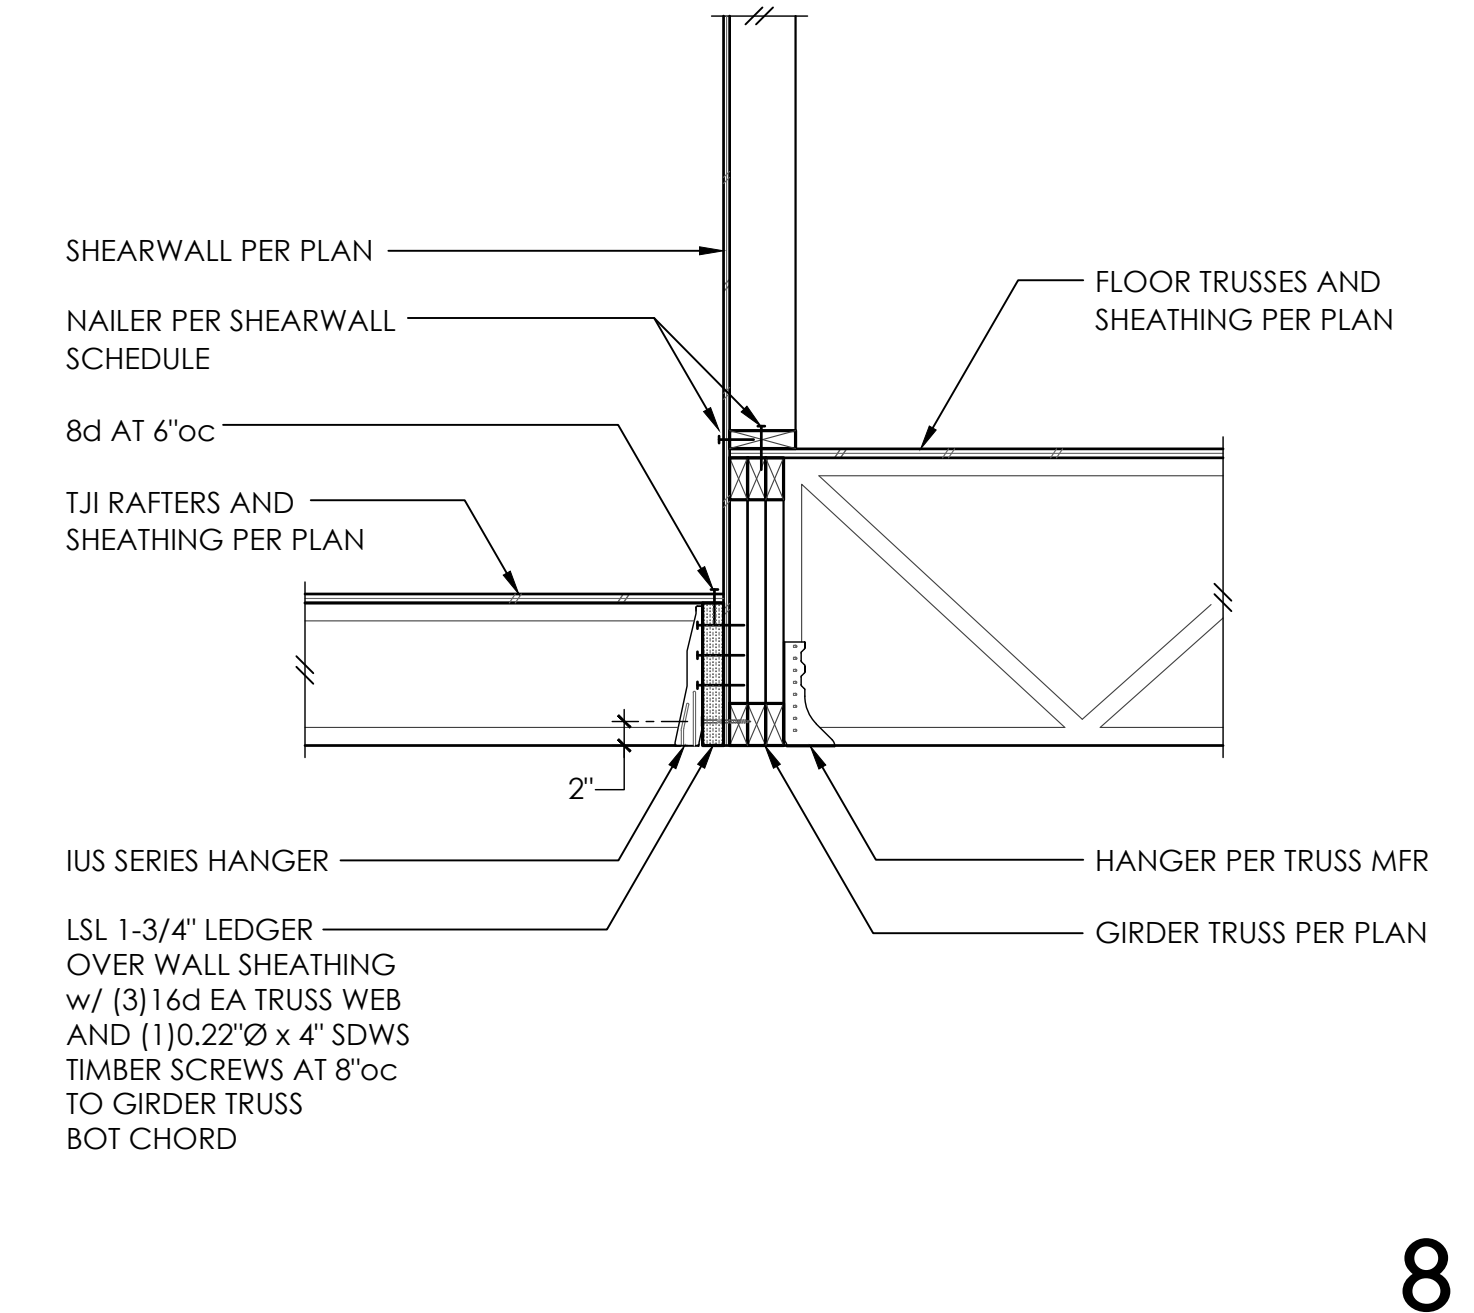


7

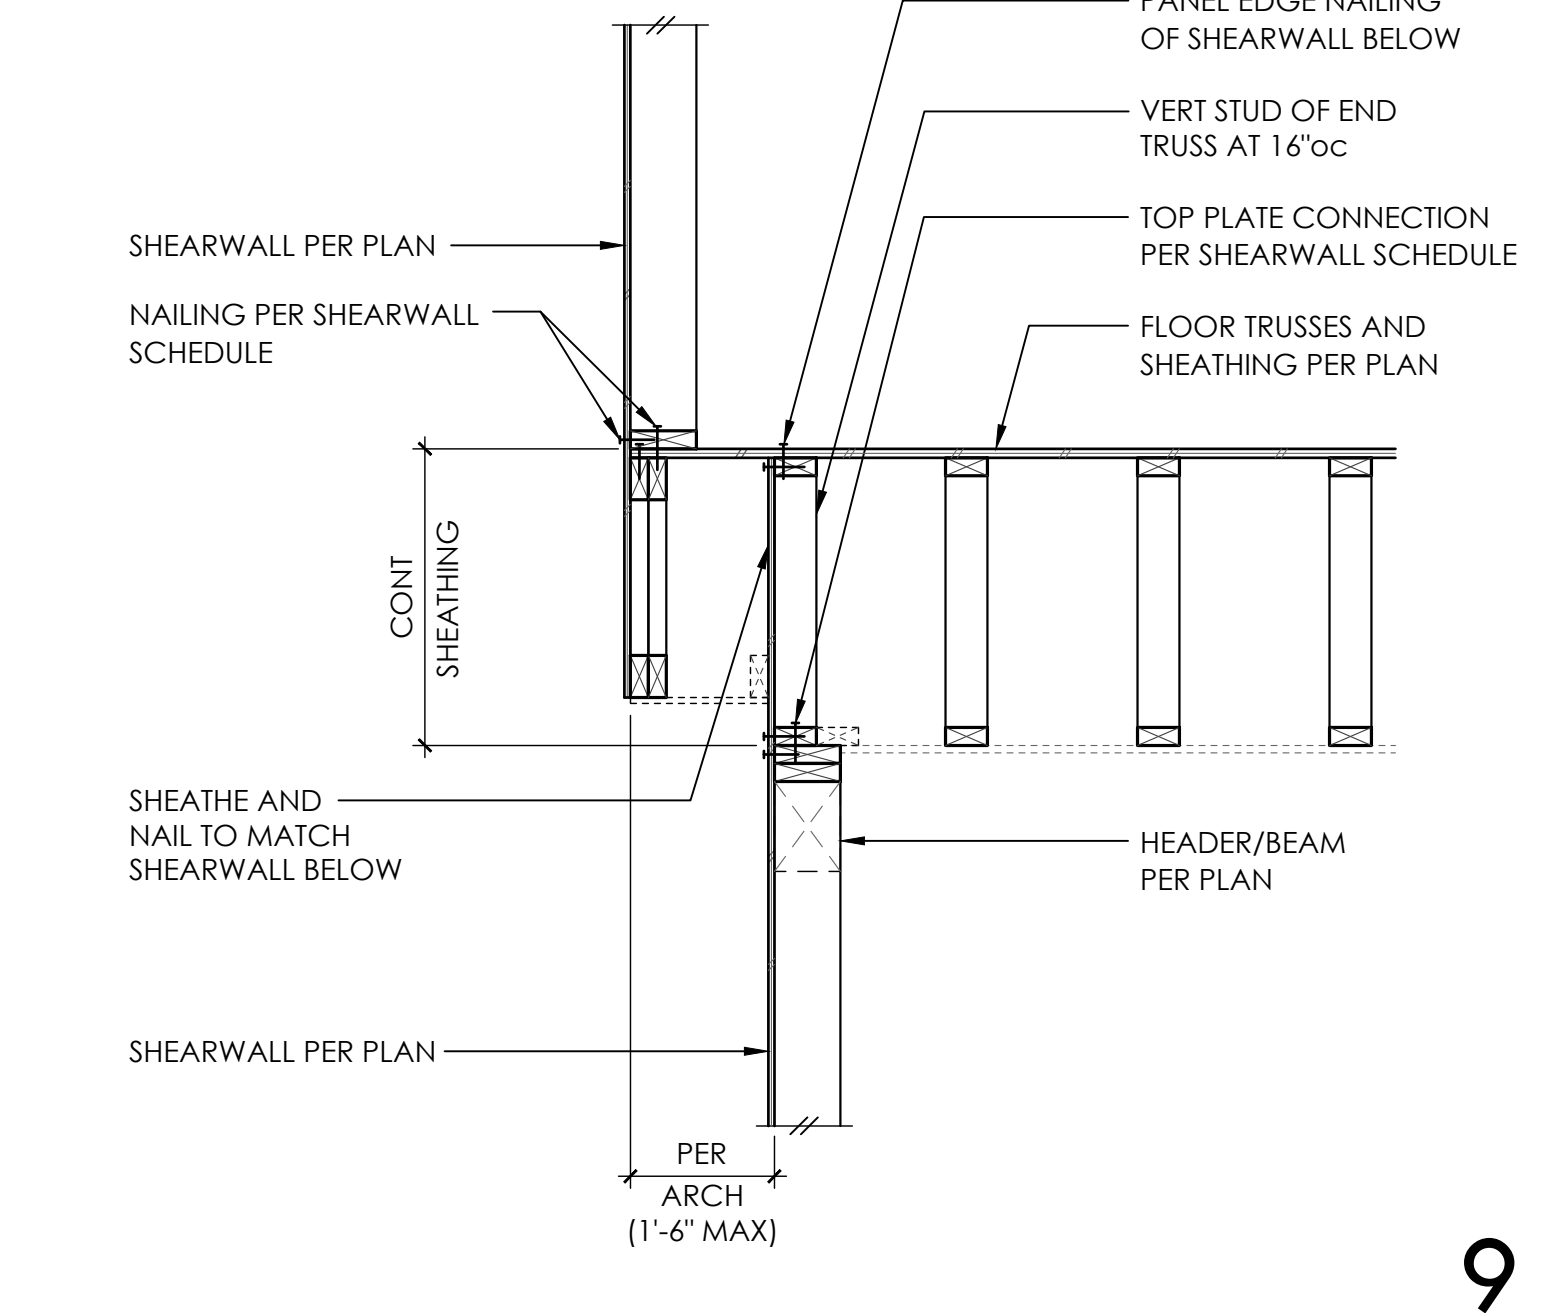


8

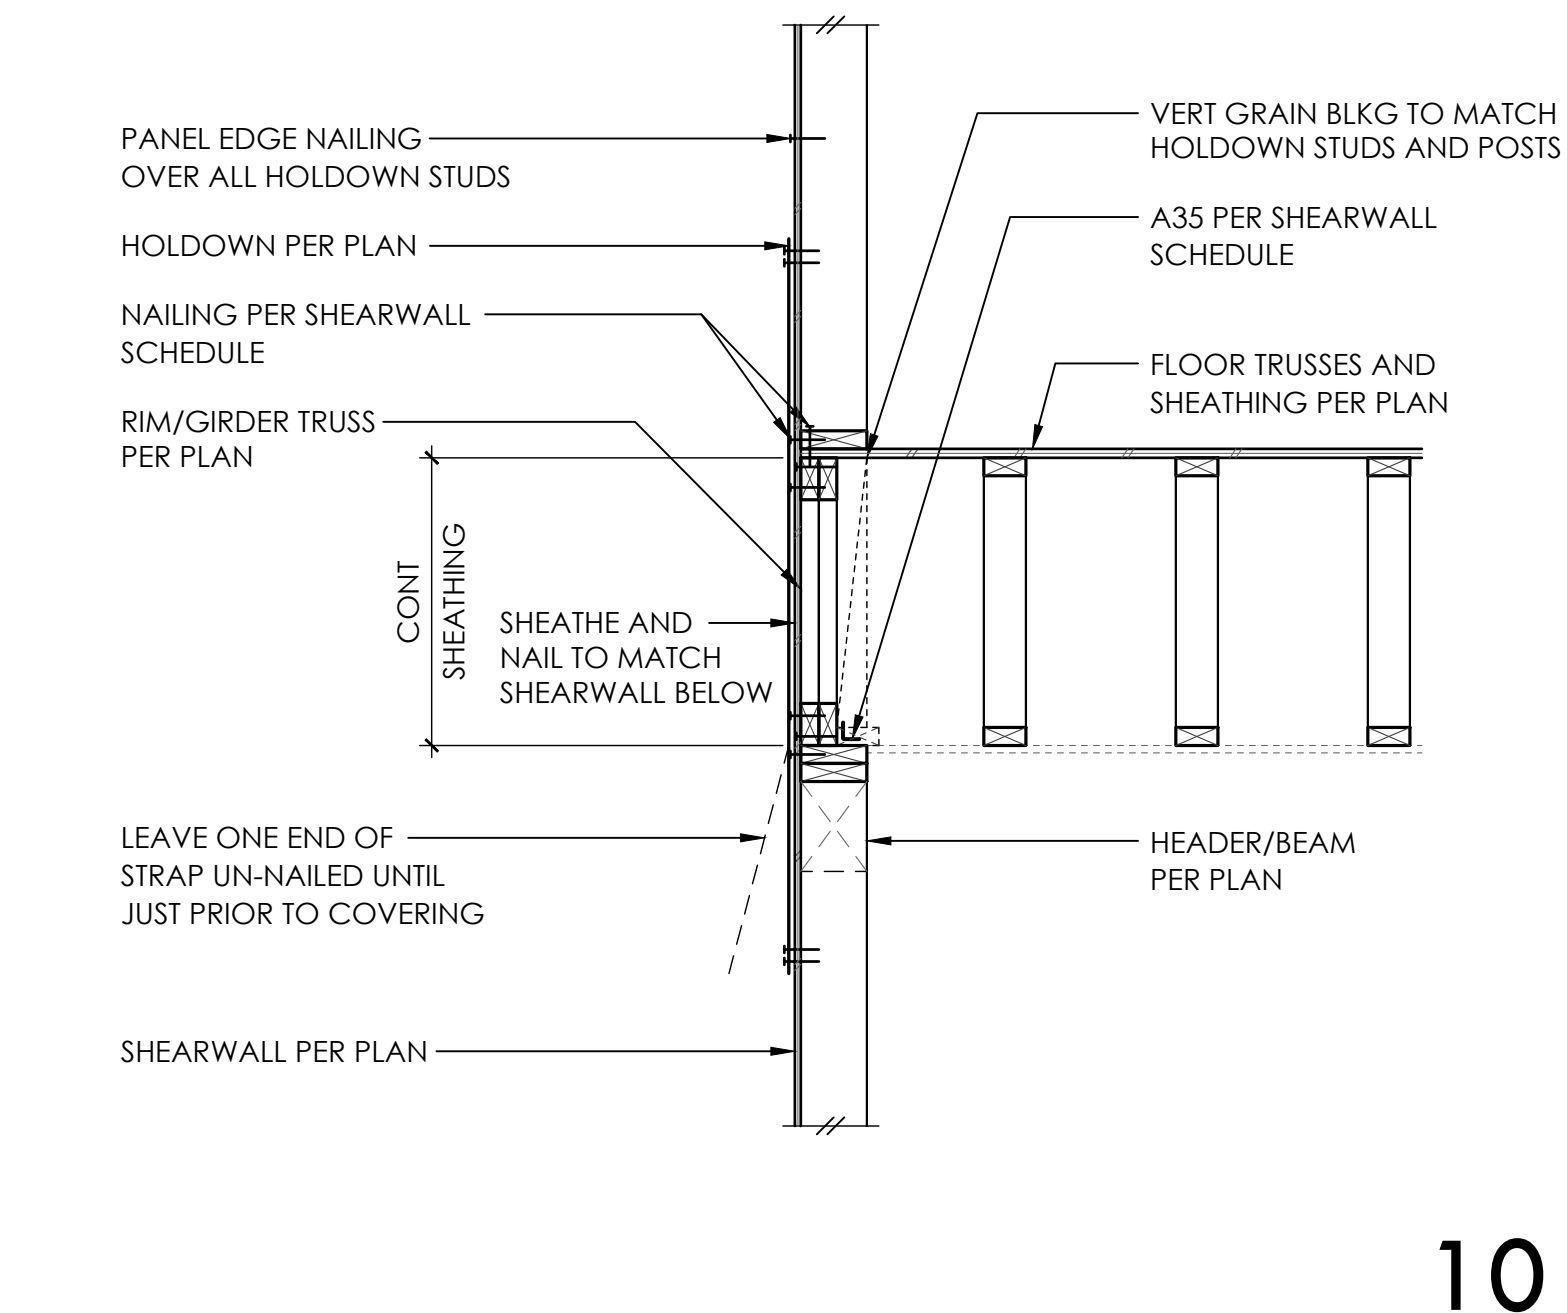


9

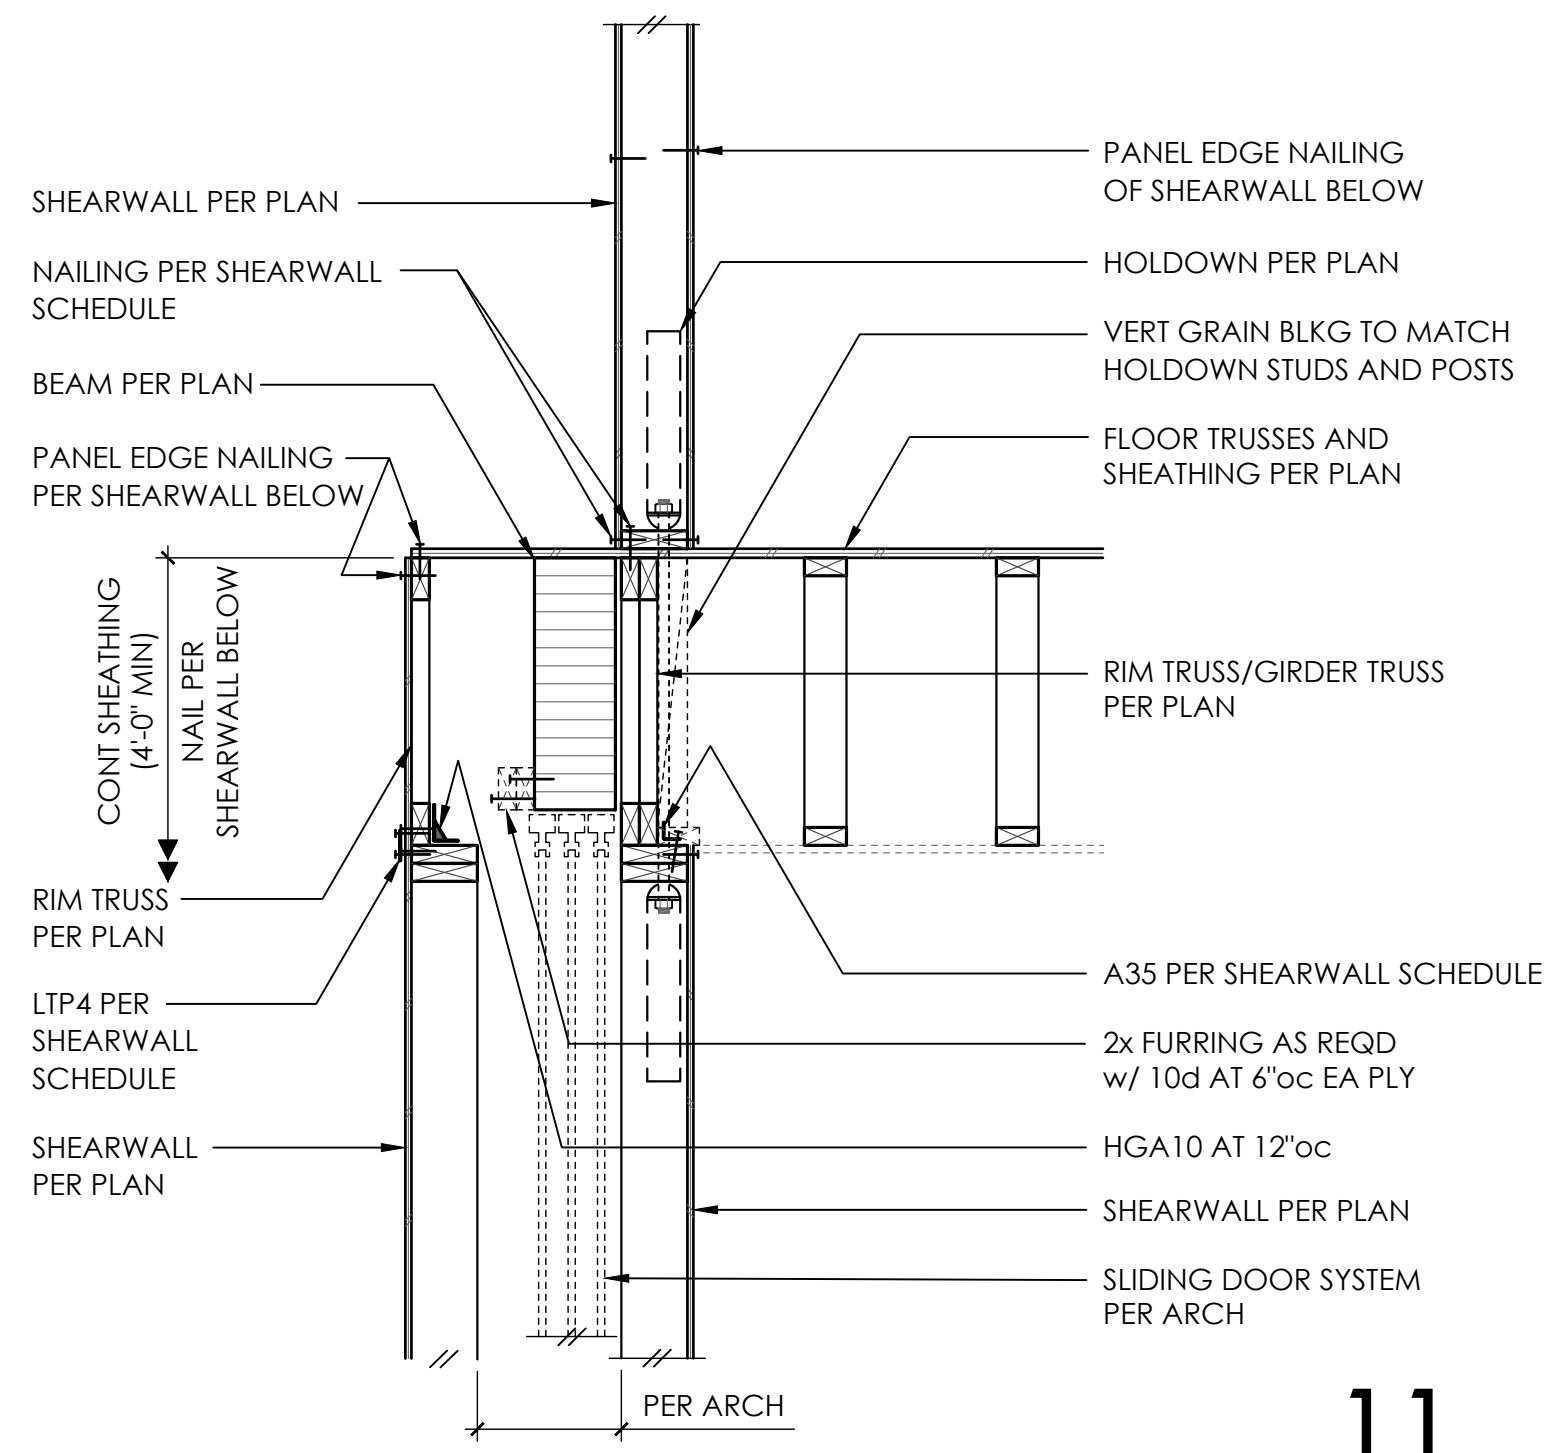


10

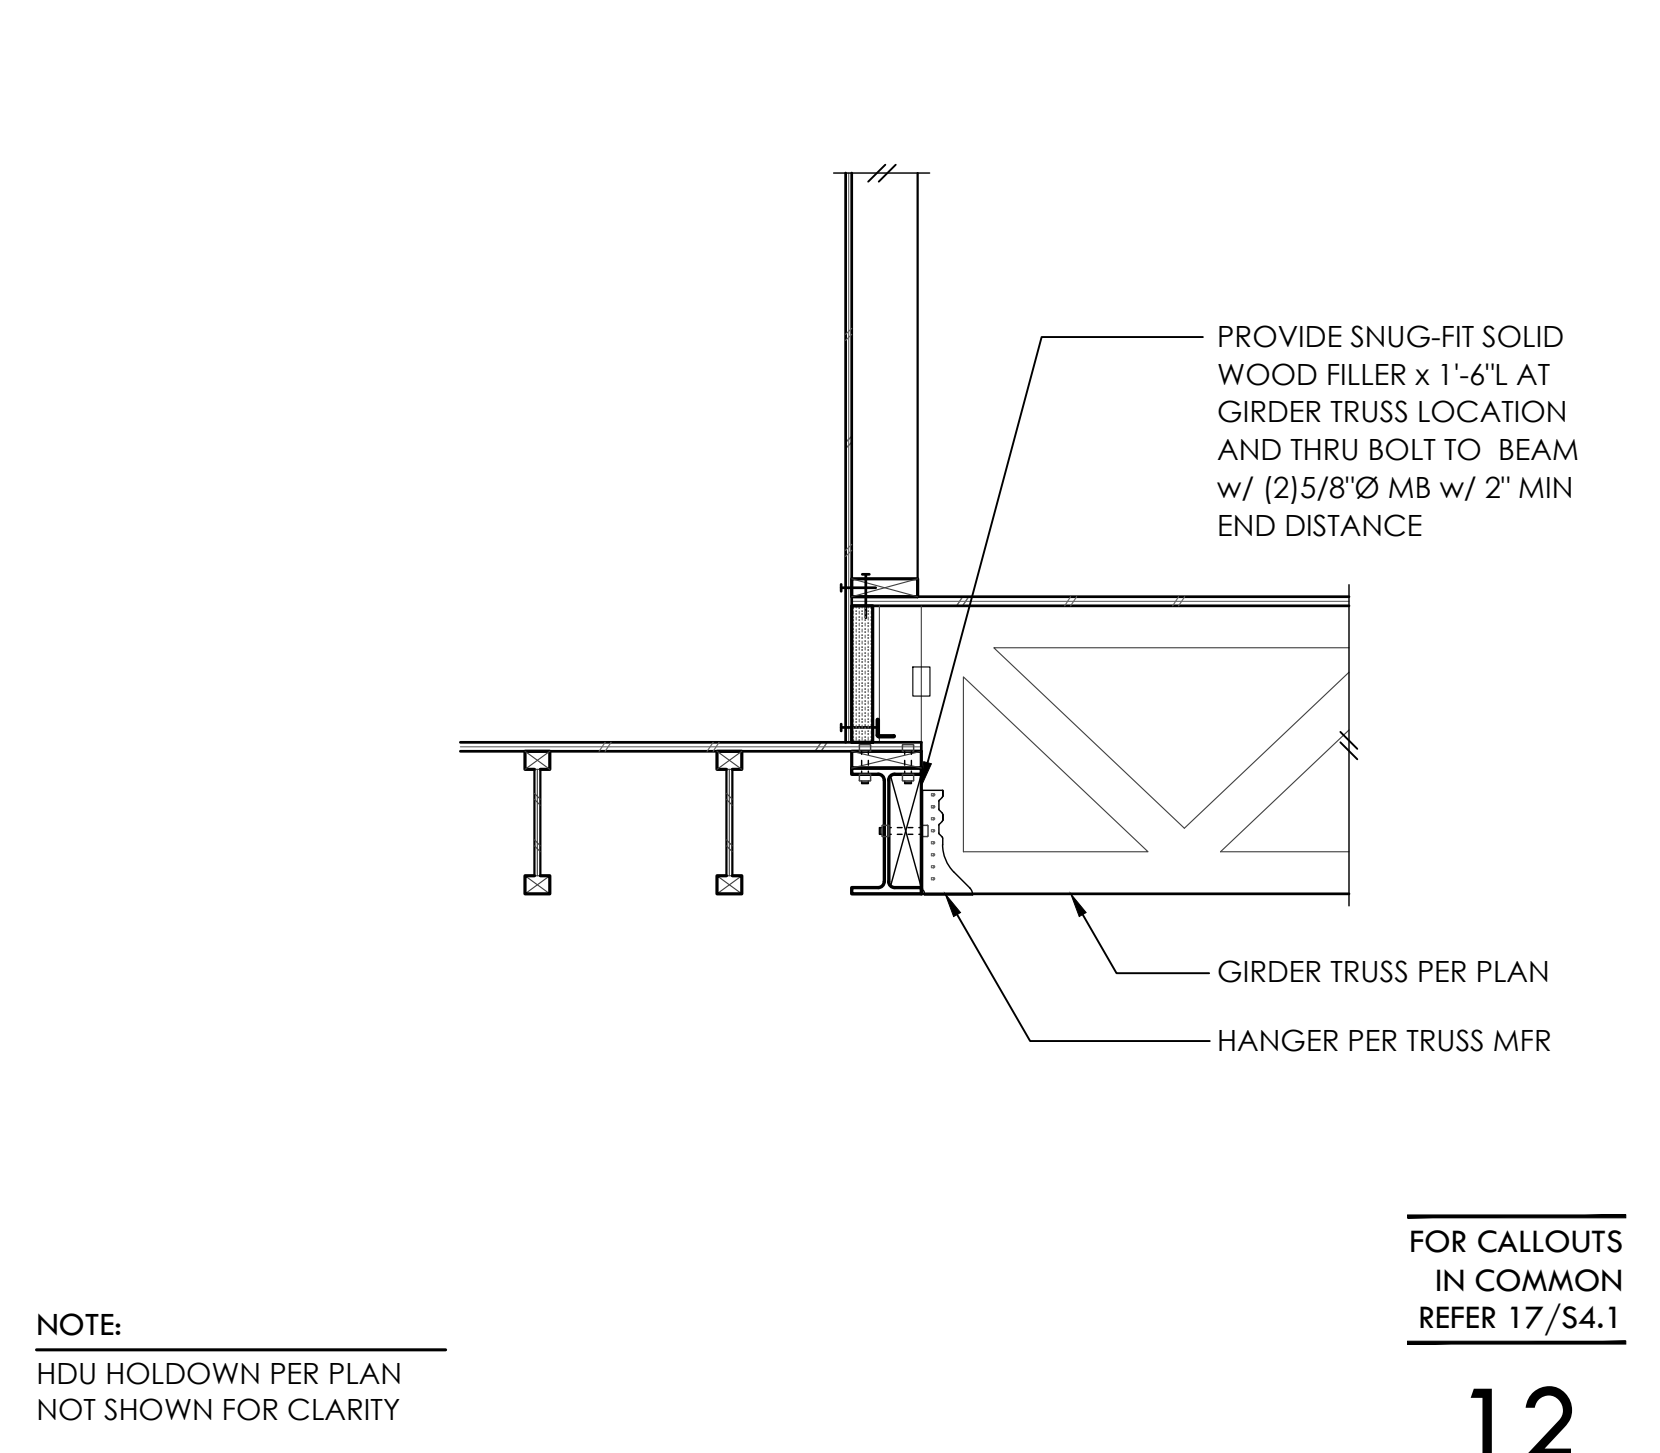


11

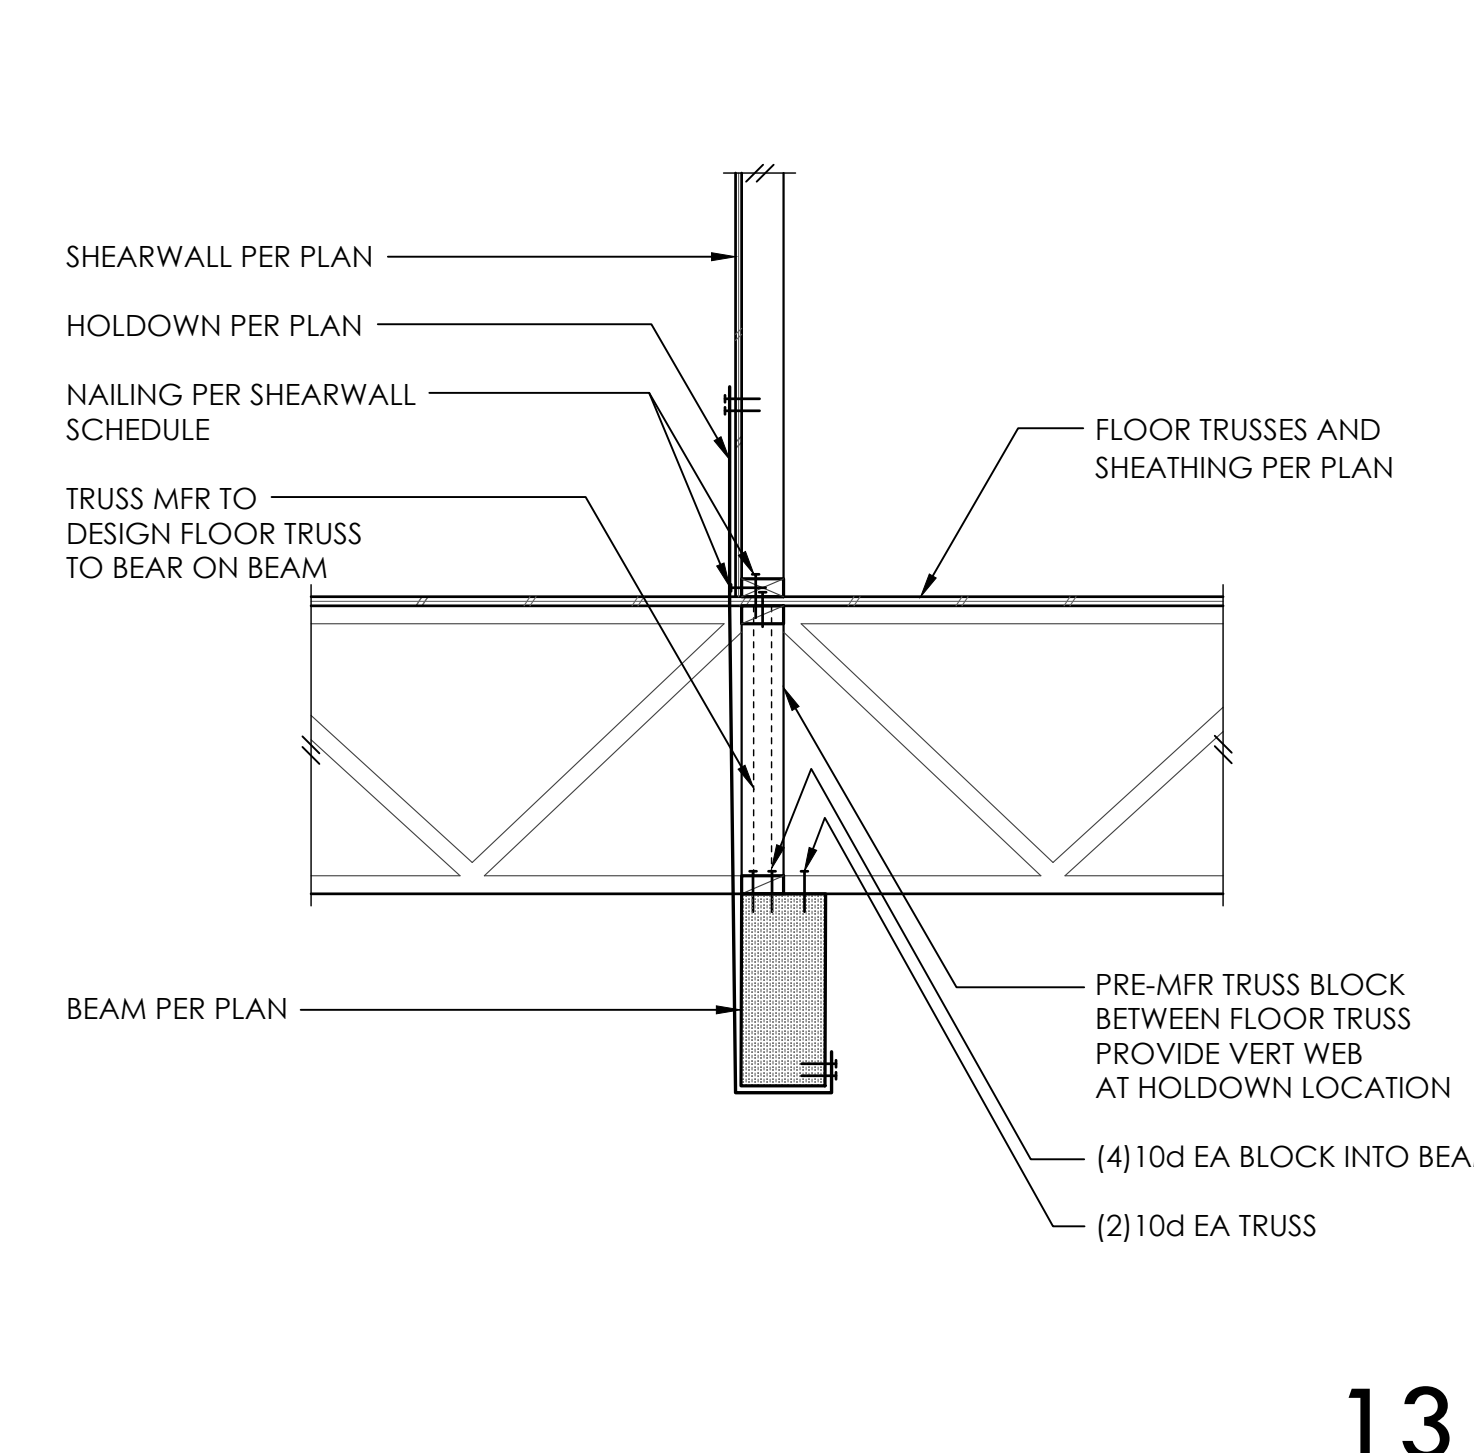


12

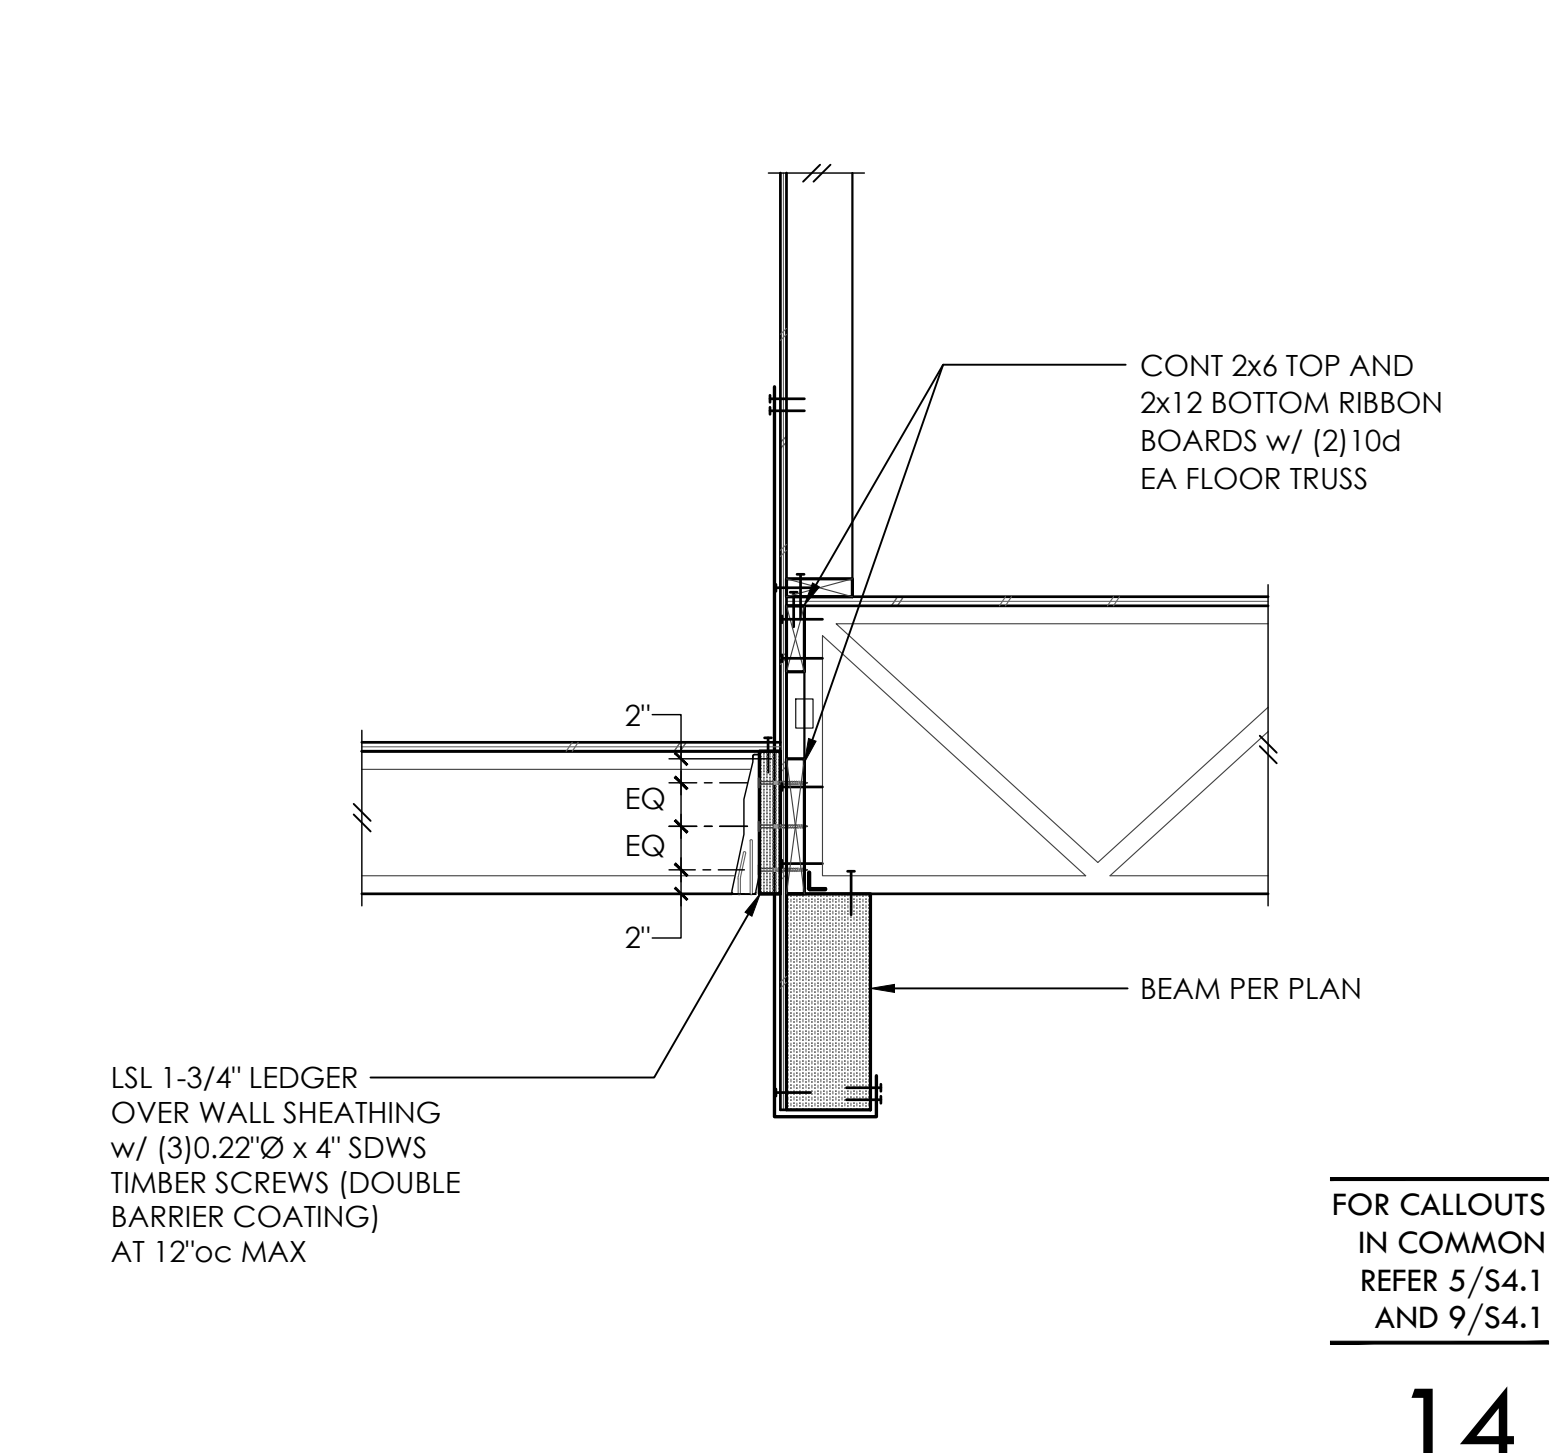


13

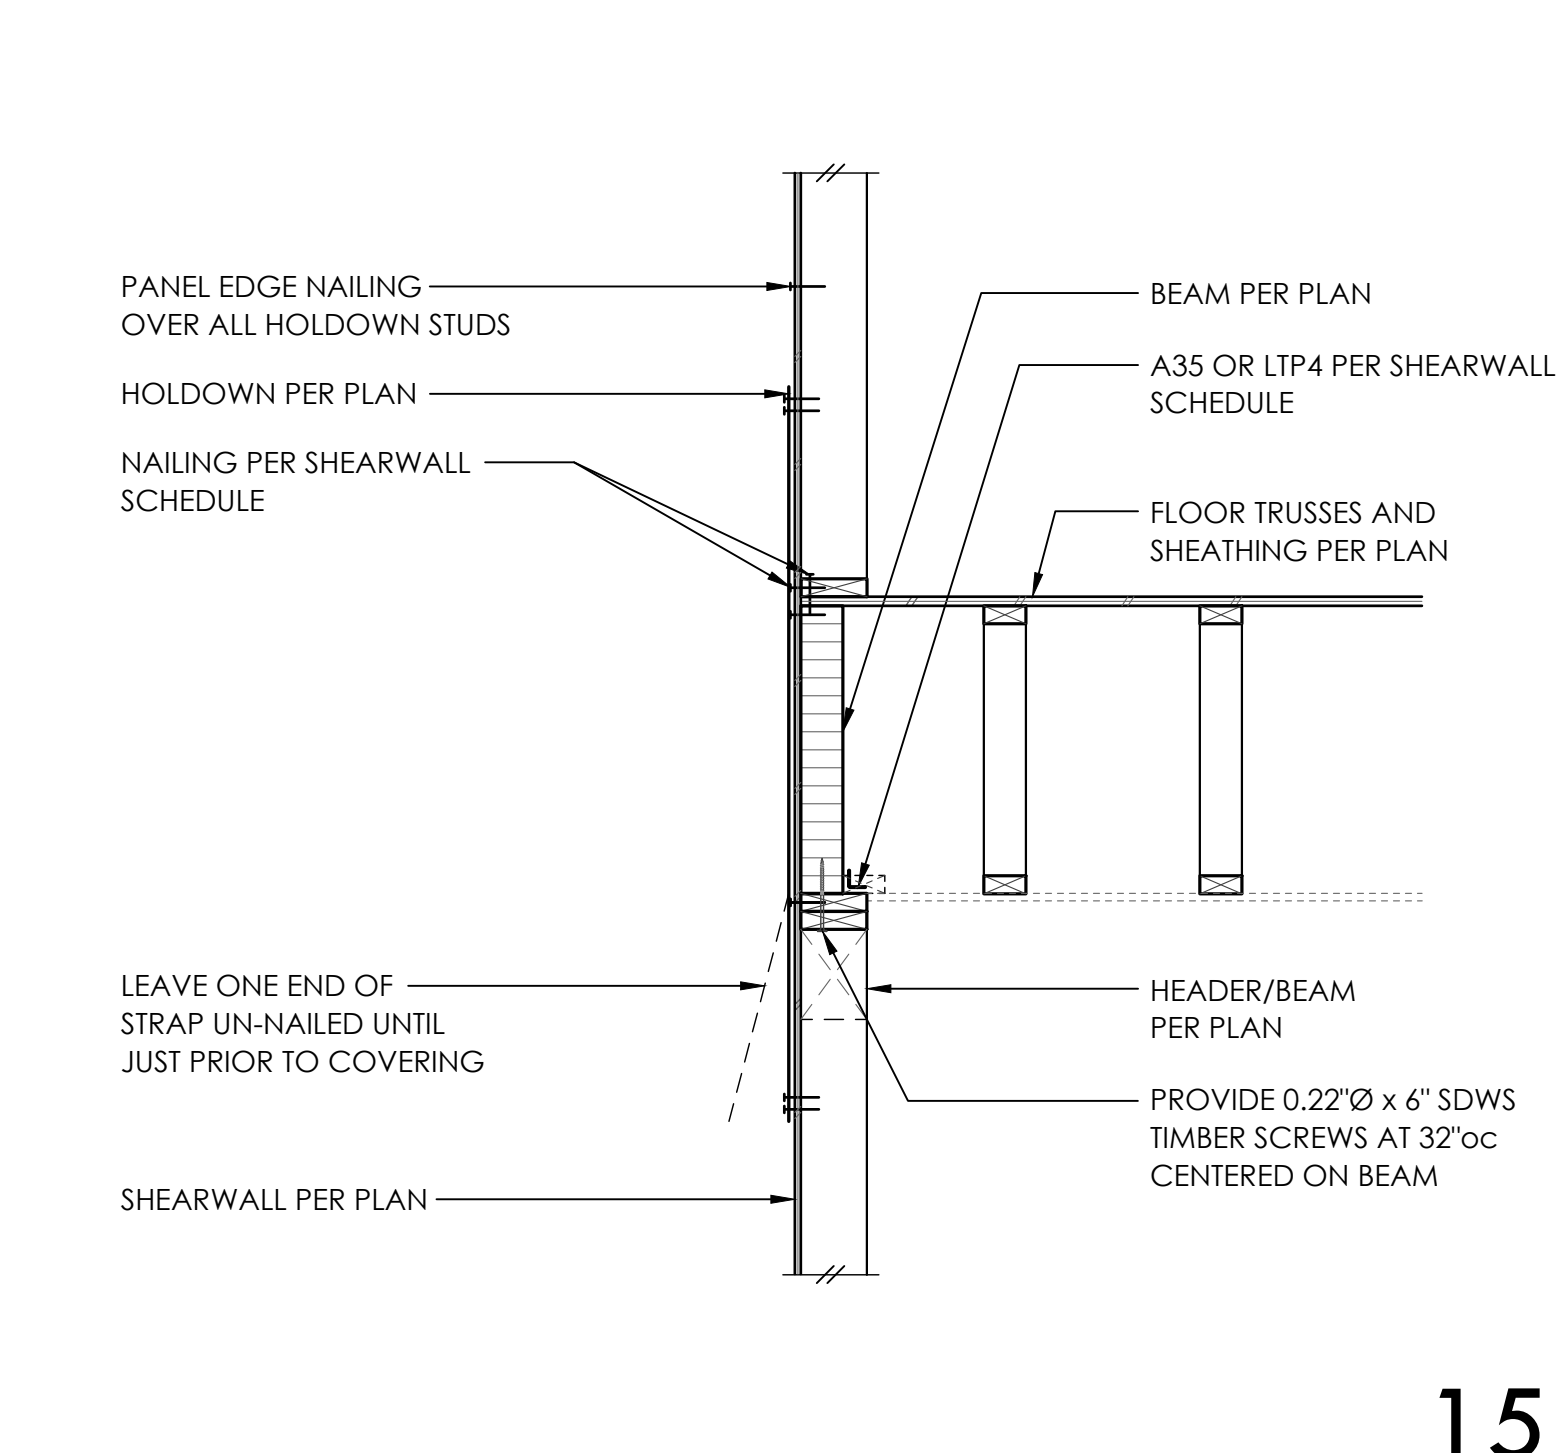


14

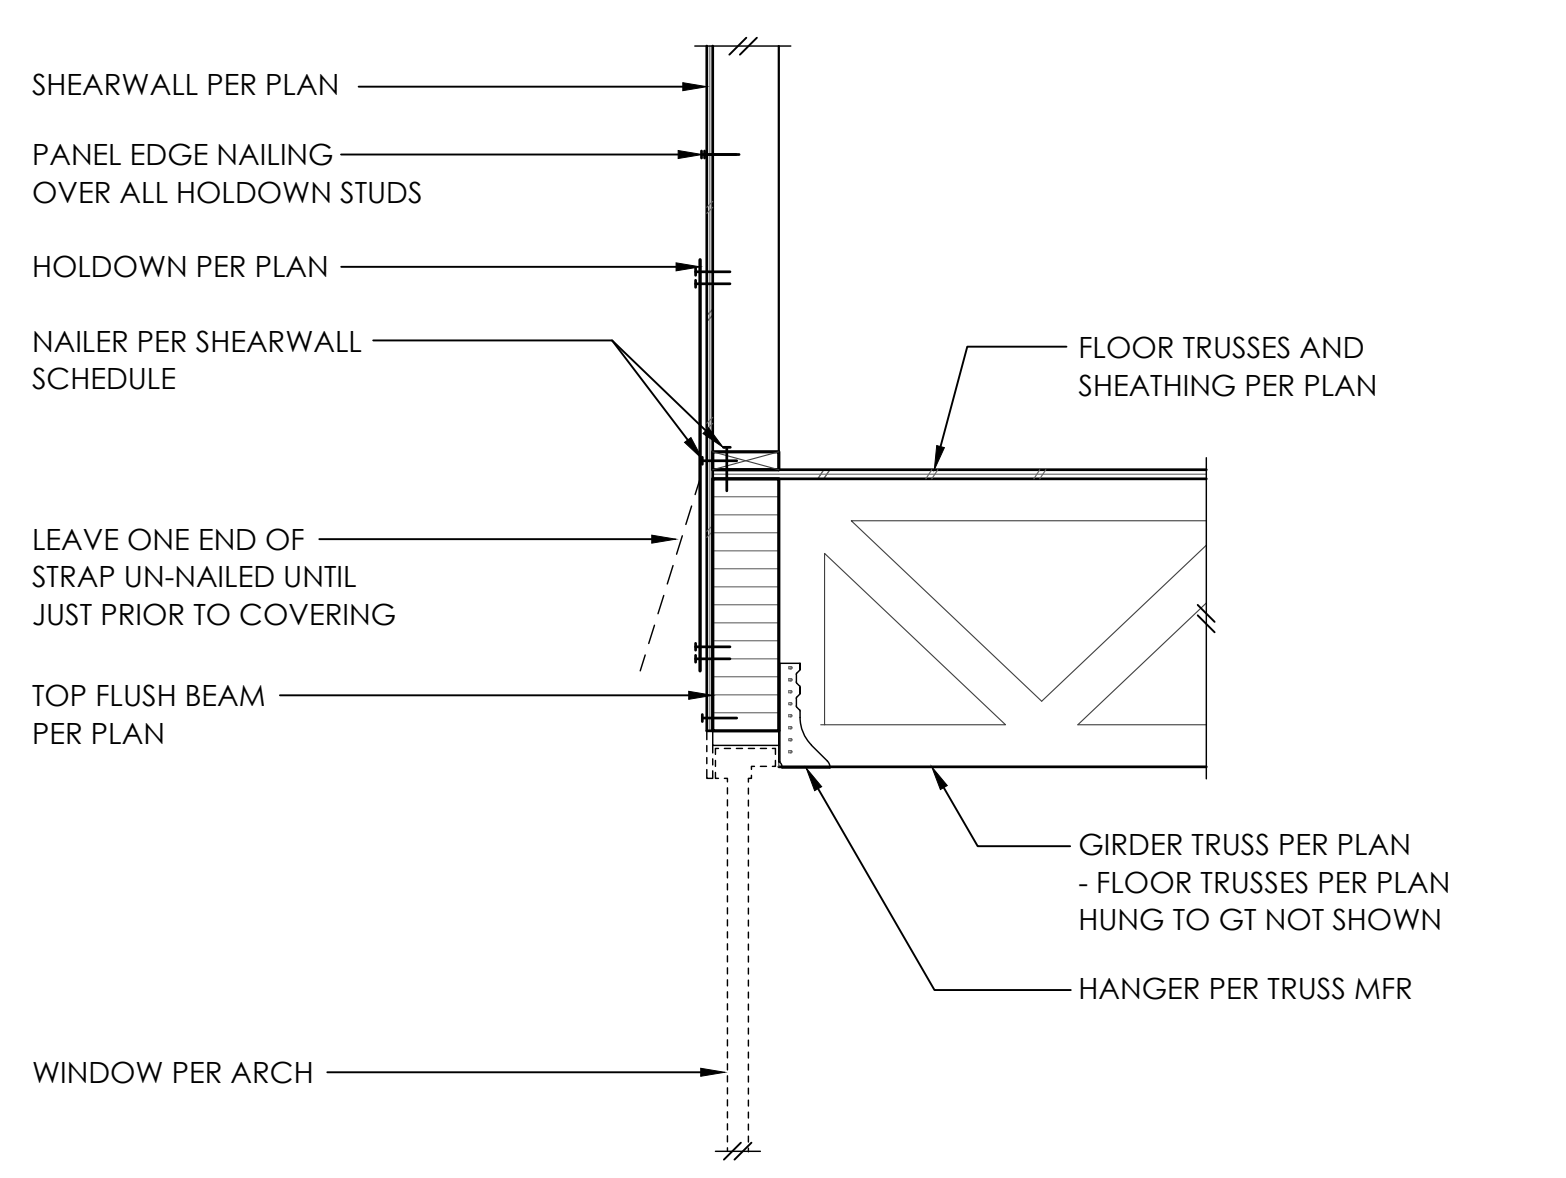


15

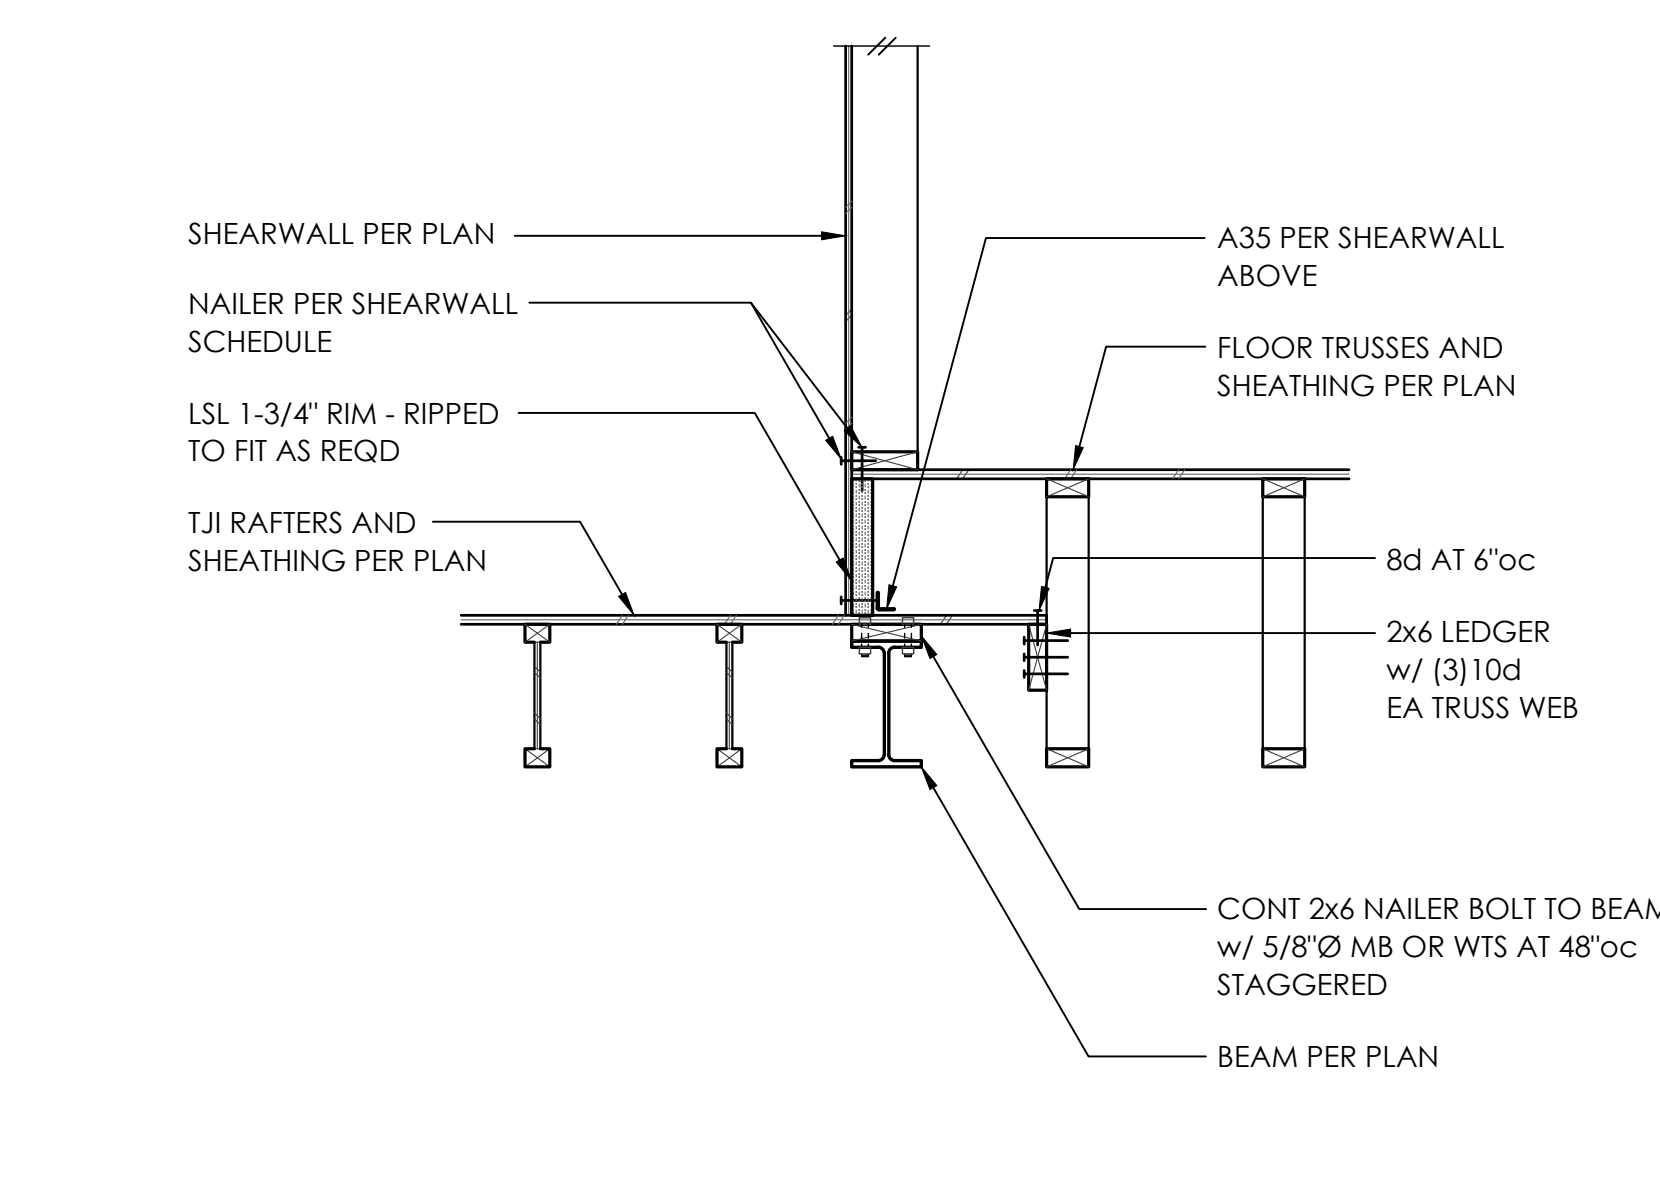


16

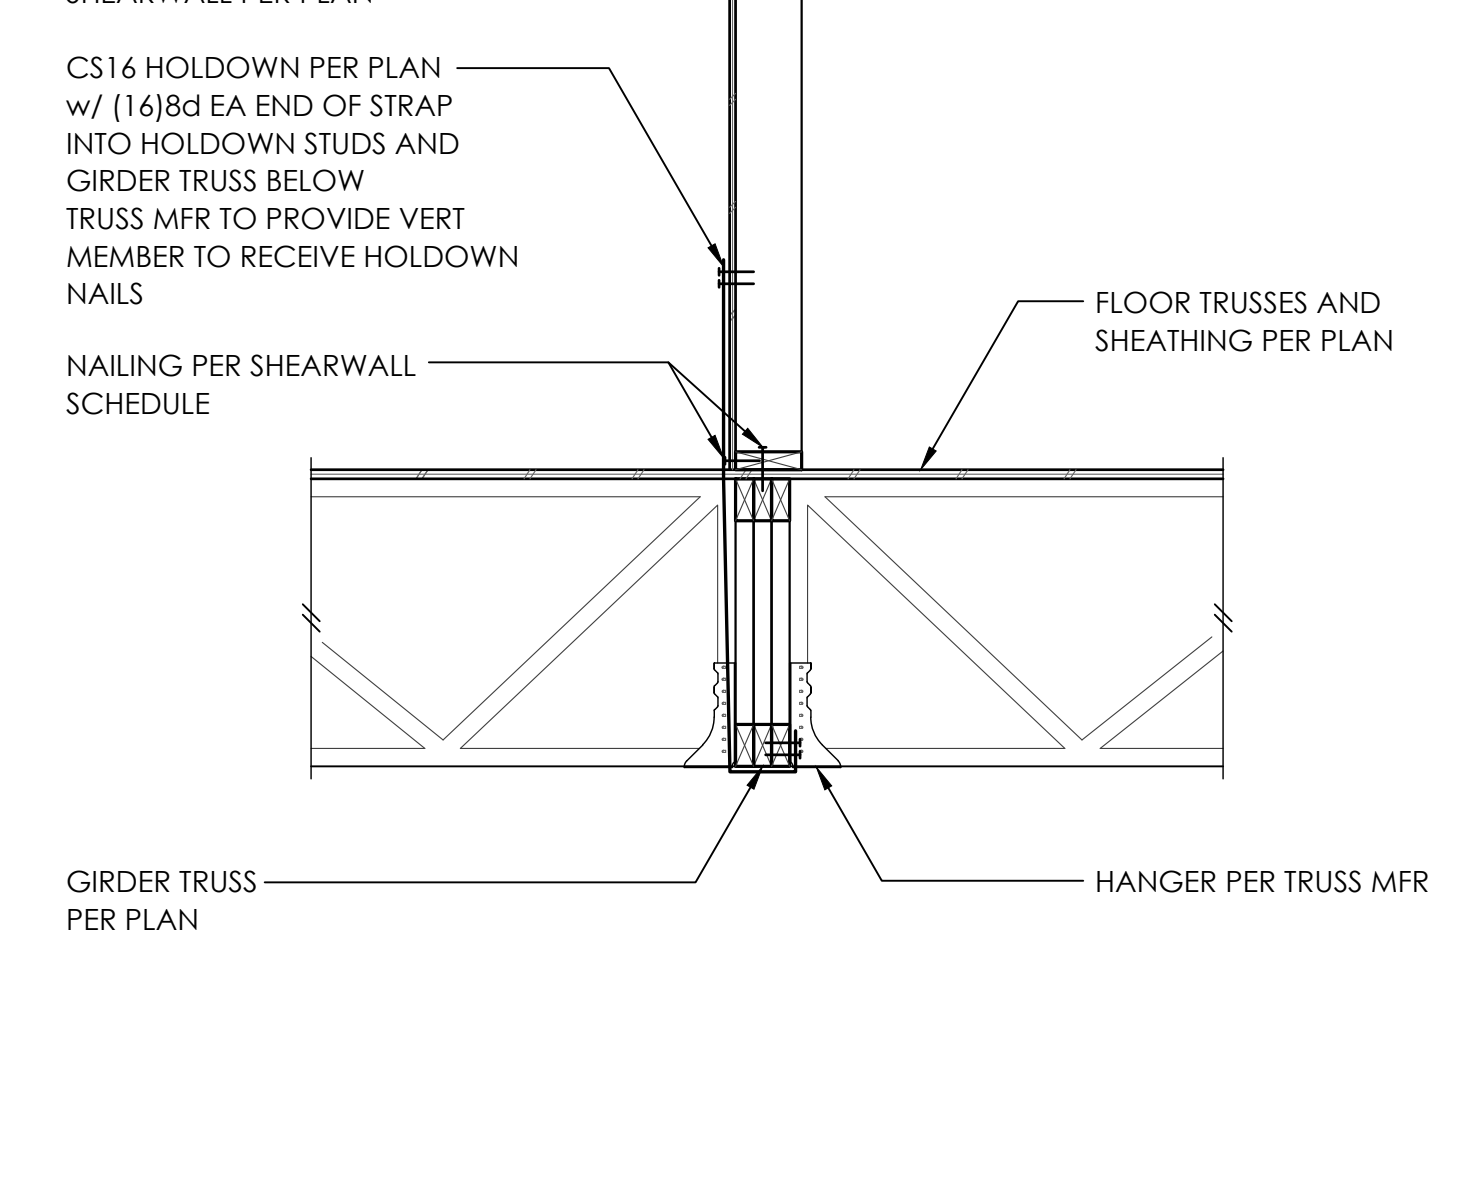


17

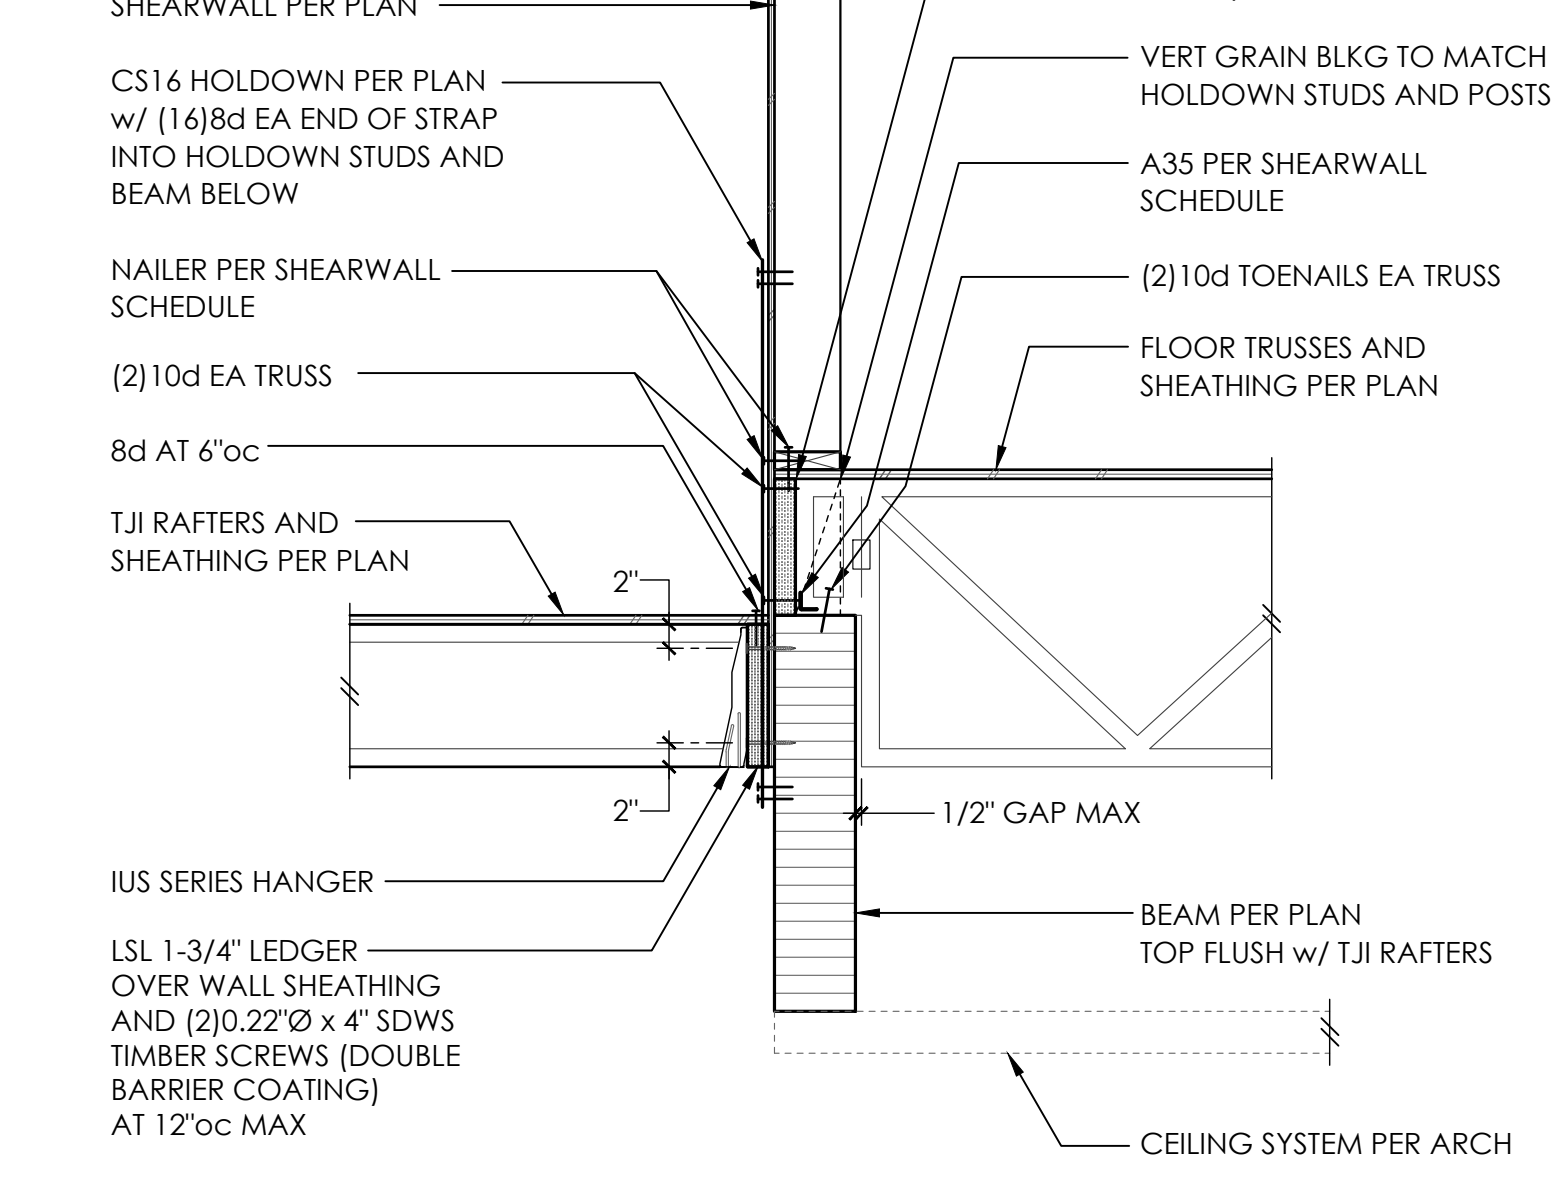


18

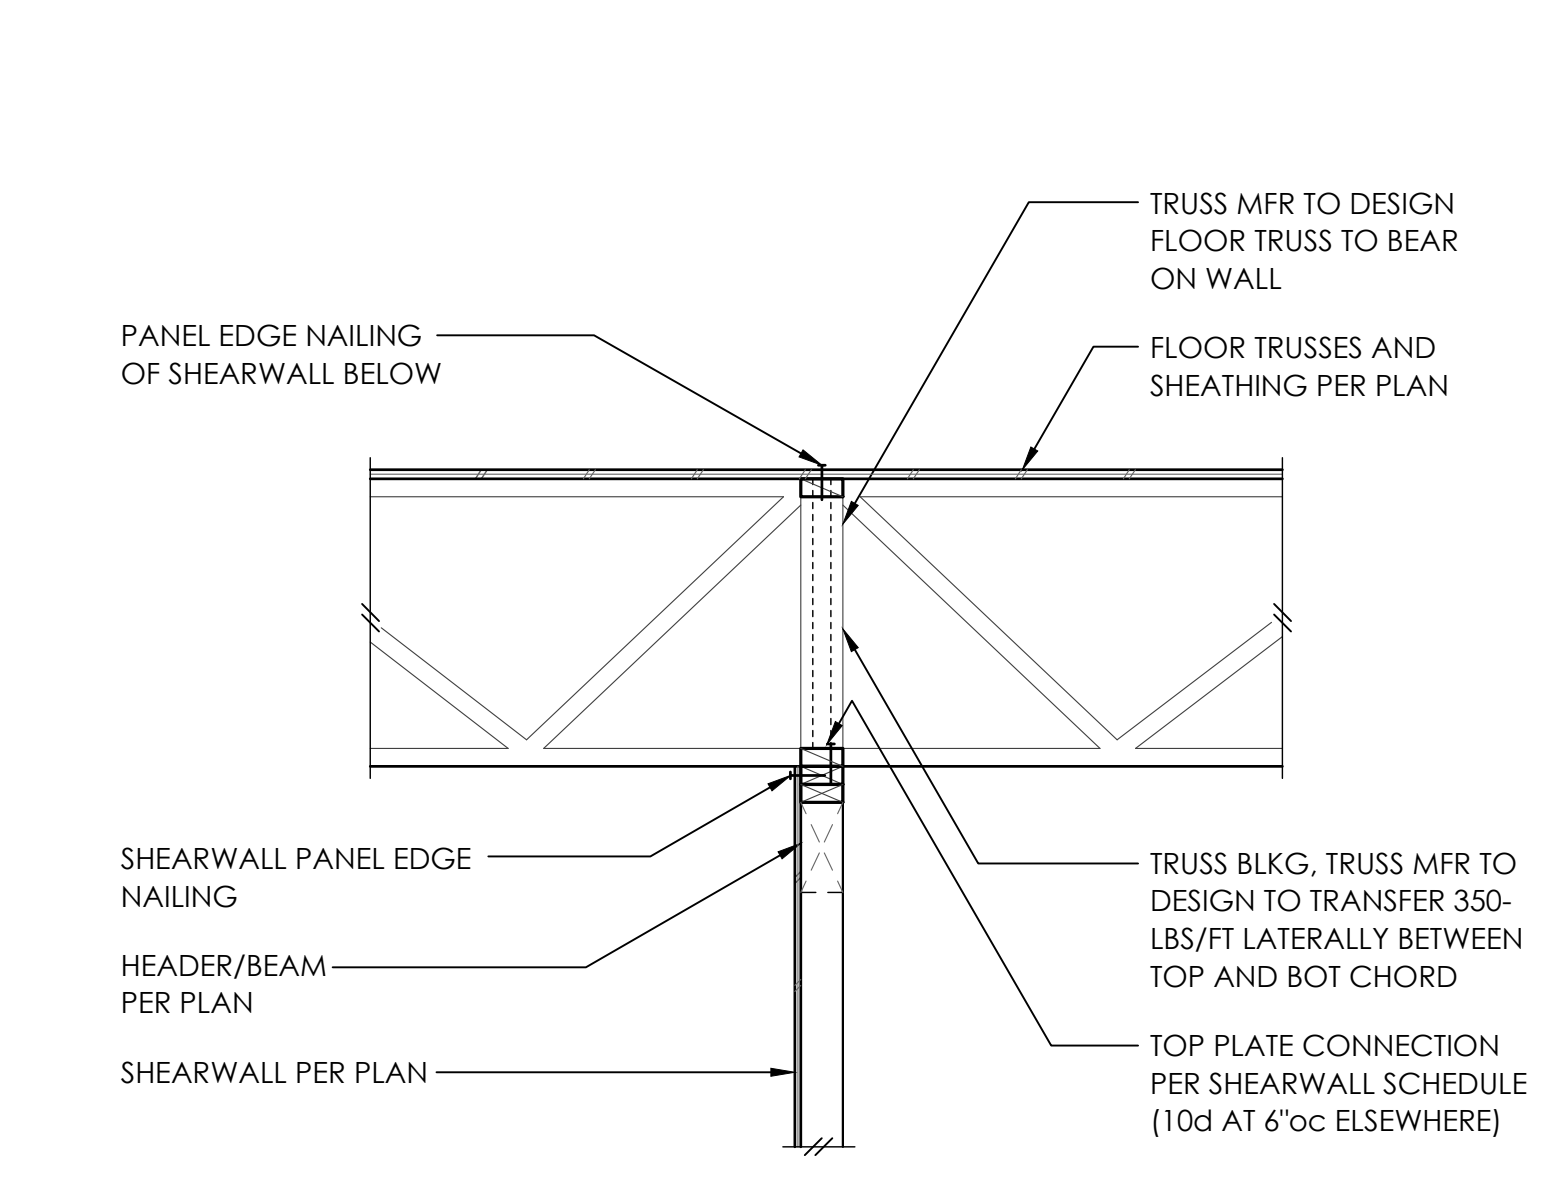


19

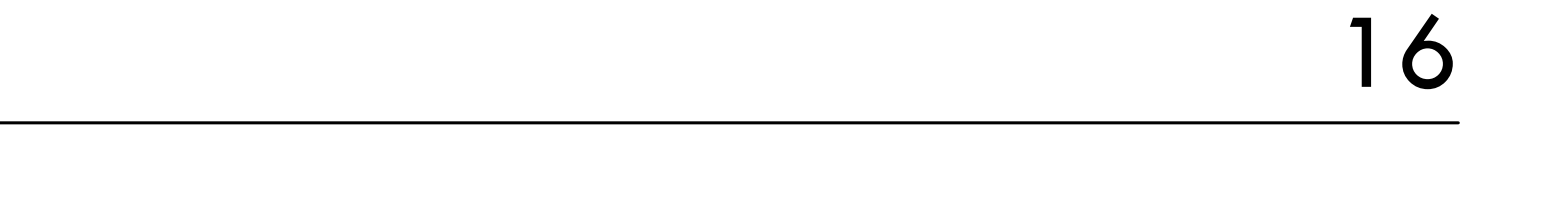


20

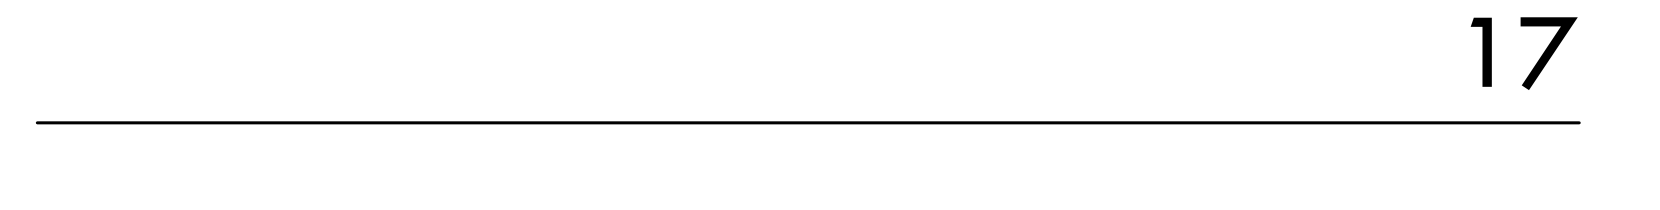


21

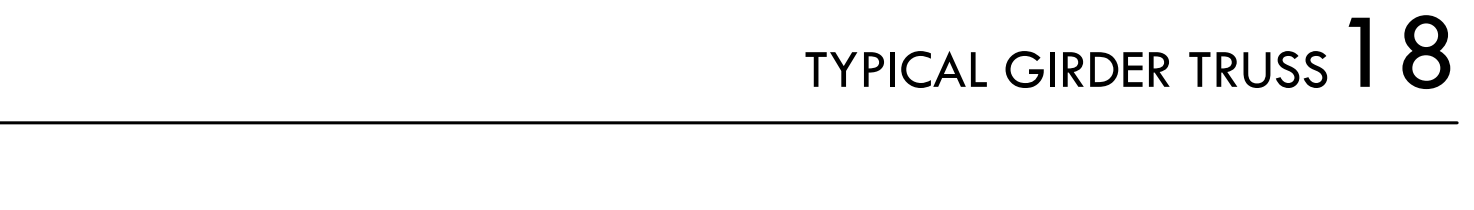


22

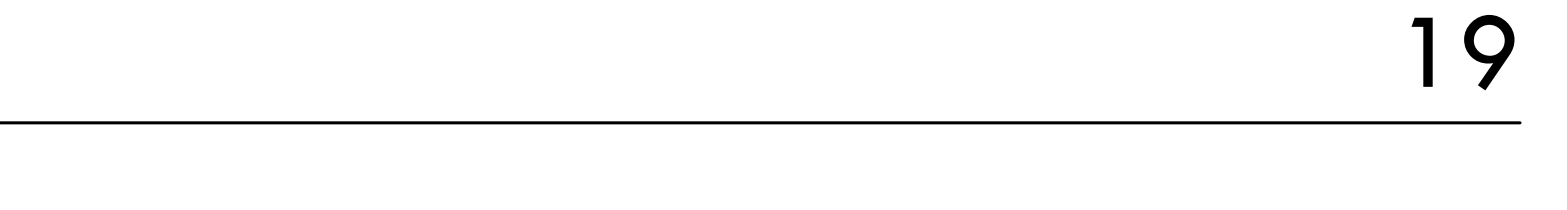


23

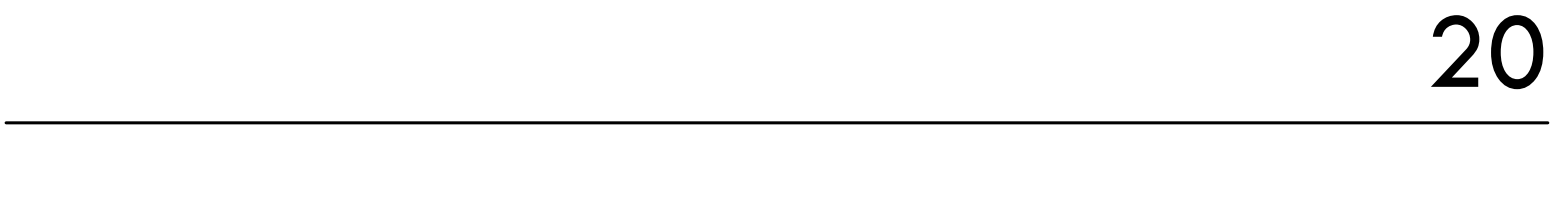


24

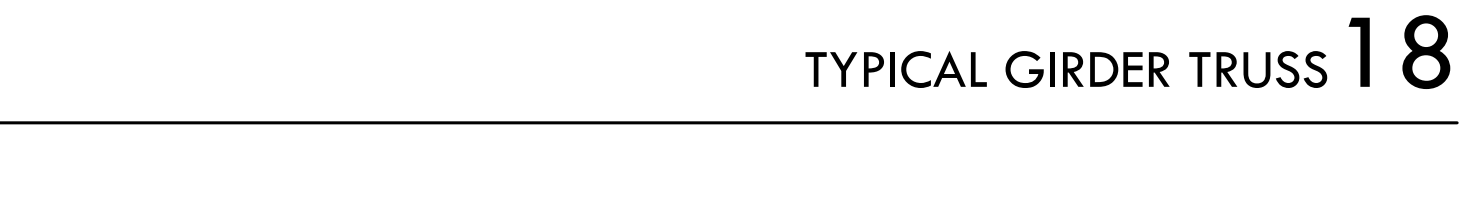

TYPICAL GIRDER TRUSS

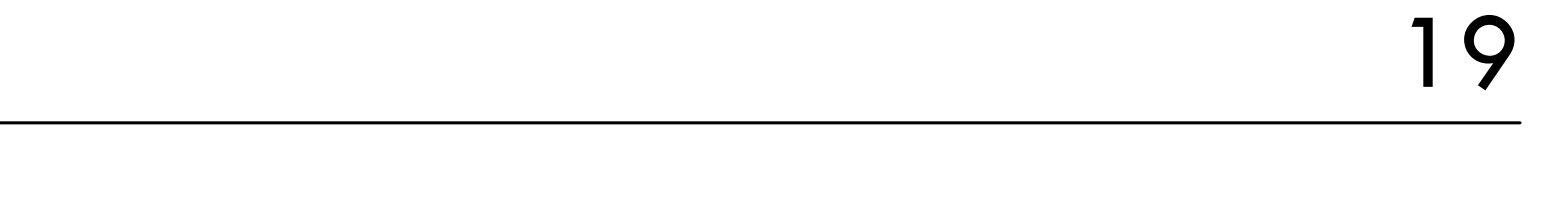

26

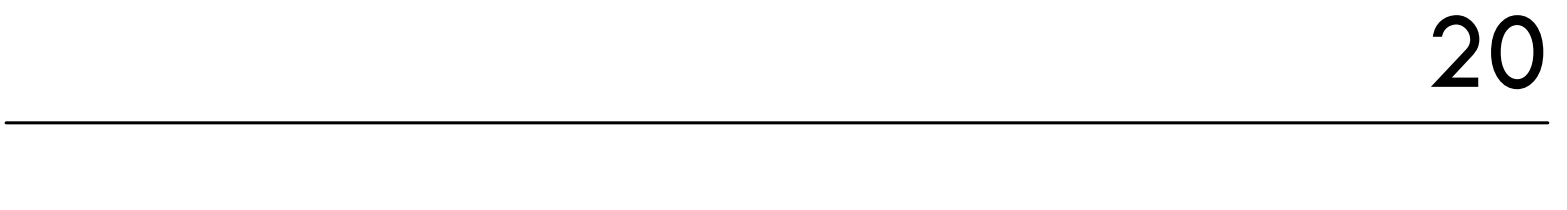

27

NOTE:  
HDU HOLDOWN PER PLAN NOT SHOWN FOR CLARITY

FOR CALLOUTS IN COMMON REFER 17/S4.1

FOR CALLOUTS IN COMMON REFER 5/S4.1 AND 9/S4.1




PROJECT NO	0426-2021-0301	DATE	12.23.21
PROJECT MANAGER	JAS	WAC	
DRAWN	JOSEPH MARQUEZ	ENGINEER	206.692.5122
JOSEPHM@MALSANGTSANG.COM			
REV	DESCRIPTION	DATE	
▲	PERMIT CORRECTIONS	5.5.22	
▲	PERMIT CORRECTIONS	7.13.22	
▲	PERMIT CORRECTIONS	8.19.22	
ARCH	MACULLOUGH ARCHITECTS		206.443.1181


WOOD FRAMING DETAILS

S4.1  
SCALE: 3/4" = 1'-0"




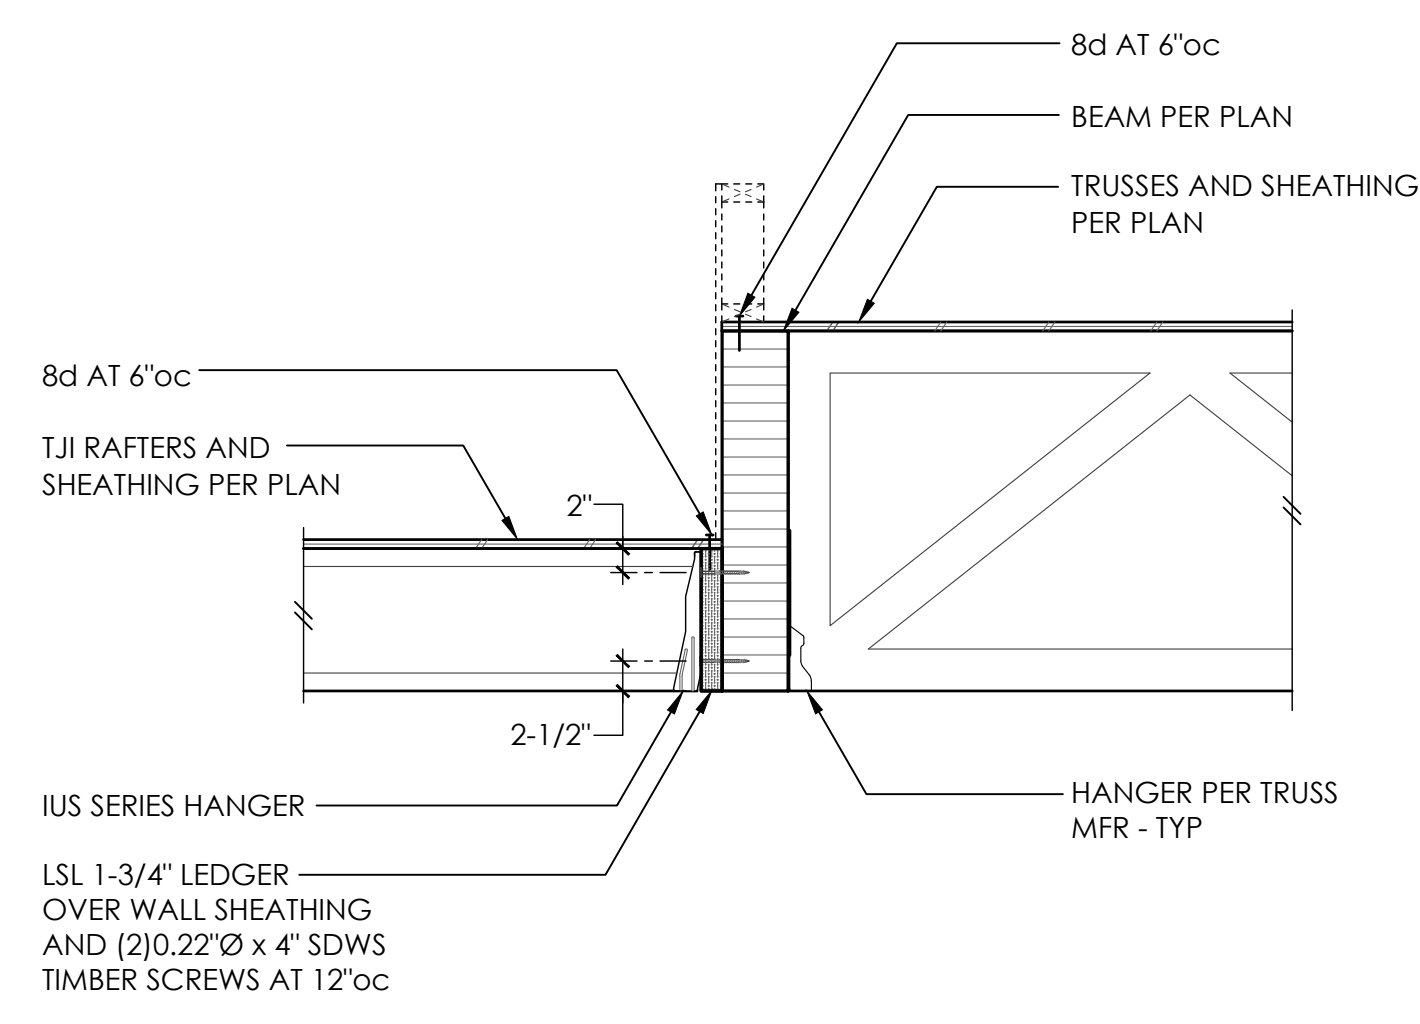


1

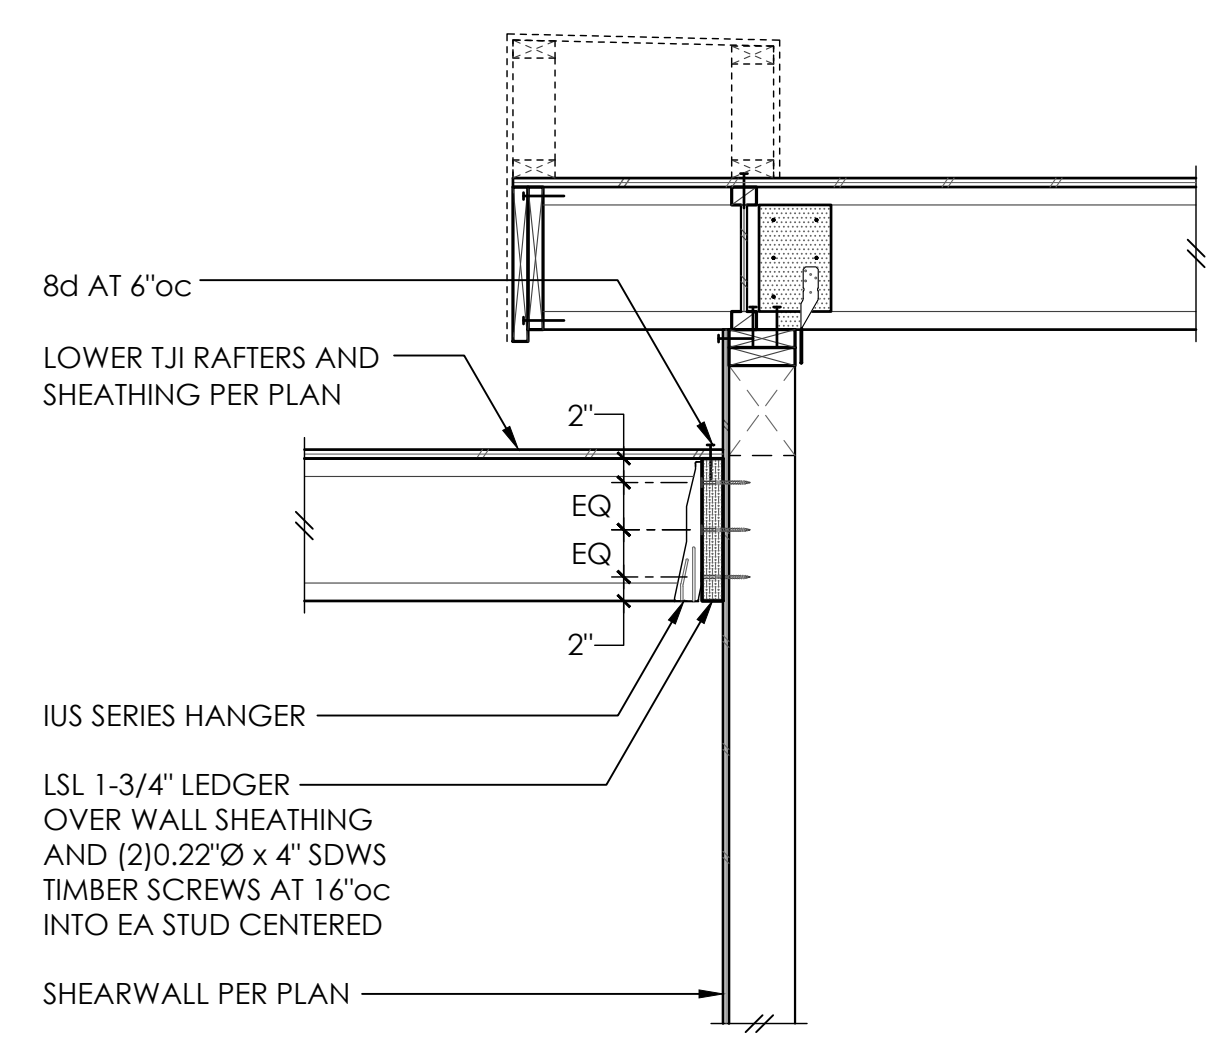


FOR CALLOUTS IN COMMON REFER 13/S4.2  
 2

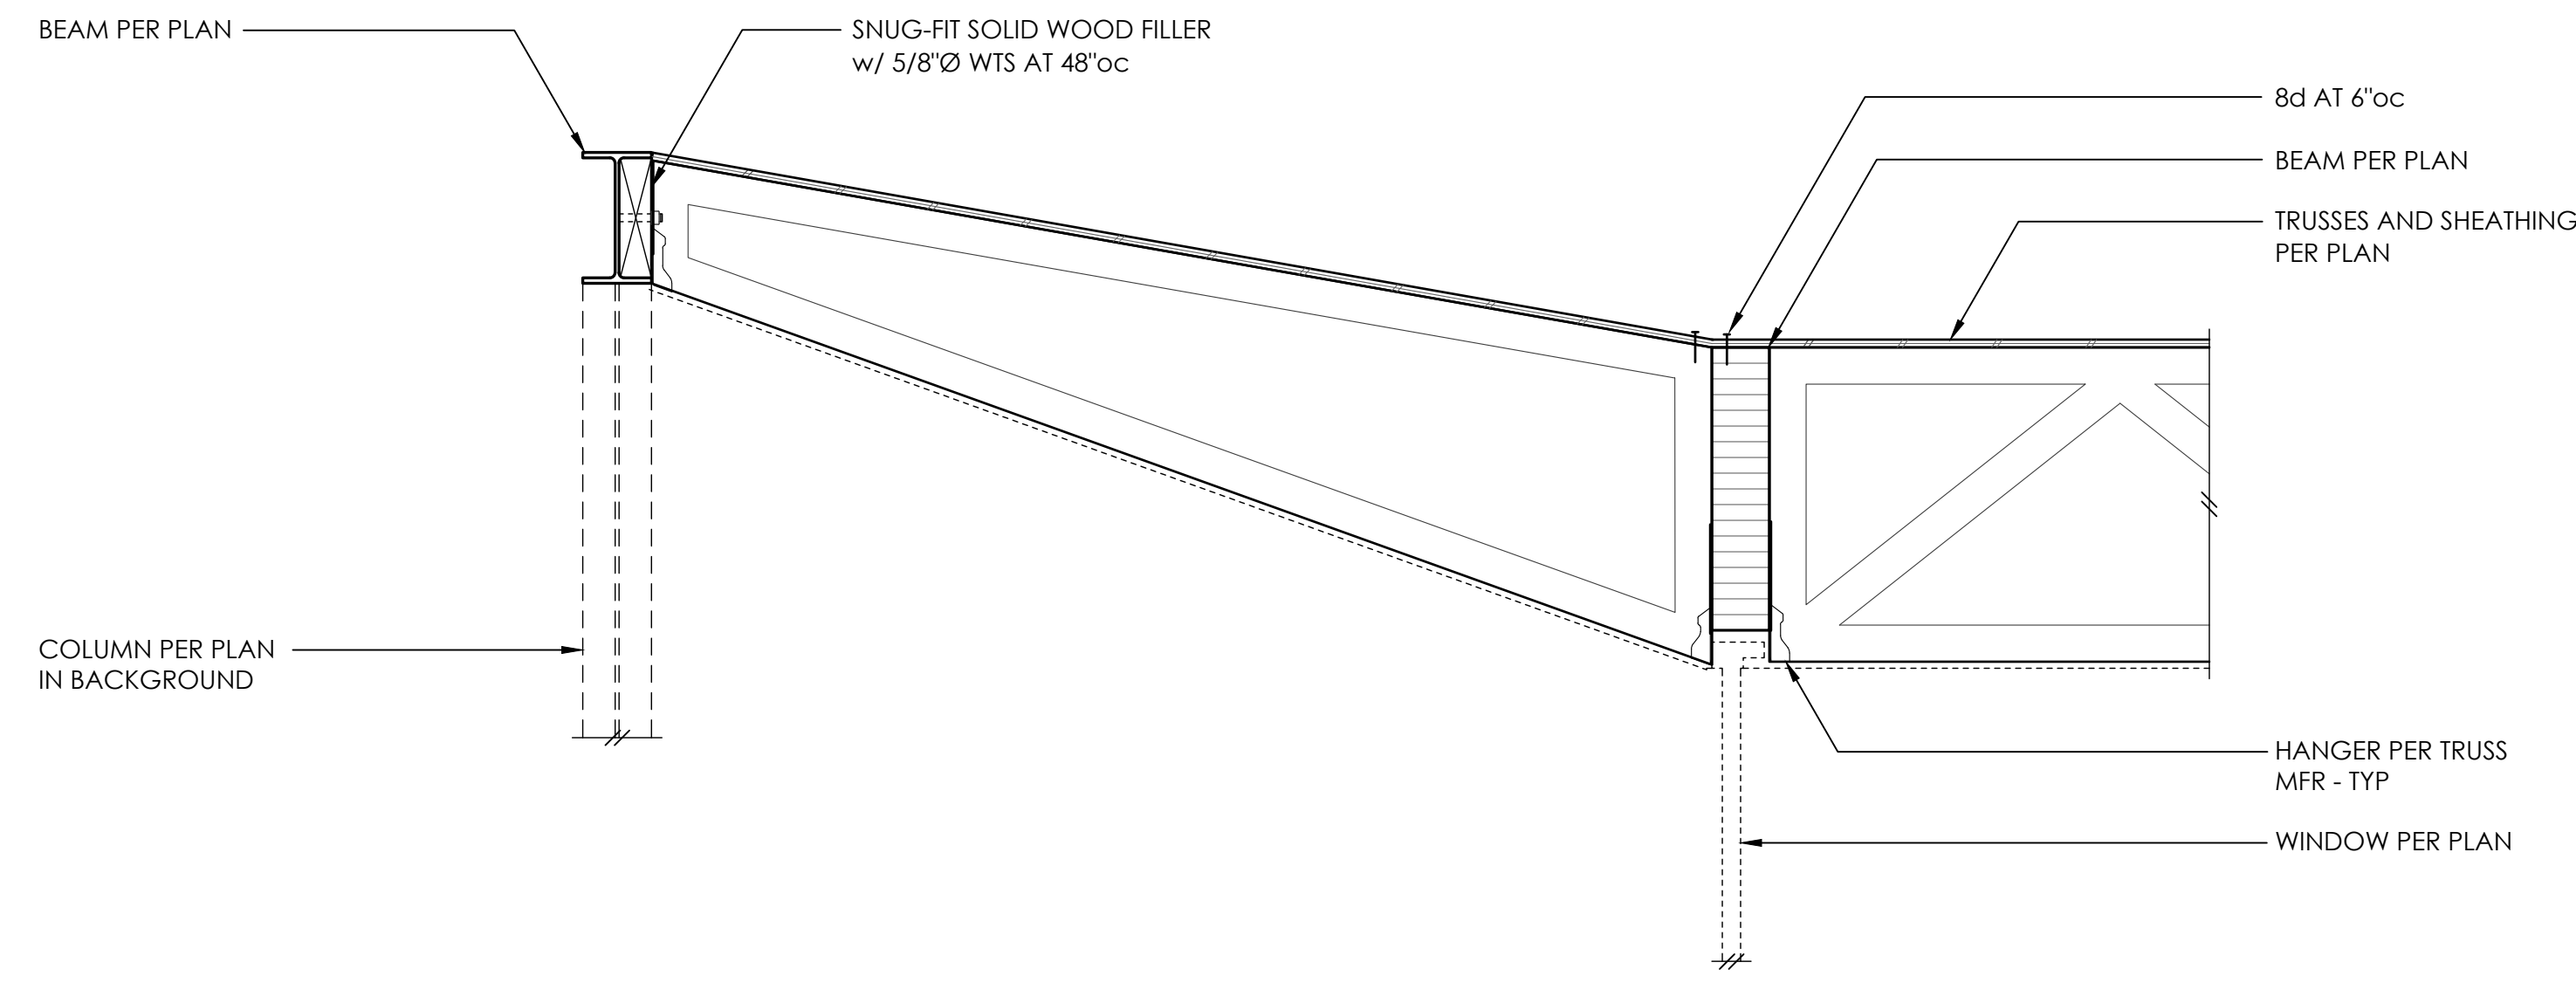


4

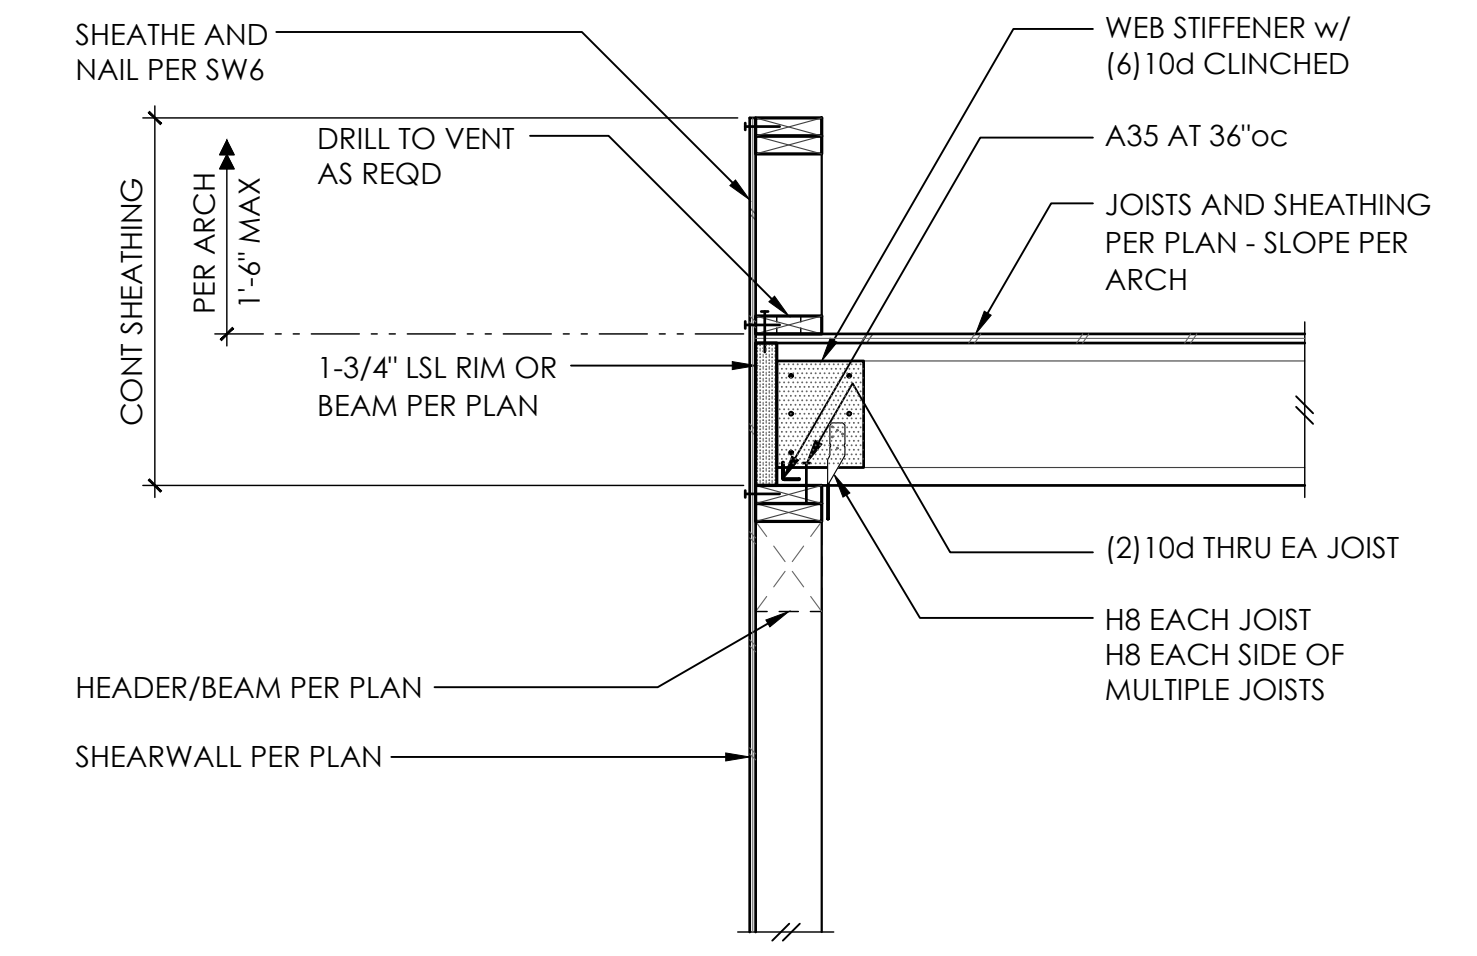


5

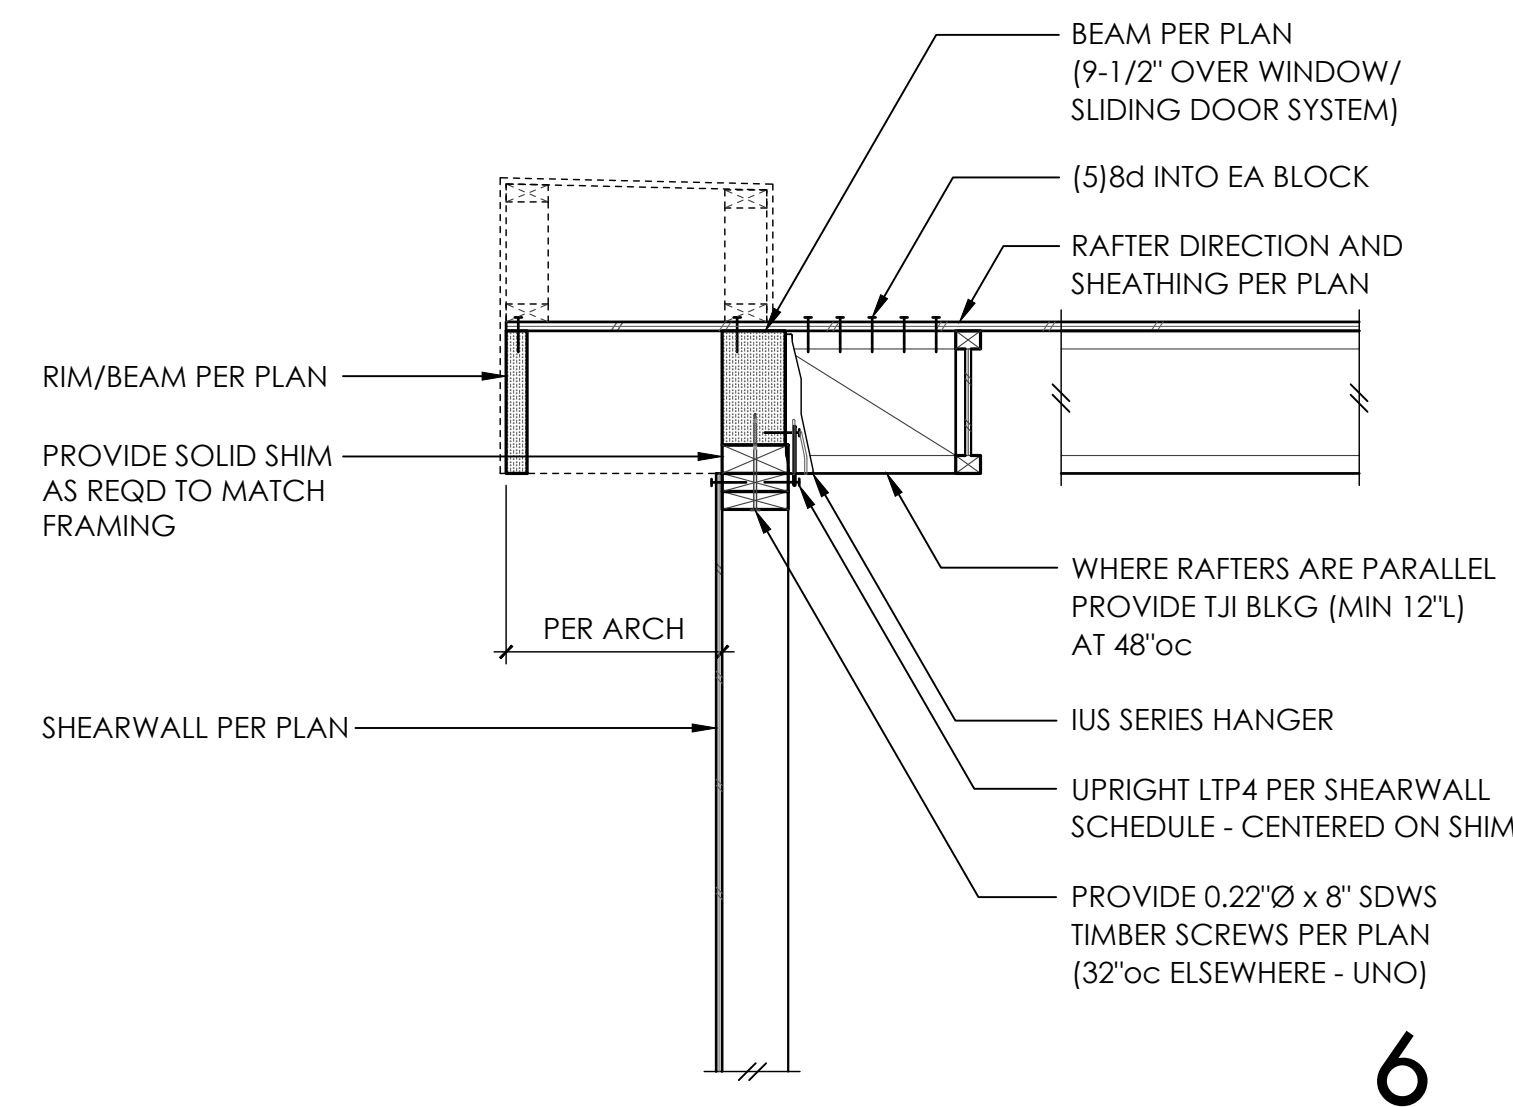


6

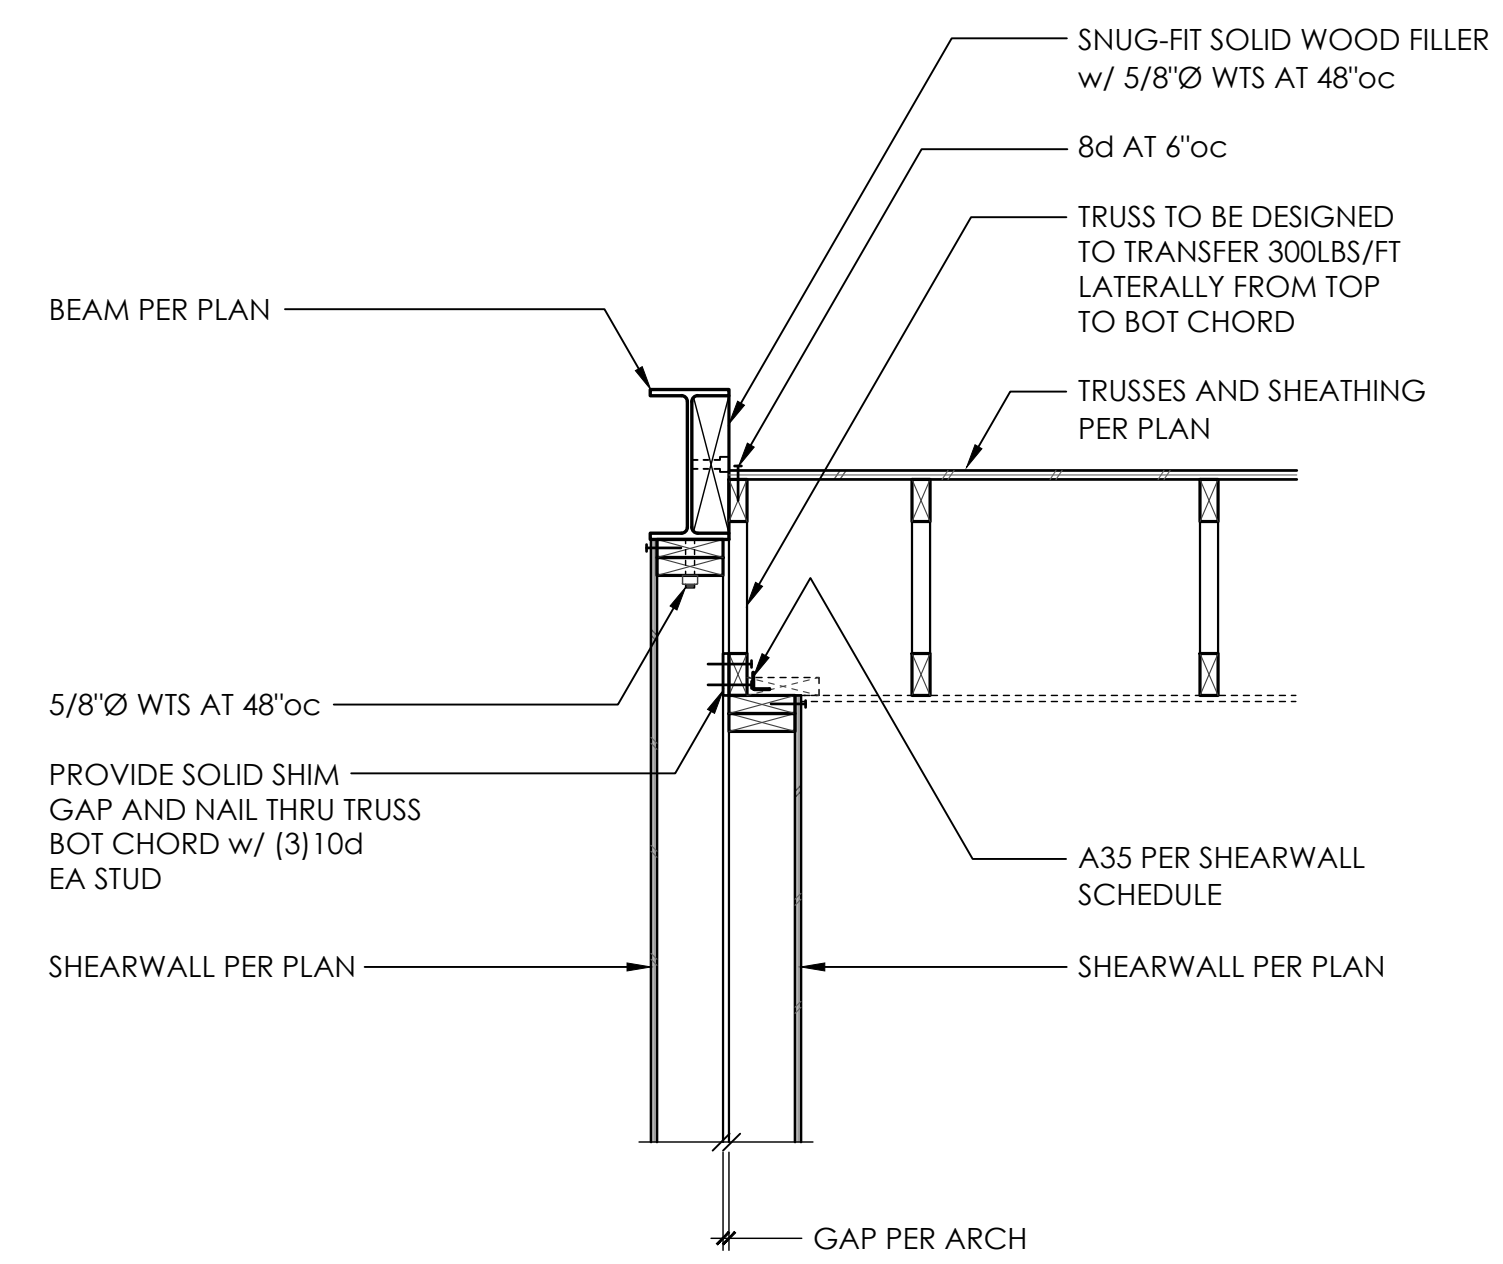


7

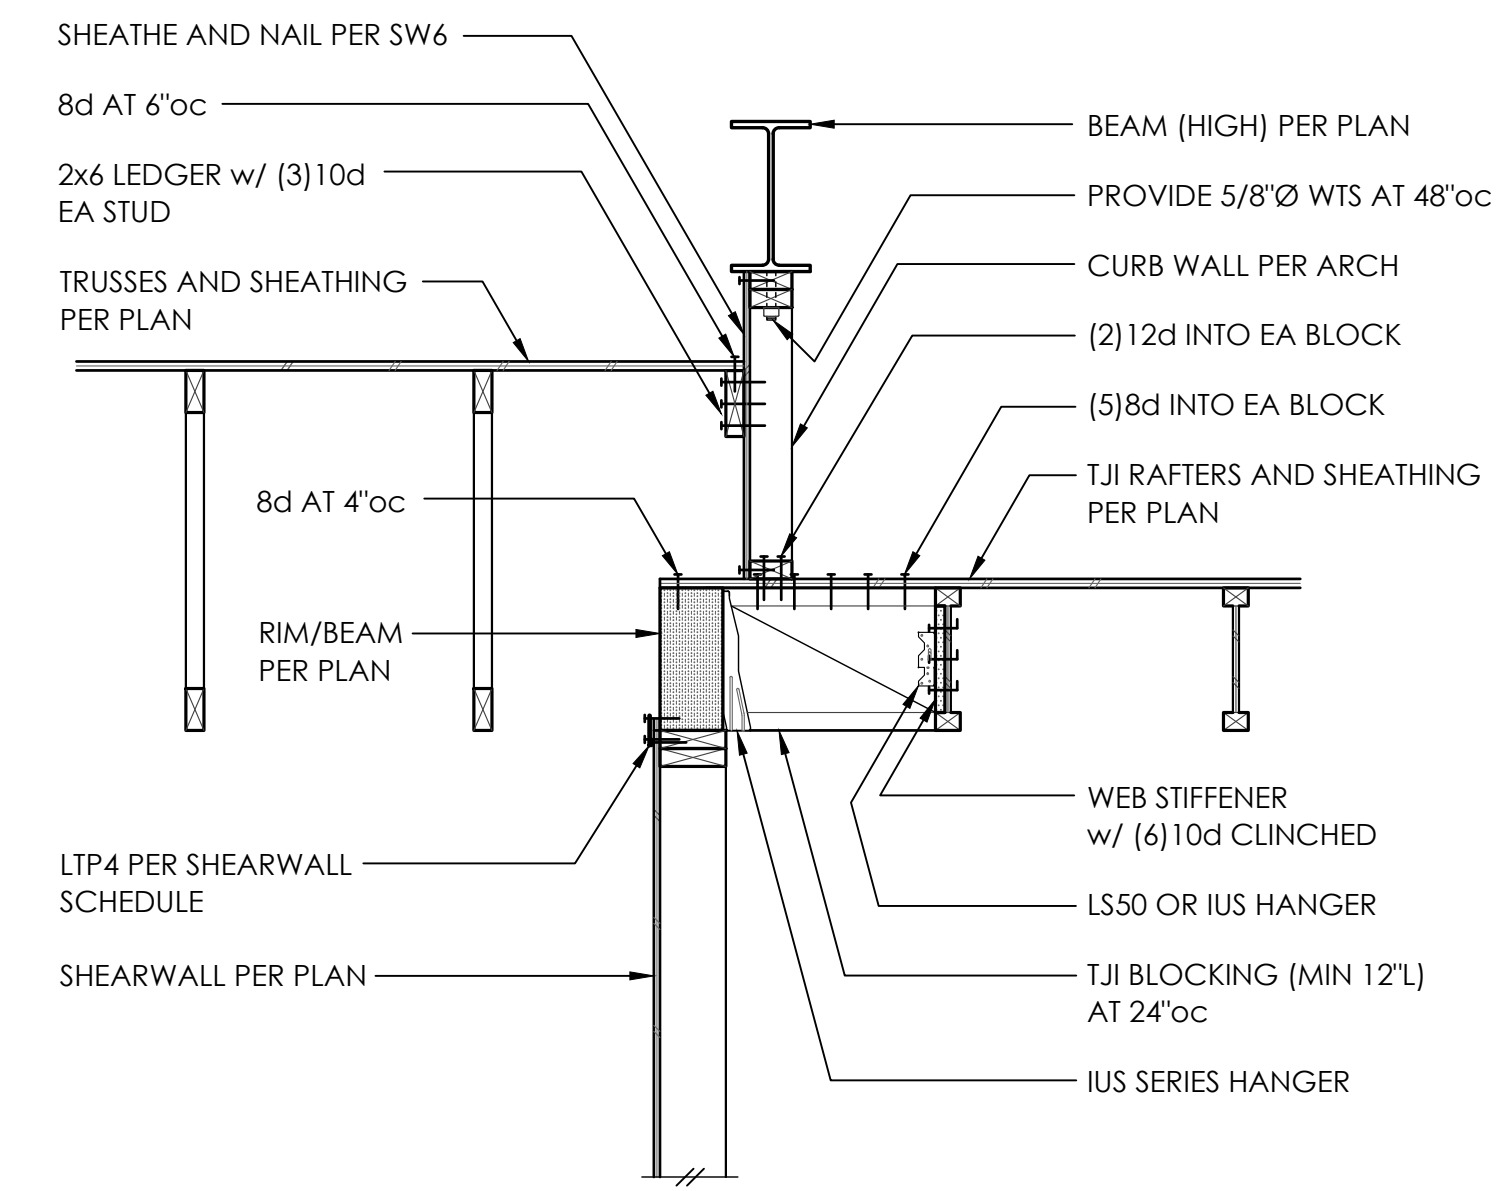


8

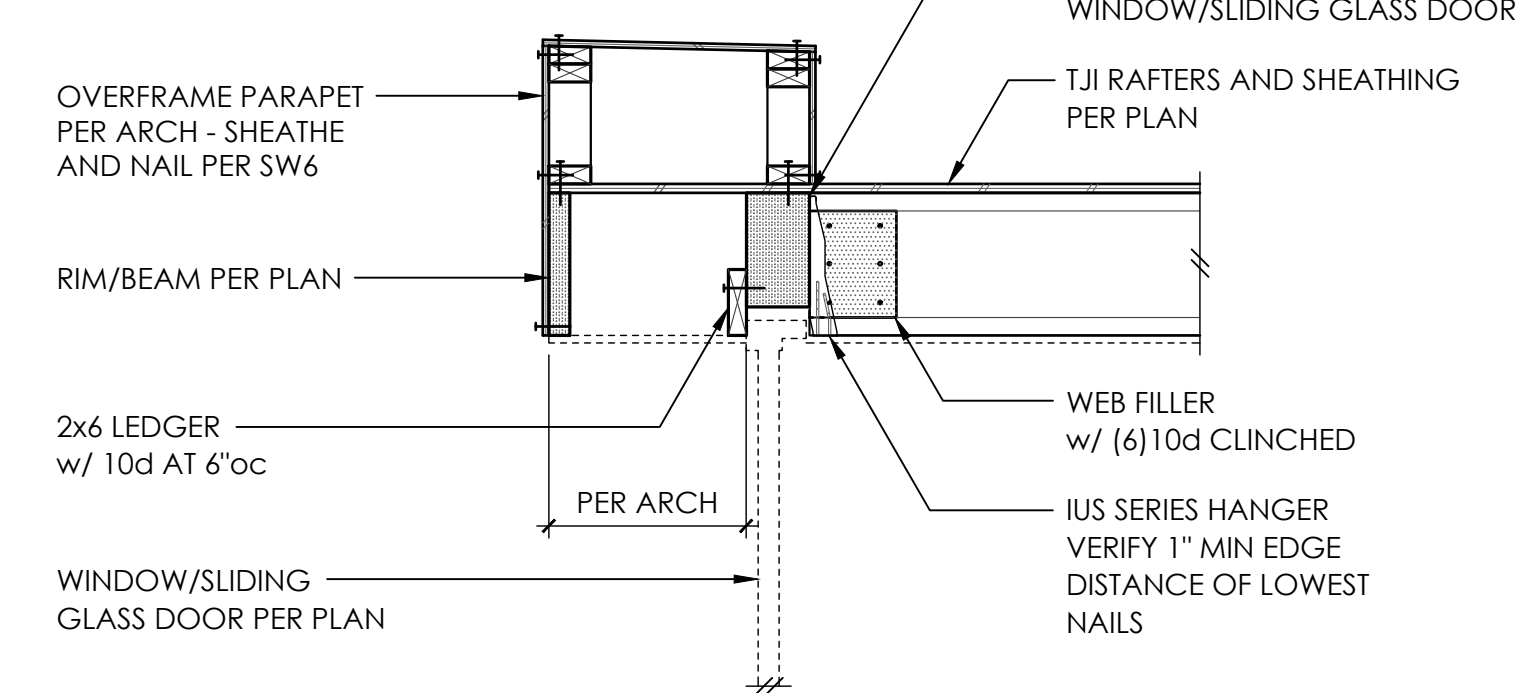

9

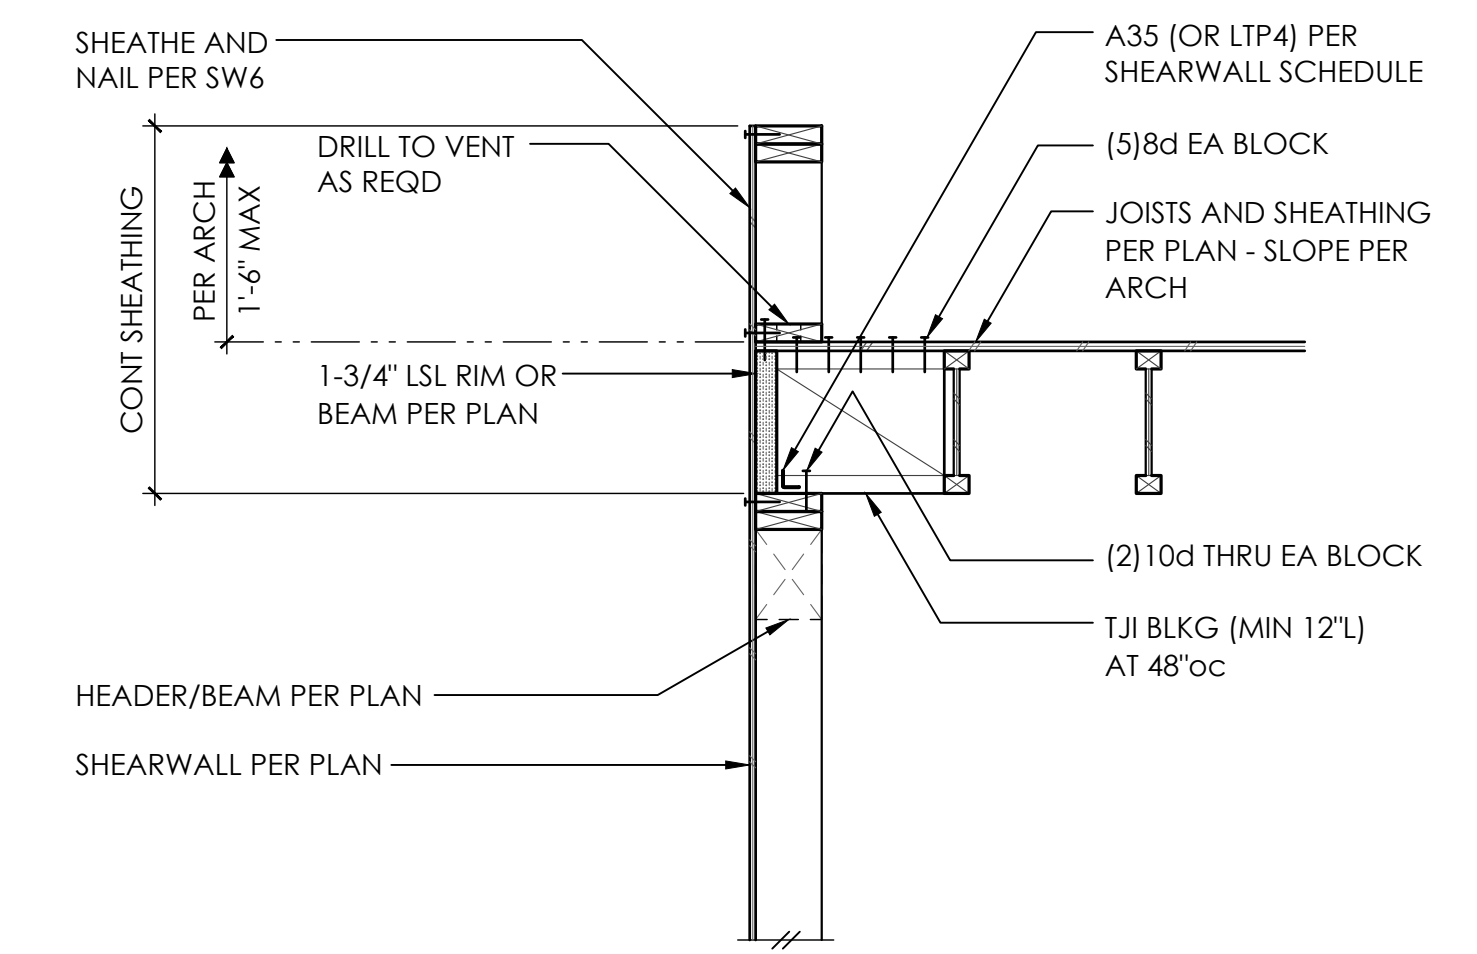


10

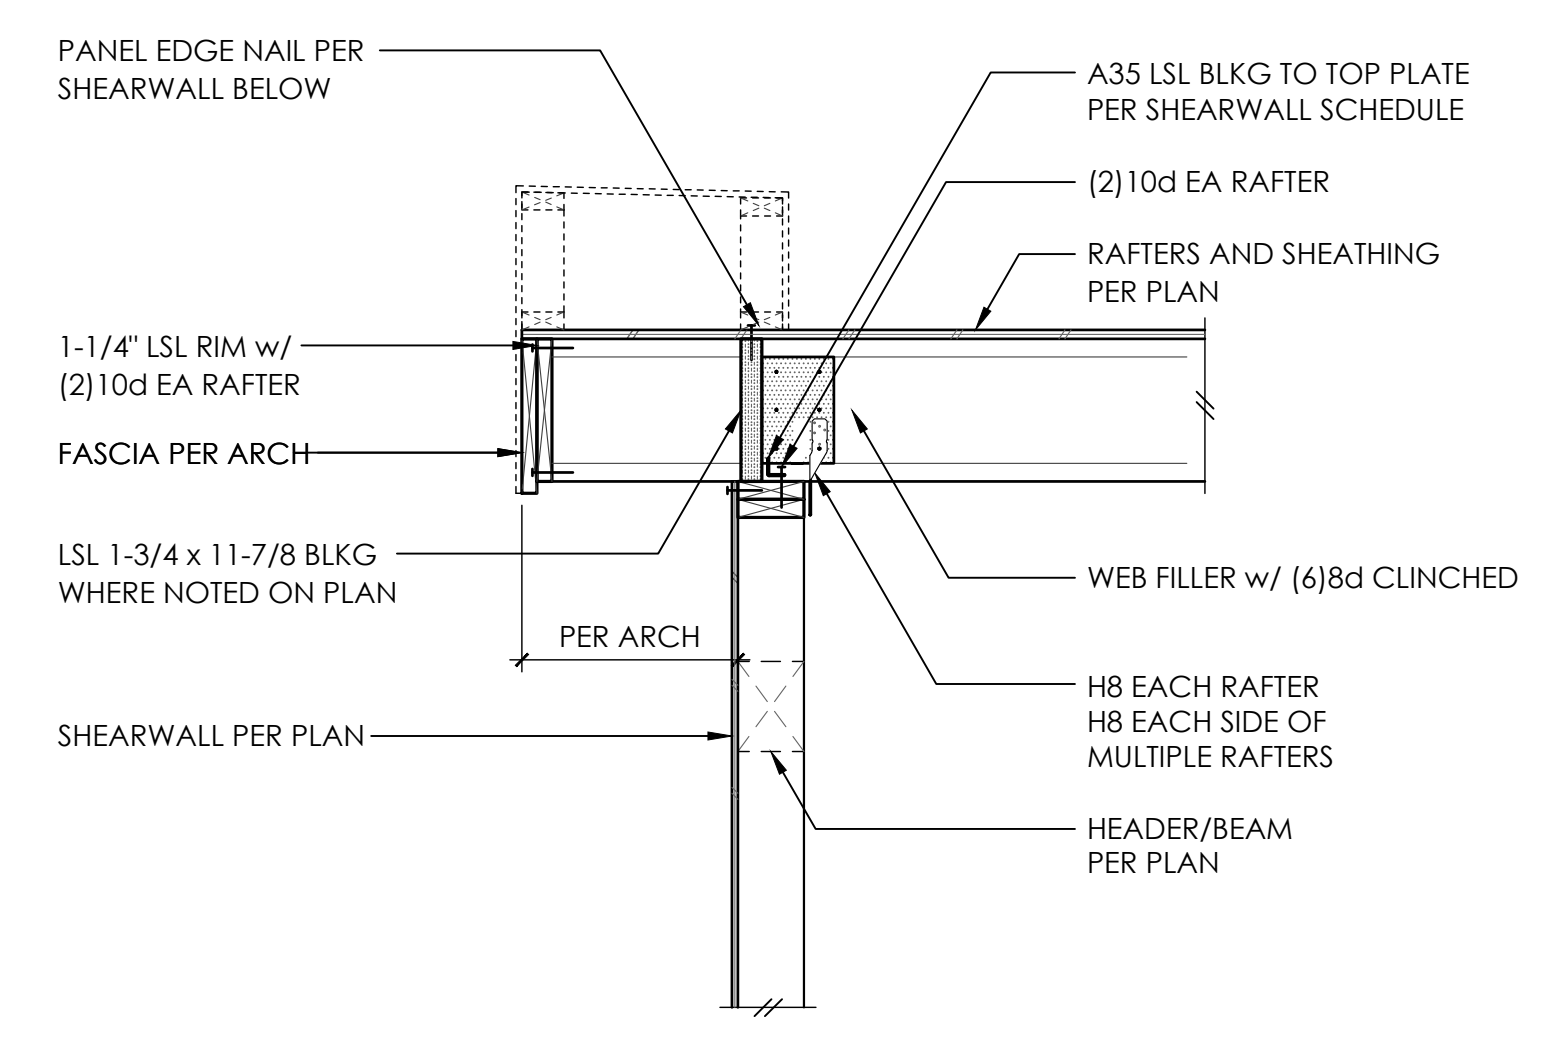


11

12


13

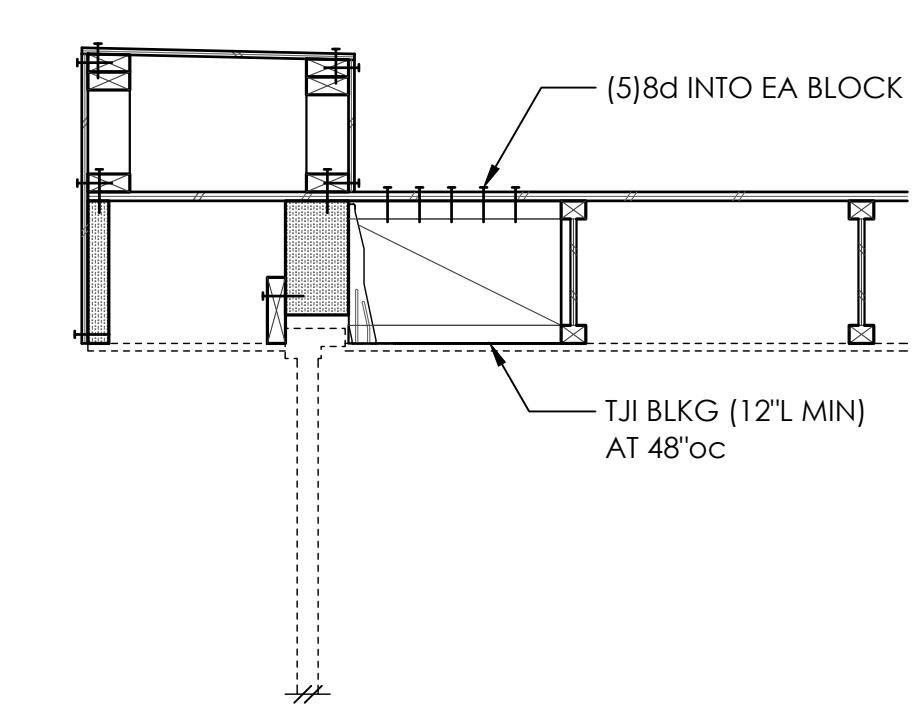

FOR CALLOUTS IN COMMON REFER 9/S4.2  
 14

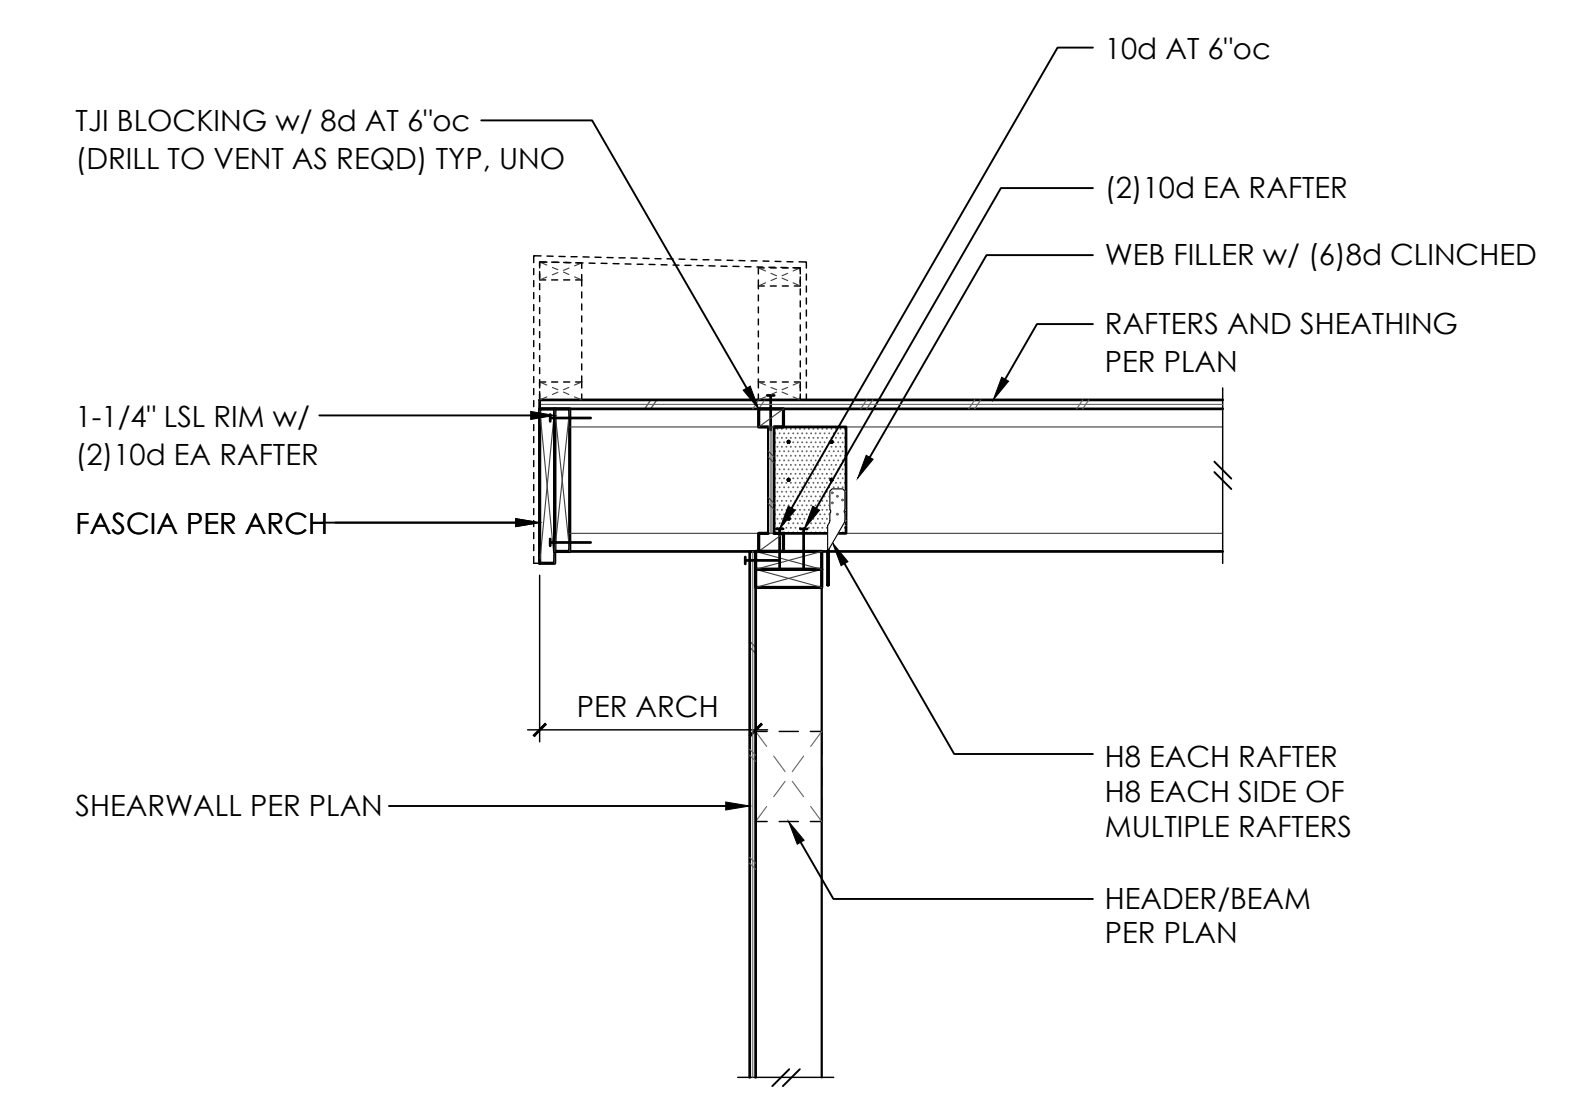


15

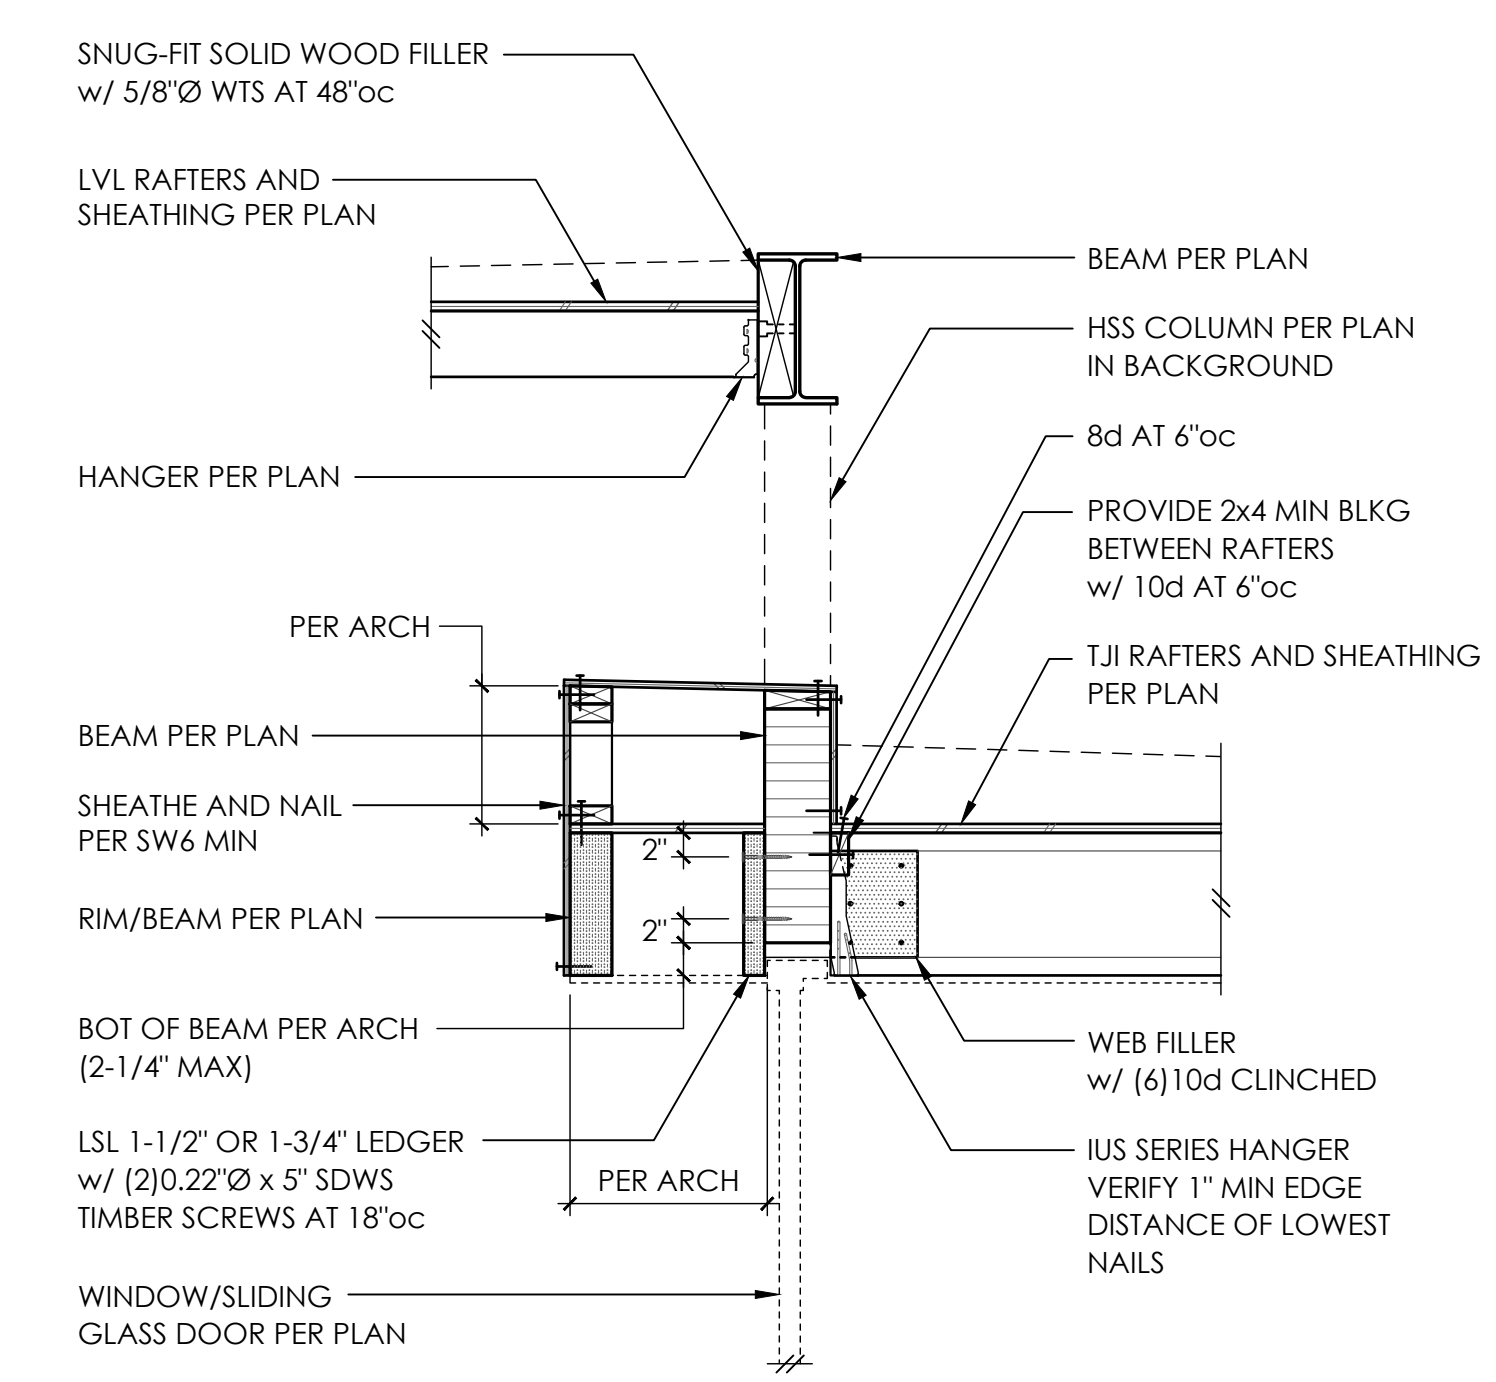


16

17


18

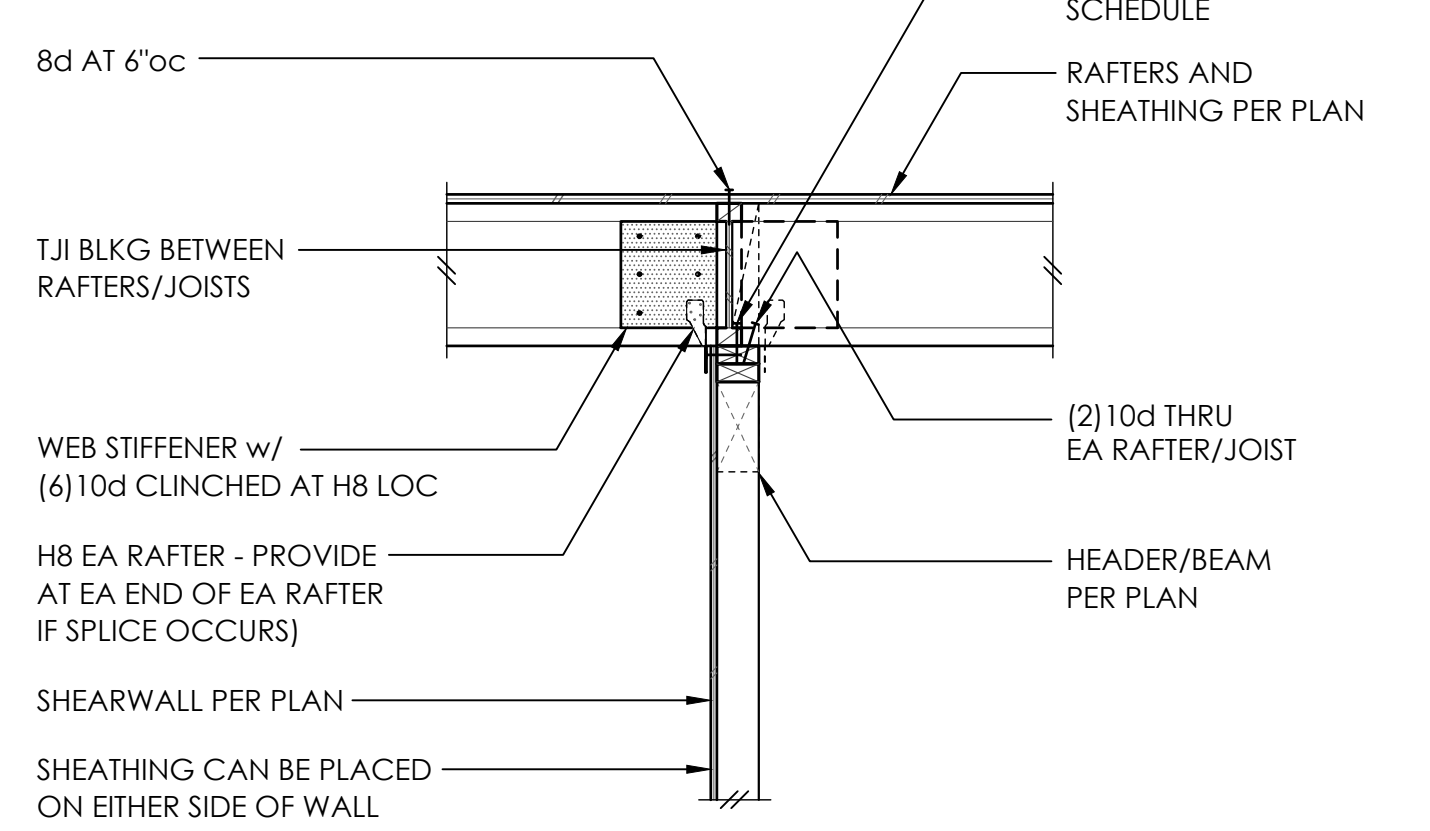

19

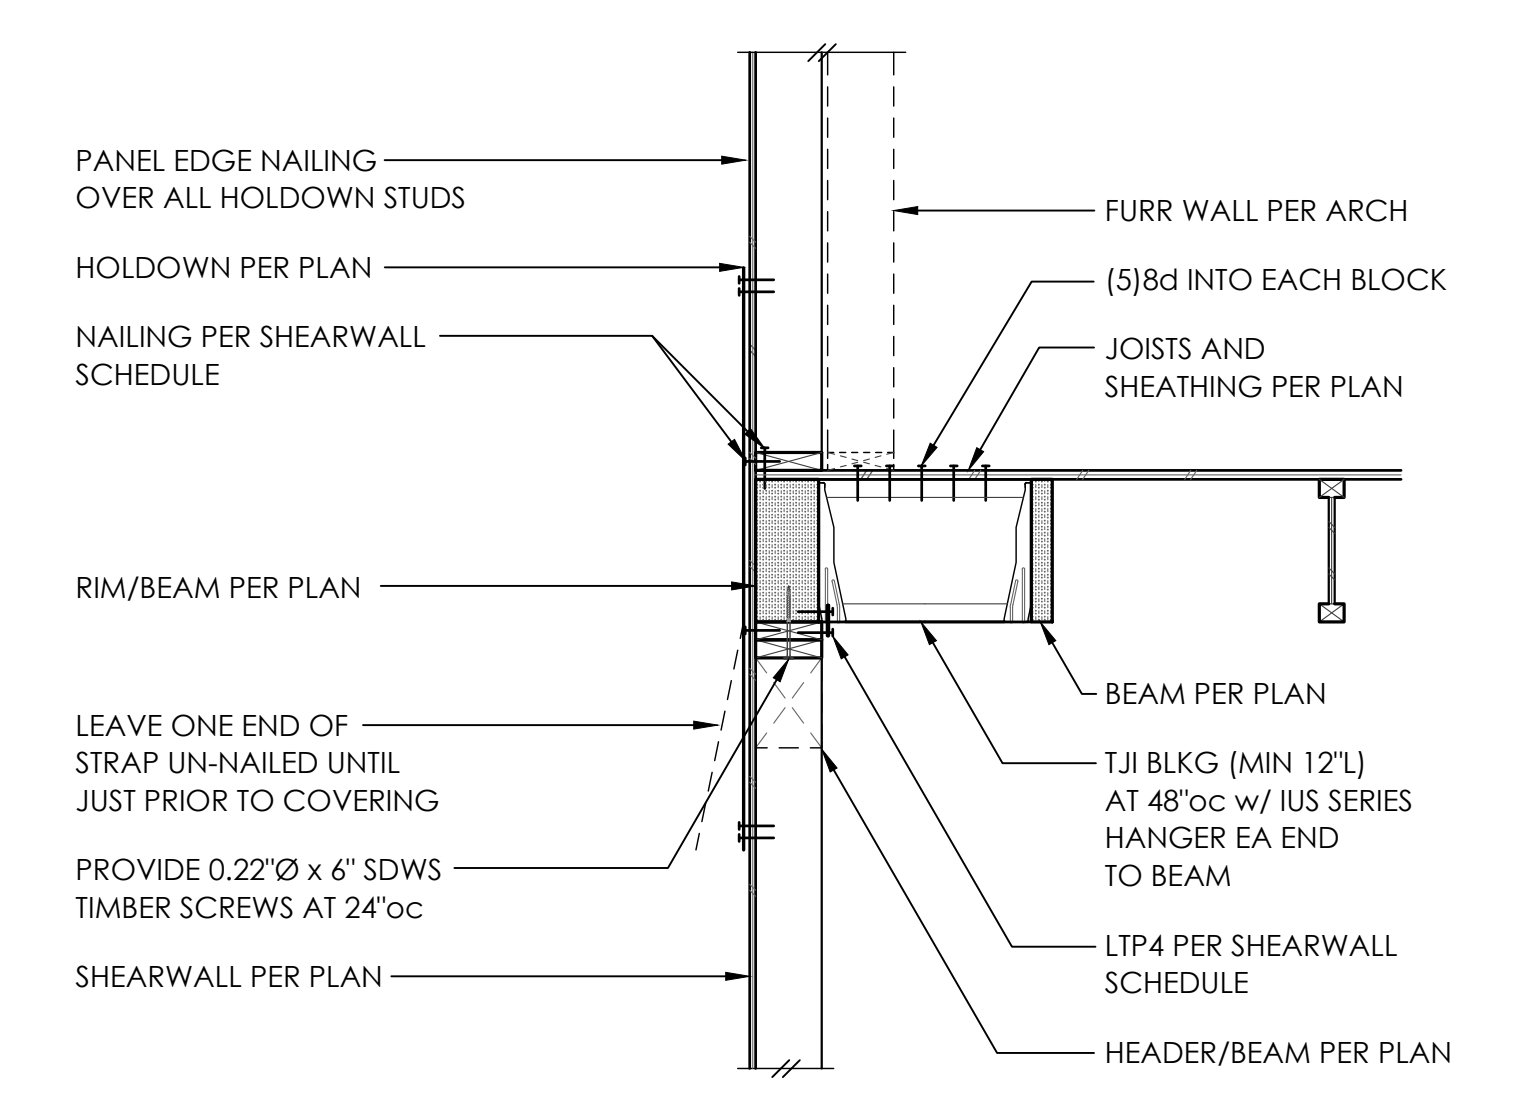

20

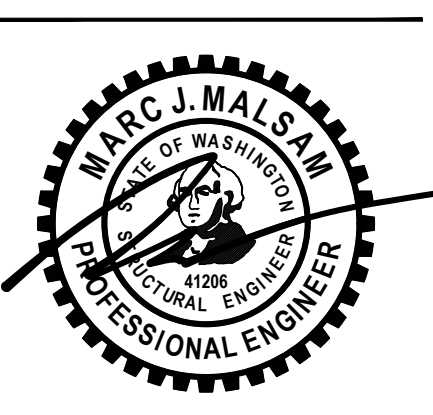

PROJECT NO	0426-2021-03101	VAC
PROJECT MANAGER	JAS	
DRAWN	JOSEPH MARQUEZ	206-692-5122
ENGINEER	JOSEPH MARQUEZ	206-692-5122
	JOSEPHM@MALSAM-TSANG.COM	
REV	DESCRIPTION	DATE
	PERMIT SET	12.23.21
▲	PERMIT CORRECTIONS	5.5.22
▲	PERMIT CORRECTIONS	7.13.22
▲	PERMIT CORRECTIONS	8.19.22


ARCH: MACULLOUGH ARCHITECTS 206-443-1181

WOOD FRAMING DETAILS

COPYRIGHT © 2021 MALSAM TSANG ENGINEERING CORPORATION - ALL RIGHTS RESERVED

Printed On: Malsam Tsang, Inc. 10/2022, 1:12pm  
 Printed On: Malsam Tsang, Inc. 10/2022, 1:12pm



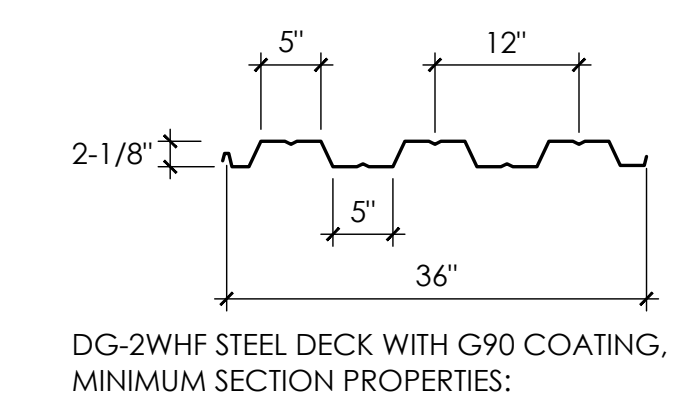


DECK GAUGE


1'	1'	5'	5'
(in <sup>4</sup> )	(in <sup>4</sup> )	(in <sup>3</sup> )	(in <sup>3</sup> )
16	1.303	1.132	0.803
			0.792

[PROPERTIES PER FOOT OF WIDTH]

- USE 16 GAUGE DECK AS NOTED AT LEFT AND ON PLAN.
- FOLLOW SPAN LAYOUTS AS SHOWN ON PLAN.
- CONNECT DECK SEAMS WITH BUTT PUNCHES AT 24"oc AND ARC SPOT WELD AT 12"oc EA END - PROVIDE 2" MIN BEARING LENGTH EACH END.
- DECK TYPE MUST STRICTLY MEET CRITERIA LISTED AT LEFT. SUBMIT DECK INFORMATION TO ENGINEER PRIOR TO BEGINNING SHOP DRAWINGS.
- 2" THICK MAX [19.0 PSF MAX] WASHED GRAVEL TOPPING OVER STEEL PAN DECK.

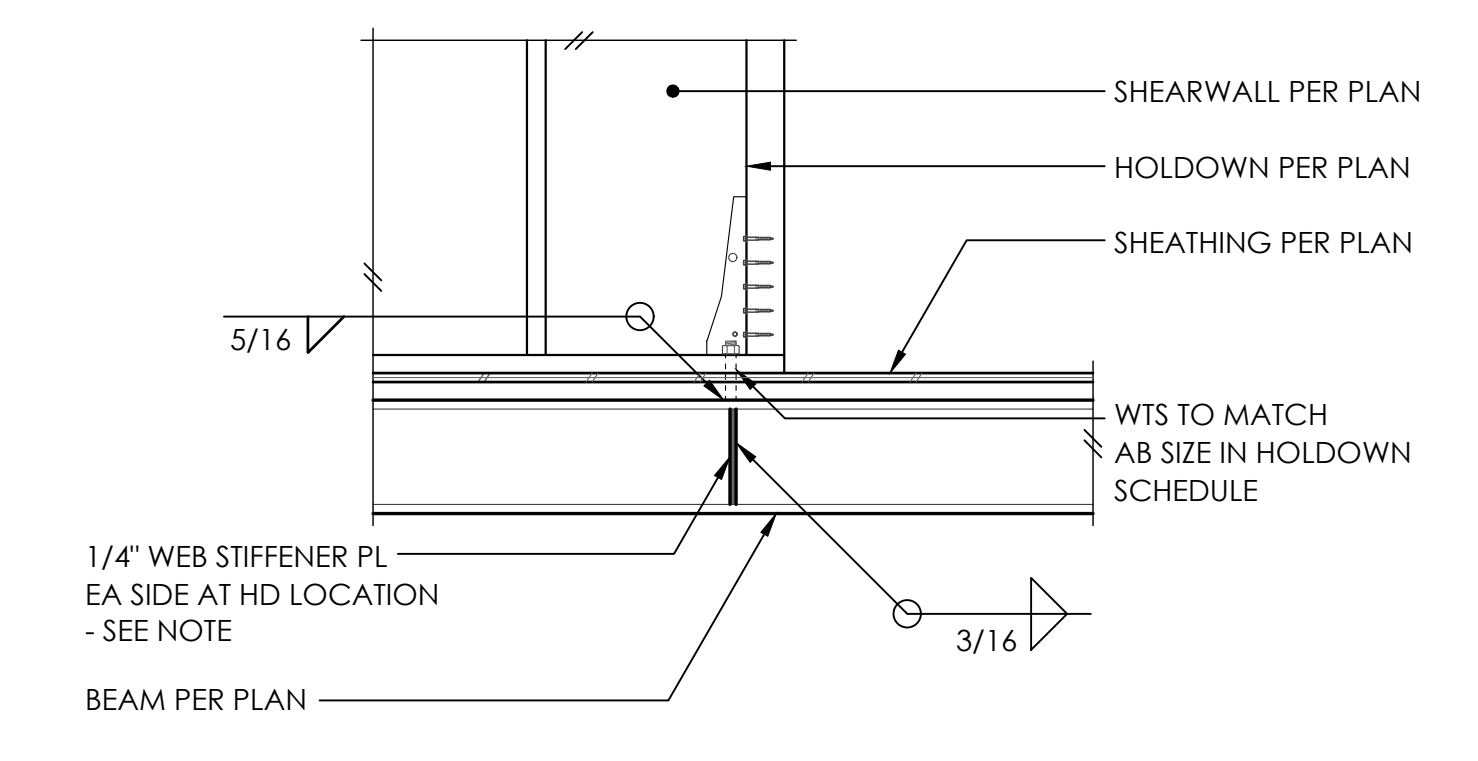

NOTE:  
STIFFENER PLATE MAY BE OMITTED FOR HD/2 HOLDOWN TO CLEAR SNUG-FIT SOLID WOOD FILLER PER PLAN.

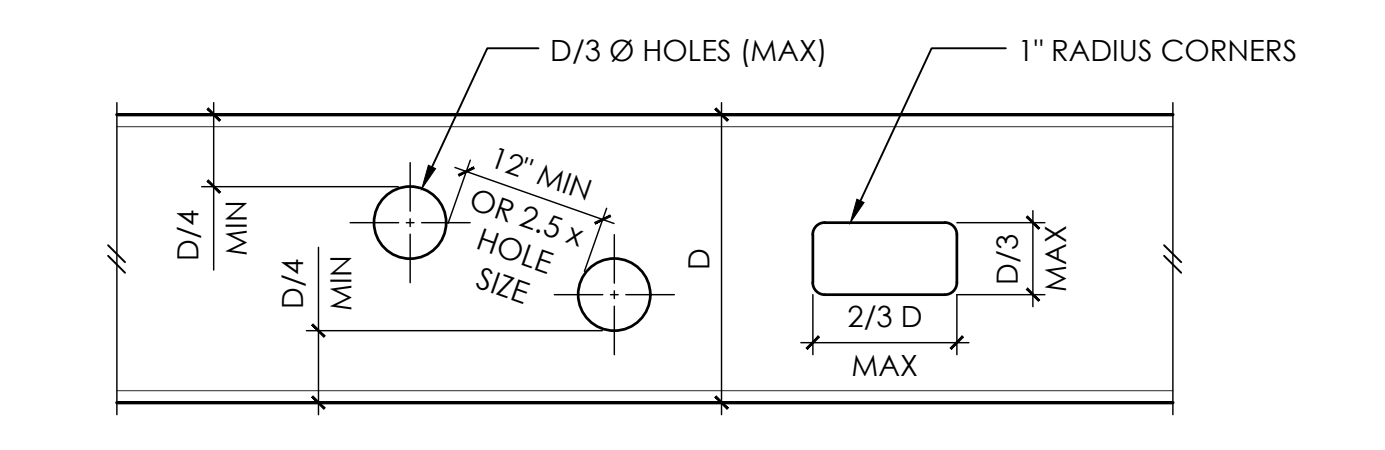


- CONTRACTOR SHALL COORDINATE SIZES AND LOCATIONS OF ALL BEAM PENETRATIONS w/ MECHANICAL DRAWINGS. ALL PENETRATIONS LARGER THAN 2"Ø SHALL BE SHOWN ON SHOP DRAWINGS OR SKETCHES AND SHALL BE SUBMITTED TO THE ENGINEER FOR APPROVAL. FIELD CUTTING NOT PERMITTED WITHOUT APPROVAL.
- OPENINGS MAY OCCUR IN MIDDLE HALF OF BEAM LENGTH ONLY.
- NO CUTTING MAY OCCUR IN TOP OR BOTTOM QUARTER OF BEAM DEPTH.
- ADJACENT OPENINGS MUST BE SPACED AT THE GREATER OF 12" OR 2.5 x LARGER OPENING SIZE, EDGE TO EDGE.
- MAXIMUM SIZES OF OPENINGS SHALL BE D/3 Ø OR D/3 x 2D/3 AS SHOWN.
- NO OPENINGS SHALL OCCUR WITHIN 12" OF AN ADJACENT BEAM CONNECTION.
- REQUIRED OPENINGS NOT MEETING ABOVE CRITERIA SHALL BE SUBMITTED TO ENGINEER FOR REINFORCING DESIGN.

1

ASC STEEL ROOF DECK 3


4

TYPICAL STEEL BEAM PENETRATIONS 5

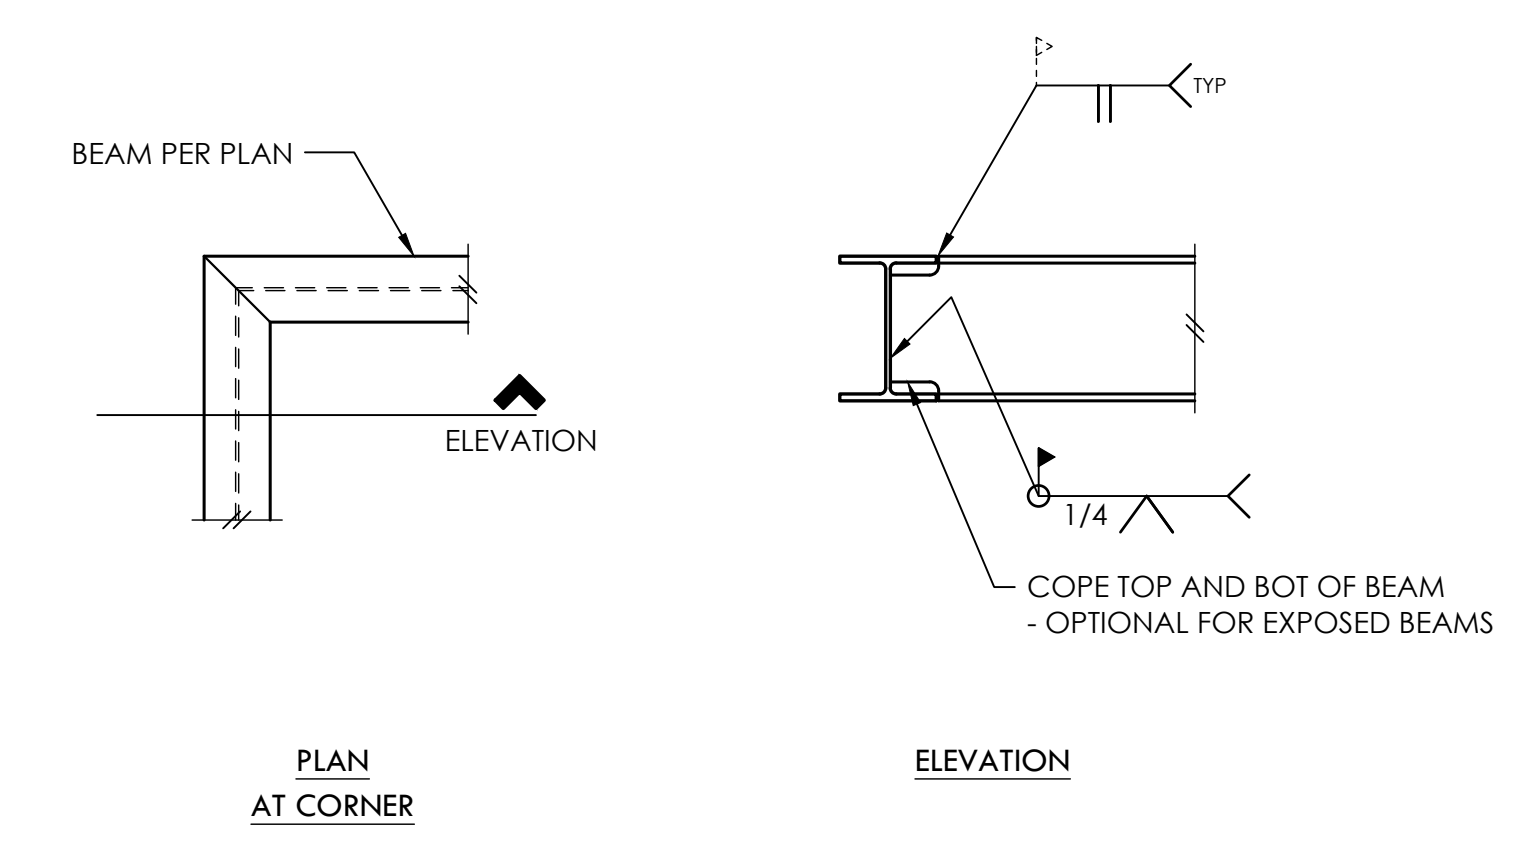


6

TYPICAL BEAM CORNER CONNECTION (WELD) 7

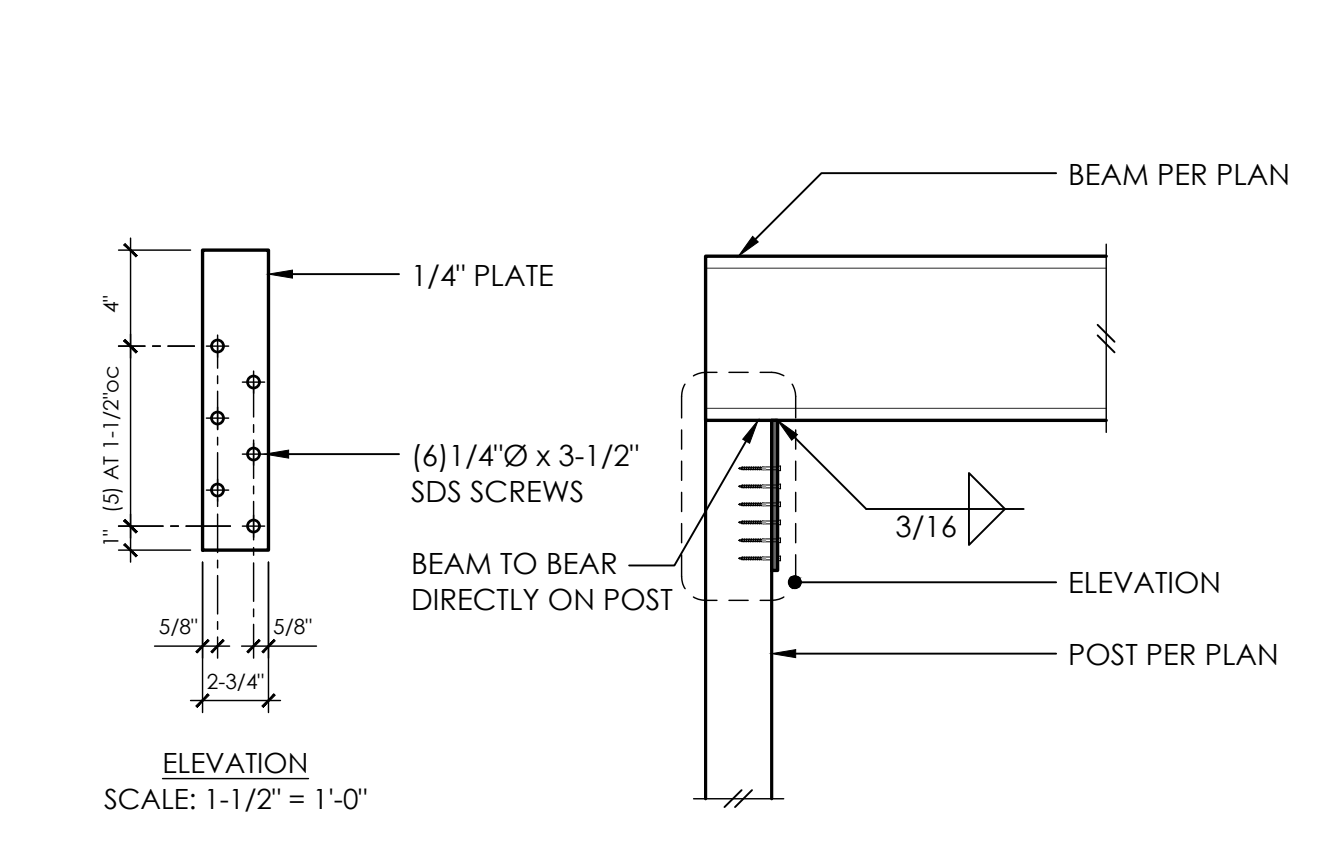


8


TYPICAL CCOQ / ECCOQ COLUMN CAP 9

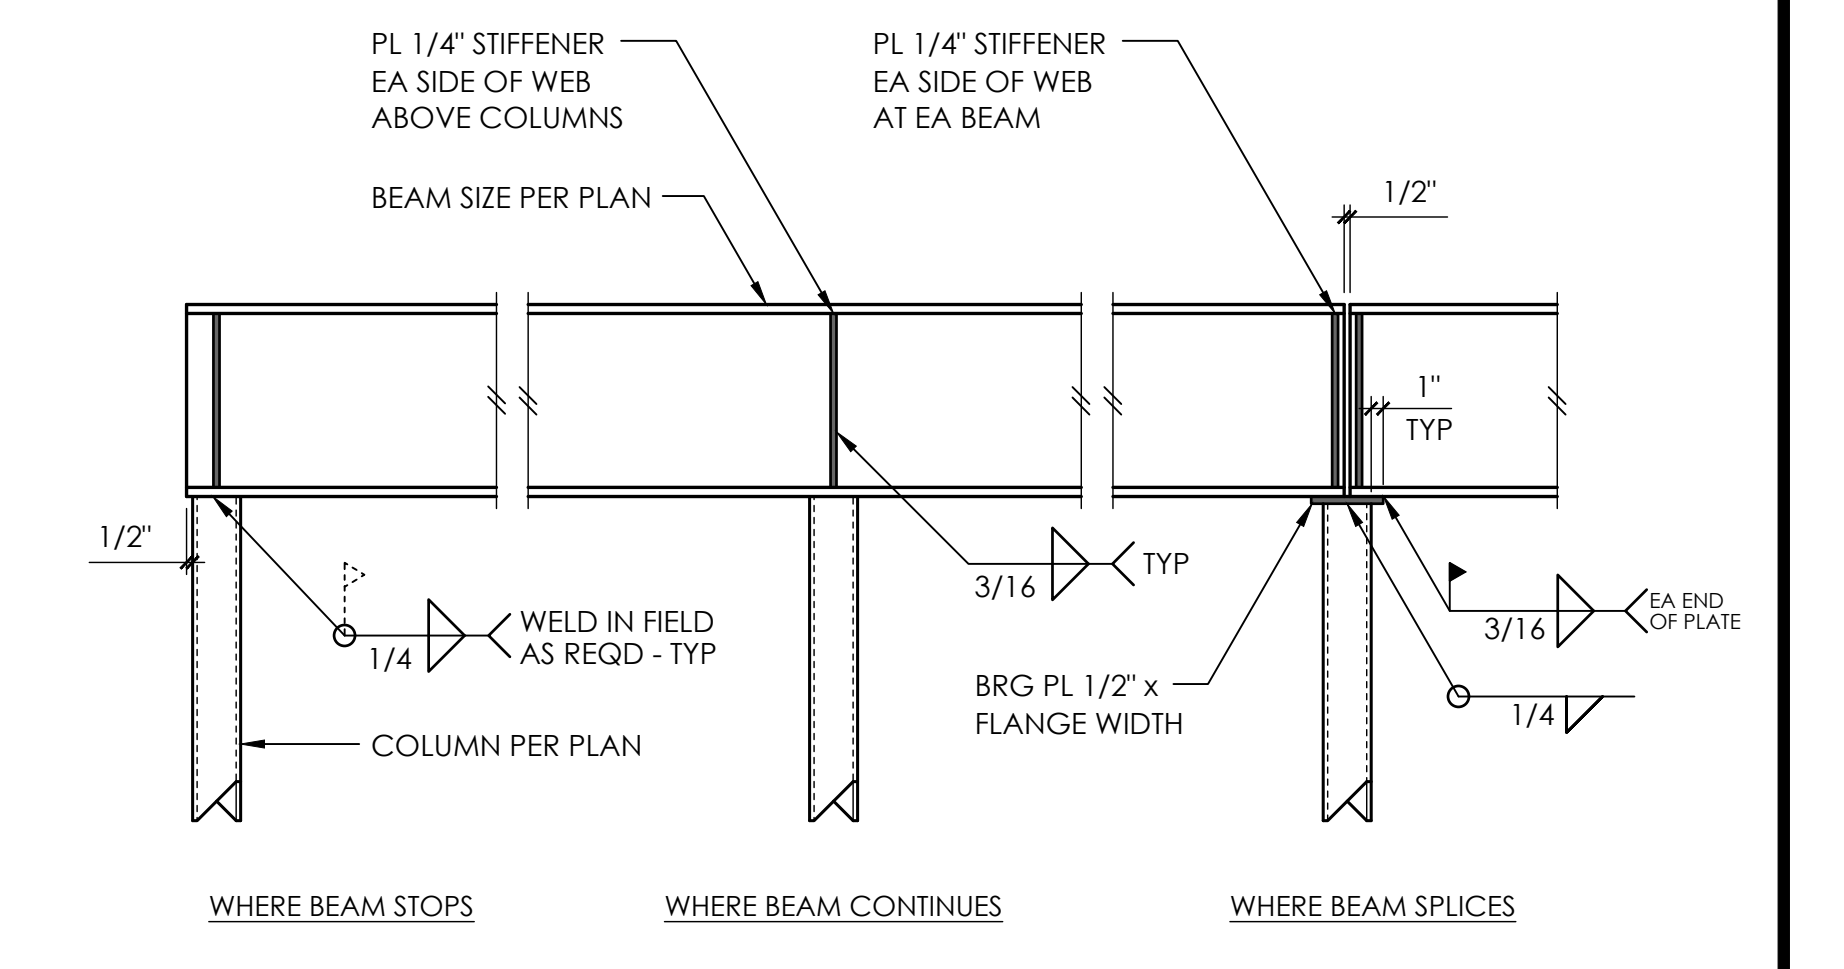


10

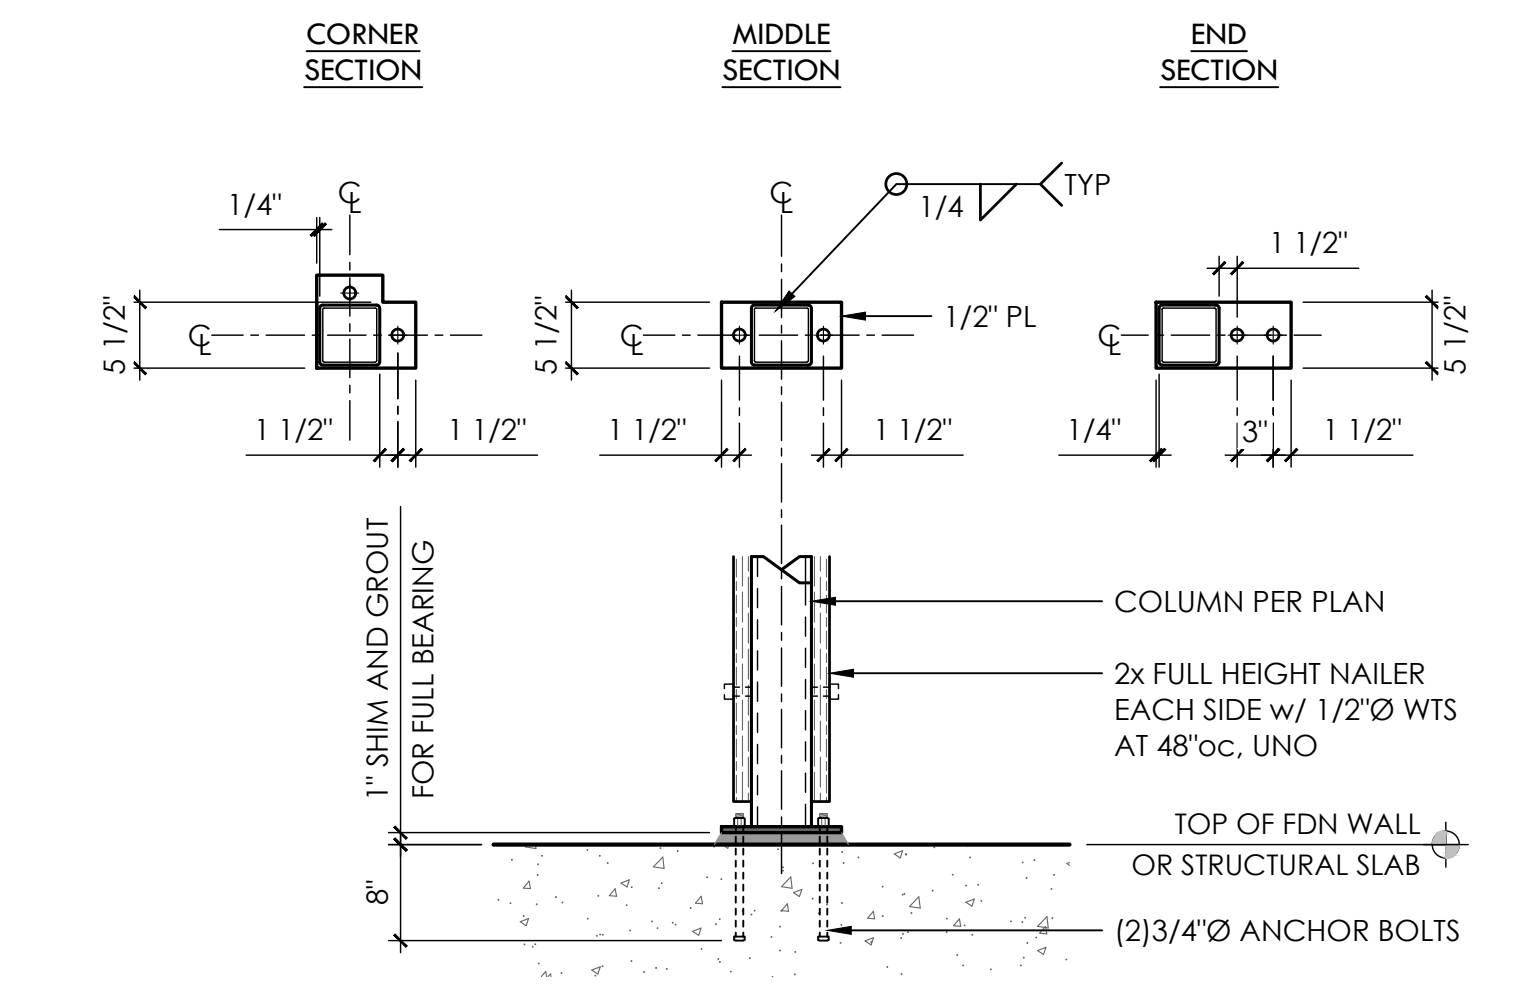

BASEPLATE - HSS COLUMN 14

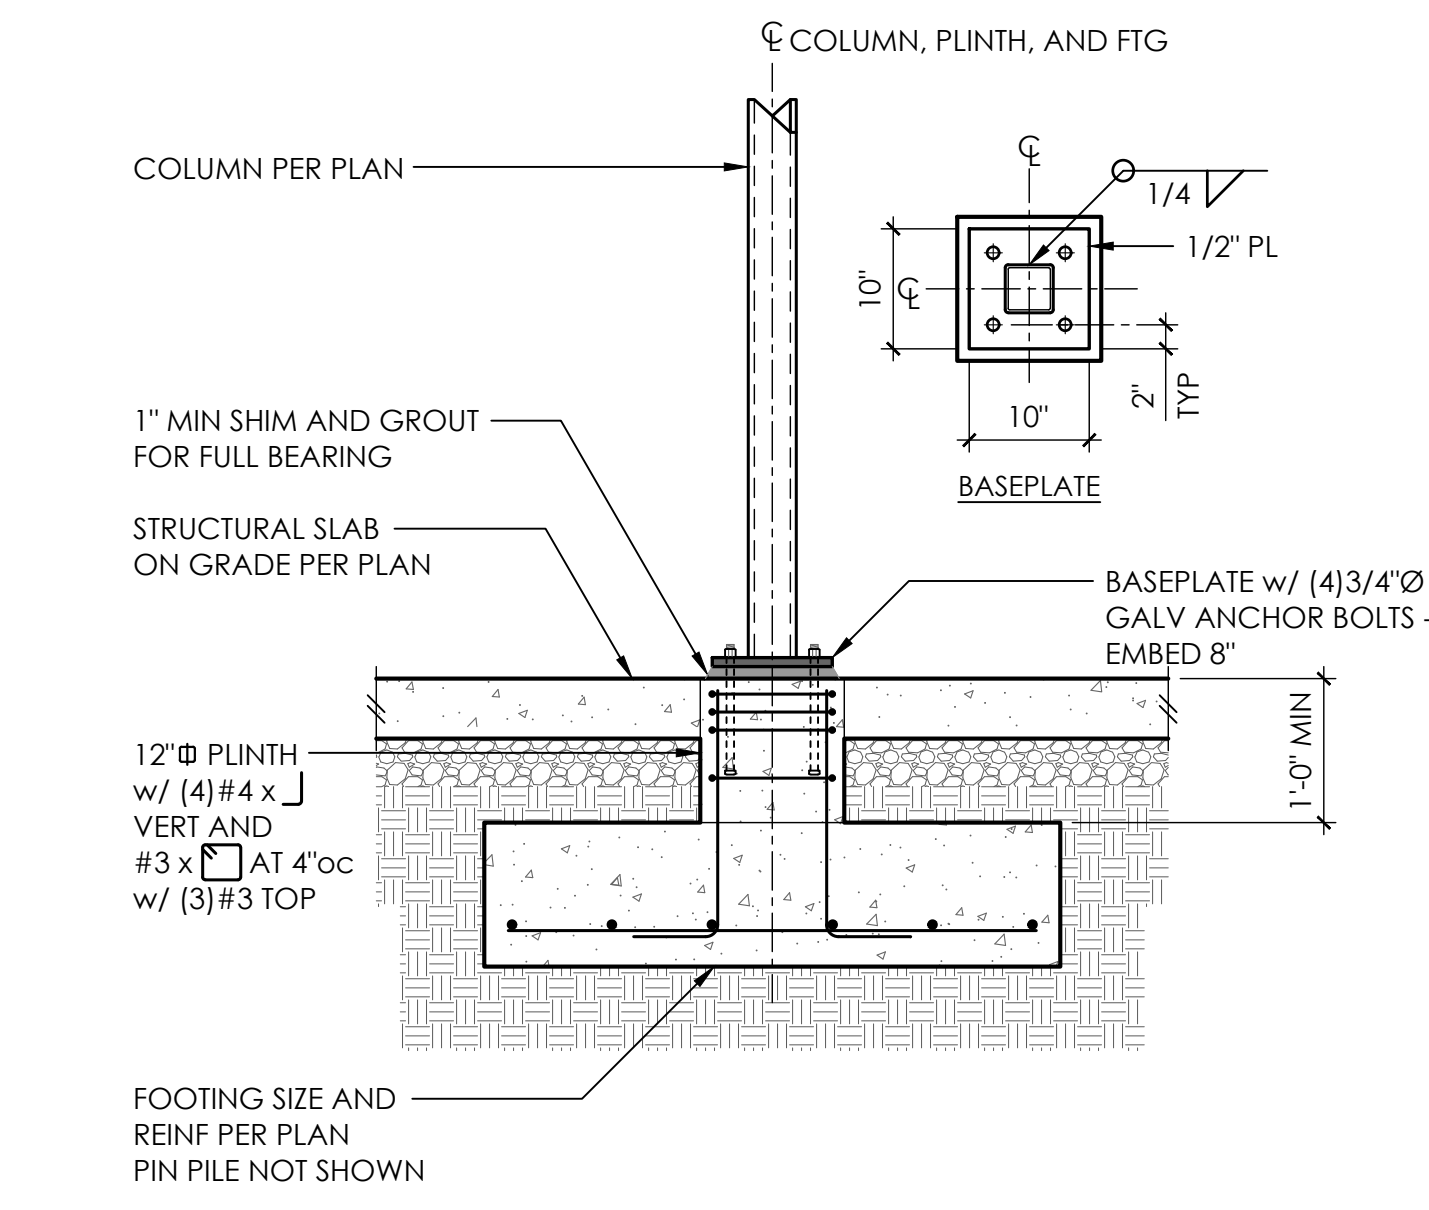


15

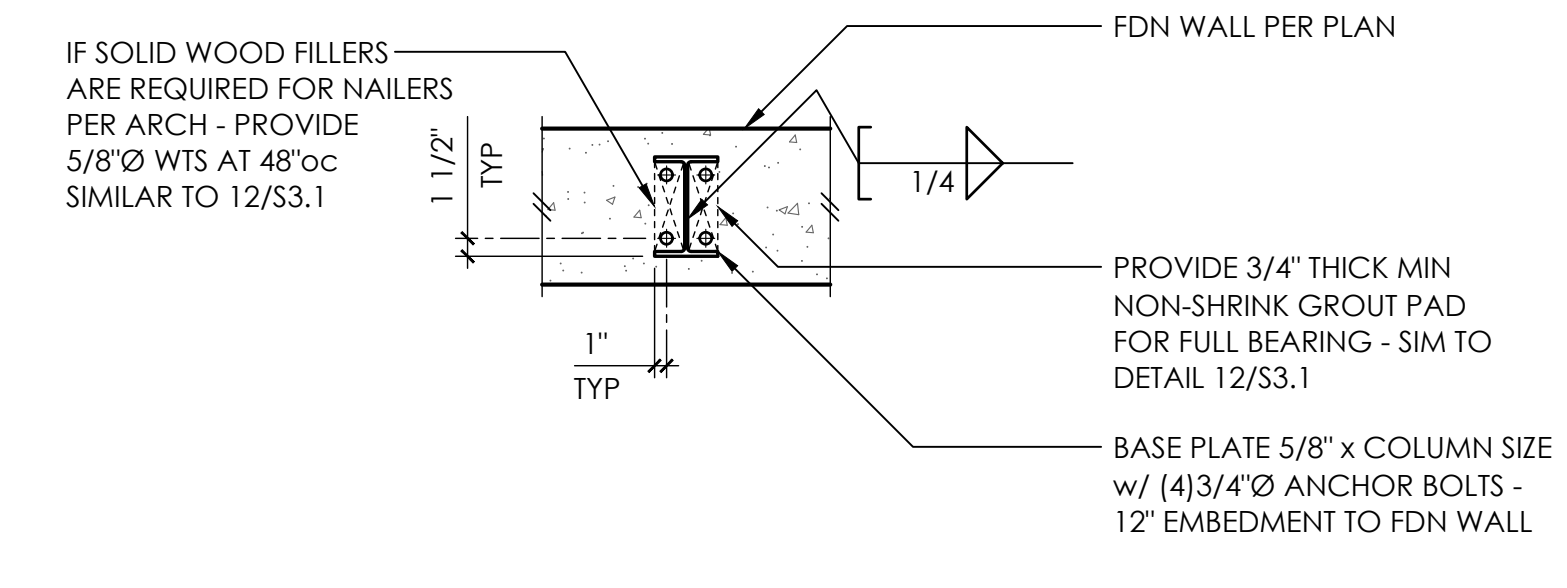


WIDE FLANGE COLUMN BASE PLATE (PLAN) 13

11

12

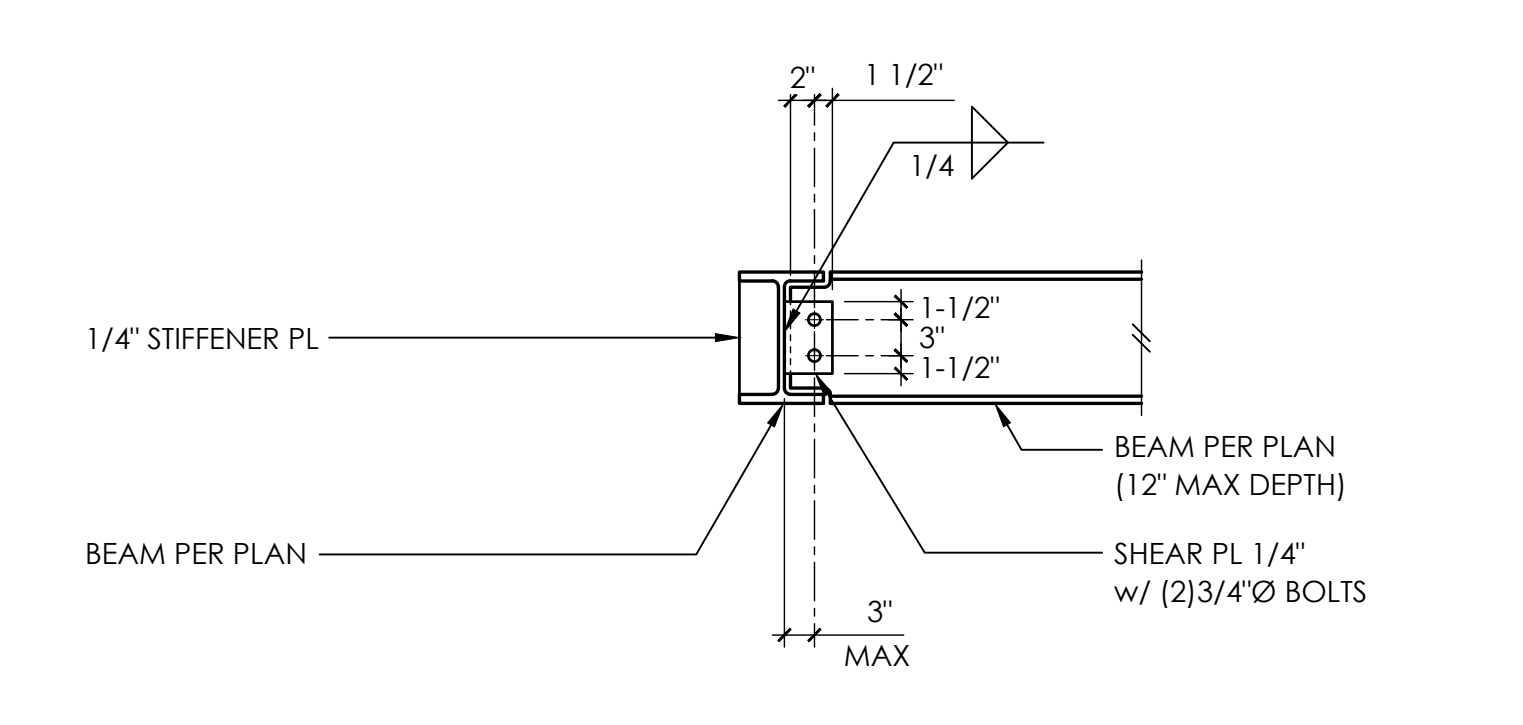

TYPICAL BEAM TO BEAM CONNECTION 19

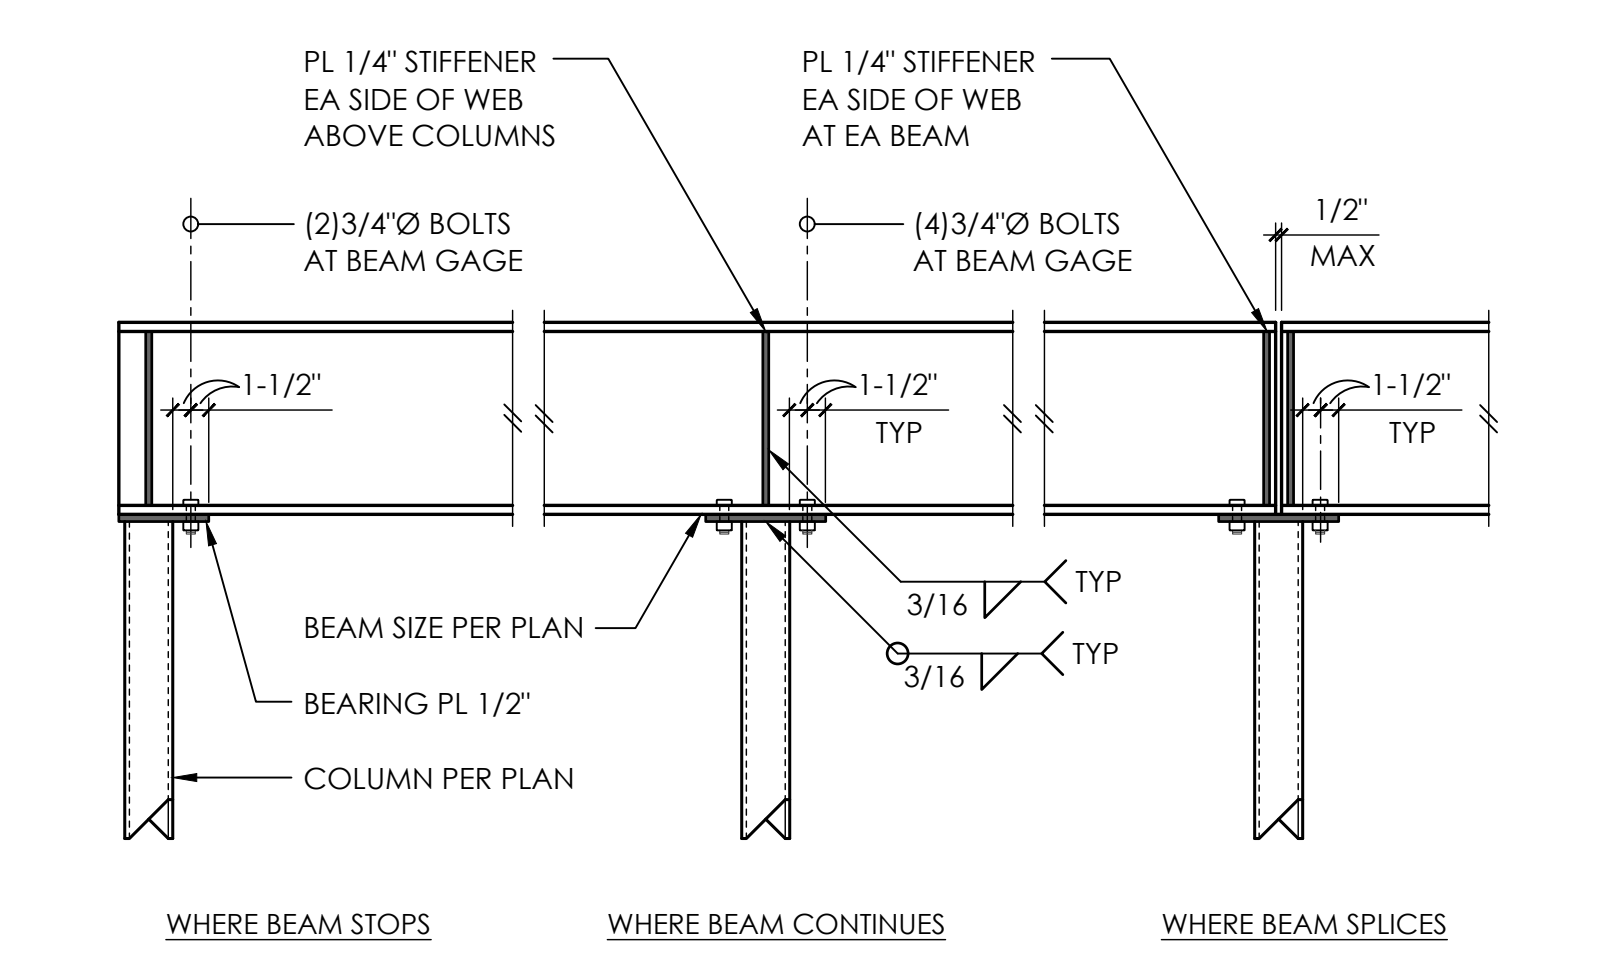

NOTE:  
BEARING PLATE THICKNESS SHALL BE 3/4" WHERE DEPTH OF SUPPORTED MEMBER EXCEEDS 24"

20



PROJECT NO: 0426-2021-0301  
PROJECT MANAGER: JAS  
DRAWN: JOSEPH MARQUEZ  
ENGINEER: JOSEPH MARQUEZ  
JOSEPH@MALSAM-TSANG.COM



REV	DESCRIPTION	DATE
PERMIT SET		12.23.21
PERMIT CORRECTIONS	5.5.22	
PERMIT CORRECTIONS	7.13.22	
PERMIT CORRECTIONS	8.19.22	

ARCH: MACULLOUGH ARCHITECTS  
206-443-1181


STEEL FRAMING DETAILS

**S5.0**  
SCALE: 3/4" = 1'-0"




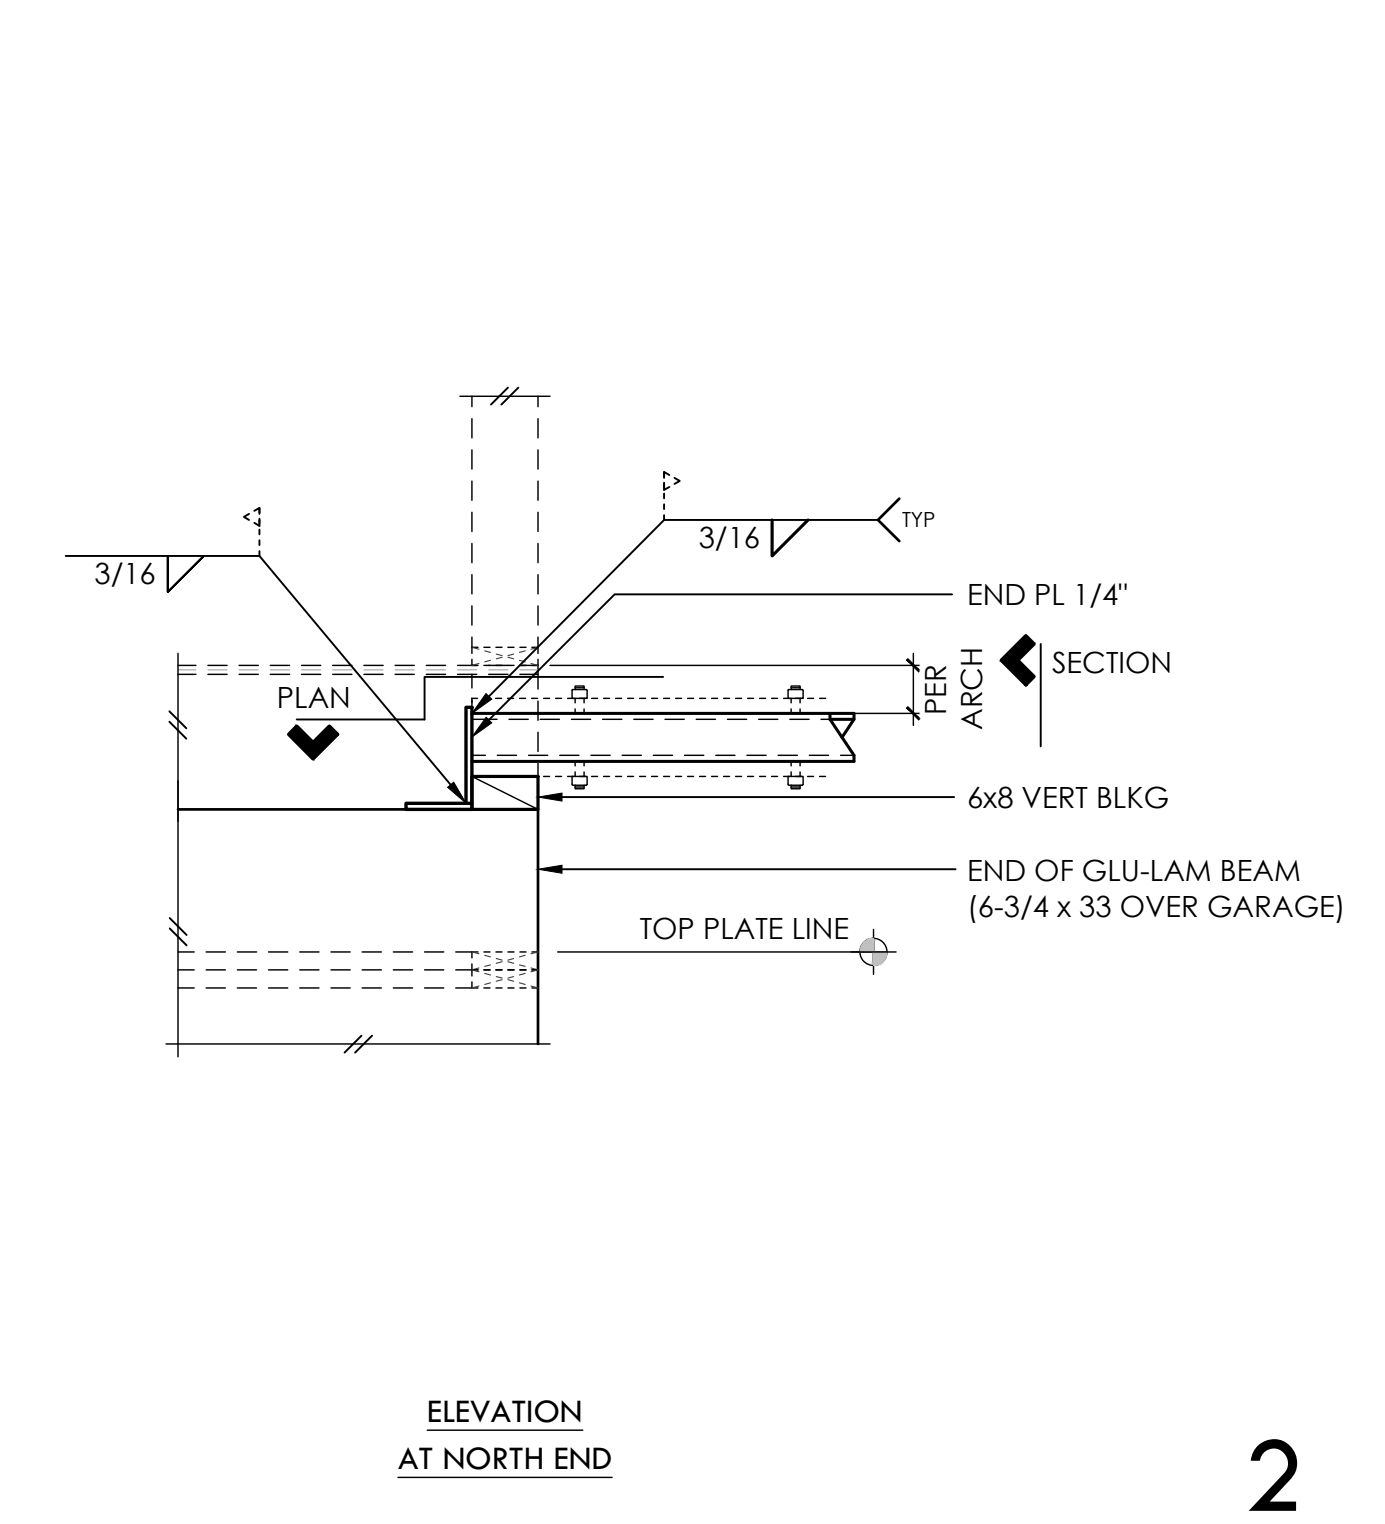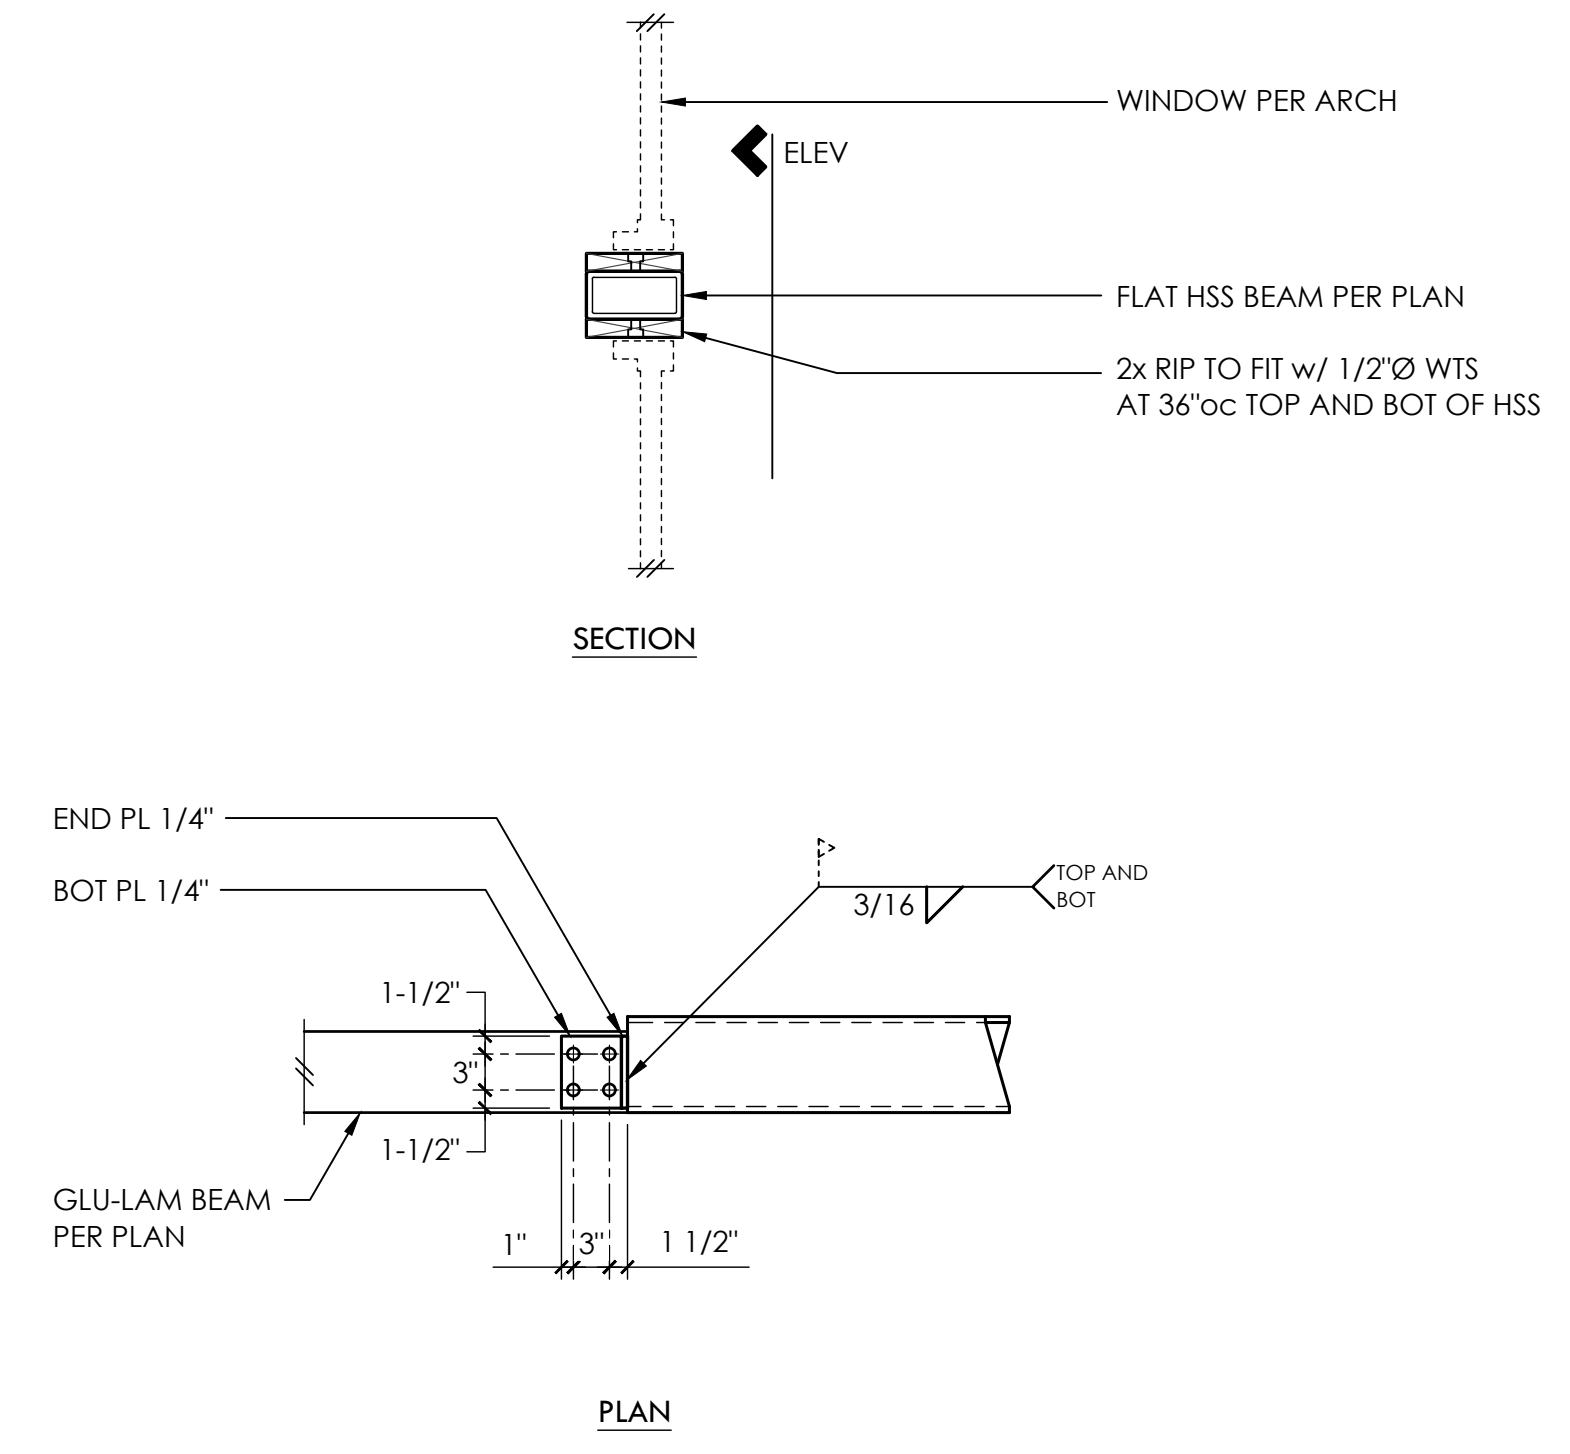


2

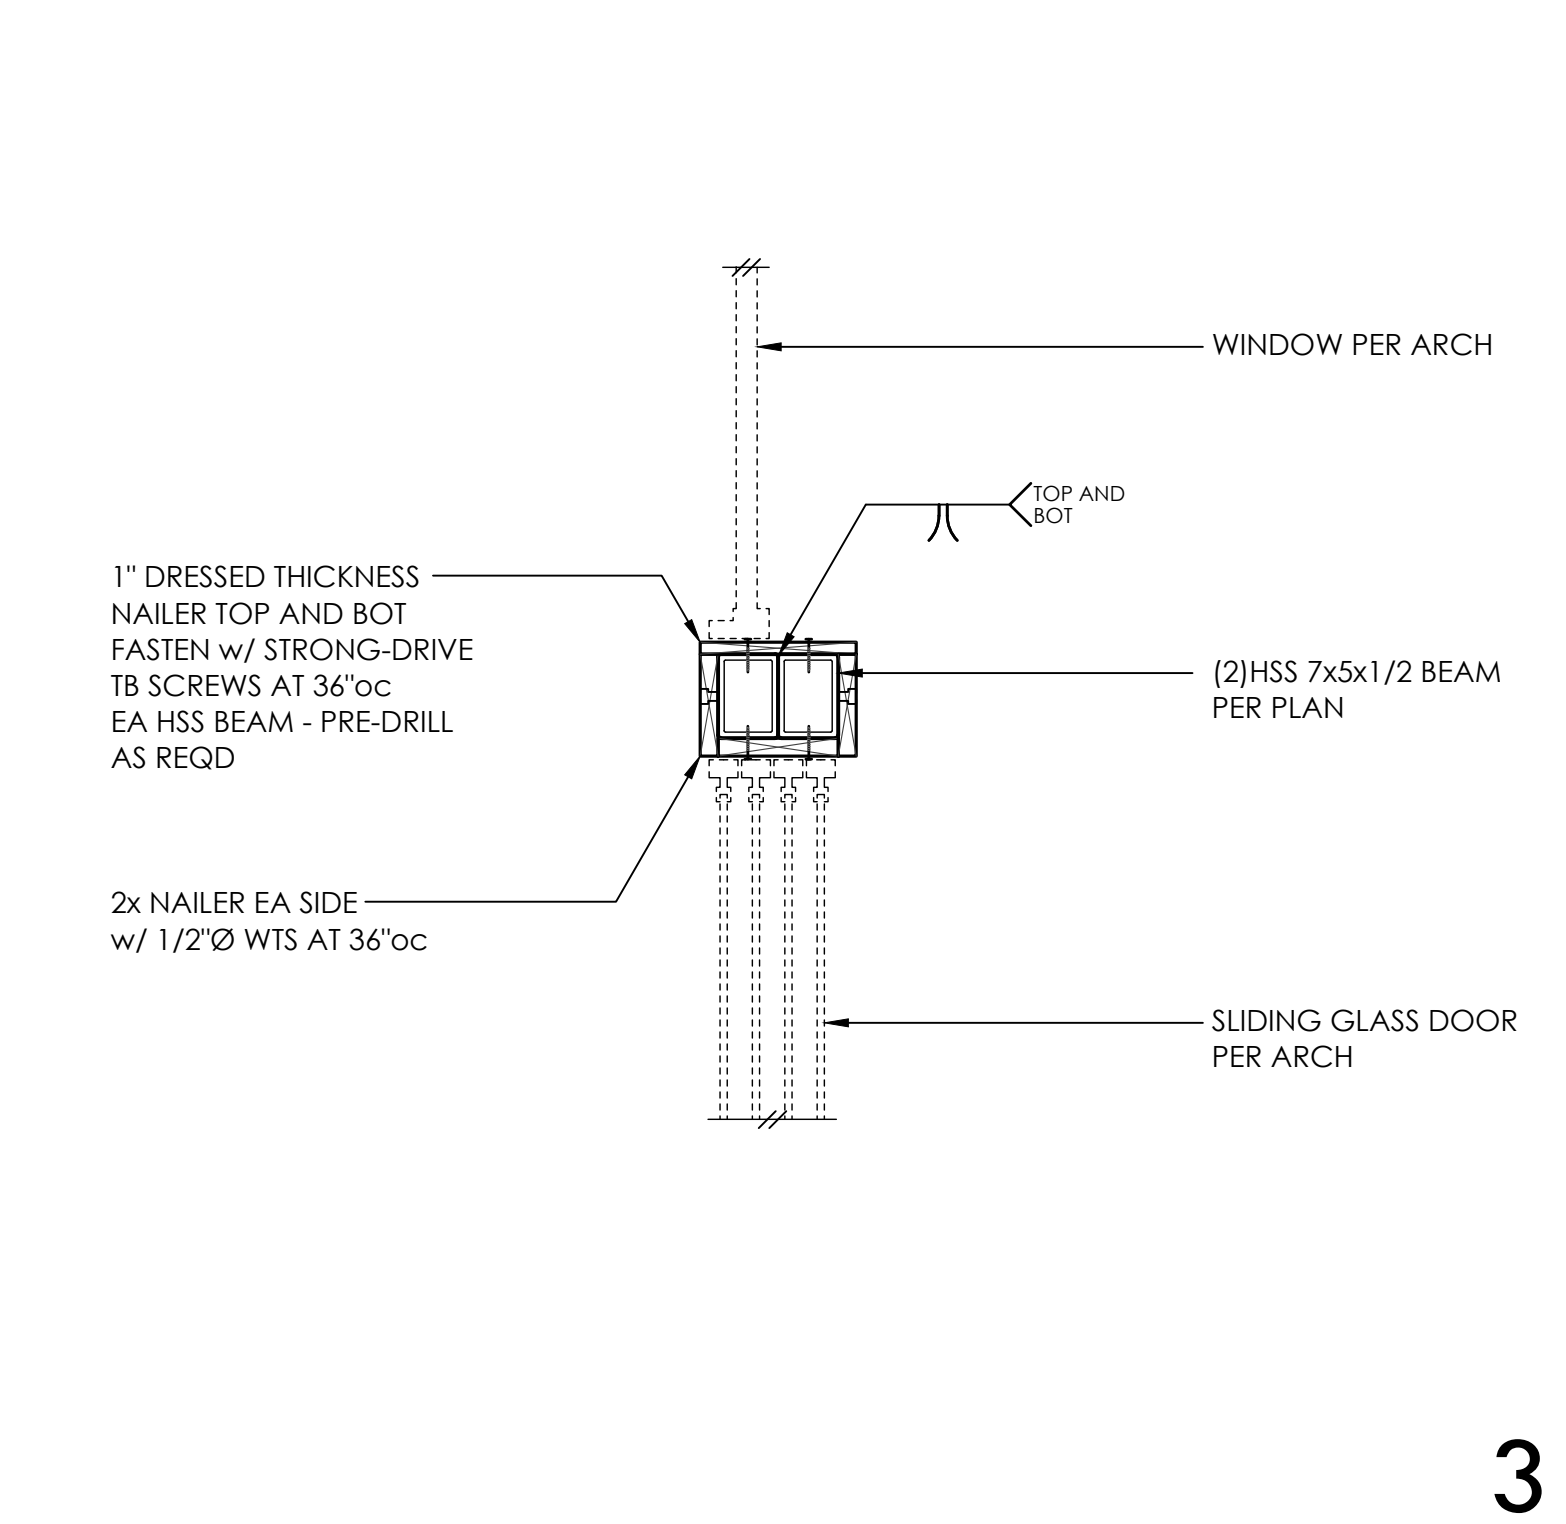


3

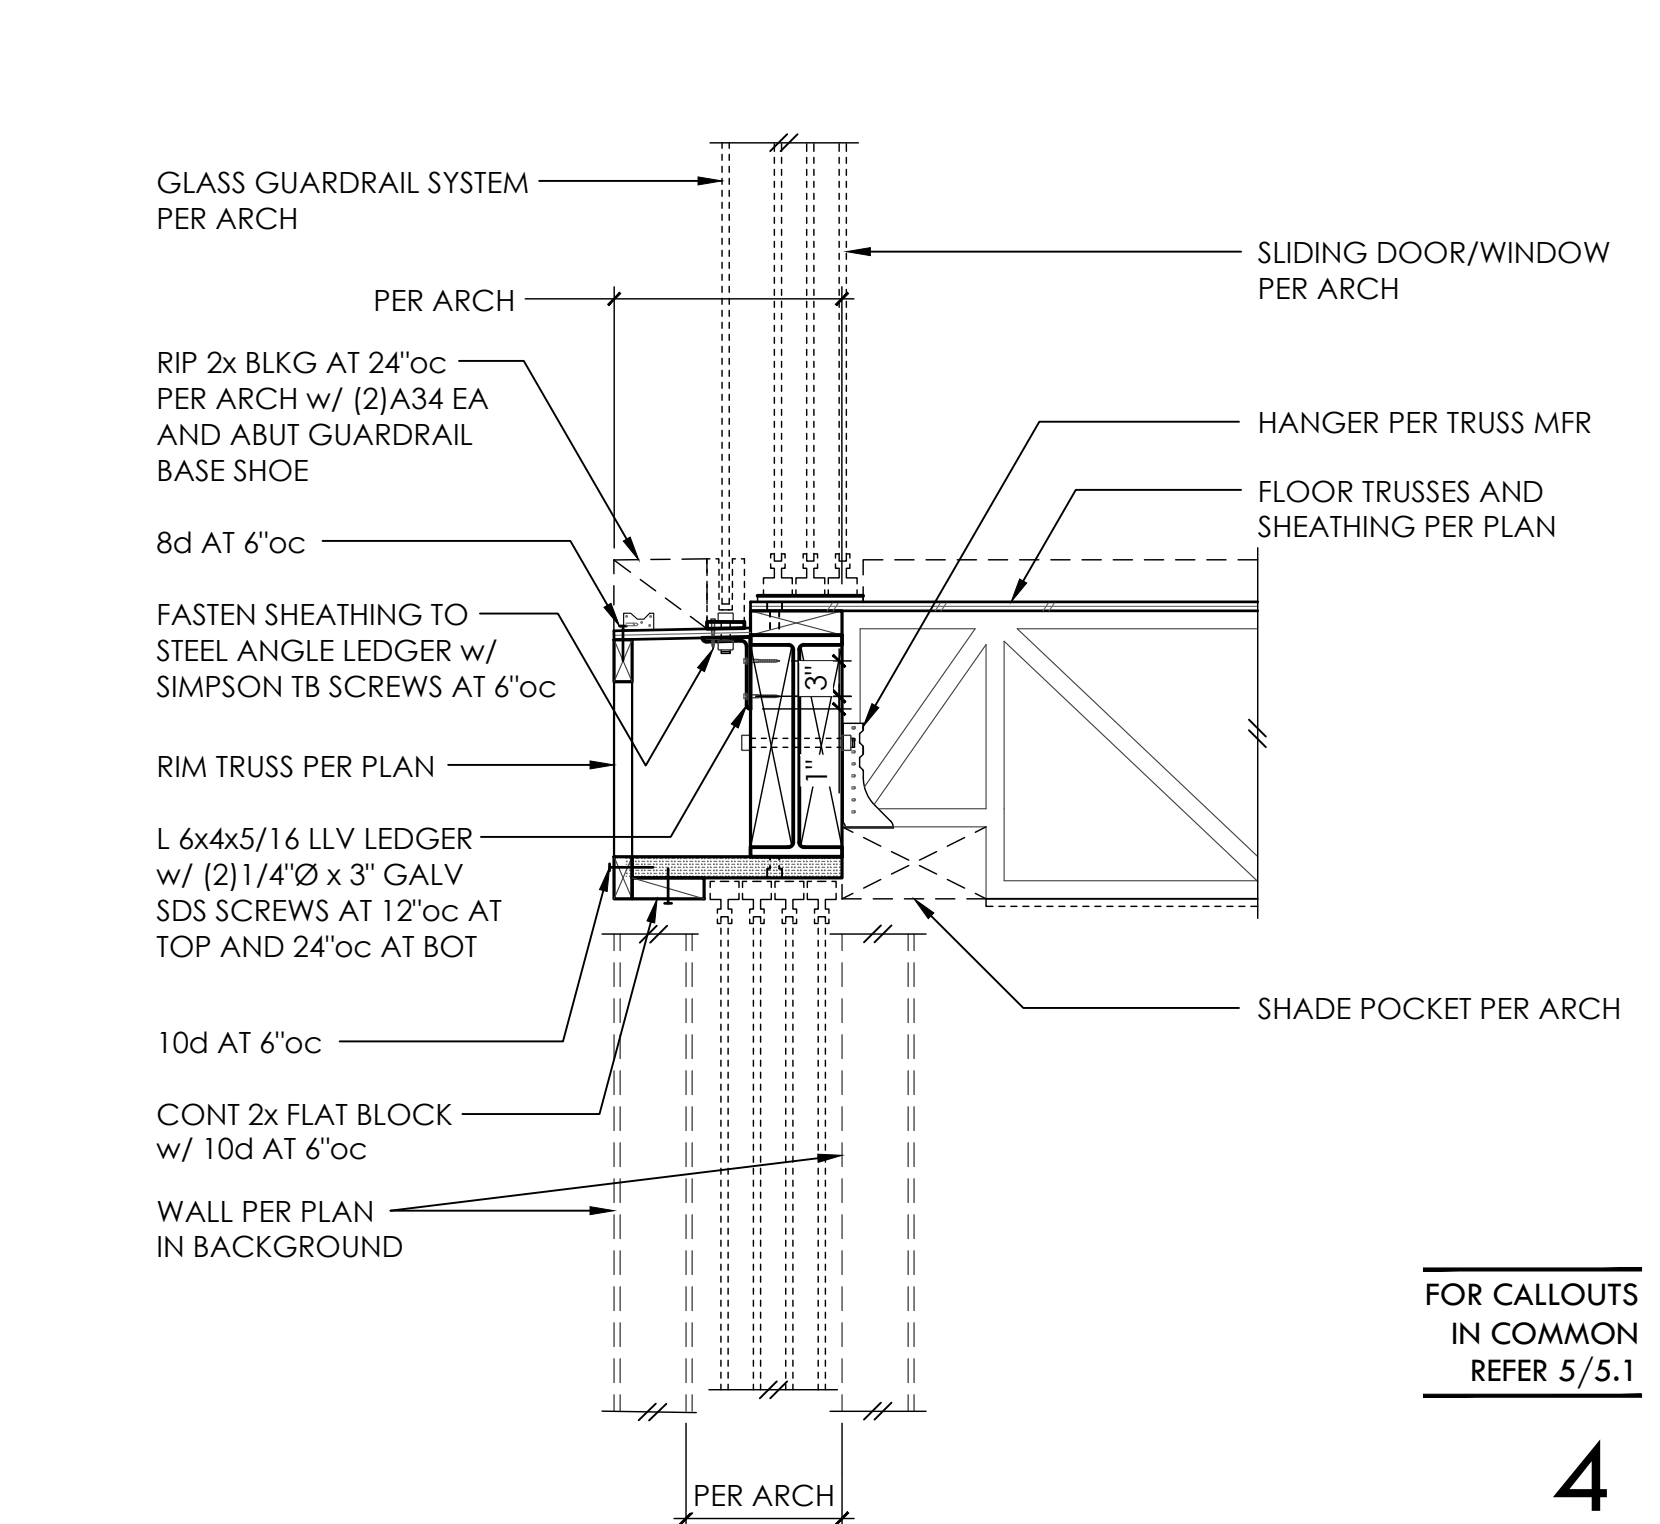


4

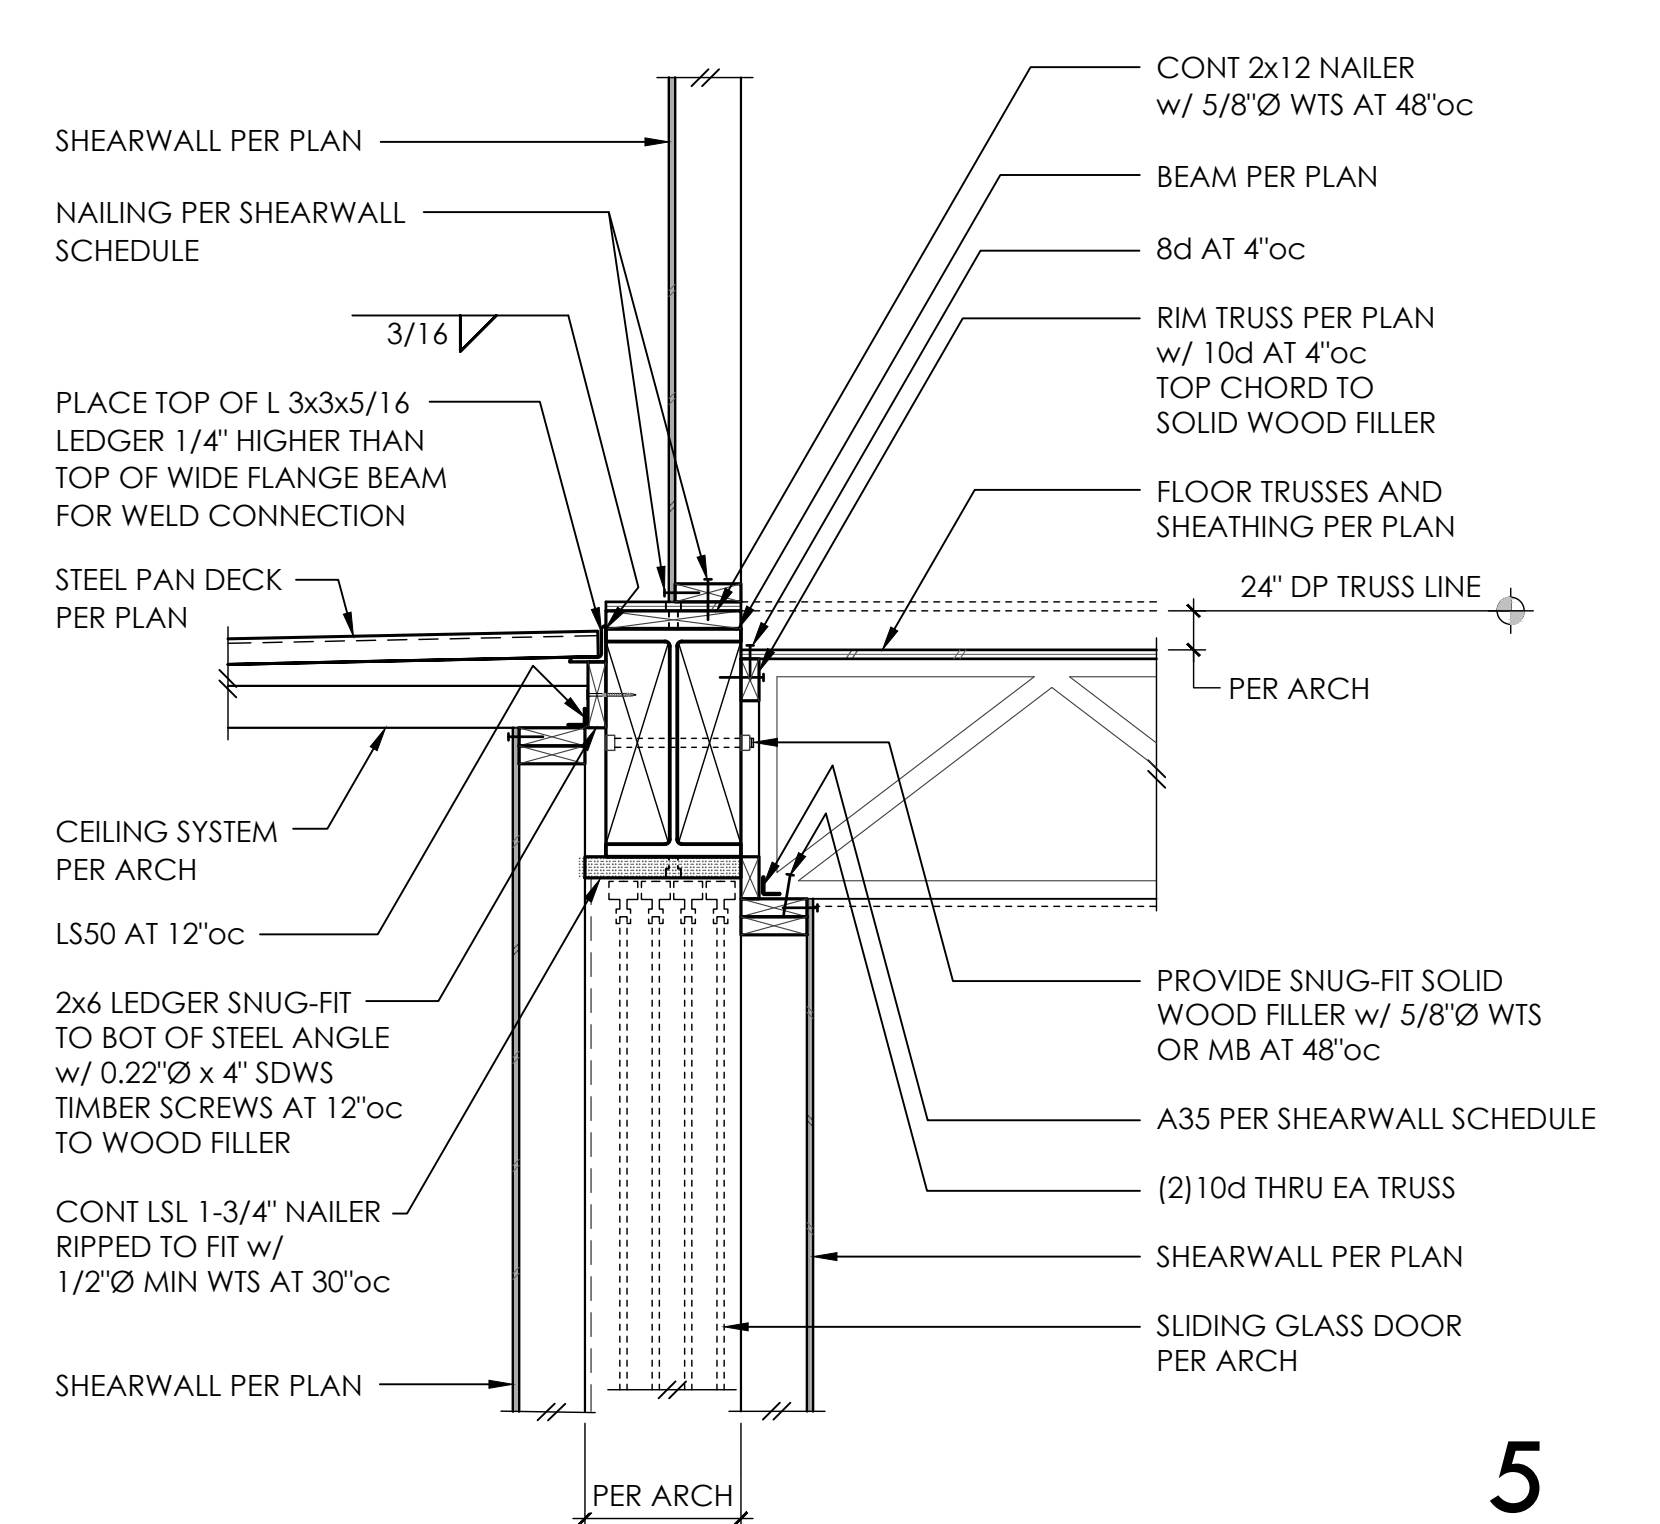


5

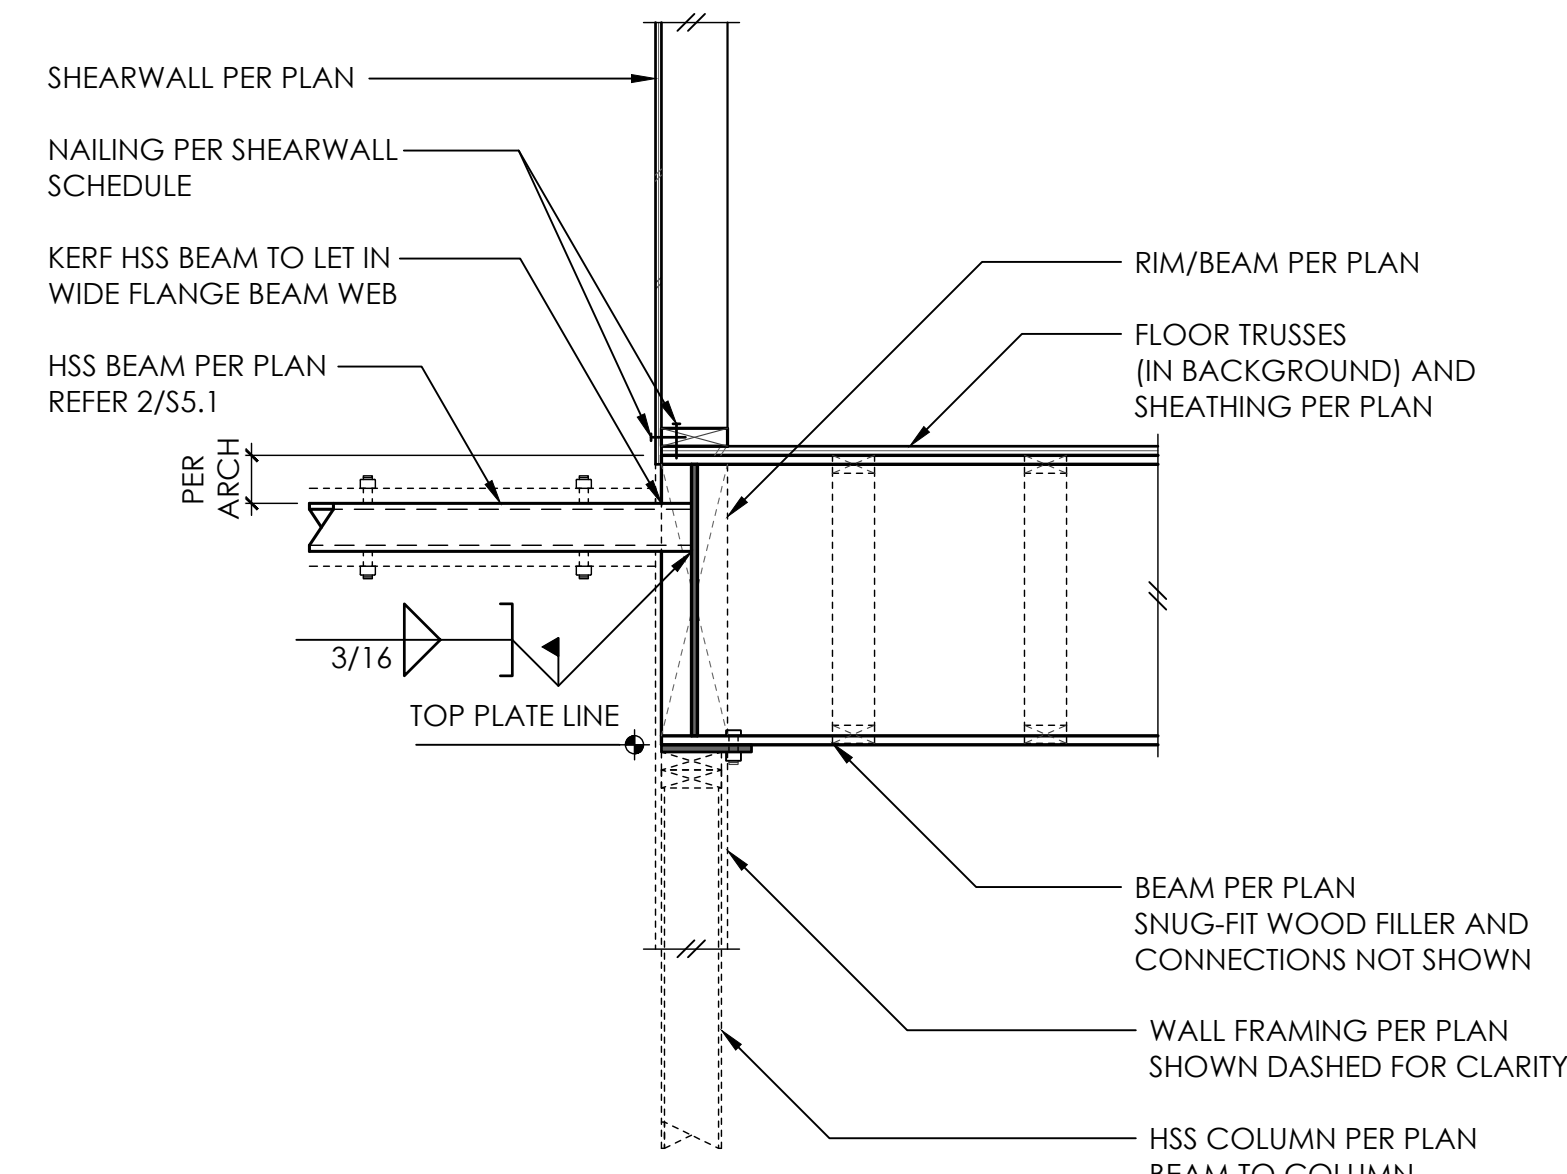


6

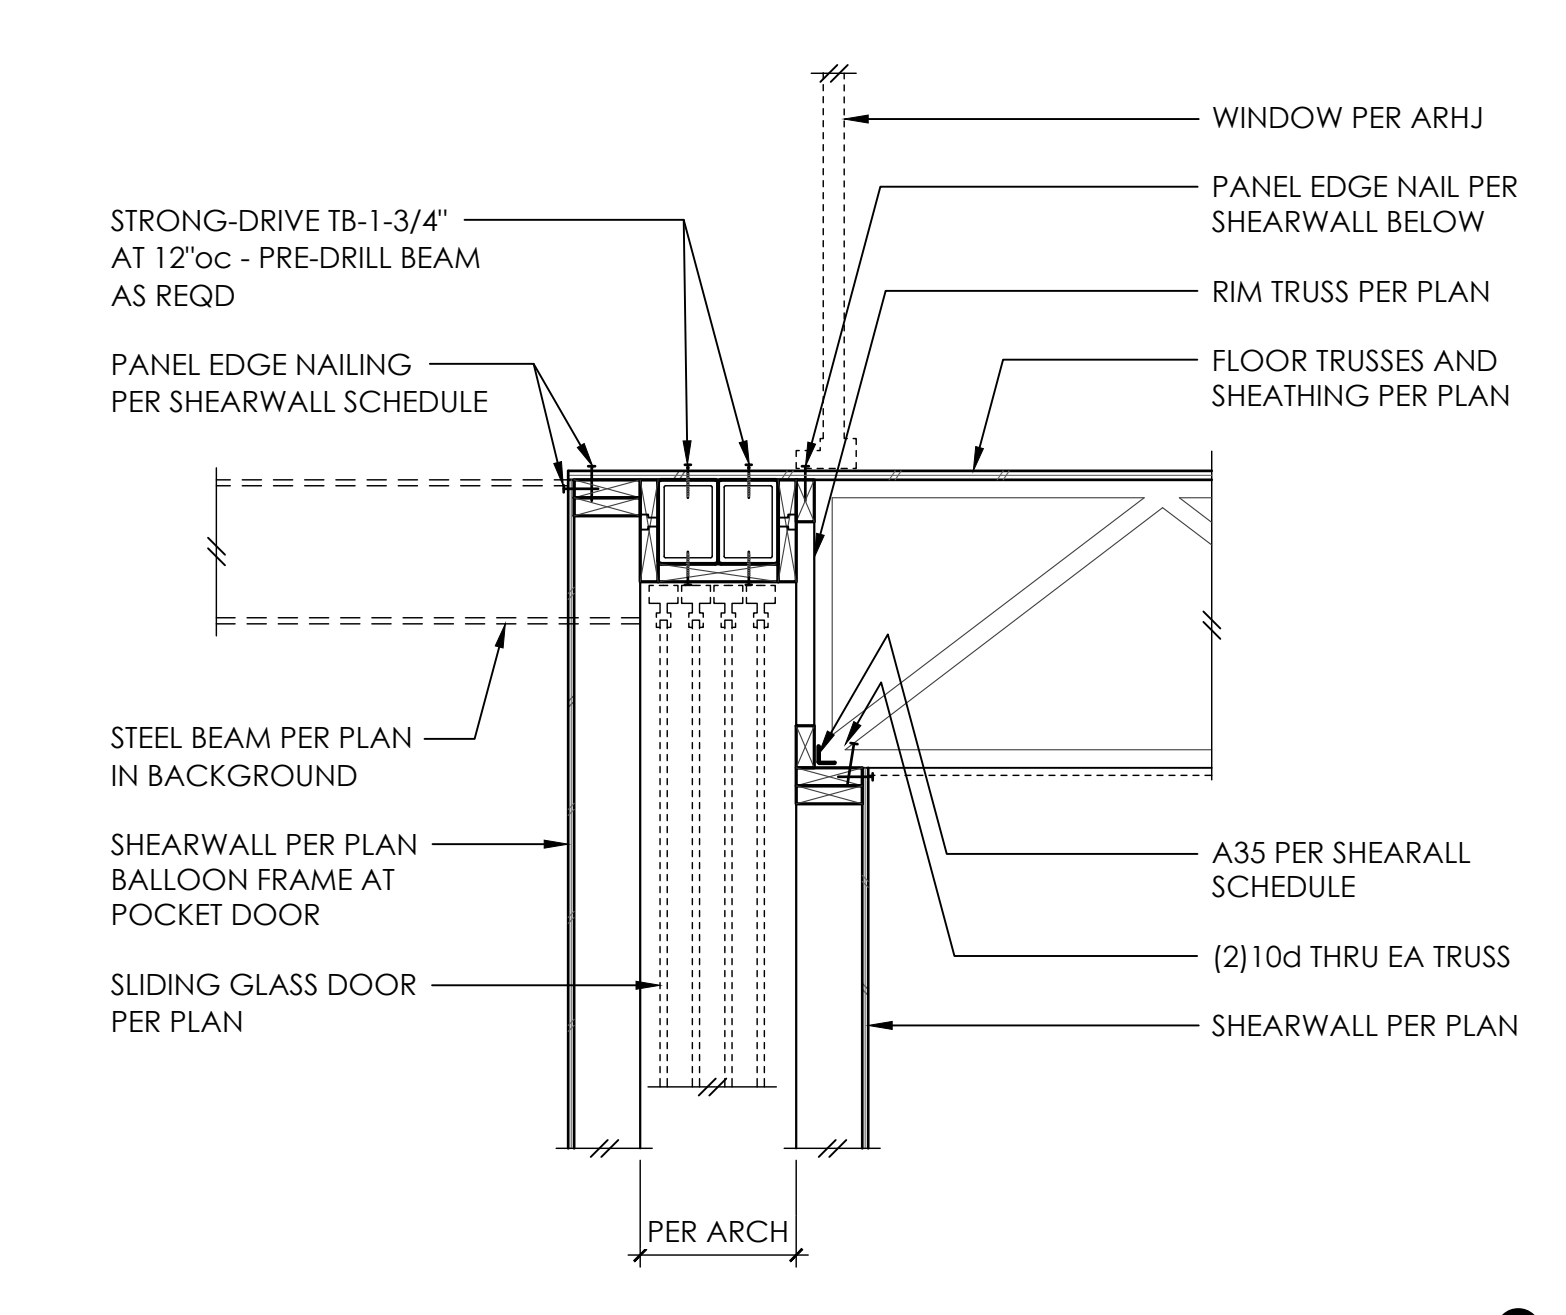


8

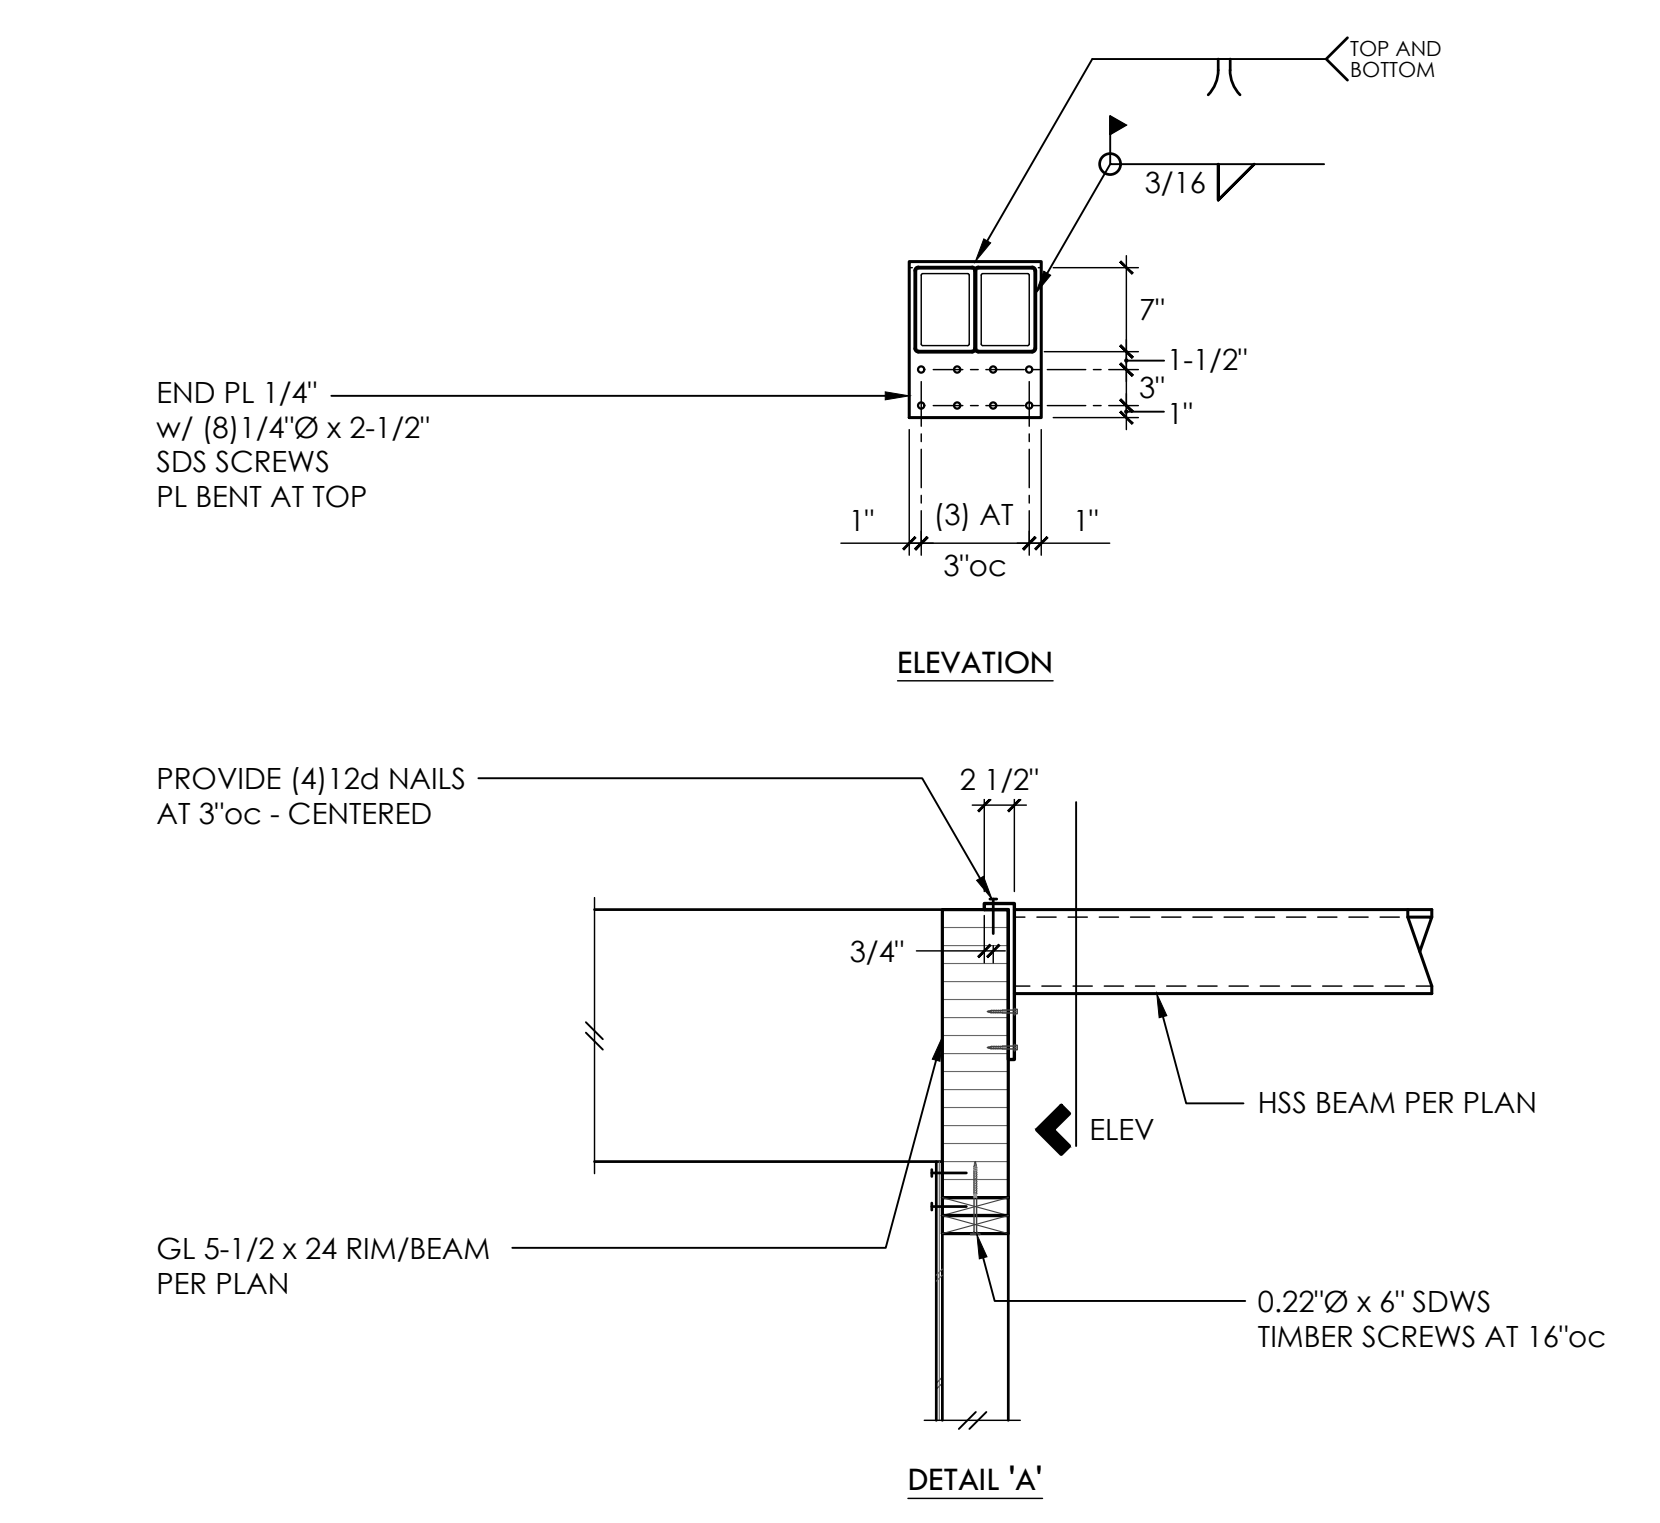


10

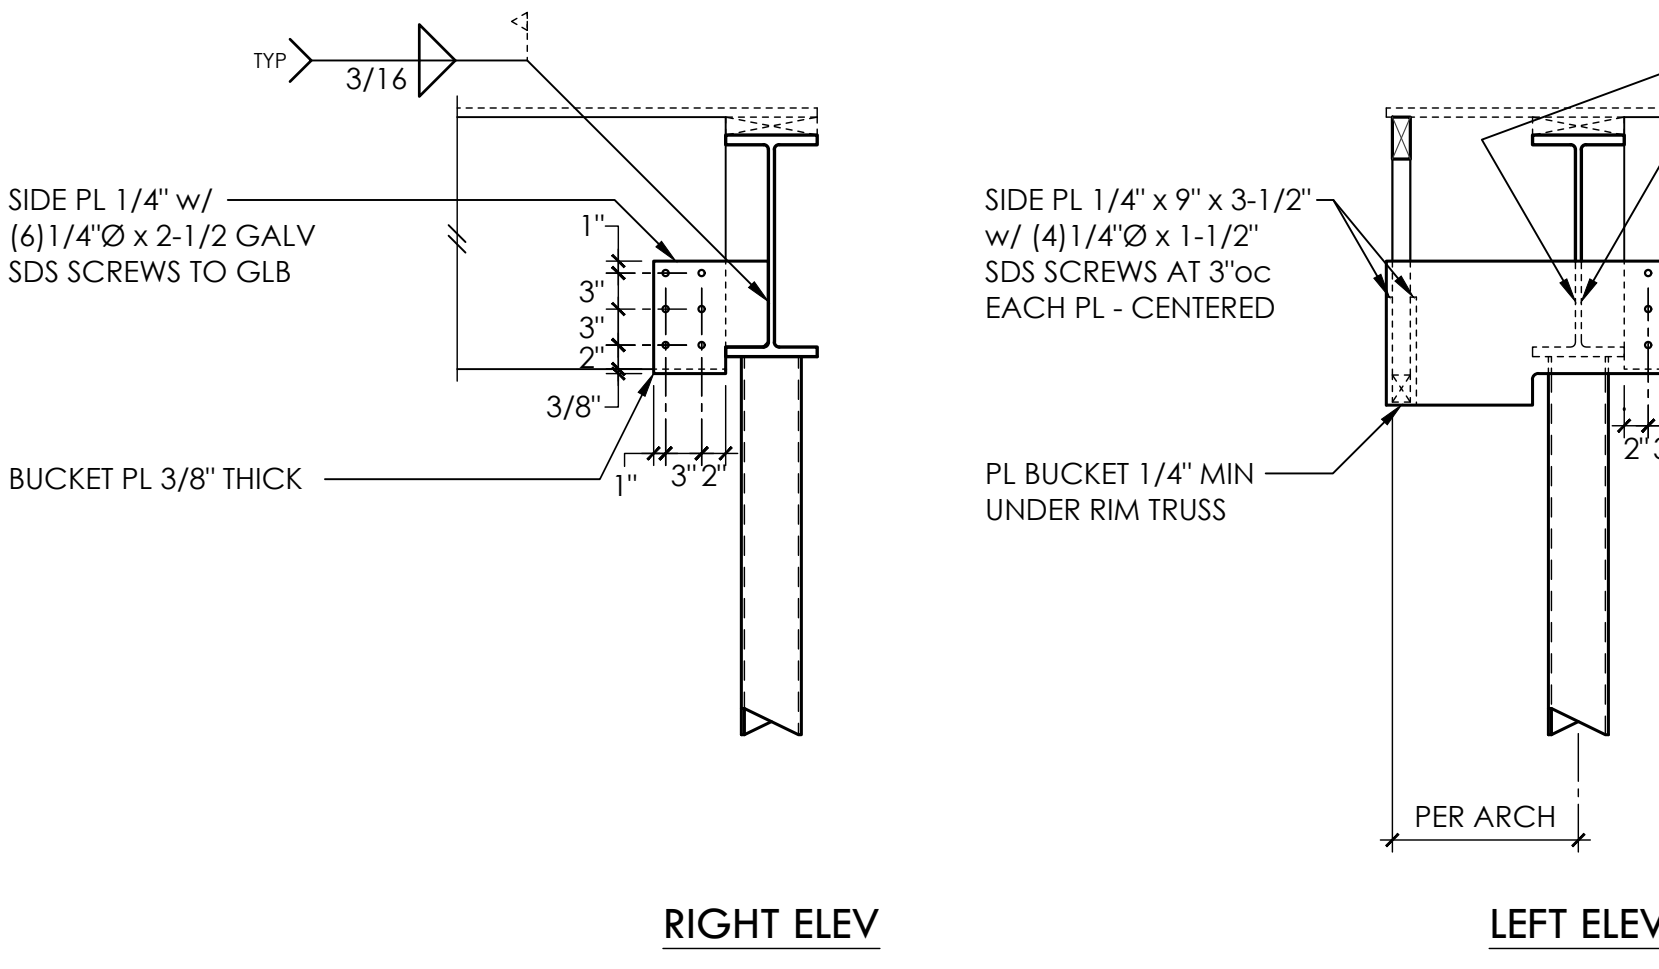


12

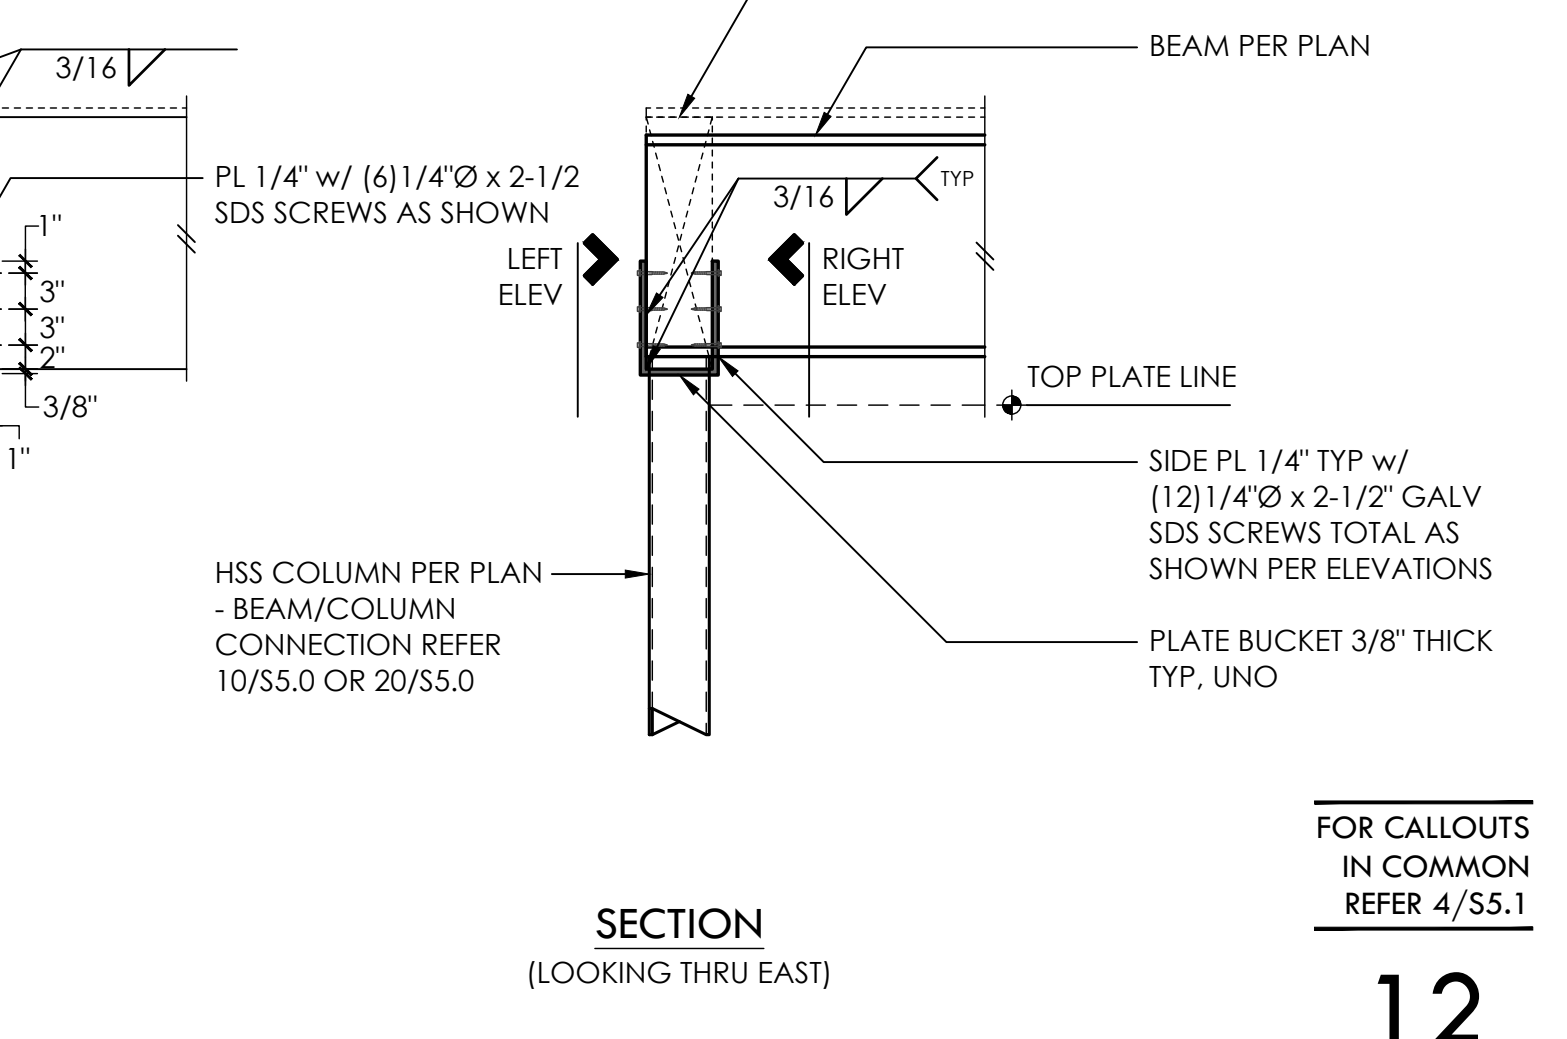


12

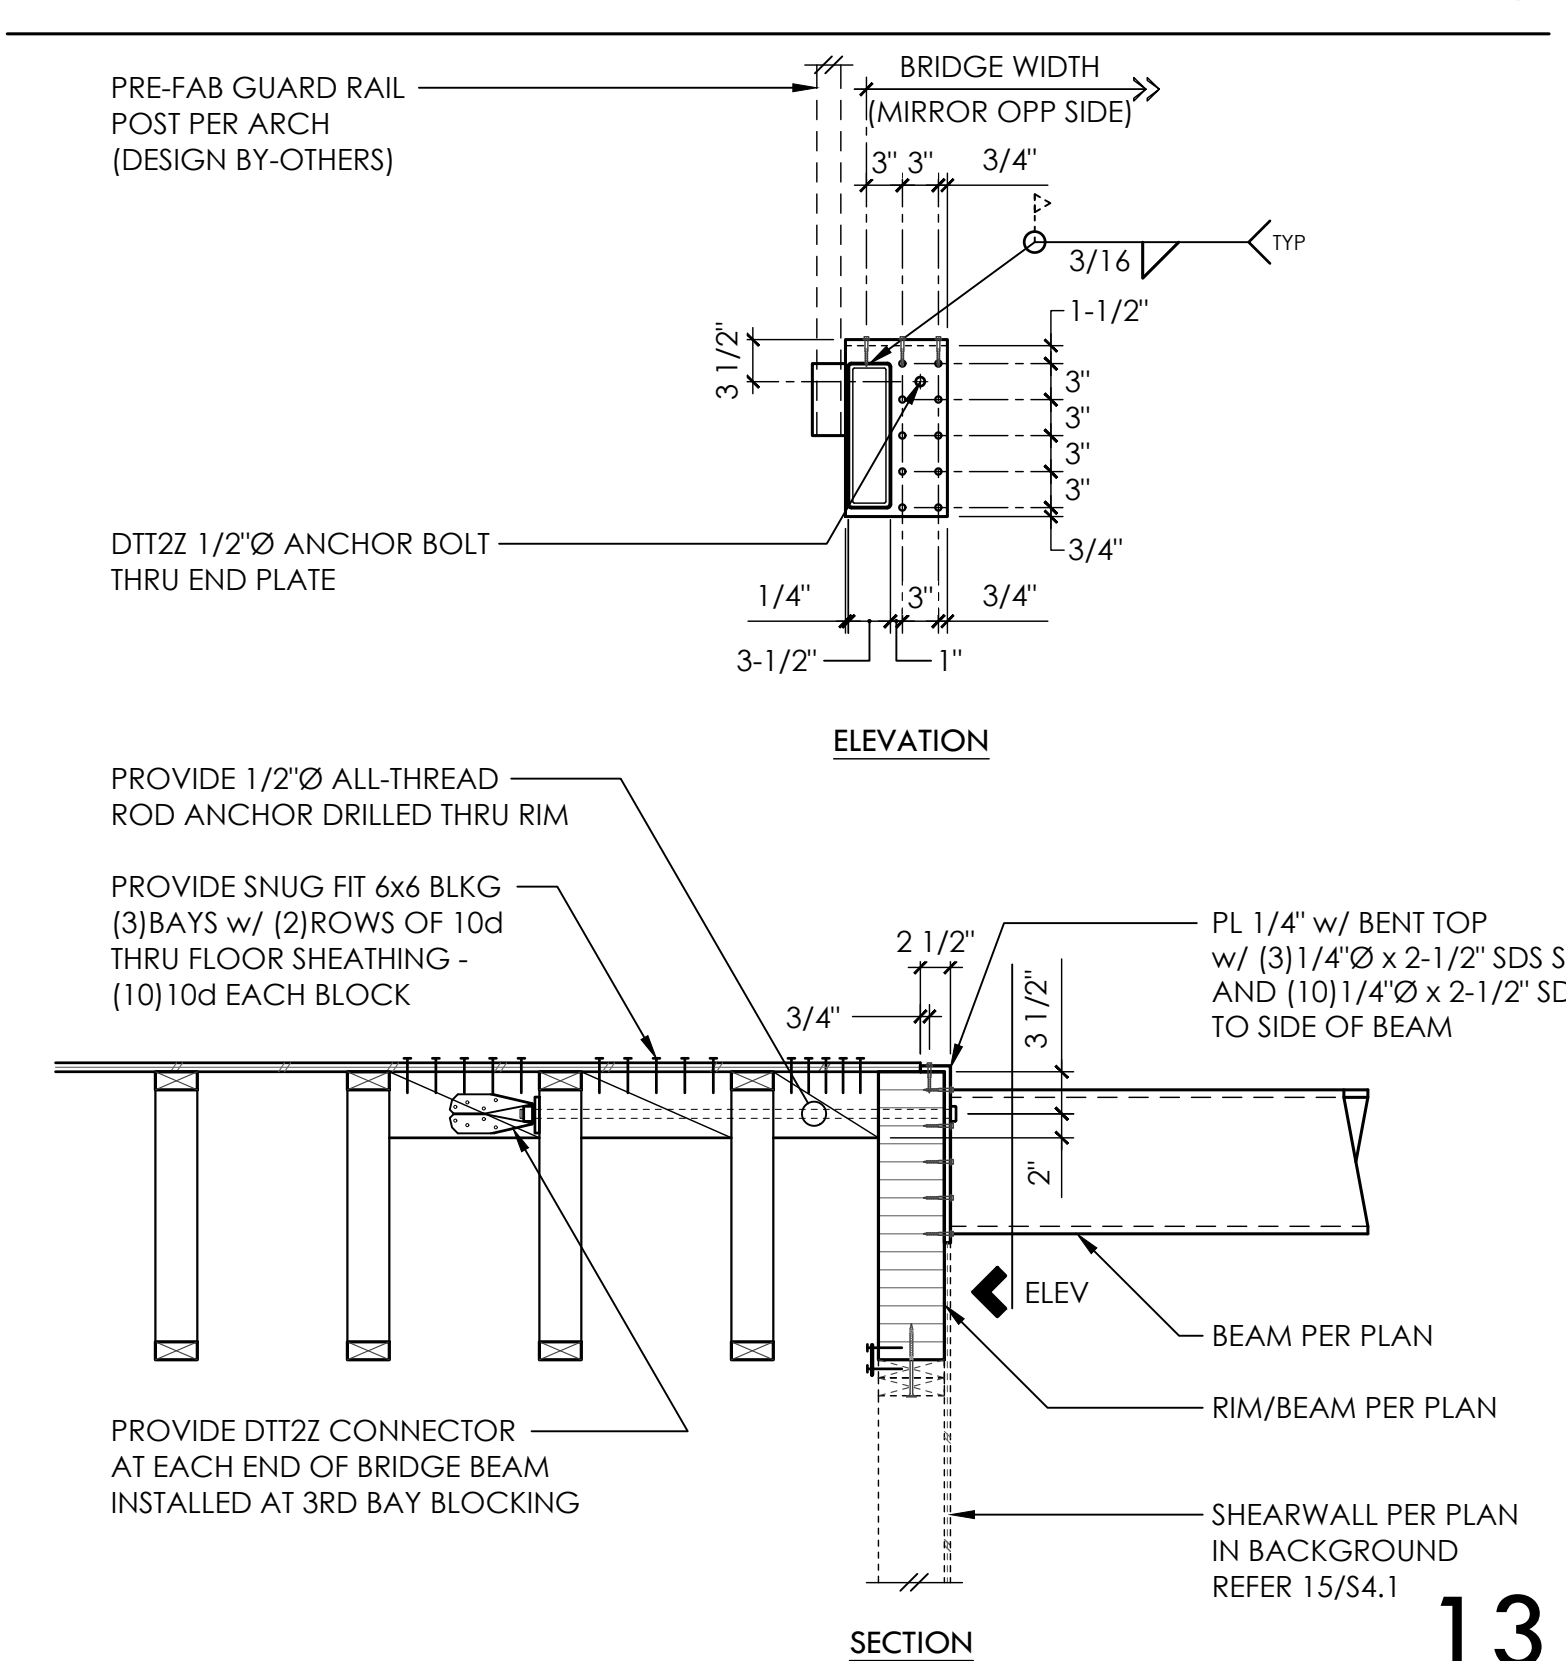

13

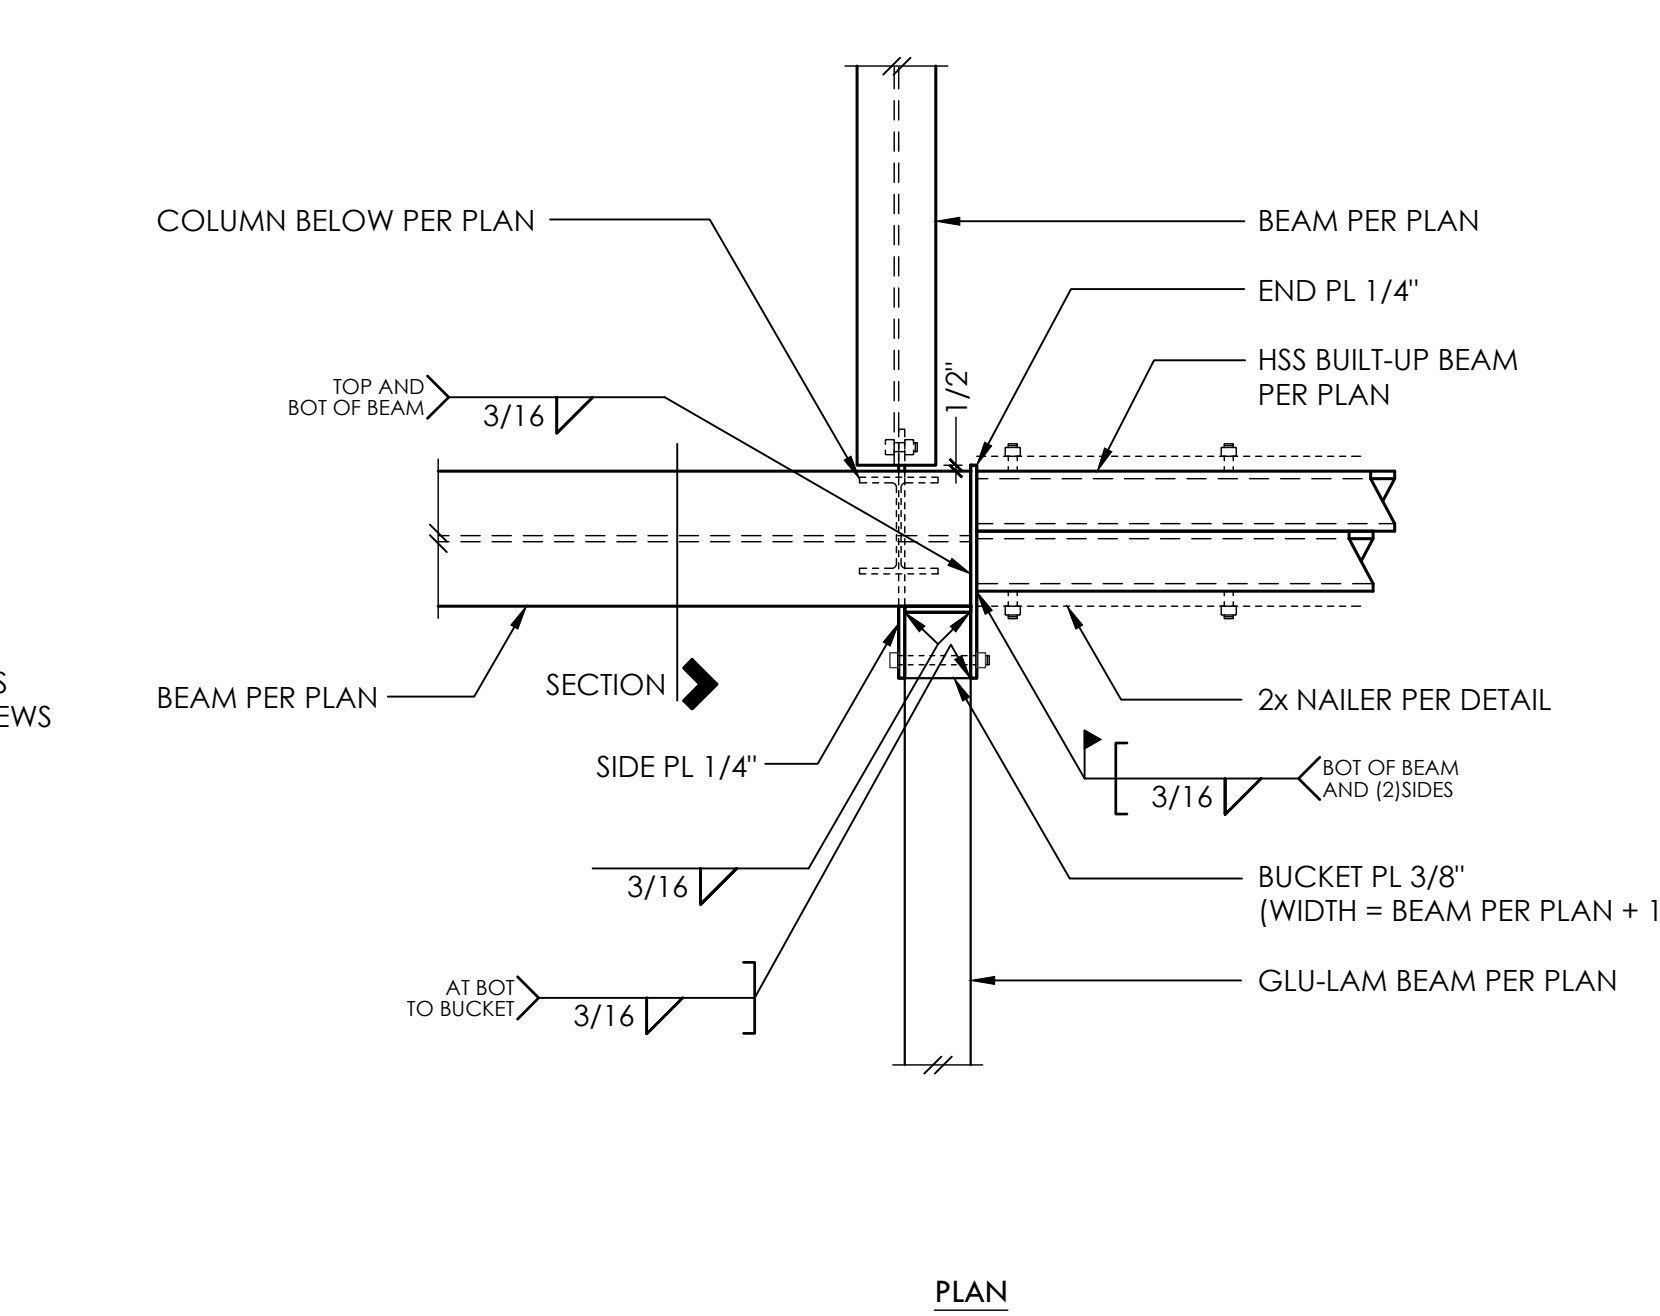


15

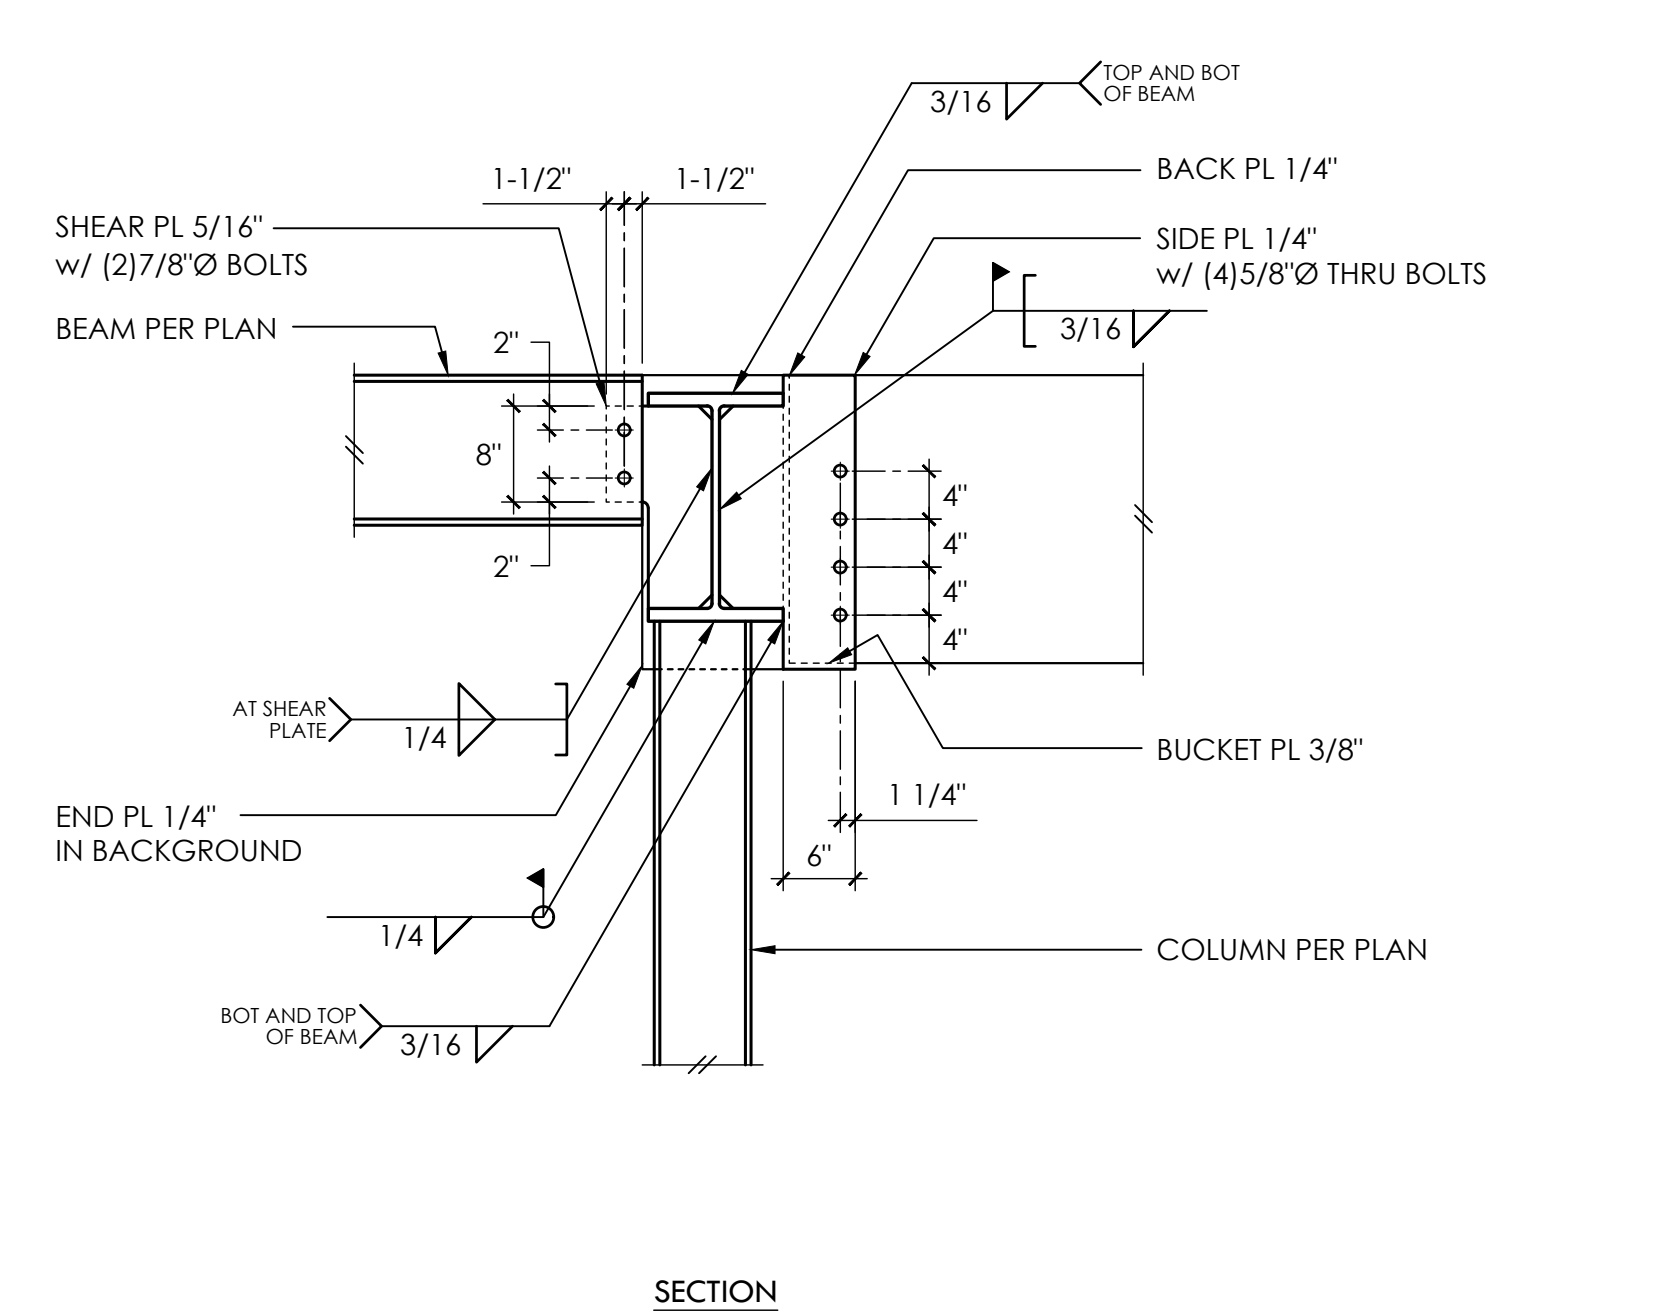


16





17

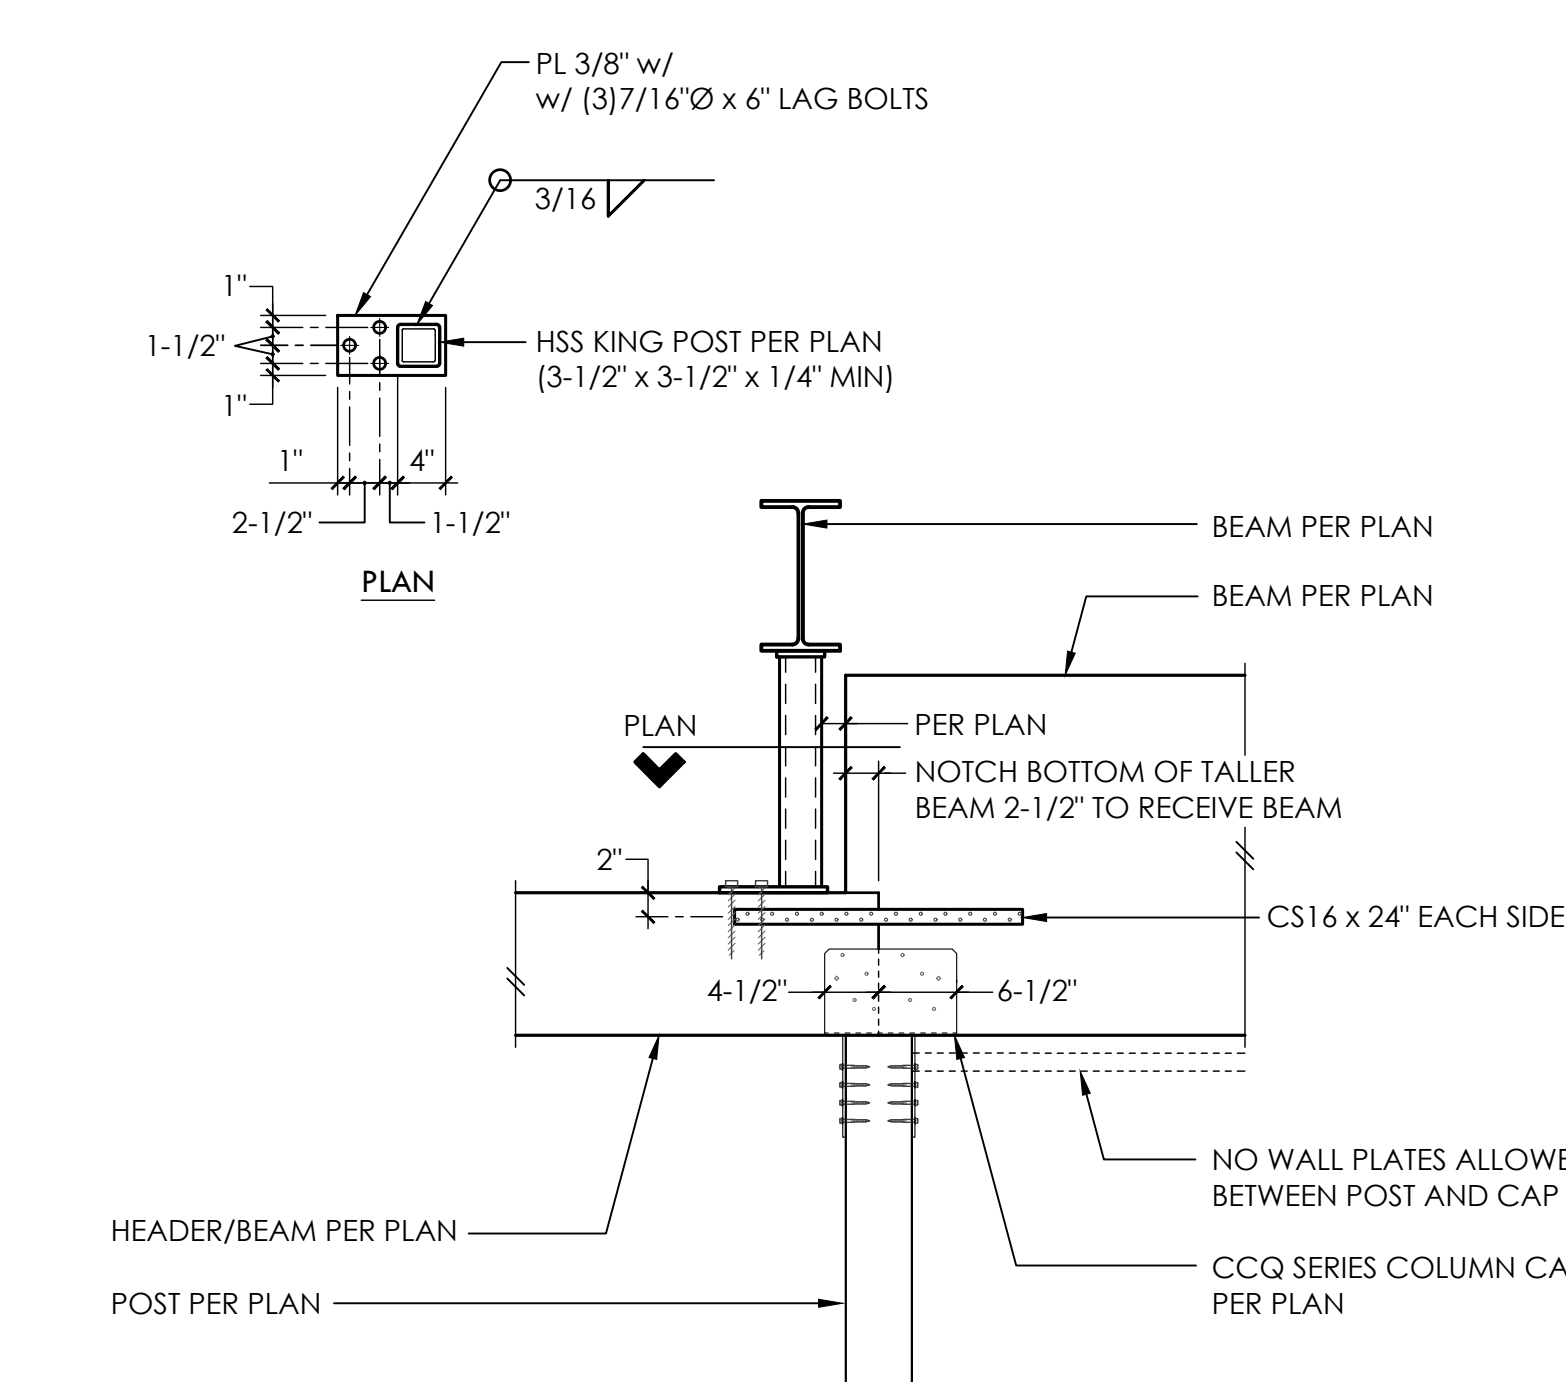

18

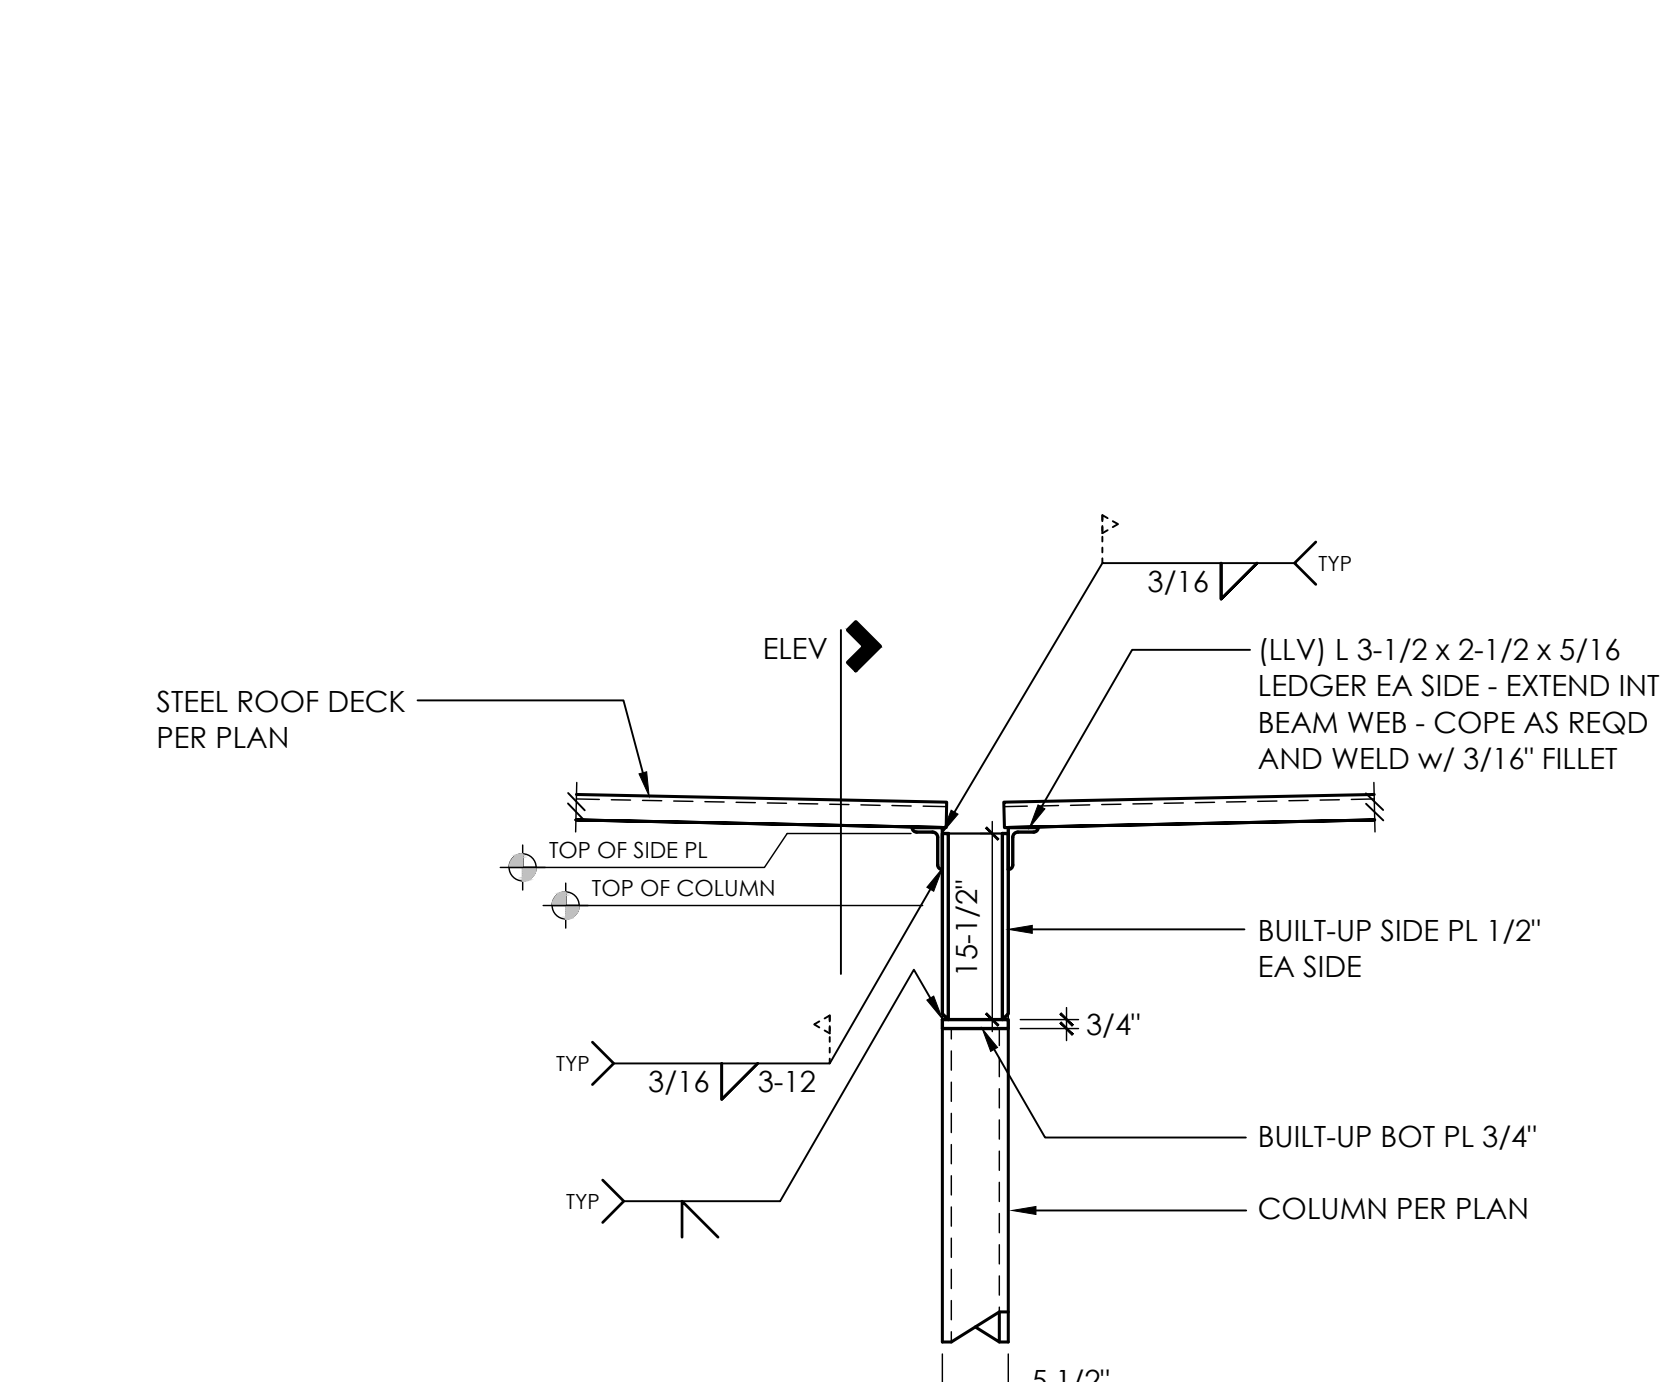

20

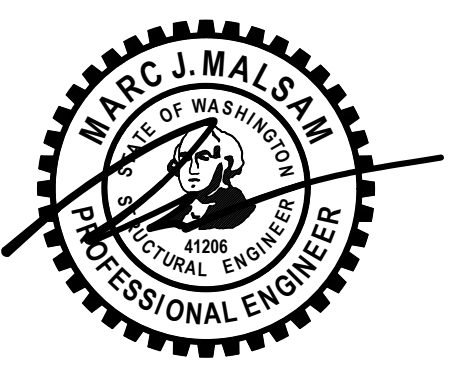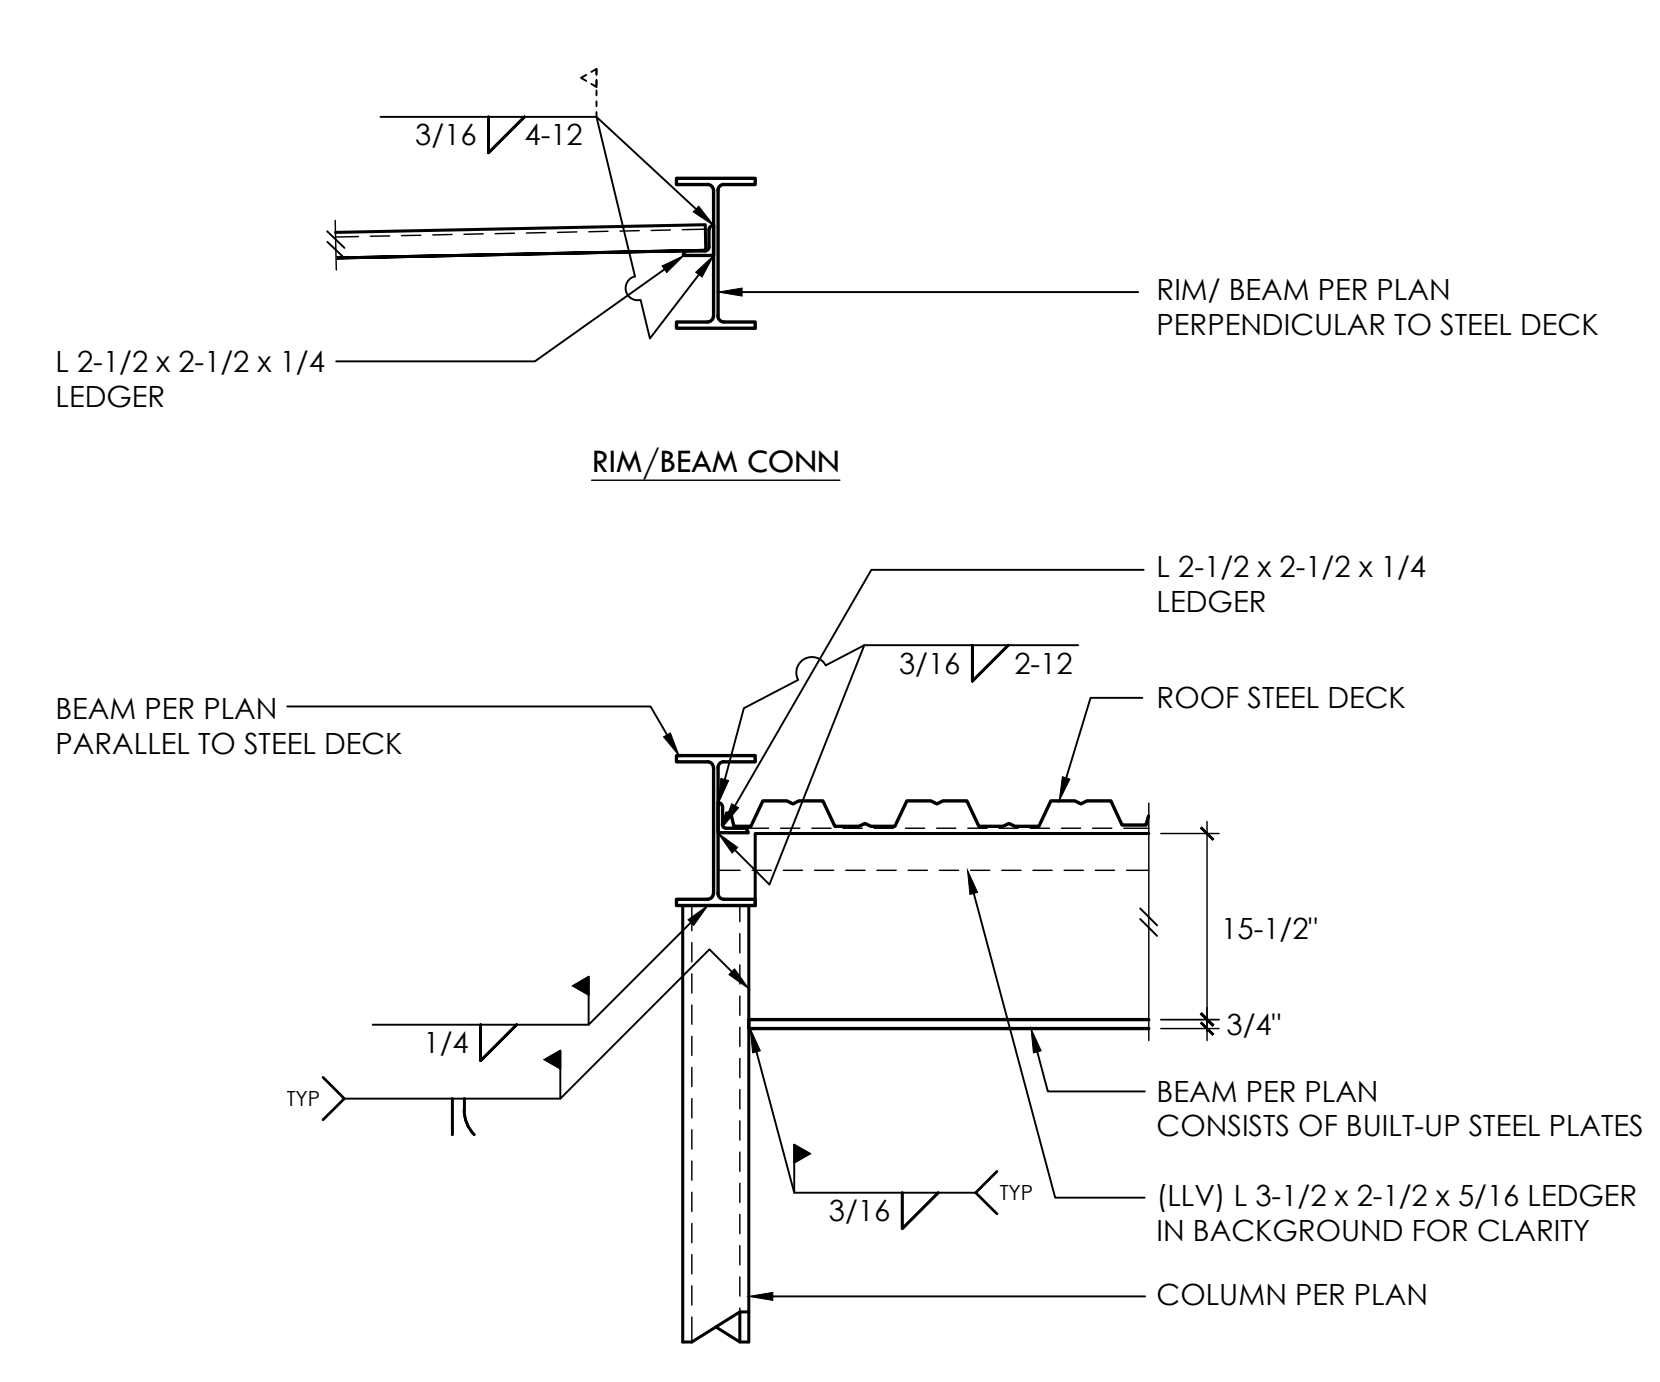

PROJECT NO.	0426-2021-0301	WAC
PROJECT MANAGER	JAS	ENGINEER
DRAWN	JOSEPH MARQUEZ	206.692.5122
ENGINEER	JOSEPH MARQUEZ	206.692.5122
	JOSEPH@MALSAM-TSANG.COM	
REV.	DESCRIPTION	DATE
	PERMIT SET	12.23.21
▲	PERMIT CORRECTIONS	5.5.22
▲	PERMIT CORRECTIONS	7.13.22
▲	PERMIT CORRECTIONS	8.19.22
ARCH	MACULLOUGH ARCHITECTS	206.443.1181

STEEL FRAMING DETAILS

**S5.1**  
SCALE: 3/4" = 1'-0"